





CITY OF ALBUQUERQUE PUBLIC WORKS DEPARTMENT PLANS FOR CONSTRUCTION WEST MESA DIVERSION PROJECT PHASE I

VICINITY MAP

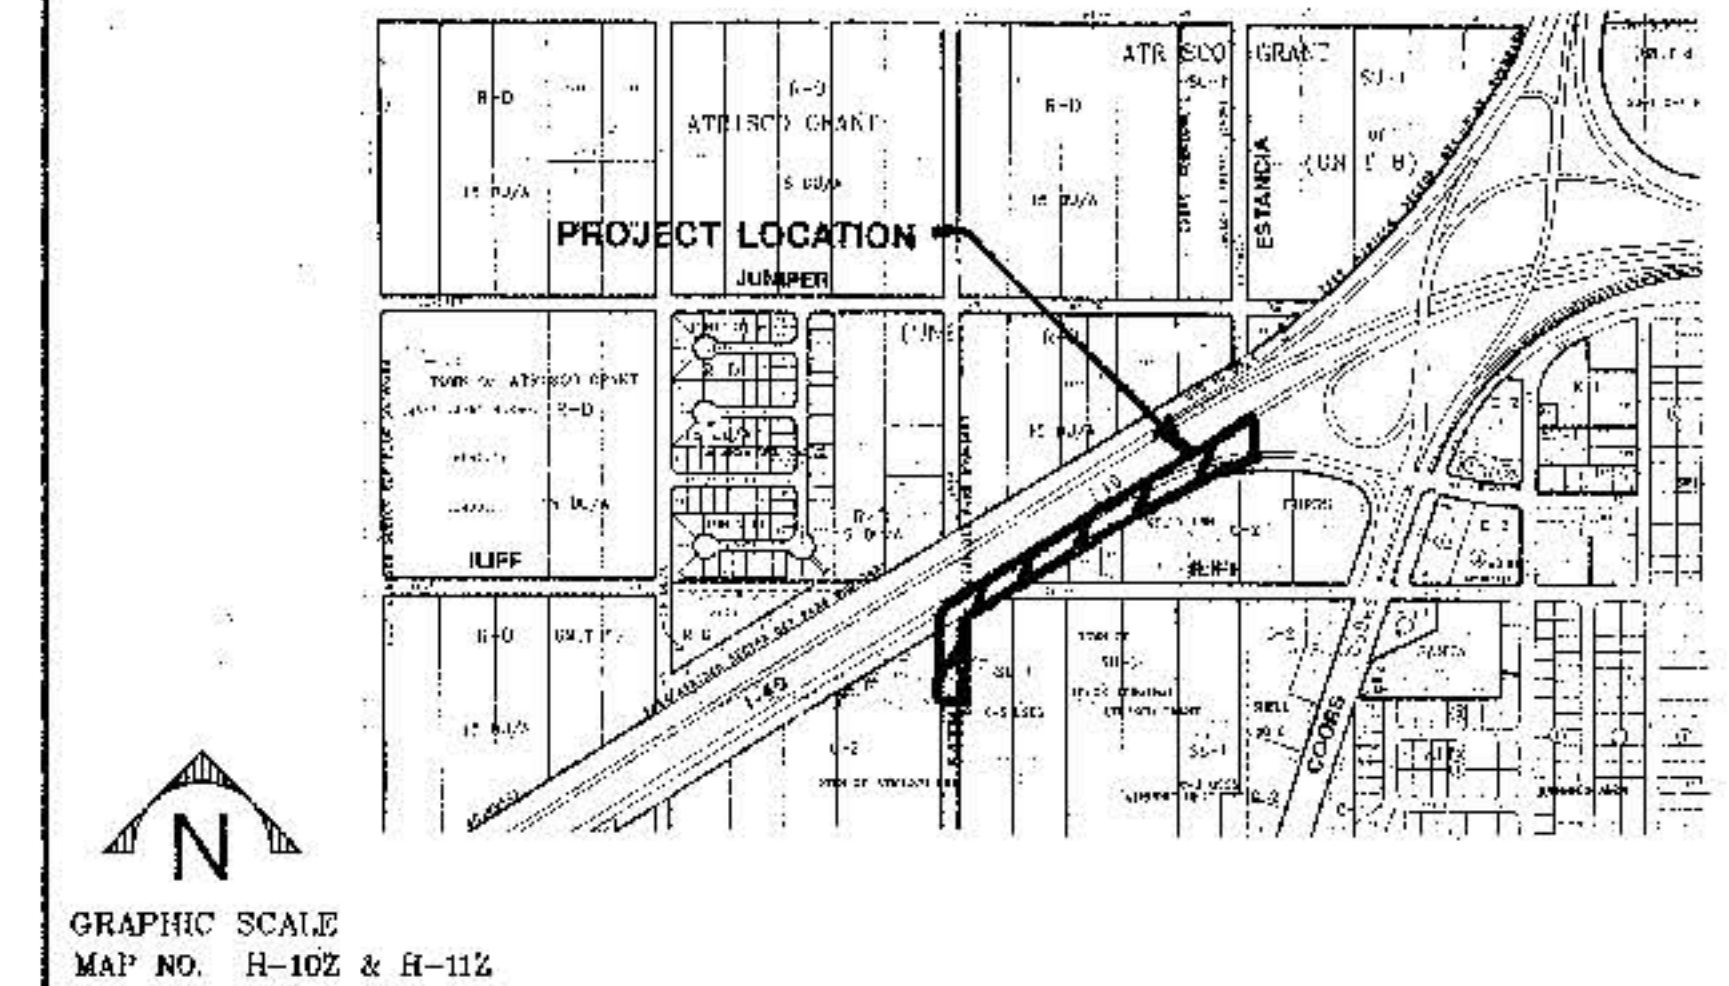

NOTE: THE CONTRACTOR MUST CONTACT Ms. BENITA BECK OF THE NEW MEXICO STATE HIGHWAY & TRANSPORTATION DEPARTMENT (NMHS&TD) AT (505) 841-2764 OR FAX (505) 841-2790 TO NOTIFY THE NMHS&TD OF THE CONSTRUCTION START DATE. THE NMHS&TD MUST HAVE A FIVE (5) DAY ADVANCE NOTICE AND A FIVE (5) DAY NOTICE OF COMPLETION OF THIS PROJECT.

INDEX TO DRAWINGS

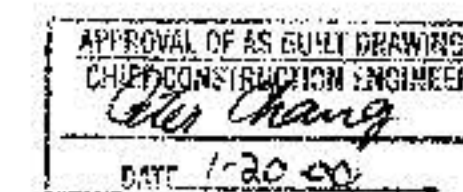

SHEET NO.	TITLE	SHEET NO.	TITLE
1	TITLE SHEET, VICINITY MAP, SHEET INDEX	11	DOUBLE 10' X 12' CONCRETE BOX CULVERT EXTENSION PLAN AND DETAILS
2	GENERAL NOTES, LEGEND AND SURVEY CONTROL INFORMATION SHEET	12	DOUBLE 10' X 12' CONCRETE BOX CULVERT EXTENSION STRUCTURAL DETAILS
3	WORK AREA AND EASEMENT PLAN SHEET	13	LA QUINTA EXISTING PILE/SHORING DETAIL SHEET
4	REMOVAL SHEET	14	WATERLINE P & P: ILIFF ROAD: STA 16+00 TO 22+17.72
5	REMOVAL SHEET	15	WATERLINE P & P: DRAINAGE EASEMENT: STA 19+66.81 TO 22+13.57
6	STORM DRAIN P & P: DOUBLE 10'X12' CONCRETE BOX CULVERT EXTENSION: STA 12+00 TO 16+00	16	WATERLINE P & P: 64TH STREET: STA 10+00 TO 14+00
7	STORM DRAIN P & P: DRAINAGE EASEMENT: STA 10+00 TO 14+60	17	WATER SHUT OFF PLAN
8	STORM DRAIN P & P: DRAINAGE EASEMENT: STA 14+60 TO 19+00	18	TRAFFIC CONTROL
9	STORM DRAIN P & P: DRAINAGE EASEMENT: STA 19+00 TO 22+29.79	19	TYPICAL TRAFFIC CONTROL & SIGNING EXAMPLES
10	STORM DRAIN P & P: 64TH STREET: STA 10+00 TO 12+22.34	20	SIGNING & CONSTRUCTION TRAFFIC CONTROL STANDARDS

UTILITY COMPANY CONTACTS

PNM

Jim Vorn
4201 Edith Blvd. NE
Albuquerque, New Mexico 87107
(505) 848-3426

GAS CO.

Debbie O'Callaghan
4825 Edith Blvd. NE
Albuquerque, New Mexico 87107
(505) 241-7705

AT&T


Ishmael Pantoja
111 Third St. NW
Albuquerque, New Mexico 87103
(505) 842-2806

JONES INTERCABLE

Karen Shore
4611 Montiel Pl. NE
P.O. Box 27138
Albuquerque, New Mexico 87125-7138
(505) 761-6220

US WEST COMMUNICATIONS

Norma Carrillo
201 Third Street
P.O. Box 1355, Sta. 952
Albuquerque, New Mexico 87103
(505) 245-8706

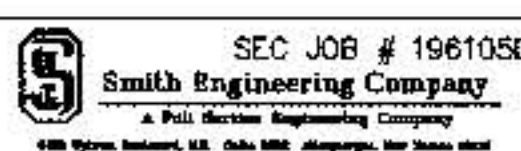

REV.	SHEETS	CITY ENGINEER	DATE	USER DEPARTMENT	DATE	USER DEPARTMENT	DATE
ENGINEERS STAMP & SIGNATURE		APPROVED	ENGINEER	DATE	APPROVED FOR CONSTRUCTION		
		DRG. Checker:	<i>Julian G. Gonsky</i>	5-28-98			
		Transportation	<i>Julian G. Gonsky</i>	5/26/98			
		Water/Wastewater	<i>Julian G. Gonsky</i>	5/26/98			
		Hydrology	<i>Carlos A. Montoya</i>	5-26-98			
		CIP	<i>Julian G. Gonsky</i>	5-26-98			
		Const. Mgmt.	<i>Julian G. Gonsky</i>	5-28-98	CITY ENGINEER		
		Owner Coordinator	<i>Julian G. Gonsky</i>	5-28-98	DATE		
PROJECT NUMBER				5381.91	SHEET 1 OF 20		

GENERAL NOTES:

- 1 FIVE (5) WORKING DAYS PRIOR TO BEGINNING CONSTRUCTION, THE CONTRACTOR WILL SUBMIT A DETAILED CONSTRUCTION SCHEDULE TO THE CITY CONSTRUCTION COORDINATION DIVISION. TWO (2) DAYS PRIOR TO CONSTRUCTION, THE CONTRACTOR WILL OBTAIN A BARRICADING PERMIT FROM THE CONSTRUCTION COORDINATION DIVISION. CONTRACTOR SHALL NOTIFY BARRICADE ENGINEER (768-2551) PRIOR TO OCCUPYING AN INTERSECTION. REFER TO SECTION 19 OF SPECIFICATIONS.
- 2 THE CONTRACTOR WILL NOTIFY THE FIELD ENGINEER NOT LESS THAN SEVEN (7) DAYS PRIOR TO STARTING WORK, IN ORDER THAT THE FIELD ENGINEER MAY TAKE NECESSARY MEASURES TO INSURE THE PRESERVATION OF SURVEY MONUMENTS. THE CONTRACTOR WILL NOTIFY THE ENGINEER IF A MONUMENT IS DISTURBED. REPLACEMENT WILL BE DONE ONLY BY THE CITY OF ALBUQUERQUE SURVEY SECTION. WHEN A CHANGE IS MADE IN THE FINISHED ELEVATION OF THE PAVEMENT OF ANY ROADWAY IN WHICH A PERMANENT SURVEY MONUMENT IS LOCATED, CONTRACTOR WILL, AT HIS OWN EXPENSE, HAVE THE CITY SURVEY SECTION ADJUST THE MONUMENT COVER TO THE NEW GRADE UNLESS OTHERWISE SPECIFIED. REFER TO SECTION 4 OF SPECIFICATIONS.
- 3 THE SPECIFICATIONS USED FOR THIS PROJECT ARE THE CITY OF ALBUQUERQUE STANDARD SPECIFICATIONS FOR PUBLIC WORKS CONSTRUCTION, 1986 EDITION INCLUDING ALL UPDATES THROUGH UPDATE NO. 6.
- 4 ALL NEW MANHOLES SHALL BE TYPE "E" (COA DWG. 2102) UNLESS OTHERWISE NOTED ON THE PLANS.
- 5 THE CONTRACTOR WILL BE RESPONSIBLE FOR DISPOSING OF ALL DEBRIS, INCLUDING, BUT NOT LIMITED TO HAZARDOUS WASTE AT DISPOSAL SITES APPROVED BY GOVERNMENTAL AGENCIES REGULATING THE DISPOSAL OF SUCH MATERIALS.
- 6 ALL EXISTING WATER VALVE BOXES AND MANHOLES IN THE STREET CONSTRUCTION ARE TO BE ADJUSTED TO FINISH GRADE AND WILL BE MEASURED AND PAID PER EACH.
- 7 SUBGRADE PREPARATION UNDER SIDEWALKS AND DRIVE PADS, AND SUBGRADE AND SUBBASE PREPARATION UNDER CURB AND GUTTER IS CONSIDERED INCIDENTAL TO THE CONSTRUCTION OF SUCH, AND NO DIRECT PAYMENT SHALL BE MADE FOR THOSE ITEMS OF WORK.
- 8 ALL EXCAVATION WILL BE GOVERNED BY FEDERAL, STATE AND LOCAL LAWS, RULES, AND REGULATIONS CONCERNING CONSTRUCTION SAFETY AND HEALTH.
- 9 ALL SIGNS AND CODING WILL BE IN ACCORDANCE WITH THE "MANUAL ON UNIFORM TRAFFIC CONTROL DEVICES FOR STREETS AND HIGHWAYS" CURRENT EDITION PUBLISHED BY THE U.S. DEPARTMENT OF TRANSPORTATION.
- 10 THE CONTRACTOR IS TO EXERCISE CARE TO AVOID DISTURBING ANY EXISTING UNDERGROUND UTILITIES. IT WILL BE HIS RESPONSIBILITY TO COORDINATE WITH THE UTILITY COMPANIES IN ORDER TO PREVENT ANY SERVICE DISRUPTION. SEE SECTION 18 "UTILITIES", CITY OF ALBUQUERQUE, STANDARD SPECIFICATIONS FOR CONTRACTOR REQUIREMENTS.
- 11 WHEN ABUTTING NEW PAVEMENT TO EXISTING PAVEMENT, SAW CUT EXISTING PAVEMENT TO A STRAIGHT LINE AND AT RIGHT ANGLES AND REMOVE ANY BROKEN OR CRACKED PAVEMENT. NO DIRECT PAYMENT WILL BE MADE FOR SAW CUTTING.
- 12 ALL GAS VALVES, GAS MANHOLES, ELECTRICAL MANHOLES, TELEPHONE MANHOLES, AND UTILITY POLES WILL BE ADJUSTED TO GRADE BY EACH UTILITY COMPANY. CONTRACTOR WILL COORDINATE THROUGH CITY UTILITY COORDINATOR.
- 13 WHEN REMOVAL OF EXISTING CURB AND GUTTER OR SIDEWALK IS REQUIRED, REMOVE BACK TO NEAREST SUITABLE JOINT UNLESS OTHERWISE DIRECTED BY THE CITY FIELD ENGINEER.
- 14 THE CONTRACTOR WILL NOTIFY THE UTILITY COMPANIES BY CALLING NEW MEXICO ONE CALL SYSTEM 260-1990 TWO (2) WORKING DAYS PRIOR TO COMMENCING WORK IN NEW AREAS.
- 15 CONTRACTOR WILL PLACE BITUMINOUS MATERIAL WITH THE USE OF A LAYDOWN MACHINE WHERE PAVEMENT IS 7 FEET IN WIDTH OR WIDER.
- 16 CONTRACTOR WILL NOT PAVE OVER ANY SURFACE FEATURE, I.E., GAS VALVE, MANHOLE COVER, ETC. WITHOUT PRIOR APPROVAL FROM THE CITY FIELD ENGINEER.
- 17 CONTRACTOR WILL CONFINED HIS WORK WITHIN THE CONSTRUCTION EASEMENT LIMITS AND/OR RIGHT-OF-WAY, OR PROVIDE COPIES OF AGREEMENTS WITH ADJACENT LANDOWNERS TO THE CITY OF ALBUQUERQUE.
- 18 MINIMUM BOTTOM WIDTH OF TRENCHES FOR RIGID PIPE SHALL BE EQUAL TO THE OUTSIDE DIAMETER PLUS 18 INCHES. BEDDING MATERIAL SHALL BE CLASS II, III, OR IV UNLESS OTHERWISE SPECIFICALLY NOTED ON THE PLANS.
- 19 MINIMUM BOTTOM WIDTH OF TRENCHES FOR NON-RIGID PIPE SHALL BE EQUAL TO THE OUTSIDE DIAMETER PLUS 12 INCHES. BEDDING MATERIAL SHALL BE CLASS I, II, OR III.
- 20 THE CONTRACTOR AGREES TO TAKE NECESSARY SAFETY PRECAUTIONS AS REQUIRED BY FEDERAL, STATE AND LOCAL AUTHORITIES TO PROTECT PEDESTRIAN AND VEHICULAR TRAFFIC IN THE CONSTRUCTION AREA, WHICH INCLUDE BUT ARE NOT LIMITED TO: MAINTAINING ADEQUATE WARNING SIGNS, BARRICADES, LIGHTS, GUARD FENCES, WALKS AND BRIDGES.
- 21 THE CONTRACTOR SHALL CONSTRUCT CITY OF ALBUQUERQUE STANDARD WHEELCHAIR RAMPS THAT CONFORM TO CURRENT ADA REQUIREMENTS.

- 22 PRIOR TO CONSTRUCTION, THE CONTRACTOR WILL EXCAVATE AND VERIFY THE HORIZONTAL AND VERTICAL LOCATIONS OF ALL POTENTIAL CONFLICTING UTILITIES. SHOULD A CONFLICT EXIST BETWEEN THE FIELD INFORMATION AND THE PLANS, THE CONTRACTOR WILL NOTIFY THE CITY FIELD ENGINEER SO THE CONFLICT CAN BE RESOLVED WITH MINIMUM AMOUNT OF DELAY.
- 23 THE REPLACEMENT OF THE EXISTING UTILITIES AND THE INSTALLATION OF NEW UTILITY LINES WILL BE COMPLETED IN ADVANCE OF STARTING THE PAVEMENT WORK. TEMPORARY PAVEMENT WILL BE PLACED IN ALL TRENCHES REQUIRED FOR THE UTILITY REPLACEMENTS IN THOSE AREAS THAT MUST MAINTAIN TRAFFIC UNTIL THE FINAL PAVEMENT WORK STARTS IN EACH AREA. TEMPORARY STRIPING SHALL BE THE CONTRACTOR'S RESPONSIBILITY. MAINTENANCE OF THE TEMPORARY PAVING AND STRIPING WILL BE AT THE CONTRACTOR'S EXPENSE.
- 24 TACK COAT FOR SURFACE COURSE REQUIREMENTS WILL BE DETERMINED BY THE CITY FIELD ENGINEER.
- 25 BACKFILL COMPACTION SHALL BE ACCORDING TO SPECIFIED STREET USE.
- 26 ALL NEW STREET PAVING, DRIVEWAYS, SIDEWALKS, AND CURB AND GUTTERS, ABUTTING EXISTING AREAS SHALL MATCH THE ELEVATION OF THOSE AREAS.
- 27 PERMANENT PAVEMENT STRIPING AND MARKINGS WILL BE PLACED BY THE CONTRACTOR. ROAD SHALL NOT BE OPENED TO TRAFFIC UNTIL IT IS STRIPED. ALL STRIPING, PAVEMENT MARKINGS INCLUDING CROSSWALKS, ARROWS AND LINE MARKINGS ARE TO BE CONSTRUCTED OF HOT PLASTIC OR COLD PLASTIC IN ACCORDANCE WITH THE MANUAL ON UNIFORM TRAFFIC CONTROL DEVICES.
- 28 ALL EXCAVATED MATERIAL THAT IS NOT REQUIRED TO BE REUSED MUST BE REMOVED FROM THE PROJECT AREA WITHIN FOUR DAYS OF EXCAVATION. SPOIL PILES WILL BE ALLOWED ONLY AS DIRECTED BY THE CITY FIELD ENGINEER.
- 29 THE CONTRACTOR WILL COORDINATE THE CONSTRUCTION ACTIVITIES WITH ALL OTHER CONTRACTORS AND UTILITY COMPANIES WORKING IN THE SAME AREA. THE CONTRACTOR MAY BE REQUIRED TO RESCHEDULE THEIR ACTIVITIES TO ALLOW UTILITY CREWS TO PERFORM THEIR REQUIRED WORK. NO ADDITIONAL COMPENSATION WILL BE ALLOWED FOR DELAYS OR INCONVENIENCE CAUSED BY UTILITY COMPANY WORK CREWS. A CONTRACT EXTENSION MAY BE ALLOWED AS DELINEATED IN CITY OF ALBUQUERQUE STANDARD SPECIFICATIONS.
- 30 EXISTING MEDIAN CURB AND CUTTER AND STANDARD CURB AND GUTTER, NOT DISTURBED BY CONTRACTOR, BUT OUT OF ALIGNMENT, DISPLACED VERTICALLY, BADLY BROKEN AND/OR DETERIORATED, WILL BE REPLACED AS DIRECTED BY THE CITY FIELD ENGINEER AND PAID FOR AT CONTRACT UNIT PRICES.
- 31 ALL TRAFFIC CONTROL DEVICES REQUIRED FOR DRIVEWAY CLOSURES, UTILITY CONSTRUCTION OR FOR OTHER REASONS AND NOT SHOWN ON THE SIGNING PLANS WILL BE FURNISHED BY THE CONTRACTOR AND WILL BE PAID AS SPECIFIED IN THE TECHNICAL SPECIFICATIONS AND BID PROPOSAL. PRIOR TO PLACING THE TRAFFIC CONTROL DEVICES, THE CONTRACTOR WILL NOTIFY THE AFFECTED OWNERS IN ACCORDANCE WITH THE SPECIFICATIONS. CONTRACTOR MUST MAKE PROVISIONS TO PROVIDE ACCESS TO PROPERTIES. REFER TO SECTION 19 OF THE SPECIFICATIONS.
- 32 ALL UTILITY LINES WHICH ARE NOT SPECIFICALLY DESIGNATED TO BE REMOVED AND REPLACED ON THE PLANS, WILL BE MAINTAINED IN SERVICE. SHORING, SHEETING AND OTHER MEANS OF SUPPORT SHALL BE EMPLOYED BY THE CONTRACTOR TO PREVENT DAMAGE OR LOSS OF THESE EXISTING UTILITIES. BEAM AND CABLE OR OTHER ADEQUATE SUPPORTS WILL BE USED FOR TEMPORARY SUPPORT OF ALL UTILITY LINES WHICH CROSS THE TRENCH. ANY DAMAGE TO EXISTING UTILITIES WILL PROMPTLY BE REPAIRED AT THE CONTRACTOR'S EXPENSE. THE CONTRACTOR WILL NOTIFY THE ENGINEER IMMEDIATELY OF ANY SIGNIFICANT DEVIATION OF EXPOSED UTILITIES FROM THE LOCATIONS SHOWN ON THE PLANS SO THAT CONFLICTS CAN BE RESOLVED IN A TIMELY MANNER.
- 33 THE CONTRACTOR WILL ASSUME RESPONSIBILITY FOR ANY DAMAGE TO EXISTING COA INFRASTRUCTURE (C & G, PAVING, ETC.) DURING CONSTRUCTION, APART FROM THOSE SECTIONS INDICATED FOR REMOVAL ON THE PLANS, AND WILL REPAIR OR REPLACE SAME AT HIS OWN EXPENSE. HE WILL SUITABLY PROTECT THE CURB AND GUTTER FROM INCIDENTAL SPLASHING DURING THE TACK COAT APPLICATION AND WILL BE RESPONSIBLE FOR CLEANING SAME AT HIS OWN COST SHOULD SPLASHING OCCUR.
- 34 ALL INTERFERING PORTIONS OF ABANDONED UTILITY LINES WHICH ARE EXPOSED AS A RESULT OF CONSTRUCTION WILL BE REMOVED AND DISPOSED OF BY THE CONTRACTOR.
- 35 SHORING COSTS WILL BE CONSIDERED INCIDENTAL TO THE TRENCH AND BACKFILL COSTS.
- 36 THE CONTRACTOR WILL BE RESPONSIBLE FOR SECURING NPDES PERMITS REQUIRED BY APPLICABLE CITY, STATE, AND FEDERAL REGULATIONS.
- 37 THE TERM REMOVE USED IN THIS PLAN SET INCLUDES THE DISPOSAL OF SAID MATERIAL IN ACCORDANCE WITH CITY OF ALBUQUERQUE SPECIFICATIONS, LATEST EDITION.
- 38 ALL ASPHALTIC CONCRETE SHALL BE MINIMUM 1800 LB. STABILITY AND COMPACTED TO 95% MODIFIED MARSHALL DENSITY UNLESS OTHERWISE NOTED ON THE PLANS.
- 39 ALL STRUCTURAL CONCRETE TO BE 4000 PSI UNLESS OTHERWISE NOTED ON PLANS.
- 40 ALL REINFORCING STEEL TO BE GRADE 60 UNLESS OTHERWISE NOTED ON PLANS.
- 41 STATIONS OF STORM DRAIN INLETS ARE TO THE CENTER OF GRATE. ALL STORM DRAIN INLETS WILL BE TYPE "A" UNLESS OTHERWISE NOTED ON THE PLANS.
- 42 ALL STORM DRAIN AND CONNECTOR PIPE WILL BE CLASS IV REINFORCED CONCRETE PIPE UNLESS OTHERWISE NOTED ON THE PLANS.

- 43 EXCESS EXCAVATION REQUIRED TO CONSTRUCT THE PROJECT THAT DOES NOT HAVE A CORRESPONDING BID ITEM (I.E. EXCAVATION OF SUBGRADE OR DIRT) SHALL BE REMOVED AND DISPOSED OF AT NO ADDITIONAL COST TO THE OWNER AND WILL BE CONSIDERED INCIDENTAL TO CONSTRUCTION.
- 44 EXCAVATION, TRENCHING AND SHORING ACTIVITIES MUST BE CARRIED-OUT IN ACCORDANCE WITH OSHA 29 CFR 1926.650.
- 45 CONTRACTOR IS ADVISED TO VISIT THE PROJECT SITE PRIOR TO BIDDING AND FAMILIARIZE THEMSELVES WITH FIELD CONDITIONS INCLUDING THE LOCATION OF UTILITIES SHOWN ON THE PLANS AND OTHER UTILITIES/ OBSTACLES CLEARLY VISIBLE IN THE FIELD. IT IS THE RESPONSIBILITY OF THE CONTRACTOR TO PLAN THEIR CONSTRUCTION METHODS TO ADEQUATELY SUPPORT AND/OR AVOID ALL UTILITIES SHOWN ON THE PLANS AND ALL UTILITIES/OBSTRUCTIONS CLEARLY VISIBLE IN THE FIELD. ANY RELOCATION OF UTILITIES OBSTACLES SHOWN ON THE PLANS OR VISIBLE IN THE FIELD IN ORDER TO COMPLETE THE REQUIRED WORK WILL BE CONSIDERED TO BE CONTRACTOR CONVENIENCE AND BE THE RESPONSIBILITY OF THE CONTRACTOR, UNLESS THE UTILITY/OBSTRUCTION IS IDENTIFIED ON THE PLANS AS BEING RELOCATABLE AS PART OF THE PROJECT. IT WILL BE THE RESPONSIBILITY OF THE CONTRACTOR TO COORDINATE ALL REQUIRED RELOCATIONS WITH APPROPRIATE UTILITIES/INDIVIDUALS.
- 46 CONTRACTOR SHALL NOT PLACE ANY EXCESS MATERIAL OVER ANY NEW REINFORCED CONCRETE PIPE HE/SHE HAS INSTALLED ABOVE OR OVER THE ELEVATIONS SHOWN ON THESE PLANS.
- 47 CONTRACTOR SHALL ONLY WORK BETWEEN THE HOURS OF 7:00 AM AND 6:00 PM.
- 48 CONTRACTOR SHALL "SEED" ALL NATURAL AREAS DISTURBED DURING CONSTRUCTION. SEE SECTION 1012 OF CITY OF ALBUQUERQUE STANDARD SPECIFICATIONS, 1990 EDITION, INCLUDING ALL UPDATES.

64TH STREET CONSTRUCTION CENTERLINE SURVEY CONTROL INFORMATION

STATION	NORTHING	EASTING
10+00.00	1493594.03	362328.75
11+00.00	1493494.03	362327.70
12+00.00	1493394.04	362328.64
13+00.00	1493294.04	362325.59
20+00.00	1492594.08	362318.20
30+00.00	1491594.14	362307.84

LIFF ROAD CONSTRUCTION CENTERLINE SURVEY CONTROL INFORMATION

STATION	NORTHING	EASTING
15+00.00	1493660.75	363111.82
16+00.00	1493661.80	363011.82
17+00.00	1493662.86	362911.83
18+00.00	1493663.91	362811.83
19+00.00	1493664.96	362711.84
20+00.00	1493666.02	362611.85

DOUBLE 10' X 12' CBC CENTERLINE SURVEY CONTROL INFORMATION

STATION	NORTHING	EASTING
10+00.00	1494489.33	363369.91
11+00.00	1494389.34	363368.84
12+00.00	1494289.35	363367.77
13+00.00	1494189.35	363366.69
14+00.00	1494089.35	363365.62
14+26.00	1494063.36	363365.34

LOCAL SURVEY CONTROL INFORMATION

POINT NUMBER	NORTHING	EASTING	ELEVATION	DESCRIPTION	DRAINAGE EASEMENT CONSTRUCTION CENTERLINE STATION AND OFFSET	64TH STREET CONSTRUCTION CENTERLINE STATION AND OFFSET	DOUBLE 10'X12' CBC CENTERLINE STATION AND OFFSET	LIFF ROAD CONSTRUCTION CENTERLINE STATION AND OFFSET
CP-1	1494103.24	363222.47	5099.97	NO. 5 REBAR & PLASTIC CAP "CONTROL PT. NMPS 11599"	12+00.28, 74.70' RT	N/A	13+87.66, 143.29' RT	13+94.01, 443.63' RT
CP-2	1493542.47	362274.43	5107.02	NO. 5 REBAR & PLASTIC CAP "CONTROL PT. NMPS 11599"	N/A	10+52.13, 53.77' RT	N/A	N/A
CP-3	1492988.45	362175.55	5102.62	NO. 5 REBAR & PLASTIC CAP "CONTROL PT. NMPS 11599"	N/A	16+09.15, 146.78' RT	N/A	N/A

DRAINAGE EASEMENT CONSTRUCTION CENTERLINE SURVEY CONTROL INFORMATION

STATION	NORTHING	EASTING
10+00.00	1494086.68	363444.09
12+69.12	1494004.87	363189.23
13+98.46	1493945.84	363074.15
22+71.00	1493494.03	362327.70

LEGEND:


- X--- EXISTING CHAIN LINK FENCE
- O--- EXISTING OVERHEAD ELECTRIC
- E--- EXISTING 2" HP GAS
- E--- EXISTING 48" SAS
- E--- EXISTING SAS
- E--- EXISTING WATER
- E--- EXISTING STORMDRAIN
- E--- EXISTING BLOCK WALL
- E--- EXISTING WATER GATE VALVE
- E--- EXISTING CATCH BASIN
- E--- EXISTING WATER METER
- E--- EXISTING MANHOLE
- E--- NEW MANHOLE
- E--- NEW JUNCTION BOX
- E--- EXISTING FIRE HYDRANT
- E--- EXISTING LIGHT POLE
- E--- NEW ASPHALT PAVEMENT
- E--- EXISTING TRAFFIC LIGHT
- E--- EXISTING ASPHALT PAVEMENT
- E--- C.O.A. CITY OF ALBUQUERQUE
- E--- EXISTING SPOT ELEVATION
- E--- EXISTING CONTOUR LINE
- E--- EXISTING TREE
- E--- NEW STORM DRAIN
- E--- CENTERLINE
- E--- TOP OF ASPHALT ELEVATION
- E--- EXISTING BUILDING
- E--- EXISTING CURB AND GUTTER
- E--- SURVEY CONTROL POINT
- E--- EXISTING SIGN
- E--- ROW
- E--- EXISTING EASEMENT LINE
- E--- PROPERTY LINES
- E--- PROPOSED EASEMENT LINE
- E--- PROPOSED CONTOURS
- E--- PROPOSED WATERLINE
- E--- PROPOSED WATERLINE GATE VALVE
- E--- PROPOSED WATERLINE BEND
- E--- PROPOSED FIRE HYDRANT
- E--- PROPOSED BUTTERFLY VALVE
- E--- EXISTING BUTTERFLY VALVE

1961050
Smith Engineering Company
A Full Service Engineering Company
8000 Alameda, S.E., Suite 1000, Albuquerque, New Mexico 87105

CITY OF ALBUQUERQUE
PUBLIC WORKS DEPARTMENT
ENGINEERING DEVELOPMENT GROUP

TITLE: WEST MESA DIVERSION PROJECT PHASE I
GENERAL NOTES, LEGEND AND SURVEY CONTROL INFORMATION SHEET

Design Review Committee	City Engineer Approval	NO. / DAY / YR.	NO. / DAY / YR.
DATE	DATE	DATE	DATE
CITY PROJECT NO.	Zone Map No.	Sheet	Of
538191	H-102, H-112	2	20

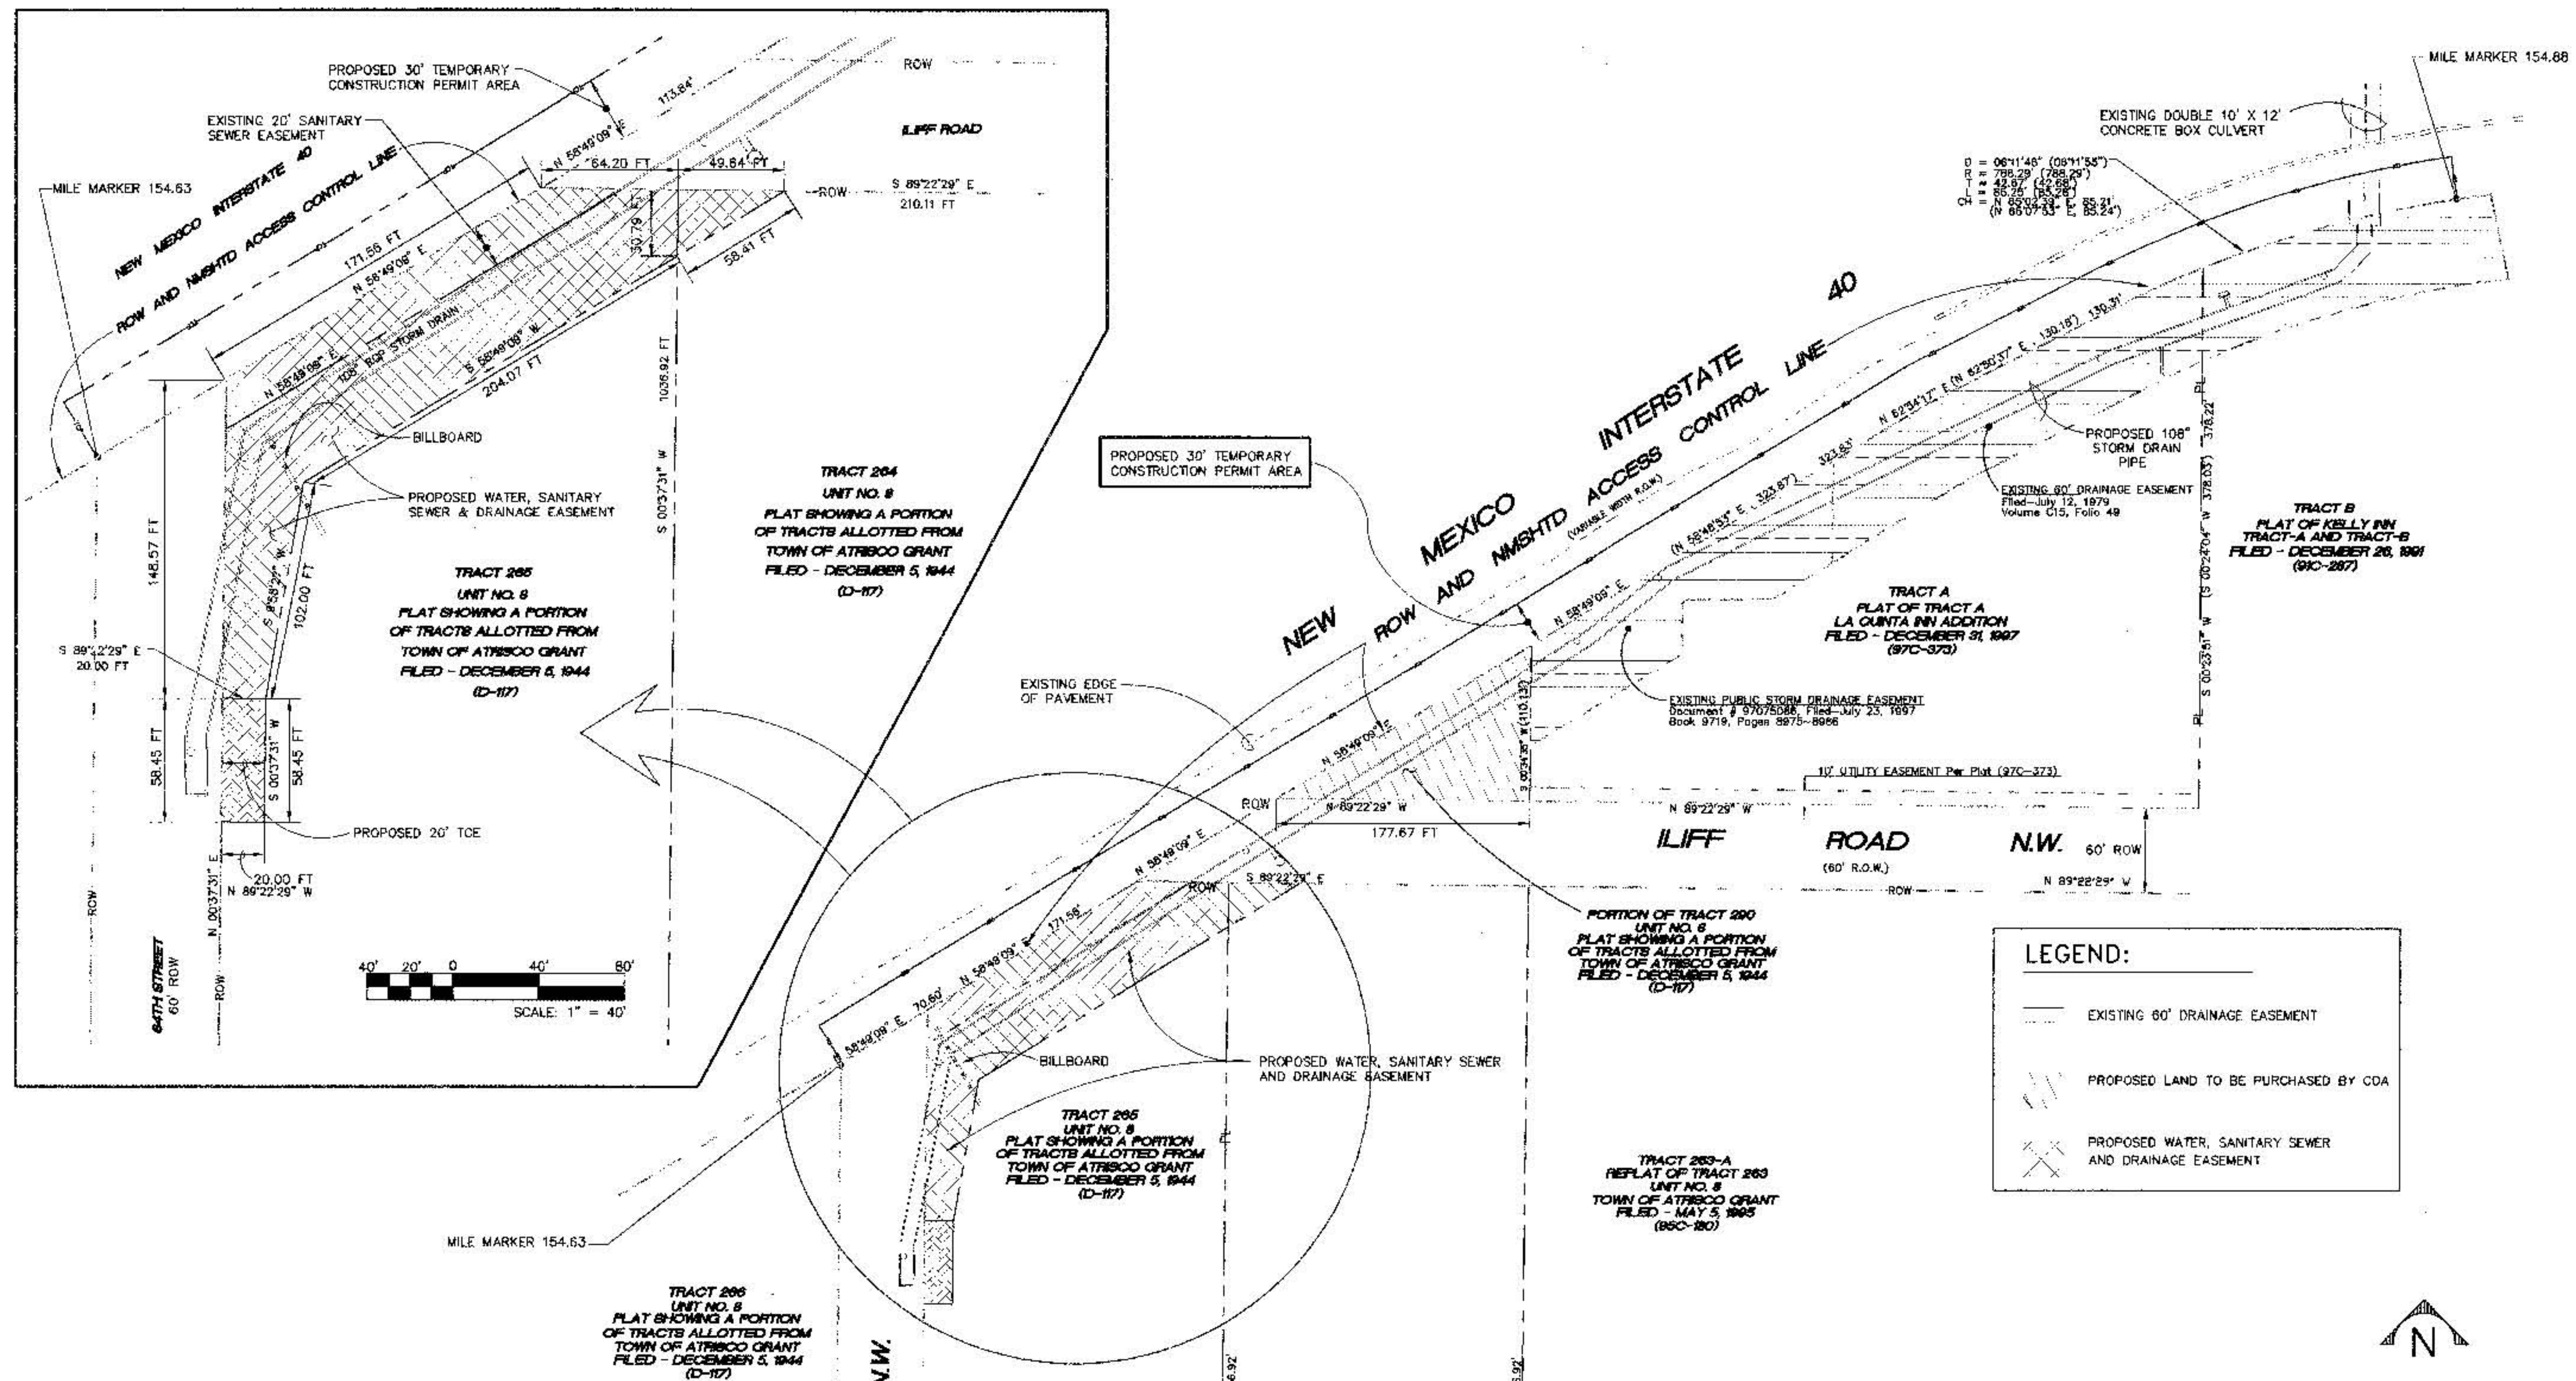

LAND REQUIREMENTS TABLE

DESCRIPTION OF PLATTED LANDS	AREA REQUIRED FOR WATER, SANITARY SEWER AND DRAINAGE EASEMENT	AREA REQUIRED FOR FOR TEMPORARY CONSTRUCTION EASEMENT	AREA TO BE PURCHASED BY THE CITY OF ALBUQUERQUE	AREA REQUIRED FOR TEMPORARY CONSTRUCTION PERM
TRACT 265 UNIT NO.8 * TOWN OF ATRISCO GRANT	0.367 AC	0.027 AC	0.000 AC	0.000 AC
TRACT 264 UNIT NO.8 TOWN OF ATRISCO GRANT	0.018 AC	0.000 AC	0.000 AC	0.000 AC
PORTION OF TRACT 290 UNIT NO. 8 TOWN OF ATRISCO GRANT	0.000 AC	0.000 AC	0.225 AC	0.000 AC
NMSHTD INTERSTATE 40 RIGHT OF WAY	0.000 AC	0.000 AC	0.000 AC	0.892 AC

* 20' WIDE SANITARY SEWER EASEMENT CURRENTLY EXISTS ON PROPERTY

LEGEND:

- EXISTING 80' DRAINAGE EASEMENT
- PROPOSED LAND TO BE PURCHASED BY COA
- PROPOSED WATER, SANITARY SEWER
AND DRAINAGE EASEMENT



Smith Engineering Company
A Full Service Engineering Company
5400 Uptown Boulevard, N.E. Atlanta, GA 30305, Atlanta, GA 30305

CITY OF ALBUQUERQUE
PUBLIC WORKS DEPARTMENT
ENGINEERING DEVELOPMENT GROUP

TITLE WEST MESA DIVERSION PROJECT PHASE I
WORK AREA AND EASEMENT PLAN SHEET

[illegible]

City Project No.	538191	Zone Map No.	H-17 H-17	Sheet	3	Of	20
------------------	--------	--------------	-----------	-------	---	----	----

[illegible]

10


11

12

13

14

15

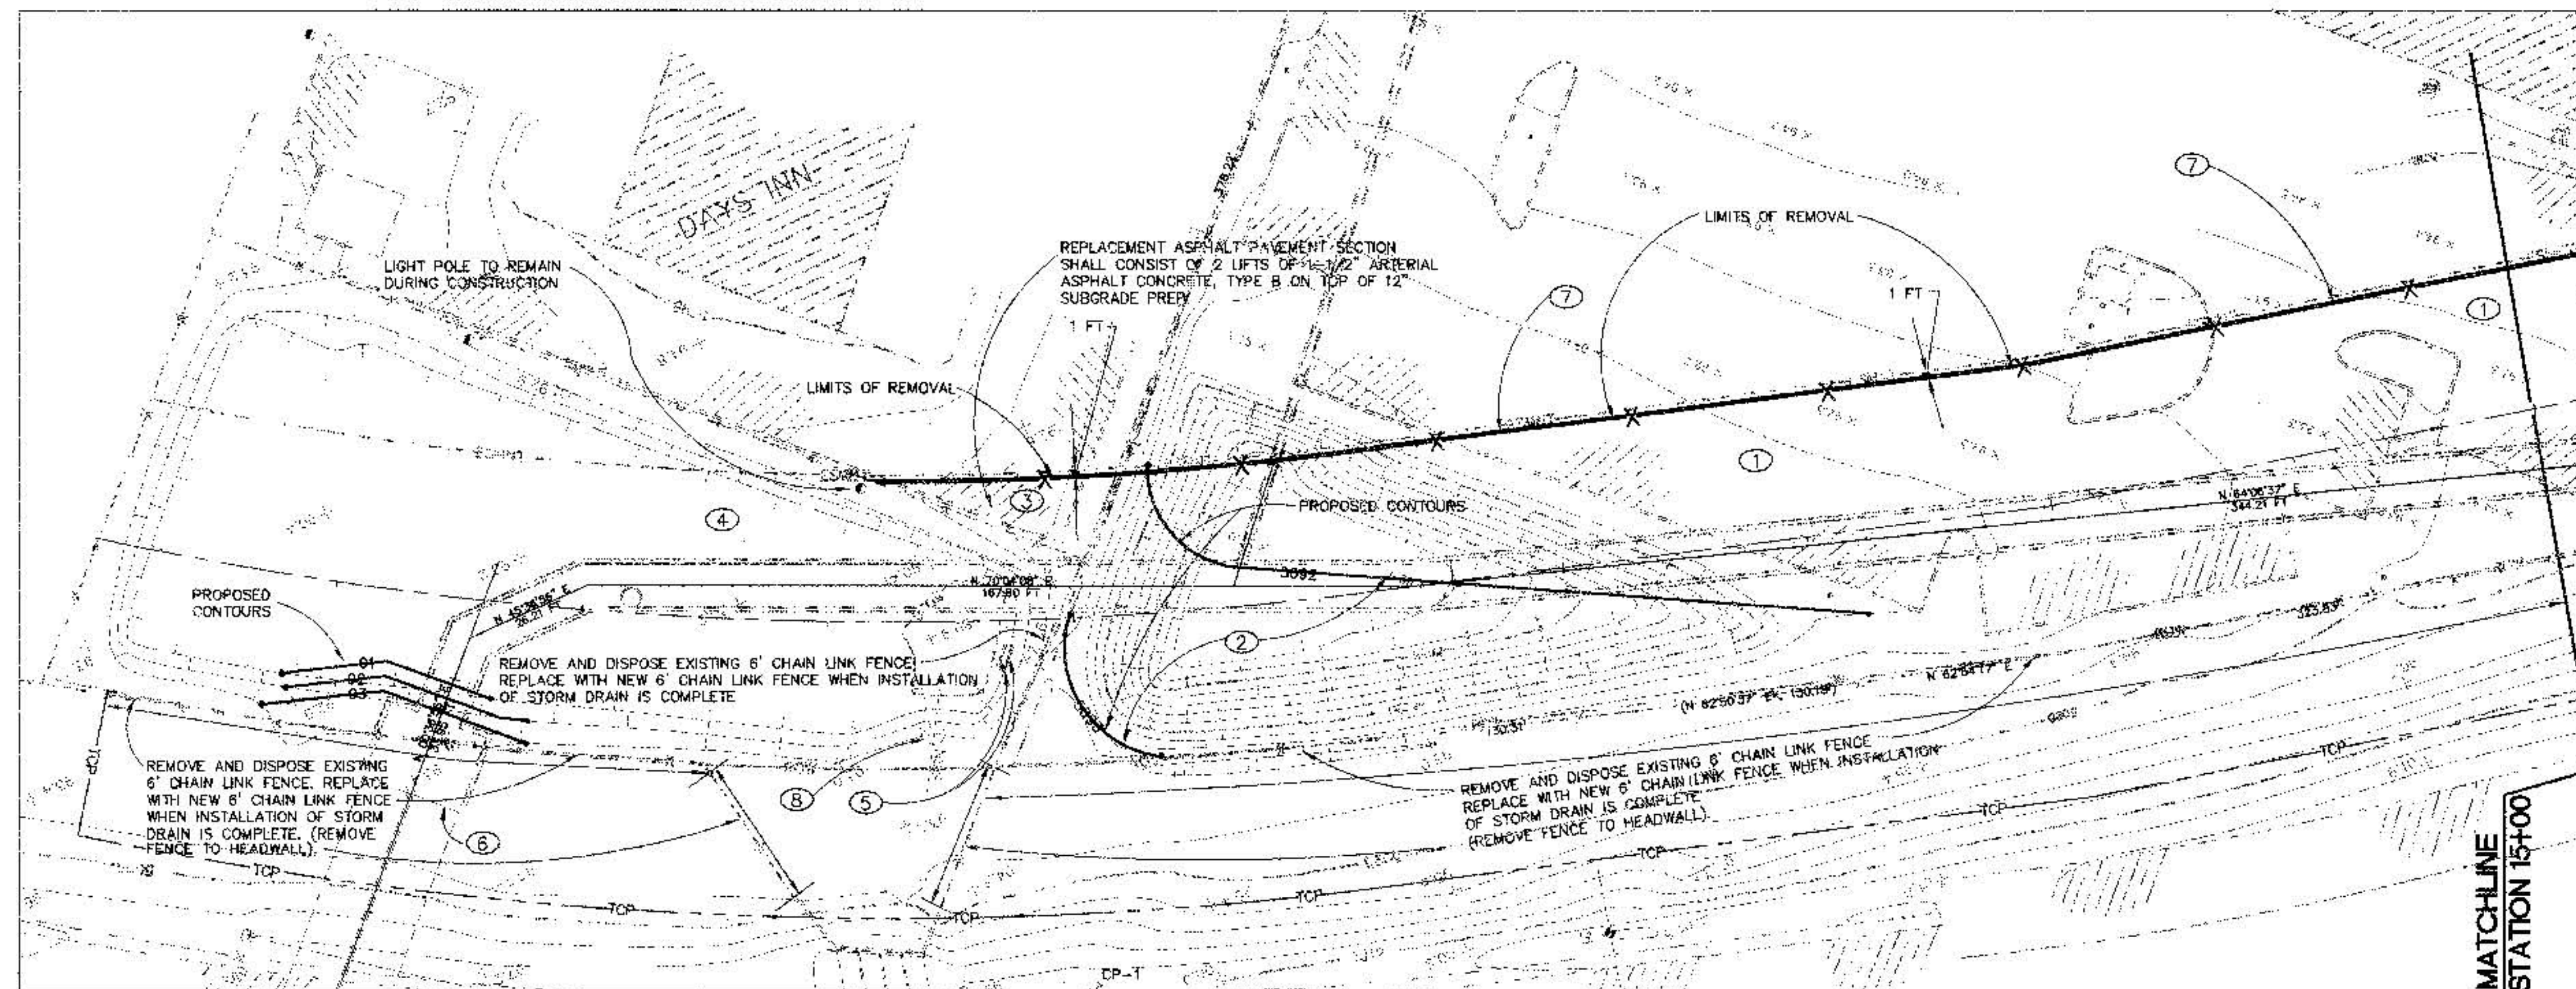

DRAINAGE EASEMENT


15

16

17

18

19

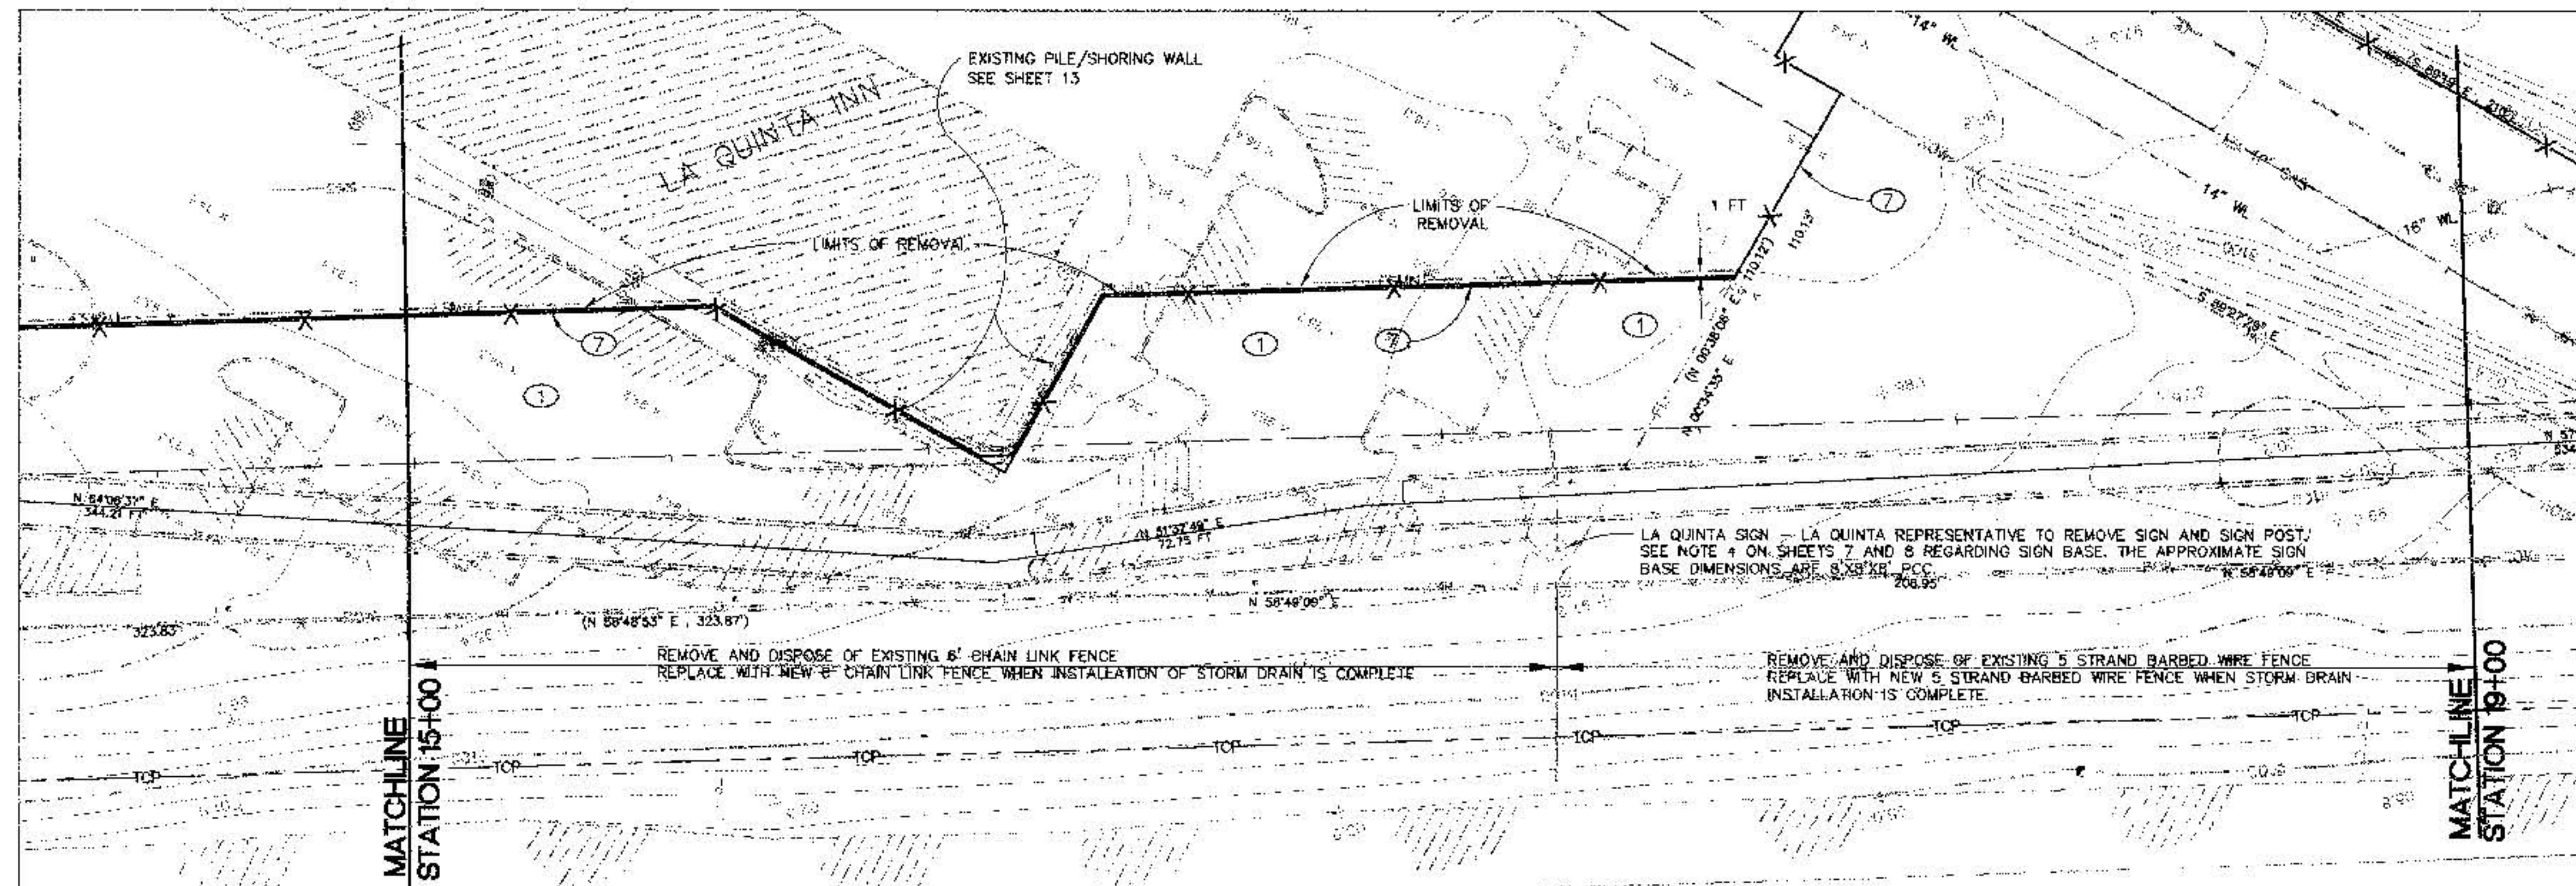

DRAINAGE EASEMENT

KEYED NOTES:

1. REMOVE AND DISPOSE OF LA QUINTA IMPROVEMENTS TO THE LIMITS SHOWN. THE CONTRACTOR SHALL NOT RESTORE ANY OF THE LA QUINTA IMPROVEMENTS THAT ARE SHOWN TO BE REMOVED. THE CONTRACTOR SHALL BACKFILL AND COMPACT THE TRENCH AREA TO THE ELEVATIONS SHOWN. THE BACKFILL SHALL BE COMPACTED TO 90% ASTM D-1557.
2. THE CONTRACTOR SHALL FILL THE LA QUINTA POND TO THE PROPOSED ELEVATIONS SHOWN, WHEN THE STORM DRAIN INSTALLATION IS COMPLETE. THE BACKFILL SHALL BE COMPACTED TO 90% ASTM D-1557. PRIOR TO BACKFILLING OF LA QUINTA POND, THE CONTRACTOR SHALL REMOVE AND DISPOSE OF ALL LARGE ROCKS, BARK, LANDSCAPING, ETC. THIS REMOVAL SHALL BE PAID FOR UNDER THE LA QUINTA REMOVAL BID ITEM.
3. REMOVE AND DISPOSE OF DAYS INN IMPROVEMENTS TO THE LIMITS SHOWN. CONTRACTOR SHALL REPLACE ALL IMPROVEMENTS TO DAYS INN SITE AFTER STORM DRAIN INSTALLATION IS COMPLETE. IT IS THE CONTRACTOR'S RESPONSIBILITY TO BUILD THE REPLACEMENT IMPROVEMENTS TO MATCH EXISTING HORIZONTAL GEOMETRY AND ELEVATION.
4. AFTER STORM DRAIN INSTALLATION IS COMPLETE, THE CONTRACTOR SHALL REGRADE THE DAYS INN DETENTION POND TO MATCH THE ELEVATIONS SHOWN.
5. REMOVE AND DISPOSE OF EXISTING 18" CMP WEIR/ORIFICE. REMOVE AND DISPOSE 30 LF OF 18" CMP. PLUG OR CAP EXISTING END OF 18" CMP. PLUGGING OF PIPE IS INCIDENTAL TO CONSTRUCTION.
6. REMOVE AND DISPOSE OF EXISTING RAILROAD TIES. THE RAILROAD TIES CURRENTLY ACT AS A PLUG/CAP FOR THE EXISTING DOUBLE 10' X 12' CBC. THE CONTRACTOR SHALL REMOVE ALL DIRT FROM EXISTING CBC. THE REMOVAL OF DIRT FROM THE EXISTING CBC WILL BE CONSIDERED INCIDENTAL TO CONSTRUCTION.
7. INSTALL TEMPORARY CHAINLINK FENCE, 5' HIGH, INCLUDING POSTS AND HARDWARE. REMOVE & DISPOSE WHEN CONTRACTOR CONSTRUCTION OF PERMANENT FENCING IS COMPLETE.
8. DAYS IN SIGN - SIGN, POST & FOUNDATION TO REMAIN IN PLACE DURING CONSTRUCTION. SEE GENERAL NOTE 4 OF THIS SHEET.

GENERAL NOTES:

1. THE CONTRACTOR SHALL CUT AND CAP ALL EXISTING WATER/IRRIGATION LINES IN THE EASEMENT WORK AREA ON THE LA QUINTA AND DAYS INN PROPERTY. THE CONTRACTOR SHALL COORDINATE THIS WORK WITH LA QUINTA AND DAYS INN (SEE NOTE 4 ON SHEETS 7 AND 8 RELATIVE TO NOTIFYING LA QUINTA OF WORK ON LA QUINTA PROPERTY). THIS WORK WILL BE CONSIDERED INCIDENTAL TO THE REMOVAL WORK REQUIRED ON THESE TWO PROPERTIES.
2. THE CONTRACTOR SHALL COORDINATE ALL ELECTRICAL SHUT DOWNS (RELATIVE TO PARKING LOT LIGHTING AND SIGN LIGHTING) WITH LA QUINTA AND DAYS INN. (SEE NOTE 4 ON SHEETS 7&8 RELATIVE TO NOTIFYING LA QUINTA OF WORK ON LA QUINTA PROPERTY). ANY WORK CORRELATED WITH EXISTING ELECTRICAL LINES RELATIVE TO DAYS INN OR LA QUINTA PROPERTIES WILL BE CONSIDERED INCIDENTAL TO THE REMOVAL WORK REQUIRED ON THESE TWO PROPERTIES.
3. REMOVE AND SALVAGE ALL PARKING LOT LIGHT POLES ON LA QUINTA PROPERTY TO LA QUINTA.

CITY OF ALBUQUERQUE
PUBLIC WORKS DEPARTMENT
ENGINEERING DEVELOPMENT GROUP


TITLE: WEST MESA DIVERSION PROJECT PHASE I

REMOVAL SHEET


Design Review: <i>[Signature]</i>	City Engineer Approval: <i>[Signature]</i>	City Engineer: <i>[Signature]</i>
Drawn By: C.R.D.L.A.	Checked By: C.R.D.L.A.	Zone Map No. H-102, H-112

City Project No. 5381.91 Sheet 4 of 20


AS BUILT INFORMATION		BENCH MARKS		SURVEY INFORMATION	
CONTRACTOR: <i>[Signature]</i>	DATE: 5-11-98	STATION: 15+00	ELEV. 5103.98 FEET (SLD 1929)	DATE: 5-11-98	BY: <i>[Signature]</i>
INSPECTOR: <i>[Signature]</i>	DATE: 5-11-98	STATION: 15+00	ELEV. 5103.98 FEET (SLD 1929)	DATE: 5-11-98	BY: <i>[Signature]</i>
STANDARD: 1-40-18"	DATE: 5-11-98	STATION: 15+00	ELEV. 5103.98 FEET (SLD 1929)	DATE: 5-11-98	BY: <i>[Signature]</i>
STANDARD: 1-40-18"	DATE: 5-11-98	STATION: 15+00	ELEV. 5103.98 FEET (SLD 1929)	DATE: 5-11-98	BY: <i>[Signature]</i>

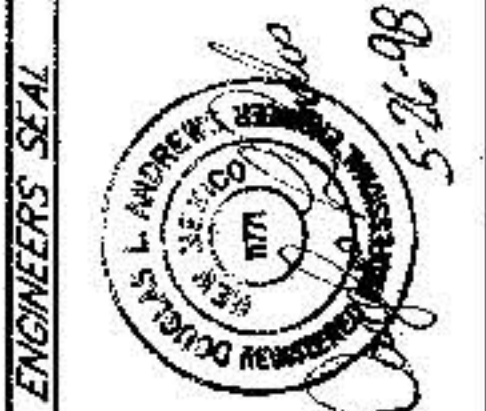

NO.	DATE	REVISIONS	BY
1	04/98	DESIGN	C.R.D.L.A.
2	04/98		C.R.D.L.A.
3	04/98		C.R.D.L.A.

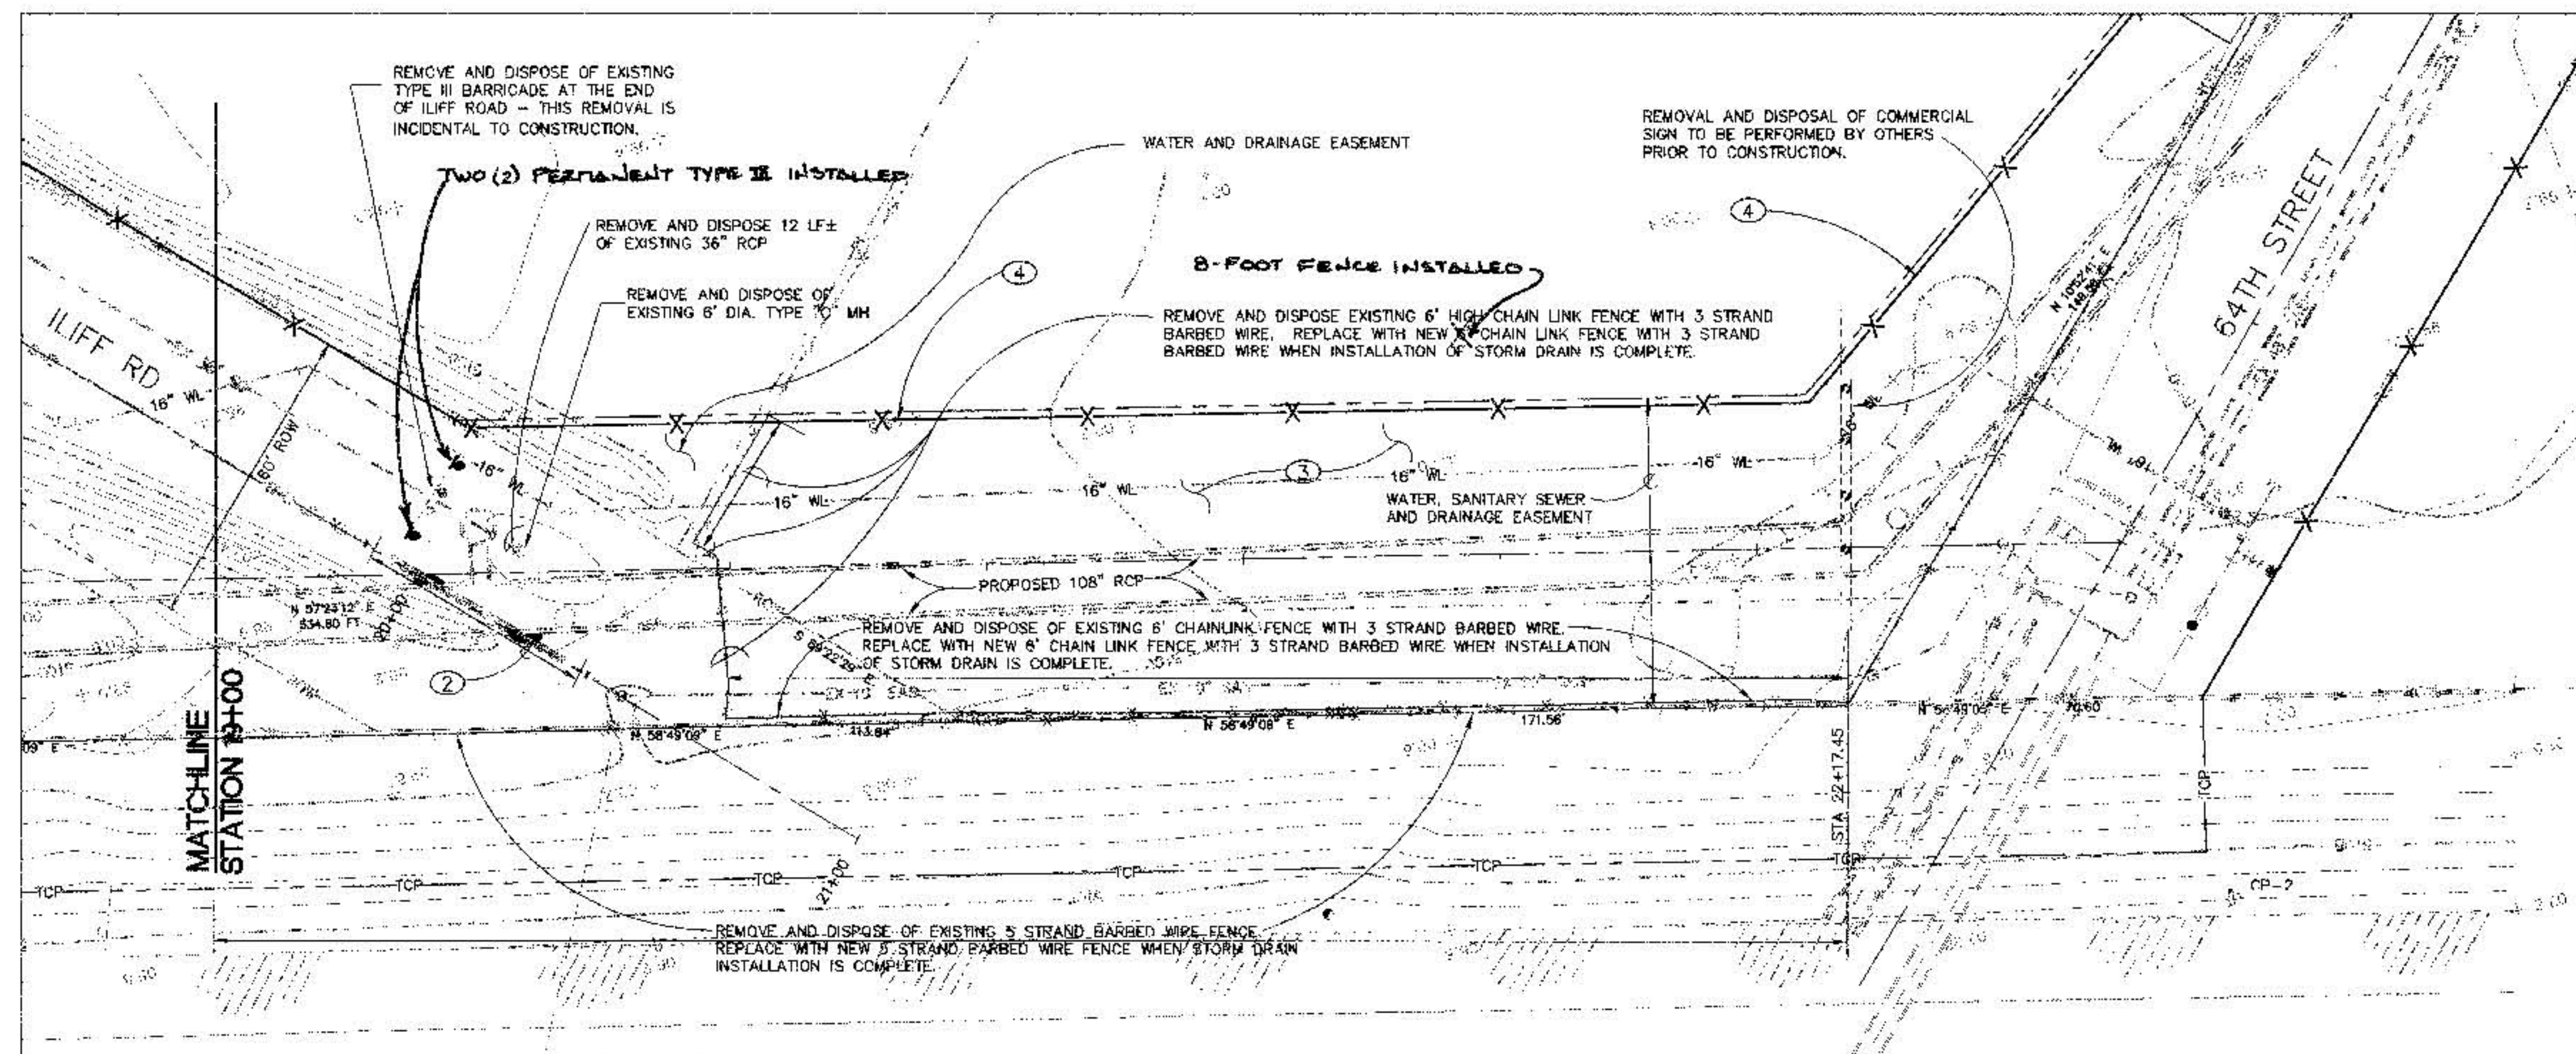



DRAINAGE EASEMENT

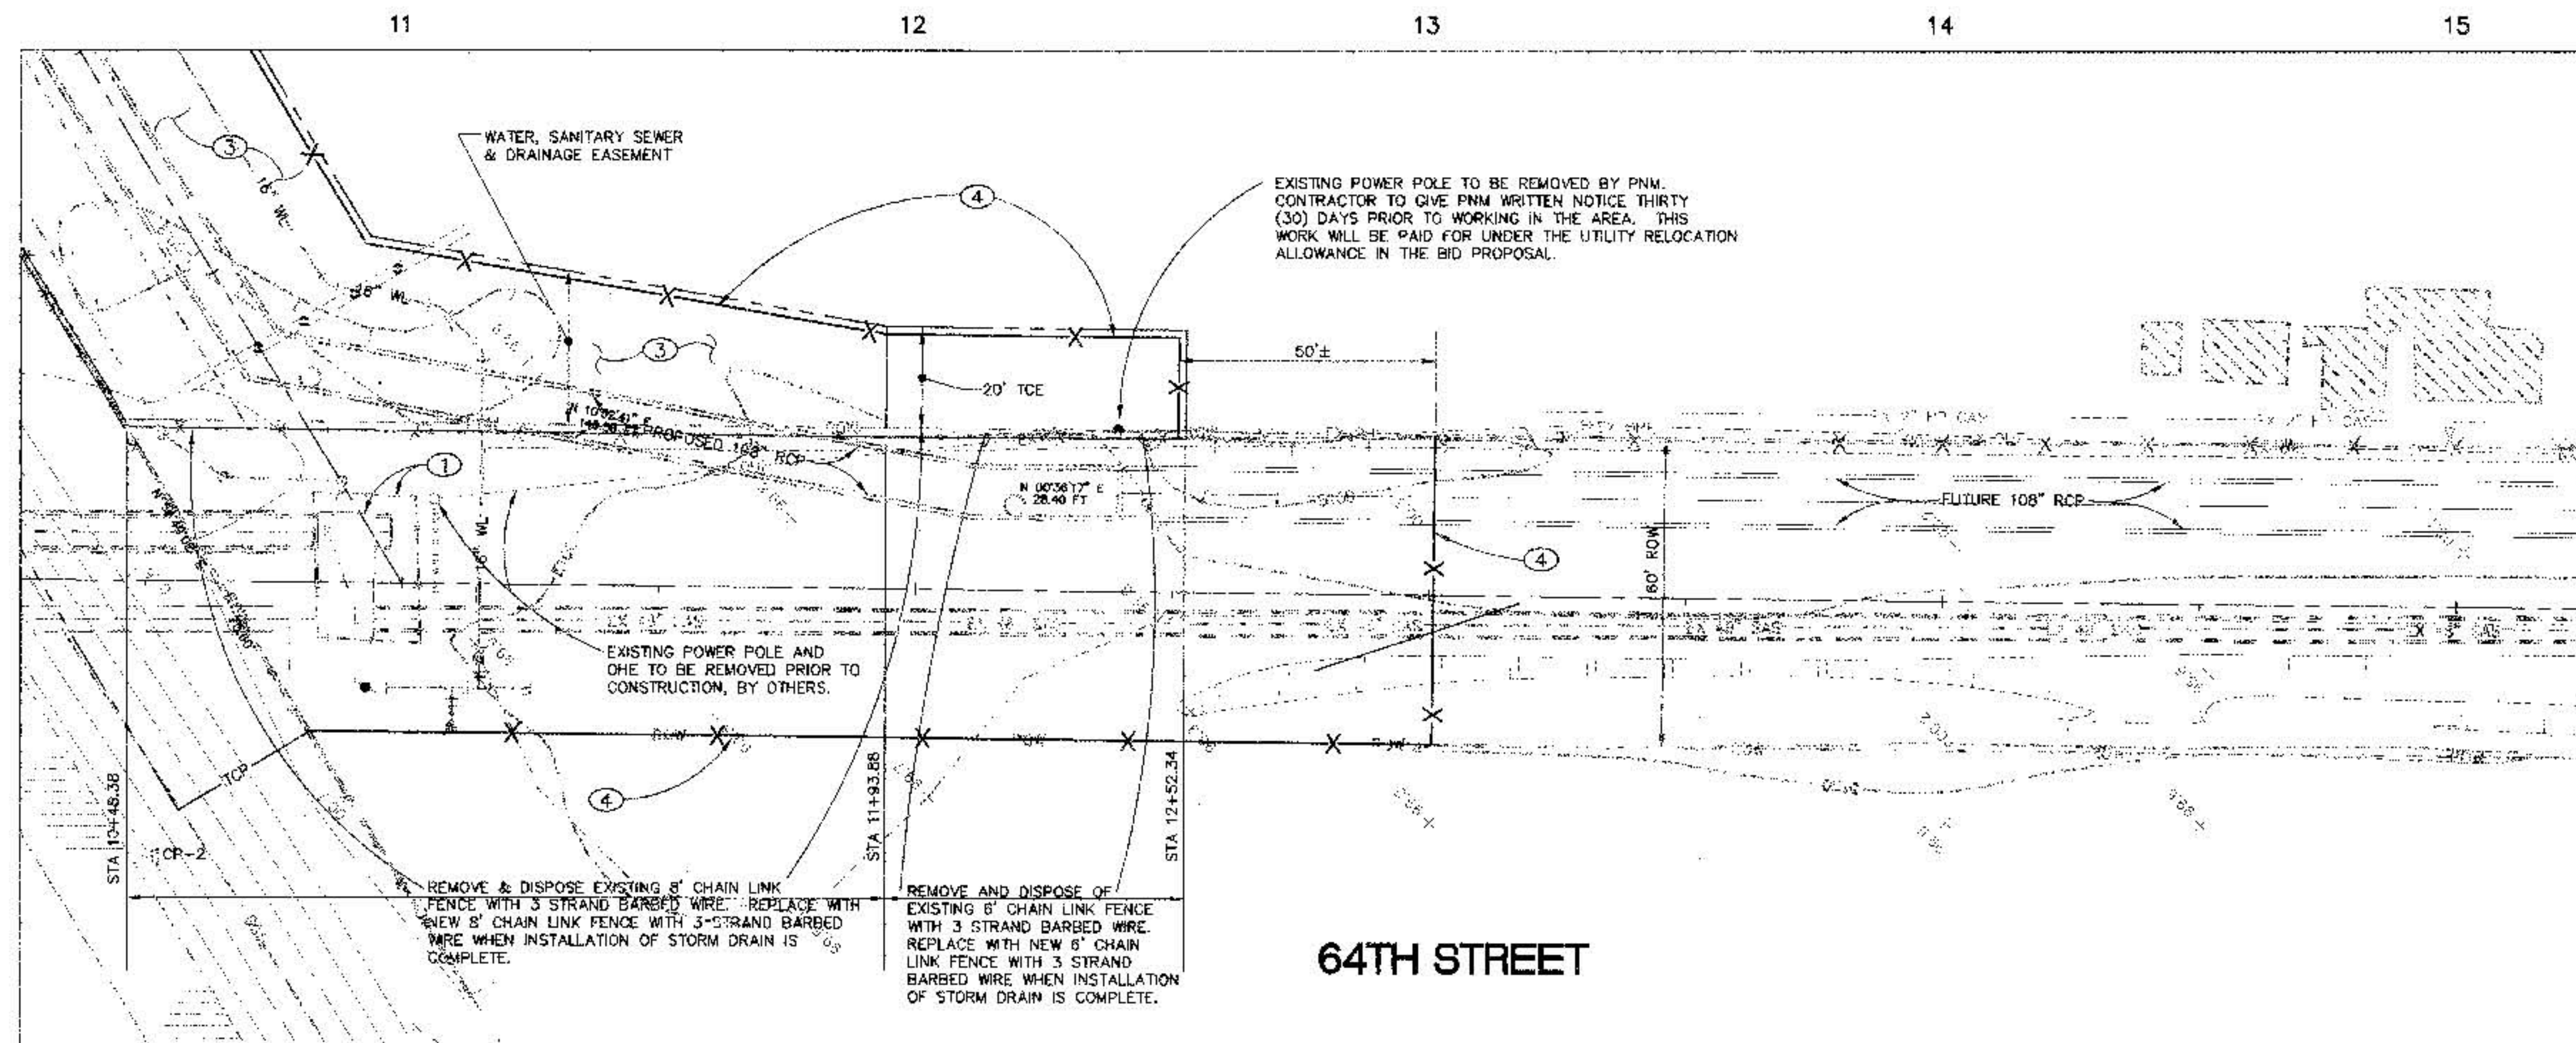

○ KEYED NOTES:

- ① HYDROGEN PEROXIDE STATION TO REMAIN IN SERVICE DURING CONSTRUCTION. CHAIN LINK FENCE AROUND THE HYDROGEN PEROXIDE STATION SHALL REMAIN IN PLACE AT ALL TIMES DURING CONSTRUCTION.
- ② CONTRACTOR TO REMOVE AND DISPOSE OF 50 LF OF EXISTING 10" SAS PIPE. (SEE SHEET 9 FOR INSTALLATION OF NEW 10" SAS PIPE ALONG WITH 18" STEEL CASING PIPE THROUGH THE 108" RCP). DURING THIS WORK, THE CONTRACTOR SHALL PUMP THE EXISTING SEWAGE FROM THE FIRST UPSTREAM MH TO THE FIRST DOWNSTREAM MH ALONG THIS SAS LINE. THE CONTRACTOR WILL BE PAID BY THE HOUR FOR THE HANDLING OF THIS SEWAGE. HOWEVER, THE CONTRACTOR WILL NOT BE PAID FOR MORE THAN 72 HOURS FOR HANDLING THE SEWAGE.
- ③ EXISTING MOBILE HOMES TO BE REMOVED FROM WORK AREA PRIOR TO CONSTRUCTION, BY OTHERS.
- ④ INSTALL TEMPORARY CHAINLINK FENCE, 5' HIGH, INCLUDING POSTS AND HARDWARE. REMOVE & DISPOSE WHEN CONSTRUCTION OF PERMANENT FENCING IS COMPLETE.

[illegible]

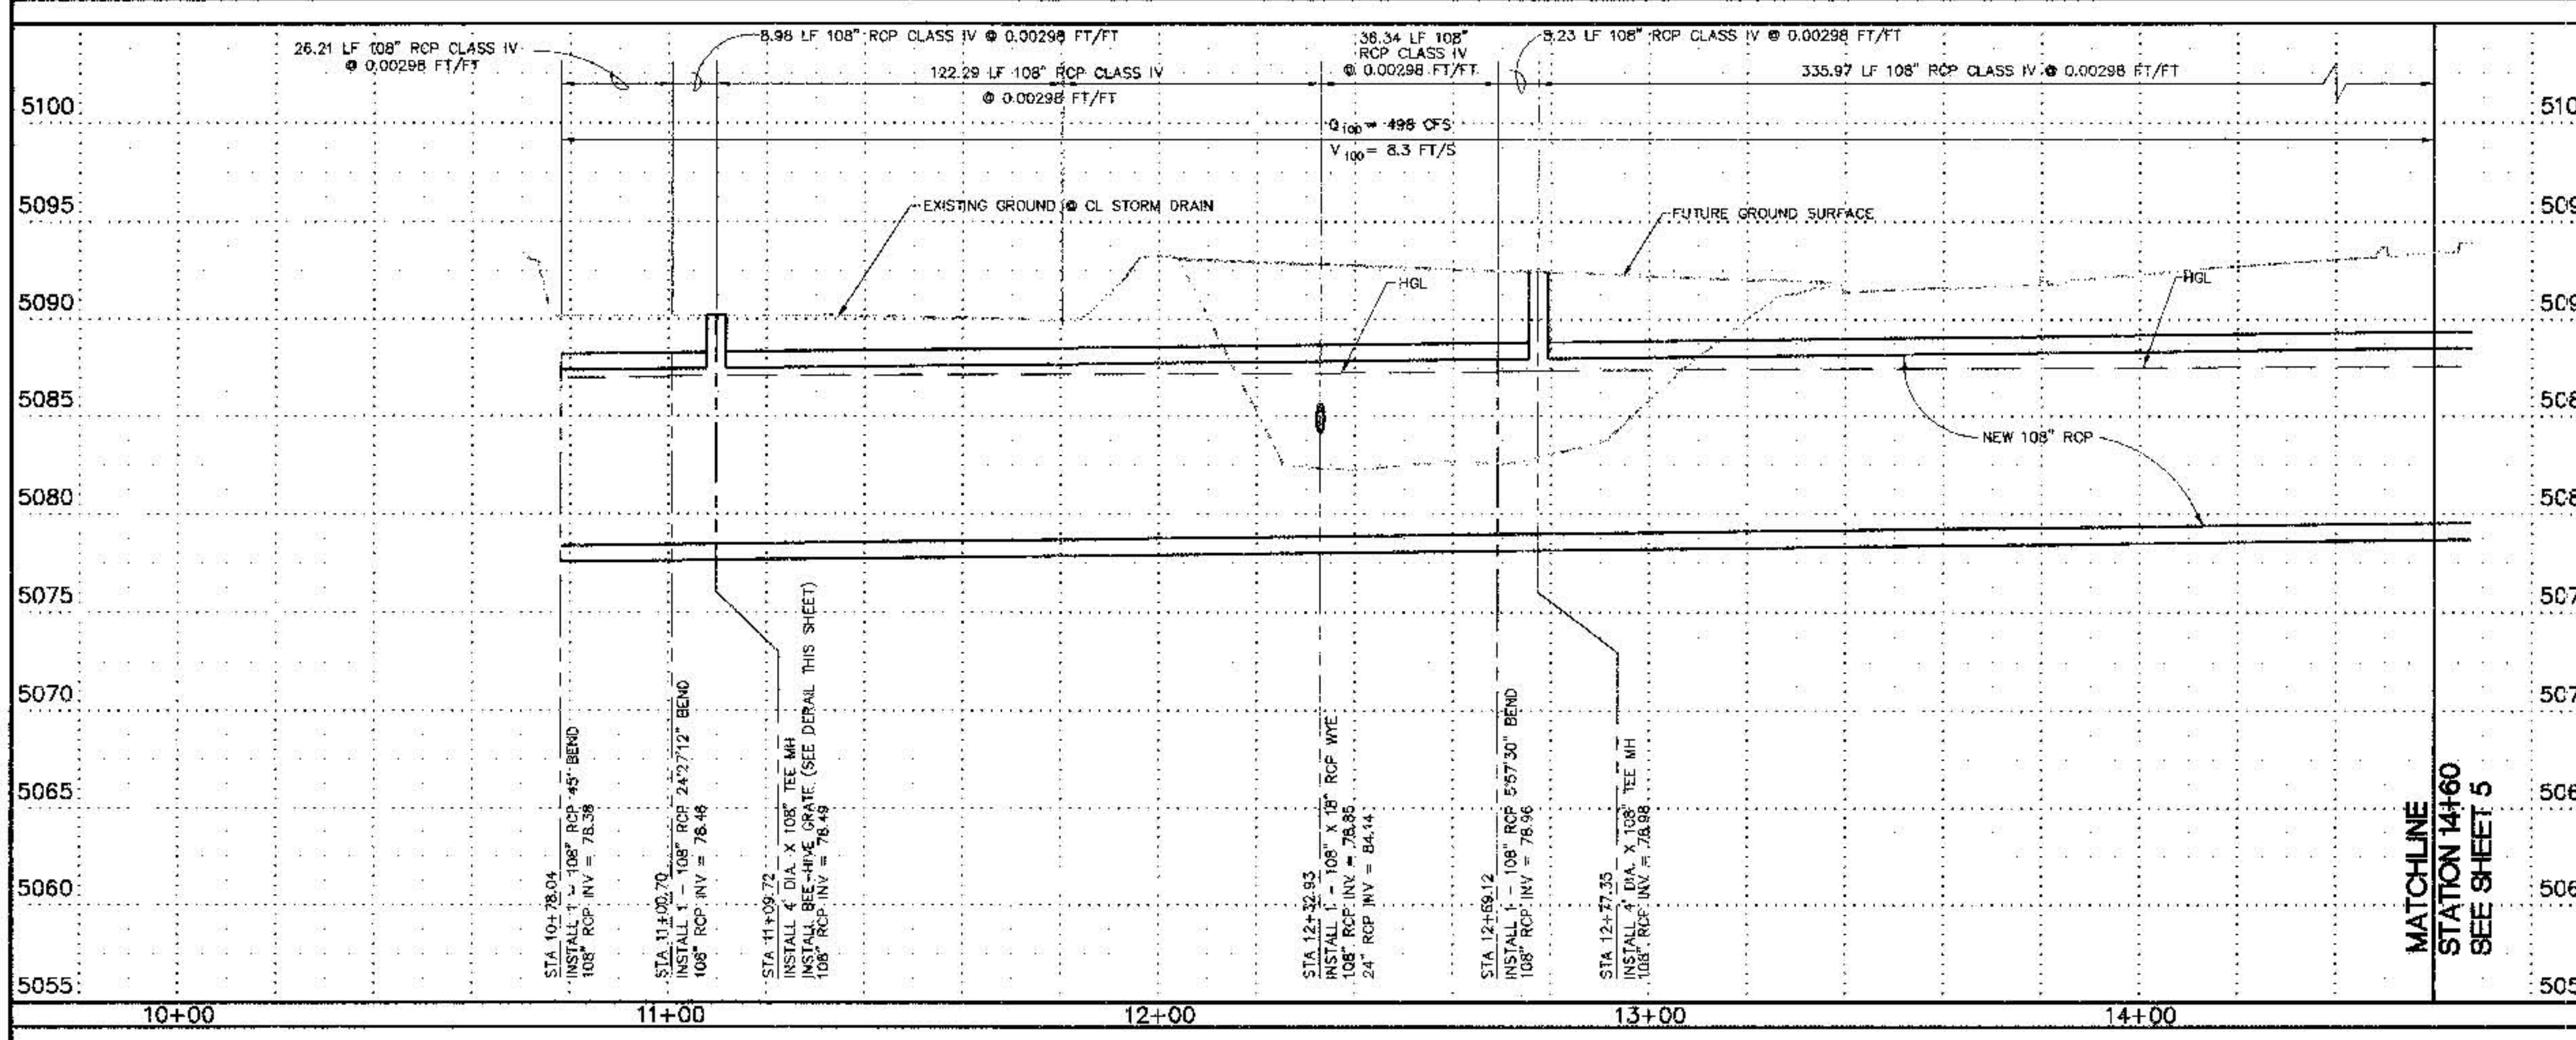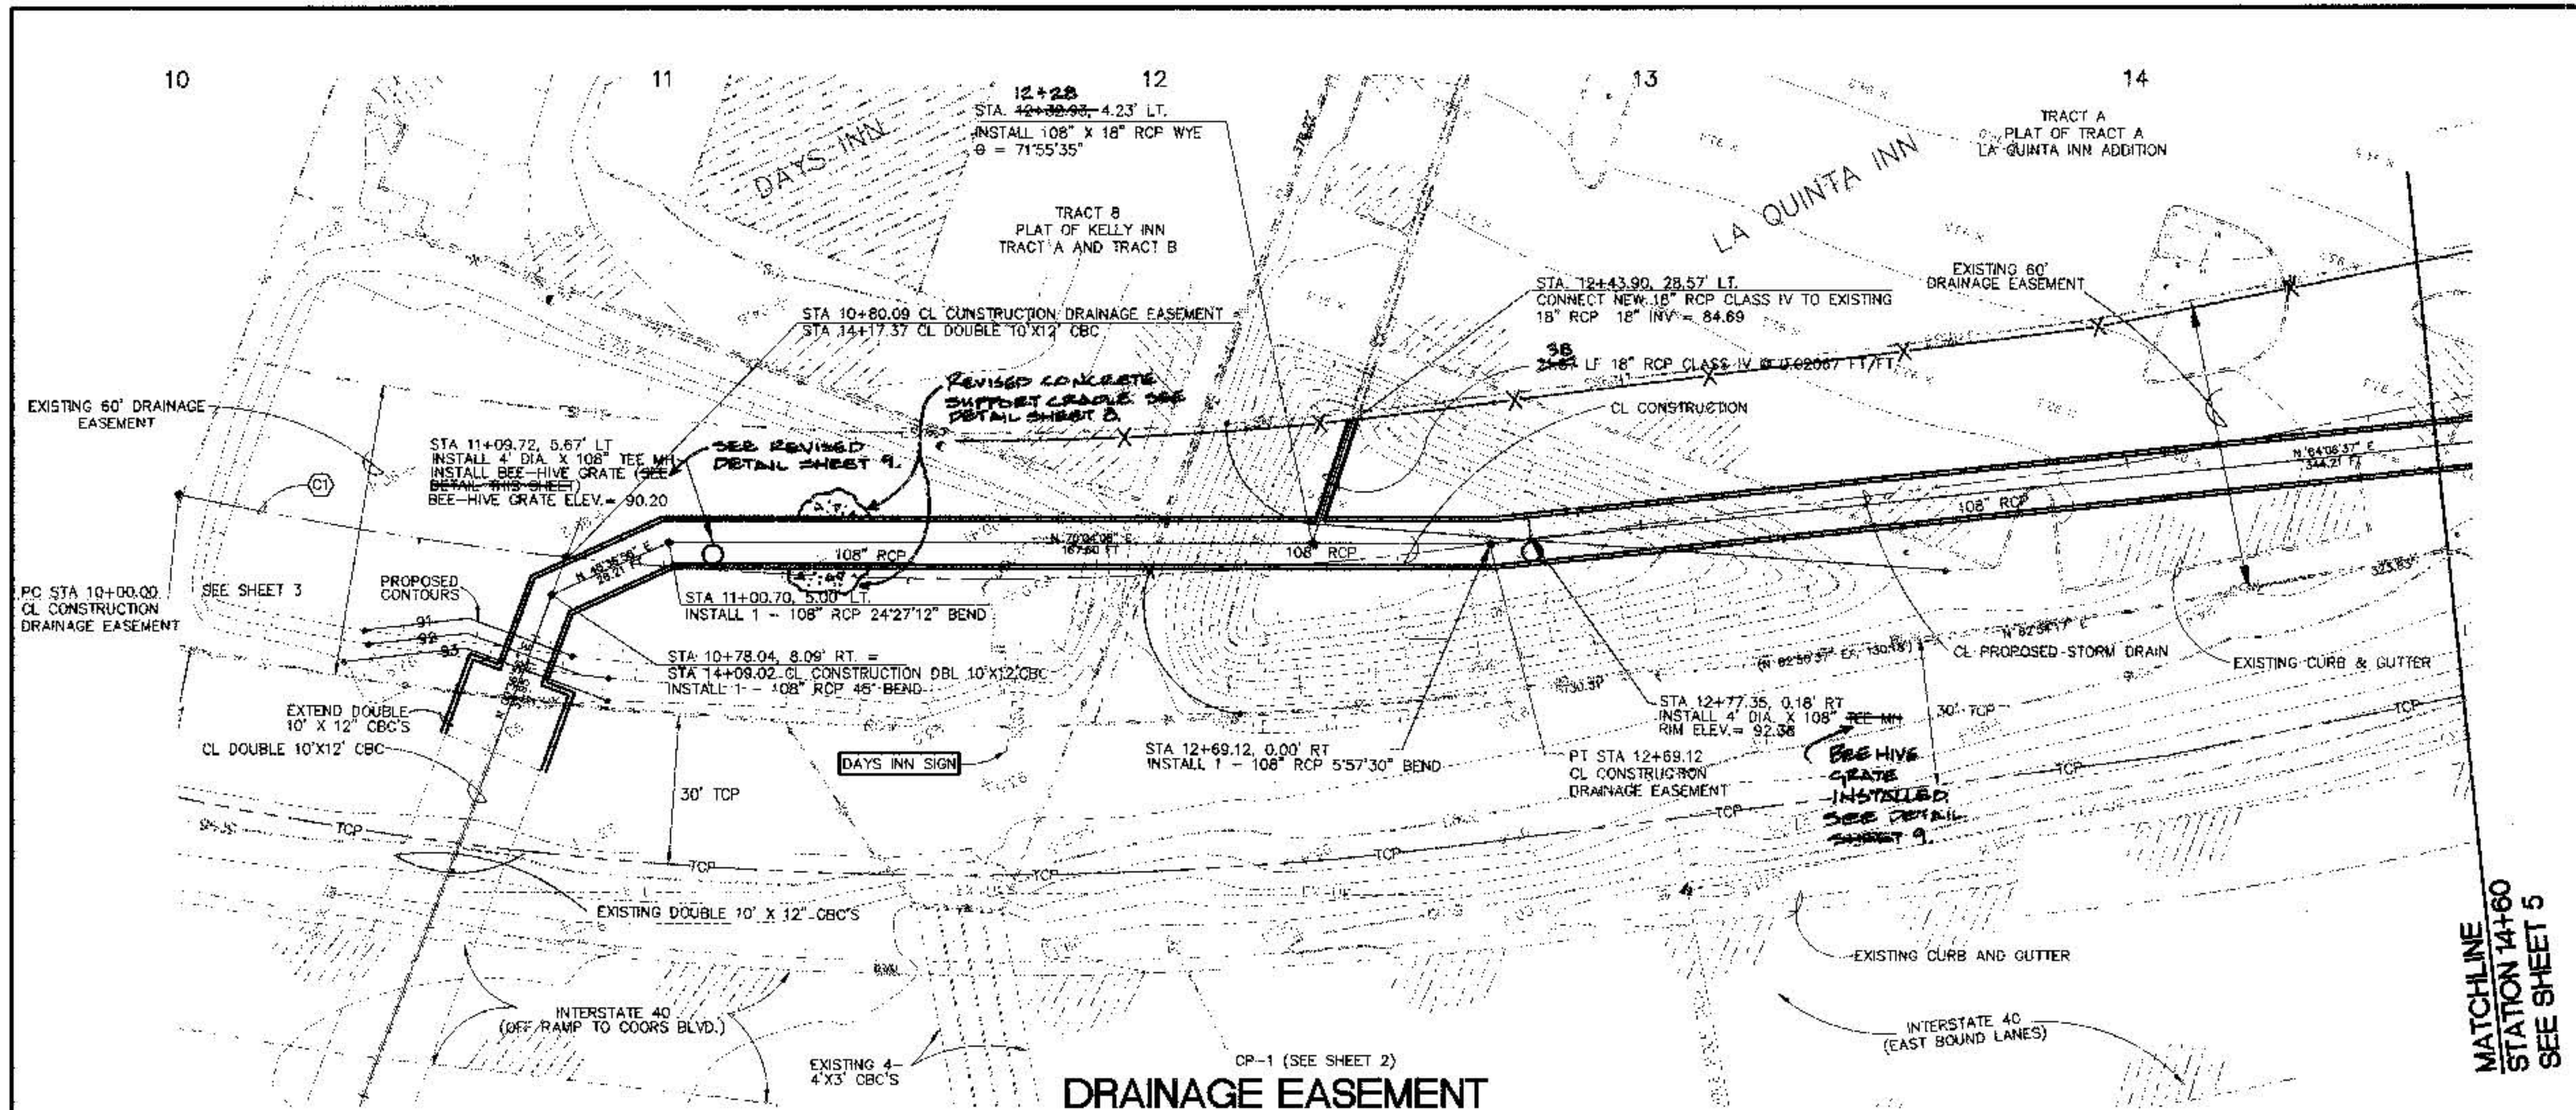

GENERAL NOTES RELATIVE TO LA QUINTA SITE

- AT ALL TIMES DURING CONSTRUCTION, AT LEAST ONE-THIRD OF THE EASEMENT PROPERTY ON THE LA QUINTA SITE SHALL BE MAINTAINED BY THE CONTRACTOR SO IT CAN BE USED BY LA QUINTA.
- THE CONTRACTOR SHALL HAVE NO MORE THAN 200 FEET OF OPEN TRENCH ON THE LA QUINTA EASEMENT PROPERTY AT ANY ONE TIME.
- AT NO TIME SHALL LA QUINTA'S CERTIFICATE OF OCCUPANCY BE SUSPENDED DUE TO THE CONSTRUCTION OF THE DRAINAGE IMPROVEMENTS.
- THE CONTRACTOR SHALL GIVE LA QUINTA AT LEAST THIRTY (30) DAYS PRIOR WRITTEN NOTICE PRIOR TO COMMENCING CONSTRUCTION OF THE DRAINAGE IMPROVEMENTS. THE CONTRACTOR SHALL COORDINATE THE TRENCHING OF THE EASEMENT PROPERTY IN THE VICINITY OF THE LA QUINTA SIGN TO AFFORD LA QUINTA WITH THE OPPORTUNITY TO PROVIDE SHORING (IF POSSIBLE) TO PROTECT THE SIGN FOUNDATION. IF POSSIBLE, IT MAY BE DETERMINED (IN THE FIELD) THAT THE SIGN FOUNDATION CAN NOT BE "SAVED". IF THE SIGN FOUNDATION CAN NOT BE SAVED, IT SHALL BE REMOVED.

KEYED NOTES:

- PROVIDE NEENAH "HIGH BEEHIVE GRATE & FRAME", R-2561, OR APPROVED EQUAL IN LIEU OF STANDARD CITY OF ALBUQUERQUE MANHOLE FRAME & COVER. SEE DETAIL BELOW.
- INSTALL A 5'x5' CONCRETE PAD.

NOTE: CONTRACTOR TO REGRADE AREA AROUND BEEHIVE GRATES AS REQUIRED TO DIRECT DRAINAGE TOWARDS INLET.

BEEHIVE GRATE DETAIL

NOT TO SCALE. REVISED. SEE SHEET 9

CURVE DATA

NUMBER	DELTA	RADIUS	TANGENT	ARC LENGTH
C1	20°16'35"	760.44	135.98	269.12

Horizontal Scale: 1"=20'

Vertical Scale: 1"=5'

AS-BUILT INFORMATION

CONTRACTOR	DATE	NO.
LA QUINTA	04/98	04/98


ENGINEER'S SEAL

CITY OF ALBUQUERQUE
PUBLIC WORKS DEPARTMENT
ENGINEERING DEVELOPMENT GROUP


TITLE: WEST MESA DIVERSION PROJECT PHASE I
STORM DRAIN P & P: DRAINAGE EASEMENT: STA 10+00 TO 14+60

DESIGNED BY: C.R.D.A. DATE: 04/98
DRAWN BY: C.R.D.A. DATE: 04/98
CHECKED BY: D.A. DATE: 04/98

City Project No. 538191 Zone Map No. H-102, H-112 Sheet 7 of 20

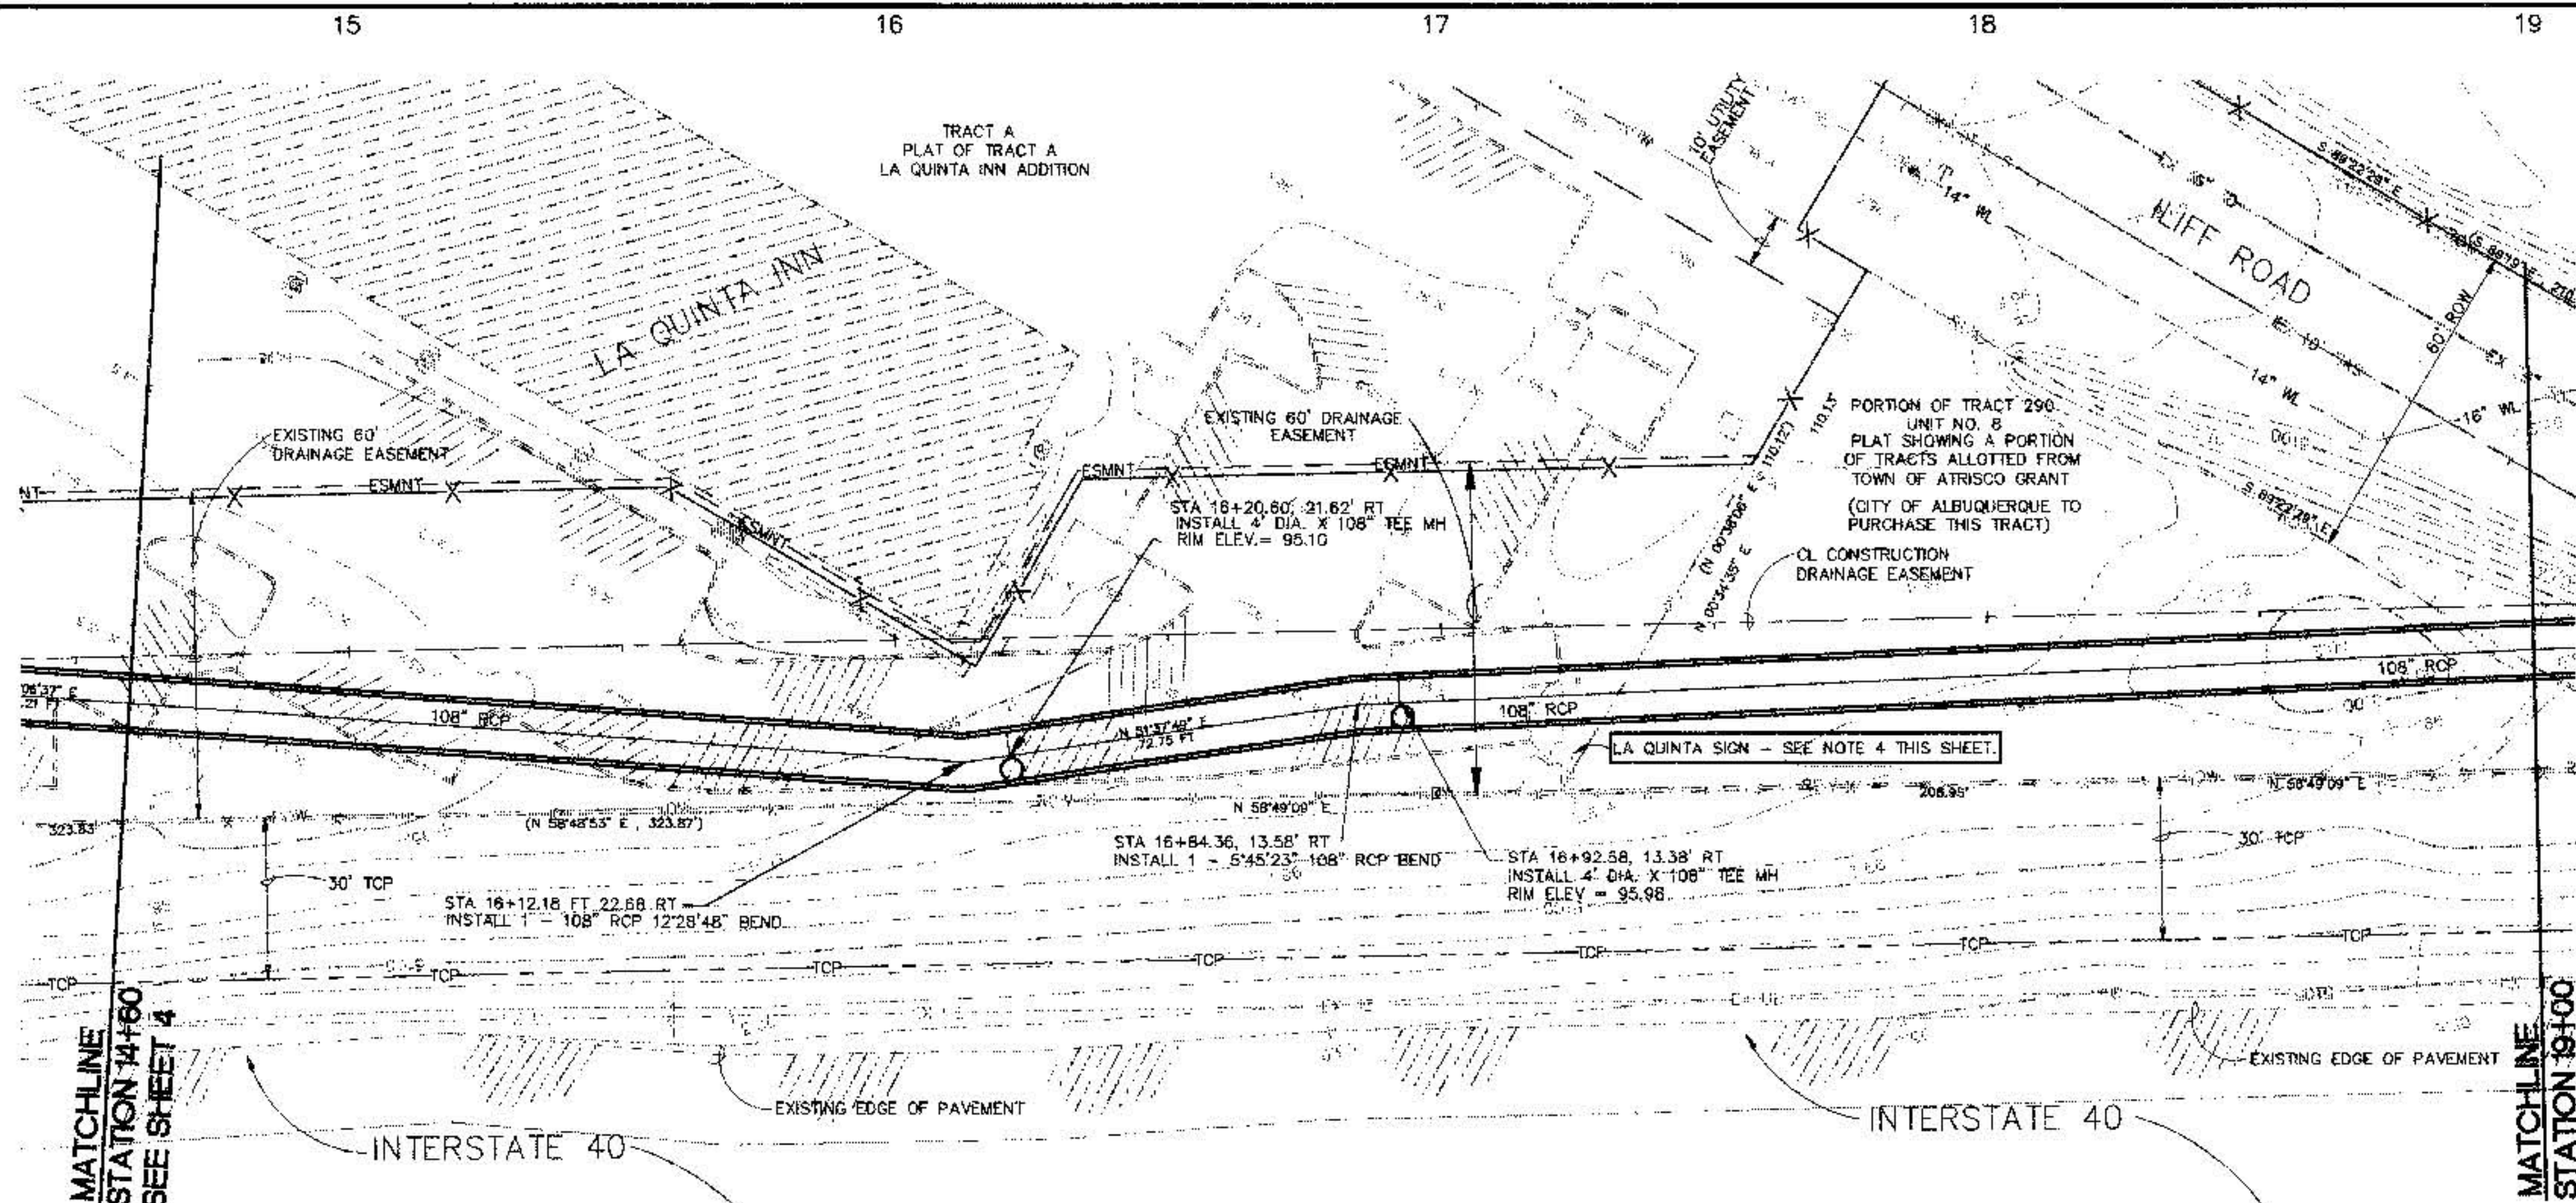

DRAINAGE EASEMENT

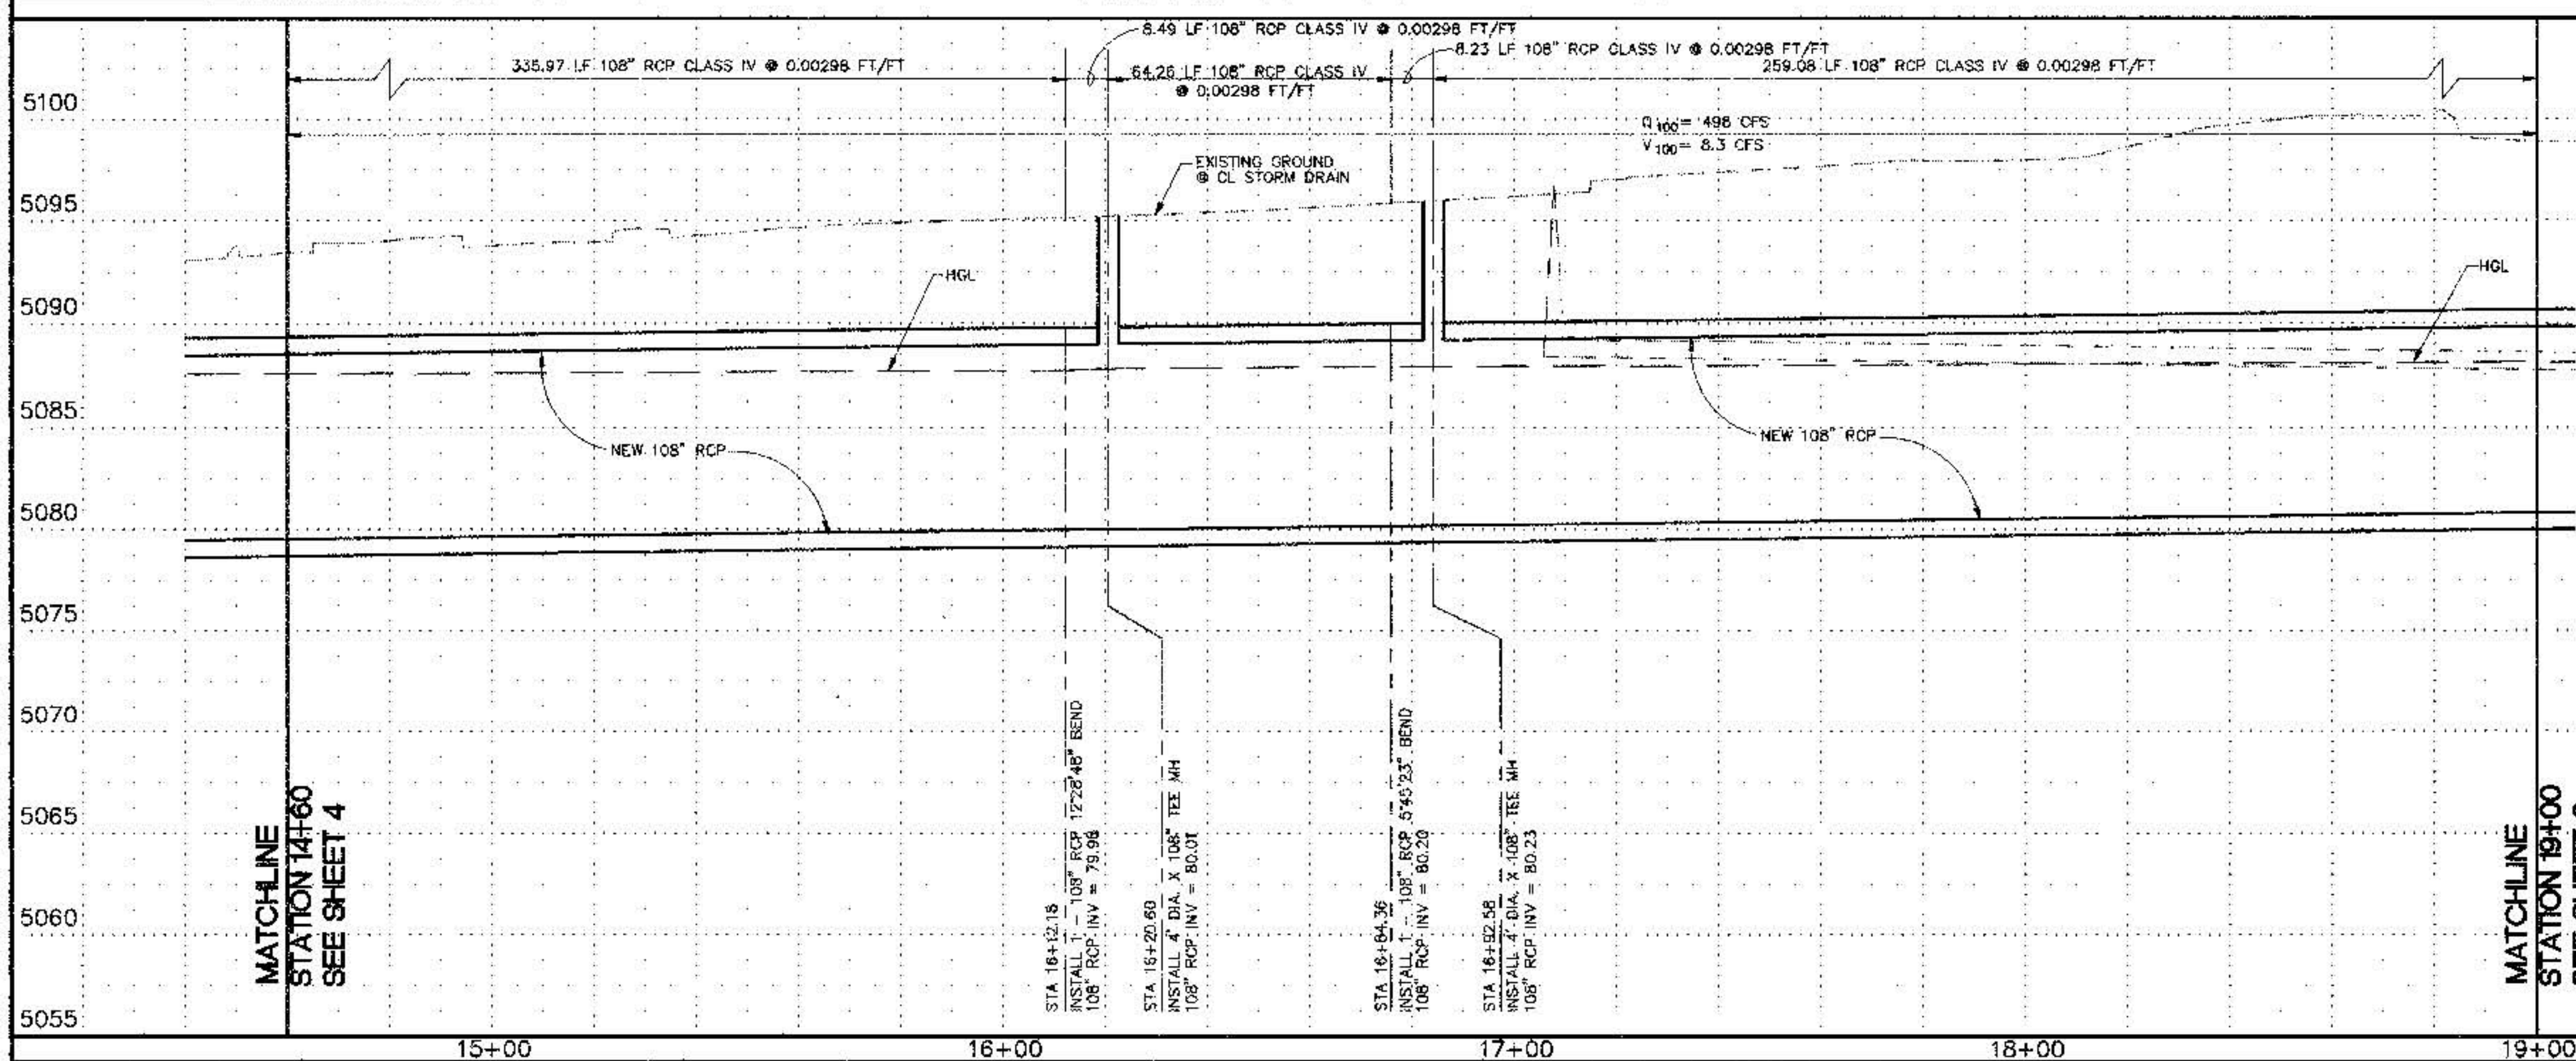


GENERAL NOTES RELATIVE TO LA QUINTA SITE

1. AT ALL TIMES DURING CONSTRUCTION, AT LEAST ONE-THIRD OF THE EASEMENT PROPERTY ON THE LA QUINTA SITE SHALL BE MAINTAINED BY THE CONTRACTOR SO IT CAN BE USED BY LA QUINTA.
2. THE CONTRACTOR SHALL HAVE NO MORE THAN 200 FEET OF OPEN TRENCH ON THE LA QUINTA EASEMENT PROPERTY AT ANY ONE TIME.
3. AT NO TIME SHALL LA QUINTA'S CERTIFICATE OF OCCUPANCY BE SUSPENDED DUE TO THE CONSTRUCTION OF THE DRAINAGE IMPROVEMENTS.
4. THE CONTRACTOR SHALL GIVE LA QUINTA AT LEAST THIRTY (30) DAYS PRIOR WRITTEN NOTICE PRIOR TO COMMENCING CONSTRUCTION OF THE DRAINAGE IMPROVEMENTS. THE CONTRACTOR SHALL COORDINATE THE TRENCHING OF THE EASEMENT PROPERTY IN THE VICINITY OF THE LA QUINTA SIGN TO AFFORD LA QUINTA WITH THE OPPORTUNITY TO PROVIDE SHORING (IF POSSIBLE) TO PROTECT THE SIGN FOUNDATION. IF POSSIBLE, IT MAY BE DETERMINED (IN THE FIELD) THAT THE SIGN FOUNDATION CAN NOT BE "SAVED". IF THE SIGN FOUNDATION CAN NOT BE "SAVED", IT SHALL BE REMOVED.


KEYED NOTES:

- ① BACKFILL COMPACTED PER COA STD SPECIFICATIONS.
- ② 24\"/>

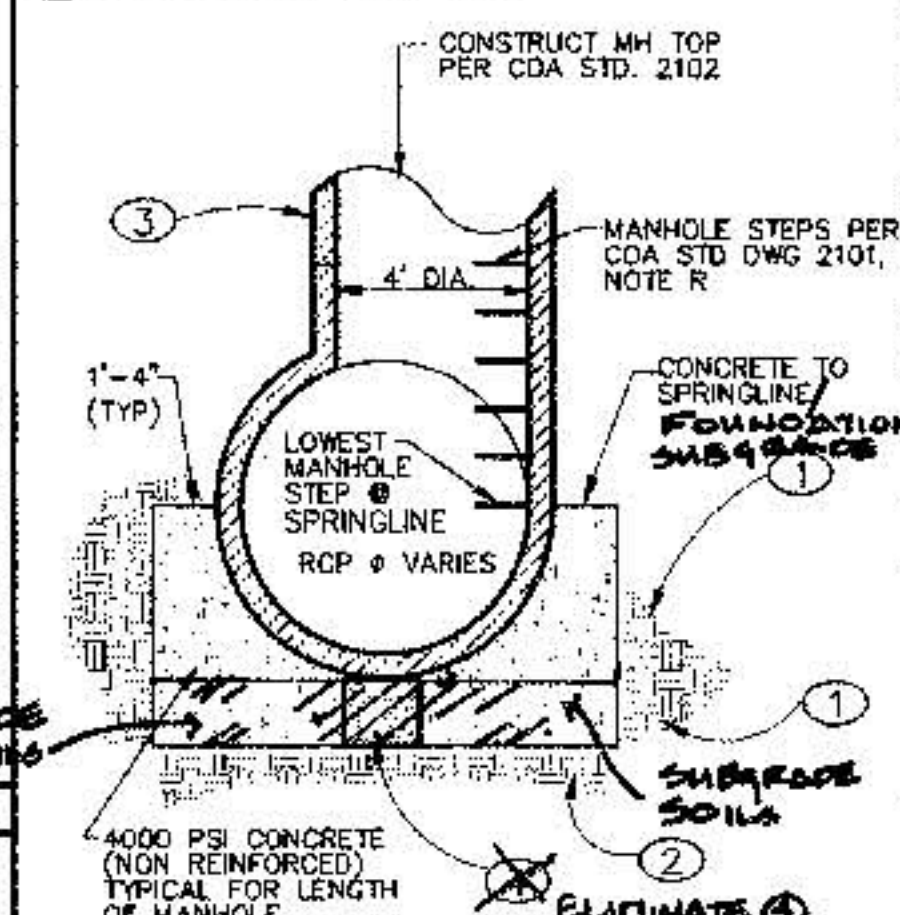

PRECAST MANHOLE SUPPORT SADDLE

SCALE: 1/4\"/>

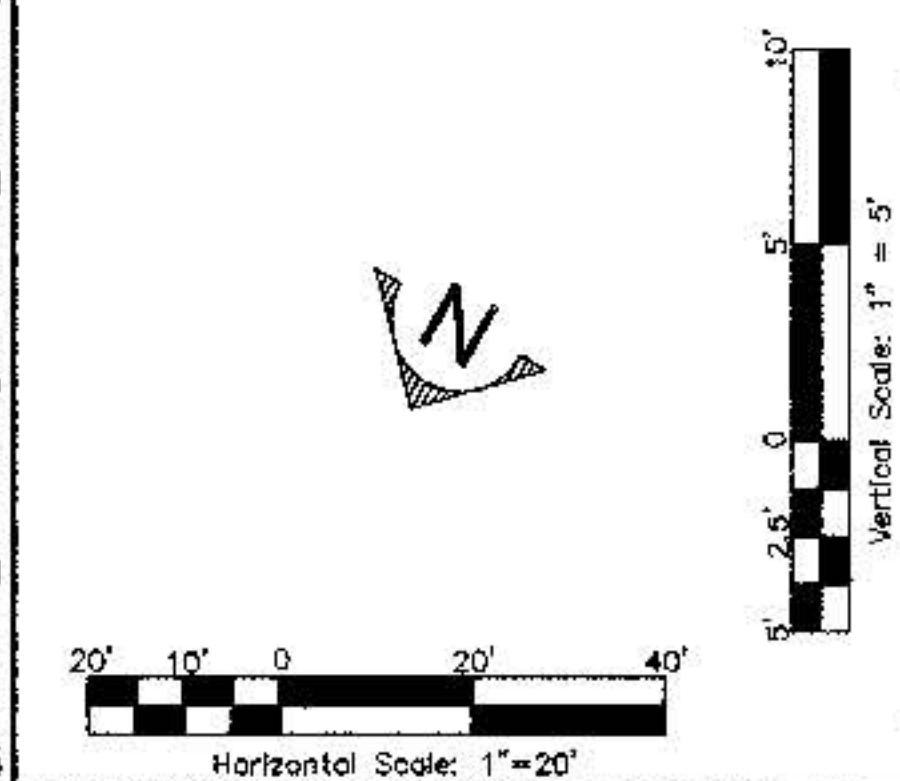

Smith Engineering Company
1961050
A Full Service Engineering Company
4000 Canyon Boulevard, N.E. Suite 1000 Albuquerque, New Mexico 87110

**CITY OF ALBUQUERQUE
PUBLIC WORKS DEPARTMENT
ENGINEERING DEVELOPMENT GROUP**


**TITLE: WEST MESA DIVERSION PROJECT PHASE I
STORM DRAIN P & P: DRAINAGE EASEMENT: STA 14+60 TO 19+00**

Design Review Committee City Engineer Approval Last Design Update


City Project No. 538191 Zone Map No. H-102, H-112 Sheet 8 of 20

ENGINEERS SEAL		SURVEY INFORMATION		BENCH MARKS		AS BUILT INFORMATION		
		FIELD NOTES		1-40-18 NWSHC/ACS ELEV. 5103.98 FEET (SLD 1929)		CONTRACTOR: ECHT, INC.		
		NO.	BY	DATE	STATION IS LOCATED 3.5 MILES NW OF DOWNTOWN ALBUQUERQUE, AT THE HIGHWAY I-40 AND STATE ROAD 448 (COORS RD., NW) INTERCHANGE. STATION MARK IS A STANDARD NWSHC BRASS TABLET, STAMPED "STA I-40-18", SET IN TOP OF A CONCRETE POST FLUSH WITH THE GROUND. (N 1494359.08, E 364190.93)	WORK STAKED BY: L. ANDREW RODRIGUEZ DATE: 5-99		
						FIELD CHECKED BY: L. ANDREW RODRIGUEZ DATE: 5-99		
						ACCEPTANCE BY: L. ANDREW RODRIGUEZ DATE: 5-99		
						CORRECTION BY: L. ANDREW RODRIGUEZ DATE: 5-99		
DESIGNED BY: CURDIA		DATE: 04/98					MICRO-FILM INFORMATION	
DRAWN BY: CURDIA		DATE: 04/98					RECORDED BY: DATE:	
CHECKED BY: O.A.		DATE: 04/98					NO.	


PROJECT PHASE I		
ST: STA 14+60 TO 19+00		
No. / Day / Yr.	No. / Day / Yr.	

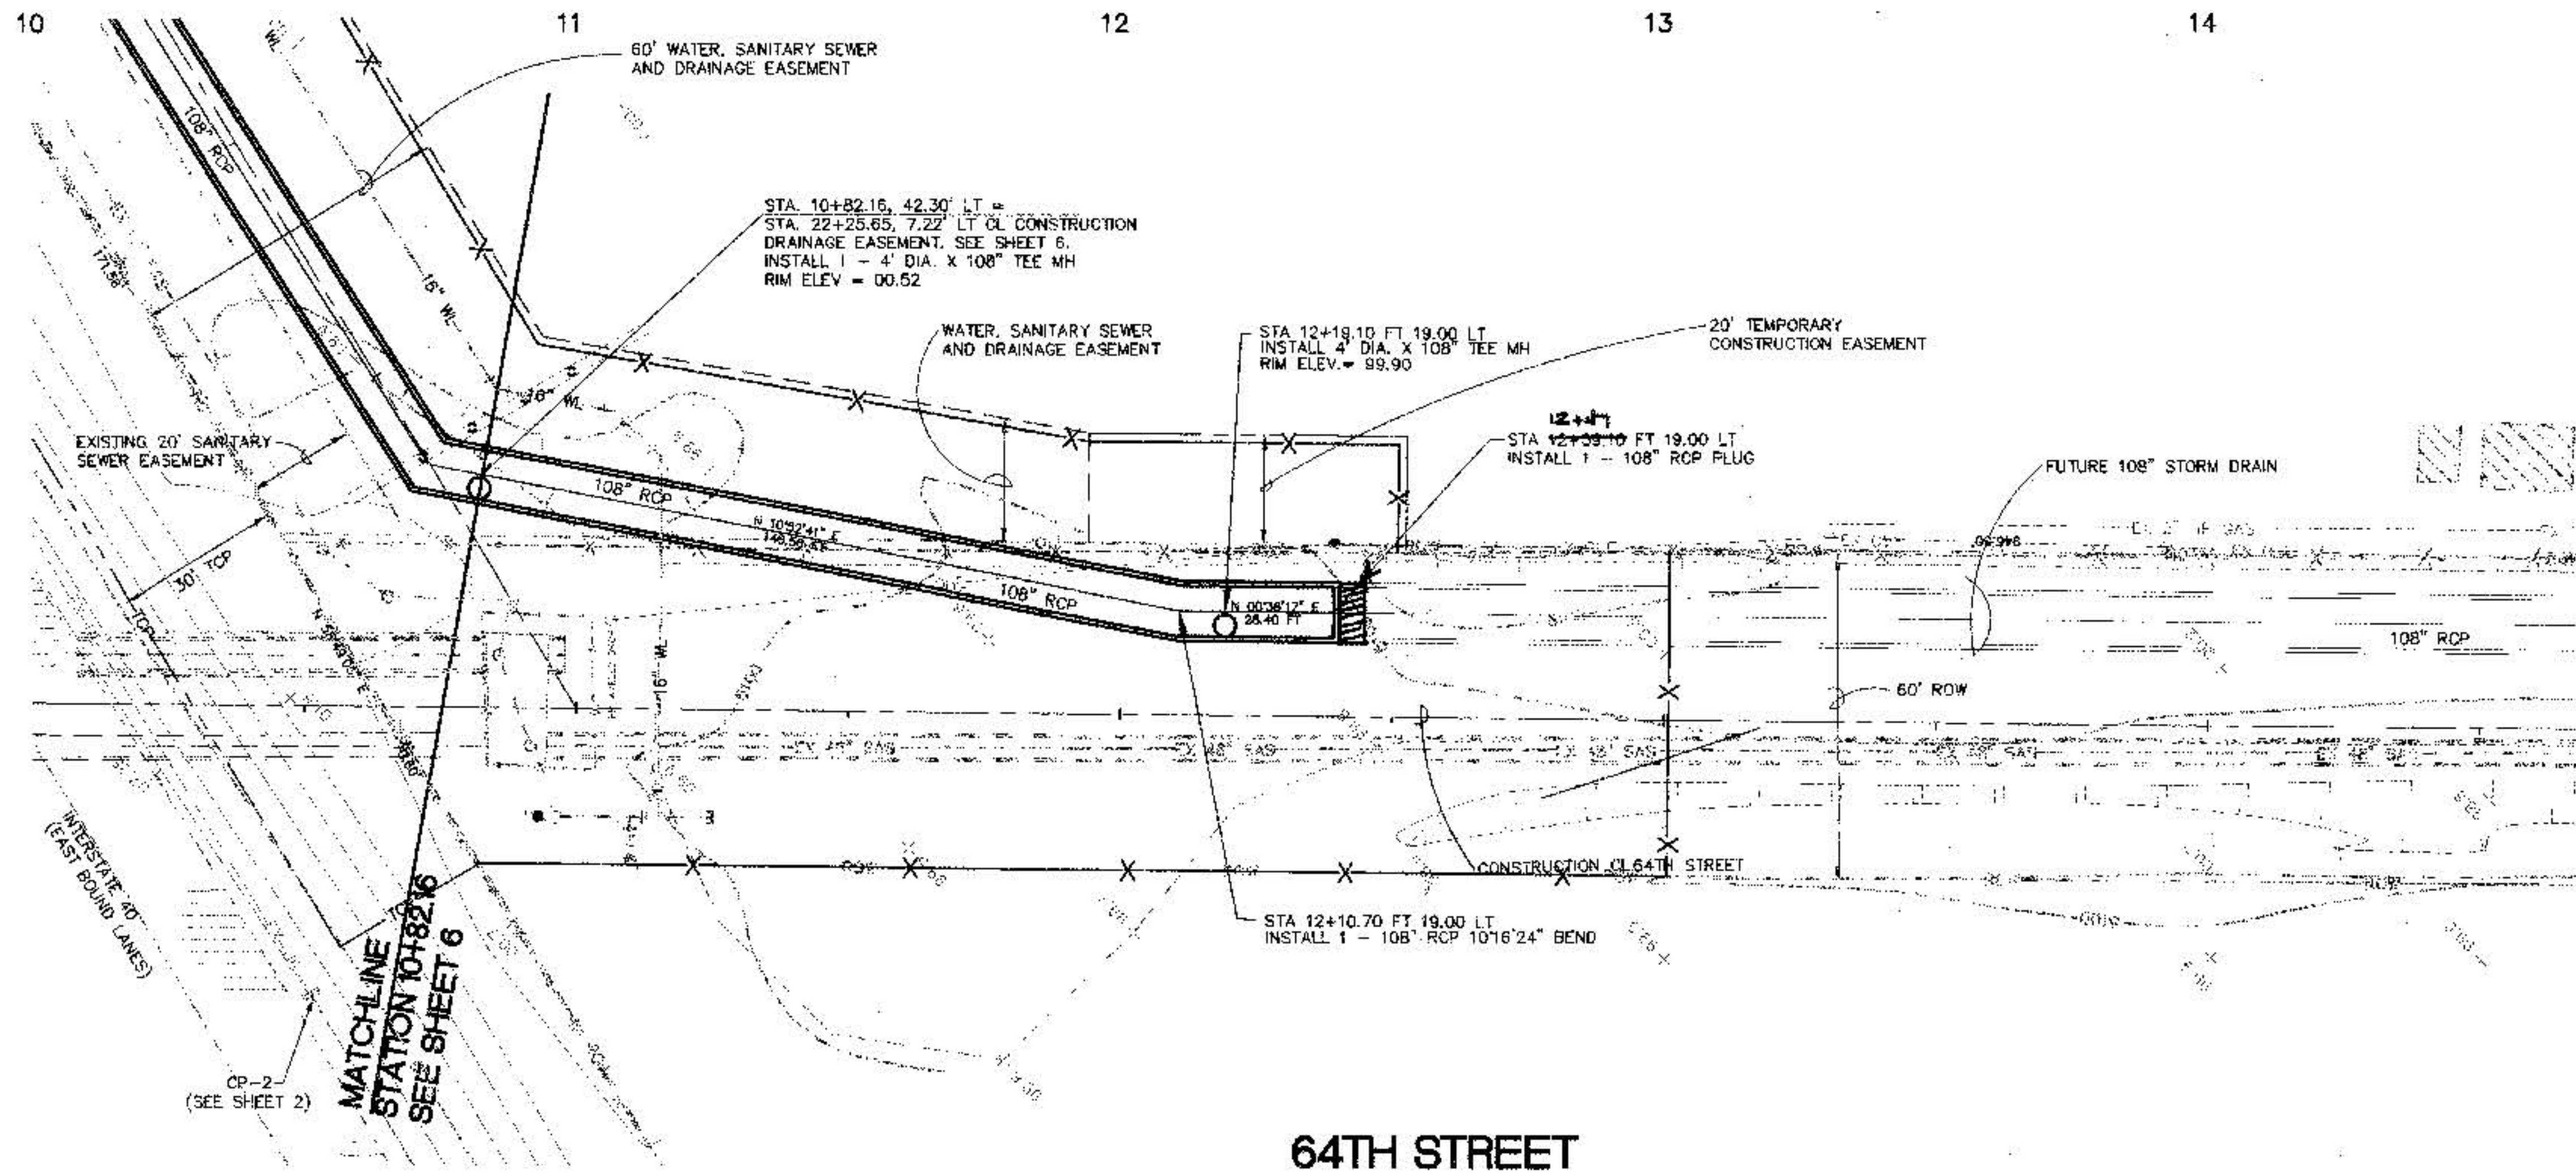

64TH STREET

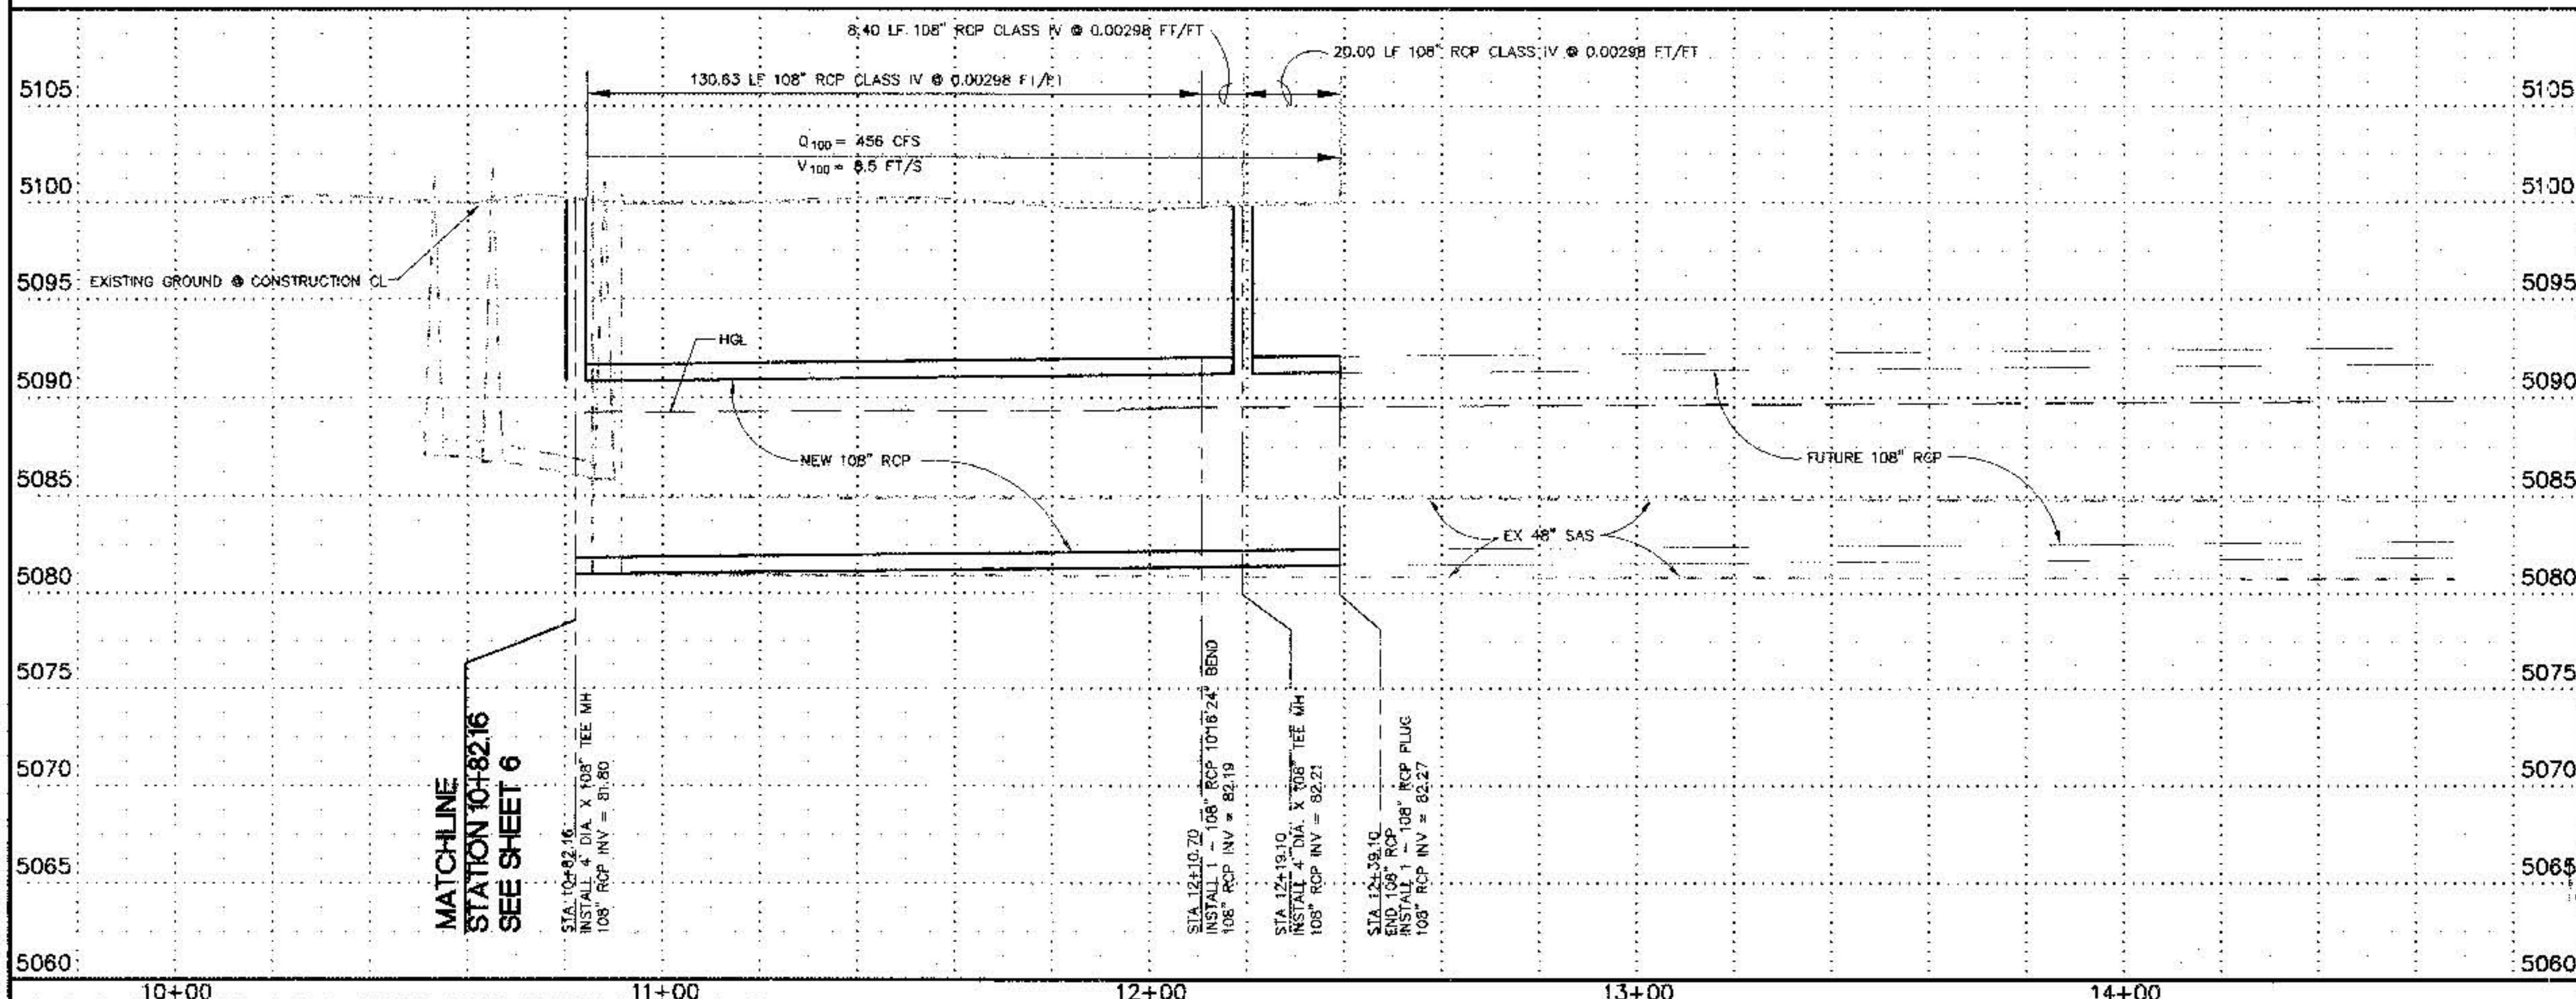

KEYED NOTES:

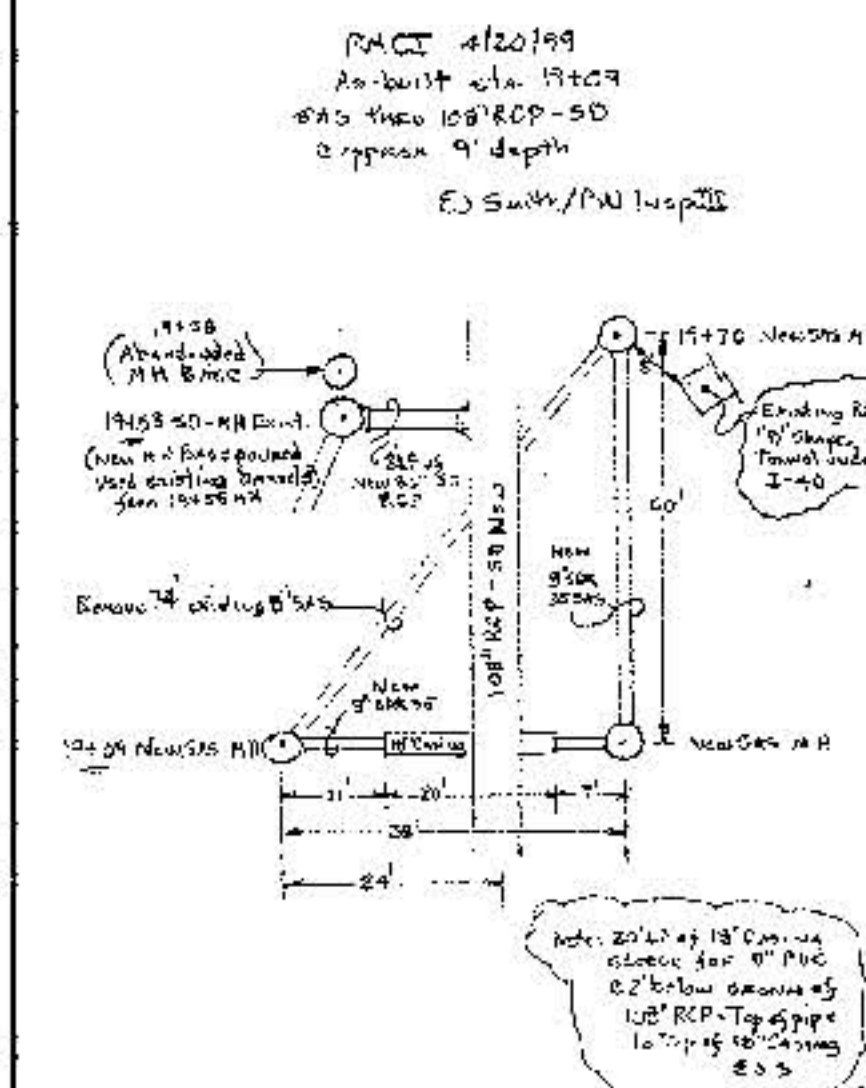

AS BUILT INFORMATION		BENCH MARKS		SURVEY INFORMATION		ENGINEER'S SEAL	
CONTRACTOR	DATE	STATION	ELEV.	NO.	DATE	NO.	DATE
ALBUQUERQUE	5-99	10+82.16	5103.08	1	5-99	1	5-99
INSPECTED BY	DATE	STATION	ELEV.	NO.	DATE	NO.	DATE
ALBUQUERQUE	5-99	10+82.16	5103.08	1	5-99	1	5-99
FIELD	DATE	STATION	ELEV.	NO.	DATE	NO.	DATE
ALBUQUERQUE	5-99	10+82.16	5103.08	1	5-99	1	5-99
RECORDED BY	DATE	STATION	ELEV.	NO.	DATE	NO.	DATE
ALBUQUERQUE	5-99	10+82.16	5103.08	1	5-99	1	5-99
NO.	DATE	STATION	ELEV.	NO.	DATE	NO.	DATE
1	5-99	10+82.16	5103.08	1	5-99	1	5-99

DESIGNED BY: CURDIA
DRAWN BY: CURDIA
CHECKED BY: DLA

DATE: 04/98
DATE: 04/98
DATE: 04/98


REVISIONS
DESIGN

SMITH ENGINEERING COMPANY
A Full Service Engineering Company
4000 Camino Real, N.E. Suite 200 Albuquerque, New Mexico 87109

CITY OF ALBUQUERQUE
PUBLIC WORKS DEPARTMENT
ENGINEERING DEVELOPMENT GROUP


TITLE: WEST MESA DIVERSION PROJECT PHASE I
STORM DRAIN P & P: 64TH STREET: STA 10+00 TO 12+22.34

City Project No. 538191
Zone Map No. H-102, H-112
Sheet 10 of 20

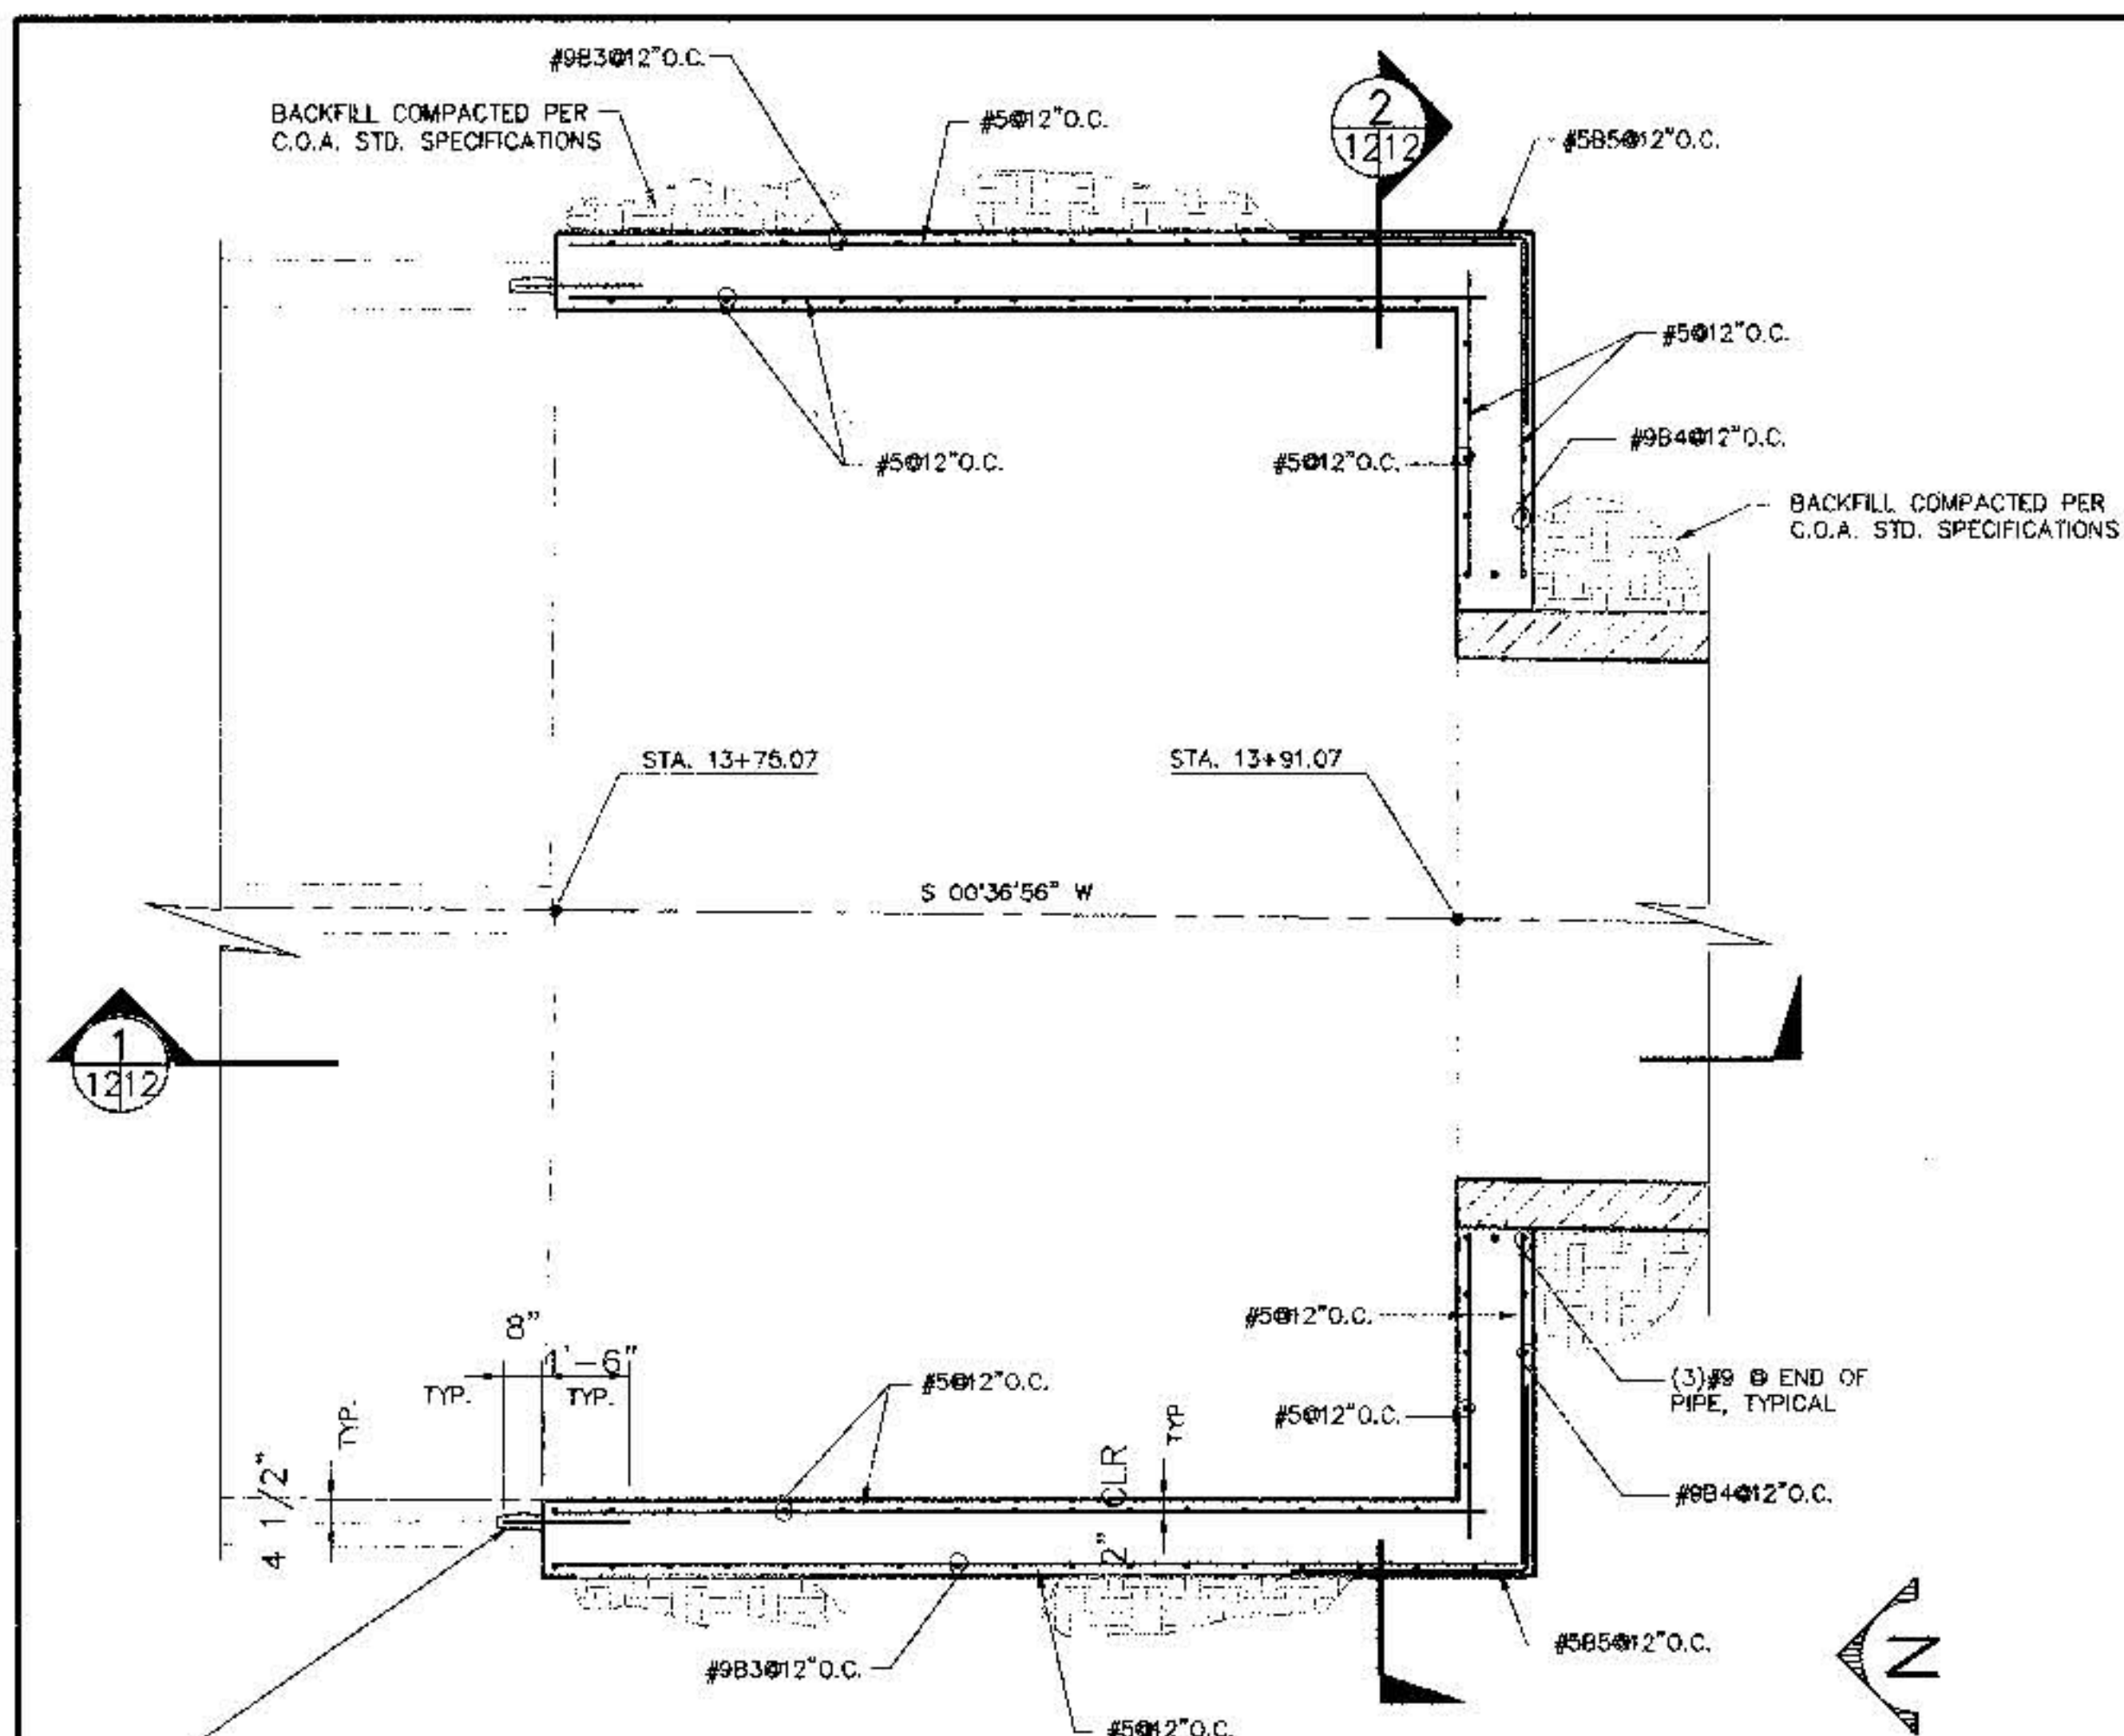


PLAN SECTION AT C PIPE
SCALE: 3/8" = 1'-0"

#6 DOWEL @ 12" O.C., EPOXY INTO EXISTING CONCRETE BOX CULVERT, TYPICAL. USE SIMPSON ET22 EPOXY SYSTEM OR EQUIVALENT. TYPICAL AT ALL WALLS AND TOP AND BOTTOM SLABS. ROUGHEN MATING SURFACES OF EXISTING CBC PRIOR TO PLACING CONCRETE.

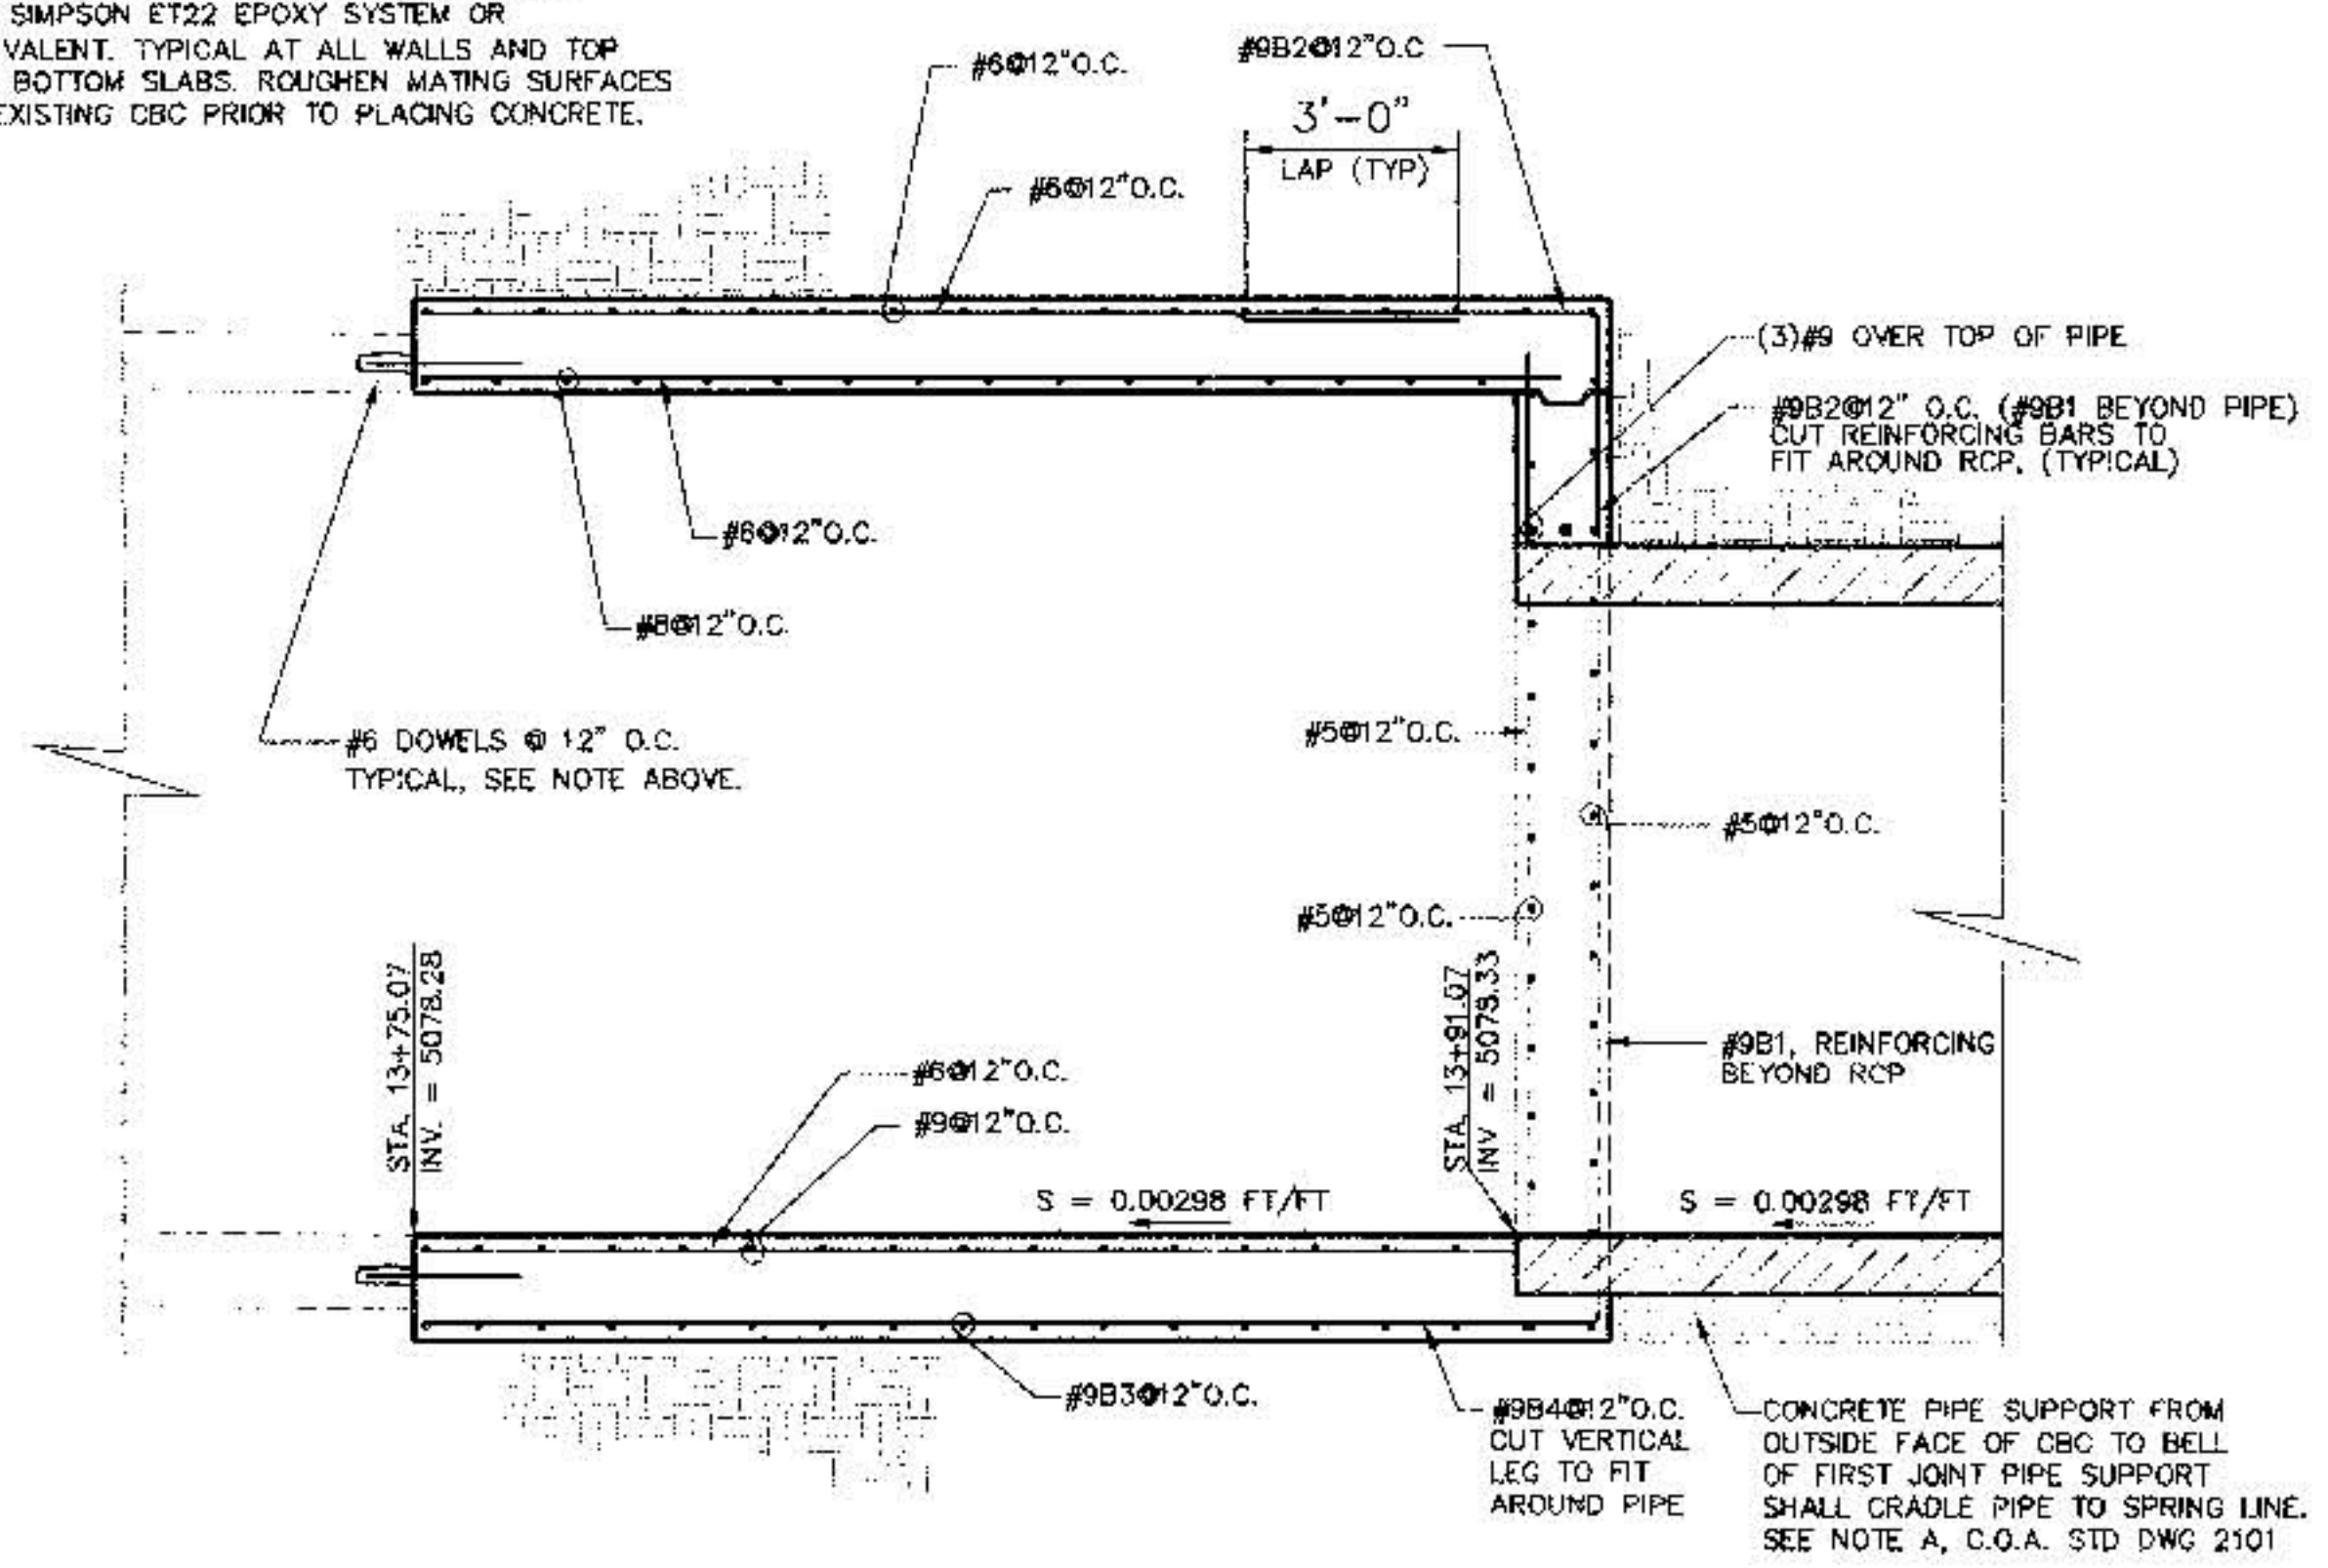


SECTION
SCALE: 3/8" = 1'-0"

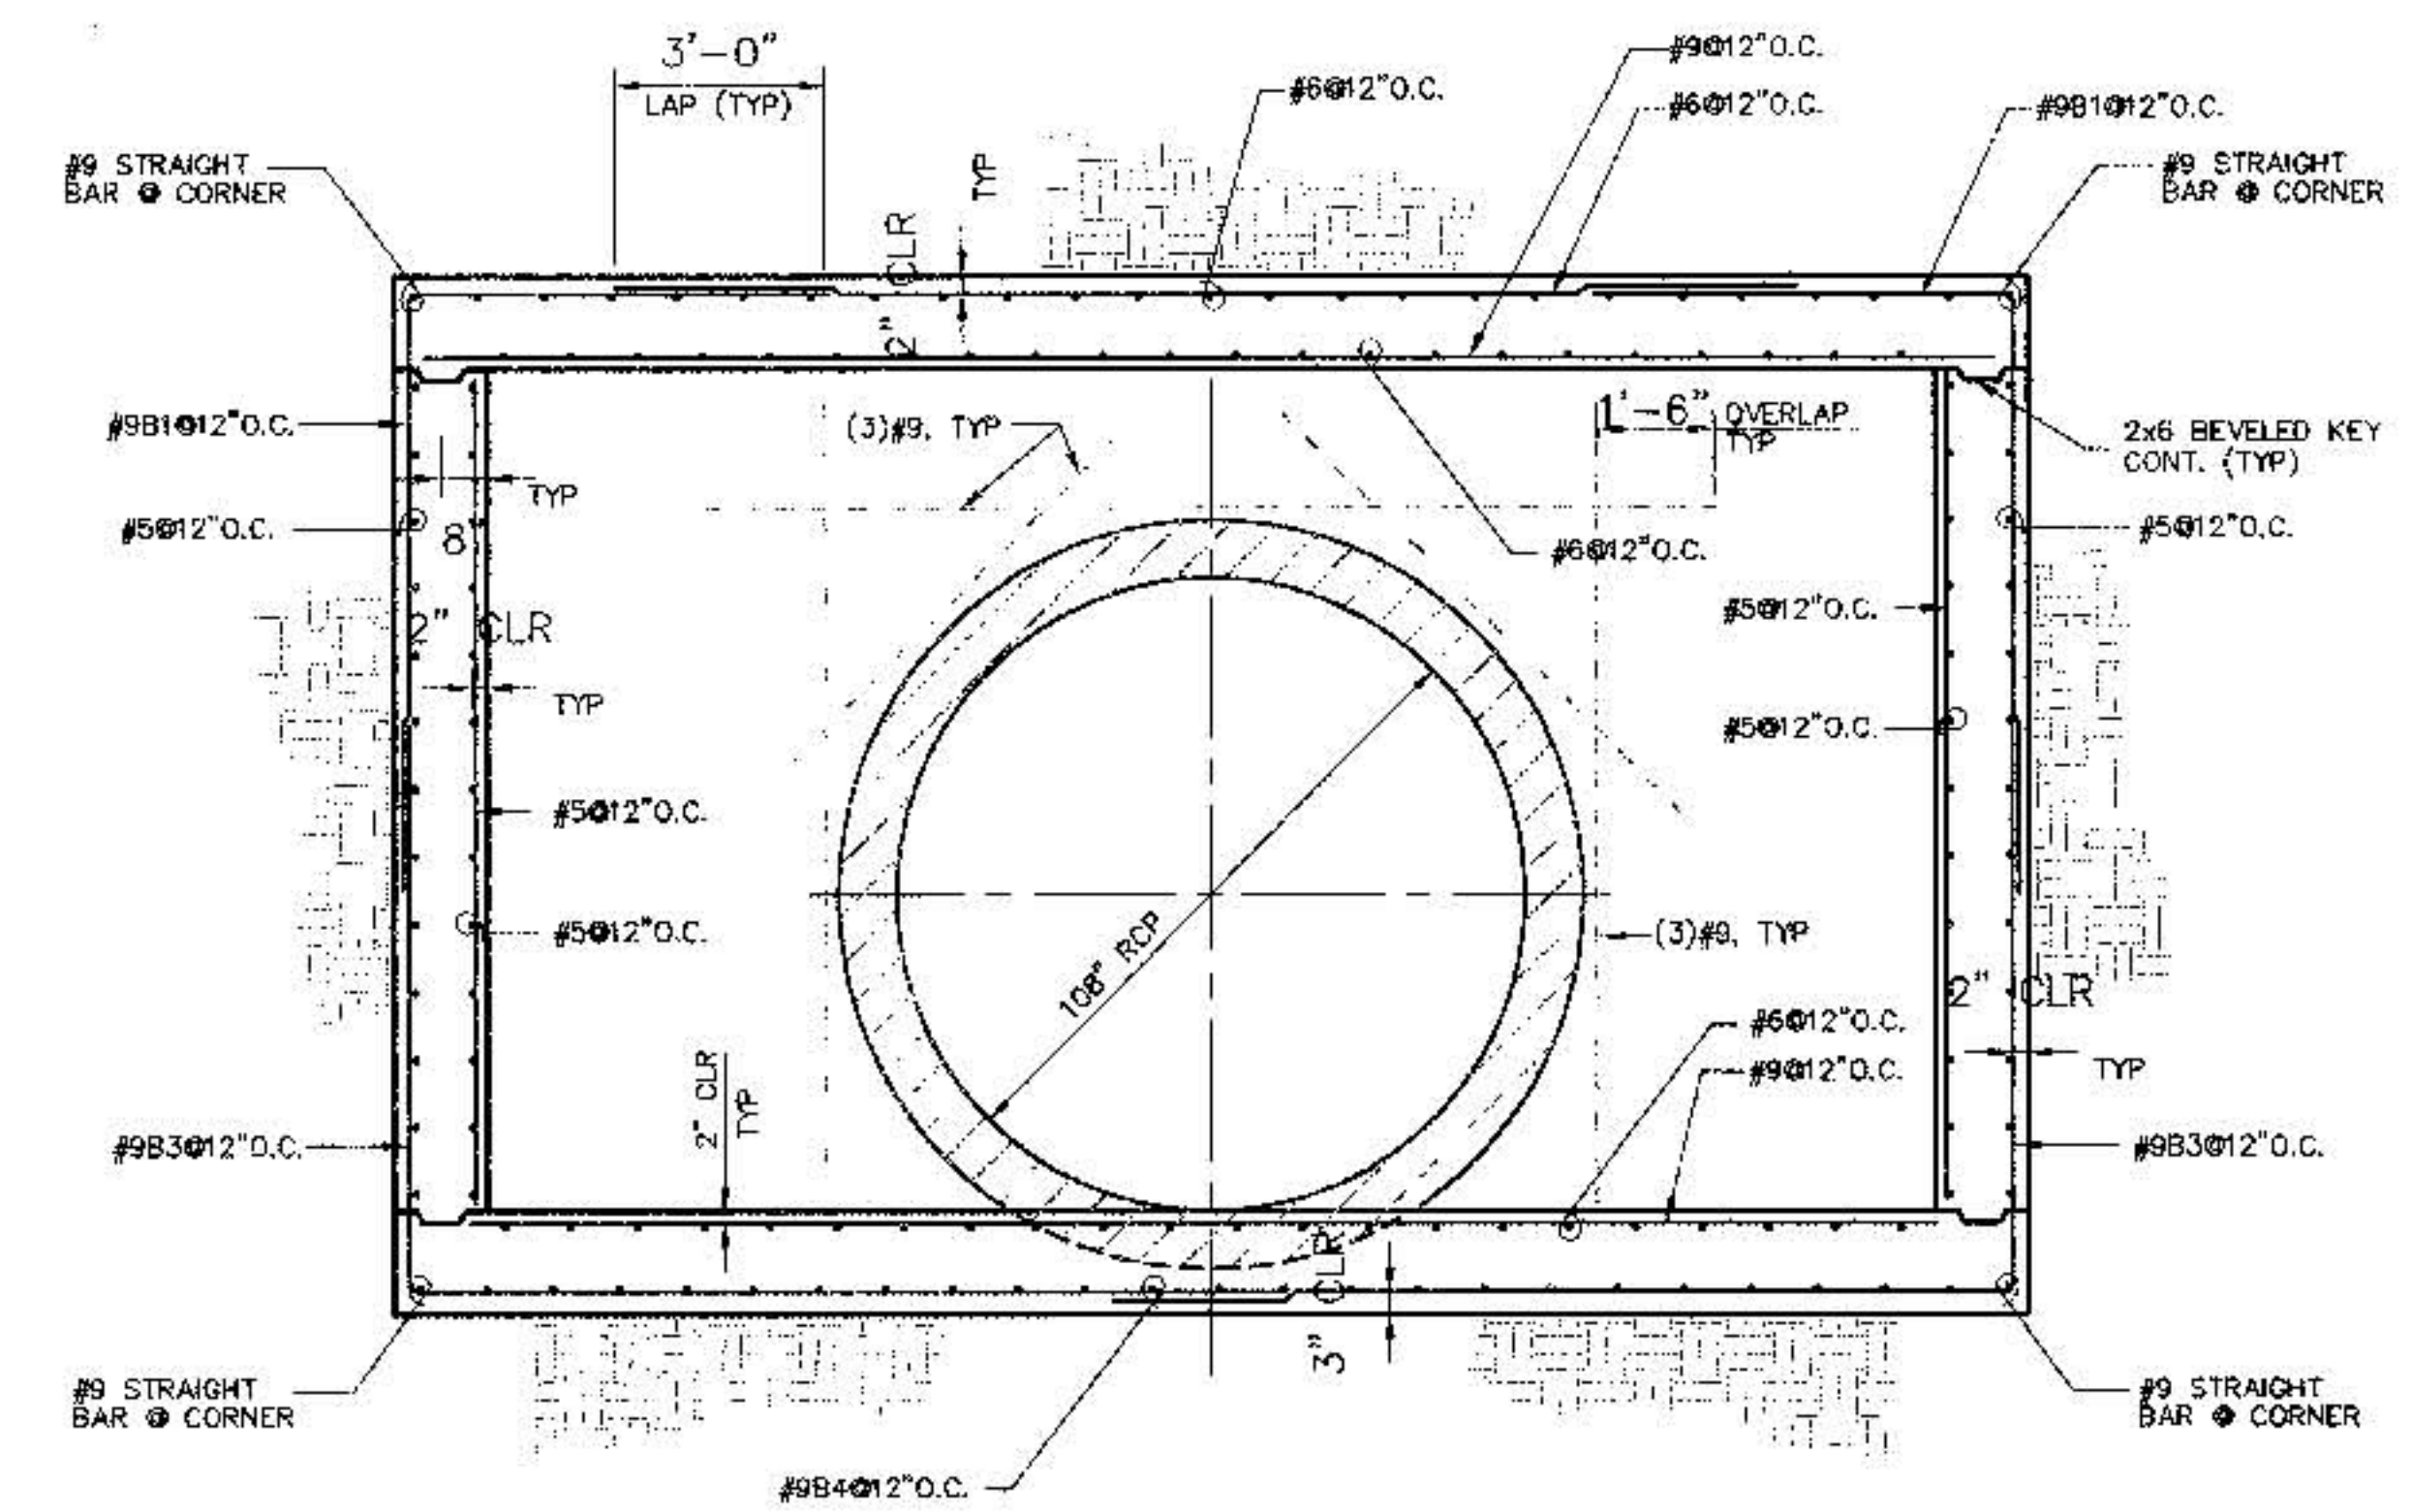

SECTION
SCALE: 3/8" = 1'-0"

BENDING BAR DIAGRAMS

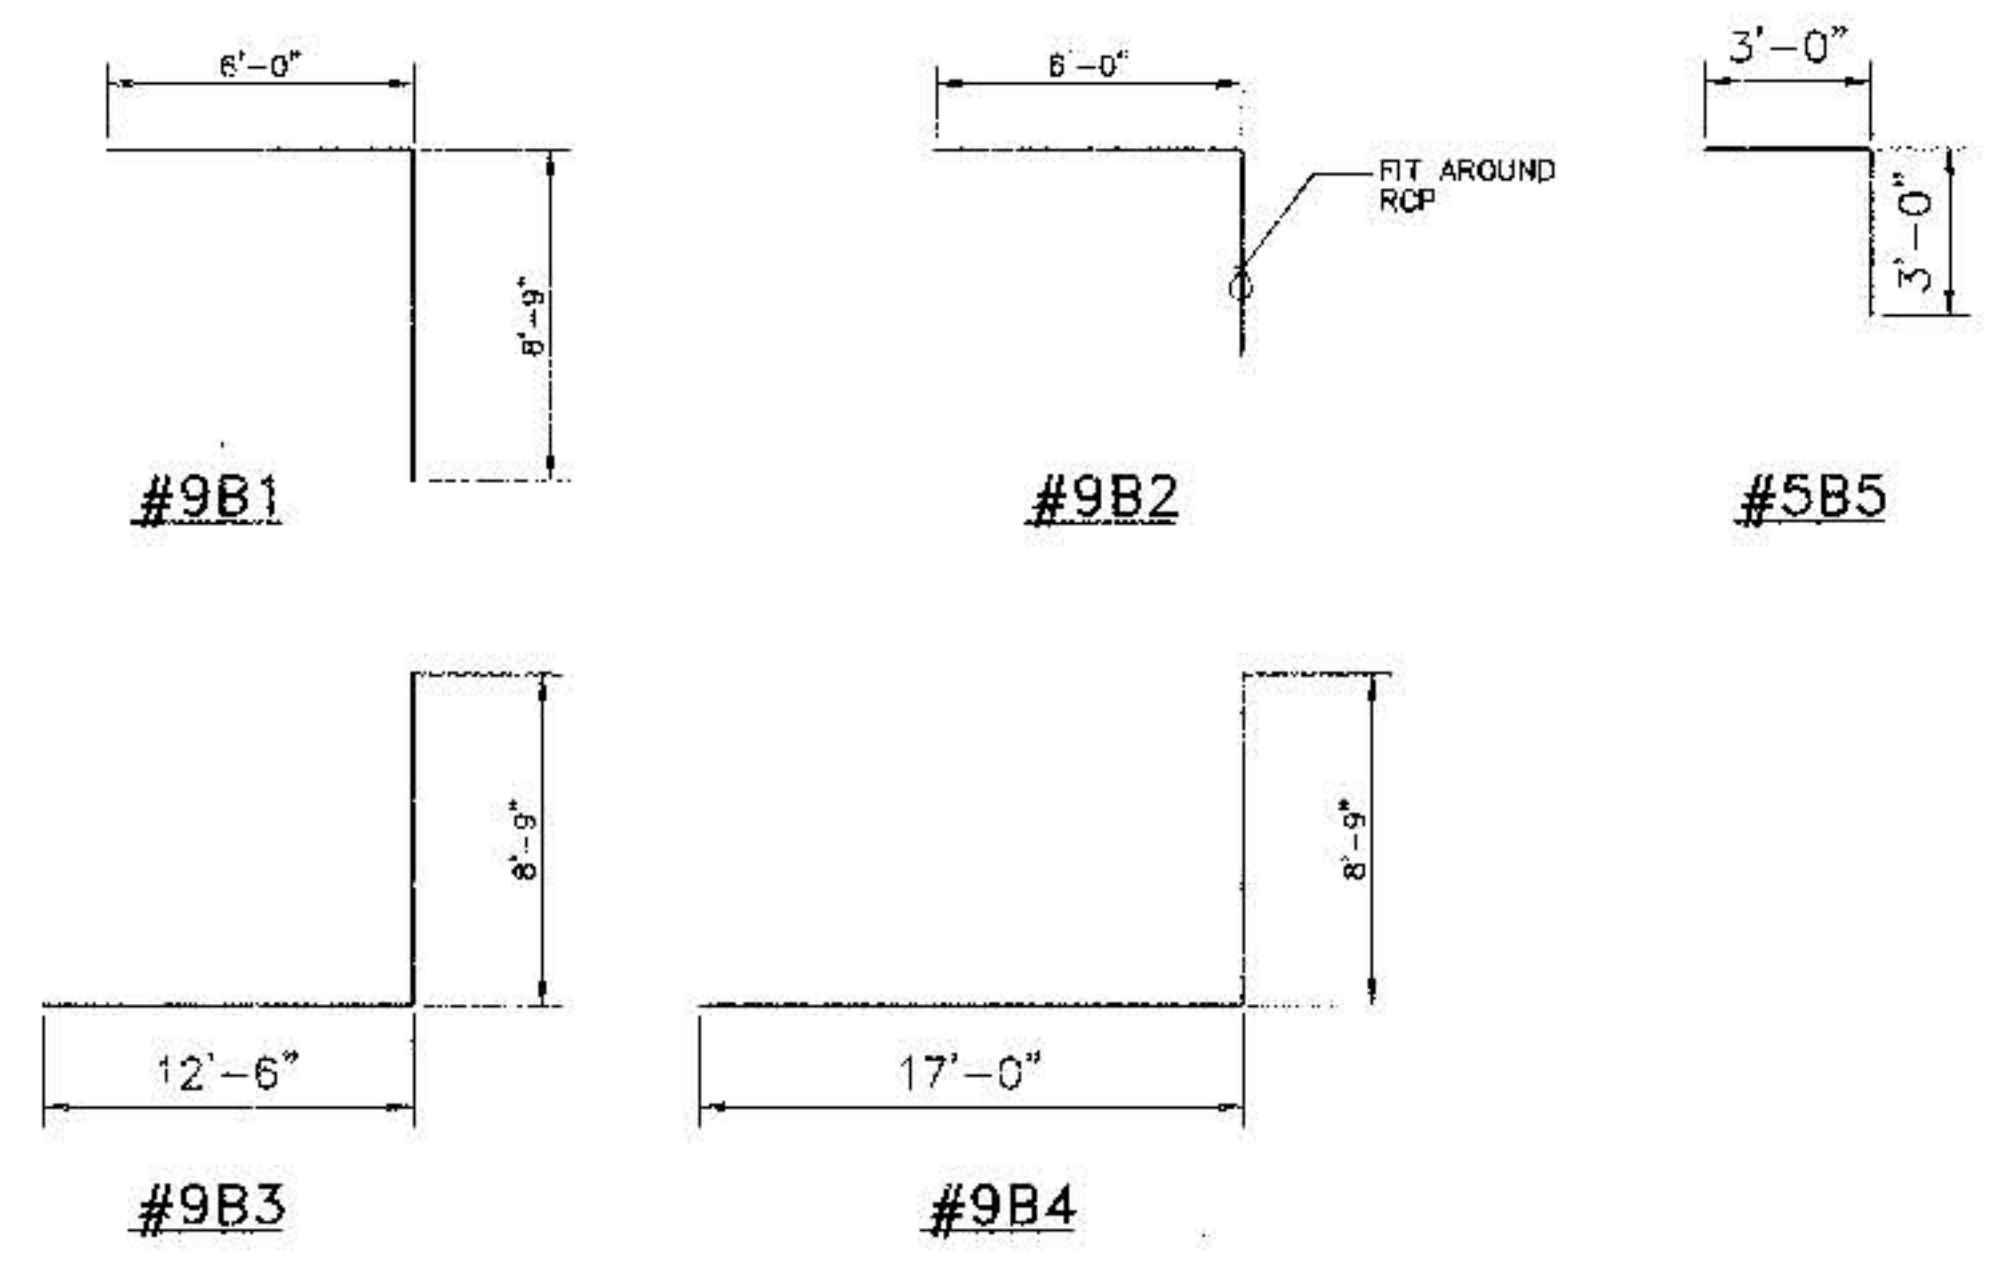

NOTE
ALL RADIUS DIMENSIONS ARE FROM CENTER OF BAR TO CENTER OF BAR

MAIN REINFORCEMENT	
BAR	R
#4	1 3/4"
#5	2 3/16"
#6	2 5/8"
#7	3 1/16"
#8	3 1/2"
#9	5 5/16"

BAR BENDING RADII



CITY OF ALBUQUERQUE
PUBLIC WORKS DEPARTMENT
ENGINEERING DEVELOPMENT GROUP


TITLE: WEST MESA DIVERSION PROJECT PHASE I
DOUBLE 10'X12' CONCRETE BOX CULVERT EXTENSION STRUCTURAL DETAILS

NO.	DATE	REVISIONS	BY

DESIGNED BY: CURDLA DATE: 03/98
DRAWN BY: CURDLA DATE: 03/98
CHECKED BY: DLA DATE: 03/98


City Project No. 538191 Zone Map No. H-102, H-112 Sheet 12 of 20

AS BUILT INFORMATION		BENCH MARKS		SURVEY INFORMATION		ENGINEERS SEAL	
CONTRACTOR: CH2M, INC.	ELEV. 5103.88 FEET (SLD. 1929)	DATE	BY	NO.	DATE	NO.	DATE
WARRANTY DATE: 5-99	STATION IS LOCATED 3.5 MILES NW OF DOWNTOWN ALBUQUERQUE, AT THE HIGHWAY I-40 AND STATE ROAD 448 (COORS RD., NW) INTERCHANGE. STATION MARK IS A STANDARD NMHC BRASS TABLET, STAMPED "STA. I-40-18", SET IN TOP OF A CONCRETE POST FLUSH WITH THE GROUND. (N 1484859.08, E 364150.93)						
DESIGNED BY: CURDLA	DATE: 03/98						
DRAWN BY: CURDLA	DATE: 03/98						
CHECKED BY: DLA	DATE: 03/98						

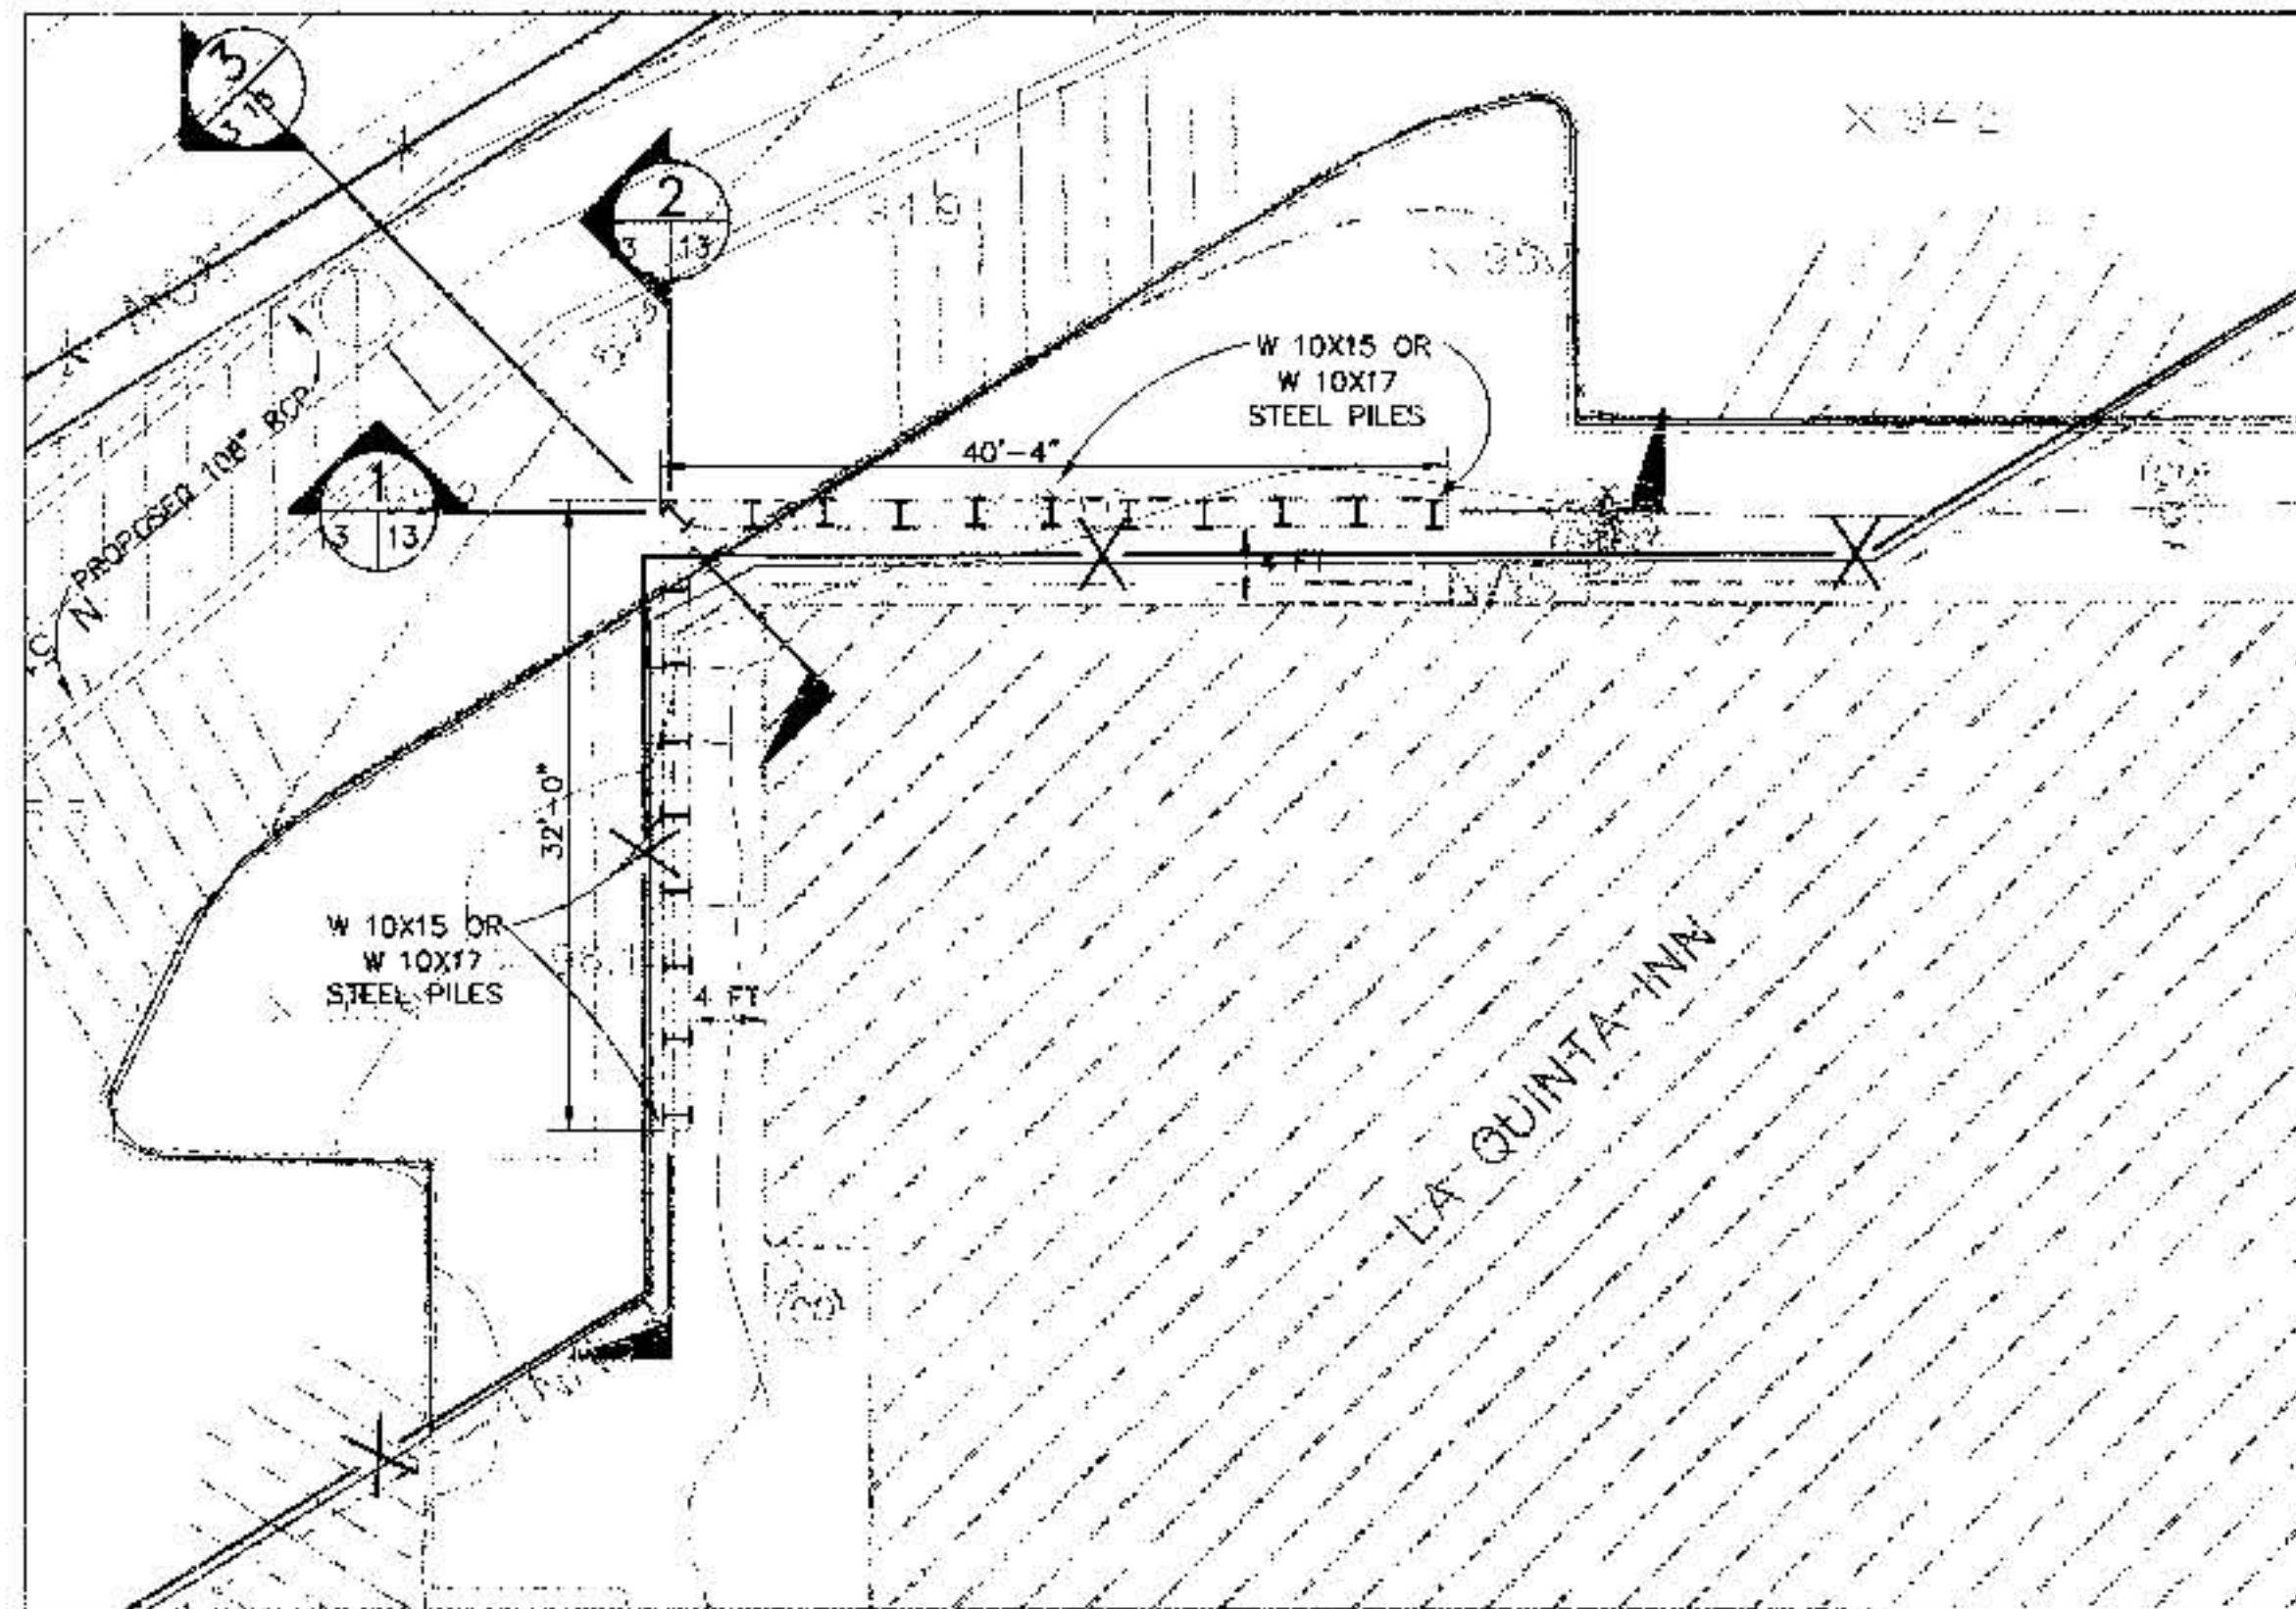


PILE/SHORING WALL PLAN VIEW

SCALE: 1" = 10'-0"

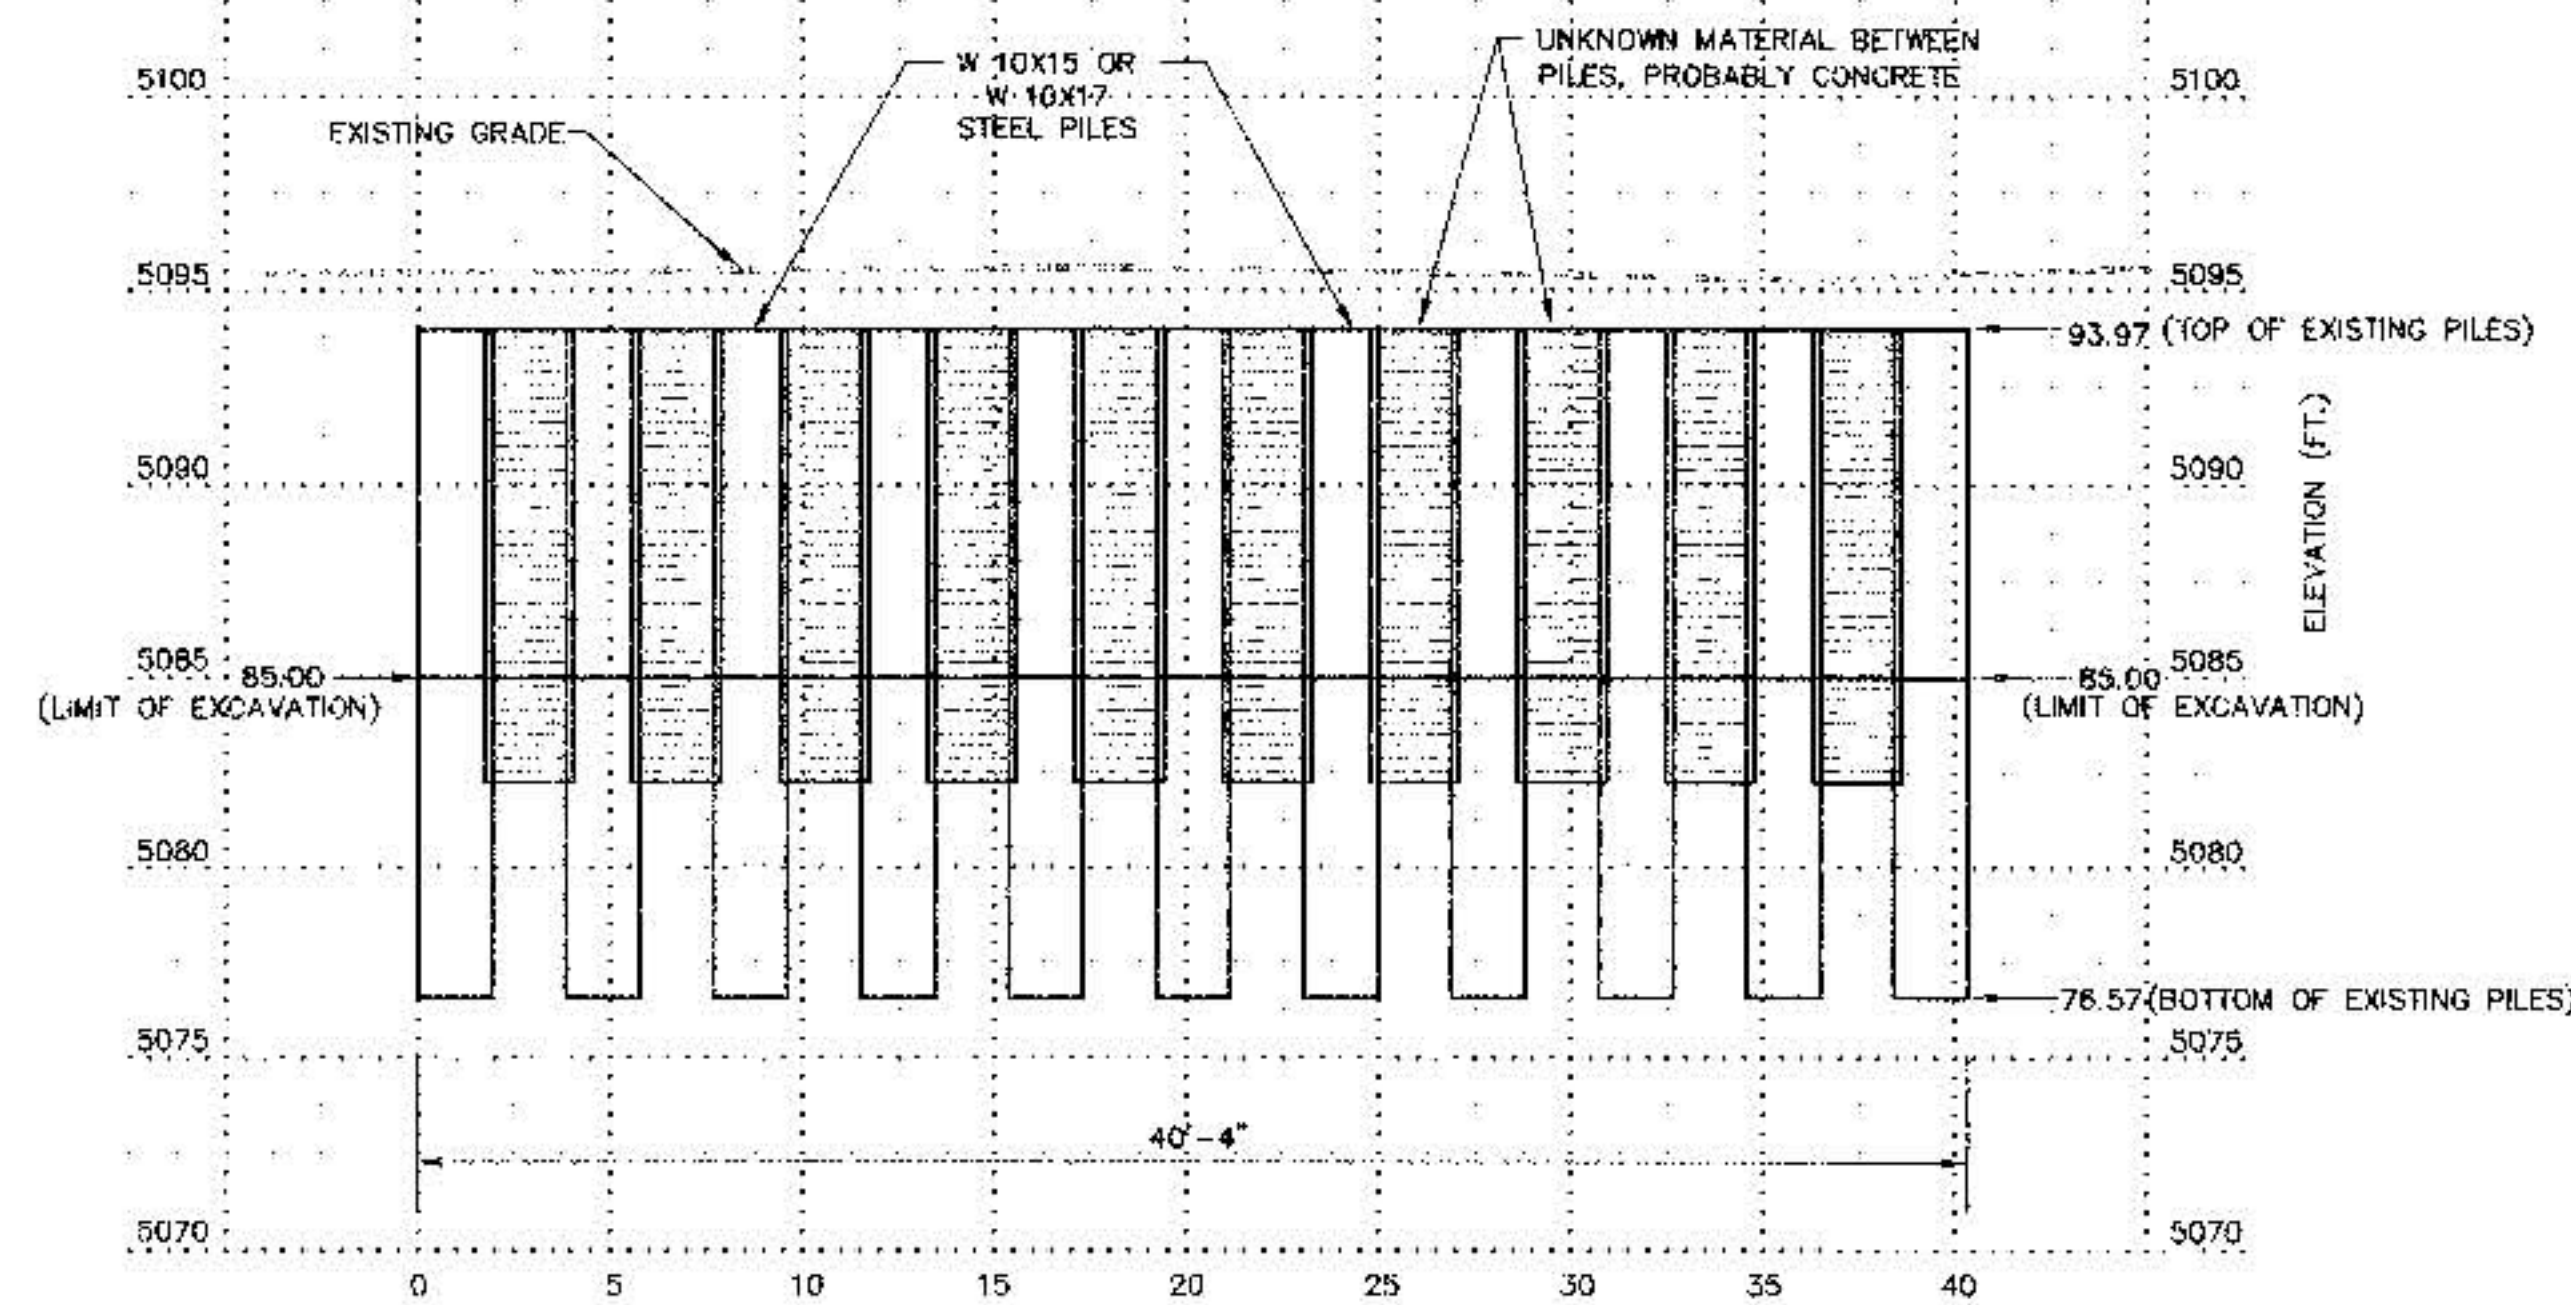


NORTH PILE/SHORING WALL

SCALE: 1" = 5'-0" VERTICAL
1" = 5'-0" HORIZONTAL

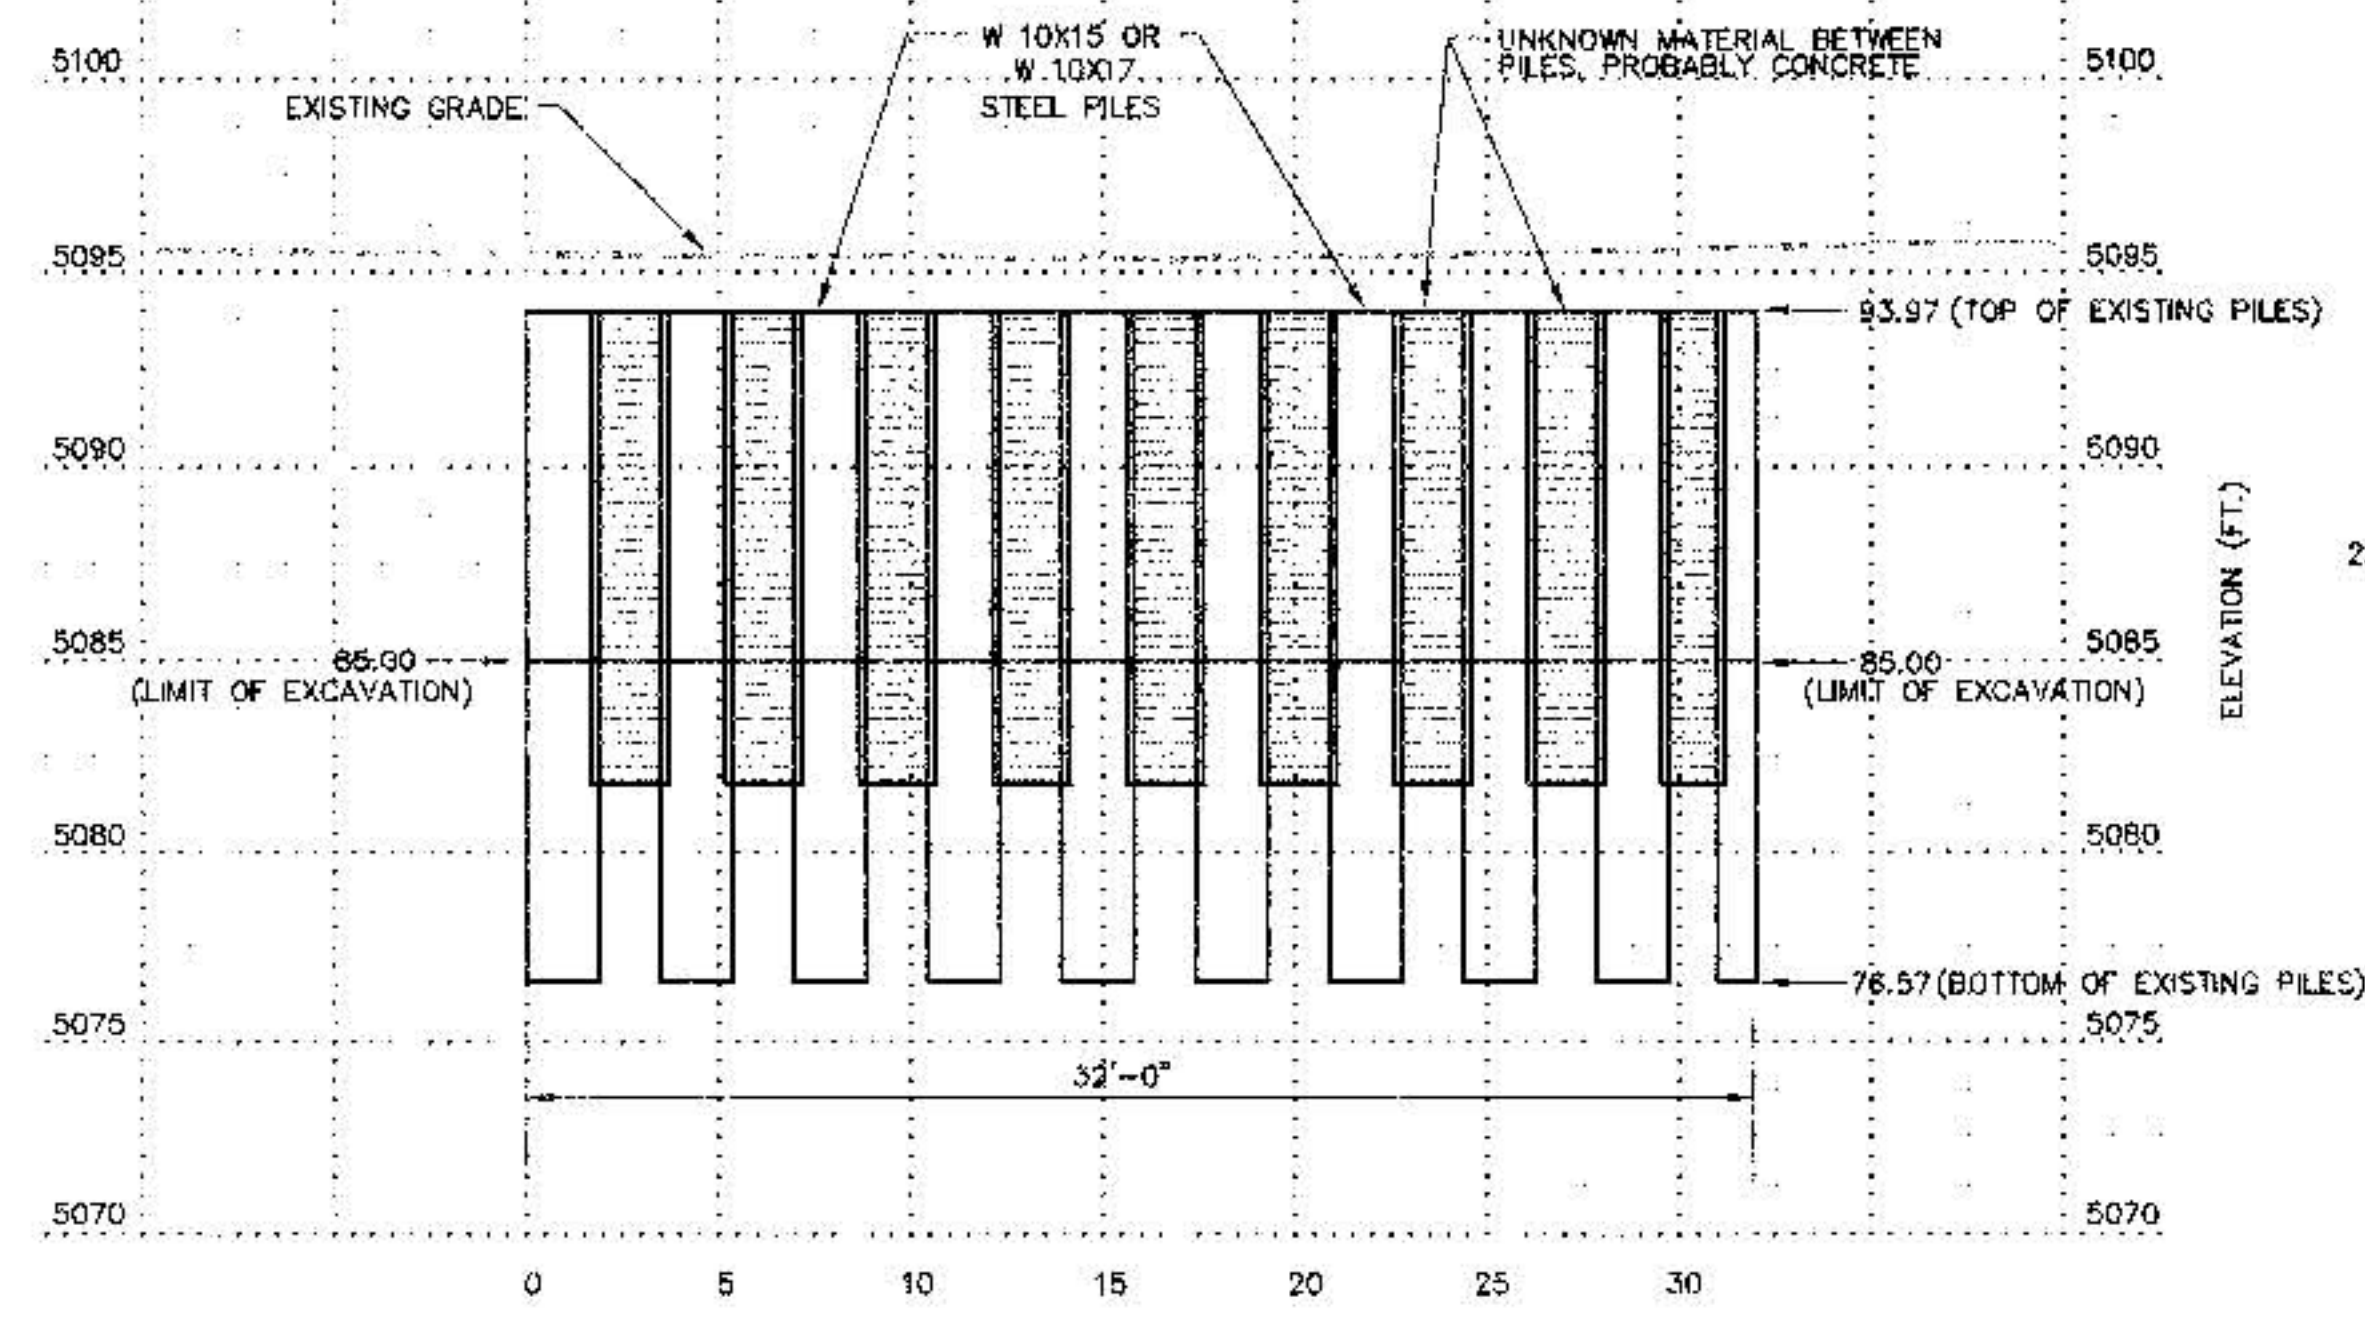

WEST PILE/SHORING WALL

SCALE: 1" = 5'-0" VERTICAL
1" = 5'-0" HORIZONTAL

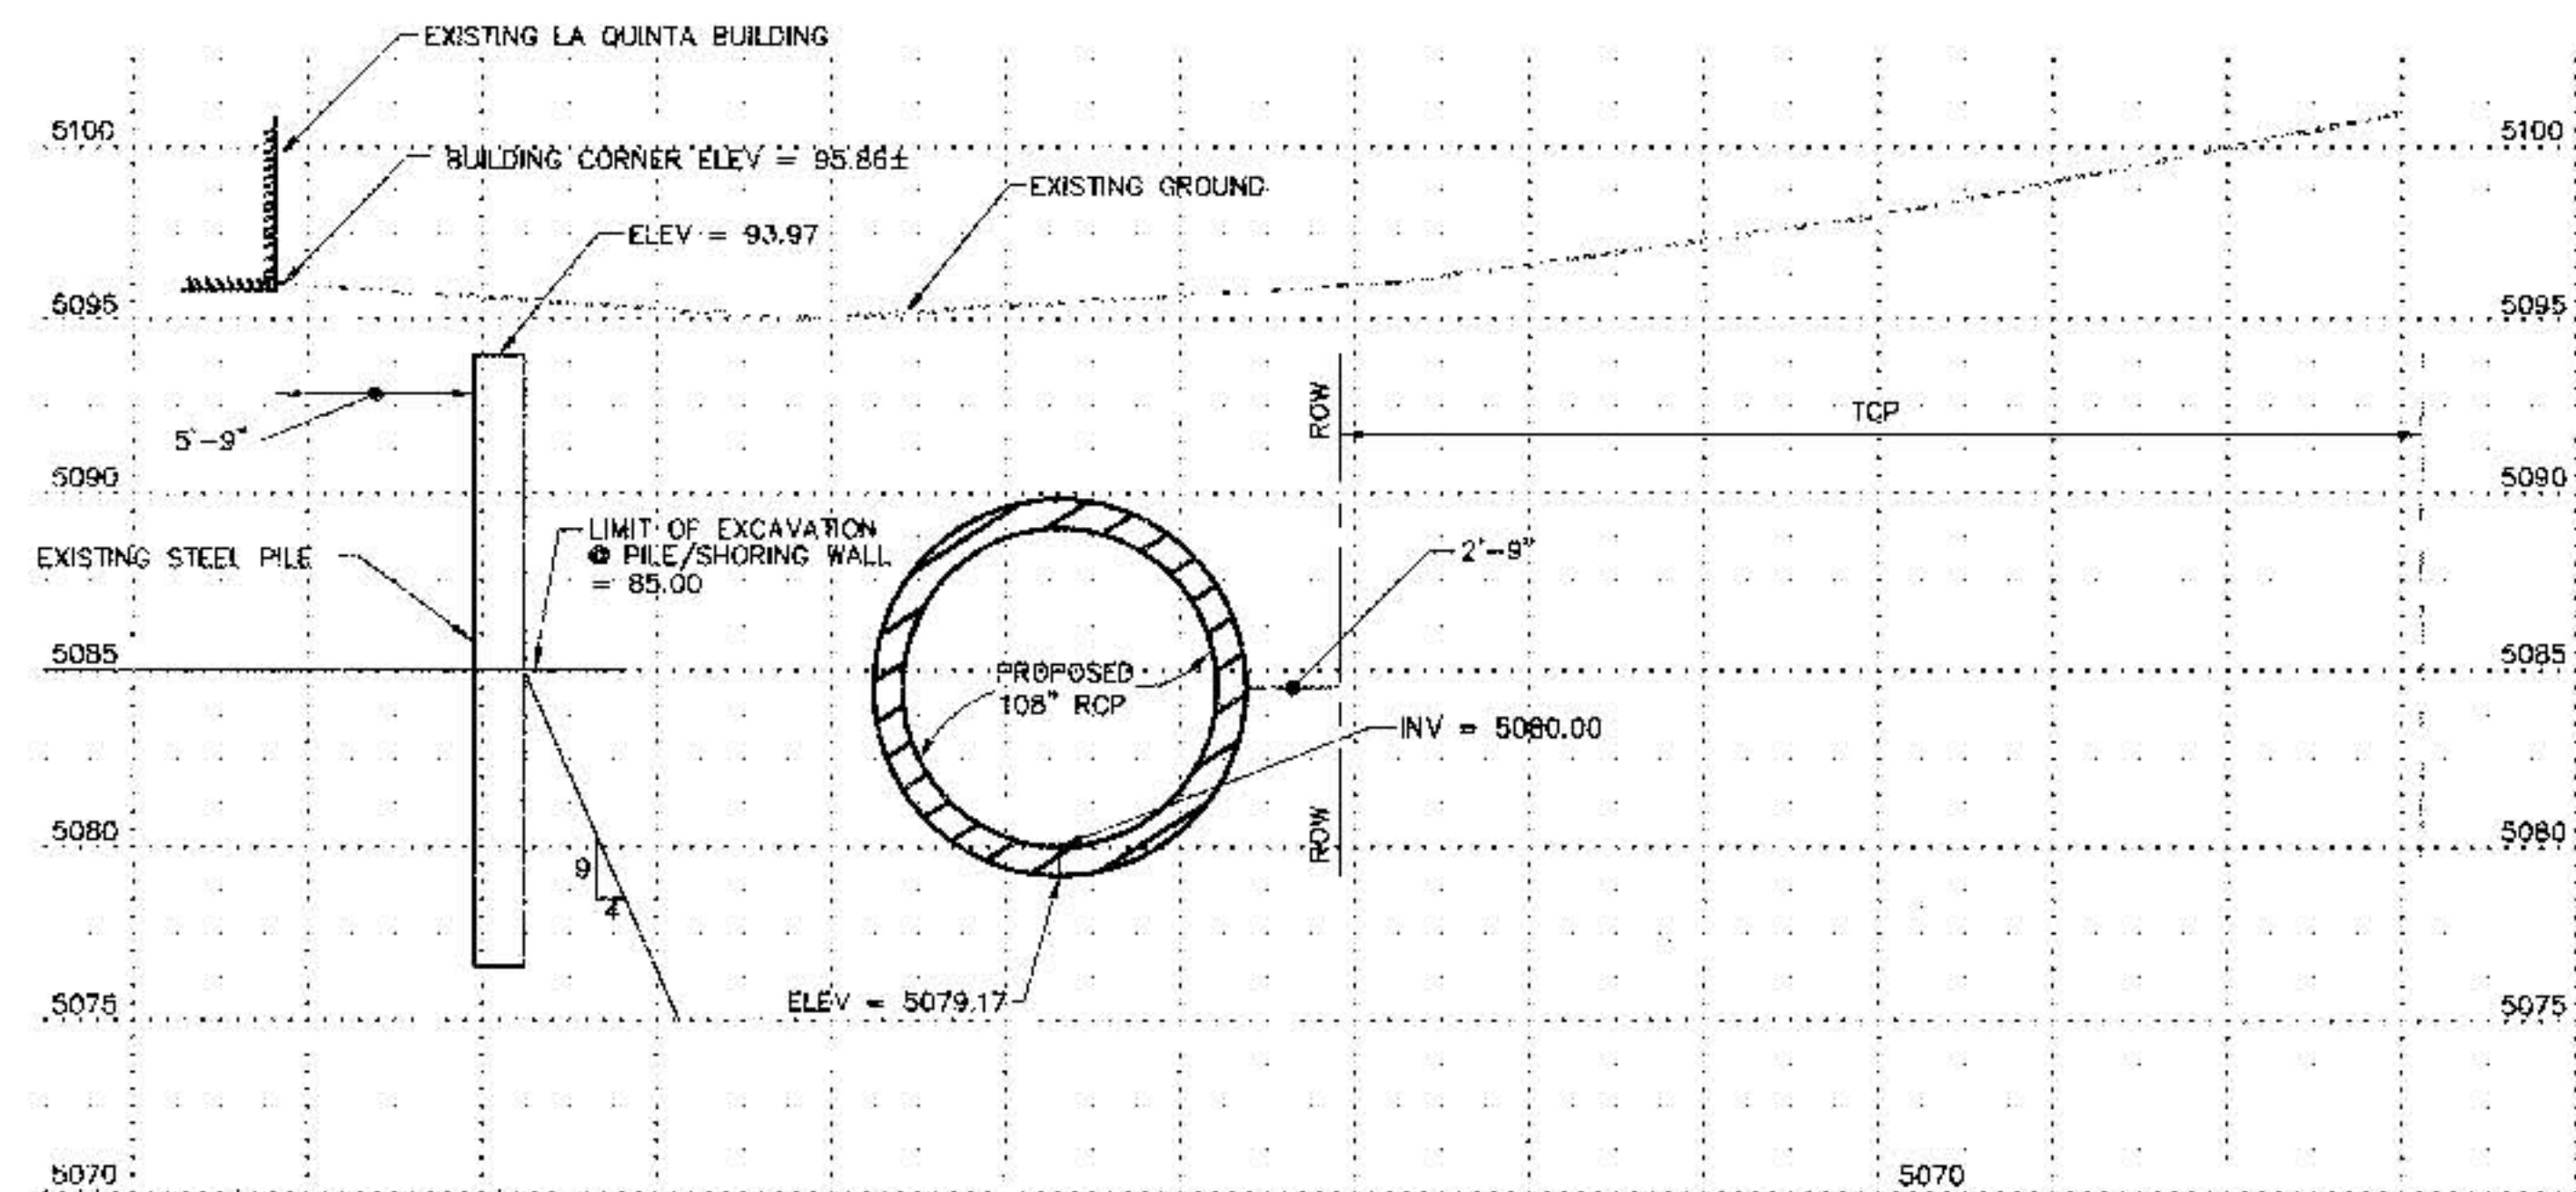

SHORING DETAIL

SCALE: 1" = 5'-0"

GENERAL NOTES:

1. BURIED SHEET PILING (ACTING AS SHORING) IS LOCATED IN THE VICINITY OF THE NORTHWEST CORNER OF THE LA QUINTA STRUCTURE. THE LOCATION OF THE SHORING SHOWN ON THIS DRAWING WAS TAKEN FROM THE PERMANENT EASEMENT AGREEMENT BETWEEN THE CITY OF ALBUQUERQUE AND LA QUINTA. THE SHORING WAS CONSTRUCTED TO A DEPTH TO ALLOW A VERTICAL CUT AT THE SHORING FACE TO AN ELEVATION 5085, THE SHORING WAS DESIGNED BASED UPON A TRENCH SLOPE OF 4 FEET HORIZONTAL TO 9 FEET VERTICAL (STARTING @ 5085) AND THE SOIL BEING COMPOSED OF EXISTING MATERIALS. SHOULD OVER EXCAVATION OF THE STORM DRAIN TRENCH BE REQUIRED FOR ANY REASON, THE CONTRACTOR MUST PROVIDE THE ADDITIONAL SUPPORT AT HIS EXPENSE. ANY DAMAGE TO THE LA QUINTA IMPROVEMENTS DUE TO THIS OVEREXCAVATION WILL BE THE CONTRACTOR'S RESPONSIBILITY.
2. CONTRACTOR MUST LOCATE THE SHORING PRIOR TO TRENCHING IN THE AREA OF THE SHORING. TO VERIFY ITS LOCATION, IF THE SHORING IS NOT IN THE LOCATION SHOWN ON THIS SHEET, THE CONTRACTOR SHALL CONTACT THE PROJECT ENGINEER AS SOON AS POSSIBLE.

AS BUILT INFORMATION		BENCH MARKS		SURVEY INFORMATION		ENGINEER'S SEAL		REVISIONS		DESIGN	
CONTRACTOR	DATE	NO.	BY	NO.	BY	NO.	BY	NO.	DATE	NO.	DATE
CONTRACTOR: SLD 1929	DATE: 5-99	1-40-18	DATE: 5-99	1-40-18	DATE: 5-99	1-40-18	DATE: 5-99	1-40-18	DATE: 5-99	1-40-18	DATE: 5-99
STATION IS LOCATED 3.5 MILES NW OF DOWNTOWN ALBUQUERQUE, AT THE HIGHWAY 1-40 AND STATE ROAD 448 (CORS RD. NW) INTERCHANGE. STATION MARK IS A STANDARD NMHC BRASS TABLET, STAMPED "STA 1-40-18", SET IN TOP OF A CONCRETE POST FLUSH WITH THE GROUND. (N 1494859.00, E 364150.93)	INSPECTED BY: L. LORNEZ	INSPECTED BY: L. LORNEZ	INSPECTED BY: L. LORNEZ	INSPECTED BY: L. LORNEZ	INSPECTED BY: L. LORNEZ	INSPECTED BY: L. LORNEZ	INSPECTED BY: L. LORNEZ	INSPECTED BY: L. LORNEZ	INSPECTED BY: L. LORNEZ	INSPECTED BY: L. LORNEZ	INSPECTED BY: L. LORNEZ
RECORDED BY: NO	RECORDED BY: NO	RECORDED BY: NO	RECORDED BY: NO	RECORDED BY: NO	RECORDED BY: NO	RECORDED BY: NO	RECORDED BY: NO	RECORDED BY: NO	RECORDED BY: NO	RECORDED BY: NO	RECORDED BY: NO



CITY OF ALBUQUERQUE
PUBLIC WORKS DEPARTMENT
ENGINEERING DEVELOPMENT GROUP

TITLE: WEST MESA DIVERSION PROJECT PHASE I
LA QUINTA EXISTING PILE/SHORING DETAIL SHEET

DESIGN	APPROVAL	DATE	BY
DESIGN	APPROVAL	DATE	BY
DESIGN	APPROVAL	DATE	BY

THIS SHEET IS FOR INFORMATION PURPOSES ONLY

16

17

18


19

20

LENGTH OF RESTRAINED PIPE (LF) IF MJ FITTINGS ARE TO BE USED

PIPE SIZE	90°	45°	22 1/2°	11 1/4°	TEE	VALVE
14"	32	13	6	3	22	76
16"	36	15	7	4	32	86



NOTE: IF MJ FITTINGS ARE TO BE USED, RESTRAINING GLANDS SHALL BE USED AT ALL FITTINGS AND THE CONNECTING PIPE SHALL BE RESTRAINED WITH HARNESSES AS PER TABLE.

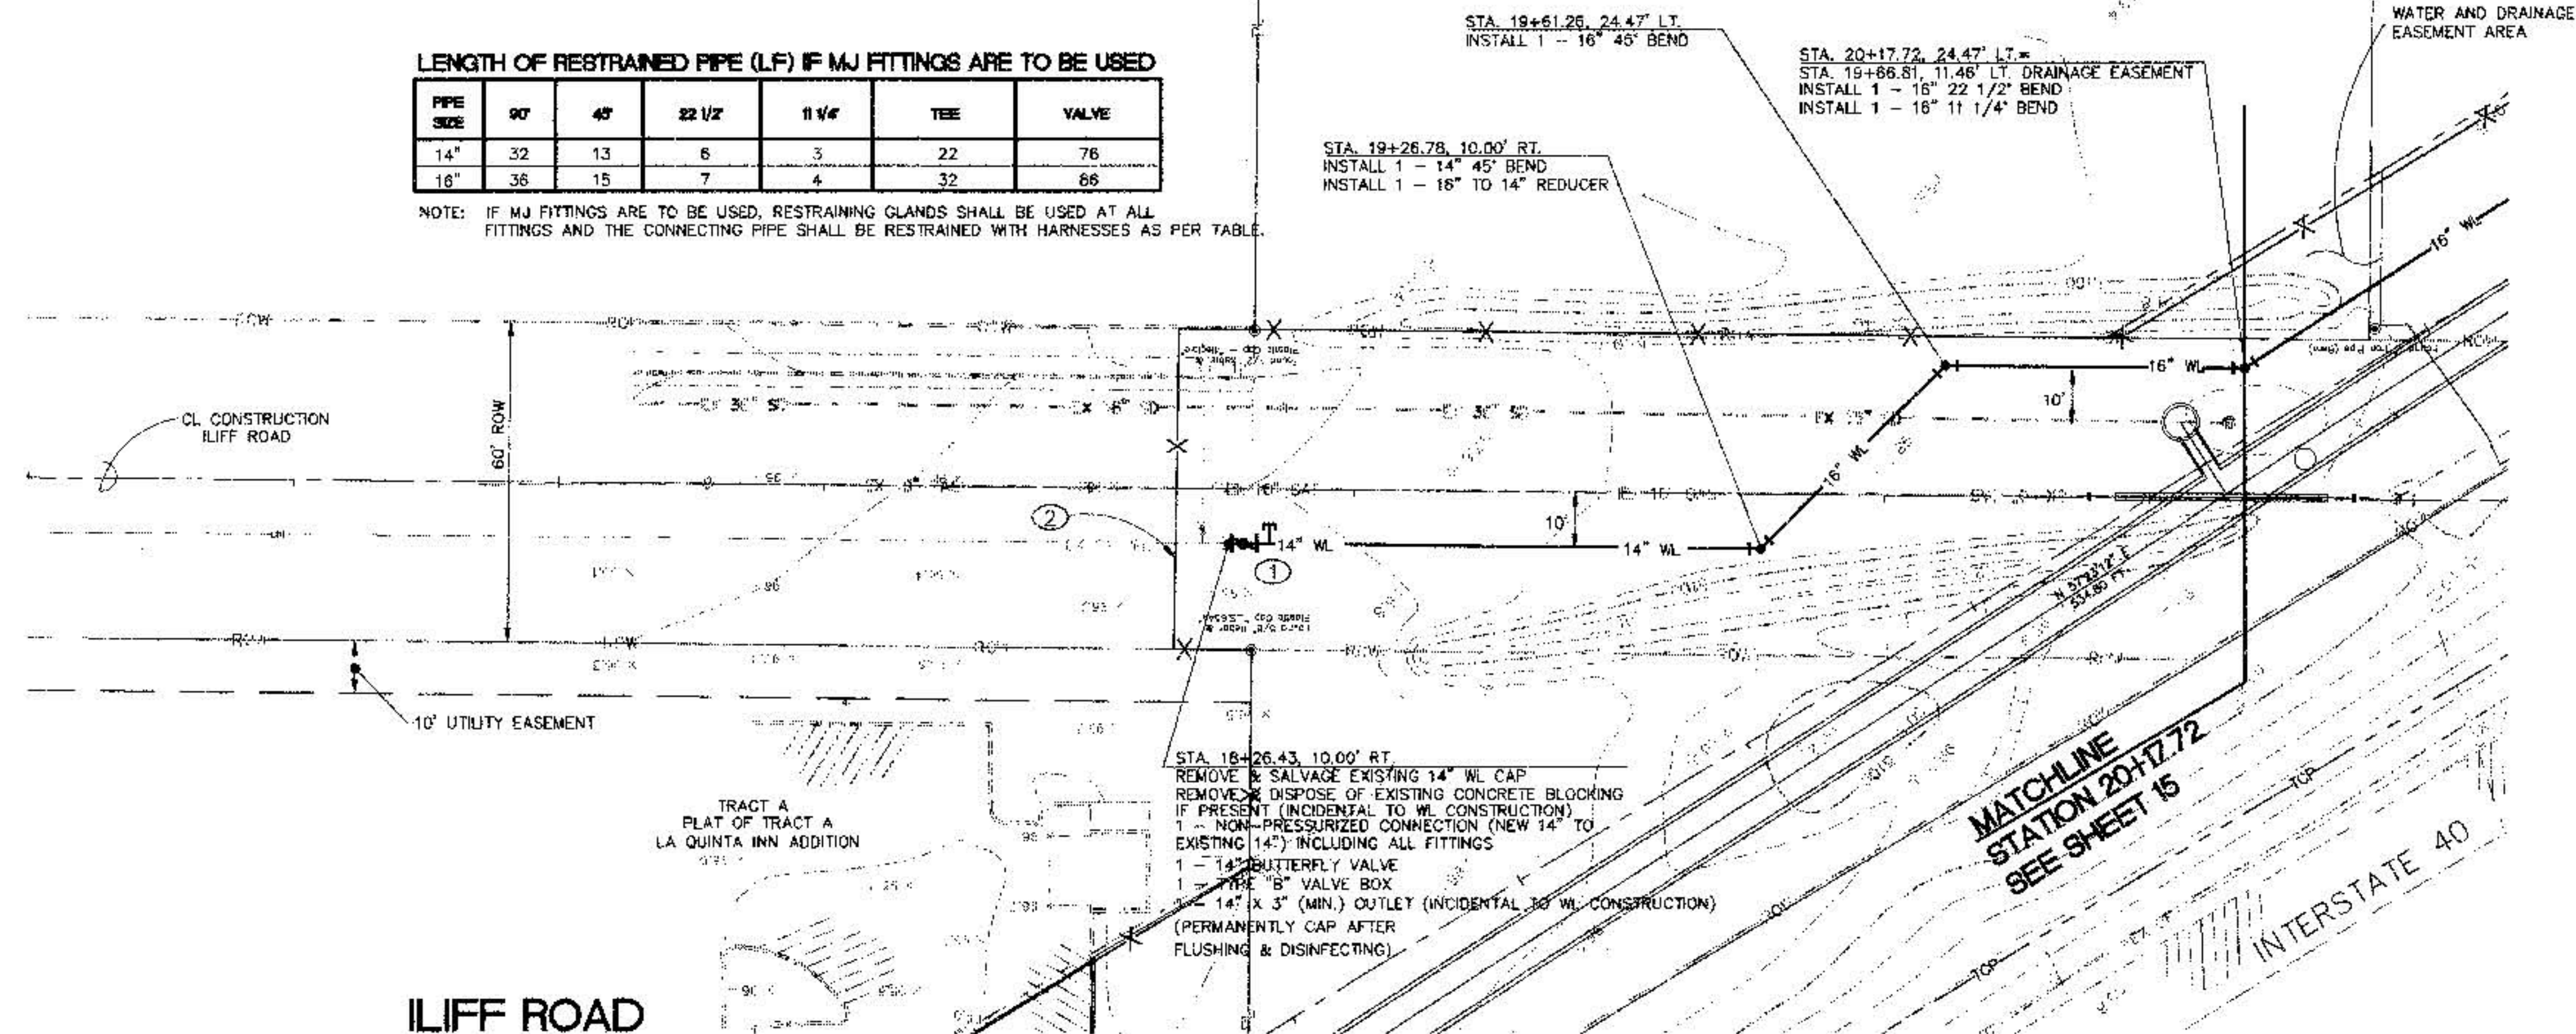

KEYED NOTES:

- FILLING, FLUSHING, AND DISINFECTION VIA EXISTING FIREHYDRANT. USE OWNER PROVIDED 3\"/>
- INSTALL TEMPORARY CHAIN-LINK FENCE, 5' HIGH, INCLUDING POSTS & HARDWARE. REMOVE & DISPOSE WHEN CONSTRUCTION OF PERMANENT FENCING IS COMPLETE.

AS BUILT INFORMATION		BENCH MARKS		SURVEY INFORMATION		ENGINEERS SEAL	
CONTRACTOR: ENCI, S.A.C.	DATE: 5-99	1-40-16 NMHC/ACS	ELEV: 5103.66 FEET (SLD 1929)	FIELD NOTES	BY		5-76-98 L. ANDREWS, P.E. No. 10000, State of New Mexico, Mechanical Engineering
STATION: 3.5 MILES NW OF DOWNTOWN ALBUQUERQUE, AT THE HIGHWAY I-40 AND STATE ROAD 448 (COORS RD., NW) INTERCHANGE. STATION MARK IS A STANDARD NMHC BRASS TABLET, STAMPED "STA. I-40-16", SET IN TOP OF A CONCRETE POST FLUSH WITH THE GROUND. (N 1494859.08, E 364150.93)	INSPECTOR: L. ANDREWS, P.E.	DATE: 5-99	DATE: 5-99	NO.	DATE		
DESIGNED BY: CURDLA	DATE: 04/98	DRAWN BY: CURDLA	DATE: 04/98	REVISIONS	BY		
CHECKED BY: DLA	DATE: 04/98	DESIGN	DATE	DATE	DATE		

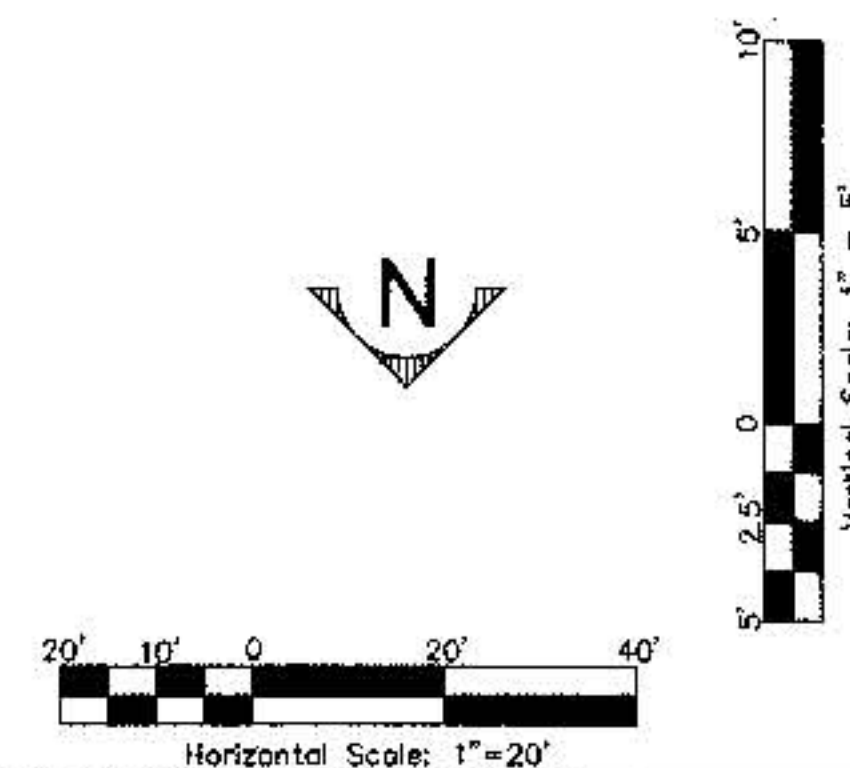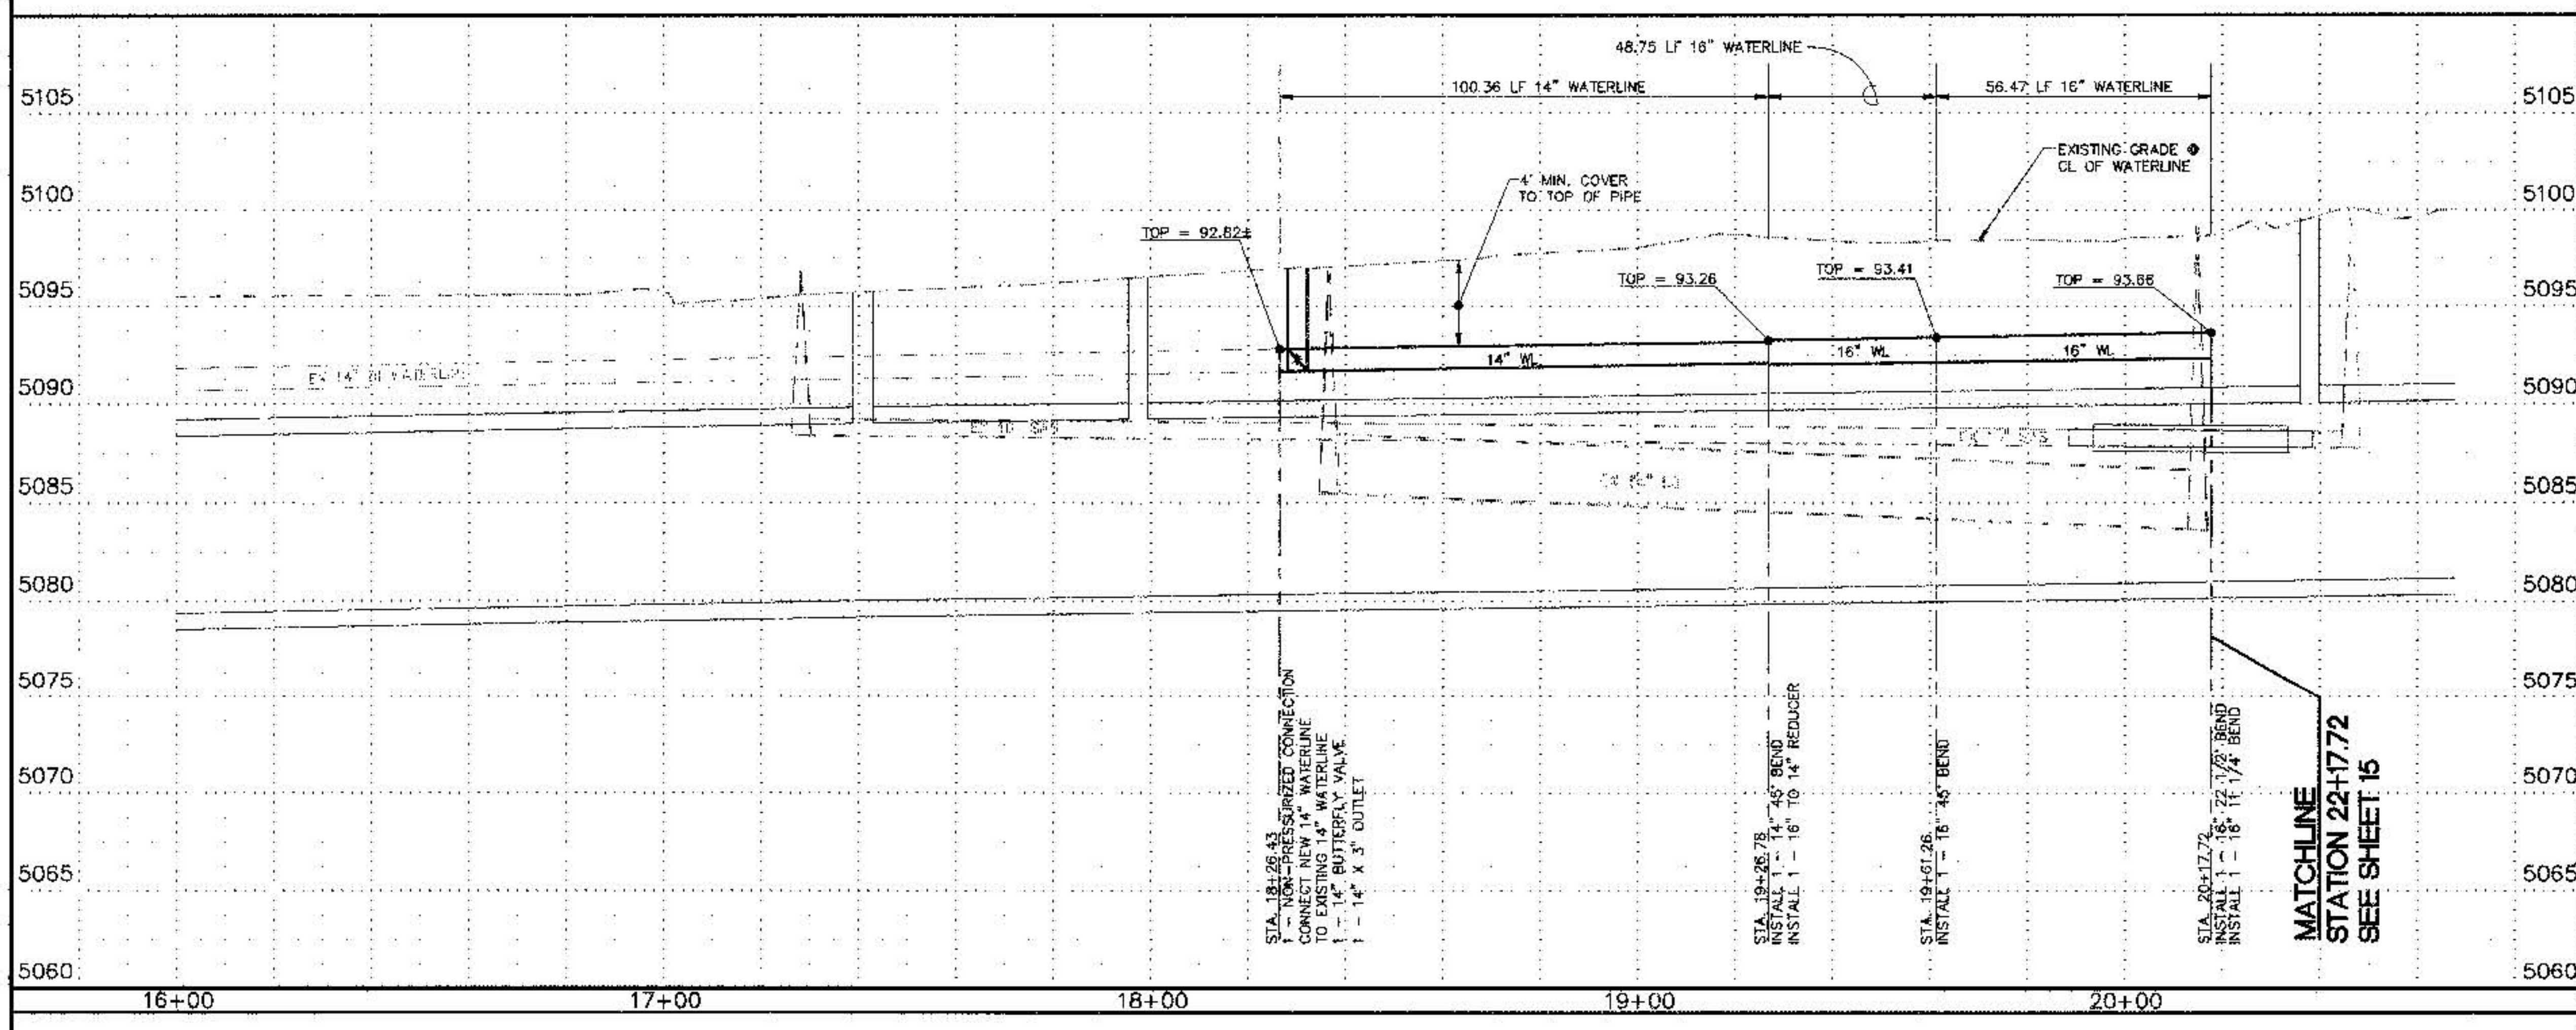

1961050
Smith Engineering Company
 A Full Service Engineering Company
 4400 Canyon Blvd., N.E., Suite 2000, Albuquerque, New Mexico 87110



CITY OF ALBUQUERQUE
 PUBLIC WORKS DEPARTMENT
 ENGINEERING DEVELOPMENT GROUP

TITLE: WEST MESA DIVERSION PROJECT PHASE I
WATERLINE P & P: ILIFF ROAD: STA 16+00 TO 22+17.72

City Project No.	538191	Zone Map No.	H-102, H-112	Sheet	14 of 20
------------------	--------	--------------	--------------	-------	----------


LENGTH OF RESTRAINED PIPE (LF) IF MJ FITTINGS ARE TO BE USED						
PIPE SIZE	90°	45°	22 1/2°	11 1/4°	TEE	VALVE
14"	32	13	8	3	22	78
16"	38	15	7	4	32	86

NOTE: IF MJ FITTINGS ARE TO BE USED, RESTRAINING GLANDS SHALL BE USED AT ALL FITTINGS AND THE CONNECTING PIPE SHALL BE RESTRAINED WITH HARNESSSES AS PER TABLE.

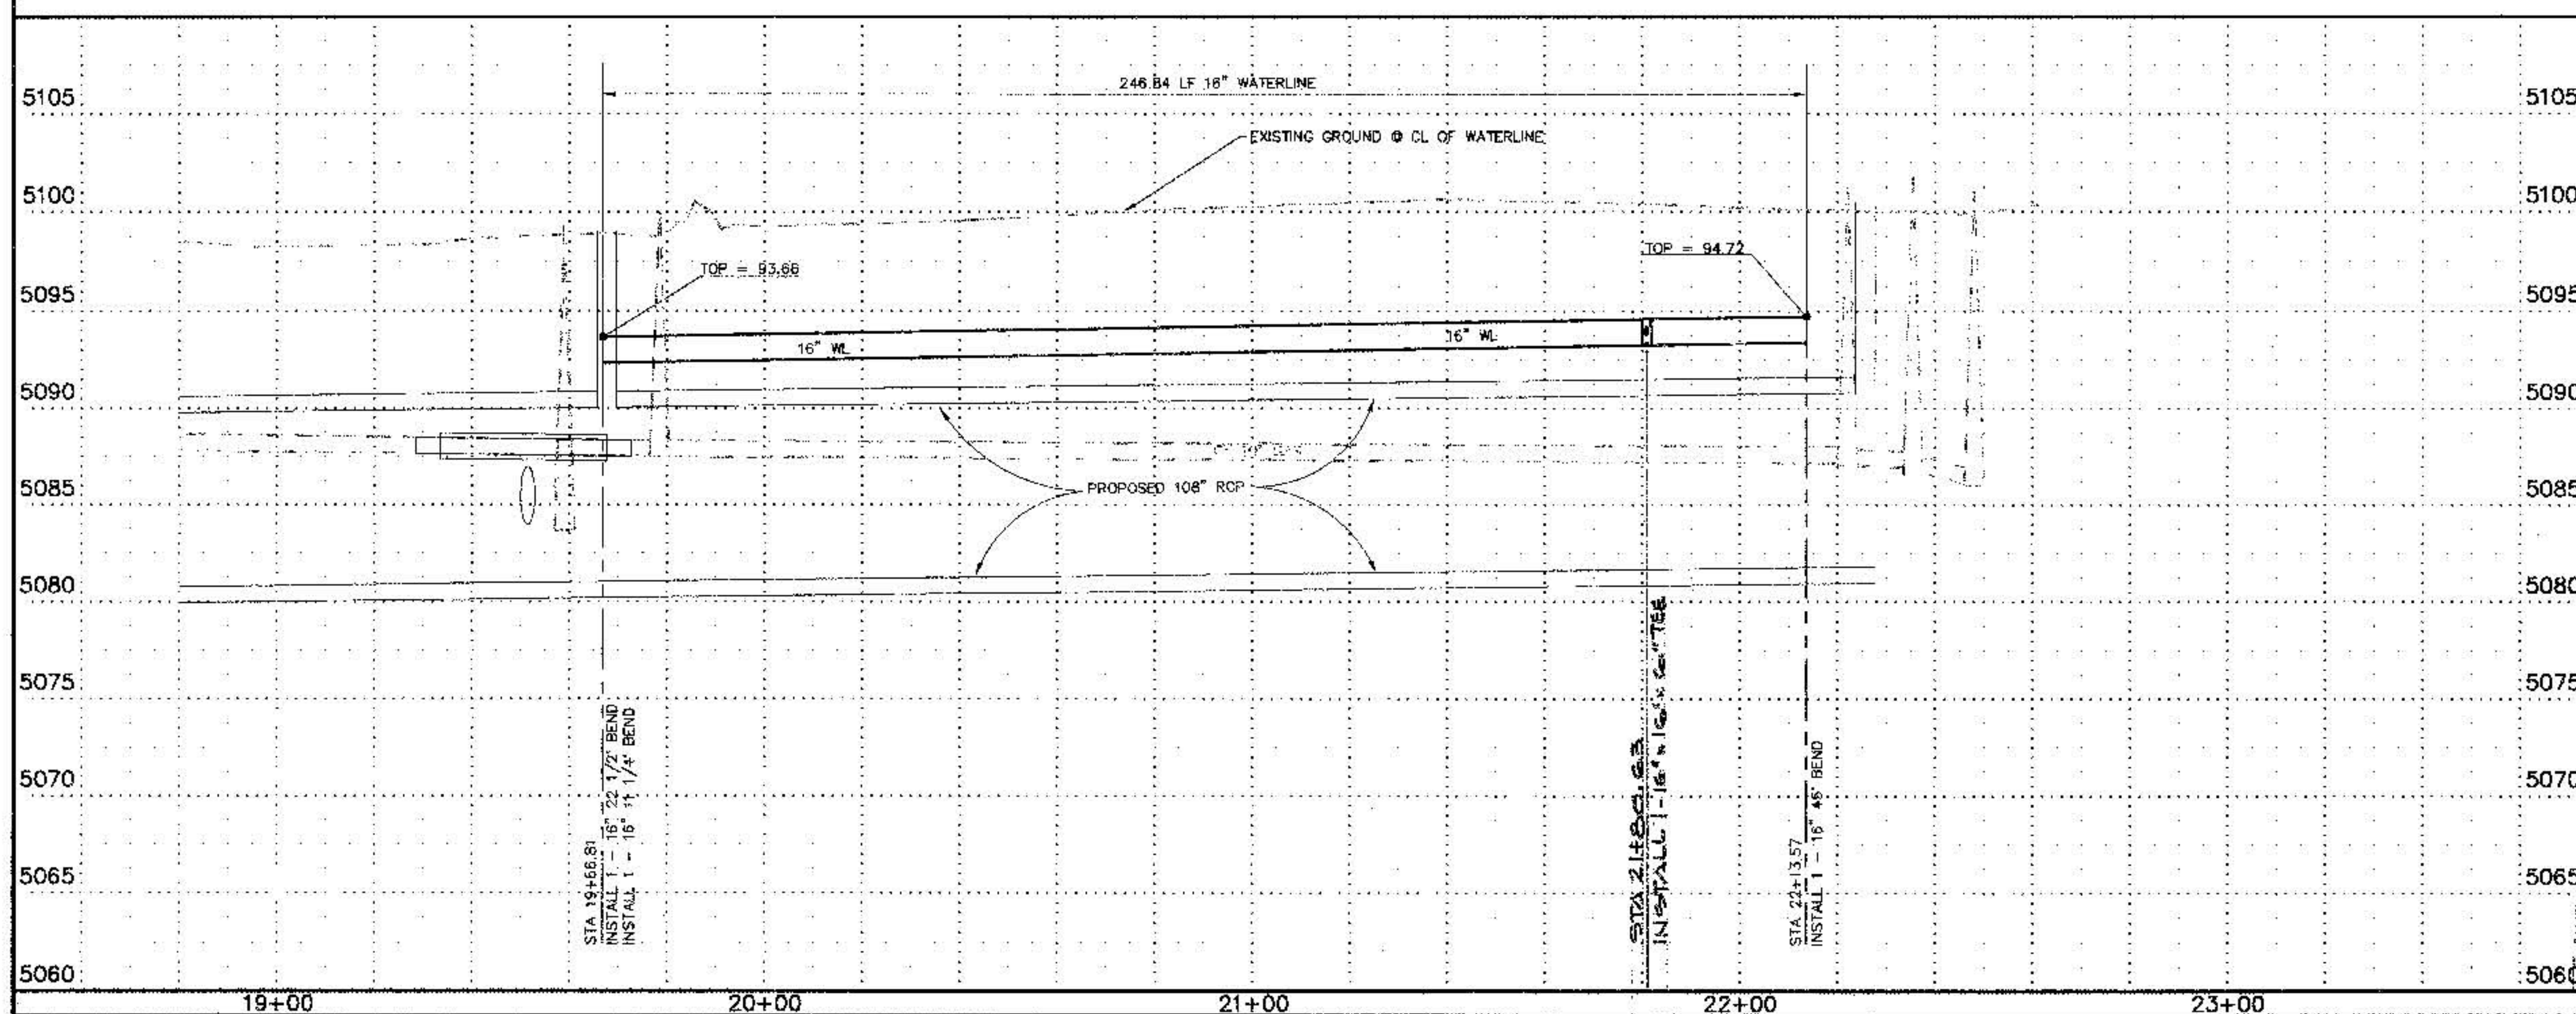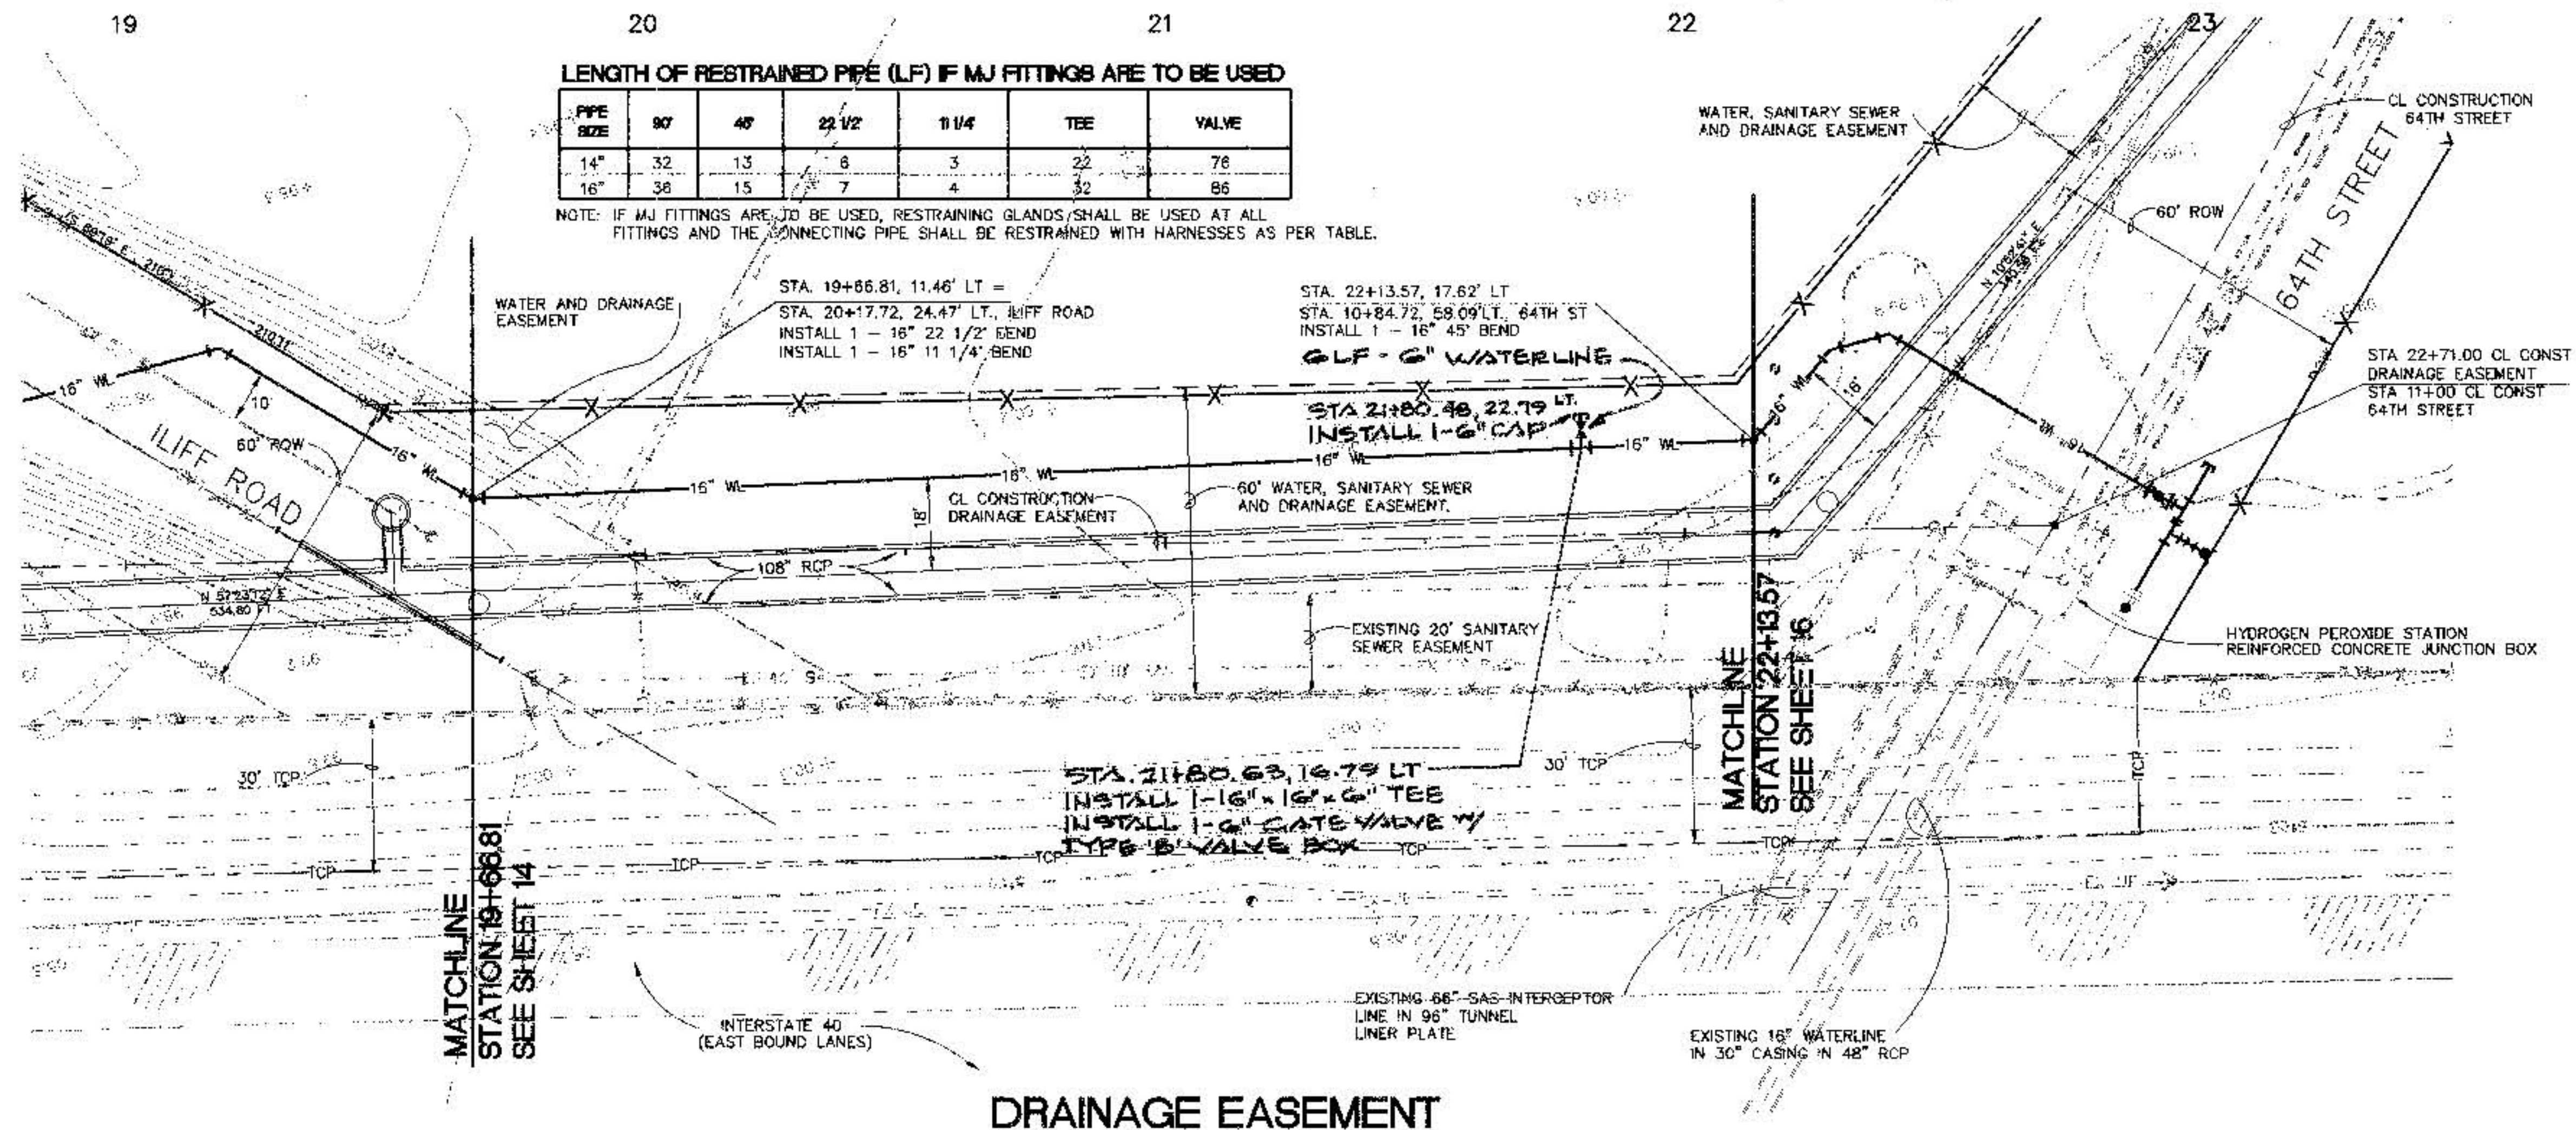


○ KEYED NOTES:

PROJECT PHASE I STA 19+66.81 TO 22+13.5 Sheet 15 of 20	
No. / Day / Yr. No. / Day / Yr.	
DESIGNED BY CAROLA DRAWN BY CAROLA CHECKED BY CAROLA DATE 04/98 DATE 04/98 DATE 04/98 REMARKS REVISIONS DESIGN	
ENGINEERS SEAL DOUGLAS L. ANDREWS NEW MEXICO REGISTERED PROFESSIONAL ENGINEER NO. 171 5-26-98 SURVEY INFORMATION FIELD NOTES NO. BY DATE	
BENCH MARKS 1+40-18 NM5HC/ACS ELEV. 5103.98 FEET (SLD 1929) STATION IS LOCATED 3.5 MILES NW OF DOWNTOWN ALBUQUERQUE, AT THE HIGHWAY I-40 AND STATE ROAD 448 (COORS RD., NW) INTERCHANGE. STATION MARK IS A STANDARD NM5HC BRASS TABLET, STAMPED "STA 1+40-18", SET IN TOP OF A CONCRETE POST FLUSH WITH THE GROUND. (N 1494859.08, E 364150.93) AS-BUILT INFORMATION CONTRACTOR PRICE, INC. DRAWN BY JAMES DATE 5-11 CHECKED BY JAMES DATE 5-11 VERIFICATION BY L. LOPEZ DATE 11-99 MICRO-FILM INFORMATION RECORDED BY DATE NO.	

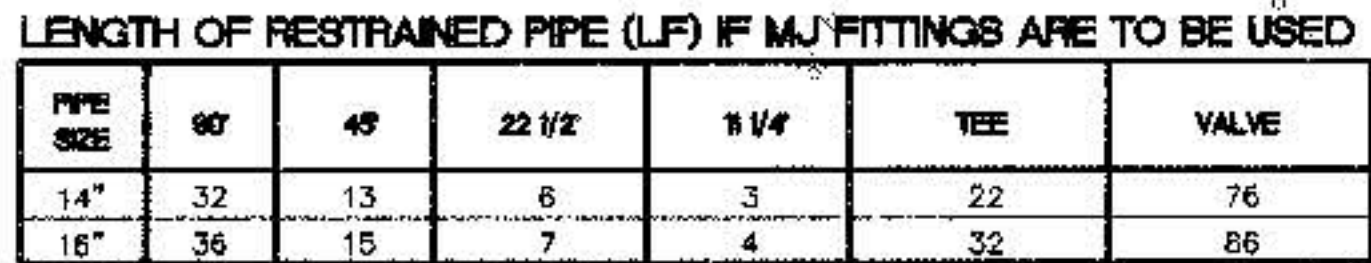

NOTE: IF MJ FITTINGS ARE TO BE USED, RESTRAINING GLANDS SHALL BE USED AT ALL FITTINGS AND THE CONNECTING PIPE SHALL BE RESTRAINED WITH HARNESSSES AS PER TABLE.

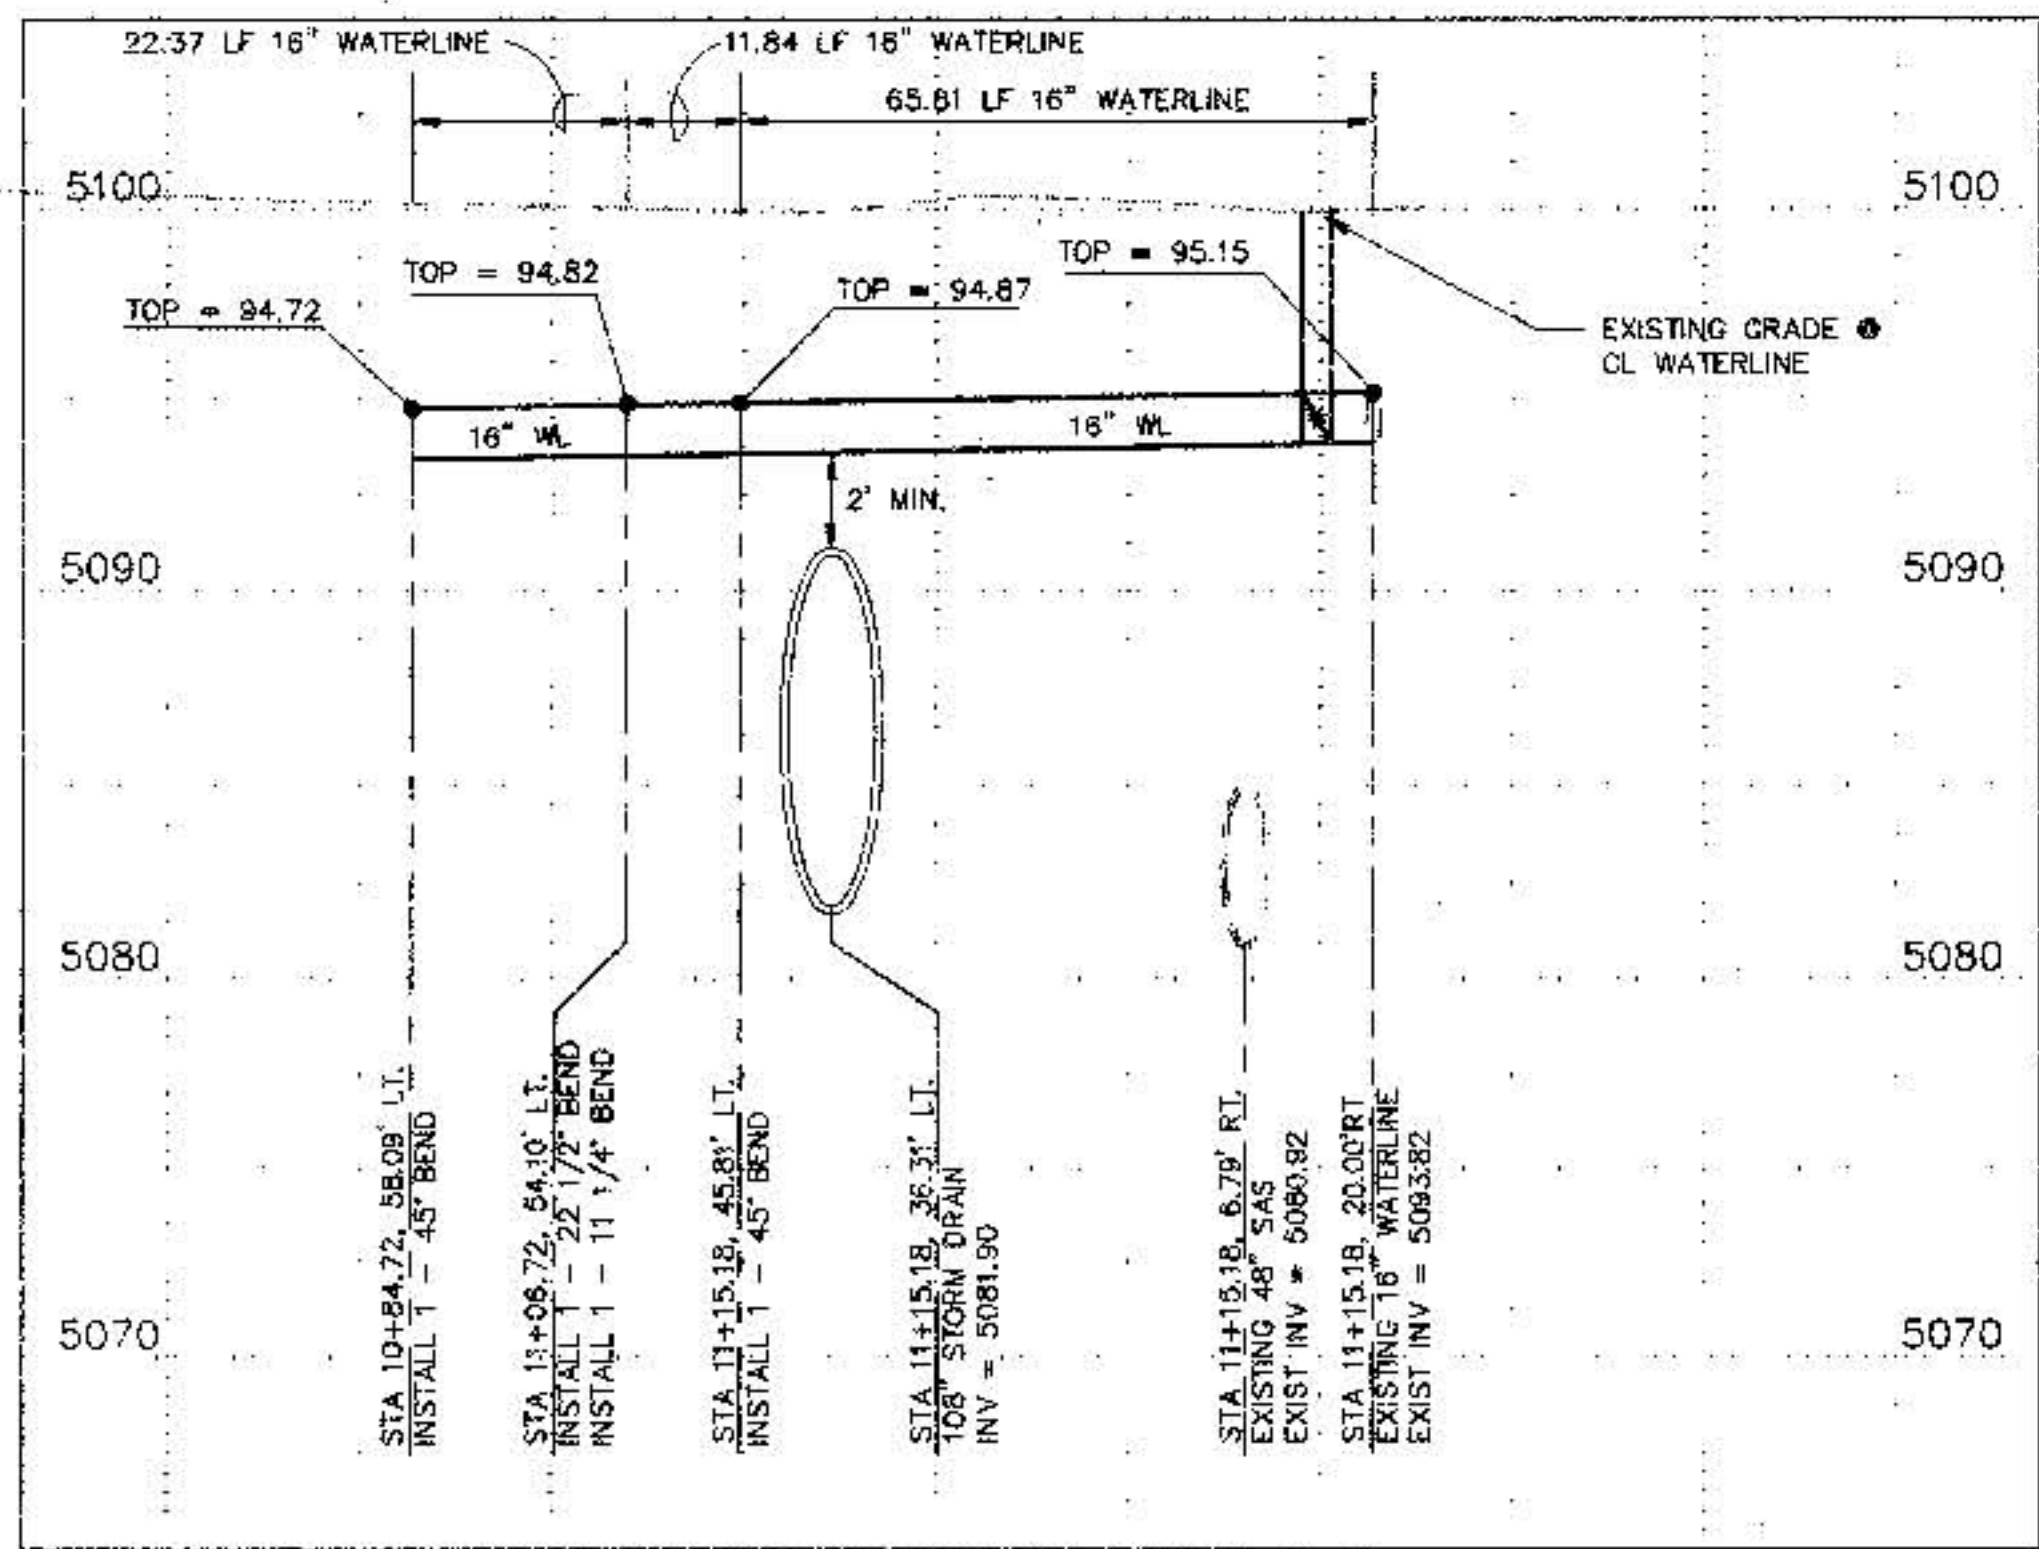

PROFILE OF LINE

SCALE: 1" = 20' HORIZONTAL
1" = 5' VERTICAL

○ KEYED NOTES:

- ① USE NEW FIRE HYDRANT AS OUTLET FOR
FLUSHING. DRAIN WATER TO STORM DRAIN
OR SANITARY SEWER.

[illegible]

1. DISINFECTION AND FILLING OF WATER LINES SHALL CONFORM TO THE CITY OF ALBUQUERQUE STANDARD SPECIFICATIONS 801.17 EXCEPT AS MODIFIED HEREIN. THIS WORK IS INCIDENTAL TO THE WATERLINE CONSTRUCTION. NO ADDITIONAL PAYMENT WILL BE MADE.
2. ALL NECESSARY MEASURES SHALL BE TAKEN TO PREVENT CONTAMINATED MATERIALS FROM ENTERING THE WATER LINE DURING STORAGE, CONSTRUCTION, OR REPAIR INCLUDING CAPPING THE WATER LINE AT NIGHT AND DURING ALL BREAKS IN PIPE LAYING.
3. REMOVE ANY MATERIALS, DIRT OR DEBRIS THAT MAY HAVE ENTERED THE WATER LINE PRIOR TO DISINFECTION.
4. ADD A FLUSHING/DRAINING PORT TO ALL DEAD END LINES DISCHARGE POINTS AND FILLING POINTS WHICH ARE NOT FIRE HYDRANTS. PORT SHALL BE 2" MIN. UNLESS SHOWN OTHERWISE. PORT SHALL ALLOW PIPE TO FULLY DRAIN.
5. FILL THE WATER LINE PER THE PLAN SHOWN ON THIS SHEET THROUGH AN APPROVED BACK FLOW PREVENTION DEVICE. CONTRACTOR SHALL USE NECESSARY METHODS TO ALLOW ALL AIR IN THE WATER LINE TO RELEASE WITHOUT CONTAMINATING ANY EXISTING WATER LINES OR FIELD TAPPING CONCRETE CYLINDER PIPE.
6. PRESSURE TEST IN ACCORDANCE WITH CITY OF ALBUQUERQUE STANDARD SPECIFICATION 801.16.
7. DISINFECT THE WATER LINE PER CITY OF ALBUQUERQUE STANDARD SPECIFICATIONS 801.17 AND AWWA C651 (LATEST EDITION). SODIUM OR CALCIUM HYPOCHLORITE ARE THE ONLY PERMISSIBLE FORMS OF CHLORINE TO BE USED. GRANULES OR TABLETS SHALL NOT BE PLACED IN THE WATER LINE, HOWEVER THEY MAY BE USED TO PREMIX A HIGHLY CHLORINATED SOLUTION. CONTRACTOR SHALL ENSURE THAT GRANULES OR TABLETS NOT DISSOLVED ARE NOT INTRODUCED INTO THE WATER LINE FROM THE HIGHLY CHLORINATED WATER BY SCREENING THE DISCHARGE FROM THE PRE-MIXING VESSEL OR BY OTHER PROVEN MEANS.
8. THE SLUG OR CONTINUOUS-FEED METHOD SHALL BE USED (WITH PRELIMINARY FLUSHING ON LINES LESS THAN 24" IN DIAMETER AND BROOM SWEEPING ON LINES 24" AND LARGER).
9. AFTER THE REQUIRED RETENTION PERIOD, HEAVILY CHLORINATED WATER SHALL BE FLUSHED FROM THE WATER LINE PER THIS PLAN. INTRODUCE FLUSH WATER THROUGH AN APPROVED BACK FLOW DEVICE. DECHLORINATION IS REQUIRED WHEN NOTED ON THIS PLAN.
10. FLUSH THE WATER LINE BY CAREFULLY THROTTLING THE VALVE AT THE DISCHARGE END TO PREVENT A VACUUM IN THE WATER LINE AND TO PREVENT INUNDATING THE DISCHARGE STRUCTURE.
11. IF FLUSHING INTO A SANITARY SEWER NOTIFY THE WASTEWATER UTILITY DIVISION AT 873-7015 PRIOR TO FLUSHING. IF FLUSHING TO A CITY OF ALBUQUERQUE STORM SEWER OR DRAINAGE CHANNEL NOTIFY THE HYDROLOGY DIVISION AT 768-3654. IF FLUSHING TO AN AMAFCA STRUCTURE NOTIFY AMAFCA AT 884-2215 PRIOR TO FLUSHING. FLUSHING LINE SHALL BE SUPPORTED BY A STAND TO MAINTAIN AN 18" SEPARATION BETWEEN THE FLUSHING LINE AND THE DISCHARGE POINT OR MANHOLE RIM.
12. WHEN THE FLUSH WATER RESIDUAL CHLORINE IS LESS THAN 2.0 mg/L, THE CITY WILL TAKE A POTABILITY TEST. UPON PASSING THE CONTRACTOR SHALL REMOVE THE METER AND BACK FLOW PREVENTION DEVICE. IF LINE DOES NOT PASS, CONTRACTOR SHALL REPEAT DISINFECTION AND/OR FLUSHING UNTIL LINE PASSES.
13. PROVIDE CITY WITH A RECORD OF THE WATER VOLUME USED TO FILL AND FLUSH THE WATER LINE BASED ON WATER METER READINGS.
14. CONTRACTOR MAY SUBMIT AN ALTERNATE FILLING, DISINFECTING, AND FLUSHING PLAN FOR REVIEW AND APPROVAL AT LEAST 5 WORKING DAYS PRIOR TO FILLING.
15. THROTTLING SHALL BE PERFORMED USING VALVES NOT FIRE HYDRANTS.
16. THE CONTRACTOR SHALL BE GRANTED FREE WATER FOR TESTING AND FLUSHING. IF THE WATER LINE FAILS THE HYDROSTATIC OR POTABILITY TEST, THE CONTRACTOR SHALL PAY FOR THE ADDITIONAL WATER REQUIRED FOR RETESTING.

EXISTING 16" BUTTERFLY VALVE 1141

 
EXISTING 16" WATERLINE

1. CONTRACTOR SHALL BE RESPONSIBLE FOR TIMING AND COORDINATION OF THE WATER SHUT-OFF REQUIREMENTS IN CONJUNCTION WITH THE COMPLETION OF THIS PROJECT.
2. AT LEAST FIVE (5) WORKING DAYS PRIOR TO CONSTRUCTION, CONTRACTOR SHALL CONTACT THE PUBLIC WORKS DEPARTMENT WATER SYSTEMS DIVISION (857-8200) TO INITIATE IMPLEMENTATION OF THIS WATER SHUT-OFF PLAN.

NOTE: EXISTING VALVE NUMBER
111111 NOT AVAILABLE

FOR WATERLINE CONNECTIONS
EXISTING WATERLINES ARE TO BE
SHUT DOWN. CLOSE VALVE [119]
[114] AND CLOSEST VALVE ON
ILIFF ROAD

LEGEND:

	16" WL	NEW WATERLINE
		EXISTING WATERLINE
		EXISTING COA VALVE NUMBER
		PROPOSED VALVE
		PROPOSED FIRE HYDRANT
		EXISTING VALVE
		EXISTING FIRE HYDRANT

NOTE: CASING SPACERS ARE CONSIDERED INCIDENTAL
TO SAS CONSTRUCTION.

18" STEEL CASING PIPE


BELL DIAMETER — 10" SAS — NEW 10" SAS PIPE




SAS CASING SPACER DETAIL
SCALE: NTS

SAS CASING DETAIL

SCALE: 1" = 10'-0"

- ① CONTRACTOR TO CORE THROUGH 108" RCP WALLS.
- ② GROUT VOID AREA BETWEEN RCP AND STEEL CASING PIPE.
(INCIDENTAL TO SAS CONSTRUCTION)
- ③ 18" STEEL CASING.
- ④ NEW 10" SAS.
- ⑤ 10" TRANSITION COUPLING.

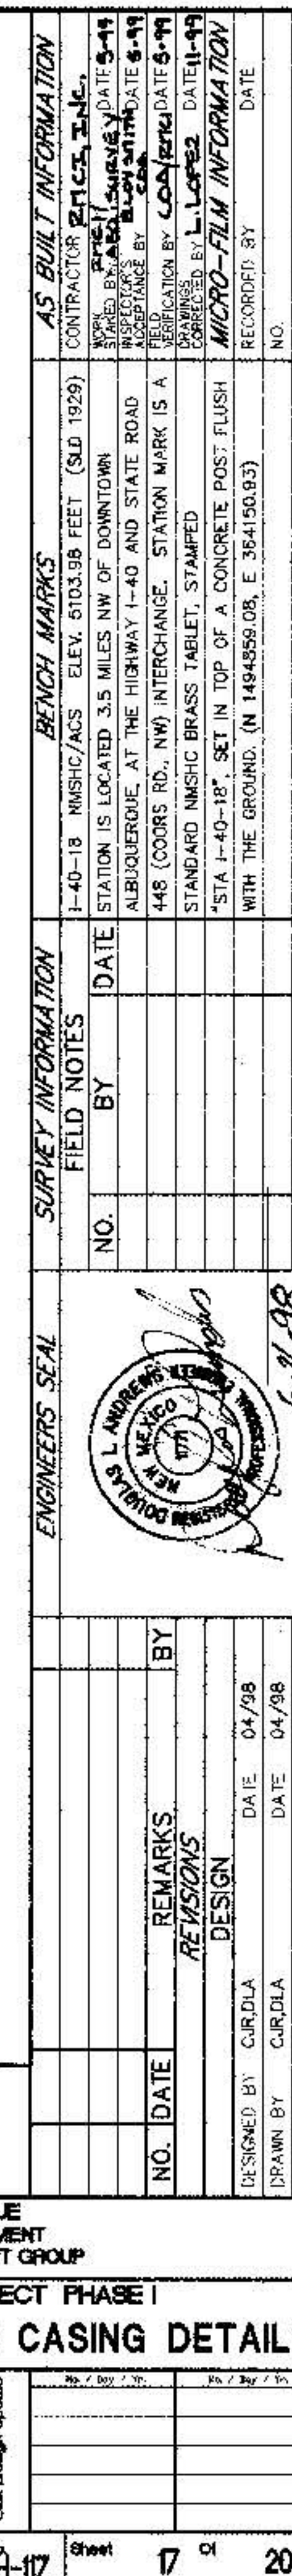

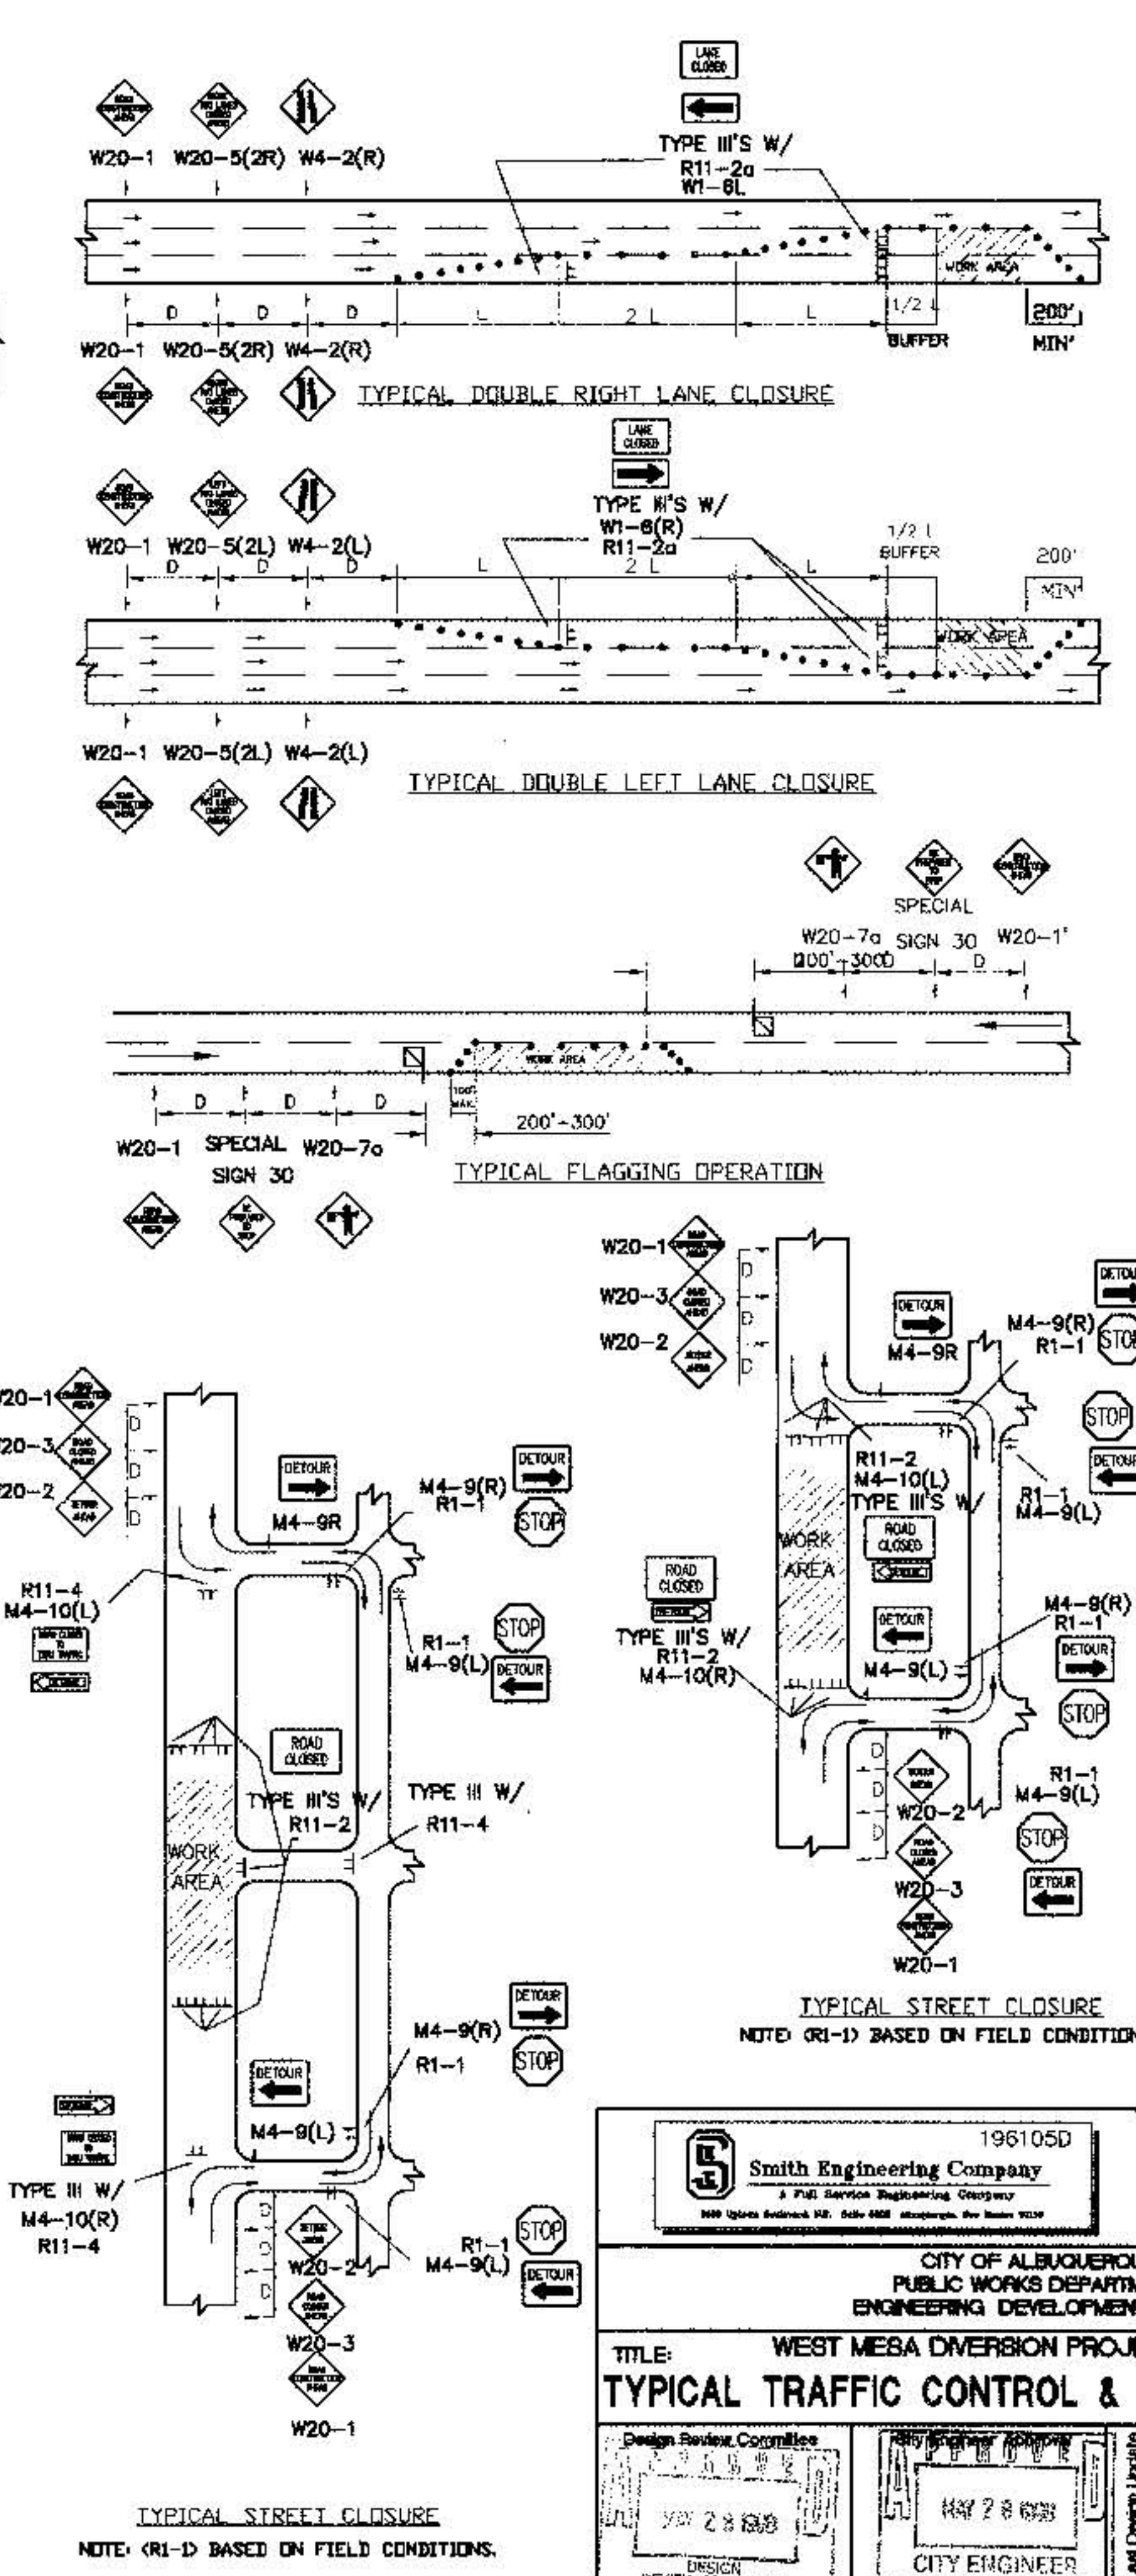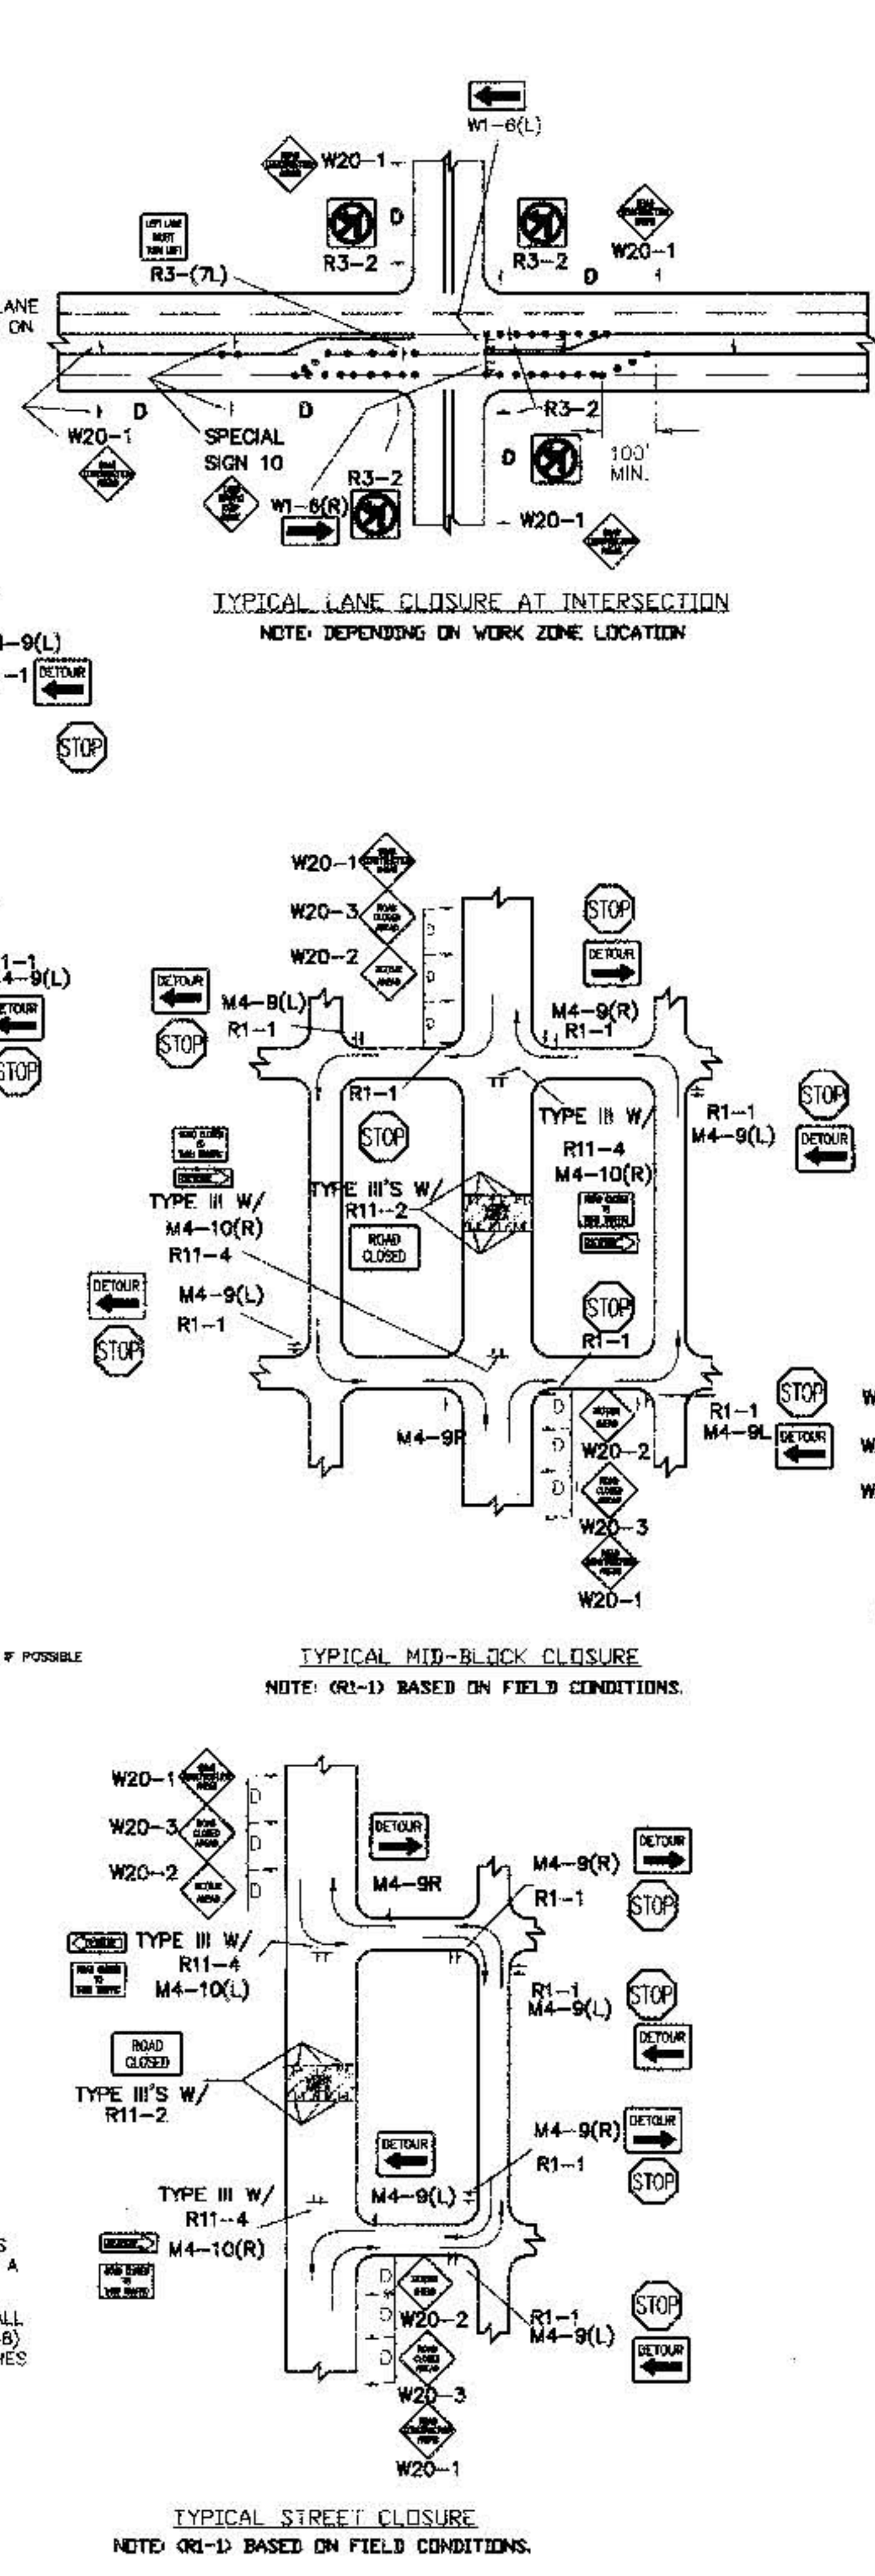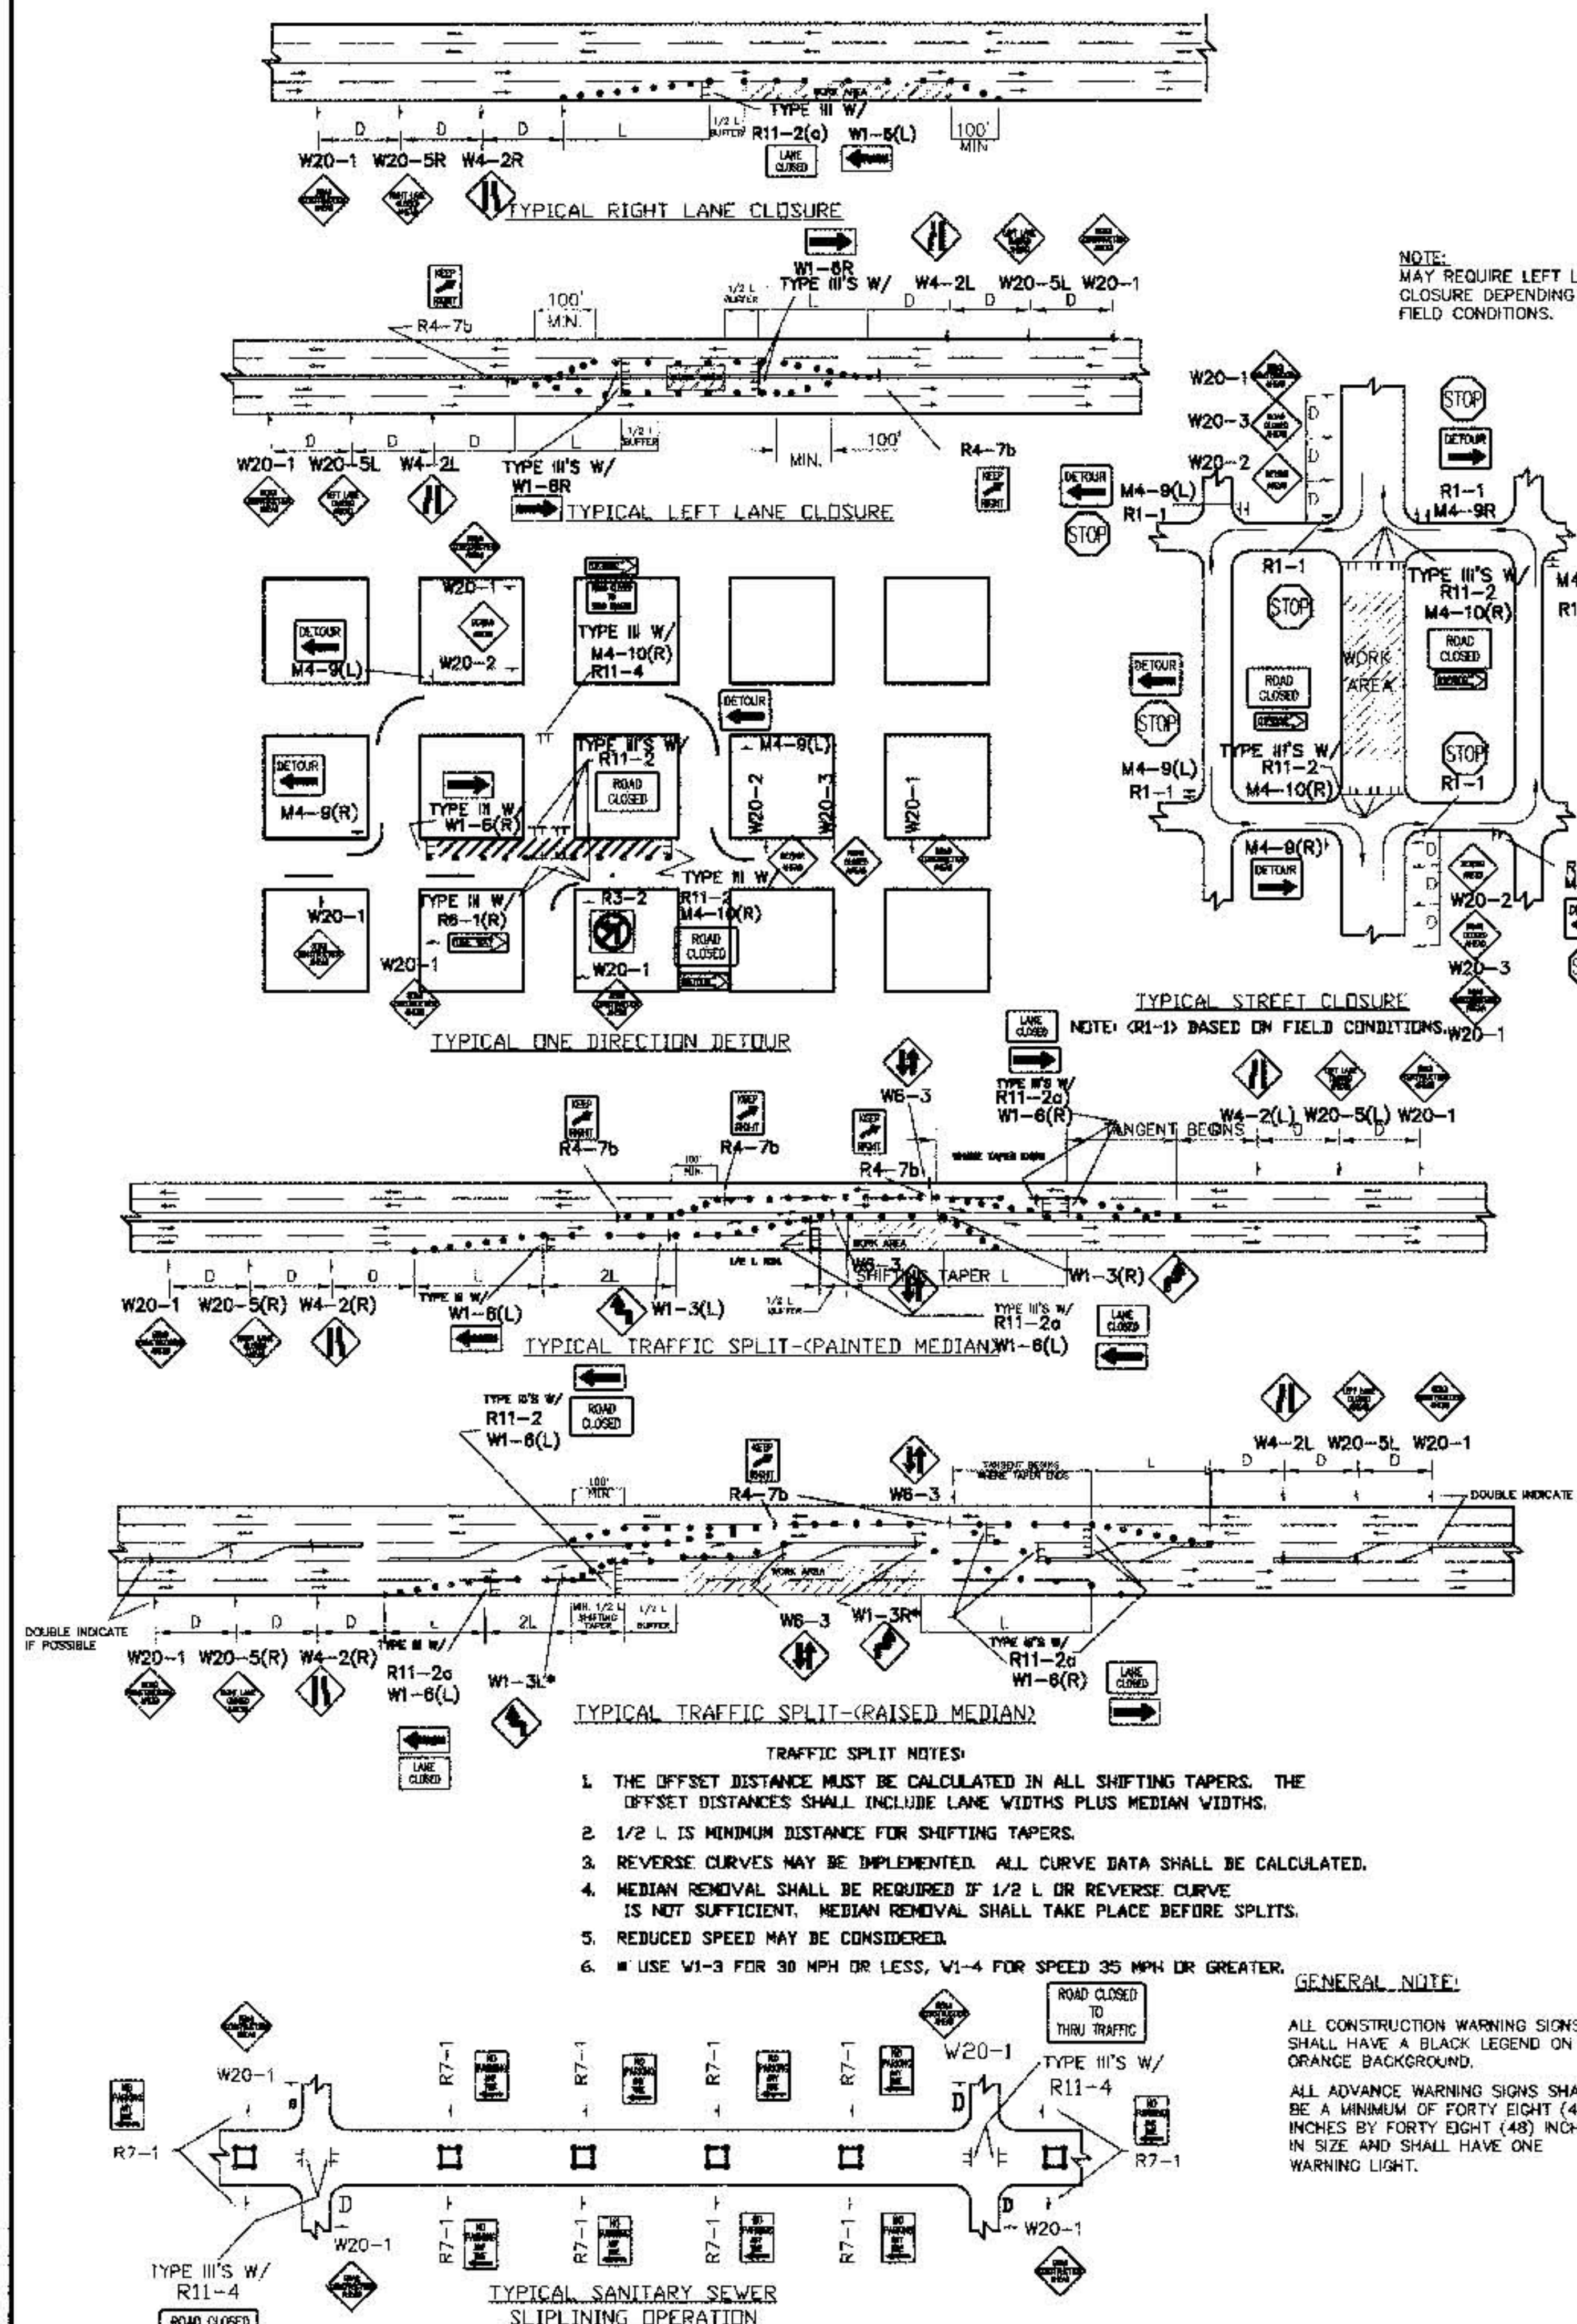

- TRAFFIC SPLIT NOTES:**
1. THE OFFSET DISTANCE MUST BE CALCULATED IN ALL SHIFTING TAPERS. THE OFFSET DISTANCES SHALL INCLUDE LANE WIDTHS PLUS MEDIAN WIDTHS.
 2. 1/2 L IS MINIMUM DISTANCE FOR SHIFTING TAPERS.
 3. REVERSE CURVES MAY BE IMPLEMENTED. ALL CURVE DATA SHALL BE CALCULATED.
 4. MEDIAN REMOVAL SHALL BE REQUIRED IF 1/2 L OR REVERSE CURVE IS NOT SUFFICIENT. MEDIAN REMOVAL SHALL TAKE PLACE BEFORE SPLITS.
 5. REDUCED SPEED MAY BE CONSIDERED.
 6. * USE W1-3 FOR 30 MPH OR LESS, W1-4 FOR SPEED 35 MPH OR GREATER.

GENERAL NOTE:

ALL CONSTRUCTION WARNING SIGNS SHALL HAVE A BLACK LEGEND ON AN ORANGE BACKGROUND.

ALL ADVANCE WARNING SIGNS SHALL BE A MINIMUM OF FORTY EIGHT (48) INCHES BY FORTY EIGHT (48) INCHES IN SIZE AND SHALL HAVE ONE WARNING LIGHT.

Smith Engineering Company
196105D
A Full Service Engineering Company
1000 Upper Eastwood, S.E., Suite 1000, Albuquerque, New Mexico 87105

**CITY OF ALBUQUERQUE
PUBLIC WORKS DEPARTMENT
ENGINEERING DEVELOPMENT GROUP**

**TITLE: WEST MESA DIVERION PROJECT PHASE I
TYPICAL TRAFFIC CONTROL & SIGNING EXAMPLES**

Design Review Committee: [Signature] Date: 2/8/98
City Engineer: [Signature] Date: 2/8/98

City Project No. 538191 Zone Map No. H-102, H-112 Sheet 19 of 20

AS BUILT INFORMATION		BENCH MARKS		SURVEY INFORMATION		ENGINEER'S SEAL		REVISIONS		DATE	
CONTRACTOR	PLATE, INC.	ELEV. 5103.95 FEET (S.D. 1928)	STATION IS LOCATED 3.5 MILES NW OF DOWNTOWN ALBUQUERQUE, AT THE HIGHWAY I-40 AND STATE ROAD 143 (COORS RD., NW) INTERCHANGE. STATION MARK IS A STANDARD NMASC BRASS TABLET, STAMPED "STA 1+40-18", SET IN TOP OF A CONCRETE POST FLUSH WITH THE GROUND. (N 1494858.09, E 364150.93)	DATE	DATE	NO.	BY	NO.	DATE	NO.	DATE
RECORDED BY	DATE	NO.	DATE	NO.	DATE	NO.	DATE	NO.	DATE	NO.	DATE

CONSTRUCTION TRAFFIC CONTROL GENERAL NOTES

1. CONTRACTOR MUST OBTAIN FROM CONSTRUCTION COORDINATION AN EXCAVATION/BARRICADING PERMIT BEFORE ENGAGING IN ANY CONSTRUCTION, MAINTENANCE OR REPAIR WORK IN ANY OF THE CITY OF ALBUQUERQUE'S RIGHTS-OF-WAY. EMERGENCY WORK THAT WOULD PRESERVE LIFE OR PROPERTY IS EXCLUDED WITH THE UNDERSTANDING, THAT A PERMIT SHALL BE OBTAINED WITHIN 24 TO 48 HOURS.

2. CONTRACTOR SHALL AT THE TIME OF PERMIT REQUEST, SUBMIT FOR APPROVAL BY CONSTRUCTION COORDINATION, A TRAFFIC CONTROL PLAN DETAILING ALL EXISTING TOPOGRAPHY SUCH AS LANE WIDTHS, DRIVEWAYS, AND BUSINESS/RESIDENTIAL ACCESSES. THE TRAFFIC CONTROL PLAN SHALL INCLUDE ALL PHASES OF WORK AND SCHEDULES INVOLVED IN THE CONSTRUCTION PROJECT. ANY SEPARATE PHASES OF A CONSTRUCTION PROJECT SHALL BE GIVEN AN INDIVIDUAL PERMIT EACH. BLANKET PERMITS WILL NOT BE ISSUED.

3. THESE TYPICAL TRAFFIC CONTROL PLANS DO NOT REFLECT THE EXISTING TOPOGRAPHY SUCH AS DRIVEWAYS, LANE WIDTHS, AND BUSINESS/RESIDENTIAL ACCESSES. EVERY LOCATION THAT REQUIRES CONSTRUCTION TRAFFIC CONTROL SHALL HAVE A DETAILED TRAFFIC CONTROL PLAN SHOWING ALL EXISTING TOPOGRAPHY.

4. CONSTRUCTION SHALL NOT BEGIN UNLESS A TRAFFIC CONTROL PLAN HAS BEEN APPROVED AND VERIFIED BY CONSTRUCTION COORDINATION.

5. CONSTRUCTION COORDINATION SHALL BE NOTIFIED 48 HOURS PRIOR TO ANY TRAFFIC CONTROL CHANGES NEEDED BY CONTRACTOR, THAT WERE NOT PREVIOUSLY APPROVED. THESE TRAFFIC CONTROL CHANGES SHALL BE REQUESTED IN WRITING ACCOMPANIED WITH A TRAFFIC CONTROL PLAN REFLECTING SUCH CHANGES.

6. ALL CONSTRUCTION TRAFFIC CONTROL DEVICES SHALL COMPLY TO THE MANUAL ON UNIFORM TRAFFIC CONTROL DEVICES (MUTCD), LATEST EDITION. IT IS THE RESPONSIBILITY OF THE CONTRACTOR TO INSTALL, SERVICE AND MAINTAIN ALL TRAFFIC CONTROL DEVICES. TRAFFIC CONTROL DEVICES SHALL NOT BE REMOVED OR ALTERED IN ANY WAY WITHOUT THE APPROVAL OF CONSTRUCTION COORDINATION, PER SECTION 6A-4 OF THE MUTCD, LATEST EDITION.

7. THE CONSTRUCTION TRAFFIC CONTROL INITIAL SET-UP SHALL BE BY AN AMERICAN TRAFFIC SAFETY SERVICES ASSOCIATION (ATSSA) CERTIFIED WORKSITE TRAFFIC SUPERVISOR. THE MAINTENANCE AND SERVICING SHALL ALSO BE DONE BY AN ATSSA CERTIFIED WORKSITE TRAFFIC SUPERVISOR OR EQUIVALENT.

8. CONTRACTOR IS RESPONSIBLE TO MAINTAIN AND SERVICE ALL TRAFFIC CONTROL DEVICES 24 HOURS A DAY, 7 DAYS A WEEK THROUGHOUT LENGTH OF PROJECT. CONTRACTOR IS RESPONSIBLE THAT ALL TRAFFIC CONTROL DEVICES COMPLY WITH THE MUTCD, LATEST EDITION.

9. ALL ADVANCE WARNING SIGNS SHALL BE DOUBLE INDICATED WHENEVER THERE ARE MULTI-LANE TRAFFIC IN ANY ONE GIVEN DIRECTION AND THERE IS SUFFICIENT MEDIAN SPACE.

10. ALL BARRICADES IN ALL TAPERS AND TANGENTS SHALL BE PLACED APART, A DISTANCE MEASURED IN FEET, EQUAL TO THAT OF THE POSTED SPEED LIMIT. NO EXCEPTIONS UNLESS APPROVED BY CONSTRUCTION COORDINATION PER MUTCD SECTION 6A-4.

11. ALL WORK IN ARTERIAL ROADWAYS SHALL BE ON A CONTINUOUS 24-HOUR PER DAY BASIS UNTIL COMPLETED.

12. CONTRACTOR IS RESPONSIBLE TO PROVIDE CONSTRUCTION COORDINATION, A WEEKLY LOG OF DAILY INSPECTIONS OF BARRICADE AND MAINTENANCE SCHEDULES ON PROJECTS THAT ARE OVER ONE WEEK DURATION.

13. EQUIPMENT OR MATERIALS SHALL NOT BE STORED WITHIN 15 FEET OF A TRAVELLED TRAFFIC LANE DURING NON-WORKING HOURS WITHOUT THE APPROVAL OF CONSTRUCTION COORDINATION.

14. CONTRACTOR SHALL PROVIDE AND MAINTAIN A SAFE AND ADEQUATE MEANS OF CHANNELIZING PEDESTRIAN TRAFFIC AROUND AND THROUGH THE CONSTRUCTION AREA.

15. CONTRACTOR IS RESPONSIBLE FOR OBLITERATION OF ANY CONFLICTING STRIPING AND RESPONSIBLE FOR ALL TEMPORARY STRIPING.

16. CONTRACTOR SHALL MAINTAIN ACCESS TO ALL FACILITIES, BUSINESSES AND/OR RESIDENTS AT ALL TIMES.

17. CONTRACTOR SHALL PROVIDE ACCESS SIGNS FOR BUSINESSES LOCATED WITHIN THE CONSTRUCTION AREA UNDER THE SUPERVISION OF CONSTRUCTION COORDINATION. EACH ACCESS SIGN SHALL HAVE 5 INCH, WHITE OPAQUE LETTERING ON BLUE REFLECTORIZED BACKGROUND. ACCESS SIGNS SHALL BE CONSIDERED INCIDENTAL TO THE BID AND NOT PART OF THE CONTRACT UNLESS OTHERWISE INDICATED. NO MORE THAN 3 BUSINESSES SHALL BE LISTED ON A ACCESS SIGN. SHOPPING CENTERS AND MALLS SHALL BE LISTED AS SUCH.

18. ALL ADVANCE WARNING SIGNS SHALL MEET THE MINIMUM REFLECTIVE INTENSITY REQUIREMENTS SET FORTH BY THE CITY OF ALBUQUERQUE. CONSTRUCTION COORDINATION SHALL DETERMINE ALL REQUIREMENTS AND APPROVE OR DISAPPROVE ANY ADVANCE WARNING SIGN PER SECTION 6A-4 OF THE MUTCD, LATEST EDITION.

19. 48-HOURS PRIOR TO OCCUPYING OR CLOSING OF A RIGHT-OF-WAY, CONTRACTOR SHALL NOTIFY: POLICE, FIRE DEPARTMENT, SCHOOLS, HOSPITALS, TRANSIT AUTHORITY, BUSINESSES AND/OR RESIDENTS THAT WILL BE AFFECTED BY THE CONSTRUCTION.

20. ANY FIELD ADJUSTMENTS SHALL BE APPROVED BY CONSTRUCTION COORDINATION.

21. EXCAVATIONS SHALL BE PLATED, TEMPORARILY PATCHED OR RESURFACED PRIOR TO OPENING OF TRAFFIC. A MINIMUM OF 11 FEET SHALL BE PROVIDED FOR TRAFFIC IN ANY GIVEN DIRECTION. CONTRACTOR IS RESPONSIBLE FOR ANY WORK INVOLVED IN SATISFYING THESE REQUIREMENTS.

22. CONTRACTOR SHALL AT ALL TIMES COMPLY WITH THE FOLLOWING:
1. STANDARDS AND REQUIREMENTS SET FORTH IN THE MANUAL ON UNIFORM TRAFFIC CONTROL DEVICES, LATEST EDITION.
2. THE CITY OF ALBUQUERQUE TRAFFIC CODE, LATEST EDITION.
3. SECTION 19 OF THE CITY OF ALBUQUERQUE'S STANDARD SPECIFICATIONS FOR PUBLIC WORK CONSTRUCTION, AS WELL AS OTHER SECTIONS.

23. FAILURE TO COMPLY WITH ANY OF THE ABOVE MENTIONED, WILL BE ADEQUATE CAUSE TO CEASE ALL WORK ON ANY CONSTRUCTION PROJECT. WORK WILL NOT RESUME UNTIL ALL REQUIREMENTS ARE ADDRESSED AND APPROVED BY CONSTRUCTION COORDINATION.


24. ALL TRAFFIC CONTROL DEVICES SHALL BE KEPT IN NEW-CLEAN CONDITION. WASHING OF EQUIPMENT IS INCIDENTAL TO ITS PLACEMENT AND MAINTENANCE.

25. TRAFFIC CONTROL STANDARDS APPLY ONLY WHERE THE CONSTRUCTION TRAFFIC CONTROL PLANS ARE NOT SPECIFIC.


26. ADVANCE WARNING SIGNS SHALL BE 36"x36" WITH SUPER ENGINEERING GRADE SHEETING OR BETTER. MOUNTING HEIGHT AT TOP OF SIGN SHALL BE THE SAME AS FOR A 48-INCH SIGN AS INDICATED IN THE MUTCD.

27. CONTRACTOR SHALL MAINTAIN A GRAFFITI-FREE WORK SITE. CONTRACTOR SHALL PROMPTLY REMOVE ANY AND ALL GRAFFITI FROM ALL EQUIPMENT, WHETHER PERMANENT OR TEMPORARY.

28. CONSTRUCTION COORDINATION DIVISION RESERVES THE RIGHT TO WITHHOLD BARRICADE AND EXCAVATION PERMITS IN ORDER TO ELIMINATE CONFLICTS WITH OTHER ON-GOING PROJECTS IN THE VICINITY OF OTHER SPECIAL EVENTS. BARRICADING PERMITS EFFECTING LANES OF TRAFFIC ON EITHER GOLF COURSE ROAD OR IRVING BOULEVARD WILL NOT BE ISSUED FOR THE PERIOD BETWEEN DECEMBER 8, 1997 UNTIL DECEMBER 28, 1997.

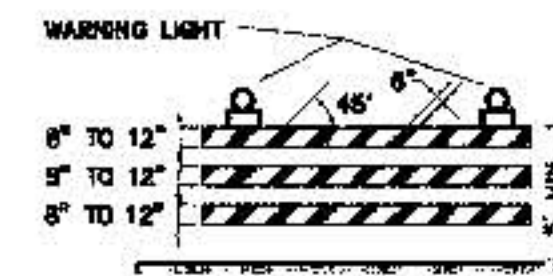


TYPE II BARRICADE

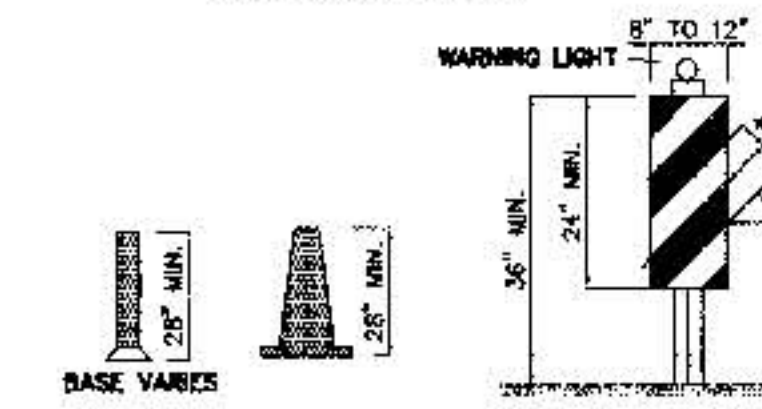


TYPE I BARRICADE



TYPE II BARRICADE

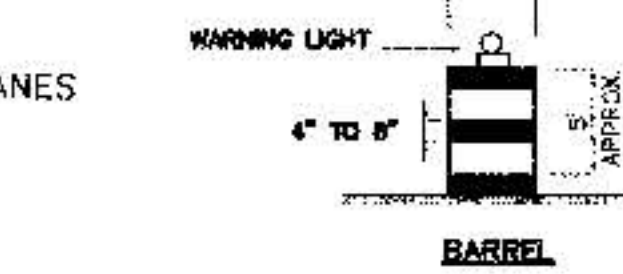

TYPE I BARRICADE

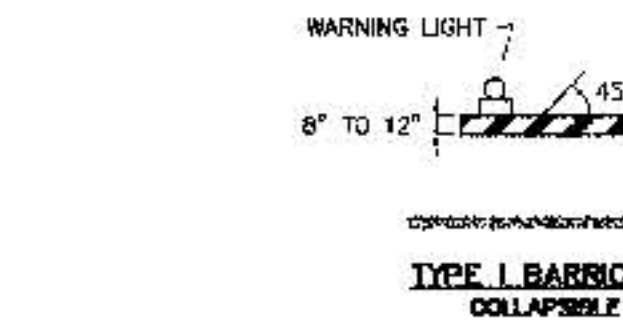

TYPE II BARRICADE

- LEGEND**
- WORK AREA
 - BARRICADE - TYPE I, TYPE II, OR BARREL
 - BARRICADE - TYPE III
 - VERTICAL PANEL
 - WARNING SIGN
 - DISTANCE BETWEEN SIGNS - A DISTANCE MEASURED IN FEET EQUAL TO A VALUE OF TEN TIMES THE SPEED LIMIT OF THE STREET FLAGMAN POSITION
 - SPACING BETWEEN BARRICADES - A DISTANCE MEASURED IN FEET EQUAL TO THE SPEED LIMIT OF THE STREET
 - TAPER LENGTH - SEE CHART BELOW
 - THE TANGENT LENGTH IS EQUAL TO THE TAPER LENGTH FOR A GIVEN STREET.

TAPER REQUIREMENTS

SPEED LIMIT (MPH)	TAPER LENGTH (L) (FEET)			MINIMUM NUMBER OF DEVICES FOR TAPER	MAXIMUM SPACING IN FEET	
	10' LANE	11' LANE	12' LANE		BEFORE TAPER	AFTER TAPER
20	70	75	80	5	20	20
25	105	115	125	6	25	25
30	150	165	180	7	30	30
35	205	225	245	8	35	35
40	270	295	320	9	40	40
45	350	385	420	10	45	45
50	450	495	540	11	50	50
55	550	605	660	12	55	55

RECOMMENDED SIGN SPACING (D) FOR ADVANCE WARNING SIGN SERIES

SPEED LIMIT (MPH)	MINIMUM DISTANCE IN FEET BETWEEN SIGNS	MINIMUM DISTANCE IN FEET FROM LAST SIGN TO TAPER
0-20	10 X SPEED LIMIT	10 X SPEED LIMIT
25-30	10 X SPEED LIMIT	10 X SPEED LIMIT
30-35	10 X SPEED LIMIT	10 X SPEED LIMIT
40-45	10 X SPEED LIMIT	10 X SPEED LIMIT
50-60	10 X SPEED LIMIT	10 X SPEED LIMIT

TAPER CRITERIA


TYPE OF TAPER	TAPER LENGTH
UPSTREAM TAPER:	
MERGING TAPER	L MINIMUM
SHIFTER TAPER	1/2 L MINIMUM
SHOULDER TAPER	1/2 L MINIMUM
TWO-WAY TRAFFIC TAPER	100 FEET MAXIMUM
DOWNSTREAM TAPERS	100 FEET PER LANE

TAPER LENGTH COMPUTATION

SPEED LIMIT	L = W x S
40 MPH OR LESS	L = W x S
45 MPH OR GREATER	L = W x S

L = TAPER LENGTH
W = WIDTH OF OFFSET IN FEET
S = POSTED SPEED OR OFF-PEAK 85-PERCENTILE SPEED IN MPH

SIGN FACE DETAILS

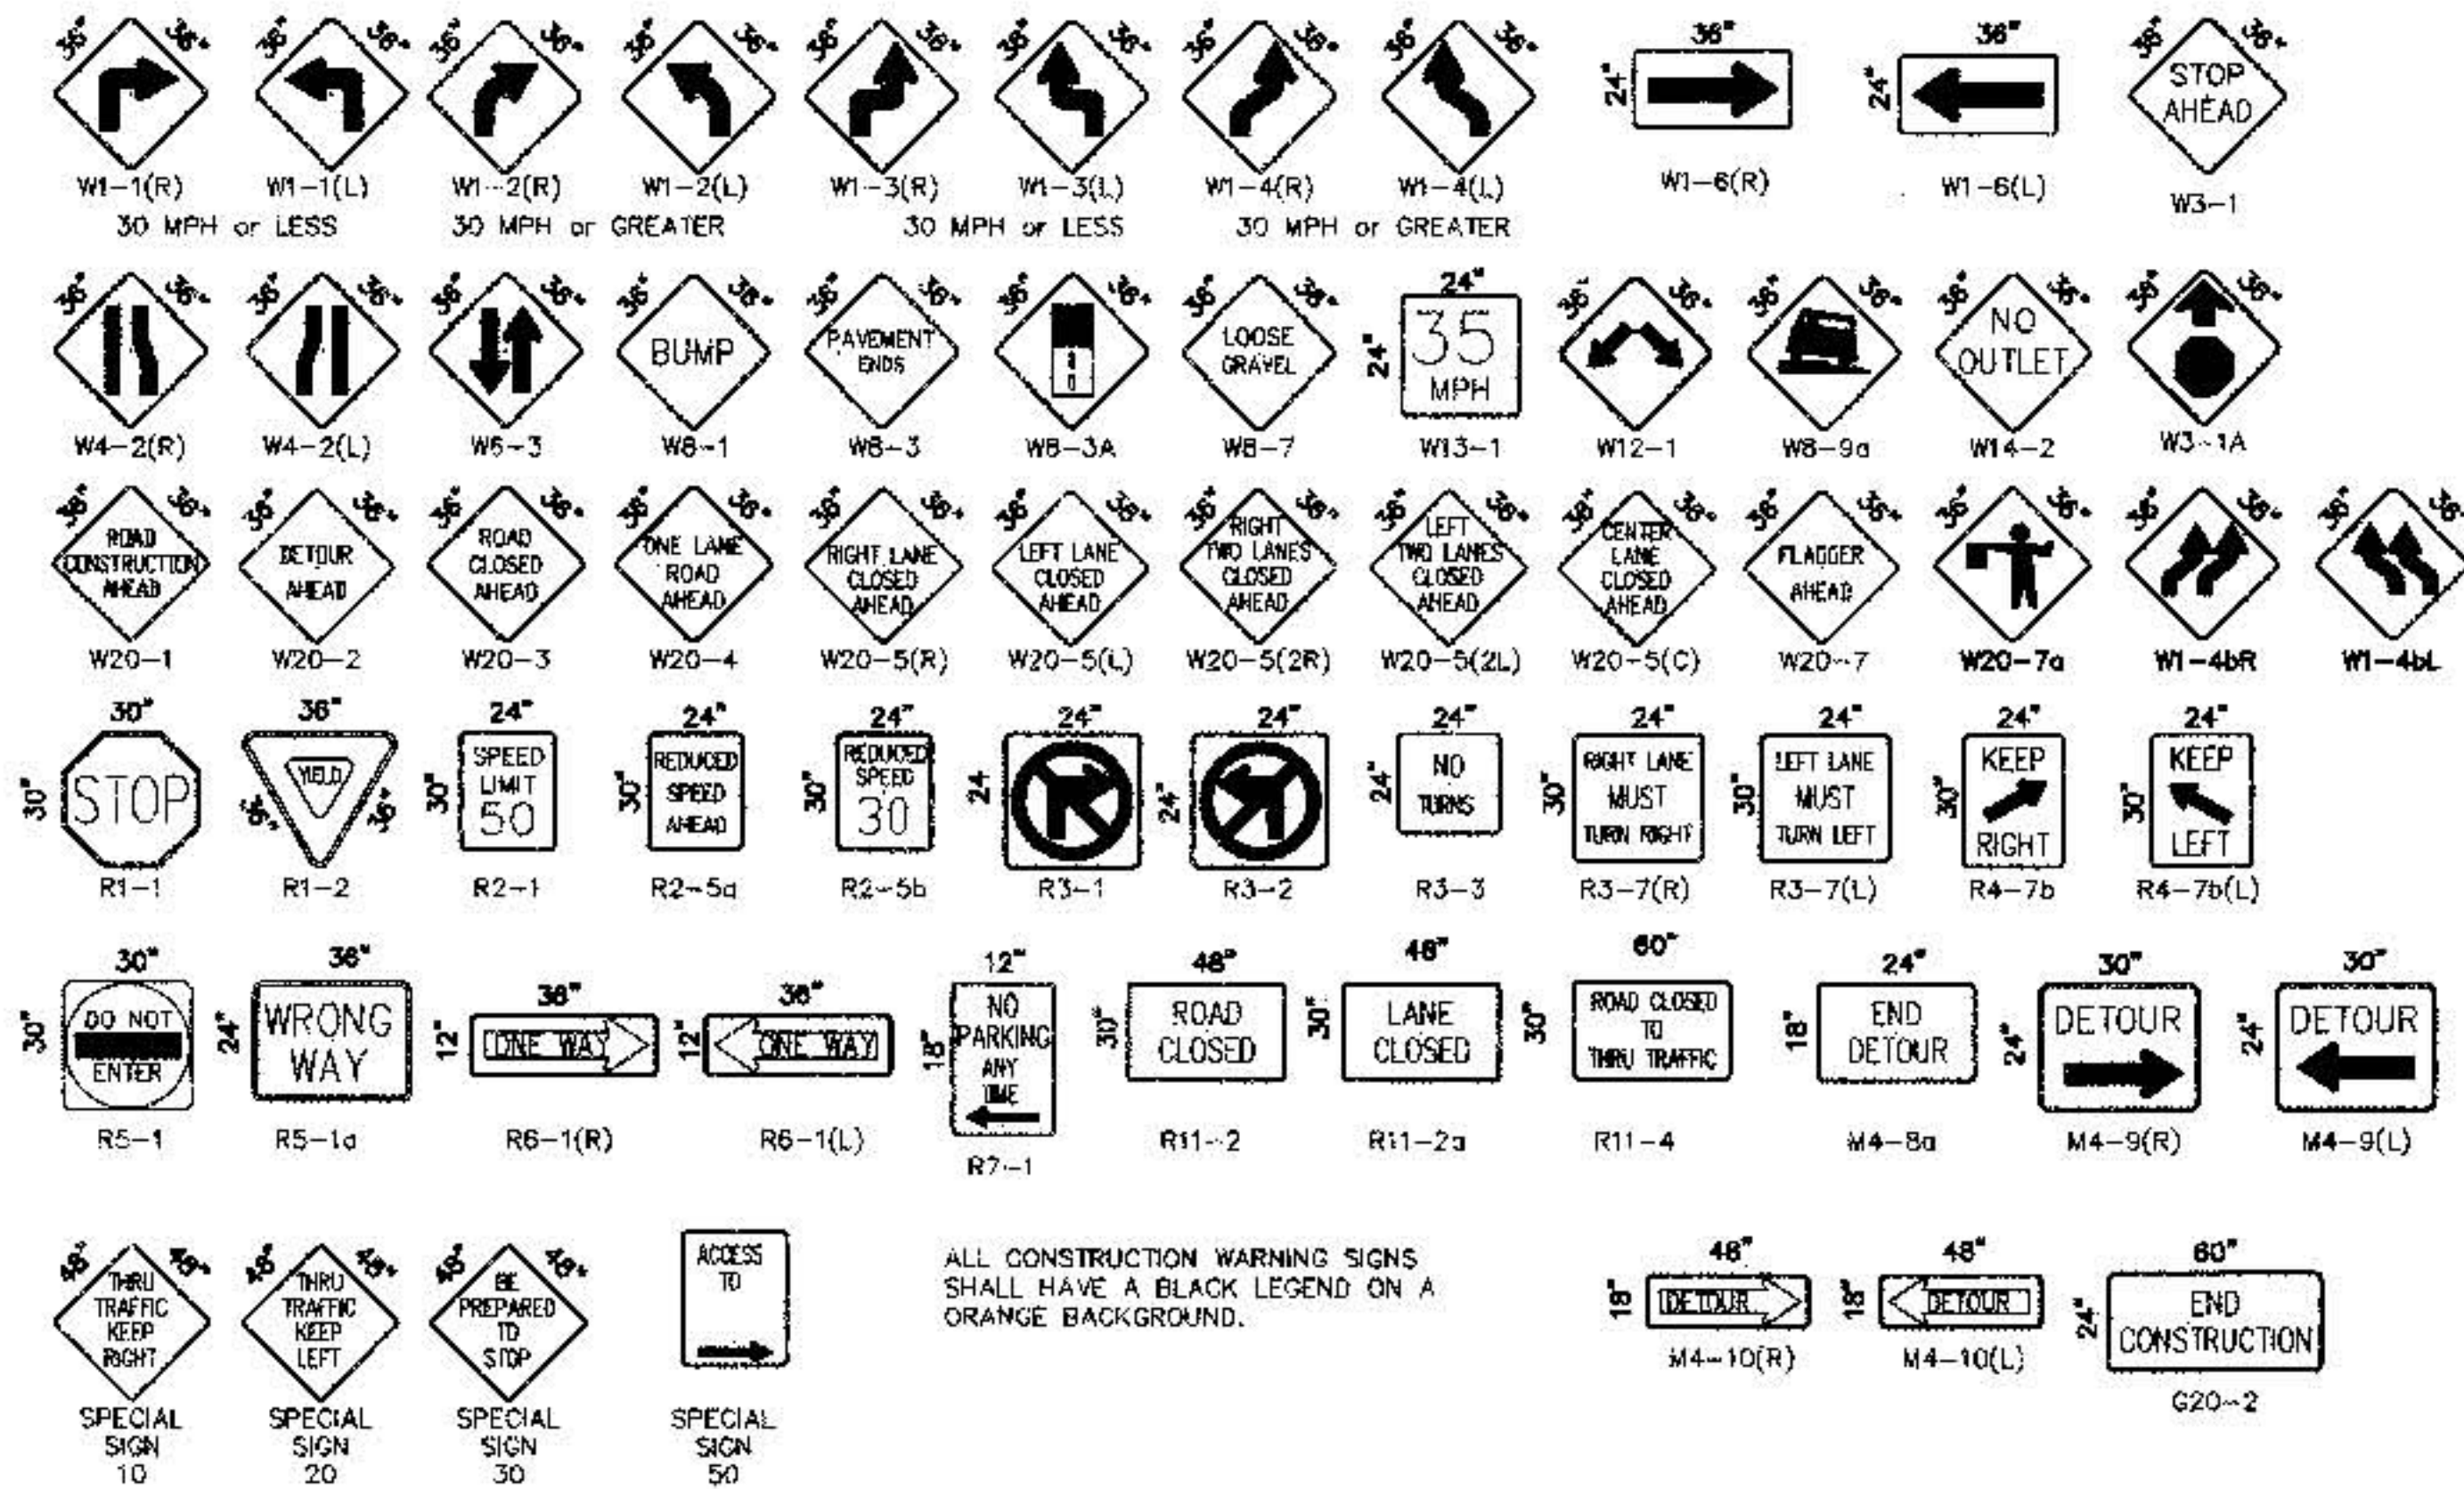

ALL CONSTRUCTION WARNING SIGNS SHALL HAVE A BLACK LEGEND ON A ORANGE BACKGROUND.



CITY OF ALBUQUERQUE
PUBLIC WORKS DEPARTMENT
ENGINEERING DEVELOPMENT GROUP

TITLE: WEST MESA DIVERSION PROJECT PHASE I
SIGNING & CONSTRUCTION TRAFFIC CONTROL STANDARDS

City Project No. 538191
Zone H-102, H-112
Sheet 20 of 20

DESIGNED BY: C.R.D.L.A.
DRAWN BY: C.R.D.L.A.
CHECKED BY: D.L.A.

DATE: 04/98
DATE: 04/98
DATE: 04/98

AS BUILT INFORMATION

CONTRACTOR: P.T.C.I., INC.
DATE: 5-99
REVISIONS: 1-99, 2-99, 3-99, 4-99, 5-99, 6-99, 7-99, 8-99, 9-99, 10-99, 11-99, 12-99

FIELD NOTES

DATE: 5-98
BY: [Signature]

ENGINEER'S SEAL

5-26-98