
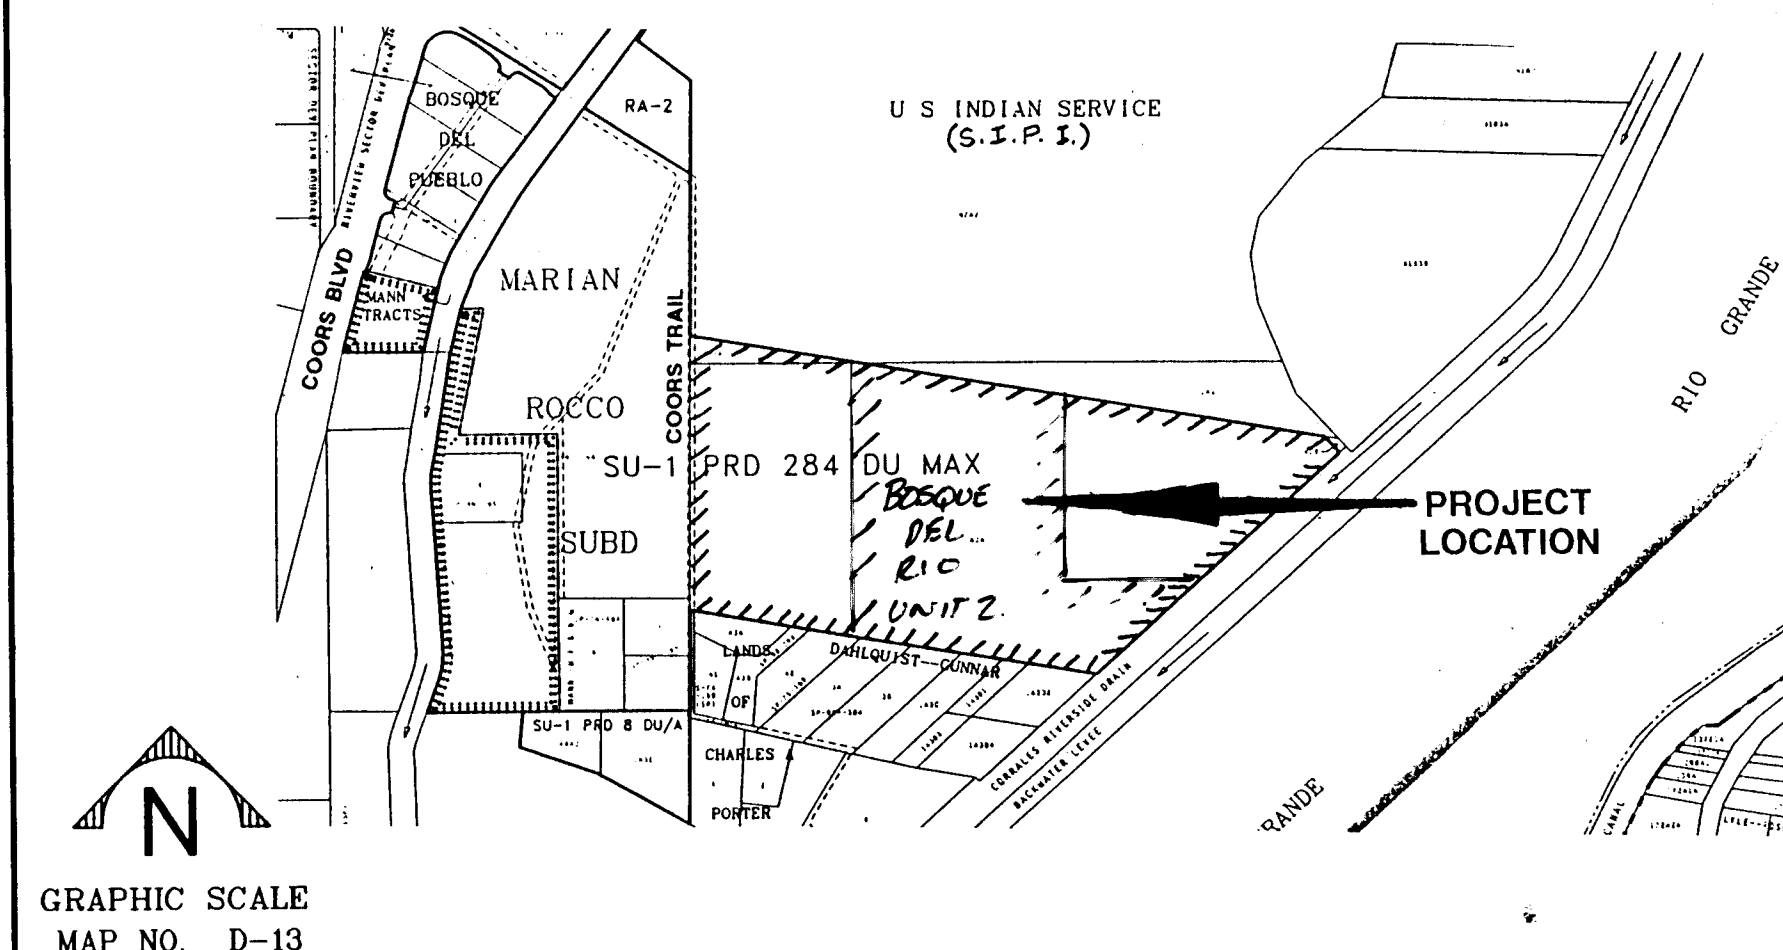
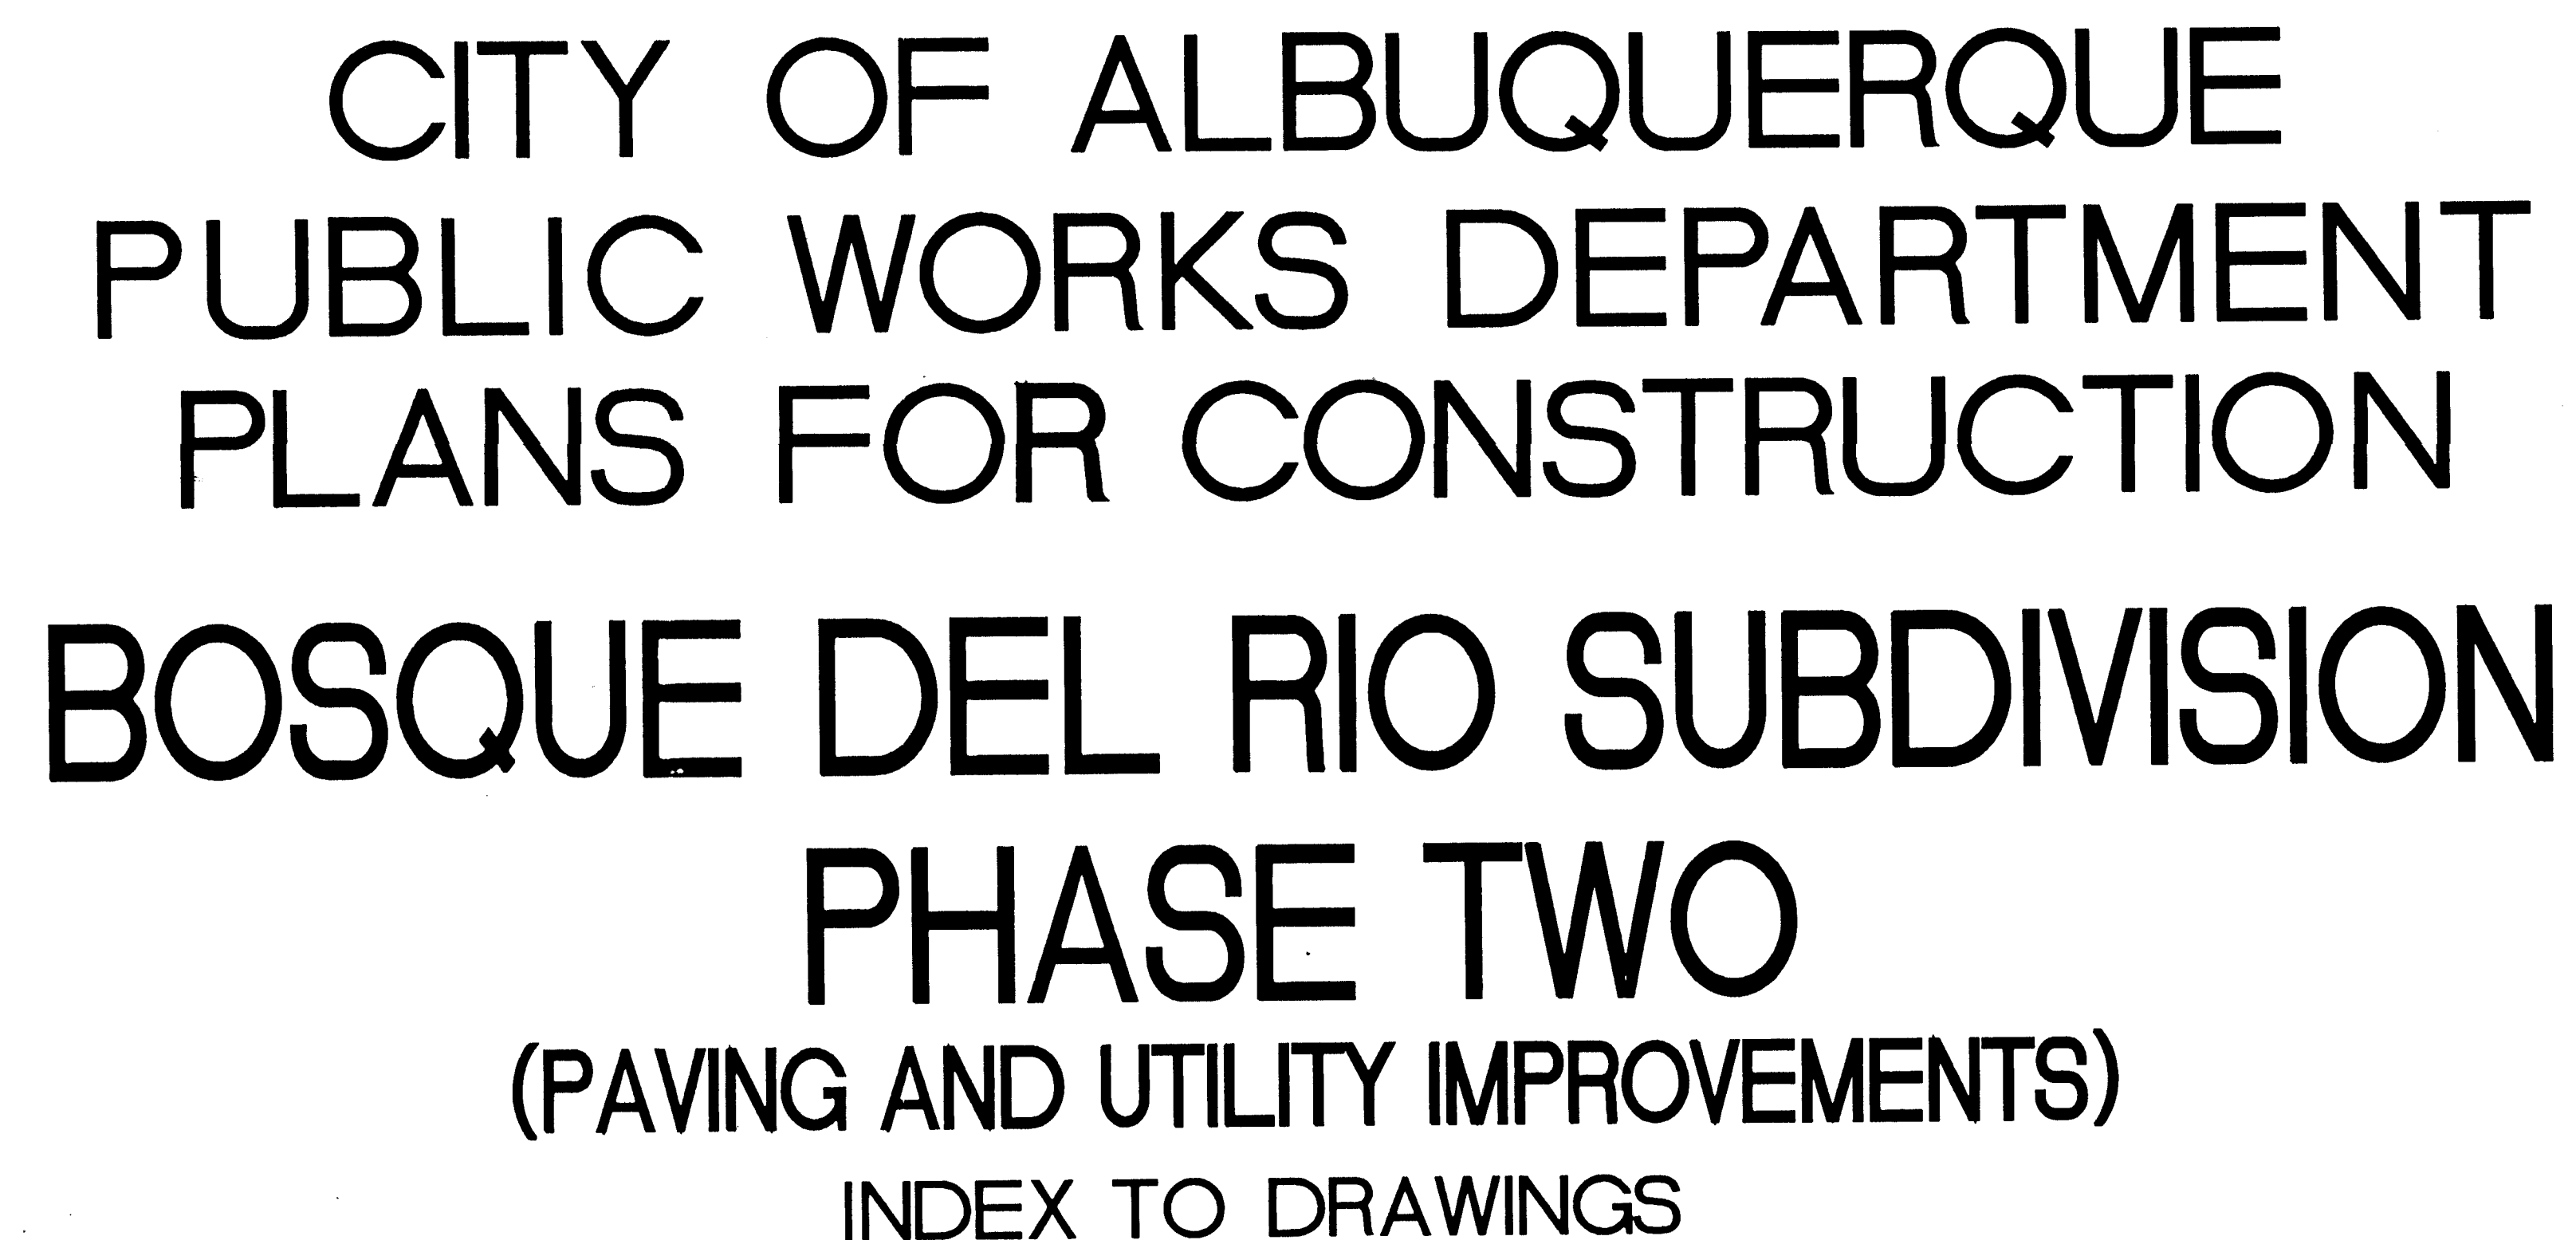


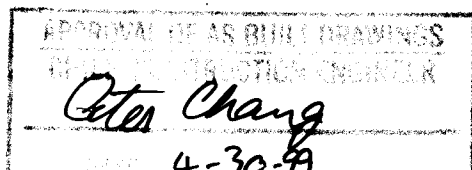

<u>TITLE</u>	<u>PLAN NUMBER</u>
UTILITY P & P: BOSQUE DEL SOL LANE: STA 1+00 TO 5+50	
UTILITY P & P: BOSQUE DEL SOL LANE: STA 5+50 TO 10+04.65	
UTILITY P & P: PUEBLO GRANDE TRAIL: STA 1+00 TO 5+50	
UTILITY P & P: PUEBLO GRANDE TRAIL: STA 5+50 TO 7+14.39	
UTILITY P & P: RIO ORILLA LANE: STA 1+00 TO 5+00	
UTILITY P & P: RIO ORILLA LANE: STA 5+00 TO 9+50	
UTILITY P & P: RIO ORILLA LANE: STA 9+50 TO 10+85.57	
UTILITY P & P: OFFSITE WATERLINE: STA 1+00 TO 4+90	
PRESSURE SANITARY SEWER DETAILS	
STREET SECTIONS AND DETAILS	26 5406.8299D13
GRADING & DRAINAGE DETAILS	

KENT M. WHITMAN
NEW MEXICO
6170
REGISTERED PROFESSIONAL ENGINEER

DRB 94-578

**CALL BEFORE
YOU DIG!**


**STATEWIDE
1-800-321-ALERT**

**ALBUQUERQUE
260-1990**

 SEC JOB # 197629
Smith Engineering Company
A Full Service Engineering Company
6000 Urbana Boulevard, N.E. Suite 6000, Albuquerque, New Mexico 87110

[illegible]

Drawing name: N:\197629\OPTION\03PLAT.DWG
Saved on: October 22, 1997 at 6:08 AM

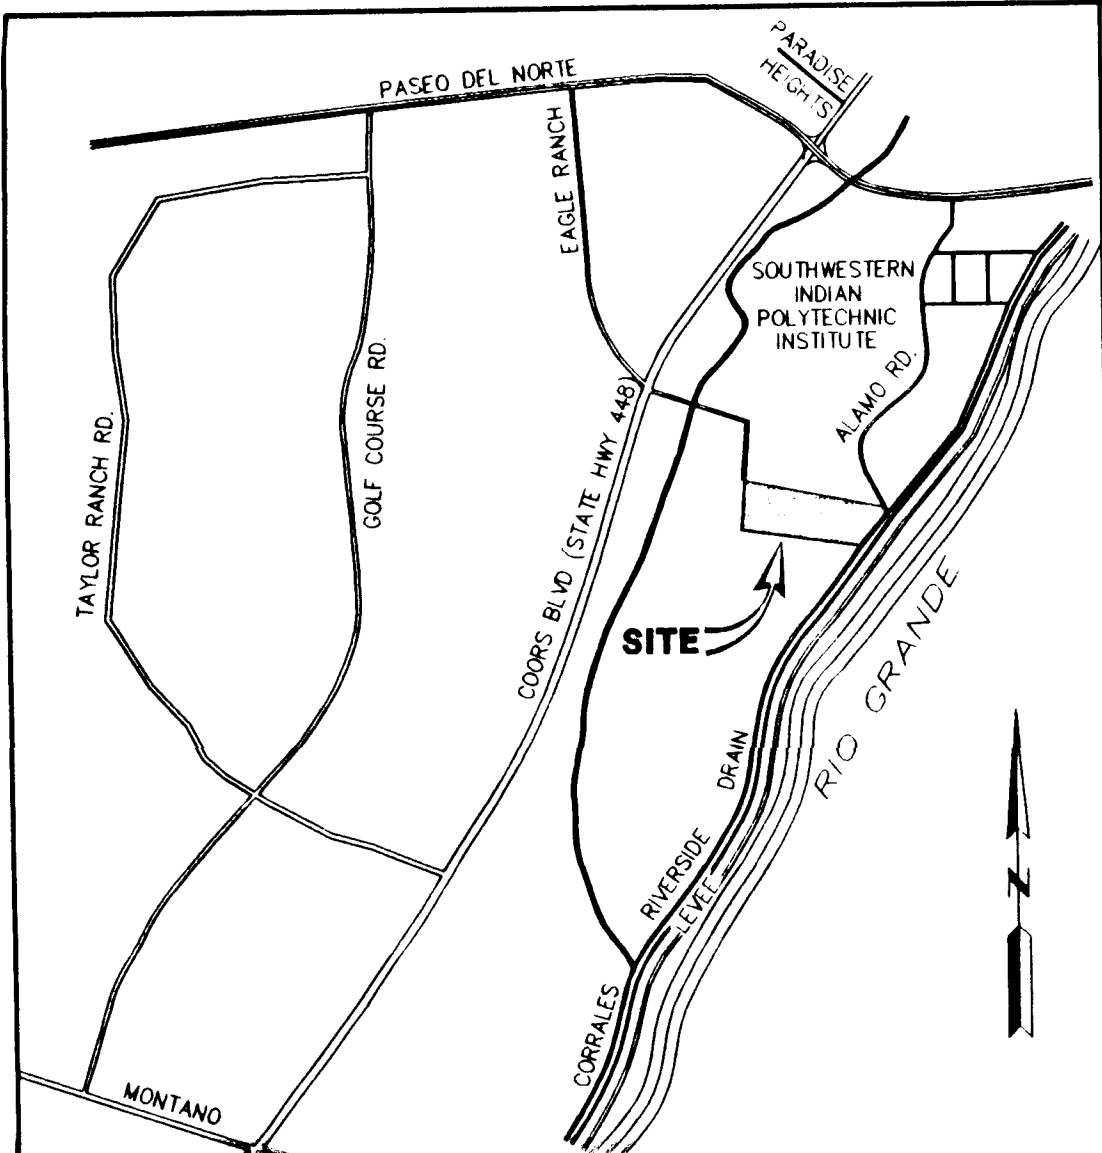

LOCATION MAP
NOT TO SCALE
ZONE ATLAS MAP D-13

NOTES

- THE PURPOSE OF THIS PLAT IS TO SUBDIVIDE THE LOTS IN PHASE 2, AND TO GRANT THE REQUIRED EASEMENTS.
- BEARINGS ARE BASED ON THE EAST LINE OF THE MARIAN ROCCO SUBDIVISION PLAT FILED OCTOBER 23, 1986, AND ARE STATE PLANE GRID BEARINGS AS INDICATED THEREON.
- BEARINGS AND DISTANCES SHOWN IN PARENTHESIS ARE FROM PREVIOUSLY RECORDED PLATS AND DEEDS.
- ALL BOUNDARY CORNERS ARE MARKED BY A REBAR WITH AN ALUMINUM CAP STAMPED "AAR LS 4071", UNLESS OTHERWISE INDICATED HEREON.
- PRIOR TO DEVELOPMENT, CITY OF ALBUQUERQUE WATER AND SANITARY SEWER SERVICE TO TRACTS MUST BE VERIFIED AND COORDINATED WITH THE PUBLIC WORKS DEPARTMENT, CITY OF ALBUQUERQUE.
- THE ROADWAYS HEREIN ARE PRIVATE, WITH PRIVATE ACCESS EASEMENTS TO THE OWNERS OF BOSQUE DEL RIO AND THE COORS TRAIL NEIGHBORS ONLY, AS PROVIDED HEREIN AND BY SETTLEMENT AGREEMENT DATED JANUARY 12, 1996. THE ROADWAY IMPROVEMENTS WILL BE THE RESPONSIBILITY OF THE INDIVIDUAL PHASE DEVELOPERS, AND THE MAINTENANCE OF THE ROADWAY IMPROVEMENTS WILL BECOME THE RESPONSIBILITY OF A HOMEOWNERS ASSOCIATION.
- THE PRIVATE PARK SHOWN HEREON IS FOR THE USE AND BENEFIT OF THE BOSQUE DEL RIO OWNERS ONLY, AND WILL BE OWNED AND MAINTAINED BY A HOMEOWNERS ASSOCIATION.
- THE PEDESTRIAN AND EQUESTRIAN ACCESS EASEMENT SHOWN HEREON IS PRIVATE, FOR THE USE AND BENEFIT OF THE BOSQUE DEL RIO OWNERS AND THE COORS TRAIL NEIGHBORS ONLY, AS PROVIDED BY SETTLEMENT AGREEMENT DATED JANUARY 12, 1996. THE ROADWAY AND TRAIL IMPROVEMENTS WILL BE THE RESPONSIBILITY OF THE INDIVIDUAL PHASE DEVELOPERS, AND THE MAINTENANCE OF THE IMPROVEMENTS AND EASEMENTS WILL BECOME THE RESPONSIBILITY OF A HOMEOWNERS ASSOCIATION.
- GRAVITY SANITARY SEWER SERVICE IS NOT AVAILABLE TO ANY OF THE LOTS RECORDED WITHIN THIS PLAT THEREFORE, ALL LOTS WILL BE SERVED BY A PRESSURE SANITARY SEWER SYSTEM. MAINTENANCE OF THE INDIVIDUAL GRINDER PUMPS LOCATED WITHIN EACH LOT IS THE RESPONSIBILITY OF EACH INDIVIDUAL HOMEOWNER.

CURVE DATA TABLE

CURVE	RADIUS	LENGTH	TANGENT	CHORD	BEARING
1	450.00'	244.72'	125.47'	241.72'	N63°33'25"W
2	20.00'	25.16'	14.55'	23.53'	N84°01'03"W
3	45.00'	113.22'	139.15'	85.63'	N47°58'39"W
4	20.00'	25.16'	14.55'	23.53'	N11°56'16"W
5	20.00'	31.42'	20.00'	28.28'	N87°01'21"E
6	20.00'	31.42'	20.00'	28.28'	N02°58'39"W
7	20.00'	31.42'	20.00'	28.28'	N87°01'21"E
8	20.00'	31.42'	20.00'	28.28'	N02°58'39"W
9	250.00'	252.98'	138.52'	242.32'	N71°00'43"E
10	250.00'	139.66'	71.71'	134.15'	N62°19'16"W
11	120.00'	115.96'	62.96'	111.50'	N72°19'51"E
12	1000.00'	300.46'	151.37'	299.33'	N71°26'46"W
13	20.00'	31.28'	19.86'	28.19'	N35°10'52"W
14	20.00'	32.29'	20.89'	28.89'	N55°52'14"E
15	300.00'	169.64'	87.16'	167.39'	N25°49'23"E

TALOS LOG NO. 970723 1122 0307

DESCRIPTION

A certain tract of land situate within Section 19, Township 11 North, Range 3 East, New Mexico Principal Meridian, City of Albuquerque, Bernalillo County, New Mexico, being and comprising all of Parcel "C" and Parcel "D" as the same are shown and designated on the Plat of BOSQUE DEL RIO SUBDIVISION, UNIT 1, filed in the office of the County Clerk of Bernalillo County, New Mexico, on August 29, 1996 in plat book 96C, page 377, and being more particularly described as follows:

Beginning at the northwesterly corner of said Parcel "C" from whence the control survey station "R. Alameda B-2" bears N30°33'23"W, 2,839.09 feet distance, thence, from said point of beginning,

S79°59'55"E, 706.92 feet along the northerly line of said Parcel "C" to a point, thence,
S12°34'34"W, 206.01 feet to a point, thence,
S48°49'24"E, 111.78 feet to a point, thence,
N42°01'19"E, 4.03 feet to a point of curvature, thence,
Northeasterly, 20.81 feet along the arc of a curve bearing to the right, having a radius of 273.00 feet and a chord bearing N44°12'11"E, 20.89 feet to a point on curve, thence,
S43°36'36"E, 152.56 feet to a point, thence,
S37°01'26"W, 120.68 feet to a point, thence,
S35°47'31"W, 44.01 feet to a point, thence,
S42°01'21"W, 196.53 feet to a point, thence,
S36°32'37"W, 14.07 feet to a point, thence,
S79°59'09"E, 483.45 feet to a point, thence,
S11°11'56"E, 130.10 feet to a point on curve, thence,
Northeasterly, 32.30 feet along the arc of a curve bearing to the left, having a radius of 98.00 feet, and a chord bearing N54°05'17"E, 32.15' to a point of tangency, thence,
N44°38'50"E, 445.95 feet to a point, thence,
S45°21'10"E, 253.30 feet to a point being the northeasterly corner of said Parcel "D", thence,
S47°49'49"W, 645.86 feet along the southeasterly line of said Parcel "D" to the southeasterly corner, thence,
N79°59'09"W, 570.96 feet to the southwesterly corner of said Parcel "D", thence,
N10°00'51"E, 201.50 feet to a point, thence,
N79°59'09"W, 187.43 feet to a point, thence,
S10°00'51"W, 121.50 feet to a point, thence,
N79°59'09"W, 93.96 feet to a point, thence,
N10°21'15"E, 121.89 feet to a point on curve, thence,
Northwesterly, 95.98 feet along the arc of a curve bearing the right, having a radius of 1,023.00 feet and a chord which bears N74°18'14"W, 95.94 feet to a point on curve, thence,
N14°23'40"E, 142.00 feet to a point, thence,
N30°19'58"E, 107.10 feet to a point, thence,
N42°01'21"E, 113.27 feet to a point, thence,
N42°34'49"W, 203.79 feet to a point, thence,
N67°14'25"W, 140.43 feet to a point, thence,
N79°08'11"W, 213.97 feet to a point, thence,
N10°51'49"E, 174.00 feet to a point, thence,
N19°08'11"W, 24.23 feet to a point, thence,
N10°51'49"E, 118.34 feet to the point of beginning of the tract herein described, containing 17.539 acres, more or less.

FREE CONSENT STATEMENT

The plat as shown hereon is with the free consent of, and in accordance with the wishes and desires of the undersigned owners and/or proprietors thereof, and said owners and/or proprietors do hereby grant all utility easements shown hereon by dashed lines, including the right of ingress and egress and the right to trim interfering trees, and do grant to the City of Albuquerque all sanitary sewer and waterline easements as shown hereon, including the right to construct and maintain sanitary sewers and water line facilities therein. And do hereby grant the private access easements as shown hereon for the common benefit of the owners of the lots and parcels in Bosque del Rio. The undersigned owners and/or proprietors do hereby freely consent to all the foregoing and do hereby represent that we are authorized to so act.

OWNERS
GARRETT GROUP, INC., A NEW MEXICO CORPORATION

By: Ted E. Garrett, Jr.
and on behalf of GARRETT GROUP, INC.
A New Mexico Corporation


ACKNOWLEDGEMENT

STATE OF NEW MEXICO)
COUNTY OF BERNALILLO)

The foregoing instrument was acknowledged before me this 25TH day of July, 1997, by TED E. GARRETT, JR., President, for and on behalf of GARRETT GROUP, INC. A New Mexico Corporation

NOTARY PUBLIC

My commission expires 9-4-2000

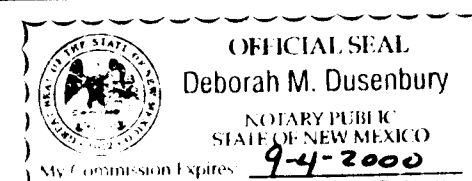

In approving this plat, PNM Electric Services and Gas Services (PNM) has conducted a Title Search of the proposed subdivision, and in so doing, PNM does not waive nor release any easement or easement rights to which it may be entitled.

PLAT OF BOSQUE DEL RIO SUBDIVISION UNIT 2

ALBUQUERQUE, NEW MEXICO

JULY, 1997

State of New Mexico)
County of Bernalillo)
This instrument was filed for record on

SEP 09 1997
RECORDED IN VOL. 265
OF RECORDS AT SAN JUAN COUNTY CLERK'S OFFICE
Sally D. Buchanan, Clerk & Recorder
Deputy Clerk

THIS IS TO CERTIFY THAT TAXES ARE CURRENT AND PAID ON LRP # 103-003-245-346 2014
103-003-150-399 2015

PROPERTY OWNER OF RECORD MATSUBARA, Charles

BERNALILLO COUNTY TREASURER'S OFFICE Cassandra L. Green

APPROVALS 9-97-Exo

Phil Phill 8-13-97 Richard Watson 8/13/97
PNM ELECTRIC SERVICES DATE JONES INTERCABLE DATE
Catharina Schneider 08-13-97 Phil Phill 8-13-97
U.S. WEST COMMUNICATIONS DATE PNM GAS SERVICES DATE

Phil Phill 072797
CITY SURVEYOR, CITY OF ALBUQUERQUE
PUBLIC WORKS DEPARTMENT

Phil Phill 9-08-97
PROPERTY MANAGER, CITY OF ALBUQUERQUE
TRAFFIC ENGINEER, CITY OF ALBUQUERQUE
PUBLIC WORKS DEPARTMENT

Edward R. Hwang 9-8-97
PARKS AND GENERAL SERVICES DEPARTMENT,
ALBUQUERQUE

Roger A. Green 09-08-97
UTILITY DEVELOPMENT DIVISION, CITY OF
ALBUQUERQUE PUBLIC WORKS DEPARTMENT

Frank J. Cigni 9-8-97
FLOOD CONTROL AUTHORITY

Frank J. Cigni 9-8-97
CITY ENGINEER, CITY OF ALBUQUERQUE
PUBLIC WORKS DEPARTMENT

APPROVAL AS SPECIFIED BY THE ALBUQUERQUE SUBDIVISION ORDINANCE

Kym L. Dine 9-8-97
CHAIRMAN, ALBUQUERQUE/BERNALILLO COUNTY
DEVELOPMENT REVIEW BOARD

DRB CASE NO. 94-578

PLAT NO. _____


SURVEYOR'S CERTIFICATE

I, GAYLE D. JEWELL, A REGISTERED LAND SURVEYOR UNDER THE LAWS OF THE STATE OF NEW MEXICO, DO HEREBY CERTIFY THAT THIS PLAT WAS PREPARED BY ME OR UNDER MY SUPERVISION, SHOWS ALL EASEMENTS OF RECORD MADE KNOWN TO ME BY THE OWNERS/PROPRIETORS, UTILITY COMPANIES OR OTHER PARTIES EXPRESSING AN INTEREST, MEETS THE MINIMUM REQUIREMENTS FOR MONUMENTATION AND SURVEYS FOR THE ALBUQUERQUE SUBDIVISION ORDINANCE, AND IS TRUE AND CORRECT TO THE BEST OF MY KNOWLEDGE AND BELIEF.

Gayle D. Jewell 07/24/97
GAYLE D. JEWELL, N.M.E.S. No. 4071 DATE



SHEET 1 OF 2
ANDREWS, ASBURY & ROBERT, INC.
ALBUQUERQUE, NEW MEXICO 85-746

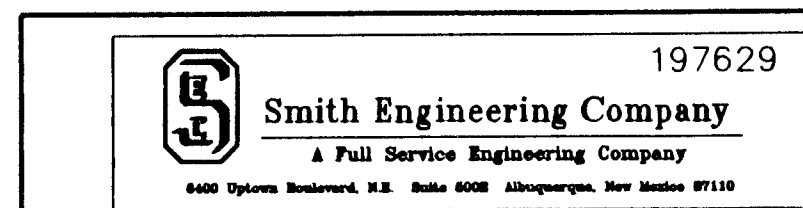

CITY OF ALBUQUERQUE
PUBLIC WORKS DEPARTMENT
ENGINEERING DEVELOPMENT GROUP


TITLE: BOSQUE DEL RIO SUBDIVISION - PHASE 2
PLAT OF BOSQUE DEL RIO SUBDIVISION : UNIT 2

Design Review Committee	City Engineer Approval	Last Design Update	No. / Day / Yr.	No. / Day / Yr.
<u>DRB</u>	<u>[Signature]</u>	<u>[Signature]</u>		

City Project No. 540682 Zone Map No. D-13 Sheet 03 of 23

GENERAL NOTES:

- 1 THE ELEVATIONS OF ANY LOT PAD SHALL NOT BE LOWER THAN THE ELEVATION SHOWN.
- 2 SEE SHEET 23 FOR TYPICAL LOT DETAIL.
- 3 SEE SHEET 23 FOR EARTHWORK AND POND SCHEMATIC.
- 4 PLACE EXCAVATED SURFACE SOILS ON LOTS 107-P1 THROUGH 111-P1, AS SHOWN ON SHEET 23. DO NOT PLACE SURFACE SOILS BENEATH PAD AREAS.
- 5 HOUSE PADS SHALL BE PLACED AT 10'-0" FROM SIDE LOT LINES EXCEPT WHERE SPECIFICALLY NOTED.

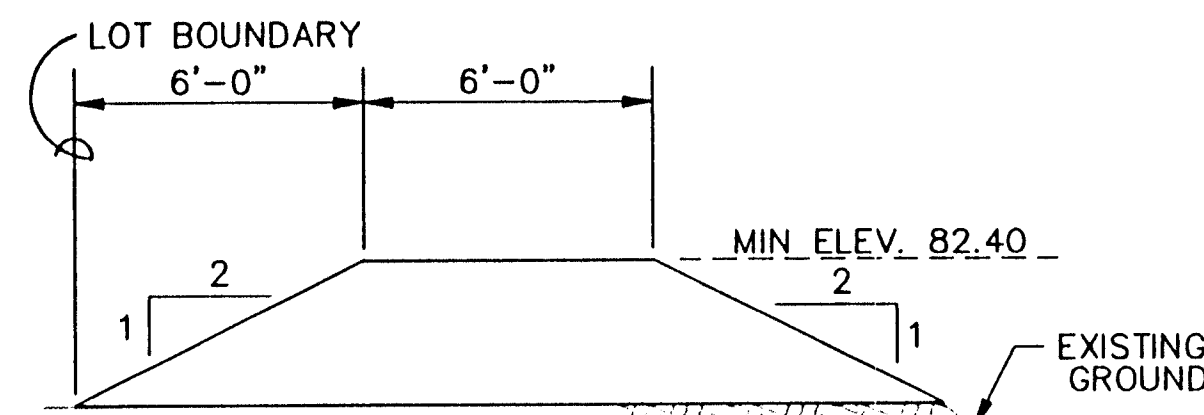


TEMPORARY EARTH BERM - PHASE 2
NOT TO SCALE

KEYED NOTES:

- 1 FLOWLINE ELEVATION = 4980.81
TOP BACK OF CURB ELEVATION = 4980.76
- 2 FLOWLINE ELEVATION = 4981.53
TOP BACK OF CURB ELEVATION = 4981.48
- 3 FLOWLINE ELEVATION = 4981.51
TOP BACK OF CURB ELEVATION = 4981.46



AS BUILT INFORMATION		SURVEY INFORMATION		ENGINEER'S SEAL		REVISIONS		DESIGN	
CONTRACTOR	DATE	NO.	DATE	NO.	DATE	NO.	DATE	NO.	DATE
CONTRACTOR: A/A	DATE: A/A	NO. 4071	DATE: 07/97	NO. 1	DATE: 10/23/97	NO. 2	DATE: 10/23/97	NO. 3	DATE: 10/23/97
WORK BY: A/A	DATE: A/A	BY: GAYLE JEWELL	DATE: 07/97	BY: [Signature]	DATE: 10/23/97	BY: [Signature]	DATE: 10/23/97	BY: [Signature]	DATE: 10/23/97
FIELD ACCEPTANCE BY: A/A	DATE: A/A	U.S. COE STA. "R. ALAMEDA B-2"	DATE: 07/97	U.S. COE STA. "R. ALAMEDA B-2"	DATE: 07/97	U.S. COE STA. "R. ALAMEDA B-2"	DATE: 07/97	U.S. COE STA. "R. ALAMEDA B-2"	DATE: 07/97
FIELD VERIFICATION BY: A/A	DATE: A/A	N.M. STATE PLAN COORDINATES (CENTRAL ZONE)	DATE: 07/97	N.M. STATE PLAN COORDINATES (CENTRAL ZONE)	DATE: 07/97	N.M. STATE PLAN COORDINATES (CENTRAL ZONE)	DATE: 07/97	N.M. STATE PLAN COORDINATES (CENTRAL ZONE)	DATE: 07/97
FIELD CORRECTION BY: A/A	DATE: A/A	X=373,513.20	DATE: 07/97	X=373,513.20	DATE: 07/97	X=373,513.20	DATE: 07/97	X=373,513.20	DATE: 07/97
FIELD CORRECTION BY: A/A	DATE: A/A	Y=1,520,142.81	DATE: 07/97	Y=1,520,142.81	DATE: 07/97	Y=1,520,142.81	DATE: 07/97	Y=1,520,142.81	DATE: 07/97
FIELD CORRECTION BY: A/A	DATE: A/A	ELEVATION=5,058.25	DATE: 07/97	ELEVATION=5,058.25	DATE: 07/97	ELEVATION=5,058.25	DATE: 07/97	ELEVATION=5,058.25	DATE: 07/97
FIELD CORRECTION BY: A/A	DATE: A/A	G/G FACTOR=0.99967638	DATE: 07/97	G/G FACTOR=0.99967638	DATE: 07/97	G/G FACTOR=0.99967638	DATE: 07/97	G/G FACTOR=0.99967638	DATE: 07/97
RECORDED BY: A/A	DATE: A/A	RECORDED BY: A/A	DATE: A/A	RECORDED BY: A/A	DATE: A/A	RECORDED BY: A/A	DATE: A/A	RECORDED BY: A/A	DATE: A/A

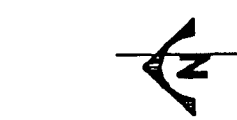

3 HORIZ TO 1 VERT @
NORTH SUBDIVISION
BOUNDARY TO MATCH
EXISTING GRADE AT
PROPERTY LINE

REMOVE EXISTING
IRRIGATION LATERAL
@ SUBDIVISION
BOUNDARY





GENERAL NOTES:

- ELEVATIONS SHOWN ARE SUBJECT TO FINAL EARTHWORK COMPUTATION AND BALANCE OF CUT AND FILL. OVERALL ELEVATIONS MAY CHANGE ± 0.5 FT. RELATIVE ELEVATIONS (I.E., LOT TO LOT, LOT TO POND AND LOT TO ROAD) WILL REMAIN AS SHOWN.
- THE ELEVATIONS OF ANY PAD GRADE SHALL NOT BE LOWER THAN THE ELEVATION SHOWN. THE ELEVATIONS OF THE PAD GRADES (BUT NOT THE POND OR STREET GRADES) OF LOTS 12, 13, 61 THROUGH 65, AND 102 THROUGH 114 MAY BE 0.80 FEET HIGHER THAN THE ELEVATIONS SHOWN. THE ELEVATIONS OF ALL OTHER PAD GRADES (BUT NOT THE POND OR STREET GRADES) MAY BE 0.05 FEET HIGHER THAN THE ELEVATIONS SHOWN. RAISING LOT PADS MAY REQUIRE IMPORT OF FILL MATERIALS.
- PORTIONS OF THIS PROPERTY ARE WITHIN THE 100-YEAR FLOOD ZONE (ZONE AH, ELEV. 4981) AS SHOWN ON THE FEMA FLOOD INSURANCE RATE MAP (COMMUNITY PANEL NO. 350002-0008C, OCT. 19, 1983). LOTS WITHIN THIS FLOOD ZONE DESIGNATION MAY BE SUBJECT TO FLOOD INSURANCE REQUIREMENTS. PROPERTY OWNERS MAY BE REQUIRED TO PURCHASE FLOOD INSURANCE UNTIL SUCH TIME THAT THE ALBUQUERQUE METROPOLITAN ARROYO FLOOD CONTROL AUTHORITY (AMAFCA) COMPLETES AND FEMA APPROVES A LETTER OF MAP REVISION APPLICATION FOR THE EXISTING PIEDRAS MARCADAS DAM. LOTS WITHIN THE AH FLOOD ZONE DESIGNATION INCLUDE 1-P1 THROUGH 14-P1, 34-P1 THROUGH 36-P1, 42-P1 THROUGH 54-P1, AND 61-P1 THROUGH 108-P1.

LEGEND

- + EXISTING GROUND ELEVATION
- NEW GROUND OR STREET ELEVATION
- DESIGN PAD ELEVATION
- CMU WALL

NORTH

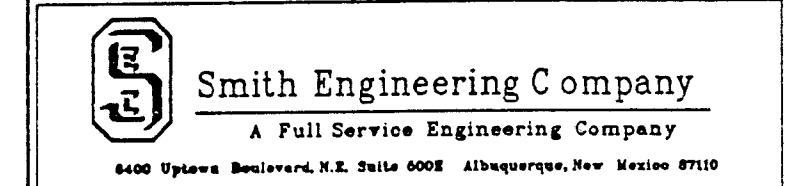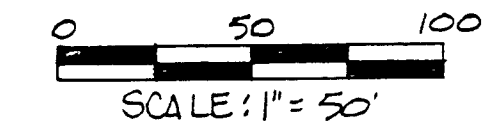

CITY OF ALBUQUERQUE
PUBLIC WORKS DEPARTMENT
ENGINEERING GROUP

TITLE: **Bosque del Rio**

MASTER GRADING AND DRAINAGE PLAN


APPROVALS	ENGINEER	DATE	APPROVALS	ENGINEER	DATE
DRC CHAIRMAN			WATER		
TRANSPORTATION			WASTEWATER		
HYDROLOGICAL					

PROJECT NO. **540682** MAP NO. D-13 SHEET **DR 5A** OF **1823**

AS BUILT INFORMATION	
CONTRACTOR	N/A
WORKED BY	N/A
DATE	N/A
INSPECTED BY	N/A
DATE	N/A
ACCEPTANCE BY	N/A
DATE	N/A
REVISIONS BY	N/A
DATE	N/A
REVISIONS BY	N/A
DATE	N/A
MICRO-FILM INFORMATION	
RECORDED BY	N/A
DATE	N/A

BENCH MARKS	
CONTRACTOR	N/A
WORKED BY	N/A
DATE	N/A
INSPECTED BY	N/A
DATE	N/A
ACCEPTANCE BY	N/A
DATE	N/A
REVISIONS BY	N/A
DATE	N/A
REVISIONS BY	N/A
DATE	N/A

SURVEY INFORMATION	
FIELD NOTES	DATE
BY	

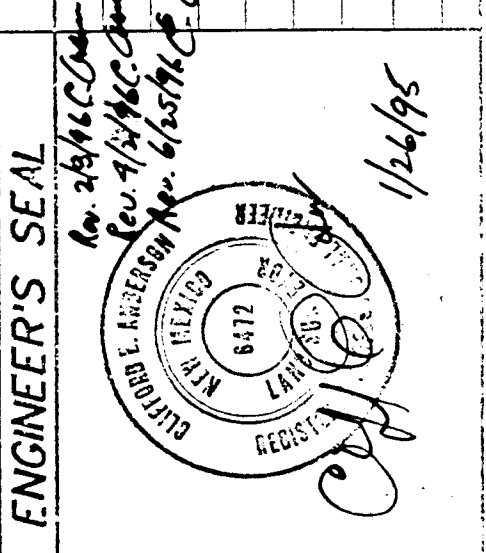


ENGINEER'S SEAL	
DESIGNED BY	C. Anderson
DRAWN BY	
CHECKED BY	
DATE	1/24/95

3 HORIZ. TO 1 VERT. @
NORTH SUBDIVISION
BOUNDARY TO MATCH
EXISTING GRADE
AT PROPERTY LINE

REMOVE EXISTING
IRRIGATION
LATERAL @
SUBDIVISION
BOUNDARY

1. SEE SHT. D2 FOR
NOTES PERTAINING TO
GRADING AND DRAINAGE
PLANS.

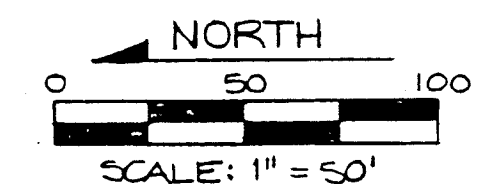


Smith Engineering Company
A Full Service Engineering Company
4001 Upland Boulevard, N.E. Suite 3000 Albuquerque, New Mexico 87110

CITY OF ALBUQUERQUE
PUBLIC WORKS DEPARTMENT
ENGINEERING GROUP

TITLE: **Bosque del Rio**
MASTER GRADING AND DRAINAGE PLAN



APPROVALS	ENGINEER	DATE	APPROVALS	ENGINEER	DATE
DRC CHAIRMAN					
TRANSPORTATION					
HYDROLOGY					
PROJECT NO.	540682	MAP NO.	D-13	SHEET	OF
				58	1523

AS BUILT INFORMATION			BENCH MARKS		SURVEY INFORMATION		ENGINEER'S SEAL	
CONTRACTOR	N/A							
WORK	N/A	DATE						
SYNOPSIS	N/A	DATE						
ACCEPTANCE BY	N/A	DATE						
FIELD	N/A	DATE						
VERIFICATION BY	N/A	DATE						
CORRECTION BY	N/A	DATE						
RECORDED BY	N/A	DATE						
MICRO-FILM INFORMATION								
NO.								

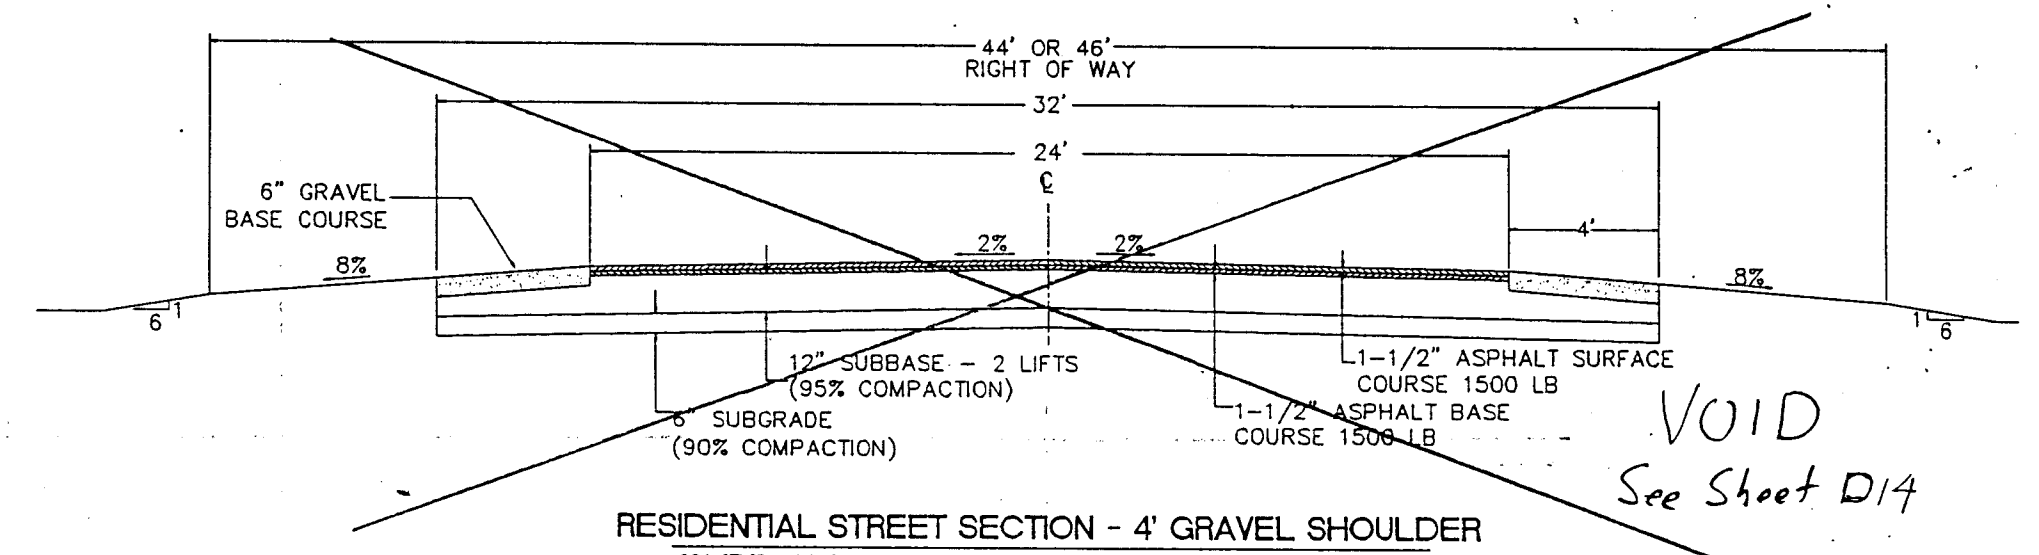

GENERAL NOTES
1. SEE SHEET D2 FOR NOTES
NOTES PERTAINING TO GRADING
AND DRAINAGE PLANS.

AS BUILT INFORMATION	
CONTRACTOR	N/A
WORK BY	N/A
INSPECTED BY	N/A
ACCEPTANCE BY	N/A
DATE	
DATE	
MICRO-FILM INFORMATION	
RECORDED BY	
DATE	

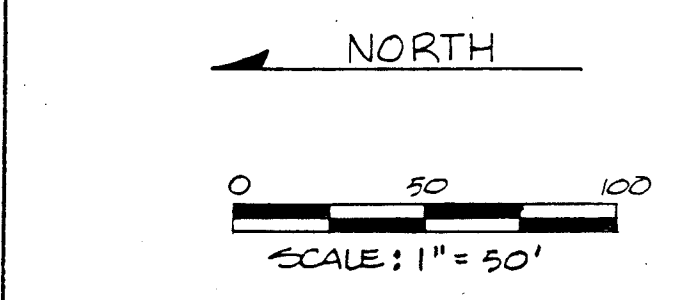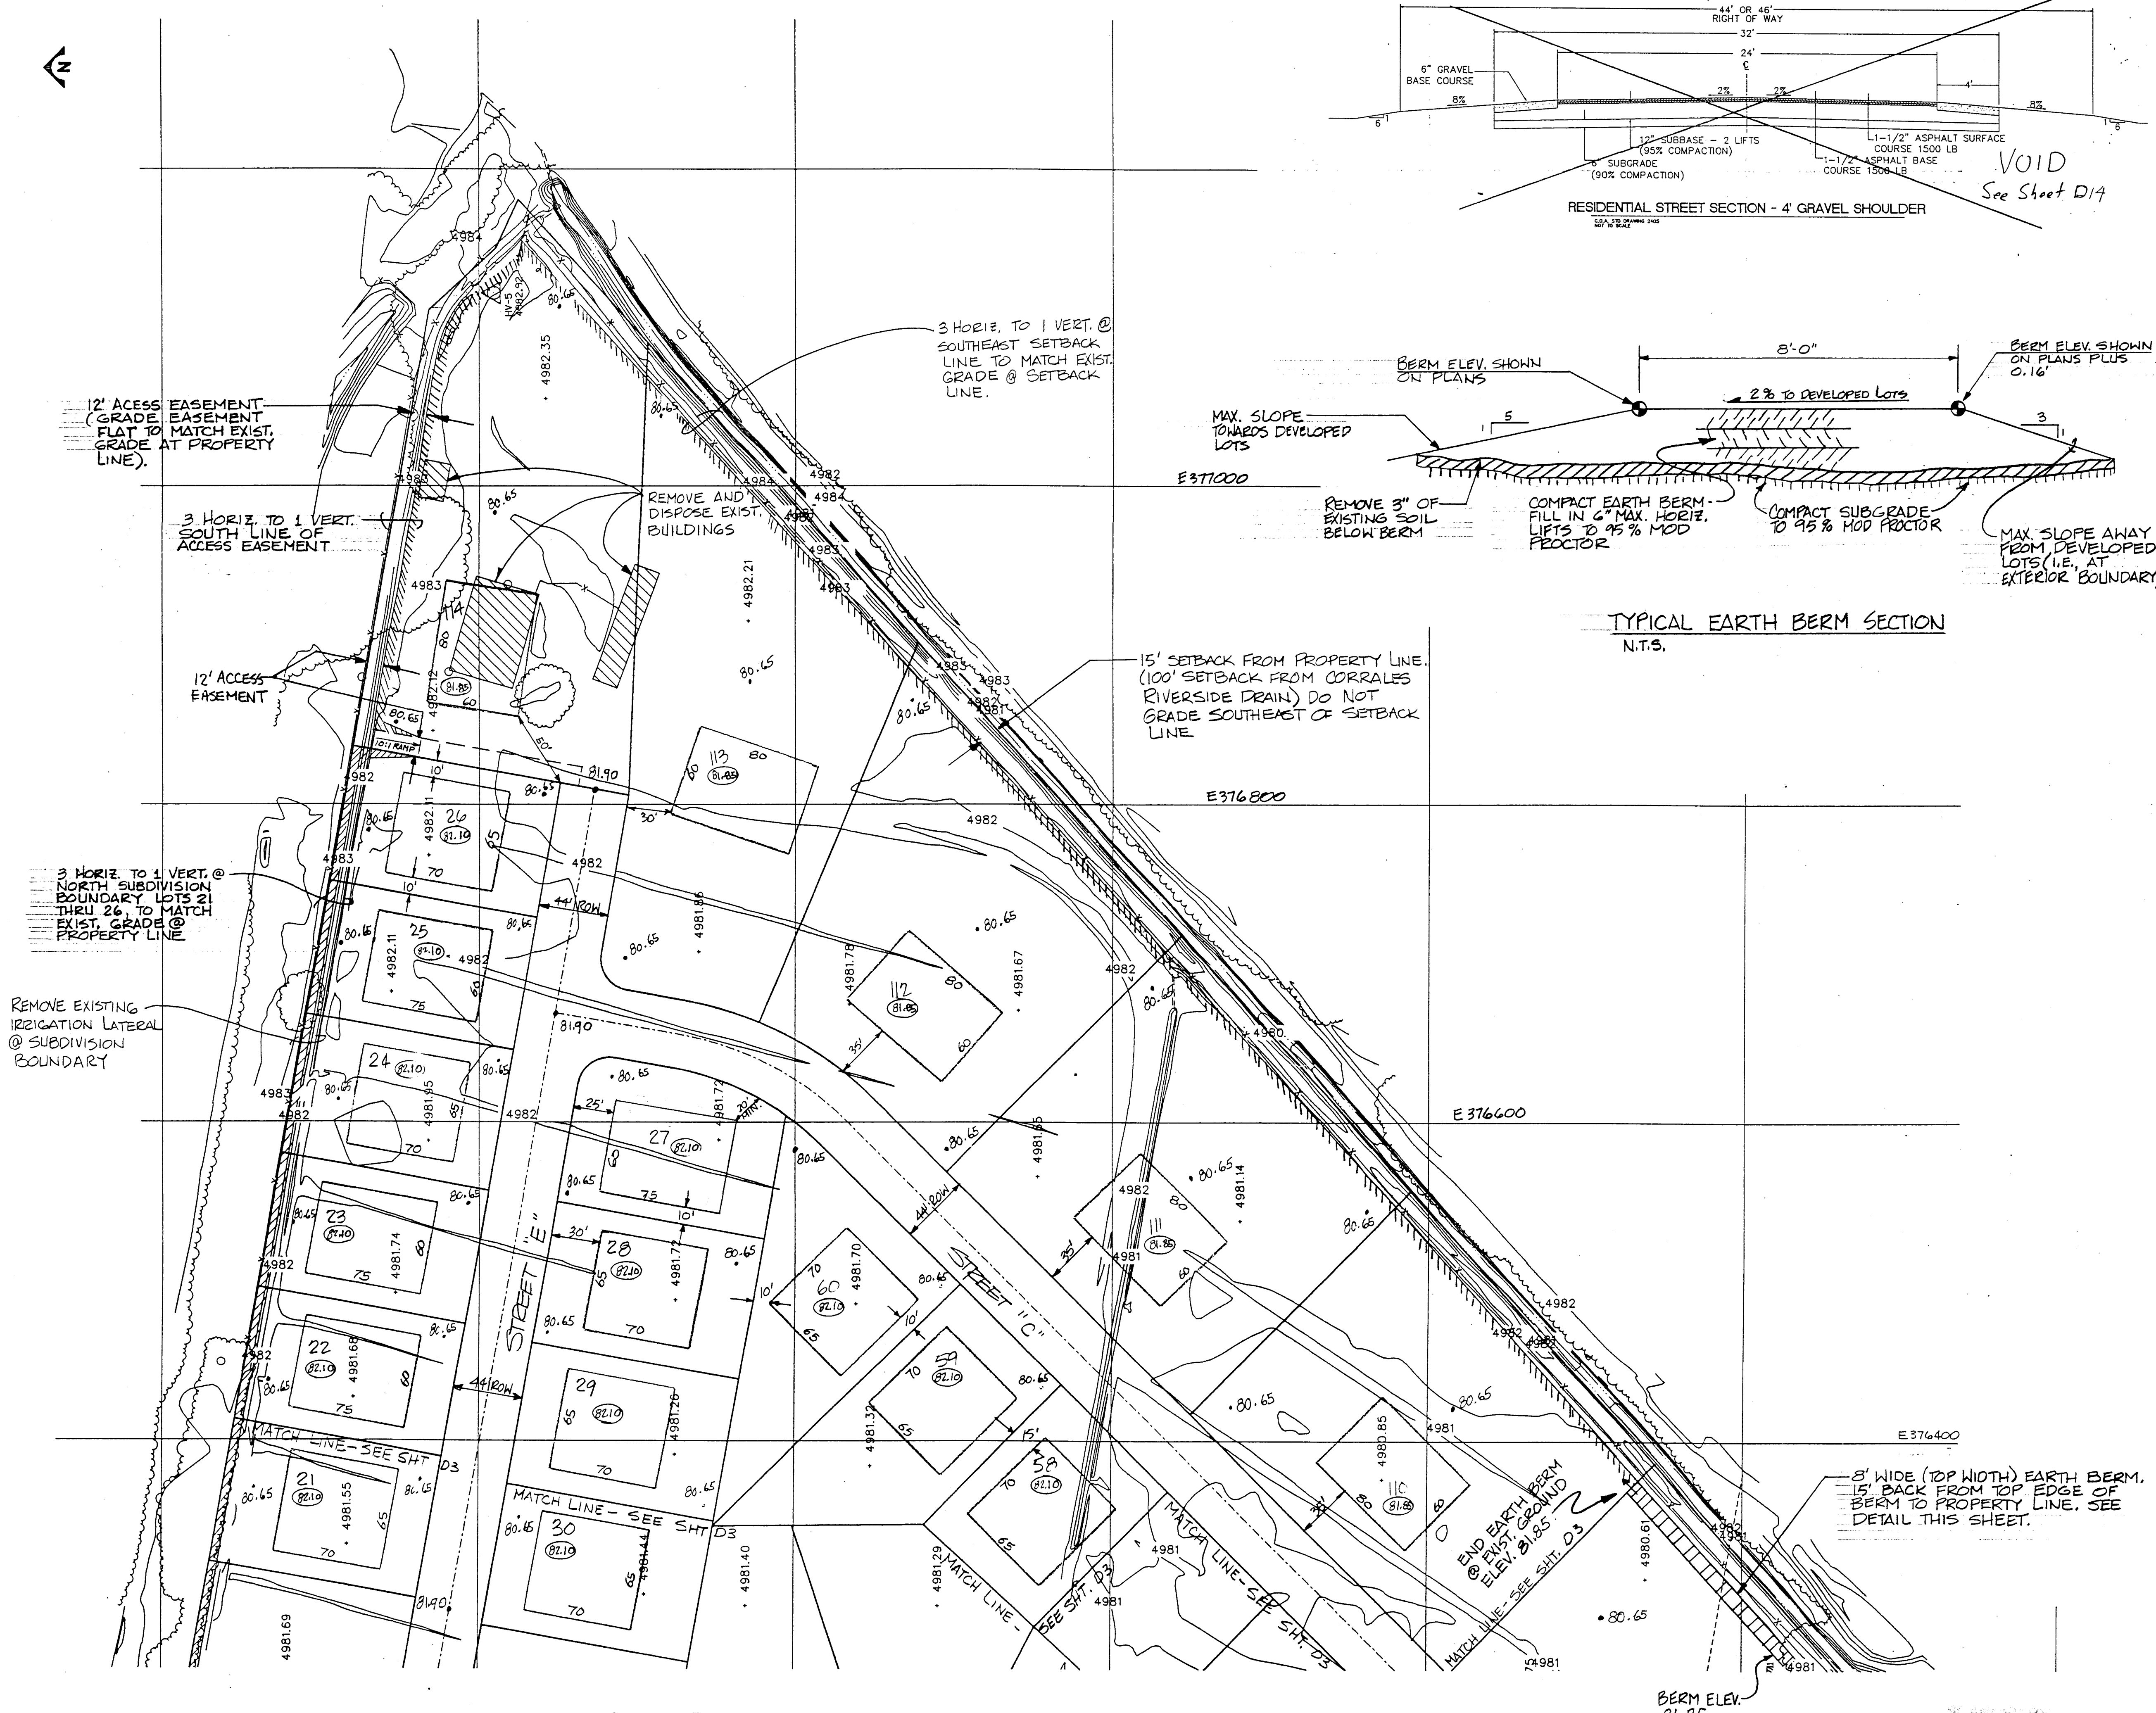

Smith Engineering Company
A Full Service Engineering Company
6400 Uptown Boulevard, N.E. Suite 6000 Albuquerque, New Mexico 87110

CITY OF ALBUQUERQUE
PUBLIC WORKS DEPARTMENT
ENGINEERING GROUP

TITLE: Bosque del Rio			
MASTER GRADING AND DRAINAGE PLAN			
APPROVALS	ENGINEER	DATE	APPROVALS
DRC CHAIRMAN	DATE	DATE	ENGINEER
TRANSPORTATION	DATE	DATE	DATE
HYDROLOGIST	DATE	DATE	DATE
DESIGNED BY C. Anderson DATE 11/20/95			
DRAWN BY DRB DATE 11/20/95			
CHECKED BY DRB DATE 11/20/95			
PROJECT NO. 540682	MAP NO. D-13	SHEET 25 OF 25	


NOTE:
SEE PAVING PLAN AND PROFILE SHEETS
FOR ADDITIONAL DETAILS OF ROADS.

U.S.COE STA "R,ALAMEDA B-2"
N.M. STATE PLANE COORDINATES
(CENTRAL ZONE) BY ACS
X=373,513.20
Y=1,520,142.81
ELEVATION=5,058.25
G/G FACTOR=0.99967638

FUTURE
DEVELOPMENT

BOSQUE DEL RIO SUBDIVISION
PHASE ONE
(COMPLETED - COA PROJ NO. 540681)

CURVE DATA				
NUMBER	DELTA	RADIUS	TANGENT	ARC LENGTH
C1	31°09'32"	450.00	125.47	244.72
C2	32°23'56"	300.00	87.15	169.64
C3	55°22'01"	120.00	62.96	115.96

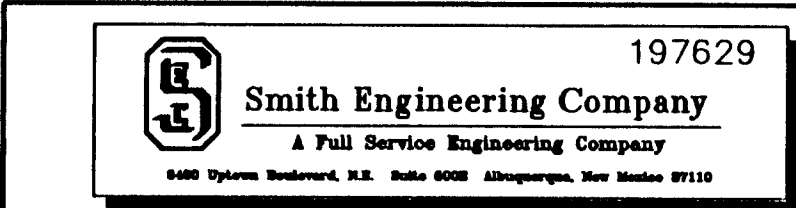


CITY OF ALBUQUERQUE PUBLIC WORKS DEPARTMENT ENGINEERING DEVELOPMENT GROUP	
TITLE: BOSQUE DEL RIO SUBDIVISION - PHASE 2 OVERALL PAVING PLAN	
Design Review Committee	City Engineer Approval
City Project No. 540682	Zone Map No. D-13
Sheet 5A of 23	RECORD DRAWING

AS BUILT INFORMATION		BENCH MARKS		SURVEY INFORMATION		ENGINEER'S SEAL	
CONTRACTOR NEW CONCEPTS	WORKED BY C S C	DATE 9/98	U.S.COE STA. "R,ALAMEDA B-2"	FIELD NOTES	NO.	DATE	BY
INSPECTOR'S ACCEPTANCE BY C S C	DATE 4/98	DATE 4/98	N.M. STATE PLANE COORDINATES (CENTRAL ZONE) BY ACS	BY GAYLE JEWELL	4071	07/97	
VERIFICATION BY C S C	DATE 4/98	DATE 4/98	X=373,513.20				
DRAWINGS BY C S C	DATE 4/98	DATE 4/98	Y=1,520,142.81				
MICRO-FILM INFORMATION		ELEVATION=5,058.25		REMARKS		DESIGN	
RECORDED BY		G/G FACTOR=0.99967638		DATE 10/23/97		DATE 10/23/97	
NO.				DATE 10/23/97		DATE 10/23/97	

NOTE:
SEE UTILITY PLAN AND PROFILE SHEETS FOR
ADDITIONAL DETAILS OF UTILITY INSTALLATION.

FUTURE DEVELOPMENT

BOSQUE DEL RIO SUBDIVISION
PHASE ONE
(COMPLETED - COA PROJ NO. 540681)

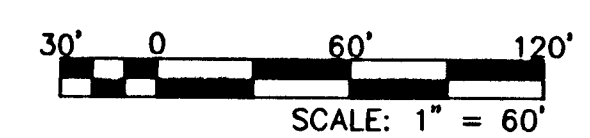

 197629
Smith Engineering Company
A Full Service Engineering Company
6400 Uptown Boulevard, N.E. Suite 6000, Albuquerque, New Mexico 87110

CITY OF ALBUQUERQUE
PUBLIC WORKS DEPARTMENT
ENGINEERING DEVELOPMENT GROUP


TITLE: BOSQUE DEL RIO SUBDIVISION - PHASE 2
OVERALL UTILITY PLAN

Design Review Committee	City Engineer Approval	Last Design Update	No. / Bay / Tr.	No. / Bay / Tr.
City Project No. 540682	Zone Map No. D-13	Sheet SE 33	Of 23	


City Project No.	540682	Zone Map No.	D-13	Sheet	5E 5B	Of	23
------------------	--------	--------------	------	-------	------------------	----	----

RECORD DRAWING

Drawing name: N:\197629\OPTION1\06PPMP.DWG
Saved on: October 22, 1997 at 6:35 AM
This is Plot # 1 of 1 Printed on: October 22, 1997 at 6:35 AM

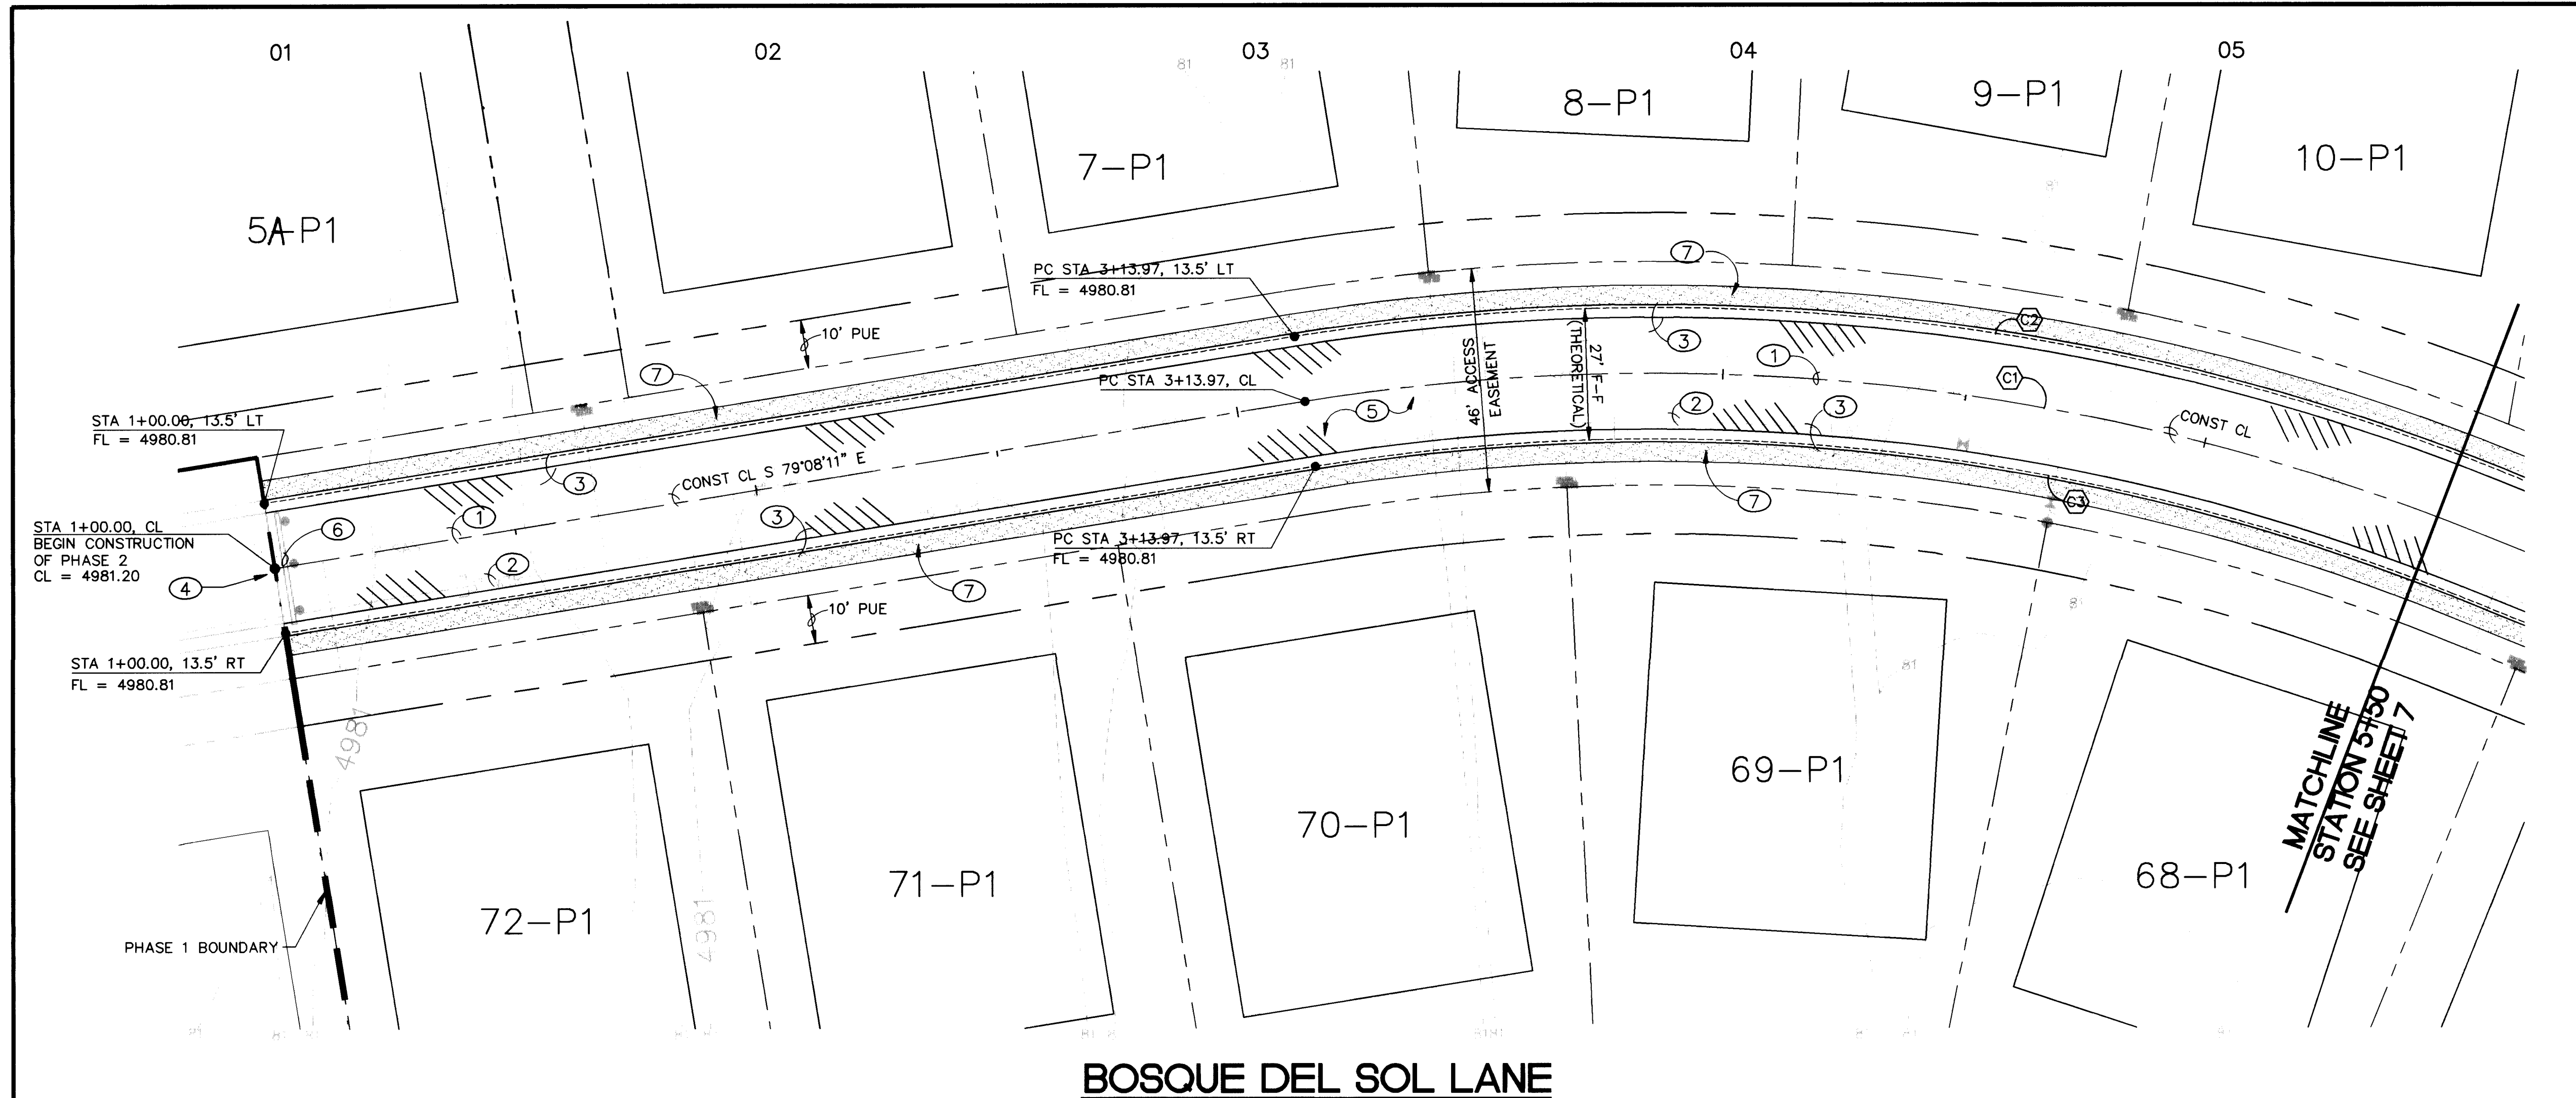

BOSQUE DEL SOL LANE


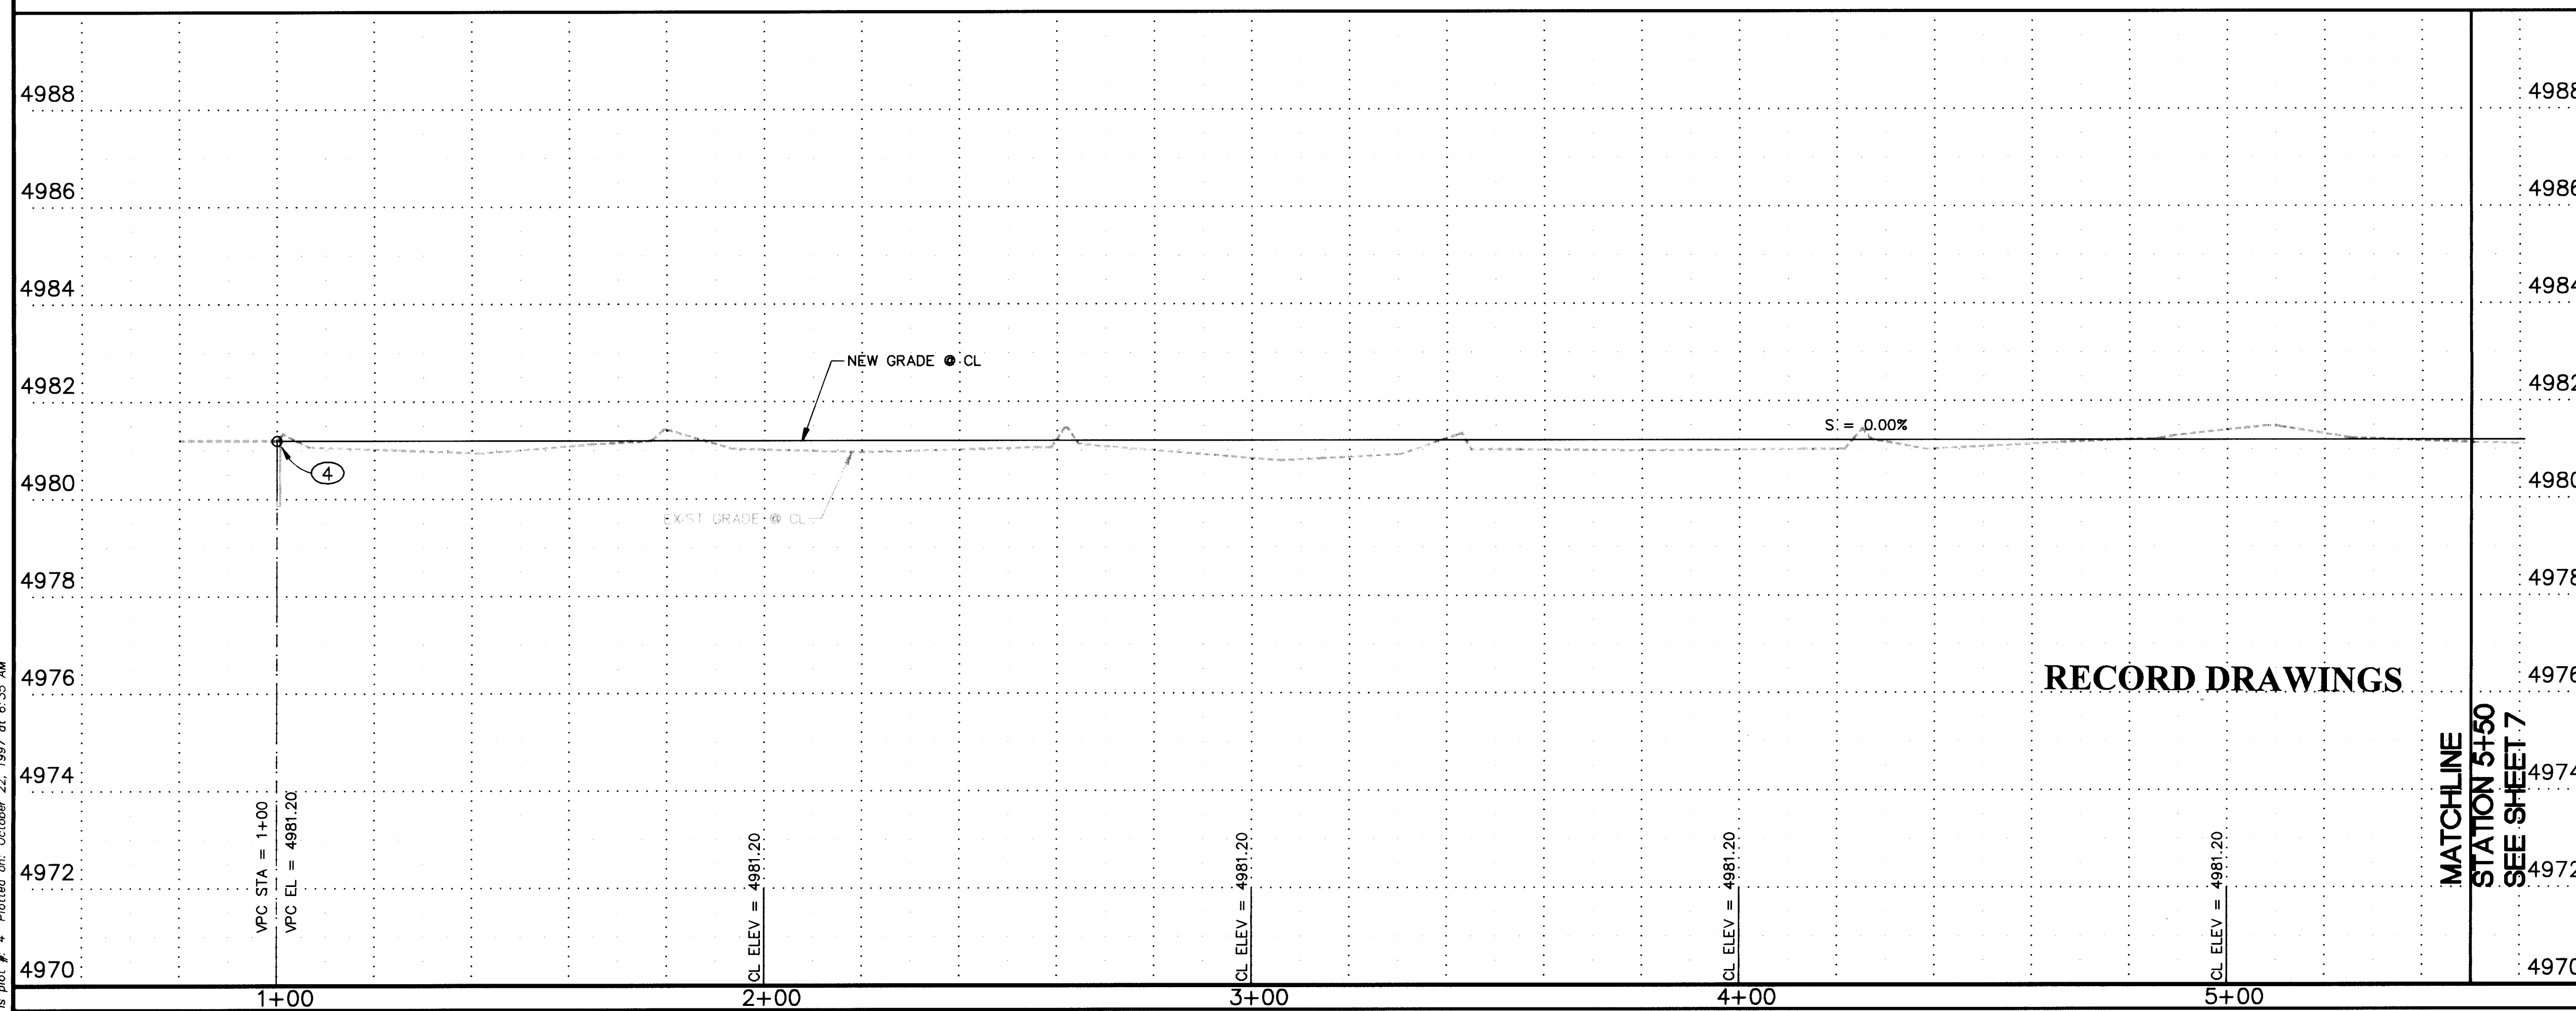


KEYED NOTES:

- 1 CONSTRUCT NEW 3" PRESSURE SANITARY SEWER. SEE UTILITY PLAN AND PROFILE SHEETS 13-19 FOR DETAILS.
- 2 CONSTRUCT NEW 6" PVC WATER LINE. SEE UTILITY PLAN AND PROFILE SHEETS 13-20 FOR DETAILS.
- 3 CONSTRUCT NEW ESTATE TYPE CURB PER PER COA STD DWG 2415.
- 4 REMOVE AND DISPOSE OF EXISTING CUT-OFF WALL. MATCH EXISTING GRADE OF BOSQUE DEL SOL LANE, PHASE 1.
- 5 SEE SHEET 22 FOR STREET SECTIONS.
- 6 REMOVE AND RELOCATE TYPE III BARRICADE TO END OF BOSQUE DEL SOL PHASE 2 CONSTRUCTION.
- 7 CONSTRUCT 4-FOOT GRAVEL SHOULDER. SEE TYPICAL ROAD SECTION, SHEET 22.


CURVE DATA

NUMBER	DELTA	RADIUS	TANGENT	ARC LENGTH
C1	31°09'32"	450.00	125.47	244.72
C2	31°09'32"	463.50	129.23	252.06
C3	31°09'32"	436.50	121.70	237.38

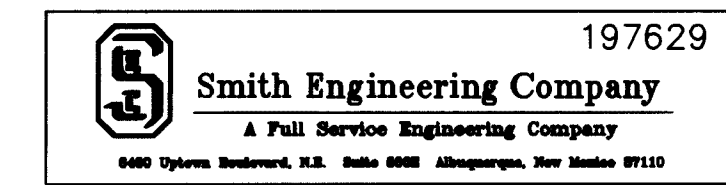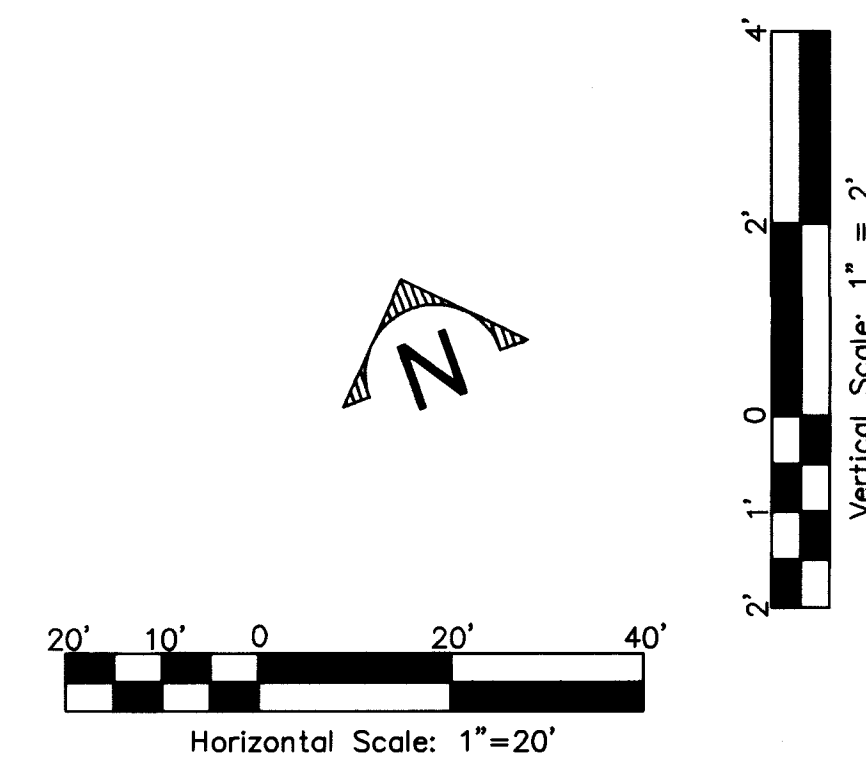

CITY OF ALBUQUERQUE PUBLIC WORKS DEPARTMENT ENGINEERING DEVELOPMENT GROUP	
TITLE: BOSQUE DEL RIO SUBDIVISION - PHASE 2 PAVING P & P: BOSQUE DEL SOL LANE: STA 1+00 TO 5+50	
Design Review Committee DEC 19 1997	City Engineer Approval No. / Day / Yr. No. / Day / Yr.
City Project No. 540682	Zone Map No. D-13
Sheet 6 of 23	

Drawing name: N:\197629\OPTION\107629P.DWG
Saved on: 10/23/97 at 6:53 AM
User: JASON
Plot on: 10/23/97 at 6:53 AM
Plotter: HP-GL/2
Printer: HP-GL/2

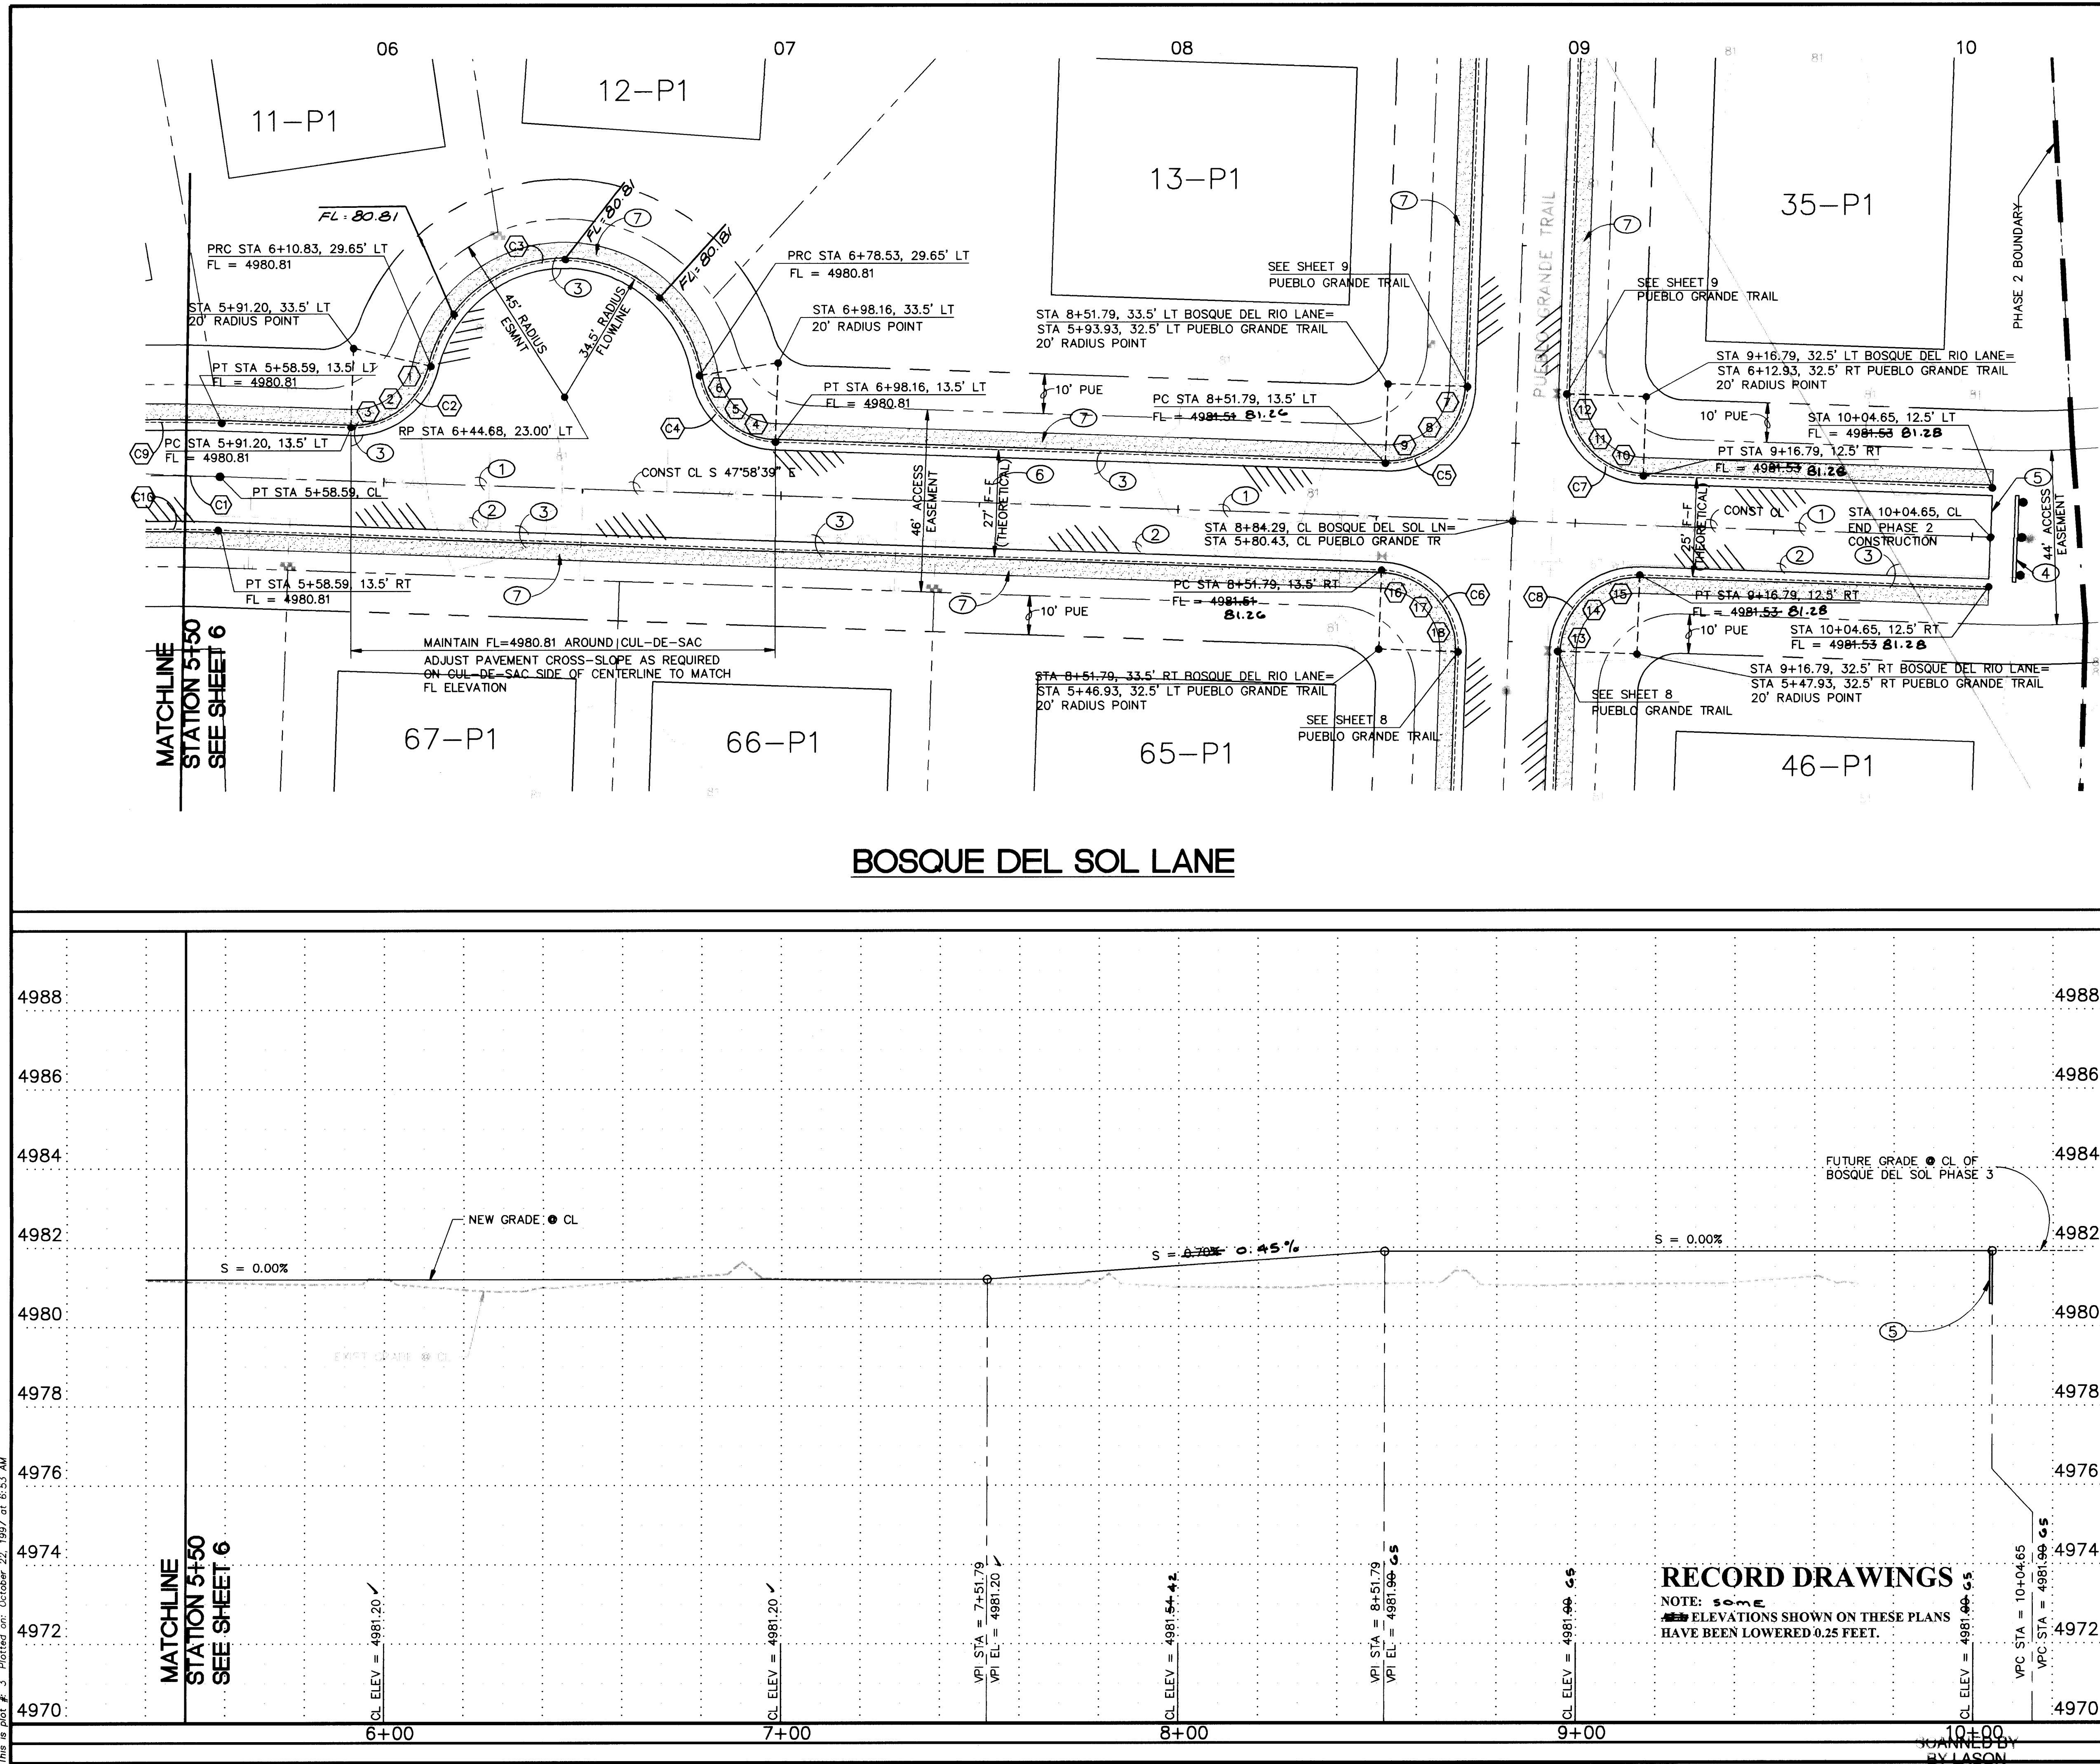

KEYED NOTES:

- CONSTRUCT NEW 3" PRESSURE SANITARY SEWER. SEE UTILITY PLAN AND PROFILE SHEETS 13-19 FOR DETAILS.
- CONSTRUCT NEW 6" PVC WATER LINE. SEE UTILITY PLAN AND PROFILE SHEETS 13-20 FOR DETAILS.
- CONSTRUCT NEW ESTATE TYPE CURB PER COA STD DWG 2415.
- REUSE EXISTING BARRICADE FROM BEGINNING OF BOSQUE DEL SOL CONSTRUCTION. SEE TYPE III BARRICADE WITH RED AND WHITE STRIPING PER MUTCD, 1992 ED FOR DETAILS.
- CONSTRUCT CUT-OFF WALL FROM LIP (LT) TO LIP (RT) AT END OF ROADWAY (PHASE TWO) PER COA STANDARD DRAWING 2415.
- SEE SHEET 22 FOR STREET SECTION.
- CONSTRUCT 4-FOOT GRAVEL SHOULDER. SEE TYPICAL ROAD SECTION, SHEET 22.

CURVE DATA

NUMBER	DELTA	RADIUS	TANGENT	ARC LENGTH
C1	31°09'32"	450.00	125.47	244.72
C2	78°53'31"	20.00	16.46	27.54
C3	157°47'02"	34.50	175.72	95.01
C4	78°53'31"	20.00	16.46	27.54
C5	90°00'00"	20.00	20.00	31.42
C6	90°00'00"	20.00	20.00	31.42
C7	90°00'00"	20.00	20.00	31.42
C8	90°00'00"	20.00	20.00	31.42
C9	31°09'32"	463.50	129.23	252.06
C10	31°09'32"	436.50	121.70	237.38


CURB RETURN DATA

POINT NO.	DATE OF CURB	FLOW LINE
1	4980.76	4980.81
2	4980.76	4980.81
3	4980.76	4980.81
4	4980.76	4980.81
5	4980.76	4980.81
6	4980.76	4980.81
7	4981.48 2.3	4981.53 2.8
8	4981.47 2.2	4981.52 2.7
9	4981.47 2.2	4981.52 2.7
10	4981.48 2.3	4981.53 2.8
11	4981.48 2.3	4981.53 2.8
12	4981.48 2.3	4981.53 2.8
13	4981.48 2.3	4981.53 2.8
14	4981.48 2.3	4981.53 2.8
15	4981.48 2.3	4981.53 2.8
16	4981.47 2.2	4981.52 2.7
17	4981.47 2.2	4981.52 2.7
18	4981.48 2.3	4981.53 2.8

AS BUILT INFORMATION		CONTRACTOR: NEW CONC		DATE: 10/23/97	
INSPECTOR'S SIGNATURE		DATE: 10/23/97		DATE: 10/23/97	
FIELD VERIFICATION BY		DATE: 10/23/97		DATE: 10/23/97	
CORRECTED BY		DATE: 10/23/97		DATE: 10/23/97	
MICRO-FILM INFORMATION		RECORDED BY		NO.	
NO.		NO.		NO.	

ENGINEERS SEAL
NEW MEXICO
1044
REGISTERED PROFESSIONAL ENGINEER
10/23/97

NO.	DATE	REMARKS	BY
1	10/23/97	DESIGN	AUG / BAC
2	10/23/97	DESIGN	BAC
3	10/23/97	DESIGN	PJC

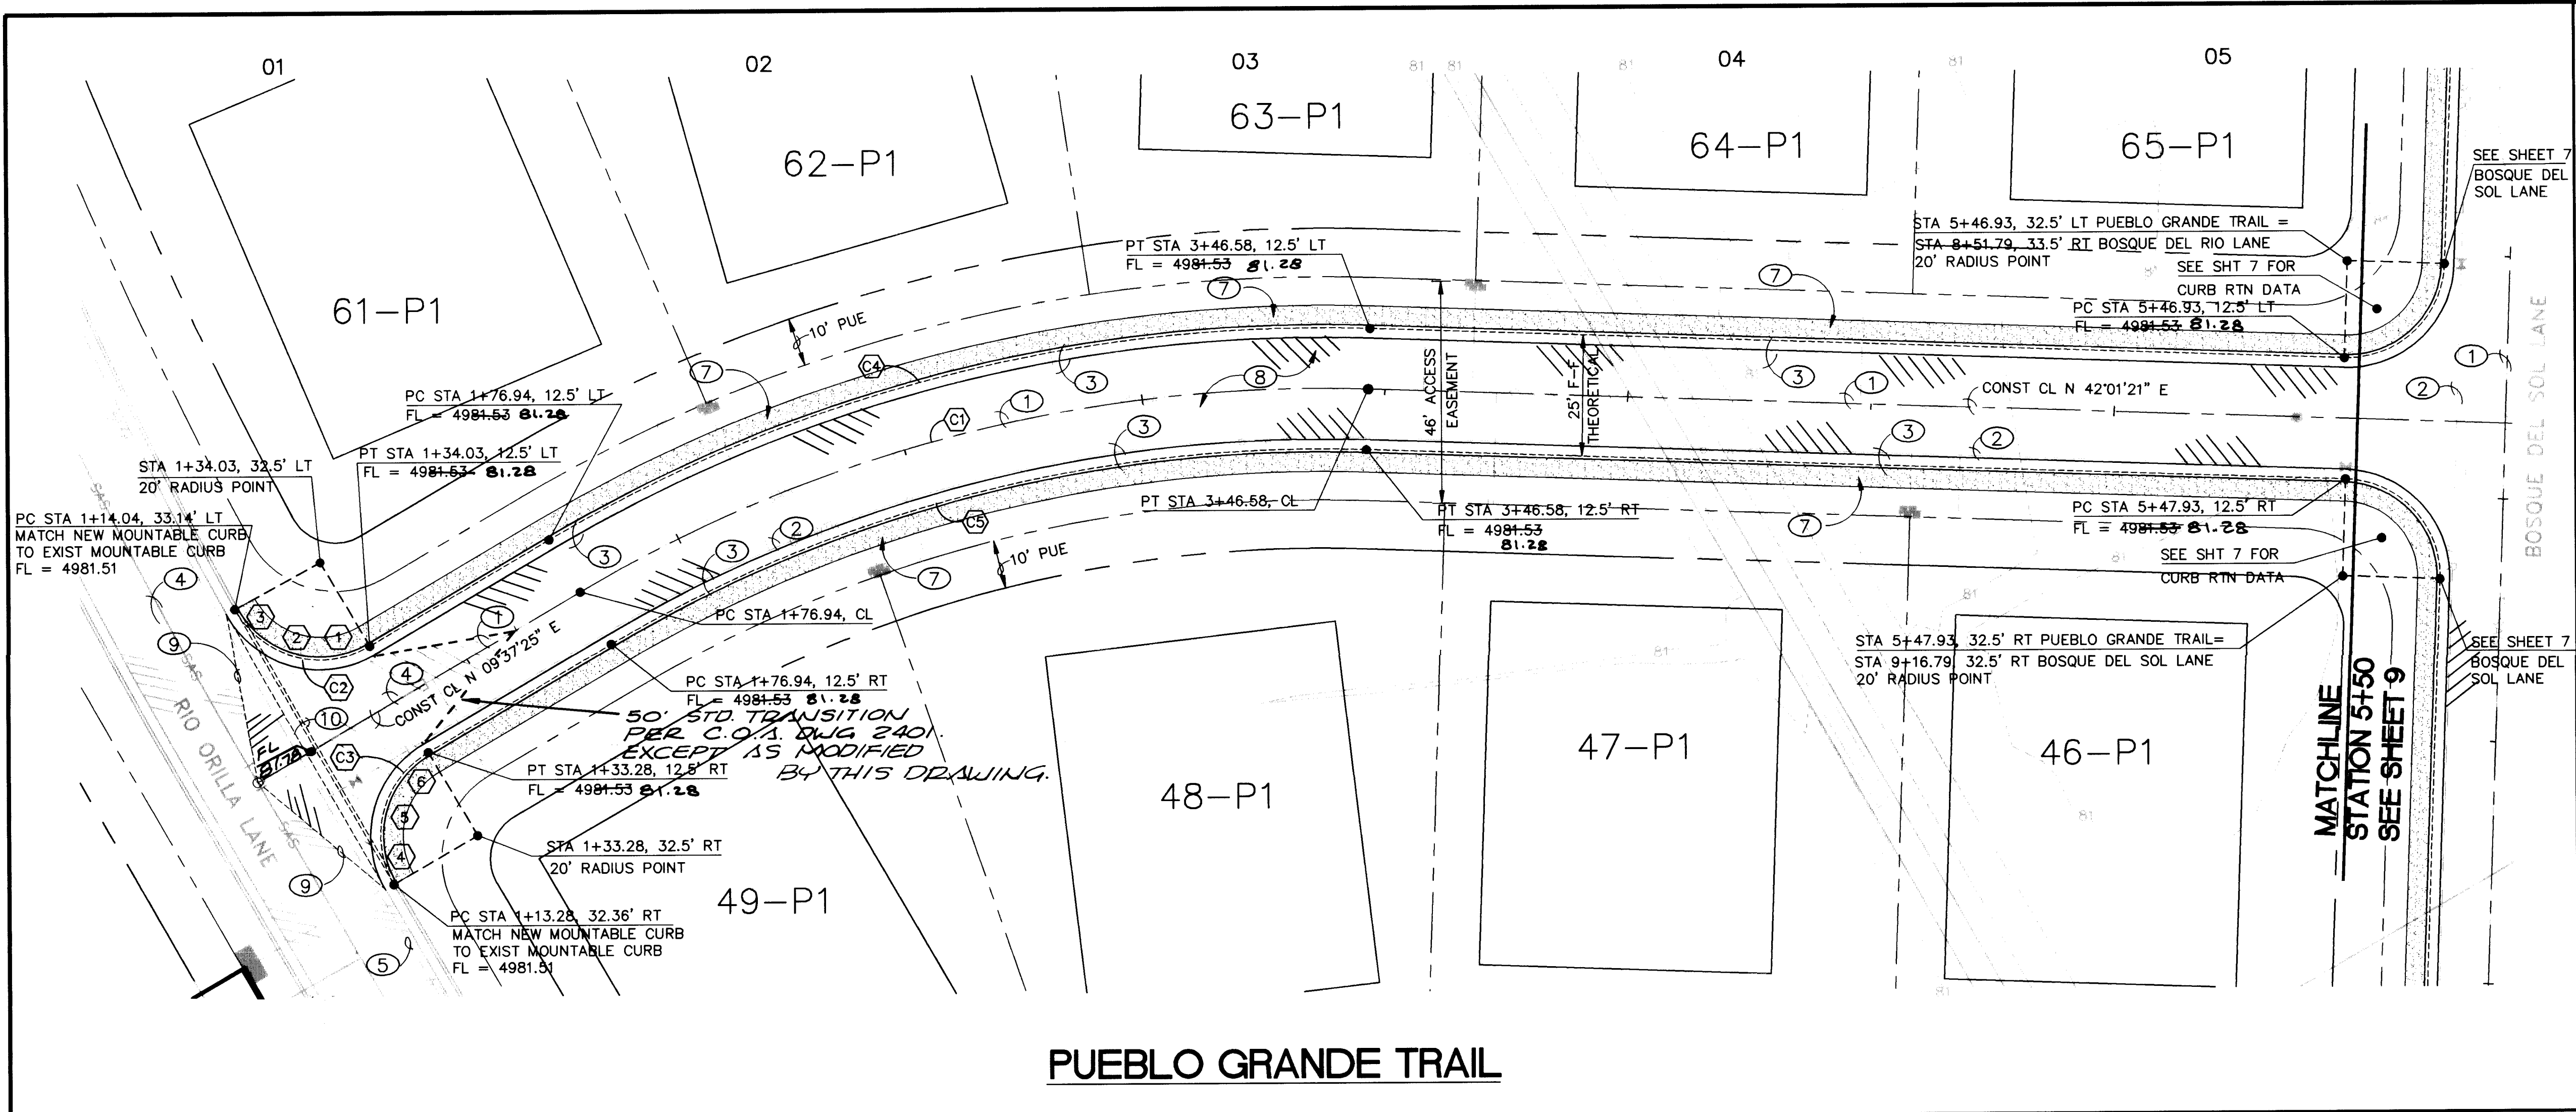

KEYED NOTES:


- CONSTRUCT NEW 3" PRESSURE SANITARY SEWER. SEE UTILITY PLAN AND PROFILE SHEETS 13-19 FOR DETAILS.
- CONSTRUCT NEW 6" PVC WATER LINE. SEE UTILITY PLAN AND PROFILE SHEETS 13-20 FOR DETAILS.
- CONSTRUCT NEW ESTATE TYPE CURB PER COA STD DWG 2415.
- EXISTING SANITARY SEWER.
- EXISTING WATER LINE.
- EXISTING 27' FLOWLINE TO FLOWLINE (THEORETICAL) ROADWAY.
- CONSTRUCT 4-FOOT GRAVEL SHOULDER. SEE TYPICAL ROAD SECTION, SHEET 22.
- SEE SHEET 22 FOR STREET SECTION.
- MATCH NEW PAVEMENT TO EXISTING PAVEMENT. SAWCUT EXISTING PAVEMENT AND REMOVE. PLACE NEW PAVEMENT TO NEW GRADES SHOWN.
- SAWCUT AND REMOVAL LIMITS OF EXISTING ESTATE TYPE CURB.

CURVE DATA

NUMBER	DELTA	RADIUS	TANGENT	ARC LENGTH
C1	32°23'56"	300.00	87.15	169.64
C2	91°50'48"	20.00	20.66	32.06
C3	89°36'34"	20.00	19.86	31.28
C4	32°23'56"	312.50	90.79	176.71
C5	32°23'56"	287.50	83.52	162.57

CURB RETURN DATA

POINT NO.	TOP OF CURB	FLOW LINE
1	4981.30-28	4981.35-23
2	4981.12-16	4981.17-
3	4980.94-	4980.99-
4	4980.94-	4980.99-
5	4981.12-	4981.17-
6	4981.30-	4981.35-

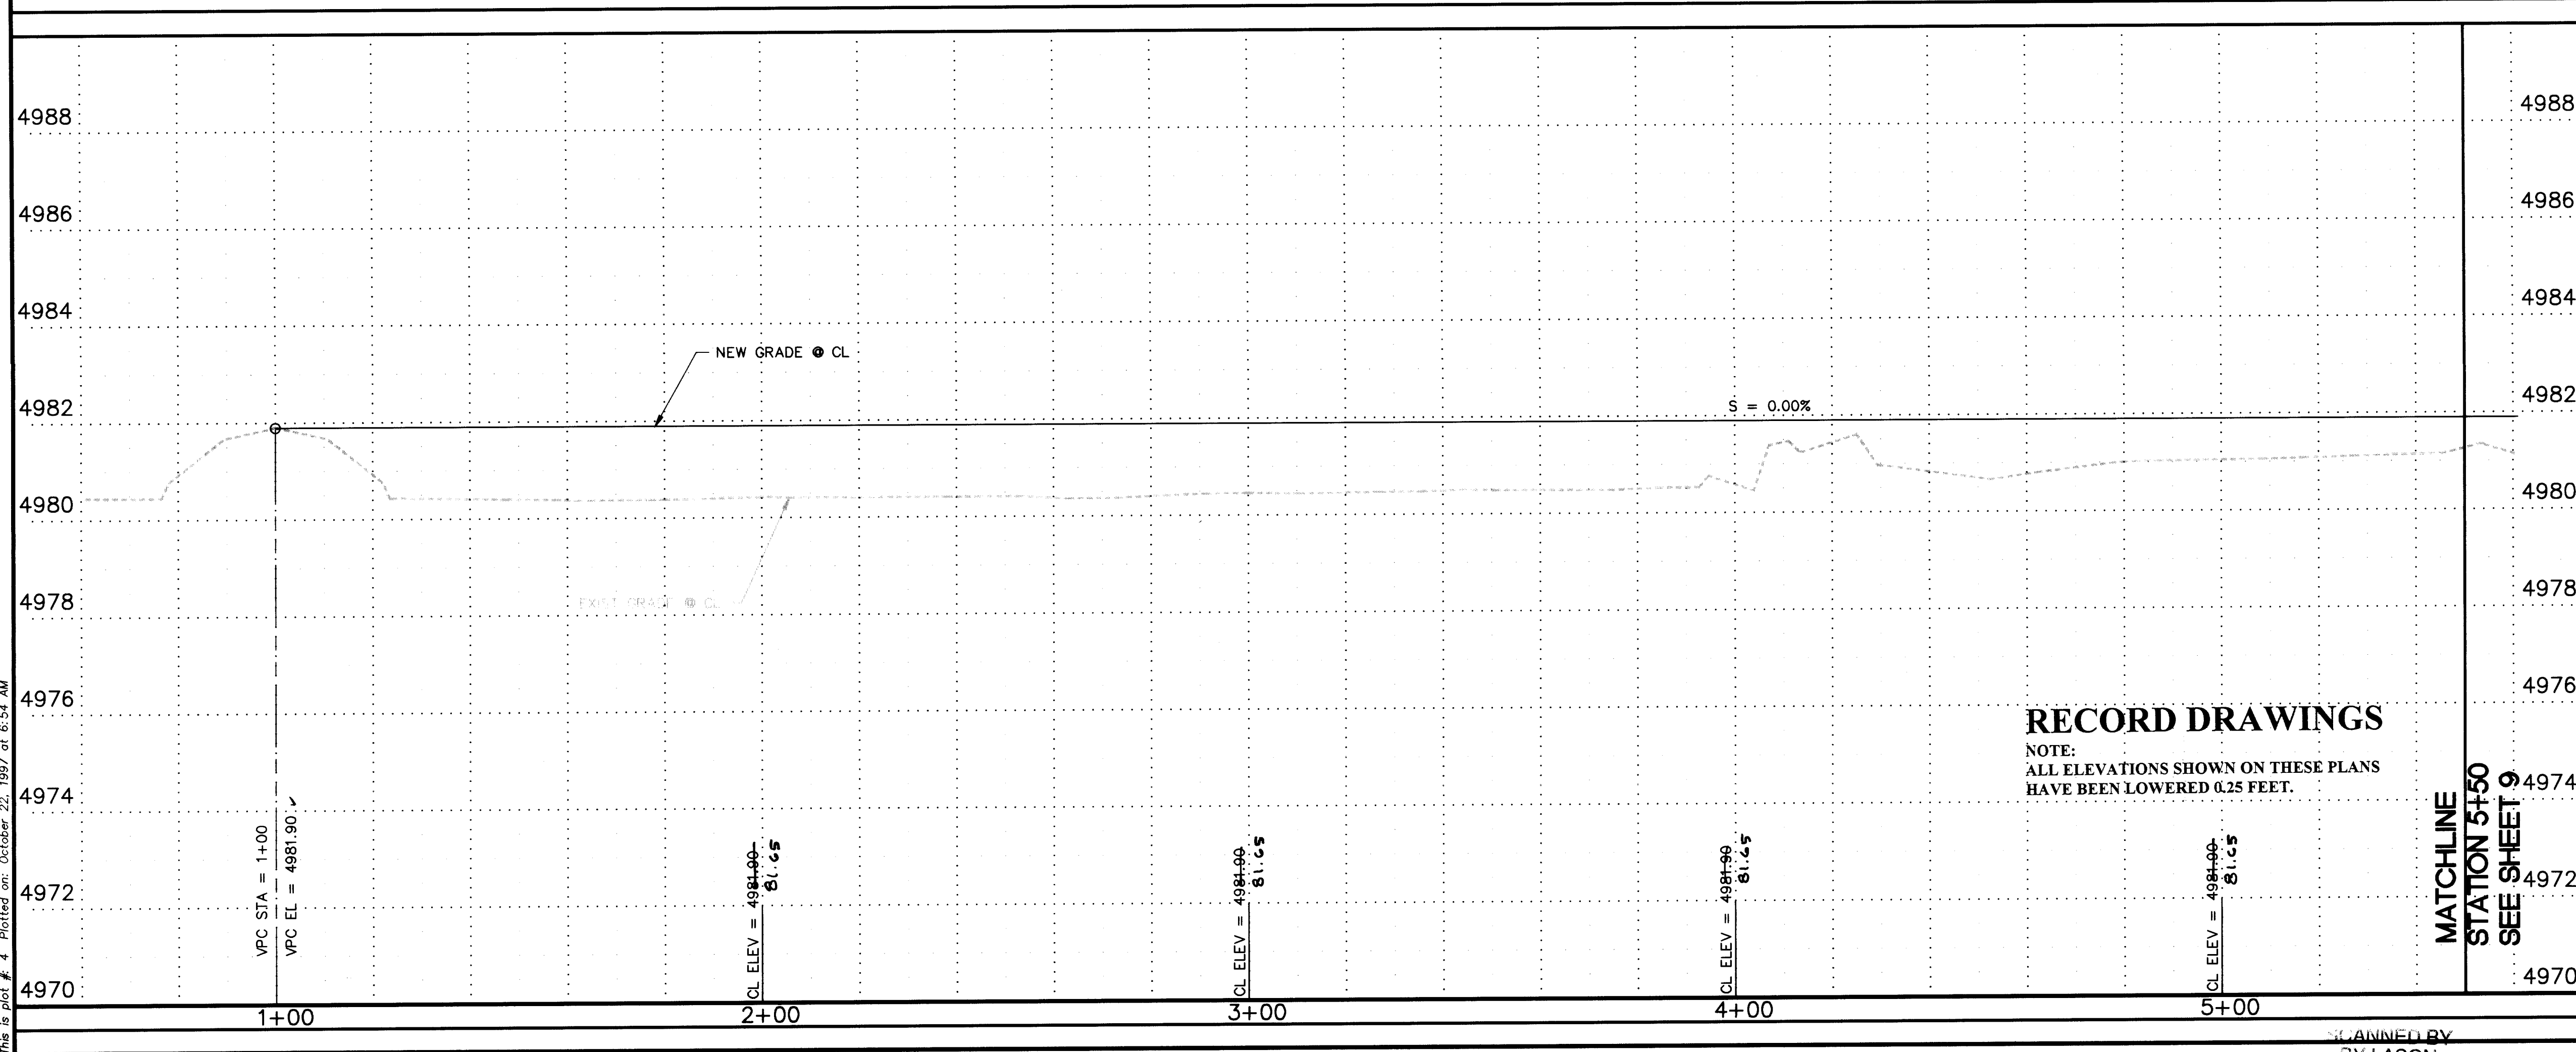

RECORD DRAWINGS

NOTE:
ALL ELEVATIONS SHOWN ON THESE PLANS
HAVE BEEN LOWERED 0.25 FEET.

SMITH ENGINEERING COMPANY
A Full Service Engineering Company
6400 Uptown Boulevard, N.E. Suite 2000 Albuquerque, New Mexico 87110
197629

**CITY OF ALBUQUERQUE
PUBLIC WORKS DEPARTMENT
ENGINEERING DEVELOPMENT GROUP**

**TITLE: BOSQUE DEL RIO SUBDIVISION - PHASE 2
PAVING P & P: PUEBLO GRANDE TRAIL: STA 1+00 TO 5+50**

DESIGN REVIEW COMMITTEE
DEC 19 1997

CITY ENGINEER APPROVAL

**DESIGNED BY: AUG / BAC
DRAWN BY: BAC
CHECKED BY: PJC**

**DATE: 10/23/97
DATE: 10/23/97
DATE: 10/23/97**



City Project No. 540682

Zone Map No. D-13

Sheet 8 of 23

Drawing name: N:\197629\OPTION\OBPPNP.DWG
Saved on: October 22, 1997 at 6:54 AM
This is Plot # 4. Plotted on: October 22, 1997 at 6:54 AM

Drawing name: N:\197629\OPTION1\09ppnp.dwg
Saved on: October 22, 1997 at 6:55 AM
Printed on: October 22, 1997 at 6:55 AM

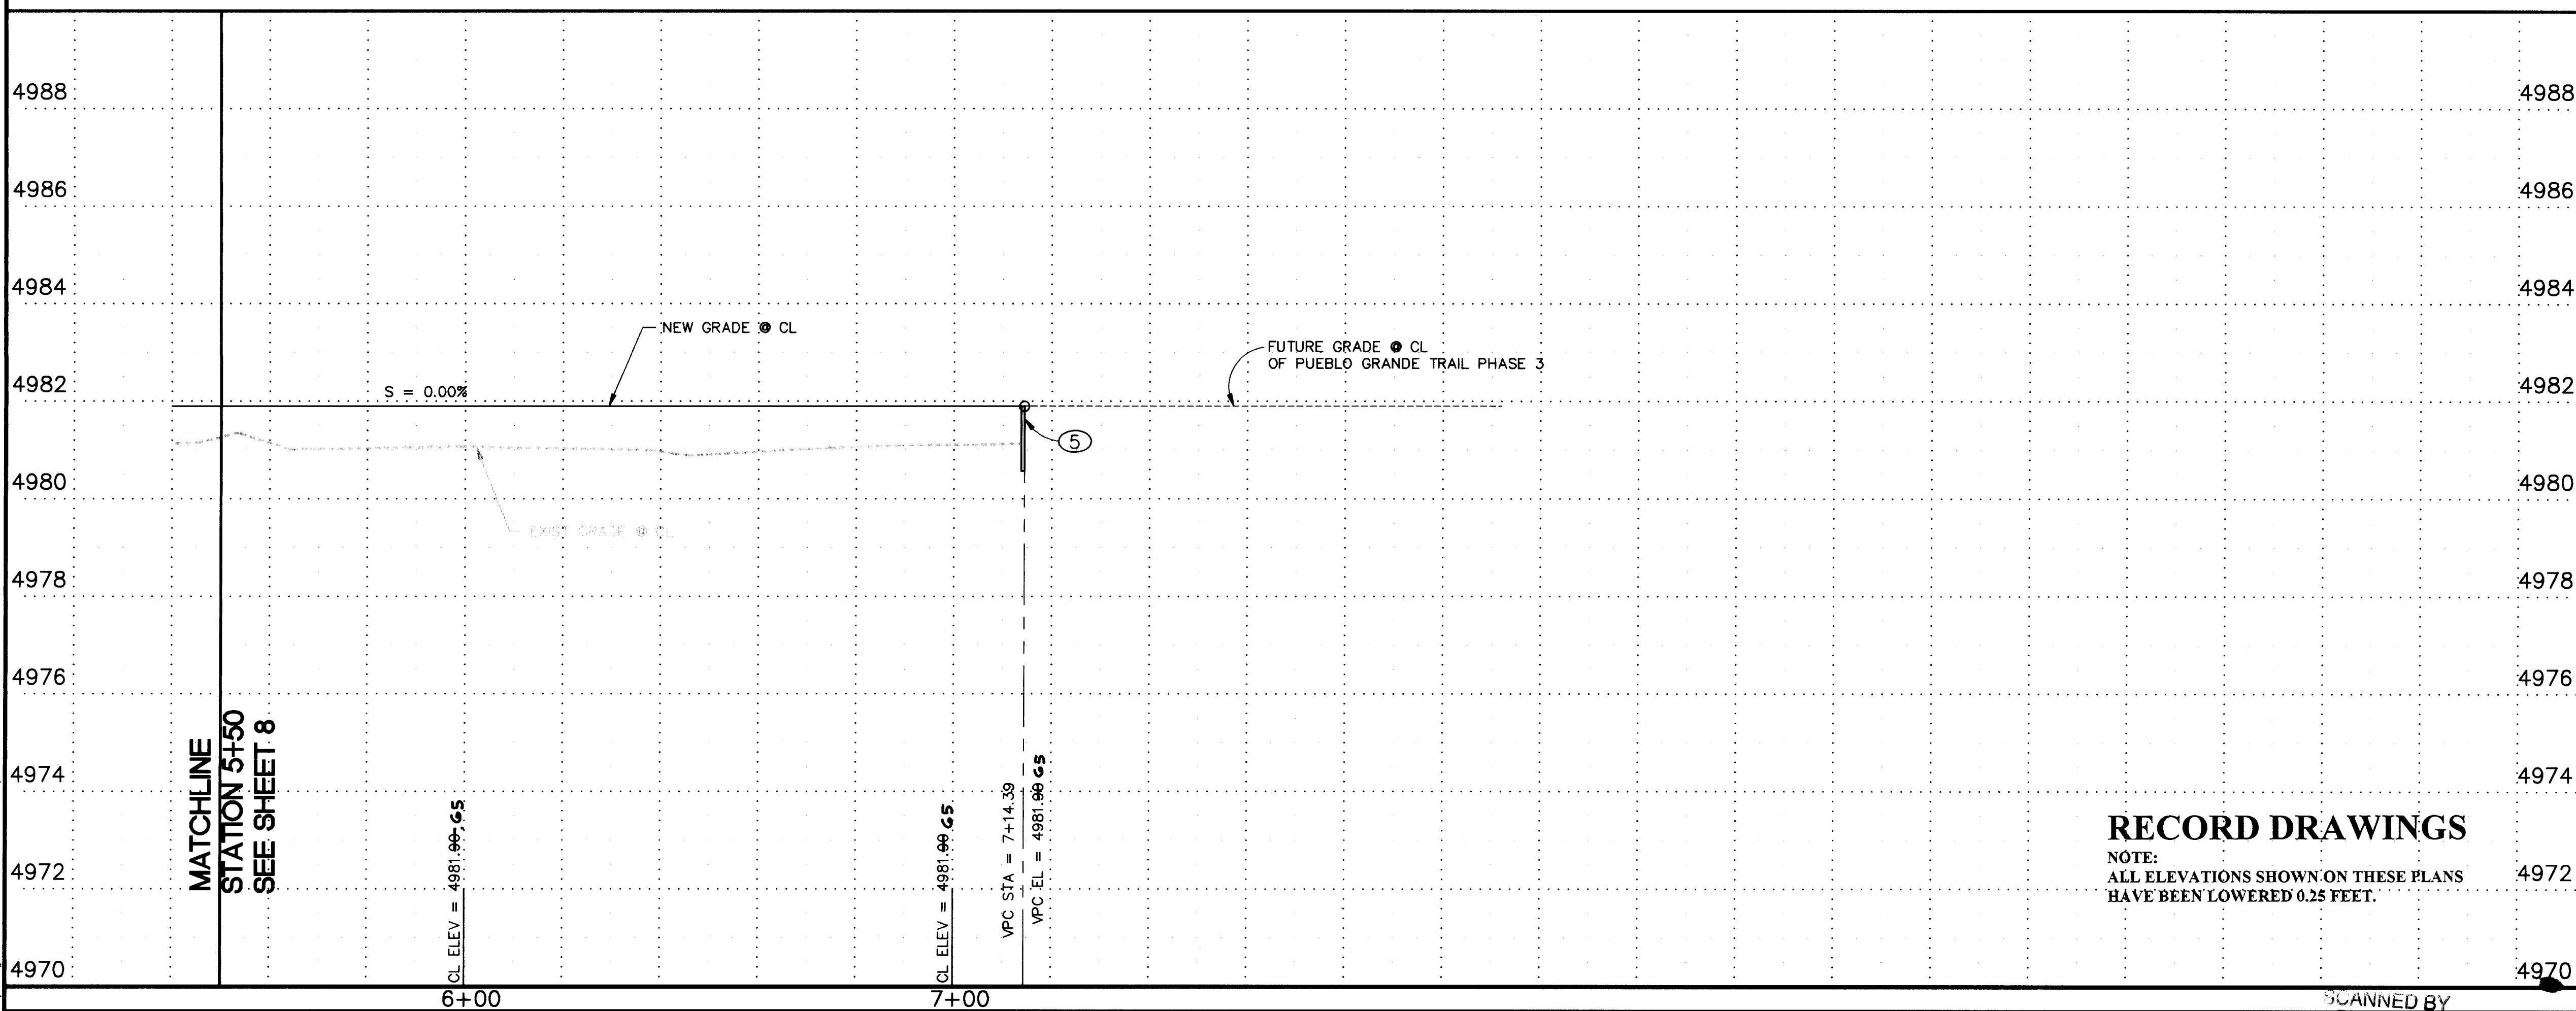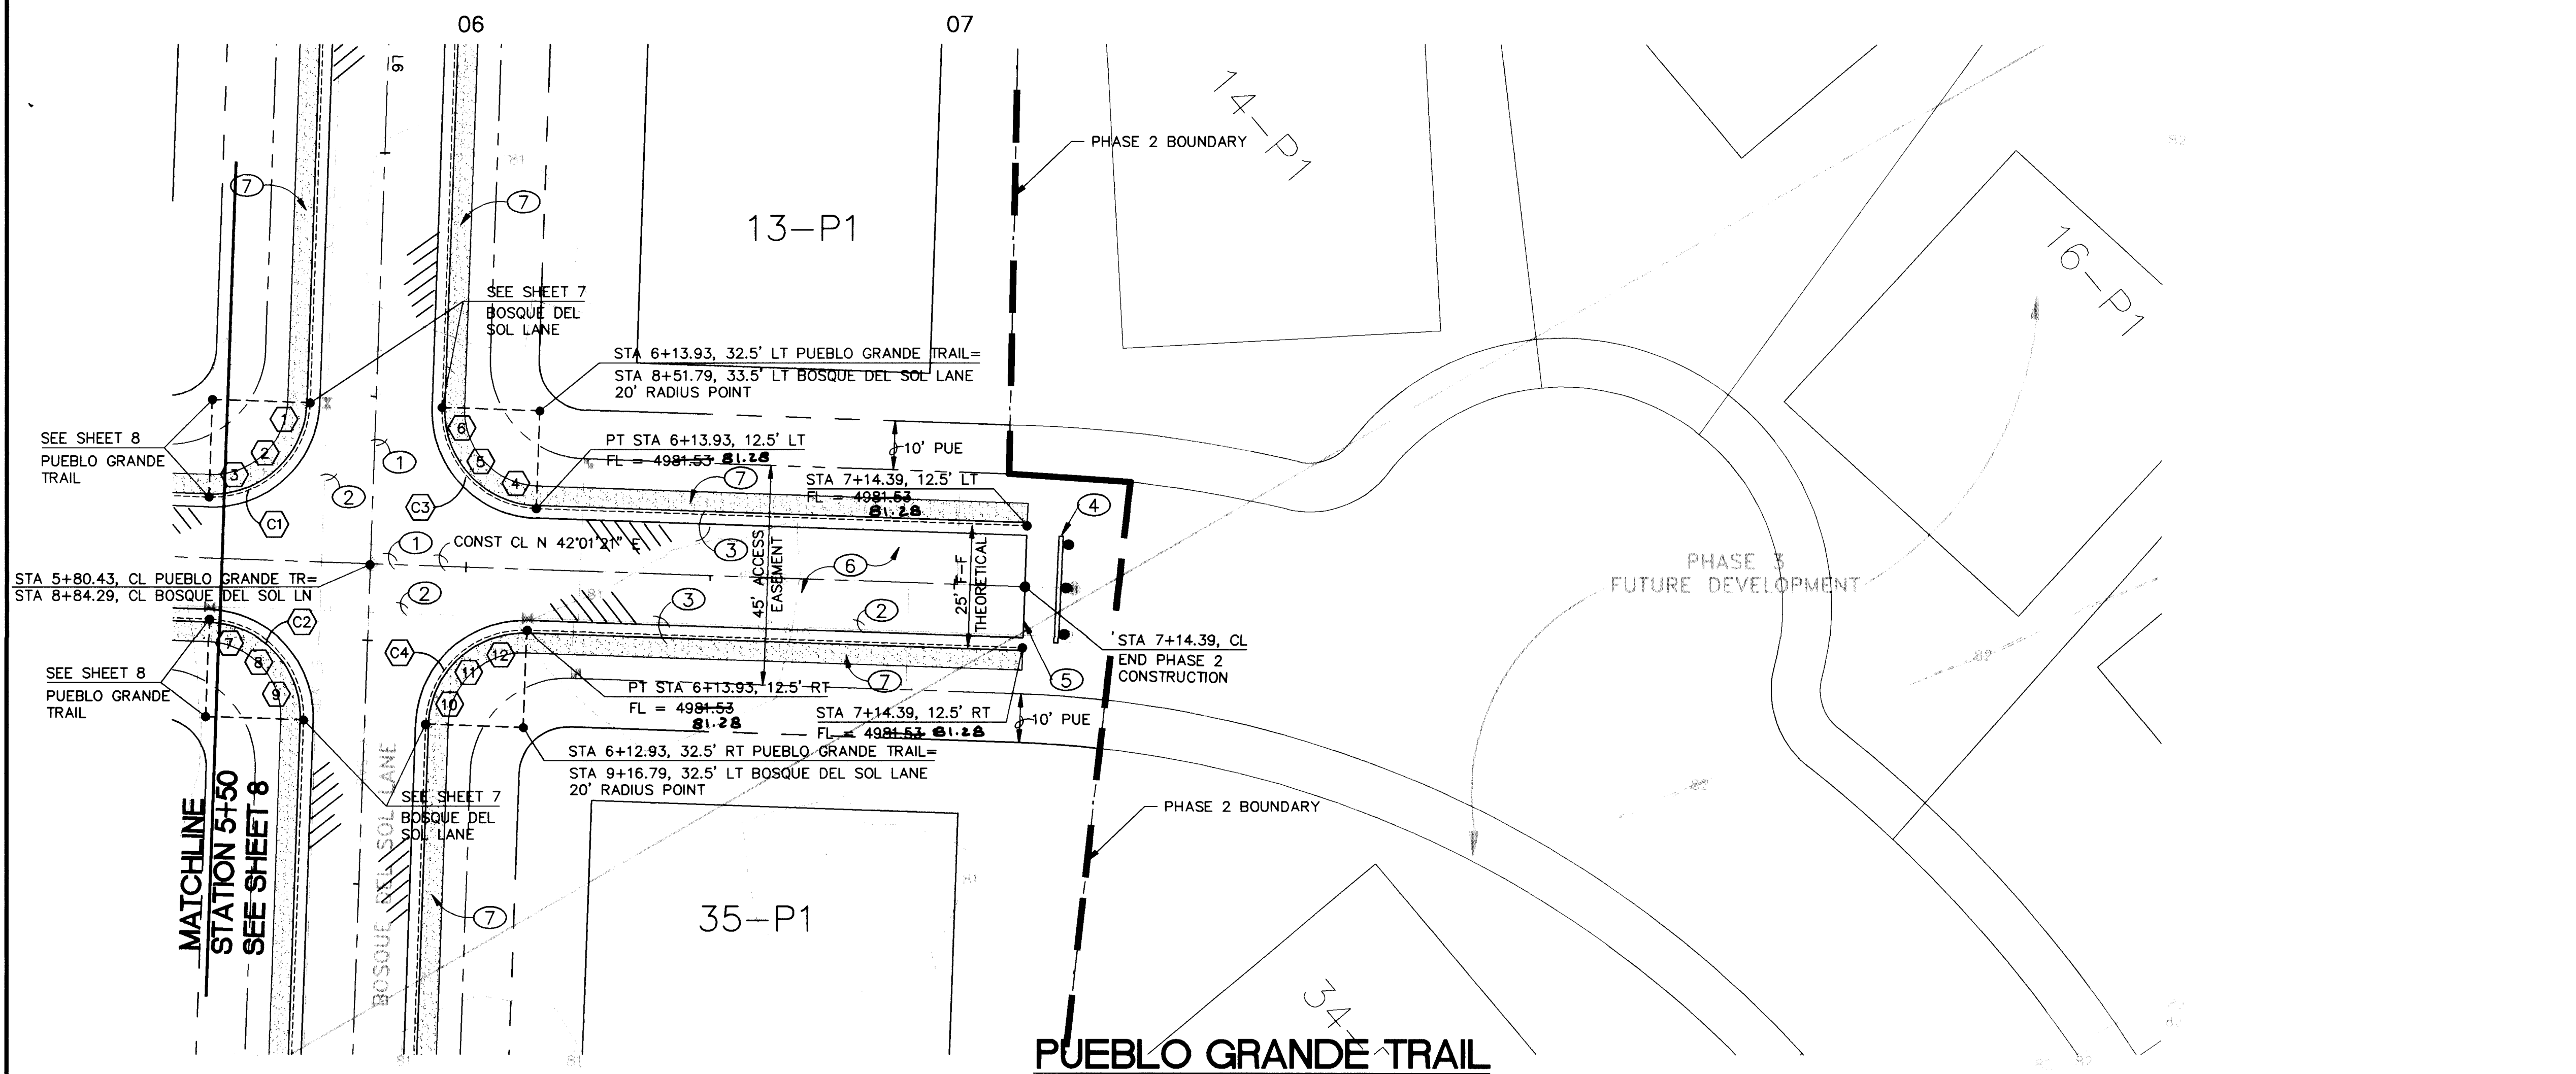

RECORD DRAWINGS

NOTE:
ALL ELEVATIONS SHOWN ON THESE PLANS
HAVE BEEN LOWERED 0.25 FEET.

KEYED NOTES:



- 1 CONSTRUCT NEW 3" PRESSURE SANITARY SEWER. SEE UTILITY PLAN AND PROFILE SHEETS 13-19 FOR DETAILS.
- 2 CONSTRUCT NEW 6" PVC WATER LINE. SEE UTILITY PLAN AND PROFILE SHEETS 13-20 FOR DETAILS.
- 3 CONSTRUCT NEW ESTATE TYPE CURB PER COA STD DWG 2415.
- 4 NEW TYPE III BARRICADE WITH RED AND WHITE STRIPING. SEE MUTCD, 1992 ED. FOR DETAILS.
- 5 CONSTRUCT CUT-OFF WALL FROM LIP (LT) TO LIP (RT) AT END OF ROADWAY (PHASE TWO) PER COA STD DWG 2415.
- 6 SEE SHEET 22 FOR STREET SECTION.
- 7 CONSTRUCT 4-FOOT GRAVEL SHOULDER. SEE TYPICAL ROAD SECTION, SHEET 22.

CURVE DATA

NUMBER	DELTA	RADIUS	TANGENT	ARC LENGTH
C1	90°00'00"	20.00	20.00	31.42
C2	90°00'00"	20.00	20.00	31.42
C3	90°00'00"	20.00	20.00	31.42
C4	90°00'00"	20.00	20.00	31.42



CURB RETURN DATA

POINT NO.	TOP OF CURB	FLOW LINE
1	4981.47 2.2	4981.62 2.7
2	4981.47 2.2	4981.62 2.7
3	4981.48 2.3	4981.63 2.8
4	4981.48 2.3	4981.63 2.8
5	4981.47 2.2	4981.62 2.7
6	4981.47 2.3	4981.62 2.7
7	4981.48 2.3	4981.63 2.8
8	4981.48 2.3	4981.63 2.8
9	4981.48 2.3	4981.63 2.8
10	4981.48 2.3	4981.63 2.8
11	4981.48 2.3	4981.63 2.8
12	4981.48 2.3	4981.63 2.8

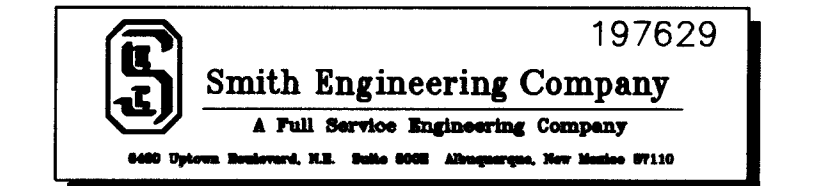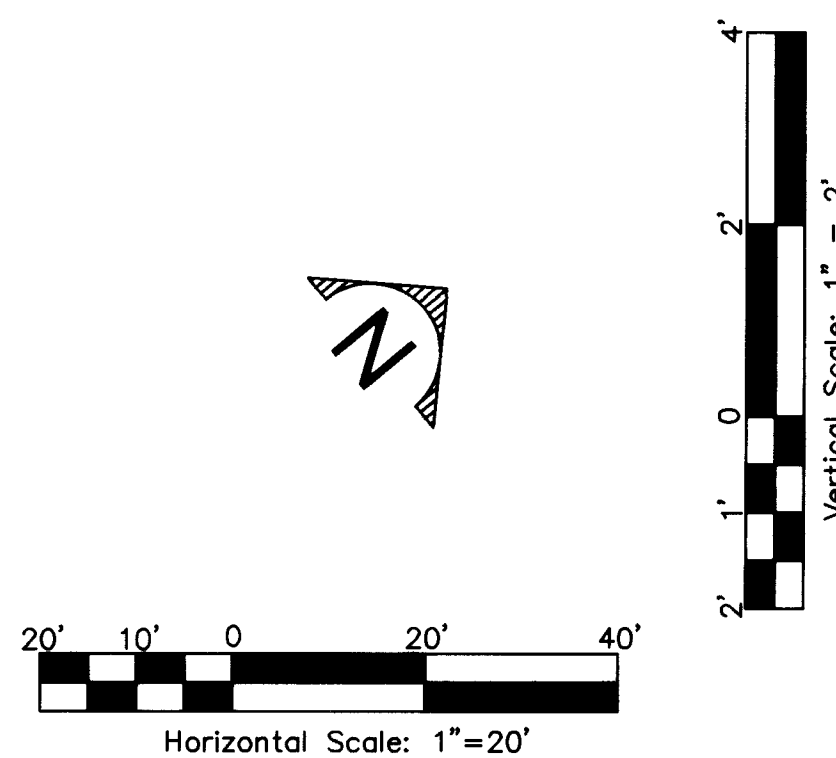

CITY OF ALBUQUERQUE PUBLIC WORKS DEPARTMENT ENGINEERING DEVELOPMENT GROUP			
TITLE: BOSQUE DEL RIO SUBDIVISION - PHASE 2 PAVING P & P: PUEBLO GRANDE TRAIL: STA 5+50 TO 7+14.39			
Design Review Committee	City Engineer Approval	Last Design Update	
DEC 19 1997			
City Project No. 540682	Zone Map No. D-13	Sheet 9 of 23	

Drawing Name: N:\197629\OP\101\OP\PPWP.DWG
Drawing Date: 10/23/97
Drawing Time: 6:57 AM
Drawing Plot: 10/23/97 at 6:57 AM

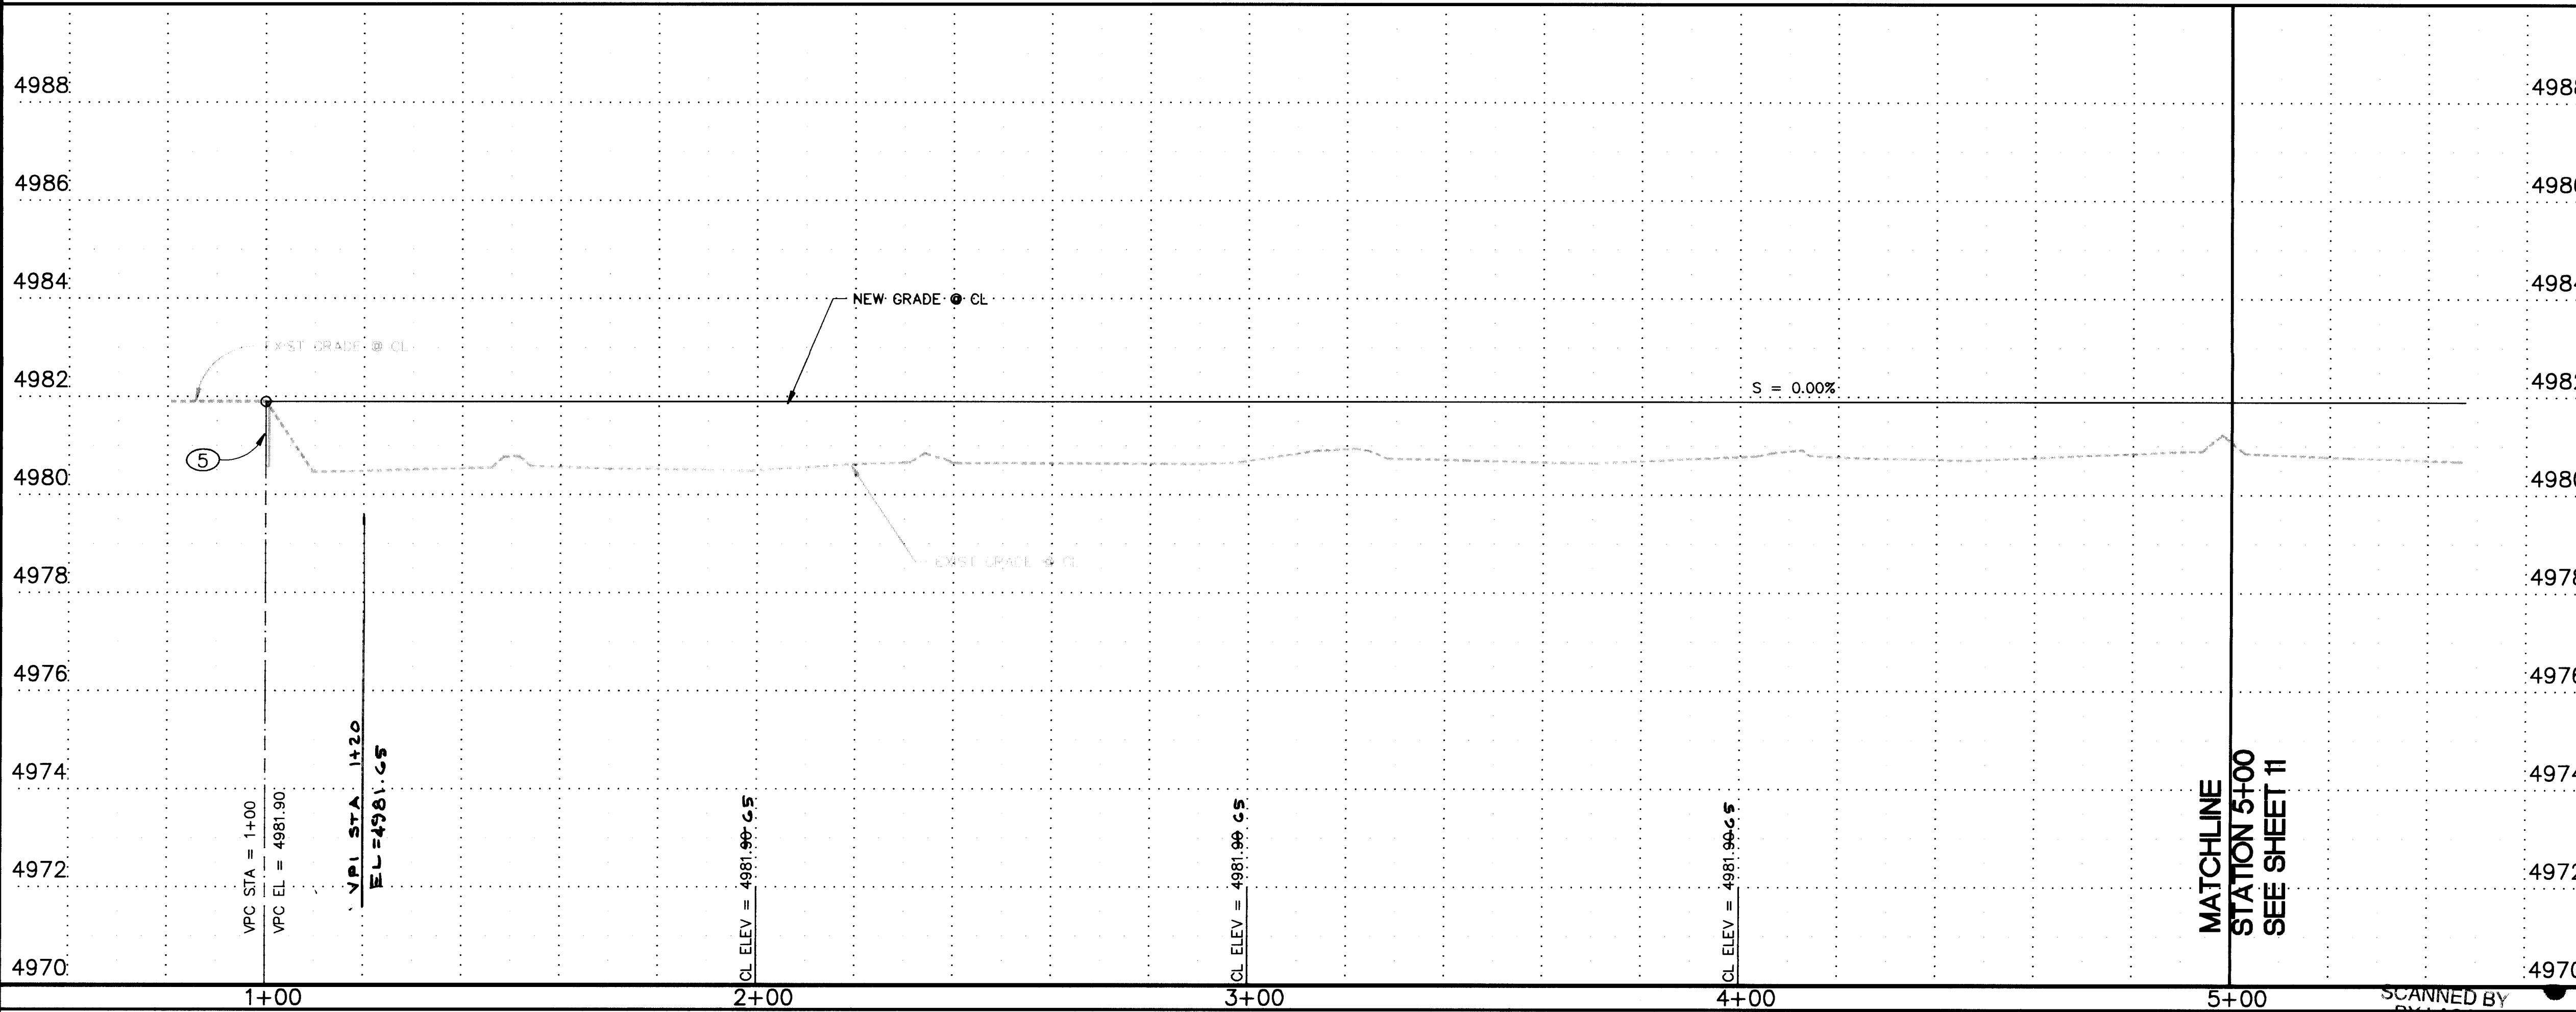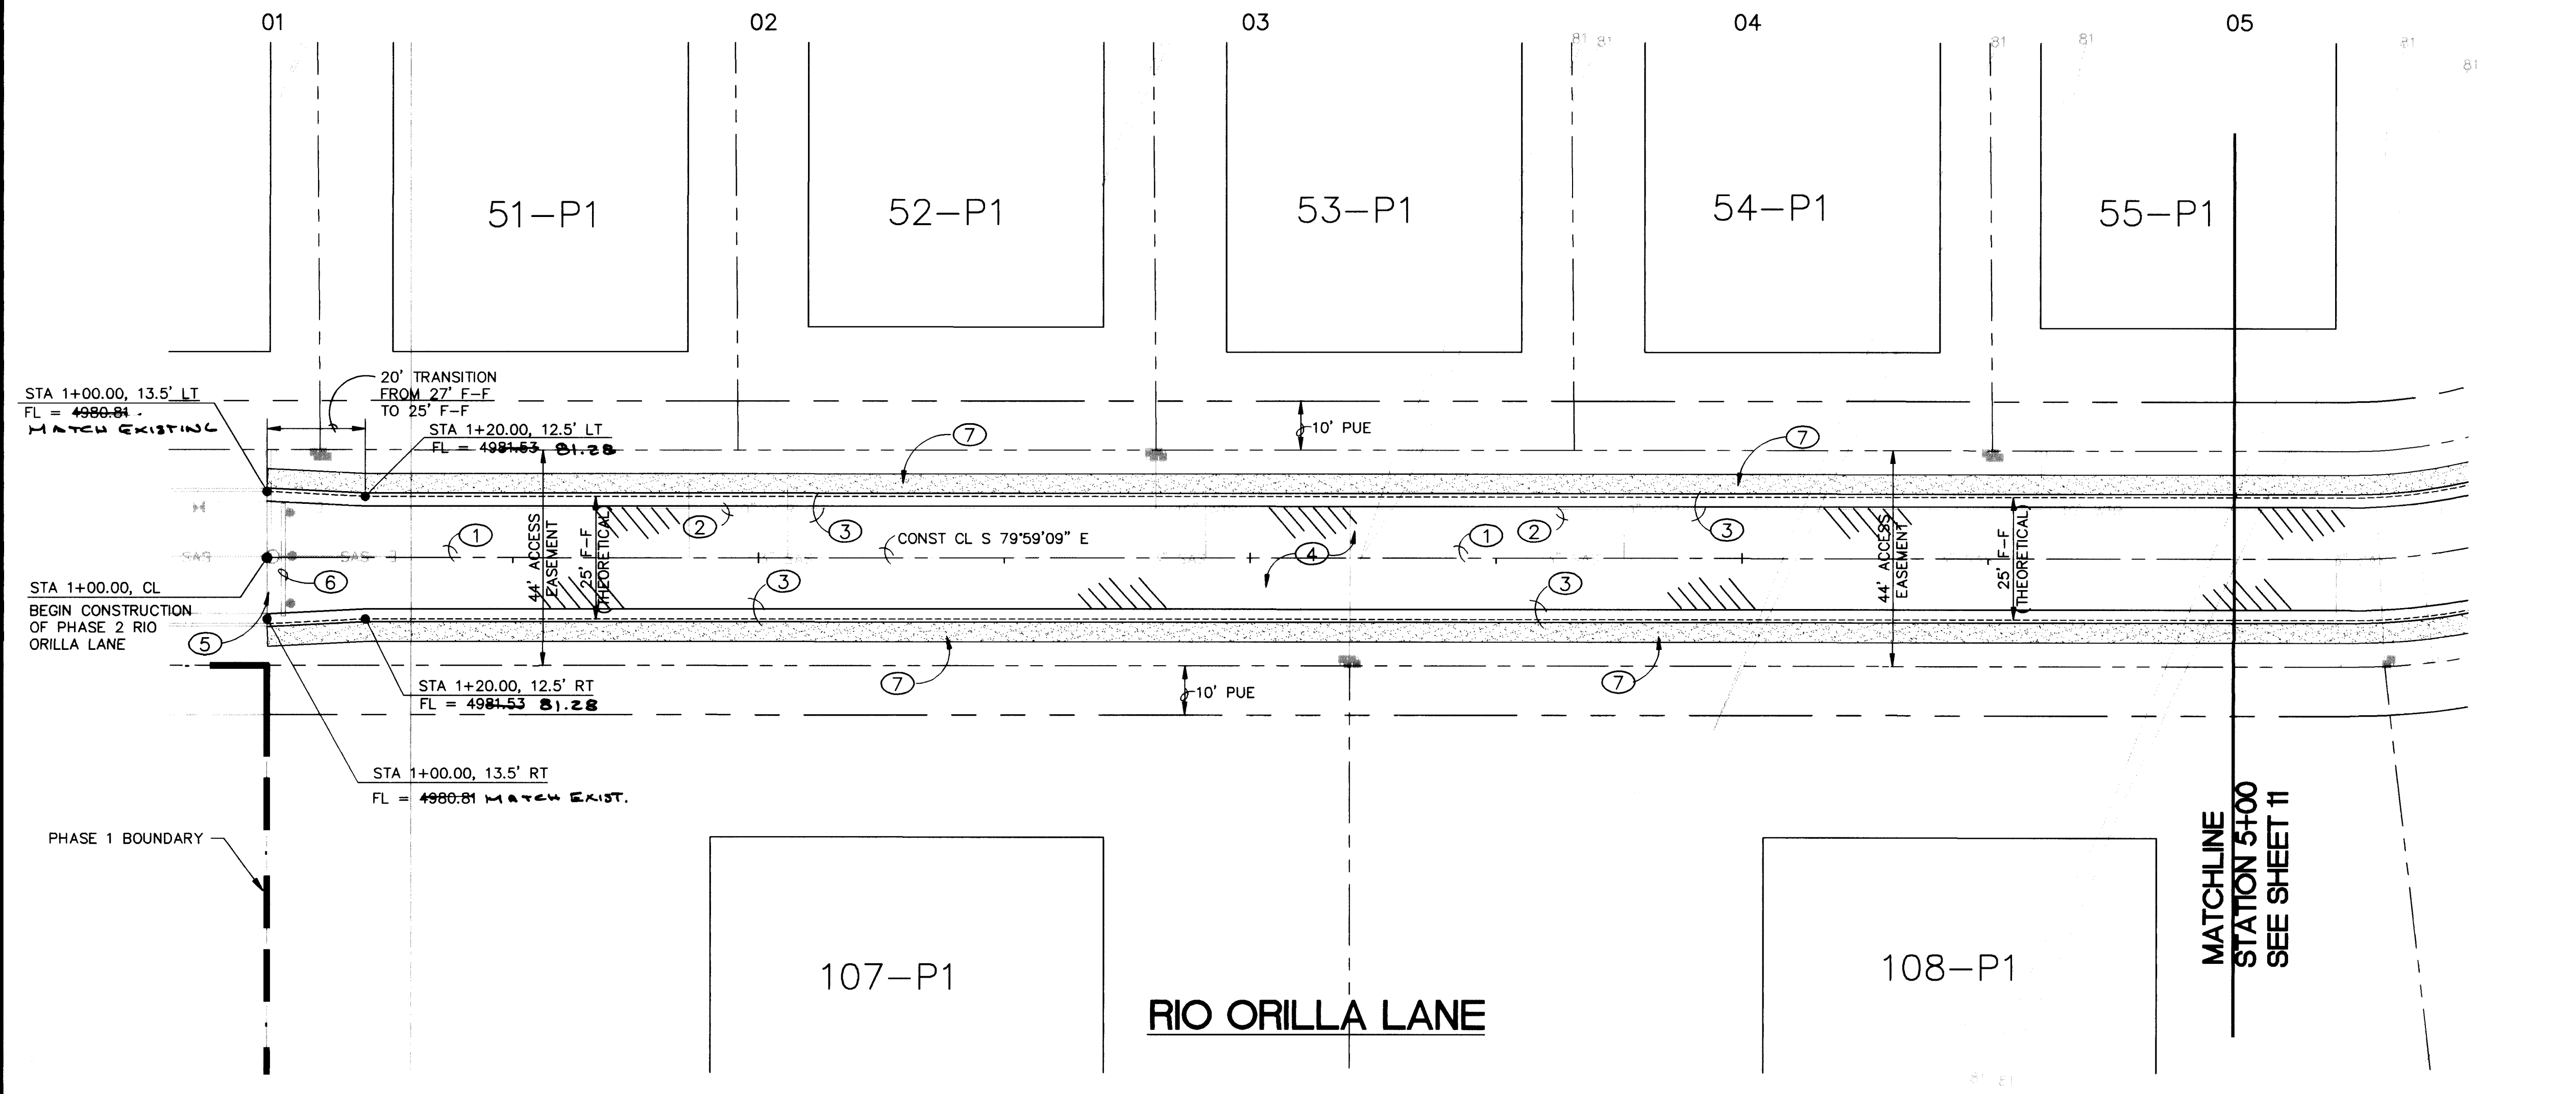

KEYED NOTES:

- CONSTRUCT NEW 3" PRESSURE SANITARY SEWER. SEE UTILITY PLAN AND PROFILE SHEETS 13-19 FOR DETAILS.
- CONSTRUCT NEW 10" PVC WATER LINE. SEE UTILITY PLAN AND PROFILE SHEETS 13-20 FOR DETAILS.
- CONSTRUCT NEW ESTATE TYPE CURB PER COA STD DWG 2415.
- SEE SHEET 22 FOR STREET SECTION.
- REMOVE AND DISPOSE OF EXISTING CUT-OFF WALL. MATCH EXISTING GRADE OF RIO ORILLA LANE, PHASE 1.
- REMOVE AND RELOCATE TYPE III BARRICADE TO END OF RIO ORILLA LANE PHASE 2 CONSTRUCTION.
- CONSTRUCT 4-FOOT GRAVEL SHOULDER. SEE TYPICAL ROAD SECTION, SHEET 22.

AS-BUILT INFORMATION

CONTRACTOR	NEW CONCEPTS
WORKED BY	CSC
INSPECTED BY	CSC
DATE	10/23/97
ACCEPTANCE BY	CSC
DATE	10/23/97
VERIFICATION BY	CSC
DATE	10/23/97
DRAWN BY	CSC
DATE	10/23/97
RECORDED BY	CSC
DATE	10/23/97

BENCH MARKS

U.S. COE STA.	"R ALAMEDA B-2"
N.M. STATE PLAN COORDINATES (CENTRAL ZONE)	BY ACS
X=373,513.20	DATE 07/97
Y=1,520,142.81	BY GAYLE JEWELL
ELEVATION=5,058.25	NO. 4071
G/G FACTOR=0.99967638	

SURVEY INFORMATION

FIELD NOTES	DATE	BY
	07/97	GAYLE JEWELL

ENGINEERS SEAL

PAUL J. CONLEY
NEW MEXICO
1041
REGISTERED PROFESSIONAL ENGINEER
10/23/97

RECORD DRAWINGS

NOTE:
ALL ELEVATIONS SHOWN ON THESE PLANS
HAVE BEEN LOWERED 0.25 FEET.

Horizontal Scale: 1"=20'
Vertical Scale: 1"=2'

Smith Engineering Company
A Full Service Engineering Company
6000 Olympic Boulevard, N.E. Suite 6000 Albuquerque, New Mexico 87110
197629



**CITY OF ALBUQUERQUE
PUBLIC WORKS DEPARTMENT
ENGINEERING DEVELOPMENT GROUP**

**TITLE: BOSQUE DEL RIO SUBDIVISION - PHASE 2
PAVING P & P: RIO ORILLA LANE: STA 1+00 TO 5+00**

DESIGN REVIEW COMMITTEE	City Engineer Approval	Last Design Update
DEC 19 1997		

City Project No. **540682**
Zone Map No. **D-13**
Sheet **10** of **23**

Drawing name: N:\197629\OPTION\197629.DWG
Drawn by: J. L. Lason
Checked by: J. L. Lason
Date: 10/23/97
Time: 6:59 AM

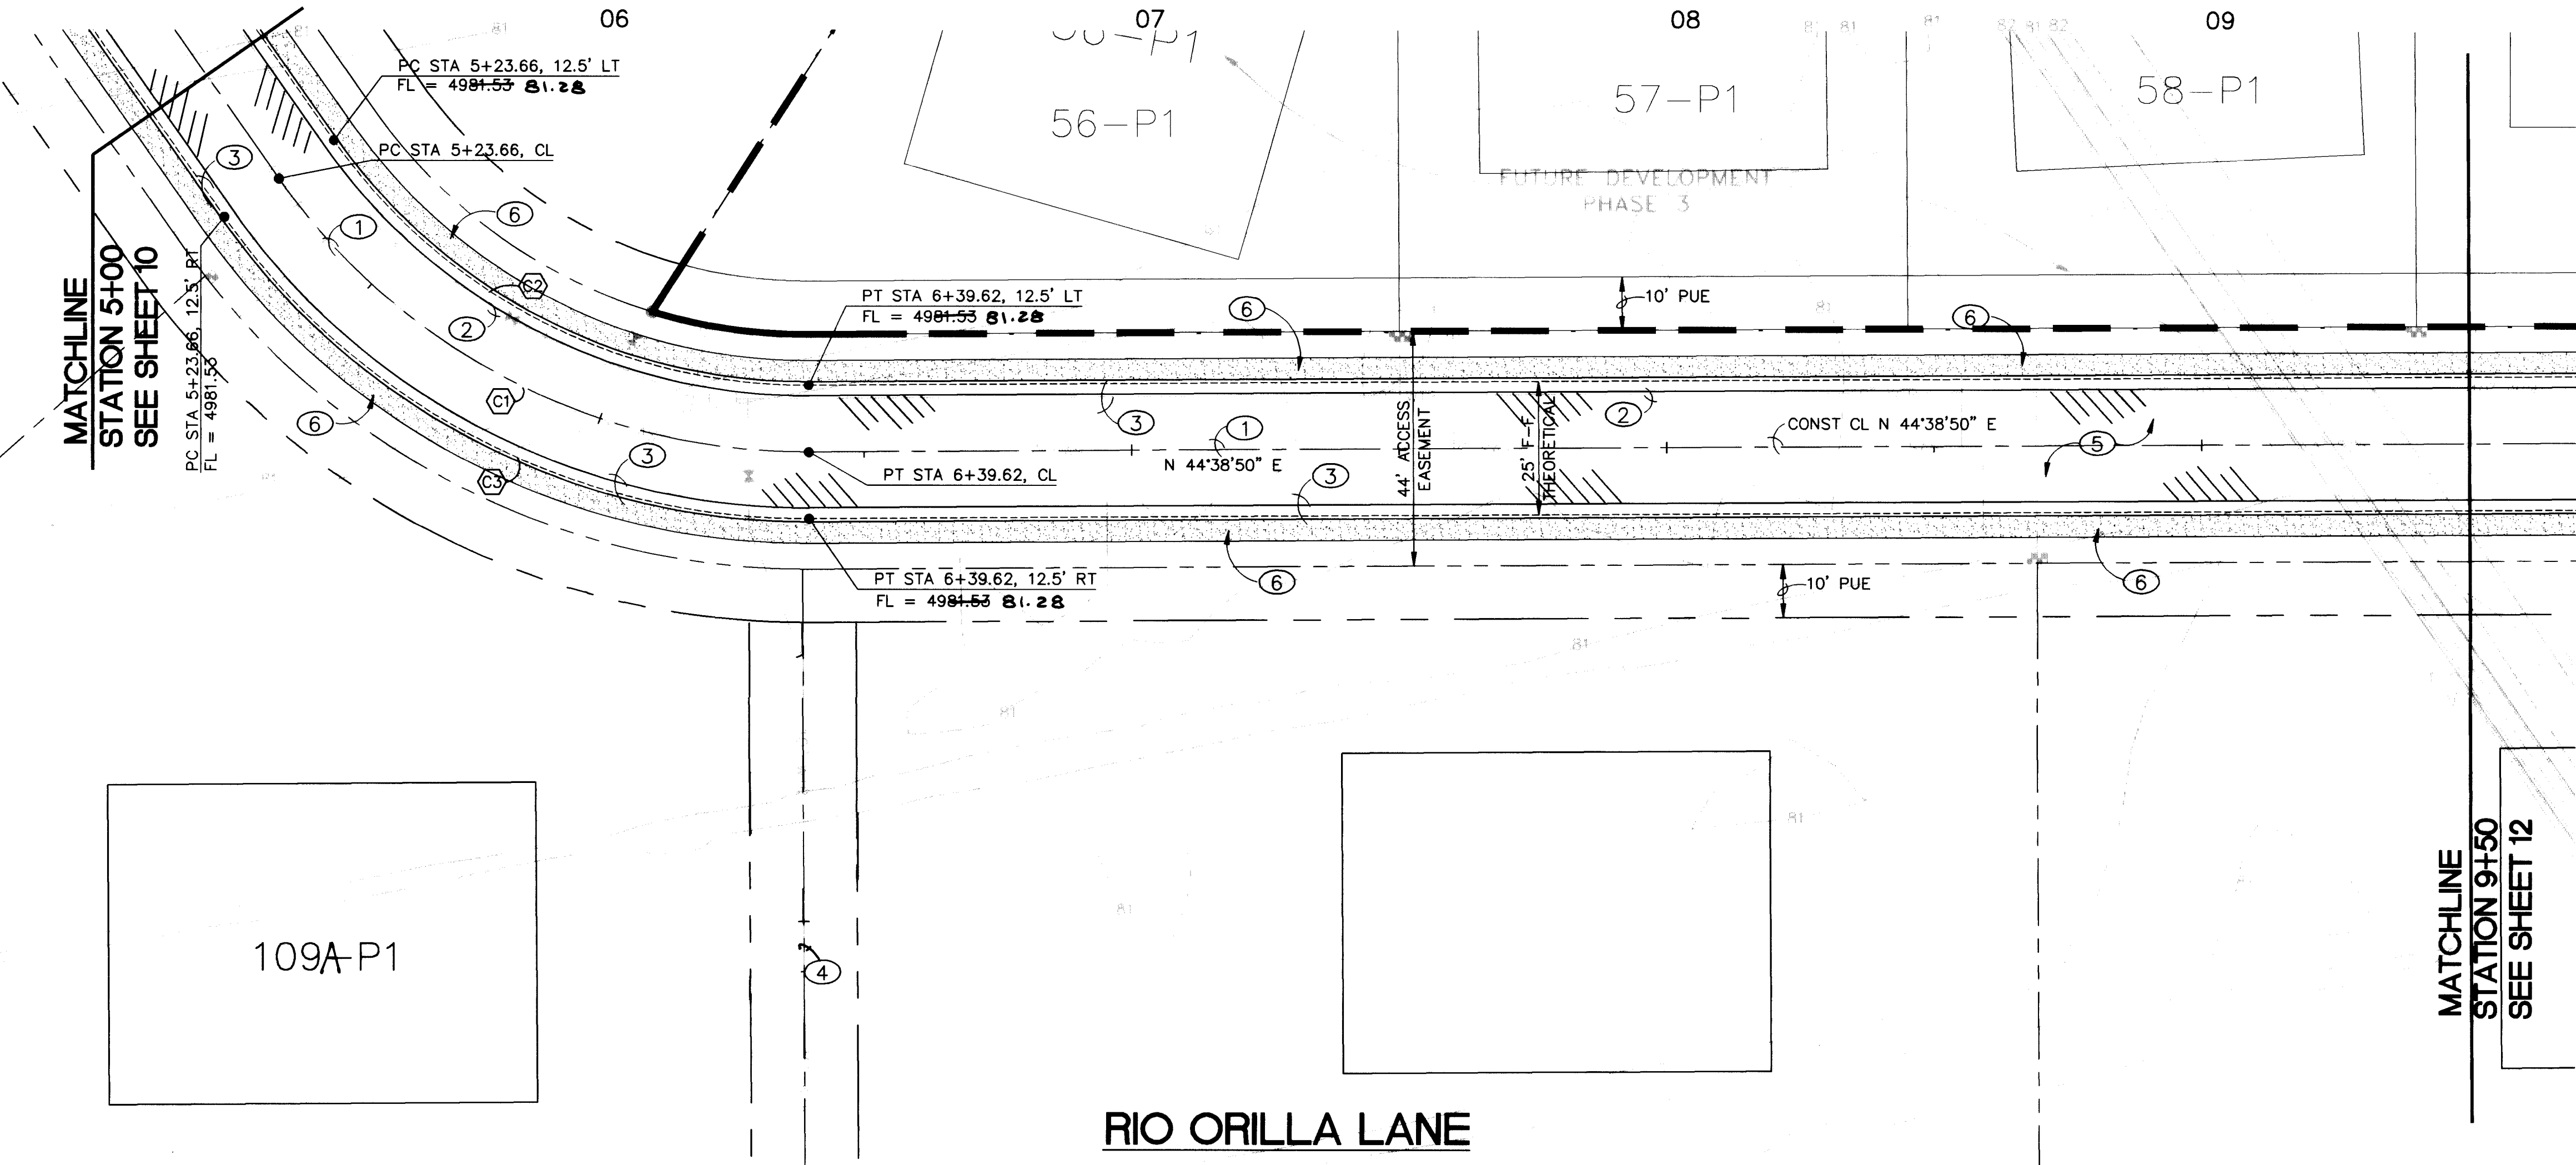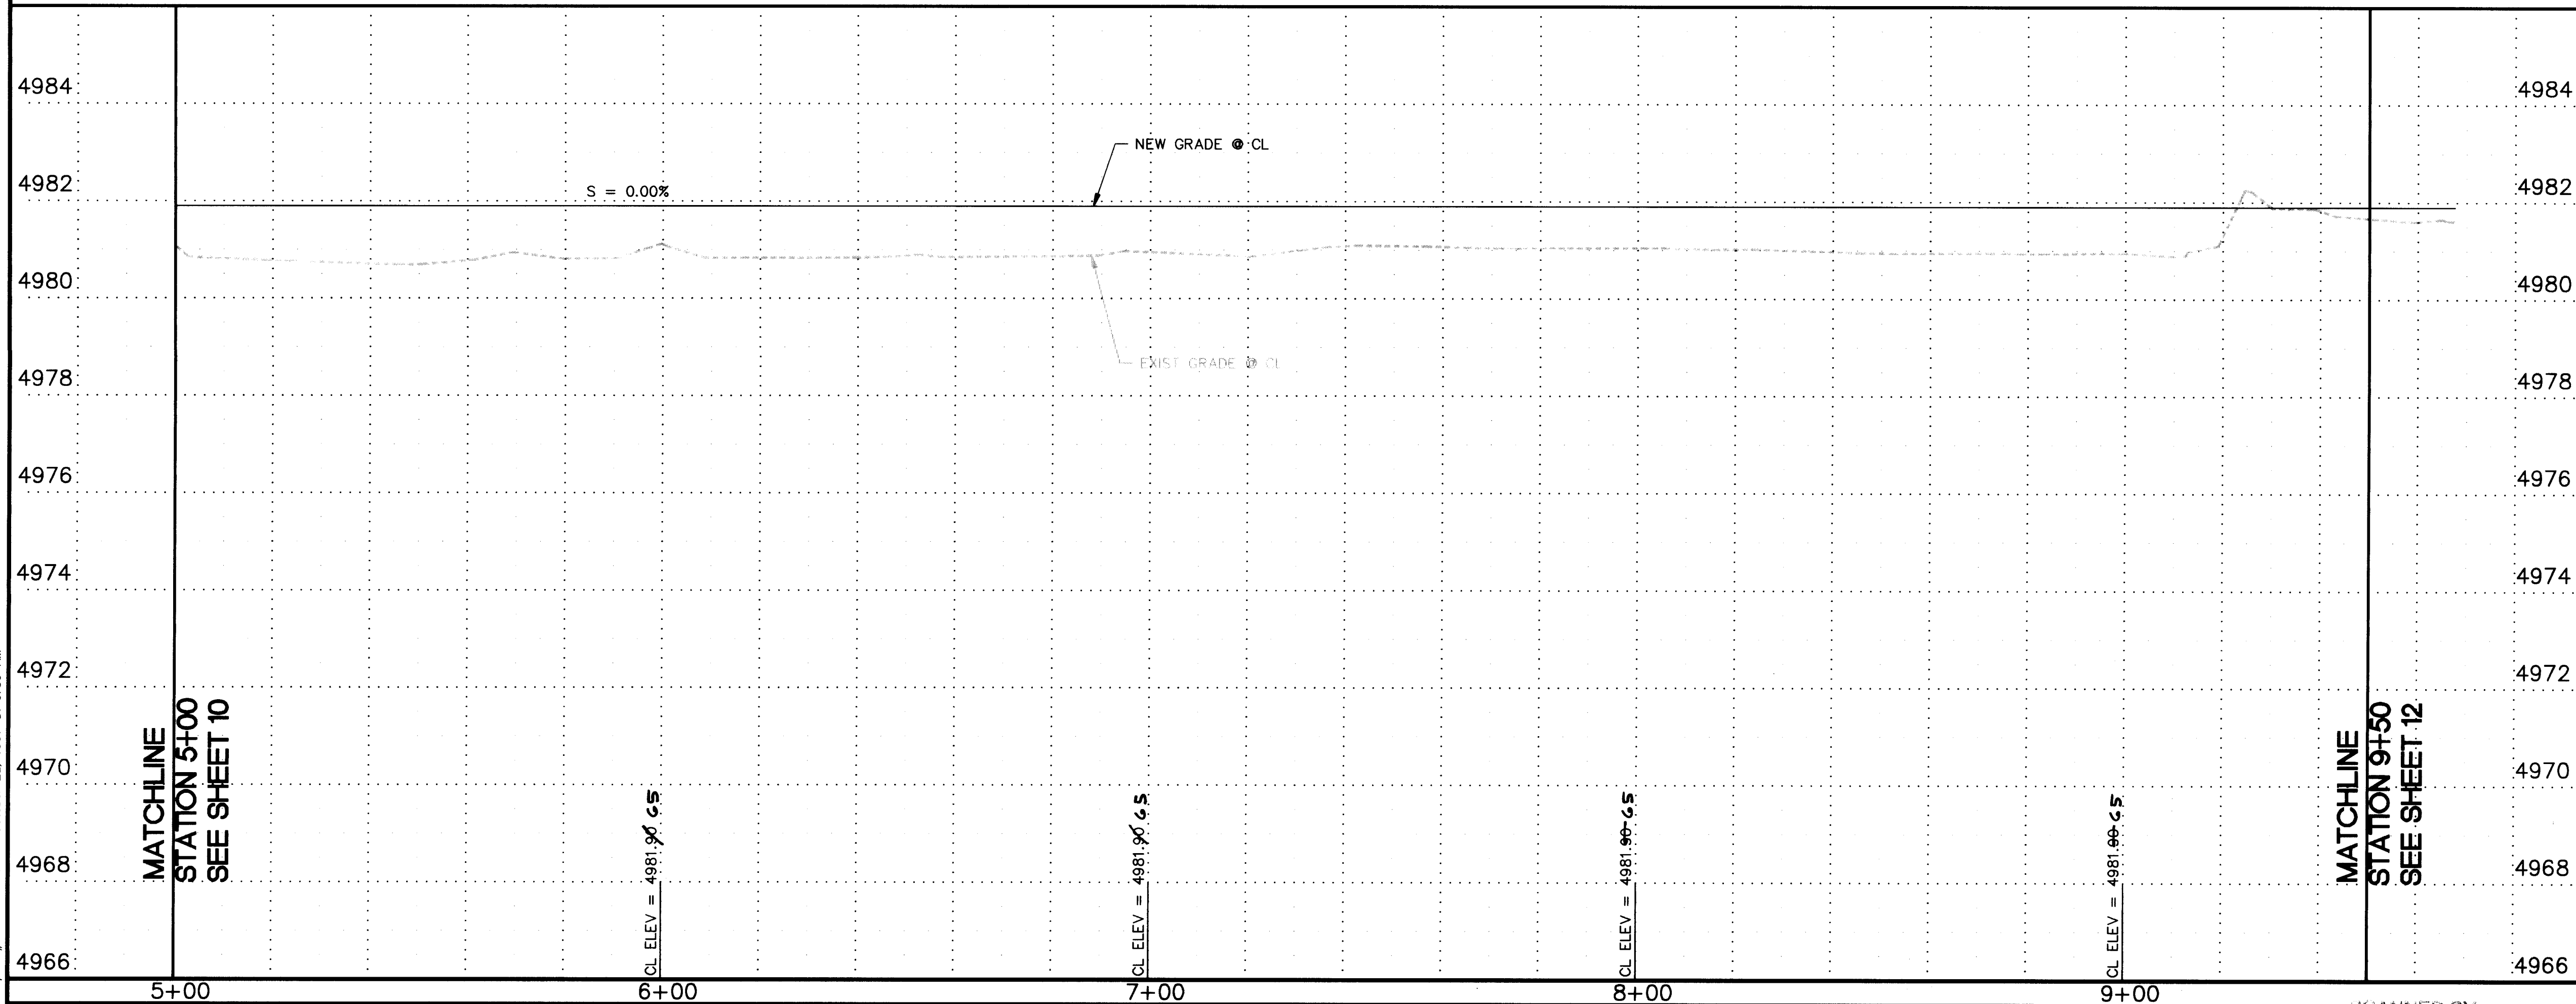

KEYED NOTES:



- CONSTRUCT NEW 3" PRESSURE SANITARY SEWER. SEE UTILITY PLAN AND PROFILE SHEETS 13-19 FOR DETAILS.
- CONSTRUCT NEW 10" PVC WATER LINE. SEE UTILITY PLAN AND PROFILE SHEETS 13-20 FOR DETAILS.
- CONSTRUCT NEW ESTATE TYPE CURB PER PER COA STD DWG 2415.
- CONSTRUCT NEW 10" PVC WATERLINE. SEE SHEET 20 FOR DETAILS.
- SEE SHEET 22 FOR STREET SECTION.
- CONSTRUCT 4-FOOT GRAVEL SHOULDER. SEE TYPICAL ROAD SECTION, SHEET 22.

CURVE DATA

NUMBER	DELTA	RADIUS	TANGENT	ARC LENGTH
C1	55°22'01"	120.00	62.96	115.96
C2	55°22'01"	107.50	56.40	103.88
C3	55°22'01"	132.50	69.52	128.04


RECORD DRAWINGS

NOTE:
ALL ELEVATIONS SHOWN ON THESE PLANS
HAVE BEEN LOWERED 0.25 FEET.

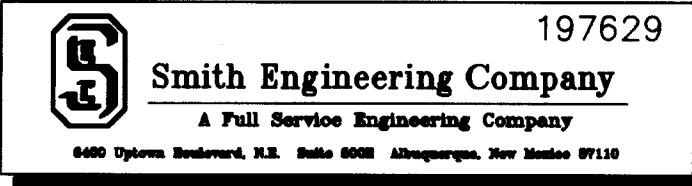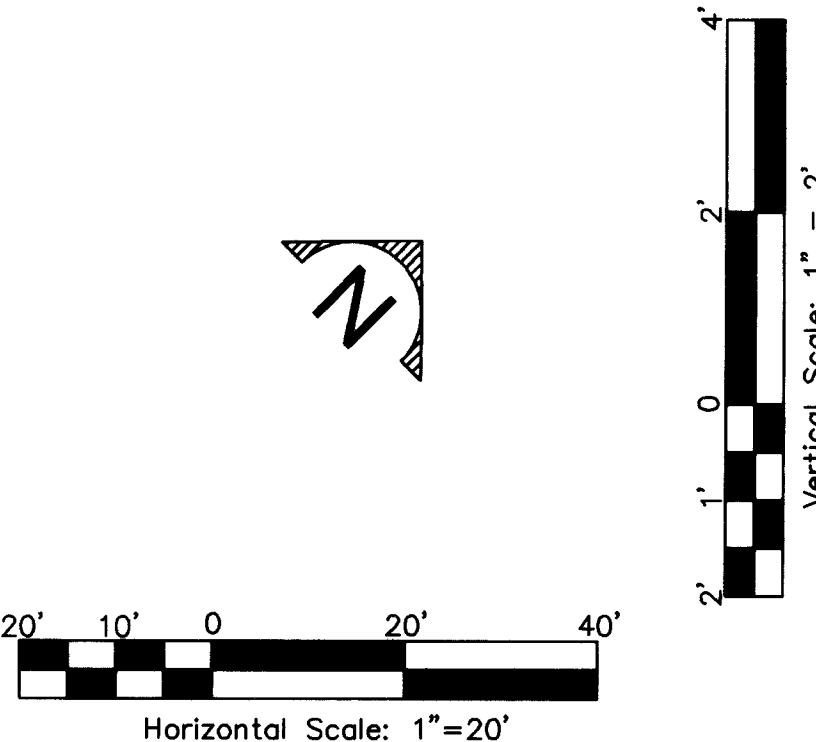


CITY OF ALBUQUERQUE PUBLIC WORKS DEPARTMENT ENGINEERING DEVELOPMENT GROUP			
TITLE: BOSQUE DEL RIO SUBDIVISION - PHASE 2 PAVING P & P: RIO ORILLA LANE: STA 5+00 TO 9+50			
DESIGN REVIEW COMMITTEE DEC 19 1997	CITY ENGINEER APPROVAL	DESIGN REVIEW COMMITTEE	DESIGN REVIEW COMMITTEE
City Project No. 540682	Zone Map No. D-13	Sheet 11 of 23	

Drawing name: N:\197629\OPTION\1296PWP.DWG
Saved on: October 22, 1997 at 7:01 AM
Printed on: October 22, 1997 at 7:01 AM

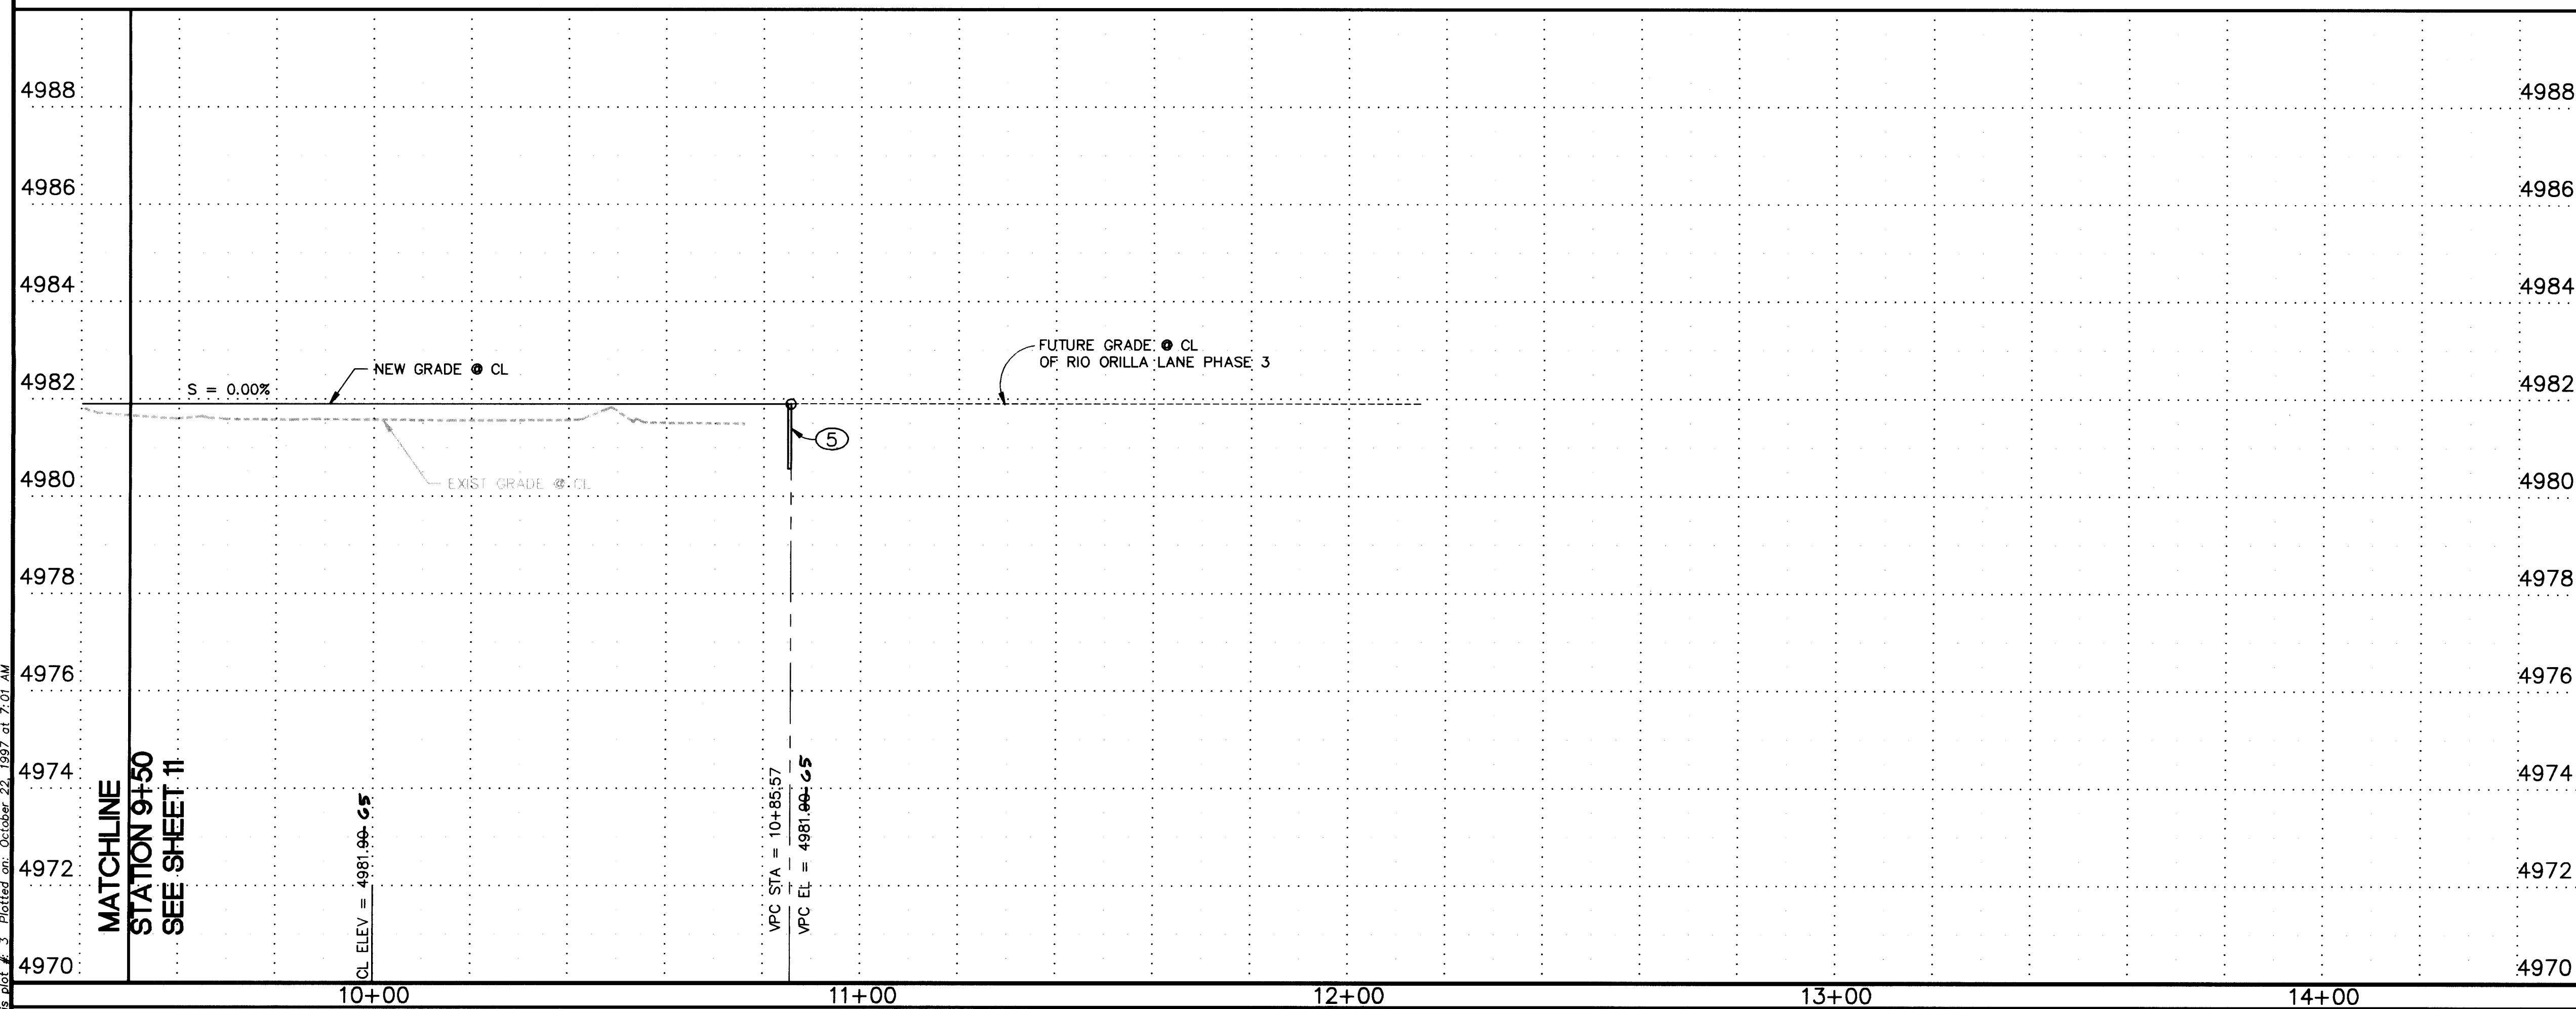

MATCHLINE
STATION 9+50
SEE SHEET 11

MATCHLINE
STATION 9+50
SEE SHEET 11

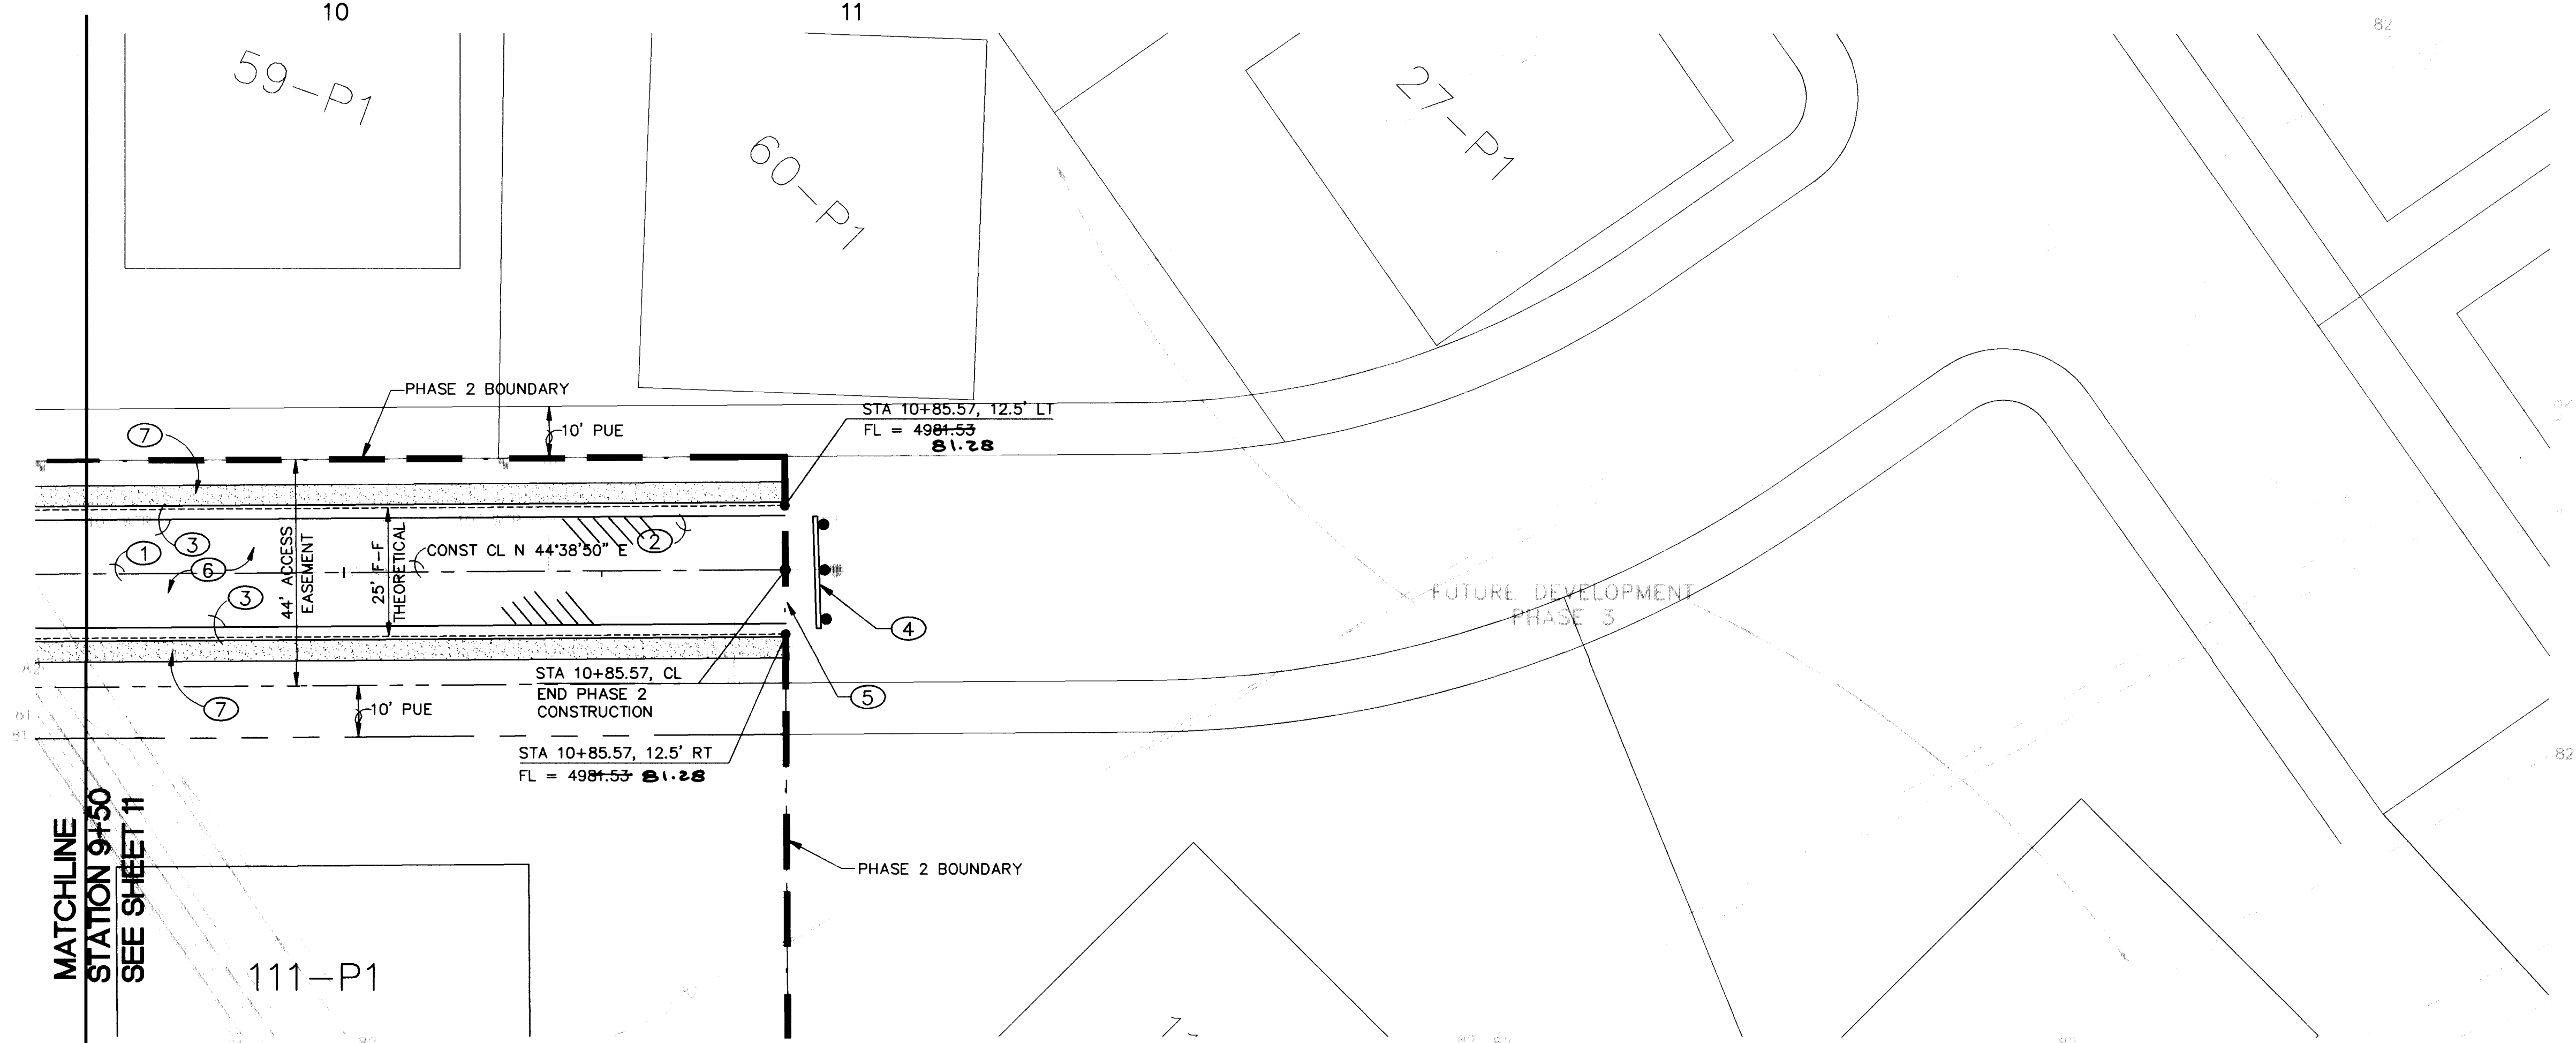



RIO ORILLA LANE

KEYED NOTES:

1. CONSTRUCT NEW 3" PRESSURE SANITARY SEWER. SEE UTILITY PLAN AND PROFILE SHEETS 13-19 FOR DETAILS.
2. CONSTRUCT NEW 10" PVC WATER LINE. SEE UTILITY PLAN AND PROFILE SHEETS 13-20 FOR DETAILS.
3. CONSTRUCT NEW ESTATE TYPE CURB PER COA STD DWG 2415.
4. REUSE EXISTING BARRICADE FROM BEGINNING OF RIO ORILLA LANE CONSTRUCTION. SEE TYPE III BARRICADE WITH RED AND WHITE STRIPING PER MUTCD, 1992 ED FOR DETAILS.
5. CONSTRUCT CUT-OFF WALL FROM LIP (LT) TO LIP (RT) AT END OF ROADWAY (PHASE TWO) PER COA STD DWG 2415.
6. SEE SHEET 22 FOR STREET SECTION.
7. CONSTRUCT 4-FOOT GRAVEL SHOULDER. SEE TYPICAL ROAD SECTION, SHEET 22.


RECORD DRAWINGS

NOTE:
ALL ELEVATIONS SHOWN ON THESE PLANS
HAVE BEEN LOWERED 0.25 FEET.

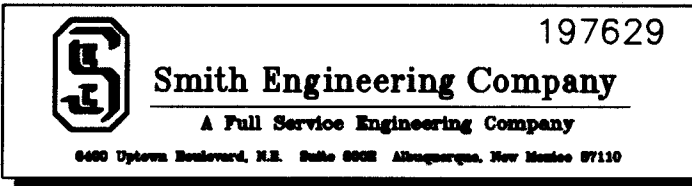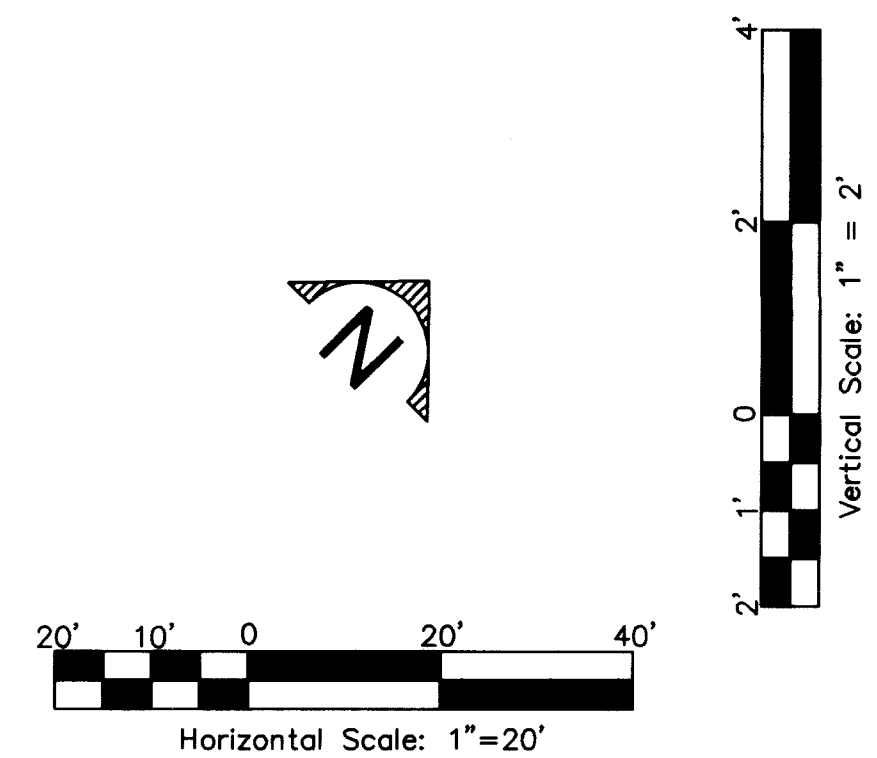

CITY OF ALBUQUERQUE PUBLIC WORKS DEPARTMENT ENGINEERING DEVELOPMENT GROUP	
TITLE: BOSQUE DEL RIO SUBDIVISION - PHASE 2 PAVING P & P: RIO ORILLA LANE: STA 9+50 TO 10+85.57	
DESIGNED BY: AUG / BAC	DATE: 10/23/97
DRAWN BY: BAC	DATE: 10/23/97
CHECKED BY: PJC	DATE: 10/23/97
City Project No. 540682	Zone Map No. D-13
Sheet 12 of 23	

Drawing name: N:\197623\OPTION\13UPWP.DWG
Saved on: October 22, 1997 at 7:03 AM
This is Plot # 1 of 1. Plotted on: October 22, 1997 at 7:03 AM

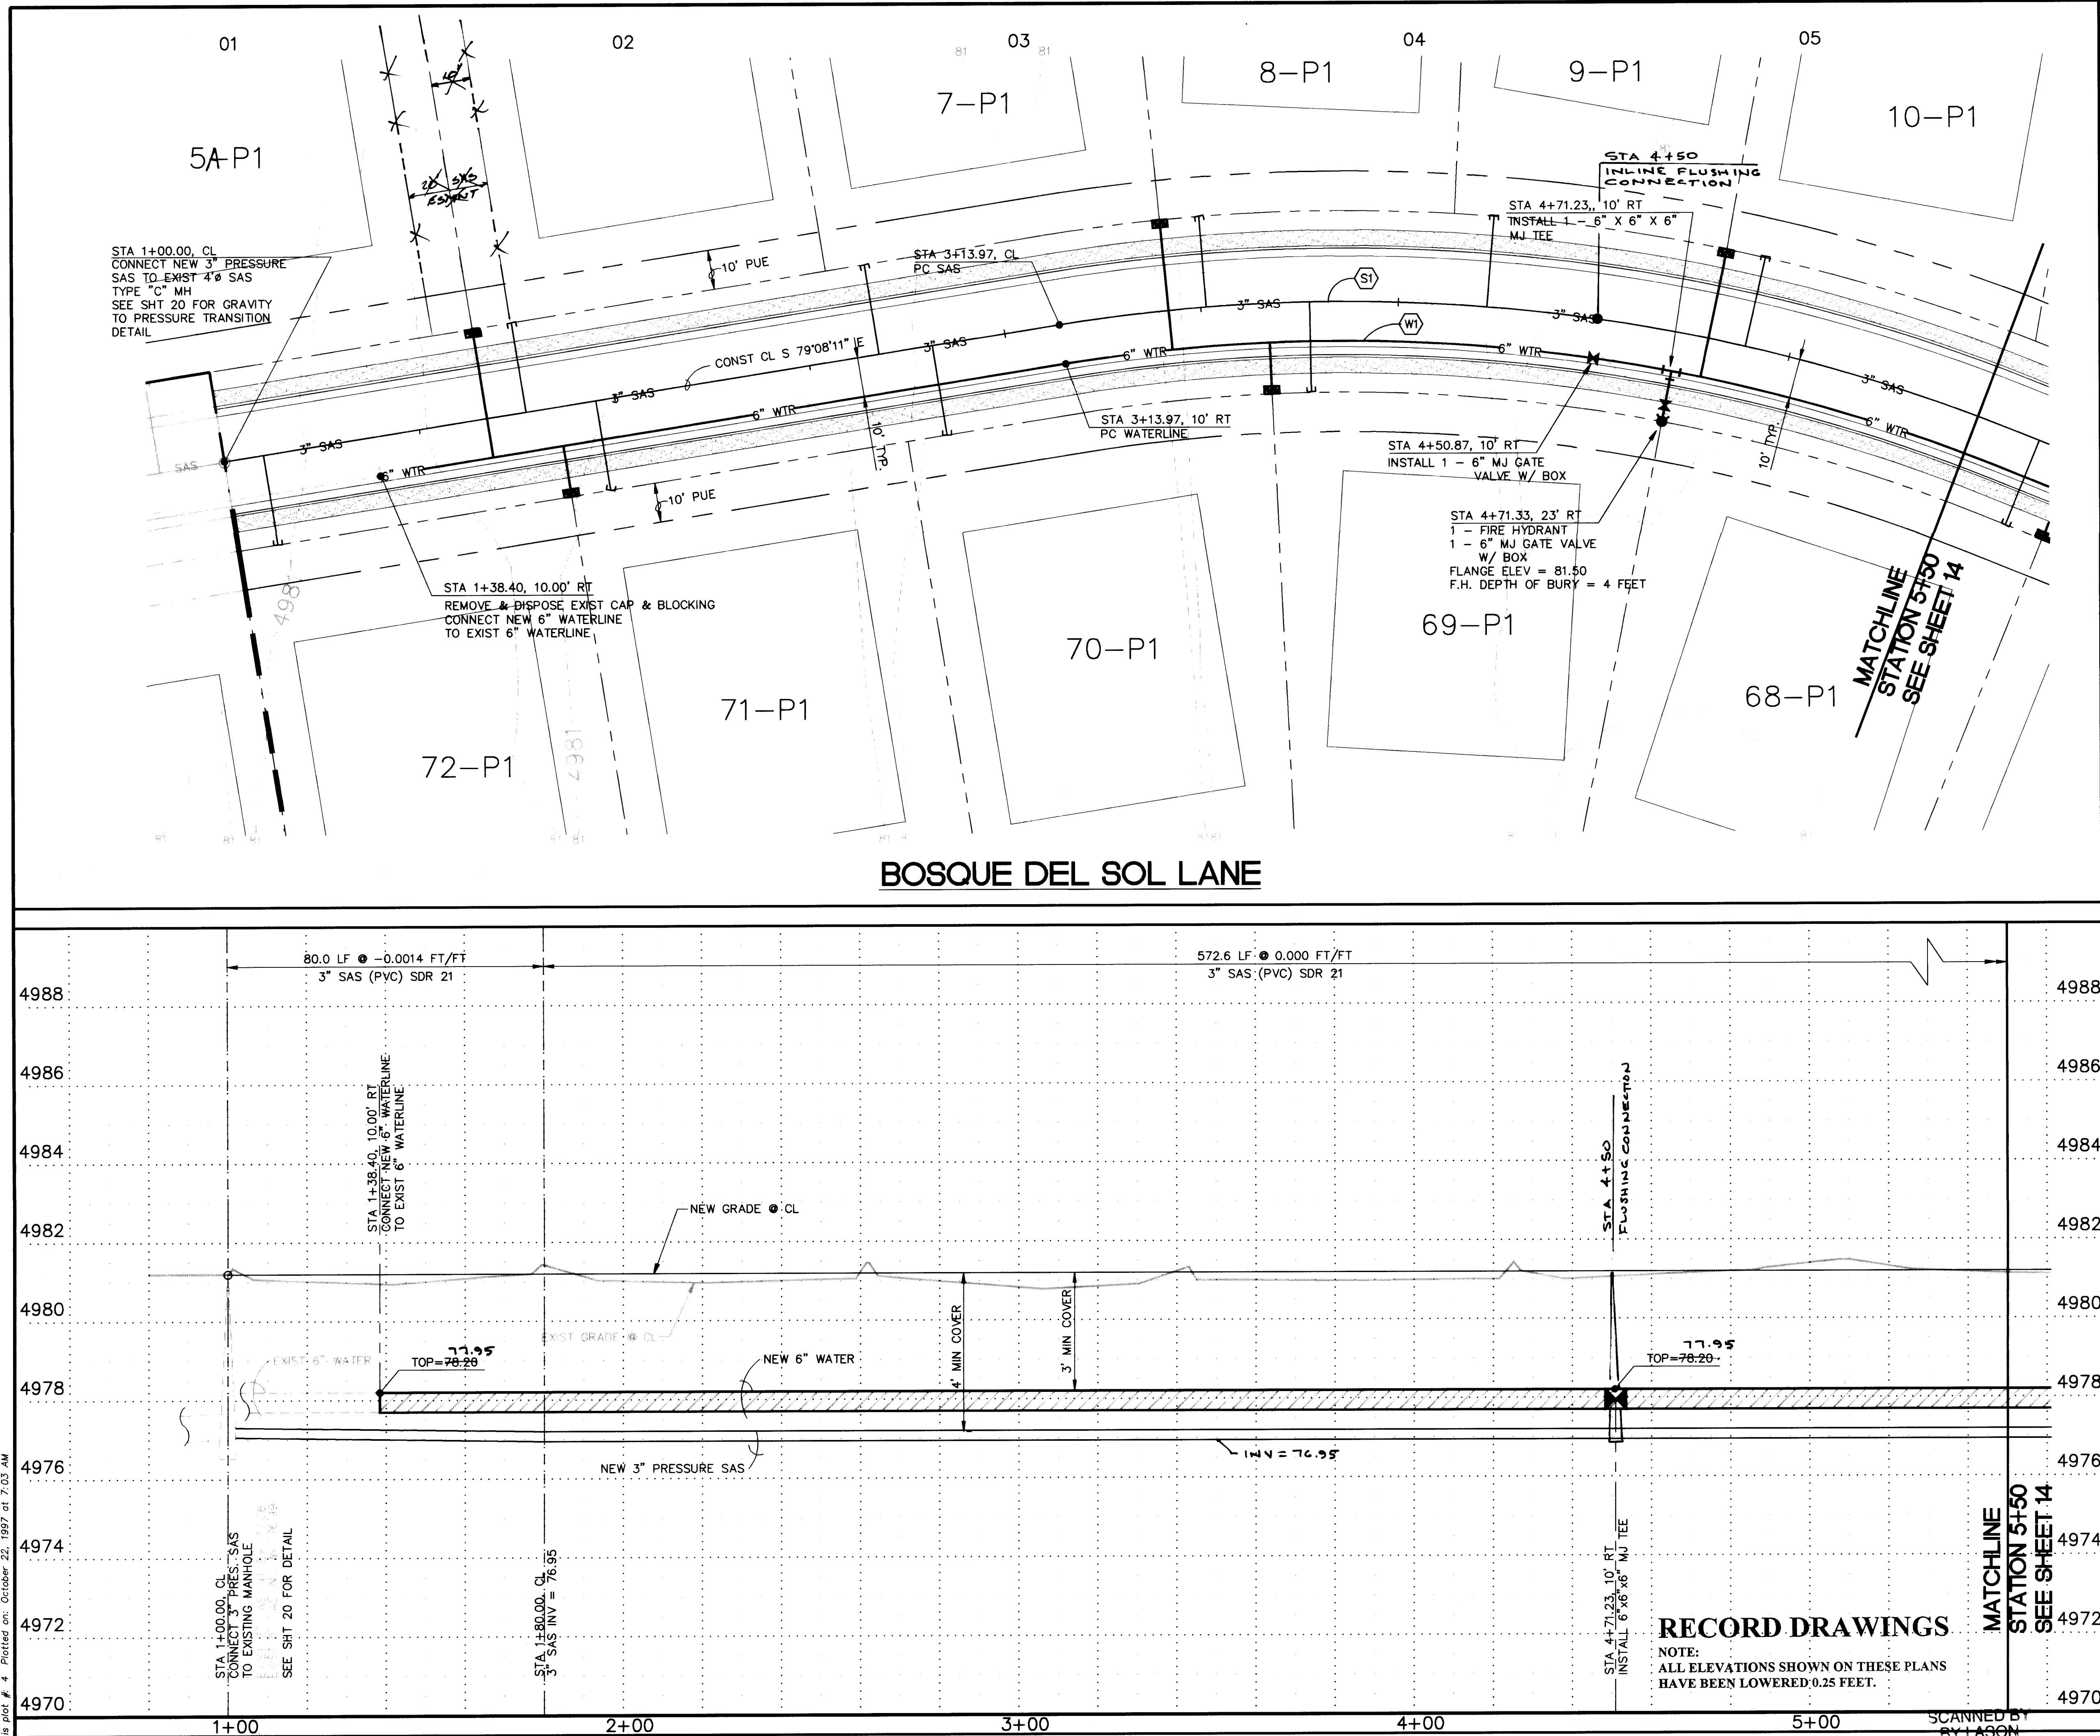

GENERAL NOTES:

- ALL WATERLINE FITTINGS TO BE RESTRAINED "MJ". SEE RESTRAINT LENGTH TABLE THIS SHEET.
- FOR WATER SERVICE CONNECTIONS SEE COA STD DWG 2363.
- FOR SANITARY SERVICE CONNECTIONS SEE DETAIL SHEET 21.
- BACKFLOW PREVENTERS TO BE INSTALLED ON ALL WATER SERVICES.

SAS CURVE DATA

NUMBER	DELTA	RADIUS	TANGENT	ARC LENGTH
S1	31°09'32"	450.00	125.47	244.72

WATERLINE CURVE DATA

NUMBER	DELTA	RADIUS	TANGENT	ARC LENGTH
W1	31°09'32"	440.00	122.68	239.28

WATERLINE RESTRAINT LENGTHS:

LENGTH OF RESTRAINT FOR TEES

BRANCH SIZE	LENGTH OF RESTRAINT (FT)
6"x6"x6"	24'
10"x10"x6"	RESTRAIN BRANCH AT FITTING ONLY 10'
10"x10"x10"	64'

* EACH PIPE RUN SHALL HAVE A MINIMUM OF 10' W/O JOINTS ON EACH SIDE OF BRANCH OR FITTINGS. FOR TEES RESTRAIN PIPE IN THREE DIRECTIONS.

LENGTH OF RESTRAINT FOR HORIZ BENDS, REDUCERS, VALVES AND DEAD ENDS 10"x6"

PIPE SIZE	11.25"	22.5"	REDUCER	VALVE	
SIZE	10"	14"	SMALL SIDE	LARGE SIDE	DEAD END
6"	10'	14'	18'	10'	73'
10"	15'	21'	27'	15'	115'

BOSQUE DEL SOL LANE SANITARY SEWER SERVICES

LOT NO.	STATION	OFFSET	LENGTH	IN ELEV AT CL	TYPE
5A-P1	1+77.28	CL	23'	76.99	PRES
7-P1	2+67.75	CL	23'	76.95	PRES
8-P1	3+51.33	CL	23'	76.95	PRES
9-P1	4+22.39	CL	23'	76.95	PRES
10-P1	4+88.47	CL	23'	76.95	PRES
69-P1	3+77.52	CL	23'	76.95	PRES
70-P1	2+81.40	CL	23'	76.95	PRES
71-P1	1+95.20	CL	23'	76.95	PRES
72-P1	1+10.00	CL	23'	76.95	PRES

BOSQUE DEL SOL LANE 5A-P1 WATER SERVICES

LOT NO.	STATION	LENGTH	SIZE	TYPE
5A-P1	1+67.28	10'RT	3/4"	DBL
7-P1	3+41.82	10'RT	3/4"	DBL
8-P1	4+78.97	10'RT	3/4"	DBL
9-P1	3+66.99	10'RT	3/4"	DBL
10-P1	1+85.20	10'RT	3/4"	DBL

RECORD DRAWINGS

NOTE: ALL ELEVATIONS SHOWN ON THESE PLANS HAVE BEEN LOWERED 0.25 FEET.

APPROVE

DEC 19 1997

DESIGN REVIEW COMMITTEE

City Engineer Approval

No. / Day / Yr.

No. / Day / Yr.

DESIGNED BY AUG / BAC
DRAWN BY BAC
CHECKED BY PUC

DATE 10/23/97
DATE 10/23/97
DATE 10/23/97

CITY OF ALBUQUERQUE PUBLIC WORKS DEPARTMENT ENGINEERING DEVELOPMENT GROUP

TITLE: BOSQUE DEL RIO SUBDIVISION - PHASE 2

UTILITY P & P: BOSQUE DEL SOL LANE: STA 1+00 TO 5+50

City Project No. 540682

Zone Map No. D-13

Sheet 13 of 23

AS-BUILT INFORMATION

CONTRACTOR: NEW CONCEPTS
STARTED BY: CSC
DATE: 3/98
INSPECTOR'S FIELD VERIFICATION BY: CSC
DATE: 4/98
CORRECTED BY: CSC
DATE: 5/98
MICRO-FILM INFORMATION
RECORDED BY: DATE
NO.

BENCH MARKS

U.S. COE STA. "R" ALAMEDA B-2"
N.M. STATE PLAN COORDINATES (CENTRAL ZONE) BY ACS
X=373,513.20
Y=1,520,142.81
ELEVATION=5,058.25
G/G FACTOR=0.99967636

SURVEY INFORMATION

FIELD NOTES
DATE: 07/97
BY: GAYLE JEWELL
NO. 4071

ENGINEERS SEAL

10/23/97

10/23/97


REVISIONS

NO.	DATE	REMARKS	BY
1			


DESIGN

DESIGNED BY: AUG / BAC
DATE: 10/23/97
DRAWN BY: BAC
DATE: 10/23/97
CHECKED BY: PUC
DATE: 10/23/97

Drawing name: N:\197629\OPTION\14\BWP.DWG
Saved on: October 22, 1997 at 7:05 AM
User: JASON
Plotted on: October 22, 1997 at 7:05 AM

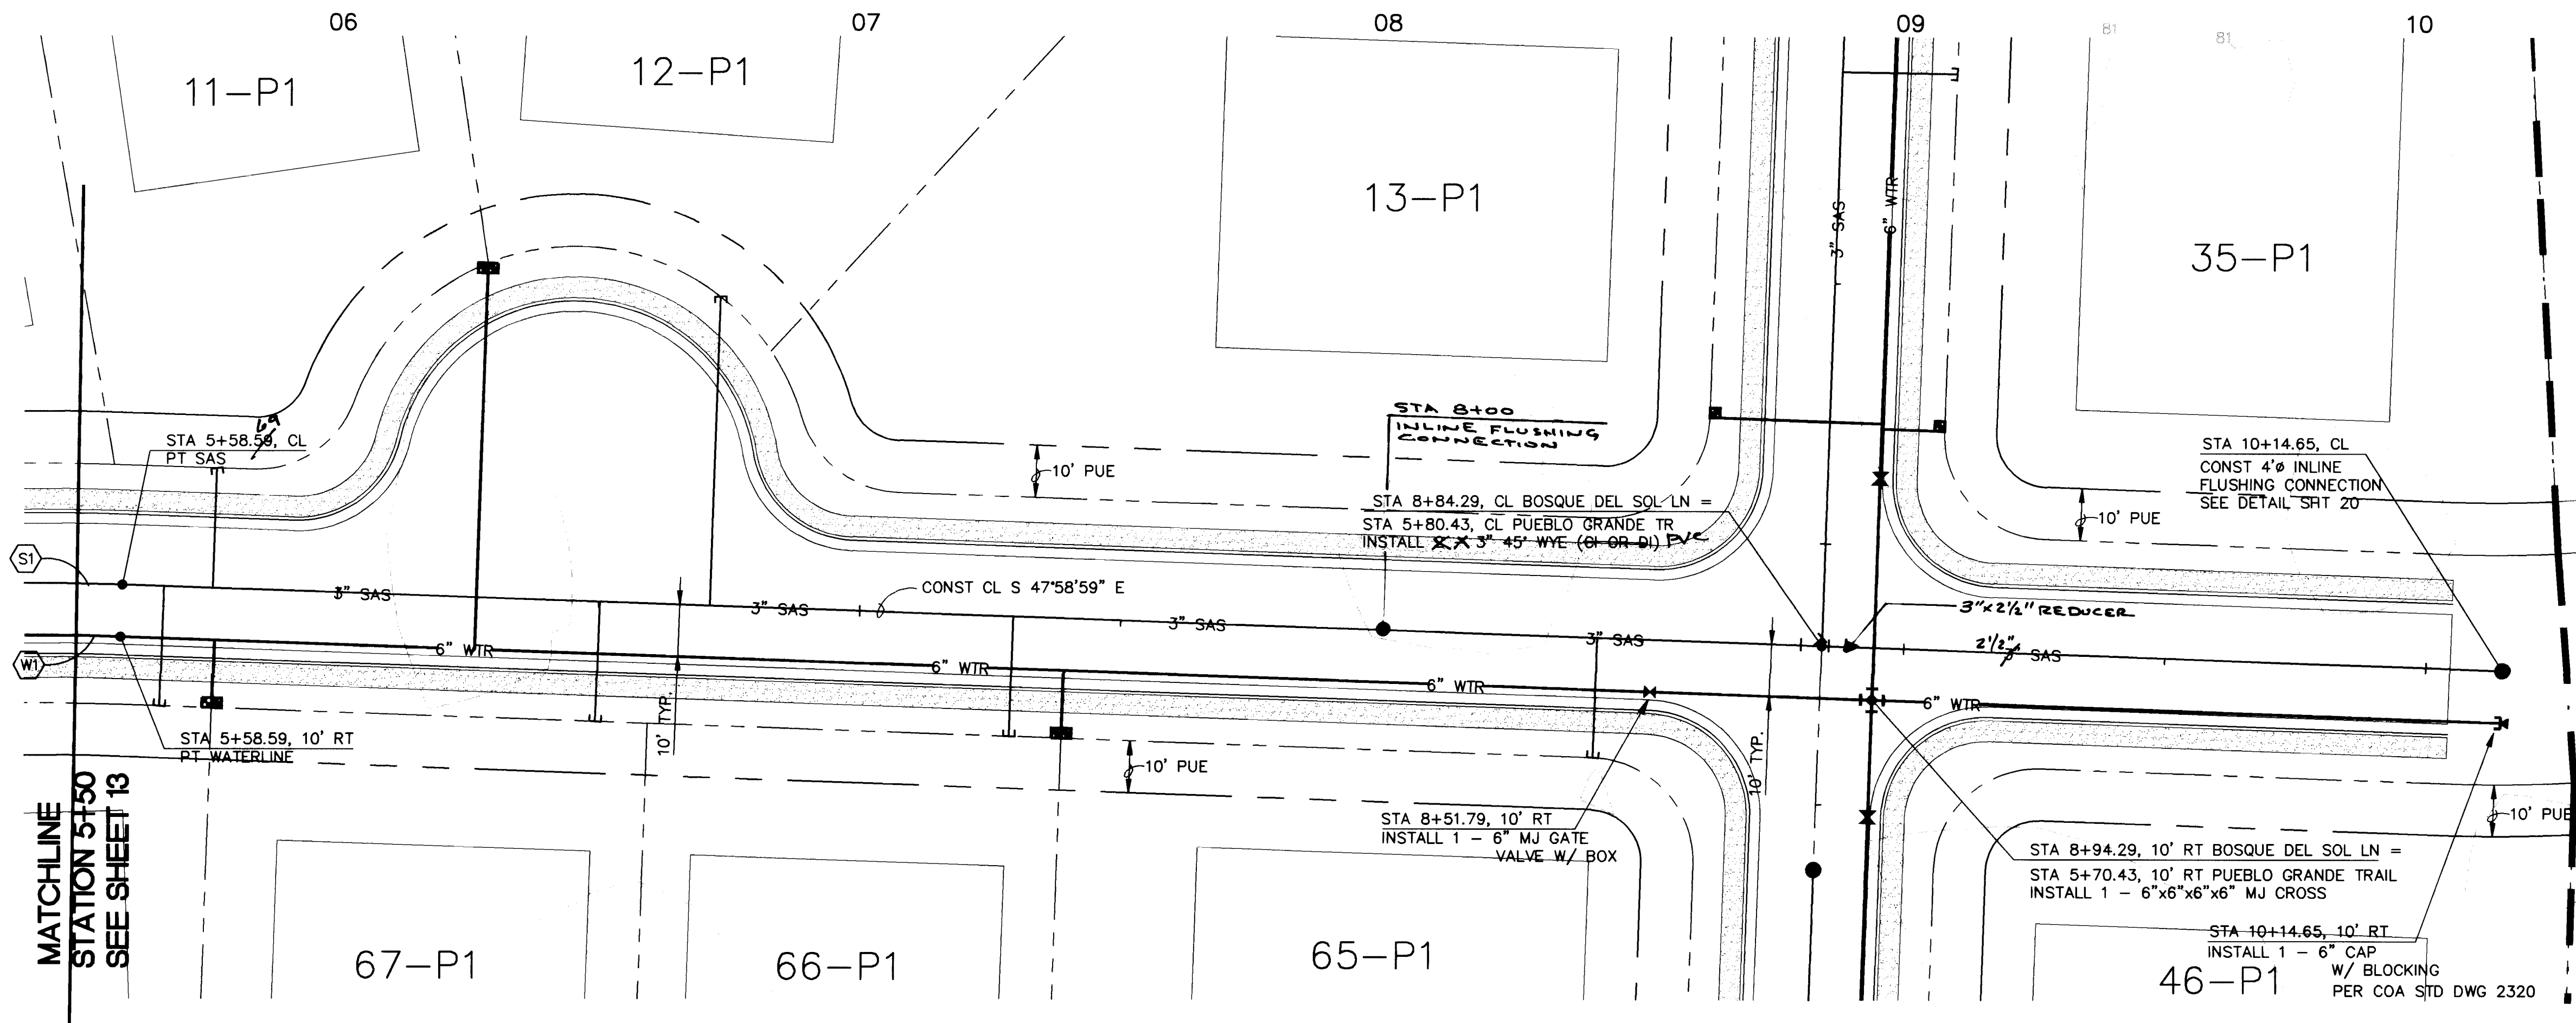

BOSQUE DEL SOL LANE

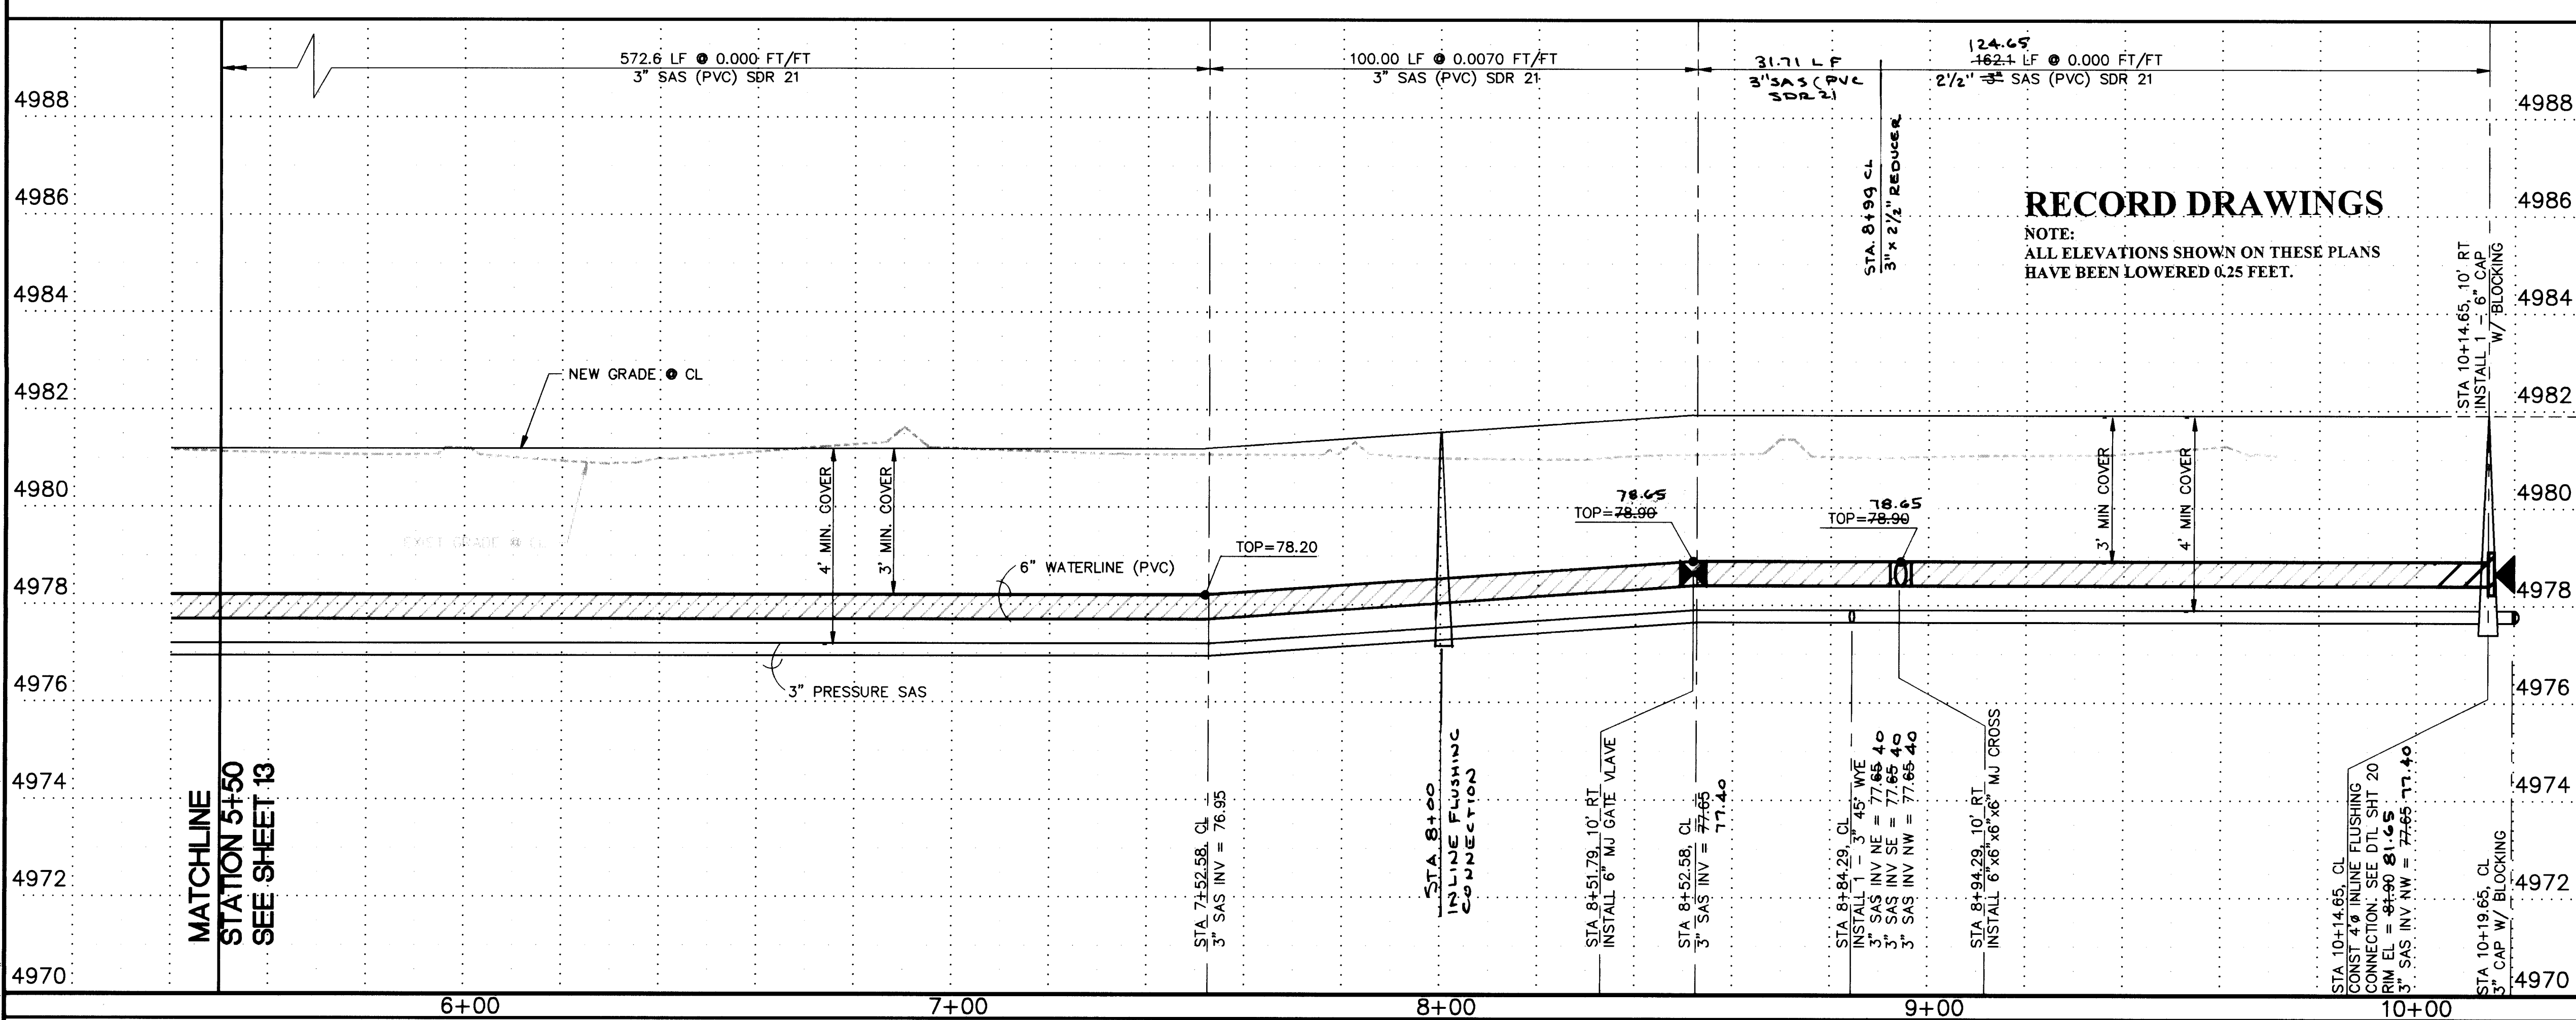

GENERAL NOTES:

- ALL WATERLINE FITTINGS TO BE RESTRAINED "MJ". SEE RESTRAINT LENGTH TABLE THIS SHEET.
- FOR WATER SERVICE CONNECTIONS SEE COA STD DWG 2363.
- FOR SANITARY SERVICE CONNECTIONS SEE DETAIL SHEET 21.
- BACKFLOW PREVENTERS TO BE INSTALLED ON ALL WATER SERVICES.

SAS CURVE DATA

NUMBER	DELTA	RADIUS	TANGENT	ARC LENGTH
S1	31°09'32"	450.00	125.47	244.72

WATERLINE CURVE DATA

NUMBER	DELTA	RADIUS	TANGENT	ARC LENGTH
W1	31°09'32"	440.00	122.68	239.28

WATERLINE RESTRAINT LENGTHS:

LENGTH OF RESTRAINT FOR TEES

BRANCH SIZE	LENGTH OF RESTRAINT (FT)
6"x6"x6"	24'
10"x10"x6"	RESTRAINT BRANCH AT FITTING ONLY 10'
10"x10"x10"	64'

* EACH PIPE RUN SHALL HAVE A MINIMUM OF 10' W/O JOINTS ON EACH SIDE OF BRANCH OR FITTINGS. FOR TEES RESTRAINT PIPE IN THREE DIRECTIONS.

LENGTH OF RESTRAINT FOR HORIZ BENDS, REDUCERS, VALVES AND DEAD ENDS



PIPE SIZE	11.25'	22.5'	REDUCER	VALVE/ DEAD END
6"	10'	14'	10' 10'	73'
10"	15'	21'	21' 15'	115'

BOSQUE DEL SOL LANE SANITARY SEWER SERVICES


LOT NO.	STATION	OFFSET	LENGTH	IN. ELEV	TYPE
11-P1	5+75.99	CL	23'	76.95	PRES
12-P1	6+71.24	CL	59'	76.95	PRES
65-P1	8+41.29	CL	23'	77.57	PRES
66-P1	7+29.44	CL	23'	76.95	PRES
67-P1	6+50.15	CL	23'	76.95	PRES
68-P1	5+66.65	CL	23'	76.95	PRES

BOSQUE DEL SOL LANE WATER SERVICES


LOT NO.	STATION	LENGTH	SIZE	TYPE
11-P1	6+26.51	10' RT	3/4"	DBL
12-P1	7+39.44	10' RT	3/4"	DBL
65-P1	5+76.65	10' RT	3/4"	DBL

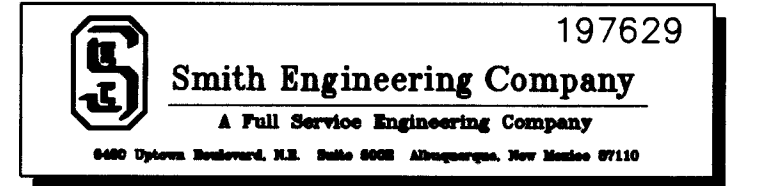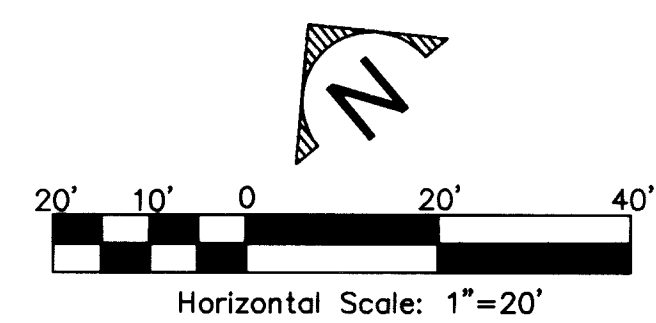

CITY OF ALBUQUERQUE PUBLIC WORKS DEPARTMENT ENGINEERING DEVELOPMENT GROUP	
TITLE: BOSQUE DEL RIO SUBDIVISION - PHASE 2 UTILITY P & P: BOSQUE DEL SOL LANE: STA 5+50 TO 10+04.65	
DESIGN APPROVAL DEC 19 1997	CITY ENGINEER APPROVAL
DESIGN REVIEW COMMITTEE	NO. / DAY / YR.
CITY PROJECT NO. 540682	Zone Map No. D-13
Sheet 14 of 23	

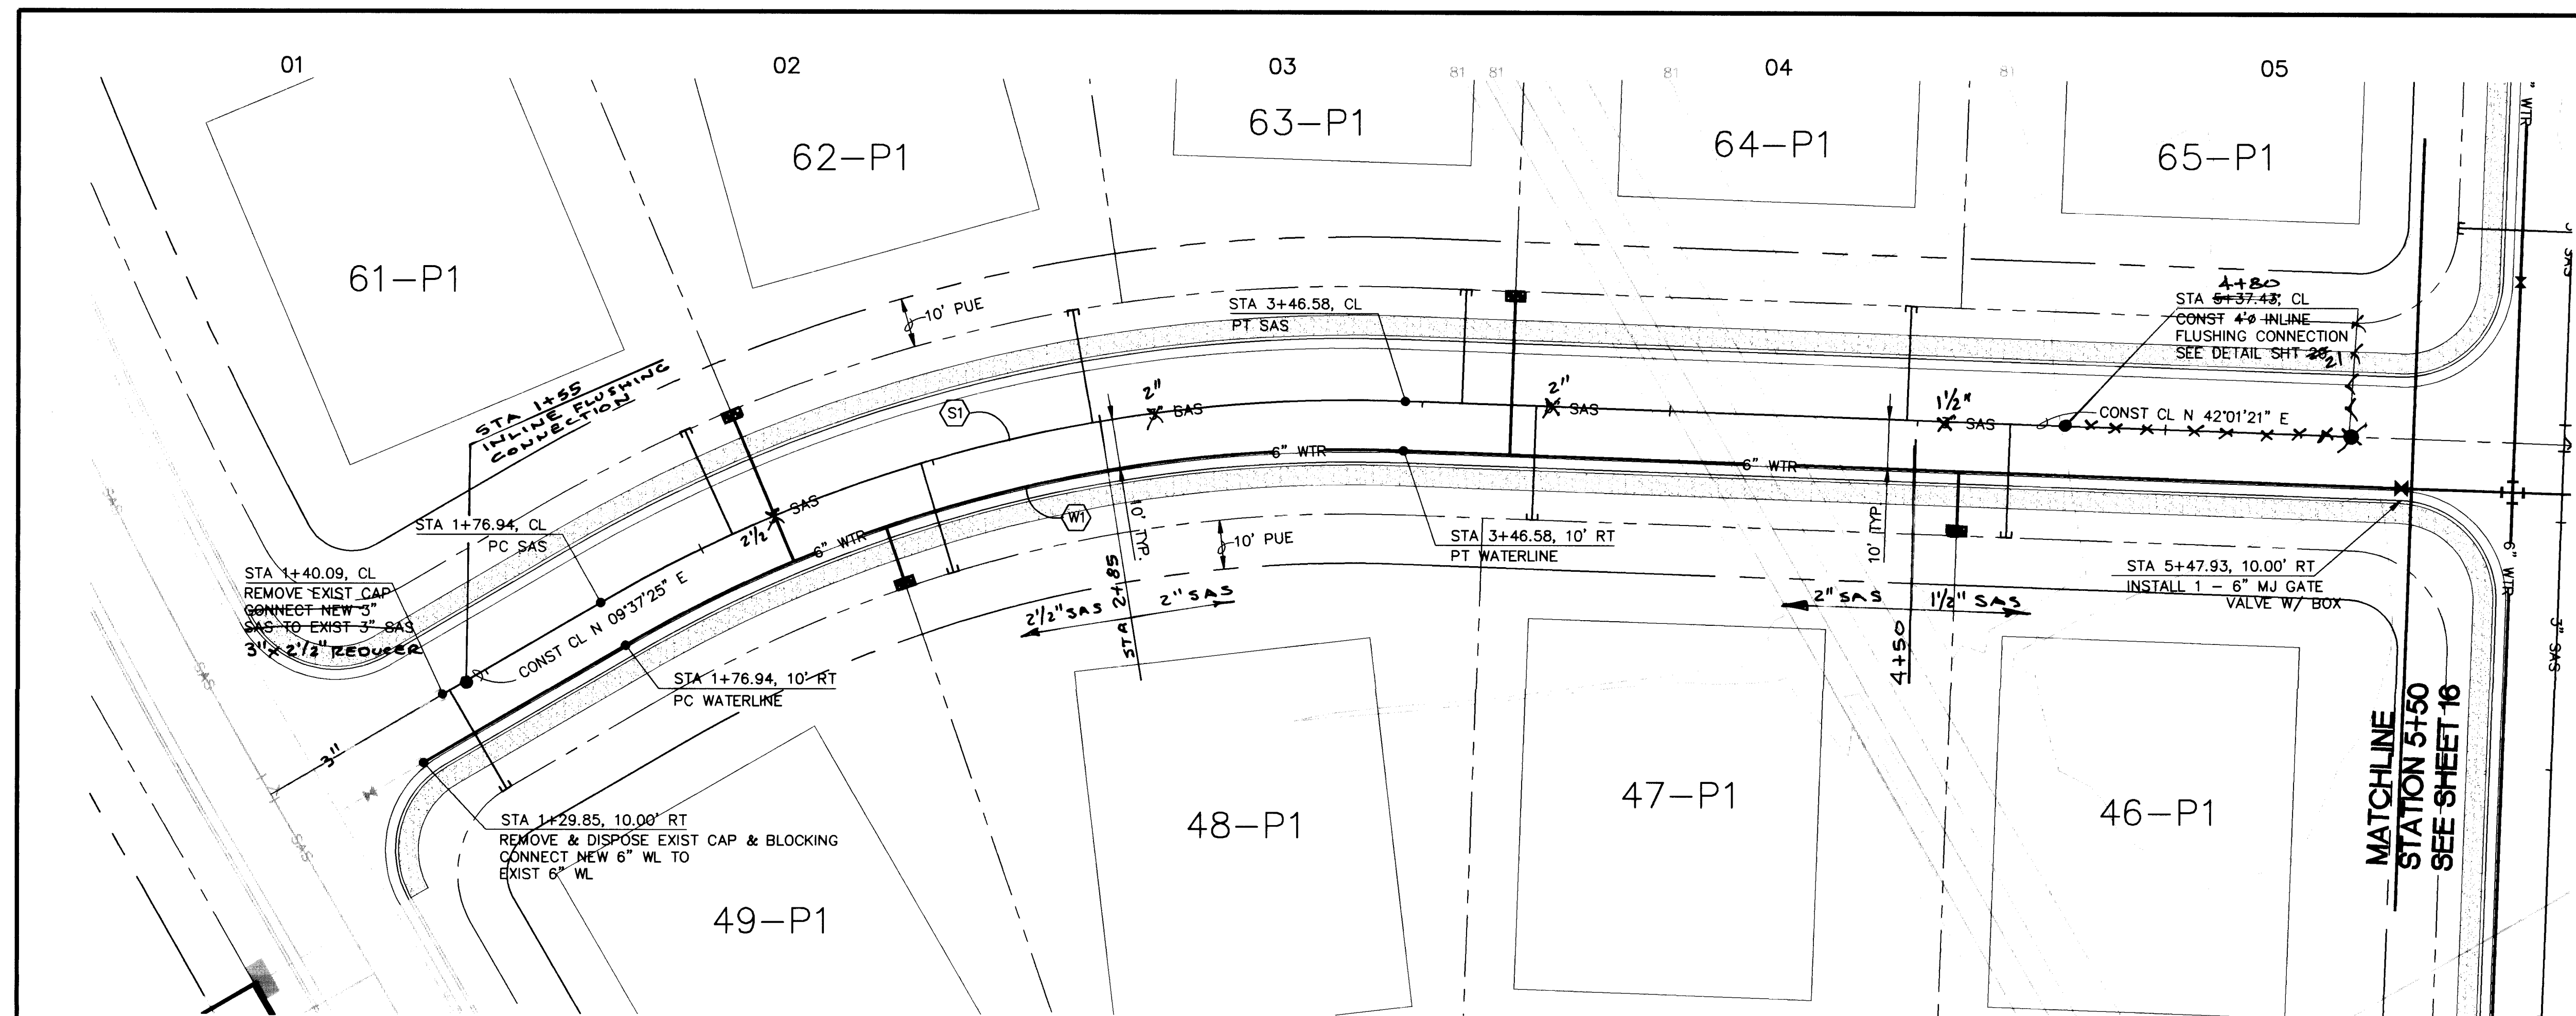

PUEBLO GRANDE TRAIL

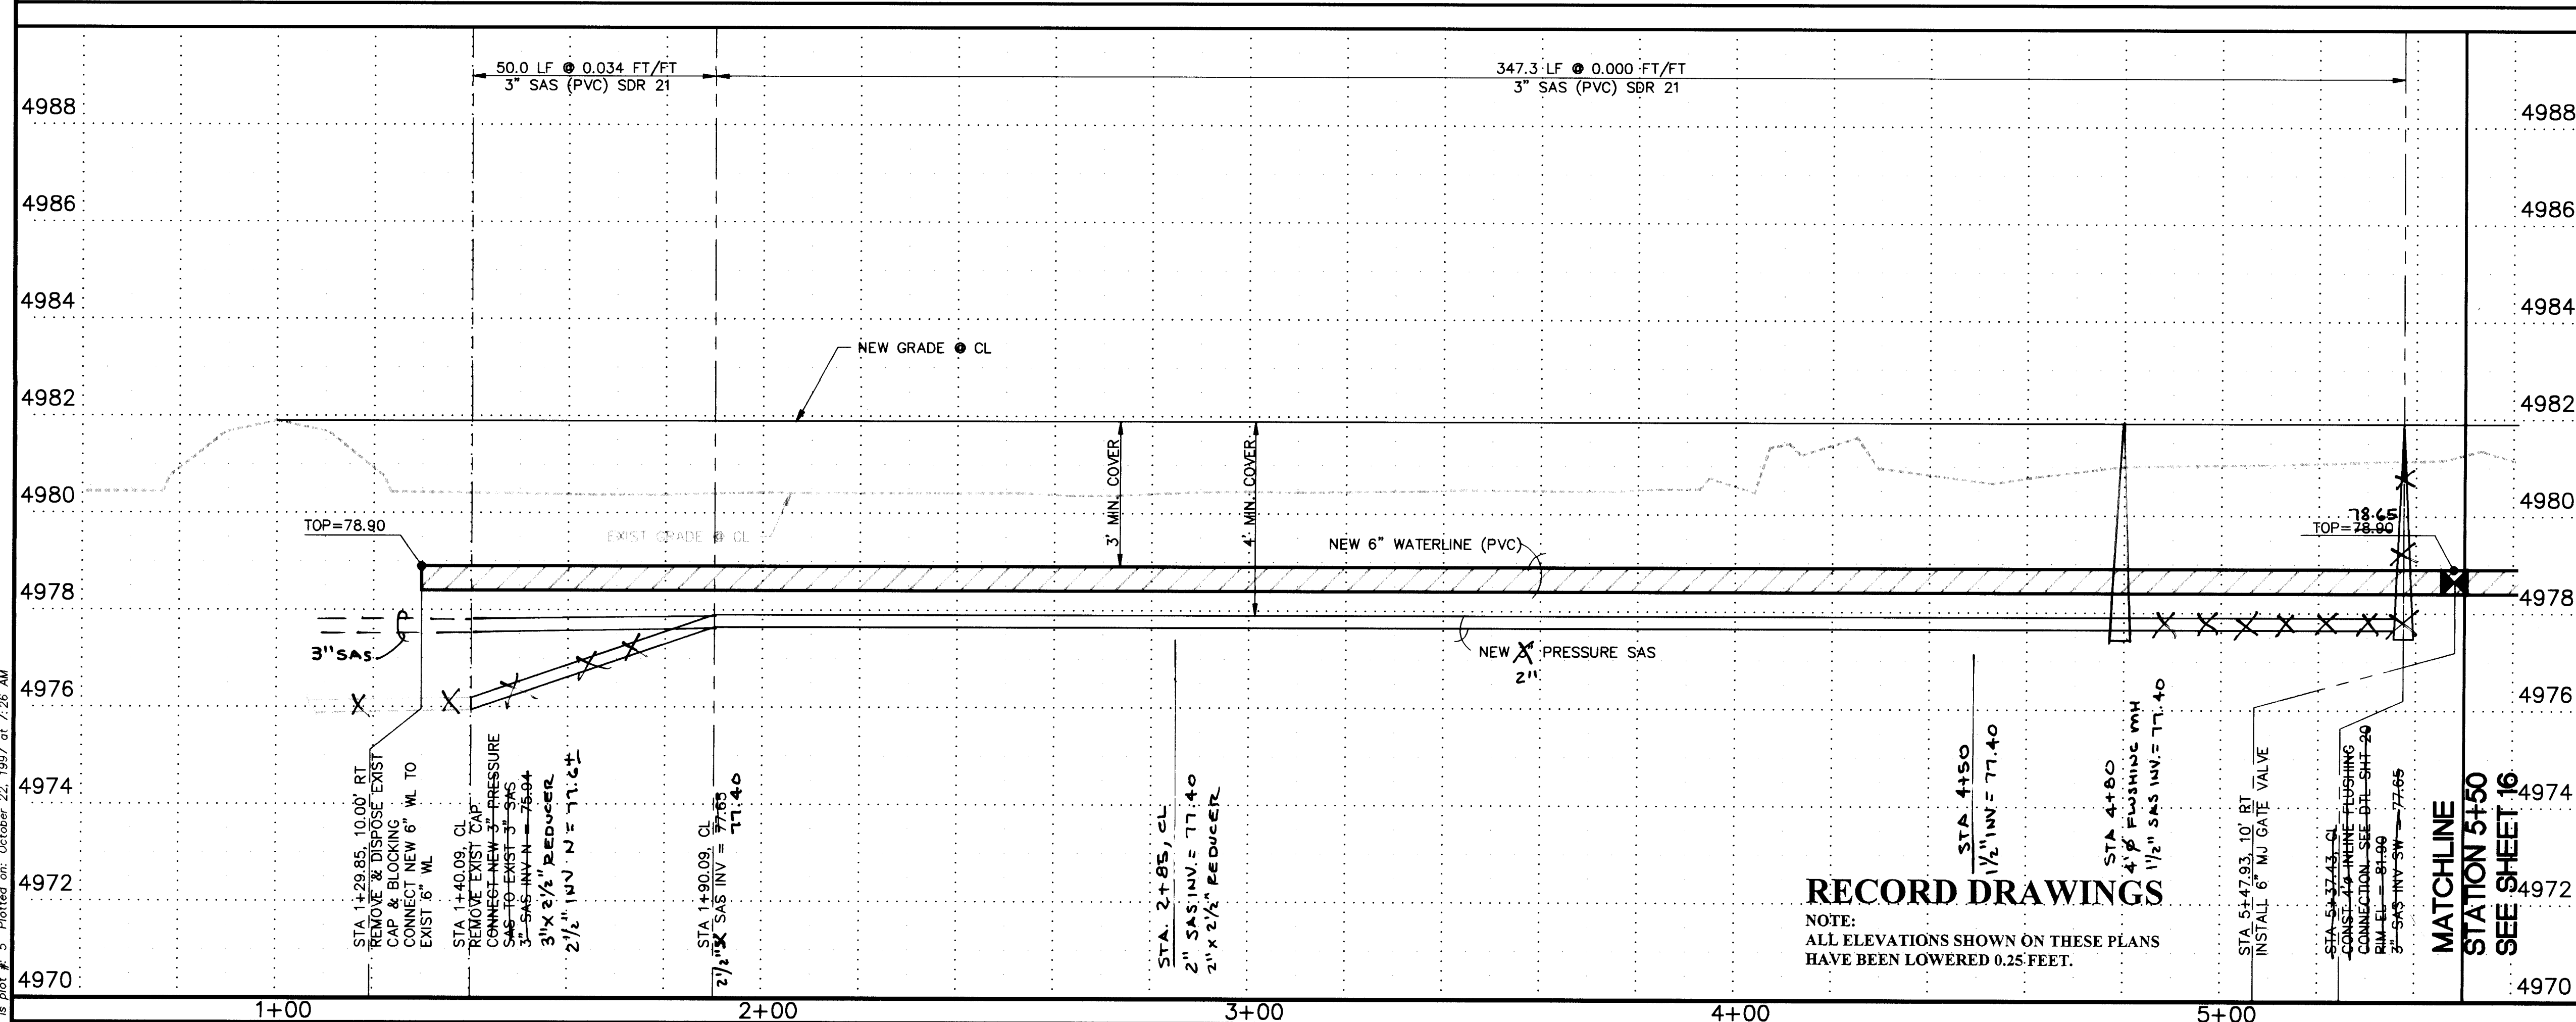

GENERAL NOTES:

- 1 ALL WATERLINE FITTINGS TO BE RESTRAINED "MJ".
SEE RESTRAINT LENGTH TABLE THIS SHEET.
- 2 FOR WATER SERVICE CONNECTIONS SEE COA STD
DWG 2363.
- 3 FOR SANITARY SERVICE CONNECTIONS SEE DETAIL
SHEET 21.
- 4 BACKFLOW PREVENTERS TO BE INSTALLED ON
ALL WATER SERVICES.

 SAS CURVE DATA

NUMBER	DELTA	RADIUS	TANGENT	ARC LENGTH
S1	32°23'56"	300.00	87.15	169.64

W1 WATERLINE CURVE DATA

NUMBER	DELTA	RADIUS	TANGENT	ARC LENGTH
W1	32°23'56"	290.02	84.26	164.00

WATERLINE
RESTRAINT LENGTHS:

LENGTH OF RESTRAINT FOR TEES

BRANCH SIZE	LENGTH OF RESTRAINT (FT)
6"x6"x6"	24'
10"x10"x6"	RESTRAIN BRANCH AT FITTING ONLY 10'
10"x10"x10"	64'

- * EACH PIPE RUN SHALL HAVE A MINIMUM OF 10' W/O JOINTS ON EACH SIDE OF BRANCH OR FITTINGS. FOR TEES RESTRAIN PIPE IN THREE DIRECTIONS.

LENGTH OF RESTRAINT FOR HORIZ BENDS, REDUCERS, VALVES AND DEAD ENDS $< 10 \times 6"$



PIPE SIZE	11.25 38.75	48	22.5 58.25	REDUCER		VALVE/ DEAD
				SMALL SIDE	LARGE SIDE	
6"	10'	14'	18' 10"	—	—	73'
10"	15'	21'	27' 10"	116'	71'	115'

**PUEBLO GRANDE TRAIL
SANITARY SEWER SERVICES**

LOT NO.	STATION	OFFSET	LENGTH	HW ELEV AT FL	TYPE
46-P1	4+68.66	CL	23'	77.65	PRES
47-P1	3+73.01	CL	23'	77.65	PRES
48-P1	2+47.55	CL	23'	77.65	PRES
49-P1	1+41.74	CL	23'	77.65	PRES
61-P1	2+06.94	CL	23'	77.65	PRES
62-P1	2+83.23	CL	23'	77.65	PRES
63-P1	3+57.99	CL	23'	77.65	PRES
64-P1	4+47.86	CL	23'	77.65	PRES

**PUEBLO GRANDE TRAIL
WATER SERVICES**

LOT NO.	STATION	OFFSET	SIZE	TYPE
46-P1	4+58.66	10'RT	3/4"	DBL
47-P1				
48-P1	2+36.72	10'RT	3/4"	DBL
49-P1				
61-P1	2+16.22	10'RT	3/4"	DBL
62-P1				
63-P1	3+67.99	10'RT	3/4"	DBL
64-P1				

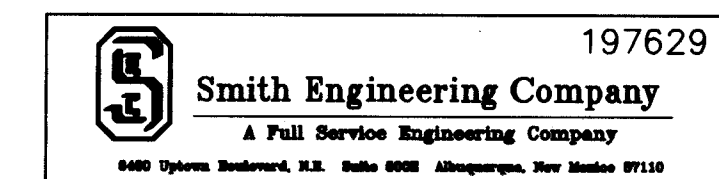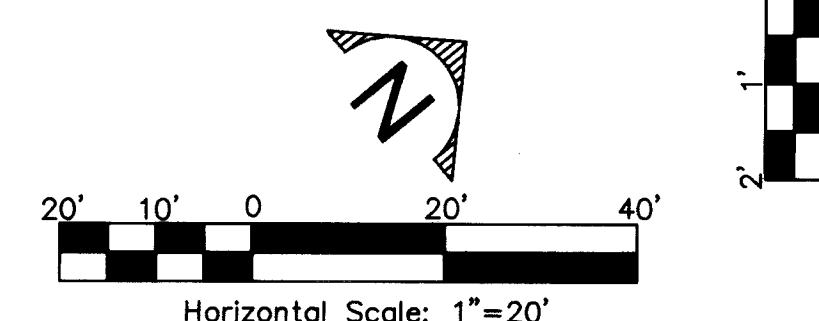

CITY OF ALBUQUERQUE
PUBLIC WORKS DEPARTMENT
ENGINEERING DEVELOPMENT GROUP


TITLE: BOSQUE DEL RIO SUBDIVISION - PHASE 2
UTILITY P & P: PUEBLO GRANDE TRAIL: STA 1+00 TO 5+50

Design Review Committee DEC 19 1997 DESIGN REVIEW COMMITTEE	City Engineer Approval	Assistant Design Update <table style="width: 100%; border-collapse: collapse;"> <tr> <th style="width: 50%; text-align: center;">Mo. / Day / Yr.</th> <th style="width: 50%; text-align: center;">Mo. / Day / Yr.</th> </tr> <tr><td> </td><td> </td></tr> <tr><td> </td><td> </td></tr> <tr><td> </td><td> </td></tr> <tr><td> </td><td> </td></tr> <tr><td> </td><td> </td></tr> <tr><td> </td><td> </td></tr> <tr><td> </td><td> </td></tr> <tr><td> </td><td> </td></tr> <tr><td> </td><td> </td></tr> <tr><td> </td><td> </td></tr> </table>	Mo. / Day / Yr.	Mo. / Day / Yr.																				
Mo. / Day / Yr.	Mo. / Day / Yr.																							

City Project No.	5406 82	Zone Map No.	D-13	Sheet	15	Of	23
------------------	---------	--------------	------	-------	----	----	----

SCANNED BY
BY LASON

Drawing name: N:\197629\OPTIONAL\1619P.DWG
Saved on: October 22, 1997 at 7:28 AM
This is plot # 4. Plotted on: October 22, 1997 at 7:28 AM

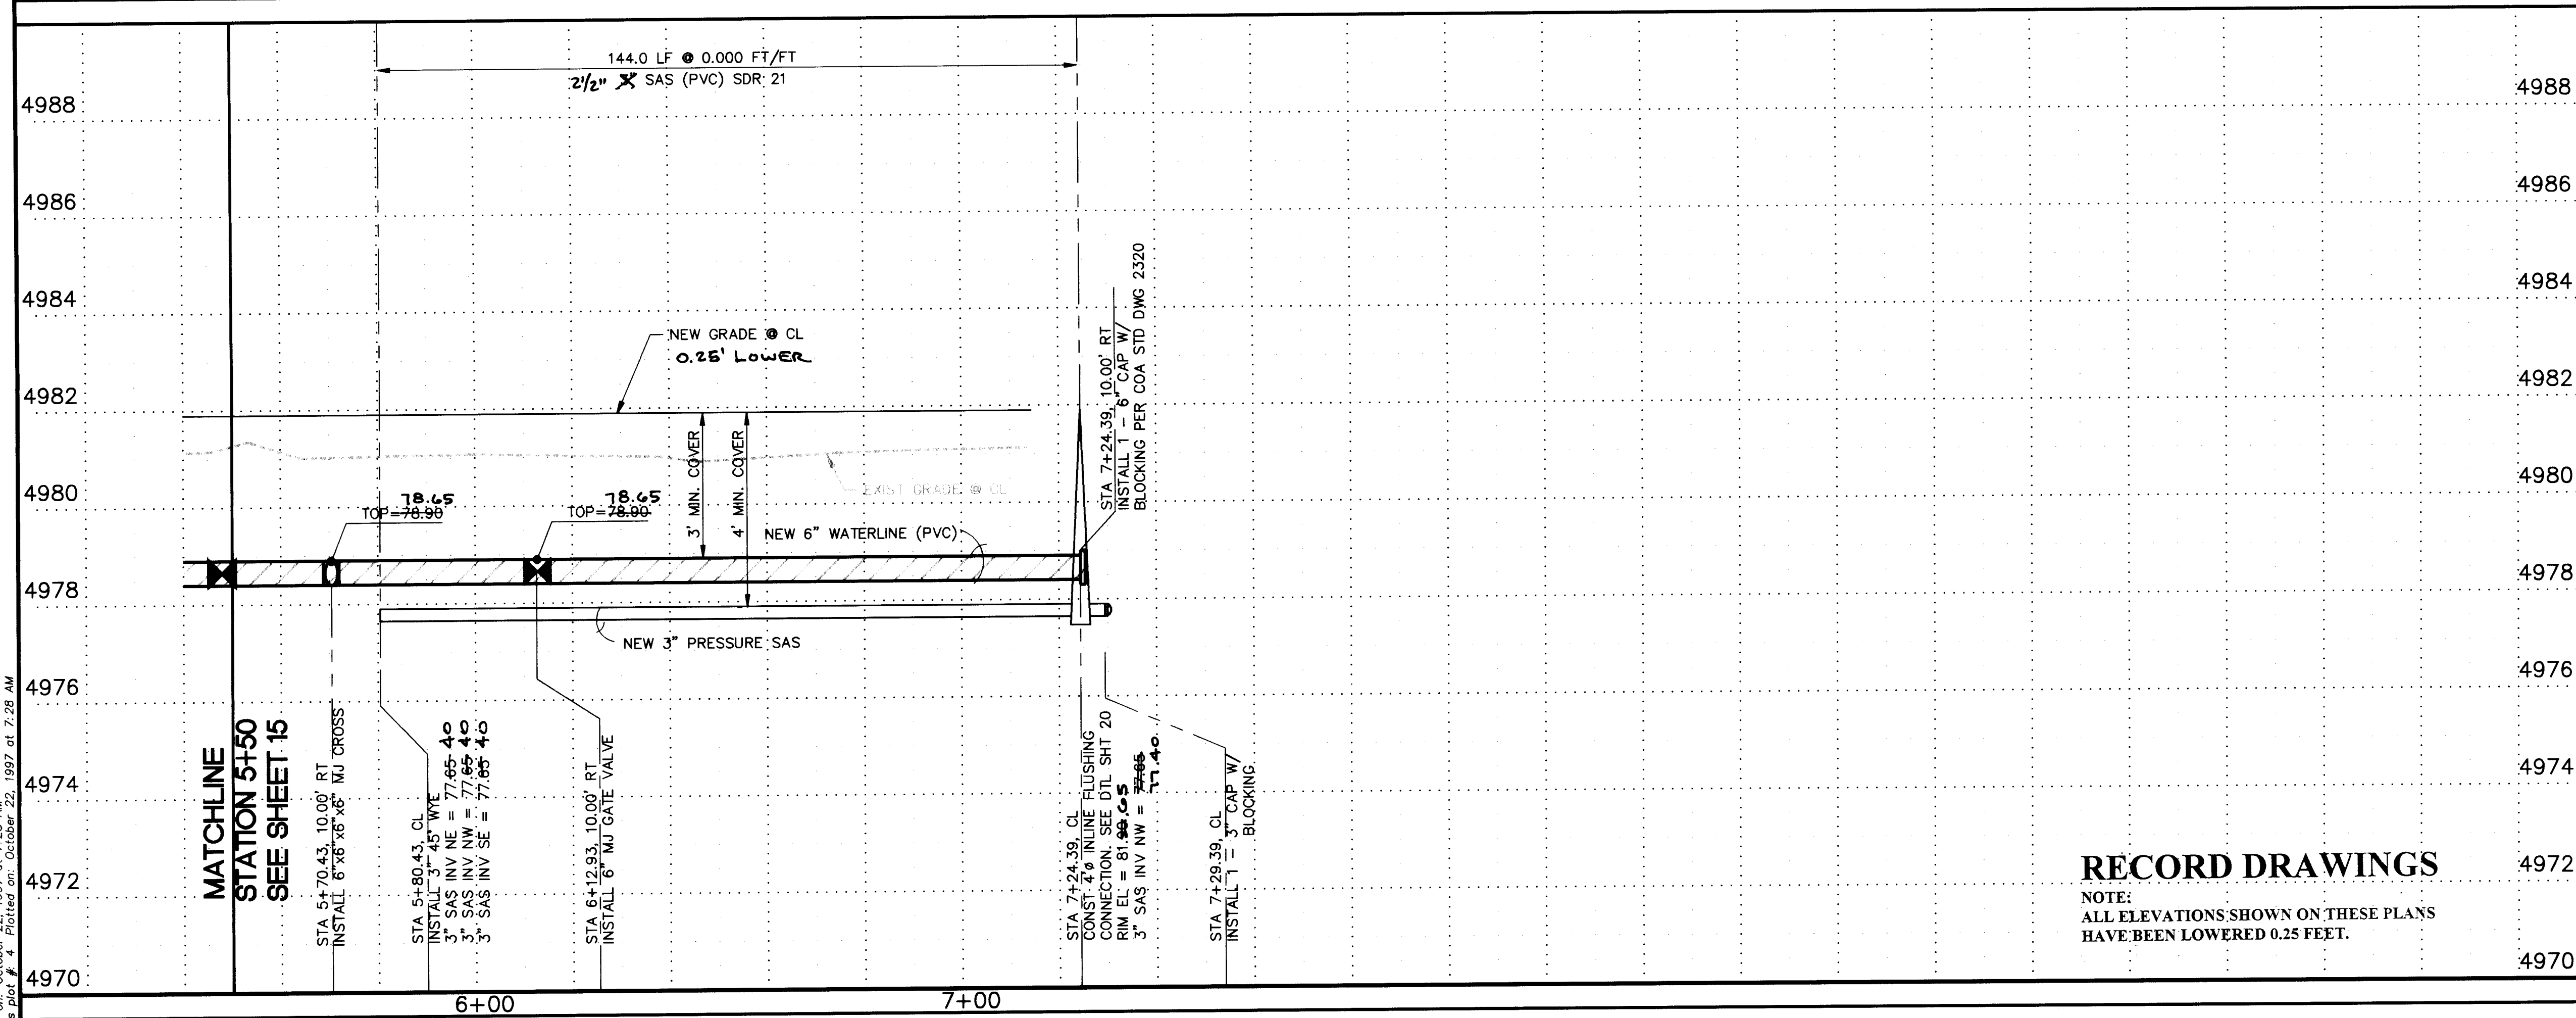

RECORD DRAWINGS

NOTE:
ALL ELEVATIONS SHOWN ON THESE PLANS
HAVE BEEN LOWERED 0.25 FEET.

GENERAL NOTES:

- ALL WATERLINE FITTINGS TO BE RESTRAINED "MJ". SEE RESTRAINT LENGTH TABLE THIS SHEET.
- FOR WATER SERVICE CONNECTIONS SEE COA STD DWG 2363.
- FOR SANITARY SERVICE CONNECTIONS SEE DETAIL SHEET 21.
- BACKFLOW PREVENTERS TO BE INSTALLED ON ALL WATER SERVICES.

WATERLINE RESTRAINT LENGTHS:

LENGTH OF RESTRAINT FOR TEES	
BRANCH SIZE	LENGTH OF RESTRAINT (FT)
6"x6"x6"	24'
10"x10"x6"	RESTR. BRANCH AT FITTING ONLY
10"x10"x10"	64'

* EACH PIPE RUN SHALL HAVE A MINIMUM OF 10' W/O JOINTS ON EACH SIDE OF BRANCH OR FITTINGS. FOR TEES RESTRAIN PIPE IN THREE DIRECTIONS.

LENGTH OF RESTRAINT FOR HORIZ BENDS, REDUCERS, VALVES AND DEAD ENDS


PIPE SIZE	1/2"	3/4"	1"	1 1/2"	2"	REDUCER SMALL SIDE	REDUCER LARGE SIDE	VALVE/ DEAD END
6"	10'	14'	16'	16'	16'	-	-	73'
10"	15'	21'	27'	27'	27'	116'	71'	115'

PUEBLO GRANDE TRAIL SANITARY SEWER SERVICES

LOT NO.	STATION	OFFSET	LENGTH	IN ELEV AT FL	TYPE
13-P1	7+00.29	CL	23'	77.65	PRES
35-P1	6+90.96	CL	22'	77.65	PRES

PUEBLO GRANDE TRAIL WATER SERVICES

LOT NO.	STATION	OFFSET	SIZE	TYPE
13-P1	6+23.43	10' RT	3/4" SNG	
35-P1	6+22.43	10' RT	3/4" SNG	

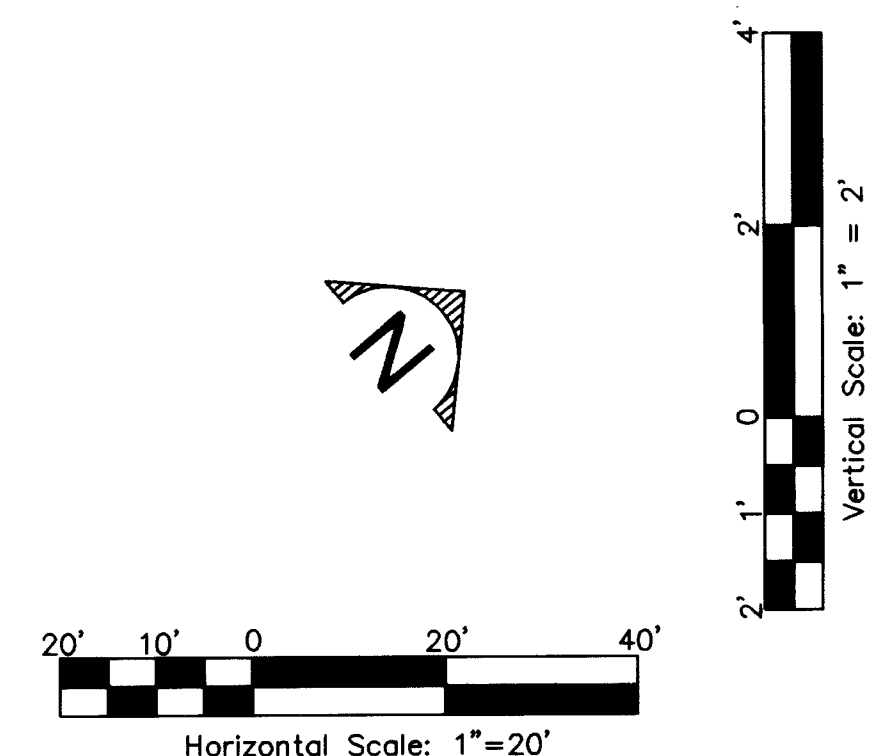


CITY OF ALBUQUERQUE PUBLIC WORKS DEPARTMENT ENGINEERING DEVELOPMENT GROUP

TITLE: BOSQUE DEL RIO SUBDIVISION - PHASE 2
UTILITY P & P: PUEBLO GRANDE TRAIL: STA 5+50 TO 7+14.39

DESIGN REVIEW COMMITTEE		City Engineer Approval		Last Design Update	
APPROVED	DEC 19 1997	DESIGN REVIEW COMMITTEE			
City Project No.	540682	Zone Map No.	D-13	Sheet	16 of 23

SCANNED BY
BY: LASON

Drawing name: N:\197629\OPTION\7\UPNP.DWG
Saved on: October 22, 1997 at 7:32 AM
File is plot # 3. Plotted on: October 22, 1997 at 7:32 AM

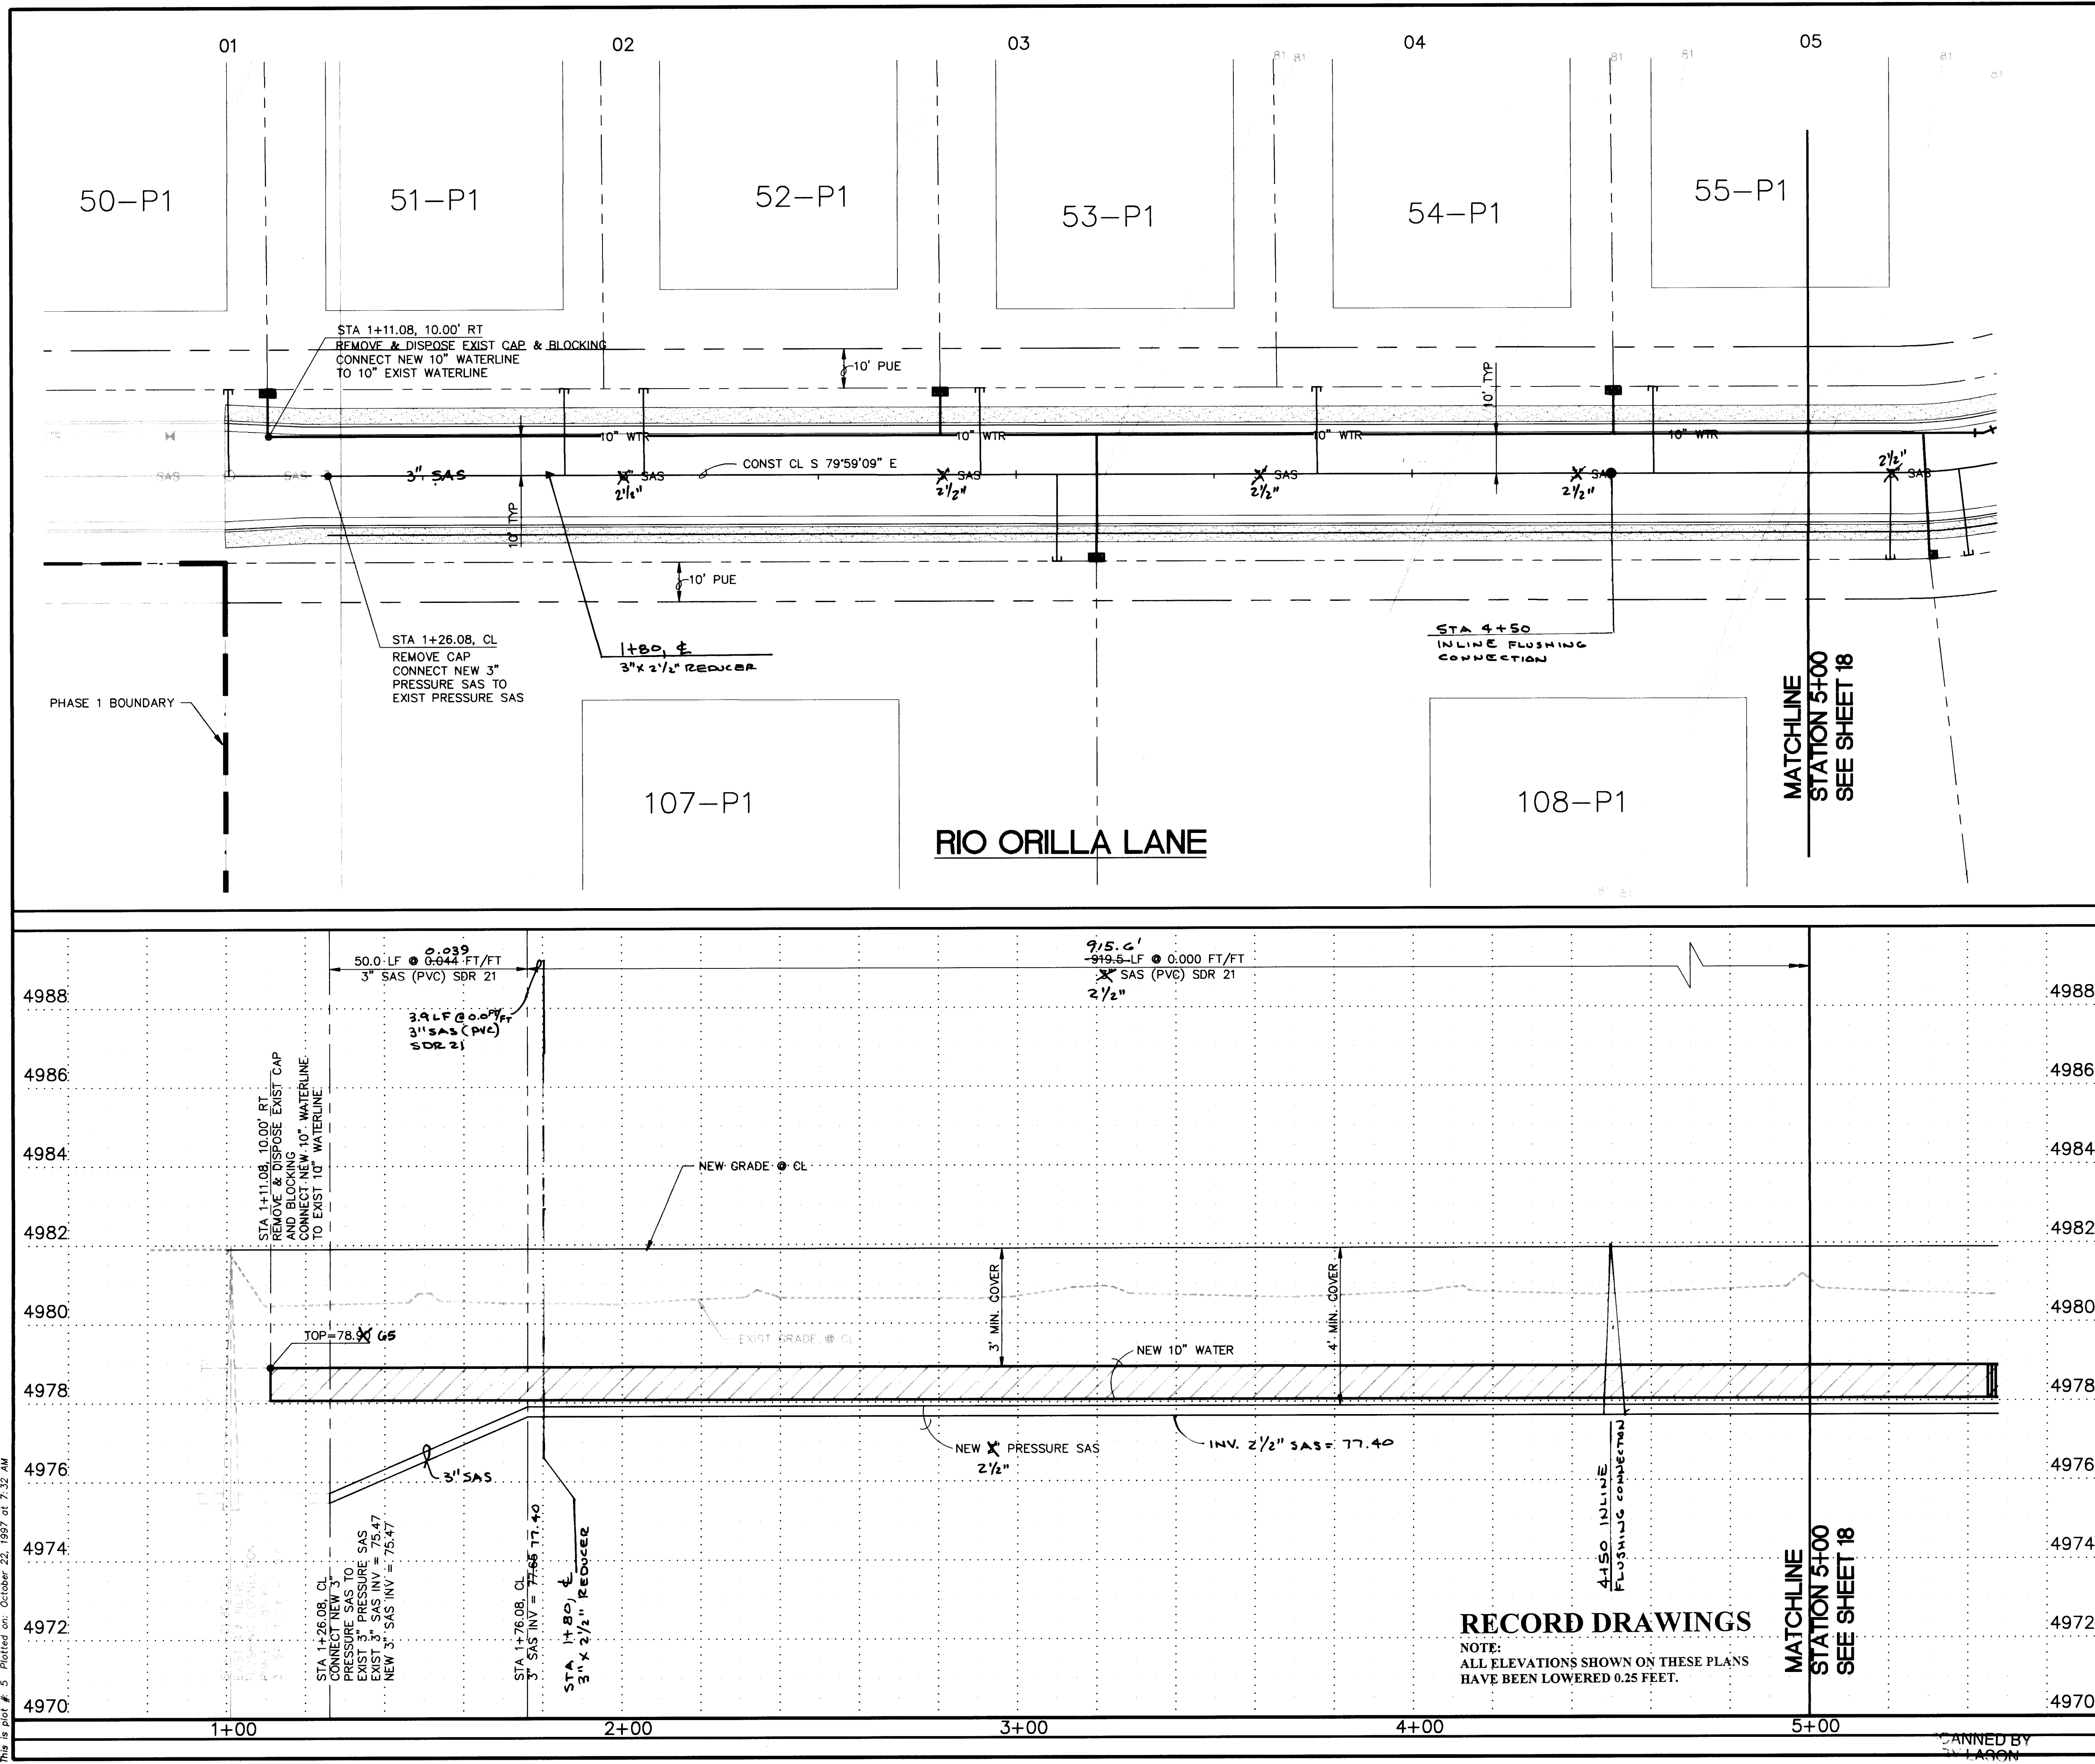

GENERAL NOTES:

- ALL WATERLINE FITTINGS TO BE RESTRAINED "WJ". SEE RESTRAINT LENGTH TABLE THIS SHEET.
- FOR WATER SERVICE CONNECTIONS SEE COA STD DWG 2363.
- FOR SANITARY SERVICE CONNECTIONS SEE DETAIL SHEET 21.
- BACKFLOW PREVENTERS TO BE INSTALLED ON ALL WATER SERVICES.

WATERLINE RESTRAINT LENGTHS:

LENGTH OF RESTRAINT FOR TEES

BRANCH SIZE	LENGTH OF RESTRAINT (FT)
6"x6"x6"	24'
10"x10"x6"	RESTRAIN BRANCH AS FITTING ONLY 10'
10"x10"x10"	64'

* EACH PIPE RUN SHALL HAVE A MINIMUM OF 10' W/O JOINTS ON EACH SIDE OF BRANCH OR FITTINGS. FOR TEES RESTRAIN PIPE IN THREE DIRECTIONS.

LENGTH OF RESTRAINT FOR HORIZ BENDS, REDUCERS, VALVES AND DEAD ENDS

PIPE SIZE	11.25' 45'	22.5' 90.25'	REDUCER SMALL SIDE	REDUCER LARGE SIDE	VALVE/ DEAD END
6"	10'	14'	10'	-	73'
10"	15'	21'	15'	116'	71'

RIO ORILLA LANE SANITARY SEWER SERVICES

LOT NO.	STATION	OFFSET	LENGTH	INVERT AT FL	TYPE
50-P1	1+00.81	CL	22'	75.47	PRES
51-P1	1+85.81	CL	22'	77.65	PRES
52-P1	2+05.81	CL	22'	77.65	PRES
53-P1	2+90.81	CL	22'	77.65	PRES
54-P1	3+75.81	CL	22'	77.65	PRES
55-P1	4+60.81	CL	22'	77.65	PRES
107-P1	3+10.28	CL	22'	77.65	PRES

RIO ORILLA LANE WATER SERVICES

LOT NO.	STATION	OFFSET	SIZE	TYPE
50-P1	1+10.81	10' LT	3/4"	DBL
51-P1	1+85.81	10' LT	3/4"	DBL
52-P1	2+05.81	10' LT	3/4"	DBL
53-P1	2+90.81	10' LT	3/4"	DBL
54-P1	3+75.81	10' LT	3/4"	DBL
55-P1	4+60.81	10' LT	1"	DBL
107-P1	3+10.28	10' LT	1"	DBL

CITY OF ALBUQUERQUE
PUBLIC WORKS DEPARTMENT
ENGINEERING DEVELOPMENT GROUP

TITLE: BOSQUE DEL RIO SUBDIVISION - PHASE 2
UTILITY P & P: RIO ORILLA LANE: STA 1+00 TO 5+00

DESIGN REVIEW COMMITTEE

DEC 19 1997


City Engineer Approval

City Project No. **540682**

Zone Map No. **D-13**

Sheet **17** of **23**

Drawing name: N:\197629\GPR\1\BUPNP.DWG
This is plot # 3. Plotted on: October 22, 1997 at 7:34 AM

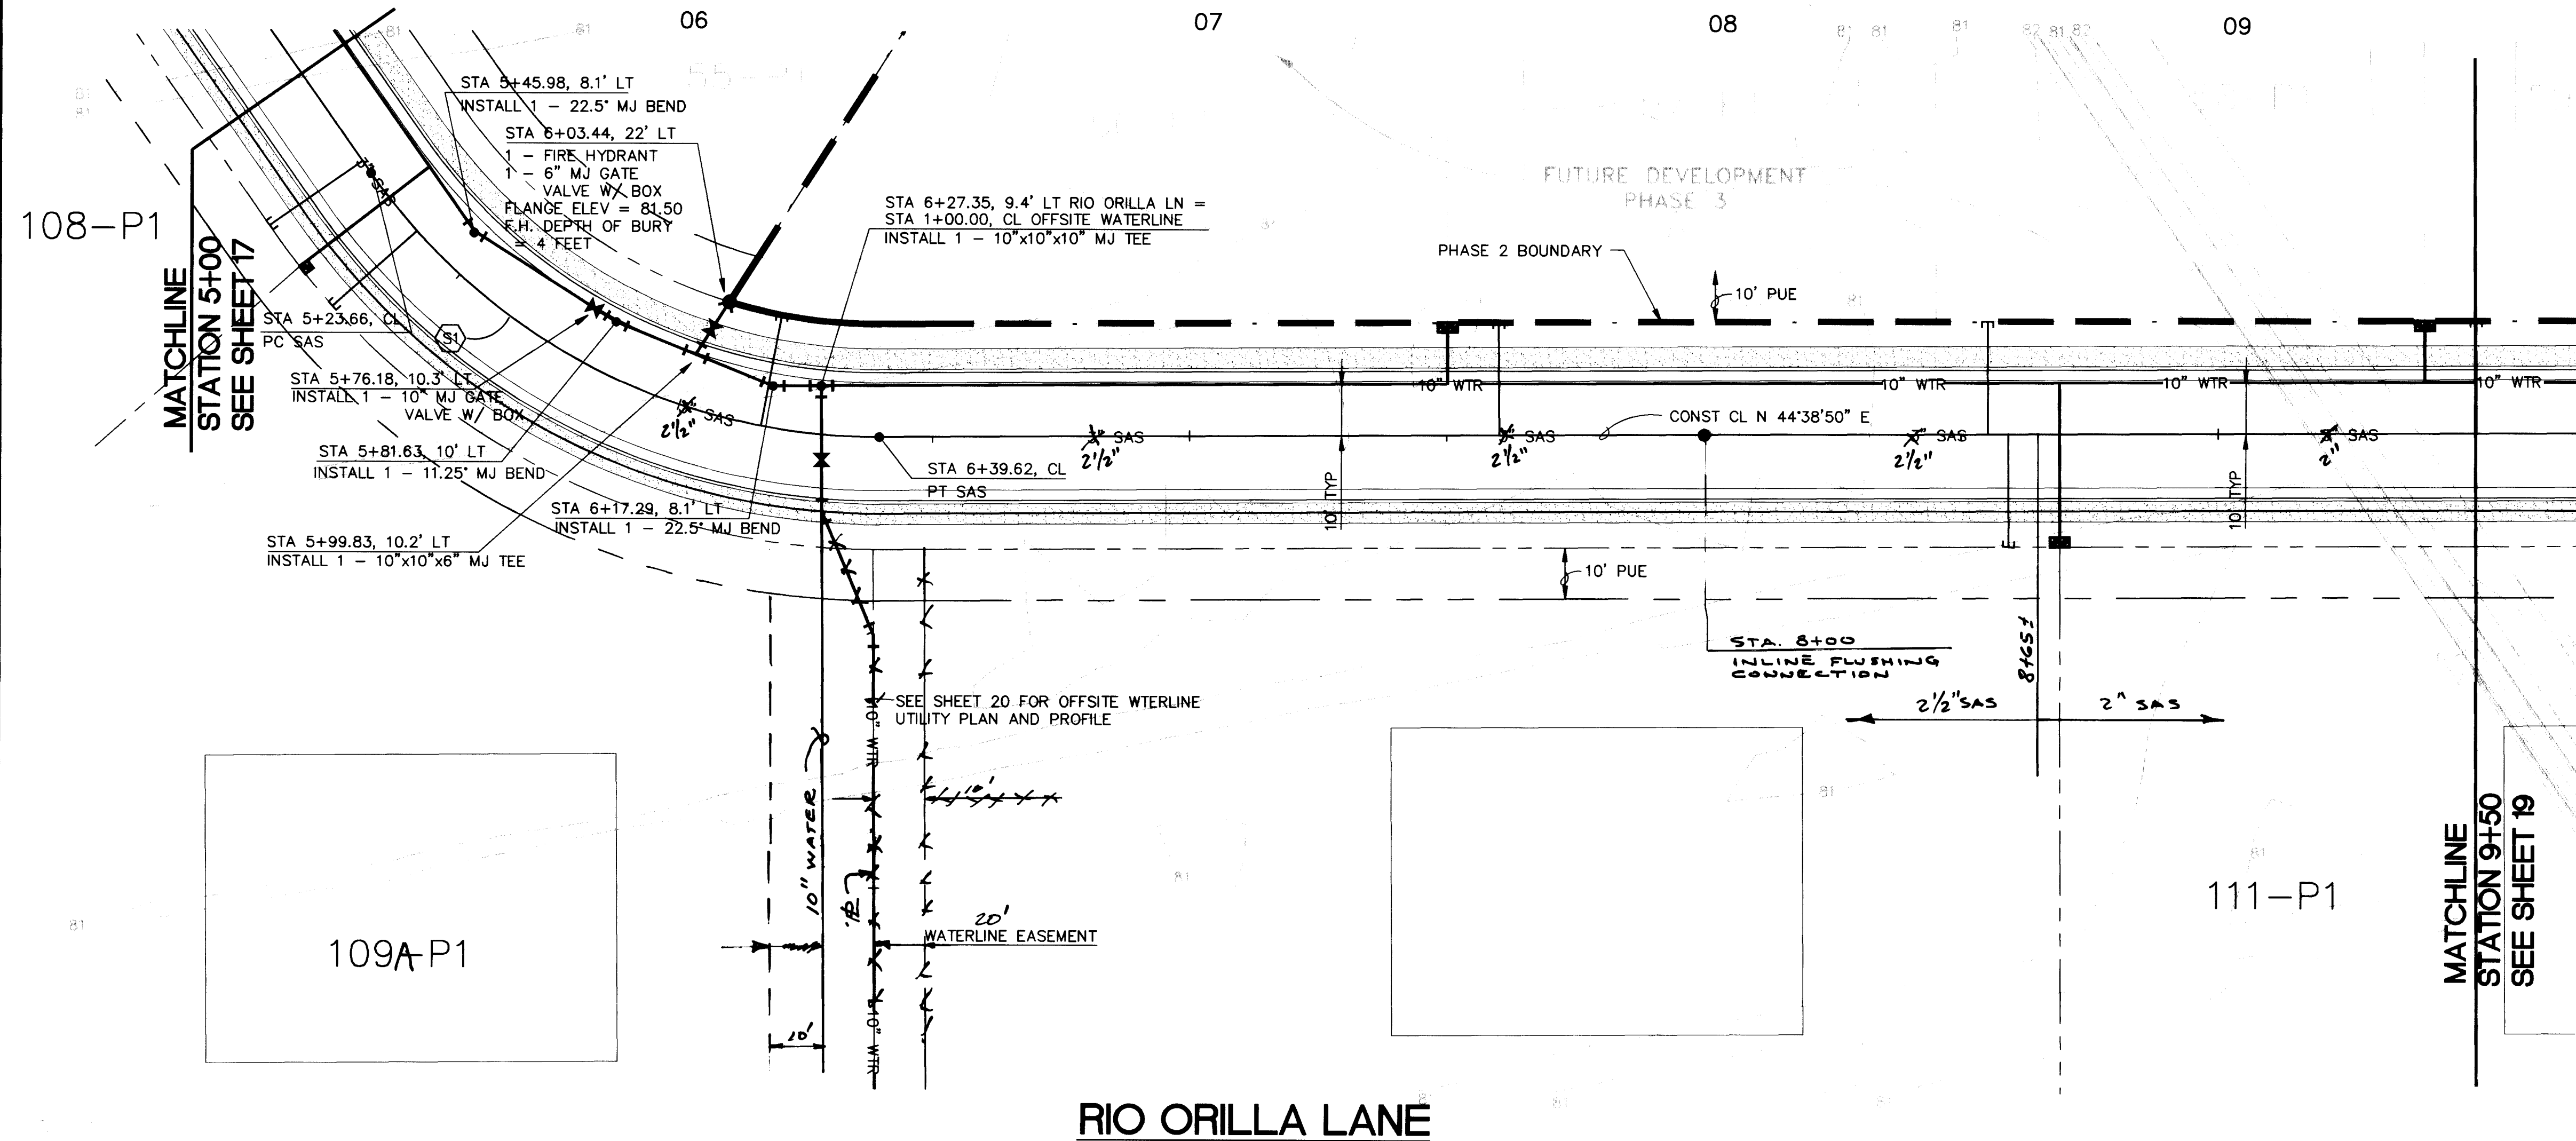

GENERAL NOTES:

- ALL WATERLINE FITTINGS TO BE RESTRAINED "MJ". SEE RESTRAINT LENGTH TABLE, SHEET 20.
- FOR WATER SERVICE CONNECTIONS SEE COA STD DWG 2363.
- FOR SANITARY SERVICE CONNECTIONS SEE DETAIL SHEET 21.
- SEE SHEET 21 FOR WATER AND SANITARY SEWER SERVICE STATION LOCATION INFORMATION.
- BACKFLOW PREVENTERS TO BE INSTALLED ON ALL WATER SERVICES.

SAS CURVE DATA

NUMBER	DELTA	RADIUS	TANGENT	ARC LENGTH
S1	55°22'46"	120.00	62.96	115.96

WATERLINE RESTRAINT LENGTHS:

LENGTH OF RESTRAINT FOR TEES

BRANCH SIZE	LENGTH OF RESTRAINT (FT)
6"x6"x6"	24'
10"x10"x6"	RESTRAINT BRANCH AT FITTING ONLY
10"x10"x10"	64'

* EACH PIPE RUN SHALL HAVE A MINIMUM OF 10' W/O JOINTS ON EACH SIDE OF BRANCH OR FITTINGS. FOR TEES RESTRAINT PIPE IN THREE DIRECTIONS.

LENGTH OF RESTRAINT FOR HORIZ BENDS, REDUCERS, VALVES AND DEAD ENDS



PIPE SIZE	11.25°	22.5°	REDUCER		VALVE/ DEAD END
			SMALL SIDE	LARGE SIDE	
6"	10'	14'	18'	10'	73'
10"	15'	21'	27'	16'	115'

RIO ORILLA LANE SANITARY SEWER SERVICES

LOT NO.	STATION	OFFSET	LENGTH	IN/ELEV AT FL	TYPE
56-P1	6+16.38	CL	22'	77.65'	PRES
57-P1	7+50.16	CL	22'	77.65'	PRES
58-P1	8+55.16	CL	22'	77.65'	PRES
108-P1	5+20.75	CL	22'	77.65'	PRES
109A-P1	5+38.06	CL	22'	77.65'	PRES
111-P1	8+59.09	CL	22'	77.65'	PRES

RIO ORILLA LANE WATER SERVICES

LOT NO.	STATION	OFFSET	SIZE	TYPE
56-P1	7+50.16	10' LT	3/4"	DBL
57-P1	9+40.16	10' LT	3/4"	DBL
58-P1	5+29.60	10' LT	1"	SNL
109A-P1	8+69.09	10' LT	1"	DBL

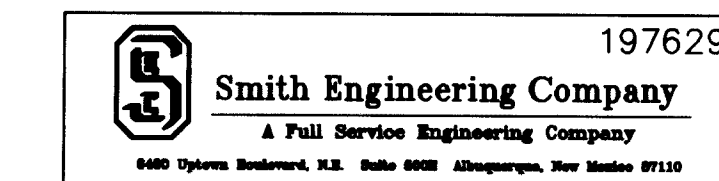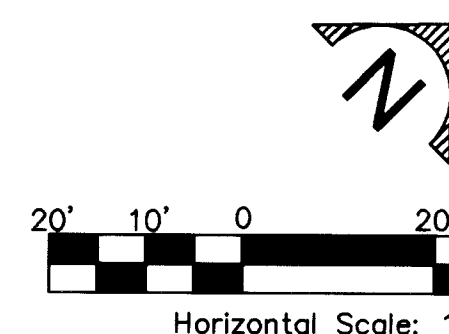

CITY OF ALBUQUERQUE
PUBLIC WORKS DEPARTMENT
ENGINEERING DEVELOPMENT GROUP
TITLE: BOSQUE DEL RIO SUBDIVISION - PHASE 2
UTILITY P & P: RIO ORILLA LANE: STA 5+00 TO 9+50


DESIGNED BY AG / BAC	DATE 10/23/97	DESIGNED BY P/C	DATE 10/23/97
DRAWN BY BAC	DATE 10/23/97	CHECKED BY P/C	DATE 10/23/97

City Project No. 540682
Zone Map No. D-13
Sheet 18 of 23

RECORD DRAWINGS

NOTE:
ALL ELEVATIONS SHOWN ON THESE PLANS
HAVE BEEN LOWERED 0.25 FEET.

Drawing name: N:\197629\OPTION1\91UPHP.DWG
Saved on: October 22, 1997 at 7:36 AM
Printed on: October 22, 1997 at 7:36 AM

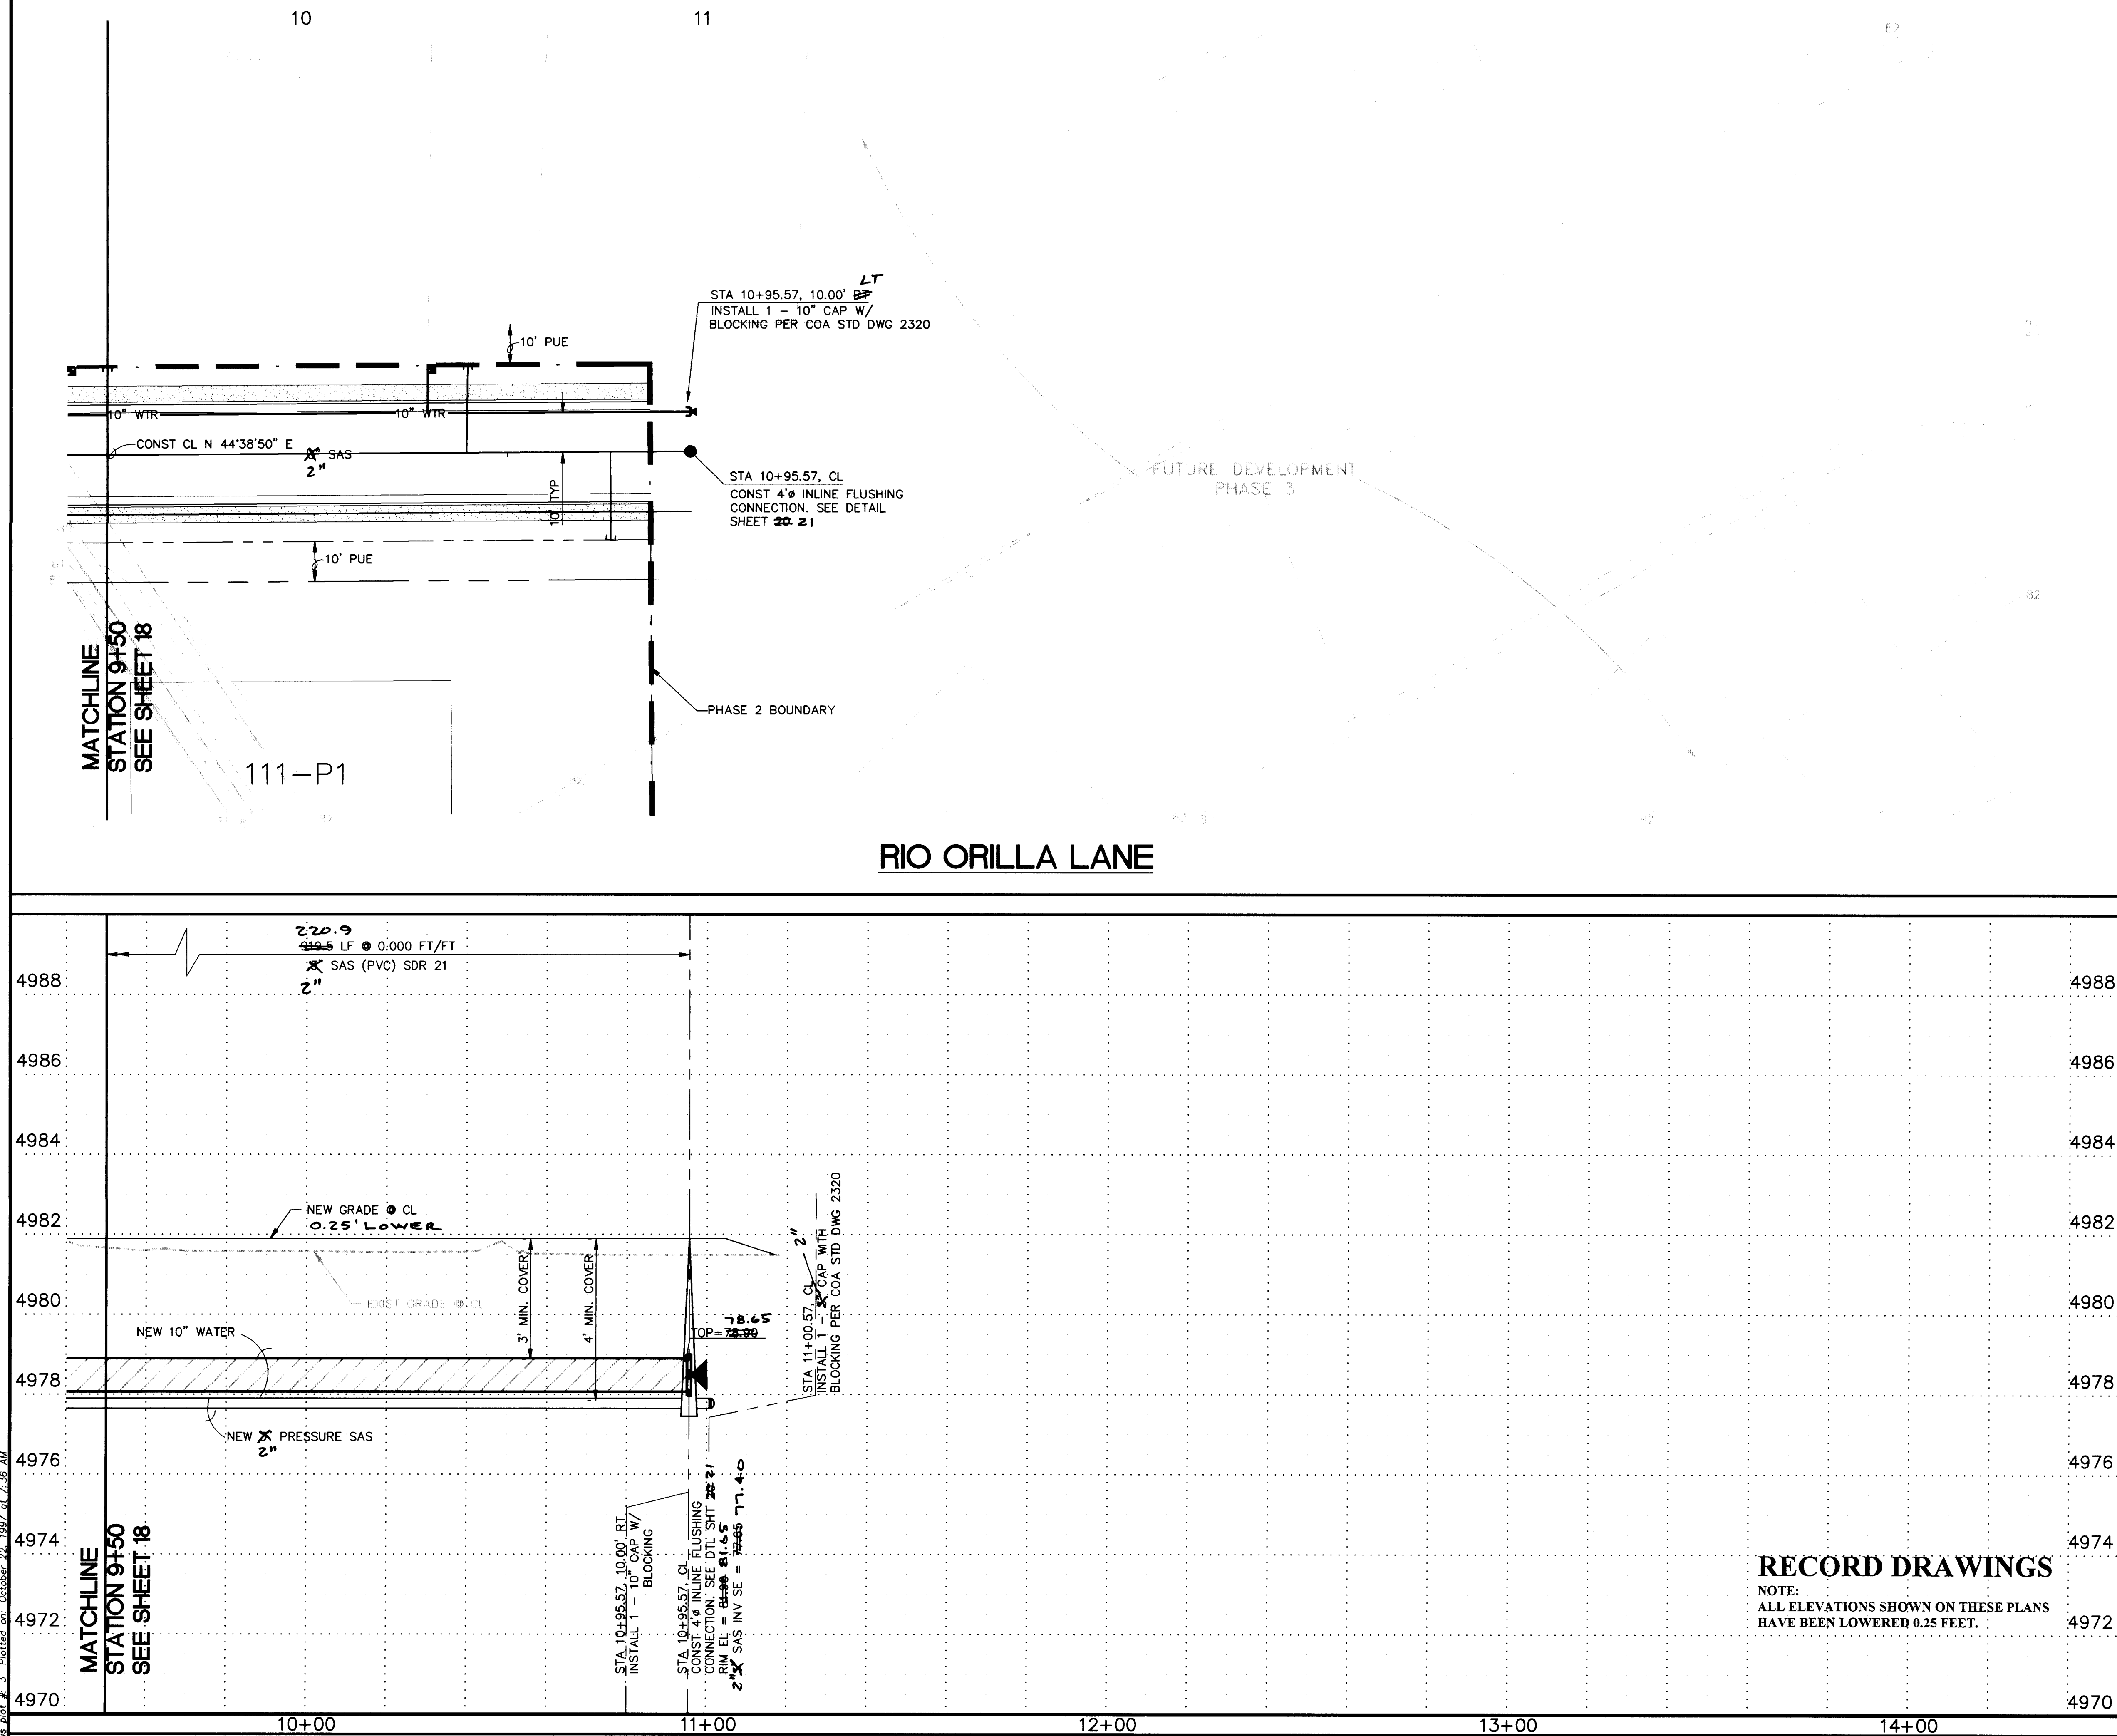

GENERAL NOTES:

- ALL WATERLINE FITTINGS TO BE RESTRAINED "MJ". SEE RESTRAINT LENGTH TABLE, SHEET 20.
- FOR WATER SERVICE CONNECTIONS SEE COA STD DWG 2363.
- FOR SANITARY SERVICE CONNECTIONS SEE DETAIL SHEET 21.
- SEE SHEET 20 FOR WATER AND SANITARY SEWER SERVICE STATION LOCATION INFORMATION.
- BACKFLOW PREVENTERS TO BE INSTALLED ON ALL WATER SERVICES.

WATERLINE RESTRAINT LENGTHS:

LENGTH OF RESTRAINT FOR TEES	
BRANCH SIZE	LENGTH OF RESTRAINT (FT)
6"x6"x6"	24'
10"x10"x6"	RESTRAIN BRANCH AT FITTING ONLY 10'
10"x10"x10"	64'

* EACH PIPE RUN SHALL HAVE A MINIMUM OF 10' W/O JOINTS ON EACH SIDE OF BRANCH OR FITTINGS. FOR TEES RESTRAIN PIPE IN THREE DIRECTIONS.

LENGTH OF RESTRAINT FOR HORIZ BENDS, REDUCERS, VALVES AND DEAD ENDS

PIPE SIZE	11.25' 45°		22.5' 90°		REDUCER		VALVE/ DEAD END
	SMALL SIDE	LARGE SIDE	SMALL SIDE	LARGE SIDE			
6"	10'	14'	10'	14'	-	73'	
10"	15'	21'	21'	116'	71'	115'	

RIO ORILLA LANE SANITARY SEWER SERVICES

LOT NO.	STATION	OFFSET	LENGTH	INV ELEV AT PL	TYPE
60-P1	10+40.14	CL	22'	77.65	PRES
111-P1	10+75.57	CL	22'	77.65	PRES

RIO ORILLA LANE WATER SERVICES

LOT NO.	STATION	OFFSET	SIZE	TYPE
60-P1	10+30.14	10' LT	3/4"	SNL

RECORD DRAWINGS

NOTE: ALL ELEVATIONS SHOWN ON THESE PLANS HAVE BEEN LOWERED 0.25 FEET.

AS BUILT INFORMATION

CONTRACTOR	NEW CONCEPTS
WORKED BY	CSC
INSPECTOR'S ACCEPTANCE BY	CSC
DATE	3/98
VERIFICATION BY	CSC
DATE	4/98
DRAWINGS BY	CSC
DATE	5/98
RECORDED BY	
DATE	

BENCH MARKS

U.S. COE STA.	"R. ALAMEDA B-2"
N.M. STATE PLAN COORDINATES (CENTRAL ZONE)	BY ACS
DATE	07/97
BY	GAYLE JEWELL
NO.	4071

SURVEY INFORMATION

FIELD NOTES	
DATE	07/97
BY	GAYLE JEWELL
NO.	4071

ENGINEERS SEAL



Professional Engineer Seal for Gayle Jewell, State of New Mexico, No. 4071, dated 10/23/97.

DESIGNED BY	AG / BAC	DATE	10/23/97
DRAWN BY	BAC	DATE	10/23/97
CHECKED BY	PJC	DATE	10/23/97

CITY OF ALBUQUERQUE PUBLIC WORKS DEPARTMENT ENGINEERING DEVELOPMENT GROUP

TITLE: BOSQUE DEL RIO SUBDIVISION - PHASE 2
UTILITY P & P: RIO ORILLA LANE: STA 9+50 TO 10+85.57

City Engineer Approval	City Project No. 540682	Zone Map No. D-13	Sheet 19 of 23
------------------------	-------------------------	-------------------	----------------

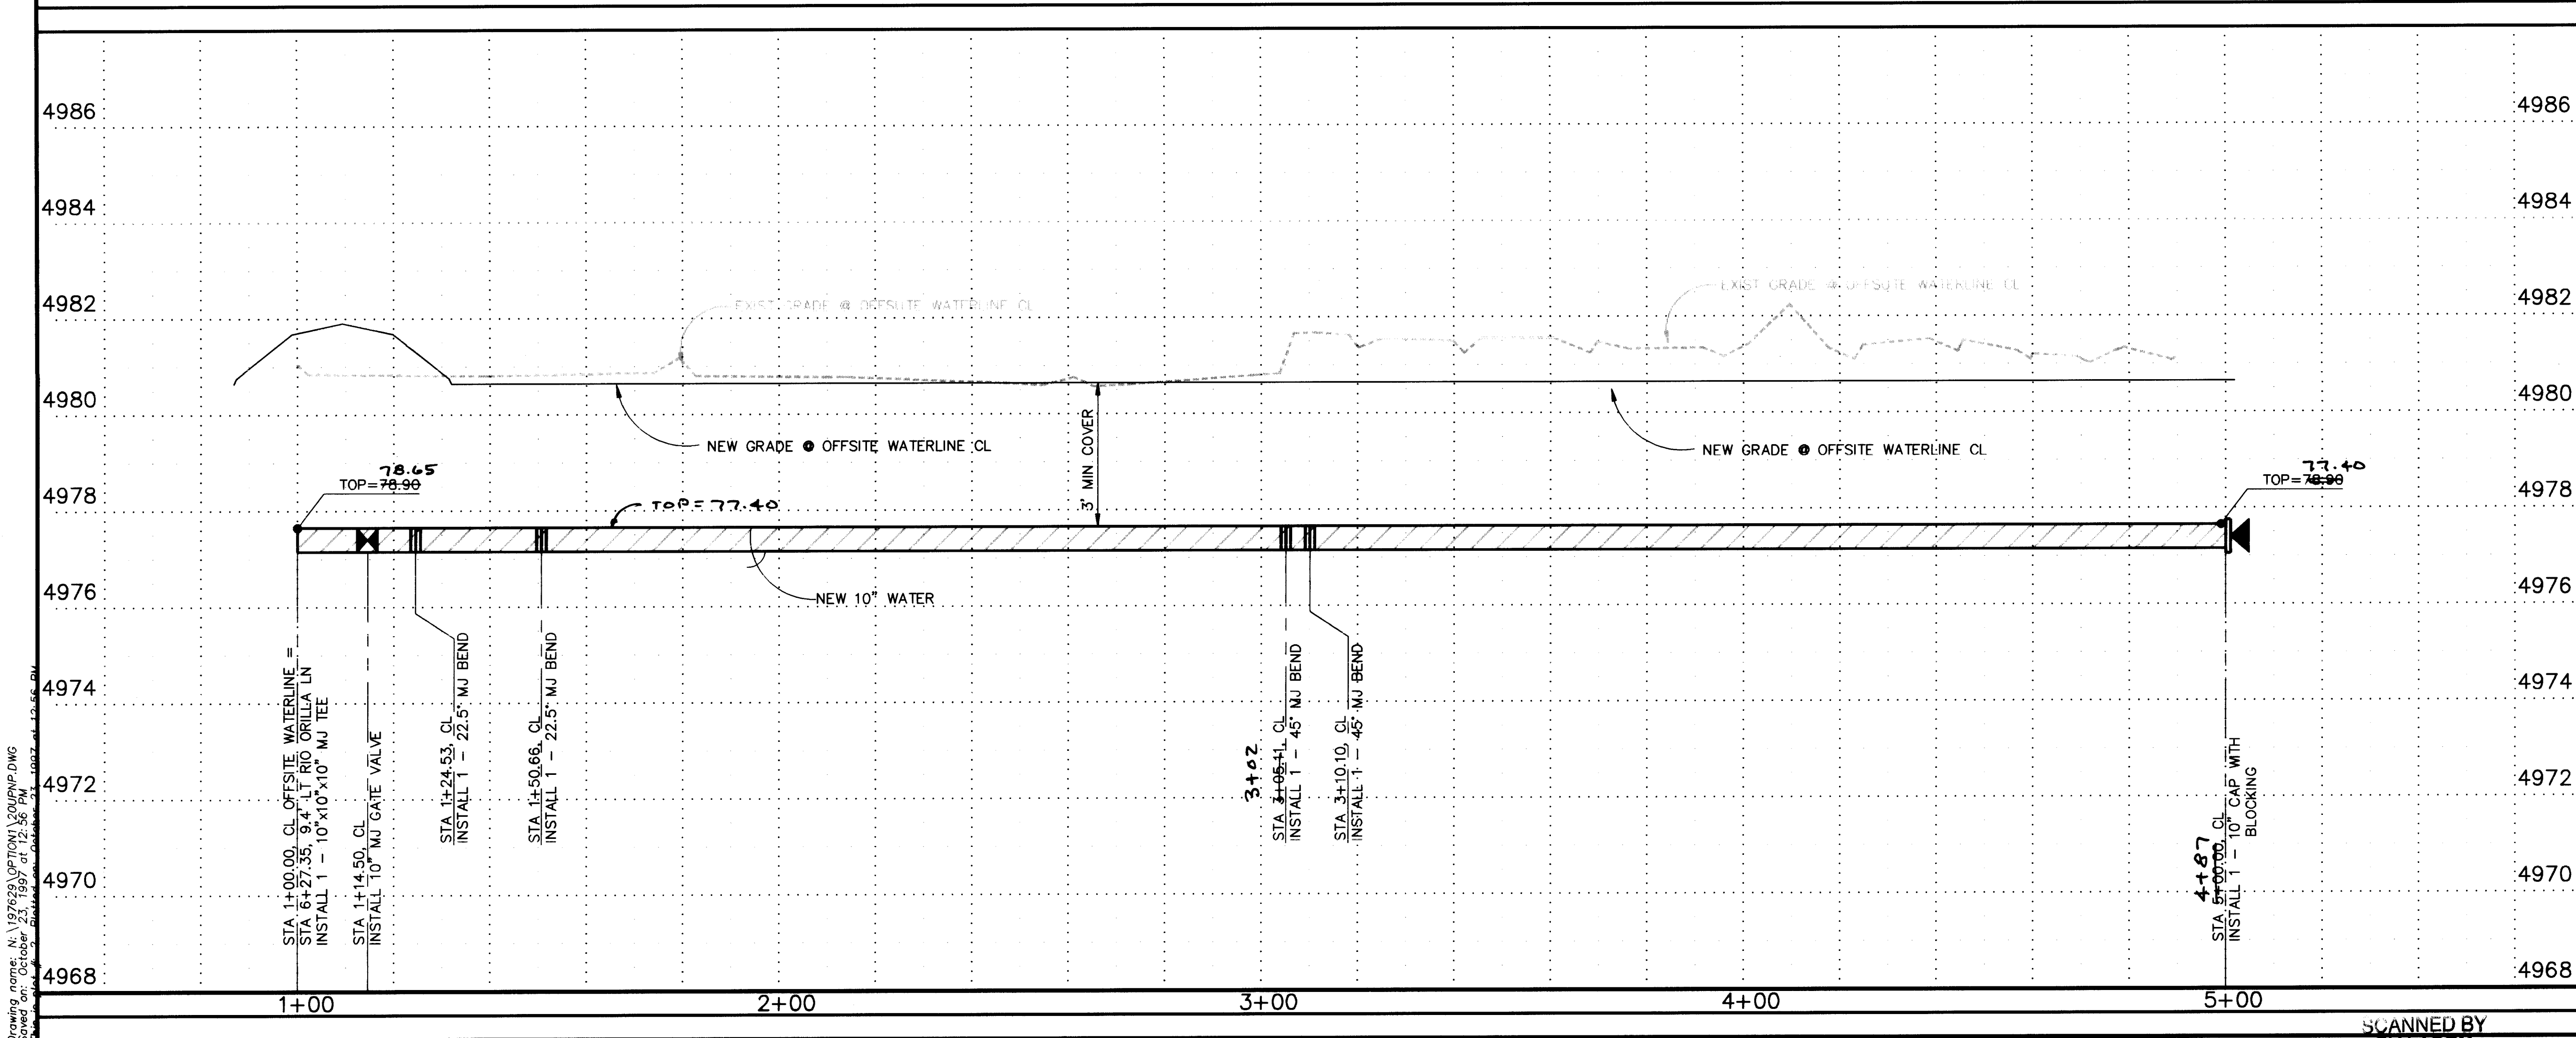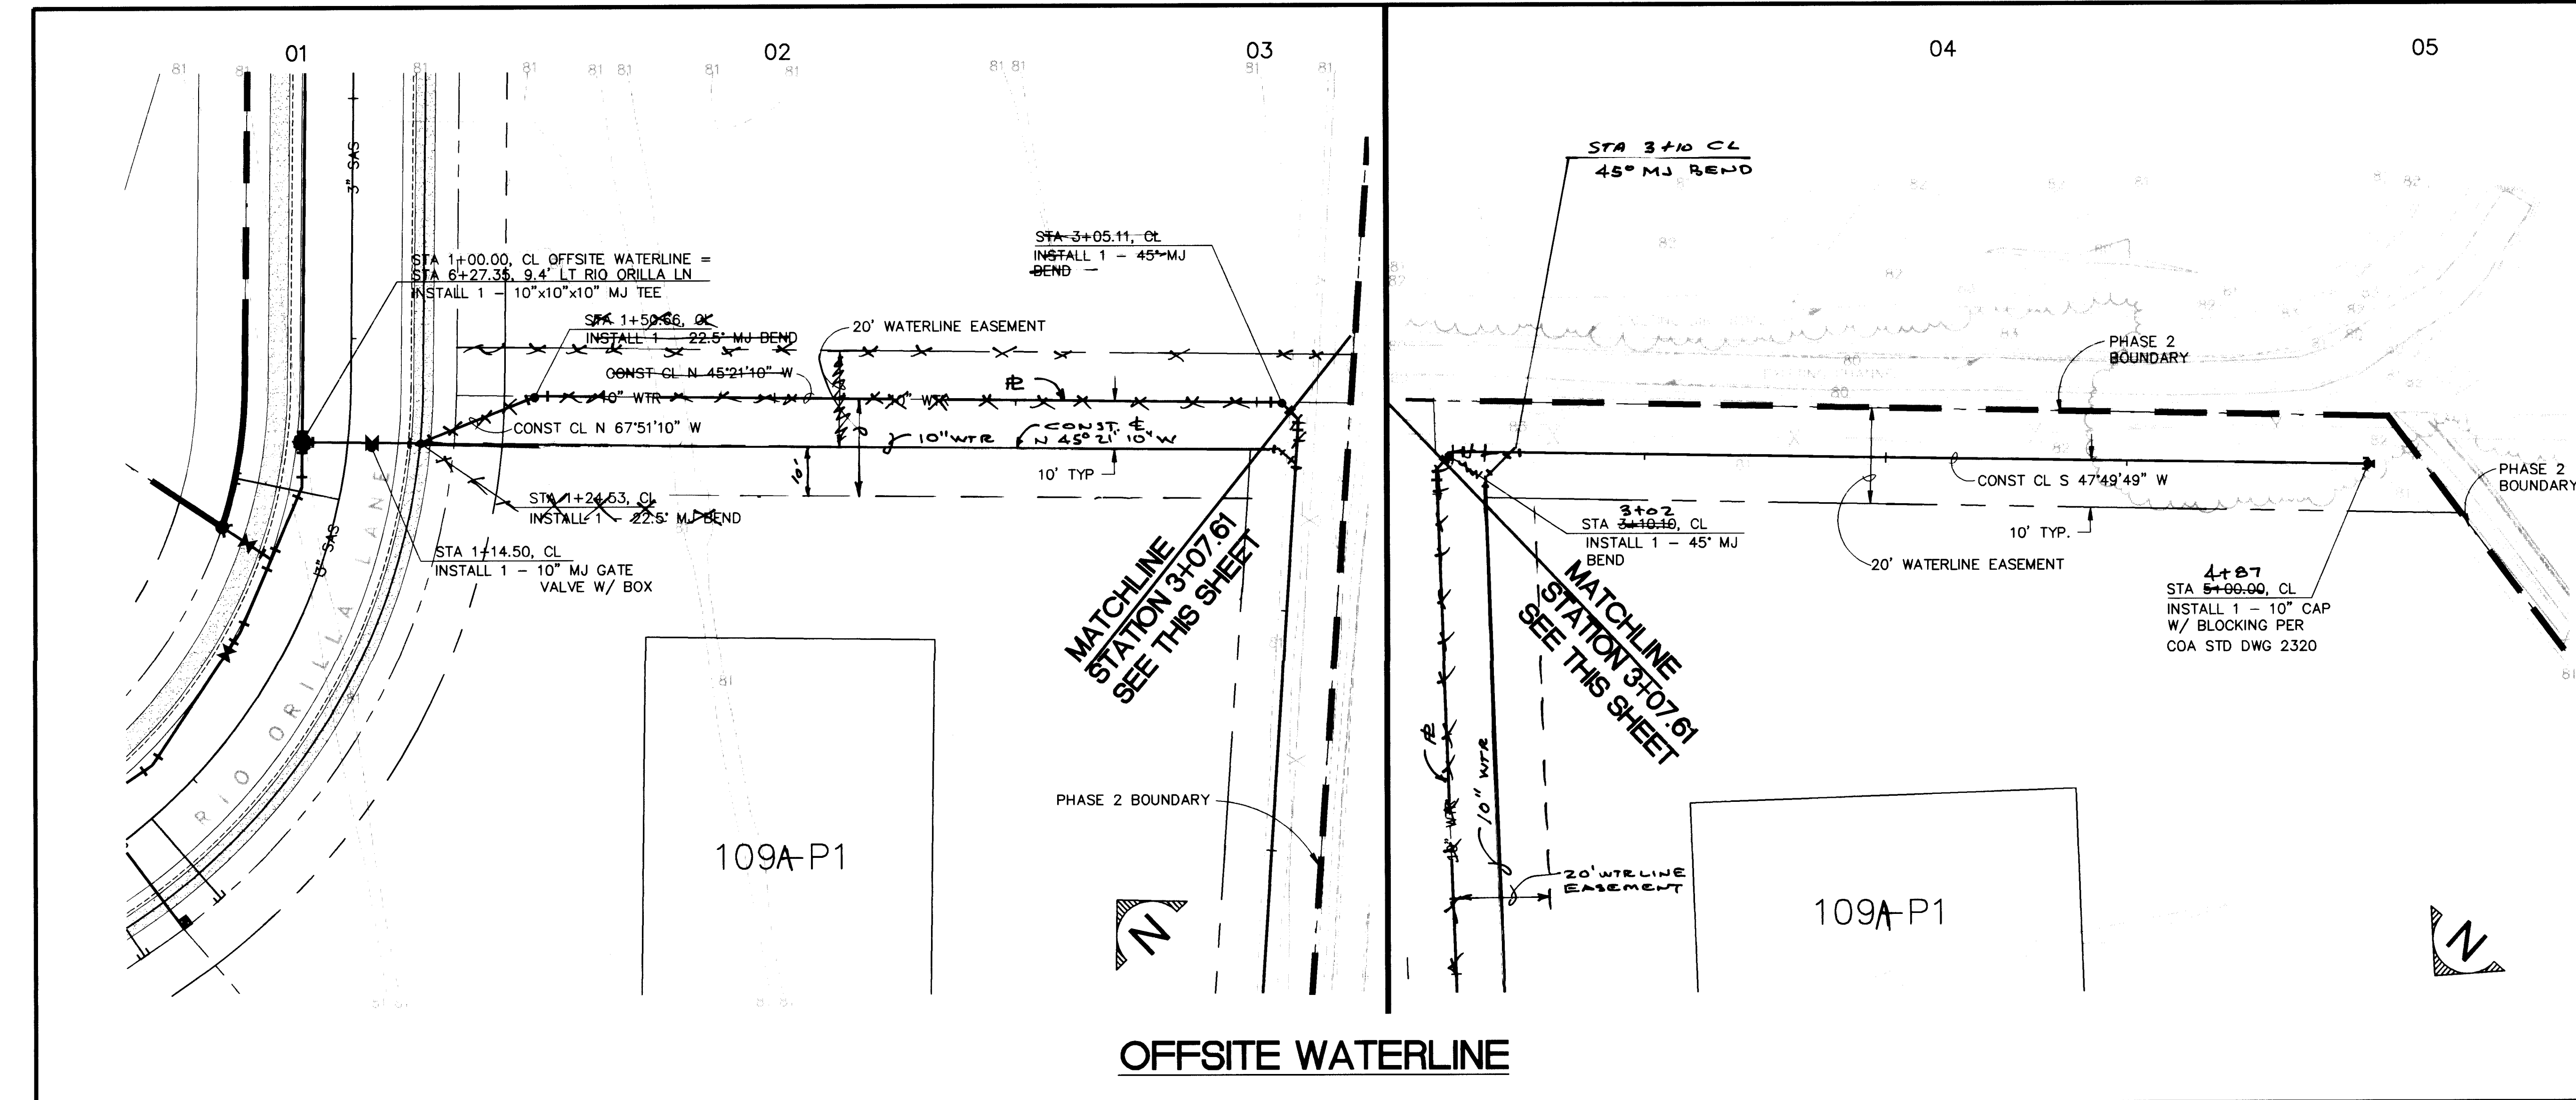

WATERLINE RESTRAINT LENGTHS:

LENGTH OF RESTRAINT FOR TEES

BRANCH SIZE	LENGTH OF RESTRAINT (FT)
6"x6"x6"	24'
10"x10"x6"	RESTRAIN BRANCH AT FITTING ONLY 10'
10"x10"x10"	64'

* EACH PIPE RUN SHALL HAVE A MINIMUM OF 10' W/O JOINTS ON EACH SIDE OF BRANCH OR FITTINGS. FOR TEES RESTRAIN PIPE IN THREE DIRECTIONS.

LENGTH OF RESTRAINT FOR HORIZ BENDS, REDUCERS, VALVES AND DEAD ENDS


PIPE SIZE	11.25'	22.5'	REDUCER	VALVE/ DEAD END
			SMALL SIDE	LARGE SIDE
6"	10'	14'	10'	73'
10"	15'	21'	116'	115'

RECORD DRAWINGS

NOTE: ALL ELEVATIONS SHOWN ON THESE PLANS HAVE BEEN LOWERED 0.25 FEET.

Horizontal Scale: 1"=20'

Vertical Scale: 1"=2'

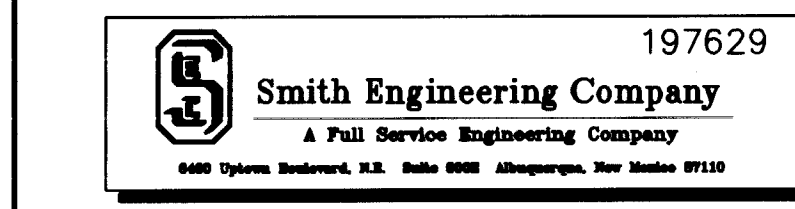

CITY OF ALBUQUERQUE PUBLIC WORKS DEPARTMENT ENGINEERING DEVELOPMENT GROUP

TITLE: BOSQUE DEL RIO SUBDIVISION - PHASE 2 UTILITY P & P: OFFSITE WATERLINE: STA 1+00 TO 4+90

DESIGNED BY: AUG / BAC DATE: 10/23/97
DRAWN BY: BAC DATE: 10/23/97
CHECKED BY: PJC DATE: 10/23/97

APPROVED: DEC 19 1997
DESIGN REVIEW COMMITTEE

City Engineer Approval

City Project No. 540682 Zone Map No. D-13 Sheet 20 of 23

AS-BUILT INFORMATION

CONTRACTOR: NEW CONCEPTS
STARTED BY: [Signature]
DATE: [Blank]
INSPECTOR'S: [Blank]
DATE: [Blank]
FIELD TAPE BY: [Blank]
DATE: [Blank]
VERIFICATION BY: [Blank]
DATE: [Blank]
CORRECTED BY: [Blank]
DATE: [Blank]

ENGINEERS SEAL

PAUL J. CONLEY
NEW MEXICO
REGISTERED PROFESSIONAL ENGINEER
No. 14742

SURVEY INFORMATION

U.S. CODE STA. "R. ALAMEDA B-2"
N.M. STATE PLAN COORDINATES (CENTRAL ZONE) BY ACS
X=373,513.20
Y=1,520,142.81
ELEVATION=5,058.25
G/G FACTOR=0.9997638

FIELD NOTES

DATE: 07/97
BY: GAYLE JEWELL
NO. 4071

REVISIONS

NO.	DATE	REMARKS	BY
1		DESIGN	

CANNED BY
 BY LASON.

