



VICINITY MAP

COORS TRAIL

PRD 284 DU MAX

ROBERTSON RANCH

RIO GRANDE

LOVELL

TAINES

PROJECT LOCATION

GRAPHIC SCALE
MAP NO. D-13

Douglas L. Andrews 4-21-99
DOUGLAS L. ANDREWS, NMPE 11771 DATE

APPROVAL OF AS BUILT DRAWING
CIVIL CONSTRUCTION ENGINEER
Peter Chang
4-30-99

UTILITY COMPANY CONTACTS

PNM

Jim Vann
4201 Edith Blvd. NE
Albuquerque, New Mexico 87107
(505) 848-3426

GAS CO.

Tim Cynova
4625 Edith Blvd. NE
Albuquerque, New Mexico 87107
(505) 761-7775

AT&T

Ishmael Panofja
11 Third ST., NW
Albuquerque, New Mexico 87103
(505) 842-2806

JONES INTERCABLE

Karen Shure
4611 Montiel Pl. NE
P.O. Box 2738
Albuquerque, New Mexico 87125-7138
(605) 761-6220

US WEST COMMUNICATIONS

Al Sales
201 Third Street NW
P.O. Box 1356, Sta. 952
Albuquerque, New Mexico 87103
(505) 245-6691


SEC JOB # 198628
Smith Engineering Company
A Full Service Engineering Company

ONE THIRTY SEVEN TWO SIX WEST ALBUQUERQUE, NEW MEXICO 87102

REV.	SHEETS	CITY ENGINEER	DATE	USER DEPARTMENT	DATE	USER DEPARTMENT	DATE
ENGINEERS STAMP & SIGNATURE		APPROVED	ENGINEER	DATE	APPROVED FOR CONSTRUCTION		
		DRC Checklist	<i>Billy G. Anderson</i>	8-4-98			
		Transportation	<i>R. A. Kane</i>	8-4-98			
		Water/Wastewater	<i>R. A. Kane</i>	8-4-98			
		Hydrology	<i>Steve Salazar</i>	8-4-98			
		CIP					
		Constr. Maint.					
		Smith Local	N/A	<i>J. R. Cobb</i>	9-17-98	CITY ENGINEER	DATE
PROJECT NUMBER				5406.83			
SHEET				1 OF 22			

GENERAL NOTES:

1. ALL WORK DETAILED ON THESE PLANS TO BE PERFORMED UNDER CONTRACT, AND UNLESS STATED OTHERWISE OR PROVIDED FOR HEREON, SHALL BE CONSTRUCTED IN ACCORDANCE WITH THE CITY OF ALBUQUERQUE STANDARD SPECIFICATIONS, PUBLIC WORKS CONSTRUCTION, 1986 EDITION, AS AMENDED THROUGH UPDATE NO. 6.
2. TWO WORKING DAYS PRIOR TO ANY EXCAVATION, THE CONTRACTOR MUST CONTACT NEW MEXICO ONE CALL, 280-1990, FOR LOCATION OF EXISTING UTILITIES.
3. PRIOR TO CONSTRUCTION, THE CONTRACTOR SHALL EXCAVATE AND VERIFY THE HORIZONTAL AND VERTICAL LOCATIONS OF EXISTING UTILITIES BEING CONNECTED TO AND ALL POTENTIAL OBSTRUCTIONS. SHOULD A CONFLICT EXIST, THE CONTRACTOR SHALL NOTIFY THE ENGINEER SO THAT THE CONFLICT CAN BE RESOLVED WITH A MINIMUM AMOUNT OF DELAY.
4. ALL EXCAVATION, TRENCHING AND SHORING ACTIVITIES MUST BE CARRIED-OUT IN ACCORDANCE WITH OSHA 29CFR 1926.550 subpart P. ALL OTHER WORK ON THIS PROJECT SHALL BE PERFORMED IN ACCORDANCE WITH APPLICABLE FEDERAL, STATE, AND LOCAL LAWS, RULES, AND REGULATIONS CONCERNING SAFETY AND HEALTH.
5. CONTRACTOR SHALL MAINTAIN ACCESS TO ADJACENT PROPERTIES DURING CONSTRUCTION.
6. ALL GAS, ELECTRIC, TELEPHONE LINES, CABLES AND APPURTENANCES ENCOUNTERED DURING CONSTRUCTION THAT REQUIRE RELOCATION SHALL BE DONE BY THE RESPONSIBLE UTILITY. THE CONTRACTOR SHALL BE RESPONSIBLE FOR COORDINATION OF ALL NECESSARY UTILITY ADJUSTMENTS.
7. IT SHALL BE THE CONTRACTOR'S RESPONSIBILITY TO PROTECT AND MAINTAIN IN SERVICE ALL EXISTING UTILITIES.
8. THE CONTRACTOR SHALL BE REQUIRED TO CONFINE HIS WORK WITHIN THE CONSTRUCTION LIMITS AND/OR PUBLIC RIGHT-OF-WAY OR EASEMENTS TO PRESERVE EXISTING VEGETATION AND PRIVATE PROPERTY. OVERNIGHT PARKING OF EQUIPMENT AND/OR STORAGE OF MATERIALS IS NOT ALLOWED EXCEPT BY PERMISSION OF PROPERTY OWNER. RESTORATION OF PRIVATE IMPROVEMENTS WILL BE AT THE CONTRACTOR'S EXPENSE.
9. A DISPOSAL SITE FOR ALL EXCESS EXCAVATION MATERIAL, ASPHALTIC PAVING, CONCRETE CURBS AND SIDEWALKS, ETC. SHALL BE OBTAINED BY THE CONTRACTOR IN COMPLIANCE WITH APPLICABLE ENVIRONMENTAL REGULATIONS AND APPROVED BY THE FIELD ENGINEER. ALL COSTS INCURRED IN OBTAINING A DISPOSAL SITE AND HAUL THERE TO SHALL BE CONSIDERED INCIDENTAL TO THE PROJECT AND NO SEPARATE MEASUREMENT OR PAYMENT SHALL BE MADE.
10. WHEN ABUTTING EXISTING PAVEMENT TO NEW, SAWCUT EXISTING PAVEMENT TO A STRAIGHT EDGE AND AT A RIGHT ANGLE, OR AS APPROVED BY THE PROJECT ENGINEER. REMOVAL OF BROKEN OR CRACKED PAVEMENT WILL ALSO BE REQUIRED.
11. FIVE (5) WORKING DAYS PRIOR TO BEGINNING CONSTRUCTION, THE CONTRACTOR SHALL SUBMIT TO THE CONSTRUCTION COORDINATION DIVISION A DETAILED CONSTRUCTION SCHEDULE. TWO (2) WORKING DAYS PRIOR TO CONSTRUCTION, THE CONTRACTOR SHALL OBTAIN A BARRICADING PERMIT FROM THE CONSTRUCTION COORDINATION DIVISION. CONTRACTOR SHALL NOTIFY BARRICADE ENGINEER (788-2551) PRIOR TO OCCUPYING AN INTERSECTION. SEE SECTION 19 OF THE SPECIFICATIONS.
12. ALL FINAL BACKFILL FOR TRENCHES SHALL BE COMPACTED TO A MINIMUM 90% MAXIMUM DENSITY PER ASTM D-1557 AND AS DIRECTED BY SECTION 701.14.2 AND STANDARD DRAWING NUMBER 2315.
13. CONTRACTOR SHALL SUBMIT A REVEGETATION PLAN TO ENGINEER FOR PRIOR APPROVAL.
14. THE CONTRACTOR WILL NOTIFY THE FIELD ENGINEER NOT LESS THAN SEVEN (7) DAYS PRIOR TO STARTING WORK, IN ORDER THAT THE FIELD ENGINEER MAY TAKE NECESSARY MEASURES TO INSURE THE PRESERVATION SURVEY MONUMENTS. THE CONTRACTOR WILL NOTIFY THE ENGINEER IF A MONUMENT IS DISTURBED. REPLACEMENT WILL BE DONE BY CITY SURVEY SECTION. WHEN A CHANGE IS MADE IN THE FINISHED ELEVATION OF THE PAVEMENT OF ANY ROADWAY IN WHICH A PERMANENT SURVEY MONUMENT IS LOCATED, CONTRACTOR WILL, AT HIS OWN EXPENSE, ADJUST THE MONUMENT COVER TO THE NEW GRADE UNLESS OTHERWISE SPECIFIED. REFER TO SECTION 4 OF SPECIFICATIONS.
15. CONTRACTOR SHALL MAINTAIN A GRAFFITI-FREE WORK SITE. CONTRACTOR SHALL PROMPTLY REMOVE ANY AND ALL GRAFFITI FROM ALL EQUIPMENT, WHETHER PERMANENT OR TEMPORARY.

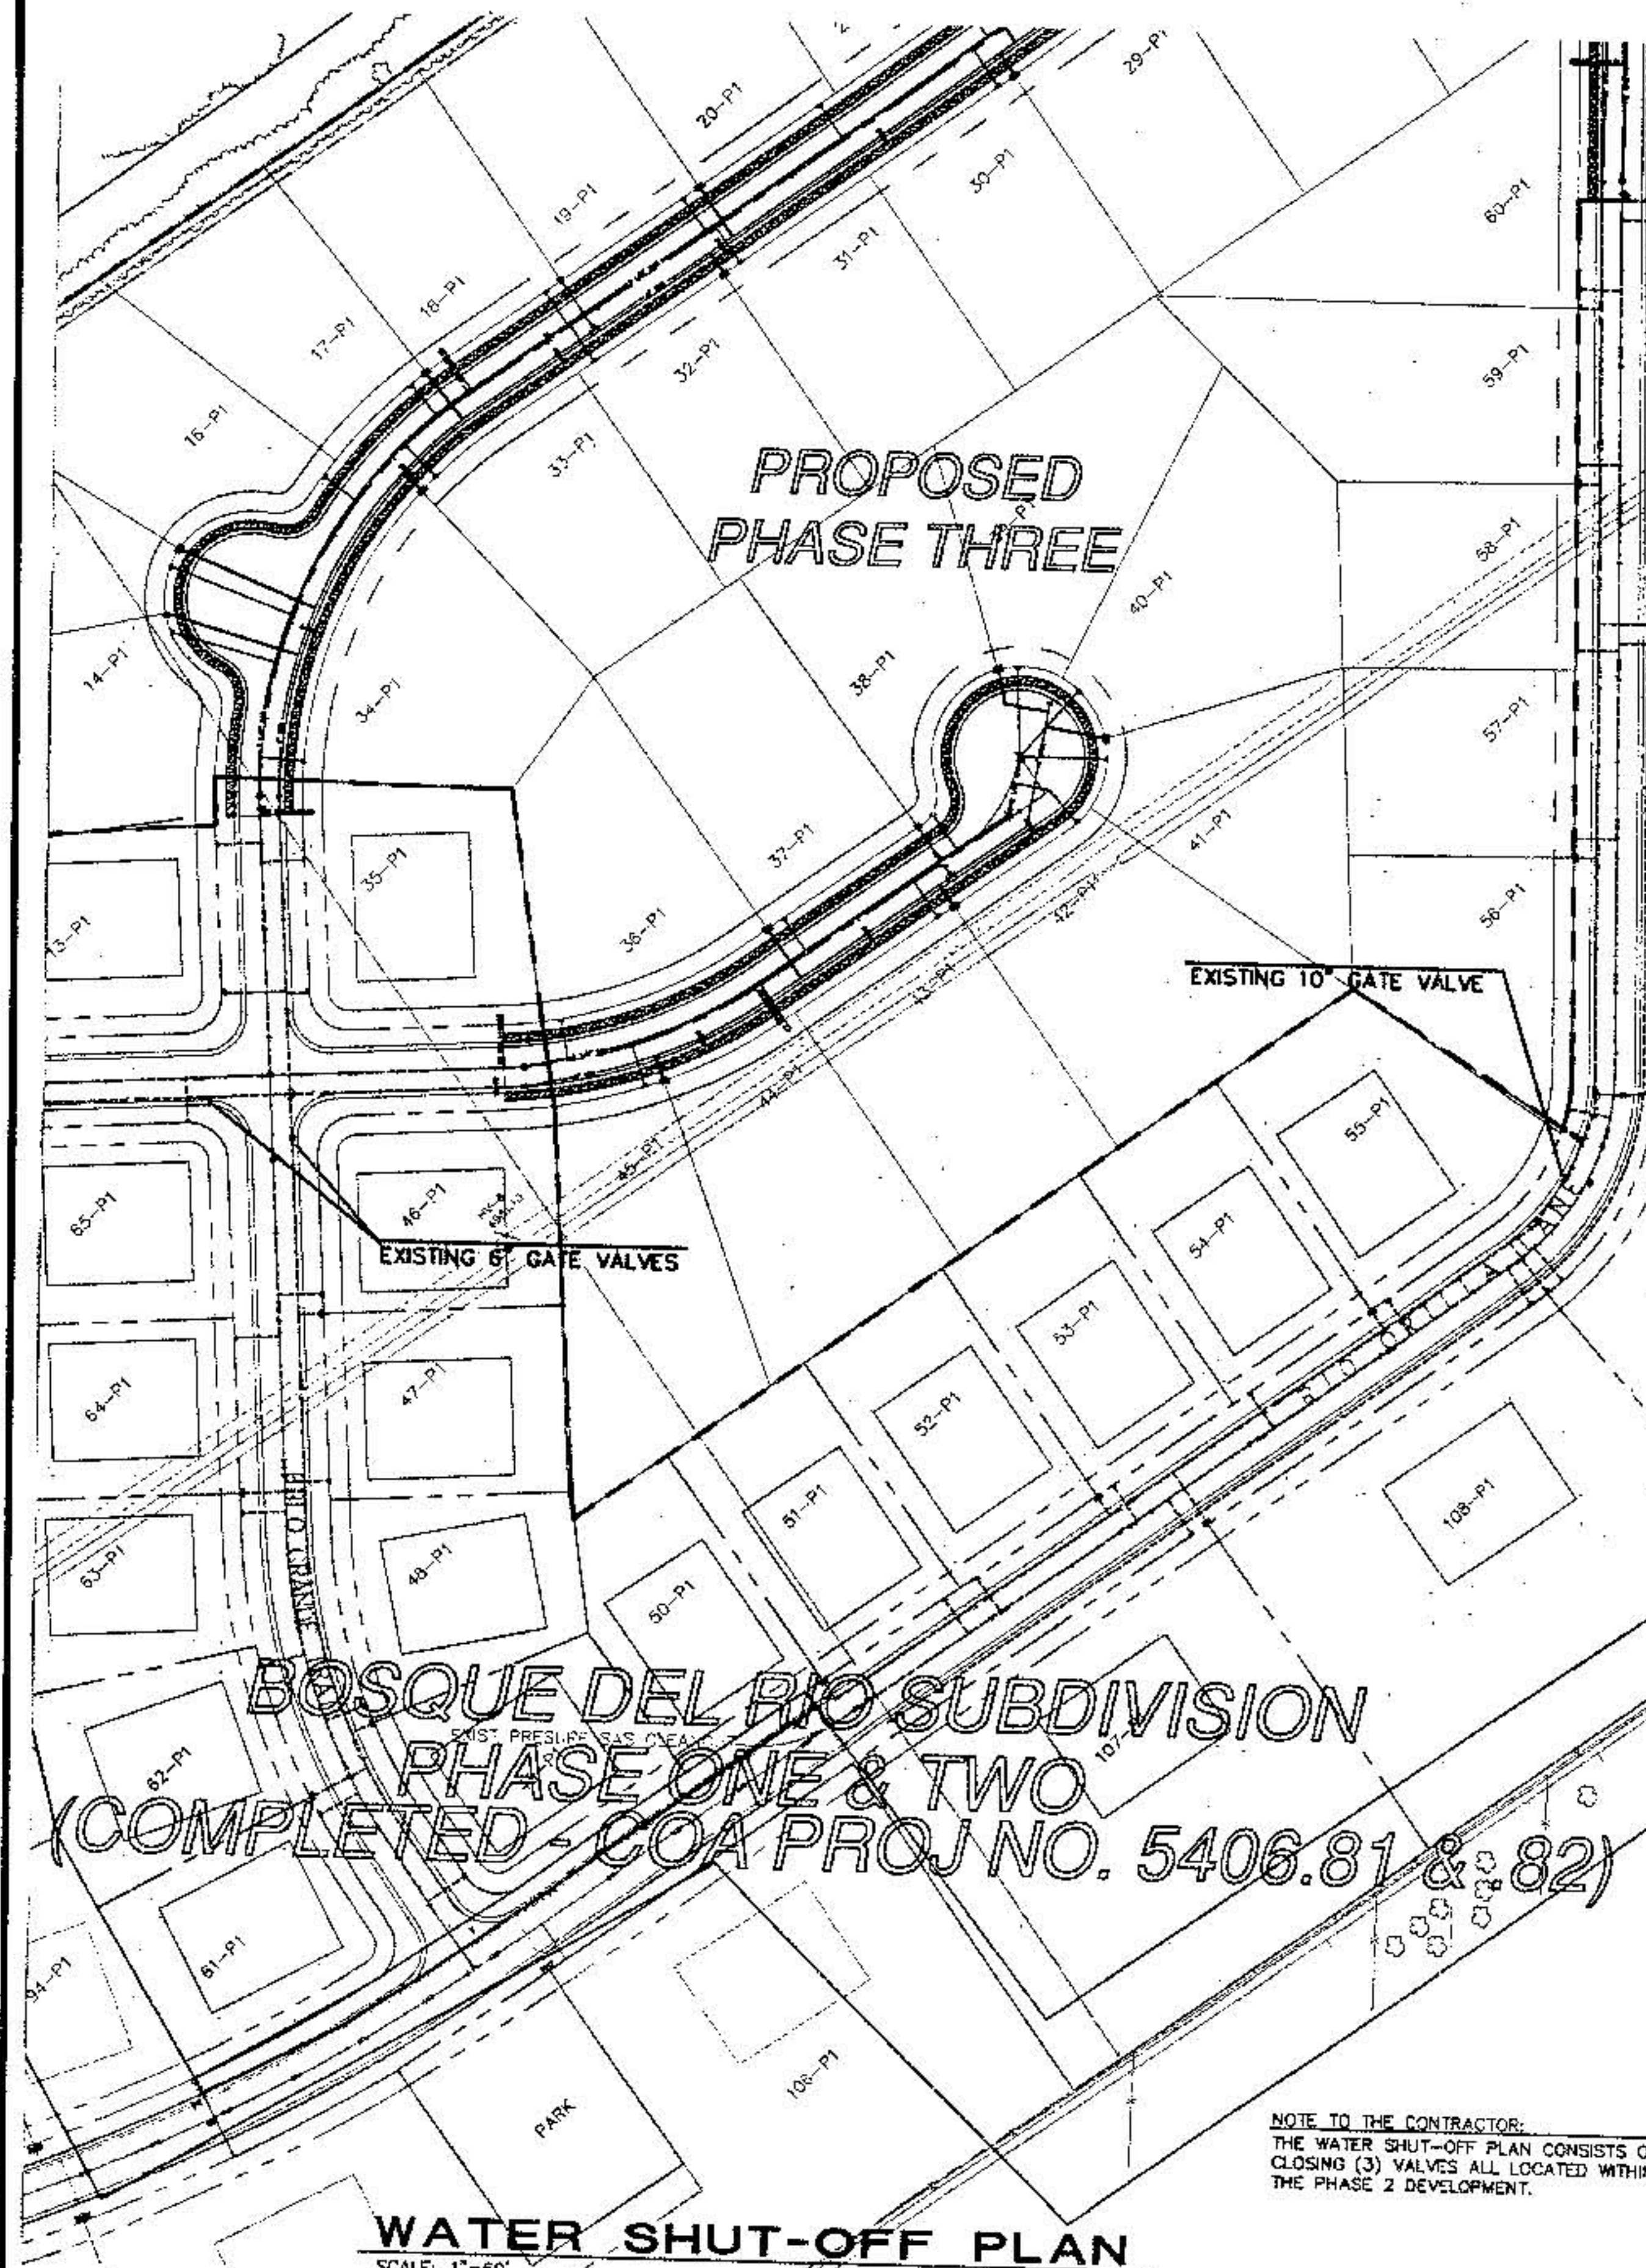

NOTE TO THE CONTRACTOR:
THE WATER SHUT-OFF PLAN CONSISTS OF CLOSING (3) VALVES ALL LOCATED WITHIN THE PHASE 2 DEVELOPMENT.

WATER SHUT-OFF PLAN
SCALE: 1"=60'


LEGEND:

	PROPOSED	EXISTING
SANITARY SEWER LINE	3" SAS	SAS
SANITARY SEWER MANHOLE		
WATER LINE	6" WTR	
GATE VALVE		
FIRE HYDRANTS		
REDUCERS		
SINGLE WATER SERVICE CONNECTION		
DOUBLE WATER SERVICE CONNECTION		
SANITARY SEWER SERVICE CONNECTION		
PERMANENT EARTH BERM		
TEMPORARY EARTH BERM		
CENTERLINE BOUNDARY		
PROPERTY/LOT AND ACCESS EASEMENT LINE		
EASEMENT LINE		
CMU WALL		
SPOT ELEVATION	80.85	
PAD SPOT ELEVATION	80.85	
TOP OF CURB	TOC	
TOP BACK CURB	TBC	
TOP OF PIPE	TOP	
PROPERTY LINE	PL	
POINT TANGENCY STATION	PT STA.	
POINT CURVE STATION	PC STA.	
PUBLIC UTILITY EASEMENT	PUE	
TOP OF CURB	TOC	
POINT VERTICAL TANGENCY	PVT	
POINT VERTICAL CURVE	PVC	
VERTICAL POINT CURVE	VPC	
POINT VERTICAL INTERSECTION	PVI	
VERTICAL POINT INTERSECTION STATION	VPI STA.	
VERTICAL POINT INTERSECTION ELEVATION	VPI EL.	
WATER LINE	WL	
CITY OF ALBUQUERQUE	COA	
RIGHT OF WAY	ROW	

RECORD DRAWINGS

Smith Engineering Company A Full Service Engineering Company 1000 North Central Ave., Suite 200, Albuquerque, New Mexico 87102		197629
CITY OF ALBUQUERQUE PUBLIC WORKS DEPARTMENT ENGINEERING DEVELOPMENT GROUP		
TITLE: BOSQUE DEL RIO SUBDIVISION - PHASE 3 GENERAL NOTES AND LEGEND		
City Engineer Approval 	Lead Design Engineer 	Date: 11-96 Date: 11-96 Date: 11-96
City Project No. 5406.83	Zone Map No. D-3	Sheet 2 of 22

Drawing name: N:\197629\BOSQUE DEL RIO\NOTES.DWG
 This is plot 6 of 6. Plotted on: October 22, 1997 at 8:07 AM

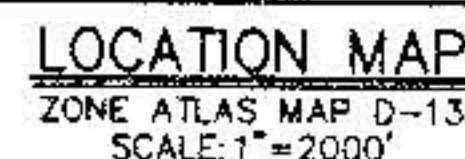

1. THE PURPOSE OF THIS PLAT IS TO SUBDIVIDE THE LOTS IN PHASE 3, AND TO GRANT THE REQUIRED EASEMENTS.
2. BEARINGS ARE BASED ON THE PLAT OF BOSQUE DEL RIO SUBDIVISION, UNIT 1, FILED AUGUST 29, 1998, AND ARE STATE PLANE (NAD) BEARINGS AS INDICATED THEREON.
3. ALL BOUNDARY CORNERS ARE MARKED BY A NEARBY WITH AN ALUMINUM CAP STAMPED "AAR LS 4071", UNLESS OTHERWISE INDICATED HEREON.
4. PRIOR TO DEVELOPMENT, CITY OF ALBUQUERQUE WATER AND SANITARY SEWER DIVISION TO TRACTS MUST BE VERIFIED AND COORDINATED WITH THE PUBLIC WORKS DEPARTMENT, CITY OF ALBUQUERQUE.
5. THE ROADWAYS HEREIN ARE PRIVATE, WITH PRIVATE ACCESS EASEMENTS TO THE OWNERS OF BOSQUE DEL RIO AND COORS TRAIL NEIGHBORS ONLY, AS PROVIDED HEREIN AND BY SETTLEMENT AGREEMENT DATED JANUARY 12, 1998. THE ROADWAY IMPROVEMENTS WILL BE THE RESPONSIBILITY OF THE INDIVIDUAL PHASE DEVELOPERS, AND THE MAINTENANCE OF THE ROADWAY IMPROVEMENTS WILL BECOME THE RESPONSIBILITY OF A HOMEOWNERS ASSOCIATION.
6. THE PEDESTRIAN AND EQUESTRIAN ACCESS EASEMENT (P & E.A.E.) SHOWN HEREON IS PRIVATE, FOR THE USE AND BENEFIT OF THE BOSQUE DEL RIO OWNERS AND THE COORS TRAIL NEIGHBORS. THE PROVIDER OF THE PEDESTRIAN AND EQUESTRIAN ACCESS DATED JANUARY 12, 1998, THE ROADWAY AND TRAIL IMPROVEMENTS WILL BE THE RESPONSIBILITY OF THE INDIVIDUAL PHASE DEVELOPERS, AND THE MAINTENANCE OF THE IMPROVEMENTS AND EASEMENTS WILL BECOME THE RESPONSIBILITY OF A HOMEOWNERS ASSOCIATION.
7. GRAVITY SANITARY SEWER SERVICE IS NOT AVAILABLE TO ANY OF THE LOTS RECORDED WITHIN THIS PLAT. THEREFORE, ALL LOTS WILL BE SERVED BY A PRESSURE SANITARY SEWER SYSTEM. MAINTENANCE OF THE PRESSURE SANITARY SEWER PIPES LOCATED WITHIN EACH LOT IS THE RESPONSIBILITY OF EACH INDIVIDUAL HOMEOWNER.

Paul = Phill 6-30-78 Viola Watson 4/30/98
PHN ELECTRIC SERVICES DATE JONES-INTERCABLE DATE
Christopher Schneider 4/30-98 Paul = Phill 6-30-98
U.S. WEST COMMUNICATIONS DATE PHN GAS SERVICES DATE

PUBLIC UTILITY EASEMENTS shown on this plat granted for the common and joint use of:

- A. PMR Electric Service for installation, maintenance, and service of underground electrical lines, transformers, and other equipment and related facilities reasonably necessary to provide electrical service.
- B. U.S. West Communications for the installation, maintenance, and service of such lines, poles, and other related equipment and facilities reasonably necessary to provide communication services, including but not limited to ground pedestals and closures.
- C. PMR Gas Services for the installation, maintenance, and service of such lines, and other related equipment and facilities reasonably necessary to provide gas service.
- D. Jones Intertele for the installation, maintenance, and service of such lines, and other related equipment and facilities reasonably necessary to provide Cable TV service.

Included is the right to build, rebuild, construct, reconstruct, locate, relocate, change, remove, modify, rename, separate, and maintain facilities for the purposes described herein, together with free access to, from, and over said easements, including sufficient working area space for electric transformers, with the right and privilege to trim and remove trees, shrubs or bushes which interfere with the purpose set forth herein. No building, sign, pool (above-ground or below-ground), hot tub, concrete or other structure shall be constructed or erected on the easement constructed on said easement, nor shall any well be drilled or operated thereon. Property owners shall be solely responsible for correcting any violations of the National Electric Safety Code, including those of poles, decking, or any structures adjacent to or near easements shown on this plat.

A certain tract of land abuts within Section 19, Township 11 North, Range 3 East, New Mexico Principal Meridian, City of Albuquerque, Bernalillo County, New Mexico, being and comprising all of Parcel lettered "E" of BOSQUE DEL RIO SUBDIVISION as the same is shown and designated on the Plat of Unit 1 filed August 29, 1996 in plot volume 86C, page 377, and on the Plat of Unit 2 September 9, 1997 in plot volume 87C, page 263 filed and being more particularly described as follows:

Beginning at the northwesterly corner of said Parcel E, from whence the control survey station "X Almondre B-2" bears N39°48'13"W, 334.217 feet distance, and running thence from said point of beginning, 579.55°35"E, 1587.89 feet along the northerly line of said Parcel E to a point; thence, 542°44'56"E, 57.30 feet to a point; thence, 365°44'55"E, 34.14 feet to the northwesterly corner of said Parcel E; thence, 547°49'46"W, 823.40 feet along the easterly line of said Parcel E to a point; thence, 540°21'10"W, 254.30 feet to a point; thence, 542°35'50"E, 645.08 feet to a point of curve; thence, 544°35'50"E, 330.30 feet along the arc of a curve to the right having a radius of 98.00 feet and chord bearing S54°05'18"W, 32.15 feet to a non-tangent point on curve; thence, N11°11'56"W, 130.10 feet to a point; thence, N79°55'06"W, 403.45 feet to a point; thence, N36°32'29"E, 14.07 feet to a point; thence, N42°01'21"E, 196.53 feet to a point; thence, N36°47'31"E, 44.01 feet to a point; thence, N37°01'26"E, 120.68 feet to a point; thence, N43°36'36"E, 182.36 feet to non-tangent point on curve; thence, Southwesterly, 20.81 feet along the arc of a curve to the left having a radius of 273.00 feet and chord bearing S44°12'23"W, 20.81 feet to a point of tangent; thence, S42°01'21"W, 4.03 feet to a point; thence, S42°02'47"W, 111.78 feet to a point; thence, N12°34'34"E, 206.01 feet to the northwestern corner and point of beginning of the tract herein described; containing 888.647 acres (15,813.37 acres), more or less.

The plot as shown herein is with the free consent of, and in accordance with the wishes and desires of the undersigned owners and/or proprietors do hereby grant all rights and interests therein to the City of Milwaukee, including the right of ingress and egress and the right to trim trees and shrubs growing thereon, and the right to install, construct, alter, repair, reconstruct, remove or replace, as shown herein, indicated by the red lines, sewerage and watermain easements and appurtenances thereon. And do hereby grant the private easement as shown herein for the common benefit of the owners of the lots adjoining said plot, and the undersigned owners and/or proprietors do hereby freely consent to all the foregoing and do hereby represent that we are authorized to execute this agreement.

MANUFACTURED BY:
GARRETT GROUP, INC., A NEW MEXICO CORPORATION

BY: Ted E. Garrett
BY: TED E. GARRETT, JR., President, for
and on behalf of GARRETT GROUP, INC.
A New Mexico Corporation

ACKNOWLEDGEMENT

STATE OF NEW MEXICO)
COUNTY OF BERNALILLO) ss

The foregoing instrument was acknowledged before me this 26th day of June, 1998, by TED E. GARRETT, JR., President, for and on behalf of GARRETT GROUP, a New Mexico Corporation.

NOTARY PUBLIC

My correspondence address

THIS IS TO CERTIFY THAT TAXES ARE CURRENT AND PAID ON UPC #

PROPERTY OWNER OF RECORD:

BERNALILLO COUNTY TREASURER'S OFFICE

Wendy C. [Signature] 070148
CITY SURVEYOR, CITY OF ALBUQUERQUE
PUBLIC WORKS DEPARTMENT DATE

PROPERTY MANAGEMENT, CITY OF ALBUQUERQUE DATE

TRAFFIC ENGINEER, CITY OF ALBUQUERQUE DATE
PUBLIC WORKS DEPARTMENT

PARKS AND GENERAL SERVICES DEPARTMENT, DATE
CITY OF ALBUQUERQUE

UTILITY DEVELOPMENT DIVISION, CITY OF ALBUQUERQUE PUBLIC WORKS DEPARTMENT DATE

ALBUQUERQUE METROPOLITAN ARROYO
FLOOD CONTROL AUTHORITY DATE

CITY ENGINEER, CITY OF ALBUQUERQUE DATE

APPROVAL AS SPECIFIED BY THE ALBUQUERQUE SUBDIVISION ORDINANCE

CHAIRMAN, ALBUQUERQUE/BERNALILLO COUNTY
NEW CRIMINAL JUSTICE BOARD

CASE No. _____

PLAT No. _____

I, GAYLE D. JEWELL, A REGISTERED LAND SURVEYOR UNDER THE LAWS OF THE STATE OF NEW MEXICO, DO HEREBY CERTIFY THAT THIS PLAN WAS PREPARED BY ME OR UNDER MY SUPERVISION, SHOWS ALL EASEMENTS OF RECORD MADE BY ME BY THE SURVEY/PROPORTIONS, UTILITY COMPANIES OR OTHER PARTIES EXPRESSING AN INTEREST IN THE SURVEYED PROPERTY, AND THAT THE MONUMENTATION AND SURVEYS FOR THE ALBUQUERQUE REGIONAL GROWTHMAN AND ITS TRAIL ARE CORRECT TO THE BEST OF MY KNOWLEDGE AND BELIEF.

Gayle D. Jewell 6/25/98
GAYLE D. JEWELL, REG. P.L.S. No. 4071 DATE



SHEET 1 OF 2

ANDREWS, ASBURY & ROBERT, INC.

RECORD DRAWINGS


[illegible]

 198628
Smith Engineering Company
A Full Service Engineering Company
2000 O'Brien Boulevard, E.E. 2nd Fl. E.E. 2nd Fl. E.E. 2nd Fl.

CITY OF ALBUQUERQUE
PUBLIC WORKS DEPARTMENT
ENGINEERING DEVELOPMENT GROUP

TITLE: BOSQUE DEL RIO SUBDIVISION - PHASE 3
PLAT OF BOSQUE DEL RIO:UNIT 3

Design Review Committee	City Engineer Approval	Local Design Director	No. of Days / Mth	No. of Days / Yr			
City Project No.	5406.83	Zone Map No.	D-13	Sheet	3	Of	22

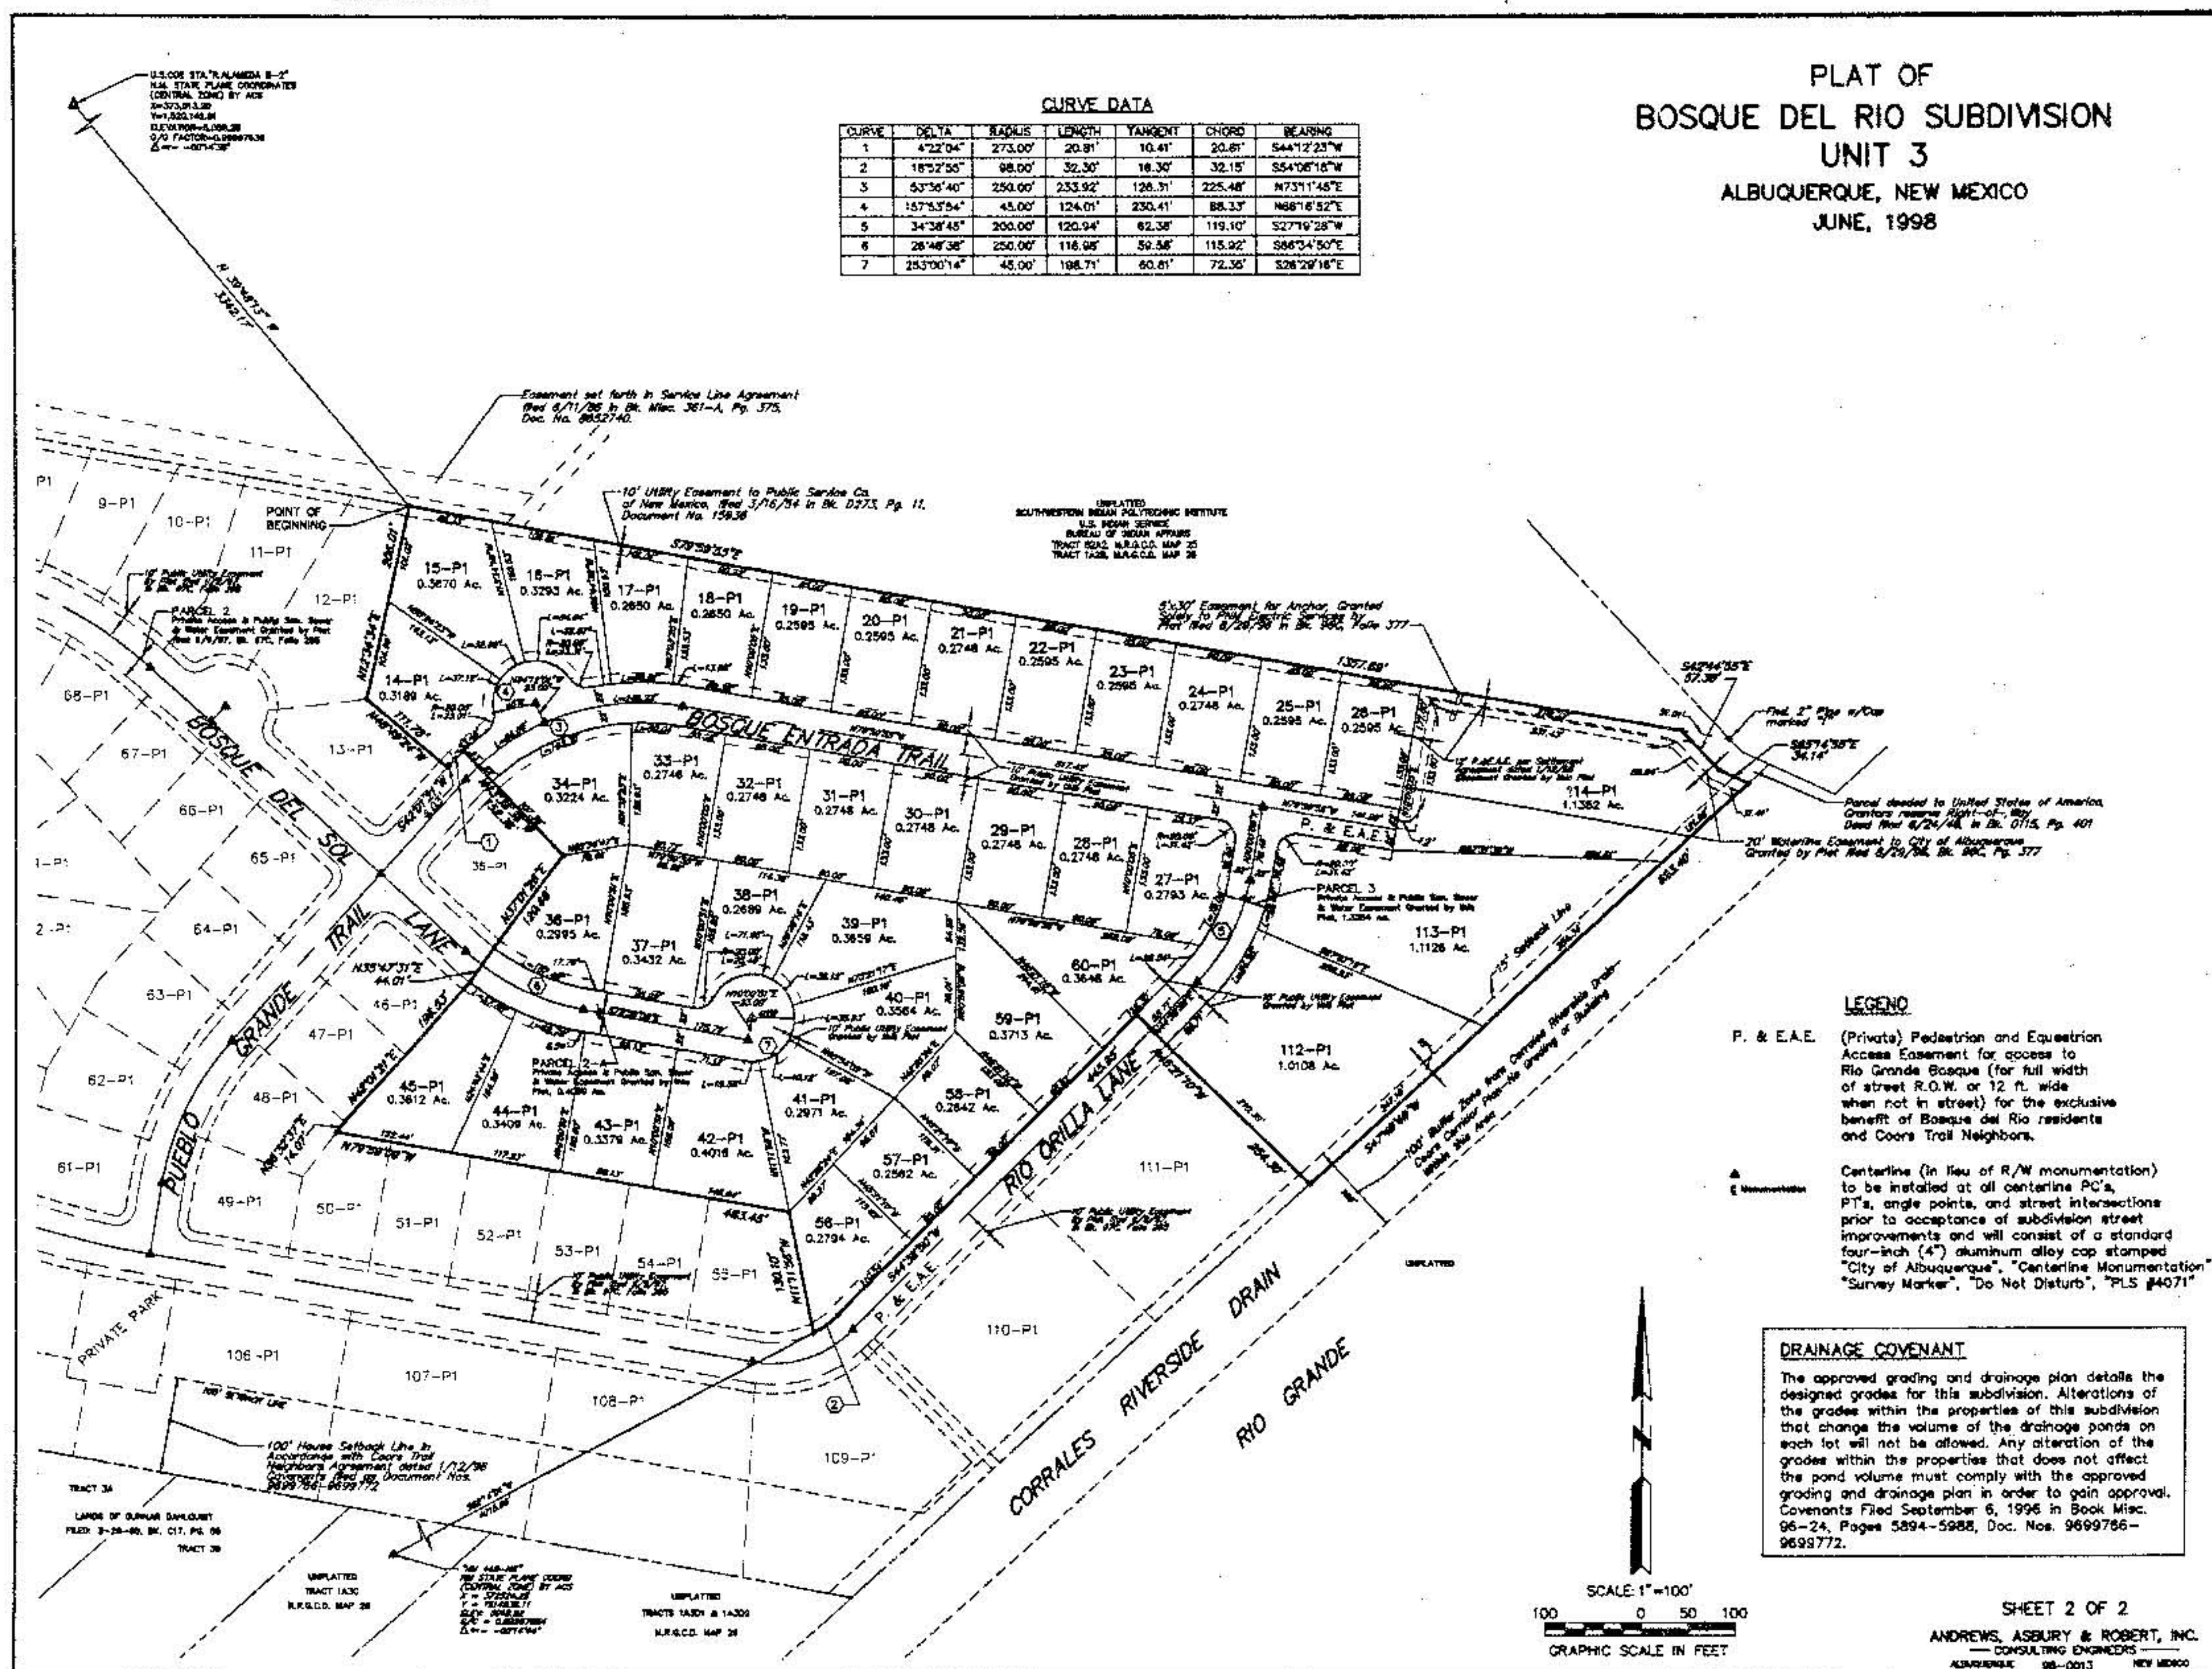

CURVE DATA						
CURVE	DELTA	RADIUS	LENGTH	TANGENT	CHORD	BEARING
1	4°22'04"	273.00'	20.81'	10.41'	20.81'	S44°12'23"W
2	18°52'35"	98.00'	32.30'	18.30'	32.15'	S54°06'16"W
3	53°36'40"	250.00'	233.92'	126.31'	225.48'	N73°11'45"E
4	157°53'54"	45.00'	124.01'	230.41'	88.33'	N68°16'52"E
5	34°38'45"	200.00'	120.04'	62.38'	119.10'	S27°19'28"W
6	28°48'38"	250.00'	116.95'	59.38'	115.92'	S86°34'50"E
7	253°00'14"	45.00'	108.71'	60.61'	72.35'	S28°29'18"E

PLAT OF
BOSQUE DEL RIO SUBDIVISION
UNIT 3
ALBUQUERQUE, NEW MEXICO
JUNE, 1998

LEGEND

P. & E.A.E. (Private) Pedestrian and Equestrian Access Easement for access to Rio Grande Bosque (for full width of street R.O.W. or 12 ft. wide when not in street) for the exclusive benefit of Bosque del Rio residents and Coors Trail Neighbors.

Centerline (In lieu of R/W monumentation) to be installed at all centerline P.C.'s, P.T.'s, angle points, and street intersections prior to acceptance of subdivision street improvements and will consist of a standard four-inch (4") aluminum alloy cap stamped "City of Albuquerque", "Centerline Monumentation", "Survey Marker", "Do Not Disturb", "PLS #4071"

DRAINAGE COVENANT

The approved grading and drainage plan details the designed grades for this subdivision. Alterations of the grades within the properties of this subdivision that change the volume of the drainage ponds on each lot will not be allowed. Any alteration of the grades within the properties that does not affect the pond volume must comply with the approved grading and drainage plan in order to gain approval. Covenants Filed September 6, 1996 in Book Misc. 96-24, Pages 5894-5988, Doc. Nos. 9699786-9699772.

AS-BUILT INFORMATION		BENCH MARKS		SURVEY INFORMATION		ENGINEER'S SEAL		REVISIONS		BY	
CONTRACTOR	DATE	U.S.G.S. STA. "N. ALAMEDA B-2"	DATE	FIELD NOTES	NO.			NO.	DATE	NO.	DATE
WORK	DATE	U.S.G.S. STA. PLAN COORDINATES (CENTRAL ZONE)	DATE	BY				DESIGN	DATE	DESIGN	DATE
ACCEPTANCE BY	DATE	U.S.G.S. STA. PLAN COORDINATES (CENTRAL ZONE)	DATE					REVISIONS	DATE	REVISIONS	DATE
DESIGNED BY	DATE	U.S.G.S. STA. PLAN COORDINATES (CENTRAL ZONE)	DATE					DESIGN	DATE	DESIGN	DATE
DRAWN BY	DATE	U.S.G.S. STA. PLAN COORDINATES (CENTRAL ZONE)	DATE					DESIGN	DATE	DESIGN	DATE
CHECKED BY	DATE	U.S.G.S. STA. PLAN COORDINATES (CENTRAL ZONE)	DATE					DESIGN	DATE	DESIGN	DATE
RECORDED BY	DATE	U.S.G.S. STA. PLAN COORDINATES (CENTRAL ZONE)	DATE					DESIGN	DATE	DESIGN	DATE

198628
Smith Engineering Company
A Full Service Engineering Company
2000 University Avenue, S.E. Suite 1000 Albuquerque, New Mexico 87106

CITY OF ALBUQUERQUE
PUBLIC WORKS DEPARTMENT
ENGINEERING DEVELOPMENT GROUP

TITLE: BOSQUE DEL RIO SUBDIVISION - PHASE 3
PLAT OF BOSQUE DEL RIO: UNIT 3

Design Review Committee: _____ City Engineer Approval: _____

City Project No. 5406.83 Zone Map No. D-18 Sheet 4 of 22

RECORD DRAWINGS

GENERAL NOTES:

- 1 THE ELEVATIONS OF ANY LOT PAD SHALL NOT BE LOWER THAN THE ELEVATION SHOWN.
- 2 SEE SHEET 23 FOR TYPICAL LOT DETAIL.
- 3 SEE SHEET 23 FOR EARTHWORK AND POND SCHEMATIC.
- 4 PLACE EXCAVATED SURFACE SOILS ON LOTS 107-P1 THROUGH 111-P1, AS SHOWN ON SHEET 23. DO NOT PLACE SURFACE SOILS BENEATH PAD AREAS.
- 5 HOUSE PADS SHALL BE PLACED AT 10'-0" FROM SIDE LOT LINES EXCEPT WHERE SPECIFICALLY NOTED.


KEYED NOTES:

- 1 FLOWLINE ELEVATION = 4981.28
TOP BACK OF CURB ELEVATION = 4981.23

BOSQUE DEL RIO
PHASE 1 & 2 COMPLETED


BOSQUE DEL RIO
PHASE 1 & 2 COMPLETED

RECORD DRAWINGS
RECORD DRAWINGS

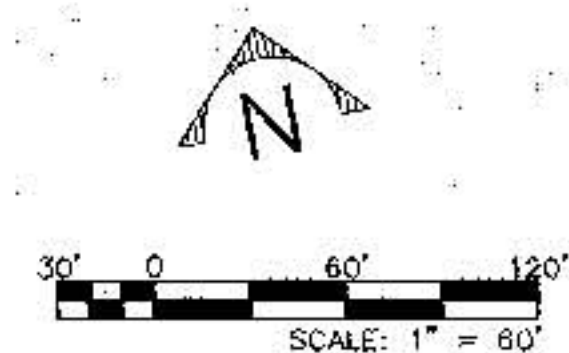

Smith Engineering Company A Full Service Engineering Company 4400 Alameda, NE, Suite 200, Albuquerque, NM 87112	
CITY OF ALBUQUERQUE PUBLIC WORKS DEPARTMENT ENGINEERING DEVELOPMENT GROUP	
TITLE: BOSQUE DEL RIO SUBDIVISION - PHASE 3 OVERALL GRADING PLAN	
Design Review Committee	City Engineer Approval
No. 7 Day / 1 yr.	No. 7 Day / 1 yr.
DESIGNED BY: JCS DRAWN BY: JCS CHECKED BY: DLA	DATE: 05-20-88 DATE: 05-20-88 DATE: 05-20-88
Zone Map No. D-13	Sheet 5 of 22

COA INSPECTOR: RAY SACA	
AS BUILT INFORMATION	
CONTRACTOR: NEW CONCEPTS	DATE:
INSPECTOR: AL'S	DATE:
FIELD SURVEY BY: JCS	DATE:
ELEVATION BY: JCS	DATE:
MICRO-FILM INFORMATION	DATE:
RECORDED BY: NO	DATE:
SURVEY INFORMATION	
U.S. COE STA. "R ALAMEDA B-2"	DATE:
N.M. STATE PLAN COORDINATES (CENTRAL ZONE) BY ACS	BY:
X=373,513.20 Y=1,520,142.81 ELEVATION=5,058.25 G/GS FACTOR=0.9987638	NO.
FIELD NOTES	
NO.	BY:
ENGINEER'S SEAL	
L. ANDREWS REGISTERED PROFESSIONAL ENGINEER No. 10000 Exp. 12/31/00	
NO.	BY:
REMARKS REVISIONS	DATE: 05-20-88
DESIGN	DATE: 05-20-88

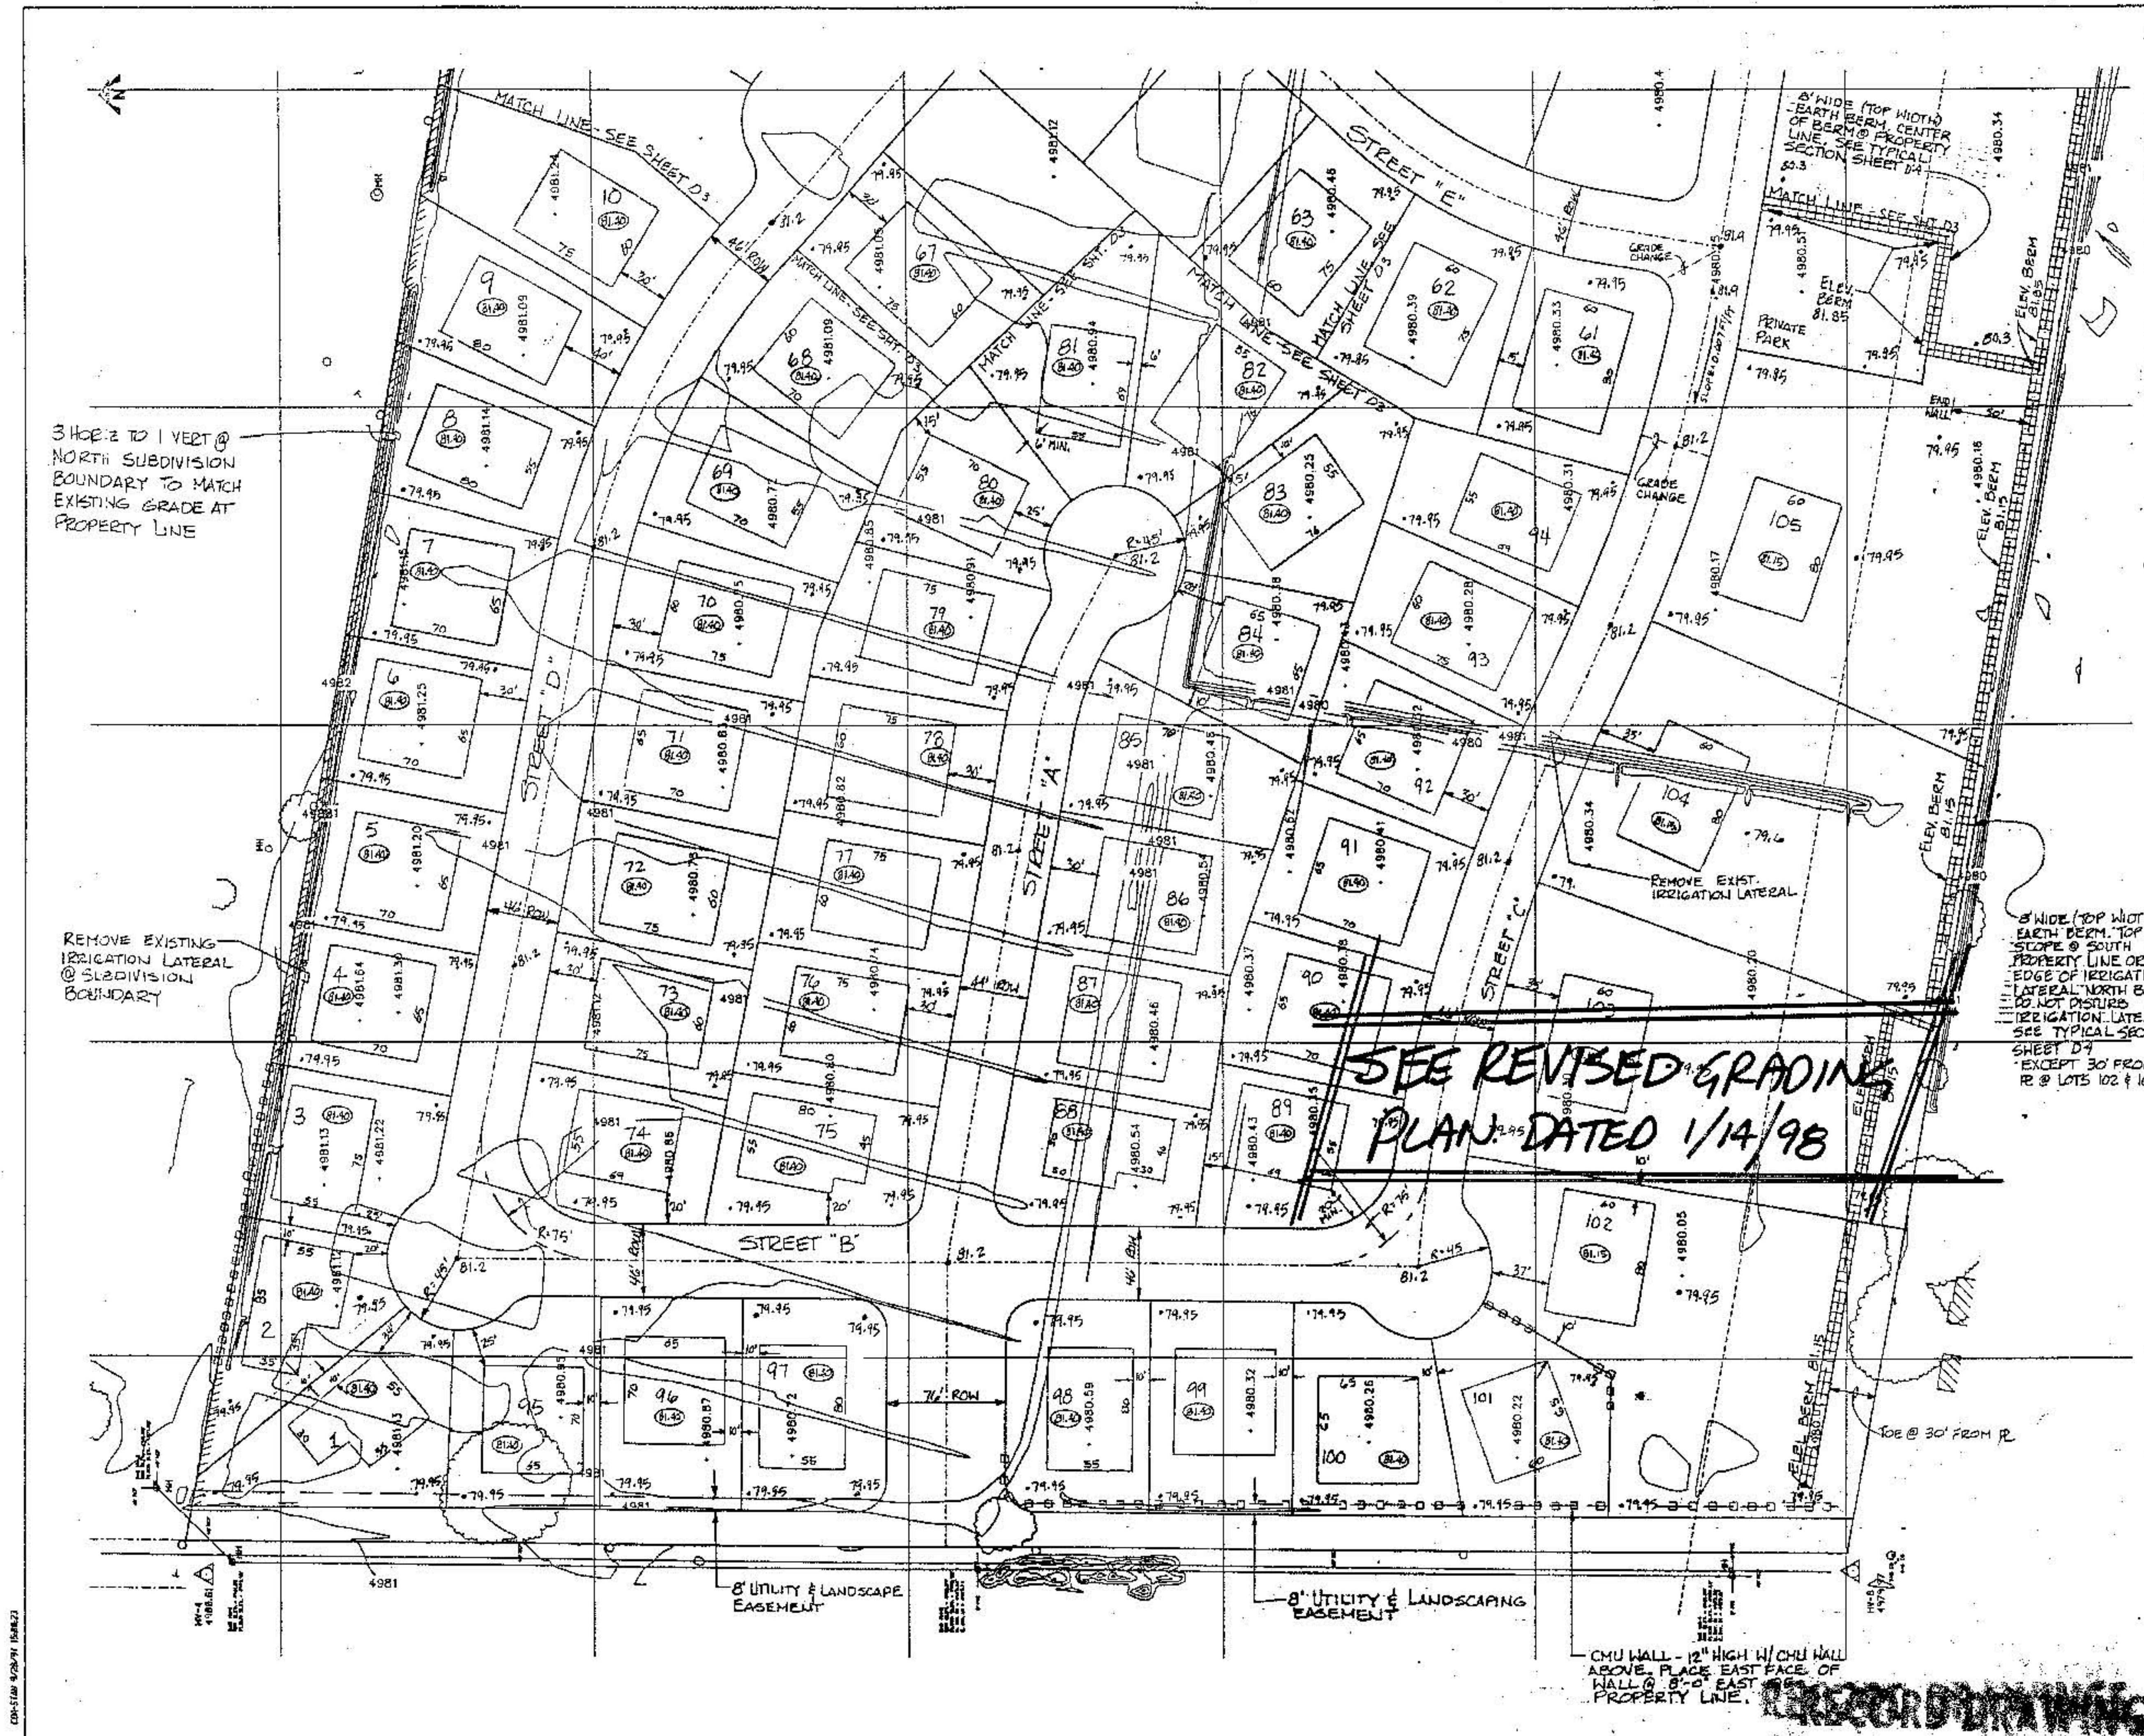

GENERAL NOTES:

- ELEVATIONS SHOWN ARE SUBJECT TO FINAL EARTHWORK COMPUTATION AND BALANCE OF CUT AND FILL. OVERALL ELEVATIONS MAY CHANGE ± 0.5 FT. RELATIVE ELEVATIONS (I.E. LOT TO LOT, LOT TO POND AND LOT TO ROAD) WILL REMAIN AS SHOWN.
- THE ELEVATIONS OF ANY PAD GRADE SHALL NOT BE LOWER THAN THE ELEVATION SHOWN. THE ELEVATIONS OF THE PAD GRADES (BUT NOT THE POND OR STREET GRADES) OF LOTS 12, 13, 61 THROUGH 63, AND 102 THROUGH 114 MAY BE 0.30 FEET HIGHER THAN THE ELEVATIONS SHOWN. THE ELEVATIONS OF ALL OTHER PAD GRADES (BUT NOT THE POND OR STREET GRADES) MAY BE 0.05 FEET HIGHER THAN THE ELEVATIONS SHOWN. RAISING LOT PADS MAY REQUIRE IMPORT OF FILL MATERIALS.
- PORTIONS OF THIS PROPERTY ARE WITHIN THE 100-YEAR FLOOD ZONE (ZONE AH, ELEV. 4981) AS SHOWN ON THE FEMA FLOOD INSURANCE RATE MAP (COMMUNITY PANEL NO. 350002-0000C, OCT. 19, 1983.) LOTS WITHIN THIS FLOOD ZONE DESIGNATION MAY BE SUBJECT TO FLOOD INSURANCE REQUIREMENTS. PROPERTY OWNERS MAY BE REQUIRED TO PURCHASE FLOOD INSURANCE UNTIL SUCH TIME THAT THE ALBUQUERQUE METROPOLITAN ARROYO FLOOD CONTROL AUTHORITY (AMAFCA) COMPLETES AND FEMA APPROVES A LETTER OF MAP REVISION APPLICATION FOR THE EXISTING PIEDRAS MARCADAS DAM. LOTS WITHIN THE AH FLOOD ZONE DESIGNATION INCLUDE 1-P1 THROUGH 14-P1, 34-P1 THROUGH 36-P1, 42-P1 THROUGH 54-P1, AND 61-P1 THROUGH 108-P1.

LEGEND

- + EXISTING GROUND ELEVATION
- NEW GROUND OR STREET ELEVATION
- DESIGN PAD ELEVATION
- CMU WALL

SCALE: 1" = 50'

NORTH

Smith Engineering Company
A Full Service Engineering Company
8000 University Blvd., N.E., Suite 2000, Albuquerque, New Mexico 87113

CITY OF ALBUQUERQUE
PUBLIC WORKS DEPARTMENT
ENGINEERING GROUP

TITLE: **Bosque del Rio**

MASTER GRADING AND DRAINAGE PLAN

APPROVALS	ENGINEER	DATE	PROV. DATE	ENGINEER	DATE
DRG CHAIRMAN					
TRANSPORTATION					
HYDROLOGICAL					

PROJECT NO. **540683** MAP NO. **D-13** SHEET **6** OF **22**


DESIGNED BY: **C. Anderson** DATE: **12/1/95**
DRAWN BY: **C. Anderson** DATE: **12/1/95**
CHECKED BY: **C. Anderson** DATE: **12/1/95**

RECORD DRAWINGS

CD-PLAN 5/20/97 (540683)



3 HORIZ. TO 1 VERT. @
NORTH CURDIVISION
BOUNDARY TO MATCH
EXISTING GRADE
AT PROPERTY LINE

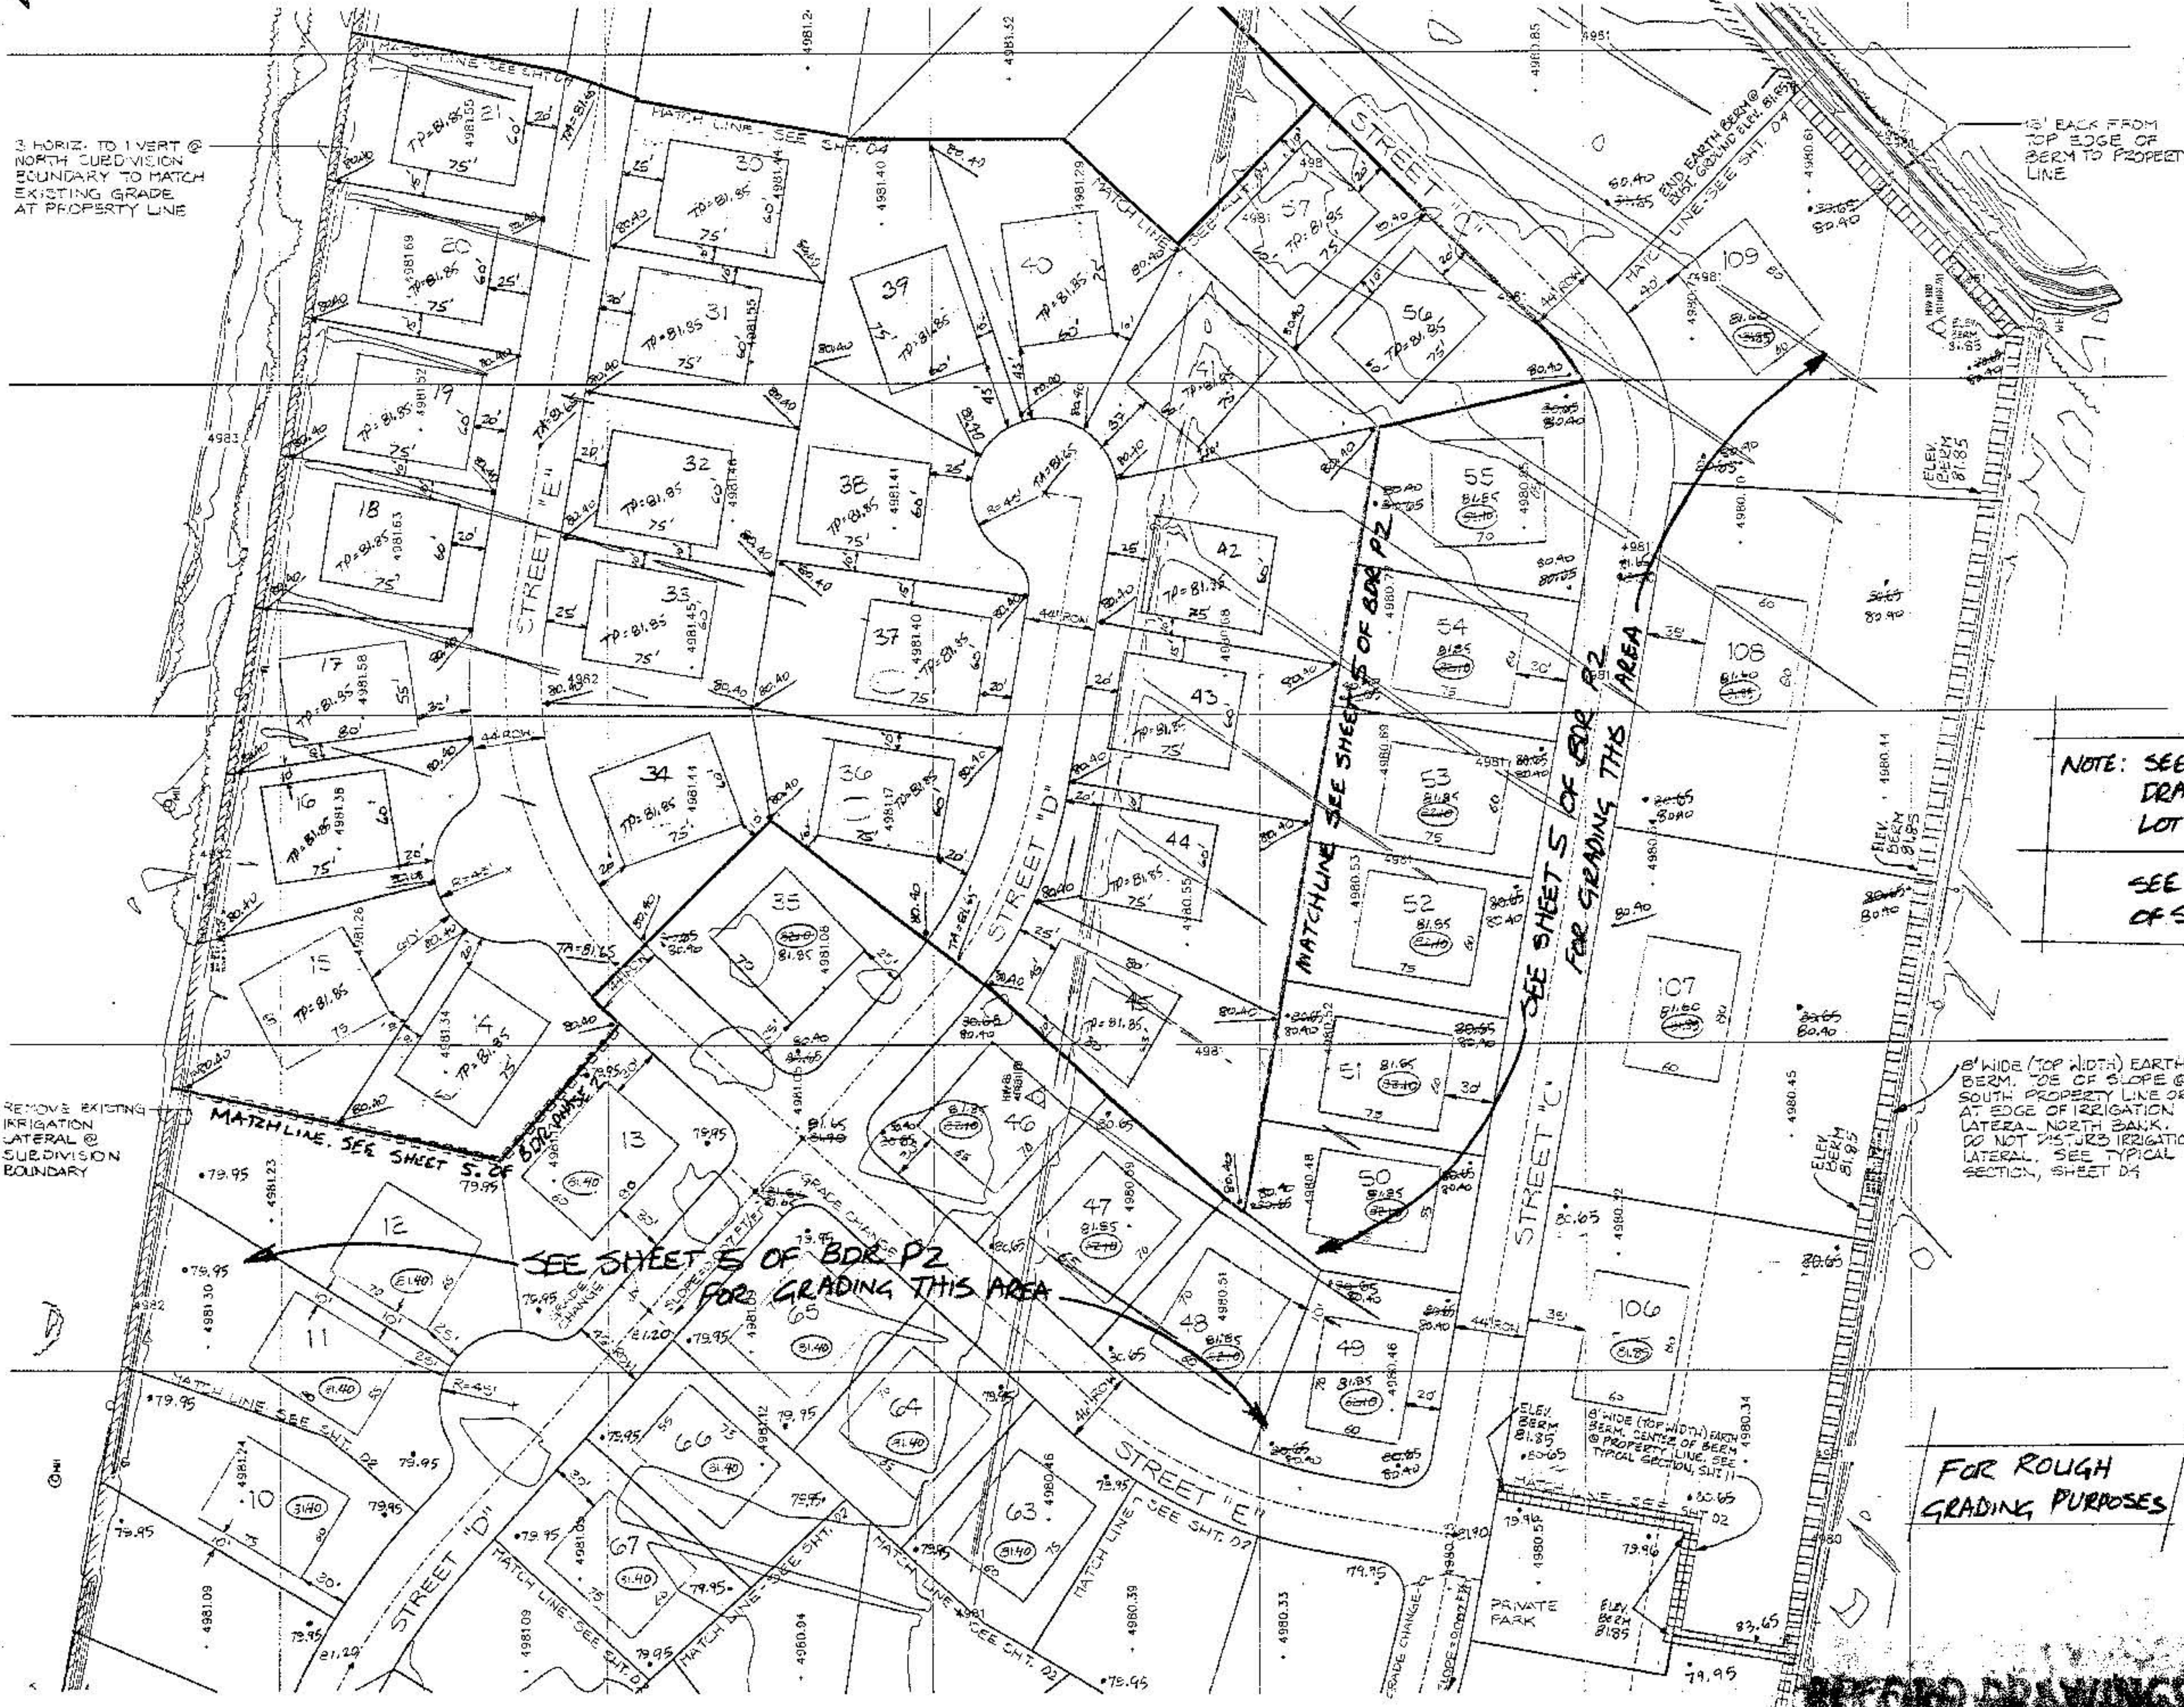


SEE SHT. 02 FOR
NOTES PERTAINING TO
GRADING AND DRAINAGE
PLANS

NOTE: SEE SHEET 23 OF BDR P2
DRAWINGS FOR TYPICAL
LOT GRADING DETAILS

SEE PLAT FOR LAYOUT
OF STREETS AND LOT LINES

80.40 SPOT ELEV.
TP=81.35 TOP OF PAD
TA=81.65 TOP OF ASPHALT

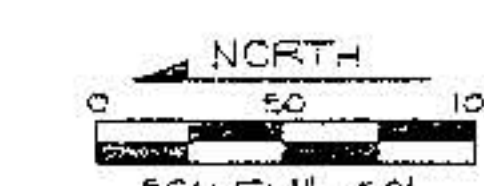

Smith Engineering Company
A Full Service Engineering Company
4000 University Blvd., Suite 1000, Albuquerque, New Mexico 87106

CITY OF ALBUQUERQUE
PUBLIC WORKS DEPARTMENT
ENGINEERING GROUP

TITLE:		Bosque del Rio	
PHASE 3		GRADING AND DRAINAGE PLAN	
APPROVALS	ENGINEER	DATE	APPROVALS
ENGINEER	DATE	ENGINEER	DATE
DRG. CHAIRMAN	DATE	WATER	
TRANSPORTATION	DATE	WASTE WATER	
HYDROLOGY	DATE		
PROJECT NO.	540683	MAP NO.	D-13
SHEET	7	OF	22

AS BUILT INFORMATION	
DATE	
BY	
REVISIONS	
NO.	DATE
1	10/1/15
2	10/1/15
3	10/1/15
BENCH MARKS	
DATE	
BY	
REVISIONS	
NO.	DATE
1	10/1/15
2	10/1/15
3	10/1/15
SURVEY INFORMATION	
DATE	
BY	
REVISIONS	
NO.	DATE
1	10/1/15
2	10/1/15
3	10/1/15
ENGINEER'S SEAL	
DATE	
BY	
REVISIONS	
NO.	DATE
1	10/1/15
2	10/1/15
3	10/1/15
FIELD NOTES	
DATE	
BY	
REVISIONS	
NO.	DATE
1	10/1/15
2	10/1/15
3	10/1/15
REVISIONS	
DATE	
BY	
REVISIONS	
NO.	DATE
1	10/1/15
2	10/1/15
3	10/1/15
DESIGNED BY	
DATE	
BY	
REVISIONS	
NO.	DATE
1	10/1/15
2	10/1/15
3	10/1/15
CHECKED BY	
DATE	
BY	
REVISIONS	
NO.	DATE
1	10/1/15
2	10/1/15
3	10/1/15
32	10/1/

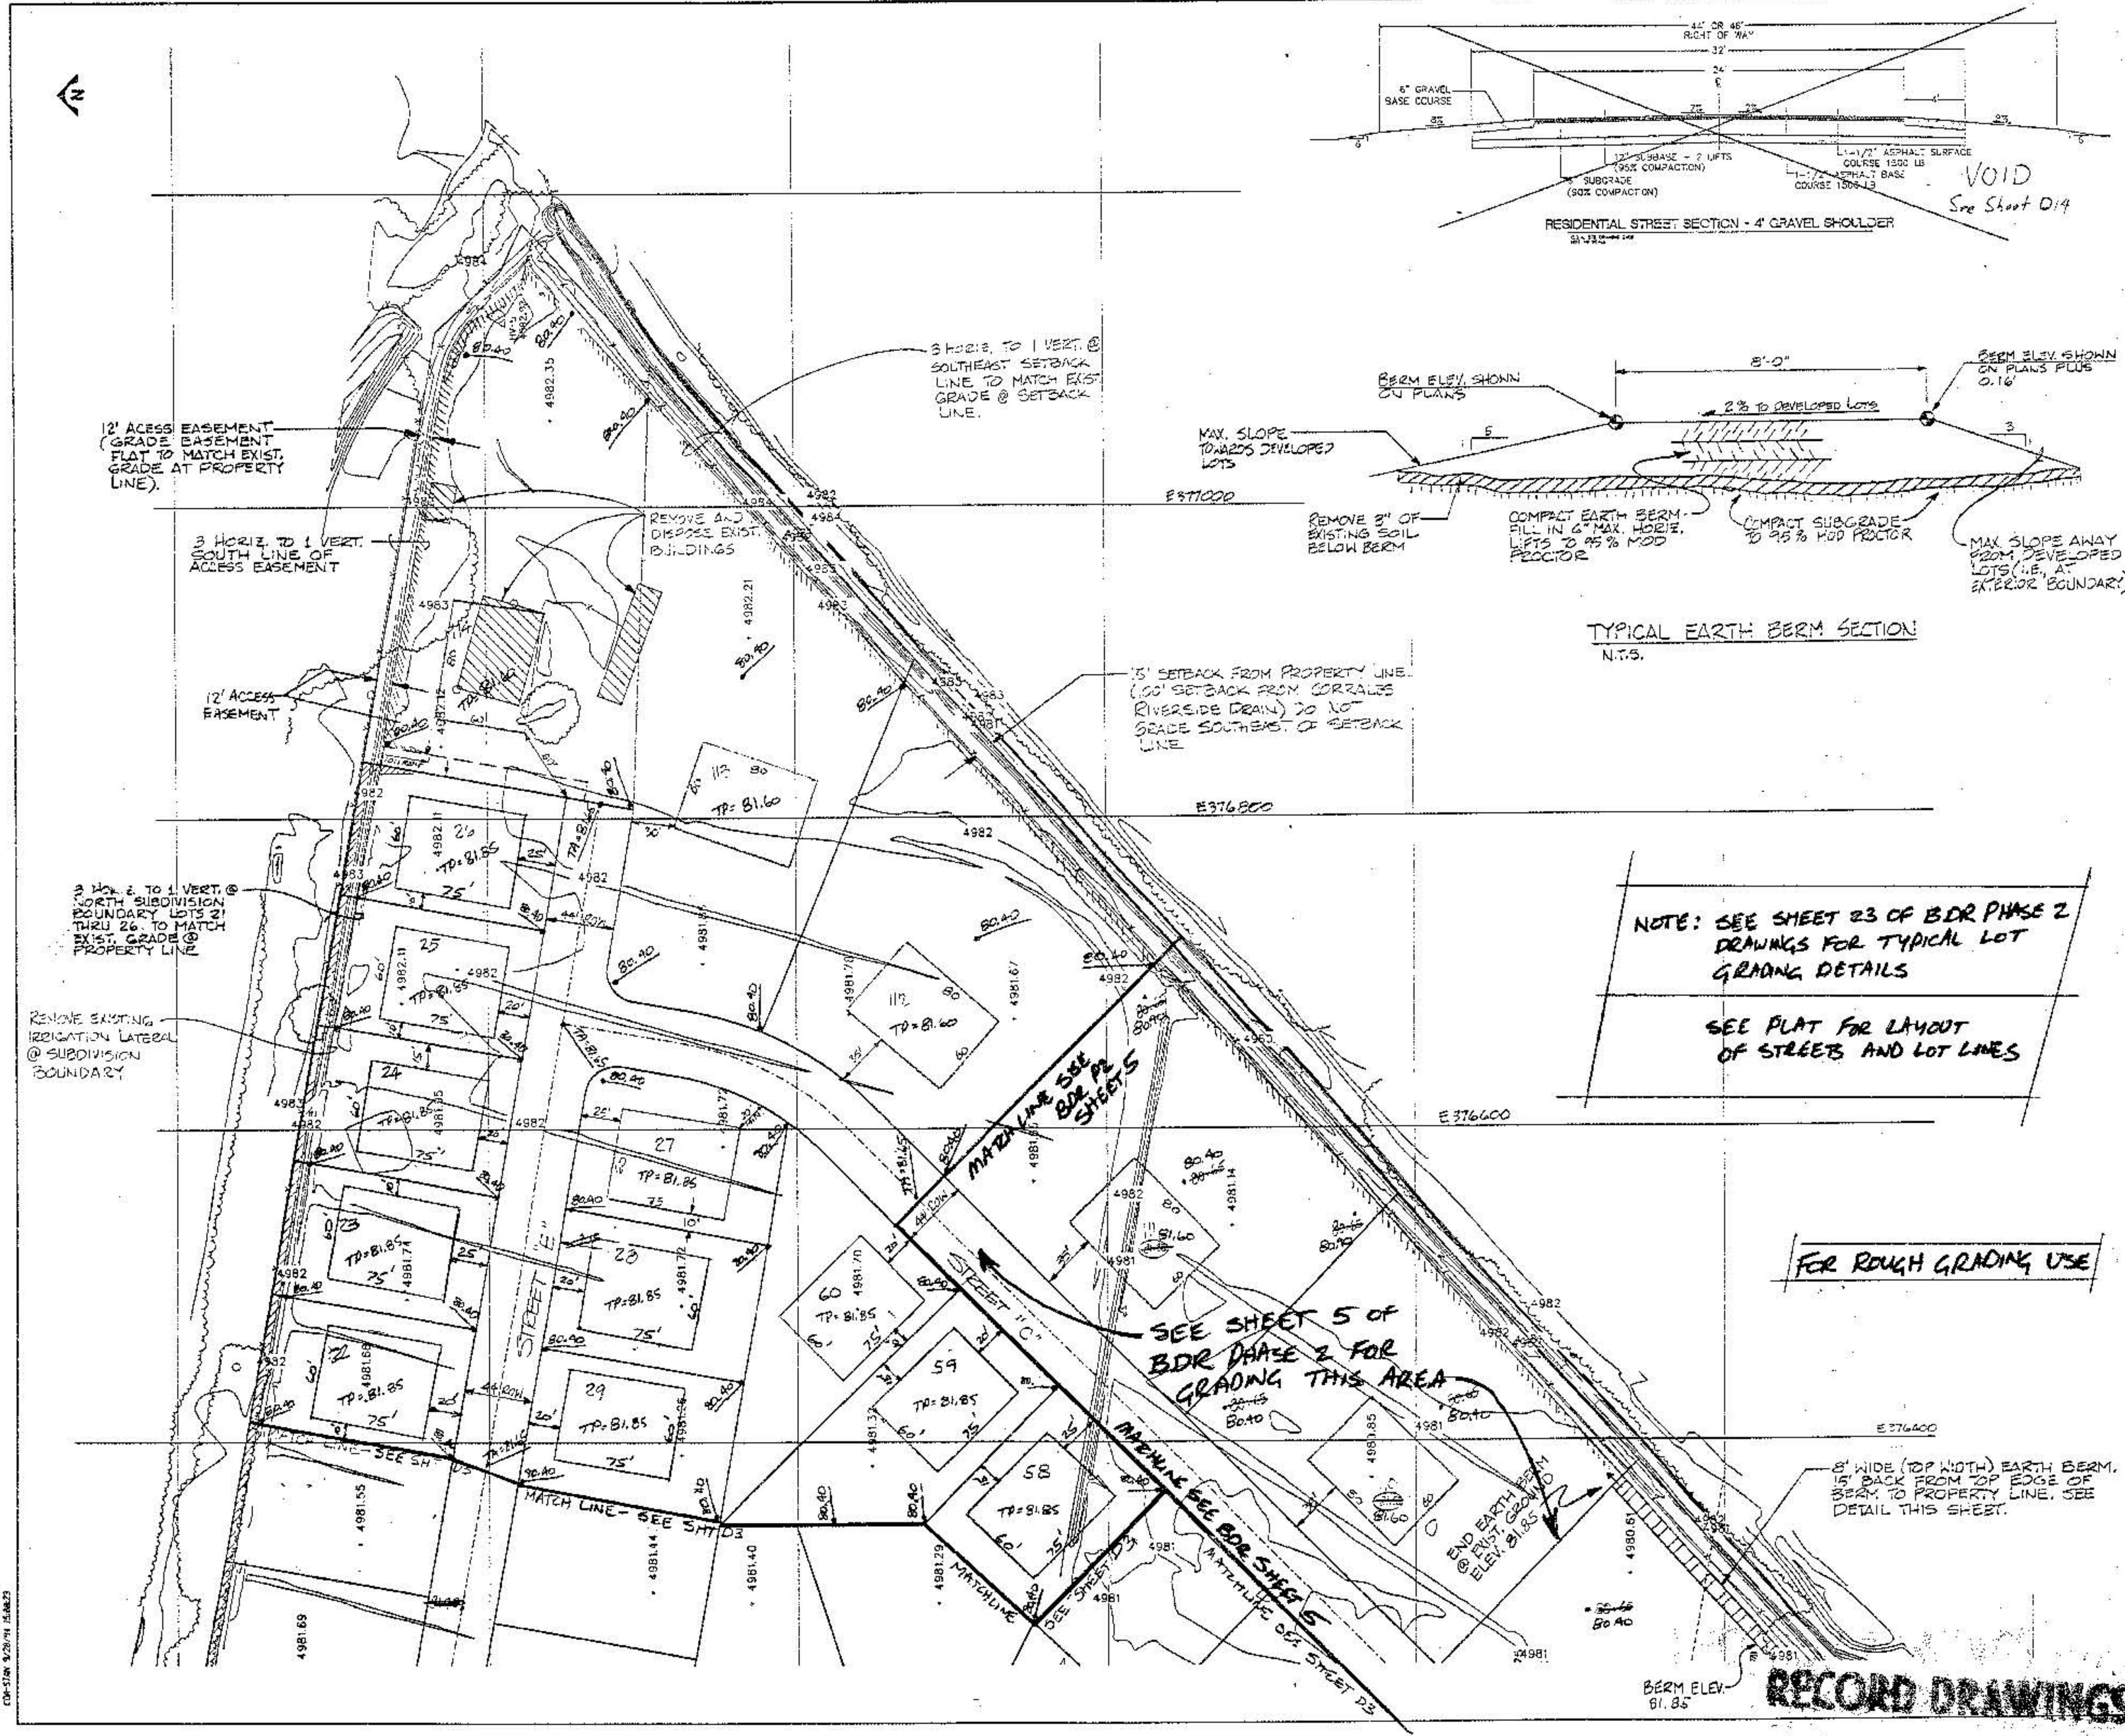

GENERAL NOTES
1. SEE SHEET D2 FOR NOTES
NOTES PERTAINING TO GRADING
AND DRAINAGE PLANS.

AS BUILT INFORMATION			
DATE	DATE	DATE	DATE
BY	BY	BY	BY

BENCH MARKS			
DATE	DATE	DATE	DATE
BY	BY	BY	BY

SURVEY INFORMATION			
DATE	DATE	DATE	DATE
BY	BY	BY	BY

ENGINEER'S SEAL			
DATE	DATE	DATE	DATE
BY	BY	BY	BY

REVISIONS			
NO.	DATE	DESCRIPTION	BY
1	1/2/15	Initial design to reduce cuts	CA
2	1/2/15	Added all the earth from the E. Property	CA
3	1/2/15	Added all the earth from the E. Property	CA

DESIGNED BY	DATE	1/2/15
DRAWN BY	DATE	1/2/15
CHECKED BY	DATE	1/2/15

Smith Engineering Company
A Full Service Engineering Company
1000 Tjorne Road, Suite 100, Santa Fe, NM 87505

CITY OF ALBUQUERQUE
PUBLIC WORKS DEPARTMENT
ENGINEERING GROUP

TITLE: **Bosque del Rio**
Phase 3 GRADING AND DRAINAGE PLAN

APPROVALS	ENGINEER	DATE	APPROVALS	ENGINEER	DATE
DRC CHAIRMAN			WATER		
TRANSPORTATION			WASTE WATER		
HYDROLOGY					

PROJECT NO. **540683** MAP NO. **D-13** SHEET **8** OF **22**

RECORD DRAWINGS

1 SEE PLAN & PROFILE SHEETS FOR
ADDITIONAL DETAILS OF ROADS.

CURVE DATA				
NUMBER	DELTA	RADIUS	TANGENT	ARC LENGTH
C1	57°56'44"	250.00	138.52	252.98
C2	34°38'46"	200.00	62.38	120.94
C3	32°00'30"	250.00	71.71	139.66



RECORD DRAWINGS

[illegible]

GENERAL NOTES:

- SEE UTILITY PLAN & PROFILE SHEETS FOR ADDITIONAL DETAILS OF UTILITY INSTALLATION.
- ALL FIRE HYDRANTS, GATE VALVES, BENDS, WTR. SERVICES & ALL OTHER APPURTENANCES SHALL BE INSTALLED PER COA STANDARD SPECIFICATIONS.
- SEE DETAILS SHEETS 21-23 FOR PRESSURE SAS BACKFILL DATA & DRAINAGE DETAILS.
- FOR SANITARY SEWER SERVICE, SEE SHT 21 FOR DETAILS.


KEYED NOTES:

- STA 1+10.00, CL
TIE INTO EXISTING MANHOLE.
BEGIN NEW 2 1/2" SAS LINE
- STA 1+10.00, 10' RT
REMOVE EXISTING CAP.
BEGIN NEW 6" PVC WATERLINE.
- STA 4+00.00, 1.5' LT
NEW INLINE FLUSHING CONNECTION.
- STA 4+22.36, 22' LT
NEW FIRE HYDRANT
- STA 7+50.00, 1.5' LT
NEW INLINE FLUSHING CONNECTION.
- STA 9+37.90, 22' RT
NEW FIRE HYDRANT
- STA 11+05.00, 1.5' LT
NEW INLINE FLUSHING CONNECTION.
WITH 7' STUB-OUT.
- STA 1+10.00, 10' LT
REMOVE EXISTING 10" CAP.
CONTINUE 10" PVC WATERLINE
- STA 1+10.00, CL
TIE INTO EXISTING CONNECTION.
BEGIN NEW 2" SAS LINE
- STA 2+57.15, 1.5' RT
NEW INLINE FLUSHING CONNECTION.
- STA 3+35.63, 8.5' LT
NEW 10" GATE VALVE w/BOX.
- STA 1+10.00, 10' RT
REMOVE EXISTING CAP.
INSTALL 6" GATE VALVE w/BOX.
- STA 1+10.00, CL
TIE INTO EXISTING CONNECTION.
BEGIN NEW 2 1/2" SAS LINE
- STA 3+92.45, 1.5' LT
NEW INLINE FLUSHING CONNECTION.
- STA 4+16.45, 23' LT
NEW INLINE FLUSHING CONNECTION.
- STA 4+01.92, 22' LT
NEW FIRE HYDRANT
- STA 10+80.00, 8.5' RT
INSTALL 1-10" 45° BEND
- STA 11+00.00, 8.5' LT
INSTALL 1-10" 45° BEND
- STA 3+59.63, 8.5' LT
INSTALL 1-10"x10"x10" TEE
1-10"x6" REDUCER (WEST)
w/BLOCKING
- STA 5+11.50, CL
INSTALL 1-10" 22.5° BEND
& 1-10" 11.25° BEND
- STA 4+55.62, 42.95 LT
INSTALL 1-8" CAP
w/BLOCKING
- STA 5+67.50, CL
INSTALL 1-10" 22.5° BEND
- STA 5+99.50, CL
INSTALL 1-10" CAP
w/BLOCKING
- STA 2+46.50, CL
INSTALL 1-10" 90° BEND
- STA 1+10.00, CL
INSTALL 1-10" 90° BEND

BOSQUE DEL RIO
PHASE 1 & 2 COMPLETED


EQUATION:
STA 11+12.49, 8.5' LT, BOSQUE ENTRADA TRAIL=
STA 1+00.00, LOT 114 WATERLINE EXTENSION
SEE SHT 19A FOR DETAILS

BOSQUE DEL RIO
PHASE 1 & 2 COMPLETED

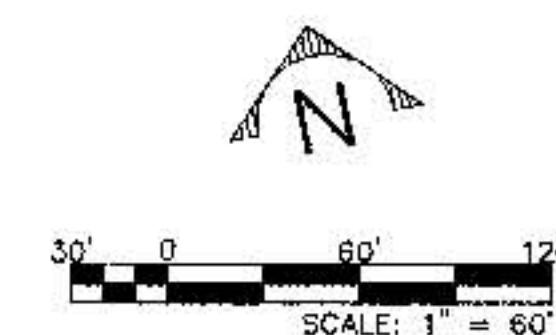

CITY OF ALBUQUERQUE PUBLIC WORKS DEPARTMENT ENGINEERING DEVELOPMENT GROUP	
TITLE: BOSQUE DEL RIO SUBDIVISION - PHASE 3	
OVERALL UTILITY PLAN	
DESIGNED BY: JCS	DATE: 05-20-98
DRAWN BY: JCS	DATE: 05-20-98
CHECKED BY: DLA	DATE: 05-20-98
CITY PROJECT NO. 5406.83	ZONE MAP NO. D-13
SHEET 10	OF 22

AS BUILT INFORMATION	
CONTRACTOR: NEW CHASE PPS	DATE: 11/2/97
INSPECTOR: JCS	DATE: 11/2/97
REVISION: 1	DATE: 11/2/97
REVISION: 2	DATE: 11/2/97
REVISION: 3	DATE: 11/2/97
REVISION: 100	DATE: 11/2/97

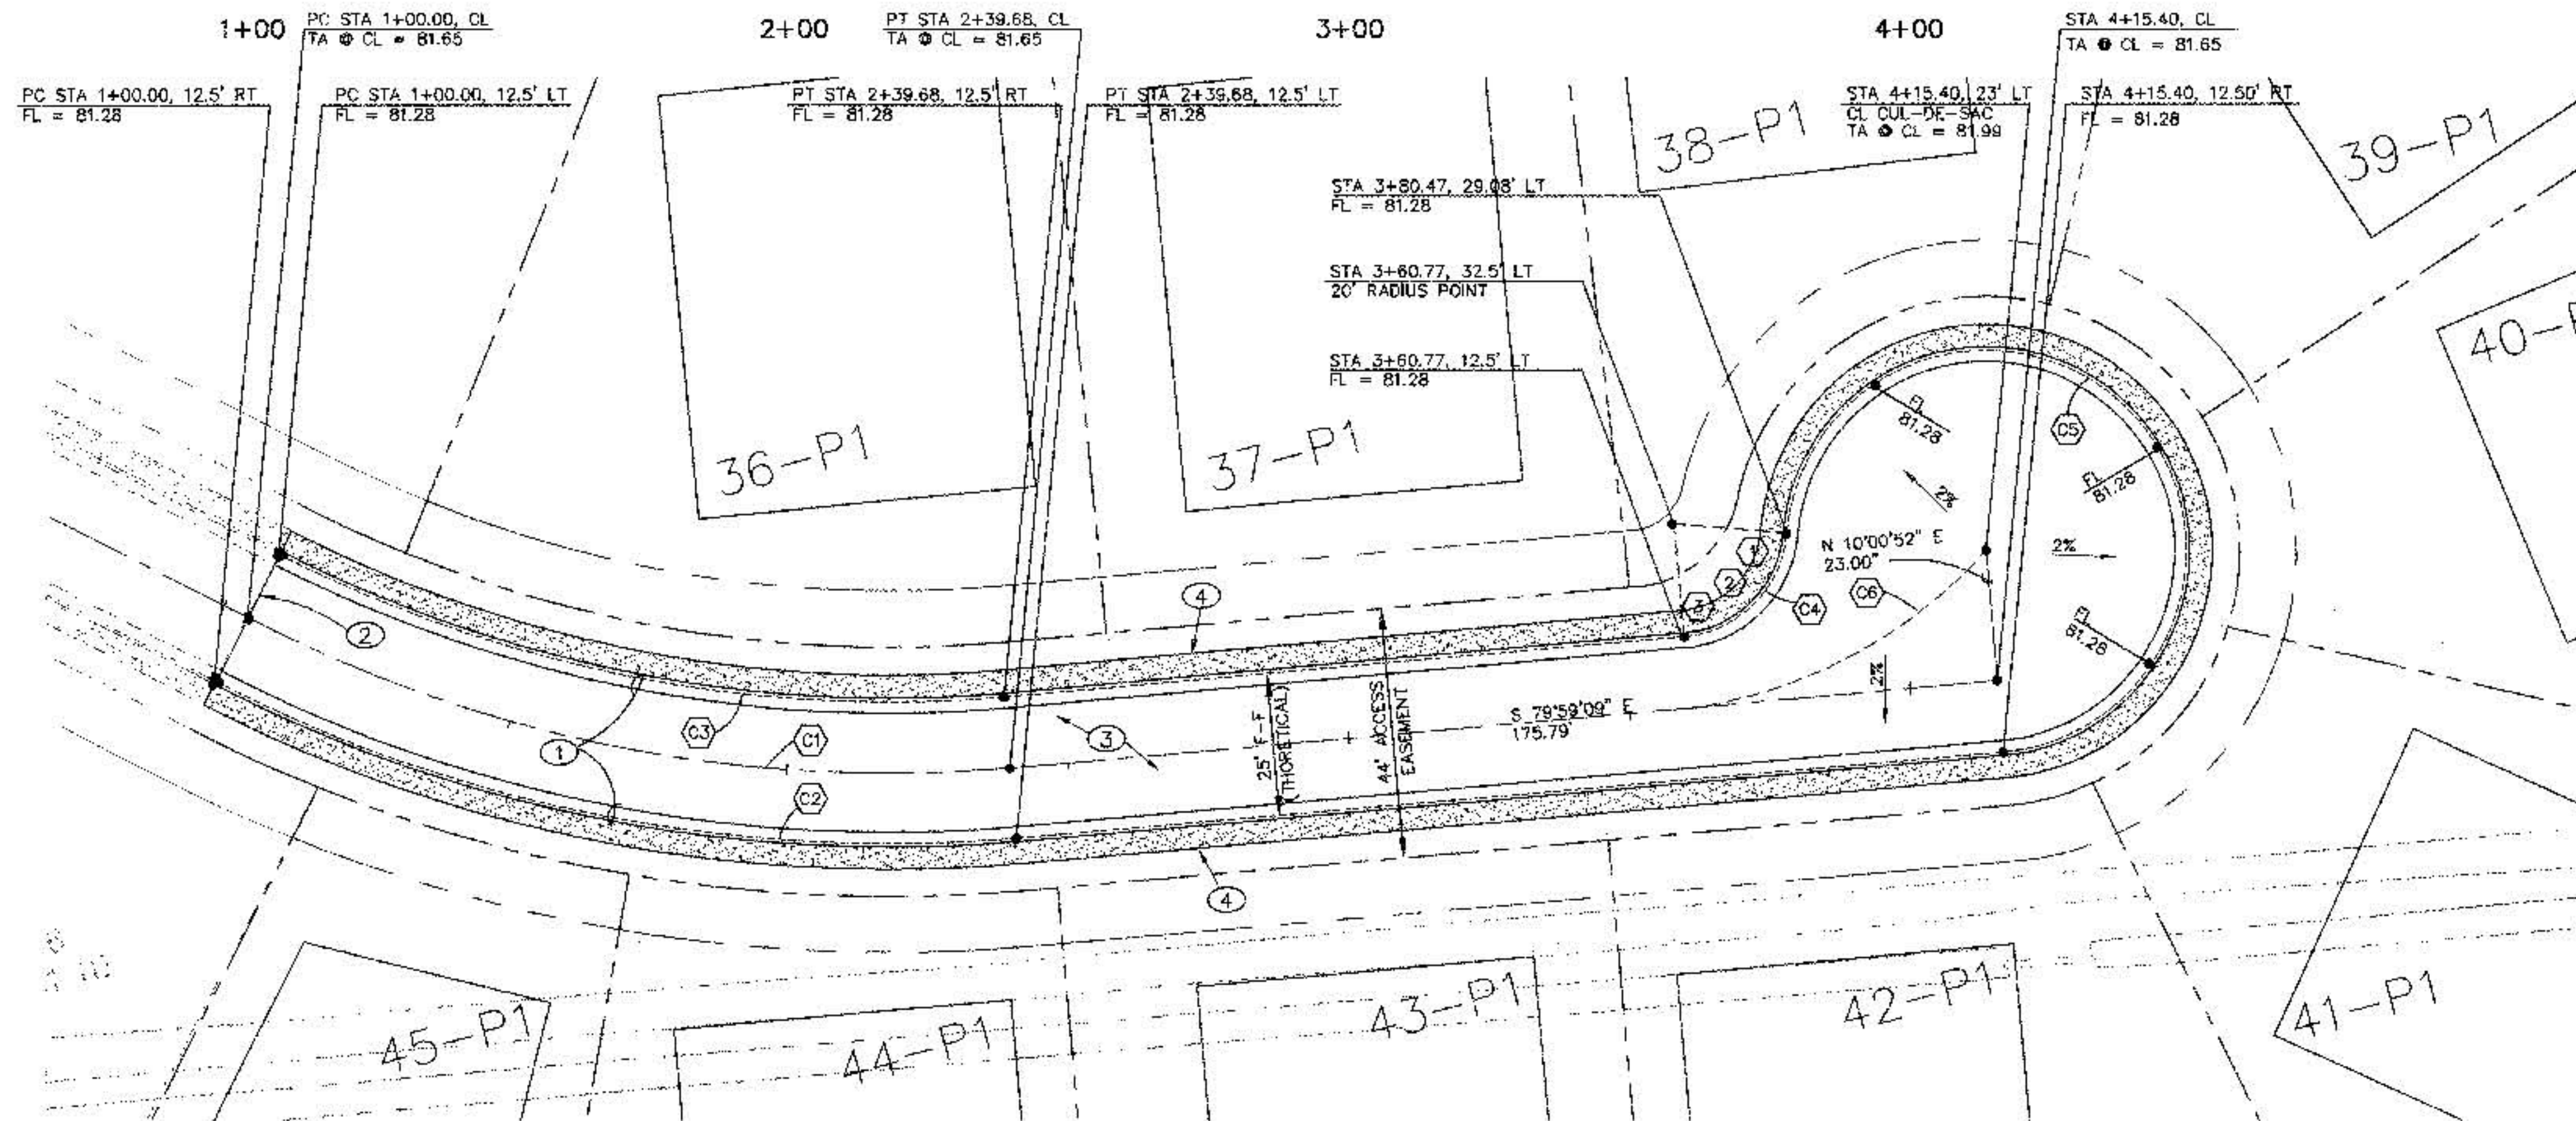

BOSQUE DEL SOL LANE

KEYED NOTES:


1. CONSTRUCT NEW ESTATE TYPE CURB PER COA STD DWG 2415.
2. REMOVE & DISPOSE OF EXISTING CUT-OFF WALL. NEW PAVING SHALL MATCH EXISTING ROAD GRADES.
3. SEE SHEET 22 FOR STREET SECTION.
4. CONSTRUCT 4-FOOT GRAVEL SHOULDER. SEE TYPICAL ROAD SECTION, SHEET 22.

CURB RETURN DATA

POINT NO.	BACK OF CURB	FLOW LINE
1	81.23	81.28
2	81.23	81.28
3	81.23	81.28

CURVE DATA

NUMBER	DELTA	RADIUS	TANGENT	ARC LENGTH
C1	32°00'29"	250.00	71.71	139.66
C2	26°48'38"	262.50	62.66	122.83
C3	27°00'35"	237.50	67.04	111.96
C4	80°08'39"	20.00	16.82	27.98
C5	280°08'39"	35.50	42.20	161.18
C6	40°37'29"	85.44	31.63	60.58

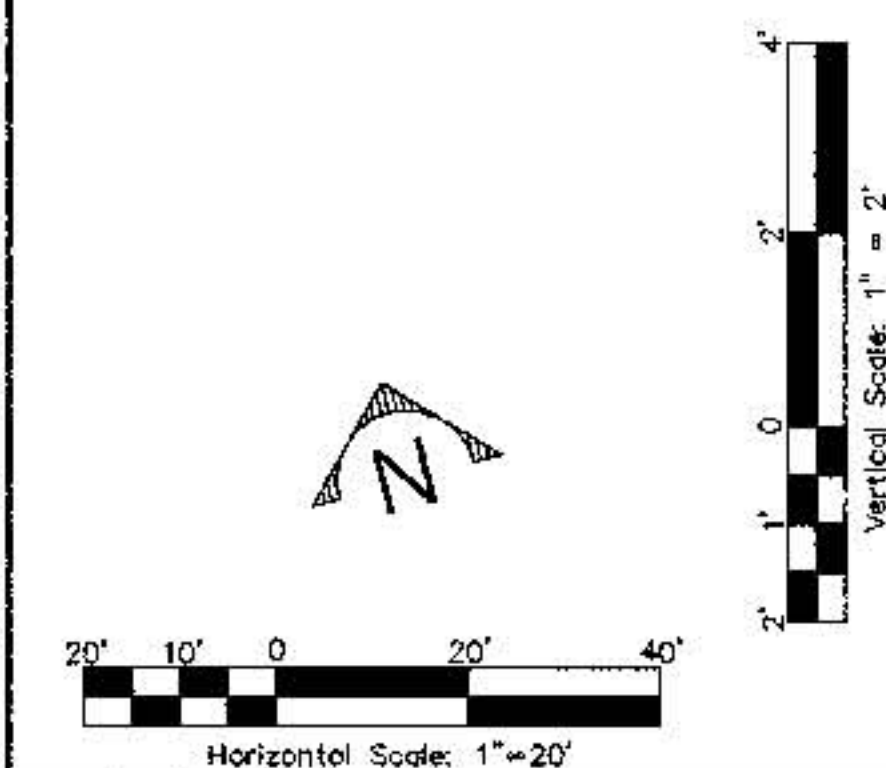

CITY OF ALBUQUERQUE
PUBLIC WORKS DEPARTMENT
ENGINEERING DEVELOPMENT GROUP

TITLE: BOSQUE DEL RIO SUBDIVISION - PHASE 3
PAVING P & P: BOSQUE DEL SOL LN: STA 1+00 TO 4+15.40

DESIGNED BY: JCS	DATE: 05-20-98
DRAWN BY: JCS	DATE: 05-20-98
CHECKED BY: DIA	DATE: 05-20-98

City Engineer Approval

Design Review Committee


City Map No. D-13

City Project No. 5406.83


Sheet 11 of 22

RECORD DRAWINGS

DESIGNED BY: N. V. GARCIA, CIVIL ENGINEER
DRAWN BY: J. GARCIA, CIVIL ENGINEER
CHECKED BY: J. GARCIA, CIVIL ENGINEER
DATE: 05-20-98

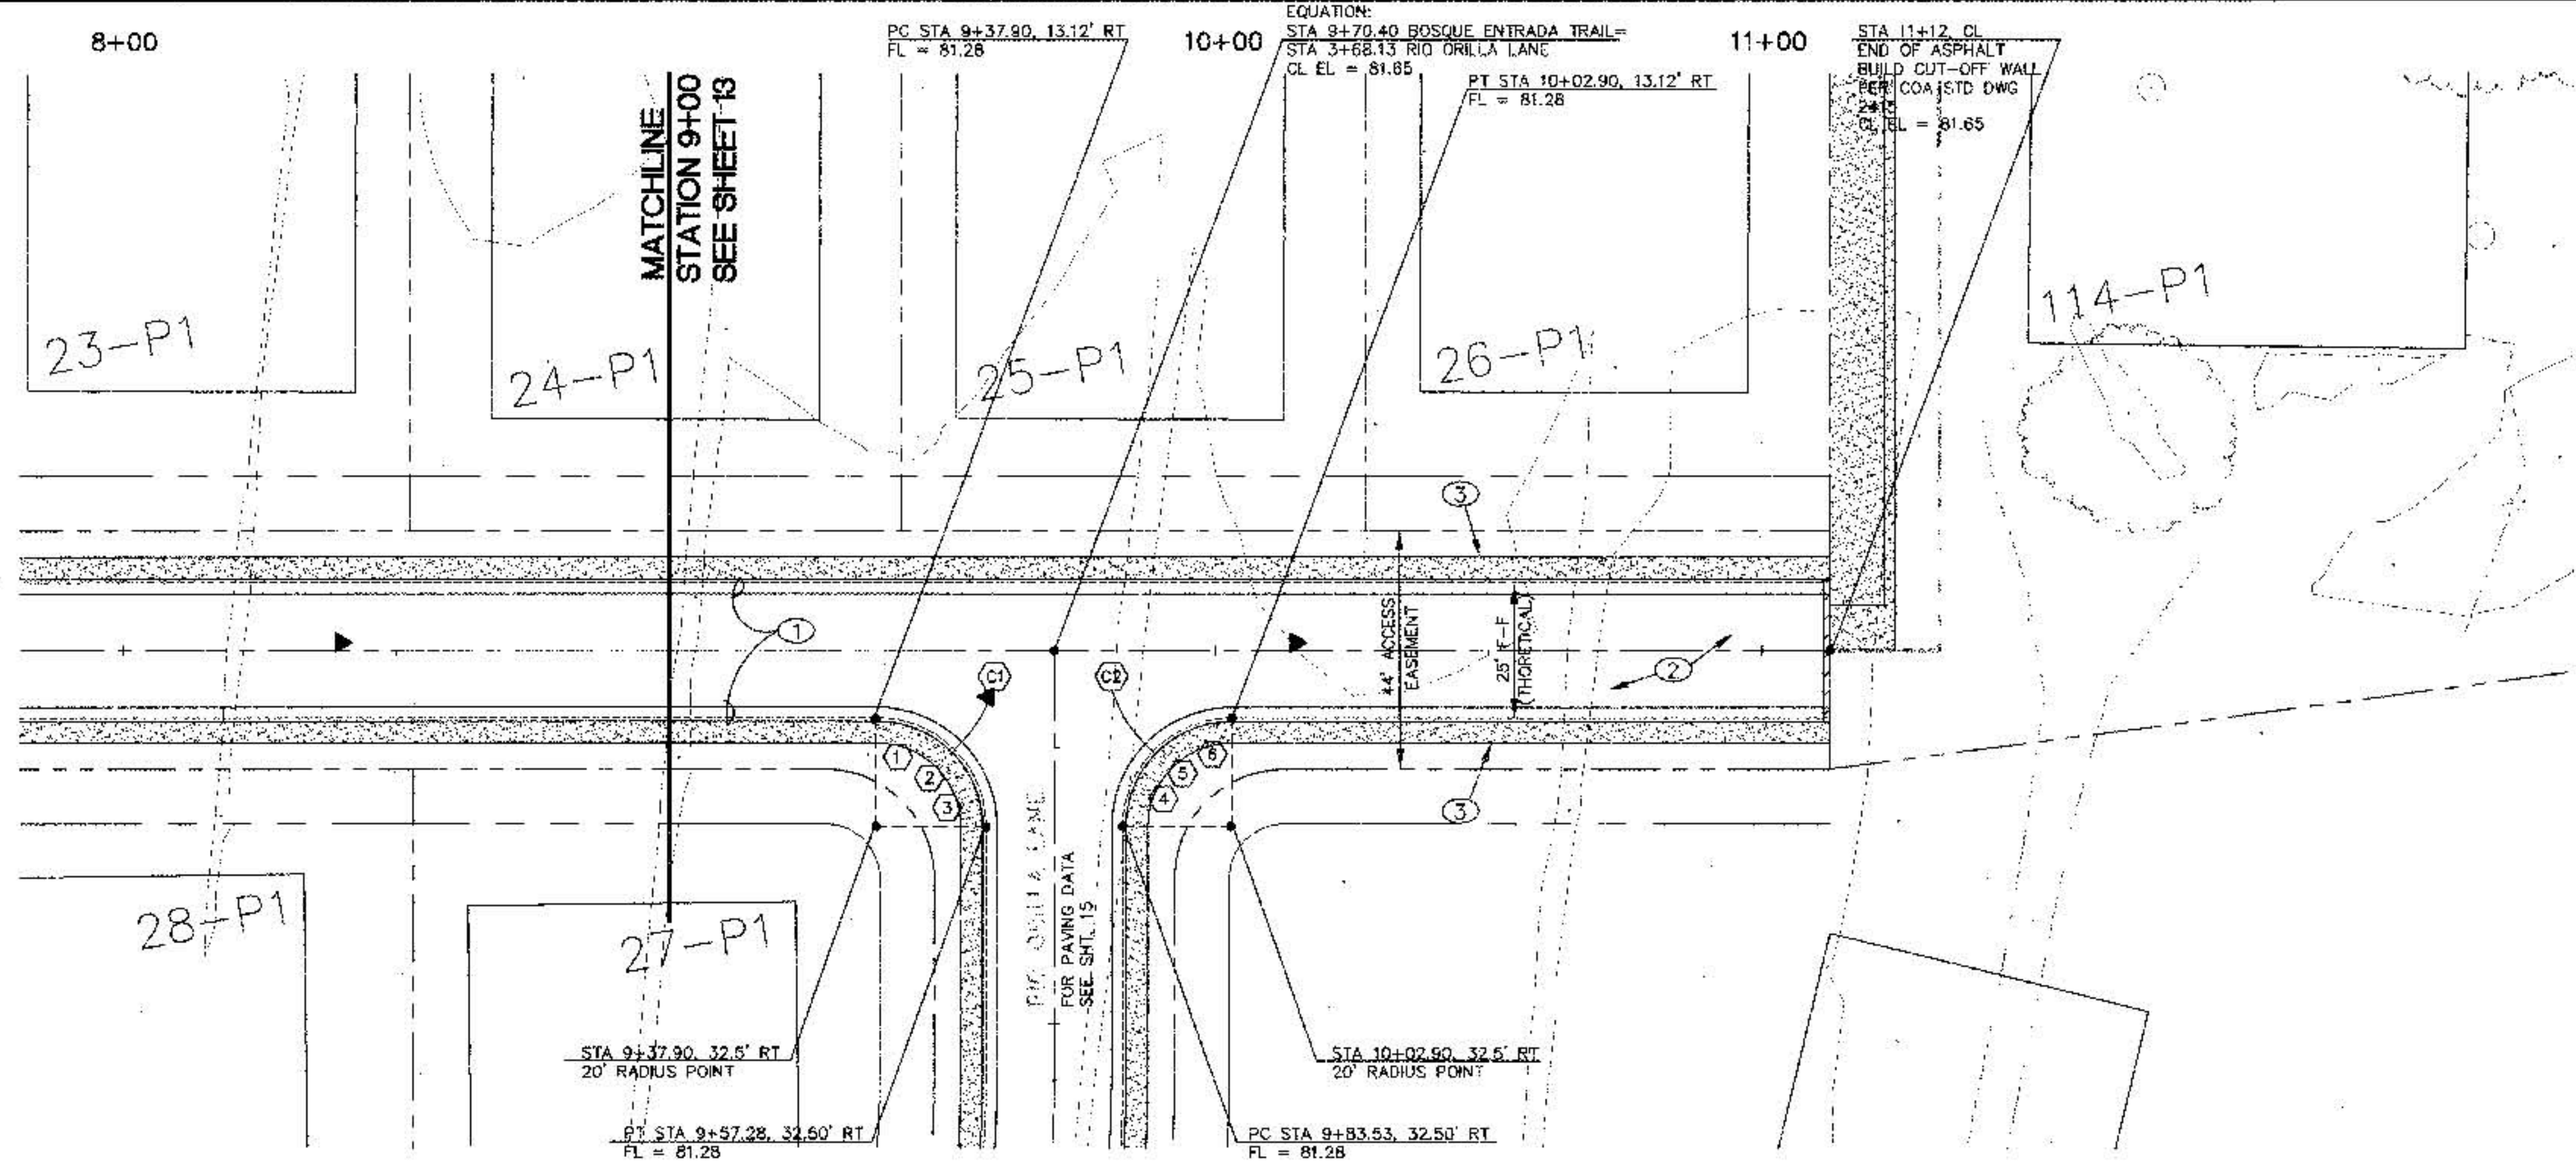

BOSQUE ENTRADA TRAIL

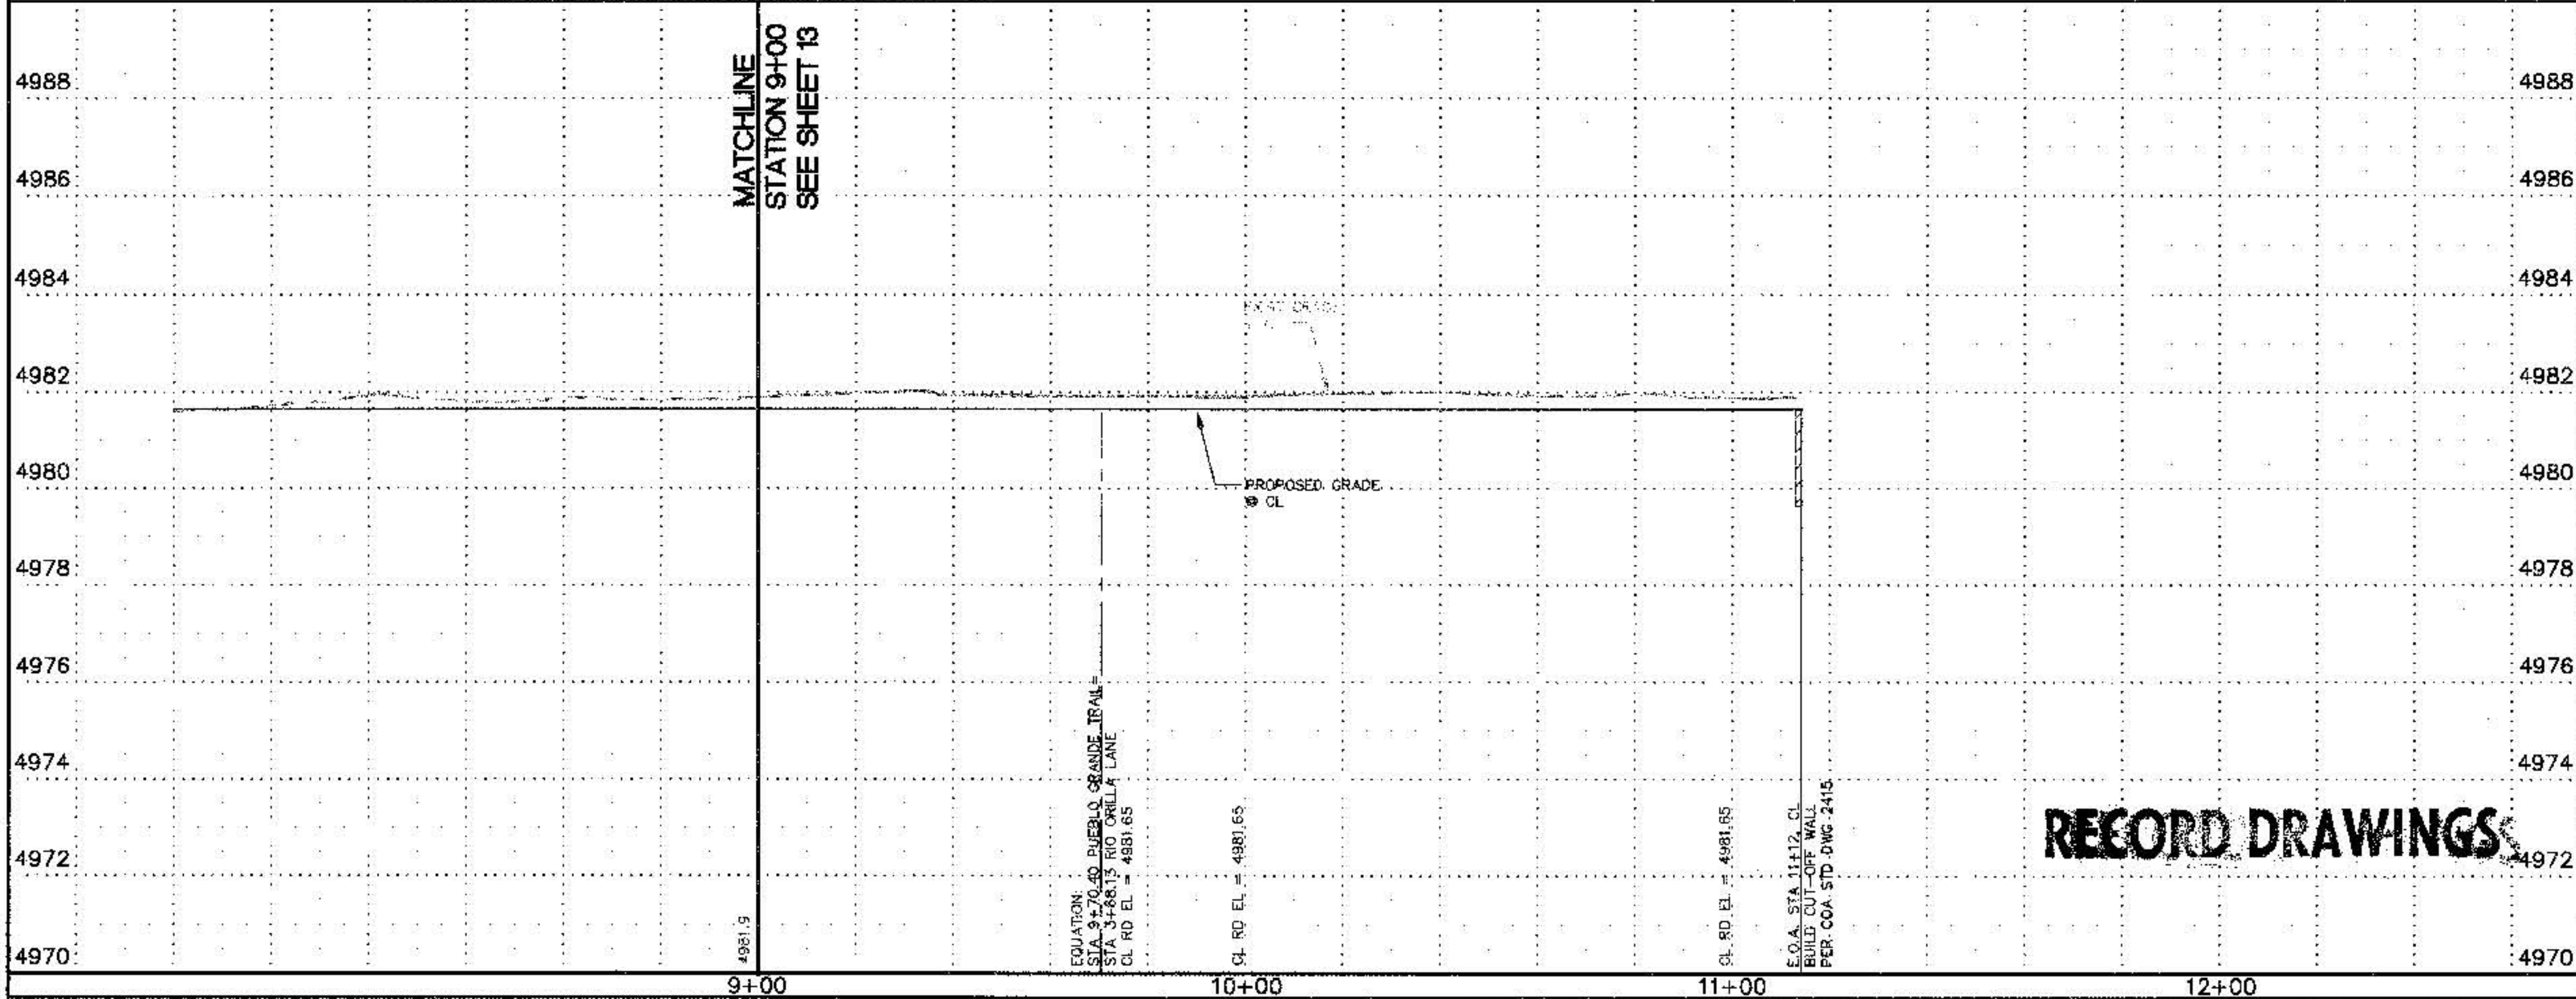

RECORD DRAWINGS


- KEYED NOTES:
1. CONSTRUCT NEW ESTATE TYPE CURB PER COA STD DWG 2415.
 2. SEE SHEET 22 FOR STREET SECTION.
 3. CONSTRUCT 4' GRAVEL SHOULDER, SEE TYPICAL ROAD SECTION SECTION, SHEET 22.

CURB RETURN DATA

POINT NO.	BACK OF CURB	FLOW LINE
1	81.23	81.28
2	81.23	81.28
3	81.23	81.28
4	81.23	81.28
5	81.23	81.28
6	81.23	81.28

CURVE DATA

NUMBER	DELTA	RADIUS	TANGENT	ARC LENGTH
C1	90°00'42"	20.00	20.00	31.42
C2	90°00'42"	20.00	20.00	31.42

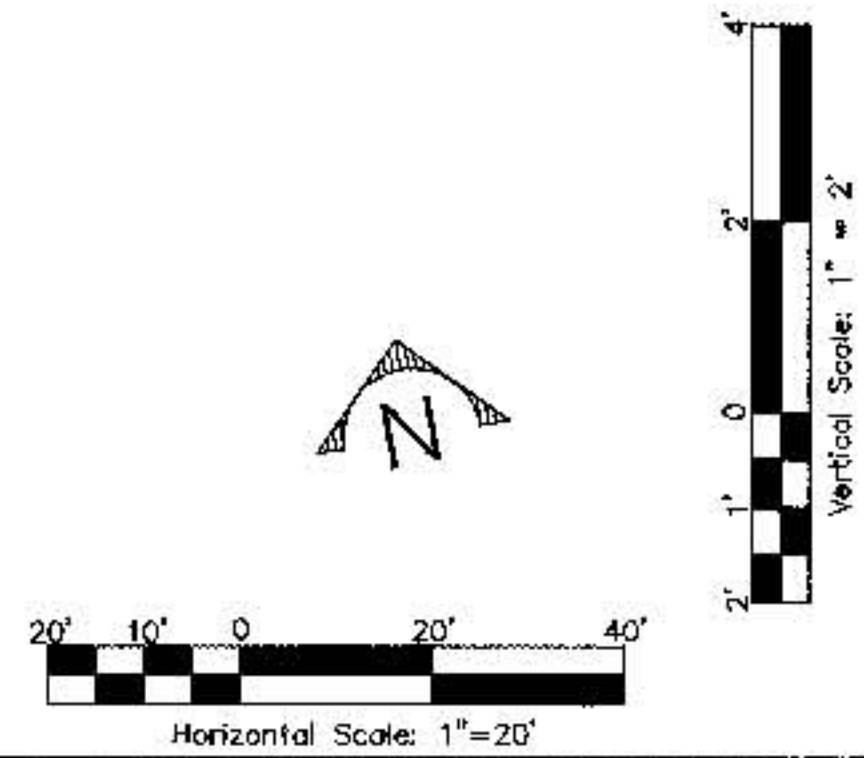

Smith Engineering Company
A Full Service Engineering Company
198628


CITY OF ALBUQUERQUE
PUBLIC WORKS DEPARTMENT
ENGINEERING DEVELOPMENT GROUP

TITLE: BOSQUE DEL RIO SUBDIVISION - PHASE 3
PAVING P & P: BOSQUE ENTRADA TR.: STA 9+00 TO 11+12

DESIGNED BY: JCS DATE: 05-20-98
DRAWN BY: JCS DATE: 05-20-98
CHECKED BY: JCS DATE: 05-20-98

City Engineer Approval: [Signature]
Last Design Update: [Signature]


City Project No. 5406.83
Zone Map No. D-13
Sheet 14 of 22

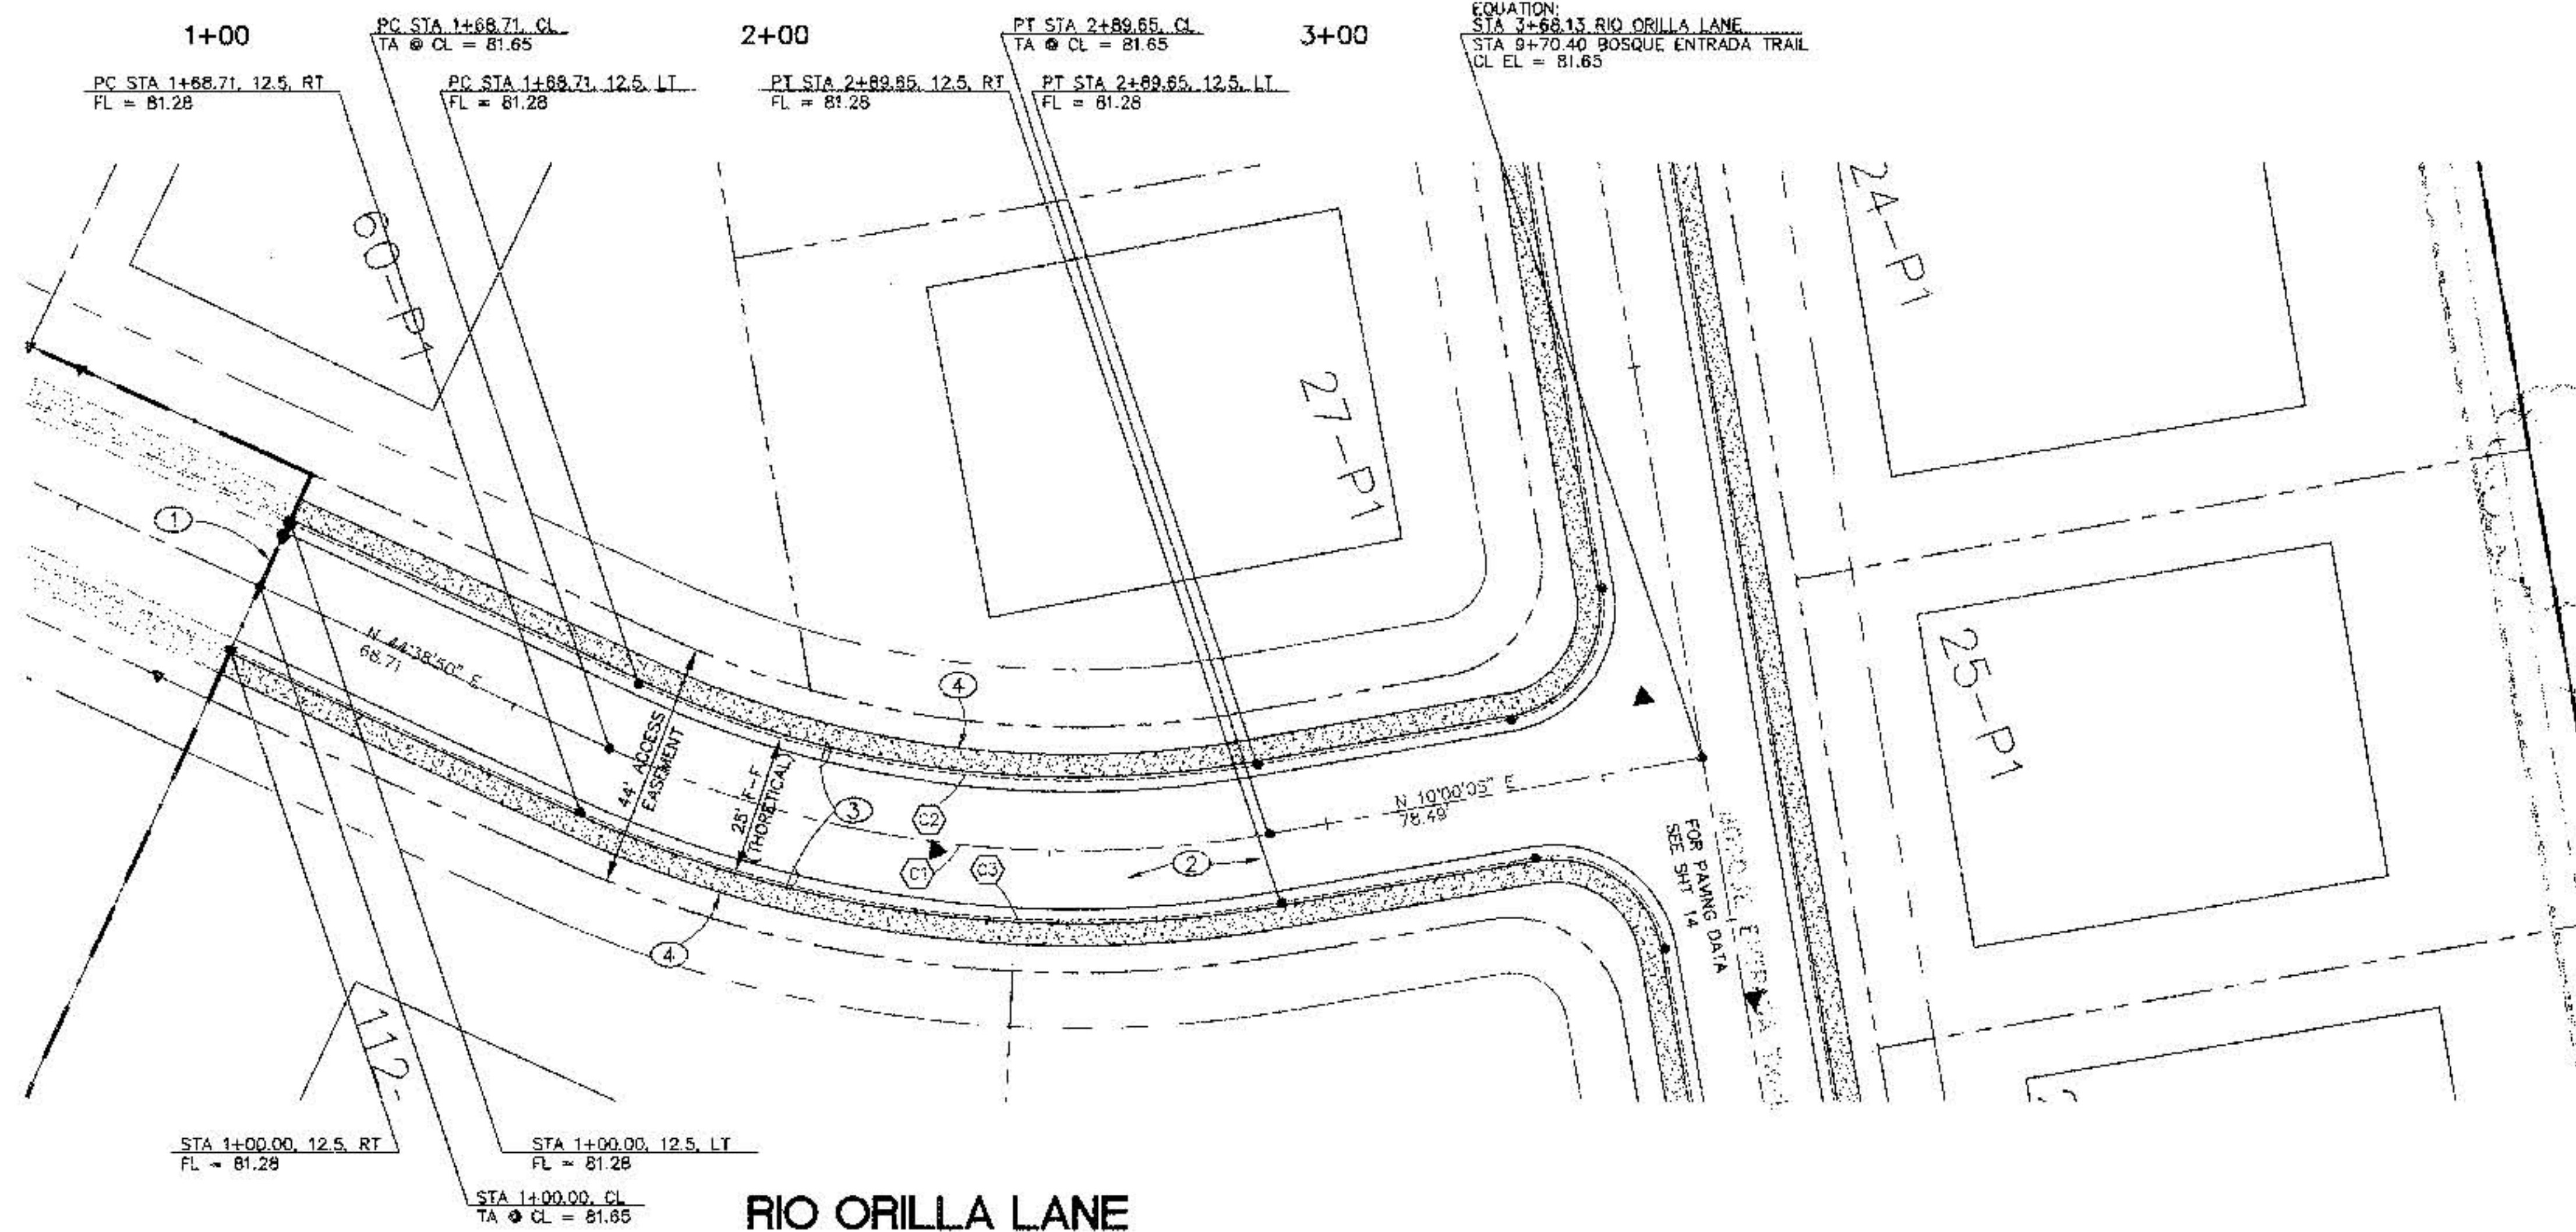

- KEYED NOTES:**
- 1 REMOVE & DISPOSED OF EXIST. CONCRETE CUT-OFF WALL.
 - 2 SEE SHEET 22 FOR STREET SECTION.
 - 3 CONSTRUCT NEW ESTATE TYPE CURB PER COA STD DWG 2415.
 - 4 CONSTRUCT 4" GRAVEL SHOULDER, SEE TYPICAL ROAD SECTION, SHEET 22.

CURVE DATA

NUMBER	DELTA	RADIUS	TANGENT	ARC LENGTH
C1	34°38'45"	200.00	62.38	120.94
C2	34°38'45"	187.50	58.48	113.38
C3	34°38'45"	212.50	66.28	128.50

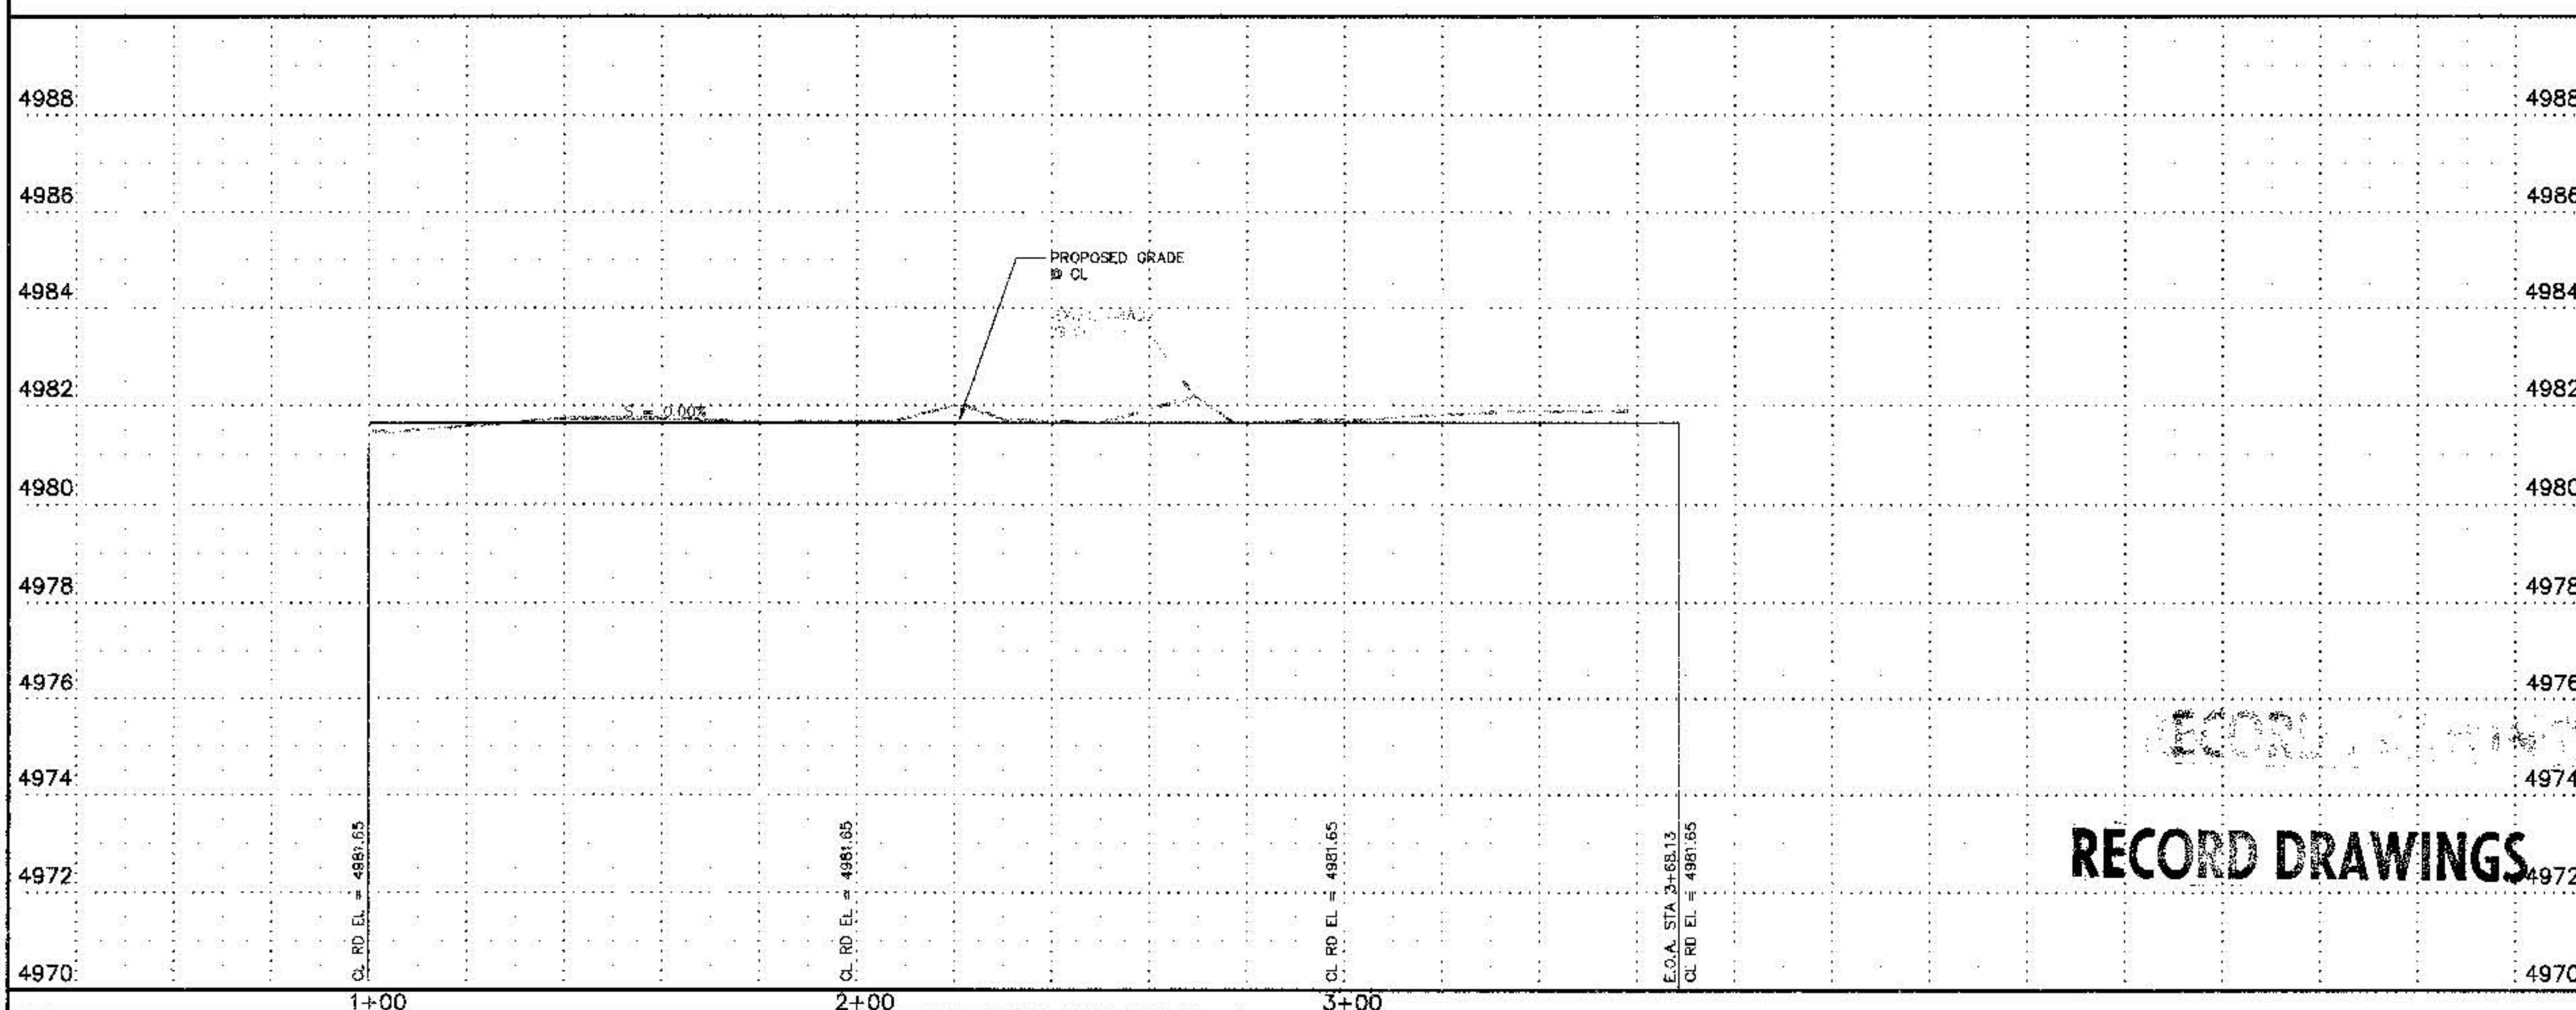

ENGINEER'S SEAL

REVISIONS

NO.	DATE	REMARKS	BY
1	05-20-98	DESIGN	JCS
2	05-20-98		JCS
3	05-20-98		DIA


CITY OF ALBUQUERQUE
PUBLIC WORKS DEPARTMENT
ENGINEERING DEVELOPMENT GROUP

TITLE: BOSQUE DEL RIO SUBDIVISION - PHASE 3
PAVING P & P: RIO ORILLA LN: STA 1+00 TO 3+00

DESIGNER: Smith Engineering Company
A Full Service Engineering Company
8001 Camino Real, N.E. Suite 1000 Albuquerque, New Mexico 87109

City Engineer Approval

City Project No. 5406.83
Zone Map No. D-13
Sheet 15 of 22

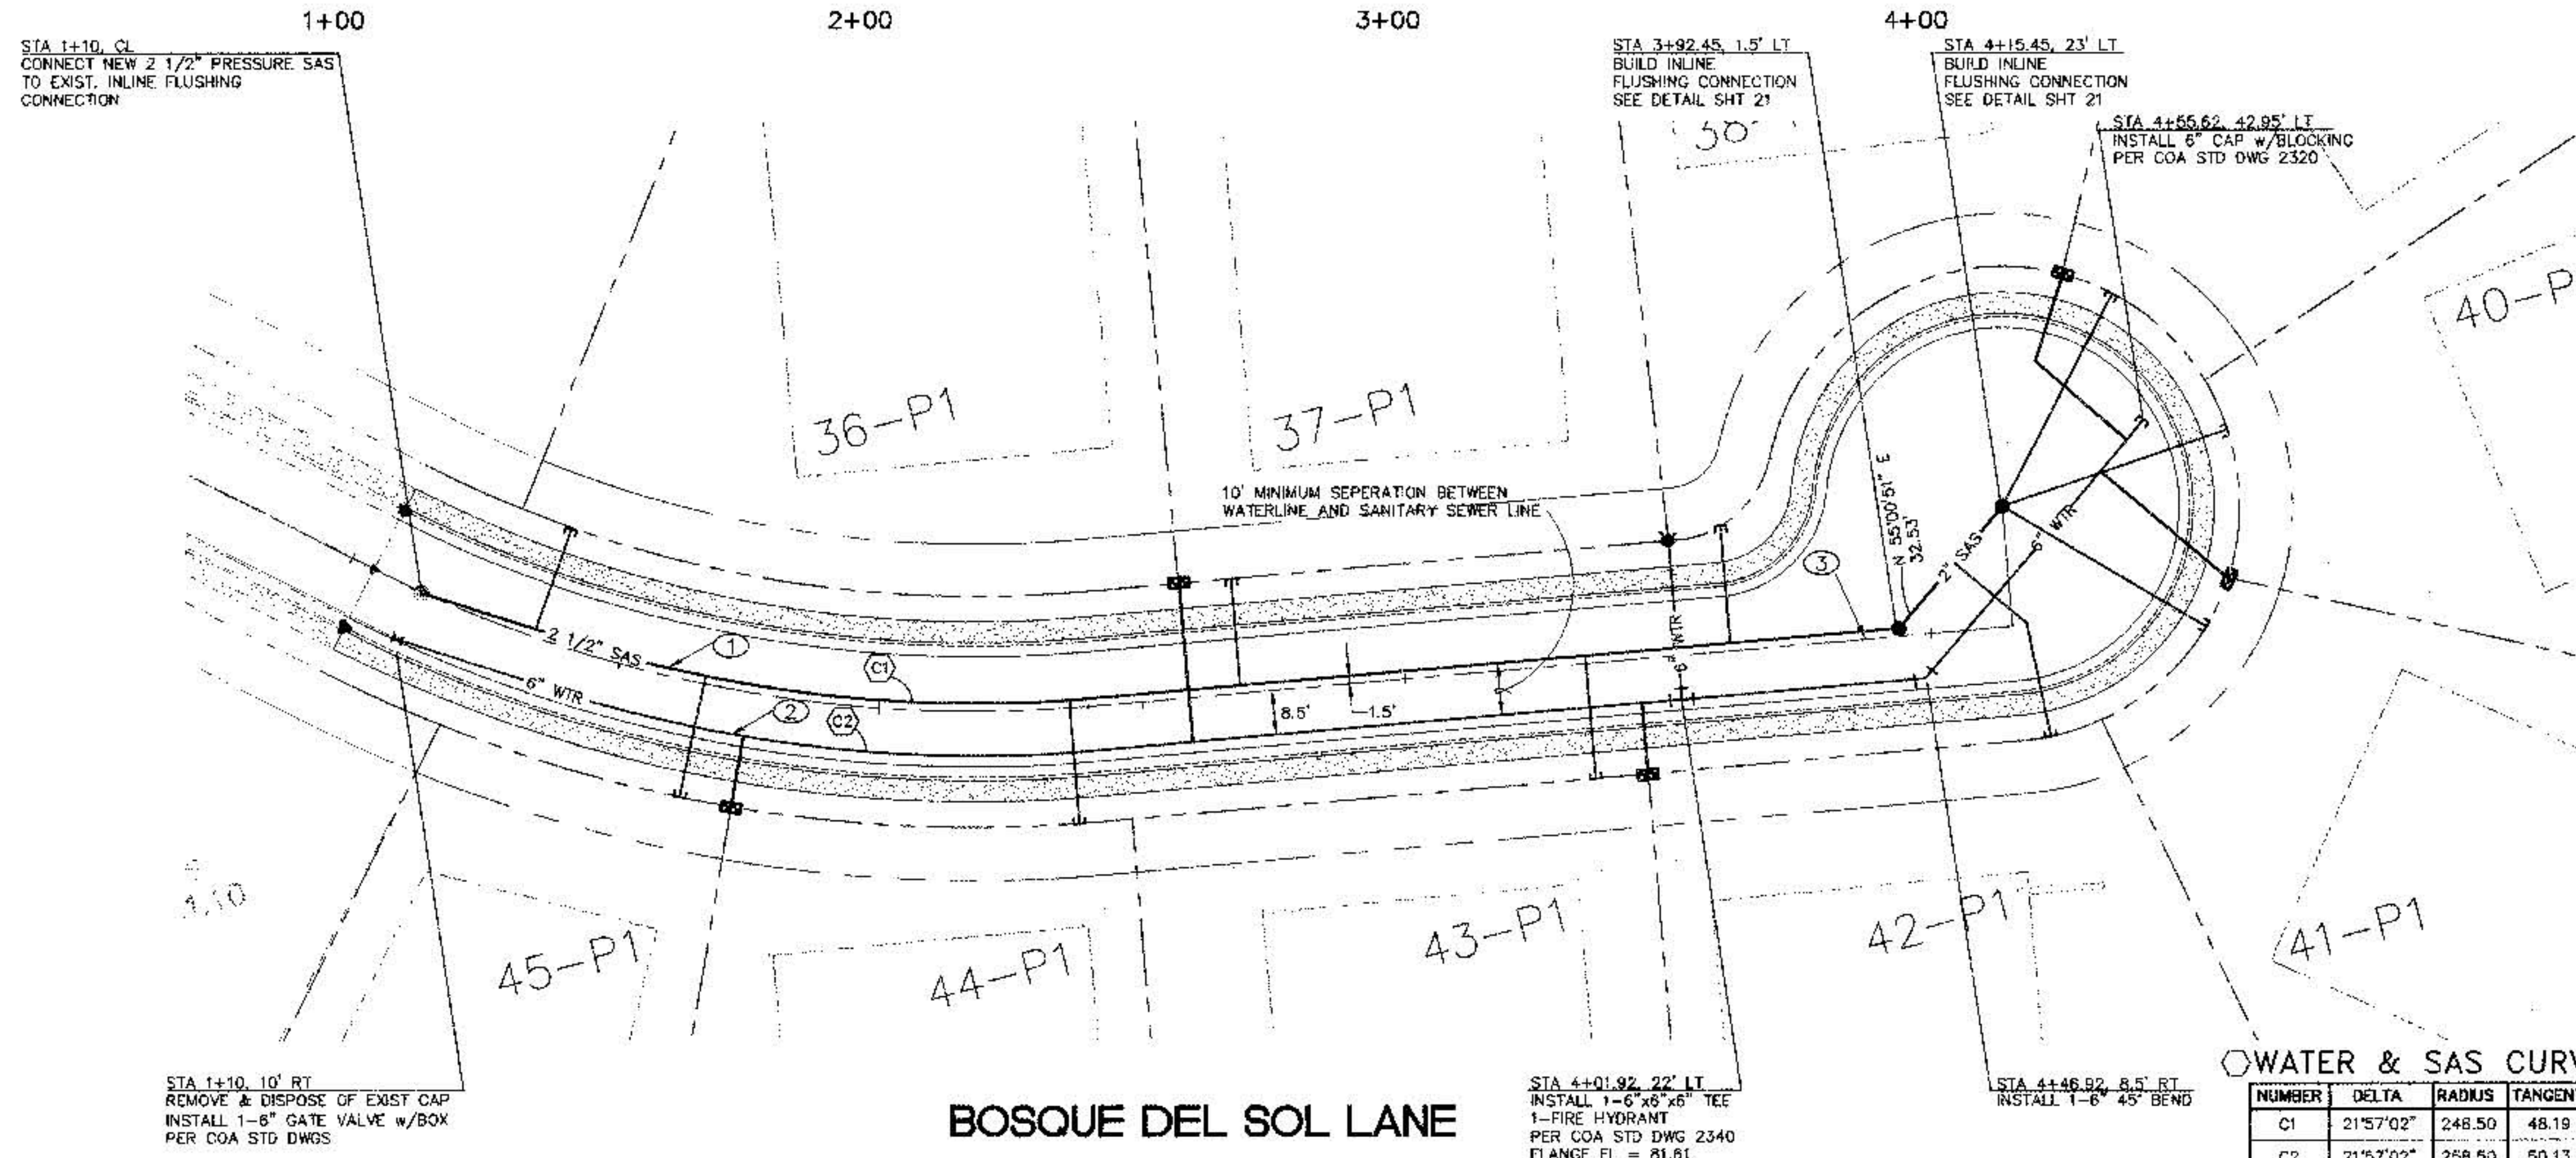

- KEYED NOTES:**
- CONTRACTOR SHALL INSTALL PRESSURE SAS LINE PER CURVE DATA TABLE THIS SHEET.
 - CONTRACTOR SHALL INSTALL 6" PVC WATERLINE PER CURVE DATA TABLE THIS SHEET.
- GENERAL NOTES:**
- ALL WATERLINE FITTINGS TO BE RESTRAINED "M". SEE RESTRAINT LENGTH TABLE THIS SHT.
 - FOR WATER SERVICE CONNECTIONS, SEE COA STD DWG 2363.
 - FOR SANITARY SEWER SERVICE CONNECTIONS, SEE DETAIL SHT 21.
 - BACKFLOW PREVENTORS SHALL BE INSTALLED ON ALL WATER SERVICES.
 - CONTRACTOR SHALL INSTALL WATERLINE 2' FROM THE LIP OF GUTTER, UNLESS OTHERWISE NOTED ON PLANS.

WATERLINE RESTRAINT LENGTHS:

LENGTH OF RESTRAINT FOR TEES

BRANCH SIZE	LENGTH OF RESTRAINT (FT)
6"x6"x6"	24'
10"x10"x8"	10'
10"x10"x10"	64'

* EACH PIPE RUN SHALL HAVE A MINIMUM OF 10' W/O JOINTS ON EACH SIDE OF BRANCH OR FITTINGS FOR TEES. RESTRAIN PIPE IN THREE DIRECTIONS.

LENGTH OF RESTRAINT FOR HORIZ BENDS, REDUCERS, VALVES AND DEAD ENDS

PIPE SIZE	11 1/4'	45'	22 1/2'	10% REDUCER		VALVE/ DEAD END
				SMALL SIDE	LARGE SIDE	
6"	10'	14'	10'	-	-	73'
10"	15'	21'	15'	116'	71'	115'

WATER & SAS CURVE DATA



NUMBER	DELTA	RADIUS	TANGENT	ARC LENGTH
C1	21°57'02"	248.50	48.19	95.20
C2	21°57'02"	258.50	50.13	99.03

BOSQUE DEL SOL LANE SANITARY SEWER SERVICES

LOT NO.	STATION	OFFSET	LENGTH	IN/ELEV AT/L	TYPE
36-P1	1+32.86	CL	22'	77.45	PRES
37-P1	2+68.72	CL	22'	77.45	PRES
38-P1	3+61.93	CL	24'	77.45	PRES
39-P1	4+39.58	CL	45'	77.45	PRES
40-P1	4+59.16	CL	45'	77.45	PRES
41-P1	4+52.03	CL	45'	77.45	PRES
42-P1	4+20.90	CL	40'	77.45	PRES
43-P1	2+34.34	CL	22'	77.45	PRES
44-P1	2+36.21	CL	22'	77.45	PRES
45-P1	1+66.47	CL	22'	77.45	PRES

BOSQUE DEL SOL LANE WATER SERVICES

LOT NO.	STATION	LENGTH	SIZE	TYPE
36-P1	1+32.85	32'	3/4"	DBL
37-P1	2+58.85	32'	3/4"	DBL
38-P1	4+30.59	40'	3/4"	DBL
39-P1	4+57.00	32'	3/4"	DBL
40-P1	4+57.00	32'	3/4"	DBL
41-P1	3+44.25	22'	3/4"	DBL
42-P1	1+75.44	22'	3/4"	DBL

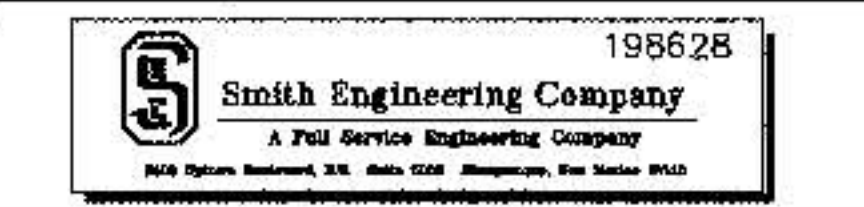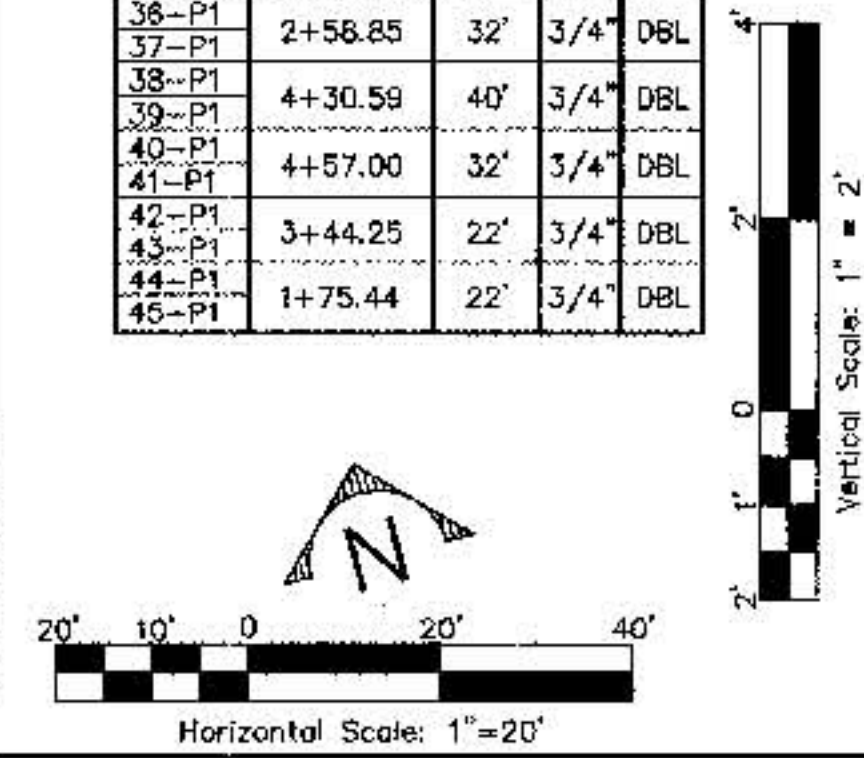

RECORD DRAWINGS

CITY OF ALBUQUERQUE PUBLIC WORKS DEPARTMENT ENGINEERING DEVELOPMENT GROUP

TITLE: BOSQUE DEL RIO SUBDIVISION - PHASE 3



UTILITY P & P: BOSQUE DEL SOL LN: STA 1+00 TO 4+15.40

DESIGN REVIEW COMMENTS	CITY ENGINEER APPROVAL	NO. / DAY / YR.

DESIGNED BY: JCS DATE: 05-20-98
DRAWN BY: JCS DATE: 05-20-98
CHECKED BY: DLA DATE: 05-20-98

City Project No. **5406.83** Zone Map No. **D-13** Sheet **16** of **22**

Drawn by: JCS Date: 05-20-98
Checked by: DLA Date: 05-20-98

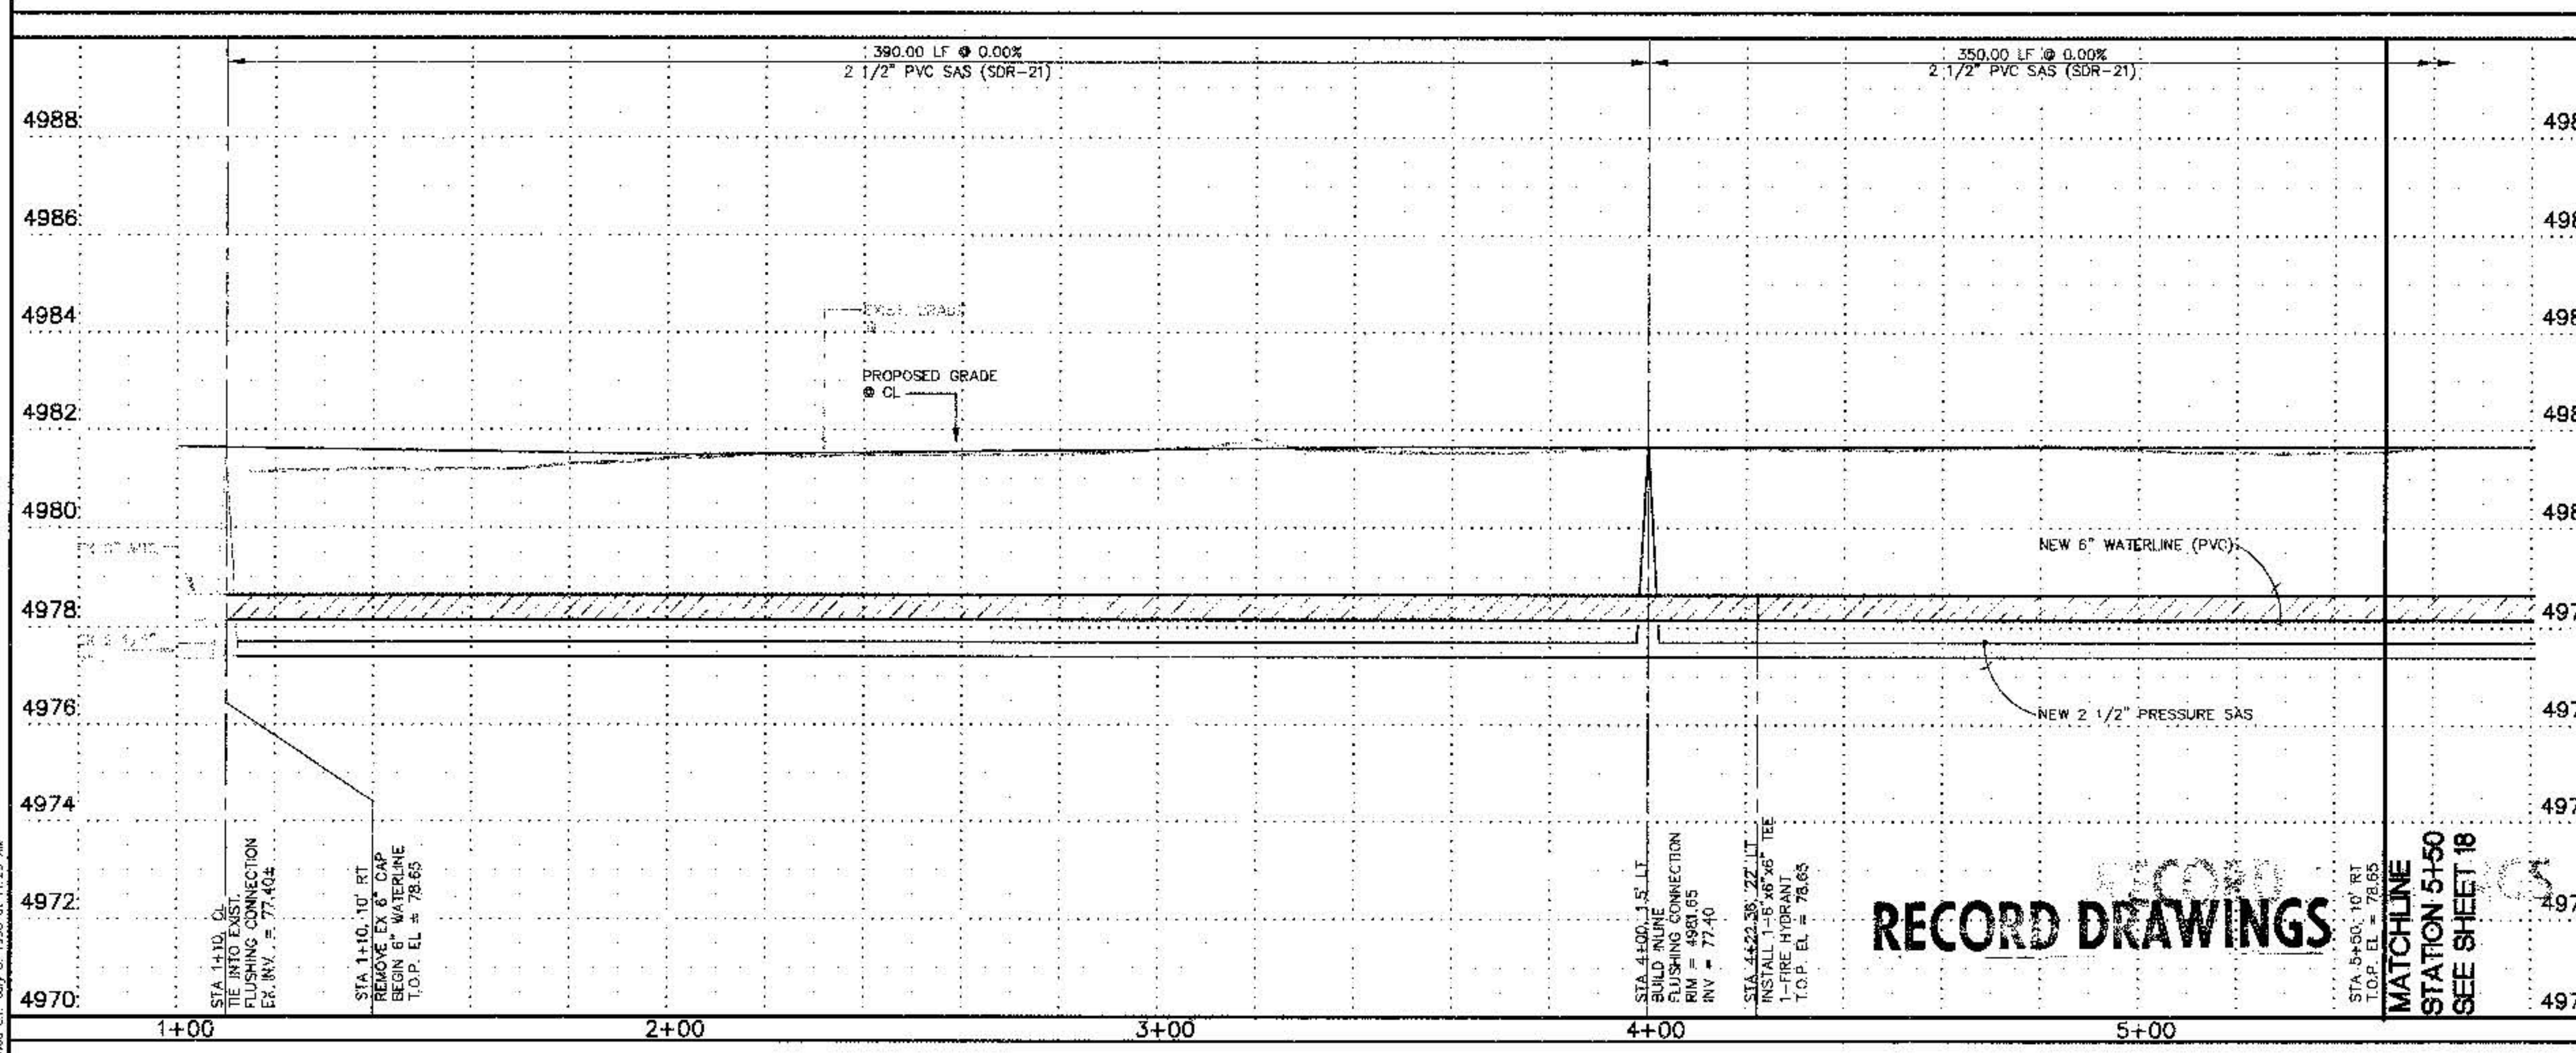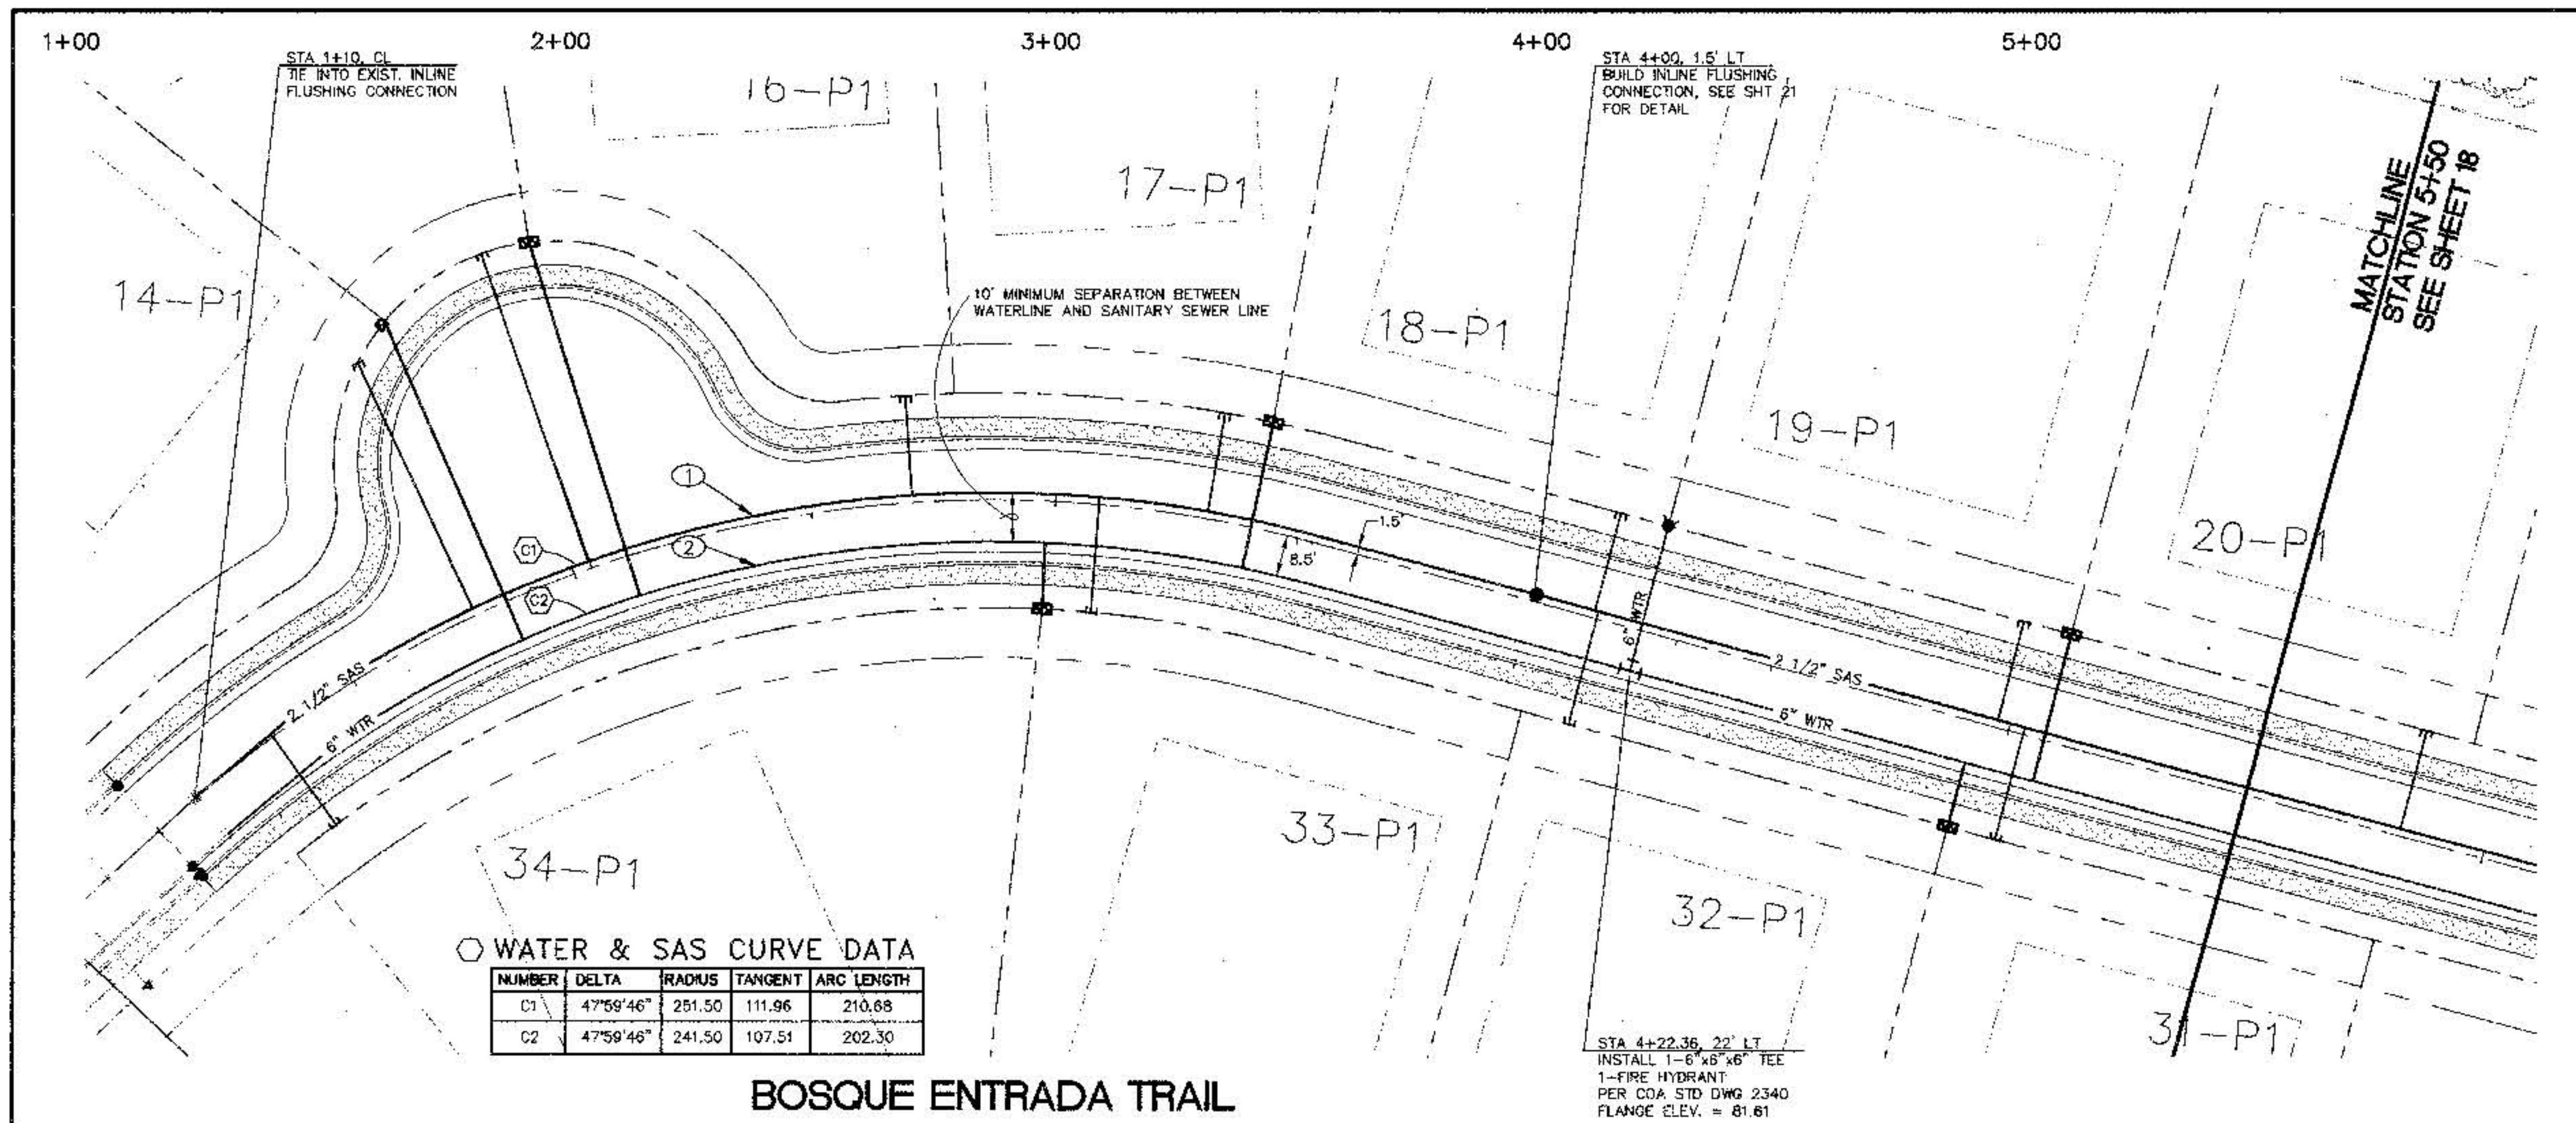

KEYED NOTES:

- CONTRACTOR SHALL INSTALL PRESSURE SAS LINE PER CURVE DATA TABLE THIS SHEET.
- CONTRACTOR SHALL INSTALL 6" PVC WATERLINE PER CURVE DATA TABLE THIS SHEET.

GENERAL NOTES:

- ALL WATERLINE FITTINGS TO BE RESTRAINED "MJ". SEE RESTRAINT LENGTH TABLE THIS SHT.
- FOR WATER SERVICE CONNECTIONS, SEE COA STD DWG 2363.
- FOR SANITARY SEWER SERVICE CONNECTIONS, SEE DETAIL SHT 21.
- BACKFLOW PREVENTORS SHALL BE INSTALLED ON ALL WATER SERVICES.
- CONTRACTOR SHALL INSTALL WATERLINE 2' FROM THE LIP OF GUTTER, UNLESS OTHERWISE NOTED ON PLANS.

WATERLINE RESTRAINT LENGTHS:

LENGTH OF RESTRAINT FOR TEES

BRANCH SIZE	LENGTH OF RESTRAINT (FT)
6"x6"x6"	24'
10"x10"x6"	10'
10"x10"x10"	64'

* EACH PIPE RUN SHALL HAVE A MINIMUM OF 10' W/O JOINTS ON EACH SIDE OF BRANCH OR FITTINGS. FOR TEES RESTRAIN PIPE IN THREE DIRECTIONS.

LENGTH OF RESTRAINT FOR HORIZ BENDS, REDUCERS, VALVES AND DEAD ENDS

PIPE SIZE	11/4"	45"	22 1/2"	10" REDUCER SMALL SIDE	10" REDUCER LARGE SIDE	VALVE/ DEAD END
6"	10'	14'	10'	-	-	73'
10"	15'	21'	15'	116'	71'	115'

BOSQUE ENTRADA TRAIL SANITARY SEWER SERVICES

LOT NO.	STATION	OFFSET	LENGTH	BY ELEV AT EL	TYPE
14-P1	1+68.13	CL	57'	77.45	PRES
15-P1	1+93.48	CL	68'	77.45	PRES
16-P1	2+60.71	CL	22'	77.45	PRES
17-P1	3+20.93	CL	22'	77.45	PRES
18-P1	4+12.36	CL	22'	77.45	PRES
19-P1	4+97.37	CL	22'	77.45	PRES
31-P1	5+03.03	CL	22'	77.45	PRES
32-P1	4+13.03	CL	22'	77.45	PRES
33-P1	2+98.79	CL	22'	77.45	PRES
34-P1	1+20.03	CL	22'	77.45	PRES

BOSQUE ENTRADA TRAIL WATER SERVICES

LOT NO.	STATION	LENGTH	SIZE	TYPE
14-P1	1+76.05	72'	3/4"	SGL
15-P1	2+01.42	77'	3/4"	DBL
16-P1	3+30.10	32'	3/4"	DBL
17-P1	5+07.39	32'	3/4"	DBL
18-P1	4+93.04	12'	3/4"	DBL
31-P1	3+20.10	12'	3/4"	DBL

Smith Engineering Company
A Full Service Engineering Company
1400 Lomas Verde, N.E., Suite 1000, Albuquerque, New Mexico 87106

**CITY OF ALBUQUERQUE
PUBLIC WORKS DEPARTMENT
ENGINEERING DEVELOPMENT GROUP**

**TITLE: BOSQUE DEL RIO SUBDIVISION - PHASE 3
UTILITY P & P: BOSQUE ENTRADA TR: STA 1+00 TO 5+50**

DESIGNED BY: JCS **CHECKED BY: DLA** **DATE: 05-20-98**

DRAWN BY: JCS **DATE: 05-20-98**

CITY ENGINEER APPROVAL

City Project No. 5406.83 **Zone Map No. D-13** **Sheet 17 of 22**

Drawn by JWS, 05/20/98, 10:00 AM
Checked by JWS, 05/20/98, 10:00 AM

8+00

9+00

10+00

11+00

EQUATION:
STA 9+70.40 BOSQUE ENTRADA TRAIL
STA 3+68.13 RIO ORILLA LANE

MATCHLINE
STATION 9+00
SEE SHEET 18


23-P1

24-P1

25-P1

26-P1

114-P1

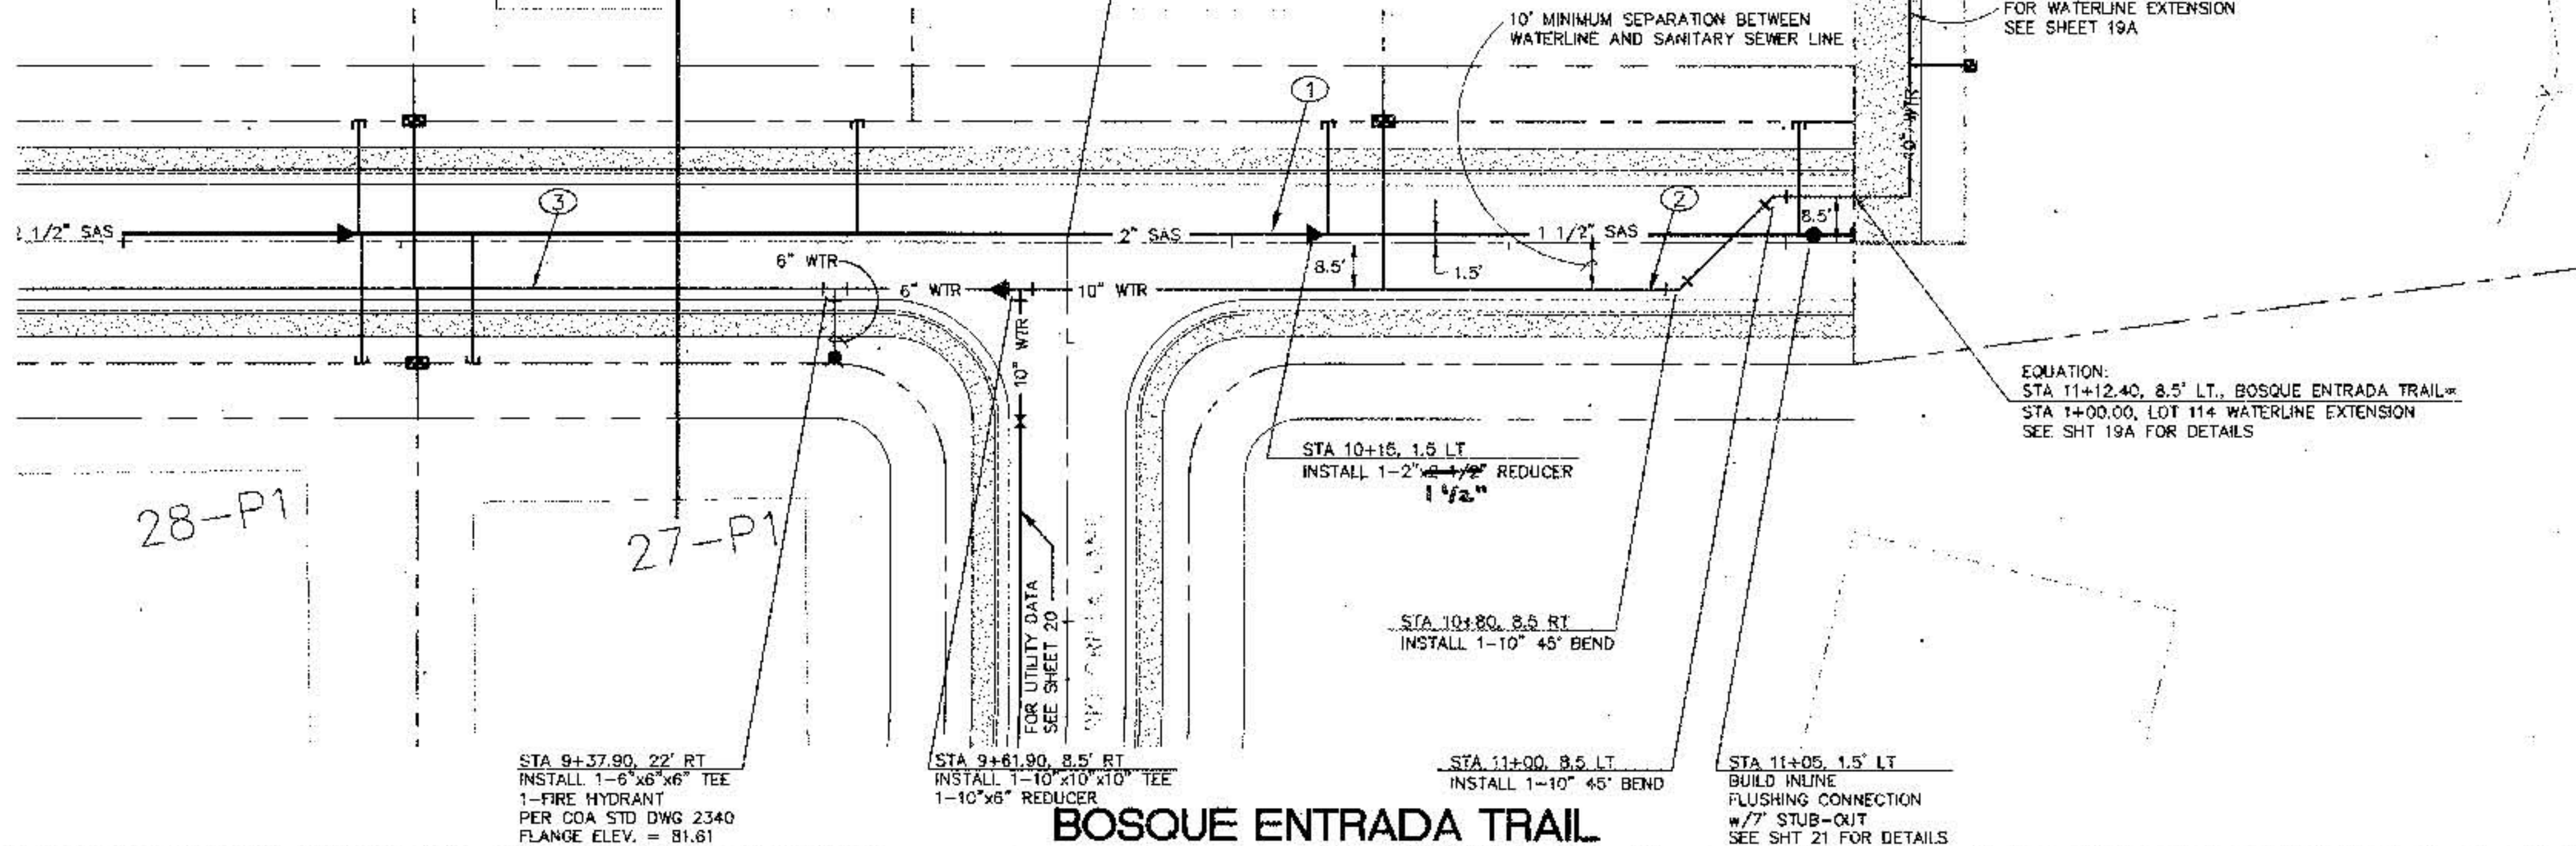

STA 9+37.90, 22' RT
INSTALL 1-6\"/>

STA 9+61.90, 8.5' RT
INSTALL 1-10\"/>


STA 10+15, 1.5' LT
INSTALL 1-2\"/>

STA 10+80, 8.5' RT
INSTALL 1-10\"/>

STA 11+00, 8.5' LT
INSTALL 1-10\"/>

STA 11+05, 1.5' LT
BUILD INLINE
FLUSHING CONNECTION
W/7\"/>

BOSQUE ENTRADA TRAIL

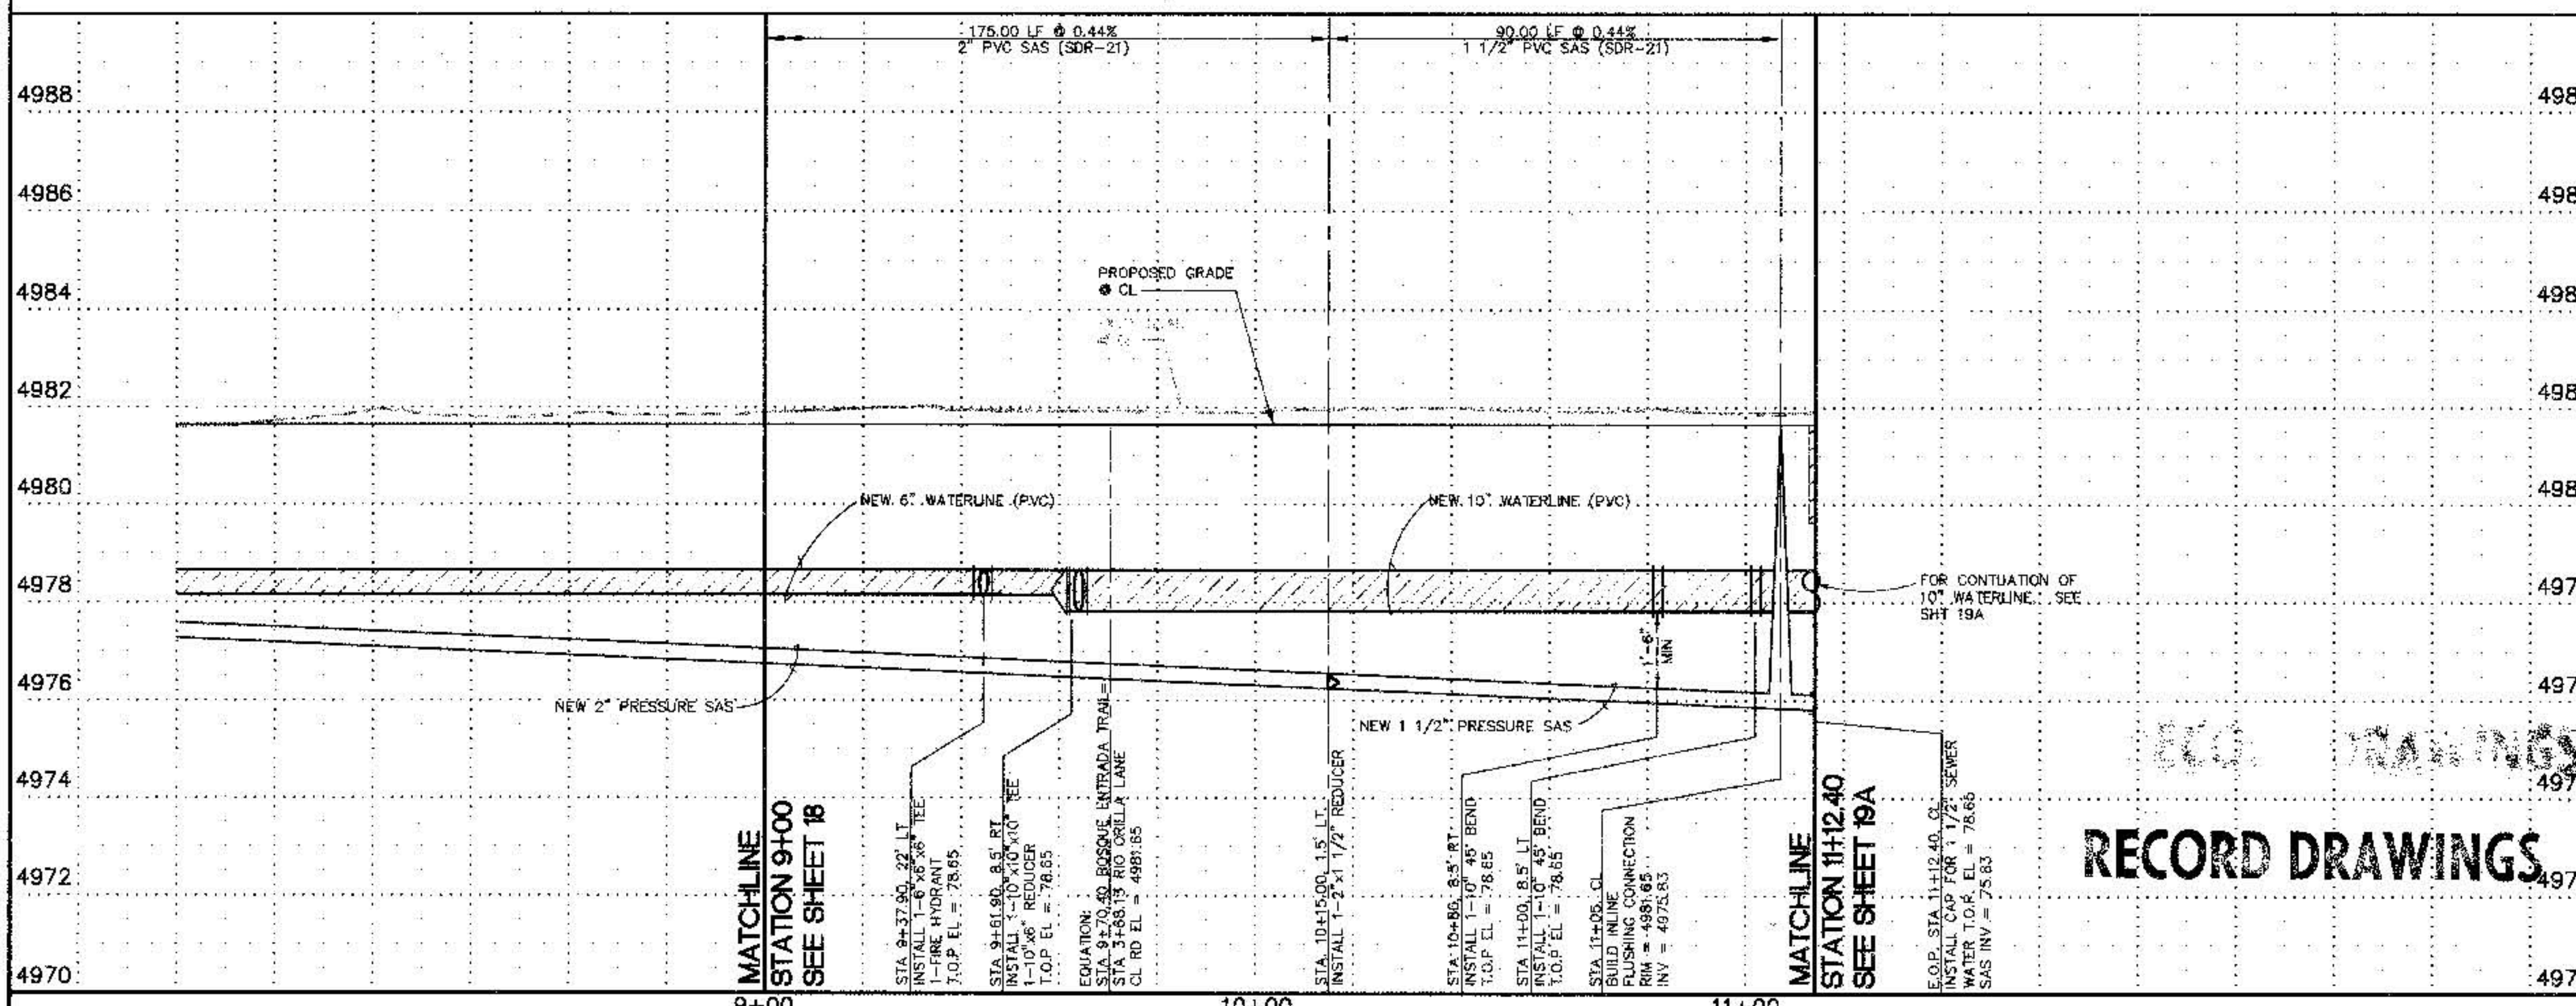

MATCHLINE
STATION 9+00
SEE SHEET 18

MATCHLINE
STATION 11+12.40
SEE SHEET 19A

RECORD DRAWINGS

KEYED NOTES:

- NEW 2 1/2" WATERLINE (PRESSURIZED)
- NEW 10" WATERLINE (PVC)
- NEW 6" WATERLINE (PVC)

GENERAL NOTES:

- ALL WATERLINE FITTINGS TO BE RESTRAINED "M". SEE RESTRAINT LENGTH TABLE THIS SHT.
- FOR WATER SERVICE CONNECTIONS, SEE COA STD DWG 2363.
- FOR SANITARY SEWER SERVICE CONNECTIONS, SEE DETAIL SHT 21.
- BACKFLOW PREVENTORS SHALL BE INSTALLED ON ALL WATER SERVICES.
- CONTRACTOR SHALL INSTALL WATERLINE 2' FROM THE LIP OF GUTTER, UNLESS OTHERWISE NOTED ON PLANS.

WATERLINE

RESTRAINT LENGTHS:

LENGTH OF RESTRAINT FOR TEES

BRANCH SIZE	LENGTH OF RESTRAINT (FT)
6"x6"x6"	24'
10"x10"x6"	10'
10"x10"x10"	64'

* EACH PIPE RUN SHALL HAVE A MINIMUM OF 10' W/O JOINTS ON EACH SIDE OF BRANCH OR FITTINGS. FOR TEES RESTRAIN PIPE IN THREE DIRECTIONS.

LENGTH OF RESTRAINT FOR HORIZ BENDS, REDUCERS, VALVES AND DEAD ENDS


PIPE SIZE	11 1/4"	45"	22 1/2"	10\"/>
6"	10'	14'	10'	73'
10"	15'	21'	15'	115'

BOSQUE ENTRADA TRAIL SANITARY SEWER SERVICES

LOT NO.	STATION	OFFSET	LENGTH	BY ELEV AT/CL	TYPE
24-P1	9+32.36	CL	22'	77.45	PRES
25-P1	10+17.36	CL	22'	77.45	PRES
26-P1	11+02.36	CL	22'	77.45	PRES
114-P1	11+12.36	CL	CL	77.45	PRES

BOSQUE ENTRADA TRAIL WATER SERVICES

LOT NO.	STATION	LENGTH	SIZE	TYPE
25-P1	10+27.38	32'	3/4"	DBL
26-P1	11+12.36	CL(WTR)	3/4"	SGL

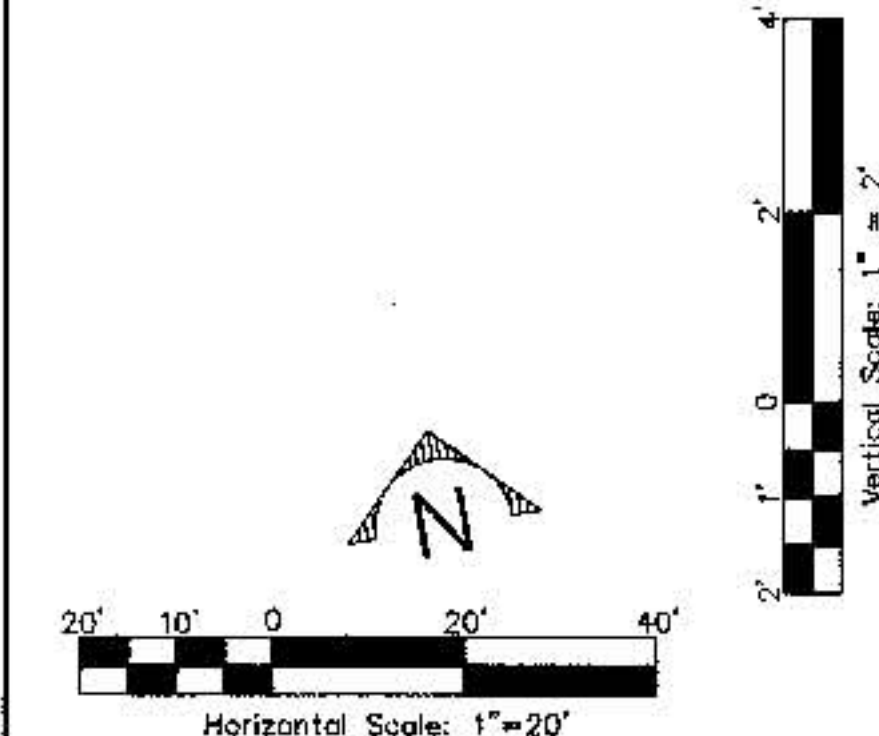



198628
Smith Engineering Company
A Full Service Engineering Company
4401 Camino Real, N.E. Albuquerque, NM 87105

CITY OF ALBUQUERQUE
PUBLIC WORKS DEPARTMENT
ENGINEERING DEVELOPMENT GROUP

TITLE: BOSQUE DEL RIO SUBDIVISION - PHASE 3
UTILITY P & P: BOSQUE ENTRADA TR: STA 9+00 TO 11+12

Design Review Committee	City Engineer Approval	20' / Day / Yr	10' / Day / Yr

City Project No. 5406.83
Zone Map No. D-13
Sheet 19 of 22

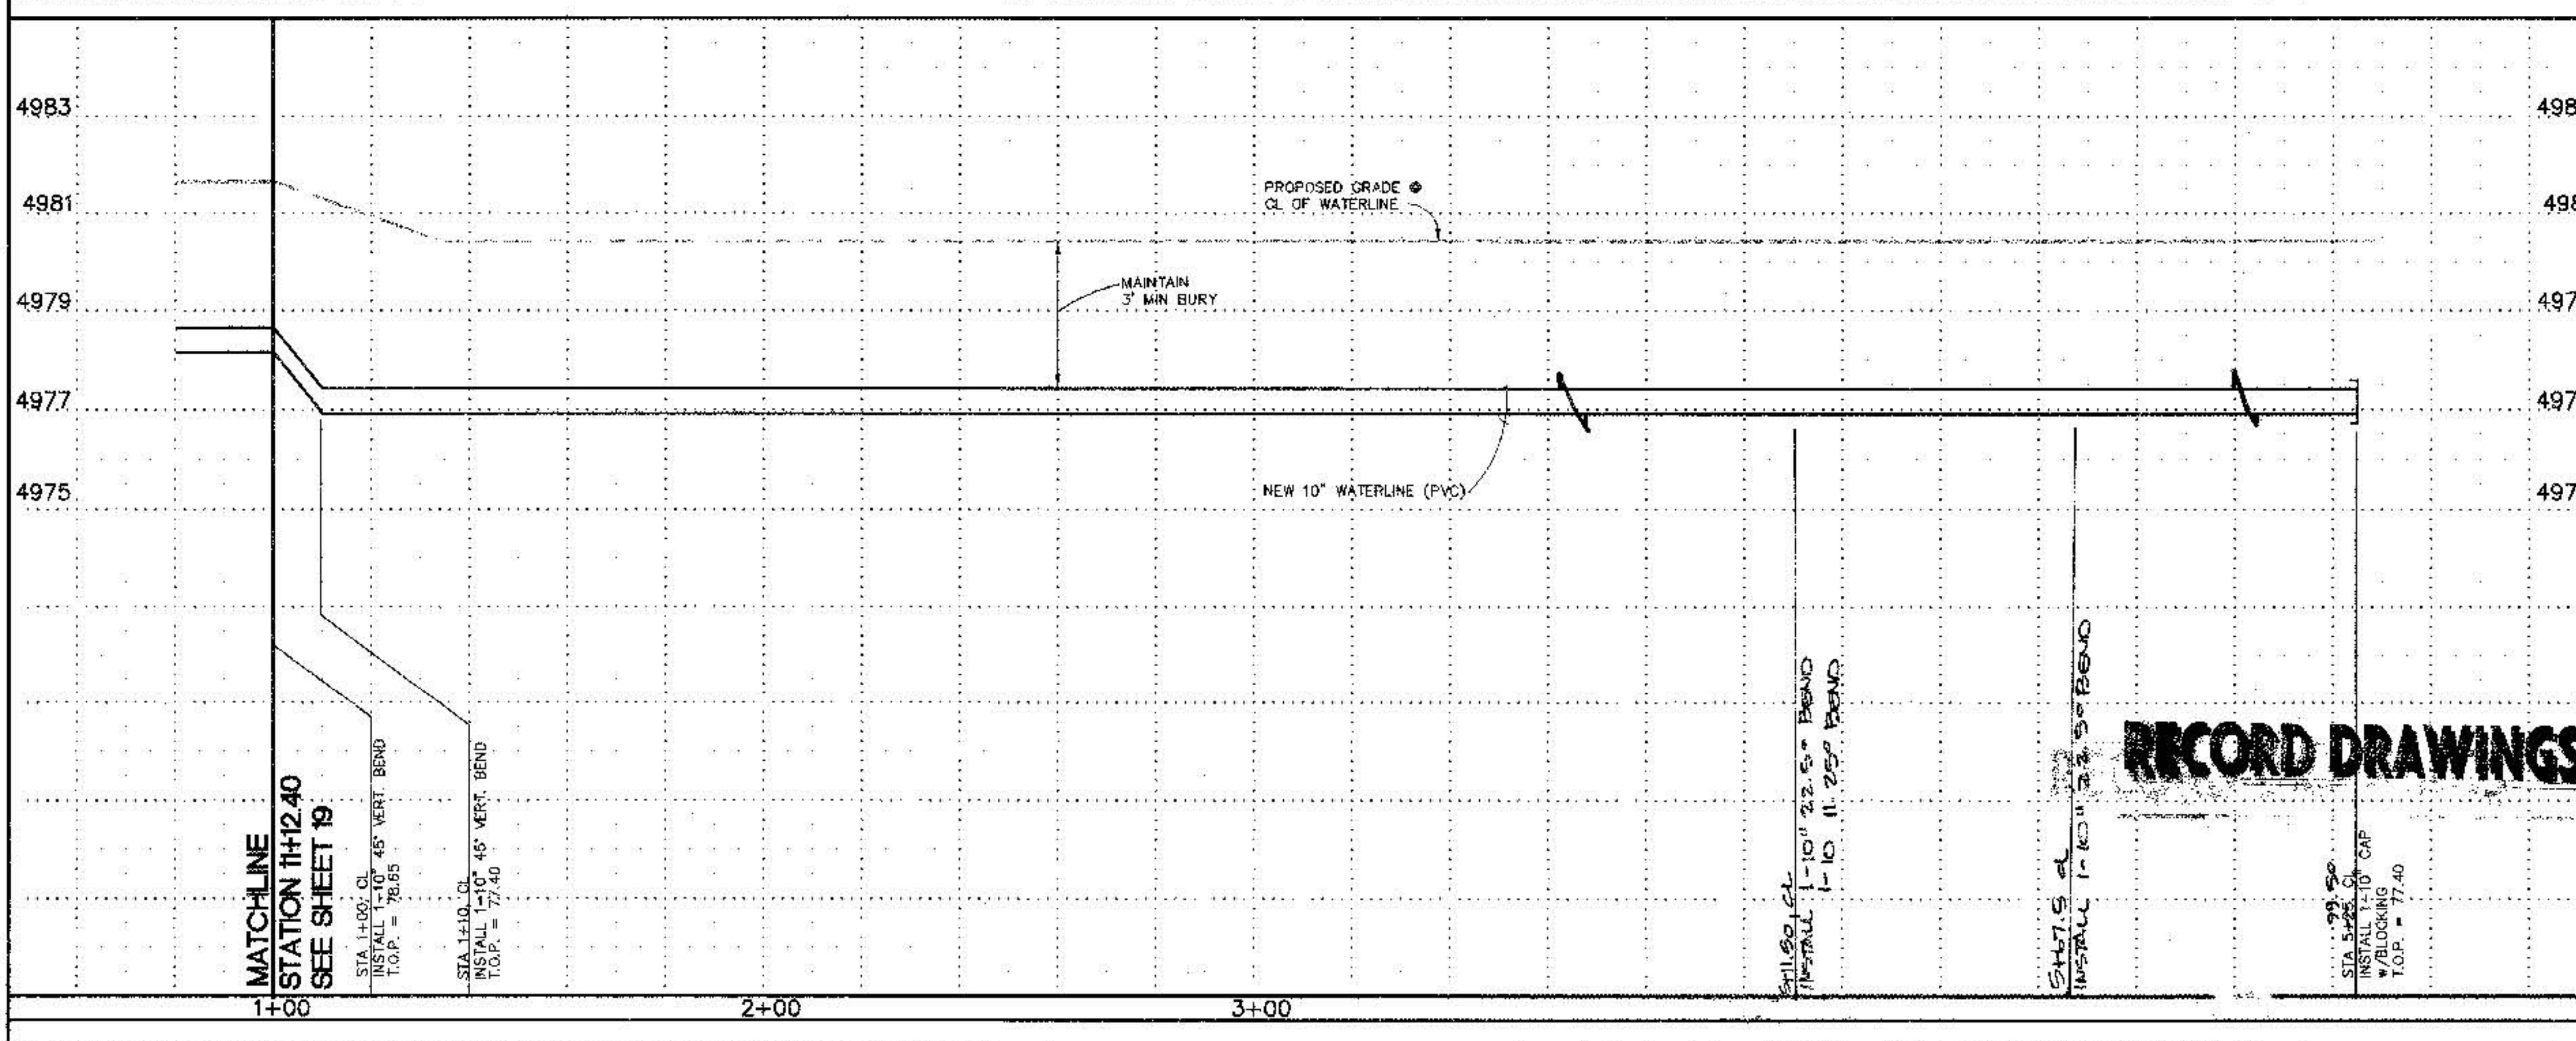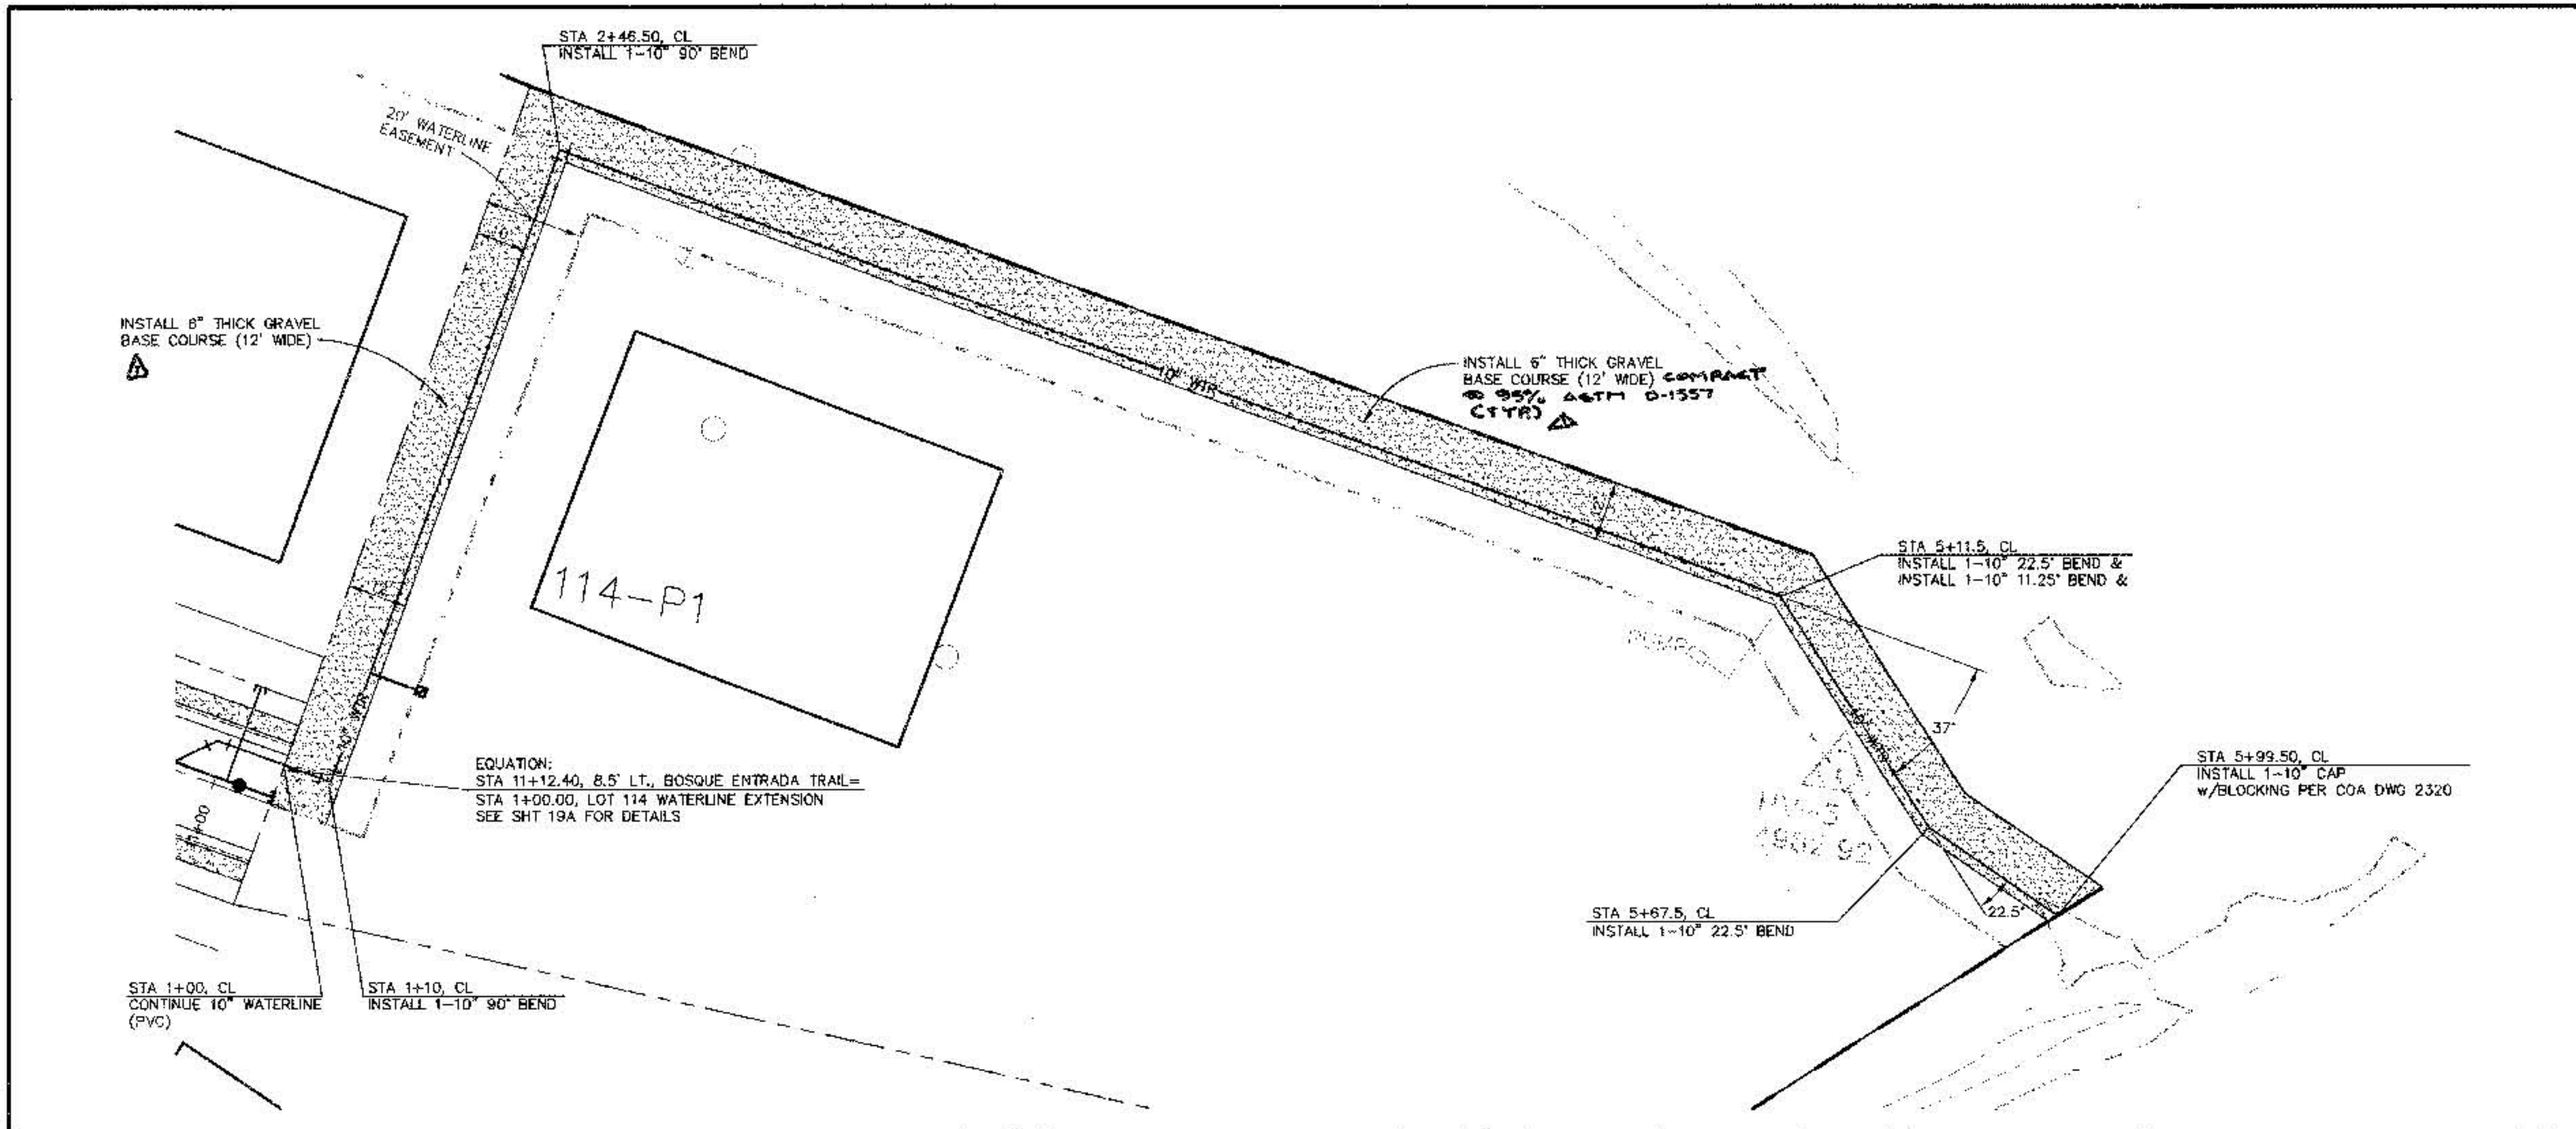

GENERAL NOTES:

- ALL WATERLINE FITTINGS TO BE RESTRAINED "MJ". SEE RESTRAINT LENGTH TABLE THIS SHT.
- FOR WATER SERVICE CONNECTIONS, SEE COA STD DWG 2363.
- FOR SANITARY SEWER SERVICE CONNECTIONS, SEE DETAIL SHT 21.
- BACKFLOW PREVENTORS SHALL BE INSTALLED ON ALL WATER SERVICES.
- CONTRACTOR SHALL INSTALL WATERLINE 2' FROM THE LIP OF GUTTER, UNLESS OTHERWISE NOTED ON PLANS

WATERLINE RESTRAINT LENGTHS:


LENGTH OF RESTRAINT FOR TEES

BRANCH SIZE	LENGTH OF RESTRAINT (FT)
6"x6"x6"	24'
10"x10"x6"	10'
10"x10"x10"	64'

* EACH PIPE RUN SHALL HAVE A MINIMUM OF 10' W/O JOINTS ON EACH SIDE OF BRANCH OR FITTINGS. FOR TEES RESTRAIN PIPE IN THREE DIRECTIONS.

LENGTH OF RESTRAINT FOR HORIZ BENDS, REDUCERS, VALVES AND DEAD ENDS

PIPE SIZE	11 1/4"	45°	22 1/2°	10" REDUCER SMALL SIDE	10" REDUCER LARGE SIDE	VALVE/ DEAD END
6"	10'	14'	10'	-	-	73'
10"	15'	21'	15'	116'	71'	115'

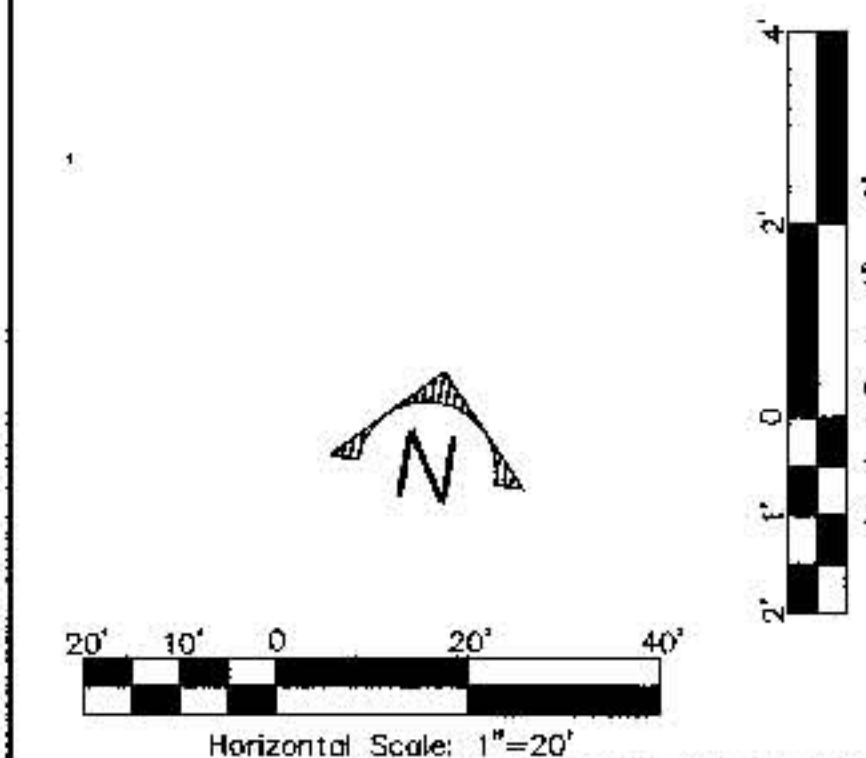

198628
Smith Engineering Company
A Full Service Engineering Company
1000 University Avenue, N.E. Albuquerque, N.M. 87102

RECORD DRAWINGS

CITY OF ALBUQUERQUE
PUBLIC WORKS DEPARTMENT
ENGINEERING DEVELOPMENT GROUP
TITLE: BOSQUE DEL RIO SUBDIVISION - PHASE 3
UTILITY P & P: LOT 114 WATERLINE EXTENSION

DESIGNED BY: J. J. J.	CITY ENGINEER APPROVAL:	DATE: 05-20-98
DRAWN BY: J. J. J.	DATE: 05-20-98	CHECKED BY: D.A.
DESIGNED BY: J. J. J.	DATE: 05-20-98	CHECKED BY: D.A.

City Project No. 5406.83 Zone Map No. D-13 Sheet 19A of 22

CONTRACTOR: NEW BUREAU	DATE: 05-20-98
INSPECTOR: J. J. J.	DATE: 05-20-98
FIELD ENGINEER: J. J. J.	DATE: 05-20-98
VERIFICATION BY: J. J. J.	DATE: 05-20-98
APPROVED BY: J. J. J.	DATE: 05-20-98
RECORDED BY: J. J. J.	DATE: 05-20-98

U.S. COE STA. "R. ALAMEDA B-2"

N.M. STATE PLAN COORDINATES (CENTRAL ZONE) BY AGS

X=373,513.20

Y=1,520,142.81

ELEVATION=5,058.25

Q/Q FACTOR=0.9987638

AS BUILT INFORMATION

BENCH MARKS

SURVEY INFORMATION

FIELD NOTES

ENGINEERS SEAL


198628

Smith Engineering Company

A Full Service Engineering Company


1000 University Avenue, N.E. Albuquerque, N.M. 87102

DESIGNED BY: JCS
DRAWN BY: JCS
CHECKED BY: DLA
DATE: 05-20-98
DATE: 05-20-98
DATE: 05-20-98
This is plot of a drawing on October 22, 1997 at 7:09 AM

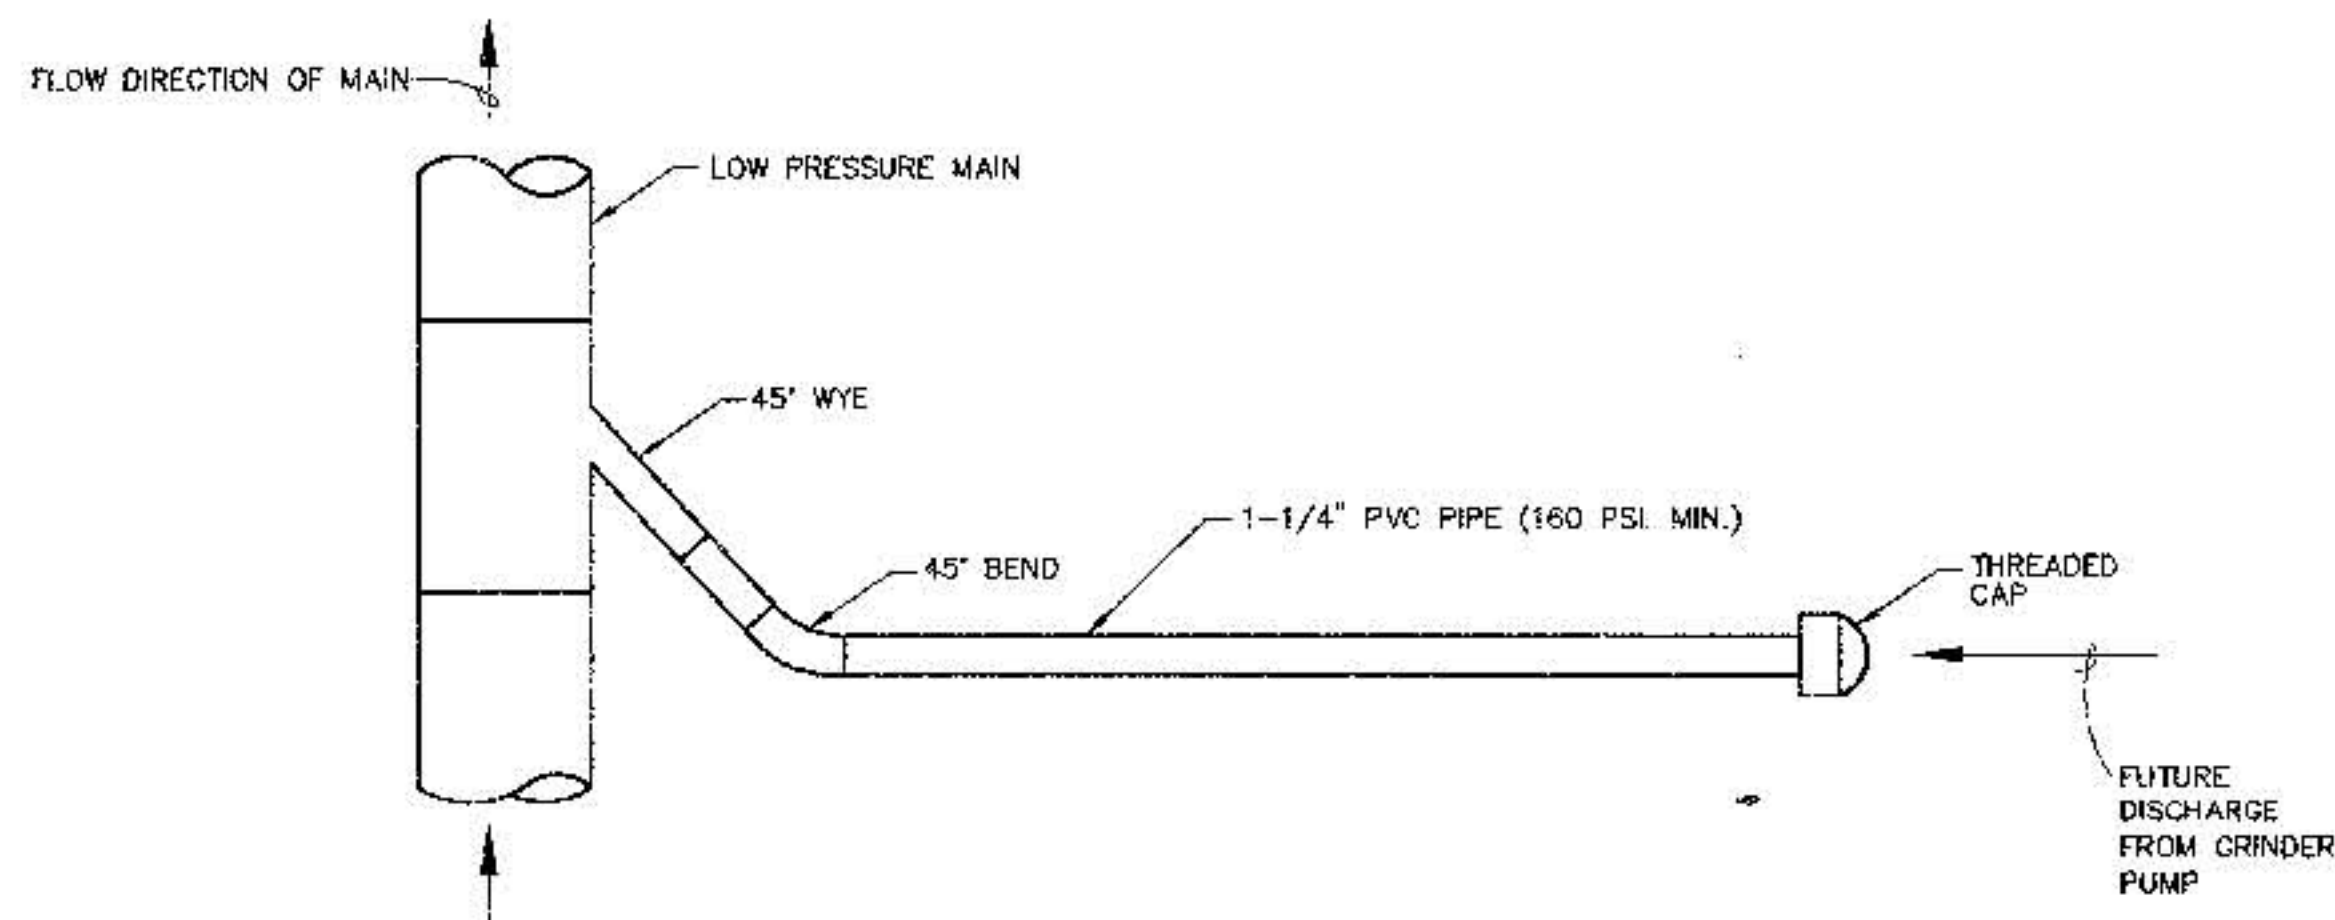


PRESSURE SEWER SERVICE LINE DETAIL (PLAN)

SCALE: NTS

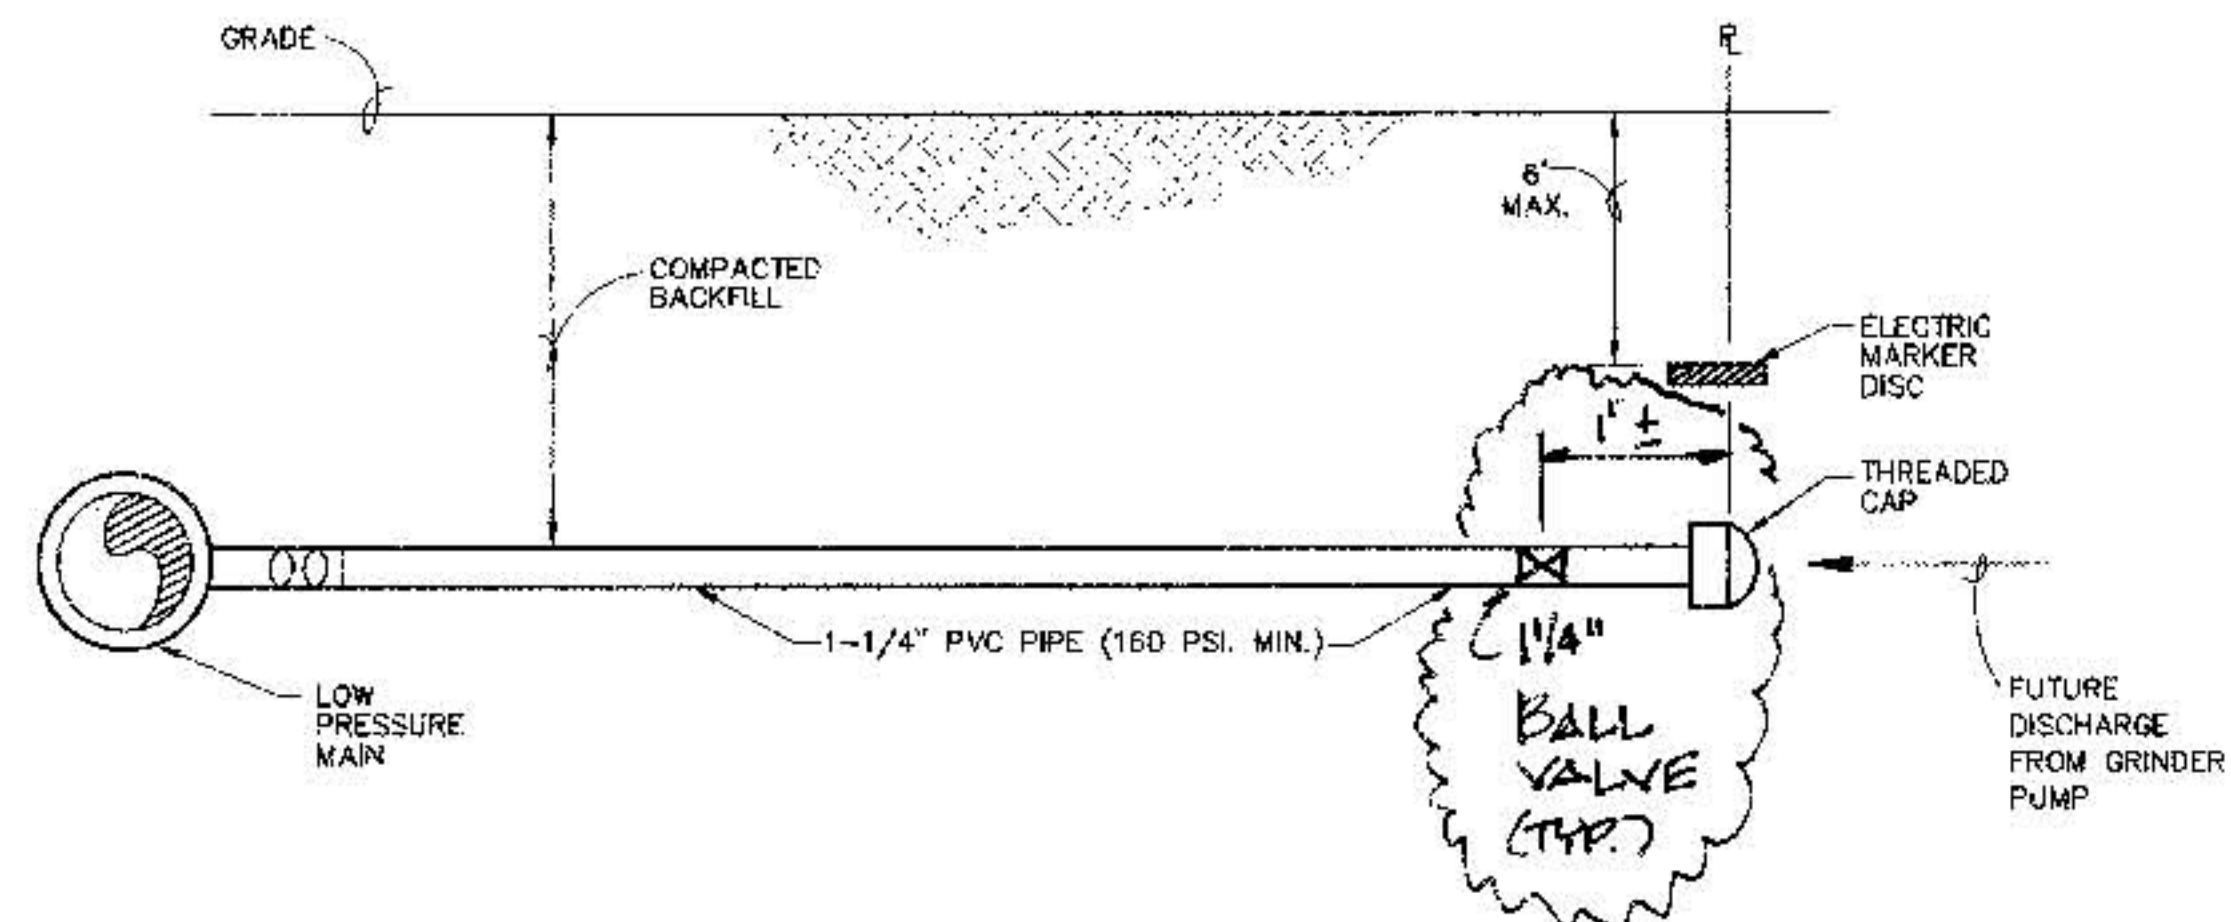

PRESSURE SEWER SERVICE LINE DETAIL (ELEVATION)

SCALE: NONE

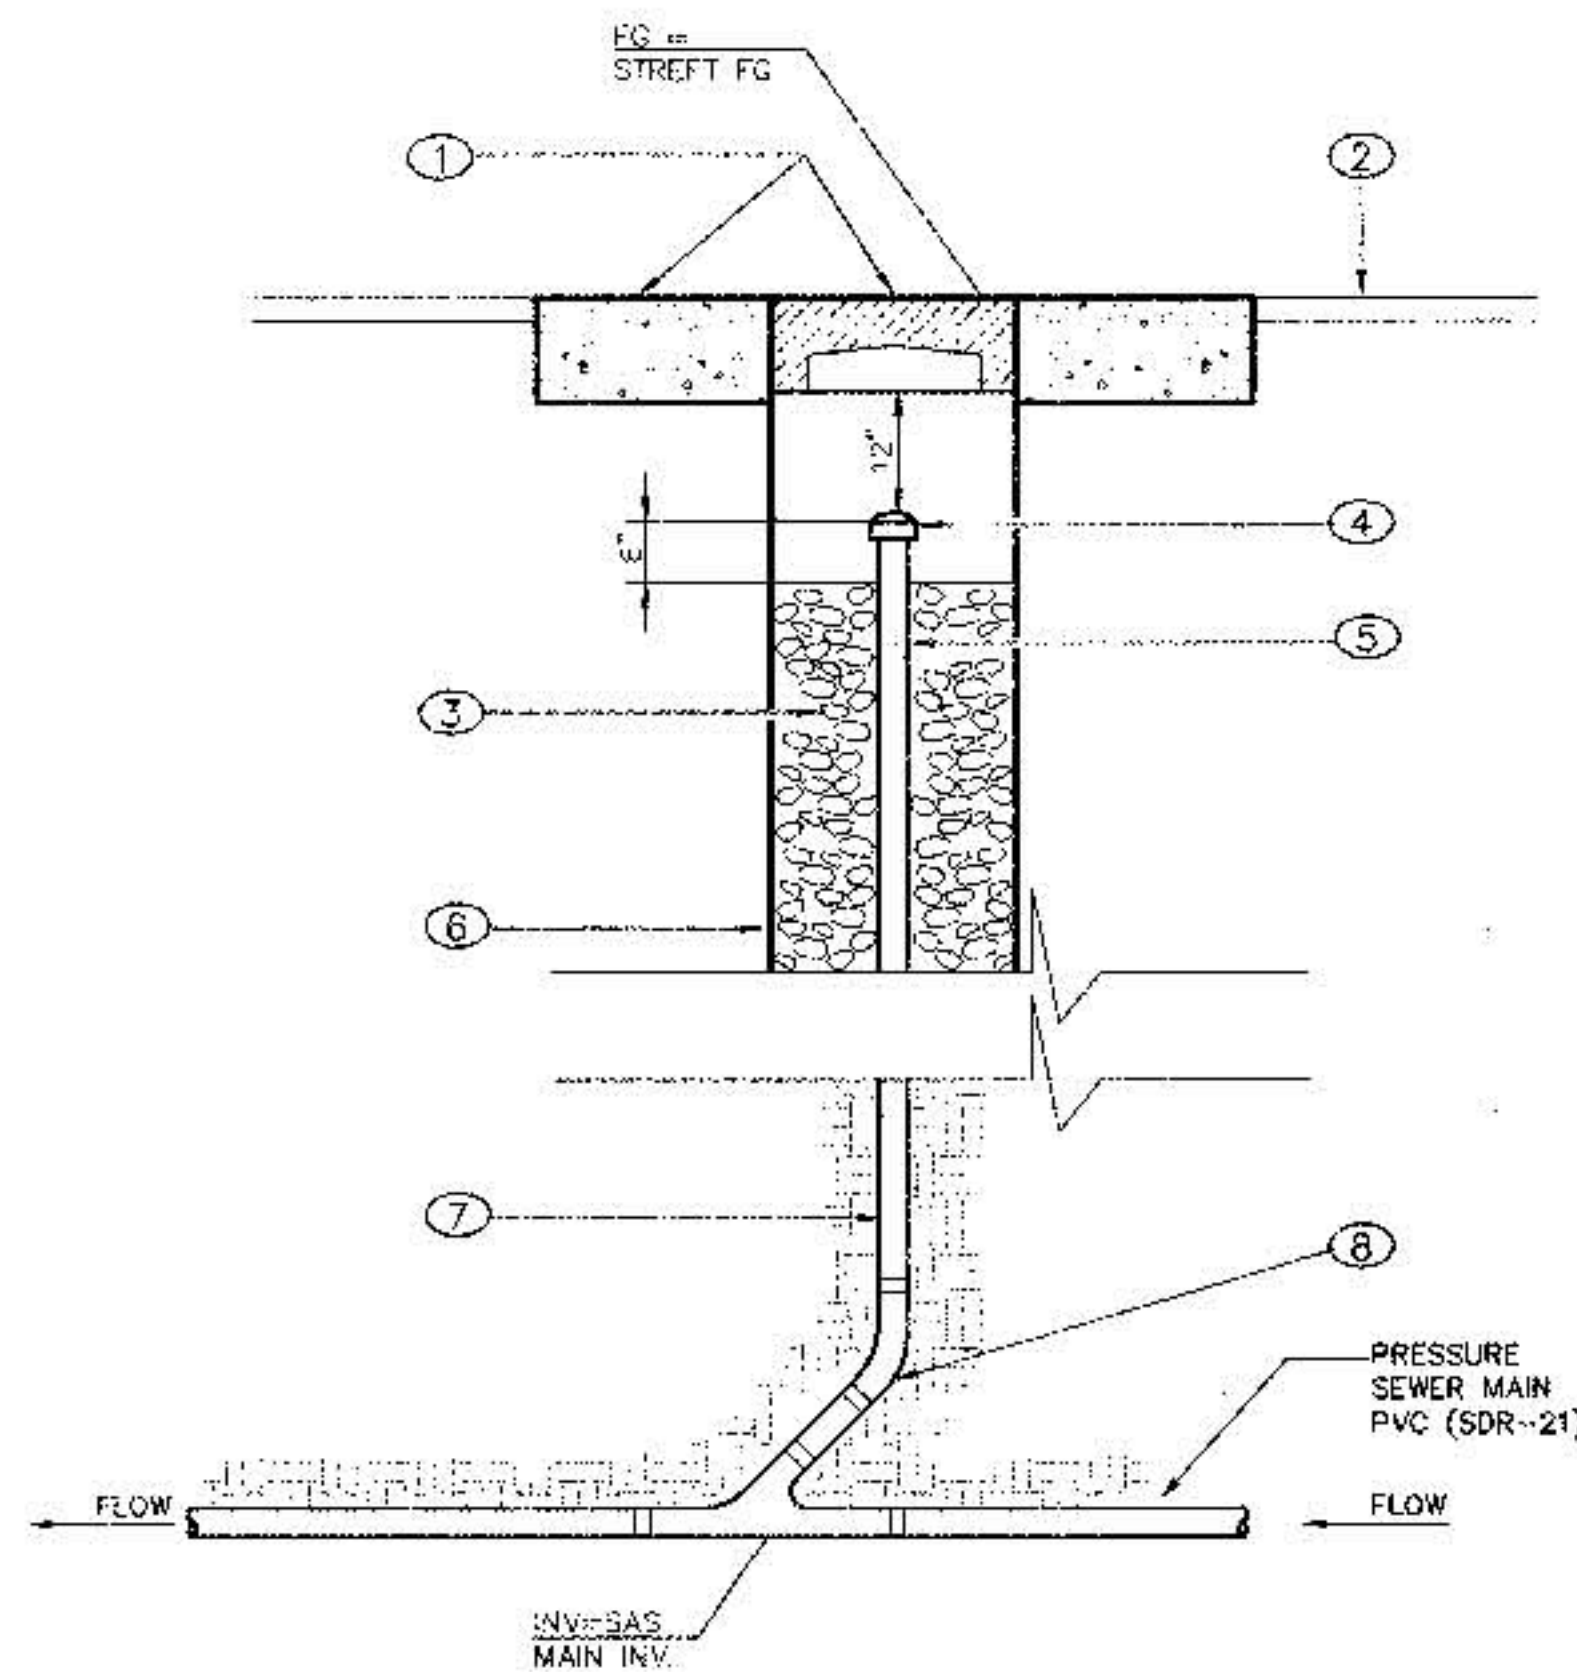

INLINE FLUSHING CONNECTION

SCALE: NONE

KEYED NOTES:

1. COLLAR LID & RISER PER COA STD DWS 2350 USE LID MARKED "SANITARY SEWER".
2. FAVING TYP.
3. GRAVEL OR DIRT FILL AROUND RISER
4. COUNTER SUNK PVC CLEAN-OUT FERRULE.
5. RISER PIPE SHALL BE SAME SIZE AS SAS MAIN.
6. TERMINATE CMP AT LEAST 8" ABOVE SAS MAIN. DO NOT ALLOW RISER TO REST ON SAS MAIN.
7. ALL JOINTS WITHIN FLUSHING CONNECTION SHALL BE CLEANED THEN GLUED.
8. LONG SWEEP.



CITY OF ALBUQUERQUE
PUBLIC WORKS DEPARTMENT
ENGINEERING DEVELOPMENT GROUP
TITLE: BOSQUE DEL RIO SUBDIVISION - PHASE 3
PRESSURE SANITARY SEWER DETAILS

Design Review Committee	City Engineer Approval	Last Design Update	05/20/98	05/20/98
City Project No.	5406.83	Zone Map No.	D-13	Sheet 21 of 22

AS BUILT INFORMATION		BENCH MARKS		SURVEY INFORMATION		ENGINEERS SEAL	
CONTRACTOR	DATE	U.S. CODE STA.	"R" ALAMEDA B-2"	FIELD NO.	DATE		
INSPECTOR	DATE	N.M. STATE PLAN COORDINATES (CENTRAL ZONE)	BY ACS	BY	DATE		
DATE	DATE	X=373,513.20				REMARKS	BY
DATE	DATE	Y=1,520,142.81				REVISIONS	DATE
DATE	DATE	ELEVATION=5,058.25				DESIGN	DATE
DATE	DATE	S/G FACTOR=0.99967638				DESIGNED BY JCS	DATE 05-20-98
DATE	DATE					DRAWN BY JCS	DATE 05-20-98
DATE	DATE					CHECKED BY DLA	DATE 05-20-98

RECORD DRAWINGS

Drawing name: A:\197629\NOTION\23D\FINAL PLW.DWG
 Saved on: July 6, 1996 at 1:53 PM
 File is: C:\197629\4\Blackboard\197629.Dxf
 File is: C:\197629\4\Blackboard\197629.Dxf