


ALBUQUERQUE, NEW MEXICO

SHEET NUMBER	DESCRIPTION
1	TITLE SHEET
2,3	BULKLAND PLAT
4, 4A	OVERALL PLAN & GENERAL NOTES
	WATERLINE PLAN AND PROFILE
5	LADERA STA. 10+00 TO STA. 21+00
6, 6A	LADERA STA. 21+00 TO STA. 29+46 TO STA. 4+55
7	CASA VERDE STA. 4+55.33 TO STA. 15+00
8	CASA VERDE STA. 15+00 TO STA. 25+50
9	CASA VERDE STA. 25+50 TO STA. 32+63
10	SELLWAY STA. 10+07 TO STA. 20+00
11	SELLWAY STA. 20+00 TO STA. 25+15.48
12	MISCELLANECUS DETAILS

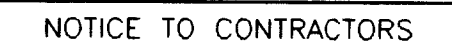


- THE FOLLOWING NOTES ALSO APPLY WHEN CHECKED
- ☒ ALL UTILITIES AND UTILITY SERVICE LINES SHALL BE INSTALLED PRIOR TO PAVING.
- ☐ BACKFILL COMPACTION SHALL BE ACCORDING TO SPECIFIED STREET USE.
- ☐ TACK COAT REQUIREMENTS SHALL BE DETERMINED BY THE CITY ENGINEER.
- ☐ SIDEWALKS AND WHEELCHAIR RAMP WITHIN THE CURB RETURNS SHALL BE CONSTRUCTED WHEREVER A NEW CURB RETURN IS CONSTRUCTED.
- ☐ IF CURB IS DEPRESSIONED FOR A DRIVEPAD, THE DRIVEPAD SHALL BE CONSTRUCTED PRIOR TO ACCEPTANCE OF CURB AND GUTTER.
- ☐ ALL STORM DRAINAGE FACILITIES SHALL BE COMPLETED PRIOR TO FINAL ACCEPTANCE.
- ☒ THE REQUESTOR OR DEVELOPER SHALL BE RESPONSIBLE FOR REPAIR OR REPLACEMENT OF ALL CURB AND GUTTER OR SIDEWALK DAMAGED AFTER APPROVAL BY THE CITY ENGINEER OF WORK COMPLETED BY THE CONTRACTOR.

I PROJECT NO.
DRO:[H96178A2100.GAVIN.AC.D]COVER.DWG
5/96

26-5A09.90 0197

96076305 PLAT OF
THE CROSSING
ALBUQUERQUE, NEW MEXICO
APRIL, 1996

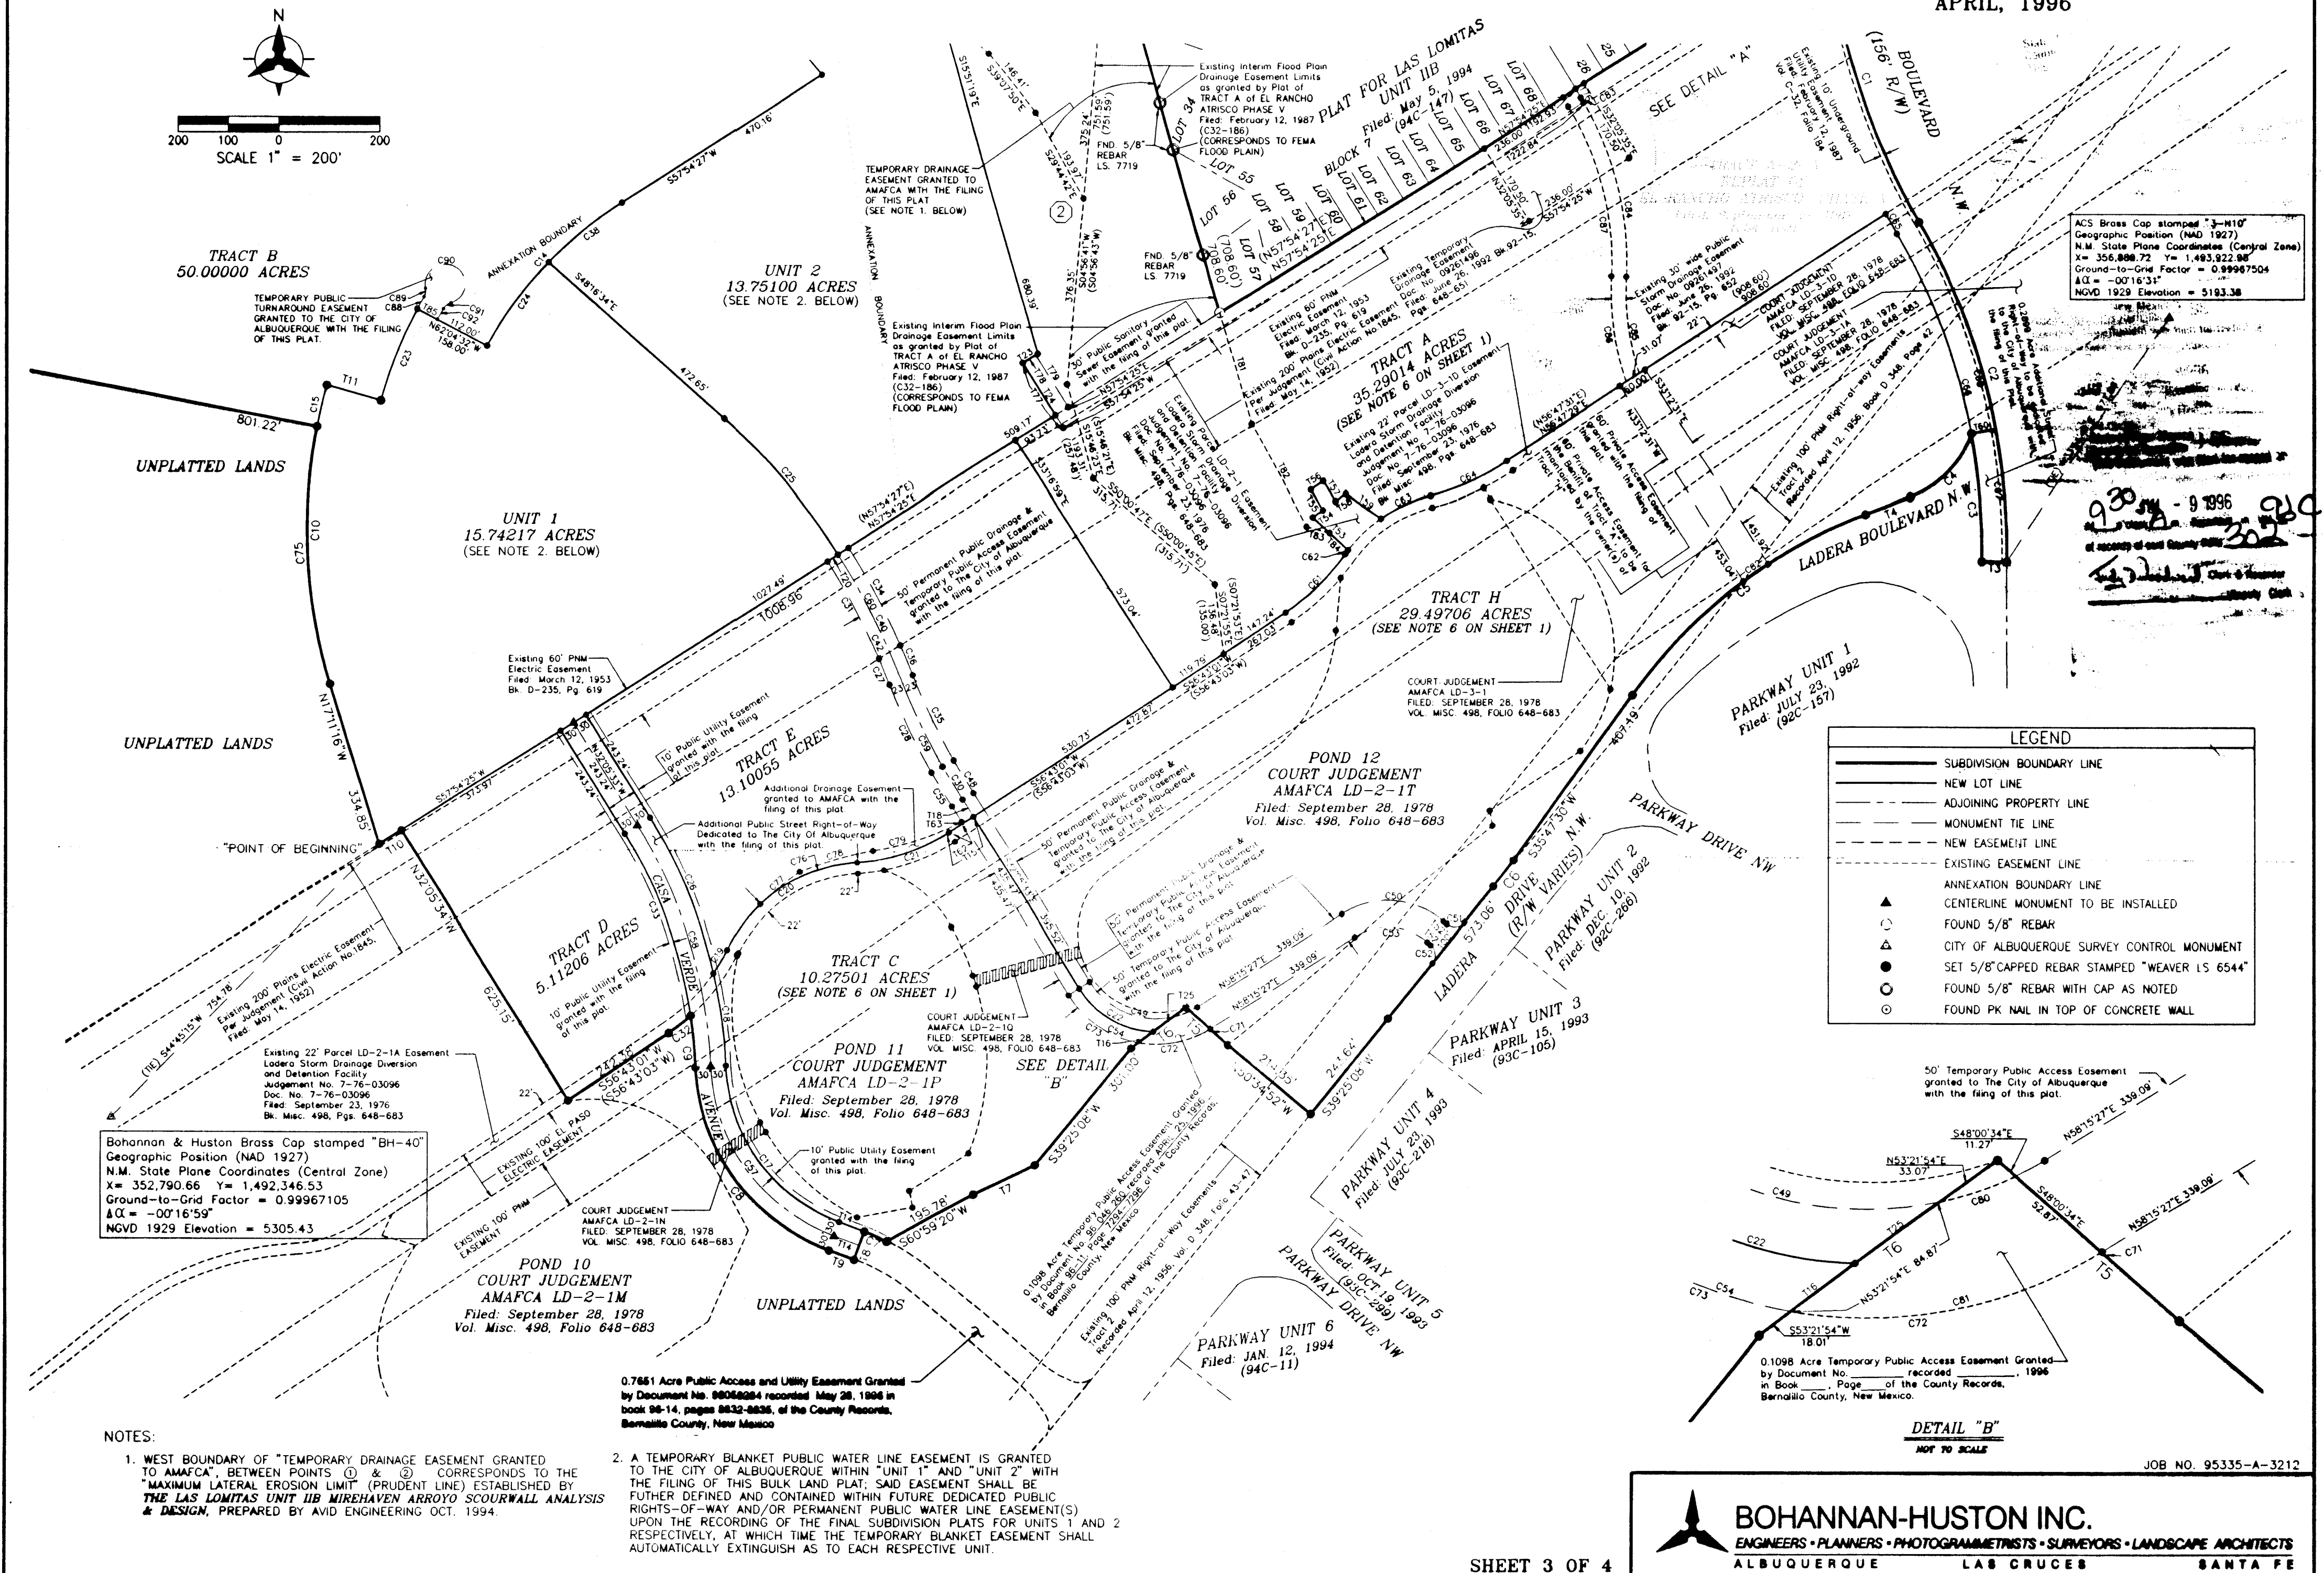


BOHANNAN-HUSTON INC.
ENGINEERS • PLANNERS • PHOTOGRAMMETRISTS • SURVEYORS • LANDSCAPE ARCHITECTS
ALBUQUERQUE LAS CRUCES SANTA FE
SHEET 3 OF 4
JOB NO. 95335-A-3212

CURVE DATA													
CURVE	RADIUS	LENGTH	TANGENT	CHORD	CHORD BEARING	DELTA	CURVE	RADIUS	LENGTH	TANGENT	CHORD	CHORD BEARING	DELTA
C1	1478.00'	608.33'	308.53'	604.04'	S18°03'18"E	23°34'56"	C50	175.00'	217.35'	125.20'	203.65'	S86°09'43"E	71°09'41"
	(1478.00')	(608.33')				(23°34'56")	C51	25.00'	39.27'	25.00'	35.36'	N84°25'08"E	90°00'00"
C2	1322.00'	703.54'	360.32'	695.27'	S14°36'01"E	30°29'30"	C52	25.00'	39.27'	25.00'	35.36'	N05°34'52"W	90°00'00"
	(1322.00')	(703.54')			(S14°35'59"E)	(30°29'30")	C53	125.00'	155.25'	89.43'	145.46'	N86°09'43"W	71°09'41"
C3	1272.00'	247.68'	124.23'	247.28'	N04°55'57"W	11°09'23"	C54	205.00'	320.76'	203.75'	269.03'	N76°56'03"W	89°39'00"
	(1272.00')	(246.83')	(123.80')	(245.45')	(N04°54'21.5"W)	(11°07'05")	C55	1525.00'	78.78'	39.40'	78.77'	N30°36'45"W	02°57'36"
C4	200.00'	179.26'	96.16'	173.32'	S44°22'36"W	51°21'17"	C56	4599.13'	296.82'	148.46'	296.77'	S87°48'18"E	03°41'52"
C5	993.00'	593.80'	306.08'	584.99'	S52°55'22"W	34°15'44"	C57	380.00'	443.72'	251.06'	418.94'	N36°03'33"W	66°54'13"
C6	1047.00'	66.28'	33.15'	66.27'	S37°36'19"W	03°37'38"	C58	970.00'	499.17'	255.24'	493.68'	N17°21'00"W	29°29'06"
C7	443.00'	48.96'	24.51'	48.94'	N66°20'41"W	06°19'58"	C59	1500.00'	269.39'	135.06'	269.03'	N26°56'51"W	10°17'23"
C8	410.00'	478.75'	270.88'	452.01'	N36°03'33"W	66°54'13"	C60	1350.00'	276.15'	138.56'	275.67'	N27°39'46"W	11°43'13"
C9	940.00'	101.41'	50.75'	101.36'	N05°41'53"W	06°10'52"	C61	463.58'	165.44'	83.61'	164.56'	S46°29'36"W	20°26'53"
C10	1032.00'	590.98'	303.84'	582.94'	N00°46'56"W	37°48'39"		(463.58')	(165.44')			(S46°29'38"W)	(20°26'51")
C11	1608.00'	33.59'	16.80'	33.59'	N15°46'38"E	01°11'49"	C62	291.25'	9.99'	5.00'	9.99'	S37°15'08"W	01°57'55"
C12	1100.00'	1444.55'	847.76'	1342.96'	N52°48'00"E	75°14'32"		(291.25')	(9.99')			(S37°15'10"W)	(01°57'55")
C13	4646.34'	309.11'	154.61'	309.05'	S87°53'44"E	03°48'42"	C63	291.25'	108.45'	54.86'	107.83'	S66°36'47"W	21°20'05"
C14	762.00'	398.90'	204.13'	394.36'	S42°55'17"W	25°59'38"		(291.25')	(107.89')			(S66°33'11"W)	(21°13'29")
C15	1032.00'	84.20'	42.12'	84.17'	S13°17'09"W	04°40'28"	C64	463.58'	165.45'	83.61'	164.57'	S66°26'17"W	20°26'53"
C16	4546.13'	284.88'	142.49'	284.84'	S87°45'25"E	03°35'26"		(463.58')	(165.44')			(S66°56'29"W)	(20°26'53")
C17	350.00'	408.69'	231.24'	385.86'	N36°03'33"W	66°54'13"	C65	1528.00'	46.61'	23.31'	46.61'	N28°58'20"W	01°44'52"
C18	1000.00'	183.12'	91.82'	182.86'	N07°51'12"W	10°29'31"		(1528.00')	(46.61')			(N28°58'18"W)	(01°44'52")
C19	373.09'	52.84'	26.47'	52.80'	N30°54'42"E	08°06'54"	C66	1272.00'	429.26'	216.69'	427.22'	N20°10'42"W	19°20'07"
C20	312.25'	325.49'	179.28'	310.95'	N56°43'01"E	59°43'32"	C67	1322.00'	257.41'	129.11'	257.00'	S04°55'57"E	11°09'23"
C21	373.09'	194.66'	99.49'	192.26'	N71°38'54"E	29°51'46"		(1322.00')	(256.53')	(128.67')	(256.13')	S04°54'21.5"E	(11°07'05")
C22	180.00'	176.83'	96.28'	169.80'	S60°14'06"E	56°17'07"	C68	1322.00'	446.13'	225.21'	444.02'	S20°10'42"E	19°20'07"
C23	920.00'	197.52'	99.14'	197.14'	N21°46'25"E	12°18'05"	C69	4546.13'	117.41'	58.71'	117.41'	S86°42'06"E	01°28'47"
C24	762.00'	208.45'	104.88'	207.80'	N35°45'41"E	15°40'26"	C70	4546.13'	116.61'	58.31'	116.61'	S88°49'02"E	01°28'11"
C25	1350.00'	347.61'	174.77'	346.65'	S40°53'58"E	14°45'12"	C71	205.00'	0.42'	0.21'	0.42'	S58°18'57"W	00°07'01"
C26	1000.00'	331.49'	167.28'	329.98'	N22°35'46"W	18°59'35"	C72	205.00'	148.13'	77.47'	144.93'	S79°04'31"W	41°24'07"
C27	1325.00'	55.21'	27.61'	55.20'	S22°59'47"E	02°23'14"	C73	205.00'	172.21'	91.55'	167.19'	N56°09'29"W	48°07'52"
C28	1525.00'	195.09'	97.68'	194.96'	S25°28'03"E	07°19'48"	C74	1100.00'	193.20'	96.85'	192.96'	N20°12'38"E	10°03'48"
C29	1500.00'	269.39'	135.06'	269.03'	N26°56'51"W	10°17'23"	C75	1032.00'	506.78'	256.61'	507.71'	N03°07'11"W	28°08'10"
C30	1325.00'	216.46'	108.47'	216.21'	S28°52'12"E	09°21'36"	C76	312.25'	215.49'	112.24'	211.24'	S66°48'33"W	39°32'29"
C31	395.09'	55.23'	27.66'	55.18'	S52°42'45"W	08°00'32"	C77	800.00'	101.71'	50.92'	101.64'	N50°40'51"E	07°17'05"
C32	940.00'	382.33'	193.84'	379.70'	S20°26'26"E	23°18'15"	C78	800.00'	153.45'	76.96'	153.21'	N73°59'09"E	10°59'24"
C33	1375.00'	216.96'	108.70'	216.73'	N28°58'36"W	09°02'26"	C79	558.00'	186.42'	94.08'	185.55'	N71°38'03"E	19°08'28"
C34	1475.00'	188.65'	94.45'	188.52'	N25°28'00"W	07°19'41"	C80	155.00'	37.07'	18.62'	36.98'	N70°44'46"E	13°42'08"
C35	1375.00'	63.69'	31.85'	63.68'	N23°07'46"W	02°39'14"	C81	205.00'	148.13'	77.47'	144.93'	S79°04'31"W	41°24'07"
C36	1375.00'	149.79'	75.41'	149.28'	S24°01'44"E	16°20'51"	C82	993.00'	60.02'	30.02'	60.01'	S55°43'23"W	03°27'47"
C37	762.00'	190.45'	95.72'	189.95'	N50°45'30"E	14°19'12"	C83	610.00'	10.00'	5.00'	10.00'	S31°37'24"E	00°56'22"
C38	1375.00'	280.64'	140.81'	280.15'	S27°38'59"E	11°41'39"	C84	610.00'	372.83'	192.44'	367.05'	S14°35'01"E	35°01'08"
C39	1325.00'	271.66'	136.31'	271.19'	N27°40'35"W	11°44'50"		(610.00')	(372.83')				
C40	100.00'	131.23'	77.00'	122.01'	N50°12'10"E	75°11'22"	C85	550.00'	198.07'	100.12'	197.00'	S07°23'27"E	20°38'00"
C41	50.00'	79.32'	50.78'	71.26'	N58°03'11"E	90°53'24"		(550.00')	(196.86')				
C42	4546.13'	50.86'	25.43'	50.86'	S87°45'43"E	00°38'28"	C86	580.00'	217.17'	109.87'	215.91'	N07°48'03"W	21°27'14"
C43	525.00'	73.73'	36.93'	73.67'	S36°13'34"E	08°02'49"		(580.00')	(215.97')				
C44	475.00'	66.71'	33.41'	66.66'	N36°13'34"W	08°02'49"	C87	580.00'	354.49'	182.98'	349.00'	N14°35'01"W	35°01'08"
C45	1475.00'	76.25'	38.13'	76.24'	S30°36'41"E	02°57'43"		(580.00')	(354.49')				
C46	155.00'	242.53'	154.06'	218.53'	S76°55'03"E	89°39'00"	C88	920.00'	28.55'	14.28'	28.55'	N28°48'48"E	01°46'41"

TANGENT DATA			TANGENT DATA			TANGENT DATA			TANGENT DATA		
TANGENT	BEARING	DISTANCE	TANGENT	BEARING	DISTANCE	TANGENT	BEARING	DISTANCE	TANGENT	BEARING	DISTANCE
T1	S04°30'40"W	107.74'	T31	S56°18'36"E	56.71'	T58	S56°43'01"W	25.00'	T76	S32°05'35"E	20.00'
T2	S53°49'09"E	168.93'	T32	S68°44'58"E	75.94'	T59	S56°43'03"W	(25.00')	T77	S32°05'35"W	152.13'
T3	S53°49'09"E	(168.93')	T33	S68°59'14"E	74.81'	T60	N56°50'01"W	(84.52')	T78	N57°54'25"E	30.00'
T4	N89°20'49"W	(50.00')	T34	N87°16'25"E	43.77'	T61	N79°29'21"E	50.00'	T79	S32°05'35"E	122.13'
T5	S70°03'14"W	94.29'	T35	S81°52'11"E	79.84'	T62	N79°32'06"E	(50.00')	T80	S32°05'35"E	20.00'
T6	N48°00'34"W	111.00'	T36	S74°55'53"E	76.00'	T63	N15°10'44"E	94.89'	T81	S15°51'59"E	230.67'
T7	S53°21'54"W	135.94'	T37	S60°54'19"E	64.28'	T64	S56°43'01"W	32.86'	T82	S28°59'41"E	(227.15')
T8	S63°39'20"W	135.54'	T38	N75°57'50"E	59.81'	T65	S32°05'33"E	4.00'	T83	S75°42'14"E	47.94'
T9	S20°29'20"W	60.00'	T39	N60°56'43"E	89.61'	T66	N78°35'24"E	84.85'	T84	S48°38'04"E	50.36'
T10	S57°54'25"W	53.96'	T40	N73°18'03"E	30.29'	T67	N78°35'24"E	84.85'	T85	N62°04'32"W	46.00'
T11	S74°22'37"E	112.00'	T41	S82°52'31"E	23.39'	T68	S08°19'45"E	131.26'			
T12	N08°19'45"W	108.75'	T42	S81°01'39"E	55.81'	T69	S08°19'45"E	(131.12')			
T13	S08°19'45"E	114.79'	T43	S90°00'00"E	37.72'	T70	S86°19'34"E	125.00'			
T14	N69°30'40"W	53.96'	T44	N72°53'50"E	39.46'	T71	S86°19'34"E	100.00'			
T15	N56°43'01"E	57.86'	T45	N61°23'22"E	72.71'	T72	S83°31'06"W	155.08'			
T16	S53°21'54"W	55.03'	T46	N87°47'51"E	64.50'	T73	S83°31'17"W	35.00'			
T17	S32°05'33"E	39.95'	T47	S55°00'29"E	87.79'						
T18	N57°54'25"E	25.01'	T48	S39°48'20"E	93.62'						
T19	S15°51'19"E	8.00'	T49	S34°41'43"E	75.81'						
T20	N74°08'41"E	110.00'	T50	S47°56'58"E	99.57'						
T21	S57°54'25"W	35.35'	T51	S57°47'50"E	50.00'						
T22	S32°05'35"E	122.13'	T52	S50°34'52"E	8.24'						
T23	S53°21'54"W	80.91'	T53	S48°38'04"E	95.89'						
T24	S53°07'48"E	58.98'	T54	S48°38'02"E	(95.89')						
T25	S60°56'43"E	40.48'	T55	S56°43'03"W	(25.00')						
			T56	S33°16'59"E	45.00'						
			T57	S33°16'57"E	(45.00')						

96076305 PLAT OF
THE CROSSING
ALBUQUERQUE, NEW MEXICO
APRIL, 1996

CURVE DATA CONT.						
CURVE	RADIUS	LENGTH	TANGENT	CHORD	CHORD BEARING	DELTA
C89	25.00'	17.91'	9.36'	17.53'	N09°10'32"E	01°43'12"
C90	40.00'	184.84'	59.09'	58.09'	S58°28'13"E	26°15'41"
C91	25.00'	19.14'	10.06'	18.67'	S51°28'53"W	4°35'31"
C92	874.00'	24.83'	12.42'	24.83'	S28°44'18"W	01°37'40"
C93	475.00'	11.12'	5.56'	11.12'	N32°52'24"W	01°20'20"
C94	25.00'	26.56'	14.68'	25.32'	N63°57'58"W	60°50'04"
C95	40.00'	163.45'	71.24'	71.24'	N22°40'23"E	23°40'29"
C96	525.00'	73.88'	37.00'	73.82'	S36°14'02"E	08°03'48"

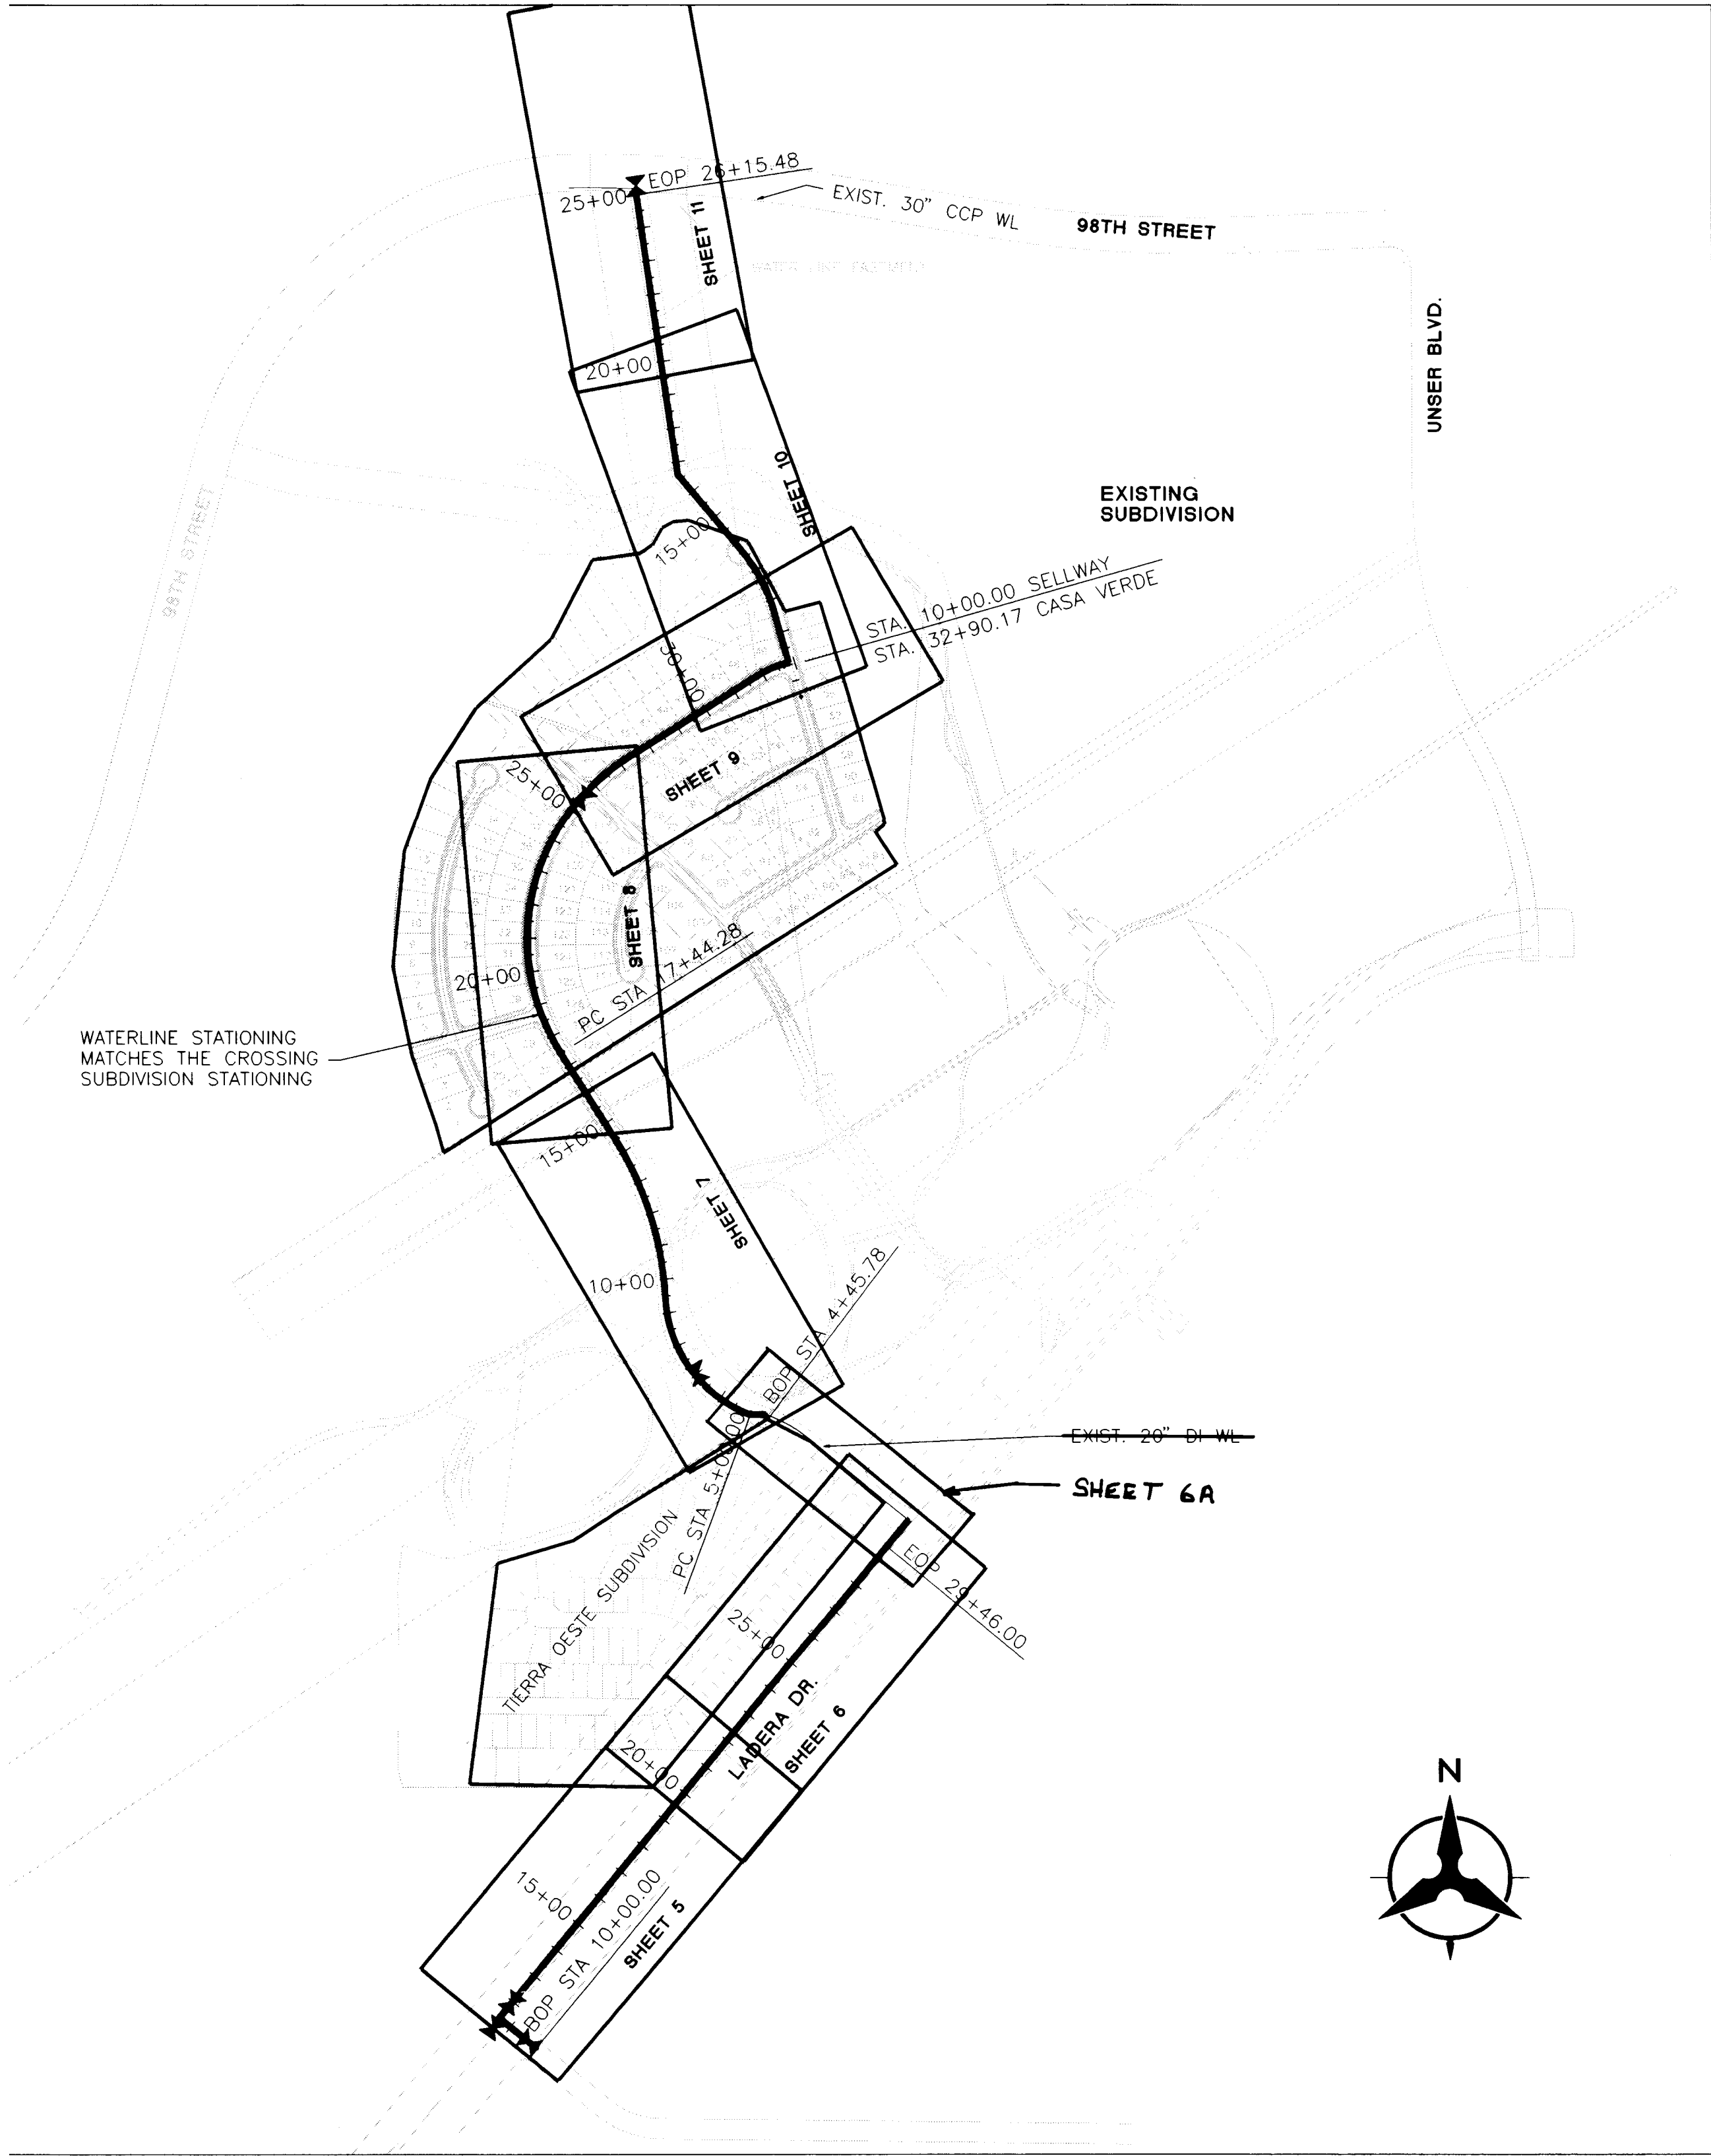

OVERALL PLAN

NTS. ZONE MAP No. H-9-J-9

RESTRAINED JOINT LENGTH SCHEDULE

FITTING NO.	LOCATION	STATION	FITTING	LENGTH	COMMENT
①	GAVIN RD.	10+00	12" CAP & 12" GATE VALVE	50.0'	RESTRAIN JOINTS: FROM STA. 10+00 TO STA. 10+50
②	LADERA DR.	11+38	1-20"x12" TEE	86.0' & 16.0'	RESTRAIN JOINTS: FROM 20" CAP TO STA. 12+24 AND FROM STA. 11+22 TO STA. 11+38
③	LADERA DR.	29+46	TIE TO EXIST. 20" WL.	6.0'	RESTRAIN JOINTS: FROM STA. 29+40 TO STA. 29+46
④	CASA VERDE AVE.	4+55.33, 10'RT.	20" 22.5' BEND	9.0'	
⑤	CASA VERDE AVE.	5+00, 7'LT.	20" 22.5' BEND	9.0'	
⑥	CASA VERDE AVE.	7+00, 7' LT.	20" BUTTERFLY VALVE	80.0'	
⑦	CASA VERDE AVE.	25+29, 7'LT.	20" BUTTERFLY VALVE	80.0'	
⑧	CASA VERDE AVE.	32+24.11, 10.09'LT.	20" 22.5' BEND	9.0'	
⑨	CASA VERDE AVE. SELLWAY PL.	32+63, 7'LT. 10+27, 7'LT.	2-20" 45' BEND	18.0'	RESTRAIN JOINTS: FROM STA. 32+45, 7' LT. (CASA VERDE) TO STA. 10+45, 7' LT. (SELLWAY)
⑩	ARROYO CROSSING	15+50, 7'LT. 17+10, 7'LT.	20" 11.25' BEND 20"-22.5' BEND	4.0' 8.0'	RESTRAIN JOINTS: FROM 15+46, 7'LT. TO 15+54, 7'LT.
⑪	ARROYO CROSSING	17+15.00, 7'LT.	20" 45' BEND (VERTICAL)	11.0'	RESTRAIN JOINTS: FROM STA. 17+02, 7' LT. TO STA. 17+47, 7' LT.
⑫	ARROYO CROSSING	17+22.08, 7'LT.	20" 45' BEND (VERTICAL)	25.0'	
⑬	98TH ST.	25+16, 7'LT.	20" TAPPING VALVE	87.0'	RESTRAIN JOINTS: FROM STA. 24+28, 7' LT. TO STA. 25+15.48, 1.07' RT

NOTE: RESTRAINED JOINTS ON ALL FITTINGS. RESTRAINED JOINTS LENGTHS EACH SIDE OF FITTING UNLESS OTHERWISE NOTED.

GENERAL NOTES:

- WHEN CONFLICTS EXIST BETWEEN THE "STANDARD SPECIFICATIONS" AND THE "PLANS" ("PLANS" SHALL MEAN THE SHEETS NUMBERED 1 OF 12 THROUGH 12 OF 12 ENTITLED "CONSTRUCTION PLANS FOR COLLEGE TRUNK - MASTER PLAN 20" WATERLINE"), THE CONSTRUCTION OBSERVER SHALL BE NOTIFIED IMMEDIATELY FOR RESOLUTION. SEE SEC. 3.2 OF THE STD. SPECS.
- ALL WORK ON THIS PROJECT SHALL BE PERFORMED IN ACCORDANCE WITH APPLICABLE FEDERAL, STATE AND LOCAL LAWS, RULES AND REGULATIONS GOVERNING CONSTRUCTION SAFETY AND HEALTH.
- ALL BIDDERS ARE CAUTIONED TO INVESTIGATE SITE CONDITIONS BEFORE SUBMITTING THEIR BIDS.
- PRIOR TO CONSTRUCTION, THE CONTRACTOR SHALL EXCAVATE AND VERIFY THE HORIZONTAL AND VERTICAL LOCATIONS OF ALL POTENTIAL OBSTRUCTIONS. SHOULD A CONFLICT EXIST, THE CONTRACTOR SHALL NOTIFY THE CONSTRUCTION OBSERVER SO THAT THE CONFLICT CAN BE RESOLVED WITH A MINIMUM AMOUNT OF DELAY.
- PRIOR TO CONSTRUCTION, THE CONTRACTOR SHALL FIELD VERIFY LOCATION AND QUANTITIES. SHOULD A CONFLICT EXIST, THE CONTRACTOR SHALL NOTIFY THE ENGINEER SO CONFLICTS CAN BE RESOLVED WITHOUT UNREASONABLE DELAY.
- THE CONTRACTOR SHALL BE REQUIRED TO CONFINE ITS WORK WITHIN THE CONSTRUCTION LIMITS AND/OR PUBLIC RIGHT-OF-WAY OR EASEMENT TO PRESERVE EXISTING VEGETATION AND PRIVATE PROPERTY.
- THE CONTRACTOR SHALL OBTAIN ALL THE NECESSARY PERMITS PRIOR TO COMMENCING CONSTRUCTION (I.E. BARRICADEING, TOPSOIL DISTURBANCE AND EXCAVATION PERMITS, ETC.)
- ALL TRENCHES AND EXCAVATIONS SHALL BE SLOPED, SHORED, SHEETED, BRACED, OR OTHERWISE SUPPORTED ACCORDING TO OSHA CONSTRUCTION SAFETY AND HEALTH STANDARDS. JOB SAFETY IS THE SOLE RESPONSIBILITY OF THE CONTRACTOR.
- ALL STATIONING IS BASED ON WATERLINE CENTERLINE, UNLESS OTHERWISE NOTED.
- THE CONTRACTOR SHALL SUPPLY SHOP DRAWINGS TO THE ENGINEER FOR ALL FABRICATED MATERIALS TO BE SUPPLIED WITH THIS CONTRACT.

WATERLINE REQUIREMENTS:

- ALL NEW PIPING MUST BE DISINFECTED AND PRESSURE TESTED PRIOR TO BEING PUT INTO SERVICE.
- THE CONTRACTOR SHALL KEEP OR DISPOSE OF ALL REMOVED WATERLINE AND FITTINGS. COST IS INCIDENTAL TO THE PROJECT.
- ALL FITTINGS SHALL HAVE RESTRAINED JOINTS. RESTRAINED JOINTS SHALL ALSO BE PROVIDED AS SPECIFIED IN THE PLANS AND IN THE TABLE ON THIS SHEET.

EXISTING UTILITIES:

- THESE DRAWINGS REFLECT INFORMATION ON UTILITIES GATHERED BY SITE INSPECTION, DISCUSSIONS WITH LOCAL UTILITIES, ENGINEERING OFFICIALS, AND PREVIOUS CONSTRUCTION DRAWINGS PROVIDED TO OR OBTAINED BY THE ENGINEER. IT IS POSSIBLE THAT THE EXACT LOCATION OF LINES IN THE IMMEDIATE VICINITY OF THE PROJECT MAY BE SLIGHTLY DIFFERENT FROM THE LOCATION SHOWN ON THIS DRAWING. IF ADDITIONAL LINES ARE ENCOUNTERED, THEY SHALL BE EXPOSED AND IDENTIFIED BY THIS CONTRACTOR. WHERE ADDITIONAL LINES AND/OR DIFFERING LOCATIONS ARE ENCOUNTERED, THE CONTRACTOR SHALL REQUEST THAT THE ENGINEER MAKE A RULING AS TO ANY NECESSARY CHANGE OF MATERIALS, RE-ROUTING, ABANDONING OR RELOCATING OF SUCH LINES.
- TWO (2) WORKING DAYS PRIOR TO ANY EXCAVATION, THE CONTRACTOR SHALL CONTACT LINE LOCATION SERVICE (765-1234) FOR LOCATION OF EXISTING UTILITIES.

- ALL ELECTRICAL, TELEPHONE, CABLE TV, AND OTHER UTILITY LINES, CABLES, AND APPURTENANCES ENCOUNTERED DURING CONSTRUCTION THAT REQUIRE RELOCATION, SHALL BE COORDINATED WITH THAT UTILITY OWNER. THE CONTRACTOR SHALL BE RESPONSIBLE FOR COORDINATION OF ALL NECESSARY UTILITY ADJUSTMENTS.
- IT WILL BE THE CONTRACTOR'S RESPONSIBILITY TO PROTECT AND MAINTAIN IN SERVICE, ALL EXISTING UTILITIES.
- CONTRACTOR SHALL PAY FOR ANY AND ALL COSTS OF PERMITS, LINE EXTENSIONS, FIRELINES, METER INSTALLATION, ETC., AS REQUIRED BY LOCAL GOVERNING UTILITIES ENGINEERING OFFICIALS.

CONSTRUCTION SIGNING: UNLESS GOVERNED BY A SPECIFIC PLAN, THE FOLLOWING NOTES APPLY:

- ALL BARRICADES AND SIGNING SHALL CONFORM TO APPLICABLE SECTIONS OF THE "MANUAL ON UNIFORM TRAFFIC CONTROL DEVICES" (MUTCD), U.S. DEPARTMENT OF TRANSPORTATION, LATEST REVISION EDITION.
- CONTRACTOR SHALL PREPARE A CONSTRUCTION SIGNING PLAN AND OBTAIN APPROVAL OF SUCH PLAN FROM THE CITY OF ALBUQUERQUE, TRAFFIC DIVISION, PRIOR TO BEGINNING ANY CONSTRUCTION WORK ON OR ADJACENT TO EXISTING STREETS.
- CONTRACTOR SHALL MAINTAIN ALL BARRICADES AND SIGNING AT ALL TIMES. THE CONTRACTOR SHALL VERIFY THE PROPER LOCATION OF ALL BARRICADES AT THE END AND BEGINNING OF EACH DAY.

EARTHWORK:

- SITE STRIPINGS FROM WATERLINE EXCAVATION SHALL BE WINDROWED ADJACENT TO WATERLINE TRENCH AS DIRECTED BY THE CONSTRUCTION OBSERVER. STRIPINGS SHALL BE ULTIMATELY PLACED OVER THE BACKFILLED TRENCHES.

BOHANNAN-HUSTON INC.
ENGINEERS • PLANNERS • PHOTOGRAMMETRISTS • SURVEYORS • LANDSCAPE ARCHITECTS
ALBUQUERQUE LAS CRUCES SANTA FE

CITY OF ALBUQUERQUE
PUBLIC WORKS DEPARTMENT
ENGINEERING DEVELOPMENT GROUP

COLLEGE TRUNK - MASTER PLAN
20" WATERLINE
OVERALL PLAN

DESIGN REVIEW COMMITTEE



CITY ENGINEER APPROVAL

LAST DESIGN UPDATE

CITY PROJECT NO.
5409.90

ZONE MAP NO.
H-9-J-9

SHEET 4 OF 12

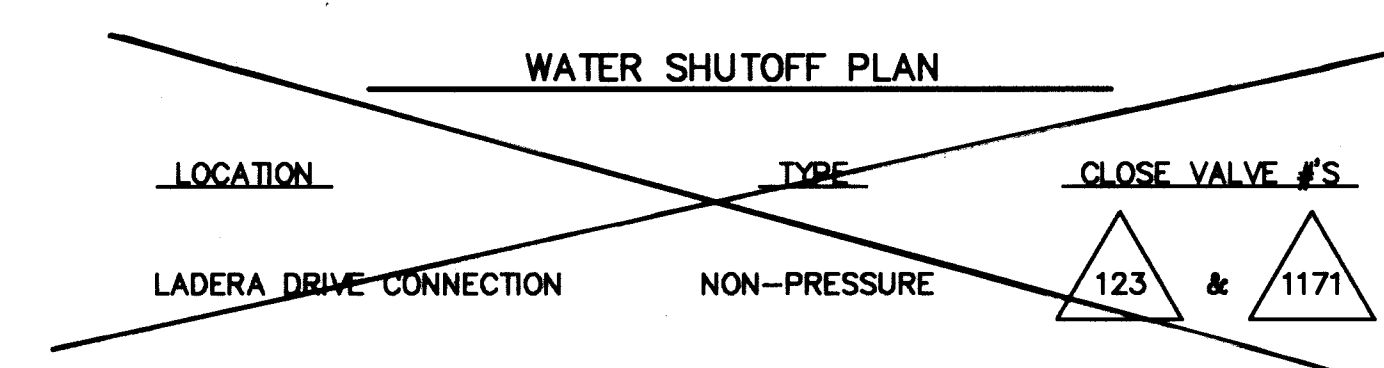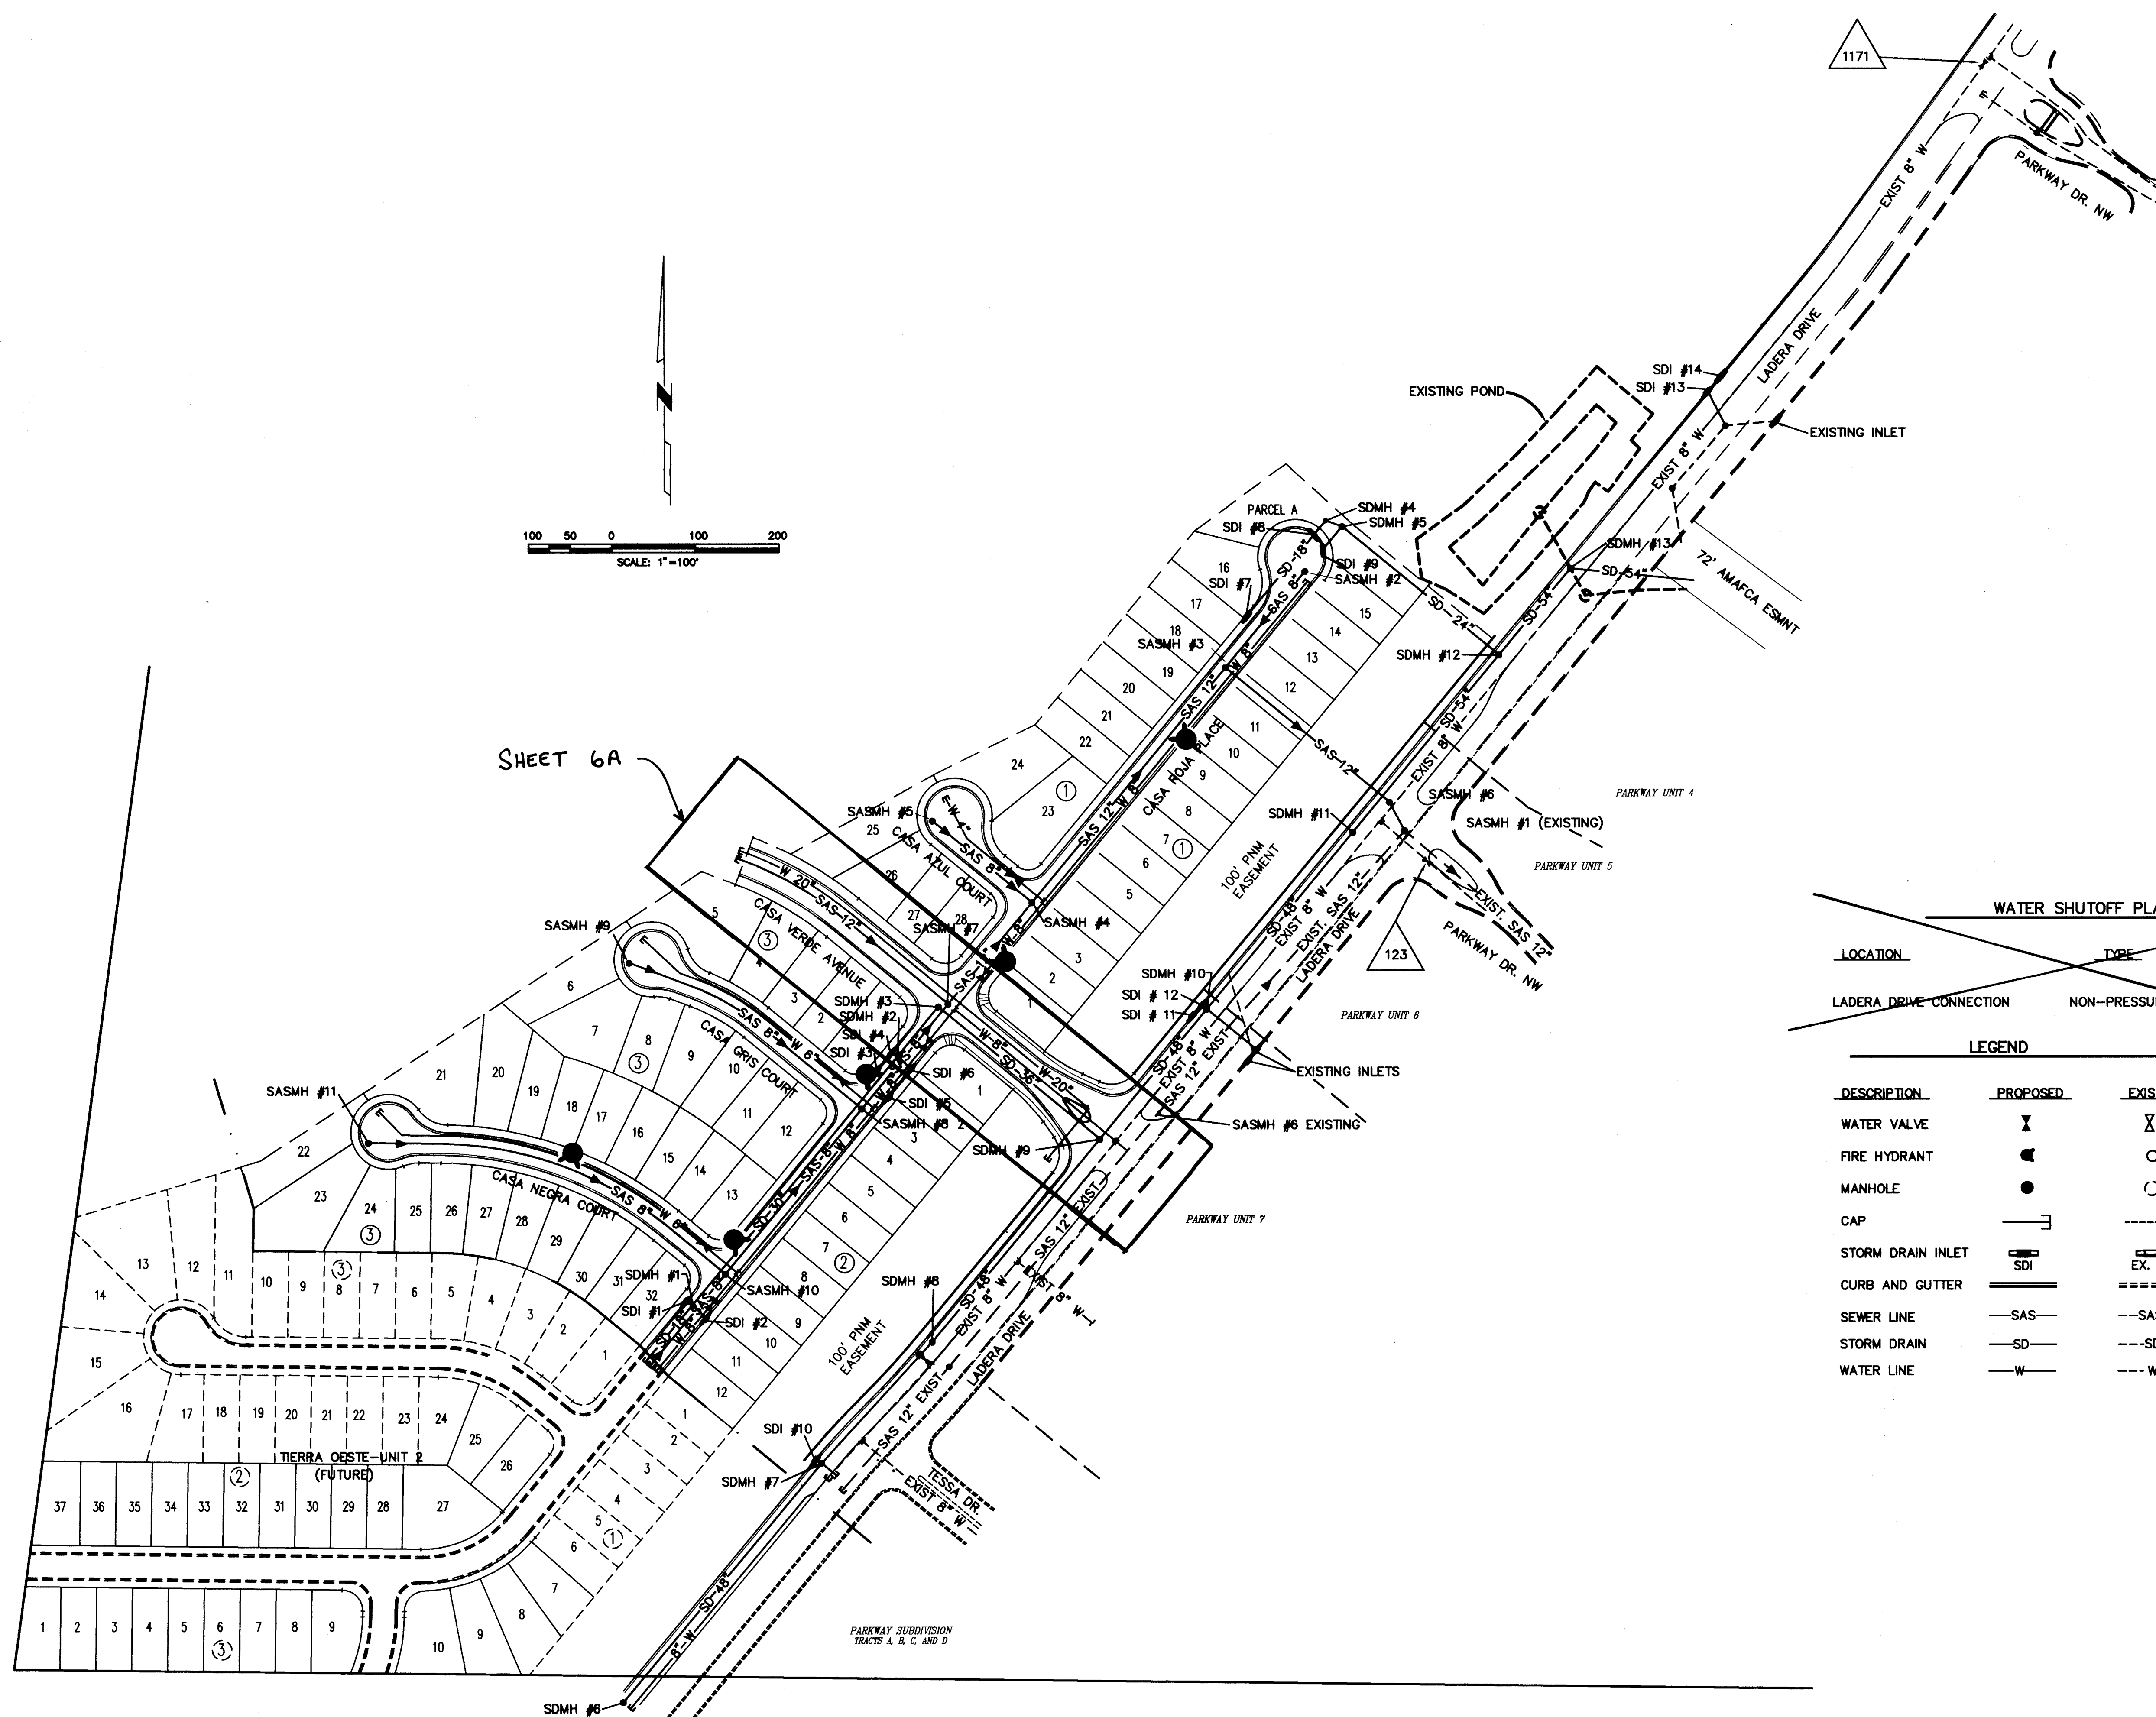


DESCRIPTION	PROPOSED	EXISTING
WATER VALVE	X	X
FIRE HYDRANT	⬤	⬤
MANHOLE	●	○
CAP	—	—
STORM DRAIN INLET	SDI	EX. SDI
CURB AND GUTTER	=====	=====
SEWER LINE	—SAS—	—SAS—
STORM DRAIN	—SD—	—SD—
WATER LINE	—W—	—W—

333 Rio Rancho Dr. N.E., Ste. 101
Rio Rancho, New Mexico 87124

CITY OF ALBUQUERQUE PUBLIC WORKS DEPARTMENT ENGINEERING GROUP					
TITLE: TIERRA OESTE LIMITED CO. COMPOSITE UTILITY PLAN TIERRA OESTE UNIT 1					
APPROVALS	ENGINEER	DATE	APPROVALS	ENGINEER	DATE
D.R.C. Chair			Hydrology		
Trans. Dev.					
Utility Dev.					
PROJECT NO. 5207.00 5409.90		MAP NO. H9 & J9		SHEET 4A 21 OF 30	


ENGINEER'S SEAL		SURVEY INFORMATION		AS BUILT INFORMATION			
		NO.	BY	DATE	NO.	BY	DATE
		ALBUQUERQUE ACS MONUMENT "BH-40"			CONTRACTOR MCC INC.		
		LOCATED APPROXIMATELY 623' NORTH OF AND 888' WEST OF THE NORTHWEST CORNER OF UNIT 1 BETWEEN TWO POWER POLES.			FIELD ACCEPTANCE BY CoA DATE 9/97		
		ELEVATION = 5305.43			DRAWN BY CoA DATE 9/97		
REVISIONS		MICRO-FILM INFORMATION					
DESIGNED	RGG	DATE	3-19-96	RECORDED BY		DATE	
DRAWN BY	RGG	DATE	3-19-96	NO.			
CHECKED BY	LDR	DATE	3-19-96				

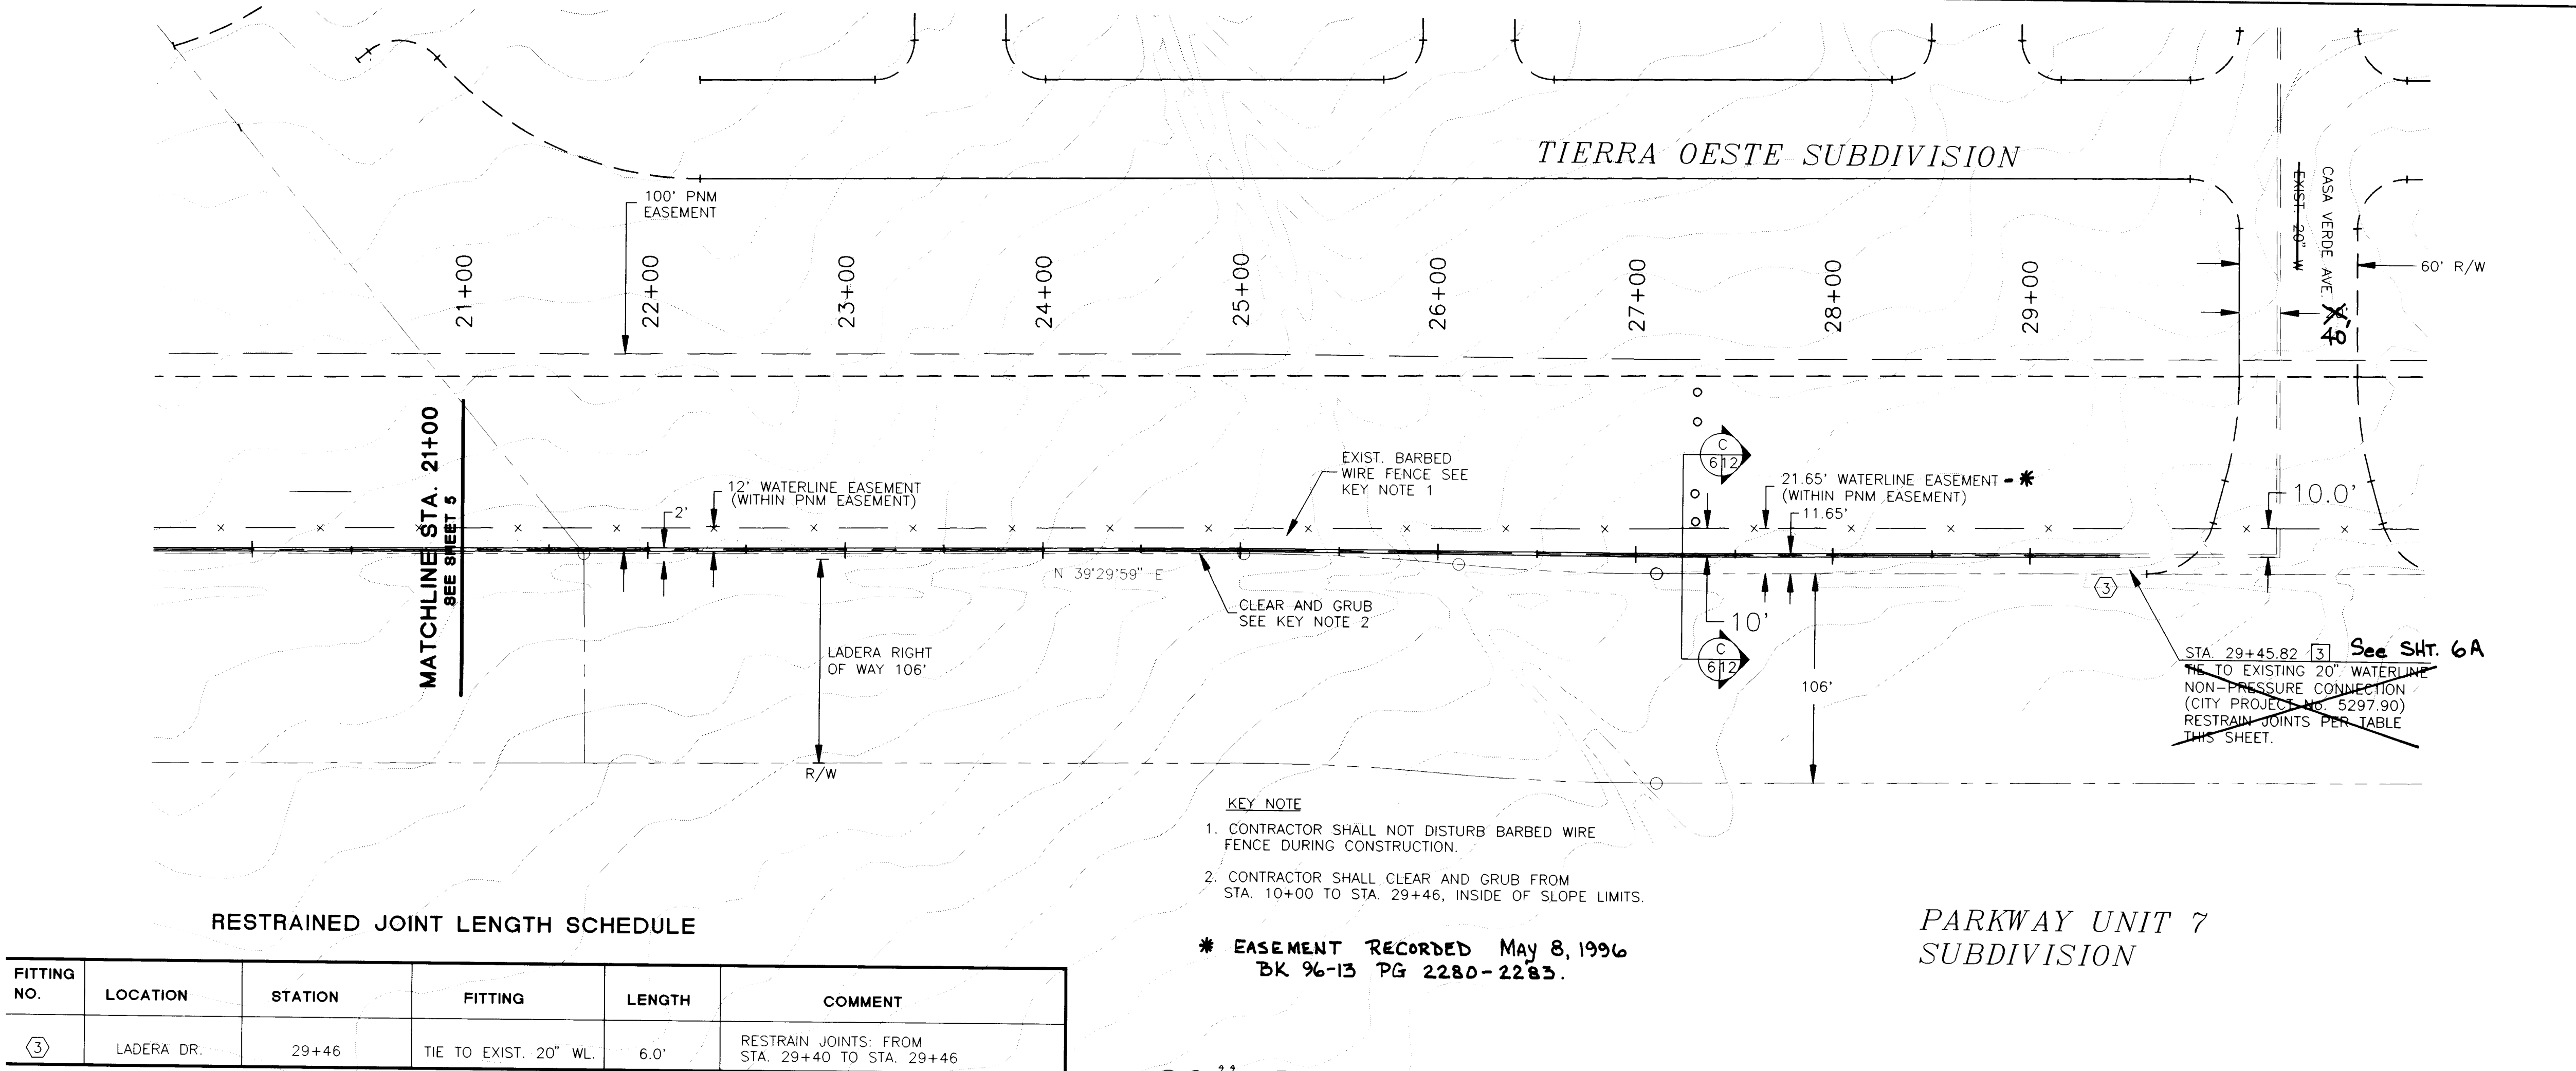

RESTRAINED JOINT LENGTH SCHEDULE

FITTING NO.	LOCATION	STATION	FITTING	LENGTH	COMMENT
③	LADERA DR.	29+46	TIE TO EXIST. 20" WL	6.0'	RESTRAIN JOINTS FROM STA. 29+40 TO STA. 29+46

NOTE: RESTRAINE JOINTS ON ALL FITTING. RESTRAINED JOINTS LENGTHS EACH SIDE OF FITTING UNLESS OTHERWISE NOTED.

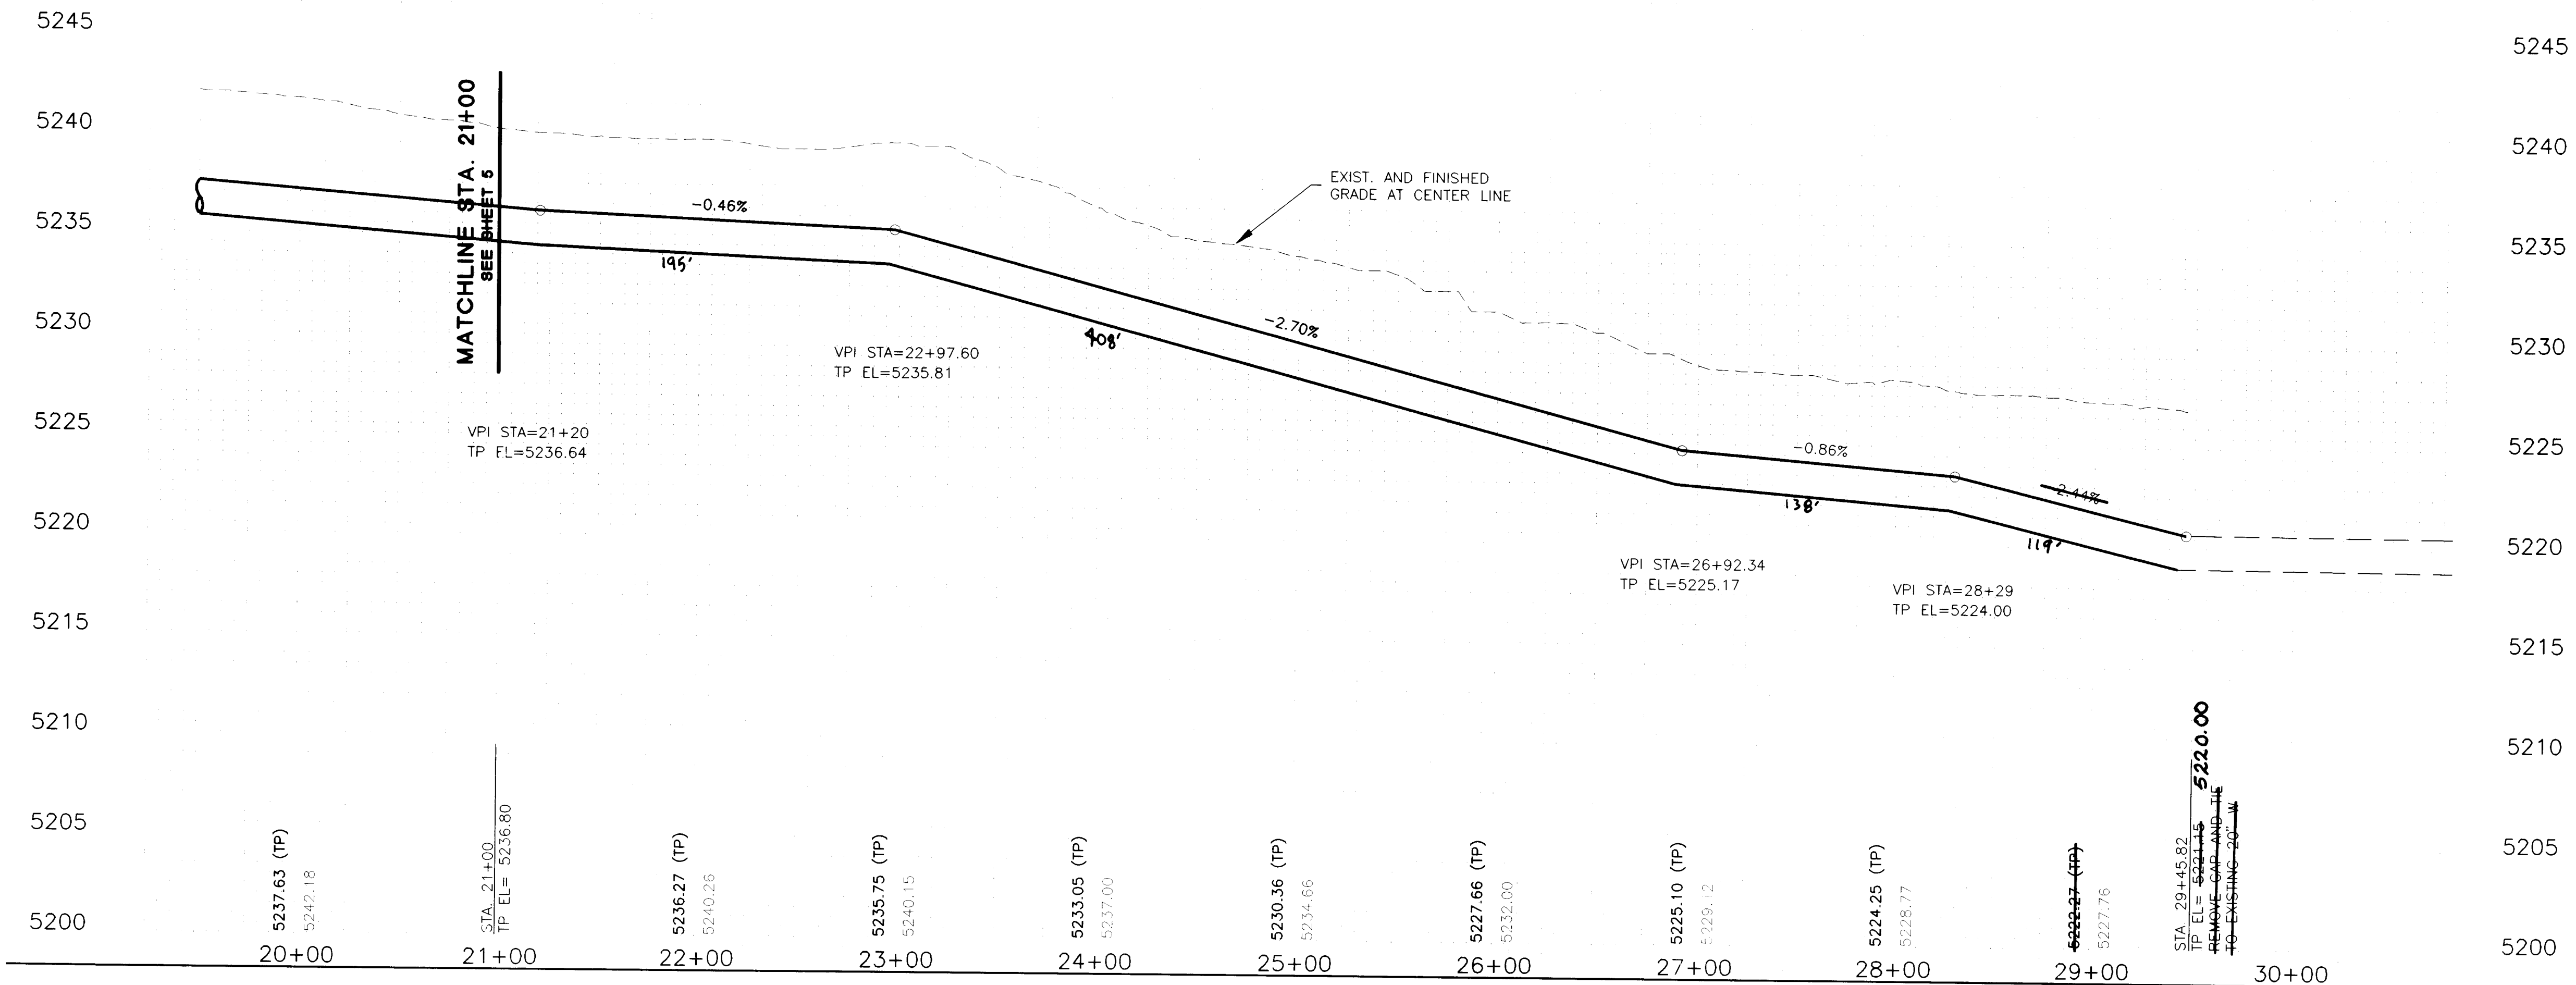

GENERAL NOTES:


- ALL PROFILE ELEVATIONS GIVEN ARE TOP OF PIPE (TP) OF 20" WATERLINE, AND EXISTING GROUND AT WATERLINE.
- THE CONTRACTOR SHALL FIELD VERIFY ALL EXISTING UTILITY LOCATIONS AND NOTIFY THE ENGINEER IMMEDIATELY OF ANY DISCREPANCIES.
- CONTRACTOR SHALL PARK EQUIPMENT AND VEHICLES AS NOT TO INTERFERE WITH NORMAL ACTIVITIES OF OTHER CONTRACTORS ON SITE.
- ALL VALVES REQUIRE A WATER VALVE CRADLE PER DETAILS SHEET 12.
- MINIMUM COVER ON 20" WATERLINE IS 4.0'.

SURVEY DATA

POINT No.	STA.	X	Y
③	29+45.82	354,750.7329	1,492,203.8233

LEGEND:

- ○ ○ ○ EXIST. POWER POLES
- x — EXIST. BARBED WIRE FENCE
- — — SLOPE LIMITS
- — — PROPOSED 20" WATERLINE
- ① FITTING NUMBER (SEE SHEET 4)
- ✕ PROPOSED VALVE
- — — RIGHT OF WAY (R/W)

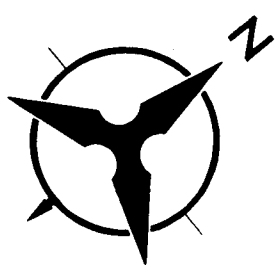

BOHANNAN-HUSTON INC.
ENGINEERS • PLANNERS • PHOTOGRAMMETRISTS • SURVEYORS • LANDSCAPE ARCHITECTS
ALBUQUERQUE LAS CRUCES SANTA FE

CITY OF ALBUQUERQUE
PUBLIC WORKS DEPARTMENT
ENGINEERING DEVELOPMENT GROUP

COLLEGE TRUNK-MASTER PLAN 20" WATERLINE
WATERLINE PLAN & PROFILE
LADERA STA. 21+00 TO 29+46.00

DESIGN REVIEW COMMITTEE CITY ENGINEER APPROVAL

LAST DESIGN UPDATE

CITY PROJECT NO. 5409.90 ZONE MAP NO. H-9;J-9 SHEET 6 OF 12


DESIGNED BY: DEB DATE 6/96
DRAWN BY: JA DATE 6/96
CHECKED BY: CWH DATE 6/96

STORM DRAIN PIPE									
		UPSTREAM			DOWNSTREAM				
SDP #	DIAMETER*	STATION	OFFSET	INVERT	STATION	OFFSET	INVERT	LENGTH	SLOPE
10	36"	9+93.00	10.0 RT	21.66	12+43.50	10.0 RT	13.33	250.50	3.33%


CASA ROJA PLACE
(SEE SHEET 22)

NOTE
20" WATERLINE SHALL
BE BUILT BY OTHERS
CITY PROJECT 5409.90

LADERA DRIVE
(SEE SHEET 26)

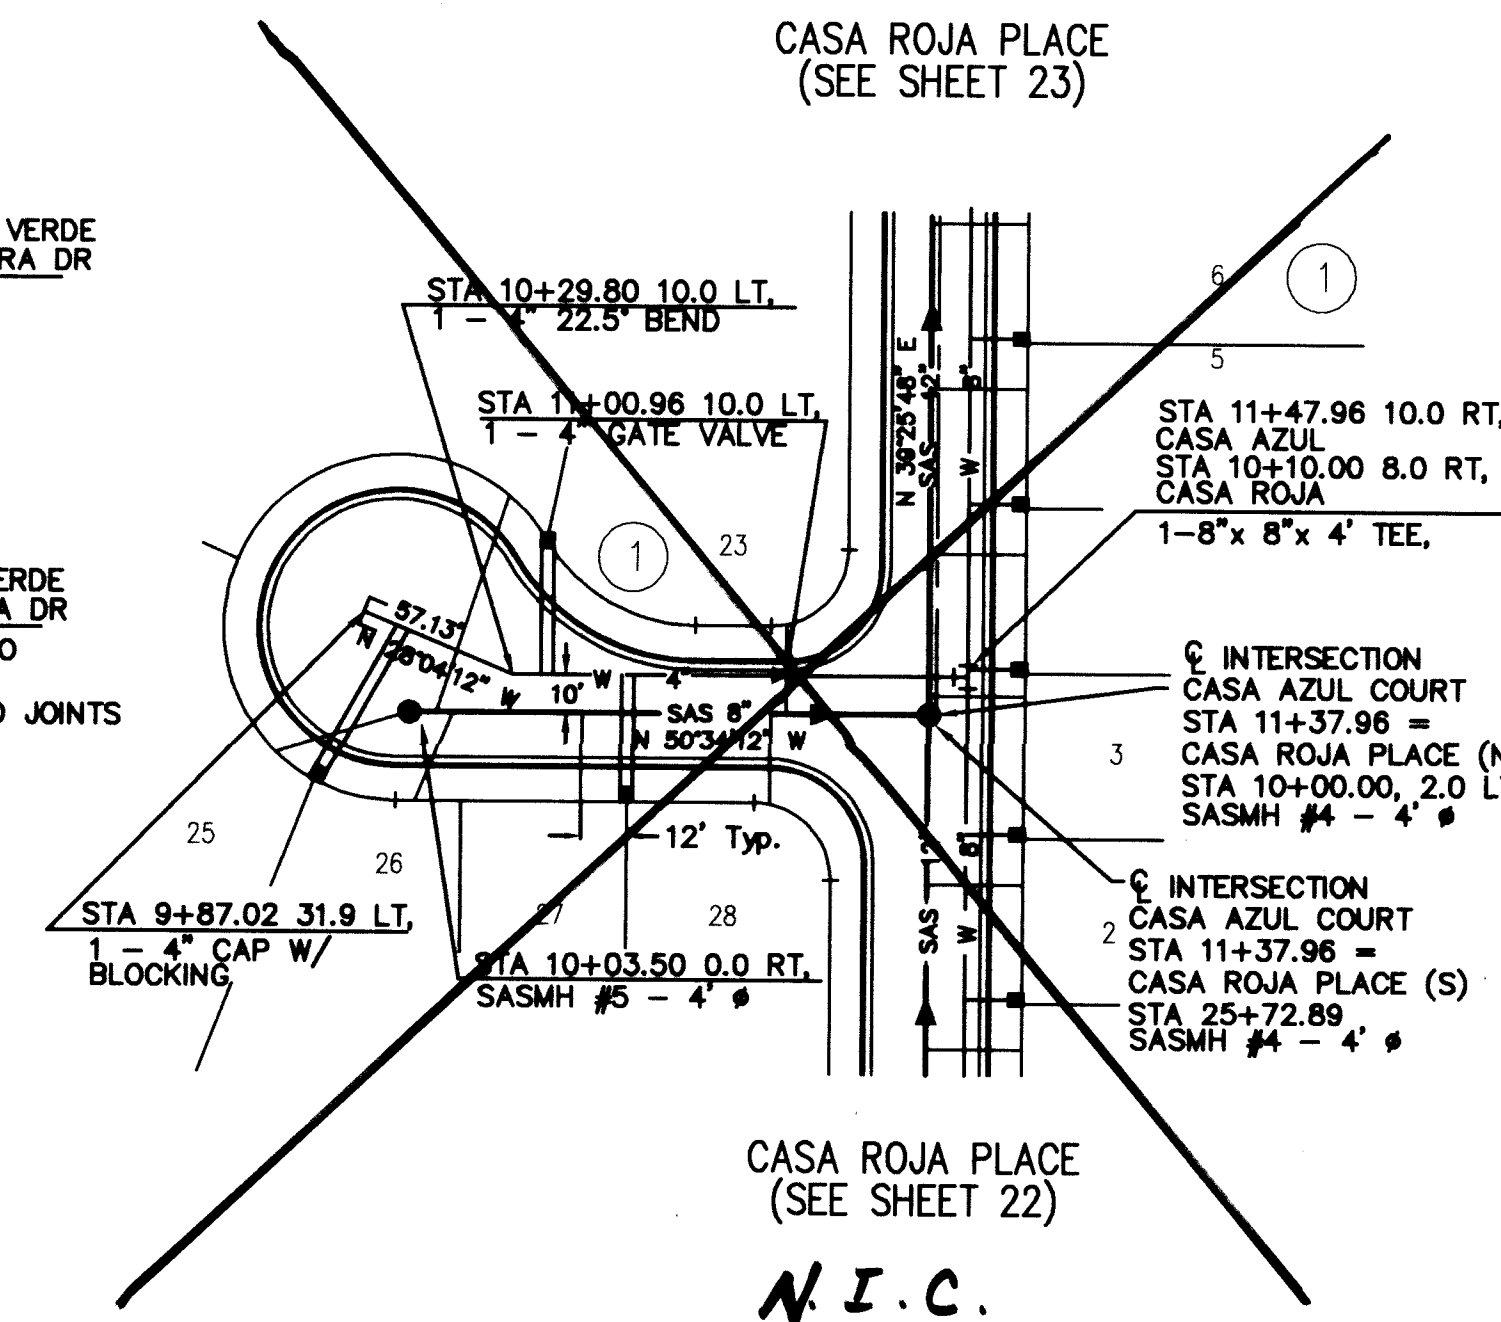

CASA AZUL COURT

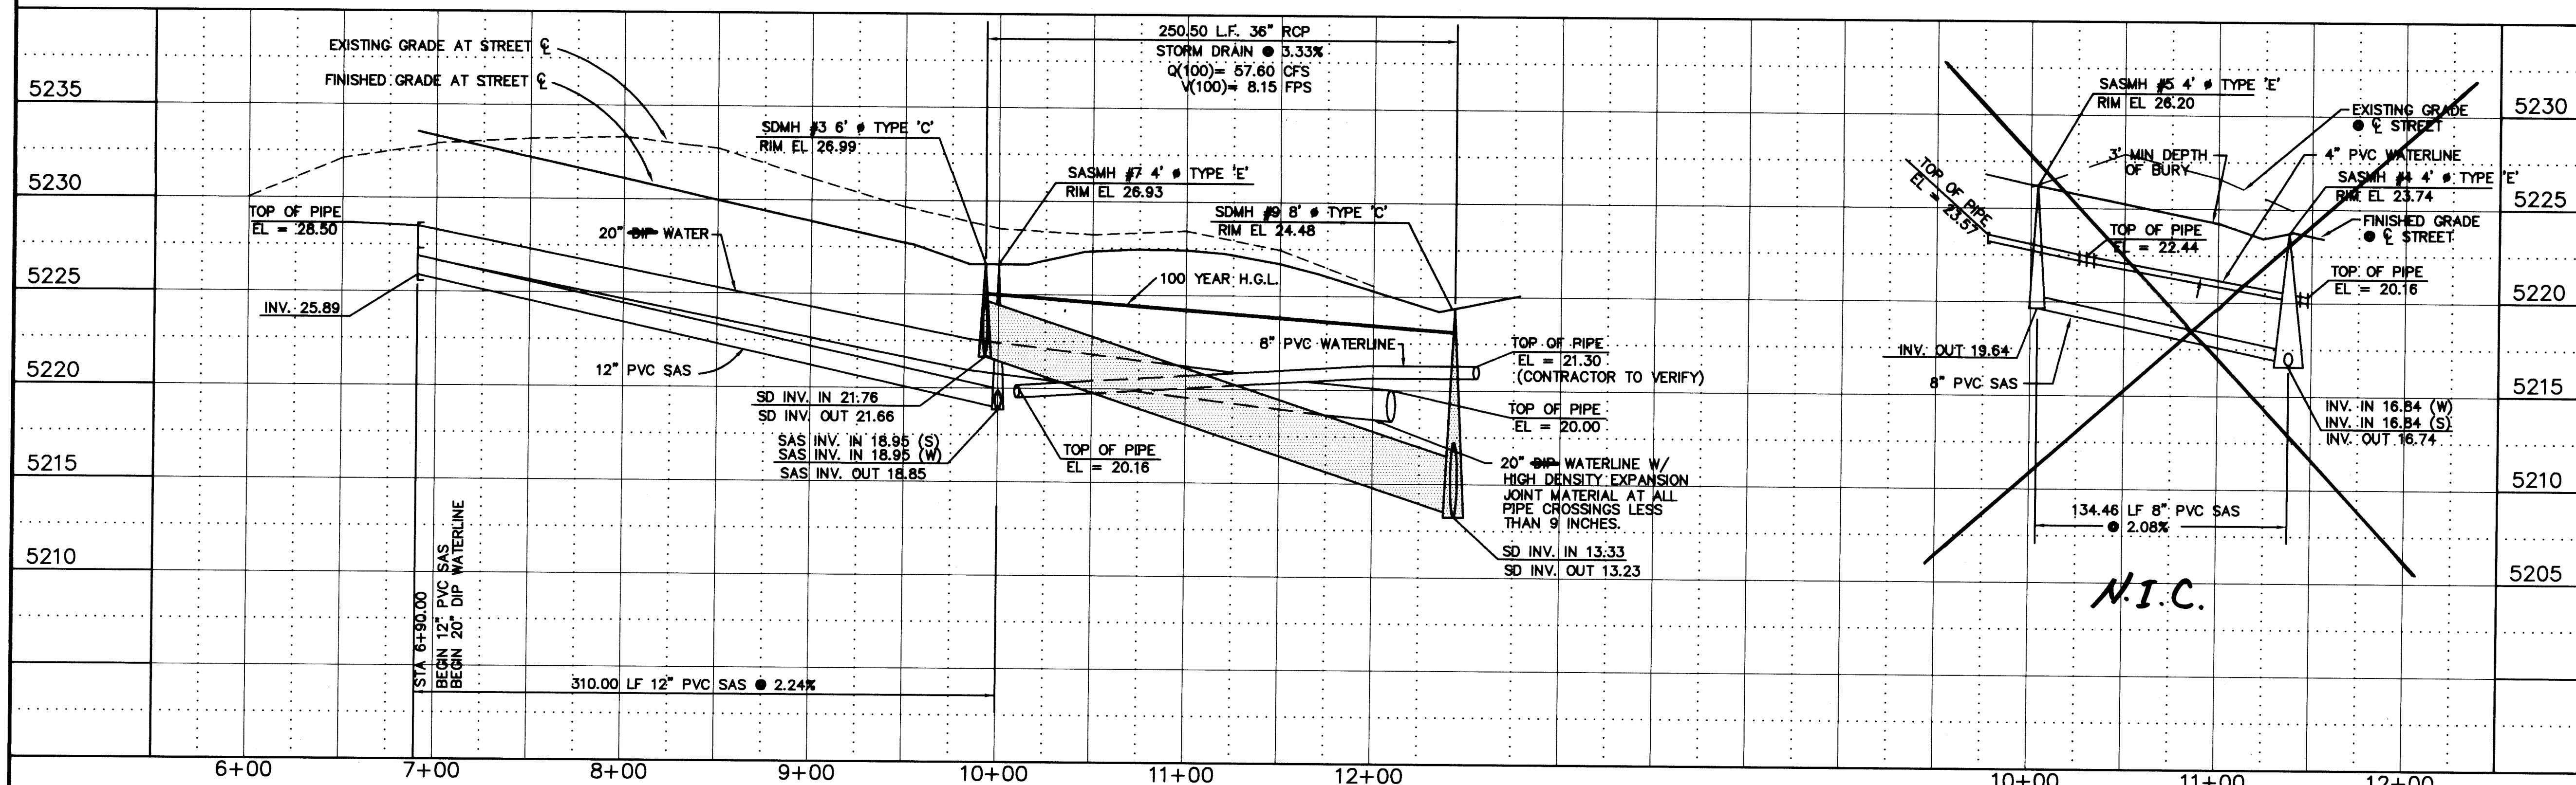

1. CONTRACTOR SHALL SUPPORT ALL EXISTING UNDERGROUND UTILITY LINES WHICH BECOME EXPOSED DURING CONSTRUCTION. PAYMENT FOR SUPPORTING MATERIALS WILL BE INCIDENTAL TO WATERLINE AND/OR SEWERLINE COSTS.
2. ALL WATERLINE AND SEWERLINE STATIONING REFERS TO STREET CENTERLINE STATIONING.
3. ALL FITTINGS ON WATERLINE SHALL HAVE RESTRAINED JOINTS PER TABLE THIS SHEET.
4. ~~CONSTRUCT GAS SERVICES PER C&A DWG 10100~~
5. ~~CONSTRUCT FOR UNDERPAID PER DESIGNATED DETAILS~~
~~AND LENGTHS PER C&A DWG 10100~~
6. ~~CONSTRUCT ALL WATER SERVICE PER C&A DWG 10100~~
~~UNLESS OTHERWISE NOTED~~
7. ~~UNLESS OTHERWISE NOTED, ALL S&D MANHOLES~~
~~SHALL BE 18" DIAMETER TYPE 2 PER C&A DWG 10102~~
8. ~~ALL CURBLINE AND WATERLINE AND WATERLINE~~
~~SHALL BE BENT USING THE SEGMENTS WITH A 6" DEFLECTION AT THE JOINT~~
9. ~~ALL SEWERLINE AND WATERLINE SHALL BE~~
~~CONSTRUCTED OF 18" UNLESS SPECIFIED OTHERWISE~~
10. ~~ALL STORM DRAIN SHALL BE CONSTRUCTED OF 24"~~
~~GLASS UNLESS SPECIFIED OTHERWISE~~
11. ALL ELEVATIONS ARE BASED ON A DATUM ELEVATION 5200 AS ESTABLISHED BY BENCH MARKS.

LEGEND

<u>DESCRIPTION</u>	<u>PROPOSED</u>
WATER VALVE	
FIRE HYDRANT	
MANHOLE	
CAP	
DROP INLET	
PIPE TEE	
PIPE CROSS	
PIPE BEND	
WATER SERVICE SINGLE	
WATER SERVICE DOUBLE	
CURB AND GUTTER	
SEWER LINE	—SAS—
STORM DRAIN	—SD—
WATER LINE	—W—

RESTRAINED JOINT TABLE	
JOINT	RESTRAIN LENGTH
4* GATE VALVE	84"
4* 90°S HORIZ. BEND	36"
4* 180° VERT. OFFSET	36"
0* GATE VALVE	84"
0* 22.5° HORIZ. BEND	24"
0* 18° HORIZ. BEND	24"
0* 90° VERT. OFFSET	24"
0* 90° VERT. OFFSET	BRANCH: 21 RUN: 21
0* X 0° X 0° TEE	BRANCH: 21 RUN: 21
0* X 0° X 0° TEE	BRANCH: 21 RUN: 21
0* GATE VALVE	84"
0* 11.25° HORIZ. BEND	24"
0* 22.50° HORIZ. BEND	24"
0* 18° HORIZ. BEND	24"
0* 22.5° VERT. OFFSET	24"
20* 90° HORIZ. BEND	84"
20* 90° HORIZ. BEND	84"

SEWER SERVICE TABLE			
CASA AZUL COURT			
BLOCK 1			
STATION ● PL	LOT	INV EL	● PI
STA 9+68.66	25	22.20	
STA 10+04.96	26	21.30	
STA 10+28.81	24	22.10	
STA 10+47.96	27	20.30	
STA 10+86.96	28	19.50	
STA 11+02.66	23	19.30	

N.I.C.



CNR ENGINEERING
INC.

333 Rio Rancho Dr. N.E., Ste. 10
Rio Rancho, New Mexico 87124

CITY OF ALBUQUERQUE
PUBLIC WORKS DEPARTMENT
ENGINEERING GROUP

TITLE: TIERRA OESTE LIMITED CO.
UTILITY PLAN & PROFILE-CASA VERDA/CASA AZUL CT
TIERRA OESTE UNIT 1

APPROVALS	ENGINEER	DATE	APPROVALS	ENGINEER	DATE
D.R.C. Chair			Hydrology		
Trans. Dev.					
Utility Dev.					

PROJECT NO. <u>540290</u>	MAP NO. H9 & J9	SHEET OF <u>6A 25</u> <u>30</u>
---------------------------	-----------------	---------------------------------

SCANNED BY
BY LASON

1	2	3	4	5	6	7	8	9	10	11	12	13	14
26	-	54	59	.	96						6A	97	

AMAFCA LADERA DAM No. 10

THE CROSSING UNIT I

STATIONING: 4+00, 5+00, 6+00, 7+00, 8+00, 9+00, 10+00, 11+00, 12+00, 13+00, 14+00, 15+00, 16+00

STATION 4+55.33, 10' RT. INSTALL: 1-20" X 22.5" BEND RESTRAIN JOINTS PER TABLE THIS SHEET.

STATION 5+00, 7' LT. INSTALL: 1-20" X 22.5" BEND RESTRAIN JOINTS PER TABLE THIS SHEET.

STATION 7+00, 7' LT. INSTALL: 1-20" BUTTERFLY VALVE W/ TYPE "B" BOX & LID PER COA STD. DWG. 2326 RESTRAIN JOINTS PER TABLE THIS SHEET.

WATERLINE CURVE DATA (A)

PC STA=5+00

PT STA=14+43.05

RESTRAINED JOINT LENGTH SCHEDULE

FITTING NO.	LOCATION	STATION	FITTING	LENGTH	COMMENT
4	CASA VERDE AVE.	4+55.33, 10' RT.	20" 22.5" BEND	9.0'	
5	CASA VERDE AVE.	5+00, 7' LT.	20" 22.5" BEND	9.0'	
6	CASA VERDE AVE.	7+00, 7' LT.	20" BUTTERFLY VALVE	80.0'	

NOTE: RESTRAINED JOINTS ON ALL FITTINGS. RESTRAINED JOINTS LENGTHS EACH SIDE OF FITTING UNLESS OTHERWISE NOTED.

20" WATERLINE

NOTE: RESTRAINED JOINTS ON ALL FITTINGS. RESTRAINED JOINTS LENGTHS EACH SIDE OF FITTING UNLESS OTHERWISE NOTED.

20'' WATERLINE

1. ALL PROFILE ELEVATIONS GIVEN ARE TOP OF PIPE (TP) OF 20" WATERLINE, AND EXISTING GROUND AT WATERLINE.
2. MINIMUM COVER ON 20" WATERLINE IS 4.0'
3. CONTRACTOR SHALL PARK EQUIPMENT AND VEHICLES AS NOT TO INTERFERE WITH NORMAL ACTIVITIES OF OTHER CONTRACTORS ON SITE.
4. ALL VALVES REQUIRE A WATER VALVE CRADLE PER DETAILS SHEET 12.


POINT No.	STA.	X	Y
4	4+45.78	354,398.5244	1,492,581.046
5	7+51.05	354,112.5899	1,492,687.952
6	11+99.04	354,089.6383	1,493,193.815

SURVEY INFORMATION		FIELD NOTES		BENCH MARKS		AS-BUILT INFORMATION	
NO.	BY	DATE	BOHANNAN & HUSTON	STAMPED "BH-40"	CONTRACTOR	WORKED BY	DATE
1	BOHANNAN-HUSTON	10/95	GEO. GRAPHIC POSITION (NAD 1927) N.M. STATE PLANE COORDINATES X=352,790.66 Y=1,492,346.53 GROUND-TO-GRID FACTOR=0.999677105 ADC=-0016'59" NGVD 1929 ELEVATION= 5305.43		NCC, Inc.	CoA	8/97
					INSPECTOR'S ACCEPTANCE BY	DATE	
					VERIFICATION BY	DATE	
					DRAWINGS CORRECTED BY	DATE	
					MICRO-FILM INFORMATION	DATE	
					RECORDED BY		
					NO.		

ENGINEER'S SEAL



	SLOPE LIMITS
	PROPOSED 20" WATERLINE
	FITTING NUMBER (SEE SHEET 4)
	WATERLINE CURVE DATA
	PROPOSED VALVE

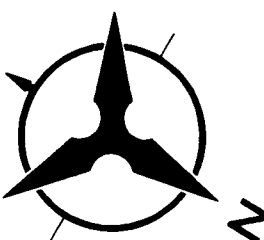

BOHANNAN-HUSTON INC.
ENGINEERS • PLANNERS • PHOTOGRAMMETRISTS • SURVEYORS • LANDSCAPE ARCHITECTS
 ALBUQUERQUE LAS CRUCES SANTA FE

CITY OF ALBUQUERQUE
PUBLIC WORKS DEPARTMENT
ENGINEERING DEVELOPMENT GROUP

COLLEGE TRUNK-MASTER PLAN 20" WATERLINE
WATERLINE PLAN & PROFILE
CASA VERDE STA. 4+55.33 TO 15+00




CITY ENGINEER APPROVAL	LAST DESIGN UPDATE	MO./DAY/YR.	MO./DAY/YR.

CITY PROJECT NO.	ZONE MAP NO.	SHEET	OF
5409.90	H-9; J-9	7	12

SCANNED BY
BY LASON

1 2 3 4 5 6 7 8 9 10 11 12 13 14
26-5484-98-0797

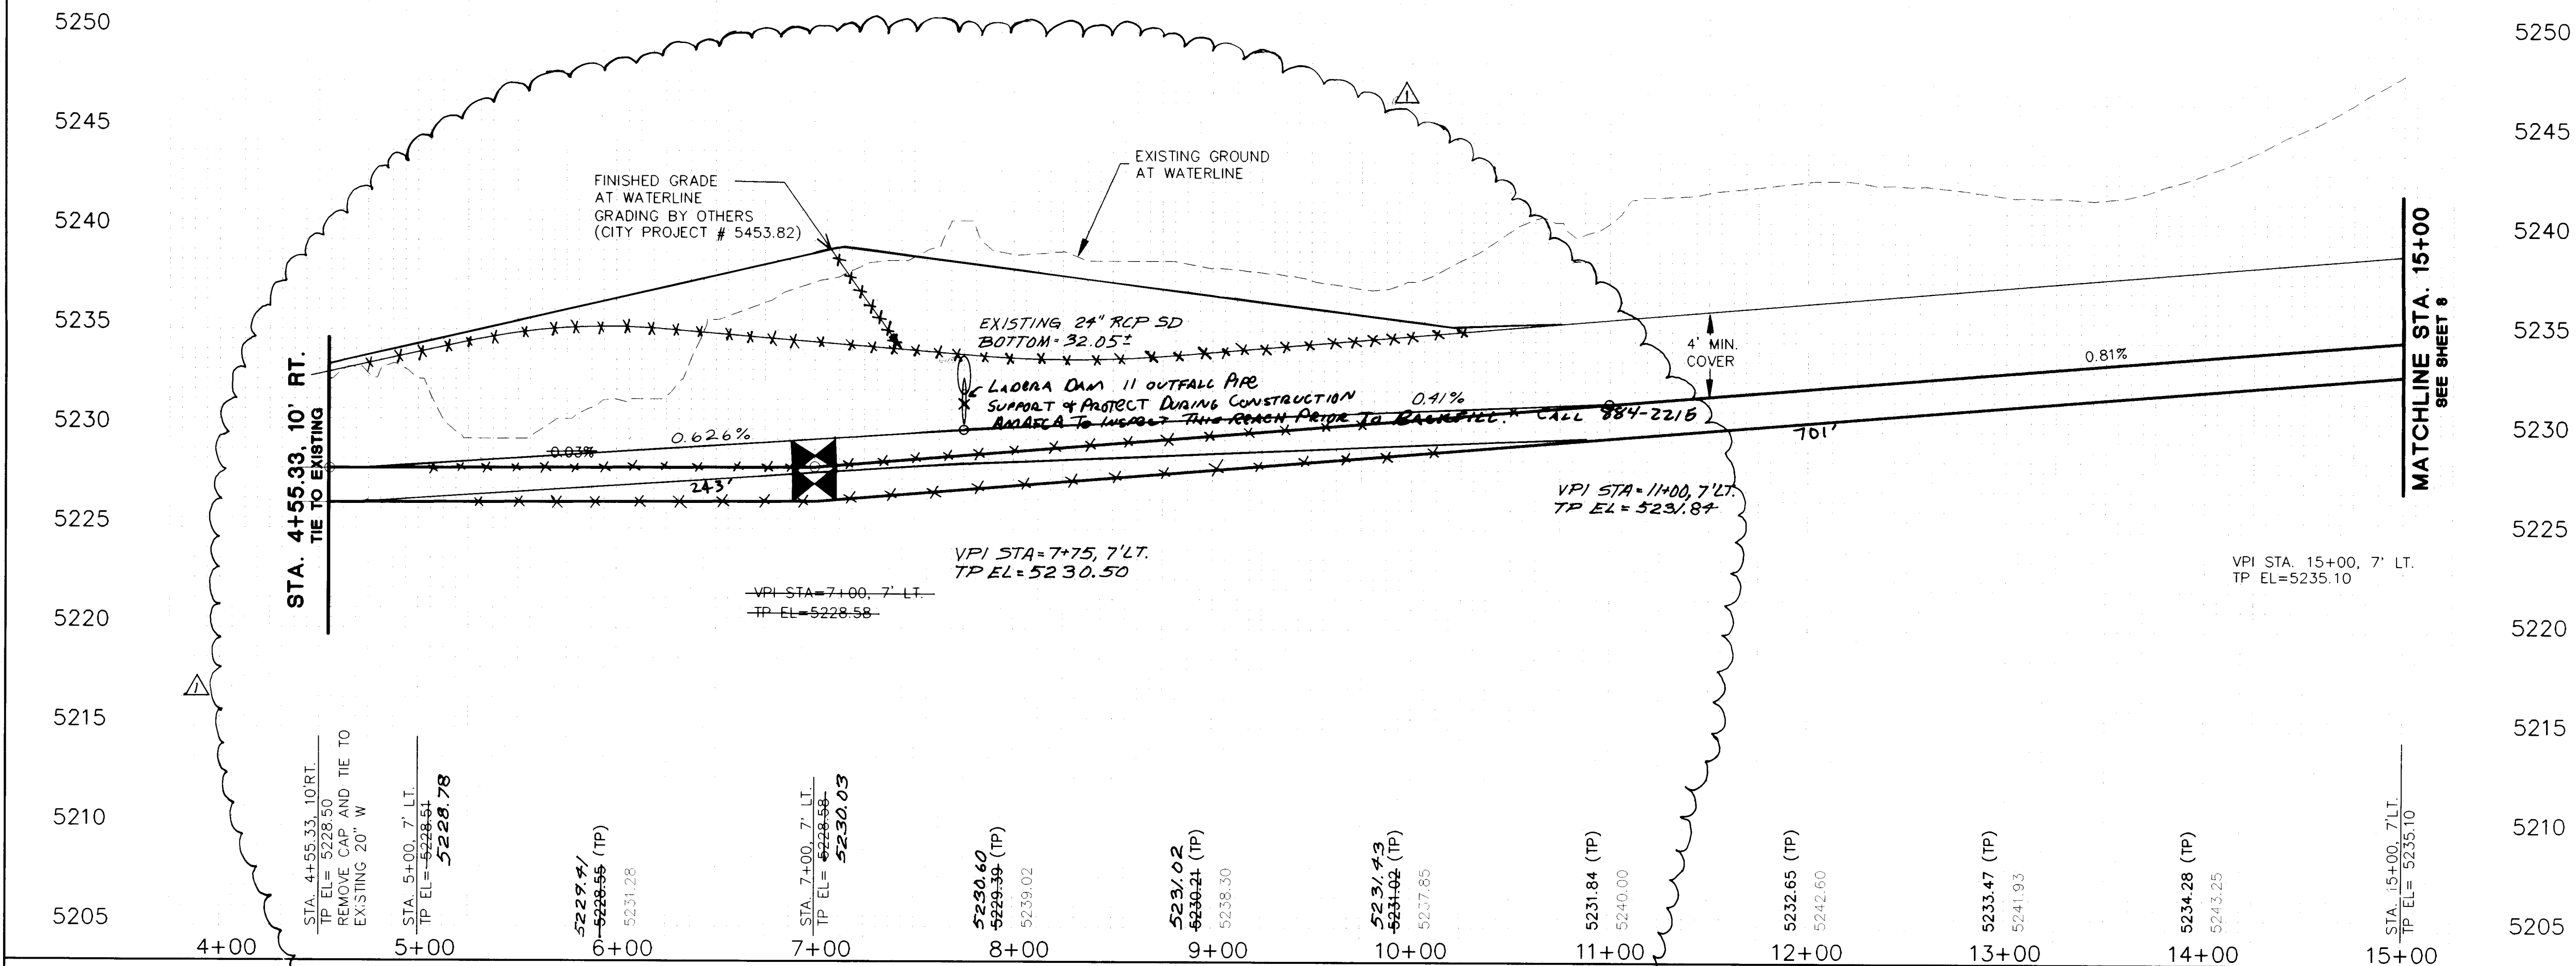


SCALES: 1" = 50' HORIZONTAL
1" = 5' VERTICAL

CITY PROJECT NO. 5409.90


ZONE MAP NO.
H-9; J-9

SHEET 7 OF 12

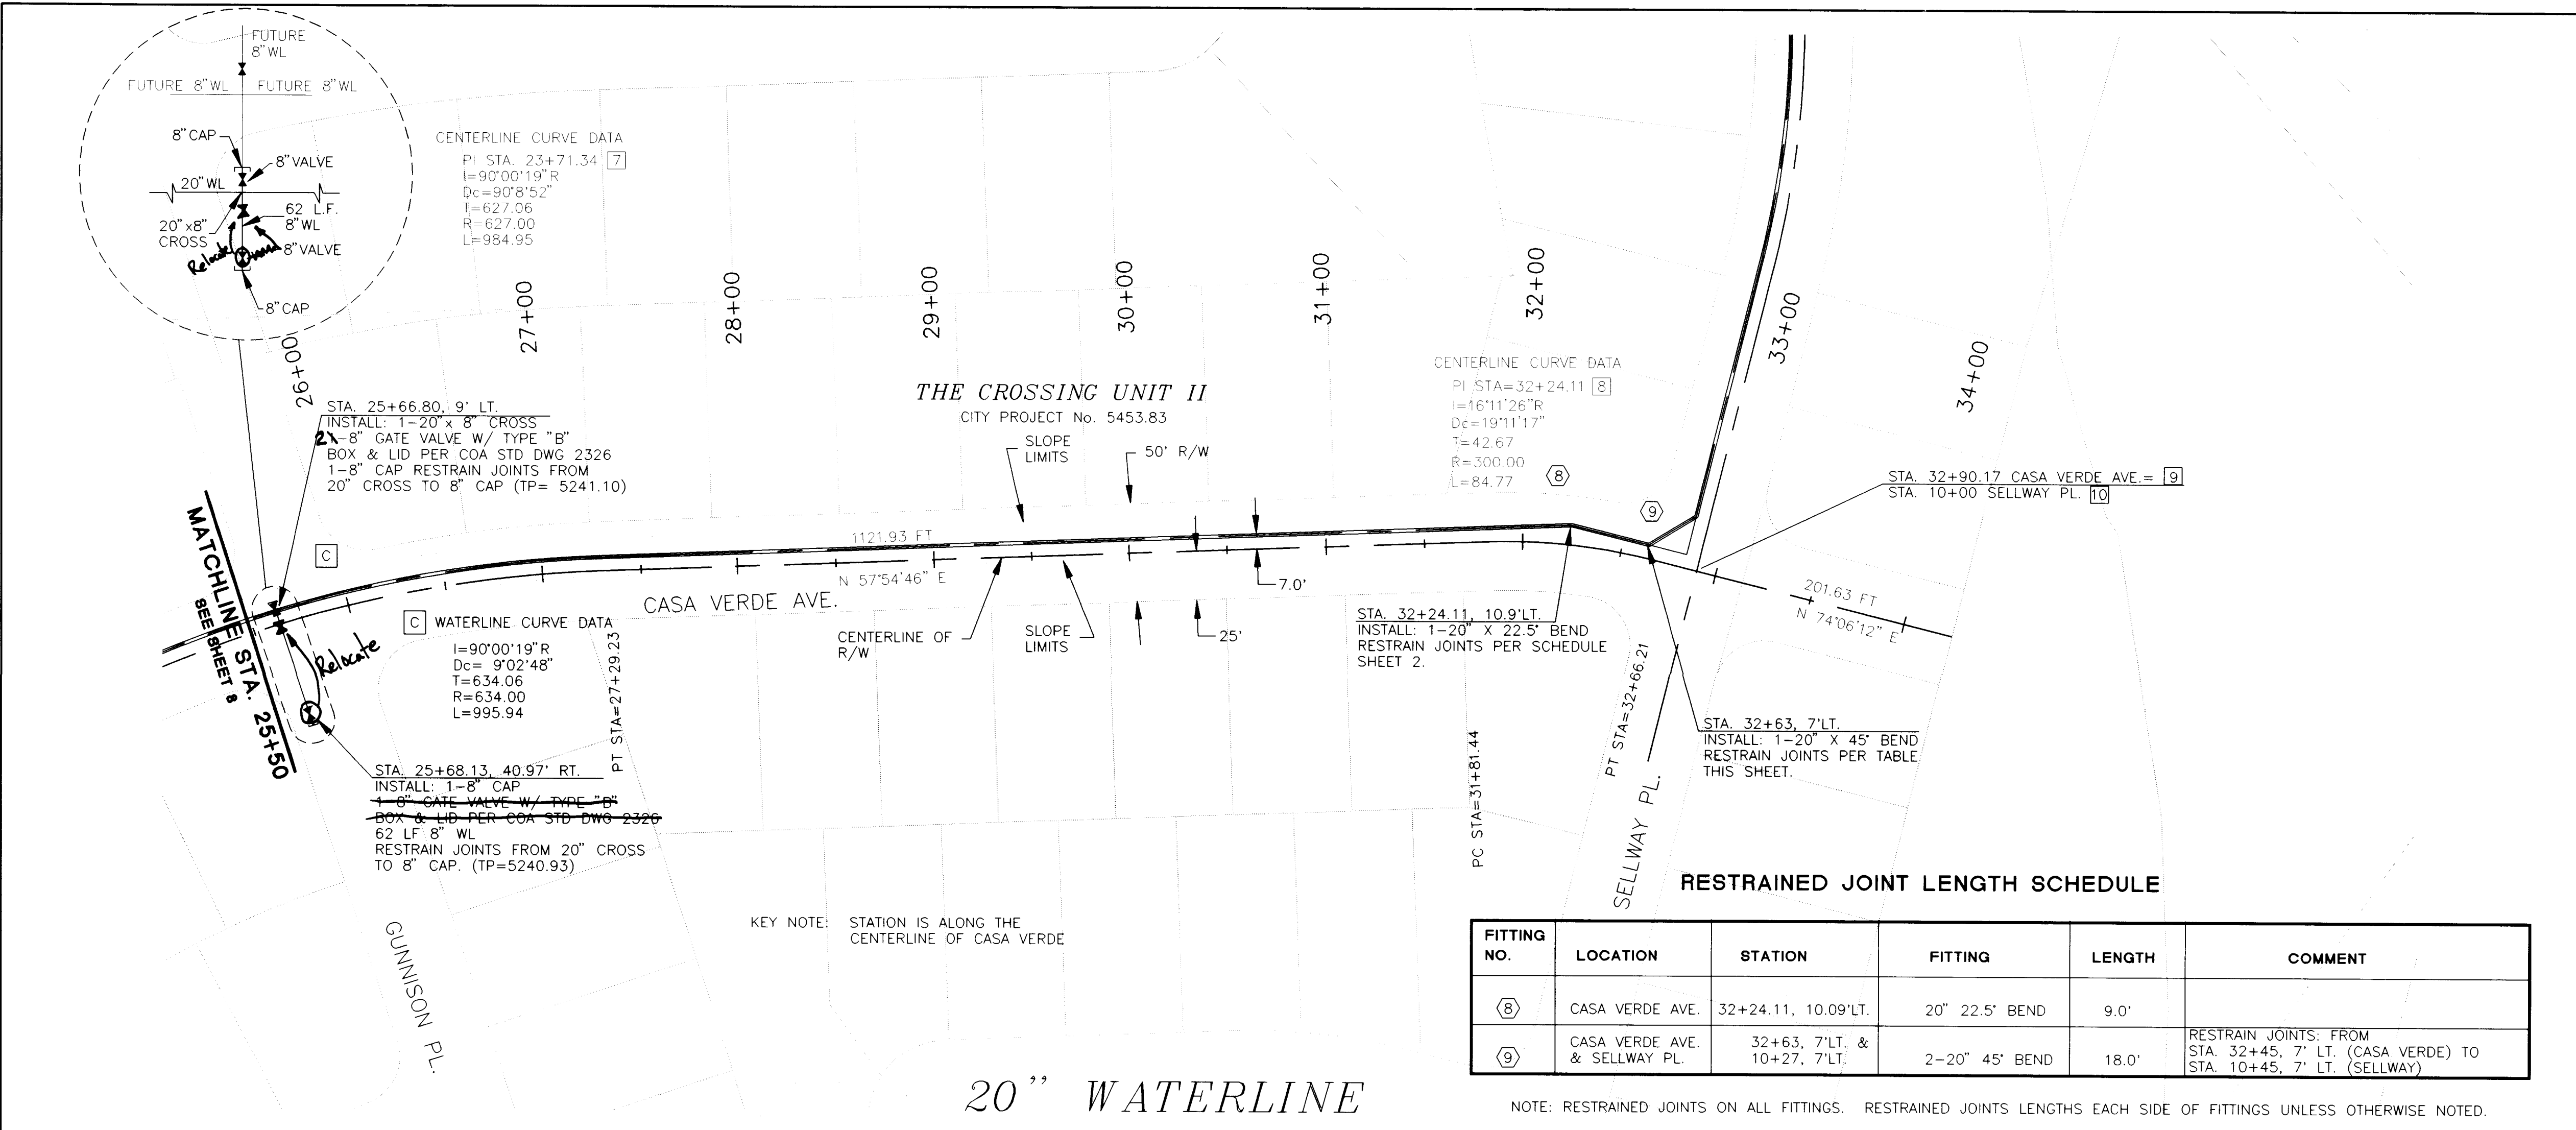

FITTING NO.	LOCATION	STATION	FITTING	LENGTH	COMMENT
8	CASA VERDE AVE.	32+24.11, 10.09' LT.	20" 22.5' BEND	9.0'	
9	CASA VERDE AVE. & SELLWAY PL.	32+63, 7' LT. & 10+27, 7' LT.	2-20" 45' BEND	18.0'	RESTRAIN JOINTS: FROM STA. 32+45, 7' LT. (CASA VERDE) TO STA. 10+45, 7' LT. (SELLWAY)

NOTE: RESTRAINED JOINTS ON ALL FITTINGS. RESTRAINED JOINTS LENGTHS EACH SIDE OF FITTINGS UNLESS OTHERWISE NOTED.

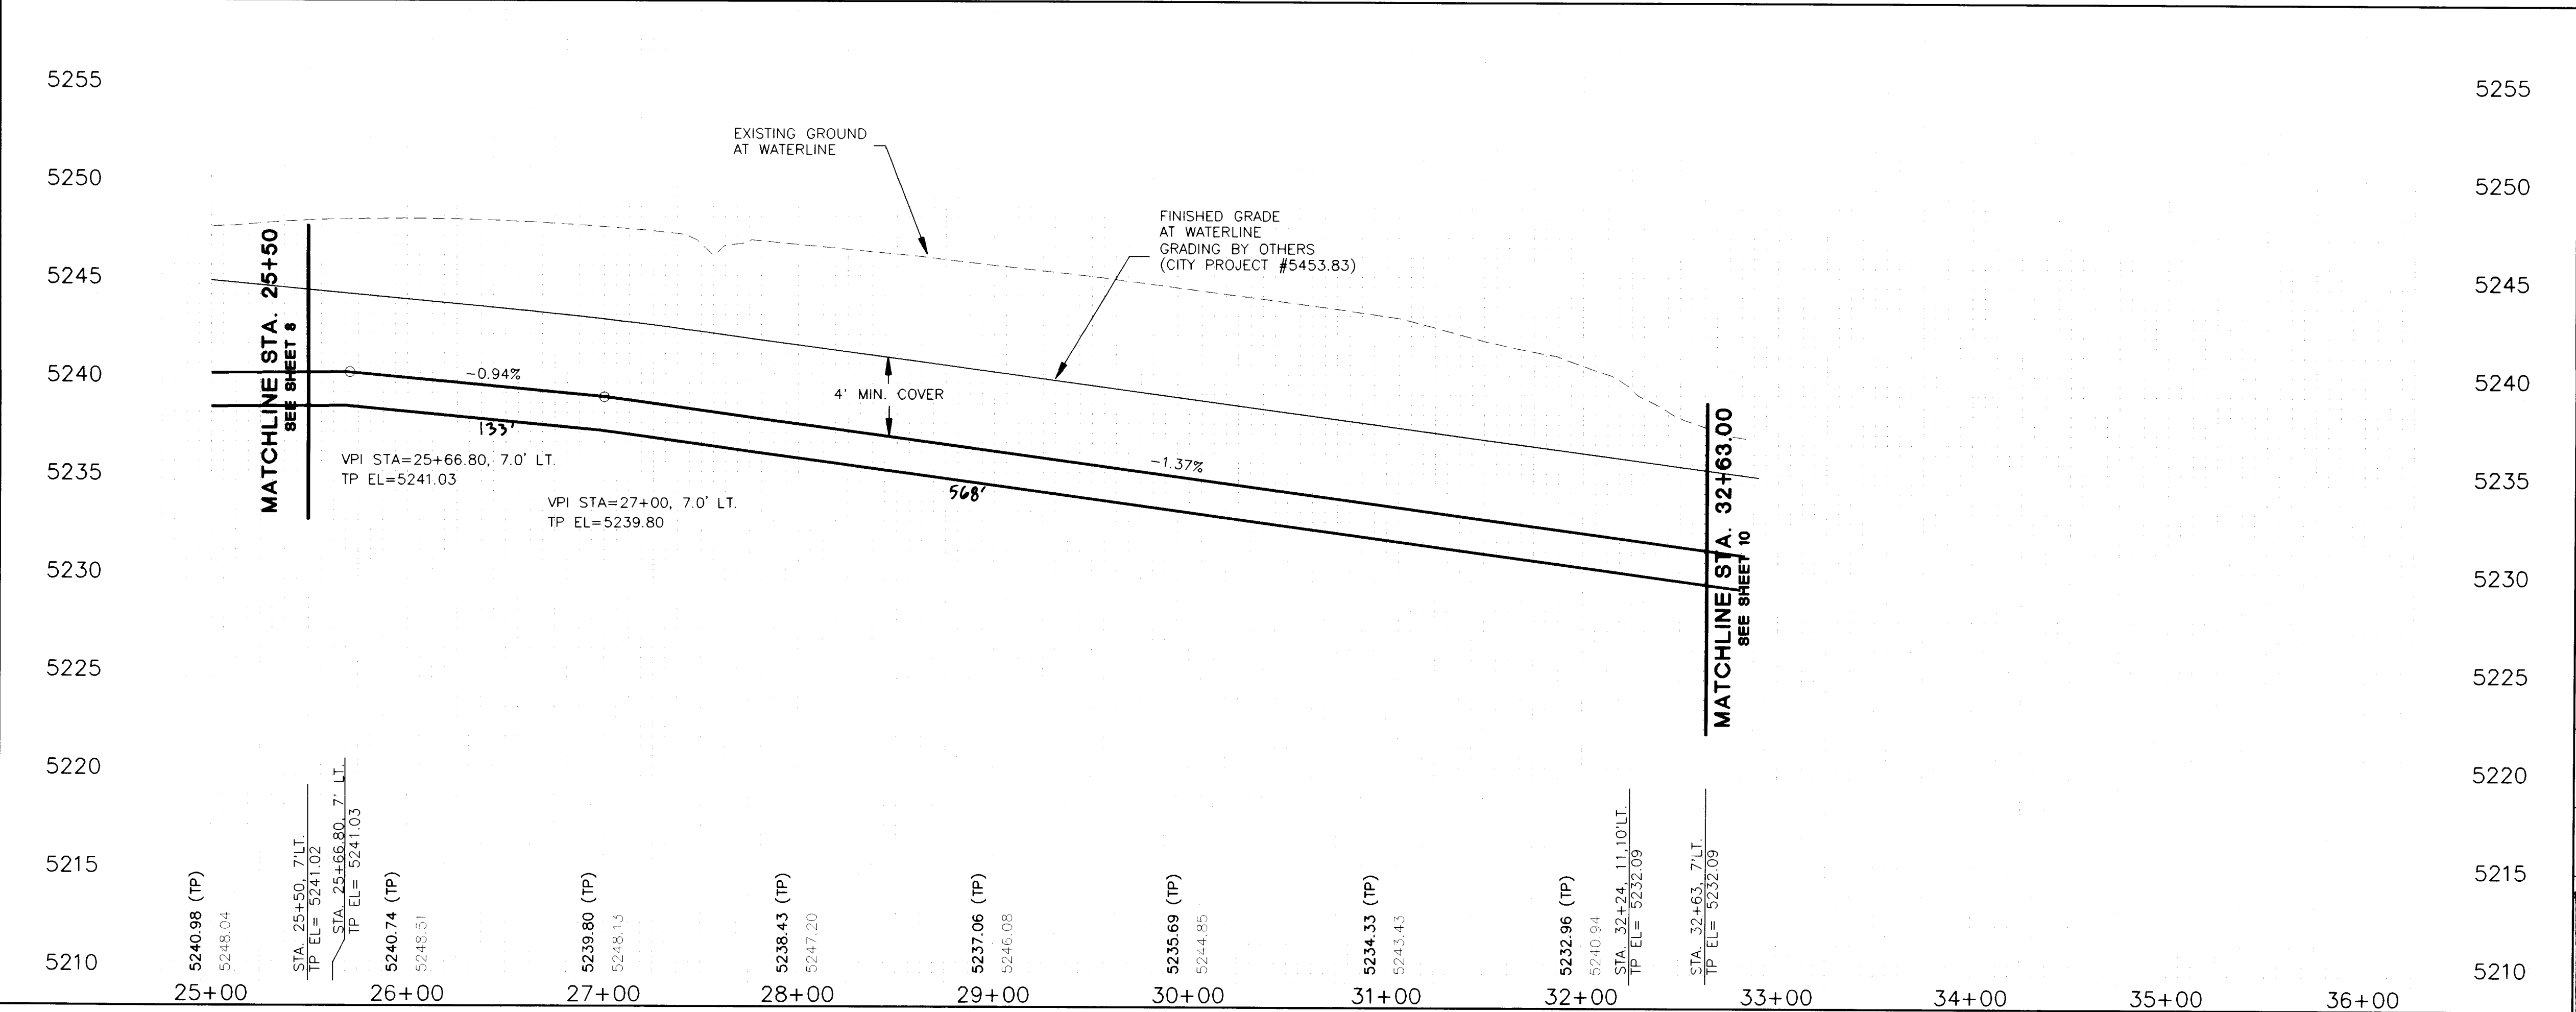

GENERAL NOTES:

- ALL PROFILE ELEVATIONS GIVEN ARE TOP OF PIPE (TP) OF 20" WATERLINE, AND EXISTING GROUND AT WATERLINE.
- MINIMUM COVER ON 20" WATERLINE IS 4.0'.
- CONTRACTOR SHALL PARK EQUIPMENT AND VEHICLES AS NOT TO INTERFERE WITH NORMAL ACTIVITIES OF OTHER CONTRACTORS ON SITE.
- ALL VALVES REQUIRE A WATER VALVE CRADLE PER DETAILS SHEET 12.

SURVEY DATA

POINT No.	STA.	X	Y
7	23+71.34	353,460.7911	1,494,196.574
8	32+24.11	354,411.3390	1,494,792.557
9	32+90.17	354,475.4214	1,494,810.8078
10	10+00.00	354,475.4214	1,494,810.8078

LEGEND:

- SLOPE LIMITS
- PROPOSED 20" WATERLINE
- FITTING NUMBER (SEE SHEET 4)
- WATERLINE CURVE DATA

AS-BUILT INFORMATION

CONTRACTOR	DATE
BOHANNAN & HUSTON INC.	8/17

NO.	DATE	REMARKS
1	8/17	DESIGN
2	8/17	REVISIONS
3	8/17	DESIGN

DESIGNED BY: DEB
DRAWN BY: JA
CHECKED BY: CWH

ENGINEER'S SEAL

BOHANNAN-HUSTON INC.
ENGINEERS • PLANNERS • PHOTOGRAMMETRISTS • SURVEYORS • LANDSCAPE ARCHITECTS
ALBUQUERQUE LAS CRUCES SANTA FE


CITY OF ALBUQUERQUE
PUBLIC WORKS DEPARTMENT
ENGINEERING DEVELOPMENT GROUP

COLLEGE TRUNK-MASTER PLAN 20" WATERLINE
WATERLINE PLAN & PROFILE
CASA VERDE STA. 25+50 TO 32+63


DESIGN REVIEW COMMITTEE CITY ENGINEER APPROVAL

LAST DESIGN UPDATE

ZONE MAP NO. H-9; J-9 SHEET 9 OF 12


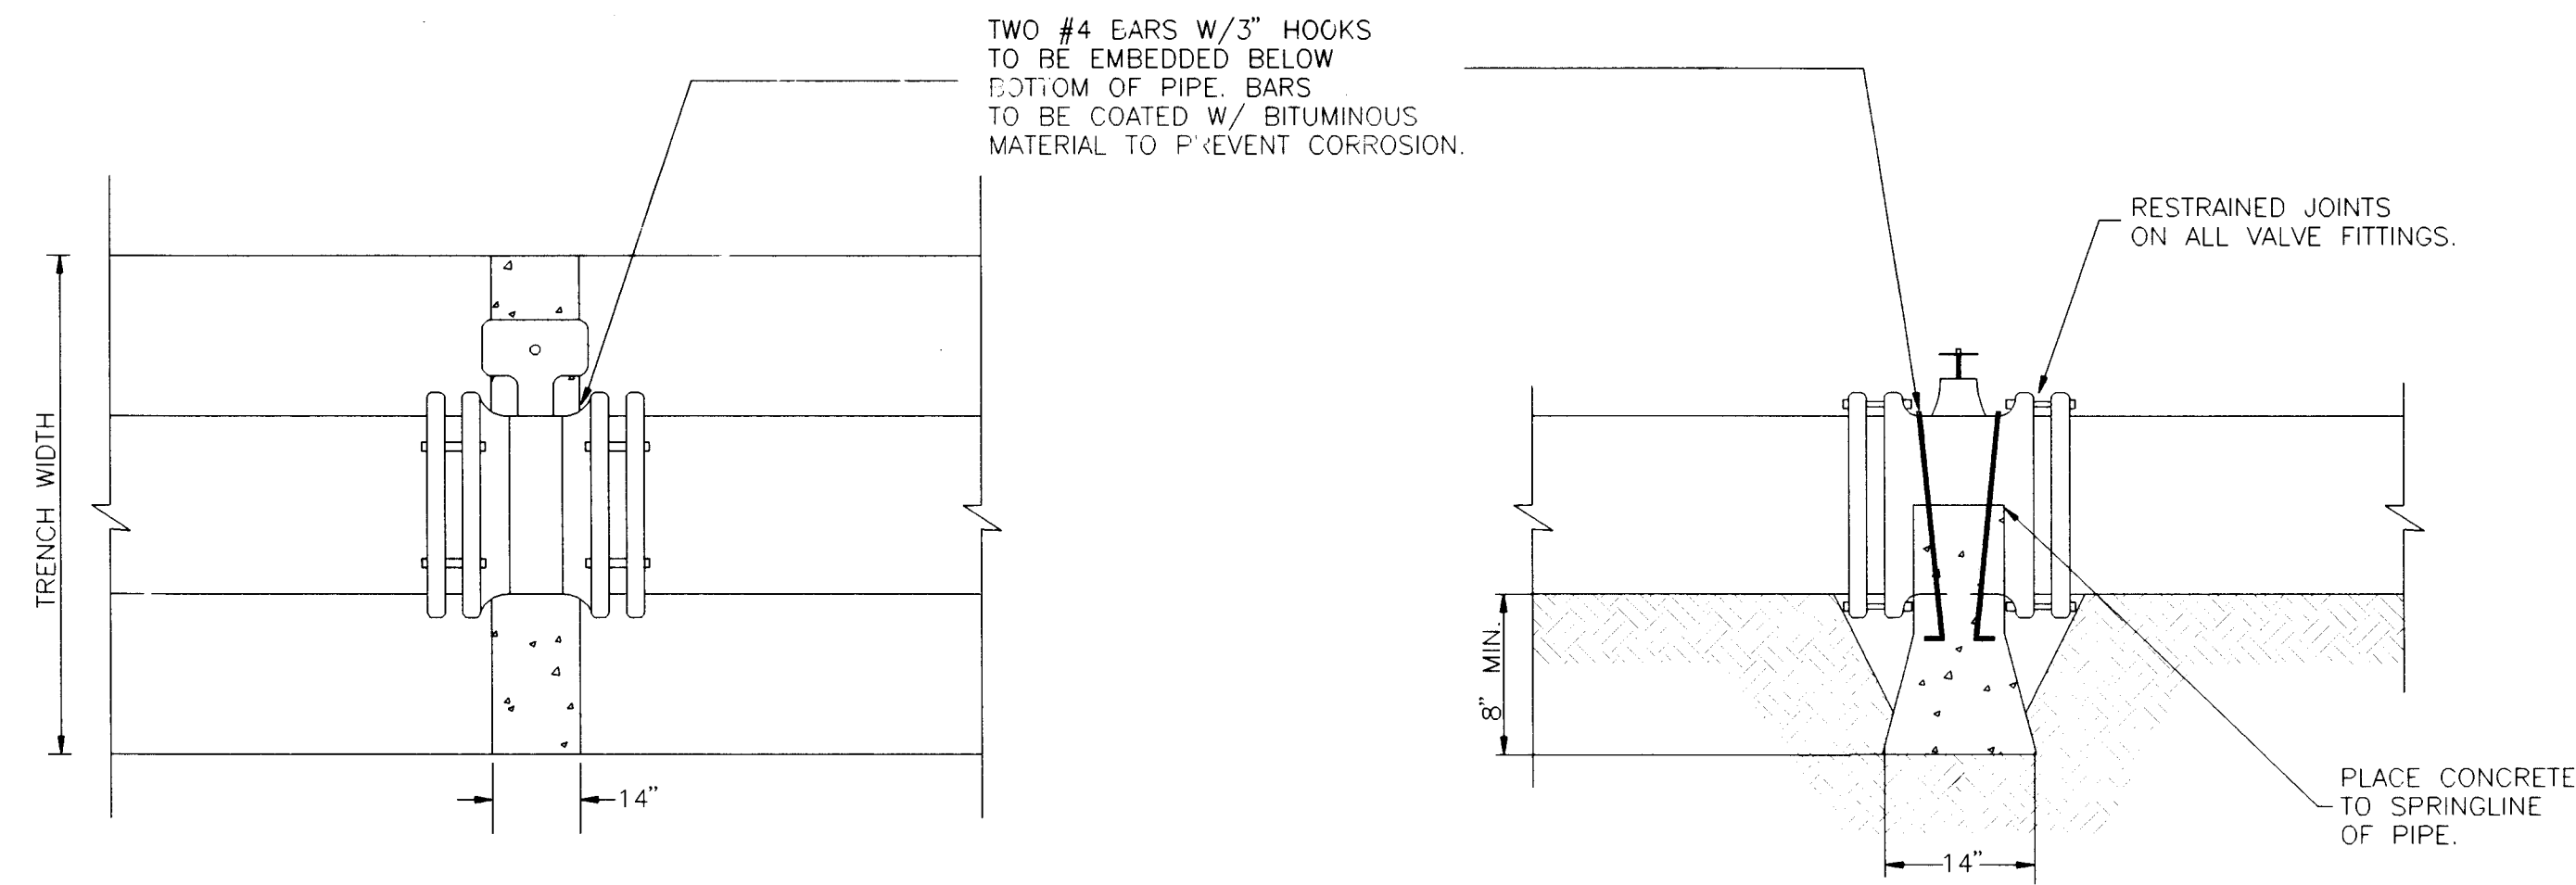


WATER VALVE CRADLE
NTS.

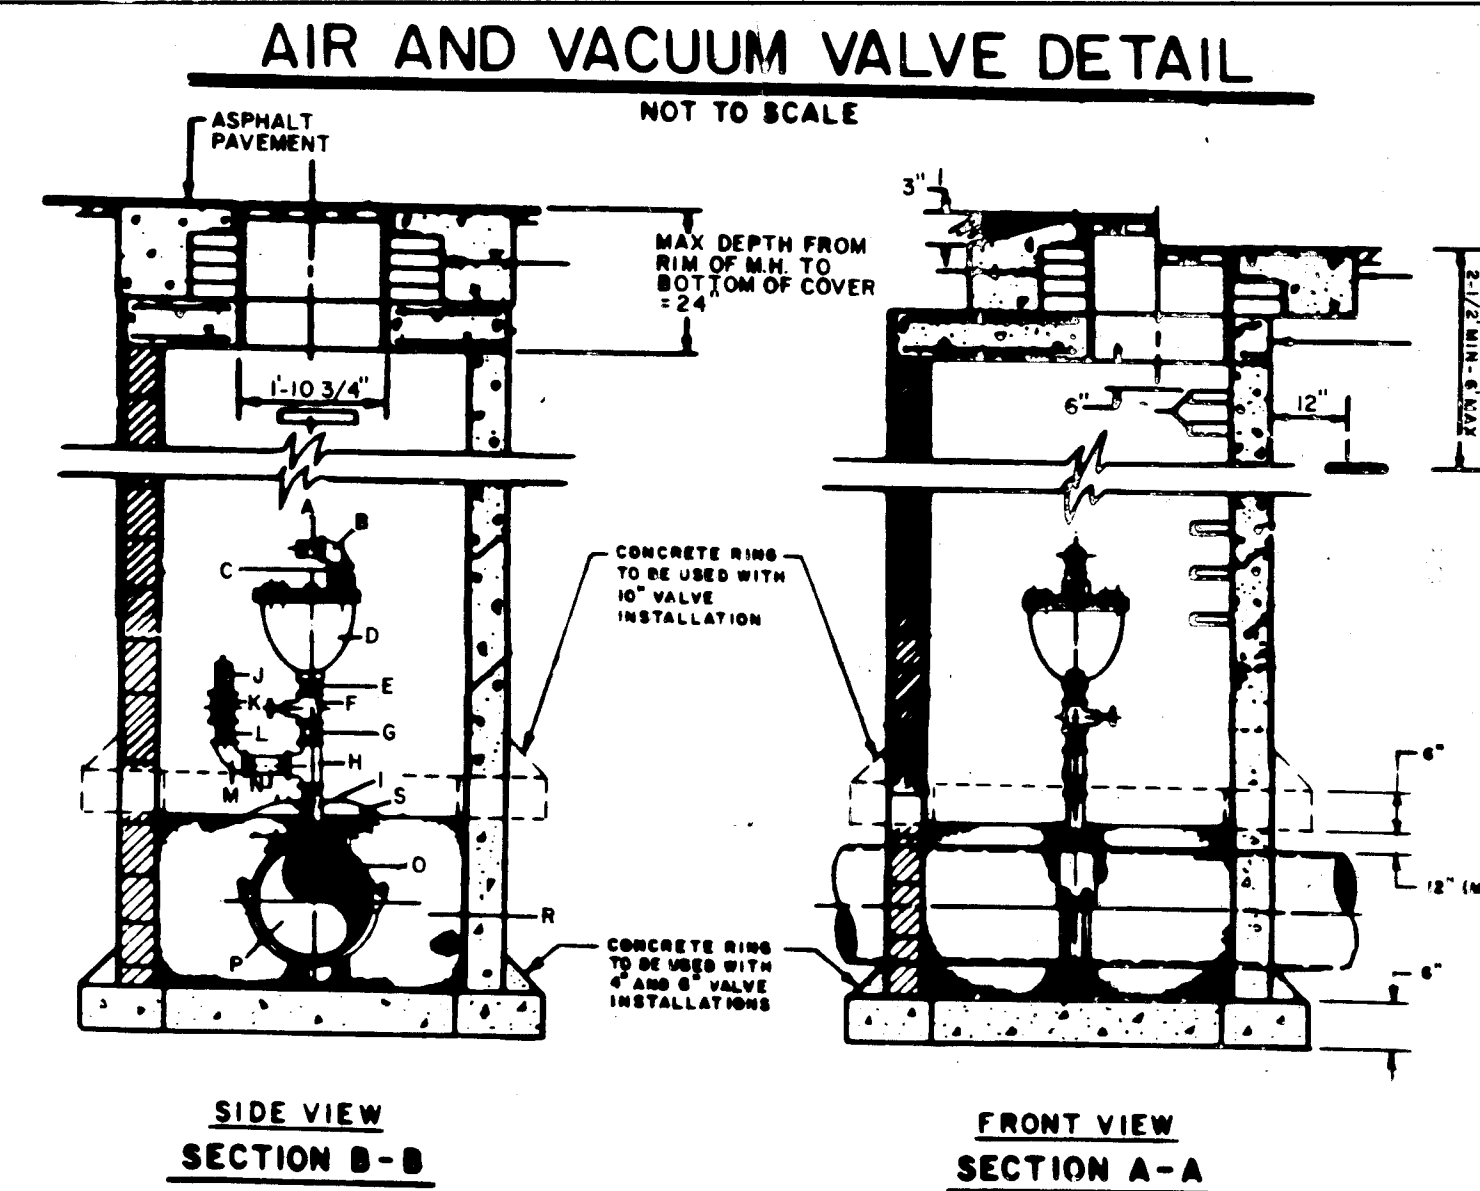


- CONSTRUCTION NOTES:**
- ALL PIPING AND FITTINGS SHALL BE SCH 40, THREADED GALV. IRON.
 - USE STANDARD C.I. M.H. RINGS AND COVERS. SEE C.O.A. FOR 2100 COVER MARKED "WATER".
 - FOR FUTURE ADJUSTMENT OF M.H. FRAME TO PAVEMENT GRADE, AND ADJUSTMENT RINGS OR GRADE, USE BRICK AS SHOWN ON SH. DETAILS. SEE C.O.A. FOR DIMS. 2101 AND 2102.


- MATERIALS LIST ***
- ① 2" THREADED NIPPLE
 - ② 90° ELBOW
 - ③ 6" THREADED NIPPLE
 - ④ COMBINATION AIR VALVE
 - ⑤ 8" THREADED NIPPLE
 - ⑥ GATE VALVE
 - ⑦ 2" THREADED NIPPLE
 - ⑧ 1" TEE
 - ⑨ 6" THREADED NIPPLE
 - ⑩ 2" THREADED NIPPLE FOR VENT AND HOSE CONNECTION
 - ⑪ GATE VALVE
 - ⑫ 6" THREADED NIPPLE
 - ⑬ 90° ELBOW
 - ⑭ 4" THREADED NIPPLE
 - ⑮ TAPPING SADDLE FOR P.V.C. OR D.I. PIPE THREADED OUTLET FOR CONC. CYL. PIPE
 - ⑯ WATER MAIN
 - ⑰ CONC. COLLAR USE IN ALL AREAS
 - ⑱ 1 CU. YD. 1" CLEAN GRAVEL
 - ⑲ CUT CONCRETE RING AND MANHOLE COME TO PROVIDE A MINIMUM 4" CLEARANCE AROUND WATER MAIN
 - * SIZES ARE DETERMINED BY SPECIFIC AIR AND VACUUM VALVE TO BE INSTALLED.

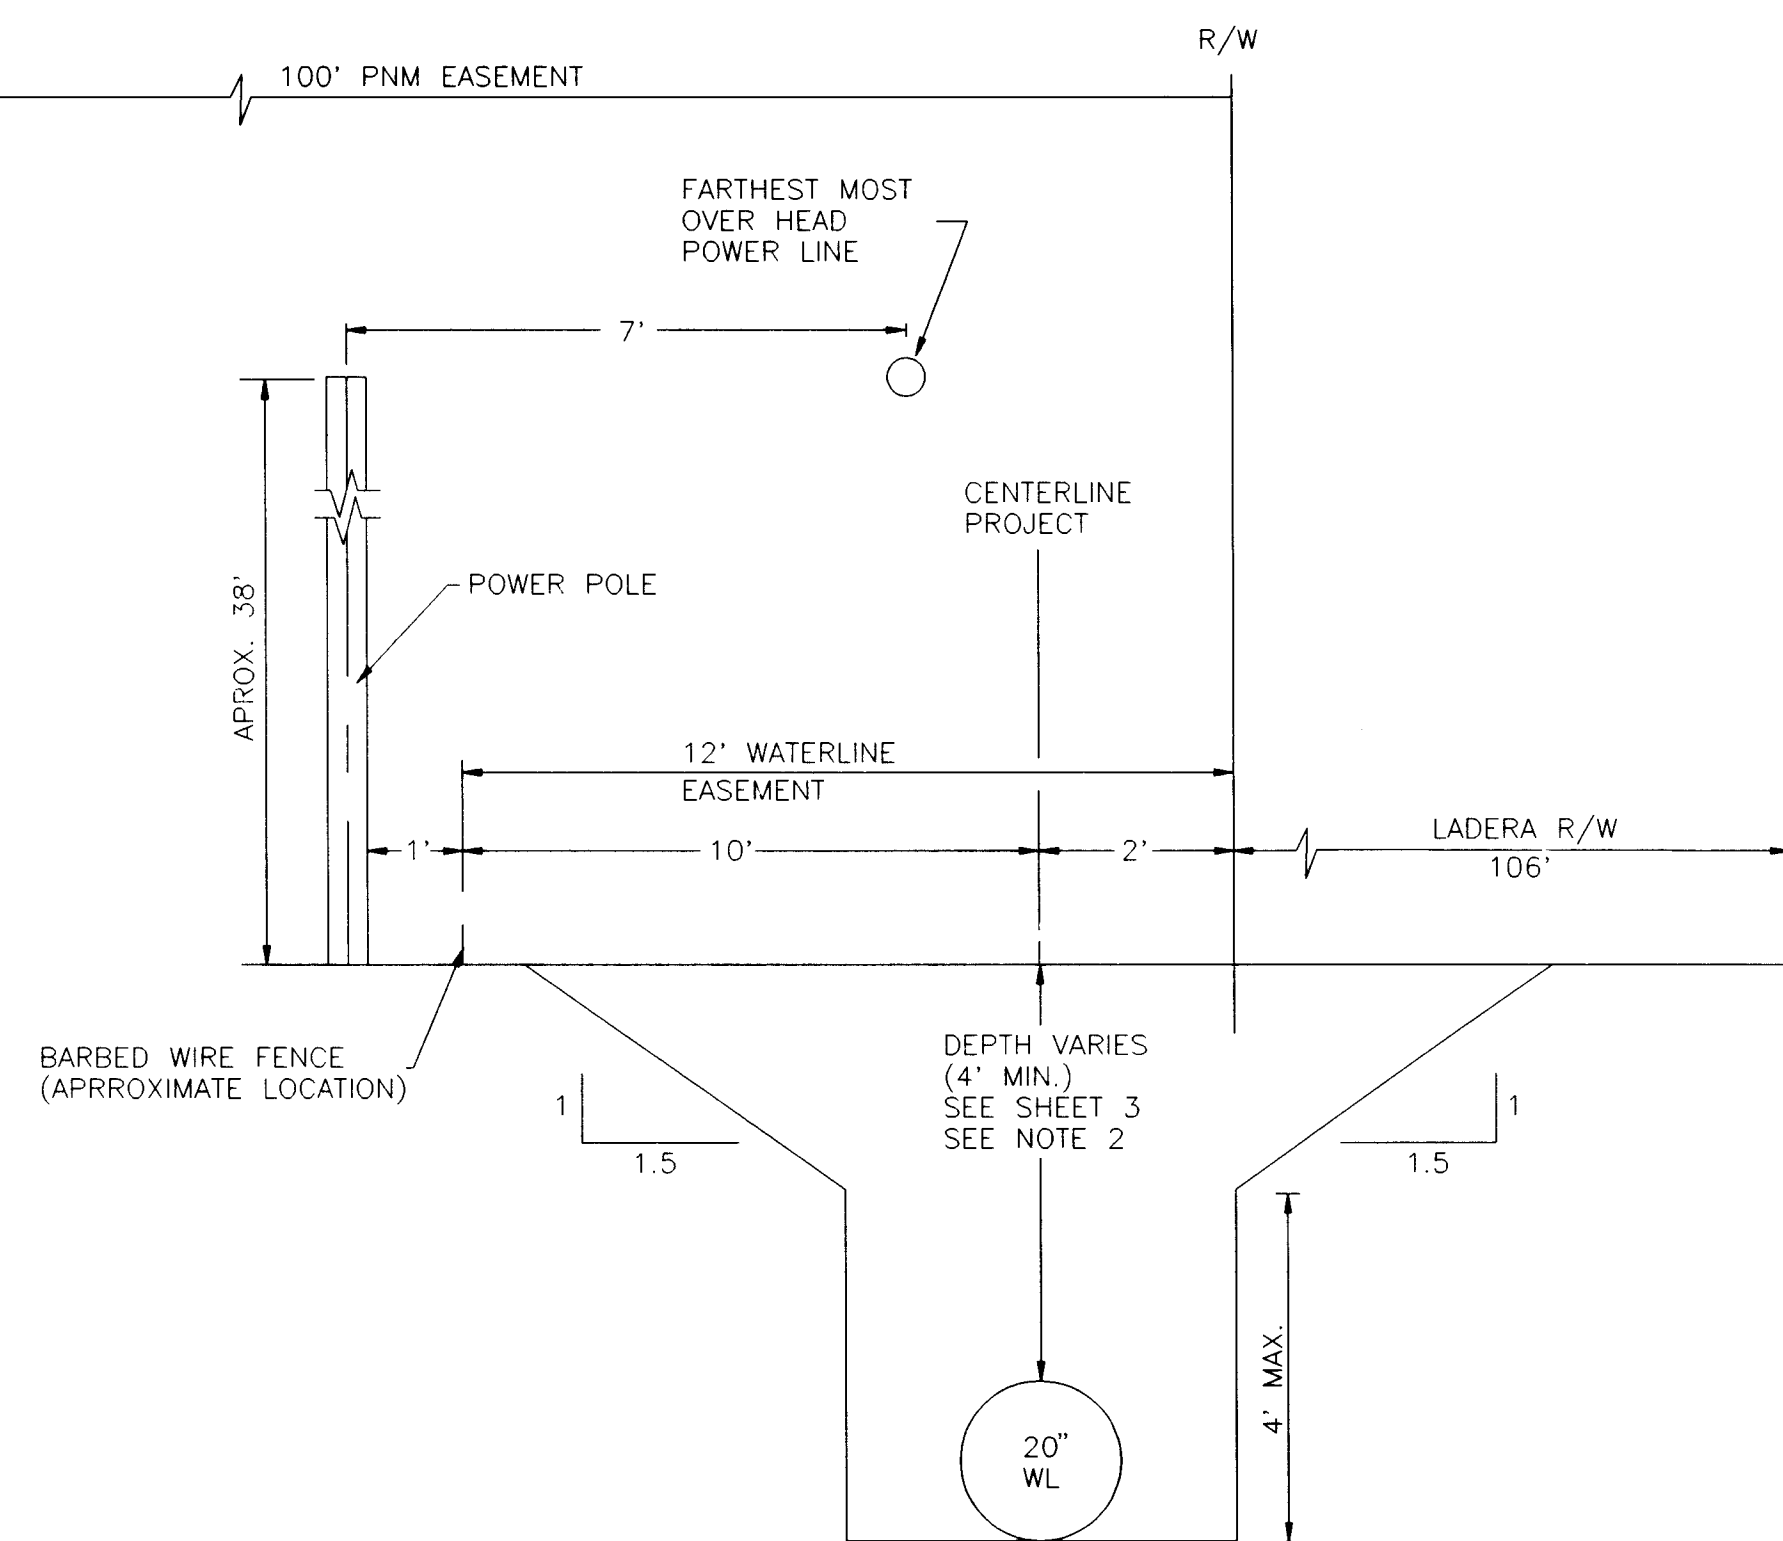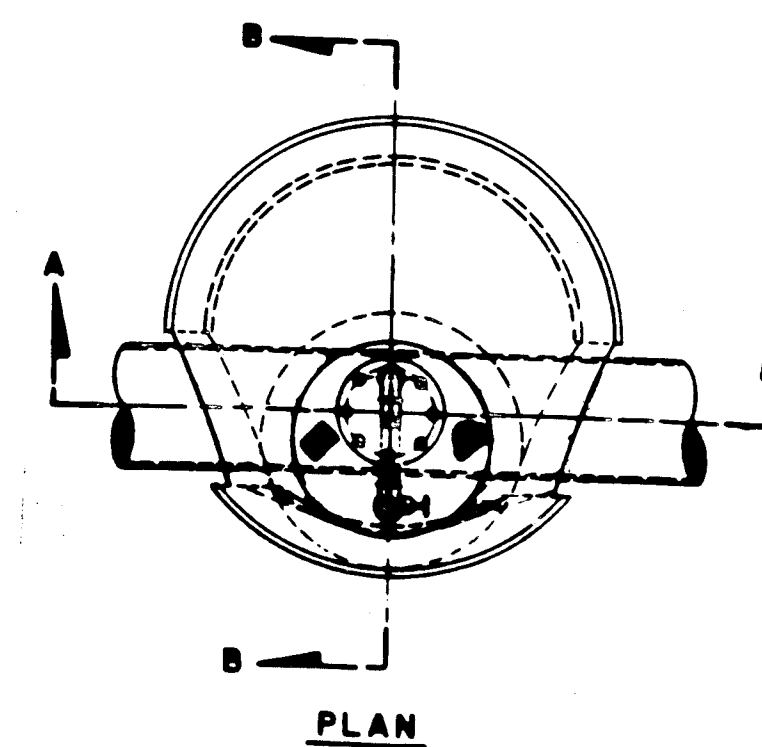


CROSS-SECTION AT POWER POLES
NTS.

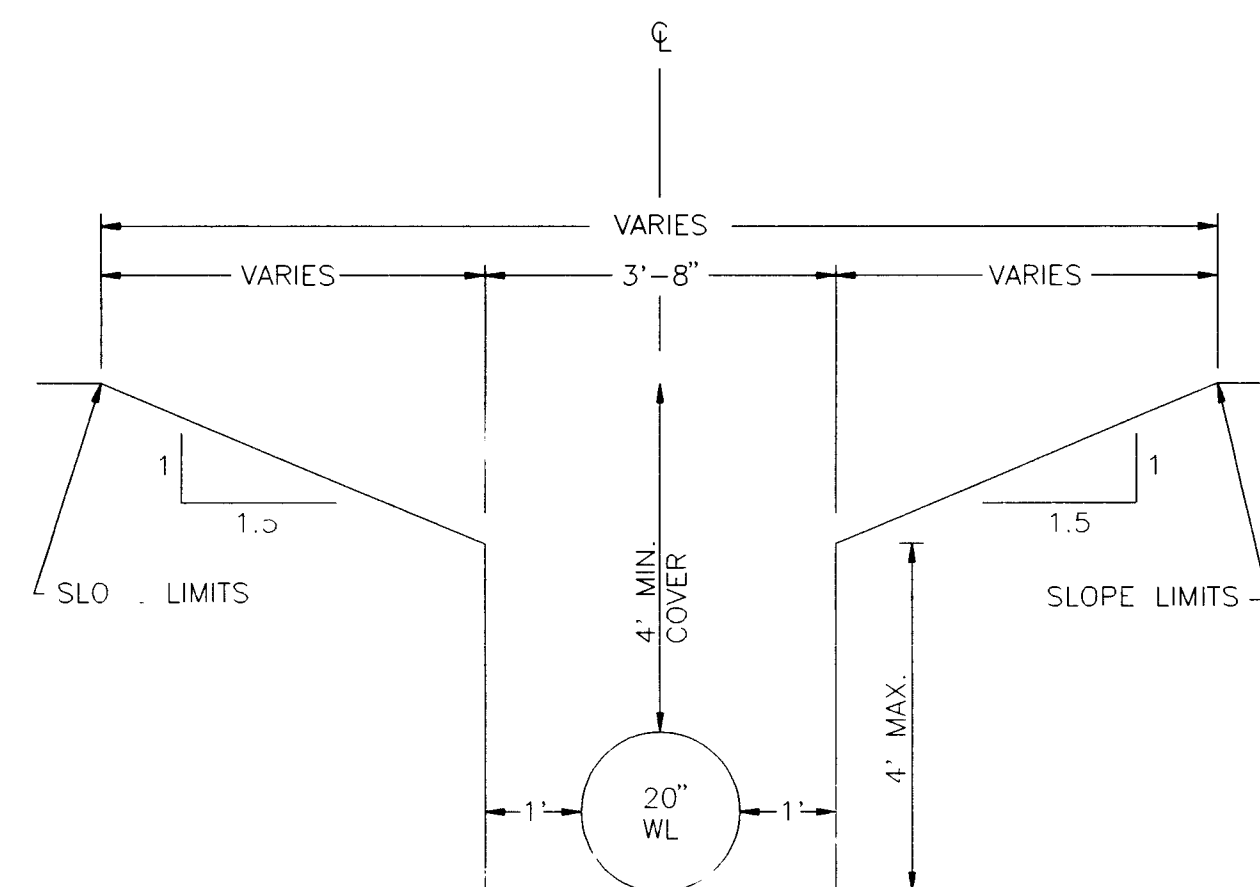

TYPICAL TRENCH CROSS-SECTION
NTS.

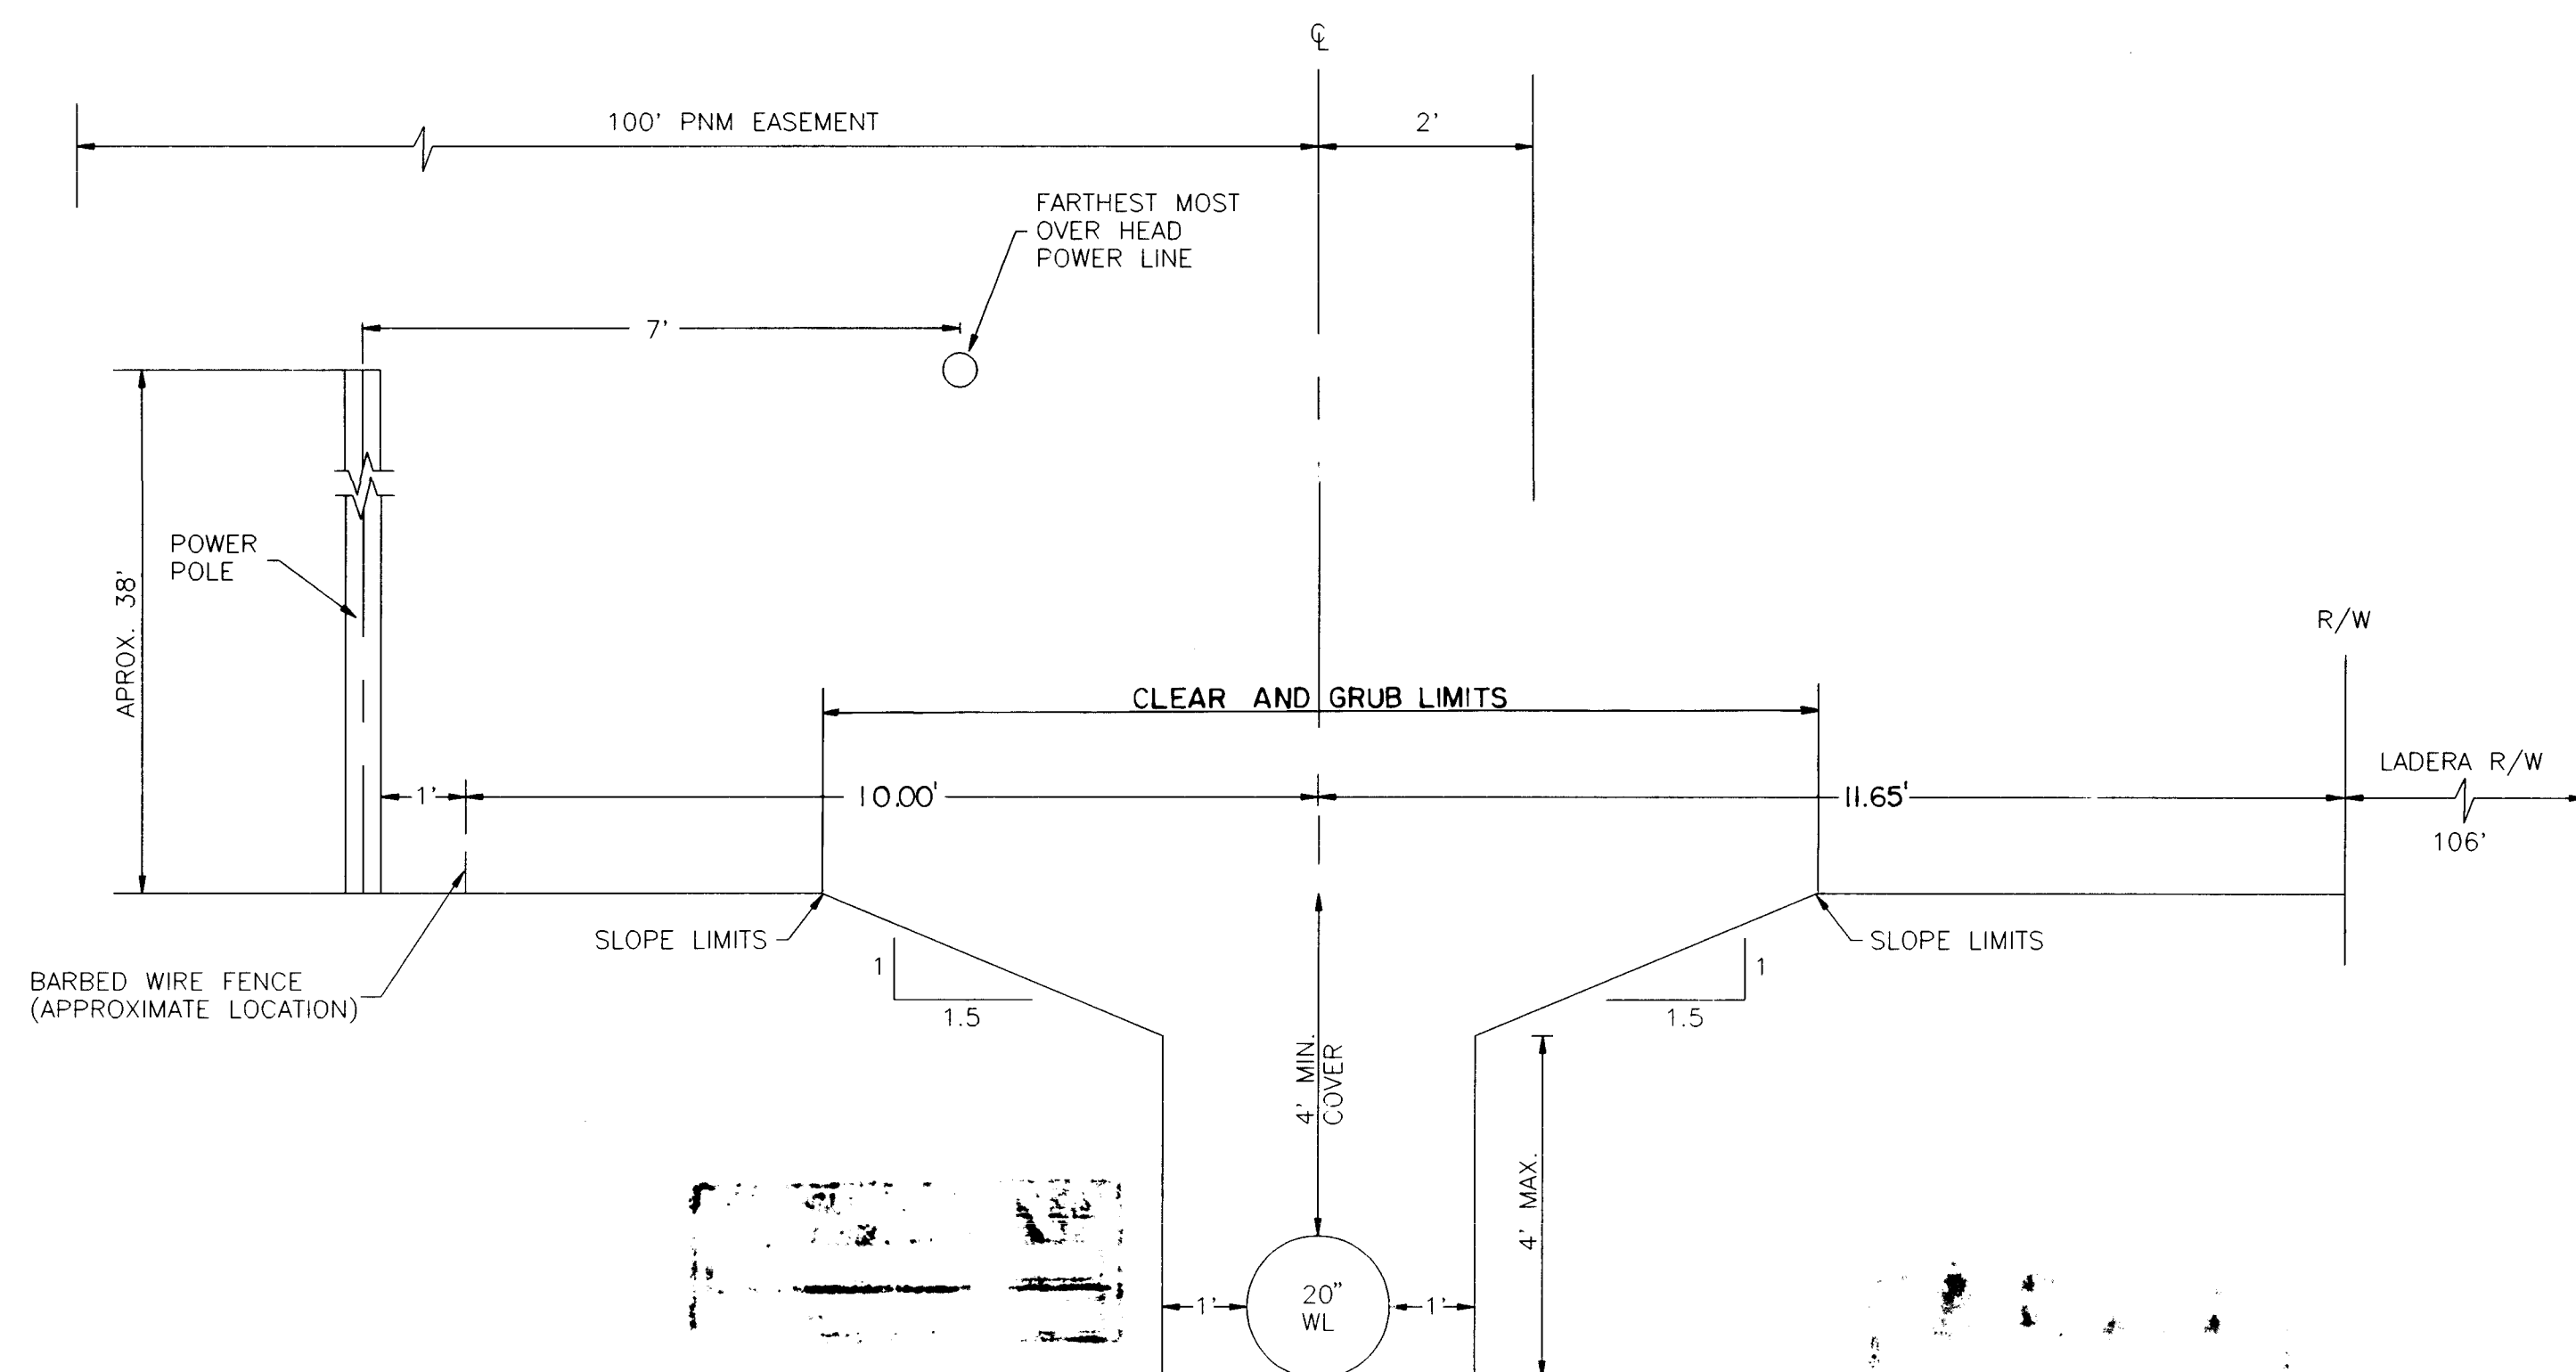

CROSS-SECTION AT LAST POWER POLE
NTS.

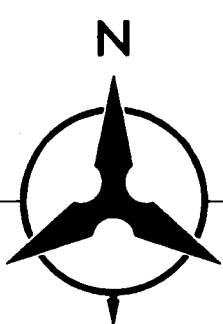

NOTES:

- COST OF WATER VALVE CRADLE SHALL BE INCIDENTAL TO THE COST OF THE PROJECT.
- CONTRACTOR SHALL PROVIDE TRENCH SLOPE PROTECTION FROM STATION 11+25 TO 12+50.

AS-BUILT INFORMATION		BENCH MARKS		SURVEY INFORMATION		ENGINEER'S SEAL	
CONTRACTOR	DATE	BOHANNAN & HUSTON BRASS CAP	STAMPED "BH-40"	FIELD NOTES	DATE	NO.	BY
BOHANNAN-HUSTON	8/97	BOHANNAN-HUSTON	8/97	BOHANNAN-HUSTON	8/97	1	BOHANNAN-HUSTON
INSPECTOR'S	DATE	GEO. GRAPHIC POSITION (NAD 1927)					
VERIFICATION BY	DATE	N.M. STATE PLANE COORDINATES					
CORRECTED BY	DATE	X=352,790.66 Y=1,492,346.53					
MICRO-FILM INFORMATION		GROUND-TO-GRID FACTOR=0.99967105					
RECORDED BY	DATE	ADG--001659					
NO.		NGVD 1929 ELEVATION= 5305.43					

BOHANNAN-HUSTON INC.
ENGINEERS • PLANNERS • PHOTOGRAMMETRISTS • SURVEYORS • LANDSCAPE ARCHITECTS
ALBUQUERQUE LAS CRUCES SANTA FE

CITY OF ALBUQUERQUE
PUBLIC WORKS DEPARTMENT
ENGINEERING DEVELOPMENT GROUP

COLLEGE TRUNK - MASTER PLAN
20" WATERLINE
MISCELLANEOUS DETAILS

CITY ENGINEER APPROVAL

LAST DESIGN UPDATE

MO./DAY/YR.

MO./DAY/YR.

DESIGN REVIEW COMMITTEE

CITY PROJECT NO. 5409.90

ZONE MAP NO. H-9; J-9

SHEET 12 OF 12

SCANNED BY BY LASON

1 2 3 4 5 6 7 8 9 10 11 12 13 14 15

20 21 22 23 24 25 26 27 28 29 30 31 32 33 34 35