

INFRASTRUCTURE IMPROVEMENTS

JO8 NO.: N08-100-5193//10-10-94
FILE: PBC-COV.DWG
REV: 06-07-96

PRELIMINARY PLAT FOR PARADISE BLUFF

COMPRISED OF TRACT A-2C, PARADISE BLUFF
AND TRACT "B", MARTIN APARTMENTS SITE

SITUATE WITHIN
TOWN OF ALAMEDA GRANT
PROJECTED SECTIONS 11 AND 12, T11N, R3E, NMPM
CITY OF ALBUQUERQUE, BERNALILLO COUNTY, NEW MEXICO

JANUARY, 1995

SITE DATA:

CASE NO.DRB-
TOTAL AREA.....39.60 ACRES
ZONE ATLAS NO.....B-11-Z, B-12-Z
EXISTING ZONING.....R1 AND RT
NO. OF LOTS CREATED.....141
NO. OF PARCELS CREATED.....4

GENERAL NOTES:

1. THE PURPOSE OF THIS PLAT IS TO VACATE 50' R/W ADJACENT TO TRACT B, MARTIN APARTMENTS, AND A 20' WATER AND SEWER EASEMENT, AND TO SUBDIVIDE 39.60 ACRES INTO 141 SINGLE FAMILY LOTS, 4 PARCELS, AND ADJOINING STREETS.
2. STREET RIGHTS-OF-WAY AND PAVEMENT WIDTHS HAVE BEEN REDUCED PER THE STANDARD REQUIREMENTS FOR INTERMITTENT PARKING DESIGN. ALL RESIDENTIAL LOTS SHALL HAVE A "P-1" SUFFIX ON THE FINAL PLAT (P-1 DENOTES INTERMITTENT PARKING FOR THE PURPOSE OF DETERMINING STREET WIDTHS). THE P-1 SUFFIX TO LOT NUMBERS DESIGNATES SPECIAL ON-SITE PARKING CRITERIA WHICH JUSTIFIED THE CITY ALLOWING REDUCED STREET WIDTHS IN THIS SUBDIVISION. SPECIFICALLY, THE PARKING DENSITY CATEGORY OF "INTERMITTENT" IS MET BY EACH LOT PROVIDING 4 PARKING SPACES (INCLUDING THE GARAGE) FOR 3.4 BEDROOMS. ALL DWELLINGS WILL HAVE 2-4 BEDROOMS AND 2-CAR ATTACHED GARAGES WITH 2-CAR DRIVEWAYS.
3. MINIMUM DWELLING SETBACKS FOR LOTS ARE DEFINED IN THE ZONING CODE FOR RT AND R1 ZONING. LOTS SHOWN WITH ASTERISKS (*) MUST COMPLY WITH SOLAR SETBACK REQUIREMENTS.
4. MOUNTABLE CURBS TO BE USED ON ALL PUBLIC STREETS EXCEPT WHERE OTHERWISE REQUIRED BY DRAINAGE.
5. NO DIRECT DRIVEWAY ACCESS WILL BE ALLOWED FROM ANY LOT ADJACENT TO LILIENTHAL NW.
6. THIS PROPERTY IS WITHIN THE NEW MEXICO UTILITIES, INC. (NMU, INC.) FRANCHISE AREA. WATER AND SANITARY SEWER SYSTEMS CAPABILITIES ARE BASED ON NMU, INC.'S FACILITIES. NOT THE CITY OF ALBUQUERQUE. WATER AND SANITARY SEWER INFRASTRUCTURE IMPROVEMENTS MUST, HOWEVER, MEET THE CITY OF ALBUQUERQUE AND NMU, INC. DESIGN AND CONSTRUCTION STANDARDS.
7. PARCEL A TO BE DEDICATED TO THE CITY OF ALBUQUERQUE OPEN SPACE DIVISION.
8. PARCELS B, C, AND D ARE TO BE OWNED AND MAINTAINED BY THE HOMEOWNER'S ASSOCIATION. PARCELS B AND G ARE ENCUMBERED BY A BLANKET DRAINAGE, SANITARY SEWER, AND WATER LINE EASEMENT.
9. A 55' PUBLIC DRAINAGE, SANITARY SEWER, AND WATERLINE EASEMENT WILL BE GRANTED ON LOT 20, BLOCK 3 OF EXECUTIVE ESTATES OF PARADISE HILLS BY SEPARATE DOCUMENT.
10. AN EXISTING 15 FOOT BUILDING HEIGHT LIMITATION PER PARADISE BLUFFS PLAT FILED FOR RECORD ON AUGUST 16, 1989 IN VOLUME C39, FOLIO 143 WHERE INDICATED. THIS LIMITATION CONFORMS WITH THE AREA DESCRIBED IN THE NORTHWEST MESA ESCARPMENT PLAN, AS AMENDED IN 1989. FOR THIS AREA, ALL APPLICABLE PROVISIONS OF THE NORTHWEST MESA ESCARPMENT PLAN WILL BE FOLLOWED.
11. 100-YEAR STORM RUNOFF DISCHARGES FROM EACH LOT SHALL NOT EXCEED THE VALUES GIVEN IN TABLE A. DRAINAGE STRUCTURES AT THE REAR LOT LINES OF THESE LOTS SHALL NOT BE BLOCKED, ALTERED, OR MODIFIED IN ANY WAY, BUT SHALL BE OPEN AT ALL TIMES TO CONVEY STORM RUNOFF AS DESIGNED.
12. DRAINAGE STRUCTURES IN THE DRAINAGE EASEMENT ON LOTS 65 & 76, BLOCK A SHALL NOT BE OBSTRUCTED, ALTERED, OR MODIFIED IN ANY WAY, BUT SHALL BE MAINTAINED BY THE LOT OWNER AND SHALL BE OPEN AT ALL TIMES TO CONVEY STORM RUNOFF AS DESIGNED.

NOTES:

1. UNLESS OTHERWISE NOTED ALL BOUNDARY CORNERS SHOWN THUS _____ SHALL BE MARKED BY A #5 REBAR WCAP STAMPED "P.L.S. #4972."
2. ALL STREET CENTERLINE MONUMENTATION SHALL BE INSTALLED AT ALL CENTERLINE PC'S, PT'S ANGLE POINTS, AND STREET INTERSECTIONS AND SHOWN THUS _____ WILL BE MARKED BY A FOUR INCH (4") ALUMINUM CAP STAMPED "CITY OF ALBUQUERQUE CENTERLINE MONUMENTATION MARKET, DO NOT DISTURB, P.L.S.#4972."
3. BOUNDARY SHALL BE TIED TO THE NEW MEXICO STATE PLANE COORDINATE SYSTEM AS SHOWN.
4. BASIS OF BEARING SHALL BE NEW MEXICO STATE PLANE GRID BEARINGS.
5. ALL DISTANCES SHALL BE GROUND DISTANCES.
6. MAN-HOLES WILL BE OFFSET AT ALL POINTS OF CURVATURE, POINTS OF TANGENCY, STREET INTERSECTIONS, AND ALL OTHER ANGLE POINTS TO ALLOW USE OF CENTERLINE MONUMENTATION.

APPROVED FOR MONUMENTATION AND STREET NAMES

Bill Chel
CITY SURVEYOR

010495
DATE

DEVELOPER

ATTN: MICHAEL NASH
BAILE DEL SOL
200 MARCY ST. #129
SANTA FE, N.M. 87504-1984
PHONE: (505) 237-2017

SURVEY

ATTN: CLIFF SPIROCK
COMMUNITY SCIENCES CORPORATION
P.O. BOX 1328
CORRALES, NEW MEXICO, 87048
PHONE: (505) 897-0000

ENGINEER

ATTN: BILL TOWERS/JOE KELLEY
CHAVEZ-GRIEVES ENGINEERS
5639 JEFFERSON STREET NE
ALBUQUERQUE, NEW MEXICO, 87109
PHONE: (505) 344-4080



LOT, BLOCK	DISCHARGE (CFS)	LOT, BLOCK	DISCHARGE (CFS)
4, A	0.25	40, A	0.75
5, A	0.80	41, A	0.77
6, A	0.27	42, A	0.79
7, A	0.25	43, A	0.74
8, A	0.30	44, A	0.75
9, A	0.40	45, A	0.80
10, A	0.44	46, A	0.90
11, A	0.45	47, A	0.80
12, A	0.63	48, A	0.76
13, A	0.50	49, A	0.75
14, A	0.62	50, A	0.75
15, A	0.59	51, A	0.78
16, A	0.59	52, A	0.78
17, A	0.15	53, A	0.78
18, A	0.12	54, A	0.78
19, A	0.10	55, A	0.78
20, A	0.10	56, A	0.78
21, A	0.08	57, A	0.78
22, A	0.23	58, A	0.72
23, A	0.17	59, A	0.44
24, A	0.28	60, A	0.15
25, A	0.28	61, A	0.35
26, A	0.40	62, A	0.37
27, A	0.24	63, A	0.37
28, A	0.80	64, A	3.70

8. PARCELS B, C AND D ARE TO BE OWNED AND MAINTAINED BY THE HOMEOWNER'S ASSOCIATION. PARCEL B IS ENCUMBERED BY A 15' C.O.A. STORM DRAIN EASEMENT AND A 20' N.M.U.' SANITARY SEWER AND WATER LINE EASEMENT. PARCEL C IS ENCUMBERED BY A BLANKET SANITARY SEWER AND WATER LINE EASEMENT.
9. A 15' C.O.A. STORM DRAIN EASEMENT AND A 20' MINIMUM N.M.U.' SANITARY SEWER AND WATER LINE EASEMENT WILL BE GRANTED ON LOT 20, BLOCK 3 OF EXECUTIVE ESTATES OF PARADISE HILLS BY SEPARATE DOCUMENT.

EXECUTIVE ESTATES OF PARADISE HILLS (FILED 6-19-62, VOL. D3, FOL. 37)

VACATION REQUEST
20' WATER AND SEWER ESMT.
(BK MISC 397 FOLIO 675)

VACATION REQUEST
50' RIGHT-OF-WAY
TRACT B, MARTIN APARTMENTS
(FILED 6-5-74, VOL. D5, FOL. 38)

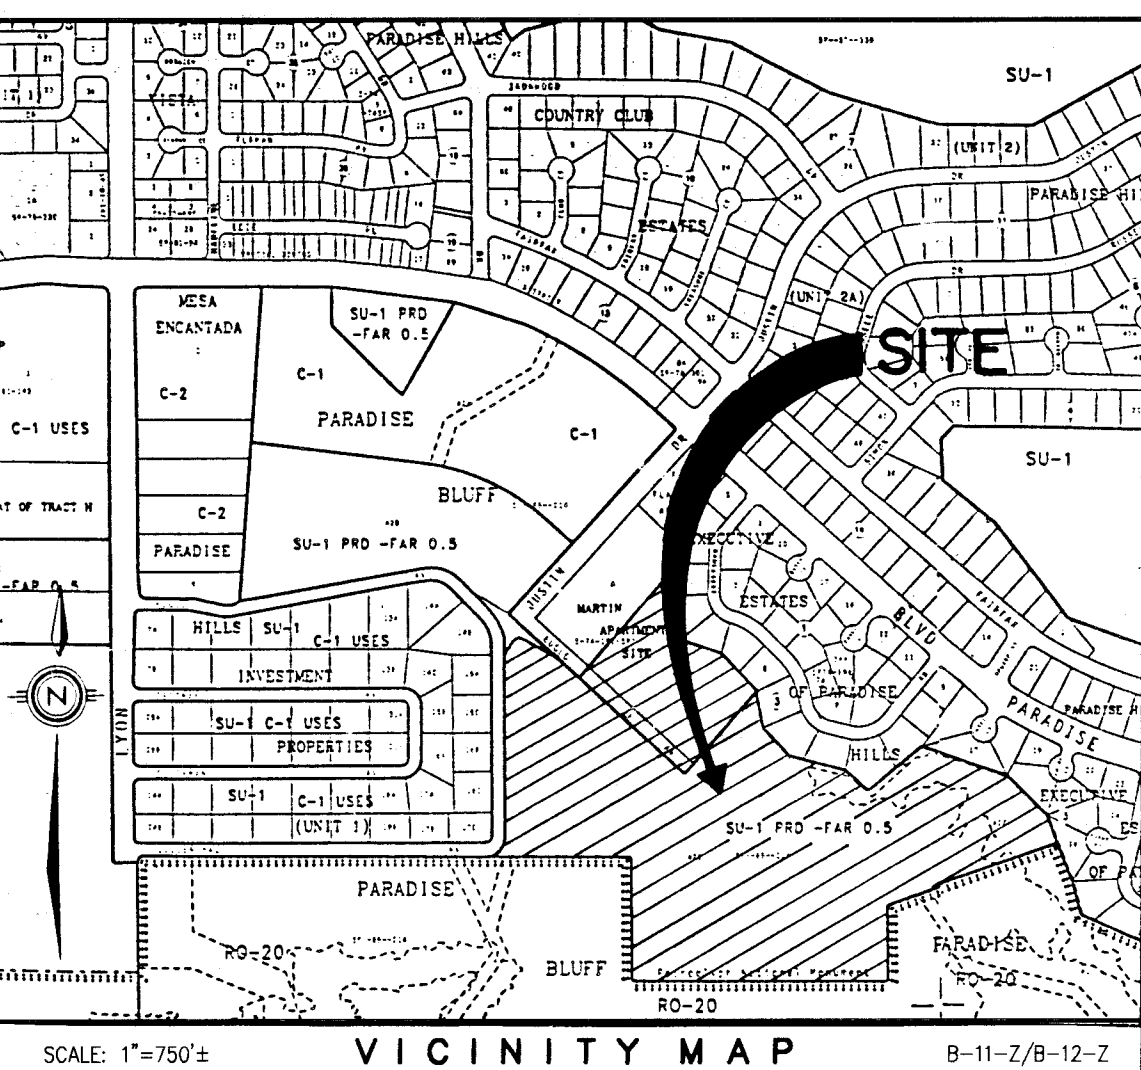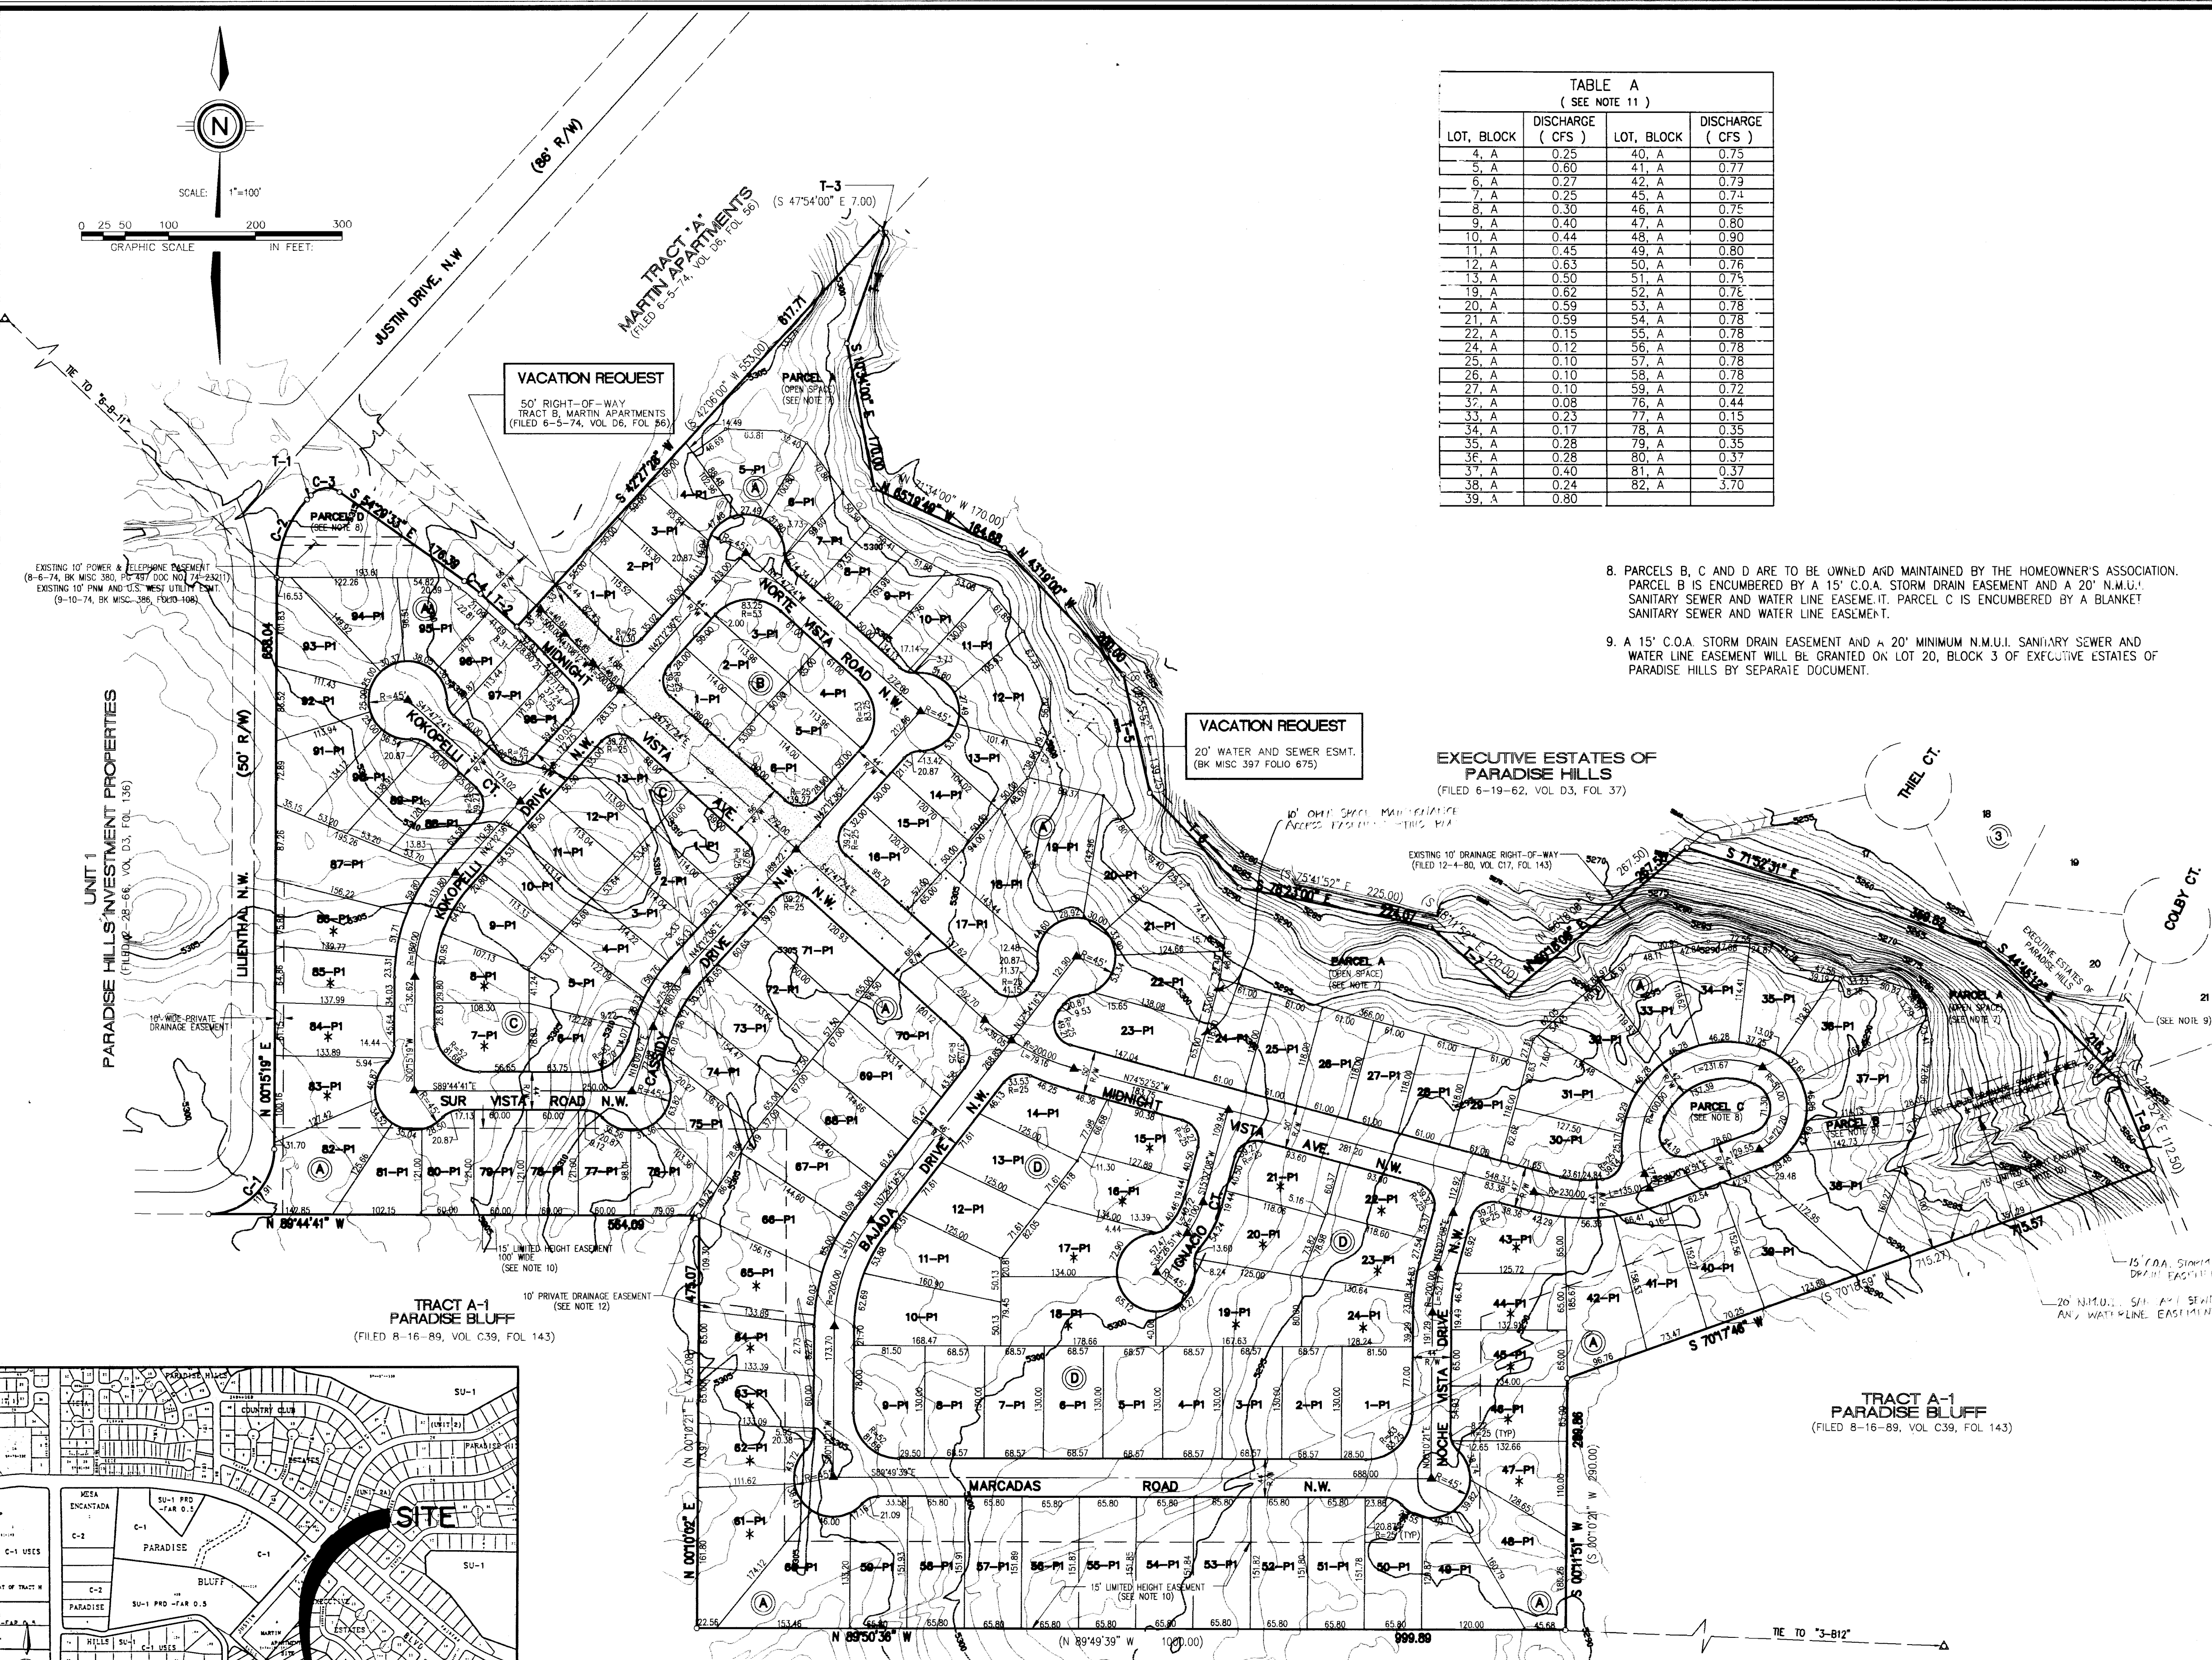

T-1	N 42°12'36" E	6.72
T-2	S 47°47'24" E	56.05
T-3	S 47°27'54" E	6.77
T-4	S 19°06'00" W	135.00
T-5	S 12°39'07" W	139.81
T-6	S 43°25'57" W	150.00
T-7	S 48°11'46" E	120.03
T-8	S 21°48'49" E	112.30

CURVE	RADIUS	ARC LENGTH	CURVE DELTA
C1	75.00	117.81	90°00'00"
C2	134.71	98.61	41°56'33"
C3	25.00	36.35	83°17'51"
C4	205.00	23.98	06°42'09"

TRACT A-1 PARADISE BLUFF (FILED 8-16-89, VOL. C39, FOL. 143)

REVISE 1-3-95

DATE: JANUARY, 1995
SCALE: 1"=100'
DESIGNED: R.D.Q.
DRAWN: D.E.R.
JOB NO.: 345-02-605

community
sciences
corporation

LAND PLANNING ENGINEERING SURVEYING
P.O. Box 1328 Corrales, N.M. 87048

ASB HAS NOT REVIEWED THIS DRAWING FOR CONFORMANCE WITH THE CITY OF ALBUQUERQUE STANDARD SPECIFICATIONS FOR PUBLIC WORKS CONSTRUCTION, 1986 EDITION, AS AMENDED THROUGH UPDATE #6.

FILE: PRC-NOTED.DWG
REV: 06-07-98-08

CIVIL CONSTRUCTION NOTES

GENERAL

CONTRACTOR IS RESPONSIBLE FOR OBTAINING ALL REQUIRED CONSTRUCTION PERMITS, INCLUDING A TOP SOIL DISTURBANCE PERMIT, PRIOR TO START OF CONSTRUCTION.

ALL WORK ON THIS PROJECT SHALL BE PERFORMED IN ACCORDANCE WITH APPLICABLE FEDERAL, STATE AND LOCAL LAWS, RULES AND REGULATIONS CONCERNING CONSTRUCTION SAFETY AND HEALTH.

REFERENCE MADE TO COA STD DWGS. REFER TO CITY OF ALBUQUERQUE STANDARD SPECIFICATIONS FOR PUBLIC WORKS PROJECTS, 1986 EDITION, AS AMENDED THROUGH UPDATE #6.

REFERENCE MADE TO APWA REFERS TO AMERICAN PUBLIC WORKS ASSOCIATION.

THE CONTRACTOR SHALL NOT INSTALL ITEMS AS SHOWN ON THE PLANS WHEN IT IS OBVIOUS THAT FIELD CONDITIONS ARE DIFFERENT THAN SHOWN IN THE DESIGN. SUCH CONDITIONS SHOULD BE BROUGHT TO THE ATTENTION OF THE ENGINEER. IN THE EVENT THE CONTRACTOR DOES NOT NOTIFY THE ENGINEER, THE CONTRACTOR ASSUMES FULL RESPONSIBILITY AND EXPENSE FOR ANY REVISIONS NECESSARY.

EXISTING IMPROVEMENTS WHICH ARE DAMAGED OR DISPLACED BY THE CONTRACTOR SHALL BE REMOVED AND REPLACED BY THE CONTRACTOR AT THE CONTRACTOR'S OWN EXPENSE. REPAIRS SHALL BE APPROVED BY THE OWNER PRIOR TO CONSTRUCTION OF THE REPAIRS. REPAIRS SHALL BE ACCEPTED BY THE OWNER PRIOR TO FINAL PAYMENT.

EXISTING FENCING THAT IS NOT DESIGNATED FOR REMOVAL SHALL NOT BE DISTURBED. ANY FENCING THAT IS DISTURBED OR ALTERED BY THE CONTRACTOR SHALL BE RESTORED TO ITS ORIGINAL CONDITION AT THE CONTRACTOR'S EXPENSE. IF THE CONTRACTOR WOULD LIKE TO REMOVE FENCING TO FACILITATE CONSTRUCTION OPERATIONS, THIS MAY BE DONE WITH THE OWNER'S PERMISSION, AND THE CONTRACTOR SHALL RESTORE THE FENCE TO ITS ORIGINAL CONDITION PRIOR TO THE CLOSE OF THE PROJECT. CONTRACTOR IS RESPONSIBLE FOR SECURITY OF THE SITE UNTIL THE FENCE IS REPLACED.

ALL PAVEMENTS, STRUCTURES, UTILITIES, VEGETATION AND DELETERIOUS MATERIAL SCHEDULED FOR REMOVAL SHALL BE DISPOSED OF OFFSITE BY, AND AT THE CONTRACTOR'S OWN EXPENSE IN ACCORDANCE WITH ALL GOVERNING AGENCIES.

THE CONTRACTOR MAY SELECT AN ON-SITE STAGING AREA FOR STORAGE OF EQUIPMENT AND MATERIAL. NO MATERIAL OR EQUIPMENT MAY BE STORED OR LEFT ON-SITE AT ANY OTHER LOCATION. THE OWNER ASSUMES NO LIABILITY FOR CONTRACTOR'S EQUIPMENT OR MATERIAL IN THE STAGING AREA. SECURITY SHALL BE THE RESPONSIBILITY OF THE CONTRACTOR.

WORK WITHIN CITY RIGHT-OF-WAY

CONTRACTOR SHALL NOTIFY THE ENGINEER NOT LESS THAN SEVEN (7) DAYS PRIOR TO STARTING WORK IN ORDER THAT THE CITY SURVEYOR MAY TAKE NECESSARY MEASURES TO INSURE THE PRESERVATION OF SURVEY MONUMENTS. CONTRACTOR SHALL NOT DISTURB PERMANENT SURVEY MONUMENTS WITHOUT THE CONSENT OF THE CITY SURVEYOR AND SHALL NOTIFY THE CITY SURVEYOR AND BEAR THE EXPENSE OF REPLACING ANY THAT MAY BE DISTURBED WITHOUT PERMISSION. REPLACEMENT SHALL BE DONE ONLY BY THE CITY SURVEYOR. WHEN A CHANGE IS MADE IN THE FINISHED ELEVATIONS OF THE PAVEMENT OF ANY ROADWAY IN WHICH A PERMANENT SURVEY MONUMENT IS LOCATED, CONTRACTOR SHALL, AT HIS EXPENSE, OBTAIN THE SERVICES OF THE CITY SURVEYOR TO ADJUST THE MONUMENT COVER TO THE NEW GRADE UNLESS OTHERWISE SPECIFIED. REFER TO SECTION 4.4 OF THE GENERAL CONDITIONS OF THE STANDARD SPECIFICATIONS.

ALL CONSTRUCTION WITHIN CITY R.O.W. OR EASEMENTS MUST BE DONE FROM WORK ORDER DOCUMENTS APPROVED BY THE CITY OF ALBUQUERQUE.

CONTRACTOR IS RESPONSIBLE FOR OBTAINING ALL PERMITS TO CONSTRUCT FACILITIES WITHIN CITY RIGHT-OF-WAY.

ELECTRONIC MARKER DISCS SHALL BE PLACED IN ACCORDANCE WITH SECTION 170 OF THE CITY OF ALBUQUERQUE, STANDARD SPECIFICATIONS, PUBLIC WORKS CONSTRUCTION.

INSTALL NEW RESIDENTIAL PAVING IN ACCORDANCE WITH COA STANDARD DRAWING 2405, UNLESS OTHERWISE NOTED.

INSTALL NEW CURB AND GUTTER IN ACCORDANCE WITH COA STANDARD DRAWING 2415. ALL CURB AND GUTTER SHALL BE STANDARD 8" CURB AND GUTTER UNLESS OTHERWISE NOTED.

SIDEWALKS WILL BE INSTALLED IN FRONT OF INDIVIDUAL LOTS AS EACH LOT IS DEVELOPED. CONSTRUCT PER COA STANDARD DRAWING 2430.

INSTALL NEW WHEELCHAIR RAMPS AT ALL NEW CURB RETURNS IN ACCORDANCE WITH COA STANDARD DRAWINGS 2441 CASE II UNLESS OTHERWISE NOTED.

CONCRETE VALLEY GUTTERS AND FILLET PAVING, WHERE SHOWN, SHALL BE INSTALLED IN ACCORDANCE WITH COA STANDARD DRAWING 2420, ALTERNATE "B" AT STREET INTERSECTIONS, AND DRAWING 2421 AT KNUCKLES.

AN EXCAVATION/CONSTRUCTION PERMIT WILL BE REQUIRED BEFORE BEGINNING ANY WORK WITHIN CITY RIGHT-OF-WAY. AN APPROVED COPY OF THESE PLANS MUST BE SUBMITTED AT THE TIME OF APPLICATION FOR THIS PERMIT.

ALL WORK DETAILED ON THESE PLANS TO BE PERFORMED, EXCEPT AS OTHERWISE STATED OR PROVIDED HEREON, SHALL BE CONSTRUCTED IN ACCORDANCE WITH CITY OF ALBUQUERQUE STANDARD SPECIFICATIONS FOR PUBLIC WORKS CONSTRUCTION, 1986 EDITION UPDATE #6.

TWO WORKING DAYS PRIOR TO ANY EXCAVATION, CONTRACTOR MUST CONTACT LINE LOCATING SERVICE, (260-1990) FOR LOCATION OF EXISTING UTILITIES.

THE CONTRACTOR SHALL PROVIDE ALL REQUIRED TRAFFIC CONTROL PLANS

ALL SIGNS, BARRICADES, CHANNELIZATION DEVICES, SIGN FRAMES AND ERECTION OF SUCH DEVICES SHALL CONFORM TO THE REQUIREMENTS OF "MANUAL OF UNIFORM TRAFFIC CONTROL DEVICES FOR STREETS AND HIGHWAYS" LATEST EDITION. ALL ADVANCE WARNING SIGNS SHALL BE EQUIPPED WITH TYPE A FLASHING WARNING LIGHTS. ALL CHANNELIZATION DEVICES SHALL BE EQUIPPED WITH TYPE C STEADY BURN WARNING LIGHTS.

SOILS

UNLESS OTHERWISE SPECIFIED SUBGRADE SOILS AND STRUCTURAL FILL MATERIALS SHALL BE COMPACTED TO THE FOLLOWING PERCENTAGES OF THE ASTM D 1557 MAXIMUM DENSITY.

MATERIAL	PERCENT COMPACTION
STRUCTURAL FILL IN THE BUILDING AREA	95
SUBBASE FOR SLAB SUPPORT	95
MISCELLANEOUS BACKFILL BELOW STRUCTURAL FILL OR ROAD PAVEMENT	95
MISCELLANEOUS BACKFILL BELOW UNPAVED, NON-BUILDING AREAS	90
ROAD PAVEMENT SUBGRADE	95
SIDEWALK SUBGRADE	90
CURB AND GUTTER SUBGRADE	95

UTILITIES

IF ANY UTILITY LINES, PIPELINES, OR UNDERGROUND UTILITY LINES ARE SHOWN ON THESE DRAWINGS, THEY ARE SHOWN IN AN APPROXIMATE MANNER ONLY, AND SUCH LINES MAY EXIST WHERE NONE ARE SHOWN. IF ANY SUCH EXISTING LINES ARE SHOWN, THE LOCATION IS BASED UPON INFORMATION PROVIDED TO THE ENGINEER BY OTHERS, AND THE INFORMATION MAY BE INCOMPLETE, OR MAY BE OBSOLETE BY THE TIME CONSTRUCTION COMMENCES. THE CONTRACTOR SHALL VERIFY THE LOCATION OF ANY UTILITY LINE, PIPELINE OR UNDERGROUND UTILITY LINE IN OR NEAR THE AREA OF THE WORK IN ACCORDANCE WITH CHAPTER 62, ARTICLE 14-1 THROUGH 14-8, NMSA 1978.

THE EXISTING UTILITIES DEPICTED ON THESE PLANS WERE DERIVED FROM INFORMATION PROVIDED TO THE ENGINEER BY OTHERS. PRIOR TO CONSTRUCTION, THE CONTRACTOR SHALL EXCAVATE AND VERIFY THE HORIZONTAL AND VERTICAL LOCATIONS OF PERTINENT UTILITIES. SHOULD A CONFLICT EXIST, THE CONTRACTOR SHALL NOTIFY THE ENGINEER SO THAT THE CONFLICT CAN BE RESOLVED WITH A MINIMUM AMOUNT OF DELAY. CONTRACTOR IS TO EXERCISE DUE CARE TO AVOID DISTURBING ANY EXISTING UNDERGROUND UTILITIES. IT SHALL BE THE CONTRACTOR'S RESPONSIBILITY TO COORDINATE ANY POTENTIAL DISRUPTIONS IN UTILITY SERVICE WITH THE UTILITY COMPANIES AFFECTED AT LEAST 24 HOURS PRIOR TO THE DISRUPTION.

CONTRACTOR SHALL EXPOSE AND VERIFY INVERT ELEVATIONS OF RELEVANT SANITARY SEWER LINES BEFORE SETTING ANY NEW INVERTS. SHOULD INVERTS DIFFER MORE THAN 0.20' FROM THOSE SHOWN ON THE PLANS, THE ENGINEER SHALL BE NOTIFIED TO DETERMINE ANY RESULTING CHANGES IN DESIGN.

CONTRACTOR SHALL COORDINATE WITH NEW MEXICO UTILITIES, INC. (896-2661) THREE WORKING DAYS IN ADVANCE OF ANY WORK THAT MAY AFFECT EXISTING PUBLIC WATER OR SEWER UTILITIES.

EXISTING VALVES TO BE OPERATED BY NMUI PERSONNEL ONLY. CONTRACTOR SHALL CONTACT NEW MEXICO UTILITIES, INC. (896-2661) THREE DAYS PRIOR TO NEEDING VALVES TURNED ON OR OFF.

MINIMUM DEPTH OF COVER: WATER = 48" SEWER = 24" GAS = 24".

CONTRACTOR SHALL RECORD DATA ON ALL UTILITY LINES AND ACCESSORIES AS REQUIRED BY NEW MEXICO UTILITIES, INC. (896-2661) FOR THE PREPARATION OF "AS CONSTRUCTED" DRAWINGS. CONTRACTOR SHALL NOT COVER UTILITY LINES AND ACCESSORIES UNTIL ALL DATA HAS BEEN RECORDED.

SANITARY SEWER LINES SHALL BE PVC SDR-35. WATER LINES SHALL BE PVC C-900.

TYPE "C" MANHOLES SHALL BE INSTALLED IN ACCORDANCE WITH COA STANDARD DRAWING 2101.

TYPE "E" MANHOLES SHALL BE INSTALLED IN ACCORDANCE WITH COA STANDARD DRAWING 2102.

TYPE "A" STORM INLETS SHALL BE INSTALLED IN ACCORDANCE WITH COA STANDARD DRAWING 2201.

TYPE "B" STORM INLETS SHALL BE INSTALLED IN ACCORDANCE WITH COA STANDARD DRAWING 2203.

TYPE "C" STORM INLETS SHALL BE INSTALLED IN ACCORDANCE WITH COA STANDARD DRAWING 2205.

TYPE "D" STORM INLETS SHALL BE INSTALLED IN ACCORDANCE WITH COA STANDARD DRAWING 2206.

ALL INLETS ON GRADE SHALL HAVE AN ALTERNATE GRATE IN ACCORDANCE WITH COA STANDARD DRAWING 2221. ALL INLETS AT A LOW POINT SHALL HAVE A STANDARD GRATE IN ACCORDANCE WITH COA STANDARD DRAWING 2220.

INSTALL NEW GATE VALVES WITH TYPE "A" VALVE BOX IN ACCORDANCE WITH COA STANDARD DRAWING 2325.

INSTALL CONCRETE BLOCKING AT ALL NEW FITTINGS IN ACCORDANCE WITH COA STANDARD 2320.

INSTALL NEW FIRE HYDRANTS WITH BLOCKING AND GRAVEL AROUND WEEP HOLES IN ACCORDANCE WITH COA STANDARD DRAWINGS 2340 AND 2366.

SANITARY SEWER LINES ARE TO BE TESTED AFTER INSTALLATION OF WATER LINES.

ALL WATERLINES SHALL BE PVC (C-900) UNLESS OTHERWISE NOTED.

INSTALL NEW SAS SERVICE LINES IN ACCORDANCE WITH COA STANDARD DRAWING 2125.

CONCRETE ENCASEMENT SHALL BE INSTALLED IN ACCORDANCE WITH COA STANDARD DRAWING 2140. C-900 PVC PIPE WITH PRESSURE-TYPE JOINTS MAY BE INSTALLED AS AN ALTERNATE.

WATER AND SANITARY SEWER LINES SHALL BE INSTALLED PER NEW MEXICO UTILITIES INC. SPECIFICATIONS.

PAVING

WHEN ABUTTING NEW PAVEMENT TO EXISTING, CUT BACK EXISTING PAVEMENT TO A NEAT, STRAIGHT LINE AS REQUIRED TO REMOVE ANY BROKEN OR CRACKED PAVEMENT AND MATCH NEW PAVING TO EXISTING.

ALL UTILITIES AND UTILITY SERVICE LINES SHALL BE INSTALLED AND APPROVED PRIOR TO PAVING.

ALL WATER VALVE BOXES AND ELECTRICAL, TELEPHONE, TV & SEWER MANHOLES IN THE CONSTRUCTION AREA SHALL BE ADJUSTED TO FINISHED GRADE.

TRAFFIC CONTROL

THREE WORKING DAYS PRIOR TO BEGINNING OF CITY OF ALBUQUERQUE STREET CONSTRUCTION, CONTRACTOR SHALL SUBMIT A DETAILED CONSTRUCTION SCHEDULE TO THE CONSTRUCTION COORDINATION DIVISION. TWO WORKING DAYS PRIOR TO CONSTRUCTION, CONTRACTOR SHALL OBTAIN A BARRICADING PERMIT FROM THE CONSTRUCTION COORDINATION DIVISION. THE CONTRACTOR SHALL NOTIFY THE BARRICADE ENGINEER (768-2551) PRIOR TO OCCUPYING AN INTERSECTION. SEE SECTION 19 OF THE SPECIFICATIONS.

BIDDER'S INFORMATION:

TO ESTABLISH THE ROCK PROFILE SHOWN ON THESE DRAWINGS, A TRENCH WAS DUG AT THE CENTERLINE OF STREETS.

DIMENSIONS

ALL DIMENSIONS IN PARKING AREAS AND DRIVES ARE TO FACE OF CURB UNLESS OTHERWISE NOTED.

ALL STATIONING IS TO CENTERLINE OF RIGHT-OF-WAY UNLESS OTHERWISE NOTED.

ALL SLOPES AND GRADES ARE IN FEET/FOOT UNLESS OTHERWISE NOTED.

ELEVATIONS SHOWN FOR CURB AND GUTTER ARE FLOWLINE ELEVATIONS UNLESS OTHERWISE NOTED. SEE DETAIL SHEET FOR CURB HEIGHT ABOVE FLOWLINE.

EROSION CONTROL, ENVIRONMENTAL PROTECTION, AND STORM WATER POLLUTION PREVENTION PLAN

THE CONTRACTOR SHALL CONFORM TO ALL CITY, COUNTY, STATE, AND FEDERAL DUST AND EROSION CONTROL REGULATIONS. THE CONTRACTOR SHALL PREPARE AND OBTAIN ANY NECESSARY DUST OR EROSION CONTROL PERMITS FROM REGULATORY AGENCIES.

THE CONTRACTOR SHALL SECURE A "TOP SOIL DISTURBANCE PERMIT" FROM THE CITY OF ALBUQUERQUE ENVIRONMENTAL HEALTH DIVISION PRIOR TO BEGINNING CONSTRUCTION.

THE CONTRACTOR SHALL PROMPTLY REMOVE ANY MATERIAL EXCAVATED WITHIN THE PUBLIC RIGHT-OF-WAY TO KEEP IT FROM WASHING OFF THE PROJECT SITE.

THE CONTRACTOR SHALL ENSURE THAT NO SOIL ERODES FROM THE SITE ONTO OTHER PROPERTY BY CONSTRUCTING TEMPORARY EROSION CONTROL BERMS OR INSTALLING SILT FENCES AT THE PROPERTY LINES AND WETTING THE SOIL TO KEEP IT FROM BLOWING.

WATERING, AS REQUIRED FOR CONSTRUCTION AND DUST CONTROL, SHALL BE CONSIDERED INCIDENTAL TO CONSTRUCTION AND NO MEASUREMENT OR PAYMENT SHALL BE MADE THEREFOR. CONSTRUCTION AREAS SHALL BE WATERED FOR DUST CONTROL IN COMPLIANCE WITH GOVERNMENT ORDINANCES. THE CONTRACTOR SHALL BE RESPONSIBLE FOR LOCATING AND SUPPLYING WATER AS REQUIRED.

ANY AREAS DISTURBED BY CONSTRUCTION AND NOT COVERED BY LANDSCAPING OR AN IMPERVIOUS SURFACE SHALL BE REVEGETATED WITH RECLAMATION SEEDING PER COA SPEC. SECTION 1012.

THE CONTRACTOR SHALL PROPERLY HANDLE AND DISPOSE OF ALL ASPHALT REMOVED ON THE PROJECT BY HAULING TO AN APPROVED LANDFILL IN ACCORDANCE WITH THE REQUIREMENTS OF THE NEW MEXICO SOLID WASTE ACT.

ALL WASTE PRODUCTS FROM THE CONSTRUCTION SITE, INCLUDING ITEMS DESIGNED FOR REMOVAL, CONSTRUCTION WASTE, CONSTRUCTION EQUIPMENT WASTE PRODUCTS (OIL, GAS, TIRES, ETC.), GARBAGE, GRUBBING, EXCESS CUT MATERIAL, VEGETATIVE DEBRIS, ETC. SHALL BE APPROPRIATELY DISPOSED OF OFF-SITE AT NO ADDITIONAL COST TO THE OWNER. IT SHALL BE THE CONTRACTORS RESPONSIBILITY TO OBTAIN ANY PERMITS REQUIRED FOR HAUL OR DISPOSAL OF WASTE PRODUCTS. IT SHALL BE THE CONTRACTOR'S RESPONSIBILITY TO ENSURE THAT THE WASTE DISPOSAL SITE COMPLIES WITH GOVERNMENT REGULATIONS REGARDING THE ENVIRONMENT, ENDANGERED SPECIES, AND ARCHAEOLOGICAL RESOURCES.

THE CONTRACTOR SHALL BE RESPONSIBLE FOR THE CLEAN-UP AND REPORTING OF SPILLS OF HAZARDOUS MATERIALS ASSOCIATED WITH THE CONSTRUCTION SITE. HAZARDOUS MATERIALS INCLUDES GASOLINE, DIESEL FUEL, MOTOR OIL, SOLVENTS, CHEMICALS, PAINT, ETC. WHICH MAY BE A THREAT TO THE ENVIRONMENT. THE CONTRACTOR SHALL REPORT THE DISCOVERY OF PAST OR PRESENT SPILLS TO THE NEW MEXICO ENVIRONMENT DEPARTMENT EMERGENCY RESPONSE AT 1-505-822-1558 OR 1-800-219-6157.

THE CONTRACTOR SHALL COMPLY WITH ALL APPLICABLE REGULATIONS CONCERNING SURFACE AND UNDERGROUND WATER. CONTACT WITH SURFACE WATER BY CONSTRUCTION EQUIPMENT AND PERSONNEL SHALL BE MINIMIZED. EQUIPMENT MAINTENANCE AND REFUELING OPERATIONS SHALL BE PERFORMED IN AN ENVIRONMENTALLY SAFE MANNER IN COMPLIANCE WITH GOVERNMENT REGULATIONS.

THE AIR POLLUTION CONTROL REGULATIONS OF THE ALBUQUERQUE/BERNALILLO COUNTY AIR QUALITY CONTROL BOARD (505-768-2638) LIMIT THE EMISSIONS OF PARTICULATES AND THE USE OF CUTBACK ASPHALT. THE CONTRACTOR SHALL APPRISE HIMSELF OF THESE REGULATIONS PRIOR TO BIDDING AND PERFORMING THE WORK.

THE CONTRACTOR SHALL COMPLY WITH ALL APPLICABLE REGULATIONS CONCERNING CONSTRUCTION NOISE AND HOURS OF OPERATIONS.

ABBREVIATIONS

A = AIR	HI PT = HIGH POINT	TS = TOP OF SIDEWALK
A.B.I. = ADDITIVE BID ITEM	INV = INVERT ELEVATION	TW = TOP OF WALL
AD = AREA DRAIN	IP = IRON PIPE	TYP = TYPICAL
AIP = ABANDONED IN PLACE	IW = INDUSTRIAL WASTE	TB = TELEPHONE BOX
AP = ANALYSIS POINT	LEN. = LENGTH	TR = TELEPHONE RISER
BLDG = BUILDING	LF = LINEAR FEET	TS = TRAFFIC SIGN
BM = BENCHMARK	LP = LIGHT POLE	UE = UNDERGROUND TELEPHONE LINE
BW = BASE OF WALL	L/S = LANDSCAPING	UT = UNDERGROUND ELECTRICAL LINE
CATV = CABLE TV LINE	LT = LEFT	UN = UNKNOWN
CB = CATCH BASIN	MH = MANHOLE	VC = VERTICAL CURVE
C&G = CURB AND GUTTER	MTBL = MOUNTABLE	W = WATER
CIP = CAST IRON PIPE	NG = NATURAL GRADE	WM = WATER METER
CMP = CORRUGATED METAL PIPE	OAE = OR APPROVED EQUIVALENT	WV = WATER VALVE
CMPA = CORRUGATED METAL PIPE ARCH	O.C. = ON CENTER	W/ = WITH
CMU = CONCRETE MASONRY UNIT	PB = PULL BOX	
CO = CLEANOUT	P = PROPERTY LINE	
COA = CITY OF ALBUQUERQUE	PC = POINT OF CURVE	
CONC = CONCRETE	PCC = PORTLAND CEMENT CONCRETE	
CL = CHAIN LINK	PCC = POINT OF COMPOUND CURVE	
CT = COURT	P.I. = POINT OF INTERSECTION	
CLR = CLEAR	PP = POWER POLE	
Q = CENTER LINE	PRC = POINT OF REVERSE CURVE	
DI = DIAMETER	PSI = POUNDS PER SQUARE INCH	
DI = DUCTILE IRON	PT = POINT OF TANGENT	
DIP = DUCTILE IRON PIPE	PVI = POINT OF VERTICAL INTERSECTION	
E = ELECTRIC	PVC = POLYVINYL CHLORIDE PIPE	
ELEV = ELEVATION	RCP = REINFORCED CONCRETE PIPE	
ES = END SECTION	RD = ROOF DRAIN	
ESMT = EASEMENT	ROW = RIGHT OF WAY	
EXIST = EXISTING	R/W = RIGHT OF WAY	
EB = ELECTRIC BOX	RT = RIGHT	
FD = FLOOR DRAIN	S = SLOPE	
FF = FINISHED FLOOR ELEVATION	SAS = SANITARY SEWER LINE	
F/F = FACE TO FACE	SD = STORM DRAIN	
FG = FINISHED GRADE	SP = STEEL PIPE	
FH = FIRE HYDRANT	STA = STATION	
FL = FLOW LINE	STD = STANDARD	
FM = FORCE MAIN	T = TELEPHONE LINE	
FTG. = FOOTING	T = TOP OF ASPHALT	
FW = FIRE WATER	TAC = TOP OF ASPHALT CURB	
FF = FINISHED FLOOR ELEVATION	TC = TOP OF CONCRETE	
FP = FINISHED PAD	TCC = TOP OF CONCRETE CURB	
G = GAS	TD = TOP OF DOCK	
GM = GAS METER	TG = TOP OF GRATE	
GV = GATE VALVE	TH = TOP OF HEADWALL	
HC = HANDICAP	TP = TOP OF PIPE	
HGL = 100-YR HYDRAULIC GRADE LINE		

DESCRIPTION	EXISTING	NEW
ASPHALT		
WATER VALVE		
FIRE HYDRANT		
CURB AND GUTTER (ESTATE TYPE)		
CURB AND GUTTER		
SPOT ELEVATION		
SANITARY SEWER		
WATER LINE		
MANHOLE		
CONCRETE ENCASEMENT (SAS)		
CONST. BASE LINE		
DROP INLET		
DIRECTION OF FLOW		
DIRECTION OF SLOPE		
PROPERTY LINE		
RIGHT OF WAY LINE		
LOT LINE		
BLOCK NO.		
SWALE		
LIMIT OF GRADING		
DRAINAGE BASIN BOUNDARY		
TEMP. EROSION CONTROL BERM		
CONTOUR		
CENTERLINE		
WHEELCHAIR RAMP PER 2441, CASE II		
DEFERRED 4' SIDEWALK		
WHEELCHAIR RAMP PER 2418		




CITY OF ALBUQUERQUE PUBLIC WORKS DEPARTMENT ENGINEERING DEVELOPMENT GROUP

TITLE: PARADISE BLUFF SUBDIVISION CIVIL CONSTRUCTION NOTES & PROJECT LEGEND

Design Review Committee		City Engineer Approval		Mo./Day/Yr.		Mo./Day/Yr.	
APPROVE ALLG 1996 DESIGN REVIEW COMMITTEE		Last Design Update					
City Project No.		542681	Zone Map No.	B-11/12	Sheet	3	Of 32



SCANNED BY
BY LASON

QSR NO. 108-100-5103
FILE PBC-OVAL.DWG (VIEW PAV AREA LAYOUT)
REV. 08-17-96

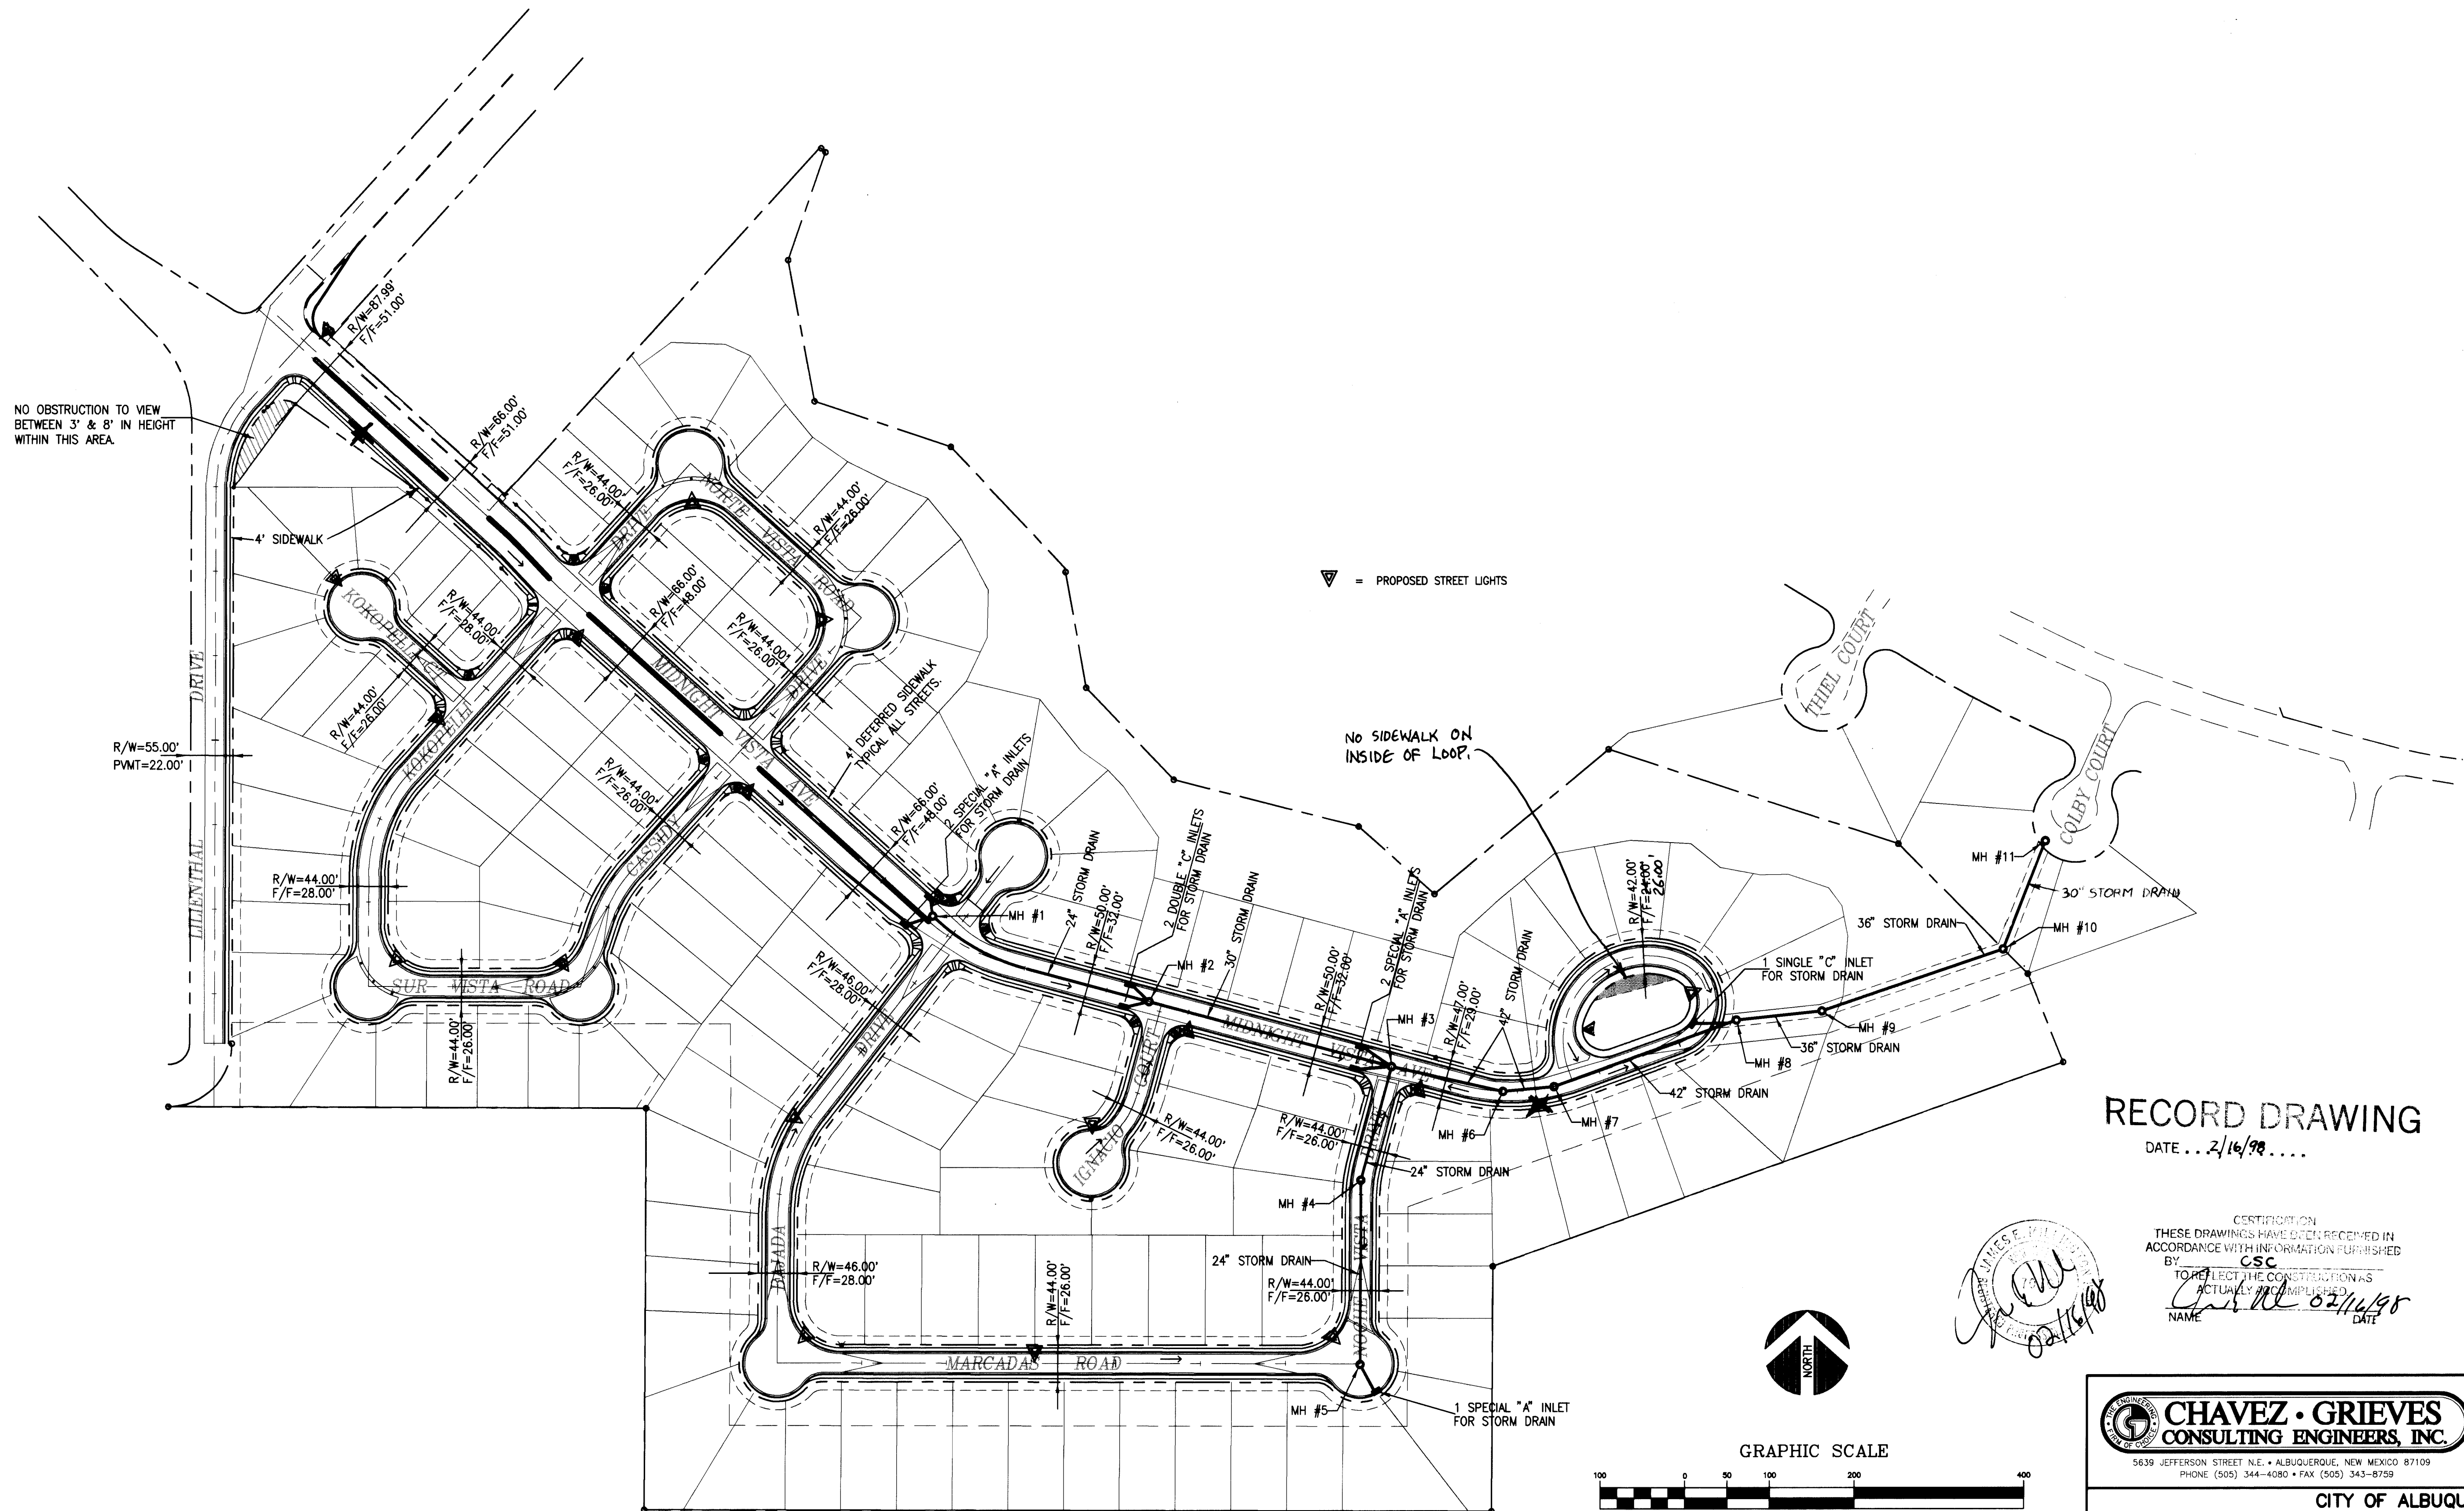

RECORD DRAWING
DATE .. 2/16/98

CERTIFICATION
THESE DRAWINGS HAVE BEEN RECEIVED IN
ACCORDANCE WITH INFORMATION FURNISHED
BY **CSC**
TO REFLECT THE CONSTRUCTION AS
ACTUALLY ACCOMPLISHED.
NAME *Chavez* DATE *02/16/98*

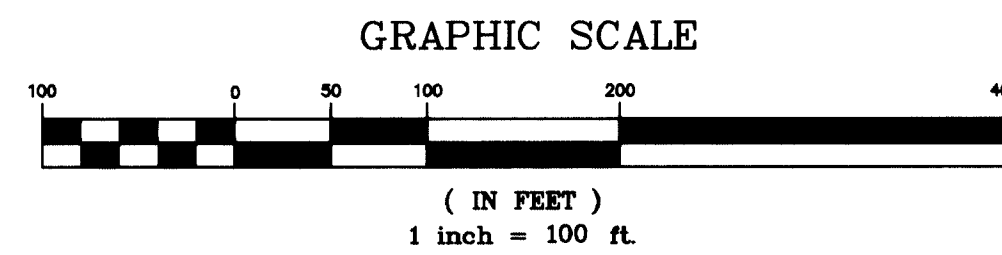
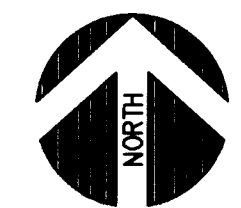


CITY OF ALBUQUERQUE PUBLIC WORKS DEPARTMENT ENGINEERING DEVELOPMENT GROUP	
TITLE: PARADISE BLUFF SUBDIVISION OVERALL ROADWAY & STORM DRAIN PLAN	
APPROVED 	City Engineer Approval
Mo./Day/Yr.	No./Day/Yr.
City Project No. 542681	Zone Map No. B-11/12
Sheet 4	of 32

																																																																																																																																																																																																																																																																																																																																																																																																																																																																																																																																																																																																																																																																																																																																																																																																																																																																																																																																																																																																																																																																																																																																																																																																																																																																																																																																																																																																																					</
--	--	----

SCANNED BY
BY LASON


JOB NO.: N08-100-5193
FILE: PBC-OVALDWC (VIEW UTIL XREF:UTLAYOUT)
REV: 06-08-96

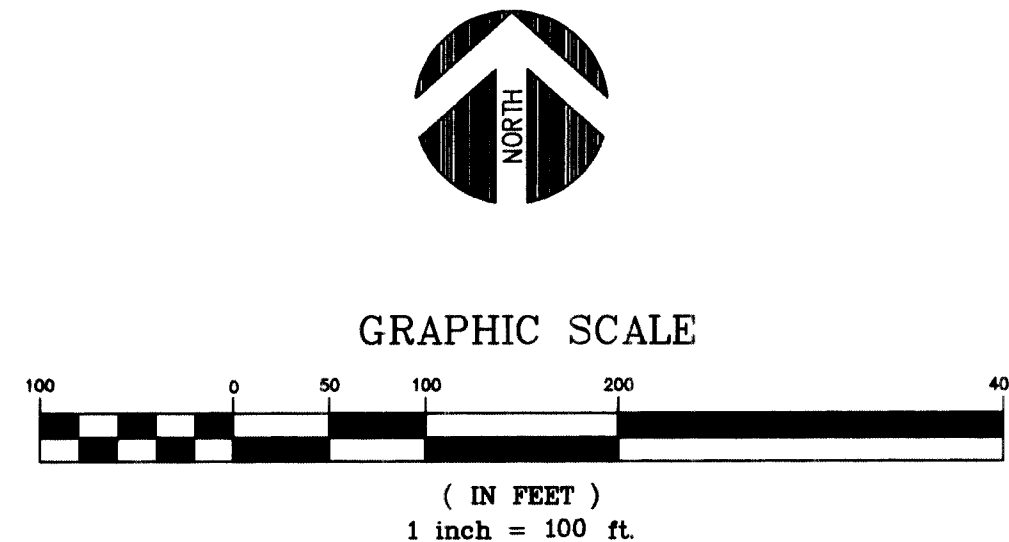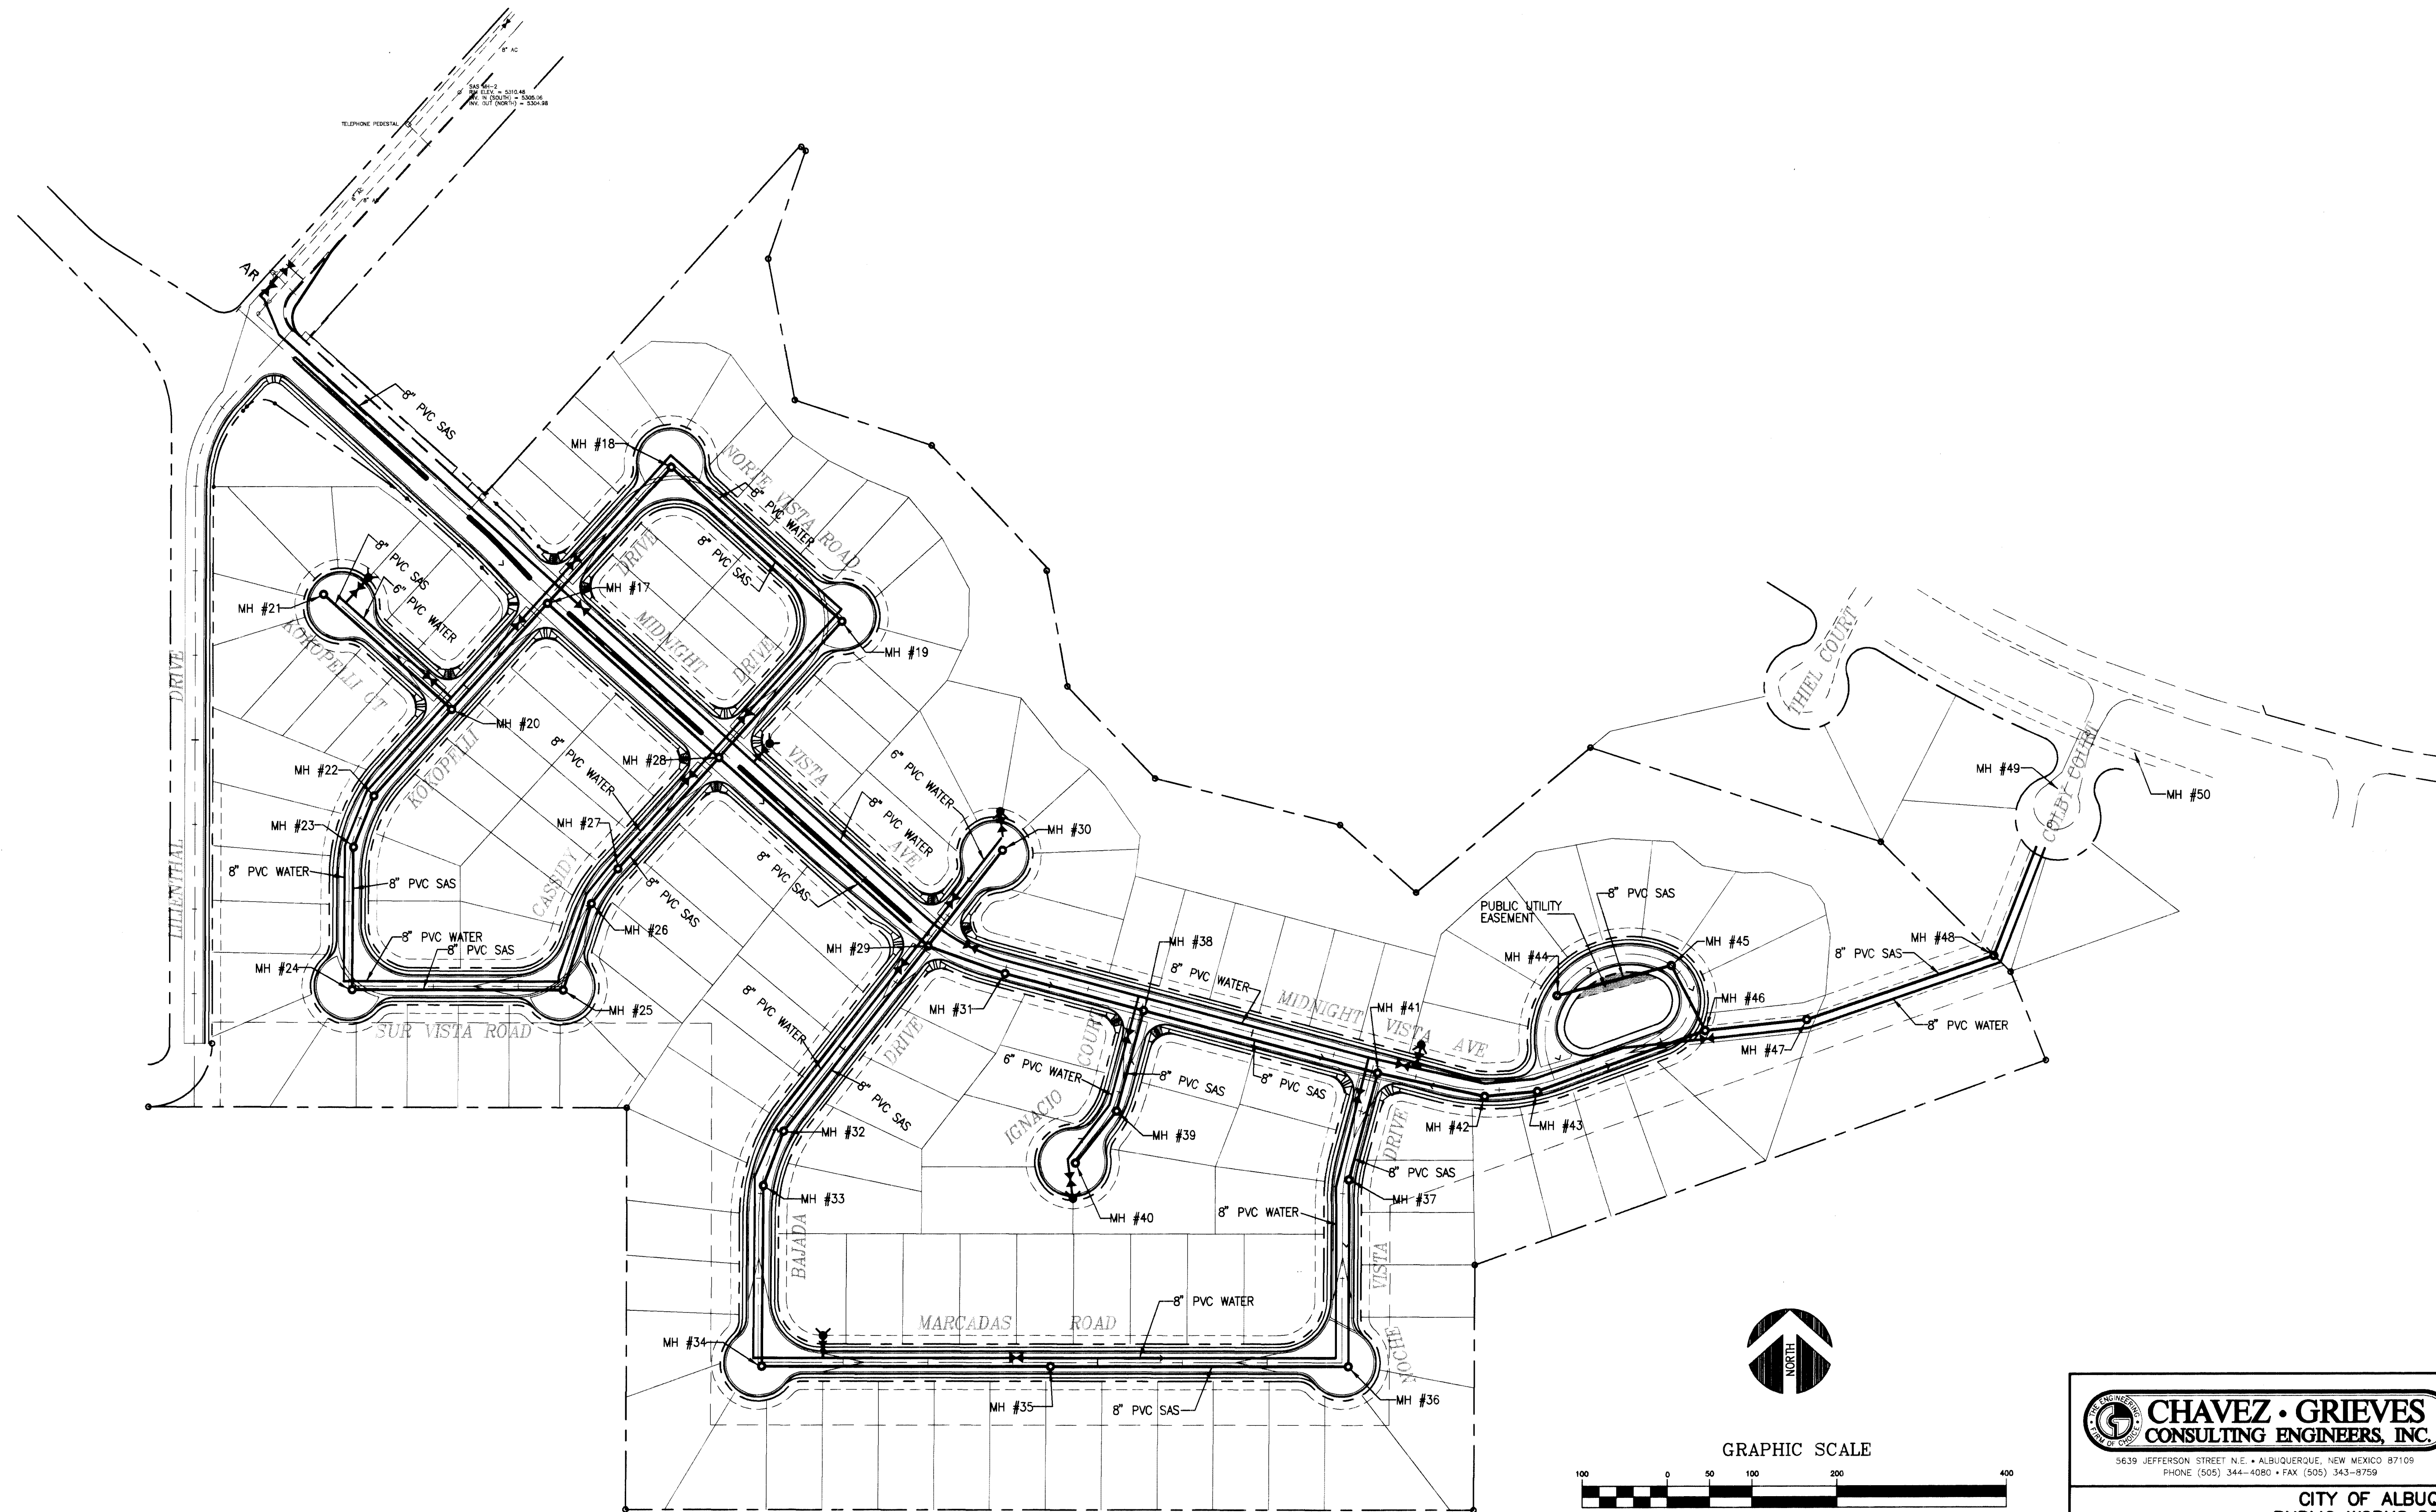

CITY OF ALBUQUERQUE PUBLIC WORKS DEPARTMENT ENGINEERING DEVELOPMENT GROUP			
TITLE: PARADISE BLUFF SUBDIVISION OVERALL WATER & SANITARY SEWER PLAN			
Design Review Committee	City Engineer Approval	Mo./Day/Yr.	Mo./Day/Yr.
APPROVE AUG 1996 DESIGN REVIEW COMMITTEE			
City Project No. 542681	Zone Map No. B-11/12	Sheet 5	of 32

ENGINEER'S SEAL		SURVEY INFORMATION		BENCH MARKS		AS BUILT INFORMATION	
 JOE P. KELLEY NEW MEXICO 9996 REGISTERED PROFESSIONAL ENGINEER 6/10/96	FIELD NOTES		ACCS BRASS CAP STAMPED "ACS 6-RHT 1986"		CONTRACTOR <u>Albino Underground</u>		
	REMARKS	NO.	DATE	BY	DATE	LOCATED 475 FEET NORTHEAST OF THE INTERSECTION	
						OF JUSTIN DRIVE AND BURGLO AVENUE. ELEV. = 5328.378	
						SURVEY BY COMMUNITY	
						SCIENCES CORP.	
	CORRALES, NM.		7-22-94		INSPECTOR'S DATE <u>2/96</u>		
	TOPOGRAPHIC MAPPING				STAKE BY <u>W. Towers</u>		
	BY T. MANN & ASSOC.				FIELD VERIFICATION BY <u>C.S.I./E. B.</u>		
	ABQ. NM.		12-01-93		CORRECTED BY <u>C-G</u>		
	DESIGNED J. P. KELLEY		DATE 03-95		MICRO-FILM INFORMATION		
	DRAWN BY W. M. TOWERS		DATE 03-95		RECORDED BY		
CHECKED BY V.J. CHAVEZ		DATE 03-95		NO.			
				DATE			

SCANNED BY
BY LASON

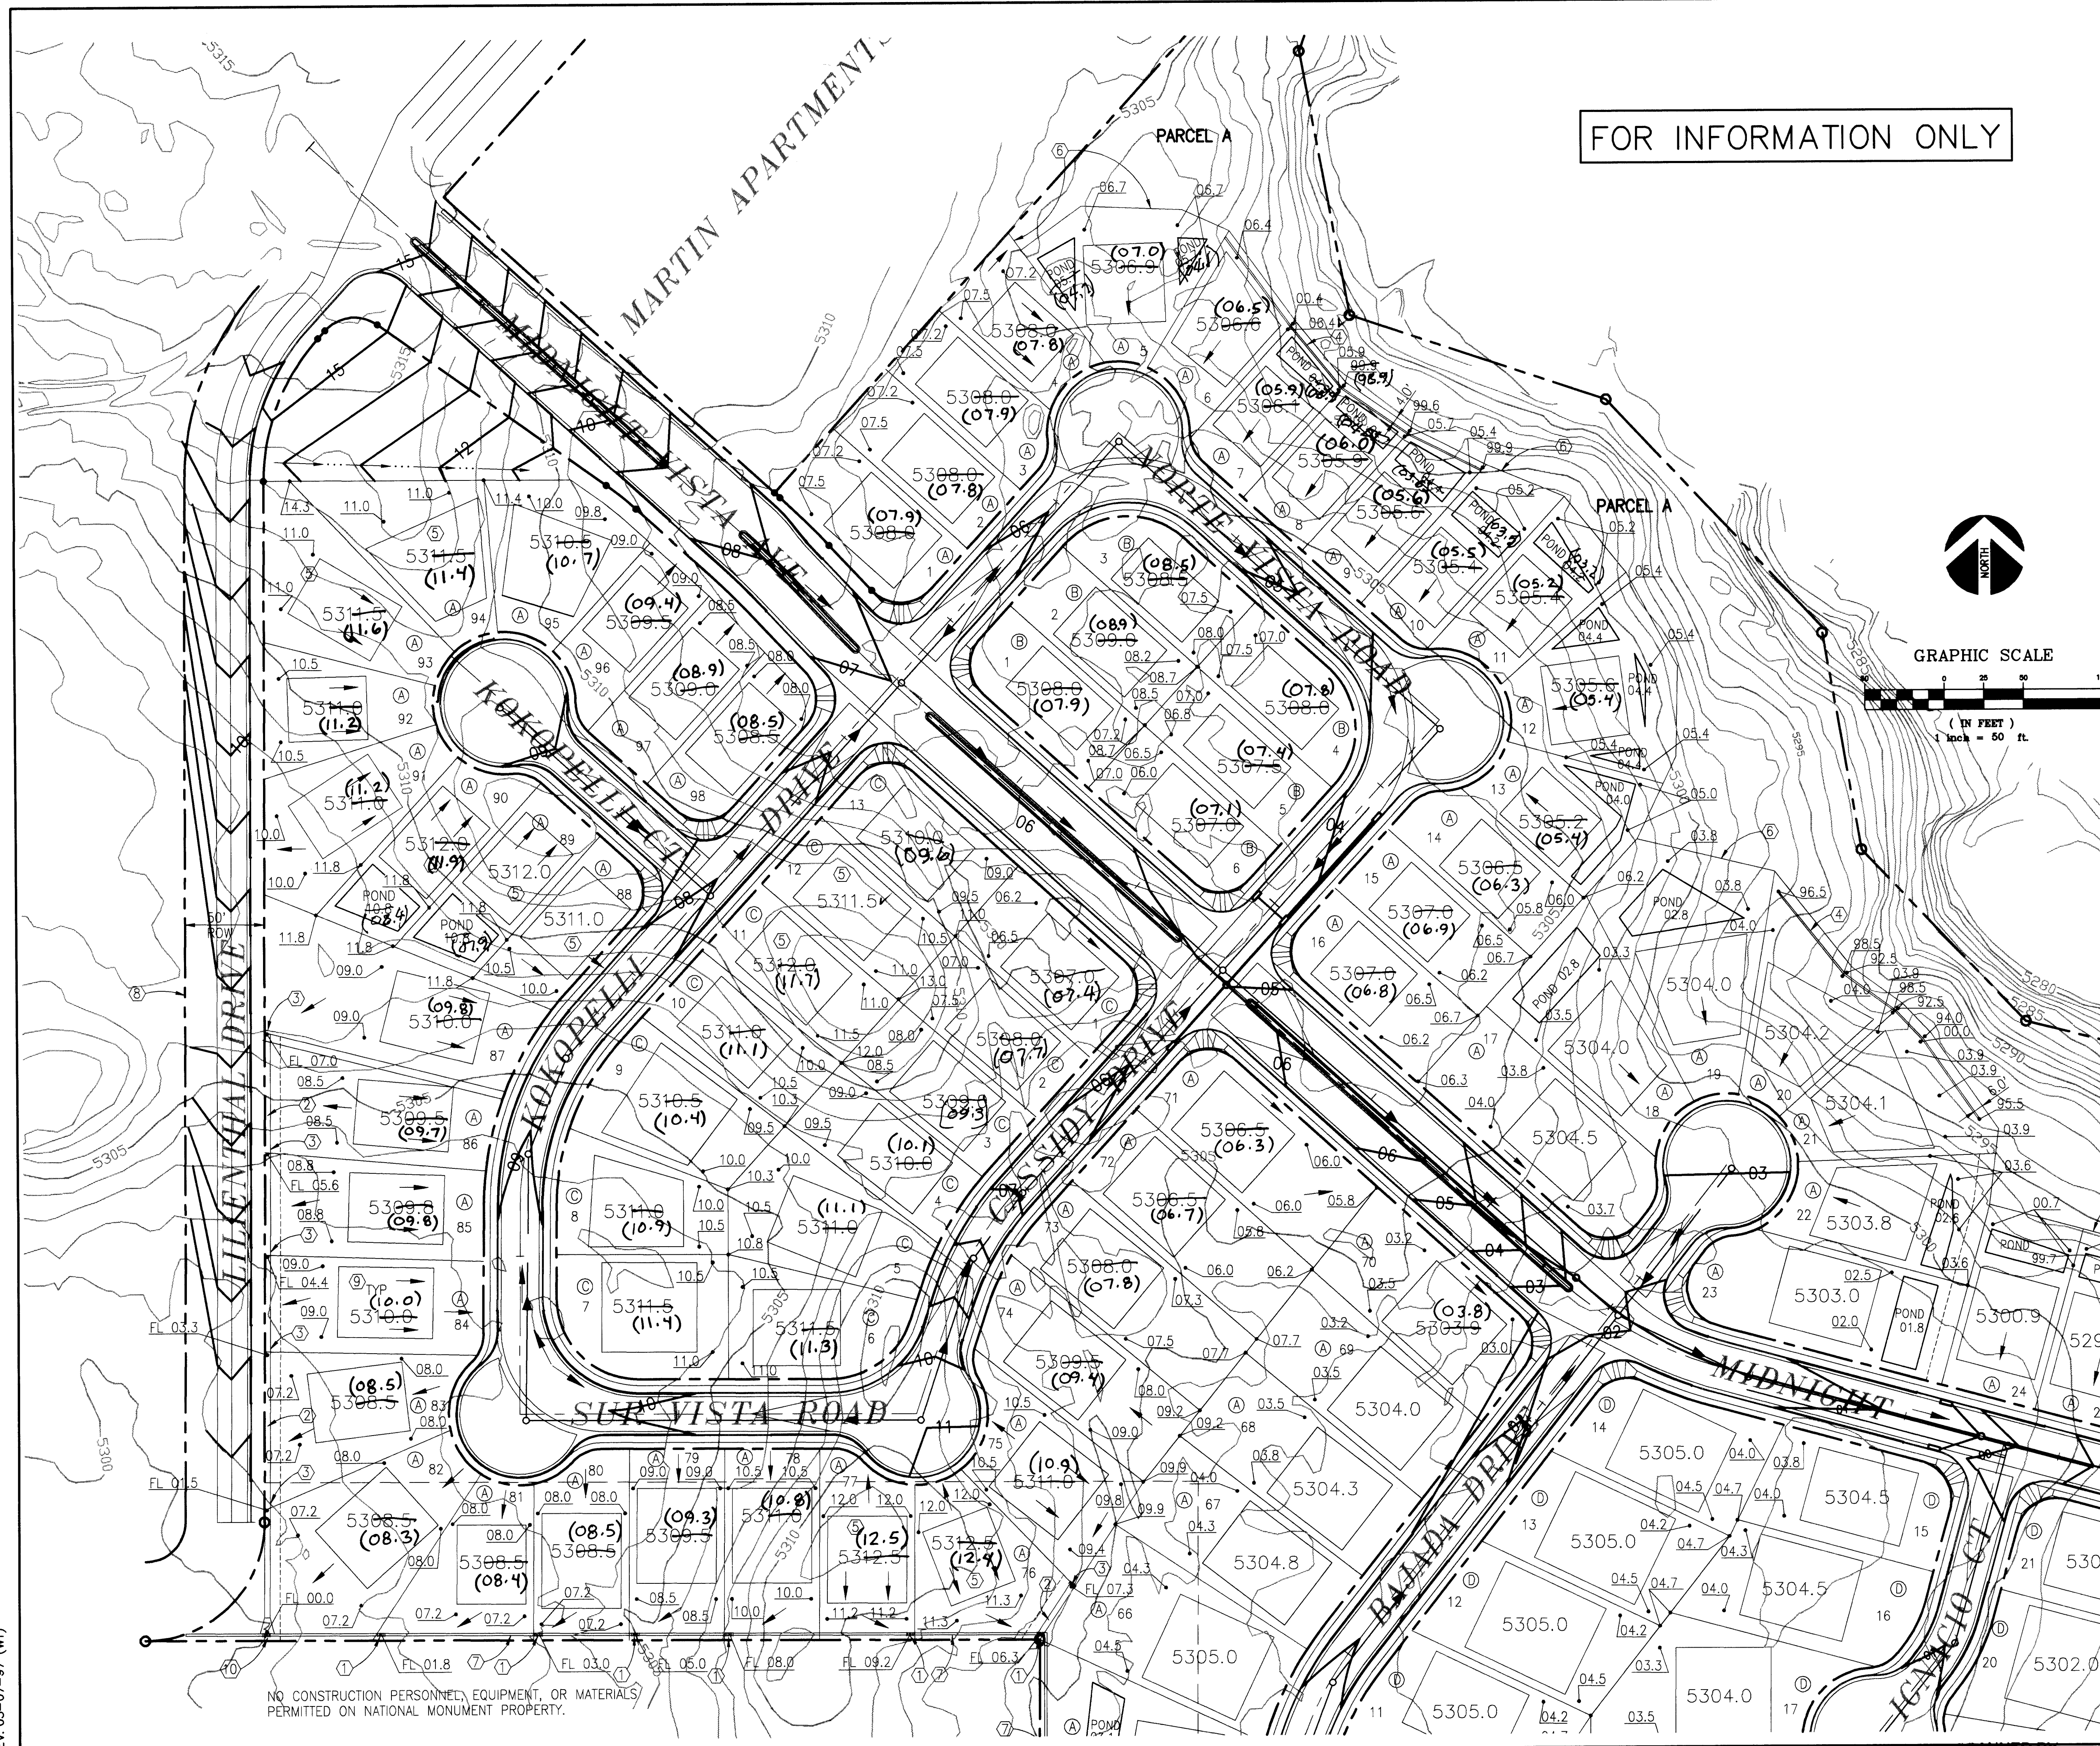


FOR INFORMATION ONLY

I HEREBY CERTIFY THAT THIS PLAN
IS IN SUBSTANTIAL COMPLIANCE
WITH THE APPROVED DRAINAGE
PLAN.

SIGNED: *James W. Paulsen*

DATE: *7-31-98*
17 26199

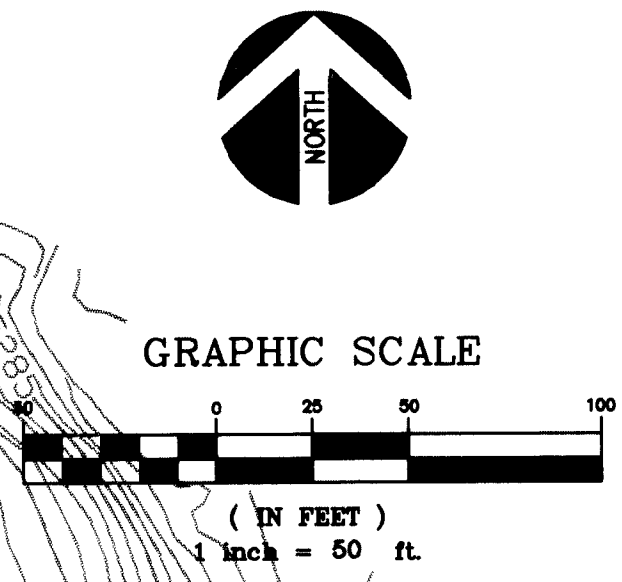

- KEYED NOTES**
- 1 INSTALL WALL DRAIN PER DETAIL 2/8.
 - 2 INSTALL RIBBON CHANNEL PER DETAIL 9/9.
 - 3 INSTALL RIBBON CHANNEL WALL CROSSING PER DETAIL 10/9.
 - 4 INSTALL 4' TO 6' RETAINING WALL PER DETAIL 8/9
 - 5 NOTE TO GRADING CONTRACTOR: THIS LOT MAY REQUIRE OVER-EXCAVATION.
 - 6 MATCH EXISTING ELEVATION AT PARCEL A BOUNDARY, TYPICAL.
 - 7 MATCH EXISTING ELEVATION AT PETROGLYPH BOUNDARY, TYPICAL. INSTALL CMU WALL, PER DETAIL 1/9.
 - 8 NO GRADING ALLOWED BEYOND R/W LINE.
 - 9 ROOF RUNOFF SHALL BE DISCHARGED TO THE STREET ON LOTS WHERE ROOF FLOW IS INDICATED TOWARDS THE STREET.
 - 10 INSTALL THREE WALL DRAINS PER DETAIL 2/8. WIDEN RIBBON CHANNEL TO 9' WIDE IN 10 LF JUST UPSTREAM OF OPENING. INSTALL 6x6 W1.4 x W1.4 WELDED WIRE FABRIC IN WIDENED PORTION OF RIBBON CHANNEL.

APPROVED FOR ROUGH GRADING $\pm 1'$

HYDROLOGY DIVISION _____

DATE _____

NOTE: ENGINEER'S CERTIFICATION WILL BE REQUIRED
PRIOR TO FINANCIAL GUARANTEE RELEASE.






 **CHAVEZ • GRIEVES**
CONSULTING ENGINEERS, INC.
5639 JEFFERSON STREET N.E. • ALBUQUERQUE, NEW MEXICO 87109
PHONE (505) 344-4080 • FAX (505) 343-8759

CITY OF ALBUQUERQUE
PUBLIC WORKS DEPARTMENT
ENGINEERING DEVELOPMENT GROUP

TITLE: PARADISE BLUFF SUBDIVISION
GRADING AND DRAINAGE PLAN


Design Review Committee	City Engineer Approval	Last Design Update	Mo./Day/Yr.	Mo./Day/Yr.

City Project No.	542681	Zone Map No.	B-11/12	Sheet	6	Of	32
------------------	--------	--------------	---------	-------	---	----	----

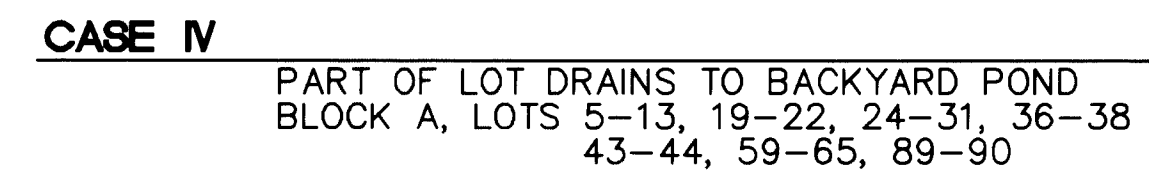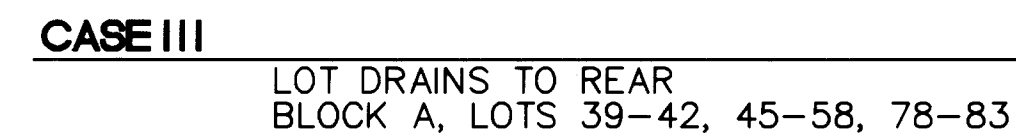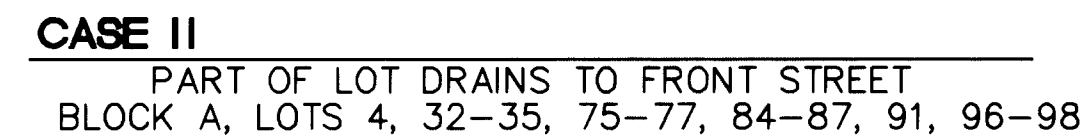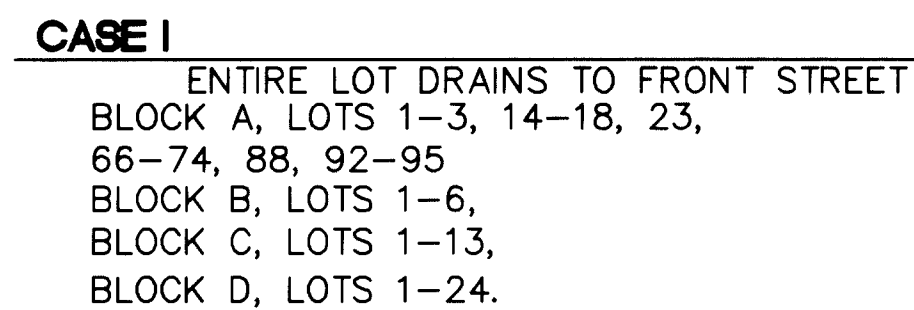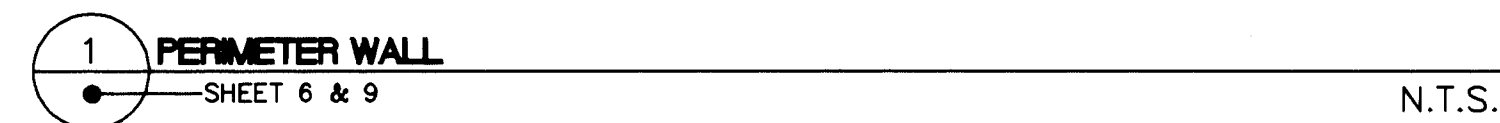


DIVISION		PROJECT GROUP		SHEET	
Mo./Day/Yr.		Mo./Day/Yr.		Mo./Day/Yr.	
2		Sheet		of 32	
NO. DATE		REMARKS		BY	
NO. DATE		REVISIONS		BY	
DESIGNED		J. P. KELLEY		DATE 03-95	
DRAWN BY		W. M. TOWERS		DATE 03-95	
CHECKED BY		V.J. CHAVEZ		DATE 03-95	
ENGINEER'S SEAL					
FIELD NOTES		NO. BY DATE SURVEY BY COMMUNITY SCIENCES CORP. CORALLLES, NM 7-22-94			
SURVEY INFORMATION		ACS BRASS CAP STAMPED "ACS 6-B11, 1986" LOCATED 475 FEET NORTHEAST OF THE INTERSECTION OF JUSTIN DRIVE AND BUGLO AVENUE. ELEV. = 5328.378			
BENCH MARKS		WORK ORDER BY INSPECTOR'S ACCEPTANCE BY VERIFICATION BY DRAWINGS CORRECTED BY DATE			
AS BUILT INFORMATION		MICRO-FILM INFORMATION RECORDED BY DATE NO.			

SCANNED BY
BY LASON

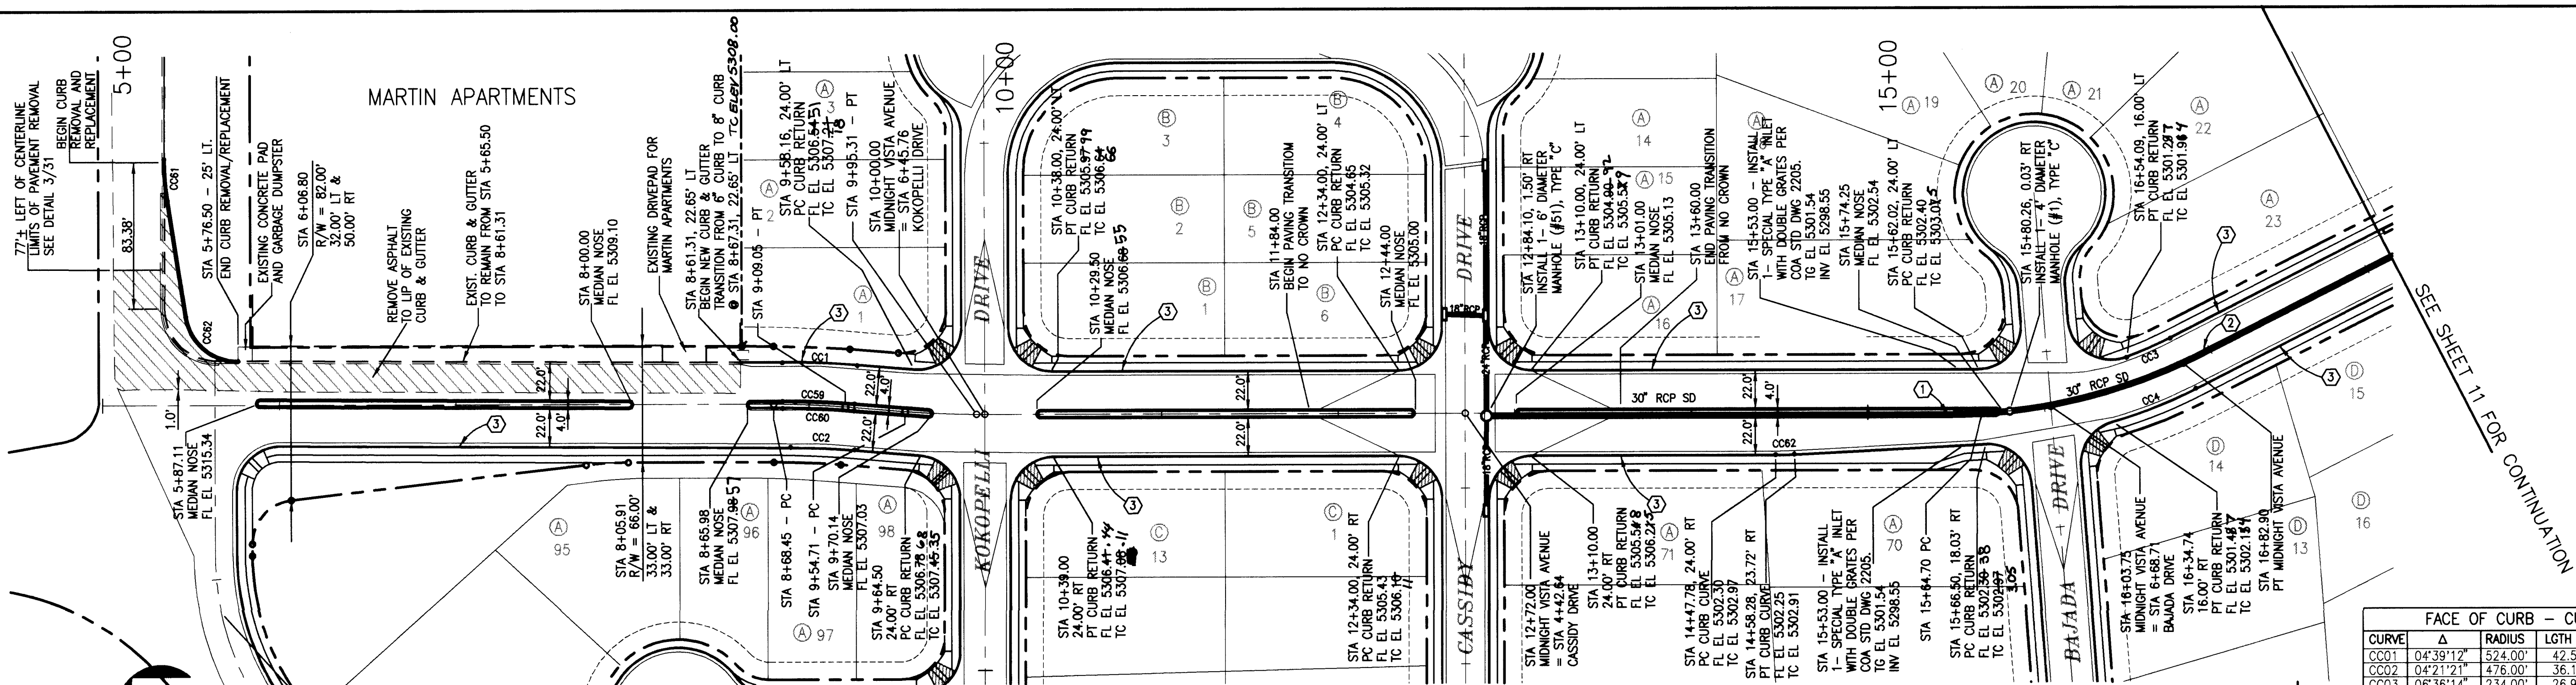


GRAPHIC SCALE

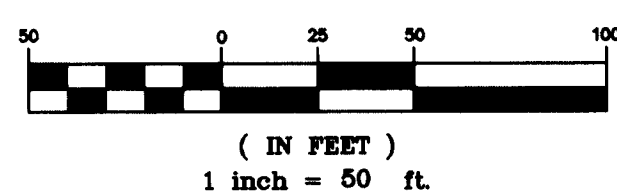

SCALE
HORIZ: 1"=50'
VERT: 1"=5'

MIDNIGHT VISTA AVENUE - PLAN

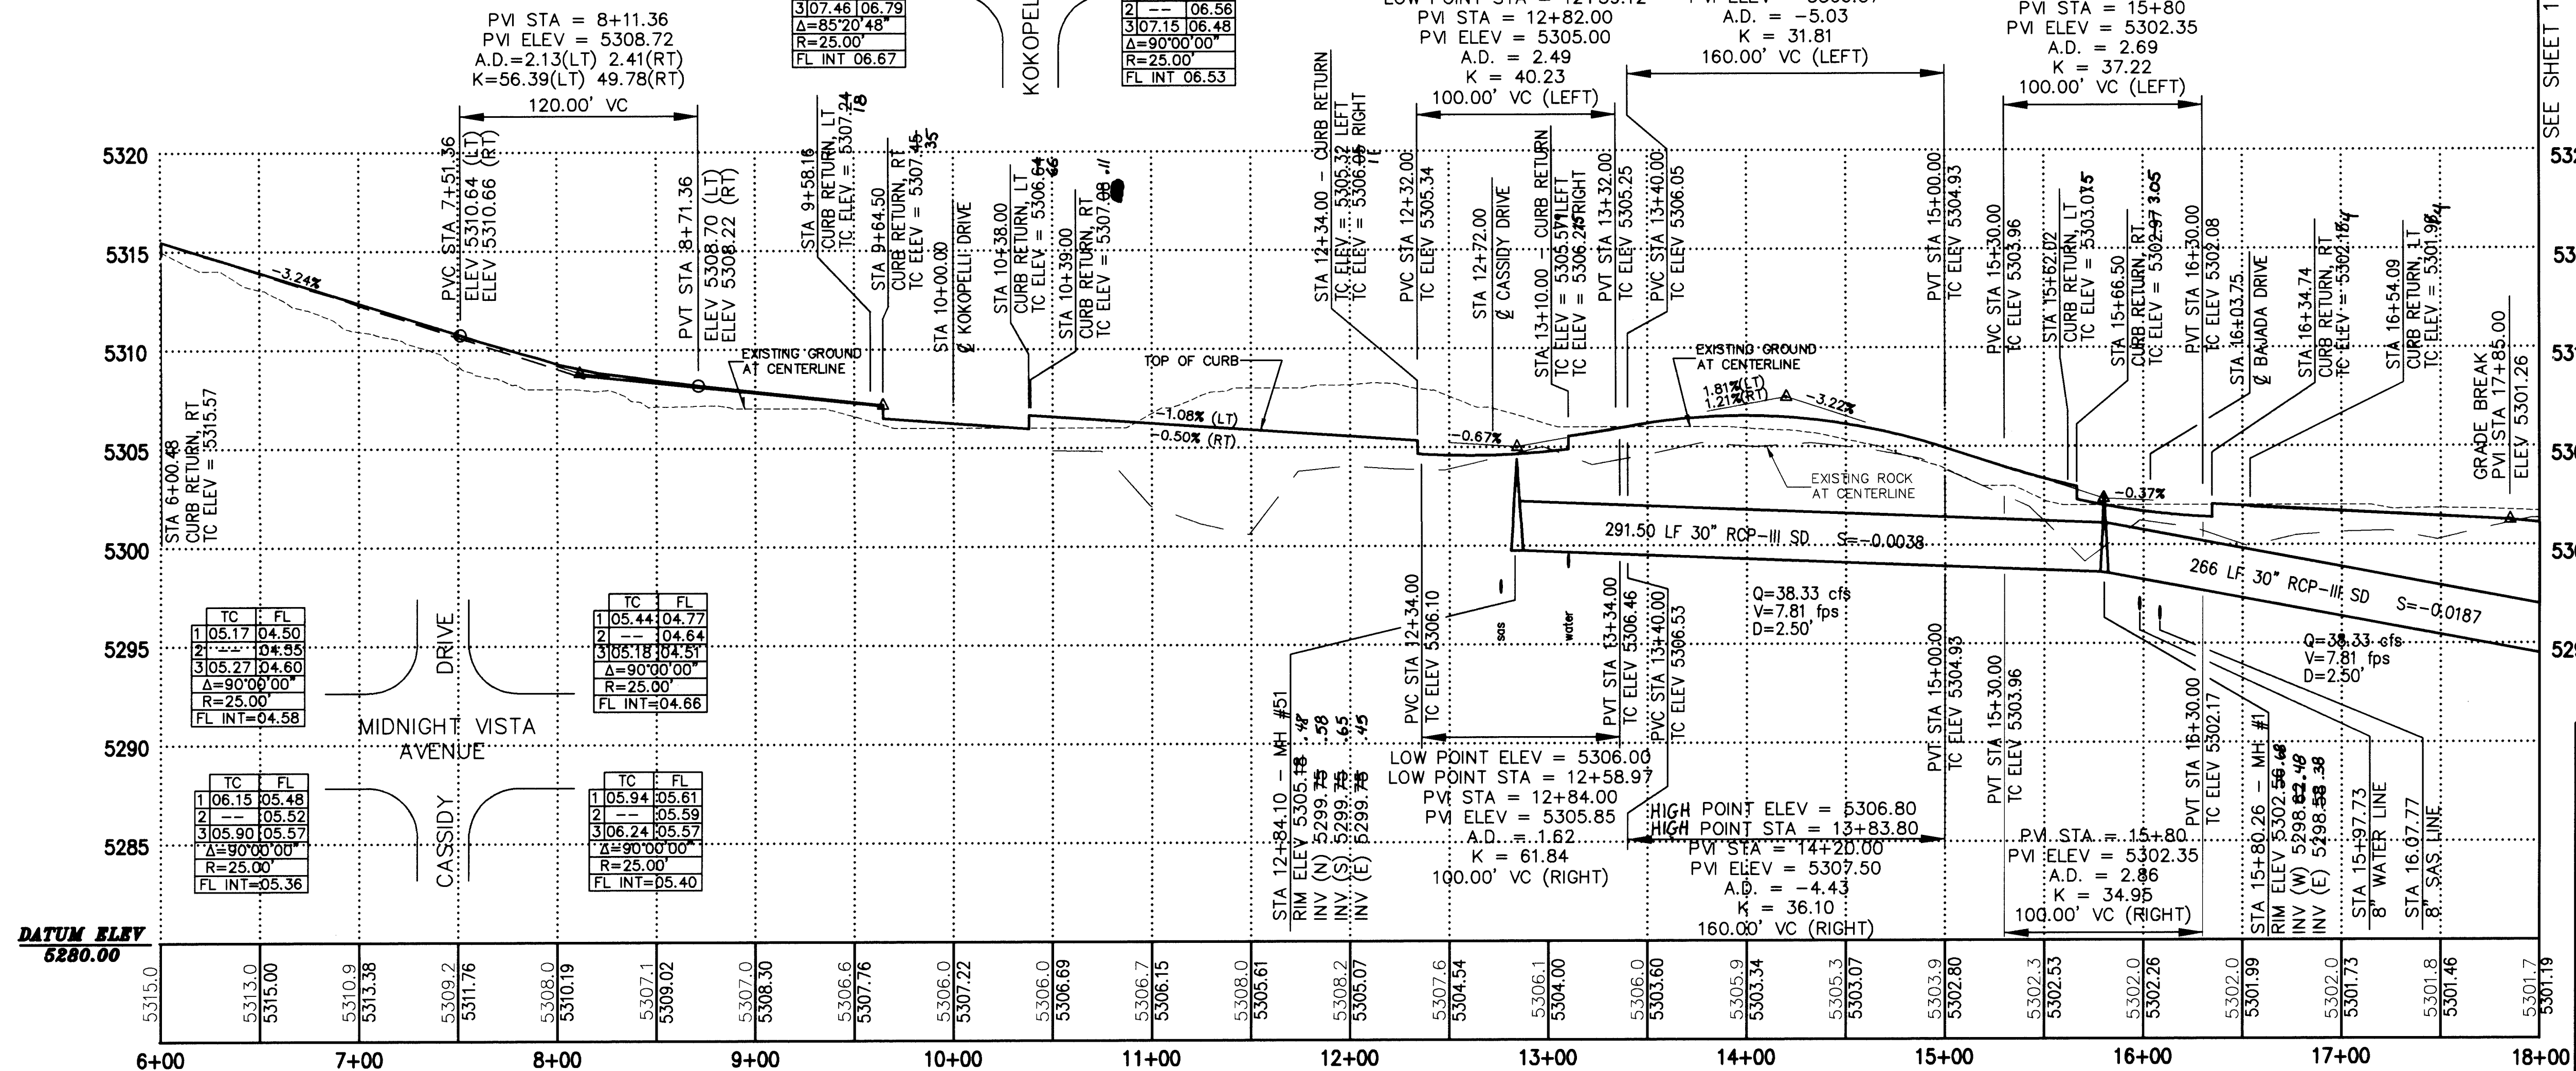

MIDNIGHT VISTA AVENUE - PROFILE

RECORD DRAWING

DATE: 2/16/98

CURVE	Δ	RADIUS	LGTH	CHORD
CC001	04°39'12"	524.00'	42.56'	545'27'48"
CC002	04°21'12"	476.00'	36.19'	545'18'52"
CC003	08°36'14"	234.00'	26.97'	571'34'45"
CC004	11°02'19"	266.00'	51.25'	569'21'43"
CC005	04°39'12"	502.00'	40.77'	545'27'48"
CC006	04°39'12"	498.00'	40.45'	545'27'48"
CC007	09°00'53"	150.00'	23.60'	537'48'21"
CC008	80°47'28"	30.00'	42.30'	507'05'49"
CC009	03°00'36"	200.00'	10.50'	549'17'42"

TC	FL
1 02.48	02.15
2 --	02.24
3 02.98	02.31
Δ=94°18'20"	
R=25.00'	
FL INT=01.82	

TC	FL
1 07.45	06.78
2 --	06.86
3 07.46	06.79
Δ=85°20'48"	
R=25.00'	
FL INT=06.67	

TC	FL
1 02.90	01.42
2 --	01.55
3 02.01	01.68
Δ=78°15'11"	
R=25.00'	
FL INT=01.48	

MIDNIGHT VISTA AVENUE

TC	FL
1 02.90	02.23
2 --	02.16
3 02.75	02.08
Δ=85°41'40"	
R=25.00'	
FL INT=01.88	

TC	FL
1 02.90	01.62
2 --	01.58
3 02.01	01.53
Δ=78°15'11"	
R=25.00'	
FL INT=01.58	


CERTIFICATION
THESE DRAWINGS HAVE BEEN RECEIVED IN
ACCORDANCE WITH INFORMATION FURNISHED
BY
TO REFLECT THE CONSTRUCTION AS
ACTUALLY COMPLETED
NAME: *[Signature]* DATE: 5/10/97

KEYED NOTES
1 STA 15+44.90, 1.50' RT
PC 320' RADIUS STORM DRAIN
2 STA 16+96.48
PT 320' RADIUS STORM DRAIN
3 INSTALL STD. 8" CURB & GUTTER
PER C.O.A. STD. DWG. 2415


CHAVEZ • GRIEVES
CONSULTING ENGINEERS, INC.
5639 JEFFERSON STREET N.E. • ALBUQUERQUE, NEW MEXICO 87109
PHONE: (505) 344-4080 • FAX (505) 343-8759

CITY OF ALBUQUERQUE PUBLIC WORKS DEPARTMENT ENGINEERING DEVELOPMENT GROUP	
TITLE: PARADISE BLUFF SUBDIVISION MIDNIGHT VISTA AVENUE ROADWAY & STORM DRAIN PLAN & PROFILE STA 6+00.00 TO STA 18+00.00	
Design Review Committee	City Engineer Approval
City Project No. 542681	Zone Map No. B-11/12
Sheet 10	of 32

SURVEY INFORMATION		BENCH MARKS		AS BUILT INFORMATION	
NO.	DATE	NO.	DATE	NO.	DATE
1	02-48	1	02-48	1	02-48
2	02-48	2	02-48	2	02-48
3	02-48	3	02-48	3	02-48
143	02-48	143	02-48	143	02-48
144	02-48	144			

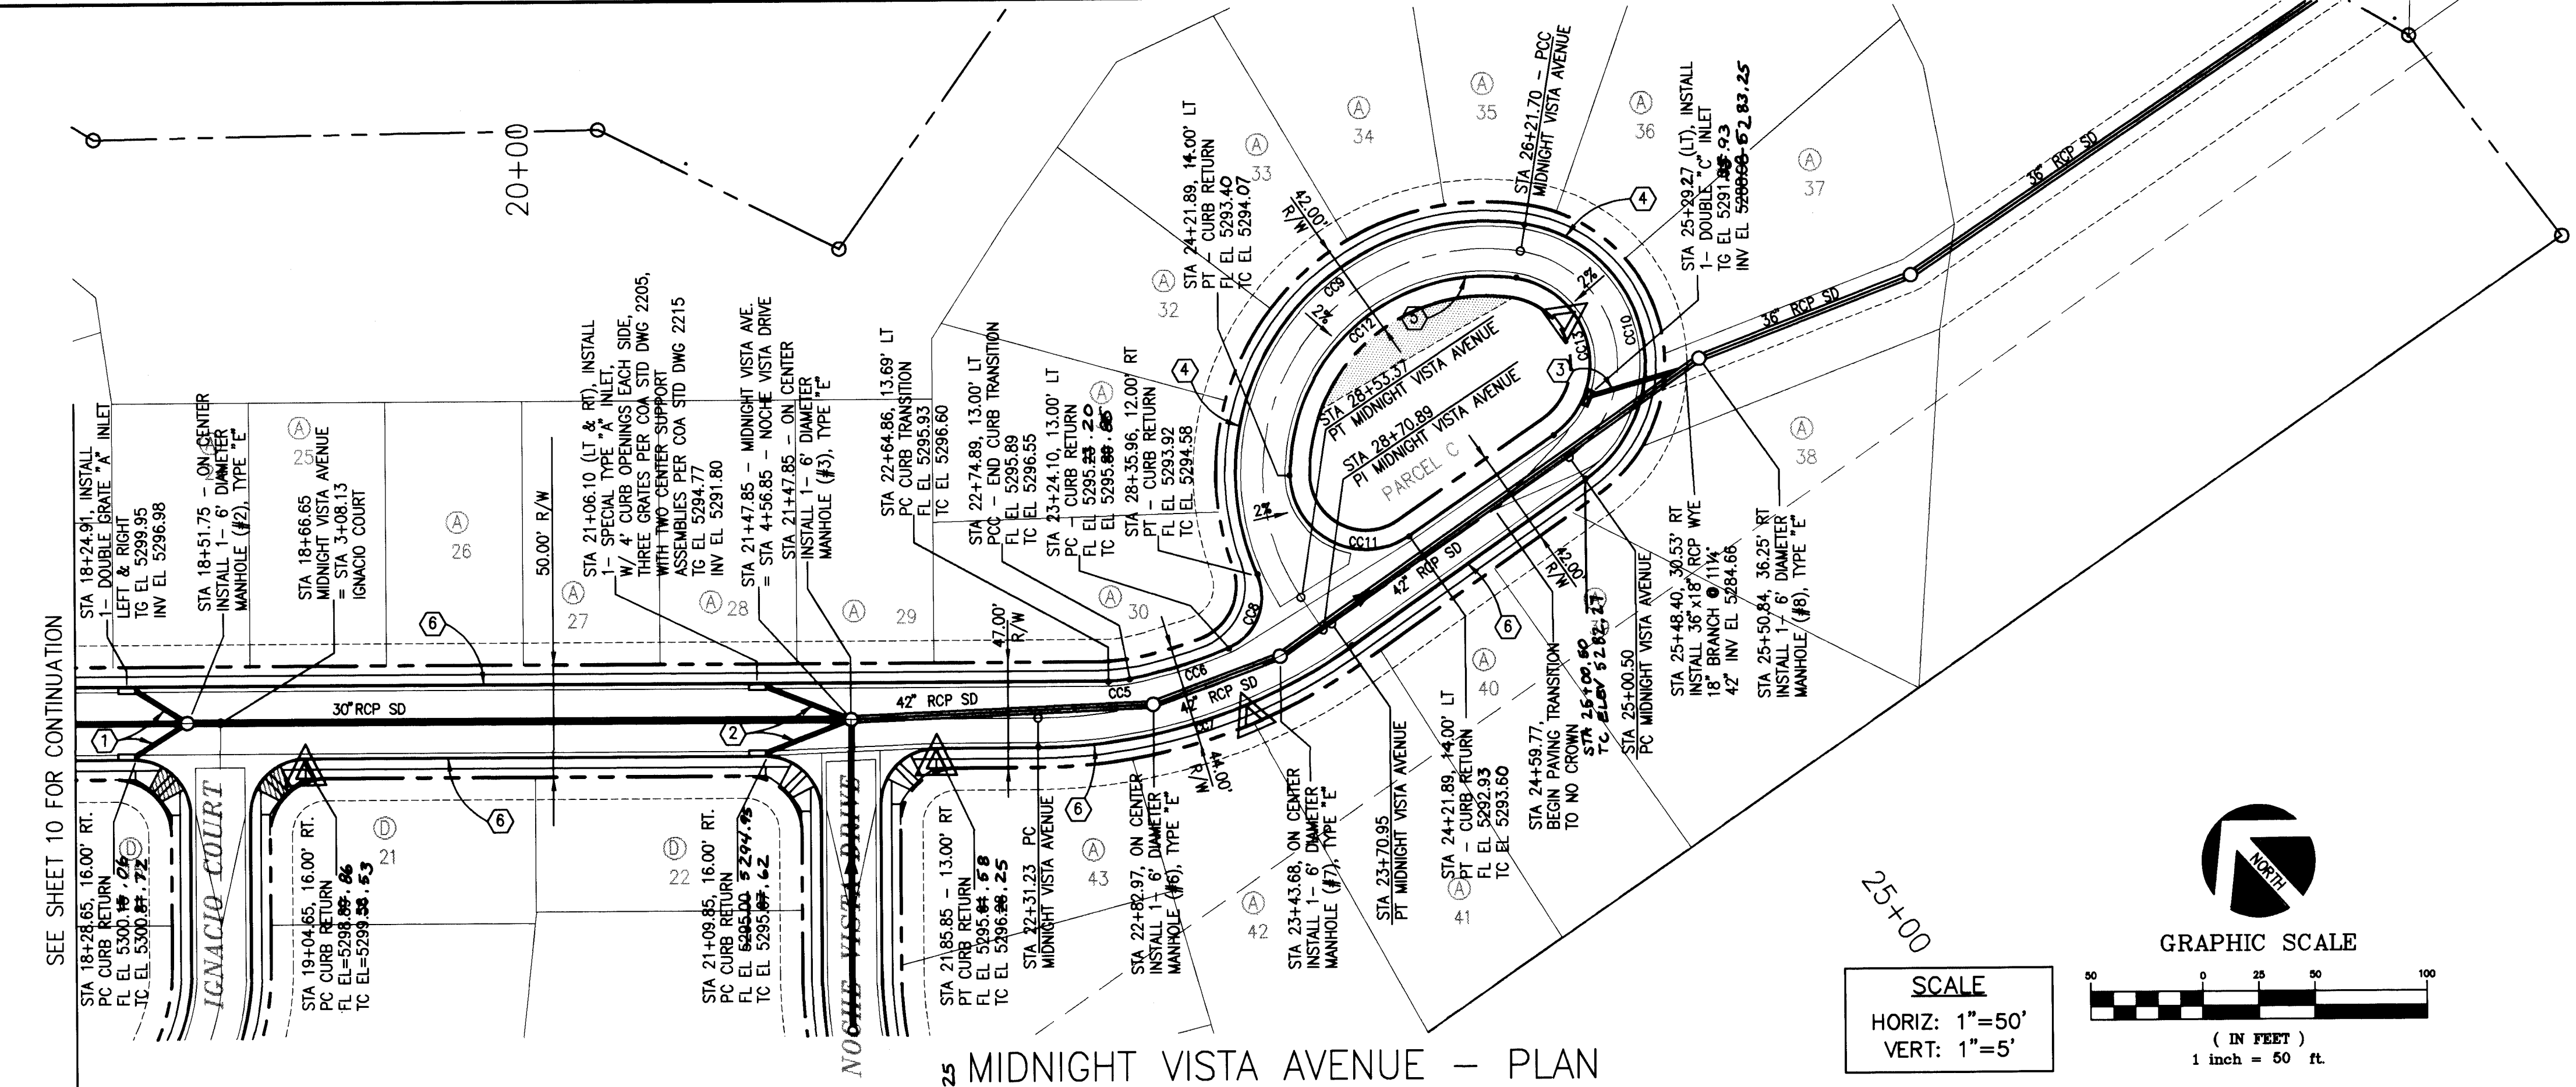

MIDNIGHT VISTA AVENUE - PLAN

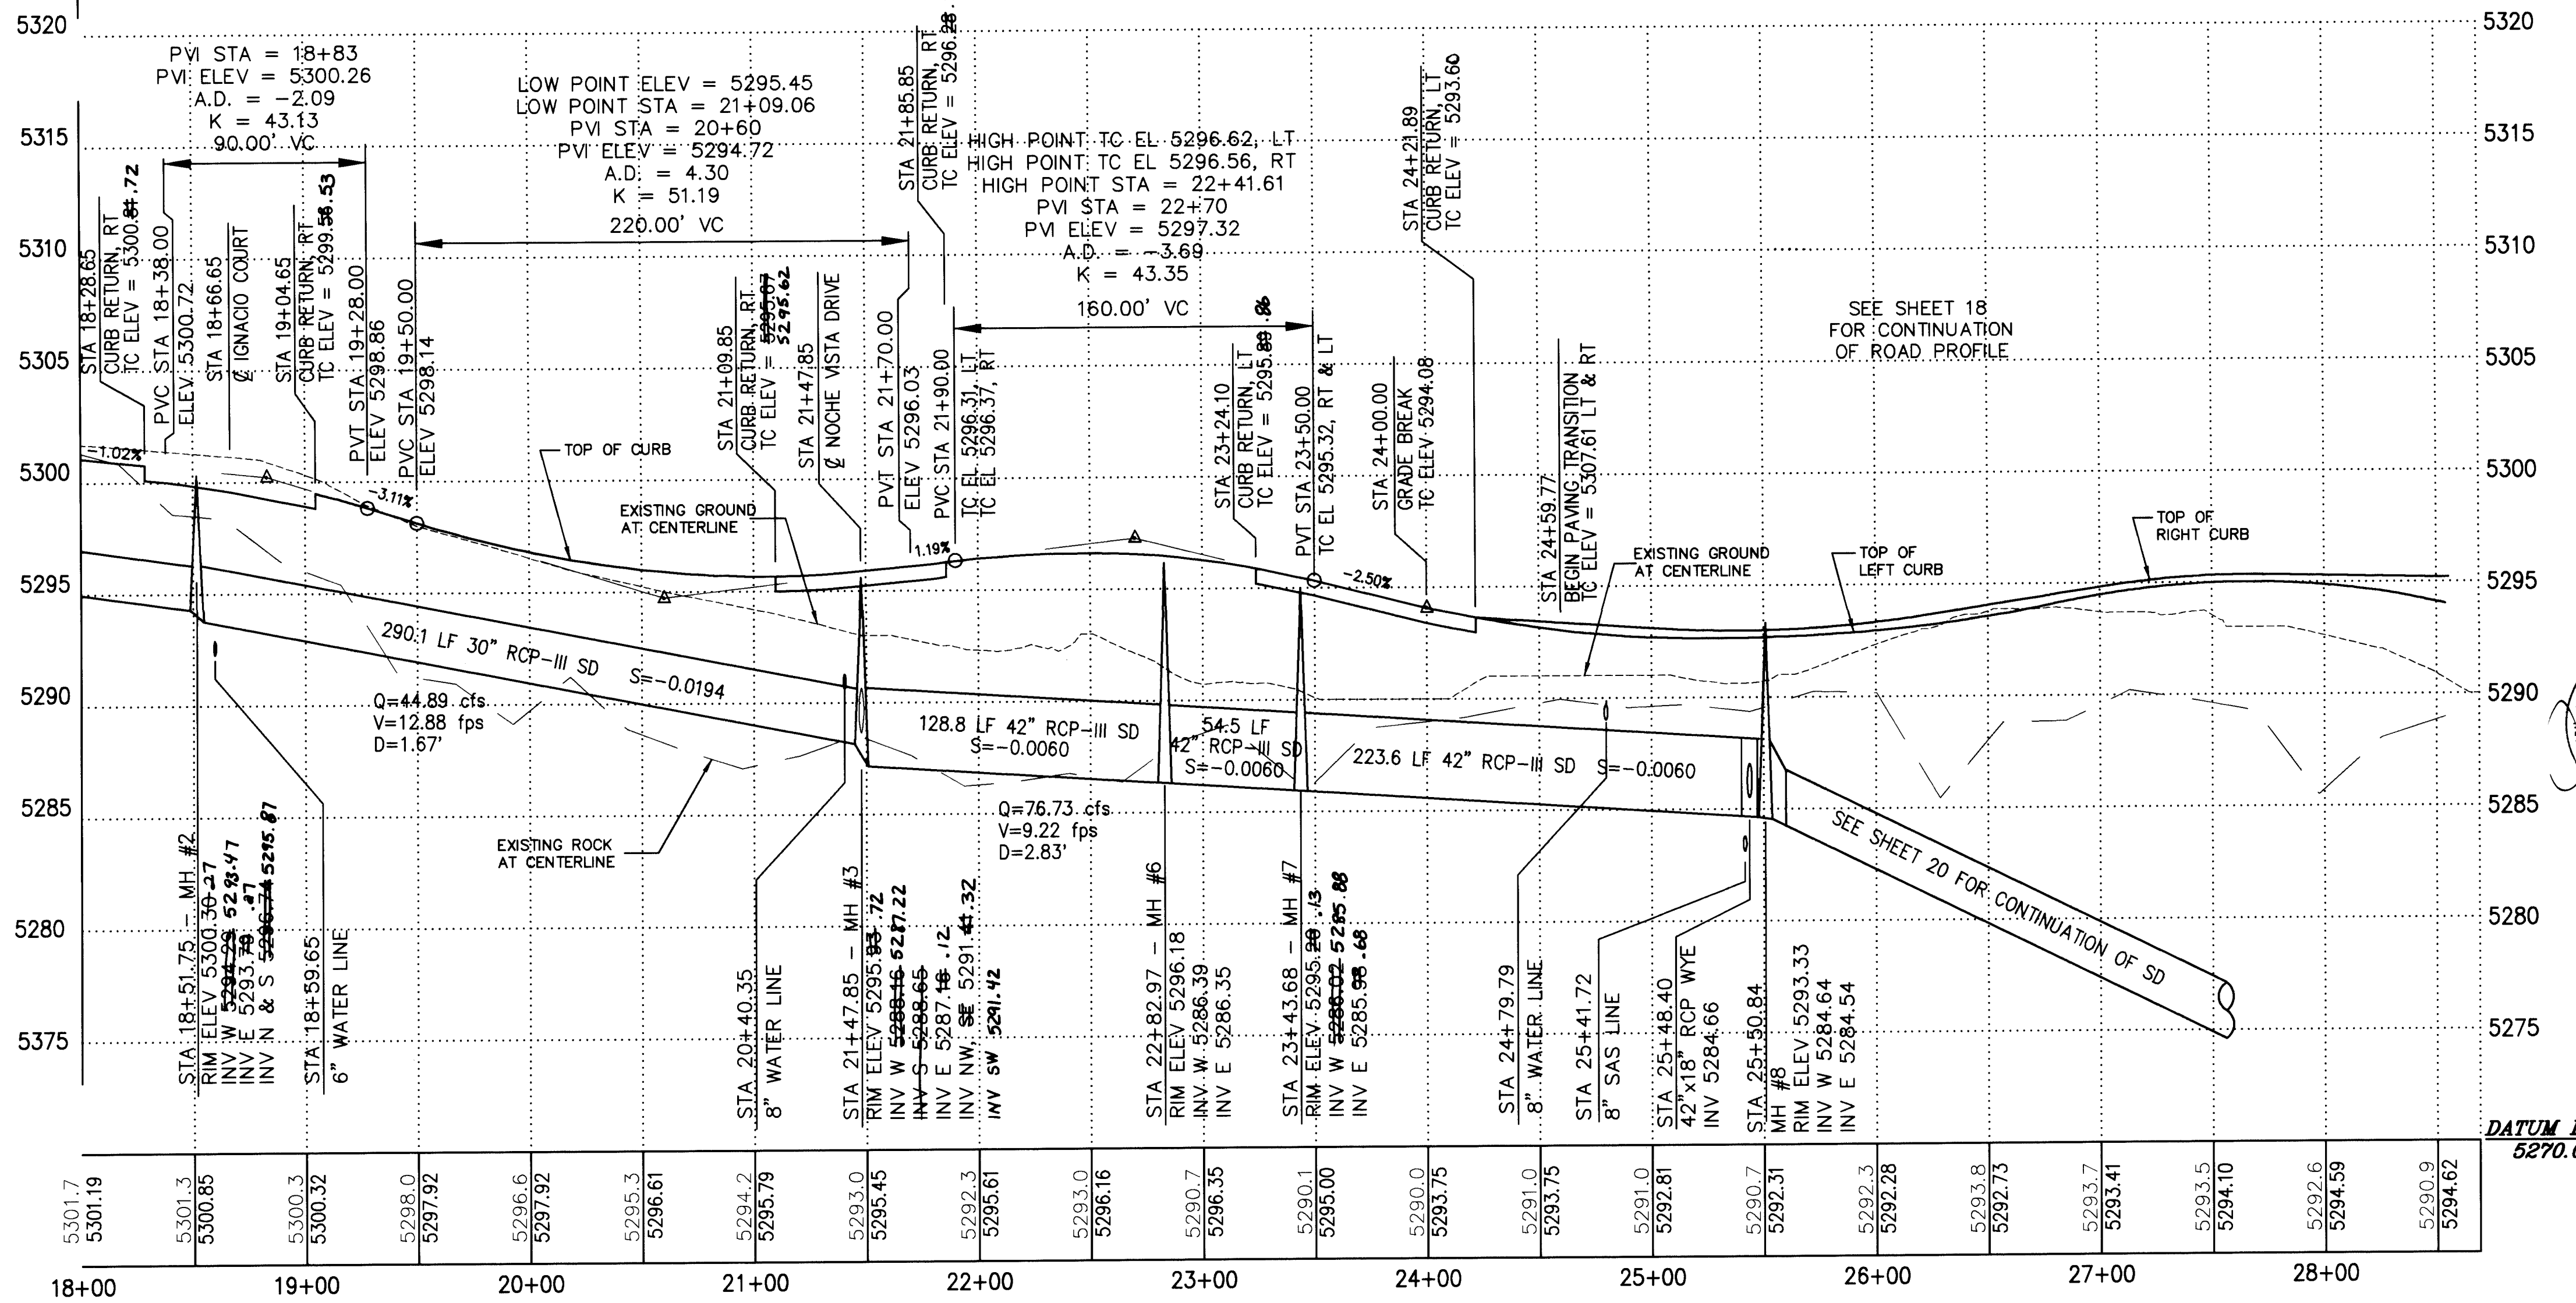


MIDNIGHT VISTA AVENUE - PROFILE

FACE OF CURB - CURVE TABLE				
CURVE	Δ	RADIUS	LGTH	CHORD
CC05	10°52'36"	50.00'	9.49'	S80°19'10"E 9.48'
CC06	12°15'31"	217.00'	46.43'	N88°08'46"E 46.34'
CC07	35°14'58"	243.00'	149.50'	N87°29'39"E 147.15'
CC08	106°37'42"	75.00'	46.53'	N36°41'09"E 35.54'
CC09	122°45'38"	112.00'	239.97'	N52°46'06"E 196.63'
CC10	135°43'15"	63.00'	149.23'	S02°00'33"W 116.71'
CC11	124°11'24"	32.00'	64.34'	S47°35'27"E 58.56'
CC12	9°38'35"	86.00'	149.56'	S47°18'38"W 131.41'
CC13	13°09'56"	37.00'	87.13'	N42°13'53"E 68.65'

KEYED NOTES

1. INSTALL 24 LF OF 18" RCP-111 STORM DRAIN LINE.
2. INSTALL 38 LF OF 18" RCP-111 STORM DRAIN LINE.
3. INSTALL 20 LF OF 18" RCP-111 STORM DRAIN LINE.
4. INSTALL DEPRESSED GUTTER CURBING, RIGHT OF CENTERLINE, PER COA STD. DWG. 2415 FROM STA 25+10.00 TO STA 28+36.00.
5. INSTALL STD. 8" CURB AND GUTTER AT INTERIOR OF CURB LOOP PER COA STD. DWG. 2415.
6. INSTALL STD. 8" CURB AND GUTTER PER COA STD. DWG. 2415.

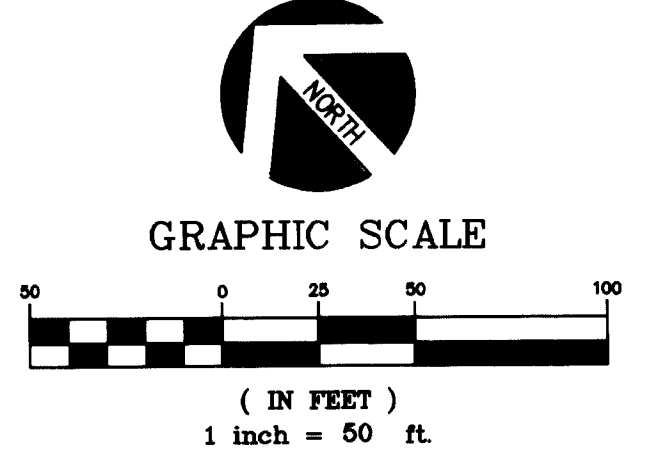

SCALE
HORIZ: 1"=50'
VERT: 1"=5'

IGNACIO COURT	
TC	FL
1 00.77	00.10
2 -	00.05
3 00.32	99.99
A=90°00'00"	
R=25.00'	
FL INT=99.86	

NOCHE VISTA DRIVE	
TC	FL
1 99.83	99.50
2 -	99.30
3 99.76	99.09
A=90°00'00"	
R=25.00'	
FL INT=99.43	

MIDNIGHT VISTA AVENUE	
TC	FL
1 95.75	95.08
2 -	95.15
3 95.90	95.23
A=90°00'00"	
R=25.00'	
FL INT=95.06	

NOCHE VISTA DRIVE	
TC	FL
1 96.19	95.52
2 -	95.56
3 96.25	95.58
A=90°00'00"	
R=25.00'	
FL INT=95.26	

RECORD DRAWING
DATE...2/16/98...


CERTIFICATION
THESE DRAWINGS HAVE BEEN RECEIVED IN ACCORDANCE WITH INFORMATION FURNISHED BY
BY: *[Signature]*
TO: DIRECTOR OF CONSTRUCTION
NAME: *[Signature]* DATE: 02/14/98

CHAVEZ • GRIEVES
CONSULTING ENGINEERS, INC.
5639 JEFFERSON STREET N.E. • ALBUQUERQUE, NEW MEXICO 87109
PHONE: (505) 344-4080 • FAX: (505) 343-8759

CITY OF ALBUQUERQUE PUBLIC WORKS DEPARTMENT ENGINEERING DEVELOPMENT GROUP	
TITLE: PARADISE BLUFF SUBDIVISION MIDNIGHT VISTA AVENUE ROADWAY & STORM DRAIN PLAN & PROFILE STA 18+00.00 TO STA 28+70.89	
DESIGNED BY: J. P. KELLEY DATE: 03-95	REVISIONS DESIGN
DRAWN BY: W. M. TOWERS DATE: 03-95	NO. DATE
CHECKED BY: V.J. CHAVEZ DATE: 03-95	BY
City Project No. 542681	
Zone Map No. B-11/12	
Sheet 11 of 32	


SURVEY INFORMATION		ENGINEER'S SEAL	
NO.	DATE	NO.	DATE
1	7-22-94	1	7/5/96
SURVEY BY: COMMUNITY SCIENCES CORP.		BY: J. P. KELLEY	
CORRALES, NM.		DATE: 03-95	
TOPOGRAPHIC MAPPING		DATE: 03-95	
BY: T. MANN & ASSOC.		DATE: 03-95	
ABQ. NM.		DATE: 03-95	
12-01-93			

BENCH MARKS		AS BUILT INFORMATION	
CONTRACTOR: ABC	DATE: 10/96	CONTRACTOR: ABC	DATE: 10/96
STAMPED BY: C.S.I.	DATE: 10/96	STAMPED BY: C.S.I.	DATE: 10/96
ACCEPTANCE BY: J. KELLEY	DATE: 2/98	ACCEPTANCE BY: J. KELLEY	DATE: 2/98
FIELD NOTES BY: C.S.I.	DATE: 2/98	FIELD NOTES BY: C.S.I.	DATE: 2/98
CORRECTED BY: C-G	DATE: 2/98	CORRECTED BY: C-G	DATE: 2/98
RECORDED BY:	DATE:	RECORDED BY:	DATE:
NO.		NO.	

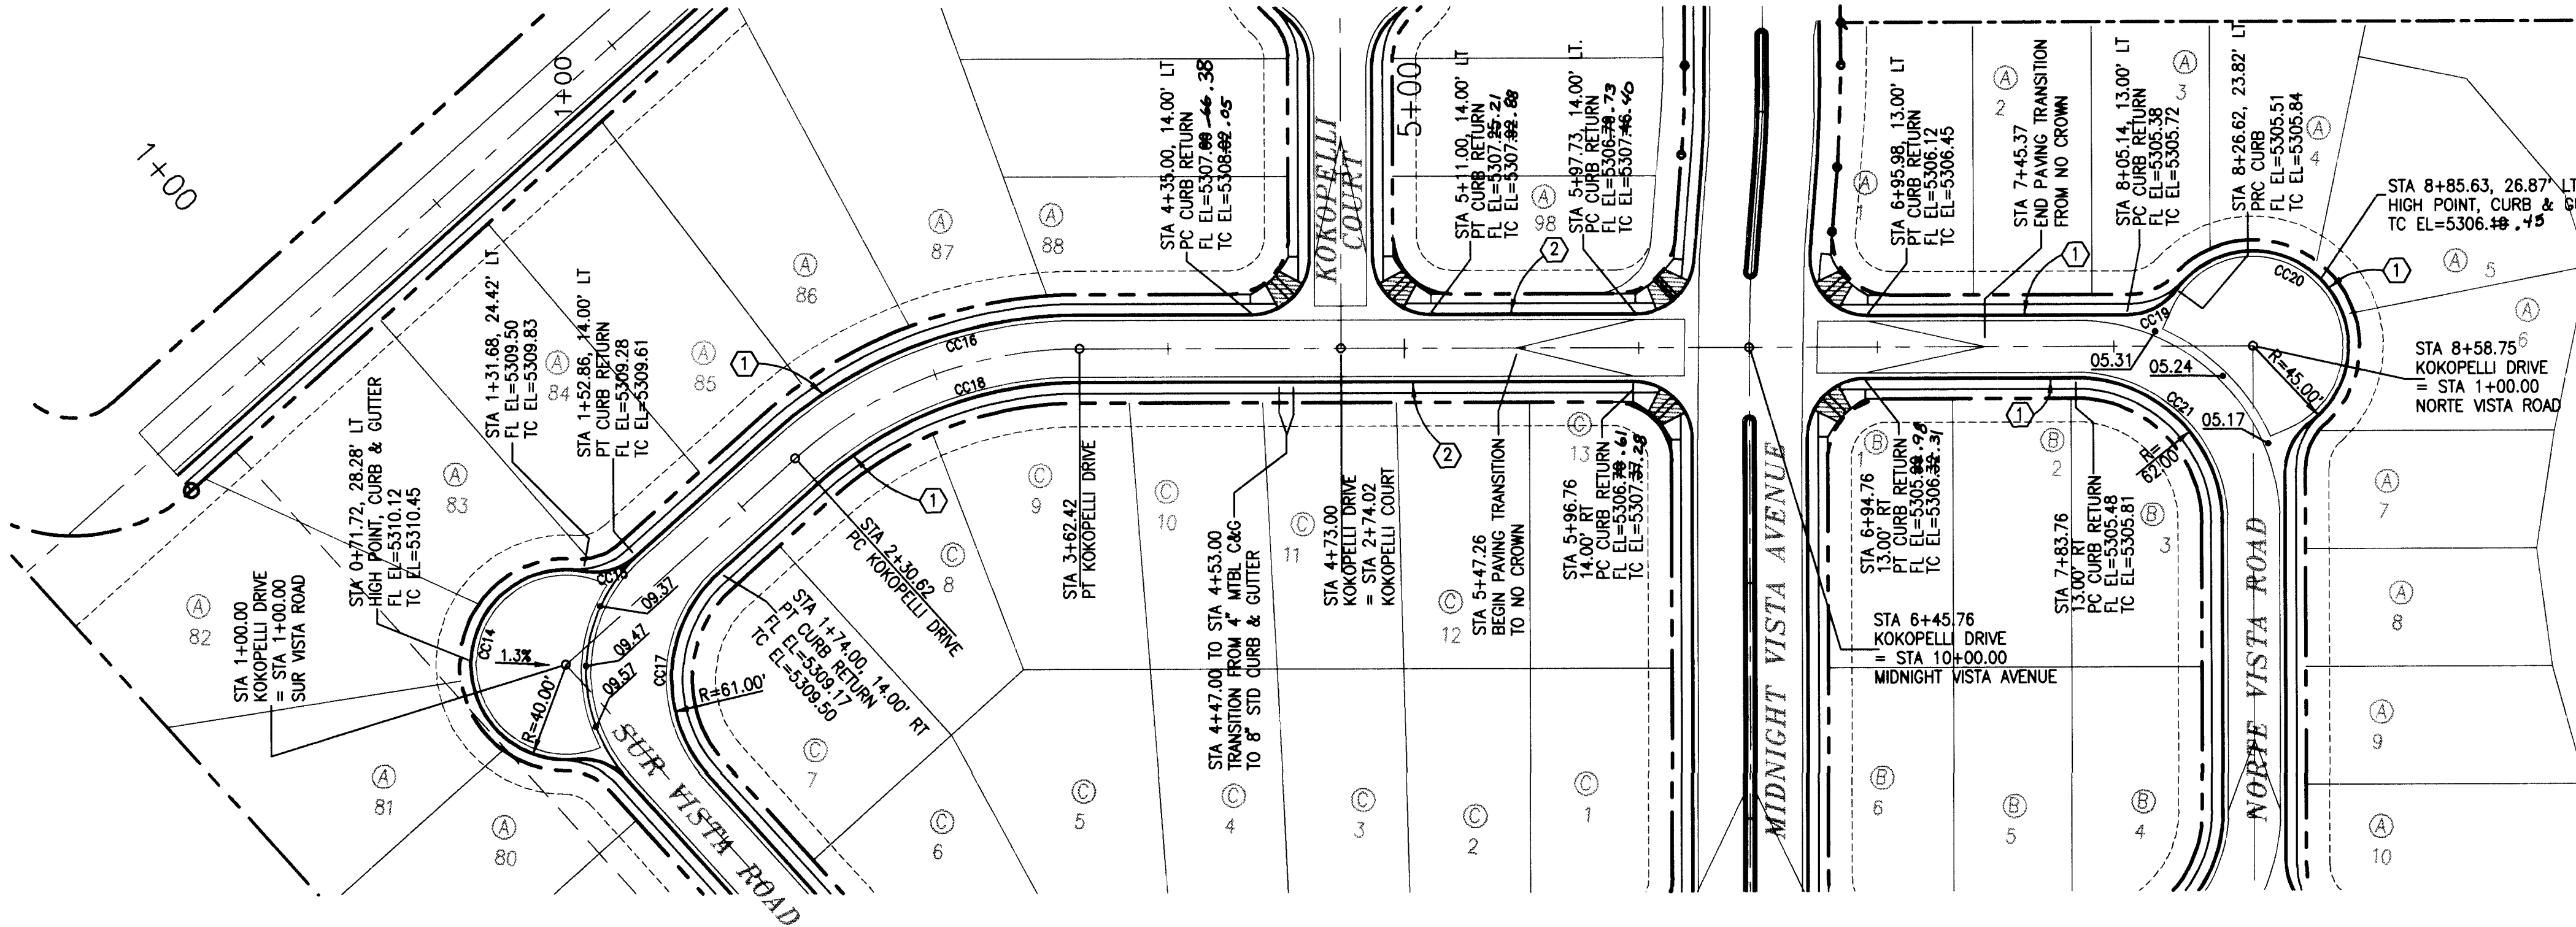

KOKOPELLI DRIVE- PLAN

SCALE
HORIZ: 1"=50'
VERT: 1"=5'

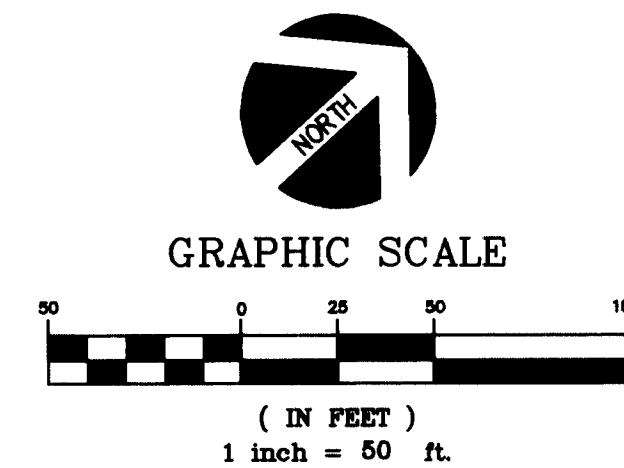

FACE OF CURB - CURVE TABLE				
CURVE	Δ	RADIUS	LGTH	CHORD
CC14	195°50'06"	40.00'	136.72'	N45°16'58" W 79.24'
CC15	52°22'46"	26.74'	24.45'	N26°26'42" E 23.05'
CC16	41°57'17"	194.00'	142.06'	N21°13'57" E 138.90'
CC17	90°00'00"	61.00'	95.82'	N44°44'41" E 86.27'
CC18	41°57'17"	166.00'	121.55'	N21°13'57" E 118.86'
CC19	52°22'46"	26.74'	24.95'	N15°28'56" E 24.05'
CC20	196°54'40"	40.00'	137.47'	N87°12'36" E 79.13'
CC21	90°00'00"	62.00'	97.39'	N87°12'36" E 87.68'

- KEYED NOTES
- 1 MOUNTABLE CURB & GUTTER, PER COA STD. DWG. 2415.
 - 2 STANDARD CURB & GUTTER, PER COA STD. DWG. 2415.

TC	FL
1 08.23	07.90
2 --	07.78
3 07.99	07.66
Δ=90°00'00"	
R=25.00'	
FL INT 07.54	

KOKOPELLI COURT

TC	FL
1 07.86	07.53
2 --	07.68
3 08.49	07.83
Δ=90°00'00"	
R=25.00'	
FL INT 07.39	

TC	FL
1 07.45	06.78
2 --	06.78
3 07.46	06.79
Δ=85°20'48"	
R=25.00'	
FL INT 06.67	


MIDNIGHT VISTA AVENUE

TC	FL
1 06.87	06.20
2 --	06.32
3 07.11	06.44
Δ=94°39'12"	
R=25.00'	
FL INT 06.32	

KOKOPELLI DRIVE

TC	FL
1 07.30	06.63
2 --	06.56
3 07.15	06.48
Δ=90°00'00"	
R=25.00'	
FL INT 06.53	

TC	FL
1 06.35	06.02
2 --	06.06
3 06.76	06.09
Δ=90°00'00"	
R=25.00'	
FL INT 06.14	

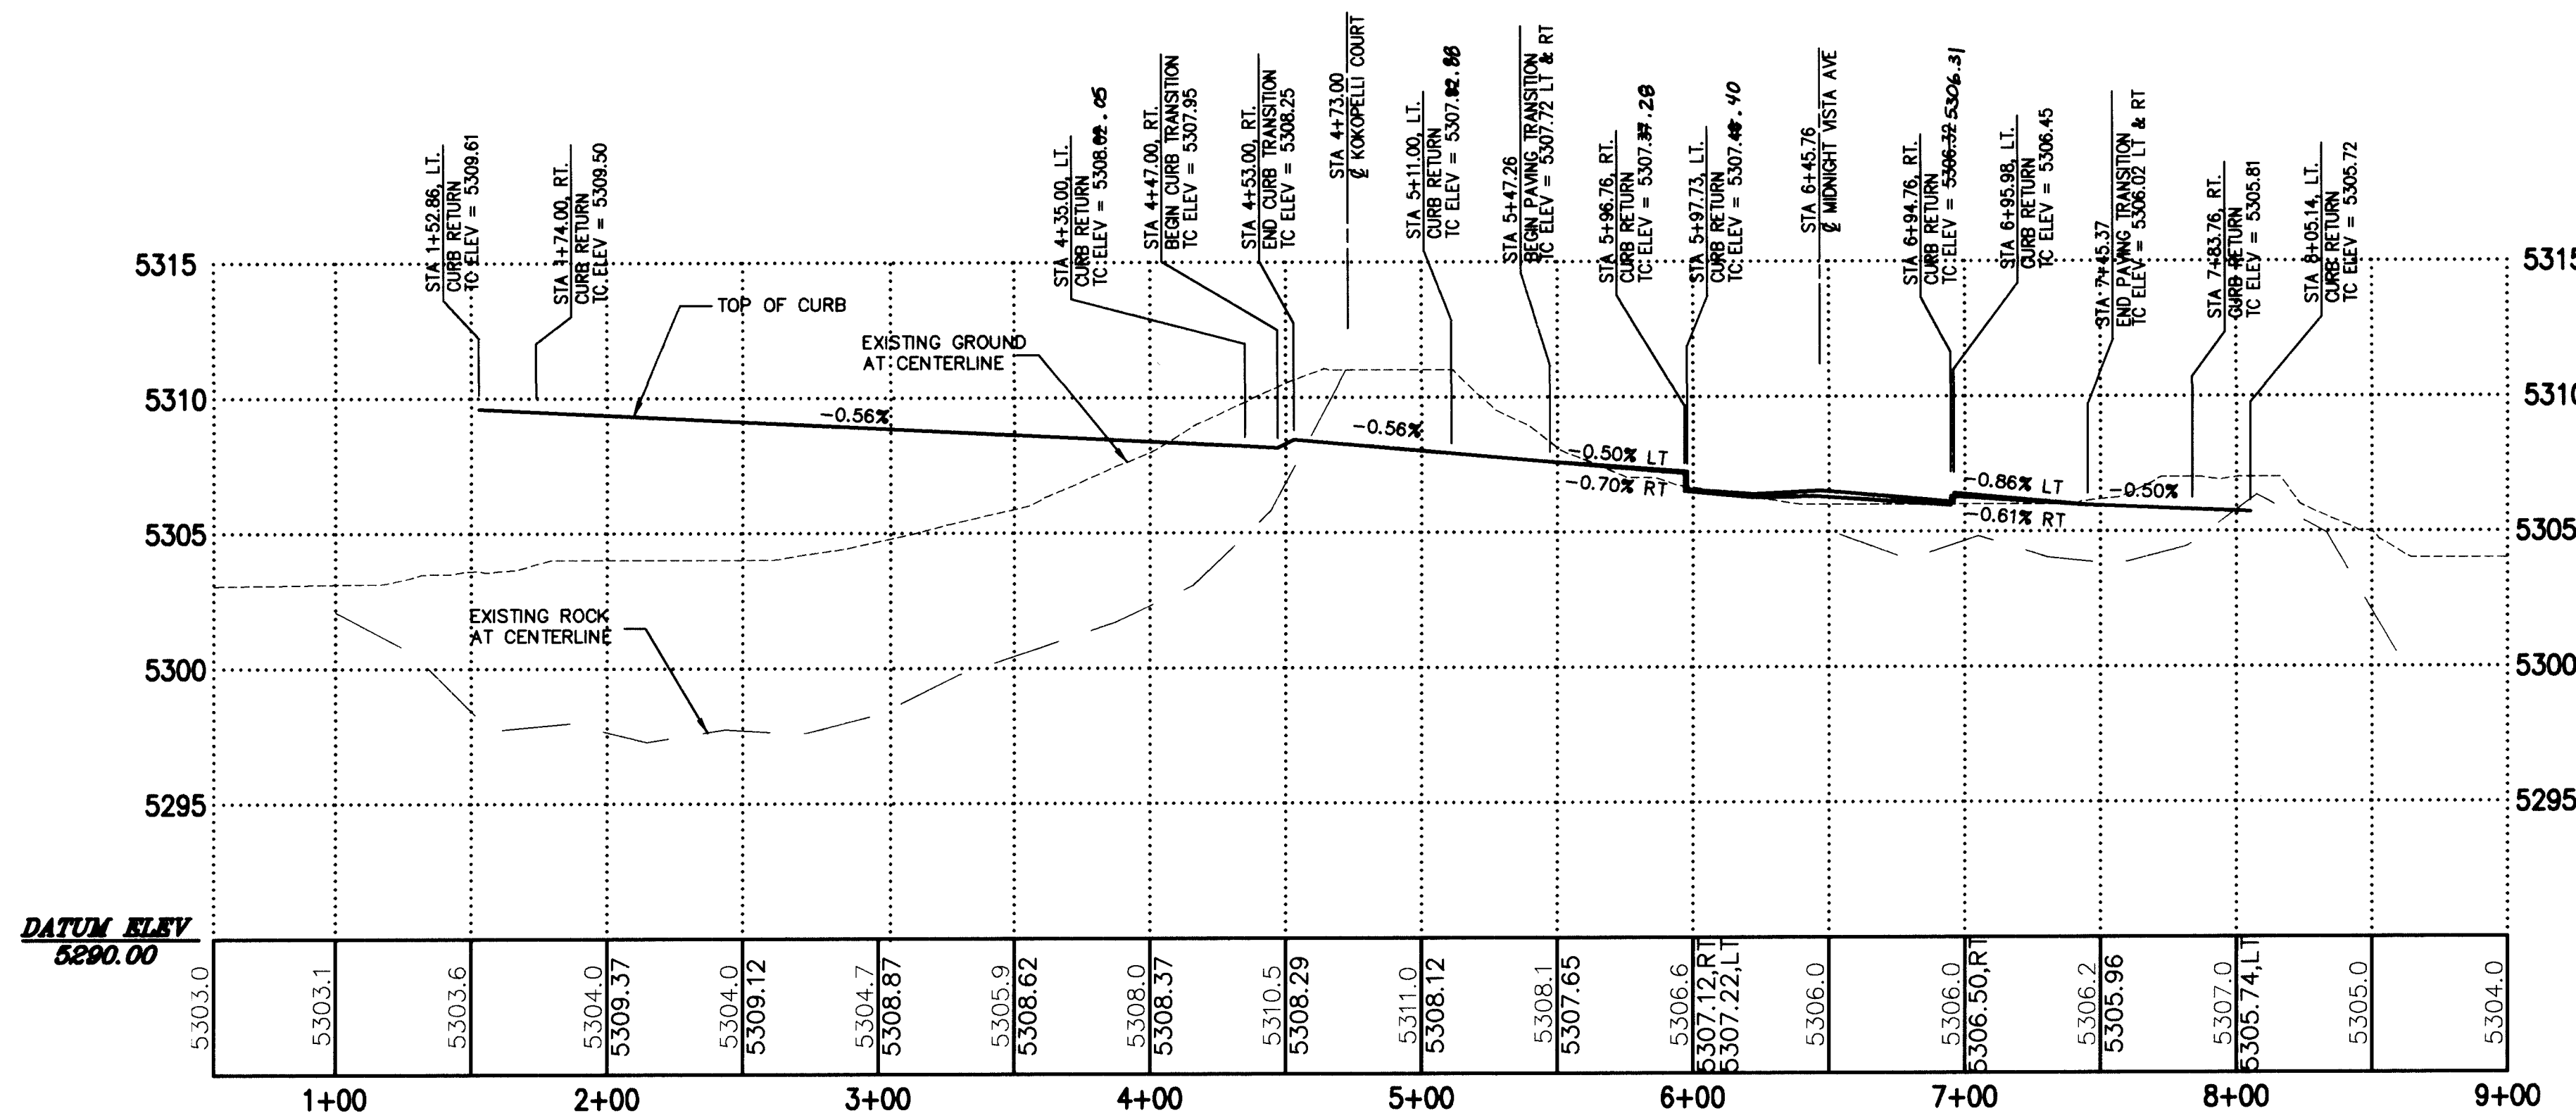


KOKOPELLI DRIVE - PROFILE

RECORD DRAWING
DATE ... 2/16/98 ...

02/16/98

CERTIFICATION
THESE DRAWINGS HAVE BEEN RECEIVED IN ACCORDANCE WITH INFORMATION FURNISHED BY
BY: **CSC**
TO: **CHAVEZ • GRIEVES CONSULTING ENGINEERS, INC.**
NAME: **CHAVEZ** DATE: **02/16/98**

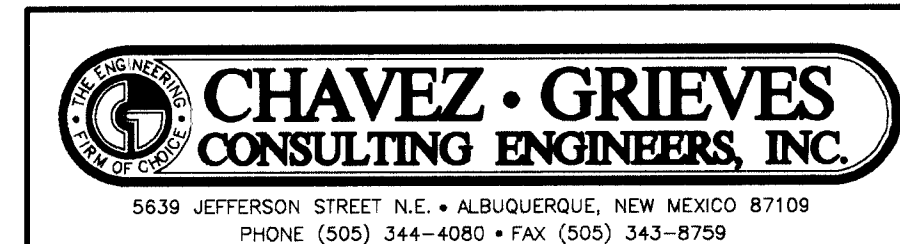


CITY OF ALBUQUERQUE
PUBLIC WORKS DEPARTMENT
ENGINEERING DEVELOPMENT GROUP

TITLE: PARADISE BLUFF SUBDIVISION
KOKOPELLI DRIVE
ROADWAY - PLAN & PROFILE

Design Review Committee	City Engineer Approval	Mo./Day/Yr.	Mo./Day/Yr.


City Project No. 542681 Zone Map No. B-11/12 Sheet 12 of 32

ENGINEER'S SEAL		SURVEY INFORMATION		BENCH MARKS		AS BUILT INFORMATION	
		FIELD NOTES		ACS BRASS CAP STAMPED "ACS 6-BT1, 1986" LOCATED 475 FEET NORTHEAST OF THE INTERSECTION OF JUSTIN DRIVE AND BUGIO AVENUE. ELEV. = 5328.378		CONTRACTOR: ALBUQUERQUE	
		NO.	DATE	INSPECTOR'S: C.S.I.		DATE: 10/96	
		SURVEY BY COMMUNITY		INSPECTOR'S: C.S.I.		DATE: 2/98	
		SCIENCE CORP.		INSPECTOR'S: C.S.I.		DATE: 2/98	
		CORRALES, NM.		INSPECTOR'S: C.S.I.		DATE: 2/98	
		7-22-94		INSPECTOR'S: C.S.I.		DATE: 2/98	
		TOPOGRAPHIC MAPPING		INSPECTOR'S: C.S.I.		DATE: 2/98	
		BY T. MANN & ASSOC.		INSPECTOR'S: C.S.I.		DATE: 2/98	
		ABQ, NM.		INSPECTOR'S: C.S.I.		DATE: 2/98	
		12-01-93		INSPECTOR'S: C.S.I.		DATE: 2/98	

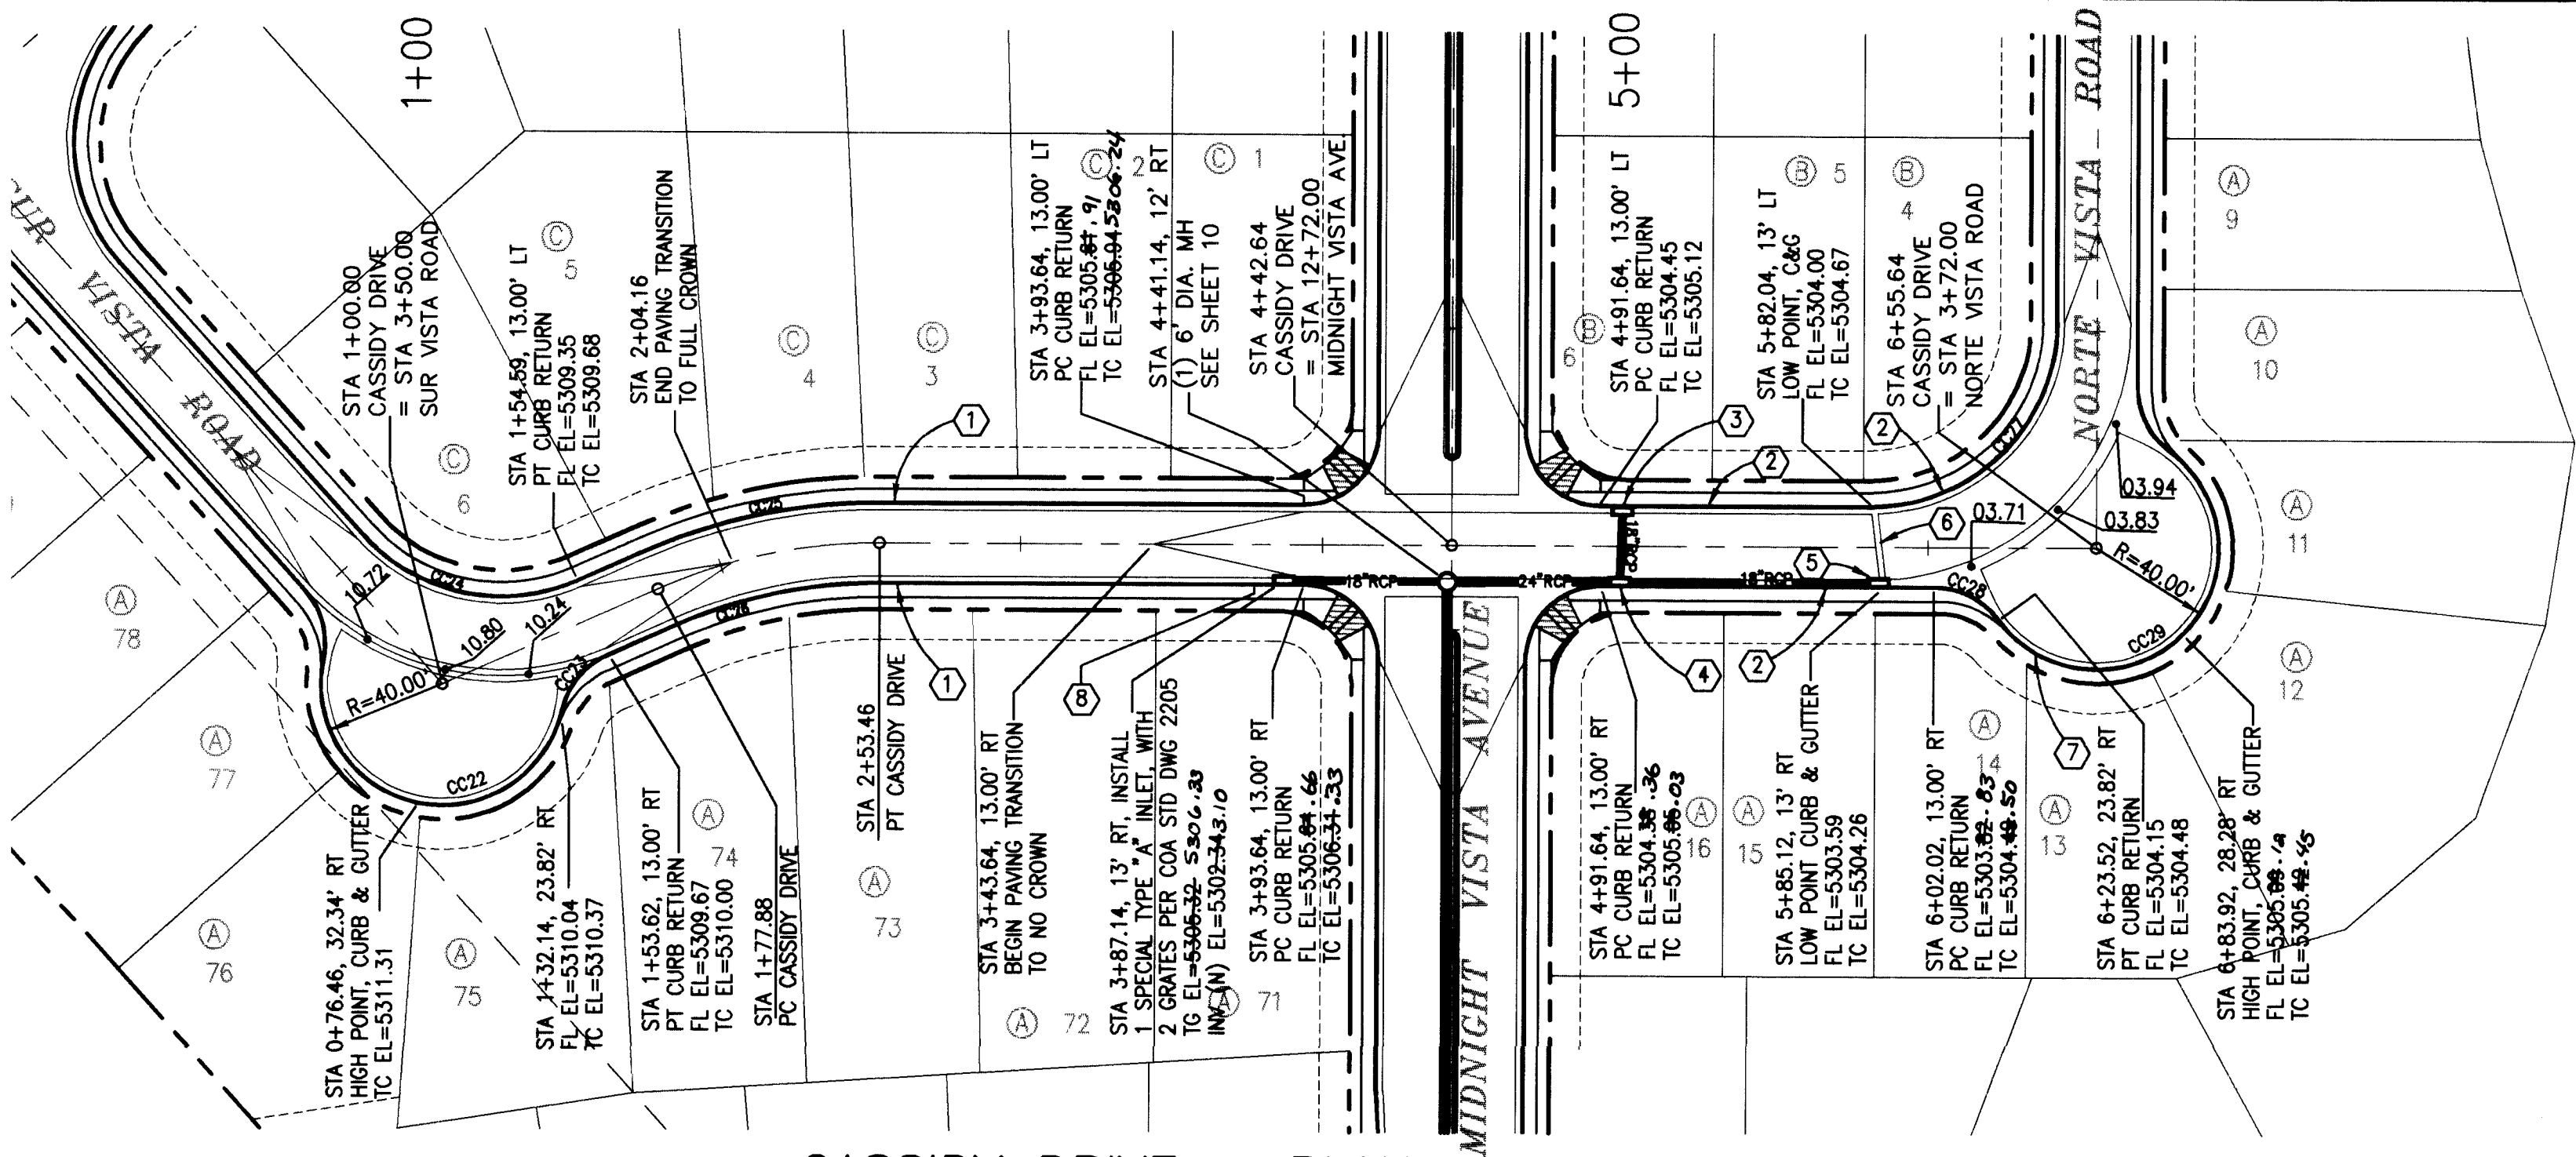

CASSIDY DRIVE - PLAN

SCALE
HORIZ: 1"=50'
VERT: 1"=5'

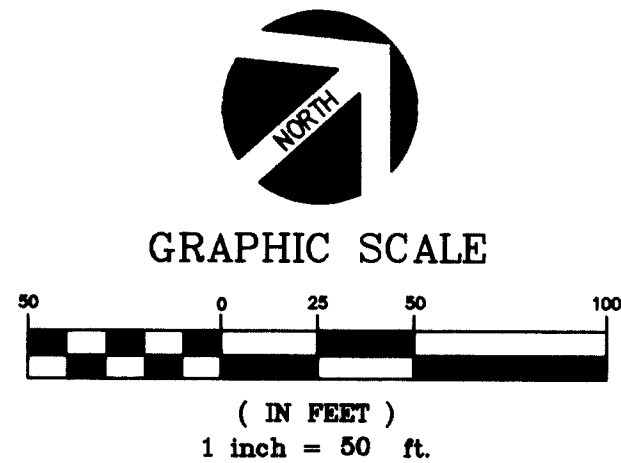

TC	FL
1 06.15	05.48
2 --	05.52
3 05.90	05.57
Δ=90°00'00"	
R=25.00'	
FL INT=05.36	


TC	FL
1 06.28	05.61
2 --	05.59
3 06.24	05.57
Δ=90°00'00"	
R=25.00'	
FL INT=05.40	

TC	FL
1 05.17	04.50
2 --	04.55
3 05.27	04.60
Δ=90°00'00"	
R=25.00'	
FL INT=04.58	

TC	FL
1 05.44	04.77
2 --	04.64
3 05.18	04.51
Δ=90°00'00"	
R=25.00'	
FL INT=04.66	

FACE OF CURB - CURVE TABLE				
CURVE	Δ	RADIUS	LGTH	CHORD
CC22	175°00'52"	40.00'	124.98'	S54°12'13"W 80.00'
CC23	53°27'20"	26.74'	24.95'	S05°34'35"E 24.05'
CC24	72°06'12"	62.00'	78.02'	S54°12'13"W 72.98'
CC25	24°03'29"	193.00'	81.04'	S30°10'51"W 80.45'
CC26	24°03'29"	167.00'	70.12'	S30°10'51"W 69.61'
CC27	90°00'00"	62.00'	97.39'	S07°47'24"W 87.68'
CC28	53°27'20"	26.74'	24.95'	S68°58'16"W 24.05'
CC29	196°54'40"	40.00'	137.47'	S07°47'24"E 79.13'

- KEYED NOTES
- MOUNTABLE CURB & GUTTER PER COA STD. DWG. 2415.
 - STANDARD CURB & GUTTER PER COA STD. DWG. 2415.
 - STA 4+98.89, 13' RT. - INSTALL 1 TYPE "B" INLET PER COA STD DWG 2203, WITH 4" CURB OPENING ON UPSTREAM SIDE PER STD DWG 2205. TG EL 5304.19 INV (W) EL 5301.21 5309.90
 - STA 4+98.14, 13' RT. - INSTALL 1 TYPE "B" INLET PER COA STD DWG 2203, WITH 4" CURB OPENING ON UPSTREAM SIDE PER STD DWG 2205. TG EL 5304.01 INV (N) EL 5306.32 5304.30 INV (S) EL 5306.25 5304.90
 - STA 5+82.83, 13' RT. - INSTALL 1 SPECIAL TYPE "A" INLET WITH 4" CURB OPENINGS EACH SIDE, AND 2 GRATES PER COA STD DWG 2205 TG EL 5303.37 INV (S) EL 5304.44 5302.70
 - INSTALL ALLEY GUTTER PER COA STD DWG 2415 FROM STA 5+82.27, 11' LT TO STA 5+84.77, 11' RT. INSTALL DEPRESSIONED GUTTER SECTION PER COA STD DWG 2415 FROM STA 5+79.22, 13' LT, TO STA 5+85.22, 13' LT, WITH LIP OF GUTTER 3/8" BELOW THE FLOWLINE AT STA 5+82.04.
 - STA 6+28.00, 28.92' RT FL EL=4304.33 TO EL=5305.00 TO STA 6+32.64, 32.73' RT FL EL=5304.41 TC EL=5304.74 TRANSITION TO MOUNTABLE CURB & GUTTER
 - STA 3+77.39, 13.00' RT FL EL=4305.59 TC EL=5305.92 TO STA 3+83.39, 13.00' RT FL EL=5305.56 TO EL=5306.23 TRANSITION TO STANDARD CURB & GUTTER

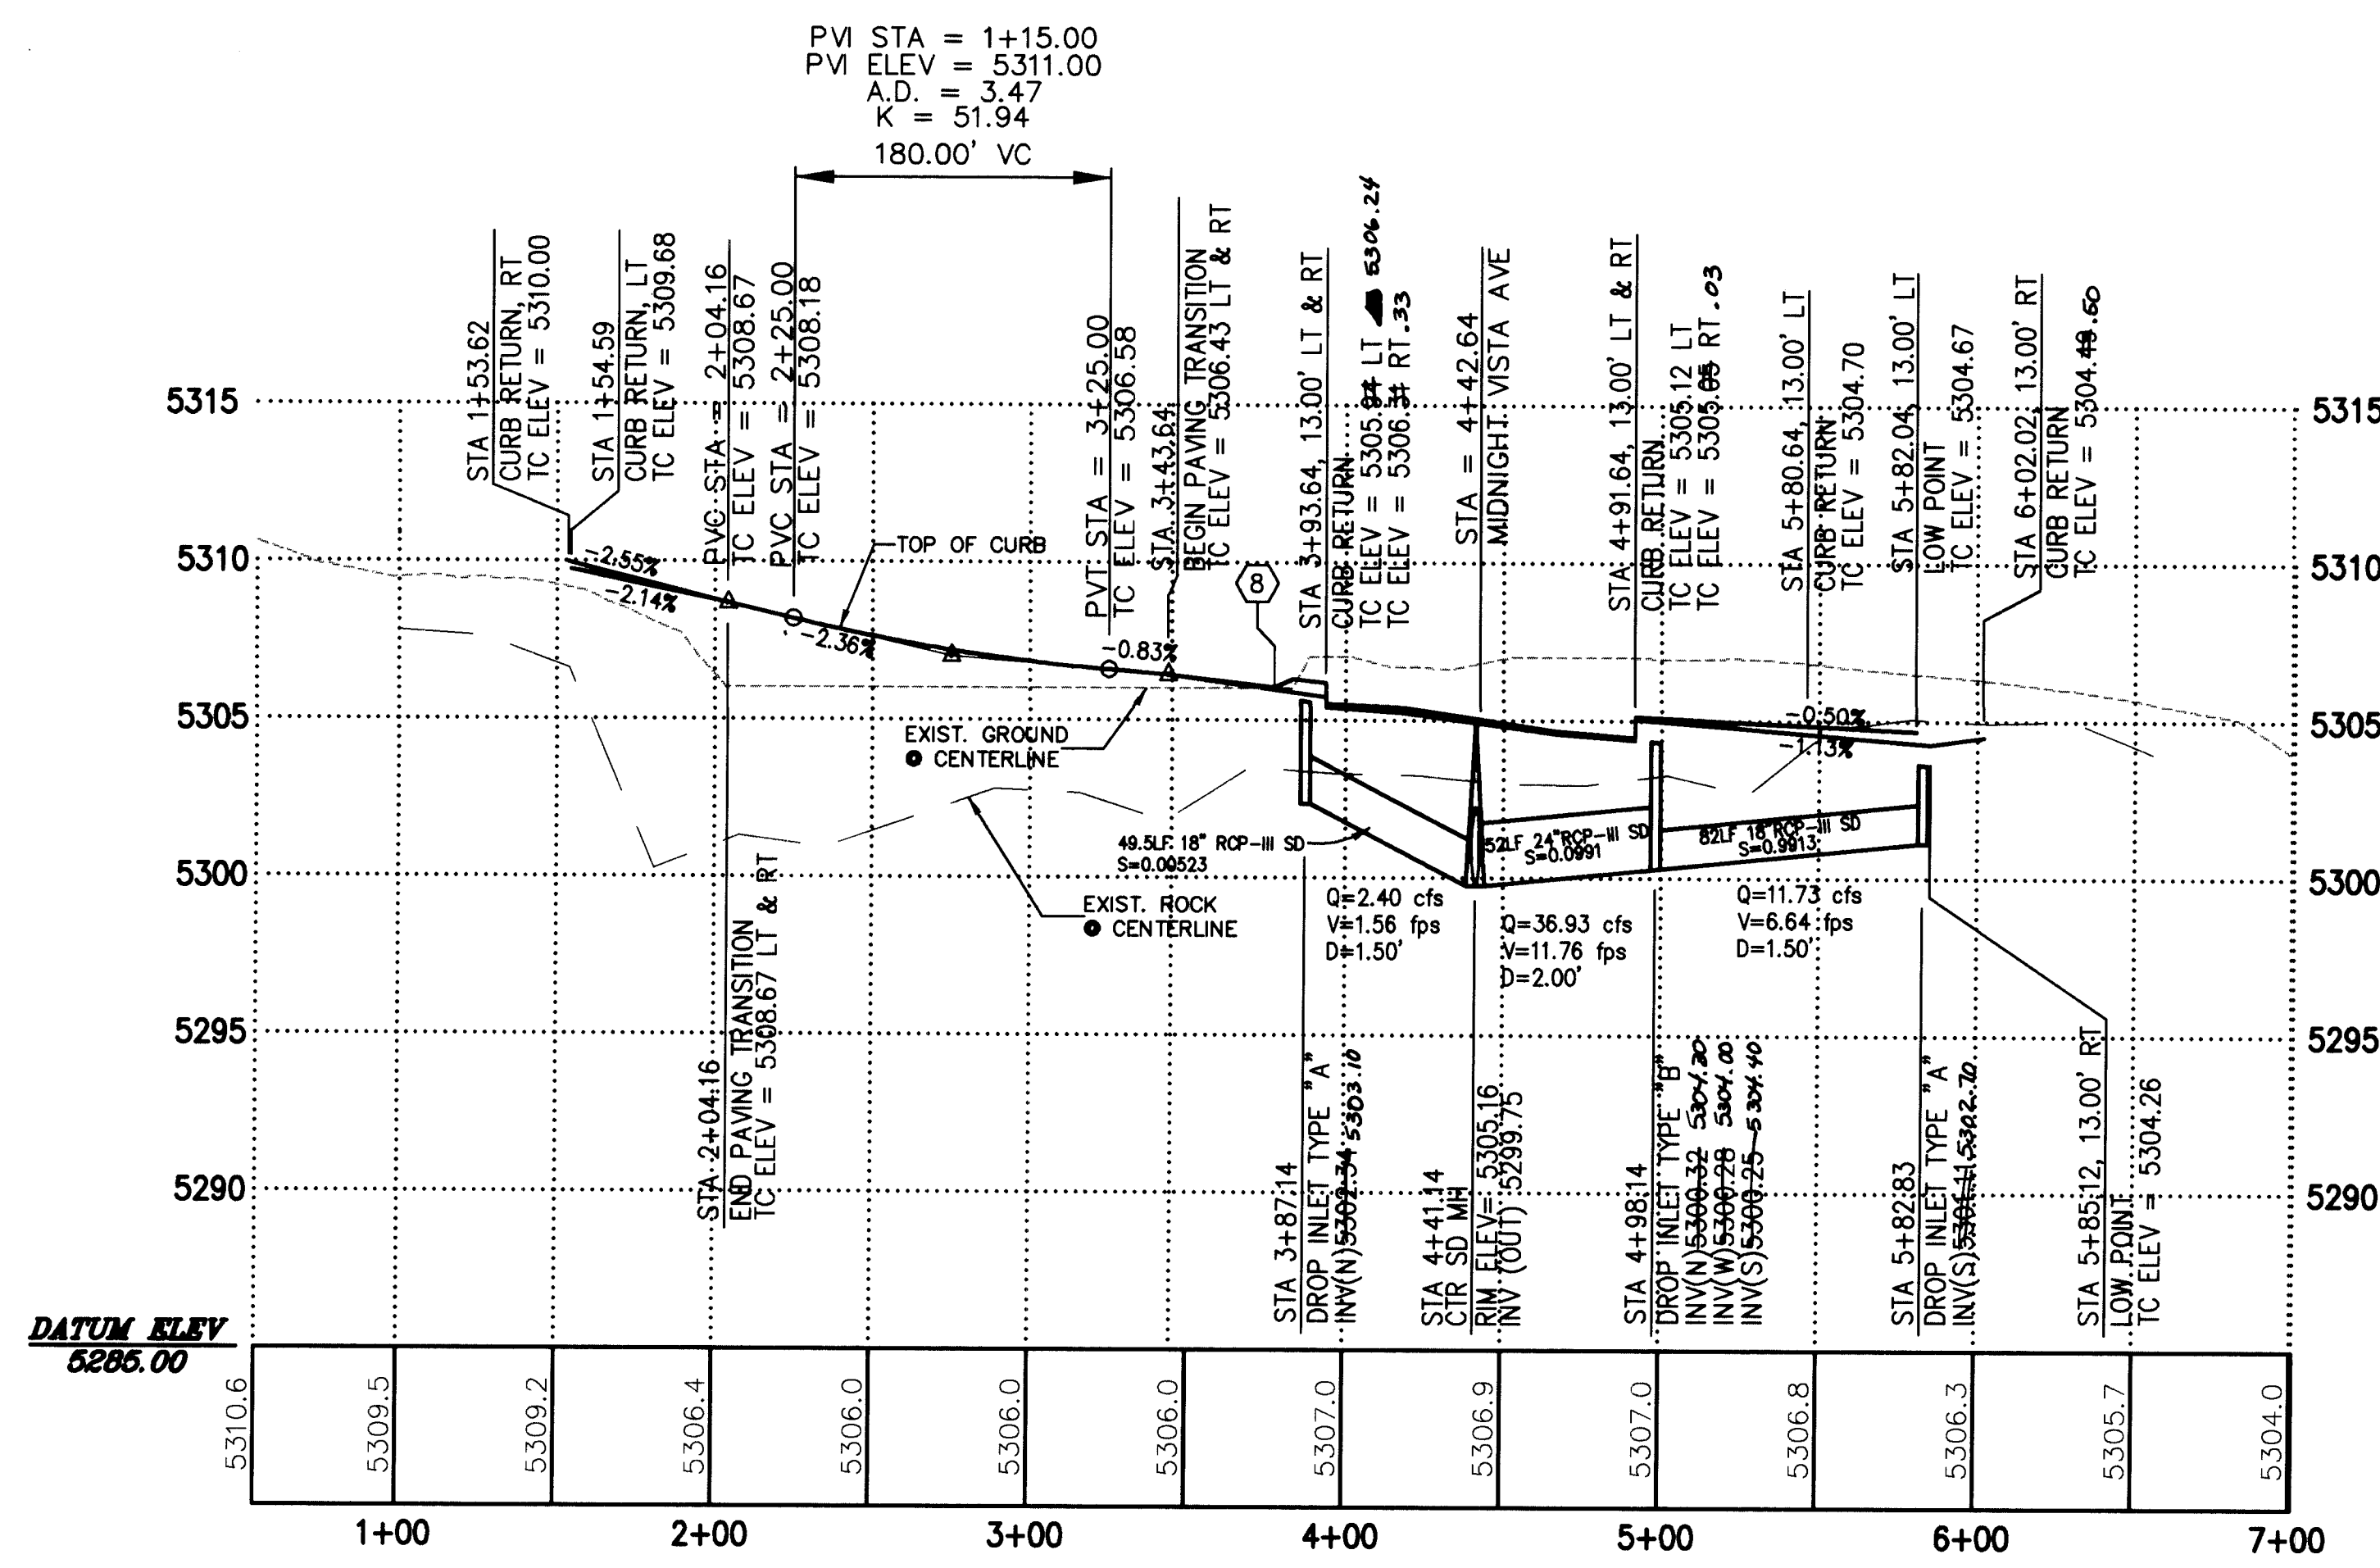

CASSIDY DRIVE - PROFILE

RECORD DRAWING
DATE 2/16/98


02/16/98

CERTIFICATION
THESE DRAWINGS HAVE BEEN RECEIVED IN ACCORDANCE WITH INFORMATION FURNISHED BY CS&G TO REFLECT THE CONSTRUCTION AS ACTUALLY ACCOMPLISHED.
NAME: J. P. KELLEY DATE: 02/16/98

CHAVEZ • GRIEVES
CONSULTING ENGINEERS, INC.
5630 JEFFERSON STREET N.E. • ALBUQUERQUE, NEW MEXICO 87109
PHONE (505) 344-4080 • FAX (505) 343-8759



CITY OF ALBUQUERQUE PUBLIC WORKS DEPARTMENT ENGINEERING DEVELOPMENT GROUP	
TITLE: PARADISE BLUFF SUBDIVISION CASSIDY DRIVE ROADWAY - PLAN & PROFILE	
Design Review Committee	City Engineer Approval
City Project No. 542681	Zone Map No. B-11/12
Sheet 13	Of 32

SURVEY INFORMATION		FIELD NOTES		ENGINEER'S SEAL	
NO.	DATE	NO.	DATE	[Seal]	
ACCS BRASS CAP STAMPED "ACS 6-BT1, 1986" LOCATED 475 FEET NORTHEAST OF THE INTERSECTION OF JUSTIN DRIVE AND BUGLO AVENUE. ELEV. = 5328.378		DATE 10/96		DATE 03-95	
SURVEY BY COMMUNITY SCIENCES CORP.		DATE 7-22-94		DATE 03-95	
CORRALES, NM.		DATE 7-22-94		DATE 03-95	
TOPOGRAPHIC MAPPING BY T. MANN & ASSOC.		DATE 12-01-93		DATE 03-95	
ABQ, NM.		DATE 12-01-93		DATE 03-95	

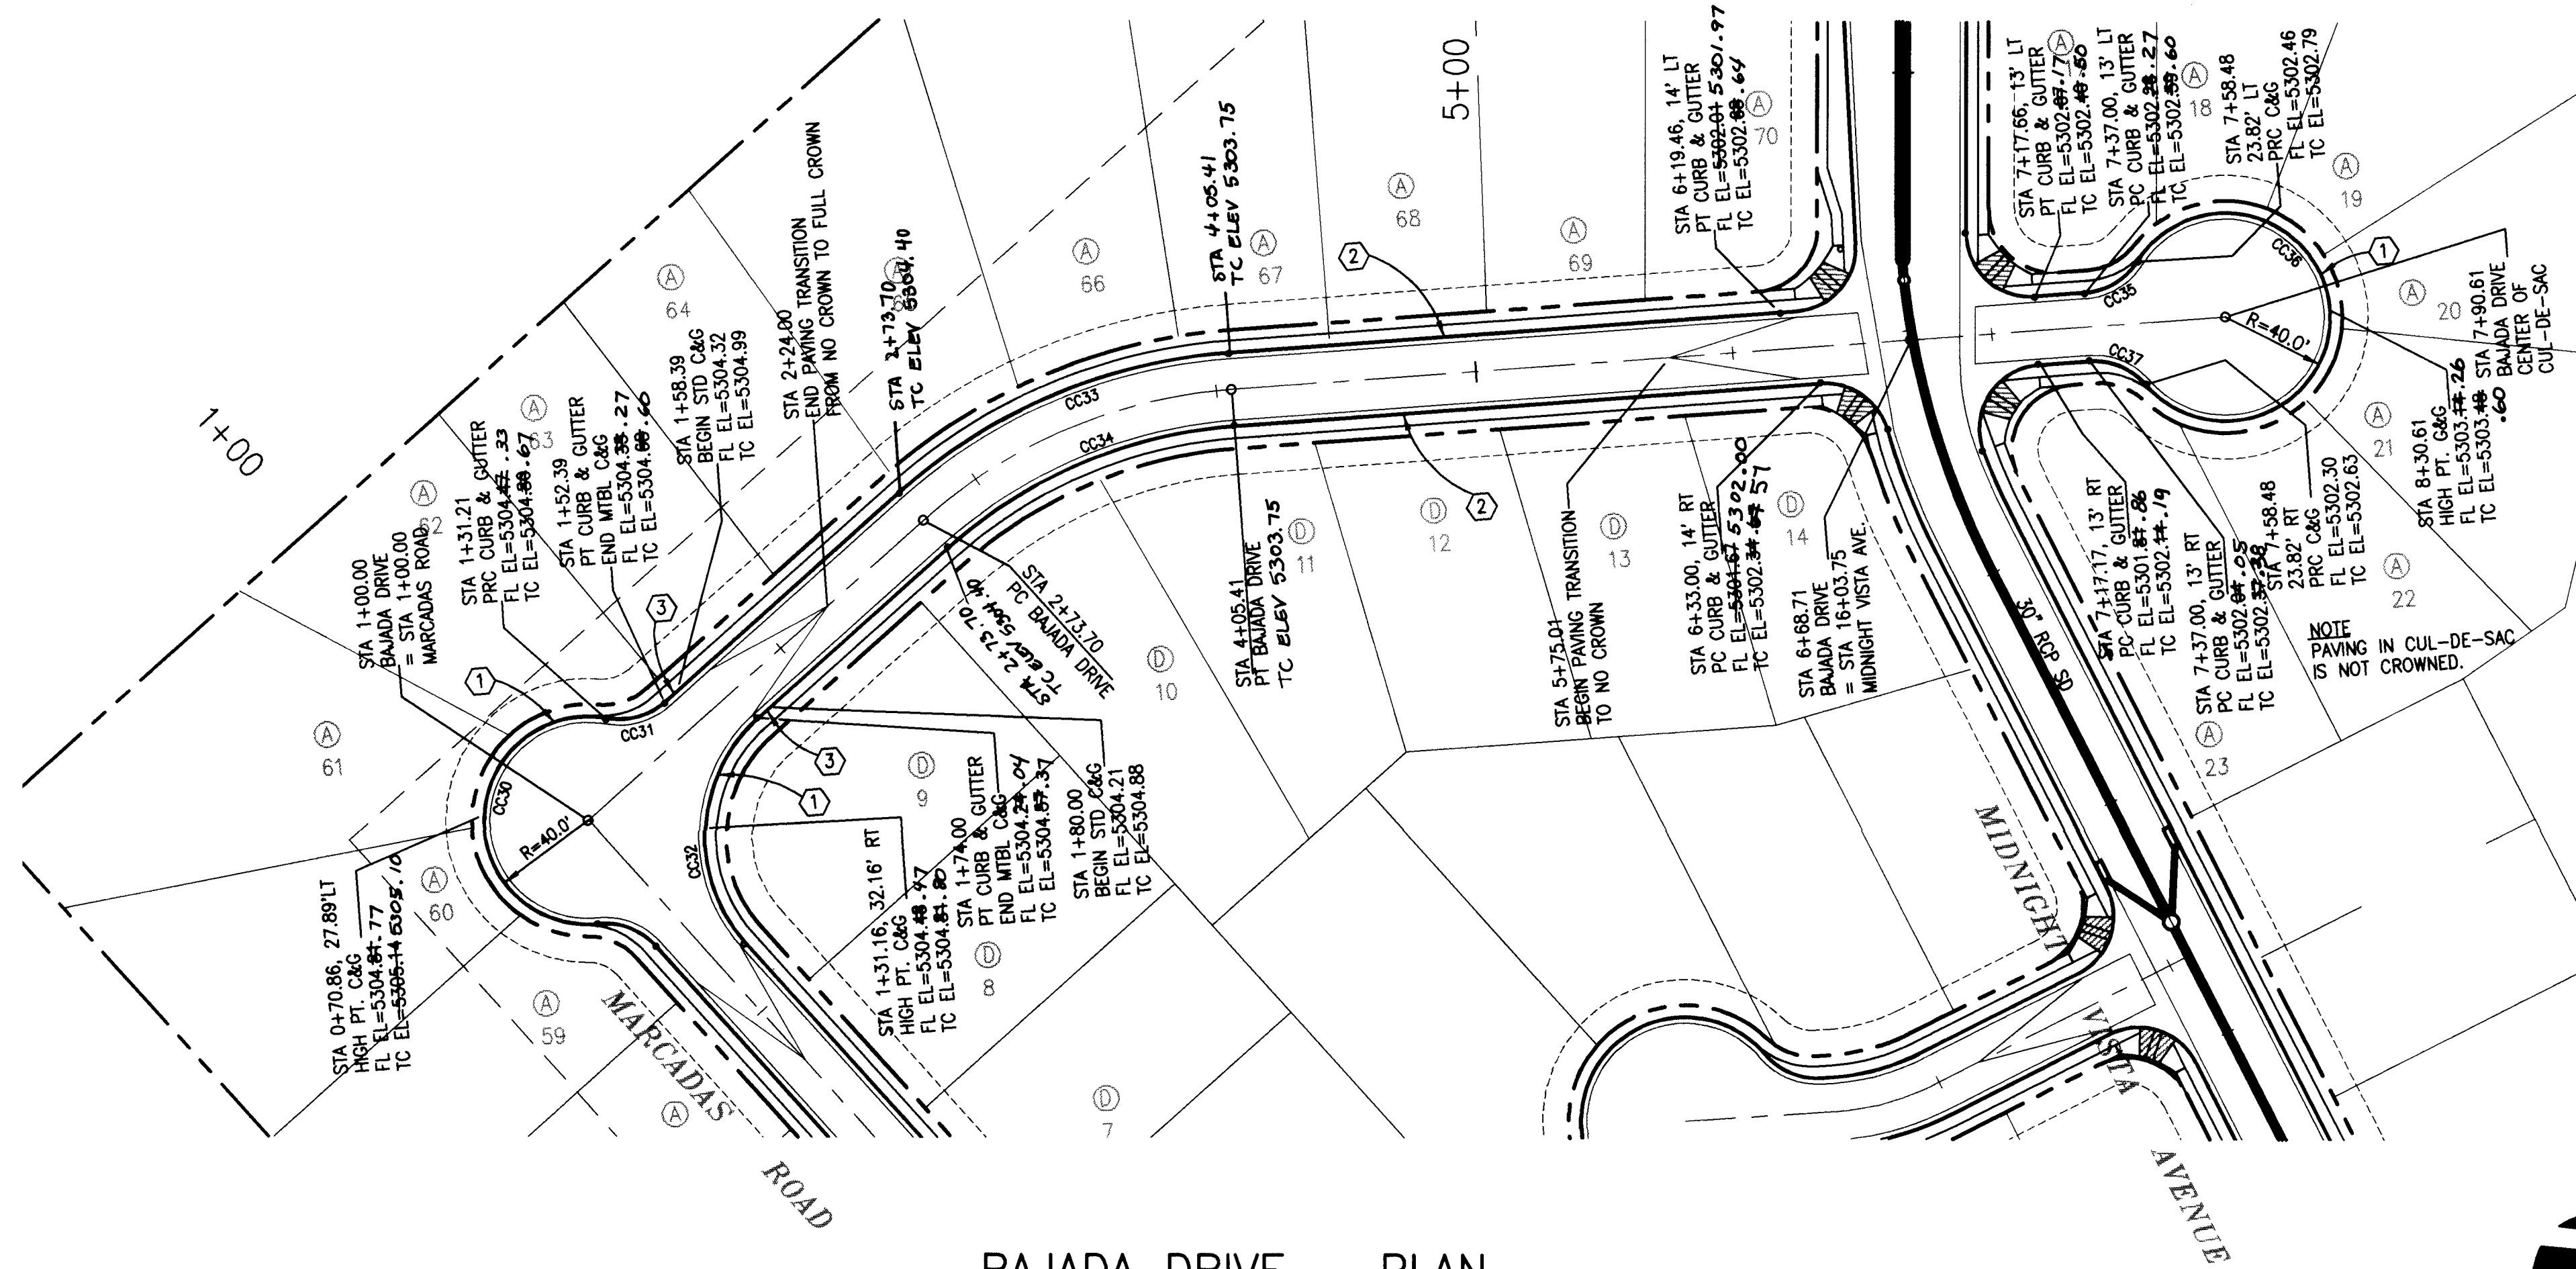

BAJADA DRIVE - PLAN

SCALE
HORIZ: 1"=50'
VERT: 1"=5'

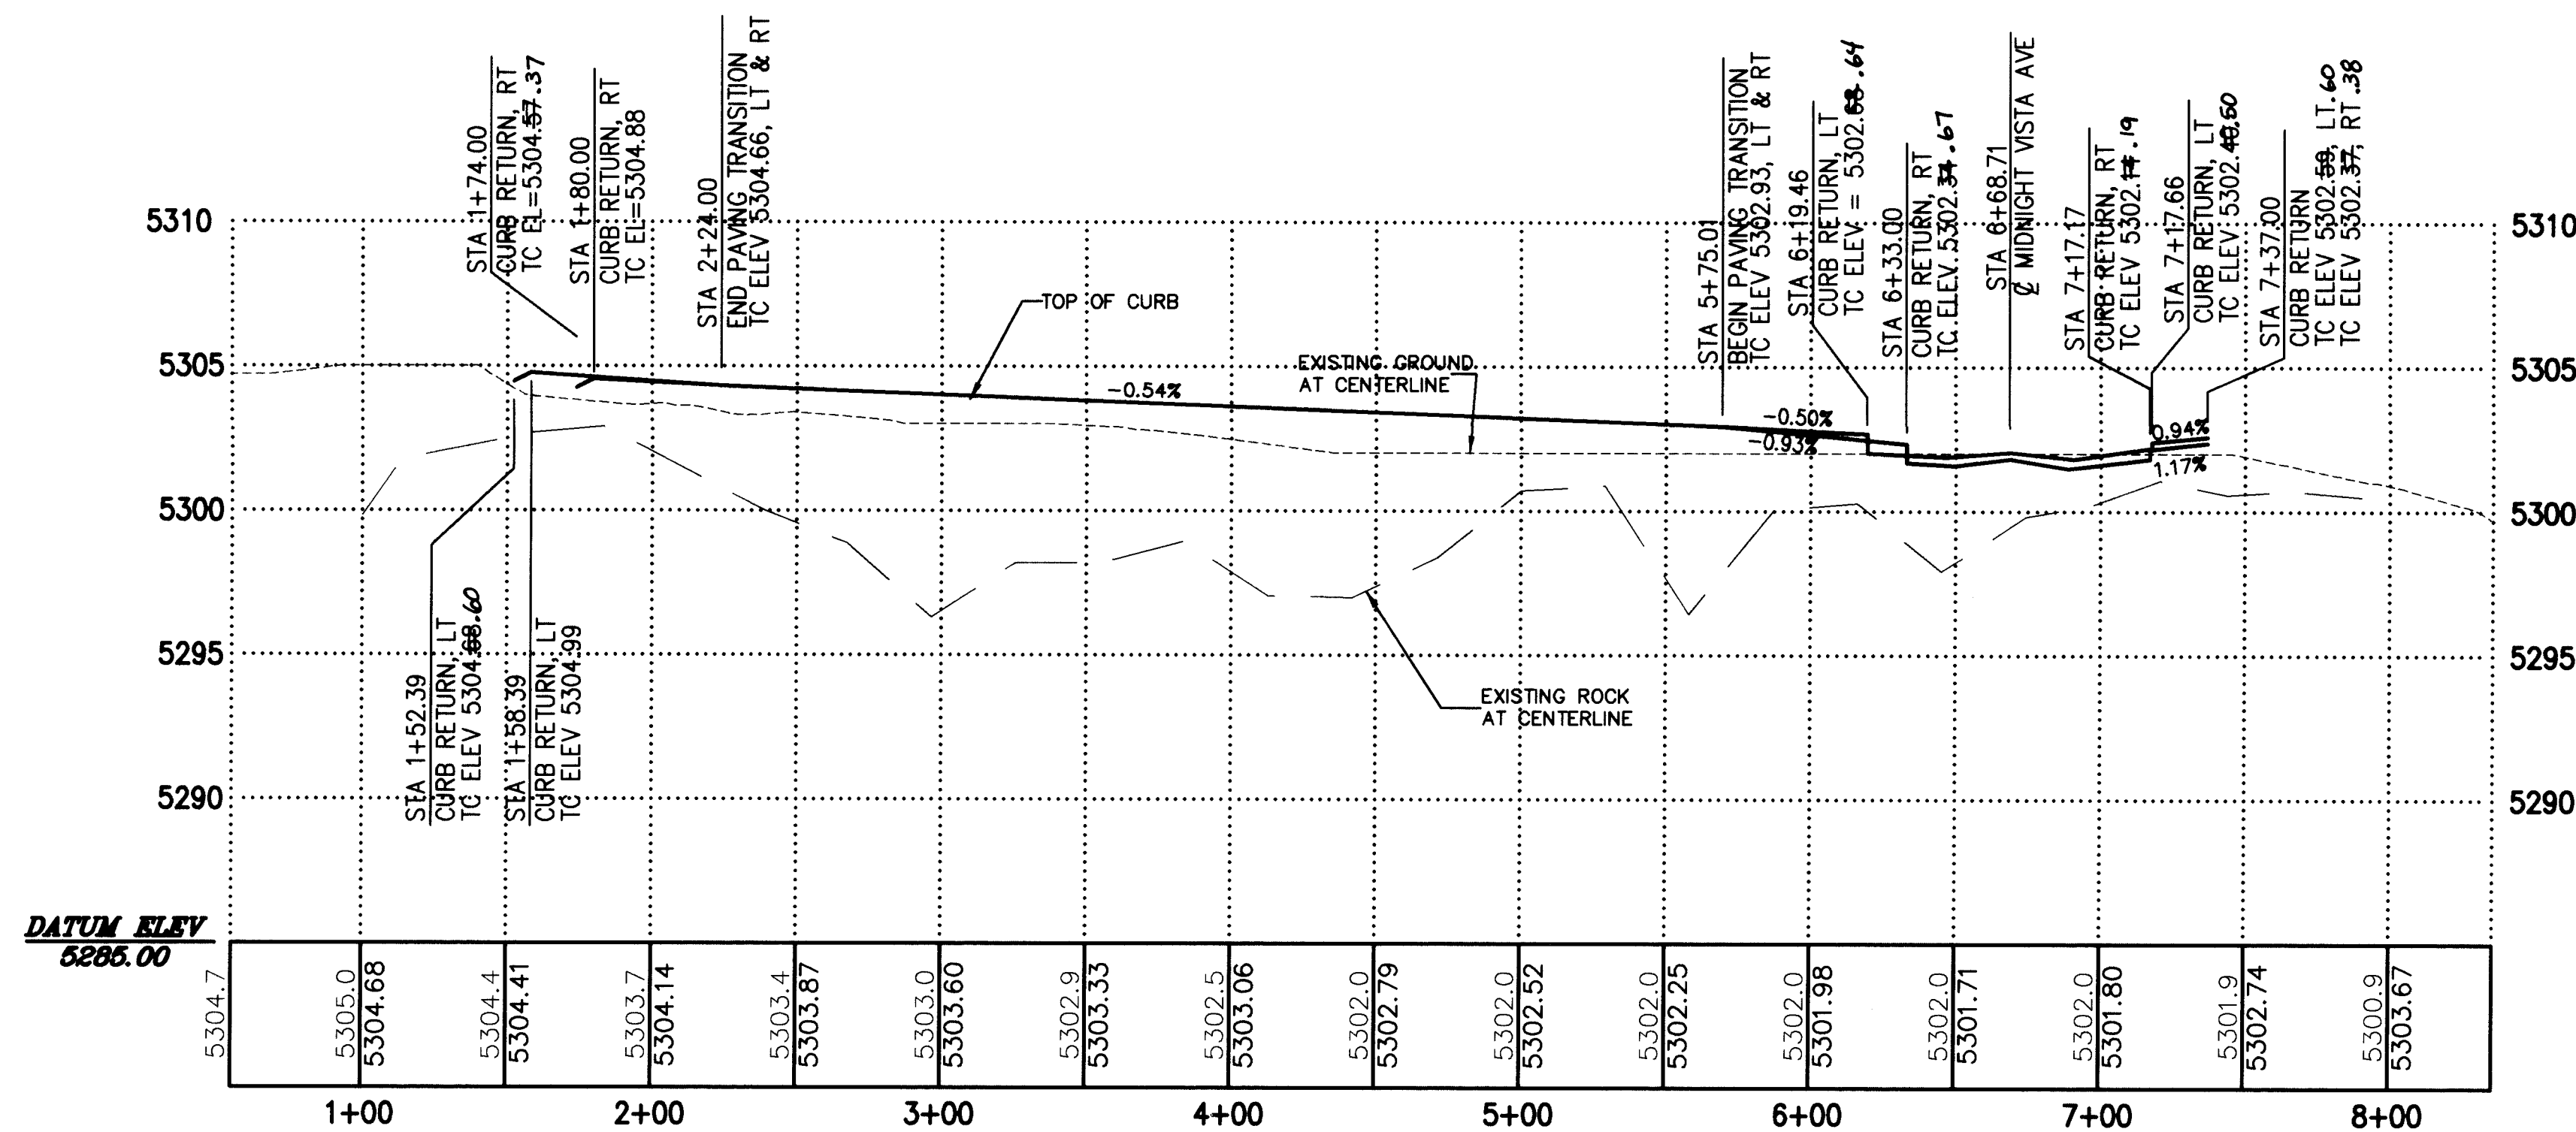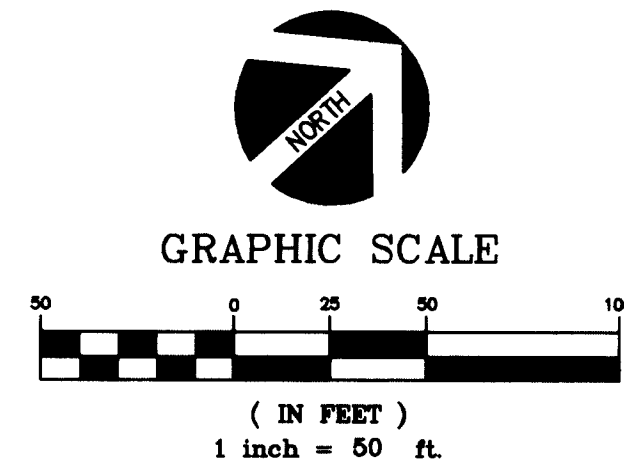

BAJADA DRIVE - PROFILE

FACE OF CURB - CURVE TABLE				
CURVE	Δ	RADIUS	LGTH	CHORD
CC30	196°20'08"	40.00'	137.07'	N45°36'56"W 79.19'
CC31	52°22'46"	26.74'	24.45'	N26°21'44"E 23.60'
CC32	90°00'00"	62.00'	97.39'	N44°49'39"W 87.68'
CC33	374°3'55"	214.00'	140.93'	N19°02'19"E 138.40'
CC34	374°3'55"	186.00'	122.49'	N19°02'19"E 120.29'
CC35	53°27'20"	26.74'	24.95'	N11°10'36"E 24.05'
CC36	286°54'40"	40.00'	200.30'	S52°05'44"E 47.64'
CC37	53°27'20"	26.74'	24.95'	S64°37'56"W 24.05'

- KEYED NOTES
- 1 MOUNTABLE CURB & GUTTER PER COA STD. DWG. 2415.
 - 2 STANDARD CURB & GUTTER PER COA STD. DWG. 2415.
 - 3 TRANSITION FROM STANDARD CURB AND GUTTER TO MOUNTABLE CURB AND GUTTER.

TC	FL
1 02.90	02.23
2 --	02.16
3 02.75	02.08
Δ=85°41'40"	
R=25.00'	
FL INT=01.88	

BAJADA DRIVE

TC	FL
1 02.48	02.15
2 --	02.24
3 02.98	02.31
Δ=94°18'20"	
R=25.00'	
FL INT=01.82	

TC	FL
1 02.09	01.42
2 --	01.58
3 02.01	01.68
Δ=106°10'54"	
R=25.00'	
FL INT=01.48	


RECORD DRAWING
DATE: 2/16/98

5/17/98




CHAVEZ • GRIEVES
CONSULTING ENGINEERS, INC.
5639 JEFFERSON STREET N.E. • ALBUQUERQUE, NEW MEXICO 87109
PHONE (505) 344-4080 • FAX (505) 343-8759

CITY OF ALBUQUERQUE PUBLIC WORKS DEPARTMENT ENGINEERING DEVELOPMENT GROUP	
TITLE: PARADISE BLUFF SUBDIVISION BAJADA DRIVE ROADWAY - PLAN & PROFILE	
Design Review Committee	City Engineer Approval
Mo./Day/Yr.	Mo./Day/Yr.
City Project No. 542681	Zone Map No. B-11/12
Sheet 14	Of 32

SURVEY INFORMATION		ENGINEER'S SEAL		BENCH MARKS		AS BUILT INFORMATION	
NO.	BY	DATE	NO.	BY	DATE	NO.	BY
1	SCIENCE CORP.	7-22-94	1	SCIENCE CORP.	7-22-94	1	SCIENCE CORP.
2	CORRALES, NM.	7-22-94	2	CORRALES, NM.	7-22-94	2	CORRALES, NM.
3	TOPOGRAPHIC MAPPING		3	TOPOGRAPHIC MAPPING		3	TOPOGRAPHIC MAPPING
4	BY T. MANN & ASSOC.		4	BY T. MANN & ASSOC.		4	BY T. MANN & ASSOC.
5	ABQ. NM.	12-01-93	5	ABQ. NM.	12-01-93	5	ABQ. NM.

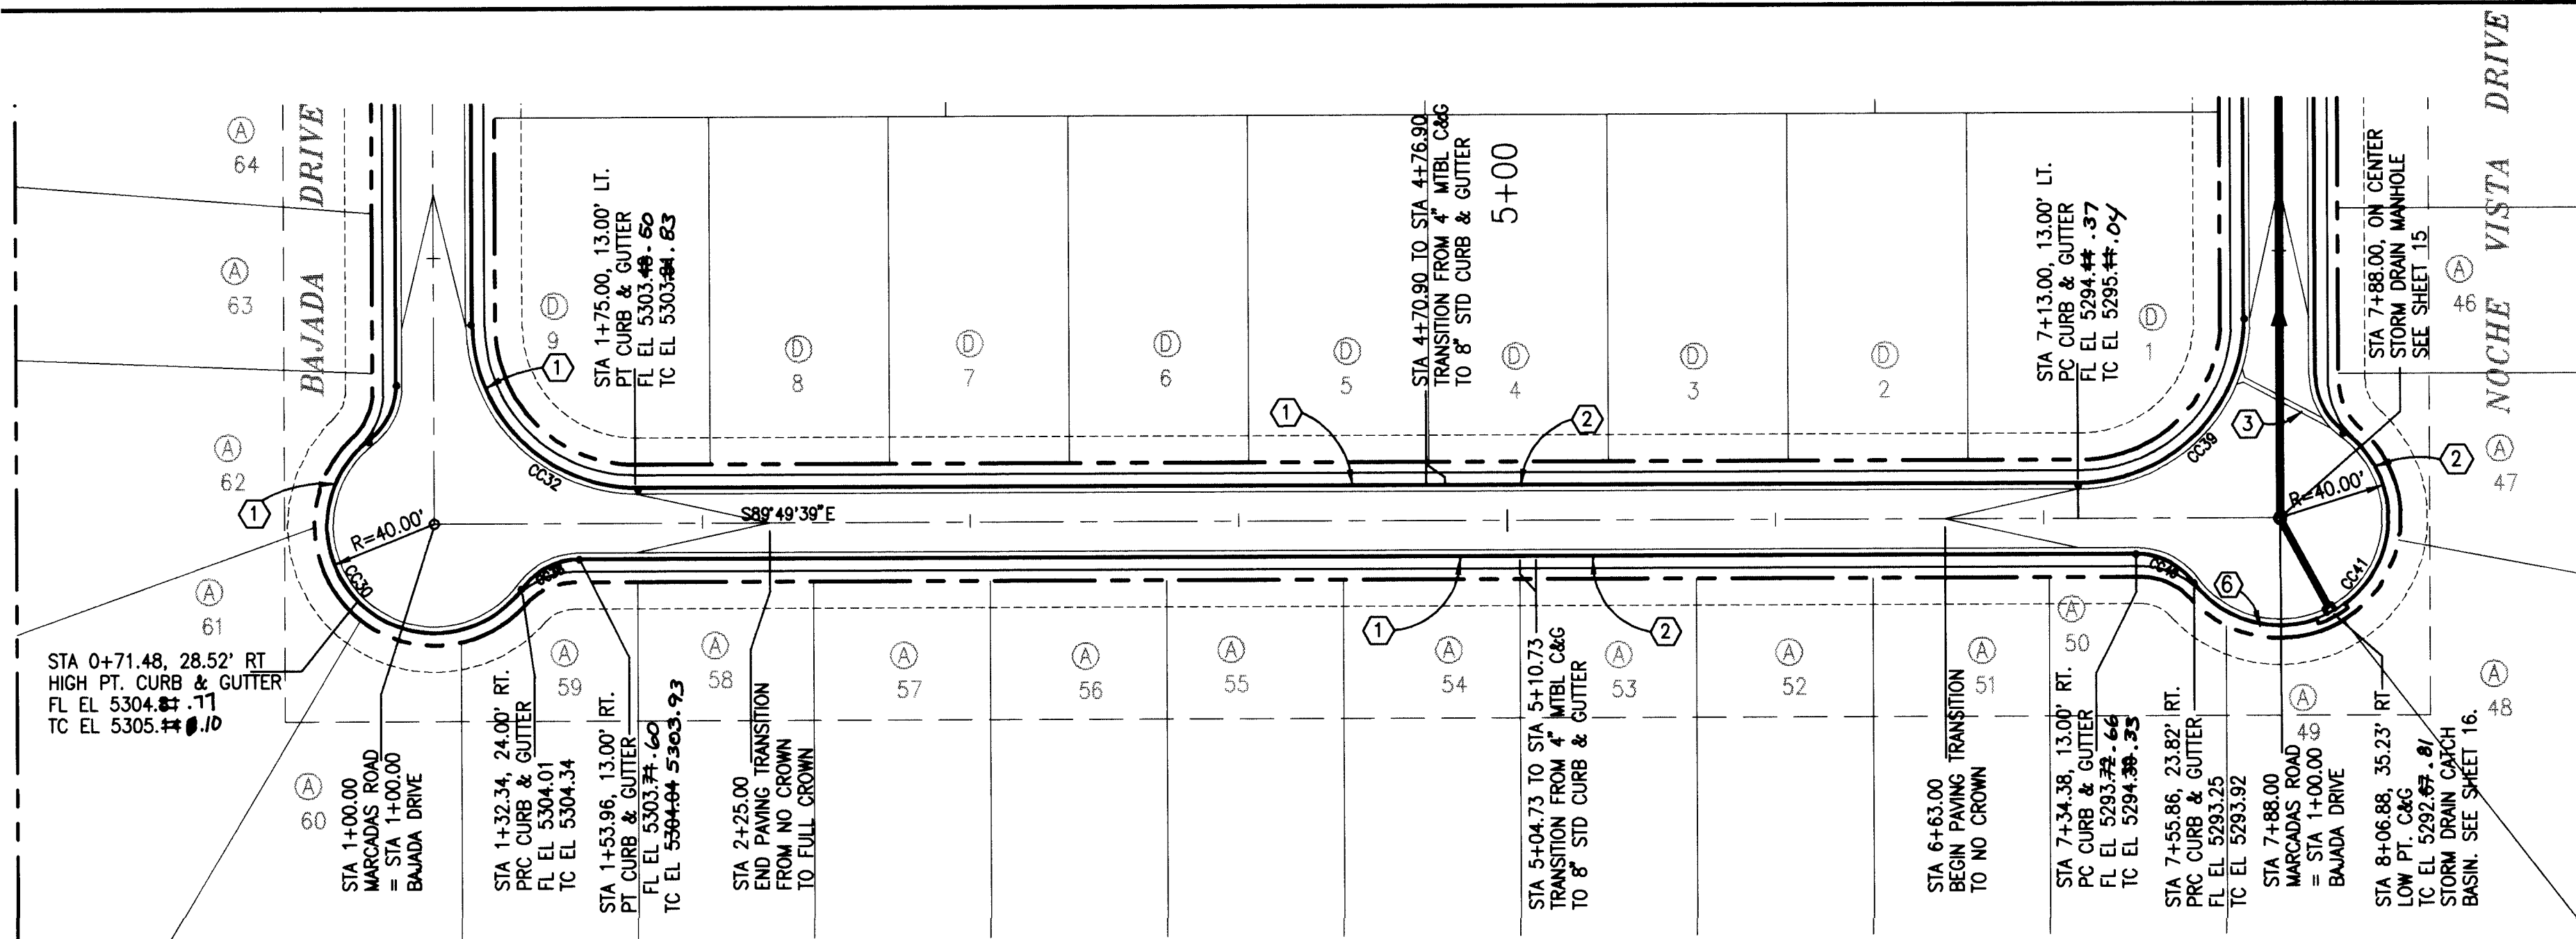

MARCADAS ROAD - PLAN

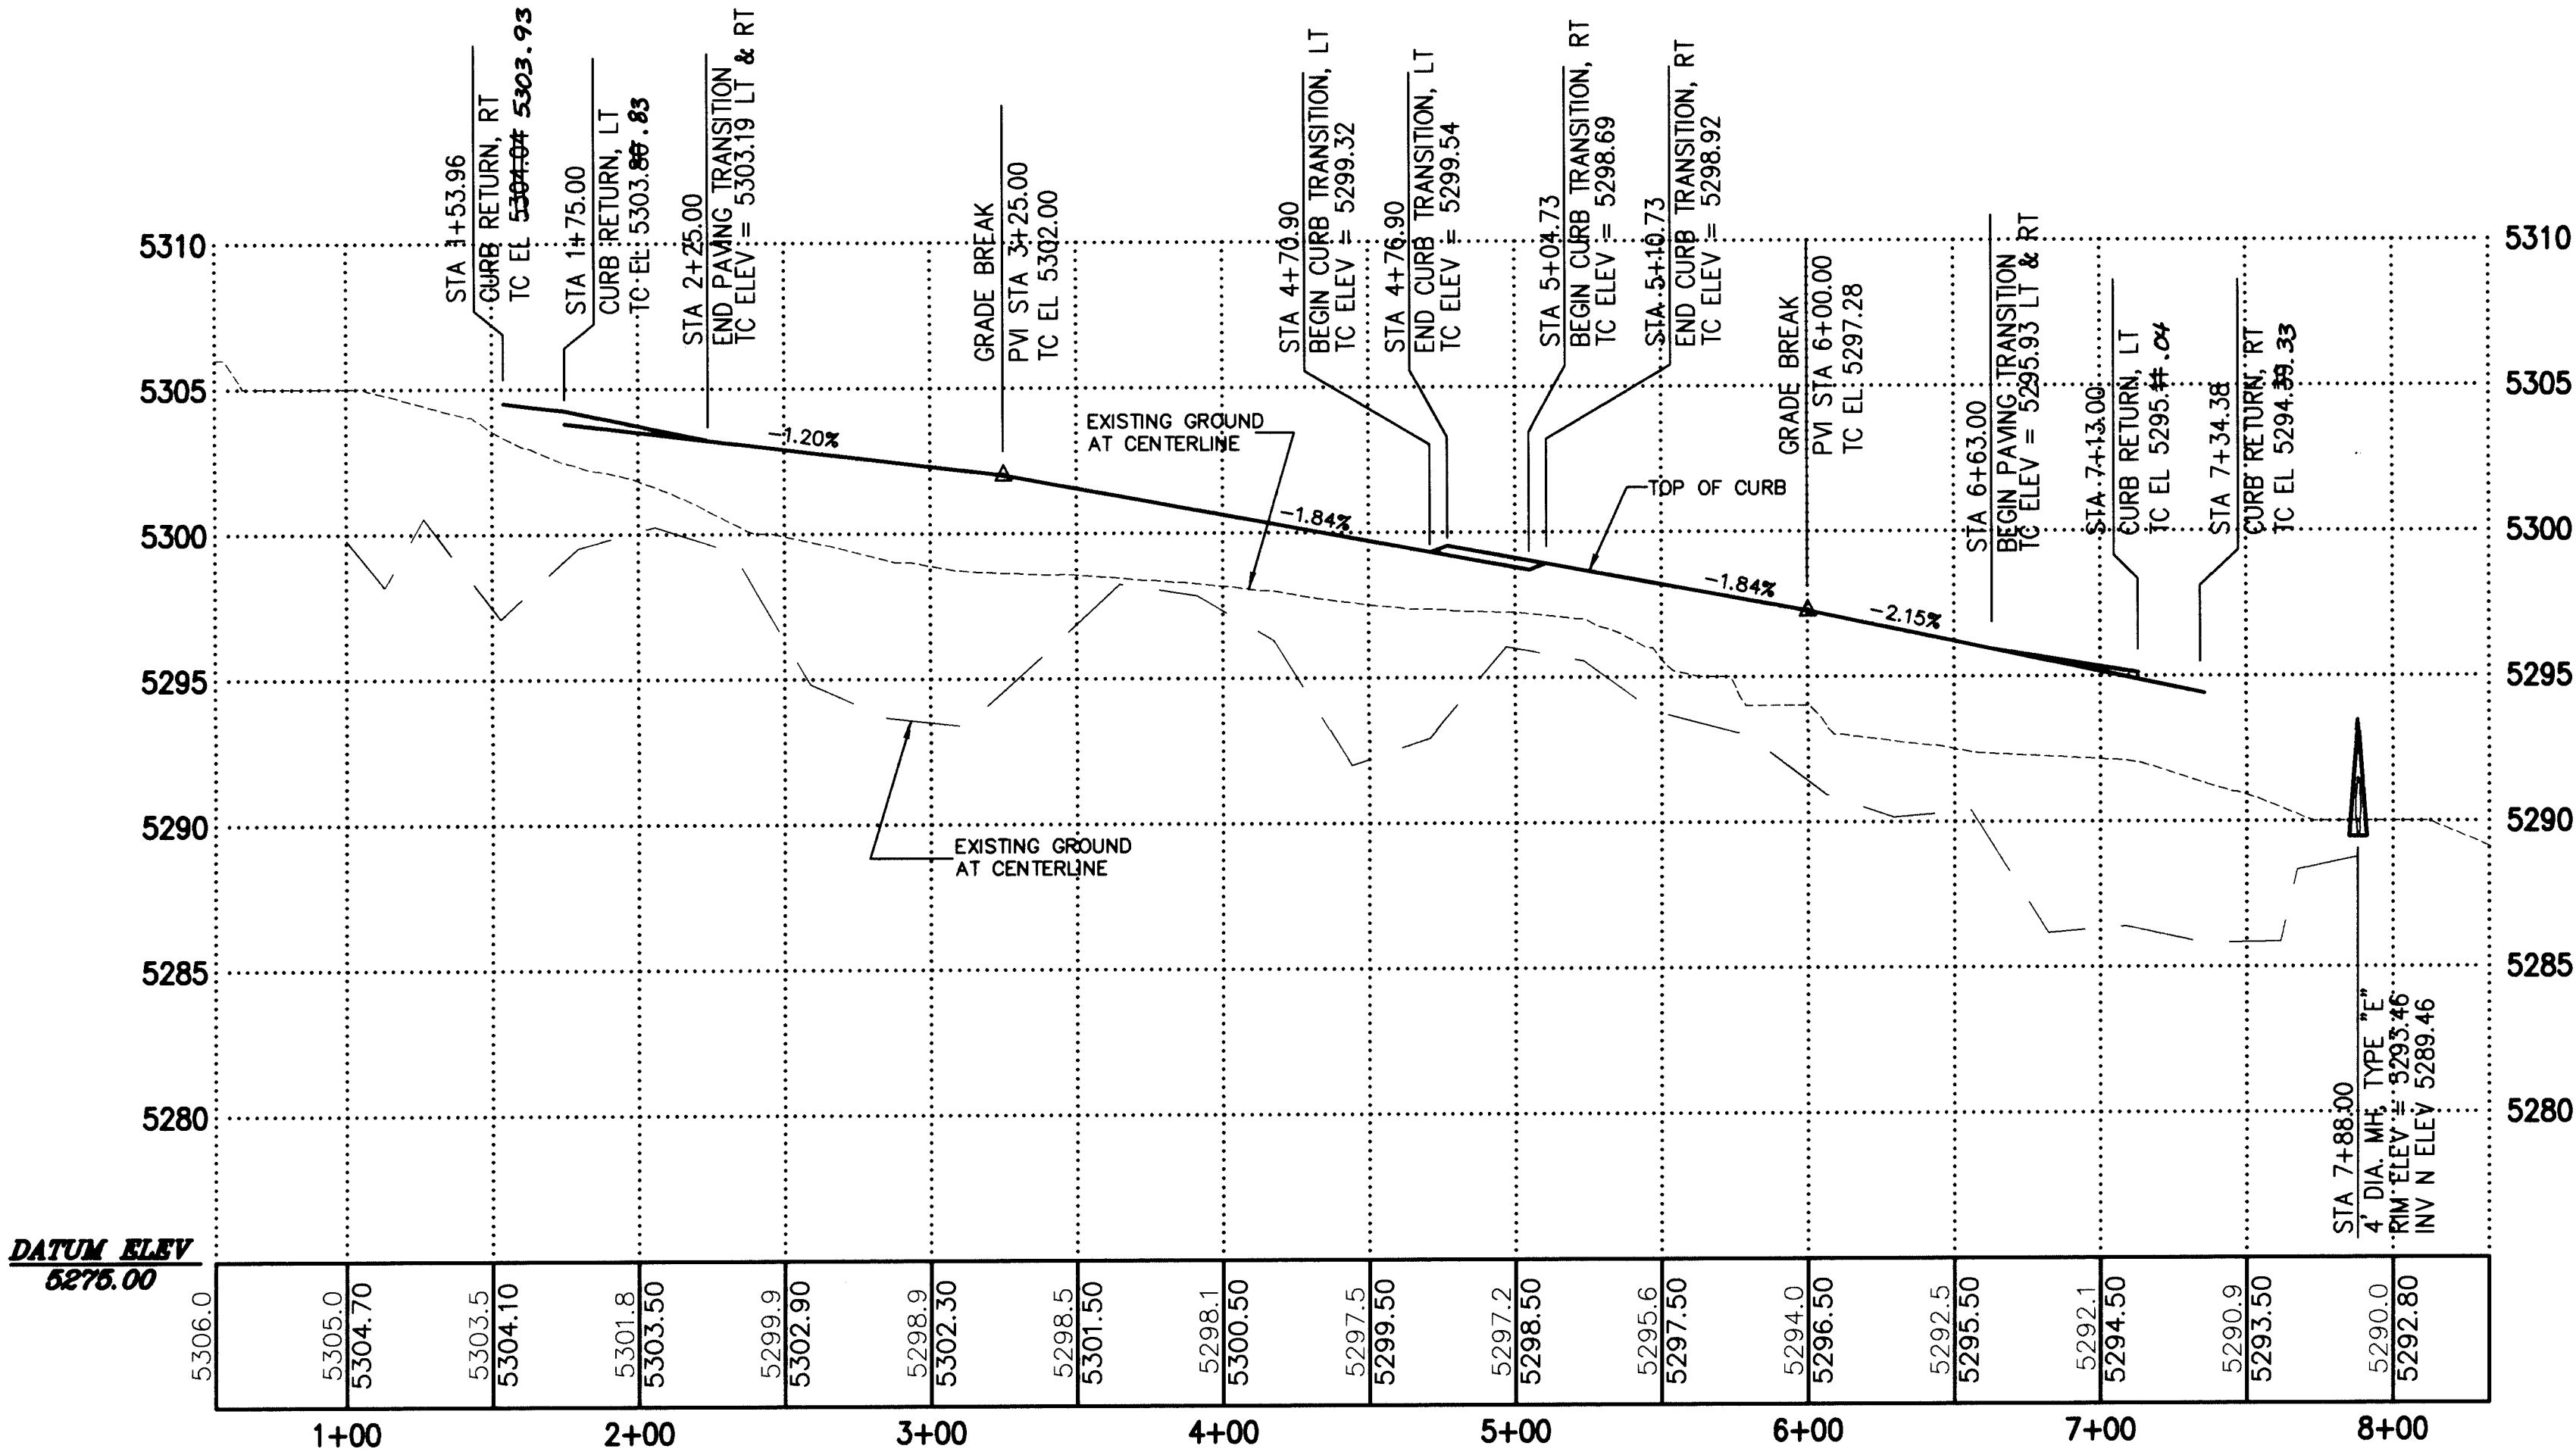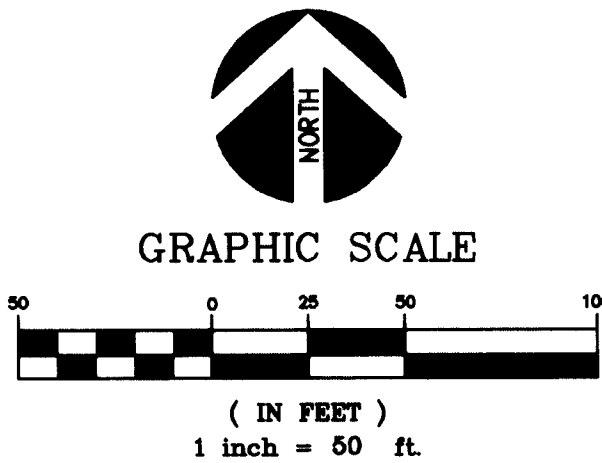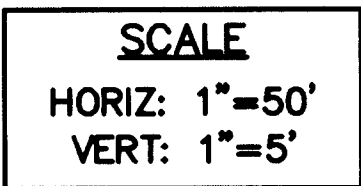

MARCADAS ROAD - PROFILE


FACE OF CURB - CURVE TABLE				
CURVE	Δ	RADIUS	LGTH	CHORD
CC30	196°20'08"	40.00'	137.07'	N45°36'56" W 79.19'
CC32	90°00'00"	62.00'	97.39'	N44°49'39" W 87.68'
CC38	53°57'20"	26.74'	25.18'	S63°11'41" W 24.26'
CC39	90°00'00"	62.00'	97.39'	S45°10'21" W 87.68'
CC40	53°27'20"	26.74'	24.95'	N63°05'59" W 24.05'
CC41	196°54'40"	40.00'	137.47'	S45°14'19" W 79.75'

- KEYED NOTES
- 1 MOUNTABLE CURB & GUTTER PER COA STD. DWG. 2415.
 - 2 STANDARD CURB & GUTTER PER COA STD. DWG. 2415.
 - 3 ALLEY GUTTER. SEE SHEET 16.

RECORD DRAWING
DATE .. 2/16/98




CERTIFICATION
THESE DRAWINGS HAVE BEEN RECEIVED IN
ACCORDANCE WITH INFORMATION FURNISHED
BY
CSC
FOR THE CONSTRUCTION AS
NOTED
NAME DATE

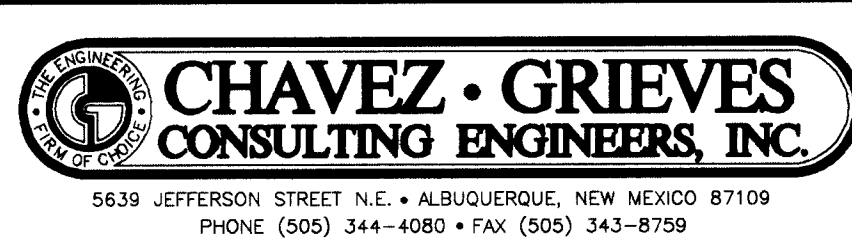


CITY OF ALBUQUERQUE PUBLIC WORKS DEPARTMENT ENGINEERING DEVELOPMENT GROUP			
TITLE: PARADISE BLUFF SUBDIVISION MARCADAS ROAD ROADWAY - PLAN & PROFILE			
Design Review Committee	City Engineer Approval	Mo./Day/Yr.	Mo./Day/Yr.
City Project No.	542681	Zone Map No.	B-11/12
		Sheet	15 of 32

SCANNED BY
BY LASON

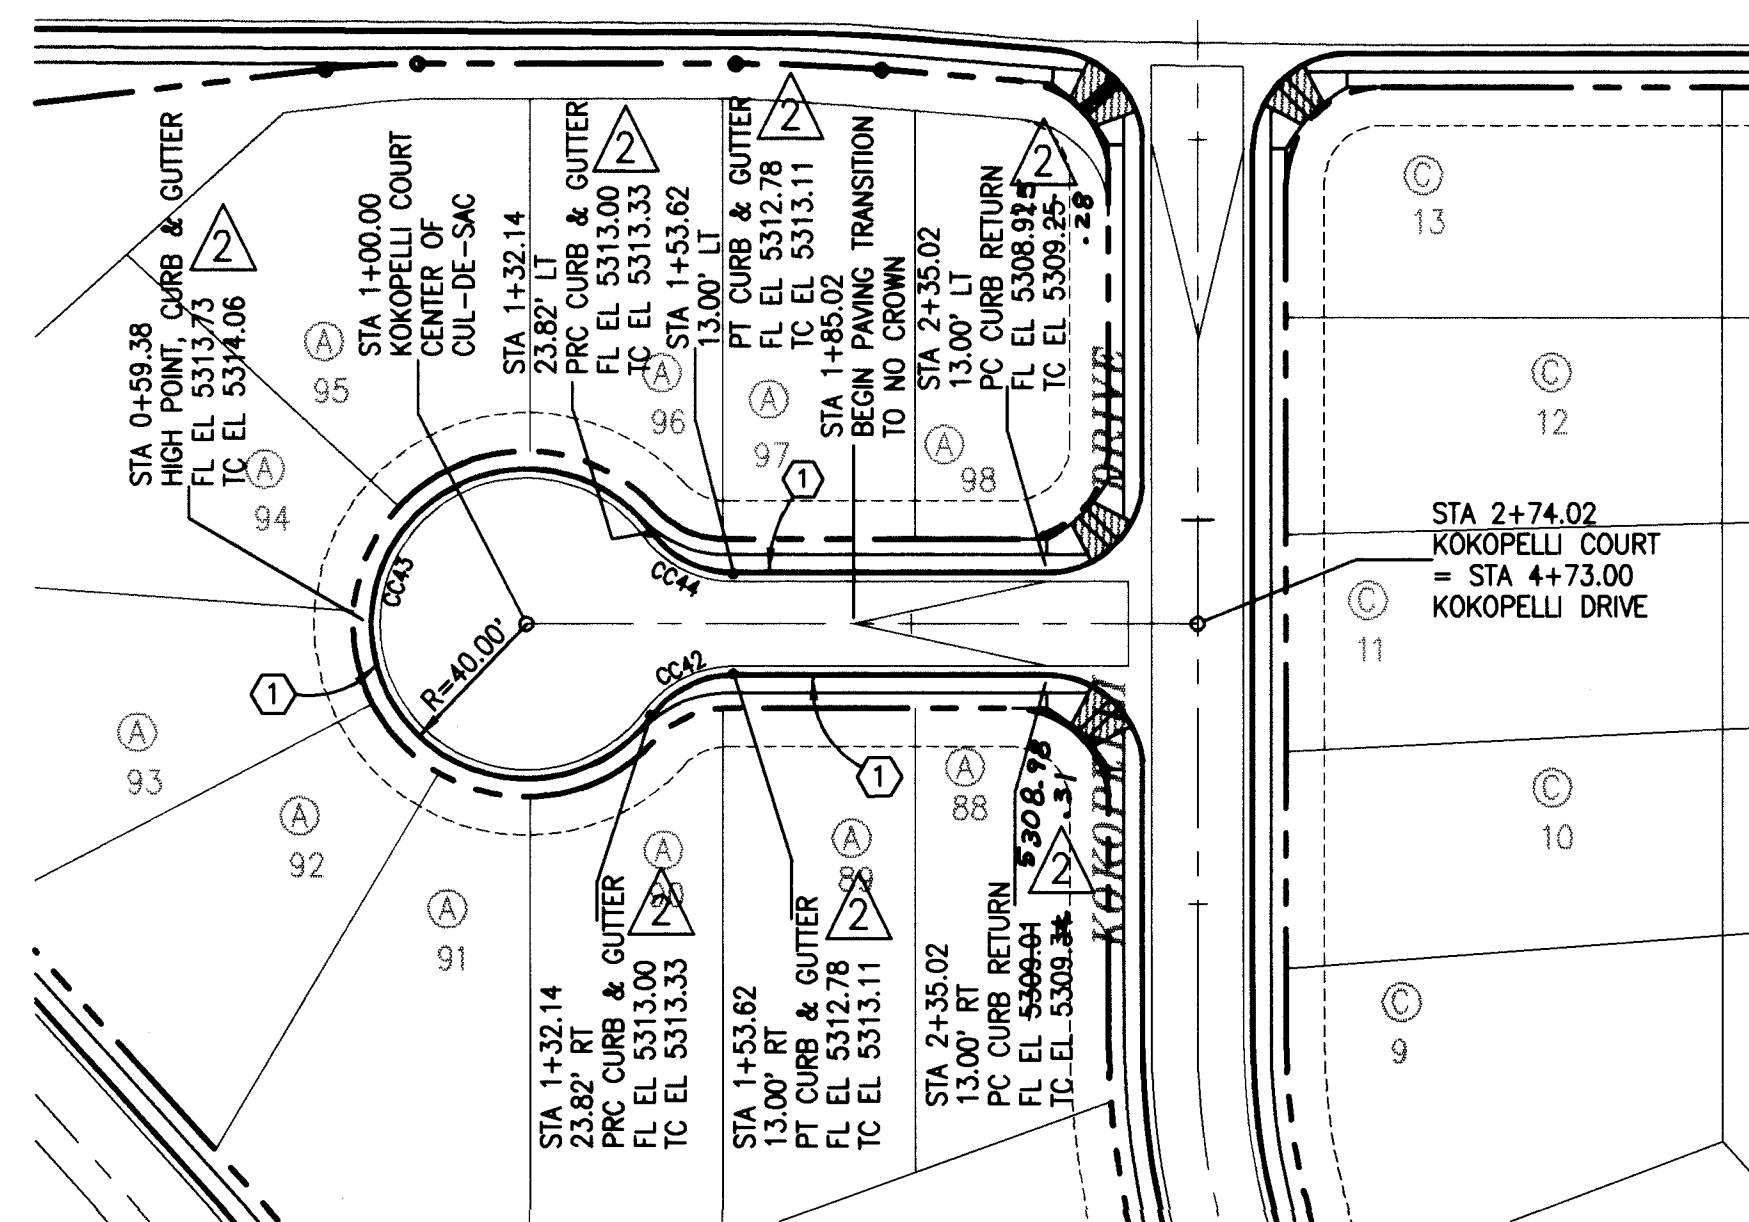

KOKOPELLI COURT - PLAN


SCALE
HORIZ: 1"=50'
VERT: 1"=5'

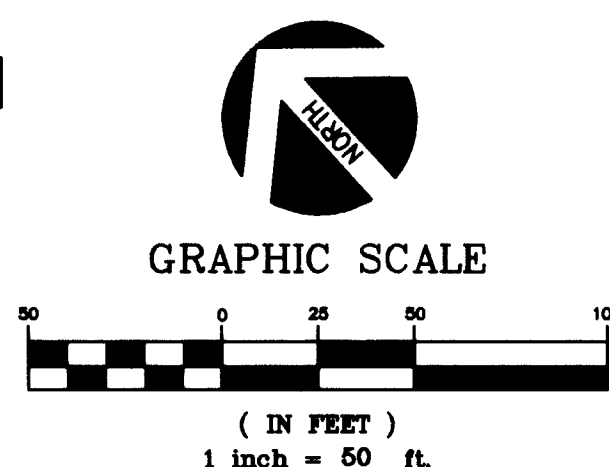

TC	FL
1 08.33	07.67
2 --	08.09
3 08.84	08.50
Δ=90°00'00"	
R=25.00'	
FL INT 07.40	


TC	FL
1 09.01	08.68
2 --	08.35
3 08.35	08.02
Δ=90°00'00"	
R=25.00'	
FL INT 07.54	

KOKOPELLI DRIVE

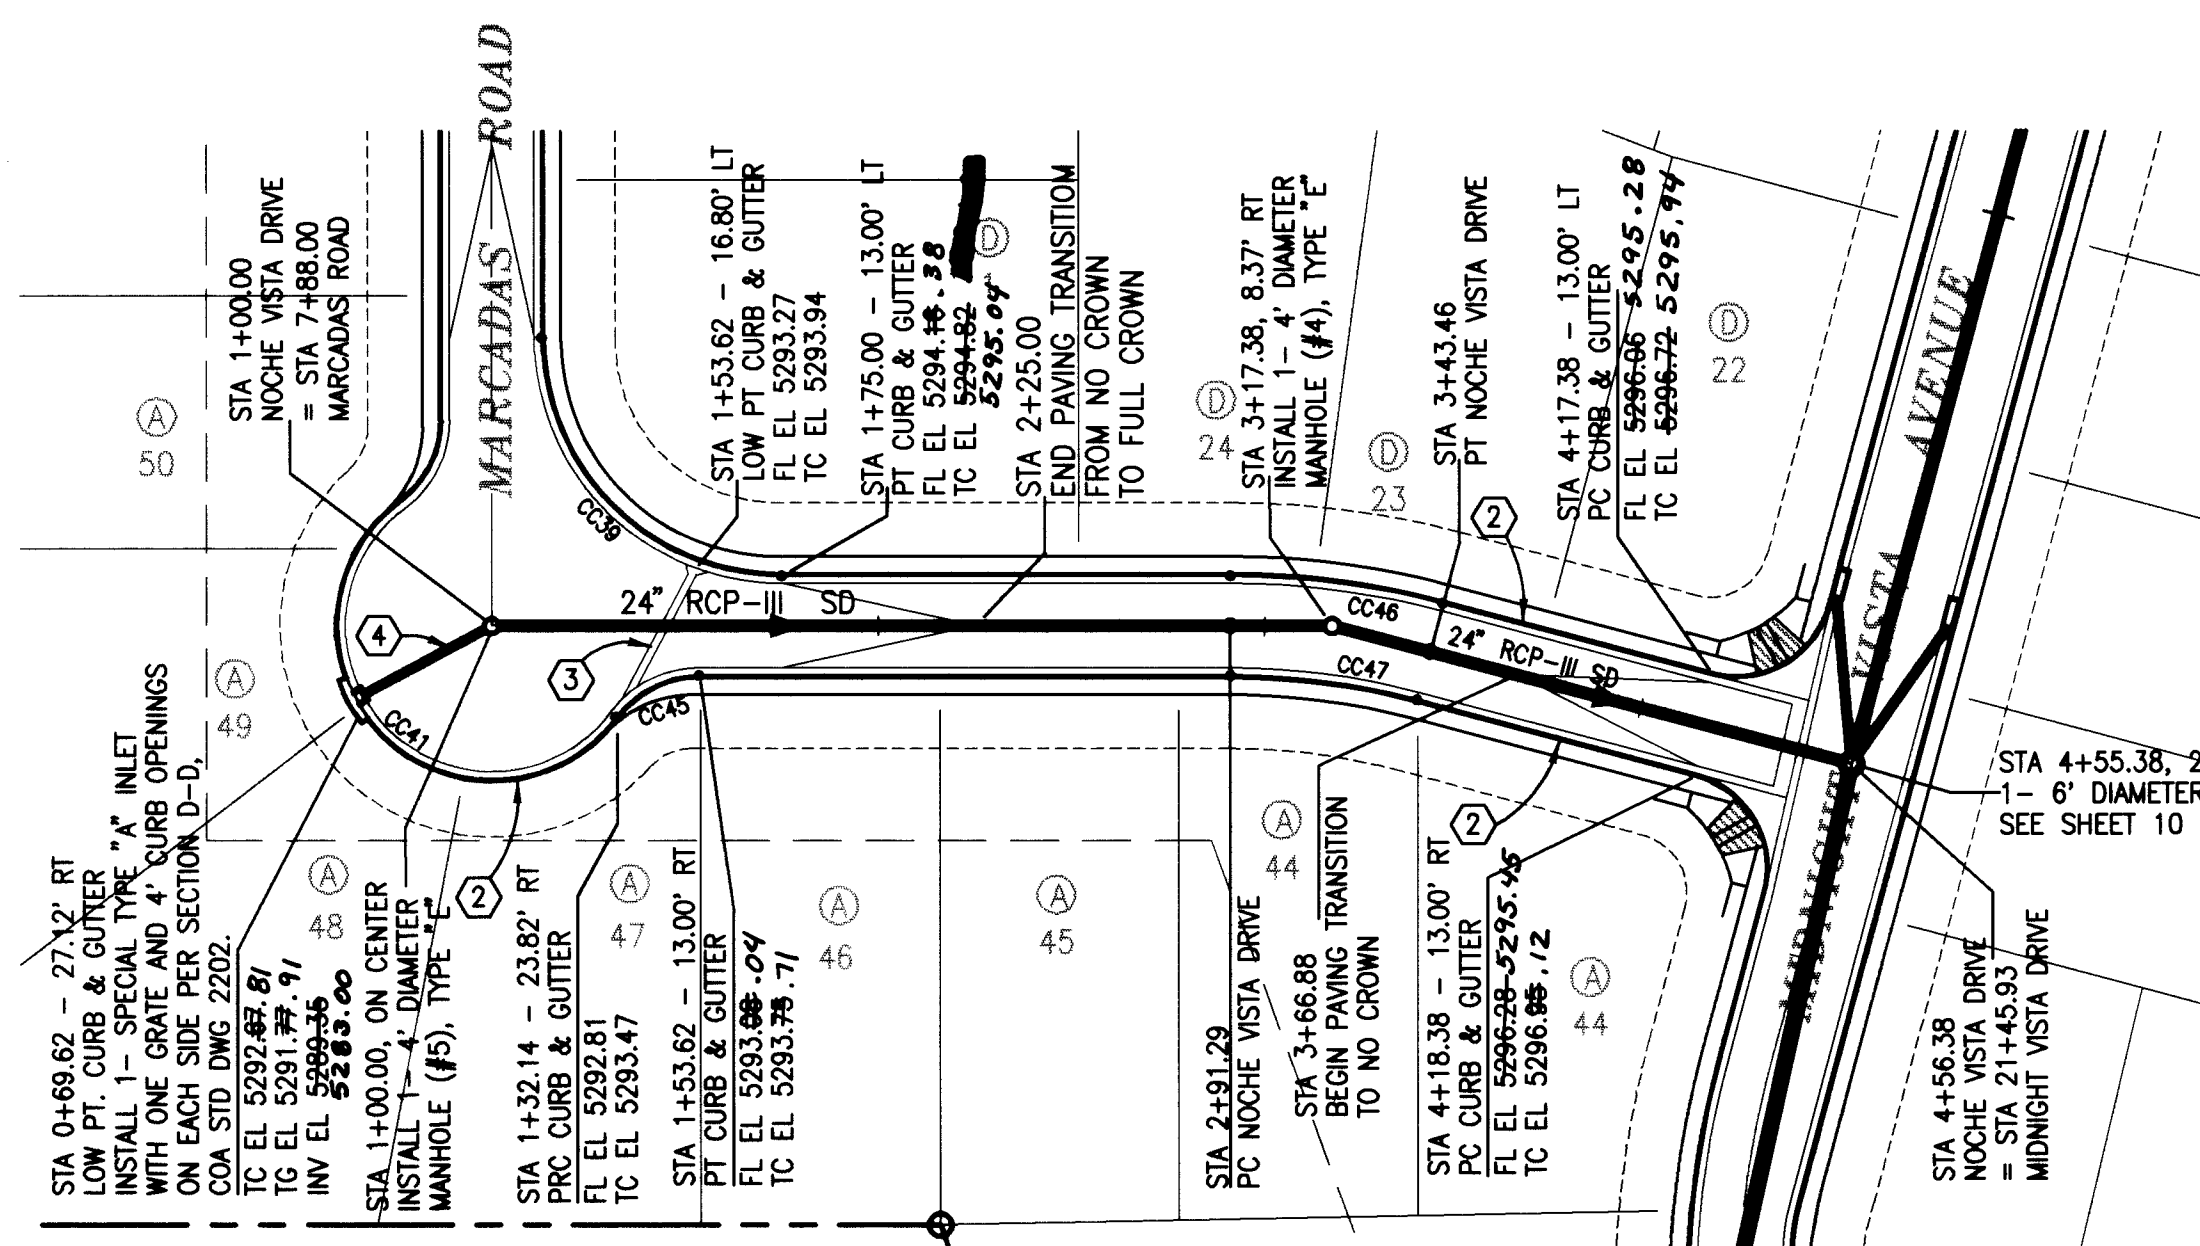

NOCHE VISTA DRIVE - PLAN

SCALE
HORIZ: 1"=50'
VERT: 1"=5'

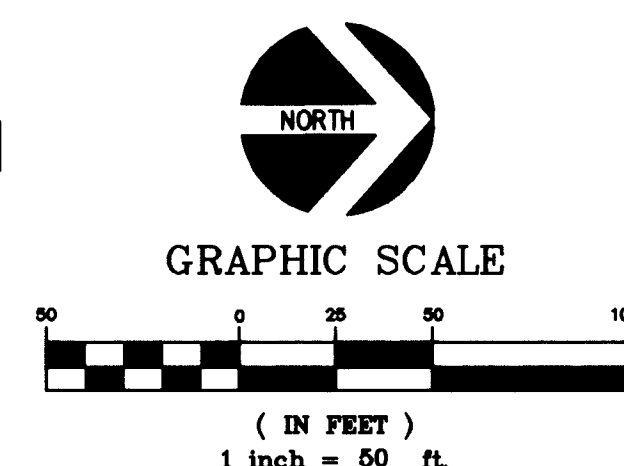


TC	FL
1 95.75	95.08
2 --	95.15
3 95.90	95.23
Δ=90°00'00"	
R=25.00'	
FL INT=95.06	

TC	FL
1 96.19	95.52
2 --	95.56
3 96.25	95.58
Δ=90°00'00"	
R=25.00'	
FL INT=95.26	


NOCHE VISTA DRIVE

- KEYED NOTES
- 1 MOUNTABLE CURB & GUTTER PER COA STD. DWG. 2415.
 - 2 STANDARD CURB & GUTTER PER COA STD. DWG. 2415.
 - 3 INSTALL 2' WIDE ALLEY GUTTER PER C.O.A. STD DWG 2415. INSTALL 6 LF DEPRESSED CURB & GUTTER AT WEST END OF ALLEY GUTTER PER C.O.A. STD DWG 2415.
 - 4 INSTALL 35 LF OF 24" RCP-111 STORM DRAIN LINE.

CURVE	Δ	RADIUS	LGTH	CHORD
CC39	90°00'00"	62.00'	97.39'	S45°10'21" W 87.68'
CC41	196°54'40"	40.00'	137.47'	S45°14'19" W 79.75'
CC42	53°27'20"	26.74'	24.95'	N74°31'04" W 24.05'
CC43	286°54'40"	40.00'	200.30'	N42°12'36" E 47.64'
CC44	53°27'20"	26.74'	24.95'	S21°03'44" E 24.05'
CC45	53°27'20"	26.74'	24.95'	S26°33'19" E 24.05'
CC46	14°56'47"	213.00'	55.56'	S07°38'44" W 55.41'
CC47	14°56'47"	187.00'	48.78'	S07°38'44" W 48.64'

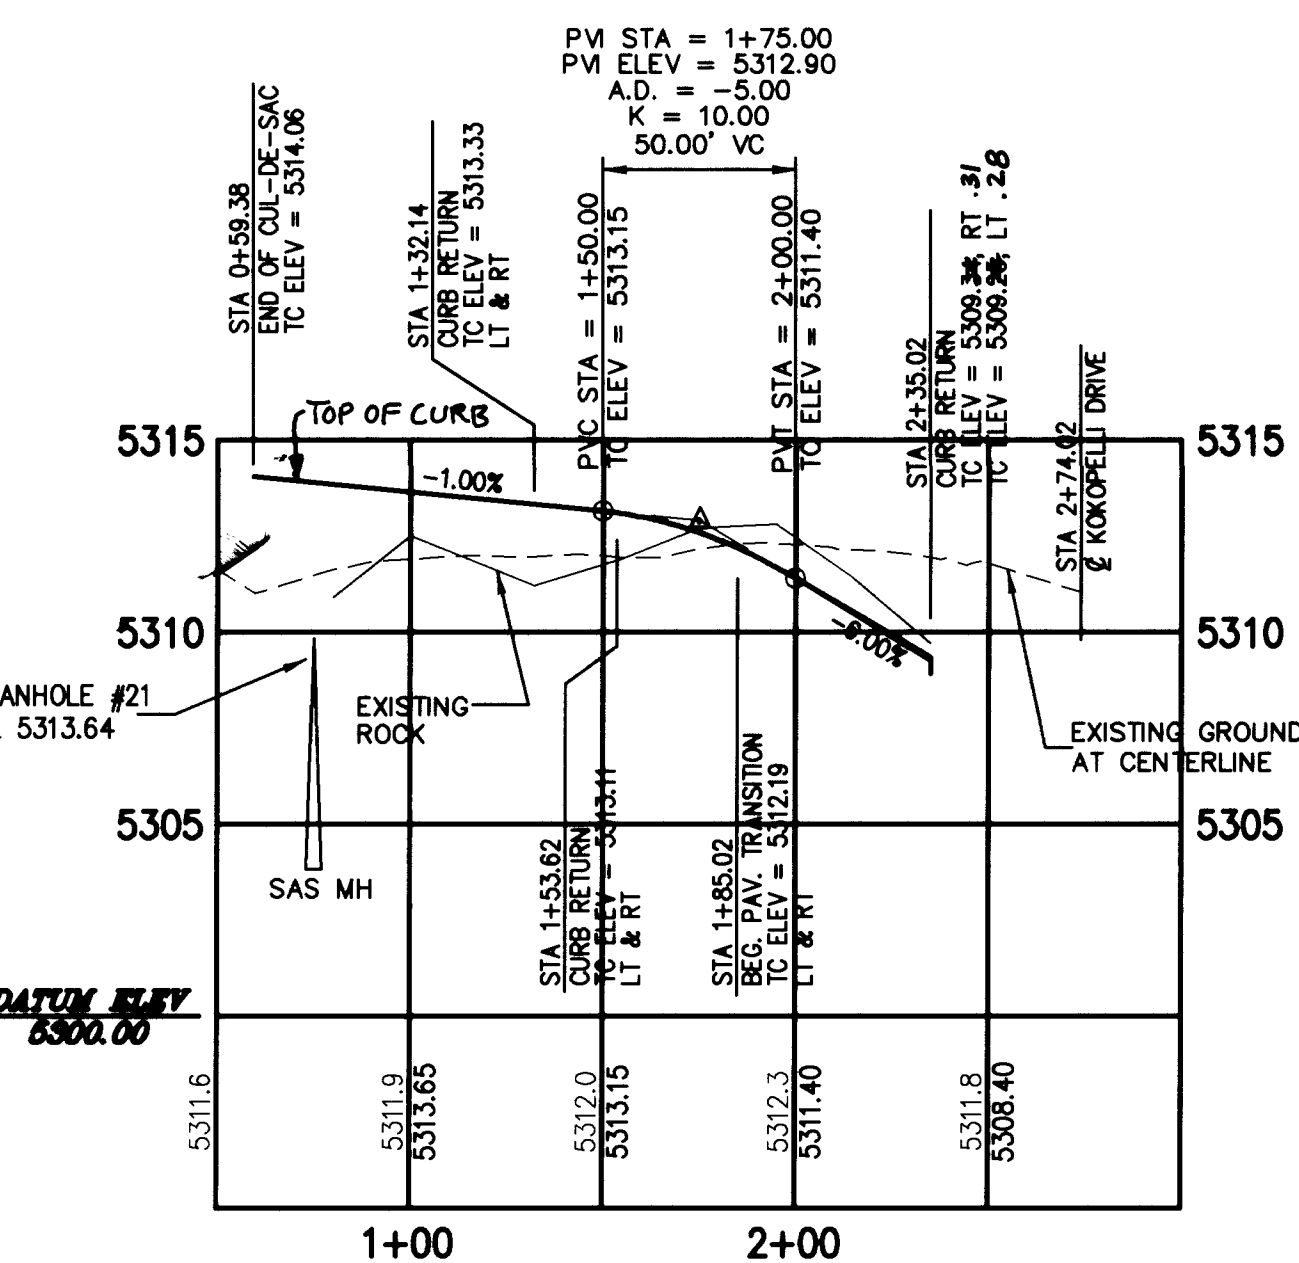

KOKOPELLI COURT - PROFILE

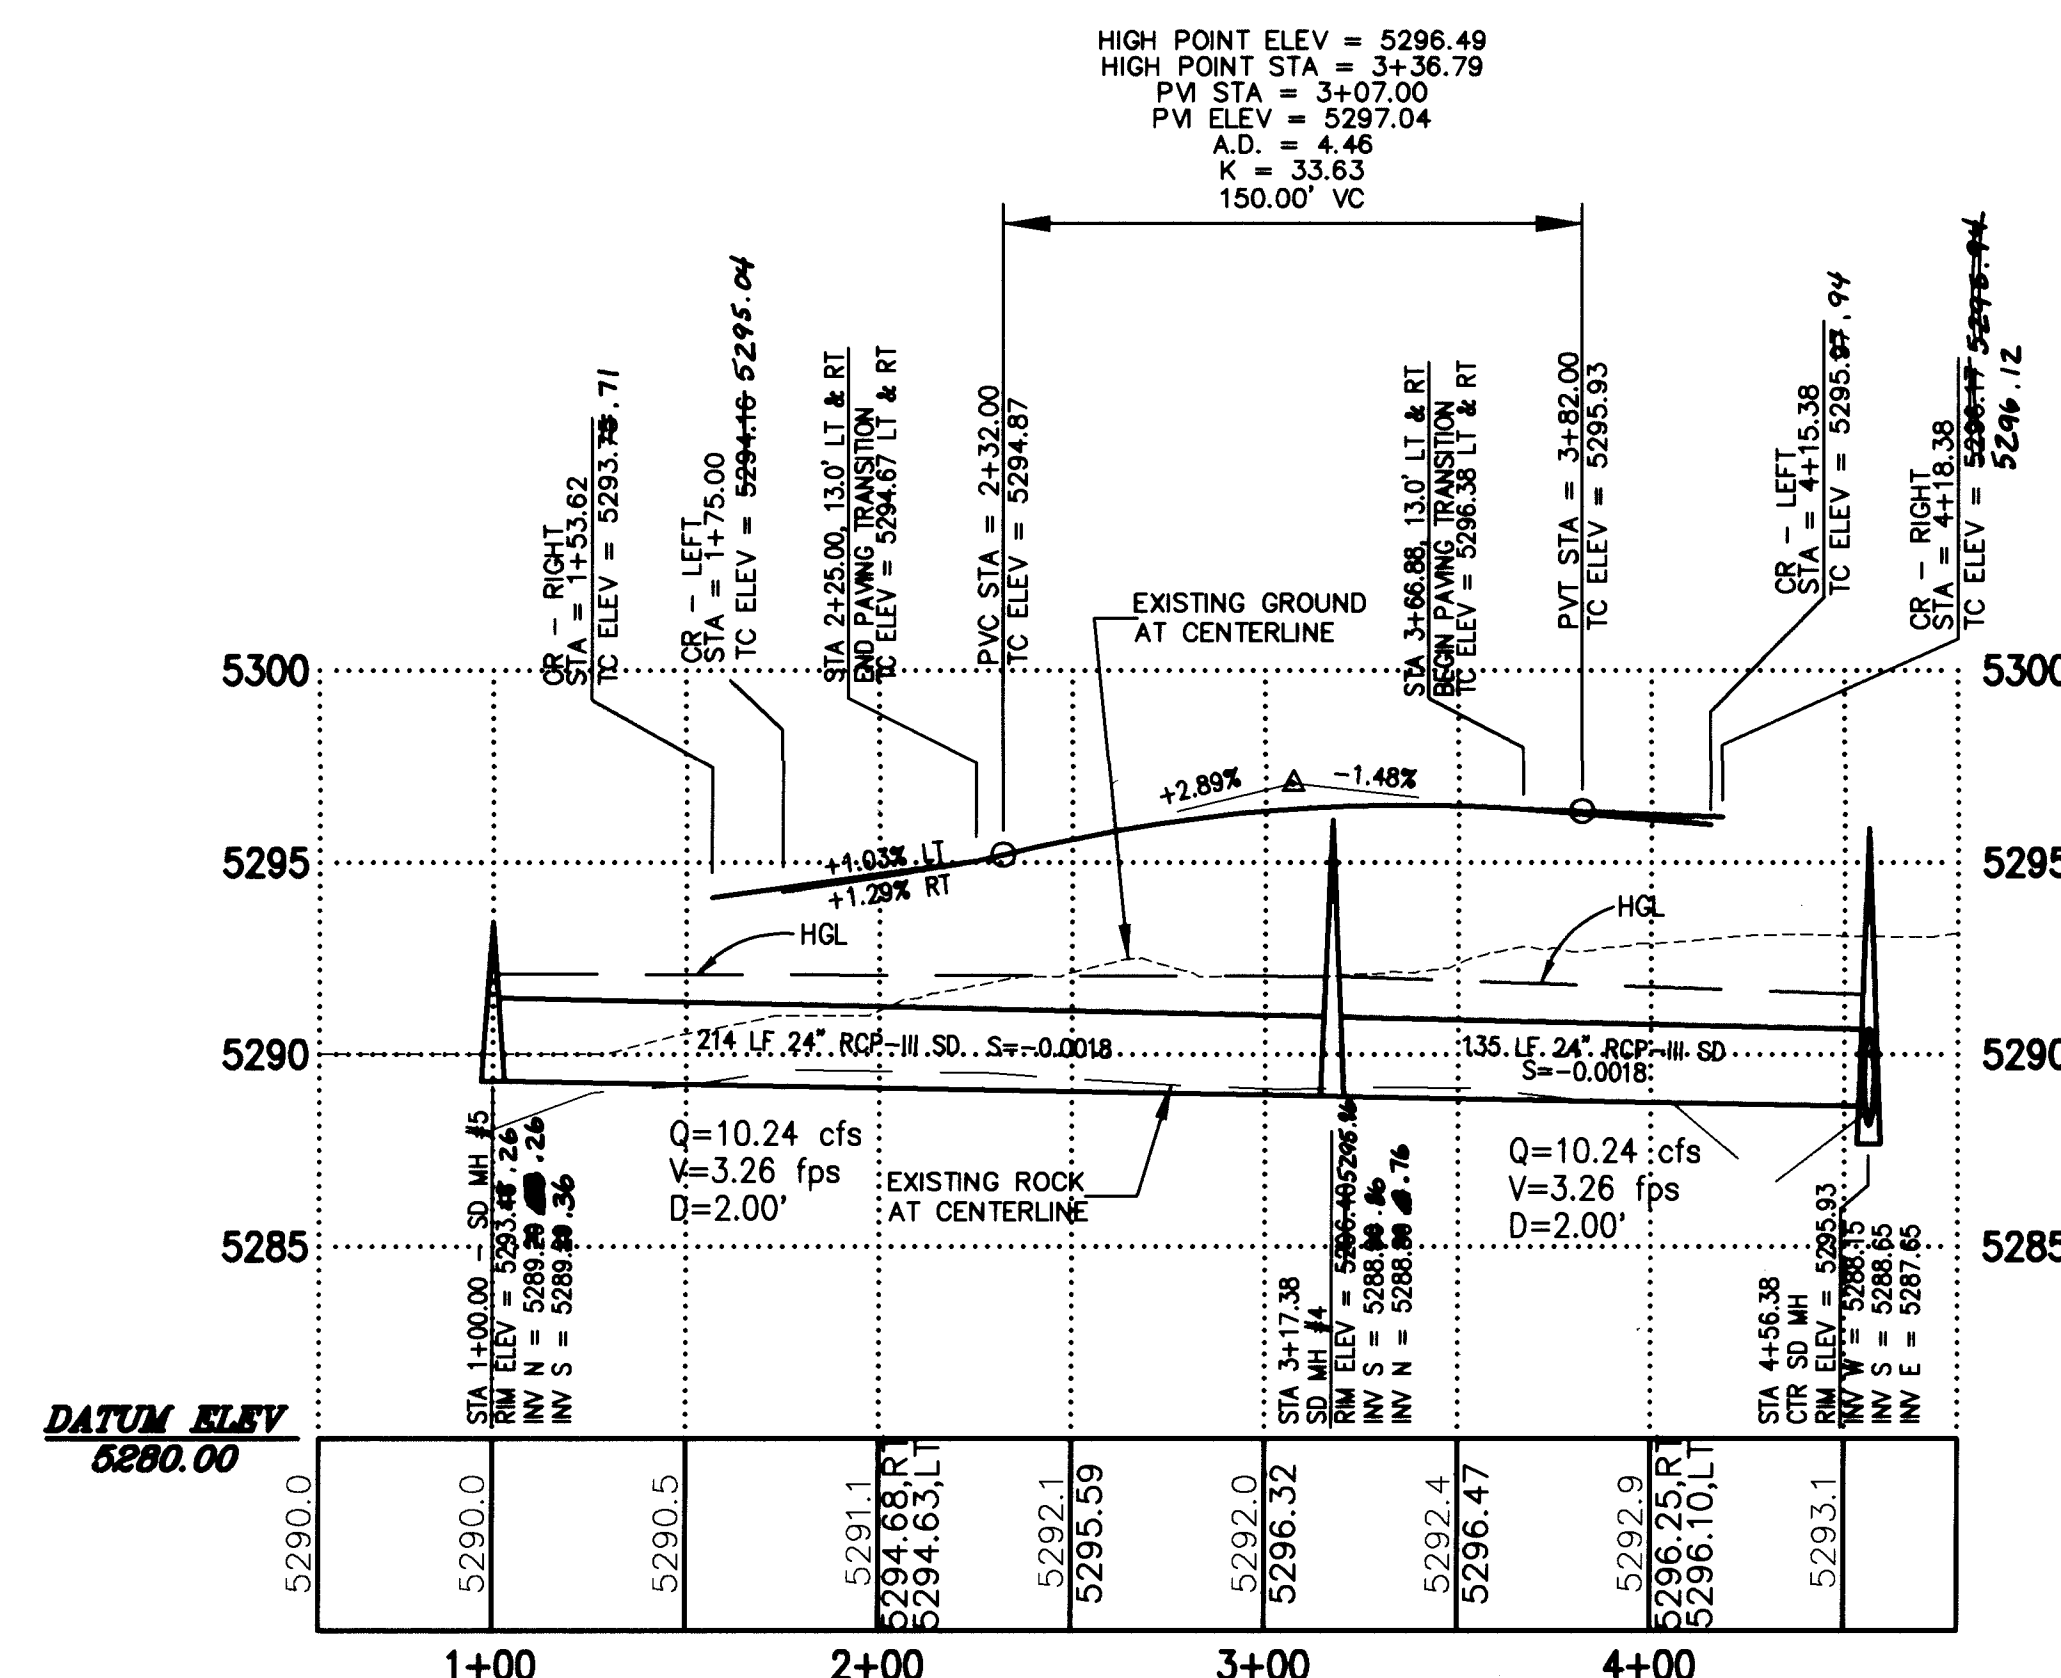

NOCHE VISTA DRIVE - PROFILE

RECORD DRAWING
DATE... 2/16/98...

CERTIFICATION
THESE DRAWINGS HAVE BEEN RECEIVED IN ACCORDANCE WITH INFORMATION FURNISHED BY CHAVEZ & GRIEVES CONSULTING ENGINEERS, INC. TO BE USED FOR CONSTRUCTION ON AS ACTUALLY CONSTRUCTED.
NAME: J. P. KELLEY DATE: 2/16/98

CHAVEZ & GRIEVES CONSULTING ENGINEERS, INC.
5639 JEFFERSON STREET N.E. • ALBUQUERQUE, NEW MEXICO 87109
PHONE (505) 344-4080 • FAX (505) 343-8799

CITY OF ALBUQUERQUE
PUBLIC WORKS DEPARTMENT
ENGINEERING DEVELOPMENT GROUP

TITLE: PARADISE BLUFF SUBDIVISION
KOKOPELLI COURT & NOCHE VISTA DRIVE
ROADWAY & STORM DRAIN - PLAN & PROFILE

DESIGN REVIEW COMMITTEE
APPROVE
JUL 31 1997

City Engineer Approval
Mo./Day/Yr.

DESIGNED BY J. P. KELLEY DATE 03-95
DRAWN BY W. M. TOWERS DATE 03-95
CHECKED BY V.J. CHAVEZ DATE 03-95

City Project No. 542681
Zone Map No. B-11/12
Sheet 16 of 32


ENGINEER'S SEAL
KELLEY
J. P. KELLEY
7/10/97

SURVEY INFORMATION
ACS BRASS CAP STAMPED "ACS 6-BT-1, 1986"
LOCATED 475 FEET NORTHEAST OF THE INTERSECTION
OF JUSTIN DRIVE AND BUGLO AVENUE. ELEV. = 5328.378


FIELD NOTES
NO. BY DATE
SURVEY BY COMMUNITY
SCIENCE CORP.
CORRALES, NM. 7-22-94

AS BUILT INFORMATION
WORK BY C.S.I.
INSPECTION BY J. P. KELLEY DATE 2/16/98
ACCEPTANCE BY J. P. KELLEY DATE 2/16/98
VERIFICATION BY C.S.I. DATE 2/16/98
DRAWING NO. 542681-1
RECORDED BY DATE


MICRO-FILM INFORMATION
RECORDED BY DATE
NO.

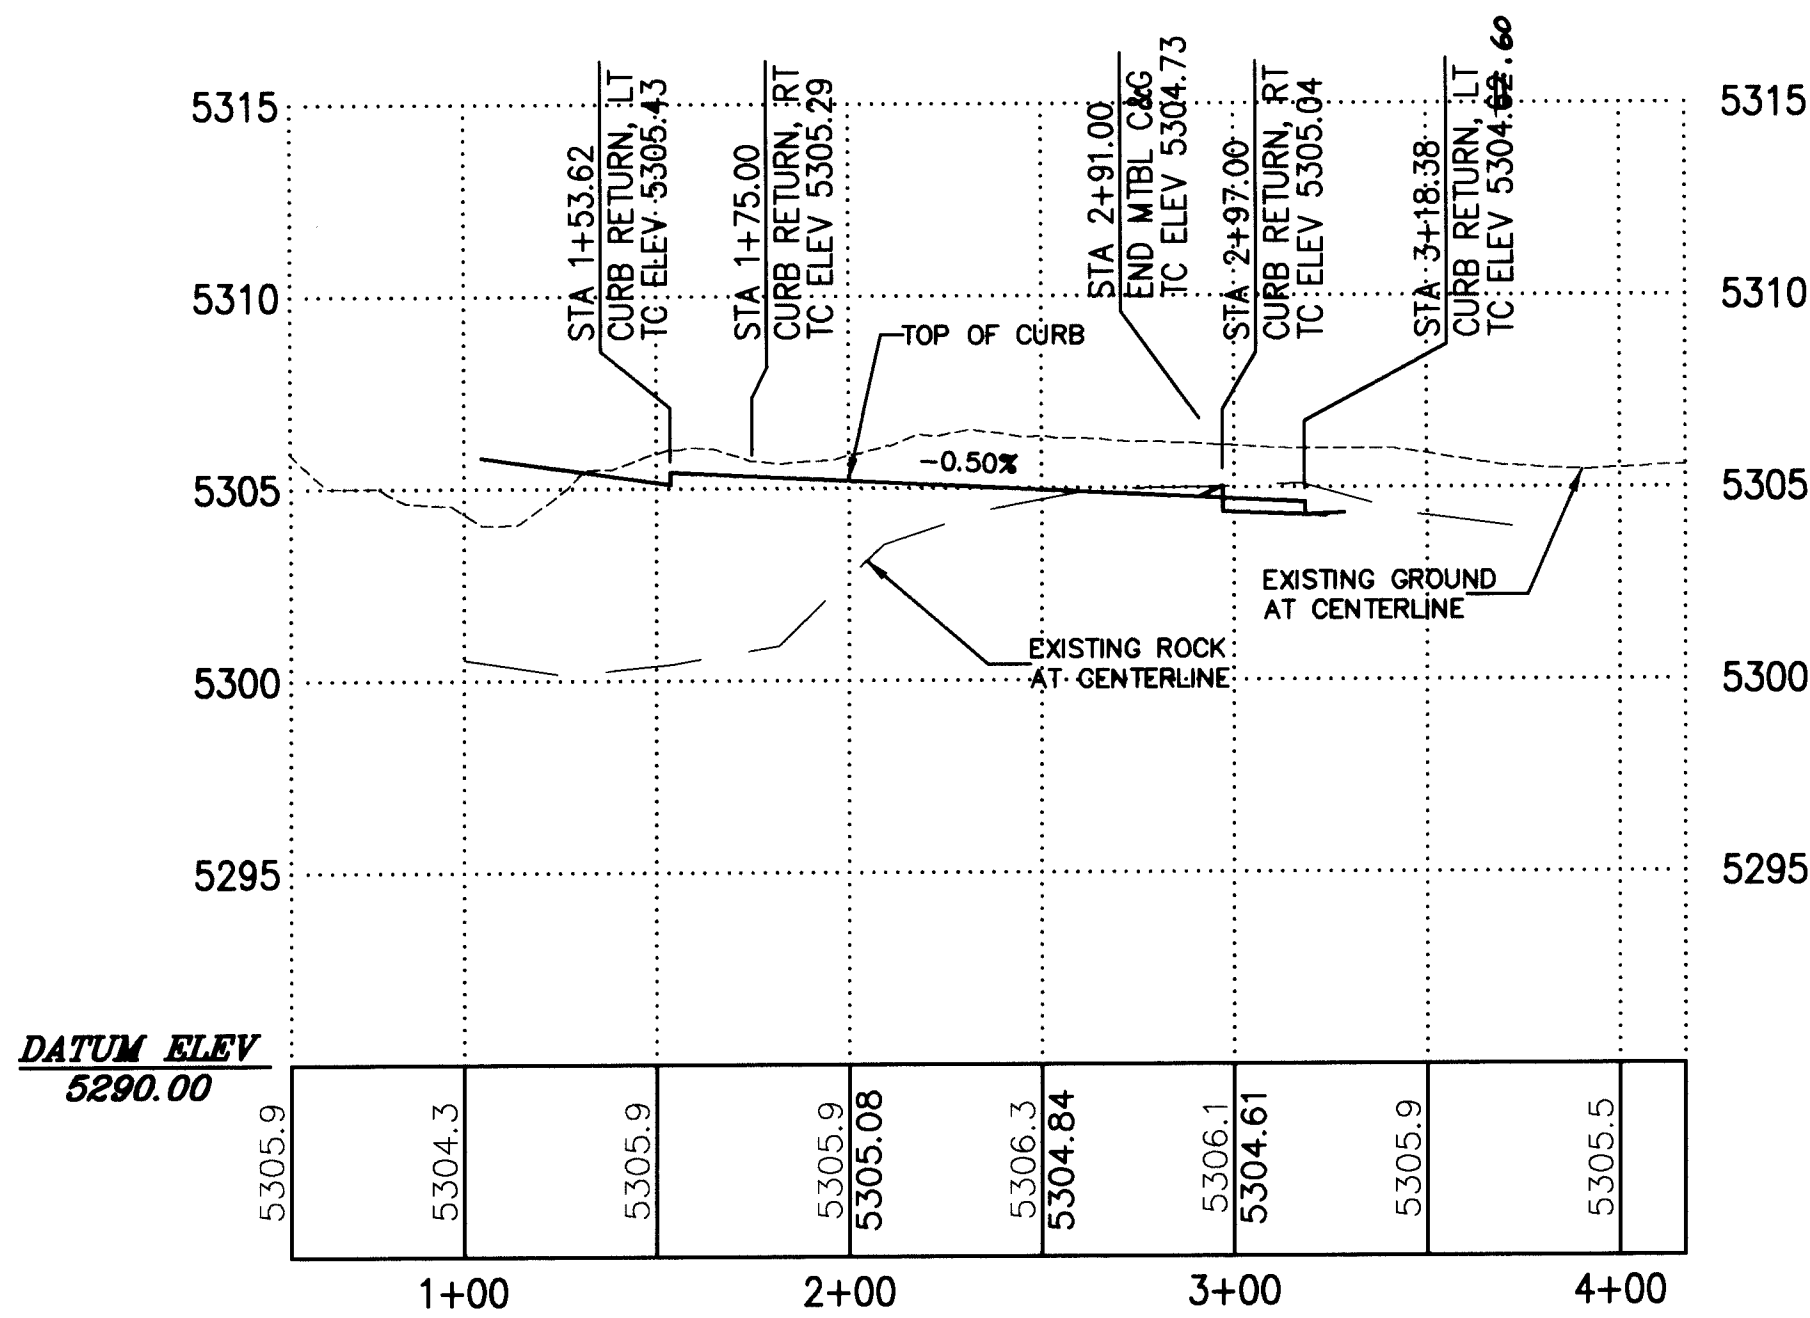

NORTE VISTA ROAD - PROFILE


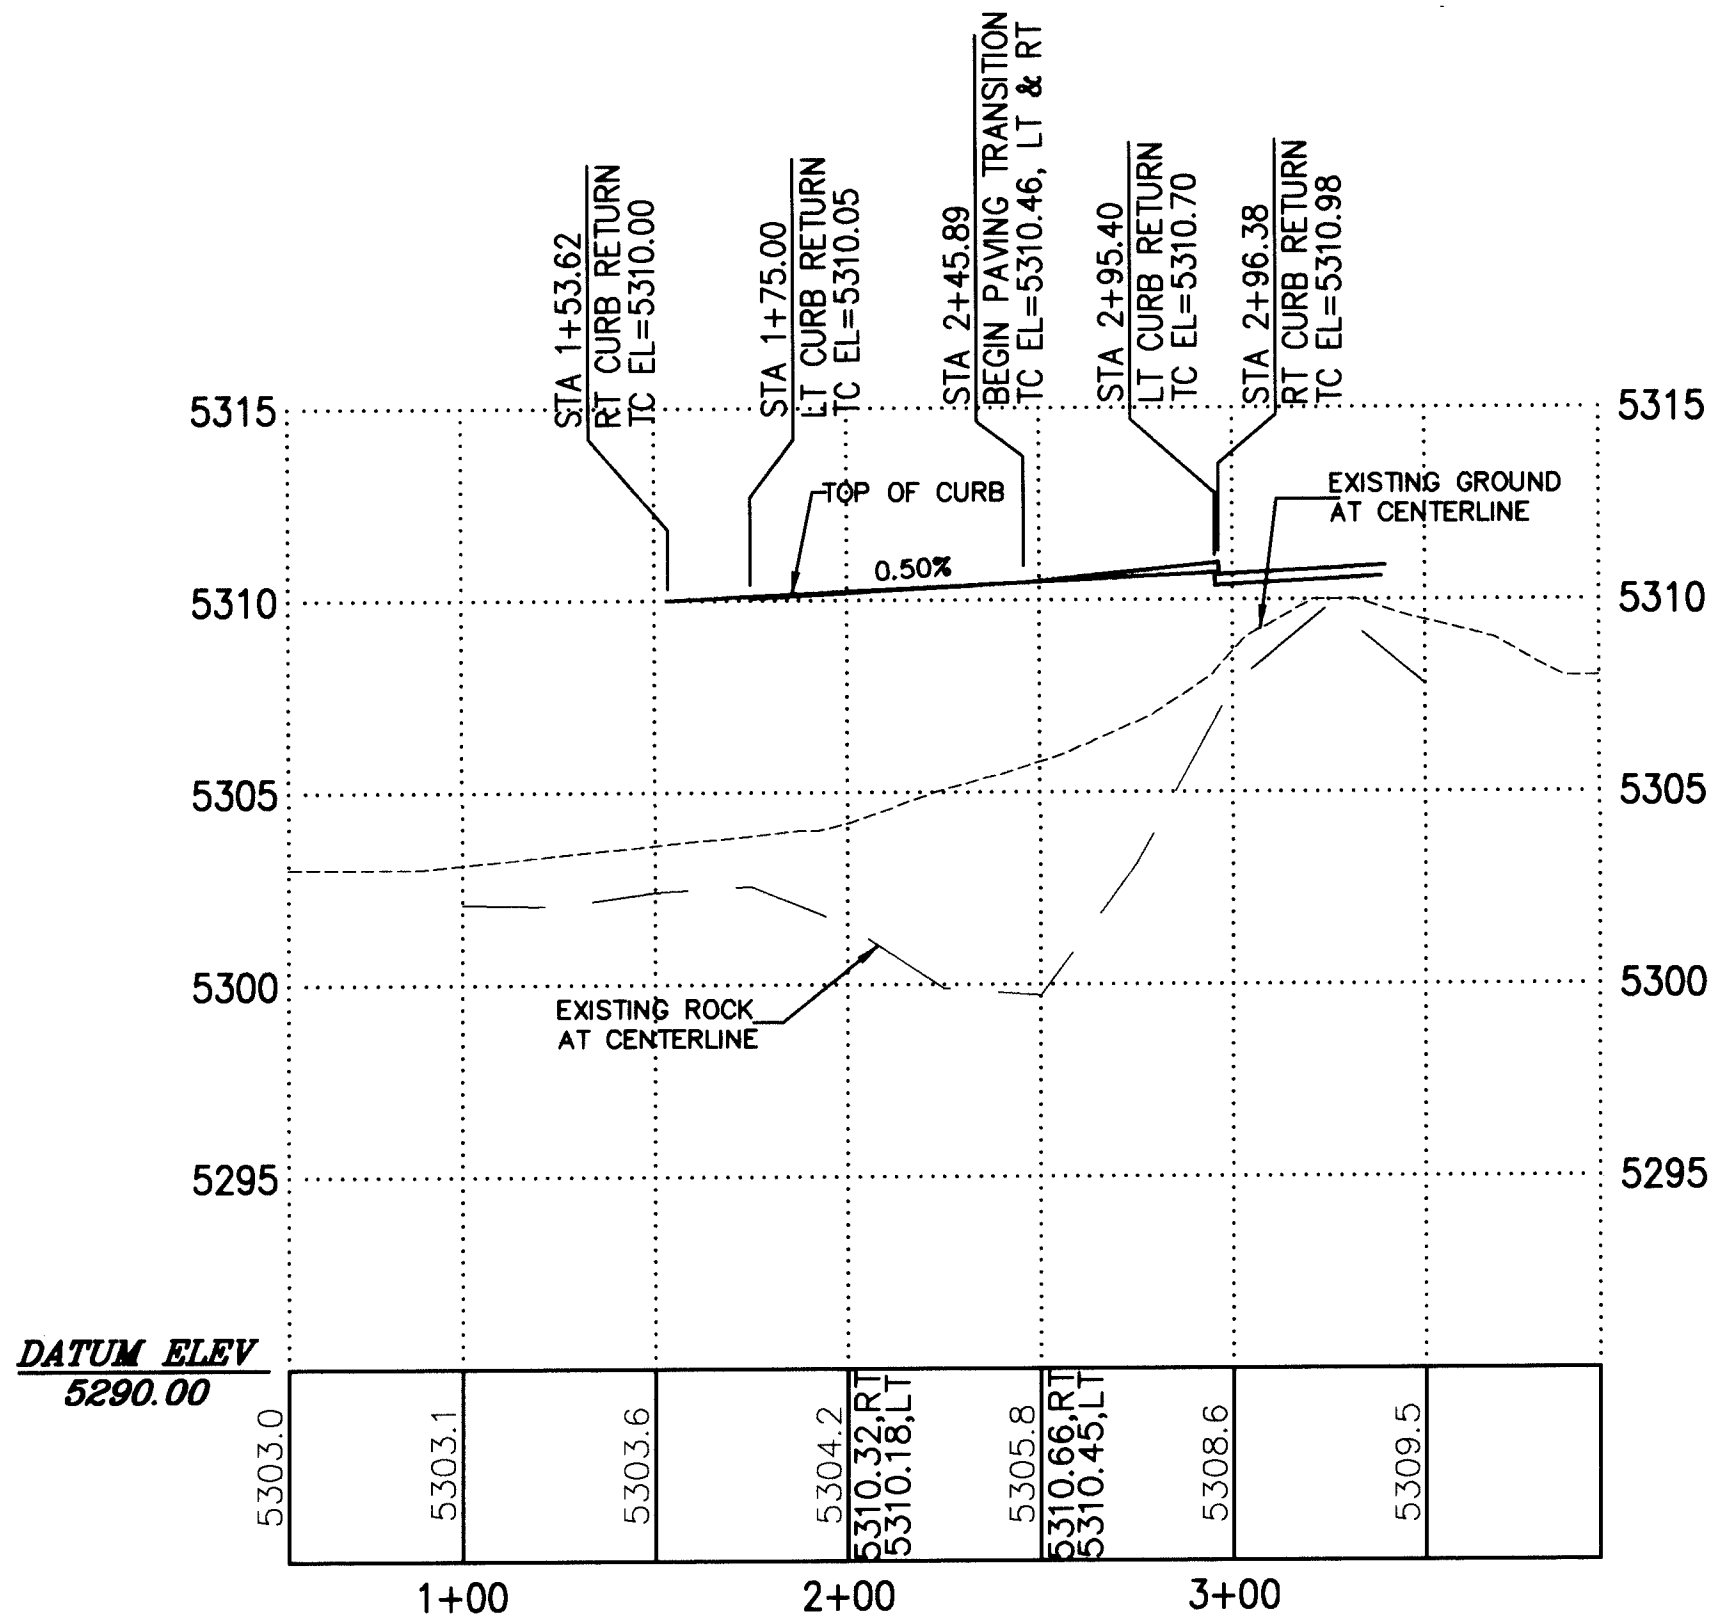


SUR VISTA ROAD - PROFILE

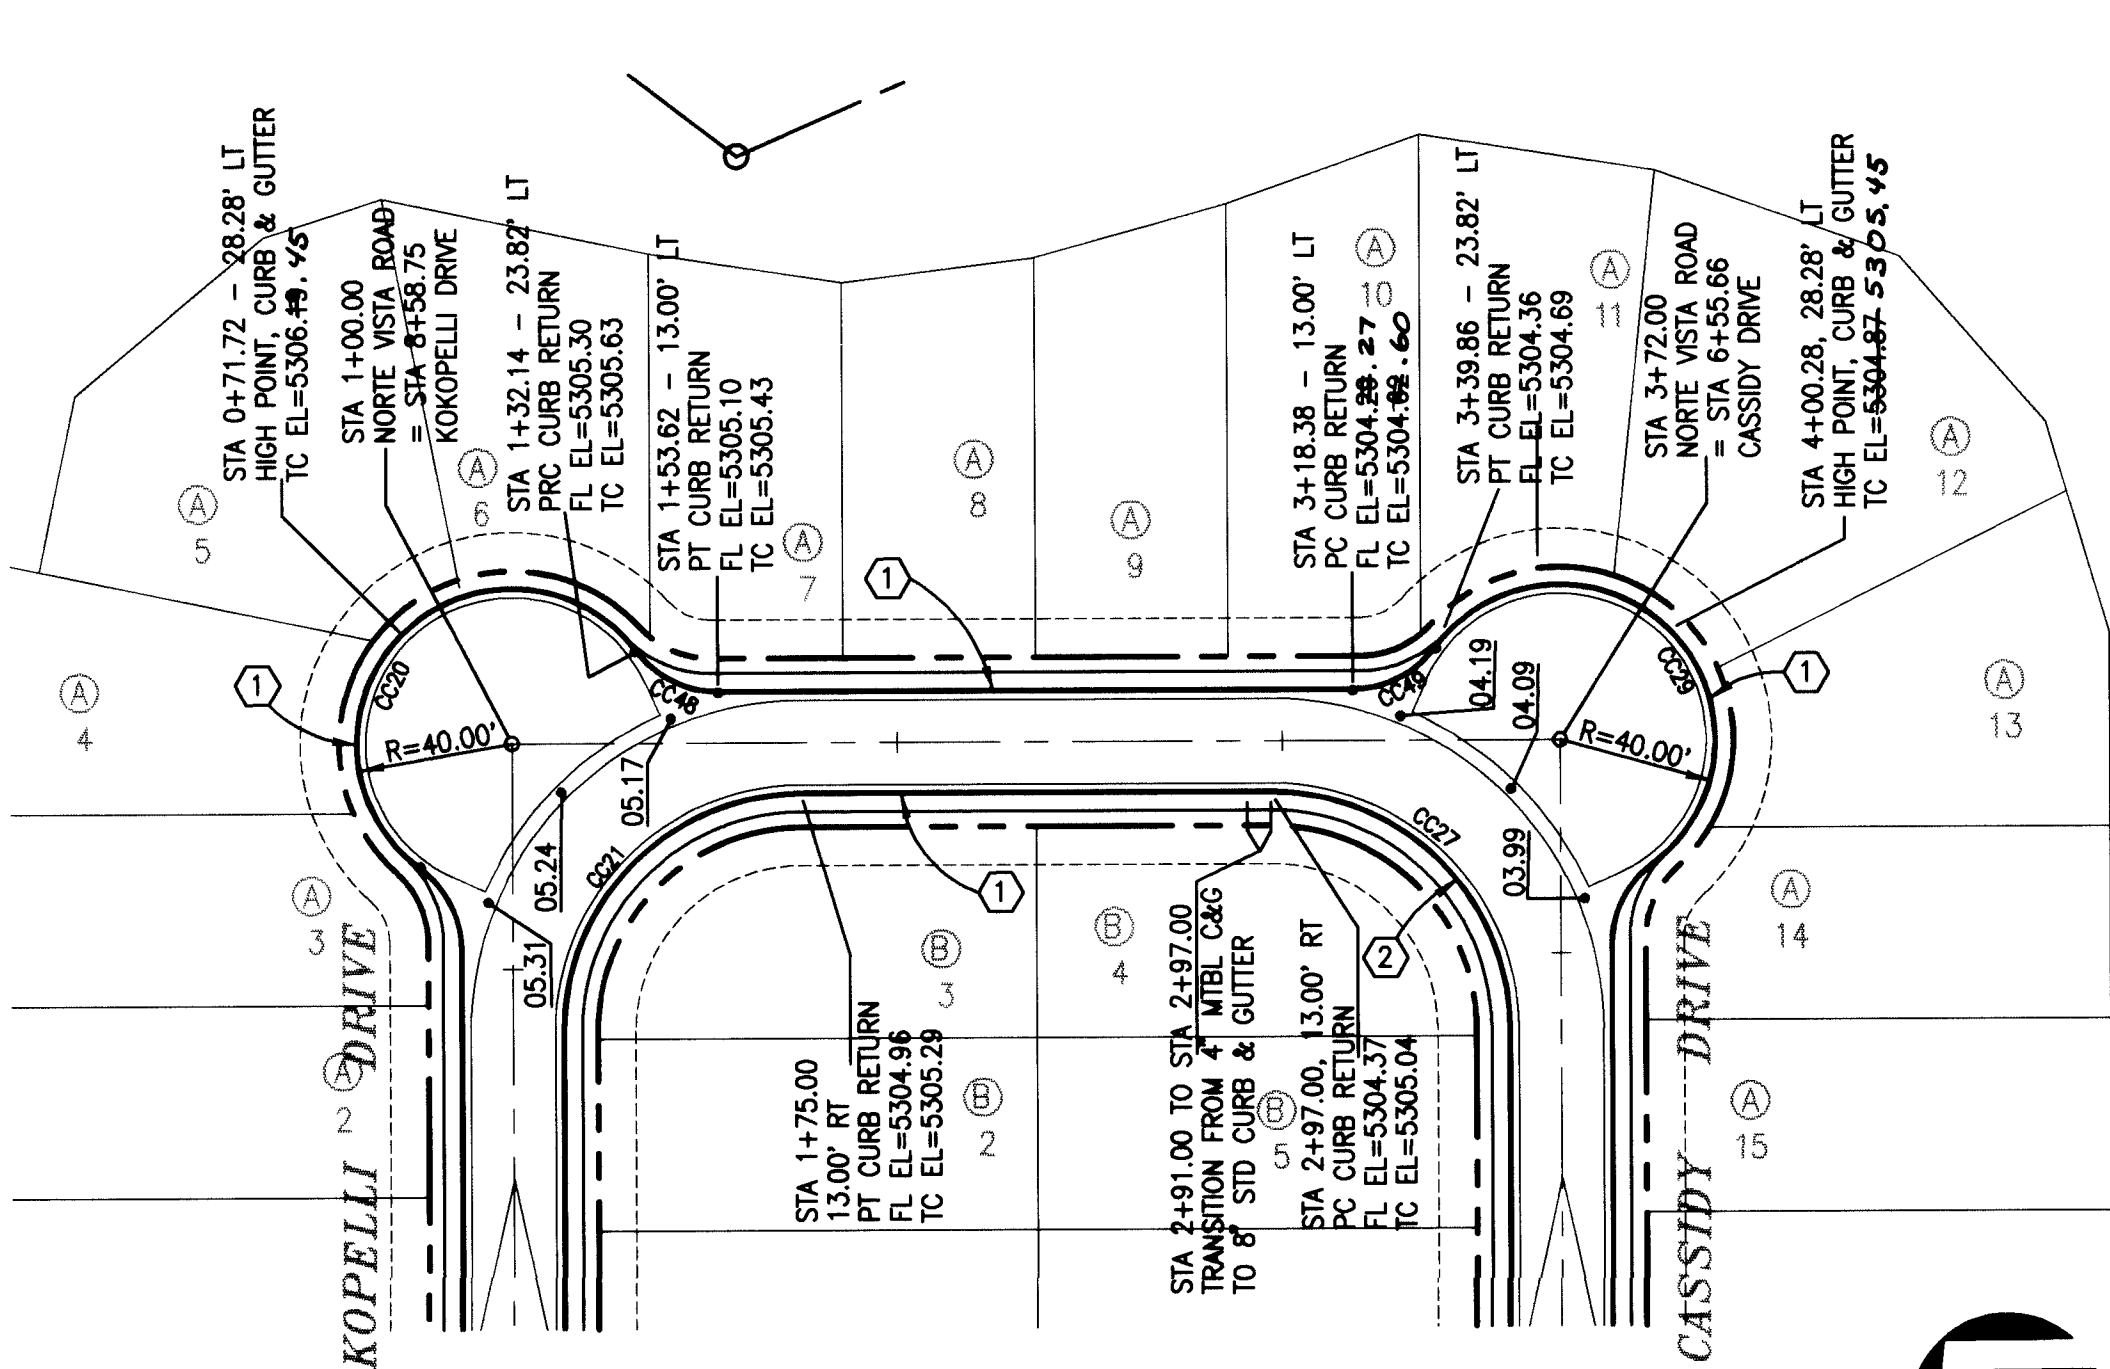


NORTE VISTA ROAD - PLAN

SCALE
HORIZ: 1"=50'
VERT: 1"=5'

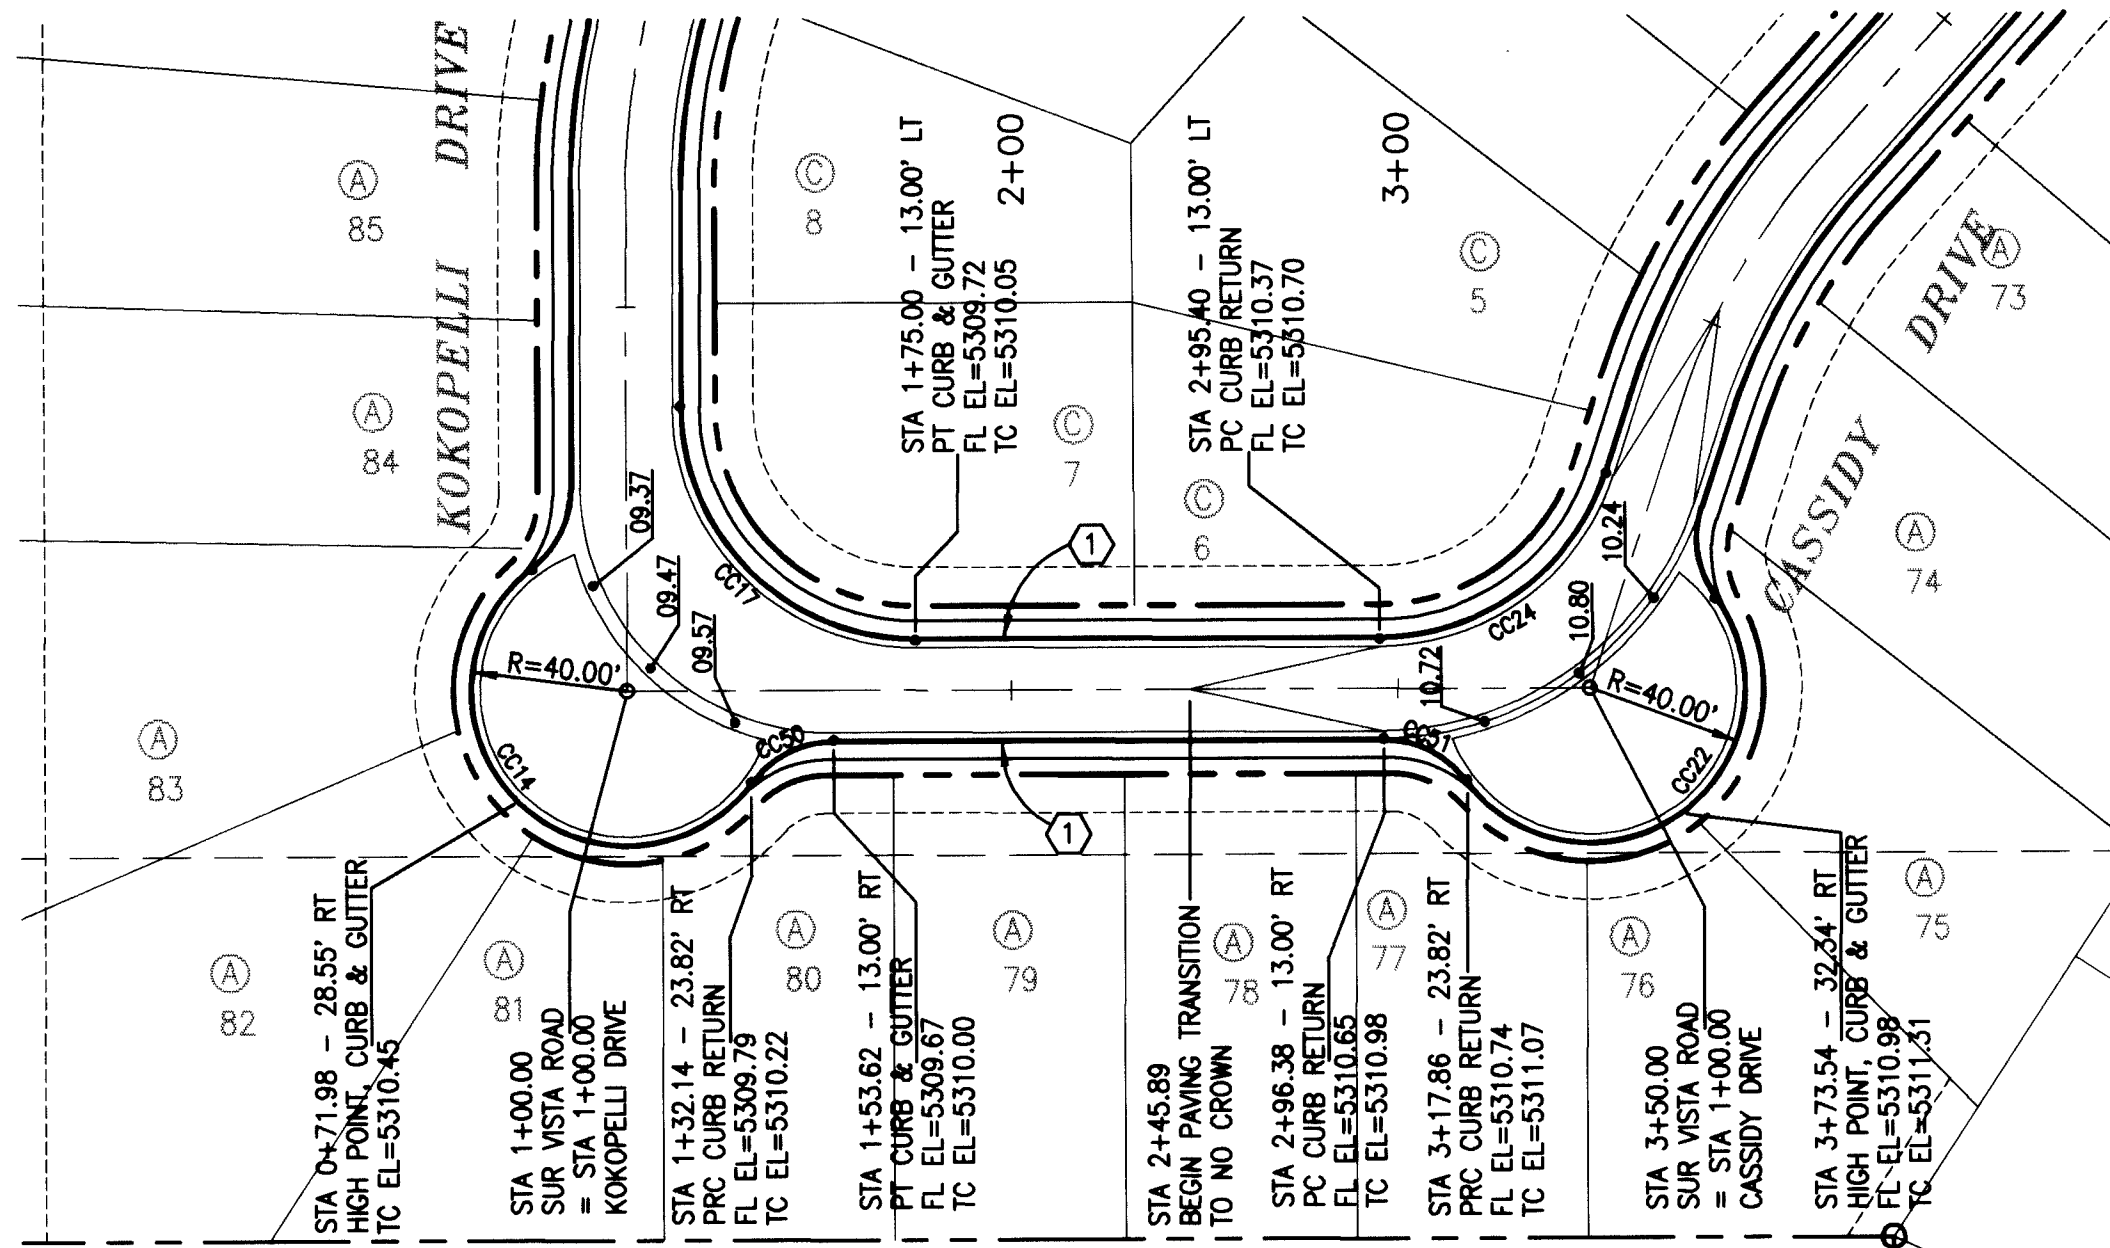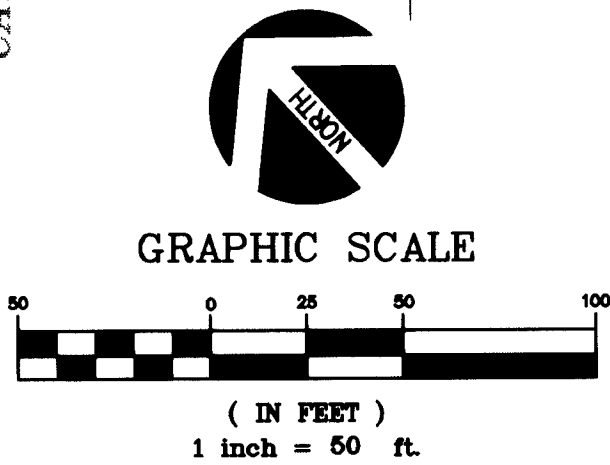

SUR VISTA ROAD - PLAN

SCALE
HORIZ: 1"=50'
VERT: 1"=5'

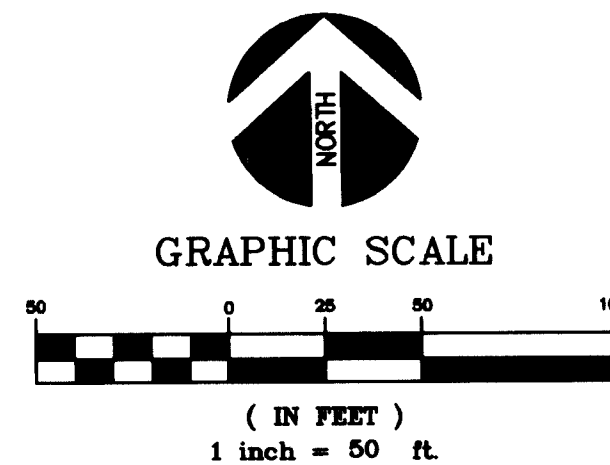

FACE OF CURB - CURVE TABLE				
CURVE	Δ	RADIUS	LGTH	CHORD
CC14	195°50'06"	40.00'	136.72'	N45°16'58" W 79.24'
CC17	90°00'00"	61.00'	95.82'	N44°44'41" E 86.27'
CC20	196°54'40"	40.00'	137.47'	N8°12'36" E 79.13'
CC21	90°00'00"	62.00'	97.39'	N8°12'36" E 87.68'
CC22	179°00'52"	40.00'	124.98'	S54°12'13" W 80.00'
CC24	72°08'12"	62.00'	78.02'	S54°12'13" W 72.98'
CC27	90°00'00"	62.00'	97.39'	S02°47'24" W 87.68'
CC29	196°54'40"	40.00'	137.47'	S02°47'24" W 79.13'
CC48	53°27'20"	26.74'	24.95'	S21°03'44" E 24.05'
CC49	53°27'20"	26.74'	24.95'	S74°31'04" W 24.05'
CC50	53°27'20"	26.74'	24.95'	S63°31'39" W 24.05'
CC51	53°27'20"	26.74'	24.95'	N63°01'01" W 24.05'

- KEYED NOTES
- 1 MOUNTABLE CURB & GUTTER
PER COA STD. DWG. 2415.
 - 2 STANDARD CURB & GUTTER
PER COA STD. DWG. 2415.


RECORD DRAWING
DATE .. 2/16/98 ..

CERTIFICATION
THESE DRAWINGS HAVE BEEN RECEIVED IN
ACCORDANCE WITH INFORMATION FURNISHED
BY
TO REFLECT THE CONSTRUCTION AS
NAME DATE


CHAVEZ • GRIEVES
CONSULTING ENGINEERS, INC.
5639 JEFFERSON STREET N.E. • ALBUQUERQUE, NEW MEXICO 87109
PHONE (505) 344-4080 • FAX (505) 343-8759

CITY OF ALBUQUERQUE PUBLIC WORKS DEPARTMENT ENGINEERING DEVELOPMENT GROUP	
TITLE: PARADISE BLUFF SUBDIVISION NORTE VISTA ROAD & SUR VISTA ROAD ROADWAY - PLAN & PROFILE	
DESIGNED BY J. P. KELLEY DATE 03-95	REVISIONS NO. DATE
DRAWN BY W. M. TOWERS DATE 03-95	BY
CHECKED BY V.J. CHAVEZ DATE 03-95	REMARKS
City Engineer Approval	
Last Design Update	
Mo./Day/Yr.	
Mo./Day/Yr.	
DESIGN REVIEW COMMITTEE	
City Project No. 542681	
Zone Map No. B-11/12	
Sheet 17 of 32	

AS BUILT INFORMATION	
CONTRACTOR ALBUQUERQUE UNDERGROUND	DATE 10/14/98
WORK BY C.S.T.	DATE 10/14/98
INSPECTOR BY C.S.T.	DATE 2/19/98
FIELD VERIFICATION BY C.S.T.	DATE 2/19/98
CORRECTED BY C.G.	DATE 2/19/98
MICRO-FILM INFORMATION	
RECORDED BY	DATE
NO.	DATE
12-01-93	

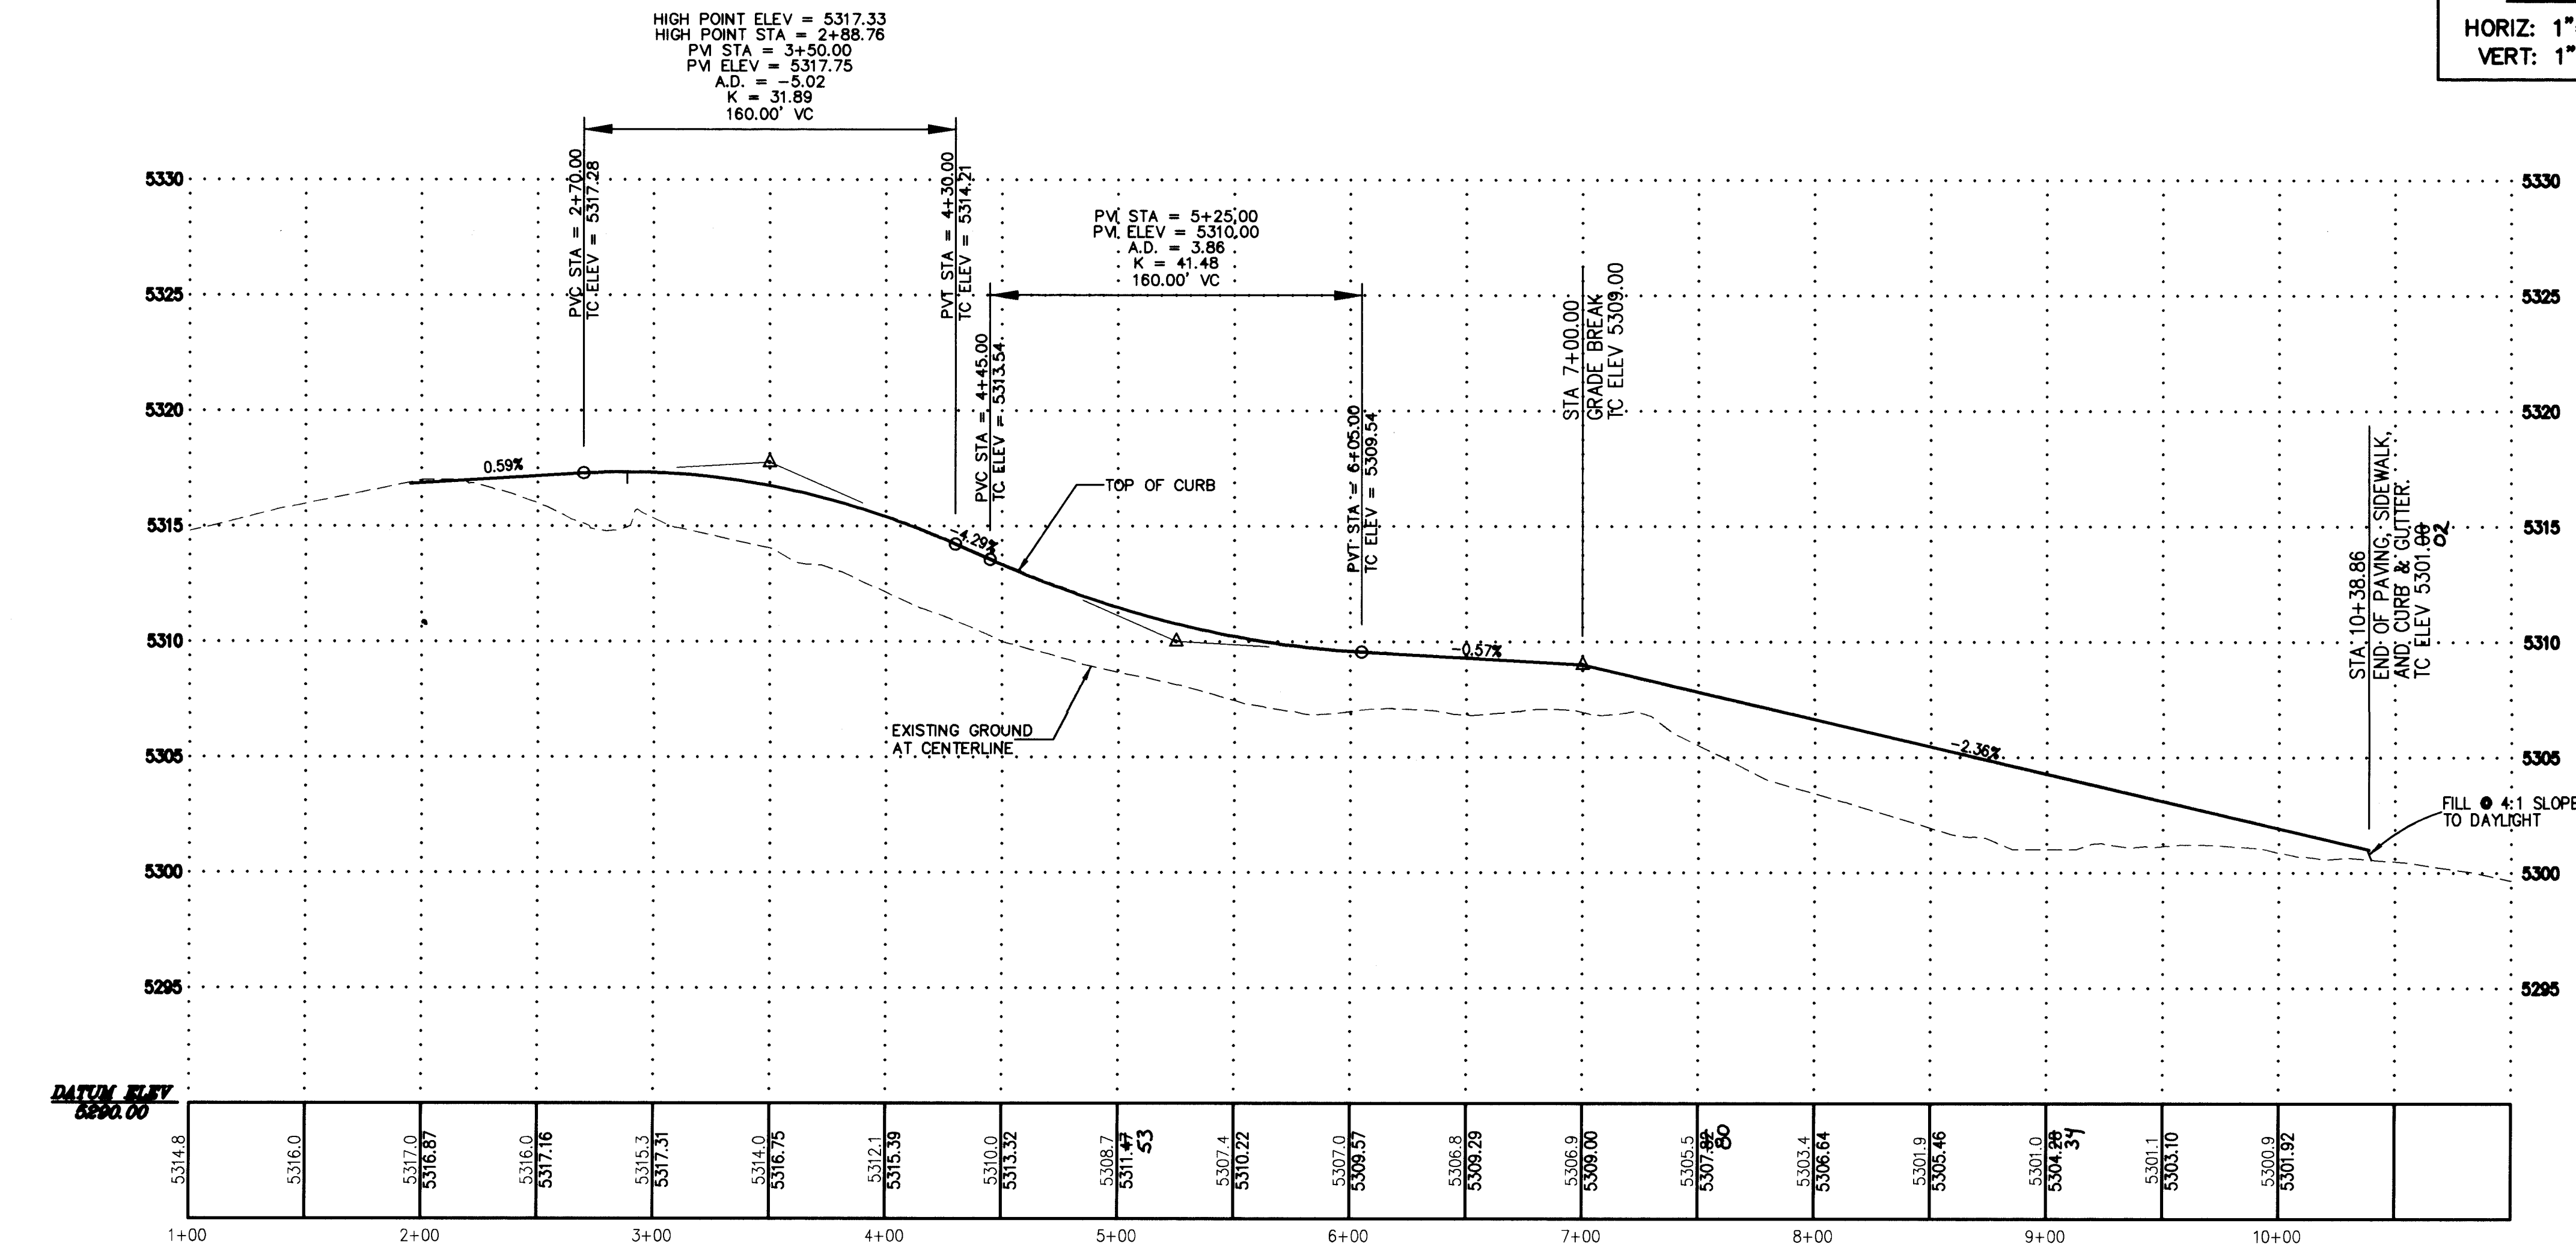

LILIENTHAL DRIVE - PROFILE

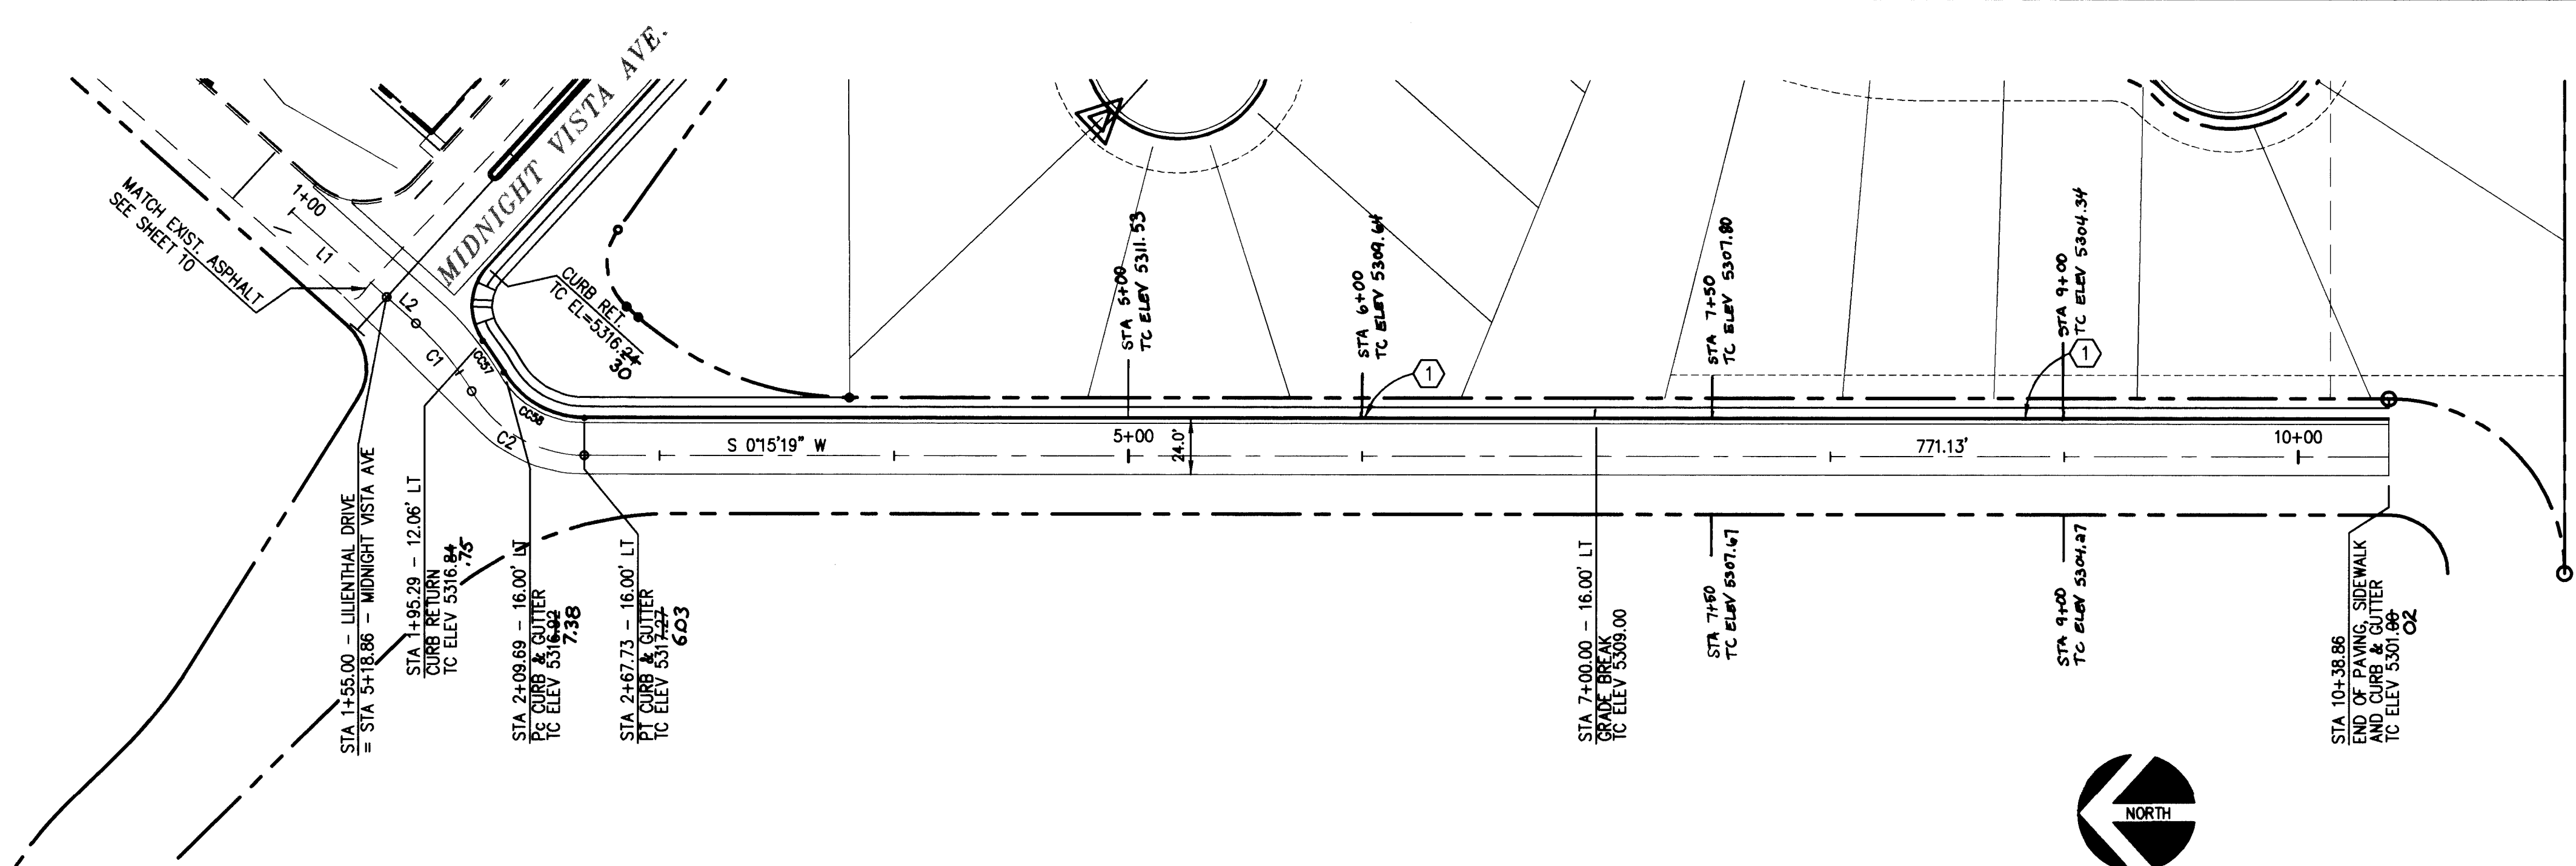

LILIENTHAL DRIVE - PLAN

FACE OF CURB - CURVE TABLE				
CURVE	Δ	RADIUS	LGTH	CHORD
CC57	6°35'53"	141.00'	16.24'	S56°20'37" W 16.23'
CC58	59°23'10"	40.00'	41.46'	S29°56'54" W 39.63'

LILIENTHAL CENTERLINE - CURVE TABLE				
CURVE	Δ	RADIUS	LGTH	CHORD
C1	1°19'42"	125.00'	37.80'	S50°58'38" W 37.66'
C2	59°23'10"	56.00'	58.04'	S29°56'54" W 55.48'

LILIENTHAL CENTERLINE LINE TABLE		
LINE	BEARING	LGTH
L1	S42°18'47" W	55.00'
L2	S42°18'47" W	16.88'

KEYED NOTES
1 STANDARD CURB & GUTTER
PER COA STD. DWG. 2415.

SCALE
HORIZ: 1"=50'
VERT: 1"=5'

RECORD DRAWING
DATE 2/16/98

02/16/98

CERTIFICATION
THESE DRAWINGS HAVE BEEN RECEIVED IN
ACCORDANCE WITH INFORMATION FURNISHED
BY C.S.C.
TO REFLECT THE CONSTRUCTION AS
ACTUALLY COMPLETED
NAME DATE

CHAVEZ • GRIEVES
CONSULTING ENGINEERS, INC.
5639 JEFFERSON STREET N.E. • ALBUQUERQUE, NEW MEXICO 87109
PHONE (505) 344-4080 • FAX (505) 343-8759

CITY OF ALBUQUERQUE PUBLIC WORKS DEPARTMENT ENGINEERING DEVELOPMENT GROUP	
TITLE: PARADISE BLUFF SUBDIVISION LILIENTHAL DRIVE ROADWAY - PLAN & PROFILE	
Design Review Committee APPROVED JUL 31 1997 DESIGN REVIEW COMMITTEE	City Engineer Approval
City Project No. 542681	Zone Map No. B-11/12
Sheet 19	Of 32

SURVEY INFORMATION		ENGINEER'S SEAL	
NO.	DATE	NO.	DATE
1	7-22-94	1	7-22-94
2	7-22-94	2	7-22-94
3	7-22-94	3	7-22-94
100	7-22-94	100	7-22-94



RECORD DRAWING

DATE 2/16/98

CERTIFICATION

THESE DRAWINGS HAVE BEEN RECEIVED IN
ACCORDANCE WITH INFORMATION FURNISHED
BY CSC
TO REFLECT THE CONSTRUCTION AS
ACTUALLY ACCOMPLISHED


2102 02/16/91

NAME _____ DATE _____

 **CHAVEZ • GRIEVES**
CONSULTING ENGINEERS, INC.
5639 JEFFERSON STREET N.E. • ALBUQUERQUE, NEW MEXICO 87109
PHONE (505) 344-4080 • FAX (505) 343-8759

CITY OF ALBUQUERQUE
PUBLIC WORKS DEPARTMENT
ENGINEERING DEVELOPMENT GROUP

TITLE: PARADISE BLUFF SUBDIVISION
OUTFLOW - COLBY CT./PARADISE BLVD. STA 10+00.00
TO 21+50.00 STORM DRAIN - PLAN & PROFILE


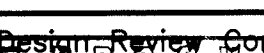
	City Engineer Approval	Last Design Update	Mo./Day/Yr.	Mo./Day/Yr.

City Project No.	542681	Zone Map No.	B-11/12	Sheet	20	Of	32
------------------	--------	--------------	---------	-------	----	----	----

[illegible]

SCANNED BY
BY LASON

JOB NO.: N08-100-5193
FILE: PBC-SD2.DWG 11-22-94
REV: 07-01-96

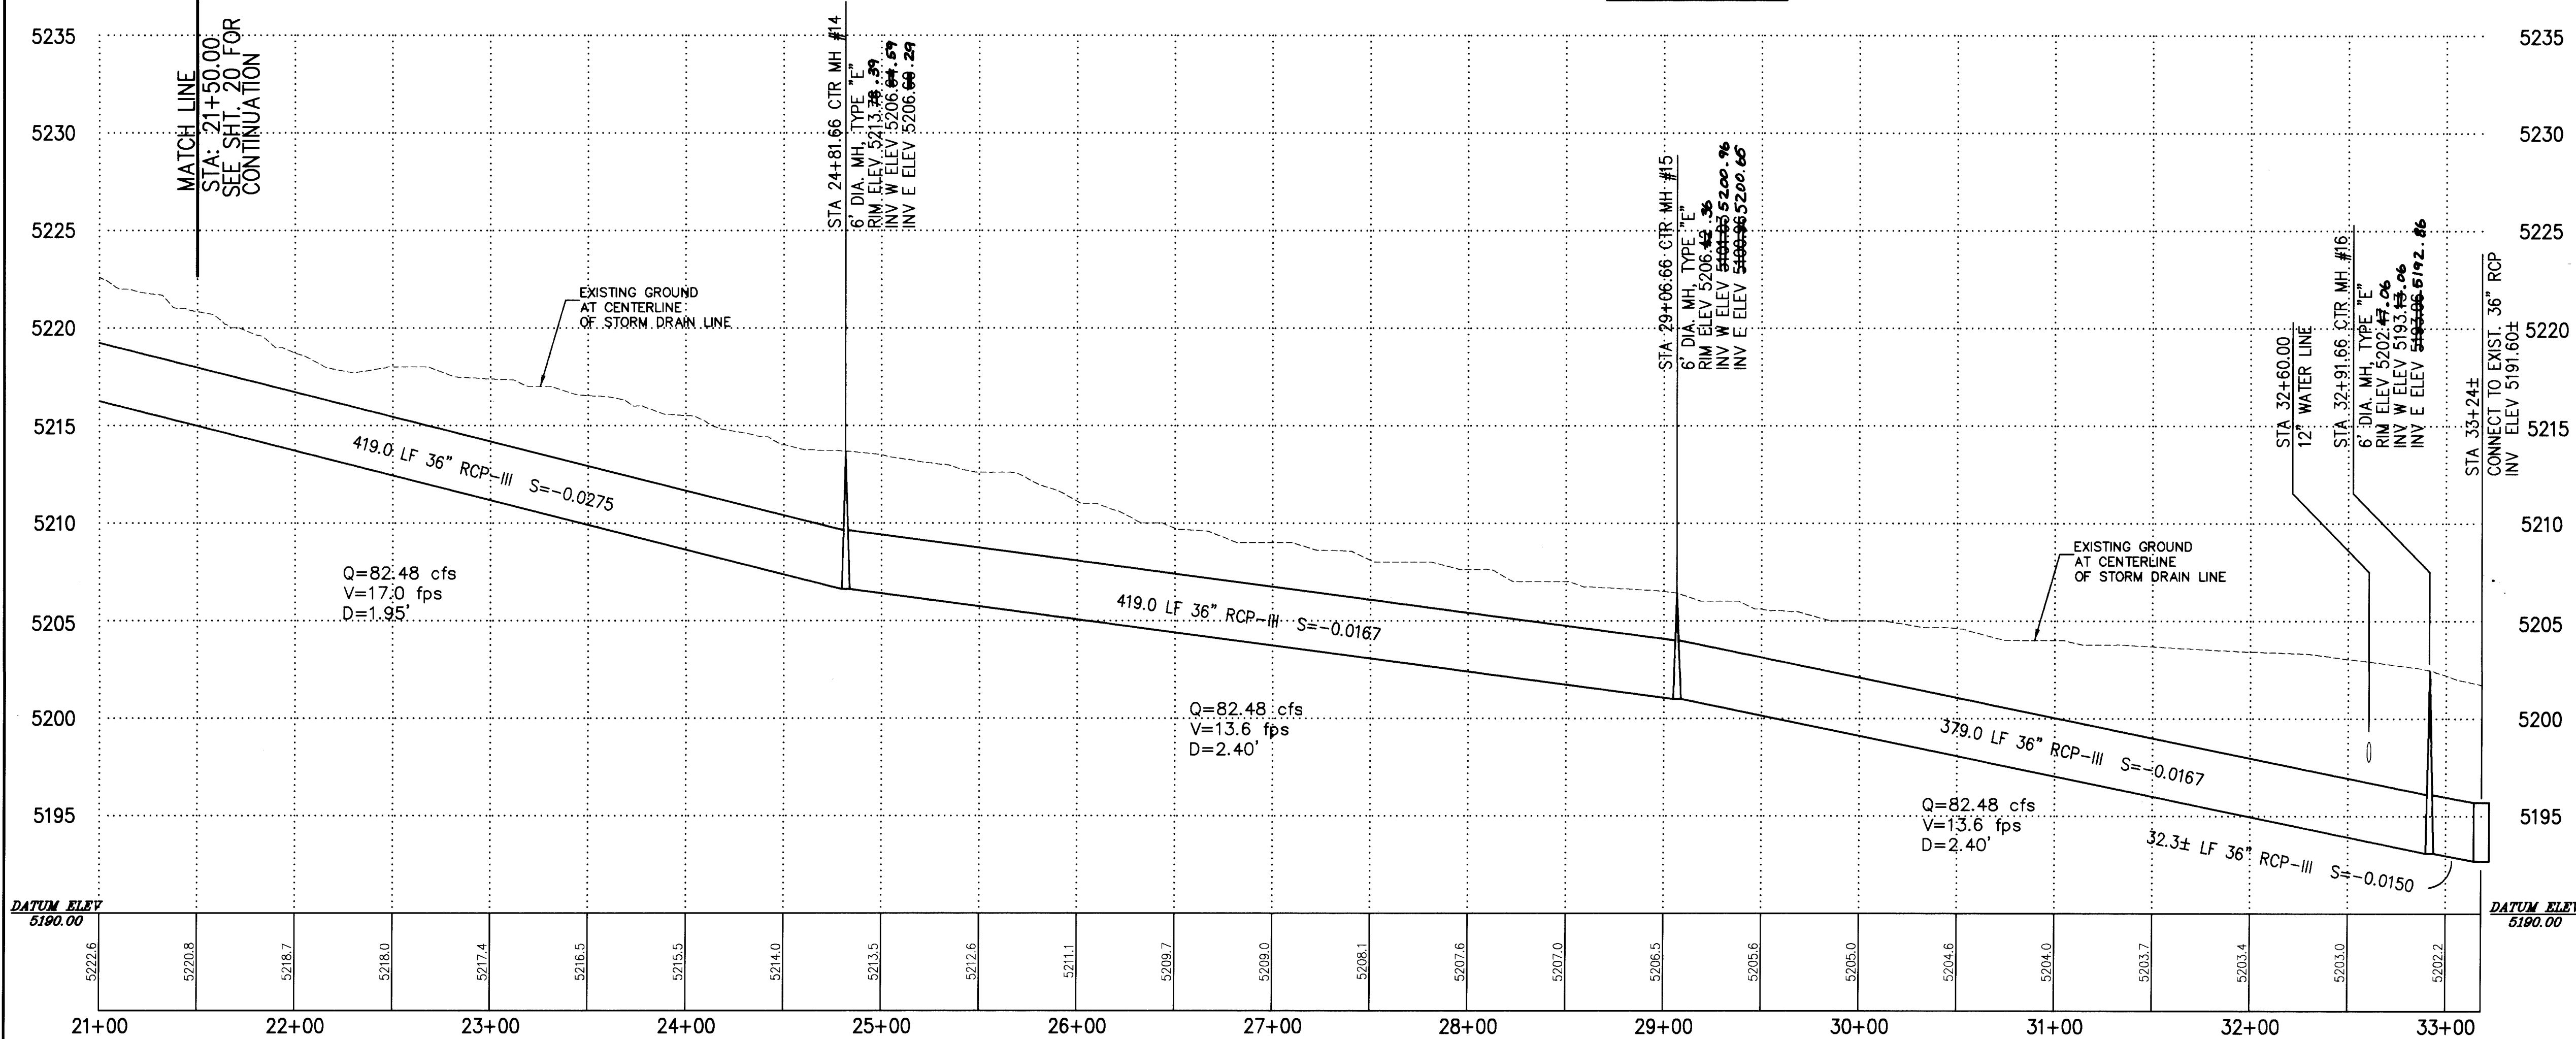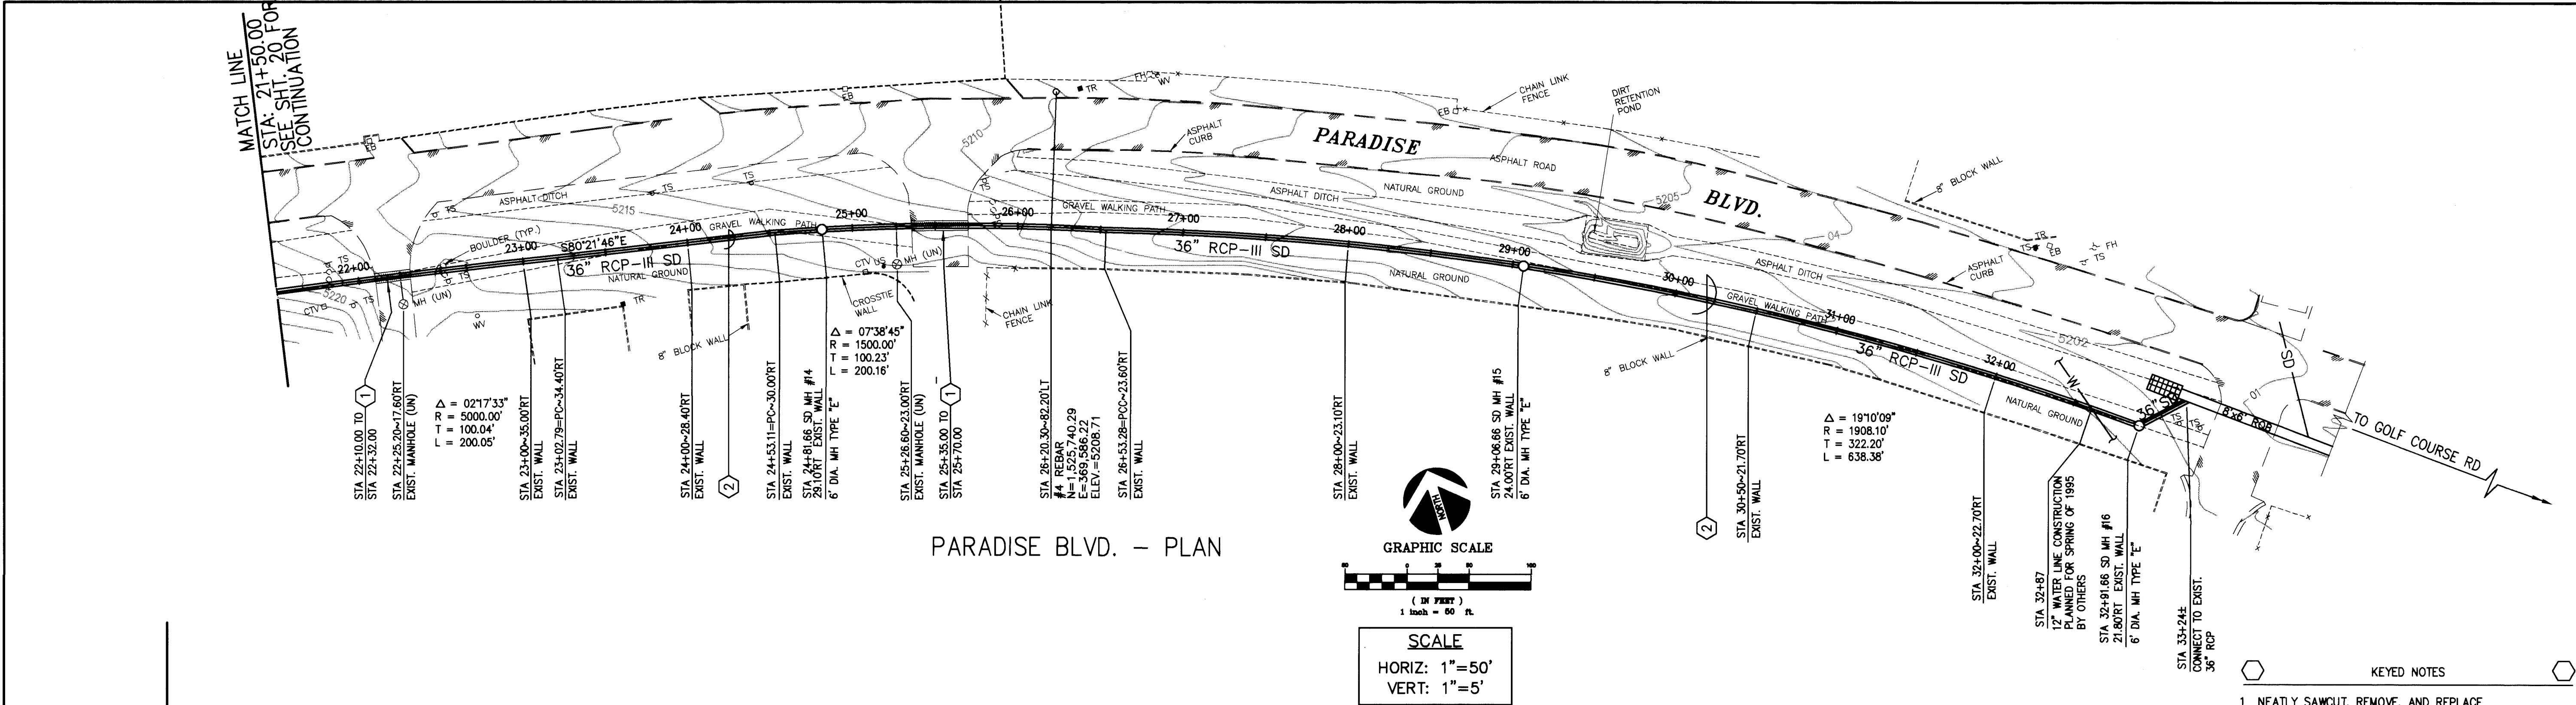

PARADISE BLVD. - PROFILE

RECORD DRAWING

DATE: 2/15/98



CERTIFICATION
THESE DRAWINGS HAVE BEEN RECEIVED IN
ACCORDANCE WITH INFORMATION FURNISHED
BY
TO REPRESENT THE CONSTRUCTION AS
ACTUALLY COMPLETED
NAME: J. P. KELLEY DATE: 2/16/98

CHAVEZ • GRIEVES
CONSULTING ENGINEERS, INC.
5639 JEFFERSON STREET N.E. • ALBUQUERQUE, NEW MEXICO 87109
PHONE (505) 344-4080 • FAX (505) 343-8759

CITY OF ALBUQUERQUE PUBLIC WORKS DEPARTMENT ENGINEERING DEVELOPMENT GROUP			
TITLE: PARADISE BLUFF SUBDIVISION OUTFLOW - COLBY CT./PARADISE BLVD. STA 21+50.00 TO STA 33+18.24 STORM DRAIN - PLAN & PROFILE			
DESIGNED BY	DRAWN BY	CHECKED BY	DATE
J. P. KELLEY	A. R. BRICENO	V.J. CHAVEZ	03-95
REVISIONS			
NO.	DATE	REMARKS	BY
1	03-95	DESIGN	J. P. KELLEY
2	03-95	REVISIONS	A. R. BRICENO
3	03-95	REVISIONS	V.J. CHAVEZ


City Project No.	Zone Map No.	Sheet	Of
5426.81	B-11/12	21	32

SCANNED BY
BY LASON

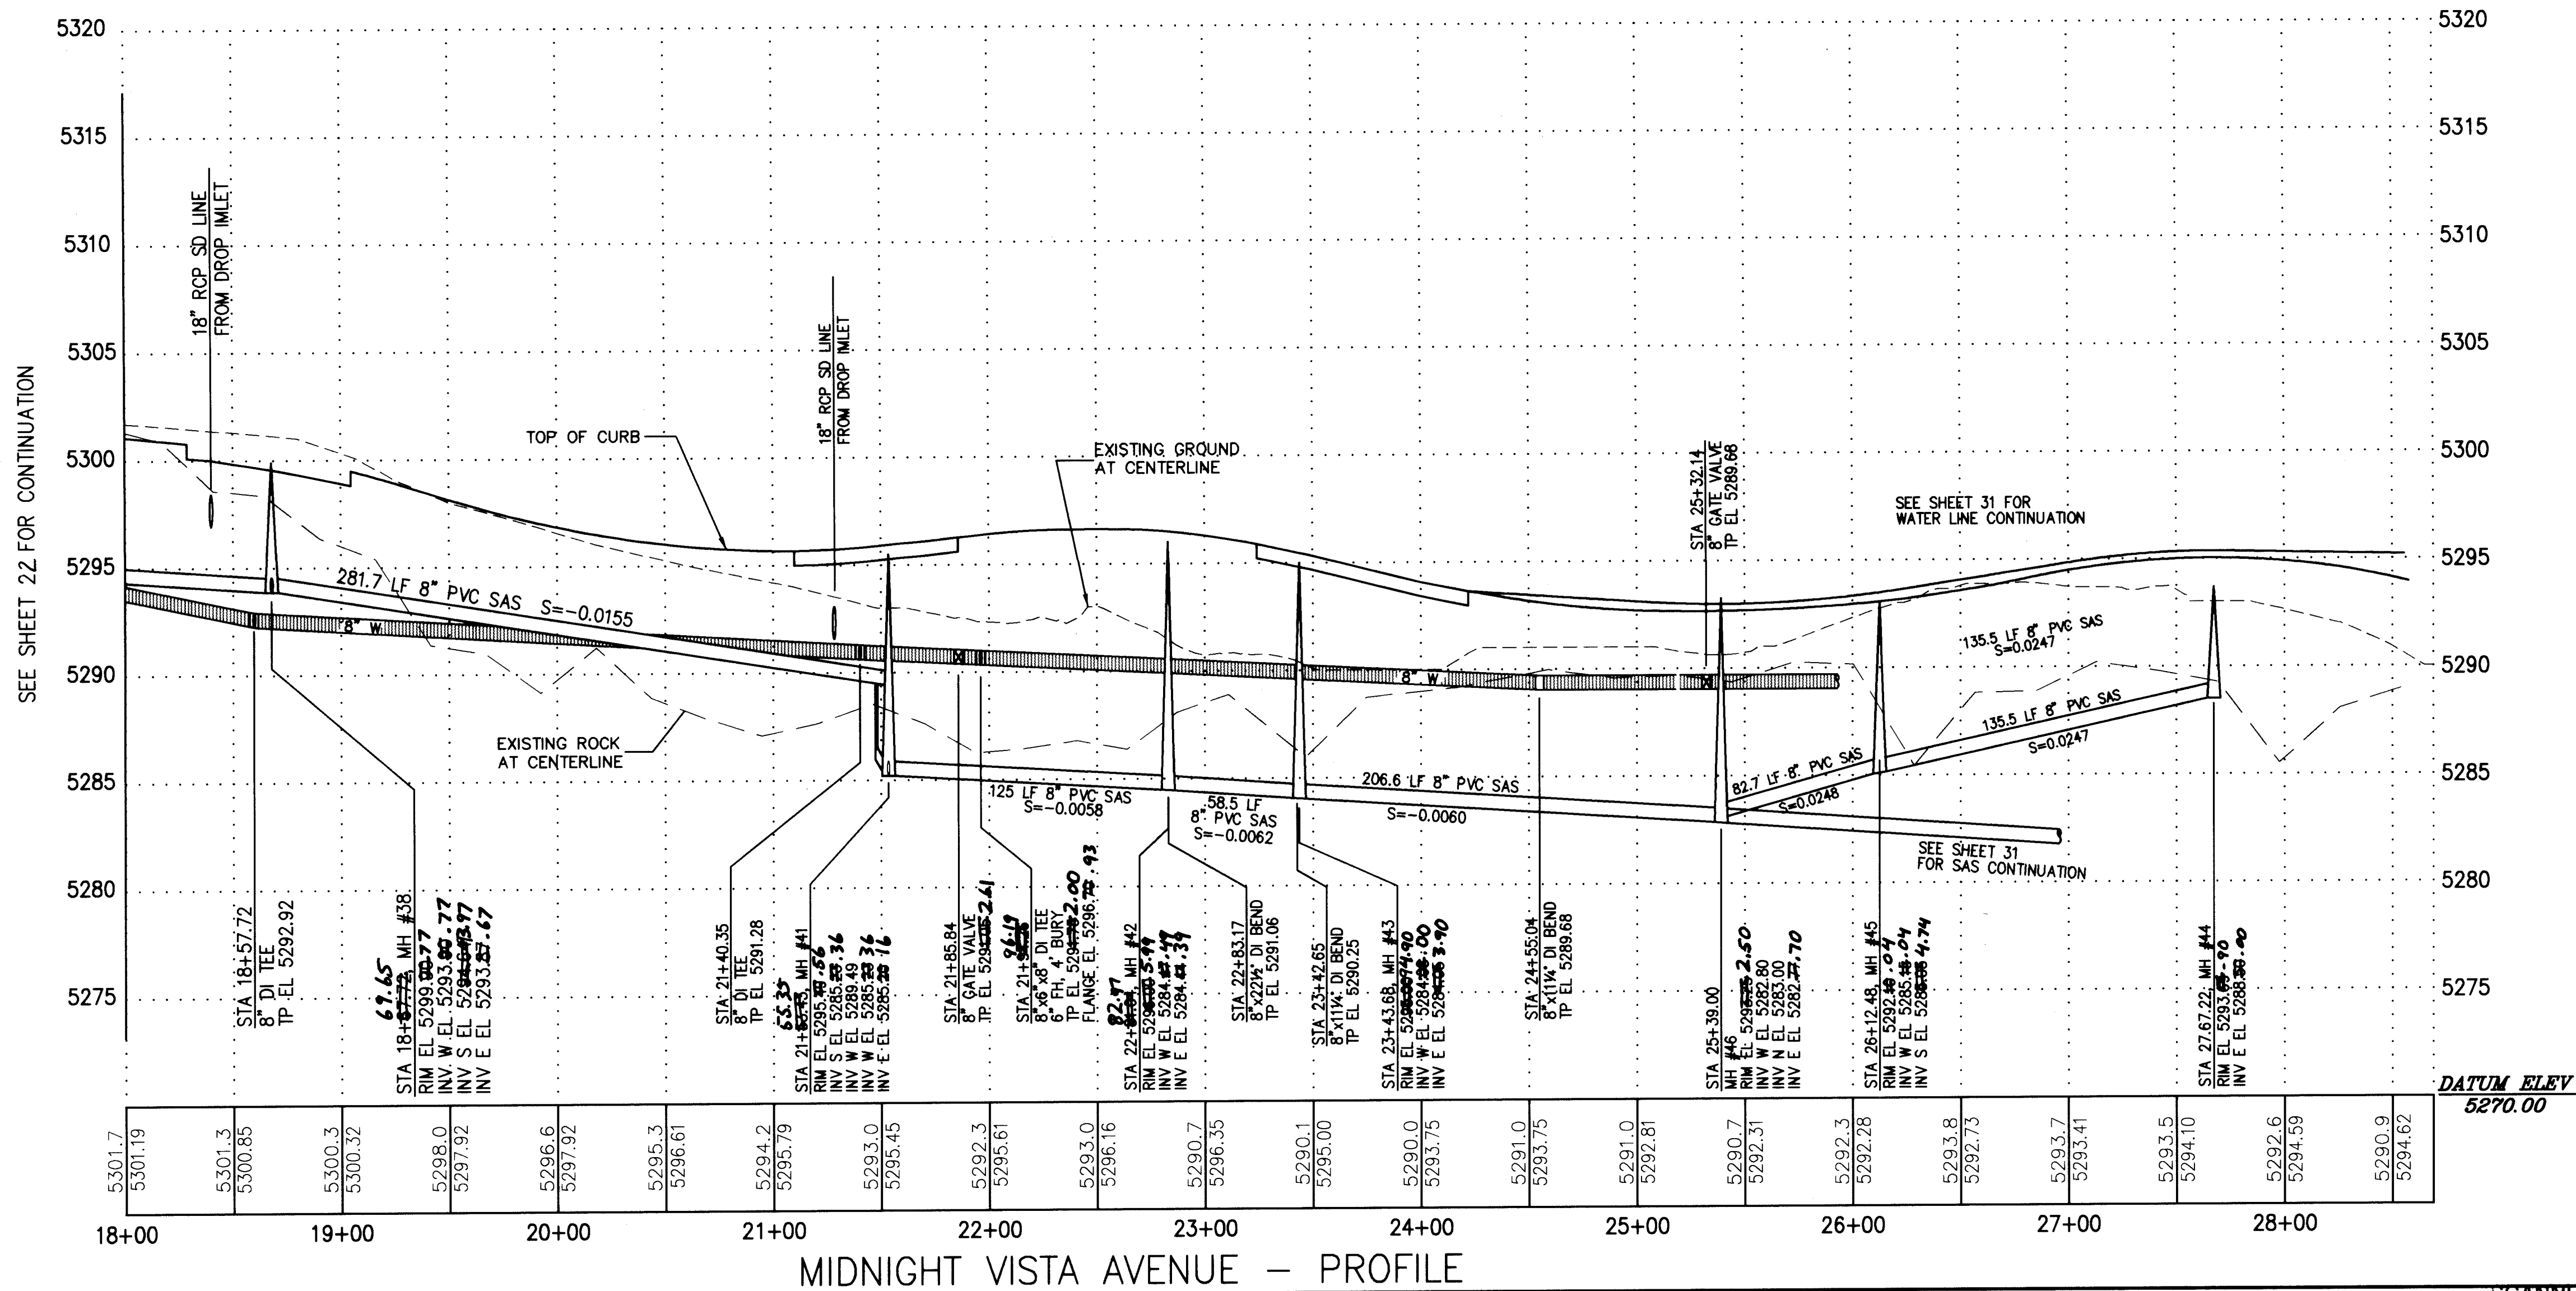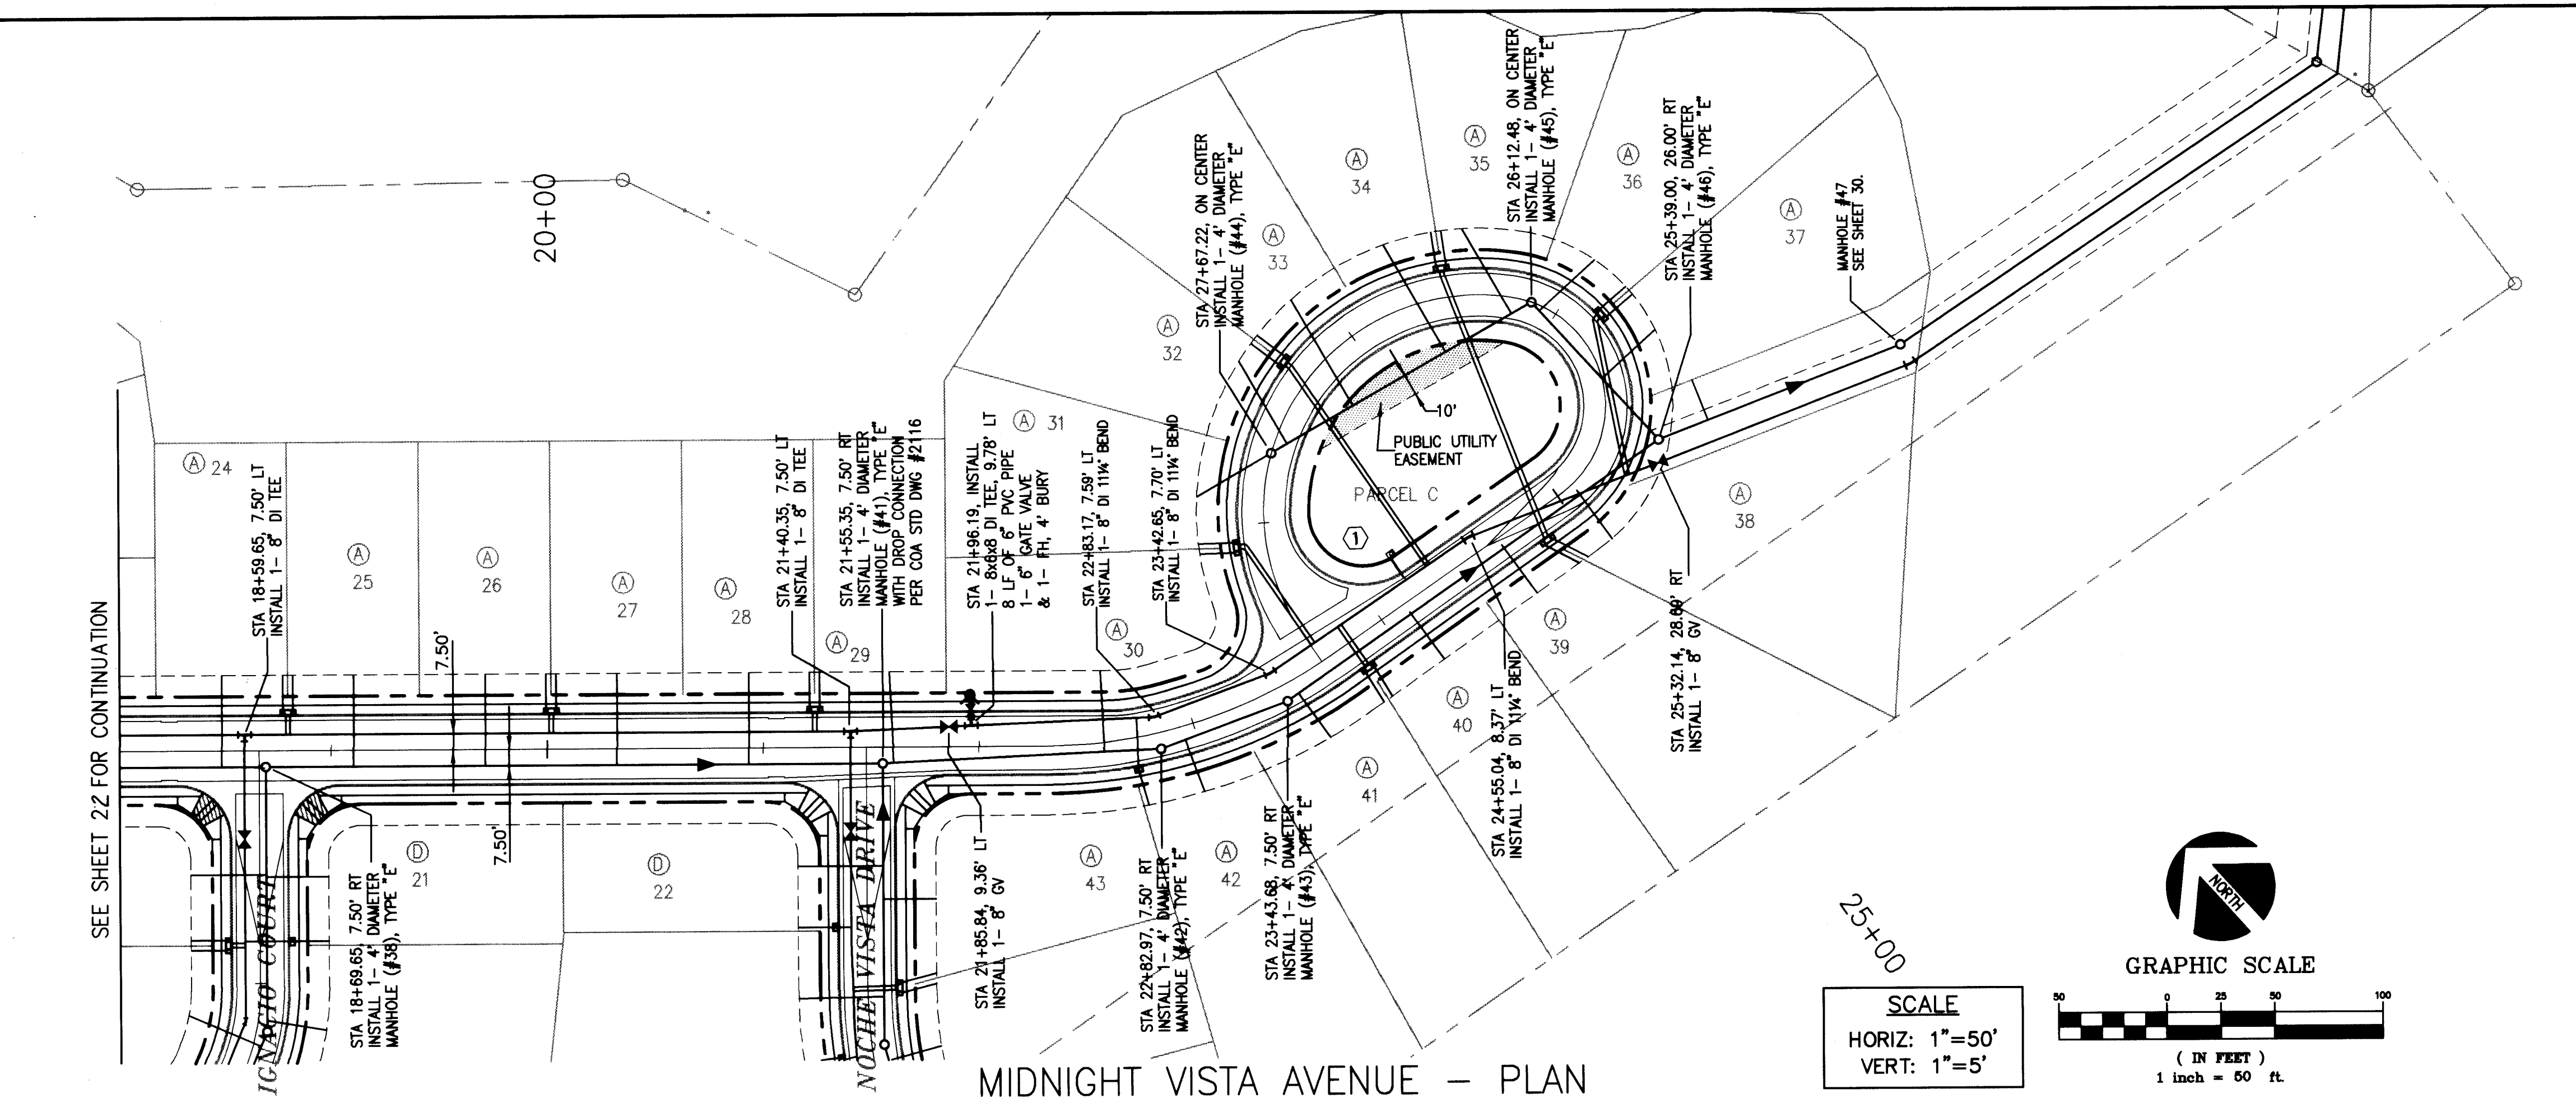

SANITARY SEWER SERVICE TABLE			
LOT	STATION	OFFSET	ELEVATION
A24	18+49.36	35.00 L	5296.33
A25	19+10.36	35.00 L	5295.11
A26	19+71.36	35.00 L	5289.30
A27	20+32.36	35.00 L	5292.02
A28	20+93.35	35.00 L	5291.47
A29	21+58.39	35.00 L	5291.68
A30	22+60.34	33.43 L	5292.31
A31	27+89.29	31.00 R	5290.65
A32	27+50.07	31.00 R	5290.59
A33	27+09.85	31.00 R	5290.23
A34	26+71.66	31.00 R	5289.71
A35	26+31.47	31.00 R	5289.16
A36	25+99.16	31.00 R	5288.72
A37	25+72.17	31.00 R	5288.42
A38	25+05.93	31.00 R	5288.28
A39	24+66.28	31.27 R	5288.60
A40	24+13.52	31.68 R	5289.47
A41	23+52.09	32.00 R	5290.95
A42	22+96.22	32.00 R	5289.01

KEYED NOTES
1 INSTALL SINGLE 1" WATER METER.

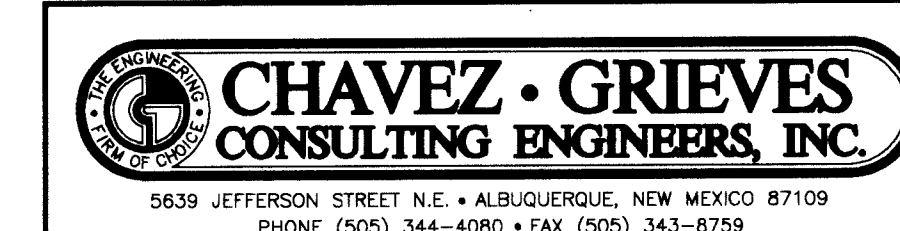


CITY OF ALBUQUERQUE PUBLIC WORKS DEPARTMENT ENGINEERING DEVELOPMENT GROUP	
TITLE: PARADISE BLUFF SUBDIVISION MIDNIGHT VISTA AVENUE - WATER & SANITARY SEWER PLAN & PROFILE STA 18+00.00 TO 28+70.00	
DESIGNED BY J. P. KELLEY	DATE 03-95
DRAWN BY W. M. TOWERS	DATE 03-95
CHECKED BY V.J. CHAVEZ	DATE 03-95
REVISIONS DESIGN	BY DATE
City Project No. 542681	
Zone Map No. B-11/12	Sheet 23 of 32

ENGINEER'S SEAL		SURVEY INFORMATION		BENCH MARKS		AS BUILT INFORMATION	
JOE P. KELLEY REGISTERED PROFESSIONAL ENGINEER 9996 6/10/95		FIELD NOTES NO. DATE BY DATE		ACS BRASS CAP STAMPED "ACS 8-B11, 1986" LOCATED 475 FEET NORTHEAST OF THE INTERSECTION OF JUSTIN DRIVE AND BUGLO AVENUE. ELEV. = 5328.378		CONTRACTOR WORKED BY DATE INSPECTOR'S DATE FIELD DATE VERIFICATION BY DATE CORRECTED BY DATE	
REMARKS		SURVEY BY COMMUNITY SCIENCES CORP. CORRALES, NM. 7-22-94		MICRO-FILM INFORMATION RECORDED BY NO.		MICRO-FILM INFORMATION RECORDED BY NO.	



SCANNED BY
BY LASON

JOB NO. N08-100-5193
FILE: UTWSTR.DWG (VIEW: SH3 XREF: LAYOUT1)
REV: 05-13-96

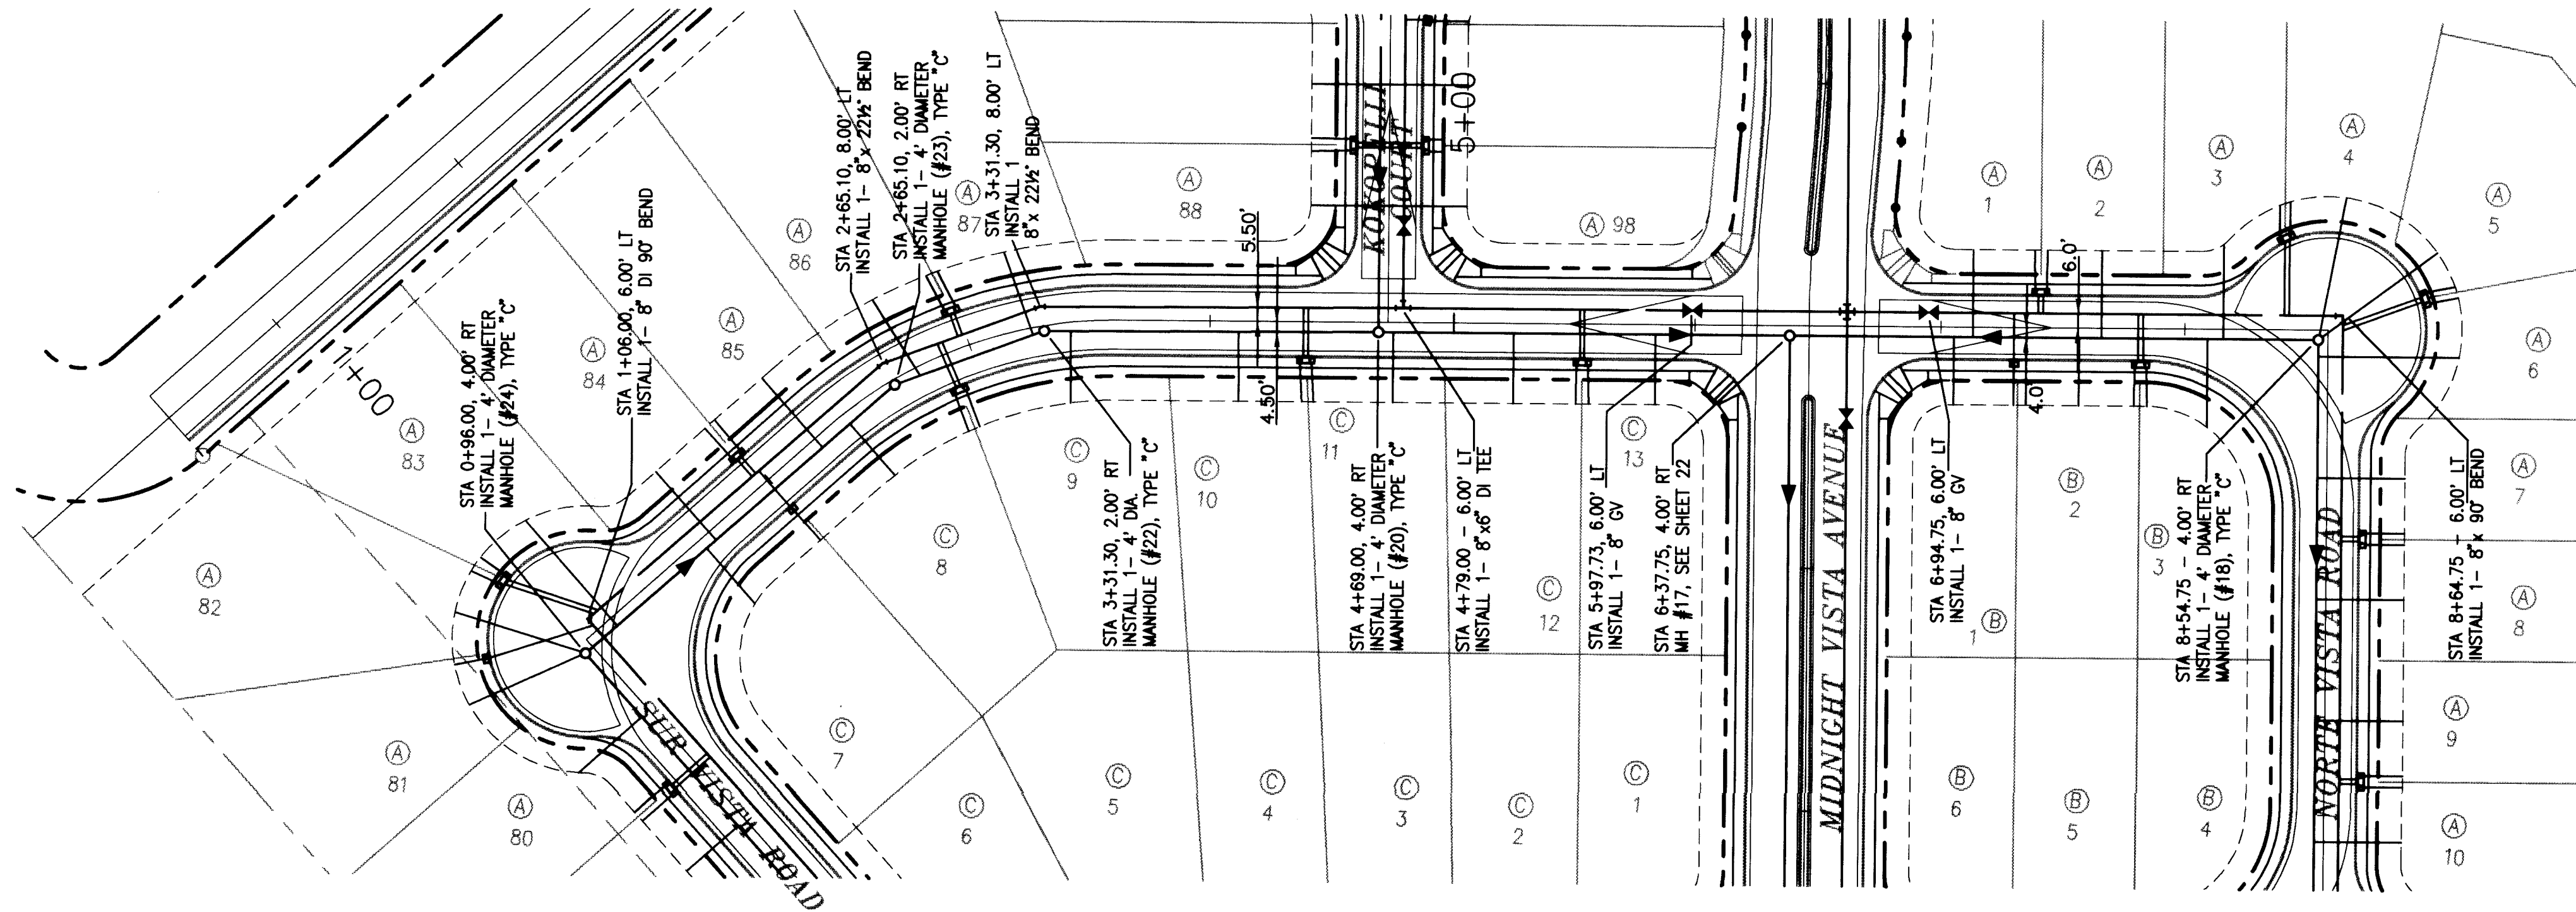

KOKOPELLI DRIVE- PLAN

SCALE
HORIZ: 1"=50'
VERT: 1"=5'

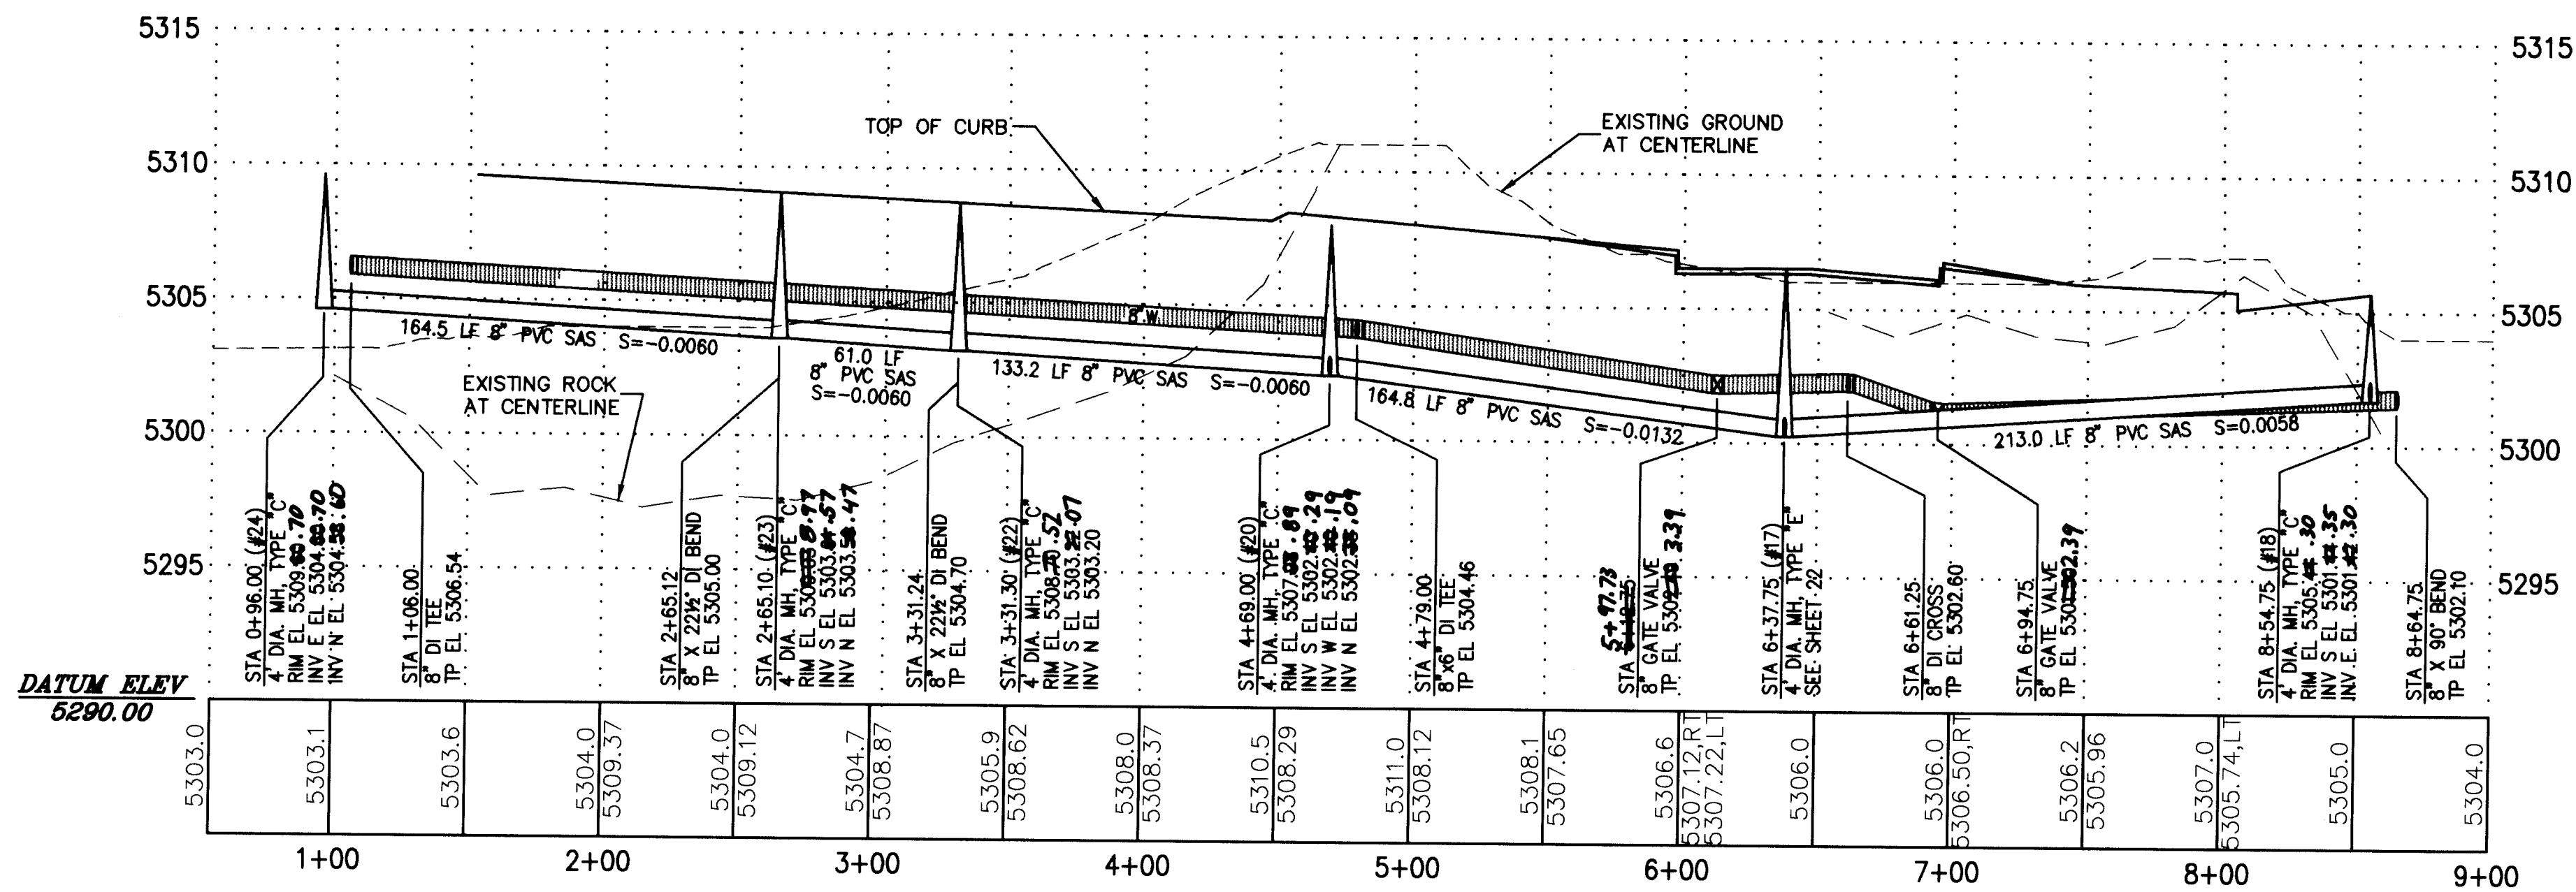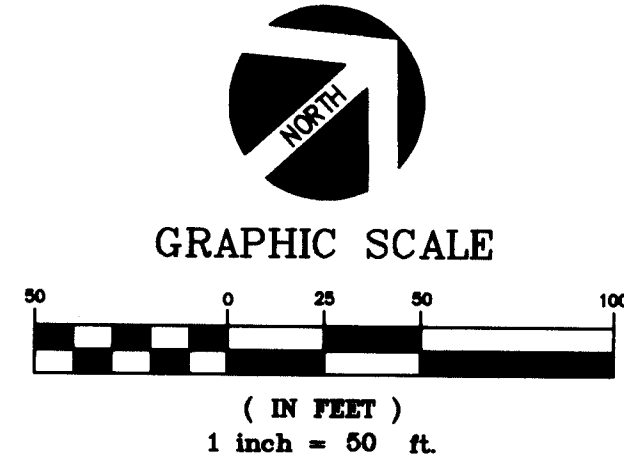


KOKOPELLI DRIVE - PROFILE

SANITARY SEWER SERVICE TABLE			
LOT	STATION	OFFSET	ELEVATION
A83	1+13.82	52.23 L	5305.83
A84	1+67.27	33.00 L	5305.56
A85	2+25.33	33.00 L	5305.14
A86	2+73.45	33.00 L	5305.03
A87	3+22.02	33.00 L	5304.79
A1	7+13.26	32.00 L	5302.9
A2	7+65.76	32.00 L	5302.45
A3	8+15.76	34.91 L	5302.02
A4	8+65.83	54.54 L	5301.86
B3	8+09.26	40.38 R	5302.08
B2	7+56.76	32.00 R	5302.53
B1	7+05.26	32.00 R	5302.97
C13	5+82.76	33.00 R	5303.04
C12	5+24.63	33.00 R	5303.58
C11	4+75.09	33.00 R	5304.02
C10	4+11.83	33.00 R	5304.34
C9	3+38.30	33.00 R	5304.48
C8	2+41.92	33.00 R	5305.19
C7	1+61.71	34.84 R	5305.59





CITY OF ALBUQUERQUE PUBLIC WORKS DEPARTMENT ENGINEERING DEVELOPMENT GROUP	
TITLE: PARADISE BLUFF SUBDIVISION KOKOPELLI DRIVE WATER & SANITARY SEWER - PLAN & PROFILE	
DESIGNED BY: J. P. KELLEY	DATE: 03-95
DRAWN BY: W. M. TOWERS	DATE: 03-95
CHECKED BY: V.J. CHAVEZ	DATE: 03-95
DESIGN REVIEW COMMITTEE	City Engineer Approval
APPROVE	Ms./Dsr./Tr.
City Project No. 5426 81	Zone Map No. B-11/12
Sheet 24	of 32

ENGINEER'S SEAL		SURVEY INFORMATION		BENCH MARKS		AS BUILT INFORMATION	
P. KELLEY 5/17/96		FIELD NOTES		ACS BRASS CAP STAMPED "ACS 6-B11, 1986" LOCATED 475 FEET NORTHEAST OF THE INTERSECTION OF JUSTIN DRIVE AND BUGLO AVENUE. ELEV. = 5328.378		CONTRACTOR	
NO. DATE		BY DATE		WORK SIGNED BY DATE		RECEIVED BY DATE	
REVISIONS		DESIGN		ACCEPTANCE BY DATE		RECEIVED BY DATE	
REVISIONS		DESIGN		ACCEPTANCE BY DATE		RECEIVED BY DATE	
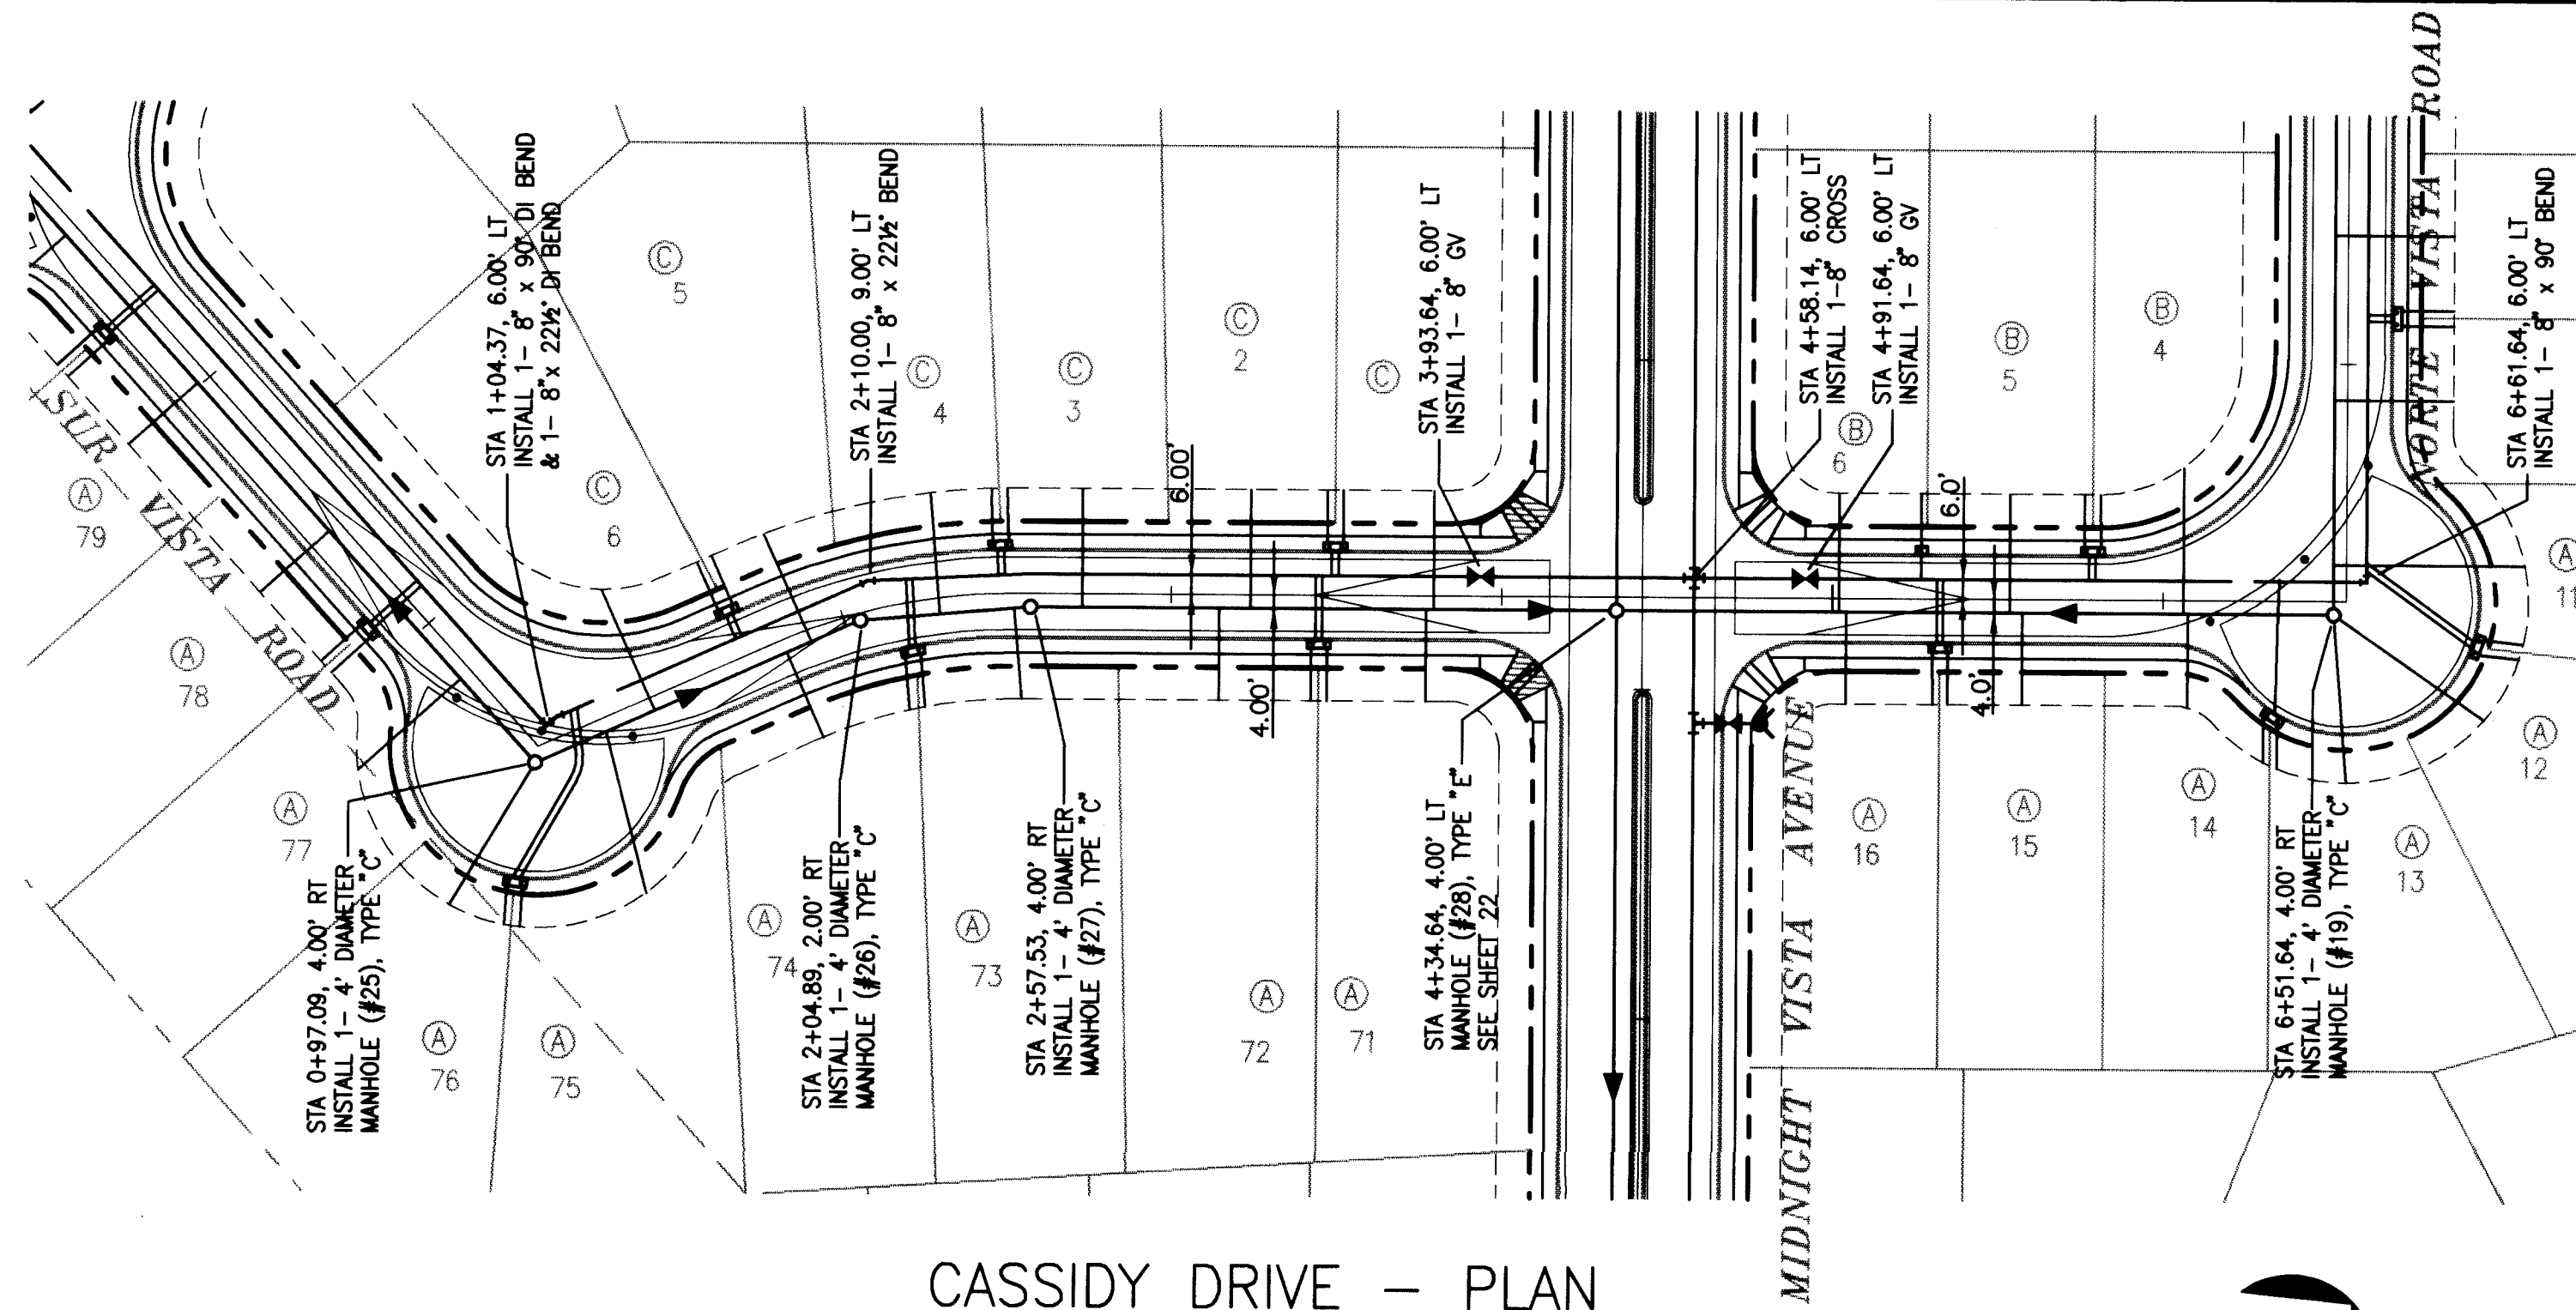


CASSIDY DRIVE - PLAN

SCALE
HORIZ: 1"=50'
VERT: 1"=5'

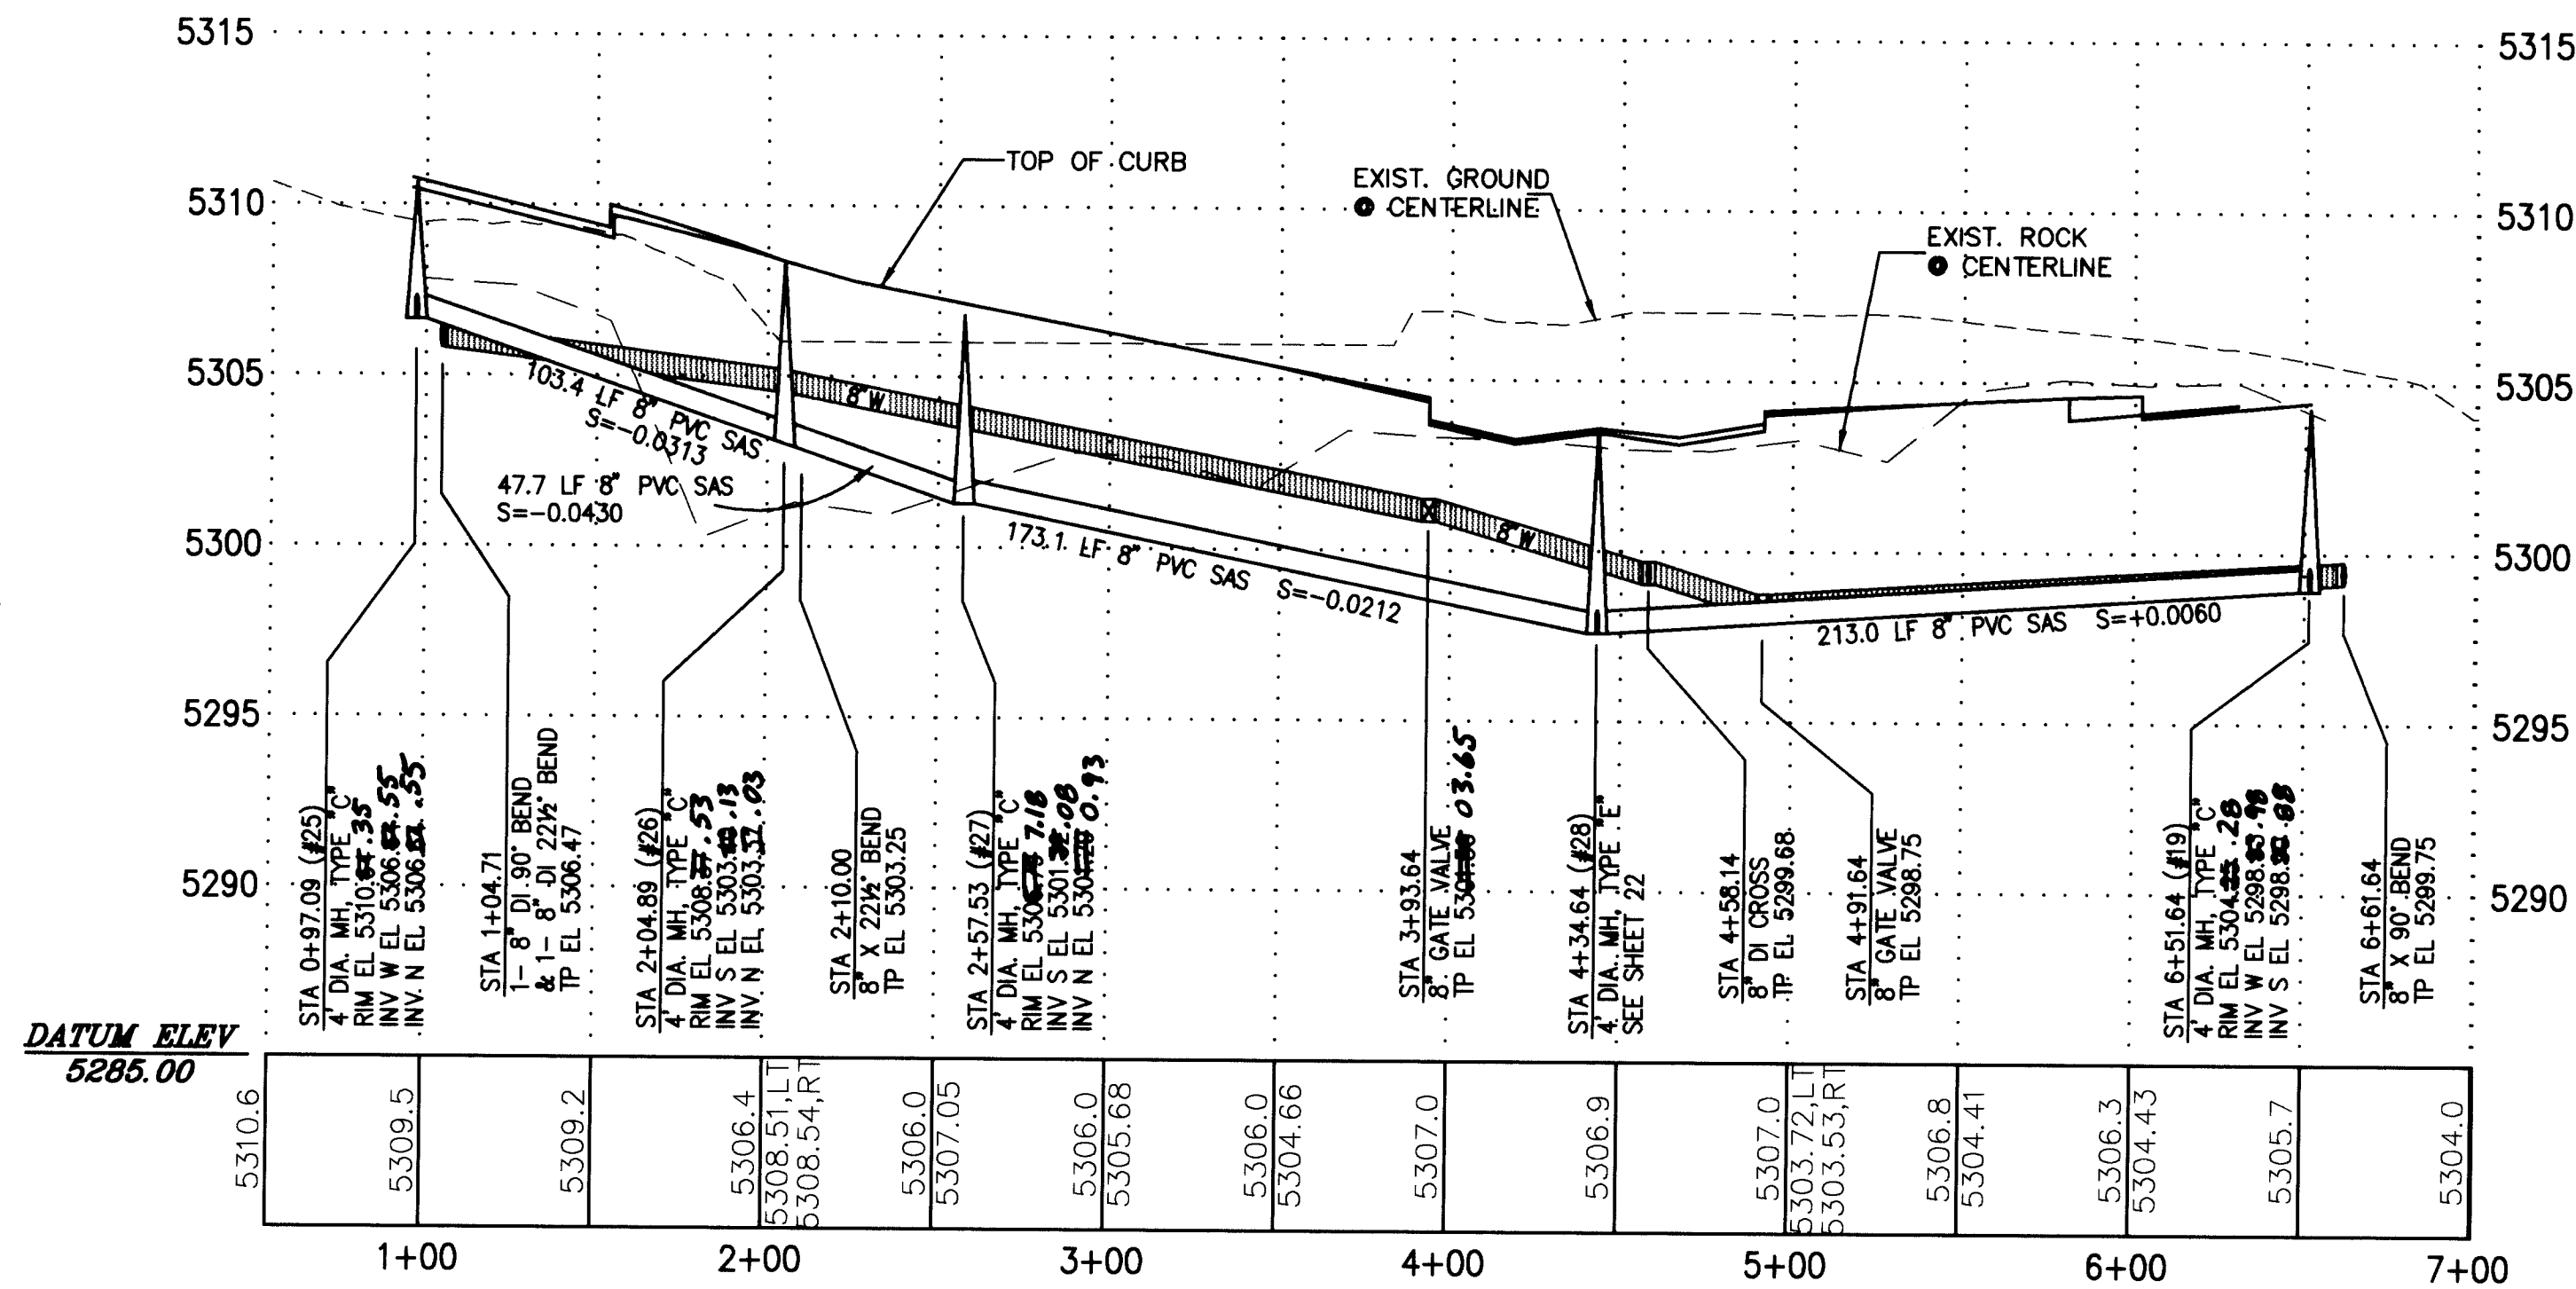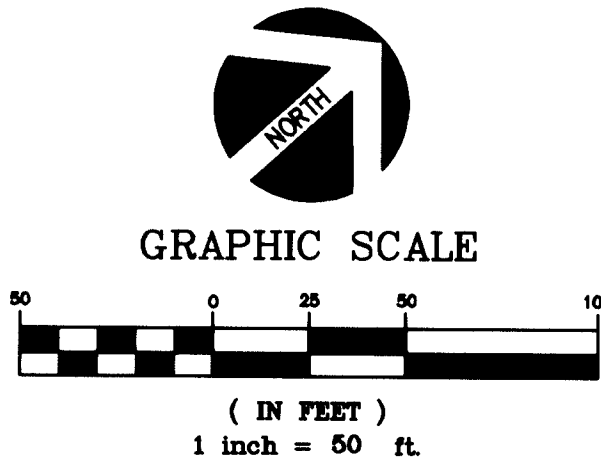


CASSIDY DRIVE - PROFILE

SANITARY SEWER SERVICE TABLE			
LOT	STATION	OFFSET	ELEVATION
A75	1+11.80	53.72 R	5306.26
A74	1+80.53	32.00 R	5305.03
A73	2+54.93	32.00 R	5302.91
A72	3+14.64	32.00 R	5301.35
A71	3+77.20	32.00 R	5300.26
A16	5+04.14	32.00 R	5299.65
A15	5+57.64	32.00 R	5299.92
A14	6+07.64	32.51 R	5300.17
A13	6+53.38	54.92 R	5300.40
B4	6+06.13	40.38 L	5300.16
B5	5+53.65	32.00 L	5299.90
B6	5+02.14	32.00 L	5299.64
C1	3+79.64	32.00 L	5300.22
C2	3+24.07	32.00 L	5301.15
C3	2+73.13	32.00 L	5302.39
C4	2+30.93	32.00 L	5301.91
C5	1+86.70	32.00 L	5304.87
C6	1+36.41	36.03 L	5305.92

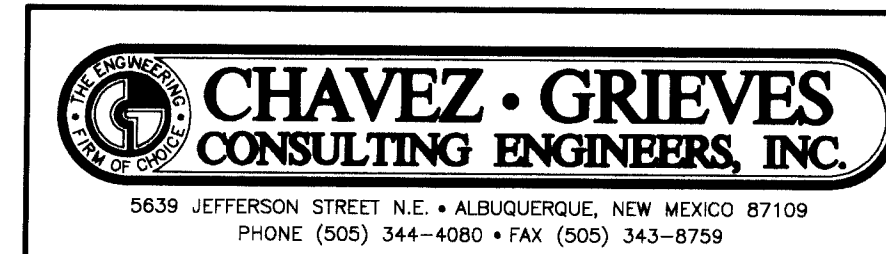


CITY OF ALBUQUERQUE PUBLIC WORKS DEPARTMENT ENGINEERING DEVELOPMENT GROUP	
TITLE: PARADISE BLUFF SUBDIVISION CASSIDY DRIVE WATER & SANITARY SEWER - PLAN & PROFILE	
DESIGNED BY: J. P. KELLEY DATE: 03-95	REMARKS REVISIONS DESIGN
DRAWN BY: W. M. TOWERS DATE: 03-95	NO. DATE
CHECKED BY: V.J. CHAVEZ DATE: 03-95	BY
City Project No. 542681	Zone Map No. B-11/12
Sheet 25	Of 32

SURVEY INFORMATION			BENCH MARKS		AS BUILT INFORMATION	
FIELD NOTES			ACS BRASS CAP STAMPED "ACS 6-B11, 1986"			
NO.	BY	DATE	LOCATED 475 FEET NORTHEAST OF THE INTERSECTION OF JUSTIN DRIVE AND BURGLO AVENUE. ELEV. = 5328.378			
SURVEY BY COMMUNITY					CONTRACTOR	
SCIENCES CORP.					WORK STAGED BY	
					INSPECTOR'S	
					FIELD OFFICE BY	
					FIELD VERIFICATION BY	
					DATE	
					DRAWINGS	
					BY	
					DATE	
					MICRO-FILM INFORMATION	
TOPOGRAPHIC MAPPING					RECORDED BY	
BY T. MANN & ASSOC.					DATE	
ABQ, NM.						
12-01-93						
					NO.	

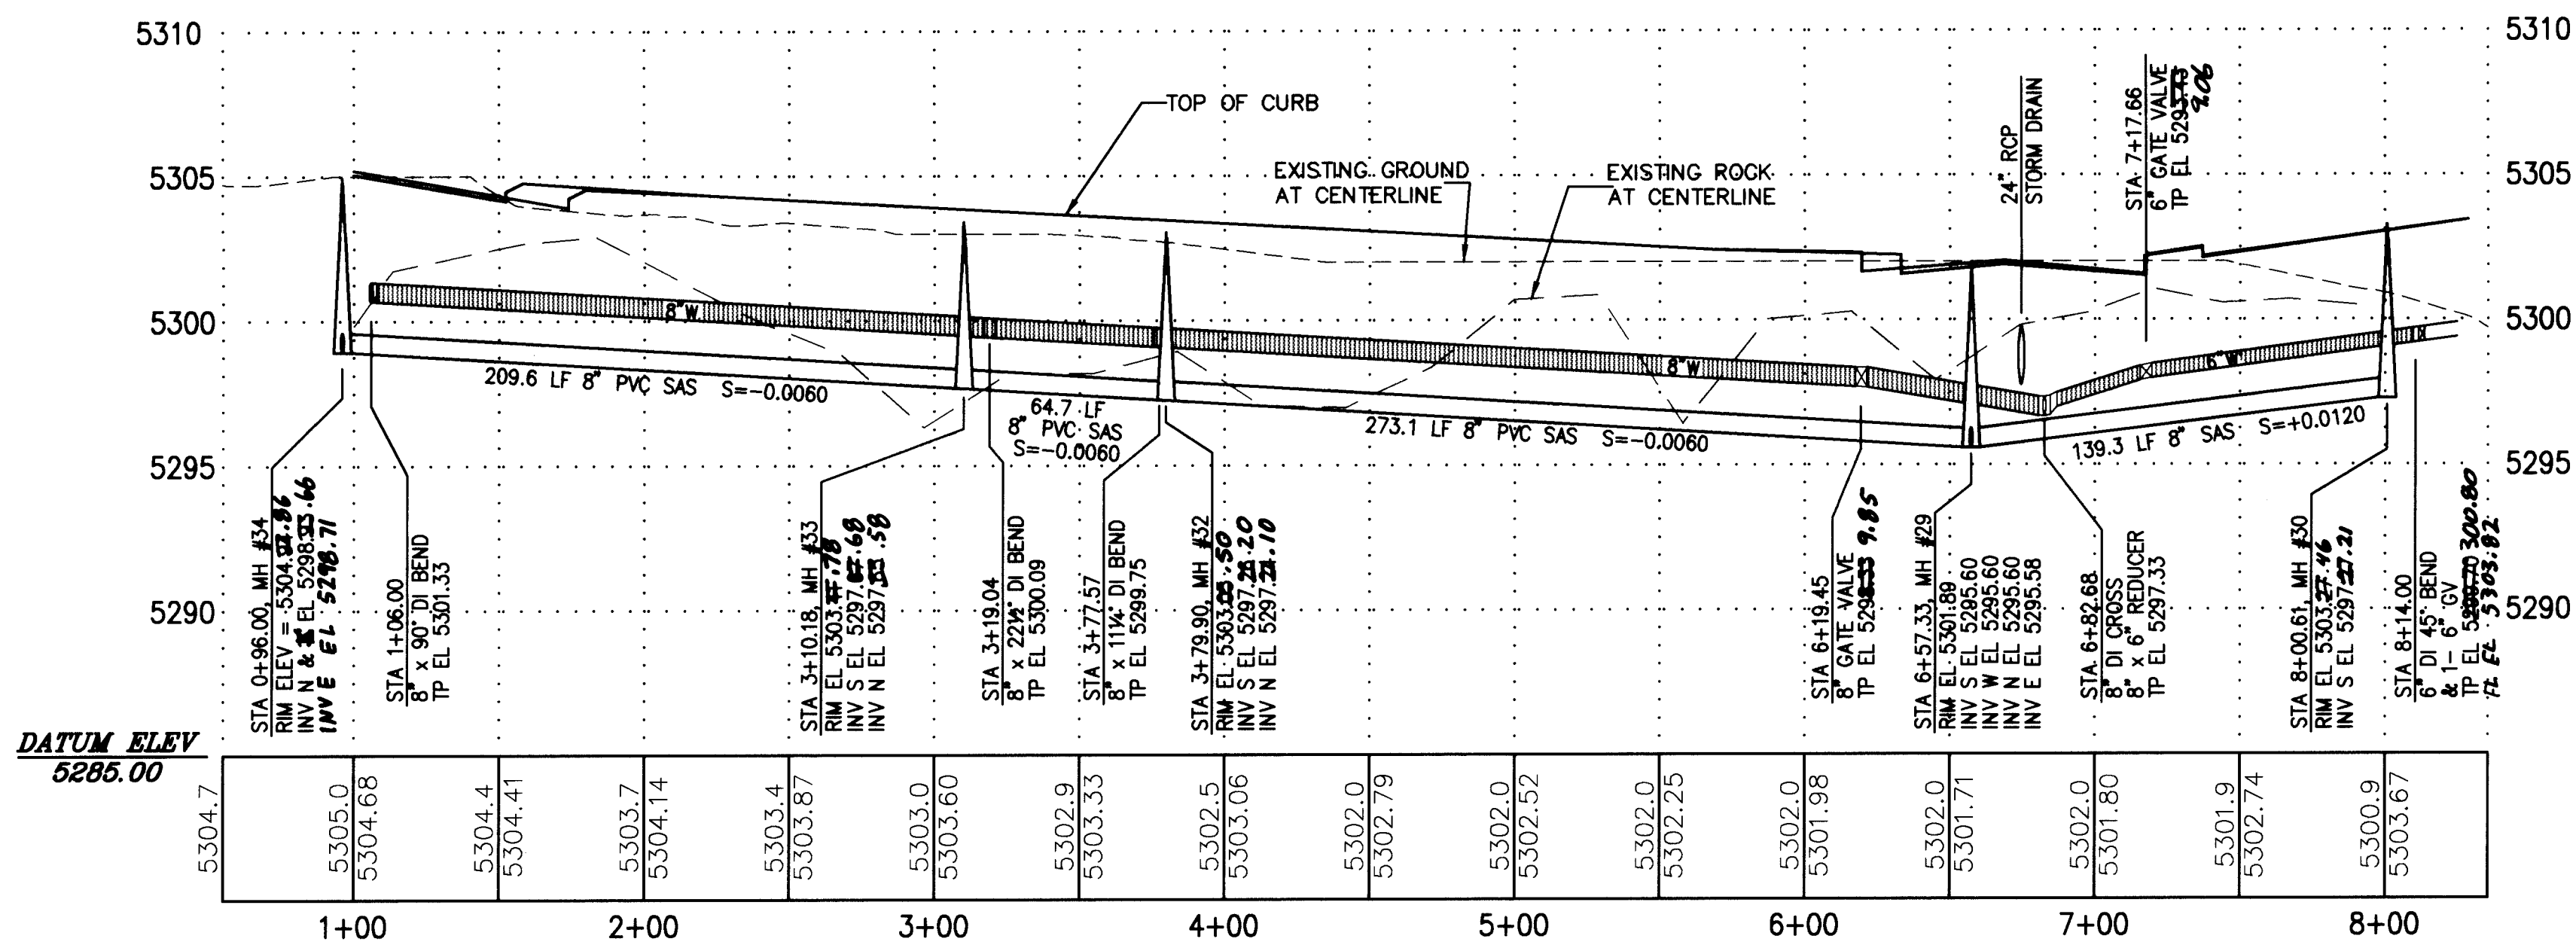

BAJADA DRIVE - PLAN


SCALE
HORIZ: 1"=50'
VERT: 1"=5'

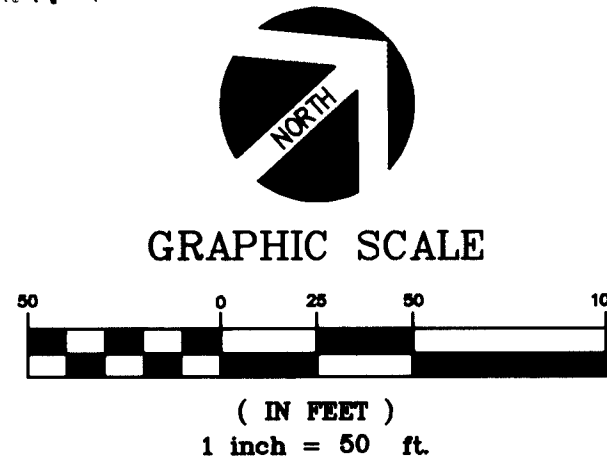


SANITARY SEWER SERVICE TABLE			
LOT	STATION	OFFSET	ELEVATION
A62	1+28.51	46.74 L	5300.83
A63	1+87.06	33.00 L	5300.22
A64	2+47.09	33.00 L	5299.89
A65	3+01.45	33.00 L	5300.14
A66	3+58.99	33.00 L	5299.29
A67	4+15.64	33.00 L	5298.99
A68	4+75.78	33.00 L	5298.66
A69	5+37.30	33.00 L	5298.33
A70	5+97.95	33.00 L	5298.00
D14	6+14.50	33.00 R	5297.91
D13	5+45.98	33.00 R	5298.28
D12	4+73.28	33.00 R	5298.67
D11	3+91.88	33.00 R	5299.11
D10	2+98.65	33.00 R	5299.52
A17	7+34.40	40.63 L	5298.29
A18	7+91.73	54.99 L	5299.12
A19	8+27.88	40.44 L	5299.67
A20	8+44.37	9.20 L	5299.88
A21	8+37.75	27.55 R	5299.66
A22	7+00.95	54.02 R	5299.27
A23	7+38.54	35.00 R	5298.35

ENGINEER'S SEAL		SURVEY INFORMATION		BENCH MARKS		AS BUILT INFORMATION	
		FIELD NOTES		ACCS BRASS CAP STAMPED "ACS 8-BIT, 1986" LOCATED 475 FEET NORTHEAST OF THE INTERSECTION OF JUSTIN DRIVE AND BUGLO AVENUE. ELEV. = 5328.378		CONTRACTOR	
		NO.		DATE		STAMPED BY	
		REMARKS		DATE		INSPECTOR'S	
		BY		DATE		FIELD	
NO.		DATE		CORRALES, NM.		VERIFICATION BY	
DESIGNED		DATE		7-22-94		CORRECTED BY	
DRAWN BY		DATE				MICRO-FILM INFORMATION	
CHECKED BY		DATE				RECORDED BY	
						NO.	


JOB NO.: N08-100-5193
FILE UPSTRONG (VIEW SHEET LAYOUT)
REV 03-15-96

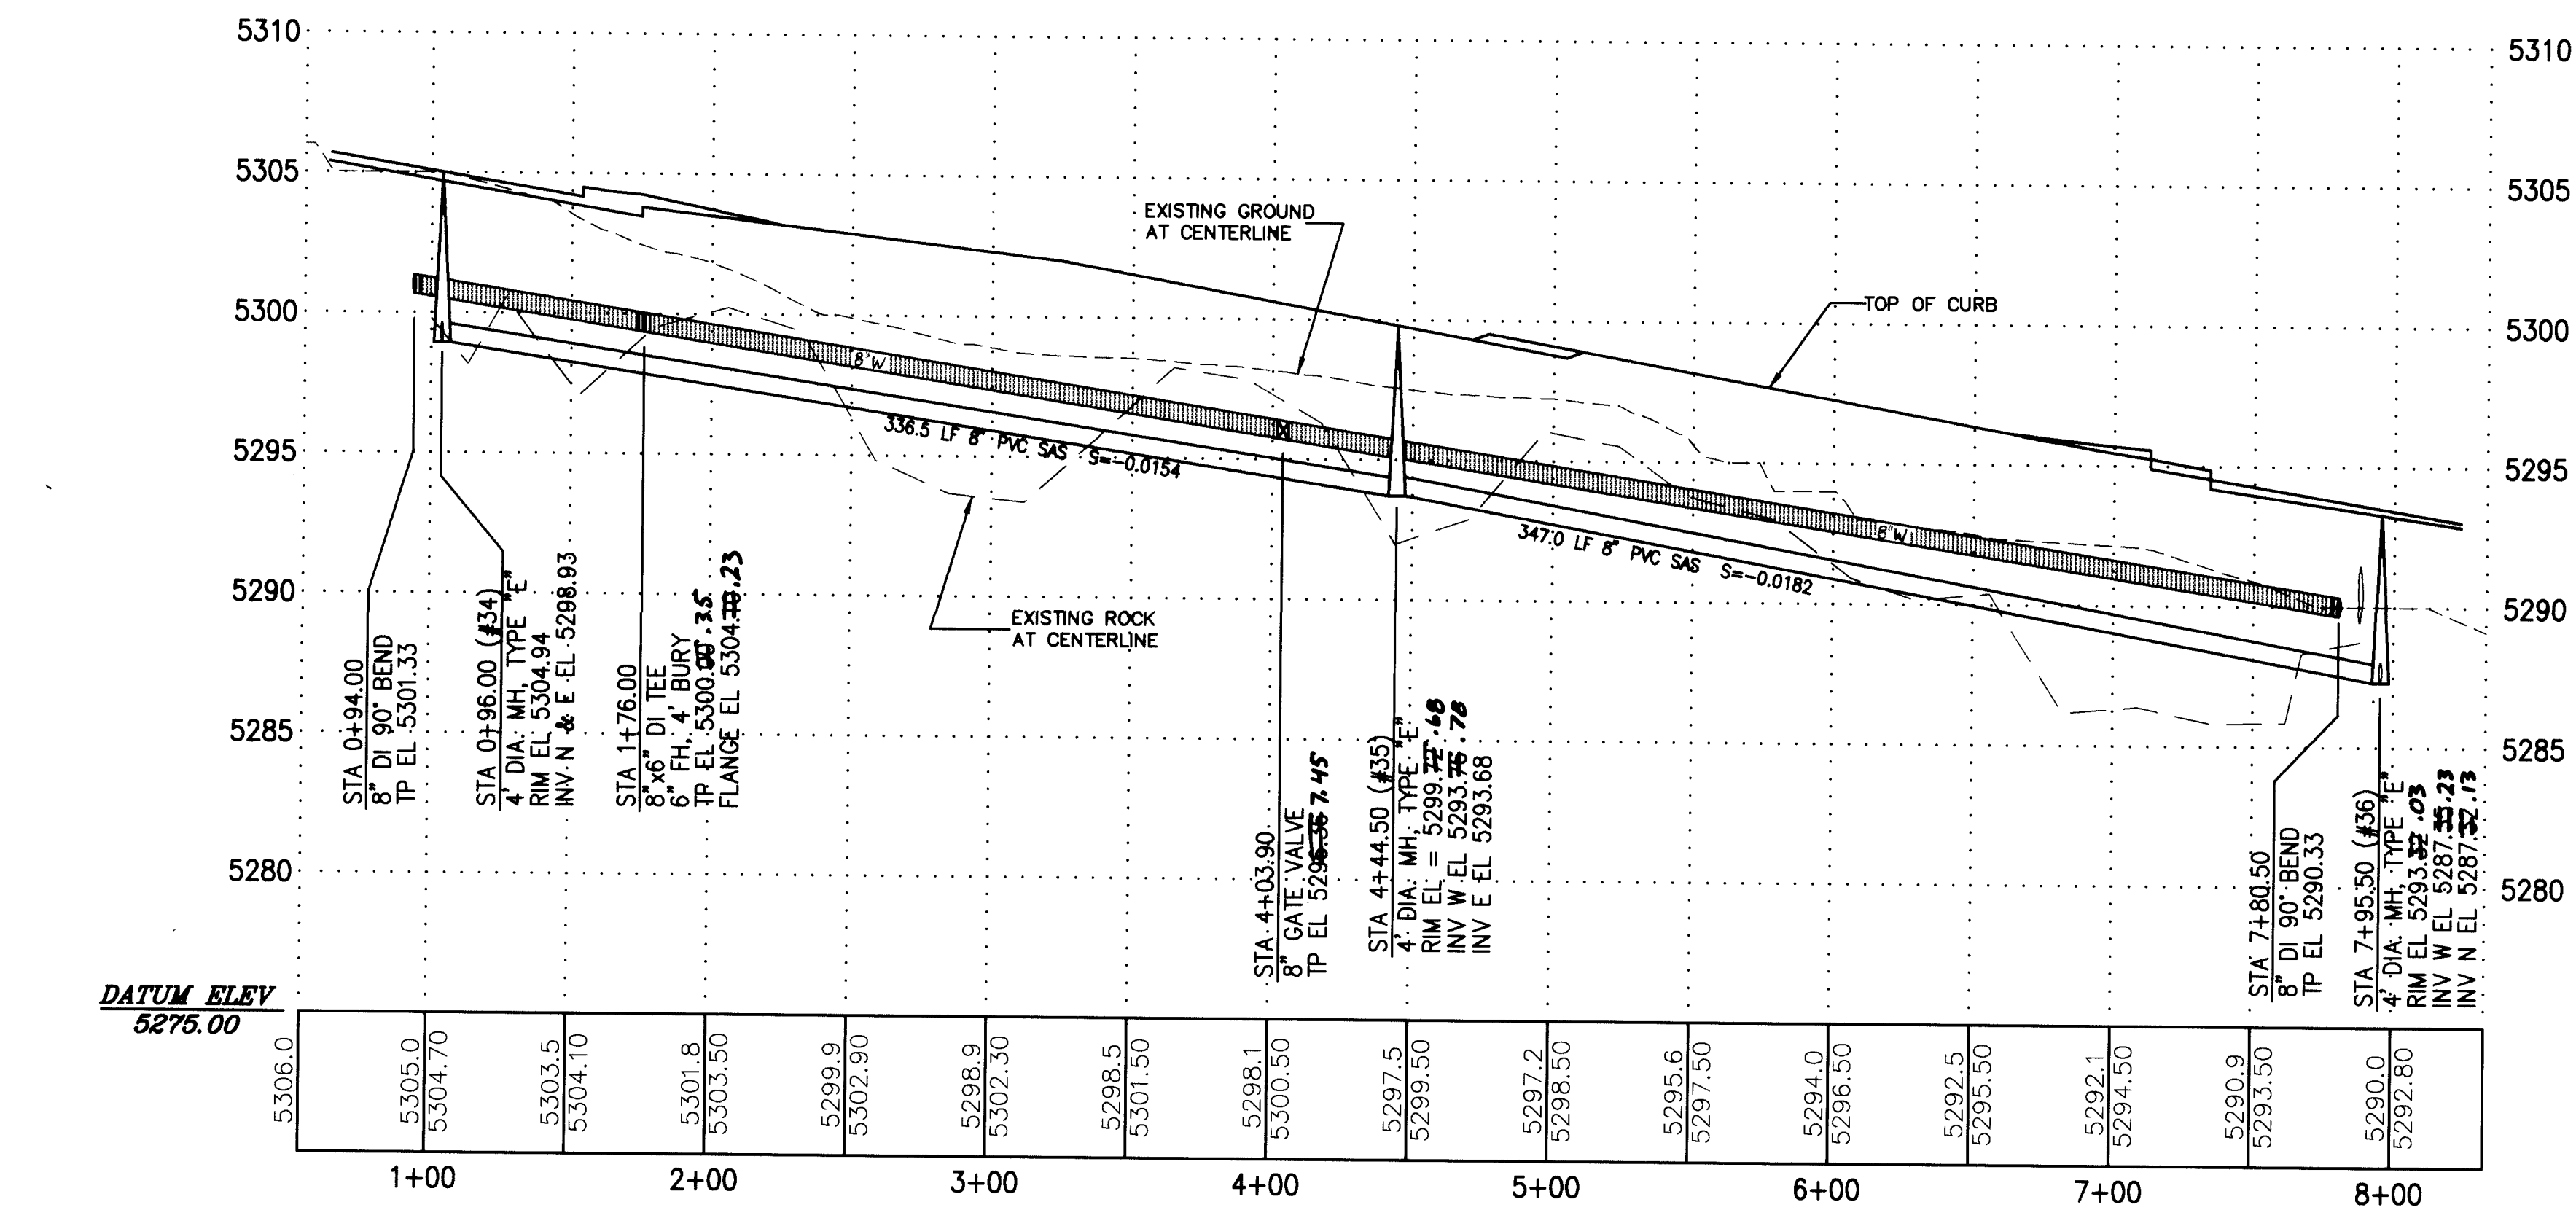

MARCADAS ROAD - PLAN

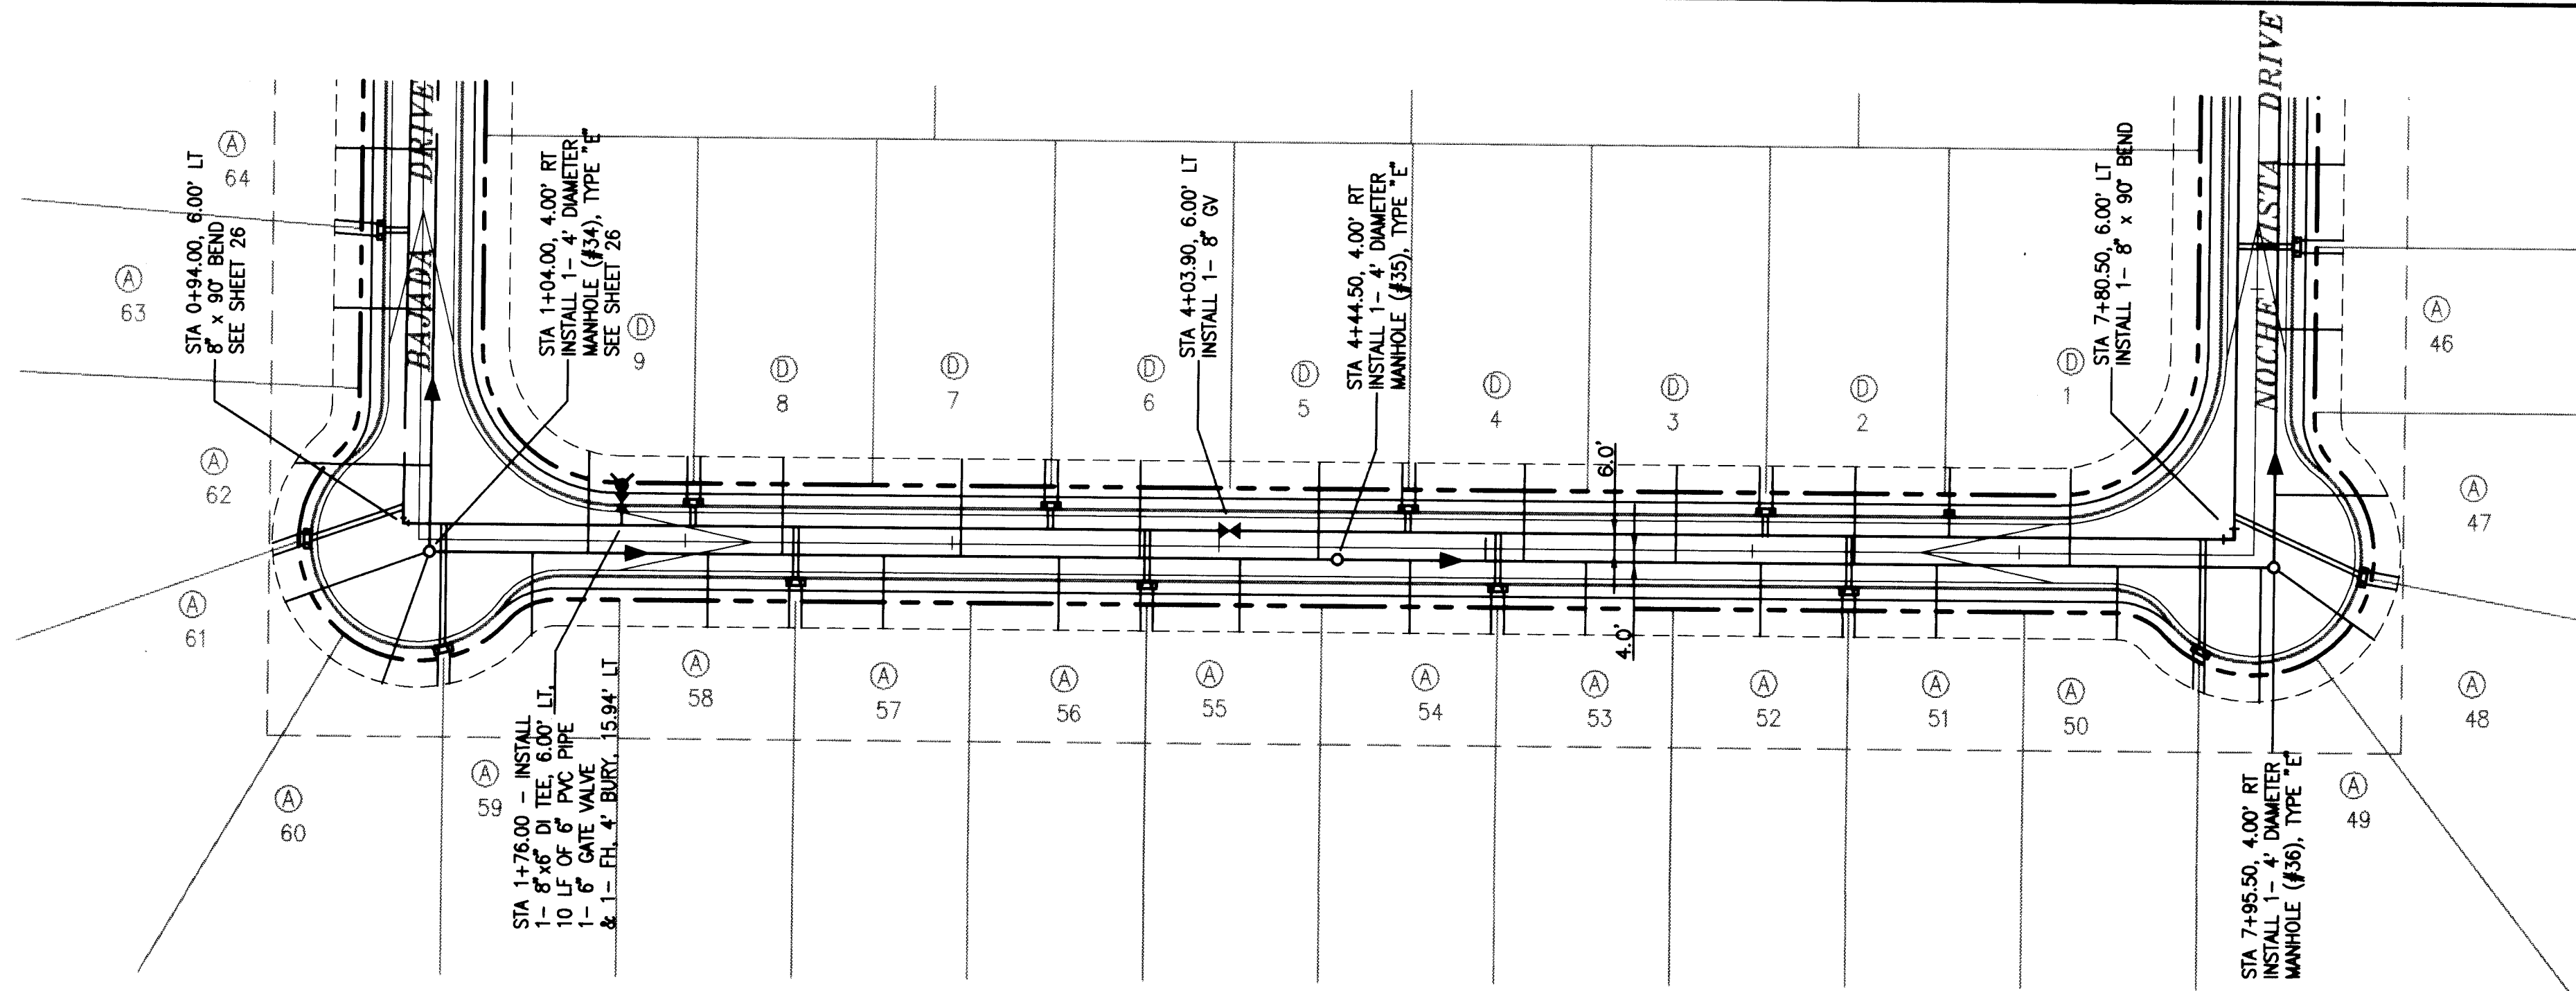


SCALE
HORIZ: 1"=50'
VERT: 1"=5'

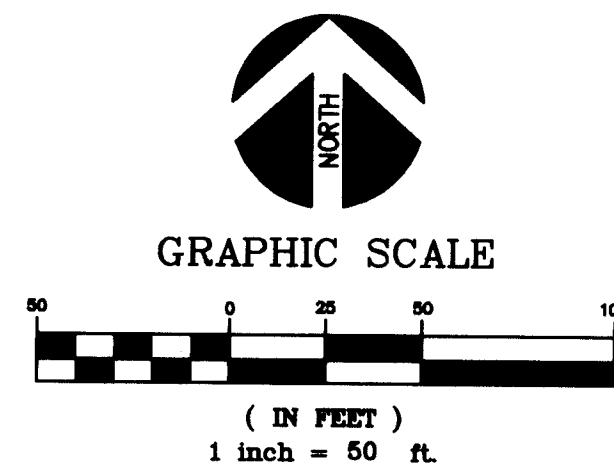

SANITARY SEWER SERVICE TABLE			
LOT	STATION	OFFSET	ELEVATION
A61	0+50.08	24.02 R	5301.00
A60	0+86.67	54.30 R	5300.76
A59	1+42.83	35.83 R	5299.96
A58	2+08.63	32.00 R	5298.84
A57	2+74.43	32.00 R	5297.73
A56	3+40.23	32.00 R	5296.64
A55	4+07.94	32.00 R	5295.46
A54	4+71.83	32.00 R	5294.37
A53	5+37.63	32.00 R	5293.25
A52	6+03.43	32.00 R	5292.14
A51	6+69.23	32.00 R	5291.02
A50	7+36.94	32.02 R	5289.87
A49	7+90.68	55.40 R	5289.00
D1	7+18.95	31.82 L	5290.17
D2	6+38.40	32.00 L	5291.54
D3	5+71.40	32.00 L	5292.68
D4	5+14.40	32.00 L	5293.65
D5	4+37.40	32.00 L	5294.96
D6	3+70.40	32.00 L	5296.10
D7	3+03.40	32.00 L	5297.23
D8	2+36.40	32.00 L	5298.37
D9	1+63.75	33.53 L	5299.61




CITY OF ALBUQUERQUE PUBLIC WORKS DEPARTMENT ENGINEERING DEVELOPMENT GROUP	
TITLE: PARADISE BLUFF SUBDIVISION MARCADAS ROAD WATER & SANITARY SEWER - PLAN & PROFILE	
APPROVED AUG 1996 DESIGN REVIEW COMMITTEE	City Engineer Approval Ms./Day/Yr. Ms./Day/Yr.
City Project No. 5426 81	Zone Map No. B-11/12
Sheet 27	Of 32

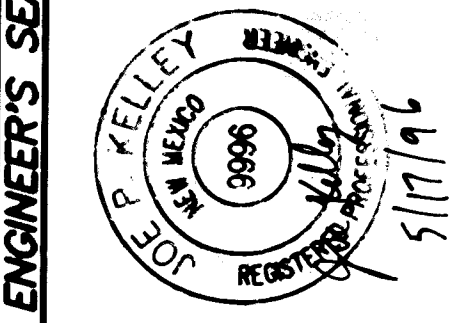

NO.	DATE	REMARKS	BY
REVISIONS			
DESIGN			
DESIGNED BY	J. P. KELLEY	DATE	03-95
DRAWN BY	W. M. TOWERS	DATE	03-95
CHECKED BY	V.J. CHAVEZ	DATE	03-95



SURVEY INFORMATION		FIELD NOTES		BENCH MARKS		AS BUILT INFORMATION	
NO.	DATE	NO.	DATE	NO.	DATE	NO.	DATE
SURVEY BY COMMUNITY SCIENCES CORP.		LOCATED 475 FEET NORTHEAST OF THE INTERSECTION OF JUSTIN DRIVE AND BUGLO AVENUE. ELEV. = 5328.378		CONTRACTOR		WORKMAN	
CORRALES, NM. 7-22-94		TOPOGRAPHIC MAPPING BY T. MANN & ASSOC.		NO.		NO.	
ABQ. NM. 12-01-93							

SCANNED BY
BY LASON

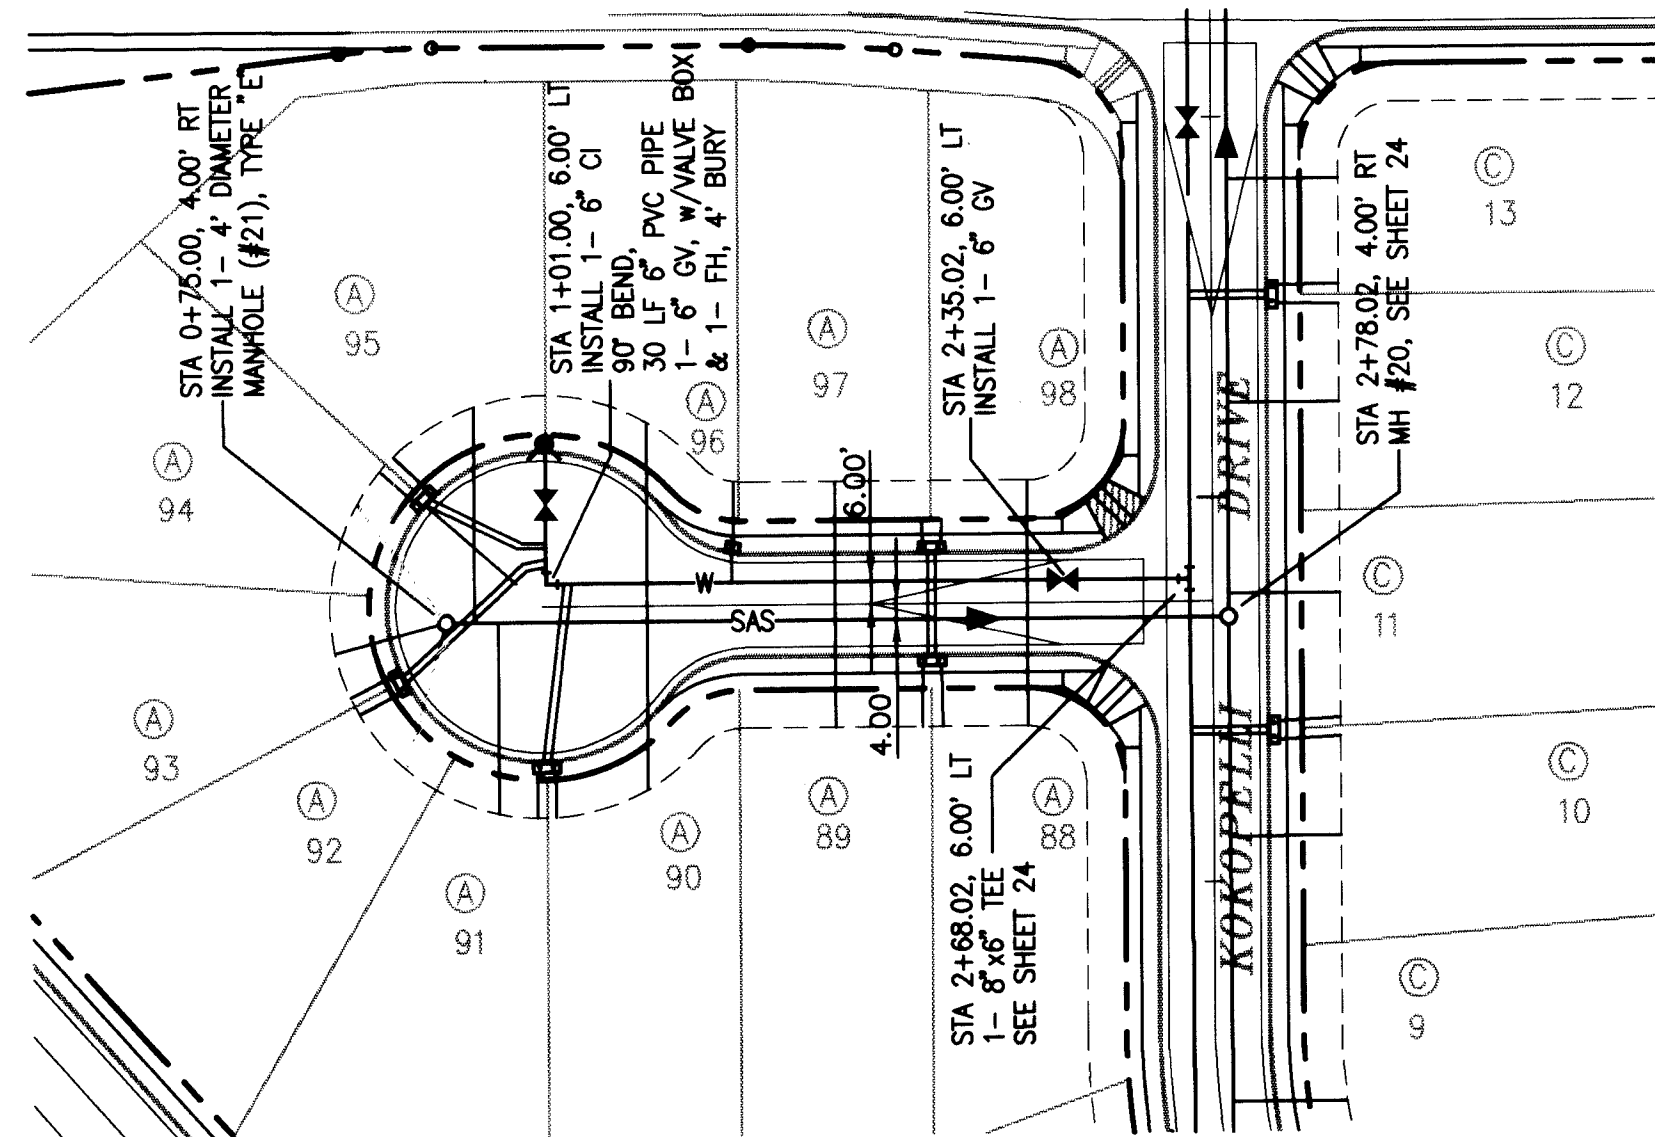


KOKOPELLI COURT - PLAN

SCALE
HORIZ: 1"=50'
VERT: 1"=5'

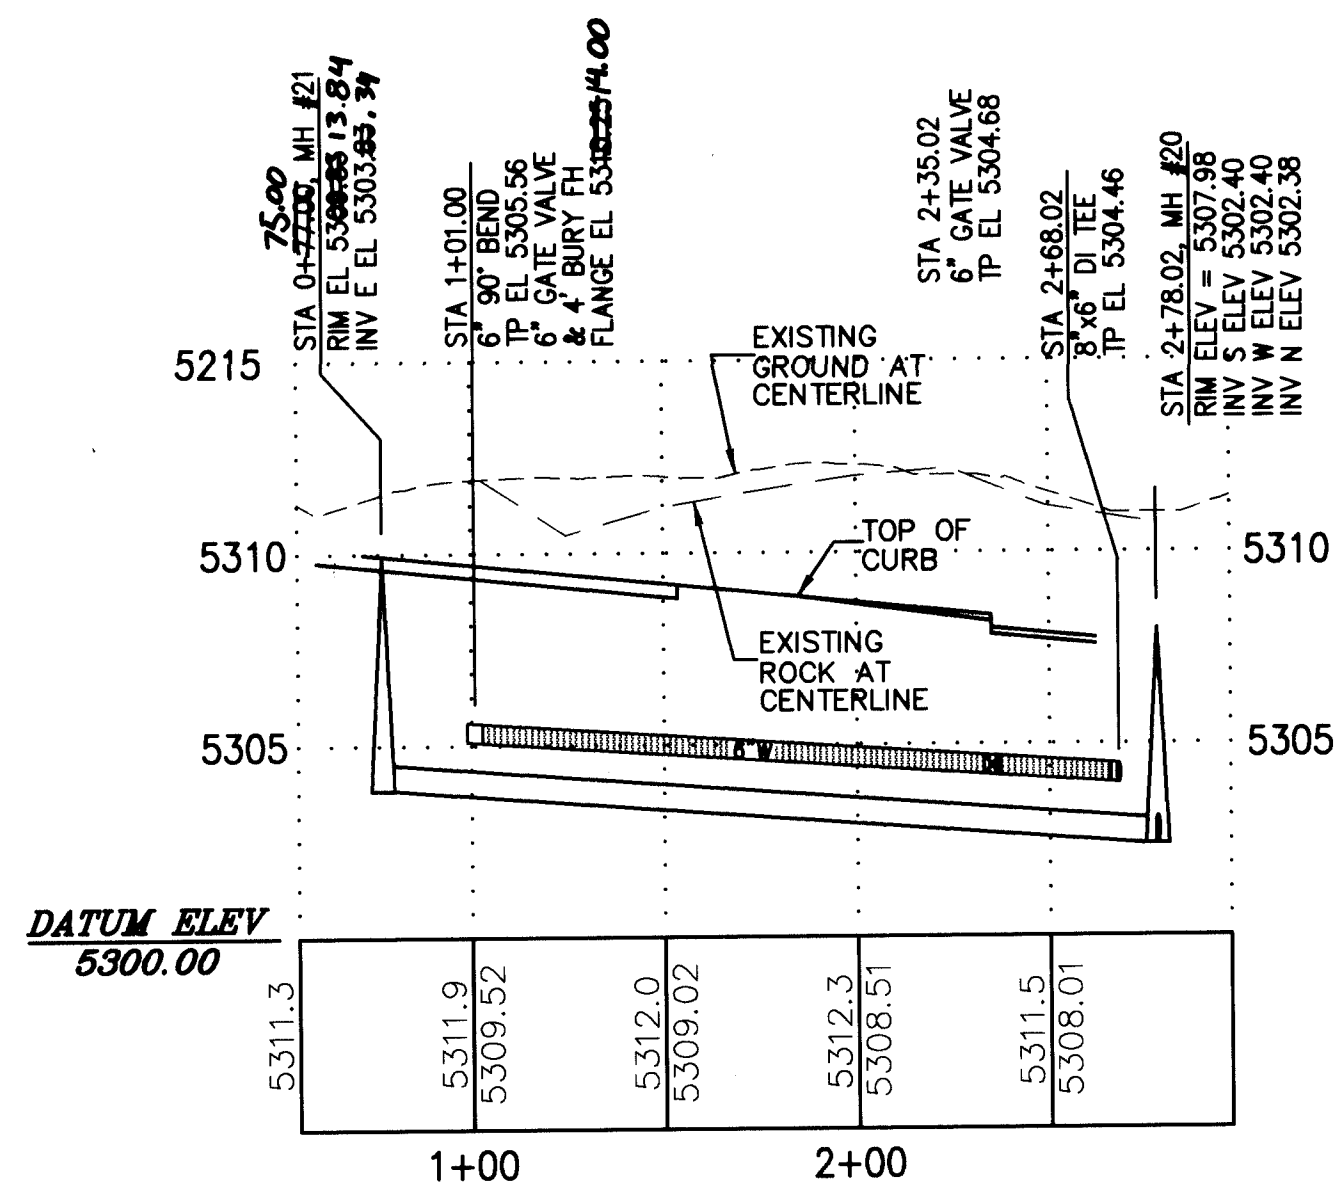
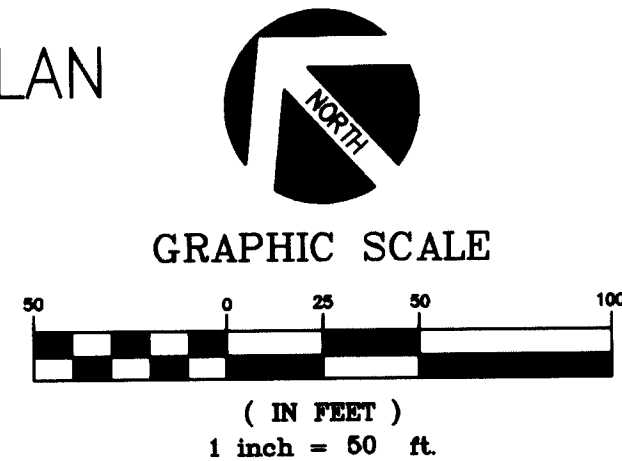


KOKOPELLI COURT - PROFILE

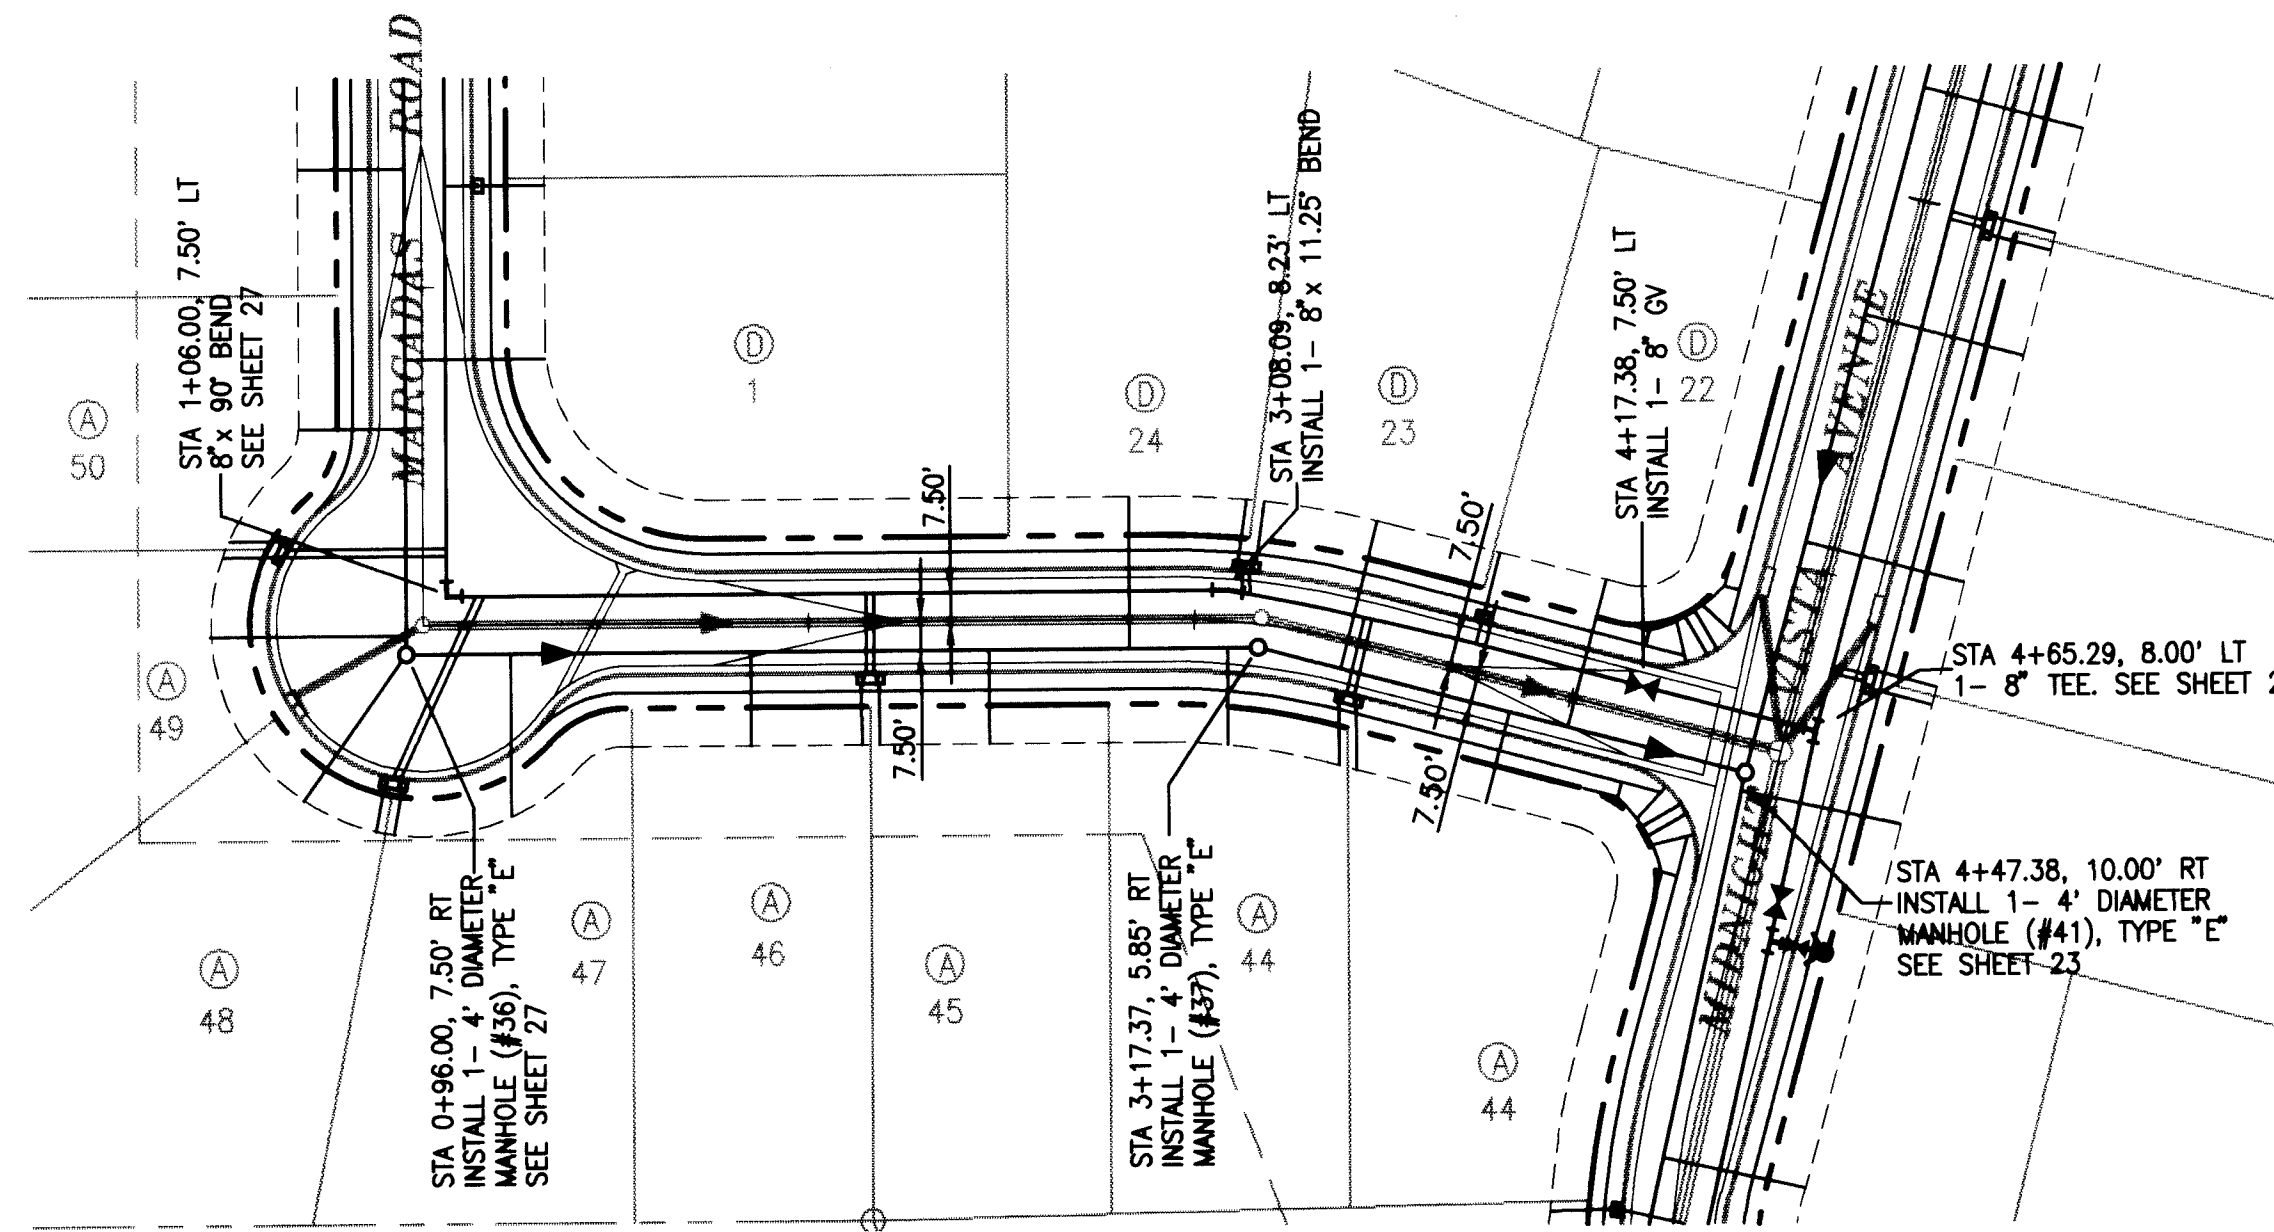

NOCHE VISTA DRIVE - PLAN

SCALE
HORIZ: 1"=50'
VERT: 1"=5'

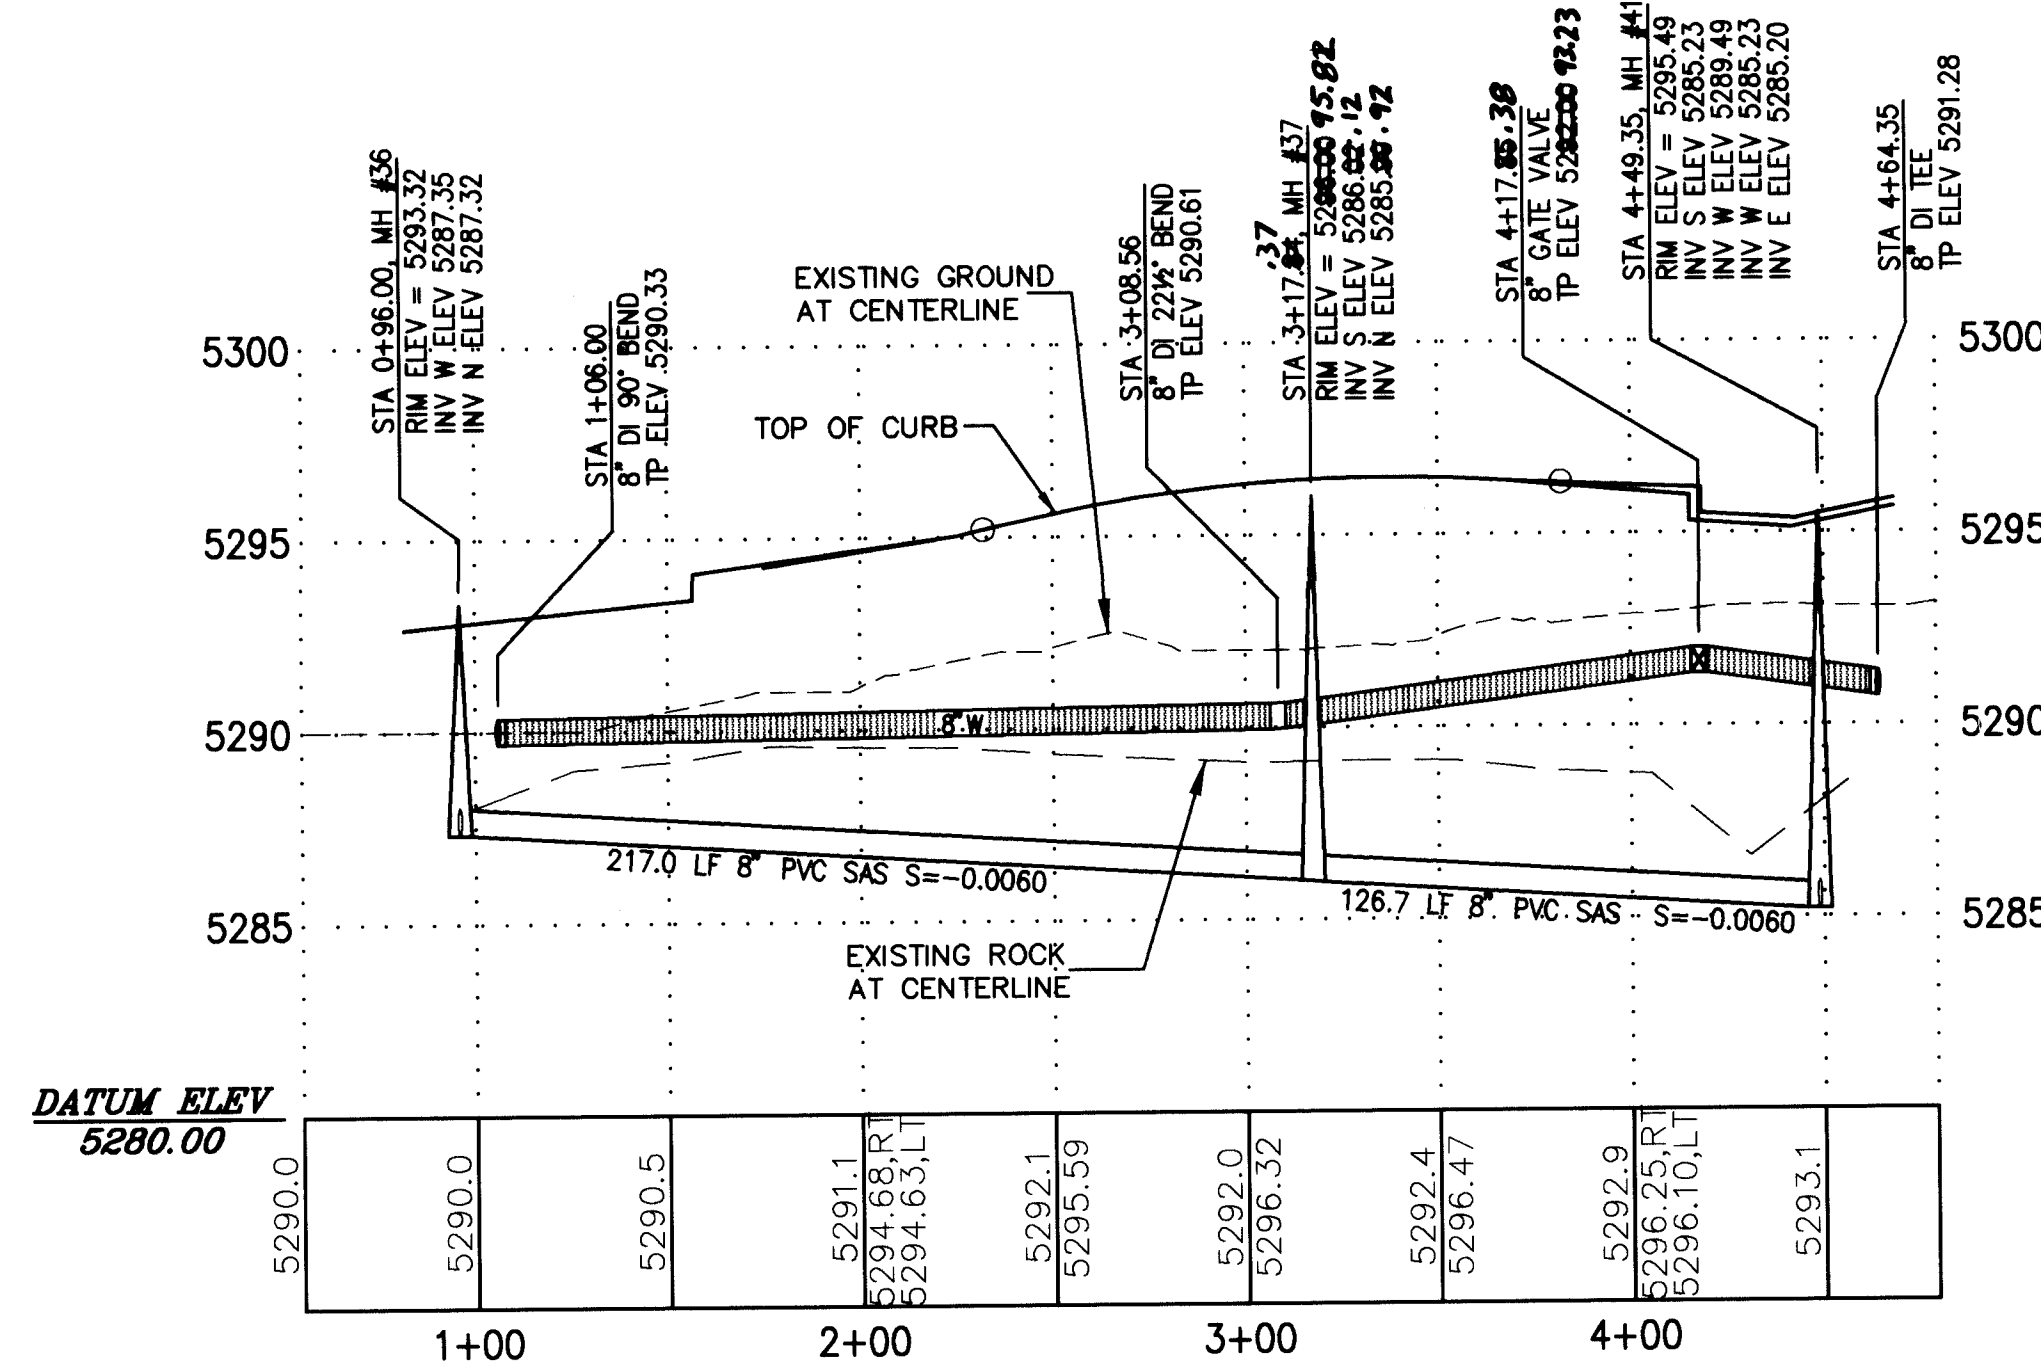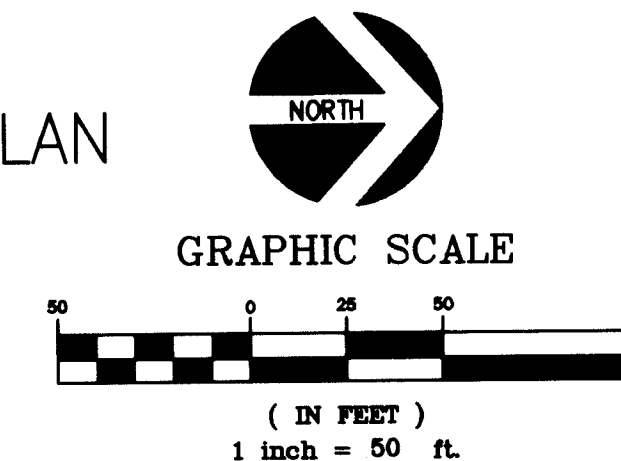

NOCHE VISTA DRIVE - PROFILE


SANITARY SEWER SERVICE TABLE			
LOT	STATION	OFFSET	ELEVATION
A98	2+26.02	32.00 L	5305.00
A97	1+76.02	32.00 L	5304.82
A96	1+27.77	47.76 L	5305.31
A95	0+73.81	52.13 L	5305.83
A94	0+52.07	26.97 L	5305.84
A93	0+46.27	11.75 R	5305.97
A92	0+64.33	41.33 R	5305.94
A91	0+88.64	58.82 R	5309.70
A90	1+27.27	47.76 R	5301.31
A89	1+76.02	32.00 R	5304.82
A88	2+26.02	32.00 R	5304.32





SANITARY SEWER SERVICE TABLE			
LOT	STATION	OFFSET	ELEVATION
A47	1+23.23	49.85 R	5289.50
A46	1+85.45	32.00 R	5291.85
A45	2+47.36	32.00 R	5291.88
D24	2+83.63	32.00 L	5292.00
A44	3+12.63	32.00 R	5291.86
D23	3+40.65	32.00 L	5291.58
A43	3+86.09	32.00 R	5291.40
D22	4+01.66	32.00 L	5291.30
A48	0+69.18	45.56 R	5288.34



CITY OF ALBUQUERQUE PUBLIC WORKS DEPARTMENT ENGINEERING DEVELOPMENT GROUP	
TITLE: PARADISE BLUFF SUBDIVISION KOKOPELLI COURT & NOCHE VISTA DRIVE WATER & SANITARY SEWER - PLAN & PROFILE	
DESIGNED BY J. P. KELLEY	DATE 03-95
DRAWN BY W. M. TOWERS	DATE 03-95
CHECKED BY V.J. CHAVEZ	DATE 03-95
NO. DATE	REMARKS
DESIGN REVIEW COMMITTEE	
City Engineer Approval	
Last Design Update	
Mo./Day/Yr.	
Mo./Day/Yr.	
City Project No. 542681	
Zone Map No. B-11/12	
Sheet 28 of 32	


SURVEY INFORMATION		BENCH MARKS		AS BUILT INFORMATION	
NO.	DATE	CONTRACTOR	DATE	CONTRACTOR	DATE
FIELD NOTES		ACROSS BRASS CAP STAMPED "ACS 6-B11, 1986"		CONTRACTOR	
SURVEY BY COMMUNITY SCIENCES CORP.		LOCATED 475 FEET NORTHEAST OF THE INTERSECTION OF JUSTIN DRIVE AND BUGLO AVENUE. ELEV. = 5328.378		CONTRACTOR	
CORRALES, NM. 7-22-94				CONTRACTOR	
TOPOGRAPHIC MAPPING BY T. MANN & ASSOC.				CONTRACTOR	
ABQ. NM.				CONTRACTOR	
12-01-93				CONTRACTOR	

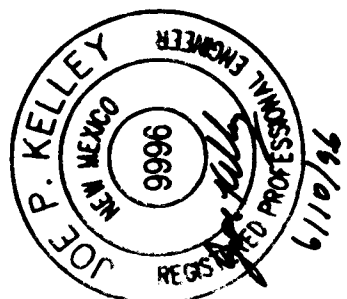

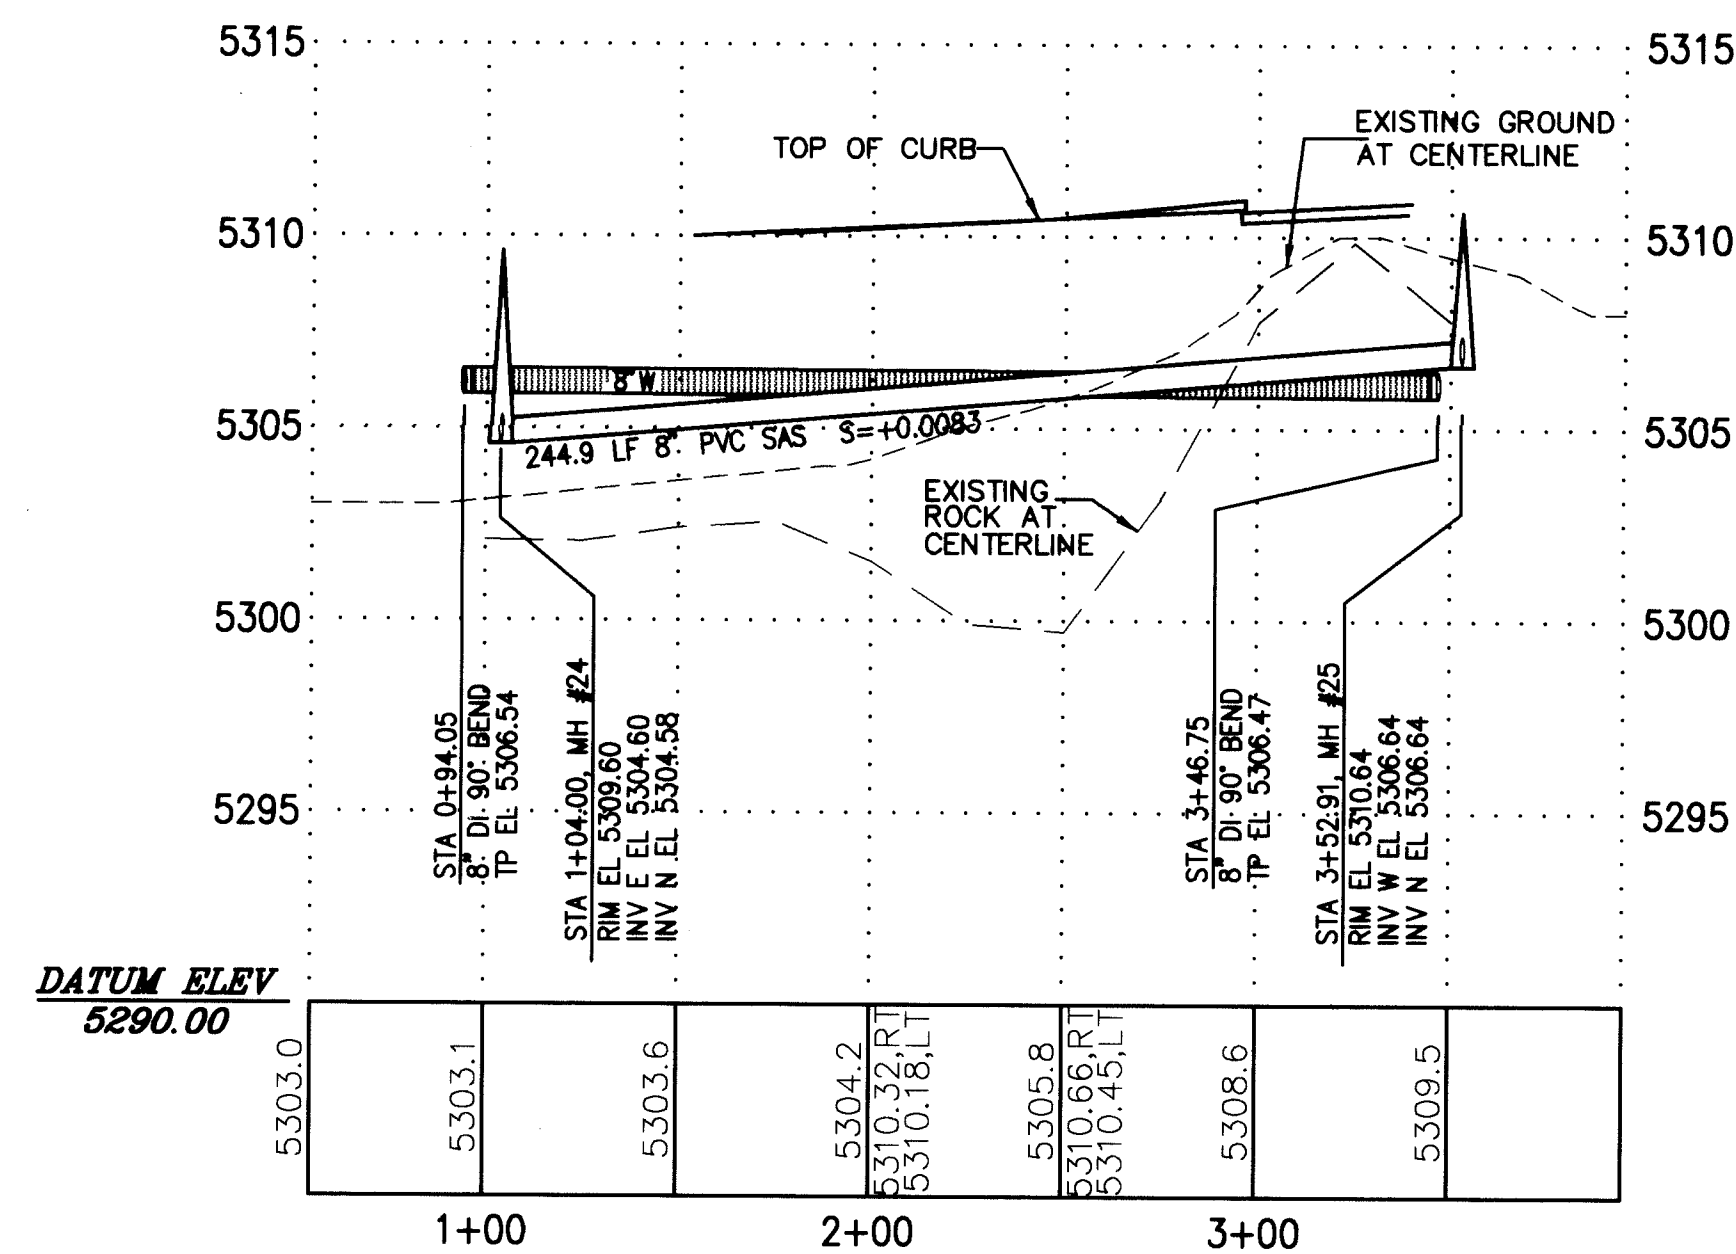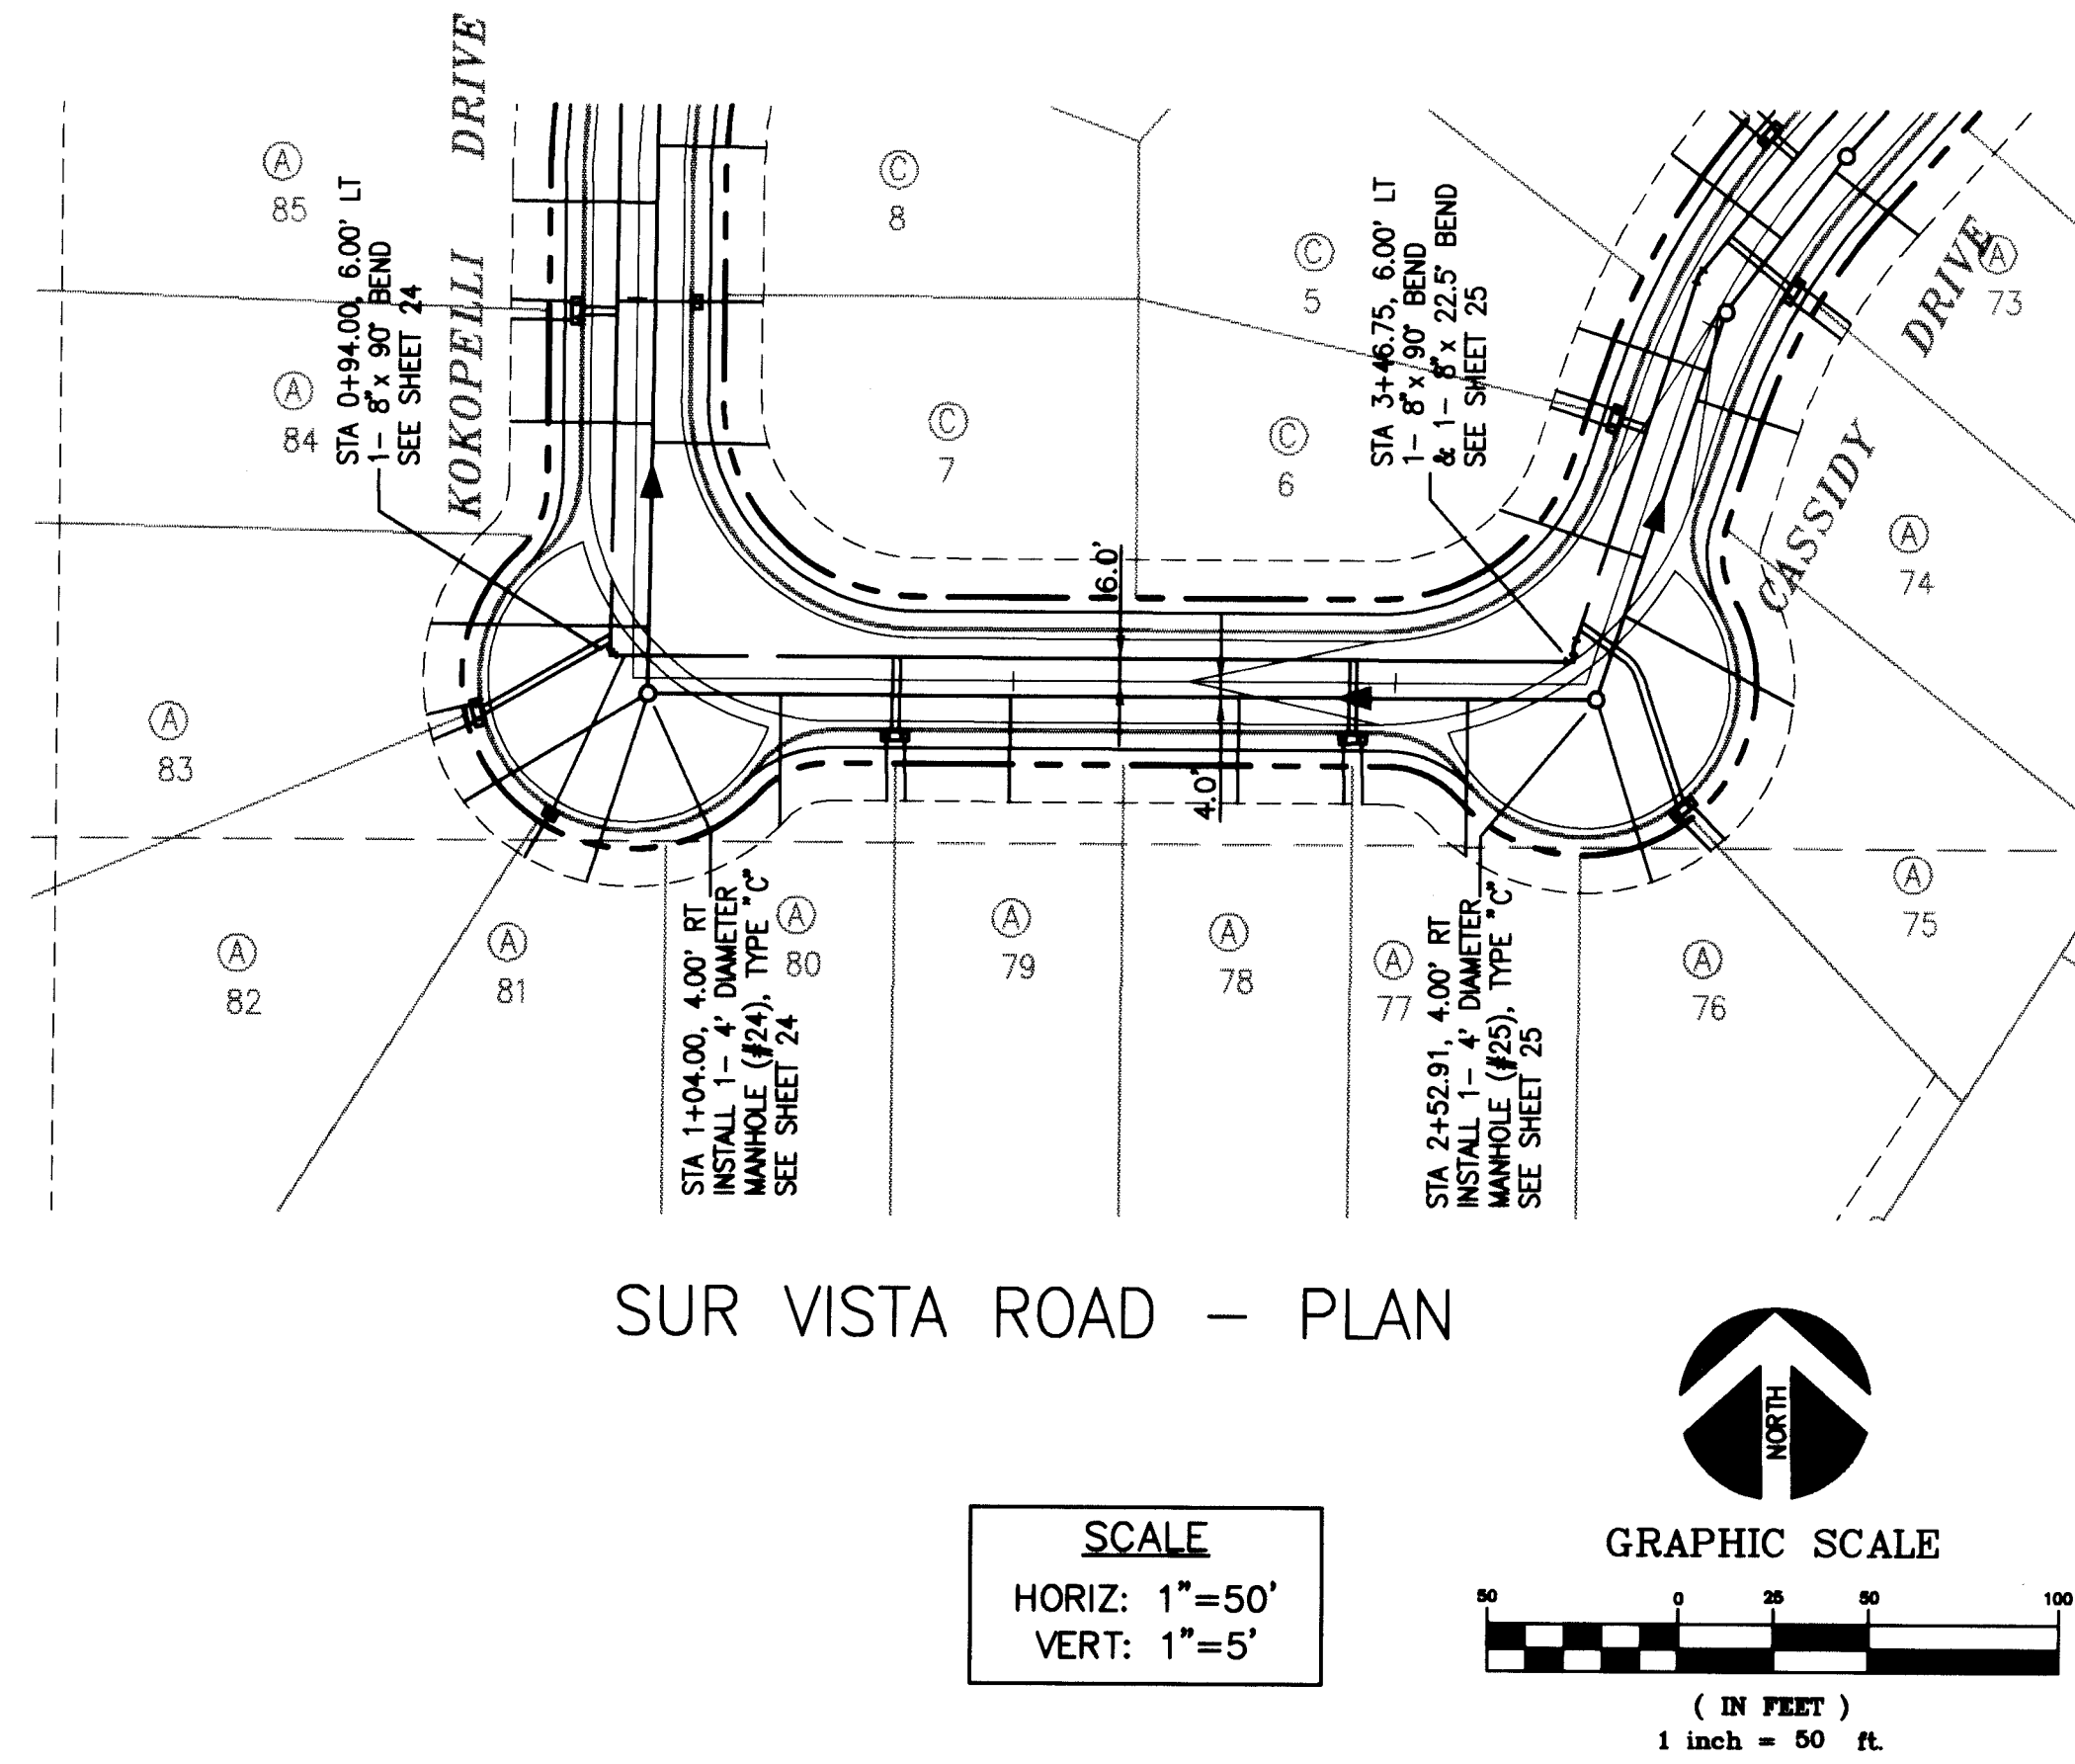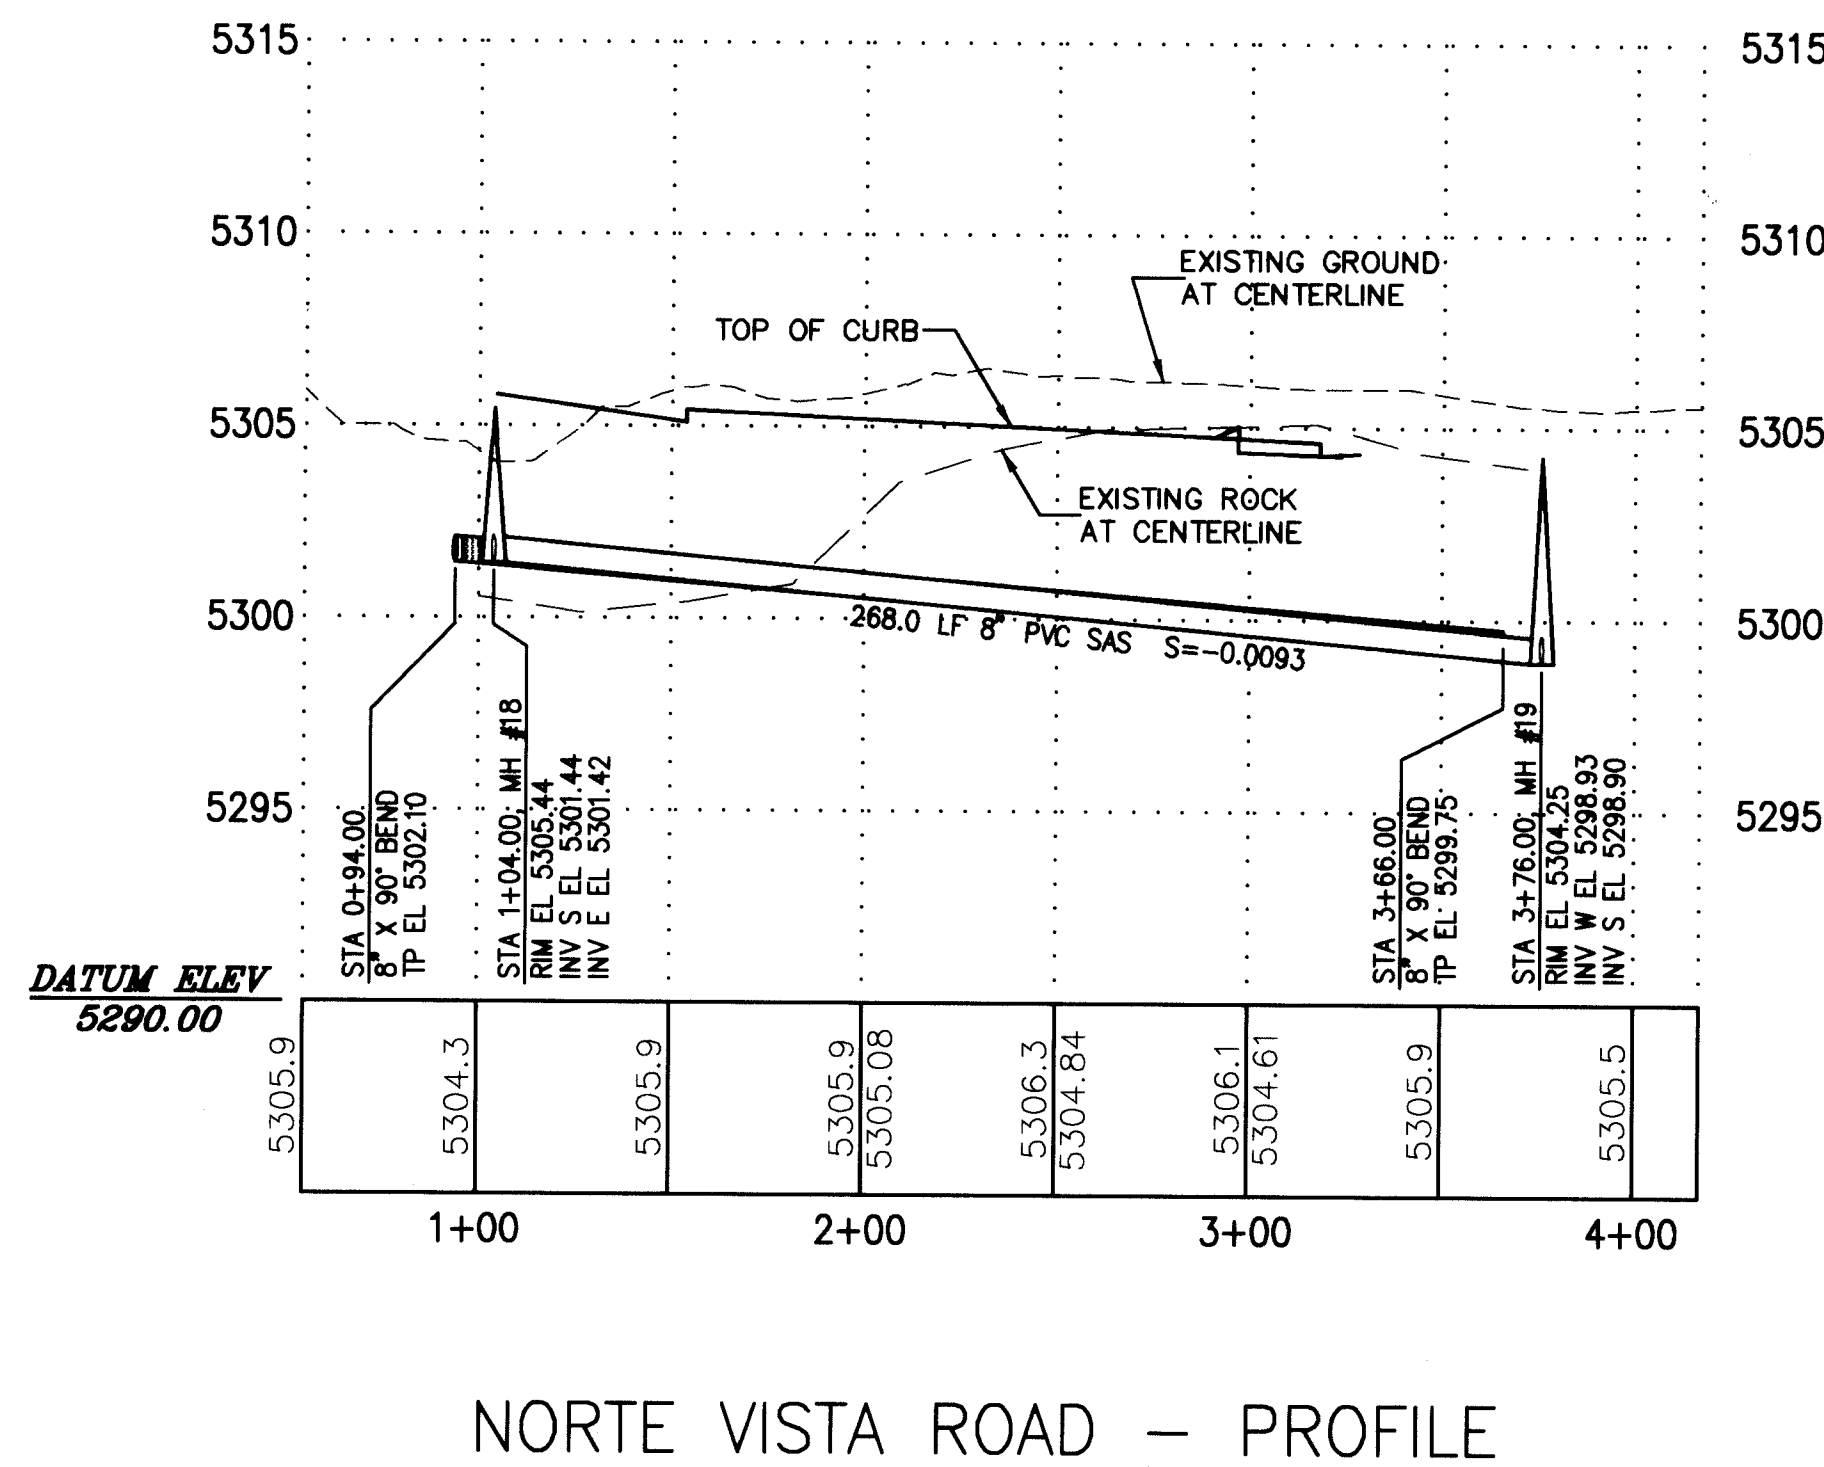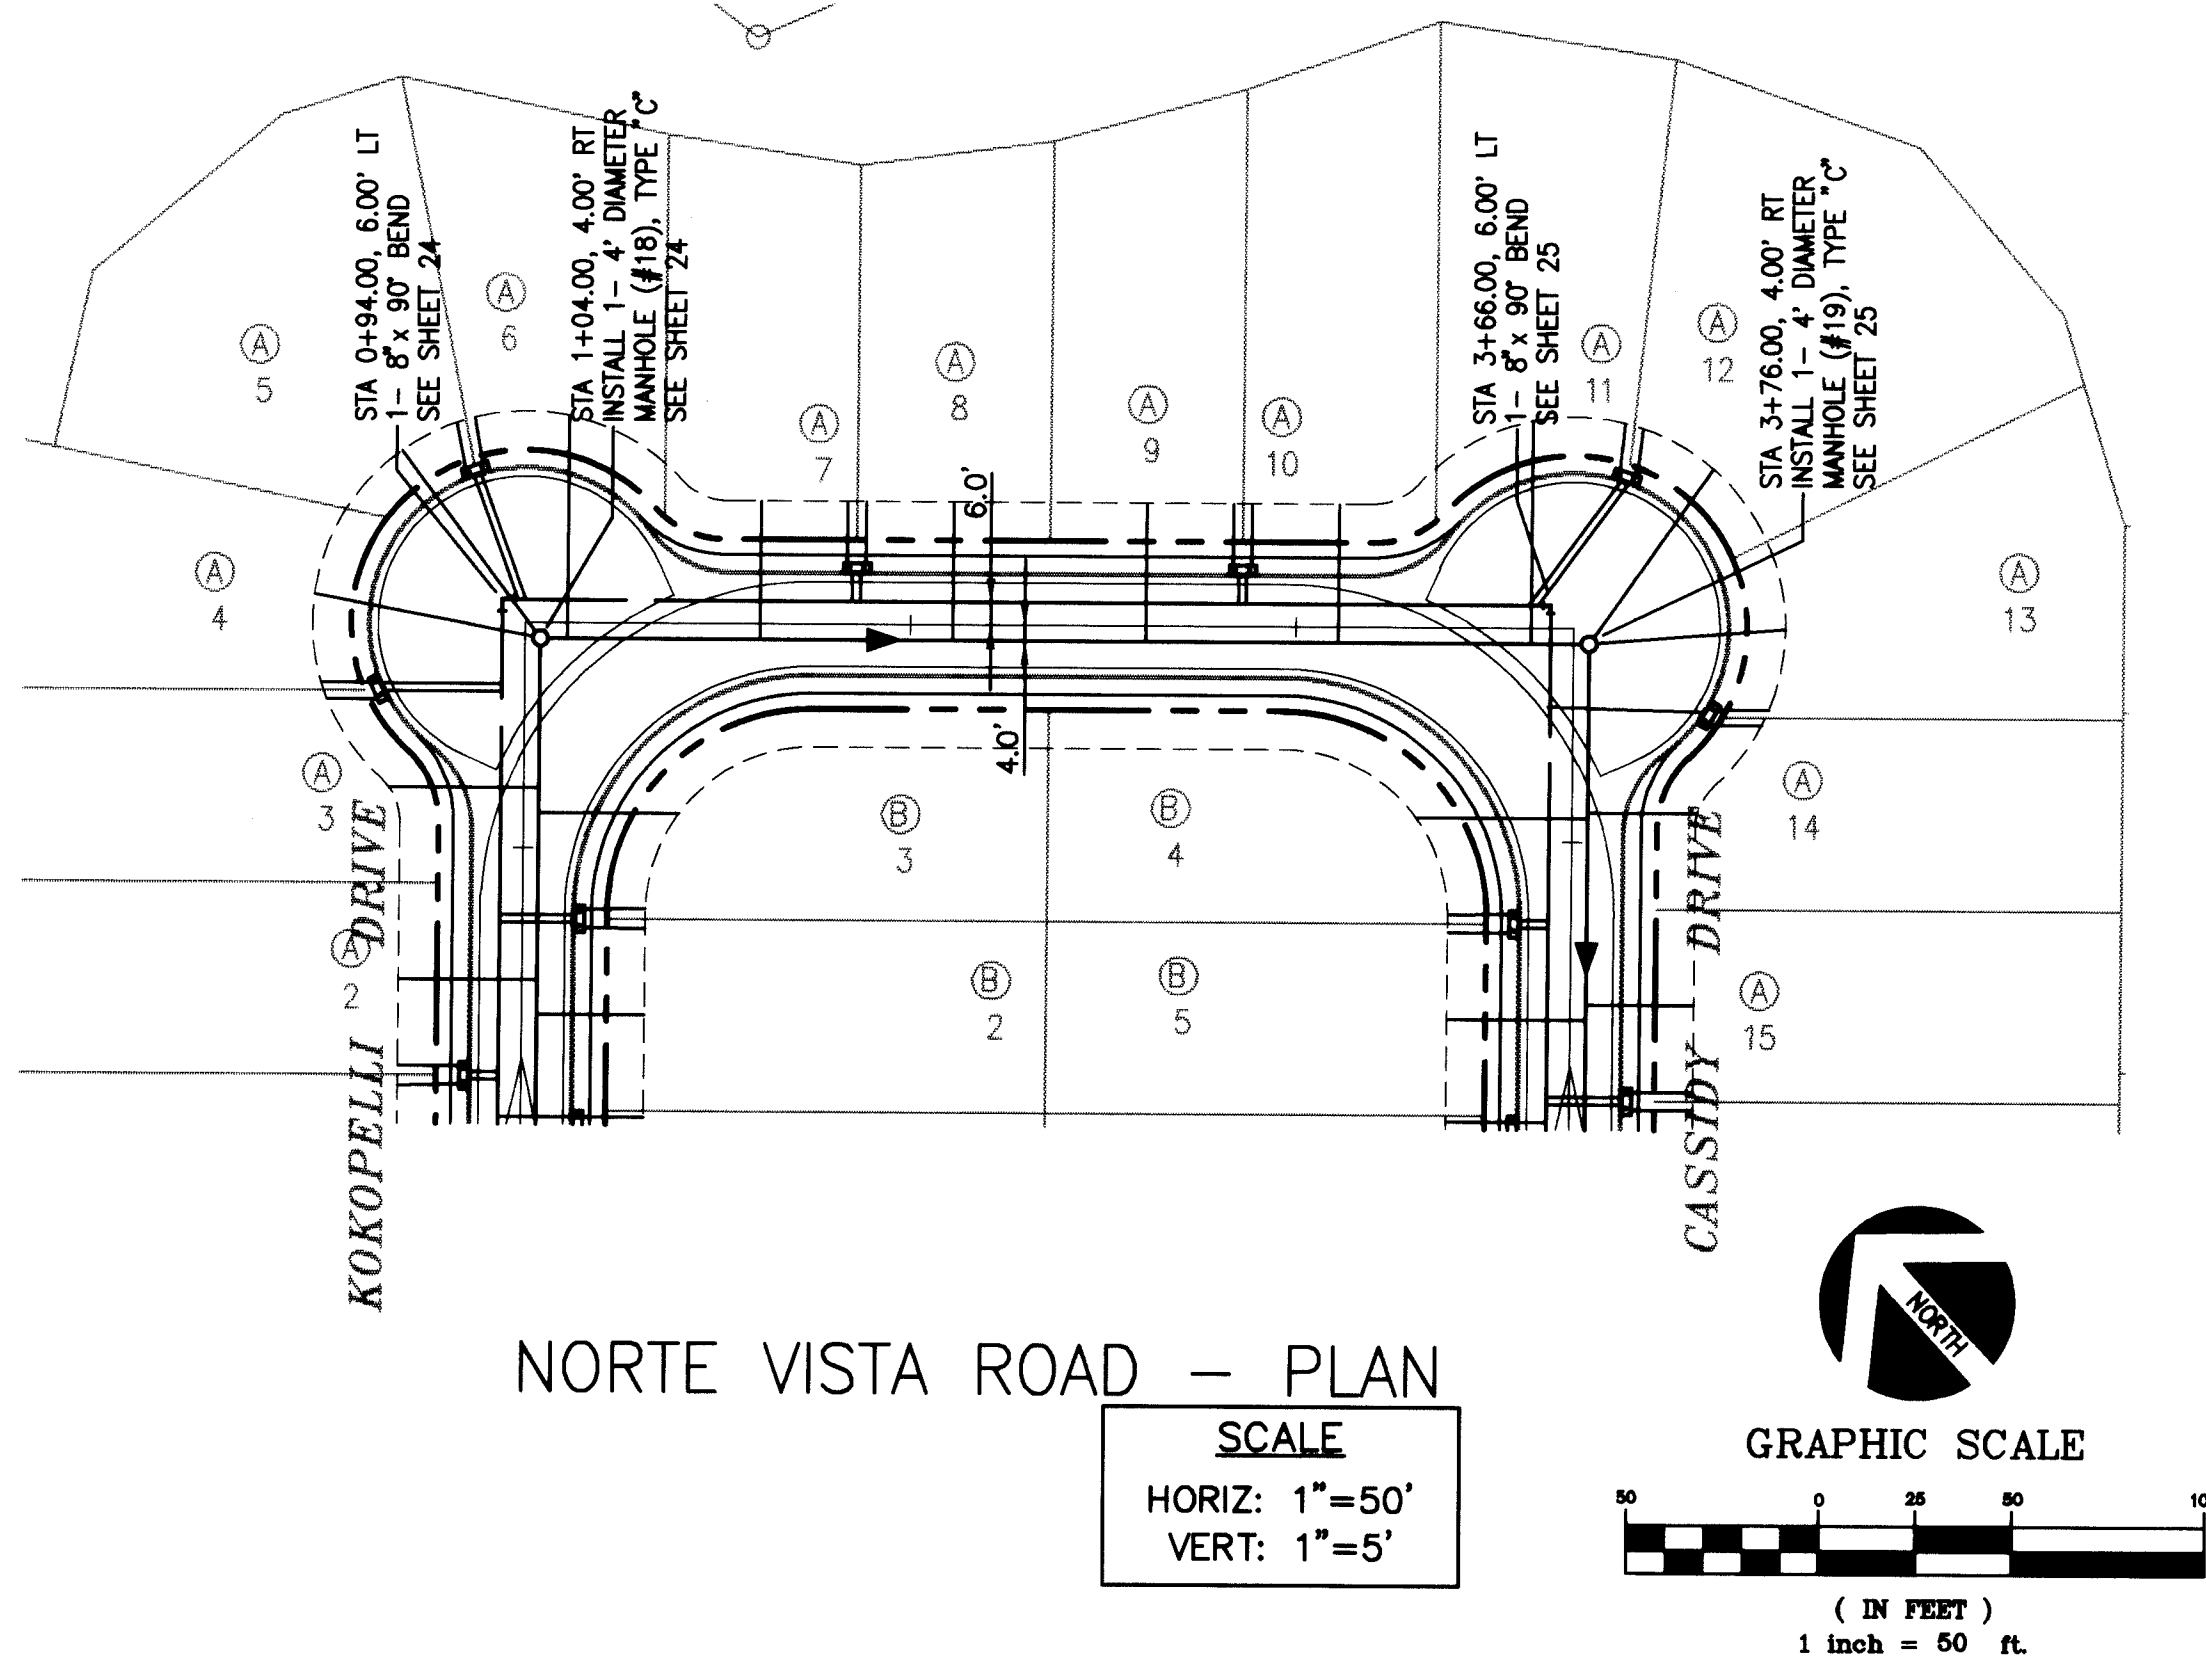


SANITARY SEWER SERVICE TABLE			
LOT	STATION	OFFSET	ELEVATION
A5	0+67.81	44.60 L	5302.16
A6	1+11.00	53.89 L	5301.85
A7	1+61.00	32.00 L	5301.60
A8	2+11.00	32.00 L	5301.35
A9	2+61.00	32.00 L	5301.32
A10	3+11.00	32.00 L	5300.85
A11	3+61.00	53.89 L	5300.76

SANITARY SEWER SERVICE TABLE			
LOT	STATION	OFFSET	ELEVATION
A82	0+55.88	32.85 R	5306.40
A81	0+88.36	53.76 R	5305.96
A80	1+39.00	38.78 R	5306.09
A79	1+99.00	32.00 R	5306.40
A78	2+50.99	32.00 R	5306.65
A77	3+19.00	55.00 R	5307.00
A76	3+67.95	51.97 R	5307.24

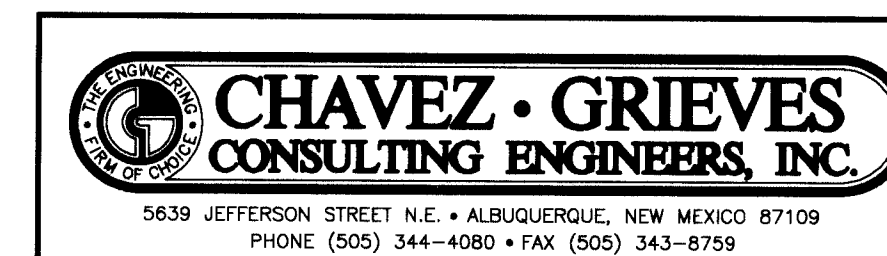


CITY OF ALBUQUERQUE PUBLIC WORKS DEPARTMENT ENGINEERING DEVELOPMENT GROUP	
TITLE: PARADISE BLUFF SUBDIVISION NORTE VISTA ROAD & SUR VISTA ROAD WATER & SANITARY SEWER - PLAN & PROFILE	
APPROVED AUG - 1996 DESIGN REVIEW COMMITTEE	City Engineer Approval Ms./Dsg/Tr. Ms./Dsg/Tr.
City Project No. 5426 81	Zone Map No. B-11/12
Sheet 29	of 32

ENGINEER'S SEAL		SURVEY INFORMATION		BENCH MARKS		AS BUILT INFORMATION	
		NO.	DATE	CONTRACTOR	DATE	CONTRACTOR	DATE
		BY	DATE	ACCS BRASS CAP STAMPED "ACS 6-811, 1986"	DATE	ACCS BRASS CAP STAMPED "ACS 6-811, 1986"	DATE
		REMARKS	DATE	LOCATED 475 FEET NORTHEAST OF THE INTERSECTION	DATE	LOCATED 475 FEET NORTHEAST OF THE INTERSECTION	DATE
		DESIGN	DATE	OF JUSTIN DRIVE AND BUGLO AVENUE. ELEV. = 5328.378	DATE	OF JUSTIN DRIVE AND BUGLO AVENUE. ELEV. = 5328.378	DATE
MICRO-FILM INFORMATION		NO.	DATE	NO.	DATE	NO.	DATE
		BY	DATE	NO.	DATE	NO.	DATE
		REMARKS	DATE	NO.	DATE	NO.	DATE
		DESIGN	DATE	NO.	DATE	NO.	DATE
MICRO-FILM INFORMATION		NO.	DATE	NO.	DATE	NO.	DATE
		BY	DATE	NO.	DATE	NO.	DATE
		REMARKS	DATE	NO.	DATE	NO.	DATE
		DESIGN	DATE	NO.	DATE	NO.	DATE
MICRO-FILM INFORMATION		NO.	DATE	NO.	DATE	NO.	DATE

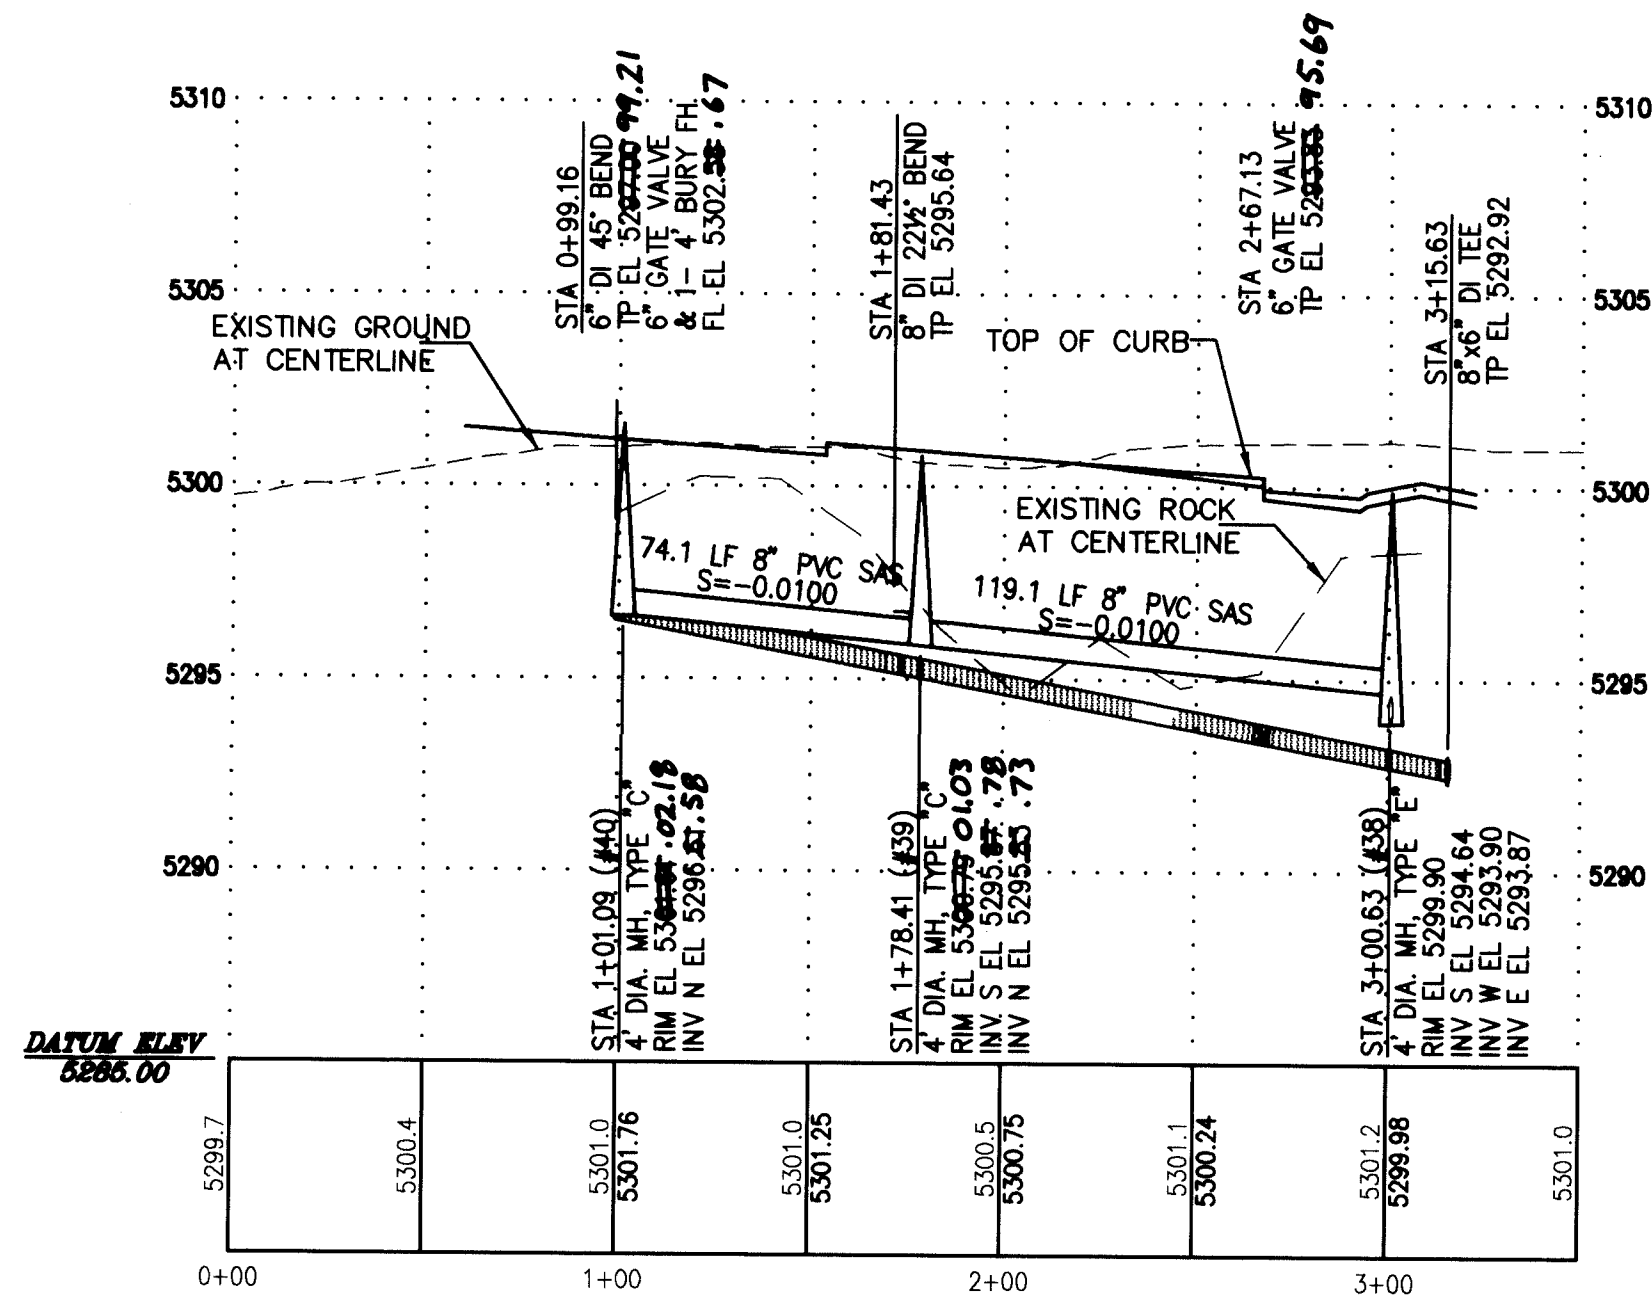


IGNACIO COURT - PROFILE

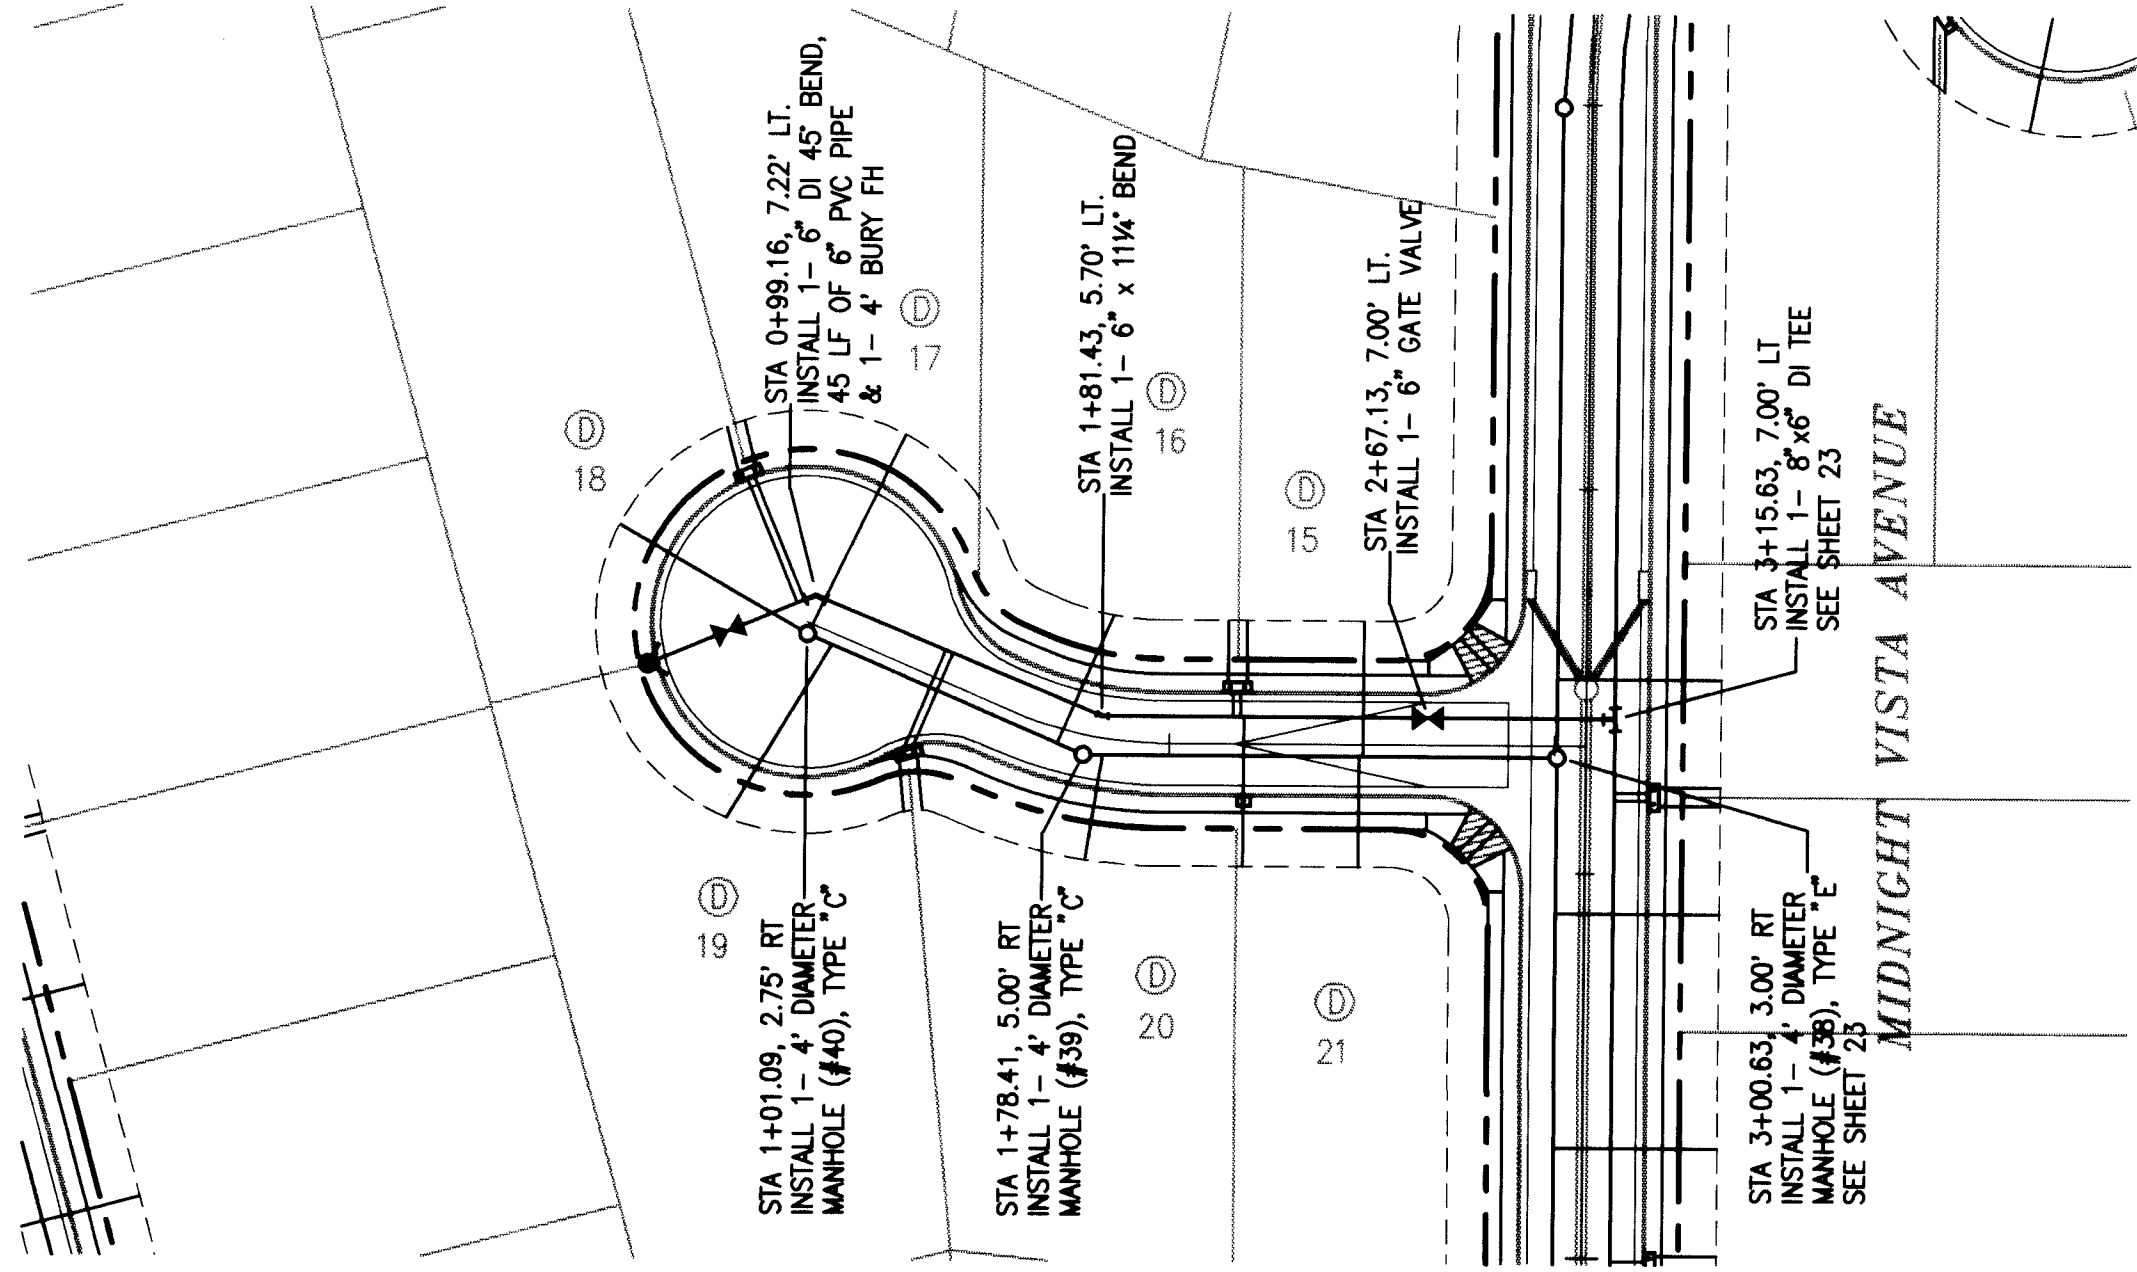

IGNACIO COURT - PLAN

SCALE
HORIZ: 1"=50'
VERT: 1"=5'







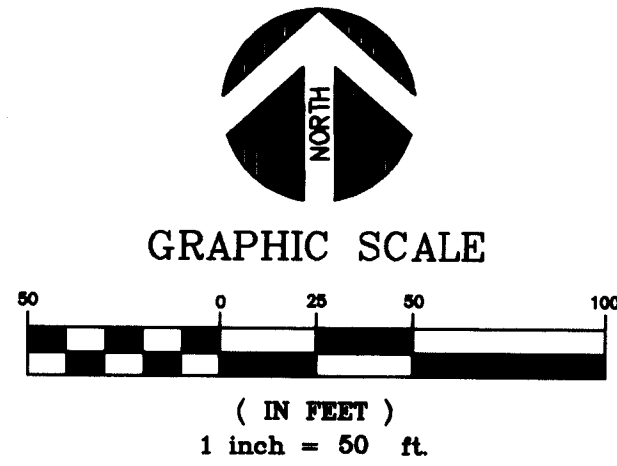


SANITARY SEWER SERVICE TABLE			
LOT	STATION	OFFSET	ELEVATION
D15	2+50.38	32.00 L	5296.24
D16	1+78.92	32.00 L	5296.96
D17	1+03.52	54.88 L	6297.72
D18	0+45.12	03.63 L	5298.13
D19	1+01.32	54.98 R	5297.74
D20	1+82.98	32.00 R	5296.92
D32	2+49.38	32.00 R	5296.25



CITY OF ALBUQUERQUE PUBLIC WORKS DEPARTMENT ENGINEERING DEVELOPMENT GROUP	
TITLE: PARADISE BLUFF SUBDIVISION IGNACIO COURT WATER & SANITARY SEWER - PLAN & PROFILE	
APPROVE AUG - 1996 DESIGN REVIEW COMMITTEE	City Engineer Approval Ms./Dsg/Yr. Ms./Dsg/Yr.
City Project No. 542681	Zone Map No. B-11/12
Sheet 30	of 32

ENGINEER'S SEAL		SURVEY INFORMATION		BENCH MARKS		AS BUILT INFORMATION	
		NO.	DATE	CONTRACTOR	DATE	CONTRACTOR	DATE
		BY	DATE	LOCATED 475 FEET NORTHEAST OF THE INTERSECTION OF JUSTIN DRIVE AND BUGLO AVENUE. ELEV. = 5328.378	DATE	LOCATED 475 FEET NORTHEAST OF THE INTERSECTION OF JUSTIN DRIVE AND BUGLO AVENUE. ELEV. = 5328.378	DATE
		REMARKS	DATE	INSPECTOR'S FIELD	DATE	INSPECTOR'S FIELD	DATE
		DESIGN	DATE	VERIFICATION BY	DATE	VERIFICATION BY	DATE
DESIGNED BY J. P. KELLEY		CORRALES, NM.		MICRO-FILM INFORMATION		MICRO-FILM INFORMATION	
DRAWN BY W. M. TOWERS		TOPOGRAPHIC MAPPING		RECORDED BY		RECORDED BY	
CHECKED BY V.J. CHAVEZ		BY T. MANN & ASSOC.		NO.		NO.	
		12-01-93					

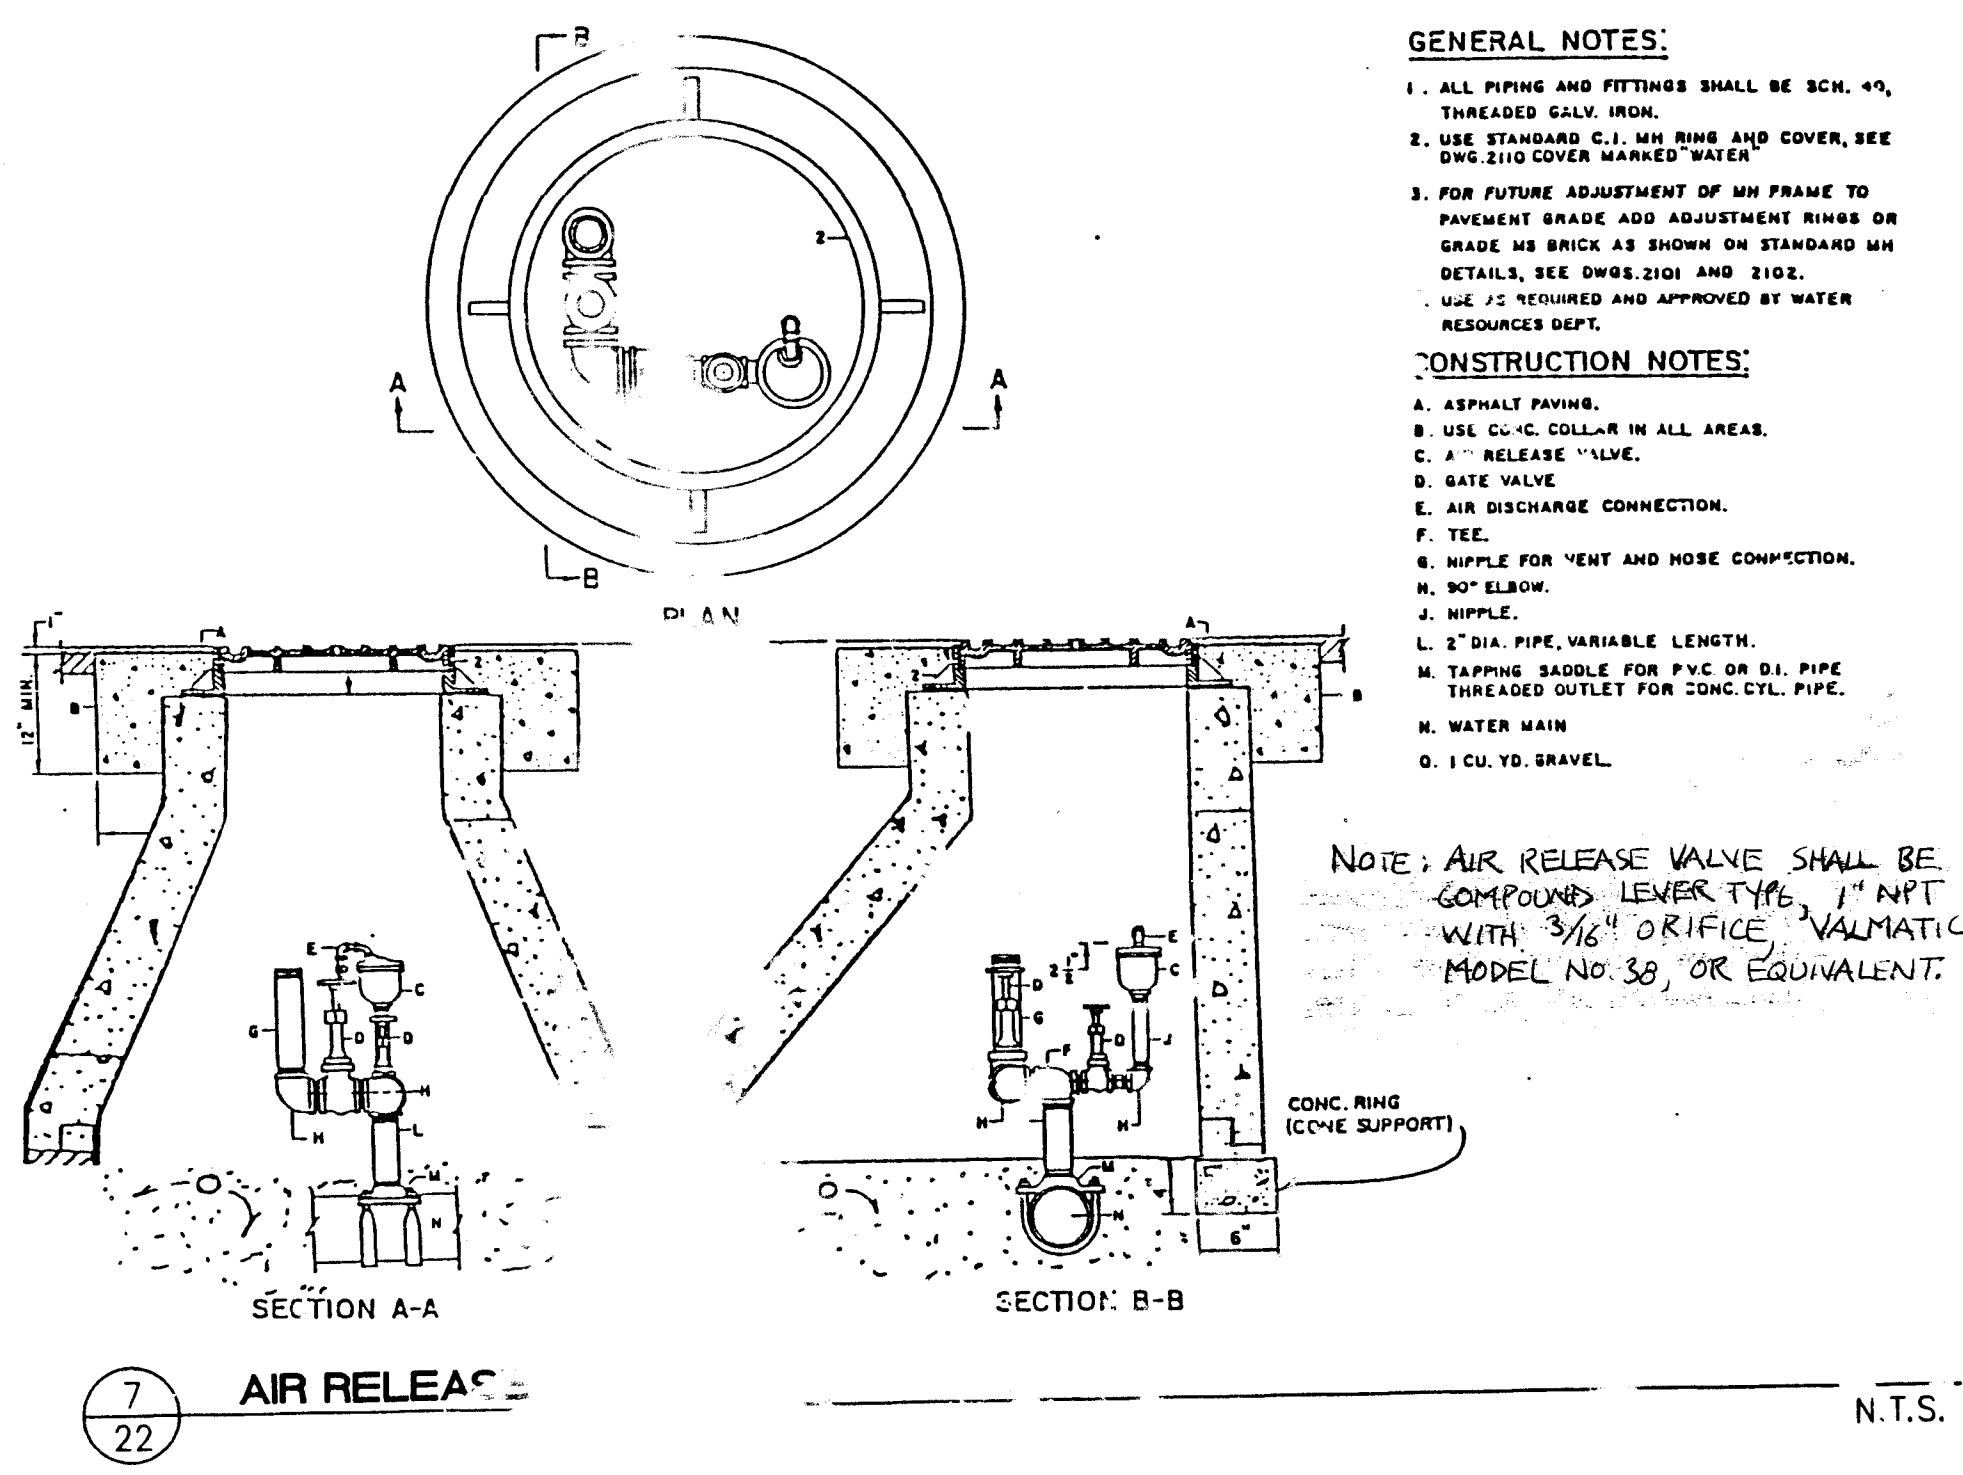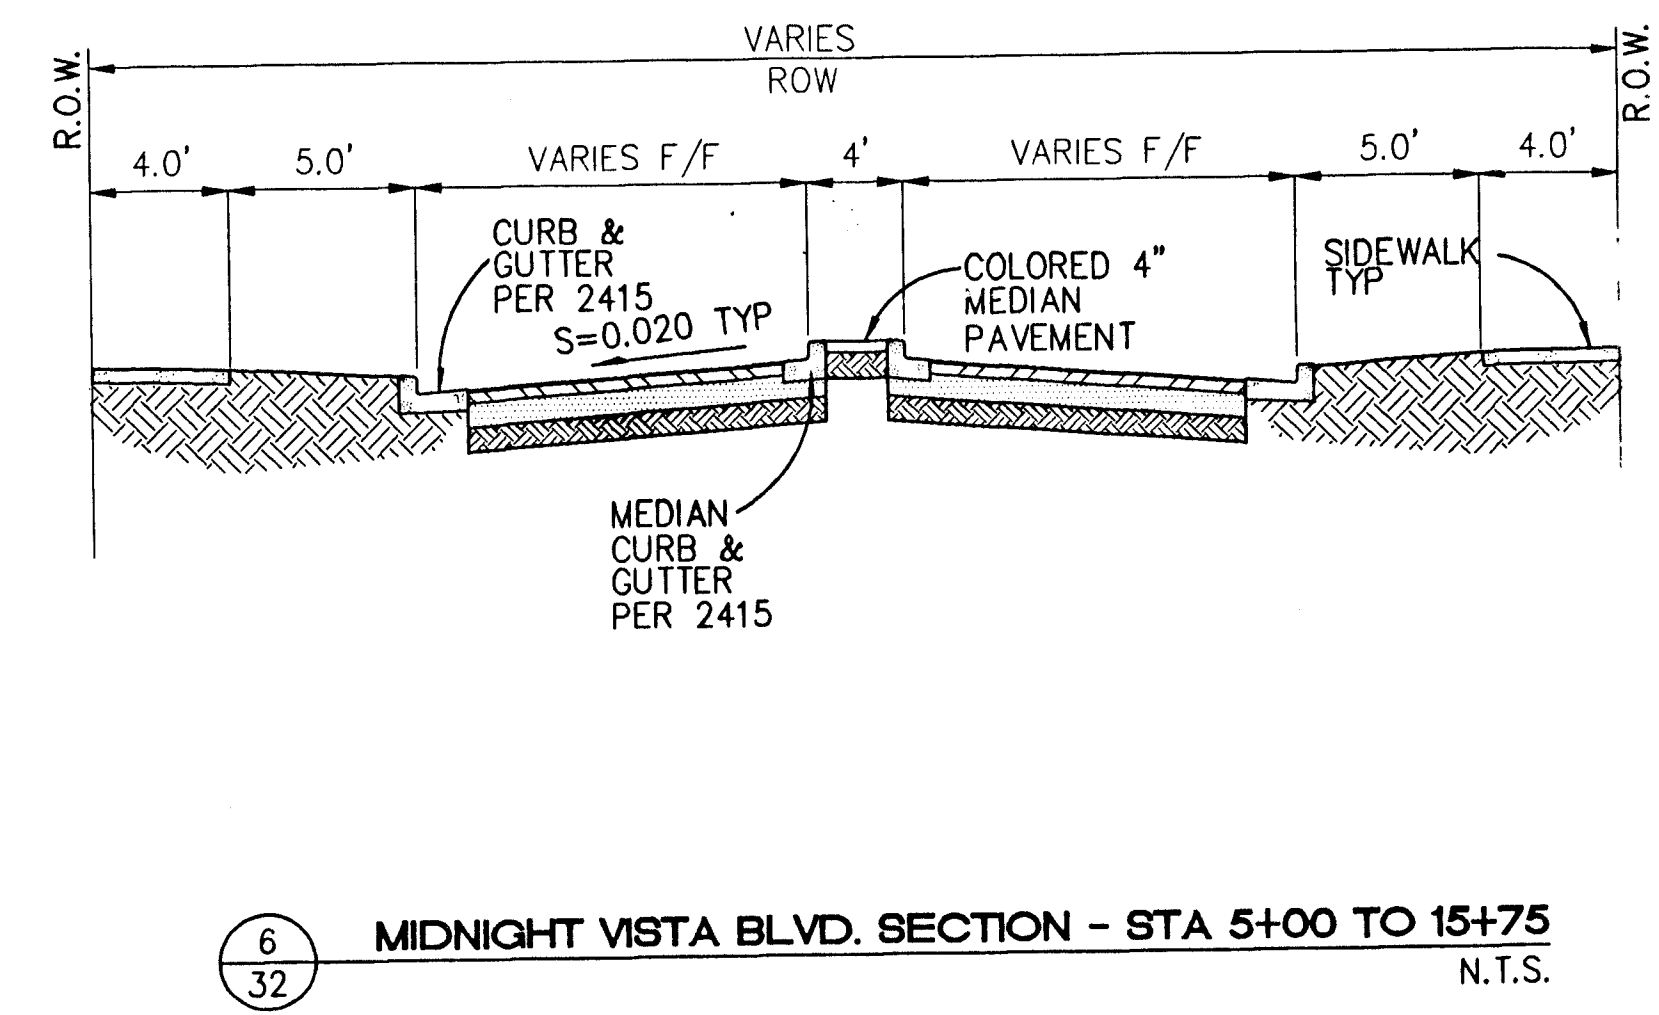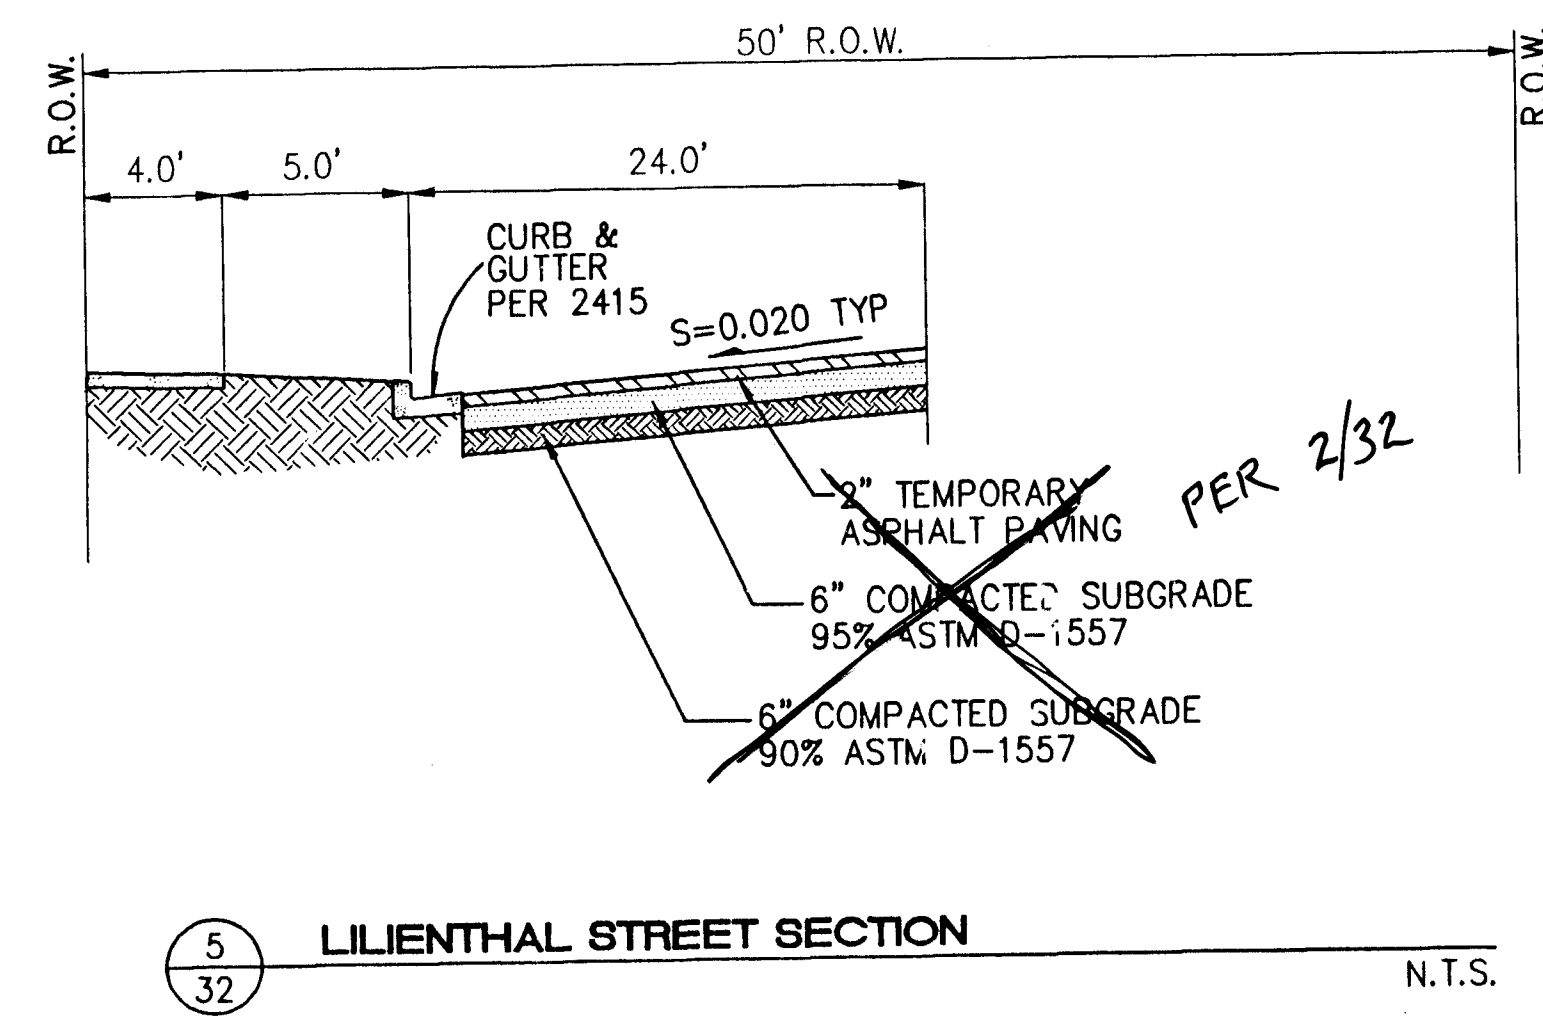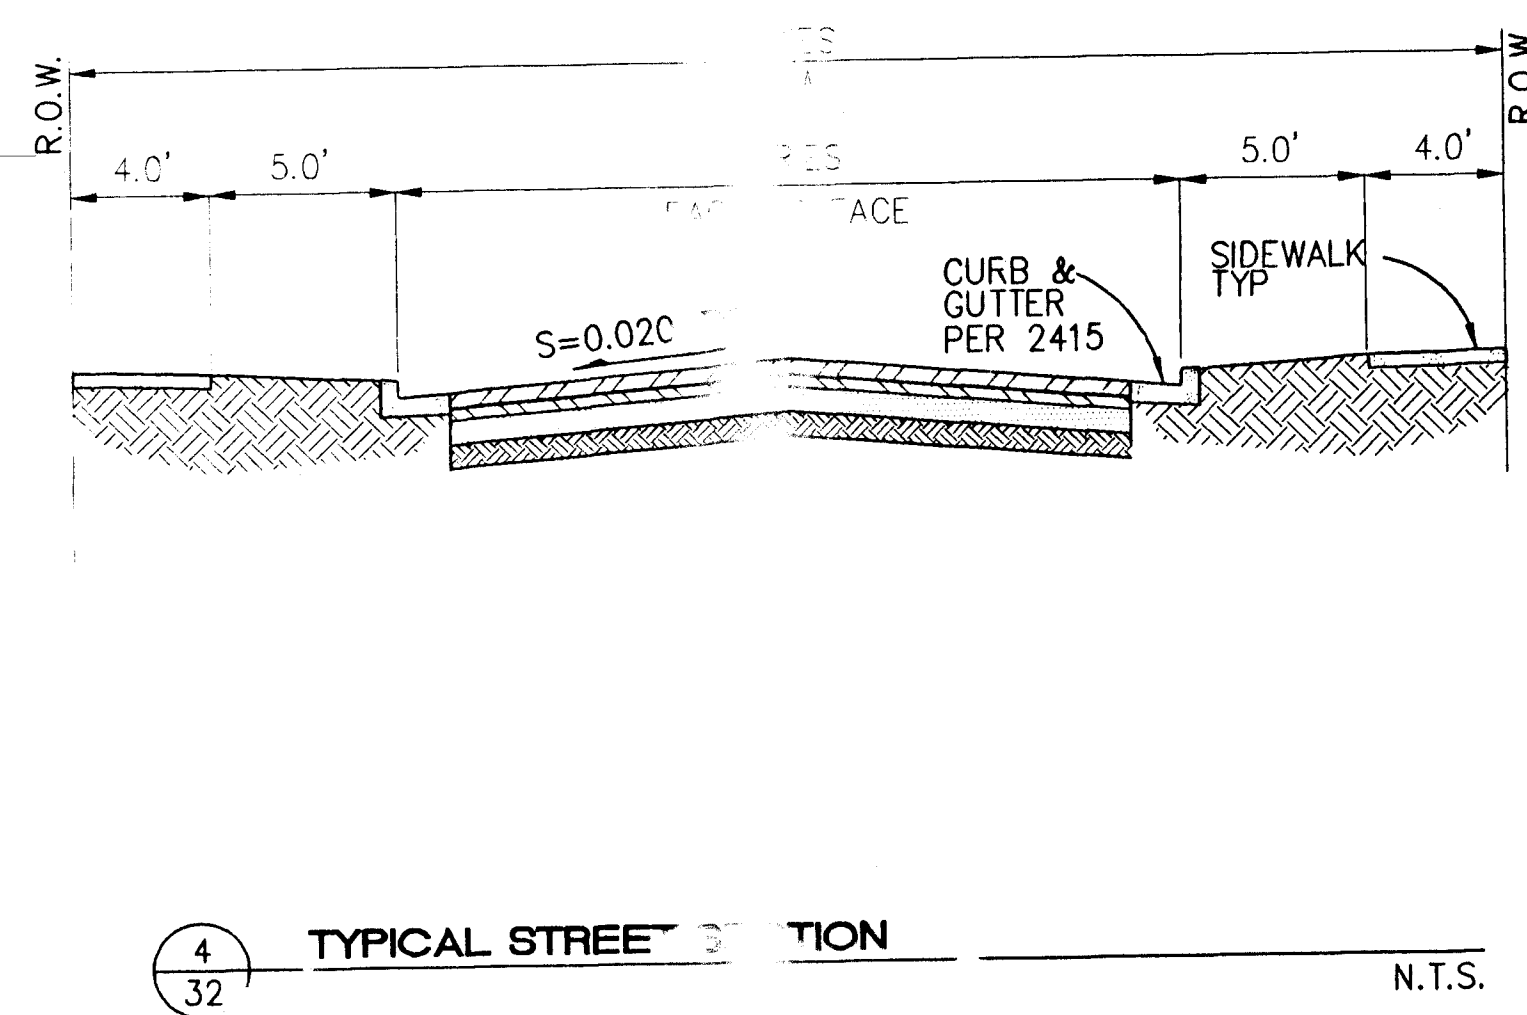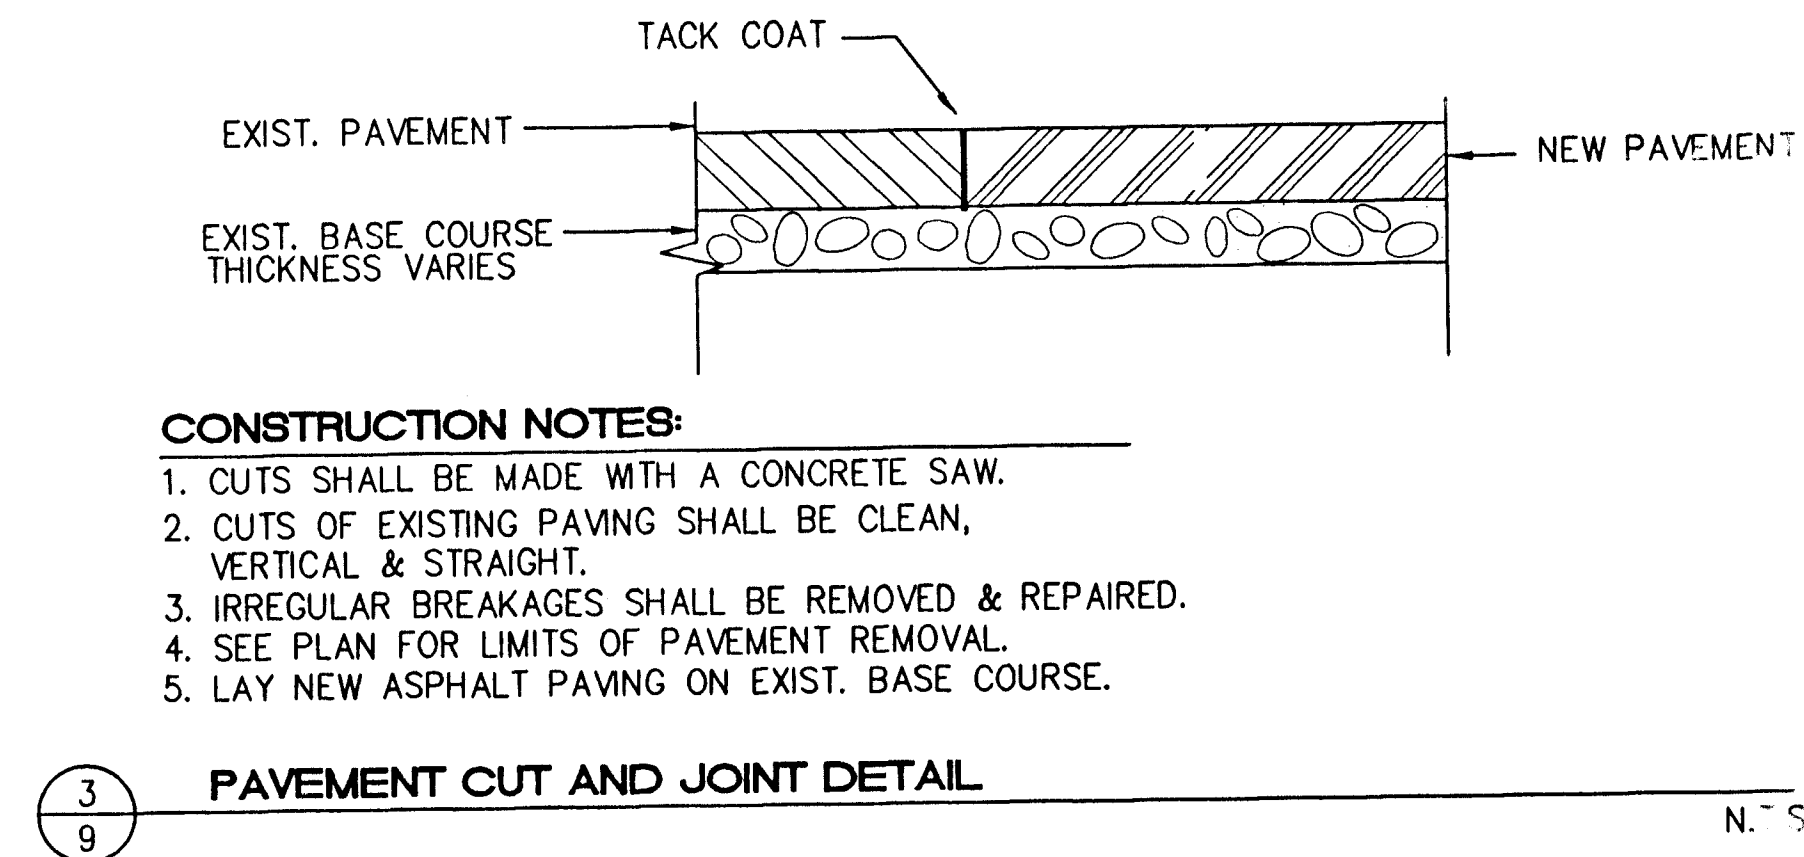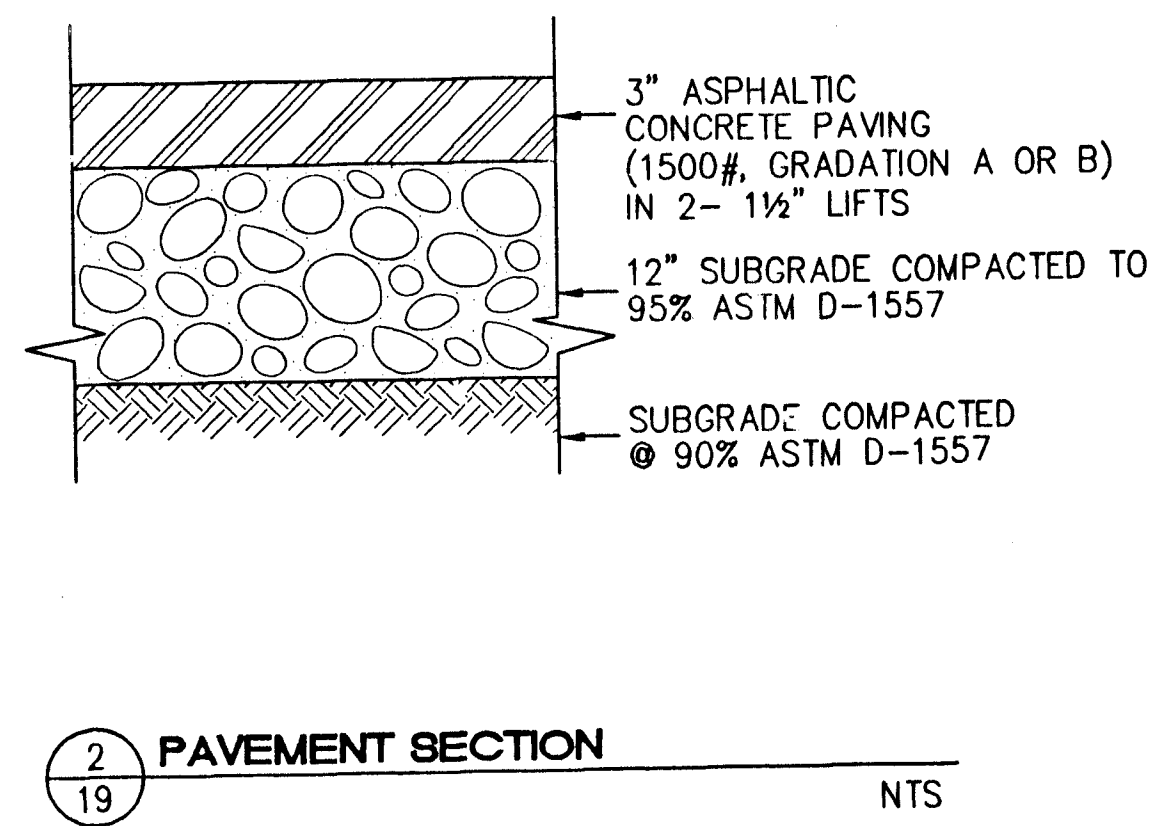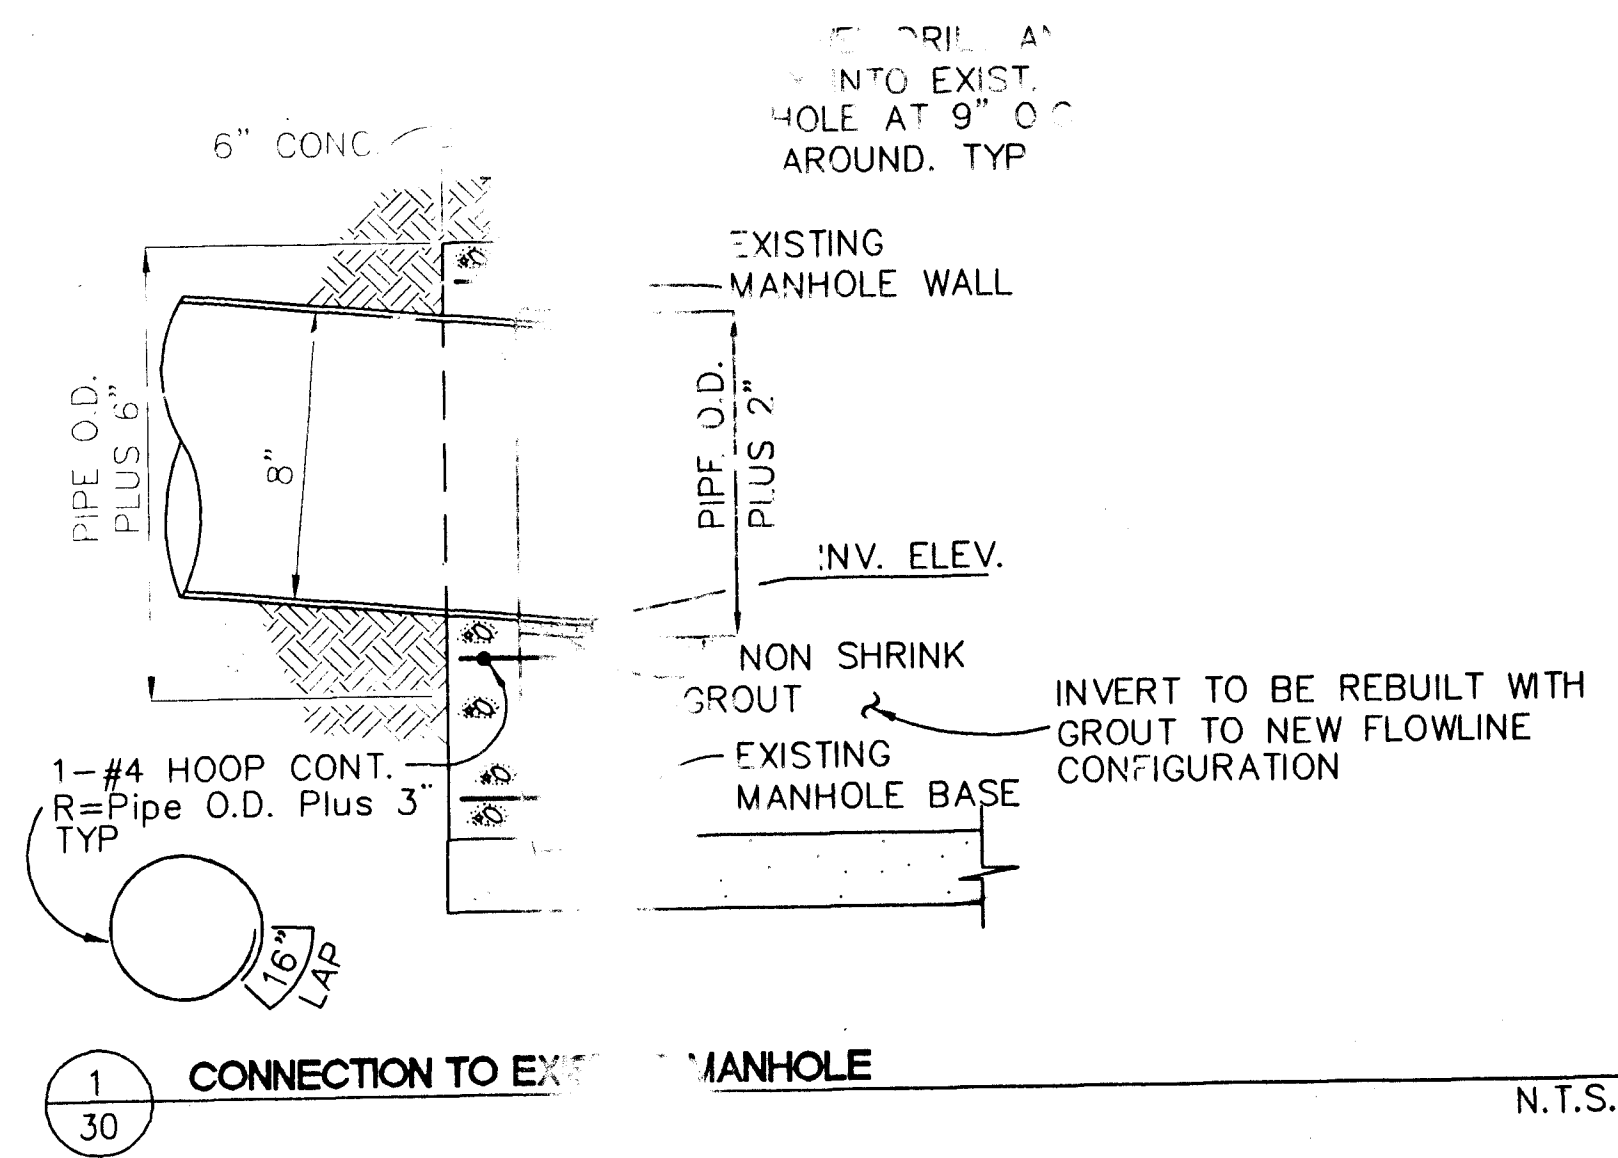

GENERAL NOTES:

1. ALL PIPING AND FITTINGS SHALL BE SCH. 40, THREADED GALV. IRON.
2. USE STANDARD G.I. MAN RINGS AND COVER, SEE DWS 2100 COVER MARKED "WATER".
3. FOR FUTURE ADJUSTMENT OF MAN FRAME TO PAVEMENT GRADE ADD ADJUSTMENT RINGS OR GRADE MAN BRICK AS SHOWN ON STANDARD MAN DETAILS, SEE DWS 2101 AND 2102.
4. USE 1/2" REQUIRED AND APPROVED BY WATER RESOURCES DEPT.

CONSTRUCTION NOTES:

- A. ASPHALT PAVING.
- B. USE G.I. COLLAR IN ALL AREAS.
- C. 1" RELEASE VALVE.
- D. GATE VALVE.
- E. AIR DISCHARGE CONNECTION.
- F. TEE.
- G. NIPPLE FOR VENT AND HOSE CONNECTION.
- H. 90° ELBOW.
- I. NIPPLE.
- J. 2" DIA. PIPE, VARIABLE LENGTH.
- K. TAPPING SADDLE FOR P.V.C. OR D.I. PIPE THREADED OUTLET FOR CONC. CYL. PIPE.
- L. WATER MAIN.
- M. 1 CU. YD. GRAVEL.

NOTE: AIR RELEASE VALVE SHALL BE COMPOUND LEVER TYPE, 1" NPT WITH 3/16" ORIFICE VALMATIC MODEL NO. 38, OR EQUIVALENT.

CHAVEZ • GRIEVES
CONSULTING ENGINEERS, INC.

5639 JEFFERSON STREET N.E. • ALBUQUERQUE, NEW MEXICO 87109
PHONE (505) 344-4080 • FAX (505) 343-8759

CITY OF ALBUQUERQUE
PUBLIC WORKS DEPARTMENT
ENGINEERING DEVELOPMENT GROUP

PROJECT: PARADISE BLUFF SUBDIVISION
DETAIL SHEET

Design Review Committee City Engineer Approval

NO. DATE

Project No. 542681 Zone Map No. B-11/12 Sheet 32 of 32

AS BUILT INFORMATION

CONTRACTOR: ALBUQUERQUE
DATE: 10/16/10
C.S.I. 2/98
C.S.I. 2/98
C.S.I. 2/98
C.S.I. 2/98

BENCH MARKS

ACS BRASS CAP STAMPED "ACS 6-BIT, 1986"
LOCATED 475 FEET NORTHEAST OF THE INTERSECTION
OF JUSTIN DRIVE AND BUGLO AVENUE. ELEV = 5328.3'

SURVEY INFORMATION

FIELD NOTES BY DATE

NO. DATE

ENGINEER'S SEAL

JOE P. KELLEY
REGISTERED PROFESSIONAL ENGINEER
6/14/10