

LOS CAMPOS

A 64 UNIT TOWNHOUSE DEVELOPMENT

CITY OF ALBUQUERQUE, NEW MEXICO

GRADING, PAVING, DRAINAGE, & CITY UTILITIES

PLANS MAY 1996

INDEX TO DRAWINGS

UTILITY COMPANY CONTACTS

CITY OF ALBUQUERQUE
(Water & Sanitary Sewer)
Bill Otto
PMD/Utility Development
P.O. Box 1293
Albuquerque, NM 87103
(505) 768-2718

PNM
4201 Edith Blvd N.E.
Albuquerque, New Mexico 87107
(505) 848-3428

GAS CO.
4625 Edith Blvd. NE
Albuquerque, New Mexico 87107
(505) 761-7705


US WEST COMMUNICATIONS
201 Third Street
P.O. Box 1355, Ste. 952
Albuquerque, New Mexico 87103
(505) 245-8706

AT&T
111 Third St., NW
Albuquerque, New Mexico 87103
(505) 842-2806

JONES INTERCABLE
Karen Shore
4811 Monabel Pl., NE
P.O. Box 27138
Albuquerque, NM 87125-7138
(505) 761-6220

ABBREVIATIONS:

AC - ASBESTOS CEMENT	DD - DEFLECT DOWN	FO - FIBER OPTIC CABLE	PRC - POINT OF REVERSE CURVATURE	SAS - SANITARY SEWER
ARV - AIR/VACUUM RELEASE VALVE	DIP - DUCTILE IRON PIPE	G - GAS	SD - STORM DRAIN	TC - TOP OF CURB
B - BASELINE	DU - DEFLECT UP	HP - HIGH PRESSURE	PT - POINT OF TANGENCY	T - TELEPHONE
BCT - BEGIN CROWN TRANSITION	E - EXISTING	I - LIGHT POLE	PUE - PUBLIC UTILITY EASEMENT	TL - TRAFFIC LIGHT
C - CONSTRUCT	ECT - END CROWN TRANSITION	LP - LIGHT POLE	R/REL - REMOVE & RELOCATE	TP - TOP OF PIPE
CAV - COMBINATION AIR VALVE	ELEV - ELEVATION	MH - MANHOLE	R/RPLC - REMOVE & REPLACE	UE - UNDERGROUND ELECTRIC
CCP - CONCRETE CYLINDER PIPE	F/F - FACE TO FACE	NMUI - NEW MEXICO UTILITIES, INC.	PVC - POLY VINYL CHLORIDE	VCP - VITRIFIED CLAY PIPE
CI - CAST IRON	F/F - FEET/FOOT	PC - POINT OF CURVATURE	REM - REMOVE	VER - VERIFY LOCATION
CL - CENTERLINE	FL - FLOW LINE	PCC - POINT OF COMPOUND CURVATURE	REL - RELOCATE	W OR WL - WATERLINE
COA - CITY OF ALBUQUERQUE		POC - POINT ON CURVE	ROW - RIGHT-OF-WAY	X - CROSSING
		FL - FLOW LINE		

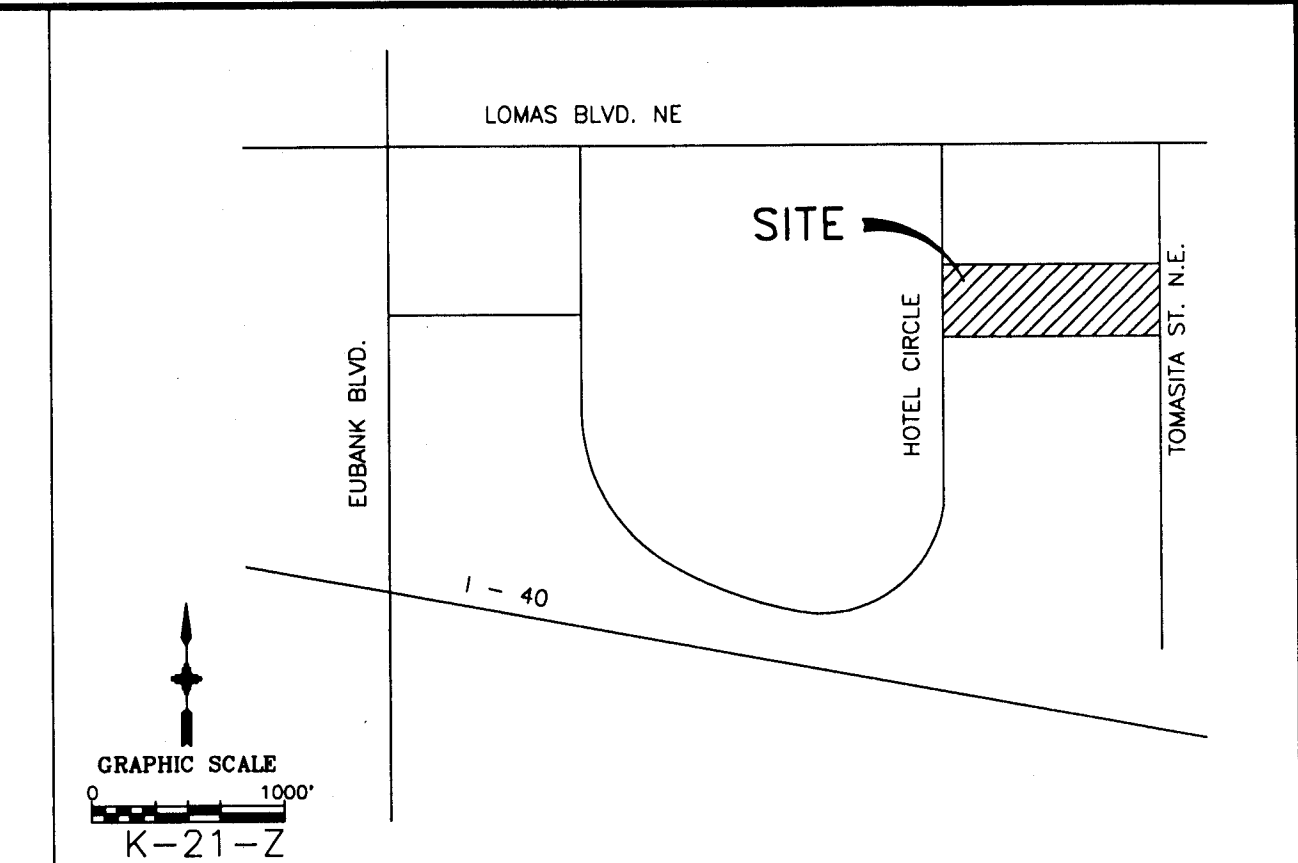

VICINITY MAP

NOTICE

THE ENGINEER HAS UNDERTAKEN LIMITED FIELD VERIFICATION OF THE LOCATION, DEPTH, SIZE, OR TYPE OF EXISTING UNDERGROUND UTILITY LINES. MAKES NO RESPONSIBILITY PERTAINING THERETO AND ASSUMES NO RESPONSIBILITY OR LIABILITY THEREFORE. THE CONTRACTOR SHALL INFORM ITSELF OF THE LOCATION OF ANY UTILITY LINE IN OR NEAR THE AREA OF THE WORK IN ADVANCE OF AND DURING EXCAVATION WORK. THE CONTRACTOR IS FULLY RESPONSIBLE FOR ANY AND ALL DAMAGE CAUSED BY ITS FAILURE TO LOCATE, IDENTIFY, AND PRESERVE ANY AND ALL EXISTING UTILITIES. THE CONTRACTOR SHALL COMPLY WITH STATE STATUTES, MUNICIPAL AND LOCAL ORDINANCES, RULES AND REGULATIONS PERTAINING TO THE LOCATION OF THESE LINES AND FACILITIES IN PLANNING AND CONDUCTING EXCAVATION, WHETHER BY CALLING OR NOTIFYING THE UTILITIES, COMPLYING WITH "BLUE STAKES" PROCEDURES, OR OTHERWISE.

THESE DRAWINGS DO NOT INCLUDE NECESSARY COMPONENTS FOR CONSTRUCTION SAFETY WHICH SHALL REMAIN THE RESPONSIBILITY OF THE CONTRACTOR.

NOTICE

THIS DOCUMENT, AND THE IDEAS AND DESIGNS INCORPORATED HEREIN, ARE INTENDED FOR USE ON THIS PROJECT AND IS NOT TO BE USED, IN WHOLE OR IN PART, FOR ANY OTHER PROJECT WITHOUT THE WRITTEN AUTHORIZATION OF BOKAY CONSTRUCTION, INC. IN THE EVENT OF UNAUTHORIZED USE, THE USER ASSUMES ALL RESPONSIBILITY AND LIABILITY WHICH RESULTS.

GENERAL NOTES

- ALL WORK DETAILED ON THESE PLANS TO BE PERFORMED UNDER CONTRACT SHALL, EXCEPT AS OTHERWISE STATED OR PROVIDED FROM HEREON, BE CONSTRUCTED IN ACCORDANCE WITH THE CITY OF ALBUQUERQUE STANDARD SPECIFICATIONS FOR PUBLIC WORKS CONSTRUCTION, 1986 EDITION AS AMENDED WITH UPDATE NO. 6.
- CONTRACTOR SHALL NOTIFY THE PROJECT ENGINEER NOT LESS THAN (7) DAYS PRIOR TO STARTING WORK IN ORDER THAT THE ENGINEER MAY TAKE NECESSARY MEASURES TO INSURE THE PRESERVATION OF SURVEY MONUMENTS. CONTRACTOR SHALL NOT DISTURB PERMANENT SURVEY MONUMENTS WITHOUT THE CONSENT OF THE ENGINEER, AND SHALL BEAR THE EXPENSE OF REPLACING ANY THAT MAY BE DISTURBED WITHOUT PERMISSION. REPLACEMENT SHALL BE DONE ONLY BY THE CITY SURVEY SECTION. WHEN A CHANGE IS MADE IN ANY ROADWAY IN WHICH A PERMANENT SURVEY MONUMENT IS LOCATED, CONTRACTOR SHALL, AT HIS OWN EXPENSE, ADJUST THE MONUMENT COVER TO THE NEW GRADE UNLESS OTHERWISE SPECIFIED. REFER TO SECTION 4.4 OF GENERAL CONDITIONS OF THE CITY OF ALBUQUERQUE STANDARD SPECIFICATIONS FOR PUBLIC WORKS CONSTRUCTION.
- THREE (3) WORKING DAYS PRIOR TO BEGINNING CONSTRUCTION, THE CONTRACTOR SHALL SUBMIT TO THE CONSTRUCTION COORDINATION DIVISION A DETAILED CONSTRUCTION SCHEDULE. TWO (2) WORKING DAYS PRIOR TO CONSTRUCTION, THE CONTRACTOR SHALL OBTAIN A BARRICADE PERMIT FROM THE CONSTRUCTION COORDINATION DIVISION. CONTRACTOR SHALL NOTIFY BARRICADE ENGINEER (768-2551) PRIOR TO OCCUPYING AN INTERSECTION. SEE SECTION 19 OF THE SPECIFICATIONS.
- TWO (2) WORKING DAYS PRIOR TO ANY EXCAVATION, CONTRACTOR MUST CONTACT LINE LOCATING SERVICE, (260-1990) FOR LOCATION OF EXISTING UTILITIES.
- PRIOR TO CONSTRUCTION, THE CONTRACTOR SHALL EXCAVATE AND VERIFY THE HORIZONTAL AND VERTICAL LOCATIONS OF ALL OBSTRUCTIONS AND EXISTING PAVEMENT. SHOULD A CONFLICT EXIST, THE CONTRACTOR SHALL NOTIFY THE ENGINEER OR SURVEYOR SO THAT THE CONFLICT CAN BE RESOLVED WITH MINIMUM AMOUNT OF DELAY.
- THE CONTRACTOR SHALL CONTACT WATER SYSTEMS DIVISION (857-8200) FIVE (5) WORKING DAYS PRIOR TO NEEDING SHUT-OFF OR TURN-ON OF VALVES. ONLY CITY WATER SYSTEMS PERSONNEL ARE AUTHORIZED TO OPERATE VALVES.
- RESTRAINED JOINTS ARE REQUIRED AT ALL WATER LINE BENDS, TEES, CAPS AND GATE VALVES.
- THE PUBLIC WATER LINE MUST BE A MINIMUM OF 18" ABOVE THE SEWER LINE AT ALL CROSSINGS.
- THE CONTRACTOR SHALL FURNISH EMD'S ON ALL WATER AND SEWER SERVICE STUBS, CAPS AND PLUGS.
- ALL UTILITIES AND UTILITY SERVICE LINES SHALL BE INSTALLED PRIOR TO PAVING.
- BACKFILL COMPACTION SHALL BE ACCORDING TO SPECIFIED STREET USE.
- TACK COAT REQUIREMENTS SHALL BE DETERMINED BY THE CITY ENGINEER.
- SIDEWALKS AND WHEELCHAIR RAMPS WITHIN THE CURB RETURNS SHALL BE CONSTRUCTED WHEREVER A NEW CURB RETURN IS CONSTRUCTED.
- IF CURB IS DEPRESSED FOR A DRIVEPAD OR A HANDICAP RAMP, THE DRIVEPAD OR RAMP SHALL BE CONSTRUCTED PRIOR TO ACCEPTANCE OF THE CURB AND GUTTER.
- ALL STORM DRAINAGE FACILITIES SHALL BE COMPLETED PRIOR TO FINAL ACCEPTANCE.
- ALL STREET STRIPING ALTERED OR DESTROYED SHALL BE REPLACED IN KIND BY CONTRACTOR TO LOCATION AND IN KIND AS EXISTING OR AS INDICATED BY THIS PLAN SET. ALL NEW STRIPING SHALL BE PLASTIC AS PER CITY STANDARDS.

26-5477.81 0197

BOKAY CONSTRUCTION, INC.
ENGINEERING SERVICES • CONSTRUCTION MANAGEMENT
5805 AZULEO CT. NW
ALBUQUERQUE, NM 87120
(505) 899-9656

REV.	SHEETS	CITY ENGINEER	DATE	USER DEPARTMENT	DATE	USER DEPARTMENT	DATE
ENGINEERS STAMP & SIGNATURE		APPROVALS	ENGINEER	DATE	*****		
		DRC Chairman		7-1-96	APPROVED FOR CONSTRUCTION		
		Transportation		7-1-96			
		Water/Wastewater		7-1-96			
		Hydrology		7-1-96			
		Parks					
		Constr. Mngmt.		7-1-96	CITY ENGINEER DATE		
City Project No.		543781		SHEET		OF 18	

SCANNED BY
BY LASON

APPROVAL OF AS BUILT DRAWINGS
CHIEF CONSTRUCTION ENGINEER

DATE 3-27-97

PLAT OF
LOTS 1 THRU 64
LOS CAMPOS

ALBUQUERQUE, BERNILLO COUNTY, NEW MEXICO
APRIL 1996

APPROVED AND ACCEPTED BY:

SUBDIVISION PLAT NO.	CITY	COUNTY
PLANNING DIRECTOR - ALBUQUERQUE/BERNALILLO COUNTY DEVELOPMENT REVIEW BOARD	DATE	
CITY ENGINEER	DATE	
A.M.A.F.C.A.	DATE	
TRAFFIC ENGINEER	DATE	
UTILITIES DEVELOPMENT DIVISION CITY OF ALBUQUERQUE PUBLIC WORKS	DATE	
CITY PARKS AND GENERAL SERVICES	DATE	
PROPERTY MANAGEMENT	DATE	
CITY SURVEYOR	DATE	
PNM ELECTRIC SERVICES	DATE	
PNM GAS SERVICES	DATE	
U.S. WEST COMMUNICATIONS	DATE	
JONES INTERCABLE, INC.	DATE	

THIS IS TO CERTIFY THAT TAXES ARE CURRENT AND PAID ON UPC#:

PROPERTY OWNER OF RECORD: _____
BERNALILLO COUNTY TREASURER'S OFFICE: _____

SURVEYOR'S CERTIFICATION

I, VLADIMIR JIRIK, A DULY QUALIFIED PROFESSIONAL SURVEYOR REGISTERED UNDER THE LAWS OF THE STATE OF NEW MEXICO, DO HEREBY CERTIFY THAT THIS PLAT WAS PREPARED BY ME OR UNDER MY DIRECT SUPERVISION, SHOWS ALL EASEMENTS MADE KNOWN TO ME BY THE OWNER, UTILITY COMPANIES OR OTHER PARTIES EXPRESSING AN INTEREST AND THAT THE SURVEY MEETS THE MINIMUM REQUIREMENTS FOR MONUMENTATION AND SURVEYS OF THE CITY OF ALBUQUERQUE SUBDIVISION ORDINANCE AND THE BERNALILLO COUNTY SUBDIVISION ORDINANCE AND IS TRUE AND CORRECT TO THE BEST OF MY KNOWLEDGE AND BELIEF.

VLADIMIR JIRIK, N.M.P.S. NO. 10464 DATE

SHEET 1 OF 2
937PS-BH

PLAT OF
LOTS 1 THRU 64
LOS CAMPOS

ALBUQUERQUE, BERNILLO COUNTY, NEW MEXICO
APRIL 1996

DIANA
ST. N.E.

TOMASITA
ST. N.E.

COTE
AVE. N.E.

NOTES:

- BEARINGS SHOWN ARE NEW MEXICO STATE PLANE GRID BEARINGS (CENTRAL ZONE).
- DISTANCES ARE GROUND DISTANCES.
- UNLESS OTHERWISE INDICATED, ALL BOUNDARY CORNERS SHOWN THUS ARE MARKED WITH A P.K. NAIL W/SHINER, SCRIBED "X" IN CONCRETE OR AN IRON STAKE SURMOUNTED WITH A CAP STAMPED "P.S. 10464".
- ELEVATIONS SHOWN ARE SLD 1929 ELEVATIONS BASED ON CITY OF ALBUQUERQUE BENCH MARK "5-K21", ELEVATION = 5498.81.
- STREET CENTERLINE MONUMENTATION SHALL BE INSTALLED AT ALL P.C.'S, P.T.'S, AND INTERSECTIONS SHOWN THUS AND SHALL BE MARKED WITH A FOUR INCH (4") ALUMINUM CAP STAMPED "CITY OF ALBUQUERQUE CENTERLINE MONUMENT, 1996, P.L.S. #10464, DO NOT DISTURB".
- * DESIGNATES LOT FRONT.
- SETBACK REQUIREMENTS:
A) THERE SHALL BE A FRONT-YARD SETBACK OF NOT LESS THAN 15 FEET. EXCEPT SETBACK FOR A GARAGE OR CARPORT SHALL BE NOT LESS THAN 20 FEET.
B) THERE SHALL BE NO REQUIRED SIDE-YARD SETBACK, EXCEPT THERE SHALL BE TEN FEET ON THE STREET SIDE OF CORNER LOTS.
C) THERE SHALL BE A REAR-YARD SETBACK OF NOT LESS THAN 15 FEET.
D) THERE SHALL BE A DISTANCE OF NOT LESS THAN TEN FEET BETWEEN RESIDENTIAL BUILDINGS.
- THE P1 SUFFIX TO LOT NUMBERS DESIGNATES SPECIAL ON-SITE PARKING CRITERIA WHICH JUSTIFIED THE CITY ALLOWING REDUCED STREET WIDTHS IN THIS SUBDIVISION, PER THE INTERMITTENT PARKING DESIGN CRITERIA OF THE CITY OF ALBUQUERQUE DEVELOPMENT PROCESS MANUAL.
- THE DATA SHOWN HEREON IS FROM AN ACTUAL FIELD SURVEY.
- THE PURPOSE OF THIS PLAT IS TO SHOW THE DIVISION INTO NEW BLOCKS, LOTS, TRACTS AND EASEMENTS, AND TO DEDICATE STREETS AS SHOWN.
- CITY OF ALBUQUERQUE WATER AND SANITARY SEWER SERVICE TO LOS CAMPOS SUBDIVISION POINT MUST BE VERIFIED AND COORDINATED WITH THE PUBLIC WORKS DEPARTMENT, CITY OF ALBUQUERQUE.
- THERE IS 10' P.U.E. ALONG ALL LOT LINES FRONTING PUBLIC RIGHTS OF WAYS AND SHOWN THUS 10' P.U.E.
- THE OPEN SPACE REQUIREMENT OF 750 SQUARE FEET PER DWELLING UNIT WILL BE MET.

OWNER'S CERTIFICATE

THE SUBDIVISION SHOWN HEREON IS WITH THE FREE CONSENT AND IN ACCORDANCE WITH THE DESIRES OF THE UNDERSIGNED OWNER(S) AND/OR PROPRIETOR(S) THEREOF AND SAID OWNER(S) AND/OR PROPRIETOR(S) DO HEREBY DEDICATE ALL STREETS AND PUBLIC RIGHTS-OF-WAY SHOWN HEREON TO THE CITY OF ALBUQUERQUE IN FEE SIMPLE WITH WARRANTY COVENANTS AND DO HEREBY GRANT ALL ACCESS, UTILITY AND DRAINAGE EASEMENTS SHOWN HEREON. SAID OWNER(S) AND/OR PROPRIETOR(S) DO HEREBY CONSENT TO ALL OF THE FOREGOING AND DO HEREBY CERTIFY THAT THIS SUBDIVISION IS THEIR FREE ACT AND DEED.

BY: BILL E. HOOTEN, GENERAL PARTNER
MARKET CENTER EAST LAND PARTNERS

DATE

ACKNOWLEDGEMENT

STATE OF _____ }
COUNTY OF _____ } ss.

THIS INSTRUMENT WAS ACKNOWLEDGED BEFORE ME

ON _____ DAY OF _____
19 _____, BY BILL E. HOOTEN.

MY COMMISSION EXPIRES: _____
NOTARY PUBLIC

PNM ELECTRIC/GAS SERVICES DISCLAIMER

In approving this plat, PNM ELECTRIC/GAS SERVICES do not waive or release any easement or easement rights which may have been granted by prior plat, replat, or other document which are not shown on this plat.

SUBDIVISION DATA

- CASE NO.: DRB-95-493
- ZONE ATLAS INDEX NO.: K-21-Z
- GROSS SUBDIVISION ACREAGE: 6.2372 ACRES
- TOTAL NUMBER OF LOTS EXISTING: 1 LOT
- TOTAL NUMBER OF LOTS CREATED: 64 LOTS
- DATE OF SURVEY: APRIL, 1996
- TALOS LOG NO. SP-9609-1015-0169
- MILES OF FULL-WIDTH STREETS CREATED: 0.3431 MILES
- TOTAL STREET DEDICATION: 69,770 SQ. FT. (1.6017 ACRES)
- ZONING: R-T
- VACATION NUMBER: V-96-37

LEGAL DESCRIPTION

Being that certain parcel of land situated within Section 21, Township 10 North, Range 4 East, New Mexico Principal Meridian, Albuquerque, Bernalillo County, New Mexico, and being identified as South 1/2 Tract 3, HORNE DEVELOPMENT ADDITION, as said South 1/2 Tract 3 is shown and designated on "PLAT FOR TRACTS 1-B1, 1-C1, 2A, 4-B1, 4-C1, 4-C2, STATION SITE NO. 3-A, SOUTH 1/2 TRACT 3 AND PARCELS 4-A(1A), 4-A(2), 4-A(3A), 4-A(4A), HORNE DEVELOPMENT ADDITION TOGETHER WITH TRACTS 1-A1 AND 1-B, C.C. & F. PROPERTIES OF ALBUQUERQUE, INC., CITY OF ALBUQUERQUE, BERNILLO COUNTY, NEW MEXICO", filed in the Office of the County Clerk, Bernalillo County, New Mexico, on June 17, 1987, in Volume C33, Folio 187, and being more particularly described by metes and bounds survey as follows:
Beginning at the northeast corner of the parcel of land herein described being a point on the westerly right of way line of Tomasita Street NE, whence the ACS Control Station "5-K21" bears N. 00° 18' 39" W., 354.45 feet distance; thence, S. 00° 12' 20" W., 347.79 feet distance to the southeast corner of the parcel of land herein described; thence, N. 87° 51' 45" W., 788.01 feet distance to the southwest corner of the parcel of land herein described being a point on the easterly right of way line of Hotel Circle NE and a point on curve; thence, Northeastly, 23.42 feet distance along the arc of a curve bearing to the left (said arc having a radius of 530.00 feet, central angle of 02° 31' 55" and a chord which bears N. 03° 25' 31" E., 23.42 feet distance) to the point of tangency; thence, N. 02° 09' 36" E., 324.24 feet distance to the northwest corner of the parcel of land herein described; thence, S. 87° 51' 29" E., 775.63 feet distance to the northeast corner and point of beginning and containing 271,692 square feet (6.2372 acres), more or less.

PUBLIC UTILITY EASEMENTS


PUBLIC UTILITY EASEMENTS shown on this plat are granted for the common and joint use of:

- The PNM Electric Services for the installation, maintenance, and service of overhead and underground electrical lines, poles and any other equipment, fixtures, structures and related facilities reasonably necessary to provide electrical service.
- The PNM Gas Services for installation, maintenance, and service of natural gas lines, valves and other equipment and facilities reasonably necessary to provide natural gas.
- Jones Intercable for the installation, maintenance, and service of such lines, cable, and other related equipment and facilities reasonably necessary to provide Cable TV service.
- U.S. West for the installation, maintenance, and service of all buried and aerial communication lines and other related equipment and facilities reasonably necessary to provide communication services, including but not limited to above ground pedestals and closures.

Included is the right to build, rebuild, construct, reconstruct, locate, relocate, change, remove, modify, renew, operate, and maintain facilities for the purposes described above, together with free access to, from, and over said easements, including sufficient working area space for electric transformers, with the right and privilege to trim and remove trees, shrubs or bushes which interfere with the purposes set forth herein. No building, sign, pool (aboveground or subsurface), hot tub, concrete or wood pool decking, or other structure shall be erected or constructed on said easements nor shall any well be drilled or operated thereon. Property owners shall be solely responsible for correcting any violations of National Electrical Safety Code caused by construction of pools, decking, or any structures adjacent to, within or near easements shown on this plat.

Plat & Survey By:
ALBUQUERQUE SURVEYING CO. INC., 2119 Menaul Blvd. N.E., Albuquerque, New Mexico 87107 Ph. (505) 884-2036

"12-K21"
ACS ALUMINUM TABLET
NEW MEXICO STATE PLANE
COORDINATE SYSTEM
(CENTRAL ZONE)(NAD 1927)
Y=1487.15787
X=415.69028
G-G=0.99964809
Aa=-000943"

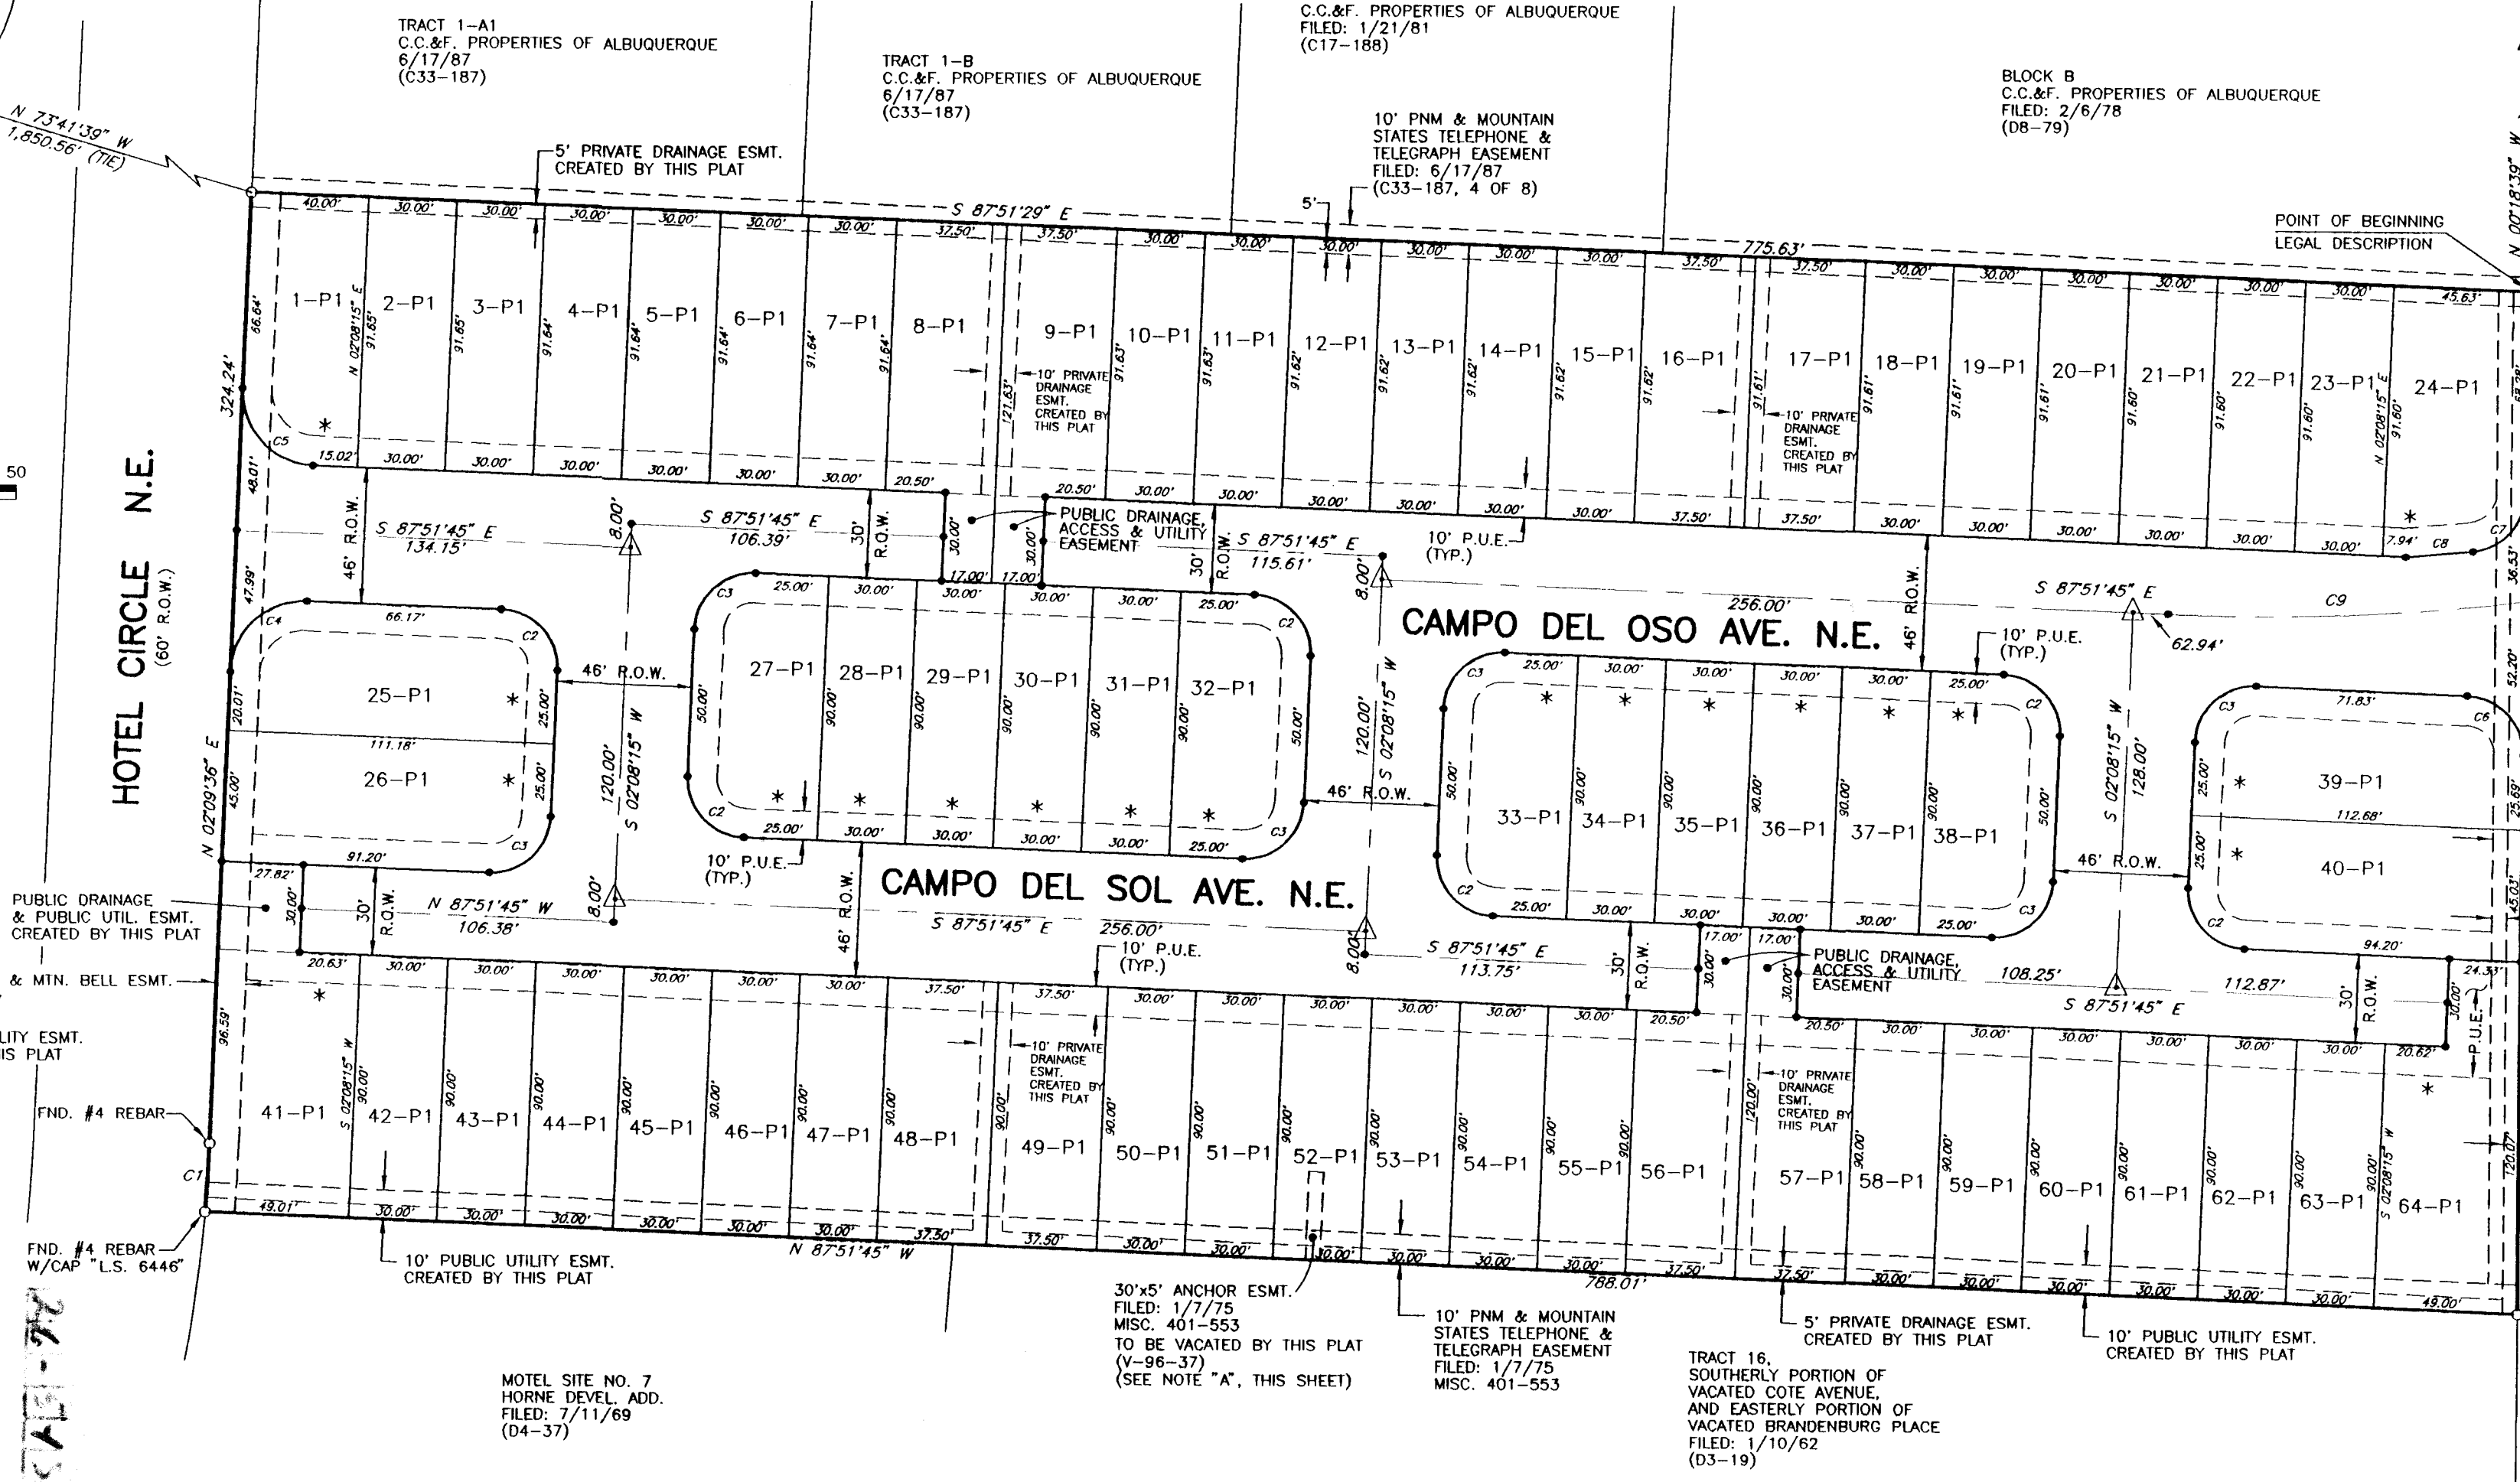

LOT AREAS
(SQUARE FEET)

1	3533	33	3878
2	2749	34	2700
3	2749	35	2700
4	2749	36	2700
5	2749	37	2700
6	2749	38	3878
7	2749	39	4871
8	3946	40	5019
9	3946	41	5202
10	2749	42	2700
11	2749	43	2700
12	2749	44	2700
13	2749	45	2700
14	2749	46	2700
15	2749	47	2700
16	3436	48	3375
17	3436	49	3375
18	2748	50	2700
19	2748	51	2700
20	2700	52	2700
21	2748	53	2700
22	2748	54	2700
23	2748	55	2700
24	4150	56	3885
25	4783	57	3895
26	4918	58	2700
27	3878	59	2700
28	2700	60	2700
29	2700	61	2700
30	2700	62	2700
31	2700	63	2700
32	3878	64	5018

CURVE	RADIUS	LENGTH	CHORD	BEARING	DELTA
C1	530.00'	23.42'	23.42'	N 03°25'31" E	02°31'55"
C2	20.00'	31.42'	28.28'	N 42°51'45" W	90°00'00"
C3	20.00'	31.42'	28.28'	N 47°08'15" E	90°00'00"
C4	25.00'	39.26'	35.35'	S 47°08'56" W	89°58'39"
C5	25.00'	39.26'	35.36'	S 42°51'04" E	90°01'21"
C6	20.00'	30.74'	27.80'	S 43°42'42" E	89°04'05"
C7	20.00'	29.27'	26.73'	S 42°08'09" W	83°51'37"
C8	231.37'	23.00'	23.00'	S 84°58'00" W	01°48'06"
C9	780.00'	146.81'	146.67'	N 86°31'14" E	11°13'22"

NOTE "A"
PNM ELECTRIC SERVICES EASEMENT RELEASE APPROVAL

PNM Electric Services hereby release, waive, quitclaim and discharge its right, title and interest in the easement (granted by prior plat, replat or document) shown to be vacated on this plat.

PNM ELECTRIC SERVICES

By _____


STATE OF NEW MEXICO }
COUNTY OF _____ } ss.

This instrument was acknowledged before me on _____ day of _____, 19____, by _____ of PNM Electric Services, being a New Mexico corporation, on behalf of said Corporation.

Notary Public _____
My Commission Expires: _____

SHEET 2 OF 2
937PS-BH

Plat & Survey By:
ALBUQUERQUE SURVEYING CO. INC., 2119 Menaul Blvd. N.E., Albuquerque, New Mexico 87107 Ph. (505) 884-2036

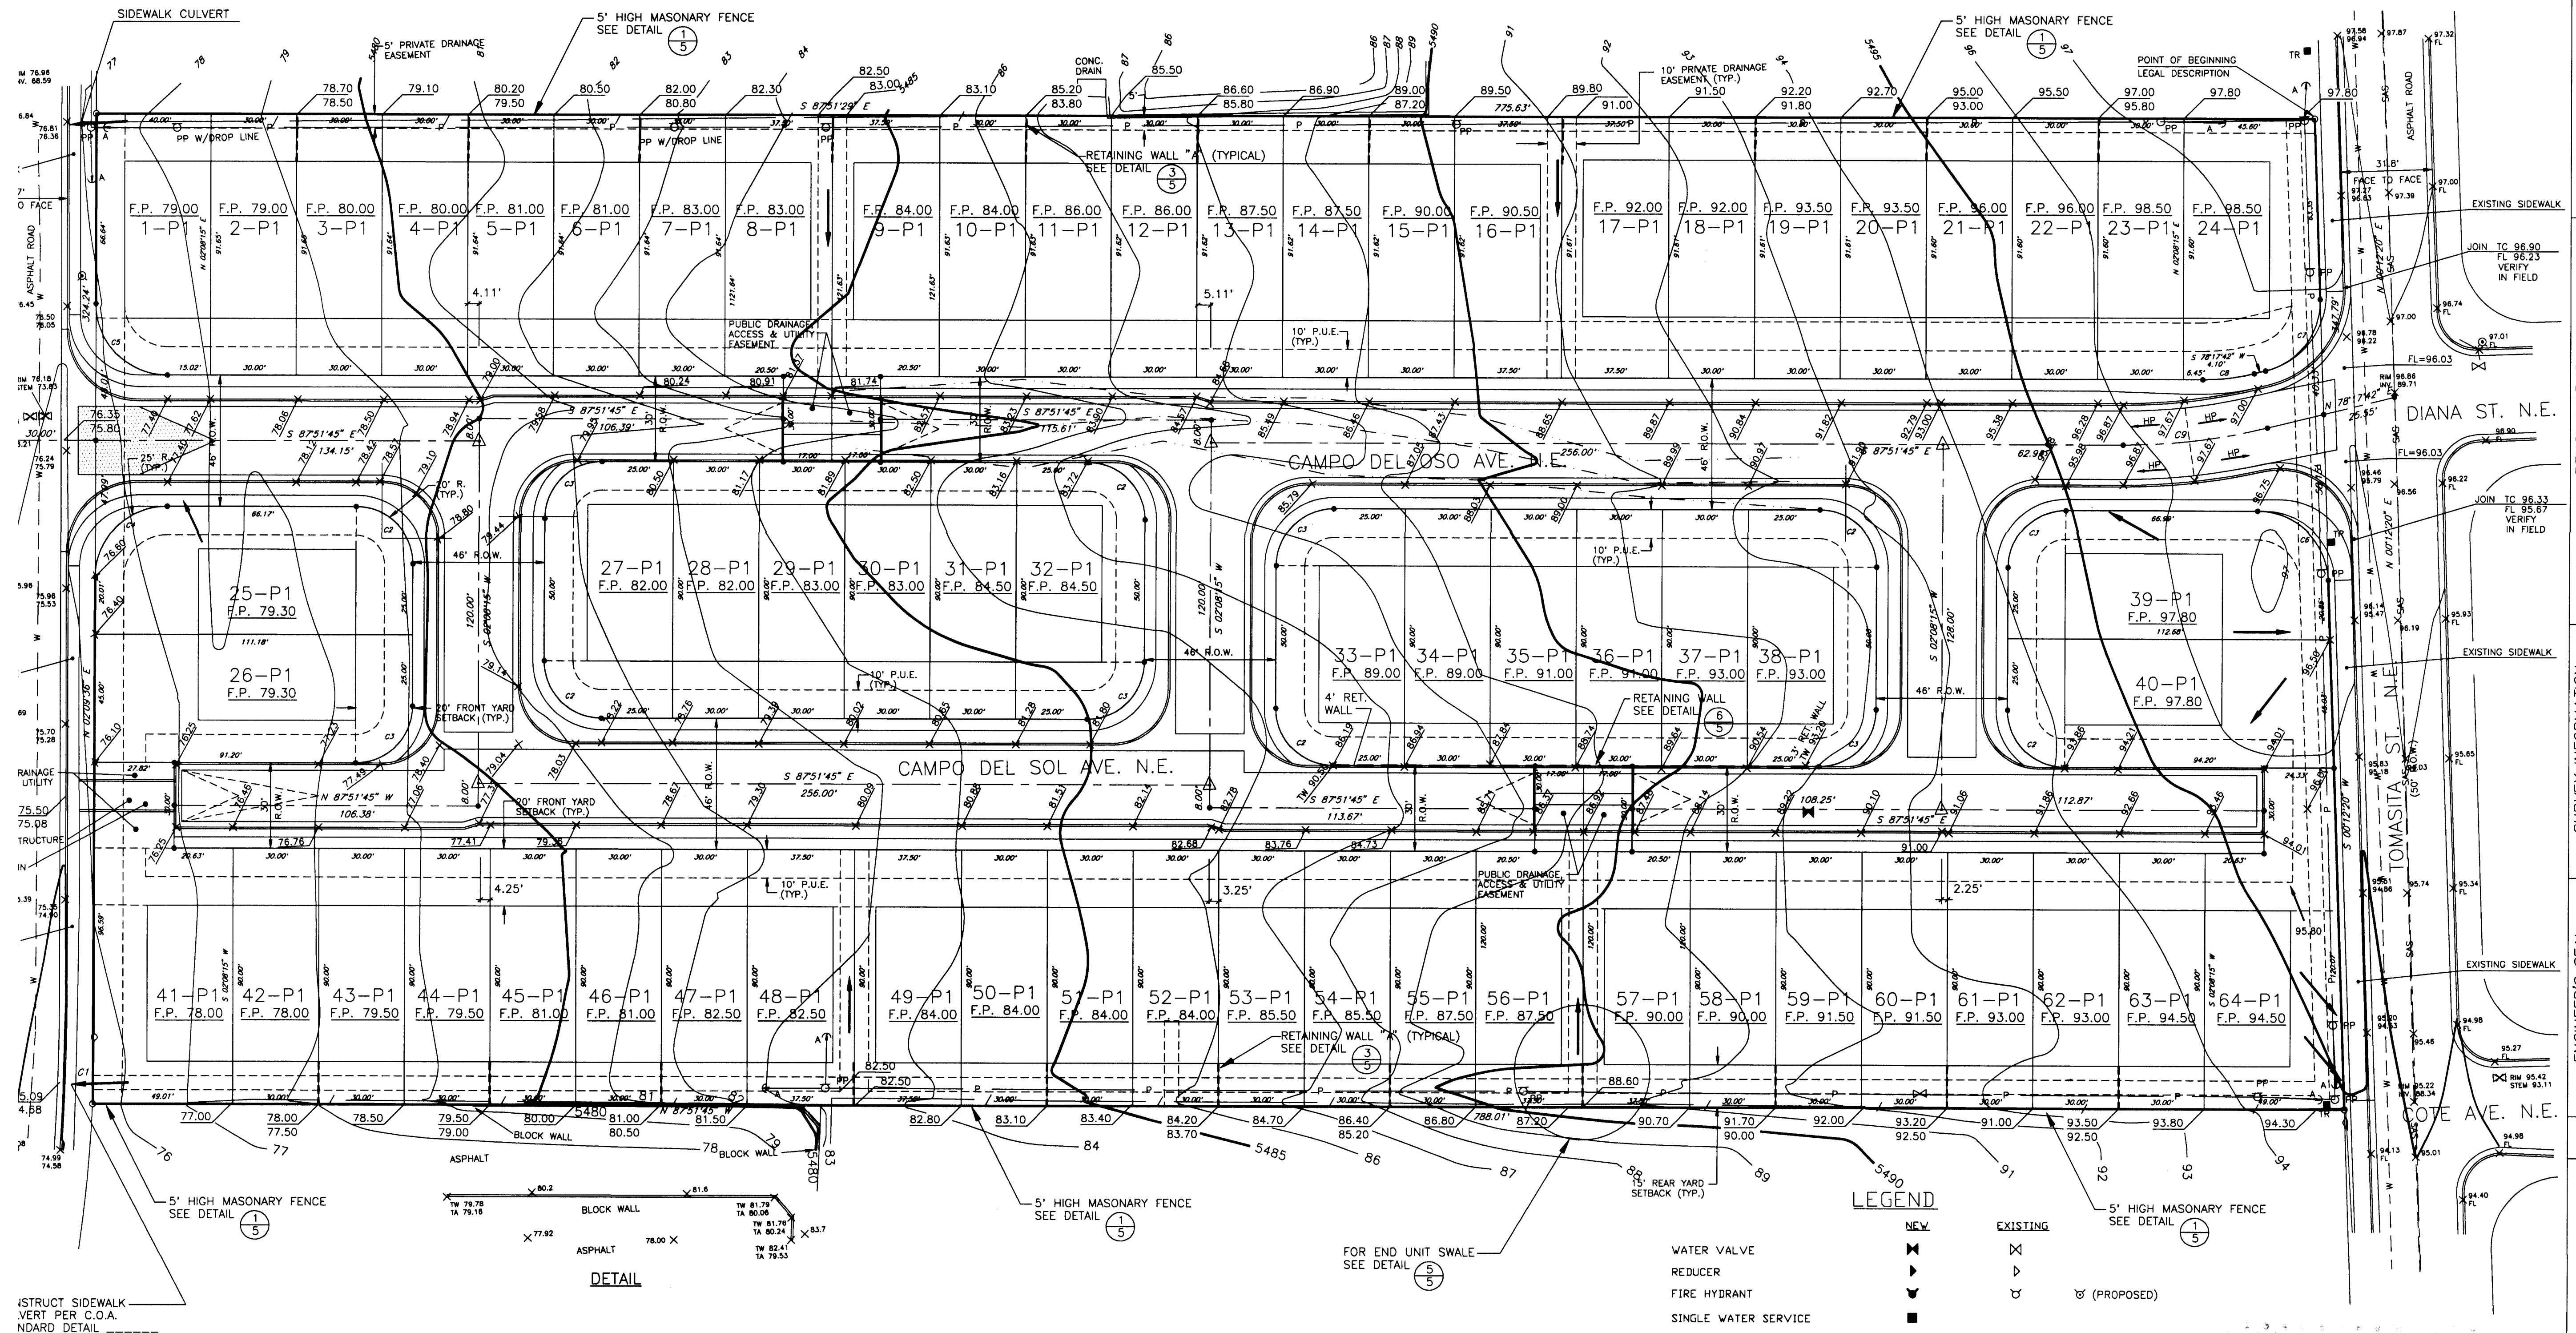

CURVE	RADIUS	LENGTH	CHORD	BEARING	DELTA
C1	750.00'	146.91'	146.67'	N 86°51'34" E	111°13'22"
C2	236.00'	112.30'	112.19'	N 87°45'59" E	08°44'31"
C3	20.00'	28.04'	28.58'	N 41°48'02" E	8°11'24"
C4	20.00'	30.85'	27.89'	N 46°19'54" E	89°21'18"
C5	264.00'	87.17'	87.12'	N 87°15'22" E	06°32'23"
C6	25.00'	39.26'	35.35'	N 47°08'55" E	89°58'39"
C7	20.00'	31.42'	28.28'	S 42°51'44" E	90°02'00"
C8	25.00'	39.28'	35.36'	S 42°51'05" E	90°01'21"
C9	20.00'	33.59'	29.78'	S 47°54'11" E	96°13'01"

- LEGEND
- | | |
|-----------------------------|-----------------------------|
| NEW | EXISTING |
| WATER VALVE | REDUCER |
| FIRE HYDRANT | SINGLE WATER SERVICE |
| DOUBLE WATER SERVICE | SANITARY SEWER MANHOLE |
| POWER POLE | ANCHOR |
| TELEPHONE RISER | TREE (DECIDUOUS) |
| OVERHEAD ELECTRIC CABLE | CHAIN LINK FENCE |
| ELEVATION AT FLOW LINE | ELEVATION ON HARD SURFACE |
| ELEVATION ON TOP OF CURB | ELEVATION AT FLOW LINE |
| ELEVATION ON TOP OF WALL | ELEVATION ON TOP OF ASPHALT |
| ELEVATION ON TOP OF CURB | ELEVATION AT FLOW LINE |
| 5' HIGH MASONRY FENCE | SEE DETAIL |
| RETAINING WALL "A" | SEE DETAIL |
| RETAINING WALL "B" | SEE DETAIL |
| FP = FINISHED PAD ELEVATION | |

26-5437.81 0397

APPROVED FOR ROUGH GRADING ± 1 FT.

CITY HYDROLOGY DATE

BOKAY CONSTRUCTION, INC.
ENGINEERING SERVICES CONSTRUCTION MANAGEMENT
5905 AZUL CT. NW
ALBUQUERQUE, NM 87120
(505) 899-9636

CITY OF ALBUQUERQUE
PUBLIC WORKS DEPARTMENT
ENGINEERING GROUP


TITLE: HOTEL CIRCLE
GRADING AND DRAINAGE PLAN

Design Review Committee City Engineers Approval


Approved @ DRB

City Project No. 543781 Zone Map No. K-21 Sheet 3 of 18


AS BUILT INFORMATION		BENCH MARKS		SURVEY INFORMATION		ENGINEER'S SEAL		REVISIONS		DESIGN		DATE		DATE	
WORKED BY	DATE	NO.	DATE	NO.	DATE	NO.	DATE	NO.	DATE	NO.	DATE	NO.	DATE	NO.	DATE
INSPECTED BY	DATE														
ACCEPTANCE BY	DATE														
VERIFICATION BY	DATE														
REVISIONS	DATE														
CORRECTED BY	DATE														
RECORDED BY	DATE														

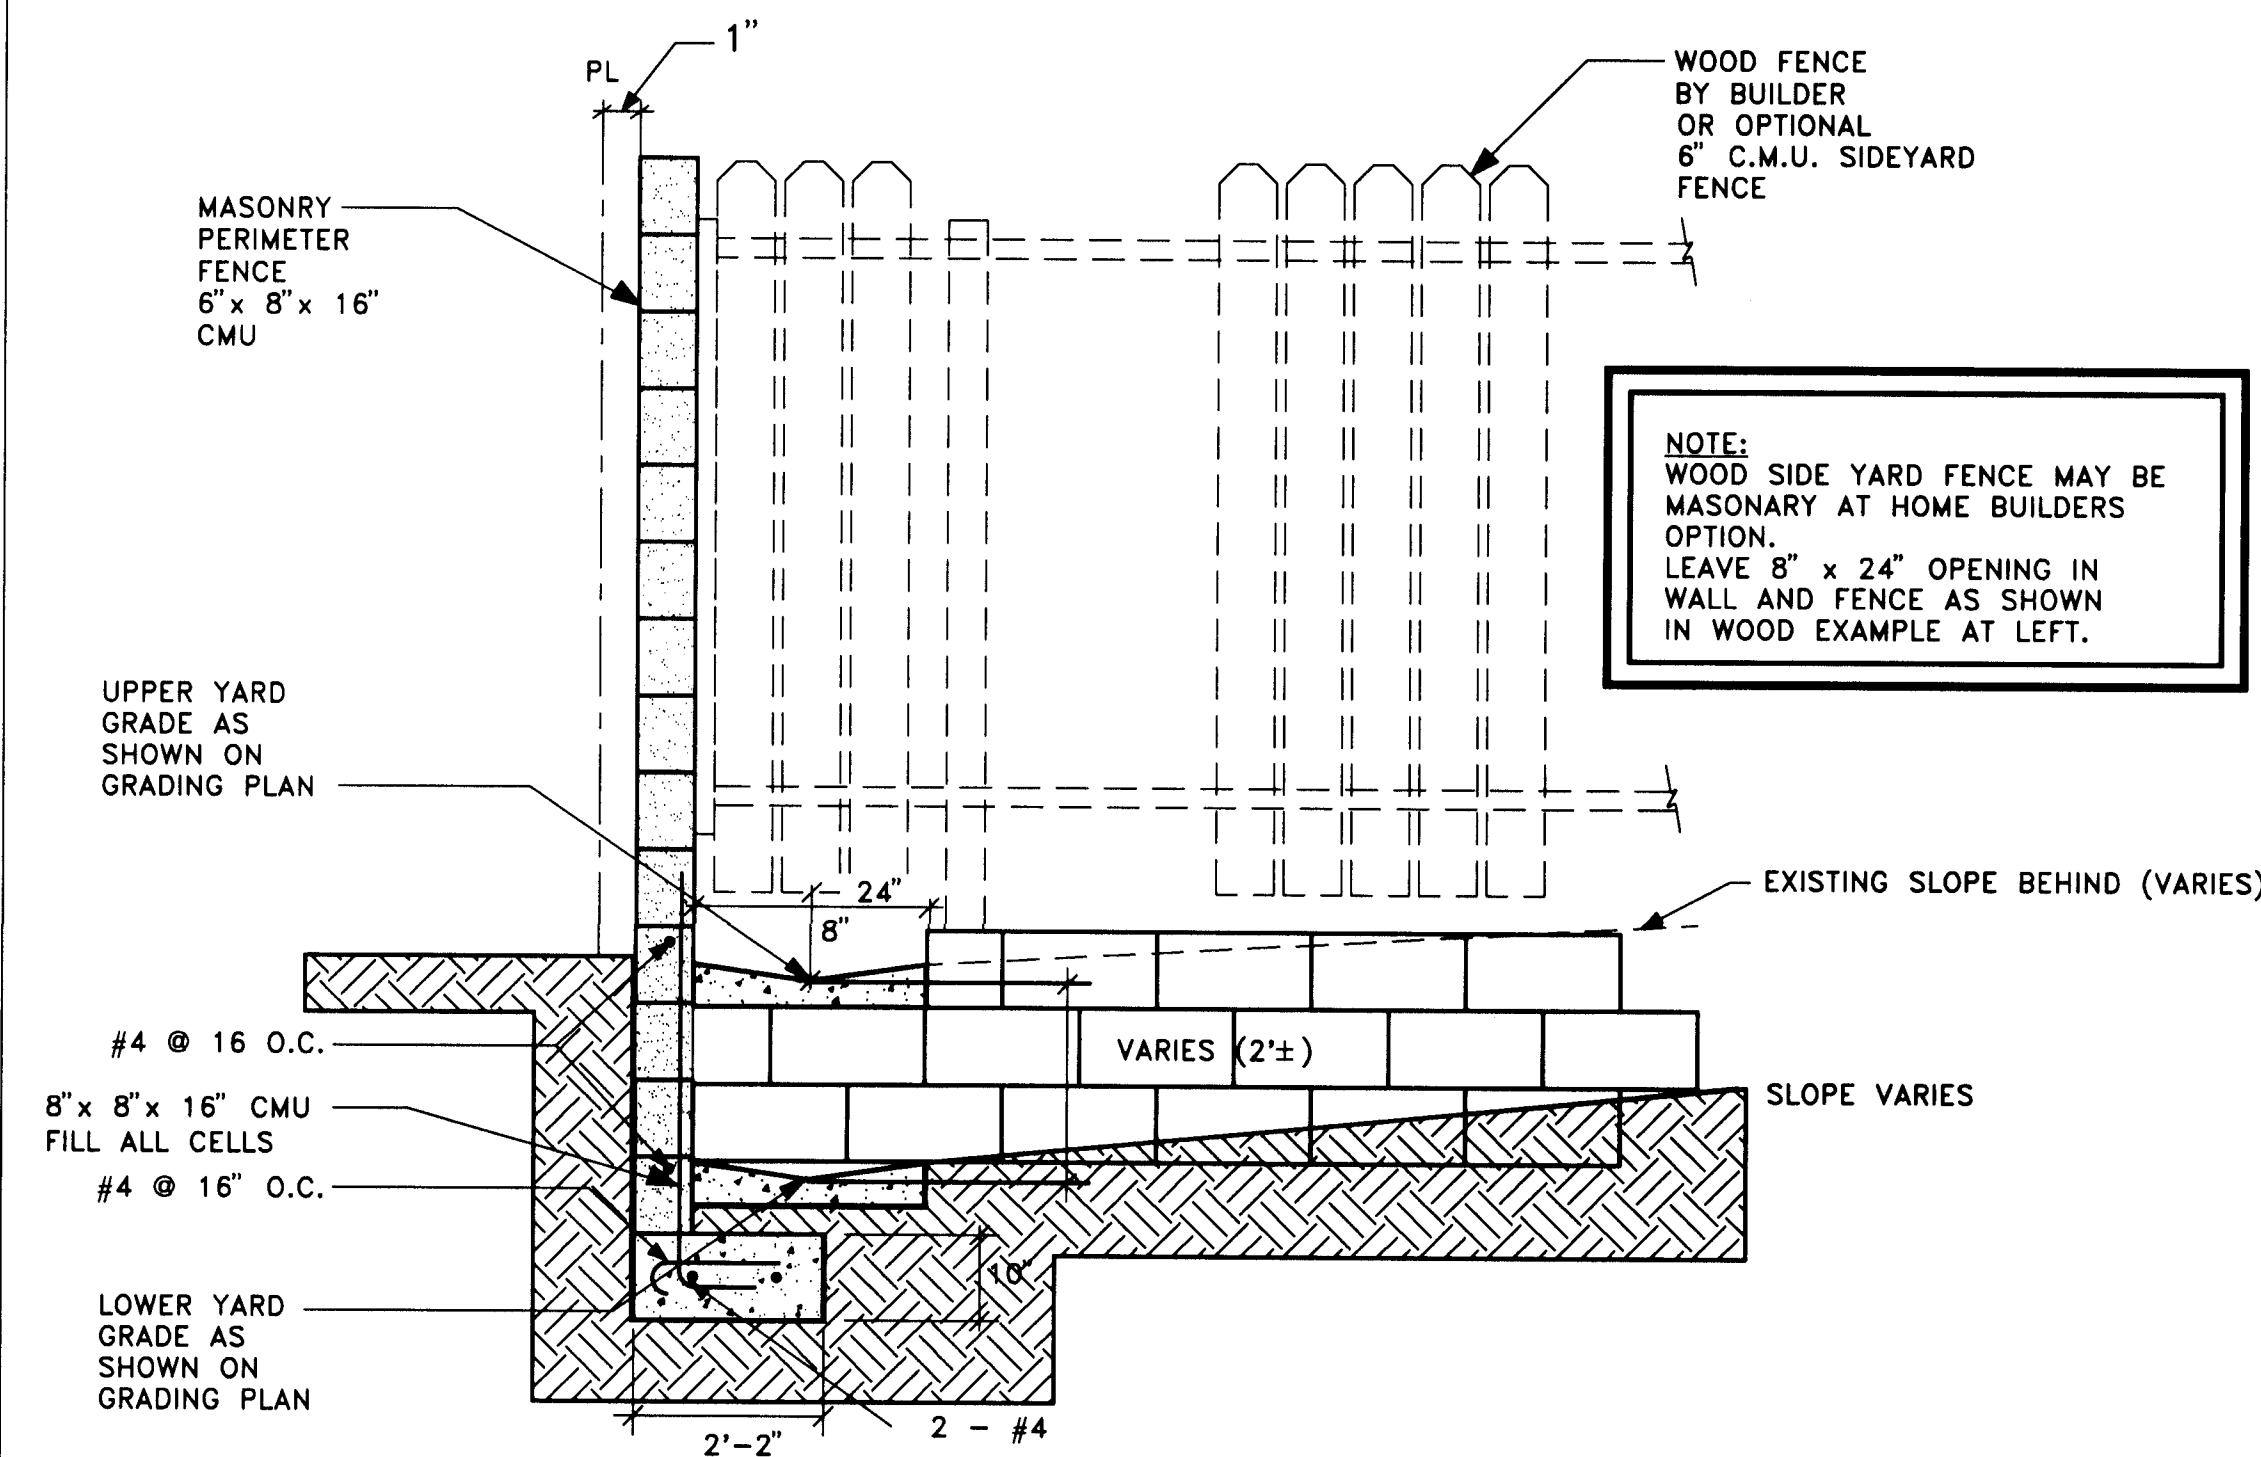


1 PERIMETER FENCE
5 NOT TO SCALE

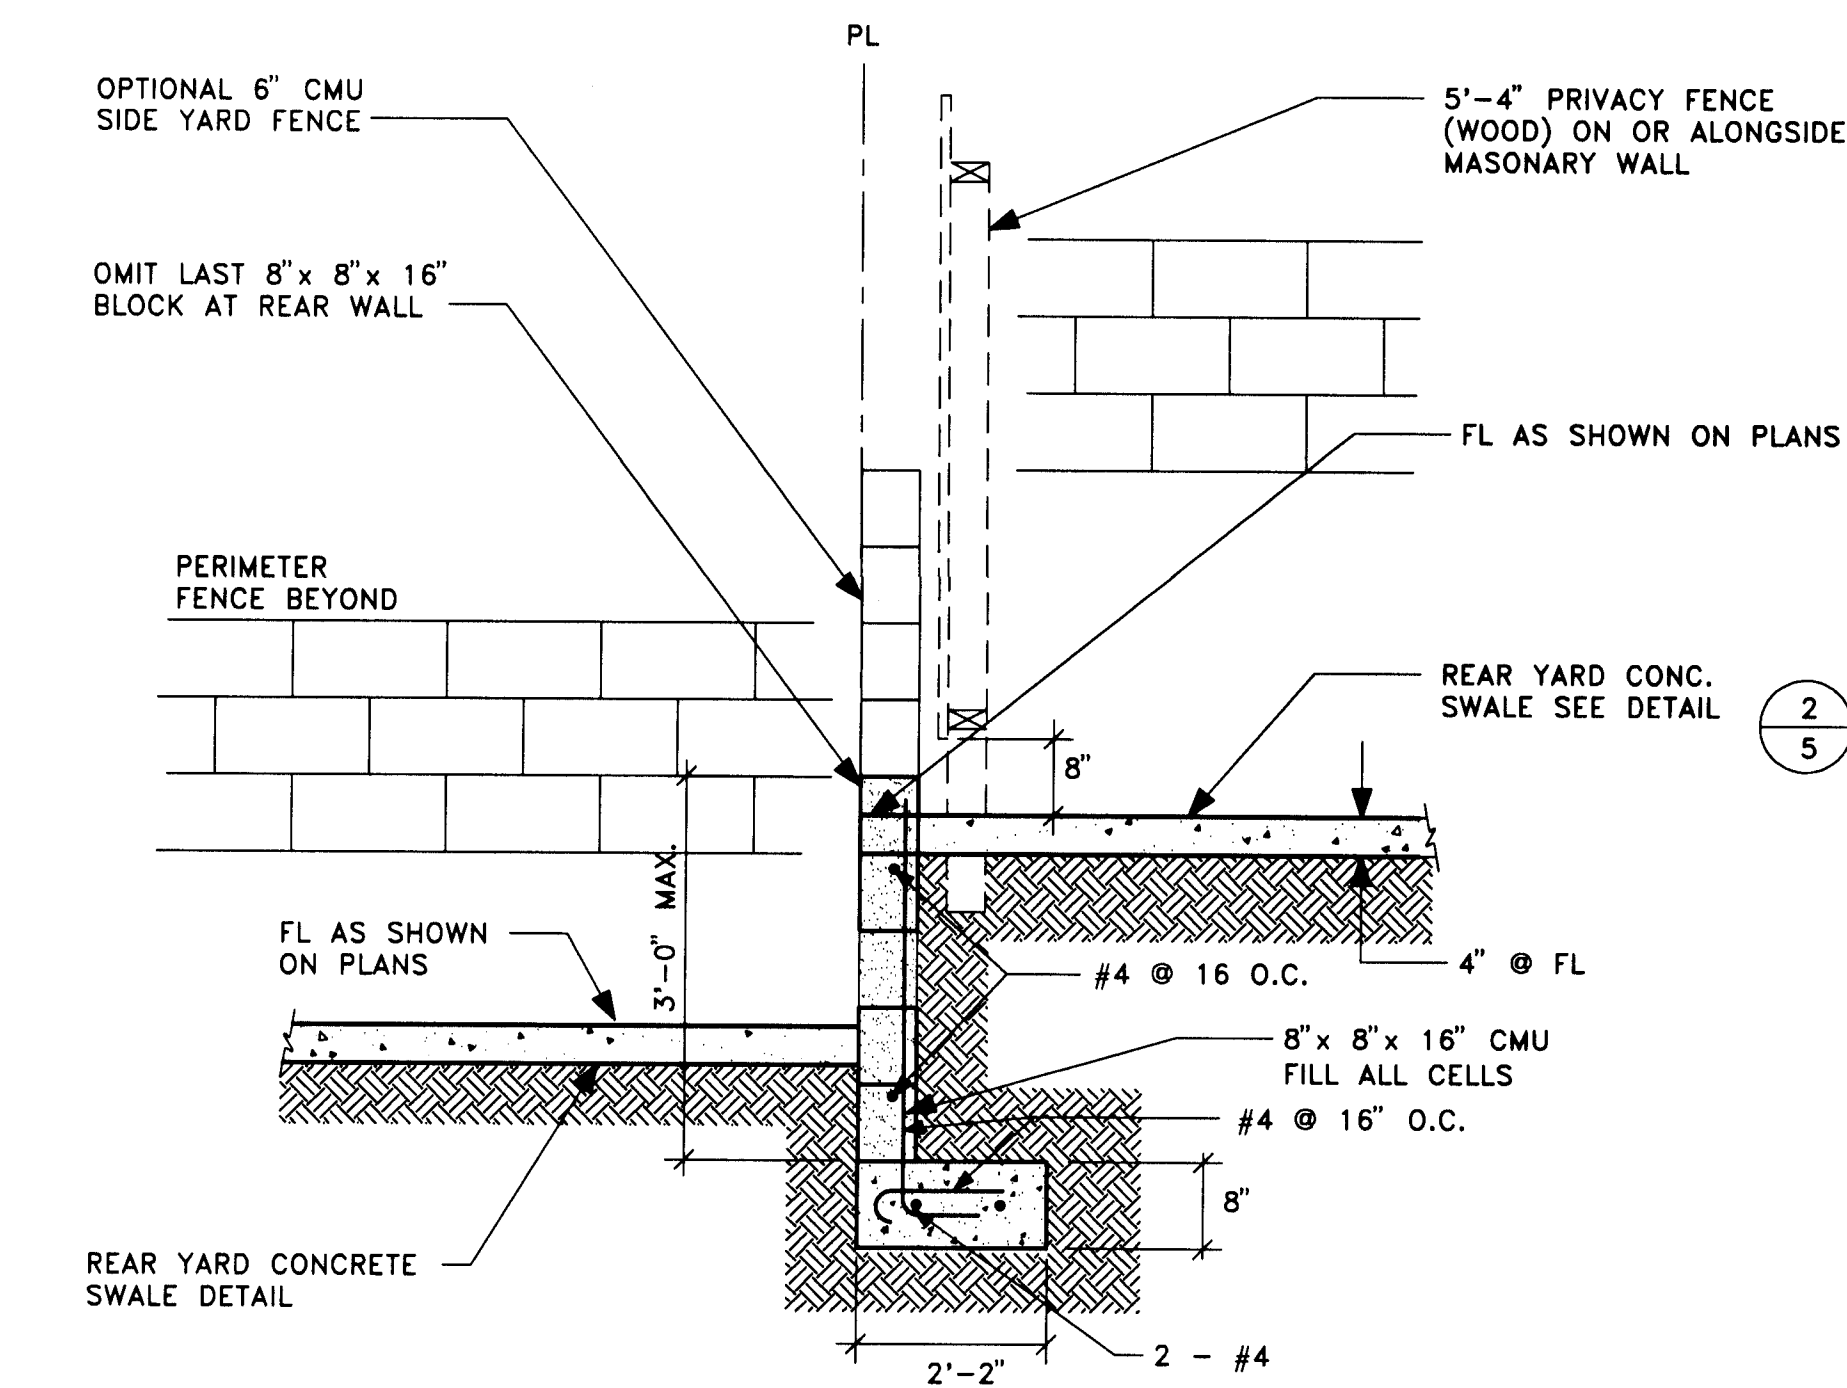


3 SIDE YARD RETAINING WALL
5 NOT TO SCALE

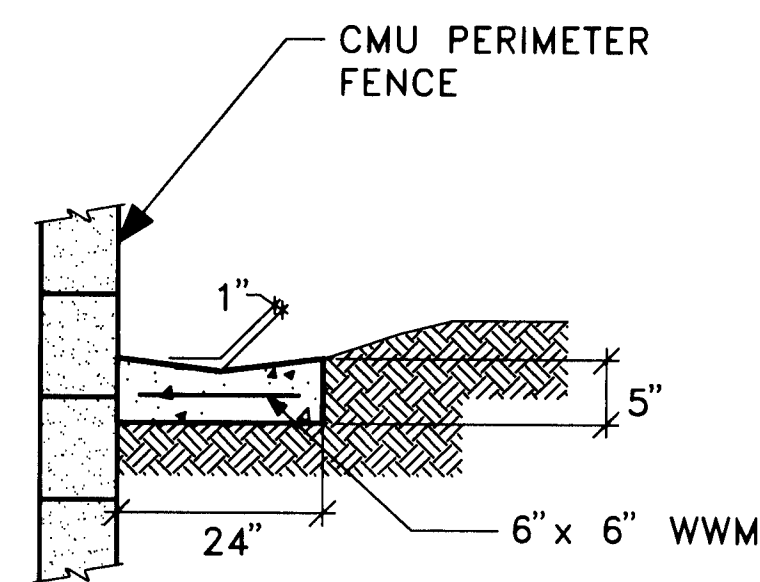


2 REAR YARD CONCRETE SWALE
5 (ALONG NORTH AND SOUTH PROPERTY LINE) NOT TO SCALE

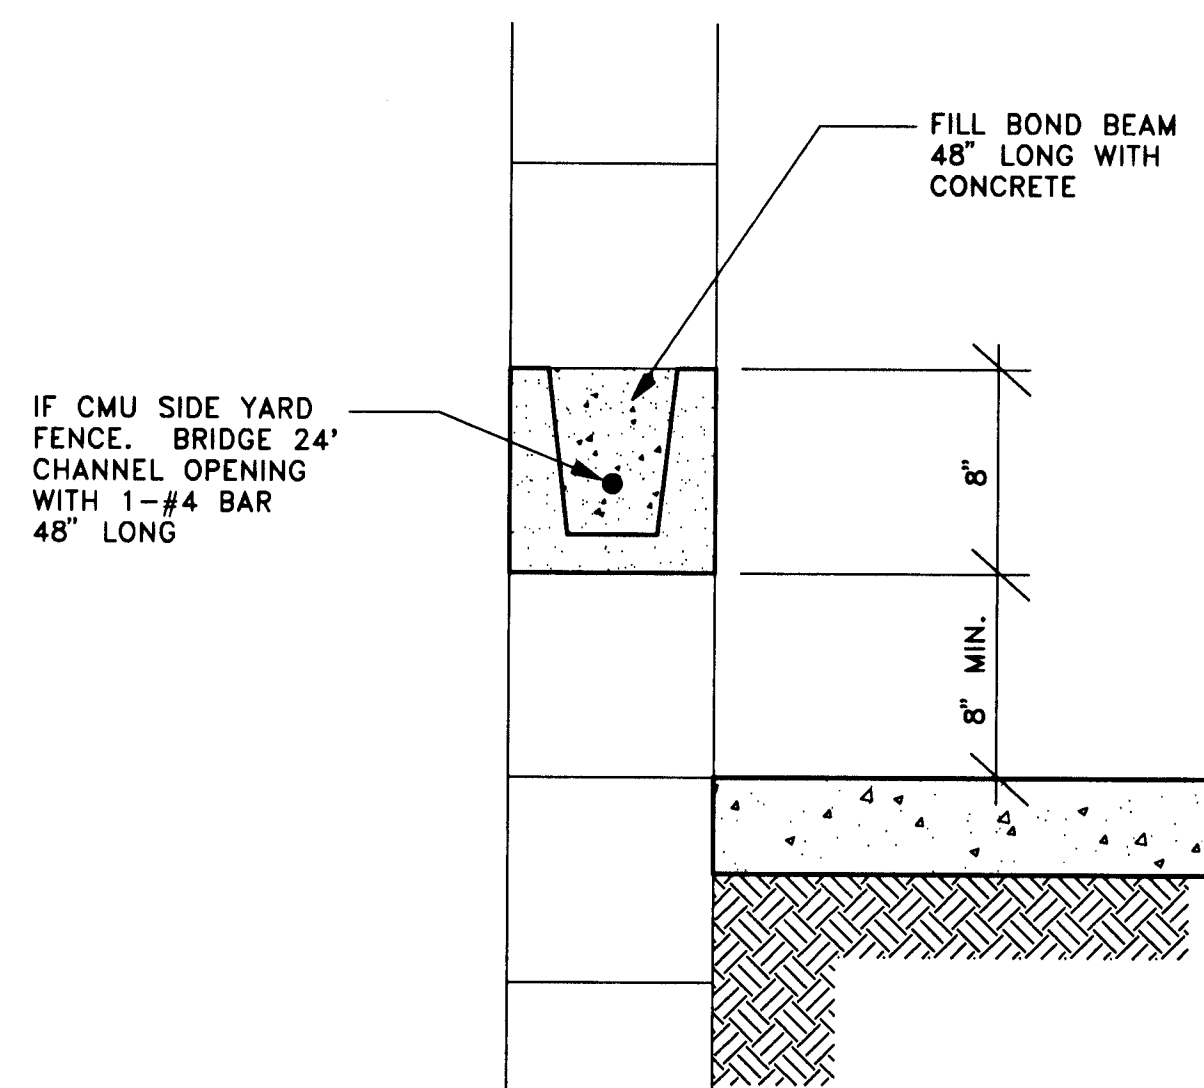


4 CONCRETE SIDE YARD SWALE
5 NOT TO SCALE

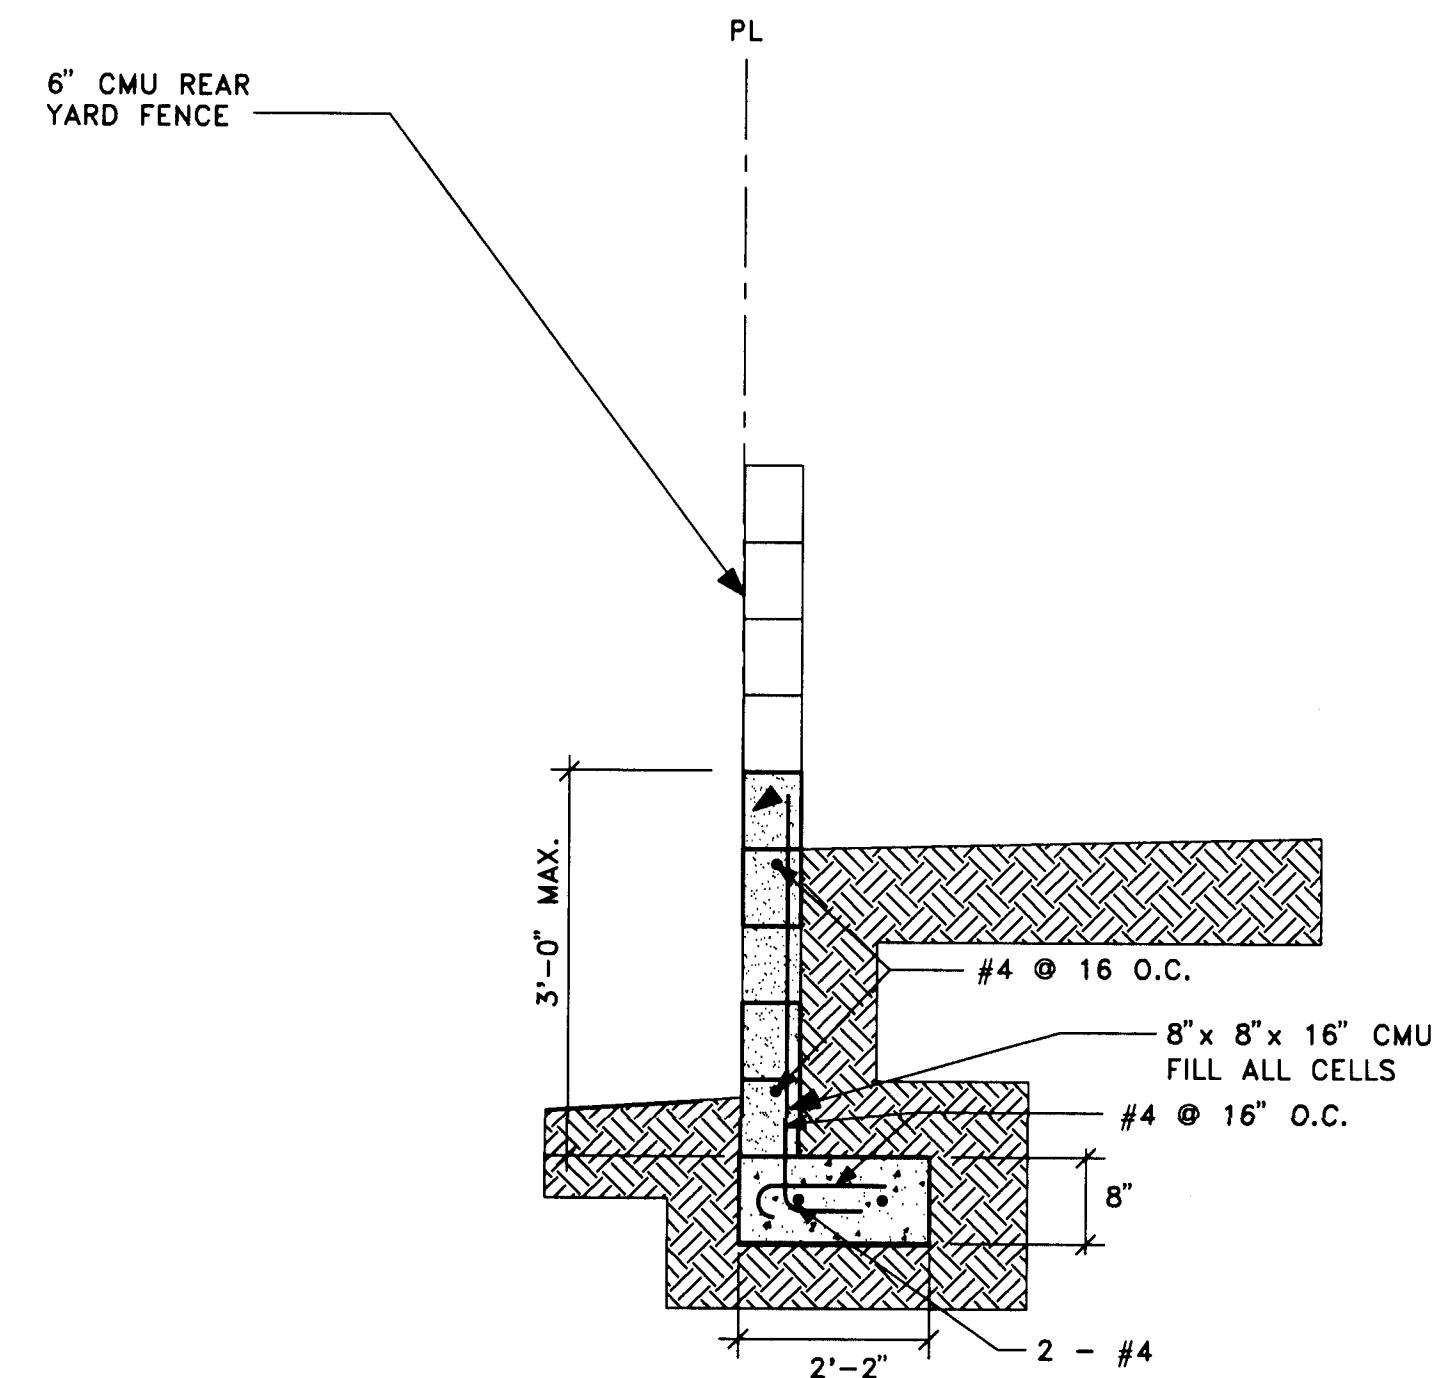

6 REAR YARD RETAINING WALL
5 NOT TO SCALE

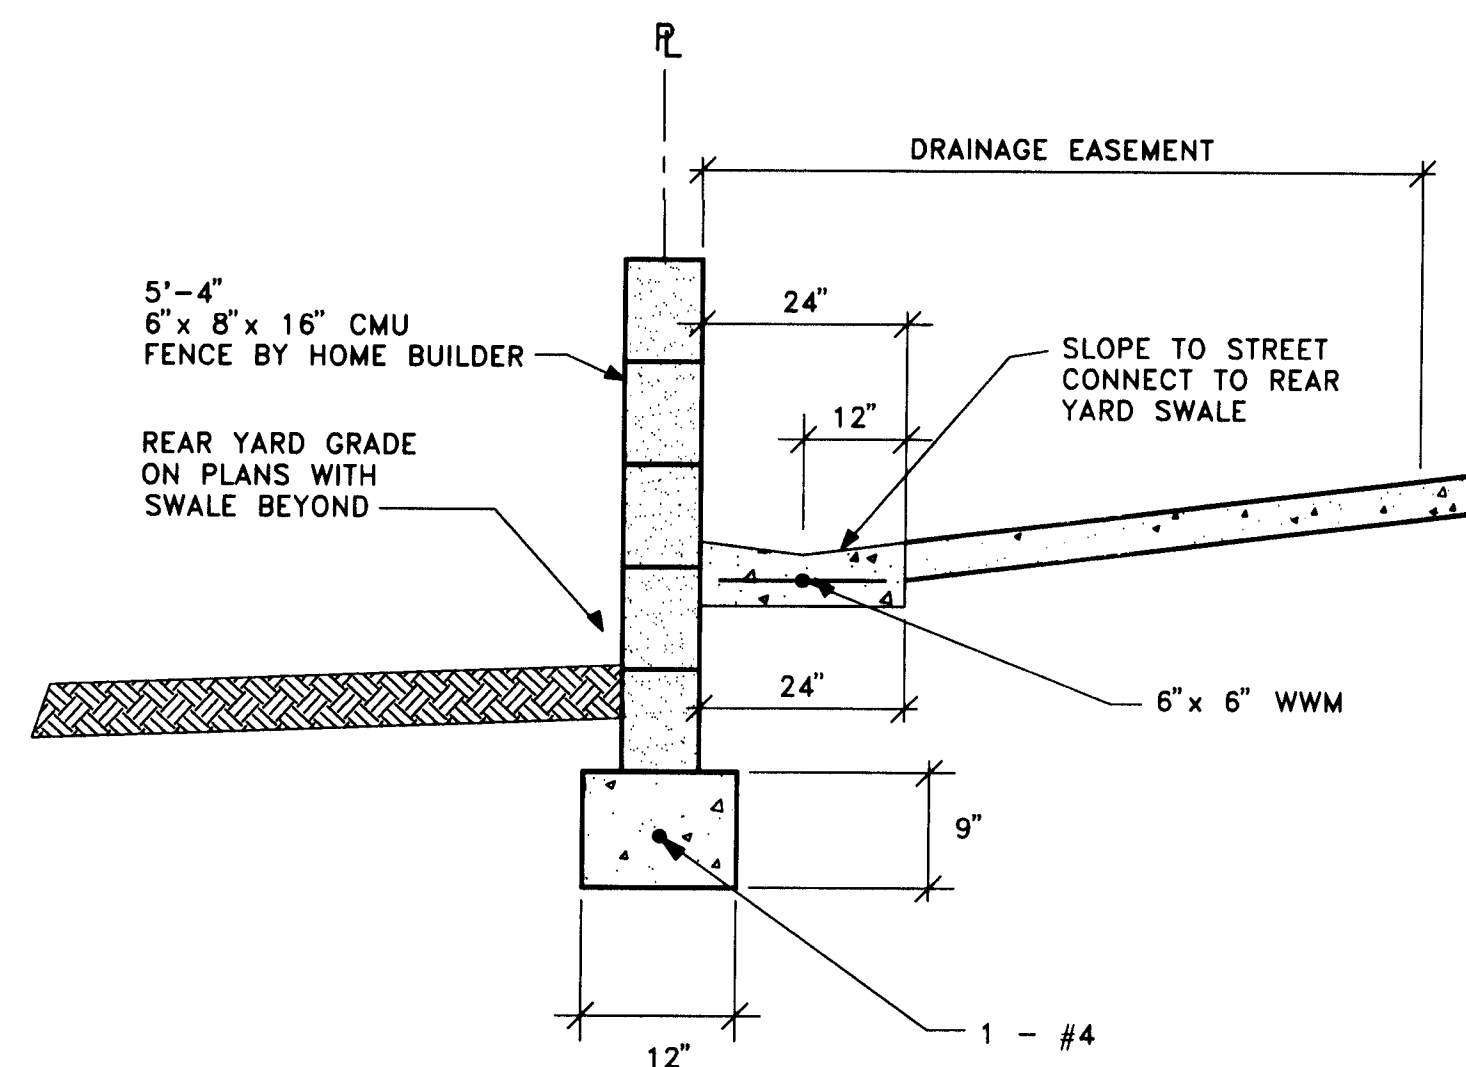

5 END UNIT SWALE DETAIL
5 NOT TO SCALE

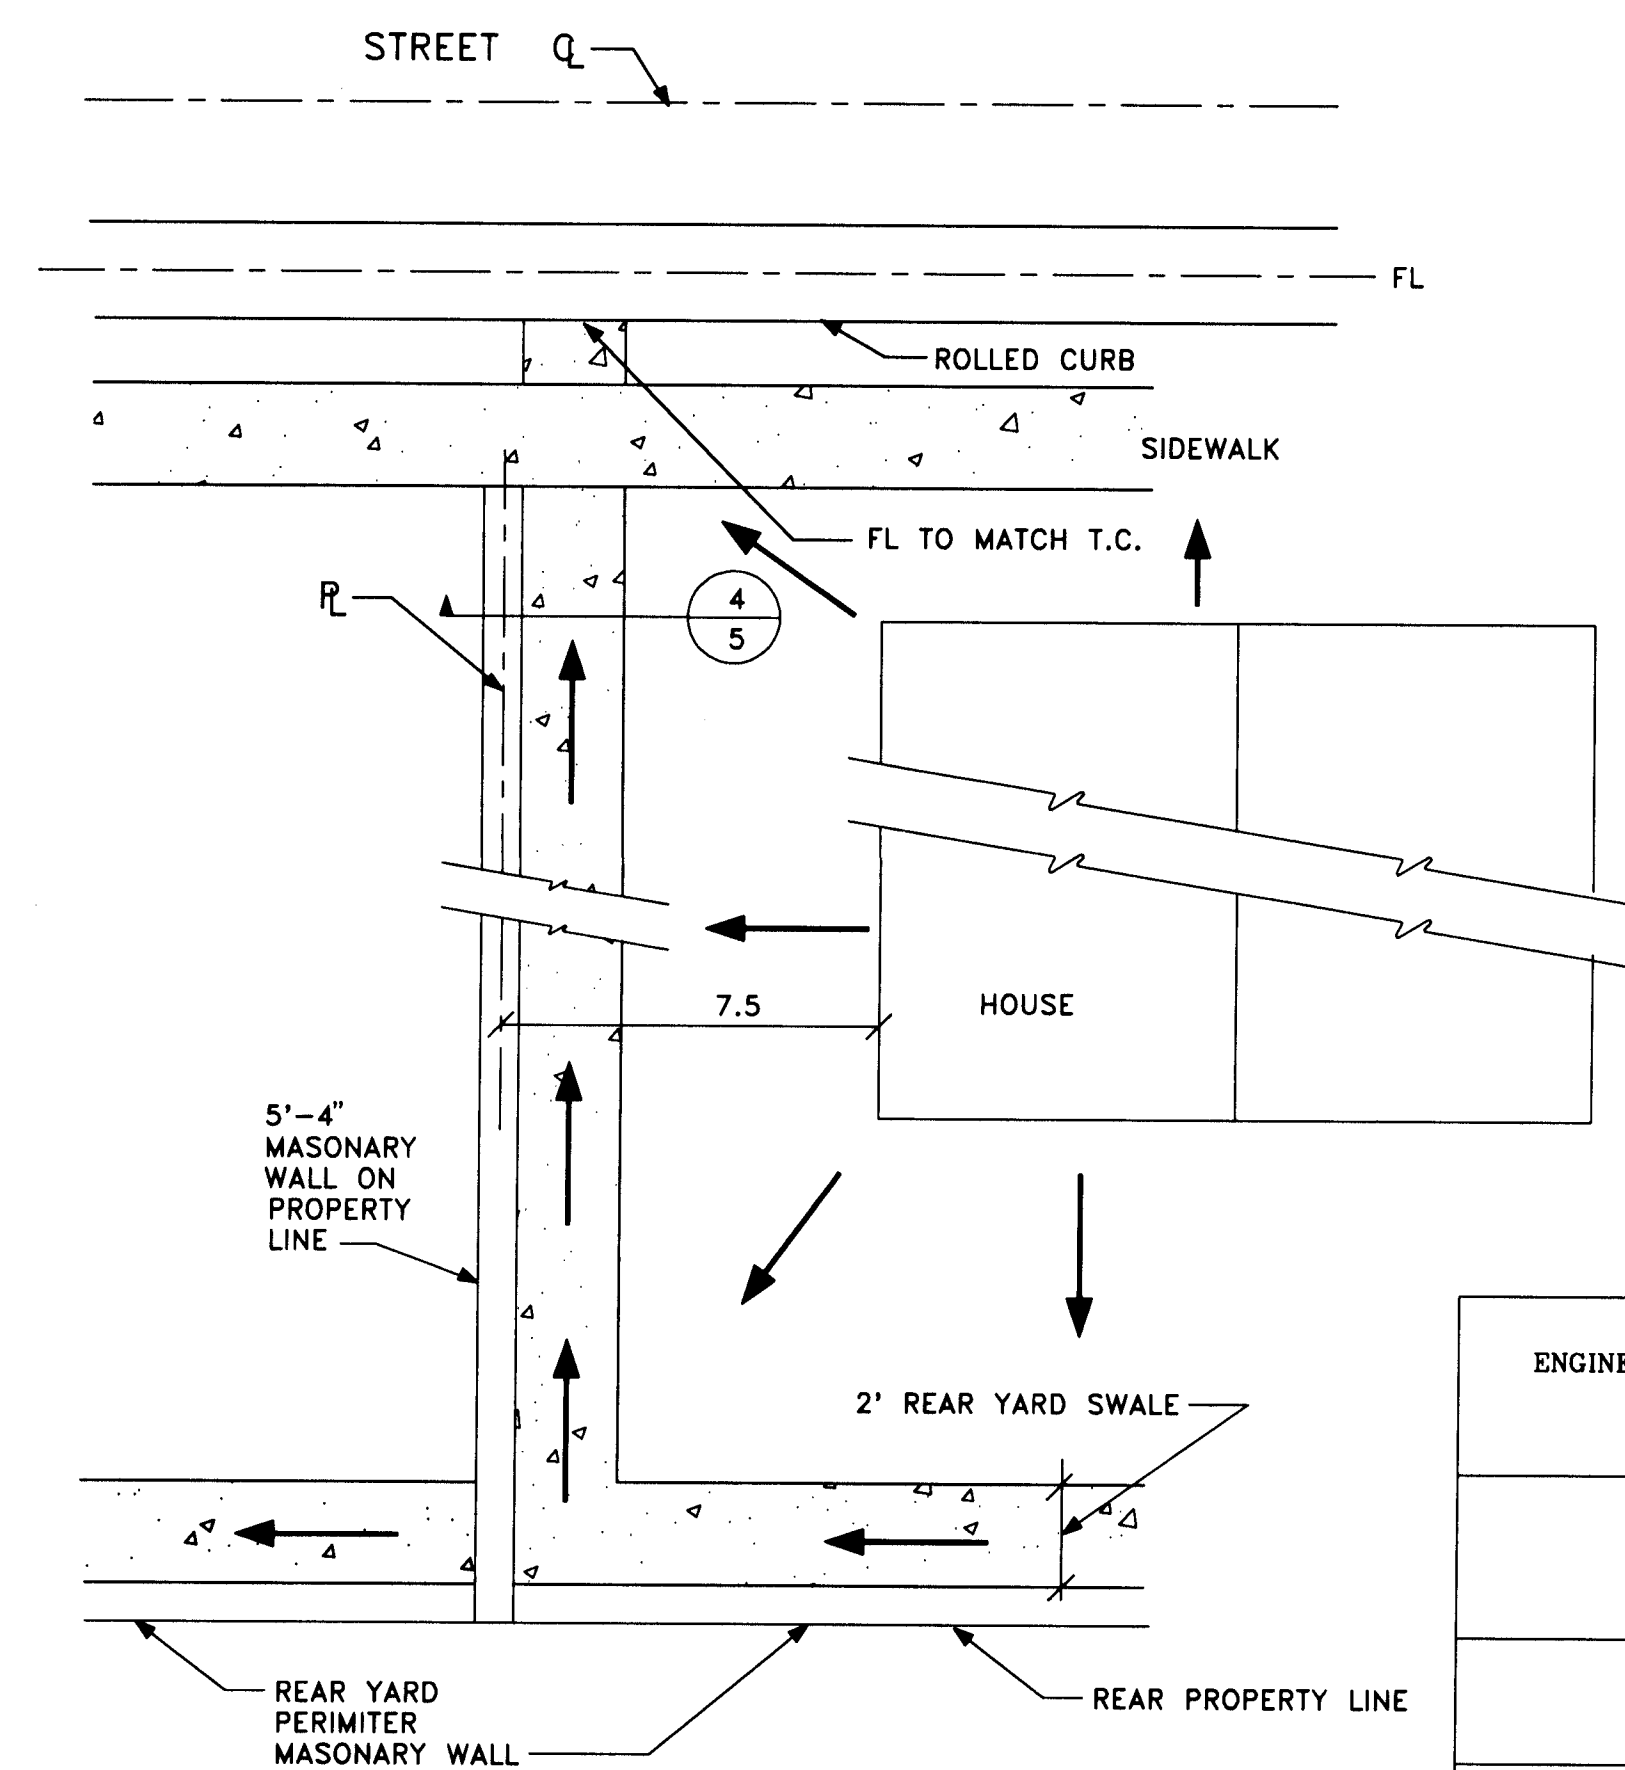


BOKAY CONSTRUCTION, INC.
ENGINEERING SERVICES CONSTRUCTION MANAGEMENT
5905 AZUELO CT. NW
ALBUQUERQUE, NM 87120
(505) 899-9656

CITY OF ALBUQUERQUE
PUBLIC WORKS DEPARTMENT
ENGINEERING GROUP


HOTEL CIRCLE
GRADING AND DRAINAGE DETAILS

Design Review Committee	City Engineers Approval	Mo/Day/Yr.	Mo/Day/Yr.
Approved @ DRB			
City Project No.	Zone Map No.	Sheet	Of
543781	K-21	4	18


AS BUILT INFORMATION	BENCH MARKS	SURVEY INFORMATION	FIELD NOTES	ENGINEER'S SEAL	REVISIONS	DESIGN	DATE
WORK SPACED BY DATE FIELD ACCEPTANCE BY DATE DRAWINGS CORRECTED BY DATE MICRO-FILM INFORMATION RECORDED BY DATE		NO.	BY	DATE	NO.	DATE	DATE
NO. 1							
NO. 2							
NO. 3							
NO. 4							
NO. 5							
NO. 6							
NO. 7							
NO. 8							
NO. 9							
NO. 10							

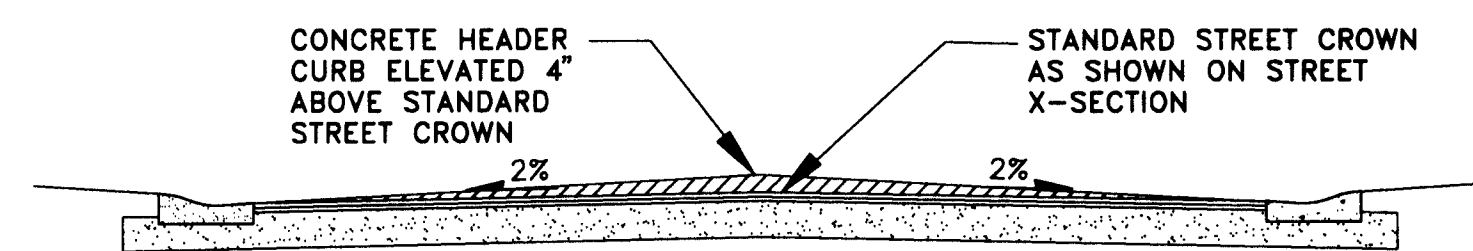


DRAINAGE RUNDOWN SECTION "A - A"
NOT TO SCALE

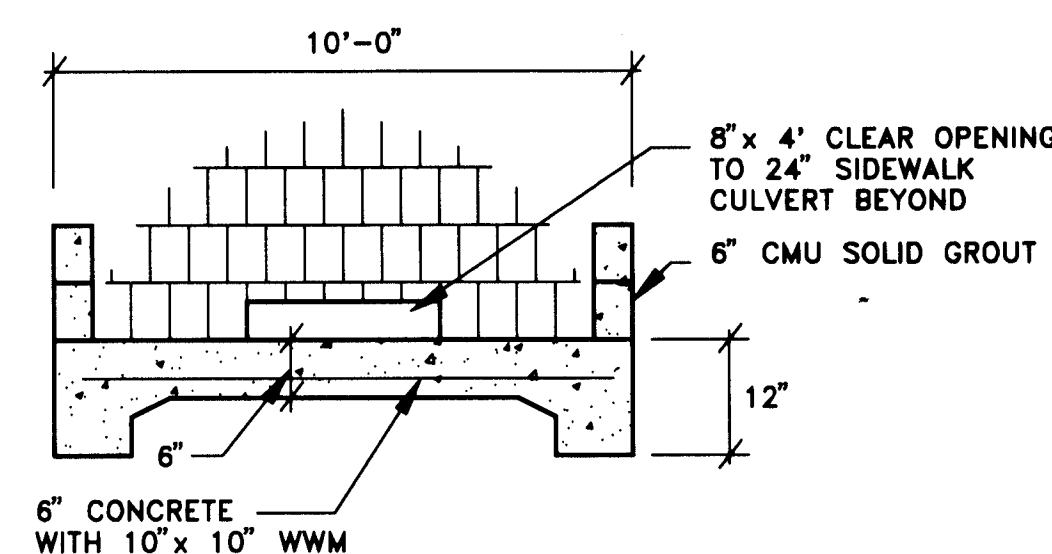


SECTION "B - B" SHT 11
NOT TO SCALE

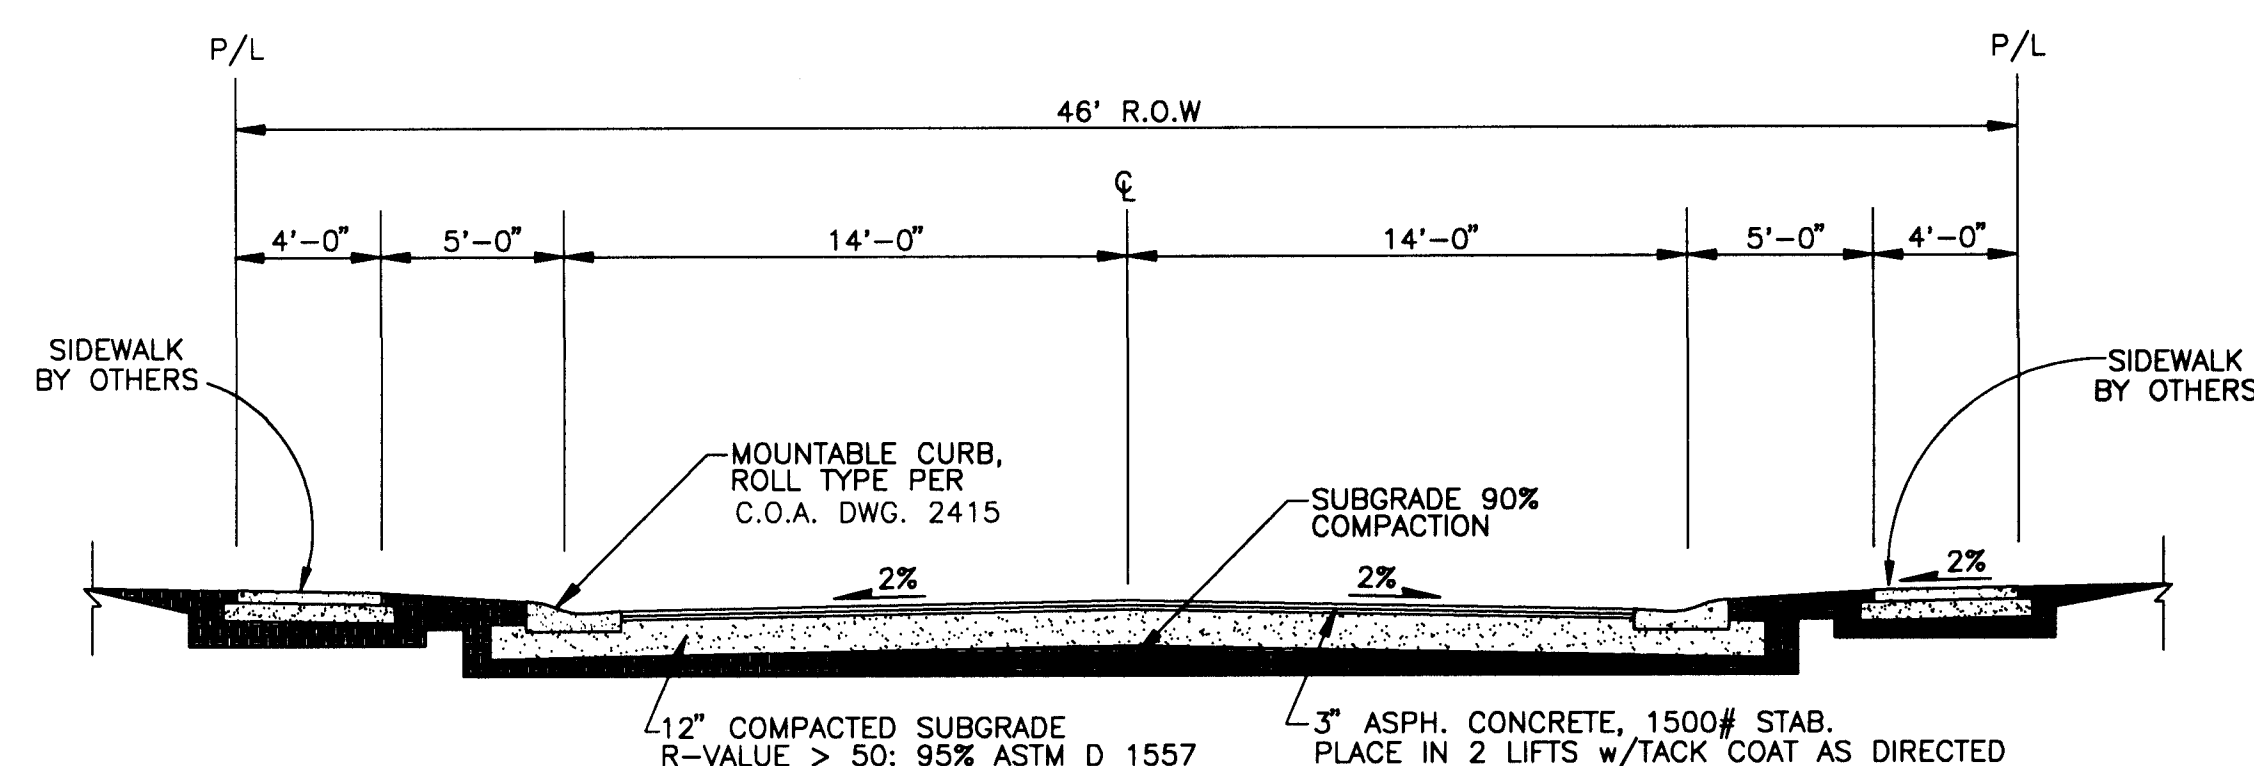

TYPICAL X-SECTION - 46' R.O.W.
NOT TO SCALE

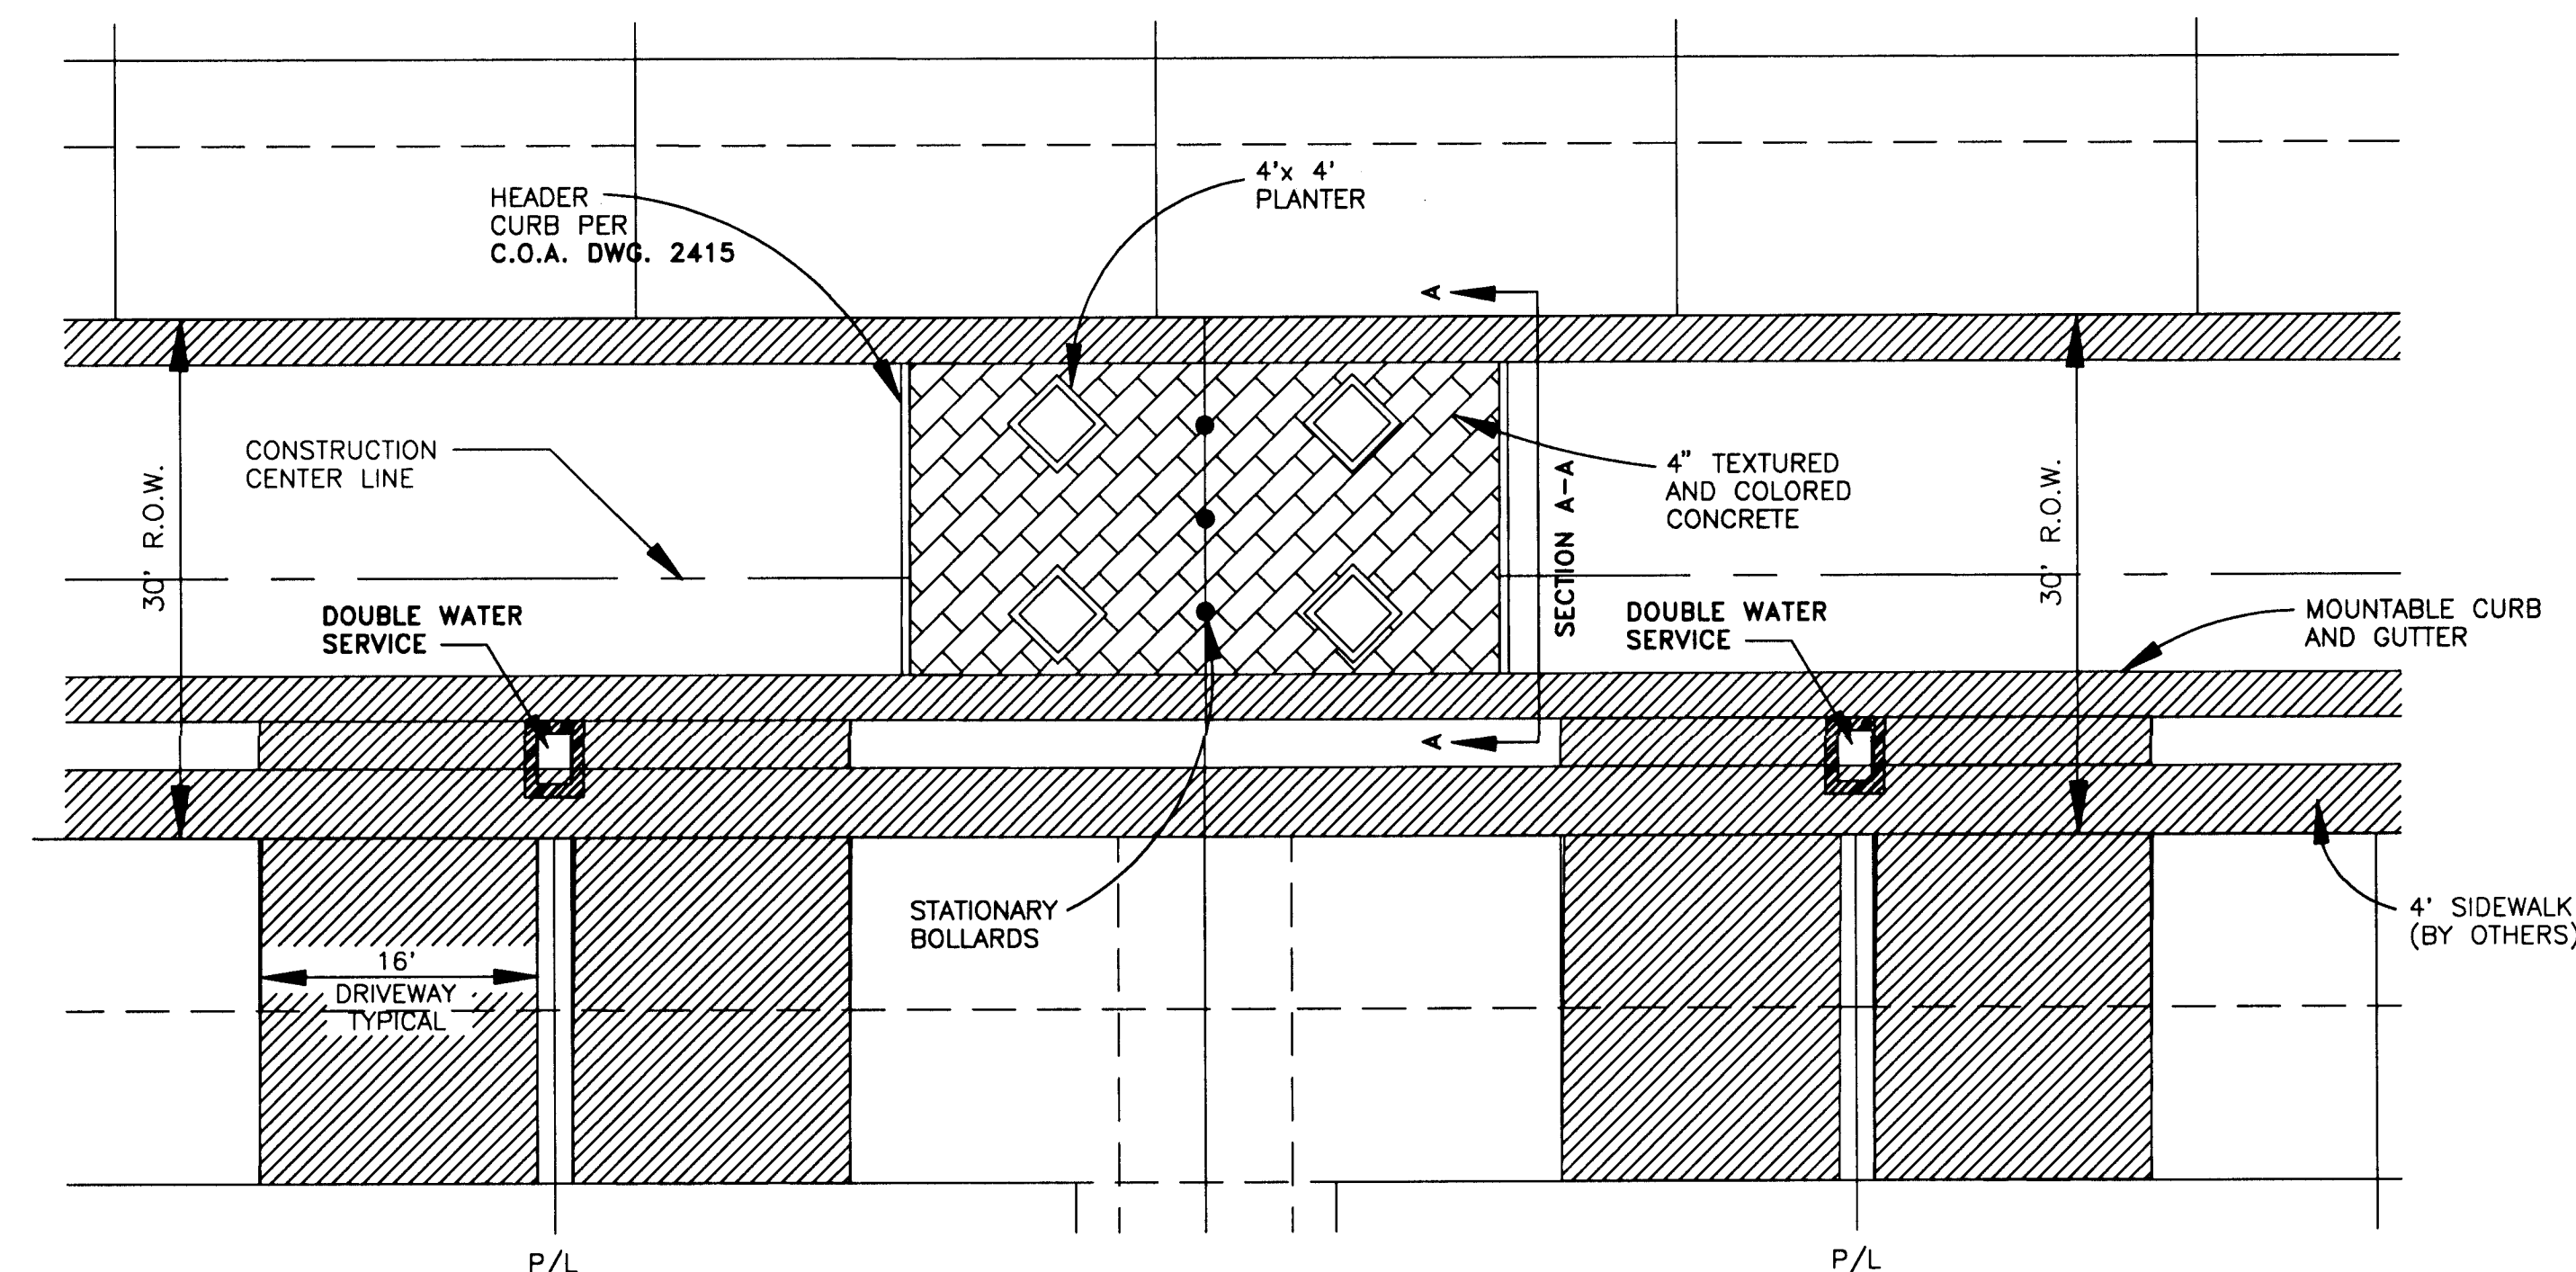

TYPICAL DETAIL @ 30' R.O.W. DEAD ENDS
SCALE: 1" = 10'-0"

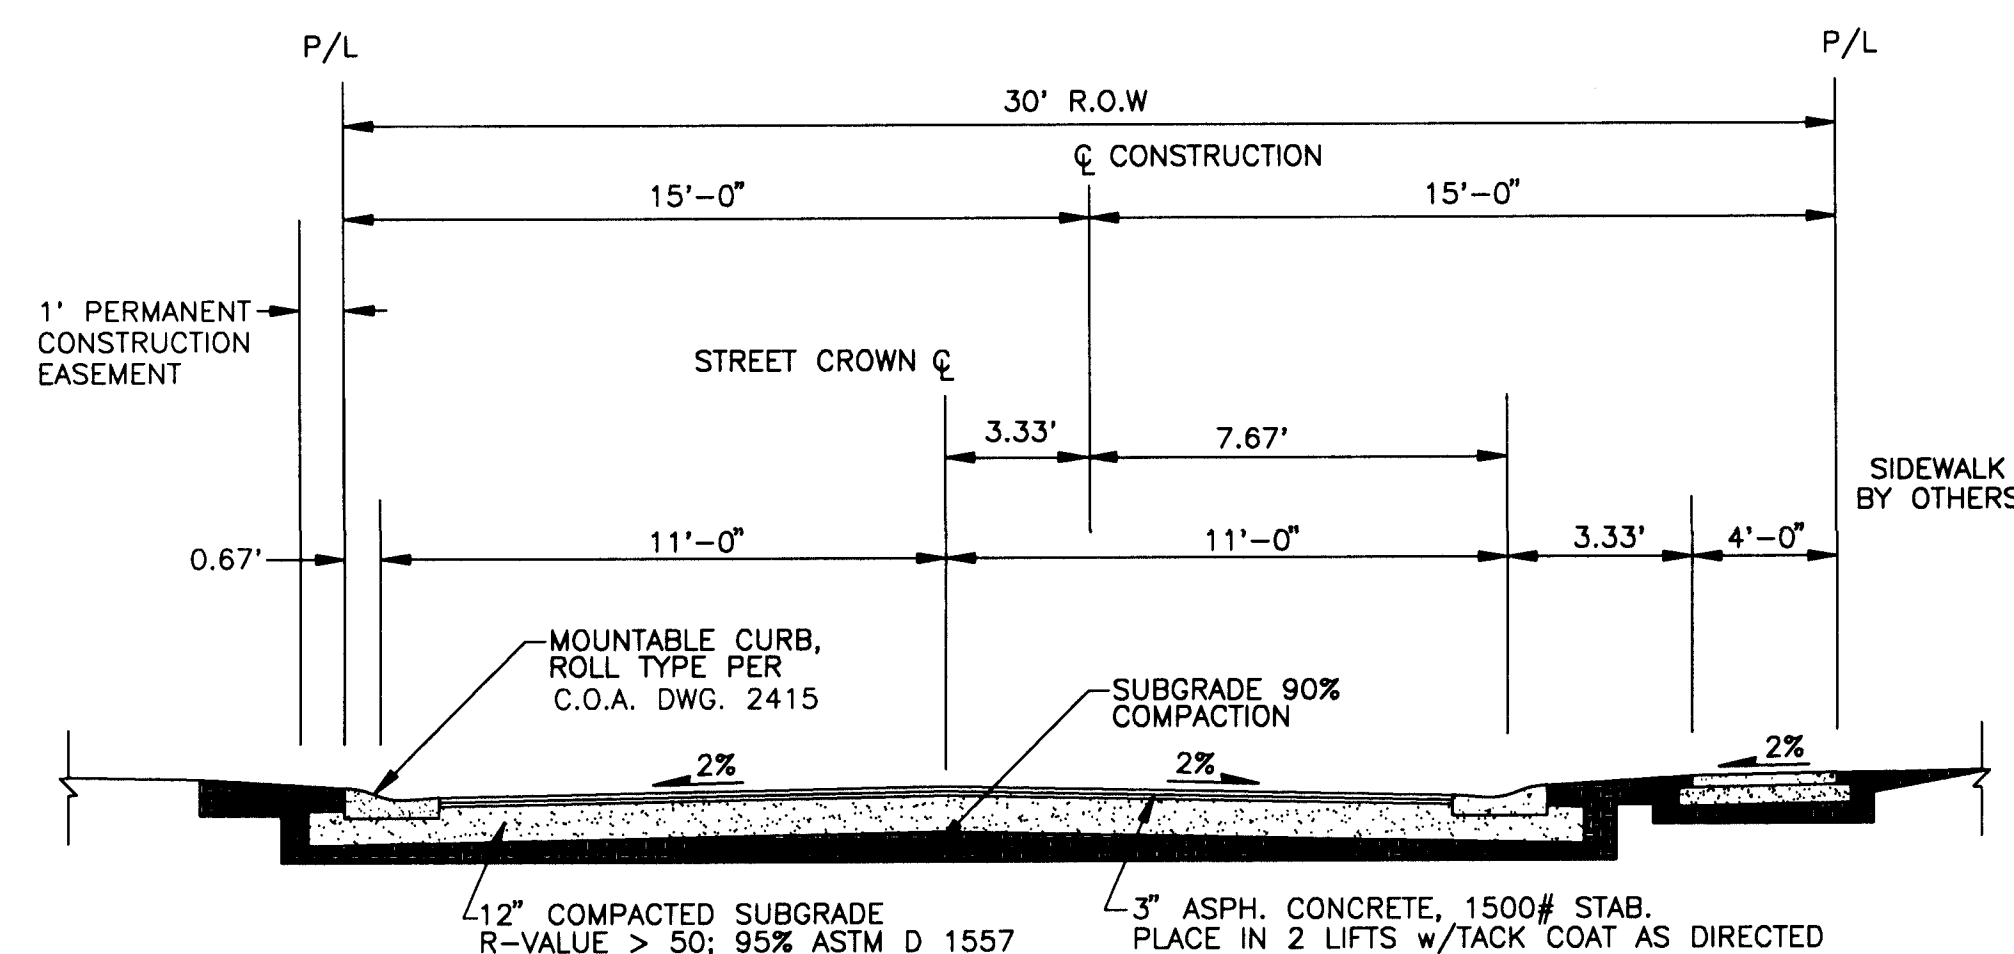

TYPICAL X-SECTION - 30' R.O.W.
NOT TO SCALE

AS BUILT INFORMATION		BENCH MARKS		SURVEY INFORMATION		ENGINEER'S SEAL	
DATE	DATE	DATE	DATE	DATE	DATE	DATE	DATE
8/98	8/98	1/99	1/99	1/99	1/99	1/99	1/99
INSPECTED BY	INSPECTED BY	INSPECTED BY	INSPECTED BY	INSPECTED BY	INSPECTED BY	INSPECTED BY	INSPECTED BY
C.O.A.	C.O.A.	C.O.A.	C.O.A.	C.O.A.	C.O.A.	C.O.A.	C.O.A.
FIELD	FIELD	FIELD	FIELD	FIELD	FIELD	FIELD	FIELD
VERIFIED BY	VERIFIED BY	VERIFIED BY	VERIFIED BY	VERIFIED BY	VERIFIED BY	VERIFIED BY	VERIFIED BY
C.O.A.	C.O.A.	C.O.A.	C.O.A.	C.O.A.	C.O.A.	C.O.A.	C.O.A.
DATE	DATE	DATE	DATE	DATE	DATE	DATE	DATE
2/99	2/99	2/99	2/99	2/99	2/99	2/99	2/99
MICRO-FILM INFORMATION		MICRO-FILM INFORMATION		MICRO-FILM INFORMATION		MICRO-FILM INFORMATION	
DATE	DATE	DATE	DATE	DATE	DATE	DATE	DATE
NO.	NO.	NO.	NO.	NO.	NO.	NO.	NO.



26-5437.81 0597

BOKAY CONSTRUCTION, INC.
ENGINEERING SERVICES CONSTRUCTION MANAGEMENT
5905 AZULEO CT. NW
ALBUQUERQUE, NM 87120
(505) 899-9656

CITY OF ALBUQUERQUE
PUBLIC WORKS DEPARTMENT
ENGINEERING GROUP

TITLE: LOS CAMPOS
STREET X-SECTIONS AND MISC DETAILS



City Engineers Approval


Last Design Update

Mo/Day/Yr.	Mo/Day/Yr.

City Project No. 543781 Zone Map No. K-21 Sheet 5 of 18

SCANNED BY -
BY LASHAW


CURVE	RADIUS	LENGTH	CHORD	BEARING	DELTA
C1	750.00'	146.91'	146.67'	N 86°31'34" E	11°13'22"
C2	736.00'	112.30'	112.19'	N 87°45'59" E	08°44'13"
C3	40.00'	26.04'	26.55'	N 41°48'02" E	85°11'24"
C4	20.00'	30.85'	27.88'	N 48°19'54" E	88°23'18"
C5	764.00'	87.17'	87.12'	N 87°15'22" E	08°33'23"
C6	25.00'	36.26'	35.35'	N 47°08'55" E	89°58'39"
C7	20.00'	31.42'	28.28'	S 42°51'45" E	90°00'00"
C8	25.00'	39.28'	35.36'	S 42°51'03" E	90°01'21"
C9	20.00'	33.59'	28.78'	S 47°24'11" E	96°13'01"

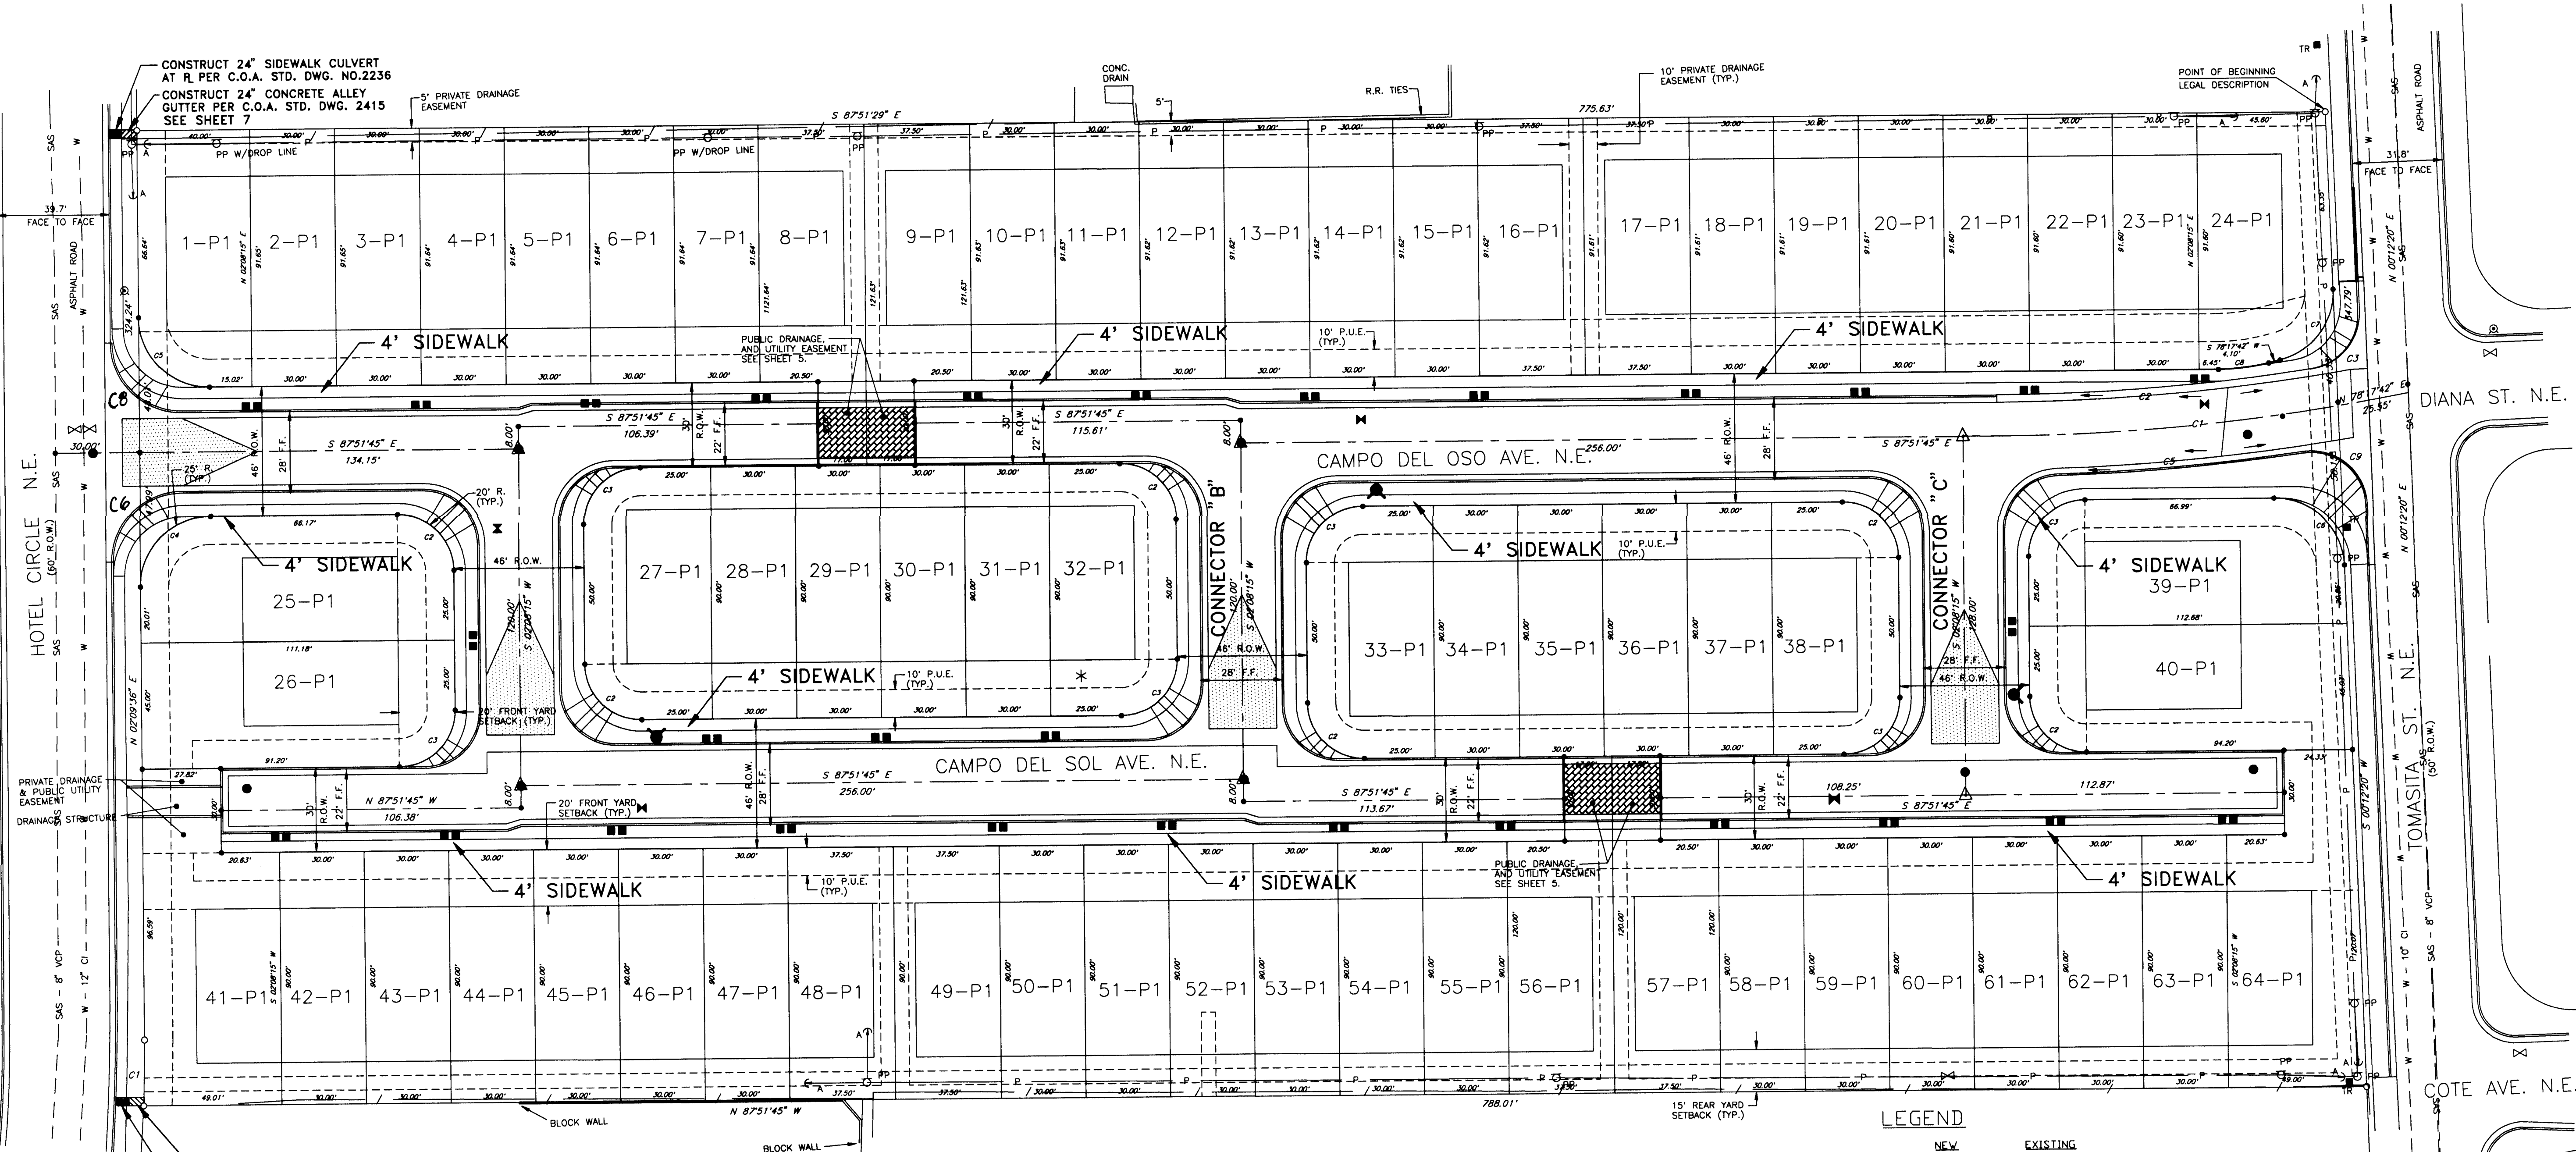

BOKAY CONSTRUCTION, INC.
ENGINEERING SERVICES CONSTRUCTION MANAGEMENT
5905 AZULEO CT. NW
ALBUQUERQUE, NM 87120
(505) 899-9656



CITY OF ALBUQUERQUE
PUBLIC WORKS DEPARTMENT
ENGINEERING GROUP



TITLE: HOTEL CIRCLE
COMPOSITE PAVING PLAN

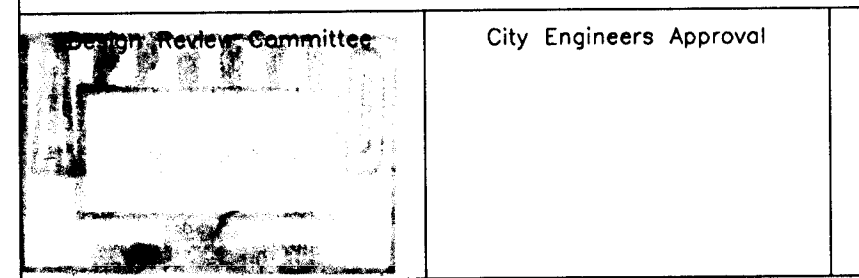



City Project No. 543781 Zone Map No. K-21

AS BUILT INFORMATION		SURVEY INFORMATION		ENGINEER'S SEAL		REVISIONS		DESIGN	
NO.	DATE	NO.	DATE	NO.	DATE	NO.	DATE	NO.	DATE
1	8/96	1	8/96	1	8/96	1	8/96	1	8/96
2	11/97	2	11/97	2	11/97	2	11/97	2	11/97
3	11/97	3	11/97	3	11/97	3	11/97	3	11/97
4	11/97	4	11/97	4	11/97	4	11/97	4	11/97
99	11/97	99	11/97	99	11/97	99	11/97	99	11/97
100	11/97	100	11/97	100	11/97	100	11/97		

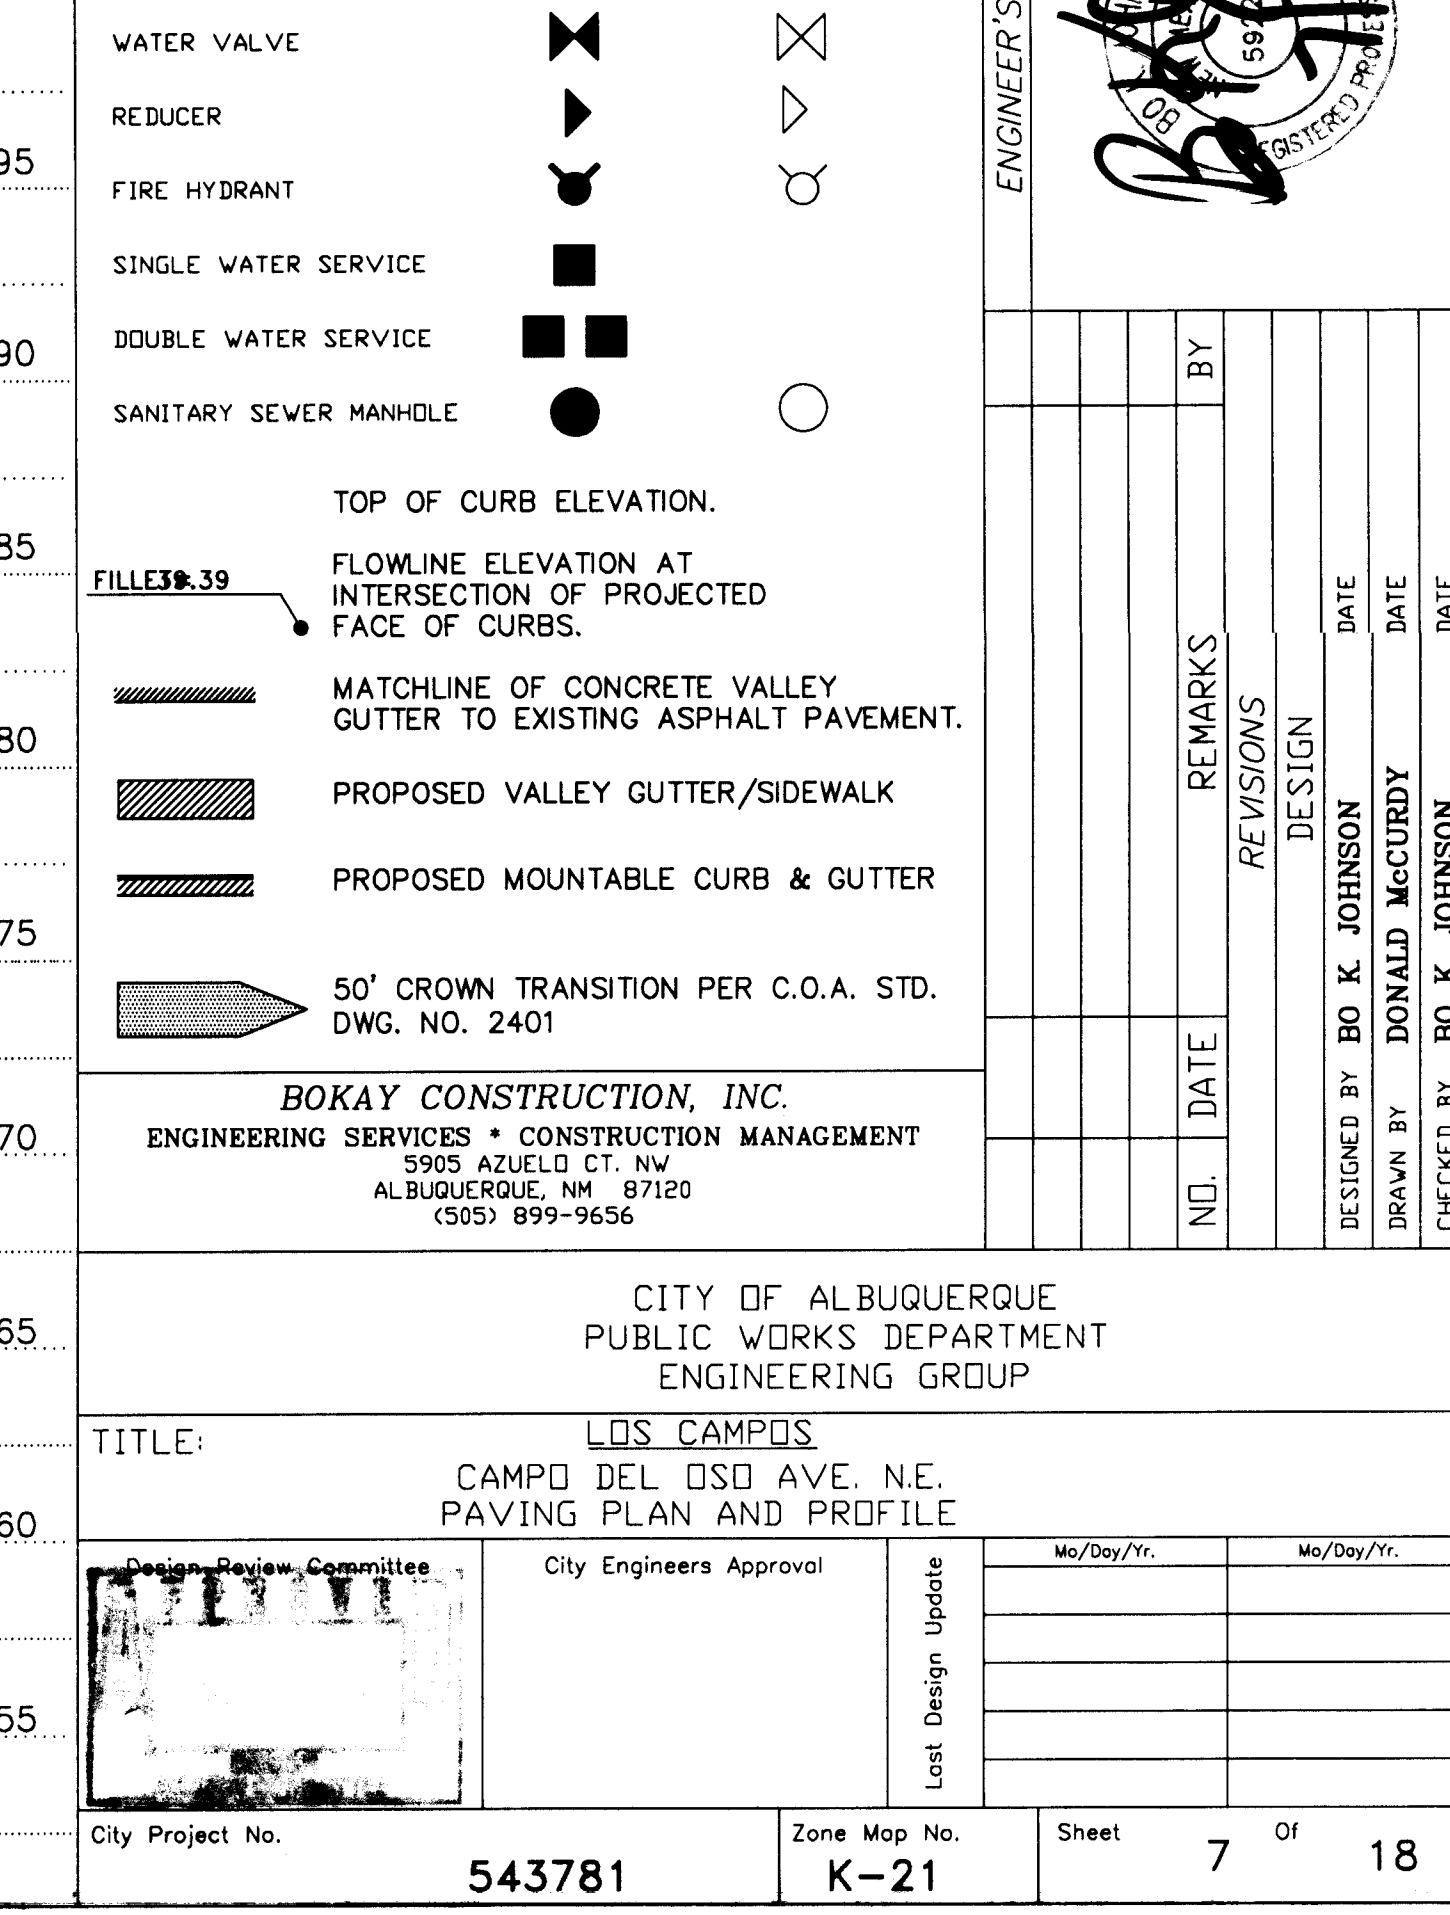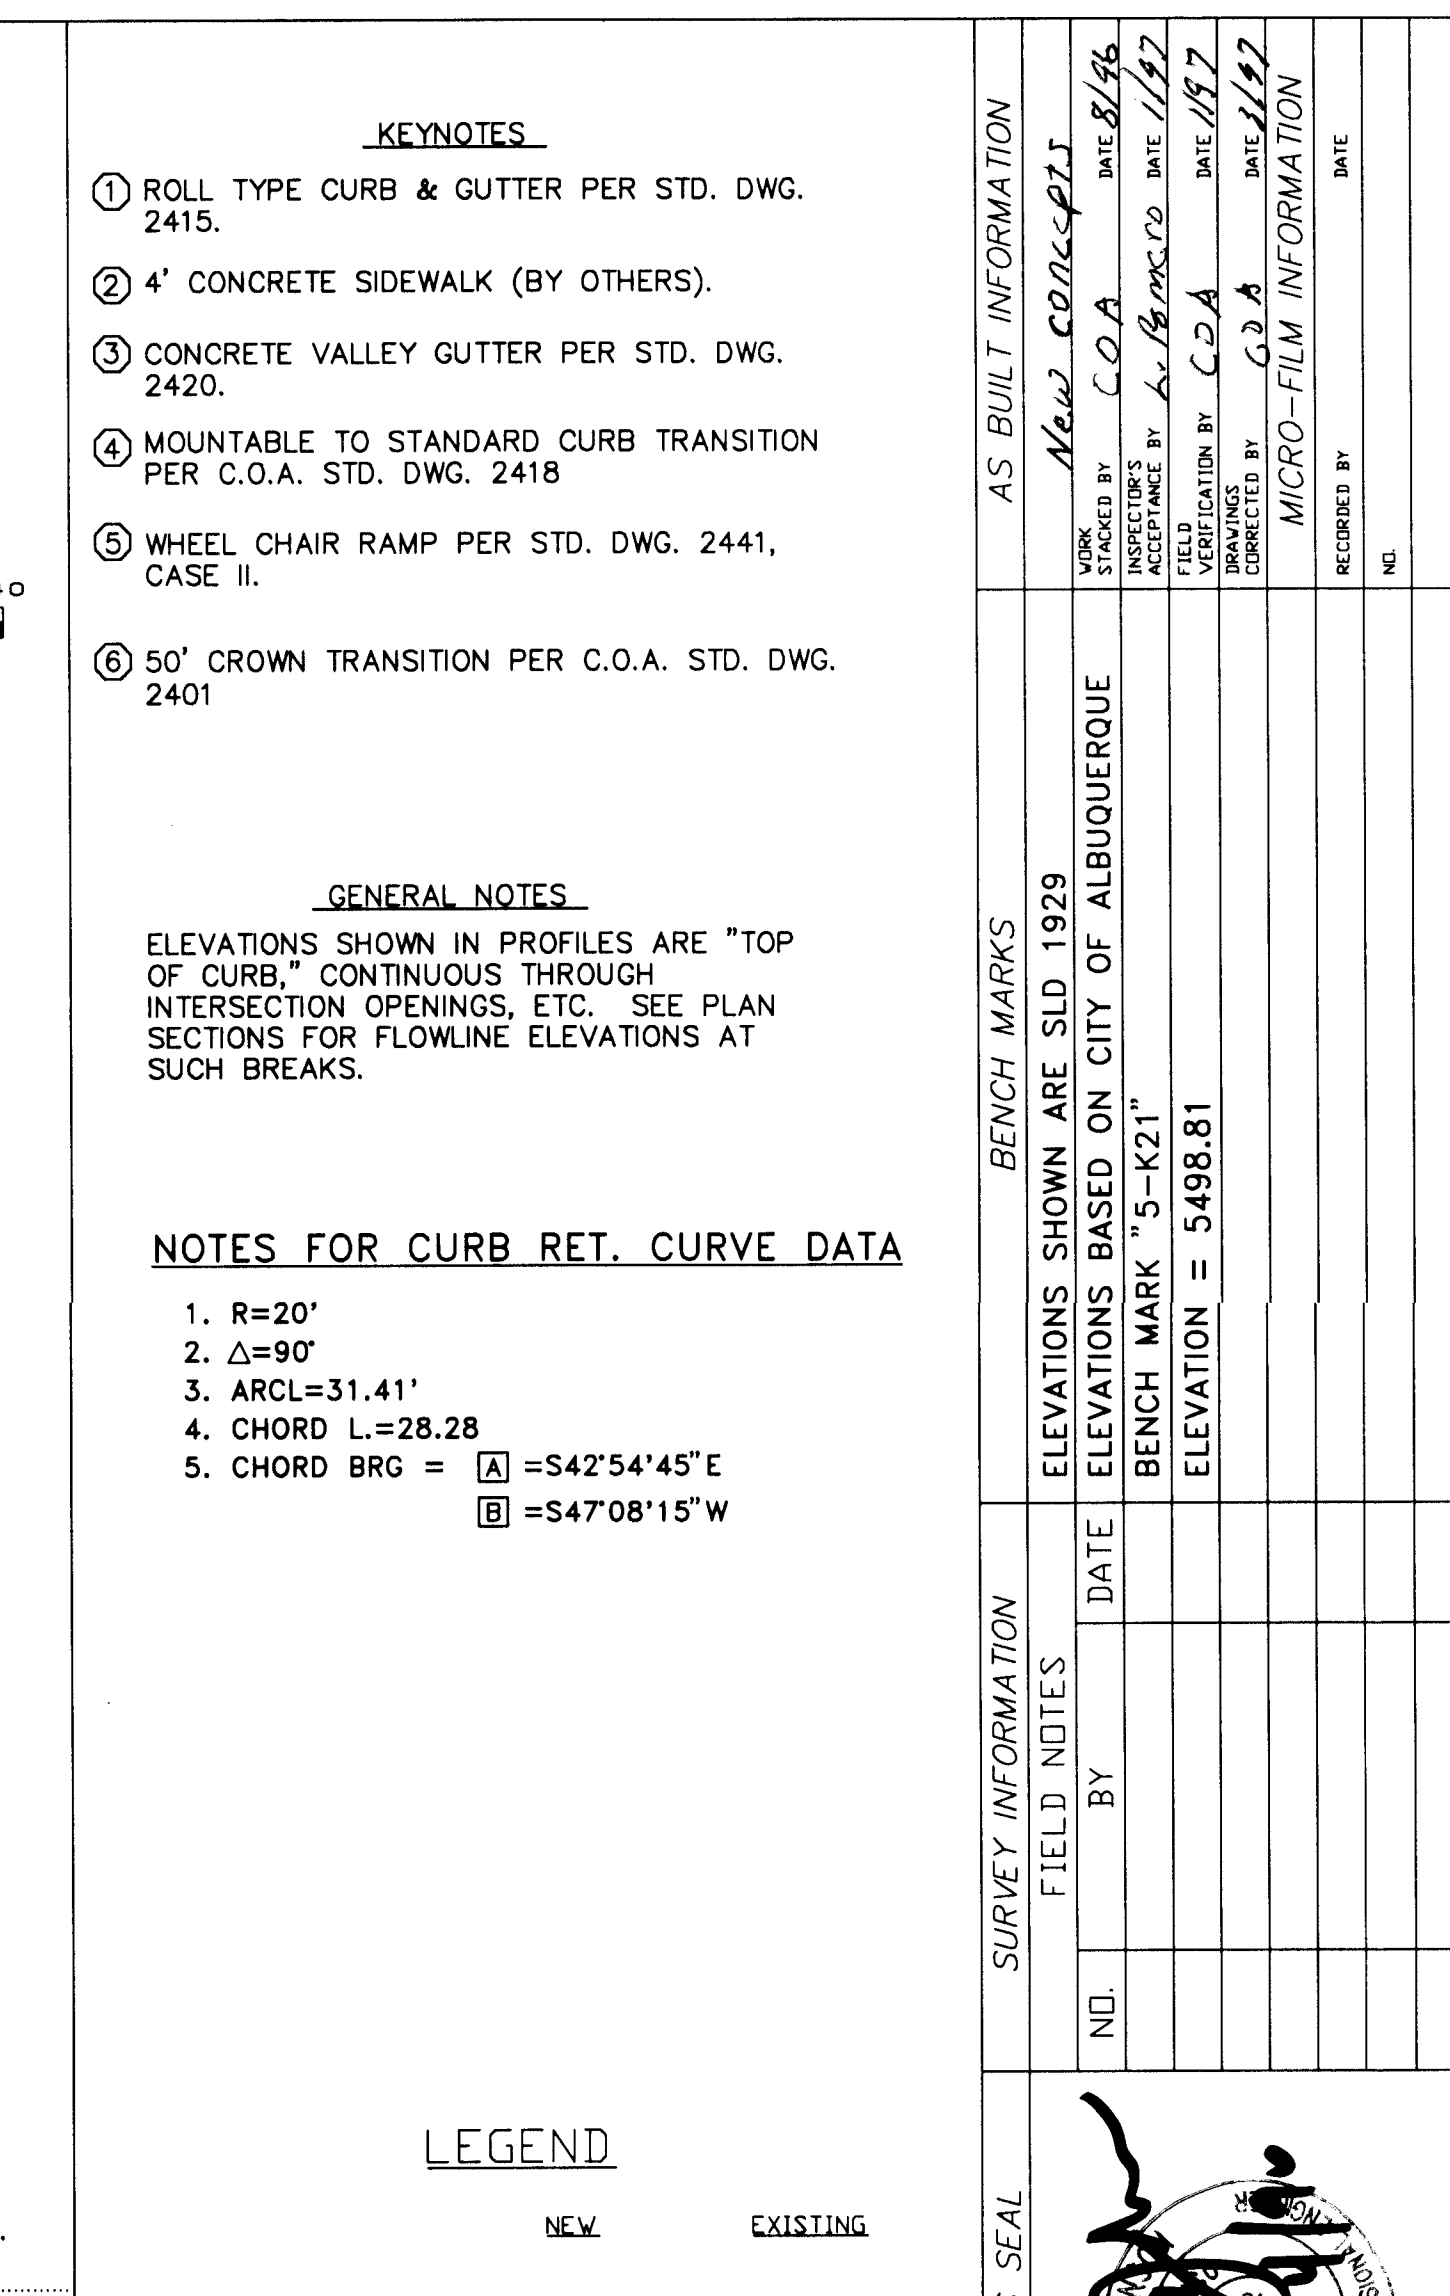


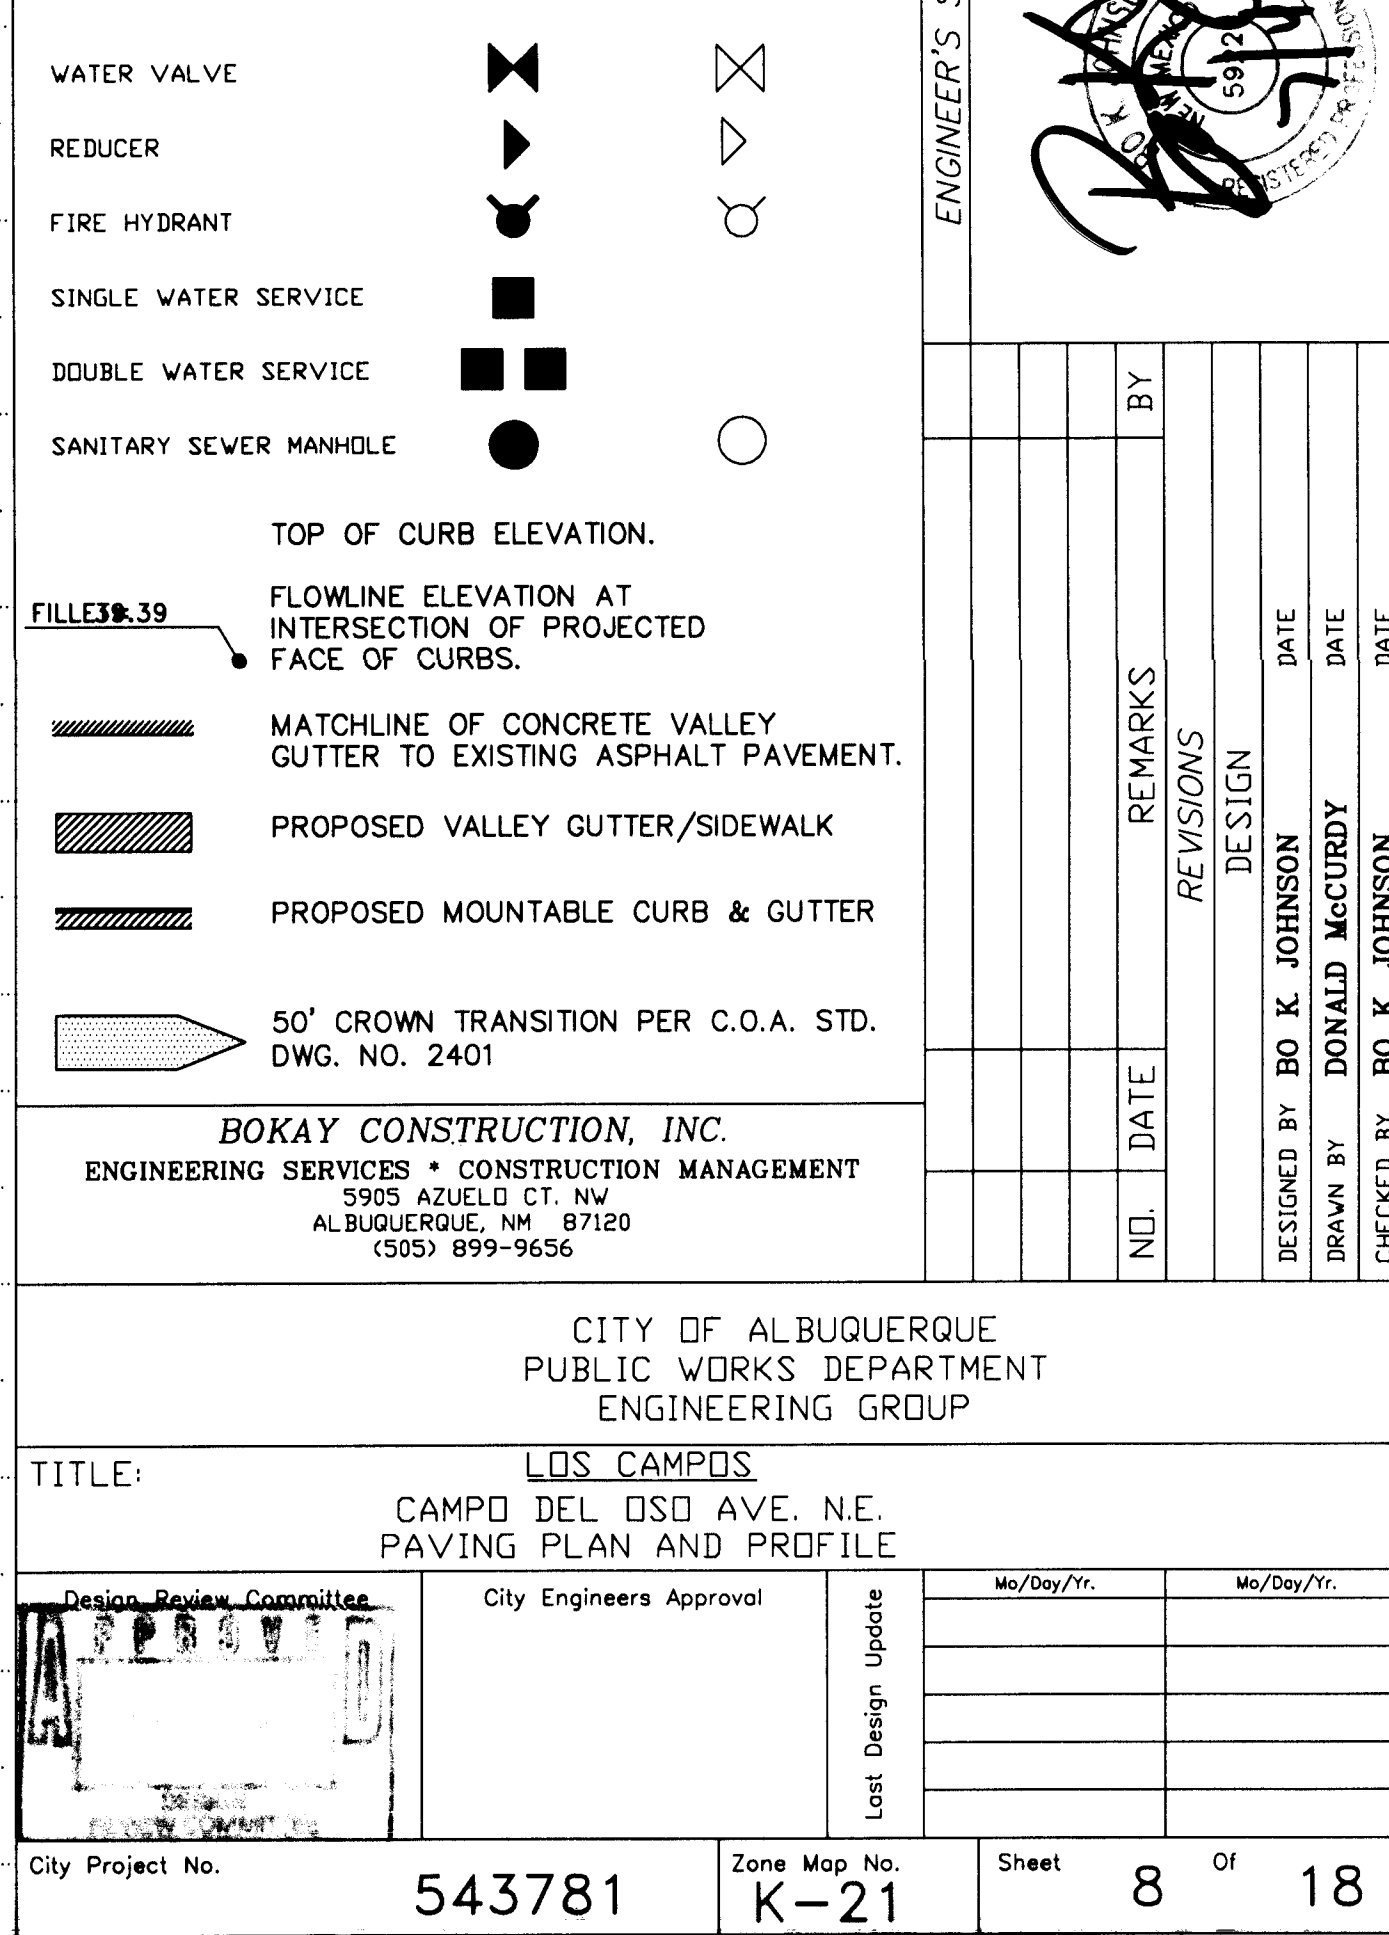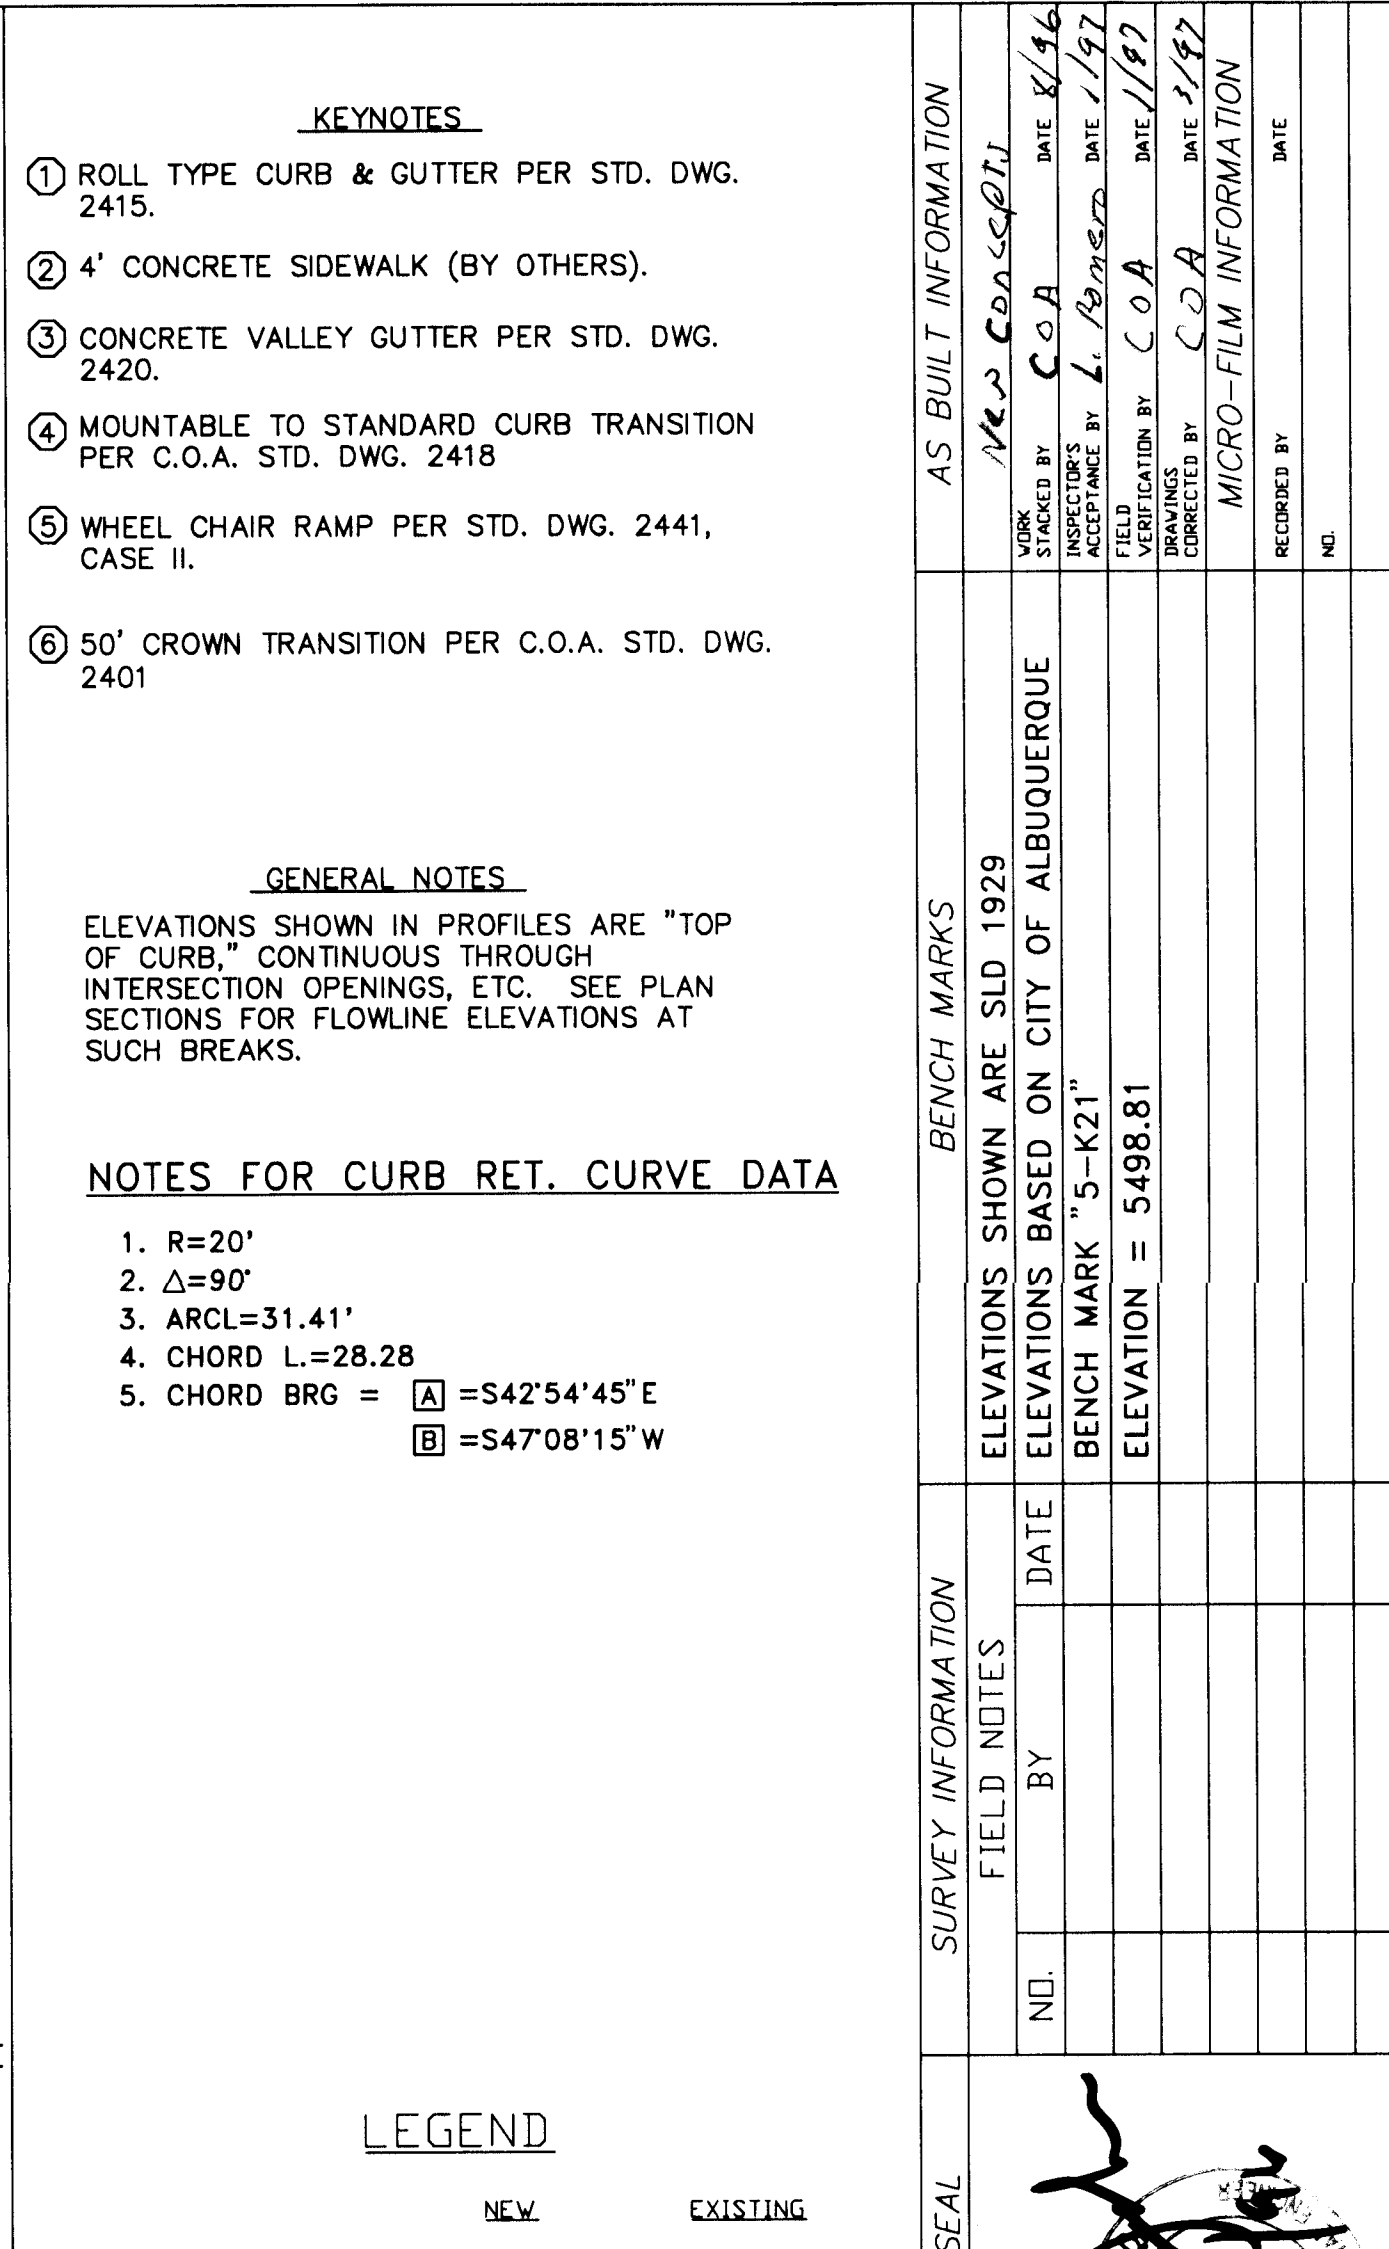

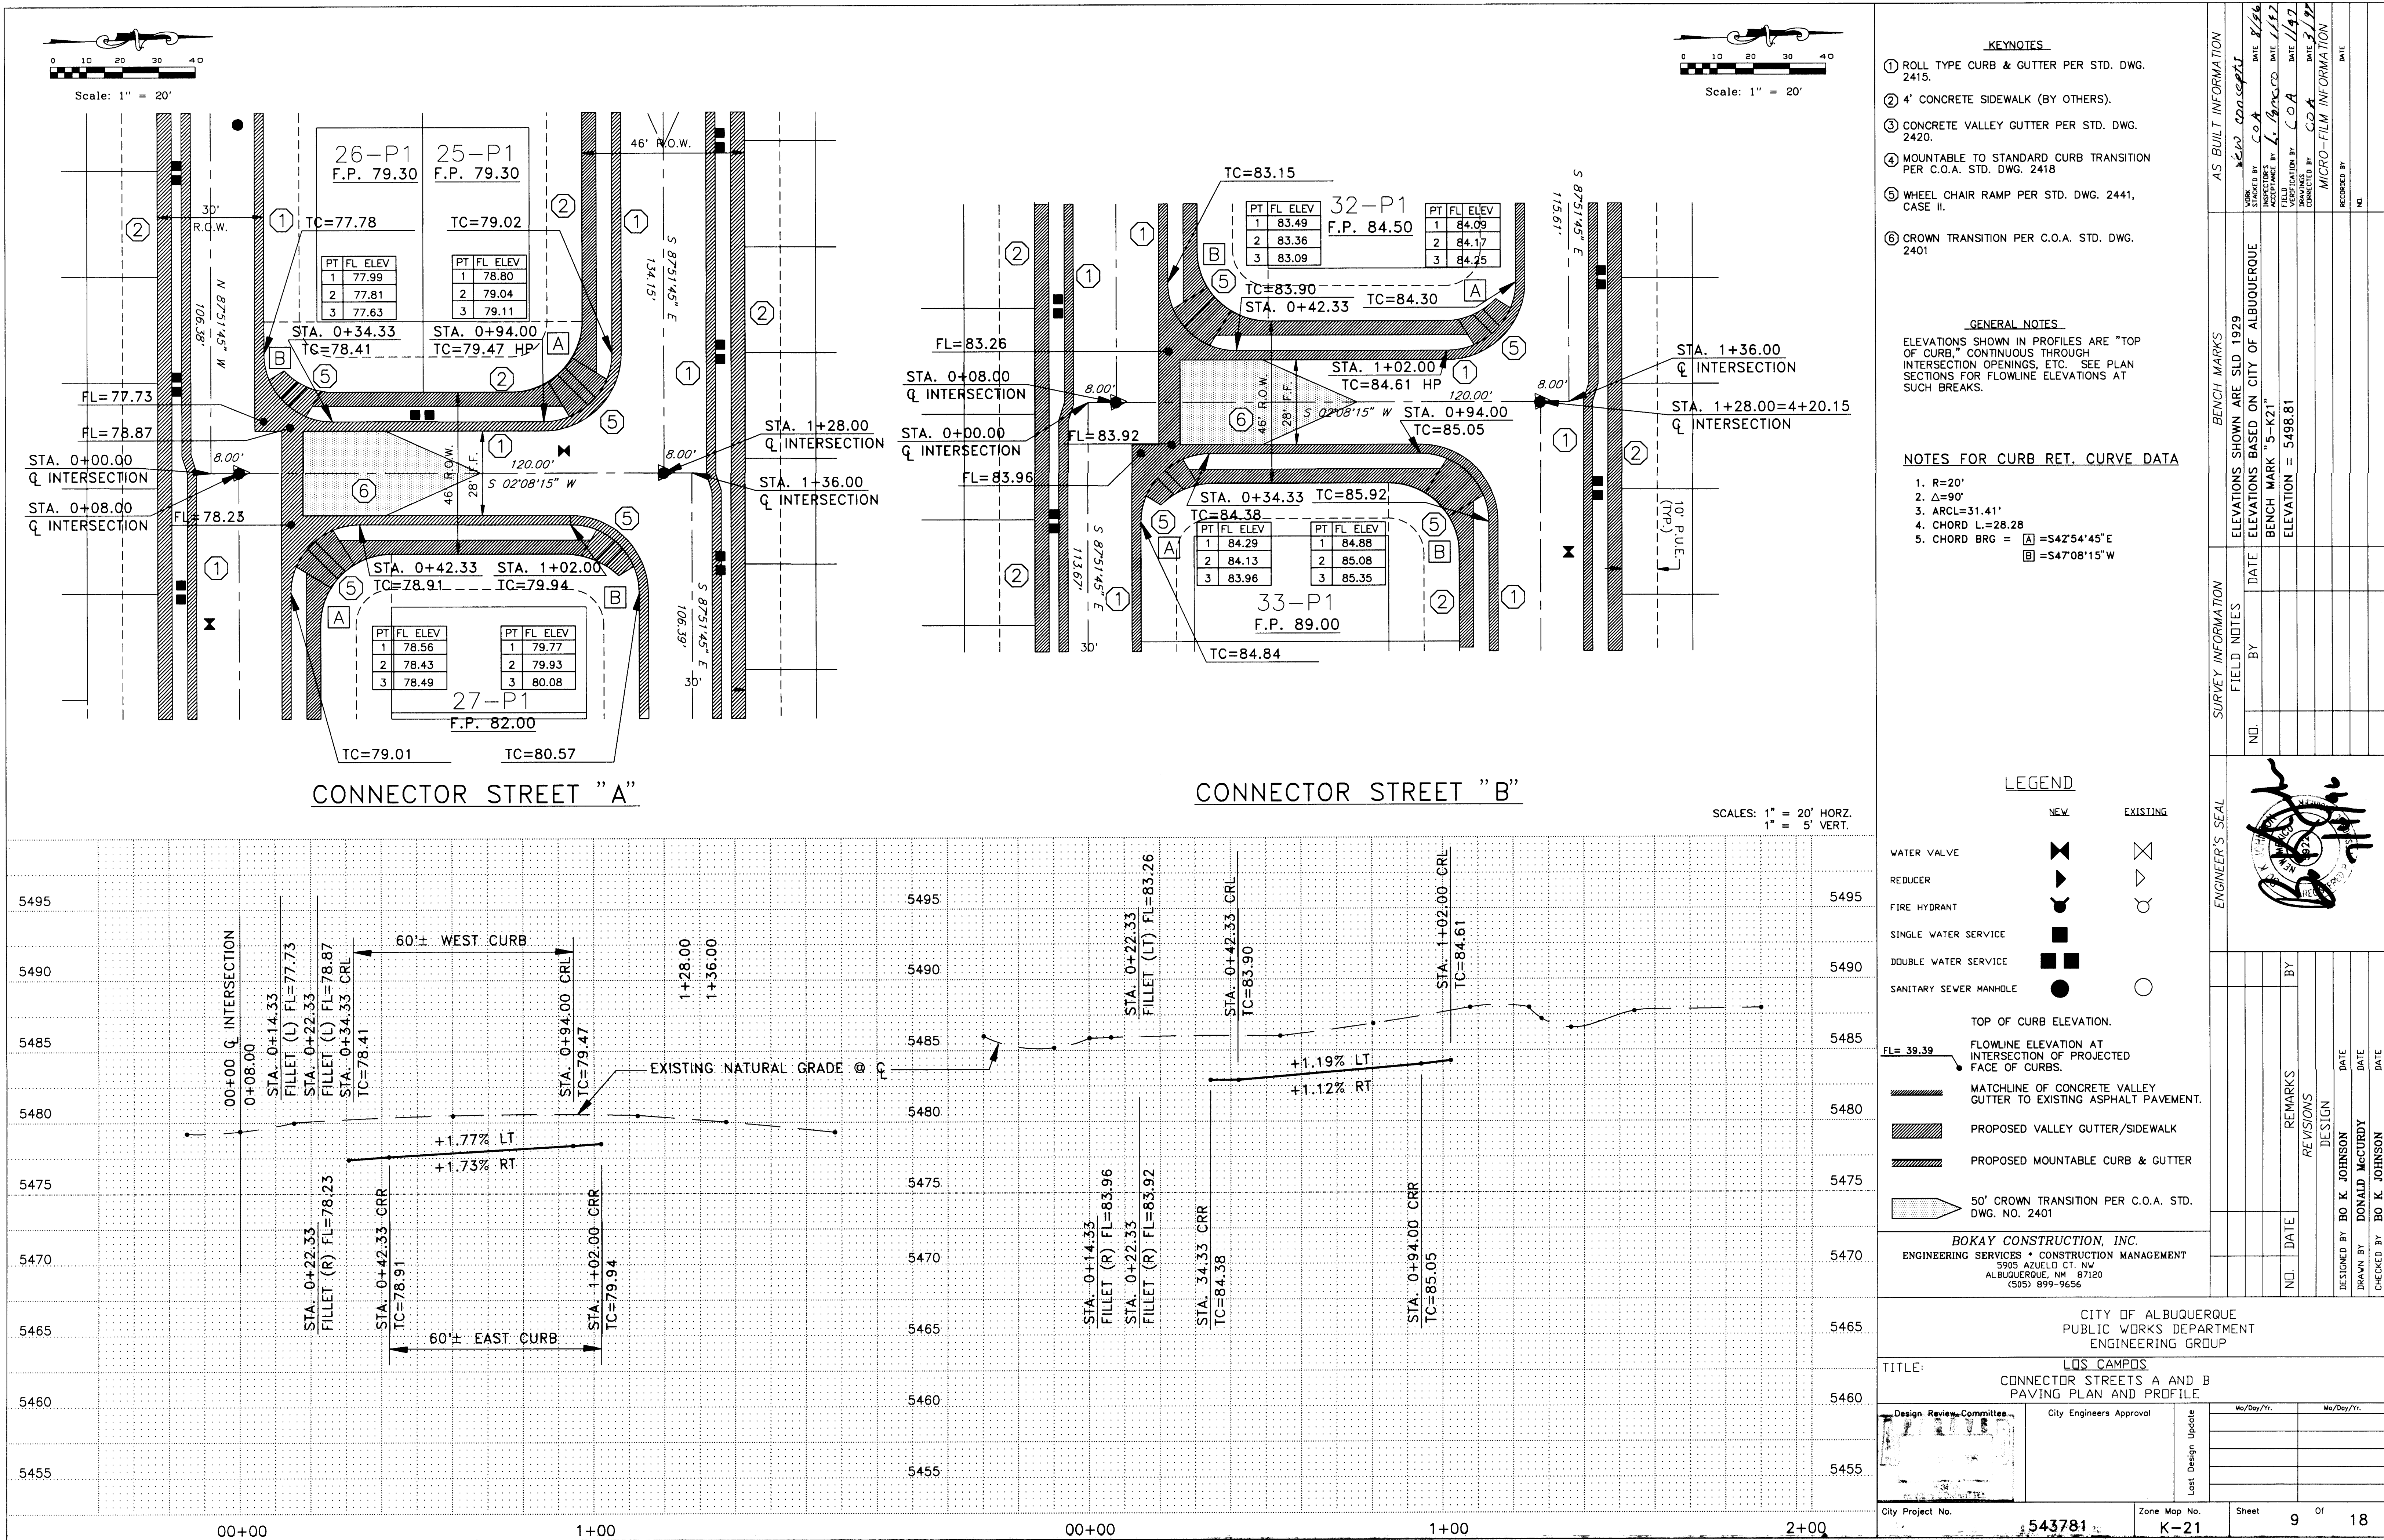

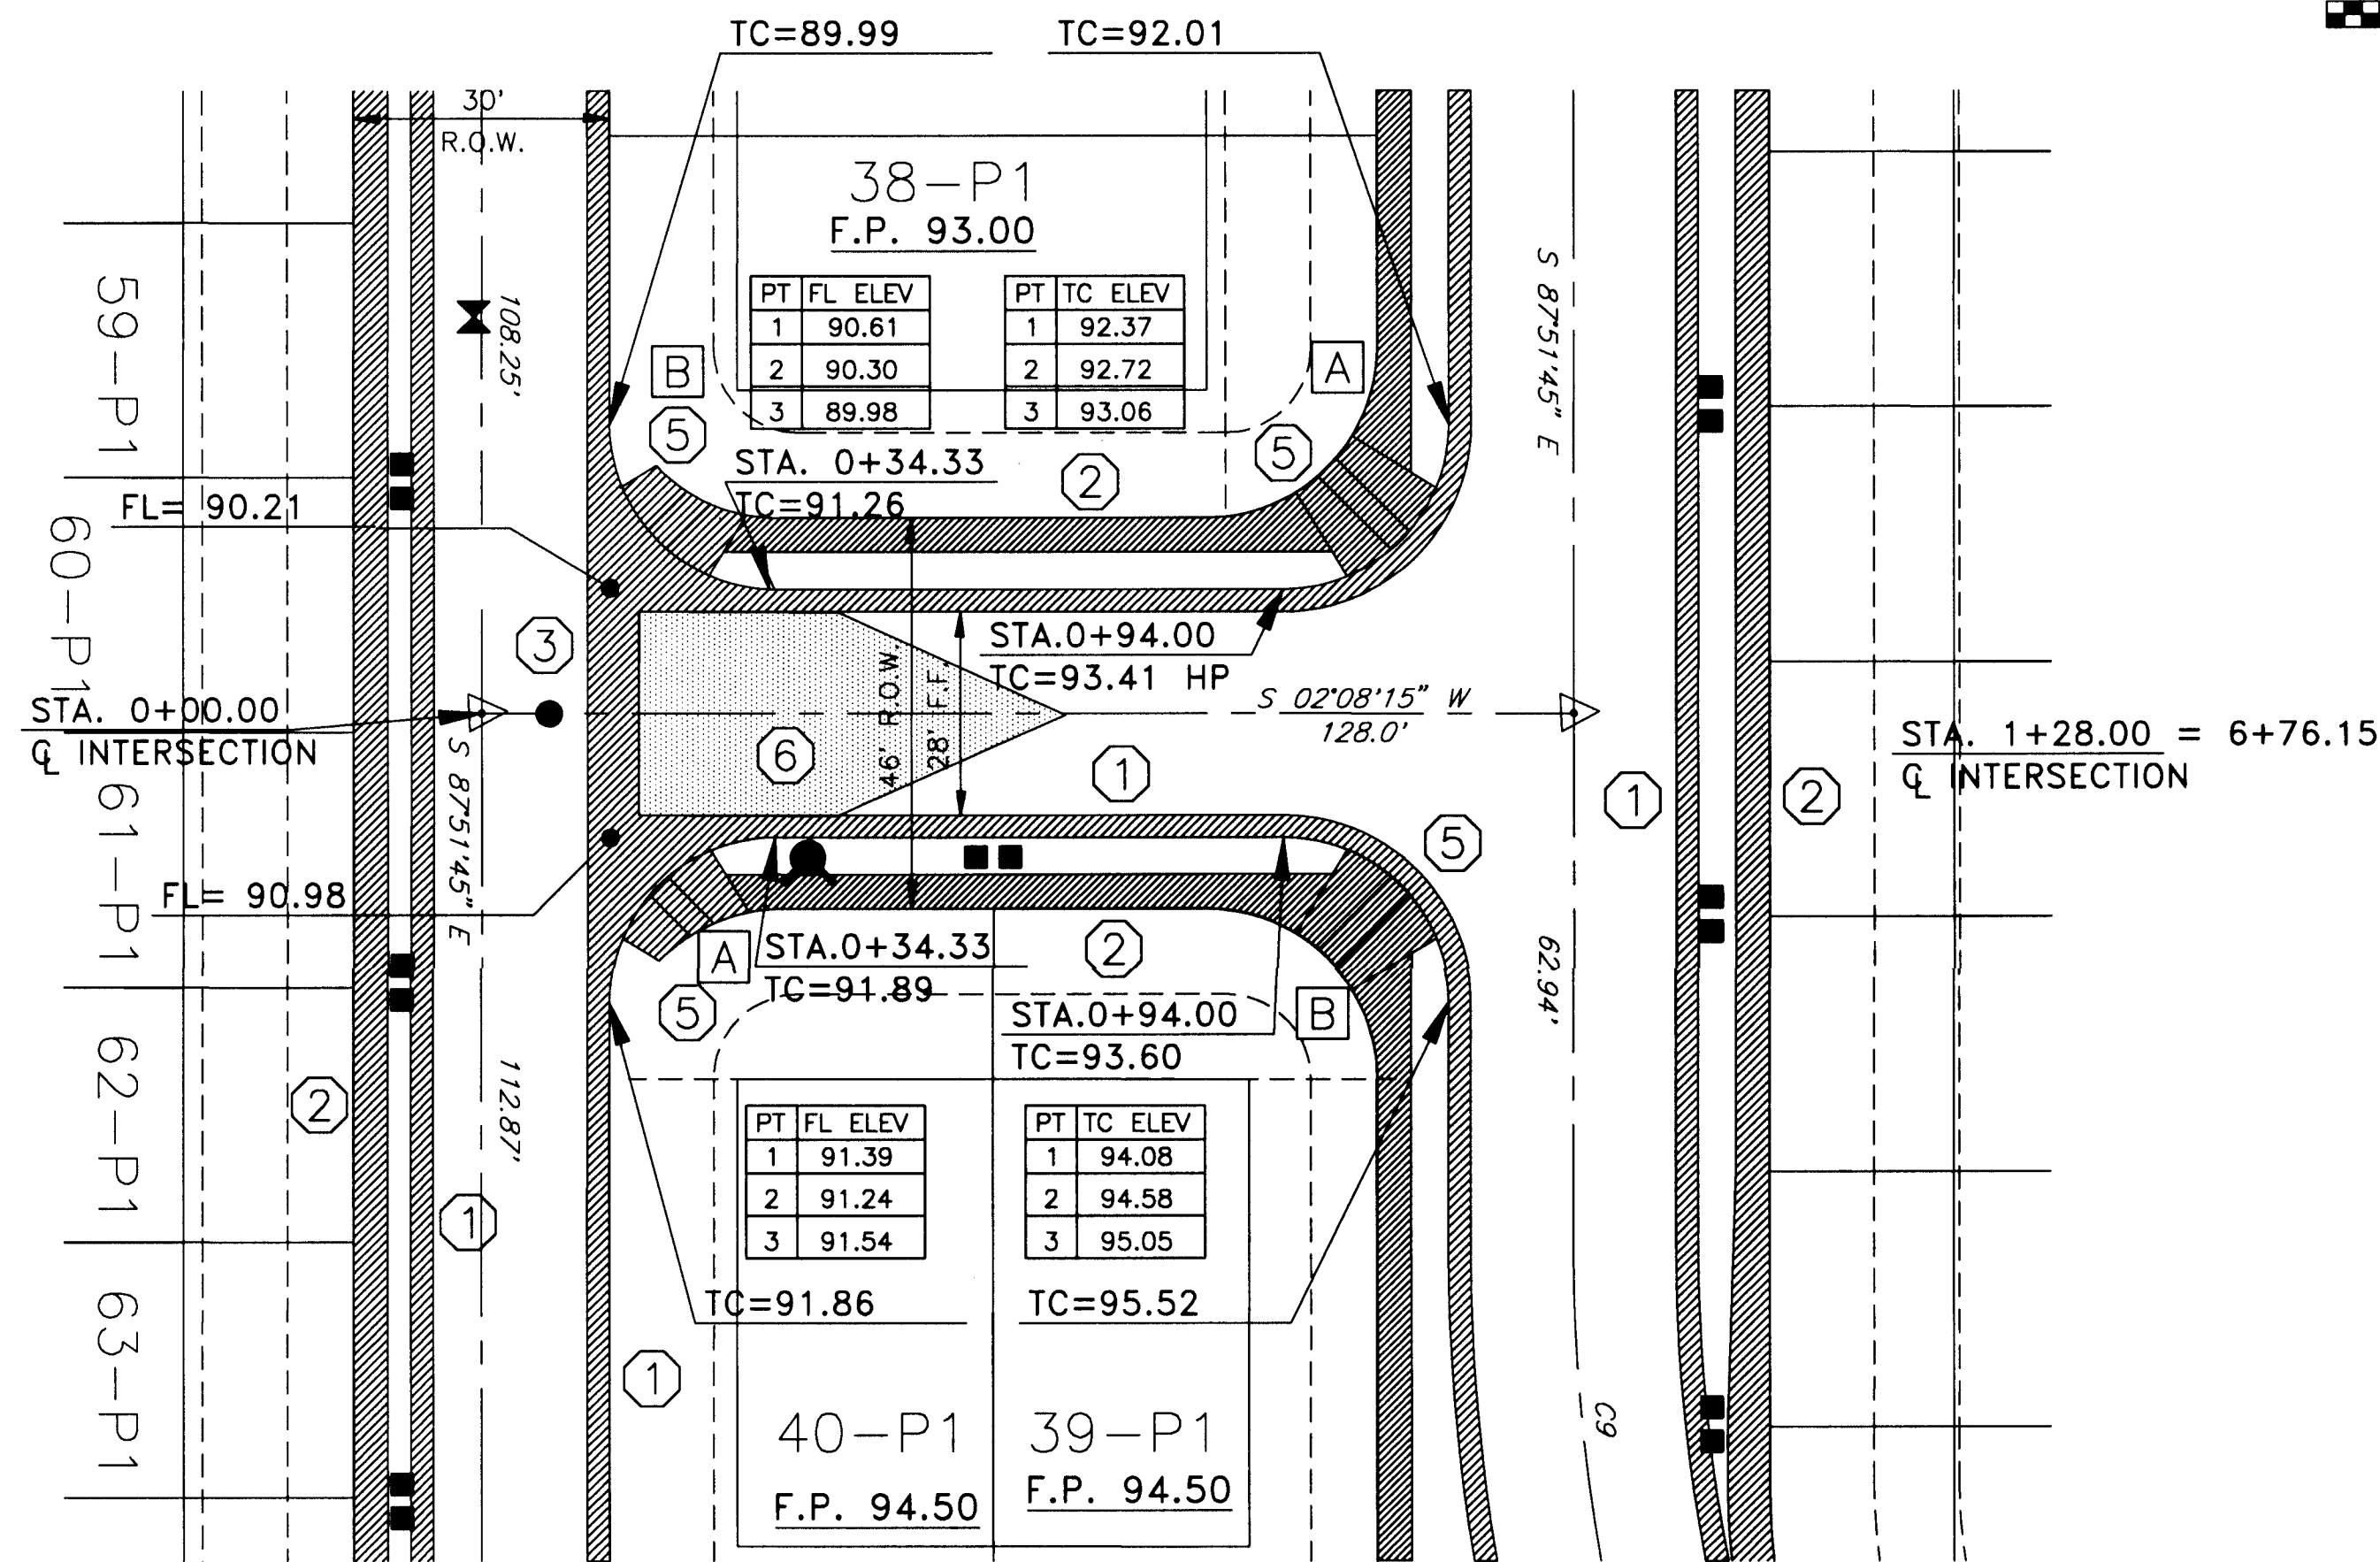

CONNECTOR STREET "C"

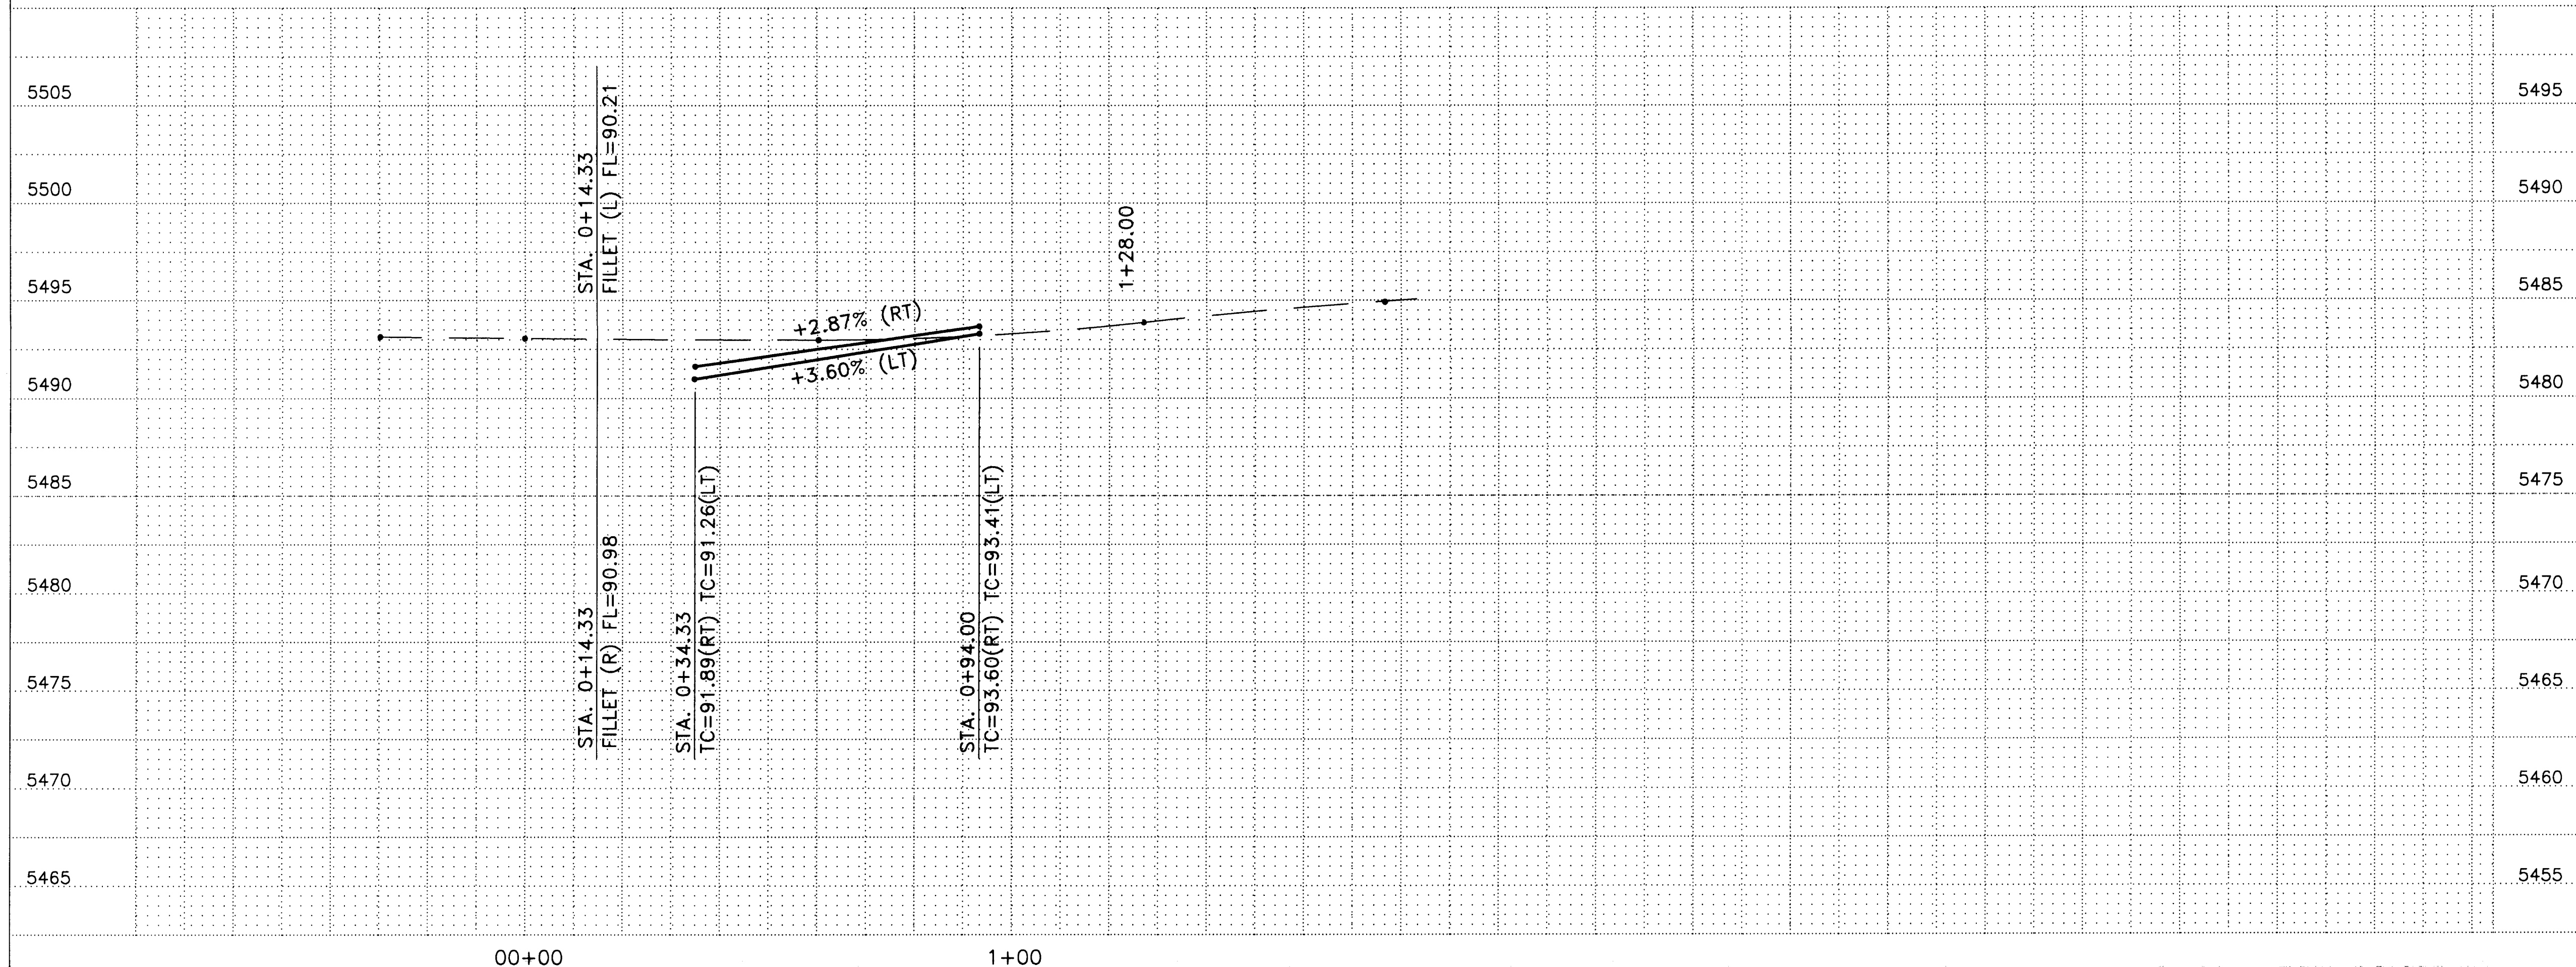

- KEYNOTES**
- ROLL TYPE CURB & GUTTER PER STD. DWG. 2415.
 - 4' CONCRETE SIDEWALK (BY OTHERS).
 - CONCRETE VALLEY GUTTER PER STD. DWG. 2420.
 - MOUNTABLE TO STANDARD CURB TRANSITION PER C.O.A. STD. DWG. 2418
 - WHEEL CHAIR RAMP PER STD. DWG. 2441, CASE II.
 - 50' CROWN TRANSITION PER C.O.A. STD. DWG. 2401

GENERAL NOTES

ELEVATIONS SHOWN IN PROFILES ARE "TOP OF CURB," CONTINUOUS THROUGH INTERSECTION OPENINGS, ETC. SEE PLAN SECTIONS FOR FLOWLINE ELEVATIONS AT SUCH BREAKS.

NOTES FOR CURB RET. CURVE DATA

- R=20'
- $\Delta=90^\circ$
- ARCL=31.41'
- CHORD L=28.28
- CHORD BRG = $\angle A = S42^\circ 54' 45" E$
 $\angle B = S47^\circ 08' 15" W$

LEGEND

- NEW** **EXISTING**
- WATER VALVE
 - REDUCER
 - FIRE HYDRANT
 - SINGLE WATER SERVICE
 - DOUBLE WATER SERVICE
 - SANITARY SEWER MANHOLE

- TOP OF CURB ELEVATION.
- FL= 39.39 FLOWLINE ELEVATION AT INTERSECTION OF PROJECTED FACE OF CURBS.
- MATCHLINE OF CONCRETE VALLEY GUTTER TO EXISTING ASPHALT PAVEMENT.
 - PROPOSED VALLEY GUTTER/SIDEWALK
 - PROPOSED MOUNTABLE CURB & GUTTER
 - 50' CROWN TRANSITION PER C.O.A. STD. DWG. NO. 2401

BOKAY CONSTRUCTION, INC.
ENGINEERING SERVICES • CONSTRUCTION MANAGEMENT
5905 AZULEO CT. NW
ALBUQUERQUE, NM 87120
(505) 899-9656

CITY OF ALBUQUERQUE
PUBLIC WORKS DEPARTMENT
ENGINEERING GROUP

TITLE: **LDS CAMPOS**
CONNECTOR STREET "C"
PAVING PLAN AND PROFILE


Design Review Committee	City Engineers Approval	Mo/Day/Yr.	Mo/Day/Yr.

City Project No. **543781** Zone Map No. **K-21** Sheet **10** of **18**

AS BUILT INFORMATION		BENCH MARKS		SURVEY INFORMATION		ENGINEER'S SEAL	
DATE	8/96	ELEVATIONS SHOWN ARE SLD 1929	DATE	NO.	BY	REMARKS	DESIGN
INSPECTED BY	C.O.A.	ELEVATIONS BASED ON CITY OF ALBUQUERQUE	DATE				
RECEIVED BY	L. J. JONES	BENCH MARK "5-K21"					
VERIFIED BY	C.O.A.	ELEVATION = 5498.81					
DRAWING	3/97						
CONSTRUCTION	3/97						
RECORDED BY	NG						
DATE							

SCANNED BY
BY LASON

26-514371.81 11/10/97

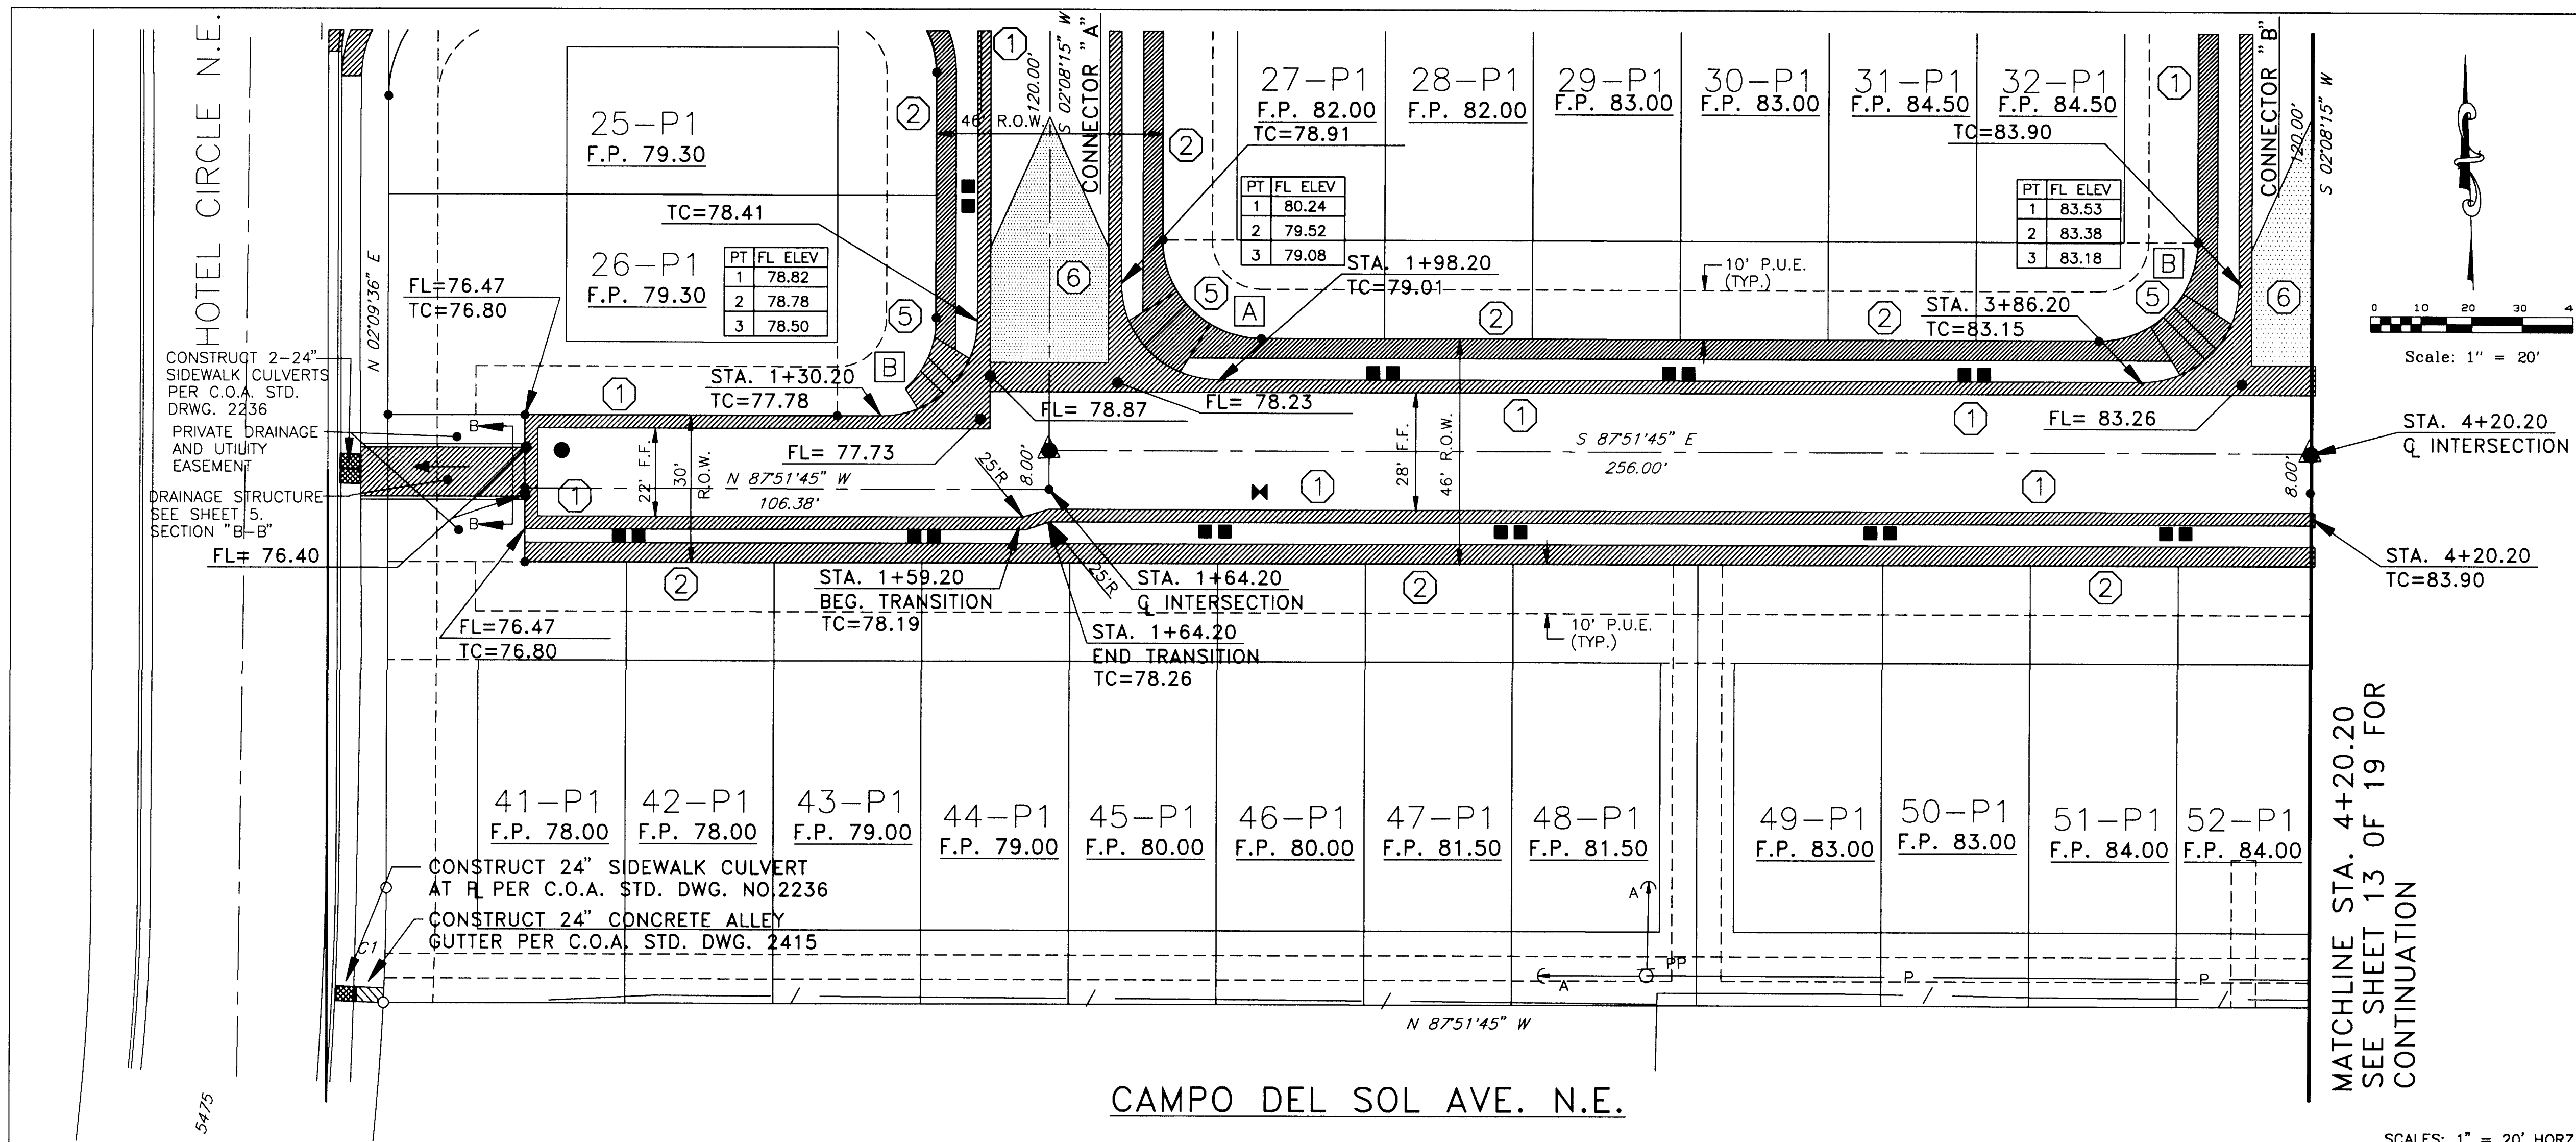

KEYNOTES


- ROLL TYPE CURB & GUTTER PER STD. DWG. 2415.
- 4' CONCRETE SIDEWALK (BY OTHERS).
- CONCRETE VALLEY GUTTER PER STD. DWG. 2420.
- MOUNTABLE TO STANDARD CURB TRANSITION PER C.O.A. STD. DWG. 2418
- WHEEL CHAIR RAMP PER STD. DWG. 2441, CASE II.
- 50' CROWN TRANSITION PER C.O.A. STD. DWG. 2401

GENERAL NOTES

ELEVATIONS SHOWN IN PROFILES ARE "TOP OF CURB," CONTINUOUS THROUGH INTERSECTION OPENINGS, ETC. SEE PLAN SECTIONS FOR FLOWLINE ELEVATIONS AT SUCH BREAKS.

NOTES FOR CURB RET. CURVE DATA

- R=20'
- $\Delta=90^\circ$
- ARCL=31.41'
- CHORD L=28.28
- CHORD BRG = $\angle A = 54^\circ 54' 45" E$
 $\angle B = 54^\circ 08' 15" W$

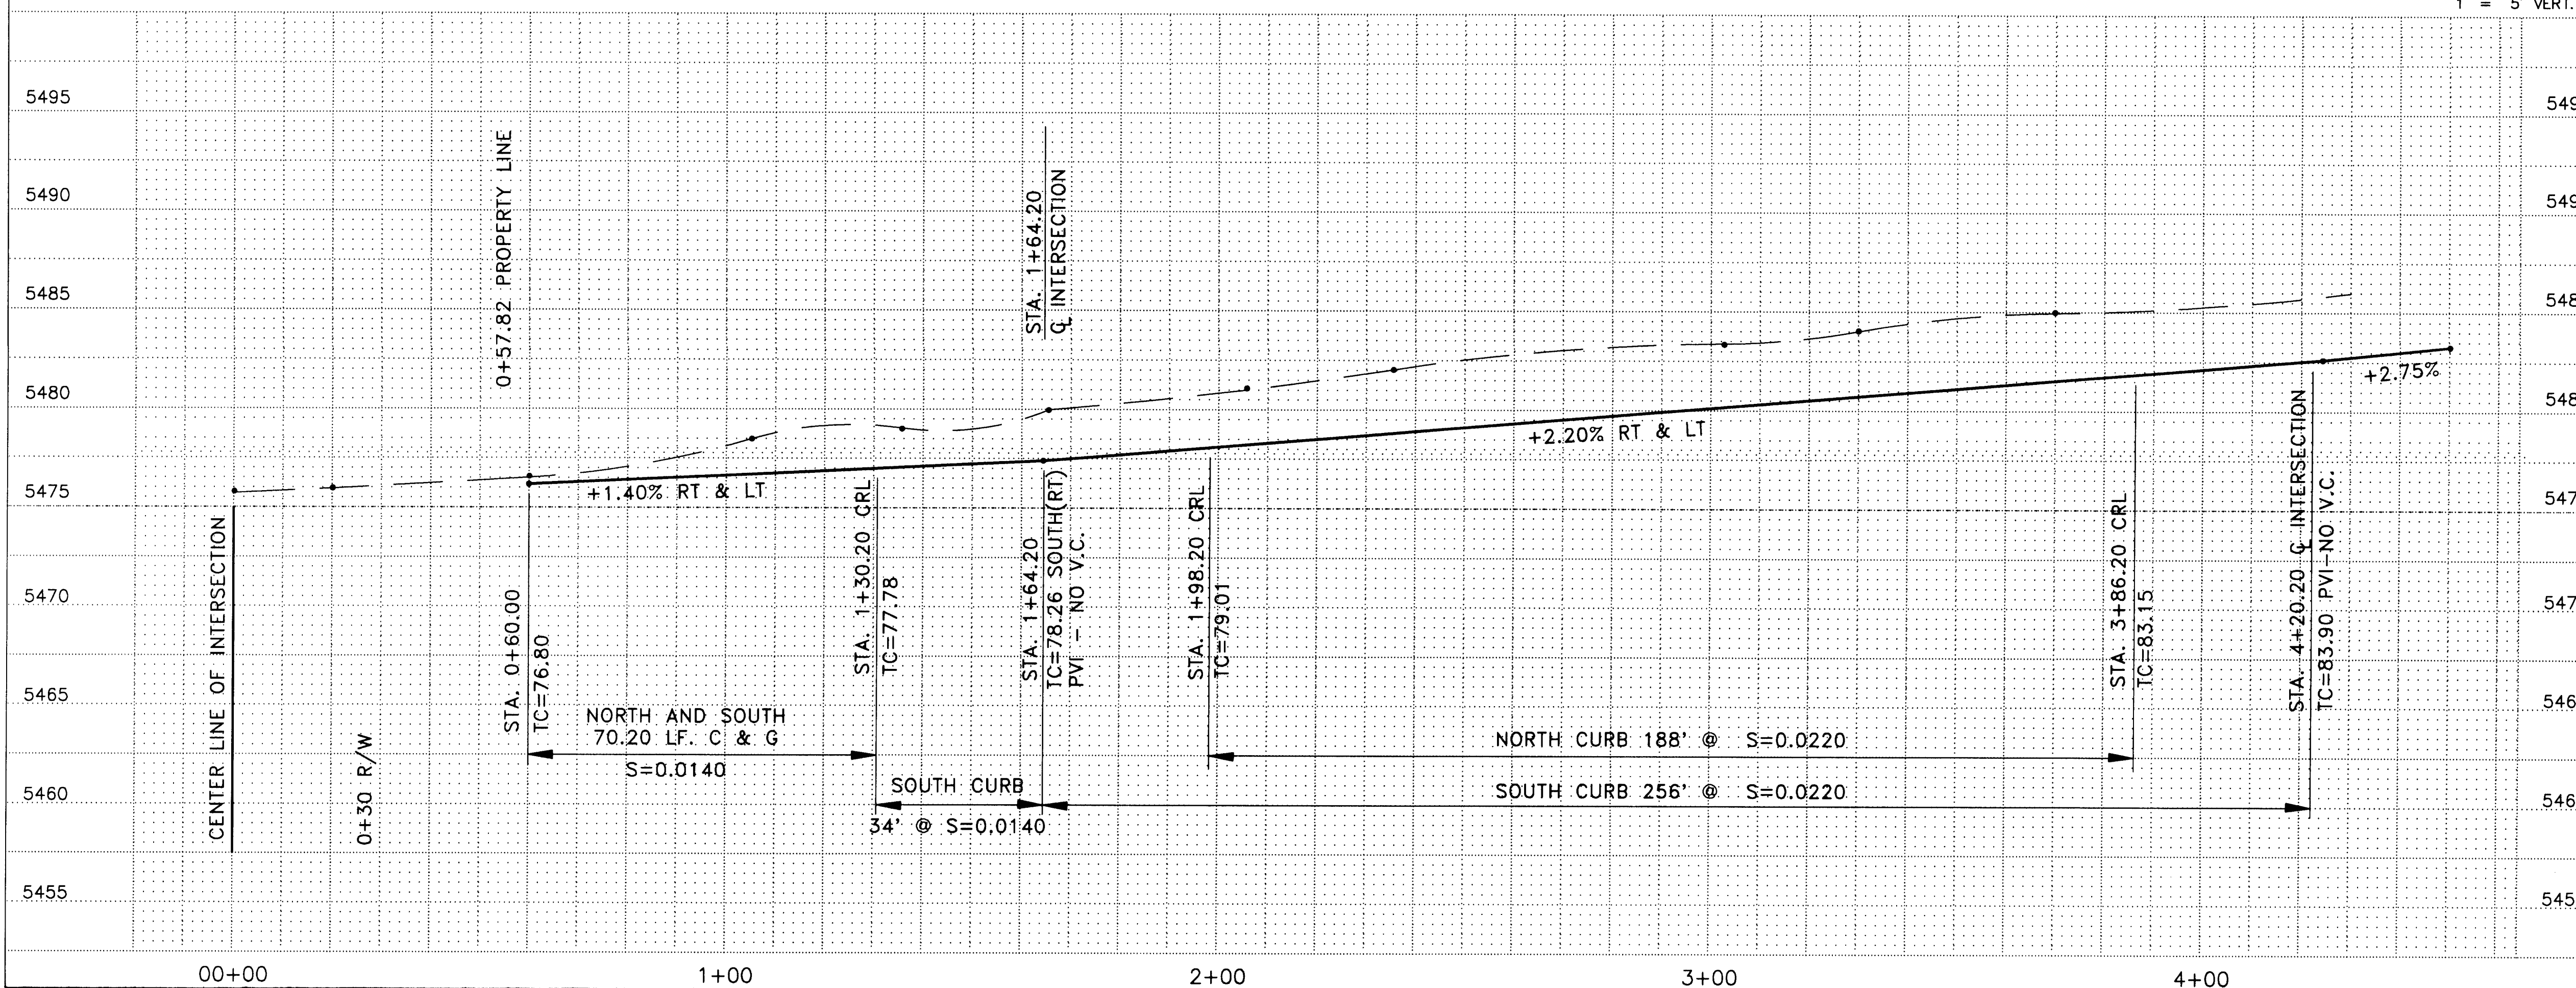

LEGEND

NEW EXISTING

WATER VALVE

REDUCER

FIRE HYDRANT

SINGLE WATER SERVICE

DOUBLE WATER SERVICE

SANITARY SEWER MANHOLE

TOP OF CURB ELEVATION.

FLOWLINE ELEVATION AT INTERSECTION OF PROJECTED FACE OF CURBS.

MATCHLINE OF CONCRETE VALLEY GUTTER TO EXISTING ASPHALT PAVEMENT.

PROPOSED VALLEY GUTTER/SIDEWALK

PROPOSED MOUNTABLE CURB & GUTTER

50' CROWN TRANSITION PER C.O.A. STD. DWG. NO.2401

BOKAY CONSTRUCTION, INC.
ENGINEERING SERVICES • CONSTRUCTION MANAGEMENT
5905 AZULEO CT. NW
ALBUQUERQUE, NM 87120
(505) 899-9656

CITY OF ALBUQUERQUE
PUBLIC WORKS DEPARTMENT
ENGINEERING GROUP


TITLE:
LOS CAMPOS
CAMPO DEL SOL AVE. N.E.
PAVING PLAN AND PROFILE

City Project No. **543781** Zone Map No. **K-21** Sheet **11** of **18**

AS BUILT INFORMATION		BENCH MARKS		SURVEY INFORMATION		ENGINEER'S SEAL	
WORK BY	DATE	ELEVATIONS SHOWN ARE SLD 1929	DATE	FIELD NOTES	BY		REVISIONS
ACCEPTANCE BY	DATE	ELEVATIONS BASED ON CITY OF ALBUQUERQUE	DATE	NO.	BY		
FIELD INSPECTION BY	DATE	BENCH MARK "5-K21"	DATE				DESIGN
DRAWINGS	DATE	ELEVATION = 5498.81	DATE				DESIGNED BY BO K. JOHNSON
CORRECTED BY	DATE		DATE				DRAWN BY DONALD McCURDY
MICRO-FILM INFORMATION	DATE		DATE				CHECKED BY BO K. JOHNSON

PLANNED BY LASON

26-543781-87 11/19/77

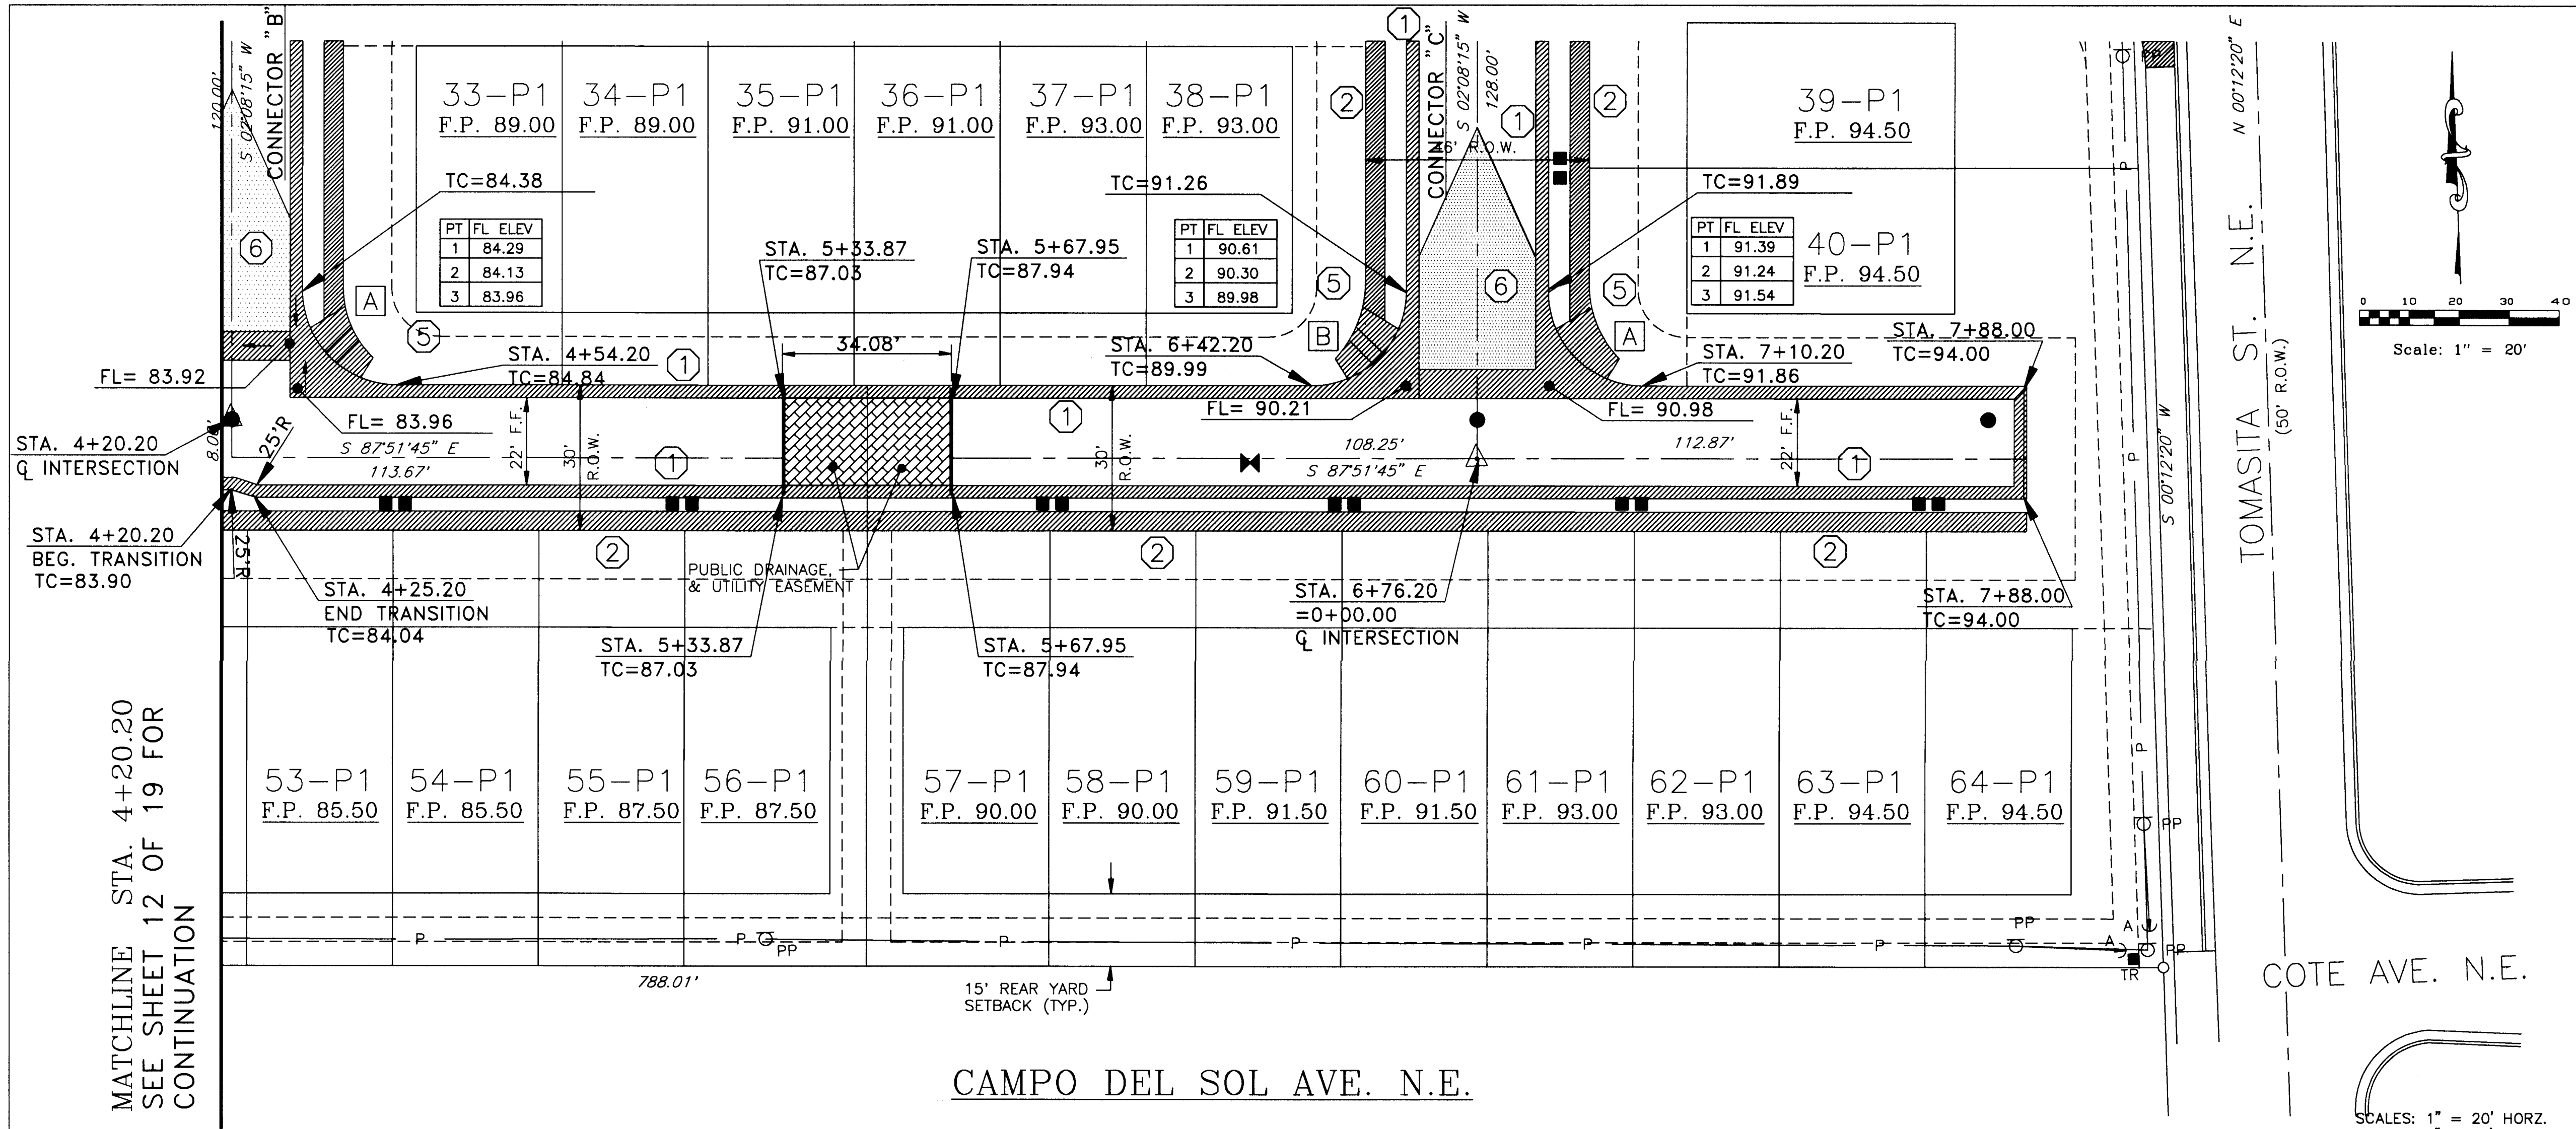

KEYNOTES

- ROLL TYPE CURB & GUTTER PER STD. DWG. 2415.
- 4' CONCRETE SIDEWALK (BY OTHERS).
- CONCRETE VALLEY GUTTER PER STD. DWG. 2420.
- MOUNTABLE TO STANDARD CURB TRANSITION PER C.O.A. STD. DWG. 2418
- WHEEL CHAIR RAMP PER STD. DWG. 2441, CASE II.
- 50' CROWN TRANSITION PER C.O.A. STD. DWG. 2401

GENERAL NOTES

ELEVATIONS SHOWN IN PROFILES ARE "TOP OF CURB," CONTINUOUS THROUGH INTERSECTION OPENINGS, ETC. SEE PLAN SECTIONS FOR FLOWLINE ELEVATIONS AT SUCH BREAKS.

NOTES FOR CURB RET. CURVE DATA

- R=20'
- $\Delta=90^\circ$
- ARCL=31.41'
- CHORD L=28.28
- CHORD BRG = $\angle A = S42^\circ54'45"E$
 $\angle B = S47^\circ08'15"W$

LEGEND

NEW EXISTING

WATER VALVE
REDUCER
FIRE HYDRANT
SINGLE WATER SERVICE
DOUBLE WATER SERVICE
SANITARY SEWER MANHOLE

TOP OF CURB ELEVATION.
FLOWLINE ELEVATION AT INTERSECTION OF PROJECTED FACE OF CURBS.

MATCHLINE OF CONCRETE VALLEY GUTTER TO EXISTING ASPHALT PAVEMENT.
PROPOSED VALLEY GUTTER/SIDEWALK
PROPOSED MOUNTABLE CURB & GUTTER

50' CROWN TRANSITION PER C.O.A. STD. DWG. NO. 2401

BOKAY CONSTRUCTION, INC.
ENGINEERING SERVICES • CONSTRUCTION MANAGEMENT
5905 AZULEO CT. NW
ALBUQUERQUE, NM 87120
(505) 899-9656

CITY OF ALBUQUERQUE
PUBLIC WORKS DEPARTMENT
ENGINEERING GROUP



TITLE: LOS CAMPOS
CAMPO DEL SOL AVE. N.E.
PAVING PLAN AND PROFILE

City Project No. 543781 Zone Map No. K-21 Sheet 12 of 18



SCANNED BY LASON


26 543781 12197

ENGINEER'S SEAL		SURVEY INFORMATION		BENCH MARKS		AS BUILT INFORMATION		
		FIELD NOTES				<i>New Concepts</i> WORK STRUCK BY <i>COA</i> DATE <i>8/96</i> INSPECTOR'S FIELD MADE BY <i>L. Boman</i> DATE <i>1/97</i> VERIFICATION BY <i>COA</i> DATE <i>1/97</i> DRAWING REVISED BY <i>COA</i> DATE <i>3/97</i> MICRO-FILM INFORMATION RECORDED BY _____ DATE _____ NO. _____		
		NO.	BY					DATE
		REMARKS						BY
		REVISIONS						
		DESIGN						
DESIGNED BY		BO K. JOHNSON		DATE				
DRAWN BY		DONALD MCCURDY		DATE				
CHECKED BY		BO K. JOHNSON		DATE				
Mo/Day/Yr.				Mo/Day/Yr.				
Sheet		13		Of		18		

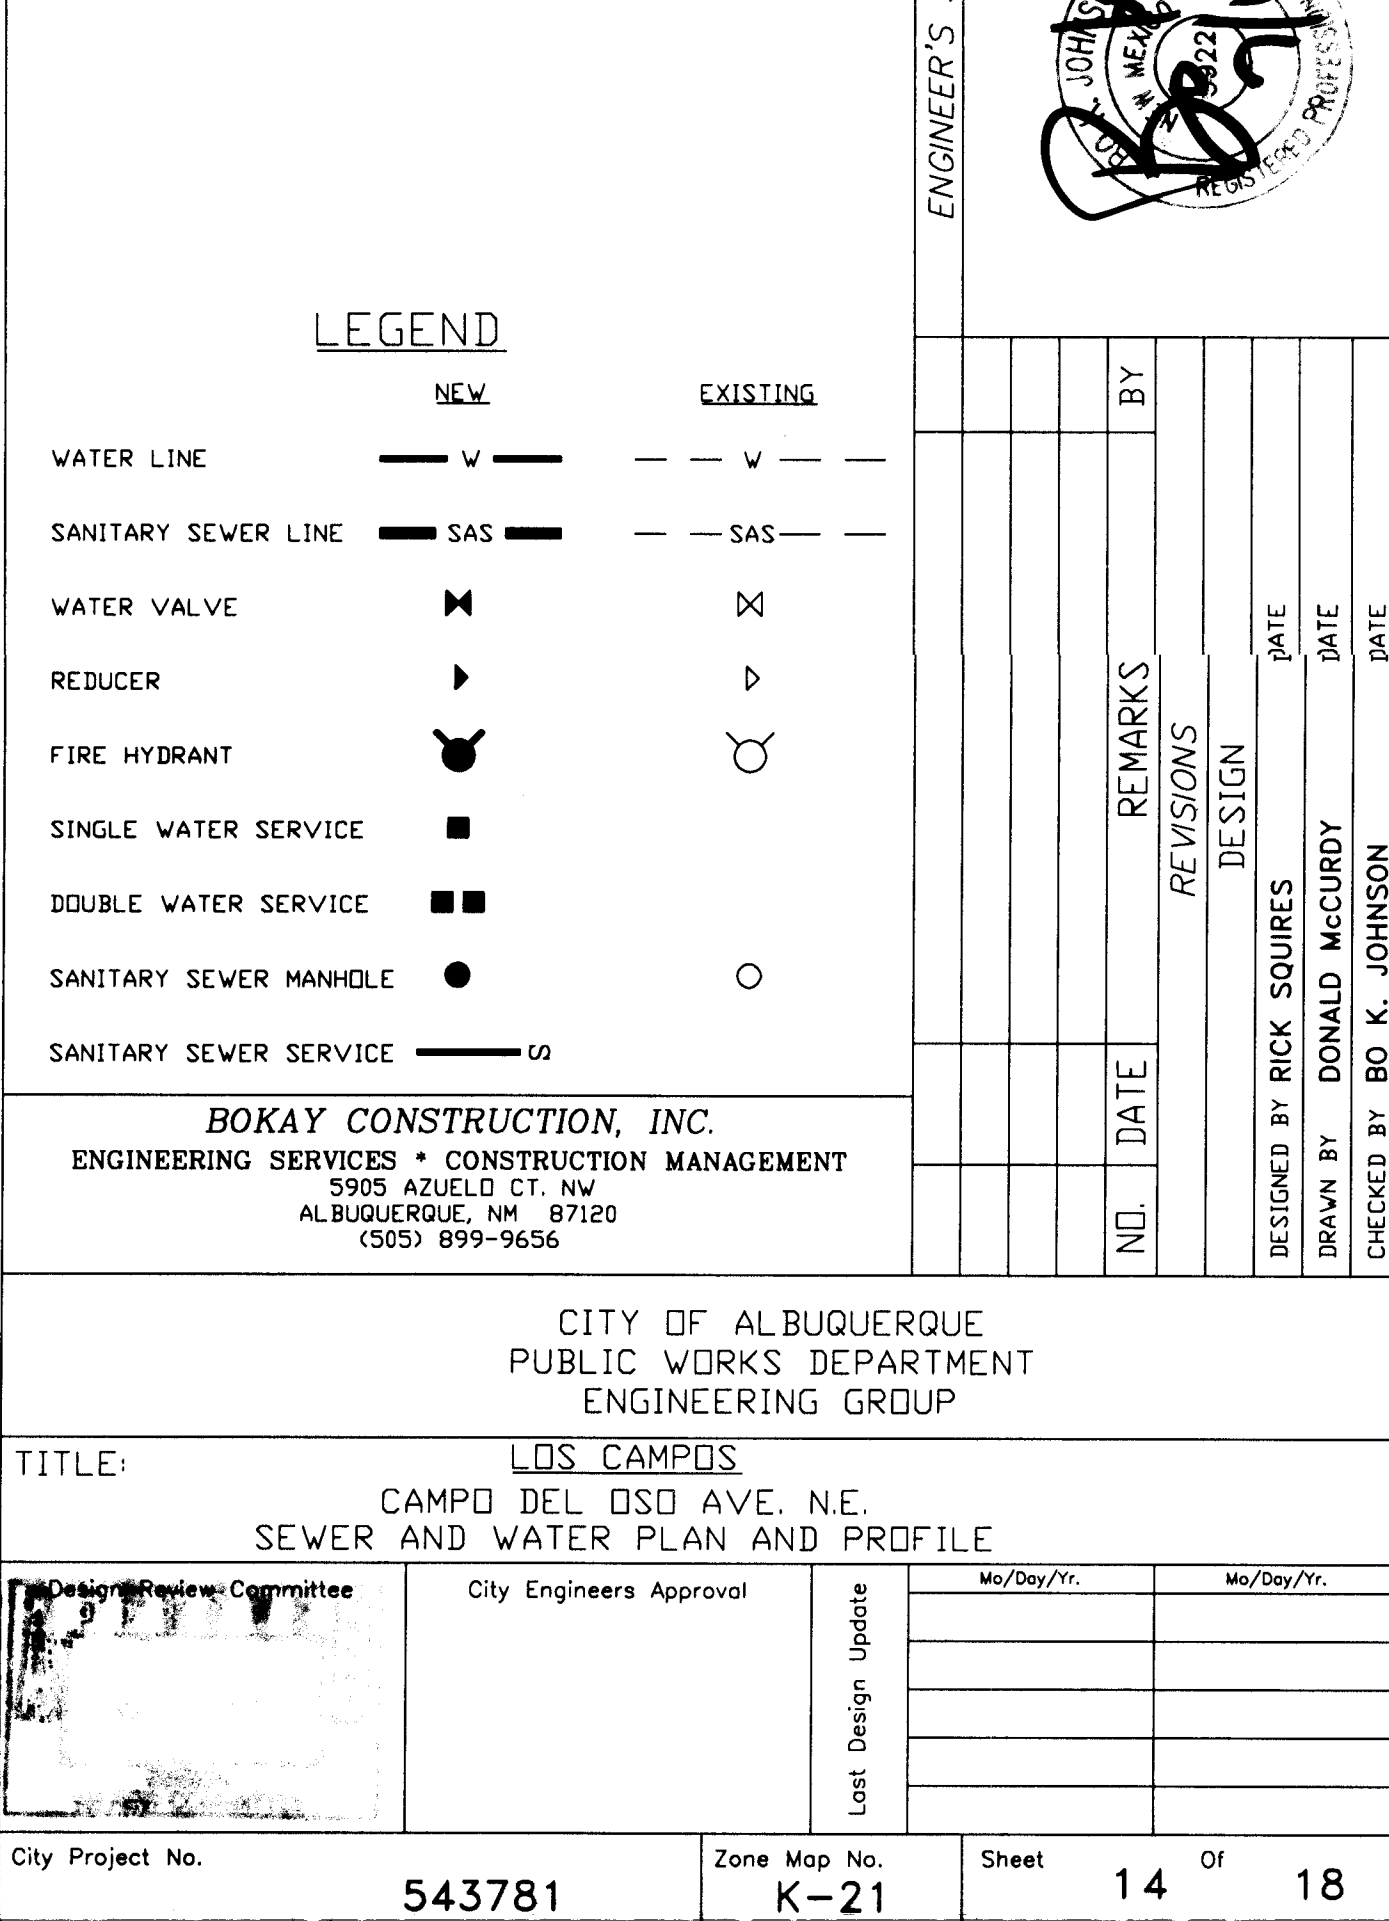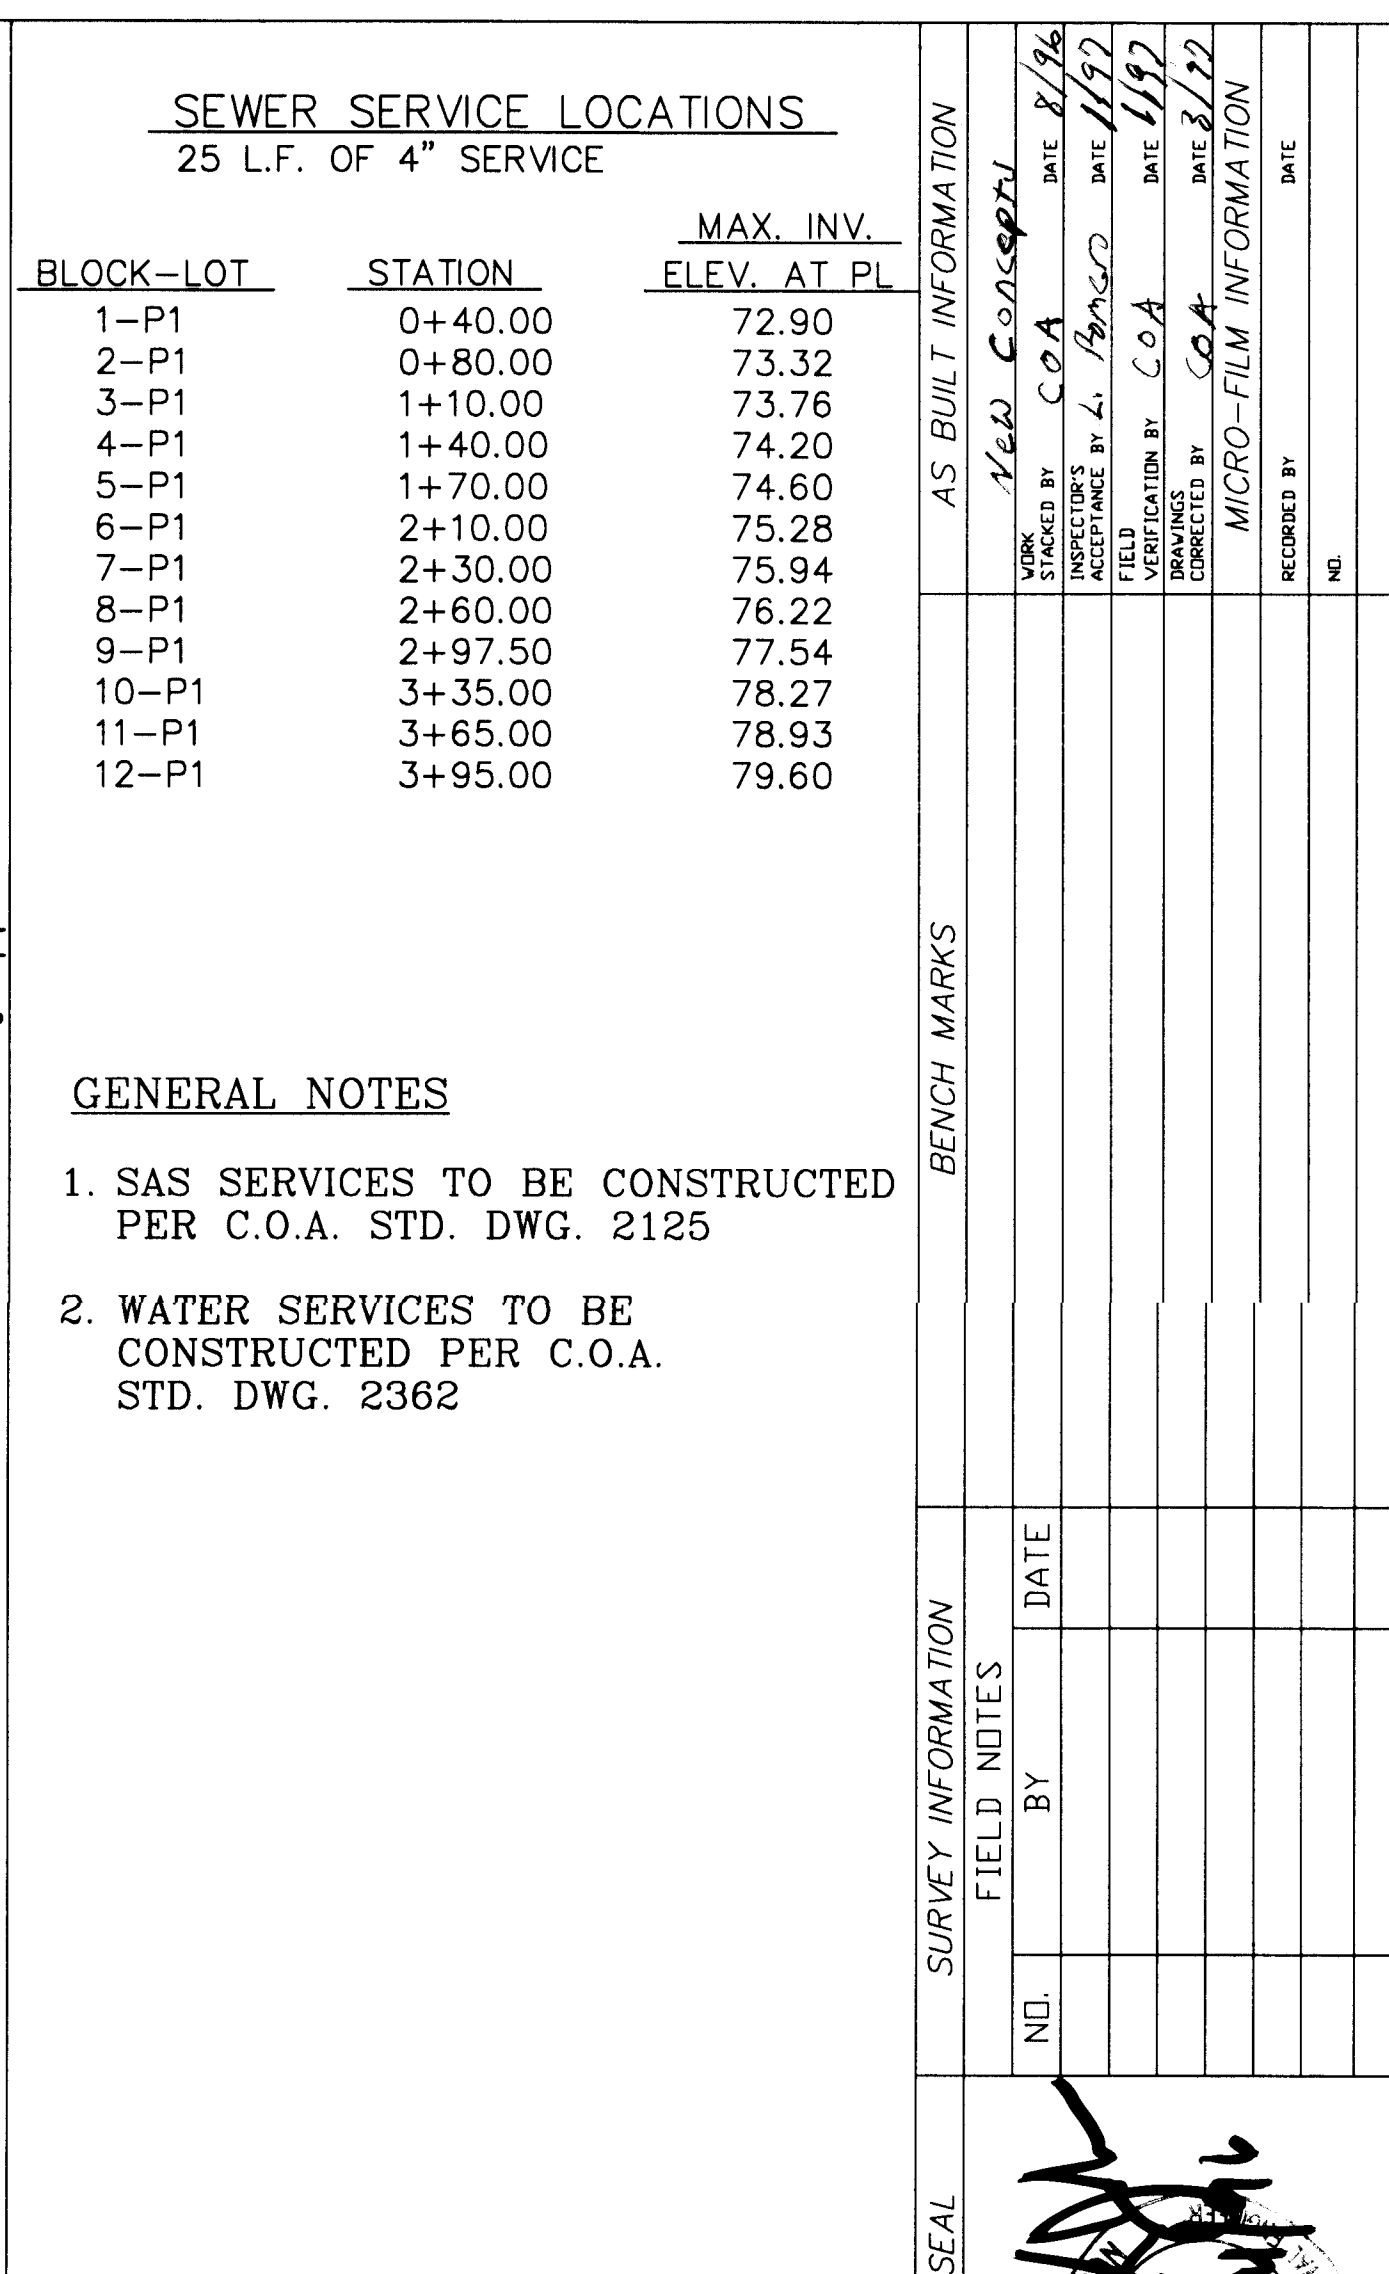

STA 4+20.15
CAMPO DEL OSO=
STA 0+00.00
CONNECTOR "B"

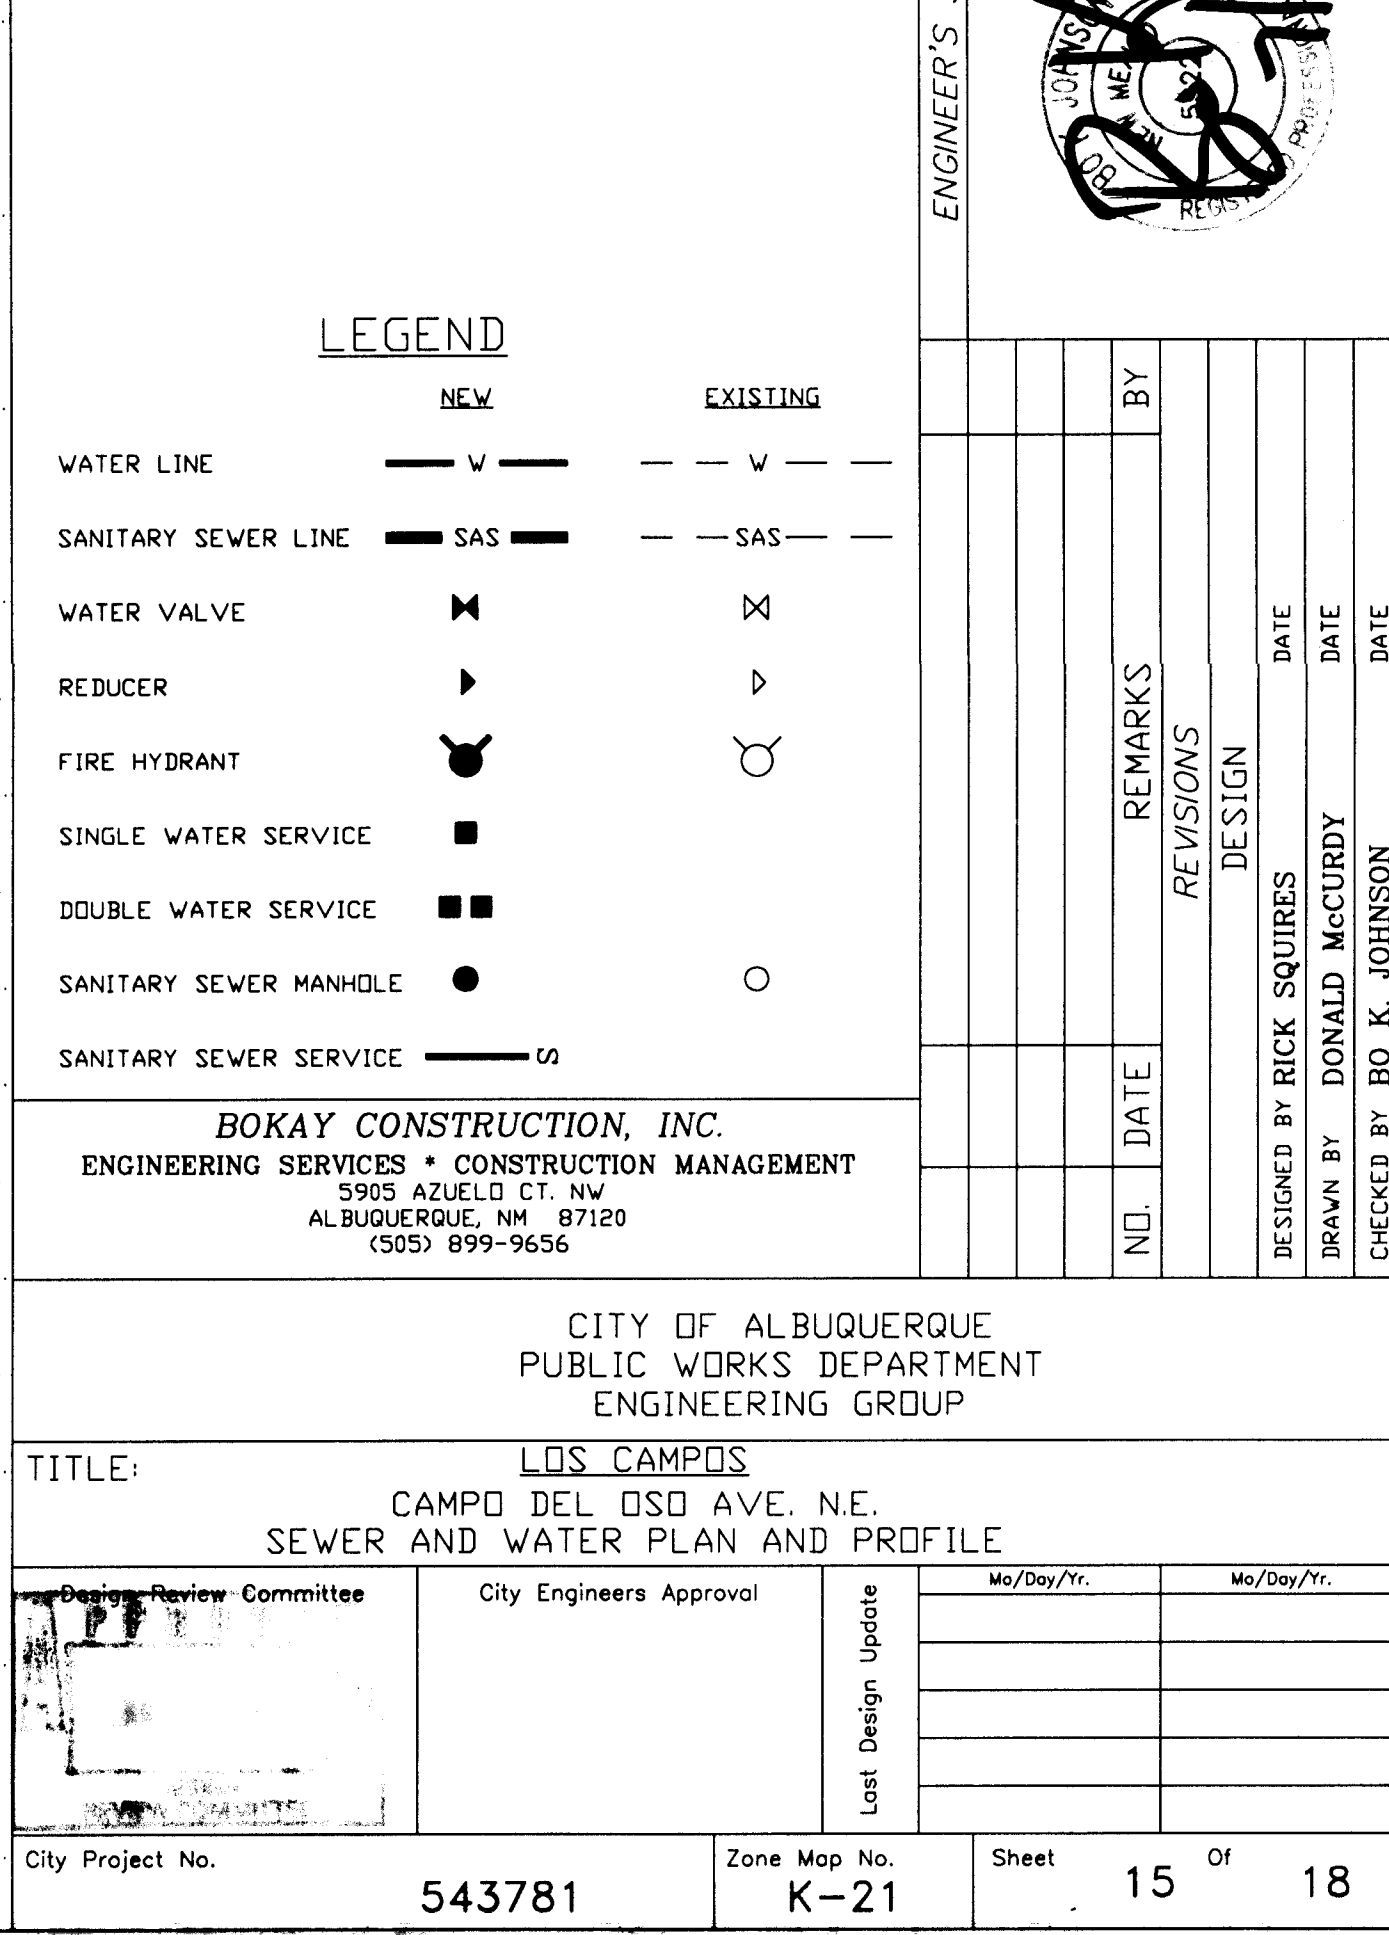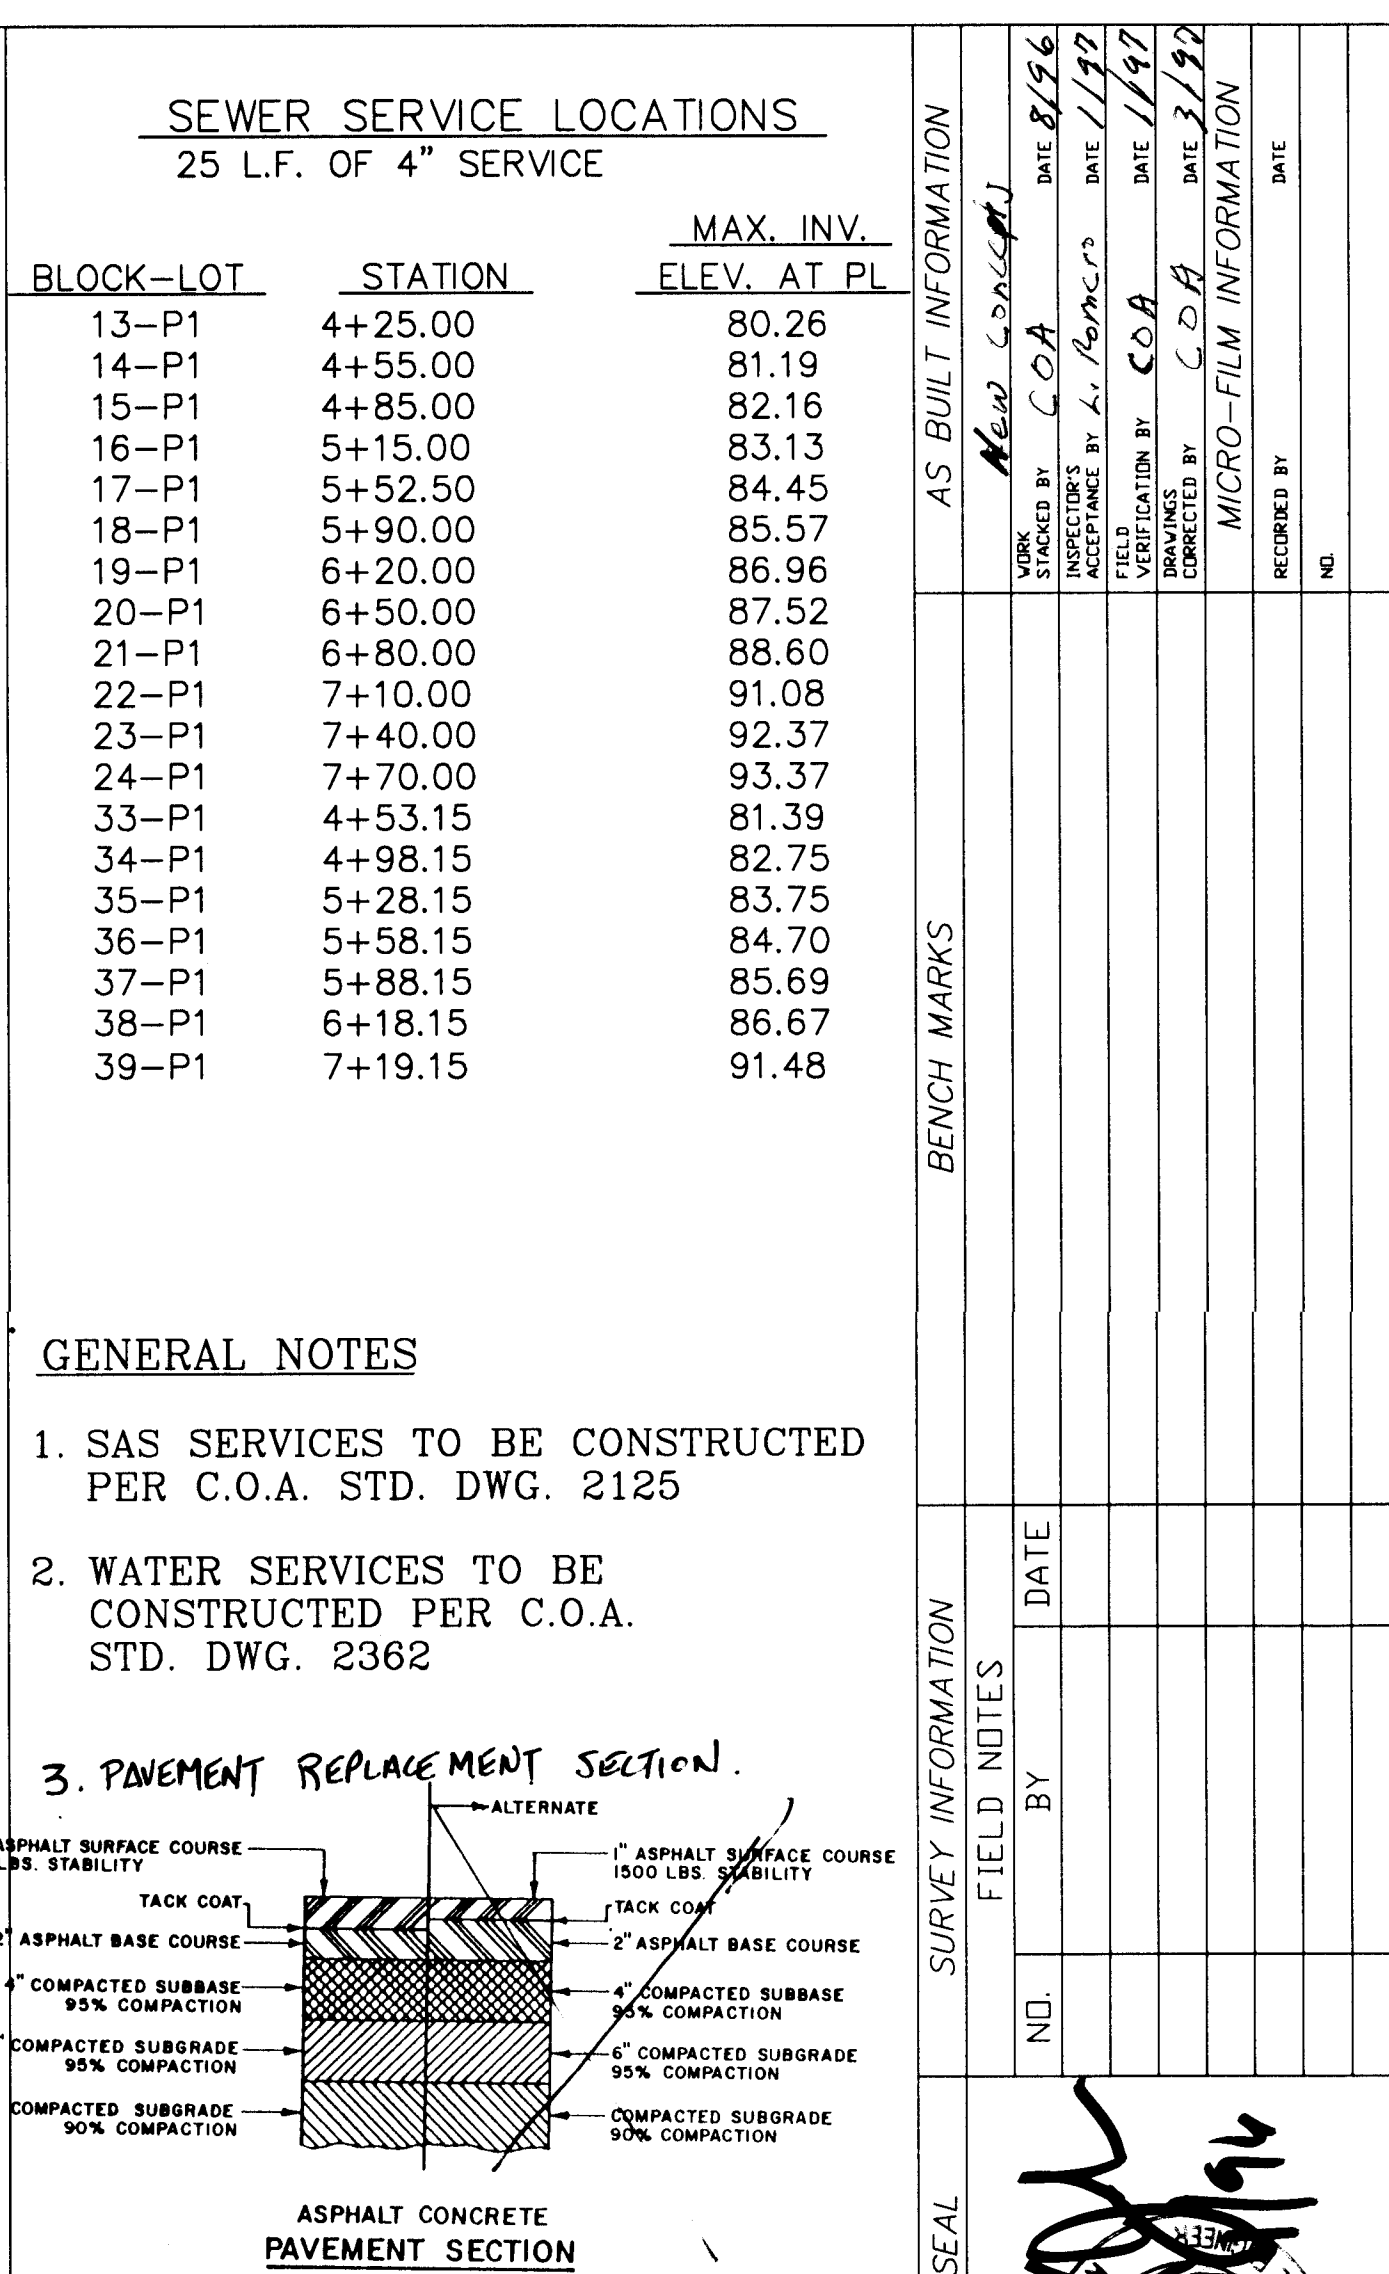

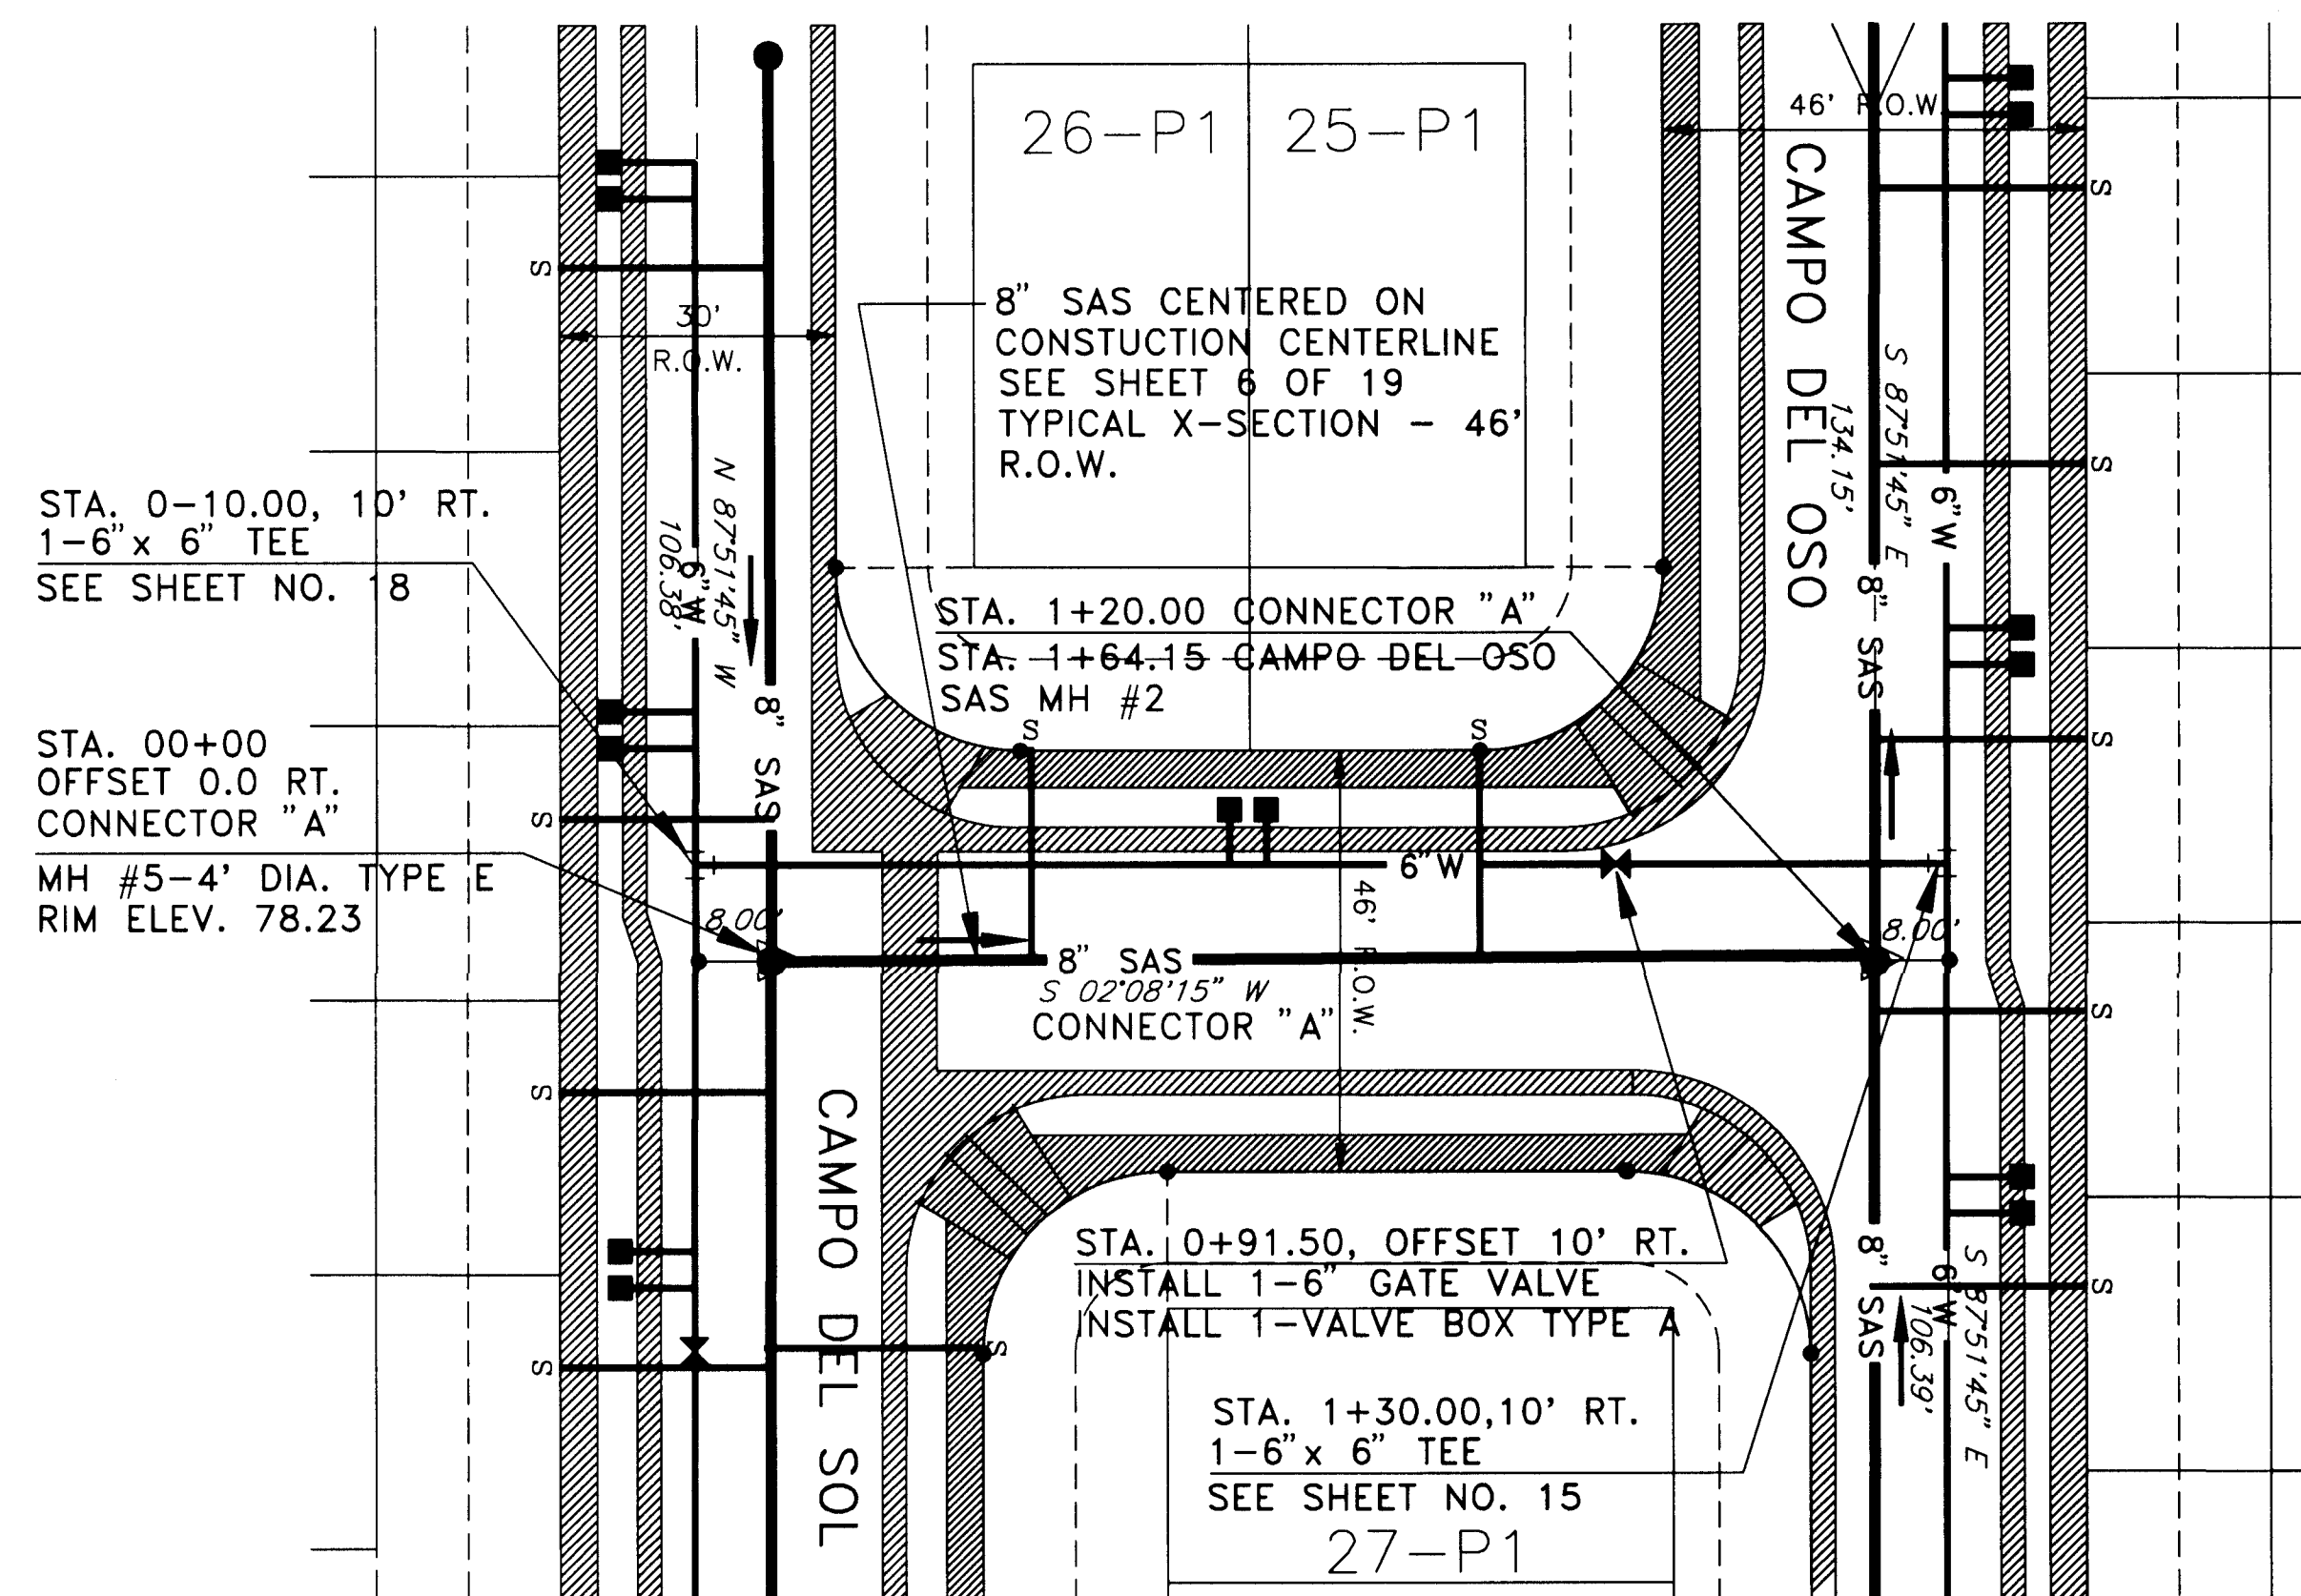

38-P1
STA. 0+10.00, 10' LT.
1-6" x 6" TEE
SEE SHEET NO. 19

STA. 0+27.00, 10' LT.
INSTALL 1-6" x 6" TEE

6" W
S 02°08'15" W
CONNECTOR "C"

46' R.O.W.
28' F.F.

39-P1
STA. 0+27.00, 14.67' RT.
INSTALL 1-4" F.H., 4'-BURY
FLANGE ELEV. = 91.78
WITH RESTRAINED JOINTS
24.67' L.F., 6" WATER LINE

MH #8
RIM EL. = 90.89

40-P1

62.94'

6" W
8" SAS


STA. 1+30.00, 10' RT.
1-6" x 6" TEE
SEE SHEET NO. 16

59-P1 60-P1 61-P1 62-P1 63-P1

CAMPO DEL SOL

MPO DEL OSO

SCALES: 1" = 20' HORZ.
1" = 5' VERT.

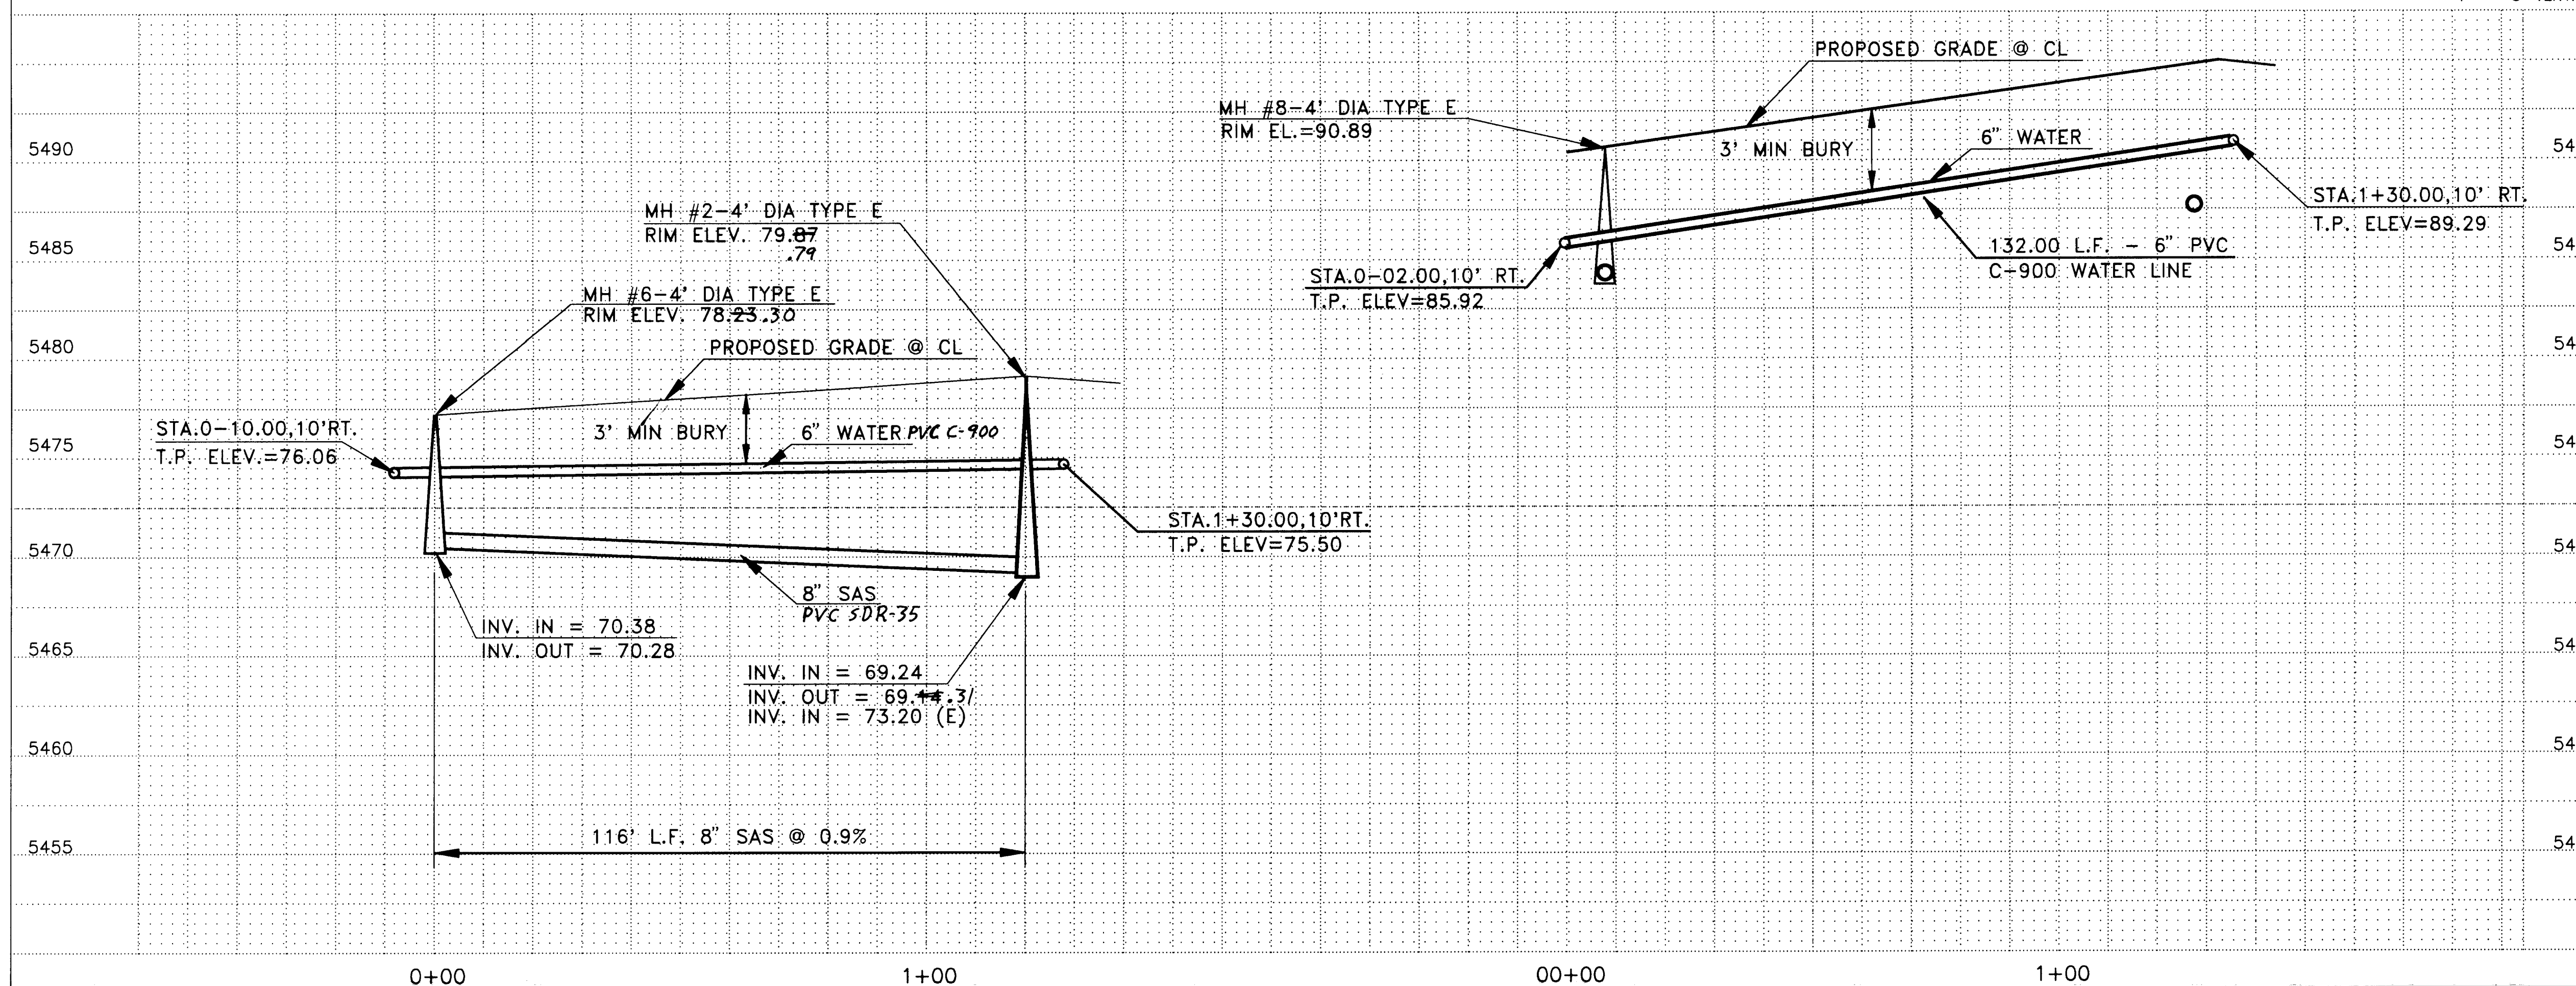

AS BUILT INFORMATION	
INSPECTOR'S DATE	DATE
10/20/97	8/9/96
RECEIVED BY	DATE
10/20/97	8/9/96
MICRO-FILM INFORMATION	
RECORDED BY	DATE
REL	

[illegible][illegible]

Professional Engineer Seal for the State of New York, No. 12199, signed by Robert J. Johnson.


[illegible]

REQUEST DEPARTMENT DUPLICATION	
C OF FILE	
Mo./Day/Yr.	Mo./Day/Yr.
Sheet	Of
16	18

CITY OF ALBUQUERQUE
PUBLIC WORKS DEPARTMENT
ENGINEERING GROUP

0. TITLE: LOS CAMPOS
CONNECTOR STREETS "A" AND "C"
SEWER AND WATER PLAN AND PROFILE

5	Design-Review Committee	City Engineers Approval	Last Design Update	Mo/Da/Yr
City Project No.		Zone Map No.	Sheet	
513781		K-21		

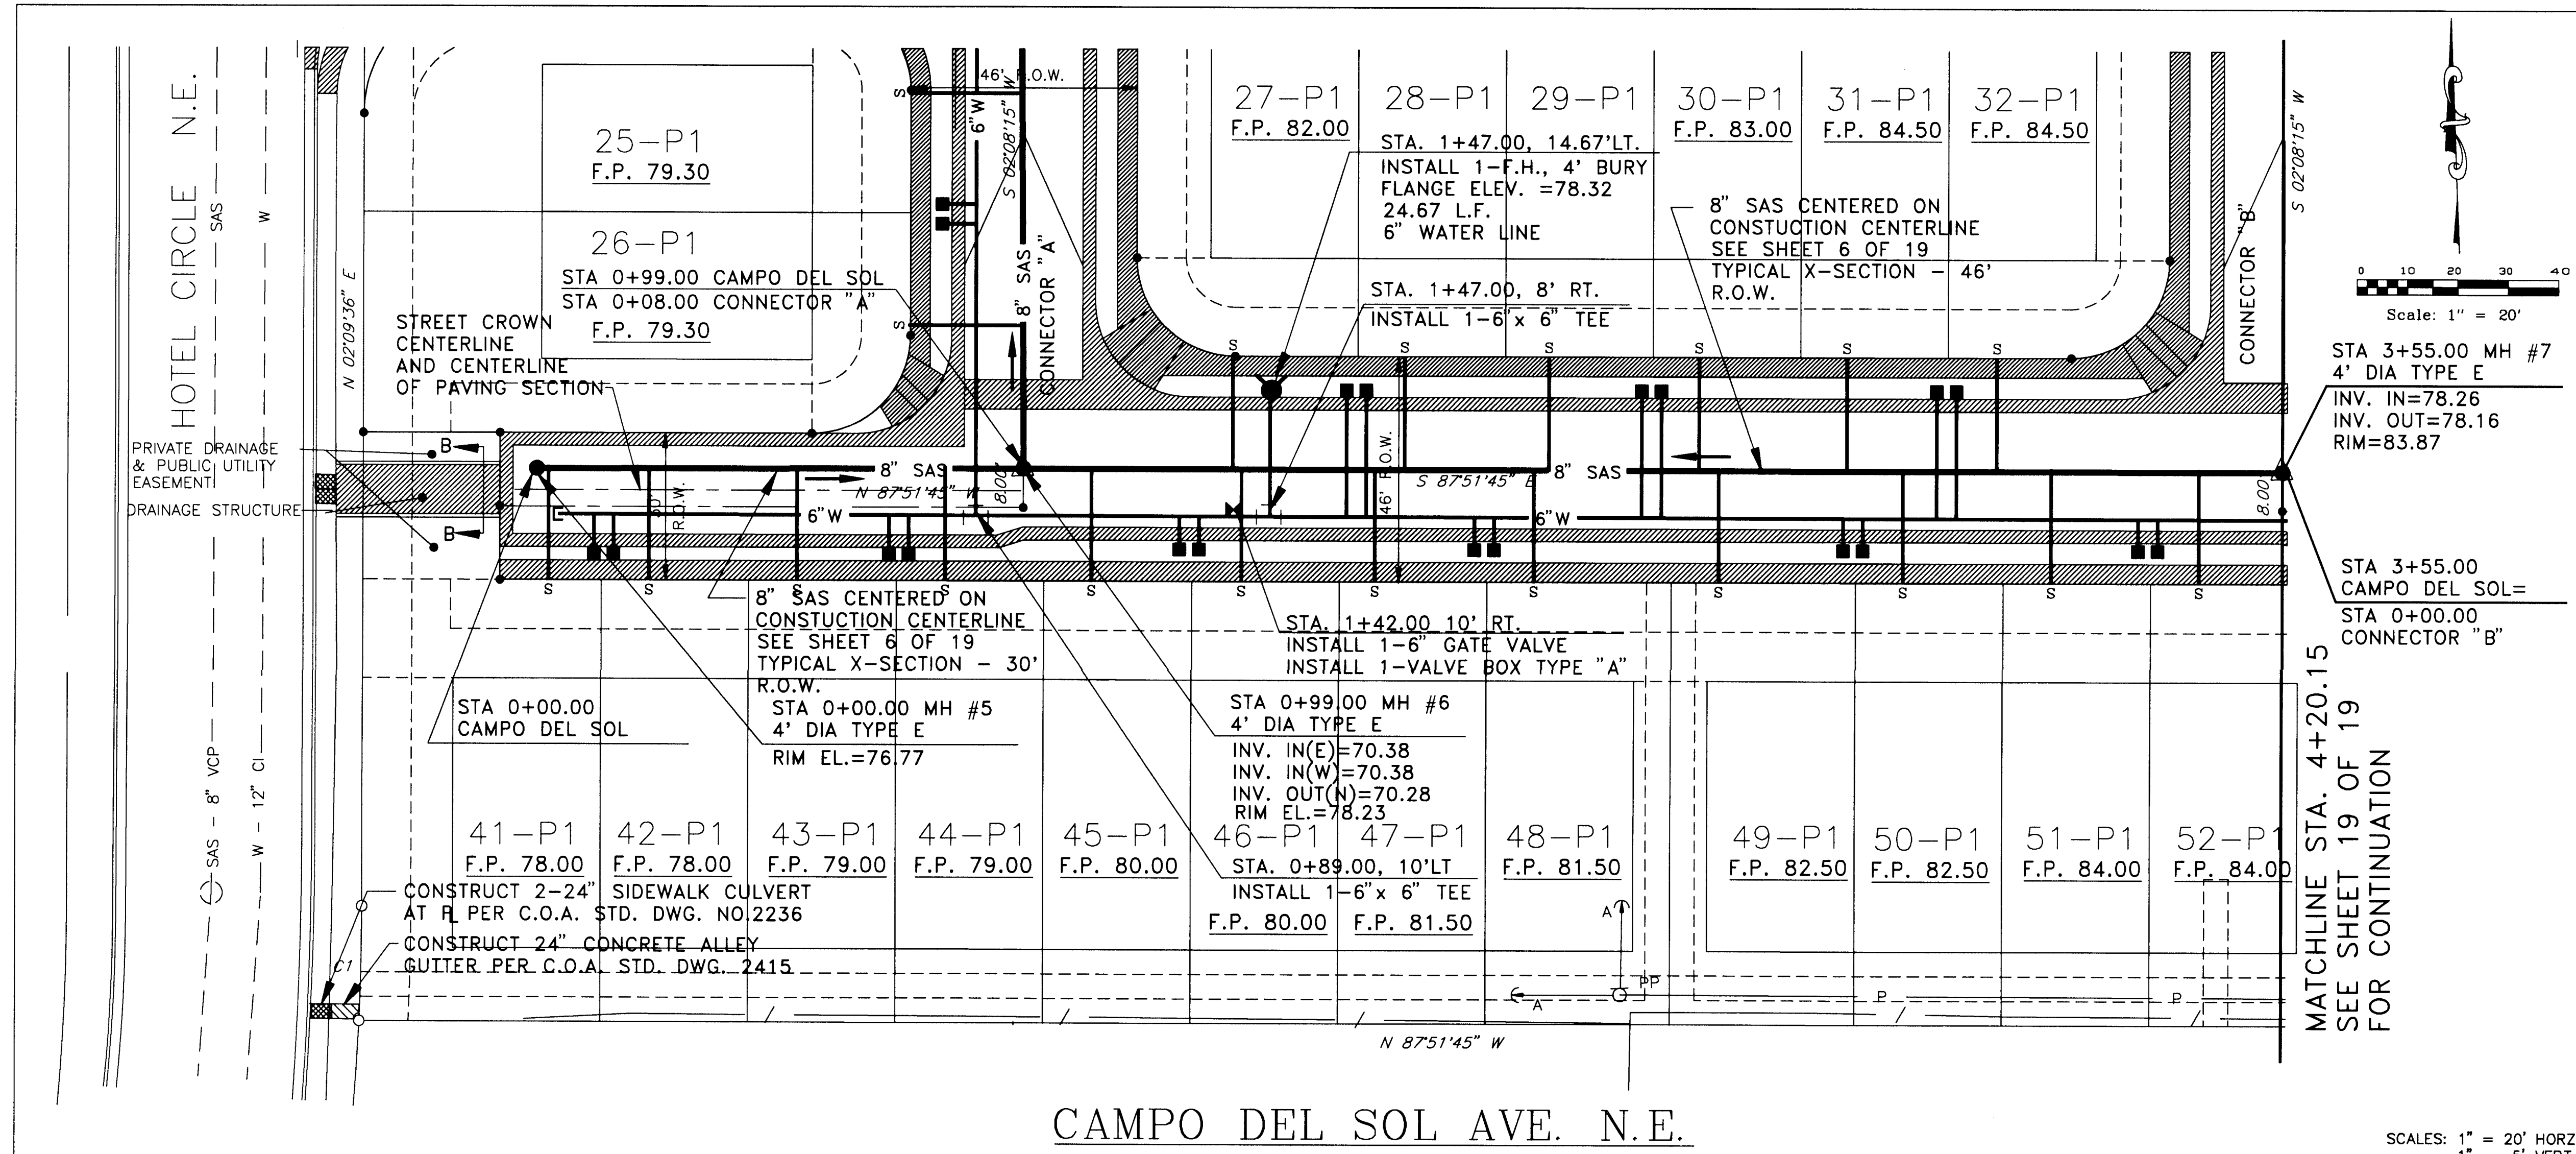


SEWER SERVICE LOCATIONS			MAX. INV.	
25 L.F. OF 4" SERVICE			ELEV. AT PL.	
BLOCK-LOT	STATION			
27-P1	1+32.00		73.72	
28-P1	1+62.00		74.56	
29-P1	1+92.00		75.09	
30-P1	2+22.00		75.72	
31-P1	2+52.00		76.35	
32-P1	2+82.00		76.98	
41-P1	0+05.00		71.75	
42-P1	0+23.00		72.16	
43-P1	0+53.00		72.56	
44-P1	0+83.00		72.76	
45-P1	1+13.00		73.11	
46-P1	1+43.00		75.06	
47-P1	1+73.00		74.37	
48-P1	2+03.00		75.00	
49-P1	2+40.50		75.89	
50-P1	2+78.00		76.58	
51-P1	3+08.00		77.21	
52-P1	3+38.00		77.84	

GENERAL NOTES

1. SAS SERVICES TO BE CONSTRUCTED PER C.O.A. STD. DWG. 2125

2. WATER SERVICES TO BE CONSTRUCTED PER C.O.A. STD. DWG. 2362

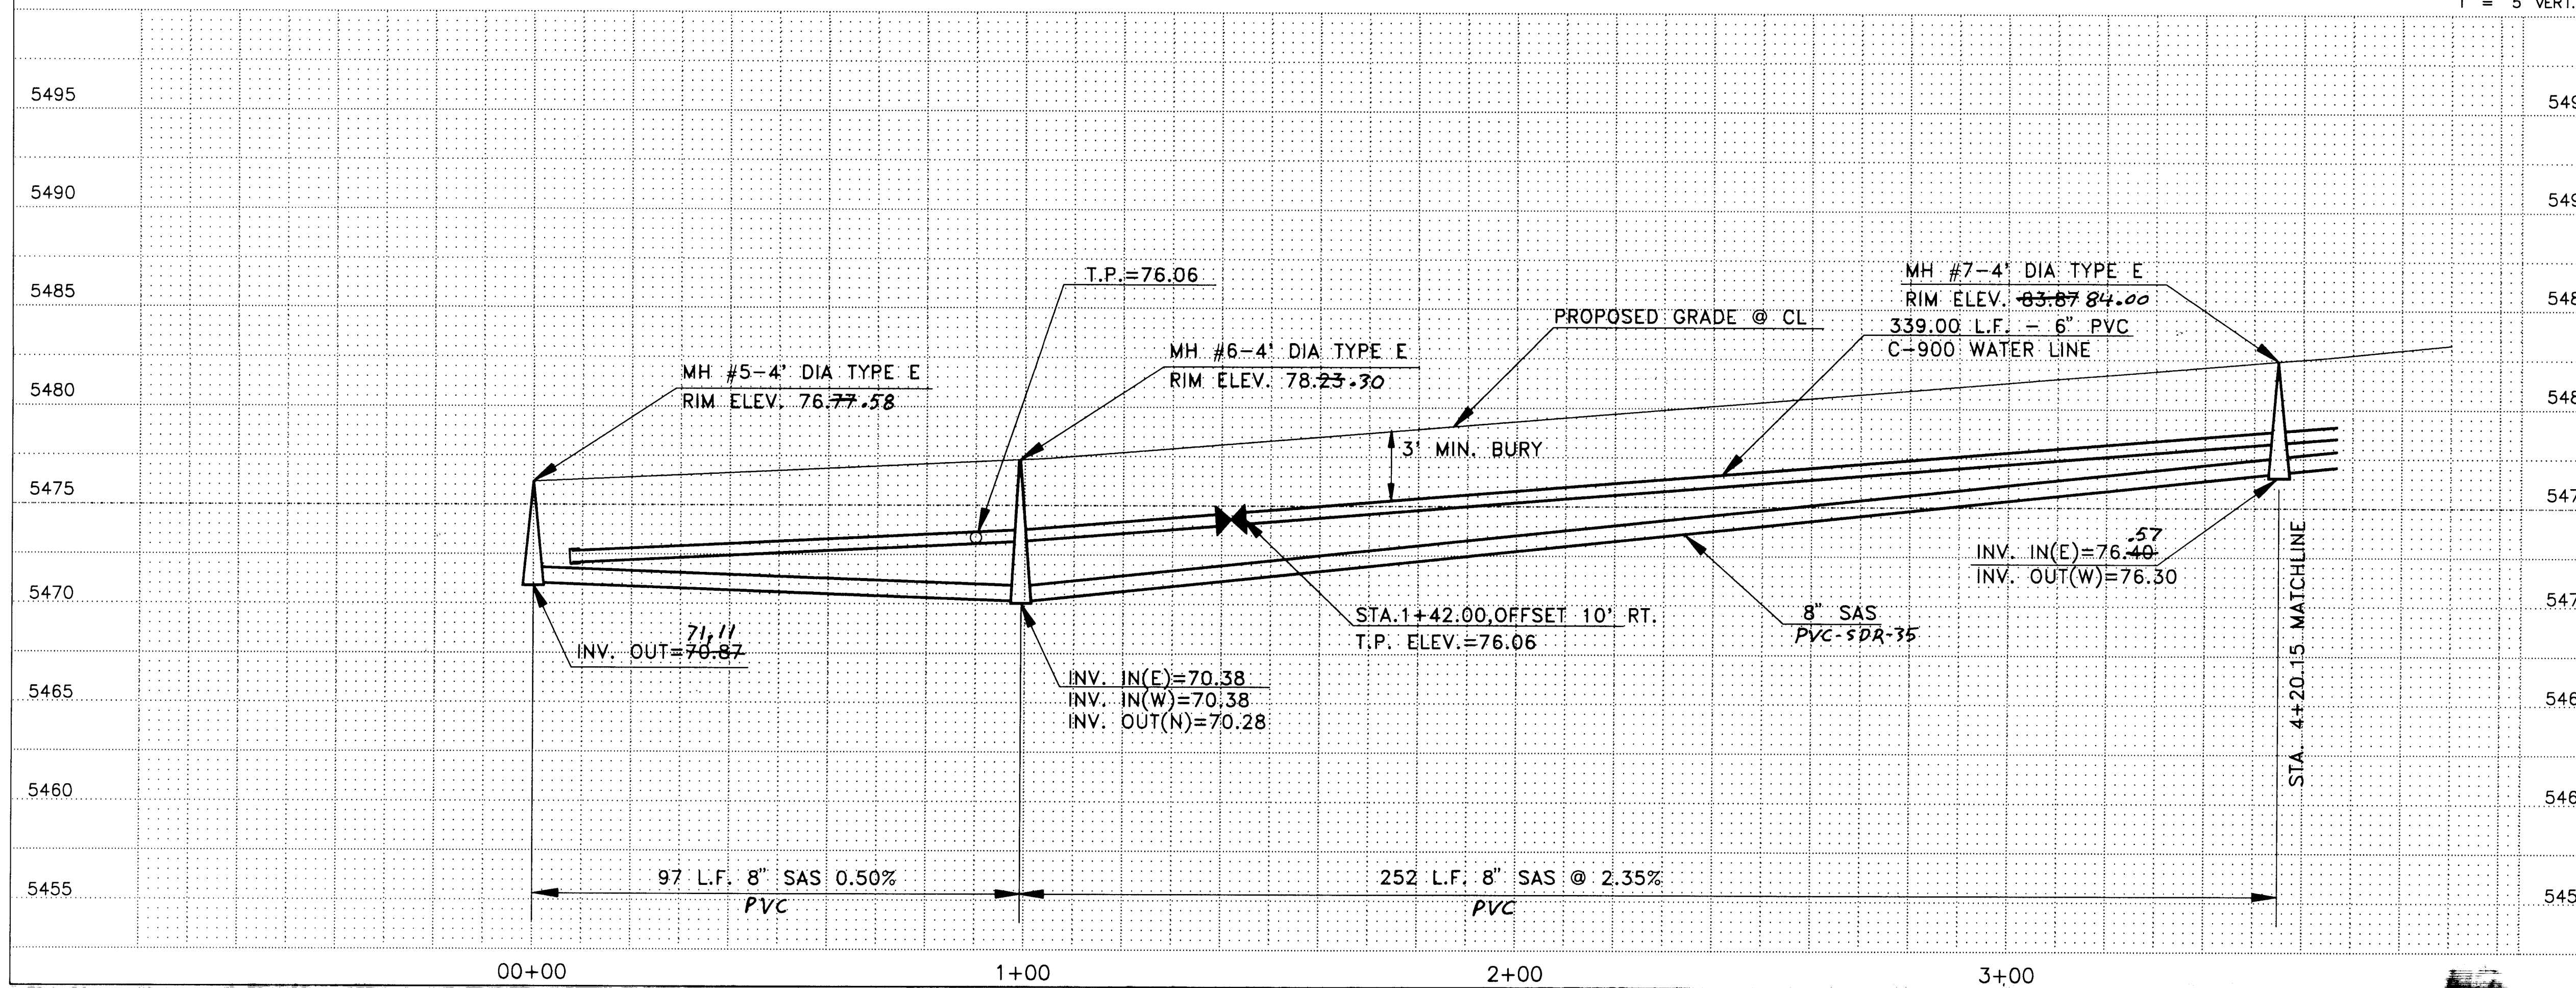

LEGEND

NEW	EXISTING
WATER LINE	---
SANITARY SEWER LINE	---
WATER VALVE	⊗
REDUCER	▷
FIRE HYDRANT	⊙
SINGLE WATER SERVICE	■
DOUBLE WATER SERVICE	■
SANITARY SEWER MANHOLE	○
SANITARY SEWER SERVICE	---

BOKAY CONSTRUCTION, INC.
ENGINEERING SERVICES • CONSTRUCTION MANAGEMENT
5905 AZULEO CT. NW
ALBUQUERQUE, NM 87120
(505) 899-9656


CITY OF ALBUQUERQUE
PUBLIC WORKS DEPARTMENT
ENGINEERING GROUP

TITLE: LOS CAMPOS
CAMPO DEL SOL AVE. N.E.
SEWER AND WATER PLAN AND PROFILE

Design Review Committee	City Engineers Approval	Mo/Day/Yr.	Mo/Day/Yr.

City Project No.	Zone Map No.	Sheet	Of
543781	K-21	17	18

SEE SHEET 18 OF 19
FOR CONTINUATION
MATCHLINE STA. 3+55.00

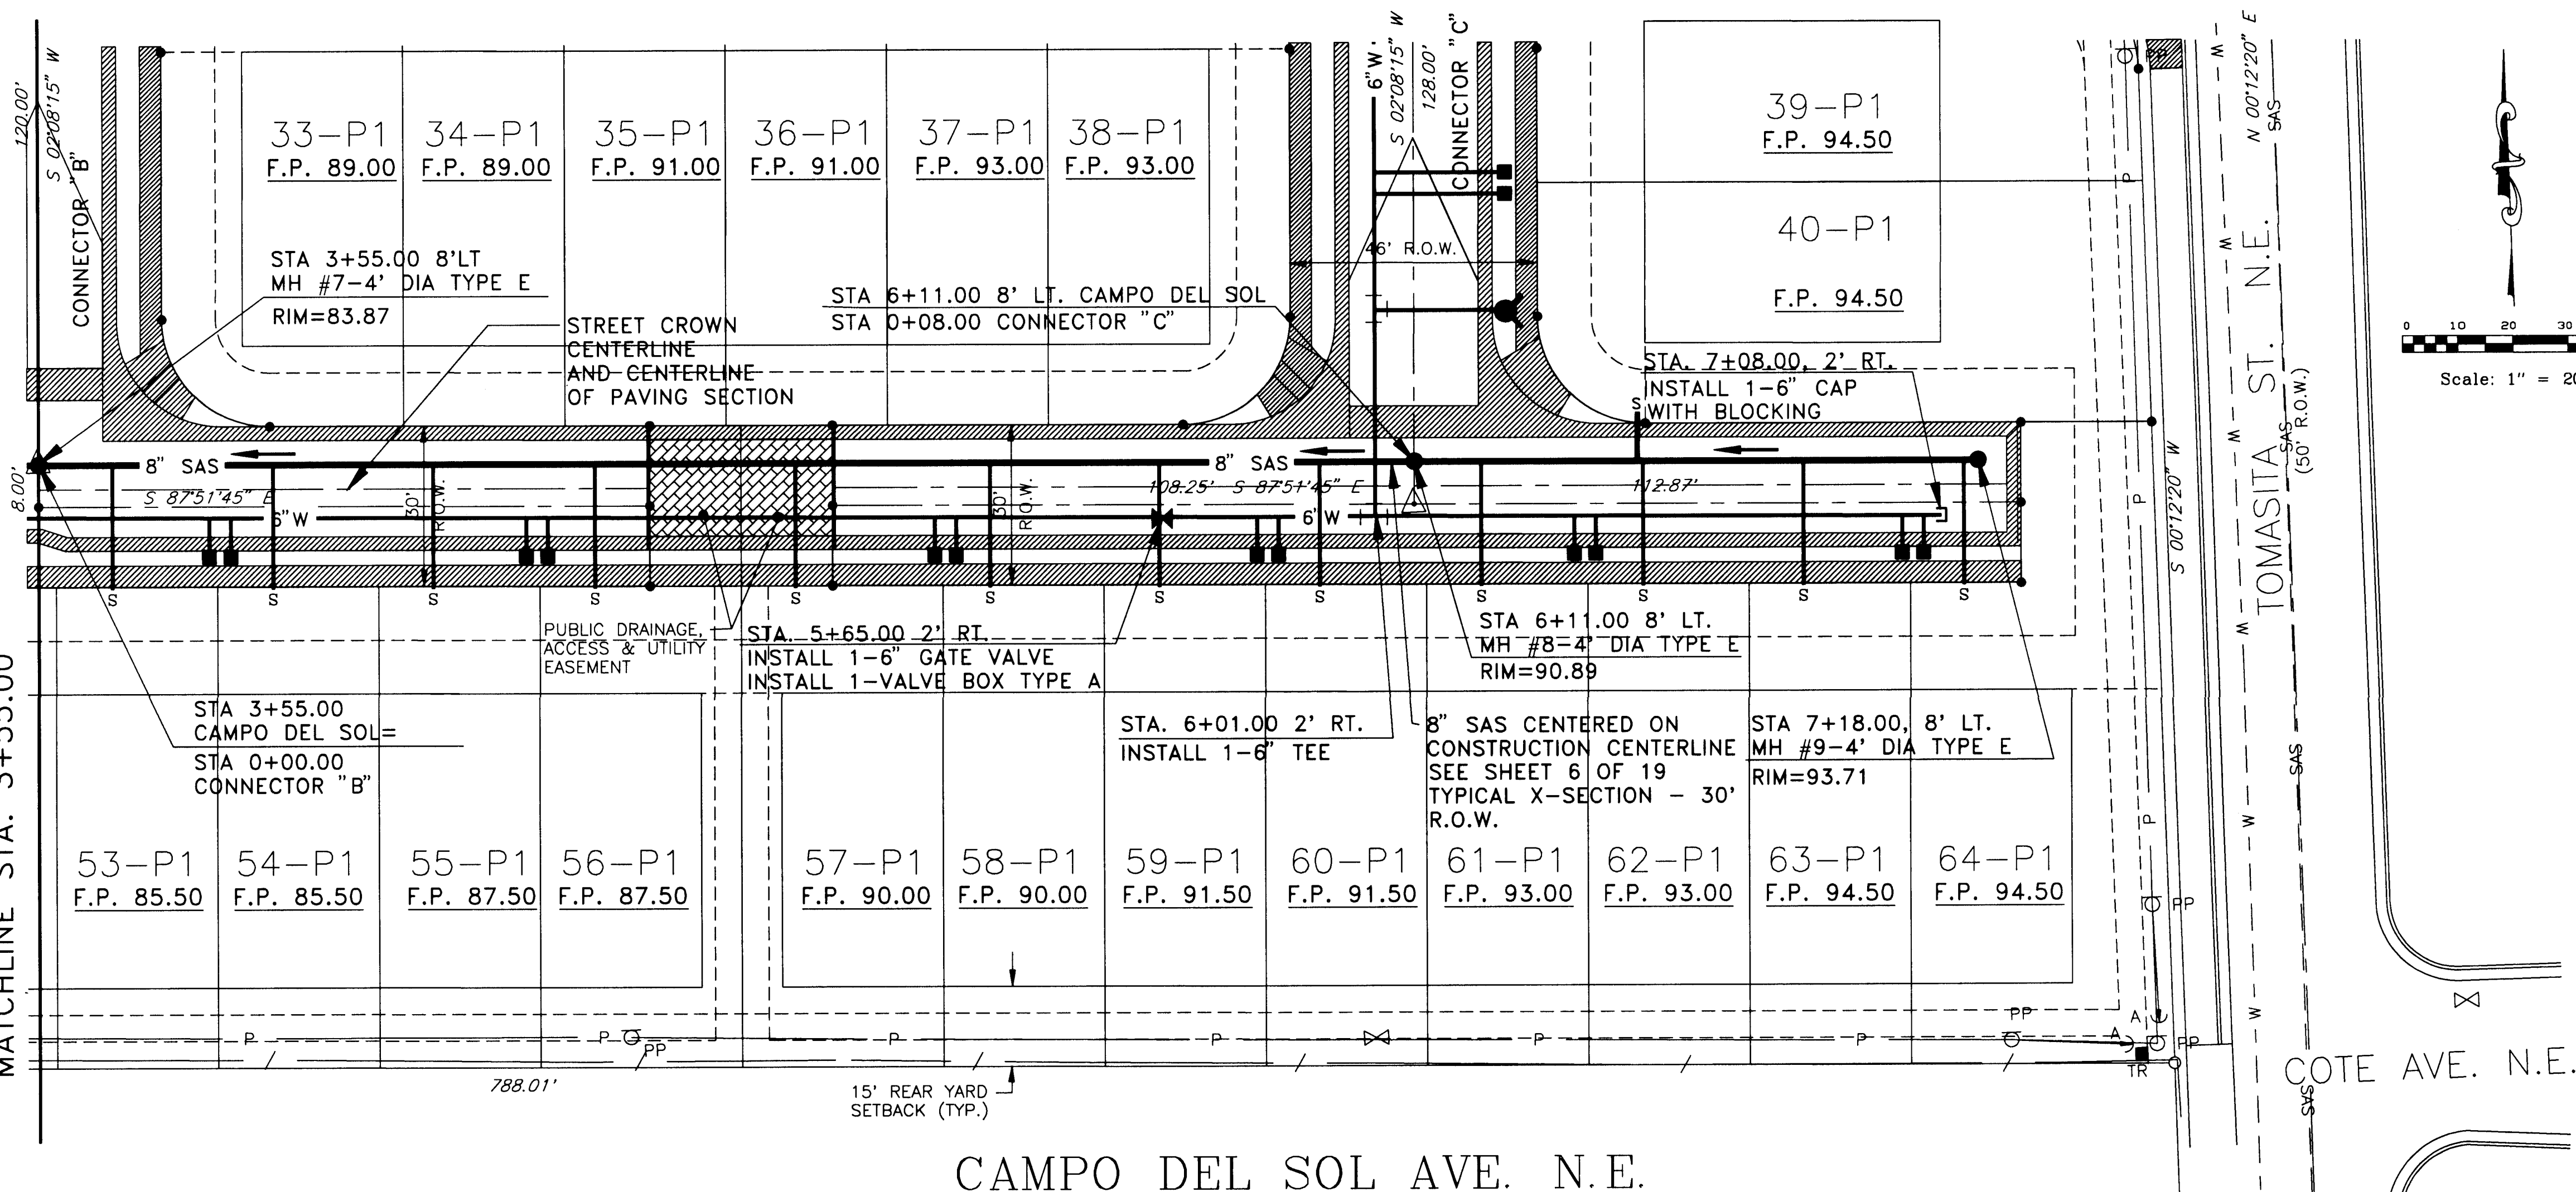

SCALES: 1" = 20' HORZ.
1" = 5' VERT.

SEWER SERVICE LOCATIONS

25 L.F. OF 4" SERVICE

BLOCK-LOT	STATION	MAX. INV. ELEV. AT PL
40-P1	6+54.00	89.36
53-P1	3+68.00	78.48
54-P1	3+98.00	79.46
55-P1	4+28.00	81.43
56-P1	4+58.00	81.41
57-P1	4+95.50	82.98
58-P1	5+33.00	83.84
59-P1	5+63.00	84.92
60-P1	5+93.00	85.80
61-P1	6+23.00	86.76
62-P1	6+53.00	87.56
63-P1	6+83.00	88.16
64-P1	7+13.00	89.16

GENERAL NOTES

- SAS SERVICES TO BE CONSTRUCTED PER C.O.A. STD. DWG. 2125
- WATER SERVICES TO BE CONSTRUCTED PER C.O.A. STD. DWG. 2362

LEGEND

	NEW	EXISTING
WATER LINE	— W —	— W —
SANITARY SEWER LINE	— SAS —	— SAS —
WATER VALVE	⊗	⊗
REDUCER	▷	▷
FIRE HYDRANT	⊙	⊙
SINGLE WATER SERVICE	■	○
DOUBLE WATER SERVICE	■	○
SANITARY SEWER MANHOLE	●	○
SANITARY SEWER SERVICE	—	—

BOKAY CONSTRUCTION, INC.
ENGINEERING SERVICES • CONSTRUCTION MANAGEMENT
5905 AZUELO CT. NW
ALBUQUERQUE, NM 87120
(505) 899-9656

CITY OF ALBUQUERQUE
PUBLIC WORKS DEPARTMENT
ENGINEERING GROUP
TITLE: LOS CAMPOS
CAMPO DEL SOL AVE. N.E.
SEWER AND WATER PLAN AND PROFILE

Design Review Committee	City Engineers Approval	Last Design Update	Mo/Day/Yr.	Mo/Day/Yr.

City Project No. 543781 Zone Map No. K-21 Sheet 18 of 18

SCANNED BY
BY LASON

26-543781-21-1817