

SCANNED BY
MESA REPRO



NOTICE TO CONTRACTORS

1. ALL WORK DETAILED ON THESE PLANS TO BE PERFORMED UNDER CONTRACT SHALL, EXCEPT AS OTHERWISE STATED OR PROVIDED FOR HEREON, BE CONSTRUCTED IN ACCORDANCE WITH THE CITY OF ALBUQUERQUE STANDARD SPECIFICATIONS FOR PUBLIC WORKS CONSTRUCTION, 1986 EDITION AND SHALL INCLUDE UPDATE No. 6
2. TWO WORKING DAYS PRIOR TO ANY EXCAVATION, THE CONTRACTOR MUST CONTACT NEW MEXICO ONE CALL SYSTEM (260-1990) FOR LOCATION OF EXISTING UTILITIES.
3. PRIOR TO CONSTRUCTION, THE CONTRACTOR SHALL EXCAVATE AND VERIFY THE HORIZONTAL AND VERTICAL LOCATIONS OF ALL OBSTRUCTIONS. SHOULD A CONFLICT EXIST, THE CONTRACTOR SHALL NOTIFY THE ENGINEER OR SURVEYOR IMMEDIATELY SO THAT THE CONFLICT CAN BE RESOLVED WITH A MINIMUM AMOUNT OF DELAY.
4. THREE (3) WORKING DAYS PRIOR TO BEGINNING CONSTRUCTION, THE CONTRACTOR SHALL SUBMIT TO CONSTRUCTION COORDINATION DIVISION A DETAILED CONSTRUCTION SCHEDULE. TWO (2) WORKING DAYS PRIOR TO CONSTRUCTION, THE CONTRACTOR SHALL OBTAIN A BARRICADING PERMIT FROM THE CONST. COORDINATION DIVISION. CONTRACTOR SHALL NOTIFY BARRICADE ENGINEER (760-2551) PRIOR TO OCCUPYING AN INTERSECTION. REFER TO SECTION 19 OF THE GENERAL CONDITIONS OF THE STANDARD SPECIFICATIONS.
5. ALL STREET STRIPING ALTERED OR DESTROYED SHALL BE REPLACED IN KIND BY CONTRACTOR TO LOCATION AND IN KIND AS EXISTING OR AS INDICATED BY THIS PLAN SET.
6. CONTRACTOR SHALL NOTIFY THE ENGINEER NOT LESS THAN SEVEN (7) DAYS PRIOR TO STARTING WORK IN ORDER THAT THE CITY SURVEYOR MAY TAKE NECESSARY MEASURES TO INSURE THE PRESERVATION OF SURVEY MONUMENTS. CONTRACTOR SHALL NOT DISTURB PERMANENT SURVEY MONUMENTS WITHOUT THE CONSENT OF THE CITY SURVEYOR AND SHALL NOTIFY THE CITY SURVEYOR AND BEAR THE EXPENSE OF REPLACING ANY THAT MAY BE DISTURBED WITHOUT PERMISSION. REPLACEMENT SHALL BE DONE ONLY BY THE CITY SURVEYOR. WHEN A CHANGE IS MADE IN THE FINISHED ELEVATIONS OF THE PAVEMENT OF ANY ROADWAY IN WHICH A PERMANENT SURVEY MONUMENT IS LOCATED, CONTRACTOR SHALL, AT HIS OWN EXPENSE, ADJUST THE MONUMENT COVER TO THE NEW GRADE UNLESS OTHERWISE SPECIFIED. REFER TO SECTION 4.4 OF THE GENERAL CONDITIONS OF THE STANDARD SPECIFICATIONS. ANY PERMANENT SURVEY MONUMENT LOCATED WITHIN 50' OF THE PROJECT LIMITS NOT SHOWN ON THE PLANS THAT IS DESTROYED DURING CONSTRUCTION WILL BE REPLACED AT DESIGNER'S EXPENSE.
7. ANY WORK WITHIN AN ARTERIAL ROADWAY REQUIRES TWENTY-FOUR HOUR CONSTRUCTION.

THE FOLLOWING NOTES ALSO APPLY WHEN CHECKED

- ☒ ALL UTILITIES AND UTILITY SERVICE LINES SHALL BE INSTALLED PRIOR TO PAVING.
- ☐ BACKFILL COMPACTION SHALL BE ACCORDING TO SPECIFIED STREET USE.
- ☐ TACK COAT REQUIREMENTS SHALL BE DETERMINED BY THE *CITY* ENGINEER.
- ☒ SIDEWALKS AND WHEELCHAIR RAMPS WITHIN THE CURB RETURNS SHALL BE CONSTRUCTED WHEREVER A NEW CURB RETURN IS CONSTRUCTED.
- ☒ IF CURB IS DERESSED FOR A DRIVEPAD, THE DRIVEPAD SHALL BE CONSTRUCTED PRIOR TO ACCEPTANCE OF CURB AND GUTTER.
- ☒ ALL STORM DRAINAGE FACILITIES SHALL BE COMPLETED PRIOR TO FINAL ACCEPTANCE.
- ☒ THE REQUESTOR OR DEVELOPER SHALL BE RESPONSIBLE FOR REPAIR OR REPLACEMENT OF ALL CURB AND GUTTER OR SIDEWALK DAMAGED AFTER APPROVAL BY THE CITY ENGINEER OF WORK COMPLETED BY THE CONTRACTOR.

HAC

COPYRIGHT BOHANNAN-HUSTON, 1996
DATE: MAY 1996

I, PATRICK J. CONLEY of the firm of SMITH ENG. CO
A Registered Professional Engineer in the State of New Mexico, do hereby certify, to
the best of my knowledge and belief, that the Infrastructure Installation project of this
project has been inspected by me, or by a qualified person under my direct supervision
and has been constructed in accordance with the plans and specifications, submit
SMITH ENG. CO, approved by the City Engineer
and the original design intent of the approved plans has been met, except as noted
by me on the as-built construction drawings. This Certification is based on site
inspections by me or personnel under my direction and survey information provided by
TIMOTHY ALDRICH (See over Name) NMPS number 7717 (PS #).



SURVEYOR'S CERTIFICATION

"I, Timothy Aldrich, a duly qualified Registered Professional Land Surveyor under the laws of the State of New Mexico, do hereby certify that the 'as-built' information shown on these drawings was obtained from field construction and 'as-built' surveys performed by me or under my supervision, that the 'as-built' information shown on these drawings was obtained in my capacity as a Registered Professional Land Surveyor, and that this 'as-built' information is true and correct to the best of my knowledge and belief." Aldrich Land Surveying is not responsible for any of the design concepts, calculations, engineering or other information shown on these drawings.

Timothy Aldrich P. S. No. 7719

Date _____

INDEX	
SHEET NUMBER	DESCRIPTION
1	TITLE SHEET
2	PLAT
3	GRADING AND DRAINAGE PLAN
4	OVERALL PAVING
	PAVING PLAN AND PROFILE SHEETS
5	ANIMAS PLACE / ARKANSAS DRIVE
6	ANIMAS PLACE FROM STA. 3+01.44
7	CASA VERDE AVENUE FROM STA. 4
8	CASA VERDE AVENUE FROM STA. 15
9	GALATIN COURT (INCLUDING STORM
10	GUNNISON PLACE FROM STA. 7+76.
10A	GUNNISON PLACE FROM STA. 14+00.
10B	GUNNISON PLACE FROM STA. 24+00.
10A-1	GUNNISON PLACE FROM STA. 15+00.
11	OVERALL UTILITY
11-A	CITY OF ALBUQUERQUE VALVE BOX D
	UTILITY PLAN AND PROFILE SHEETS
12	ANIMAS PLACE / ARKANSAS DRIVE
13	ANIMAS PLACE FROM STA. 3+01.44
14	CASA VERDE AVENUE FROM STA. 4
15	CASA VERDE AVENUE FROM STA. 15
16	GALATIN COURT
17	GUNNISON PLACE FROM STA. 7+76.
17A	GUNNISON PLACE FROM STA. 14+00.
17B	PLATTE COURT
17C 17B-1	OFFSITE SAS LINE
17D + 17C	OFFSITE SAS LINE (NOT USED)
18	PLUNGE POOL DETAILS SHEET
18A	WEST DIVERSION SWALE
18B	IMPACT BASIN DETAILS
18C	HANDRAIL DETAILS



BOHANNAN-HUSTON INC.
ENGINEERS • PLANNERS • PHOTOGRAMMETRISTS • SURVEYORS • LANDSCAPE ARCHITECTS

DRB #95-537

PWT IOR NO 95335A2405



SCANNED BY
MESA REPRO

TEMPORARY
DESILTATION POND
SEE SHEET 18A FOR DETAILS

GENERAL NOTES:
1. CONTRACTOR MUST OBTAIN A TOPSOIL DISTURBANCE PERMIT FROM THE ENVIRONMENTAL HEALTH DIVISION PRIOR TO BEGINNING ROUGH GRADING.

2. THE CONTRACTOR IS TO REFER TO EARTHWORK SPECIFICATION AS NOTED IN THE SOILS REPORT PREPARED BY VINYARD AID ASSOCIATES DATED APRIL 19, 1996. (COPY AVAILABLE FROM OWNER).

3. THE CONTRACTOR SHALL CONFORM TO ALL CITY, COUNTY, STATE, AND FEDERAL DUST CONTROL MEASURES AND REQUIREMENTS AND WILL BE RESPONSIBLE FOR PREPARING AND OBTAINING ALL NECESSARY APPLICATIONS AND APPROVALS INCLUDING EPA STORM WATER PERMIT.

4. THE CONTRACTOR SHALL ENSURE THAT NO SOIL ERODES FROM THE LOTS INTO PUBLIC RIGHT-OF-WAY. THIS CAN BE ACHIEVED BY CONSTRUCTING TEMPORARY BERMS AS PER DETAIL THIS SHEET AND WETTING THE SOIL TO KEEP IT FROM BLOWING.

5. THE CONTRACTOR SHALL NOT GRADE OR DISTURB GROUND BEYOND GRADING LIMITS SHOWN.
6. SEE SHEET 4 OF 18 FOR ROADWAY CROSS-SECTIONS.

7. STRIPPINGS SHALL BE USED IN NON-STRUCTURAL FILL AREAS.

8. ALL AREAS (NOT TO BE PAVED) OUTSIDE OF THE BOUNDARY OF UNIT I SHALL BE RESEED PER COA, STD. SPECS SECT 1012.

INSTALL 8" x 16" x 12" TYPE VL DUMPED RIPRAP OVER 6" GRAVEL FILTER PER NOTE 2 ON SHEET 18B OF 18 (BOTH SIDES OF POND)

CREST OF SPILLWAY
EL.=5255.50

TOP OF BERM BEYOND
(8' WIDE MIN.)
EL. = 5256.25

POND BOTTOM
EL. = 5254.5

1.0' SEDIMENT
STORAGE

RUNDOWN
SHALL BE
8' WIDE x 9" DEEP

FL. ELEV. @
CUT-OFF-WALL
EL. = 5249.91

SECTION A-A
NO SCALE

BUILD TEMPORARY
RETENTION POND
VOL. = 5768 CU. FT.

CREST OF SPILLWAY
EL.=5255.50

100 YR. WATER SURFACE
EL. = 5255.94

TOP OF BERM
EL.=5256.25

SECTION B-B
NO SCALE

EROSION CONTROL PLAN
NO SCALE

A BERM WITH THE DIMENSIONS SHOWN SHALL BE MAINTAINED DURING CONSTRUCTION UNTIL COMPLETION OF INDIVIDUAL HOMES WITHIN THE PROJECT.

LEGEND

PROPOSED CONTOUR
EXISTING CONTOUR
EXISTING SPOT ELEVATION
PROPOSED SPOT ELEVATION
DIRECTION OF FLOW
GRADING LIMITS
PROPOSED RETAINING WALL



SCALE: 1" = 50'

APPROVED FOR ROUGH GRADING (1:1)

HYDROLOGY ENGINEER DATE

BOHANNAN-HUSTON INC.
ENGINEERS • PLANNERS • PHOTOGRAMMETRISTS • SURVEYORS • LANDSCAPE ARCHITECTS
ALBUQUERQUE LAS CRUCES SANTA FE

THE CROSSING

Project No.

UNIT I

See

Grading & Drainage

PLAN

Drawn By:

Date:

Job No.


Checked By:

Scale:

Sheet 3 of 18

BHI JOB NO. C5335A2405




CPN 545381

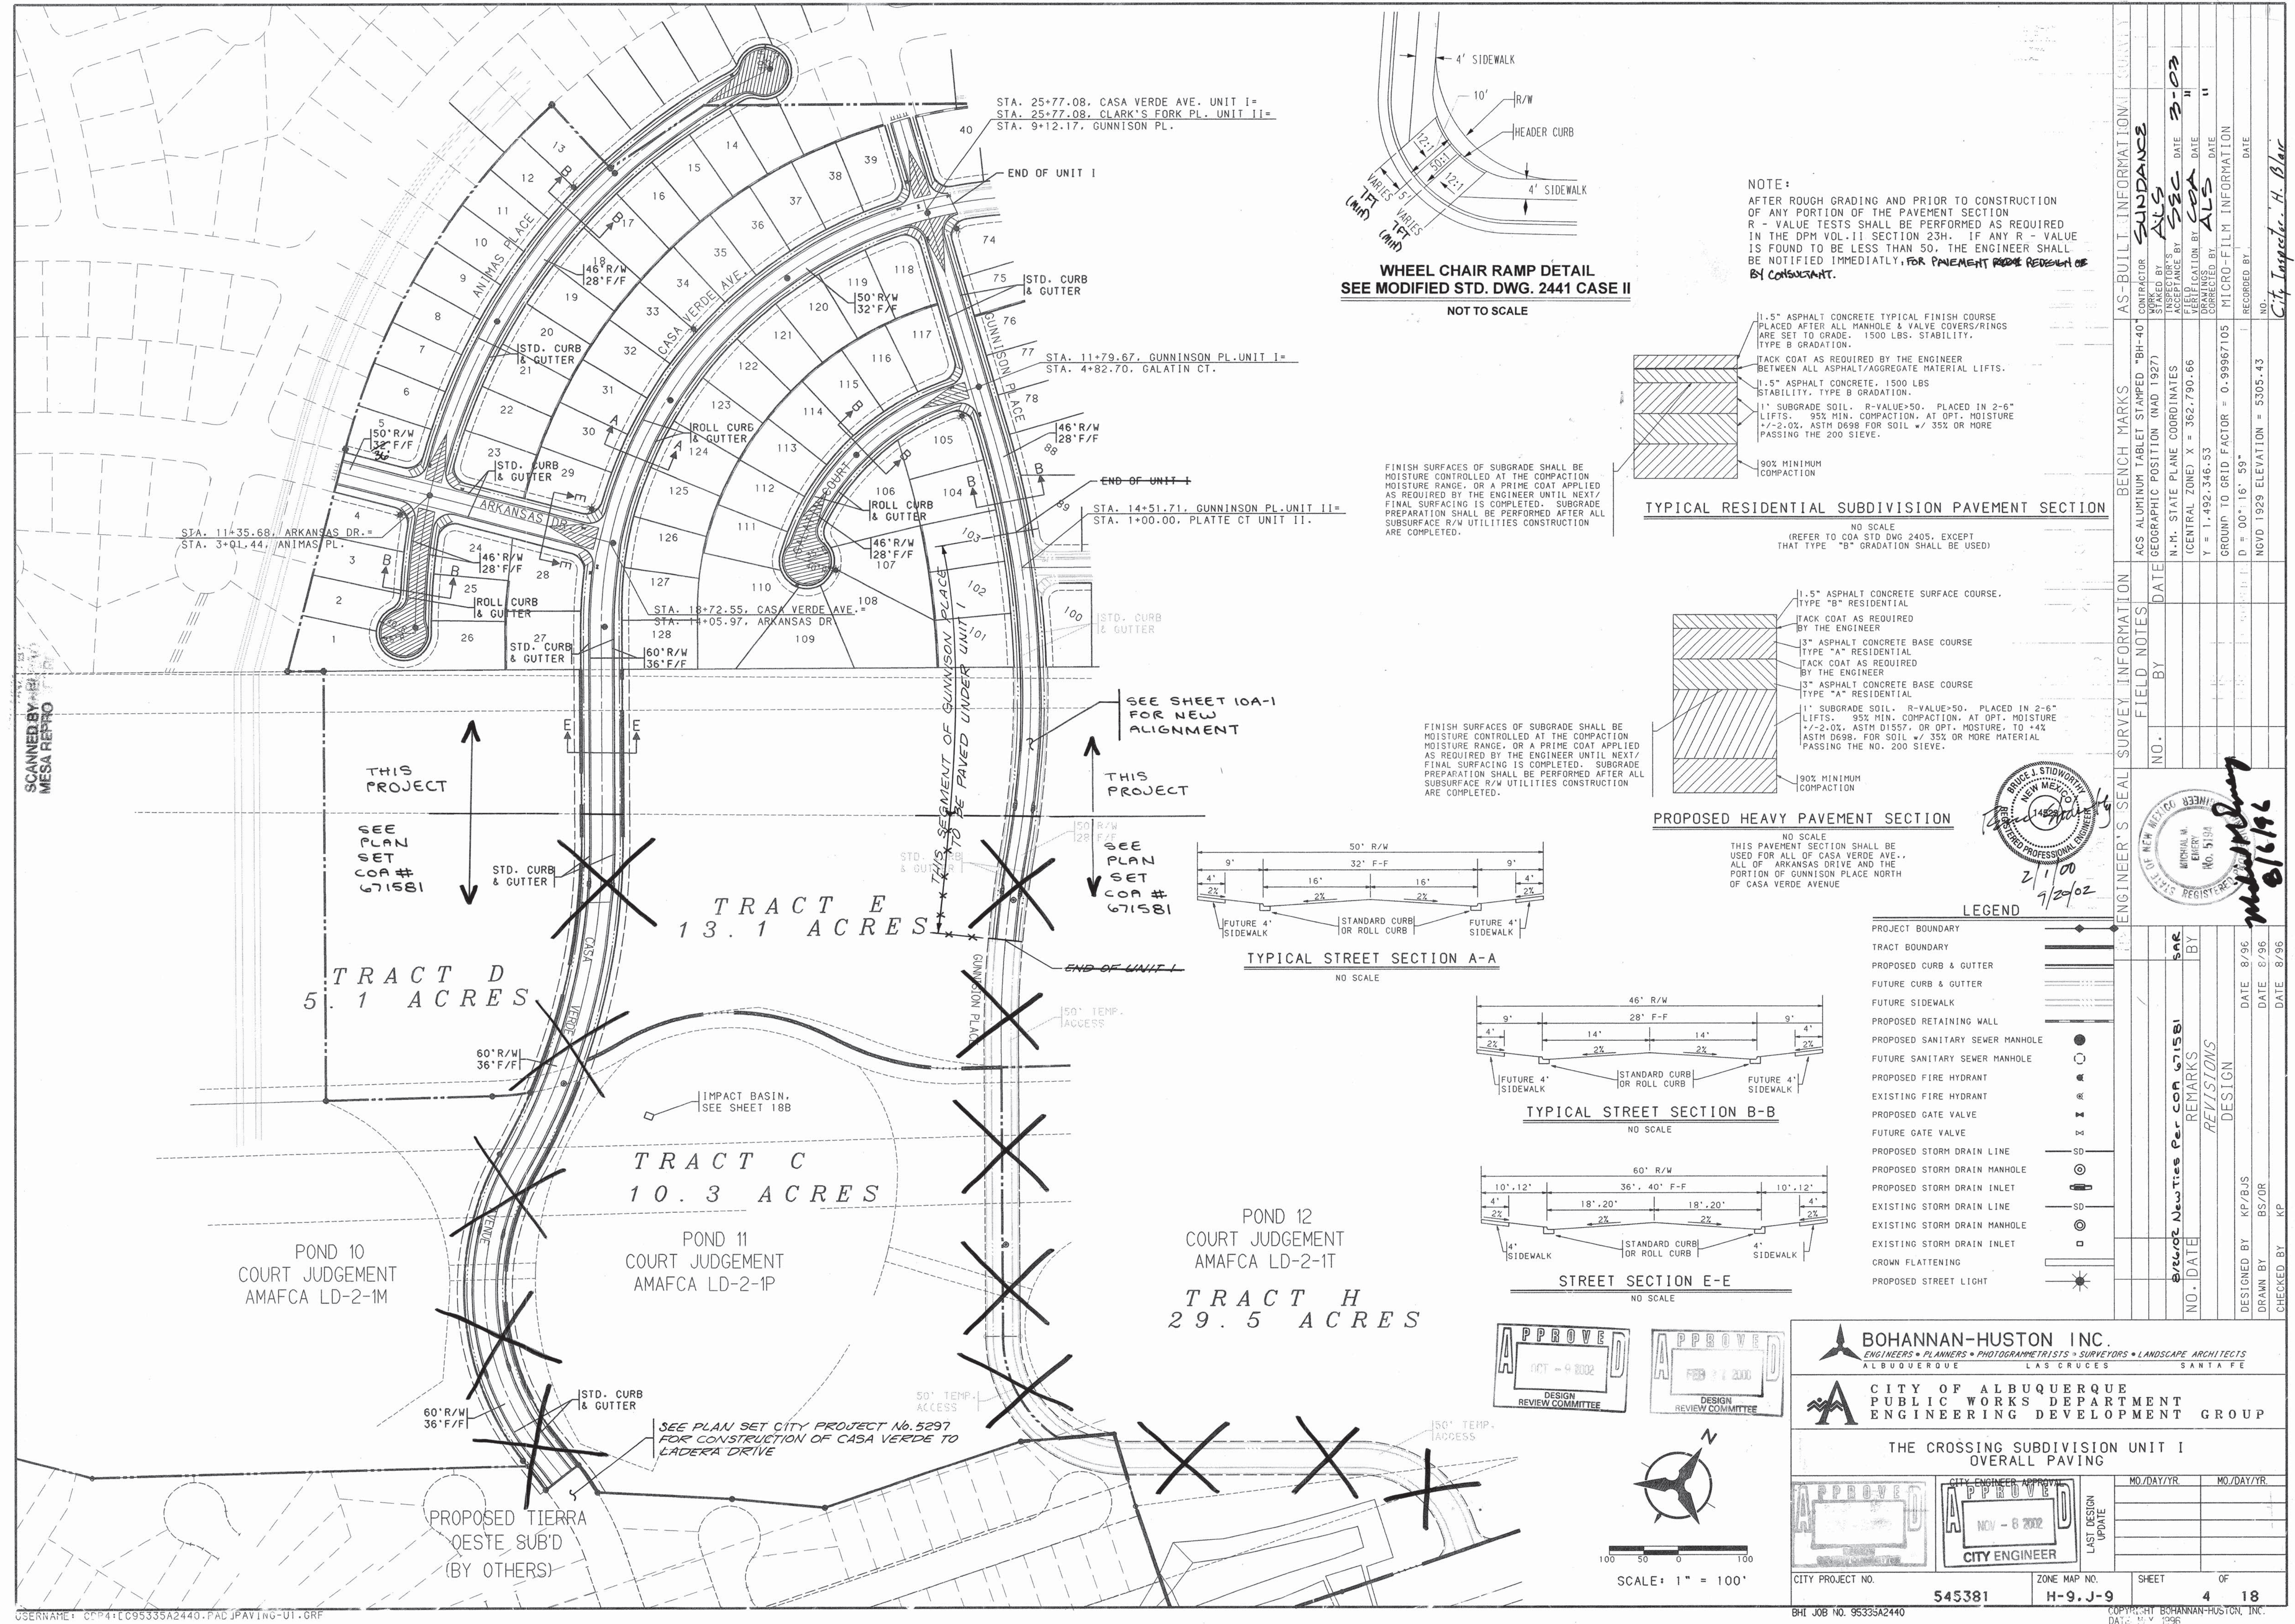

CUL-DE-SAC CURB DATA table with columns PT, TC, STATION & OFFSET, DELTA. Rows 1-9 showing stationing and offsets for a cul-de-sac.



CENTERLINE CURVE DATA TABLE and CENTERLINE TANGENT DATA TABLE. Includes columns for NUMBER, PI STA., DELTA, TANGENT, ARC, RADIUS, BEARING, and DISTANCE.

CENTERLINE TANGENT DATA TABLE. Includes columns for NUMBER, BEARING, and DISTANCE.

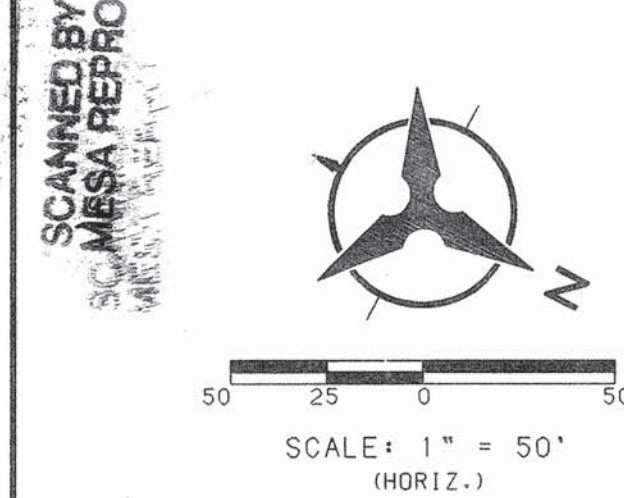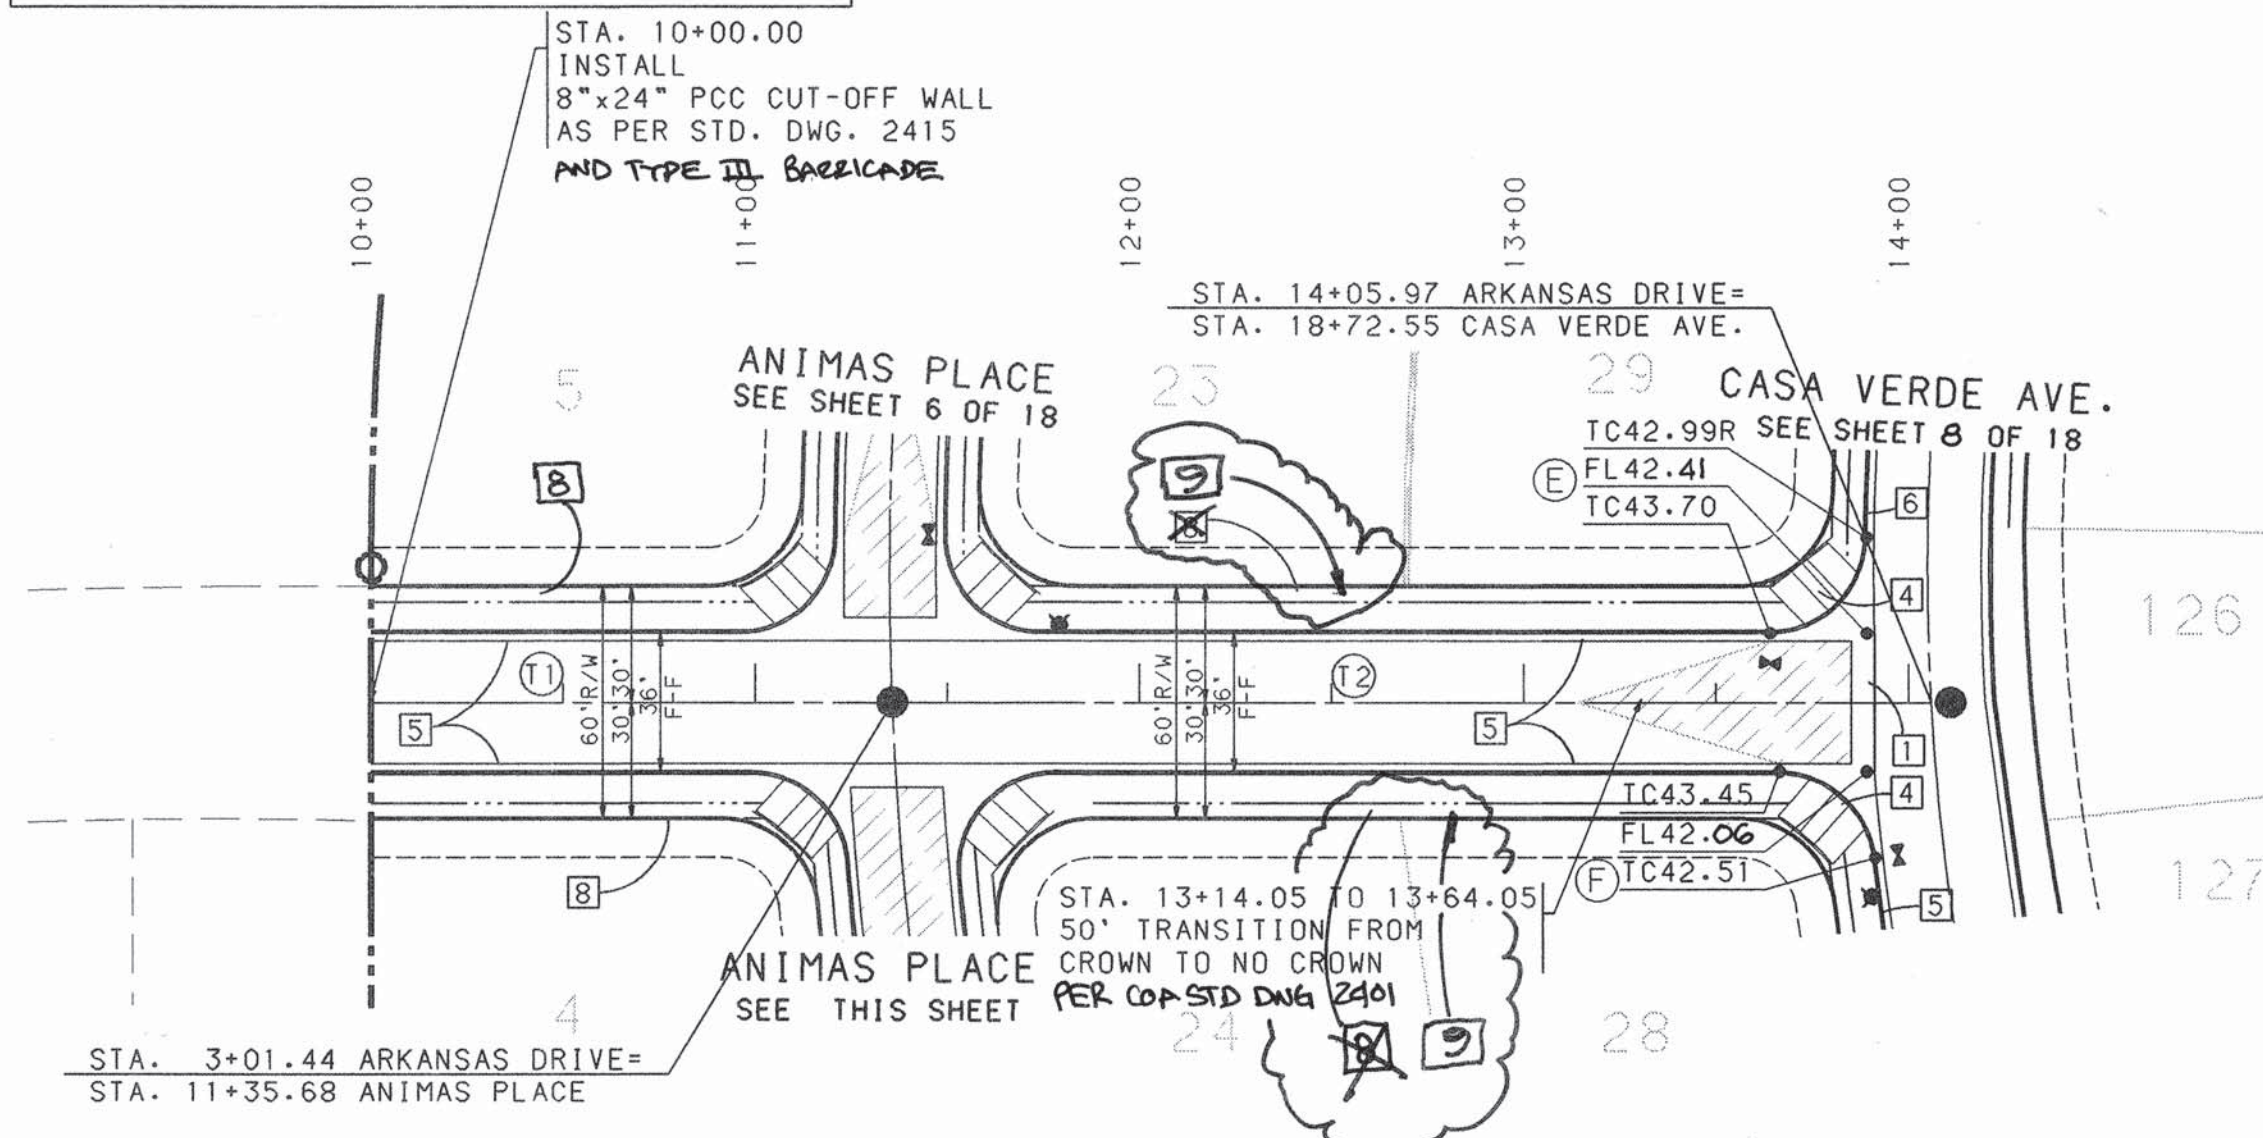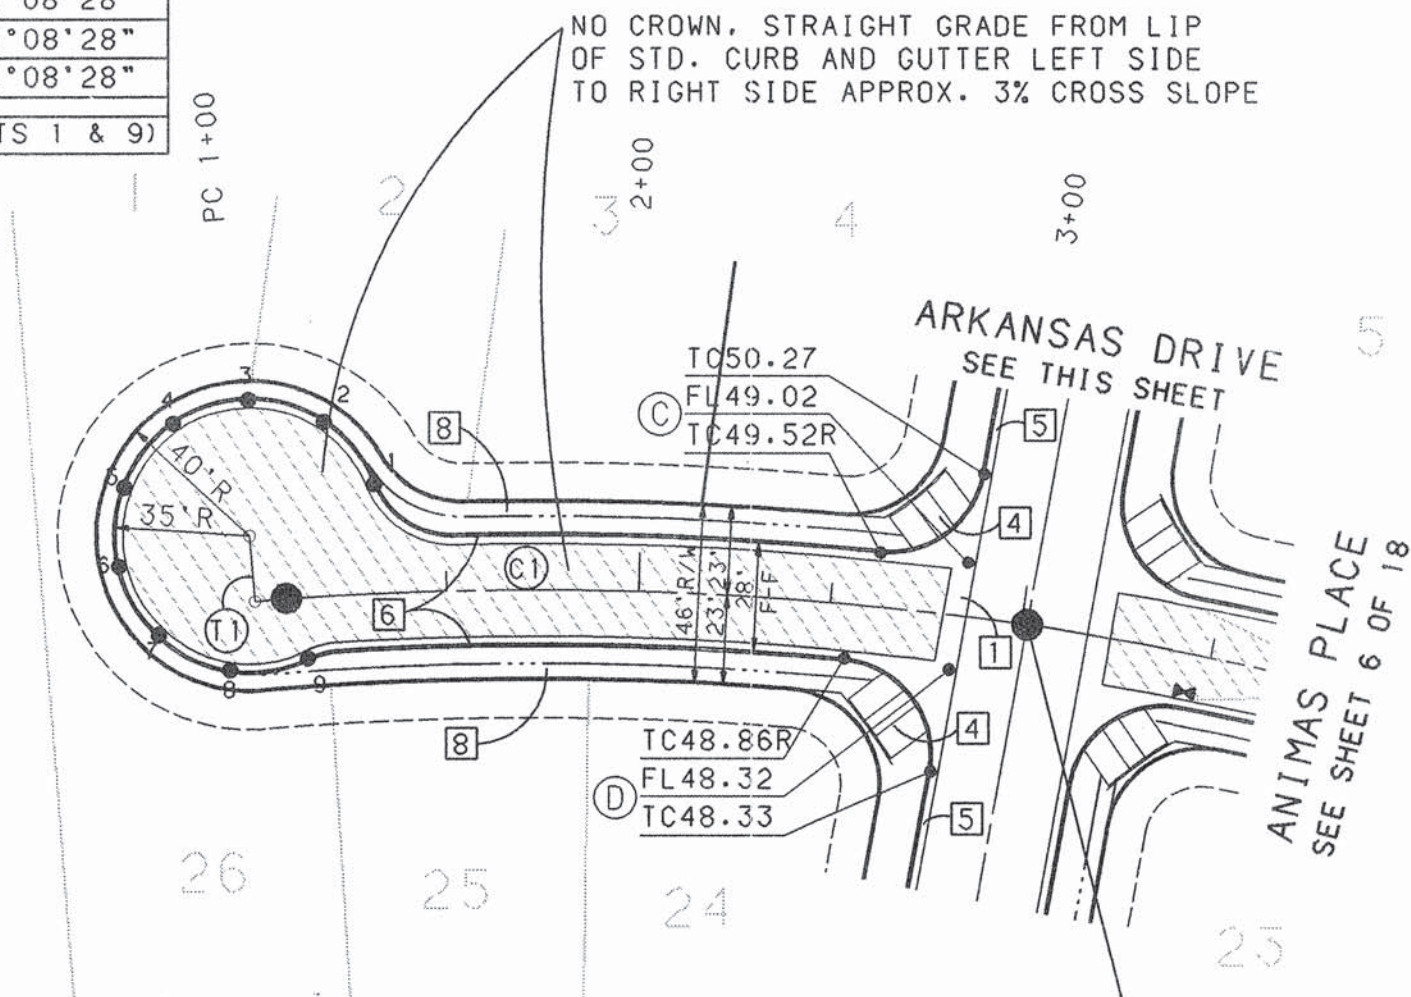

ANIMAS PLACE

ARKANSAS DRIVE

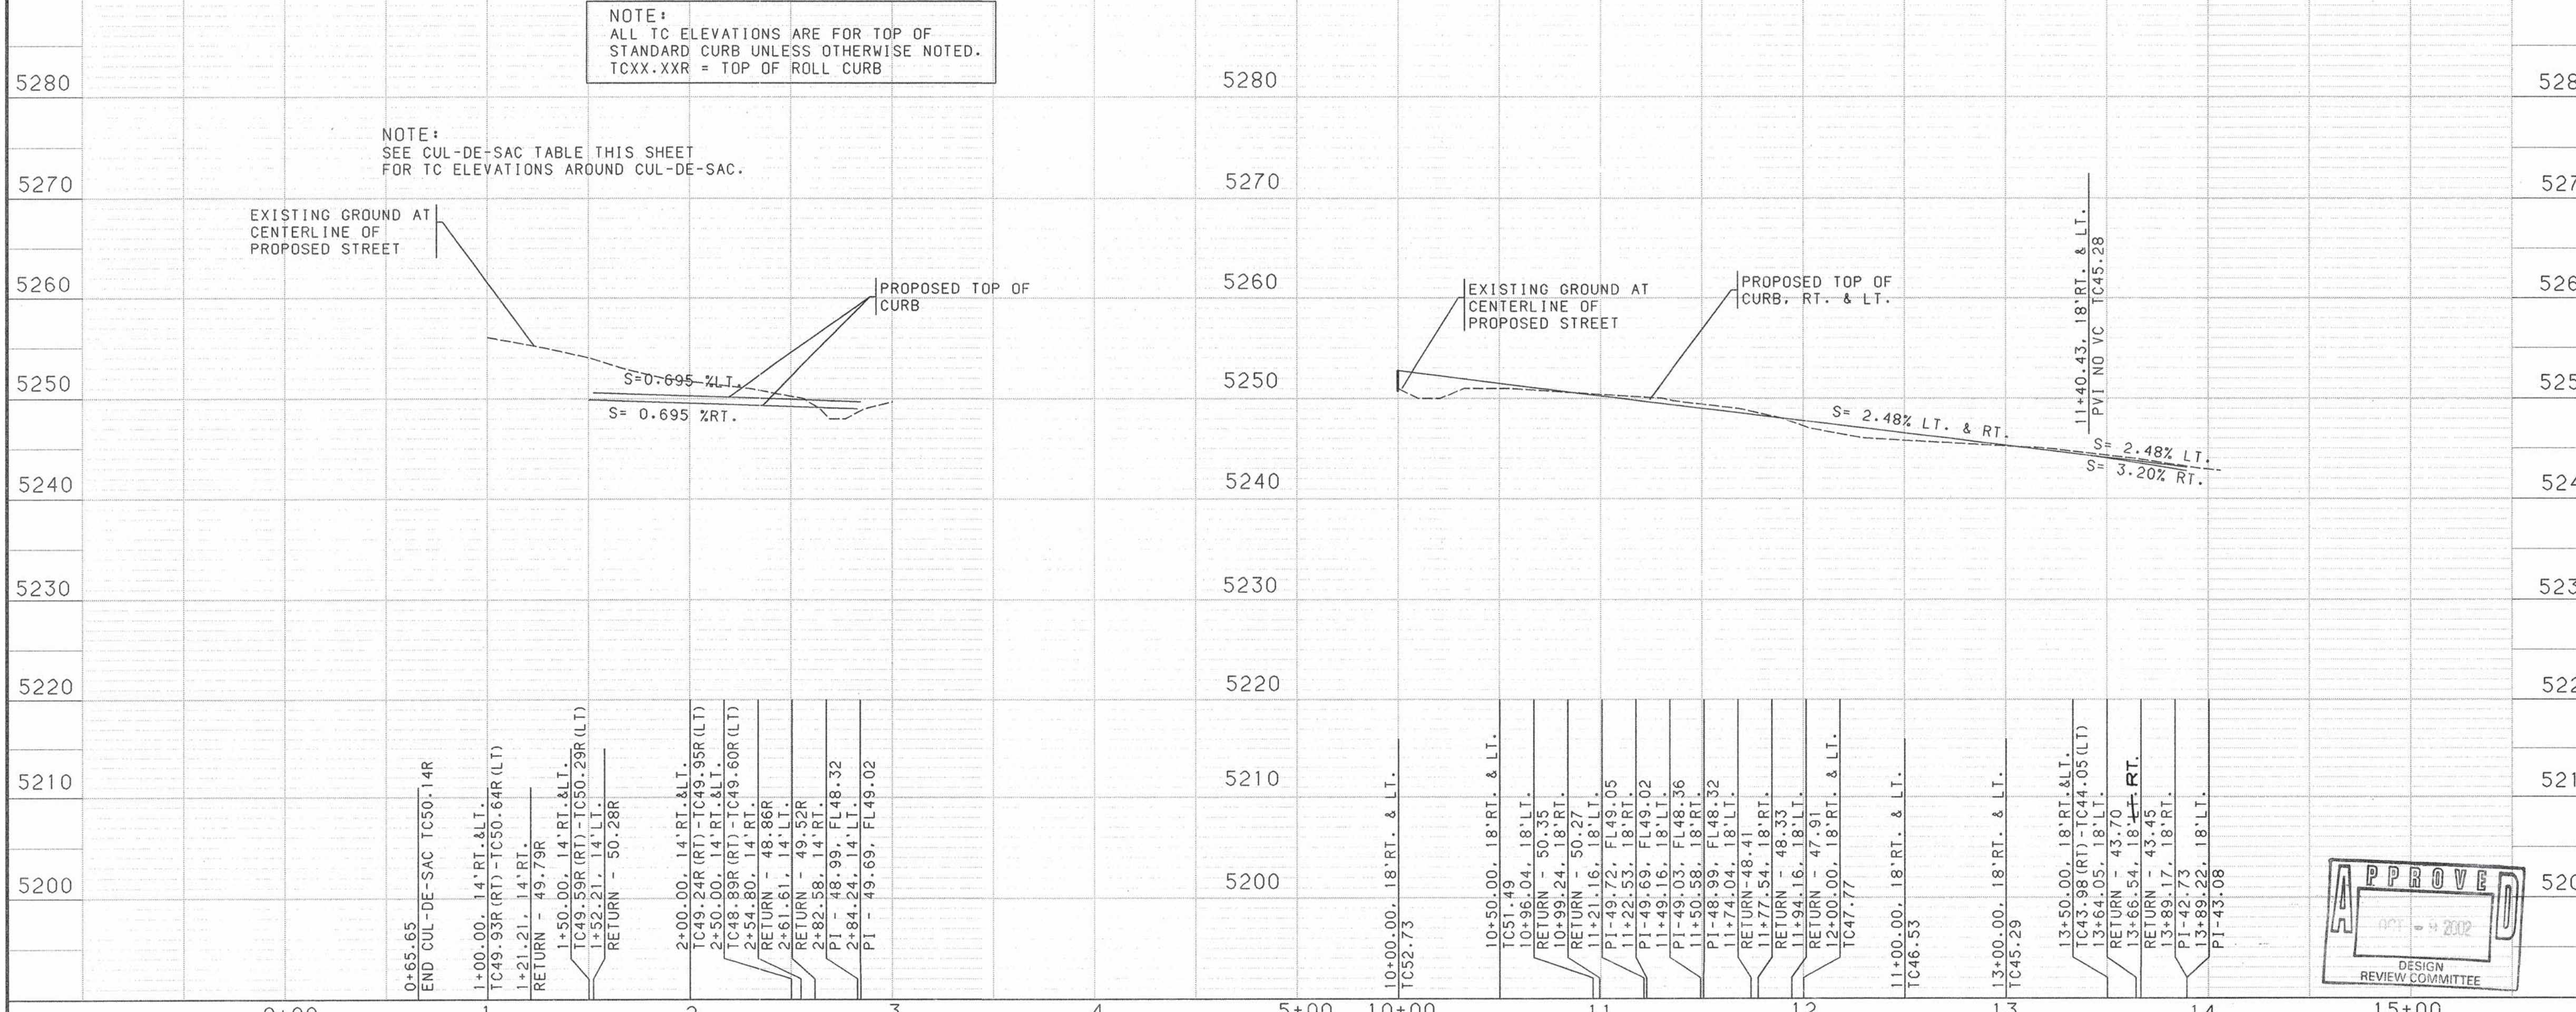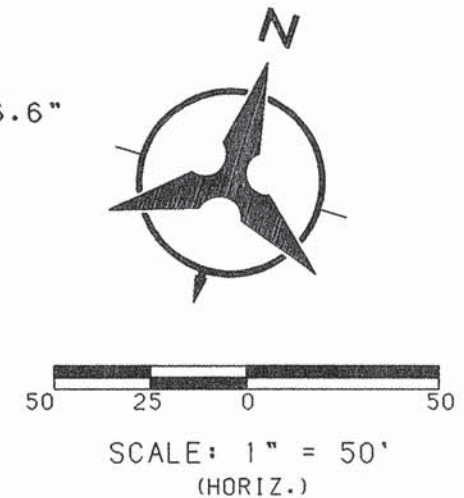

- NOTES
1. THE CONTRACTOR SHALL FIELD VERIFY ALL EXISTING UTILITY LOCATIONS AND NOTIFY THE ENGINEER IMMEDIATELY OF ANY DISCREPANCIES.
 2. ALL CURB RETURN RADI SHALL BE 25' TO FACE OF CURB UNLESS OTHERWISE SPECIFIED.
 3. ALL CURVE DATA AND DIMENSIONS REFER TO FACE OF CURB UNLESS OTHERWISE SPECIFIED.
 4. GRADE ELEVATIONS, WHERE NOTED, ARE FOR TOP OF STANDARD CURB UNLESS OTHERWISE SPECIFIED.
 5. CONTRACTOR IS TO INSTALL A 4"x4"x5' POST AND EMD AT THE END OF EACH SANITARY SEWER SERVICE.
 6. CONTRACTOR IS RESPONSIBLE FOR REPAIR AND/OR REPLACEMENT OF ALL UTILITY CONDUITS AND EXISTING LINES.
 7. ANY ADDITIONAL GRADING REQUIRED TO MATCH PROPOSED STREET GRADES SHALL BE INCIDENTAL TO PAVING ITEMS.
 8. CONTRACTOR SHALL PROVIDE THE INSPECTORS, (CITY AND PRIVATE) WITH THE PROPOSED HYDROSTATIC TESTING PLAN. THE PLAN MUST BE APPROVED BEFORE TESTING OPERATIONS BEGIN.
 9. CONTRACTOR SHALL PARK EQUIPMENT AND VEHICLES AS NOT TO INTERFERE WITH NORMAL ACTIVITIES OF RESIDENTS OR OTHER CONTRACTORS ON SITE.
 10. ANY DAMAGE TO THE EXISTING FACILITIES (CURB AND GUTTER, PAVEMENT, CONDUITS, LANDSCAPING, UTILITY LINES, ETC.) DURING CONSTRUCTION SHALL BE REPLACED AT THE CONTRACTORS EXPENSE.
 11. REMOVAL OF THE EXISTING CURB AND GUTTER SHALL BE AS PER COA STD. DWG. 2415 (SAWCUT ONLY).
 12. WHEEL CHAIR RAMPS SHALL BE CONSTRUCTED PRIOR TO ACCEPTANCE OF CURB AND GUTTER.

- KEYED GENERAL NOTES
1. INSTALL CONCRETE VALLEY GUTTER AS PER STD. DWG. 2420
 2. INSTALL CONCRETE VALLEY GUTTER AS PER STD. DWG. 2421
 3. INSTALL WHEEL CHAIR RAMP AS PER STD. DWG. 2441, CASE I
 4. INSTALL WHEEL CHAIR RAMP AS PER STD. DWG. 2441, CASE II
 5. STD. CURB & GUTTER AS PER STD. DWG. 2415
 6. ROLL CURB & GUTTER AS PER STD. DWG. 2415
 7. MEDIAN CURB & GUTTER AS PER STD. DWG. 2415
 8. DEFERRED FUTURE 4' SIDEWALK
 9. BUILD 4' SIDEWALK
 10. 10' MEANDERING ASPHALT TRAIL BY OTHERS

BOHANNAN-HUSTON INC. ENGINEERS • PLANNERS • PHOTOGRAMMETRISTS • SURVEYORS • LANDSCAPE ARCHITECTS ALBUQUERQUE LAS CRUCES SANTA FE

CITY OF ALBUQUERQUE PUBLIC WORKS DEPARTMENT ENGINEERING DEVELOPMENT GROUP

THE CROSSING SUBDIVISION UNIT I PAVING PLAN & PROFILE ANIMAS PLACE/ARKANSAS DRIVE

DESIGN REVIEW COMMITTEE APPROVED NOV - 8 2002 CITY ENGINEER


DESIGNED BY KP/BJS OR KP CHECKED BY KP

DATE 8/96 DATE 8/96 DATE 8/96

545381 H9. J9 5 18

COPYRIGHT BOHANNAN-HUSTON, INC. 1996 DATE: MAY 1996

CUL-DE-SAC CURB DATA				
PT	TC	STATION & OFFSET	DELTA	
1	57.39	10+86.06, 21.85' LT.	35°12'17"	
2	57.56	11+03.20, 33.52' LT.	35°12'17"	
3	57.76	11+23.60, 33.32' LT.	35°12'17"	
4	57.93	11+40.52, 21.31' LT.	35°12'17"	
5	58.12	11+48.01, 1.54' LT.	35°12'17"	
6	57.95	11+42.80, 18.98' RT.	35°12'17"	
7	57.79	11+26.09, 32.58' RT.	35°12'17"	
8	57.57	11+04.15, 33.89' RT.	35°12'17"	
9	57.39	10+85.81, 22.37' RT.	35°12'17"	
R=35.00', L=172.04' (BETWEEN PTS 1 & 9)				

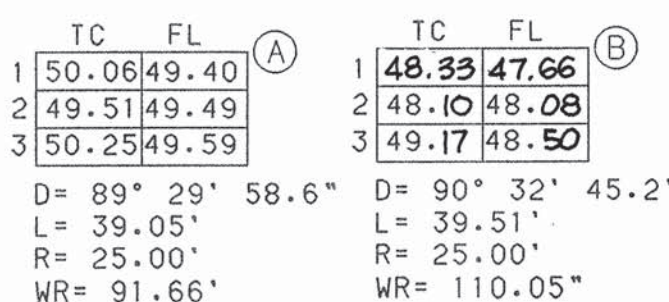

NOTE:
ALL TC ELEVATIONS ARE FOR TOP OF
STANDARD CURB UNLESS OTHERWISE NOTED.
TCXX.XXR = TOP OF ROLL CURB



ANIMAS P
DESIGN REVIEW COMMITTEE
APPROVED

PLATE FROM STA. _____
CITY ENGINEER APPROV _____
A P P R O V E
NOV - 8 2002

	LAST DESIGN UPDATE	MO./DAY/YR.

48.08	MO./DAY/YR.



BOHANNAN-HUSTON INC.
 ENGINEERS • PLANNERS • PHOTOGRAMMETRISTS • SURVEYORS • LANDSCAPE ARCHITECTS
 ALBUQUERQUE LAS CRUCES SANTA FE



CITY OF ALBUQUERQUE
PUBLIC WORKS DEPARTMENT
ENGINEERING DEVELOPMENT GROUP

THE CROSSING SUBDIVISION UNIT I
PAVING PLAN & PROFILE
ANIMAS PLACE FROM STA. 3+01.44 TO 11+48.08

DESIGN REVIEW COMMITTEE

APPROVE

CITY ENGINEER APPROV
A P P R O V E
NOV - 8 2002

	LAST DESIGN UPDATE	MO./DAY/YR.

	MO./DAY/YR.

PROJECT NO. PROVE

545381

MAP NO.	SHEET
49. 19	

OF 18

USERNAME: CDP4:[C95335A2405.PNP]ANIMAS-11.GRF



RHT JOB NO. C95335A240

54538

ZONE MAP NO


SHEET	OF
6	18

COPYRIGHT BOHANNAN-HUSTON, INC. 199
DATE: MAY 1996

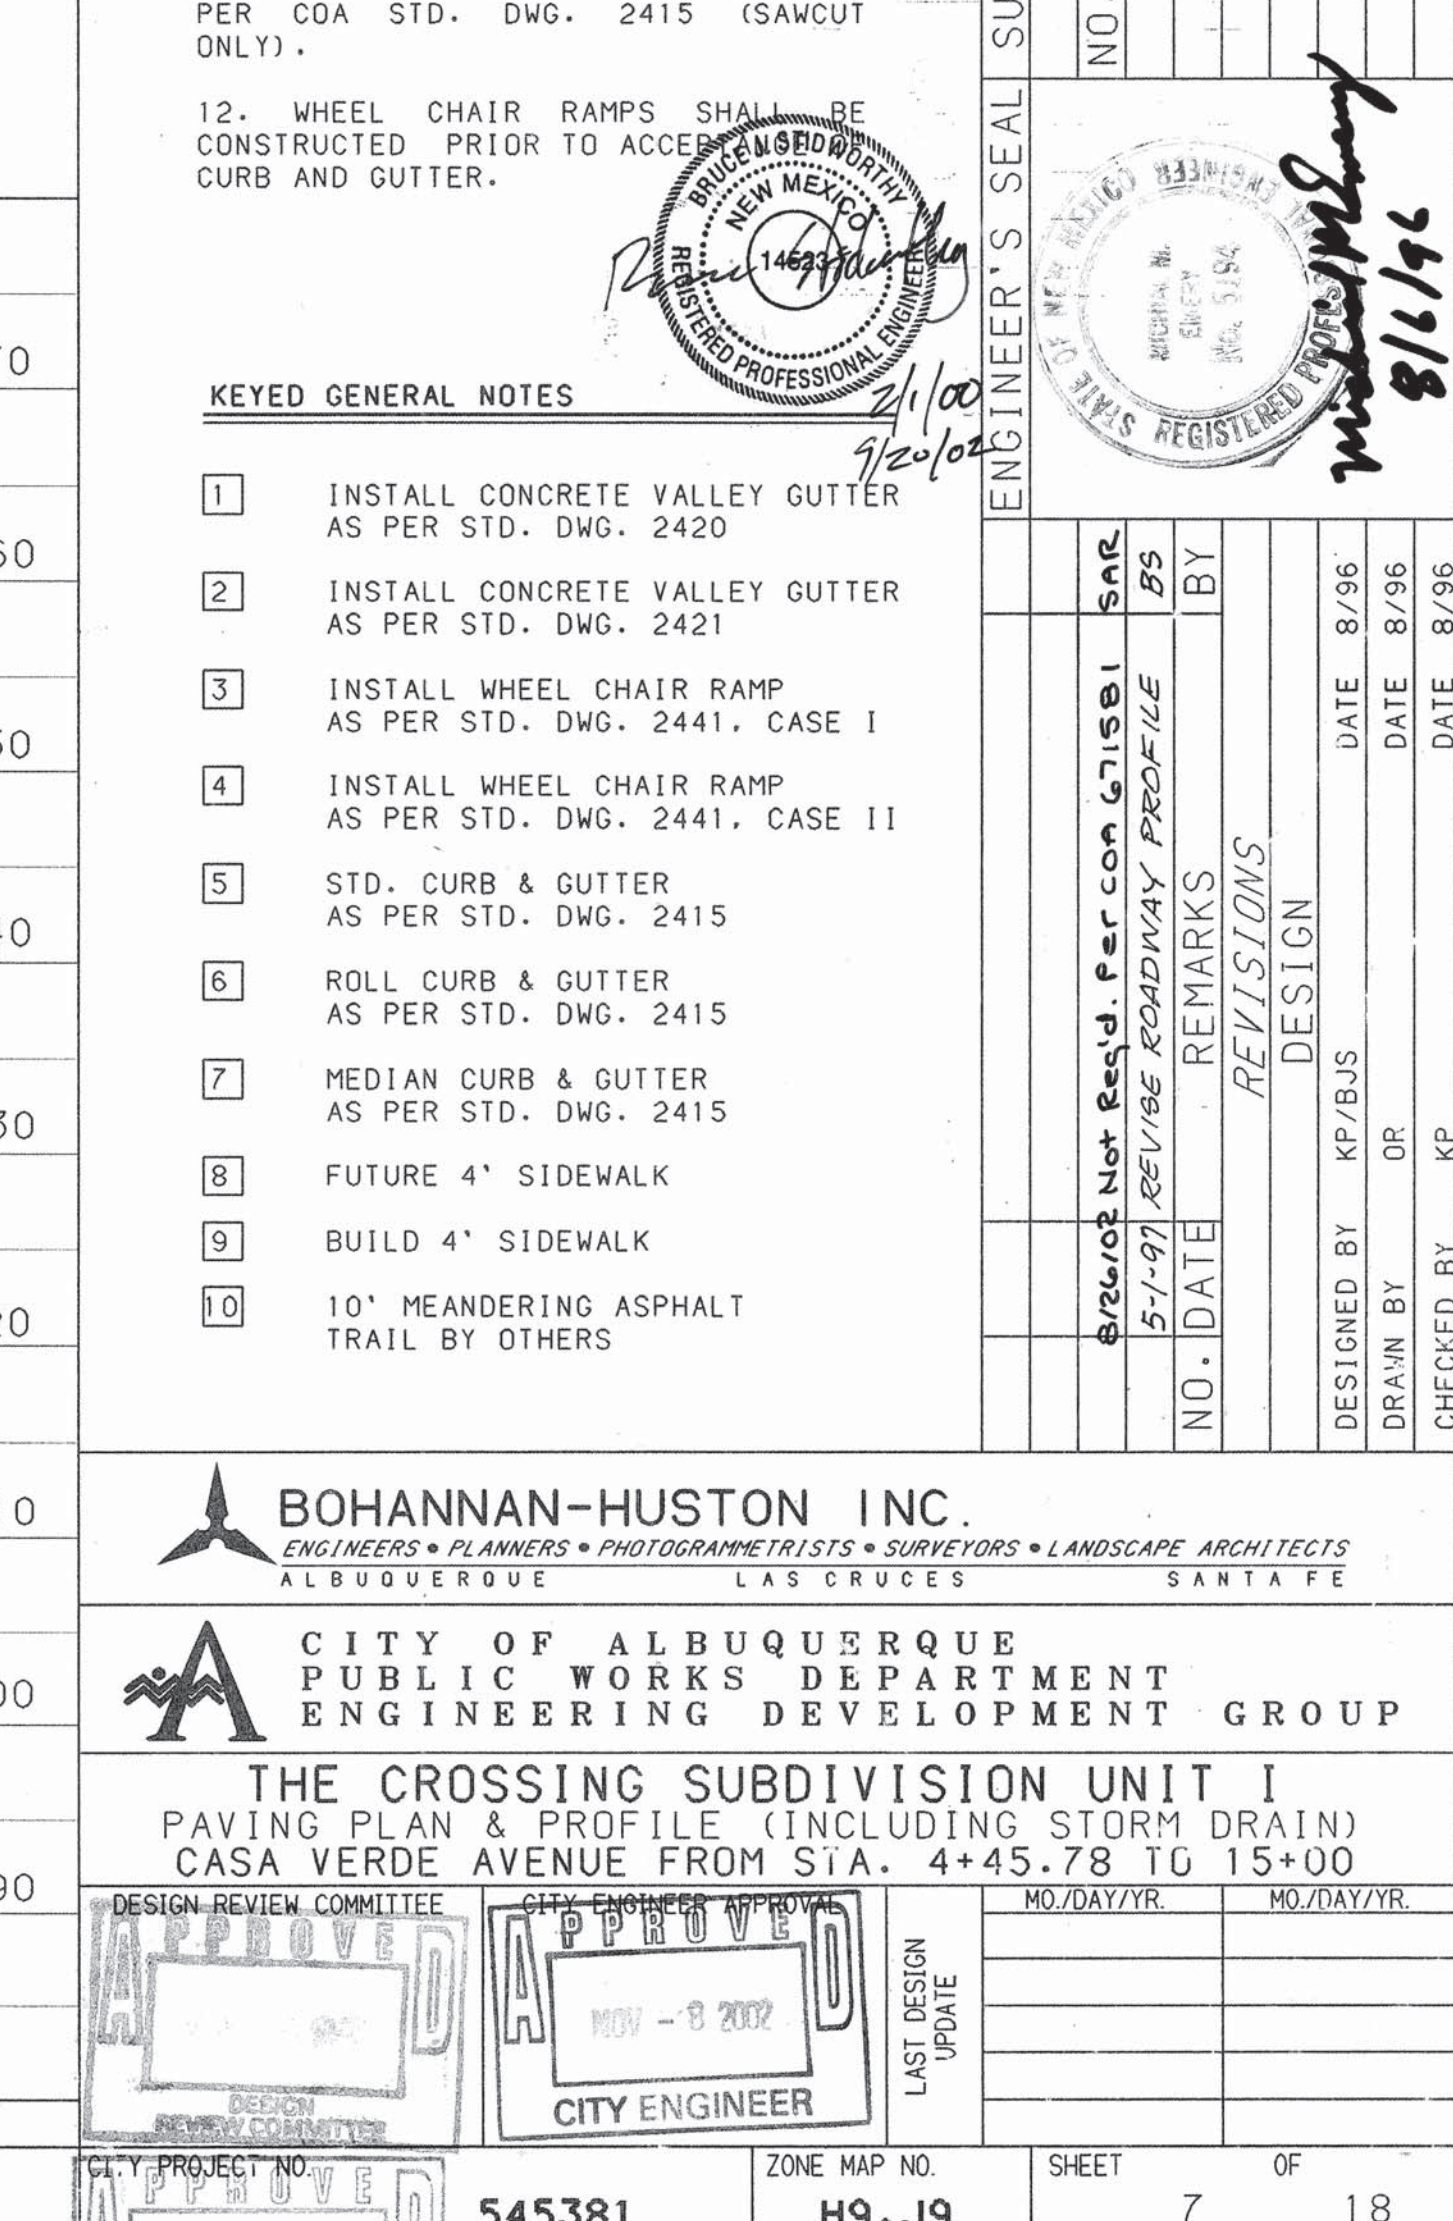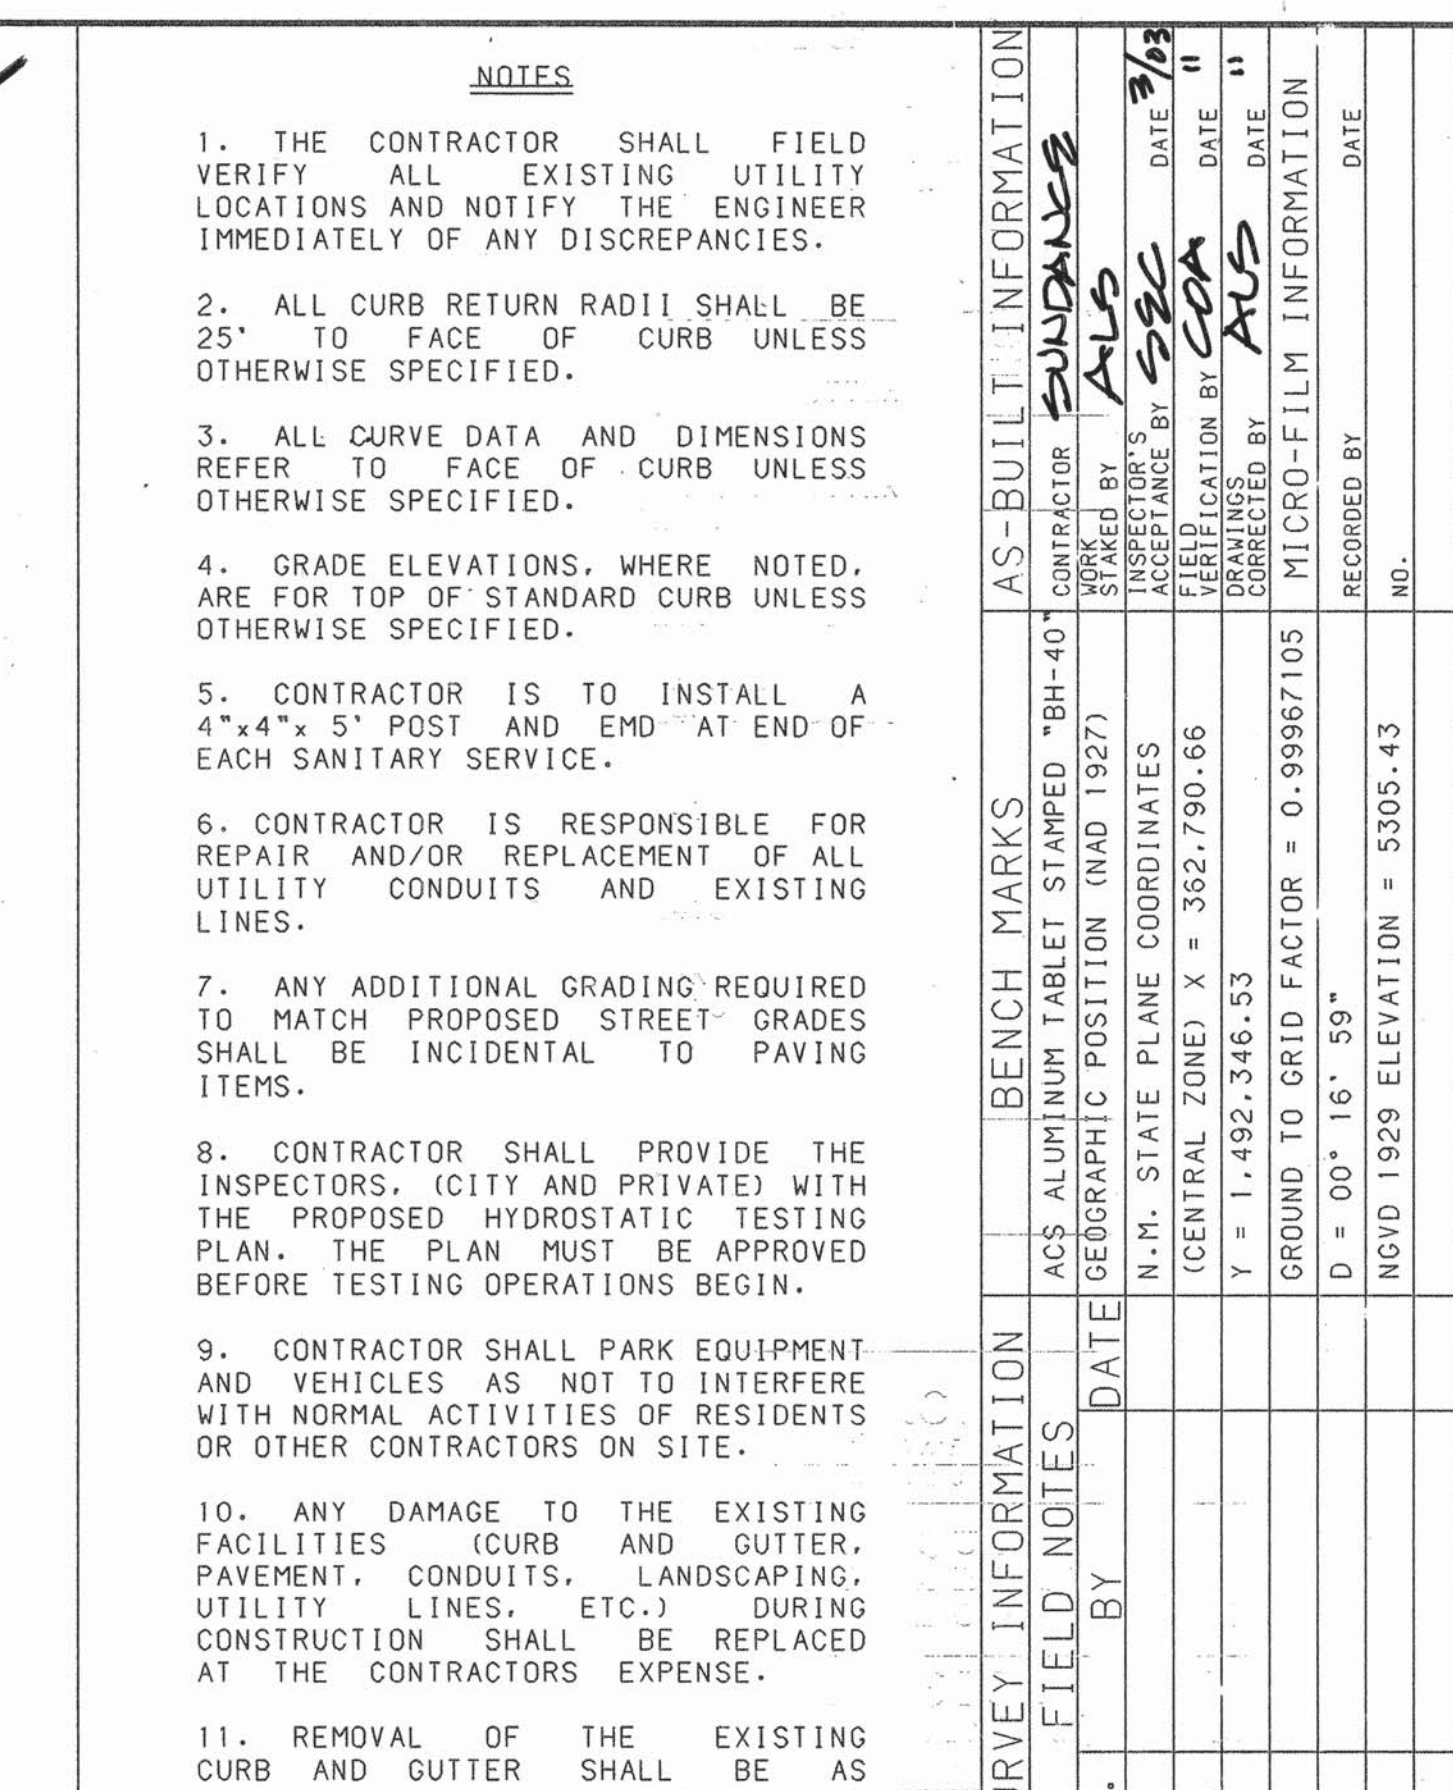

CENTERLINE CURVE DATA TABLE					
NUMBER	PI STA.	DELTA	TANGENT	ARC	RADIUS
C1	18+08.64	11°43'14.8"	64.36'	128.26'	627.00'
C2	22+67.25	64°22'50.6"	394.70'	704.53'	627.00'

CENTERLINE TANGENT DATA TABLE			
NUMBER	BEARING	DISTANCE	
T1	S32° 05' 33"E	244.29'	

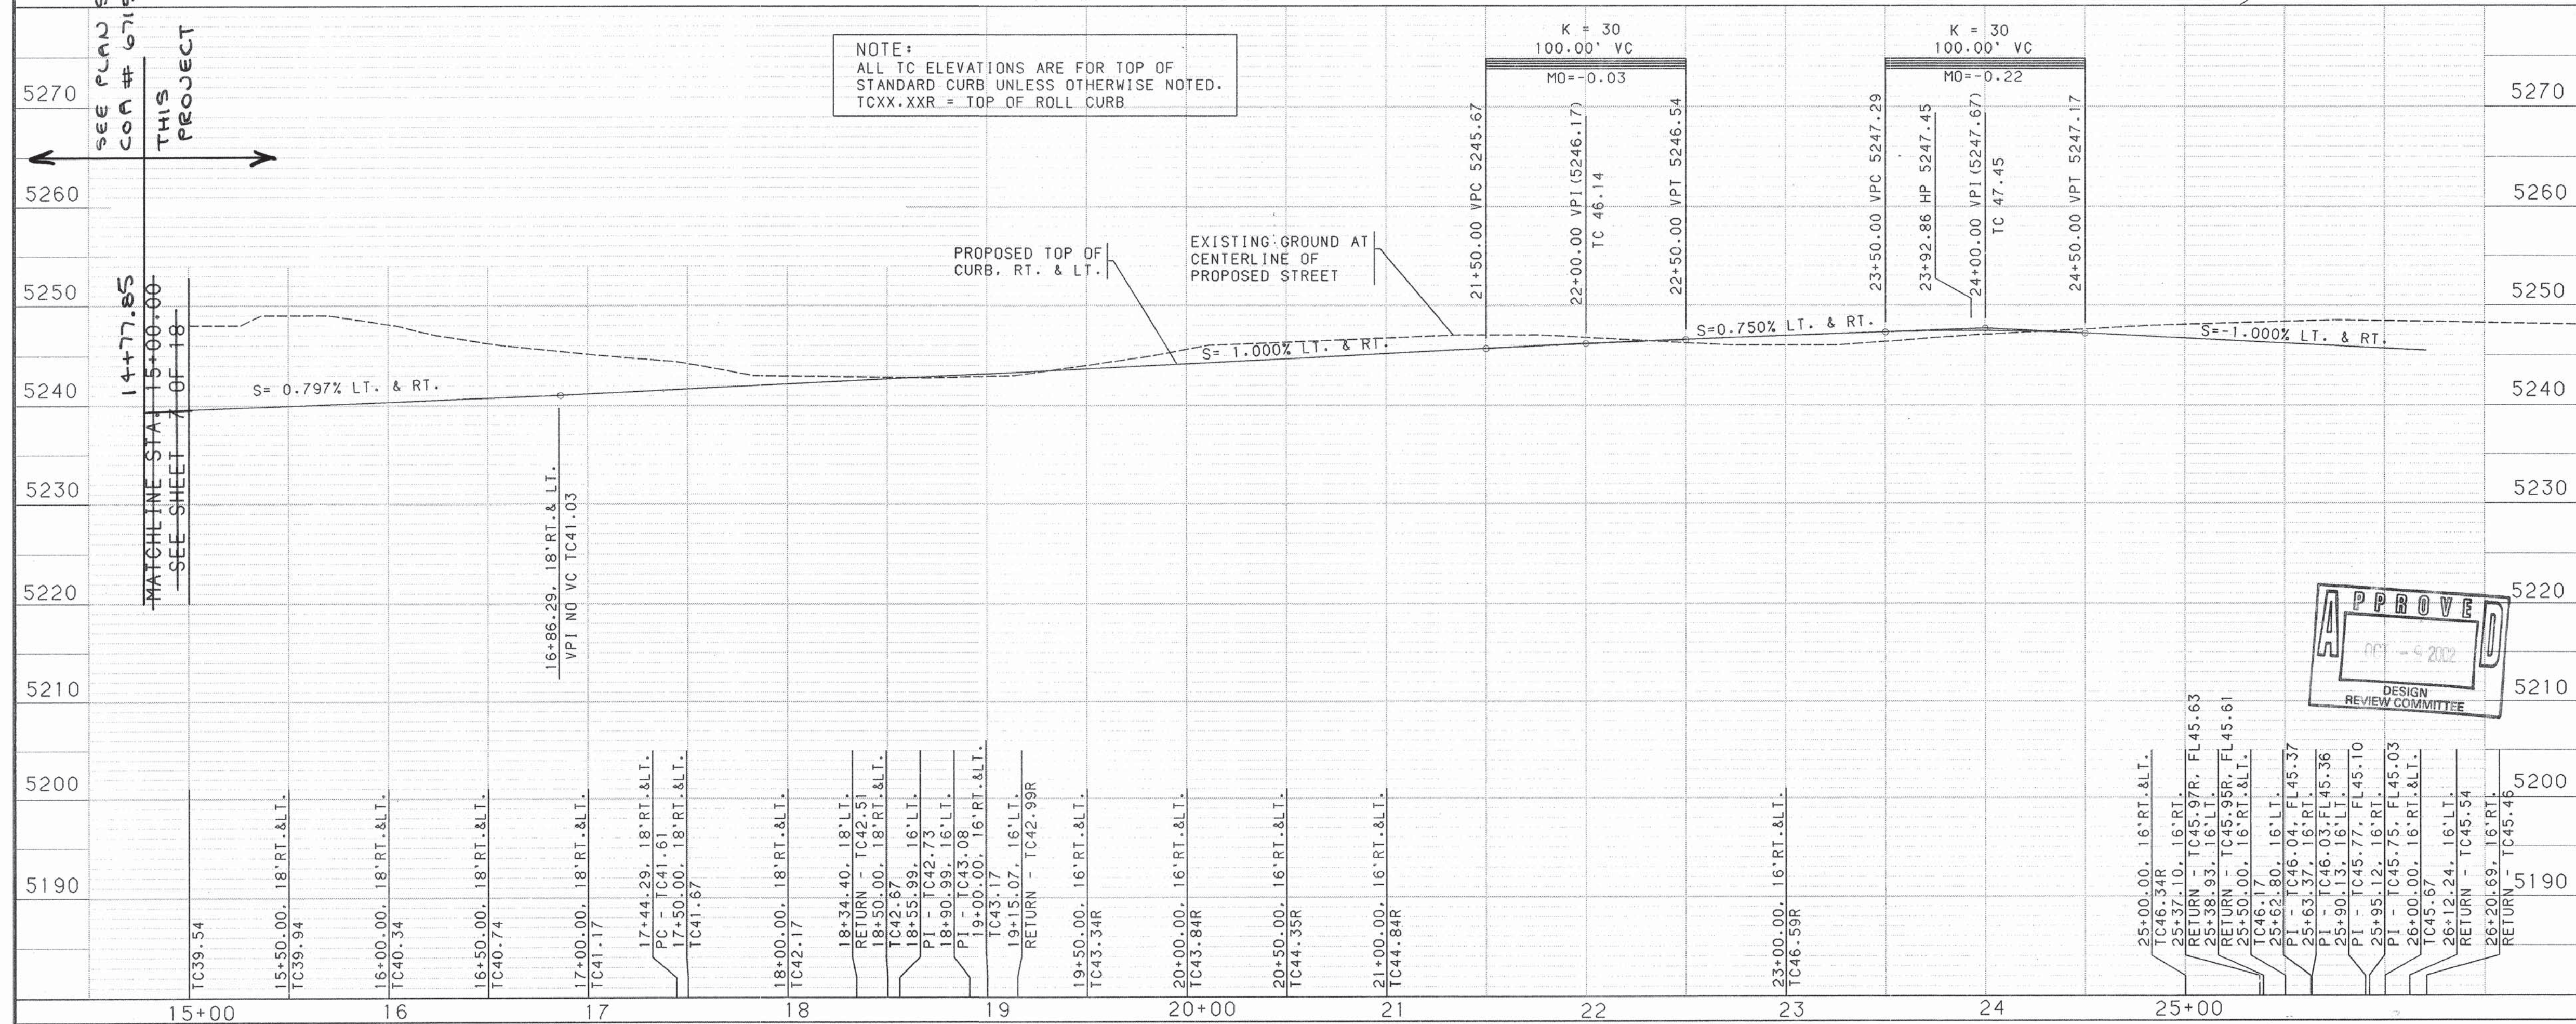

NOTES

- THE CONTRACTOR SHALL FIELD VERIFY ALL EXISTING UTILITY LOCATIONS AND NOTIFY THE ENGINEER IMMEDIATELY OF ANY DISCREPANCIES.
- ALL CURB RETURN RADI SHALL BE 25' TO FACE OF CURB UNLESS OTHERWISE SPECIFIED.
- ALL CURVE DATA AND DIMENSIONS REFER TO FACE OF CURB UNLESS OTHERWISE SPECIFIED.
- GRADE ELEVATIONS, WHERE NOTED, ARE FOR TOP OF STANDARD CURB UNLESS OTHERWISE SPECIFIED.
- CONTRACTOR IS TO INSTALL A 4"x4"x5' POST AND EMD AT THE END OF EACH SANITARY SEWER SERVICE.
- CONTRACTOR IS RESPONSIBLE FOR REPAIR AND/OR REPLACEMENT OF ALL UTILITY CONDUITS AND EXISTING LINES.
- ANY ADDITIONAL GRADING REQUIRED TO MATCH PROPOSED STREET GRADES SHALL BE INCIDENTAL TO PAVING ITEMS.
- CONTRACTOR SHALL PROVIDE THE INSPECTORS (CITY AND PRIVATE) WITH THE PROPOSED HYDROSTATIC TESTING PLAN. THE PLAN MUST BE APPROVED BEFORE TESTING OPERATIONS BEGIN.
- CONTRACTOR SHALL PARK EQUIPMENT AND VEHICLES AS NOT TO INTERFERE WITH NORMAL ACTIVITIES OF RESIDENTS OR OTHER CONTRACTORS ON SITE.
- ANY DAMAGE TO THE EXISTING FACILITIES (CURB AND GUTTER, PAVEMENT, CONDUITS, LANDSCAPING, UTILITY LINES, ETC.) DURING CONSTRUCTION SHALL BE REPLACED AT THE CONTRACTORS EXPENSE.
- REMOVAL OF THE EXISTING CURB AND GUTTER SHALL BE AS PER COA STD. DWG. 2415 (SAWCUT ONLY).
- WHEEL CHAIR RAMPS SHALL BE CONSTRUCTED PRIOR TO ACCEPTANCE CURB AND GUTTER.

KEYED GENERAL NOTES

- INSTALL CONCRETE VALLEY GUTTER AS PER STD. DWG. 2420
- DO NOT INSTALL FILLETS OR VALLEY GUTTER
- INSTALL WHEEL CHAIR RAMP AS PER STD. DWG. 2441, CASE I
- INSTALL WHEEL CHAIR RAMP AS PER STD. DWG. 2441, CASE II
- STD. CURB & GUTTER AS PER STD. DWG. 2415
- ROLL CURB & GUTTER AS PER STD. DWG. 2415
- MEDIAN CURB & GUTTER AS PER STD. DWG. 2415
- DEFERRED FUTURE 4' SIDEWALK
- BUILD 4' SIDEWALK
- 10' MEANDERING ASPHALT TRAIL BY OTHERS

BOHANNAN-HUSTON INC.
ENGINEERS • PLANNERS • PHOTOGRAMMETRISTS • SURVEYORS • LANDSCAPE ARCHITECTS
ALBUQUERQUE LAS CRUCES SANTA FE

CITY OF ALBUQUERQUE
PUBLIC WORKS DEPARTMENT
ENGINEERING DEVELOPMENT GROUP

THE CROSSING SUBDIVISION UNIT I
PAVING PLAN & PROFILE
CASA VERDE AVENUE FROM STA. 15+00 TO 25+77.08

DESIGN REVIEW COMMITTEE: **APPROVED** DATE: 8/16/96
CITY ENGINEER: **APPROVED** DATE: 8/16/96

DESIGNED BY: KP/BUS DATE: 8/96
DRAWN BY: OR DATE: 8/96
CHECKED BY: KP DATE: 8/96

ZONE MAP NO. **H-9-J-9** SHEET **8** OF **18**



SCALE: 1" = 50' (HORIZ.)
1" = 10' (VERT.)

BOHANNAN-HUSTON, INC. 1996
DATE: MAY, 1996


CUL-DE-SAC CURB DATA			
PT	TC	STATION & OFFSET	DELTA
1	39.15R	1+34.90, 29.70'RT.	33°39'20"
2	39.35R	1+21.47, 46.02'RT.	33°39'20"
3	39.49R	0+99.04, 51.99'RT.	33°39'20"
4	39.66R	0+77.03, 45.02'RT.	33°39'20"
5	39.78R	0+64.57, 28.12'RT.	33°39'20"
6	39.66R	0+64.99, 7.86'RT.	33°39'20"
7	39.54R	0+76.25, 8.97'LT.	33°39'20"
8	39.42R	0+94.00, 17.48'LT.	33°39'20"
9	39.30R	1+13.27, 15.40'LT.	33°39'20"

CENTERLINE CURVE DATA TABLE				
NUMBER	PI STA.	DELTA	TANGENT	ARC RADIUS
C1	2+95.28	57°05'17.1"	195.28'	357.70'
				359.00'

CENTERLINE TANGENT DATA TABLE		
NUMBER	BEARING	DISTANCE
T1	N41°43'20"E	25.00'
T2	N74°38'09"E	17.00'

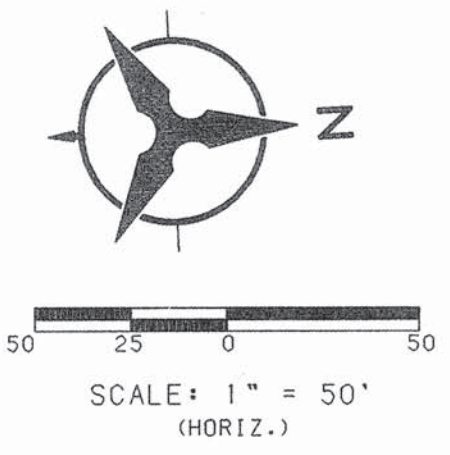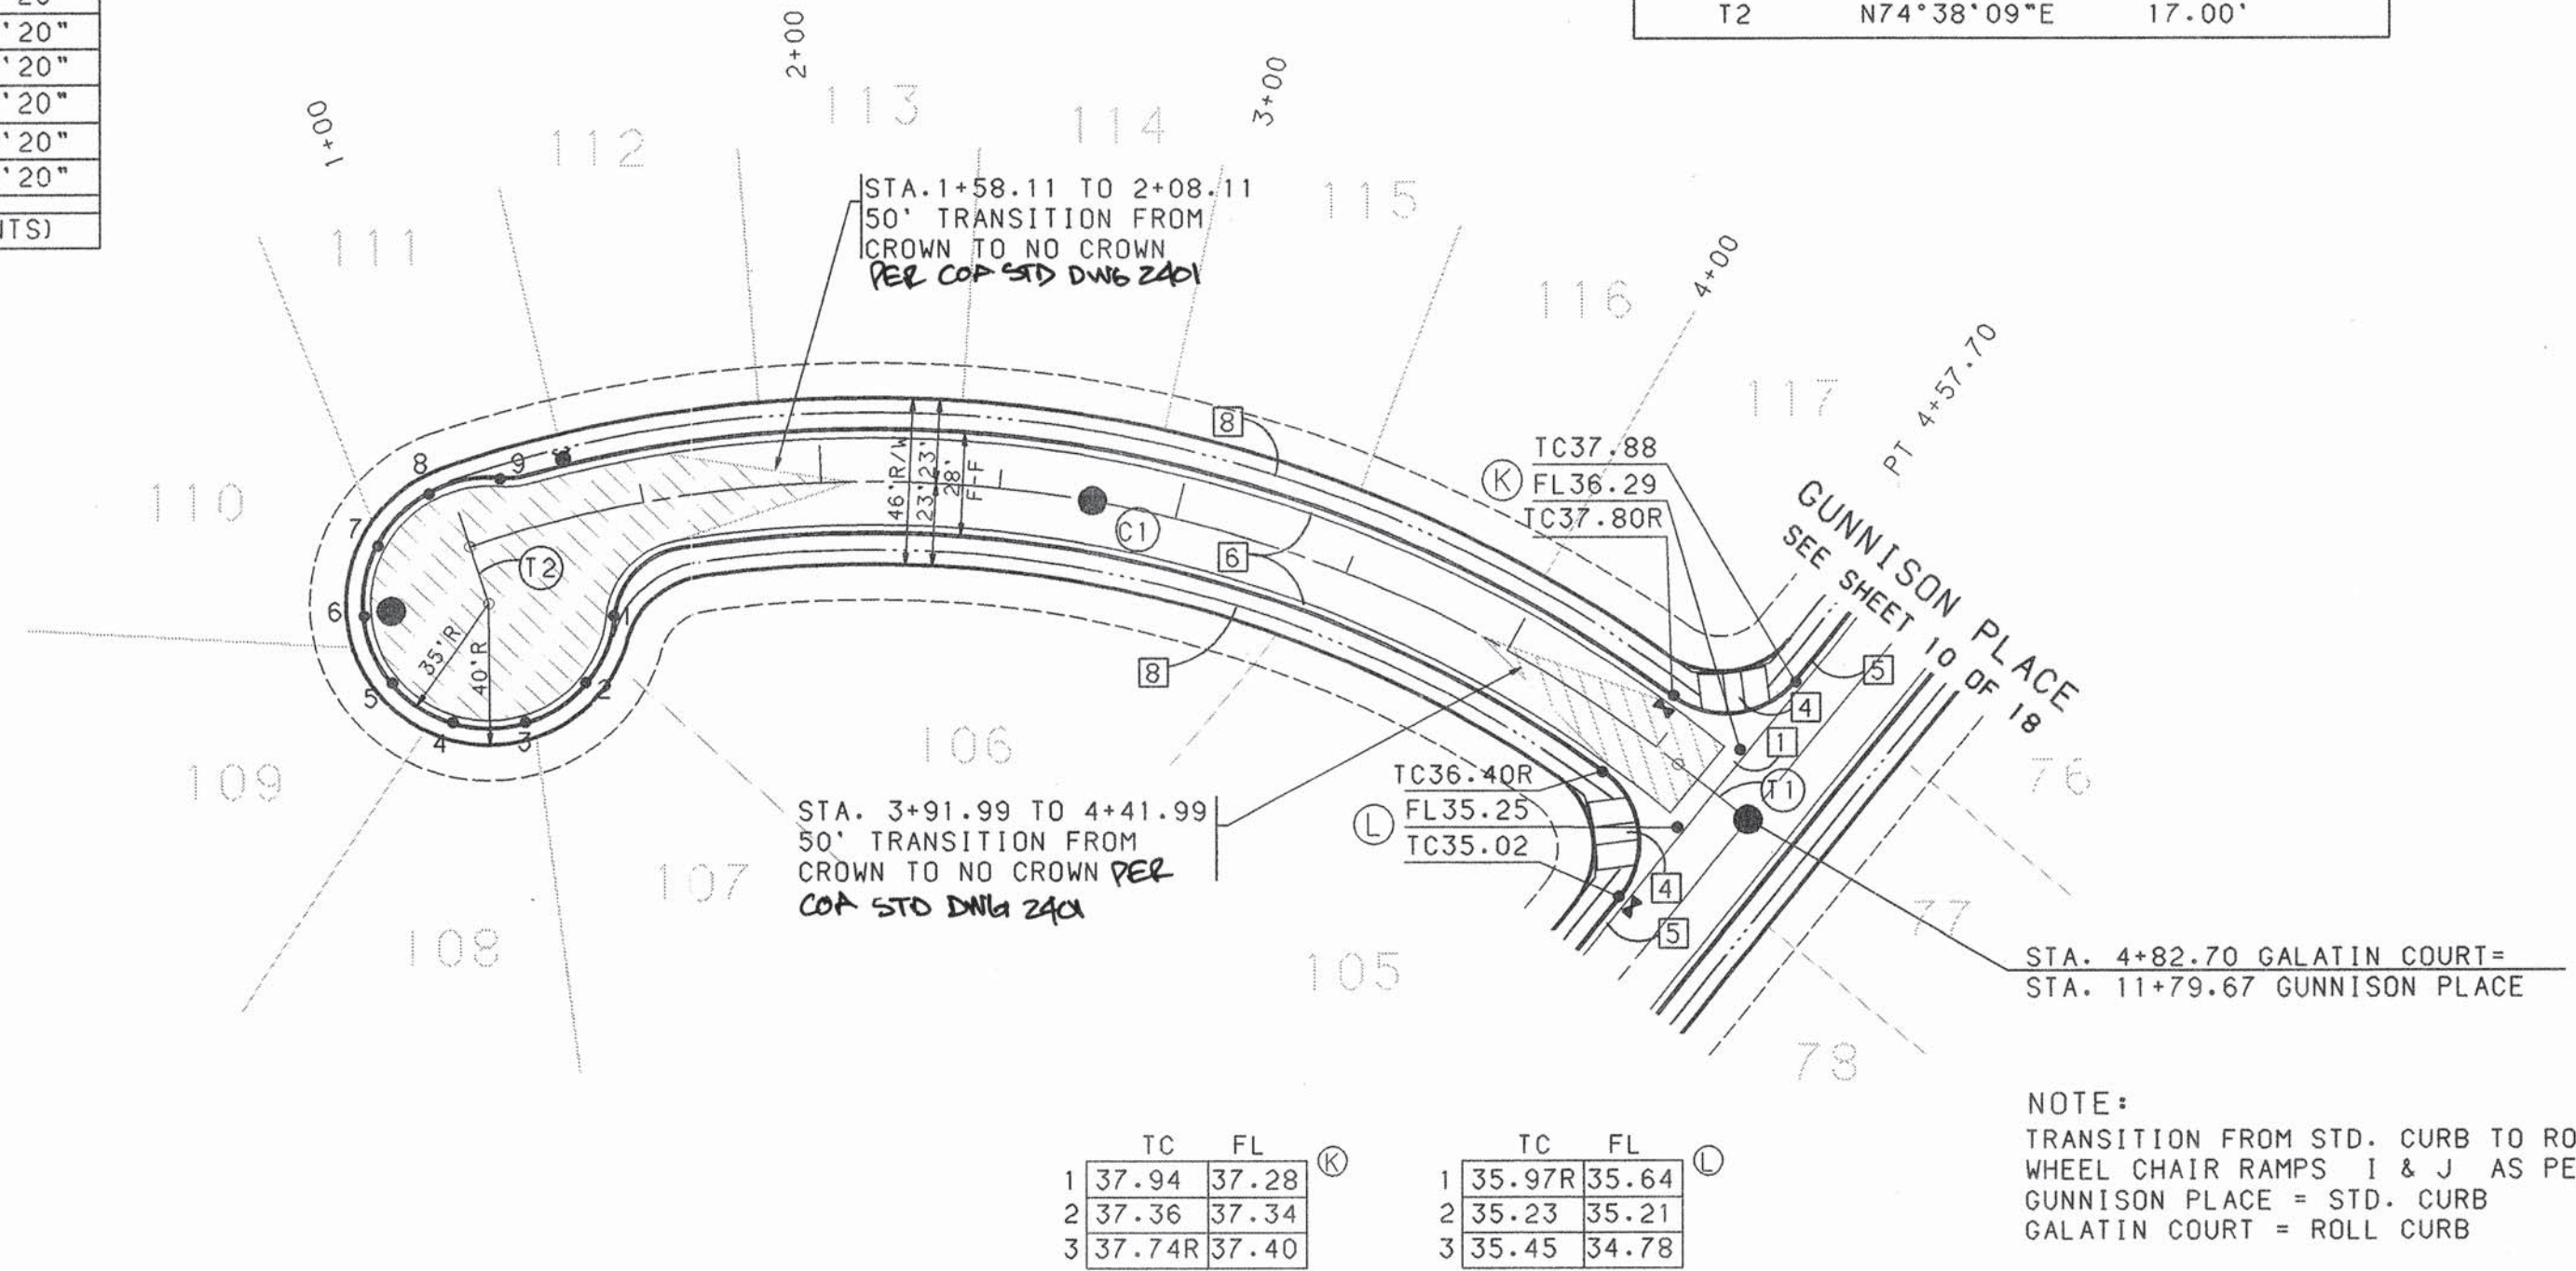

GALATIN COURT

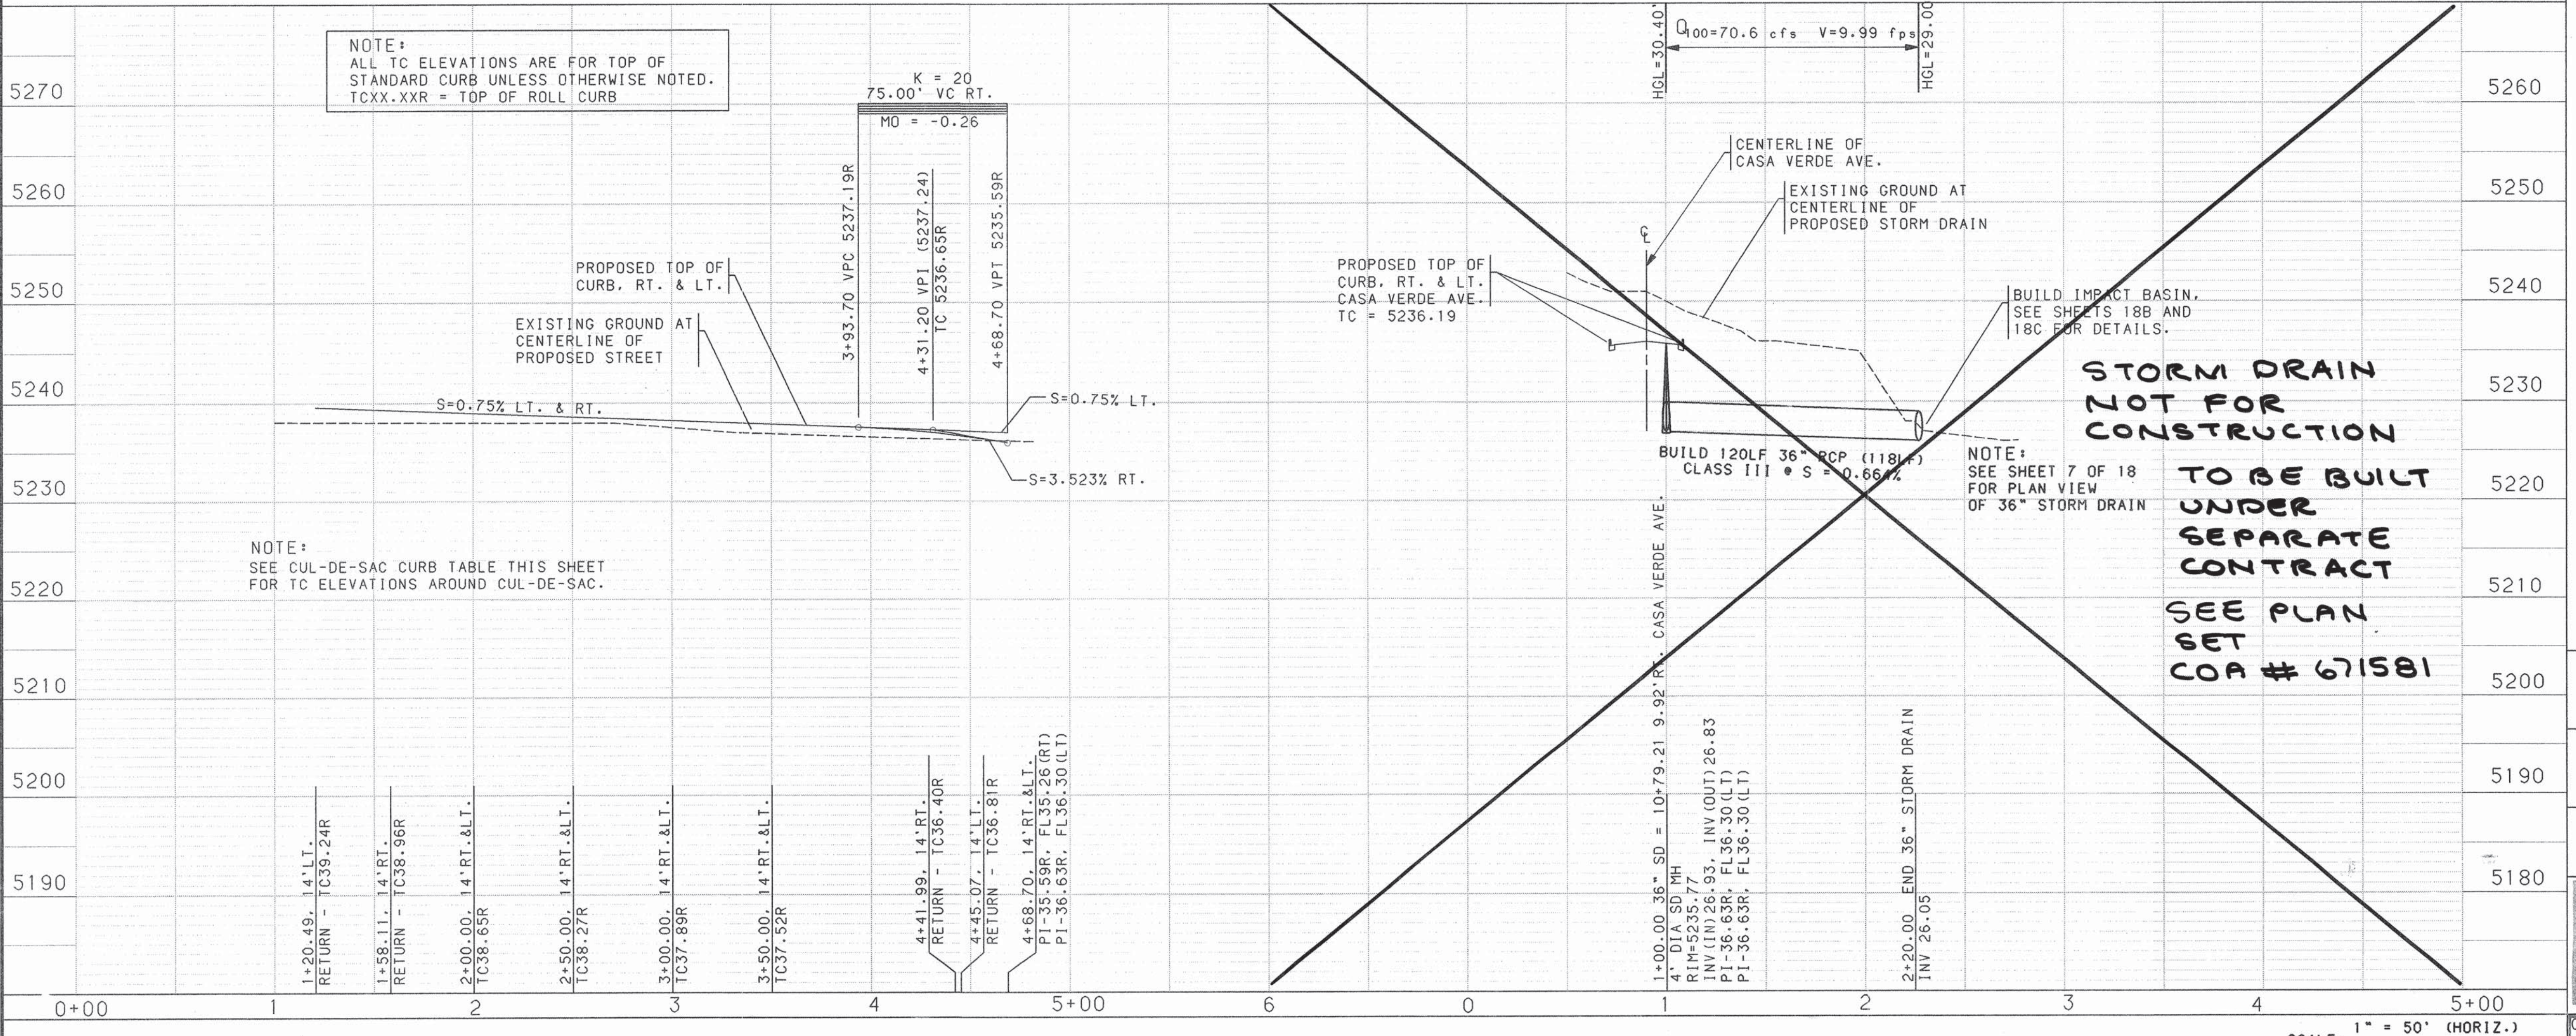

- #### NOTES
- THE CONTRACTOR SHALL FIELD VERIFY ALL EXISTING UTILITY LOCATIONS AND NOTIFY THE ENGINEER IMMEDIATELY OF ANY DISCREPANCIES.
 - ALL CURB RETURN RADII SHALL BE 25' TO FACE OF CURB UNLESS OTHERWISE SPECIFIED.
 - ALL CURVE DATA AND DIMENSIONS REFER TO FACE OF CURB UNLESS OTHERWISE SPECIFIED.
 - GRADE ELEVATIONS, WHERE NOTED, ARE FOR TOP OF STANDARD CURB UNLESS OTHERWISE SPECIFIED.
 - CONTRACTOR IS TO INSTALL A 4"x4"x5' POST AND EMD AT THE END OF EACH SANITARY SEWER SERVICE.
 - CONTRACTOR IS RESPONSIBLE FOR REPAIR AND/OR REPLACEMENT OF ALL UTILITY CONDUITS AND EXISTING LINES.
 - ANY ADDITIONAL GRADING REQUIRED TO MATCH PROPOSED STREET GRADES SHALL BE INCIDENTAL TO PAVING ITEMS.
 - CONTRACTOR SHALL PROVIDE THE INSPECTORS (CITY AND PRIVATE) WITH THE PROPOSED HYDROSTATIC TESTING PLAN. THE PLAN MUST BE APPROVED BEFORE TESTING OPERATIONS BEGIN.
 - CONTRACTOR SHALL PARK EQUIPMENT AND VEHICLES AS NOT TO INTERFERE WITH NORMAL ACTIVITIES OF RESIDENTS OR OTHER CONTRACTORS ON SITE.
 - ANY DAMAGE TO THE EXISTING FACILITIES (CURB AND GUTTER, PAVEMENT, CONDUITS, LANDSCAPING, UTILITY LINES, ETC.) DURING CONSTRUCTION SHALL BE REPLACED AT THE CONTRACTORS EXPENSE.
 - REMOVAL OF THE EXISTING CURB AND GUTTER SHALL BE AS PER COA STD. DWG. 2415 (SAWCUT ONLY).
 - WHEEL CHAIR RAMP SHALL BE CONSTRUCTED PRIOR TO ACCEPTANCE OF CURB AND GUTTER.

- #### KEYED GENERAL NOTES
- INSTALL CONCRETE VALLEY GUTTER AS PER STD. DWG. 2420
 - INSTALL CONCRETE VALLEY GUTTER AS PER STD. DWG. 2421
 - INSTALL WHEEL CHAIR RAMP AS PER STD. DWG. 2441, CASE I
 - INSTALL WHEEL CHAIR RAMP AS PER STD. DWG. 2441, CASE II
 - STD. CURB & GUTTER AS PER STD. DWG. 2415
 - ROLL CURB & GUTTER AS PER STD. DWG. 2415
 - MEDIAN CURB & GUTTER AS PER STD. DWG. 2415
 - DEFERRED FUTURE 4' SIDEWALK
 - BUILD 4' SIDEWALK
 - 10' MEANDERING ASPHALT TRAIL BY OTHERS

BOHANNAN-HUSTON, INC.
ENGINEERS • PLANNERS • PHOTOGRAMMETRISTS • SURVEYORS • LANDSCAPE ARCHITECTS
ALBUQUERQUE LAS CRUCES SANTA FE

CITY OF ALBUQUERQUE
PUBLIC WORKS DEPARTMENT
ENGINEERING DEVELOPMENT GROUP

THE CROSSING SUBDIVISION UNIT I
PAVING PLAN & PROFILE (INCLUDING STORM DRAIN)
GALATIN COURT



DESIGN REVIEW COMMITTEE	CITY ENGINEER APPROVAL	MO./DAY/YR.	MO./DAY/YR.
APPROVED	APPROVED		
DESIGN REVIEW COMMITTEE	CITY ENGINEER		

PROJECT NO. **545381** ZONE MAP NO. **H9. J9** SHEET **9** OF **18**

DATE: MAY, 1996

CENTERLINE TANGENT DATA TABLE			
NUMBER	BEARING	DISTANCE	
T1	S48° 16' 34"E	135.50'	
T2	S48° 16' 34"E	267.50'	
T3	S48° 16' 34"E	69.94'	

CENTERLINE CURVE DATA TABLE			
NUMBER	PI STA.	DELTA	TANGENT ARC RADIUS
C1	15+62.16	26°28'24.5"	317.55' 450.39' 1350.00'
	14+24.21	14°44' 13"	174.60 347.27

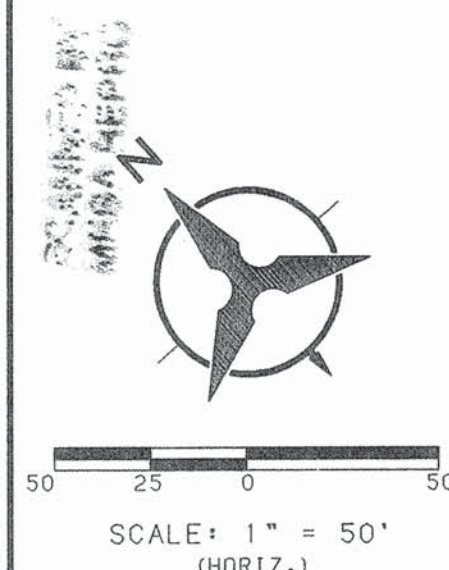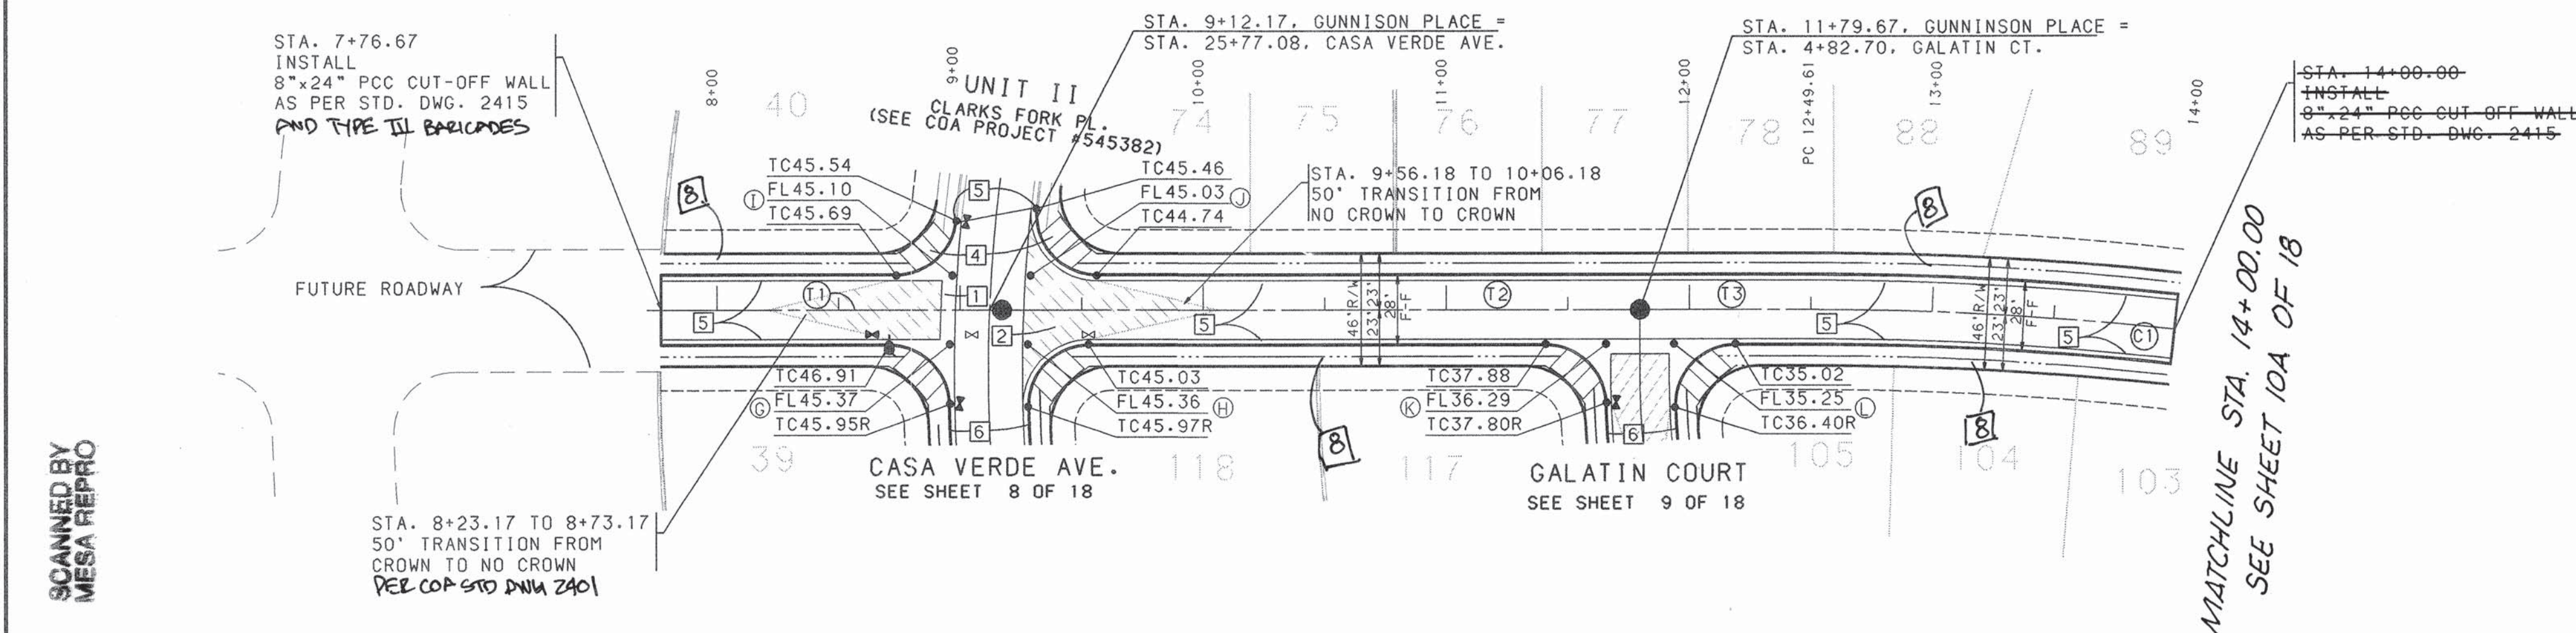


TC	FL	TC	FL	TC	FL	TC	FL	TC	FL	TC	FL
1	46.75	46.08	1	45.65	45.31	1	45.82	44.92	1	37.94	37.28
2	45.95	45.93	2	45.02	45.00	2	45.47	45.45	2	37.36	37.34
3	46.10	45.77	3	45.34	44.68	3	46.40	45.73	3	37.74	37.40
D= 88° 47' 56.8"		D= 91° 22' 08.3"		D= 84° 30' 07.7"		D= 96° 16' 12.2"		D= 87° 59' 03.0"		D= 92° 30' 26.9"	
L= 38.75'		L= 39.87'		L= 36.87'		L= 42.01'		L= 38.39'		L= 40.36'	
R= 25.00'		R= 25.00'		R= 25.00'		R= 25.00'		R= 25.00'		R= 25.00'	
WR= 62.43'		WR= 74.34'		WR= 56.63'		WR= 92.50'		WR= 59.69'		WR= 82.11'	

NOTE:
TRANSITION FROM STD. CURB TO ROLL CURB THROUGH
WHEEL CHAIR RAMPS G & H AS PER STD DWG. 2418
GUNNISON PLACE = STD. CURB
CASA VERDE AVE. = ROLL CURB

GUNNISON PLACE

NOTE:
TRANSITION FROM STD. CURB TO ROLL CURB THROUGH
WHEEL CHAIR RAMPS K & L AS PER STD DWG. 2418
GUNNISON PLACE = STD. CURB
GALATIN COURT = ROLL CURB

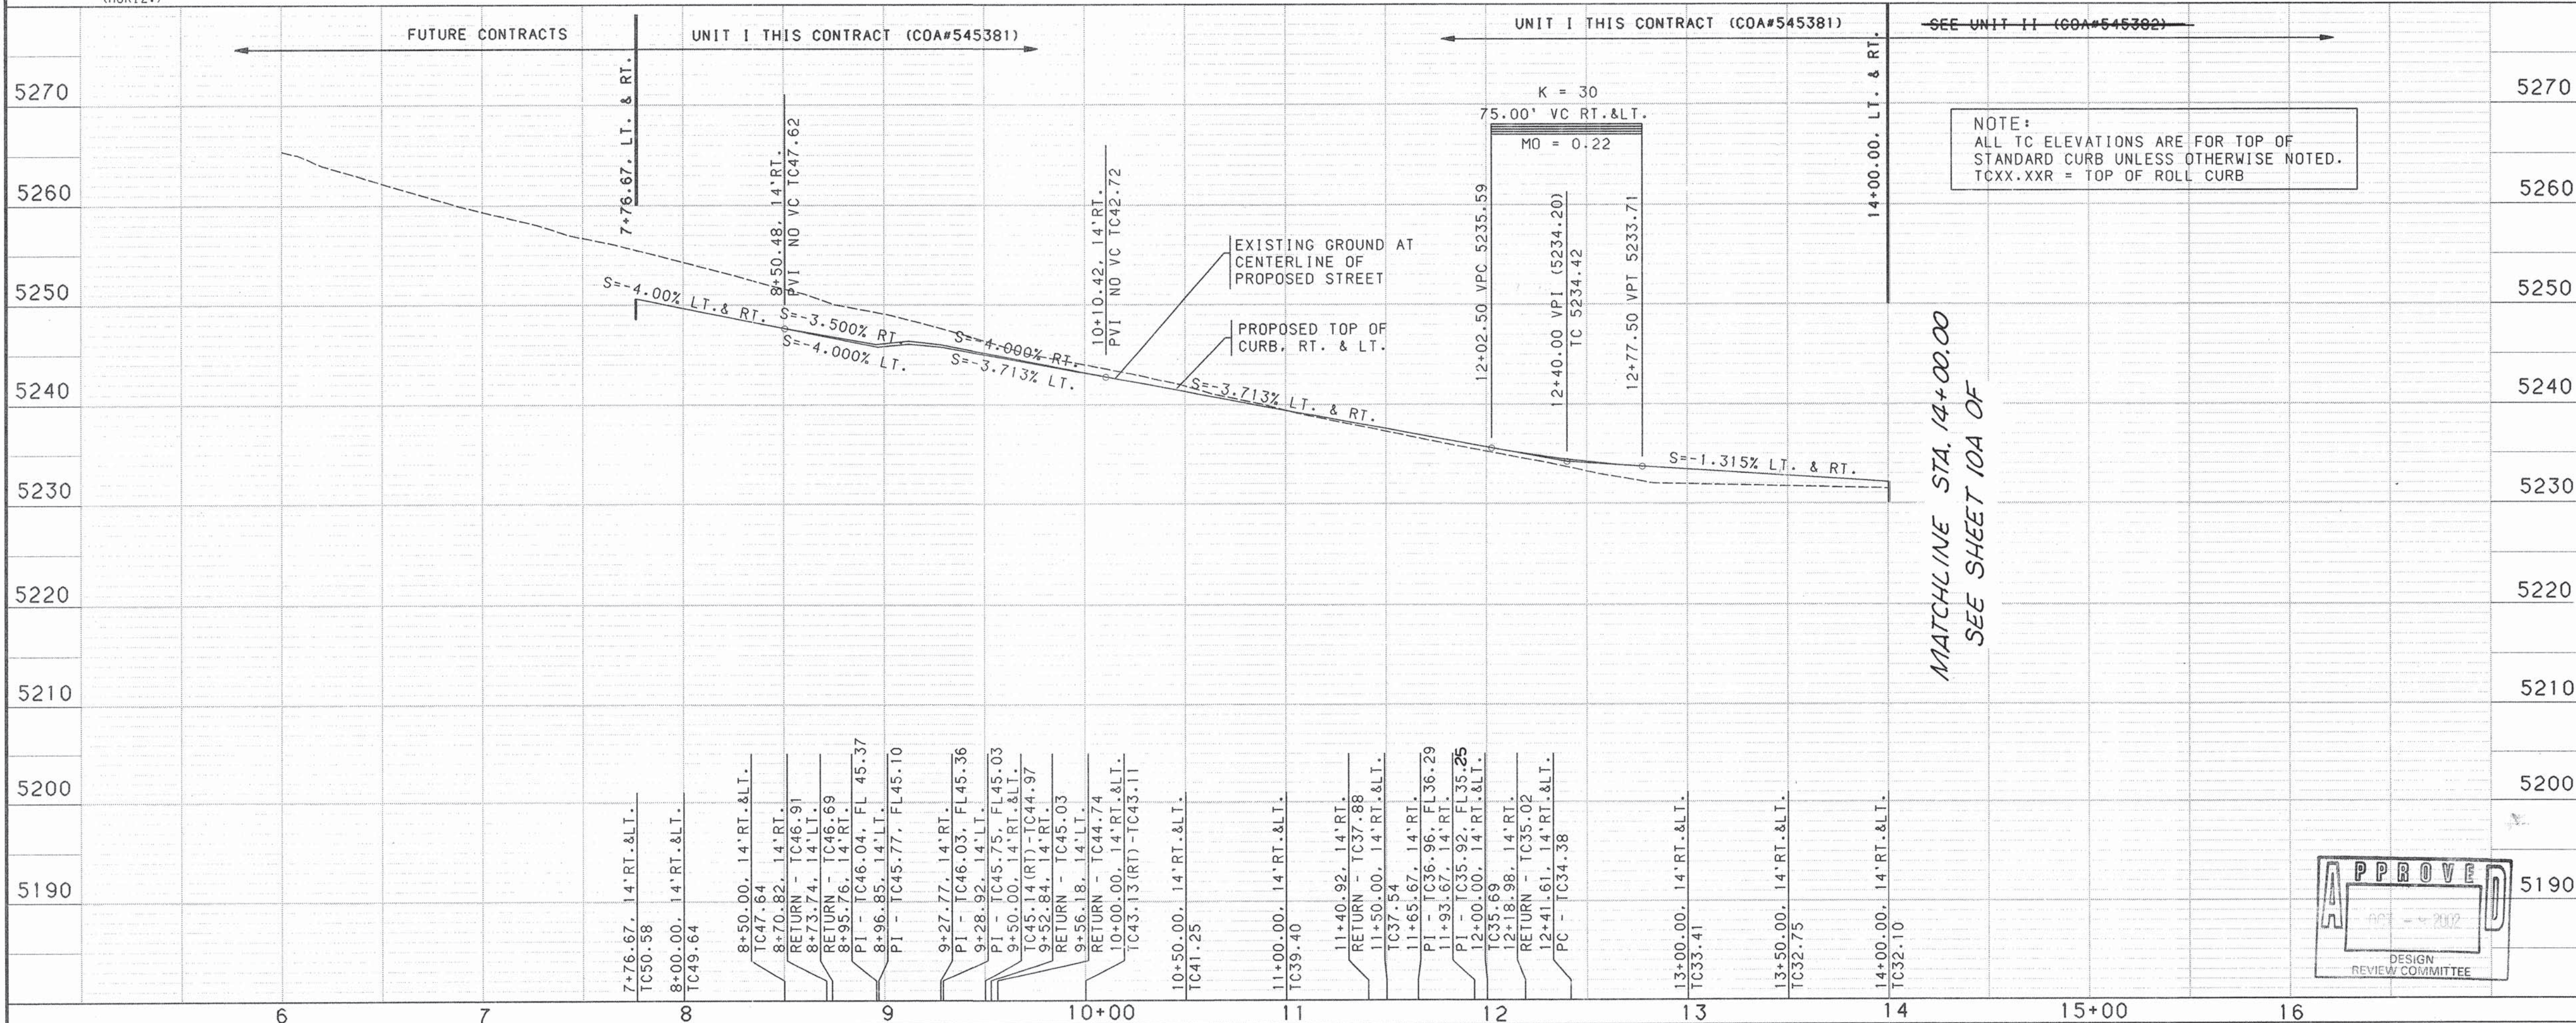

NOTE:
ALL TC ELEVATIONS ARE FOR TOP OF
STANDARD CURB UNLESS OTHERWISE NOTED.
TCXX.XXR = TOP OF ROLL CURB

- NOTES**
- THE CONTRACTOR SHALL FIELD VERIFY ALL EXISTING UTILITY LOCATIONS AND NOTIFY THE ENGINEER IMMEDIATELY OF ANY DISCREPANCIES.
 - ALL CURB RETURN RADIUS SHALL BE 25' TO FACE OF CURB UNLESS OTHERWISE SPECIFIED.
 - ALL CURVE DATA AND DIMENSIONS REFER TO FACE OF CURB UNLESS OTHERWISE SPECIFIED.
 - GRADE ELEVATIONS, WHERE NOTED, ARE FOR TOP OF STANDARD CURB UNLESS OTHERWISE SPECIFIED.
 - CONTRACTOR IS TO INSTALL A 4"x4"x5' POST AND EMD AT THE END OF EACH SANITARY SEWER SERVICE.
 - CONTRACTOR IS RESPONSIBLE FOR REPAIR AND/OR REPLACEMENT OF ALL UTILITY CONDUITS AND EXISTING LINES.
 - ANY ADDITIONAL GRADING REQUIRED TO MATCH PROPOSED STREET GRADES SHALL BE INCIDENTAL TO PAVING ITEMS.
 - CONTRACTOR SHALL PROVIDE THE INSPECTORS (CITY AND PRIVATE) WITH THE PROPOSED HYDROSTATIC TESTING PLAN. THE PLAN MUST BE APPROVED BEFORE TESTING OPERATIONS BEGIN.
 - CONTRACTOR SHALL PARK EQUIPMENT AND VEHICLES AS NOT TO INTERFERE WITH NORMAL ACTIVITIES OF RESIDENTS OR OTHER CONTRACTORS ON SITE.
 - ANY DAMAGE TO THE EXISTING FACILITIES (CURB AND GUTTER, PAVEMENT, CONDUITS, LANDSCAPING, UTILITY LINES, ETC.) DURING CONSTRUCTION SHALL BE REPLACED AT THE CONTRACTORS EXPENSE.
 - REMOVAL OF THE EXISTING CURB AND GUTTER SHALL BE AS PER COA STD. DWG. 2415 (SAWCUT ONLY).
 - WHEEL CHAIR RAMPS SHALL BE CONSTRUCTED PRIOR TO ACCEPTANCE OF CURB AND GUTTER.

KEYED GENERAL NOTES


- INSTALL CONCRETE VALLEY GUTTER AS PER STD. DWG. 2420
- DO NOT INSTALL FILLETS OR VALLEY GUTTER
- INSTALL WHEEL CHAIR RAMP AS PER STD. DWG. 2441, CASE I
- INSTALL WHEEL CHAIR RAMP AS PER STD. DWG. 2441, CASE II
- STD. CURB & GUTTER AS PER STD. DWG. 2415
- ROLL CURB & GUTTER AS PER STD. DWG. 2415
- MEDIAN CURB & GUTTER AS PER STD. DWG. 2415
- DEFERRED FUTURE 4' SIDEWALK
- BUILD 4' SIDEWALK
- 10' MEANDERING ASPHALT TRAIL BY OTHERS

BOHANNAN-HUSTON INC.
ENGINEERS • PLANNERS • PHOTOGRAMMETRISTS • SURVEYORS • LANDSCAPE ARCHITECTS
ALBUQUERQUE LAS CRUCES SANTA FE

CITY OF ALBUQUERQUE
PUBLIC WORKS DEPARTMENT
ENGINEERING DEVELOPMENT GROUP

THE CROSSING SUBDIVISION UNIT I
PAVING PLAN & PROFILE
GUNNISON PLACE FROM STA. 7+76.67 TO 14+00.00

DESIGN REVIEW COMMITTEE	MO/DAY/YR	MO/DAY/YR
APPROVED	APPROVED	APPROVED
DESIGN REVIEW COMMITTEE	CITY ENGINEER	DESIGN REVIEW COMMITTEE
DATE: 8-2002	DATE: 8-2002	DATE: 8-2002
DESIGNED BY: KP/BJ	DRAWN BY: OR	CHECKED BY: KP
DATE: 8/96	DATE: 8/96	DATE: 8/96
SHEET 10 OF 18		

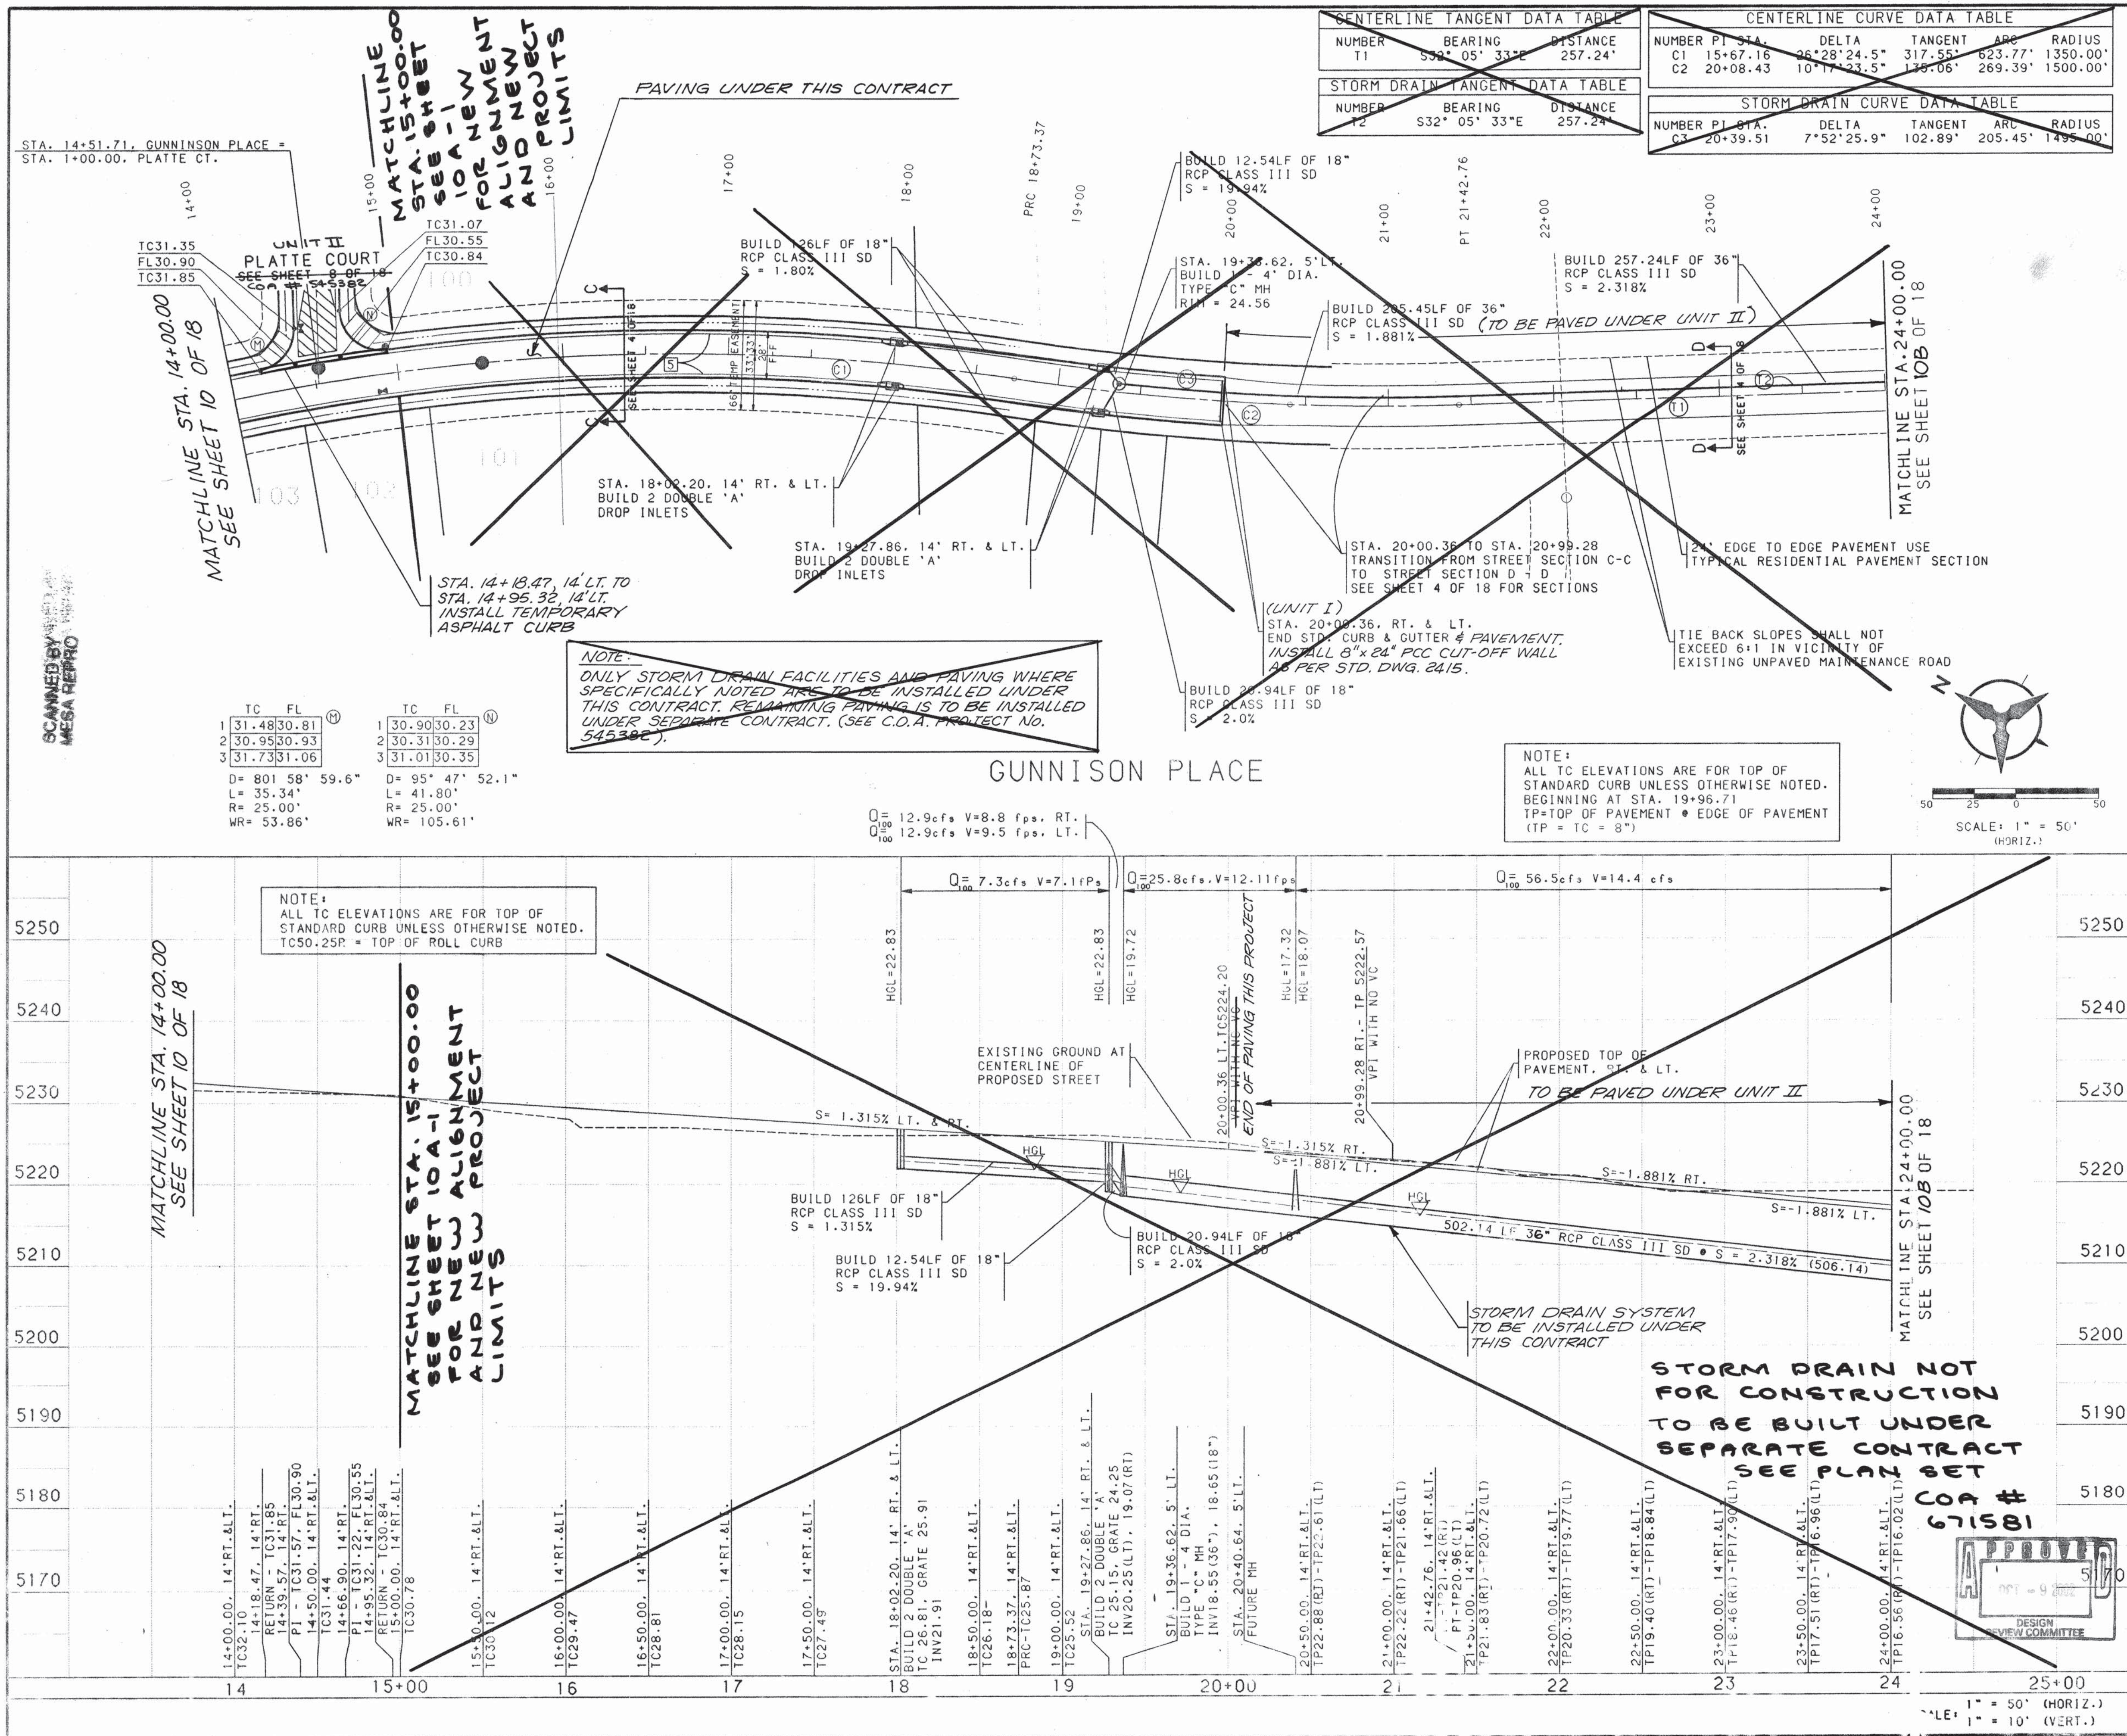

- NOTES**
1. THE CONTRACTOR SHALL FIELD VERIFY ALL EXISTING UTILITY LOCATIONS AND NOTIFY THE ENGINEER IMMEDIATELY OF ANY DISCREPANCIES.
 2. ALL CURB RETURN RADII SHALL BE 25' TO FACE OF CURB UNLESS OTHERWISE SPECIFIED.
 3. ALL CURVE DATA AND DIMENSIONS REFER TO FACE OF CURB UNLESS OTHERWISE SPECIFIED.
 4. GRADE ELEVATIONS, WHERE NOTED, ARE FOR TOP OF STANDARD CURB UNLESS OTHERWISE SPECIFIED.
 5. CONTRACTOR IS TO INSTALL A 4"x4"x5' POST AND END AT THE END OF EACH SANITARY SEWER SERVICE.
 6. CONTRACTOR IS RESPONSIBLE FOR REPAIR AND/OR REPLACEMENT OF ALL UTILITY CONDUITS AND EXISTING LINES.
 7. ANY ADDITIONAL GRADING REQUIRED TO MATCH PROPOSED STREET GRADES SHALL BE INCIDENTAL TO PAVING ITEMS.
 8. CONTRACTOR SHALL PROVIDE THE INSPECTORS, (CITY AND PRIVATE) WITH PLAN. THE PLAN MUST BE APPROVED BEFORE TESTING OPERATIONS BEGIN.
 9. CONTRACTOR SHALL PARK EQUIPMENT AND VEHICLES AS NOT TO INTERFERE WITH NORMAL ACTIVITIES OF RESIDENTS OR OTHER CONTRACTORS ON SITE.
 10. ANY DAMAGE TO THE EXISTING FACILITIES (CURB AND GUTTER, PAVEMENT, CONDUITS, LANDSCAPING, UTILITY LINES, ETC.) DURING CONSTRUCTION SHALL BE REPLACED AT THE CONTRACTORS EXPENSE.
 11. REMOVAL OF THE EXISTING CURB AND GUTTER SHALL BE AS PER COA STD. DWG. 2415 (SAWCUT ONLY).
 12. WHEEL CHAIR RAMPS SHALL BE CONSTRUCTED PRIOR TO ACCEPTANCE OF CURB AND GUTTER.

KEYED GENERAL NOTES

1. INSTALL CONCRETE VALLEY GUTTER AS PER STD. DWG. 2420
2. INSTALL CONCRETE VALLEY GUTTER AS PER STD. DWG. 2421
3. INSTALL WHEEL CHAIR RAMP AS PER STD. DWG. 2441, CASE I
4. INSTALL WHEEL CHAIR RAMP AS PER STD. DWG. 2441, CASE II
5. STD. CURB & GUTTER AS PER STD. DWG. 2415
6. ROLL CURB & GUTTER AS PER STD. DWG. 2415
7. MEDIAN CURB & GUTTER AS PER STD. DWG. 2415
8. FUTURE 4' SIDEWALK
9. BUILD 4' SIDEWALK
10. 10' MEANDERING ASPHALT TRAIL BY OTHERS

BOHANNAN-HUSTON INC.
ENGINEERS • PLANNERS • PHOTOGRAMMETRISTS • SURVEYORS • LANDSCAPE ARCHITECTS
ALBUQUERQUE LAS CRUCES SANTA FE

CITY OF ALBUQUERQUE
PUBLIC WORKS DEPARTMENT
ENGINEERING DEVELOPMENT GROUP


THE CROSSING SUBDIVISION UNIT I
PAVING PLAN & PROFILE INCLUDING STORM DRAIN
GUNNISON PLACE FROM STA. 14+00.00 TO 24+00.00

DESIGN REVIEW COMMITTEE: [Signature]
CITY ENGINEER: [Signature]
LAST DESIGN UPDATE: [Date]
MO./DAY/YR: 15/00/00

DESIGNED BY: KP/BJS DATE: 8/96
DRAWN BY: DR DATE: 8/96
CHECKED BY: KP DATE: 8/96


CITY PROJECT NO: 545381 ZONE MAP NO: H-9, J-9 SHEET OF 10A 18
DATE: MAY, 1996

CENTERLINE TANGENT DATA		
NUMBER	BEARING	LENGTH
T1	S31°28'55"E	125.00

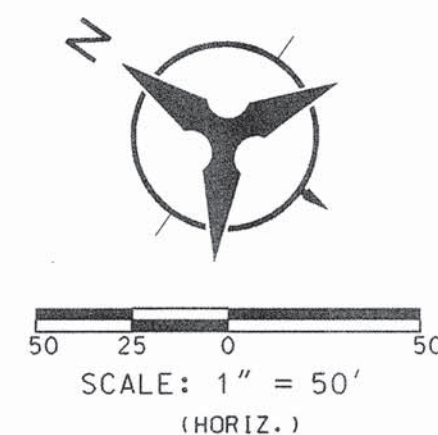

1. THE CONTRACTOR SHALL FIELD VERIFY ALL EXISTING UTILITY LOCATIONS AND NOTIFY THE ENGINEER IMMEDIATELY OF ANY DISCREPANCIES.
2. ALL CURB RETURN RADII SHALL BE 25' UNLESS OTHERWISE SPECIFIED.
3. ALL CURVE DATA AND DIMENSIONS REFER TO FACE OF CURB UNLESS OTHERWISE SPECIFIED.
4. GRADE ELEVATIONS, WHERE NOTED, ARE ALONG FLOWLINE OF STANDARD CURB UNLESS OTHERWISE SPECIFIED.
5. CONTRACTOR IS TO INSTALL A 4" X 4" X 5' POST AND EMD AT THE END OF EACH SANITARY SEWER SERVICE.
6. CONTRACTOR IS RESPONSIBLE FOR REPAIR AND/OR REPLACEMENT OF ALL UTILITY CONDUITS AND EXISTING LINES.
7. ANY ADDITIONAL GRADING REQUIRED TO MATCH PROPOSED STREET GRADES SHALL BE INCIDENTAL TO PAVING ITEMS.
8. CONTRACTOR SHALL PROVIDE THE INSPECTORS, (CITY AND PRIVATE) WITH THE PROPOSED HYDROSTATIC TESTING PLAN. THE PLAN MUST BE APPROVED BEFORE TESTING OPERATIONS BEGIN.
9. CONTRACTOR SHALL PARK EQUIPMENT AND VEHICLES AS NOT TO INTERFERE WITH NORMAL ACTIVITIES OF RESIDENTS OR OTHER CONTRACTORS ON SITE.
10. ANY DAMAGE TO THE EXISTING FACILITIES (CURB & GUTTER), PAVEMENT, CONDUITS, LANDSCAPING, UTILITY LINES, ETC.) DURING CONSTRUCTION SHALL BE REPLACED AT THE CONTRACTORS' EXPENSE.
11. REMOVAL OF THE EXISTING CURB AND GUTTER SHALL BE AS PER COA STD. DWG. 2415 (SAWCUT RAMP).
12. WHEELCHAIR RAMPS SHALL BE CONSTRUCTED PRIOR TO ACCEPTANCE OF CURB & GUTTER.

- 1 INSTALL CONCRETE VALLEY GUTTER
AS PER STD. DWG. 2420
- 2 INSTALL ^{UPSIDE} CONCRETE VALLEY GUTTER
AS PER STD. DWG. 2421
- 3 INSTALL WHEELCHAIR RAMP
AS PER STD. DWG. 2441, CASE I
- 4 INSTALL WHEELCHAIR RAMP
AS PER STD. DWG. 2441, CASE II
- 5 STD. CURB & GUTTER
AS PER STD. DWG. 2415
- 6 ROLL CURB & GUTTER
AS PER STD. DWG. 2415
- 7 MEDIAN CURB & GUTTER
AS PER STD. DWG. 2415
- 8 ~~FIGURE~~ 4' SIDEWALK
- 9 BUILD 4' SIDEWALK
- 10 10' MEANDERING ASPHALT
TRAIL, BY OTHERS

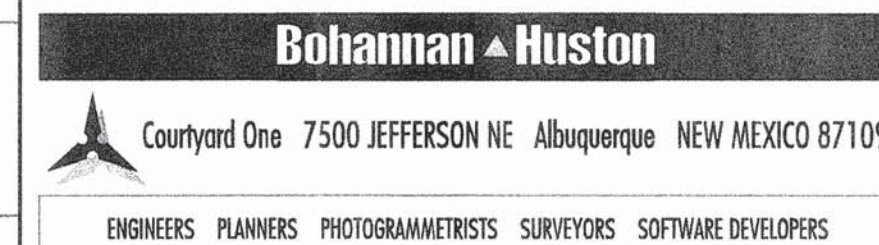

GUNNISON PLACE FROM STA. 15+00.00 TO 18+14.76



SURVEY INFORMATION		BENCH MARKS		AS-BUILT INFORMATION	
NO.	FIELD NOTES	DATE	BY	NO.	DATE
	ACS ALUMINUM TABLET STAMPED "BH-40"			CONTRACTOR'S	SUNDANCE
	GEOGRAPHIC POSITION (NAD 1927)			WORKED BY	ALS
	N.M. STATE PLANE COORD. (CENTRAL ZONE)			INSPECTOR'S	
	X=352,790.66 Y=1,492,346.53			ACCEPTANCE BY	SAC
				DATE	7/15
	GROUND TO GRID FACTOR = 0.99967105			FIELD LIGATION BY	COA
	DELTA ALPHA = -000016 MIN 59 SEC			DRAWINGS	
	NGVD 1929 ELEVATION = 5305.43			CORRECTED BY	ALS
				DATE	
				MICRO-FILM INFORMATION	
				RECORDED BY	
				DATE	
				NO.	

[illegible]

SCANNED BY
MESA REPRO



SCALE: 1" = 50'
(HORIZ.)

MATCHLINE STA. 24+00.00
SEE SHEET 10A OF 18

STA. 24+42.76, 5' LT.
BUILD 1 - 4" DIA.
TYPE "C" MH
RIM 15.84

BUILD 42.76LF OF 36"
RCP CLASS III SD
S = 1.807%

BUILD 156.21LF OF 36"
RCP CLASS III SD, S=2.02
D₁₀₀ = 56.5 cfs, V=13.5 fps
(NON - PRESSURE FLOW)

PC 25+78.23

STA. 25+24.17, 138.32' LT.
CONSTRUCT IMPACT BASIN
SEE SHEET 10B & 10C FOR DETAILS
INV = 03.33

PT 28+59.87

CENTERLINE TANGENT DATA TABLE		
NUMBER	BEARING	DISTANCE
T1	S32° 05' 33"E	178.23'
T2	N58° 15' 27"E	339.09'
T3	N58° 15' 27"E	33.67'

CENTERLINE CURVE DATA TABLE				
NUMBER	PI STA.	DELTA	TANGENT	ARC RADIUS
C1	27+57.13	89°39'0.2"	178.90'	281.64'
C2	33+06.27	71° 9'41.2"	107.31'	186.30'

STORM DRAIN TANGENT DATA TABLE		
NUMBER	BEARING	DISTANCE
T4	S32° 05' 33"E	42.76'
T5	N89° 18' 58"E	156.21'

CONSTRUCT TYP. RESIDENTIAL
PAVEMENT SECTION PER SHEET 4

STA. 34+03.65, 12' LT. & RT. TO
STA. 34+28.65, 39' RT. & LT.
BUILD ASPHALT CURB
PER COA. DWG. 2415

STA. 34+28.65, 39' RT. & LT.
SAW CUT & REMOVE EXISTING
FACE OF STD. CURB (REMOVE
FACE OF CURB ONLY)

NOTE:
ONLY STORM DRAIN FACILITIES ARE TO BE
INSTALLED UNDER THIS CONTRACT. ALL PAVING
IS TO BE INSTALLED UNDER SEPARATE CON-
TRACT. (SEE C.O.A. PROJECT NO. 545382).

LADERA DRIVE (EXISTING)

NOTE:
ENDING STATION IS APPROXIMATE.
CONNECT GUNNISON TO EXISTING
LADERA DRIVE. MATCH EXISTING GRADES

GUNNISON PLACE

NOTE:
ALL TC ELEVATIONS ARE FOR TOP OF
STANDARD CURB UNLESS OTHERWISE NOTED.
BEGINNING AT STA. 19+96.71
TP=TOP OF PAVEMENT * EDGE OF PAVEMENT
(TP = TP - 8")

END CONSTRUCTION THIS CONTRACT
COA #545382

NOT FOR CONSTRUCTION
TO BE BUILT UNDER
SEPARATE CONTRACT
SEE PLAN SET
COA # 671581

NOTES

1. THE CONTRACTOR SHALL FIELD VERIFY ALL EXISTING UTILITY LOCATIONS AND NOTIFY THE ENGINEER IMMEDIATELY OF ANY DISCREPANCIES.
2. ALL CURB RETURN RADI SHALL BE 25' TO FACE OF CURB UNLESS OTHERWISE SPECIFIED.
3. ALL CURVE DATA AND DIMENSIONS REFER TO FACE OF CURB UNLESS OTHERWISE SPECIFIED.
4. GRADE ELEVATIONS, WHERE NOTED, ARE FOR TOP OF STANDARD CURB UNLESS OTHERWISE SPECIFIED.
5. CONTRACTOR IS TO INSTALL A 4"x4"x5' POST AND EMD AT THE END OF EACH SANITARY SEWER SERVICE.
6. CONTRACTOR IS RESPONSIBLE FOR REPAIR AND/OR REPLACEMENT OF ALL UTILITY CONDUITS AND EXISTING LINES.
7. ANY ADDITIONAL GRADING REQUIRED TO MATCH PROPOSED STREET GRADES SHALL BE INCIDENTAL TO PAVING ITEMS.
8. CONTRACTOR SHALL PROVIDE THE INSPECTORS, (CITY AND PRIVATE) WITH THE PROPOSED HYDROSTATIC TESTING PLAN. THE PLAN MUST BE APPROVED BEFORE TESTING OPERATIONS BEGIN.
9. CONTRACTOR SHALL PARK EQUIPMENT AND VEHICLES AS NOT TO INTERFERE WITH NORMAL ACTIVITIES OF RESIDENTS OR OTHER CONTRACTORS ON SITE.
10. ANY DAMAGE TO THE EXISTING FACILITIES (CURB AND GUTTER, PAVEMENT, CONDUITS, LANDSCAPING, UTILITY LINES, ETC.) DURING CONSTRUCTION SHALL BE REPLACED AT THE CONTRACTORS EXPENSE.
11. REMOVAL OF THE EXISTING CURB AND GUTTER SHALL BE AS PER COA STD. DWG. 2415 (SAW CUT ONLY).
12. WHEEL CHAIR RAMPS SHALL BE CONSTRUCTED PRIOR TO ACCEPTANCE OF CURB AND GUTTER.

KEYED GENERAL NOTES

1. INSTALL CONCRETE VALLEY GUTTER AS PER STD. DWG. 2420
2. INSTALL CONCRETE VALLEY GUTTER AS PER STD. DWG. 2421
3. INSTALL WHEEL CHAIR RAMP AS PER STD. DWG. 2441, CASE I
4. INSTALL WHEEL CHAIR RAMP AS PER STD. DWG. 2441, CASE II
5. STD. CURB & GUTTER AS PER STD. DWG. 2415
6. ROLL CURB & GUTTER AS PER STD. DWG. 2415
7. MEDIAN CURB & GUTTER AS PER STD. DWG. 2415
8. FUTURE 4' SIDEWALK
9. BUILD 4' SIDEWALK
10. 10' MEANDERING ASPHALT TRAIL BY OTHERS

BOHANNAN-HUSTON INC.
ENGINEERS • PLANNERS • PHOTOGRAMMETRISTS • SURVEYORS • LANDSCAPE ARCHITECTS
ALBUQUERQUE LAS CRUCES SANTA FE

CITY OF ALBUQUERQUE
PUBLIC WORKS DEPARTMENT
ENGINEERING DEVELOPMENT GROUP

THE CROSSING SUBDIVISION UNIT 1
(STORM DRAIN ONLY)
GUNNISON PLACE FROM 24+00 TO 25+24.00


DESIGN REVIEW COMMITTEE	CITY ENGINEER APPROVAL	NO. / DAY / YR.

DESIGNED BY	DRAWN BY	CHECKED BY
KP/BJB	OR	KP



DATE	8/96
DATE	8/96
DATE	8/96

NO.	545381
ZONE MAP NO.	H-9, J-9
SHEET	18

SCANNED BY
MESA REPRO

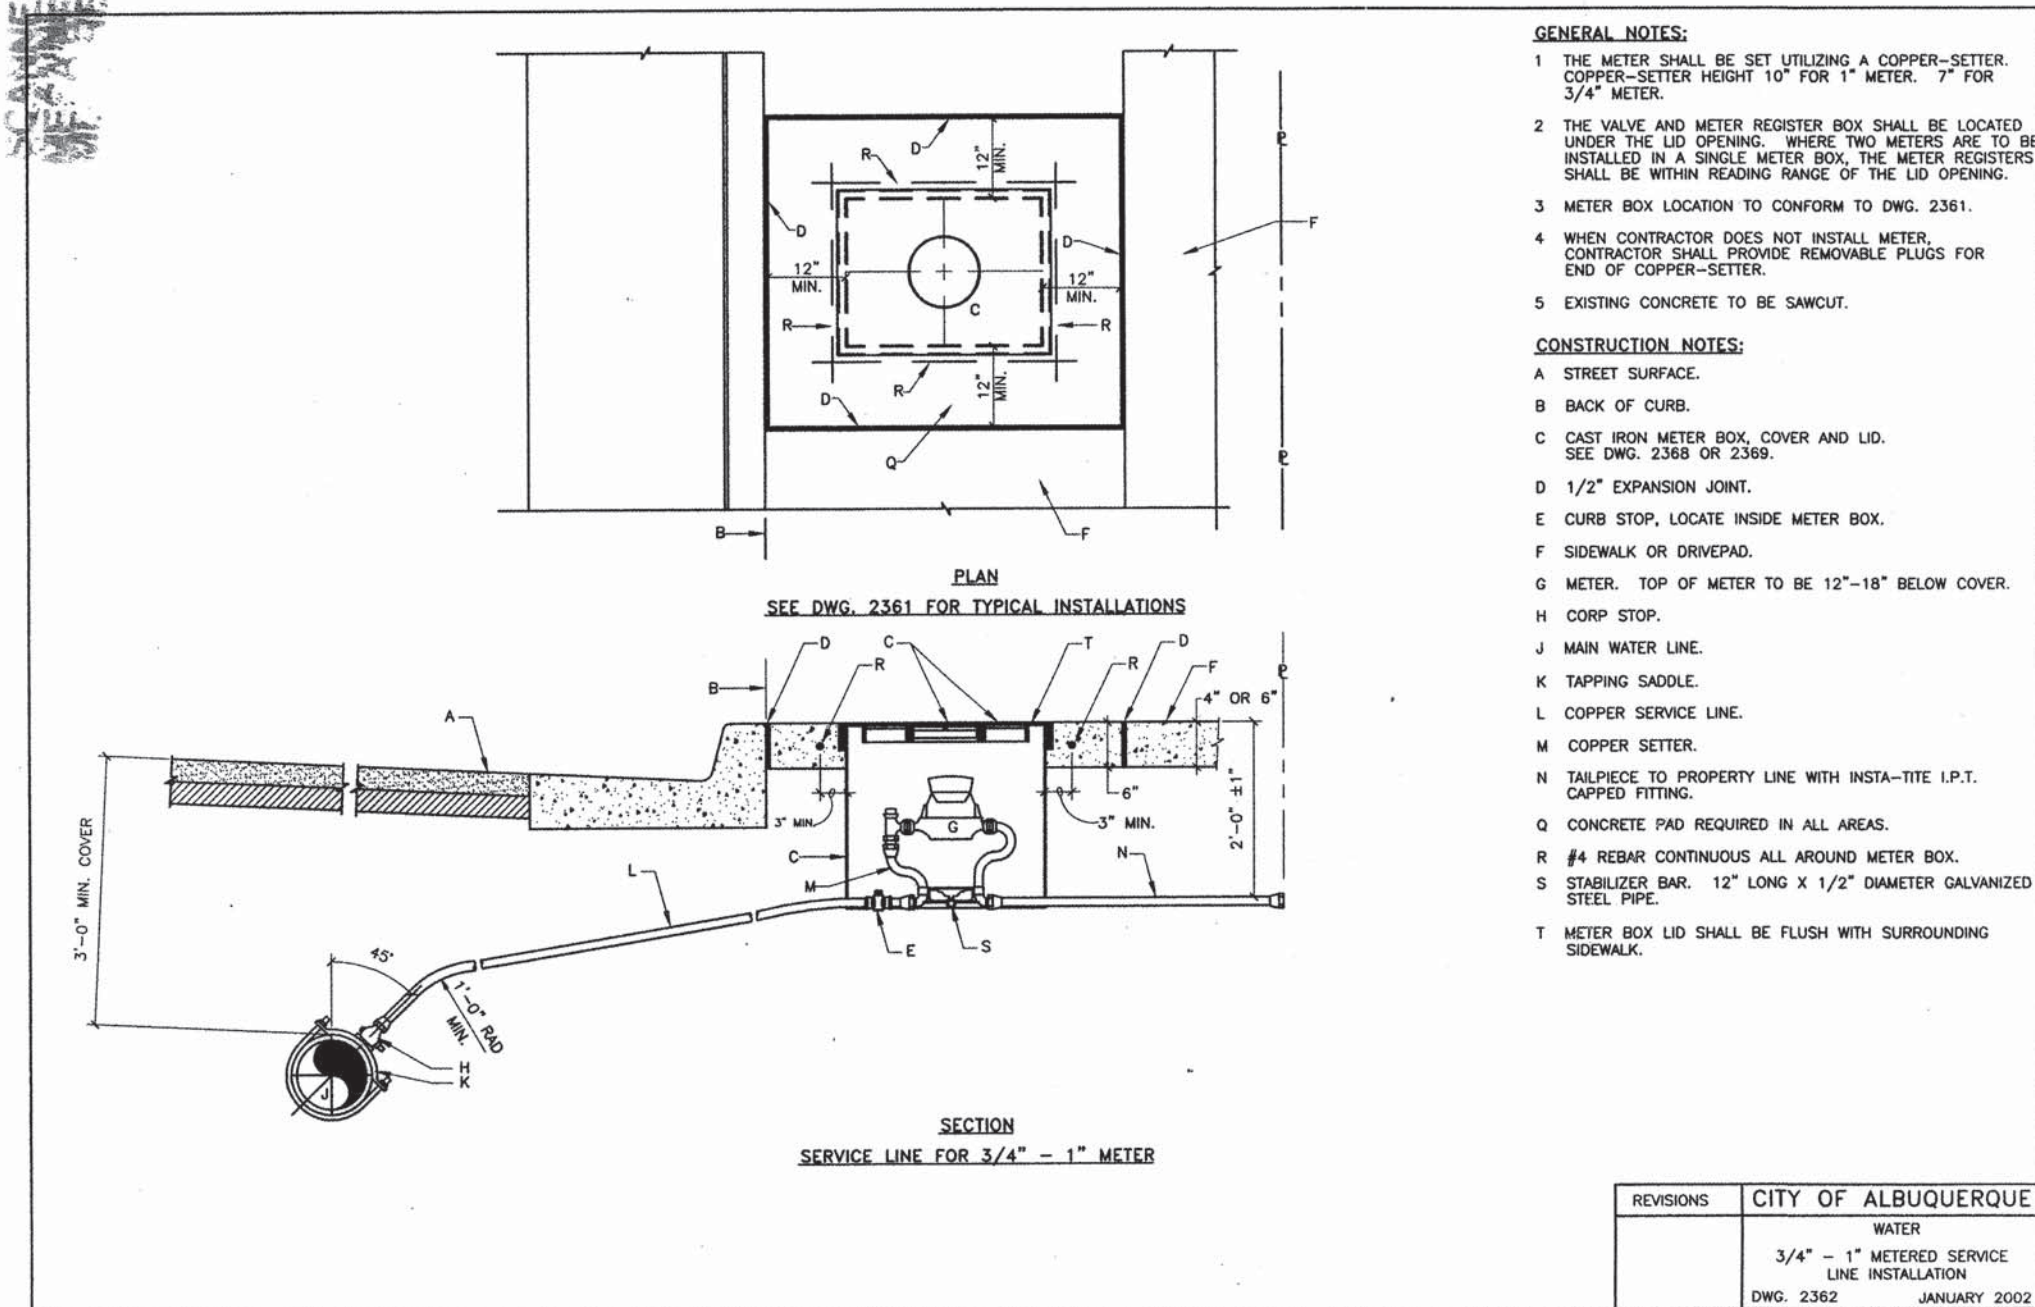

P:\020040\CDP\GENERAL\crossings-unit11-walves.dgn
10/13/2002
10133

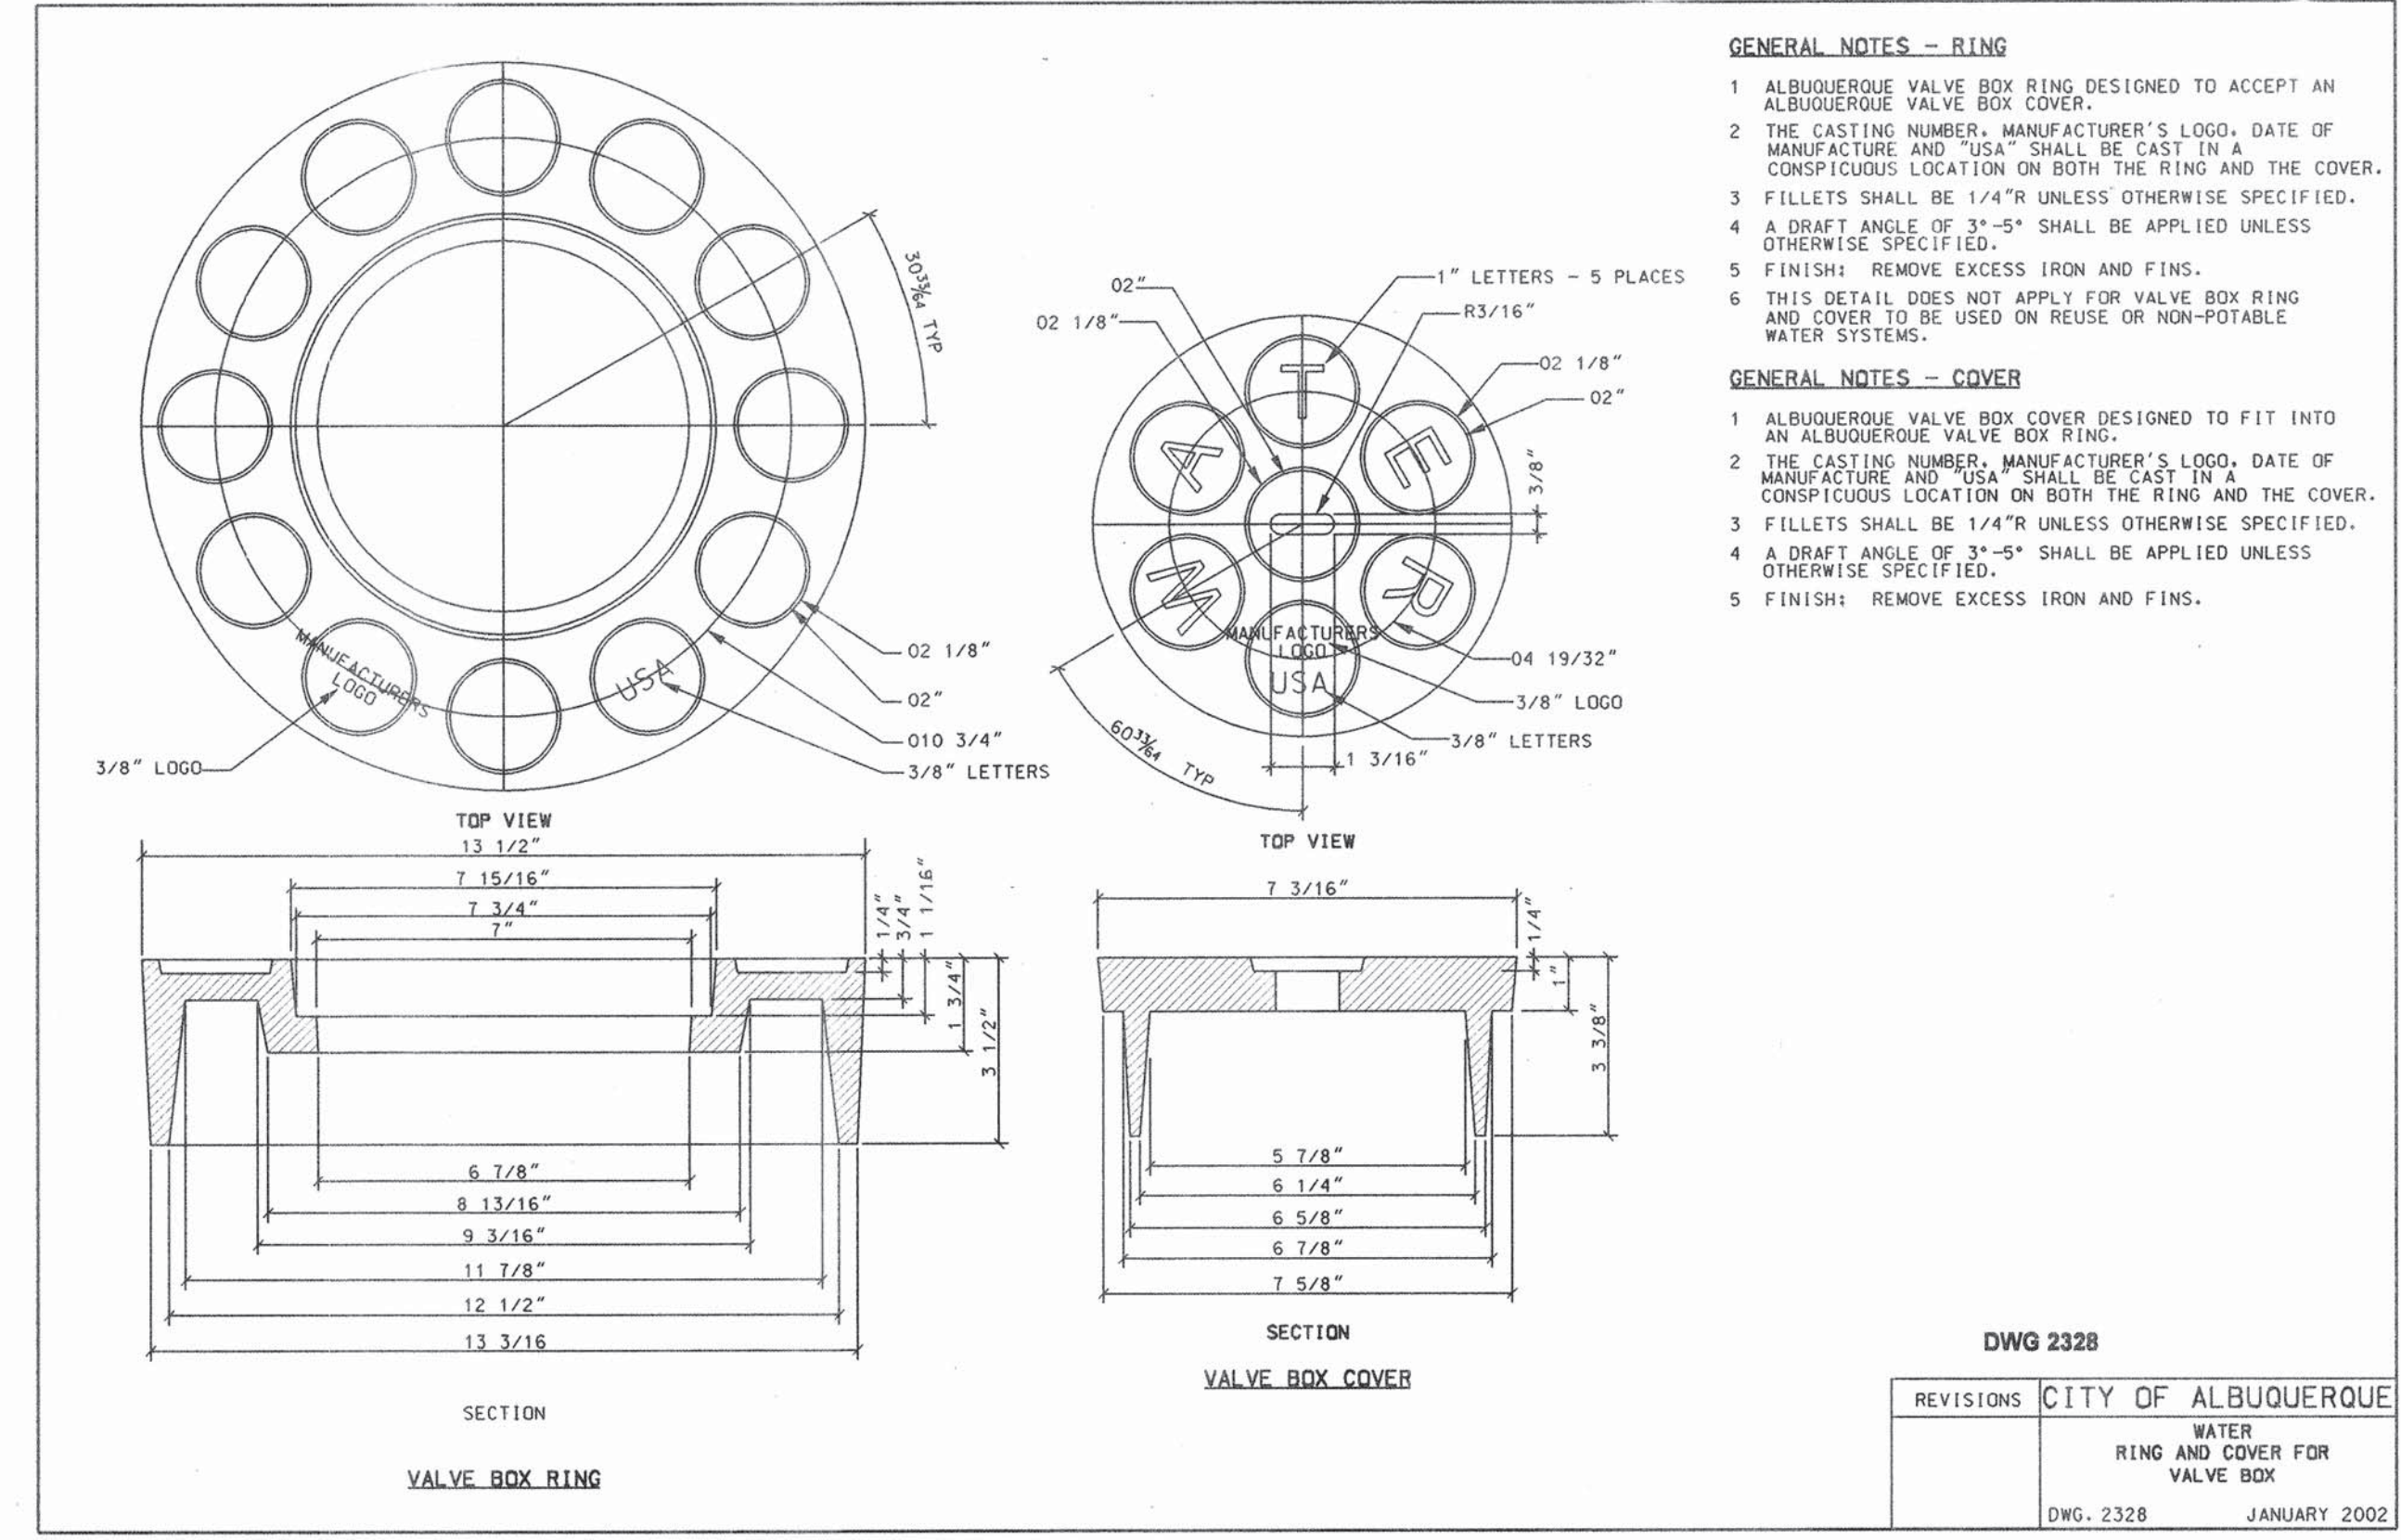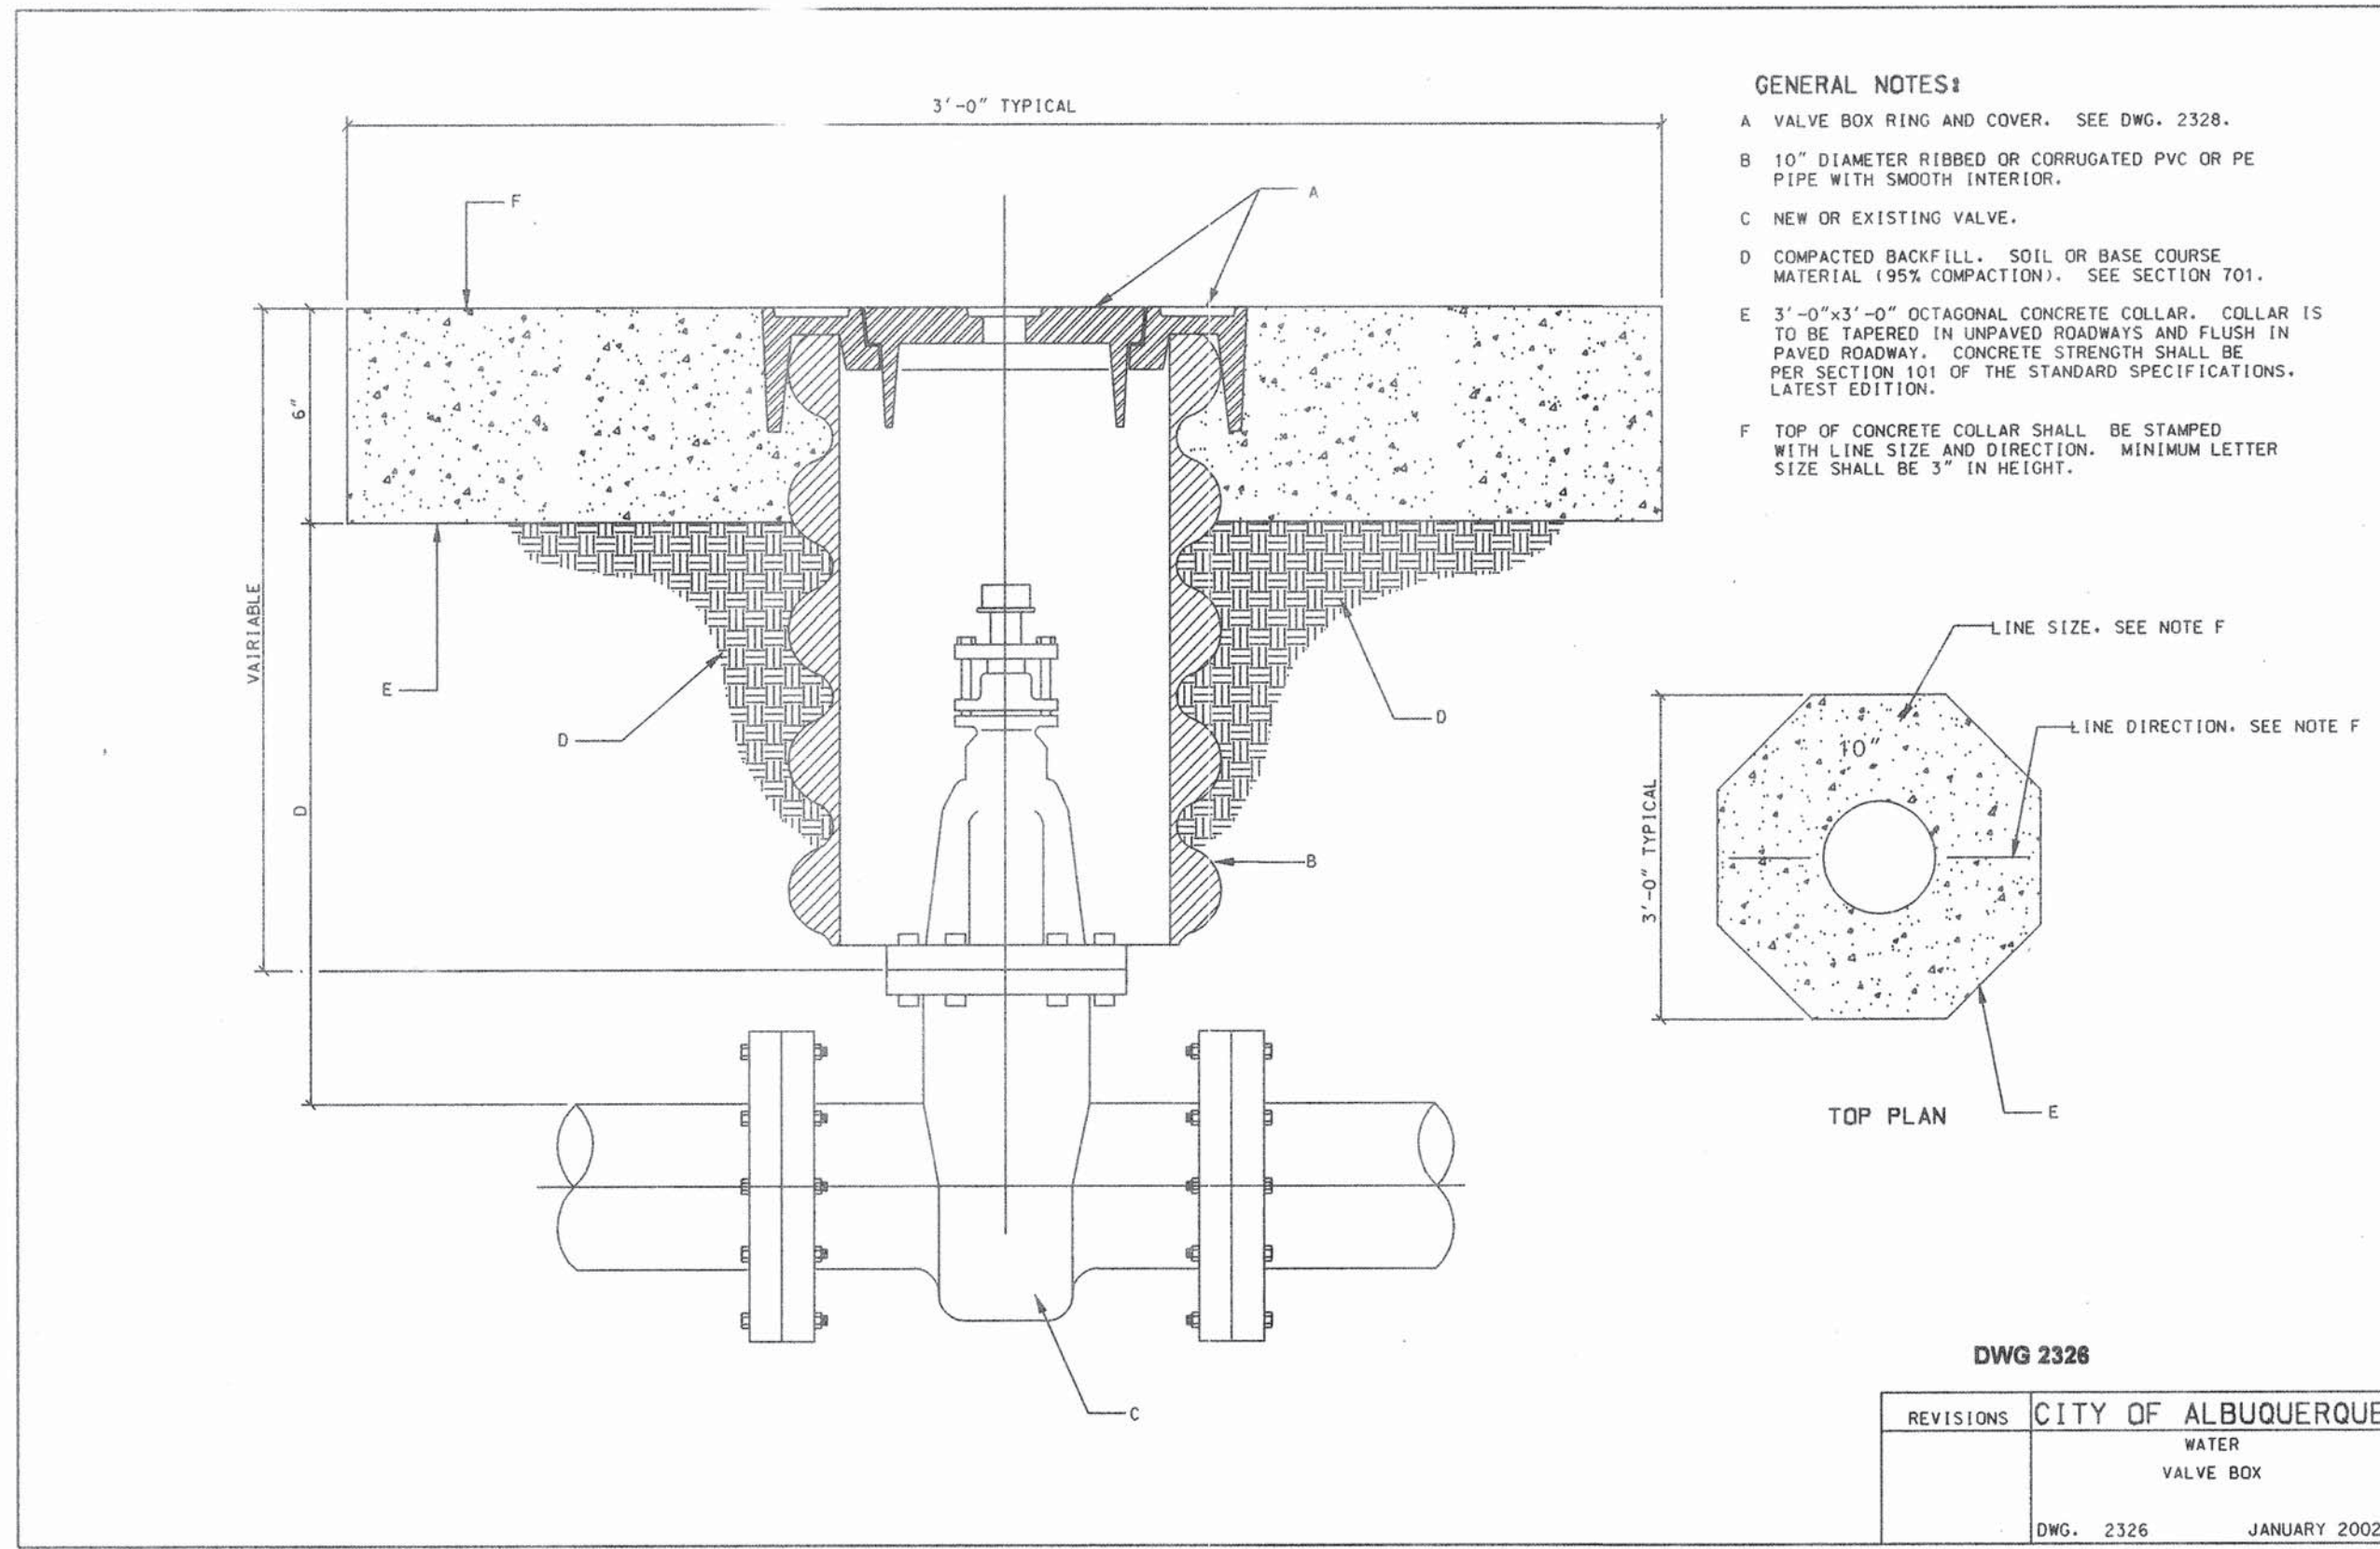

Bohannon & Huston
Courtyard One 7500 JEFFERSON NE Albuquerque NEW MEXICO 87109
ENGINEERS PLANNERS PHOTOGRAMMETRISTS SURVEYORS SOFTWARE DEVELOPERS

CITY OF ALBUQUERQUE
PUBLIC WORKS DEPARTMENT
ENGINEERING DEVELOPMENT GROUP

THE CROSSINGS SUBDIVISION UNIT I
CITY OF ALBUQUERQUE VALVE BOX DETAILS

DESIGN REVIEW COMMITTEE CITY ENGINEER APPROVAL

COA STD

CITY PROJECT NO. 545381 ZONE MAP NO. H9/J9 SHEET 11-A OF 18

ENGINEER'S SEAL

BRUCE A. STIDWORTH
REGISTERED PROFESSIONAL ENGINEER
14523

NO. 01/20/02 added Sheet Per Project Revisions
REMARKS BY
NO. DATE
DESIGNED BY COA DATE 01/2002
DRAWN BY COA DATE 01/2002
CHECKED BY COA DATE 01/2002

AS-BUILT INFORMATION



BENCH MARKS

CONTRACTOR SUNDANCE
INSPECTOR'S ACCEPTANCE BY SPC DATE 3/13
DRAWINGS CHECKED BY COA DATE 11
MICRO-FILM INFORMATION
RECORDED BY DATE
NO.

FIELD NOTES

NO. BY DATE


ACS ALUMINUM TABLET STAMPED "BH-40"
GEOGRAPHIC POSITION (NAD 1927)
N.M. STATE PLANE COORD. (CENTRAL ZONE)
X=352,790.66 Y=1,492,346.53
GROUND TO GRID FACTOR = 0.99967105
DELTA ALPHA = -000EG 16 MIN 59 SEC
NGVD 1929 ELEVATION = 5305.43

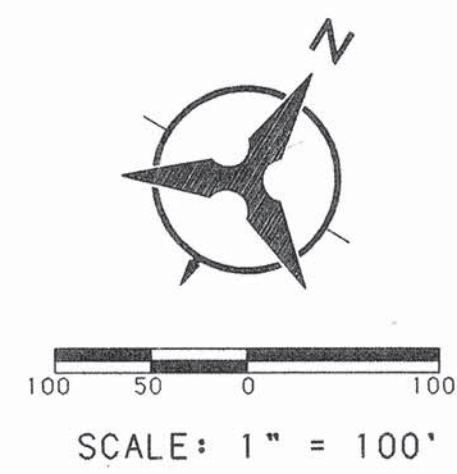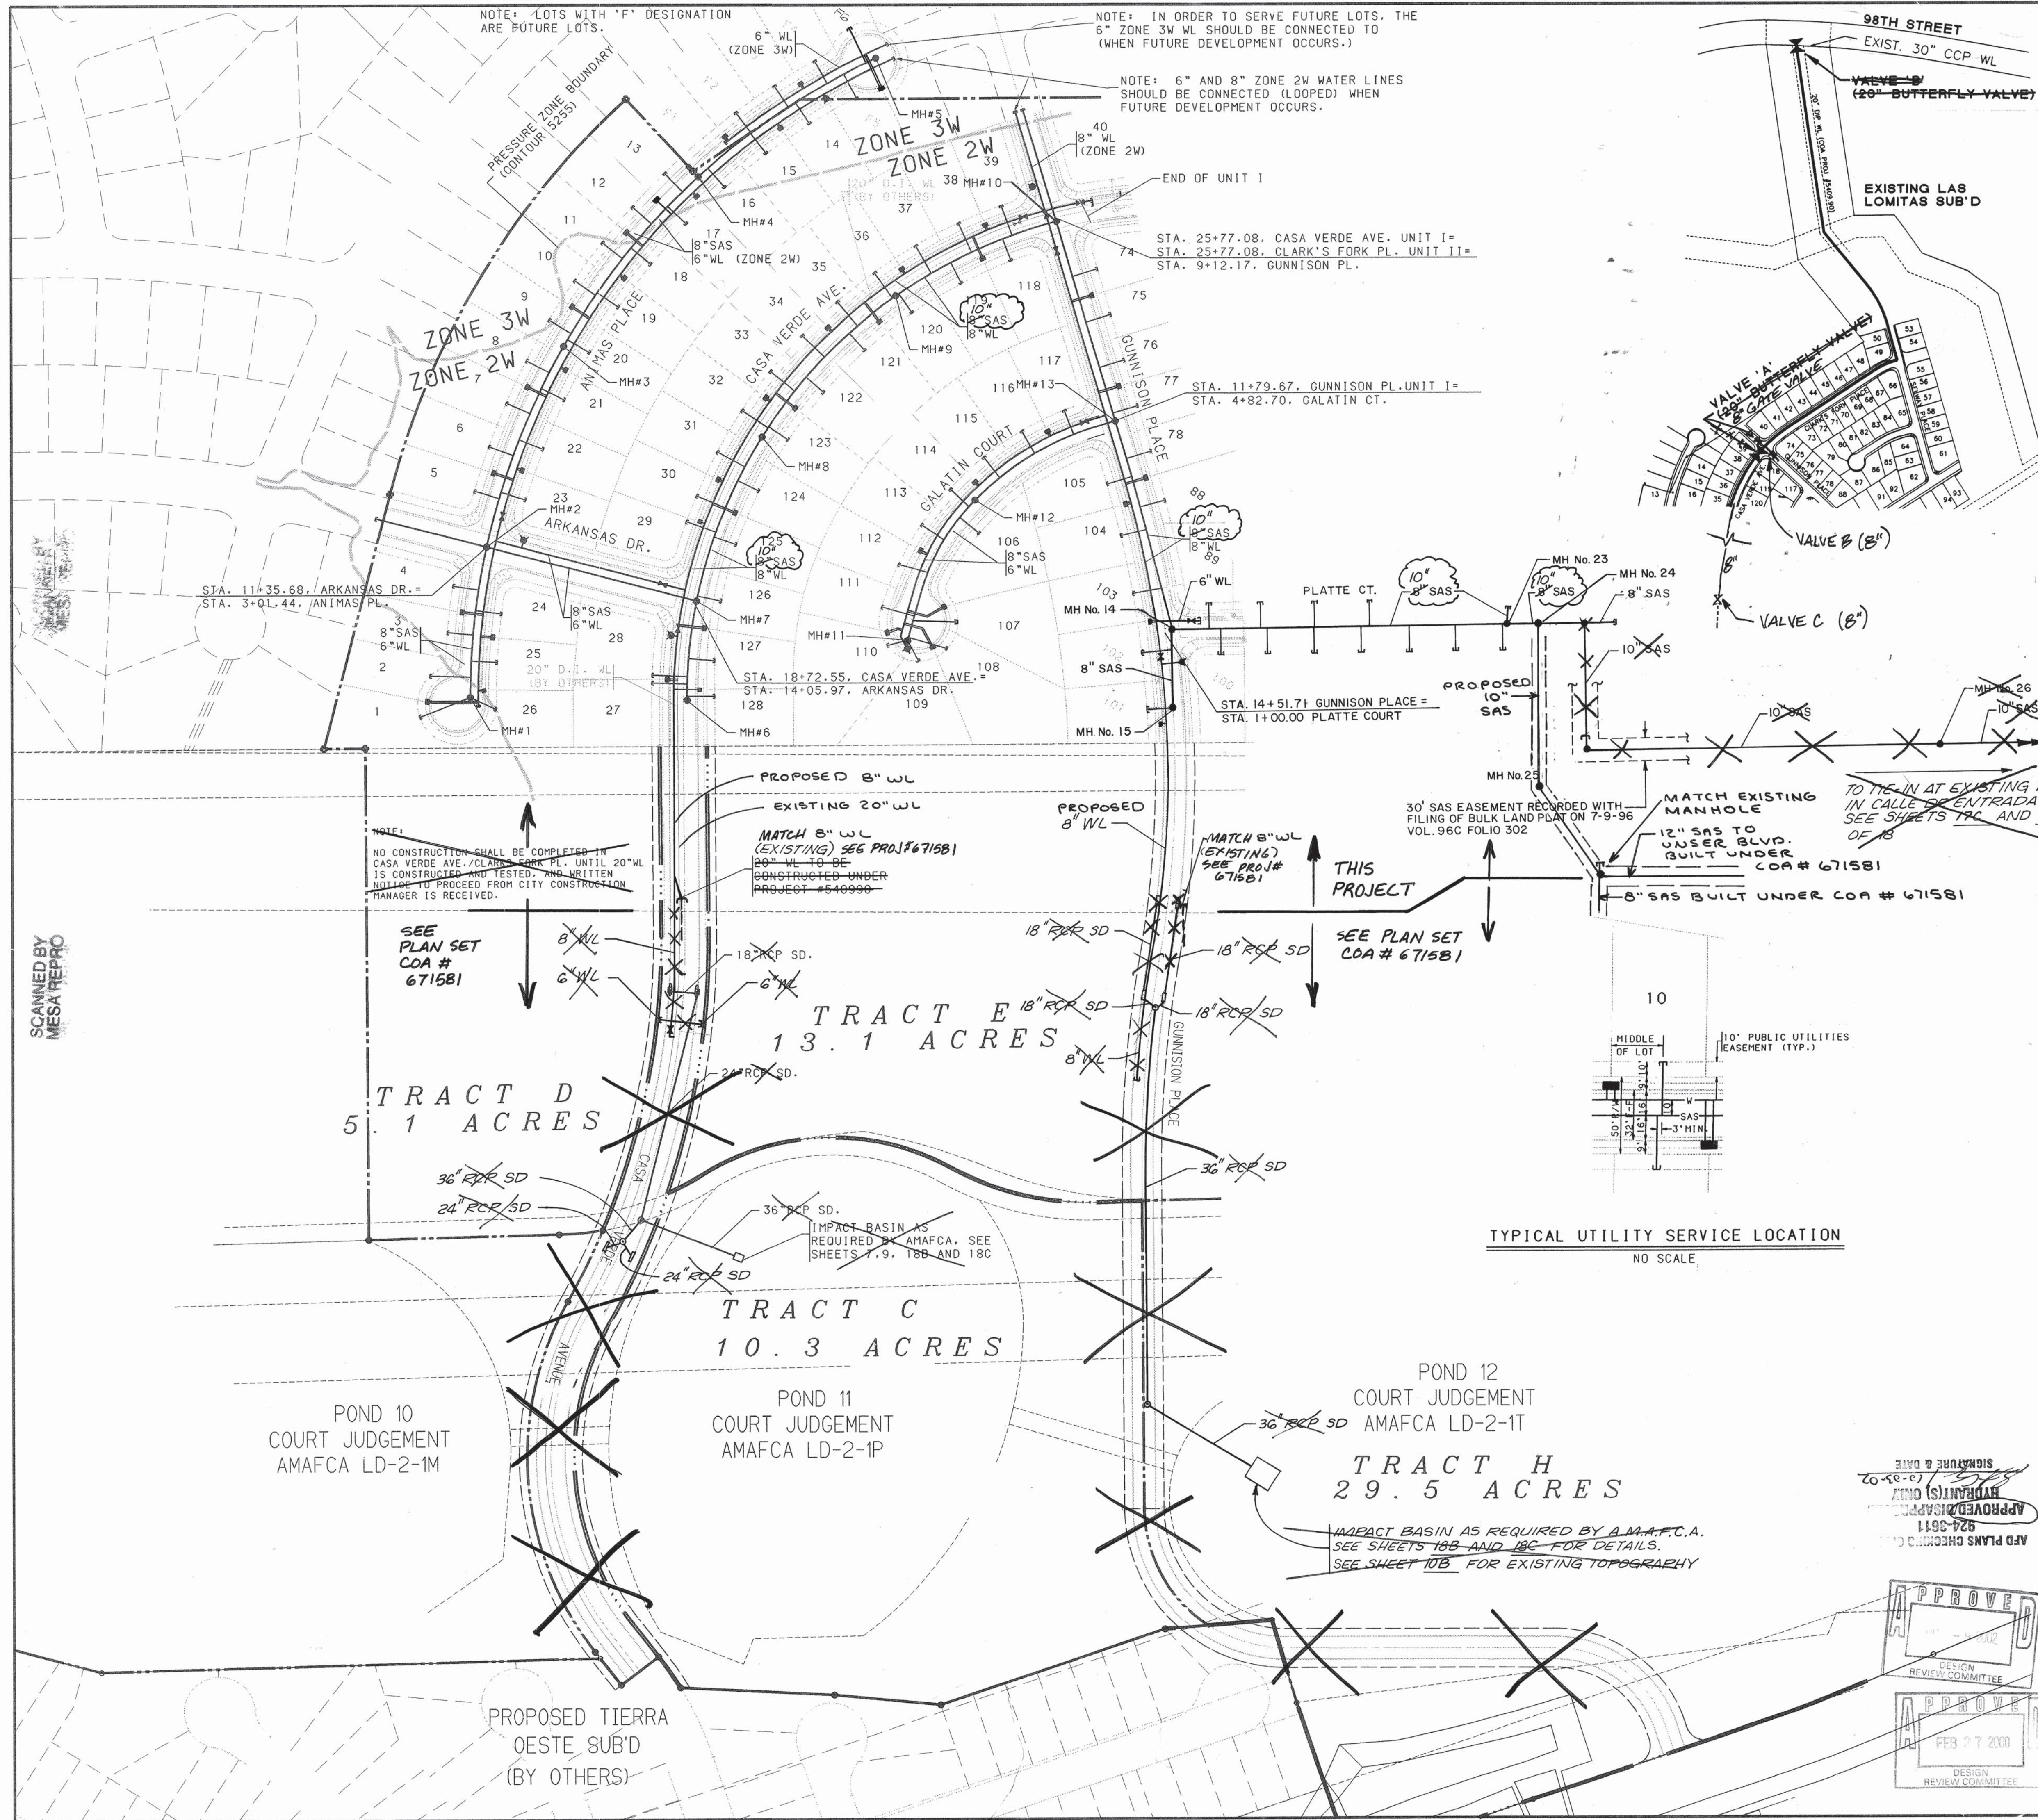

WATER SHUT-OFF REQUIREMENTS:
CONTRACTOR WILL BE RESPONSIBLE FOR THE
TIMING AND COORDINATION OF THE WATER
SHUT-OFF REQUIREMENTS IN CONJUNCTION
WITH THE COMPLETION OF THE PROJECT.
AT LEAST SEVEN (7) WORKING DAYS PRIOR
TO CONSTRUCTION, THE CONTRACTOR SHALL
CONTACT PWD/WATER SYSTEMS DIVISION
(857-8200) TO INITIATE IMPLEMENTATION
OF THIS WATER SHUT-OFF PLAN. CONTRACTOR
SHALL NOT OPERATE CITY VALVES.

WATER SHUT-OFF PLAN:
FOR CONNECTION CLOSE VALVE(S)
ALL WATER LINE CONNECTIONS A & B & C
NOTE: VALVES A & B ARE NOT SHOWN
ON THE COA. AUTOMATED WATER DISTRIBUTION
SYSTEM SECTIONAL MAPS, AND FOR
THIS REASON, ARE LABELED AS SUCH FOR
THIS PLAN ONLY. THE CONTRACTOR SHALL
COORDINATE THE SHUT-OFF PLAN WITH THE
OWNER.

LEGEND	
PROJECT BOUNDARY	---
PROPOSED SANITARY SEWER MANHOLE	●
EXISTING SANITARY SEWER MANHOLE	○
PROPOSED FIRE HYDRANT	⊕
EXISTING FIRE HYDRANT	⊕
PROPOSED GATE VALVE	⊕
EXISTING GATE VALVE	⊕
PROPOSED STORM DRAIN LINE	—SD—
PROPOSED STORM DRAIN INLET	⊕
EXISTING STORM DRAIN LINE	—SD—
EXISTING STORM DRAIN MANHOLE	⊕
EXISTING STORM DRAIN INLET	⊕
PROPOSED SANITARY SEWER LINE	—SAS—
EXISTING SANITARY SEWER LINE	—SAS—
PROPOSED WATER LINE	—W—
EXISTING WATER LINE	—W—
PROPOSED SANITARY SEWER SERVICE	—
PROPOSED WATER METER SERVICE	—

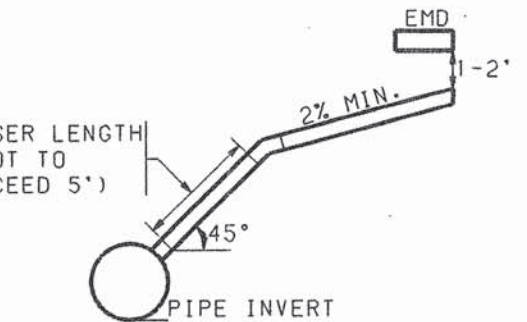

SERVICE RISER DETAIL
(SERVICE CONNECTION & INSTALLATION
TO CONFORM TO COA STD. DWG. 2134.
USE C1 SOIL PIPE ONLY)

BOHANNAN-HUSTON INC.
ENGINEERS • PLANNERS • PHOTOGRAMMETRISTS • SURVEYORS • LANDSCAPE ARCHITECTS
ALBUQUERQUE LAS CRUCES SANTA FE

CITY OF ALBUQUERQUE
PUBLIC WORKS DEPARTMENT
ENGINEERING DEVELOPMENT GROUP

**THE CROSSING SUBDIVISION UNIT I
OVERALL UTILITY**

APPROVED
DESIGN REVIEW COMMITTEE
FEB 27 2010

APPROVED
DESIGN REVIEW COMMITTEE
FEB 27 2010

APPROVED
CITY ENGINEER
FEB 27 2010


CITY PROJECT NO.	ZONE MAP NO.	SHEET	OF
545381	H-9-J-C	11	18

DESIGNED BY	DATE	DRAWN BY	DATE	CHECKED BY	DATE
KP/BJ	8/96	JS/OR	8/96	KP	8/96

REVISIONS	NO.	DATE	REMARKS
DESIGN	1	2/1/00	NEW LINES PER COA 671581
	2	9/20/02	



WATERLINE TANGENT DATA TABLE		
NUMBER	BEARING	DISTANCE
T3	N72° 48' 44"E	248.13'

SAS TANGENT DATA TABLE		
NUMBER	BEARING	DISTANCE
T4	N72° 48' 44.3"E	145.68'
T5	N72° 48' 44.3"E	275.30'

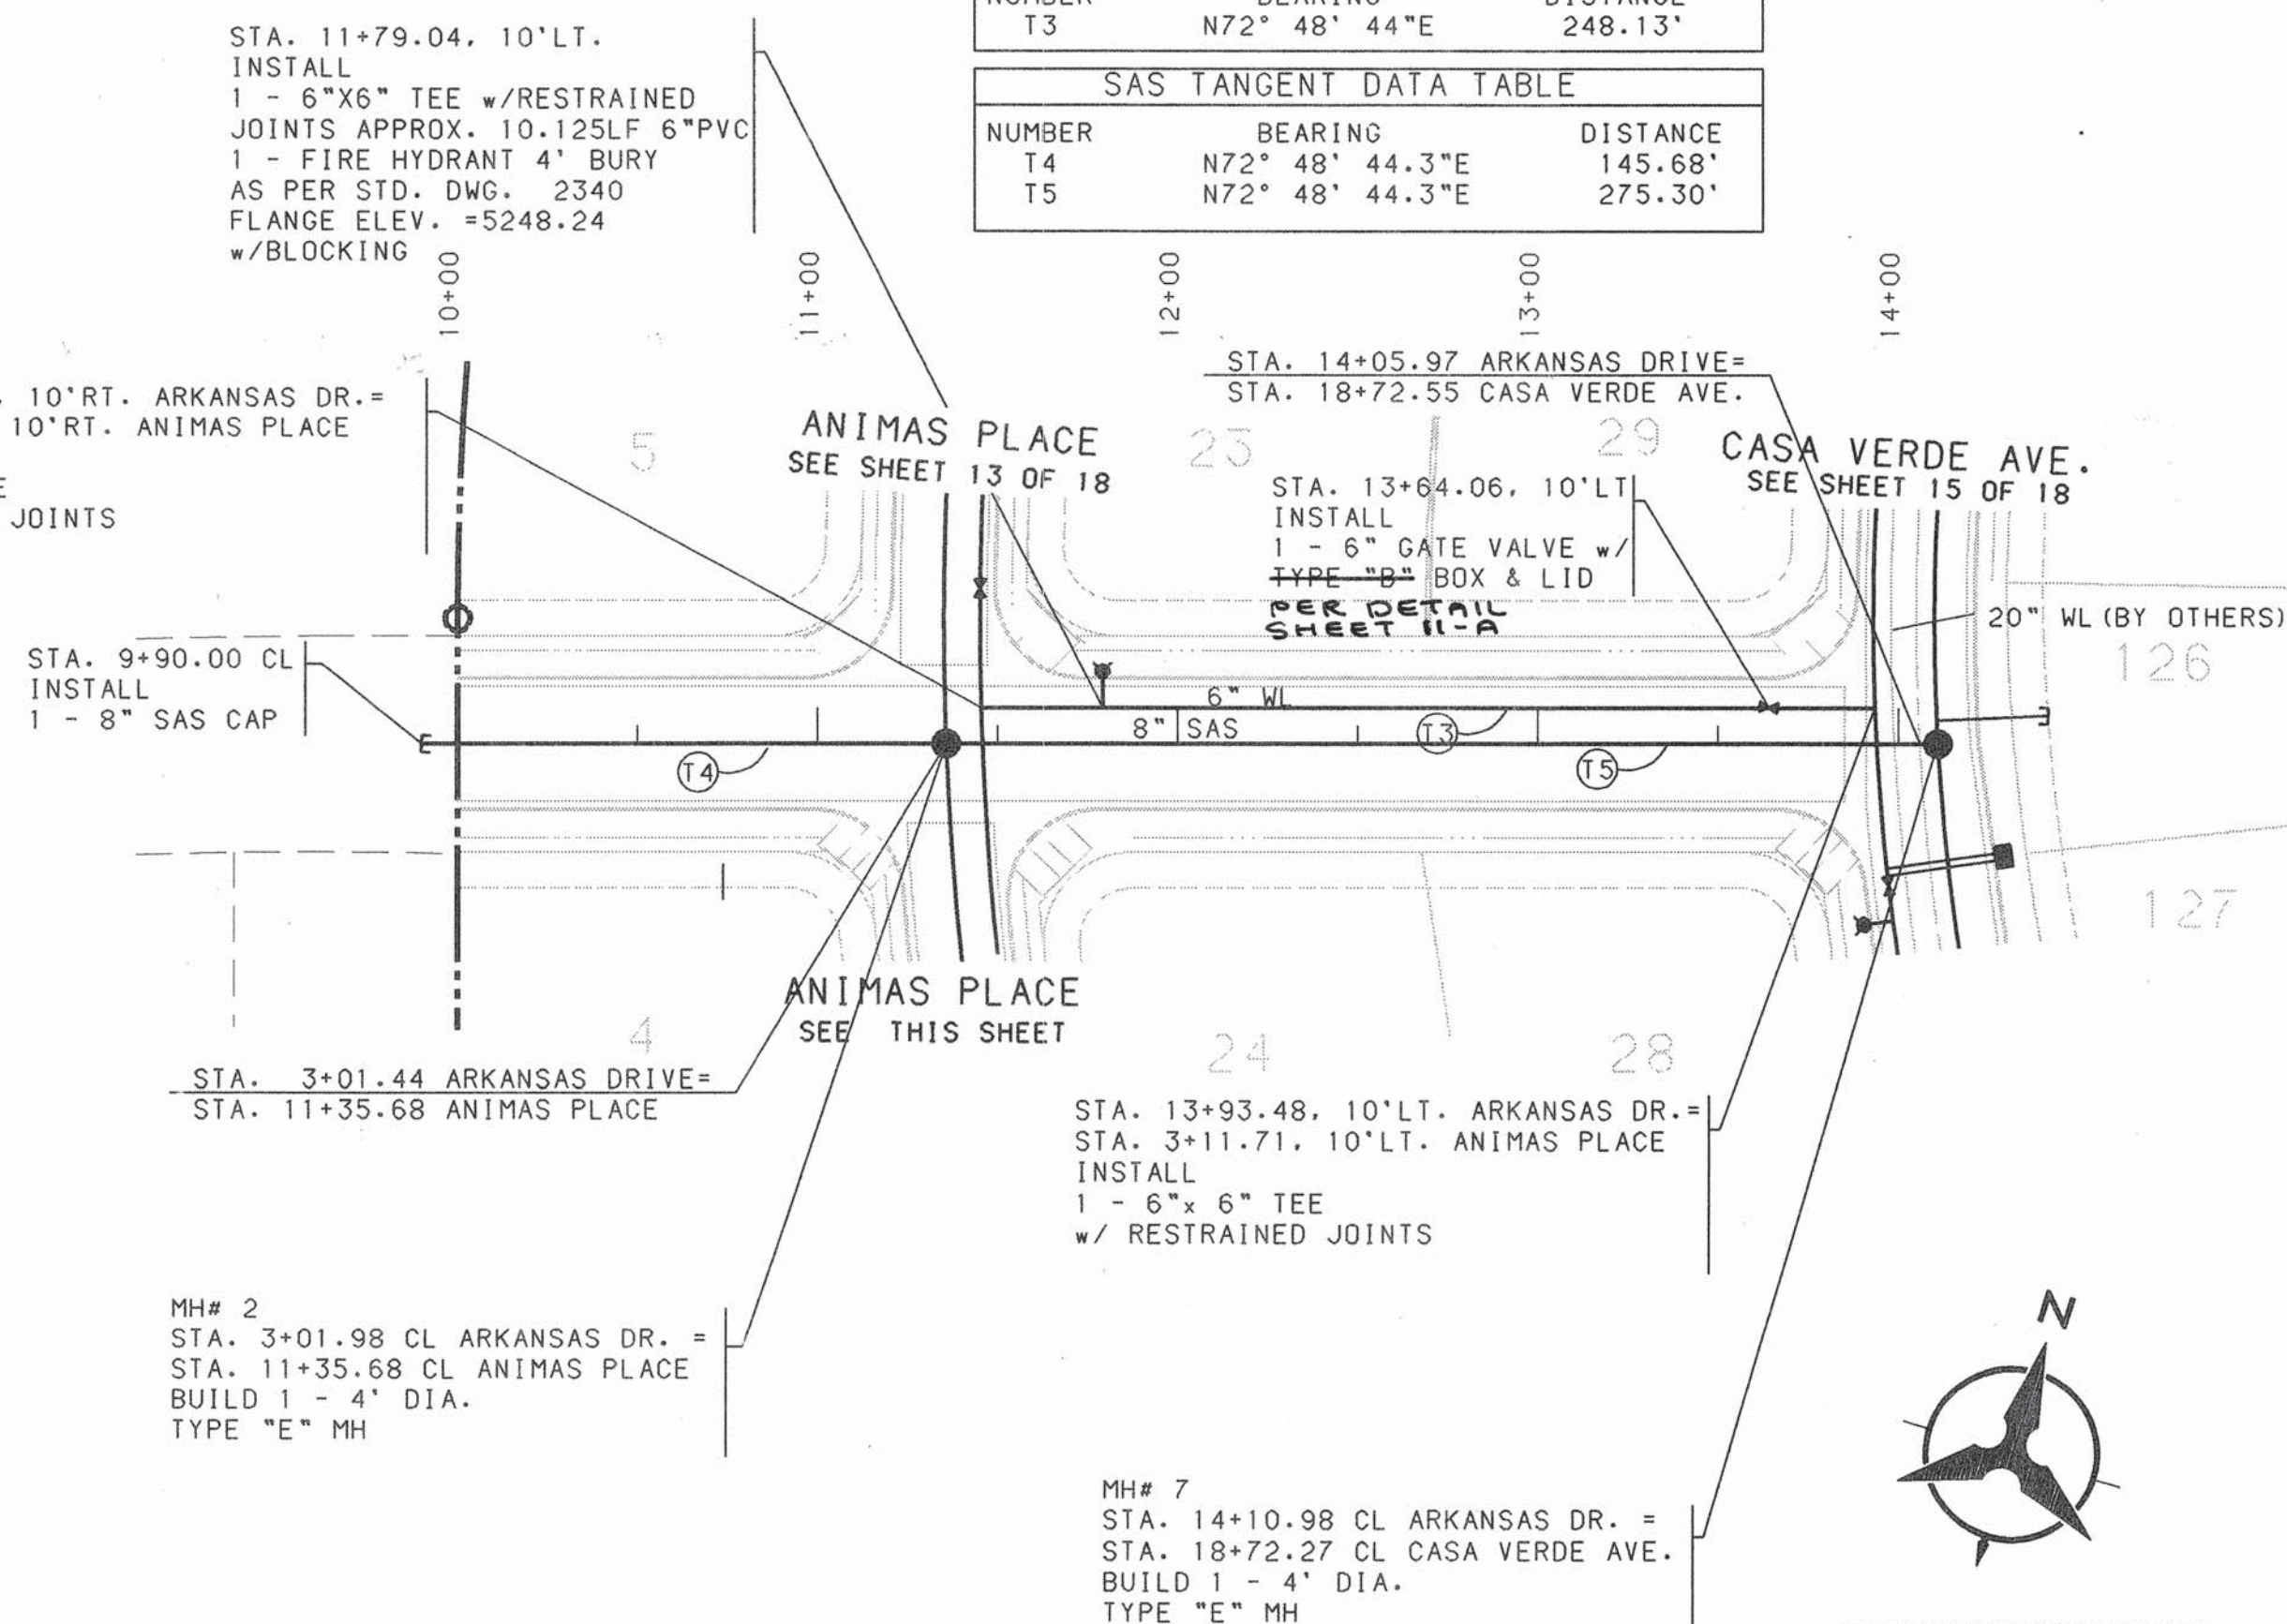

WATER & SANITARY SEWER SERVICES					
LOT NUMBER	WL STATION & OFFSET	WL TYPE	SAS STATION & OFFSET	SAS LENGTH	TOP OF PIPE AT PLUG *
1*			M+1 N37°15'46"E	68.78'	5246.79
2	1+02.54, 10' RT.	DOUBLE	1+34.68, CENTERLINE	51.70'	5246.61
3	2+14.89, 10' RT.	DOUBLE	1+88.10, CENTERLINE	33.00'	5245.49
4			2+45.69, CENTERLINE	33.00'	5245.08
24	1+87.25, 10' RT.	DOUBLE	2+18.85, CENTERLINE	33.00'	5244.94
25			1+55.23, CENTERLINE	33.00'	5245.39
26**	1+15.09, 10' RT.	SINGLE	M+1 S82°46'17"W	35.84'	5245.47

** CONNECT SAS SERVICE INTO MH PER COA STD DWG 2118

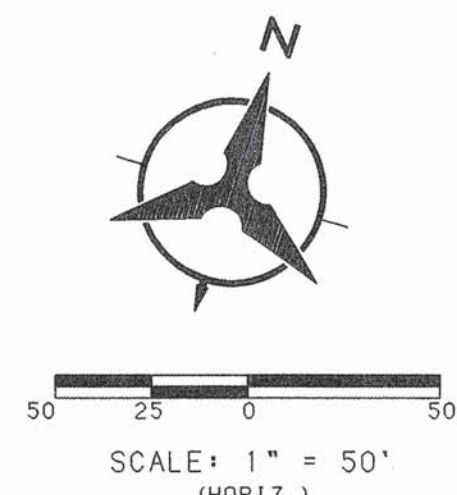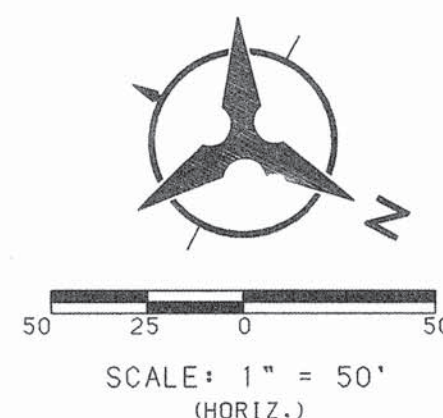



NOTES

1. THE CONTRACTOR SHALL FIELD VERIFY ALL EXISTING UTILITY LOCATIONS AND NOTIFY THE ENGINEER IMMEDIATELY OF ANY DISCREPANCIES.
2. ALL CURB RETURN RADII SHALL BE 25' TO FACE OF CURB UNLESS OTHERWISE SPECIFIED.
3. ALL CURVE DATA AND DIMENSIONS REFER TO FACE OF CURB UNLESS OTHERWISE SPECIFIED.
4. GRADE ELEVATIONS, WHERE NOTED, ARE FOR TOP OF STANDARD CURB UNLESS OTHERWISE SPECIFIED.
5. CONTRACTOR IS TO INSTALL A 4"x4"x5" POST AND EMD AT THE END OF EACH SANITARY SEWER SERVICE.
6. CONTRACTOR IS RESPONSIBLE FOR REPAIR AND/OR REPLACEMENT OF ALL UTILITY CONDUITS AND EXISTING LINES.
7. ANY ADDITIONAL GRADING REQUIRED TO MATCH PROPOSED STREET GRADES SHALL BE INCIDENTAL TO PAVING ITEMS.
8. CONTRACTOR SHALL PROVIDE THE INSPECTORS, (CITY AND PRIVATE) WITH THE PROPOSED HYDROSTATIC TESTING PLAN. THE PLAN MUST BE APPROVED BEFORE TESTING OPERATIONS BEGIN.
9. CONTRACTOR SHALL PARK EQUIPMENT AND VEHICLES AS NOT TO INTERFERE WITH NORMAL ACTIVITIES OF RESIDENTS OR OTHER CONTRACTORS ON SITE.
10. ANY DAMAGE TO THE EXISTING FACILITIES (CURB AND GUTTER, PAVEMENT, CONDUITS, LANDSCAPING, UTILITY LINES, ETC.) DURING CONSTRUCTION SHALL BE REPLACED AT THE CONTRACTORS EXPENSE.
11. REMOVAL OF THE EXISTING CURB AND GUTTER SHALL BE AS PER COA STD. DWG. 2415 (SAWCUT ONLY).
12. WHEEL CHAIR RAMPS SHALL BE CONSTRUCTED PRIOR TO ACCEPTANCE OF CURB AND GUTTER.

MECHANICAL JOINTS	LENGTH OF RESTRAINED JOINTS FROM EACH SIDE OF MJ LISTED	
	(6")	(8")
11.25" H BEND	2'	3'
22.50" H BEND	4'	5'
45° H BEND	8'	11'
90° H BEND	20'	26'
GATE VALVE	55'	72'
BTFLY VALVE	---	---
REDUCER (8"-6")	30'	30'

NOTE:

1. ALL MECHANICAL JOINTS SHALL BE RESTRAINED AT THE FITTING.
2. THE CONTRACTOR SHALL PROVIDE A MINIMUM PIPE LENGTH OF 20 LF FROM ALL MECHANICAL JOINTS. ALL PIPE JOINTS WITHIN 20 LF OF A MJ SHALL BE RESTRAINED AT THE CONTRACTORS EXPENSE.
3. THE CONTRACTOR SHALL RESTRAIN ALL PIPE JOINTS IN THE SPECIFIED DISTANCE LISTED IN THE TABLE ABOVE. (SEE NOTE 2 ABOVE)
4. THE CONTRACTOR SHALL RESTRAIN ALL FIRE HYDRANTS JOINTS FROM THE TEE ON THE MAIN TO THE FIRE HYDRANT FLANGE.
5. ALL CAPS SHALL UTILIZE PCC BLOCKING

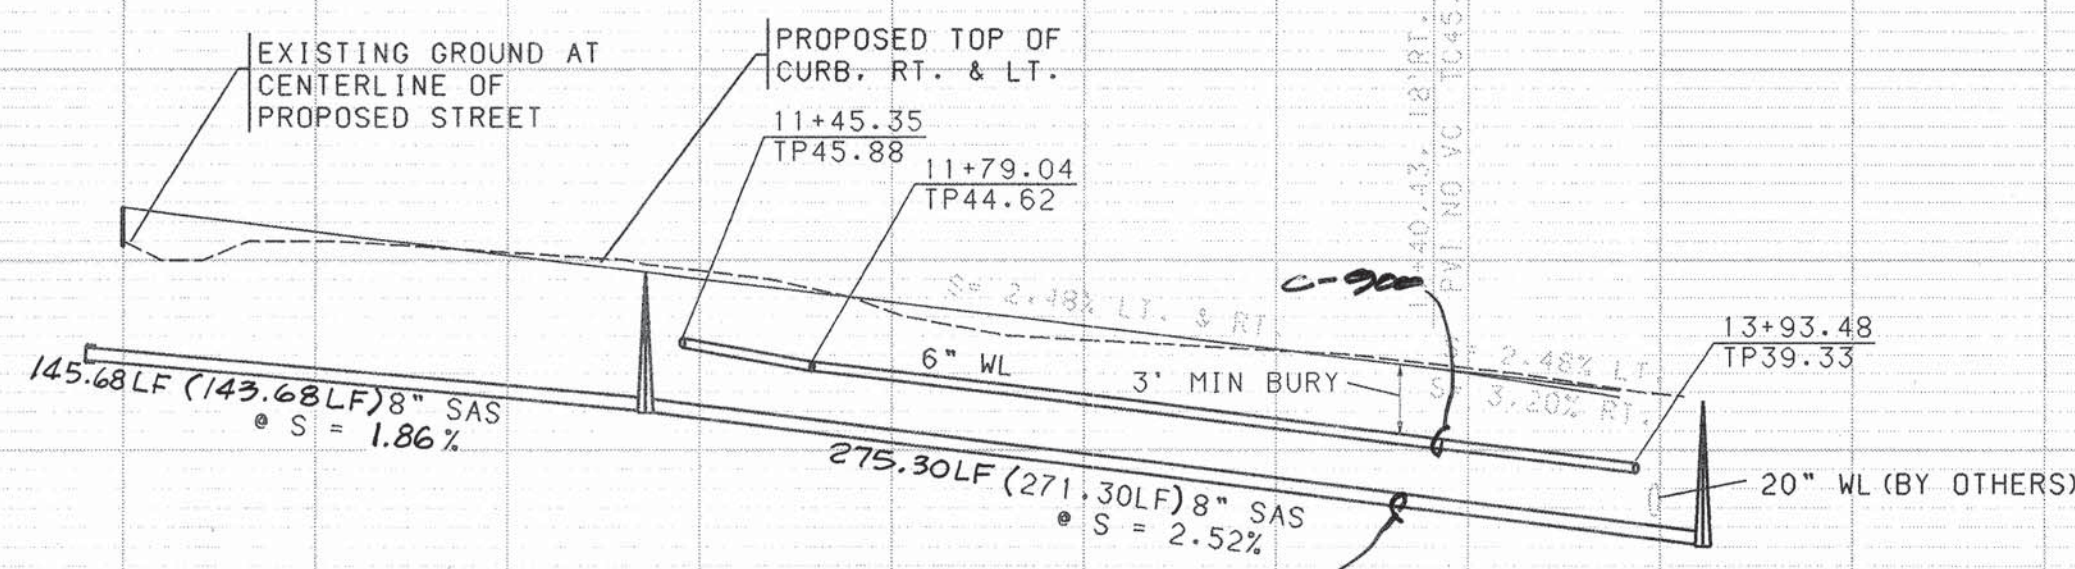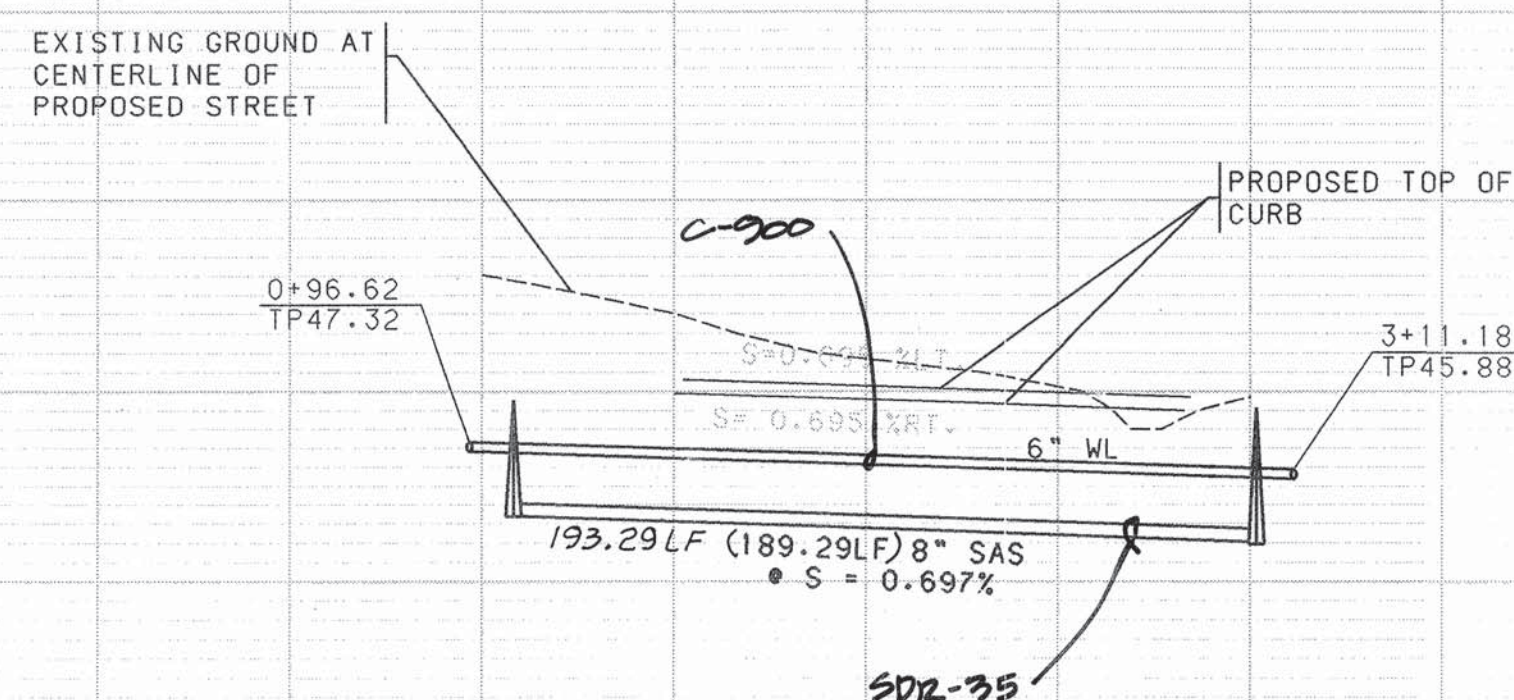

NOTE:
SAS LINE BETWEEN MH.#2 AND MH.#7
SHALL BE PRESSURE RATED PIPE (125psi
AND SHALL BE PRESSURE TESTED.

11-08-15, CL. ANIMAS PL.	
MANHOLE 2	
BUILD 4, DIA. TYPE "E" MH	
RIM 52-45-18	41-25
INV (S) 42-06	INV (E) 40-66
42-06	42-25
11-45-35, 10' RT ANIMAS PL	
TEE - TP45-88	

[illegible]

14+10.98, CL. ARKANSAS DR., =
18+72.27, CL. CASA VERDE AVE.
MANHOLE # 7
BUILD 4' DIA. TYPE "E" MH
INW (W) 35-13 42.48
INV (W) 35-13 35.36
INW (W) 35-13 35.36

APPROVED

OCT 14 2002

DESIGN REVIEW COMMITTEE

APPROVED
FEB 27 2000
DESIGN

 **BOHANNAN-HUSTON INC.**
ENGINEERS • PLANNERS • PHOTOGRAMMETRISTS • SURVEYORS • LANDSCAPE ARCHITECTS
ALBUQUERQUE LAS CRUCES SANTA FE





CITY OF ALBUQUERQUE
PUBLIC WORKS DEPARTMENT
ENGINEERING DEVELOPMENT GROUP

THE CROSSING SUBDIVISION UNIT 1
UTILITY PLAN & PROFILE
ANIMAS PLACE/ARKANSAS DRIVE

DESIGN REVIEW COMMITTEE		CITY ENGINEER APPROVAL		MO./DAY/YR.	MO./DAY/YR.
					

CITY PROJECT NO.	ZONE MAP NO.	SHEET	OF
545381	H9, J9	12	1

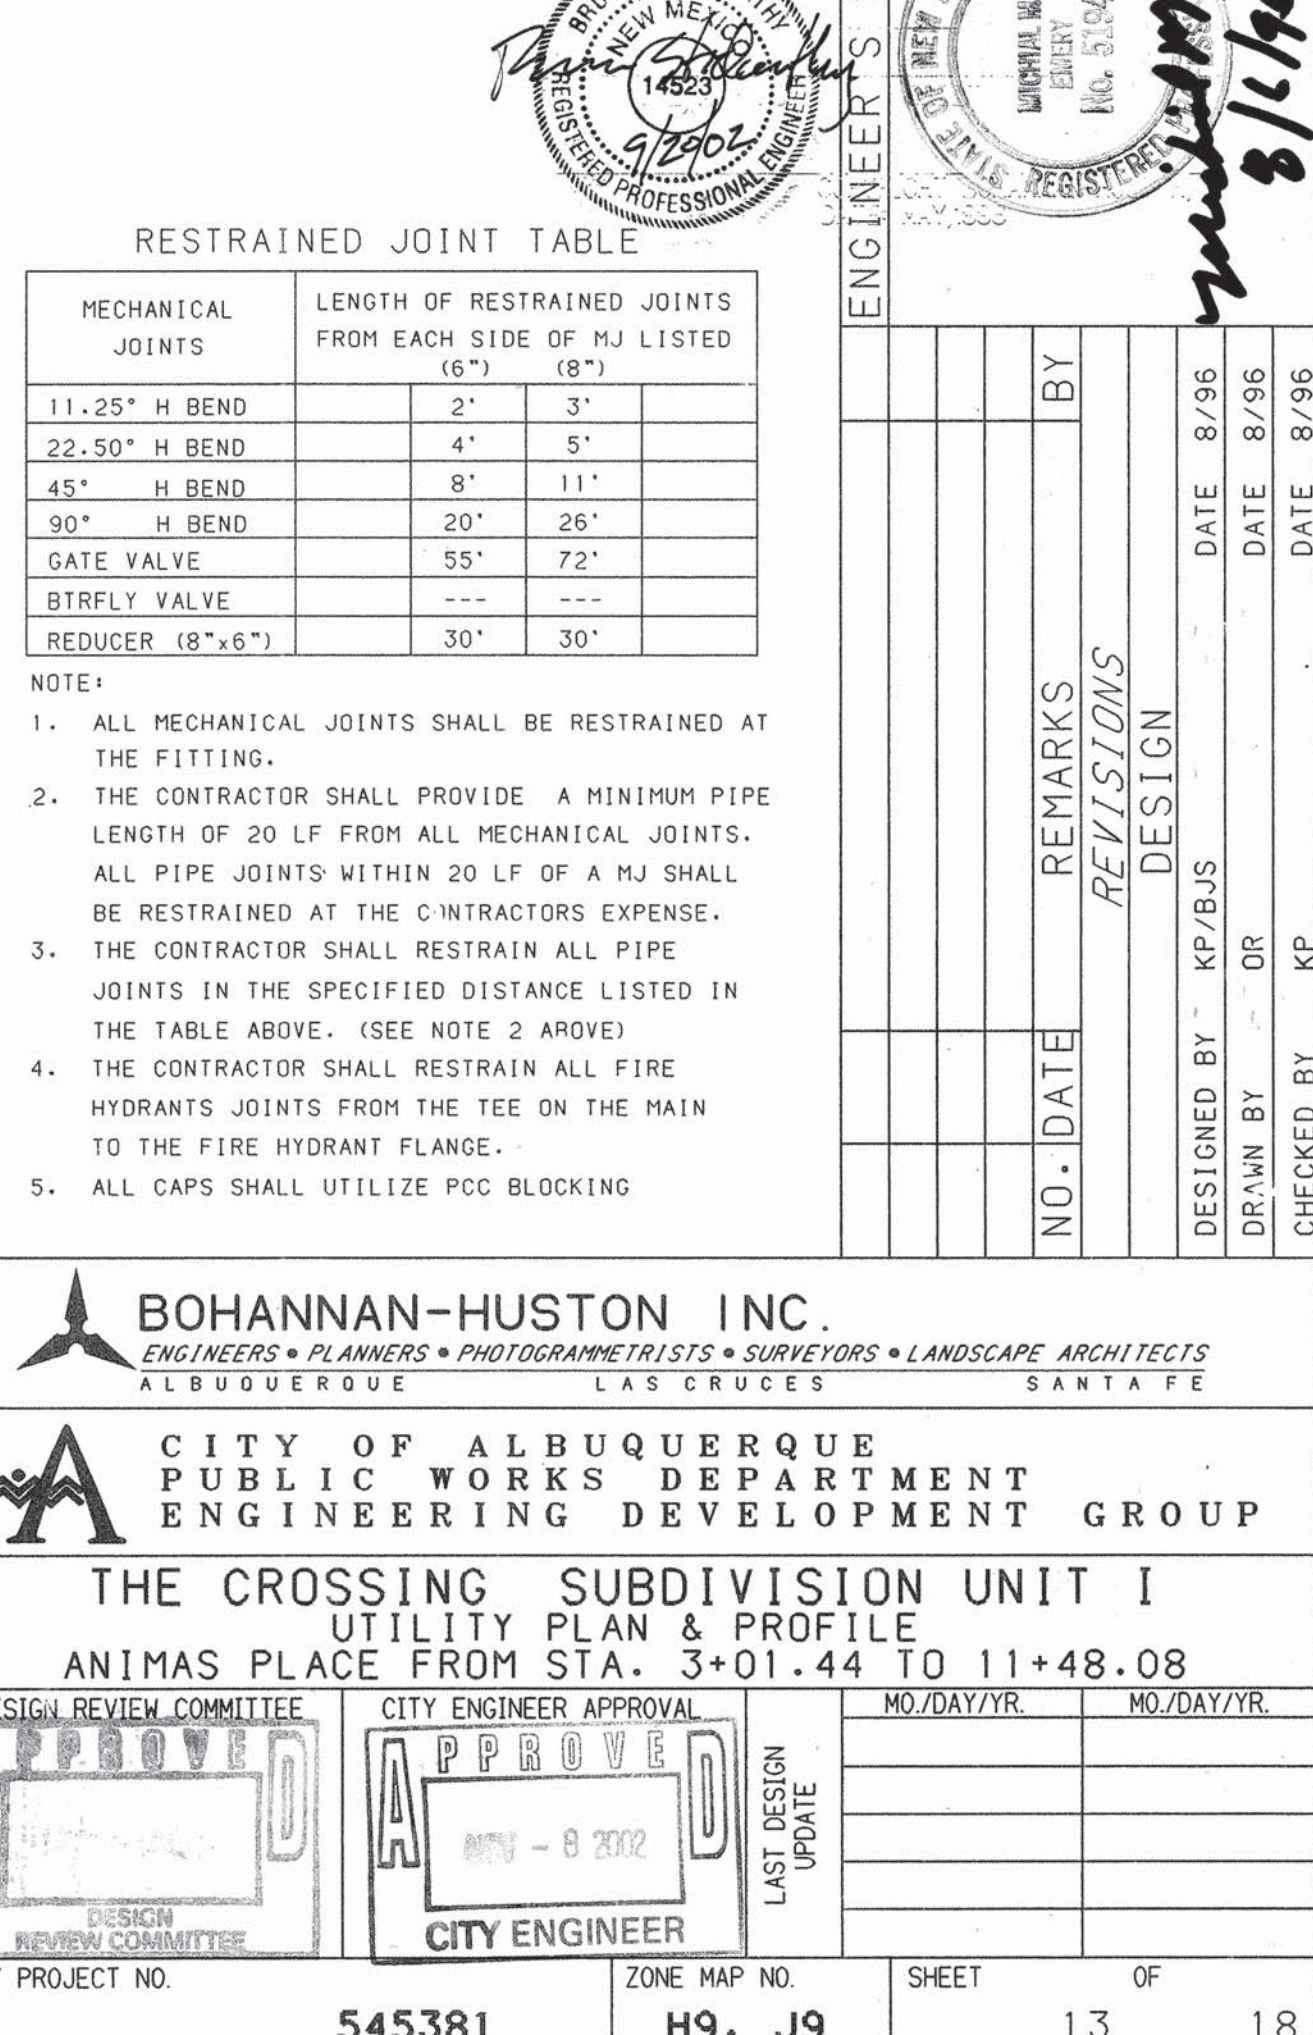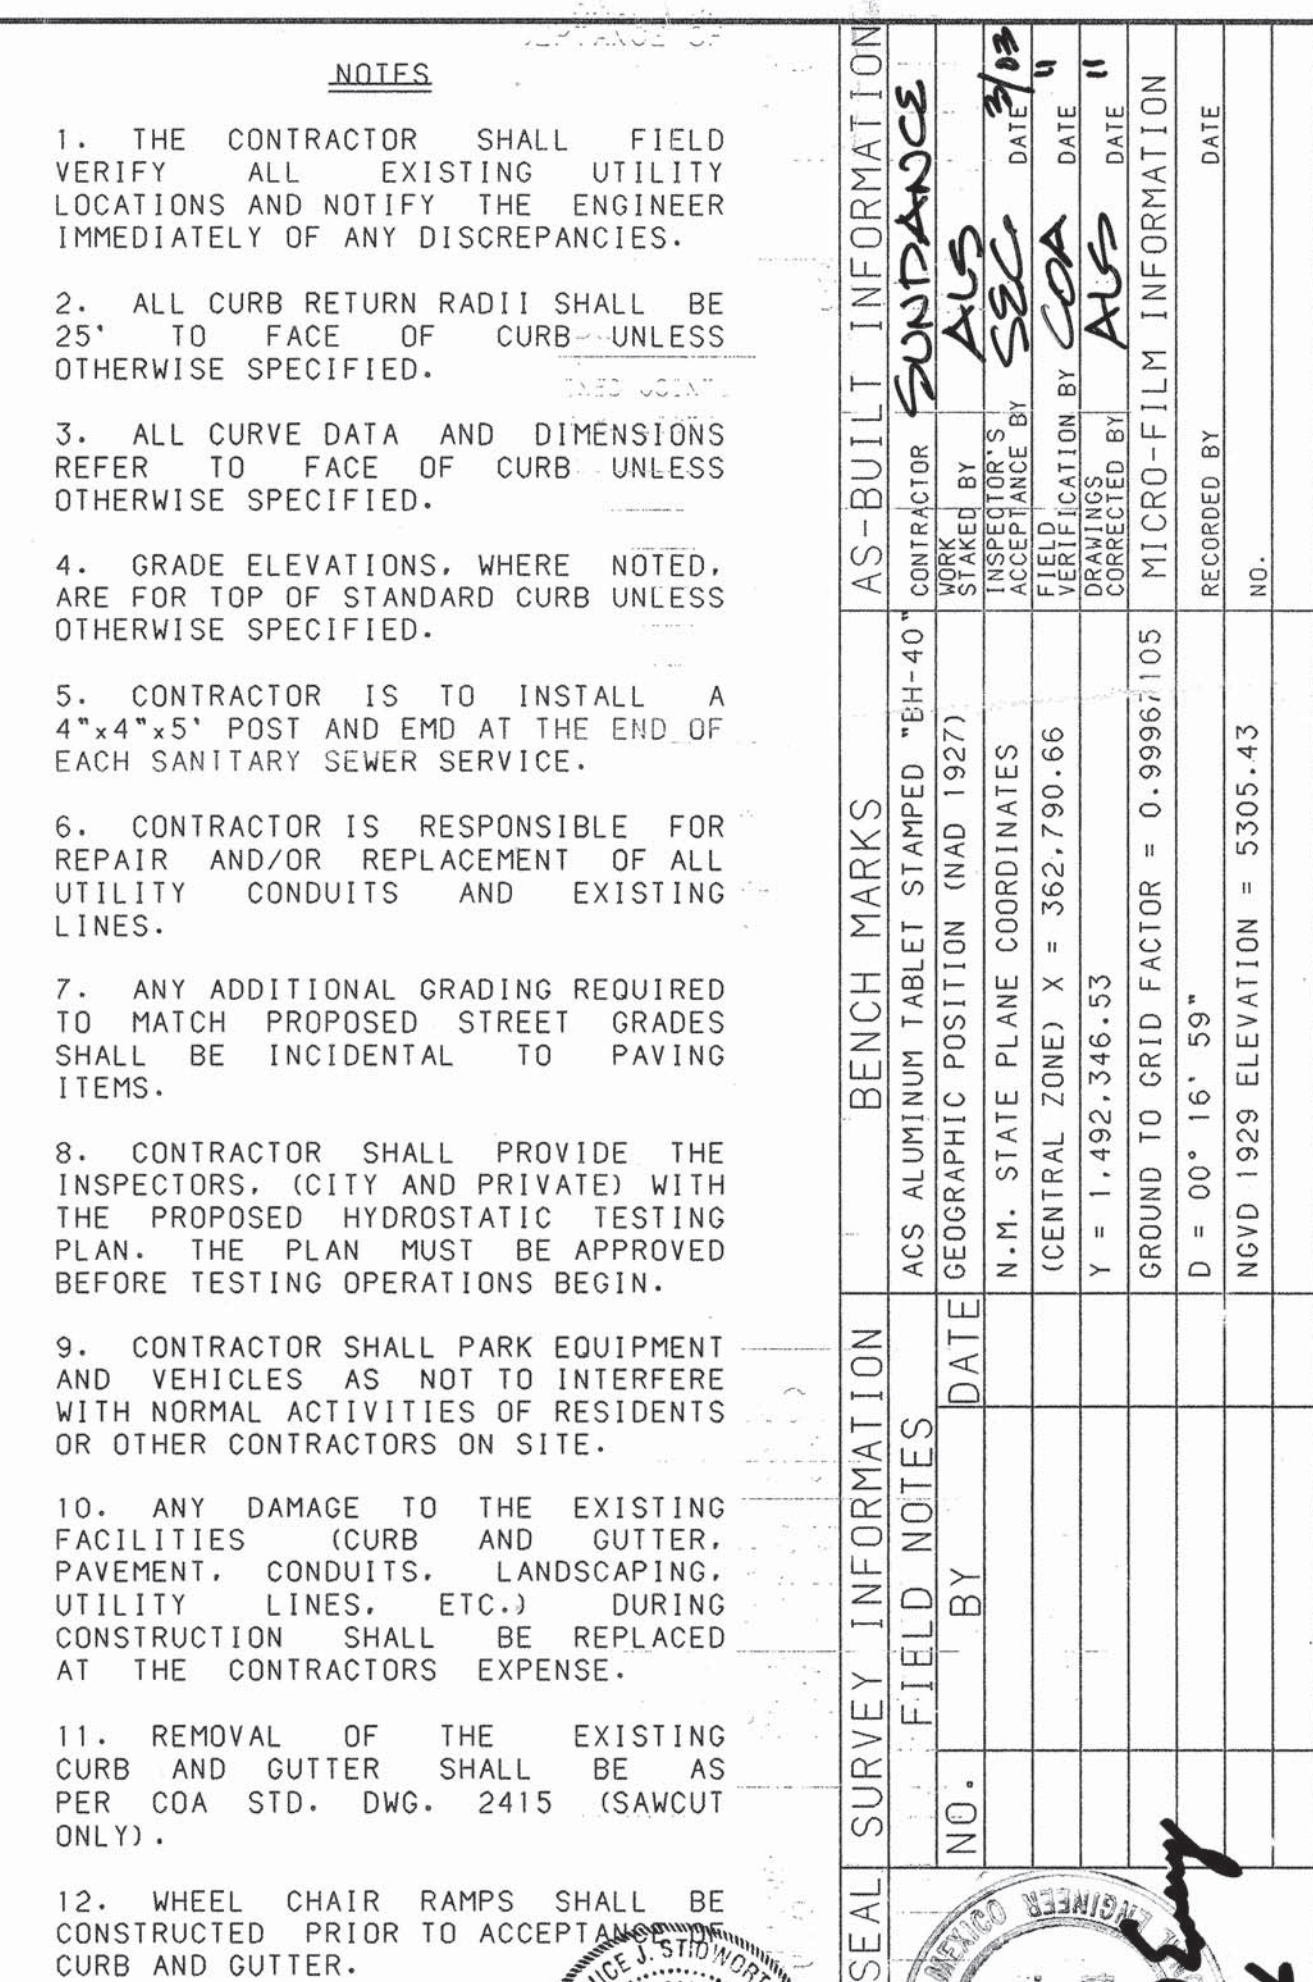

SCANNED BY
MESA REPRO
JAN 14 2003

CENTERLINE CURVE DATA TABLE					
NUMBER	PI STA.	DELTA	TANGENT	ARC	RADIUS
C1	7+51.05	66°54'08.0"	251.05'	443.71'	380.00'
C2	11+35.81	22°24'15.3"	192.10'	379.30'	970.00'
C3	13+83.1	7°5'25.7"	60.10'	120.04'	970.00'

CENTERLINE TANGENT DATA TABLE		
NUMBER	BEARING	DISTANCE
T1	N69°30'00"E	54.22'
T2	S32°05'33"W	56.95'

NOTE:
20" D.I. WATERLINE
TO BE CONSTRUCTED BY OTHERS
COA PROJECT # 5409-96

WATERLINE CURVE DATA TABLE				
NUMBER	PI STA.	DELTA	TANGENT	ARC RADIUS
C3	13+87.47	6°29'32.6"	54.33'	108.55' 958.00'

WATERLINE TANGENT DATA TABLE		
NUMBER	BEARING	DISTANCE
T3	N69°30'00"E	56.95'

INSTALL
18 LF 6" WL
1-6" CAP
W/BLOCKING

STA. 13+23.13, 12' LT.
INSTALL
1-8" GATE VALVE W/
TYPE "B" BOX & LID

STA. 13+13.13, 7' LT.
PRESSURE CONNECTION
TO EXISTING 20" WL
INSTALL
1-8" 90° BEND WITH
RESTRAINED JOINTS

STA. 13+33.13, 12' LT.
INSTALL
1-8"x6" CROSS
W/ RESTRAINED
JOINTS

INSTALL
42 LF 8" WL
1-6" CAP
W/BLOCKING

MATCHLINE STA. 15+00.00
SEE SHEET 15 OF 18



SCALE: 1" = 50'
(HORIZ.)

- NOTES**
1. THE CONTRACTOR SHALL FIELD VERIFY ALL EXISTING UTILITY LOCATIONS AND NOTIFY THE ENGINEER IMMEDIATELY OF ANY DISCREPANCIES.
 2. ALL CURB RETURN RADII SHALL BE 25' TO FACE OF CURB UNLESS OTHERWISE SPECIFIED.
 3. ALL CURVE DATA AND DIMENSIONS REFER TO FACE OF CURB UNLESS OTHERWISE SPECIFIED.
 4. GRADE ELEVATIONS, WHERE NOTED, ARE FOR TOP OF STANDARD CURB UNLESS OTHERWISE SPECIFIED.
 5. CONTRACTOR IS TO INSTALL A 4"x4"x5' POST AND EMD AT END OF EACH SANITARY SERVICE.
 6. CONTRACTOR IS RESPONSIBLE FOR REPAIR AND/OR REPLACEMENT OF ALL UTILITY CONDUITS AND EXISTING LINES.
 7. ANY ADDITIONAL GRADING REQUIRED TO MATCH PROPOSED STREET GRADES SHALL BE INCIDENTAL TO PAVING ITEMS.
 8. CONTRACTOR SHALL PROVIDE THE INSPECTORS, (CITY AND PRIVATE) WITH THE PROPOSED HYDROSTATIC TESTING PLAN. THE PLAN MUST BE APPROVED BEFORE TESTING OPERATIONS BEGIN.
 9. CONTRACTOR SHALL PARK EQUIPMENT AND VEHICLES AS NOT TO INTERFERE WITH NORMAL ACTIVITIES OF RESIDENTS OR OTHER CONTRACTORS ON SITE.
 10. ANY DAMAGE TO THE EXISTING FACILITIES (CURB AND GUTTER, PAVEMENT, CONDUITS, LANDSCAPING, UTILITY LINES, ETC.) DURING CONSTRUCTION SHALL BE REPLACED AT THE CONTRACTORS EXPENSE.
 11. REMOVAL OF THE EXISTING CURB AND GUTTER SHALL BE AS PER COA STD. DWG. 2415 (SAWCUT ONLY).
 12. WHEEL CHAIR RAMPS SHALL BE CONSTRUCTED PRIOR TO ACCEPTANCE OF CURB AND GUTTER.

RESTRAINED JOINT TABLE



MECHANICAL JOINTS	LENGTH OF RESTRAINED JOINTS FROM EACH SIDE OF MJ LISTED (6")	
	(6")	(18")
11.25" H BEND	2'	3'
22.50" H BEND	4'	5'
45" H BEND	8'	11'
90" H BEND	20'	26'
GATE VALVE	55'	72'
BIRFLY VALVE	---	---
REDUCER (8"x6")	30'	30'

- NOTE:**
1. ALL MECHANICAL JOINTS SHALL BE RESTRAINED AT THE FITTING.
 2. THE CONTRACTOR SHALL PROVIDE A MINIMUM PIPE LENGTH OF 20 LF FROM ALL MECHANICAL JOINTS. ALL PIPE JOINTS WITHIN 20 LF OF A MJ SHALL BE RESTRAINED AT THE CONTRACTORS EXPENSE.
 3. THE CONTRACTOR SHALL RESTRAIN ALL PIPE JOINTS IN THE SPECIFIED DISTANCE LISTED IN THE TABLE ABOVE. (SEE NOTE 2 ABOVE)
 4. THE CONTRACTOR SHALL RESTRAIN ALL FIRE HYDRANTS JOINTS FROM THE TEE ON THE MAIN TO THE FIRE HYDRANT FLANGE.
 5. ALL CAPS SHALL UTILIZE PCC BLOCKING

BOHANNAN-HUSTON INC.
ENGINEERS • PLANNERS • PHOTOGRAMMETRISTS • SURVEYORS • LANDSCAPE ARCHITECTS
ALBUQUERQUE LAS CRUCES SANTA FE

CITY OF ALBUQUERQUE
PUBLIC WORKS DEPARTMENT
ENGINEERING DEVELOPMENT GROUP


THE CROSSING SUBDIVISION UNIT I
UTILITY PLAN & PROFILE
CASA VERDE AVENUE FROM STA. 4+45.78 TO 15+00

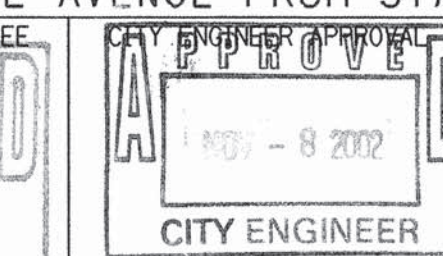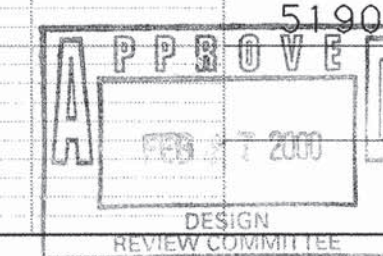

CITY PROJECT NO.

ZONE MAP NO.
545381 H9.J9

SHEET 14 OF 18

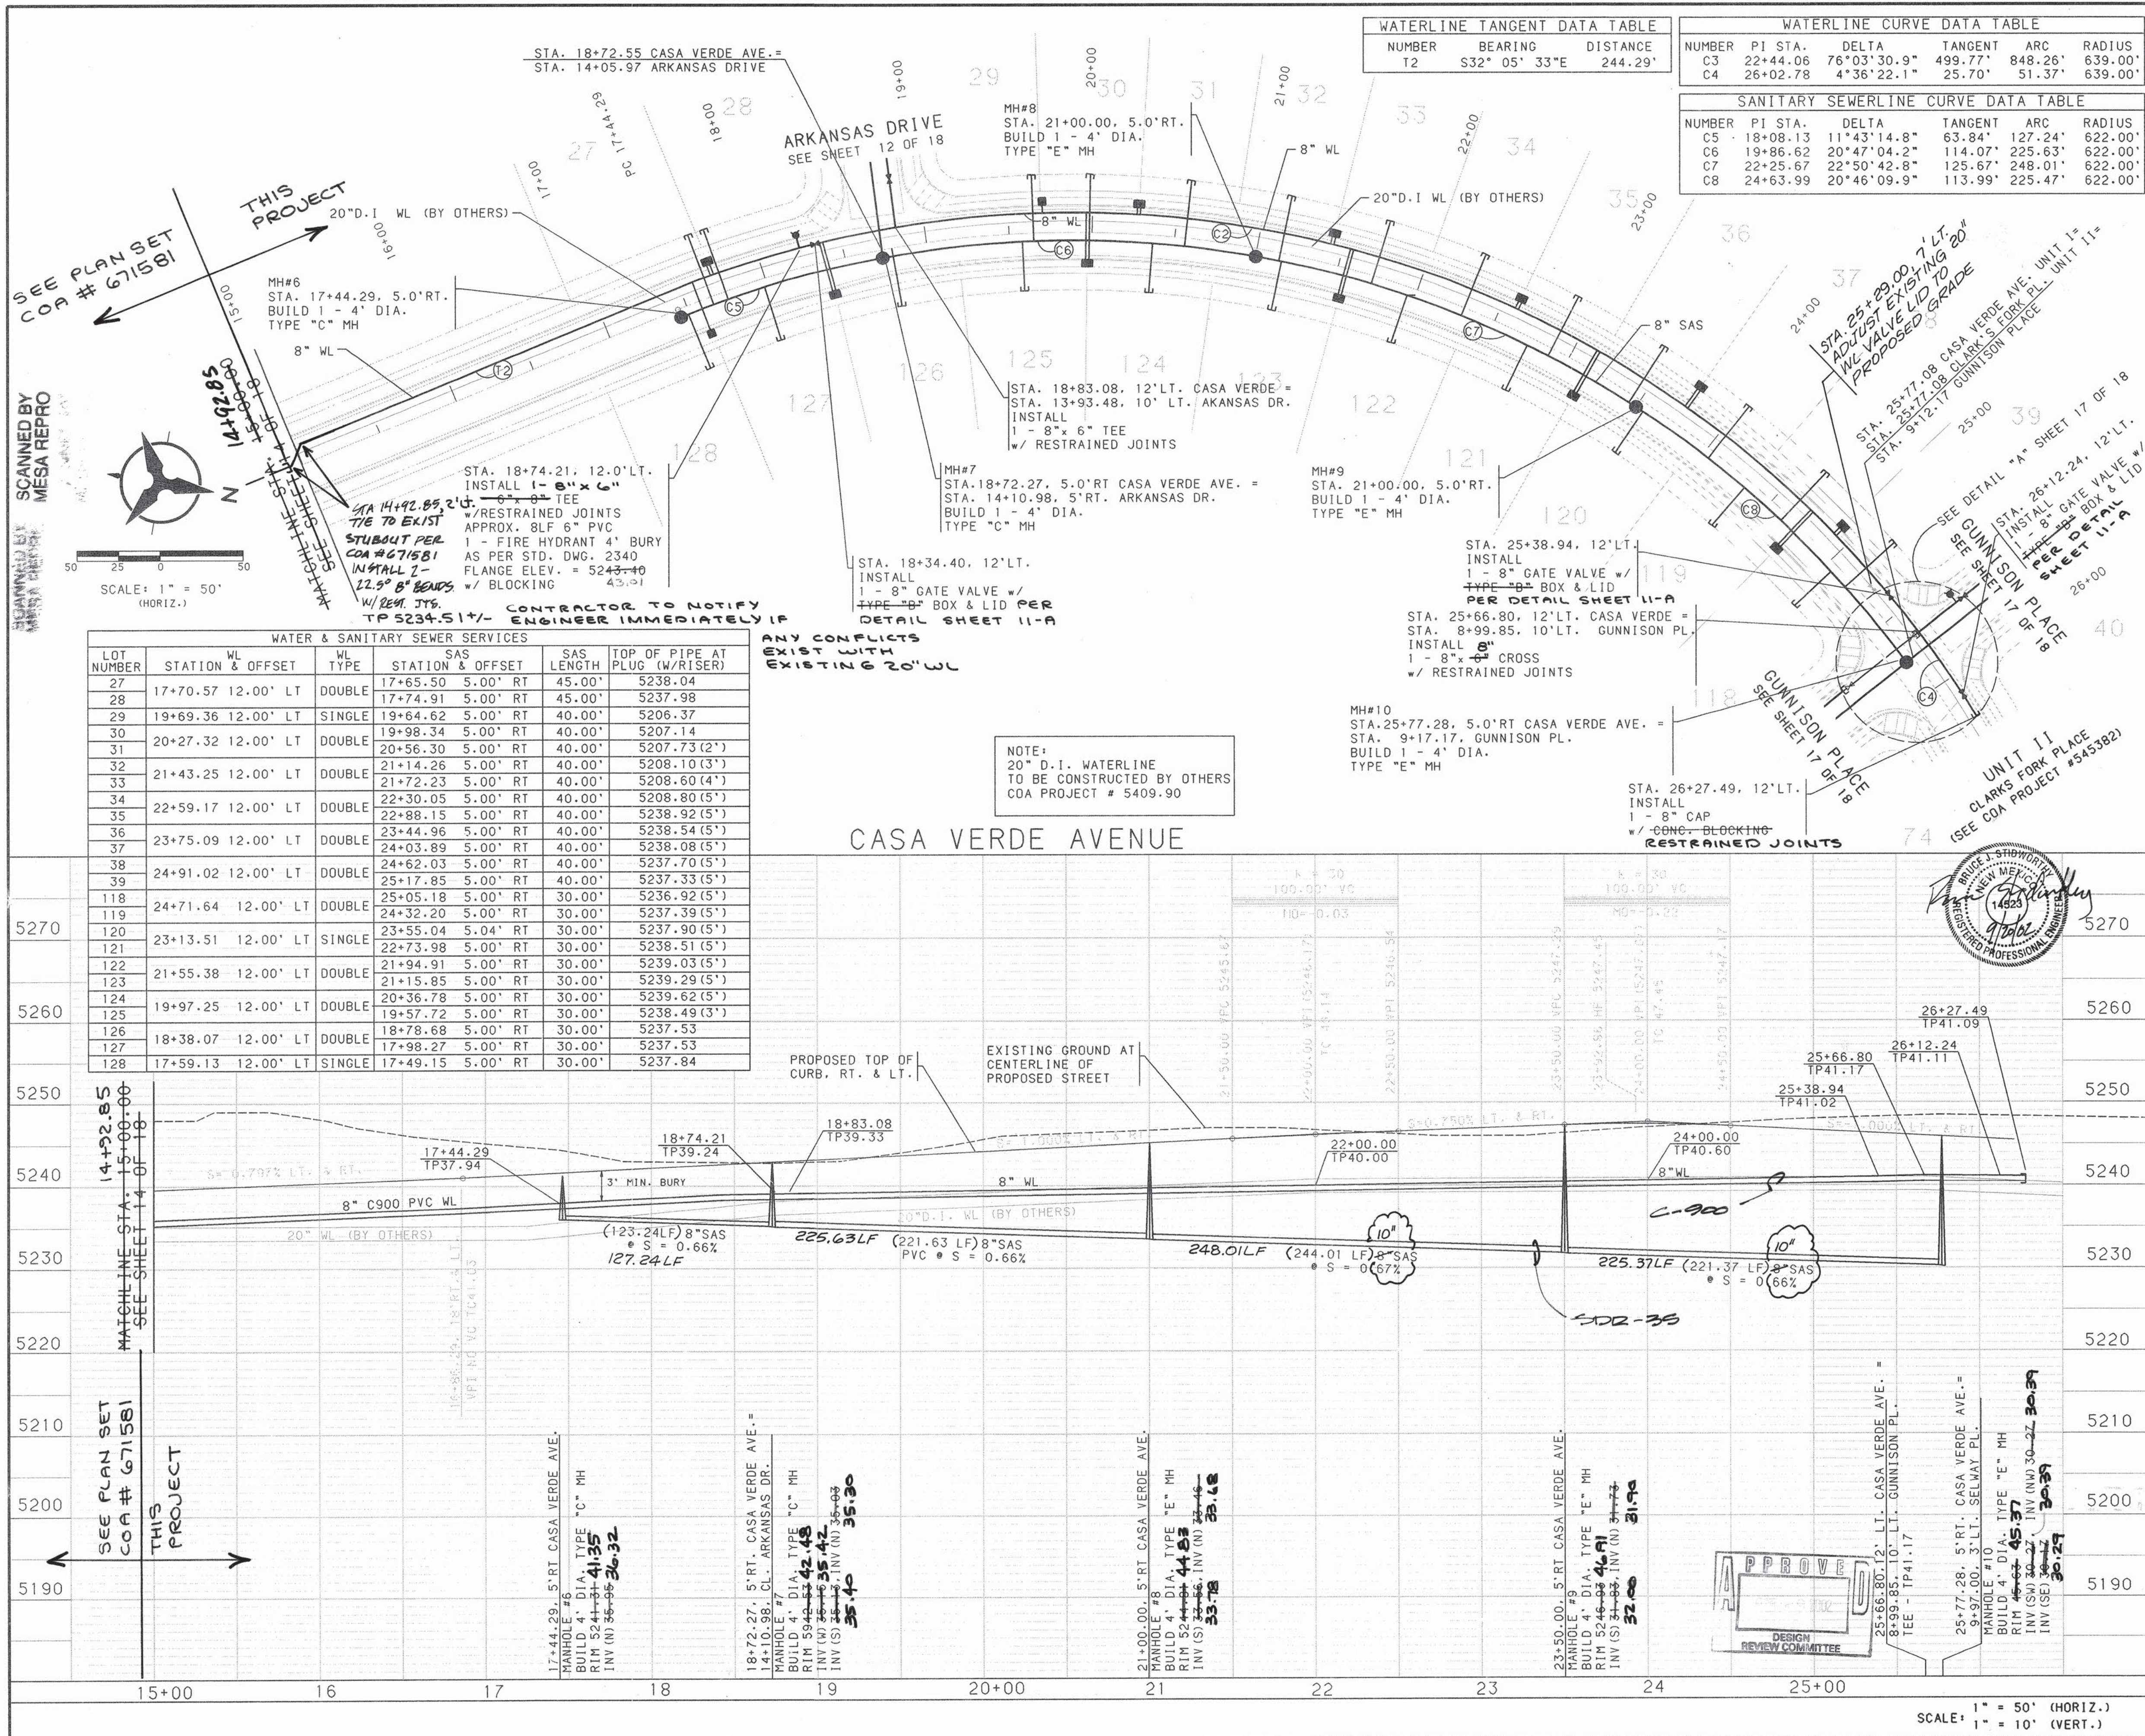

NOTES

- THE CONTRACTOR SHALL FIELD VERIFY ALL EXISTING UTILITY LOCATIONS AND NOTIFY THE ENGINEER IMMEDIATELY OF ANY DISCREPANCIES.
- ALL CURB RETURN RADII SHALL BE 25' TO FACE OF CURB UNLESS OTHERWISE SPECIFIED.
- ALL CURVE DATA AND DIMENSIONS REFER TO FACE OF CURB UNLESS OTHERWISE SPECIFIED.
- GRADE ELEVATIONS, WHERE NOTED, ARE FOR TOP OF STANDARD CURB UNLESS OTHERWISE SPECIFIED.
- CONTRACTOR IS TO INSTALL A 4"x4"x5' POST AND END AT THE END OF EACH SANITARY SEWER SERVICE.
- CONTRACTOR IS RESPONSIBLE FOR REPAIR AND/OR REPLACEMENT OF ALL UTILITY CONDUITS AND EXISTING LINES.
- ANY ADDITIONAL GRADING REQUIRED TO MATCH PROPOSED STREET GRADES SHALL BE INCIDENTAL TO PAVING ITEMS.
- CONTRACTOR SHALL PROVIDE THE INSPECTORS (CITY AND PRIVATE) WITH THE PROPOSED HYDROSTATIC TESTING PLAN. THE PLAN MUST BE APPROVED BEFORE TESTING OPERATIONS BEGIN.
- CONTRACTOR SHALL PARK EQUIPMENT AND VEHICLES AS NOT TO INTERFERE WITH NORMAL ACTIVITIES OF RESIDENTS OR OTHER CONTRACTORS ON SITE.
- ANY DAMAGE TO THE EXISTING FACILITIES (CURB AND GUTTER, PAVEMENT, CONDUITS, LANDSCAPING, UTILITY LINES, ETC.) DURING CONSTRUCTION SHALL BE REPLACED AT THE CONTRACTORS EXPENSE.
- REMOVAL OF THE EXISTING CURB AND GUTTER SHALL BE AS PER COA STD. DWG. 2415 (ISAWCUT ONLY).
- WHEEL CHAIR RAMPS SHALL BE CONSTRUCTED PRIOR TO ACCEPTANCE OF CURB AND GUTTER.
- CONTRACTOR SHALL ADJUST ALL EXISTING MANHOLE COVERS AND VALVE COVERS TO PROPOSED GRADE.

RESTRAINED JOINT TABLE

MECHANICAL JOINTS	LENGTH OF RESTRAINED JOINTS FROM EACH SIDE OF MJ LISTED (6")
11.25" H BEND	2' 3"
22.50" H BEND	4' 5"
45" H BEND	8' 11"
90" H BEND	20' 26"
GATE VALVE	55' 72"
BTRFLY VALVE	---
REDUCER (8"x6")	30' 30"

NOTE: 1. ALL MECHANICAL JOINTS SHALL BE RESTRAINED AT THE FITTING. 2. THE CONTRACTOR SHALL PROVIDE A MINIMUM PIPE LENGTH OF 20 LF FROM ALL MECHANICAL JOINTS. ALL PIPE JOINTS WITHIN 20 LF OF A MJ SHALL BE RESTRAINED AT THE CONTRACTORS EXPENSE. 3. THE CONTRACTOR SHALL RESTRAIN ALL PIPE JOINTS IN THE SPECIFIED DISTANCE LISTED IN THE TABLE ABOVE. (SEE NOTE 2 ABOVE) 4. THE CONTRACTOR SHALL RESTRAIN ALL FIRE HYDRANTS JOINTS FROM THE TEE ON THE MAIN TO THE FIRE HYDRANT FLANGE. 5. ALL CAPS SHALL UTILIZE PCC BLOCKING


BOHANNAN-HUSTON INC.
ENGINEERS • PLANNERS • PHOTOGRAMMETRISTS • SURVEYORS • LANDSCAPE ARCHITECTS
ALBUQUERQUE LAS CRUCES SANTA FE

CITY OF ALBUQUERQUE
PUBLIC WORKS DEPARTMENT
ENGINEERING DEVELOPMENT GROUP

THE CROSSING SUBDIVISION UNIT 1
UTILITY PLAN & PROFILE 14+92.85
CASA VERDE AVENUE FROM STA. 15+00 TO 25+77.08

DESIGN REVIEW COMMITTEE CITY ENGINEER APPROVAL
LAST DESIGN UPDATE MO/DAY/YR 10-26-00 MO/DAY/YR
CITY PROJECT NO. 545381 SHEET 15 OF 18
ZONE MAP NO. H-9-J-9
DESIGN REVIEW COMMITTEE APPROVAL
HAB
DESIGN REVIEW COMMITTEE APPROVAL
HAB
CITY PROJECT NO. 545381 SHEET 15 OF 18
ZONE MAP NO. H-9-J-9
DESIGN REVIEW COMMITTEE APPROVAL
HAB
DESIGN REVIEW COMMITTEE APPROVAL
HAB

SCANNED BY
MESA PERRO

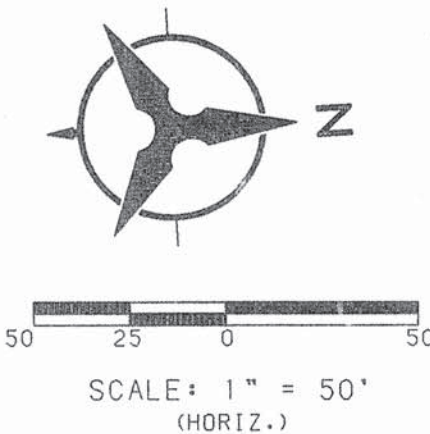

SCALE: 1" = 50'
(HORIZ.)

SAS CURVE DATA TABLE					
NUMBER	PI STA.	DELTA	TANGENT	ARC	RADIUS
C2	2+09.52	28°39'48.9"	72.81'	142.58'	285.00'
C3	3+71.49	28°58'34.5"	95.35'	186.61'	369.00'

WATERLINE TANGENT DATA TABLE		
NUMBER	BEARING	DISTANCE
T2	N41°43'20"E	15.00'
T3	S15°54'57"E	61.10'

STA. 1+30.89, 16.13' LT.
INSTALL 1 - 6" x 6" TEE
APPROX. 15LF 6" PVC
1 - FIRE HYDRANT 4" BURY
AS PER STD. DWG. 2340
FLANGE ELEV. = 5239.46
w/ BLOCKING

SAS CURVE DATA TABLE					
NUMBER	PI STA.	DELTA	TANGENT	ARC	RADIUS
C4	2+08.10	28°39'48.9"	70.26'	137.57'	275.00'
C5	3+68.91	28°58'34.0"	92.76'	181.56'	359.00'

SAS TANGENT DATA TABLE		
NUMBER	BEARING	DISTANCE
T4	S15°54'57"E	64.15'
T5	N41°43'20"E	25.00'

WATER & SANITARY SEWER SERVICES						
LOT NUMBER	STATION	WL	WL TYPE	SAS STATION & OFFSET	SAS LENGTH	TOP OF PIPE AT NO RISERS
106	1+08.68	0.09' RT	DOUBLE	2+46.59 0.37' RT	32.63'	5234.44
107				1+06.03 10.17' RT	56.37'	5234.55
108	0+92.07	0.27' RT	DOUBLE	0+76.30 9.74' RT	51.13'	5235.21
109**				N60°23'22"E @ MH	29.30'	5234.80
110**	0+83.45	0.00' LT	DOUBLE	N43°58'18"E @ MH	26.88'	5234.84
111				1+05.02 10.20' RT	43.21'	5234.07
112	1+84.74	6.51' LT	DOUBLE	1+64.39 5.24' RT	38.87'	5233.98
113				2+11.34 1.78' RT	34.78'	5233.66
114	2+91.78	10.00' LT	DOUBLE	2+64.97 0.05' RT	33.05'	5233.53
115				3+18.60 0.00' CL	33.00'	5233.01
116	3+99.05	10.00' LT	DOUBLE	3+72.23 0.00' CL	33.00'	5232.48
117				4+27.08 0.00' CL	33.00'	5231.94

** CONNECT SAS SERVICE TO MH AS PER COA STD DWG 2118.

STA. 0+72.65, 9.52' RT.
INSTALL 1 - 6" CAP
w/ RESTRAINED JOINTS

MH#11
STA. 0+72.65, 9.52' RT.
BUILD 1 - 4' DIA.
TYPE "E" MH

MH#12
STA. 2+76.14, CL
BUILD 1 - 4' DIA.
TYPE "E" MH

PCC WATERLINE 2+76.14, 10' LT

PCC SAS 2+76.14, 10' LT


STA. 4+47.07, 10' LT.
INSTALL 1 - 6" GATE VALVE w/
TYPE "B" BOX & LID
PER DETAIL
SHEET 11-A

STA. 4+72.70 10' RT. GALATIN CT =
STA. 11+69.67, 10' RT GUNNISON PL.
INSTALL 1 - 8" x 6" TEE
w/ RESTRAINED JOINTS

STA. 4+82.70 GALATIN COURT =
STA. 11+79.67 GUNNISON PLACE

MH#13
STA. 4+82.70, GALATIN CT =
STA. 11+79.67, GUNNISON PL.
BUILD 1 - 4' DIA.
TYPE "E" MH

GALATIN COURT

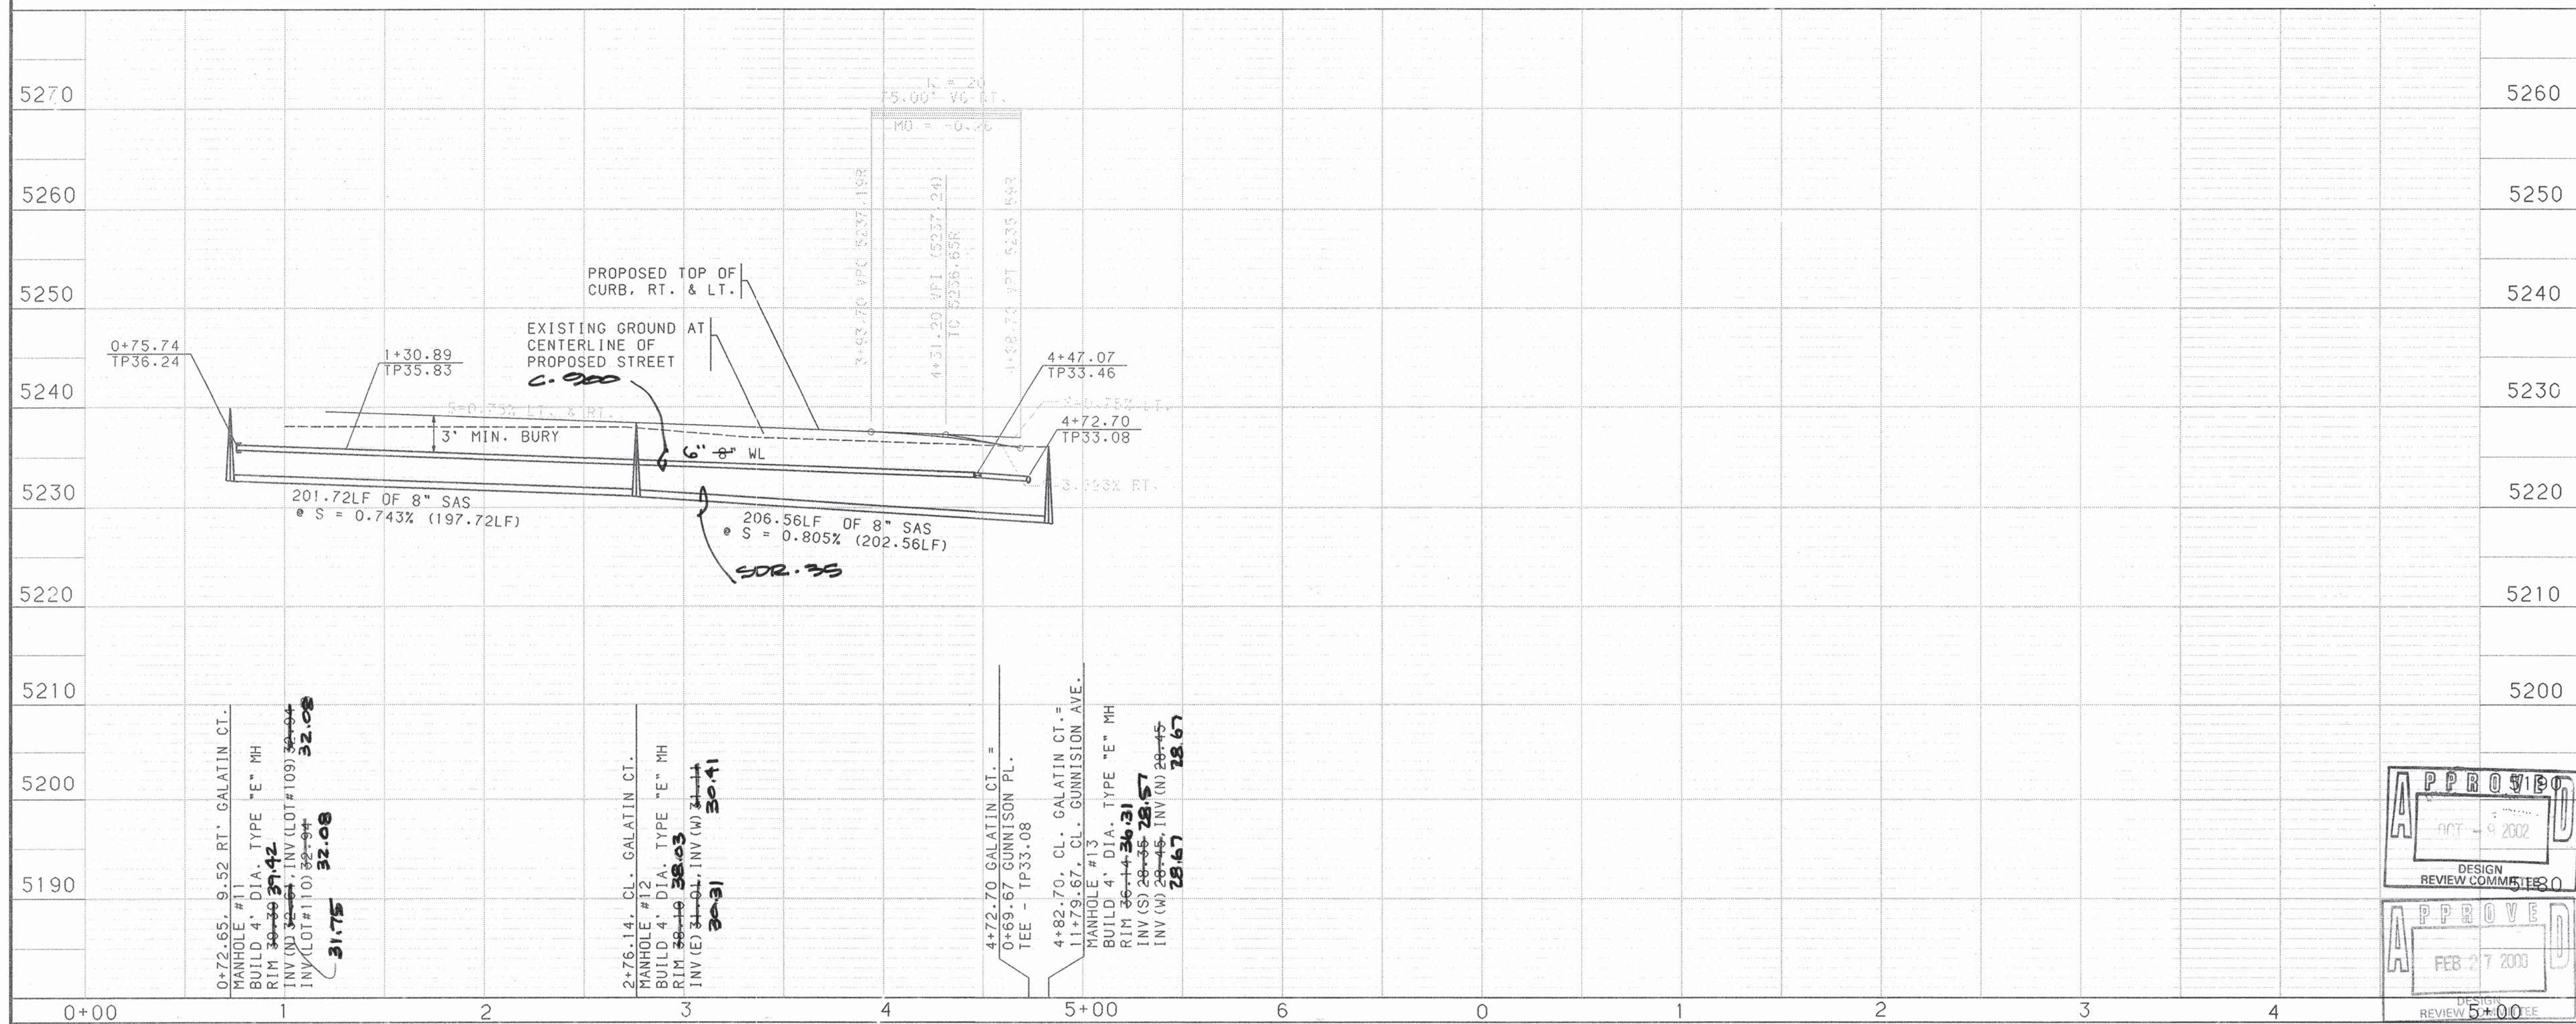

- NOTES**
1. THE CONTRACTOR SHALL FIELD VERIFY ALL EXISTING UTILITY LOCATIONS AND NOTIFY THE ENGINEER IMMEDIATELY OF ANY DISCREPANCIES.
 2. ALL CURB RETURN RADIUS SHALL BE 25' TO FACE OF CURB UNLESS OTHERWISE SPECIFIED.
 3. ALL CURVE DATA AND DIMENSIONS REFER TO FACE OF CURB UNLESS OTHERWISE SPECIFIED.
 4. GRADE ELEVATIONS, WHERE NOTED, ARE FOR TOP OF STANDARD CURB UNLESS OTHERWISE SPECIFIED.
 5. CONTRACTOR IS TO INSTALL A 4"x4"x5' POST AND EMD AT THE END OF EACH SANITARY SEWER SERVICE.
 6. CONTRACTOR IS RESPONSIBLE FOR REPAIR AND/OR REPLACEMENT OF ALL UTILITY CONDUITS AND EXISTING LINES.
 7. ANY ADDITIONAL GRADING REQUIRED TO MATCH PROPOSED STREET GRADES SHALL BE INCIDENTAL TO PAVING ITEMS.
 8. CONTRACTOR SHALL PROVIDE THE INSPECTORS, (CITY AND PRIVATE) WITH THE PROPOSED HYDROSTATIC TESTING PLAN. THE PLAN MUST BE APPROVED BEFORE TESTING OPERATIONS BEGIN.
 9. CONTRACTOR SHALL PARK EQUIPMENT AND VEHICLES AS NOT TO INTERFERE WITH NORMAL ACTIVITIES OF RESIDENTS OR OTHER CONTRACTORS ON SITE.
 10. ANY DAMAGE TO THE EXISTING FACILITIES (CURB AND GUTTER, PAVEMENT, CONDUITS, LANDSCAPING, UTILITY LINES, ETC.) DURING CONSTRUCTION SHALL BE REPLACED AT THE CONTRACTORS EXPENSE.
 11. REMOVAL OF THE EXISTING CURB AND GUTTER SHALL BE AS PER COA STD. DWG. 2415 (SAWCUT ONLY).
 12. WHEEL CHAIR RAMPS SHALL BE CONSTRUCTED PRIOR TO ACCEPTANCE OF CURB AND GUTTER.

RESTRAINED JOINT TABLE	
MECHANICAL JOINTS	LENGTH OF RESTRAINED JOINTS FROM EACH SIDE OF MJ LISTED (6") (8")
11.25" H BEND	2' 3'
22.50" H BEND	4' 5'
45" H BEND	8' 11'
90" H BEND	20' 26'
GATE VALVE	55' 72'
BTRFLY VALVE	---
REDUCER (8"x6")	30' 30'

- NOTE:**
1. ALL MECHANICAL JOINTS SHALL BE RESTRAINED AT THE FITTING.
 2. THE CONTRACTOR SHALL PROVIDE A MINIMUM PIPE LENGTH OF 20 LF FROM ALL MECHANICAL JOINTS. ALL PIPE JOINTS WITHIN 20 LF OF A MJ SHALL BE RESTRAINED AT THE CONTRACTORS EXPENSE.
 3. THE CONTRACTOR SHALL RESTRAIN ALL PIPE JOINTS IN THE SPECIFIED DISTANCE LISTED IN THE TABLE ABOVE. (SEE NOTE 2 ABOVE)
 4. THE CONTRACTOR SHALL RESTRAIN ALL FIRE HYDRANTS JOINTS FROM THE TEE ON THE MAIN TO THE FIRE HYDRANT FLANGE.
 5. ALL CAPS SHALL UTILIZE PCC BLOCKING

BOHANNAN-HUSTON INC.
ENGINEERS • PLANNERS • PHOTOGRAMMETRISTS • SURVEYORS • LANDSCAPE ARCHITECTS
ALBUQUERQUE LAS CRUCES SANTA FE

CITY OF ALBUQUERQUE
PUBLIC WORKS DEPARTMENT
ENGINEERING DEVELOPMENT GROUP

THE CROSSING SUBDIVISION UNIT I
UTILITY PLAN & PROFILE
GALATIN COURT



DESIGN REVIEW COMMITTEE APPROVED
CITY ENGINEER APPROVAL
MO/DAY/YR. MO/DAY/YR.

DESIGNED BY KP/BJS
DRAWN BY OR
CHECKED BY KP

DATE 8/96
DATE 8/96
DATE 8/96

CITY PROJECT NO. 545381
ZONE MAP NO. H9. J9
SHEET 16 OF 18

SAS TANGENT DATA TABLE		
NUMBER	BEARING	DISTANCE
T1	N46°23' 55"E	38.38'
T2	N32°05' 33"E	98.84'

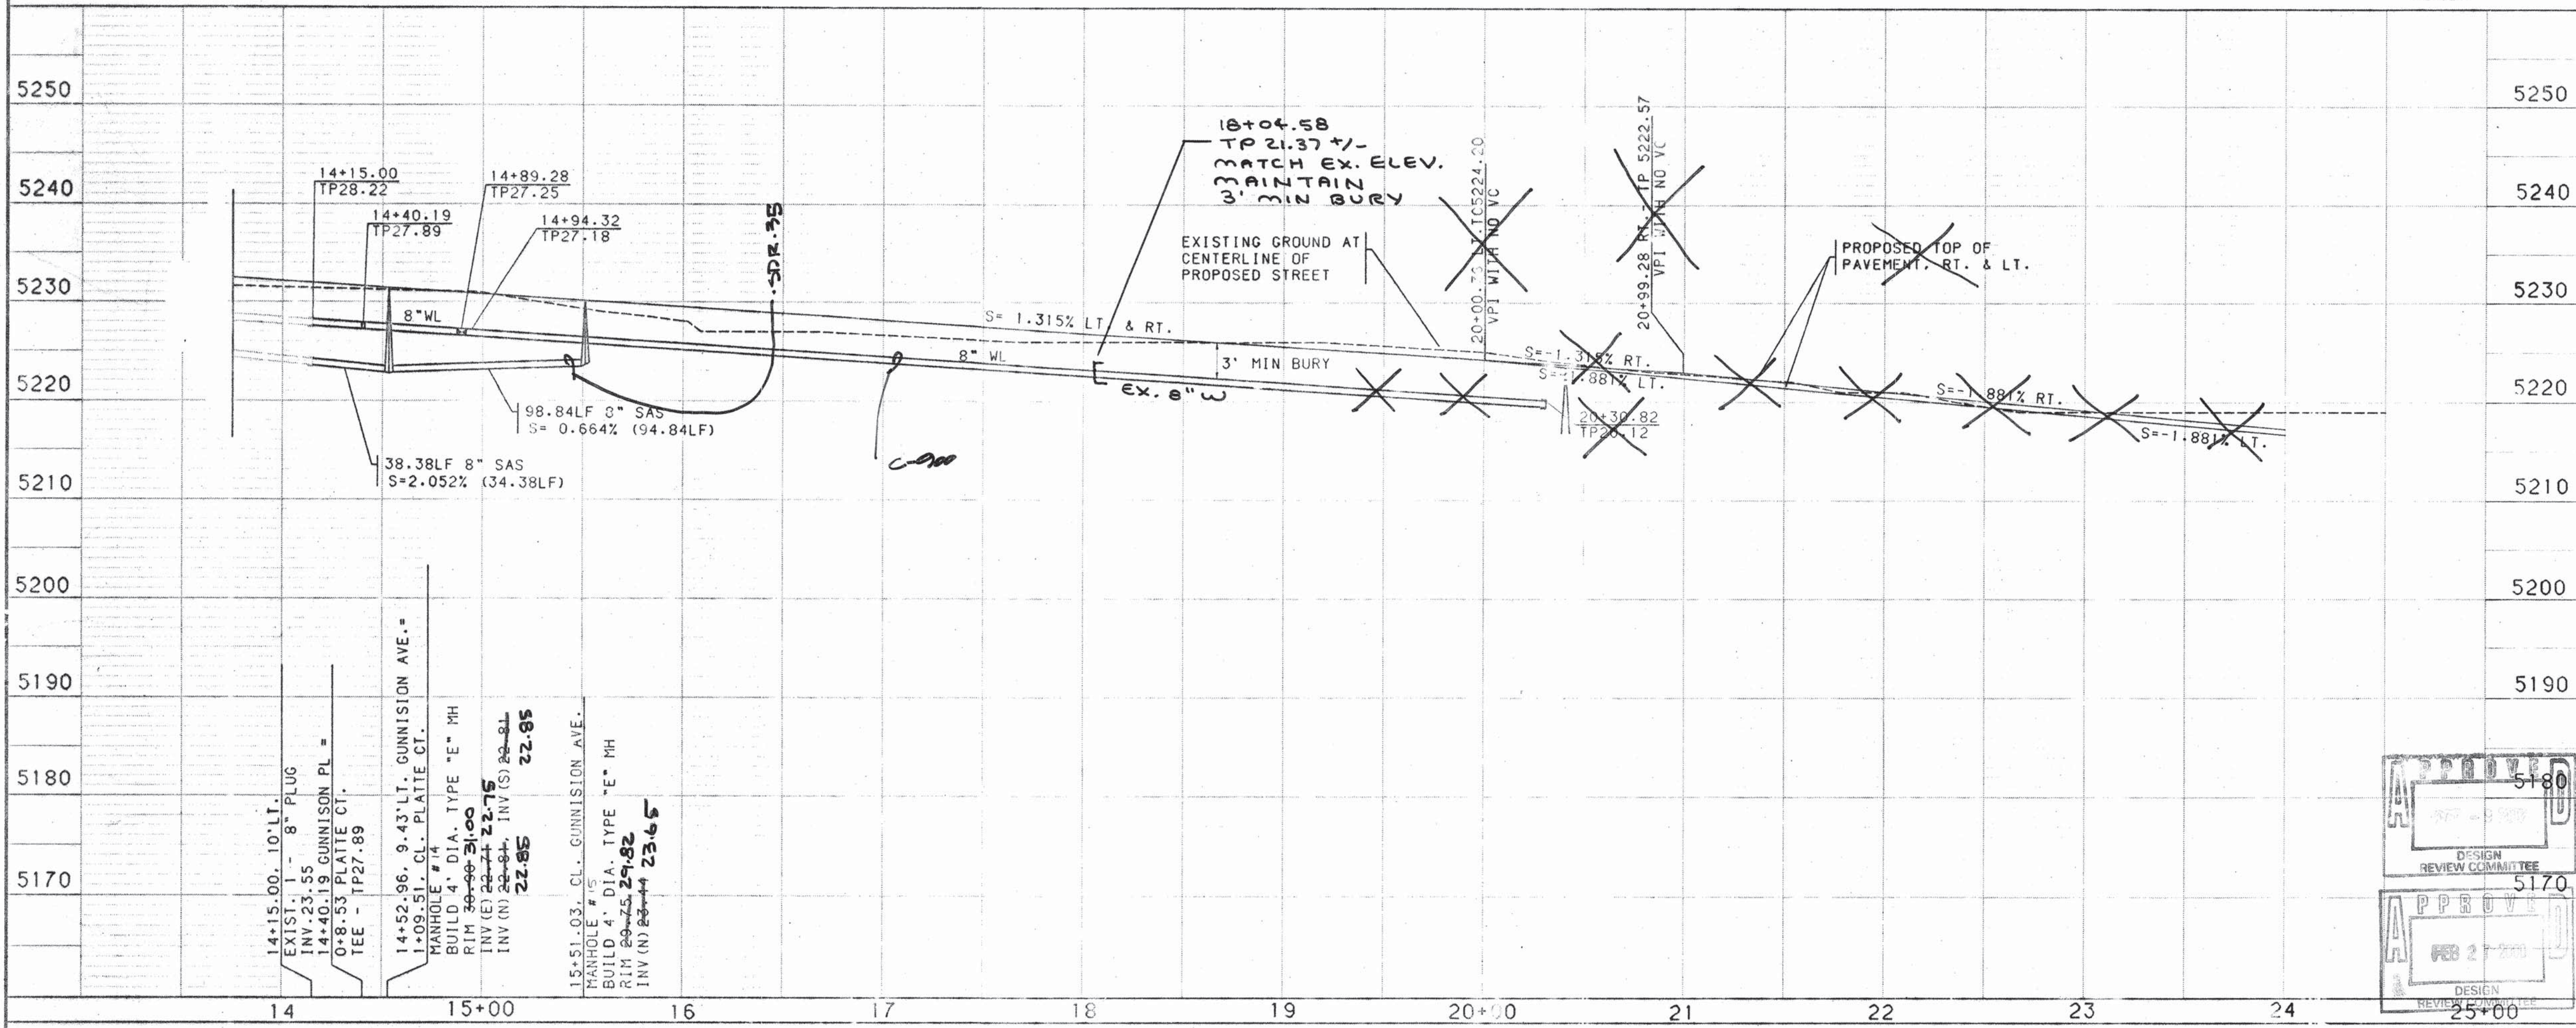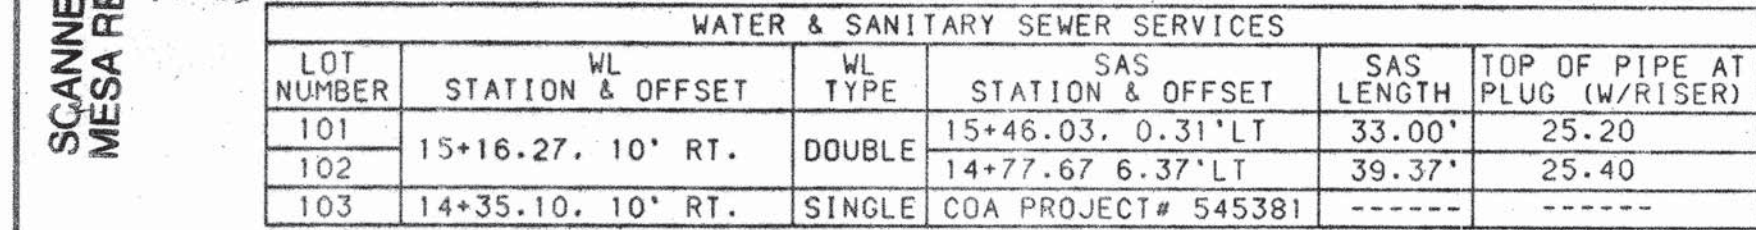

NOTES

1. THE CONTRACTOR SHALL FIELD VERIFY ALL EXISTING UTILITY LOCATIONS AND NOTIFY THE ENGINEER IMMEDIATELY OF ANY DISCREPANCIES.
2. ALL CURB RETURN RADII SHALL BE 25' TO FACE OF CURB UNLESS OTHERWISE SPECIFIED.
3. ALL CURVE DATA AND DIMENSIONS REFER TO FACE OF CURB UNLESS OTHERWISE SPECIFIED.
4. GRADE ELEVATIONS, WHERE NOTED, ARE FOR TOP OF STANDARD CURB UNLESS OTHERWISE SPECIFIED.
5. CONTRACTOR IS TO INSTALL A 4"x4"x5' POST AND END AT THE END OF EACH SANITARY SEWER SERVICE.
6. CONTRACTOR IS RESPONSIBLE FOR REPAIR AND/OR REPLACEMENT OF ALL UTILITY CONDUITS AND EXISTING LINES.
7. ANY ADDITIONAL GRADING REQUIRED TO MATCH PROPOSED STREET GRADES SHALL BE INCIDENTAL TO PAVING ITEMS.
8. CONTRACTOR SHALL PROVIDE THE INSPECTORS, (CITY AND PRIVATE) WITH PLAN. THE PLAN MUST BE APPROVED BEFORE TESTING OPERATIONS BEGIN.
9. CONTRACTOR SHALL PARK EQUIPMENT AND VEHICLES AS NOT TO INTERFERE WITH NORMAL ACTIVITIES OF RESIDENTS OR OTHER CONTRACTORS ON SITE.
10. ANY DAMAGE TO THE EXISTING FACILITIES (CURB AND GUTTER, PAVEMENT, CONDUITS, LANDSCAPING, UTILITY LINES, ETC.) DURING CONSTRUCTION SHALL BE REPLACED AT THE CONTRACTORS EXPENSE.
11. REMOVAL OF THE EXISTING CURB AND GUTTER SHALL BE AS PER COA STD. DWG. 2415 (SAWCUT ONLY).
12. WHEEL CHAIR RAMPS SHALL BE CONSIDERED PRIOR TO ACCEPTANCE OF CURB.

 <i>Bruce J. Stidworth</i> 2/1/00 9/29/02						ENGINEER'S SIGNATURE	
						STATE OF NEW MEXICO BRIAN M. ENRY REGISTERED PROFESSIONAL ENGINEER	
						NO. DATE	
						REMARKS	
						DESIGN REVISIONS	
						DESIGNED BY KP/BJS	
						DATE 8/96	
						DRAWN BY OR	
						DATE 8/96	
						CHECKED BY KP	
						DATE 8/96	



BOHANNON-HUSTON INC.

ENGINEERS • PLANNERS • PHOTOGRAMMETRISTS • SURVEYORS • LANDSCAPE ARCHITECTS

ALBUQUERQUE LAS CRUCES SANTA FE



CITY OF ALBUQUERQUE

PUBLIC WORKS DEPARTMENT



ENGINEERING DEVELOPMENT GROUP

THE CROSSING SUBDIVISION UNIT I

UTILITY PLAN & PROFILE

18 + 04.58

GUNNISON PLACE FROM STA. 14+00.00 TO 20+30.82

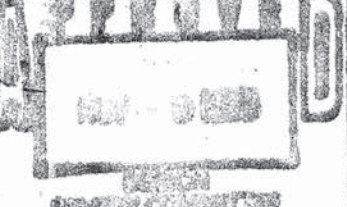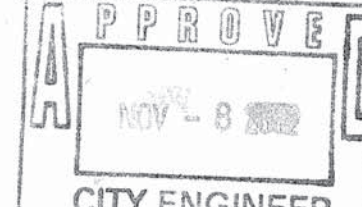DESIGN REVIEW COMMITTEE	CITY ENGINEER APPROVAL	MO./DAY/YR.	MO./DAY/YR.
			



PROJECT NO. **545381**

ZONE MAP NO. **H-9, J-9**

SHEET **17A**

OF **18**

SCANNED BY
MESA REPRO

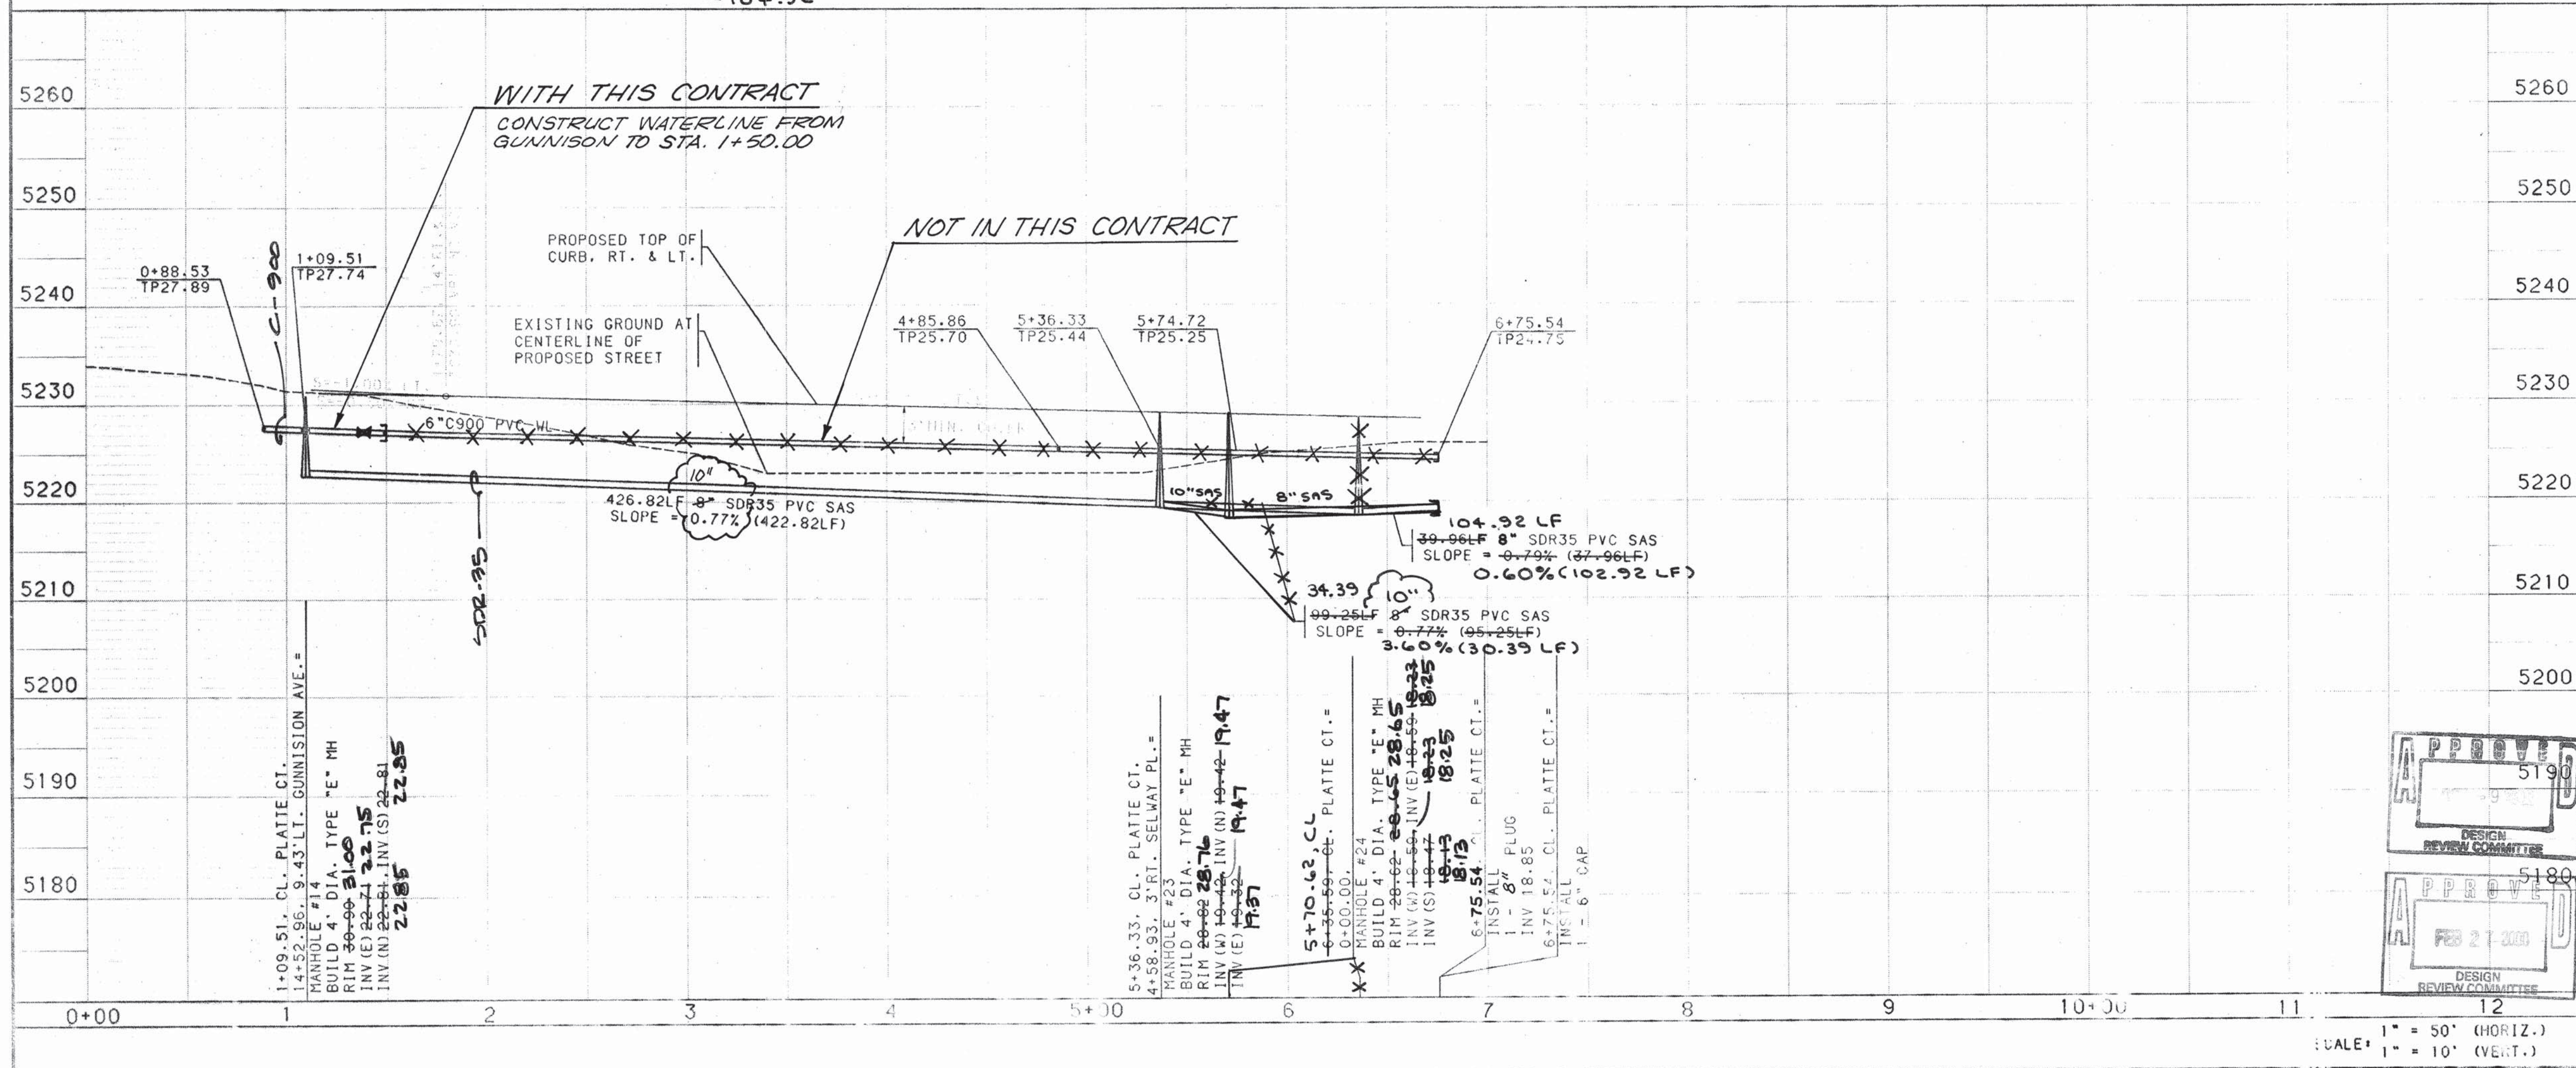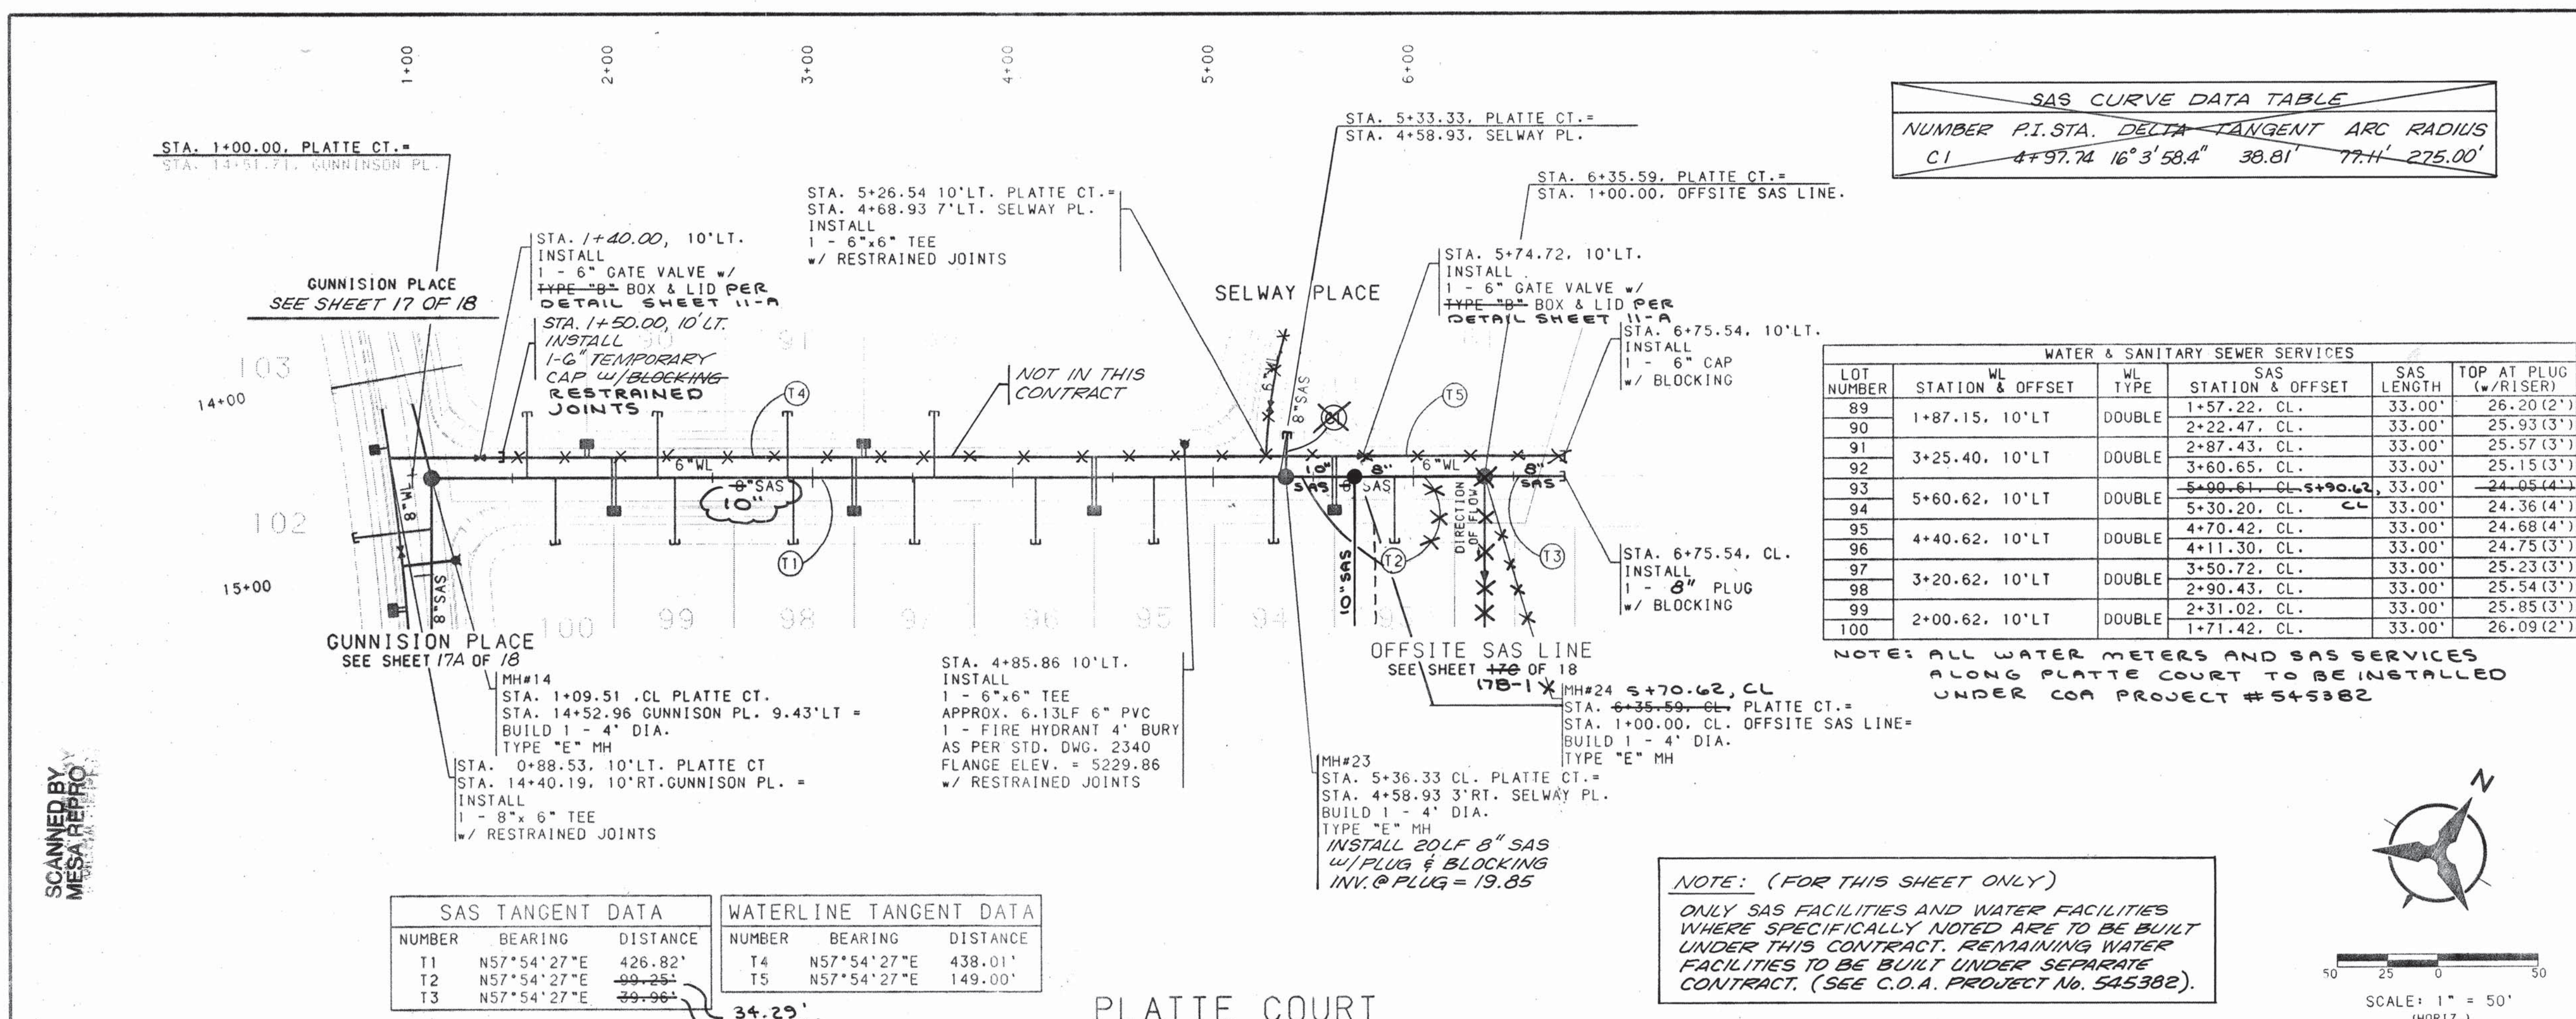

NOTES

- THE CONTRACTOR SHALL FIELD VERIFY ALL EXISTING UTILITY LOCATIONS AND NOTIFY THE ENGINEER IMMEDIATELY OF ANY DISCREPANCIES.
- ALL CURB RETURN RADII SHALL BE 25' TO FACE OF CURB UNLESS OTHERWISE SPECIFIED.
- ALL CURVE DATA AND DIMENSIONS REFER TO FACE OF CURB UNLESS OTHERWISE SPECIFIED.
- GRADE ELEVATIONS, WHERE NOTED, ARE FOR TOP OF STANDARD CURB UNLESS OTHERWISE SPECIFIED.
- CONTRACTOR IS TO INSTALL A 4"x4"x5' POST AND END AT THE END OF EACH SANITARY SEWER SERVICE.
- CONTRACTOR IS RESPONSIBLE FOR REPAIR AND/OR REPLACEMENT OF ALL UTILITY CONDUITS AND EXISTING LINES.
- ANY ADDITIONAL GRADING REQUIRED TO MATCH PROPOSED STREET GRADES SHALL BE INCIDENTAL TO PAVING ITEMS.
- CONTRACTOR SHALL PROVIDE THE INSPECTORS, (CITY AND PRIVATE) WITH THE PROPOSED HYDROSTATIC TESTING PLAN. THE PLAN MUST BE APPROVED BEFORE TESTING OPERATIONS BEGIN.
- CONTRACTOR SHALL PARK EQUIPMENT AND VEHICLES AS NOT TO INTERFERE WITH NORMAL ACTIVITIES OF RESIDENTS OR OTHER CONTRACTORS ON SITE.
- ANY DAMAGE TO THE EXISTING FACILITIES (CURB AND GUTTER, PAVEMENT, CONDUITS, LANDSCAPING, UTILITY LINES, ETC.) DURING CONSTRUCTION SHALL BE REPLACED AT THE CONTRACTORS EXPENSE.
- REMOVAL OF THE EXISTING CURB AND GUTTER SHALL BE AS PER COA STD. DWG. 2415 (SAWCUT ONLY).
- WHEEL CHAIR RAMPS SHALL BE CONSTRUCTED PRIOR TO ACCEPTANCE OF CURB AND GUTTER.

RESTRAINED JOINT

MECHANICAL JOINTS	LENGTH OF RESTRAINT FROM EACH SIDE OF MJ LISTED (6")	(8")
11.25" H BEND	2'	3'
22.50" H BEND	4'	5'
45" H BEND	8'	11'
30" H BEND	20'	26'
GATE VALVE	55'	72'
BTRFLY VALVE	---	---
REDUCER (8"x6")	30'	30'

NOTE:

- ALL MECHANICAL JOINTS SHALL BE RESTRAINED AT THE FITTING.
- THE CONTRACTOR SHALL PROVIDE A MINIMUM PIPE LENGTH OF 20 LF FROM ALL MECHANICAL JOINTS. ALL PIPE JOINTS WITHIN 20 LF OF A MJ SHALL BE RESTRAINED AT THE CONTRACTORS EXPENSE.
- THE CONTRACTOR SHALL RESTRAIN ALL PIPE JOINTS IN THE SPECIFIED DISTANCE LISTED IN THE TABLE ABOVE. (SEE NOTE 2 ABOVE)
- THE CONTRACTOR SHALL RESTRAIN ALL FIRE HYDRANTS JOINTS FROM THE TEE ON THE MAIN TO THE FIRE HYDRANT FLANGE.
- ALL CAPS SHALL UTILIZE PCC BLOCKING

BOHANNAN-HUSTON INC.
ENGINEERS • PLANNERS • PHOTOGRAMMETRISTS • SURVEYORS • LANDSCAPE ARCHITECTS
ALBUQUERQUE LAS CRUCES SANTA FE

CITY OF ALBUQUERQUE
PUBLIC WORKS DEPARTMENT
ENGINEERING DEVELOPMENT GROUP

THE CROSSING SUBDIVISION UNIT I
UTILITY PLAN & PROFILE
PLATTE COURT

DESIGN REVIEW COMMITTEE

CITY ENGINEER APPROVAL

CITY ENGINEER

DESIGN REVIEW COMMITTEE

CITY ENGINEER APPROVAL

CITY ENGINEER

DESIGN REVIEW COMMITTEE

CITY ENGINEER APPROVAL

CITY ENGINEER

NO. DATE

REMARKS

REVISIONS

DESIGN

DATE 8/96

DATE 8/96

DATE 8/96

DESIGNED BY KP/BS

DRAWN BY BS



CHECKED BY KP

CITY PROJECT NO. 545381

ZONE MAP NO. H-9-J-9


SHEET 17B OF 18

SCANNED BY
MESA REPRO

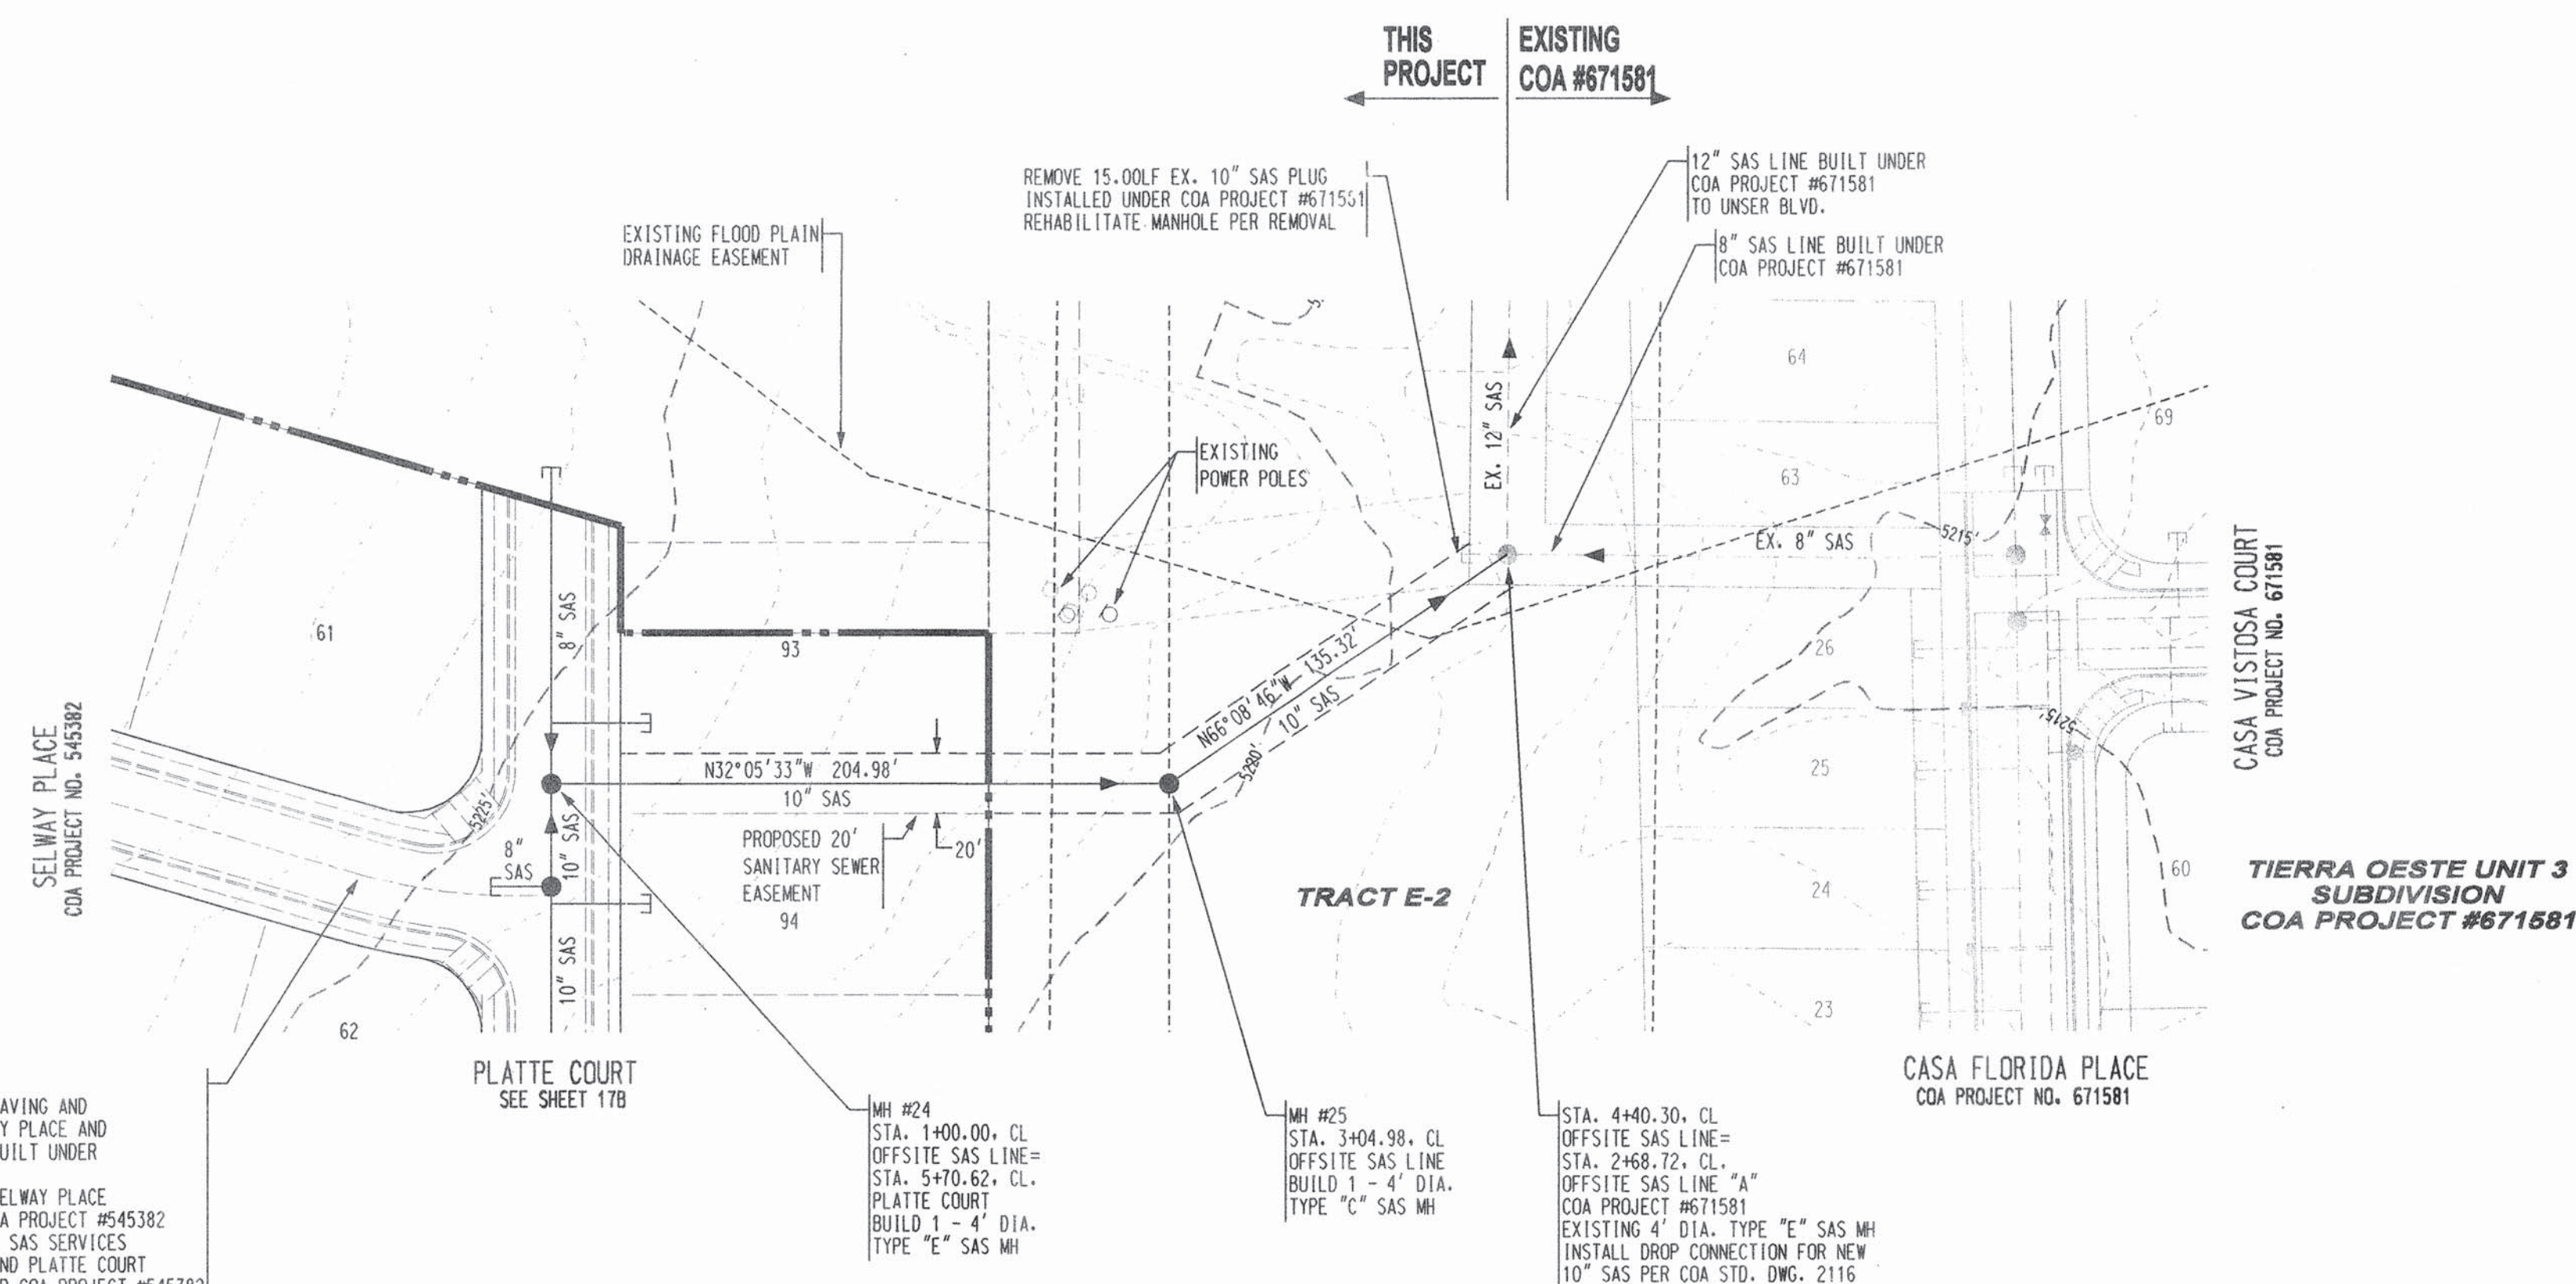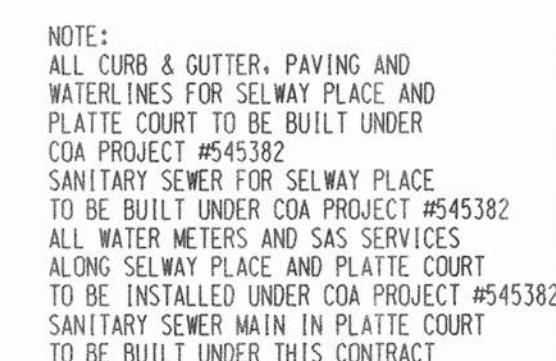

NOTES

- THE CONTRACTOR SHALL FIELD VERIFY ALL EXISTING UTILITY LOCATIONS AND NOTIFY THE ENGINEER IMMEDIATELY OF ANY DISCREPANCIES.
2. ALL CURB RETURN RADII SHALL BE 25' UNLESS OTHERWISE SPECIFIED.
3. ALL CURVE DATA AND DIMENSIONS REFER TO FACE OF CURB UNLESS OTHERWISE SPECIFIED.
4. GRADE ELEVATIONS, WHERE NOTED, ARE ALONG FLOWLINE OF STANDARD CURB UNLESS OTHERWISE SPECIFIED.
5. CONTRACTOR IS TO INSTALL A 4" X 4" X 5' POST AND END AT THE END OF EACH SANITARY SEWER SERVICE.
6. CONTRACTOR IS RESPONSIBLE FOR REPAIR AND/OR REPLACEMENT OF ALL UTILITY CONDUITS AND EXISTING LINES.
7. ANY ADDITIONAL GRADING REQUIRED TO MATCH PROPOSED STREET GRADES SHALL BE INCIDENTAL TO PAVING ITEMS.
8. CONTRACTOR SHALL PROVIDE THE INSPECTORS, (CITY AND PRIVATE) WITH THE PROPOSED HYDROSTATIC TESTING PLAN. THE PLAN MUST BE APPROVED BEFORE TESTING OPERATIONS BEGIN.
9. CONTRACTOR SHALL PARK EQUIPMENT AND VEHICLES AS NOT TO INTERFERE WITH NORMAL ACTIVITIES OF RESIDENTS OR OTHER CONTRACTORS ON SITE.
10. ANY DAMAGE TO THE EXISTING FACILITIES (CURB & GUTTER), PAVEMENT, CONDUITS, LANDSCAPING, UTILITY LINES, ETC.) DURING CONSTRUCTION SHALL BE REPLACED AT THE CONTRACTORS' EXPENSE.
11. REMOVAL OF THE EXISTING CURB AND GUTTER SHALL BE AS PER COA STD. DWG. 2415 (SAWCUT ONLY).
12. WHEELCHAIR RAMPS SHALL BE CONTRACTED PRIOR TO ACCEPTANCE OF CURB & GUTTER.

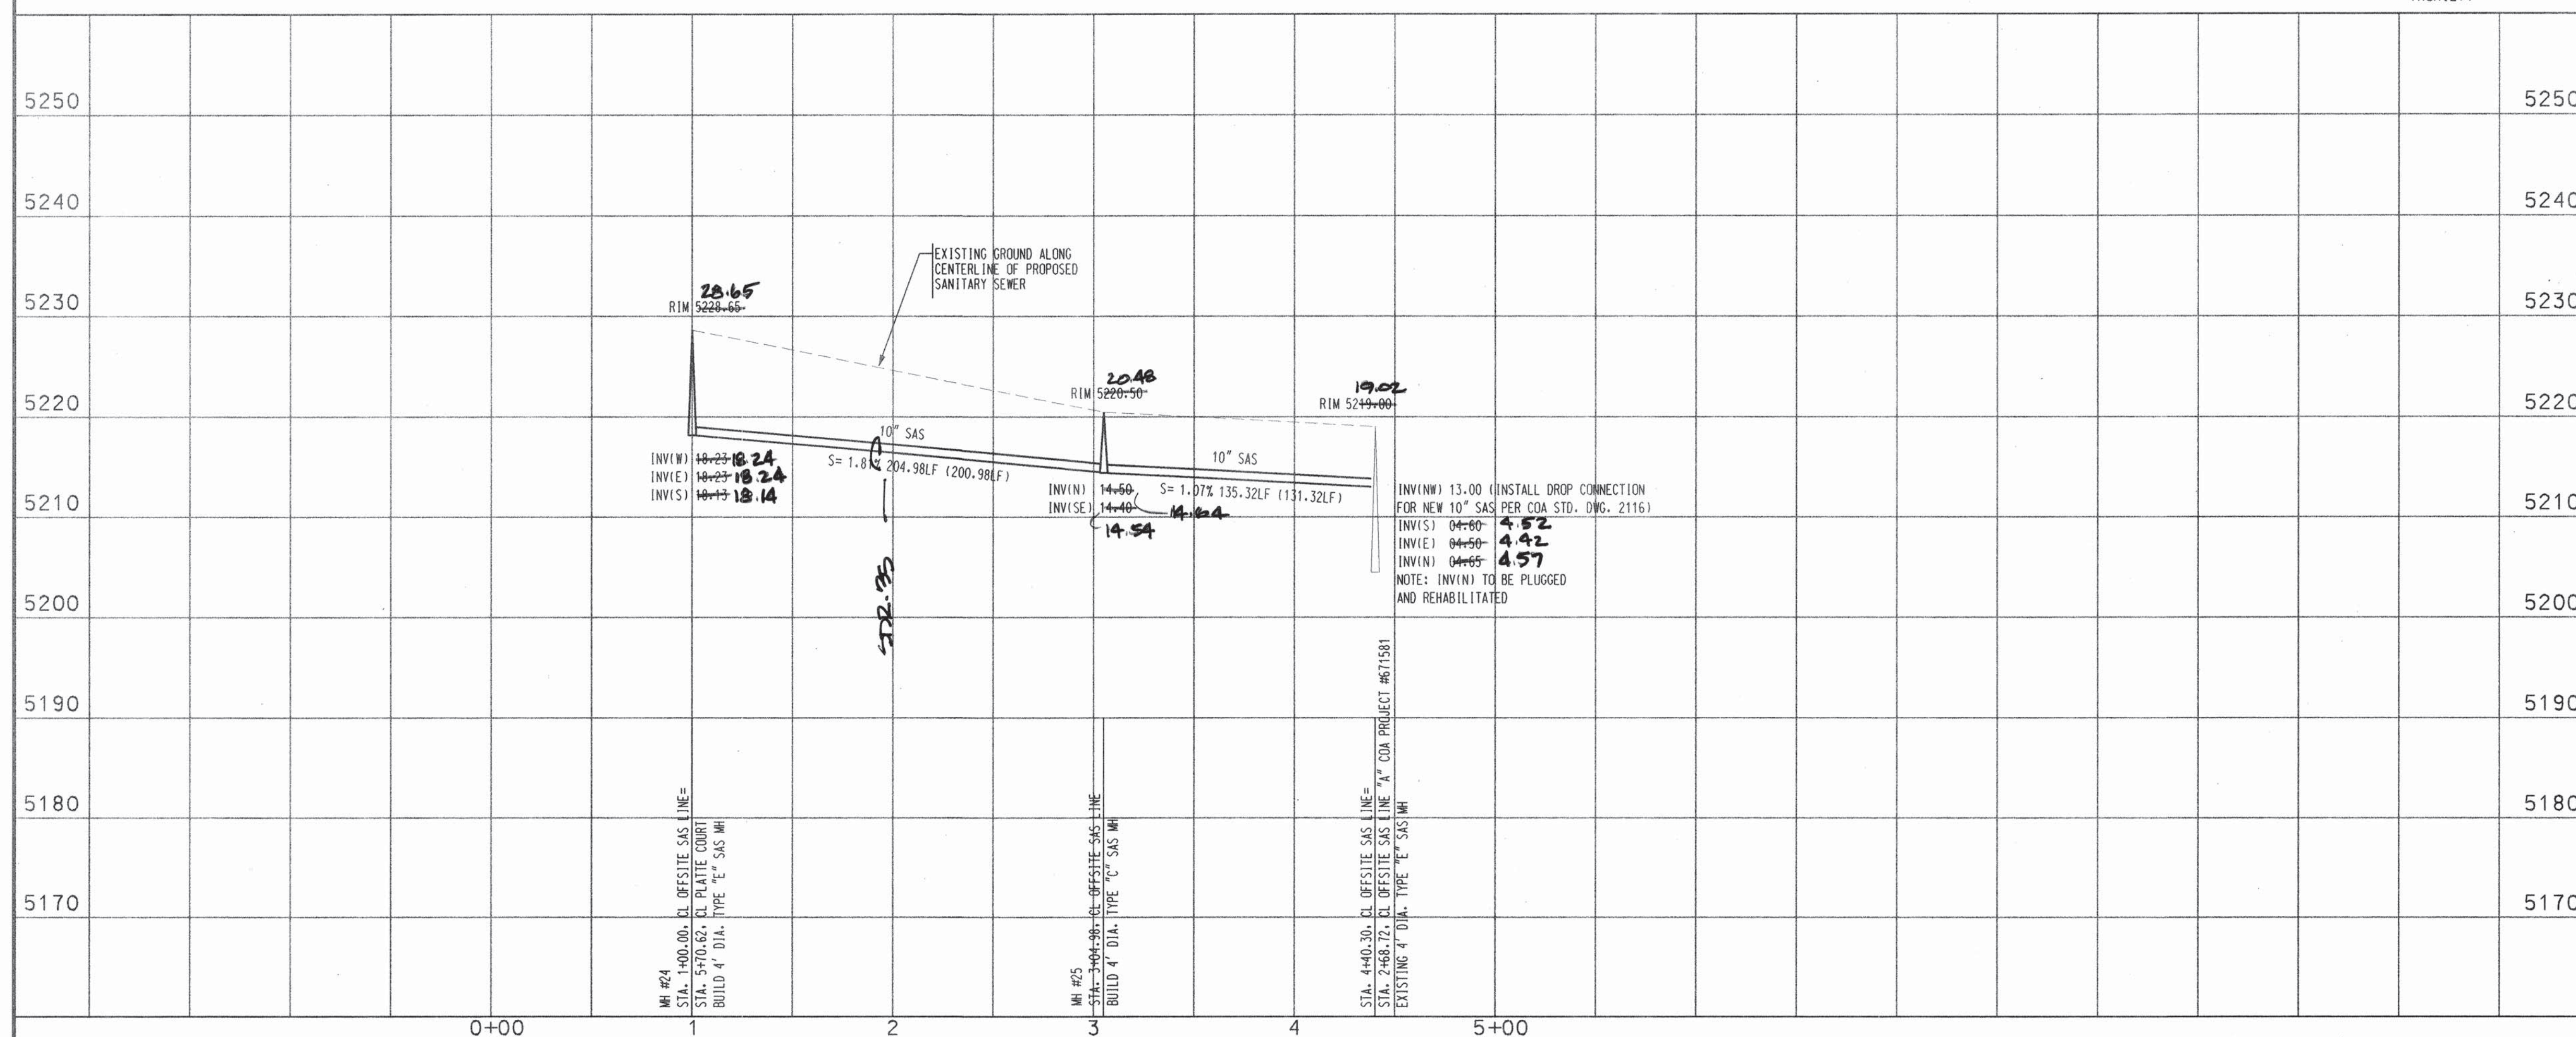

P:\020040\CDP\DESIGN*020040sas-crossings.dgn
P:\020040\cdp\enr\020040sas-crossings.dgn
18-SEP-2002

BHI JOB NO. XXXXXX XX

SCALE: 1" = 50' (HORIZ.)
1" = 10' (VERT.)

CITY PROJECT NO.	
------------------	--

ZONE MAP NO.
H9/J9

SHEET 17B-1 OF 18

ENGINEER'S SEAL		SURVEY INFORMATION		BENCH MARKS		AS-BUILT INFORMATION	
		FIELD NOTES					
NO.	BY	DATE					
				ACS ALUMINUM TABLET STAMPED "BH-40"	CONTRACTOR SUNDAKE		
				GEOGRAPHIC POSITION (NAD 1983)	STARTED BY ALS		
				N.M. STATE PLANE COORD. (CENTRAL ZONE)	INSPECTOR'S SSC	DATE 7/13	
				X=352,790.66 Y=1,492,346.53	FIELD ANCE BY CLS	DATE "	
				GROUND TO GRID FACTOR = 0.99967105	VERIFICATION BY CLS	DATE "	
				DELTA ALPHA = -00DEG 16 MIN 59 SEC	DRAWINGS		
				NOVD 1929 ELEVATION = 5305.43	COMPILED BY		
					MICRO-FILM INFORMATION		
					RECORDED BY	DATE	
					NO.		



9/19/02	Added Sheet Per Project	Revisions	5/8/92
NO.	DATE	REMARKS	BY
REVISIONS			
DESIGN			
DESIGNED BY	YOP/BJ/S	DATE	09/2002
DRAWN BY	SAR	DATE	09/2002
CHECKED BY	DJC	DATE	09/2002

Bohannon ▲ Huston

 Courtyard One 7500 JEFFERSON NE Albuquerque NEW MEXICO 87109

ENGINEERS PLANNERS PHOTOGRAMMETRISTS SURVEYORS SOFTWARE DEVELOPERS

 CITY OF ALBUQUERQUE
PUBLIC WORKS DEPARTMENT
ENGINEERING DEVELOPMENT GROUP

THE CROSSINGS SUBDIVISION UNIT I
UTILITY PLAN & PROFILE
OFFSITE SAS LINE


DESIGN REVIEW COMMITTEE CITY ENGINEER APPROVAL

A P P R O V E D

OCT - 9 2002 NOV - 8 2002

DESIGN REVIEW COMMITTEE CITY ENGINEER

LINE	LAST DESIGN UPDATE	MO./DAY/YR.	MO./DAY/YR.

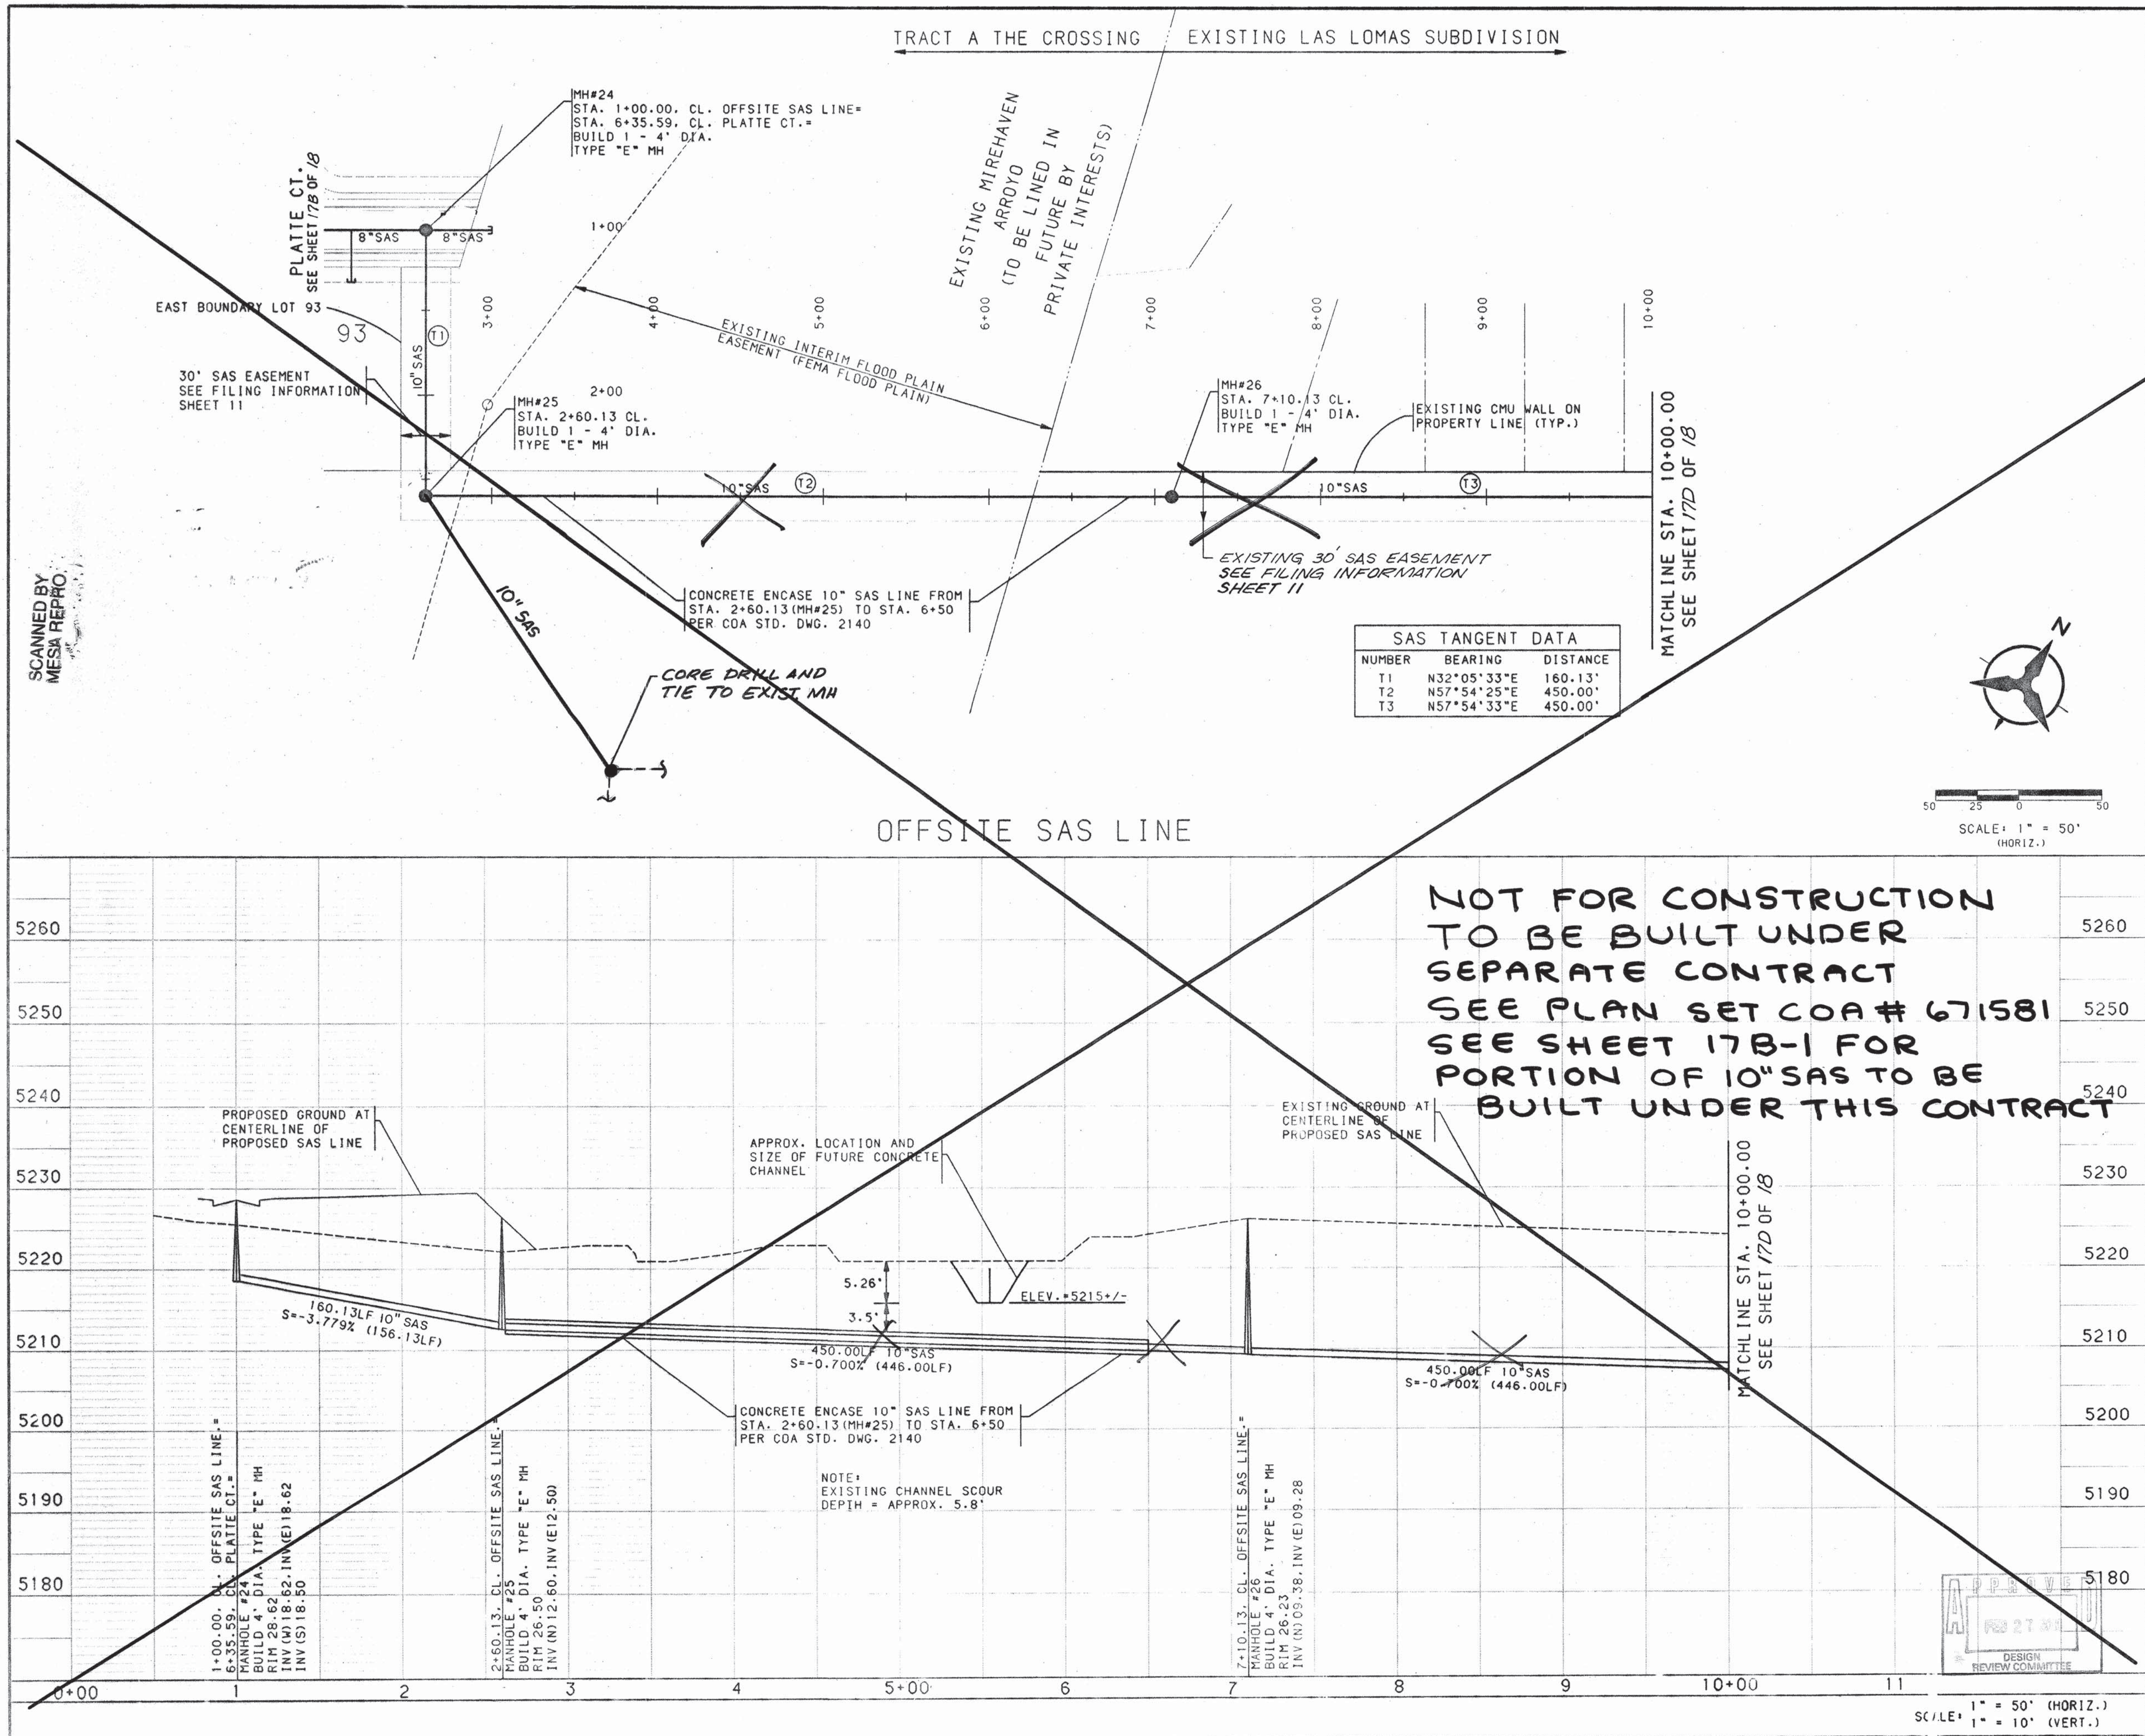

NOTES

1. THE CONTRACTOR SHALL FIELD VERIFY ALL EXISTING UTILITY LOCATIONS AND NOTIFY THE ENGINEER IMMEDIATELY OF ANY DISCREPANCIES.
2. ALL CURB RETURN RADII SHALL BE 25' TO FACE OF CURB UNLESS OTHERWISE SPECIFIED.
3. ALL CURVE DATA AND DIMENSIONS REFER TO FACE OF CURB UNLESS OTHERWISE SPECIFIED.
4. GRADE ELEVATIONS, WHERE NOTED, ARE FOR TOP OF STANDARD CURB UNLESS OTHERWISE SPECIFIED.
5. CONTRACTOR IS TO INSTALL A 4"x4"x5' POST AND EMD AT THE END OF EACH SANITARY SEWER SERVICE.
6. CONTRACTOR IS RESPONSIBLE FOR REPAIR AND/OR REPLACEMENT OF ALL UTILITY CONDUITS AND EXISTING LINES.
7. ANY ADDITIONAL GRADING REQUIRED TO MATCH PROPOSED STREET GRADES SHALL BE INCIDENTAL TO PAVING ITEMS.
8. CONTRACTOR SHALL PROVIDE THE INSPECTORS, (CITY AND PRIVATE) WITH THE PROPOSED HYDROSTATIC TESTING PLAN. THE PLAN MUST BE APPROVED BEFORE TESTING OPERATIONS BEGIN.
9. CONTRACTOR SHALL PARK EQUIPMENT AND VEHICLES AS NOT TO INTERFERE WITH NORMAL ACTIVITIES OF RESIDENTS OR OTHER CONTRACTORS ON SITE.
10. ANY DAMAGE TO THE EXISTING FACILITIES (CURB AND GUTTER, PAVEMENT, CONDUITS, LANDSCAPING, UTILITY LINES, ETC.) DURING CONSTRUCTION SHALL BE REPLACED AT THE CONTRACTORS EXPENSE.
11. REMOVAL OF THE EXISTING CURB AND GUTTER SHALL BE AS PER COA STD. DWG. 2415 (SAWCUT ONLY).
12. WHEEL CHAIR RAMPS SHALL BE CONSTRUCTED PRIOR TO ACCEPTANCE OF CURB AND GUTTER.

AS-BUILT INFORMATION

CONTRACTOR	INSPECTOR'S	DATE
STAMPED "BH-40"	STAMPED "BH-40"	
DATE	DATE	
DATE	DATE	
DATE	DATE	

FIELD NOTES

NO.	BY	DATE

ENGINEER'S SEAL

REVISIONS

NO.	DATE	REMARKS	BY

DESIGNED BY: KP/BS
DRAIN BY: BS
CHECKED BY: KP

DATE: 8/96
DATE: 8/96
DATE: 8/96

BOHANNAN-HUSTON INC.
ENGINEERS • PLANNERS • PHOTOGRAMMETRISTS • SURVEYORS • LANDSCAPE ARCHITECTS
ALBUQUERQUE LAS CRUCES SANTA FE

CITY OF ALBUQUERQUE
PUBLIC WORKS DEPARTMENT
ENGINEERING DEVELOPMENT GROUP

THE CROSSING SUBDIVISION UNIT I
UTILITY PLAN & PROFILE
OFFSITE SAS LINE


DESIGN REVIEW COMMITTEE
CITY ENGINEER APPROVAL
LAST DESIGN UPDATE
CITY ENGINEER

CITY PROJECT NO. 545381
ZONE MAP NO. H-9-J-9
SHEET 17C OF 18


NUMBER	BEARING	DISTANCE
T3	N57°54'25"E	450.00'
T4	N57°54'25"E	337.91'
T5	N32°05'33"E	140.00'

EXISTING LAS LOMITAS SUBDIVISION

CALLE DE ENTRADA N.W.
(EXISTING STREET)

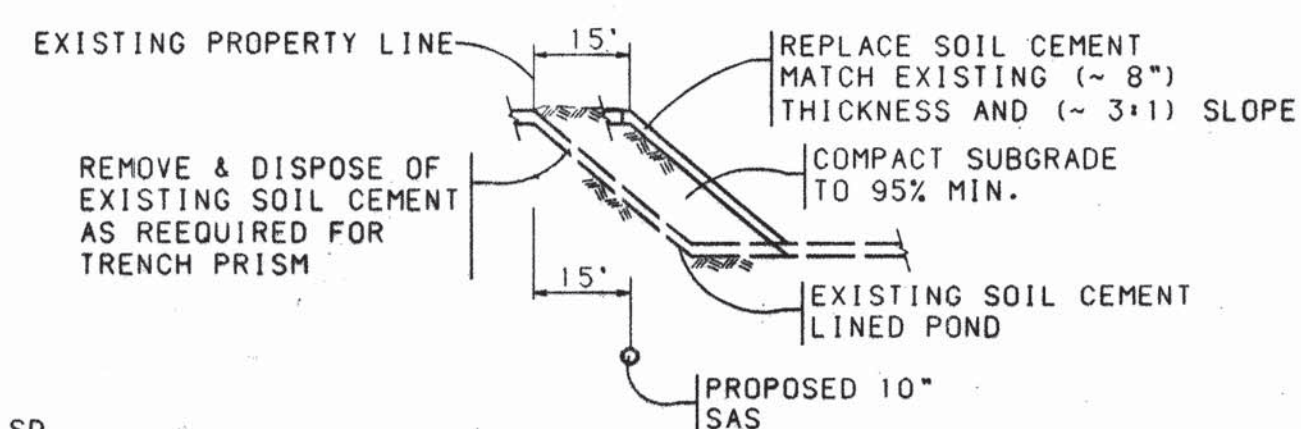

SECTION A-A
NO SCALE

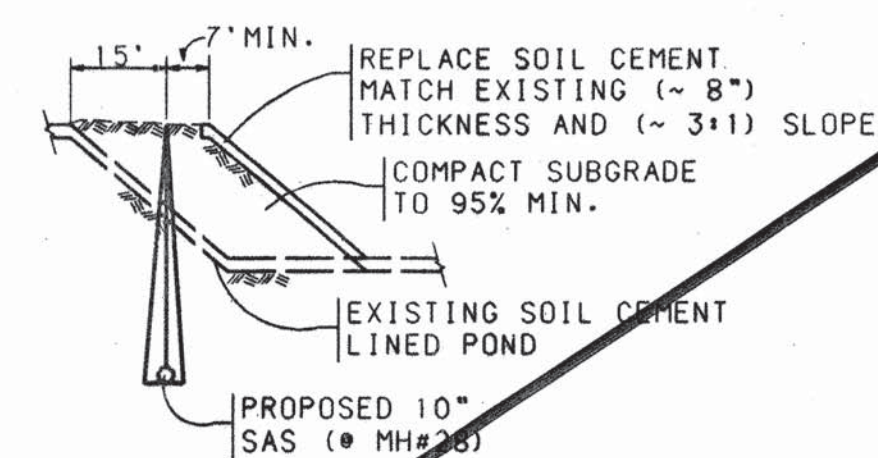

SECTION C-C
NO SCALE

SECTION B-B
NO SCALE


MATCHLINE STA. 10+00.00
SEE SHEET 17C OF 18

OFFSITE SAS LINE

**NOT FOR CONSTRUCTION
TO BE BUILT UNDER
SEPARATE CONTRACT
SEE PLAN SET COA # 671581**

- NOTES**
1. THE CONTRACTOR SHALL FIELD VERIFY ALL EXISTING UTILITY LOCATIONS AND NOTIFY THE ENGINEER IMMEDIATELY OF ANY DISCREPANCIES.
 2. ALL CURB RETURN RADI SHALL BE 25' TO FACE OF CURB UNLESS OTHERWISE SPECIFIED.
 3. ALL CURVE DATA AND DIMENSIONS REFER TO FACE OF CURB UNLESS OTHERWISE SPECIFIED.
 4. GRADE ELEVATIONS, WHERE NOTED, ARE FOR TOP OF STANDARD CURB UNLESS OTHERWISE SPECIFIED.
 5. CONTRACTOR IS TO INSTALL A 4" X 5.5' POST AND EMD AT THE END OF EACH SANITARY SEWER SERVICE.
 6. CONTRACTOR IS RESPONSIBLE FOR REPAIR AND/OR REPLACEMENT OF ALL UTILITY CONDUITS AND EXISTING LINES.
 7. ANY ADDITIONAL GRADING REQUIRED TO MATCH PROPOSED STREET GRADES SHALL BE INCIDENTAL TO PAVING ITEMS.
 8. CONTRACTOR SHALL PROVIDE THE INSPECTORS, (CITY AND PRIVATE) WITH THE PROPOSED HYDROSTATIC TESTING PLAN. THE PLAN MUST BE APPROVED BEFORE TESTING OPERATIONS BEGIN.
 9. CONTRACTOR SHALL PARK EQUIPMENT AND VEHICLES AS NOT TO INTERFERE WITH NORMAL ACTIVITIES OF RESIDENTS OR OTHER CONTRACTORS ON SITE.
 10. ANY DAMAGE TO THE EXISTING FACILITIES (CURB AND GUTTER, PAVEMENT, CONDUITS, LANDSCAPING, UTILITY LINES, ETC.) DURING CONSTRUCTION SHALL BE REPLACED AT THE CONTRACTORS EXPENSE.
 11. REMOVAL OF THE EXISTING CURB AND GUTTER SHALL BE AS PER COA STD. DWG. 2415 (SAWCUT ONLY).
 12. WHEEL CHAIR RAMPS SHALL BE CONSTRUCTED PRIOR TO ACCEPTANCE OF CURB AND GUTTER.

2/1/00
9/20/02

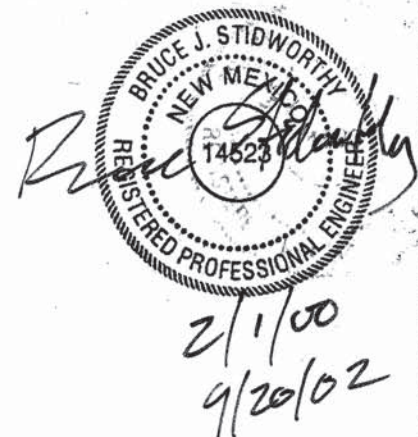

AS-BUILT INFORMATION			
CONTRACTOR	INSPECTOR'S	DATE	DATE
STAMPED BY	FIELD USE BY	DATE	DATE
NO.	BY	DATE	DATE
MICRO-FILM INFORMATION			
NO.	BY	DATE	DATE
NO.	BY	DATE	DATE

BOHANNAN-HUSTON INC.
ENGINEERS • PLANNERS • PHOTOGRAMMETRISTS • SURVEYORS • LANDSCAPE ARCHITECTS
ALBUQUERQUE LAS CRUCES SANTA FE

CITY OF ALBUQUERQUE
PUBLIC WORKS DEPARTMENT
ENGINEERING DEVELOPMENT GROUP

THE CROSSING SUBDIVISION UNIT I
UTILITY PLAN & PROFILE
OFFSITE SAS LINE


DESIGN REVIEW COMMITTEE CITY ENGINEER APPROVAL

APPROVED
FEB 27 2000
DESIGN


APPROVED
NOV - 8 2000
CITY ENGINEER

LAST DESIGN UPDATE


CITY PROJECT NO. 545381 ZONE MAP NO. H-9-J-9 SHEET 17D OF 18

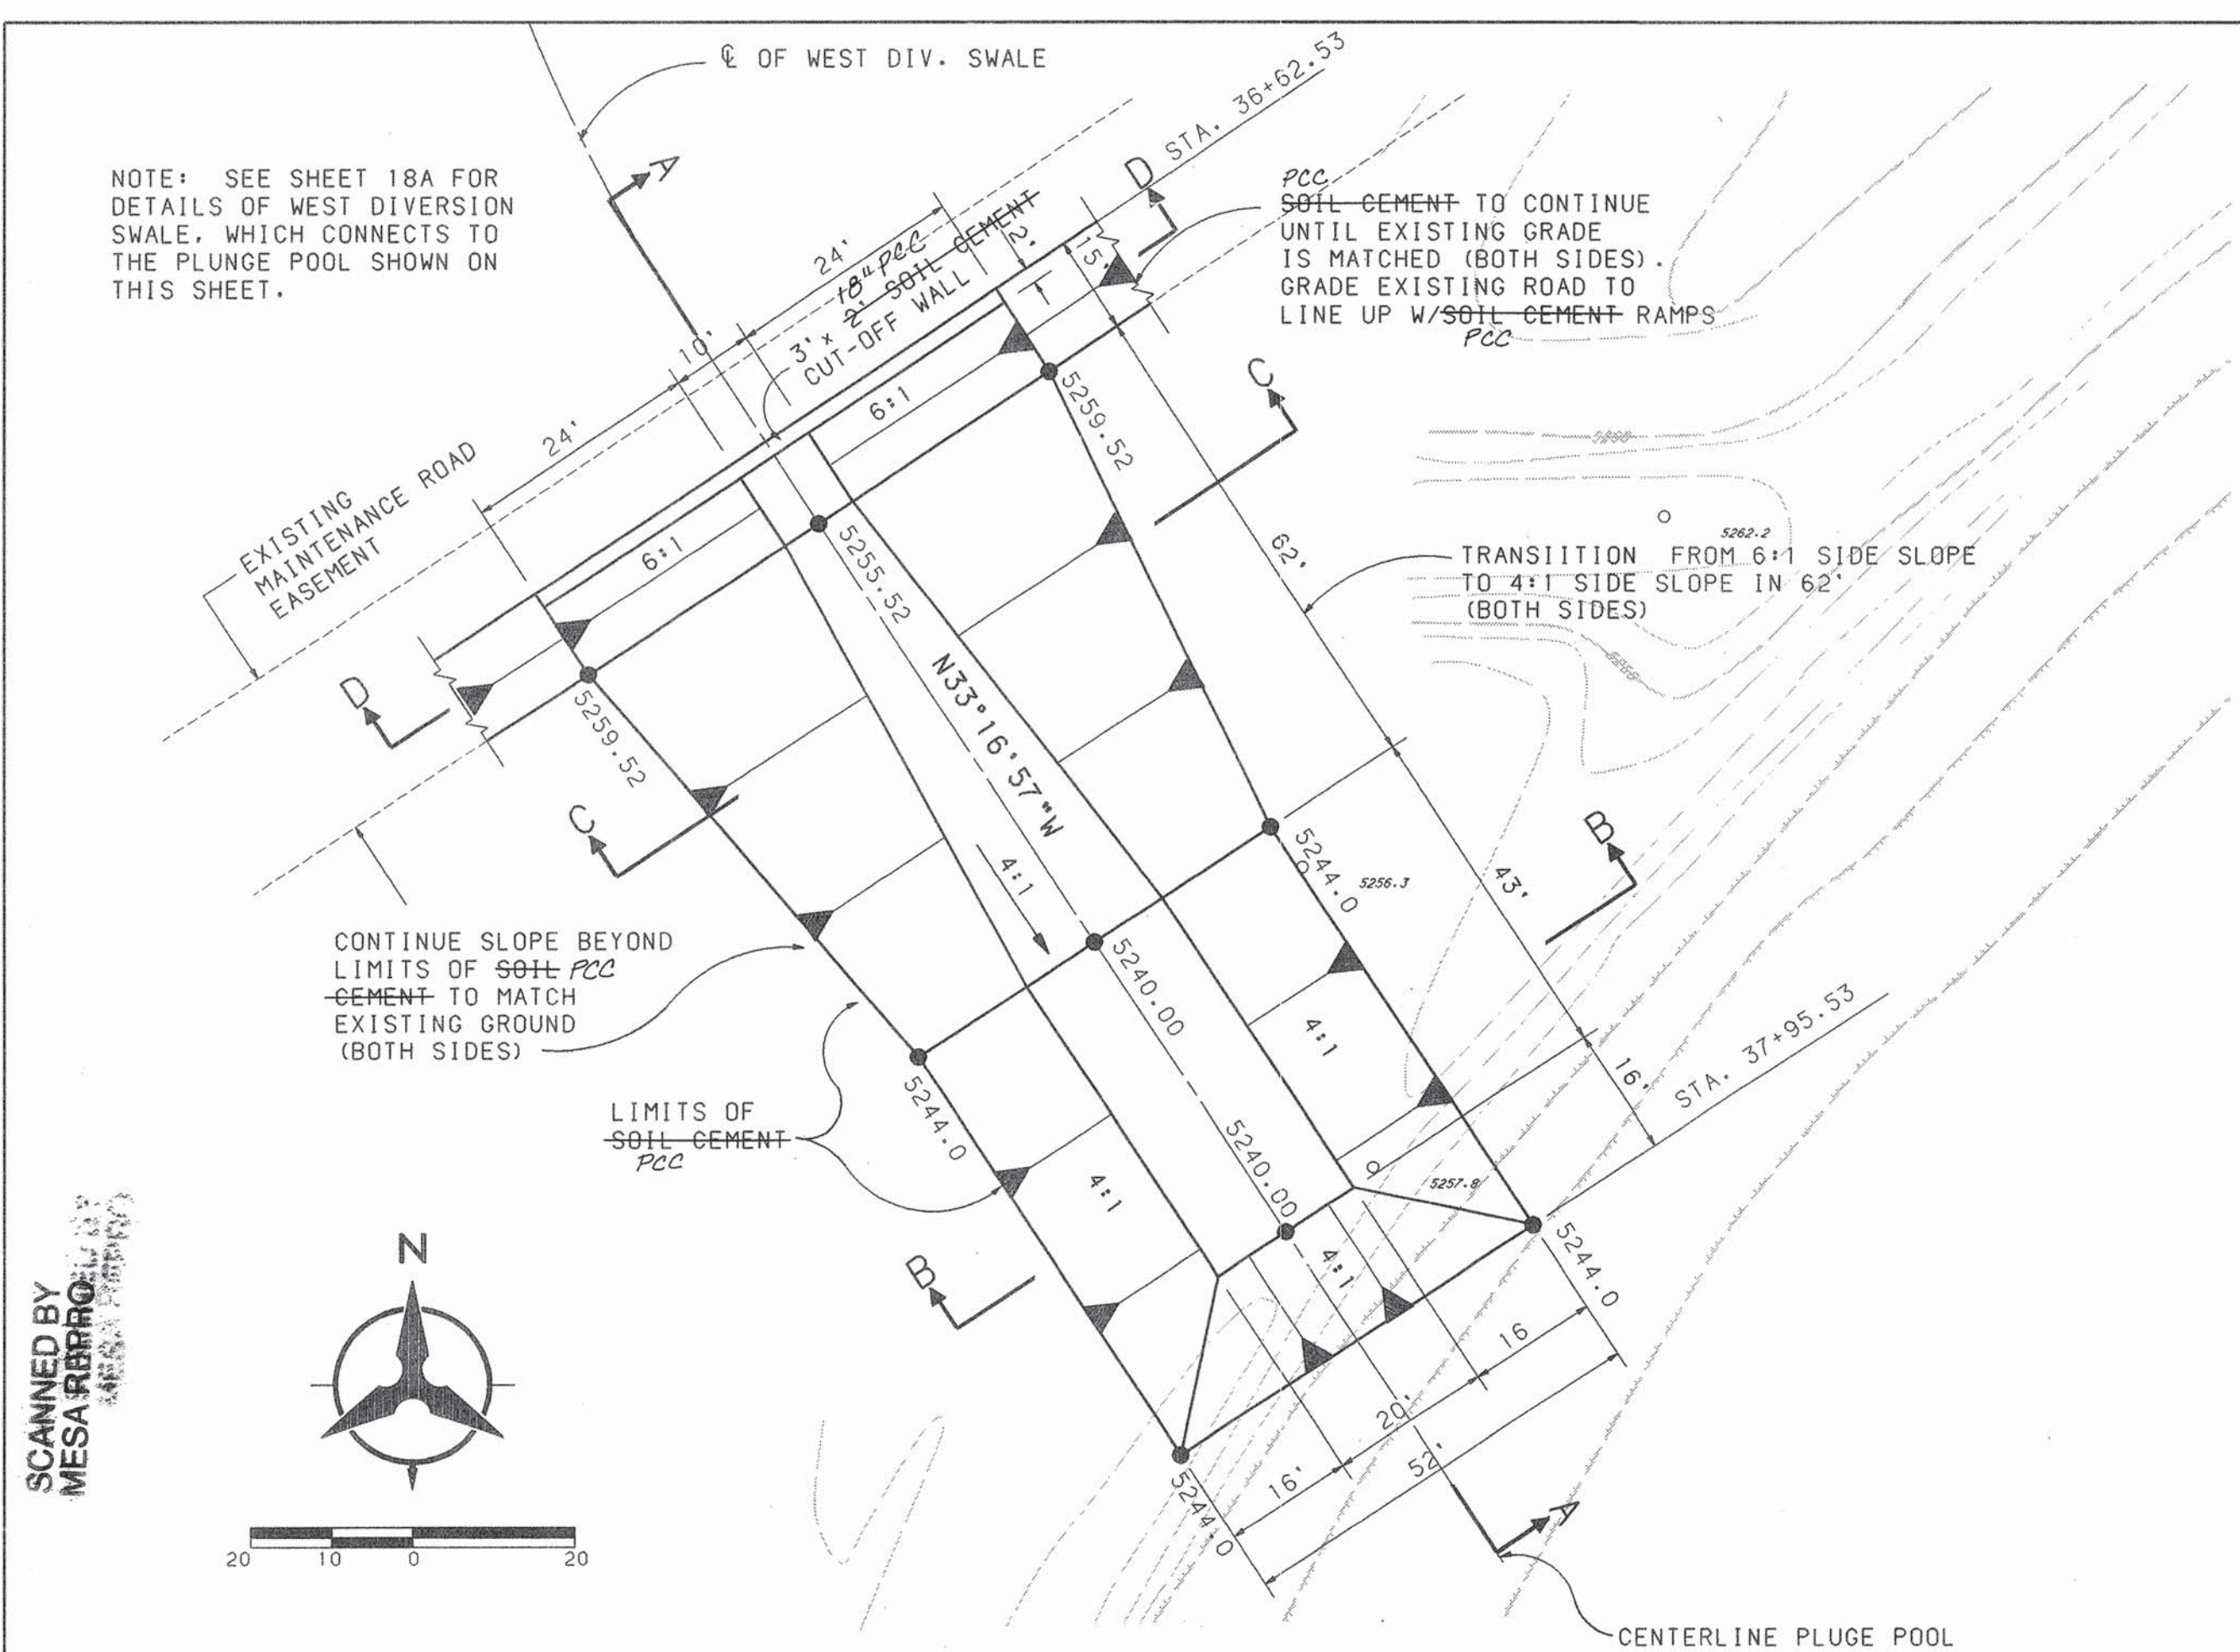


PLAN VIEW
SCALE: 1" = 20'

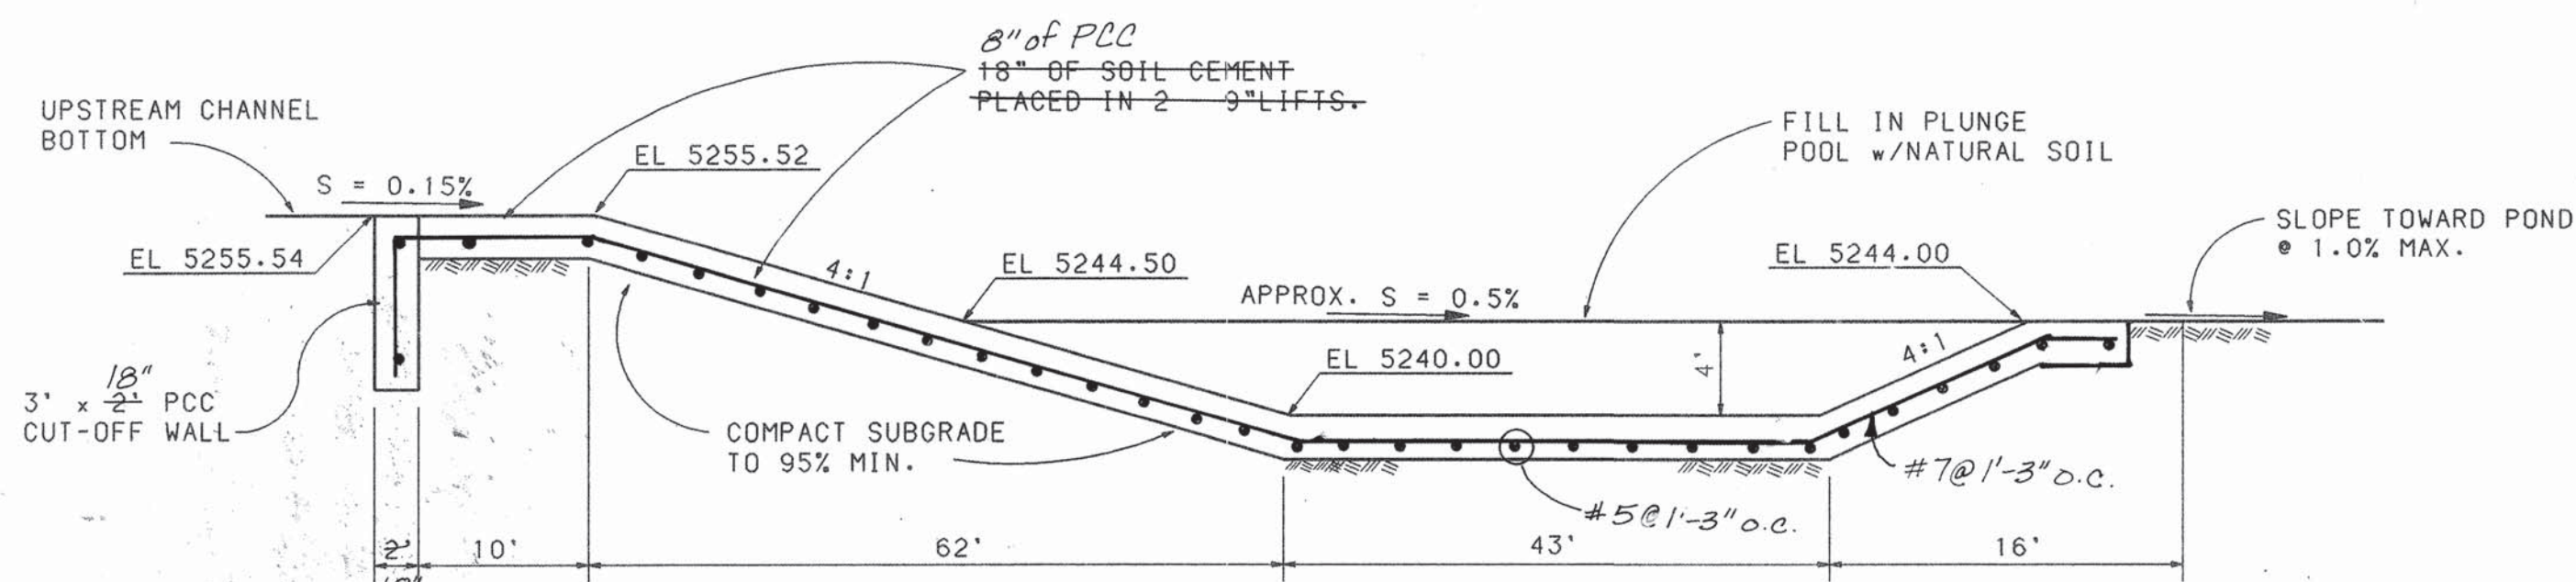


SECTION A-A
NO SCALE

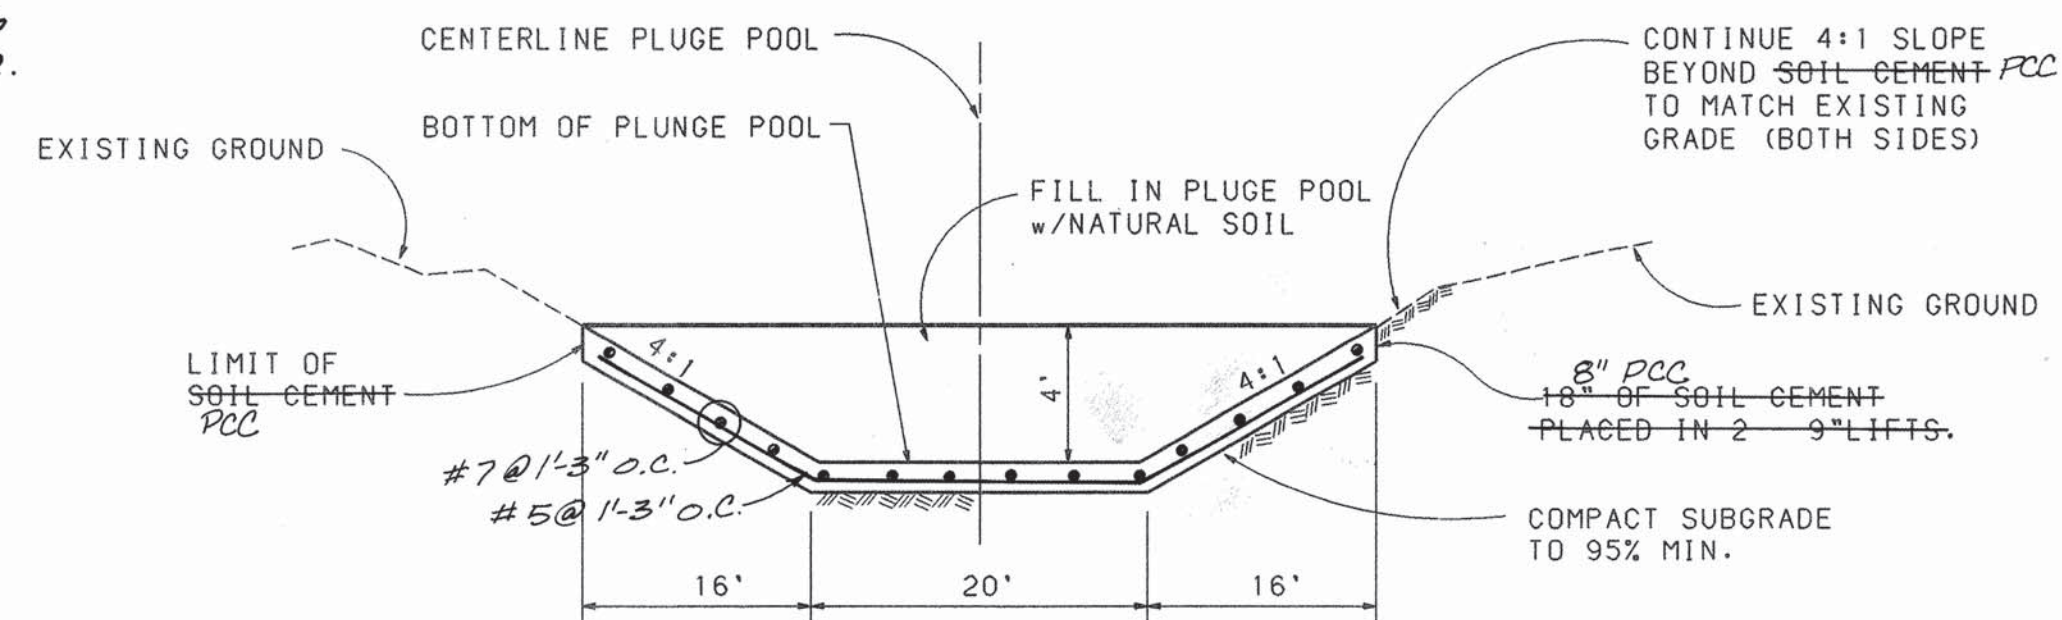

SECTION B-B
NO SCALE

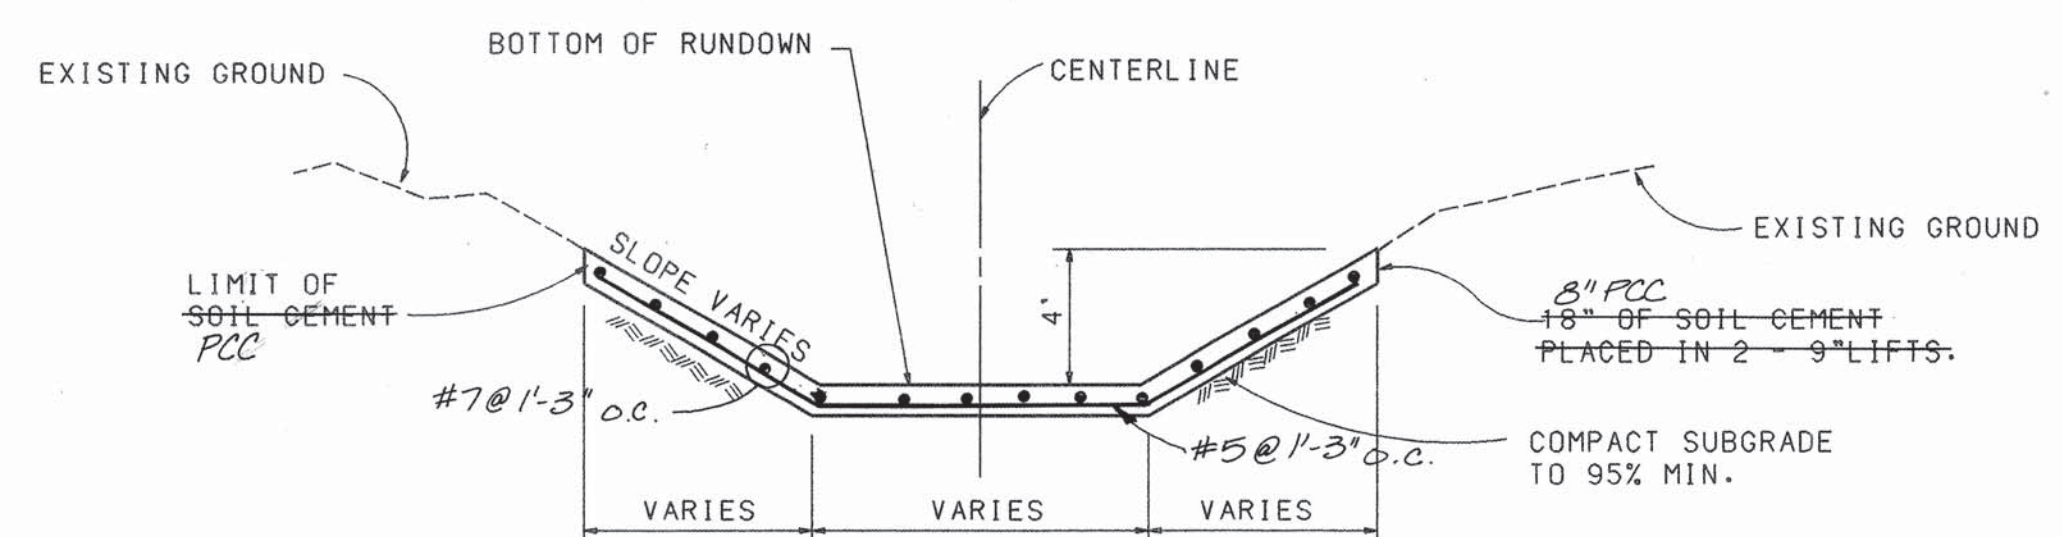

SECTION C-C
NO SCALE

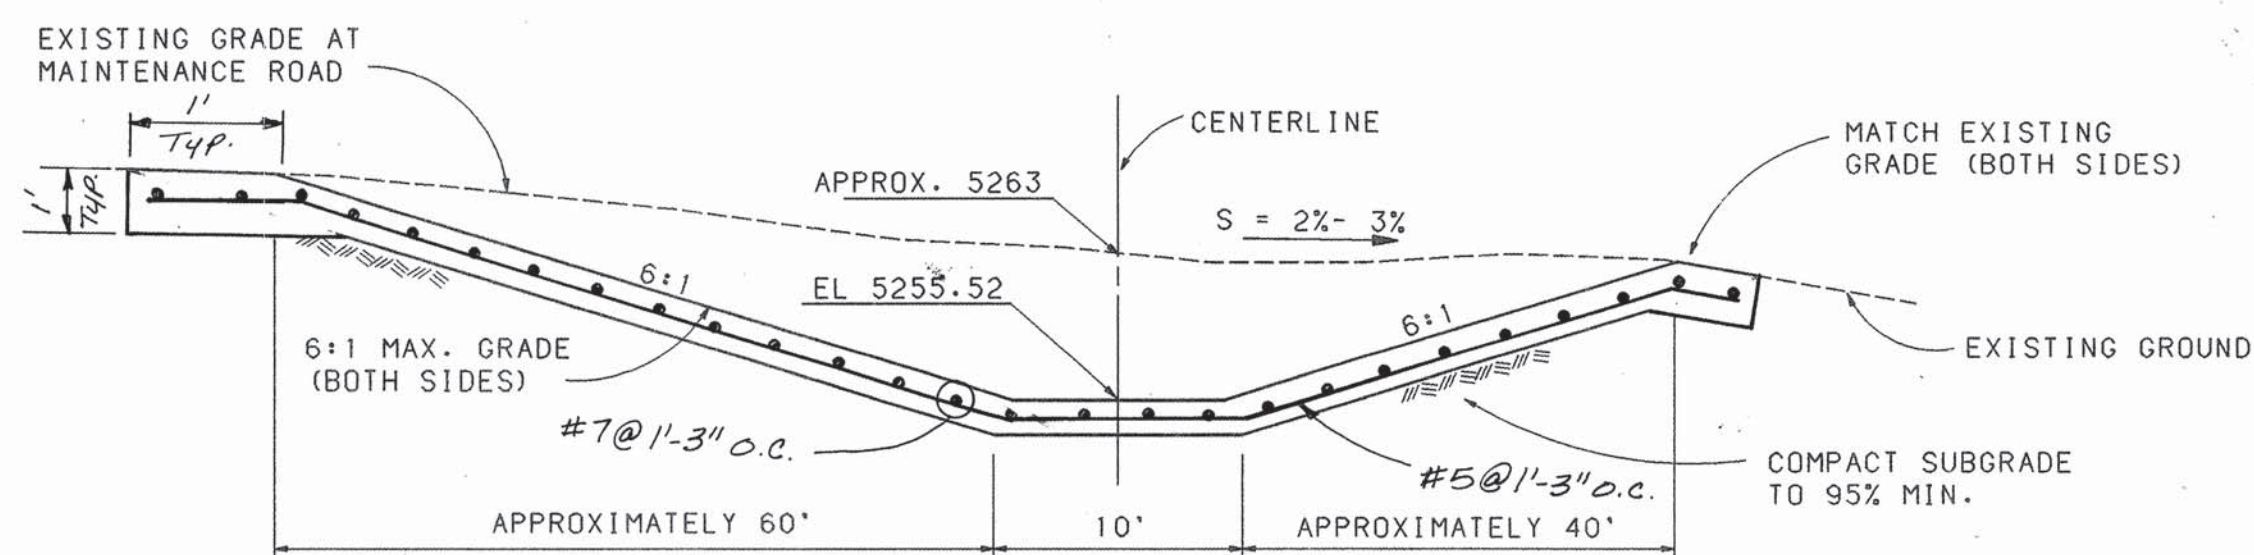

SECTION D-D
NO SCALE

NOTE: ALL SOIL CEMENT FACILITIES SHALL BE CONSTRUCTED IN ACCORDANCE WITH THE SUPPLEMENTAL TECHNICAL SPECIFICATIONS.

AS-BUILT INFORMATION		BENCH MARKS		SURVEY INFORMATION		ENGINEER'S SEAL		REVISIONS		DESIGN		CHECKED BY	
CONTRACTOR	DATE	AC'S ALUMINUM TABLE STAMPED "BH-40"	DATE	NO.	BY	NO.	BY	NO.	DATE	NO.	DATE	NO.	DATE
CONTRACTOR	DATE	GEOGRAPHIC POSITION (NAD 1927)	DATE										
STAMPED BY	DATE	N.M. STATE PLANE COORDINATES	DATE										
FIELD LOCATION BY	DATE	(CENTRAL ZONE) X = 362,790.66	DATE										
DESIGNED BY	DATE	Y = 1,492,346.53	DATE										
CHECKED BY	DATE	GROUND TO GRID FACTOR = 0.99967105	DATE										
RECORDED BY	DATE	D = 00° 16' 59"	DATE										
		NGVD 1929 ELEVATION = 5305.43											




BOHANNAN-HUSTON INC.
ENGINEERS • PLANNERS • PHOTOGRAMMETRISTS • SURVEYORS • LANDSCAPE ARCHITECTS
ALBUQUERQUE LAS CRUCES SANTA FE

CITY OF ALBUQUERQUE
PUBLIC WORKS DEPARTMENT
ENGINEERING DEVELOPMENT GROUP

THE CROSSING SUBDIVISION UNIT I
SOIL CEMENT PLUNGE POOL
PLUNGE POOL DETAIL SHEET

DESIGN REVIEW COMMITTEE	CITY ENGINEER APPROVAL	MO./DAY/YR.	MO./DAY/YR.
APPROVED	APPROVED		
DESIGN REVIEW COMMITTEE	CITY ENGINEER		

CITY PROJECT NO. **545381** ZONE MAP NO. **H9.J9** SHEET **18** OF **18**


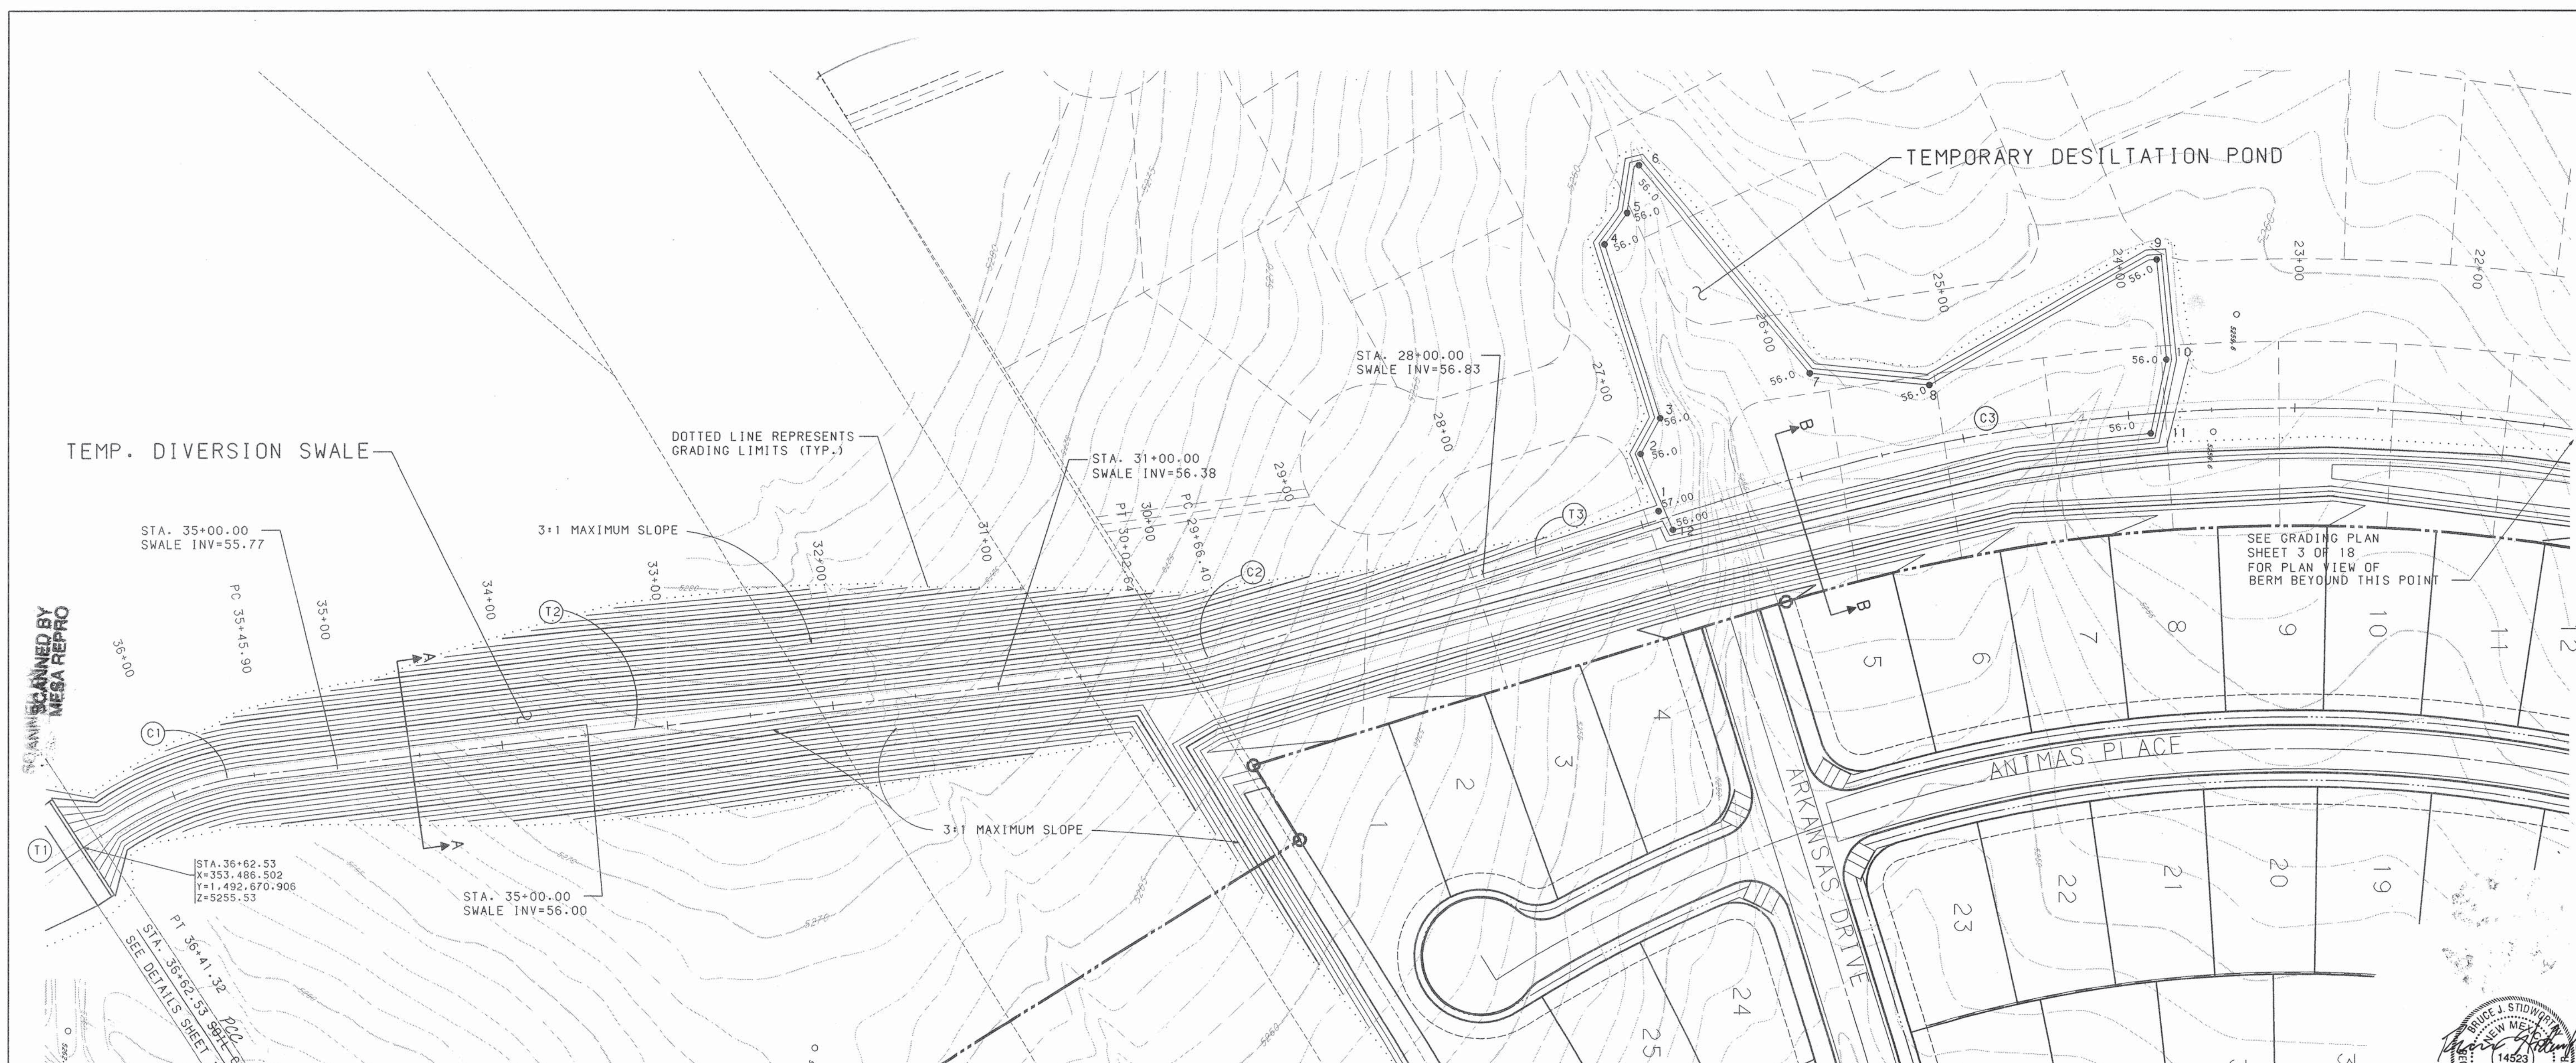


CENTERLINE CURVE DATA TABLE						
NUMBER	PI STA.	DELTA	TANGENT	ARC	RADIUS	
C1	35+95.95	26°28'38.2"	47.05'	92.42'	200.00'	
C2	29+84.57	10°22'57.0"	18.17'	36.24'	200.00'	
C3	23+86.30	25°54'34.3"	253.54'	498.42'	1102.19'	


CENTERLINE TANGENT DATA TABLE		
NUMBER	BEARING	DISTANCE
T1	N33°16'57"W	133.00'
T2	S06°48'19"E	546.26'
T3	S17°11'16"W	335.22'

DESILTATION POND X & Y COORDINATES		
1	X=348,087.10	Y=1,491,852.14
2	X=353,250.24	Y=1,493,606.18
3	X=353,228.78	Y=1,493,617.88
4	X=353,124.38	Y=1,493,584.40
5	X=353,105.86	Y=1,493,597.97
6	X=353,077.36	Y=1,493,602.22
7	X=353,202.33	Y=1,493,707.68
8	X=353,209.25	Y=1,493,779.57
9	X=353,133.56	Y=1,493,915.96
10	X=353,194.18	Y=1,493,921.90
11	X=353,238.02	Y=1,493,912.47
12	X=353,295.52	Y=1,493,625.58

WATER SURFACE TABLE			
	Q=(cfs)	D	V=(fps)
100 YR.	178	3.05'	3.04'
10 YR.	40.9	1.43'	2.01'

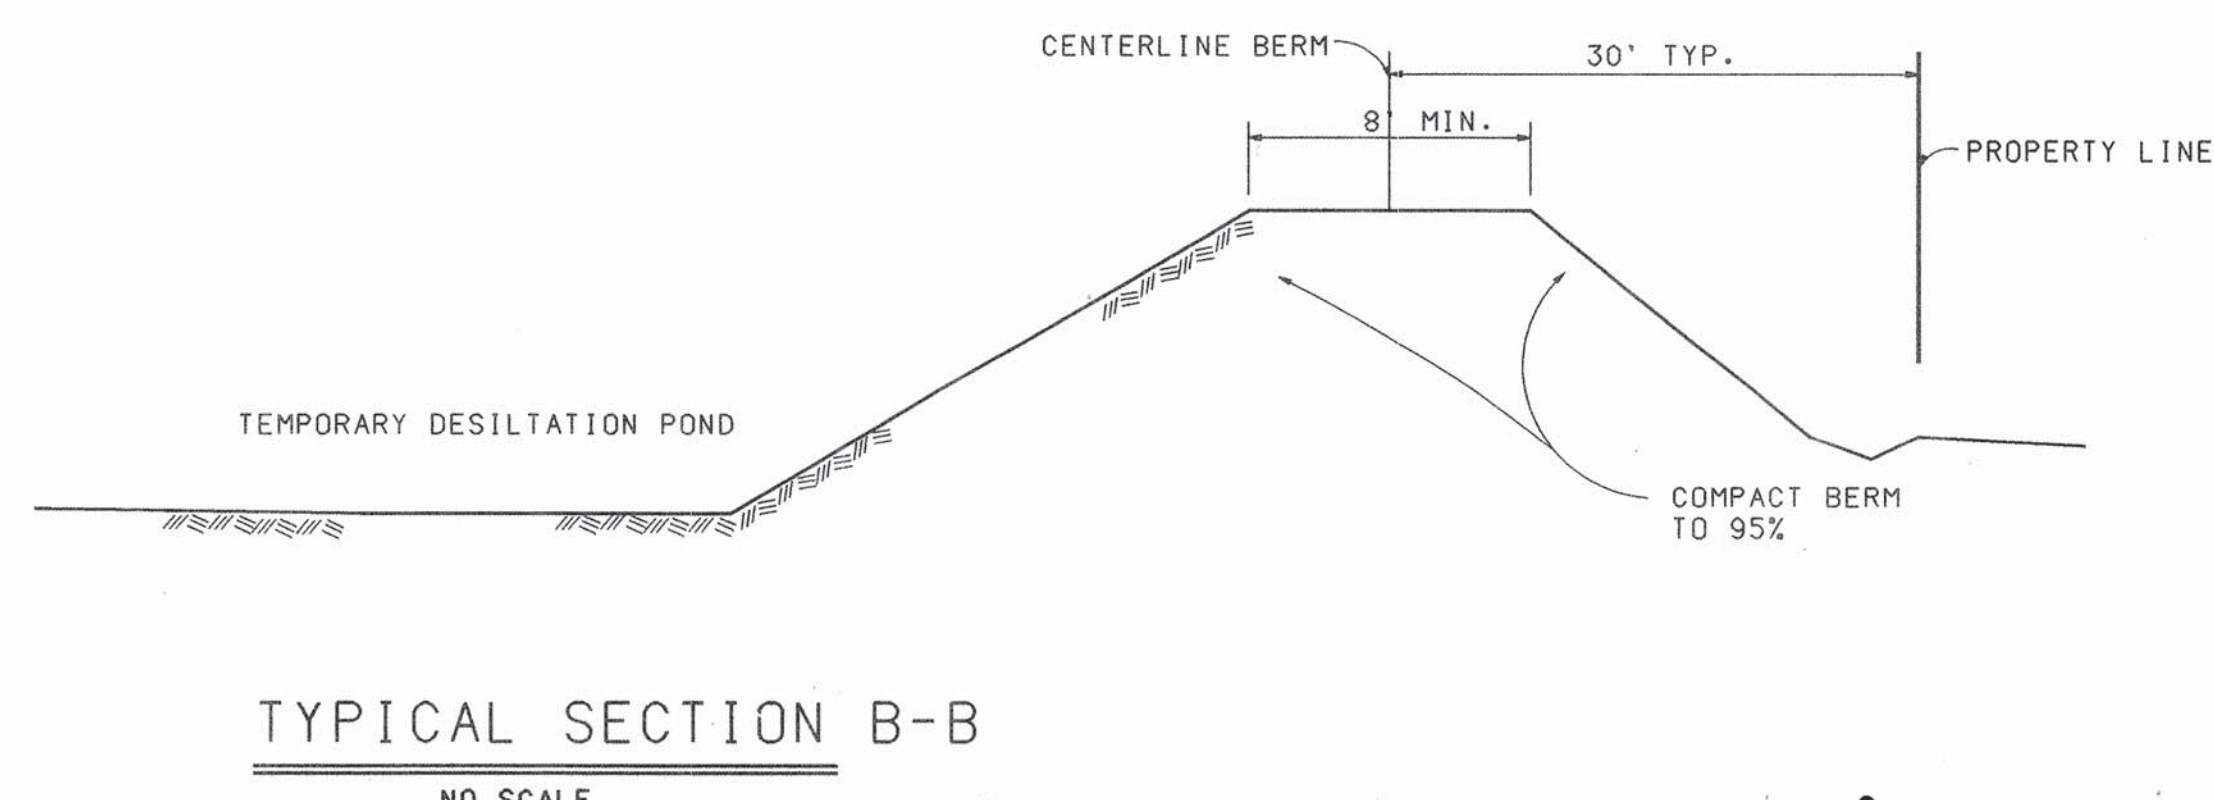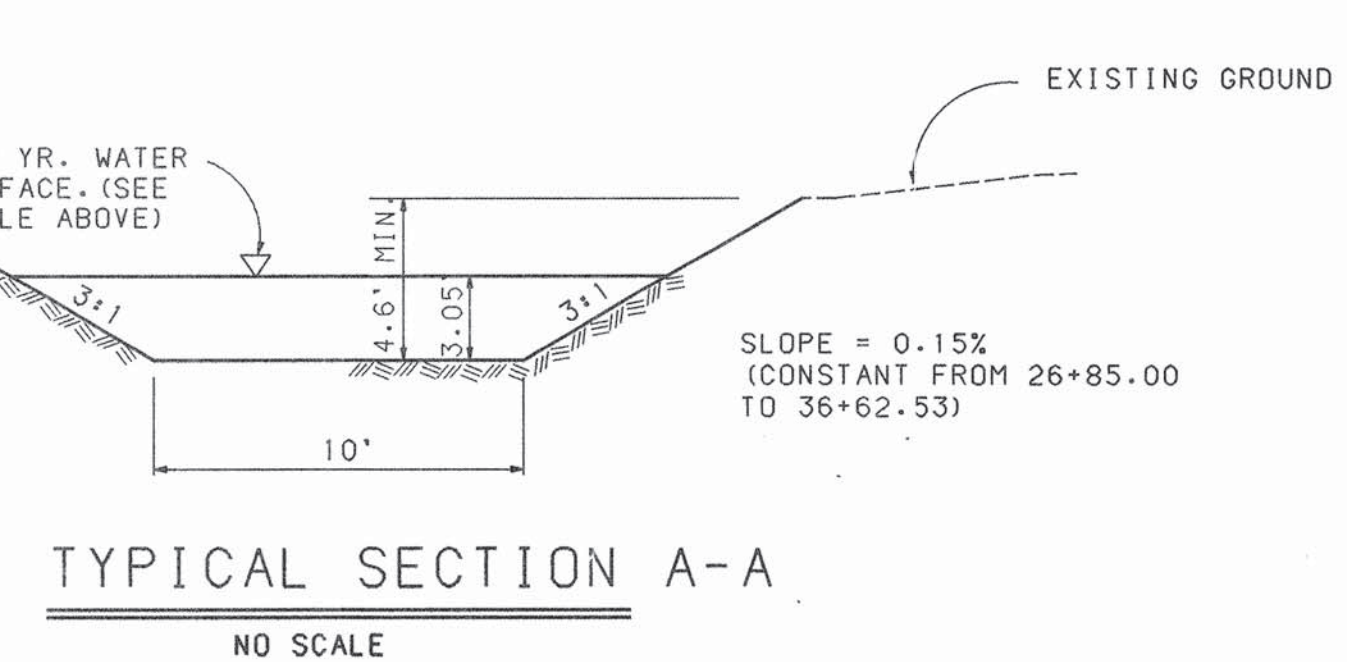

- NOTES:
- THE CONTRACTOR SHALL NOT GRADE OR DISTURB GROUND BEYOND GRADING LIMITS SHOWN.
 - SWALE, BERM AND DESILTATION POND SHALL BE RESEED PER COA STD. SPECS. SECTION 1012. SEE NOTE 8 ON GRADING PLAN.

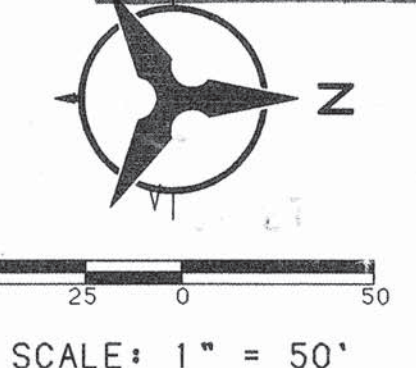

BOHANNAN-HUSTON INC.
ENGINEERS • PLANNERS • PHOTOGRAMMETRISTS • SURVEYORS • LANDSCAPE ARCHITECTS
ALBUQUERQUE LAS CRUCES SANTA FE


CITY OF ALBUQUERQUE
PUBLIC WORKS DEPARTMENT
ENGINEERING DEVELOPMENT GROUP

THE CROSSING SUBDIVISION UNIT I
DETAILS
WEST DIVERSION SWALE

DESIGN REVIEW COMMITTEE	CITY ENGINEER APPROVAL	MO/DAY/YR.	MO/DAY/YR.
CITY PROJECT NO. 545381	ZONE MAP NO. H9.J9	SHEET 18A	OF 18

ENGINEER'S SEAL		SURVEY INFORMATION		BENCH MARKS		AS-BUILT INFORMATION	
	BY	NO.	DATE	AS ALUMINUM TABLE STAMPED "BH-40"	CONTRACTOR	DATE	DATE
				GEOGRAPHIC POSITION (NAD 1927)	STAMPED BY		
				N.M. STATE PLANE COORDINATES	INSPECTOR'S		
				(CENTRAL ZONE) X = 362,790.66	FIELD CHANGE BY		
				Y = 1,492,346.53	VERIFICATION BY		
				GROUND TO GRID FACTOR = 0.99967105	CORRECTED BY		
				D = 00° 16' 59"	MICRO-FILM INFORMATION		
				NGVD 1929 ELEVATION = 5305.43	RECORDED BY		
					NO.		

SCANNED BY
MESA REPRO

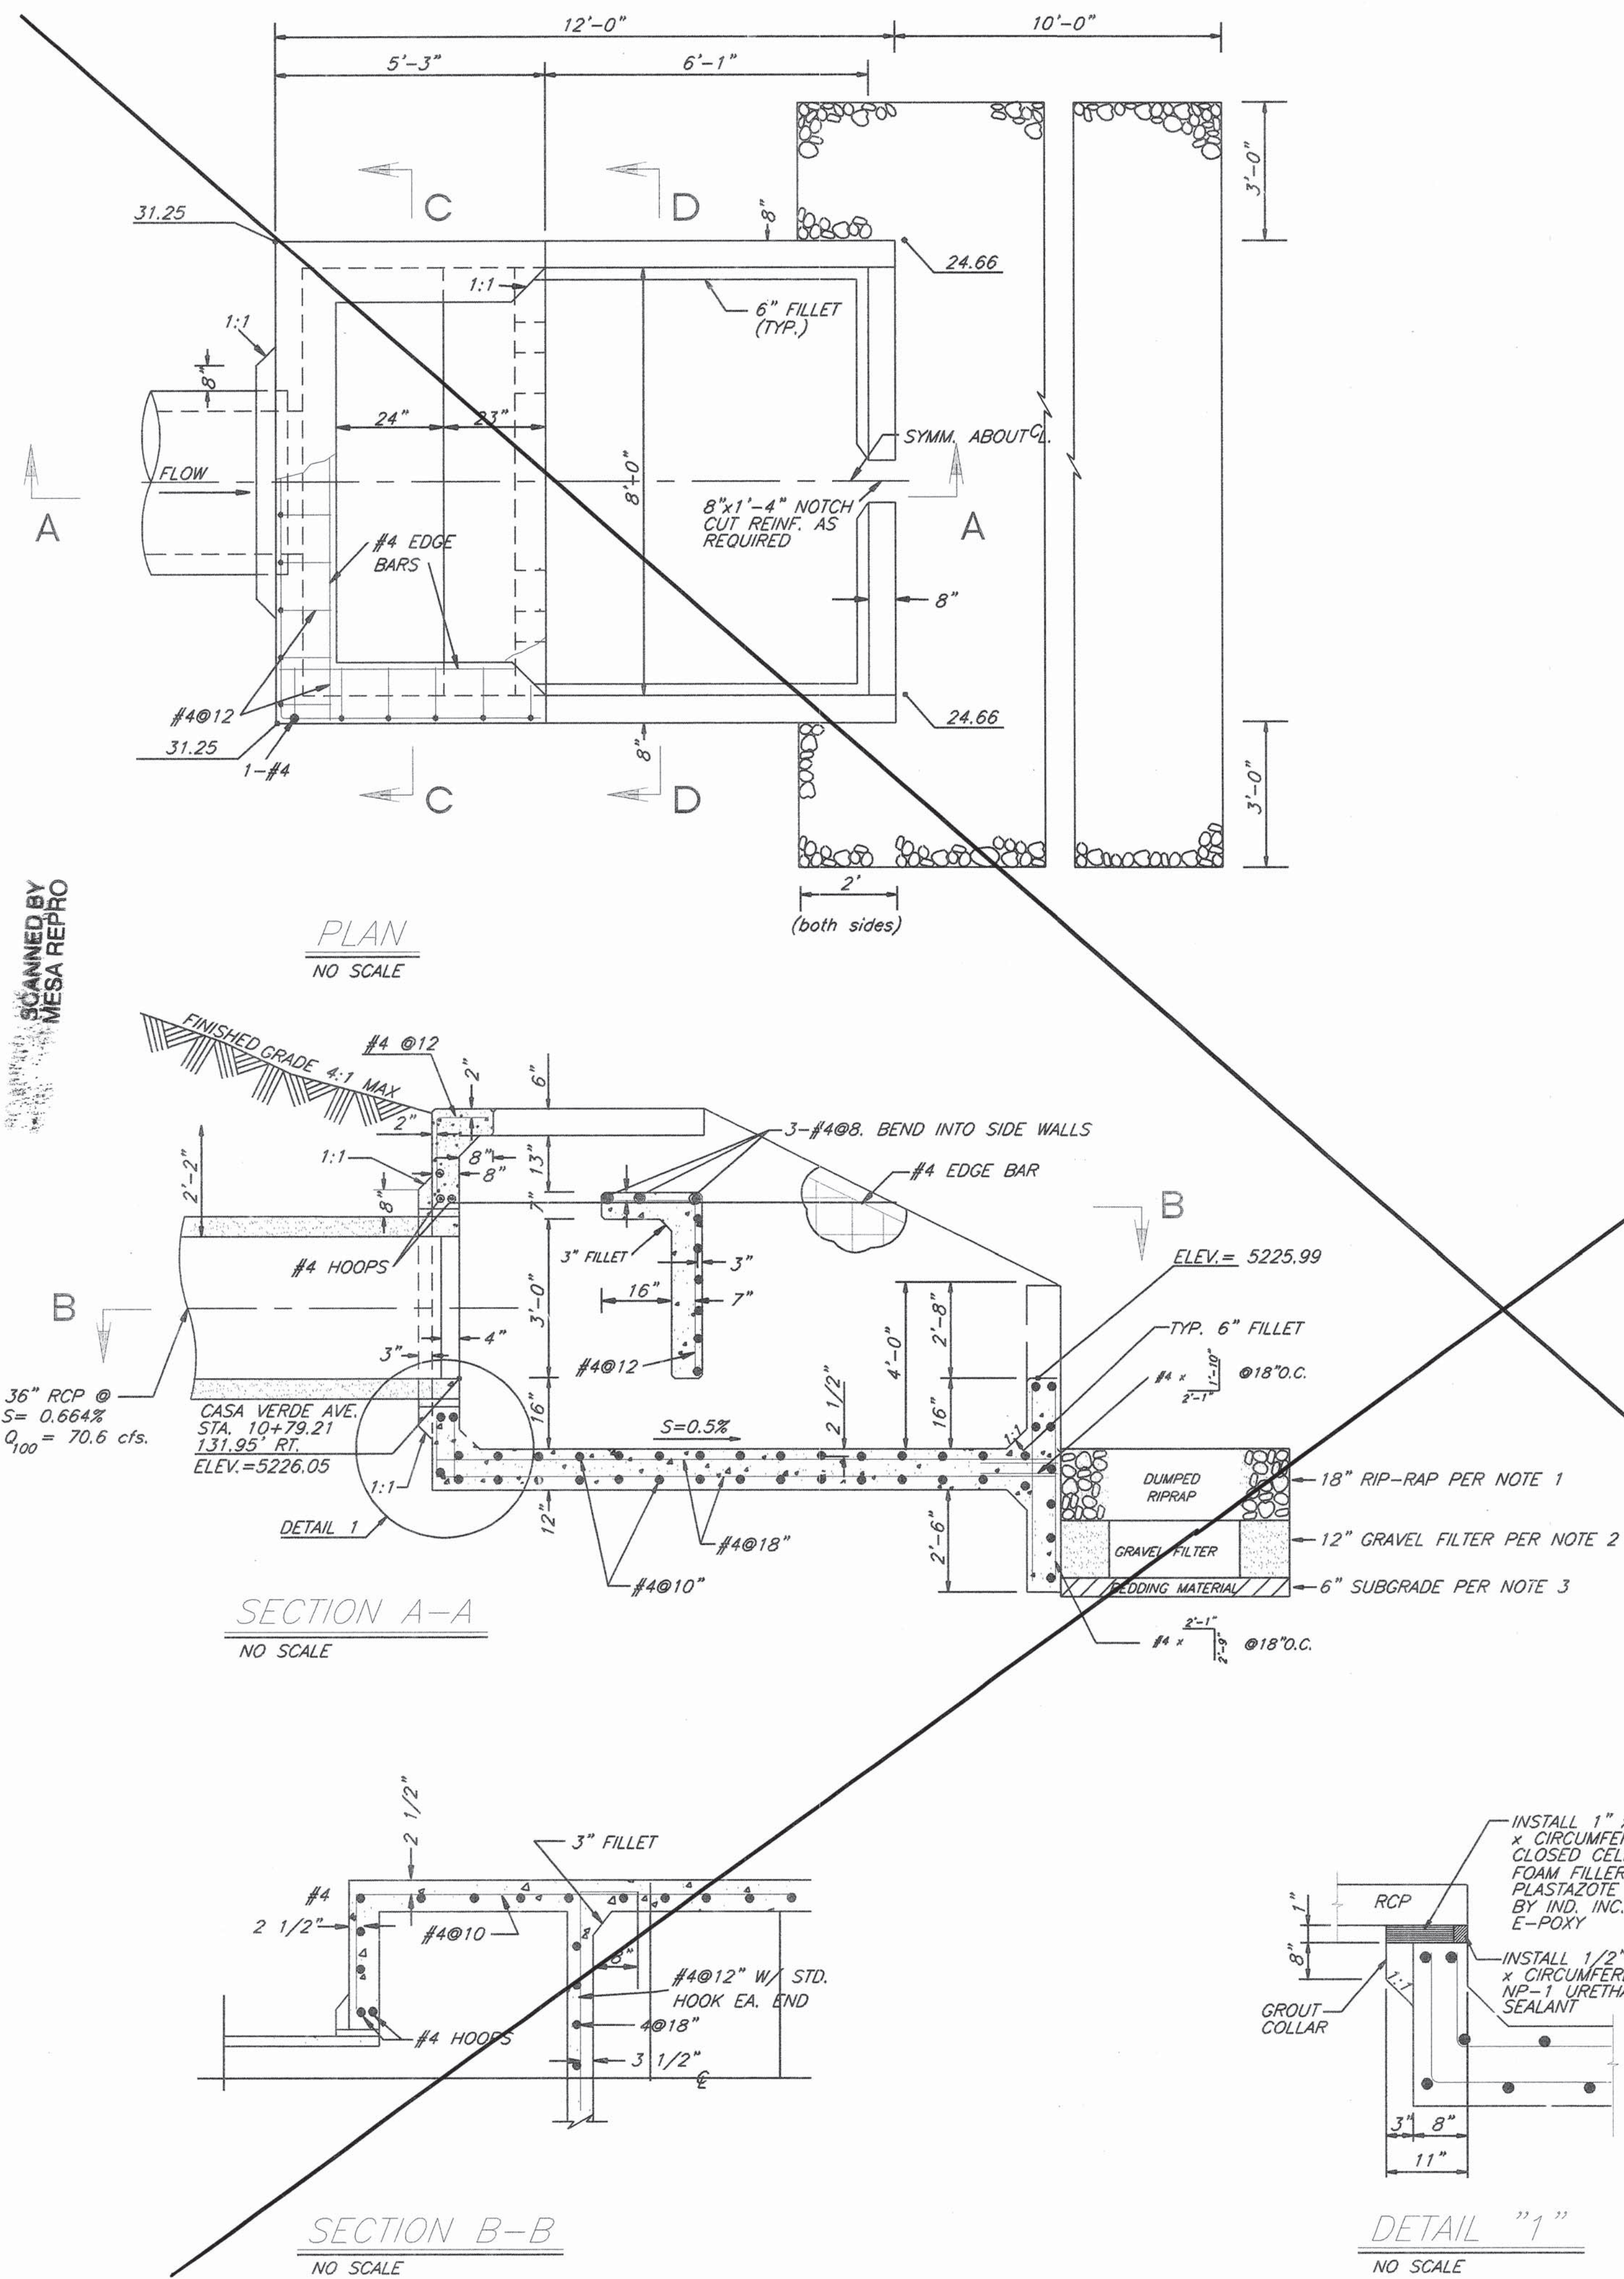

GENERAL STRUCTURAL NOTES

- CODES AND MANUALS:
Uniform Building Code, 1991 Edition
ACI 318, Latest Edition, Building Code Requirements for Reinforced Concrete.
- DESIGN LOADS:
A. Live Loads:
Soil Weight = 120 pcf
Equiv lateral = 40 pcf
Maximum Allowable soil bearing pressure: 2000psf*
*Allowable 1/3 stress increase for gravity and/or lateral loading.
- GENERAL:
A. The Contractor shall verify all dimensions in the field.
B. Shop drawings shall be furnished for review before any fabrication and erection is started. Poorly executed shop drawings shall be rejected and re submitted.
C. The Contractor shall be responsible for providing safe and adequate shoring for all parts of the wall and adjacent structures during construction, as well as worker safety and compliance with OSHA or other agency safety guidelines.
D. The Contractor shall field all existing utility locations and notify the Engineer immediately of any discrepancies.
E. The Contractor is responsible for repair and/or replacement of all utility conduits and existing lines.
F. The contractor shall park equipment and vehicles as not to interfere with normal activities of residents or other Contractors on site.
G. Any damage to existing facilities (curb and gutter, pavement, conduits, landscaping, utilities, ect.) during construction shall be replaced at the Contractors expense.
H. Chamfer all exposed corners 3/4" TYP.
- MATERIALS:
A. Cast-in-Place Concrete:
(1) All concrete shall conform to Standard Spec. Section 101. Concrete shall be 4000 psi for hydraulic structures.
B. Reinforcing Steel:
(1) All reinforcing steel shall conform to ASTM A615 Grade 60; except stirrups, ties, may conform to ASTM A615 Grade 40.
(2) Reinforcing shall be stored in such a manner as to inhibit rusting or the deposit of oils or other bond inhibiting deposits.
(3) Reinforcing steel shall be fabricated and placed in accordance with the Building Code Requirements for Reinforced Concrete (ACI 318) and the CRSI Standard Manual.
(4) Bar supports and spacers for rebar shall be provided in accordance with ACI and CRSI.
(5) All lap splices shall be class B.
(6) Concrete cover for reinforcing shall be as follows:
a. Concrete poured against earth 3 inches
b. Concrete poured in forms but exposed to weather or earth:
1. If bars are larger than No. 5 2 inches
2. If bars are No. 5 or smaller 1-1/2 inches
(7) The Contractor shall be responsible to see that all rebar is properly aligned and tied in place before placing concrete. All column, wall dowels and vertical steel shall be accurately located and secured in place so that it remains in the position shown during the concrete placing operation. Any rebar found to be improperly installed shall be removed at no additional cost to the Owner.
(8) Form ties shall be either of the threaded or snap-off type or other approved equal so that no metal will be left within 1 inch of the surface of the wall. Following removal of form ties, recesses are to be carefully filled and pointed with mortar.

**NOT FOR CONSTRUCTION
TO BE BUILT UNDER
SEPARATE CONTRACT
SEE PLAN SET
COA # 671581**

RIPRAP NOTES

- DUMPED RIPRAP SHALL BE INSTALLED IN ACCORDANCE WITH SECTION 603 OF THE STANDARD SPECIFICATIONS. RIPRAP SHALL BE TYPE M PER SECTION 109.
- RIPRAP SHALL BE PLACED ON GRAVEL FILTER MATERIAL. GRAVEL FILTER MATERIAL SHALL BE SUPPLIED AND INSTALLED PER SECTION 603.10 OF THE STANDARD SPECIFICATIONS, AND THE GRADATION SHALL BE AS FOLLOWS:

SIEVE SIZE	% PASSING
3"	90-100
3/4"	20-90
#4	0-20
#200	0-3
- RIPRAP SUBGRADE SCARIFIED AND COMPACTED TO A DEPTH OF 6" AT MINIMUM 90% ASTM D-1557 DENSITY.

NOTIFY AMAFCA 2 DAYS
PRIOR TO WORK IN R.O.W.
AMAFCA MUST INSPECT STEEL
& FORMWORK PRIOR TO
POURING CONCRETE



SCALE: 1"=50' (HORIZ.)
1"=10' (VERT.)

BOHANNAN-HUSTON INC.
ENGINEERS • PLANNERS • PHOTOGRAMMETRISTS • SURVEYORS • LANDSCAPE ARCHITECTS
ALBUQUERQUE LAS CRUCES SANTA FE







CITY OF ALBUQUERQUE
PUBLIC WORKS DEPARTMENT
ENGINEERING DEVELOPMENT GROUP

TITLE: THE CROSSING SUBDIVISION UNIT I
IMPACT BASIN DETAILS

DESIGN REVIEW COMMITTEE CITY ENGINEER APPROVAL
LAST DESIGN UPDATE

CITY PROJECT NO. 545381 ZONE MAP NO. H-9, J-9 SHEET 18B OF 18

COPYRIGHT BOHANNAN-HUSTON, INC.
8/96

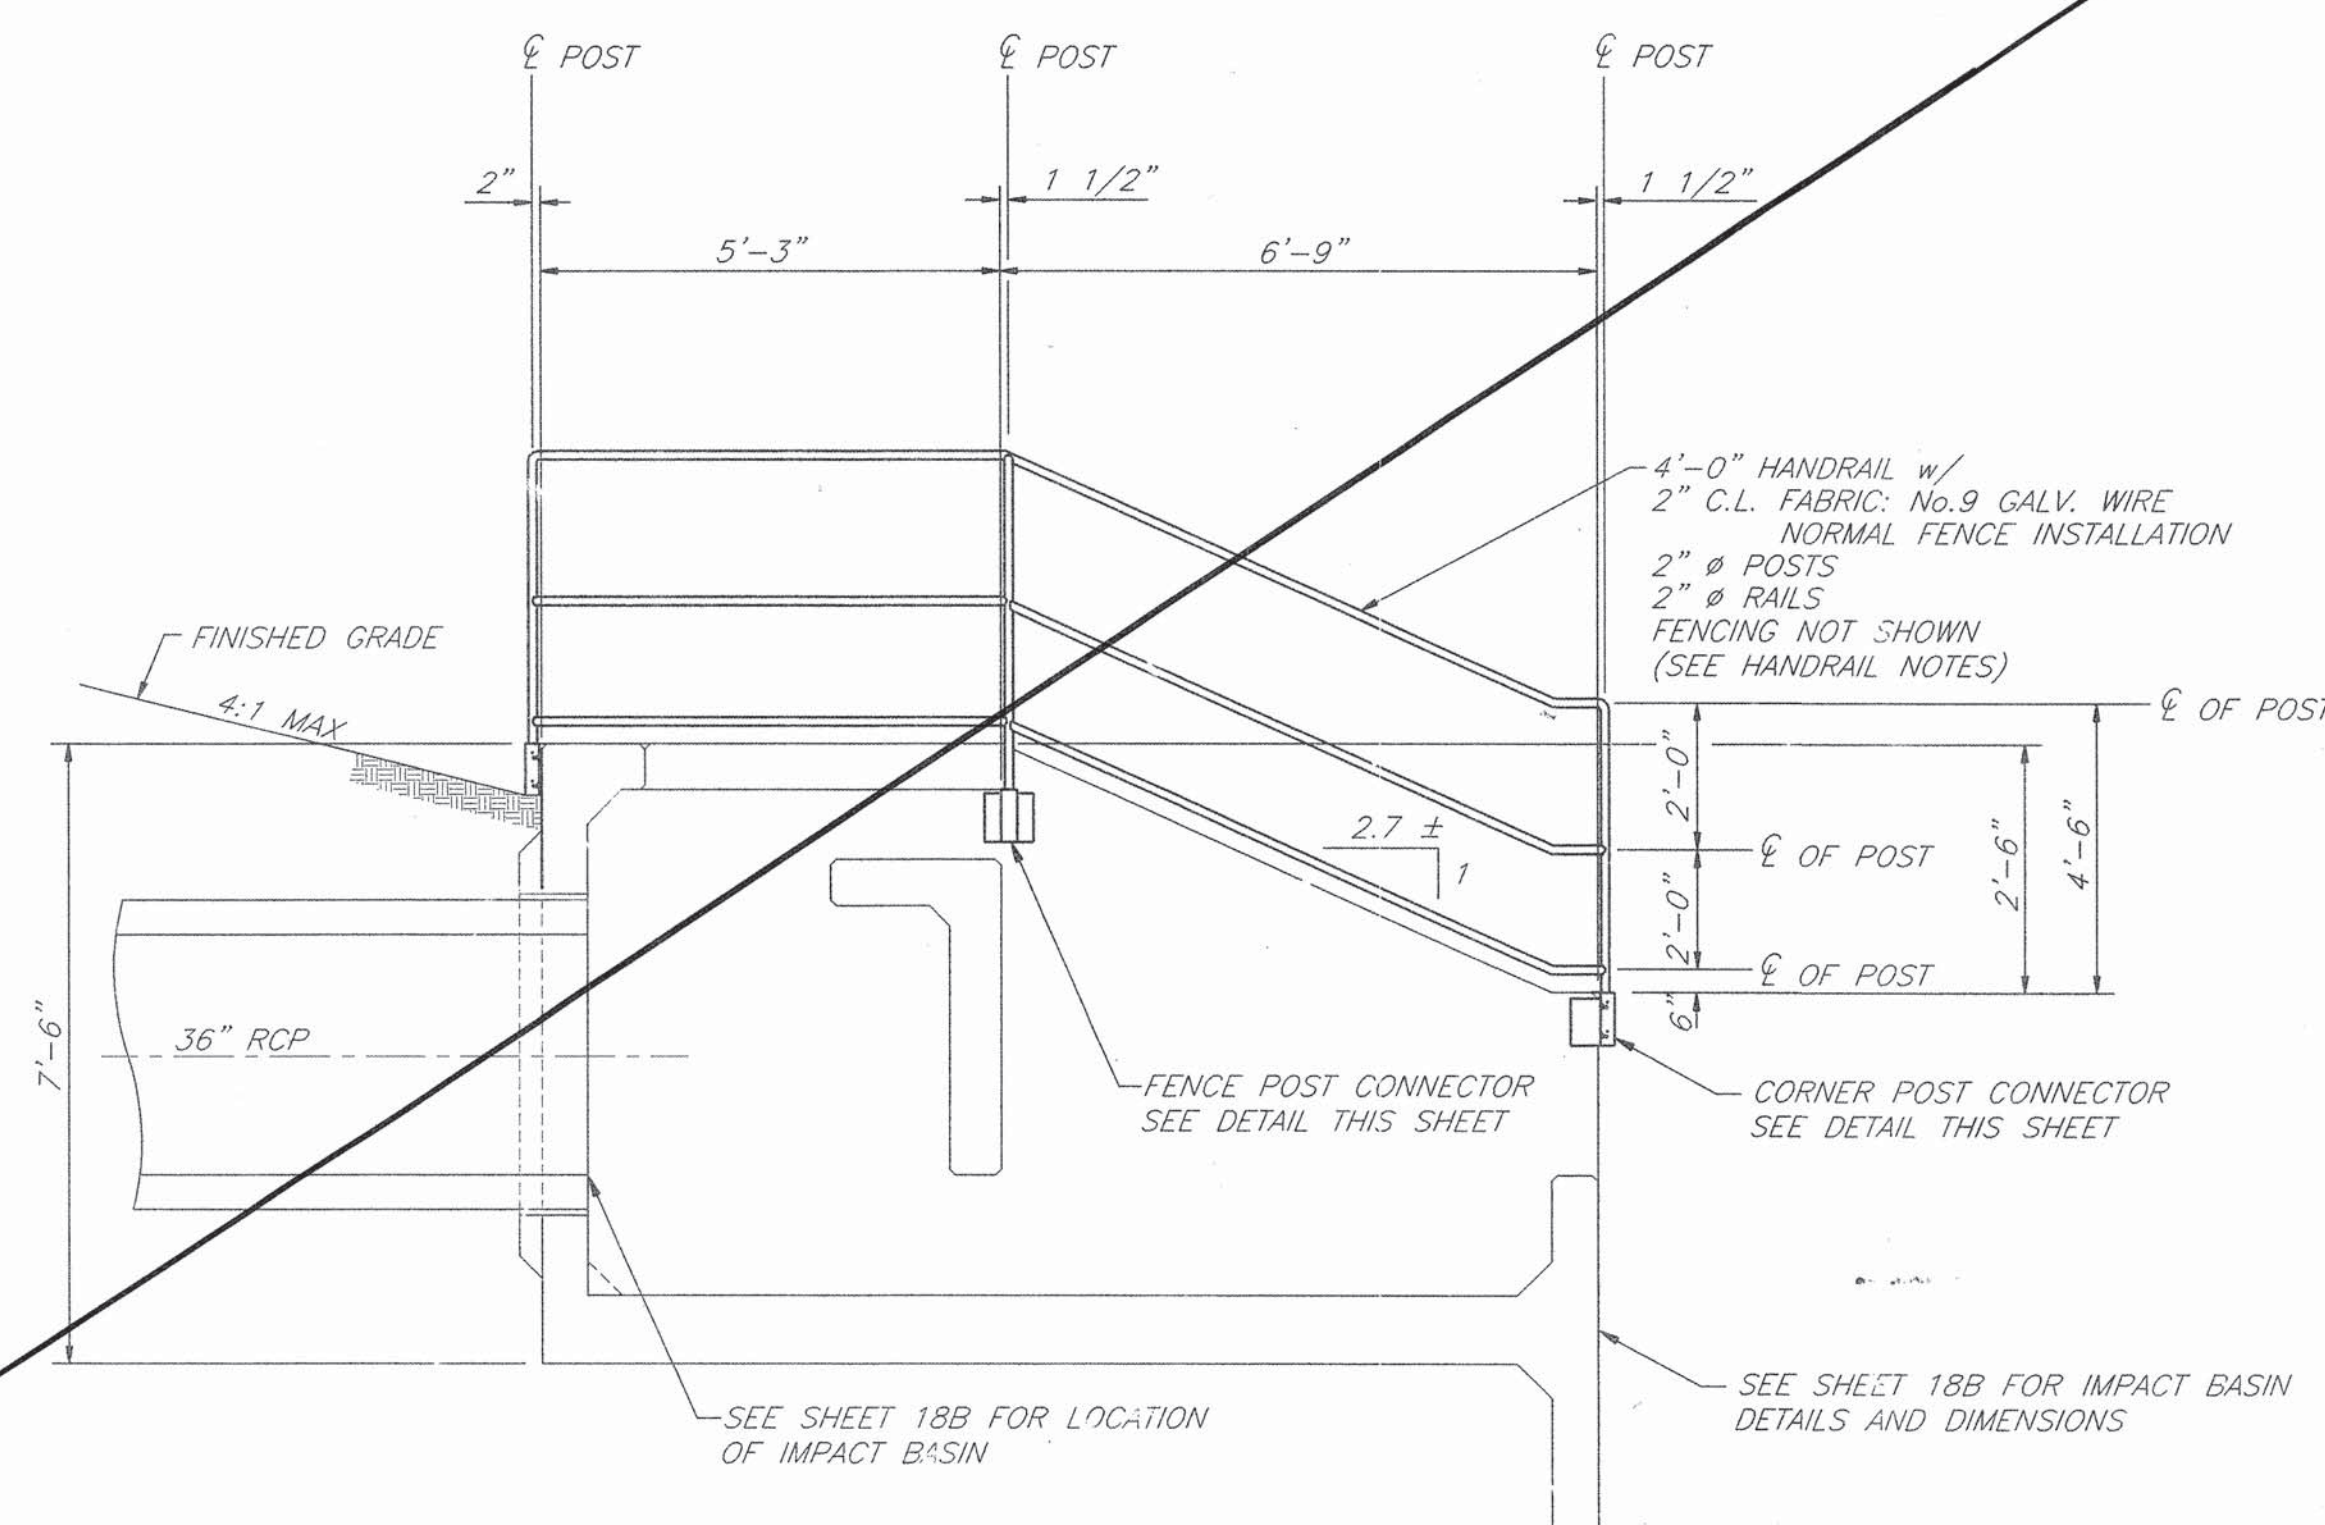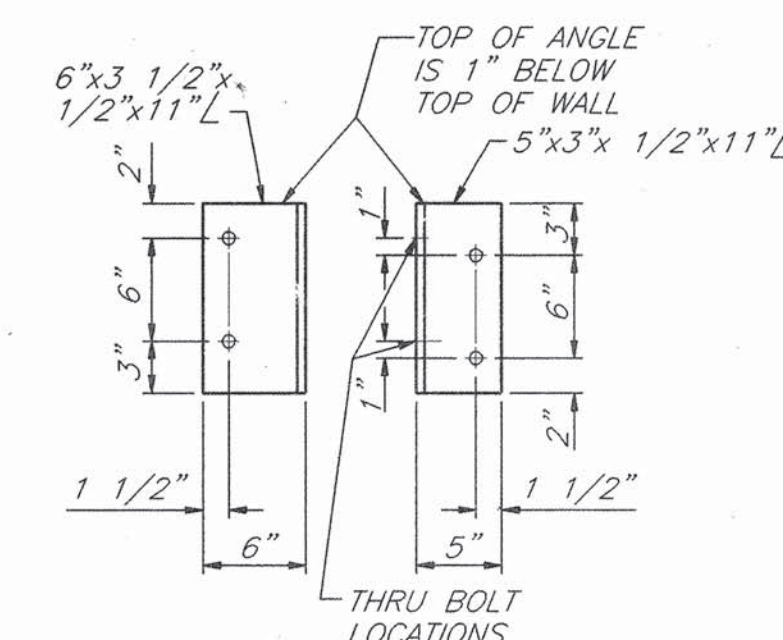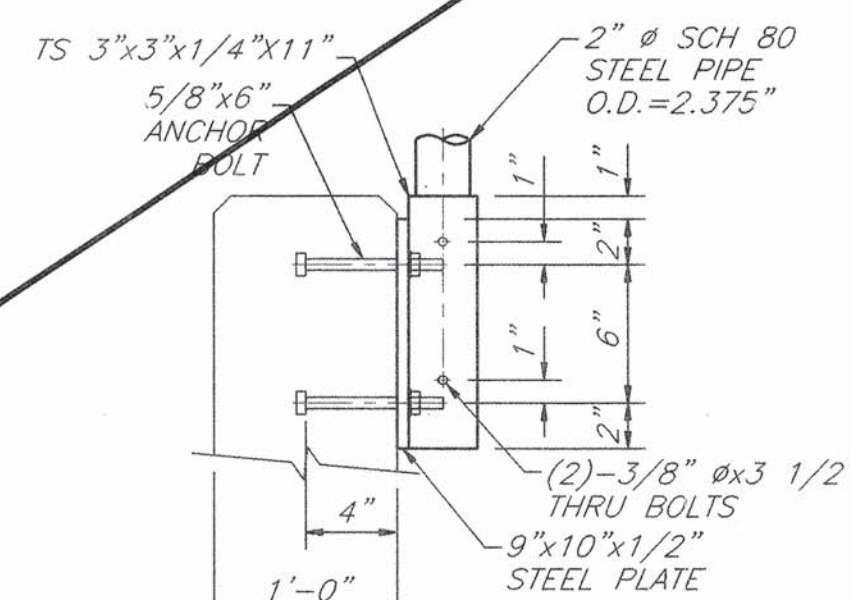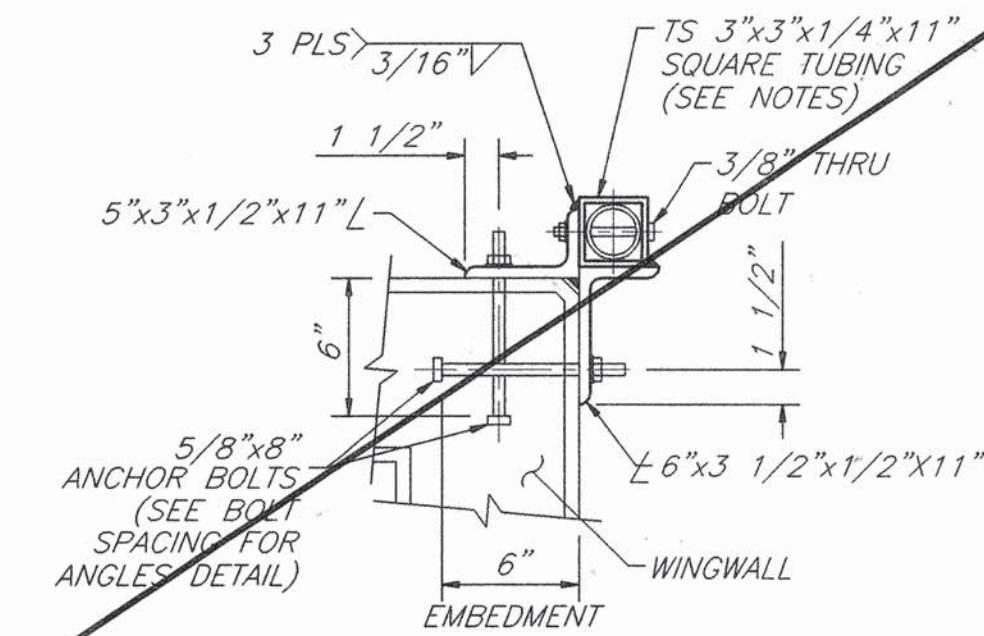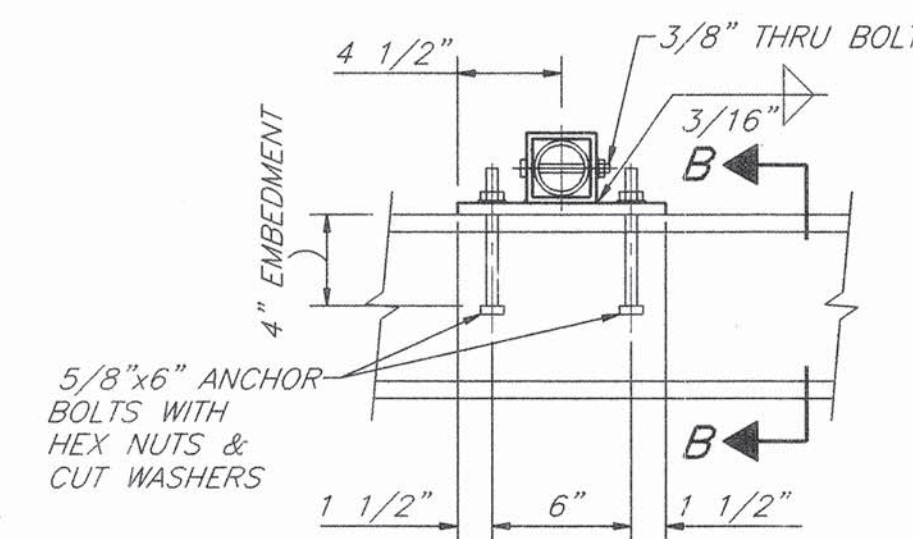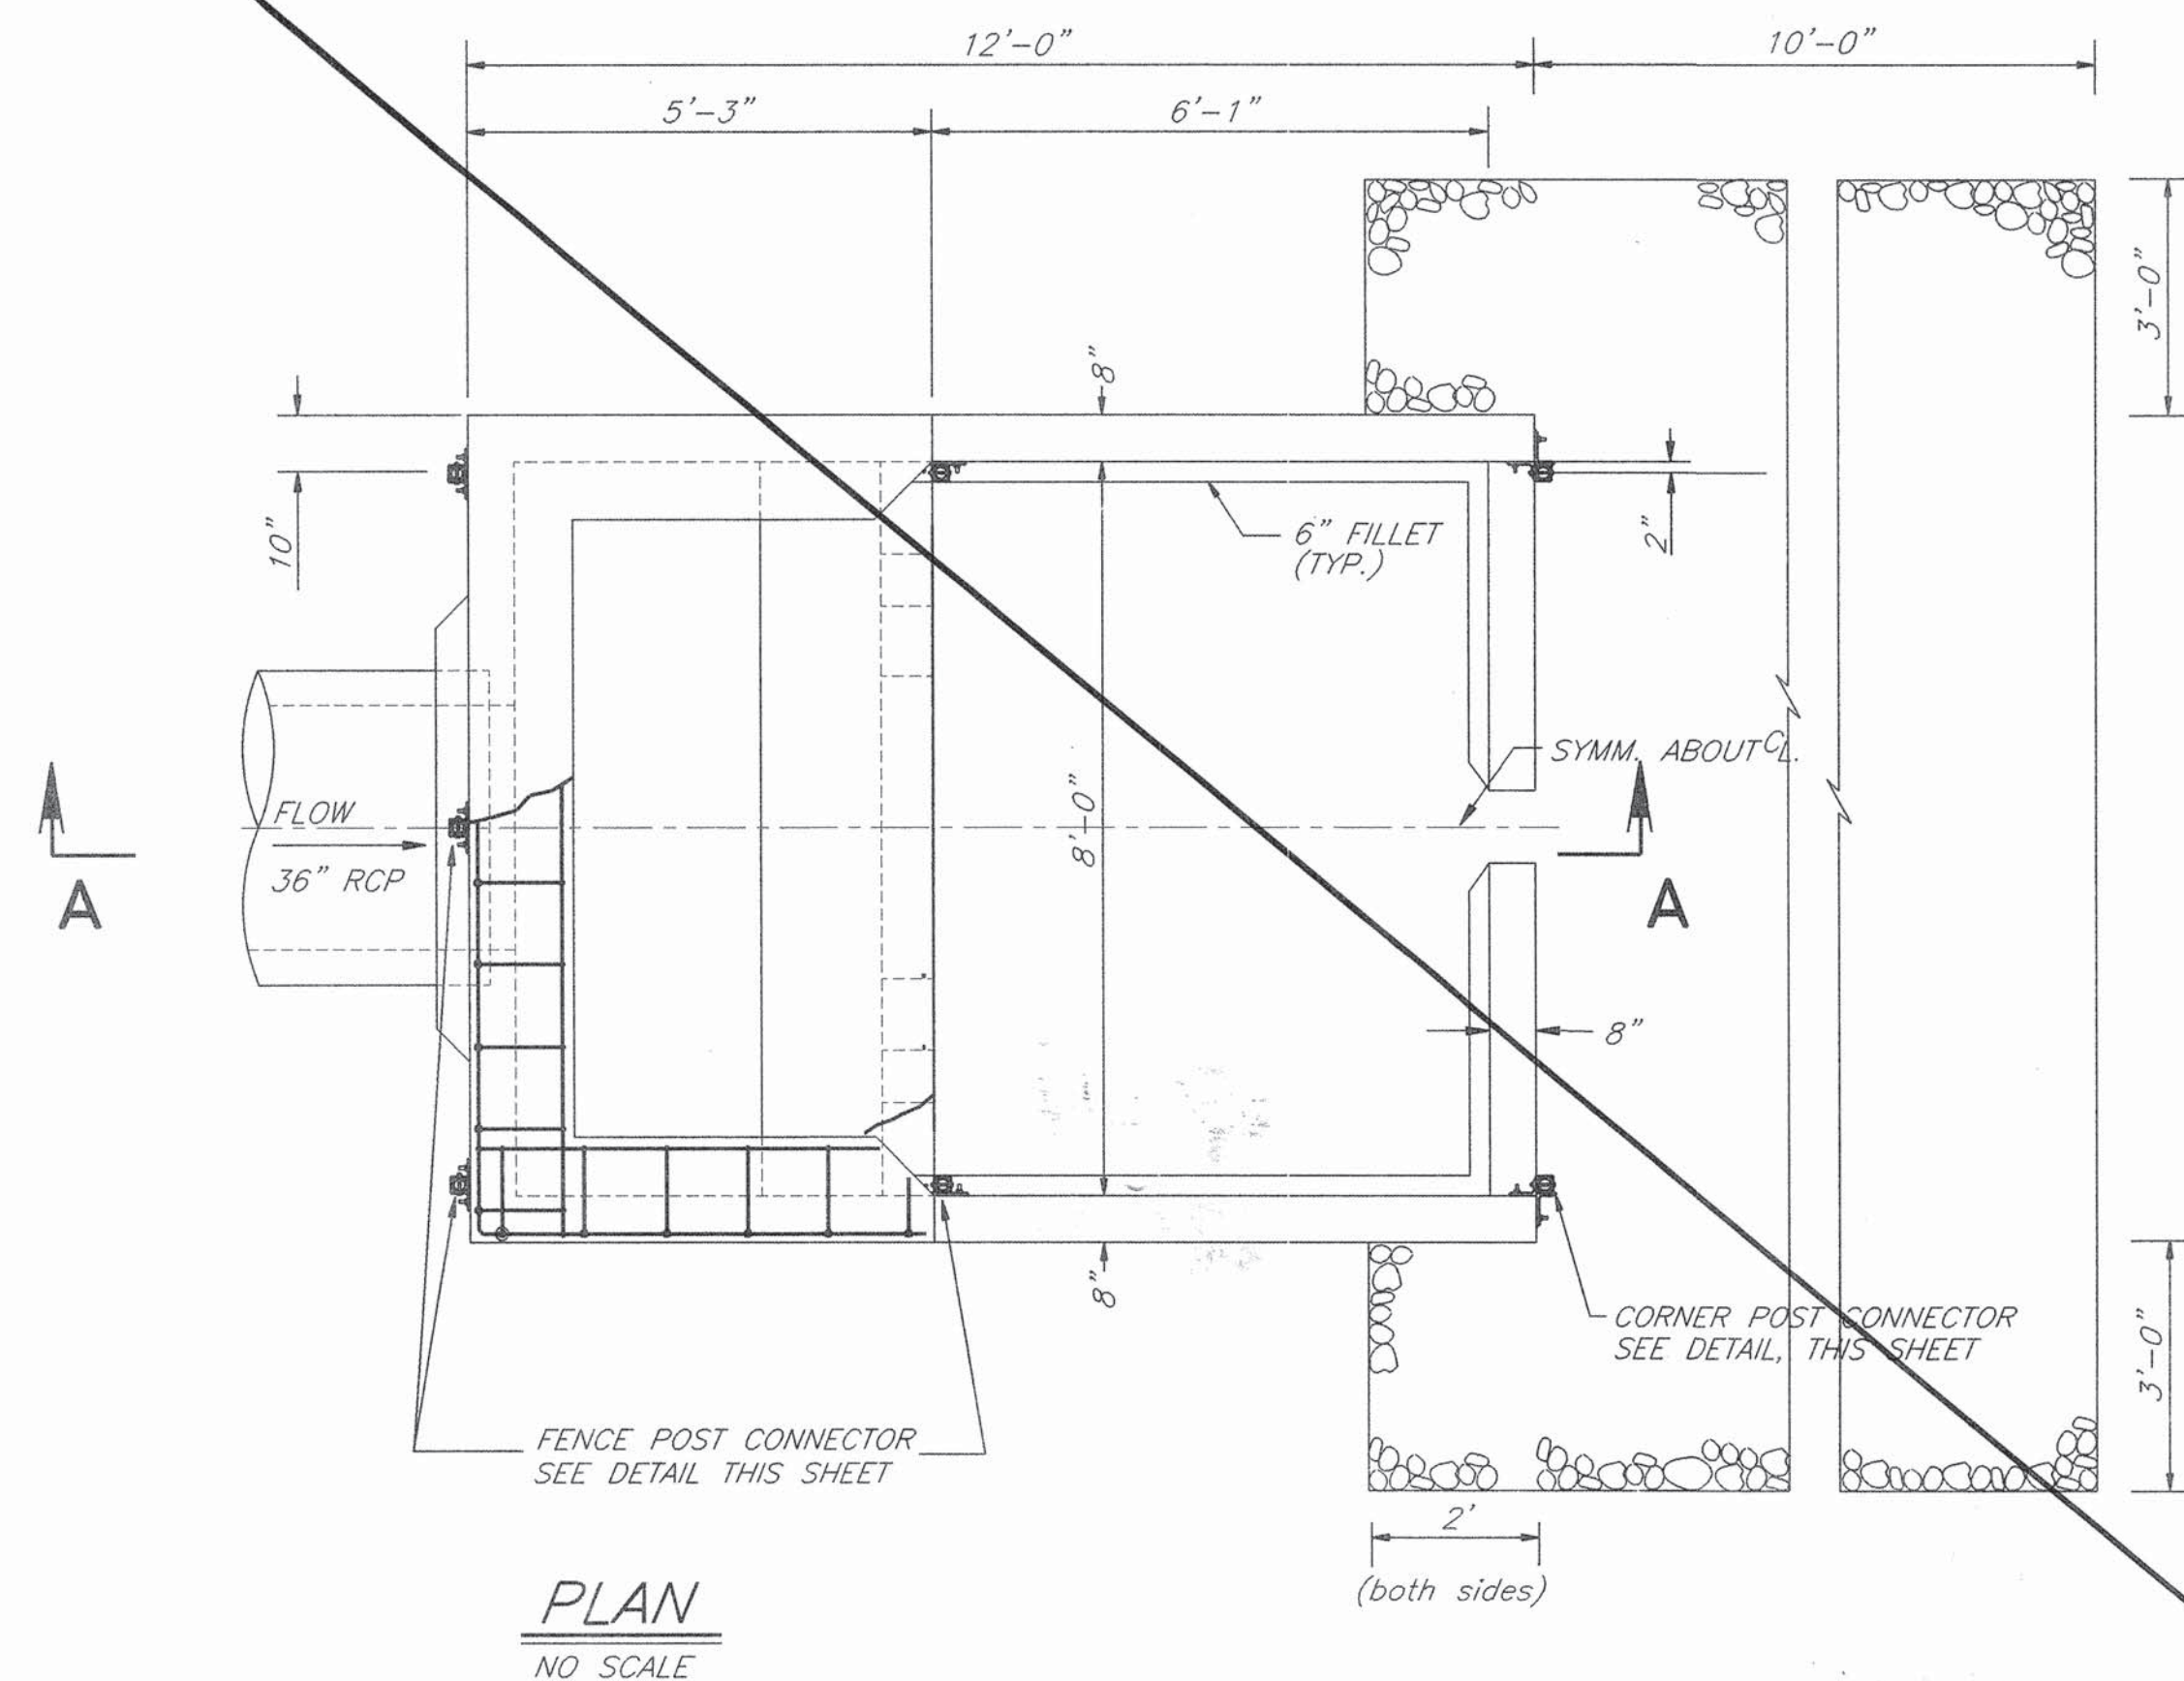

~~HANDRAIL~~ NOTES


- A. All posts, rails, plates, angles, bolts, etc. shall be of structural steel and galvanized per COA standards.
- B. Install chain link fabric on outside of rail.
- C. Tension wire shall be 7 ga. spring steel w/11 ga. wire ties @ 2 o.c.
- D. Tension bars and three (3) clamps at each corner post.
- E. Tack weld chain link fabric at 3 points along each frame member.
- F. Paint all field welds with galvanizing coating.

NOT FOR CONSTRUCTION
TO BE BUILT UNDER
SEPARATE CONTRACT

SEE PLAN SET
COA # 671581



					ENGINEER'S SEAL	SURVEY INFORMATION	BENCH MARKS	AS-BUILT INFORMATION
						NO.	BY	DATE
								CONTRACTOR STARTED BY
								DATE
								INSPECTOR'S PERFORMANCE BY
								DATE
								VERIFICATION BY
								DATE
								DRAWINGS CHECKED BY
								DATE
								MICRO-FILM INFORMATION
								RECORDED BY
								DATE
								No.

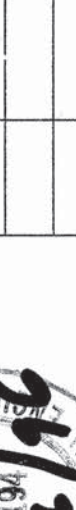

8/26/92 Noted Per CAD 671581 SAE

REMARKS

BY

DESIGN

DESIGNED BY BJS/KP DATE 8-96

DRAWN BY BS DATE 8-96

CHECKED BY KP DATE 8-96

	BOHANNON-HUSTON INC. ENGINEERS • PLANNERS • PHOTOGRAMMETRISTS • SURVEYORS • LANDSCAPE ARCHITECTS ALBUQUERQUE LAS CRUCES SANTA FE
	CITY OF ALBUQUERQUE PUBLIC WORKS DEPARTMENT ENGINEERING DEVELOPMENT GROUP
TITLE:	THE CROSSING SUBDIVISION UNIT I HANDRAIL DETAILS
DESIGN REVIEW COMMITTEE	CITY ENGINEER APPROVAL
APPROVED NOV - 8 2002 CITY ENGINEER	APPROVED NOV - 8 2002 CITY ENGINEER
CITY PROJECT NO.	ZONE MAP NO.
5453f1	H-9, J-9
SHEET	OF
11C	18