
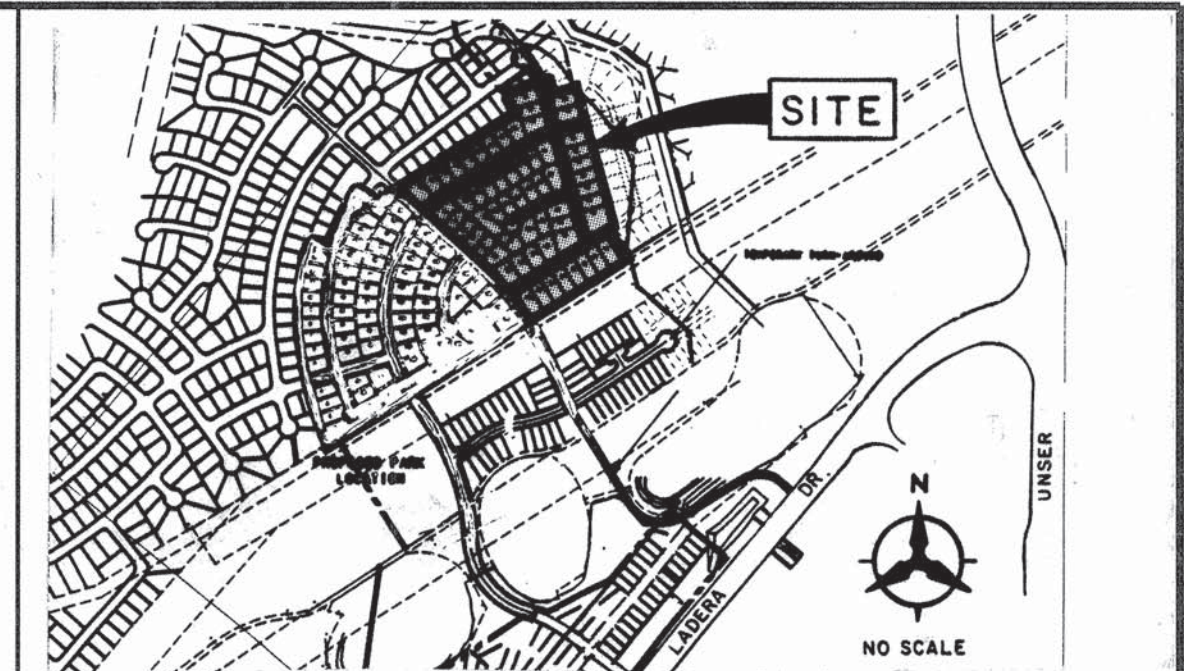


CONSTRUCTION PLANS FOR THE CROSSING SUBDIVISION UNIT II ALBUQUERQUE, NEW MEXICO

CERTIFICATE OF SUBSTANTIAL COMPLIANCE ON PLANS

I, William L. Vreeke, P.E. of the firm of Bohannon-Huston, Inc., a Registered Professional Engineer in the State of New Mexico, do hereby certify, to the best of my knowledge and belief, that the infrastructure installed as part of this project (The Crossing Subdivision, Unit II) has been inspected by me or by a qualified person under my direct supervision and has been constructed in accordance with the plans and specifications approved by the City Engineer and that the original design intent of the approved plans has been met, except as noted by me on the as-built construction drawings. This Certification is based on site inspections by me or personnel under my direction and survey information provided by the contractor, Melendez Concrete, Inc. and their surveyor, Larry Medrano, NMPS 11993, and Alan Benham, NMPS 15700, of Bohannon-Huston, Inc.

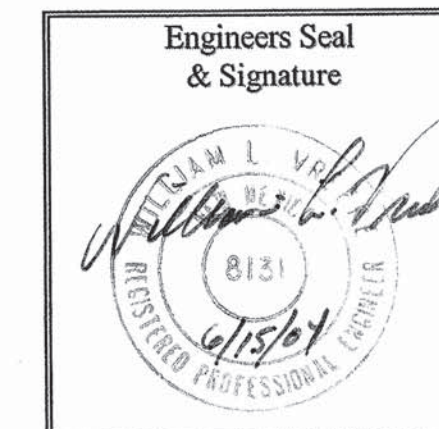

VICINITY MAP
NOT TO SCALE
H-9-J-9

NOTICE TO CONTRACTORS

- ALL WORK DETAILED ON THESE PLANS TO BE PERFORMED UNDER CONTRACT SHALL, EXCEPT AS OTHERWISE STATED OR PROVIDED FOR HEREON, BE CONSTRUCTED IN ACCORDANCE WITH THE CITY OF ALBUQUERQUE STANDARD SPECIFICATIONS FOR PUBLIC WORKS CONSTRUCTION, 1986 EDITION AND SHALL INCLUDE UPDATE No. 6.
- TWO WORKING DAYS PRIOR TO ANY EXCAVATION, THE CONTRACTOR MUST CONTACT NEW MEXICO ONE CALL SYSTEM (260-1990) FOR LOCATION OF EXISTING UTILITIES.
- PRIOR TO CONSTRUCTION, THE CONTRACTOR SHALL EXCAVATE AND VERIFY THE HORIZONTAL AND VERTICAL LOCATIONS OF ALL OBSTRUCTIONS. SHOULD A CONFLICT EXIST, THE CONTRACTOR SHALL NOTIFY THE ENGINEER OR SURVEYOR IMMEDIATELY SO THAT THE CONFLICT CAN BE RESOLVED WITH A MINIMUM AMOUNT OF DELAY.
- THREE (3) WORKING DAYS PRIOR TO BEGINNING CONSTRUCTION, THE CONTRACTOR SHALL SUBMIT TO CONSTRUCTION COORDINATION DIVISION A DETAILED CONSTRUCTION SCHEDULE. TWO (2) WORKING DAYS PRIOR TO CONSTRUCTION, THE CONTRACTOR SHALL OBTAIN A BARRICADING PERMIT FROM THE CONST. COORDINATION DIVISION. CONTRACTOR SHALL NOTIFY BARRICADE ENGINEER (768-2554) PRIOR TO OCCUPYING AN INTERSECTION. REFER TO SECTION 19 OF THE GENERAL CONDITIONS OF THE STANDARD SPECIFICATIONS.
- ALL STREET STRIPING ALTERED OR DESTROYED SHALL BE REPLACED IN KIND BY CONTRACTOR TO LOCATION AND IN KIND AS EXISTING OR AS INDICATED BY THIS PLAN SET.
- CONTRACTOR SHALL NOTIFY THE ENGINEER NOT LESS THAN SEVEN (7) DAYS PRIOR TO STARTING WORK IN ORDER THAT THE CITY SURVEYOR MAY TAKE NECESSARY MEASURES TO INSURE THE PRESERVATION OF SURVEY MONUMENTS. CONTRACTOR SHALL NOT DISTURB PERMANENT SURVEY MONUMENTS WITHOUT THE CONSENT OF THE CITY SURVEYOR AND SHALL NOTIFY THE CITY SURVEYOR AND BEAR THE EXPENSE OF REPLACING ANY THAT MAY BE DISTURBED WITHOUT PERMISSION. REPLACEMENT SHALL BE DONE ONLY BY THE CITY SURVEYOR. WHEN A CHANGE IS MADE IN THE FINISHED ELEVATIONS OF THE PAVEMENT OF ANY ROADWAY IN WHICH A PERMANENT SURVEY MONUMENT IS LOCATED, CONTRACTOR SHALL, AT HIS OWN EXPENSE, ADJUST THE MONUMENT COVER TO THE NEW GRADE UNLESS OTHERWISE SPECIFIED. REFER TO SECTION 4.4 OF THE GENERAL CONDITIONS OF THE STANDARD SPECIFICATIONS. ANY PERMANENT SURVEY MONUMENT LOCATED WITHIN 50' OF THE PROJECT LIMITS NOT SHOWN ON THE PLANS THAT IS DESTROYED DURING CONSTRUCTION WILL BE REPLACED AT DESIGNER'S EXPENSE.
- ANY WORK WITHIN AN ARTERIAL ROADWAY REQUIRES TWENTY-FOUR HOUR CONSTRUCTION.

THE FOLLOWING NOTES ALSO APPLY WHEN CHECKED

- ☒ ALL UTILITIES AND UTILITY SERVICE LINES SHALL BE INSTALLED PRIOR TO PAVING.
- ☐ BACKFILL COMPACTION SHALL BE ACCORDING TO SPECIFIED STREET USE.
- ☐ TACK COAT REQUIREMENTS SHALL BE DETERMINED BY THE CITY ENGINEER.
- ☒ SIDEWALKS AND WHEELCHAIR RAMPS WITHIN THE CURB RETURNS SHALL BE CONSTRUCTED WHEREVER A NEW CURB RETURN IS CONSTRUCTED.
- ☒ IF CURB IS DEEPENED FOR A DRIVEPAD, THE DRIVEPAD SHALL BE CONSTRUCTED PRIOR TO ACCEPTANCE OF CURB AND GUTTER.
- ☒ ALL STORM DRAINAGE FACILITIES SHALL BE COMPLETED PRIOR TO FINAL ACCEPTANCE.
- ☒ THE REQUESTOR OR DEVELOPER SHALL BE RESPONSIBLE FOR REPAIR OR REPLACEMENT OF ALL CURB AND GUTTER OR SIDEWALK DAMAGED AFTER APPROVAL BY THE CITY ENGINEER OF WORK COMPLETED BY THE CONTRACTOR.

INDEX

SHEET NUMBER	DESCRIPTION
1	TITLE SHEET
2	PLAT
3A	GRADING AND DRAINAGE PLAN
3B	GRADING AND DRAINAGE DETAILS
3C	IMPACT BASIN DETAILS (NOT USED)
3D	HANDRAIL DETAILS (NOT USED)
4	OVERALL PAVING
	PAVING PLAN AND PROFILE SHEETS
5	CLARK'S FORK PLACE
6	SELWAY PLACE
7	POWDER COURT
8	PLATTE COURT
9	CUNNISON PLACE FROM STA. 20+00.00 TO 24+00.00 (INCLUDING STORM DRAIN)
10	CUNNISON PLACE FROM STA. 24+00.00 TO 34+28.65 (INCLUDING STORM DRAIN)
11	OVERALL UTILITY
11-A	CITY OF ALBUQUERQUE VALVE BOX DETAILS
	UTILITY PLAN AND PROFILE SHEETS
12	CLARK'S FORK PLACE
13	SELWAY PLACE
14	POWDER COURT
15	PLATTE COURT
16	CUNNISON PLACE FROM STA. 14+00.00 TO 24+00.00 (NOT USED)
17	OFFSITE SAS LINE (NOT USED)
18	OFFSITE SAS LINE (NOT USED)

APPROVALS	ENGINEER	DATE
DRC Chairman	<i>[Signature]</i>	2-19-03
Transportation	<i>[Signature]</i>	10/3/02
Water/Wastewater	<i>[Signature]</i>	10/3/02
Hydrology	<i>[Signature]</i>	2/27/03
CIP		
Const. Mngmt.		
Const. Coord.	<i>[Signature]</i>	2-19-03
AMAFCA	<i>[Signature]</i>	2-24-03

APPROVALS	ENGINEER	DATE
DRC Chairman	<i>[Signature]</i>	2-15-00
Transportation	<i>[Signature]</i>	2-15-00
Water/Wastewater	<i>[Signature]</i>	2-15-00
Hydrology	<i>[Signature]</i>	2-15-00
CIP		
Const. Mngmt.		
Const. Coord.	<i>[Signature]</i>	2-15-00
AMAFCA	<i>[Signature]</i>	2-10-00



APPROVED AS RECORD DRAWINGS
DESIGN REVIEW SECTION
CITY CONSTRUCTION ENGINEER
DATE: 8/23/04

AS BUILT CERTIFICATION

I, LARRY MEDRANO, DO HEREBY ATTEST TO THE FACT THAT THE AS CONSTRUCTED INFORMATION SHOWN HEREON IS THE RESULT OF A FIELD SURVEY PERFORMED BY ME OR UNDER MY DIRECT SUPERVISION, AND THAT THE SAME ARE TRUE AND CORRECT TO THE BEST OF MY KNOWLEDGE AND BELIEF.

[Signature] 3/25/04
LARRY W. MEDRANO
NEW MEXICO PROFESSIONAL
LAND SURVEYOR NO. 11993



PRECISION SURVEYS, INC.
8714-D JEFFERSON STREET, N.E.
ALBUQUERQUE, NEW MEXICO 87113
(505) 856-5700


DRB #95-537

BH1 JOB NO. 95335A2405


BOHANNAN-HUSTON INC.
ENGINEERS • PLANNERS • PHOTOGRAMMETRISTS • SURVEYORS • LANDSCAPE ARCHITECTS
ALBUQUERQUE LAS CRUCES SANTA FE

REV.	17A	RD	6-08-04	6/8/04	6-8-04
SHEETS					
CITY ENGINEER					
DATE					
ENGINEER					
DATE					
APPROVALS					
DRC Chairman	<i>[Signature]</i>	11-9-76			
Transportation	<i>[Signature]</i>	8-15-02			
Water/Wastewater	<i>[Signature]</i>	8-14-02			
Hydrology	<i>[Signature]</i>	10-22-76			
CIP					
Const. Mngmt.					
Const. Coord.	<i>[Signature]</i>	10/21/91			
AMAFCA	<i>[Signature]</i>				
CITY PROJECT NO.	545382				
SHEET	1	OF	18		

COPYRIGHT BOHANNAN-HUSTON, 1996
DATE: MAY, 1996

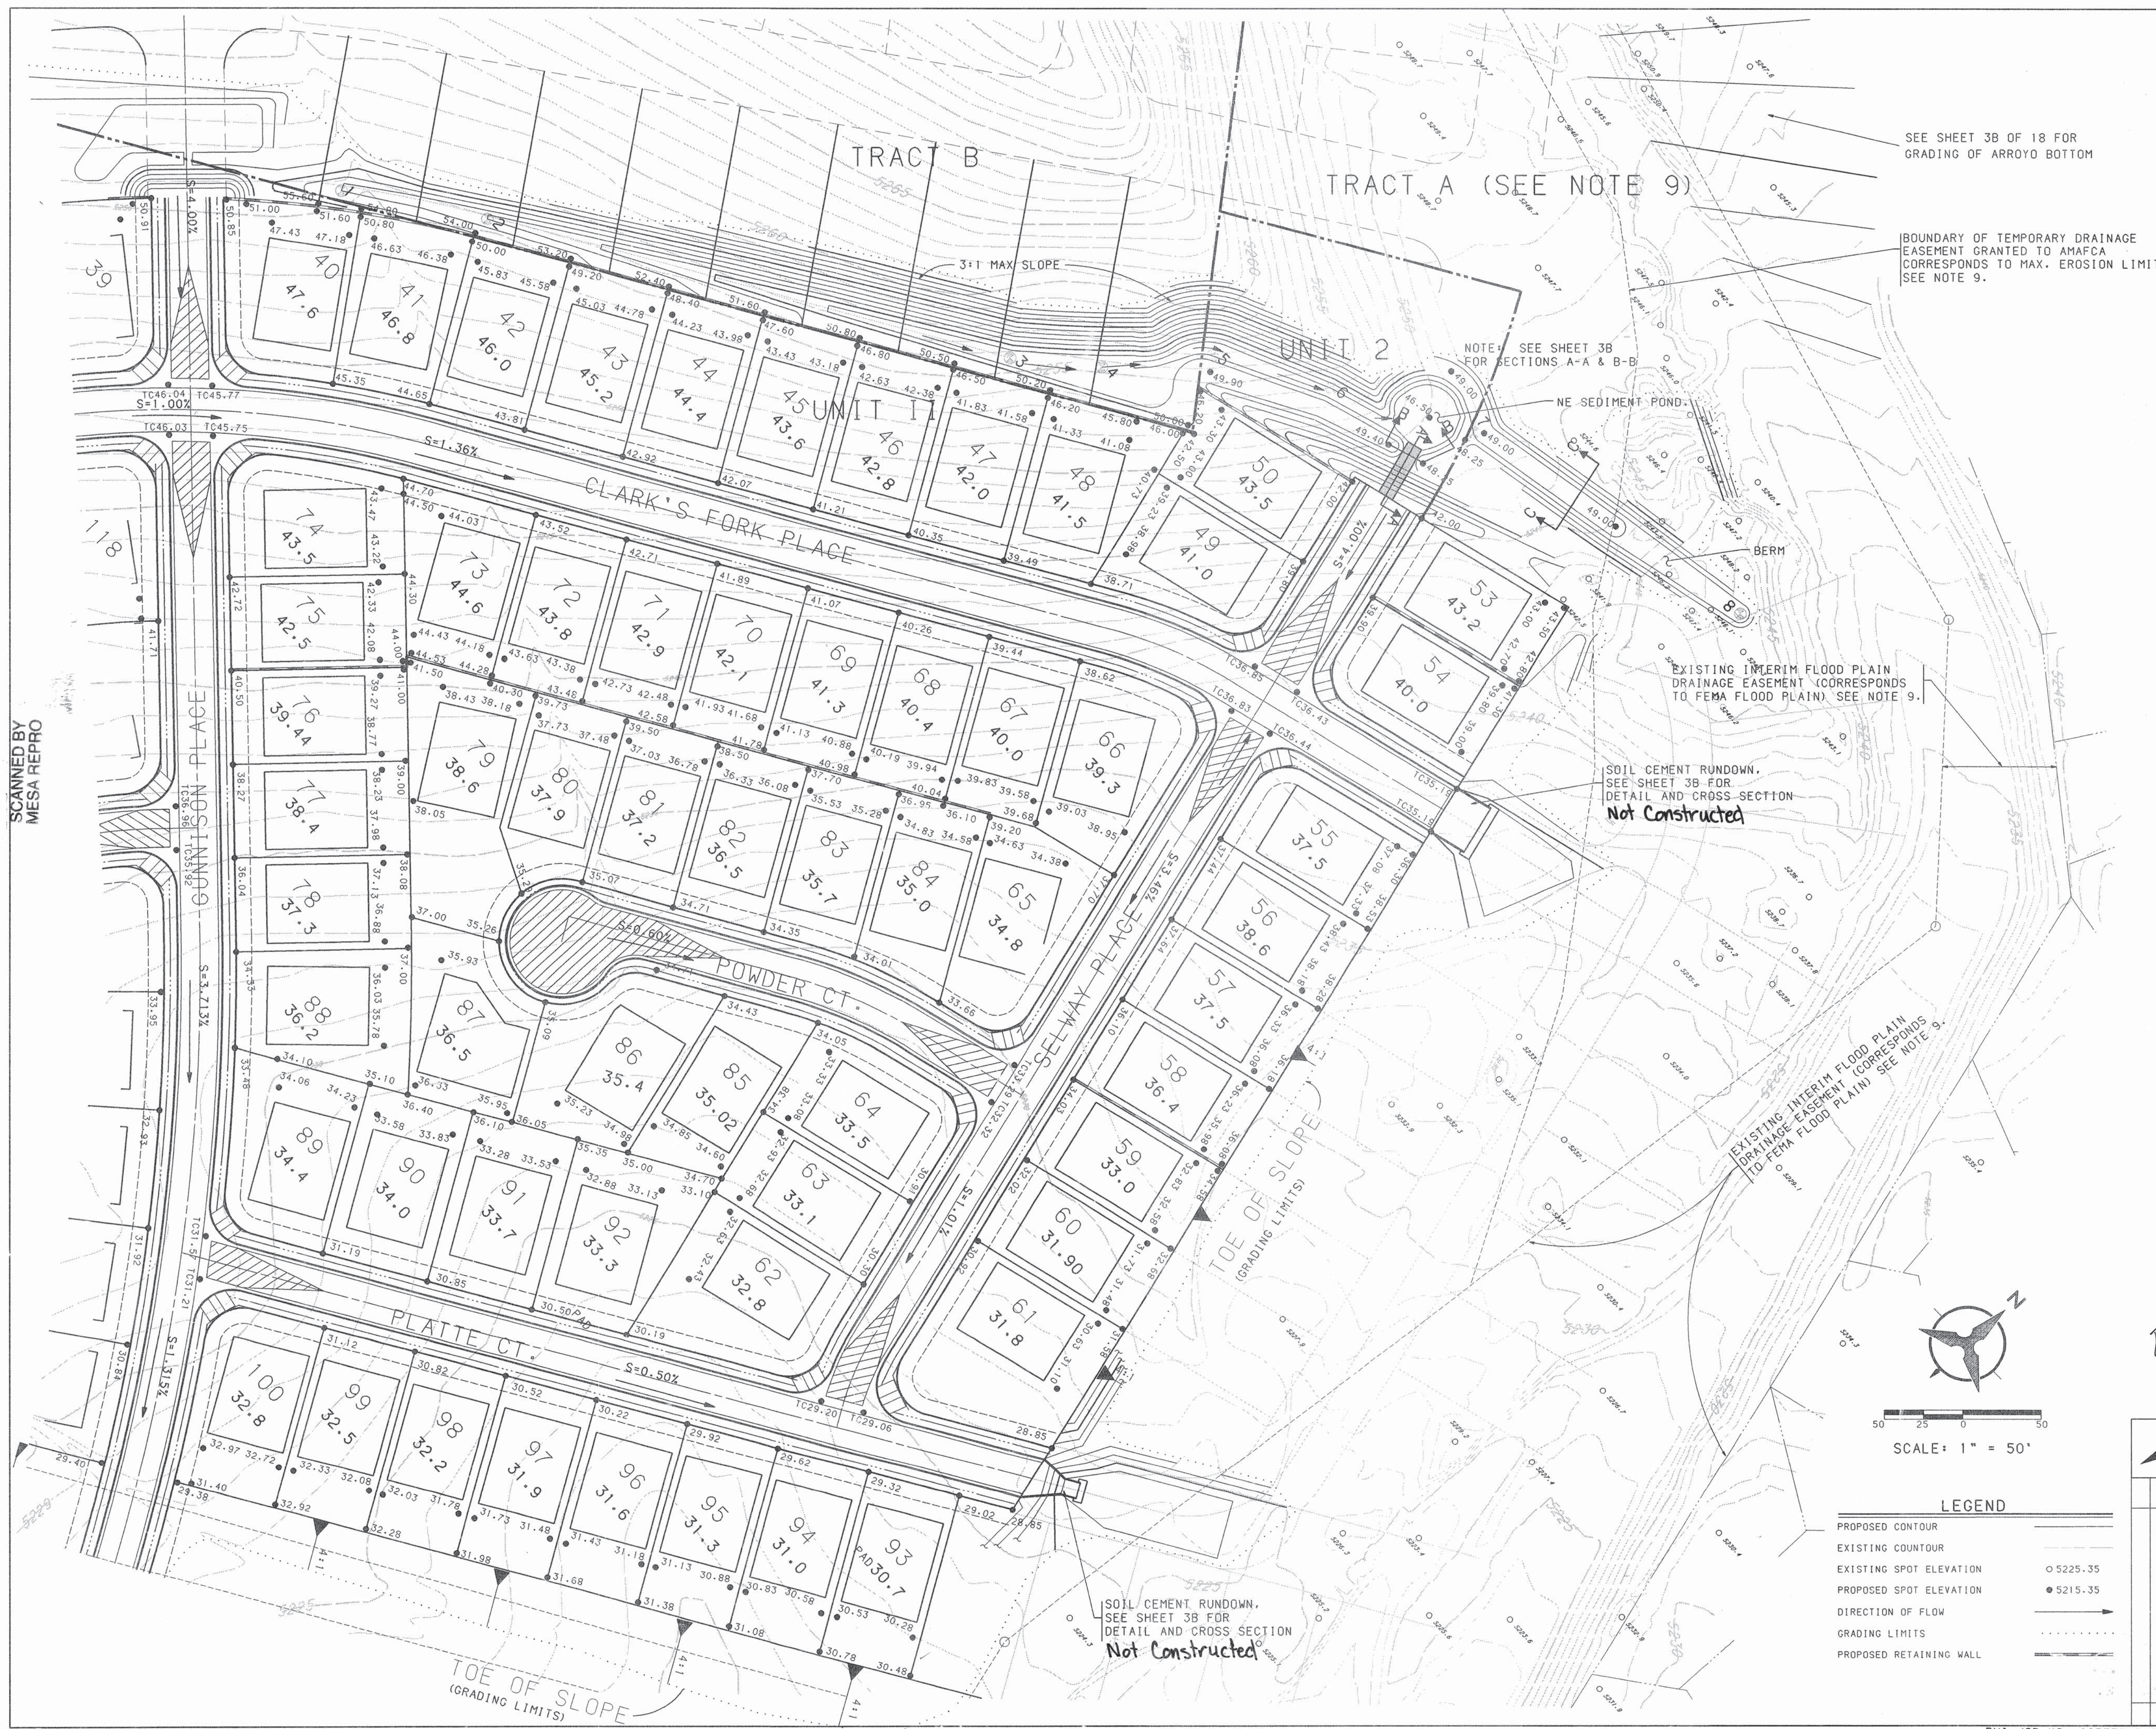

DRAINAGE FACILITY COORDINATES		
NUMBER	X	Y
1	353.836.70	1,494.599.50
2	353.913.28	1,494.655.56
3	354.204.75	1,494.840.70
4	354.248.77	1,494.879.80
5	354.291.27	1,494.936.49
6	354.357.93	1,494.978.32
7	354.440.26	1,495.025.74
8	354.640.92	1,495.072.26

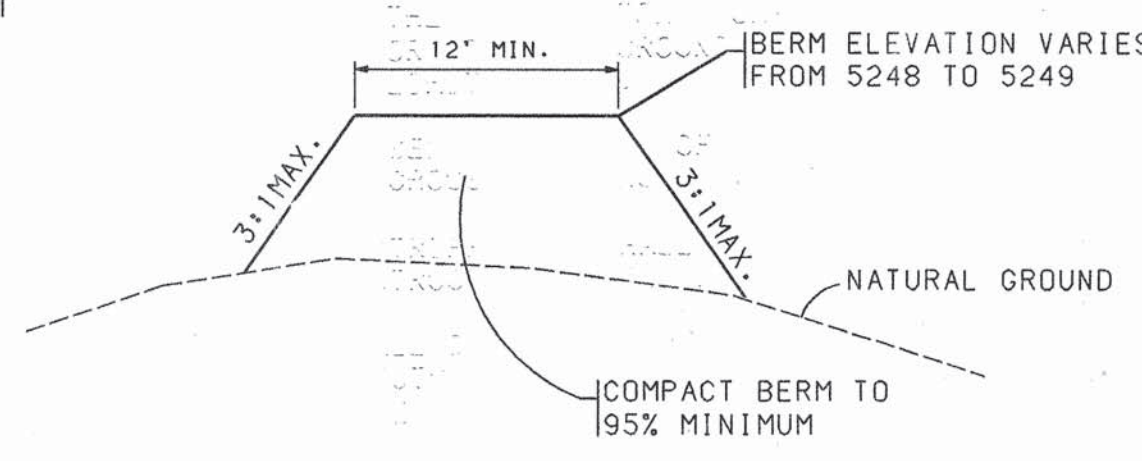

TYPICAL BERM SECTION C-C
NO SCALE

GENERAL NOTES:


1. CONTRACTOR MUST OBTAIN A TOPSOIL DISTURBANCE PERMIT FROM THE ENVIRONMENTAL HEALTH DIVISION PRIOR TO BEGINNING ROUGH GRADING.
2. THE CONTRACTOR IS TO REFER TO EARTHWORK SPECIFICATIONS AS NOTED IN THE SOILS REPORT PREPARED BY VINYARD AND ASSOCIATES DATED APRIL 19, 1996. COPY AVAILABLE FROM OWNER.
3. THE CONTRACTOR SHALL CONFORM TO ALL CITY, COUNTY, STATE, AND FEDERAL DUST CONTROL MEASURES AND REQUIREMENTS AND WILL BE RESPONSIBLE FOR PREPARING AND OBTAINING ALL NECESSARY APPLICATIONS AND APPROVALS, INCLUDING EPA STORMWATER PERMIT.
4. THE CONTRACTOR SHALL ENSURE THAT NO SOIL ERODES FROM THE LOTS INTO PUBLIC RIGHT-OF-WAY. THIS CAN BE ACHIEVED BY CONSTRUCTING TEMPORARY BERMS AS PER DETAIL SHEET 3B OF 18 AND WETTING THE SOIL TO KEEP IT FROM BLOWING.
5. THE CONTRACTOR SHALL NOT GRADE OR DISTURB GROUND BEYOND GRADING LIMITS SHOWN.
6. SEE SHEET 4 OF 18 FOR ROADWAY CROSS-SECTIONS.
7. STRIPPINGS SHALL BE USED IN NON-STRUCTURAL FILL AREAS.
8. ALL DISTURBED AREAS (NOT TO BE PAVED) OUTSIDE OF THE BOUNDARY OF UNIT II SHALL BE RESEED PER COA STD SPECS SECT 1012.
9. SEE PLAT OF THE CROSSING (BULK LAND PLAT) FOR EASEMENT DETAILS. PLAT FILED 7/9/96 IN VOL. 96C FOLIO 302.




APPROVED FOR ROUGH GRADING (1")
HYDROLOGY ENGINEER DATE

BOHANNAN-HUSTON INC.
ENGINEERS • PLANNERS • PHOTOGRAMMETRISTS • SURVEYORS • LANDSCAPE ARCHITECTS
ALBUQUERQUE LAS CRUCES SANTA FE


Project No.		UNIT II	
Seal		GRADING & DRAINAGE PLAN	
Drawn By: BS	Date: 4/96	Job No. 95335A2417	Sheet Of 3A 18
Checked By: KP	Scale: 1"=50'		

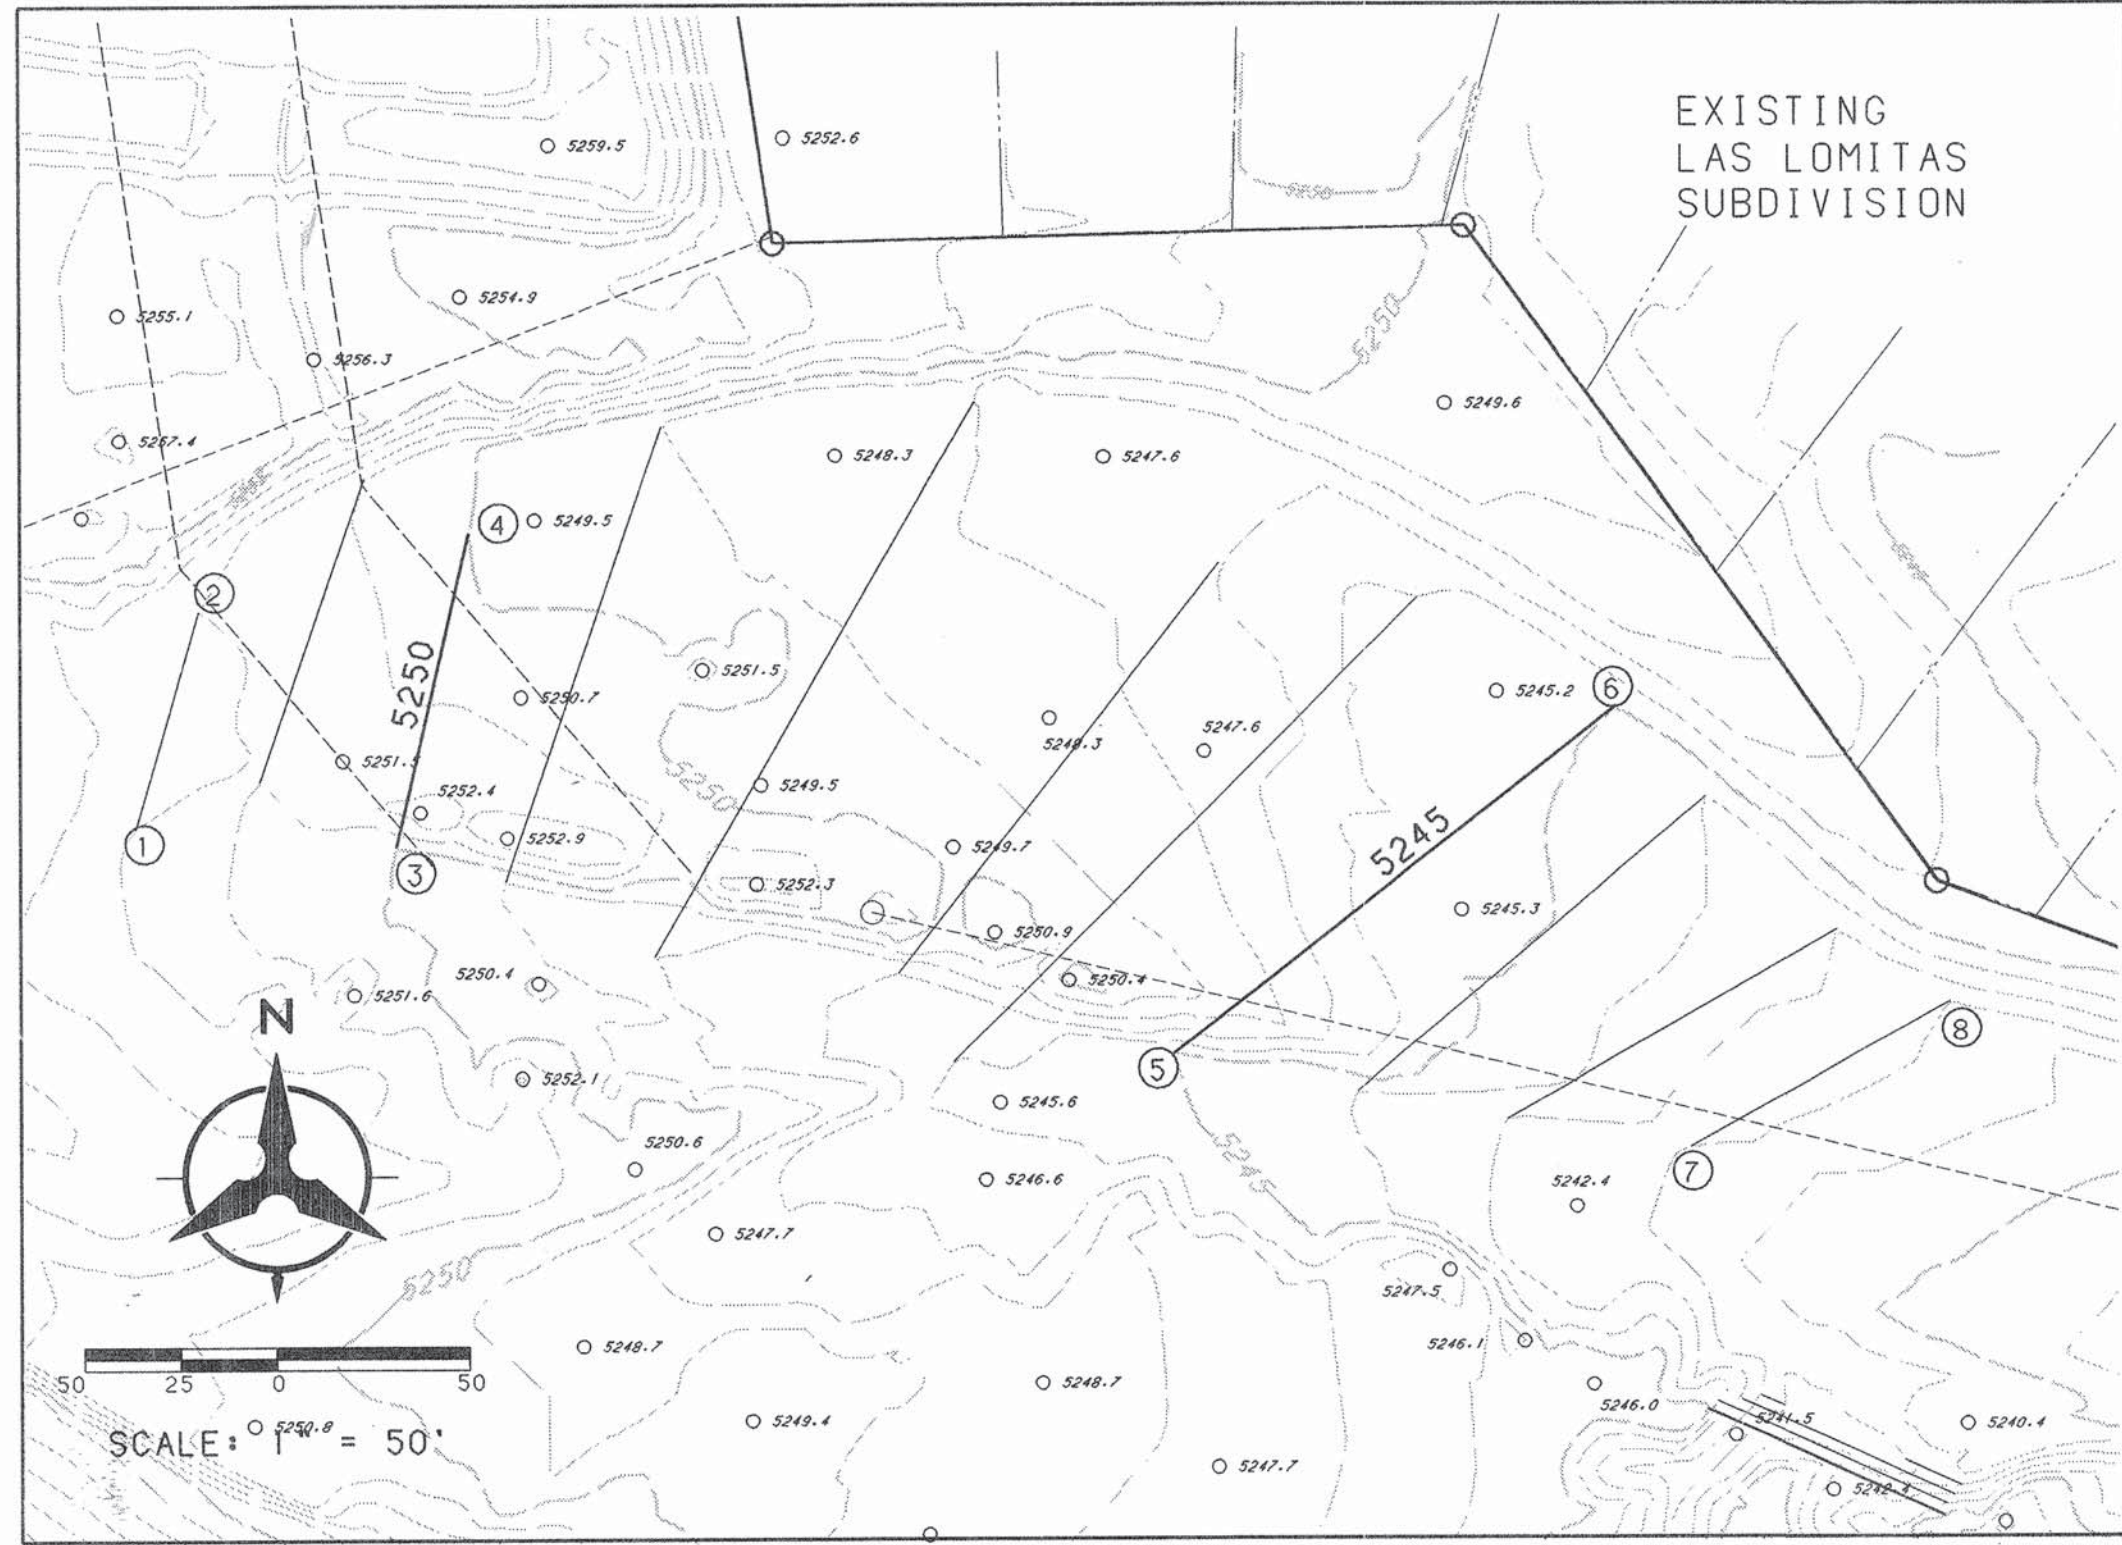


MIREHAVEN ARROYO REGRADING

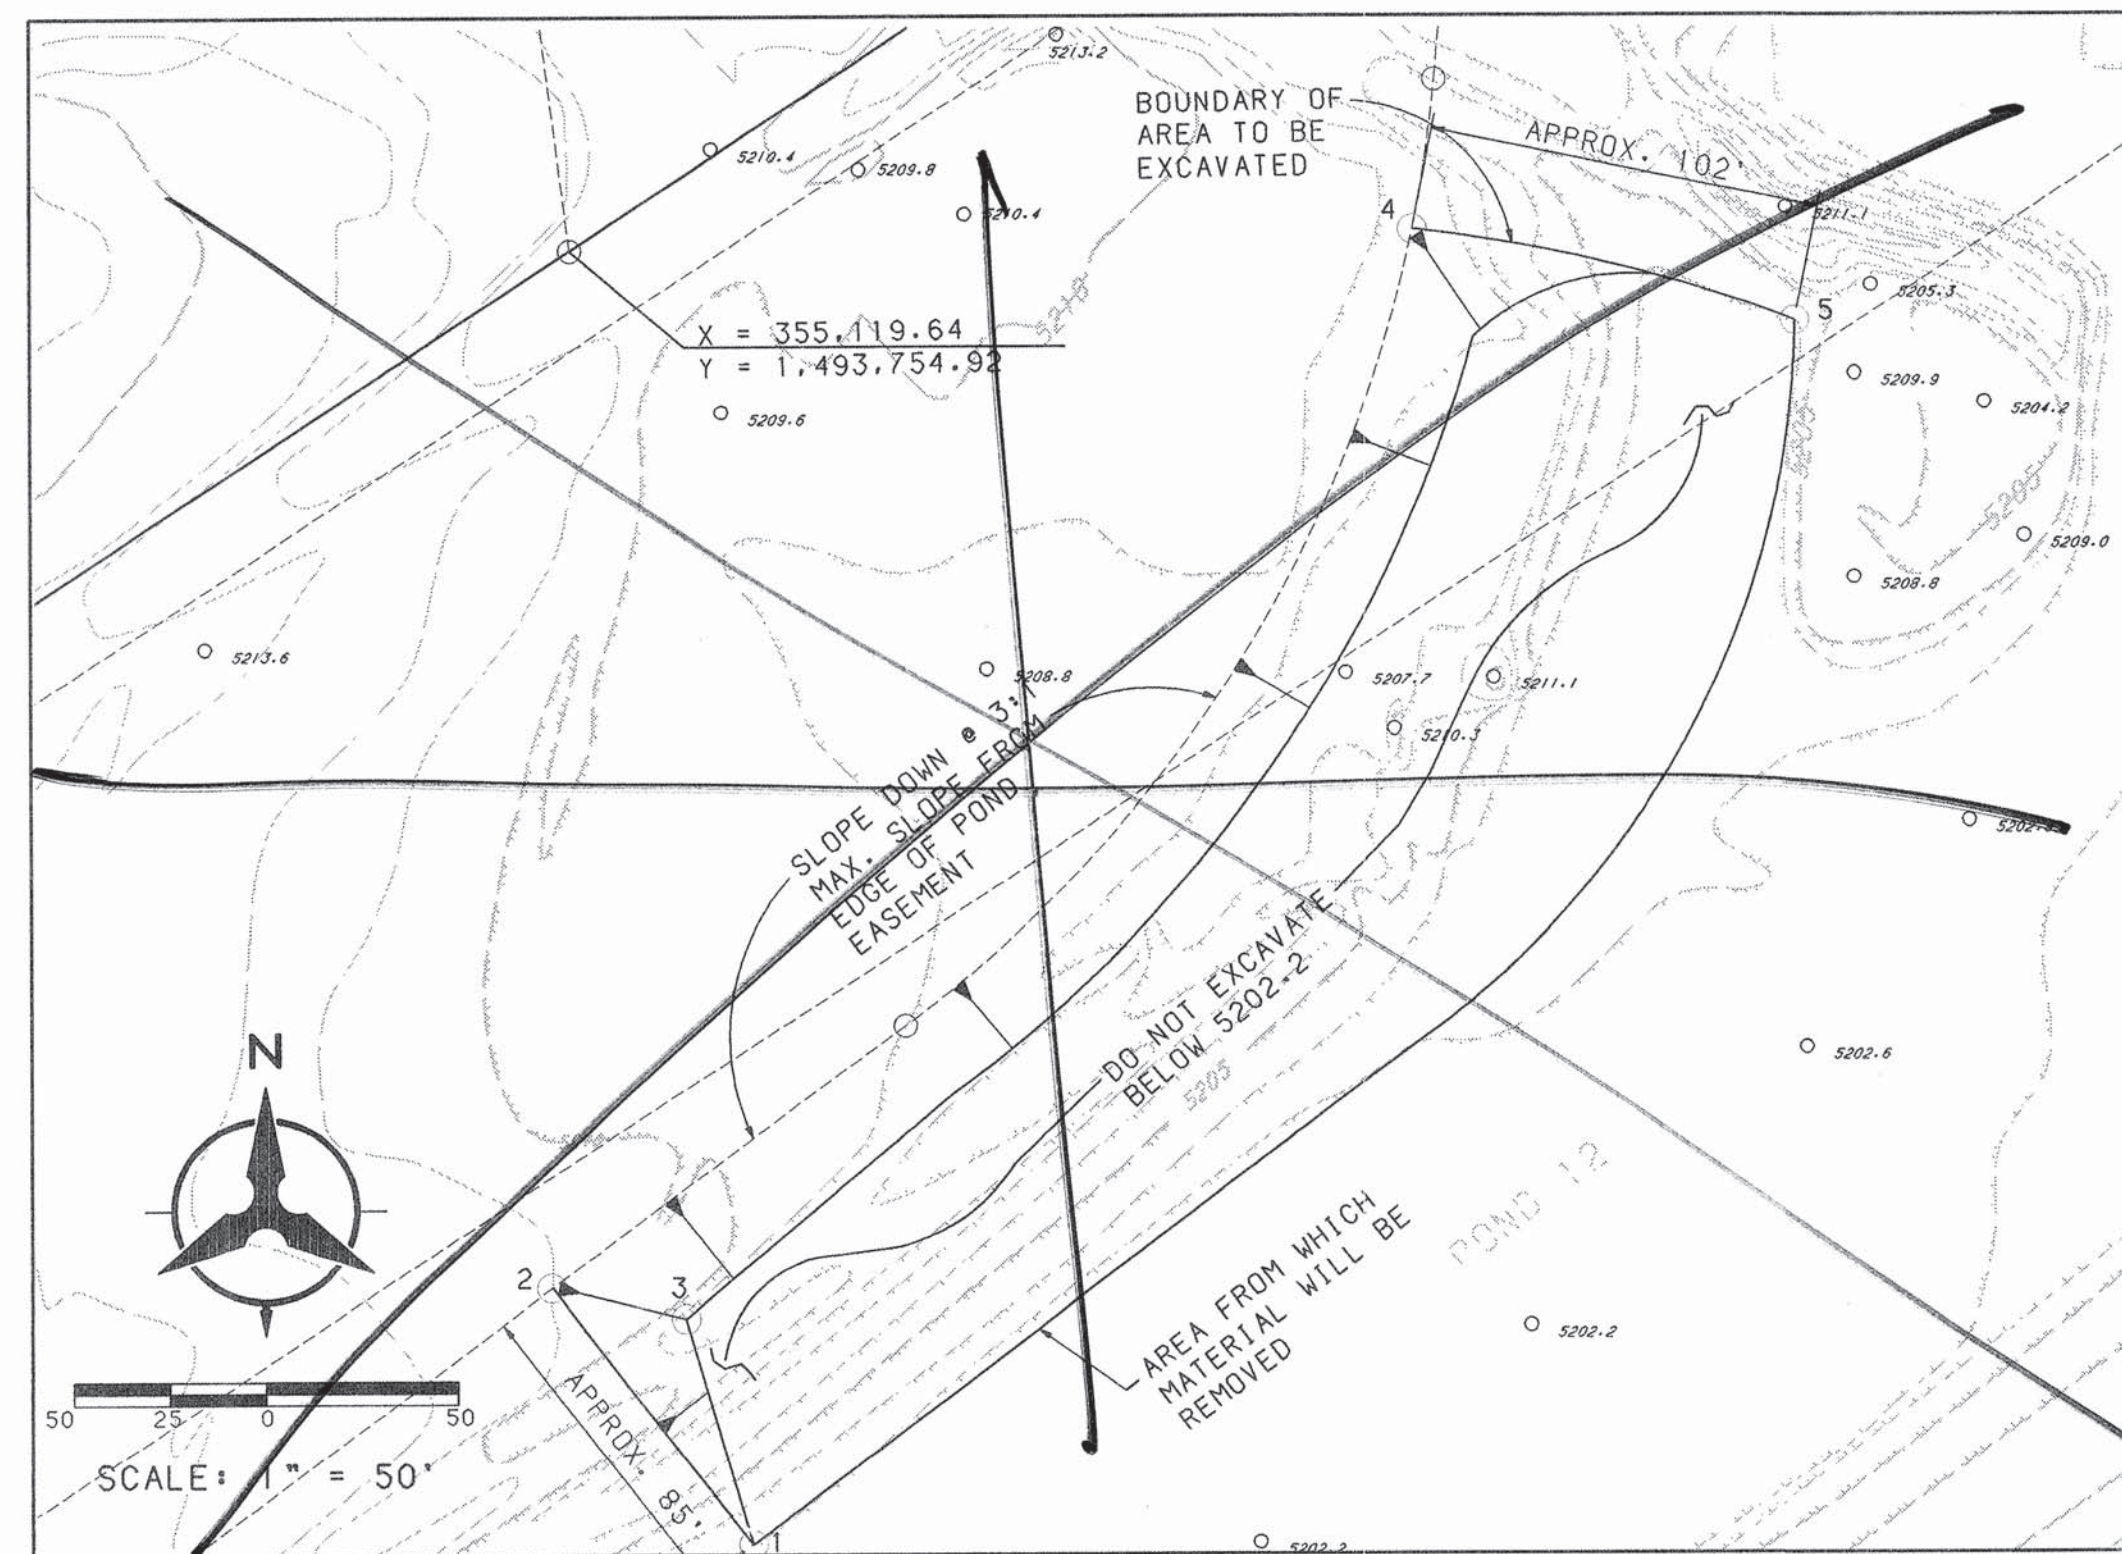

POND 12 VOLUME EXPANSION

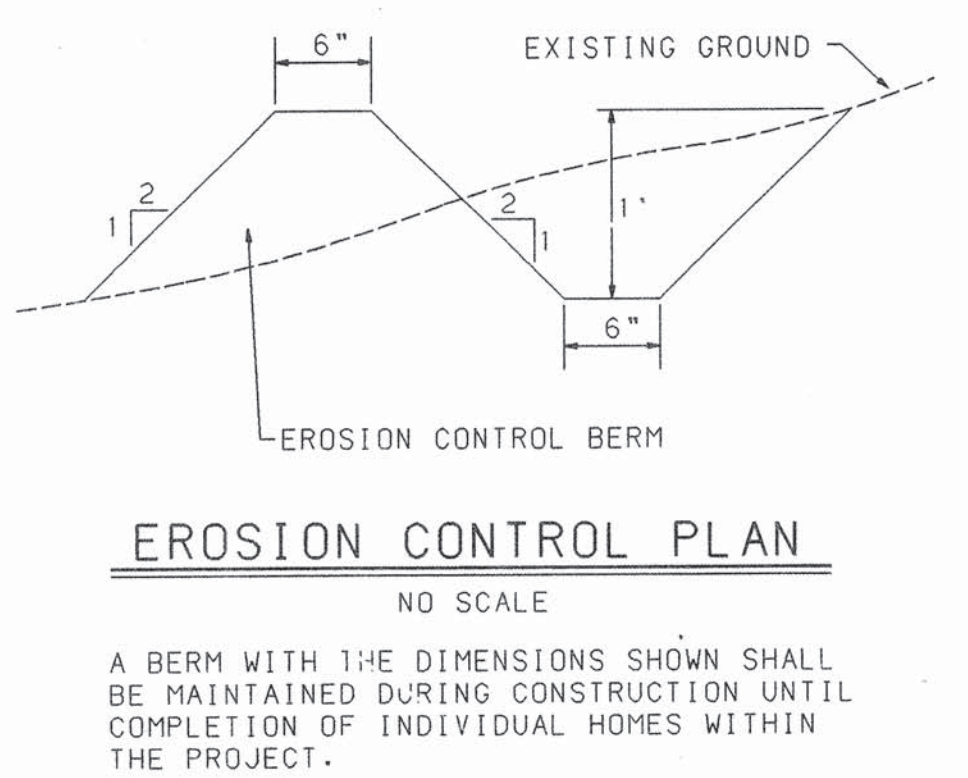


EROSION CONTROL PLAN

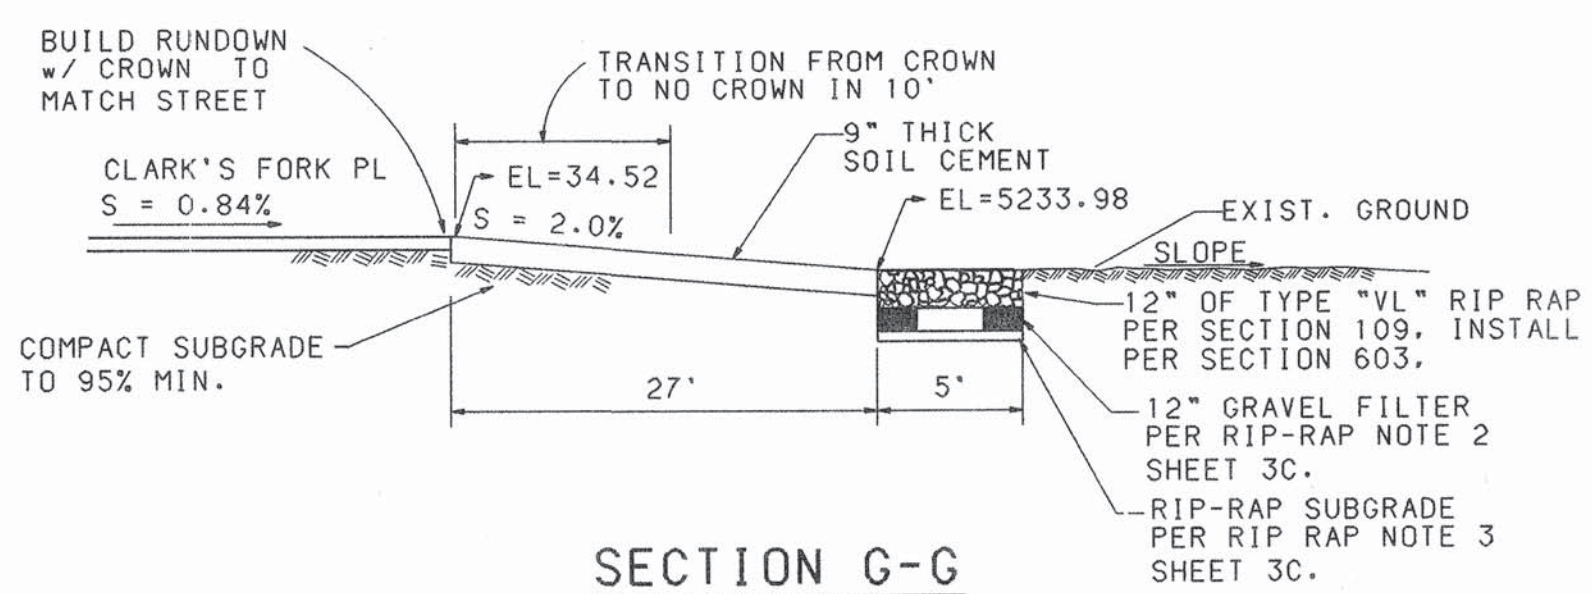

SECTION G-G

MIREHAVEN COORDINATE DATA TABLE			
NUMBER	X	Y	Z
1	354.109.82	1.495.294.38	
2	354.126.39	1.495.350.54	
3	354.177.24	1.495.287.64	
4	354.196.64	1.495.370.87	
5	354.379.96	1.495.234.65	
6	354.494.92	1.495.325.41	
7	354.514.30	1.495.210.60	
8	354.581.98	1.495.248.64	

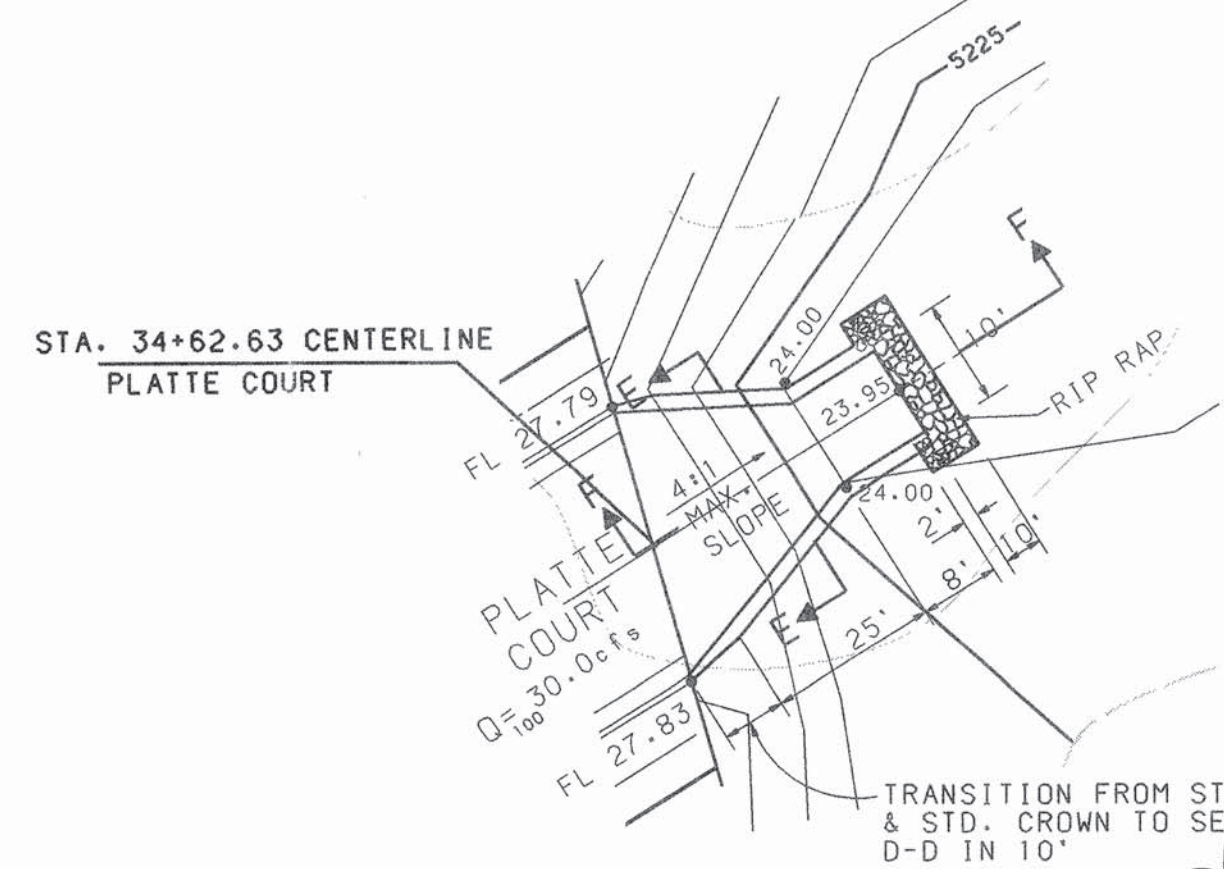


PLATTE COURT
SOIL CEMENT RUNDOWN


NOTE: ALL AREAS DISTURBED FOR MIREHAVEN ARROYO REGRADING AND POND 12 VOLUME EXPANSION SHALL BE RESEED PER COA STD. SPEC. 1012.

NOTE: CONTRACTOR SHALL OBTAIN PERMIT FROM AMAFCA, & PROVIDE PROOF OF INSURANCE PRIOR TO WORKING ON AMAFCA FACILITIES.


POND 12 COORDINATE DATA TABLE			
NUMBER	X	Y	Z
1	355.167.78	1.493.415.69	
2	355.117.62	1.493.482.92	
3	355.150.39	1.493.474.99	
4	355.340.26	1.493.759.87	
5	355.439.77	1.493.735.83	

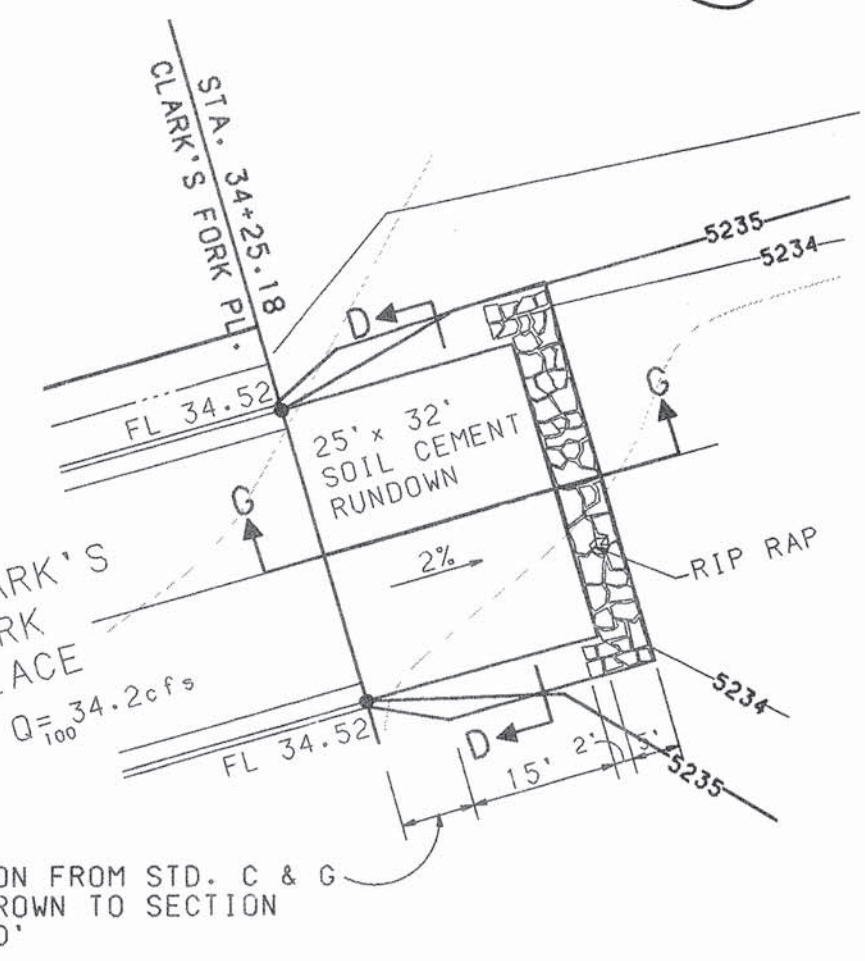

CLARK'S FORK PLACE
SOIL CEMENT RUNDOWN

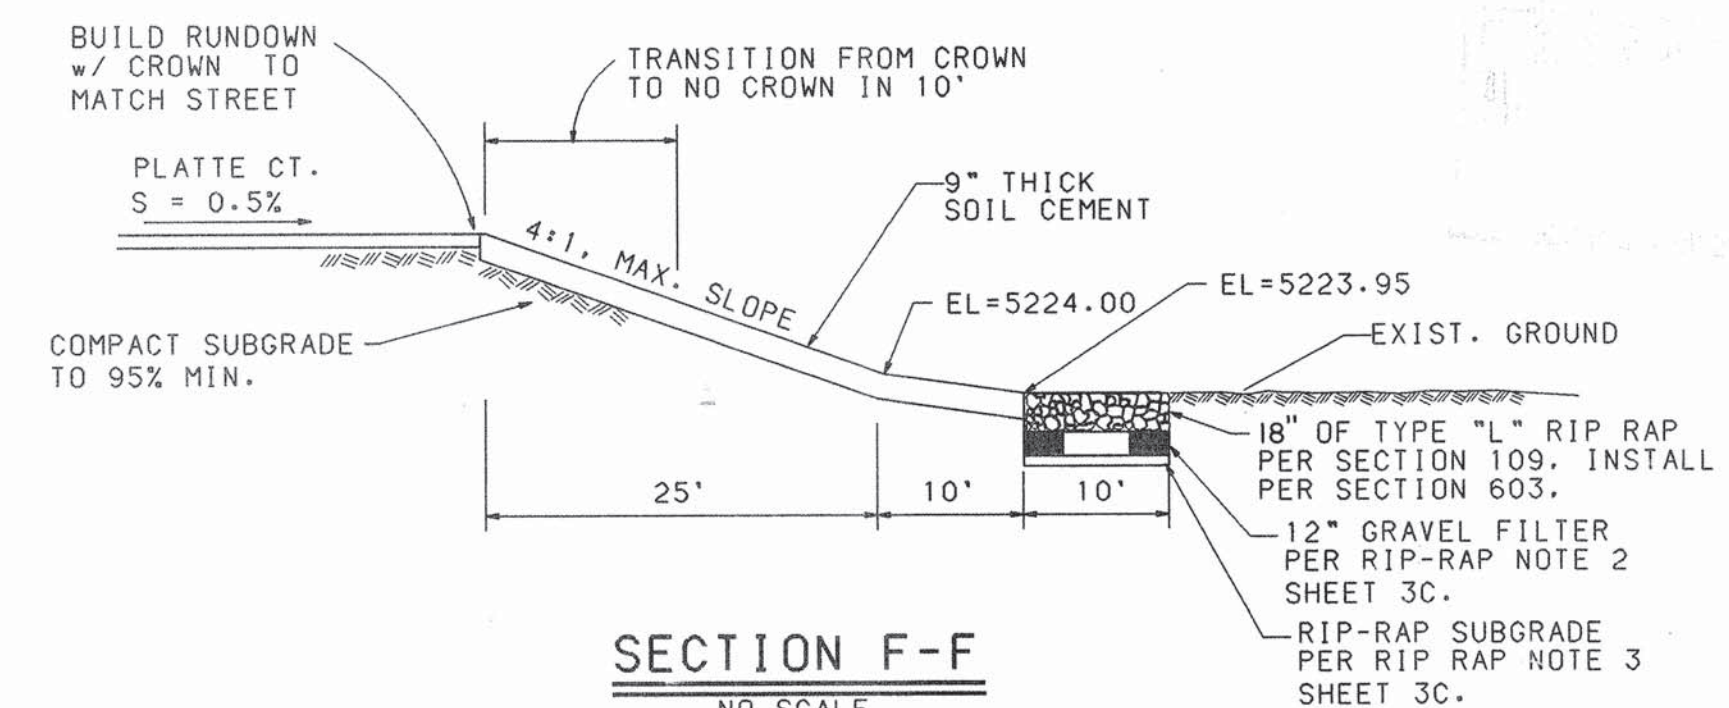


SECTION F-F

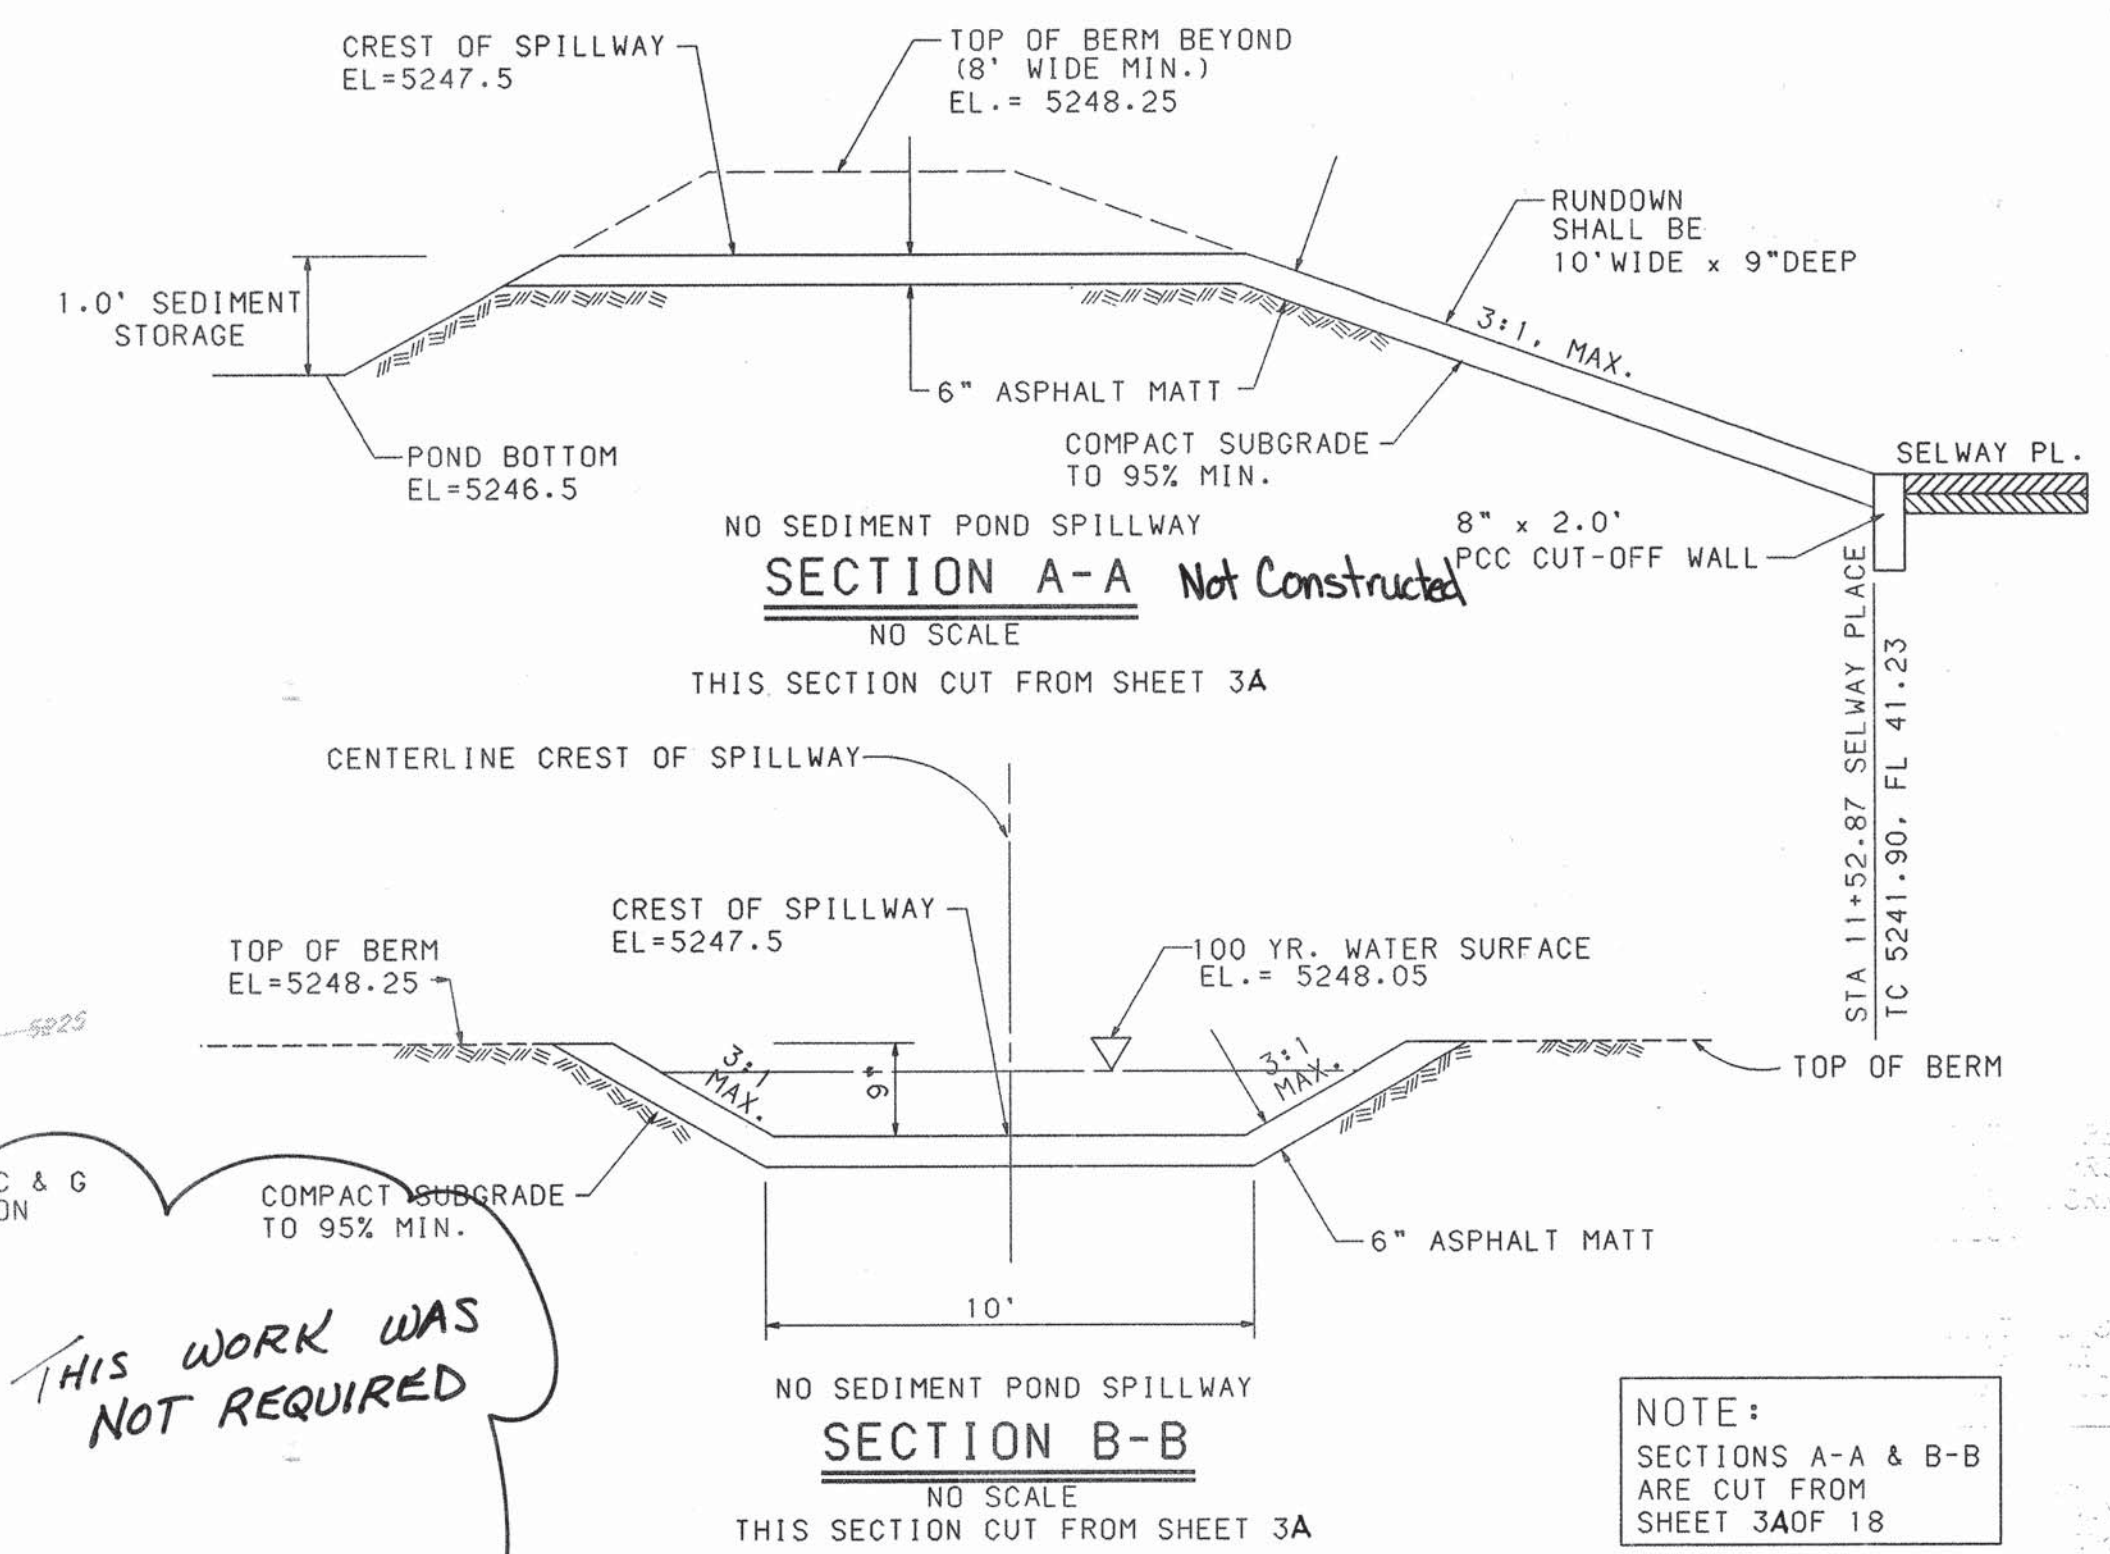

SECTION A-A Not Constructed

SECTION B-B

NOTE: SECTIONS A-A & B-B ARE CUT FROM SHEET 3A OF 18

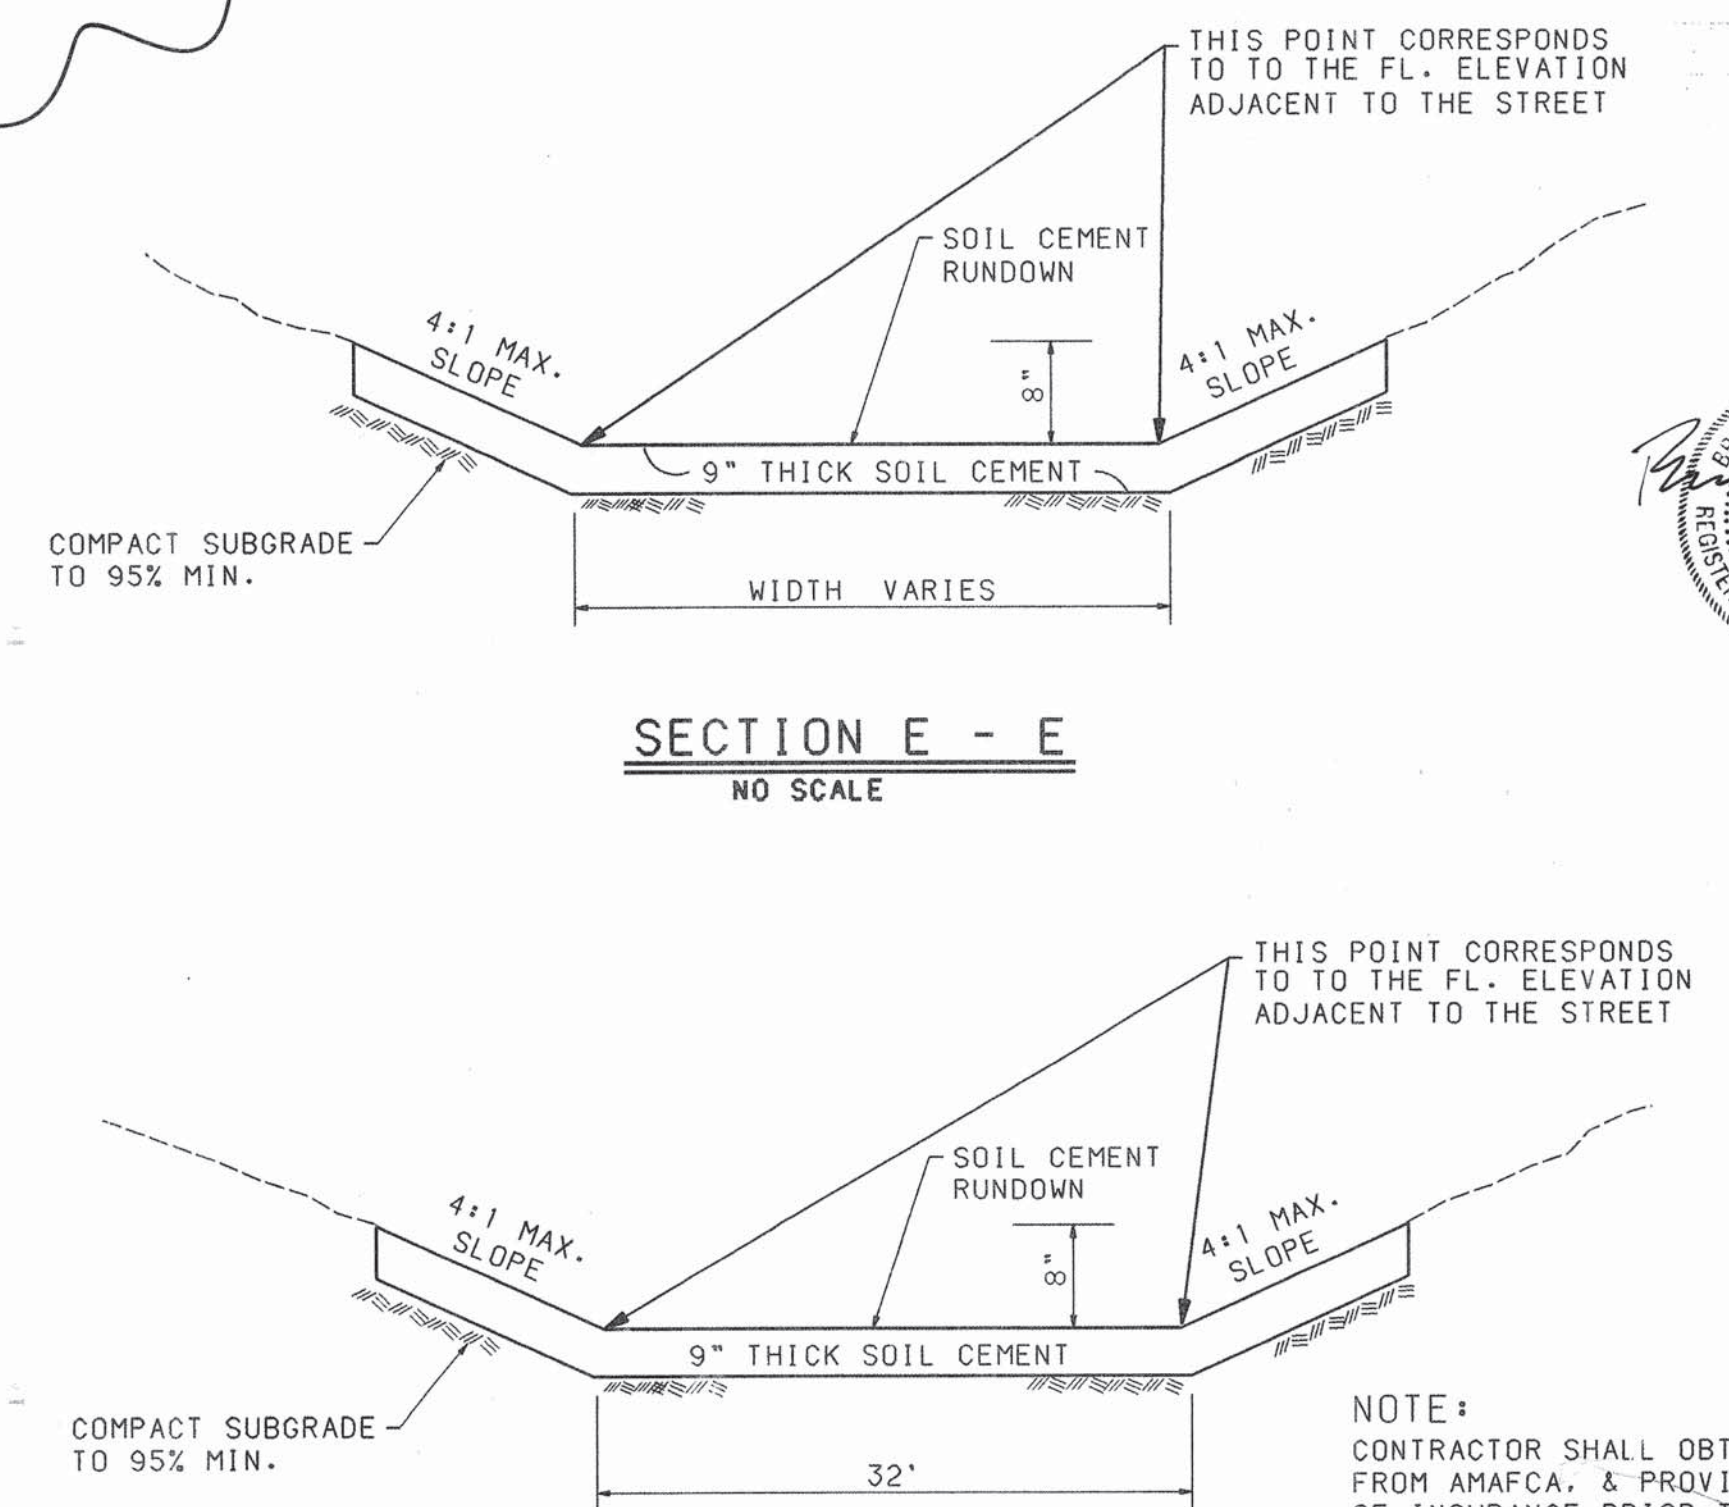

SECTION E-E

SECTION D-D

NOTE: ALL SOIL CEMENT FACILITIES SHALL BE CONSTRUCTED IN ACCORDANCE WITH THE SUPPLEMENTAL TECHNICAL SPECIFICATIONS.

BOHANNAN-HUSTON INC.
ENGINEERS • PLANNERS • PHOTOGRAMMETRISTS • SURVEYORS • LANDSCAPE ARCHITECTS
ALBUQUERQUE LAS CRUCES SANTA FE


CITY OF ALBUQUERQUE
PUBLIC WORKS DEPARTMENT
ENGINEERING DEVELOPMENT GROUP

THE CROSSING SUBDIVISION UNIT II
GRADING AND DRAINAGE DETAILS
DETAIL SHEET


DESIGN REVIEW COMMITTEE	CITY ENGINEER APPROVAL	MO/DAY/YR	MO/DAY/YR
APPROVED	APPROVED		
CITY PROJECT NO. 545382	ZONE MAP NO. H9. J9	SHEET 3B	OF 18

AS-BUILT INFORMATION				BENCH MARKS				SURVEY INFORMATION				FIELD NOTES			
CONTRACTOR	DATE	BY	NO.	CONTRACTOR	DATE	BY	NO.	CONTRACTOR	DATE	BY	NO.	CONTRACTOR	DATE	BY	NO.
CONTRACTOR	DATE	BY	NO.	CONTRACTOR	DATE	BY	NO.	CONTRACTOR	DATE	BY	NO.	CONTRACTOR	DATE	BY	NO.

SCANNED BY
MESA PERRO

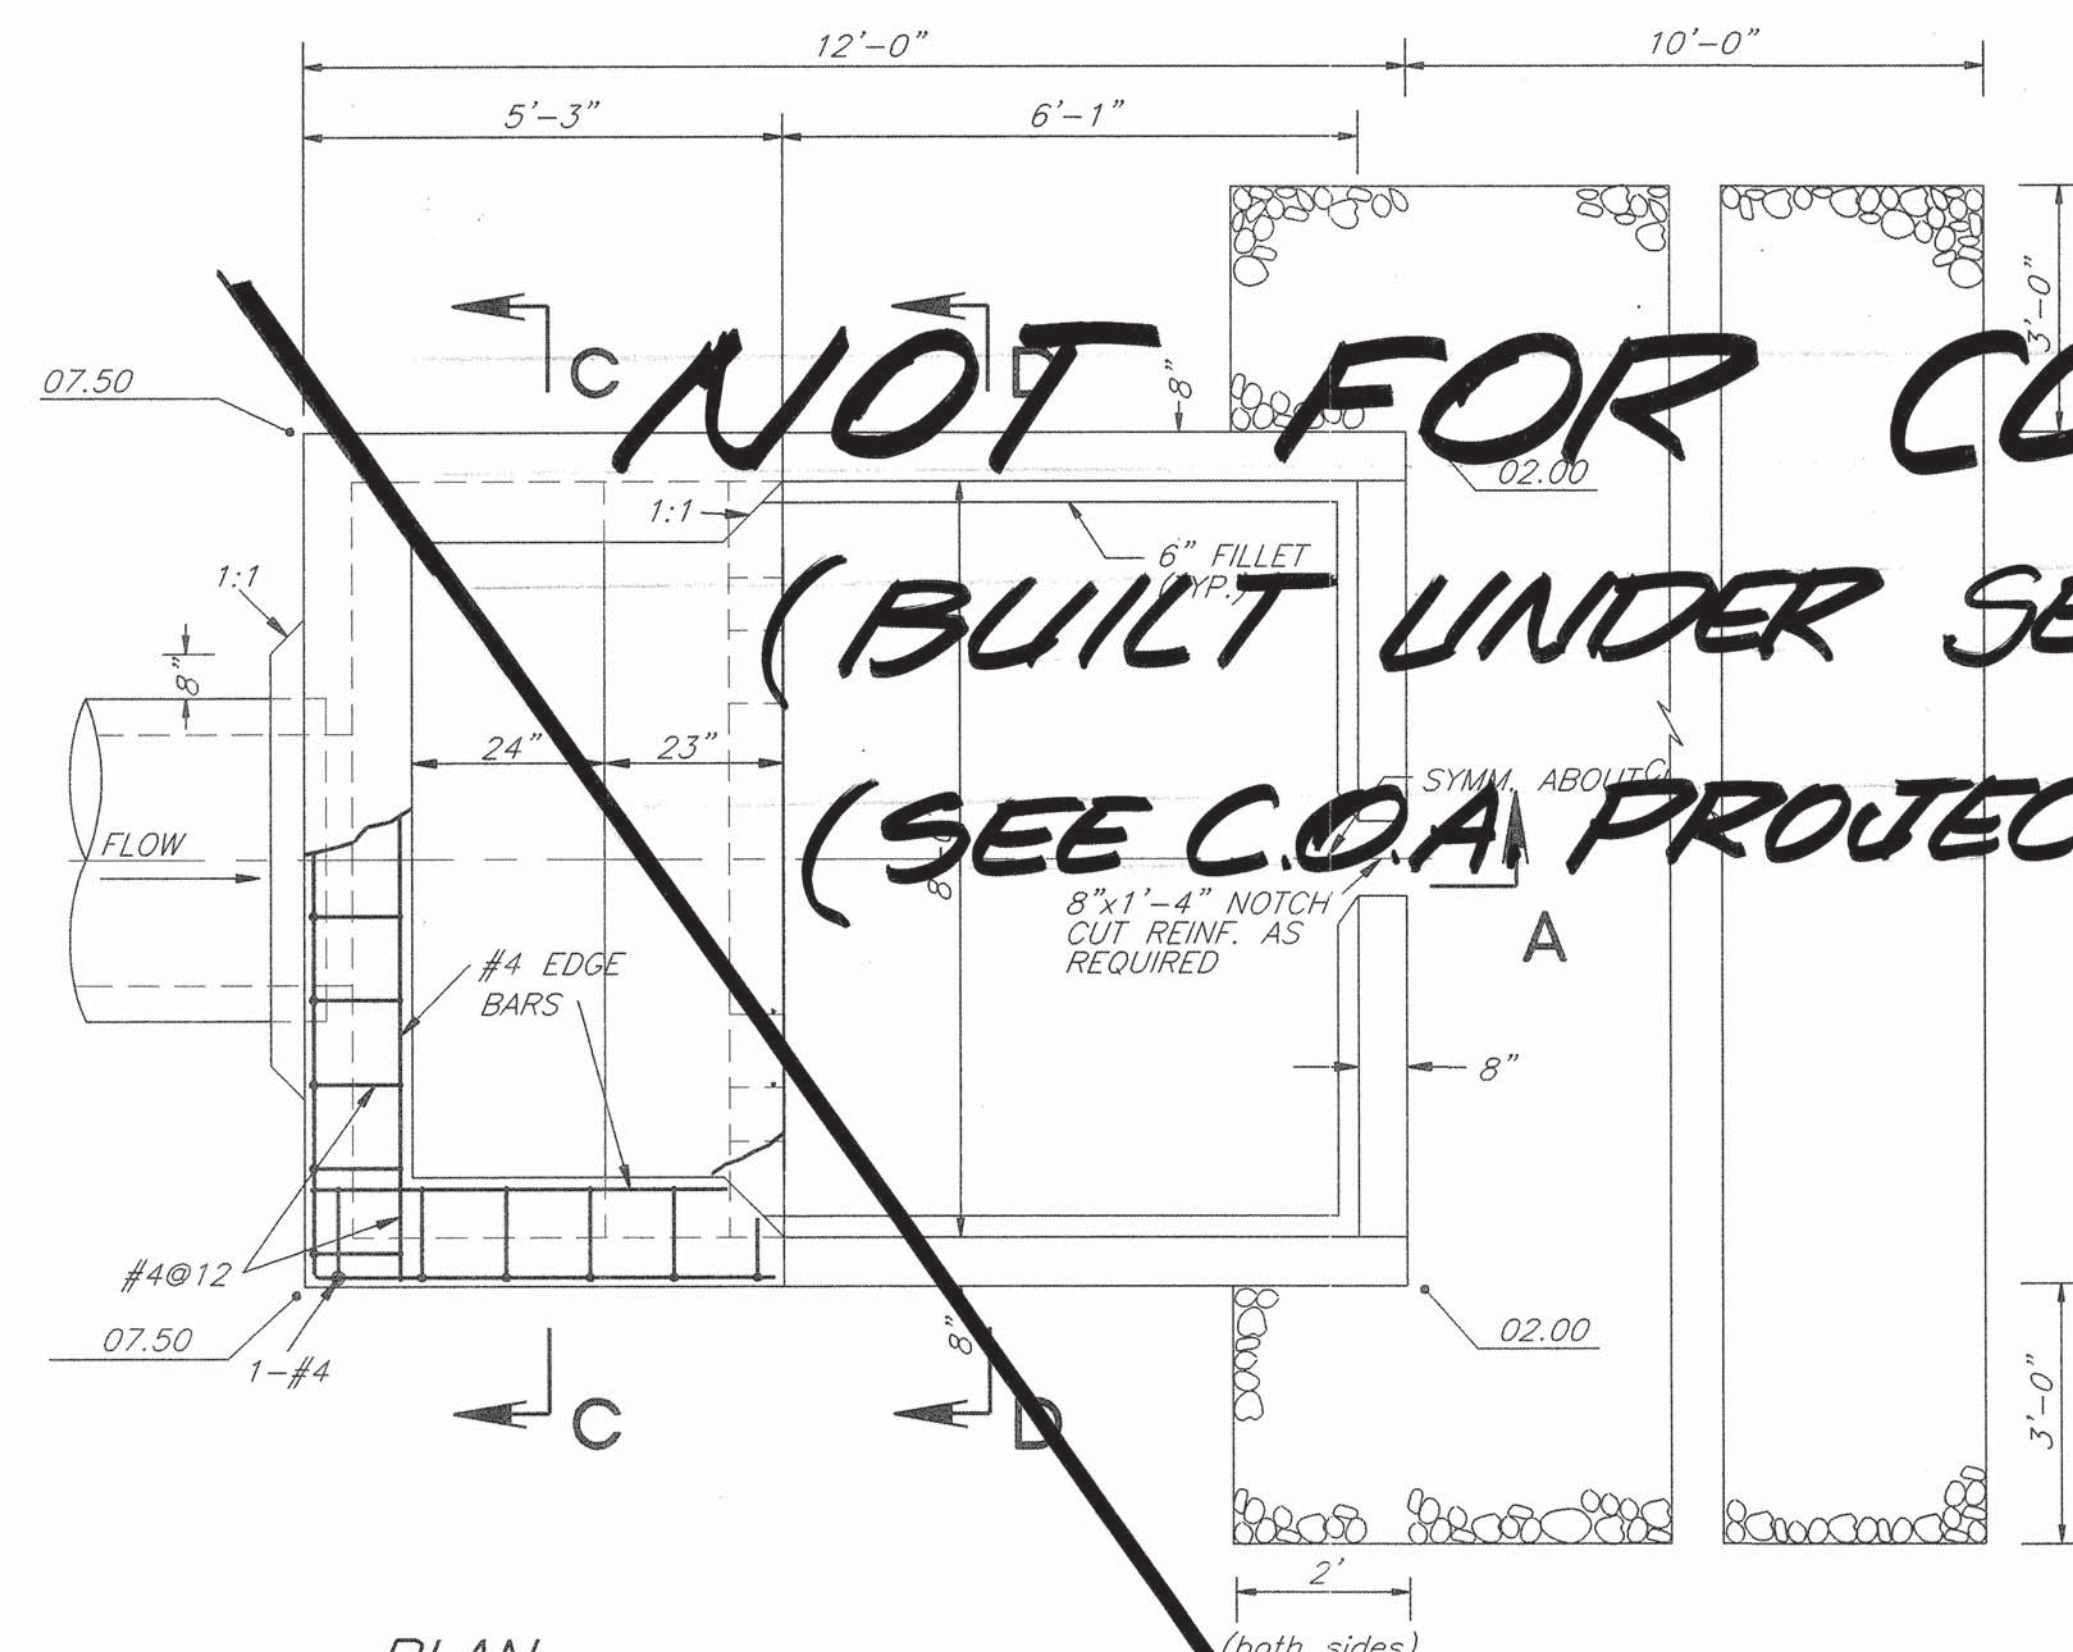


PLAN
NO SCALE

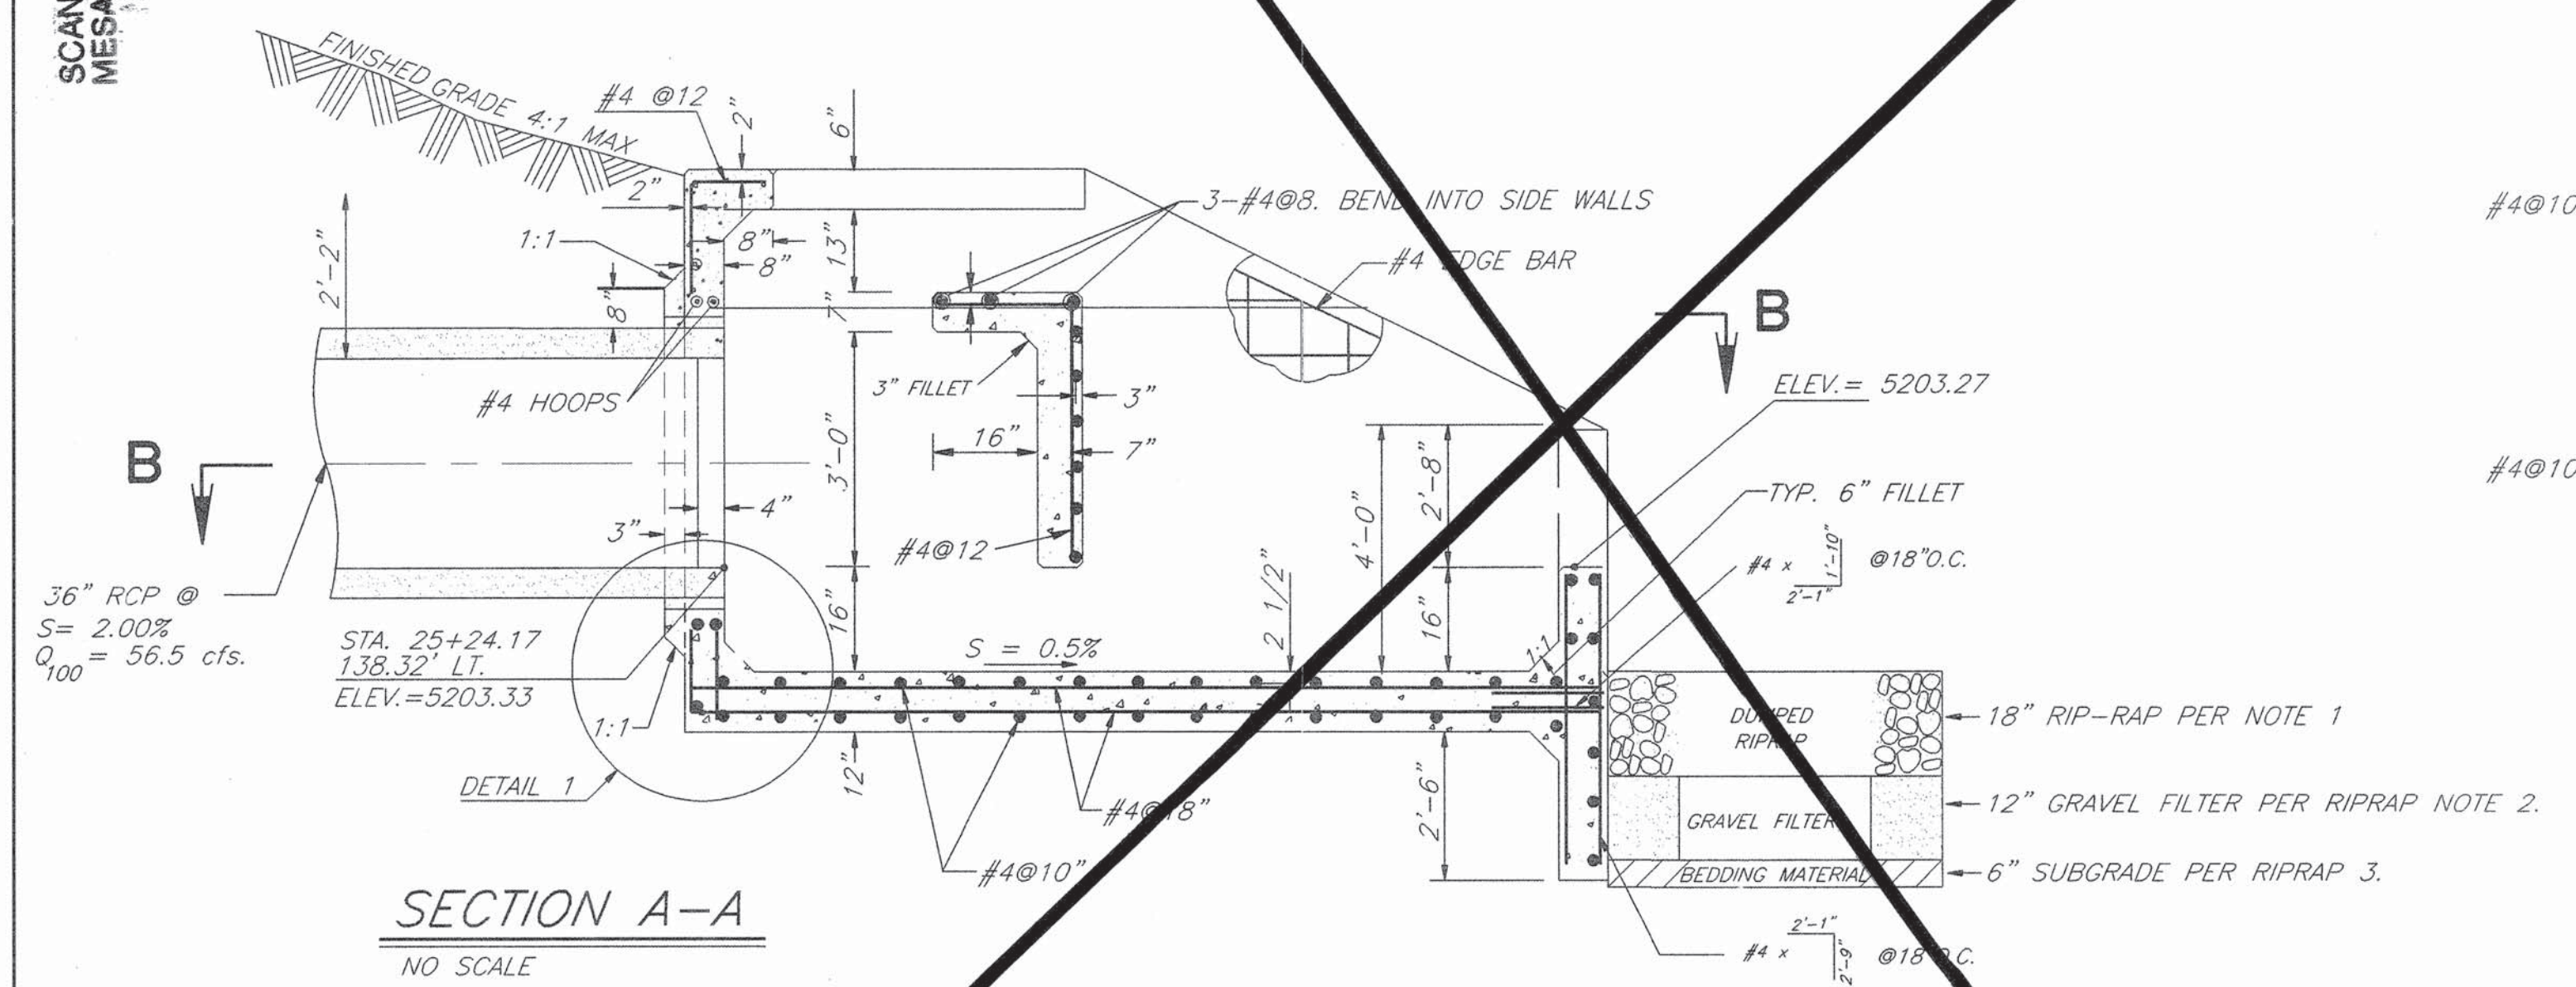


SECTION A-A
NO SCALE

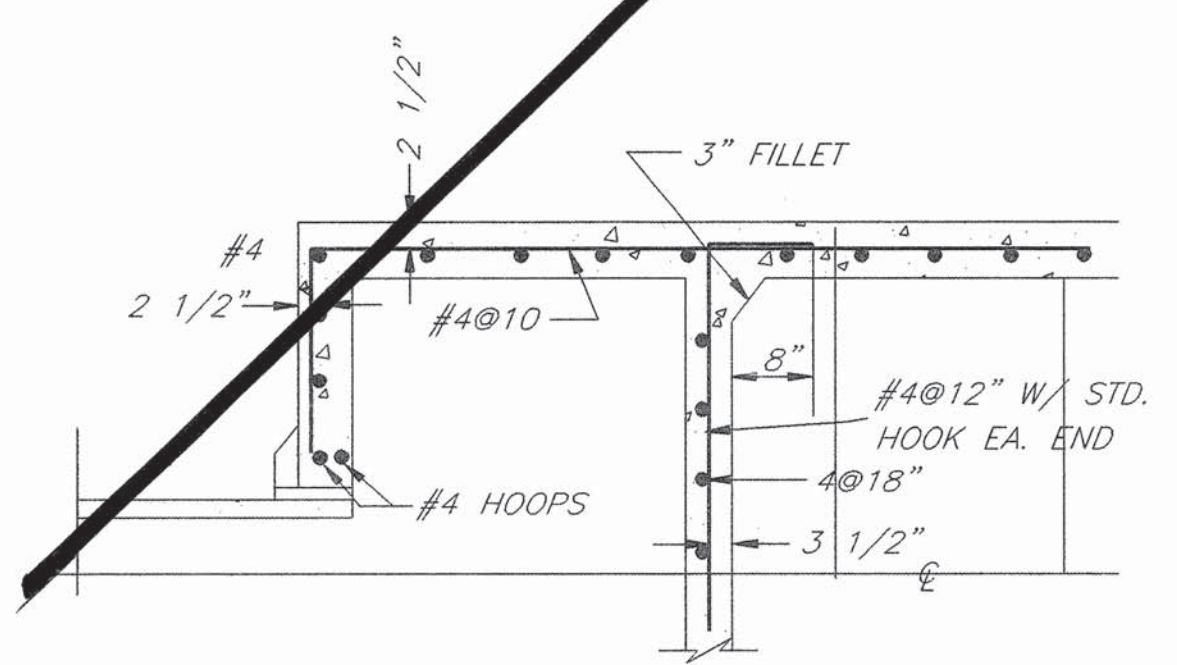


SECTION B-B
NO SCALE

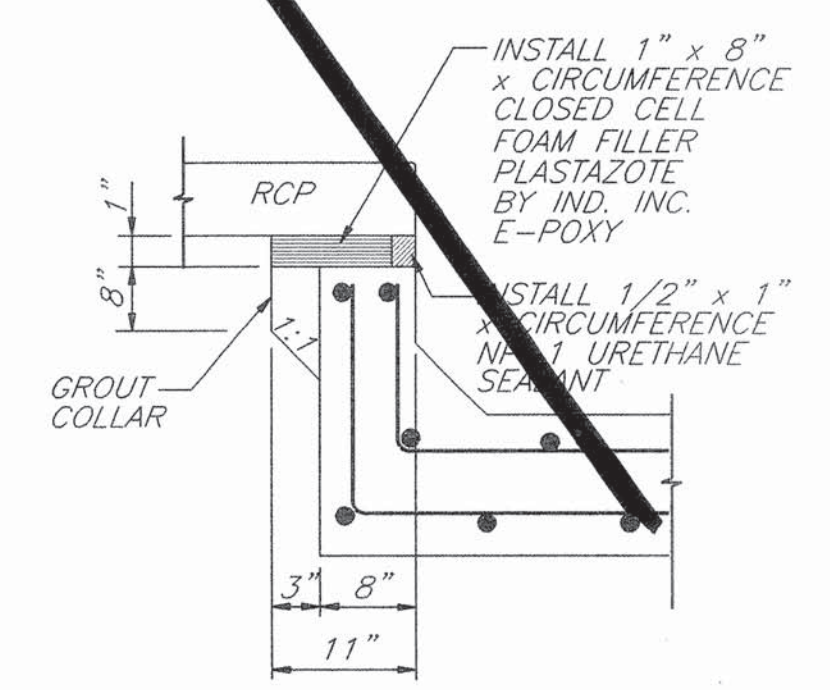

DETAIL '1'
NO SCALE

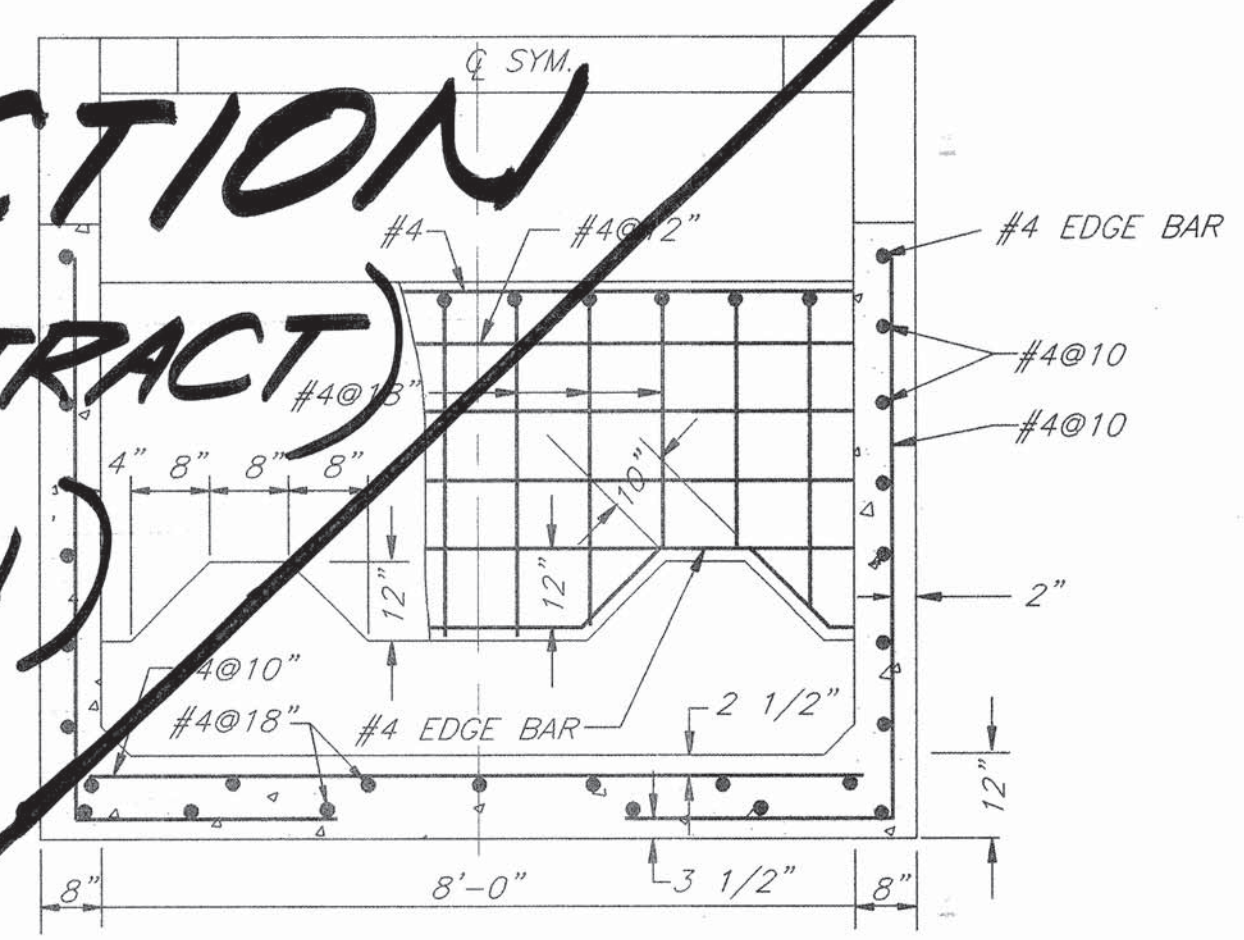

SECTION D-D
NO SCALE

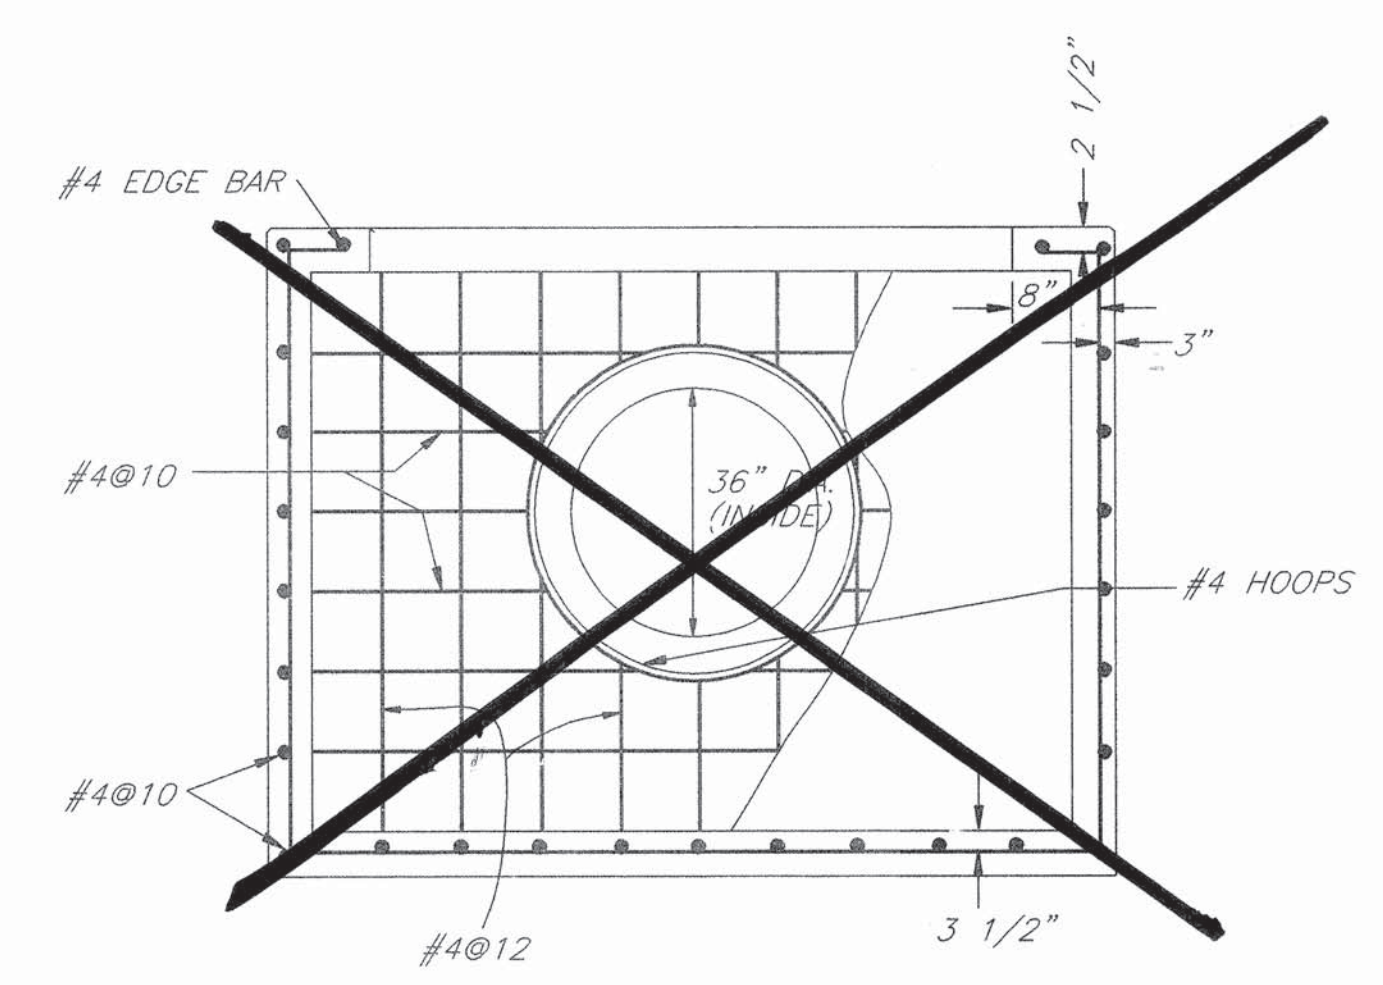

SECTION C-C
NO SCALE

THESE NOTES ARE VALID FOR THIS CONTRACT - REFER TO SHEET 3B OF 18

RIPRAP NOTES

(1) DUMPED RIPRAP SHALL BE INSTALLED IN ACCORDANCE WITH SECTION 603 OF THE STANDARD SPECIFICATIONS. RIPRAP SHALL BE TYPE M PER SECTION 109.

(2) RIPRAP SHALL BE PLACED ON GRAVEL FILTER MATERIAL. GRAVEL FILTER MATERIAL SHALL BE SUPPLIED AND INSTALLED PER SECTION 603.10 OF THE STANDARD SPECIFICATIONS, AND THE GRADATION SHALL BE AS FOLLOWS:

SIEVE SIZE	% PASSING
3"	90-100
3/4"	20-90
#4	0-20
#200	0-3

(3) RIPRAP SUBGRADE SCARIFIED AND COMPACTED TO A DEPTH OF 6" AT MINIMUM 90% ASTM D-1557 DENSITY.

INSTALL 1" x 8" x CIRCUMFERENCE CLOSED CELL FOAM FILLER PLASTAZOTE BY IND. INC. E-POXY

INSTALL 1/2" x 1" x CIRCUMFERENCE NEW 1 URETHANE SEAMANT

GROUT COLLAR

RCP

11"


3"

8"

17"

GENERAL STRUCTURAL NOTES

- CODES AND MANUALS:
Uniform Building Code, 1991 Edition
ACI 308, Latest Edition, Building Code Requirements for Reinforced Concrete.
- DESIGN LOADS:
A. Live Loads:
Soil Weight = 120 pcf
Earth lateral = 40 pcf
B. Maximum Allowable soil bearing pressure: 2000 psf*
*Allowable 1/3 stress increase for gravity and/or lateral loading.
- GENERAL:
A. The Contractor shall verify all dimensions in the field.
B. Shop drawings shall be furnished for review before any fabrication and erection is started. Properly executed shop drawings shall be rejected and re-submitted.
C. The Contractor shall be responsible for providing safe and adequate shoring for all parts of the wall and adjacent structures during construction, as well as worker safety and compliance with OSHA or other agency safety guidelines.
D. The Contractor shall field all existing utility locations and notify the Engineer immediately of any discrepancies.
E. The Contractor is responsible for repair and/or replacement of all utility conduits and existing lines.
F. The contractor shall park equipment and vehicles as not to interfere with normal activities of residents or other Contractors on site.
G. Any damage to existing facilities (curb and gutter, pavement, conduits, landscaping, utilities, ect.) during construction shall be replaced at the Contractors expense.
H. Chamfer all exposed corners 3/4" TYP.
- MATERIALS:
A. Cast-in-Place Concrete:
(1) All concrete shall conform to Standard Spec. Section 101. Concrete shall be 4000 psi for hydraulic structures.
B. Reinforcing Steel:
(1) All reinforcing steel shall conform to ASTM A615 Grade 60; except stirrups, ties, may conform to ASTM A183 Grade 40.
(2) Reinforcing shall be stored in such a manner as to inhibit rusting or the deposit of oils or other bonding inhibiting deposits.
(3) Reinforcing steel shall be fabricated and placed in accordance with the Building Code Requirements for Reinforced Concrete (ACI 318) and the CRSI Standard Manual.
(4) Bar supports and spacers for rebar shall be provided in accordance with ACI and CRSI.
(5) All lap splices shall be class
(6) Concrete cover for reinforcing shall be as follows:
a. Concrete poured against earth 3 inches
b. Concrete poured in forms but exposed to weather or earth:
1. If bars are larger than No. 5 2 inches
2. If bars are No. 5 or smaller 1-1/2 inches
(7) The Contractor shall be responsible to see that all rebar is properly aligned and tied in place before placing concrete. All column, wall dowels and vertical steel shall be accurately located and secured in place so that it remains in the position shown during the concrete placing operation. Any rebar found to be improperly installed shall be removed at no additional cost to the Owner.
(8) For ties shall be either of the threaded spigot type or other approved equal so that no metal will be left within 1 inch of the surface of the wall. Following removal of form ties, recesses are to be carefully filled and pointed with mortar.

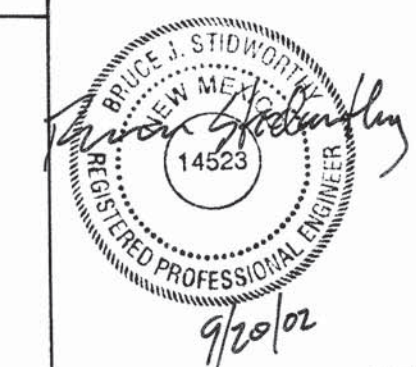

NOTIFY AMAFCA 2 DAYS PRIOR TO WORK IN R.O.W. AMAFCA MUST INSPECT STEEL & FORMWORK PRIOR TO POURING CONCRETE

BOHANNAN-HUSTON INC.
ENGINEERS • PLANNERS • PHOTOGRAMMETRISTS • SURVEYORS • LANDSCAPE ARCHITECTS
ALBUQUERQUE LAS CRUCES SANTA FE

CITY OF ALBUQUERQUE
PUBLIC WORKS DEPARTMENT
ENGINEERING DEVELOPMENT GROUP

TITLE: **THE CROSSING SUBDIVISION UNIT II**
IMPACT BASIN DETAILS

DESIGN REVIEW COMMITTEE CITY ENGINEER APPROVAL

DESIGNED BY BUS/KP
DRAWN BY PB
CHECKED BY KP

MO./DAY/YR. MO./DAY/YR.

CITY PROJECT NO. **545382** ZONE MAP NO. **H-9, J-9** SHEET **3C** OF **18**

NOTE: SEE SHEET 3D FOR HANDRAIL DETAILS.

(SEE C.O.A. PROJECT No. 545381)



- A. All posts, rails, plates, angles, bolts, etc. shall be of structural steel and galvanized per COA standards.
- B. Install chain link fabric on outside of rail.
- C. Tension wire shall be 7 ga. spring steel w/11 ga. wire ties @ 2 o.c.
- D. Tension burs and three (3) clamps at each corner post.
- E. Tack weld chain link fabric at 3 points along each frame member.
- F. Paint all field welds with galvanizing coating.

ENGINEER'S SEAL						SURVEY INFORMATION		BENCH MARKS	AS-BUILT INFORMATION	
						FIELD NOTES				
						NO.	BY	DATE		
									CONTRACTOR	DATE
									DRAWN BY	DATE
									INSPECTOR'S	DATE
					REMARKS				ACCEPTANCE BY	DATE
				BY					VERIFICATION BY	DATE
									DRAWINGS	DATE
									CHECKED BY	
					DESIGN				MICRO-FILM	INFORMATION
									RECORDED BY	DATE
					DESIGNED BY BJS/KP					
					DRAWN BY BS					
									NO.	

	BOHANNAN-HUSTON INC. ENGINEERS • PLANNERS • PHOTOGRAMMETRISTS • SURVEYORS • LANDSCAPE ARCHITECTS ALBUQUERQUE LAS CRUCES SANTA FE														
	 CITY OF ALBUQUERQUE PUBLIC WORKS DEPARTMENT ENGINEERING DEVELOPMENT GROUP														
TITLE: THE CROSSING SUBDIVISION UNIT II HANDRAIL DETAILS															
DESIGN REVIEW COMMITTEE 	CITY ENGINEER APPROVAL 	LAST DESIGN UPDATE 	<table border="1" style="width: 100%; border-collapse: collapse;"> <tr> <th style="text-align: center;">MO./DAY/YR.</th> <th style="text-align: center;">MO./DAY/YR.</th> </tr> <tr><td> </td><td> </td></tr> <tr><td> </td><td> </td></tr> <tr><td> </td><td> </td></tr> <tr><td> </td><td> </td></tr> <tr><td> </td><td> </td></tr> </table>	MO./DAY/YR.	MO./DAY/YR.										
MO./DAY/YR.	MO./DAY/YR.														
CITY PROJECT NO. 545382	ZONE MAP NO. H-9, J-9		SHEET 3D OF 18												

SCANNED BY
MESA REPRO

SCANNED BY
MESA REPRO

FOR
GUNNISON PL.
SECTION
C-C
COA #
545381

SEE
PLAN
SET
COA #
671581

THIS SEGMENT OF GUNNISON PLACE
TO BE PAVED UNDER UNIT I
COA #545381

TRANSITION FROM SECTION C-C TO
SECTION D-D SEE
SHEET 9 FOR STA. LOCATION

150' TEMPORARY ACCESS EASEMENT GRANTED TO THE
CITY OF ALBUQUERQUE w/ FILING OF BULK LAND PLAT
RECORDED ON 7/9/96 IN VOL. 56C OF FOLD 302

POND 12
COURT JUDGEMENT
AMAFCA LD-2-1T

TRACT H
29.5 ACRES

IMPACT BASIN

IDENTICAL POINT

TRACT A
35.3 ACRES

TRACT A-2-A
REPLAT OF
EL RANCHO ATRISCO, PHASE V

**NOT FOR CONSTRUCTION
(TO BE BUILT UNDER
SEPARATE CONTRACTS
671581 AND 545381)**

NOTE:
AFTER ROUGH GRADING, PRIOR TO CONSTRUCTION
OF ANY PORTION OF THE PAVEMENT SECTION,
R - VALUE TEST SHALL BE PERFORMED AS REQUIRED
IN THE DPM VOL. II SEC. 23.H. IF ANY R - VALUE
IS FOUND TO BE LESS THAN 50, THE ENGINEER SHALL
BE NOTIFIED IMMEDIATELY.

50' TEMPORARY ACCESS
24'

STREET SECTION D-D
NO SCALE

2" ASPHALT TACK
SEE PAVEMENT
SECTION THIS
SHEET




LADERA DRIVE

- LEGEND**
- PROJECT BOUNDARY
 - TRACT BOUNDARY
 - PROPOSED CURB & GUTTER
 - FUTURE CURB & GUTTER
 - FUTURE SIDEWALK
 - PROPOSED RETAINING WALL
 - PROPOSED SANITARY SEWER MANHOLE
 - FUTURE SANITARY SEWER MANHOLE
 - PROPOSED FIRE HYDRANT
 - EXISTING FIRE HYDRANT
 - PROPOSED GATE VALVE
 - FUTURE GATE VALVE
 - PROPOSED STORM DRAIN LINE
 - PROPOSED STORM DRAIN INLET
 - EXISTING STORM DRAIN LINE
 - EXISTING STORM DRAIN INLET
 - CROWN FLATTENING
 - PROPOSED STREET LIGHT


**WHEEL CHAIR RAMP DETAIL
SEE MODIFIED STD. DWG. 2441 CASE II
NOT TO SCALE**

EXISTING LAS LOMITAS
UNIT 2 - A


PLAT FOR LAS LOMITAS
UNIT IIB

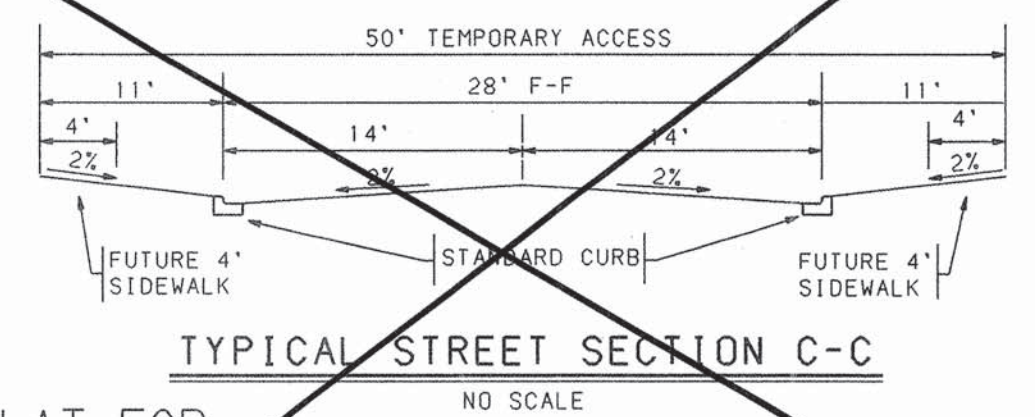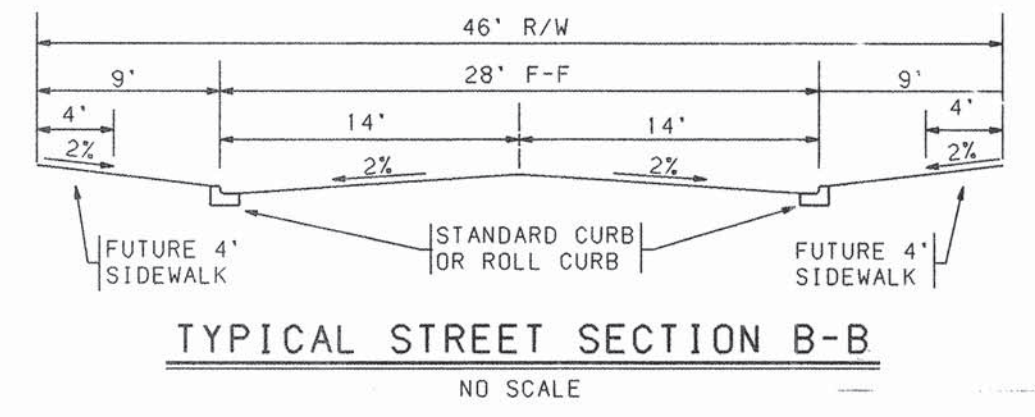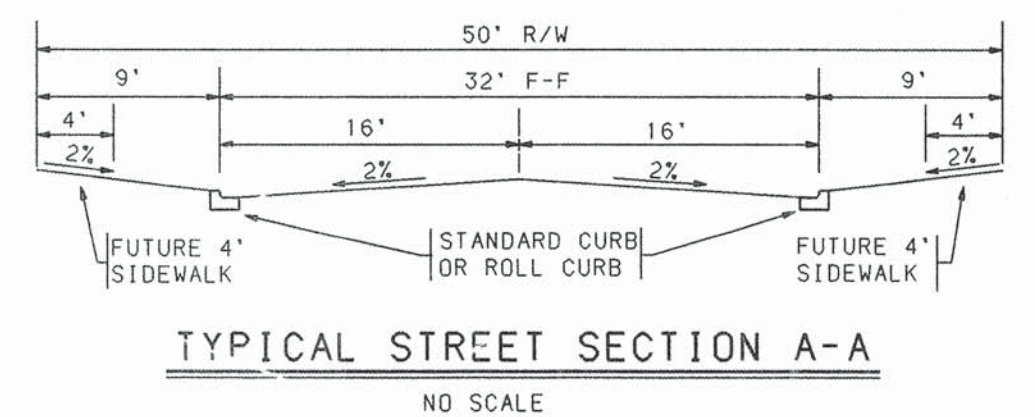

CORRECTED PLAT FOR
LAS LOMITAS
UNIT I AND UNIT II

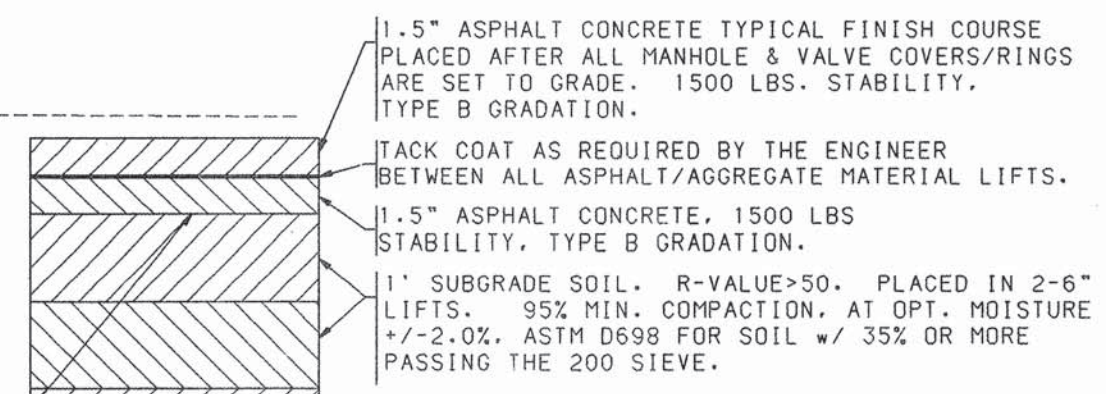

NOTE:
USE THIS PAVEMENT SECTION FOR ALL ROADS
TO BE CONSTRUCTED WITH THIS CONTRACT.

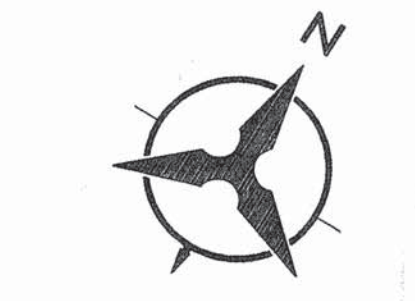

SCALE: 1" = 100'

BOHANNAN-HUSTON INC.
ENGINEERS • PLANNERS • PHOTOGRAMMETRISTS • SURVEYORS • LANDSCAPE ARCHITECTS
ALBUQUERQUE LAS CRUCES SANTA FE

**CITY OF ALBUQUERQUE
PUBLIC WORKS DEPARTMENT
ENGINEERING DEVELOPMENT GROUP**

**THE CROSSING SUBDIVISION UNIT II
OVERALL PAVING**

APPROVED
DESIGN COMMITTEE

APPROVED
CITY ENGINEER

LAST DESIGN UPDATE

MO/DAY/YR

MO/DAY/YR

DESIGNED BY KP/BSJ
DRAWN BY BS
CHECKED BY KP


ZONE MAP NO. 545382
SHEET 4 OF 18
H-9, J-9

CITY PROJECT NO. 545382
JOB NO. 9533A2440

DATE 10/19/96

DATE 10/19/96

SCANNED BY
MESA/REPRO

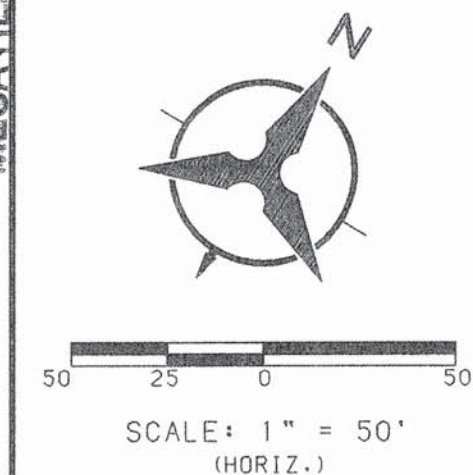

NOTE:
20" D.I. WATERLINE ZONE 2W
TO BE DESIGNED BY OTHERS
COA PROJECT # 540990

STA. 25+77.08 CASA VERDE AVE. UNIT I =
STA. 25+77.08 CLARK'S FORK PL UNIT II =
STA. 9+12.17 GUNNISON PL UNIT I

GUNNISON PLACE
COA PROJECT #545381

PT 27+29.23

28+00

29+00

30+00

31+00

32+00

33+00

NOTE:
SEE GRADING PLAN,
SHEET 3A0F 18 FOR
DRAINAGE STRUCTURE INFO

STA. 32+90.18 CLARK'S FORK PL. =
STA. 10+00.00 SELWAY PL.

PT 32+66.33

33+00

34+00

35+00


328+00

329+00

330+00

331+00

SCANNED BY
MESA PERRO

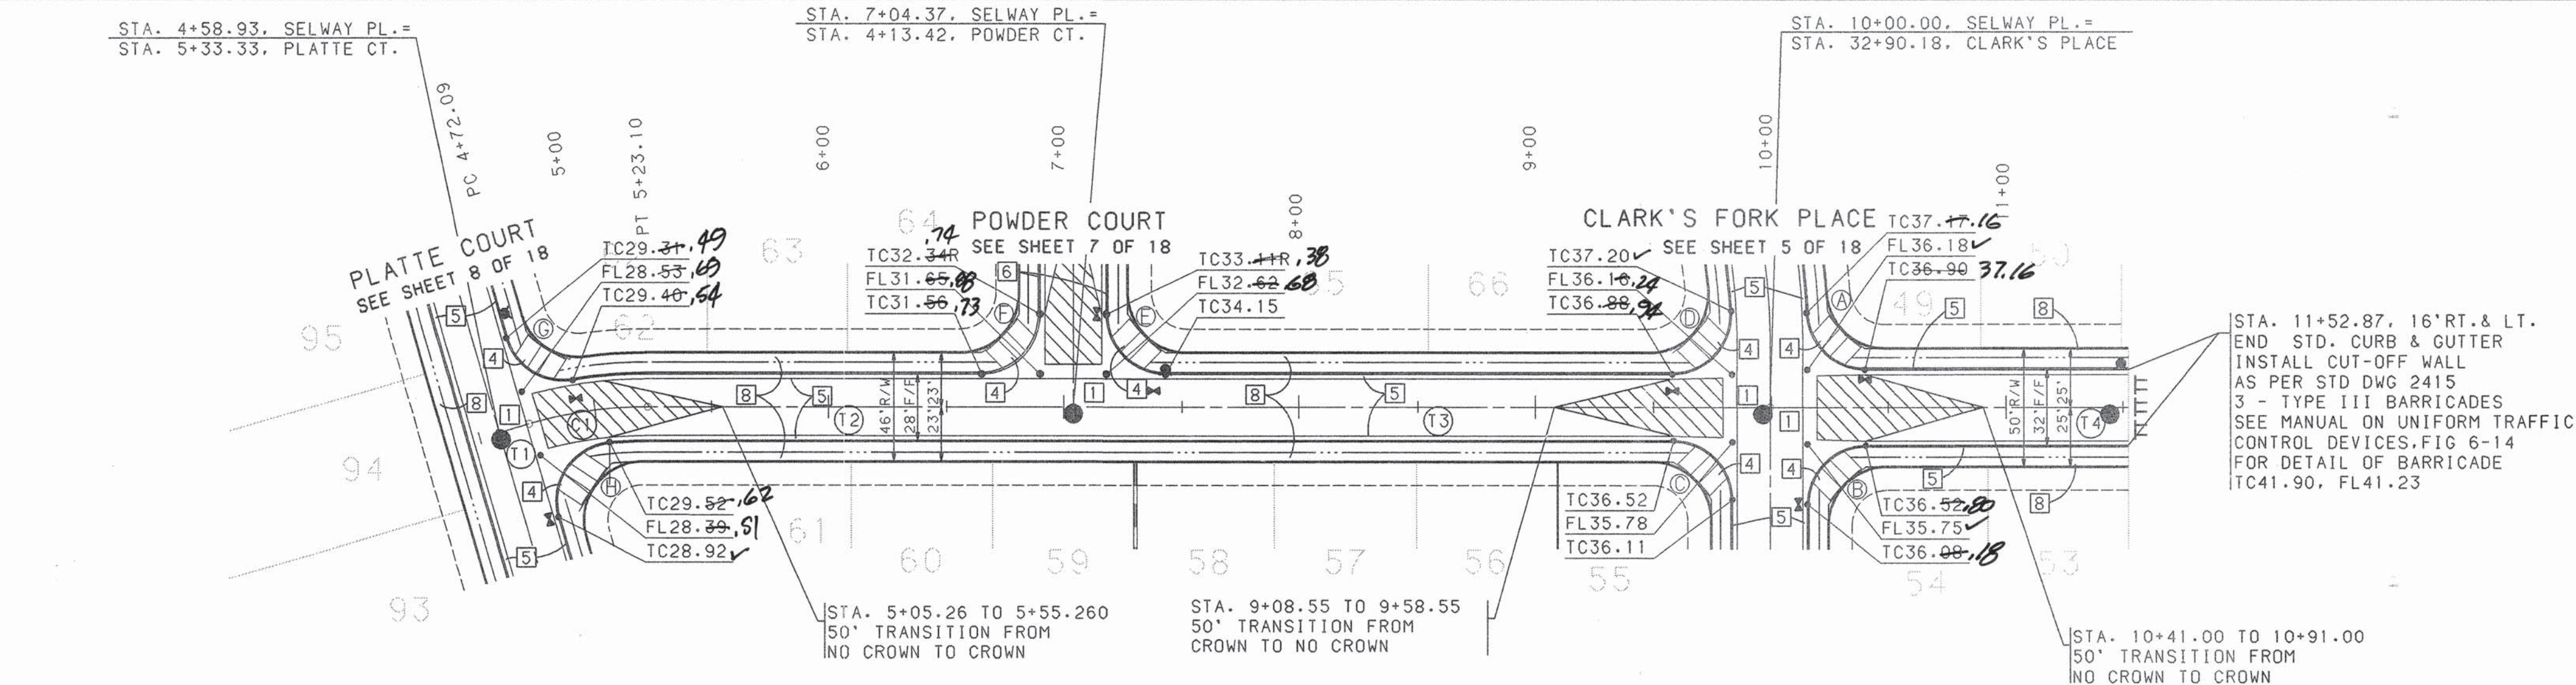


CENTERLINE TANGENT DATA		
NUMBER	BEARING	DISTANCE
T1	N32°05'33\"W	13.16'
T2	S15°51'19\"E	181.27'
T3	S15°51'19\"E	295.63'
T4	S15°51'19\"E	160.87'

CENTERLINE CURVE DATA TABLE					
NUMBER	PI STA.	DELTA	TANGENT	ARC	RADIUS
C1	4+97.77	16°14'14.0\"	25.68'	51.01'	180.00'
C2	12+68.95	24°23'39.7\"	108.08'	212.88'	500.00'


NOTE:
TRANSITION FROM STD. CURB TO
ROLL CURB THROUGH WHEEL RAMP
E & F AS PER STD. DWG. 2418.
SELWAY PLACE = STD. CURB
POWDER COURT = ROLL CURB

NOTE:
ALL TC ELEVATIONS ARE FOR TOP OF
STANDARD CURB UNLESS OTHERWISE NOTED.
TCXX.XXR = TOP OF ROLL CURB

NOTE:
SEE SHEET 4 OF 18
FOR TEMPORARY ASPHALT
CROSS SECTION DETAILS

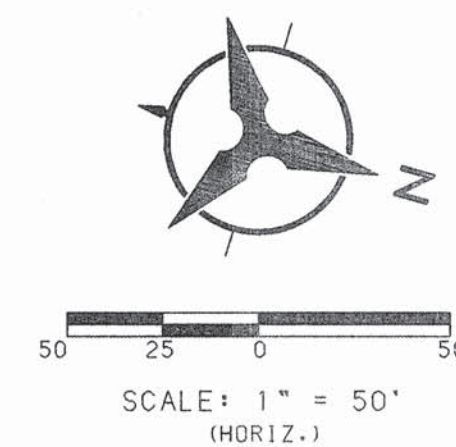

SELWAY PLACE

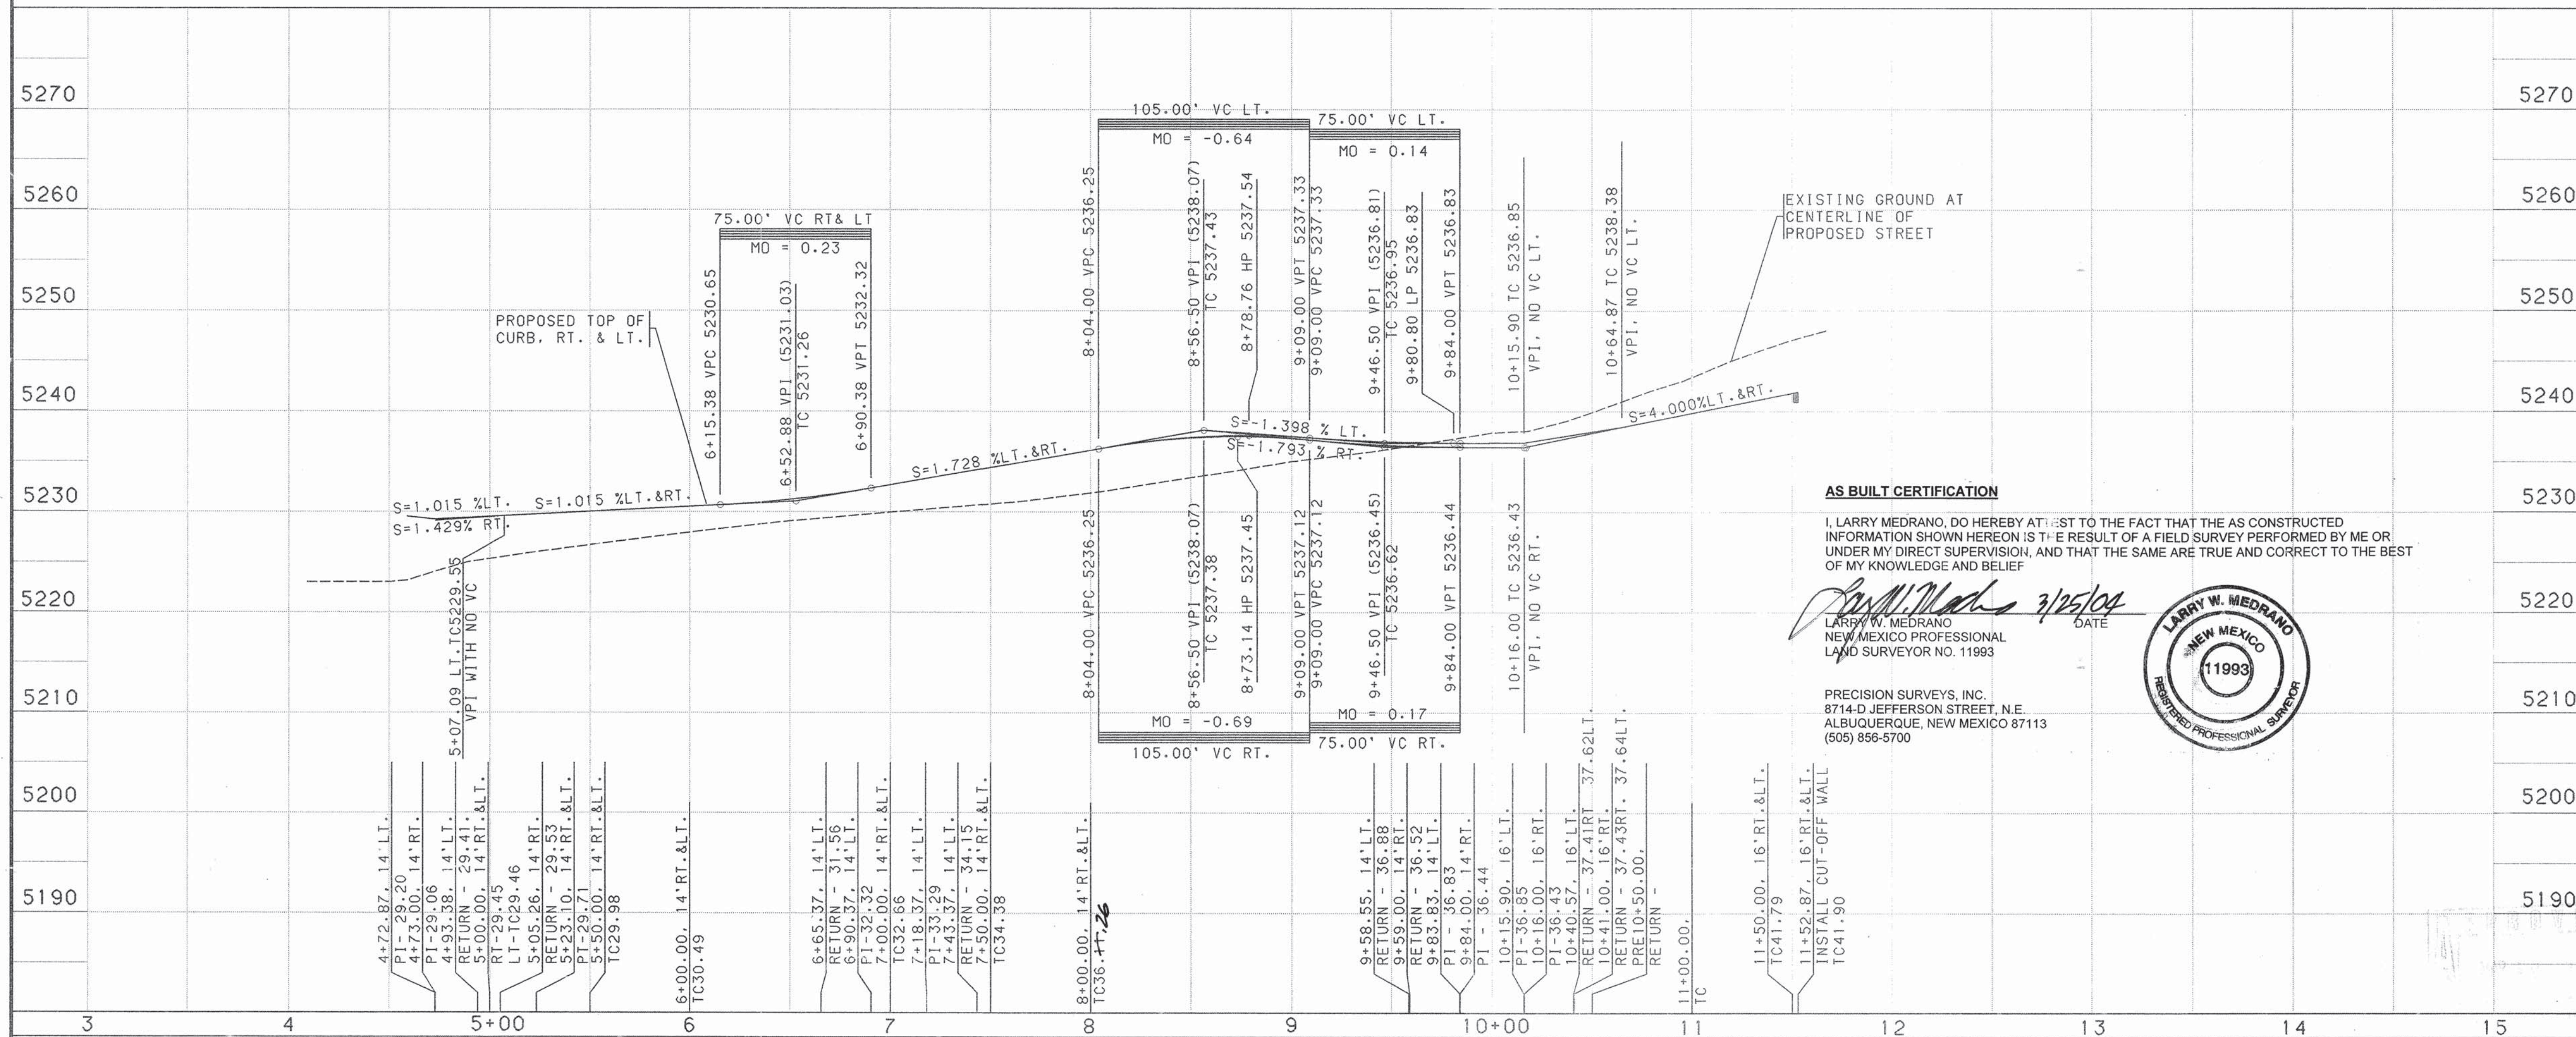

AS BUILT CERTIFICATION

I, LARRY MEDRANO, DO HEREBY CERTIFY THAT THE AS CONSTRUCTED
INFORMATION SHOWN HEREON IS THE RESULT OF A FIELD SURVEY PERFORMED BY ME OR
UNDER MY DIRECT SUPERVISION, AND THAT THE SAME ARE TRUE AND CORRECT TO THE BEST
OF MY KNOWLEDGE AND BELIEF.

Larry W. Medrano
LARRY W. MEDRANO
NEW MEXICO PROFESSIONAL
LAND SURVEYOR NO. 11993

PRECISION SURVEYS, INC.
8714-D JEFFERSON STREET, N.E.
ALBUQUERQUE, NEW MEXICO 87113
(505) 866-5700



- NOTES**
1. THE CONTRACTOR SHALL FIELD VERIFY ALL EXISTING UTILITY LOCATIONS AND NOTIFY THE ENGINEER IMMEDIATELY OF ANY DISCREPANCIES.
 2. ALL CURB RETURN RADII SHALL BE 25' TO FACE OF CURB UNLESS OTHERWISE SPECIFIED.
 3. ALL CURVE DATA AND DIMENSIONS REFER TO FACE OF CURB UNLESS OTHERWISE SPECIFIED.
 4. GRADE ELEVATIONS, WHERE NOTED, ARE FOR TOP OF STANDARD CURB UNLESS OTHERWISE SPECIFIED.
 5. CONTRACTOR IS TO INSTALL A 4"x4"x5" POST AND END AT THE END OF EACH SANITARY SEWER SERVICE.
 6. CONTRACTOR IS RESPONSIBLE FOR REPAIR AND/OR REPLACEMENT OF ALL UTILITY CONDUITS AND EXISTING LINES.
 7. ANY ADDITIONAL GRADING REQUIRED TO MATCH PROPOSED STREET GRADES SHALL BE INCIDENTAL TO PAVING ITEMS.
 8. CONTRACTOR SHALL PROVIDE THE INSPECTORS, (CITY AND PRIVATE) WITH THE PROPOSED HYDROSTATIC TESTING PLAN. THE PLAN MUST BE APPROVED BEFORE TESTING OPERATIONS BEGIN.
 9. CONTRACTOR SHALL PARK EQUIPMENT AND VEHICLES AS NOT TO INTERFERE WITH NORMAL ACTIVITIES OF RESIDENTS OR OTHER CONTRACTORS ON SITE.
 10. ANY DAMAGE TO THE EXISTING FACILITIES (CURB AND GUTTER, PAVEMENT, CONDUITS, LANDSCAPING, UTILITY LINES, ETC.) DURING CONSTRUCTION SHALL BE REPLACED AT THE CONTRACTORS EXPENSE.
 11. REMOVAL OF THE EXISTING CURB AND GUTTER SHALL BE AS PER COA STD. DWG. 2415 (SAWCUT ONLY).
 12. WHEEL CHAIR RAMPS SHALL BE CONSTRUCTED PRIOR TO ACCEPTANCE OF CURB AND GUTTER.

KEYED GENERAL NOTES

1. 6 FT WIDE
INSTALL CONCRETE VALLEY GUTTER AS PER STD. DWG. 2420
2. INSTALL CONCRETE VALLEY GUTTER AS PER STD. DWG. 2421
3. INSTALL WHEEL CHAIR RAMP AS PER STD. DWG. 2441, CASE I
4. INSTALL WHEEL CHAIR RAMP AS PER STD. DWG. 2441, CASE II
5. STD. CURB & GUTTER AS PER STD. DWG. 2415
6. ROLL CURB & GUTTER AS PER STD. DWG. 2415
7. MEDIAN CURB & GUTTER AS PER STD. DWG. 2415
8. DEFERRED FUTURE 4' SIDEWALK
9. BUILD 4' SIDEWALK
10. 10' MEANDERING ASPHALT TRAIL BY OTHERS


BOHANNAN-HUSTON INC.
ENGINEERS • PLANNERS • PHOTOGRAMMETRISTS • SURVEYORS • LANDSCAPE ARCHITECTS
ALBUQUERQUE LAS CRUCES SANTA FE

CITY OF ALBUQUERQUE
PUBLIC WORKS DEPARTMENT
ENGINEERING DEVELOPMENT GROUP

THE CROSSING SUBDIVISION UNIT II
PAVING PLAN & PROFILE
SELWAY PLACE


DESIGN REVIEW COMMITTEE	CITY ENGINEER APPROVAL	MO/DAY/YR.	MO/DAY/YR.
APPROVED	APPROVED		
DESIGN REVIEW COMMITTEE	CITY ENGINEER	LAST DESIGN UPDATE	
CITY PROJECT NO.	ZONE MAP NO.	SHEET	OF
545382	H-9, J-9	6	18
BHI JOB NO. C95335A2440			
COPYRIGHT BOHANNAN-HUSTON, INC. 1996 DATE: MAY, 1996			

SCANNED BY
MESA PERRO

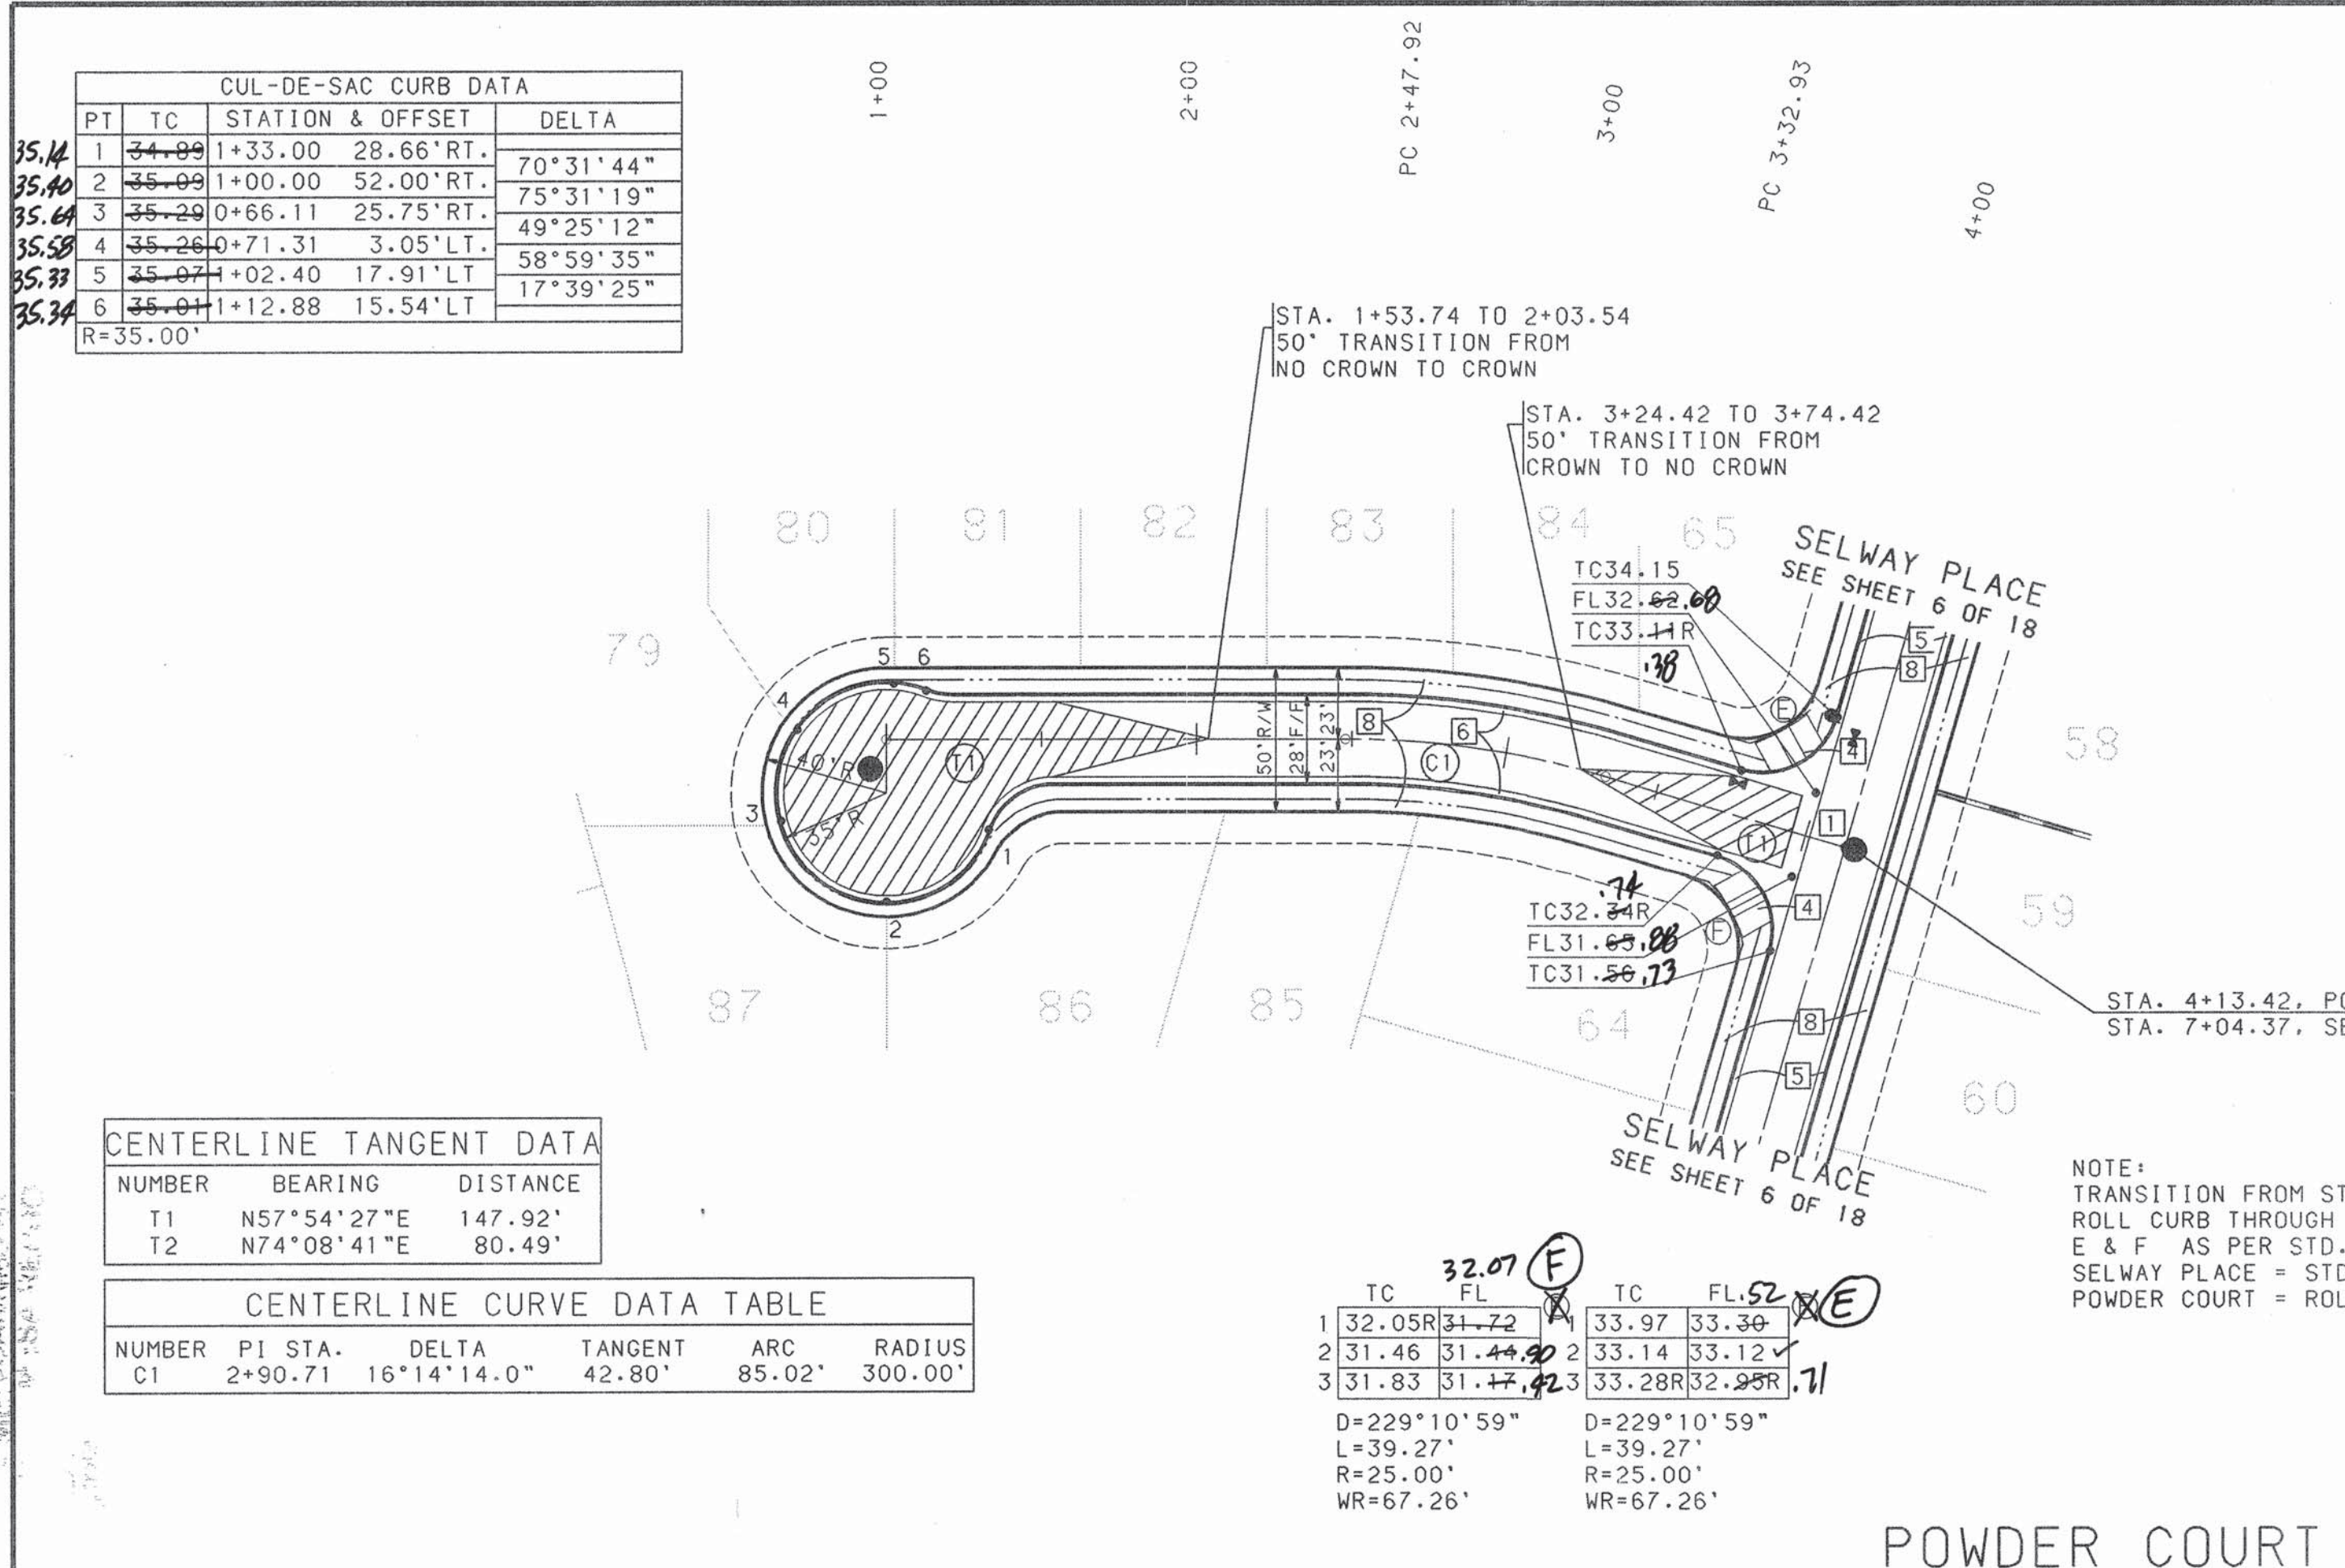

NOTE:
ALL TC ELEVATIONS ARE FOR TOP OF
STANDARD CURB UNLESS OTHERWISE NOTED.
TC50.25R = TOP OF ROLL CURB

NOTE:
TRANSITION FROM STD. CURB TO
ROLL CURB THROUGH WHEEL RAMP
E & F AS PER STD. DWG. 2418.
SELWAY PLACE = STD. CURB
POWDER COURT = ROLL CURB

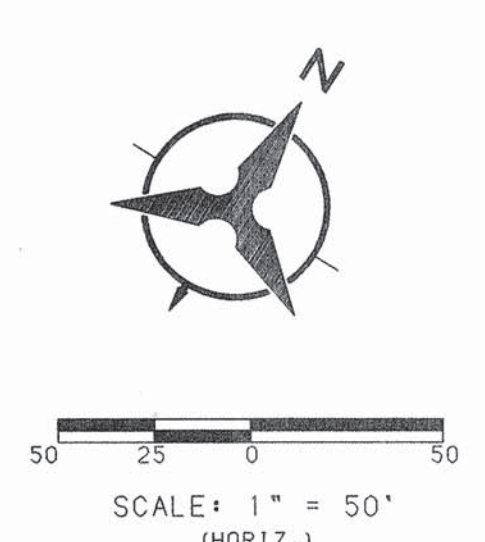

AS BUILT CERTIFICATION

I, LARRY MEDRANO, DO HEREBY ATTEST TO THE FACT THAT THE AS CONSTRUCTED
INFORMATION SHOWN HEREON IS THE RESULT OF A FIELD SURVEY PERFORMED BY ME OR
UNDER MY DIRECT SUPERVISION, AND THAT THE SAME ARE TRUE AND CORRECT TO THE BEST
OF MY KNOWLEDGE AND BELIEF.

Larry W. Medrano 3/25/04
LARRY W. MEDRANO
NEW MEXICO PROFESSIONAL
LAND SURVEYOR NO. 11993



PRECISION SURVEYS, INC.
8714-D JEFFERSON STREET, N.E.
ALBUQUERQUE, NEW MEXICO 87113
(505) 866-5700

KEYED GENERAL NOTES

- 6 FT WIDE
1. INSTALL CONCRETE VALLEY GUTTER
AS PER STD. DWG. 2420
2. INSTALL CONCRETE VALLEY GUTTER
AS PER STD. DWG. 2421
3. INSTALL WHEEL CHAIR RAMP
AS PER STD. DWG. 2441, CASE I
4. INSTALL WHEEL CHAIR RAMP
AS PER STD. DWG. 2441, CASE II
5. STD. CURB & GUTTER
AS PER STD. DWG. 2415
6. ROLL CURB & GUTTER
AS PER STD. DWG. 2415
7. MEDIAN CURB & GUTTER
AS PER STD. DWG. 2415
8. DEFERRED
FUTURE 4' SIDEWALK
9. BUILD 4' SIDEWALK
10. 10' MEANDERING ASPHALT
TRAIL BY OTHERS

BOHANNAN-HUSTON INC.
ENGINEERS • PLANNERS • PHOTOGRAMMETRISTS • SURVEYORS • LANDSCAPE ARCHITECTS
ALBUQUERQUE LAS CRUCES SANTA FE

CITY OF ALBUQUERQUE
PUBLIC WORKS DEPARTMENT
ENGINEERING DEVELOPMENT GROUP

THE CROSSING SUBDIVISION UNIT II
PAVING PLAN & PROFILE
POWDER COURT


DESIGN REVIEW COMMITTEE	CITY ENGINEER APPROVAL	MO/DAY/YR.	MO/DAY/YR.

CITY PROJECT NO. **545382** ZONE MAP NO. **H-9, J-9** SHEET **7** OF **18**

DESIGN REVIEW COMMITTEE

DATE: MAY, 1996

SCANNED BY
MESA REPRO

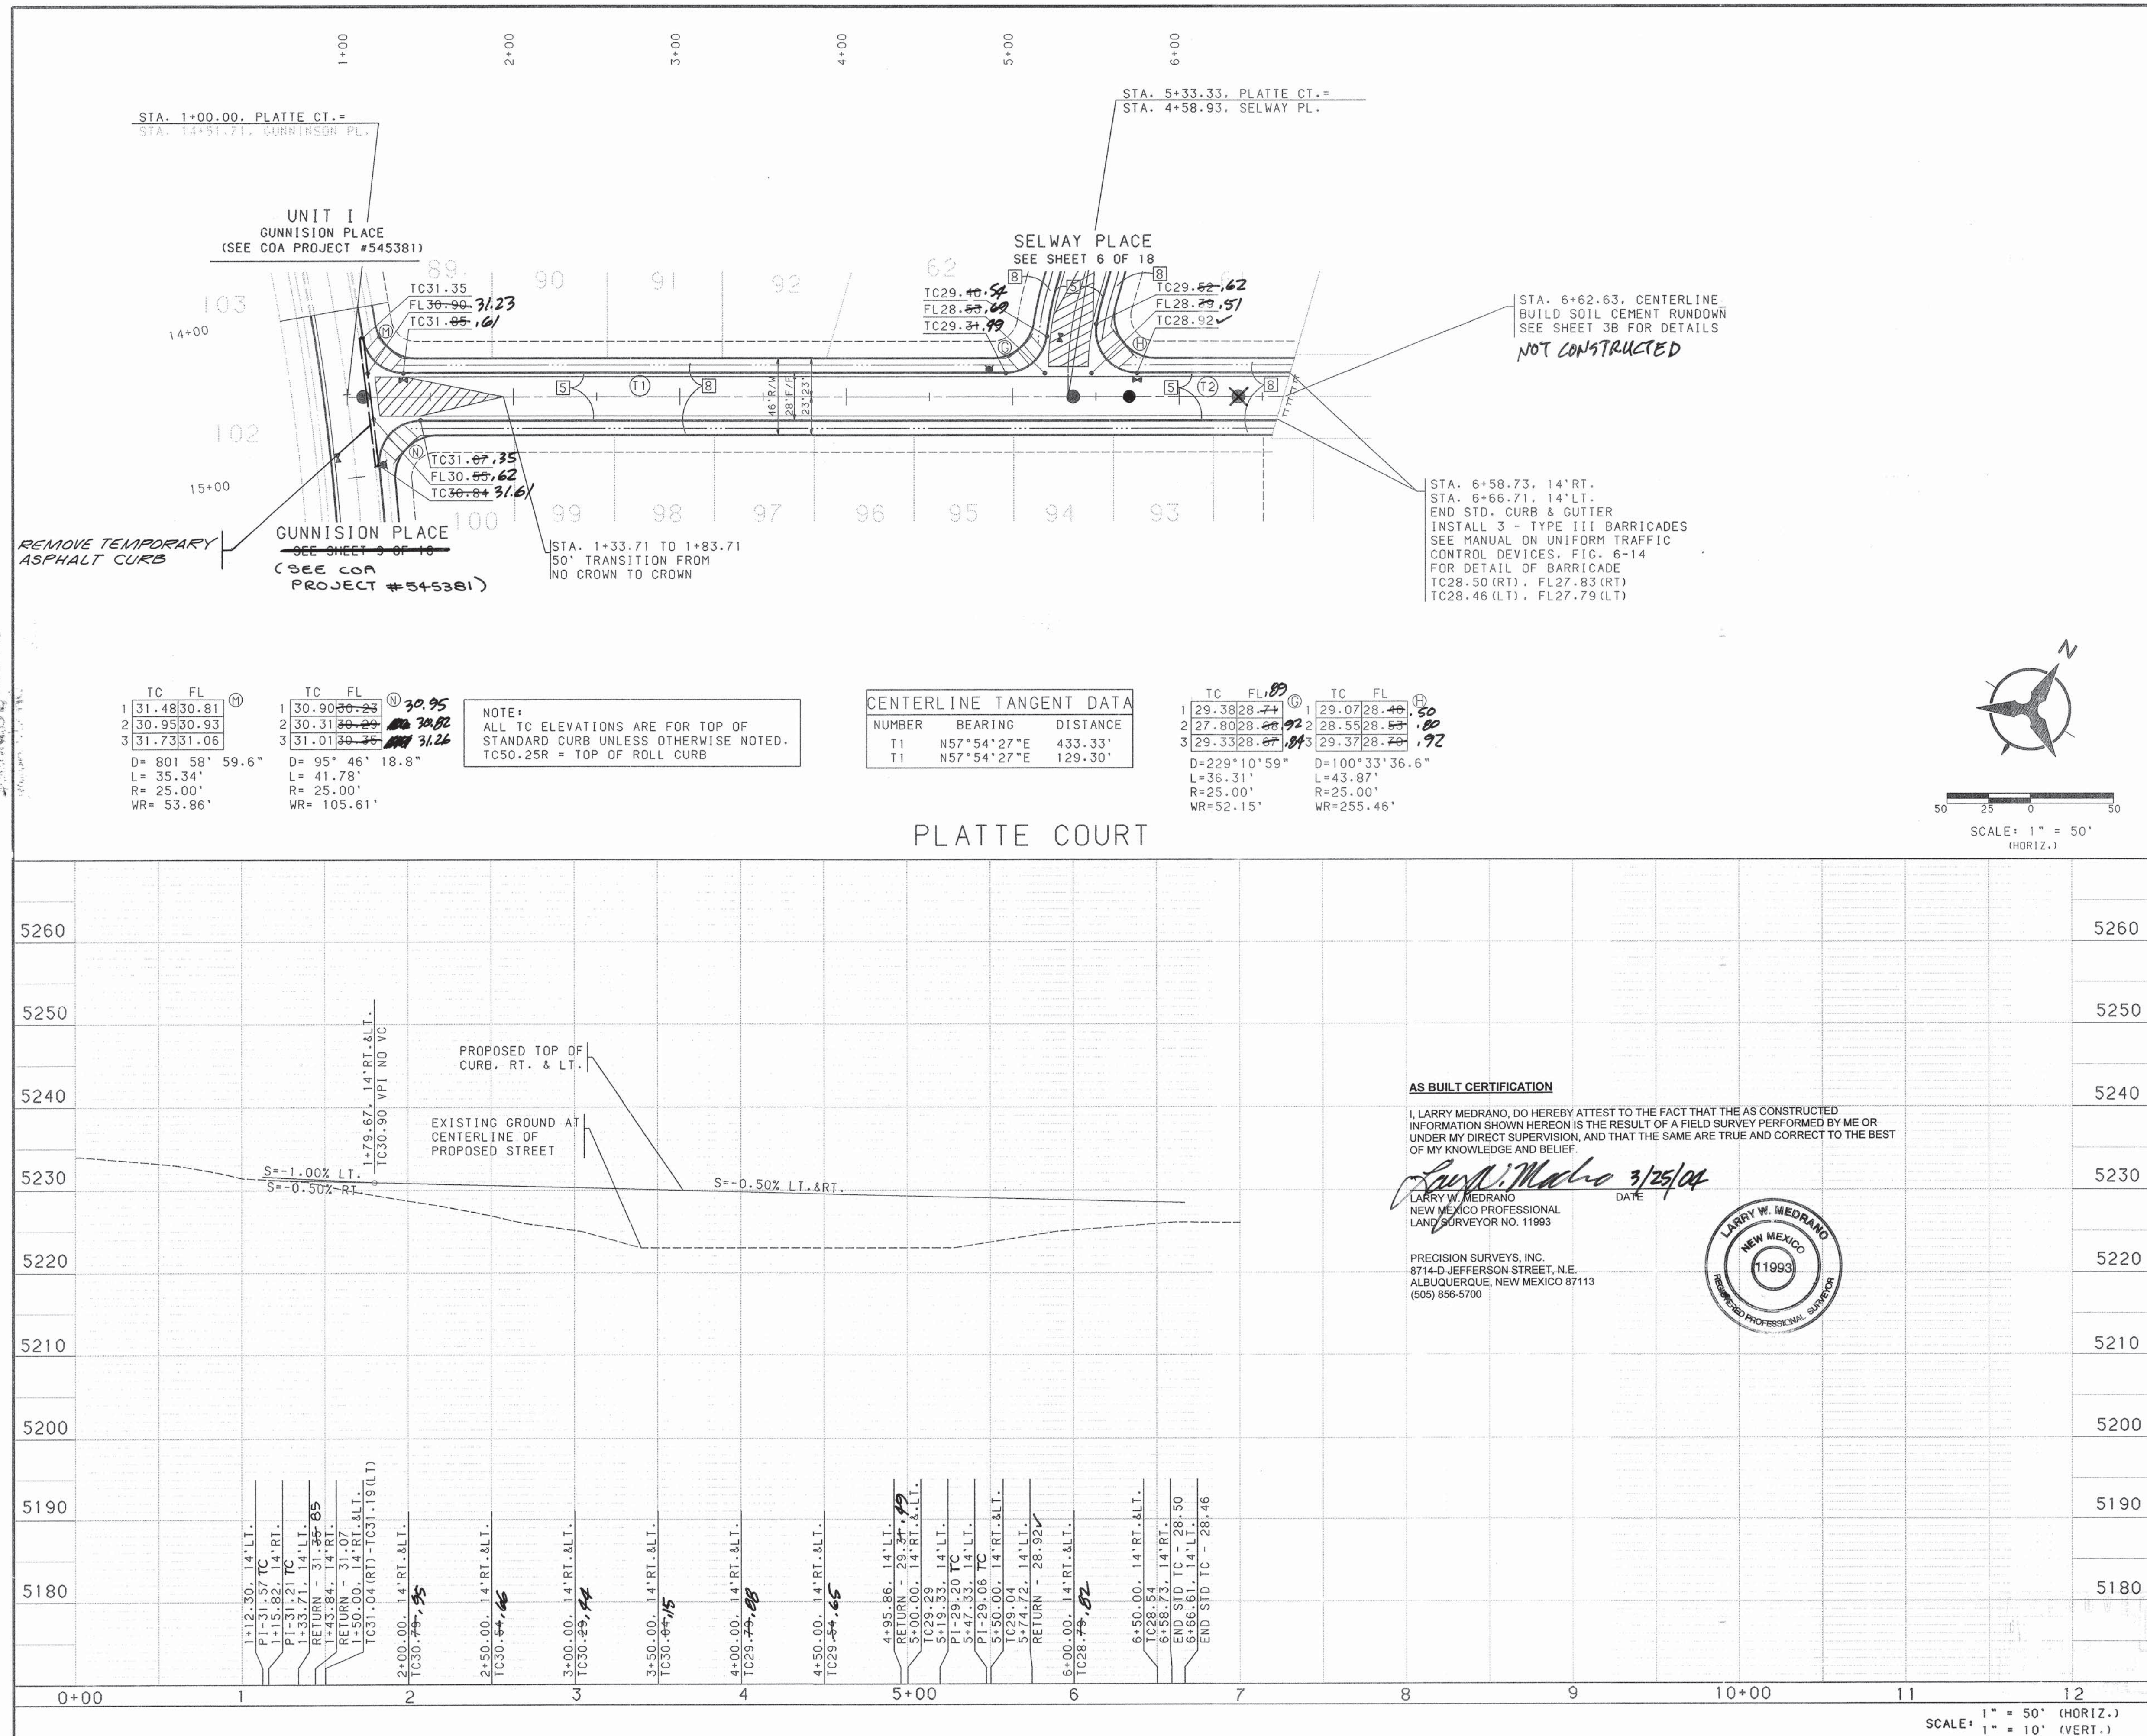

- NOTES
1. THE CONTRACTOR SHALL FIELD VERIFY ALL EXISTING UTILITY LOCATIONS AND NOTIFY THE ENGINEER IMMEDIATELY OF ANY DISCREPANCIES.
 2. ALL CURB RETURN RADIUS SHALL BE 25' TO FACE OF CURB UNLESS OTHERWISE SPECIFIED.
 3. ALL CURVE DATA AND DIMENSIONS REFER TO FACE OF CURB UNLESS OTHERWISE SPECIFIED.
 4. GRADE ELEVATIONS, WHERE NOTED, ARE FOR TOP OF STANDARD CURB UNLESS OTHERWISE SPECIFIED.
 5. CONTRACTOR IS TO INSTALL A 4"x4"x5' POST AND END AT THE END-OF-EACH SANITARY SEWER SERVICE.
 6. CONTRACTOR IS RESPONSIBLE FOR REPAIR AND/OR REPLACEMENT OF ALL UTILITY CONDUITS AND EXISTING LINES.
 7. ANY ADDITIONAL GRADING REQUIRED TO MATCH PROPOSED STREET GRADES SHALL BE INCIDENTAL TO PAVING ITEMS.
 8. CONTRACTOR SHALL PROVIDE THE INSPECTORS, (CITY AND PRIVATE) WITH THE PROPOSED HYDROSTATIC TESTING PLAN. THE PLAN MUST BE APPROVED BEFORE TESTING OPERATIONS BEGIN.
 9. CONTRACTOR SHALL PARK EQUIPMENT AND VEHICLES AS NOT TO INTERFERE WITH NORMAL ACTIVITIES OF RESIDENTS OR OTHER CONTRACTORS ON SITE.
 10. ANY DAMAGE TO THE EXISTING FACILITIES (CURB AND GUTTER, PAVEMENT, CONDUITS, LANDSCAPING, UTILITY LINES, ETC.) DURING CONSTRUCTION SHALL BE REPLACED AT THE CONTRACTORS EXPENSE.
 11. REMOVAL OF THE EXISTING CURB AND GUTTER SHALL BE AS PER COA STD. DWG. 2415 (SAWCUT ONLY).
 12. WHEEL CHAIR RAMPS SHALL BE CONSTRUCTED PRIOR TO ACCEPTANCE OF CURB AND GUTTER.

KEYED GENERAL NOTES

1. INSTALL CONCRETE VALLEY GUTTER AS PER STD. DWG. 2420
2. INSTALL CONCRETE VALLEY GUTTER AS PER STD. DWG. 2421
3. INSTALL WHEEL CHAIR RAMP AS PER STD. DWG. 2441, CASE I
4. INSTALL WHEEL CHAIR RAMP AS PER STD. DWG. 2441, CASE II
5. STD. CURB & GUTTER AS PER STD. DWG. 2415
6. ROLL CURB & GUTTER AS PER STD. DWG. 2415
7. MEDIAN CURB & GUTTER AS PER STD. DWG. 2415
8. DEFERRED FUTURE 4' SIDEWALK
9. BUILD 4' SIDEWALK
10. 10' MEANDERING ASPHALT TRAIL BY OTHERS

BOHANNAN-HUSTON INC.
ENGINEERS • PLANNERS • PHOTOGRAMMETRISTS • SURVEYORS • LANDSCAPE ARCHITECTS
ALBUQUERQUE LAS CRUCES SANTA FE

CITY OF ALBUQUERQUE
PUBLIC WORKS DEPARTMENT
ENGINEERING DEVELOPMENT GROUP

THE CROSSING SUBDIVISION UNIT II
PAVING PLAN & PROFILE
PLATTE COURT


DESIGN REVIEW COMMITTEE CITY ENGINEER APPROVAL MO/DAY/YR. MO/DAY/YR.

LAST DESIGN UPDATE

CITY PROJECT NO. 545382 ZONE MAP NO. H-9. J-9 SHEET 8 OF 18

DESIGN REVIEW COMMITTEE

BOHANNAN-HUSTON, INC. 1996
DATE: MAY, 1996

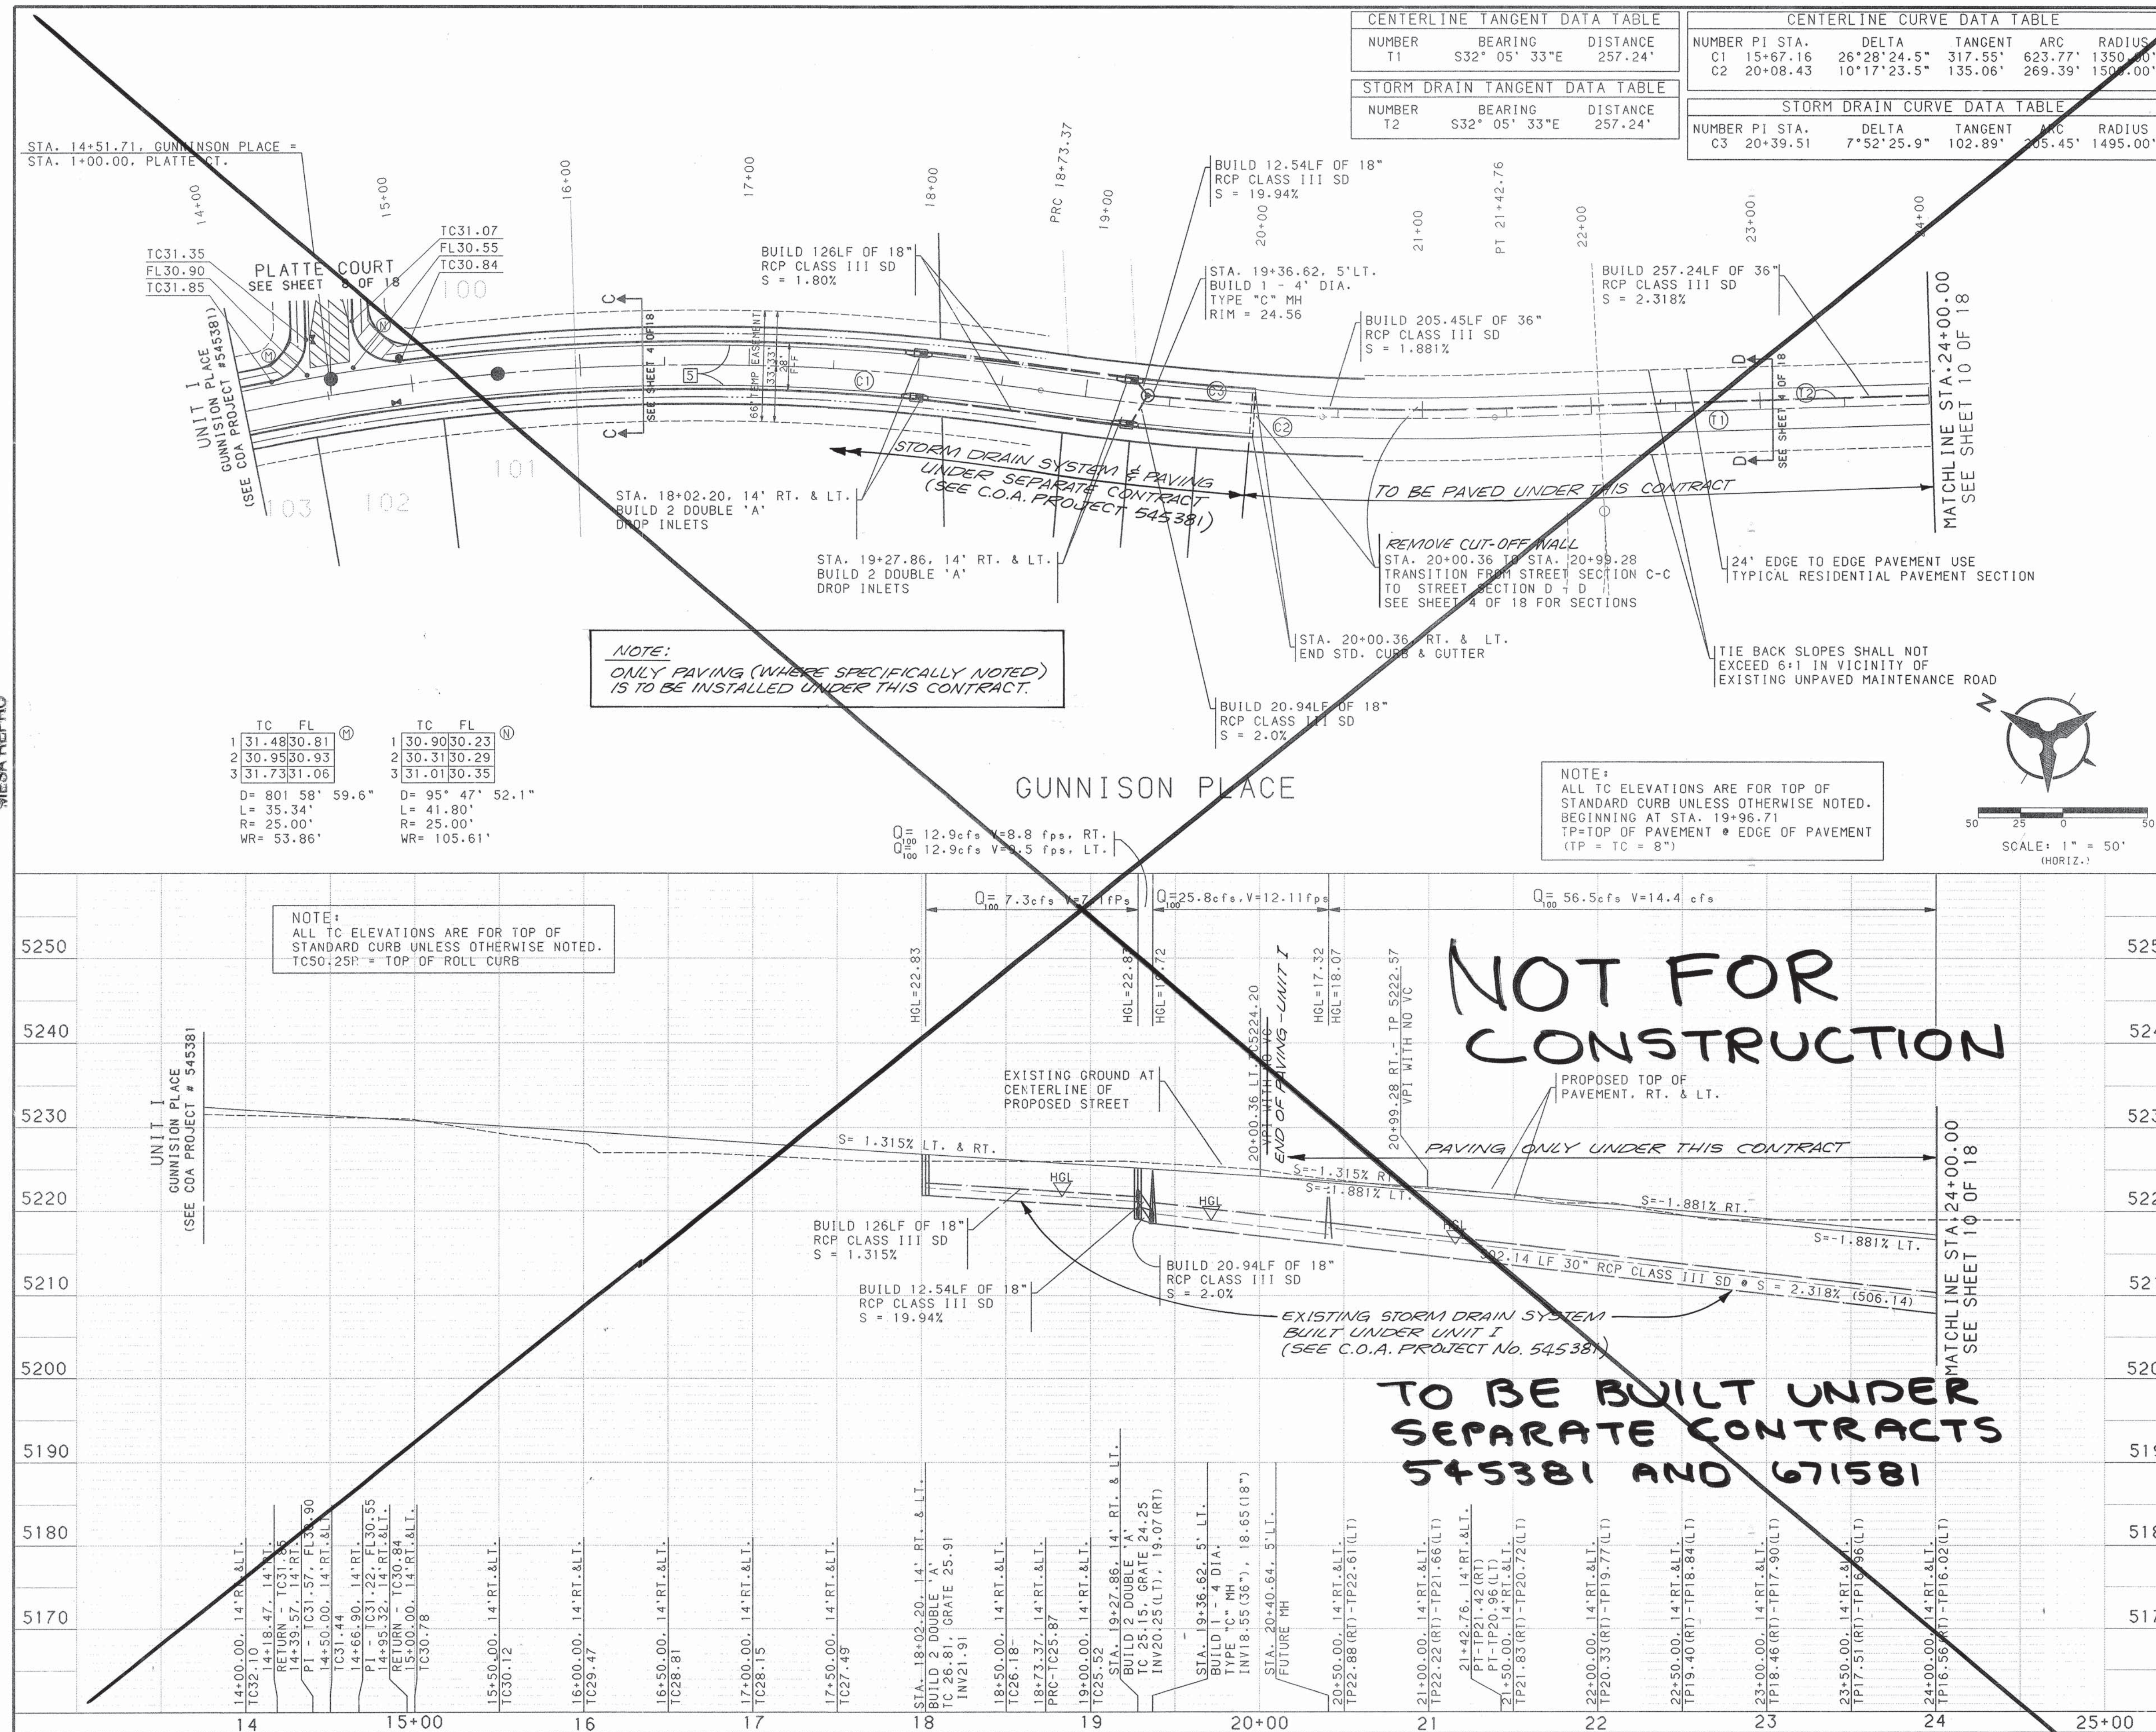

CENTERLINE TANGENT DATA TABLE			CENTERLINE CURVE DATA TABLE			
NUMBER	BEARING	DISTANCE	NUMBER	PI STA.	DELTA	TANGENT
T1	S32° 05' 33"E	257.24'	C1	15+67.16	26°28'24.5"	317.55'
T2	S32° 05' 33"E	257.24'	C2	20+08.43	10°17'23.5"	135.06'
						ARC
						1350.00'
						269.39'
						1500.00'

STORM DRAIN TANGENT DATA TABLE			STORM DRAIN CURVE DATA TABLE			
NUMBER	BEARING	DISTANCE	NUMBER	PI STA.	DELTA	TANGENT
T1	S32° 05' 33"E	257.24'	C1	15+67.16	26°28'24.5"	317.55'
T2	S32° 05' 33"E	257.24'	C2	20+08.43	10°17'23.5"	135.06'
						ARC
						1350.00'
						269.39'
						1500.00'

- NOTES**
- THE CONTRACTOR SHALL FIELD VERIFY ALL EXISTING UTILITY LOCATIONS AND NOTIFY THE ENGINEER IMMEDIATELY OF ANY DISCREPANCIES.
 - ALL CURB RETURN RADIUS SHALL BE 25' TO FACE OF CURB UNLESS OTHERWISE SPECIFIED.
 - ALL CURVE DATA AND DIMENSIONS REFER TO TOP OF STANDARD CURB UNLESS OTHERWISE SPECIFIED.
 - GRADE ELEVATIONS, WHERE NOTED, ARE FOR TOP OF STANDARD CURB UNLESS OTHERWISE SPECIFIED.
 - CONTRACTOR IS TO INSTALL A 4"x4"x5" POST AND END AT THE END OF EACH SANITARY SEWER SERVICE.
 - CONTRACTOR IS RESPONSIBLE FOR REPAIR AND/OR REPLACEMENT OF ALL UTILITY CONDUITS AND EXISTING LINES.
 - ANY ADDITIONAL GRADING REQUIRED TO MATCH PROPOSED STREET GRADES SHALL BE INCIDENTAL TO PAVING ITEMS.
 - CONTRACTOR SHALL PROVIDE THE INSPECTORS, (CITY AND PRIVATE) WITH PLAN. THE PLAN MUST BE APPROVED BEFORE TESTING OPERATIONS BEGIN.
 - CONTRACTOR SHALL PARK EQUIPMENT AND VEHICLES AS NOT TO INTERFERE WITH NORMAL ACTIVITIES OF RESIDENTS OR OTHER CONTRACTORS ON SITE.
 - ANY DAMAGE TO THE EXISTING FACILITIES (CURB AND GUTTER, PAVEMENT, CONDUITS, LANDSCAPING, UTILITY LINES, ETC.) DURING CONSTRUCTION SHALL BE REPLACED AT THE CONTRACTORS EXPENSE.
 - REMOVAL OF THE EXISTING CURB AND GUTTER SHALL BE AS PER COA STD. DWG. 2415 (SAWCUT ONLY).
 - WHEEL CHAIR RAMPS SHALL BE CONSTRUCTED PRIOR TO ACCEPTANCE OF CURB AND GUTTER.

- KEYED GENERAL NOTES**
- INSTALL CONCRETE VALLEY GUTTER AS PER STD. DWG. 2420
 - INSTALL CONCRETE VALLEY GUTTER AS PER STD. DWG. 2421
 - INSTALL WHEEL CHAIR RAMP AS PER STD. DWG. 2441, CASE I
 - INSTALL WHEEL CHAIR RAMP AS PER STD. DWG. 2441, CASE II
 - STD. CURB & GUTTER AS PER STD. DWG. 2415
 - ROLL CURB & GUTTER AS PER STD. DWG. 2415
 - MEDIAN CURB & GUTTER AS PER STD. DWG. 2415
 - FUTURE 4' SIDEWALK
 - BUILD 4' SIDEWALK
 - 10' MEANDERING ASPHALT TRAIL BY OTHERS

BOHANNAN-HUSTON INC.
ENGINEERS • PLANNERS • PHOTOGRAMMETRISTS • SURVEYORS • LANDSCAPE ARCHITECTS
ALBUQUERQUE LAS CRUCES SANTA FE

CITY OF ALBUQUERQUE
PUBLIC WORKS DEPARTMENT
ENGINEERING DEVELOPMENT GROUP

THE CROSSING SUBDIVISION UNIT II
PAVING PLAN & PROFILE (INCLUDING STORM DRAIN)
GUNNISON PLACE FROM STA. 20+00.00 TO 24+00.00


DESIGN REVIEW COMMITTEE CITY ENGINEER APPROVAL

DESIGN REVIEW COMMITTEE

DESIGNED BY KP/BJS OR DATE 8/96
DRAWN BY DATE 8/96
CHECKED BY KP DATE 8/96

PROJECT NO. 545382 ZONE MAP NO. H-9, J-9 SHEET 9 OF 18

DATE: MAY, 1996

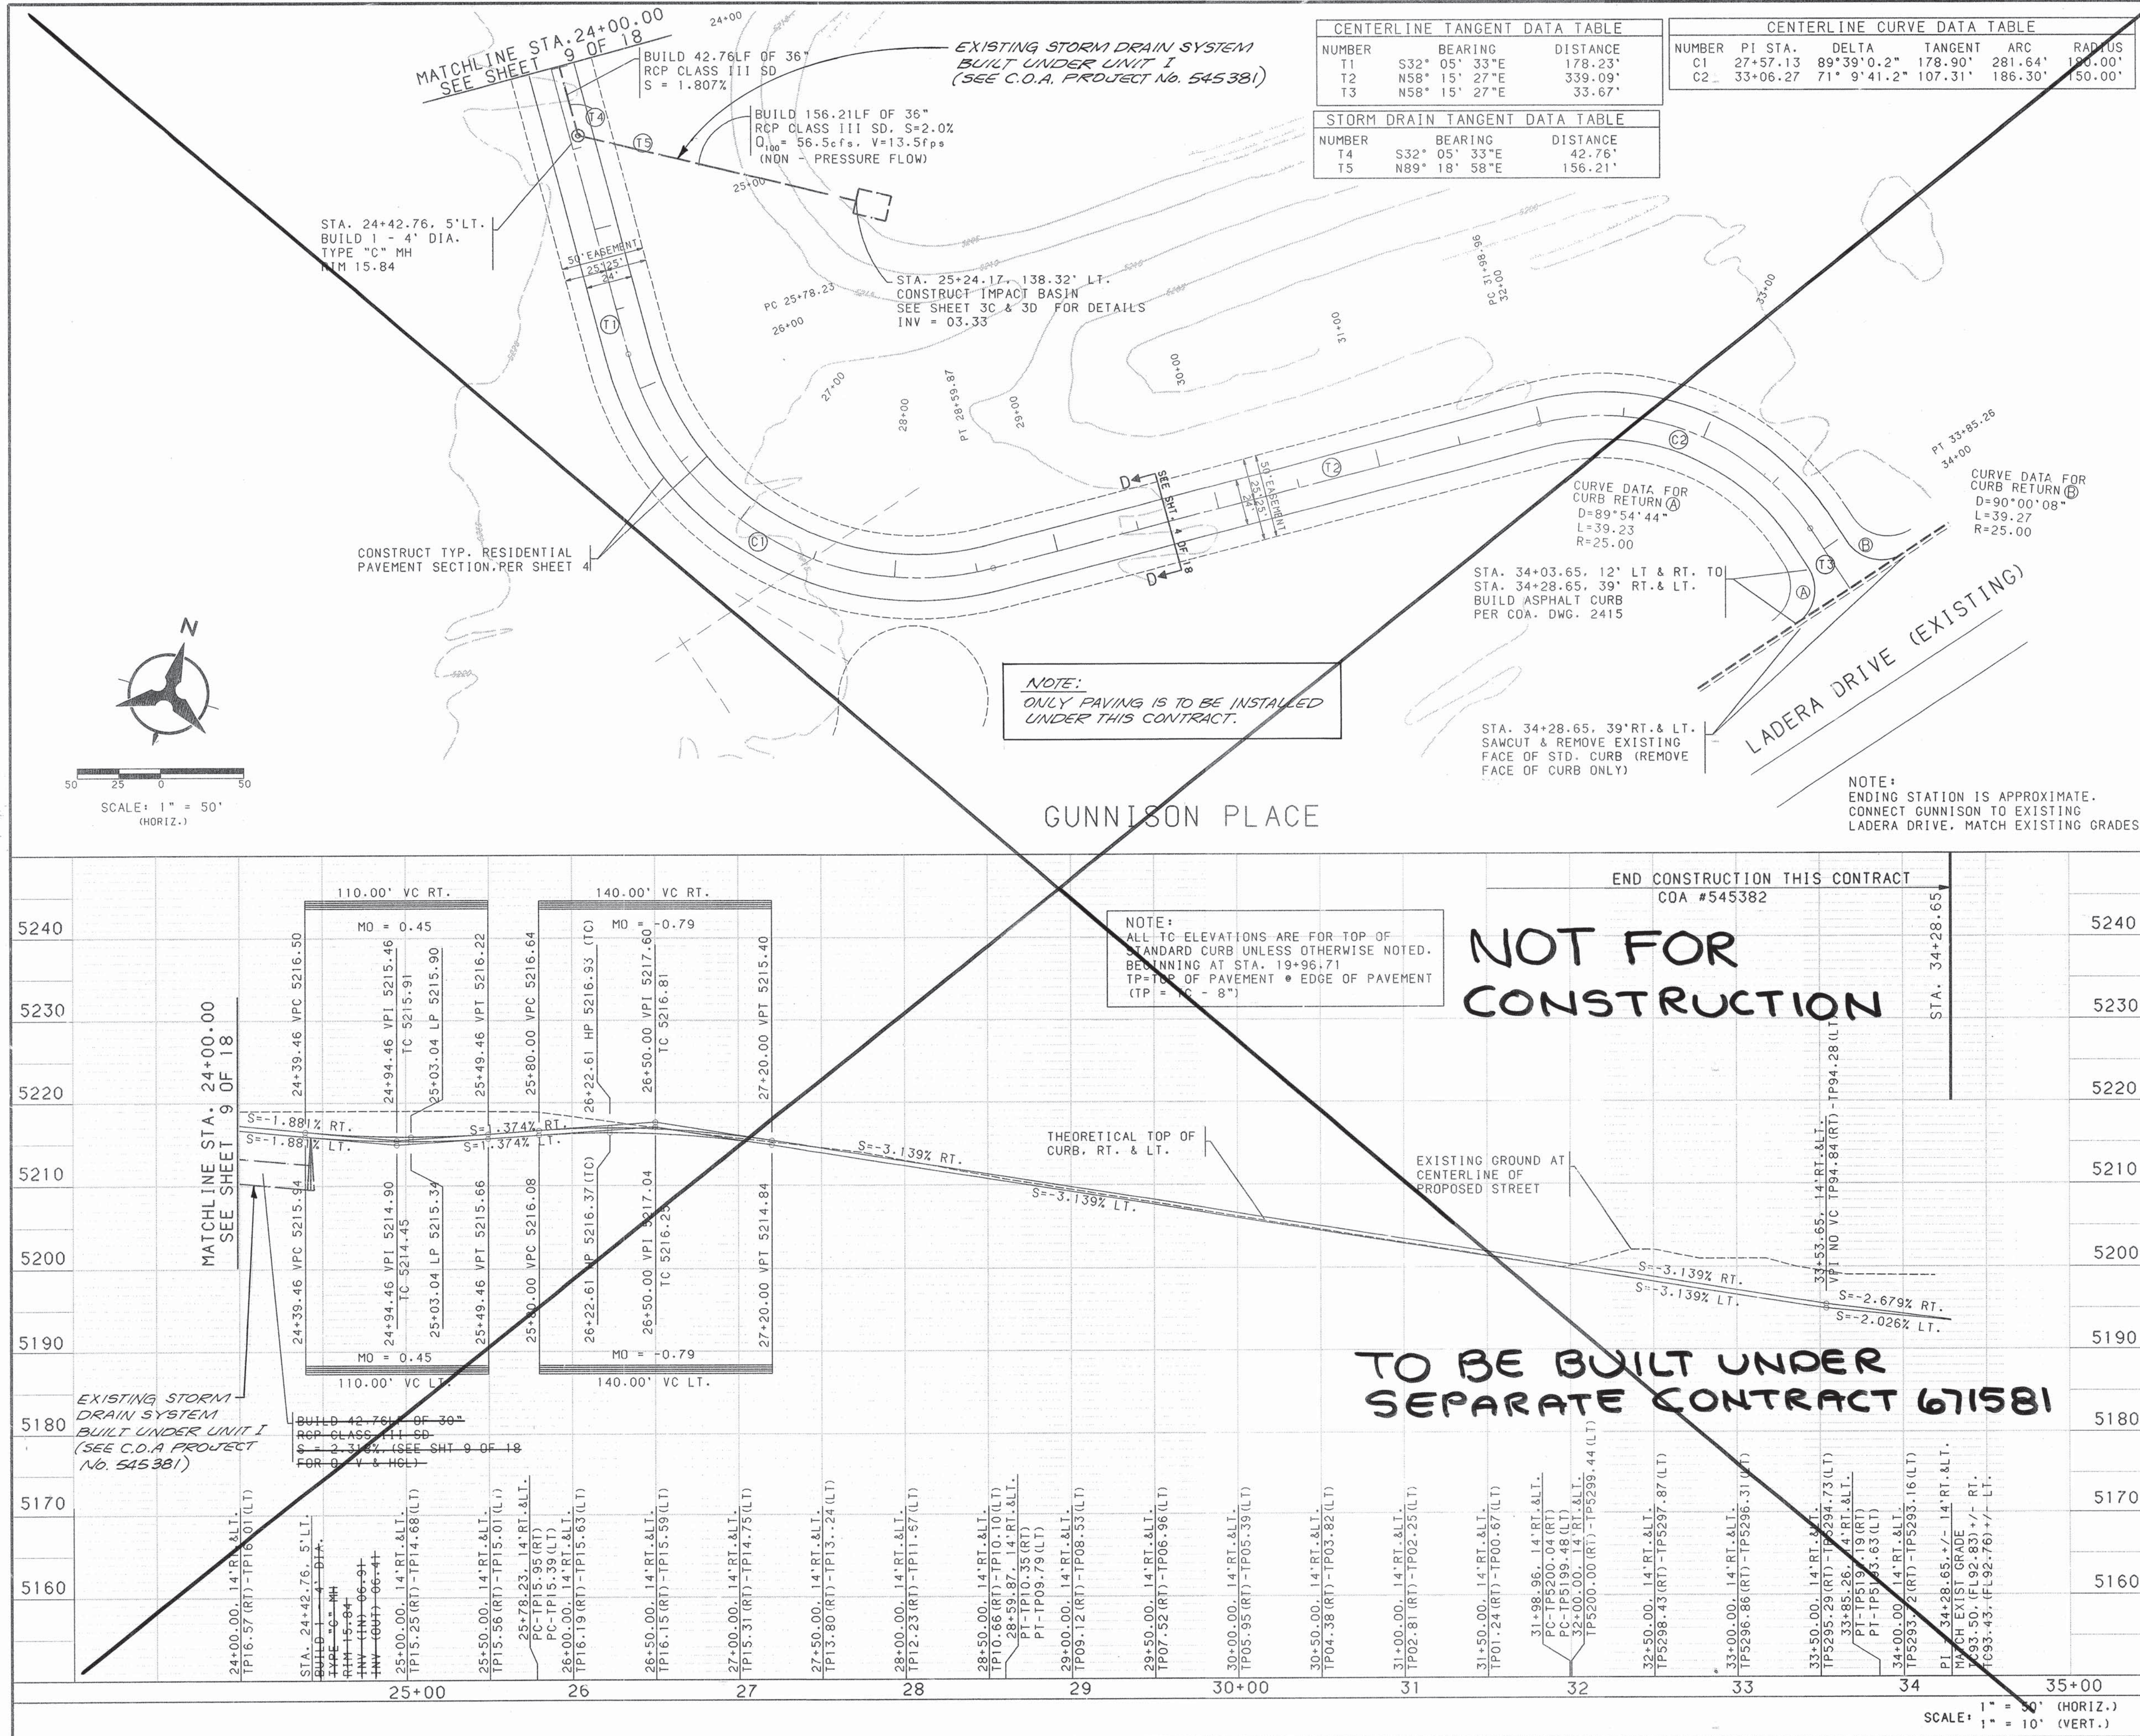

- NOTES**
1. THE CONTRACTOR SHALL FIELD VERIFY ALL EXISTING UTILITY LOCATIONS AND NOTIFY THE ENGINEER IMMEDIATELY OF ANY DISCREPANCIES.
 2. ALL CURB RETURN RADIUS SHALL BE 25' TO FACE OF CURB UNLESS OTHERWISE SPECIFIED.
 3. ALL CURVE DATA AND DIMENSIONS REFER TO FACE OF CURB UNLESS OTHERWISE SPECIFIED.
 4. GRADE ELEVATIONS, WHERE NOTED, ARE FOR TOP OF STANDARD CURB UNLESS OTHERWISE SPECIFIED.
 5. CONTRACTOR IS TO INSTALL A 4"x4"x5' POST AND END AT THE END OF EACH SANITARY SEWER SERVICE.
 6. CONTRACTOR IS RESPONSIBLE FOR REPAIR AND/OR REPLACEMENT OF ALL UTILITY CONDUITS AND EXISTING LINES.
 7. ANY ADDITIONAL GRADING REQUIRED TO MATCH PROPOSED STREET GRADES SHALL BE INCIDENTAL TO PAVING ITEMS.
 8. CONTRACTOR SHALL PROVIDE THE INSPECTORS, (CITY AND PRIVATE) WITH THE PROPOSED HYDROSTATIC TESTING PLAN. THE PLAN MUST BE APPROVED BEFORE TESTING OPERATIONS BEGIN.
 9. CONTRACTOR SHALL PARK EQUIPMENT AND VEHICLES AS NOT TO INTERFERE WITH NORMAL ACTIVITIES OF RESIDENTS OR OTHER CONTRACTORS ON SITE.
 10. ANY DAMAGE TO THE EXISTING FACILITIES (CURB AND GUTTER, PAVEMENT, CONDUITS, LANDSCAPING, UTILITY LINES, ETC.) DURING CONSTRUCTION SHALL BE REPLACED AT THE CONTRACTORS EXPENSE.
 11. REMOVAL OF THE EXISTING CURB AND GUTTER SHALL BE AS PER COA STD. DWG. 2415 (SAWCUT ONLY).
 12. WHEEL CHAIR RAMPS SHALL BE CONSTRUCTED PRIOR TO ACCEPTANCE OF CURB AND GUTTER.

- KEYED GENERAL NOTES**
1. INSTALL CONCRETE VALLEY GUTTER AS PER STD. DWG. 2420
 2. INSTALL CONCRETE VALLEY GUTTER AS PER STD. DWG. 2421
 3. INSTALL WHEEL CHAIR RAMP AS PER STD. DWG. 2441, CASE I
 4. INSTALL WHEEL CHAIR RAMP AS PER STD. DWG. 2441, CASE II
 5. STD. CURB & GUTTER AS PER STD. DWG. 2415
 6. ROLL CURB & GUTTER AS PER STD. DWG. 2415
 7. MEDIAN CURB & GUTTER AS PER STD. DWG. 2415
 8. FUTURE 4' SIDEWALK
 9. BUILD 4' SIDEWALK
 10. 10' MEANDERING ASPHALT TRAIL BY OTHERS

BOHANNAN-HUSTON INC.
ENGINEERS • PLANNERS • PHOTOGRAMMETRISTS • SURVEYORS • LANDSCAPE ARCHITECTS
ALBUQUERQUE LAS CRUCES SANTA FE

CITY OF ALBUQUERQUE
PUBLIC WORKS DEPARTMENT
ENGINEERING DEVELOPMENT GROUP




THE CROSSING SUBDIVISION UNIT II
PAVING PLAN & PROFILE (INCLUDING STORM DRAIN)
GUNNISON PLACE FROM 24+00 TO 34+28.65

DESIGN REVIEW COMMITTEE CITY ENGINEER APPROVAL LAST DESIGN UPDATE

DESIGNED BY KP/BS DATE 8/96
DRAWN BY OR DATE 8/96
CHECKED BY KP DATE 8/96

CITY PROJECT NO. 545382 ZONE MAP NO. H-9, J-9 SHEET 10 OF 18

DATE: MAY, 1996

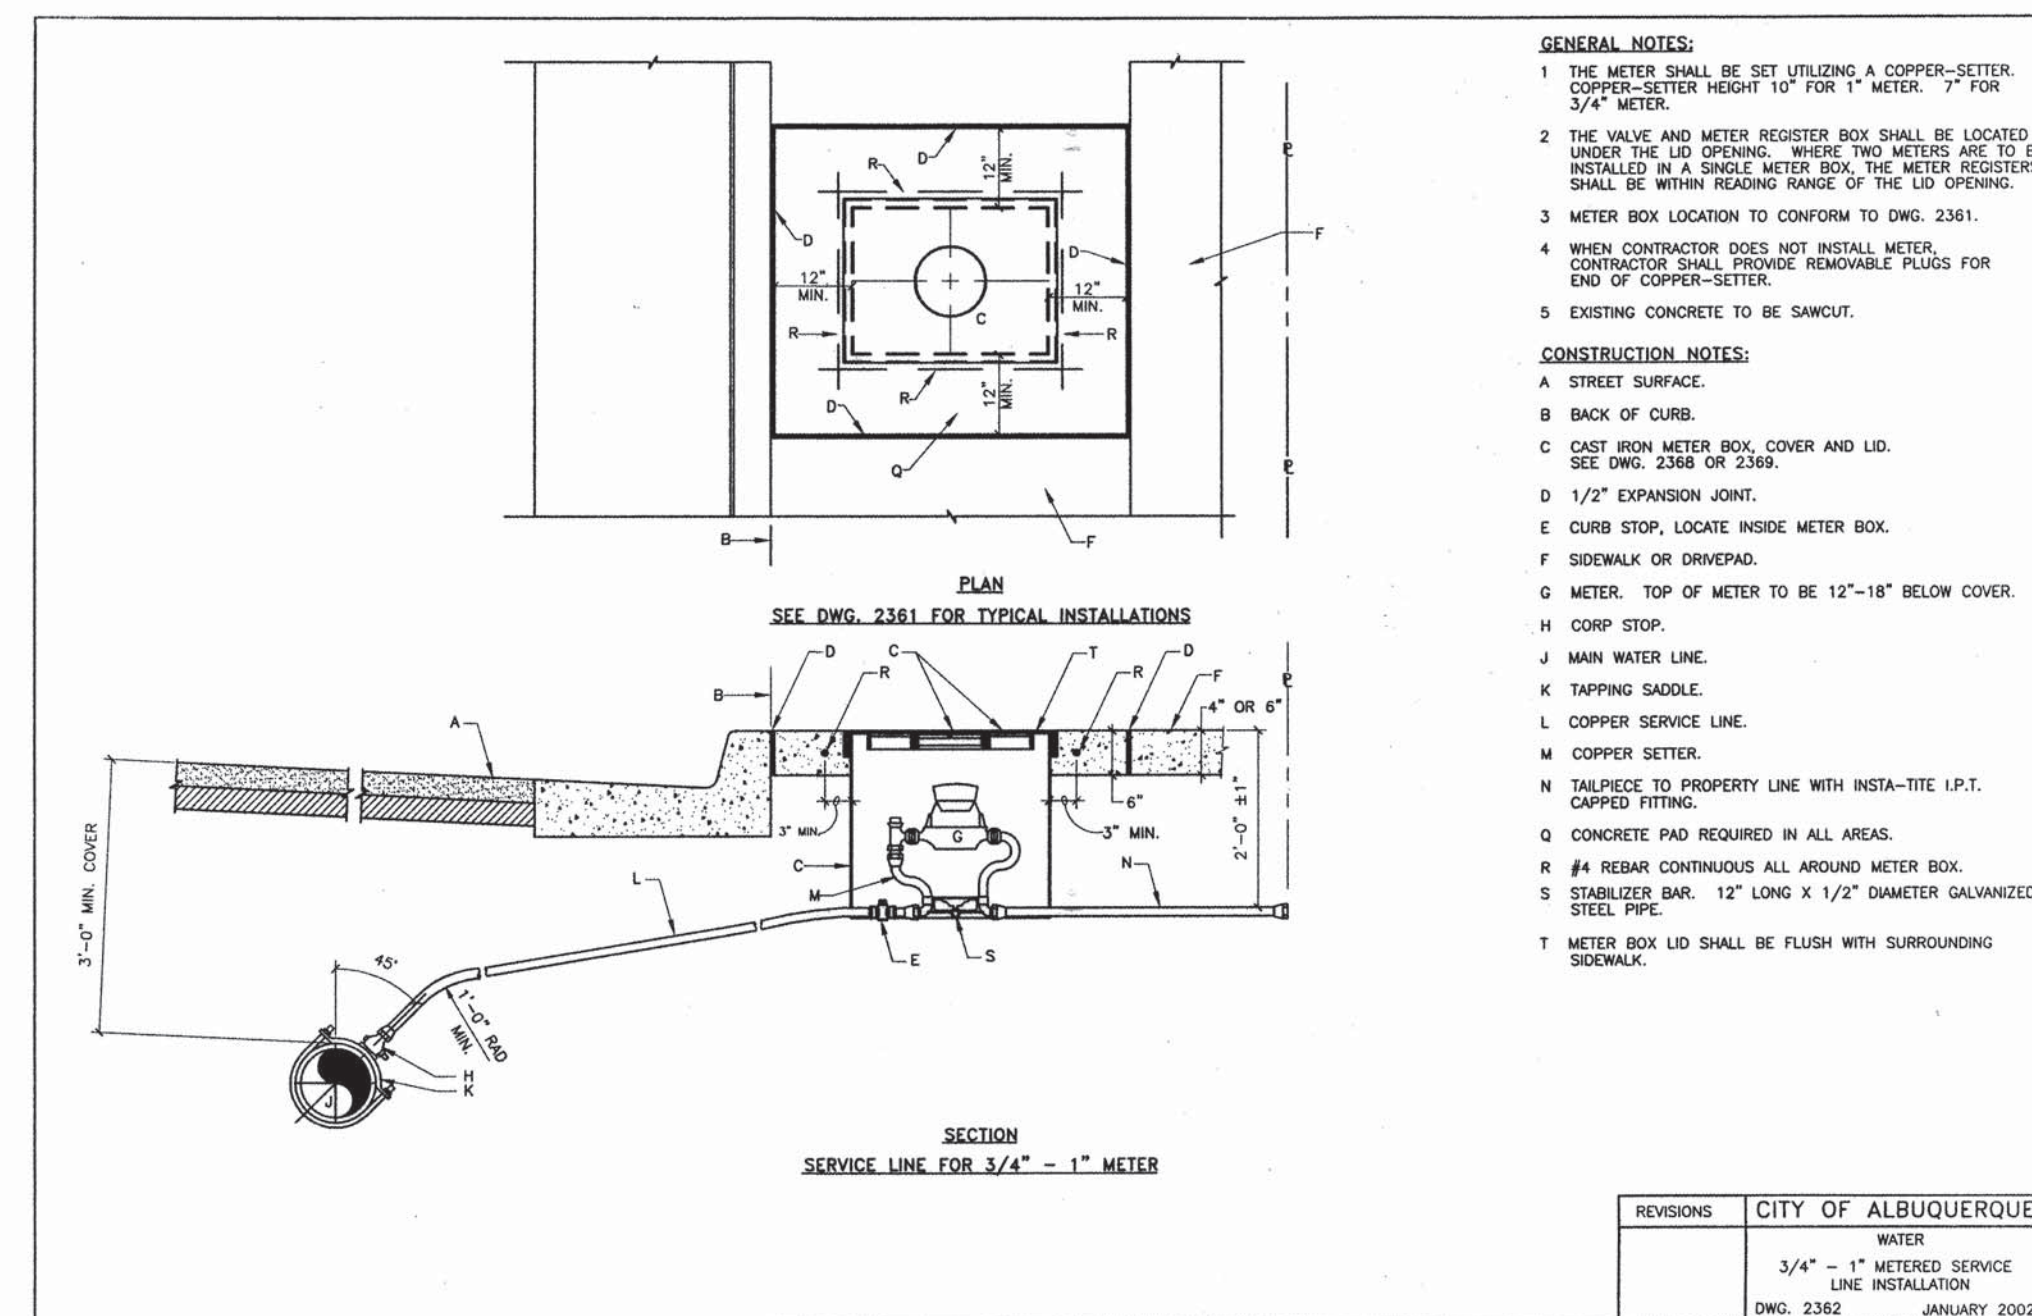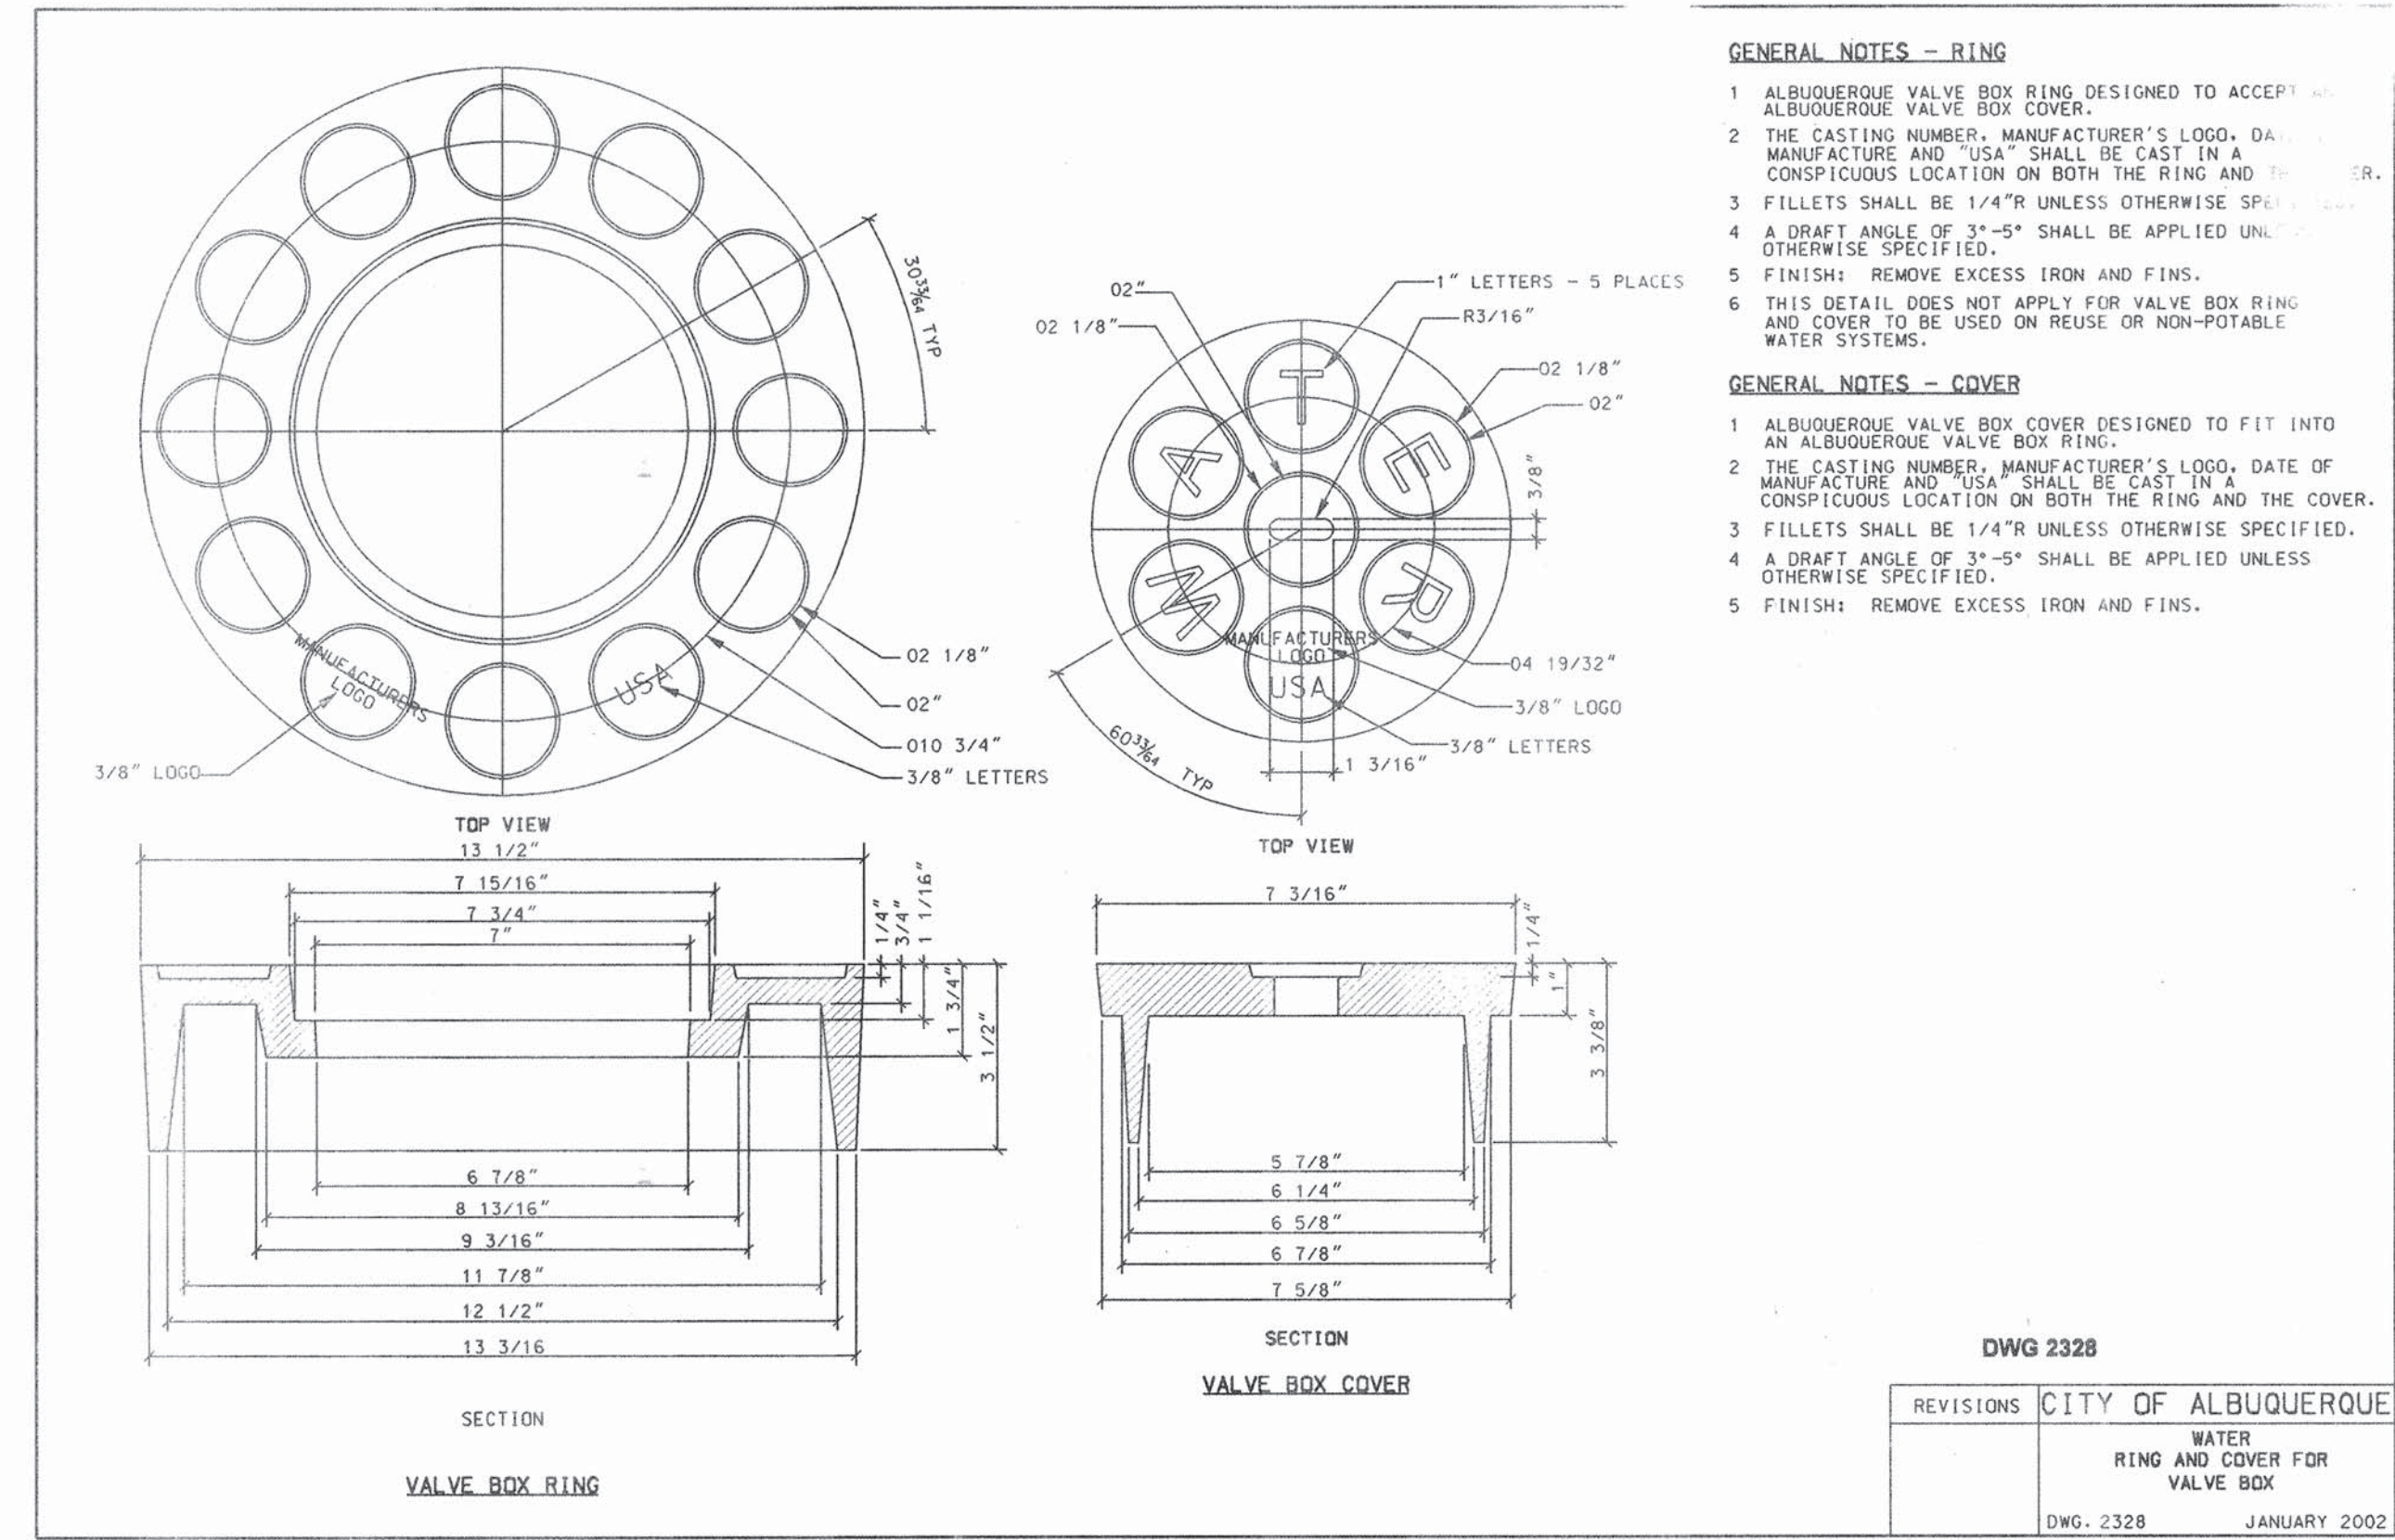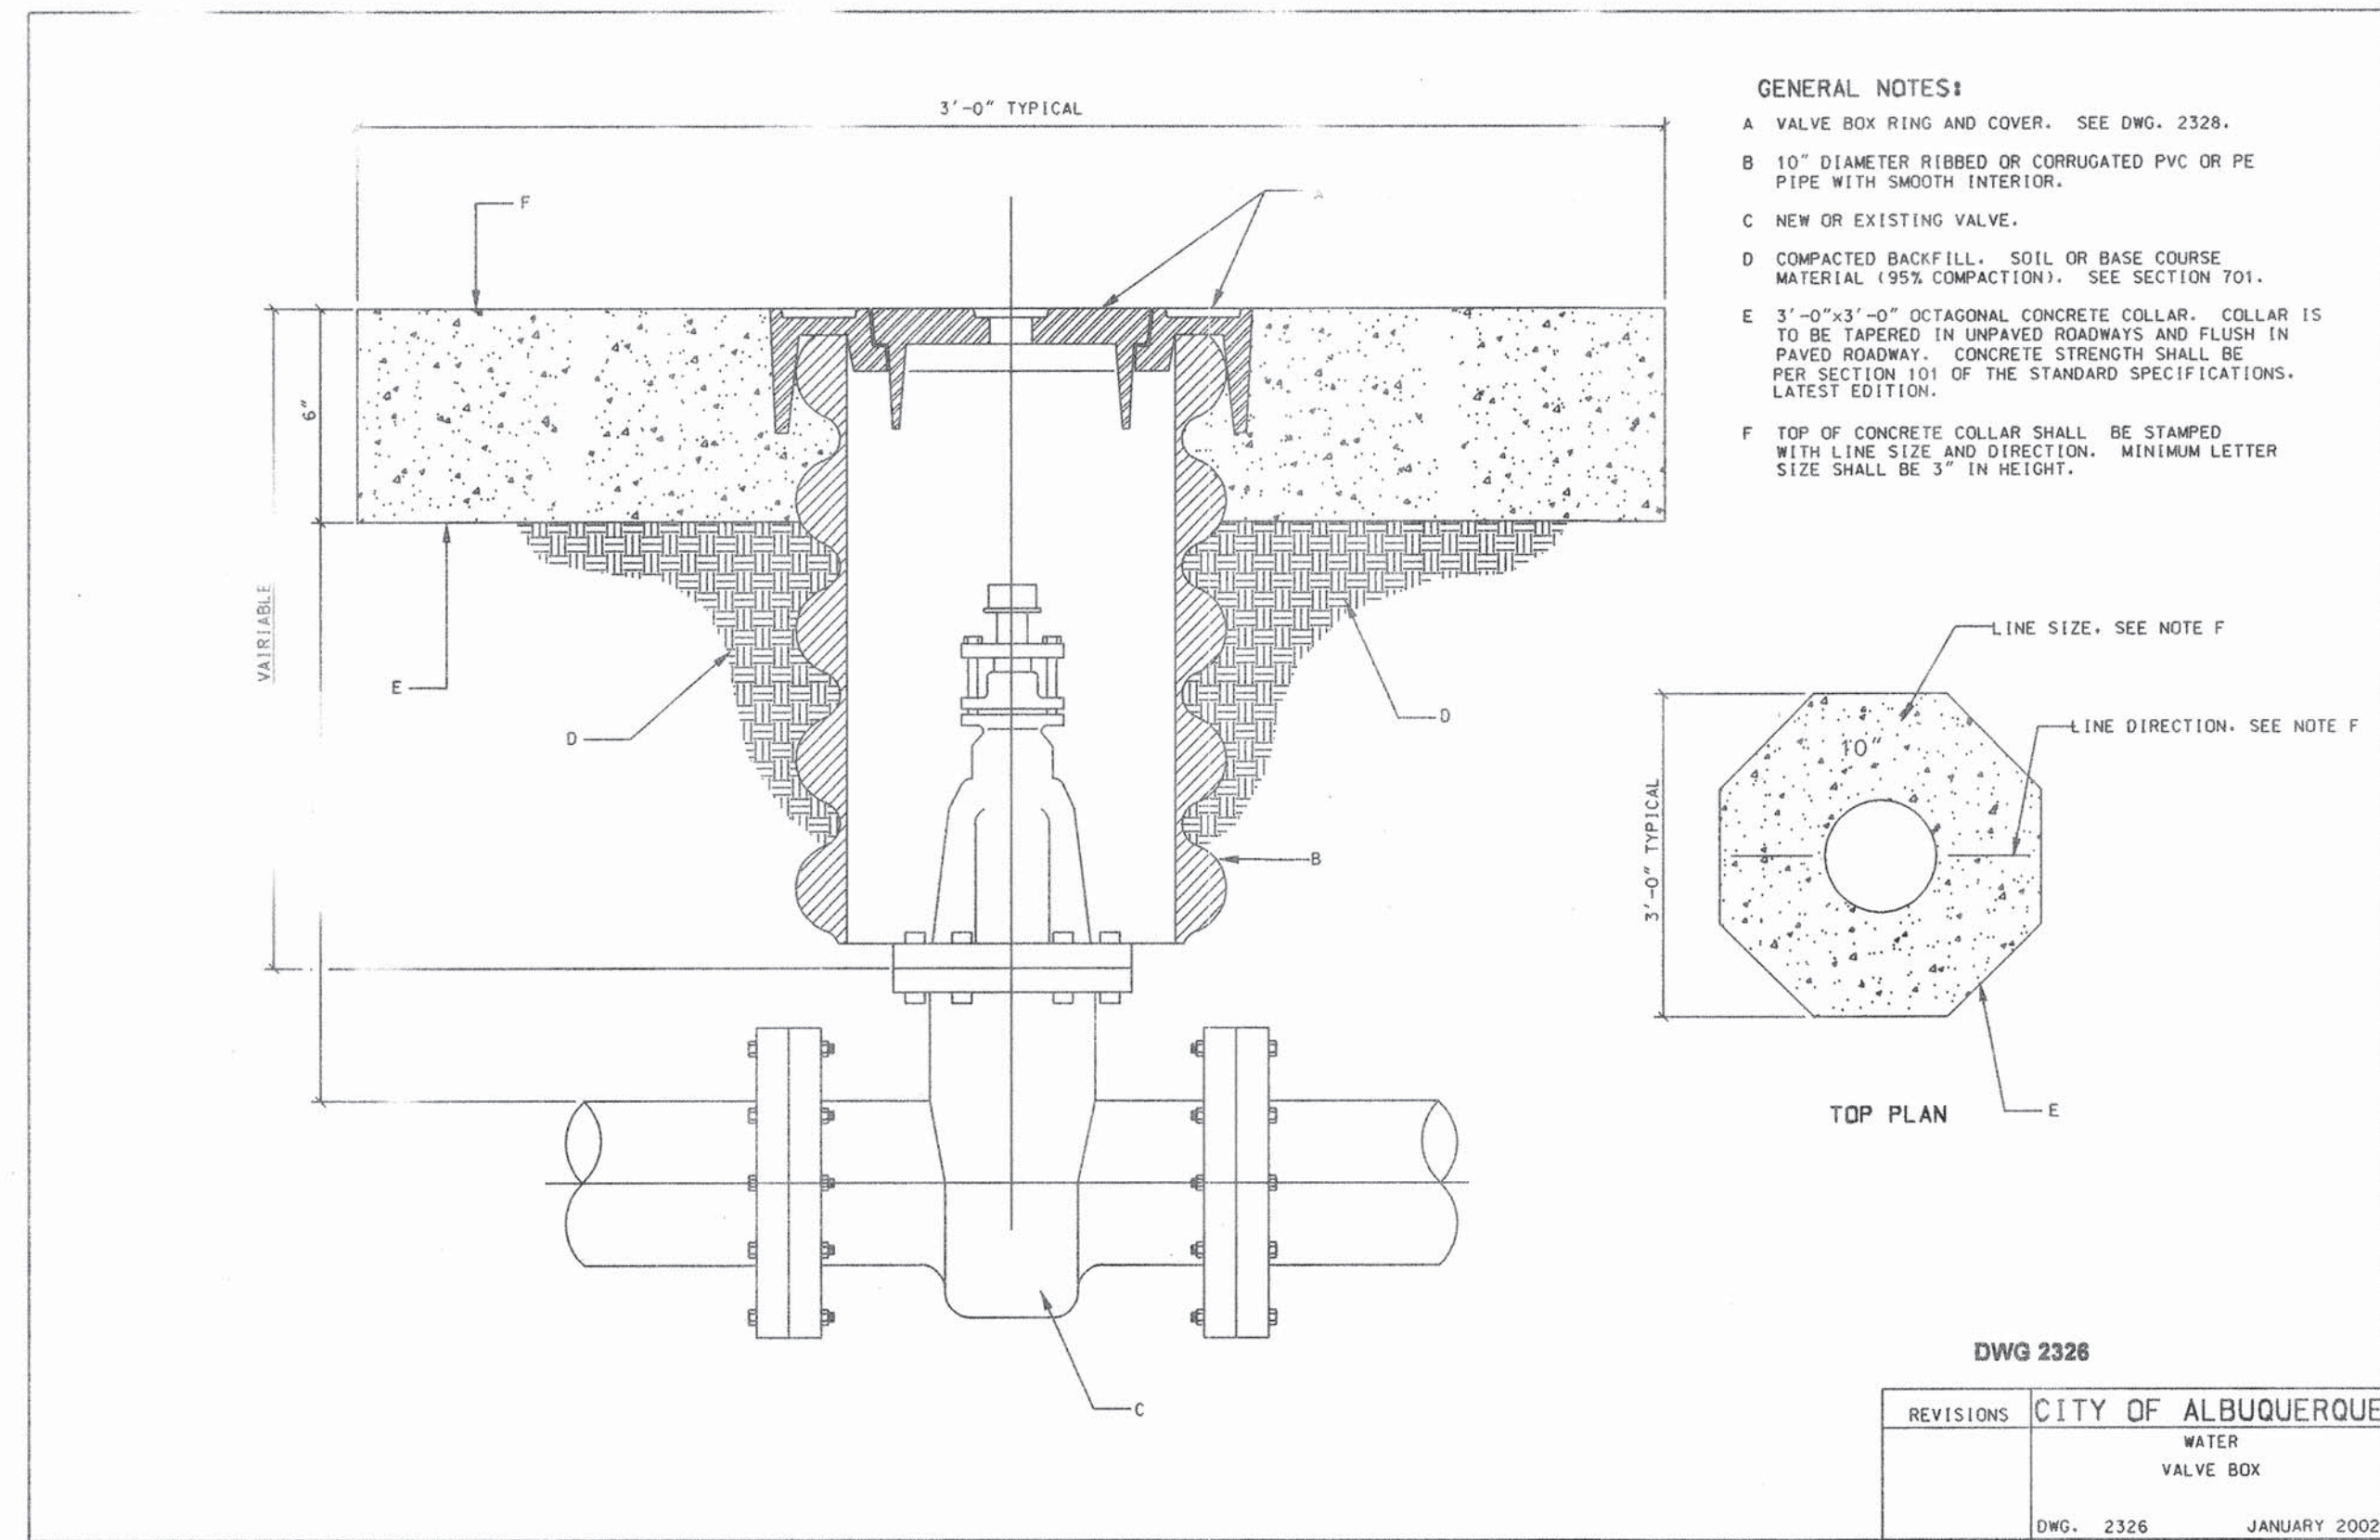

GENERAL NOTES - RING

1. ALBUQUERQUE VALVE BOX RING DESIGNED TO ACCEPT AN ALBUQUERQUE VALVE BOX COVER.
2. THE CASTING NUMBER, MANUFACTURER'S LOGO, DATE OF CASTING AND THE RING SHALL BE CAST IN A CONSPICUOUS LOCATION ON BOTH THE RING AND THE COVER.
3. FILLETS SHALL BE 1/4" UNLESS OTHERWISE SPECIFIED.
4. A DRAFT ANGLE OF 3°-5° SHALL BE APPLIED UNLESS OTHERWISE SPECIFIED.
5. FINISH: REMOVE EXCESS IRON AND FINIS.


THIS DETAIL DOES NOT APPLY FOR VALVE BOX RING TO BE USED TO BE USED ON REUSE OR NON-POTABLE WATER SYSTEMS.

GENERAL NOTES - COVER

1. ALBUQUERQUE VALVE BOX COVER DESIGNED TO FIT INTO AN ALBUQUERQUE VALVE BOX RING.
2. THE CASTING NUMBER, MANUFACTURER'S LOGO, DATE OF CASTING AND THE RING SHALL BE CAST IN A CONSPICUOUS LOCATION ON BOTH THE RING AND THE COVER.
3. FILLETS SHALL BE 1/4" UNLESS OTHERWISE SPECIFIED.
4. A DRAFT ANGLE OF 3°-5° SHALL BE APPLIED UNLESS OTHERWISE SPECIFIED.
5. FINISH: REMOVE EXCESS IRON AND FINIS.

ENGINEER'S SEAL		SURVEY INFORMATION		BENCH MARKS		AS-BUILT INFORMATION	
		FIELD NOTES					
		NO.	BY	DATE			
							
		CONTRACTOR Melendez WORK STARTED BY Precision Surveys INSPECTED BY B.H.I. DATE 9/04 FIELD LOCATION BY Precision DATE 9/04 VERIFICATION BY Precision DATE 9/04 CORRECTED BY Precision DATE 9/04 MICRO-FILM INFORMATION RECORDED BY NO. DATE NO.					
		ACS ALUMINUM TABLET STAMPED "BH-40" GEOGRAPHIC POSITION (NAD 1983) N.M. STATE PLANE COORD. (CENTRAL ZONE) X=352,790.66 Y=1,492,346.53 GROUND TO GRID FACTOR = 0.99967105 DELTA ALPHA = -00DEG 16 MIN 59 SEC NGVD 1929 ELEVATION = 5305.43					
		DESIGNED BY COA DATE 01/2002 DRAWN BY COA DATE 01/2002 CHECKED BY COA DATE 01/2002					

EXISTING WATERLINES
(BUILT UNDER UNIT I)
+ COA # 671581

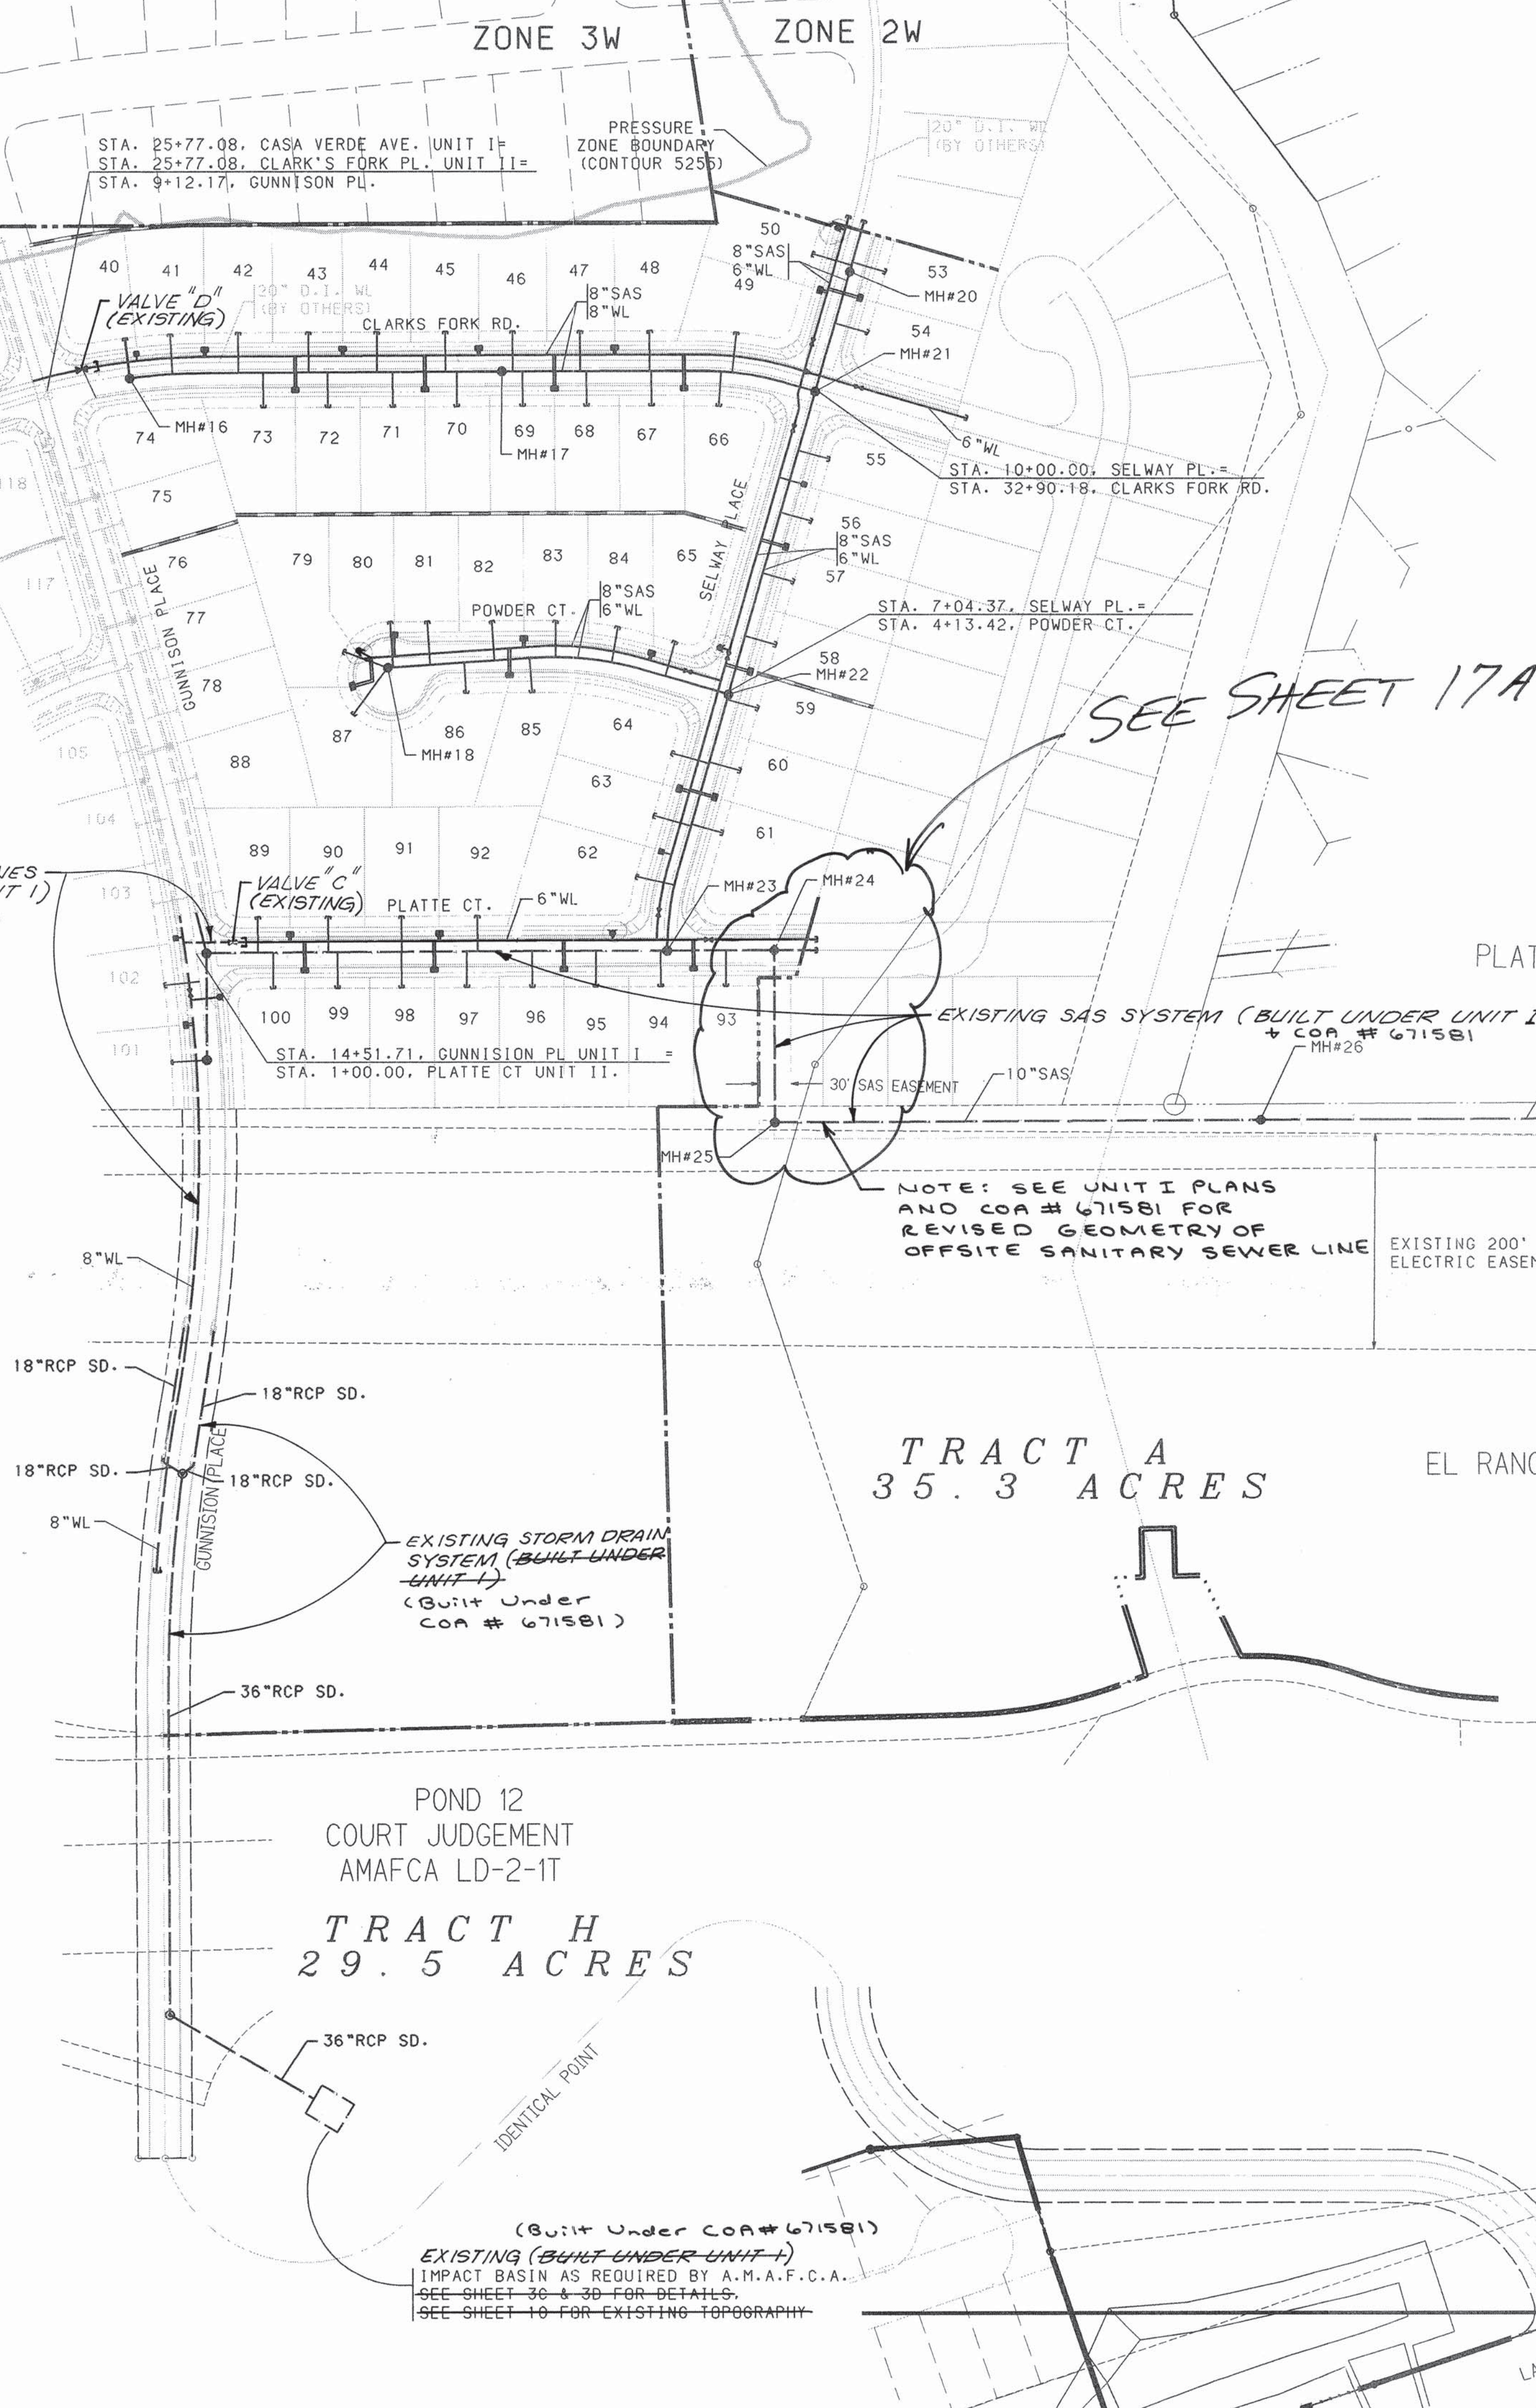


All waterlines were constructed of C-900 pipe.
All sanitary sewer mains were constructed of SDR-35.
All sanitary sewer services were constructed of SDR-26.


PLAT FOR LAS LOMITAS
UNIT IIB

NOTE: SEE UNIT I PLANS
AND COA # 671581 FOR
REVISED GEOMETRY OF
OFFSITE SANITARY SEWER LINE


TRACT A-2-A
REPLAT OF
EL RANCHO ATRISCO, PHASE V

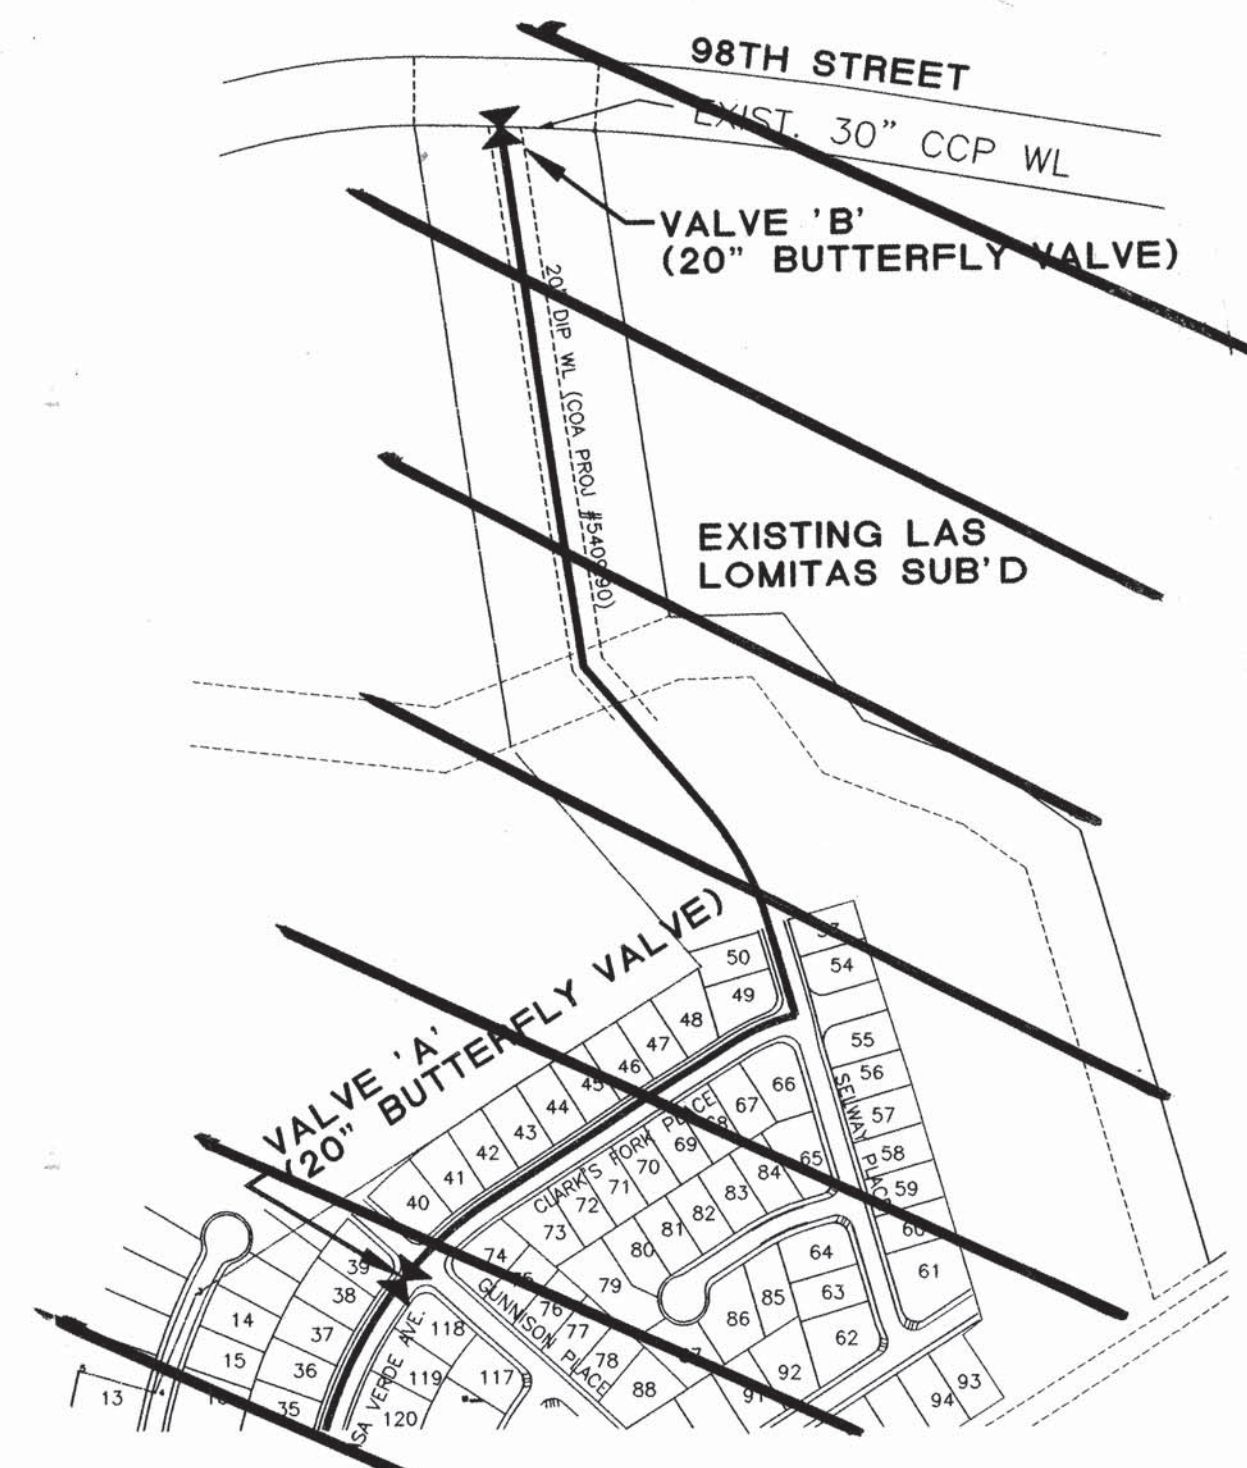

WATER SHUT-OFF REQUIREMENTS:
CONTRACTOR WILL BE RESPONSIBLE FOR THE
TIMING AND COORDINATION OF THE WATER
SHUT-OFF REQUIREMENTS IN CONJUNCTION
WITH THE COMPLETION OF THE PROJECT.
SEWER (S)
AT LEAST **FIVE (5)** WORKING DAYS PRIOR
TO CONSTRUCTION, THE CONTRACTOR SHALL
CONTACT PWD/WATER SYSTEMS DIVISION
(857-8200) TO INITIATE IMPLEMENTATION
OF THIS WATER SHUT-OFF PLAN. CONTRACTOR
SHALL NOT OPERATE CITY VALVES.
WATER SHUT-OFF PLAN:
FOR CONNECTION CLOSE VALVE(S)
ALL WATER LINE CONNECTIONS "C" & "D"
NOTE: VALVES "C" & "D" ARE NOT SHOWN
ON THE COA AUTOMATED WATER DISTRIBUTION
SYSTEM SECTIONAL MAPS, AND FOR
THIS REASON, ARE LABELED AS SUCH FOR
THIS PLAN ONLY. THE CONTRACTOR SHALL
COORDINATE THE SHUT-OFF PLAN WITH THE
OWNER.
NOTE:
SEE OVERALL PLAN FOR
LOCATIONS OF VALVES "C" & "D"

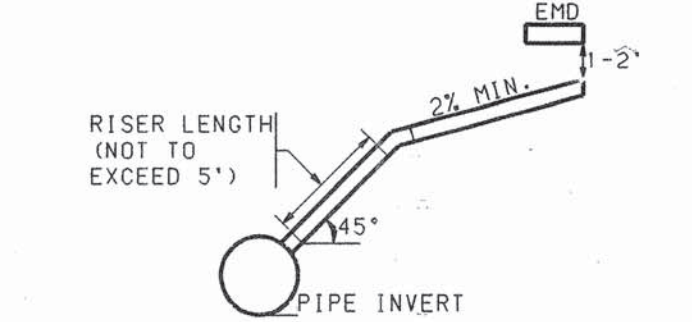

CORRECTED PLAT FOR
LAS LOMITAS
UNIT I AND UNIT II

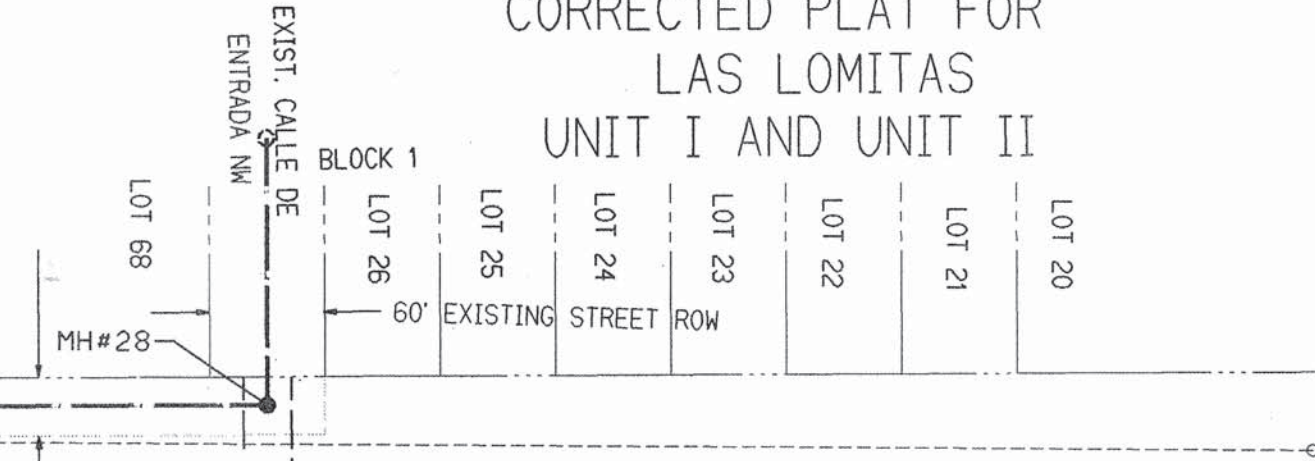


30' SAS EASEMENT RECORDED WITH FILING
OF BULK LAND PLAT ON 7/9/96
VOL. 96C FOLIO 302

2/1/00
7/20/02

LEGEND


PROJECT BOUNDARY	---
PROPOSED SANITARY SEWER MANHOLE	●
EXISTING SANITARY SEWER MANHOLE	○
PROPOSED FIRE HYDRANT	⊙
EXISTING FIRE HYDRANT	⊙
PROPOSED GATE VALVE	⊠
EXISTING GATE VALVE	⊠
PROPOSED STORM DRAIN LINE	SD
PROPOSED STORM DRAIN MANHOLE	⊙
PROPOSED STORM DRAIN INLET	⊠
EXISTING STORM DRAIN LINE	SD
EXISTING STORM DRAIN MANHOLE	⊙
EXISTING STORM DRAIN INLET	⊠
PROPOSED SANITARY SEWER LINE	SAS
EXISTING SANITARY SEWER LINE	SAS
PROPOSED WATER LINE	W
EXISTING WATER LINE	W
PROPOSED SANITARY SEWER SERVICE	---
PROPOSED WATER METER SERVICE	---

TYPICAL UTILITY SERVICE LOCATION
NO SCALE

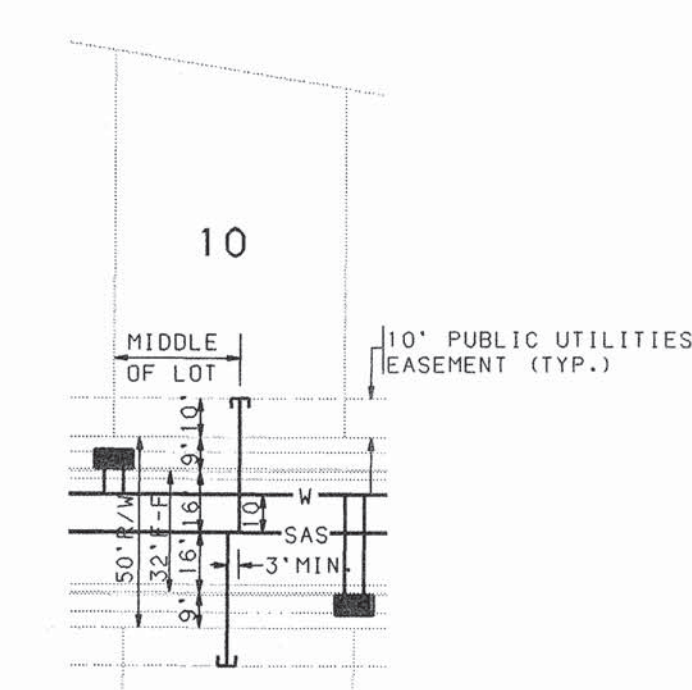

NOTE:
NO CONSTRUCTION SHALL BE COMPLETED IN
CASA VERDE AVE-CLARKS FORK PL. UNTIL 20" WL
IS CONSTRUCTED AND TESTED, AND WRITTEN
NOTICE TO PROCEED FROM CITY CONSTRUCTION
MANAGER IS RECEIVED.
(20" WL Existing)

AFD PLANS CHECKING OFFICE
924-3611
APPROVED/UNAPPROVED
HYDRANT(S) ONLY
DATE 10-03-02

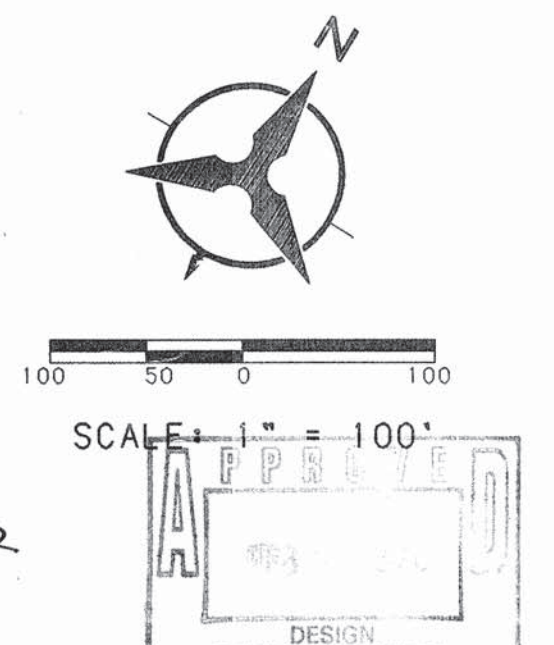

BOHANNAN-HUSTON INC.
ENGINEERS • PLANNERS • PHOTOGRAMMETRISTS • SURVEYORS • LANDSCAPE ARCHITECTS
ALBUQUERQUE LAS CRUCES SANTA FE

CITY OF ALBUQUERQUE
PUBLIC WORKS DEPARTMENT
ENGINEERING DEVELOPMENT GROUP


THE CROSSING SUBDIVISION UNIT II
OVERALL UTILITY

DESIGN	CITY ENGINEER APPROVAL	MO/DAY/YR.	MO/DAY/YR.
DESIGN	CITY ENGINEER		

CITY PROJECT NO. 545382 ZONE MAP NO. H-9. J-9 SHEET 11 OF 18

DATE: MAY 1996

SCANNED BY: PRO
MESA REPRO

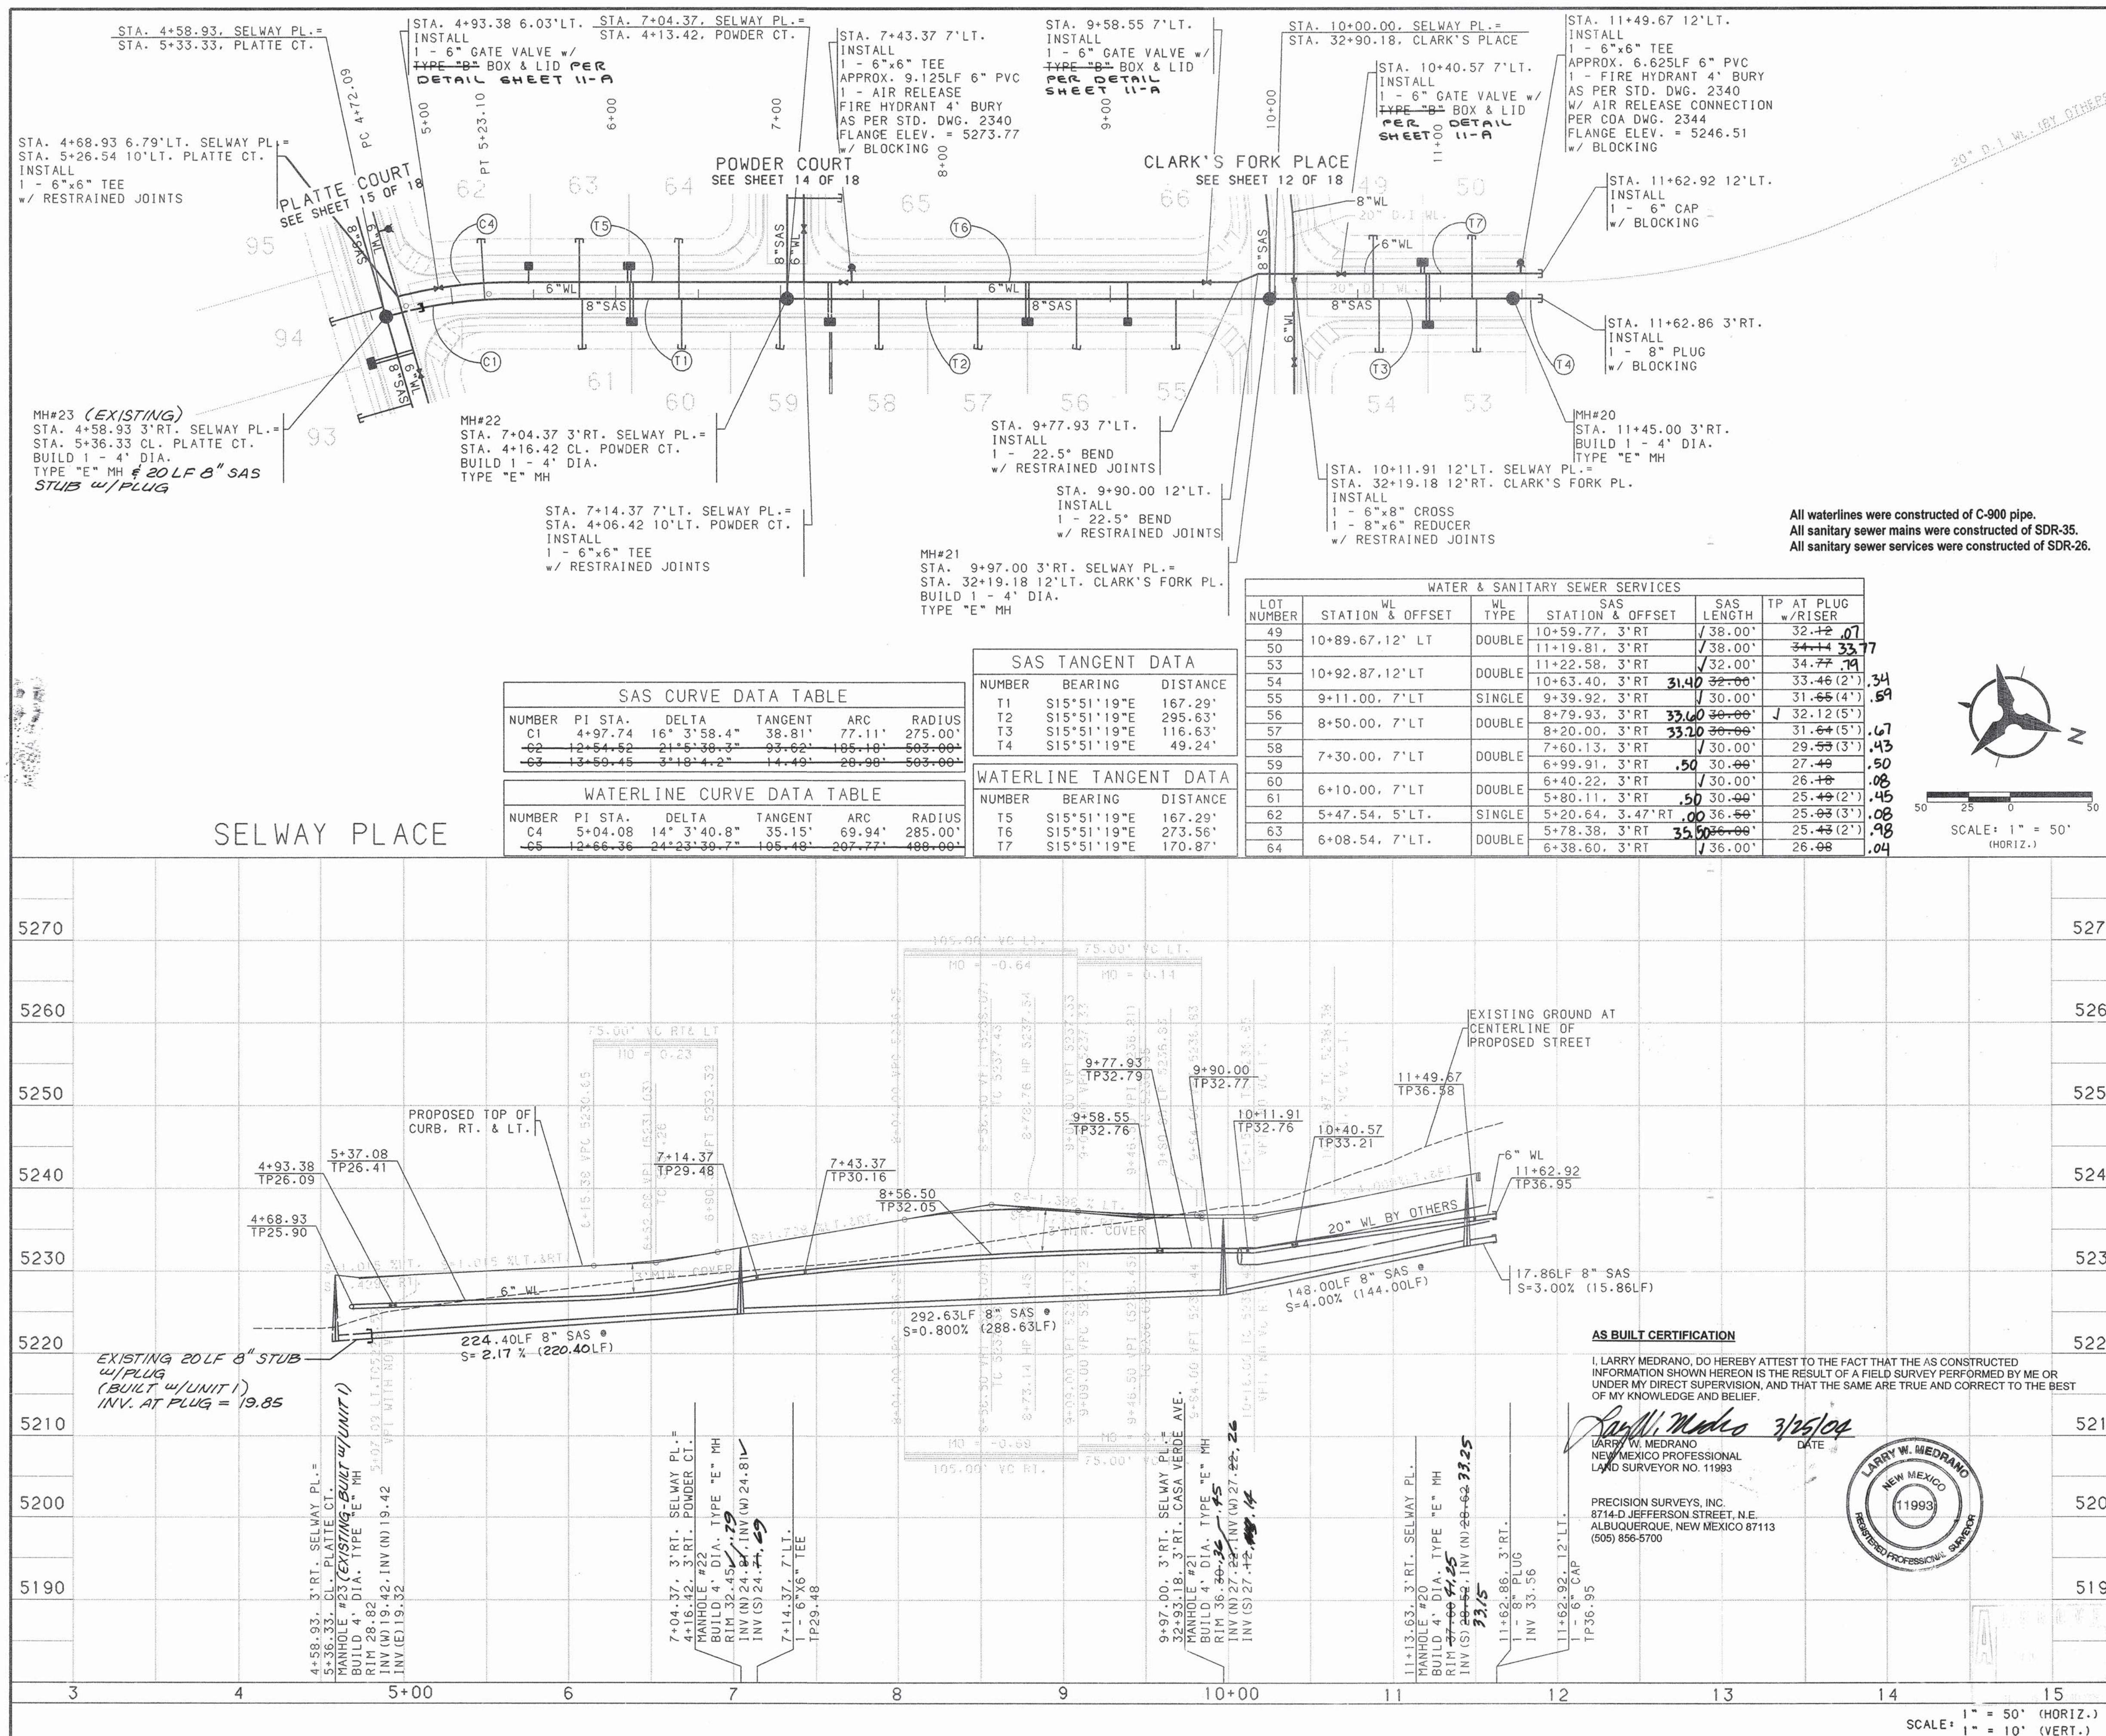

NOTES

- THE CONTRACTOR SHALL FIELD VERIFY ALL EXISTING UTILITY LOCATIONS AND NOTIFY THE ENGINEER IMMEDIATELY OF ANY DISCREPANCIES.
- ALL CURB RETURN RADI SHALL BE 25' TO FACE OF CURB UNLESS OTHERWISE SPECIFIED.
- ALL CURVE DATA AND DIMENSIONS REFER TO FACE OF CURB UNLESS OTHERWISE SPECIFIED.
- GRADE ELEVATIONS, WHERE NOTED, ARE FOR TOP OF STANDARD CURB UNLESS OTHERWISE SPECIFIED.
- CONTRACTOR IS TO INSTALL A 4"x4"x5' POST AND EMD AT THE END OF EACH SANITARY SEWER SERVICE.
- CONTRACTOR IS RESPONSIBLE FOR REPAIR AND/OR REPLACEMENT OF ALL UTILITY CONDUITS AND EXISTING LINES.
- ANY ADDITIONAL GRADING REQUIRED TO MATCH PROPOSED STREET GRADES SHALL BE INCIDENTAL TO PAVING ITEMS.
- CONTRACTOR SHALL PROVIDE THE INSPECTORS, (CITY AND PRIVATE) WITH THE PROPOSED HYDROSTATIC TESTING PLAN. THE PLAN MUST BE APPROVED BEFORE TESTING OPERATIONS BEGIN.
- CONTRACTOR SHALL PARK EQUIPMENT AND VEHICLES AS NOT TO INTERFERE WITH NORMAL ACTIVITIES OF RESIDENTS OR OTHER CONTRACTORS ON SITE.
- ANY DAMAGE TO THE EXISTING FACILITIES (CURB AND GUTTER, PAVEMENT, CONDUITS, LANDSCAPING, UTILITY LINES, ETC.) DURING CONSTRUCTION SHALL BE REPLACED AT THE CONTRACTORS EXPENSE.
- REMOVAL OF THE EXISTING CURB AND GUTTER SHALL BE AS PER COA STD. DWG. 2415 (SAWCUT ONLY).
- WHEEL CHAIR RAMPS SHALL BE CONSTRUCTED PRIOR TO ACCEPTANCE OF CURB AND GUTTER.

AS-BUILT CERTIFICATION

I, LARRY MEDRANO, DO HEREBY ATTEST TO THE FACT THAT THE AS CONSTRUCTED INFORMATION SHOWN HEREON IS THE RESULT OF A FIELD SURVEY PERFORMED BY ME OR UNDER MY DIRECT SUPERVISION, AND THAT THE SAME ARE TRUE AND CORRECT TO THE BEST OF MY KNOWLEDGE AND BELIEF.

Larry W. Medrano 3/25/04
LARRY W. MEDRANO
NEW MEXICO PROFESSIONAL LAND SURVEYOR NO. 11993

PRECISION SURVEYS, INC.
8714-D JEFFERSON STREET, N.E.
ALBUQUERQUE, NEW MEXICO 87113
(505) 856-5700

RESTRAINED JOINT TABLE

MECHANICAL JOINTS	LENGTH OF RESTRAINED JOINTS FROM EACH SIDE OF MJ LISTED (6") (8")
11.25" H BEND	2' 3"
22.50" H BEND	4' 5"
45" H BEND	8' 11"
90" H BEND	20' 26"
GATE VALVE	55' 72"
BTRFLY VALVE	---
REDUCER (8"x6")	30' 30"

NOTE:
1. ALL MECHANICAL JOINTS SHALL BE RESTRAINED AT THE FITTING.
2. THE CONTRACTOR SHALL PROVIDE A MINIMUM PIPE LENGTH OF 20 LF FROM ALL MECHANICAL JOINTS. ALL PIPE JOINTS WITHIN 20 LF OF A MJ SHALL BE RESTRAINED AT THE CONTRACTORS EXPENSE.
3. THE CONTRACTOR SHALL RESTRAIN ALL PIPE JOINTS IN THE SPECIFIED DISTANCE LISTED IN THE TABLE ABOVE. (SEE NOTE 2 ABOVE)
4. THE CONTRACTOR SHALL RESTRAIN ALL FIRE HYDRANTS JOINTS FROM THE TEE ON THE MAIN TO THE FIRE HYDRANT FLANGE.
5. ALL CAPS SHALL UTILIZE PCC BLOCKING

BOHANNAN-HUSTON INC.

ENGINEERS • PLANNERS • PHOTOGRAMMETRISTS • SURVEYORS • LANDSCAPE ARCHITECTS
ALBUQUERQUE LAS CRUCES SANTA FE

CITY OF ALBUQUERQUE

PUBLIC WORKS DEPARTMENT
ENGINEERING DEVELOPMENT GROUP

THE CROSSING SUBDIVISION UNIT II

UTILITY PLAN & PROFILE
SELWAY PLACE

DESIGN REVIEW COMMITTEE

CITY PROJECT NO. 545382

DESIGN REVIEW COMMITTEE

CITY ENGINEER APPROVAL

CITY ENGINEER

LAST DESIGN UPDATE

MO/DAY/YR

MO/DAY/YR

ZONE MAP NO. H-9-J-9 SHEET 13 OF 18

DATE: MAY, 1996

SCANNED & MESH REPRO

STA. 0+75.90 0.67' LT.
INSTALL
1-6" 45° BEND
APPROX. 8 LF 6" PVC
1-FIRE HYDRANT 4"
BURY PER STD DWG
2340 W/ RESTRAINED
JOINTS
FLNG. ELEV. = 5235.63

MH#18
STA. 0+94.72 9.51' RT.
BUILD 1 - 4' DIA.
TYPE "E" MH

STA. 3+74.42 10' LT.
INSTALL
1 - 6" GATE VALVE W/
TYPE "B" BOX & LID
PER DETAIL
SHEET 11-A

STA. 4+06.42 10' LT. POWDER CT. =
STA. 7+14.37 7' LT. SELWAY PL.
INSTALL
1 - 6"x6" TEE
W/ RESTRAINED JOINTS

MH#22
STA. 4+16.42 CL. POWDER CT. =
STA. 7+04.37 3' RT. SELWAY PL.
BUILD 1 - 4' DIA.
TYPE "E" MH

STA. 4+13.42. POWDER CT. =
STA. 7+04.37. SELWAY PL.

All waterlines were constructed of C-900 pipe.
All sanitary sewer mains were constructed of SDR-35.
All sanitary sewer services were constructed of SDR-26.

SAS CURVE DATA TABLE					
NUMBER	PI STA.	DELTA	TANGENT	ARC	RADIUS
C1	7+38.98	19°47'26.4"	52.33'	103.62'	300.00'

WATERLINE CURVE DATA TABLE					
NUMBER	PI STA.	DELTA	TANGENT	ARC	RADIUS
C2	7+46.28	16°17'0.8"	44.35'	88.10'	310.00'



SAS TANGENT DATA		
NUMBER	BEARING	DISTANCE
T1	N54°25'56"E	136.47'
T2	N74°08'41"E	81.77'

WATERLINE TANGENT DATA		
NUMBER	BEARING	DISTANCE
T3	N54°21'15"E	172.09'
T4	N74°08'41"E	73.49'

WATER & SANITARY SEWER SERVICES					
LOT NUMBER	STATION & OFFSET	WL TYPE	SAS STATION & OFFSET	SAS LENGTH	TOP OF PIPE AT PLUG
80	1+02.41, 0.98' LT.	DOUBLE	0+99.75, 9.02' RT.	457.42' 0.2'	29.92' 90
81			1+35.87, 6.96' RT.	450.39' 9.1'	29.69' 08
82			1+95.39, 3.26' RT.	374.26' 2.9'	29.44' 40
83	2+22.75, 8.45' LT.	DOUBLE	2+52.15, 0.46' RT.	340.33' 4.6'	28.89' 91
84			3+04.43, 0.16' RT.	33.17'	28.52' 57
65	3+37.64, 10' LT.	DOUBLE	3+55.61, CL	50' 33.69'	28.77' 18
85			2+27.97, 1.25' RT.	31.90'	28.97' 08
86	2+09.31, 7.61' LT.	DOUBLE	1+67.27, 5.0' RT.	40' 28.44'	29.19' 17
87**			MH#18 S 3°33'24" W	52.28'	29.86' 28.72
79**	0+80.89, 0.36' RT.	DOUBLE	MH#18 S 78°57'45" W	6042.46'	29.97' 30.36

**4 CONNECT SAS SERVICE TO MH PER
COA STD DWG 218

* NO RISERS REQUIRED FOR THIS SHEET

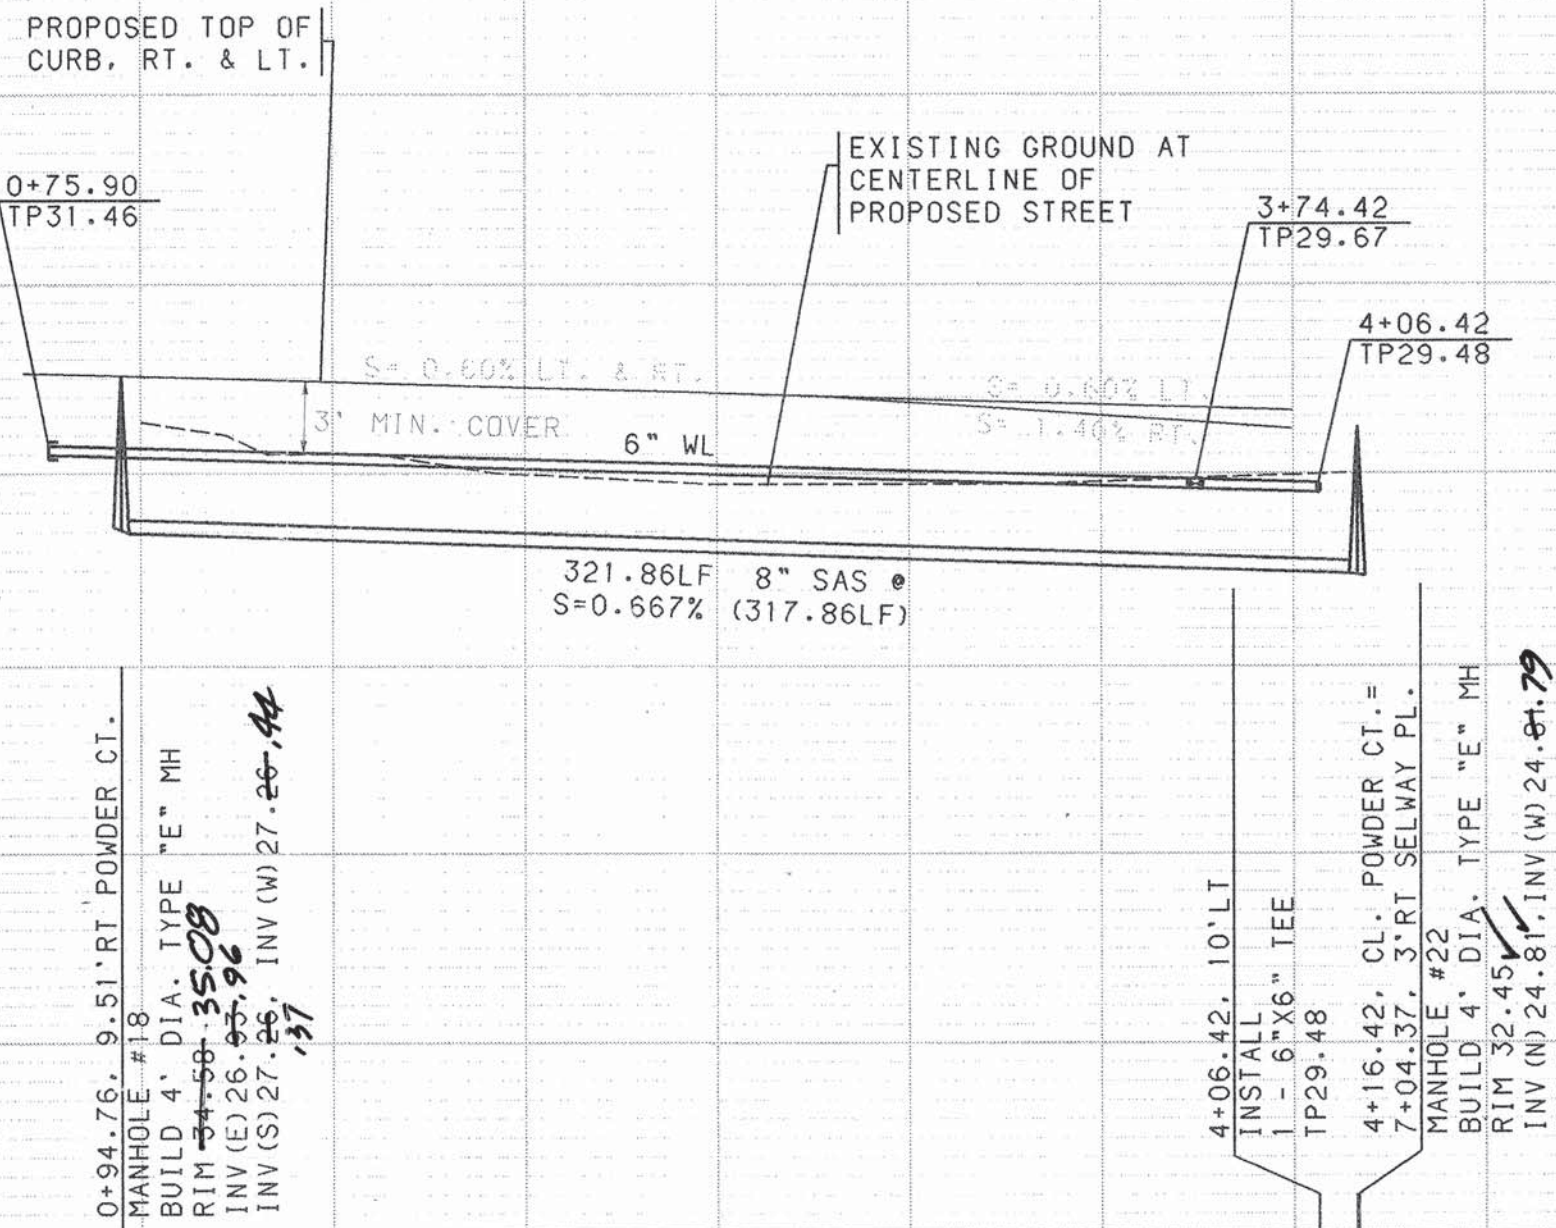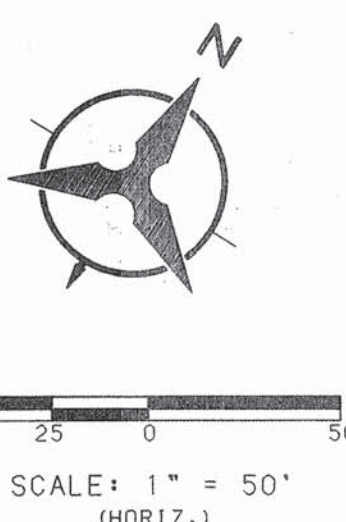

AS BUILT CERTIFICATION

I, LARRY MEDRANO, DO HEREBY ATTEST TO THE FACT THAT THE AS CONSTRUCTED INFORMATION SHOWN HEREON IS THE RESULT OF A FIELD SURVEY PERFORMED BY ME OR UNDER MY DIRECT SUPERVISION, AND THAT THE SAME ARE TRUE AND CORRECT TO THE BEST OF MY KNOWLEDGE AND BELIEF.

LARRY MEDRANO
NEW MEXICO PROFESSIONAL
LAND SURVEYOR NO. 11993

PRECISION SURVEYS, INC.
8714-D JEFFERSON STREET, N.E.
ALBUQUERQUE, NEW MEXICO 87113
(505) 856-5700



RESTRAINED JOINT TABLE

MECHANICAL JOINTS	LENGTH OF RESTRAINED JOINTS FROM EACH SIDE OF MJ LISTED	
	(6")	(8")
11.25" H BEND	2'	3'
22.50" H BEND	4'	5'
45" H BEND	8'	11'
90" H BEND	20'	26'
GATE VALVE	55'	72'
BTRFLY VALVE	---	---
REDUCER (8"x6")	30'	30'

NOTE:

- ALL MECHANICAL JOINTS SHALL BE RESTRAINED AT THE FITTING.
- THE CONTRACTOR SHALL PROVIDE A MINIMUM PIPE LENGTH OF 20 LF FROM ALL MECHANICAL JOINTS. ALL PIPE JOINTS WITHIN 20 LF OF A MJ SHALL BE RESTRAINED AT THE CONTRACTORS EXPENSE.
- THE CONTRACTOR SHALL RESTRAIN ALL PIPE JOINTS IN THE SPECIFIED DISTANCE LISTED IN THE TABLE ABOVE. (SEE NOTE 2 ABOVE)
- THE CONTRACTOR SHALL RESTRAIN ALL FIRE HYDRANTS JOINTS FROM THE TEE ON THE MAIN TO THE FIRE HYDRANT FLANGE.
- ALL CAPS SHALL UTILIZE PCC BLOCKING

BOHANNAN-HUSTON INC.
ENGINEERS • PLANNERS • PHOTOGRAMMETRISTS • SURVEYORS • LANDSCAPE ARCHITECTS
ALBUQUERQUE LAS CRUCES SANTA FE


CITY OF ALBUQUERQUE
PUBLIC WORKS DEPARTMENT
ENGINEERING DEVELOPMENT GROUP

THE CROSSING SUBDIVISION UNIT II
UTILITY PLAN & PROFILE
POWDER COURT


DESIGN REVIEW COMMITTEE	CITY ENGINEER APPROVAL	MO/DAY/YR.	MO/DAY/YR.
APPROVED OCT - 8 2000 CITY ENGINEER	APPROVED OCT - 8 2000 CITY ENGINEER		

CITY PROJECT NO. 545382
ZONE MAP NO. H-9, J-9
SHEET 14 OF 18

DESIGN REVIEW COMMITTEE
CITY PROJECT NO. 545382
ZONE MAP NO. H-9, J-9
SHEET 14 OF 18
COPYRIGHT BOHANNAN-HUSTON, INC.
DATE: MAY, 1996

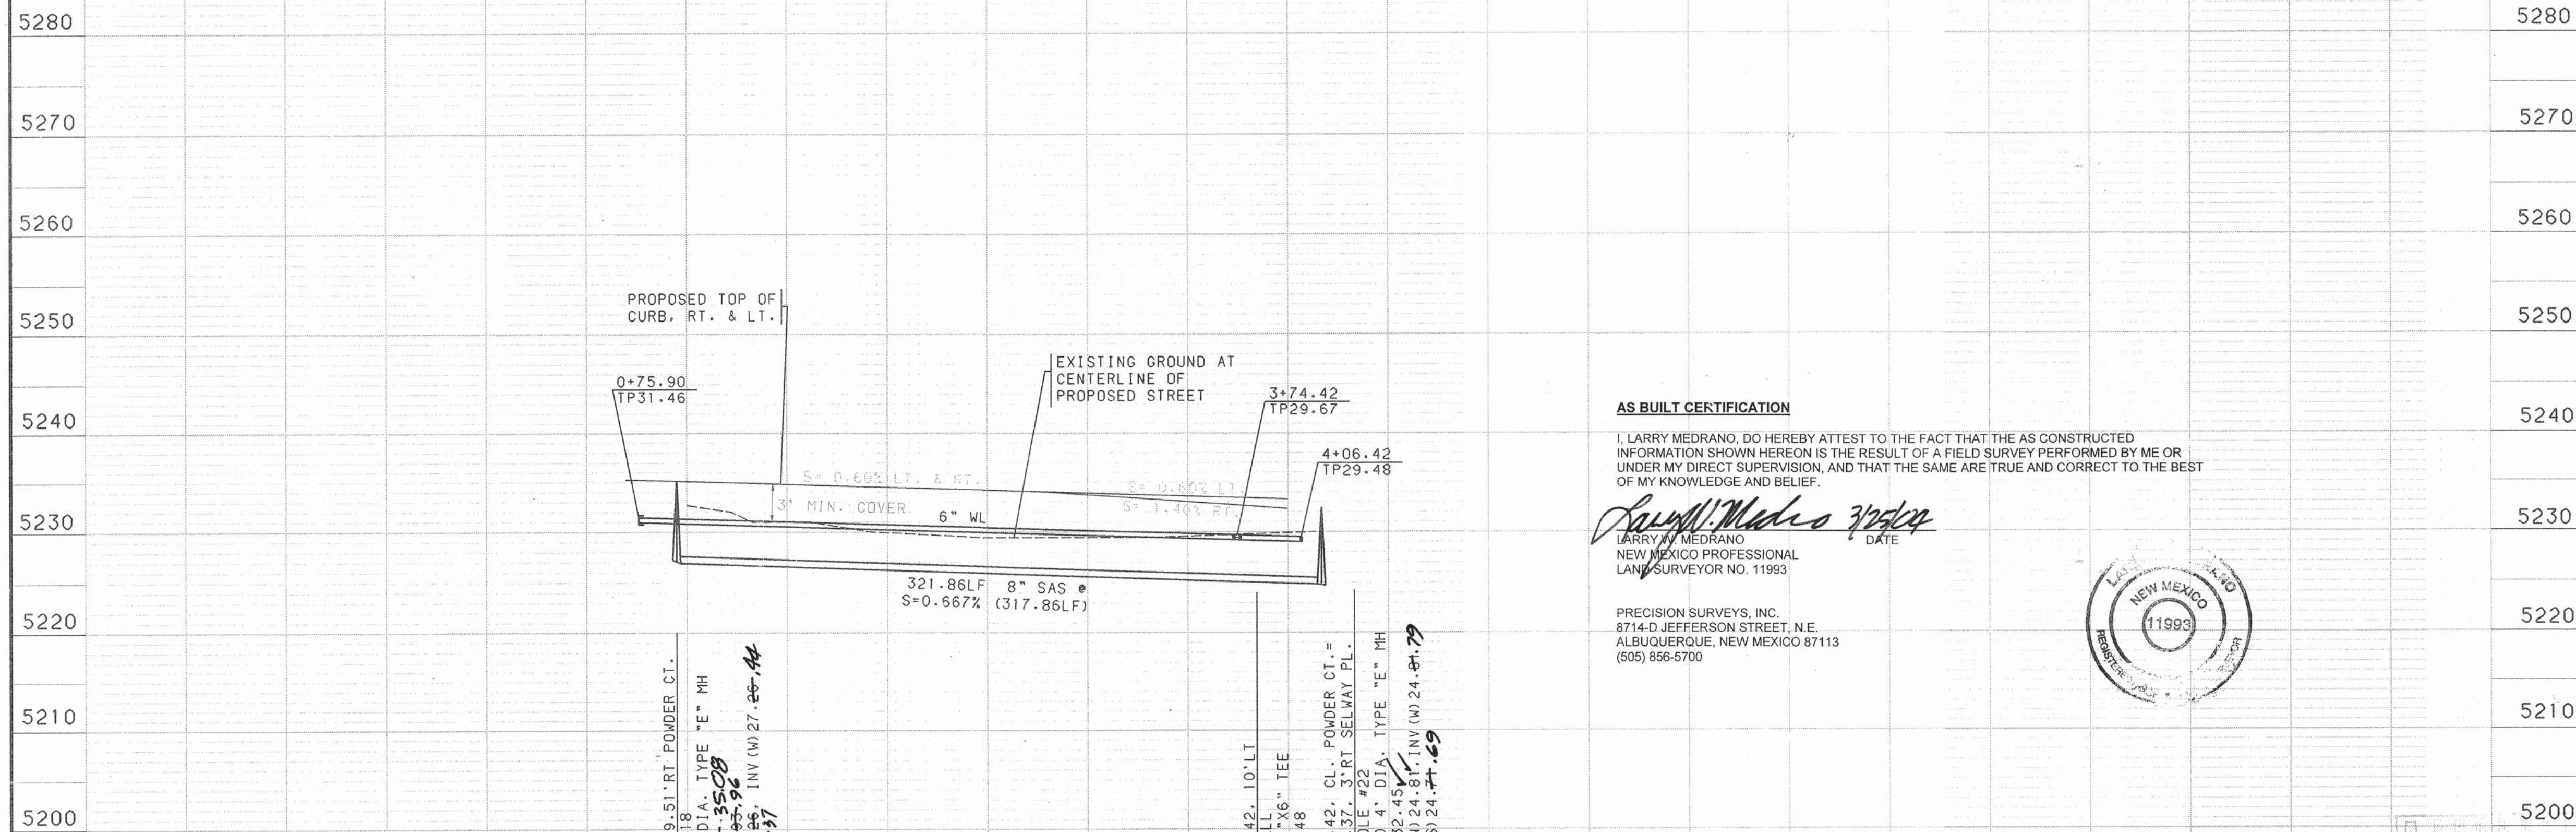

SCANNED BY
MESA REPRO

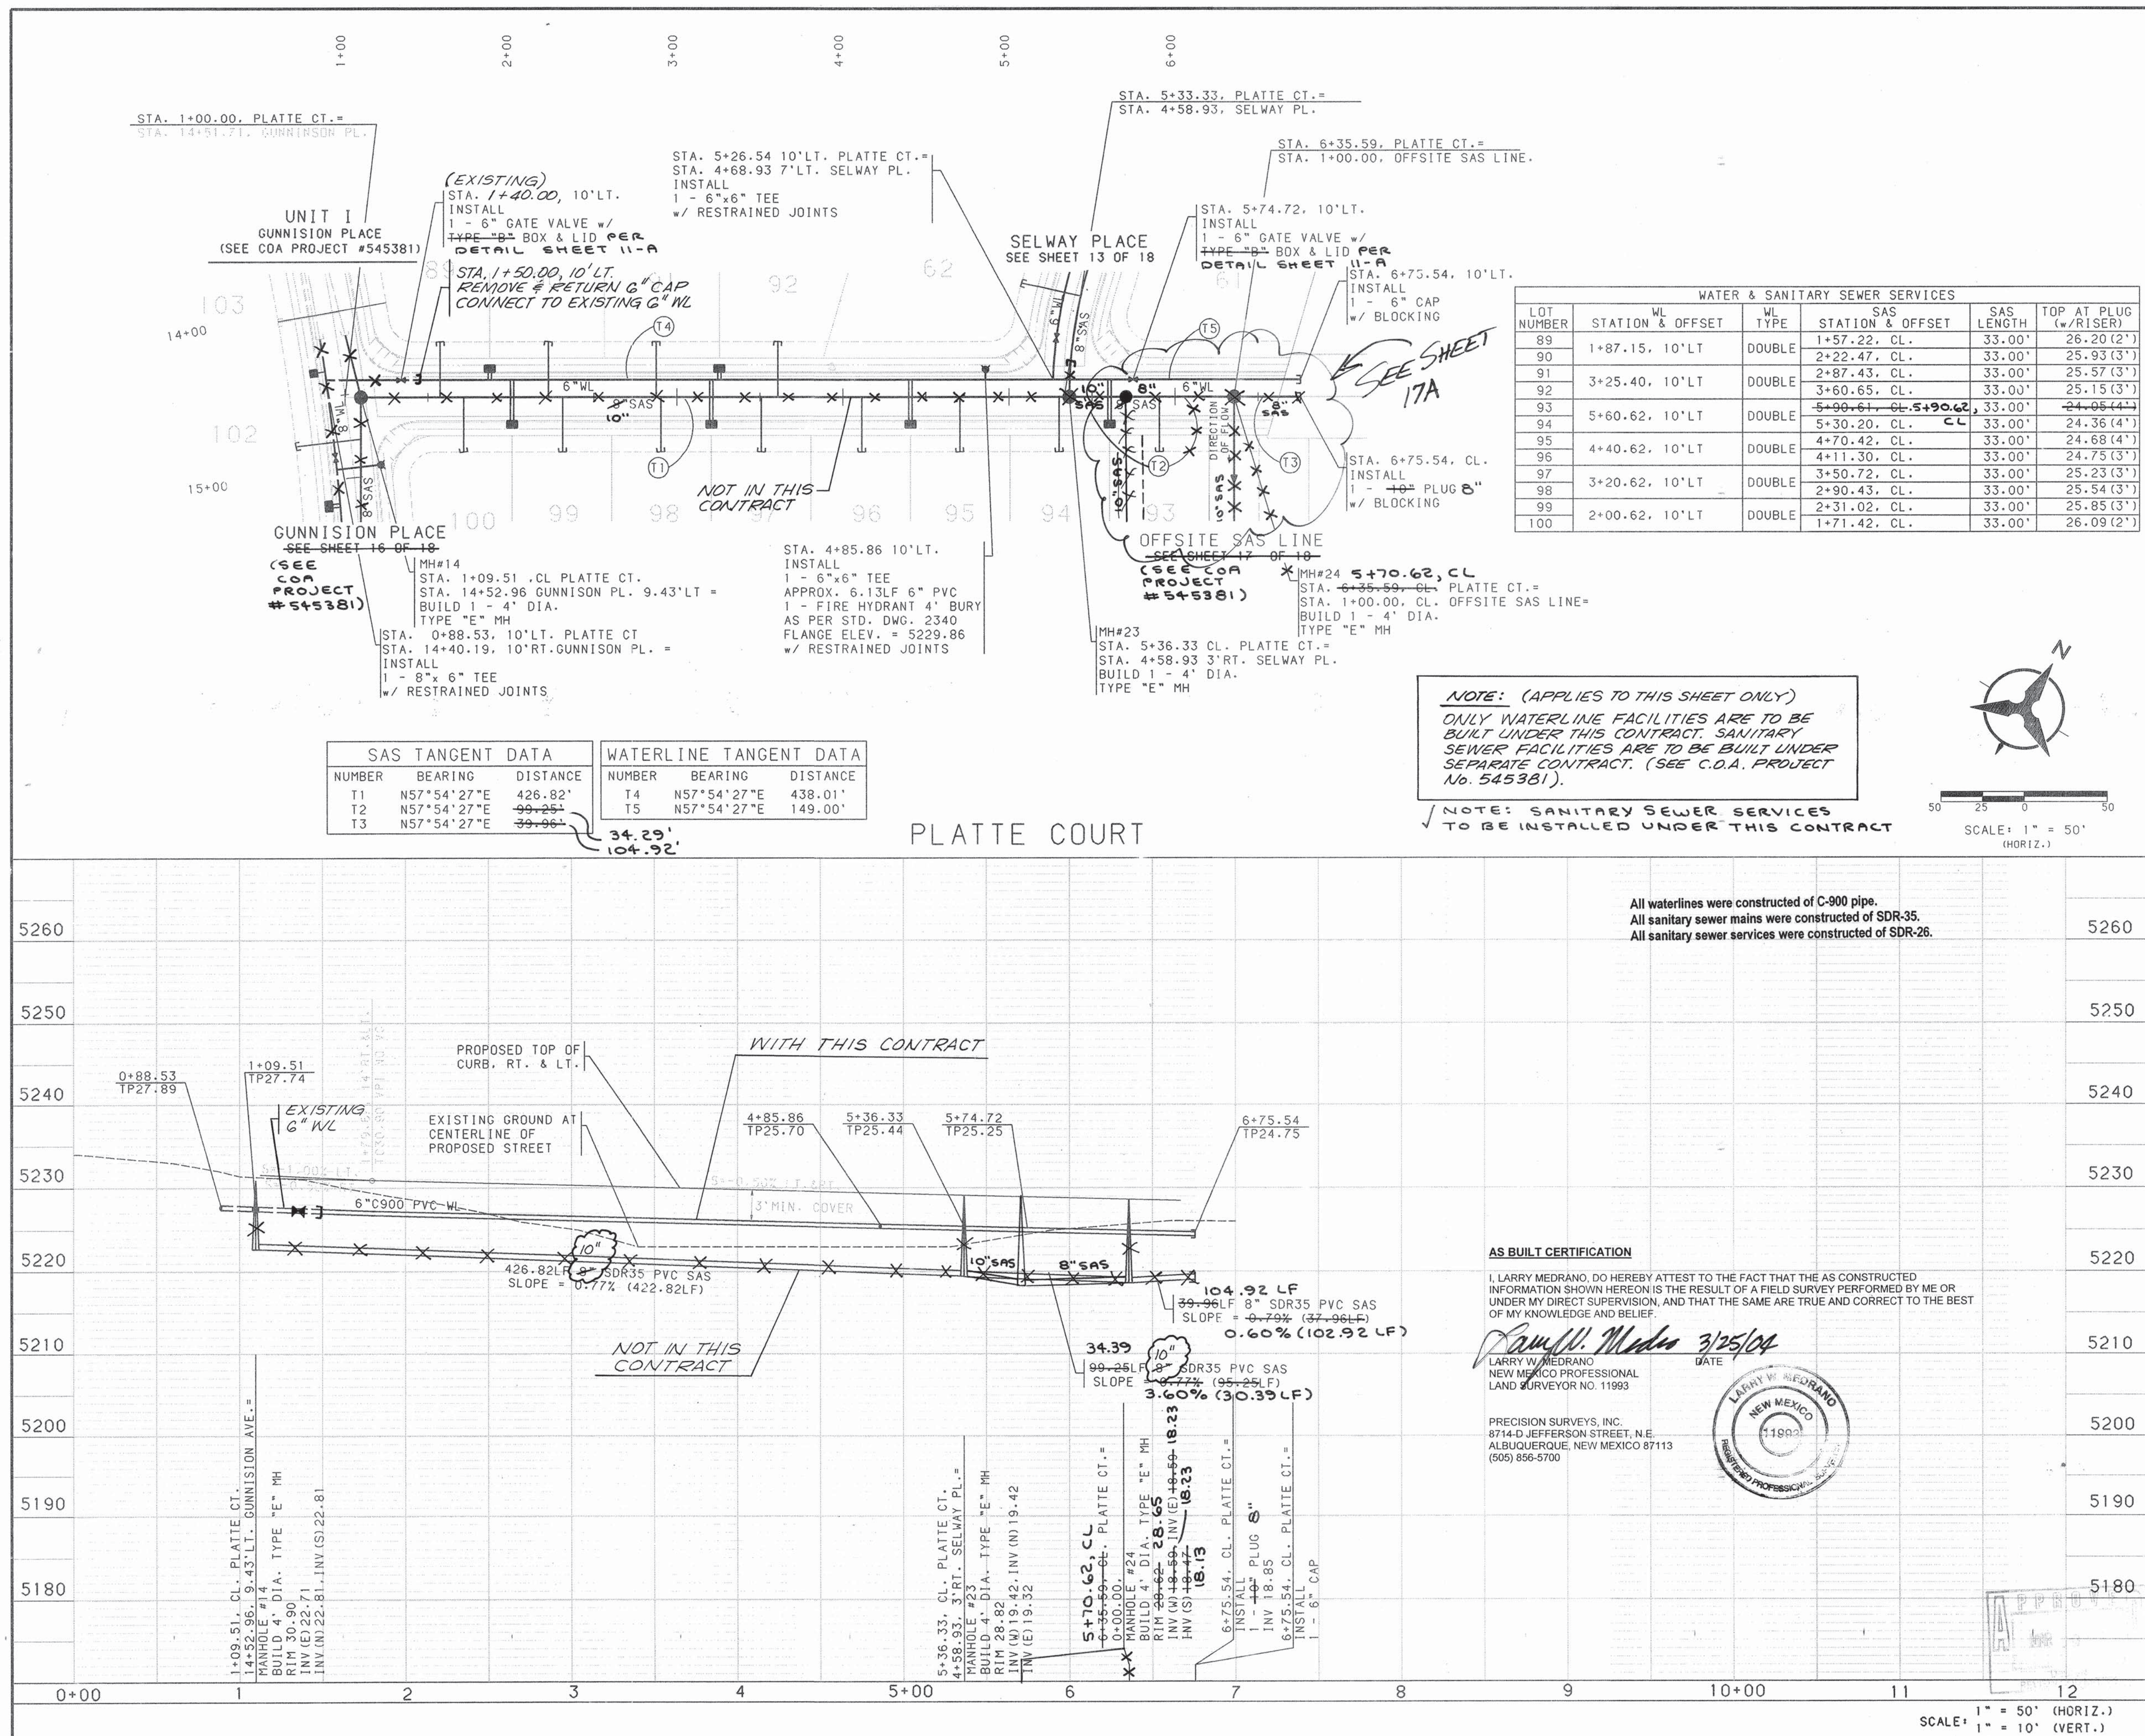

- NOTES
1. THE CONTRACTOR SHALL FIELD VERIFY ALL EXISTING UTILITY LOCATIONS AND NOTIFY THE ENGINEER IMMEDIATELY OF ANY DISCREPANCIES.
 2. ALL CURB RETURN RADII SHALL BE 25' TO FACE OF CURB UNLESS OTHERWISE SPECIFIED.
 3. ALL CURVE DATA AND DIMENSIONS REFER TO FACE OF CURB UNLESS OTHERWISE SPECIFIED.
 4. GRADE ELEVATIONS, WHERE NOTED, ARE FOR TOP OF STANDARD STREET GRADES UNLESS OTHERWISE SPECIFIED.
 5. CONTRACTOR IS TO INSTALL A 4"x4"x5" POST AND EMD AT THE END OF EACH SANITARY SEWER SERVICE.
 6. CONTRACTOR IS RESPONSIBLE FOR REPAIR AND/OR REPLACEMENT OF ALL UTILITY CONDUITS AND EXISTING LINES.
 7. ANY ADDITIONAL GRADING REQUIRED TO MATCH PROPOSED STREET GRADES SHALL BE INCIDENTAL TO PAVING ITEMS.
 8. CONTRACTOR SHALL PROVIDE THE INSPECTORS, (CITY AND PRIVATE) WITH THE PROPOSED HYDROSTATIC TESTING PLAN. THE PLAN MUST BE APPROVED BEFORE TESTING OPERATIONS BEGIN.
 9. CONTRACTOR SHALL PARK EQUIPMENT AND VEHICLES AS NOT TO INTERFERE WITH NORMAL ACTIVITIES OF RESIDENTS OR OTHER CONTRACTORS ON SITE.
 10. ANY DAMAGE TO THE EXISTING FACILITIES (CURB AND GUTTER, PAVEMENT, CONDUITS, LANDSCAPING, UTILITY LINES, ETC.) DURING CONSTRUCTION SHALL BE REPLACED AT THE CONTRACTORS EXPENSE.
 11. REMOVAL OF THE EXISTING CURB AND GUTTER SHALL BE AS PER COA STD. DWG. 2415 (SAWCUT ONLY).
 12. WHEEL CHAIR RAMPS SHALL BE CONSTRUCTED PRIOR TO ACCEPTANCE OF CURB AND GUTTER.

RESTRAINED JOINT

MECHANICAL JOINTS	LENGTH OF RESTRAINED JOINTS FROM EACH SIDE OF MJ LISTED (6") (8")
11.25" H BEND	2' 3'
22.50" H BEND	4' 5'
45" H BEND	8' 11'
90" H BEND	20' 26'
GATE VALVE	55' 72'
BTRFLY VALVE	---
REDUCER (8"x6")	30' 30'

- NOTE:
1. ALL MECHANICAL JOINTS SHALL BE RESTRAINED AT THE FITTING.
 2. THE CONTRACTOR SHALL PROVIDE A MINIMUM PIPE LENGTH OF 20 LF FROM ALL MECHANICAL JOINTS. ALL PIPE JOINTS WITHIN 20 LF OF A MJ SHALL BE RESTRAINED AT THE CONTRACTORS EXPENSE.
 3. THE CONTRACTOR SHALL RESTRAIN ALL PIPE JOINTS IN THE SPECIFIED DISTANCE LISTED IN THE TABLE ABOVE. (SEE NOTE 2 ABOVE)
 4. THE CONTRACTOR SHALL RESTRAIN ALL FIRE HYDRANTS JOINTS FROM THE TEE ON THE MAIN TO THE FIRE HYDRANT FLANGE.
 5. ALL CAPS SHALL UTILIZE PCC BLOCKING

BOHANNAN-HUSTON INC.
ENGINEERS • PLANNERS • PHOTOGRAMMETRISTS • SURVEYORS • LANDSCAPE ARCHITECTS
ALBUQUERQUE LAS CRUCES SANTA FE



CITY OF ALBUQUERQUE
PUBLIC WORKS DEPARTMENT
ENGINEERING DEVELOPMENT GROUP

THE CROSSING SUBDIVISION UNIT II
UTILITY PLAN & PROFILE
PLATTE COURT

DESIGN REVIEW COMMITTEE	CITY ENGINEER APPROVAL	MO/DAY/YR	MO/DAY/YR
APPROVED	APPROVED	10-26-00	
LAST DESIGN UPDATE			
DESIGNED BY: KP/BS	DATE: 8/96	DRAWN BY: BS	DATE: 8/96
CHECKED BY: KP	DATE: 8/96		

PROJECT NO. 545382 ZONE MAP NO. H-9-J-9 SHEET 15 OF 18

COPYRIGHT BOHANNAN-HUSTON, INC. DATE: MAY, 1996

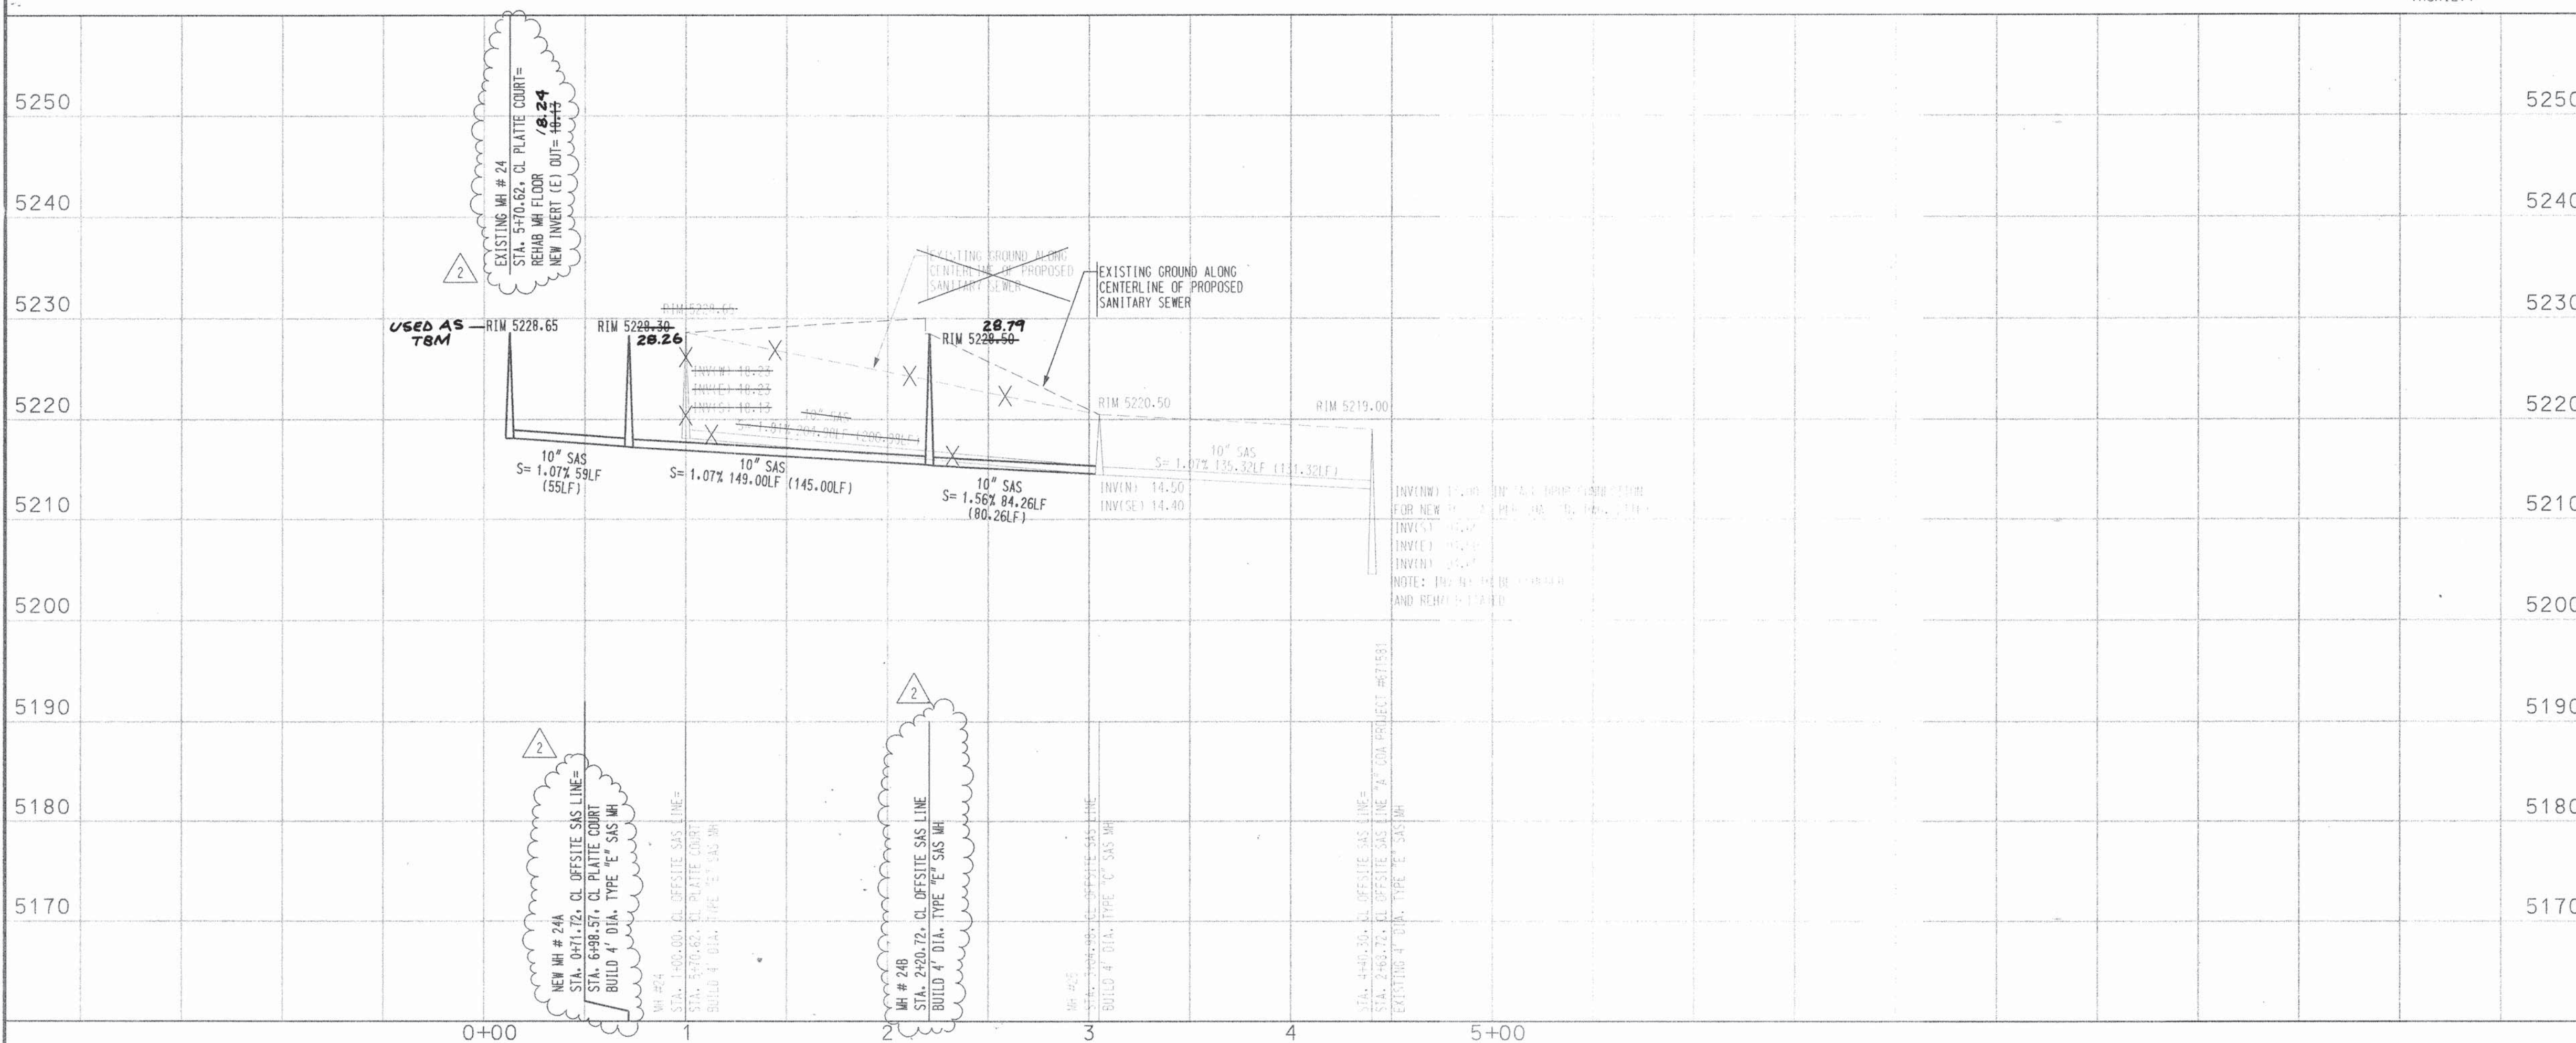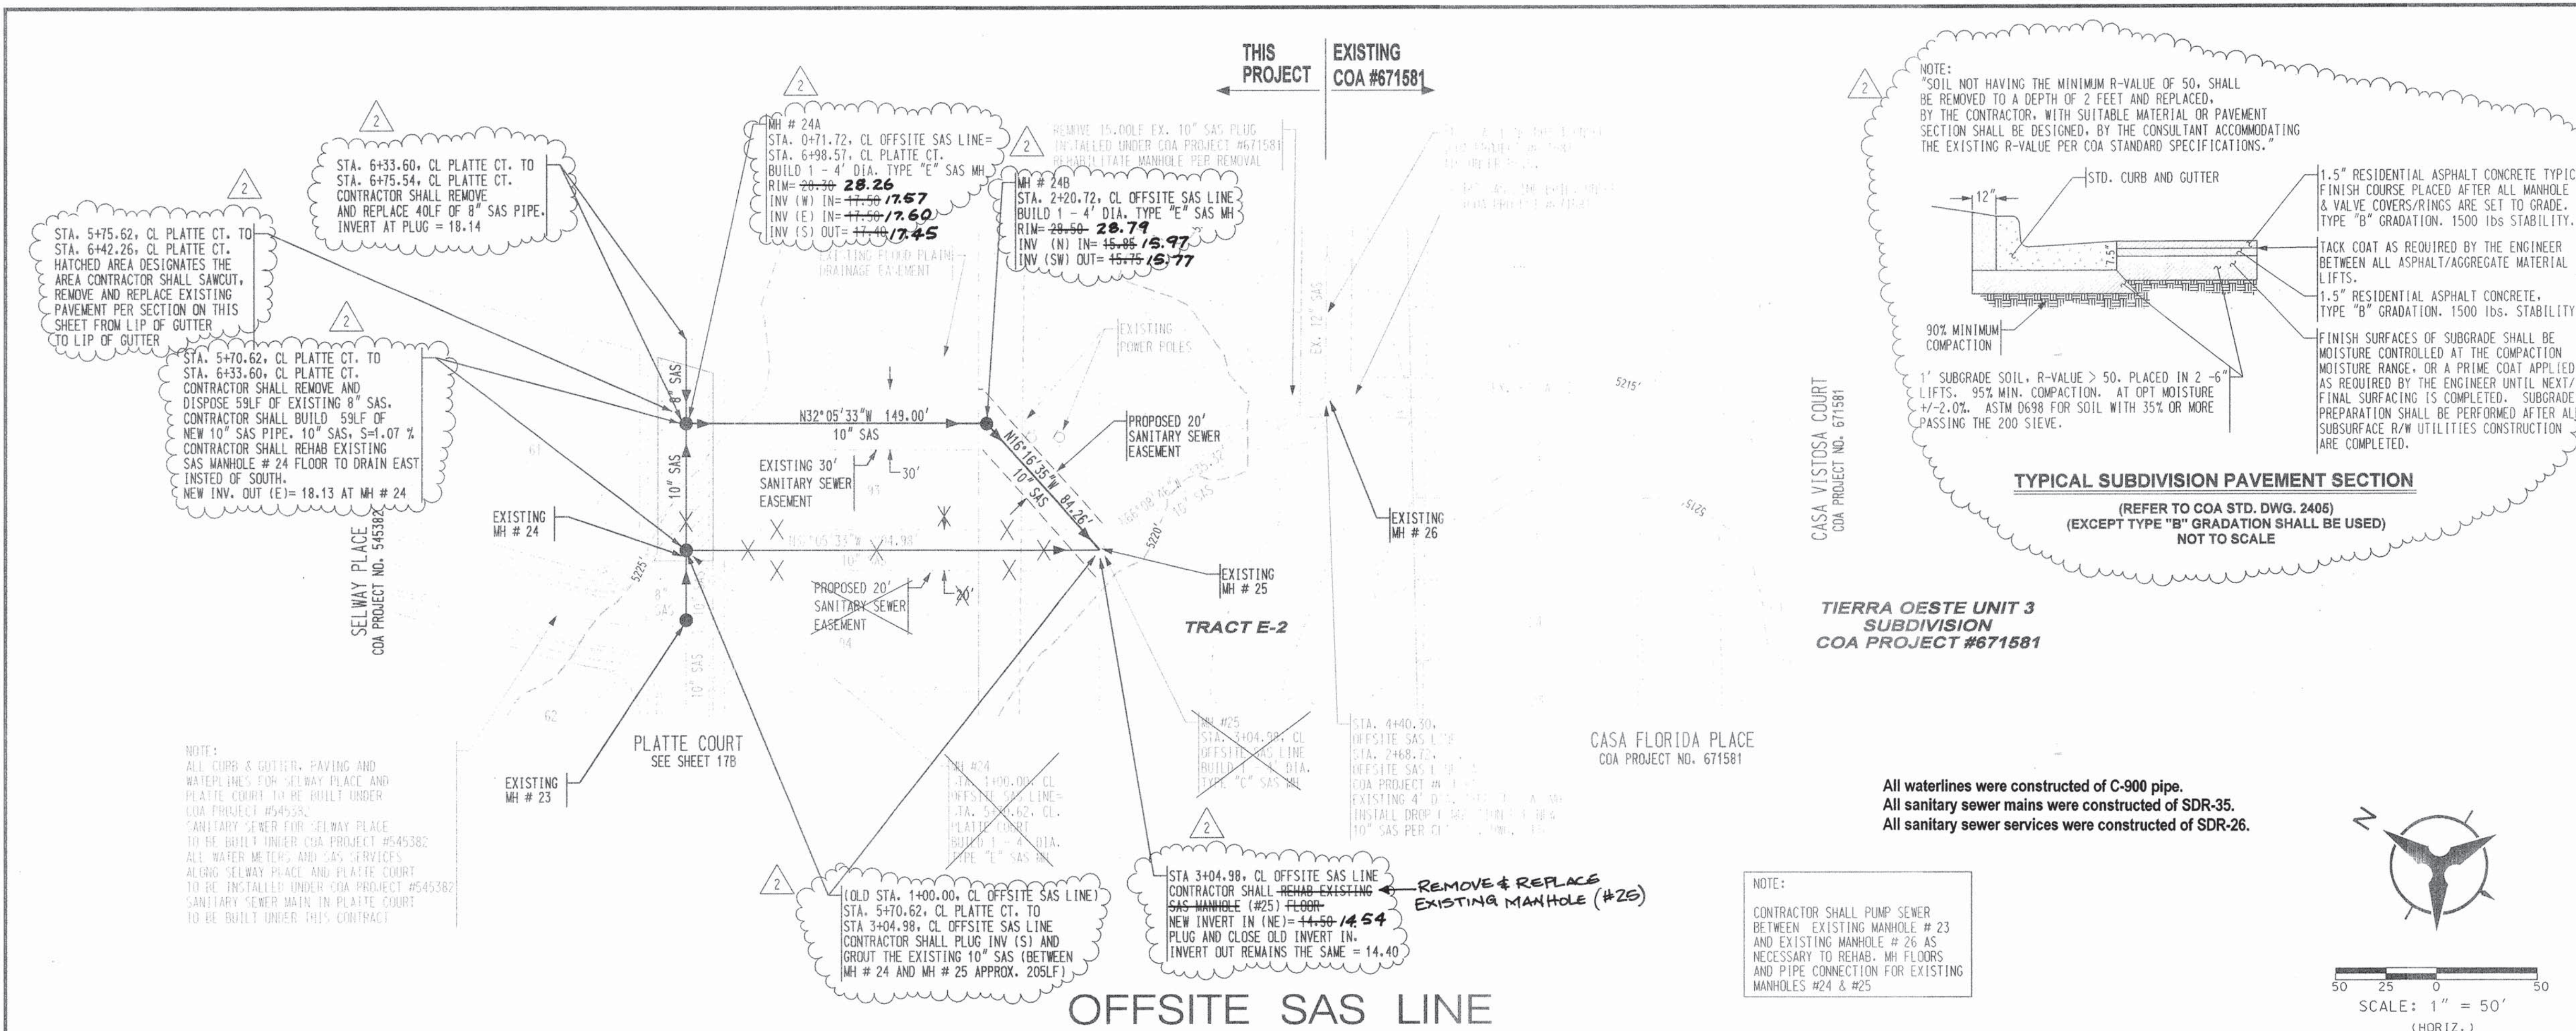

- NOTES**
- THE CONTRACTOR SHALL FIELD VERIFY ALL EXISTING UTILITY LOCATIONS AND NOTIFY THE ENGINEER IMMEDIATELY OF ANY DISCREPANCIES.
 - ALL CURB RETURN RADIUS SHALL BE 25' UNLESS OTHERWISE SPECIFIED.
 - ALL CURVE DATA AND DIMENSIONS REFER TO FACE OF CURB UNLESS OTHERWISE SPECIFIED.
 - GRADE ELEVATIONS, WHERE NOTED, ARE ALONG FLOWLINE OF STANDARD CURB UNLESS OTHERWISE SPECIFIED.
 - CONTRACTOR IS TO INSTALL A 4" X 4" X 5' POST AND EMD AT THE END OF EACH SANITARY SEWER SERVICE.
 - CONTRACTOR IS RESPONSIBLE FOR REPAIR AND/OR REPLACEMENT OF ALL UTILITY CONDUITS AND EXISTING LINES.
 - ANY ADDITIONAL GRADING REQUIRED TO MATCH PROPOSED STREET GRADES SHALL BE INCIDENTAL TO PAVING ITEMS.
 - CONTRACTOR SHALL PROVIDE THE INSPECTORS (CITY AND PRIVATE) WITH THE PROPOSED HYDROSTATIC TESTING PLAN. THE PLAN MUST BE APPROVED BEFORE TESTING OPERATIONS BEGIN.
 - CONTRACTOR SHALL PARK EQUIPMENT AND VEHICLES AS NOT TO INTERFERE WITH NORMAL ACTIVITIES OF RESIDENTS OR OTHER CONTRACTORS ON SITE.
 - ANY DAMAGE TO THE EXISTING FACILITIES (CURB & GUTTER), PAVEMENT, CONDUITS, LANDSCAPING, UTILITY LINES, ETC.) DURING CONSTRUCTION SHALL BE REPLACED AT THE CONTRACTORS' EXPENSE.
 - REMOVAL OF THE EXISTING CURB AND GUTTER SHALL BE AS PER COA STD. DWG. 2415 (SAWCUT ONLY).
 - WHEELCHAIR RAMPS SHALL BE CONSTRUCTED PRIOR TO ACCEPTANCE OF CURB & GUTTER.

RECORD DRAWING CERTIFICATION

I, Alan R. Benham, a Registered New Mexico Professional Surveyor in the State of New Mexico, do hereby certify that this record drawing for sheet 17A of 18, The Crossings Subdivision Unit II - Utility Plan & Profile has been revised in accordance with as-built information furnished by Bohannon Huston, Inc. The as-built information is the result of a field survey performed by me or under my direct supervision and is true and correct to the best of my knowledge and belief. The surveyor is not responsible for any errors or omissions in the documents. These documents are for general information only and any other application is at the sole risk of the user.

Alan R. Benham 6-15-04
Alan R. Benham, P.S.
PS No. 15700

Record Drawing

JUNE 15, 2004

Date

Bohannon & Huston

Courtyard One 7500 JEFFERSON NE Albuquerque, NEW MEXICO 87109

ENGINEERS PLANNERS PHOTOGRAMMETRISTS SURVEYORS SOFTWARE DEVELOPERS

CITY OF ALBUQUERQUE

PUBLIC WORKS DEPARTMENT

ENGINEERING DEVELOPMENT GROUP

THE CROSSINGS SUBDIVISION UNIT II

UTILITY PLAN & PROFILE


OFFSITE SAS LINE

DESIGN REVIEW COMMITTEE CITY ENGINEER APPROVAL

APPROVED JUN - 8 2004

DESIGN REVIEW COMMITTEE CITY ENGINEER

SCANNED BY
MESA REPRO

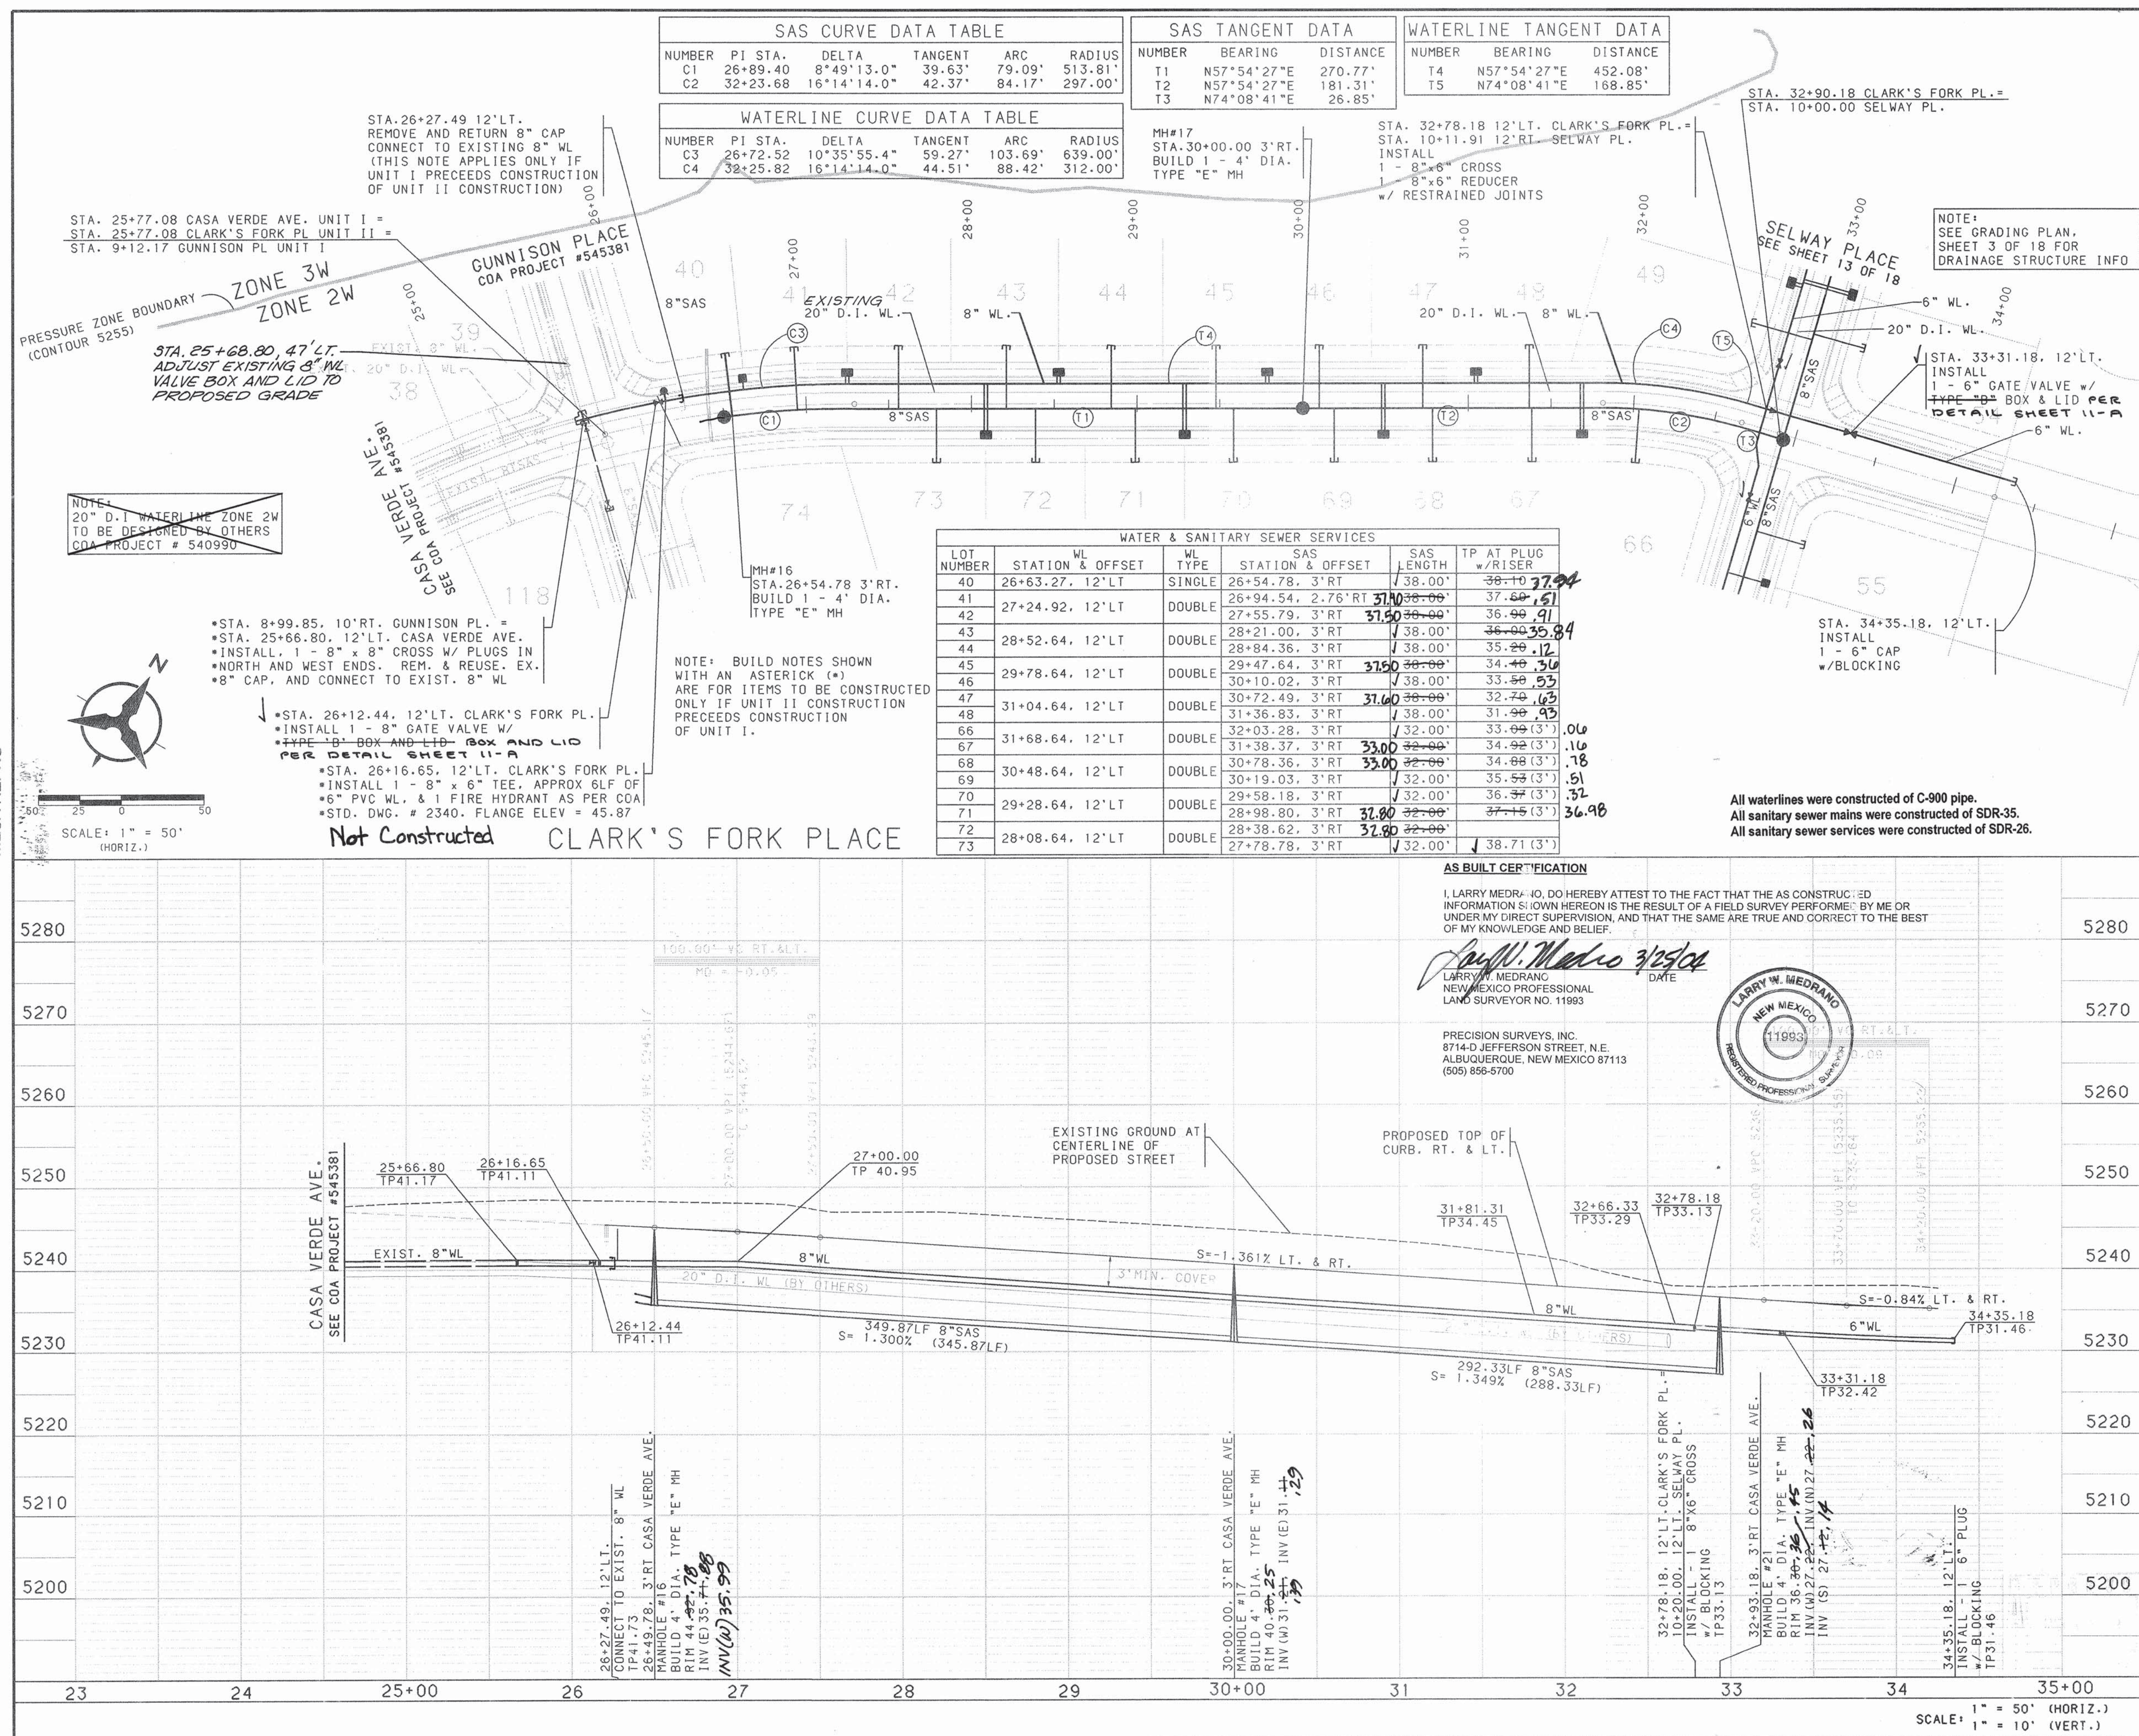

NOTES

- THE CONTRACTOR SHALL FIELD VERIFY ALL EXISTING UTILITY LOCATIONS AND NOTIFY THE ENGINEER IMMEDIATELY OF ANY DISCREPANCIES.
- ALL CURB RETURN RADII SHALL BE 25' TO FACE OF CURB UNLESS OTHERWISE SPECIFIED.
- ALL CURVE DATA AND DIMENSIONS REFER TO FACE OF CURB UNLESS OTHERWISE SPECIFIED.
- GRADE ELEVATIONS, WHERE NOTED, ARE FOR TOP OF STANDARD CURB UNLESS OTHERWISE SPECIFIED.
- CONTRACTOR IS TO INSTALL A 4"x4"x5" POST AND EMD AT THE END-OF EACH SANITARY SEWER SERVICE.
- CONTRACTOR IS RESPONSIBLE FOR REPAIR AND/OR REPLACEMENT OF ALL UTILITY CONDUITS AND EXISTING LINES.
- ANY ADDITIONAL GRADING REQUIRED TO MATCH PROPOSED STREET GRADES SHALL BE INCIDENTAL TO PAVING ITEMS.
- CONTRACTOR SHALL PROVIDE THE INSPECTORS, (CITY AND PRIVATE) WITH THE PROPOSED HYDROSTATIC TESTING PLAN. THE PLAN MUST BE APPROVED BEFORE TESTING OPERATIONS BEGIN.
- CONTRACTOR SHALL PARK EQUIPMENT AND VEHICLES AS NOT TO INTERFERE WITH NORMAL ACTIVITIES OF RESIDENTS OR OTHER CONTRACTORS ON SITE.
- ANY DAMAGE TO THE EXISTING FACILITIES (CURB AND GUTTER, PAVEMENT, CONDUITS, LANDSCAPING, UTILITY LINES, ETC.) DURING CONSTRUCTION SHALL BE REPLACED AT THE CONTRACTORS EXPENSE.
- REMOVAL OF THE EXISTING CURB AND GUTTER SHALL BE AS PER COA STD. DWG. 2415 (SAWCUT ONLY).
- WHEEL CHAIR RAMPS SHALL BE CONSTRUCTED PRIOR TO ACCEPTANCE OF CURB AND GUTTER.

RESTRAINED JOINT TABLE

MECHANICAL JOINTS	LENGTH OF RESTRAINED JOINTS FROM EACH SIDE OF MJ LISTED (6") (8")
11.25" H BEND	2' 3'
22.50" H BEND	4' 5'
45" H BEND	8' 11"
90" H BEND	20' 26"
GATE VALVE	55' 72"
BTRFLY VALVE	---
REDUCER (8"x6")	30' 30'

NOTE:

- ALL MECHANICAL JOINTS SHALL BE RESTRAINED AT THE FITTING.
- THE CONTRACTOR SHALL PROVIDE A MINIMUM PIPE LENGTH OF 20 LF FROM ALL MECHANICAL JOINTS. ALL PIPE JOINTS WITHIN 20 LF OF A MJ SHALL BE RESTRAINED AT THE CONTRACTORS EXPENSE.
- THE CONTRACTOR SHALL RESTRAIN ALL PIPE JOINTS IN THE SPECIFIED DISTANCE LISTED IN THE TABLE ABOVE. (SEE NOTE 2 ABOVE)
- THE CONTRACTOR SHALL RESTRAIN ALL FIRE HYDRANTS JOINTS FROM THE TEE ON THE MAIN TO THE FIRE HYDRANT FLANGE.
- ALL CAPS SHALL UTILIZE PCC BLOCKING





BOHANNAN-HUSTON, INC.
ENGINEERS • PLANNERS • PHOTOGRAMMETRISTS • SURVEYORS • LANDSCAPE ARCHITECTS
ALBUQUERQUE LAS CRUCES SANTA FE



CITY OF ALBUQUERQUE
PUBLIC WORKS DEPARTMENT
ENGINEERING DEVELOPMENT GROUP

THE CROSSING SUBDIVISION UNIT II UTILITY PLAN & PROFILE CLARK'S FORK PLACE

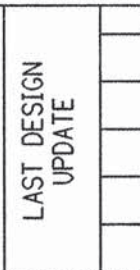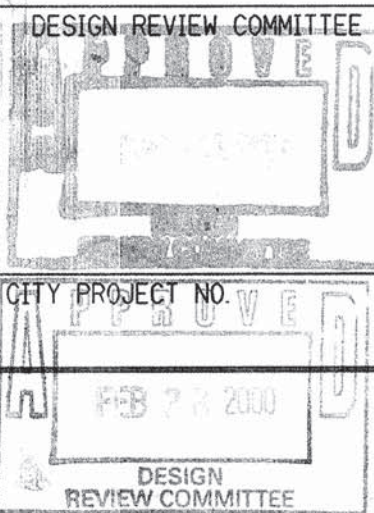

CITY PROJECT NO.

545382

ZONE MAP NO.
H-9-J-9



SHEET

OF

12


18

SAS TANGENT DATA TABLE		
NUMBER	BEARING	DISTANCE
T1	N46°23' 55"E	38.38'
T2	N32°05' 33"E	98.84'

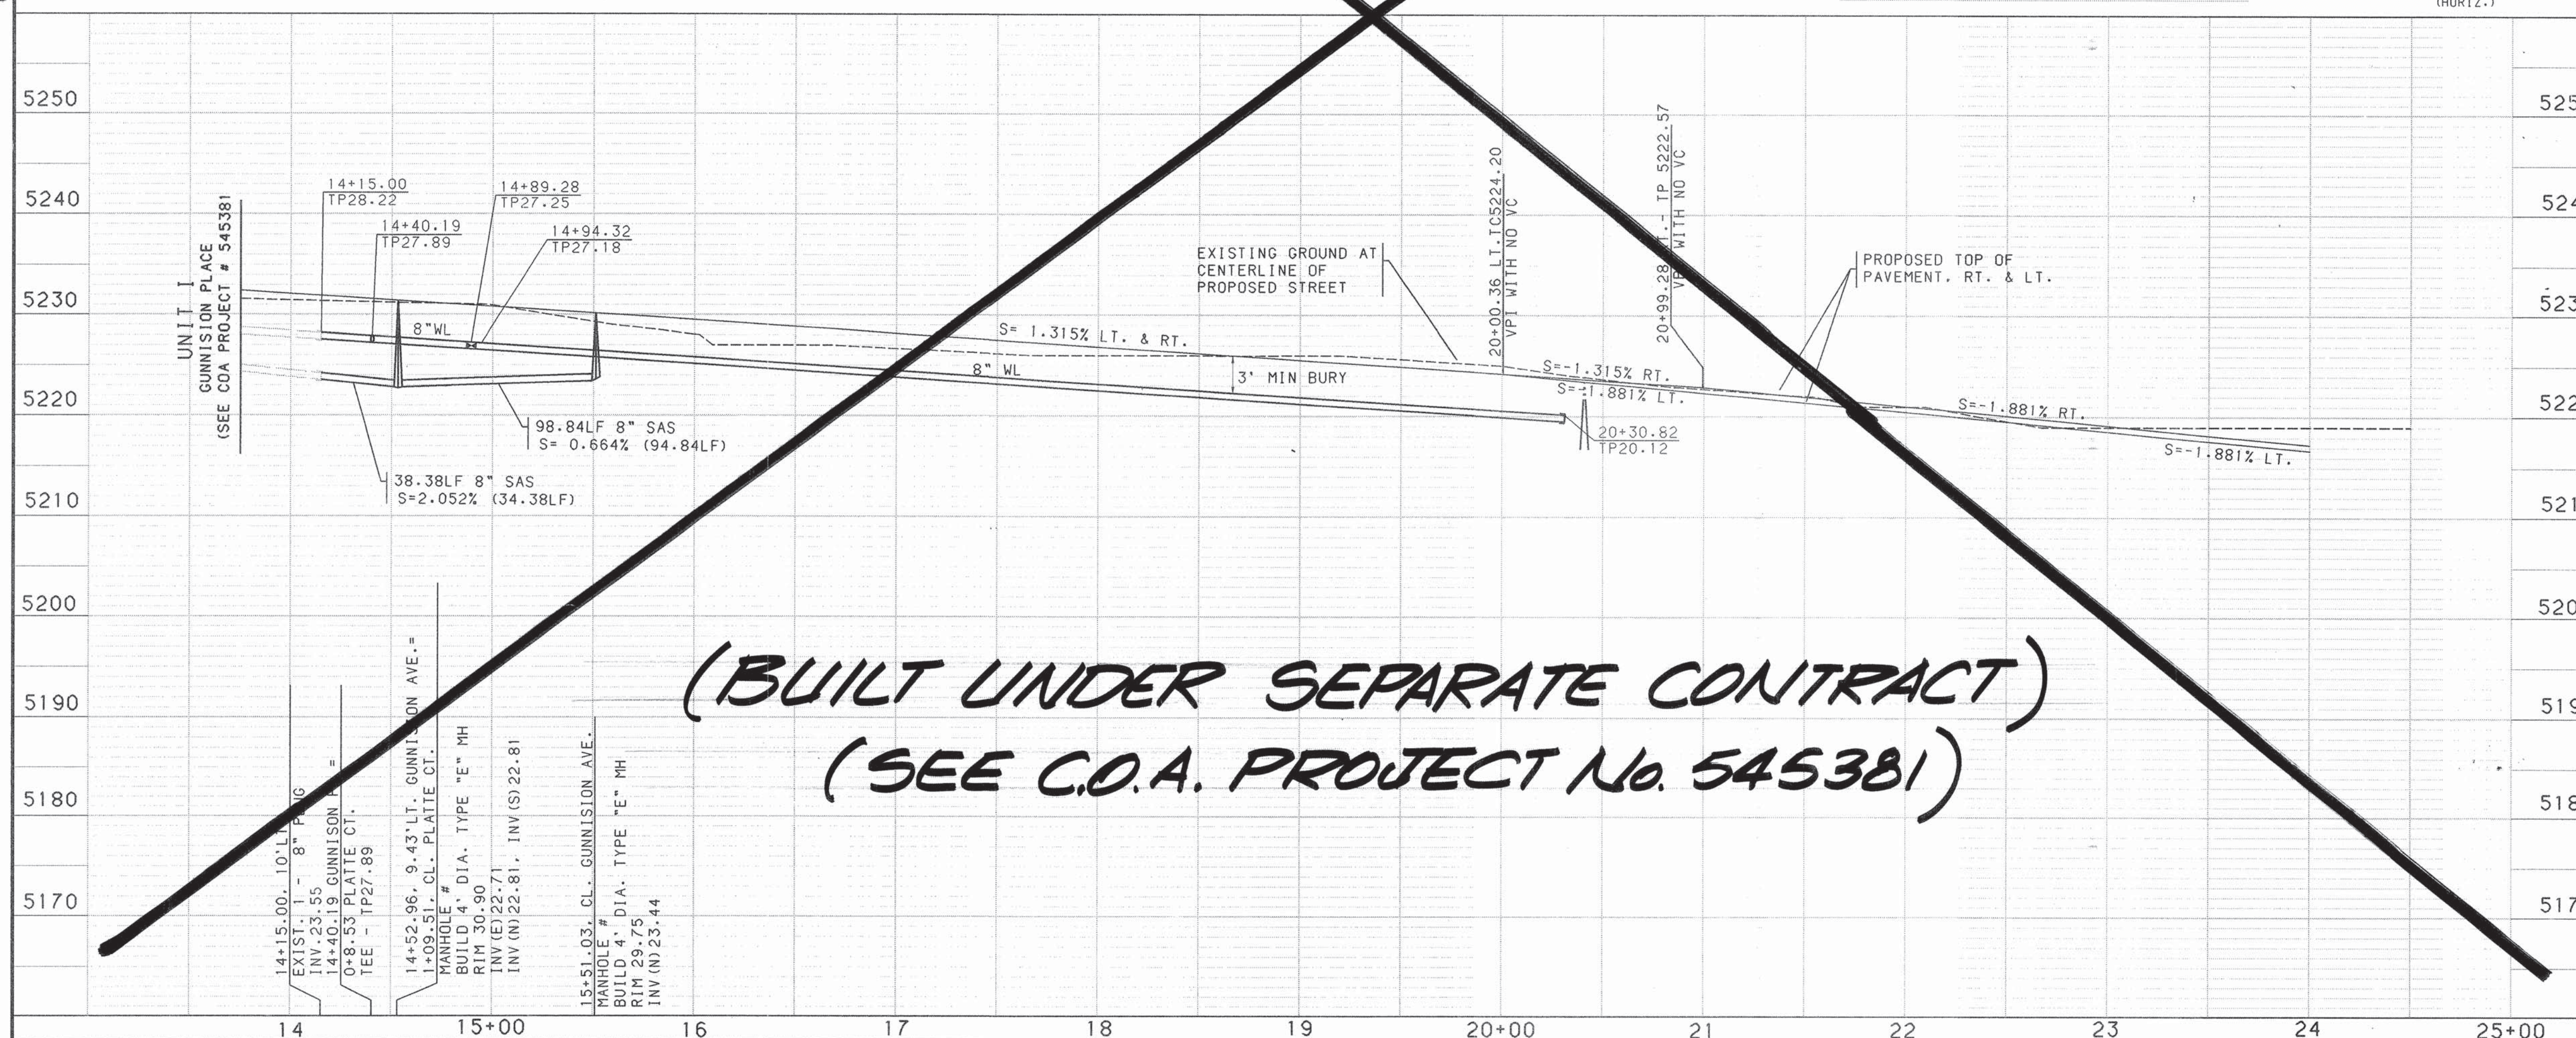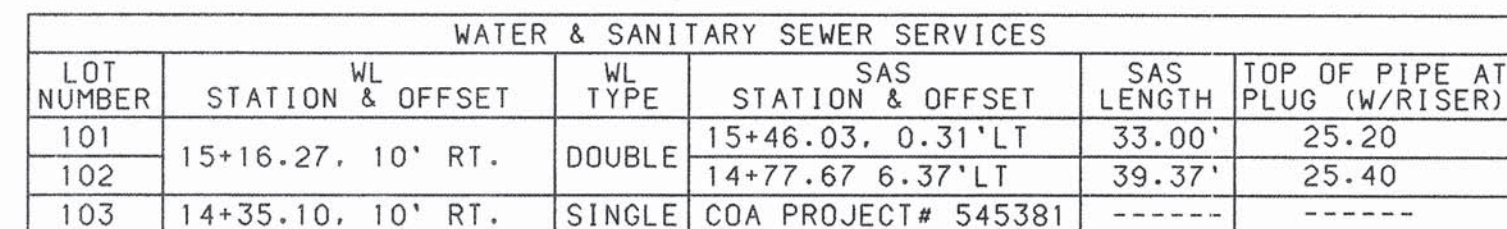

(BUILT UNDER SEPARATE CONTRACT)
(SEE C.O.A. PROJECT No. 545381)

- NOTES
1. THE CONTRACTOR SHALL FIELD VERIFY ALL EXISTING UTILITY LOCATIONS AND NOTIFY THE ENGINEER IMMEDIATELY OF ANY DISCREPANCIES.
 2. ALL CURB RETURN RADIUS SHALL BE 25' TO FACE OF CURB UNLESS OTHERWISE SPECIFIED.
 3. ALL CURVE DATA AND DIMENSIONS REFER TO FACE OF CURB UNLESS OTHERWISE SPECIFIED.
 4. GRADE ELEVATIONS, WHERE NOTED, ARE FOR TOP OF STANDARD CURB UNLESS OTHERWISE SPECIFIED.
 5. CONTRACTOR IS TO INSTALL A 4"x4"x5' POST AND END AT THE END OF EACH SANITARY SEWER SERVICE.
 6. CONTRACTOR IS RESPONSIBLE FOR REPAIR AND/OR REPLACEMENT OF ALL UTILITY CONDUITS AND EXISTING LINES.
 7. ANY ADDITIONAL GRADING REQUIRED TO MATCH PROPOSED STREET GRADES SHALL BE INCIDENTAL TO PAVING ITEMS.
 8. CONTRACTOR SHALL PROVIDE THE INSPECTORS, (CITY AND PRIVATE) WITH PLAN. THE PLAN MUST BE APPROVED BEFORE TESTING OPERATIONS BEGIN.
 9. CONTRACTOR SHALL PARK EQUIPMENT AND VEHICLES AS NOT TO INTERFERE WITH NORMAL ACTIVITIES OF RESIDENTS OR OTHER CONTRACTORS ON SITE.
 10. ANY DAMAGE TO THE EXISTING FACILITIES (CURB AND GUTTER, PAVEMENT, CONDUITS, LANDSCAPING, UTILITY LINES, ETC.) DURING CONSTRUCTION SHALL BE REPLACED AT THE CONTRACTORS EXPENSE.
 11. REMOVAL OF THE EXISTING CURB AND GUTTER SHALL BE AS PER COA STD. DWG. 2415 (SAWCUT ONLY).
 12. WHEEL CHAIR RAMPS SHALL BE CONSTRUCTED PRIOR TO ACCEPTANCE OF CURB AND GUTTER.

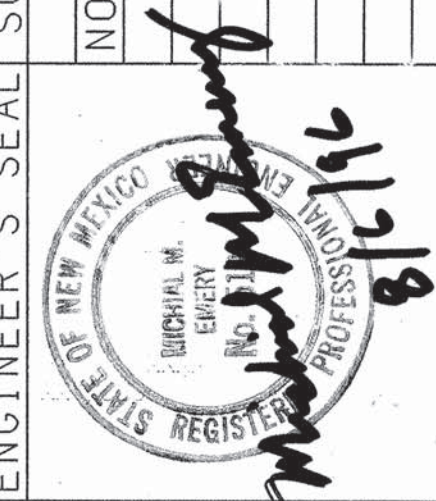

ENGINEER'S SEAL		SURVEY INFORMATION		FIELD NOTES		BENCH MARKS		AS-BUILT INFORMATION	
NO.	BY	DATE	NO.	BY	DATE				
						ACS ALUMINUM TABLE STAMPED "BH-40"		CONTRACTOR	
						GEOGRAPHIC POSITION (NAD 1927)		WORKED BY	
						N.M. STATE PLANE COORDINATES		INSPECTOR'S	
						(CENTRAL ZONE) X = 362,790.66		ACCEPTANCE BY	
						Y = 1,492,346.33		DATE	
						GROUND TO GRID FACTOR = 0.99967105		DRAWINGS	
								CORRECTED BY	
								MICRO-FILM INFORMATION	
						D = 00° 16' 59"		RECORDED BY	
						NGVD 1925 ELEVATION = 5305.43		DATE	
								NO.	







BOHANNAN-HUSTON INC.
 ENGINEERS • PLANNERS • PHOTOGRAMMETRISTS • SURVEYORS • LANDSCAPE ARCHITECTS
 ALBUQUERQUE LAS CRUCES SANTA FE



CITY OF ALBUQUERQUE
PUBLIC WORKS DEPARTMENT
ENGINEERING DEVELOPMENT GROUP

THE CROSSING SUBDIVISION UNIT II
UTILITY PLAN & PROFILE
GUNNISON PLACE FROM STA.14+00.00 TO 24+00.00

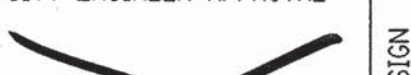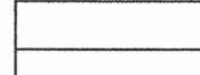
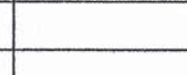
DESIGN REVIEW COMMITTEE 		CITY ENGINEER APPROVAL 		LAST DESIGN UPDATE 		MO./DAY/YR. 		MO./DAY/YR. 	
CITY PROJECT NO. 		545382		ZONE MAP NO. H-9-J-9		SHEET 16		OF 1	
DESIGN REVIEW COMMITTEE 				COPYRIGHT BOHANNAN-HUSTON, INC. DATE: MAY, 1996					

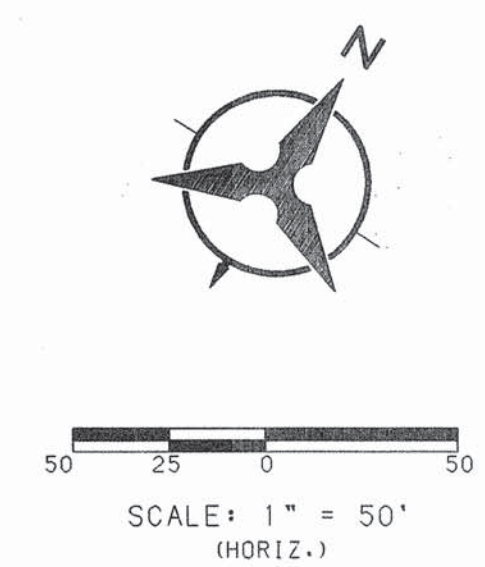

-
- BRUCE J. STIDWORTHY
NEW MEXICO
14523
REGISTERED PROFESSIONAL ENGINEER
9/20/02

BHI JOB NO. C95335A2440


NOT FOR CONSTRUCTION

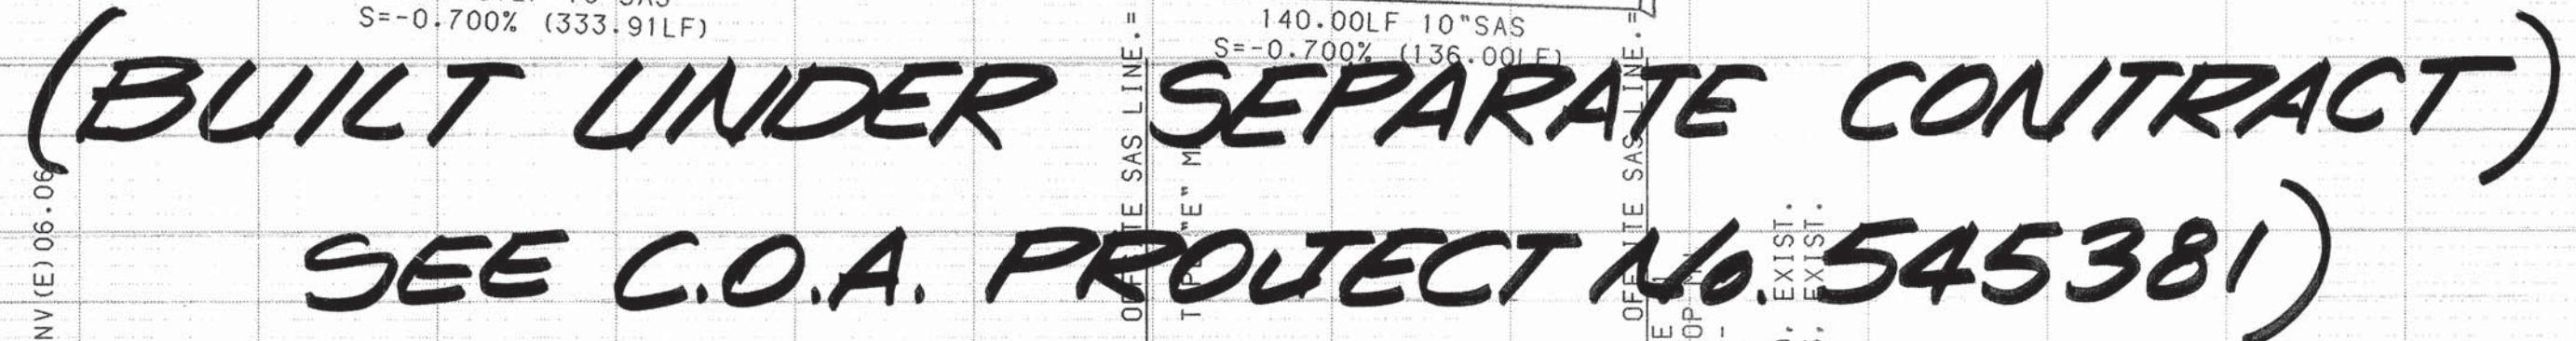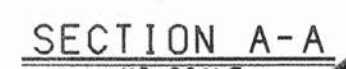

-
- BRUCE J. STIDWORTHY
NEW MEXICO
14523
REGISTERED PROFESSIONAL ENGINEER
9/20/02

	BOHANNAN-HUSTON INC. ENGINEERS • PLANNERS • PHOTOGRAMMETRISTS • SURVEYORS • LANDSCAPE ARCHITECTS ALBUQUERQUE LAS CRUCES SANTA FE
	CITY OF ALBUQUERQUE PUBLIC WORKS DEPARTMENT ENGINEERING DEVELOPMENT GROUP

THE CROSSING SUBDIVISION UNIT II
 UTILITY PLAN & PROFILE
 OFFSITE SAS LINE

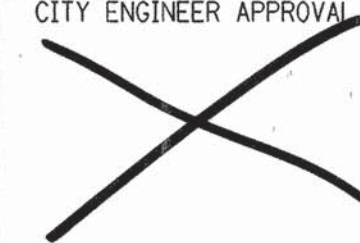DESIGN REVIEW COMMITTEE 	CITY ENGINEER APPROVAL 	LAST DESIGN UPDATE	MO./DAY/YR. <table border="1" style="width: 100%; border-collapse: collapse;"> <tr><td style="height: 20px;"></td><td style="height: 20px;"></td></tr> <tr><td style="height: 20px;"></td><td style="height: 20px;"></td></tr> <tr><td style="height: 20px;"></td><td style="height: 20px;"></td></tr> <tr><td style="height: 20px;"></td><td style="height: 20px;"></td></tr> <tr><td style="height: 20px;"></td><td style="height: 20px;"></td></tr> </table>											MO./DAY/YR. <table border="1" style="width: 100%; border-collapse: collapse;"> <tr><td style="height: 20px;"></td><td style="height: 20px;"></td></tr> <tr><td style="height: 20px;"></td><td style="height: 20px;"></td></tr> <tr><td style="height: 20px;"></td><td style="height: 20px;"></td></tr> <tr><td style="height: 20px;"></td><td style="height: 20px;"></td></tr> <tr><td style="height: 20px;"></td><td style="height: 20px;"></td></tr> </table>										

CITY PROJECT NO. 	ZONE MAP NO. H-9-J-9	SHEET 18	OF 18	COPYRIGHT BOHANNAN-HUSTON, INC. 1996 DATE: MAY, 1996
---	--------------------------------	--------------------	-----------------	---



DESIGN
 REVIEW COMMITTEE