

CITY OF ALBUQUERQUE, NEW MEXICO PUBLIC WORKS DEPARTMENT

CONSTRUCTION PLANS FOR

THE CROSSING SUBDIVISION UNIT 3

PUBLIC INFRASTRUCTURE IMPROVEMENTS

INDEX

LEGEND

EXISTING	PROPOSED
--- PROPERTY LINE	--- CENTER LINE
--- ADJACENT PROPERTY LINE	--- RIGHT OF WAY LINE
--- RIGHT OF WAY LINE	--- EASEMENT
--- EASEMENT	--- 5200 INDEX CONTOUR
--- 5200 INDEX CONTOUR	--- INTERMEDIATE CONTOUR
--- 5100 INDEX CONTOUR	--- SAS SANITARY SEWER
--- SAS SANITARY SEWER LINE	--- W WATER LINE
--- WL WATER LINE	--- FOC FACE OF CURB
--- SD STORM DRAIN	--- EOP EDGE OF PAVEMENT
--- C&G CURB & GUTTER	--- FIRE HYDRANT
--- FH FIRE HYDRANT	--- WATER VALVE
--- WV WATER VALVE	--- REDUCER
--- R REDUCER	--- SWS SINGLE WATER SERVICE
--- SSM SANITARY SEWER MANHOLE	--- DWS DOUBLE WATER SERVICE
--- SSS SAS SERVICE W/ CAP	--- SAS OR SD MANHOLE
--- UP UTILITY POLE	--- CO CLEAN OUT
--- L LIGHT	--- SSS SAS SERVICE W/ CAP
	--- SL STREET LIGHT
	--- WCR WHEELCHAIR RAMP
	--- S SIDEWALK

RECORD DRAWINGS

I, LARRY W. MEDRANO, of the firm of SMITH ENGINEERING CO., a Registered Professional Engineer in the State of New Mexico, do hereby certify, to the best of my knowledge and belief, that the infrastructure installed as part of this project has been inspected by me or by a qualified person under my direct supervision and has been constructed in accordance with the plans and specifications, while someone from Smith Engineering Company was onsite, approved by the City Engineer and that the original design intent of the approved plans has been met, except as noted by me on the as-built construction drawings. This Certification is based on site inspections by me or personnel under my direction and survey information provided by LARRY W. MEDRANO (Surveyor Name) NMPS number 11293 (PS #).



DESCRIPTION

COVER SHEET	1
GENERAL NOTES	2
PLATS AND SURVEY CONTROL	3
GRADING AND DRAINAGE PLAN	4 thru 6
OVERALL PAVING, STORM DRAIN, AND LIGHTING PLAN	7
OVERALL UTILITY PLAN	8
ROARING FORK PLACE	9
PAVING & STORM DRAIN PLAN & PROFILE SHEET	10
UTILITY PLAN & PROFILE SHEET	11
EAGLE RIVER ROAD, CLARKS FORK ROAD	12
PAVING & STORM DRAIN PLAN & PROFILE SHEET	13
UTILITY PLAN & PROFILE SHEET	14
SELWAY PLACE, HENRY FORK ROAD	15
PAVING & STORM DRAIN PLAN & PROFILE SHEET	16 AND 17
UTILITY PLAN & PROFILE SHEET	18
MIREHAVEN ARROYO TYPICAL SECTIONS AND DETAILS	19
DROP STRUCTURE DETAILS	
MIREHAVEN ARROYO PLAN & PROFILE	
STATION 1+00 TO 12+00	
MIREHAVEN ARROYO PLAN & PROFILE	
STATION 12+00 TO 23+00	

SHEET NO.



WILSON & COMPANY
2600 THE AMERICAN ROAD S.E.
SUITE 100
RIO RANCHO, NEW MEXICO
87124
(505) 898-8021

THE FOLLOWING NOTES ALSO APPLY WHEN CHECKED:

- ☒ ALL UTILITIES AND UTILITY SERVICE LINES SHALL BE INSTALLED PRIOR TO PAVING.
- ☒ BACKFILL COMPACTION SHALL BE ACCORDING TO SPECIFIED STREET USE.
- ☒ TACK COAT REQUIREMENTS SHALL BE DETERMINED BY THE ENGINEER.
- ☒ SIDEWALKS AND WHEELCHAIR RAMPS WITHIN THE CURB RETURNS SHALL BE CONSTRUCTED WHEREVER A NEW CURB RETURN IS CONSTRUCTED.
- ☒ IF CURB IS DEEPER FOR A DRIVEPAD, THE DRIVEPAD SHALL BE CONSTRUCTED PRIOR TO ACCEPTANCE OF CURB AND GUTTER.
- ☒ ALL STORM DRAINAGE FACILITIES SHALL BE COMPLETED PRIOR TO FINAL ACCEPTANCE.

AS BUILT CERTIFICATION

I, LARRY W. MEDRANO, DO HEREBY ATTEST TO THE FACT THAT THE AS-BUILT INFORMATION SHOWN HEREON IS THE RESULT OF A FIELD SURVEY PERFORMED BY ME OR UNDER MY DIRECT SUPERVISION, AND THAT THE SAME ARE TRUE AND CORRECT TO THE BEST OF MY KNOWLEDGE AND BELIEF.

Larry W. Medrano DATE: 9/23/04
LARRY W. MEDRANO
NEW MEXICO PROFESSIONAL
LAND SURVEYOR NO. 11993


PRECISION SURVEYS, INC.
8414-D JEFFERSON STREET, N.E.
ALBUQUERQUE, NM 87113
(505) 856-5700

APPROVED FOR CONSTRUCTION WITHIN
AMAFCA RIGHT OF WAY OR EASEMENT:

Larry W. Medrano 3-16-04
(AMAFCA) (DATE)

1 2 3 4 5 6 7 8 9 10 11 12 13 14 15
26 545383 05

WCEA #X3218008
MARCH 2004

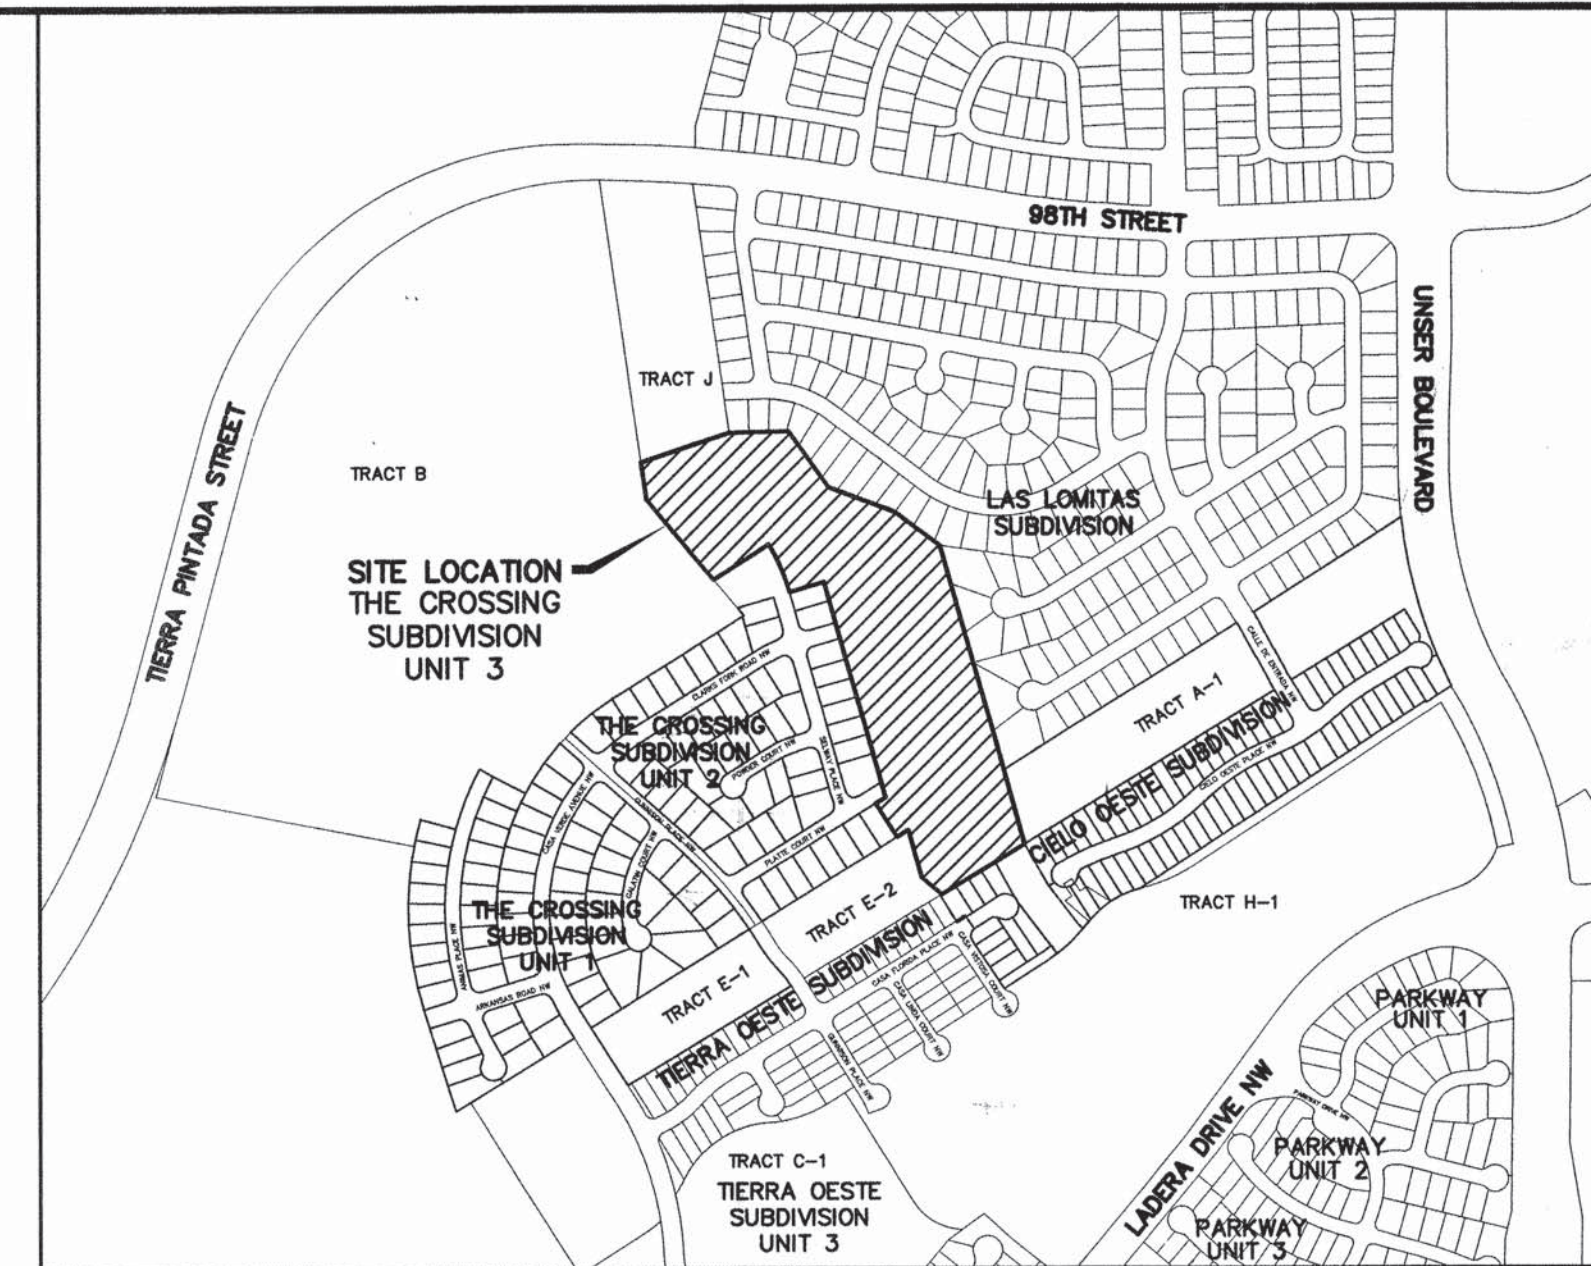

VICINITY MAP
ZONE ATLAS MAP NO. H-9-Z

NOTES

ALL WORK DETAILED ON THESE PLANS TO BE PERFORMED UNDER CONTRACT SHALL, EXCEPT AS OTHERWISE STATED OR PROVIDED FOR HEREON, BE CONSTRUCTED IN ACCORDANCE WITH THE CITY OF ALBUQUERQUE STANDARD SPECIFICATIONS FOR PUBLIC WORKS CONSTRUCTION, 1986 EDITION, AS AMENDED THROUGH UPDATE #7.

THE CONTRACTOR SHALL BE RESPONSIBLE FOR COORDINATING THE EXECUTION OF THE WATER VALVE SHUT-OFF PLAN WITH THE WATER SYSTEMS DIVISION (857-8200) FIVE (5) WORKING DAYS IN ADVANCE OF ANY WORK THAT MAY AFFECT EXISTING PUBLIC WATER UTILITIES.

TWO (2) WORKING DAY PRIOR TO ANY EXCAVATION, THE CONTRACTOR MUST CONTACT NEW MEXICO ONE CALLS SYSTEM (260-1990) FOR LOCATION OF EXISTING UTILITIES.

PRIOR TO CONSTRUCTION, THE CONTRACTOR SHALL EXCAVATE AND VERIFY THE HORIZONTAL AND VERTICAL LOCATIONS OF ALL OBSTRUCTIONS. SHOULD A CONFLICT EXIST, THE CONTRACTOR SHALL NOTIFY THE ENGINEER OR SURVEYOR IMMEDIATELY SO THAT THE CONFLICT CAN BE RESOLVED WITH A MINIMUM AMOUNT OF DELAY.

THREE (3) WORKING DAYS PRIOR TO BEGINNING CONSTRUCTION, THE CONTRACTOR SHALL SUBMIT TO CONSTRUCTION COORDINATION DIVISION A DETAILED CONSTRUCTION SCHEDULE. TWO (2) WORKING DAYS PRIOR TO CONSTRUCTION, THE CONTRACTOR SHALL OBTAIN A BARRICADE PERMIT FROM THE CONST. COORDINATION DIVISION. CONTRACTOR SHALL NOTIFY BARRICADE ENGINEER (924-3400) PRIOR TO OCCUPYING AN INTERSECTION. REFER TO SECTION 19 OF THE GENERAL CONDITIONS OF THE STANDARD SPECIFICATIONS.

ALL STREET STRIPING ALTERED OR DESTROYED SHALL BE REPLACED WITH PLASTIC REFLECTORIZED PAVEMENT MARKINGS BY CONTRACTOR TO LOCATION AS EXISTING OR AS INDICATED BY THIS PLAN SET.

CONTRACTOR SHALL NOTIFY THE ENGINEER NOT LESS THAN SEVEN (7) DAYS PRIOR TO STARTING WORK IN ORDER THAT THE ENGINEER MAY TAKE NECESSARY MEASURES TO INSURE THE PRESERVATION OF SURVEY MONUMENTS. CONTRACTOR SHALL NOT DISTURB PERMANENT SURVEY MONUMENTS WITHOUT THE CONSENT OF THE ENGINEER AND SHALL NOTIFY THE ENGINEER AND BEAR THE EXPENSE OF REPLACING ANY THAT MAY BE DISTURBED WITHOUT PERMISSION. REPLACEMENT SHALL BE DONE ONLY BY THE CITY SURVEYOR. WHEN A CHANGE IS MADE IN THE FINISHED ELEVATIONS OF THE PAVEMENT OF ANY ROADWAY IN WHICH A PERMANENT SURVEY MONUMENT IS LOCATED, CONTRACTOR SHALL, AT HIS OWN EXPENSE, ADJUST THE MONUMENT COVER TO THE NEW GRADE UNLESS OTHERWISE SPECIFIED. REFER TO SECTION 4.4 OF THE GENERAL CONDITIONS OF THE STANDARD SPECIFICATIONS.

ANY WORK AFFECTING AN ARTERIAL ROADWAY REQUIRES TWENTY-FOUR (24) CONSTRUCTION.

REV	SHEETS	CITY ENGINEER	DATE	USER DEPARTMENT	DATE	USER DEPARTMENT	DATE
ENGINEERS STAMP & SIGNATURE	APPROVALS	ENGINEER	DATE	*****	APPROVED FOR CONSTRUCTION		
	DRC Chairman	<u>[Signature]</u>	4-23-04				
	Transportation	<u>[Signature]</u>	3/25/04				
	Water/Wastewater	<u>[Signature]</u>	4/02/04				
	Hydrology	<u>[Signature]</u>	3/18/04				
	Parks	<u>[Signature]</u>	4/01/04				
	Constr. Mngmt.	<u>[Signature]</u>	4-23-04				
	Constr. Coord.	<u>[Signature]</u>	4-23-04				
City Project No.		545383	Sheet		1	Of	
					19		

SCANNED BY
MESA REPRO

GENERAL NOTES:

1. FIVE (5) WORKING DAYS PRIOR TO BEGINNING CONSTRUCTION THE CONTRACTOR SHALL SUBMIT TO THE CONSTRUCTION COORDINATION DIVISION A DETAILED CONSTRUCTION SCHEDULE. TWO (2) WORKING DAYS PRIOR TO CONSTRUCTION THE CONTRACTOR SHALL OBTAIN A BARRICADING PERMIT FROM THE CONSTRUCTION COORDINATION DIVISION. CONTRACTOR SHALL NOTIFY BARRICADE ENGINEER (924-3400) PRIOR TO OCCUPYING AN INTERSECTION. REFER TO SECTION 19 OF SPECIFICATIONS.
2. THE CONTRACTOR SHALL NOTIFY THE ENGINEER NOT LESS THAN SEVEN (7) DAYS PRIOR TO STARTING WORK IN ORDER THAT THE ENGINEER MAY TAKE NECESSARY MEASURES TO INSURE THE PRESERVATION OF SURVEY MONUMENTS. CONTRACTOR SHALL NOT DISTURB PERMANENT SURVEY MONUMENTS WITHOUT THE CONSENT OF THE ENGINEER AND SHALL NOTIFY THE ENGINEER AND BEAR THE EXPENSE OF REPLACING ANY THAT MAY BE DISTURBED WITHOUT PERMISSION. REPLACEMENT SHALL BE DONE ONLY BY THE CITY SURVEYOR. WHEN A CHANGE IS MADE IN THE FINISHED ELEVATION OF THE PAVEMENT OF ANY ROADWAY IN WHICH A PERMANENT SURVEY MONUMENT IS LOCATED, CONTRACTOR SHALL, AT HIS OWN EXPENSE, ADJUST THE MONUMENT COVER TO THE NEW GRADE UNLESS OTHERWISE SPECIFIED. REFER TO SECTION 4.4 OF THE GENERAL CONDITIONS OF THE STANDARD SPECIFICATIONS.
3. ALL WORK AFFECTING AN ARTERIAL ROADWAY REQUIRES EITHER TWENTY-FOUR (24) HOUR CONSTRUCTION.
4. THE CONTRACTOR WILL BE REQUIRED TO CONFINE HIS WORK WITHIN THE CONSTRUCTION LIMITS AND/OR R.O.W. TO PRESERVE EXISTING VEGETATION AND PRIVATE PROPERTY. OVERNIGHT PARKING OF CONSTRUCTION EQUIPMENT SHALL NOT OBSTRUCT DRIVEWAY OPENINGS OR DESIGNATED TRAFFIC LANES.
5. A DISPOSAL SITE, COMPLYING WITH ALL CITY ORDINANCES, SHALL BE OBTAINED BY THE CONTRACTOR FOR THE DISPOSAL OF ALL EXCESS EXCAVATION MATERIAL, ASPHALTIC PAVEMENT (EXCEPT MILLED BITUMINOUS CONCRETE PAVEMENT) AND OTHER WASTE MATERIALS. THE CONTRACTOR SHALL NOTIFY THE CITY OF ALBUQUERQUE OF THE LOCATION OF THE DISPOSAL SITE PRIOR TO THE REMOVAL AND ACTUAL DISPOSAL OF THE MATERIAL. ALL COSTS IN OBTAINING A DISPOSAL SITE AND HAUL THERETO SHALL BE CONSIDERED INCIDENTAL TO CONSTRUCTION AND NO DIRECT PAYMENT WILL BE MADE THEREFOR.
6. ALL RADII OF CURB RETURNS ARE SHOWN TO FACE OF CURB.
7. ALL VALLEY GUTTERS ARE 6' WIDE UNLESS OTHERWISE NOTED.
8. ALL FINISHED GRADES AND PROFILES SHOWN ARE FLOWLINE GRADES, UNLESS OTHERWISE NOTED. MATCH FLOWLINES OF GUTTERS WHEN CONNECTING NEW CURB AND GUTTER WITH EXISTING CURB AND GUTTER.
9. CURB AND GUTTER SHOWN AS EXISTING AND NOT TO BE REMOVED UNDER THIS CONTRACT WHICH IS DAMAGED OR DISPLACED BY THE CONTRACTOR SHALL BE REMOVED AND REPLACED BY THE CONTRACTOR AT HIS EXPENSE.
10. WHEN ABUTTING NEW PAVEMENT TO EXISTING PAVEMENT, SAW CUT EXISTING PAVEMENT IN A STRAIGHT LINE AS REQUIRED TO REMOVE ANY BROKEN OR CRACKED PAVEMENT. PRIOR TO LAYING NEW PAVEMENT, THE EXPOSED EXISTING ASPHALT EDGE SHALL BE TACK-COATED.
11. WHEN REMOVAL OF EXISTING CURB AND GUTTER OR SIDEWALK IS REQUIRED, REMOVE TO NEAREST JOINT.
12. CONTRACTOR TO CAREFULLY FIELD REVIEW SITE TO ASSESS EXTENT OF TRASH REMOVAL.

13. CONTRACTOR IS TO EXERCISE DUE CARE TO AVOID DISTURBING ANY EXISTING UTILITIES. IT SHALL BE HIS RESPONSIBILITY TO COORDINATE WITH THE UTILITY COMPANIES IN ORDER TO PREVENT ANY SERVICE DISRUPTION THAT MIGHT RESULT FROM PROJECT CONSTRUCTION. IT SHALL BE HIS RESPONSIBILITY TO PROTECT AND PRESERVE UTILITY EQUIPMENT AFFECTED BY PROJECT CONSTRUCTION. SHOULD HE BREAK AN EXISTING UTILITY LINE DURING CONSTRUCTION ACTIVITIES HE SHALL BE RESPONSIBLE FOR UTILITY REPAIR COSTS.
14. ALL EXISTING UTILITIES SHOWN HEREIN WERE TAKEN FROM RECORD DRAWINGS, FIELD SURVEYS, C.O.A. SYSTEMS UTILITIES MAPS AND INFORMATION PROVIDED BY THE UTILITY OWNERS AND ARE APPROXIMATE. IT WILL BE THE CONTRACTOR'S RESPONSIBILITY TO FIELD VERIFY THEIR HORIZONTAL AND VERTICAL LOCATIONS AND PROVIDE PROTECTION FOR ALL UTILITIES WITHIN THE CONSTRUCTION AREA.
15. CONTRACTOR SHALL FIELD VERIFY LOCATION AND TYPE OF EXISTING UTILITIES TO BE ADJUSTED OR EXTENDED.
16. MANHOLE RIM ELEVATIONS SHOWN ON THESE PLANS ARE APPROXIMATE AND WILL VARY WITH THE FINISHED PAVEMENT ELEVATIONS.
17. CONTRACTOR TO VERIFY ALL EXISTING FIRE HYDRANT FLANGES, PADS, VALVE BOXES, MANHOLE RIMS AND TOP OF PIPE ELEVATIONS IN THE FIELD. ELEVATIONS SHALL BE ADJUSTED TO COMPLY WITH THE REQUIREMENTS OF STANDARD CITY DETAILS.
18. ELEVATIONS FOR PROPOSED WATERLINE CONNECTIONS TO EXISTING WATERLINES SHALL BE DETERMINED BY THE CONTRACTOR IN THE FIELD.
19. ALL WATER VALVE BOXES AND SEWER MANHOLES IN THE CONSTRUCTION AREA ARE TO BE ADJUSTED TO FINISH GRADE UNDER THIS CONTRACT, AND WILL BE PAID FOR AT CONTRACT UNIT PRICES.
20. THE CONTRACTOR SHALL NOTIFY THE LOCAL FIRE DEPARTMENT AT LEAST TWO (2) WORKING DAYS IN ADVANCE OF WHEN FIRE HYDRANTS WILL BE TAKEN OUT OF SERVICE AND RETURNED TO SERVICE.
21. ALL WATER SERVICES LISTED AS "DOUBLE" REFER TO DOUBLE METER BOX. A SEPARATE SERVICE LINE TO EACH METER IS REQUIRED. REFERENCE C.O.A. STD. DRAWINGS 2361, 2362.
22. ALL UTILITY POLES ARE TO BE RELOCATED BY OTHERS.
23. ALL EXISTING GAS VALVE BOXES, GAS MANHOLES, ELECTRICAL MANHOLES, AND TELEPHONE MANHOLES WILL BE ADJUSTED TO GRADE BY OTHERS.
24. FIFTY (50) TON ROLLER OPERATION SHALL NOT BE USED IN THIS PROJECT WHERE UNDERGROUND UTILITIES ARE PRESENT. THE REQUIRED COMPACTION AT THESE LOCATIONS SHALL BE EFFECTED BY OTHER MEANS.
25. ALL EXCAVATIONS FOR STORM DRAINS, AND OTHER EXCAVATIONS AS NECESSARY, SHALL BE GOVERNED BY THE CURRENT CONSTRUCTION SAFETY AND HEALTH STANDARDS.
26. EXCAVATION, TRENCHING AND SHORING ACTIVITIES MUST BE CARRIED OUT IN IN ACCORDANCE WITH OSHA 29 CFR 1926.650 SUBPART P. THE CONTRACTOR SHALL BE RESPONSIBLE FOR HIS EMPLOYEES SAFTY.
27. INLET GRATES:
ALL CATTLE GUARD INLETS SHALL USE "ALBUQUERQUE GRATE" PER STD DWG 2220.
ALL INLETS IN SUMP CONDITION SHALL USE "ALBUQUERQUE GRATE" PER STD DWG 2220.
ALL INLETS ON SLOPE (NOT IN SUMP) SHALL USE "ALTERNATE GRATE" PER STD DWG 2221.
28. ALL WHEELCHAIR RAMP APPROACH SLOPES SHOWN AS 7' IN LENGTH ON STD DWG 2441, SHALL BE INCREASED IN LENGTH TO MAINTAIN 12:1 SLOPE WHEN GRADE IS RISING FROM RAMP. SEE TABLE BELOW.

ISING GRADE	RAMP LENGTH
0%	8.1'
0-1%	9.2'
1-2%	10.6'
2-3%	12.6'
3-4%	15.5'

UTILITY CONTACTS

COMPANY	PHONE	MOBILE	CONTACT
City of Albuquerque	768-2719		Greg Olson
PNM - ELECTRIC	241-3402		Mark A. Bouchard
PNM - GAS	241-7745		Elisabeth Gabel
QWEST	245-8706		David Muller
NM ONE CALL	260-1990		
COMCAST	761-6235		Rita Erickson

EROSION NOTES:

1. ENTIRE AREA MUST BE STABILIZED AS A PART OF THE PROJECT. ONLY LOTS WITH HOME CONSTRUCTION ACTUALLY UNDER WAY MAY BE EXCEPTED.
2. TEMPORARY EROSION FENCING (OR PERMANENT WALLS OR FENCING) SHALL BE USED TO PROTECT EXISTING RESIDENTIAL PROPERTY, STREETS LANDSCAPING AND THE DRAINAGE SYSTEMS FOR THE DEPOSITION OF ERODED MATERIAL.
3. CONSTRUCTION AREA SHALL BE CONTROLLED TO PREVENT TRESPASS USE BY 4WD'S, RV'S AND MOTORCYCLES TO MINIMIZE NOISE, DUST, DESTRUCTION OF VEGETATION, WIND AND WATER EROSION.

AS BUILT CERTIFICATION

I, LARRY W. MEDRANO, DO HEREBY ATTEST TO THE FACT THAT THE AS-BUILT INFORMATION SHOWN HEREON IS THE RESULT OF A FIELD SURVEY PERFORMED BY ME OR UNDER MY DIRECT SUPERVISION, AND THAT THE SAME ARE TRUE AND CORRECT TO THE BEST OF MY KNOWLEDGE AND BELIEF.

LARRY W. MEDRANO
NEW MEXICO PROFESSIONAL
LAND SURVEYOR NO. 11993

DATE: 9/23/04


PRECISION SURVEYS, INC.
8414-D JEFFERSON STREET, N.E.
ALBUQUERQUE, NM 87113
(505)856-5700

WILSON & COMPANY

2600 THE AMERICAN ROAD S.E.
SUITE 100
RIO RANCHO, NEW MEXICO
87124
(505) 898-8021

CITY OF ALBUQUERQUE
PUBLIC WORKS DEPARTMENT
ENGINEERING GROUP

THE CROSSING SUBDIVISION UNIT 3
GENERAL NOTES

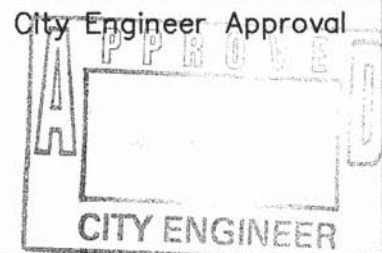

City Project No.

Zone Map No.

Sheet


Of

545383

H-9-Z

2

19

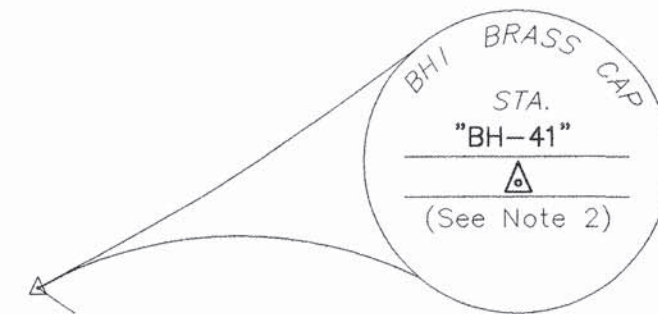

3 OF 19

GRADING AND DRAINAGE NOTES


1. THE CONTRACTOR MUST OBTAIN A TOPSOIL DISTURBANCE PERMIT FROM THE ENVIRONMENTAL HEALTH DIVISION PRIOR TO BEGINNING ROUGH GRADING.
2. THE CONTRACTOR IS TO REFER TO EARTHWORK SPECIFICATIONS AS NOTED IN THE SURVEY REPORT PREPARED BY VINYARD & ASSOCIATES DATED APRIL 19, 1996. COPY AVAILABLE FROM OWNER.
3. THE CONTRACTOR SHALL CONFORM TO ALL CITY, COUNTY, STATE, AND FEDERAL DUST CONTROL MEASURES AND REQUIREMENTS AND WILL BE RESPONSIBLE FOR PREPARING AND OBTAINING ALL NECESSARY APPLICATIONS AND APPROVALS, INCLUDING EPA STORMWATER PERMIT.
4. THE CONTRACTOR SHALL NOT GRADE OR DISTURB GROUND BEYOND GRADING LIMITS SHOWN.
5. STRIPPING SHALL BE USED IN NON-STRUCTURAL FILL AREAS.
6. ALL DISTURBED AREAS (NOT TO BE PAVED) OUTSIDE OF THE BOUNDARY OF UNIT 3 SHALL BE RESEED PER COA STD SPECS SECTION 1012.
7. SEE PLAT OF THE CROSSING (BUCKLAND PLAT) FOR EASEMENT DETAILS. PLAT FILED 07/19/96 IN VOL. 96C FOLIO 302.
8. REPAIR OF DAMAGED FACILITIES AND CLEANUP OF SEDIMENT ACCUMULATION ON ADJACENT PROPERTIES AND IN PUBLIC FACILITIES IS THE RESPONSIBILITY OF THE CONTRACTOR.

RETAINING WALL TABLE

WALL POINT	TOP OF WALL ELEV	TOP OF FOOTING ELEV	WALL HEIGHT (FT)	APPROX. WALL LENGTH (FT)
15-1	36.67	34.00	2.67-4.67	40.0
15-2	38.67	34.00	4.67	30.0
15-3	38.67/39.33	34.00	5.33	85.0
15-4	39.33	34.00		
16-1	41.00	36.33	4.67	85.0
16-2	41.00/41.67	36.33	5.33	45.0
16-3	41.67	36.33/37.00	4.67	115.0
16-4	41.67	37.00		
17-1	38.00	34.00	4.00	110.0
17-2	38.00	34.00		

RETAINING WALL TABLE

WALL POINT	TOP OF WALL ELEV	TOP OF FOOTING ELEV	WALL HEIGHT (FT)	APPROX. WALL LENGTH (FT)
18-1	36.67	32.67	4.00	60.0
18-2	36.67/37.33	32.67/33.33	4.00	60.0
18-3	37.33/38.67	33.33/34.67	4.00	60.0
18-4	38.67/37.33	34.67/34.00	3.33	65.0
18-5	37.33	34.00		
19-1	31.00	25.67	5.33	85.0
19-2	31.00/32.33	25.67/39.00	3.33	58.0
19-3	32.33	29.00		
20-1	29.00	25.00	4.00	40.0
20-2	29.00/28.33	25.00	3.33	40.0
20-3	28.33/27.67	25.00/25.67	2.00	45.0
20-4	27.67	25.67		
21-1	35.00	32.33	2.67	60.0
21-2	35.00	32.33		

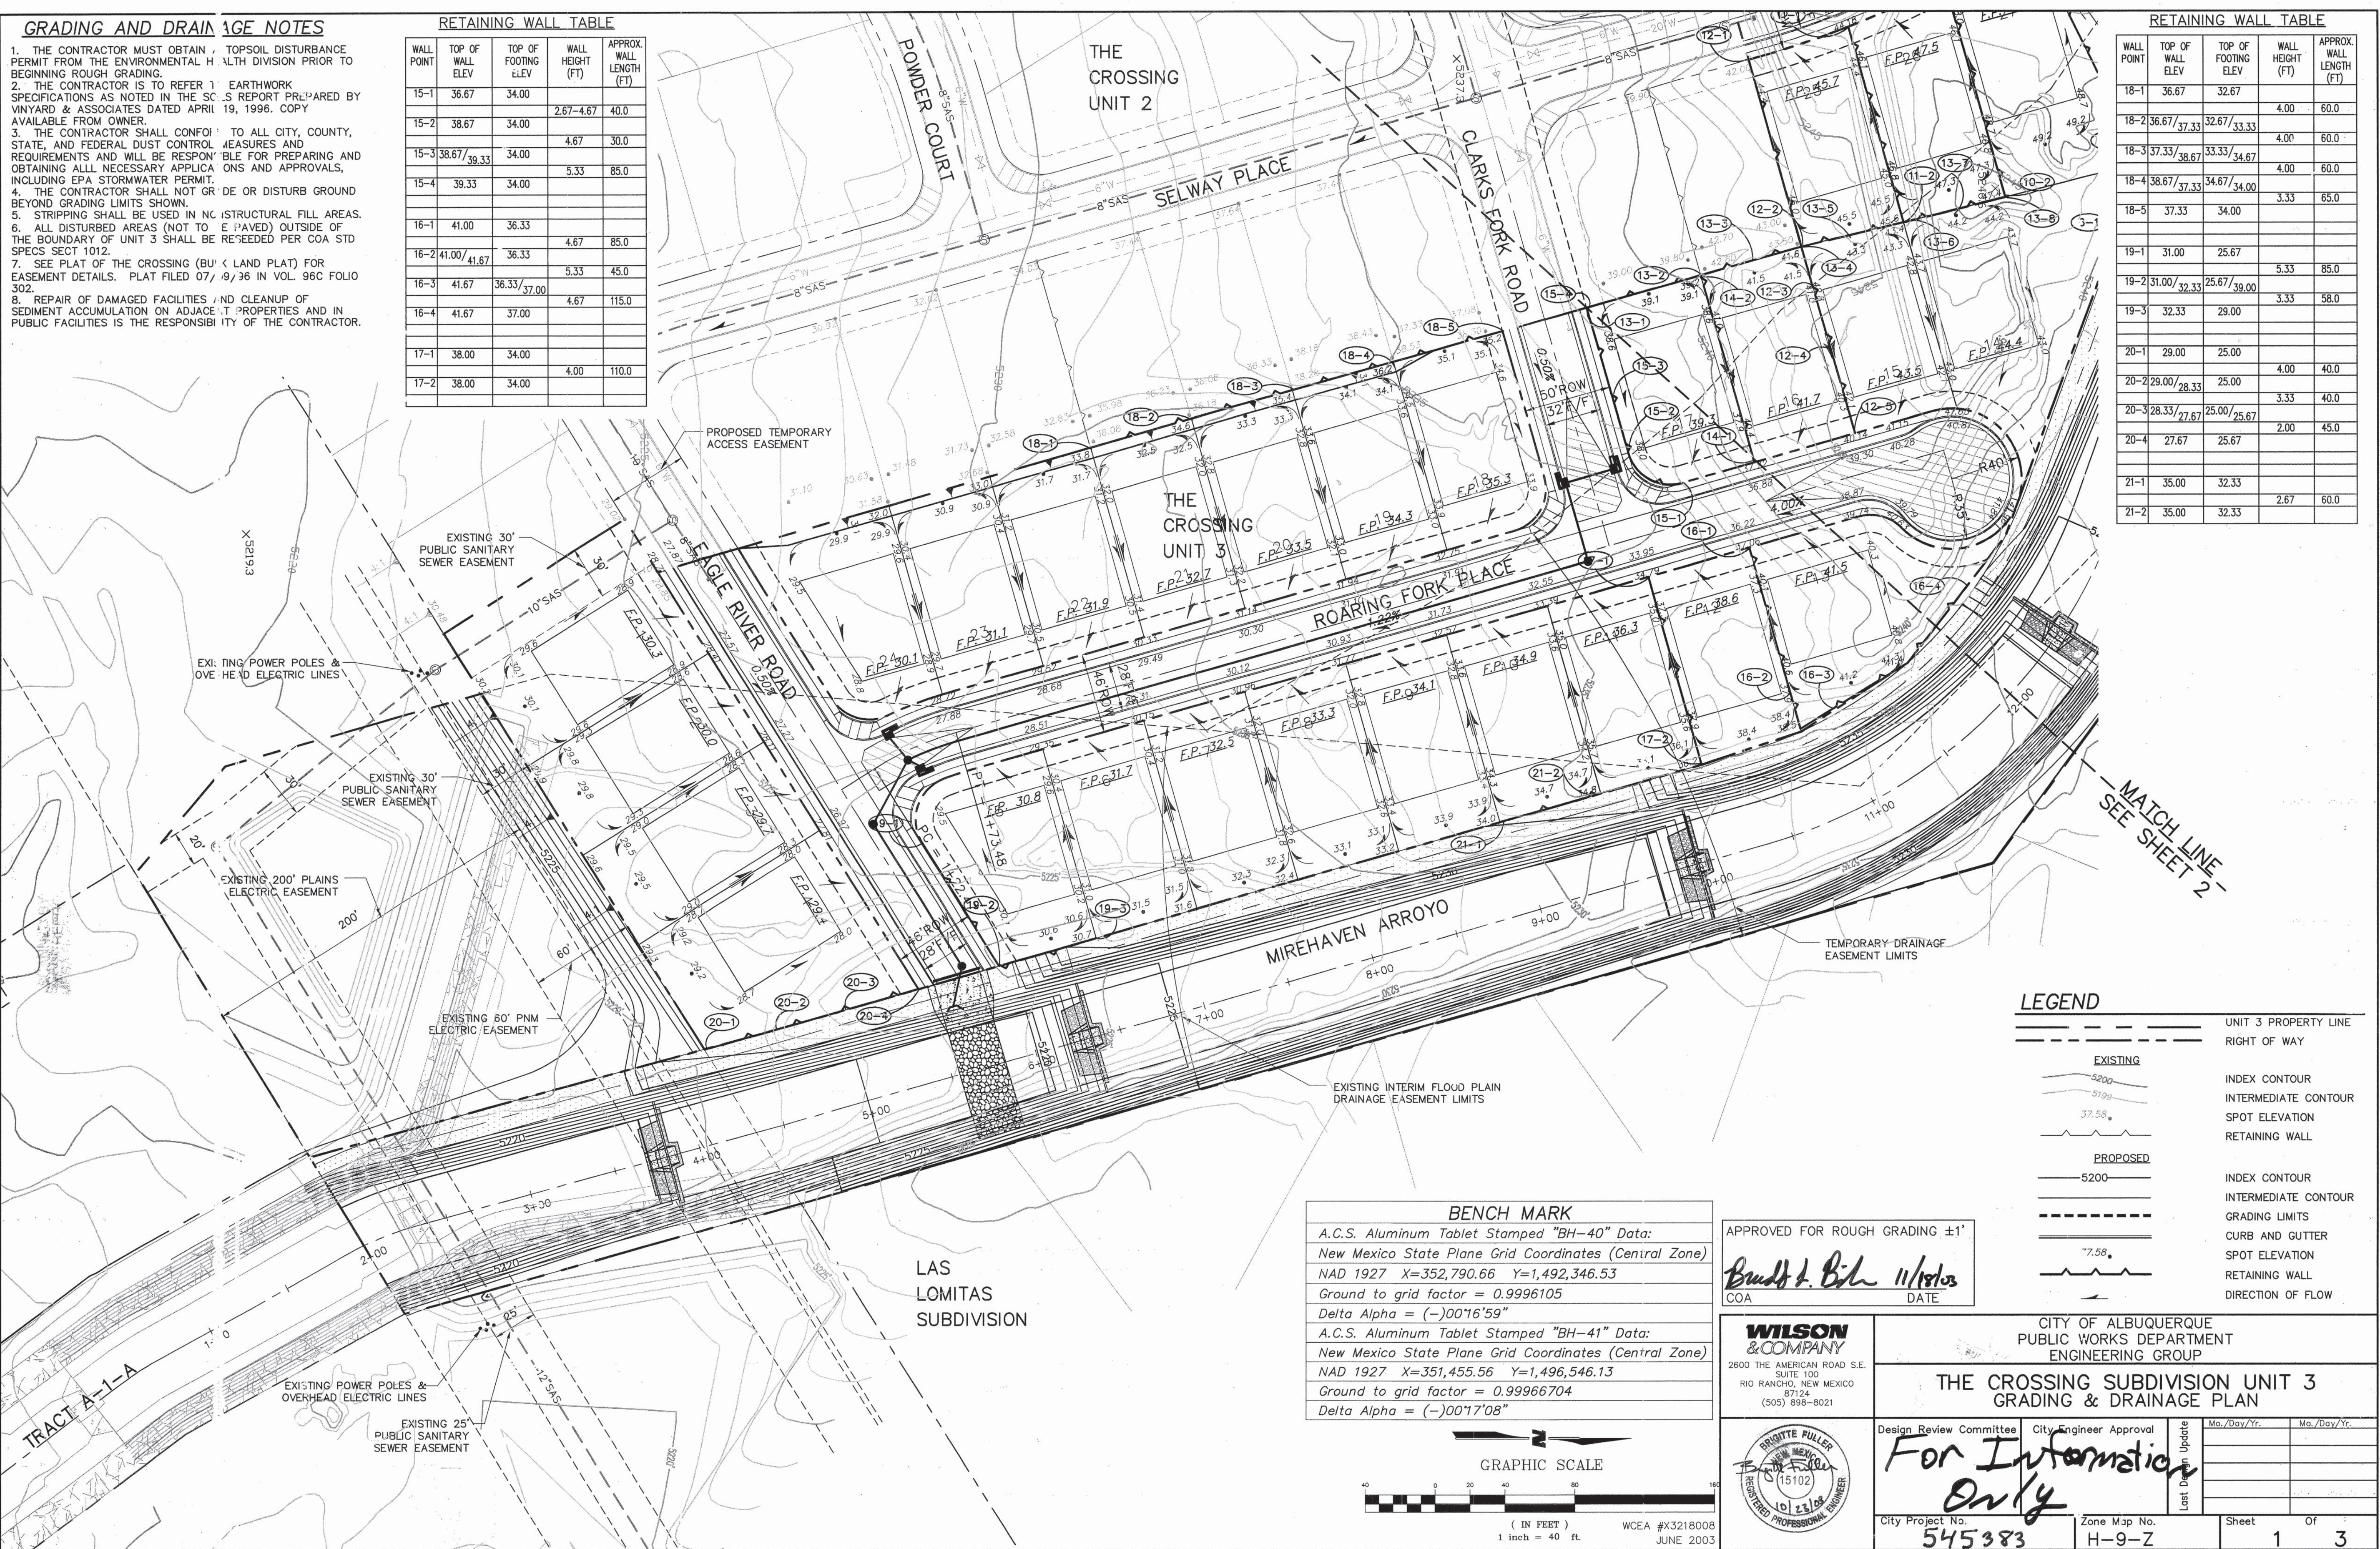

RETAINING WALL TABLE				
WALL POINT	TOP OF WALL ELEV	TOP OF FOOTING ELEV	WALL HEIGHT (FT)	PROX. WALL VERT. (FT)
2-1	54.00	50.00	4.00	0.0
2-2	54.00	50.00		
3-1	53.00	48.33		
3-2	53.00	48.33	4.67	0.0
6-1	48.00	46.00	2.00-4.00	1.0
6-2	50.00	46.00		
6-3	51.33	46.00	4.00	1.0
6-4	52.00	46.00	5.33	1.0
6-5	52.67/54.00	46.00	6.00	1.0
6-6	54.00/55.33	46.00	6.67-8.00	1.0
6-7	55.33	46.00	8.00-9.33	1.0
6-8	56.00	49.33	9.33-6.67	1.0
6-9	56.00	49.33	6.67	1.0
6-10	53.33	49.33	6.67-4.00	1.0
7-1	54.33	50.33	4.00	5.0
7-2	54.33	50.33		
8-1	52.67	48.67	4.00	15.0
8-2	52.67	48.67		
9-1	50.67	46.67	4.00	1.0
9-2	50.67	46.67		
10-1	48.67	44.67	4.00	15.0
10-2	48.67	44.67		

RETAINING WALL TABLE				
WALL POINT	TOP OF WALL ELEV	TOP OF FOOTING ELEV	WALL HEIGHT (FT)	APPROX. WALL LENGTH (FT)
11-1	47.33	43.33	4.00	115.0
11-2	47.33	43.33		
12-1	45.33	41.33	4.00	110.0
12-2	45.33	41.33/40.67	4.00-3.33	25.0
12-3	43.33	40.67/40.00	3.33	40.0
12-4	43.33/42.67	40.00/39.33	3.33	45.0
12-5	42.67	39.33		
13-1	41.33	38.00	3.33	68.0
13-2	41.33/44.00	38.00/40.00	4.00	30.0
13-3	44.00/44.67	40.00/40.67	4.00	30.0
13-4	44.67/46.00	40.67/41.33	4.67	30.0
13-5	46.00/46.67	41.33/42.00	4.67	30.0
13-6	46.67/48.00	42.00/42.67	5.33	30.0
13-7	48.00	42.67/43.33	4.67	30.0
13-8	48.00	43.33		
14-1	41.33	36.67	4.67	110.0
14-2	41.33	36.67		

BENCH MARK
A.C.S. Aluminum Tablet Stamped "BH-40" Data:
New Mexico State Plane Grid Coordinates (Central Zone)
NAD 1927 X=352,790.66 Y=1,492,346.53
Ground to grid factor = 0.9996105
Delta Alpha = (-)00°16'59"
A.C.S. Aluminum Tablet Stamped "BH-41" Data:
New Mexico State Plane Grid Coordinates (Central Zone)
NAD 1927 X=351,455.56 Y=1,496,546.13
Ground to grid factor = 0.99966704
Delta Alpha = (-)00°17'08"

LEGEND	
---	UNIT 3 PROPERTY LINE
---	RIGHT OF WAY
---	EXISTING
---	INDEX CONTOUR
---	INTERMEDIATE CONTOUR
---	SPOT ELEVATION
---	RETAINING WALL
---	PROPOSED
---	INDEX CONTOUR
---	INTERMEDIATE CONTOUR
---	GRADING LIMITS
---	CURB AND GUTTER
---	SPOT ELEVATION
---	RETAINING WALL
---	DIRECTION OF FLOW



APPROVED FOR ROUGH GRADING ±1'
Brad J. Bih 11/18/03
COA DATE


WILSON & COMPANY
2600 THE AMERICAN ROAD S.E.
SUITE 100
RIO RANCHO, NEW MEXICO
87124
(505) 898-8021

BRIGITTE FULLER
NEW MEXICO
15102
10/23/03
REGISTERED PROFESSIONAL ENGINEER


CITY OF ALBUQUERQUE
PUBLIC WORKS DEPARTMENT
ENGINEERING GROUP

**THE CROSSING SUBDIVISION UNIT 3
GRADING & DRAINAGE PLAN**

Design Review Committee	City Engineer Approval	Mo./Day/Yr.	Mo./Day/Yr.
For Information Only			
City Project No.	Zone Map No.	Sheet	Of
545383	H-9-Z	2	3

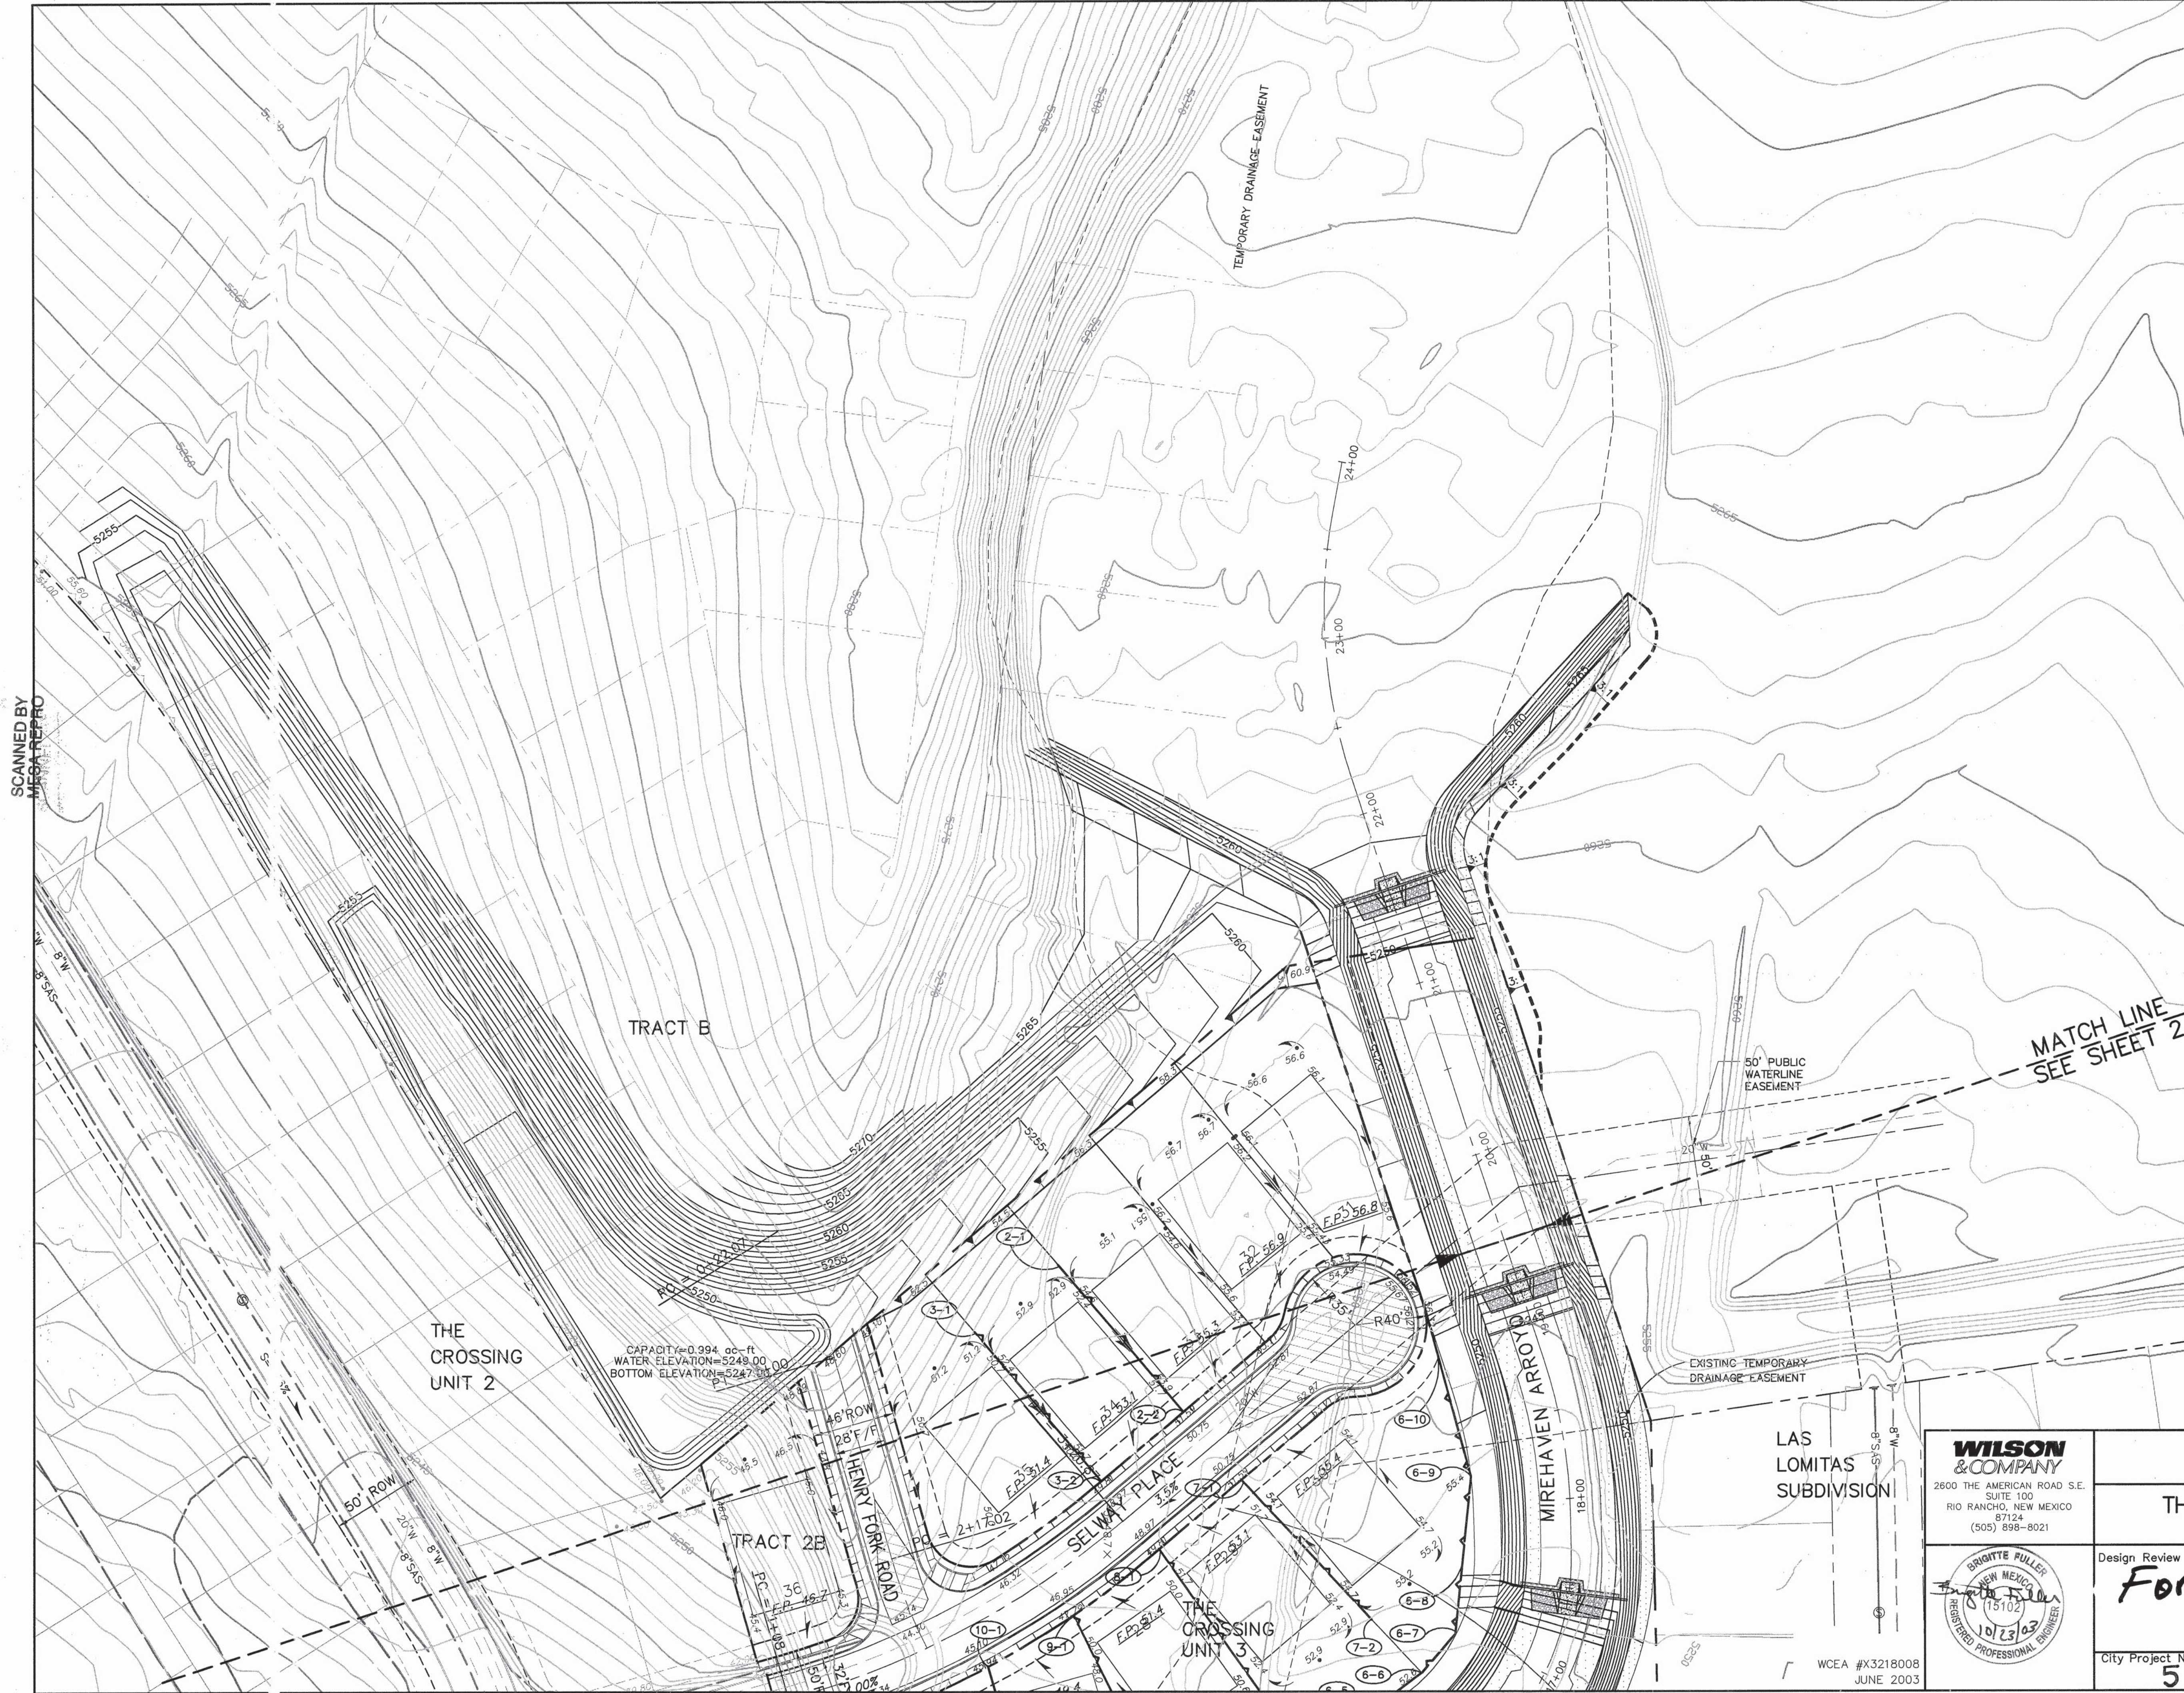

BENCH MARK	
A.C.S. Aluminum Tablet Stamped "BH-40" Data:	
New Mexico State Plane Grid Coordinates (Central Zone)	
NAD 1927	X=352,790.66 Y=1,492,346.53
Ground to grid factor = 0.9996105	
Delta Alpha = (-)00°16'59"	
A.C.S. Aluminum Tablet Stamped "BH-41" Data:	
New Mexico State Plane Grid Coordinates (Central Zone)	
NAD 1927	X=351,455.56 Y=1,496,546.13
Ground to grid factor = 0.99966704	
Delta Alpha = (-)00°17'08"	

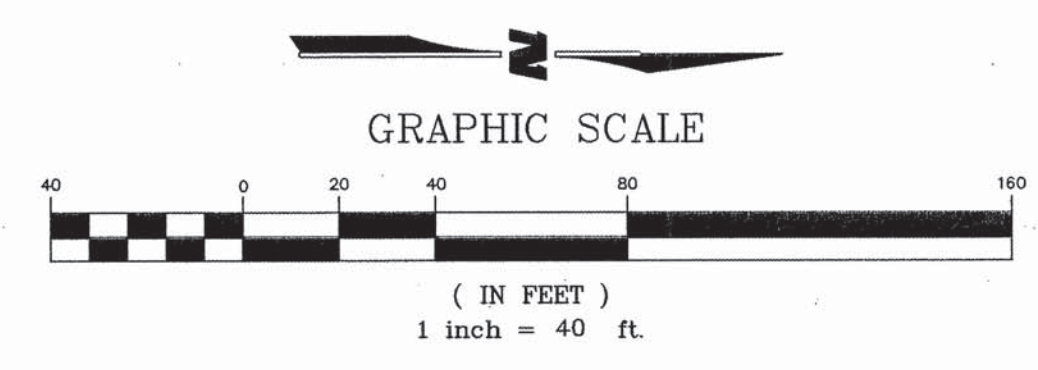

APPROVED FOR ROUGH GRADING ±1'

Bradd L. Bih 11/18/03
COA DATE


LEGEND	
	UNIT 3 PROPERTY LINE
	RIGHT OF WAY
	EXISTING
	INDEX CONTOUR
	INTERMEDIATE CONTOUR
	SPOT ELEVATION
	RETAINING WALL
	PROPOSED
	INDEX CONTOUR
	INTERMEDIATE CONTOUR
	GRADING LIMITS
	CURB AND GUTTER
	SPOT ELEVATION
	RETAINING WALL
	DIRECTION OF FLOW

WILSON & COMPANY
2600 THE AMERICAN ROAD S.E.
SUITE 100
RIO RANCHO, NEW MEXICO 87124
(505) 898-8021

CITY OF ALBUQUERQUE
PUBLIC WORKS DEPARTMENT
ENGINEERING GROUP

THE CROSSING SUBDIVISION UNIT 3
GRADING & DRAINAGE PLAN

Design Review Committee	City Engineer Approval	Mo./Day/Yr.	Mo./Day/Yr.
<i>For Information Only</i>			
City Project No.	Zone Map No.	Sheet	Of
545383	H-9-Z	3	3

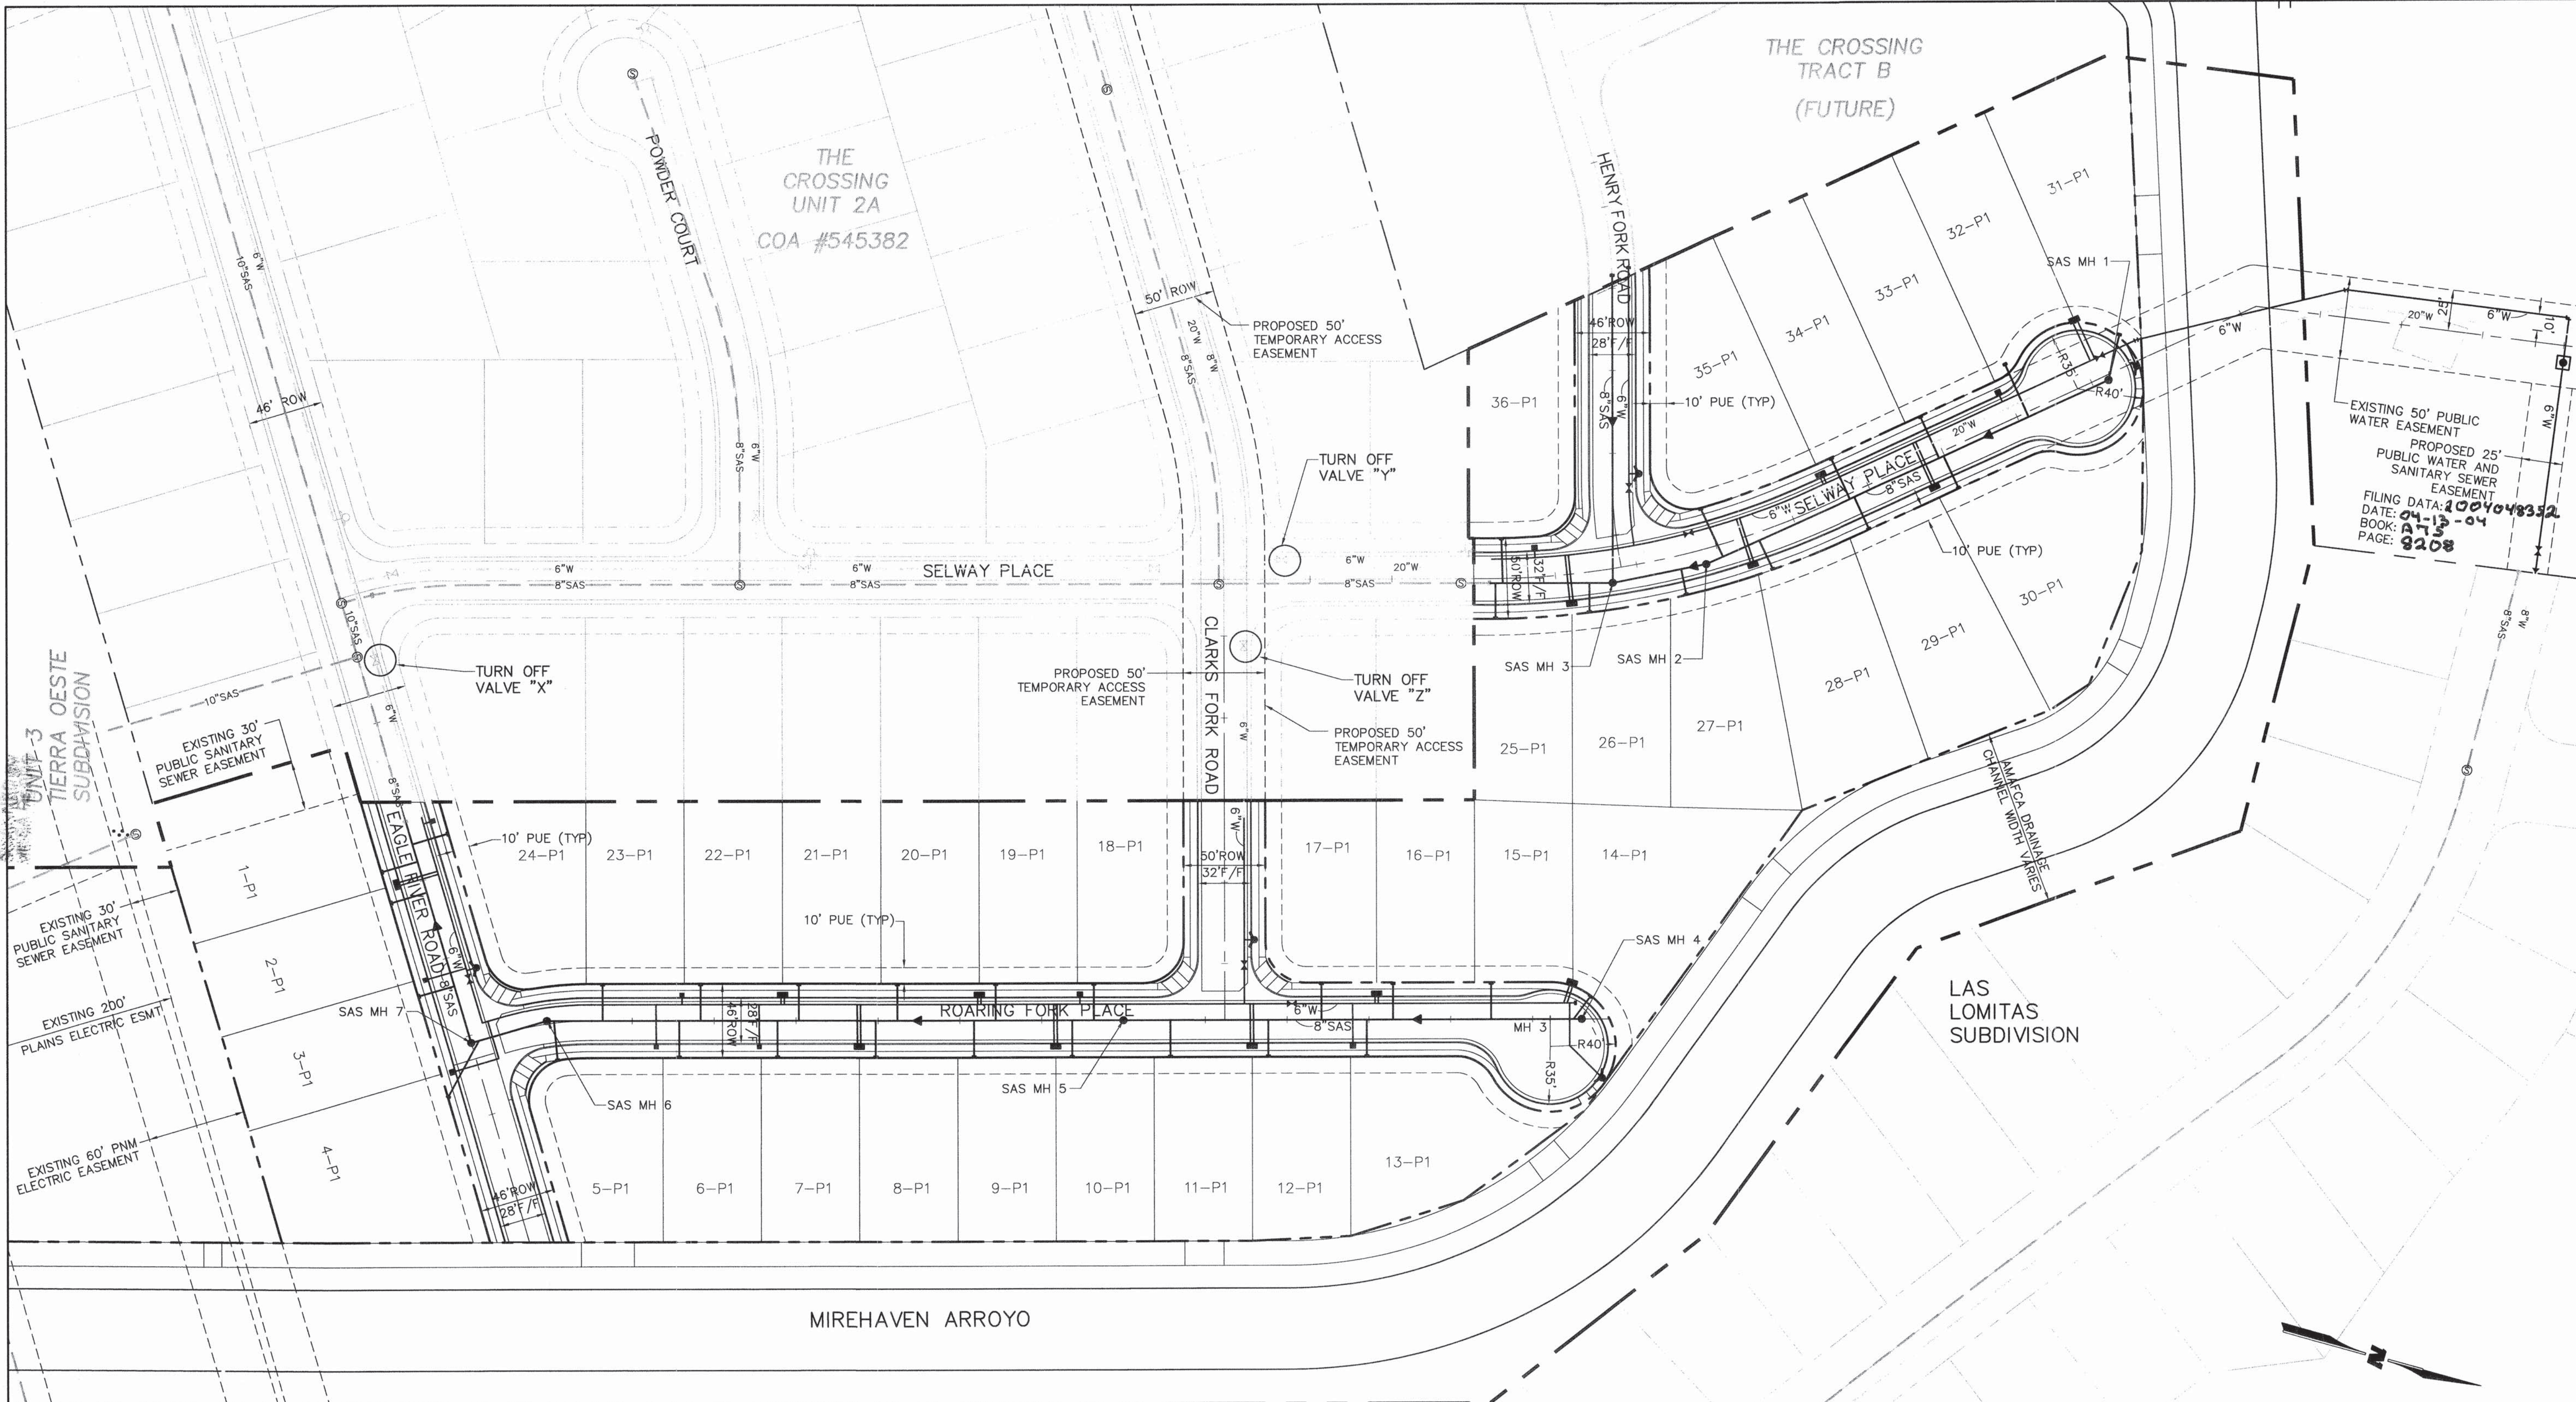

SCANNED BY
MESA REPRO

WATER SHUT-OFF REQUIREMENTS:
CONTRACTOR WILL BE RESPONSIBLE FOR THE TIMING AND COORDINATION OF THE WATER SHUT-OFF REQUIREMENTS IN CONJUNCTION WITH THE COMPLETION OF THE PROJECT.


AT LEAST SEVEN (7) WORKING DAYS PRIOR TO CONSTRUCTION, THE CONTRACTOR SHALL CONTACT PWD/WATER SYSTEMS DIVISION (857-8200) TO INITIATE IMPLEMENTATION OF THIS WATER SHUT-OFF PLAN. CONTRACTOR SHALL NOT OPERATE CITY VALVES.

WATER SHUT-OFF PLAN:

FOR CONNECTION **CLOSE VALVE(S)**
ALL WATER LINE CONNECTIONS "X", "Y" & "Z"

NOTE:
VALVES "X", "Y" & "Z", INSTALLED IN COA PROJECT #545382, ARE NOT YET SHOWN ON THE COA AUTOMATED WATER DISTRIBUTION SECTIONAL MAPS, AND AND THEREFORE ARE LABELED AS SUCH FOR THIS PLAN ONLY. THE CONTRACTOR SHALL COORDINATE THE SHUT-OFF PLAN WITH THE OWNER.



RESTRAINED JOINT TABLE – 6" PVC WL							
LENGTH OF RESTRAINED PIPE EACH WAY (L _R) (FEET)							
PIPE SIZE	90°	45°	22-1/2'	11-1/4'	TEE	VALVE/ CAP/FH	REDUCER
6"	27'	11'	5'	3'	3'	73'	20'
*TEE BRANCH – EACH RUN PIPE SHALL BE MINIMUM 10' W/O JOINTS							

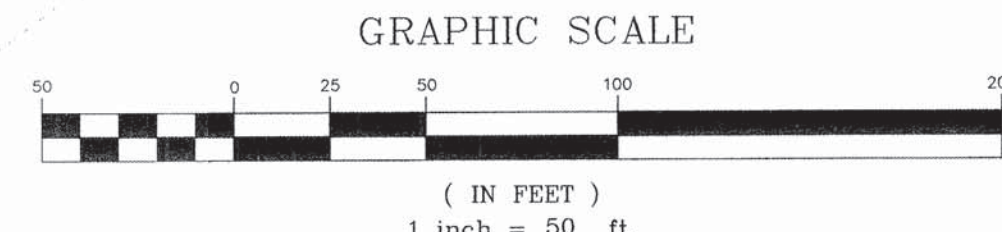

WILSON & COMPANY
2600 THE AMERICAN ROAD S.E.
SUITE 100
RIO RANCHO, NEW MEXICO
87124
(505) 898-8021

CITY OF ALBUQUERQUE
PUBLIC WORKS DEPARTMENT
ENGINEERING GROUP
THE CROSSING SUBDIVISION UNIT 3
OVERALL UTILITY & WATER SHUT OFF PLAN
Design: Review Committee City Engineer Approval
Last Design Update
City Project No. **545383** Zone Map No. **H-9-Z**
Sheet **8** Of **19**

REVISIONS	DATE	BY	REMARKS
1	DATE APRIL 2003	JMT	DESIGNED BY
2	DATE APRIL 2003	DLC	DRAWN BY
3	DATE APRIL 2003	BMS	CHECKED BY

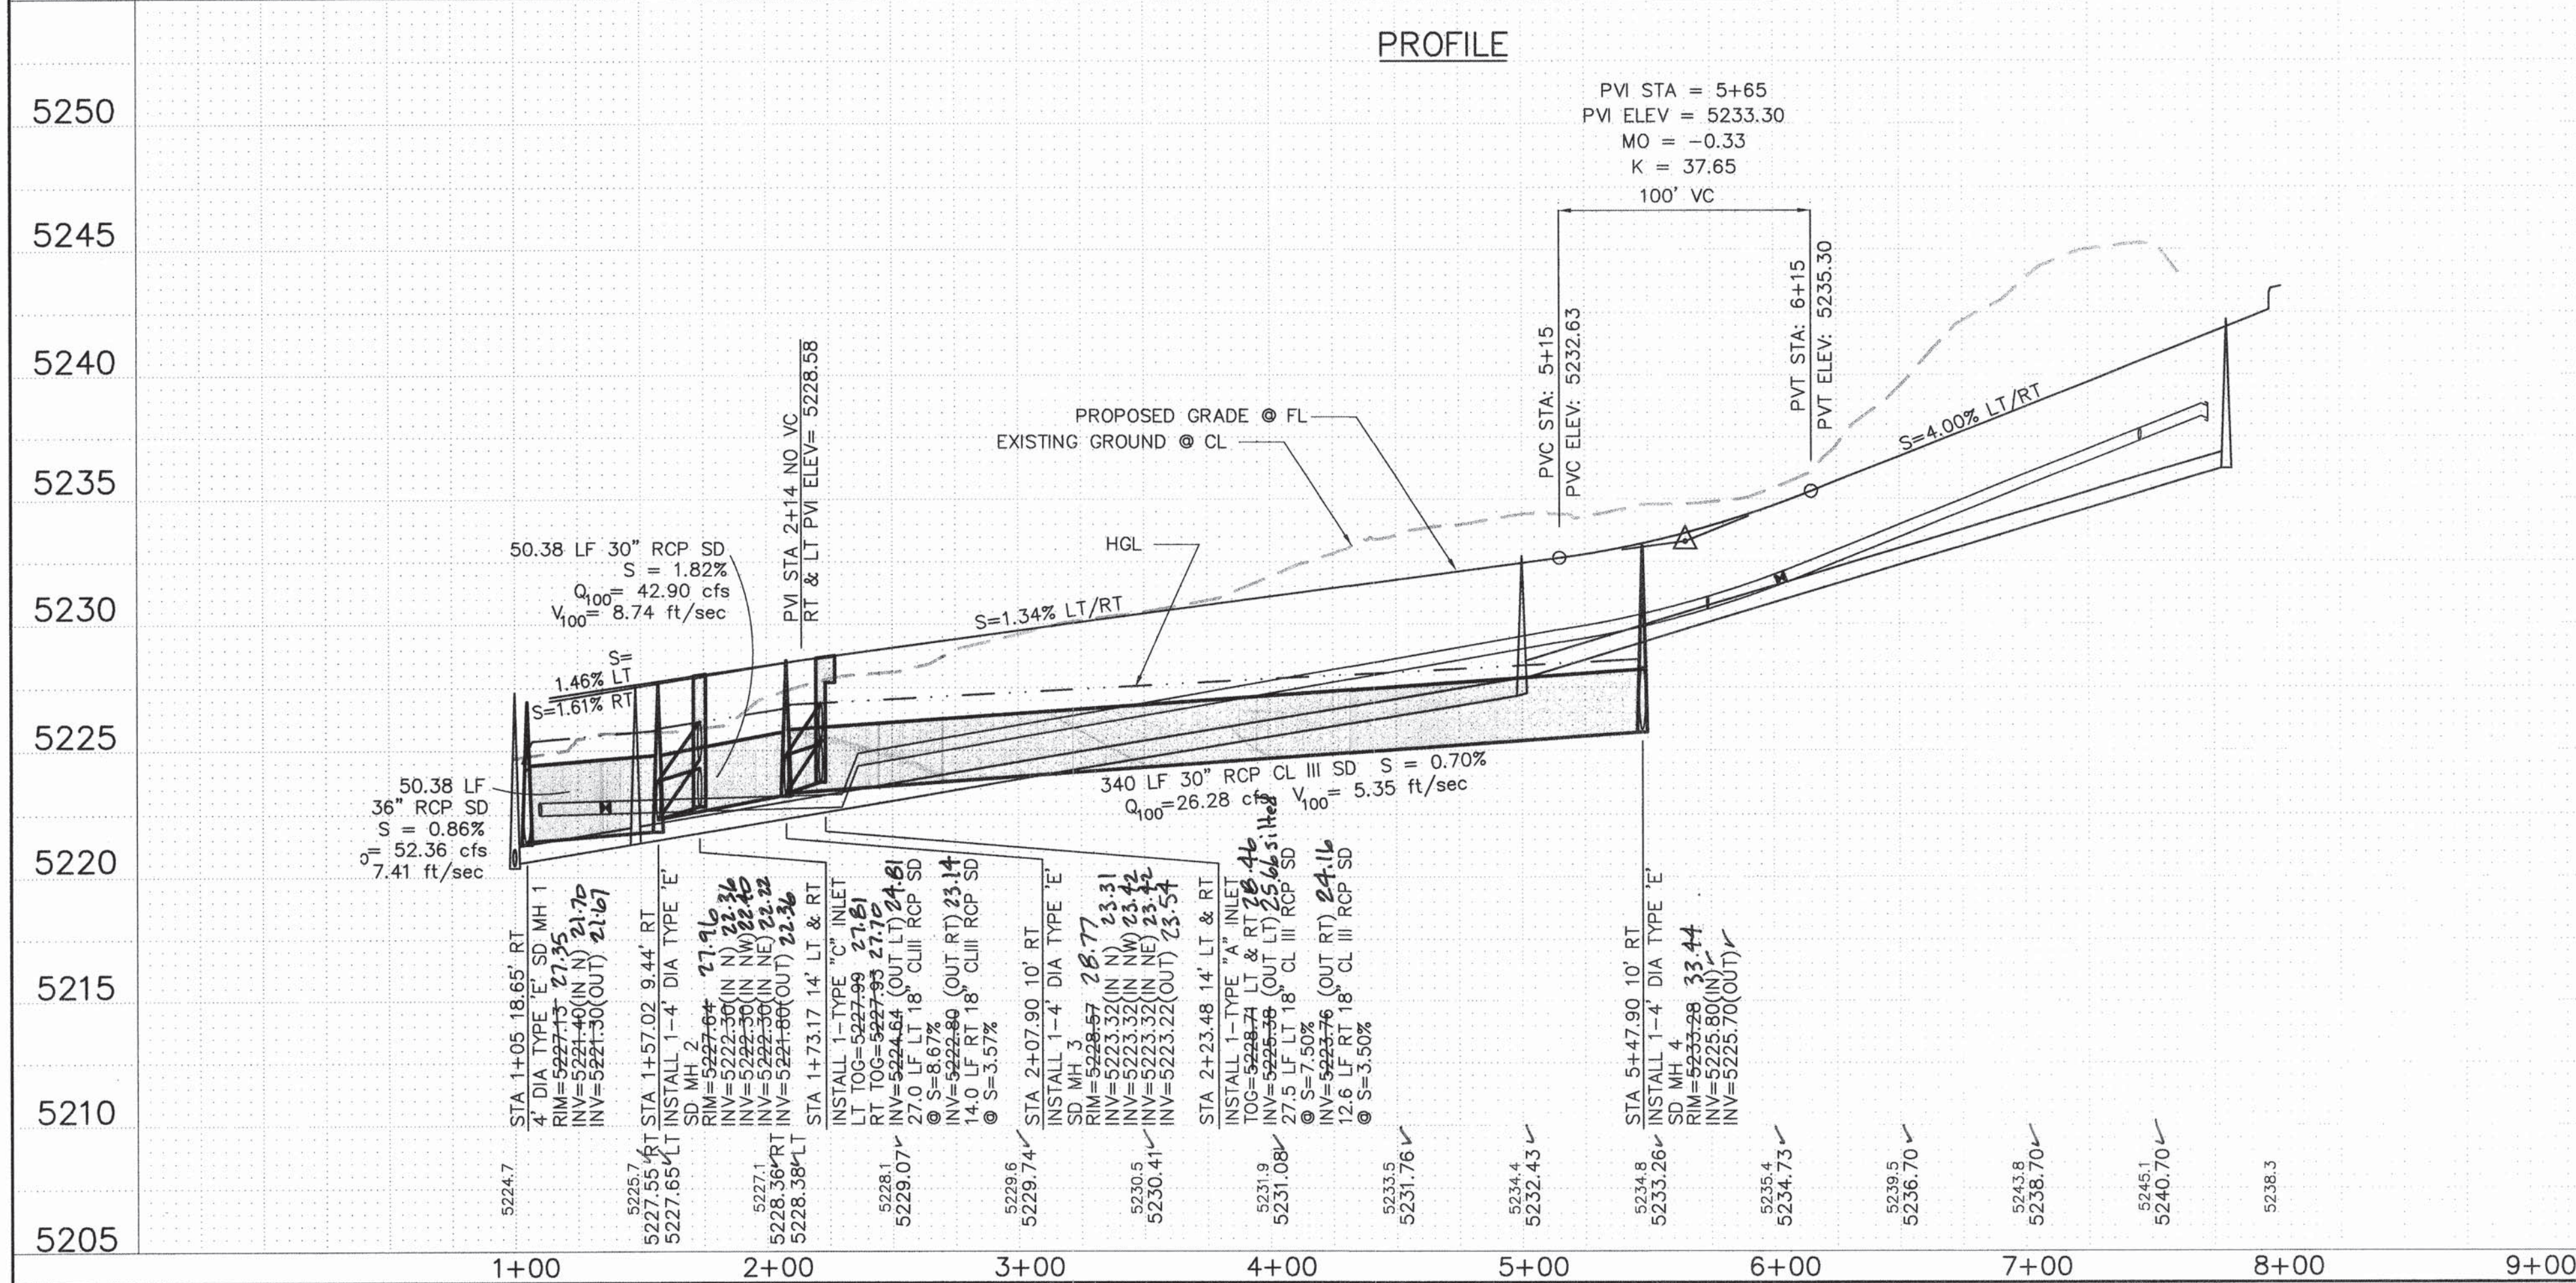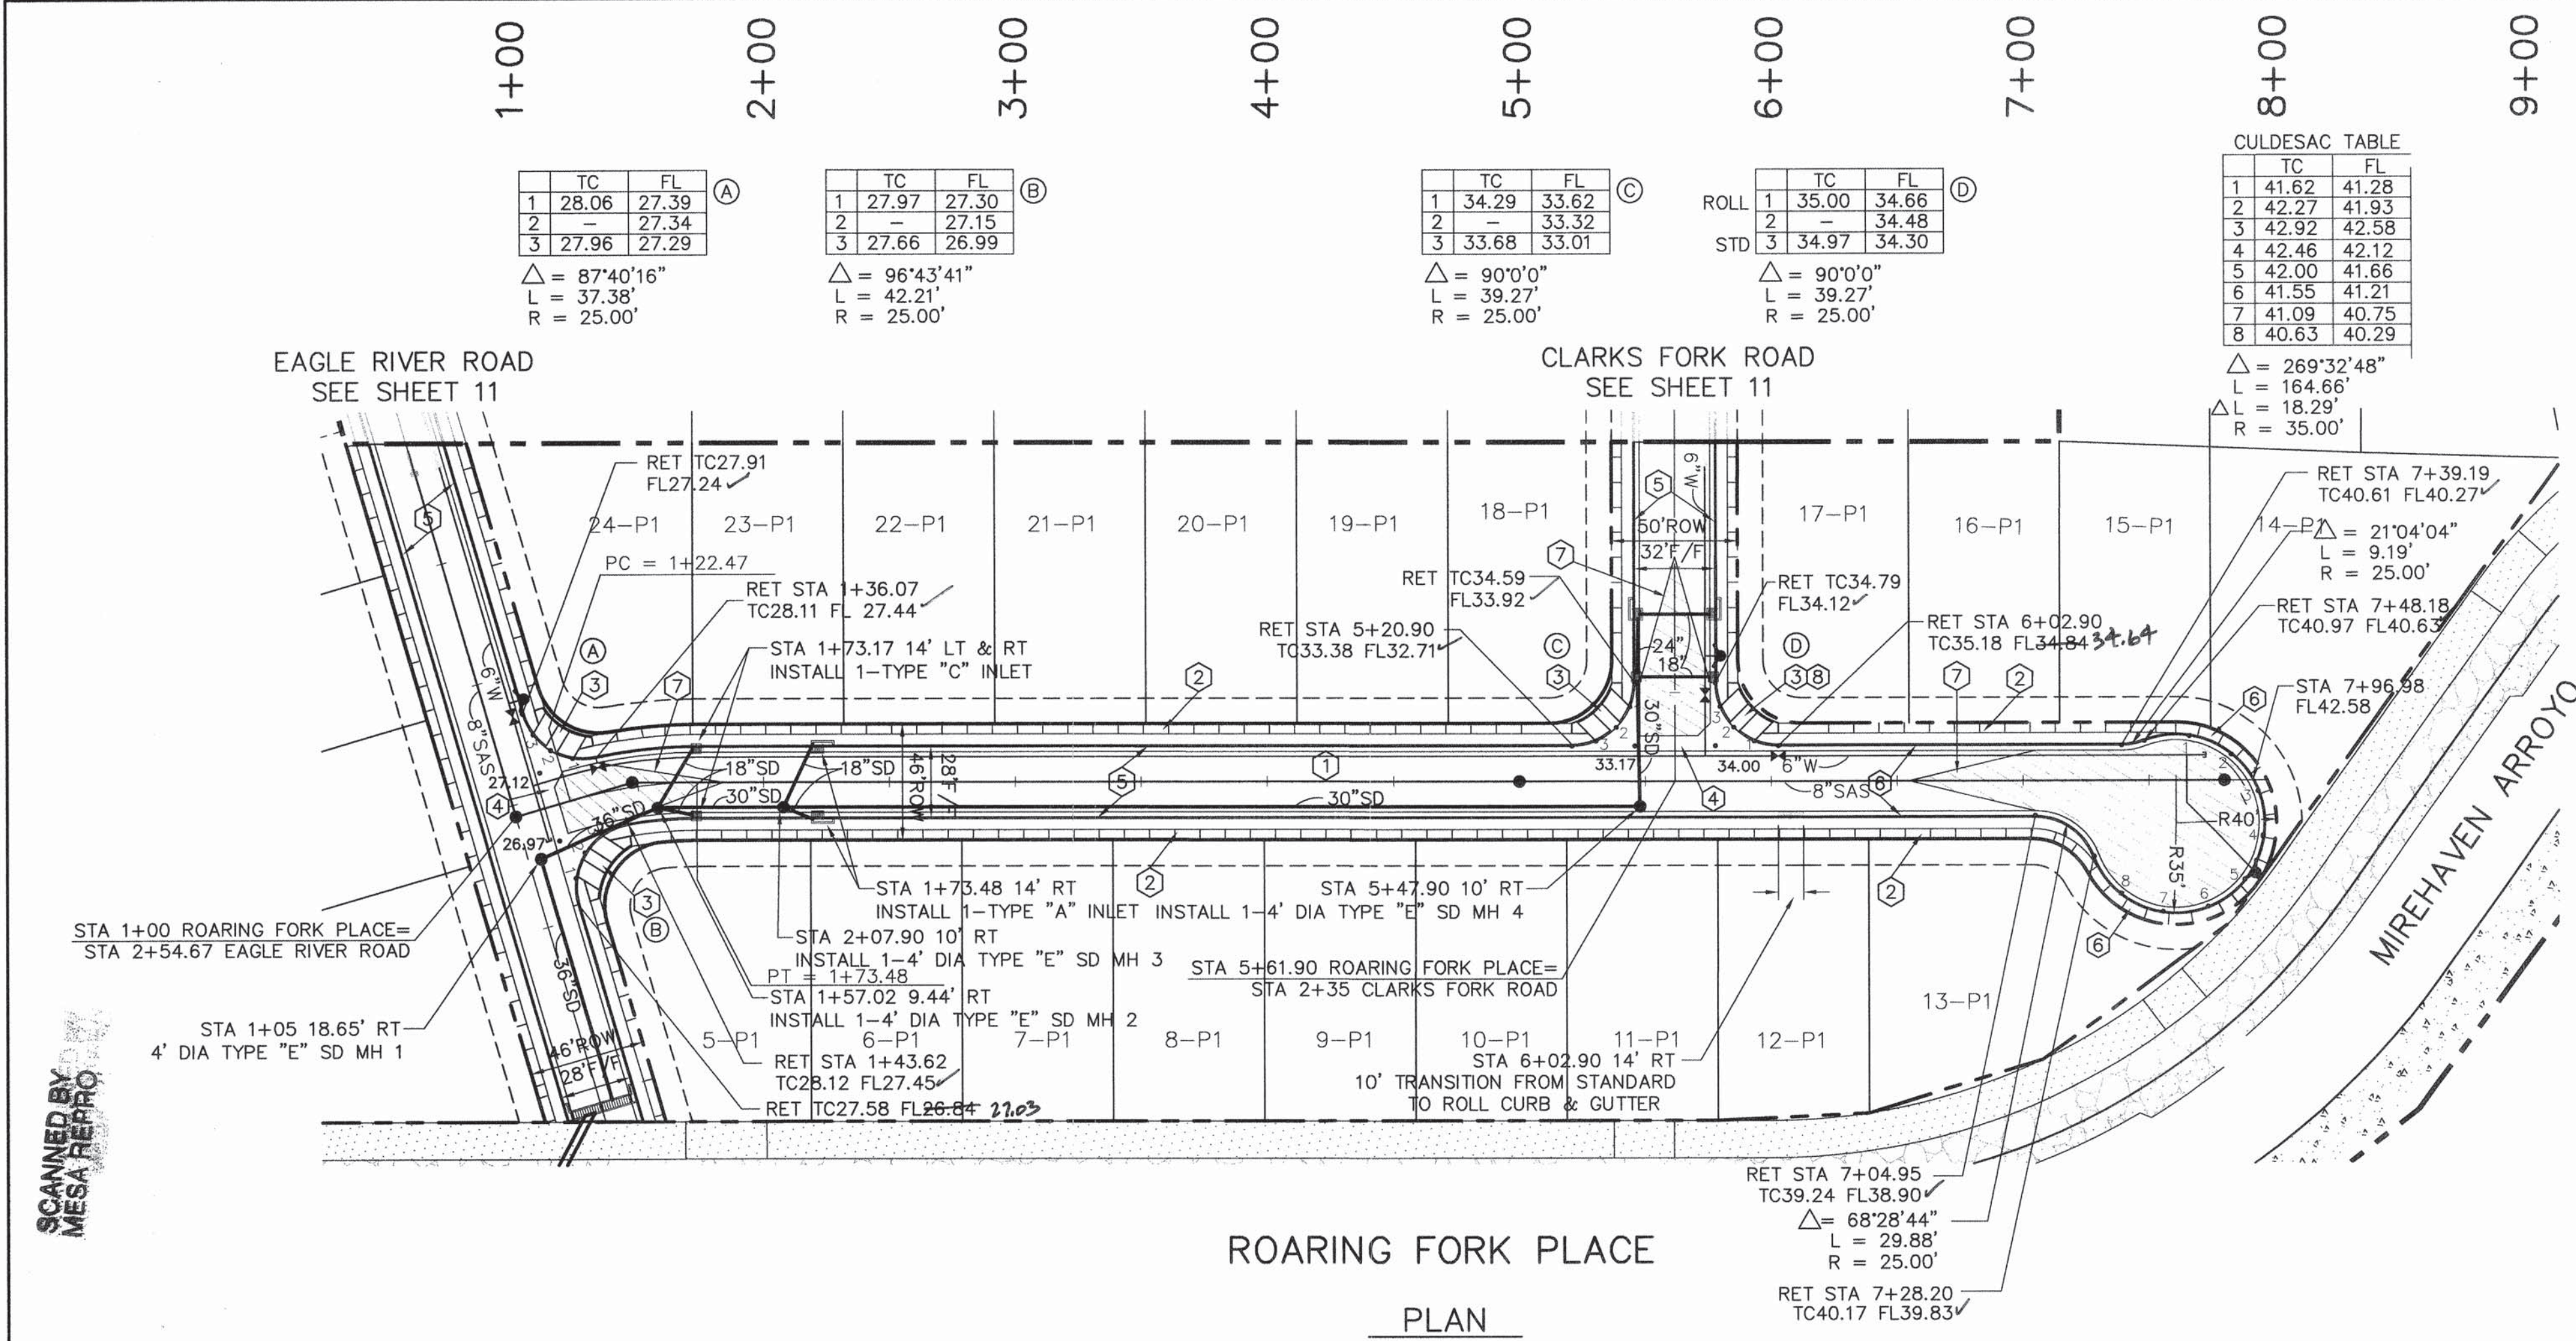

T:\PROJECTS\ M\ SHEETS\X3218008\8308PP04.DWG\03-14-04\KIS

WCEA #X3218008
MARCH 2004

City Project No.
545383

Zone Map No.
H-9-Z

Sheet
9

Of
19


WILSON
& COMPANY

PAVING CONSTRUCTION NOTES		AS-BUILT INFORMATION	
I.D.#	DESCRIPTION	CONTRACTOR	DATE
1	BUILD RESIDENTIAL PAVEMENT PER RESIDENTIAL STREET SECTION (SEE SHEET 7)	Melendez Concrete	2004
2	BUILD 4' PCC SIDEWALK PER COA STD DWG 2430 (DEFERRED)	Precision Surveys	2004
3	BUILD PCC WHEELCHAIR RAMP PER COA STD DWG 2441 CASE II	Precision Surveys	2004
4	BUILD PCC 6' CONCRETE VALLEY GUTTER PER COA STD DWG 2420	Precision Surveys	2004
5	BUILD 8" PCC STD CURB AND GUTTER PER COA STD DWG 2415A	Precision Surveys	2004
6	BUILD PCC ROLL CURB AND GUTTER PER COA STD DWG 2415A	Precision Surveys	2004
7	PAVEMENT TRANSITION FROM FULL CROWN TO NO CROWN AT RETURN	Precision Surveys	2004
8	TRANSITION FROM STD TO ROLL CURB & GUTTER THROUGH WCR PER STD DWG 2418	Precision Surveys	2004


BENCH MARKS		SURVEY INFORMATION	
NO.	DATE	FIELD NOTES	BY
1			
2			
3			
4			
5			
6			
7			
8			

ENGINEER'S SEAL		REVISIONS	
NO.	DATE	REVISIONS	BY
1			
2			
3			
4			
5			
6			
7			
8			

CITY OF ALBUQUERQUE PUBLIC WORKS DEPARTMENT ENGINEERING GROUP		THE CROSSING SUBDIVISION UNIT 3 PAVING & STORM DRAIN PLAN & PROFILE ROARING FORK PLACE	
Design, Review Committee	City Engineer Approval	Mo./Day/Yr.	Mo./Day/Yr.
DESIGNED BY	JMT	DATE	APRIL 2003
DRAWN BY	DLC	DATE	APRIL 2003
CHECKED BY	BMS	DATE	APRIL 2003

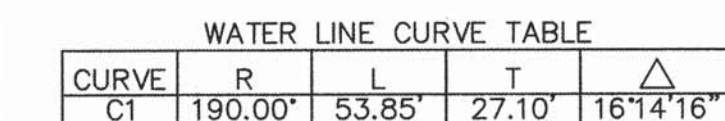

PLAN

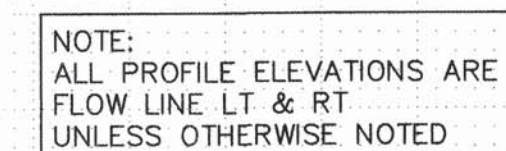

NOTE:
STA 7+70.10 DOUBLE METER
WATER SERVICE TO BE
LOCATED AT HIGH POINT
OF WATERLINE

SCALE:
HORIZ: 1" = 50'
VERT: 1" = 5'




ROARING FORK PLACE					
3/4" WATER SERVICES PER STD DWG 2362					
STATION	LOT	TYPE	LENGTH	REMARKS	
24	SEE SHEET 12				
2+14.43	5	SINGLE	24.63'	RIGHT	
2+30.48	23	SINGLE	4.63'	LEFT	
2+77.43	6	SINGLE	24.63'	RIGHT	
2+91.90	22,21	DOUBLE	4.63'	LEFT	
3+38.41	7,8	DOUBLE	24.63'	RIGHT	
4+11.90	20,19	DOUBLE	4.63'	LEFT	
4+58.43	9,10	DOUBLE	24.63'	RIGHT	
4+73.40	18	SINGLE	4.63'	LEFT	
5+78.42	11,12	DOUBLE	24.63'	RIGHT	
6+39.97	13	SINGLE	24.63'	RIGHT	
6+54.78	17,16	DOUBLE	4.63'	LEFT	
7+70.10	15,14	DOUBLE	12.14'	LEFT	
1+13.44	4	SINGLE	51.90'	RIGHT	

BENCH MARKS	
Aluminum	Tablet, Stamped "B9-40" Data:
Mexico	State Plane Grid Coordinates (Central Zone)
1927	X=352,790.66 Y=1,492,346.53
	id to grid factor = 0.99966701
Alpha =	("-00016'59" ELEV" = 5305.43" Data:
Aluminum	Tablet, Stamped "B9-41" Data:
Mexico	State Plane Grid Coordinates (Central Zone)
1927	X=351,455.56 Y=1,496,546.13
	id to grid factor = 0.99966704
Alpha =	("-00017'08" ELEV" = 5338.63" Data:

SURVEY INFORMATION					
	FIELD NOTES				
No.	BY	DATE			
A.C.S. New NAD	Groun	Delta			
A.C.S. A.C.S.	New	NAD			
Delta	Groun	Delta			

NO.		DATE	REMARKS	BY
REVISIONS				
WILSON & COMPANY, ENGINEERS & ARCHITECTS				
DESIGNED BY		JMT	DATE	APRIL 2003
DRAWN BY		DLG	DATE	APRIL 2003
CHECKED BY		BMS	DATE	APRIL 2003



CITY OF ALBUQUERQUE PUBLIC WORKS DEPARTMENT ENGINEERING GROUP					
THE CROSSING SUBDIVISION UNIT 3 UTILITY PLAN & PROFILE ROARING FORK PLACE					
Design Review Committee	City Engineer Approval	Last Design Update	Mo./Day/Yr.		Mo./Day/Yr.
					
DESIGN REVIEW COMMITTEE	CITY ENGINEER				

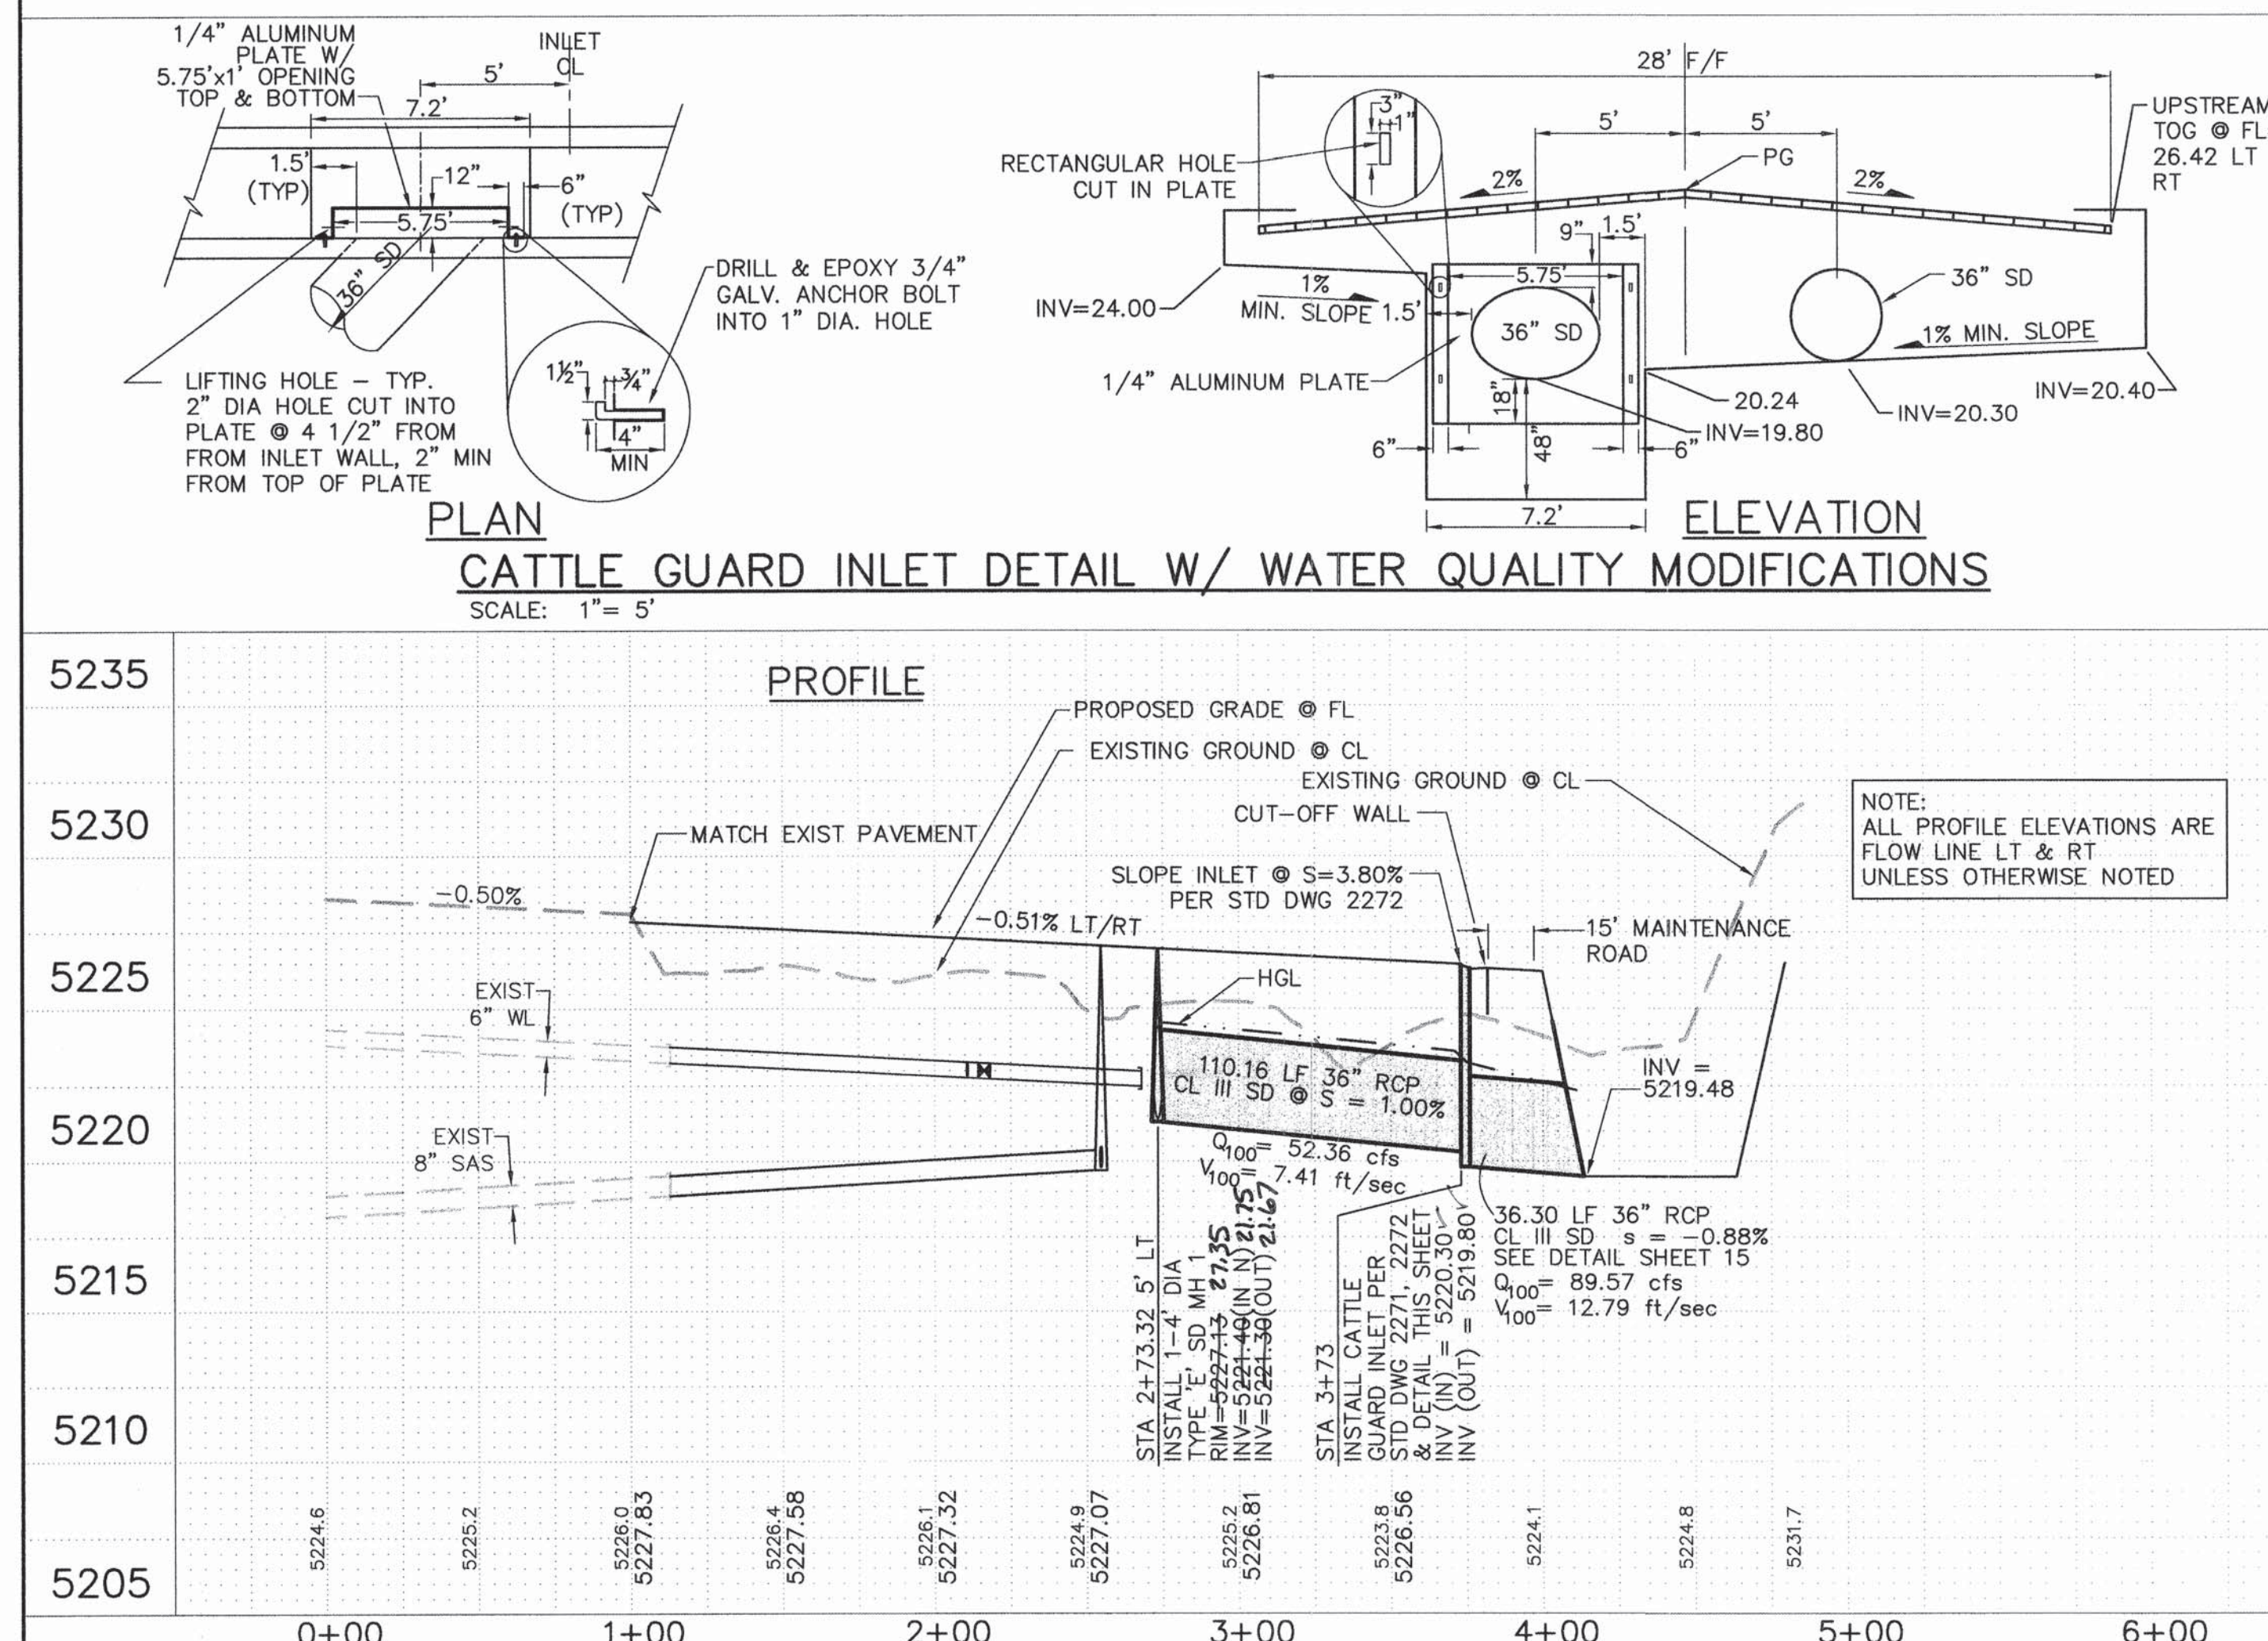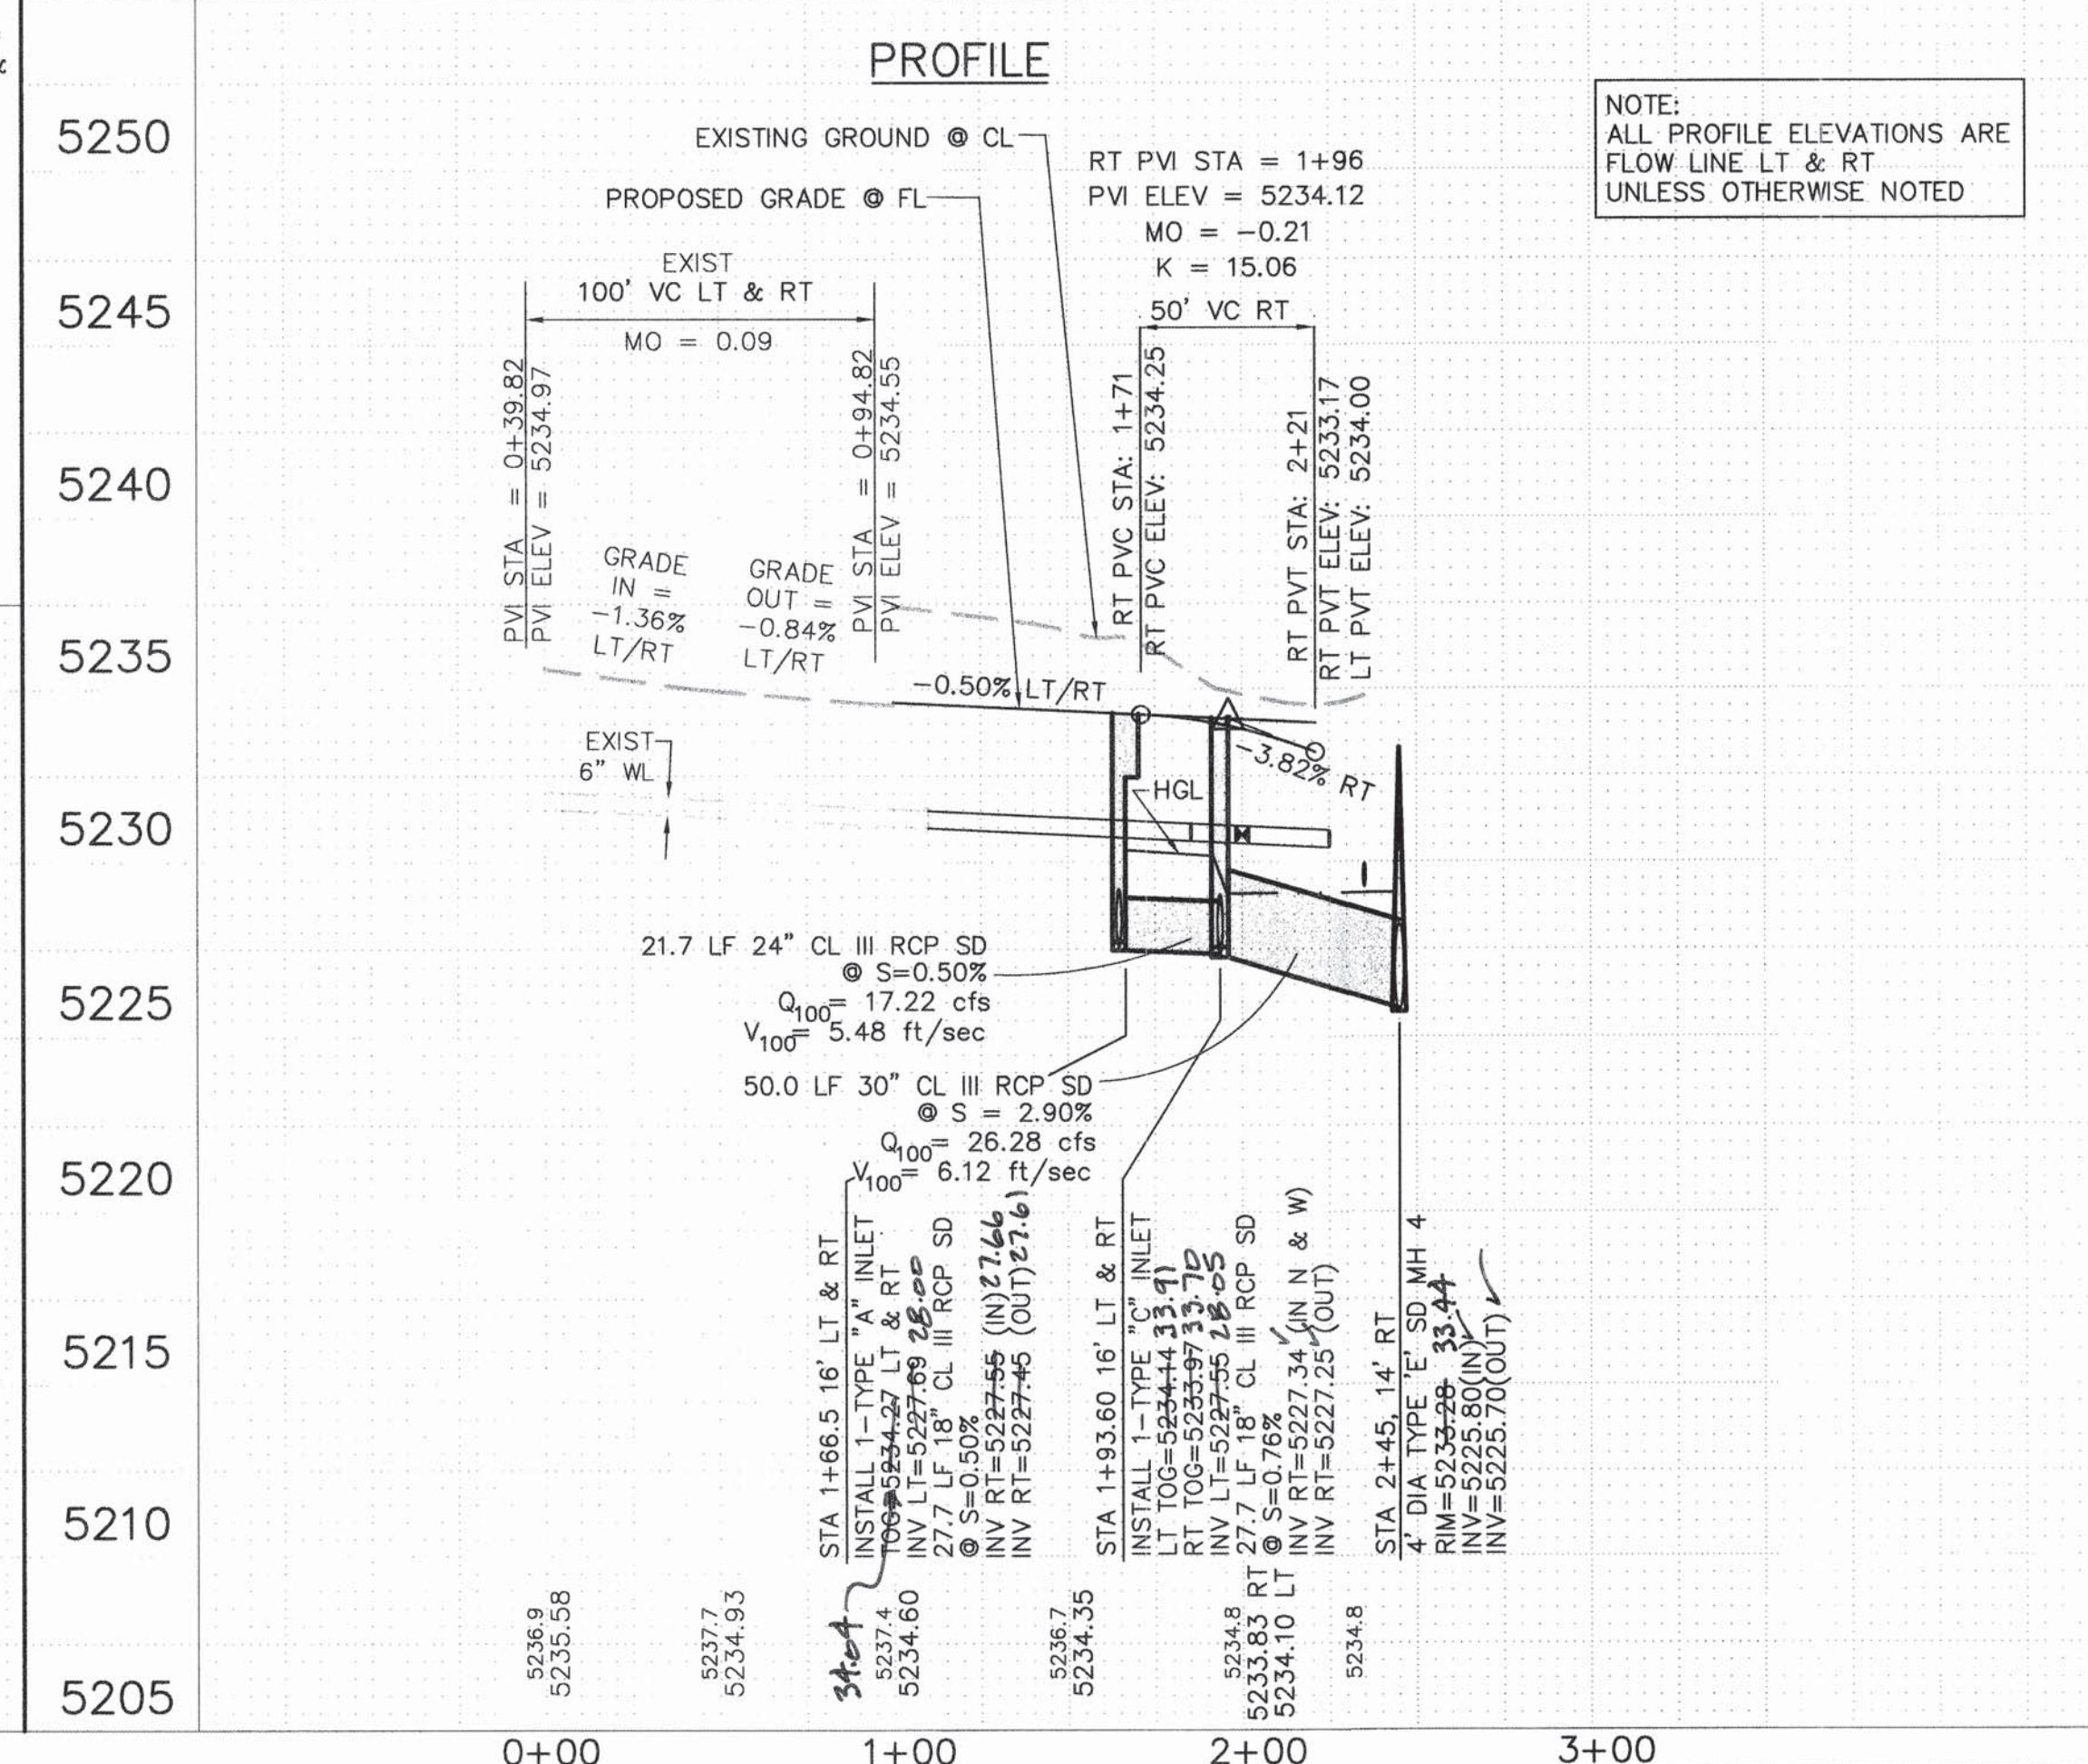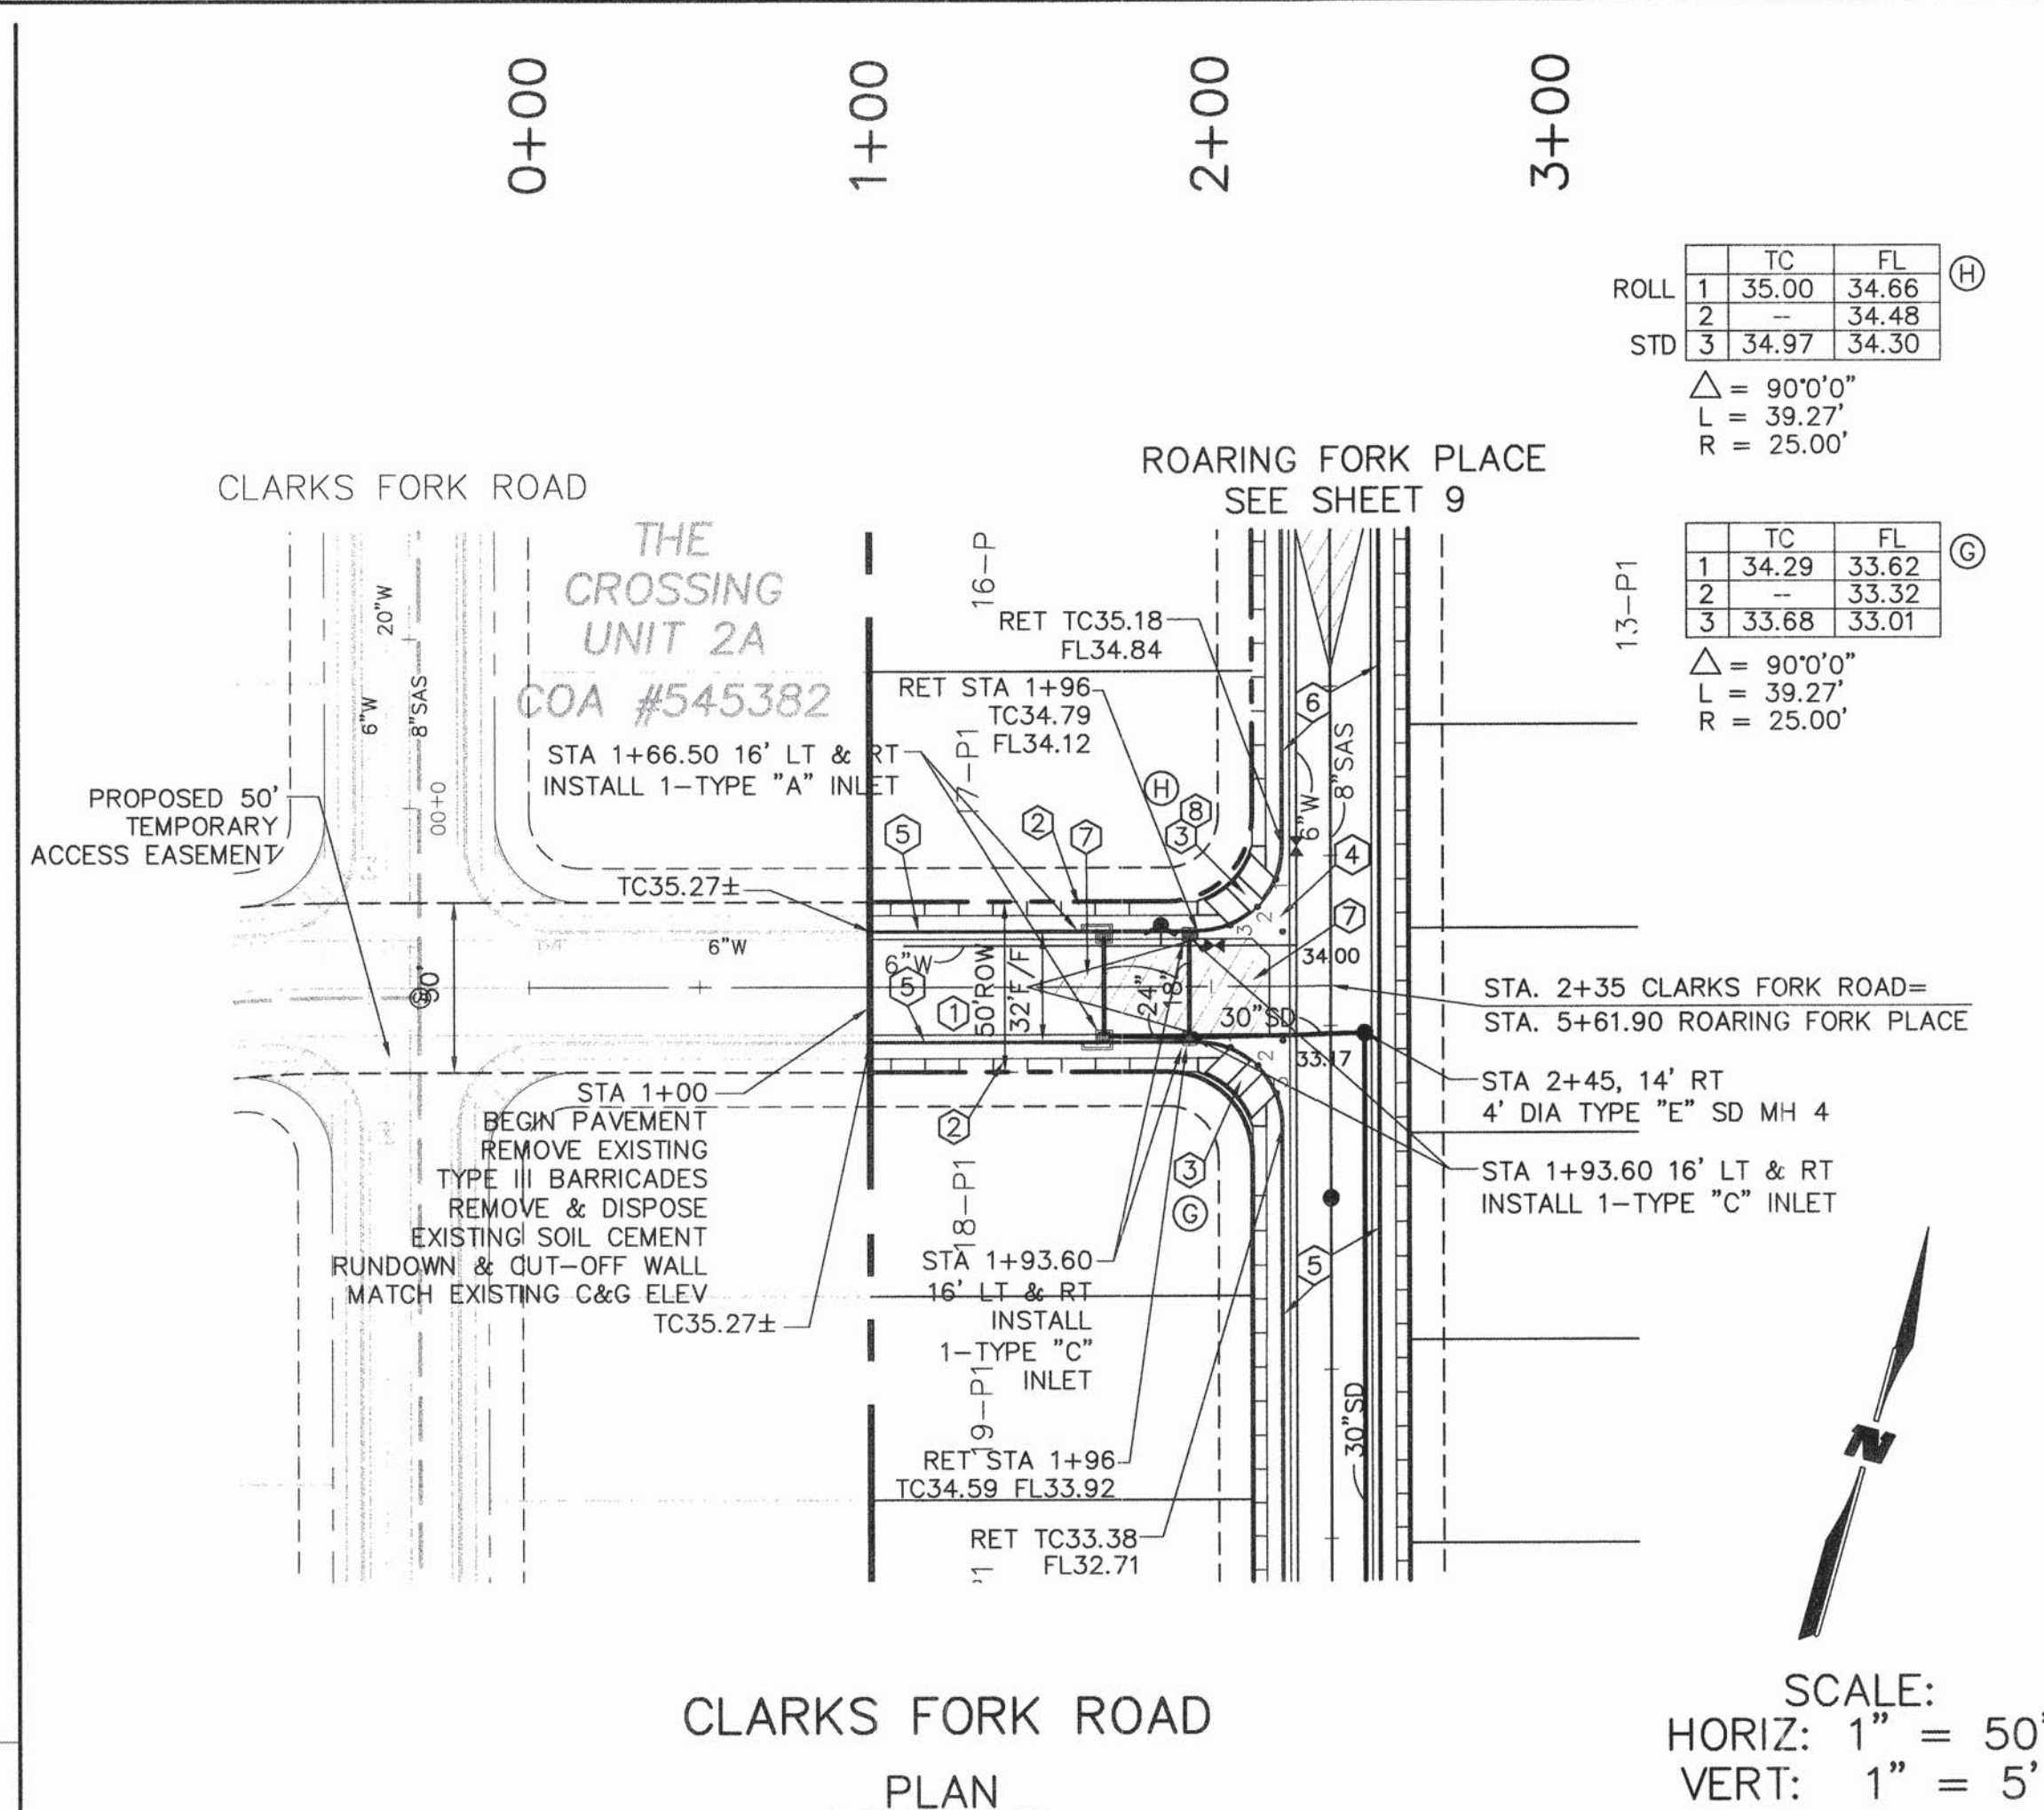


PAVING CONSTRUCTION NOTES									
I.D.#		DESCRIPTION							
1		BUILD RESIDENTIAL PAVEMENT PER RESIDENTIAL STREET SECTION (SEE SHEET 7)							
2		BUILD 4" PCC SIDEWALK PER COA STD DWG 2430 (DEFERRED)							
3		BUILD PCC WHEELCHAIR RAMP PER COA STD DWG 2441 CASE II							
4		BUILD PCC 6" CONCRETE VALLEY GUTTER PER COA STD DWG 2420							
5		BUILD 8" PCC STD CURB AND GUTTER PER COA STD DWG 2415A							
6		BUILD PCC ROLL CURB AND GUTTER PER COA STD DWG 2415A							
7		PAVEMENT TRANSITION FROM FULL CROWN TO NO CROWN AT RETURN							
8		TRANSITION FROM STD TO ROLL CURB & GUTTER THROUGH WCR PER STD DWG 2418							
GENERAL NOTES									
1. THE CONTRACTOR SHALL FIELD VERIFY ALL EXISTING UTILITY LOCATIONS AND NOTIFY THE ENGINEER IMMEDIATELY OF ANY DISCREPANCIES. 2. ALL CURB RETURN RADII SHALL BE 25' TO FACE OF CURB UNLESS OTHERWISE SPECIFIED. 3. ALL CURVE DATA AND DIMENSIONS REFER TO FACE OF CURB UNLESS OTHERWISE SPECIFIED. 4. GRADE ELEVATIONS, WHERE NOTED, ARE FOR TOP OF CURB UNLESS OTHERWISE SPECIFIED. 5. CONTRACTOR IS TO INSTALL A 4"x4"x5' POST AND EMD AT THE END OF EACH SANITARY SEWER SERVICE. 6. CONTRACTOR IS RESPONSIBLE FOR REPAIR AND/OR REPLACEMENT OF ALL UTILITY CONDUITS AND EXISTING LINES. 7. ANY ADDITIONAL GRADING REQUIRED TO MATCH PROPOSED STREET GRADES SHALL BE INCIDENTAL TO PAVING ITEMS. 8. CONTRACTOR SHALL PROVIDE THE INSPECTORS, (CITY AND PRIVATE) WITH THE PROPOSED HYDROSTATIC TESTING PLAN. THE PLAN MUST BE APPROVED BEFORE TESTING OPERATIONS BEGIN. 9. CONTRACTOR SHALL PARK EQUIPMENT AND VEHICLES SO AS NOT TO INTERFERE WITH NORMAL ACTIVITIES OF RESIDENTS OR OTHER CONTRACTORS ON SITE. 10. ANY DAMAGE TO THE EXISTING FACILITIES (CURB AND GUTTER, PAVEMENT, CONDUITS, LANDSCAPING, UTILITY LINES, ETC.) DURING CONSTRUCTION SHALL BE REPLACED AT THE CONTRACTORS EXPENSE. 11. WHEEL CHAIR RAMPS SHALL BE CONSTRUCTED PRIOR TO ACCEPTANCE OF CURB AND GUTTER.									
AS-BUILT INFORMATION		CONTRACTOR: Melendez Concrete STAMPED BY: Precision Surveys DATE: 2007 FIELD ACCEPTANCE BY: JEC FIELD DRAWINGS: Precision Surveys DATE: 2007 CORRECTED BY: Precision Surveys DATE: 2007 MICRO-FILM INFORMATION RECORDED BY: _____ DATE: _____ NO. _____							
BENCH MARKS		A.C.S. Aluminum Tablet Stamped "BH-40" Data: New Mexico State Plane Grid Coordinates (Central Zone) NAD 1927 X=352,790.66 Y=1,492,546.53 Ground to grid factor = 0.9996105 Delta Alpha = (-)00716"59" ELEV = 5305.43 A.C.S. Aluminum Tablet Stamped "BH-41" Data: New Mexico State Plane Grid Coordinates (Central Zone) NAD 1927 X=351,455.56 Y=1,496,546.13 Ground to grid factor = 0.99966704 Delta Alpha = (-)00717"08" ELEV = 5398.63							
SURVEY INFORMATION		FIELD NOTES NO. BY DATE							
ENGINEER'S SEAL									
REVISIONS		NO. DATE REMARKS BY							
WILSON & COMPANY, ENGINEERS & ARCHITECTS		DESIGNED BY JMT DATE APRIL 2003 DRAWN BY DLC DATE APRIL 2003 CHECKED BY BMS DATE APRIL 2003							
CITY OF ALBUQUERQUE PUBLIC WORKS DEPARTMENT ENGINEERING GROUP									
THE CROSSING SUBDIVISION UNIT 3 PAVING & STORM DRAIN PLAN & PROFILE EAGLE RIVER ROAD, CLARKS FORK ROAD									
Design/Review Committee		City Engineer Approval		Last Design Update		Mo./Day/Yr.		Mo./Day/Yr.	
DESIGN REVIEW COMMITTEE		CITY ENGINEER							
City Project No.		Zone Map No.		Sheet		Of			
545383		H-9-Z		11		19			



PLAN

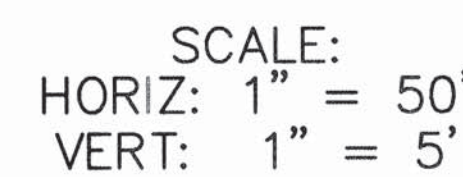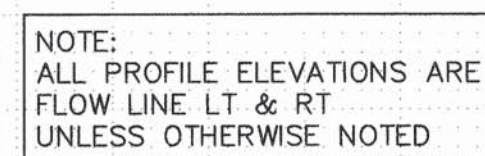

PLAN

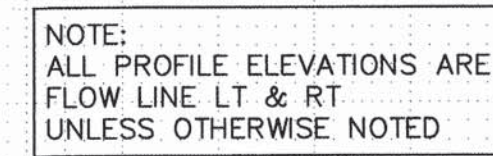




BENCH MARKS

Minimum Tablet Stamped "BH-40" Data:	
Station	State Plane Grid Coordinates (Central)
X=352,790.66	Y=1,492,346.53
grid factor	0.9996705
na = (-100176.97°	ELEV = 5305.43
Minimum Tablet Stamped "BH-41" Data:	
Station	State Plane Grid Coordinates (Central)
X=351,455.56	Y=1,496,546.13
grid factor	0.99966704
na = (-10017.08°	ELEV = 5398.63




[illegible]

NO.		DATE	REMARKS	BY
<i>REVISIONS</i>				
WILSON & COMPANY, ENGINEERS & ARCHITECTS				
DESIGNED BY	JMT	DATE	APRIL 2003	
DRAWN BY	DLC	DATE	APRIL 2003	
CHECKED BY	BMS	DATE	APRIL 2003	


CITY OF ALBUQUERQUE PUBLIC WORKS DEPARTMENT ENGINEERING GROUP															
THE CROSSING SUBDIVISION UNIT 3 UTILITY PLAN & PROFILE EAGLE RIVER ROAD, CLARKS FORK ROAD															
Design Review Committee	City Engineer Approval	Last Design Update	<table border="1"> <tr> <td>Mo./Day/Yr.</td> <td>Mo./Day/Yr.</td> </tr> <tr><td> </td><td> </td></tr> <tr><td> </td><td> </td></tr> <tr><td> </td><td> </td></tr> <tr><td> </td><td> </td></tr> <tr><td> </td><td> </td></tr> </table>	Mo./Day/Yr.	Mo./Day/Yr.										
Mo./Day/Yr.	Mo./Day/Yr.														
 DESIGN REVIEW COMMITTEE	 CITY ENGINEER	 Last Design Update	<table border="1"> <tr> <td>Sheet</td> <td>Of</td> </tr> <tr> <td>12</td> <td>19</td> </tr> </table>	Sheet	Of	12	19								
Sheet	Of														
12	19														
City Project No.	Zone Map No.														
545383	H-9-Z														

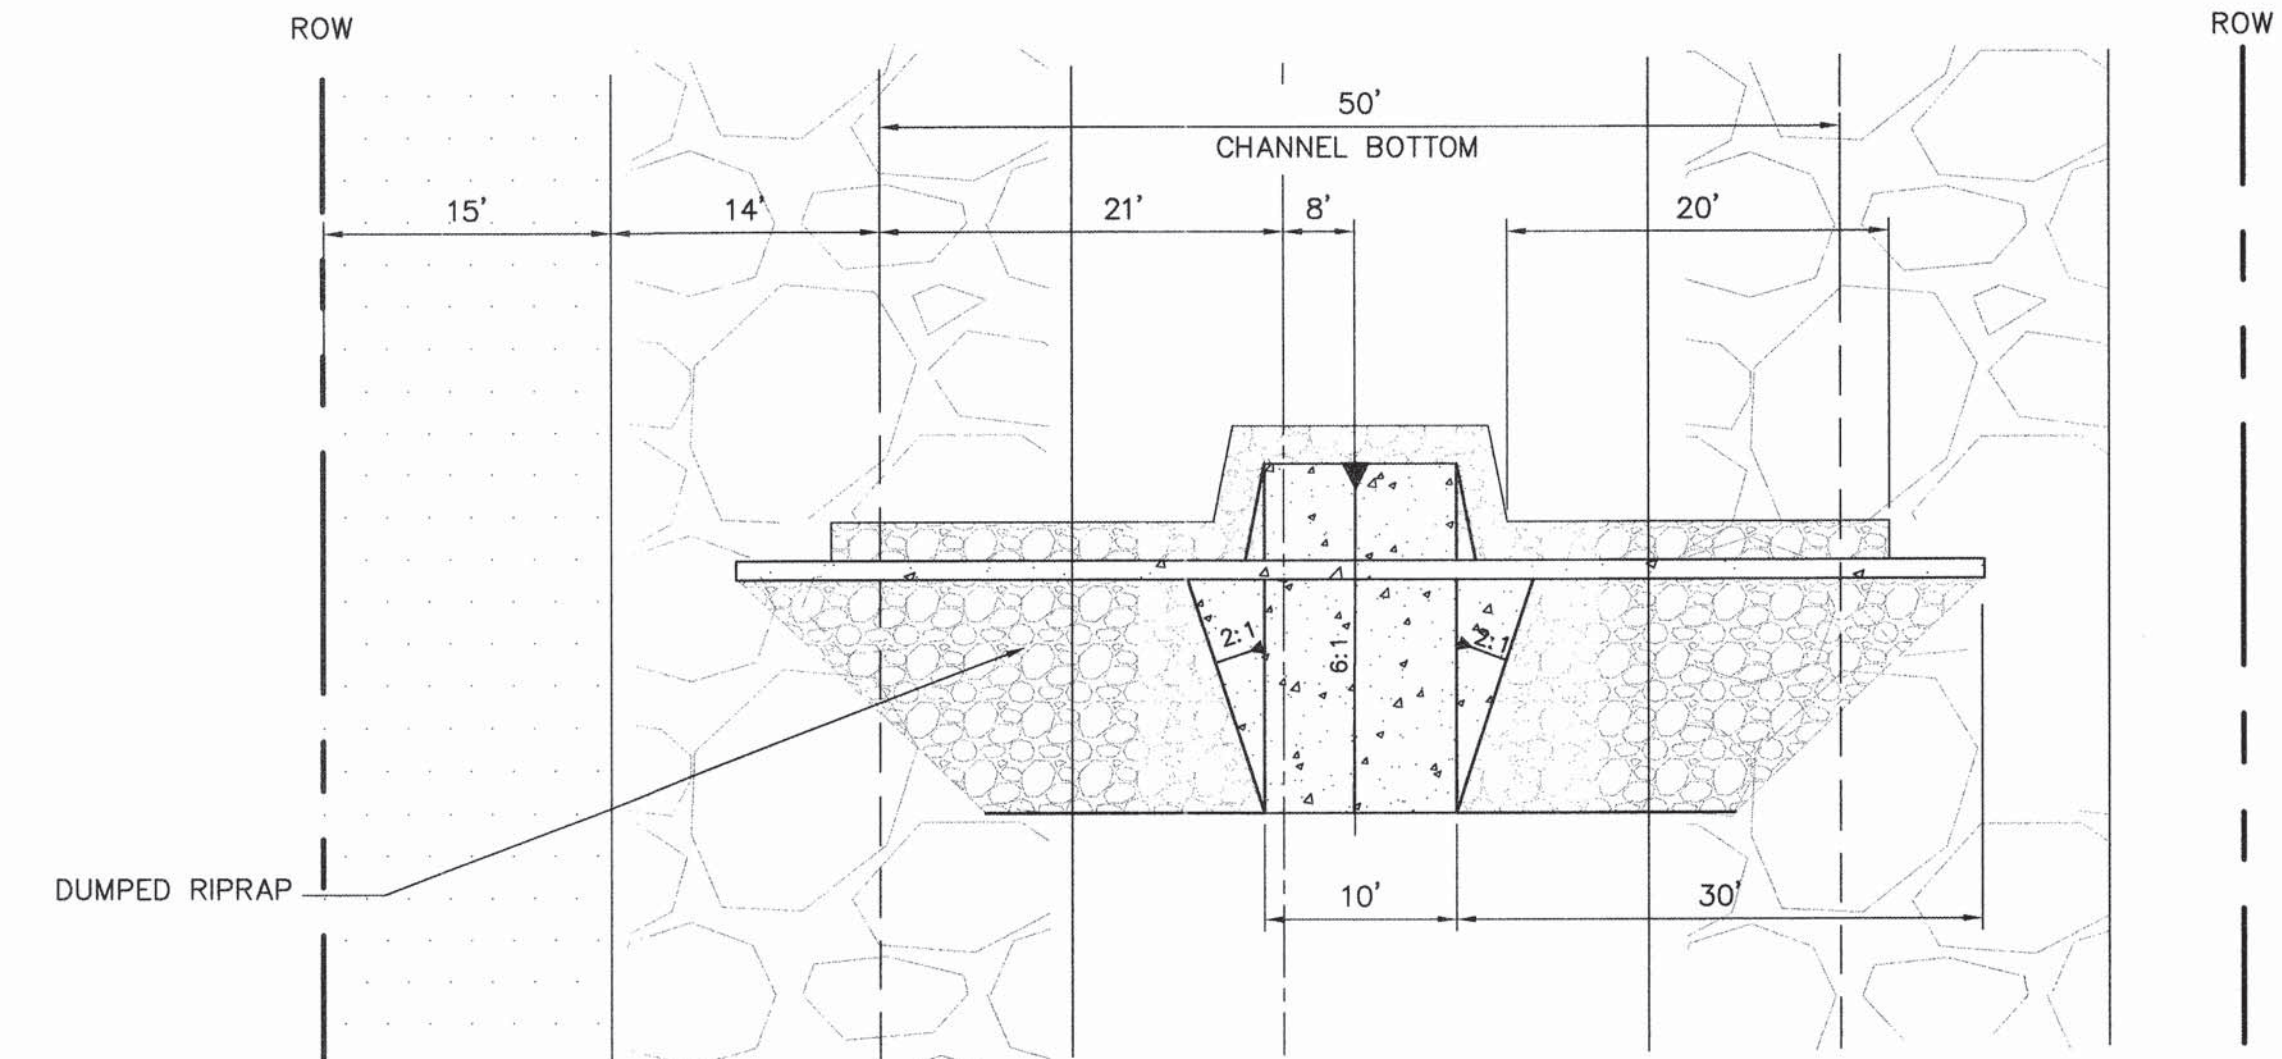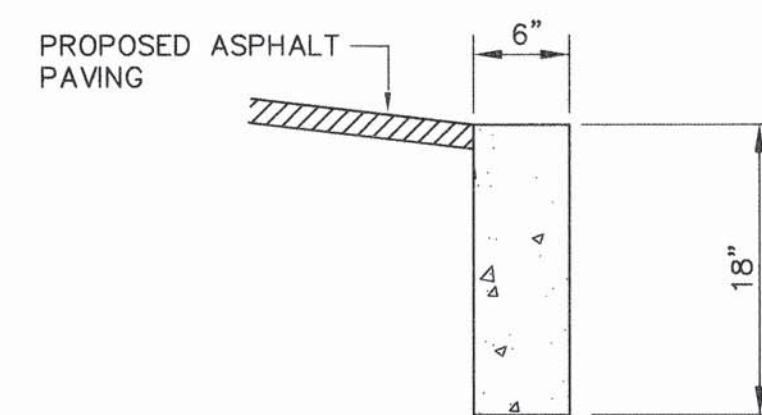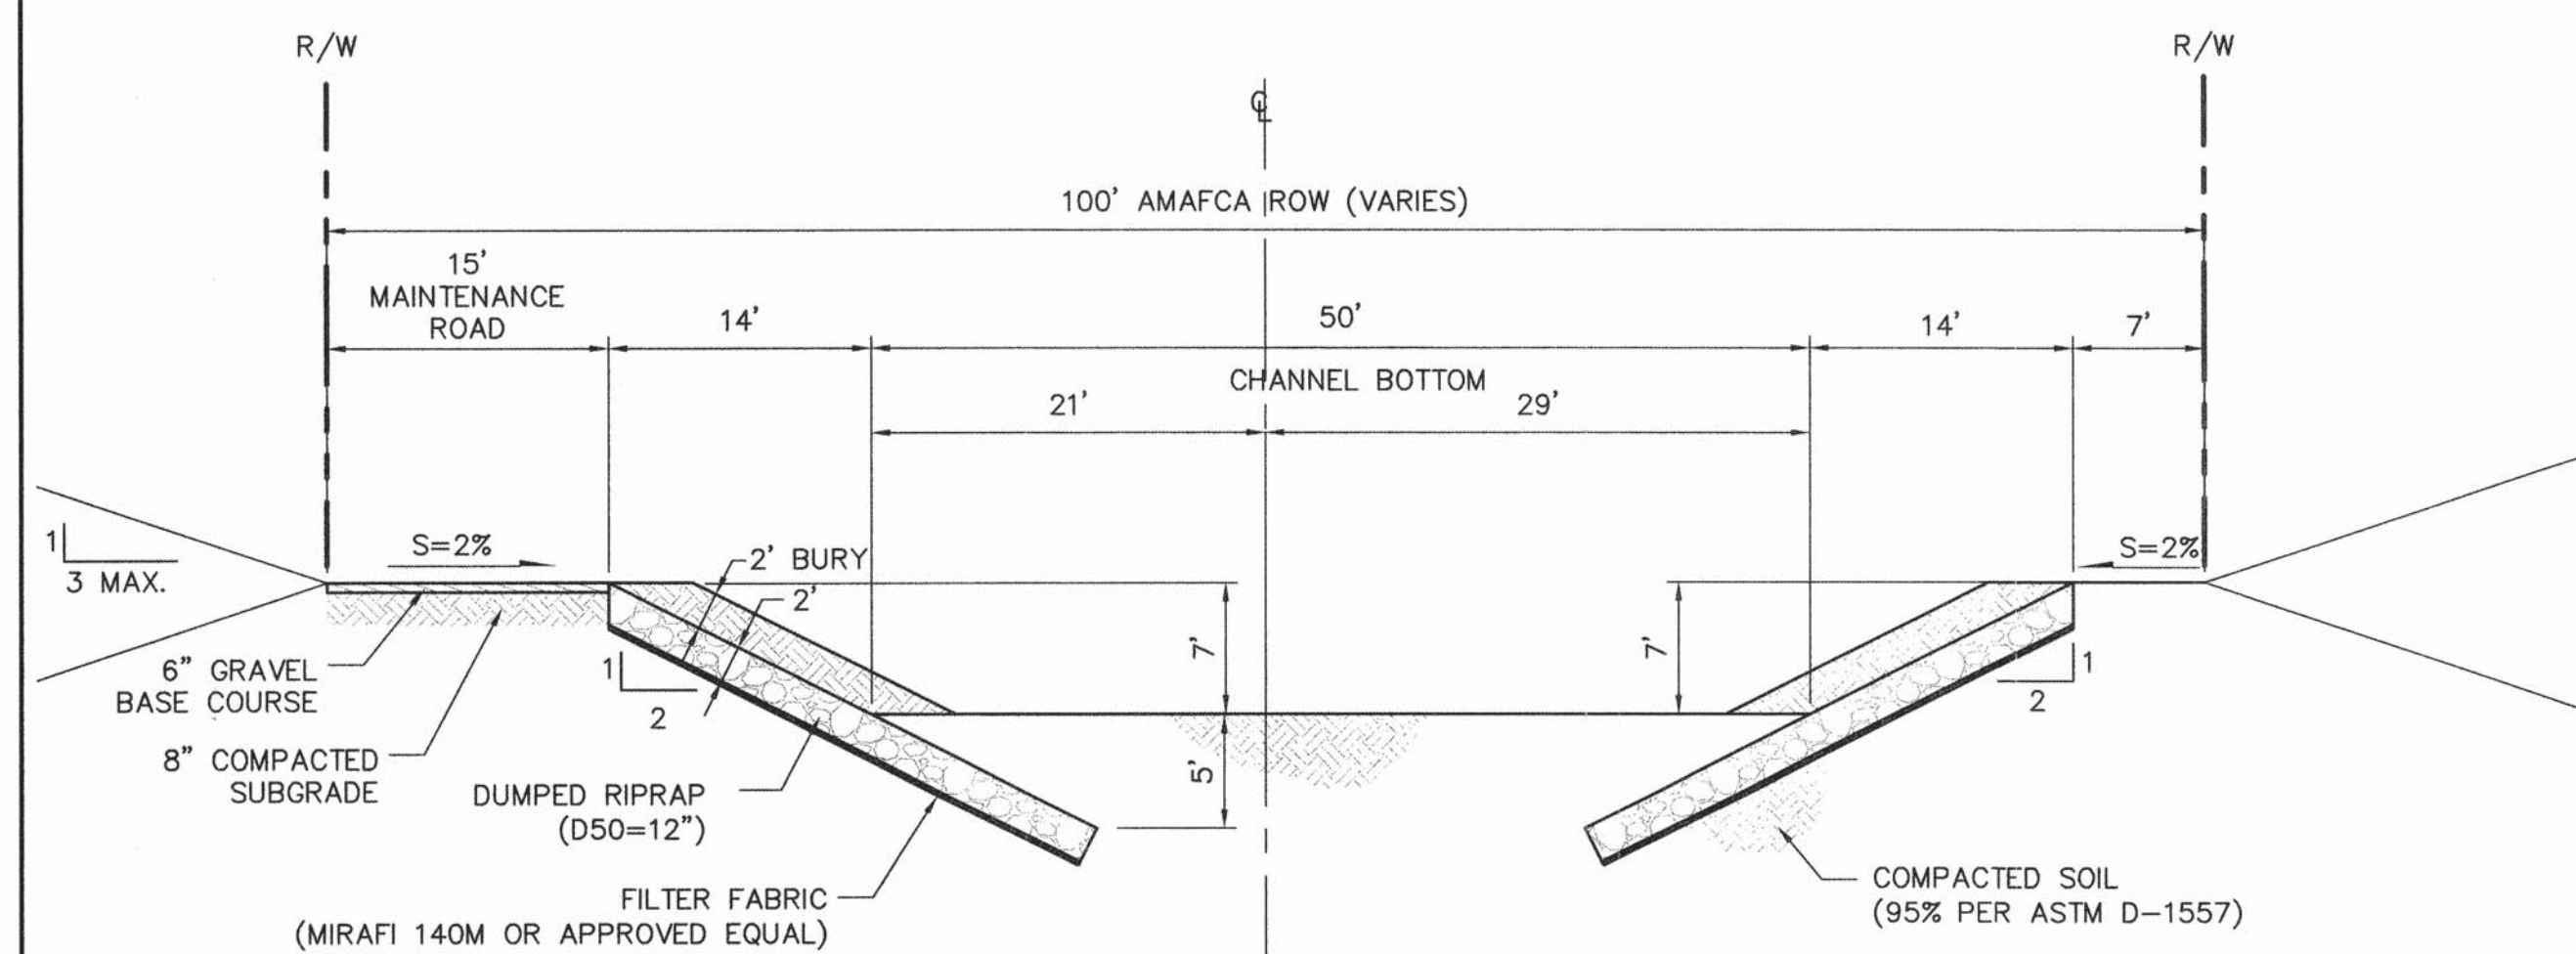

TRAPEZOIDAL ARROYO SECTION

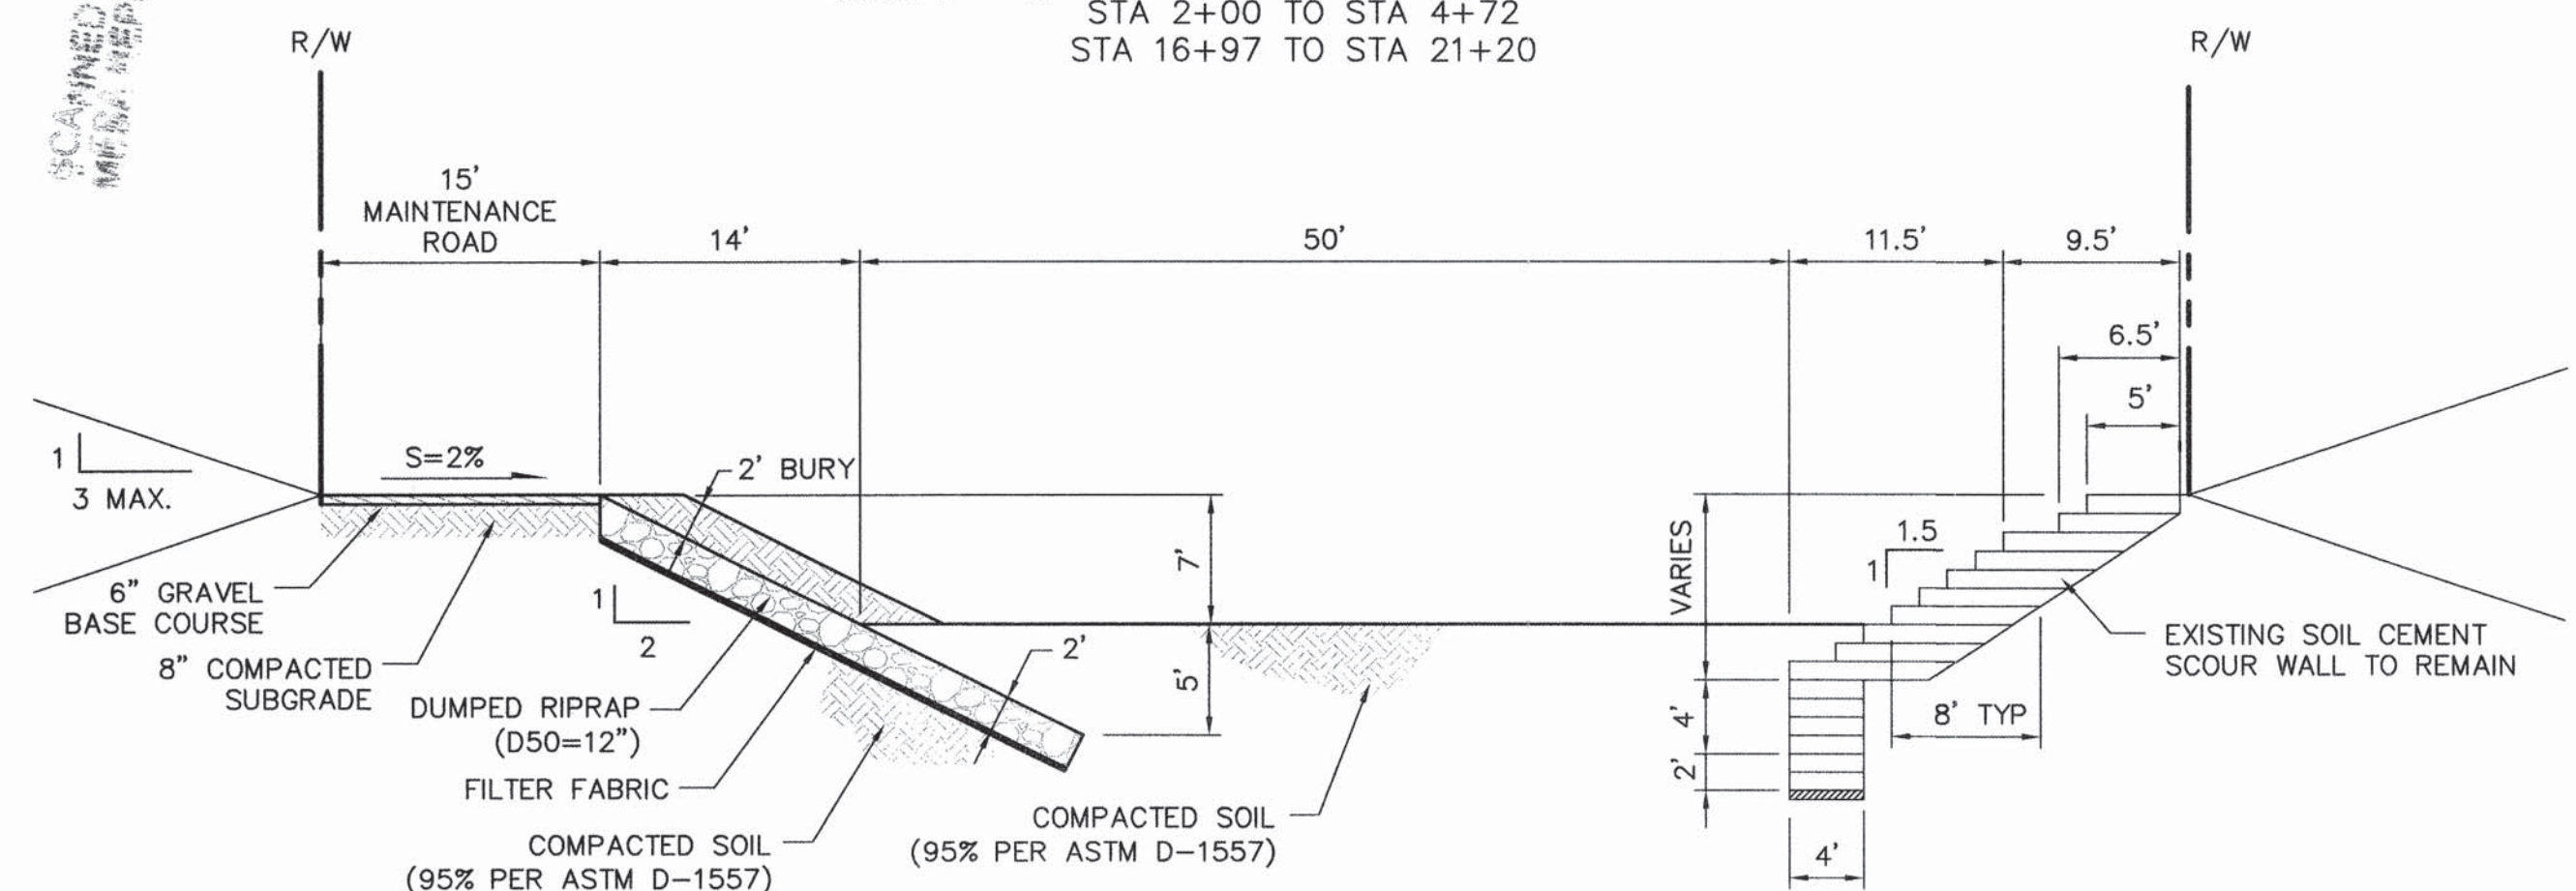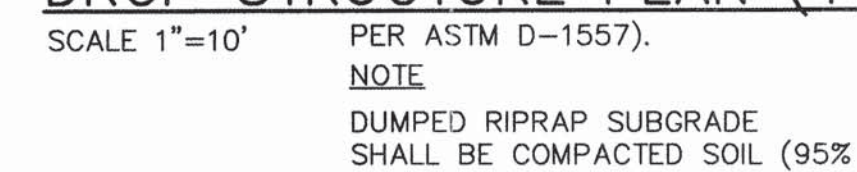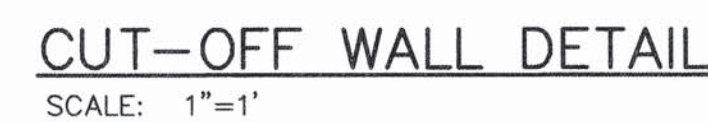


TRAPEZOIDAL ARROYO SECTION

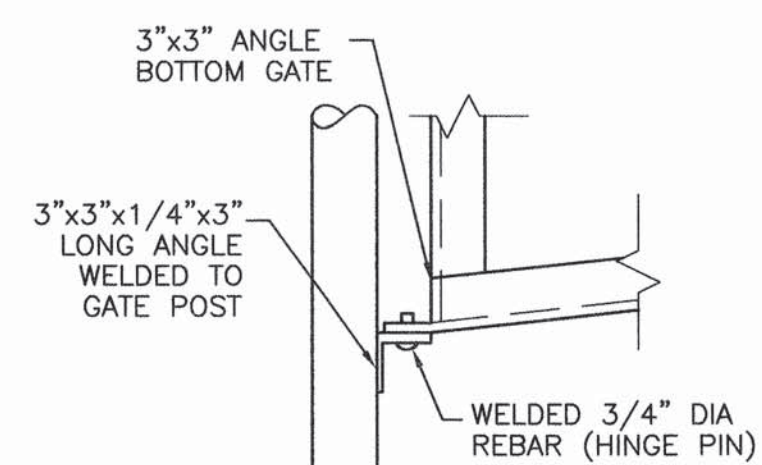


DETAIL C


NTS

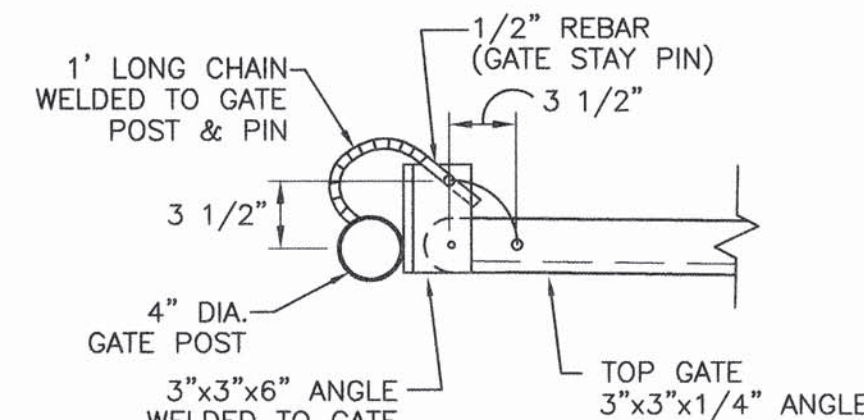


DETAIL B

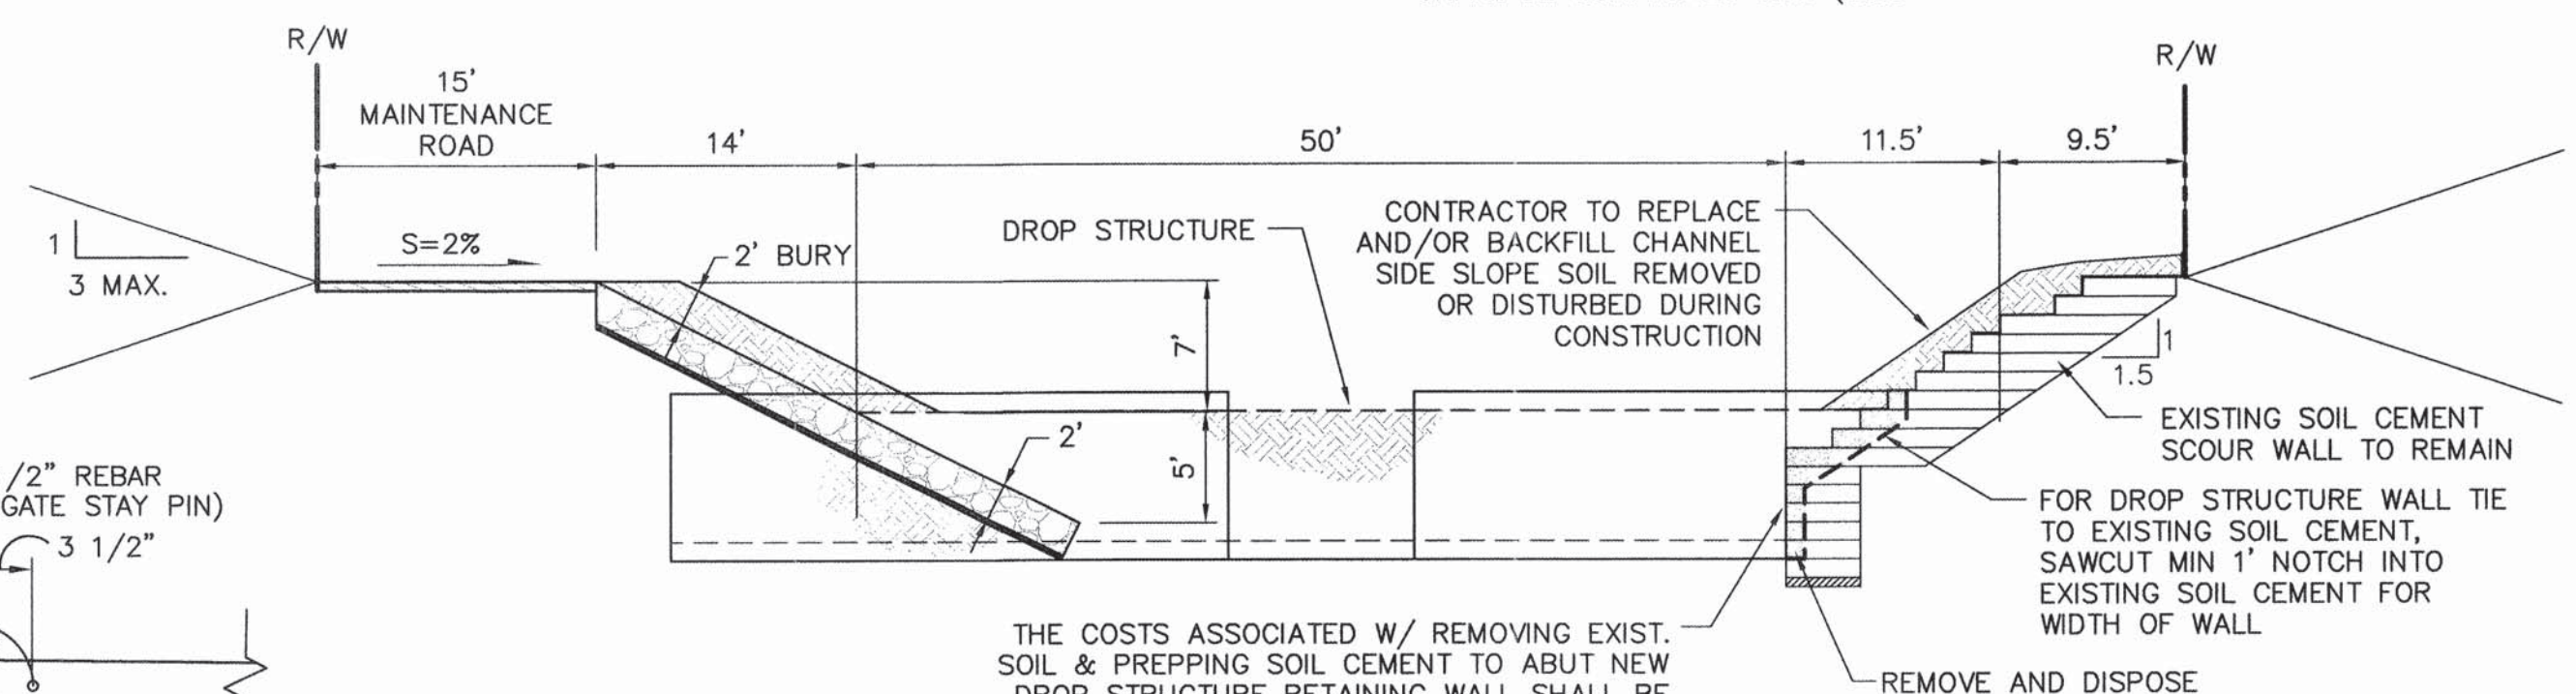


TYPICAL DROP STRUCTURE
W/TRAPEZOIDAL ARROYO SECTION

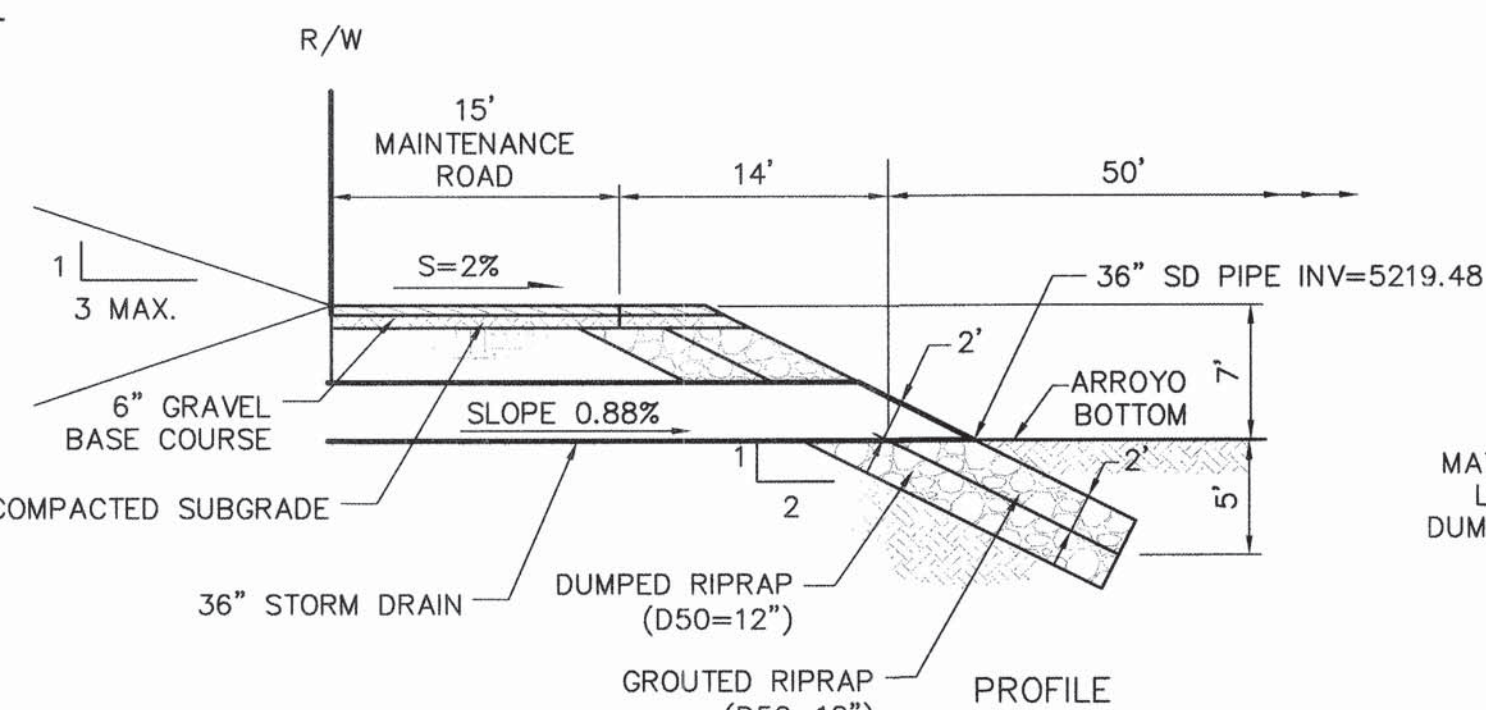

36" STORM DRAIN OUTLET DETAIL

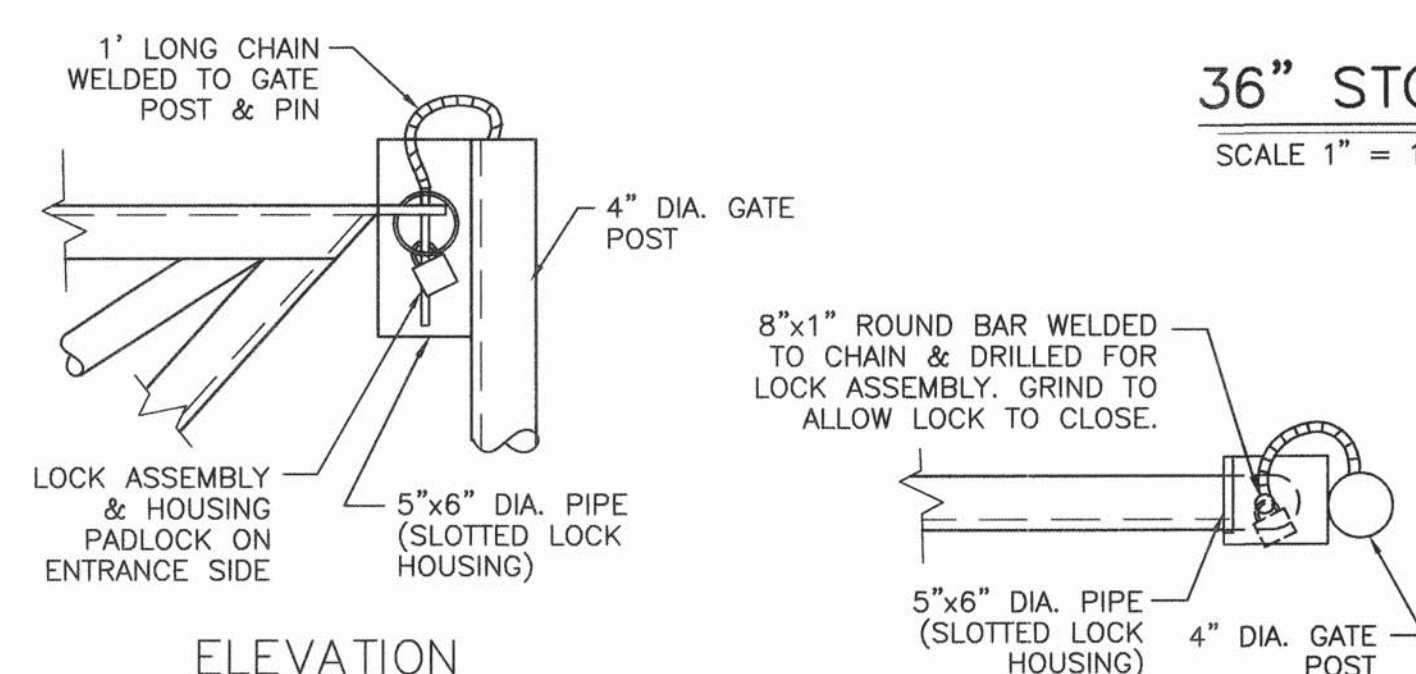



ELEVATION

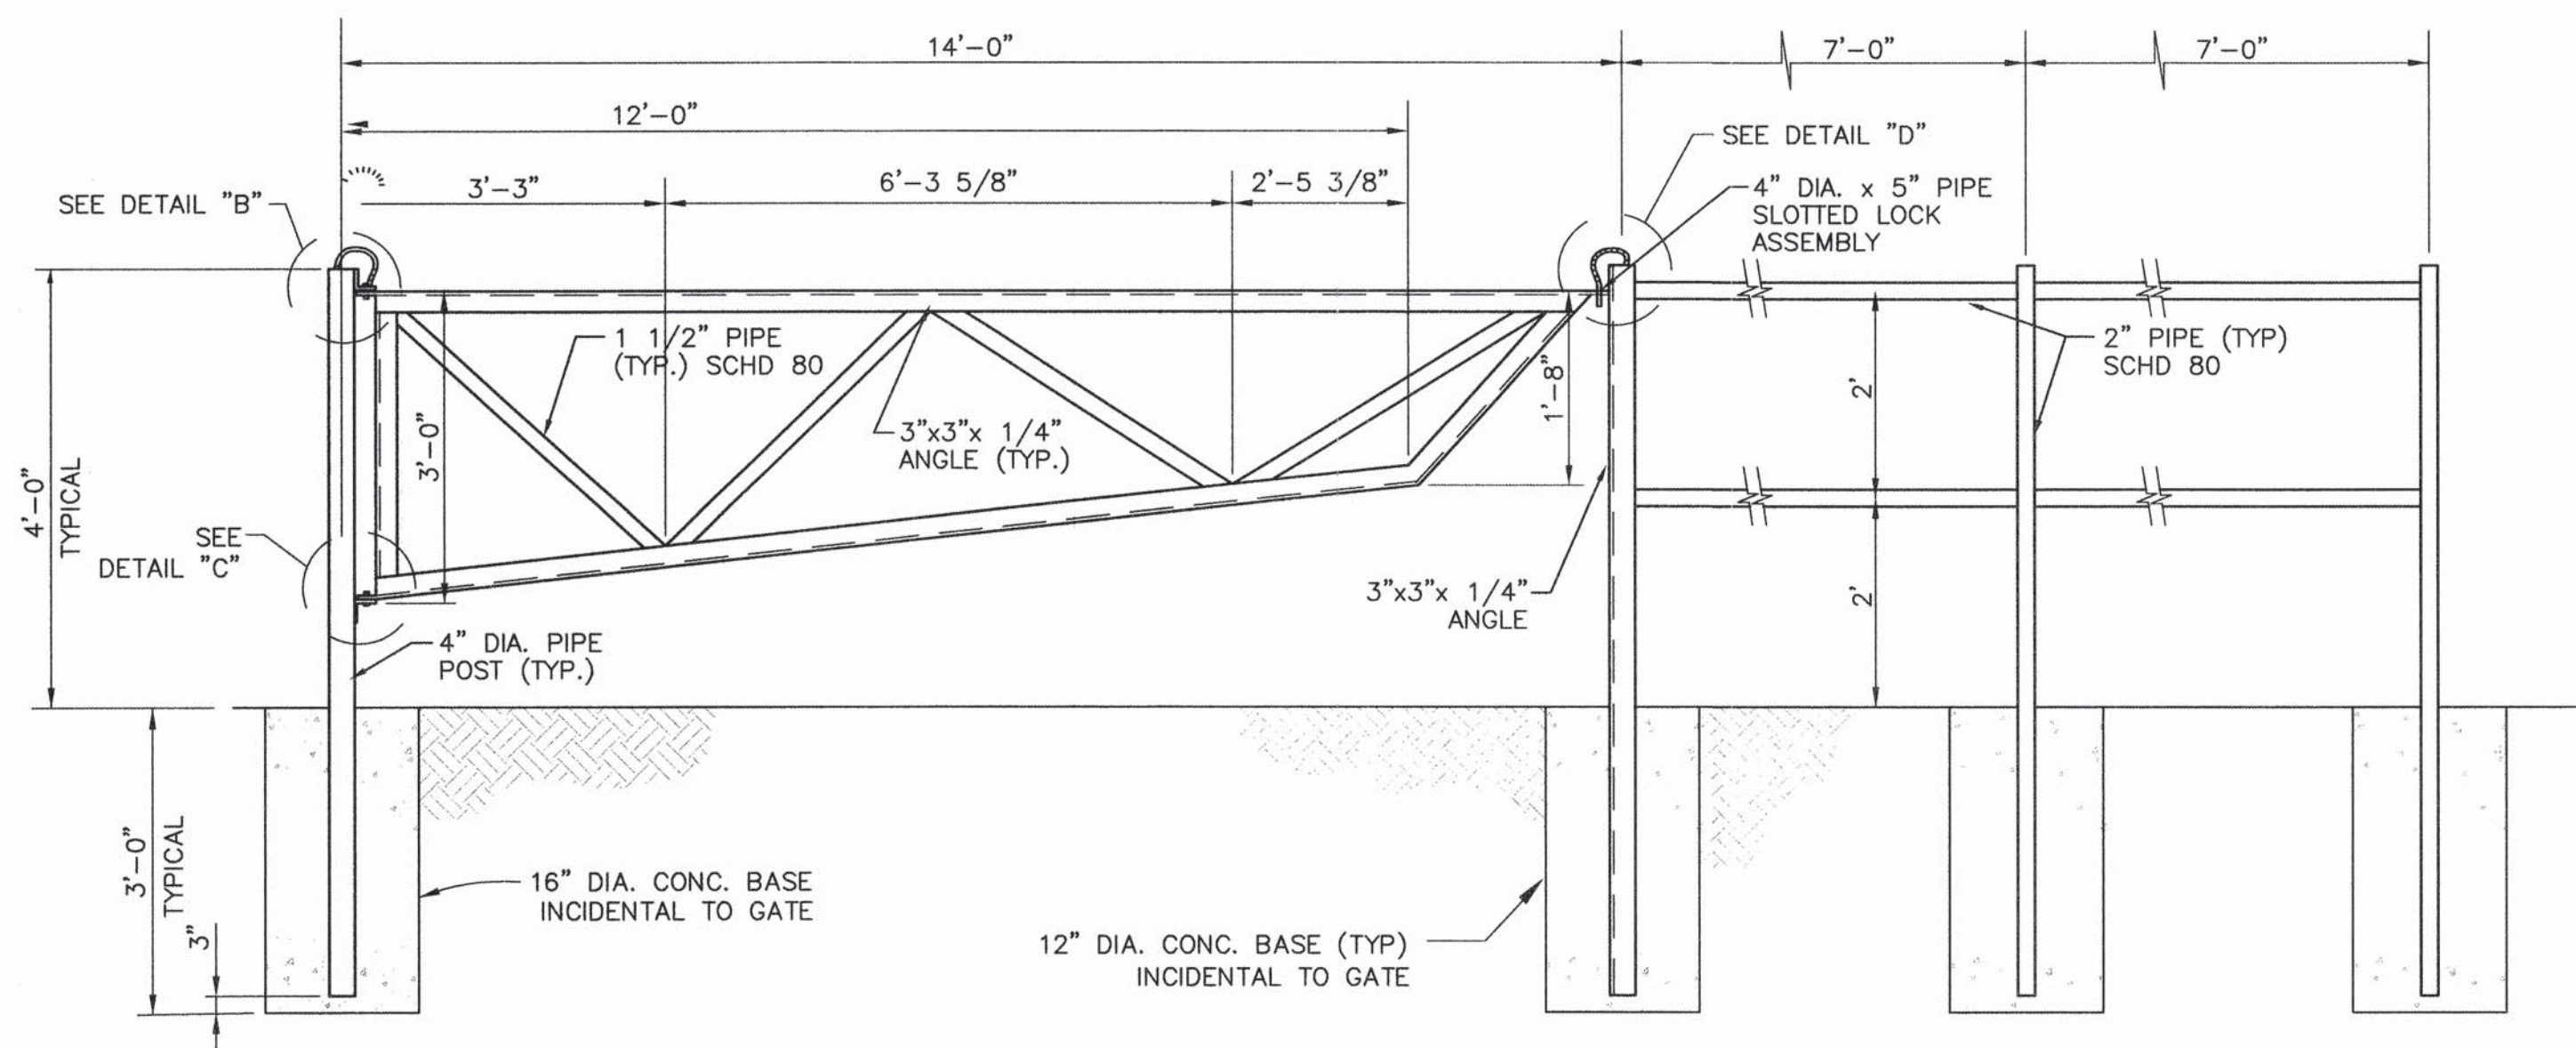


PIPE GATE DETAIL

NOTE: CLEAN AND PAINT ALL PIPE HANDRAIL WITH 1 COAT PRIMER
AND 2 COATS TNEMC 2H (MATCH WELLBORN HAZELNUT BROWN) OR EQUAL
APPROVED BY PROJECT ENGINEER. PAINT INCIDENTAL TO COST OF PIPE RAIL FENCE.

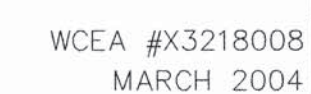


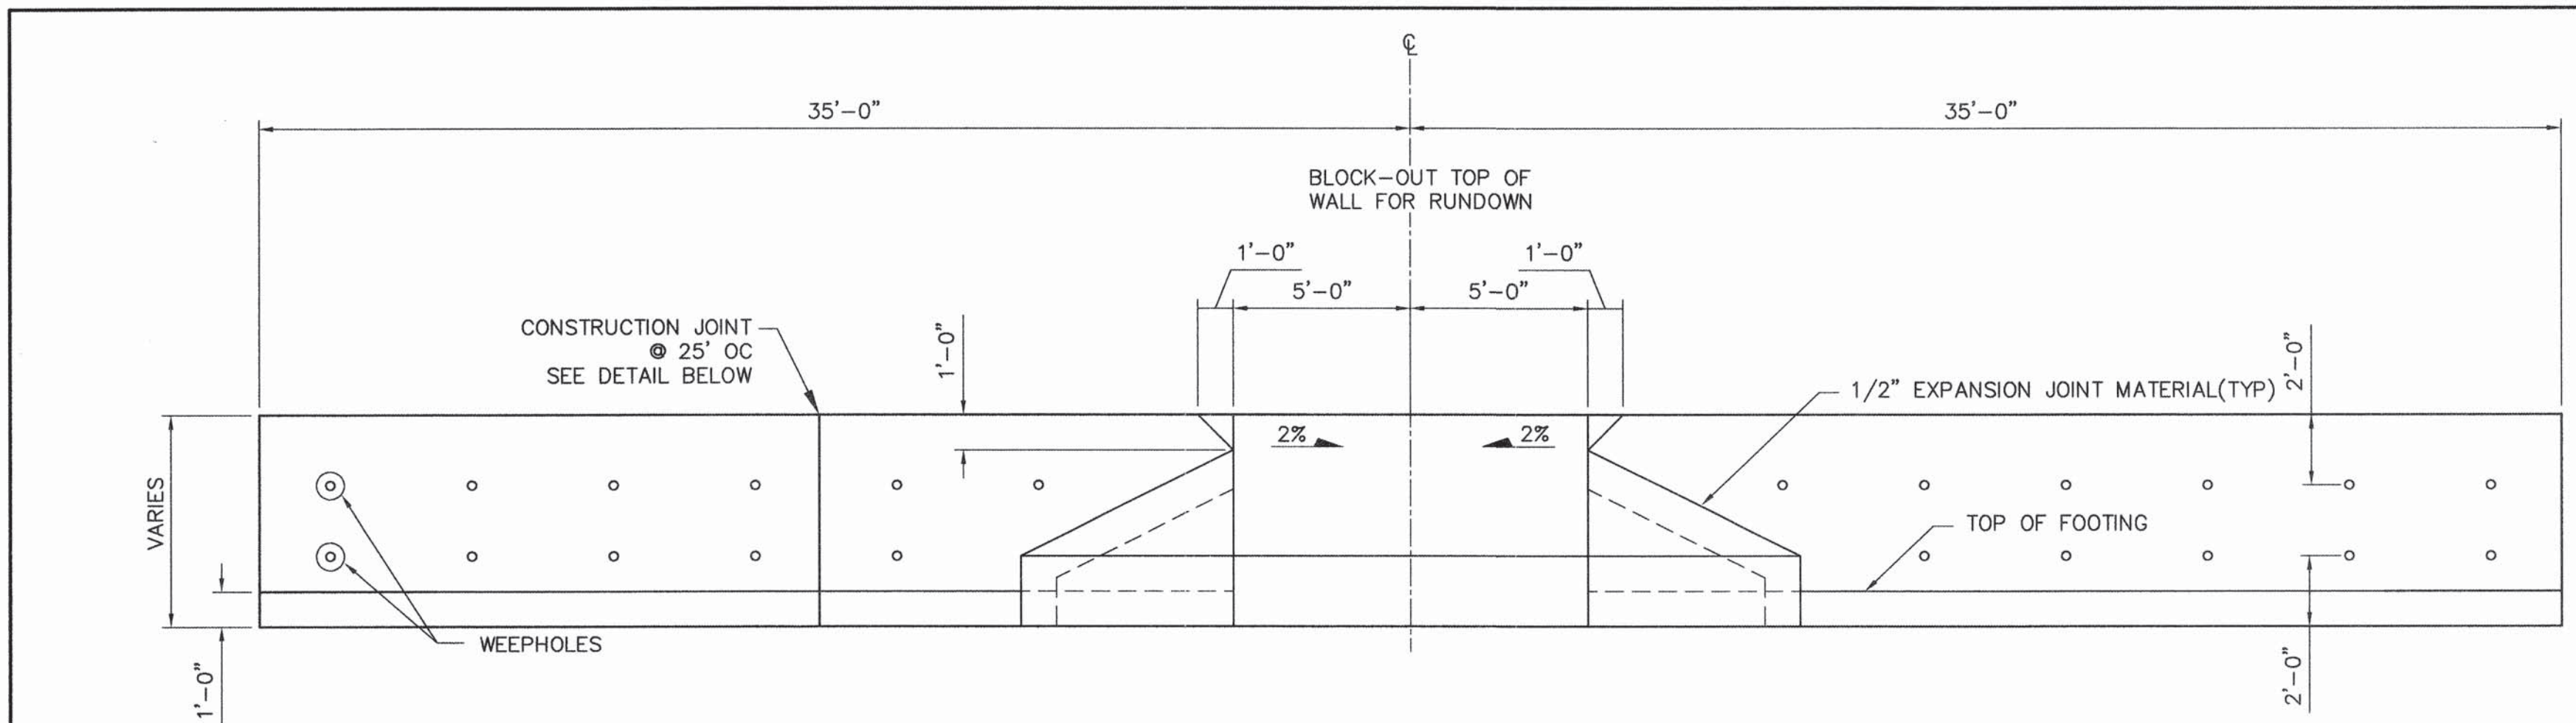


ELEVATION-GRADE CONTROL DROP STRUCTURE
SCALE: 1' = 4'

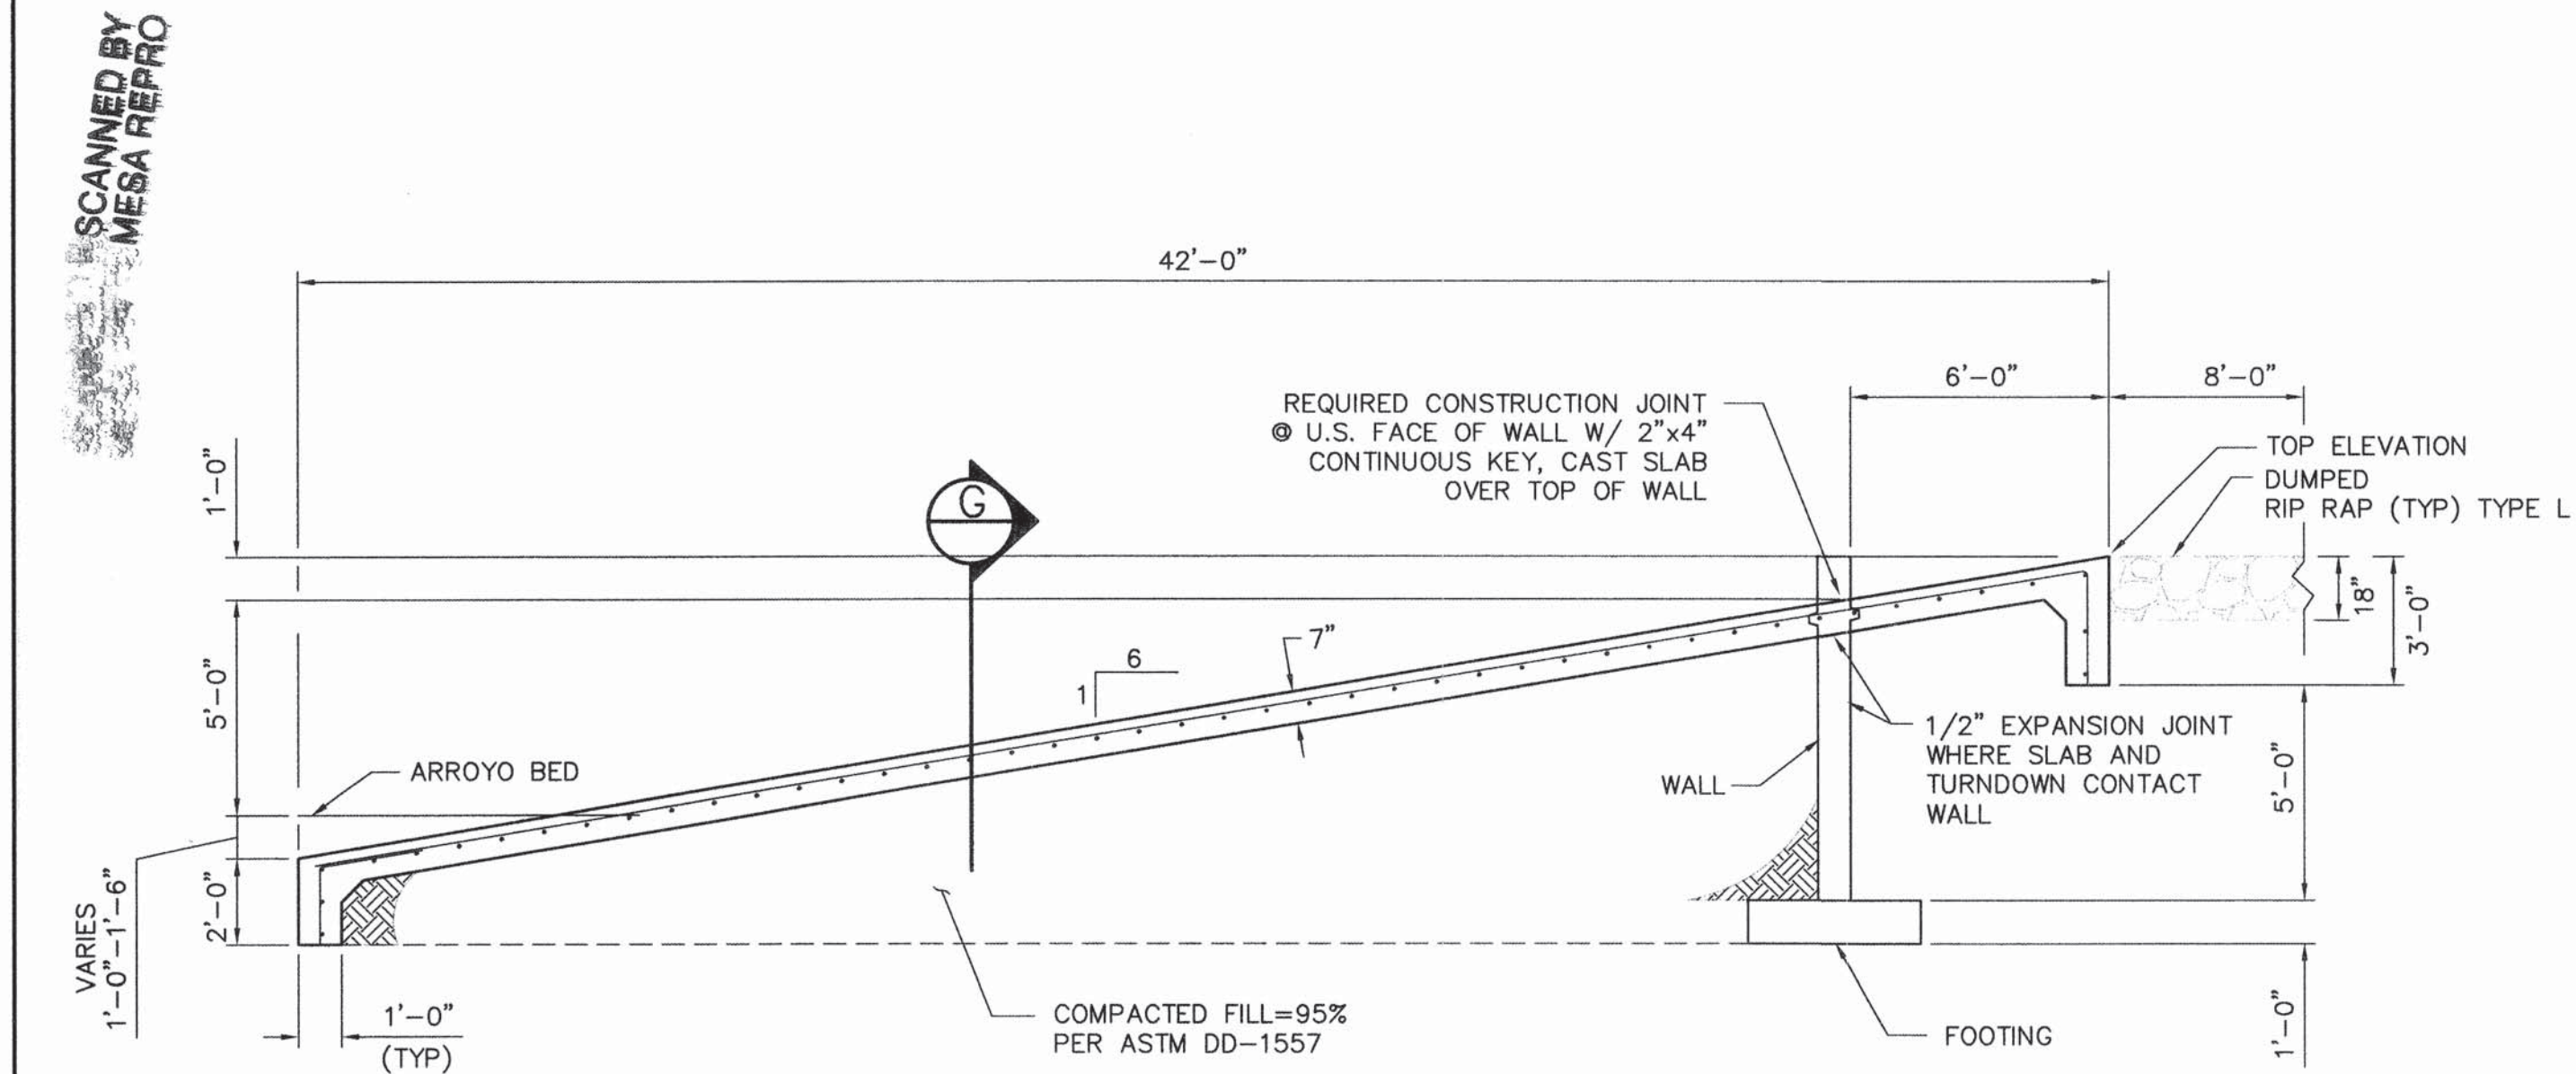


SECTION- 6' DROP STRUCTURE
SCALE: 1' = 4'

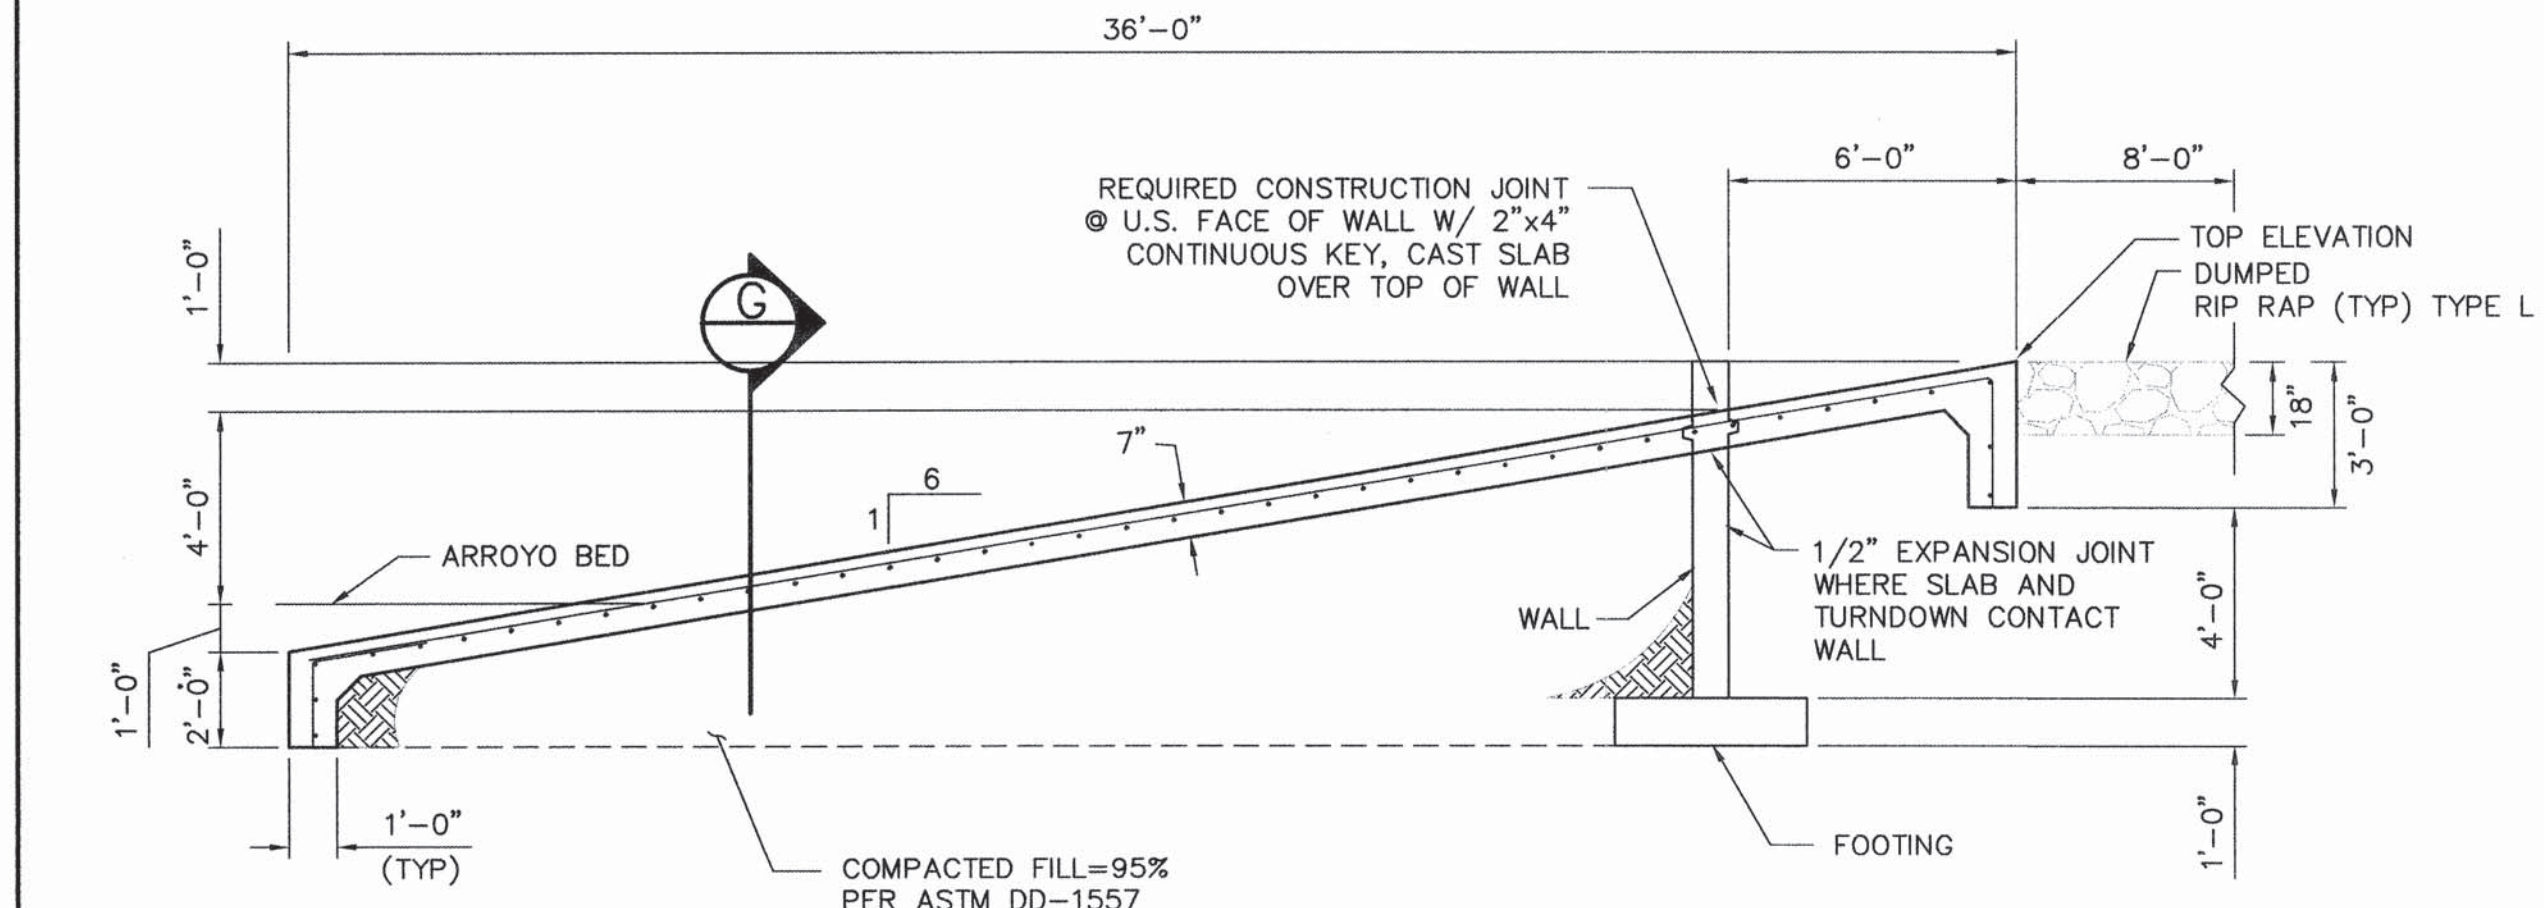


SECTION- 5' DROP STRUCTURE
SCALE: 1' = 4'

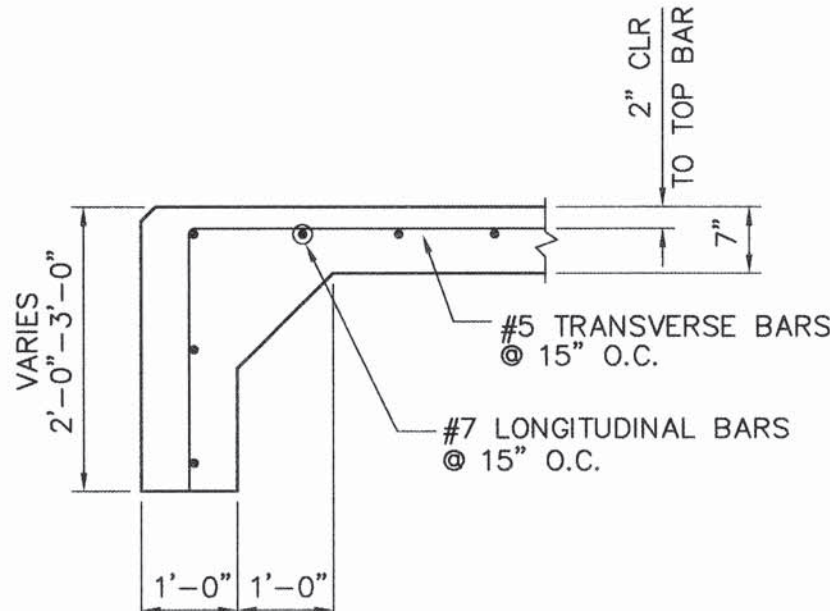


TYPICAL TURNDOWN
SCALE: 1' = 2'

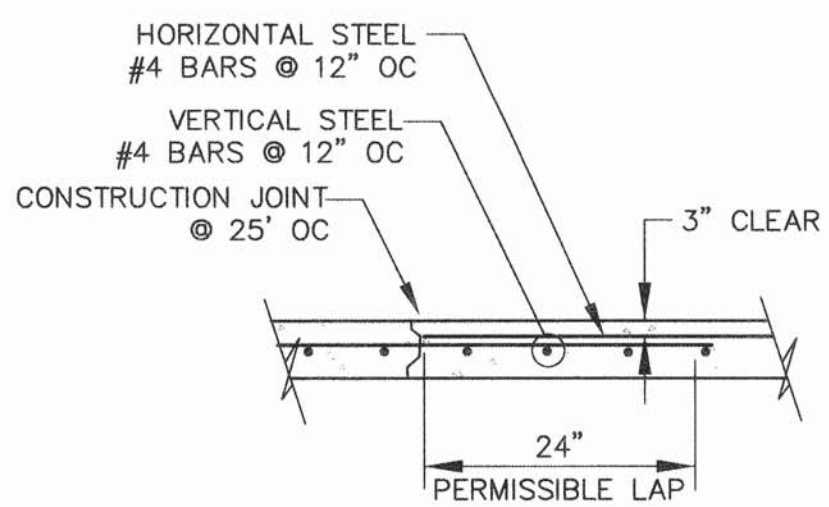


TYPICAL CONSTRUCTION JOINT
NTS

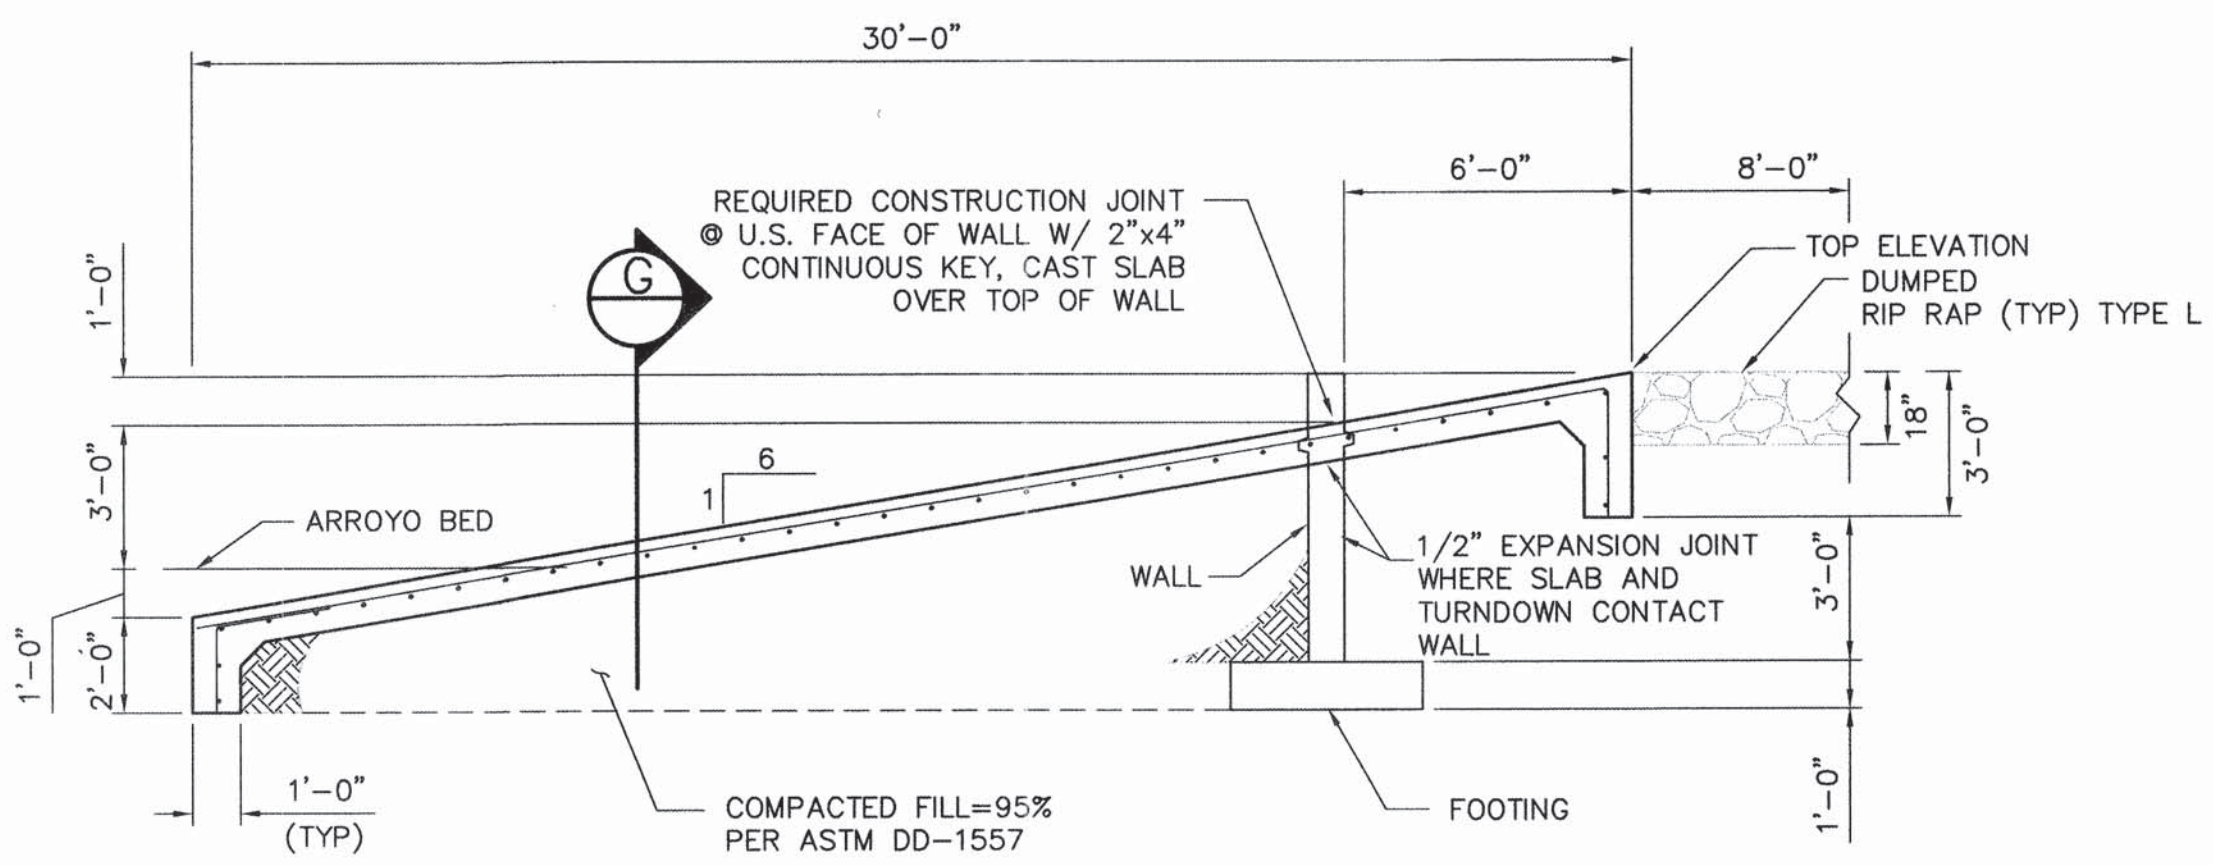

SECTION- 4' DROP STRUCTURE
SCALE: 1' = 4'

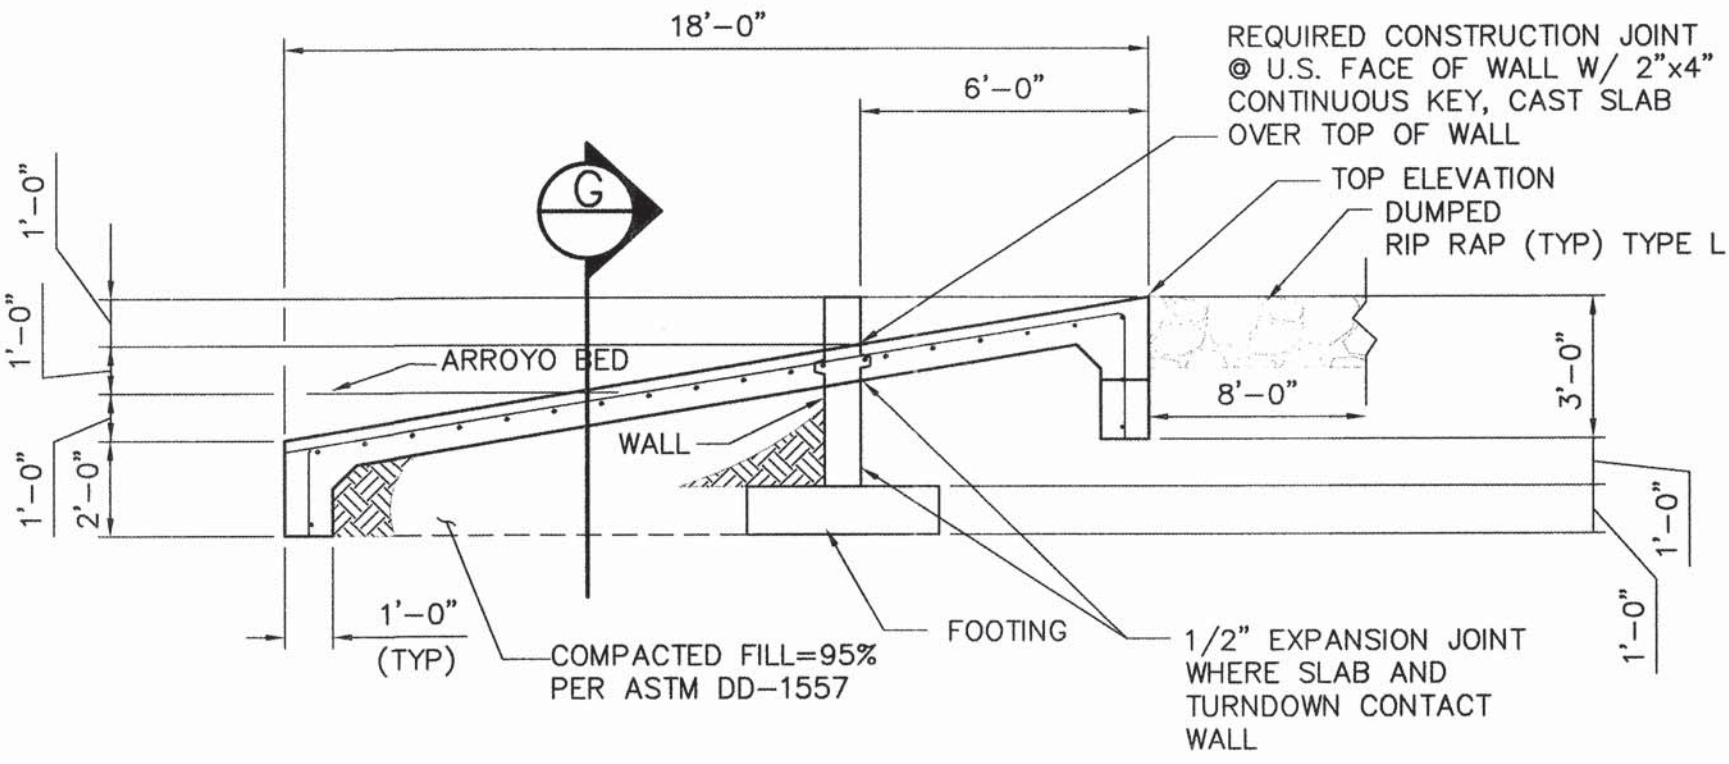

SECTION- 2' DROP STRUCTURE
SCALE: 1' = 4'

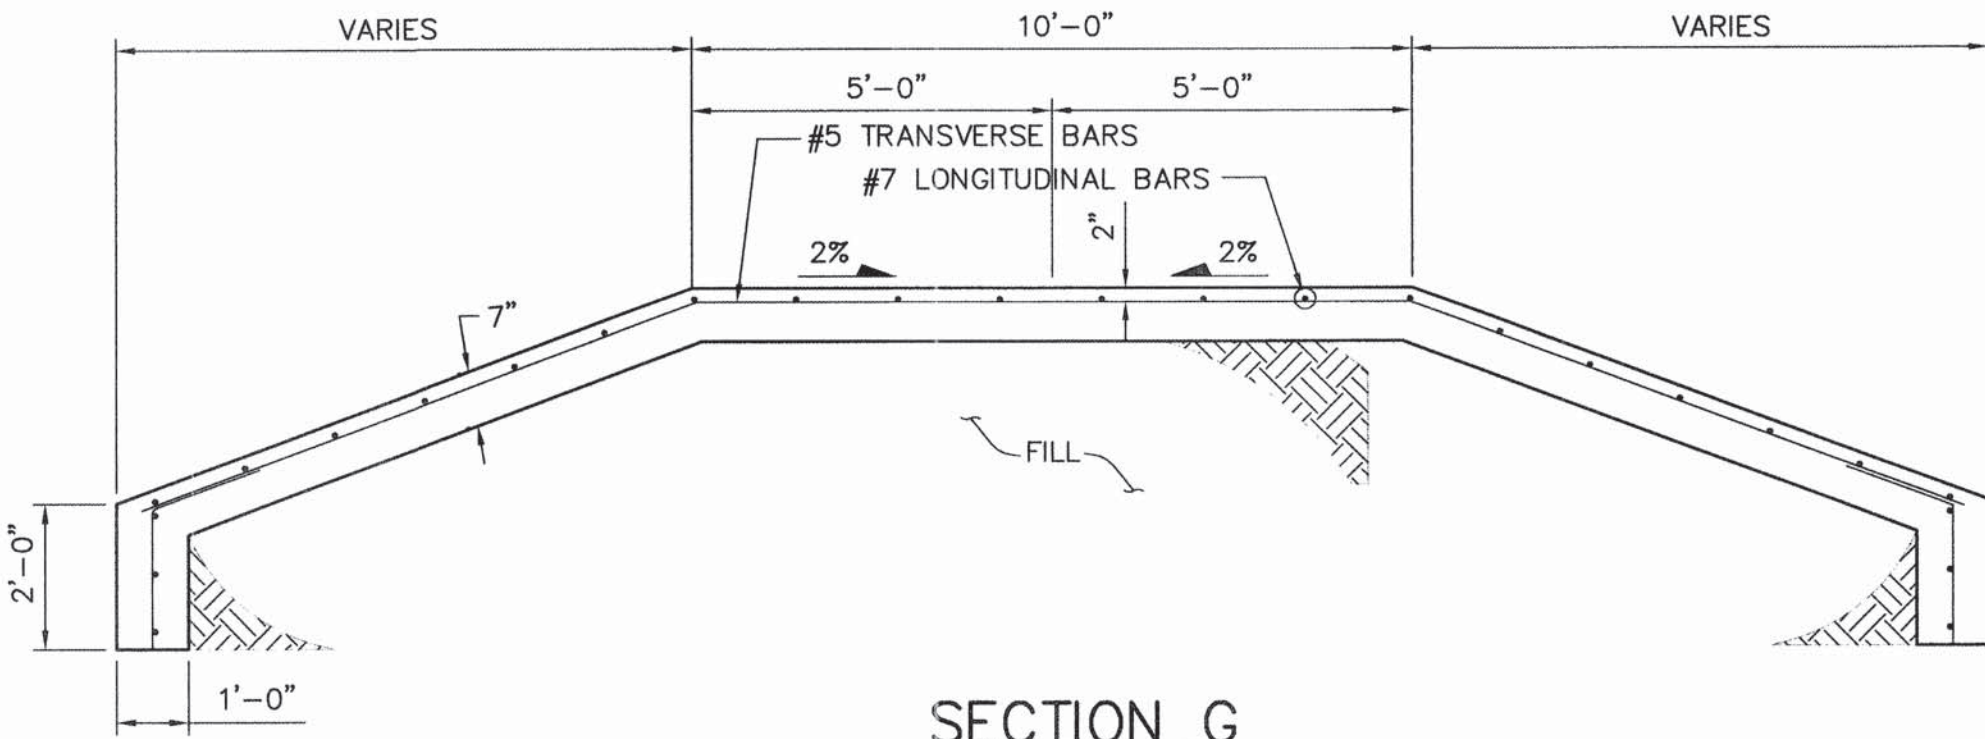

SECTION G
SCALE: 1' = 3'

WILSON & COMPANY
2600 THE AMERICAN ROAD S.E.
SUITE 100
RIO RANCHO, NEW MEXICO 87124
(505) 898-8021


CITY OF ALBUQUERQUE
PUBLIC WORKS DEPARTMENT
ENGINEERING GROUP

**THE CROSSING SUBDIVISION UNIT 3
DROP STRUCTURE DETAILS**

DESIGNED BY: JMT
DRAWN BY: DLC
CHECKED BY: BWS

Design Review Committee		City Engineer Approval		Last Design Update	
 DESIGN REVIEW COMMITTEE	 CITY ENGINEER	 DESIGN REVIEW COMMITTEE	 CITY ENGINEER	 DESIGN REVIEW COMMITTEE	 CITY ENGINEER
City Project No. 545383		Zone Map No. H-9-Z		Sheet 16 of 19	

SCANNED BY
MESA REPRO

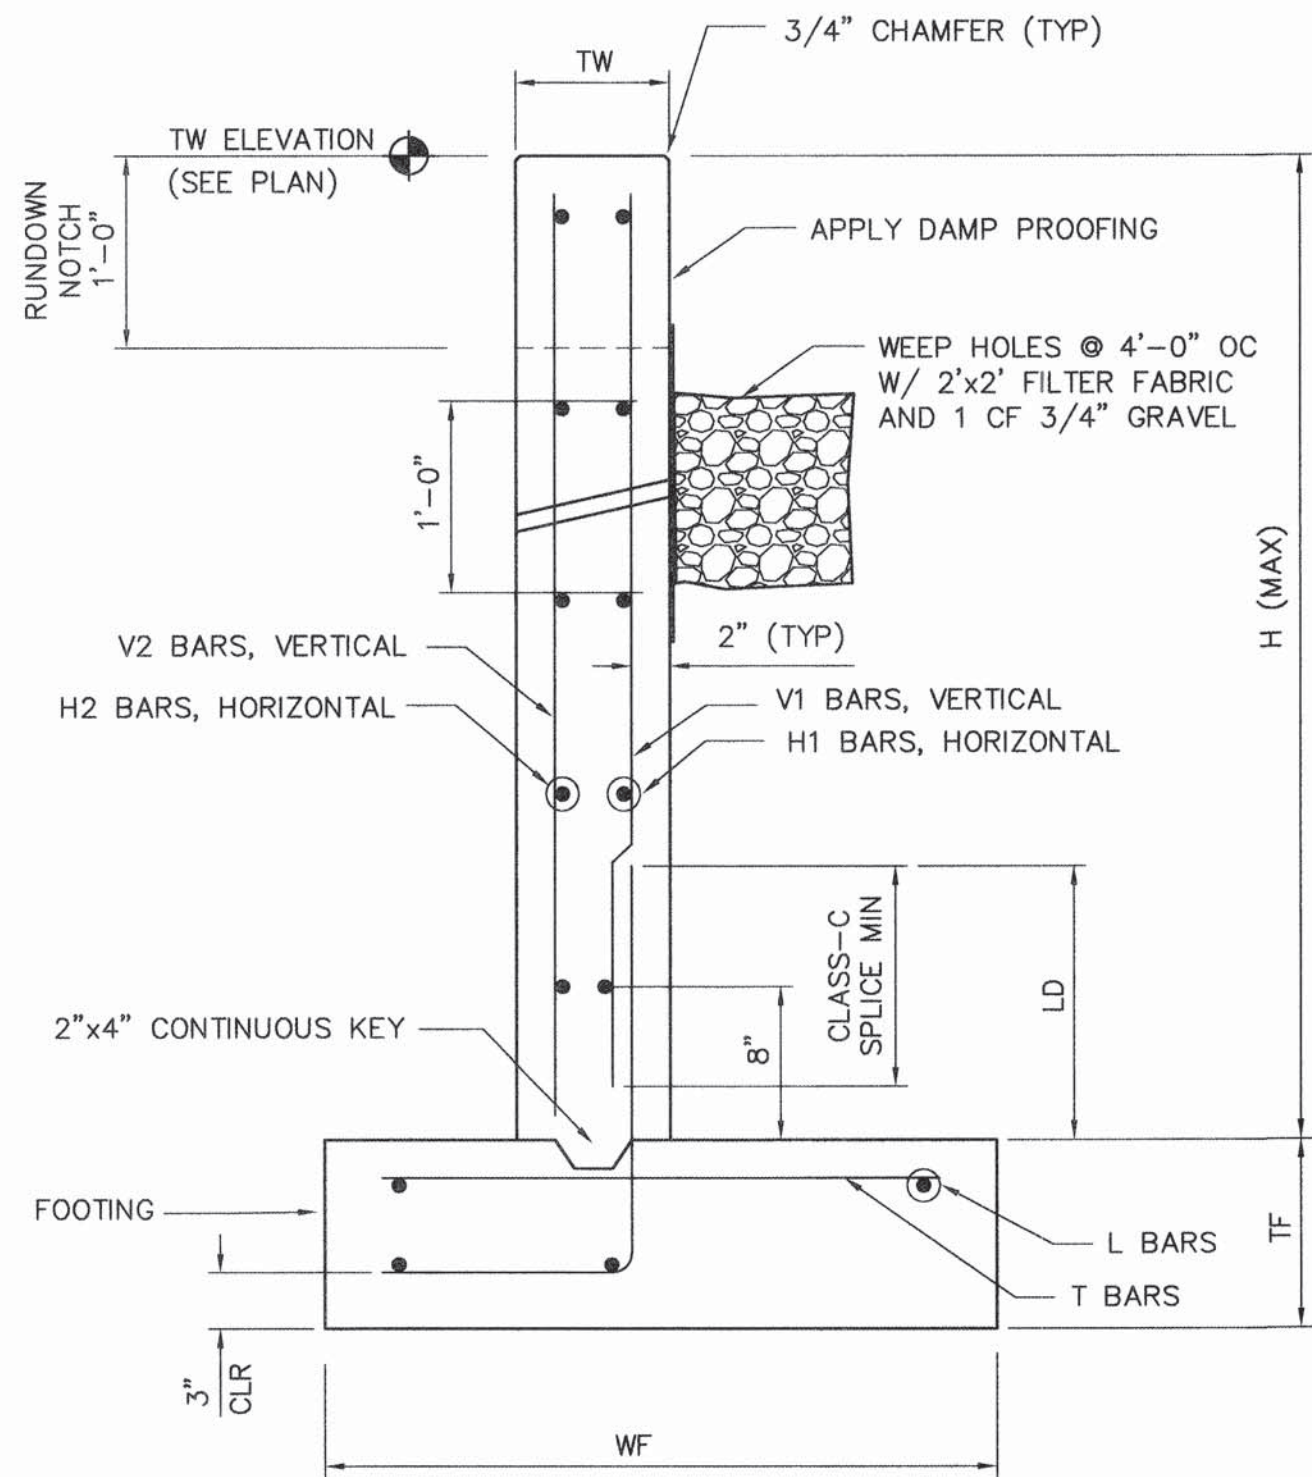

TYPICAL DROP STRUCTURE RETAINING WALL DETAIL
SCALE: 1" = 1'

DIMENSIONS									
ELEV. DROP	WALL TYPE	H (MAX) (FT)	TF (IN)	TW (IN)	TOE (IN)	HEEL (IN)	WF (IN)	LD (IN)	
2'	B1	4	12	8	18	27	45	28	
4'	B2	6	12	8	24	36	60	32	
5'	B3	7	12	8	30	42	72	32	
6'	B4	8	12	8	30	42	72	32	


REINFORCING													
WALL TYPE	D		V1		H1		V2		H2		L		T
	SIZE	SPACE	SIZE	SPACE	SIZE	SPACE	SIZE	SPACE	SIZE	SPACE	SIZE	NO. REQ'D	
B1	5	12	4	12	4	12	4	12	4	12	4	5	4 18
B2	6	12	4	12	4	12	4	12	4	12	4	7	4 18
B3	6	12	4	12	4	12	4	12	4	12	4	7	4 18
B4	6	12	4	12	4	12	4	12	4	12	4	7	4 18

RETAINING WALL TABLES

NOTES FOR CAST-IN-PLACE RETAINING WALL

1. WORKMANSHIP AND MATERIALS SHALL CONFORM TO THE STANDARD SPECIFICATIONS.
2. ALL CONCRETE SHALL BE CLASS A, 3000 PSI., TINTED, SAN DIEGO BUFF, 1#/SACK CEMENT FOR RAMP SURFACE.
3. REINFORCING BARS SHALL CONFORM TO AASHTO SPECIFICATION M31, GRADE 60. ALL DIMENSIONS ARE TO CENTERLINE OF THE BAR UNLESS NOTED OTHERWISE.
4. CAST-IN-PLACE WALL SHALL RECEIVE A FINISH OF THORO-COAT, SAN DIEGO BUFF.
5. REBAR LAP SPLICES SHALL BE CLASS "B" (ACI).
6. HORIZONTAL REBAR SHALL BE LAPPED AND CONTINUOUS EXCEPT WHERE NOTED.
7. DAMP PROOFING SHALL CONSIST OF ONE APPLICATION OF AN EMULSIFIED ASPHALT COMPOUND, HYDROCID 700B OR APPROVED EQUAL.
8. WHERE NO V1 BARS OR DIMENSION LD IS SPECIFIED, THE D BARS SHALL EXTEND TO THE TOP OF THE WALL.

LOADS
COULOMB EARTH PRESSURE FOR ϕ = 40°
SOIL UNIT WEIGHT = 120 PCF
ALLOWABLE BEARING PRESSURE = 3000 PSF
COEFFICIENT OF FRICTION FOR SLIDING = 0.40

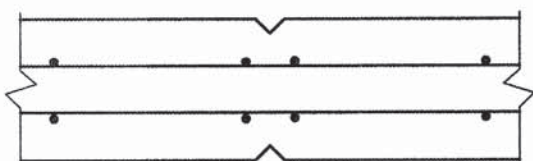


VERTICAL CONTRACTION JOINT
PLAN DETAIL @ 15' O.C.
SCALE: 1" = 2'

AS-BUILT INFORMATION		BENCH MARKS		SURVEY INFORMATION		ENGINEER'S SEAL	REVISIONS		REMARKS	
CONTRACTOR	DATE	A.C.S. Aluminum Tablet Stamped "BH-40" Data:	DATE	FIELD NOTES	DATE		NO.	DATE	BY	DATE
NeLender Concrete	2003	New Mexico State Plane Grid Coordinates (Central Zone) NAD 1927 X=352,790.66 Y=1,492,346.53	2003							
Inspector	DATE	Ground to grid factor = 0.9996105	DATE							
Verification	DATE	Delta Alpha = (-)0016"59" ELEV = 5305.43	DATE							
Drawings	DATE	A.C.S. Aluminum Tablet Stamped "BH-41" Data:	DATE							
Micro-Film	DATE	New Mexico State Plane Grid Coordinates (Central Zone) NAD 1927 X=351,455.56 Y=1,496,546.13	DATE							
Information	DATE	Ground to grid factor = 0.99966704	DATE							
		Delta Alpha = (-)0017"08" ELEV = 5398.63								

WILSON & COMPANY 2600 THE AMERICAN ROAD S.E. SUITE 100 RIO RANCHO, NEW MEXICO 87124 (505) 898-8021	CITY OF ALBUQUERQUE PUBLIC WORKS DEPARTMENT ENGINEERING GROUP	
	THE CROSSING SUBDIVISION UNIT 3 DROP STRUCTURE RETAINING WALL DETAILS	
	Design Review Committee 	City Engineer Approval
	City Project No. 545383	Zone Map No. H-9-Z
Sheet 17 Of 19		

WCEA #X3218008
MARCH 2004

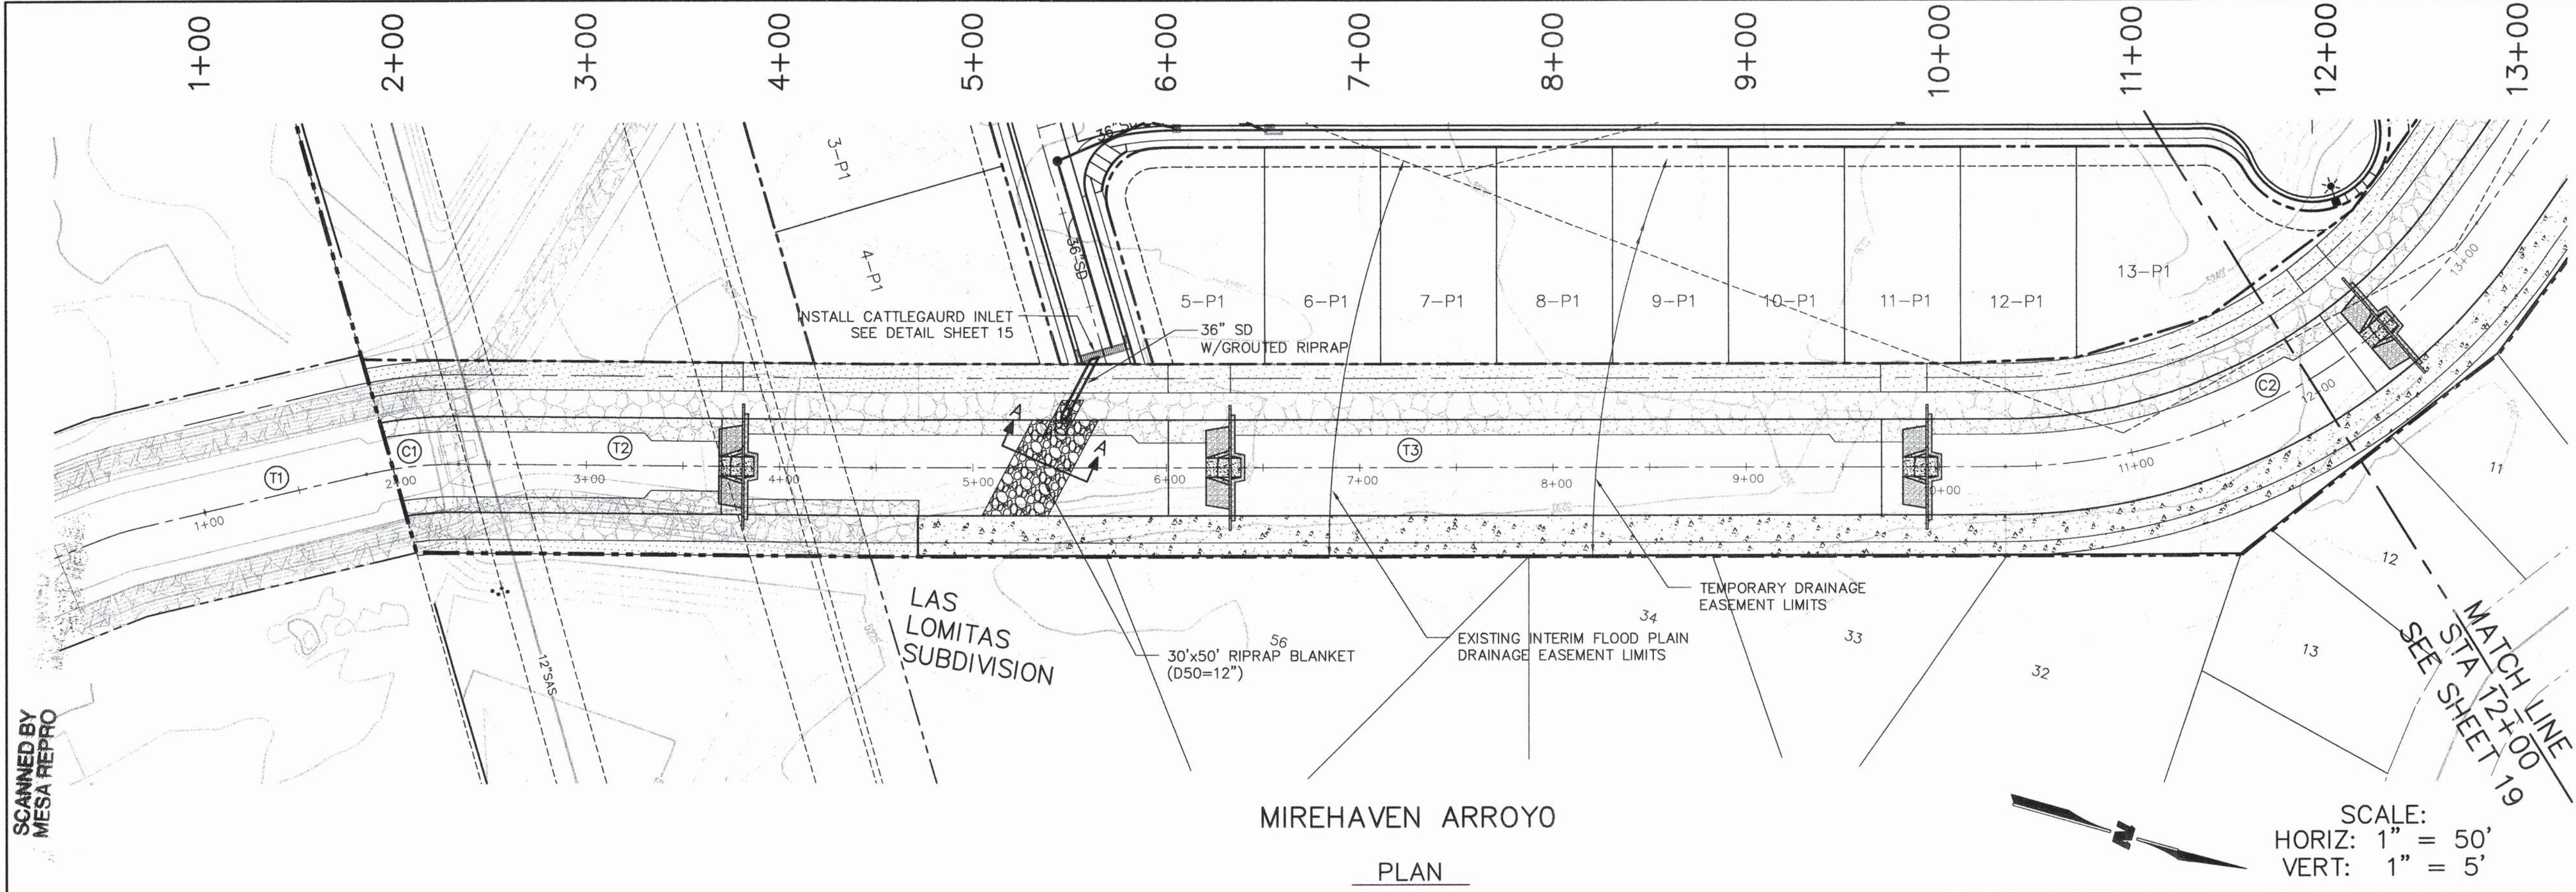

LEGEND


- PROPOSED AMAFCA MAINTENANCE ROAD
- DUMPED RIPRAP
- BURIED DUMPED RIPRAP
- EXISTING SOIL CEMENT

ARROYO CENTERLINE TANGENT TABLE

T#	BEARING	LENGTH
T1	N29°04'14"W	85.91'
T2	N15°18'49"W	213.57'
T3	N15°52'57"W	586.62'

ARROYO CENTERLINE CURVE DATA

CURVE DATA (C1)	CURVE DATA (C2)
R=200'	R=300'
L=48'	L=285'
T=24'	T=154'
Δ=13°45'25"	Δ=54°24'48"

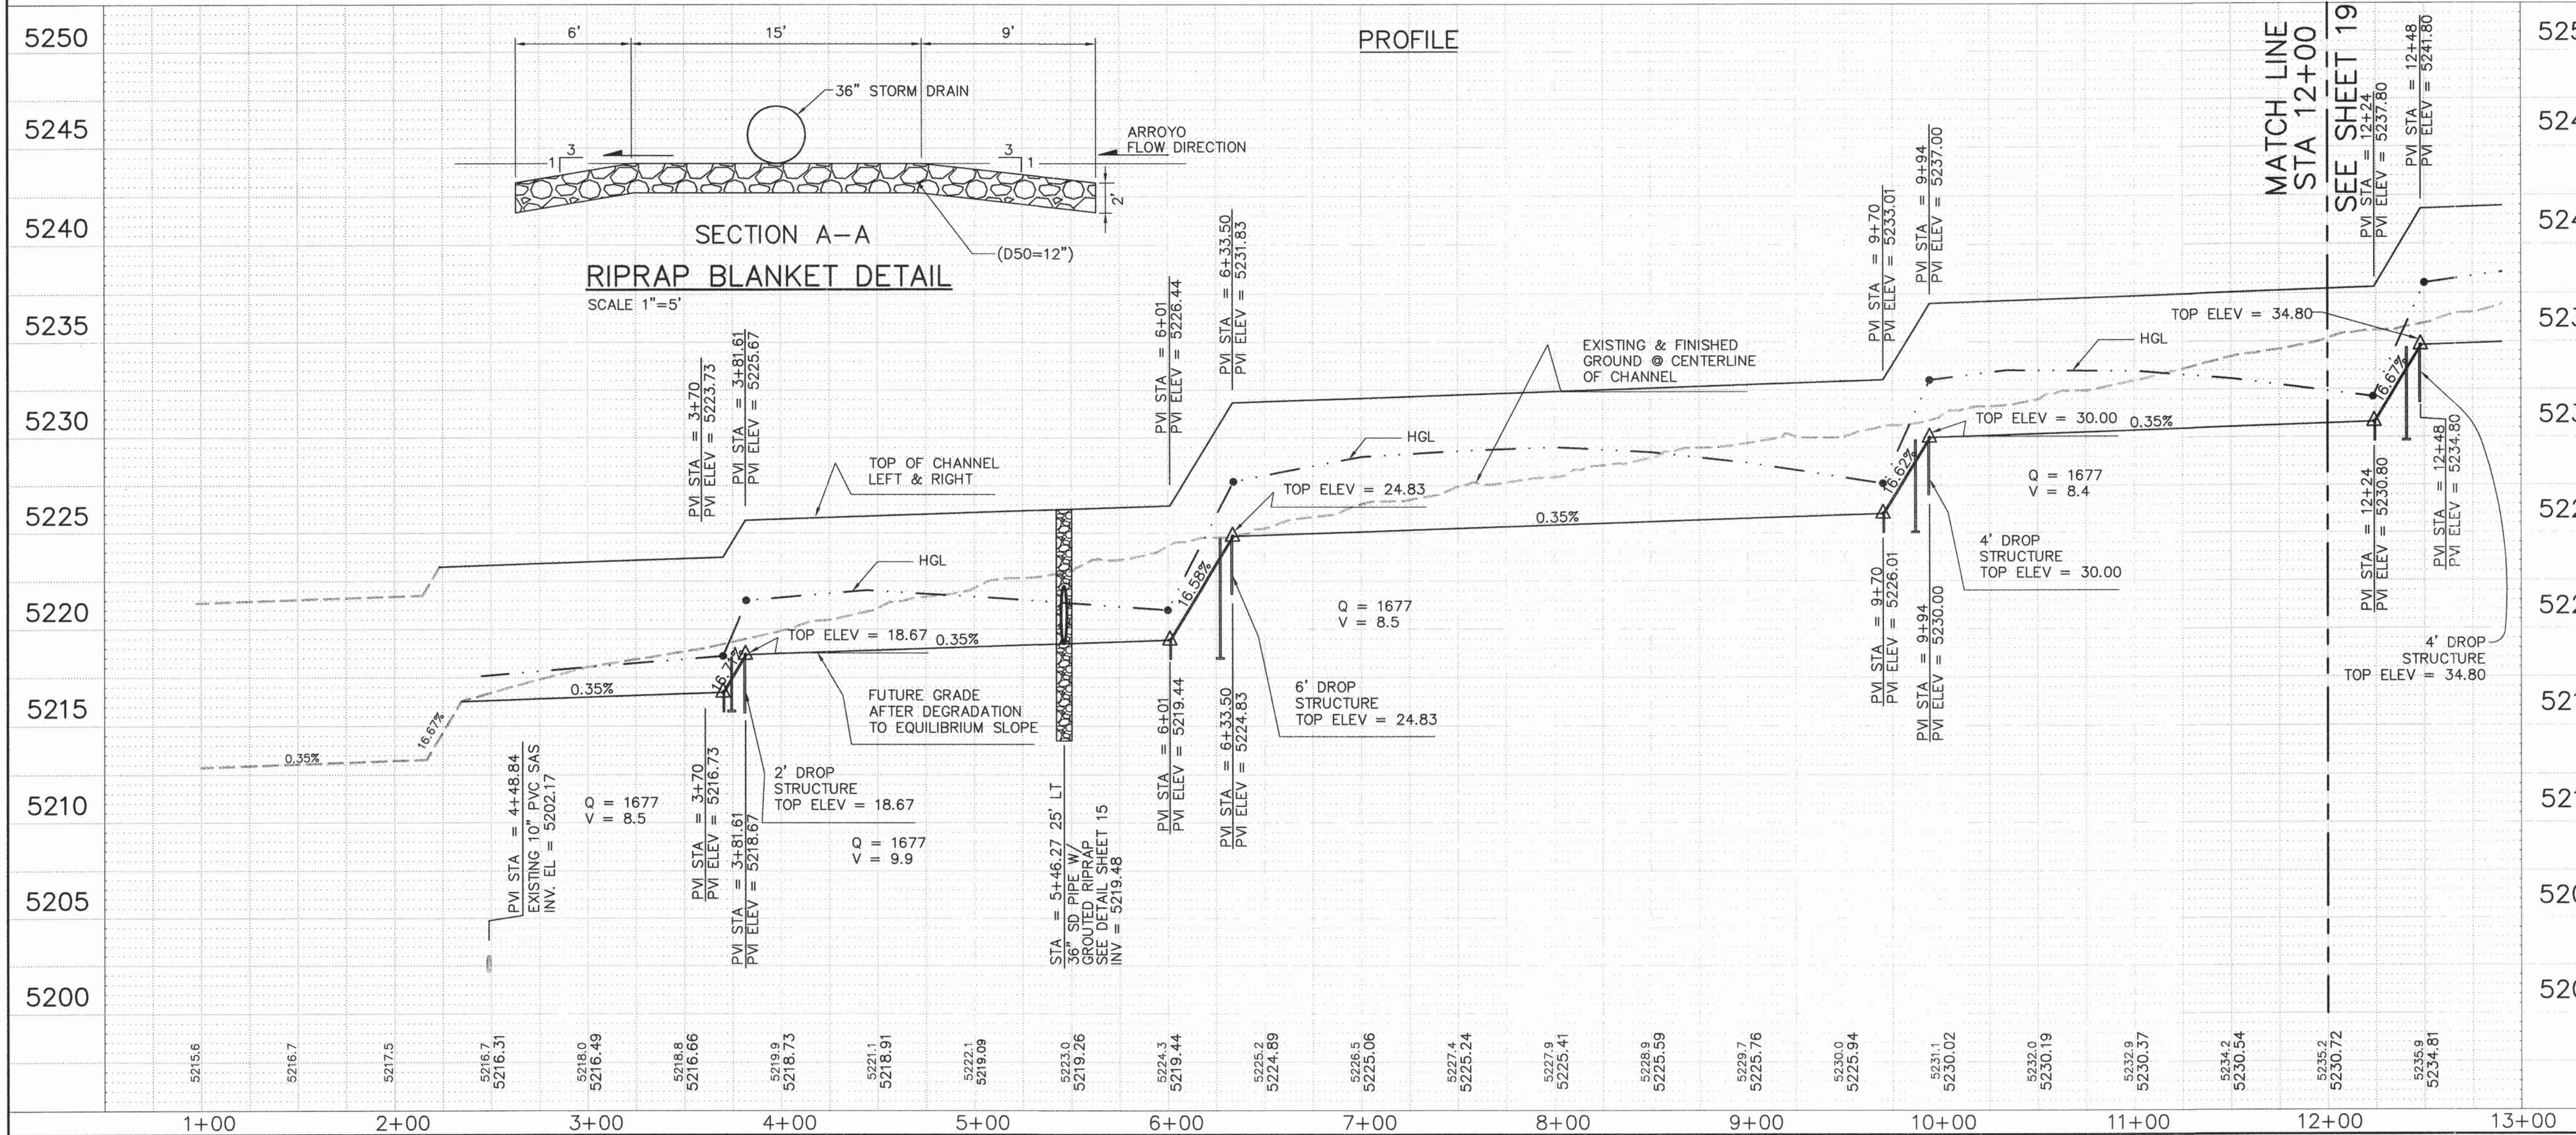

- NOTES**
1. AMAFCA FIELD ENGINEER SHALL BE NOTIFIED 48 HOURS PRIOR TO ANY WORK WITHIN THE AMAFCA R/W OR EASEMENT. TEL (505) 884-2215 JERRY LAVATO.
 2. NO WORK WILL BE PERFORMED IN THE AMAFCA R/W BETWEEN MAY 15 AND OCTOBER 15 WITHOUT WRITTEN PERMISSION FROM AMAFCA.
 3. ALL SUBGRADE, BACKFILL AND EMBANK SHALL BE COMPACTED TO 95% (MODIFIED PROCTOR) WITHIN THE AMAFCA R/W. TESTING REPORTS SHALL BE PROVIDED TO AMAFCA FIELD ENGINEER.
 4. AMAFCA FIELD ENGINEER WILL BE NOTIFIED 48 HOURS PRIOR TO FINAL INSPECTION OF ANY FACILITIES WITHIN THE AMAFCA R/W.
 5. ALL DISTURBED GROUND AREAS SHALL BE REVEGETATED IN ACCORDANCE WITH CITY OF ALBUQUERQUE STANDARD SPECIFICATIONS FOR PUBLIC WORKS CONSTRUCTION. SECTION 1012 NATIVE GRASS SEEDING AS CURRENTLY UPDATED.

APPROVED FOR CONSTRUCTION WITHIN AMAFCA RIGHT OF WAY OR EASEMENT:

[Signature] 3-16-04
(AMAFCA) (DATE)

CITY OF ALBUQUERQUE
PUBLIC WORKS DEPARTMENT
ENGINEERING GROUP

**THE CROSSING SUBDIVISION UNIT 3
MIREHAVEN ARROYO PLAN & PROFILE
STATION 1+00 TO STATION 12+00**

Design Review Committee City Engineer Approval

Mo./Day/Yr. Mo./Day/Yr.

AS-BUILT INFORMATION

CONTRACTOR: Melendez Concrete
WORKS BY: Precision Survey
INSPECTOR: Precision Survey
FIELD ENGINEER: Precision Survey
DATE: 3/16/04

BENCH MARKS

A.C.S. Aluminum Tablet Stamped "BH-40" Data:
New Mexico State Plane Grid Coordinates (Central Zone)
NAD 1927 X=352,790.66 Y=1,492,346.53
Ground to grid factor = 0.9996105
Delta Alpha = (-100°16'59" ELEV = 5305.43
A.C.S. Aluminum Tablet Stamped "BH-41" Data:
New Mexico State Plane Grid Coordinates (Central Zone)
NAD 1927 X=351,455.56 Y=1,496,546.13
Ground to grid factor = 0.9996704
Delta Alpha = (-100°17'08" ELEV = 5398.63

SURVEY INFORMATION

DATE: 3/16/04
BY: [Signature]

ENGINEER'S SEAL

REVISIONS

NO.	DATE	REMARKS	BY
1	3/16/04	DESIGNED BY	JMT
2	3/16/04	DRAWN BY	DLC
3	3/16/04	CHECKED BY	BWS

WILSON & COMPANY, ENGINEERS & ARCHITECTS
DATE: 3/16/04
DESIGNED BY: JMT
DRAWN BY: DLC
CHECKED BY: BWS

City Project No. 545383 Zone Map No. H-9-Z
Sheet 18 of 19

