







Sheet 2/8

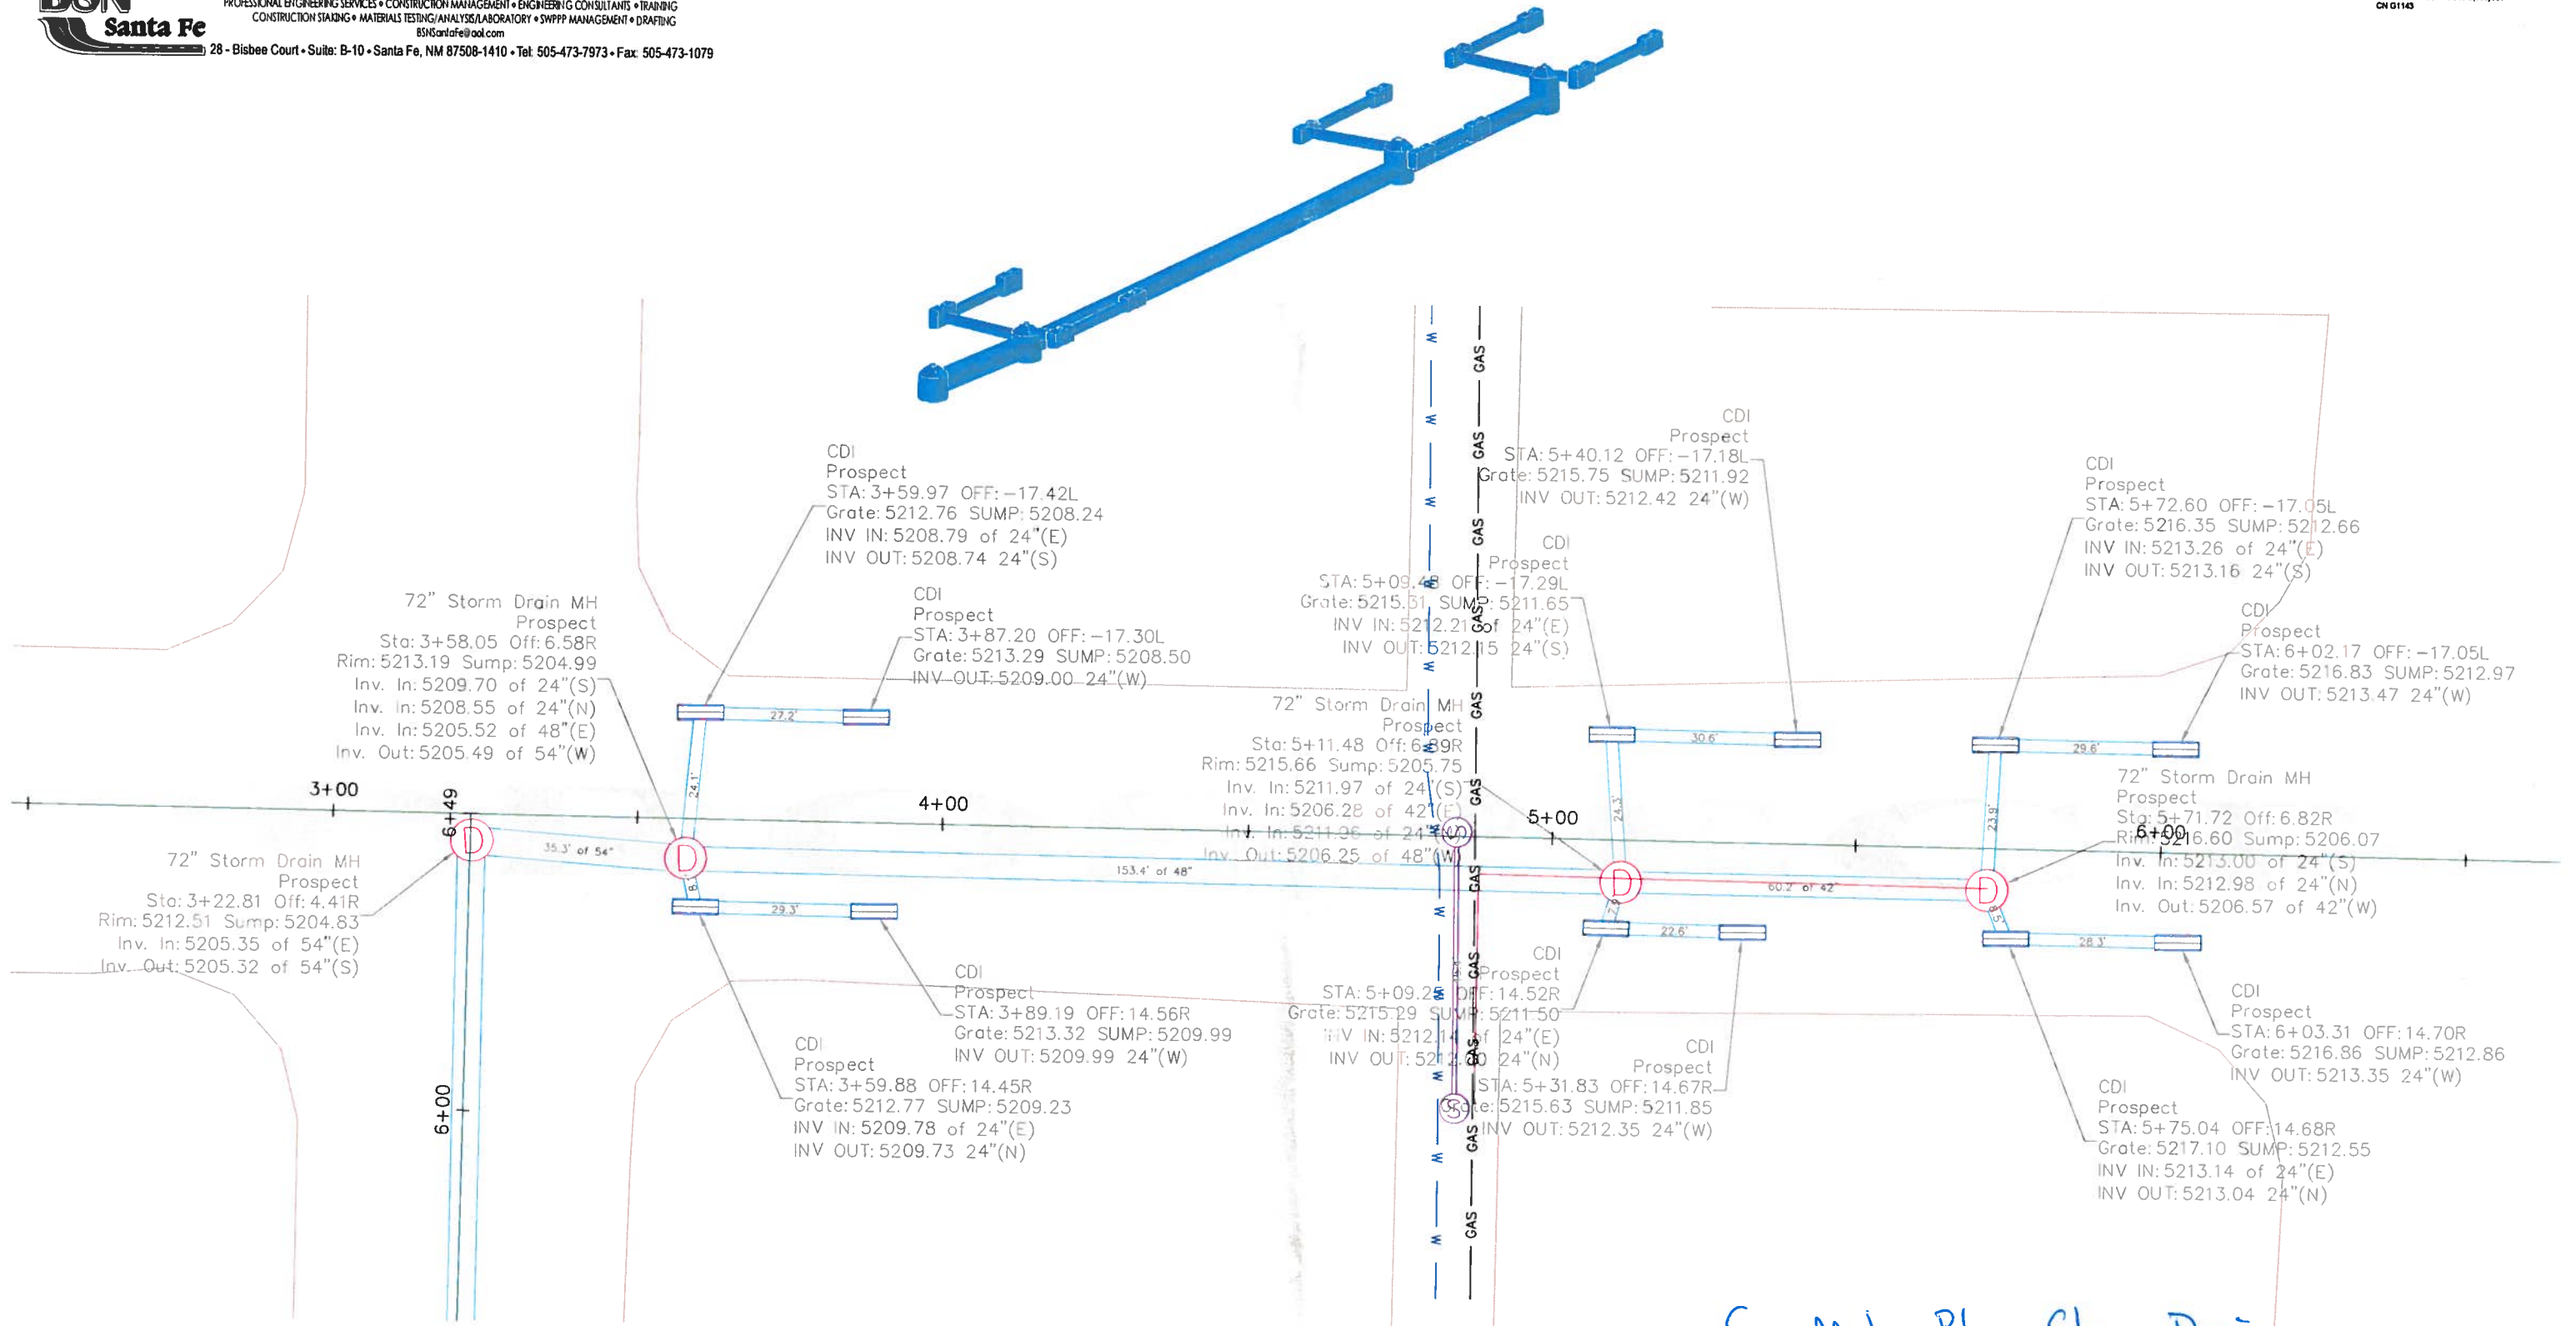

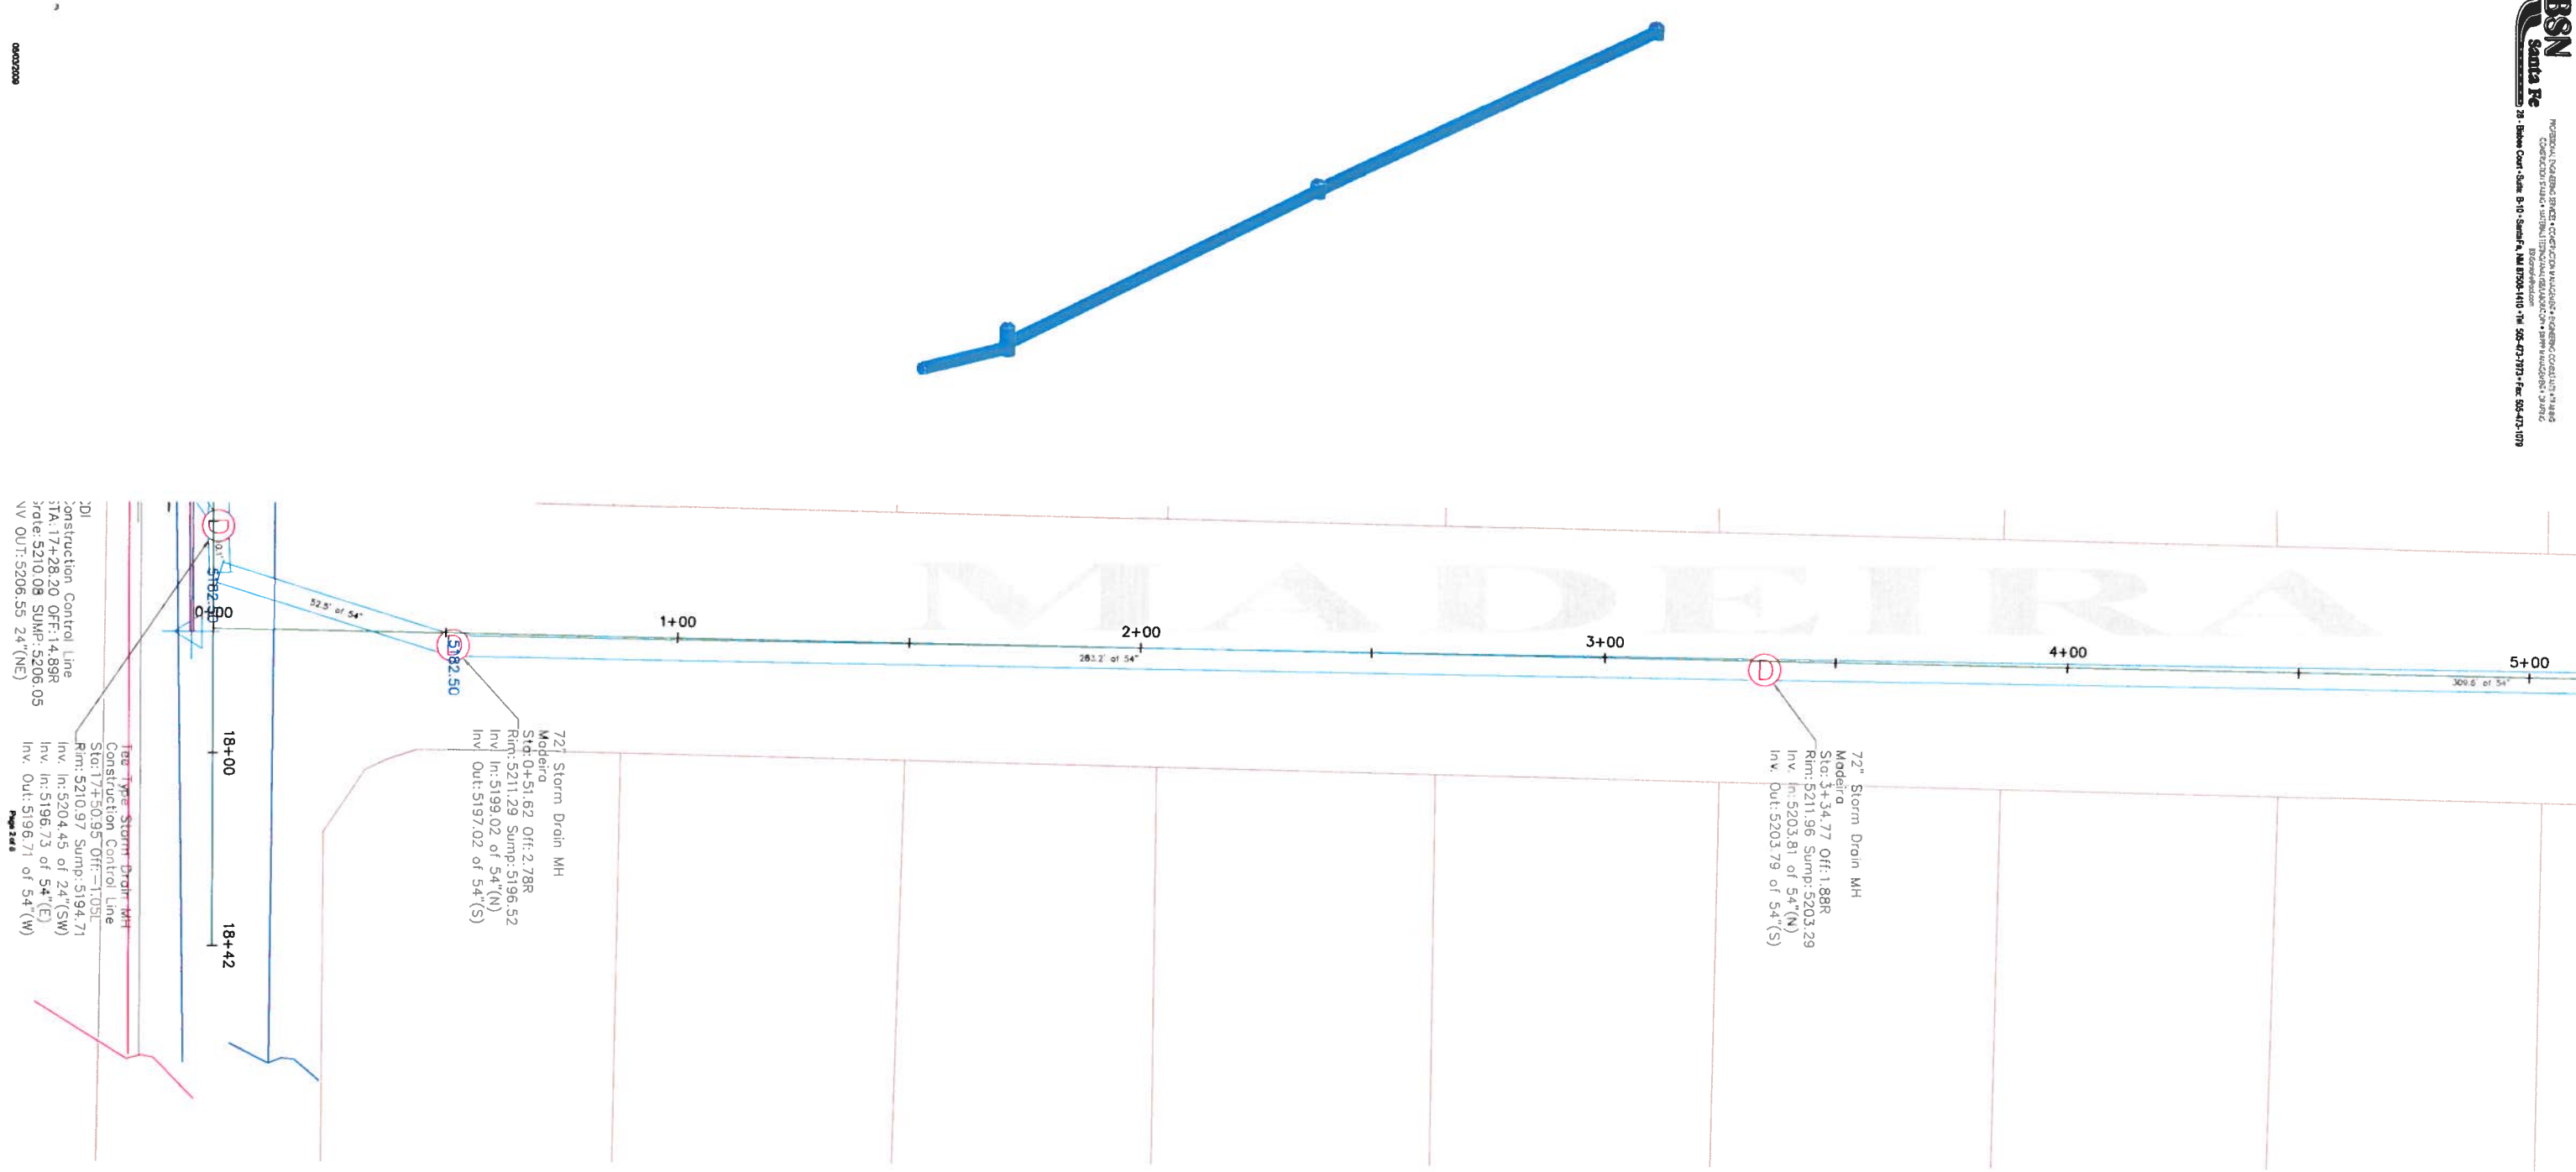

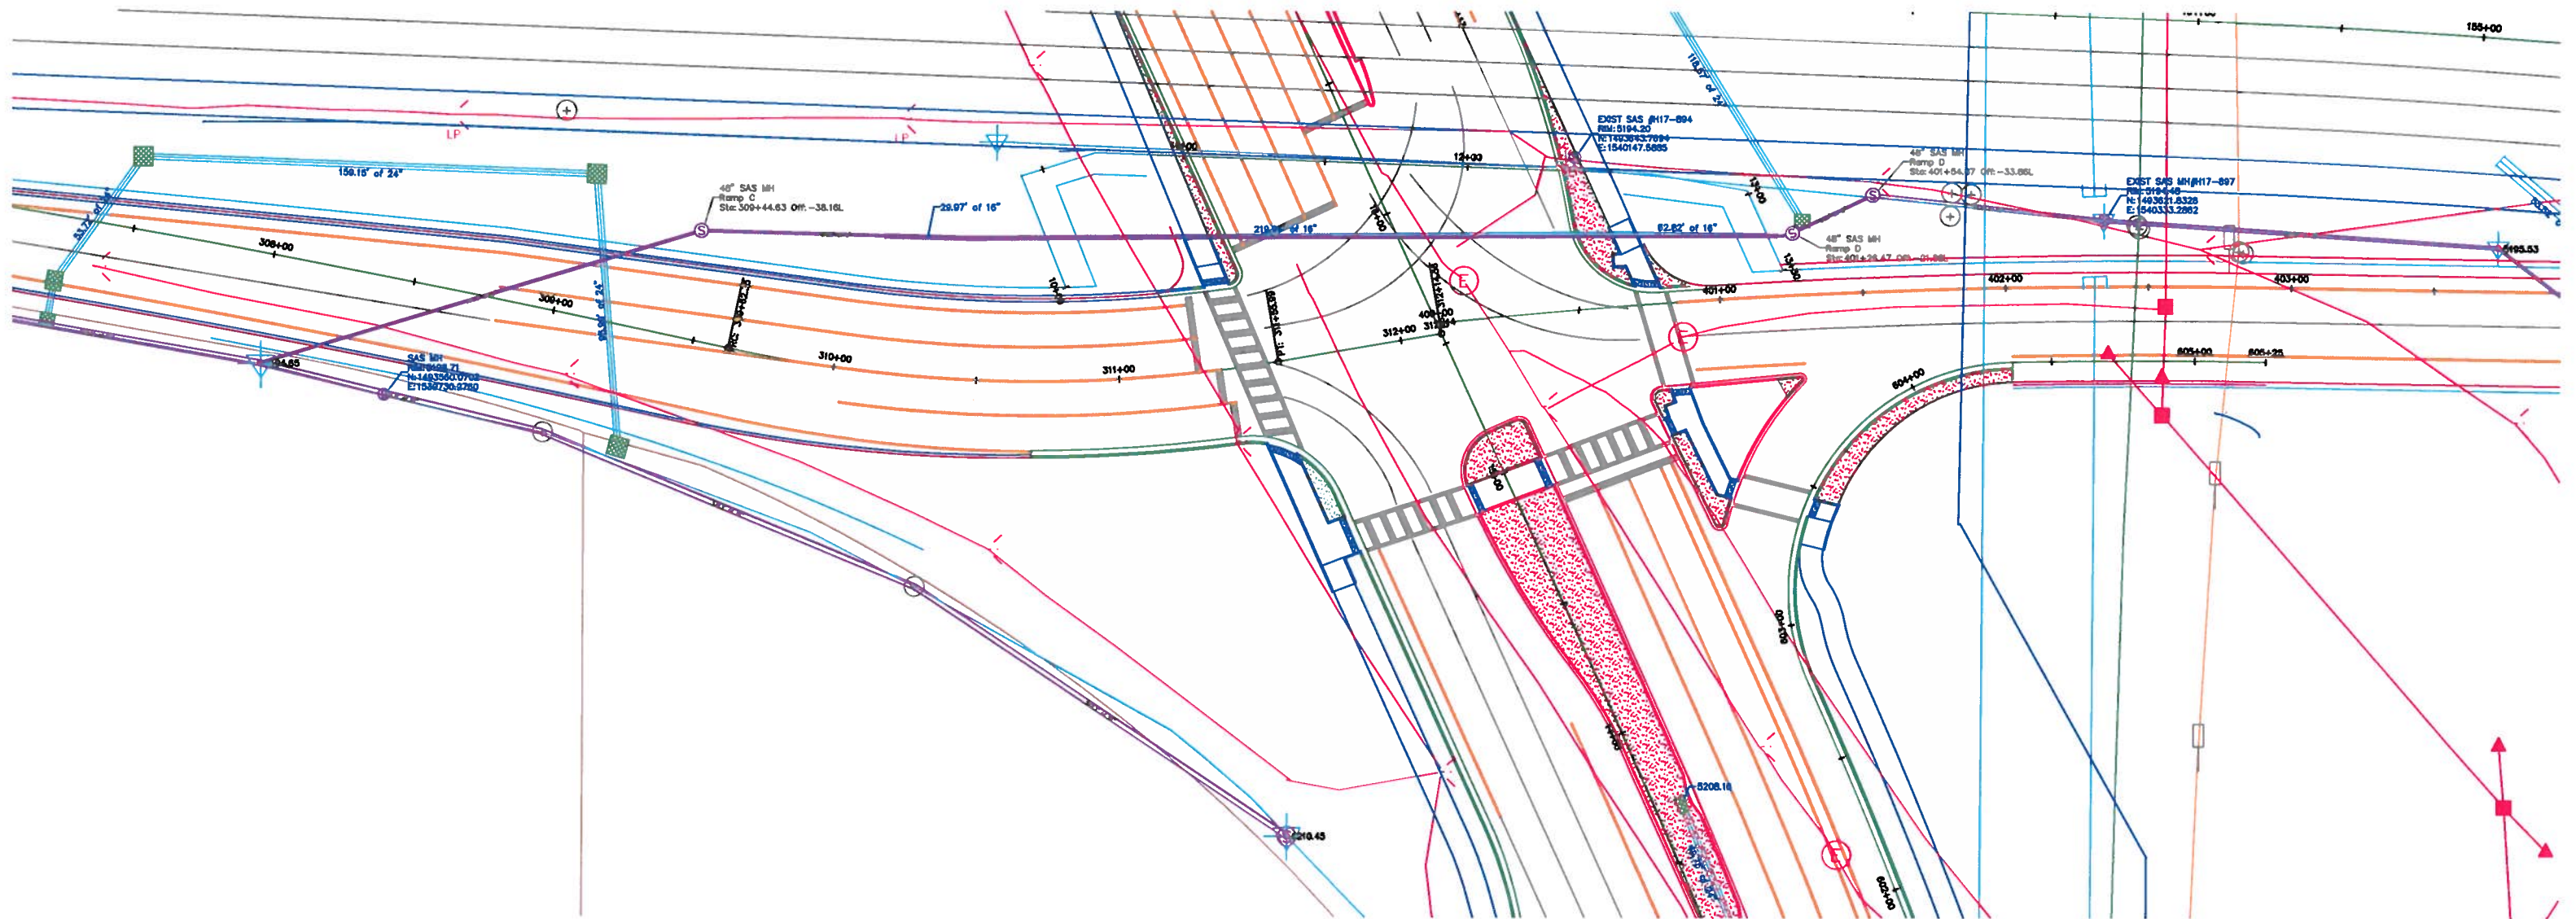

Sheet 6/8

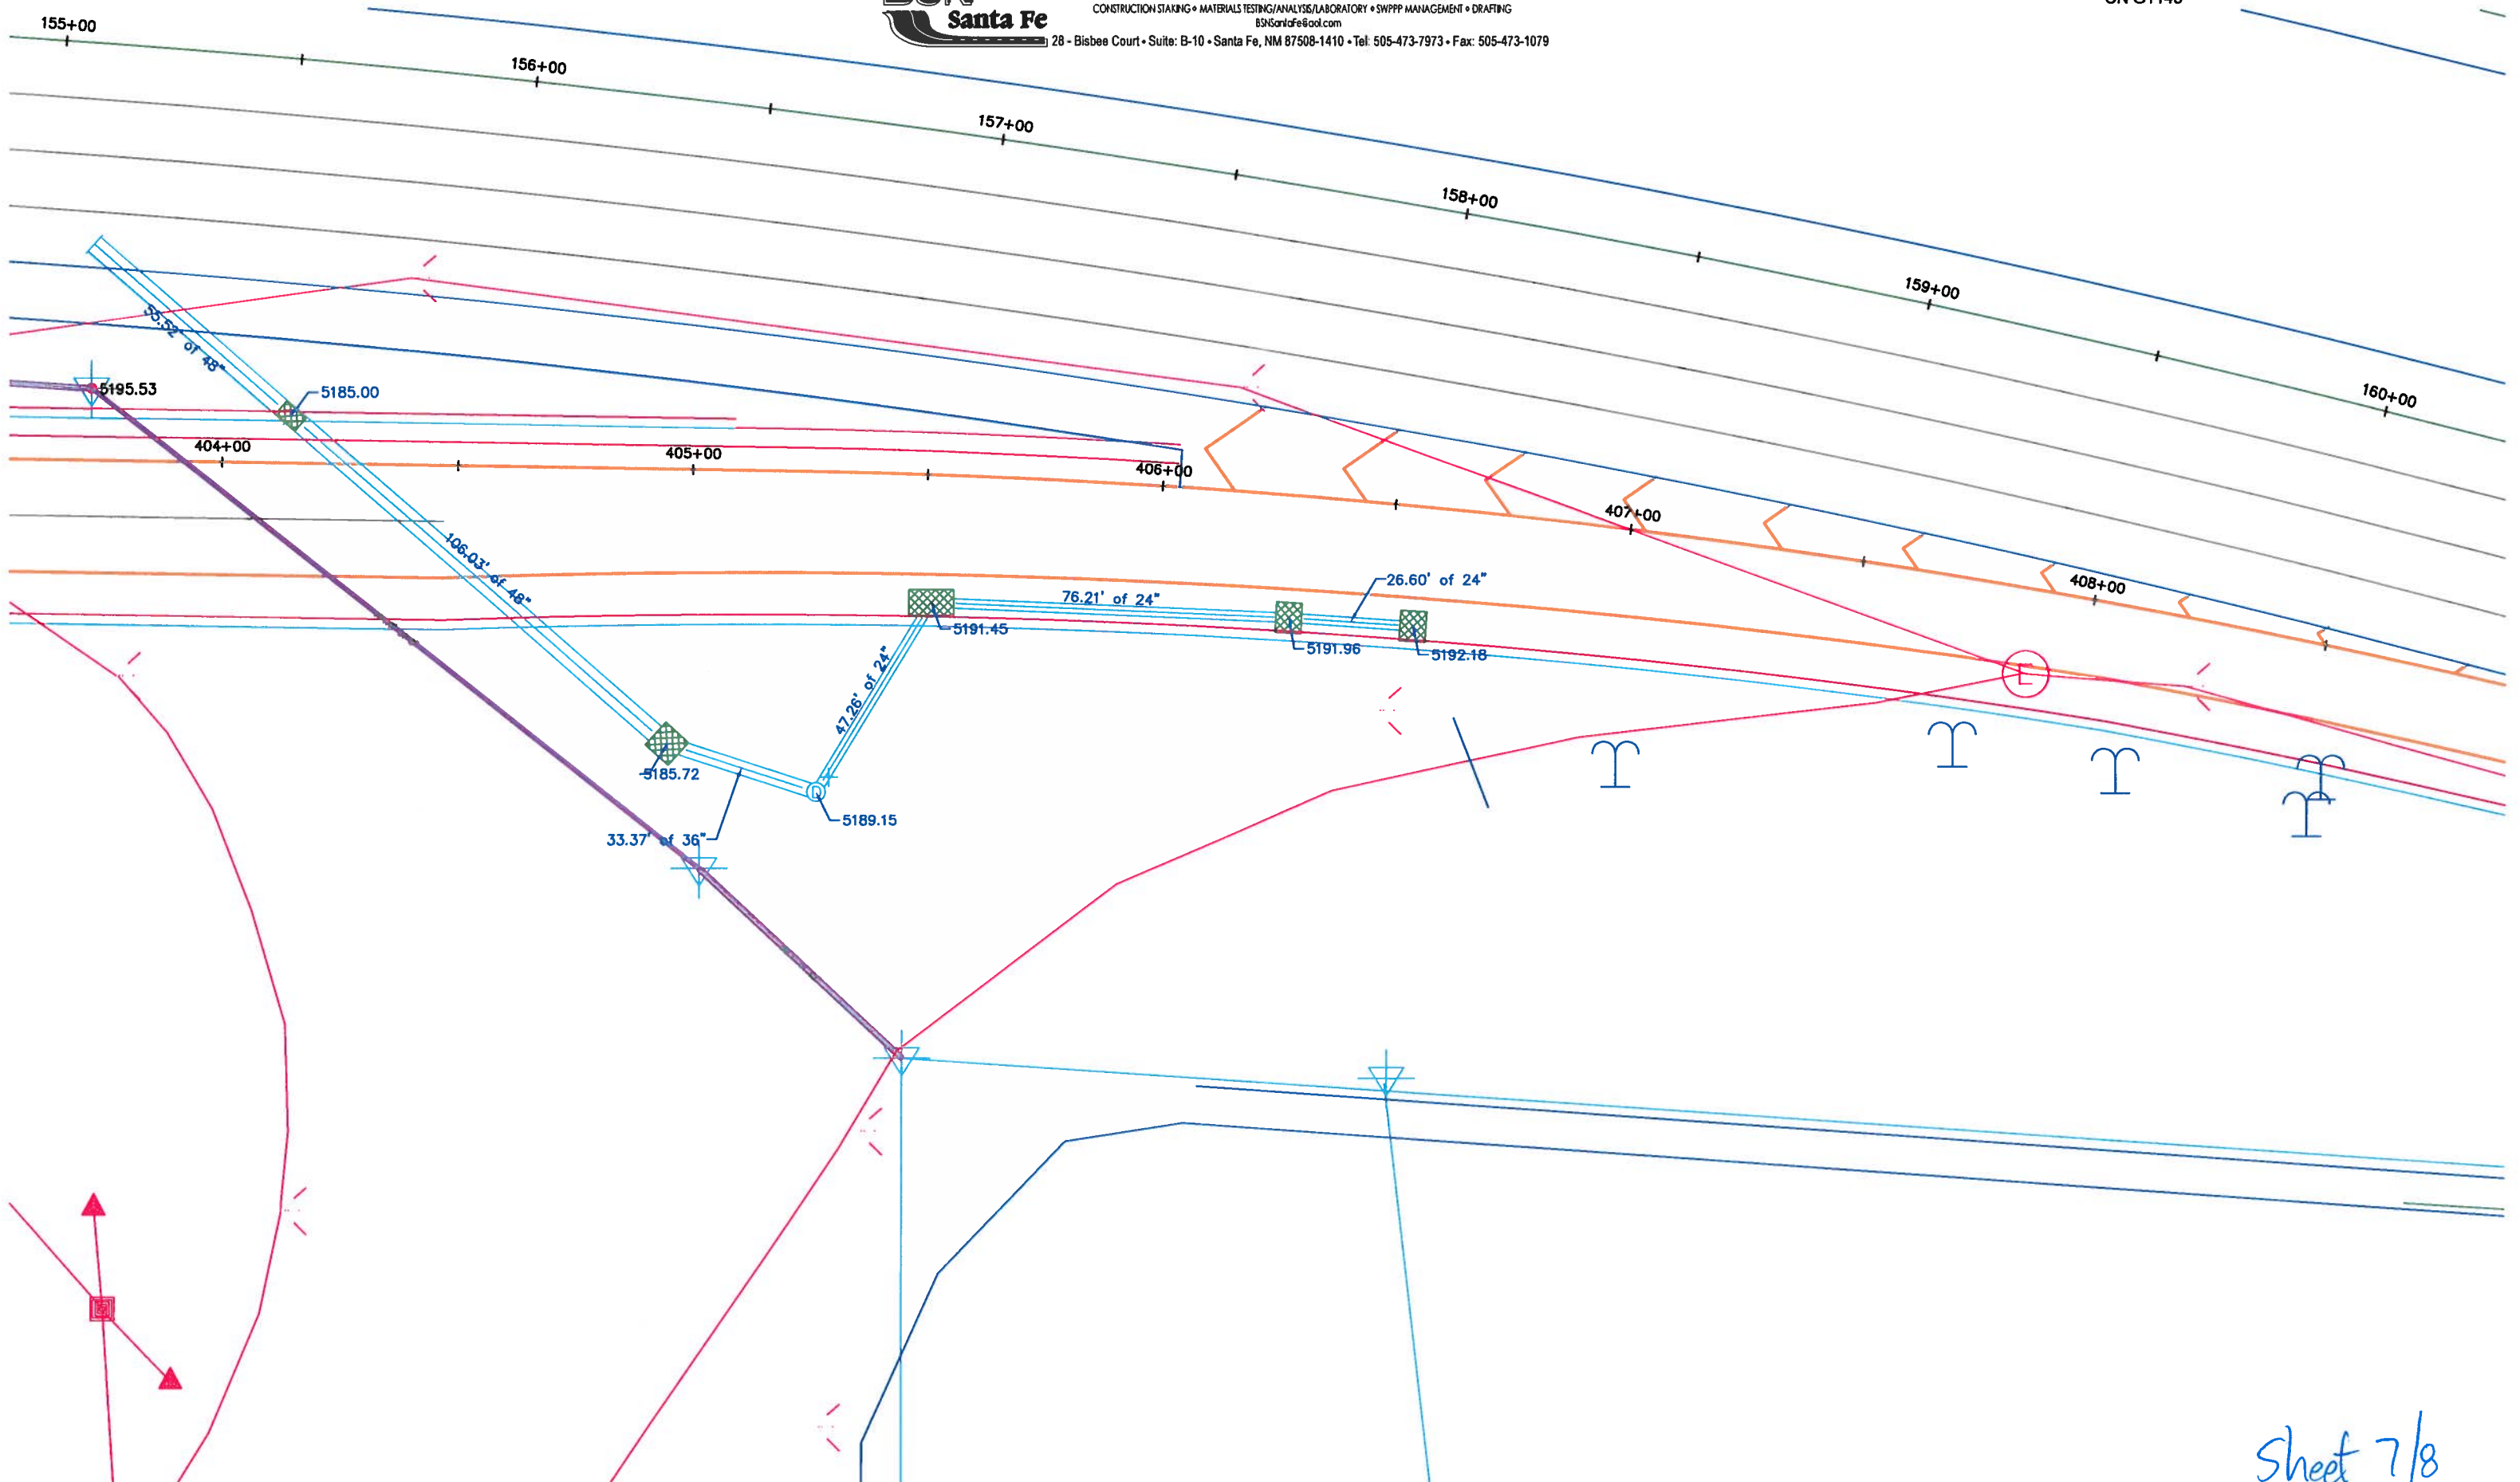

Sheet 7/8

SYMBOL LEGEND

	POWER POLE		
	LIGHT POLE		CURB INLET
	GUYWIRE		SANITARY MANHOLE
	ELECTRIC METER		STORM DRAIN MANHOLE
	ELECTRIC BOX		FIBER OPTIC MARKER
	ELECTRIC MANHOLE		UTILITY POTHOLE/TESTHOLE
	SIGNAL LIGHT JUNCTION BOX		UNDERGROUND ELECTRIC LINE
	TRAFFIC LIGHT POLE		OVERHEAD ELECTRIC LINE
	TELEPHONE PEDESTAL		WATER LINE
	TELEPHONE MANHOLE		GAS LINE
	CABLE TELEVISION PEDESTAL		BURRIED CABLE TV LINE
	FIRE HYDRANT		UNDERGROUND TELEPHONE LINE
	WATER METER		FIBER OPTIC LINE
	WATER VALVE		SANITARY LINE
	SPRINKLER CONTROL BOX		STORM DRAIN LINE
	WATER FAUCET		SANITARY SEWER LINE
	GAS VALVE		TRAFFIC SIGNAL LINE
	GAS METER		

Sheet 8/8