


CONSTRUCTION PLANS

FOR

LAS GLORIETAS SUBDIVISION

BERNALILLO COUNTY
NEW MEXICO

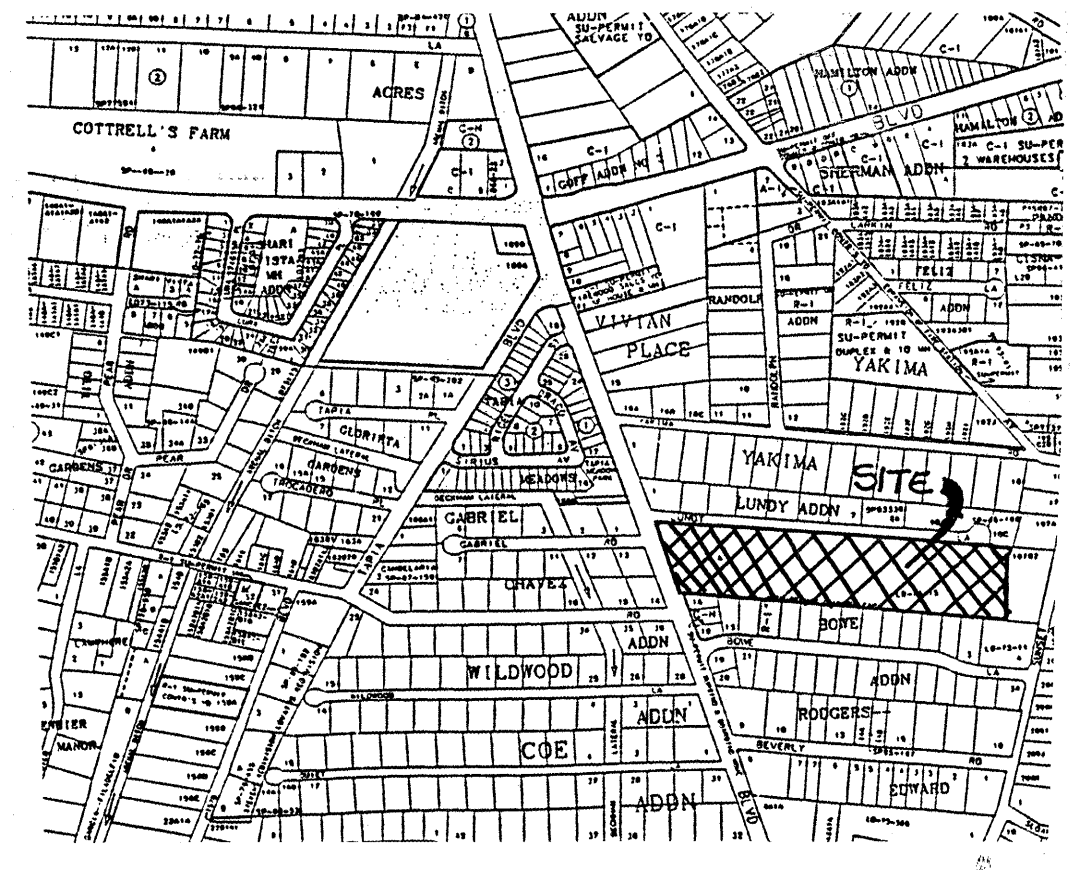

VICINITY MAP ZONE ATLAS L-12-Z
SCALE: NONE

GENERAL NOTES


NOTICE TO CONTRACTORS

1. CITY OF ALBUQUERQUE SPECIFICATIONS FOR PUBLIC WORKS CONSTRUCTION, 1986 EDITION AS AMENDED THROUGH UPDATE 6, WILL BE REFERRED TO HEREIN AS THE "STANDARD SPECIFICATIONS"*
2. TWO WORKING DAYS PRIOR TO ANY EXCAVATION, CONTRACTOR MUST CONTACT NEW MEXICO ONE CALL SYSTEM (260-1990) AND DETERMINE LOCATION OF EXISTING UTILITIES.
3. PRIOR TO ANY CONSTRUCTION, THE CONTRACTOR SHALL EXCAVATE AND VERIFY THE HORIZONTAL AND VERTICAL LOCATIONS OF ALL OBSTRUCTIONS. SHOULD A CONFLICT EXIST, THE CONTRACTOR SHALL NOTIFY THE ENGINEER OR THE SURVEYOR SO THAT THE CONFLICT CAN BE RESOLVED WITHOUT DELAY.
4. ALL EXISTING SIGNS, MARKERS, DELINEATORS, ETC., WITHIN THE CONSTRUCTION LIMITS SHALL BE REMOVED, STORED AND RE-SET BY THE CONTRACTOR.
5. THE CONTRACTOR SHALL NOTIFY THE ENGINEER NOT LESS THAN SEVEN (7) PRIOR TO STARTING WORK IN ORDER THAT THE ENGINEER MAY TAKE NECESSARY MEASURES TO INSURE THE PRESERVATION OF SURROUNDING PROPERTY. THE CONTRACTOR SHALL NOT DISTURB ANY SURVEY MONUMENTS WITHOUT THE CONSENT OF THE ENGINEER AND SHALL NOTIFY THE ENGINEER AND BEAR THE EXPENSE OF REPLACING ANY THAT MAY BE DISTURBED WITHOUT PERMISSION. REPLACEMENT SHALL BE DONE ONLY BY THE CITY SURVEYOR. WHEN A CHANGE IS MADE IN THE FINISHED ELEVATIONS OF THE PAVEMENT OF ANY ROADWAY IN WHICH A PERMANENT SURVEY MONUMENT IS LOCATED, THE CONTRACTOR SHALL BE RESPONSIBLE FOR ADJUSTING THE MONUMENT COVER TO THE NEW GRADE UNLESS OTHERWISE SPECIFIED. REFER TO SECTION 4.4 OF THE GENERAL CONDITIONS OF THE STANDARD SPECIFICATIONS.
6. THREE (3) WORKING DAYS PRIOR TO BEGINNING CONSTRUCTION THE CONTRACTOR SHALL SUBMIT TO THE CONSTRUCTION CO-ORDINATION DIVISION A DETAILED CONSTRUCTION SCHEDULE. TWO (2) WORKING DAYS PRIOR TO CONSTRUCTION THE CONTRACTOR SHALL OBTAIN A BARRICADE PERMIT FROM THE CONSTRUCTION CO-ORDINATION DIVISION. CONTRACTOR SHALL NOTIFY BARRICADE ENGINEER (768-2551) PRIOR TO OCCUPYING AN INTERSECTION.
7. ANY WORK OCCURRING WITHIN AN ARTERIAL ROADWAY REQUIRES 24 HOURS CONSTRUCTION.

THE FOLLOWING NOTES ALSO APPLY WHEN CHECKED

- ☒ ALL UTILITIES AND UTILITY SERVICE LINES SHALL BE INSTALLED PRIOR TO PAVING.
- ☒ BACKFILL COMPACTION SHALL BE ACCORDING TO SPECIFIED STREET USE.
- ☐ TACK COAT REQUIREMENTS SHALL BE DETERMINED BY THE CITY ENGINEER.
- ☒ SIDEWALK AND WHEELCHAIR RAMPS WITHIN THE CURB RETURNS SHALL BE CONSTRUCTED WHEREVER A NEW CURB RETURN IS CONSTRUCTED.
- ☐ IF CURB IS DEPRESSIONED FOR A DRIVEPAD, THE DRIVEPAD SHALL BE CONSTRUCTED PRIOR TO ACCEPTANCE OF CURB AND GUTTER.
- ☒ ALL STORM DRAINAGE FACILITIES SHALL BE COMPLETED PRIOR TO FINAL ACCEPTANCE.
- ☒ THE REQUESTOR OR DEVELOPER SHALL BE RESPONSIBLE FOR REPAIR OR REPLACEMENT OF ALL CURB AND GUTTER OR SIDEWALK DAMAGE AFTER APPROVAL BY THE CITY ENGINEER OR WORK COMPLETED BY THE CONTRACTOR.

LEGEND

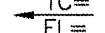	CURB AND GUTTER		WATER METER
	CONCRETE		CABLE T.V.
	ELECTRIC TRANSFORMER		POWER POLE
	ELECTRIC PANEL		ANCHOR
	SANITARY SEWER MANHOLE		LIGHT POLE
	TELEPHONE MANHOLE		TRAFFIC LIGHT
	ELECTRIC MANHOLE		CROSSWALK SIGNAL
	STORM SEWER MANHOLE		SPRINKLER CONTROL
	WATER VALVE		TRAFFIC CONTROL
	FIRE HYDRANT		LIGHTING BOX
	TELEPHONE BOX		SIGN
	SPOT ELEVATION		GRATE

INDEX TO DRAWINGS

SHEET NO.	SHEET
1	TITLE SHEET
2	PLAT
3	GRADING & DRAINAGE PLAN
4	MASTER UTILITY PLAN
5-6	PAVING IMPROVEMENTS
7-8	UTILITY IMPROVEMENTS

RECORD DRAWING

I hereby certify that the public water and sewer construction (including appurtenances) identified on this drawing has been revised in accordance with the information furnished by the contractor, Rogers Plumbing & Heating, and by the surveyor, Aldrich Land Surveying, and reflects the construction as actually accomplished. With respect to the construction of the public water and sewer, this plan as constructed is in substantial compliance with the Approved Plan.

John M. MacKenzie 4/30/98
John M. MacKenzie NMPE 11618

dekker/perich & associates
architecture
planning
interiors

601 West 1st Street, Suite 200
New York, NY 10014
Tel: 212-691-1111
Fax: 212-691-1112







NOTE: Two (2) working days prior to start of construction, the contractor shall obtain a barricading permit from County Traffic Engineering. The barricading permit shall be accompanied by a traffic control plan prepared in accordance with the County barricading ordinance.

CAUTION:
NOTE THAT ALL EXISTING UTILITIES MAY NOT BE SHOWN. ALL EXISTING SERVICE CONNECTIONS ARE NOT SHOWN. ANY EXISTING UTILITIES THAT ARE SHOWN ARE APPROXIMATE LOCATION ONLY. IT SHALL BE THE SOLE RESPONSIBILITY OF THE CONTRACTOR TO CONTACT ALL THE UTILITY OWNERS AND TO CONDUCT ALL NECESSARY FIELD INVESTIGATIONS PRIOR TO ANY EXCAVATIONS TO DETERMINE THE ACTUAL LOCATION OF UTILITIES AND OTHER IMPROVEMENTS.

* CITY SPECIFICATIONS ARE TO BE USED FOR PUBLIC WATER AND SEWER IMPROVEMENTS. BERNALILLO COUNTY STANDARD SPECIFICATIONS FOR ROAD CONSTRUCTION SHALL BE FOLLOWED FOR ALL SURFACE IMPROVEMENTS.

dmg D. MARK GOODWIN & ASSOCIATES, P.A.
CONSULTING ENGINEERS & SURVEYORS
P. O. BOX 90606
ALBUQUERQUE, NEW MEXICO 87199
(505) 345-2010

REV.	SHEETS	CITY ENGINEER	DATE	USER DEPARTMENT	DATE	USER DEPARTMENT	DATE
ENGINEERS STAMP & SIGNATURE		APPROVALS	ENGINEER	DATE	*****		
 <i>John H. McGeorge</i> 10-24-96		DRC CHAIRMAN	<i>Billy F. Goodhue</i>	5/7/97	APPROVED FOR CONSTRUCTION		
		TRANSPORTATION	<i>Nick B...</i>	11-8-91			
		WATER/WASTEWATER	<i>John A. Hume III</i>	10-23-96			
		HYDROLOGY	<i>Mike Mann - Chicago</i>	11-18-96			
		PARKS					
		CONSTR. MNGMT.					
		County Engineer	<i>Edward J. ...</i>	4/29/97			
		CITY PROJECT NO.	5538.81				
				SHEET	OF	1	7

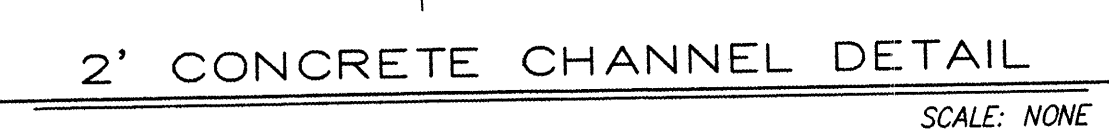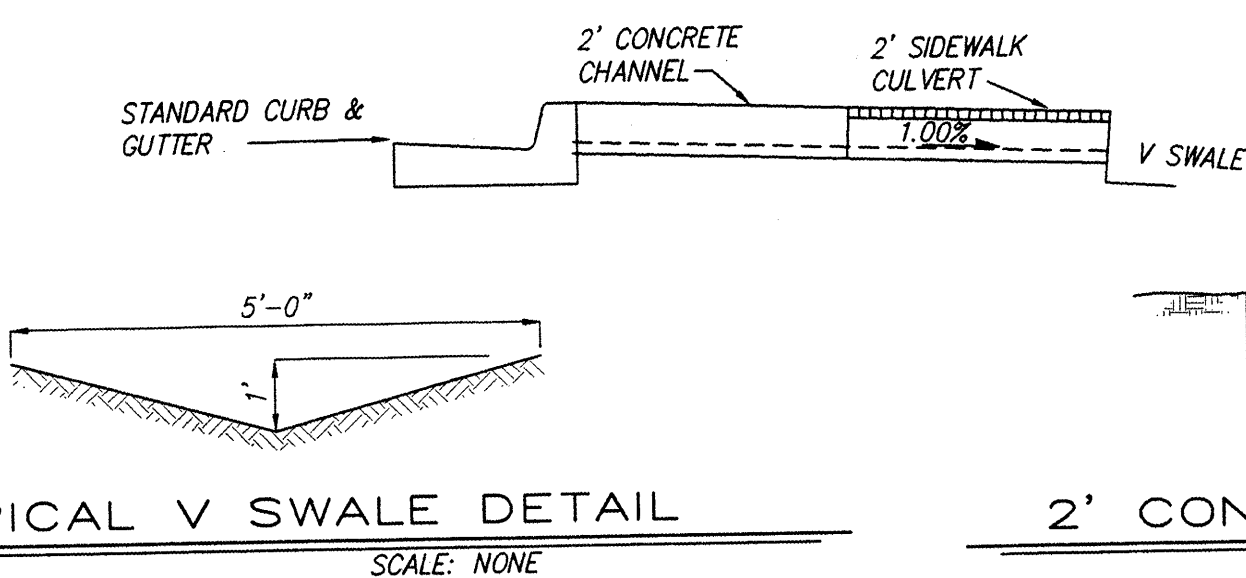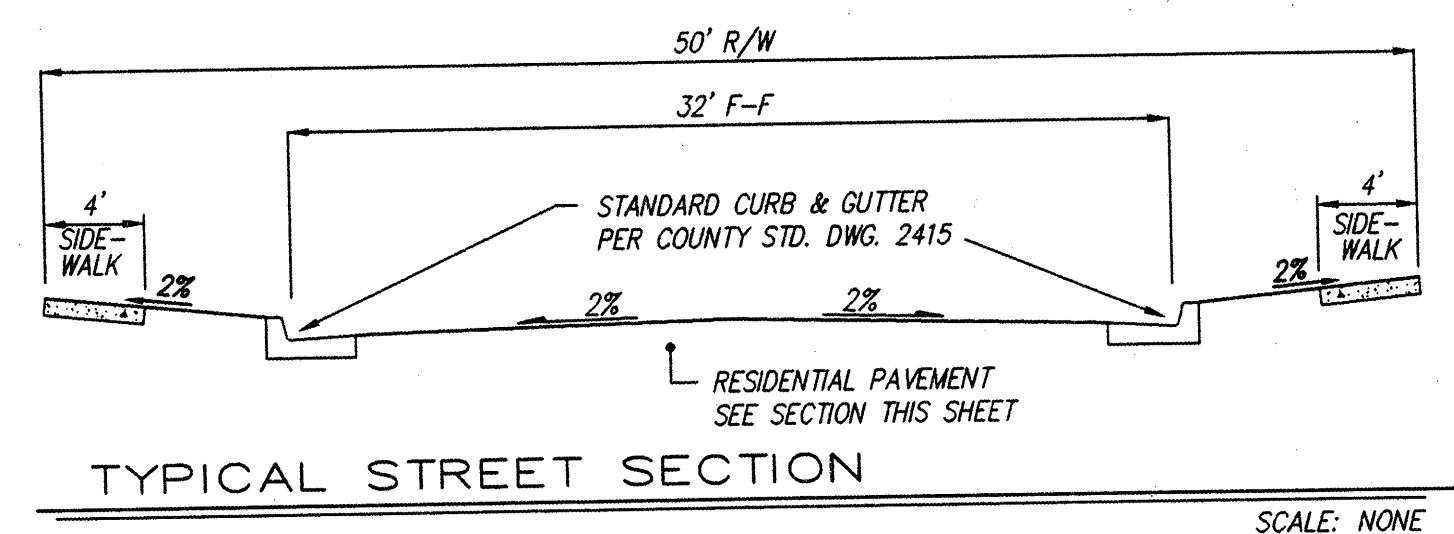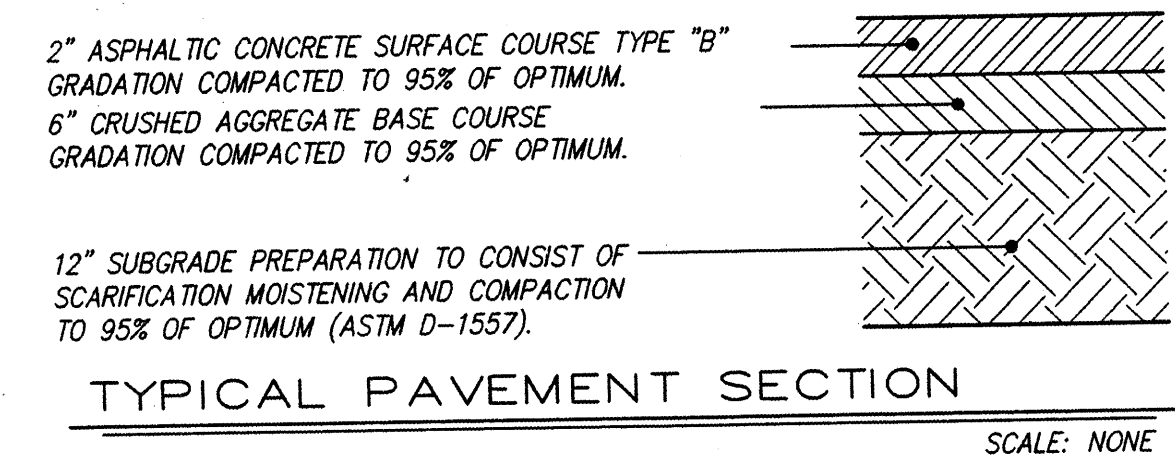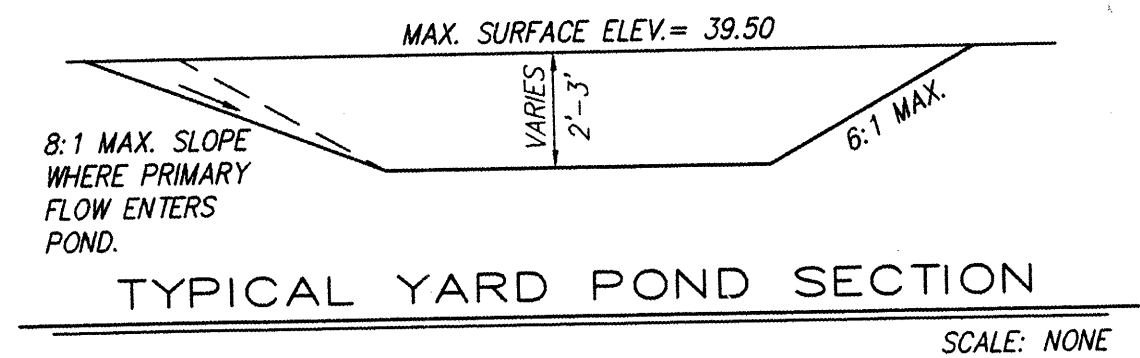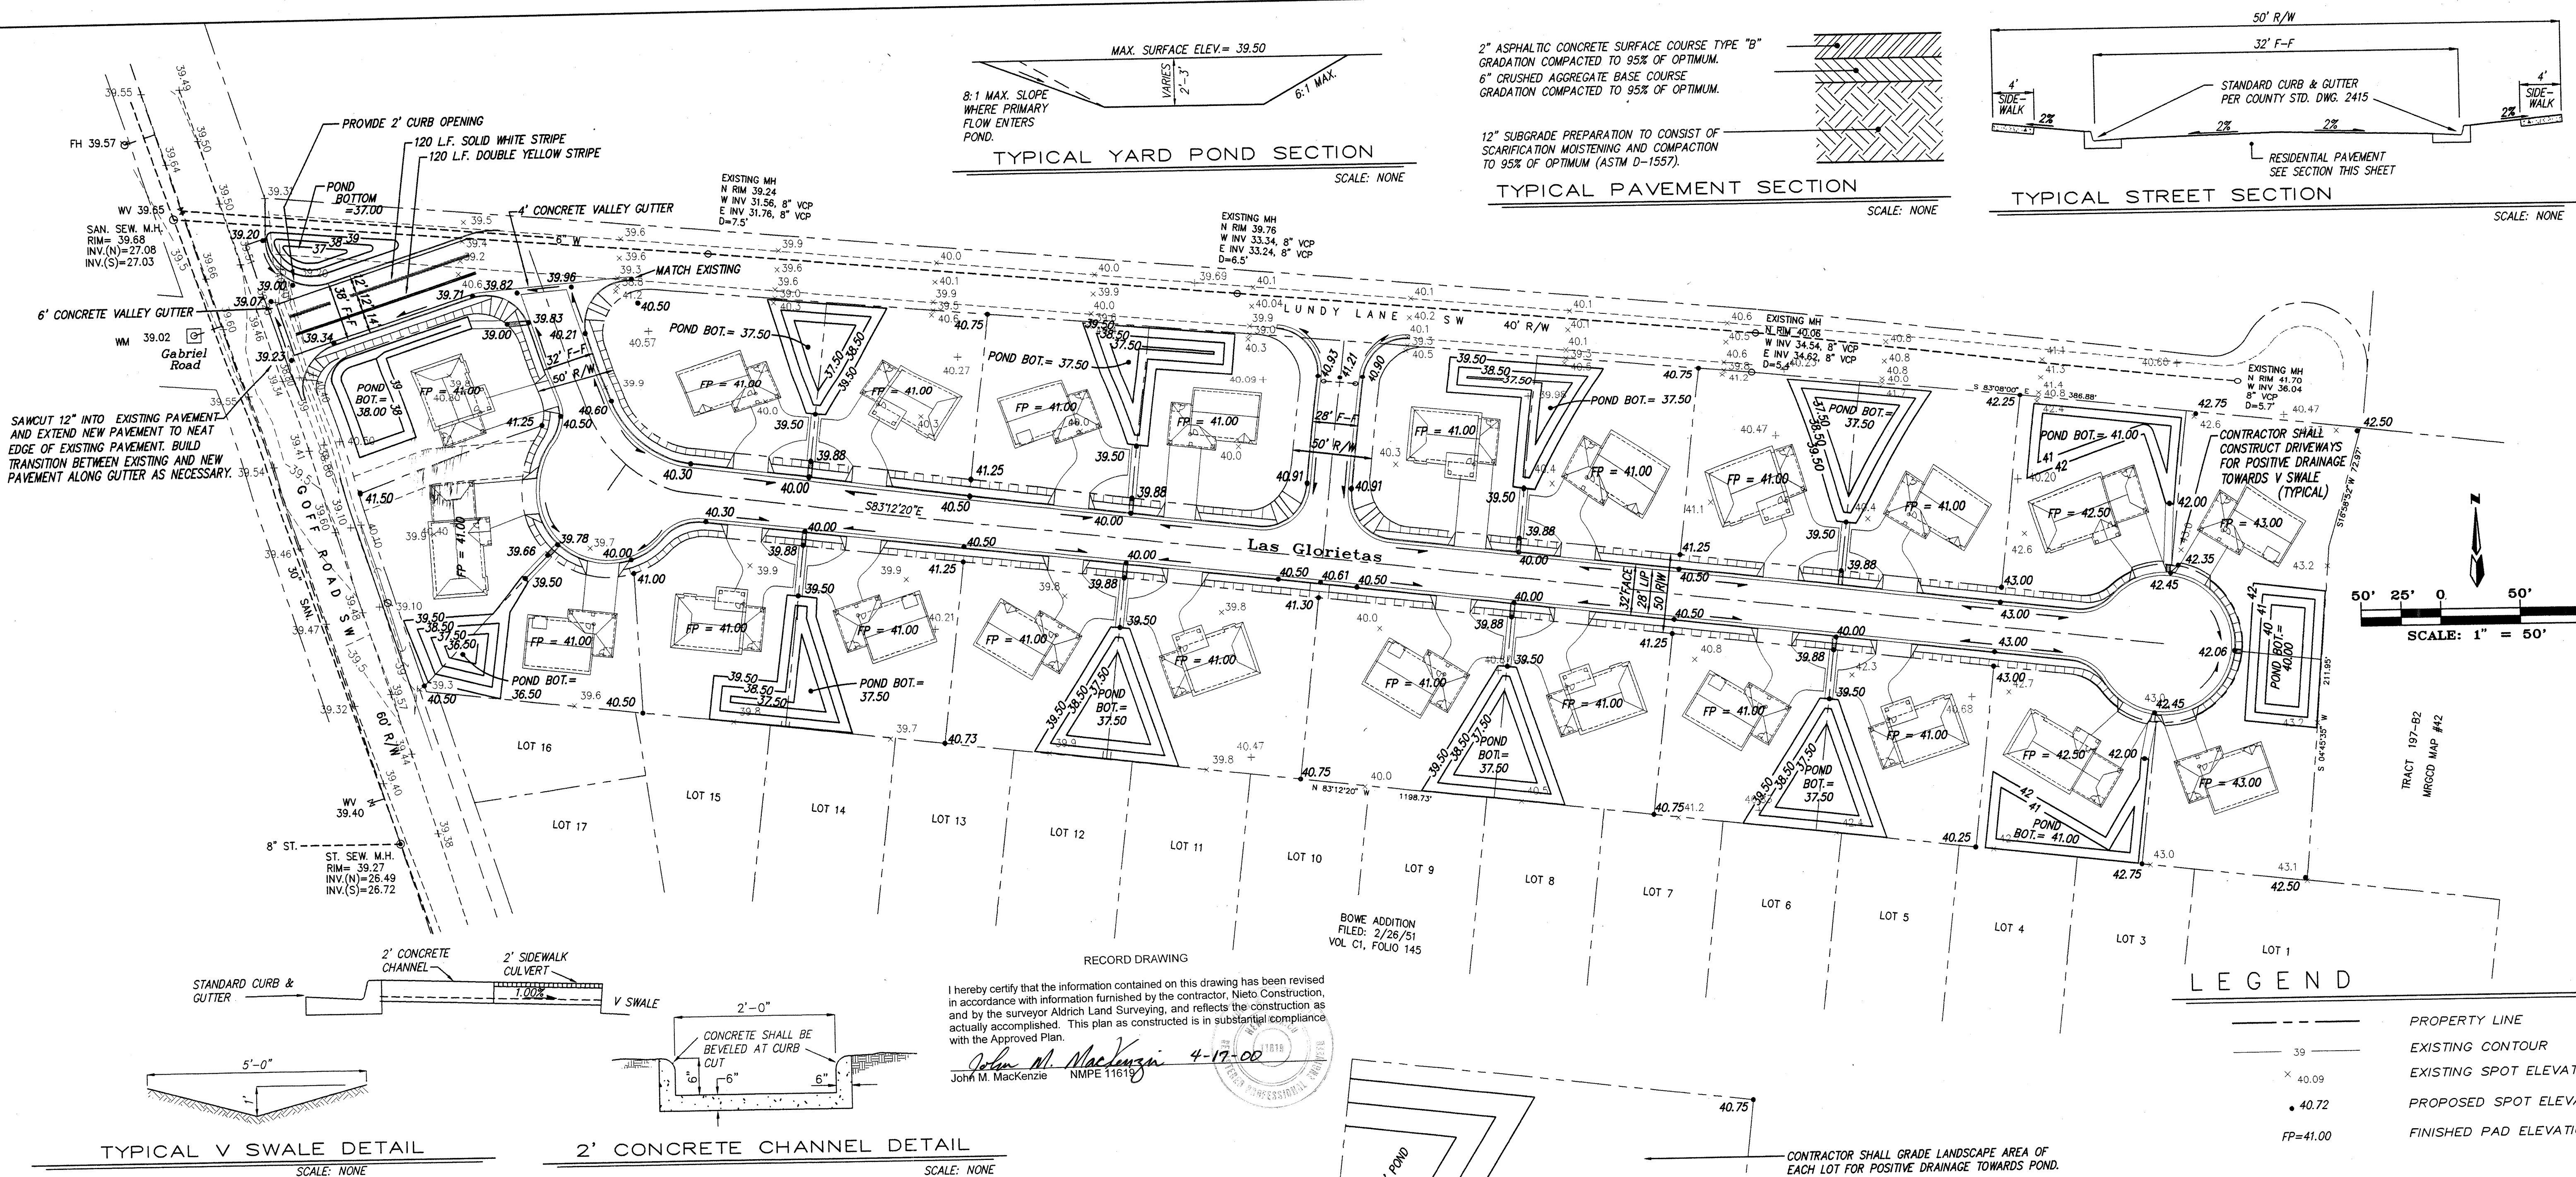

LEGAL DESCRIPTION
TRACT "A" (LD-74-15), TOWN OF ATRISCO GRANT, BERNALILLO COUNTY (7.97 ACRES)


- NOTES**
1. Per AHYMO'S 100 year-10 day storm, 2121 cu. ft. of runoff storage volume shall be provided within the yard area of each lot.
 2. On August 20, 1995, John M. MacKenzie, P.E., inspected the subject site and determined that no recent grading, filling, or excavation had occurred on-site since the topographic survey was prepared.
 3. Typical lot grading represents a guide for all lots unless otherwise noted.
 4. All ponding areas are areas of cut. All building pads are areas to be filled.
 5. Off-site flows do not adversely impact this site.
 6. Earthwork contractor is required to obtain a topsoil disturbance permit from the City of Albuquerque Environmental Health Department prior to beginning earthwork operations. Contact Larry Caudill to arrange for appropriate on-site dust and erosion control measures.
 7. All ponding areas shall be constructed 12' from any housing structure. No exceptions.

DRAINAGE CALCULATIONS

SITE AREA = 7.97 ACRES
P(100-6) = 2.26 IN.
P(100-10 day) = 3.67 in.
Incremental Time = 0.0333 hr.
Time to Peak = 0.1333 hr.

EXISTING CONDITIONS
Surface Treatment: A=100%
Q(100-6) = 11.44 cfs
Vol(100-6) = 0.323 ac. ft.

PROPOSED CONDITIONS
Surface Treatment: B=47%, C=20%, D=33%
Q(100-6) = 24.86 cfs
Vol(100-6) = 0.807 ac. ft.
Vol(100-10 day) = 1.12 ac. ft.

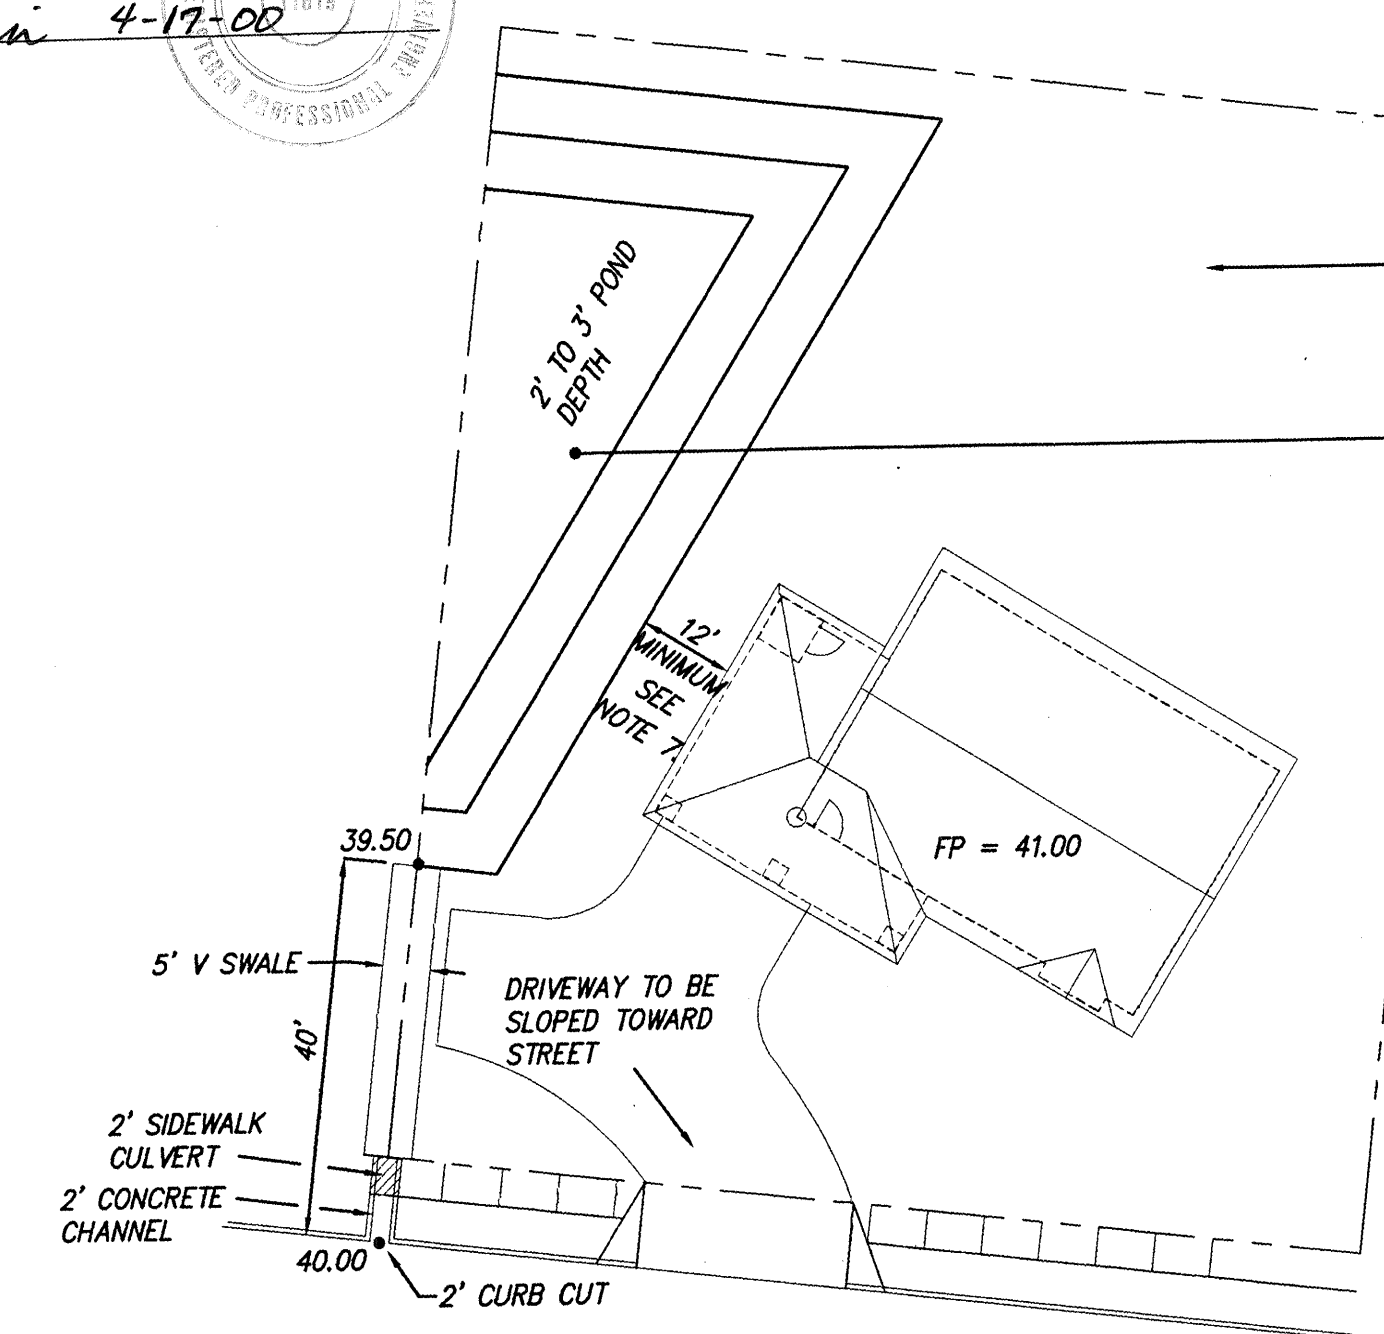

VICINITY MAP
NTS ZONE ATLAS L-12

I hereby certify that the information contained on this drawing has been revised in accordance with information furnished by the contractor, Nieto Construction, and by the surveyor Aldrich Land Surveying, and reflects the construction as actually accomplished. This plan as constructed is in substantial compliance with the Approved Plan.
John M. MacKenzie 4-17-97
John M. MacKenzie NMPE 11819

Edmund J. Pineda
COUNTY ENGINEER
4/28/97 date

LEGEND

---	PROPERTY LINE
---	EXISTING CONTOUR
x 40.09	EXISTING SPOT ELEVATION
• 40.72	PROPOSED SPOT ELEVATION
FP=41.00	FINISHED PAD ELEVATION

dekker/perich & associates
architecture
planning
interiors
6501 Americas Parkway, NE Suite 675
Albuquerque, New Mexico 87110
505 888-3111 Fax 883-8030


LAS GLORIETAS SUBDIVISION

GRADING & DRAINAGE PLAN

dmg D. MARK GOODWIN & ASSOCIATES, P.A.
CONSULTING ENGINEERS & SURVEYORS
P.O. BOX 90606
ALBUQUERQUE, NEW MEXICO 87199
(505) 345-2010

Designed: JMM	Drawn: STAFF	Checked: DMG	Sheet 3 of 7
Scale: 1"=50'	Date: 3/26/97	Job: 95043	

5043GLOR\5043GD50: 4-22-97

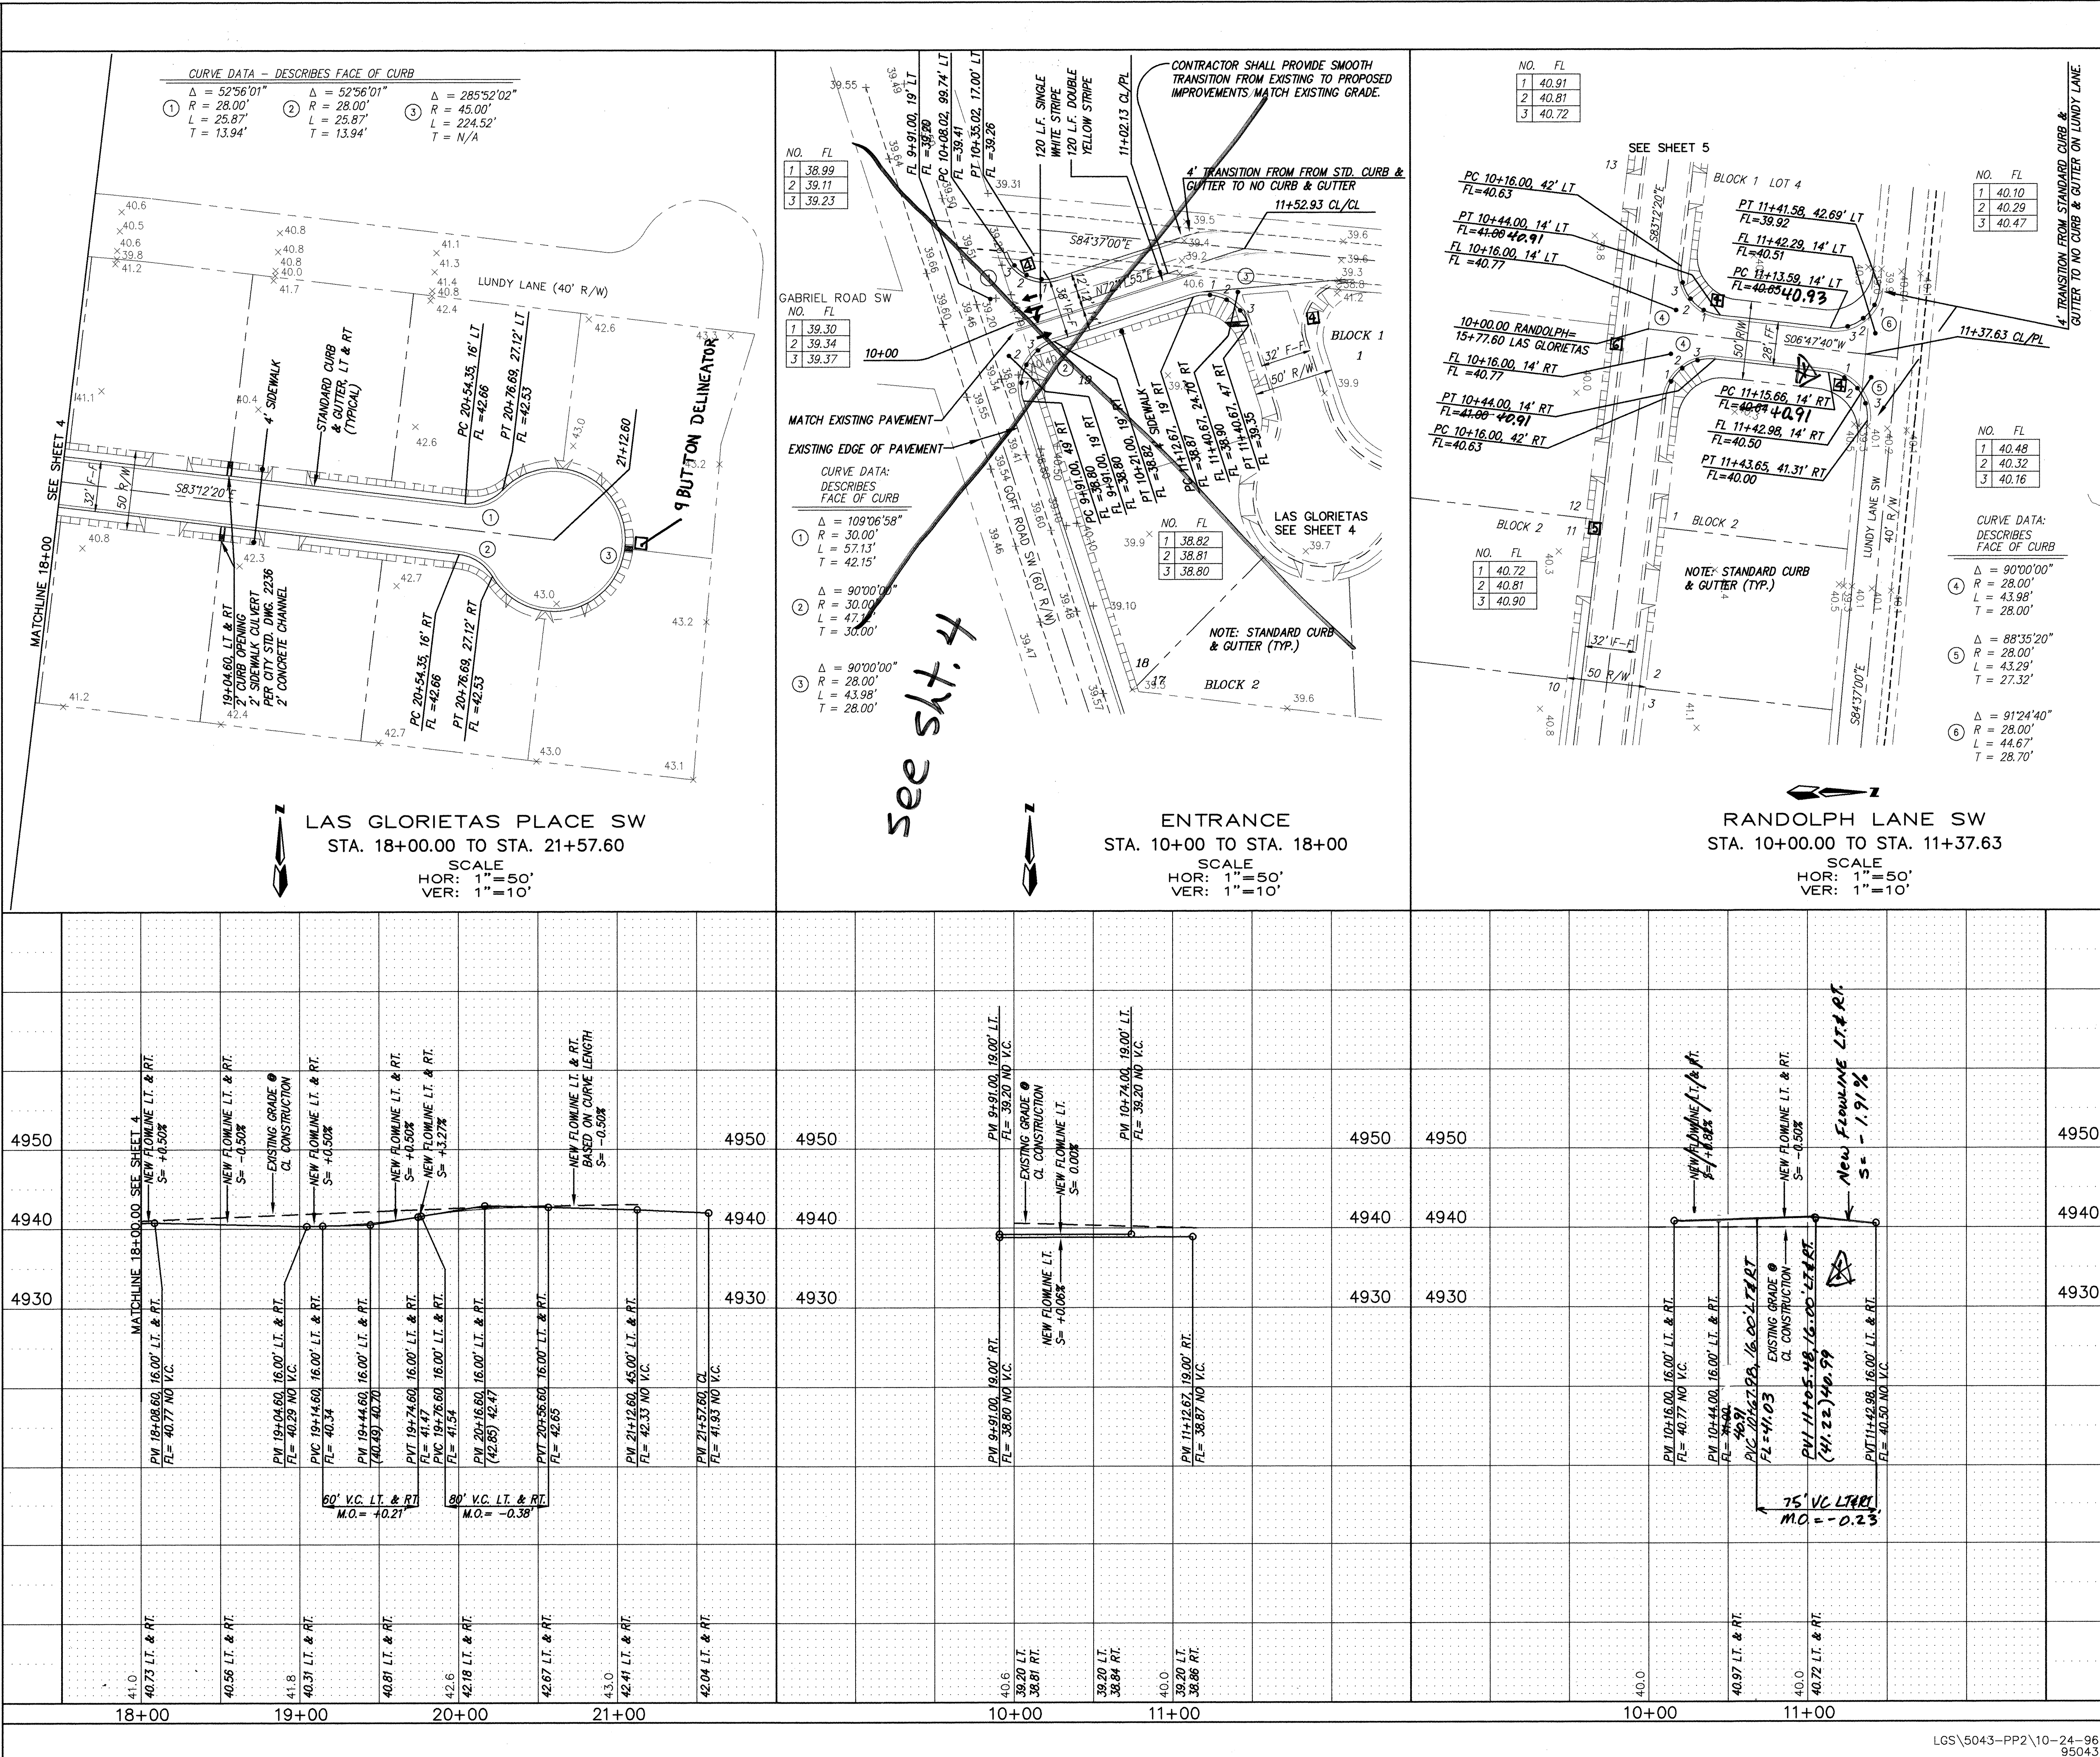

NOTES

1. FOR TYPICAL STREET SECTIONS, SEE SHEET 3.

2. ELEVATIONS SHOWN ON PROFILE STATIONING REPRESENT FLOWLINE ELEVATION.

3. ALL STATIONING IS CENTERLINE STATIONING.

4. 24" x 24" Stop Sign with Street Names (R1 - 1)

5. Speed Limit 25 Sign (R2 - 4)

6. No Outlet Sign (W14 - 2)

RECORD DRAWING

I hereby certify that the information contained on this drawing has been revised in accordance with information furnished by the contractor, Mike Construction, and by the surveyor Aldrich Land Surveying, and reflects the construction as actually accomplished. This plan as constructed is in substantial compliance with the Approved Plan.

John M. MacKenzie
John M. MacKenzie
NMPE 116193

AS BUILT INFORMATION

CONTRACTOR: *Mike Construction*

WORK ORDER BY: *ALC*

DATE: *8/97*

DESIGNED BY: *ALC*

DATE: *8/97*

CHECKED BY: *ALC*

DATE: *8/97*

RECORDED BY: *ALC*

DATE: *8/97*

NO. *1*

SURVEY INFORMATION

FIELD NOTES

NO. BY DATE

10-24-96

4-2-97

ENGINEER'S SEAL

John M. MacKenzie

10-24-96

4-2-97

4-2-97 Redraw Curve

REMARKS

REVISIONS

DESIGN

DESIGNED BY: *JMM*

DRAWN BY: *DMG*

CHECKED BY: *DMG*

BERNALILLO COUNTY PUBLIC WORKS DEPARTMENT

TITLE: LAS GLORIETAS SUBDIVISION LAS GLORIETAS, LUNDY ENTRANCE & RANDOLPH LANE PAVING IMPROVEMENTS

APPROVALS

COUNTY: *E. Samuel* 4/24/97

ENGINEER: *WATER*


DATE: *WASTE WATER*

PROJECT NO. 5538.81

MAP NO. L12

SHEET 5

OF 7

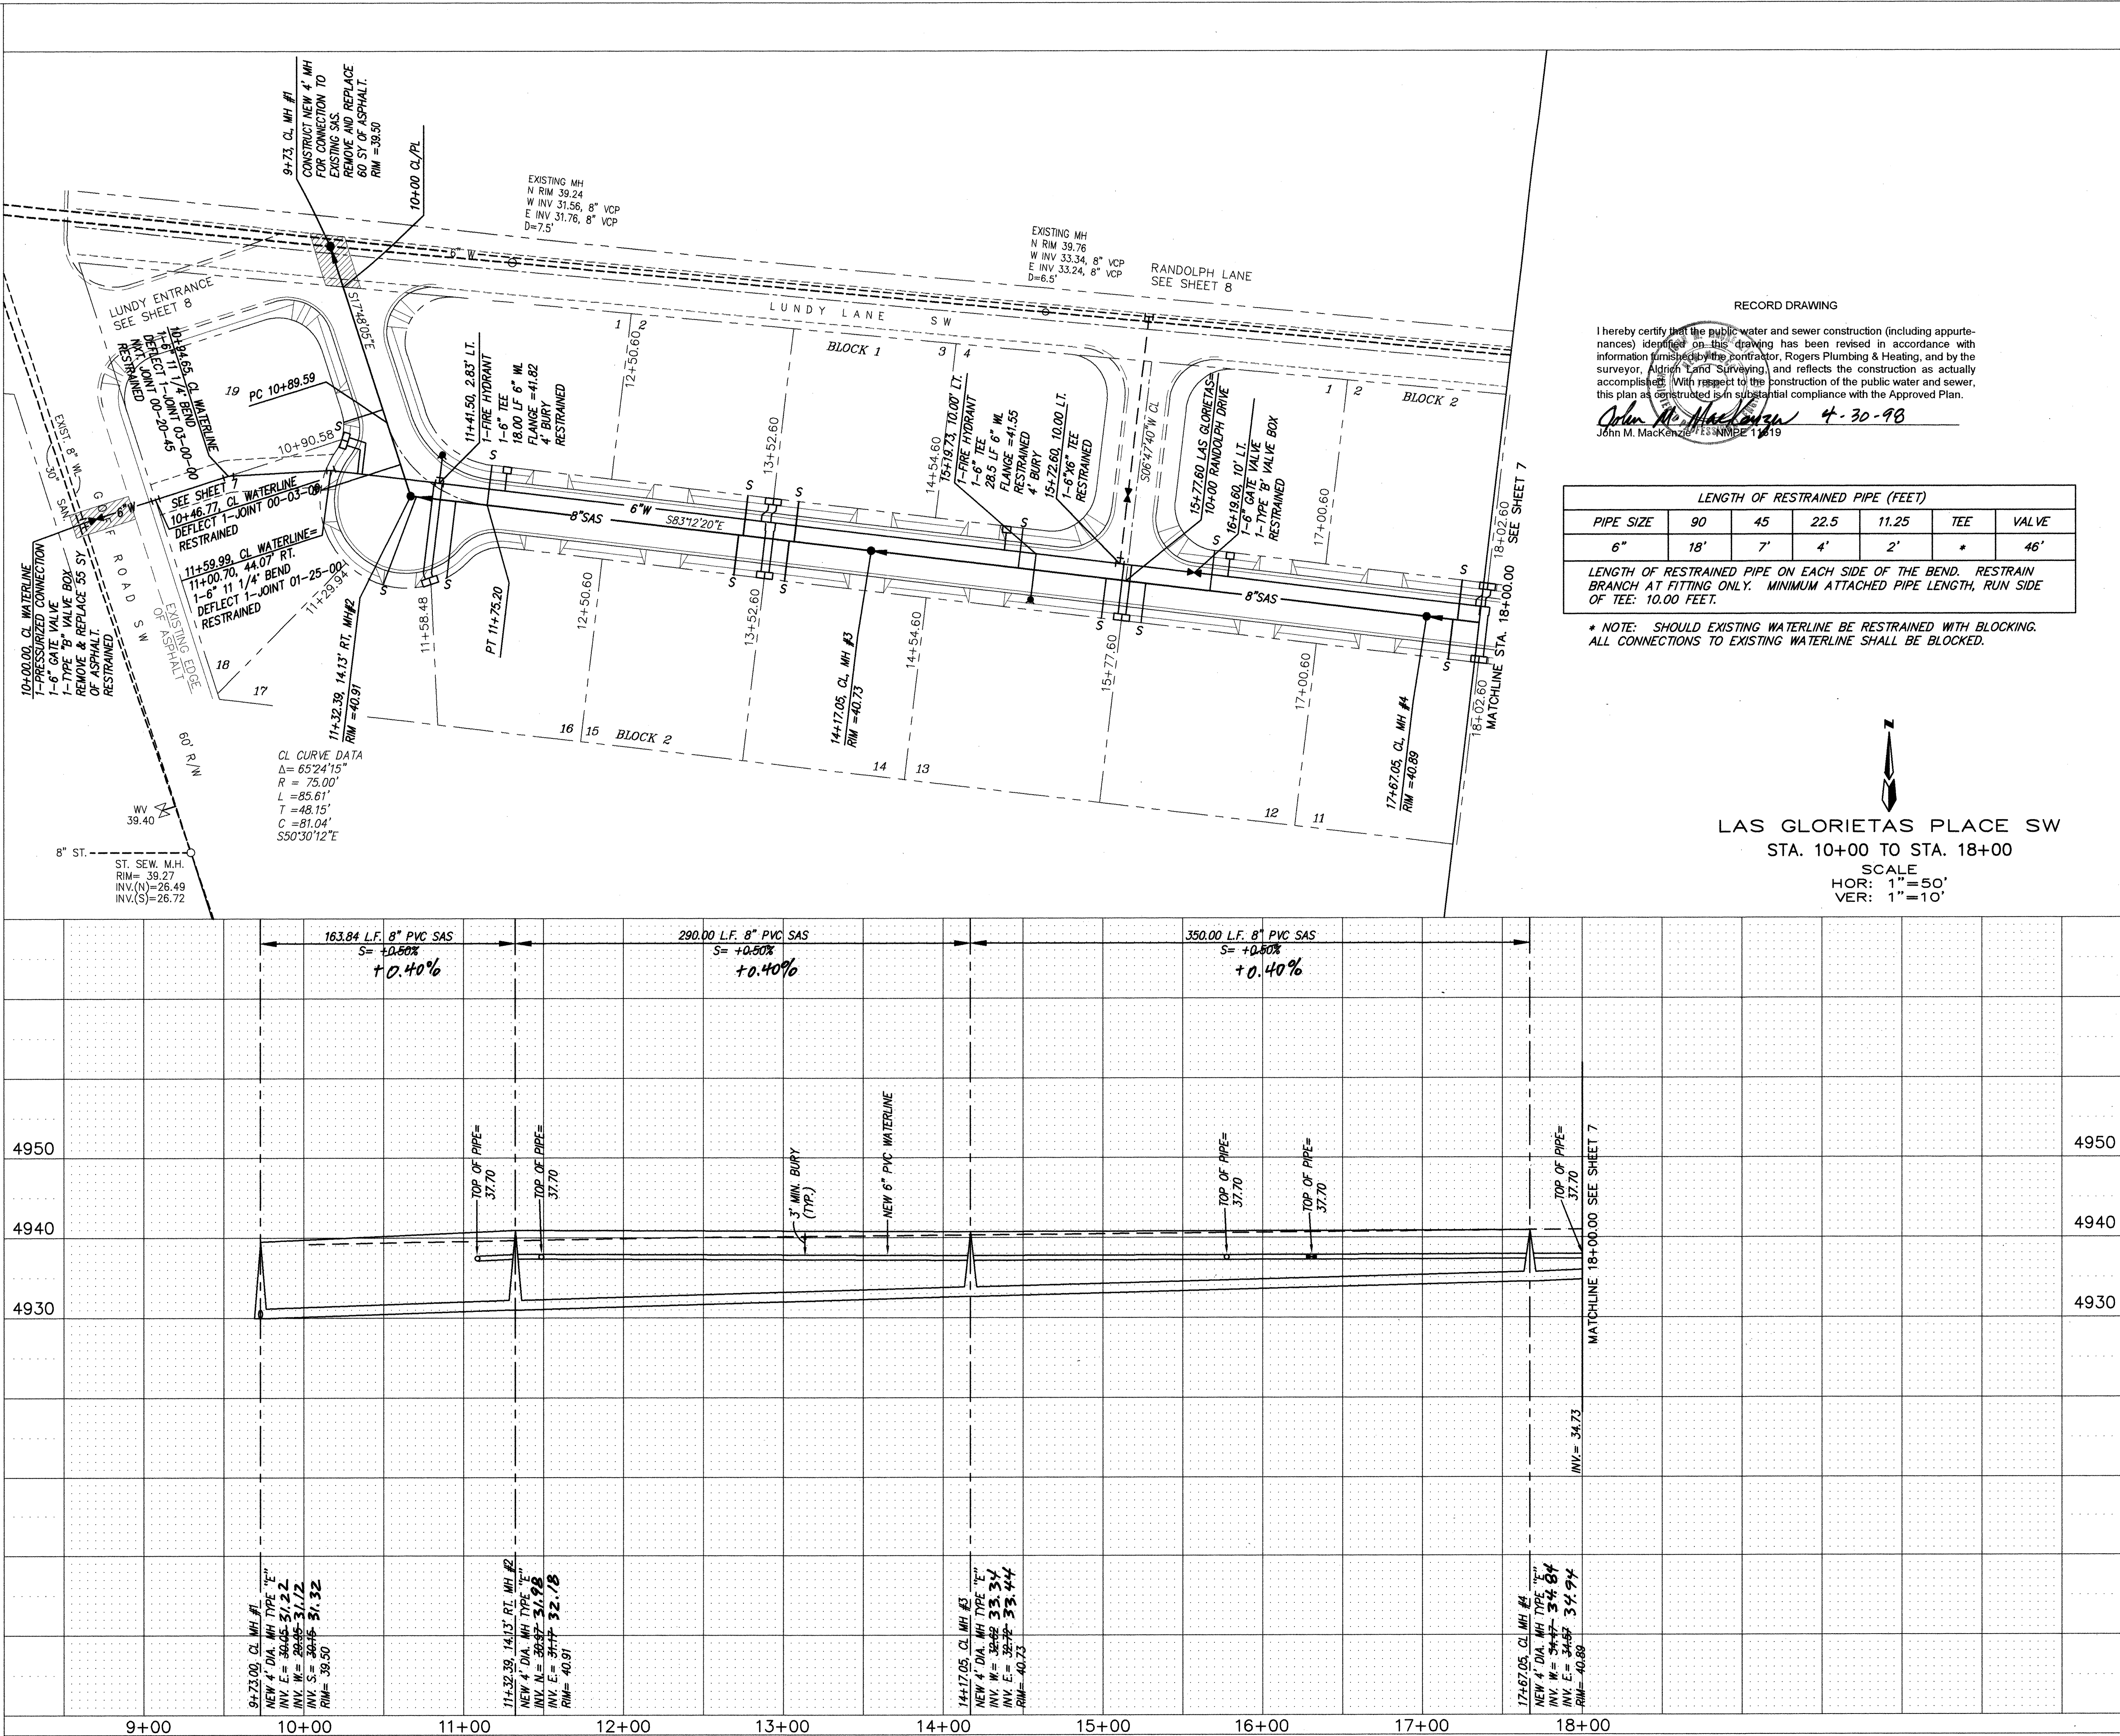

RECORD DRAWING

I hereby certify that the public water and sewer construction (including appurtenances) identified on this drawing has been revised in accordance with information furnished by the contractor, Rogers Plumbing & Heating, and by the surveyor, Aldrich Land Surveying, and reflects the construction as actually accomplished. With respect to the construction of the public water and sewer, this plan as constructed is in substantial compliance with the Approved Plan.

John M. MacKenzie 4-30-98
John M. MacKenzie, P.E., NCEM No. 1219

LENGTH OF RESTRAINED PIPE (FEET)						
PIPE SIZE	90	45	22.5	11.25	TEE	VALVE
6"	18'	7'	4'	2'	*	46'

LENGTH OF RESTRAINED PIPE ON EACH SIDE OF THE BEND. RESTRAIN BRANCH AT FITTING ONLY. MINIMUM ATTACHED PIPE LENGTH, RUN SIDE OF TEE: 10.00 FEET.

* NOTE: SHOULD EXISTING WATERLINE BE RESTRAINED WITH BLOCKING. ALL CONNECTIONS TO EXISTING WATERLINE SHALL BE BLOCKED.

LAS GLORIETAS PLACE SW
STA. 10+00 TO STA. 18+00

SCALE
HOR: 1"=50'
VER: 1"=10'

- NOTES
1. ALL STATIONING IS CENTERLINE STATIONING.
 2. BLOCKING ON WATERLINE PER BERNALILLO COUNTY STANDARDS.
 3. WATER AND SANITARY SEWER SERVICE LINES SHALL HAVE A 3" SEPARATION ON EITHER SIDE OF MAIN. NO BACK TO BACK SERVICE LINES.
 4. ALL 6" WATERLINE MAINS SHALL BE C-900 PVC.
 5. ALL 8" SANITARY SEWER MAINS SHALL BE SDR 35 PVC.
 6. ALL SANITARY SEWER SERVICES SHALL BE AT A MINIMUM OF 4' DEPTH AT PROPERTY LINE.

SANITARY SEWER SERVICES				
BLOCK	LOT	STATION AT PL	INV. ELEV. AT PL	LENGTH AT PL
1	1	11+75	36.50	25'
1	2	13+36	37.00	25'
1	3	13.68	37.00	25'
1	4	15+09	36.50	25'
BLOCK	LOT	STATION AT PL	INV. ELEV. AT PL	LENGTH AT PL
2	1	16+30	36.50	25'
2	2	17+86	37.00	25'
2	11	17+83	37.00	25'
2	12	15+87	37.25	25'
2	13	15+67	37.25	25'
2	14	13+65	37.00	25'
2	15	13+33	37.00	25'
2	16	11+63	37.00	50'
2	17	11+43	36.00	57'
2	18	10+94	37.00	52'
2	19	10+80	37.00	25'

AS BUILT INFORMATION		BENCH MARKS		SURVEY INFORMATION		ENGINEER'S SEAL	
CONTRACTOR	WORKED BY	DATE	DATE	NO.	DATE	NO.	DATE
Rogers Plumbing	ALB	7/97	8/97				
INSPECTED BY	ACCEPTANCE BY	DATE	DATE				
ALB	MLA	8/97	8/97				
VERIFICATION BY	DRAWING	DATE	DATE				
ALB	MLA	8/97	8/97				
CONTRACTOR	MICRO-FILM INFORMATION						
	RECORDED BY	DATE	DATE				
	NO.						
	CITY INSPECTOR: L. Ramon						

Edmund J. Pinal 4/28/92
COUNTY ENGINEER DATE

dekker/perich & associates
architecture
planning
interiors
6301 American Parkway NE, Suite 675
Albuquerque, New Mexico 87110
505 868-3111 Fax 868 8050


dmg D. MARK GOODWIN & ASSOCIATES, P.A.
CONSULTING ENGINEERS & SURVEYORS
P.O. BOX 90608
ALBUQUERQUE, NEW MEXICO 87199
(505) 345-2010

CITY OF ALBUQUERQUE
PUBLIC WORKS DEPARTMENT
ENGINEERING DEVELOPMENT GROUP

TITLE: LAS GLORIETAS SUBDIVISION
10+00.00 TO 18+00.00
UTILITY IMPROVEMENTS

DESIGN REVIEW COMMITTEE	CITY ENGINEER APPROVAL	LAST DESIGN UPDATE	MO./DAY/YR.	MO./DAY/YR.
APPROVED MAY - 7 1997 DESIGN REVIEW COMMITTEE				


CITY PROJECT NO.	ZONE MAP NO.	SHEET	OF
5538.81	L12	6	7

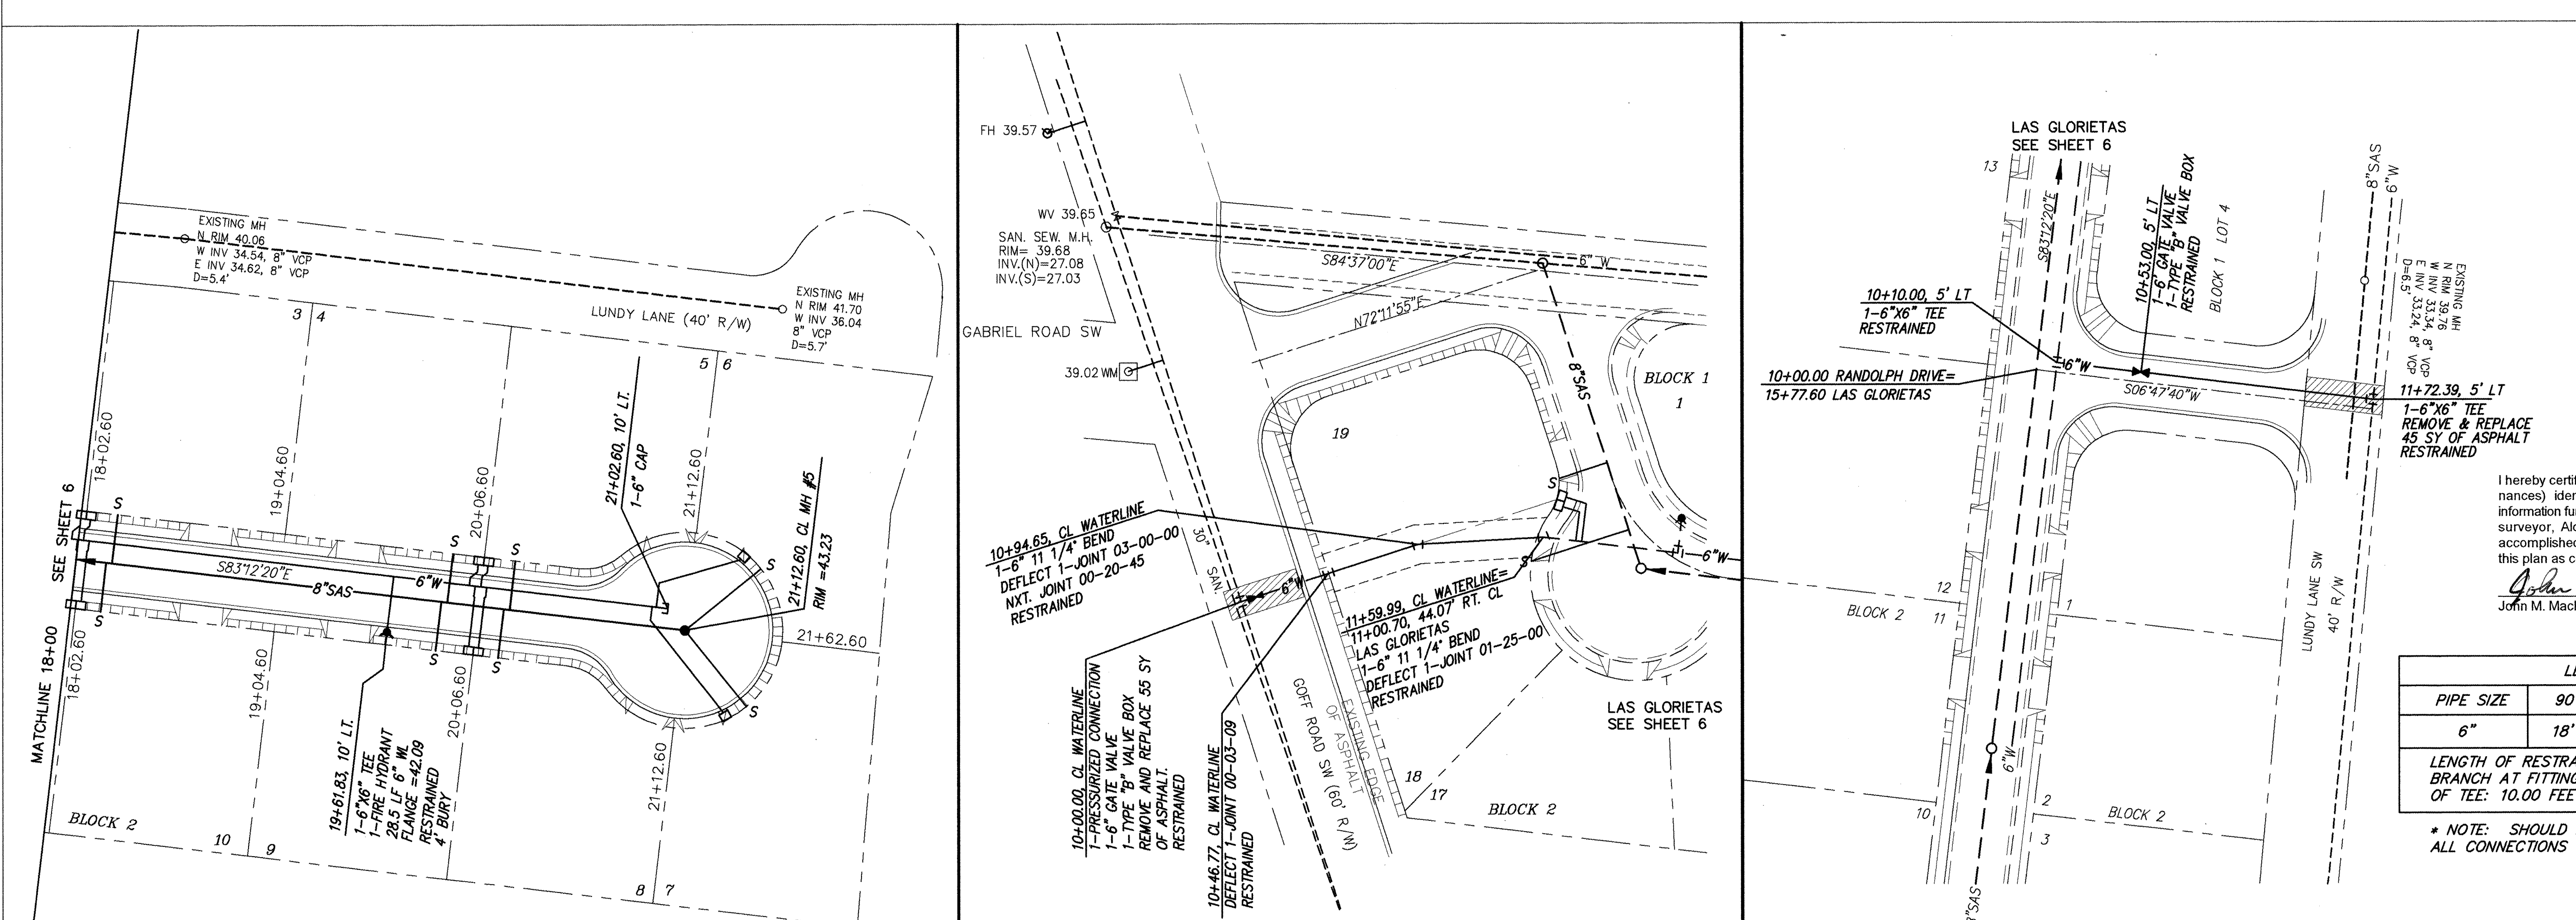

LAS GLORIETAS PLACE SW
STA. 18+00.00 TO STA. 21+57.60
SCALE
HOR: 1"=50'
VER: 1"=10'

LUNDY ENTRANCE
STA. 10+00 TO STA. 18+00
SCALE
HOR: 1"=50'
VER: 1"=10'

RANDOLPH DRIVE SW
STA. 10+00.00 TO STA. 11+37.63
SCALE
HOR: 1"=50'
VER: 1"=10'

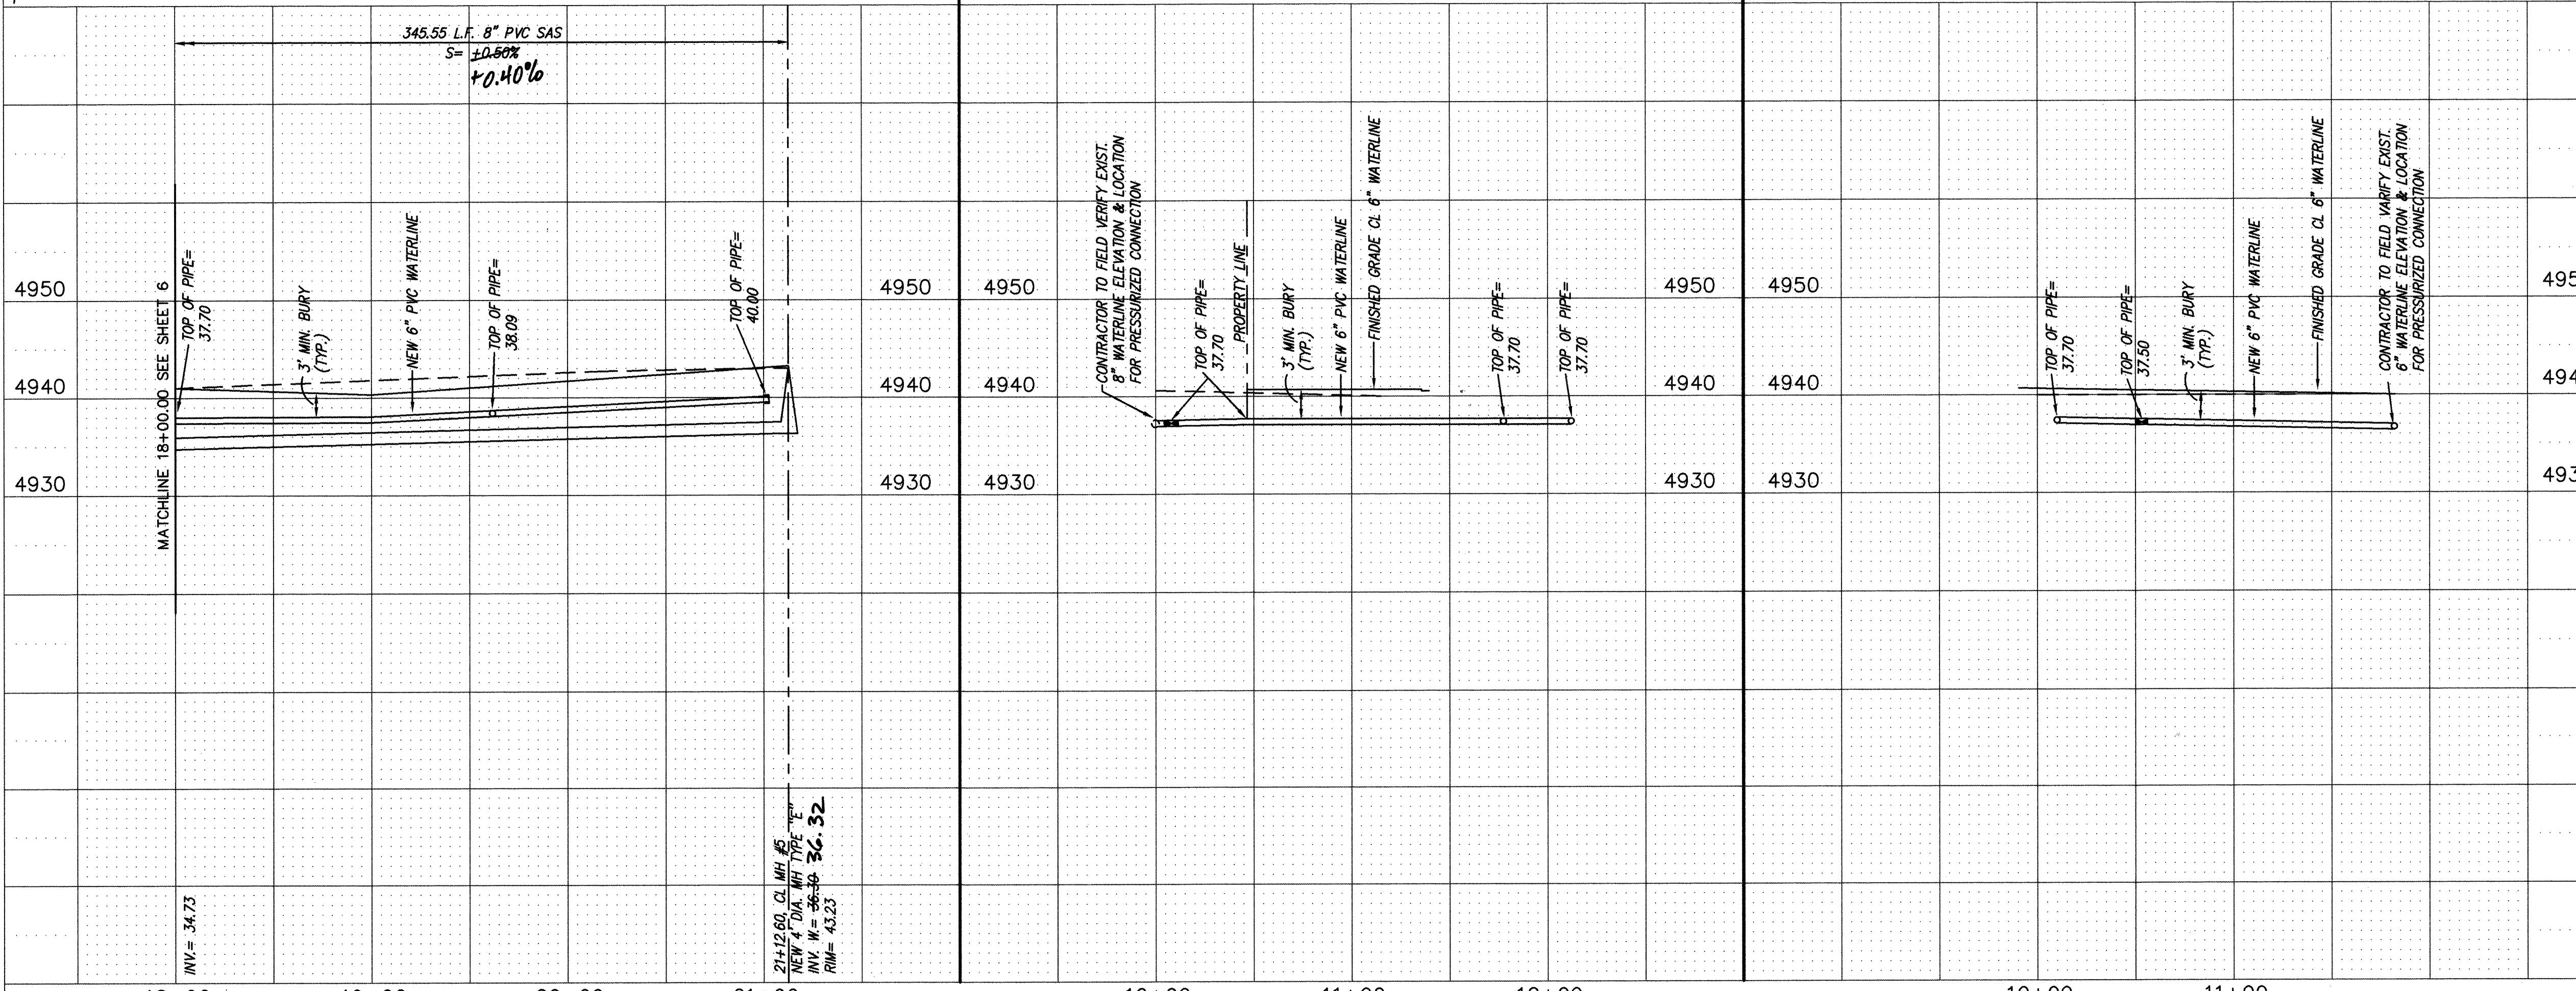

18+00 19+00 20+00 21+00 10+00 11+00 12+00 10+00 11+00

- NOTES**
1. ALL STATIONING IS CENTERLINE STATIONING.
 2. BLOCKING ON WATERLINE PER BERNALILLO COUNTY STANDARDS.
 3. WATER AND SANITARY SEWER SERVICE LINES SHALL HAVE A 3" SEPARATION ON EITHER SIDE OF MAIN. NO BACK TO BACK SERVICE LINES.
 4. ALL 6" WATERLINE MAINS SHALL BE C-900 PVC.
 5. ALL 8" SANITARY SEWER MAINS SHALL BE SDR 35 PVC.
 6. ALL SANITARY SEWER SERVICES SHALL BE AT A MINIMUM OF 4' DEPTH AT PROPERTY LINE.

RECORD DRAWING

I hereby certify that the public water and sewer construction (including appurtenances) identified on this drawing has been revised in accordance with information furnished by the contractor, Rogers Plumbing & Heating, and by the surveyor, Aldrich Land Surveying, and reflects the construction as actually accomplished. With respect to the construction of the public water and sewer, this plan as constructed is in substantial compliance with the Approved Plan.

John M. MacKenzie 4/30/97
John M. MacKenzie NMPE 11619

LENGTH OF RESTRAINED PIPE (FEET)						
PIPE SIZE	90	45	22.5	11.25	TEE	VALVE
6"	18'	7'	4'	2'	*	46'

LENGTH OF RESTRAINED PIPE ON EACH SIDE OF THE BEND. RESTRAIN BRANCH AT FITTING ONLY. MINIMUM ATTACHED PIPE LENGTH, RUN SIDE OF TEE: 10.00 FEET.

* NOTE: SHOULD EXISTING WATERLINE BE RESTRAINED WITH BLOCKING, ALL CONNECTIONS TO EXISTING WATERLINE SHALL BE BLOCKED.

SANITARY SEWER SERVICES				
BLOCK	LOT	STATION AT PL	INV. ELEV. AT PL	LENGTH AT PL
2	3	18+18	37.00	25'
2	4	19+90	38.50	25'
2	5	20+22	38.50	25'
2	6	21+47	38.00	45'
2	7	21+48	38.00	45'
2	8	20+19	38.50	25'
2	9	19+87	38.50	25'
2	10	18+15	37.00	25'

Edmund J. ... 4/28/97
COUNTY ENGINEER DATE

dekker/perich & associates
architectural
planning
interiors
5501 Avenida Parkway, NE Suite 675
Albuquerque, New Mexico 87110
505 868-3111 Fax 868-8050

dmg D. MARK GOODWIN & ASSOCIATES, P.A.
CONSULTING ENGINEERS & SURVEYORS
P.O. BOX 90608
ALBUQUERQUE, NEW MEXICO 87199
(505) 345-2010

CITY OF ALBUQUERQUE
PUBLIC WORKS DEPARTMENT
ENGINEERING DEVELOPMENT GROUP

TITLE: **LAS GLORIETAS SUBDIVISION**
LAS GLORIETAS PLACE, LUNDY ENTRANCE & RANDOLPH DRIVE
UTILITY IMPROVEMENTS

DESIGN REVIEW COMMITTEE
APPROVED
MAY - 7 1997
DESIGN REVIEW COMMITTEE

CITY ENGINEER APPROVAL
LAST DESIGN UPDATE
MO./DAY/YR.
MO./DAY/YR.

DESIGNED BY JMM
DRAWN BY STAFF
CHECKED BY DMG

CITY PROJECT NO. **5538.81**
ZONE MAP NO. **L12**
SHEET **7** OF **7**

AS BUILT INFORMATION

CONTRACTOR: *Rogers Plumbing*
WORKED BY: *AL-S*
DATE: *4/29/97*
INSPECTOR'S: *AL-S*
DATE: *4/29/97*
APPROVED BY: *AL-S*
DATE: *4/29/97*
VERIFICATION BY: *AL-S*
DATE: *4/29/97*
CORRECTED BY: *AL-S*
DATE: *4/29/97*
MICRO-FILM INFORMATION
RECORDED BY: *AL-S*
DATE: *4/29/97*
NO. *AL-S*

BENCH MARKS

SURVEY INFORMATION

FIELD NOTES
NO. *11118*
DATE *4/29/97*
BY *John M. MacKenzie*

ENGINEER'S SEAL

John M. MacKenzie
10.22.96

REVISIONS

NO. *1* DATE *4/29/97* BY *John M. MacKenzie*
REMARKS
DESIGN

DESIGNED BY JMM
DRAWN BY STAFF
CHECKED BY DMG

DATE 5/96
DATE 5/96
DATE 5/96