


UNSER BOULEVARD/LADERA DRIVE  
INTRESECTION IMPROVEMENTS  
ALBUQUERQUE, NEW MEXICO

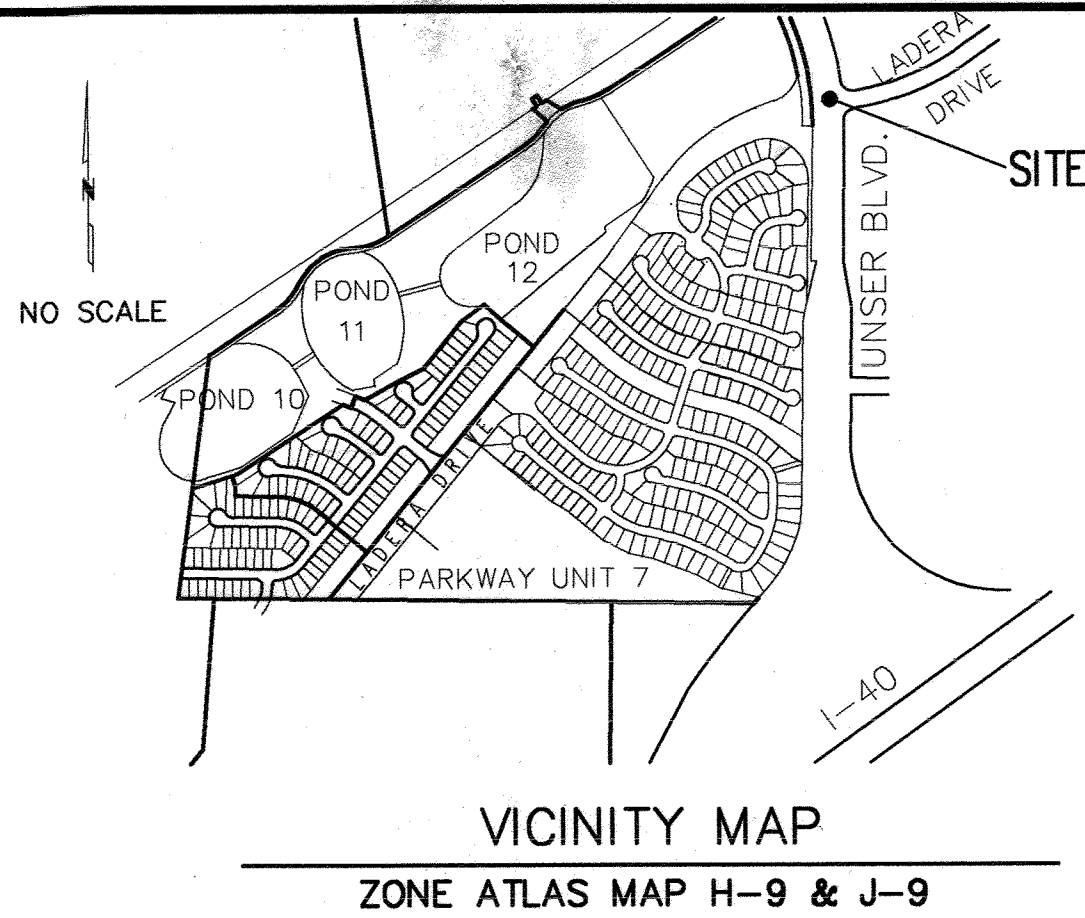

GENERAL NOTES


- ALL WORK DETAILED ON THESE PLANS TO BE PERFORMED UNDER CONTRACT SHALL, EXCEPT AS OTHERWISE STATED OR PROVIDED FOR HEREON, BE CONSTRUCTED IN ACCORDANCE WITH THE CITY OF ALBUQUERQUE STANDARD SPECIFICATIONS FOR PUBLIC WORKS CONSTRUCTION 1986 EDITION AS AMENDED WITH UPDATE NO. 6.
- PRIOR TO CONSTRUCTION, THE CONTRACTOR SHALL EXCAVATE AND VERIFY THE HORIZONTAL AND VERTICAL LOCATIONS OF ALL OBSTRUCTIONS. SHOULD A CONFLICT EXIST, THE CONTRACTOR SHALL NOTIFY THE ENGINEER SO THAT THE CONFLICT CAN BE RESOLVED WITH MINIMUM DELAY.
- TWO (2) WORKING DAYS PRIOR TO ANY EXCAVATION, CONTRACTOR MUST CONTACT LINE LOCATING SERVICE @ 260-1990 FOR LOCATION OF EXISTING UTILITIES.
- A. WARNING - EXISTING UTILITY LINE LOCATIONS ARE SHOWN IN AN APPROXIMATE MANNER ONLY, AND SUCH LINES MAY EXIST WHERE NONE ARE SHOWN. THE LOCATION OF ANY SUCH EXISTING LINES IS BASED UPON INFORMATION PROVIDED BY THE UTILITY COMPANY, THE OWNER, OR BY OTHERS, AND THE INFORMATION MAY BE INCOMPLETE OR MAY BE OBSOLETE BY THE TIME CONSTRUCTION COMMENCES.

B. THERE ARE EXISTING HIGH VOLTAGE LINES WITHIN THE PNM EASEMENT ADJACENT TO LADERA DRIVE. THESE LINES MUST REMAIN ENERGIZED AT ALL TIMES. CONTRACTOR SHALL COORDINATE WITH PNM PRIOR TO START OF CONSTRUCTION. CONTRACTOR IS ADVISED THAT OSHA REQUIRES A MINIMUM CLEARANCE OF 15' IN ALL DIRECTIONS FROM THE POWERLINE.
- THE ENGINEER HAS UNDERTAKEN NO FIELD VERIFICATION OF THE LOCATION, DEPTH, SIZE OR TYPE OF EXISTING UNDERGROUND UTILITY LINES. MAKES NO REPRESENTATION PERTAINING THEREFOR. THE CONTRACTOR SHALL INFORM ITSELF OF THE LOCATION OF ANY UTILITY LINE IN OR NEAR THE AREA OF WORK IN ADVANCE OF AND DURING EXCAVATION WORK. THE CONTRACTOR IS FULLY RESPONSIBLE FOR ANY AND ALL DAMAGE CAUSED BY ITS FAILURE TO LOCATE, IDENTIFY AND PRESERVE ANY AND ALL EXISTING UTILITIES. THE CONTRACTOR SHALL COMPLY WITH STATE STATUTES, MUNICIPAL AND LOCAL ORDINANCES, RULES AND REGULATIONS PERTAINING TO THE LOCATION OF THESE LINES AND FACILITIES, IN PLANNING AND CONDUCTING EXCAVATION, WHETHER BY CALLING OR NOTIFYING THE UTILITIES, COMPLYING WITH "BLUE STAKES" PROCEDURES, OR OTHERWISE.
- TRAFFIC CONTROL: THREE (3) WORKING DAYS PRIOR TO BEGINNING CONSTRUCTION THE CONTRACTOR SHALL SUBMIT TO THE CONSTRUCTION COORDINATION DIVISION A DETAILED CONSTRUCTION SCHEDULE. TWO (2) WORKING DAYS PRIOR TO CONSTRUCTION THE CONTRACTOR SHALL OBTAIN A BARRICADING PERMIT FROM THE CONSTRUCTION COORDINATION DIVISION. CONTRACTOR SHALL NOTIFY BARRICADE ENGINEER (768-2551) PRIOR TO OCCUPYING AN INTERSECTION. SEE SECTION 19 OF THE SPECIFICATIONS. ALL STREET STRIPING ALTERED OR DESTROYED SHALL BE REPLACED BY CONTRACTOR TO LOCATION AND IN KIND AS EXISTING AT NO ADDITIONAL COST TO THE OWNER.
- THE CONTRACTOR SHALL PROMPTLY CLEAN UP ANY MATERIAL EXCAVATED WITHIN THE PUBLIC RIGHT-OF-WAY SO THAT THE EXCAVATED MATERIAL IS NOT SUSCEPTIBLE TO BEING WASHED ON THE STREET.
- THE CONTRACTOR IS RESPONSIBLE FOR PROTECTING AND MAINTAINING ALL EXISTING MONUMENTATION CONTROLS. IN THE EVENT OF INADVERTENT DESTRUCTION OR ALTERATION THE CONTRACTOR MUST IMMEDIATELY NOTIFY THE CITY CHIEF SURVEYOR.
- ANY WORK OCCURRING WITHIN AN ARTERIAL ROADWAY REQUIRES TWENTY-FOUR HOUR CONSTRUCTION.
- ALL WHEELCHAIR RAMPS SHALL ADHERE TO CURRENT ADA REQUIREMENTS.

INDEX OF DRAWINGS

SHEET NO.	DESCRIPTION
1	TITLE SHEET
2	INTERSECTION GEOMETRIC IMPROVEMENTS
3	INTERSECTION PAVEMENT MARKINGS
4	TYPICAL DETAILS/SECTIONS
<u>SIGNALIZATION PLAN - LADERA AND UNSER</u>	
5	NOTES & LEGEND
6	ESTIMATED QUANTITIES
7 TO 8	TRAFFIC SIGNAL PLAN
9	TRAFFIC SIGNAL FUNCTIONS & DETECTORS
10	PEDESTAL POLES
11 TO 12	PULL BOX DETAILS
13	TRAFFIC SIGNAL PLAN
14	TRAFFIC CONTROL PLAN
15	SIGNING & CONSTRUCTION TRAFFIC CONTROL STANDARDS
16	TYPICAL TRAFFIC CONTROL & SIGNING EXAMPLES

APPROVAL OF AS BUILT DRAWINGS  
CHIEF CONSTRUCTION ENGINEER  
*W. Chang*  
DATE: 11-9-98

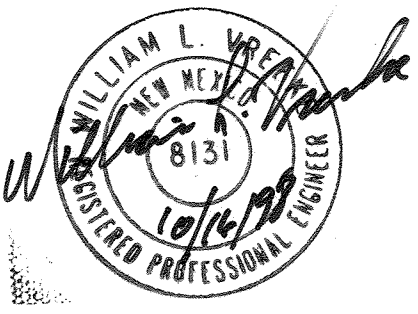


RECORD DRAWING  
DATE: 9-14-98

DRB Case#  
94-443

CINFRAN ENGINEERING INC.  
333 RIO RANCHO DR. N.E. STE. 101  
RIO RANCHO, NEW MEXICO 87124  
(505) 882-5141

REV.	SHEETS	CITY ENGINEER	DATE	USER DEPARTMENT	DATE	USER DEPARTMENT	DATE
ENGINEERS STAMP & SIGNATURE		APPROVALS	ENGINEER	DATE	*****		
		DRC Chairman	<i>Bill G. Gentry</i>	9-31-97	APPROVED FOR CONSTRUCTION <i>[Signature]</i> City Engineer Date 7/10/98		
		Transportation	<i>Don B. B...</i>	1-31-97			
		Water/Wastewater	<i>N/A</i>	2-10-97			
		Hydrology	<i>N/A PM</i>	2-11-97			
		Parks					
		Constr. Mngmt.	<i>[Signature]</i>	22 Jun 98			
		NMASH+TD					
		City Project No.	5548.81		Sheet 1 Of 16		



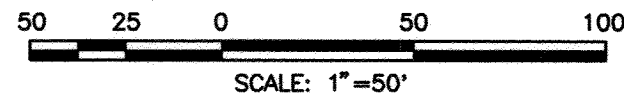

BOP STA. 33+80.00

STA 34+59.93 17.98' RT  
BEGIN TEMPORARY CONNECTION

STA 37+50.26 24.22' LT PT

STA 36+93.58 18.00' RT  
BEGIN EXTRUDED CURB

STA 37+50.26 17.22' LT  
BEGIN EXTRUDED CURB

STA 38+3.56 2.00' LT  
BEGIN LEFT TURN LANE

STA 39+61.34 2.00' LT  
END LEFT TURN LANE

STA 38+15 13.57' LT PT

STA 39+34.97 11.95' LT PC

STA 39+60.77

STA 40+43.16 LADERA DR. N.W.=

STA 100+00.00 UNSER BLVD. (ASSUMED)

LADERA DRIVE

UNSER BOULEVARD, N.W.

STA 99+21.44 .56' LT  
END DOUBLE LEFT TURN LANE


STA 97+17.48 .56' LT  
BEGIN DOUBLE LEFT TURN LANE

STA 96+11.78 20.5' RT (BC)  
BEGIN TRANSITION

MATCHLINE

BEGIN MEDIAN CURB  
STA. 93+59.48  
STA. 92+61.46, 12.77' RT, (BC)  
TIE TO EXIST. ROLLOVER CURB

MATCHLINE

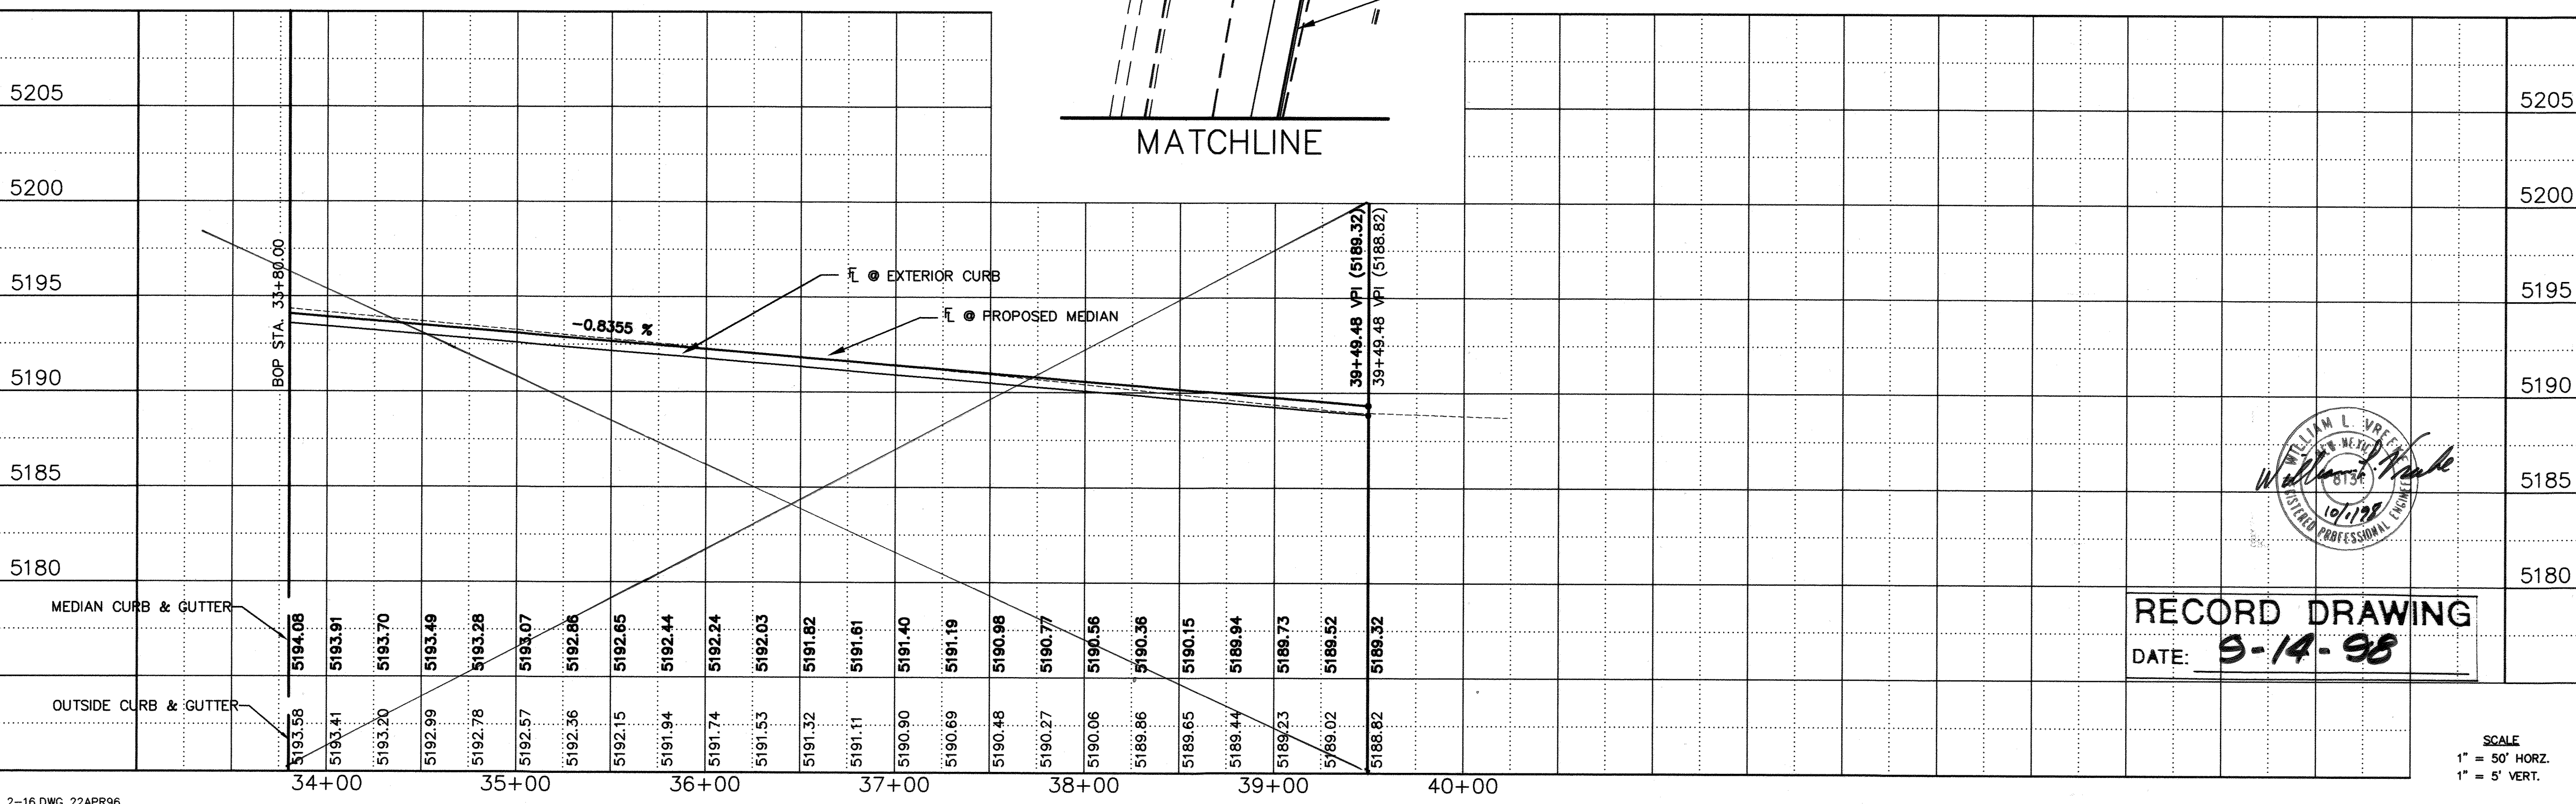

RECORD DRAWING  
DATE: 9-14-98

SCALE  
1" = 50' HORZ.  
1" = 5' VERT.

NOTES


- SEE ROADWAY TYPICAL SECTIONS AND PAVEMENT SECTION ON SHEET 4.
- SEE SHEET 3 FOR INTERSECTION PAVEMENT MARKING DETAILS.
- SEE SHEETS 5 TO 13 FOR TRAFFIC SIGNALIZATION PLAN.

BUILD NOTES

- BUILD STANDARD 1'-6" MEDIAN CURB & GUTTER, C.O.A. DWG #2415.
- BUILD 6" EXTRUDED CONCRETE MEDIAN CURB PER DETAIL SHEET 4
- BUILD ARTERIAL PAVEMENT SECTION PER DETAIL ON SHEET 4.
- BUILD TYPICAL SECTION, SEE SHEET 4.
- ELEVATION & GRADE TO MATCH EXISTING
- REMOVE EXISTING EXTRUDED CURB
- BUILD ARTERIAL PAVEMENT SECTION WITHOUT OPEN GRADED FRICTION COURSE

- C1 CURVE DATA  
 $\Delta = 20^{\circ}00'02''$   
 $R = 150.00'$   
 $T = 26.45'$   
 $L = 52.36'$
- C2 CURVE DATA  
 $\Delta = 180^{\circ}00'00''$   
 $R = 8.31'$   
 $T = NA.$   
 $L = 26.10'$
- C3 CURVE DATA  
 $\Delta = 35^{\circ}48'35''$   
 $R = 930.00'$   
 $T = 300.47'$   
 $L = 581.25'$
- C4 CURVE DATA  
 $\Delta = 6^{\circ}34'12''$   
 $R = 575.00'$   
 $T = 33.00'$   
 $L = 65.93'$
- C5 CURVE DATA  
 $\Delta = 9^{\circ}03'57''$   
 $R = 649.00'$   
 $T = 74.22'$   
 $L = 148.12'$
- C6 CURVE DATA  
 $\Delta = 32^{\circ}50'14''$   
 $R = 50.00'$   
 $T = 14.73'$   
 $L = 28.66'$
- C7 CURVE DATA  
 $\Delta = 151^{\circ}43'13''$   
 $R = 2.00'$   
 $T = 7.94'$   
 $L = 5.30'$
- C8 CURVE DATA  
 $\Delta = 21^{\circ}25'26''$   
 $R = 150.00'$   
 $T = 28.38'$   
 $L = 66.99'$
- C9 CURVE DATA  
 $\Delta = 35^{\circ}16'54''$   
 $R = 450.00'$   
 $T = 143.10'$   
 $L = 277.10'$
- C10 CURVE DATA  
 $\Delta = 11^{\circ}19'54''$   
 $R = 450.00'$   
 $T = 44.64'$   
 $L = 89.00'$
- C11 CURVE DATA  
 $\Delta = 17^{\circ}54'38''$   
 $R = 150.00'$   
 $T = 23.64'$   
 $L = 46.89'$
- C12 CURVE DATA  
 $\Delta = 24^{\circ}41'10''$   
 $R = 150.00'$   
 $T = 32.82'$   
 $L = 64.63'$

AS BUILT INFORMATION				BENCH MARKS			
CONTRACTOR	ALB. UNDERGROUND, INC.	DATE	9/98	ALBUQUERQUE ACS MONUMENT "3-H10"	DATE	9/98	
INSPECTOR	ALUT	DATE	9/98	LOCATED NORTHEAST OF THE INTERSECTION	DATE	9/98	
ACCEPTANCE BY	BLH	DATE	9/98	SECTION OF UNSER BLVD. & LADERA DR.	DATE	9/98	
VERIFICATION BY	ALUT	DATE	9/98	THE STATION MARK IS A STANDARD ACS CAP SET FLUSH IN THE	DATE	9/98	
DRAWINGS	BLH	DATE	9/98	CONCRETE SURFACE OF THE SPILLWAY.	DATE	9/98	
MICRO-FILM INFORMATION				RECORDED BY			
				ELEVATION = 5193.38			

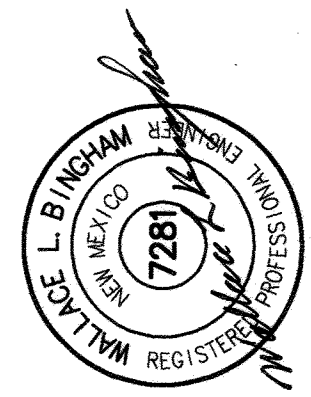



CITY OF ALBUQUERQUE  
PUBLIC WORKS DEPARTMENT  
ENGINEERING GROUP

TITLE: LADERA & UNSER INTERSECTION  
IMPROVEMENTS  
PAVING PLAN AND PROFILE - LADERA DRIVE


APPROVALS	ENGINEER	DATE	APPROVALS	ENGINEER	DATE
D.R.C. Chair					
Trans. Dev.					
Utility Dev.					
DESIGN REVIEW COMMITTEE					

PROJECT NO. 5548.81  
MAP NO. H-9&J-9  
SHEET 2 OF 16



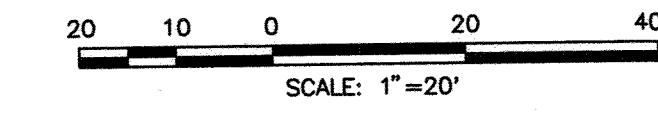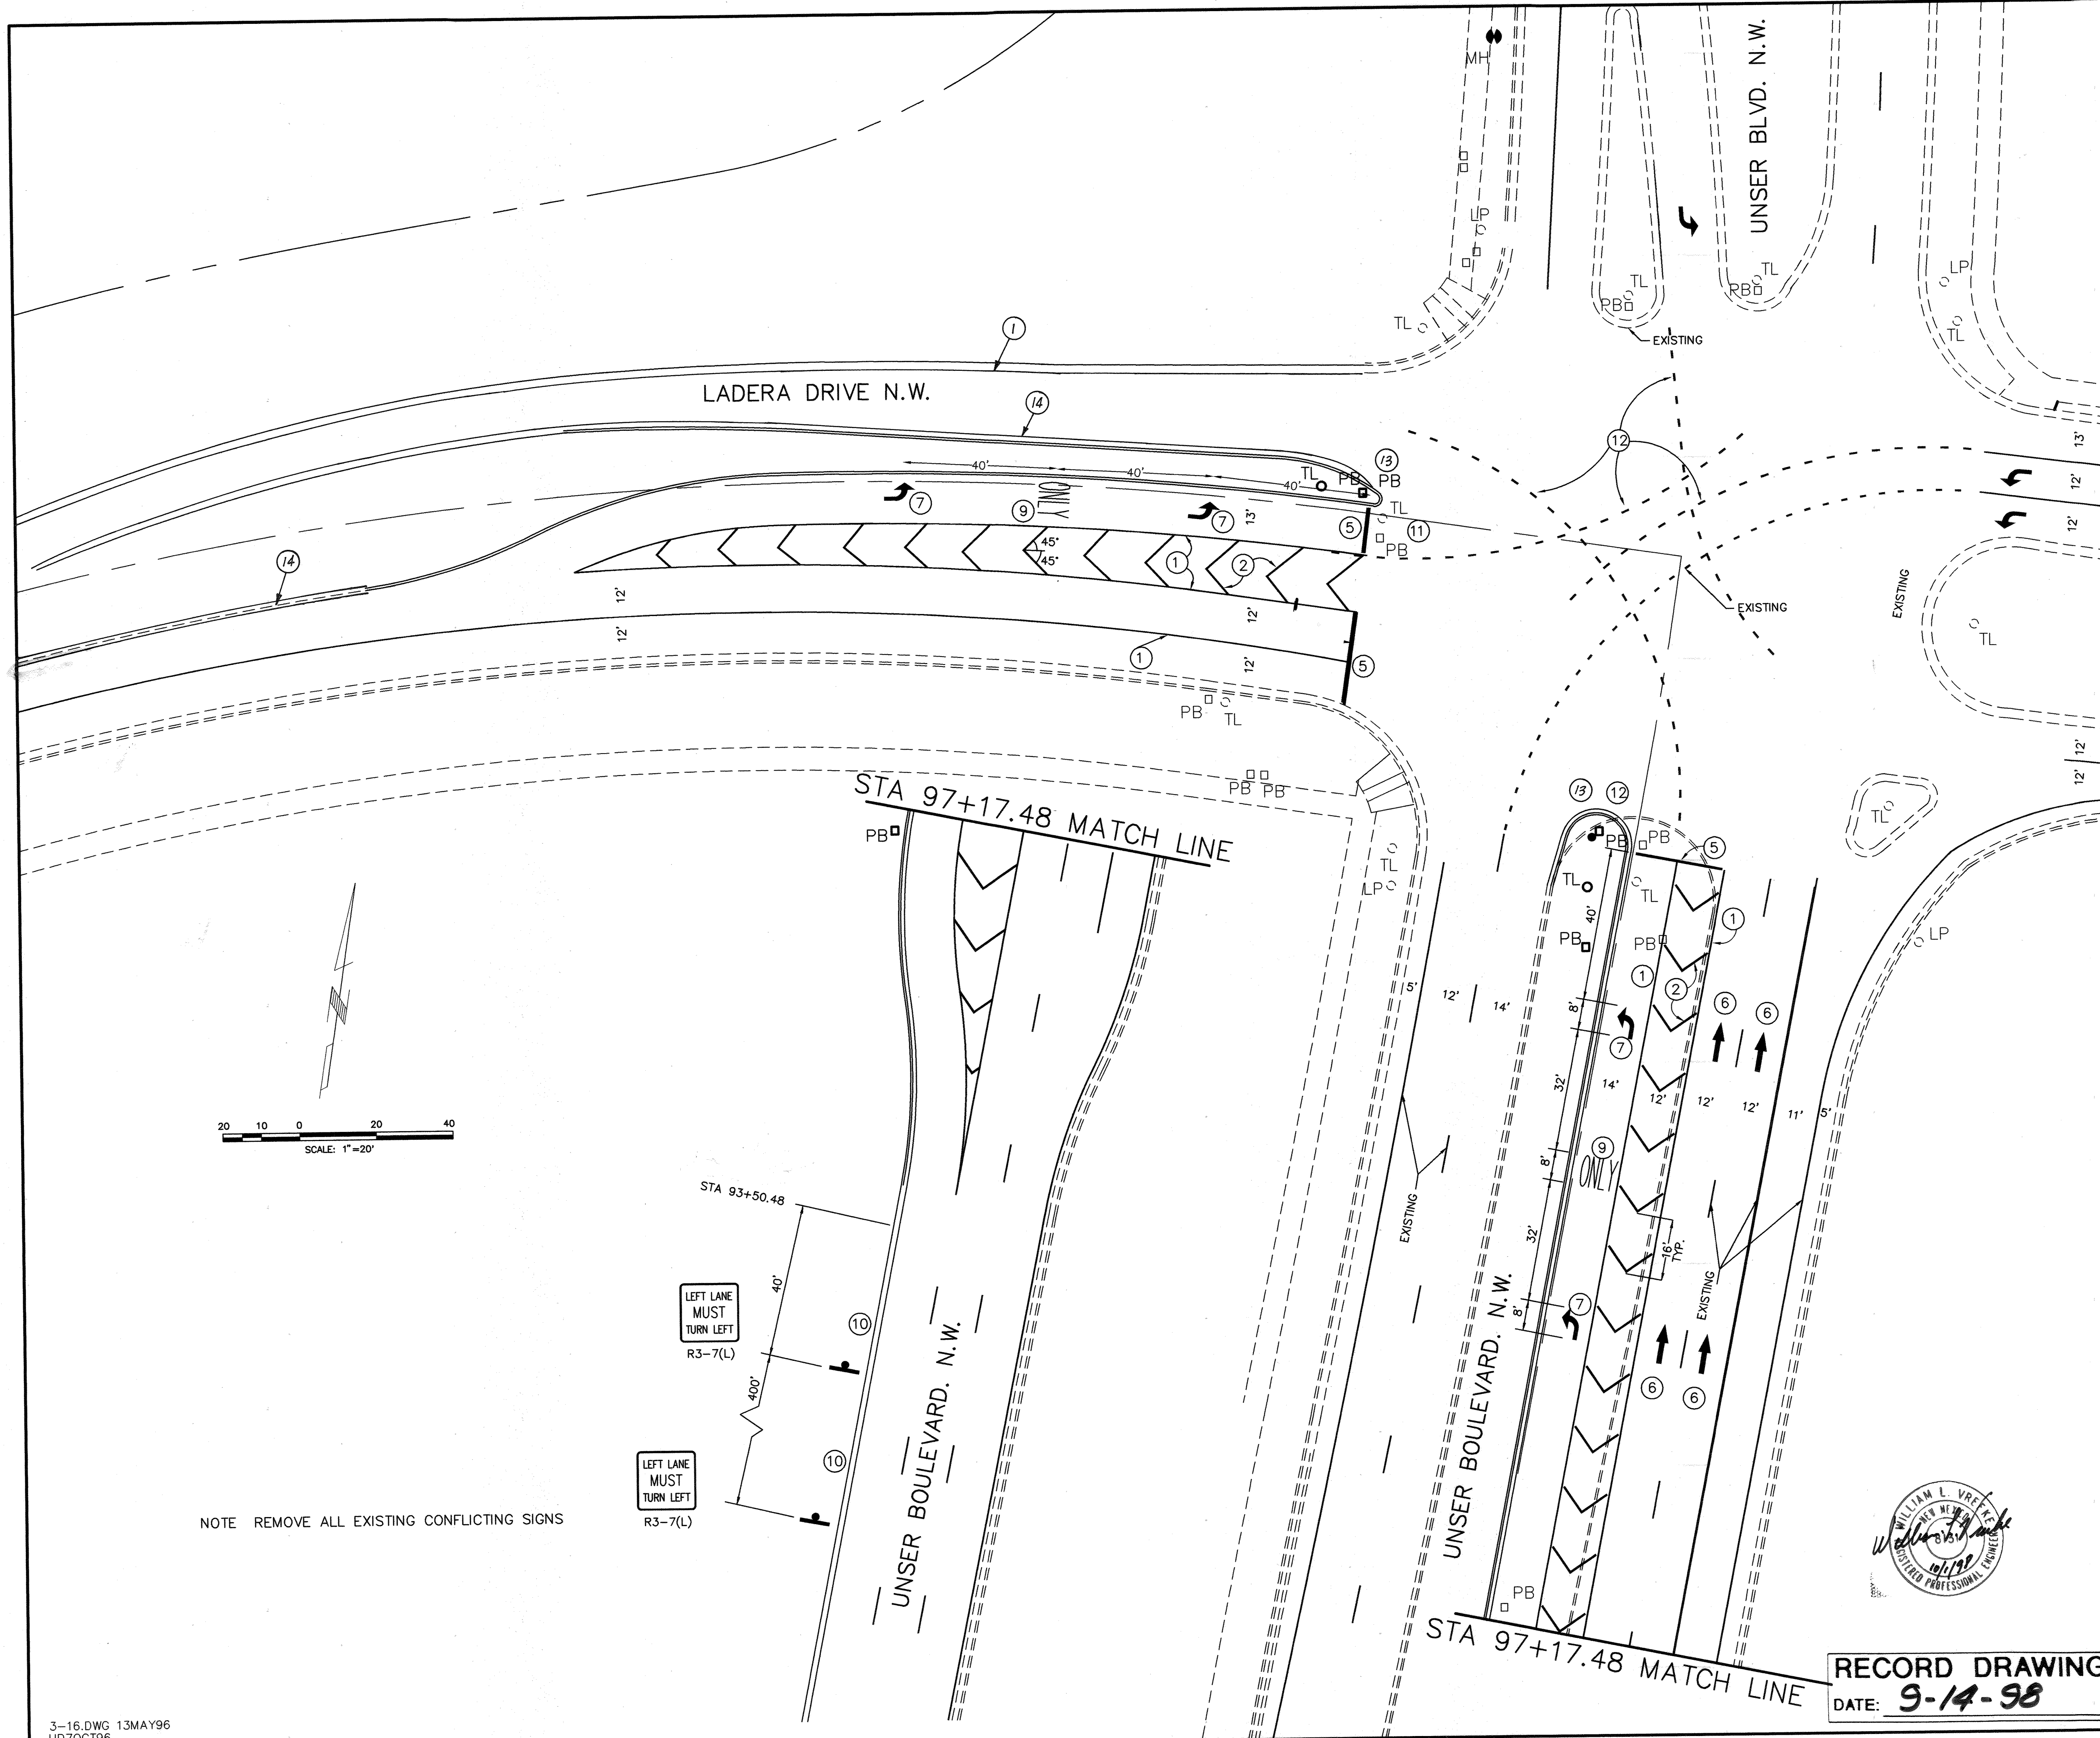


NOTE REMOVE ALL EXISTING CONFLICTING SIGNS

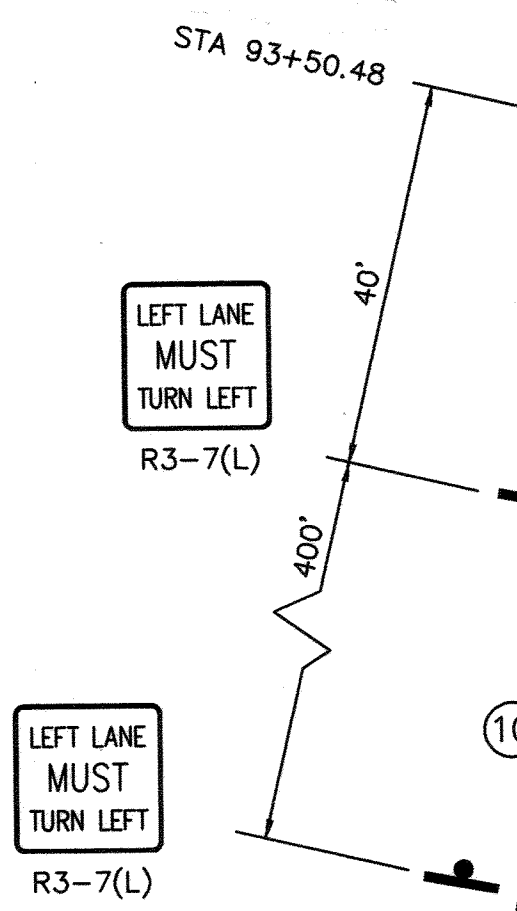

### KEYED NOTES

- 1 REFLECTORIZED WHITE PLASTIC PAVEMENT MARKING, 4", SOLID
- 2 REFLECTORIZED WHITE PLASTIC PAVEMENT MARKINGS, 6", SOLID
- 5 REFLECTORIZED WHITE PLASTIC PAVEMENT MARKING, 12", SOLID
- 6 REFLECTORIZED PLASTIC THRU ARROW
- 7 REFLECTORIZED PLASTIC LEFT ARROW
- 9 REFLECTORIZED PLASTIC WORD "ONLY"
- 10 INSTALL INDICATED SIGN AND POST
- 11 ALL SIGNAL MODIFICATION DETAILS ON SHEETS 5 THRU 13. SHOWN HERE FOR INFORMATION ONLY.
- 12 REFLECTORIZED PLASTIC SKIP MARKING, 4" X 2' AT 6' INTERVALS
- 13 PAINT MEDIAN NOSES YELLOW.
- 14 REFLECTORIZED YELLOW PLASTIC PAVEMENT MARKING, 4" SOLID.

### LEGEND


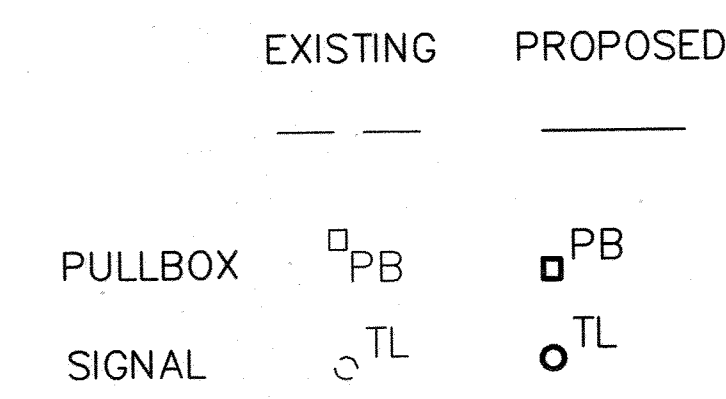


**RECORD DRAWING**  
DATE: **9-14-98**

AS BUILT INFORMATION				BENCH MARKS				SURVEY INFORMATION				ENGINEER'S SEAL			
CONTRACTOR	DATE	WORK	DATE	ALBUQUERQUE ACS MONUMENT "3-H10"	DATE	FIELD NOTES	DATE	NO.	BY	DATE	NO.	ENGINEER'S SEAL	DATE	NO.	BY
Alb. Underground, Inc.	9/98	BY AUT	9/98	LOCATED NORTHEAST OF THE INTERSECTION OF UNSER BLVD. & LADERA DR. THE STATION MARK IS A STANDARD ACS CAP SET FLUSH IN THE CONCRETE SURFACE OF THE SPILLWAY. ELEVATION = 5193.38	9/98										
SUPERVISOR	DATE	ACCEPTANCE BY	DATE												
BH	9/98	BY BH	9/98												
DRAWINGS	DATE	VERIFICATION BY	DATE												
BH	9/98	BY BH	9/98												
MICRO-FILM INFORMATION	DATE	RECORDED BY	DATE												

CITY OF ALBUQUERQUE PUBLIC WORKS DEPARTMENT ENGINEERING GROUP					
TITLE: LADERA & UNSER INTERSECTION IMPROVEMENTS INTERSECTION PAVEMENT MARKINGS					
APPROVALS	ENGINEER	DATE	APPROVALS	ENGINEER	DATE
D.R.C. Chair					
Trans. Dev.					
Utility Dev.					
DESIGN REVIEW COMMITTEE					
PROJECT NO.	5548.71	MAP NO.	H-9-Z	SHEET	3 OF 16



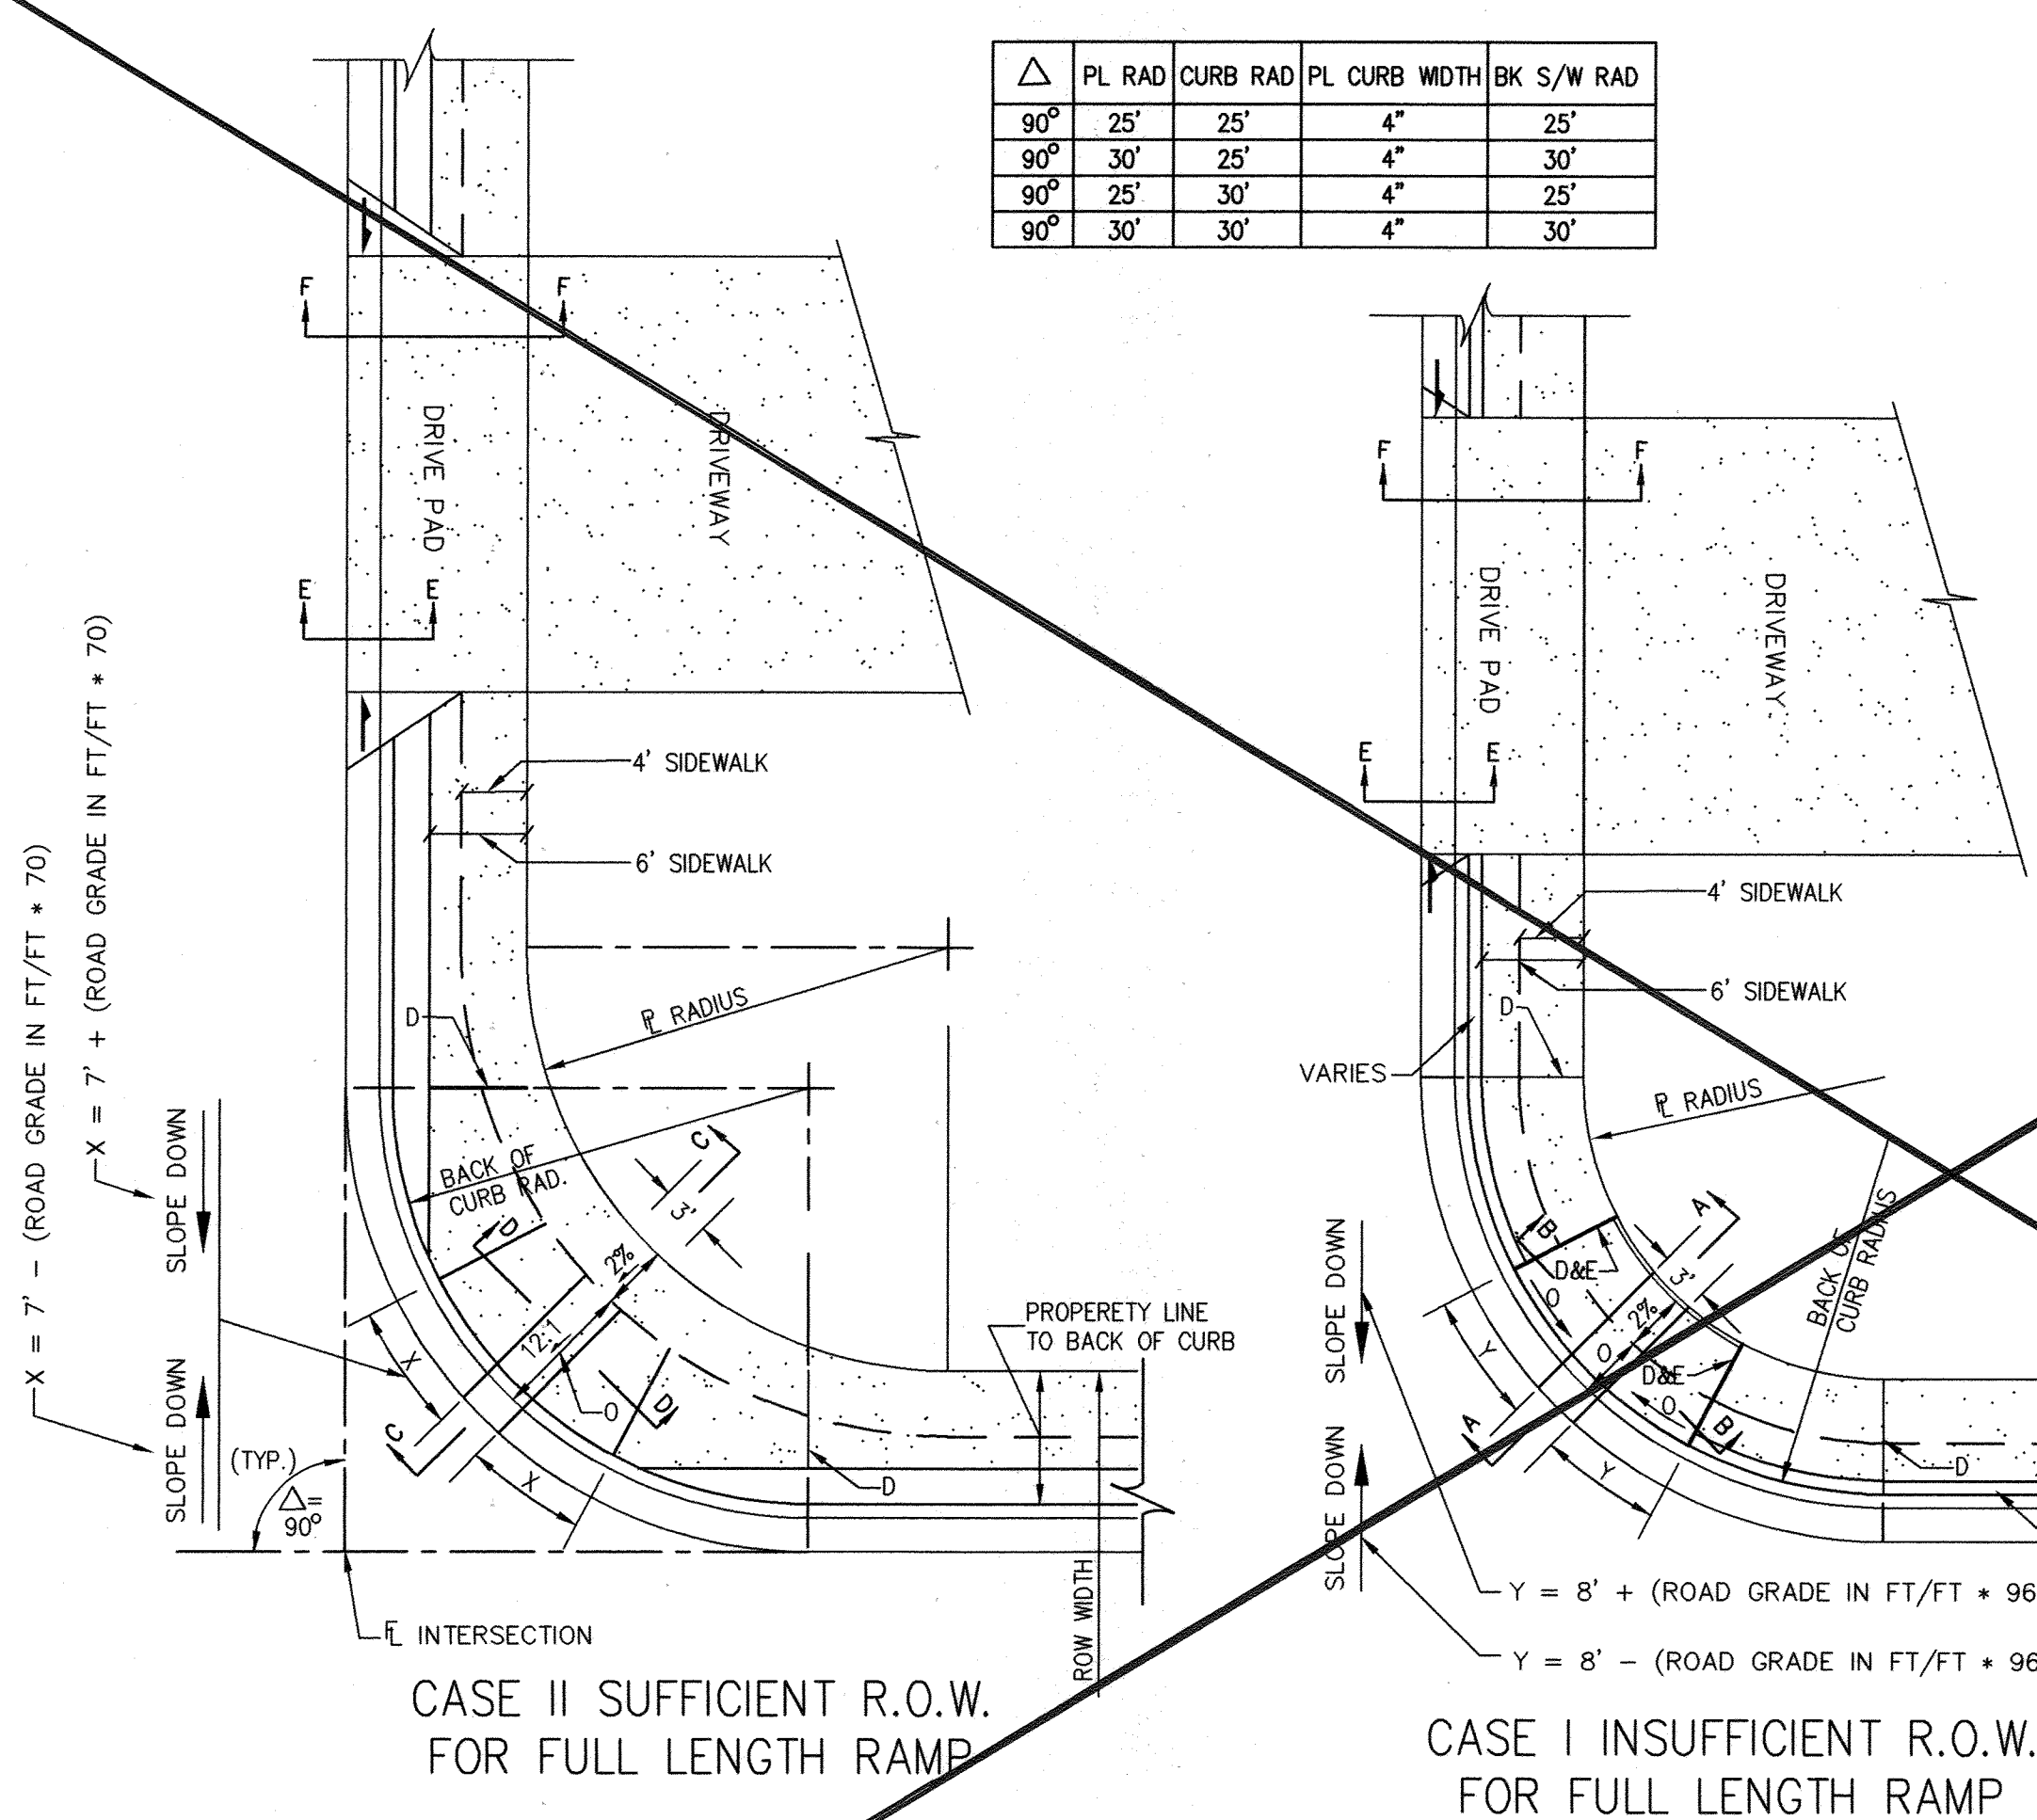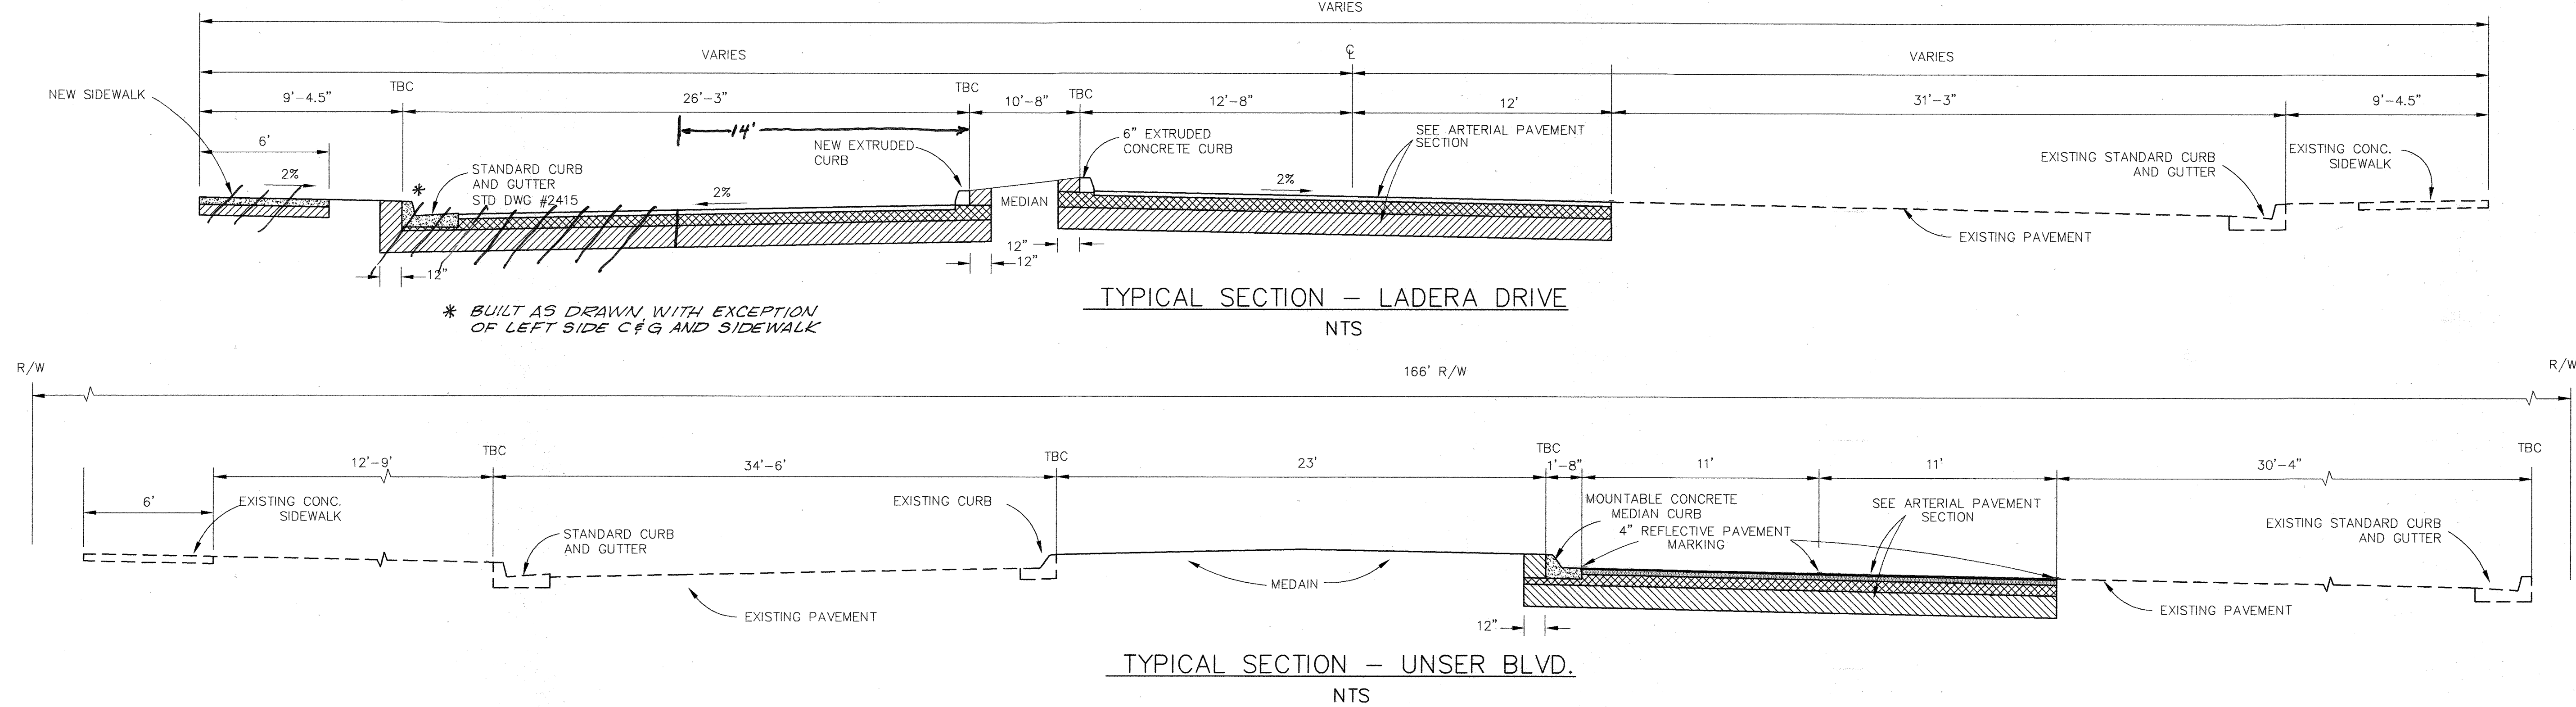









Δ	PL RAD	CURB RAD	PL Curb WIDTH	BK S/W RAD
90°	25'	25'	4'	25'
90°	30'	25'	4'	30'
90°	25'	30'	4'	25'
90°	30'	30'	4'	30'

#### GENERAL NOTES

1. WHEEL CHAIR RAMPS ARE NORMALLY TO BE LOCATED AT THE CENTER OF THE RETURN OR AS APPROVED BY THE ENGINEER.
2. SURFACE TEXTURE OF WHEEL CHAIR RAMPS SHALL BE OBTAINED BY HEAVY BROOMING (TEXTURE DEPTH 0.035"), TRAVERSE TO THE SLOPE OF THE RAMP.
3. GUTTER FLOW LINE PROFILE SHALL BE MAINTAINED THROUGH THE AREA OF THE RAMP. DRAINAGE CATCH BASIN STRUCTURES SHALL NOT BE PLACED IN LINE WITH RAMPS.
4. SUBGRADE SHALL BE COMPACTED TO 95% D1557. CONCRETE SHALL MEET 3,000 PSI, 28 DAY STRENGTH.
5. USE 1/2" EXP. JT. WHERE SIDEWALK OR DRIVEPAD ABUTS BLDGS., FENCES, WALLS OR OTHER IMMOVABLE OBJECTS.
6. ALL DRIVEPADS SHALL BE A MIN. OF 6.5' IN DEPTH OR SHALL BE CONSTRUCTED FROM BACK OF CURB TO PROP. LINE, WHICHEVER IS GREATER.
7. DRIVEPADS WIDER THAN 18' (NOMINAL) SHALL HAVE 1/2" EXP. JT. AT MIDPOINT. DRIVEPADS WIDER THAN 36' SHALL HAVE 1/2" EXP. JT. 18' MAX BETWEEN JOINTS EQUALLY SPACED.

#### CONSTRUCTION NOTES

- A. SLOPE OF GUTTER DEPENDENT ON REQUIREMENTS FOR VALLEY GUTTER.
- B. 1/2" UP ABOVE FLOW LINE.
- C. CURB & GUTTER.
- D. 1/2" EXPANSION JOINT.
- E. RADIAL LINES CONCENTRIC WITH FLOW LINE RADIUS.
- F. 8" AT FACE OF CURB.
- G. CONTRACTION (DUMMY) JOINT.
- H. VARIES WITH AVAILABLE R.O.W.
- I. VARIABLE.
- J. HEADER CURB.
- K. 6' AT FACE OF CURB.
- L. BACK OF SIDEWALK RADIUS TO BE ESTABLISHED SO AS TO MAINTAIN 12' LENGTH OF RAMP.
- N. 4-1/2" MAX.
- O. 12:1 SLOPE MAXIMUM ON RAMP.

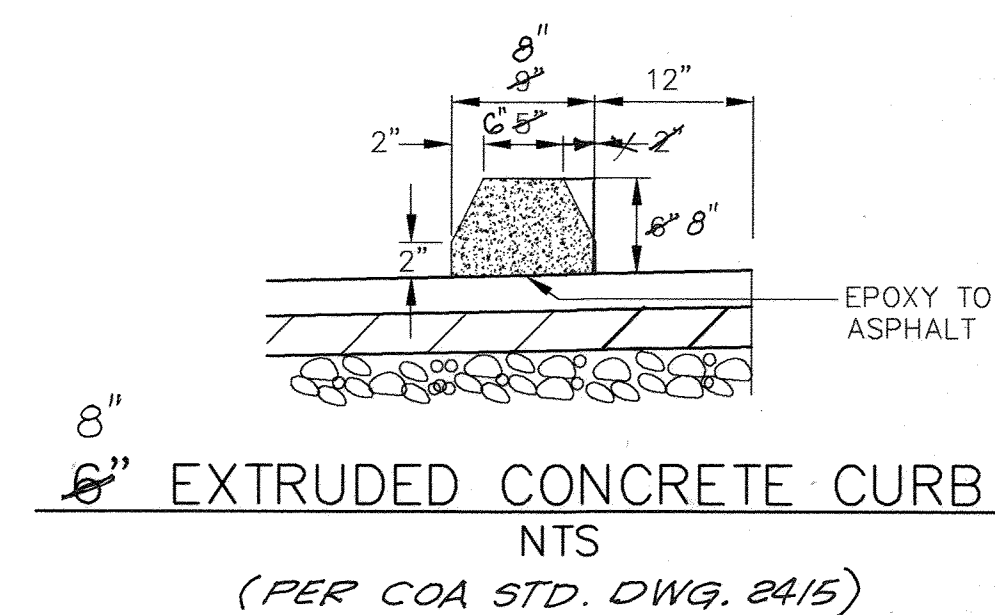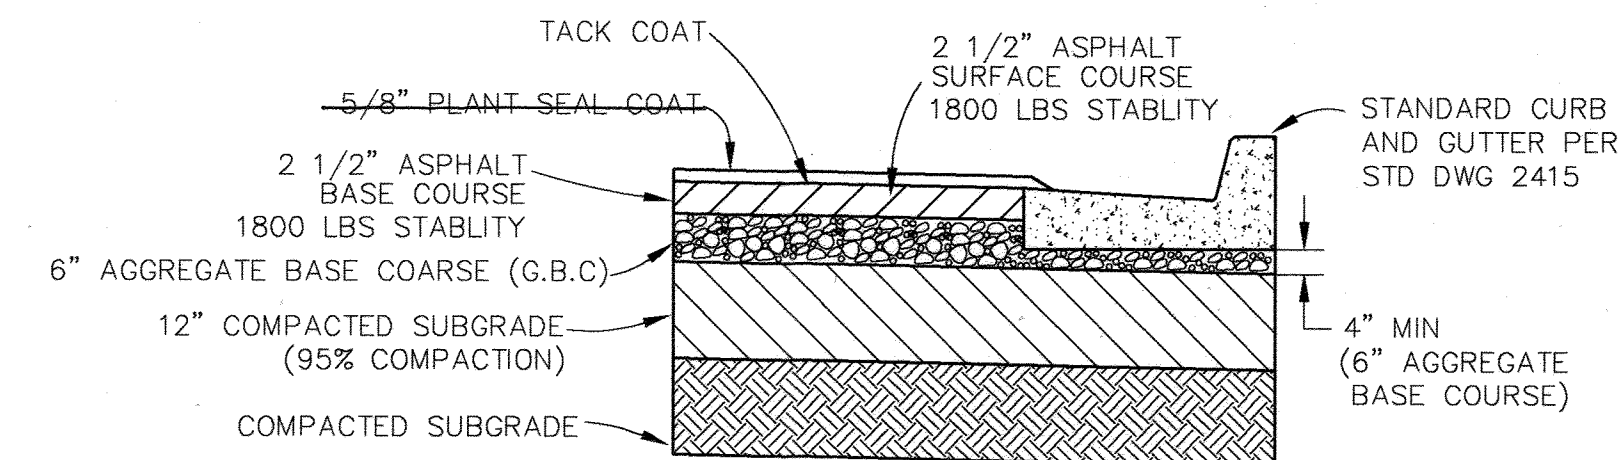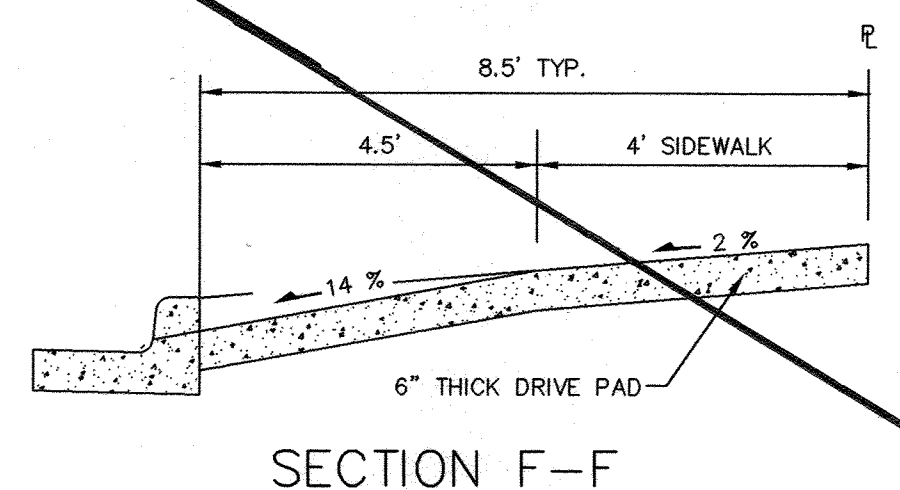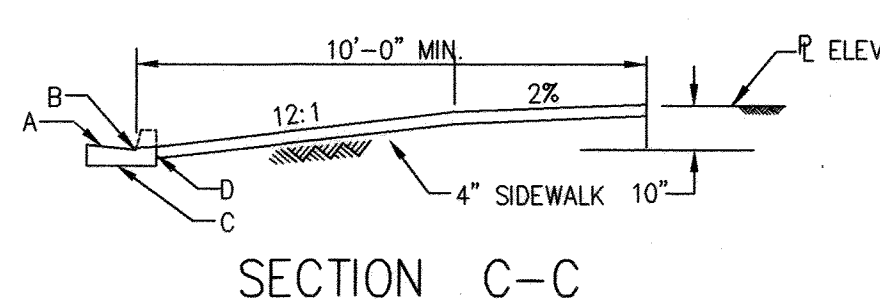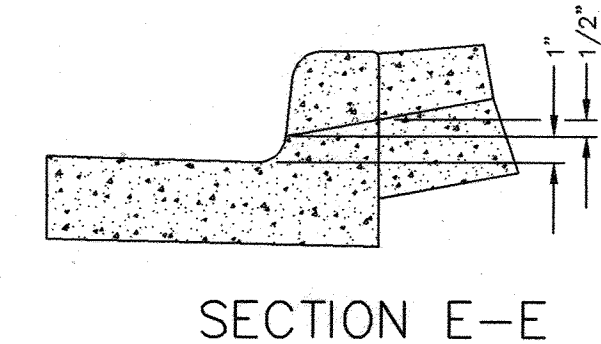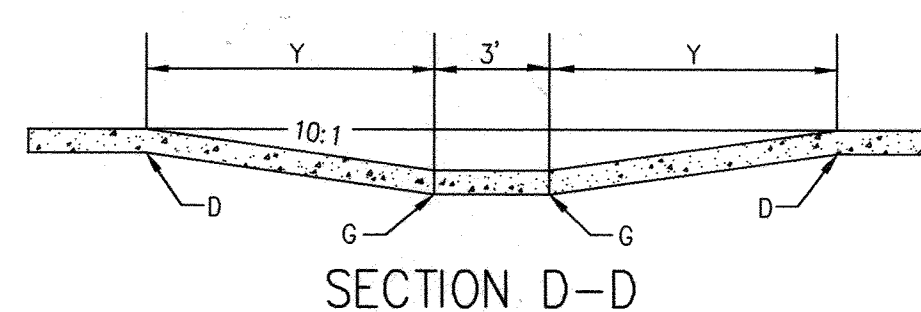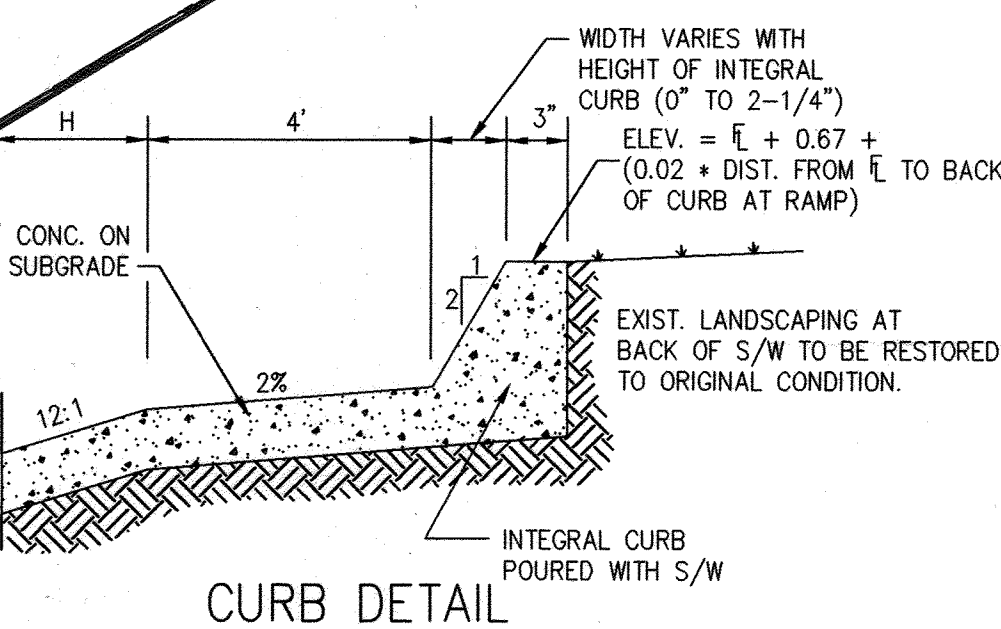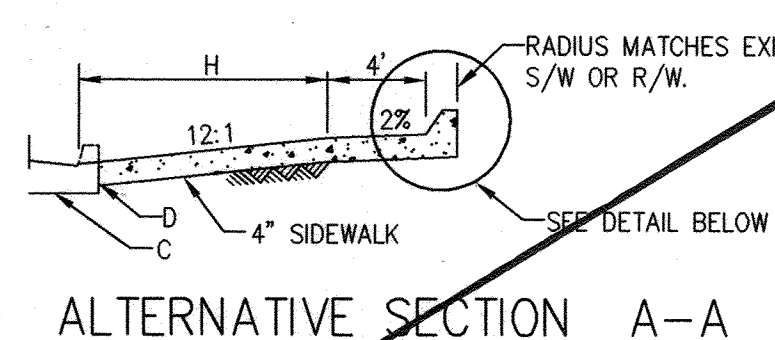

**CINFRAN** ENGINEERING INC.  
333 Rio Rancho Dr. N.E., Ste. 101  
Rio Rancho, New Mexico 87124

CITY OF ALBUQUERQUE PUBLIC WORKS DEPARTMENT ENGINEERING GROUP			
TITLE: LADERA & UNSER INTERSECTION IMPROVEMENTS TYPICAL SECTIONS			
APPROVALS	ENGINEER	DATE	APPROVALS
D.R.C. Chair			ENGINEER
Trans. Dev.			DATE
Utility Dev.			
DESIGN REVIEW COMMITTEE			
PROJECT NO. 5548.81	MAP NO. H-9-Z	SHEET 4	OF 16

**RECORD DRAWING**  
DATE: 9-14-98

AS BUILT INFORMATION		BENCH MARKS		SURVEY INFORMATION	
CONTRACTOR	ALBUQUERQUE	ACS MONUMENT	"3-H10"	ALBUQUERQUE	LOCATED NORTHEAST OF THE INTERSECTION OF UNSER BLVD. & LADERA DR. THE STATION MARK IS A STANDARD ACS CAP SET FLUSH IN THE CONCRETE SURFACE OF THE SPILLWAY. ELEVATION = 5193.38
WORK BY	ALU	DATE	9/98	NO.	
INSPECTOR'S	BY	DATE	9/98	BY	
ACCEPTANCE BY	ALU	DATE	9/98	REMARKS	
VERIFICATION BY	ALU	DATE	9/98	REVISIONS	
DESIGNED BY	WLB	DATE	2/24/96	DESIGN	
DRAWN BY	GMA	DATE	2/24/96		
CHECKED BY	WLB	DATE	2/24/96		
MICRO-FILM INFORMATION		ENGINEER'S SEAL		RECORDING	
RECORDED BY		L. BINGHAM		1/21/97	
DATE		12897			



SIGNAL NOTES

1. ALL WORK ON THESE PLANS TO BE PERFORMED UNDER THIS CONTRACT SHALL CONFORM TO THE CURRENT NATIONAL ELECTRIC CODE, AND THE STANDARDS OF THE NATIONAL BOARD OF FIRE UNDERWRITERS FOR ELECTRICAL WIRING AND APPARATUS.
2. ALL WORK ON THESE PLANS TO BE PERFORMED UNDER THIS CONTRACT SHALL CONFORM TO THE "THIRD DRAFT SPECIFICATIONS AND CONTRACT ITEM LISTING" TRAFFIC ENGINEERING OPERATIONS, CITY OF ALBUQUERQUE, JUNE, 1994. COPIES OF THESE SPECIFICATIONS ARE AVAILABLE FROM THE ENGINEER AT THE COST OF REPRODUCTION.
3. LOCATIONS OF CONDUITS, FOUNDATIONS, CONTROL CABINETS, POLES, PULL BOXES, MANHOLES, AND SPLICE CABINETS SHOWN ON THE PLANS ARE SCHEMATIC AND SHALL BE ADJUSTED IN THE FIELD TO MAXIMIZE CLEAR SPACE AVAILABLE FOR PEDESTRIANS AND WHEELCHAIRS TO COMPLY WITH THE AMERICANS WITH DISABILITIES ACT. THE CONTRACTOR SHALL MEET WITH THE CITY TRAFFIC ENGINEERING OPERATIONS PERSONNEL IN THE FIELD AT ALL LOCATIONS TO SPOT EQUIPMENT BEFORE BEGINNING THE WORK. ALL SUCH EQUIPMENT SHALL BE INSTALLED WITHIN THE RIGHT-OF-WAY.
4. THE CONTRACTOR IS WARNED THAT EXISTING CONDUITS MAY CONTAIN AC POWER AND CAUTION SHALL BE EXERCISED IN INTERCEPTING OR INSTALLING CABLE IN EXISTING CONDUIT.
5. THE CONTRACTOR SHALL BORE, DRILL, OR PUSH WHEN CROSSING EXISTING PAVEMENTS AND ANY DRIVEWAYS FOR STREET CROSSINGS. BEFORE CONDUIT CAN BE BORED, DRILLED, OR PUSHED THE CONTRACTOR SHALL LOCATE ALL EXISTING UTILITIES. THE CONTRACTOR SHALL LOCATE AND EXPOSE GAS LINES WHICH CROSS ANY PROPOSED BORES. THESE EXCAVATIONS SHALL REMAIN OPEN UNTIL AFTER THE BORE IS COMPLETE. CONTRACTOR SHALL REMOVE AND REPLACE IN KIND ANY SIDEWALK OR PAVEMENT REQUIRED TO EXPOSE SUCH LINES. THE CONTRACTOR MAY CUT, TRENCH, AND REPLACE EXISTING PAVEMENT ONLY WHEN APPROVED BY THE PROJECT MANAGER.
6. SPLICING FOR TRAFFIC SIGNALS MCC WILL BE PERMITTED IN LARGE PULL BOXES INCLUDING LARGE MEDIAN PULL BOXES. SPLICING OF OPTICAL DETECTOR CABLE WILL NOT BE PERMITTED BETWEEN THE OPTICAL DETECTOR AND THE CONTROL CABINET.
7. ALL LOOP LEAD-IN CABLES SHALL BE TAGGED AT CABINET TO IDENTIFY EACH CABLE BY PHASE AND LOOP NUMBER.
8. ALL PULL BOXES SHALL BE REINFORCED POLYMER MORTAR HEAVY DUTY TYPE WITH REINFORCED POLYMER MORTAR HEAVY DUTY COVERS. CONCRETE COVERS, STEEL COVERS, AND CONCRETE PULL BOXES WILL NOT BE ACCEPTABLE.
9. THE CONTRACTOR SHALL NOTIFY THE CITY OF ALBUQUERQUE TRAFFIC ENGINEERING OPERATIONS (857-8000) THREE WORKING DAYS IN ADVANCE OF ANY ANTICIPATED WORK ON SIGNALS, LIGHTING, AND POWER SERVICES. TRAFFIC ENGINEERING OPERATIONS PERSONNEL WILL ASSIST THE CONTRACTOR IN TESTING, FIELD LOCATION OF EQUIPMENT INCLUDING STRUCTURES, LOOP DETECTORS, AND PULL BOXES AND MUST BE PRESENT WHEN SIGNALS AND LIGHTING ARE SHUT-OFF OR TURNED ON. THE CONTRACTOR SHALL ALSO NOTIFY THE CITY OF ALBUQUERQUE TRAFFIC ENGINEERING OPERATIONS EACH TIME A TRAFFIC SIGNAL CONTROL DOOR IS OPENED. THE CONTRACTOR SHALL PERFORM ALL FIELD WIRING.
10. THE CONTRACTOR SHALL REMOVE ALL CONFLICTING SIGNING AND DELIVER TO THE CITY YARDS WHEN TRAFFIC SIGNALS ARE PUT INTO OPERATION.
11. LIVE UNUSED CONDUCTORS WILL NOT BE ALLOWED AT MASTARM POLES AND PEDESTAL POLES. ALL SUCH UNUSED CONDUCTORS SHALL BE DISCONNECTED AT THE LARGE PULL BOX ADJACENT TO THE POLE.
12. IF TRENCH WIDTHS LESS THAN 12" ARE PROPOSED BY THE CONTRACTOR, APPROVED COMPACTION METHODS SHALL BE USED DURING BACKFILL TO PREVENT LATENT TRENCH FAILURES. THE CONTRACTOR SHALL USE GROUT OR LEAN FILL AS APPROVED BY THE PROJECT MANAGER IN LIEU OF EARTH BACKFILL.
13. THE CITY OF ALBUQUERQUE TRAFFIC ENGINEERING OPERATIONS PERSONNEL WILL PROVIDE TRAFFIC SIGNAL TIMING PLANS AND WILL PROGRAM TRAFFIC SIGNAL CONTROLLER.
14. EXISTING CONDUITS TO BE REMOVED OR ABANDONED SHALL HAVE ALL WIRING REMOVED.
15. AT LOCATIONS WHERE NEW ELECTRICAL PULL BOXES AND TRAFFIC MANHOLES ARE TO BE INSERTED INTO EXISTING CONDUIT RUNS, THE EXISTING CONDUITS SHALL BE REPAIRED, ADJUSTED, OR REPLACED AS DIRECTED BY THE ENGINEER.
16. THE CONTRACTOR SHALL ARRANGE TO HAVE OFF-DUTY POLICE OFFICERS DIRECT TRAFFIC WHEN SIGNALS ARE TURNED OFF.
17. ALL DATA SHOWN HEREIN CONCERNING EXISTING UTILITIES HAS BEEN OBTAINED FROM "AS-BUILT" DRAWINGS AND FROM FIELD OBSERVATIONS WHICH MAY OR MAY NOT BE ACCURATE. THE CONTRACTOR WILL BE RESPONSIBLE FOR EXPLORATORY TRENCHING. IF NECESSARY, TO MORE SPECIFICALLY LOCATE UTILITY LINES. COST OF LOCATING UTILITY LINES INCLUDING EXPLORATORY TRENCHING WILL BE CONSIDERED INCIDENTAL TO CONSTRUCTION.

INCIDENTAL ITEMS \*

1. REMOVAL OF EXISTING CONDUITS, OR OTHER SIGNAL EQUIPMENT FOR INSTALLATION OF NEW SIGNAL EQUIPMENT.
2. CABLE TESTING AND DIAGRAMS.
3. BORING, DRILLING, PUSHING, AND TRENCHING, INCLUDING REMOVAL AND REPLACEMENT OF PAVEMENT, SIDEWALKS, DRIVEPADS, VALLEY GUTTERS, WHEELCHAIR RAMPS, CURB & CUTTER, AND LANDSCAPING (INCLUDING SPRINKLERS), FOR INSTALLATION OF PULL BOXES, CONDUITS, AND SIGNAL FOUNDATIONS, EXCEPT AS NOTED ON THE PLANS.
4. LOCATION OF UTILITY LINES INCLUDING EXPLORATORY TRENCHING AND EXPOSING OF GAS LINES WHEN BORING.
5. DESIGN, MATERIALS, INSTALLATION AND REMOVAL OF SAFETY BARRIER FOR SHIELDING EQUIPMENT OR MATERIAL.
6. APPRISING PUBLIC THROUGH THE LOCAL NEWS MEDIA.
7. HAULING OF MATERIAL TO BE DISPOSED TO CITY LANDFILL.
8. TRANSPORTATION OF SALVAGED SIGNAL EQUIPMENT TO THE CITY TRAFFIC ENGINEERING OPERATIONS YARD.
9. LEAN FILL FOR CONDUIT TRENCHES.
10. PULL BOX ADJUSTMENT TO GRADE.
11. OFF-DUTY POLICE OFFICER FOR TRAFFIC CONTROL.
12. REMOVAL AND REPLACEMENT IN KIND OR BETTER OF LANDSCAPING INCLUDING SPRINKLERS, FOR INSTALLATION OF PULL BOXES, CONDUITS AND SIGNAL FOUNDATIONS.
13. 3M REPRESENTATIVE FIELD ASSISTANCE DURING INSTALLATION.
- \* ITEMS LISTED ARE ONLY A GENERAL DESCRIPTION OF THE REQUIRED WORK AND MATERIALS, AND MAY NOT BE COMPLETE. THIS LIST DOES NOT INCLUDE ANY INCIDENTAL WORK OR MATERIALS REQUIRED BY THE SPECIAL PROVISIONS SERIALS (STANDARD DETAILS), SUPPLEMENTAL SPECIFICATIONS, OR THE STANDARD SPECIFICATIONS.

TRAFFIC SIGNAL EQUIPMENT REQUIREMENTS

1. THIS PROJECT IS A MODIFICATION OF AN EXISTING SIGNAL SYSTEM. THE CITY OF ALBUQUERQUE TRAFFIC ENGINEERING OPERATIONS DIVISION WILL MODIFY THE EXISTING CONTROLLER AND CABINET TO PROVIDE THE MODIFIED OPERATION SHOWN ON THE PLANS. THE CONTRACTOR SHALL PULL ALL FIELD WIRING REQUIRED INTO THE CABINET AND COORDINATE WITH THE CITY AS REQUIRED.
2. SPLICE CABINETS ARE EXISTING AND SHALL REMAIN IN PLACE.
3. INTERCONNECT CABLES ARE EXISTING AND SHALL REMAIN IN PLACE.
4. THE CONTRACTOR SHALL FURNISH TWO (2) 3M "OPTICOM" MODEL 562 PHASE SELECTORS, AND ONE (1) 3M "OPTICOM" MODEL 360 RACK, OR APPROVED EQUAL, WHICH ARE TO BE INSTALLED BY THE CITY. THE CONTRACTOR SHALL FURNISH AND INSTALL FOUR (4) 3M "OPTICOM" MODEL 511 OPTICAL DETECTORS, SINGLE DIRECTION, SIGNAL CHANNEL (1D/1C) AND 3M "OPTICOM" MODEL 138, DETECTOR CABLE OR APPROVED EQUAL FROM THE OPTICAL DETECTORS TO THE CONTROLLER CABINET. THE CITY WILL COMPLETE THE CONNECTIONS IN THE CONTROL CABINET TO MAKE THE SYSTEM OPERATIONAL. 3M REPRESENTATIVES SHALL FURNISH FIELD ASSISTANCE FOR THE INSTALLATION.
5. ALL NEW TRAFFIC SIGNAL POLES, EQUIPMENT, AND HARDWARE SHALL MATCH THE SPECIAL FINISH OF THE EXISTING EQUIPMENT (POWER COAT AND COLOR).


TRAFFIC SIGNAL LEGEND

NEW	EXISTING	ITEM
		PULL BOX
		METER PEDESTAL
		CONTROLLER CABINET
		CONDUIT RUN
		LOOP DETECTOR
		TRAFFIC SIGNAL & PEDESTAL POLE
		CONDUIT RUN NUMBER
		POLE WITH MASTARM, TRAFFIC SIGNAL AND BACKPLATE
		PEDESTRIAN PUSH BUTTON (MOUNTED TO SIDE OF POLE WHERE INDICATED)
		PEDESTRIAN SIGNALS (MOUNTED TO SIDE OF POLE WHERE INDICATED)
		TRAFFIC MANHOLE

DEFINITIONS

1. "ENGINEER" - FOR THE PURPOSES OF THIS PROJECT, THE TERM "ENGINEER" IS SYNONYMOUS WITH THE TERM "PROJECT MANAGER".

AS-BUILT INFORMATION		BENCH MARKS		SURVEY INFORMATION		ENGINEER'S SEAL	
CONTRACTOR'S SIGNATURE	DATE	ALBUQUERQUE ACS MONUMENT "33-H10"	LOCATED	NO.	BY		REMARKS REVISIONS DESIGN
INSPECTOR'S SIGNATURE	DATE	NORTHEAST OF THE INTERSECTION OF UNK BLVD & LADERA DR.	UNDER	NO.	BY		
ACCEPTANCE BY	DATE	A STANDARD ACS CAP SET FLUSH IN THE CONCRETE SURFACE OF THE SPILLWAY.	IS	NO.	BY		
VERIFICATION BY	DATE	ELEVATION=5193.38	VERIFIED	NO.	BY		
MICRO-FILM INFORMATION		RECORDED BY		DATE		DESIGNED BY BHI	DATE 12-95
		NO.				DRAWN BY BHI	DATE 12-95
						CHECKED BY BHI	DATE 12-95

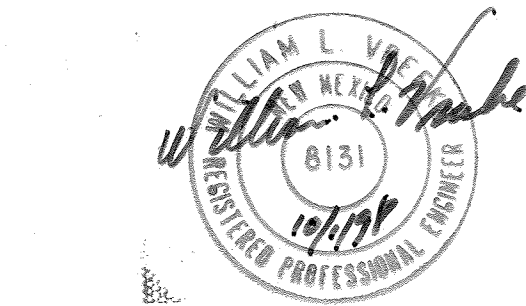




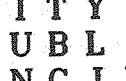

RECORD DRAWING  
DATE: 9-14-98

<b>BOHANNAN-HUSTON INC.</b> ENGINEERS • PLANNERS • PHOTOGRAMMETRISTS • SURVEYORS • LANDSCAPE ARCHITECTS ALBUQUERQUE LAS CRUCES SANTA FE			
<b>CITY OF ALBUQUERQUE</b> PUBLIC WORKS DEPARTMENT ENGINEERING GROUP			
TITLE: TRAFFIC SIGNAL NOTES AND LEGEND			
APPROVALS	ENGINEER	DATE	APPROVALS
DRC CHAIRMAN			WATER
TRANSPORTATION			WASTE WATER
HYDROLOGY			TRAF. OPER.
DESIGN REVIEW COMMITTEE			
DRAWING NO.	5548.81	MAP NO.	H-9-Z
SHEET 5		OF 16	



TRAFFIC SIGNAL ESTIMATED QUANTITIES			
ITEM NO	ITEM DESCRIPTION	UNIT	TOTAL
0422.03	TRAFFIC SIGNAL PEDESTAL POLE, 13 FOOT	EACH	4
0422.101	TRAFFIC SIGNAL PEDESTAL POLE ANY SIZE REMOVE AND SALVAGE	EACH	4
0423.01	TRAFFIC SIGNAL FOUNDATION FOR PEDESTAL POLE	EACH	2
0423.101	TRAFFIC SIGNAL FOUNDATION, REMOVE & DISPOSE	EACH	2
0424.01	RIGID ELECTRICAL CONDUIT, 1"	LIN FT	60
0424.05	RIGID ELECTRICAL CONDUIT, 2"	LIN FT	280
0424.10	RIGID ELECTRICAL CONDUIT, 3"	LIN FT	80
0425.02	ELECTRICAL PULL BOX, STANDARD	EACH	3
0425.03	ELECTRICAL PULL BOX, LARGE	EACH	2
0425.101	ELECTRICAL PULL BOX ANY SIZE REMOVE AND DISPOSE	EACH	4
0426.04	SINGLE CONDUCTOR, 8	LIN FT	305
0426.10	MULTI-CONDUCTOR CABLE 5	LIN FT	35
0426.11	MULTI-CONDUCTOR CABLE 7	LIN FT	440
0426.14	MULTI-CONDUCTOR CABLE 20	LIN FT	610
0427.02	3 SECTION TRAFFIC SIGNAL ASSEMBLY	EACH	1
0427.12	5 SECTION TRAFFIC SIGNAL ASSEMBLY	EACH	4
0427.101	TRAFFIC SIGNAL ASSEMBLY REMOVE AND SALVAGE	EACH	5
0428.21	LOOP DETECTOR WIRE	LIN FT	2918
0428.50	LOOP LEAD-IN CABLE	LIN FT	7240
0428.60	DETECTOR SAW CUT	LIN FT	1054
0428.70	PHASE SELECTOR RACK, 4 CHANNEL	EACH	1
0428.71	PHASE SELECTOR MODULE, 2 CHANNEL	EACH	2
0428.75	OPTICAL DETECTOR 1D/1C	EACH	4
0428.78	OPTICAL DETECTOR CABLE	LIN FT	1095

RECORD DRAWING  
DATE: 9-14-98


	<b>BOHANNAN-HUSTON INC.</b> ENGINEERS • PLANNERS • PHOTOGRAMMETRISTS • SURVEYORS • LANDSCAPE ARCHITECTS ALBUQUERQUE LAS CRUCES SANTA FE			
	<b>CITY OF ALBUQUERQUE</b> PUBLIC WORKS DEPARTMENT ENGINEERING GROUP			
<b>TITLE:</b> <span style="float: right;">TRAFFIC SIGNAL</span> <span style="display: block; text-align: center;">ESTIMATED IMPROVEMENTS</span>				
APPROVALS DRC CHAIRMAN TRANSPORTATION HYDROLOGY	ENGINEER  / DATE <div style="border: 1px solid black; padding: 5px; display: inline-block;">  </div>	APPROVALS WATER WASTE WATER TRAF. OPER.	ENGINEER 	DATE 1/2/96
DESIGN REVIEW COMMITTEE		MAP NO. H-9-Z	SHEET 6	OF 16
DRAWING NO. 5548.81				

[illegible]



# KEYED NOTES

- EXISTING INTERCONNECT PULL BOX LID IS LABELED AS "LIGHTING". INSTALL NEW LID LABELED "SIGNALS".
- EXISTING LIGHTING PULL BOX LID IS LABELED AS "SIGNALS". INSTALL NEW LID LABELED "LIGHTING".
- EXISTING SIGNAL PULL BOX LID IS LABELED AS "LIGHTING". INSTALL NEW LID LABELED "SIGNALS".
- REMOVE EXISTING PULL BOX.
- INSTALL NEW PULL BOX (STANDARD).
- INSTALL NEW PULL BOX (LARGE).
- ABANDON EXISTING LOOP DETECTOR.
- INSTALL NEW 6'x6' EXTEND CALL LOOP DETECTOR.
- INSTALL NEW 6'x40' RECTANGULAR 3-TURN LOOP DETECTOR.
- INSTALL NEW 6'x50' QUADRUPOLE LOOP DETECTOR.
- EXISTING LOOP DETECTOR TO REMAIN.
- REMOVE EXISTING PEDESTAL POLE SP1 AND EXISTING SIGNAL 6C AND SALVAGE. REMOVE EXISTING PEDESTAL POLE FOUNDATION.
- INSTALL PEDESTAL POLE SP1A AND NEW SIGNAL 6C.
- REMOVE EXISTING PEDESTAL POLE SP5 AND EXISTING SIGNAL 3C AND SALVAGE. REMOVE EXISTING PEDESTAL POLE FOUNDATION.
- INSTALL PEDESTAL POLE SP5A AND NEW SIGNAL 3C.
- REMOVE EXISTING PEDESTAL POLE SP4 AND EXISTING SIGNAL 2D AND SALVAGE. INSTALL NEW PEDESTAL POLE SP4A ON EXISTING FOUNDATION. INSTALL NEW SIGNAL 2D.
- REMOVE EXISTING PEDESTAL POLE SP3 AND EXISTING SIGNAL 2C AND SALVAGE. INSTALL NEW PEDESTAL POLE SP3A ON EXISTING FOUNDATION. INSTALL NEW SIGNAL 2C.
- REMOVE EXISTING SIGNAL 6D AND SALVAGE. INSTALL NEW SIGNAL 6D.
- INSTALL NEW OPTICAL DETECTOR ON EXISTING MASTARM. PULL NEW OPTICAL DETECTOR CABLE FROM NEW OPTICAL DETECTOR TO CONTROLLER CABINET IN EXISTING CONDUITS.


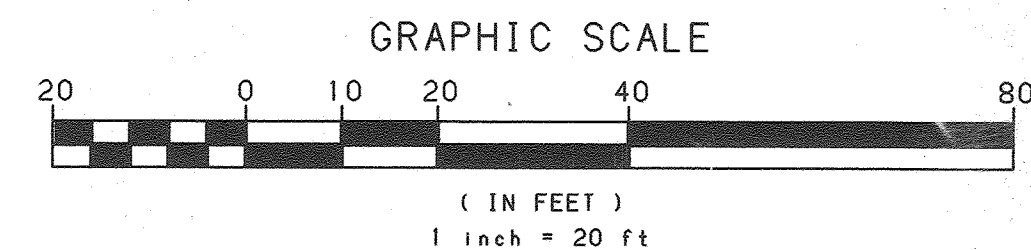


## ABBREVIATIONS


MA1	MASTARM NUMBER-EXISTING
SP1	PEDESTAL POLE NUMBER-EXISTING
SP1A	PEDESTAL POLE NUMBER-NEW
PPB1	PEDESTRIAN PUSH BUTTON NUMBER
PB1	PULL BOX NUMBER (SIGNALS)-EXISTING
PB1A	PULL BOX NUMBER (SIGNALS)-NEW
DL1 (1)	DETECTOR LOOP PHASE NO (LOOP NO)-EXISTING
DL1 (1)	DETECTOR LOOP PHASE NO (LOOP NO)-NEW
3A	SIGNAL HEAD NUMBER-EXISTING
3A	SIGNAL HEAD NUMBER-NEW
P1	PEDESTRIAN SIGNAL NUMBER-EXISTING
BP	BACK PLATE-EXISTING
EC	EXTENDED CALL-EXISTING
SD	SYSTEM DETECTOR-EXISTING
MH1	TRAFFIC MANHOLE NUMBER-EXISTING

## SYMBOL KEY


MA1	MASTARM ID-EXISTING
SP1	PEDESTAL POLE ID-EXISTING
SP1A	PEDESTAL POLE ID-NEW
99	CONDUIT RUN ID-EXISTING
99	CONDUIT RUN ID-NEW

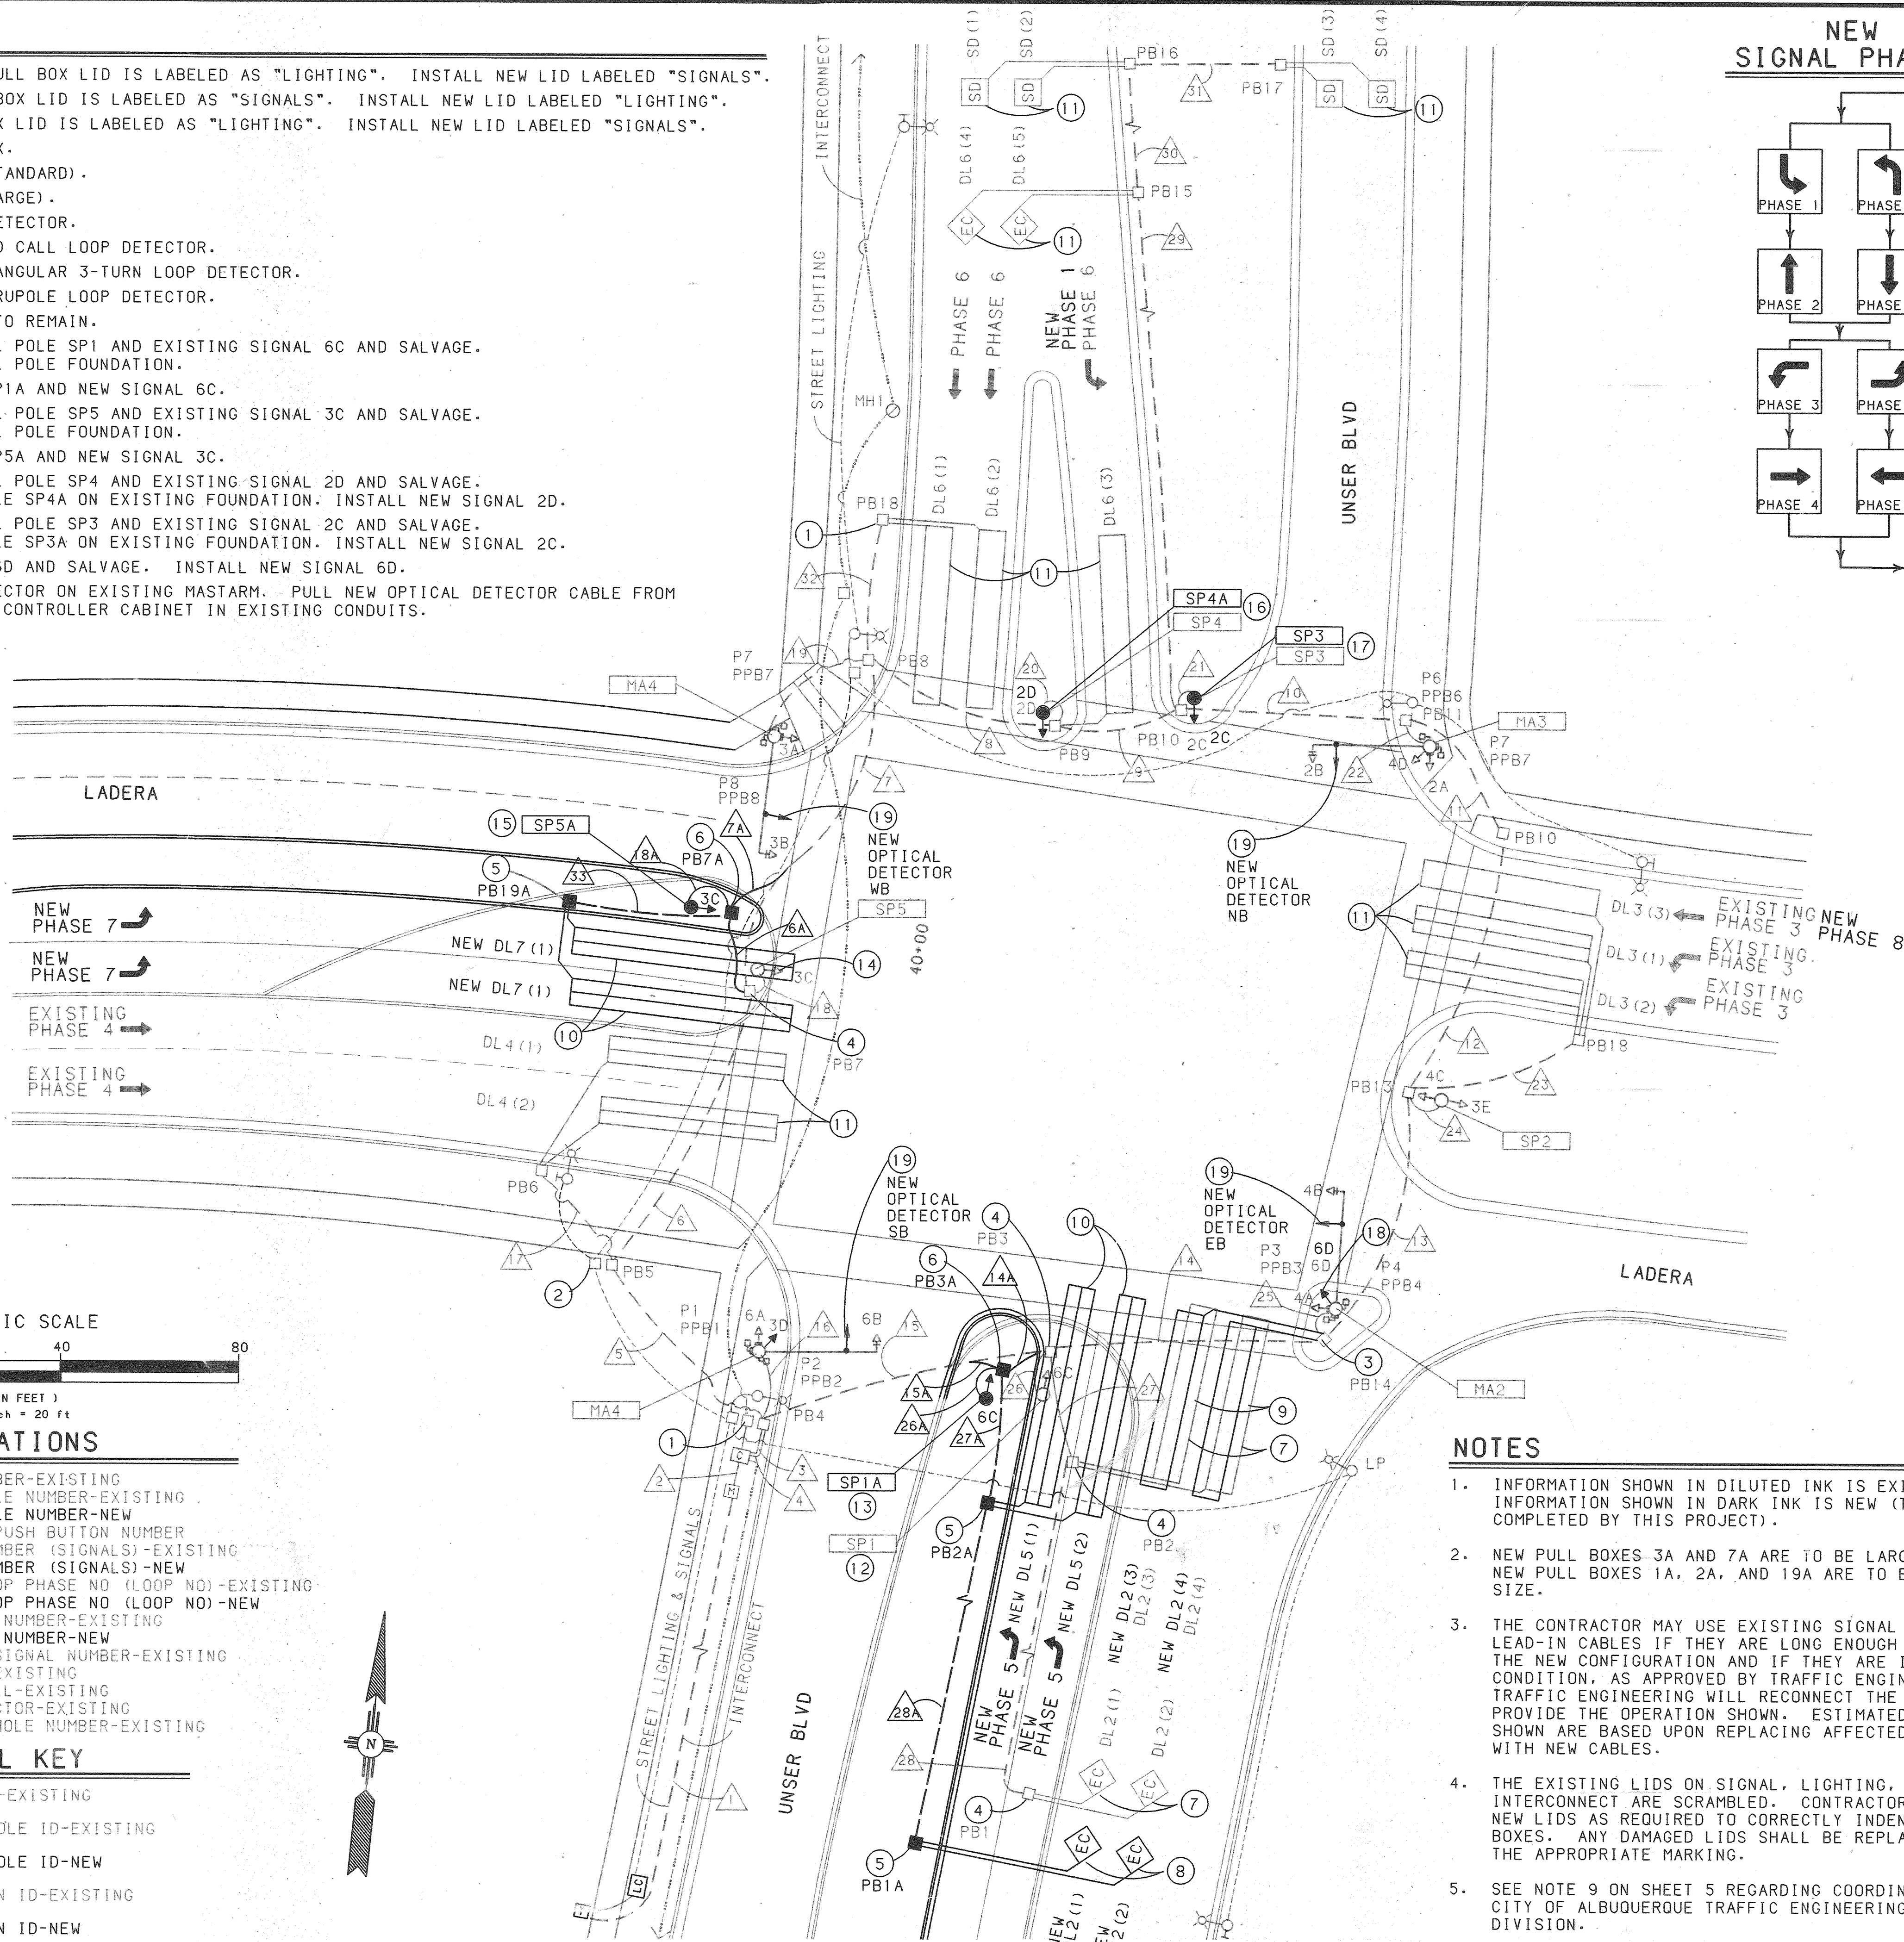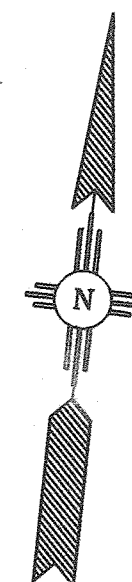



## NEW SIGNAL PHASING

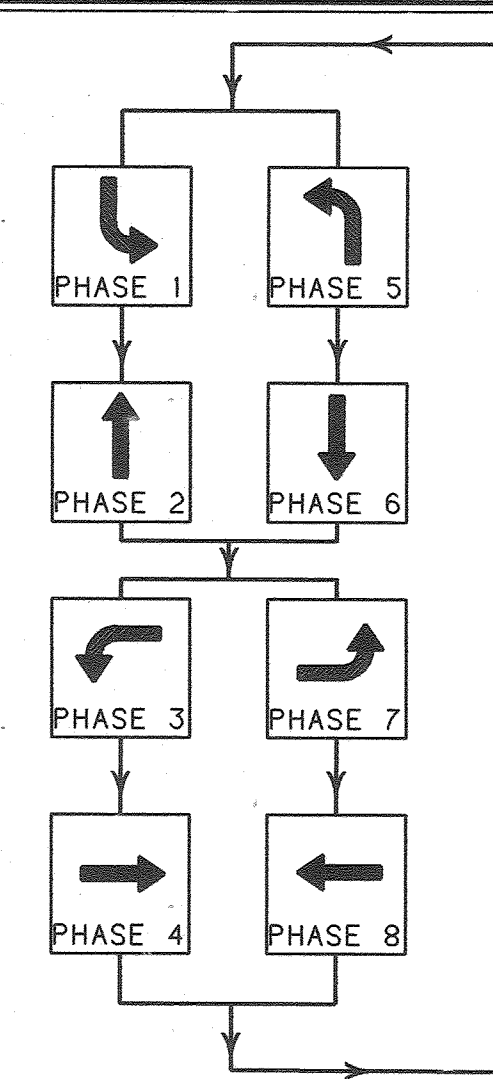

## EXISTING SIGNAL PHASING

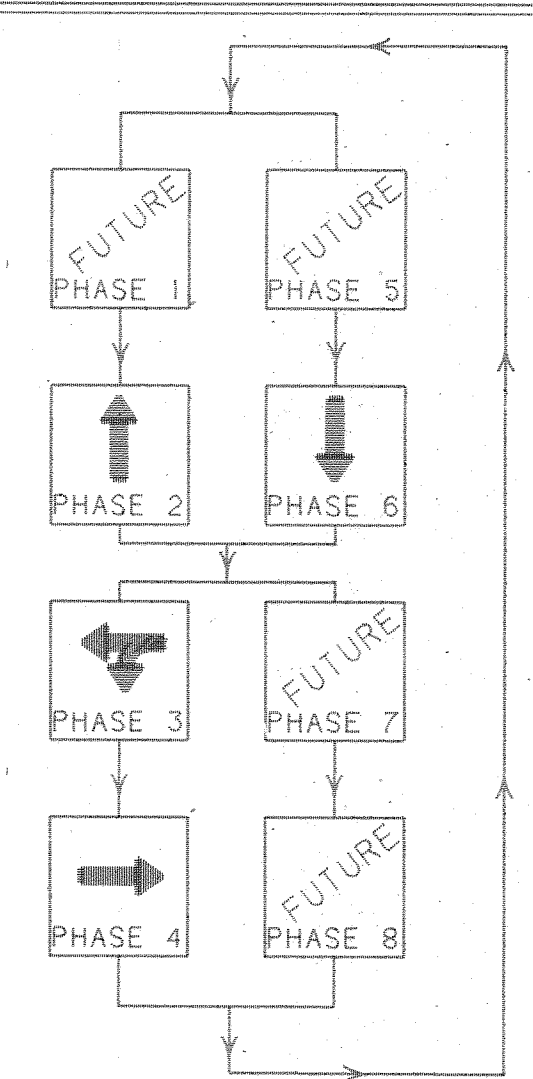

## EXISTING SIGNAL FACE DETAILS

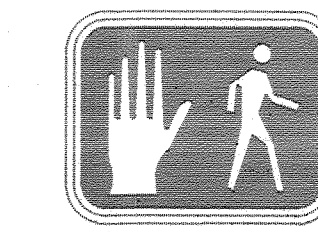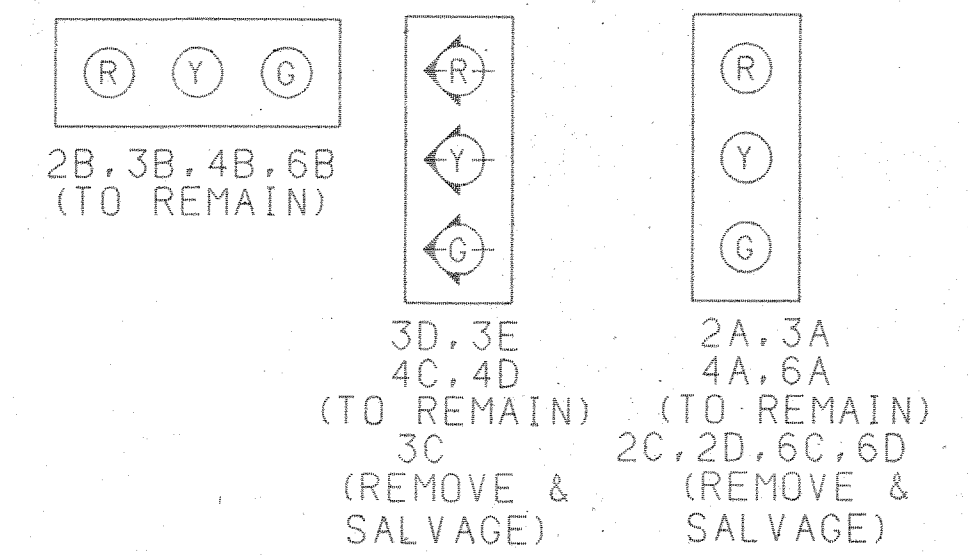


P1, P2, P3, P4, P5, P6, P7, P8 (TO REMAIN)



2B, 3B, 4B, 6B (TO REMAIN)

## NEW SIGNAL FACE DETAILS

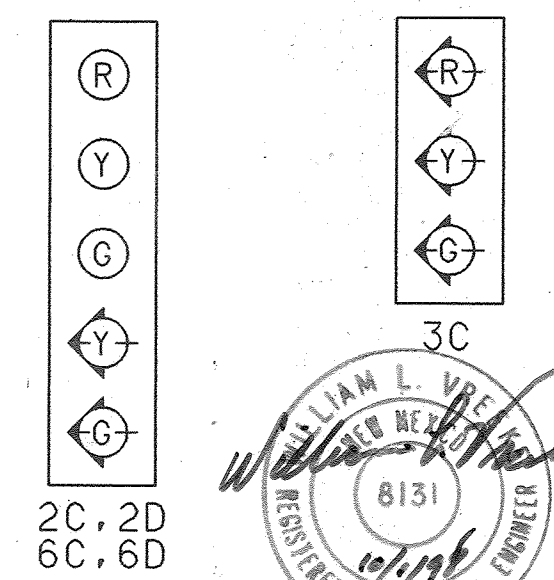

## NOTES

- INFORMATION SHOWN IN DILUTED INK IS EXISTING. INFORMATION SHOWN IN DARK INK IS NEW (TO BE COMPLETED BY THIS PROJECT).
- NEW PULL BOXES 3A AND 7A ARE TO BE LARGE SIZE. NEW PULL BOXES 1A, 2A, AND 19A ARE TO BE STANDARD SIZE.
- THE CONTRACTOR MAY USE EXISTING SIGNAL AND LOOP LEAD-IN CABLES IF THEY ARE LONG ENOUGH TO FIT THE NEW CONFIGURATION AND IF THEY ARE IN GOOD CONDITION, AS APPROVED BY TRAFFIC ENGINEERING. TRAFFIC ENGINEERING WILL RECONNECT THE CABLES TO PROVIDE THE OPERATION SHOWN. ESTIMATED QUANTITIES SHOWN ARE BASED UPON REPLACING AFFECTED CABLES WITH NEW CABLES.
- THE EXISTING LIDS ON SIGNAL, LIGHTING, AND INTERCONNECT ARE SCRAMBLED. CONTRACTOR SHALL FURNISH NEW LIDS AS REQUIRED TO CORRECTLY IDENTIFY THE PULL BOXES. ANY DAMAGED LIDS SHALL BE REPLACED WITH THE APPROPRIATE MARKING.
- SEE NOTE 9 ON SHEET 5 REGARDING COORDINATION WITH THE CITY OF ALBUQUERQUE TRAFFIC ENGINEERING OPERATIONS DIVISION.

RECORD DRAWING  
DATE: 9-14-98

<b>BOHANNAN-HUSTON INC.</b> ENGINEERS • PLANNERS • PHOTOGRAMMETRISTS • SURVEYORS • LANDSCAPE ARCHITECTS ALBUQUERQUE LAS CRUCES SANTA FE			
<b>CITY OF ALBUQUERQUE</b> PUBLIC WORKS DEPARTMENT ENGINEERING GROUP			
TITLE: TRAFFIC SIGNAL PLAN UNSER/LADERA			
APPROVALS	ENGINEER	DATE	APPROVALS
DRC CHAIRMAN			WATER
TRANSPORTATION			WASTE WATER
HYDROLOGY			TRAF. OPER.
DESIGN REVIEW COMMITTEE			
DRAWING NO.	5548.81	MAP NO.	H-9-Z
SHEET	7	OF	16




CONDUIT AND CONDUCTOR REQUIREMENTS															
CONDUIT LENGTH, SIZE, AND TYPE						CONDUIT FILL BY CONDUCTOR LENGTH AND TYPE									
RUN ID ⚠	SIZE/LENGTH			TYPE	REMARKS	MCC 5	MCC 7	MCC 20	SCC #10	SCC #2	EXIST DLIC	NEW DLIC	CC 12	OPTICOM	SCC #8
	1"	2"	3"			(# # ft)	(# # ft)	(# # ft)	(# # ft)	(# # ft)	(# # ft)	(# # ft)	(# # ft)	(# # ft)	(# # ft)
POWER ↑	1			200'	REC	POWER TO PNM TRANS				3*220'					
	2			10'	REC	METER TO CONTROLLER				3* 20'					
	3			20'	REC	CONTROLLER TO PB4		1* 30'		1* 30'		18* 30'	20* 30'	1* 30'	1* 30'
	4			20'	REC	CONTROLLER TO PB4			2* 30'	1* 30'					
	5			60'	REC	PB4 TO PB5		1* 70'	2* 70'	1* 70'		11* 70'	13* 70'	1* 70'	1* 70'
	6			70'	REC	PB5 TO PB7		1* 80'	2* 80'	1* 80'		9* 80'		1* 80'	
	6 & 6A			25'	REC	PB7A TO EX CONDUIT		1* 95'	2* 95'			11* 95'		1* 95'	1* 95'
	7			90'	REC	PB7 TO PB8		1*100'	2*100'	1*100'		9*100'		1*100'	
	7 & 7A			25'	REC	PB7A TO EX CONDUIT		1* 70'	2* 70'			9* 70'		1* 70'	1* 70'
	8			40'	REC	PB8 TO PB9		1* 50'	2* 50'	1* 50'		7* 50'	7* 50'		
	9			40'	REC	PB9 TO PB10		1* 50'	2* 50'	1* 50'		6* 50'	6* 50'		
	10			50'	REC	PB10 TO PB11		1* 60'	2* 60'	1* 60'					
	11			40'	REC	PB11 TO PB12		1* 50'	2* 50'	1* 50'				1* 50'	
	12			60'	REC	PB12 TO PB13		1* 70'	2* 70'	1* 70'				1* 70'	
	13			50'	REC	PB13 TO PB14		1* 60'	2* 60'	1* 60'		3* 60'	3* 60'	1* 60'	
	14			60'	REC	PB3 TO PB14		1* 70'	2* 70'	1* 70'		3* 60'			
INTERSECTION "BOX" RUNS ↑	14 & 14A			15'	REC	PB3 TO EX CONDUIT		1* 80'	2* 80'			5* 80'		2* 80'	1* 80'
	15			65'	REC	PB3 TO PB4		1* 75'	2* 75'	1* 75'		7* 75'			
	15 & 15A			15'	REC	PB3A TO EX CONDUIT		1* 60'	2* 60'			9* 60'		2* 60'	1* 60'
	16			20'	REC	PB4 TO MA1		5* 30'		1* 30'				1* 30'	
	17		35'		REC	PB5 TO PP6						2* 45'			
	18			10'	REC	PB7 TO SP4		1* 20'		1* 20'					
	18A		15'		REC	PB7A TO SP5A	1* 20'								
	19			30'	REC	PB8 TO MA4		4* 40'		1* 40'				1* 40'	
	20			10'	REC	PB9 TO SP4		1* 20'		1* 20'					
	20					SP4A		1* 20'							
	21			10'	REC	PB10 TO SP3		1* 20'		1* 20'					
	21					PB10 TO SP3A		1* 20'							
	22			15'	REC	PB11 TO MA3		5* 25'		1* 25'				1* 25'	
	23			55'	REC	PB13 TO SP2						3* 65'	3* 65'		
	24			15'	REC	PB13 TO SP2		2* 25'		1* 25'					
	25			5'	REC	PB14 TO MA2		5* 15'		1* 15'				1* 15'	
25					PB14 TO MA2		1* 15'								
26			15'	REC	PB3 TO SP1		1* 25'		1* 25'						
26A				REC	PB3A TO SP1A		1* 20'								
27		35'		REC	PB2 TO PB3						4* 45'				
27A		35'		REC	PB3A TO PB2A								2* 40'		
28		175'		REC	PB1 TO PB2						2*185'				
28A		175'		REC	PB2A TO PB1A								2*180'		
29		200'		REC	PB15 TO PB16						6*205'	6*205'			
30		150'		REC	PB16 TO PB15						4*155'	4*155'			
31		70'		REC	PB17 TO PB16						2* 75'	2* 75'			
32		25'		REC	PB18 TO PB8						2* 35'		1* 35'		
33		40'		REC	PB7A TO PB19A						2* 45'		2* 45'		
		60'		REC	LOOP TERMINATION										
TOTALS	60'	280'	80'				20'	380'	610'			7240'		925'	305'
SIGNAL RUNS ↑															

SIGNAL CABLES FOR INDIVIDUAL POLES

CONDUIT AND CONDUCTOR REQUIREMENTS (CONTINUED)															
CONDUIT LENGTH, SIZE, AND TYPE					CONDUIT FILL BY CONDUCTOR LENGTH AND TYPE										
RUN ID ▲	SIZE/LENGTH			TYPE	REMARKS	MCC 5	MCC 7	MCC 20	SCC#10	SCC#2	EXIST	NEW	CC 12	OPTICOM	SCC #8
	1"	2"	3"			(# ● ft)	(# ● ft)	(# ● ft)	(# ● ft)	(# ● ft)	(# ● ft)	(# ● ft)	(# ● ft)	(# ● ft)	(# ● ft)
MA1					BASE TO 6A	1● 50'									
MA1					BASE TO 6B	1● 50'									
MA1					BASE TO 3D	1● 15'									
MA1					BASE TO P1 & P2	1● 15'									
MA1					BASE TO PPB1 & PPB2	1● 15'									
MA1					BASE TO OPTICOM									1● 45'	
MA2					BASE TO 4A	1● 40'									
MA2					BASE TO 4B	1● 40'									
MA2					BASE TO 6D	1● 15'	1● 15'								
MA2					BASE TO P3 & P4	1● 15'									
MA2					BASE TO PPB3 & PPB4	1● 15'									
MA2					BASE TO OPTICOM									1● 35'	
MA3					BASE TO 2A	1● 50'									
MA3					BASE TO 2B	1● 50'									
MA3					BASE TO 4D	1● 15'									
MA3					BASE TO P5 & P6	1● 15'									
MA3					BASE TO PPB5 & PPB6	1● 15'									
MA3					BASE TO OPTICOM									1● 45'	
MA4					BASE TO 3A	1● 50'									
MA4					BASE TO 3B	1● 50'									
MA4					BASE TO P7 & P8	1● 15'									
MA4					BASE TO PPB7 & PPB8	1● 15'									
MA4					BASE TO OPTICOM									1● 45'	
SP1					BASE TO 6C	1● 15'									
SP1A					BASE TO 6C		1● 15'								
SP2					BASE TO 4C	1● 15'									
SP2					BASE TO 3E	1● 15'									
SP3					BASE TO 2C	1● 15'									
SP3A					BASE TO 2C		1● 15'								
SP4					BASE TO 2D	1● 15'									
SP4A					BASE TO 2D		1● 15'								
SP5					BASE TO 3C	1● 15'									
SP5A					BASE TO 3C	1● 15'									

# ABBREVIATIONS

CC 12	COMMUNICATION CABLE - 12 PAIR
DL	DETECTOR LOOP
MA	MASTARM
MCC	MULTI CONDUCTOR CABLE
PB	PULL BOX
PP	PEDESTAL POLE
PPB	PEDESTRIAN PUSH BUTTON
REC	RIGID ELECTRIC CONDUIT
SCC	SINGLE CONDUCTOR CABLE

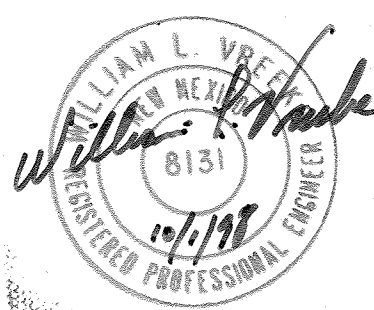

RECORD DRAWING  
DATE: 9-14-98

<b>BOHANNAN-HUSTON INC.</b> <small>ENGINEERS • PLANNERS • PHOTOGRAMMETRISTS • SURVEYORS • LANDSCAPE ARCHITECTS</small> <small>ALBUQUERQUE LAS CRUCES SANTA FE</small>			
<b>CITY OF ALBUQUERQUE</b> <b>PUBLIC WORKS DEPARTMENT</b> <b>ENGINEERING GROUP</b>			
<b>TITLE:</b> <b>TRAFFIC SIGNAL</b> <b>CABLES &amp; CONDUITS</b>			
APPROVALS	ENGINEER	DATE	APPROVALS
DRC CHAIRMAN			WATER
TRANSPORTATION			WASTE WATER
HYDROLOGY			TRAF. OPER.
DESIGN		REVIEW/COMMITTEE	
DRAWING NO.	5548.81	MAP NO.	H-9-Z
SHEET	8	OF	16



DETECTOR LOOPS											
LOOP ID	VEHICLE DETECTOR				LOOP TYPE	LOOP DIMENSIONS				LOOP WIRE	PAVEMENT SAWCUT
	MODE	CALL	UNIT NO	CHANNEL		L	W	S	T		
DL2 (1)	PULSE	EXTEND 3	FOUR	CH 1	4-TURN	6'	6'	5'	2'	115'	29'
DL2 (2)	PULSE	EXTEND 3	FOUR	CH 1	4-TURN	6'	6'	15'	2'	135'	39'
DL2 (3)	PRESENCE		TWO	CH 1	3-TURN	40'	6'	5'	2'	295'	97'
DL2 (4)	PRESENCE		TWO	CH 2	3-TURN	40'	6'	15'	2'	315'	107'
DL3 (1)	PRESENCE		FIVE	CH 1	OP	40'	6'	5'	2'	363'	137'
DL3 (2)	PRESENCE		FIVE	CH 1	OP	40'	6'	15'	2'	363'	147'
DL3 (3)	PRESENCE		FIVE	CH 1	OP	40'	6'	25'	2'	335'	117'
DL4 (1)	PRESENCE		SIX	CH 1	3-TURN	40'	6'	15'	2'	315'	107'
DL4 (2)	PRESENCE	DELAY 5	SIX	CH 2	3-TURN	40'	6'	5'	2'	295'	102'
DL6 (1)	PRESENCE		THREE	CH 1	3-TURN	40'	6'	5'	2'	295'	102'
DL6 (2)	PRESENCE		THREE	CH 1	3-TURN	40'	6'	15'	2'	315'	107'
DL6 (3)	PRESENCE		THREE	CH 2	3-TURN	40'	6'	8'	8'	313'	100'
DL6 (4)	PULSE	EXTEND 3	FOUR	CH 2	4-TURN	6'	6'	15'	2'	135'	39'
DL6 (4)	PULSE	EXTEND 3	FOUR	CH 2	4-TURN	6'	6'	5'	2'	115'	29'
SD (1)	PRESENCE		S-3	CH 1	4-TURN	6'	6'	15'	2'	135'	39'
SD (2)	PRESENCE		S-4	CH 1	4-TURN	6'	6'	5'	2'	115'	29'
SD (3)	PRESENCE		S-6	CH 1	4-TURN	6'	6'	5'	2'	115'	29'
SD (4)	PRESENCE		S-6	CH 2	4-TURN	6'	6'	15'	2'	135'	39'
DL2 (1)	PULSE	EXTEND 3	FOUR	CH 1	4-TURN	6'	6'	30'	5'	166'	54'
DL2 (2)	PULSE	EXTEND 3	FOUR	CH 1	4-TURN	6'	6'	42'	5'	190'	66'
DL2 (3)	PRESENCE		TWO	CH 1	3-TURN	40'	6'	27'	5'	376'	119'
DL2 (4)	PRESENCE		TWO	CH 2	3-TURN	40'	6'	39'	5'	358'	131'
DL5 (1)	PRESENCE		ONE	CH 2	OP	50'	6'	3'	5'	445'	165'
DL5 (2)	PRESENCE		ONE	CH 2	OP	50'	6'	15'	5'	469'	177'
DL7 (1)	PRESENCE		FIVE	CH 2	OP	50'	6'	3'	5'	445'	165'
DL7 (2)	PRESENCE		FIVE	CH 2	OP	50'	6'	15'	5'	469'	177'
TOTALS										2918 LF	1054 LF

#### QUANTITY ESTIMATING ASSUMPTIONS:

##### LOOP WIRE

6' X 30' OP LOOP = (8\*L) + (4\*W) + (2\*S) + (2\*T) + 5 = 269 + 2(S+T)  
 6' X 40' OP LOOP = (8\*L) + (4\*W) + (2\*S) + (2\*T) + 5 = 349 + 2(S+T)  
 6' X 50' OP LOOP = (8\*L) + (4\*W) + (2\*S) + (2\*T) + 5 = 429 + 2(S+T)  
 6' X 6' EC LOOP = (6\*L) + (6\*W) + (2\*S) + (2\*T) + 5 = 77 + 2(S+T)  
 6' X 6' SYS LOOP = (8\*L) + (8\*W) + (2\*S) + (2\*T) + 5 = 96 + 2(S+T)  
 6' X 40' RECT LOOP = (6\*L) + (6\*W) + (2\*S) + (2\*T) + 5 = 312 + 2(S+T)

##### PAVEMENT SAWCUT

6' X 30' OP LOOP = (3\*L) + (2\*W) + S = 102 + S  
 6' X 40' OP LOOP = (3\*L) + (2\*W) + S = 132 + S  
 6' X 50' OP LOOP = (3\*L) + (2\*W) + S = 162 + S  
 6' X 6' EC LOOP = (2\*L) + (2\*W) + S = 24 + S  
 6' X 6' SYS LOOP = (2\*L) + (2\*W) + S = 24 + S  
 6' X 40' RECT LOOP = (2\*L) + (2\*W) + S = 24 + S

##### WHERE:

L = DETECTOR LOOP LENGTH (FROM PLAN)  
 W = DETECTOR LOOP WIDTH (FROM PLAN)  
 S = SAWCUT LENGTH FROM DETECTOR LOOP TO FACE OF CURB (FROM PLAN)  
 T = LOOP WIRE TERMINAL LENGTH FROM FACE OF CURB TO PULL BOX (FROM PLAN)

#### DETECTOR RACK ASSIGNMENTS - 8 PHASE DUAL RING 16 POSITION RACK

UNIT NUMBER →	POWER SUPPLY	1	2	3	4	5	6	7	8	9	10	11	12	13	14	15	16
CHANNEL 1 →		Φ1	Φ2	Φ6	Φ2 EC	Φ3	Φ4	Φ8	Φ4 EC	SD 1	SD 3	SD 5	SD 7	SD 9	PED ISOLATION	OPTICOM 1	OPTICOM 3
CHANNEL 2 →		Φ5	Φ2	Φ6	Φ6 EC	Φ7	Φ4	Φ8	Φ8 EC	SD 2	SD 4	SD 6	SD 8	SD 10		OPTICOM 2	OPTICOM 4
DETECTOR MODULE REQUIRED →	*	✓	✓	✓	✓	✓	✓	✓		✓	✓				*	✓	✓

\* INCIDENTAL TO CONSTRUCTION

FUNCTION CHART - 115 VOLT CIRCUIT ✓						
CONDUCTOR			RING 1 - MULTI CONDUCTOR CABLE 20		RING 2 - MULTI CONDUCTOR CABLE 20 2/	
CONDUCTOR NUMBER	BASE COLOR	TRACER	FUNCTION	FIELD CONNECTION	FUNCTION	FIELD CONNECTION
1	BLACK	-	PHASE 3 WALK		SPARE	
2	WHITE	-	PHASE 3 DON'T WALK		SPARE	
3	RED	-	PHASE 1 RED		PHASE 5 RED	
4	GREEN	-	PHASE 1 GREEN	6C, 6D LEFT ARROW ③	PHASE 5 GREEN	2C, 2D LEFT ARROW ④
5	ORANGE	-	PHASE 1 YELLOW	6C, 6D LEFT ARROW ③	PHASE 5 YELLOW	2C, 2D LEFT ARROW ④
6	BLUE	-	PHASE 1 WALK		PHASE 5 WALK	
7	WHITE	BLACK	PHASE 1 DON'T WALK		PHASE 5 DON'T WALK	
8	RED	BLACK	PHASE 2 RED	2A, 2B, 2C, 2D ④	PHASE 6 RED	6A, 6B, 6C, 6D ③
9	GREEN	BLACK	PHASE 2 GREEN	2A, 2B, 2C, 2D ④	PHASE 6 GREEN	6A, 6B, 6C, 6D ③
10	ORANGE	BLACK	PHASE 2 YELLOW	2A, 2B, 2C, 2D ④	PHASE 6 YELLOW	6A, 6B, 6C, 6D ③
11	BLUE	BLACK	PHASE 2 WALK	P4, P5	PHASE 6 WALK	P1, P8
12	BLACK	WHITE	PHASE 2 DON'T WALK	P4, P5	PHASE 6 DON'T WALK	P1, P8
13	RED	WHITE	PHASE 3 RED	3A, 3B, 3C, 3D, 3E ②	PHASE 7 RED	
14	GREEN	WHITE	PHASE 3 GREEN	3A, 3B, 3C, 3D, 3E ②	PHASE 7 GREEN	
15	BLUE	WHITE	PHASE 3 YELLOW	3A, 3B, 3C, 3D, 3E ②	PHASE 7 YELLOW	
16	BLACK	RED	PHASE 4 RED	4A, 4B, 4C, 4D	PHASE 8 RED	3A, 3B ②
17	WHITE	RED	PHASE 4 GREEN	4A, 4B, 4C, 4D	PHASE 8 GREEN	3A, 3B ②
18	ORANGE	RED	PHASE 4 YELLOW	4A, 4B, 4C, 4D	PHASE 8 YELLOW	3A, 3B ②
19	BLUE	RED	PHASE 4 WALK	P2, P3	PHASE 3 WALK	P6, P7 ①
20	RED	GREEN	PHASE 4 DON'T WALK	P2, P3	PHASE 3 DON'T WALK	P6, P7 ①

#### KEYED NOTES

- MOVE SIGNALS P6 & P7 AND PUSH BUTTONS PPB5 & PPB8 FROM PHASE 3 TO PHASE 8
- MOVE SIGNALS 3A & 3B TO PHASE 8
- EXISTING SIGNALS 6C & 6D TO BE REPLACED WITH 5-SECTION HEADS
- EXISTING SIGNALS 2C & 2D TO BE REPLACED WITH 5-SECTION HEADS
- REASSIGN LOOP DL6 (3) TO PHASE 1
- REASSIGN LOOP DL3 (3) TO PHASE 8
- EXISTING LOOP TO BE ABANDONED
- INSTALL NEW LOOP

#### FUNCTION CHART - 24 VOLT CIRCUIT 3/

MULTI CONDUCTOR CABLE 5			
CONDUCTOR NUMBER	BASE COLOR	FUNCTION	FIELD CONNECTION
1	BLACK	PHASE 2 PPB	PPB4 & PPB6
2	WHITE	COMMON	PPB1 & PPB3
3	RED	PHASE 4 PPB	PPB2 & PPB3
4	GREEN	PHASE 6 PPB	PPB7 & PPB1
5	ORANGE	PHASE 3 ①	PPB8 & PPB5

#### NOTES:

- IDENTIFY CONDUCTORS LISTED AS "115 VOLTS"
- WRAP RING 2 CABLE AT EACH SPLICE POINT WITH COLORED ELECTRICAL TAPE. THE IDENTIFICATION MARKING SHALL BE PROVIDED ON EACH RING 2 CABLE AT EACH SPLICE BOX AND LOCATED 6" BACK FROM THE END.
- IDENTIFY CONDUCTORS LISTED AS "PPB - LOW VOLTAGE" AT EACH SPLICE POINT. FIVE (5) CONDUCTOR CABLE SHALL BE 24 VOLTS AND USED FOR PUSH BUTTONS ONLY.
- CONDUCTOR CABLE RUNS TO TRAFFIC SIGNALS. PEDESTRIAN SIGNALS, AND PEDESTRIAN PUSH BUTTONS SHALL BE SPLICED INTO THE MAIN CONDUCTORS AT THE NEAREST LARGE PULL BOX AND RUN WITHOUT ADDITIONAL SPLICES INTO EACH SIGNAL HEAD OR PUSH BUTTON ASSEMBLY.


#### ABBREVIATIONS

DL DETECTOR LOOP  
 EC EXTENDED CALL LOOP  
 L DETECTOR LOOP LENGTH  
 W DETECTOR LOOP WIDTH  
 S SAWCUT LOOP TO CURB  
 T TERMINAL LENGTH  
 OP QUADRAPOLE LOOP  
 SDWBA SYSTEM DETECTOR WESTBOUND APPROACH  
 SDWBD SYSTEM DETECTOR WESTBOUND DEPARTURE  
 SDEBA SYSTEM DETECTOR EASTBOUND APPROACH  
 SDEBD SYSTEM DETECTOR EASTBOUND DEPARTURE  
 SDNBA SYSTEM DETECTOR NORTHBOUND APPROACH  
 SDNBD SYSTEM DETECTOR NORTHBOUND DEPARTURE  
 SDSBA SYSTEM DETECTOR SOUTHBOUND APPROACH  
 SDSBD SYSTEM DETECTOR SOUTHBOUND DEPARTURE


**RECORD DRAWING**  
 DATE: **9-14-98**

<b>BOHANNAN-HUSTON INC.</b> ENGINEERS • PLANNERS • PHOTOGRAMMETRISTS • SURVEYORS • LANDSCAPE ARCHITECTS ALBUQUERQUE LAS CRUCES SANTA FE			
<b>CITY OF ALBUQUERQUE</b> PUBLIC WORKS DEPARTMENT ENGINEERING GROUP			
<b>TITLE: TRAFFIC SIGNAL FUNCTIONS &amp; DETECTORS</b> UNSER/LADERA			
APPROVALS	ENGINEER	DATE	APPROVALS
DRC CHAIRMAN			WATER
TRANSPORTATION			WASTE WATER
HYDROLOGY			TRAF. OPER.
DRAWING NO. 5548.81		MAP NO. H-9-Z	
SHEET 9		OF 16	



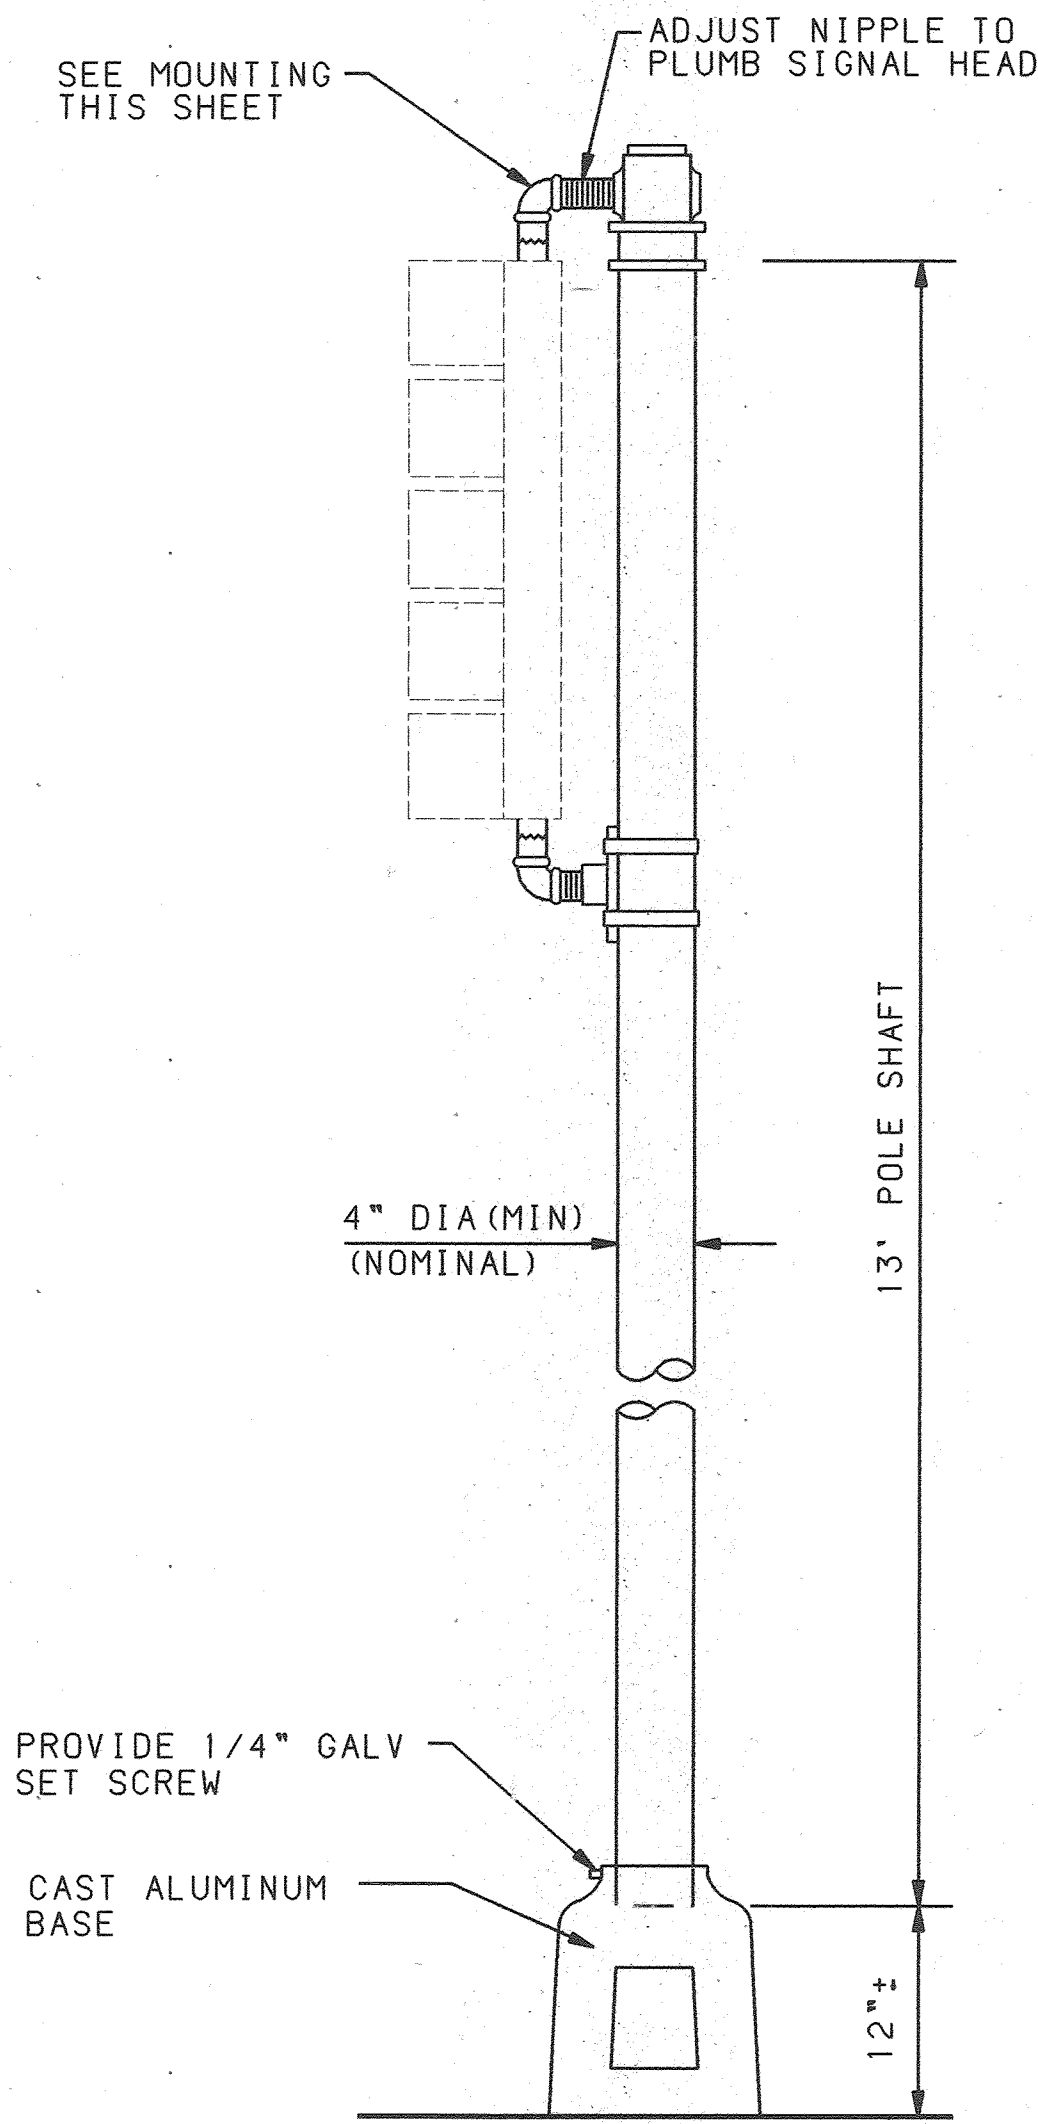

PEDESTAL POLE MOUNTING DETAIL

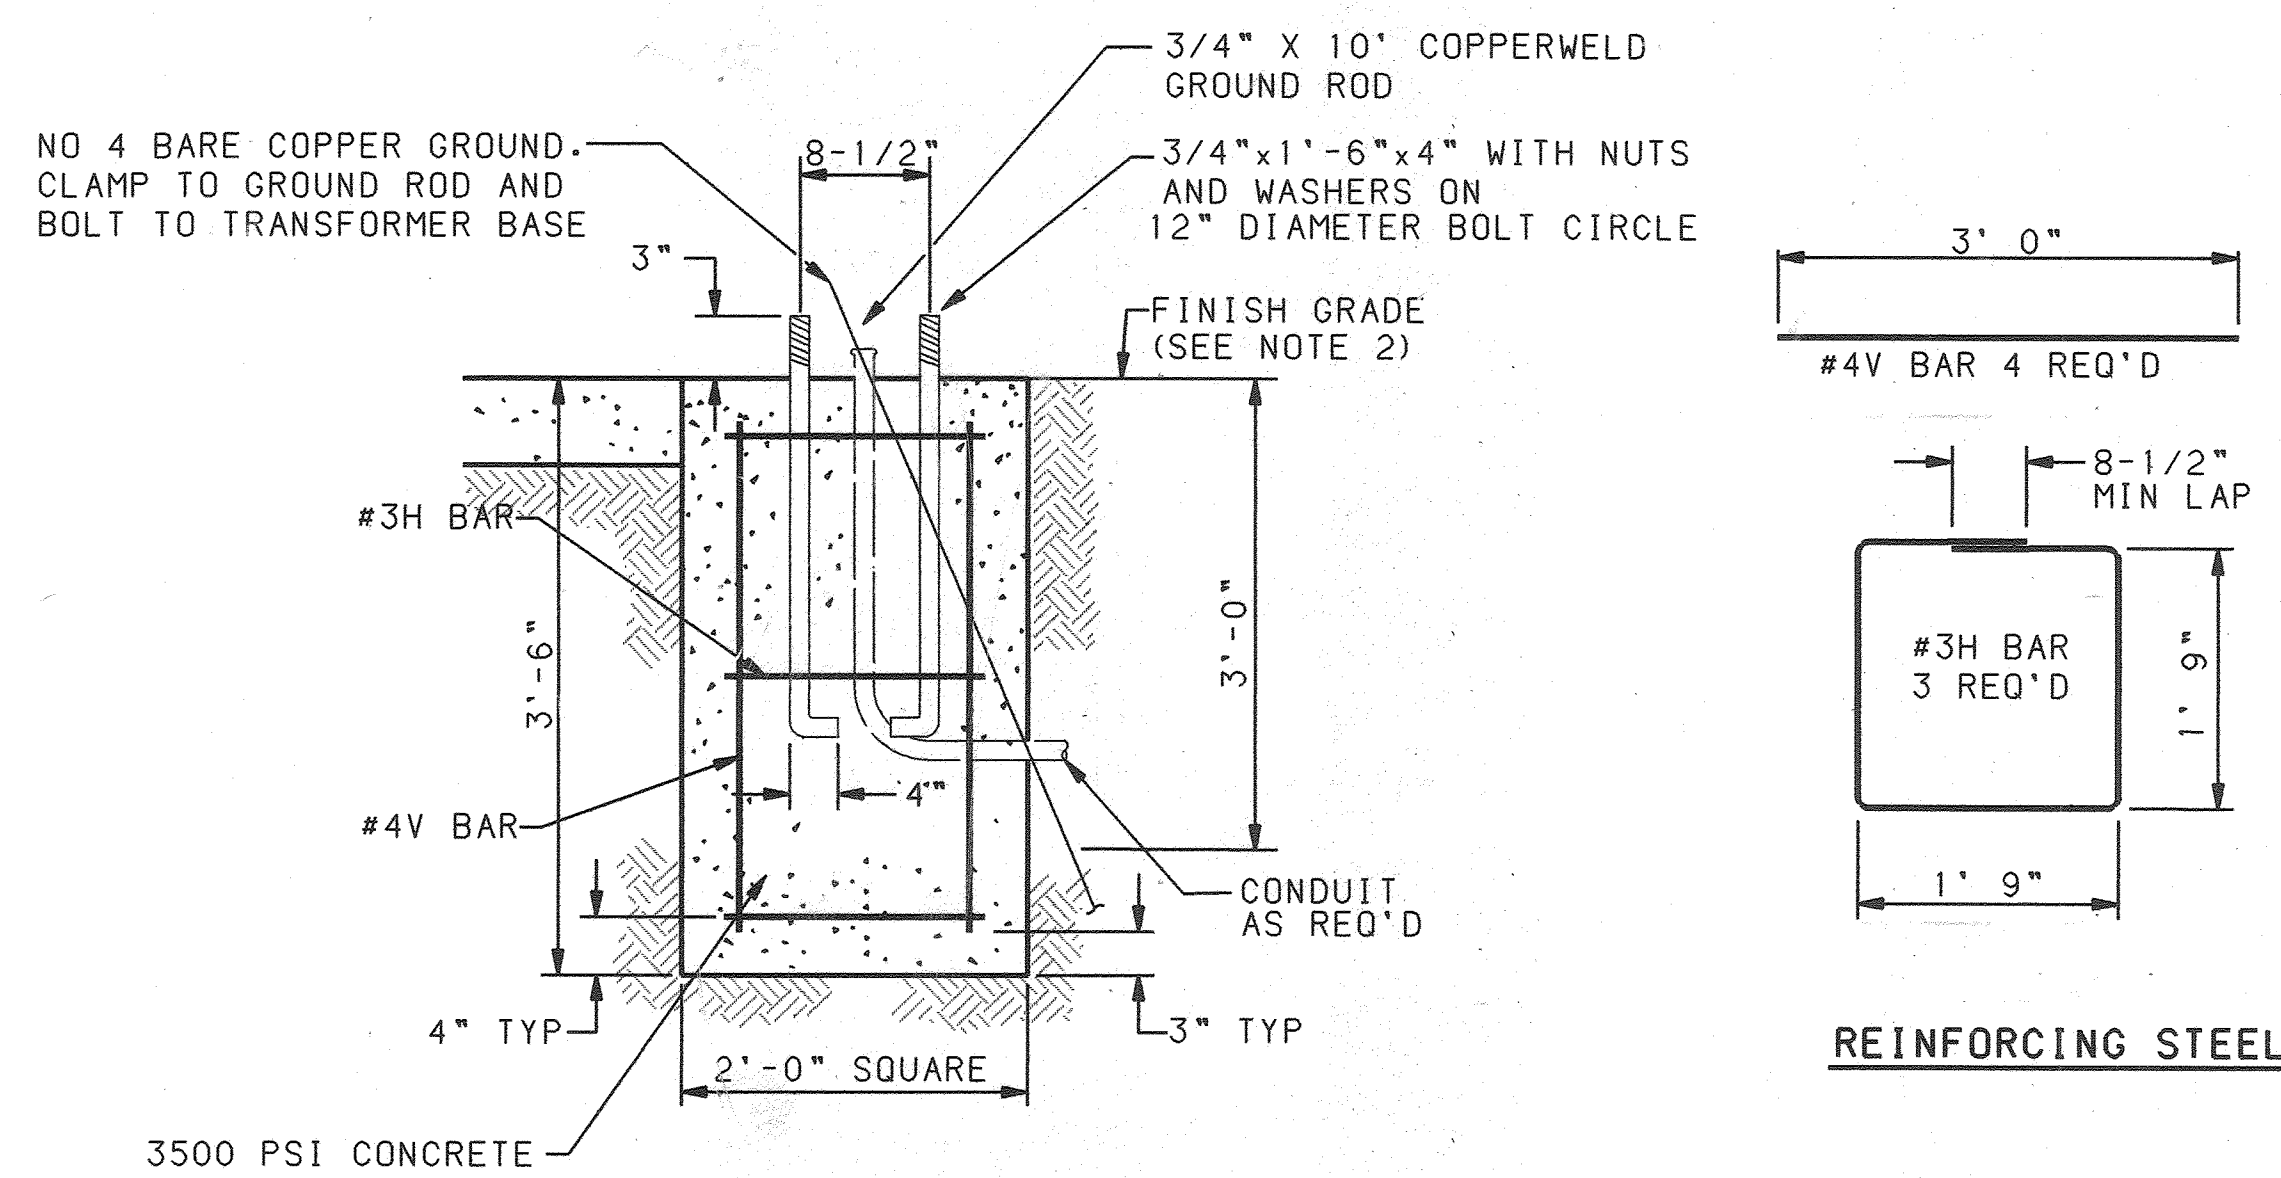

PEDESTAL FOUNDATION DETAIL


ESTIMATED QUANTITIES

FOUNDATION TYPE	3500 PSI CONCRETE CU YD	REINFORCING BARS POUNDS
PEDESTAL FOUNDATION	0.52	17

(FOR CONTRACTORS INFORMATION ONLY)

TRAFFIC SIGNAL FOUNDATION NOTES

- ALL FOUNDATIONS SHALL INCLUDE COPPERWELD GROUND RODS. ALL GROUND RODS SHALL BE 3/4" Øx10'-0" AND WILL BE CONSIDERED INCIDENTAL TO THE FOUNDATION BID ITEMS.
- FINISHED GRADE FOR ALL FOUNDATIONS TO BE DETERMINED IN THE FIELD BY THE PROJECT ENGINEER. FOUNDATIONS MAY BE SLOPED TO MATCH SIDEWALKS. SLOPES SHALL CONFORM TO THE AMERICANS WITH DISABILITIES ACT REQUIREMENTS.

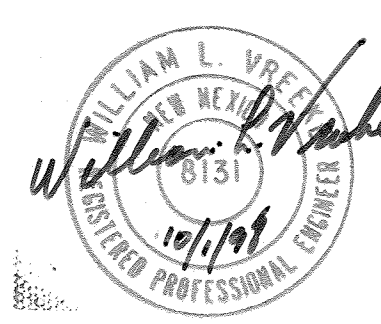

RECORD DRAWING  
DATE: 9-14-98

BOHANNAN-HUSTON INC.  
ENGINEERS • PLANNERS • PHOTOGRAMMETRISTS • SURVEYORS • LANDSCAPE ARCHITECTS  
ALBUQUERQUE LAS CRUCES SANTA FE

CITY OF ALBUQUERQUE  
PUBLIC WORKS DEPARTMENT  
ENGINEERING GROUP

TITLE: TRAFFIC SIGNAL  
PEDESTAL POLE DETAILS

APPROVALS	ENGINEER R. D. VORTE	APPROVALS	ENGINEER	DATE
DRC CHAIRMAN		WATER		
TRANSPORTATION	MAR 31 1997	WASTE WATER		
HYDROLOGY		TRAF. OPER.		12/19/96

DRAWING NO. 5548.81 MAP NO. H-9-Z SHEET 10 OF 16

ENGINEER'S SEAL	AS-BUILT INFORMATION
NO.	CONTRACTOR'S SIGNATURE
DATE	DATE 9/98
BY	DATE 9/98
REMARKS	DATE 9/98
REVISIONS	DATE 9/98
DESIGN	DATE 9/98
DESIGNED BY BHI/COA	RECORDED BY
DRAWN BY BHI/COA	NO.
CHECKED BY BHI/COA	





### TYPICAL ROADWAY LOOP SAWCUT DETAIL



## LOOP WIRE TERMINATION DETAILS











### TYPICAL LOOP WIRE PLACEMENT DETAILS

1. WIRES MUST BE WOUND IN THE DIRECTION SHOWN.
2. QUADRUPOLE LOOPS SHALL HAVE 2 TURNS.
3. EXTEND CALL LOOPS SHALL HAVE 3 TURNS.
4. SYSTEM DETECTOR LOOPS SHALL HAVE 4 TURNS.
5. LARGE RECTANGLE LOOPS SHALL HAVE 3 TURNS

1. ALL LOOP DETECTOR WIRE SHALL BE NO. 14 AWG STRANDED COPPER WIRE WITH CROSSLINKED POLYETHYLENE INSULATION (INDUSTRY TYPE XHHW) CONFORMING TO THE REQUIREMENTS OF I.M.S.A. SPECIFICATIONS NO 51-3 1984. BACKER ROD SHALL NOT BE USED IN THE INSTALLATION OF LOOP (EXCEPT PIECES LESS THAN 12" WHICH MAY BE PLACED OVER THE WIRE AT THE SAW CUT CORNERS TO HOLD THE WIRE. A 1/4" LAYER OF SEALANT SHALL BE PLACED IN THE SAWCUT BEFORE PLACEMENT OF THE WIRE AND THEN THE WIRE SHALL BE ENCAPSULATED WITH SEALANT. HOT-MELT RUBBERIZED ASPHALT LOOP DETECTOR SEALANT MANUFACTURED BY CRAFCO SHALL BE AN ACCEPTABLE SEALANT ALTERNATE.
2. ALL LOOP LEAD IN CABLES SHALL BE TAGGED AT CABINET TO IDENTIFY EACH CABLE BY LOOP AND AND PHASE NUMBER.
3. GROUND LOOP LEAD IN CABLE SHIELDING IN CONTROL CABINET.
4. SEPARATE 1" RIGID ELECTRICAL CONDUITS ARE REQUIRED FOR EACH PAIR OF DETECTOR WIRES.

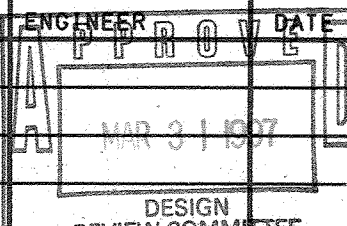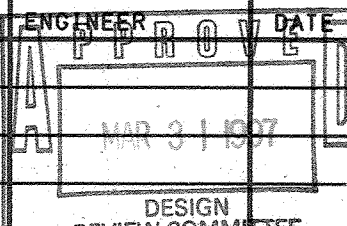RECORD DRAWING  
DATE: 9-14-98

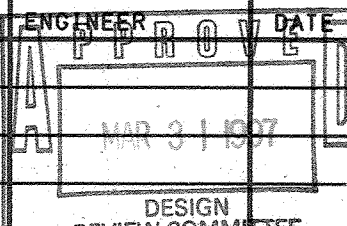	<h2 style="margin: 0;">BOHANNAN-HUSTON INC.</h2> <p style="margin: 0; font-size: 0.8em;">ENGINEERS • PLANNERS • PHOTOGRAMMETRISTS • SURVEYORS • LANDSCAPE ARCHITECTS</p> <p style="margin: 0; font-size: 0.8em;">ALBUQUERQUE LAS CRUCES SANTA FE</p>												
	<h2 style="margin: 0;">CITY OF ALBUQUERQUE</h2> <p style="margin: 0; font-size: 0.8em;">PUBLIC WORKS DEPARTMENT</p> <p style="margin: 0; font-size: 0.8em;">ENGINEERING GROUP</p>												
<p><b>TITLE:</b></p> <p style="text-align: center; font-size: 1.2em;">TRAFFIC SIGNAL LOOP DETECTOR DETAILS</p>													
<table border="1" style="width: 100%; border-collapse: collapse;"> <tr> <td style="width: 30%;">APPROVALS</td> <td style="width: 40%;">ENGINEER</td> <td style="width: 30%;">DATE</td> </tr> <tr> <td style="height: 100px; vertical-align: middle; text-align: center;">  </td> <td></td> <td></td> </tr> </table>	APPROVALS	ENGINEER	DATE				<table border="1" style="width: 100%; border-collapse: collapse;"> <tr> <td style="width: 30%;">APPROVALS</td> <td style="width: 40%;">ENGINEER</td> <td style="width: 30%;">DATE</td> </tr> <tr> <td style="height: 100px; vertical-align: middle; text-align: center;"> <p>WATER</p> <p>WASTE WATER</p> <p>TRAF. OPER.</p> </td> <td style="vertical-align: middle; text-align: center;">  </td> <td style="vertical-align: middle; text-align: center;"> <p>11/19/90</p> </td> </tr> </table>	APPROVALS	ENGINEER	DATE	<p>WATER</p> <p>WASTE WATER</p> <p>TRAF. OPER.</p>		<p>11/19/90</p>
APPROVALS	ENGINEER	DATE											
													
APPROVALS	ENGINEER	DATE											
<p>WATER</p> <p>WASTE WATER</p> <p>TRAF. OPER.</p>		<p>11/19/90</p>											
<p><b>DRAWING</b></p> <p><b>NO. 5548.81</b></p>	<p><b>MAP NO.</b></p> <p><b>H-9-Z</b></p>	<p><b>SHEET</b></p> <p style="text-align: center; font-size: 1.5em;">11</p>	<p><b>OF</b></p> <p style="text-align: center; font-size: 1.5em;">16</p>										





NOTE: THE CONCRETE COLLAR FOR THE PULL BOXES  
WILL BE CONSIDERED INCIDENTAL TO THE  
TO THE PULL BOX BID ITEMS.






DETAIL "A-1"



NOTE


- RECORD DRAWING  
DATE: 9-14-98

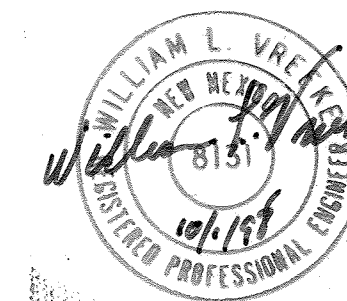


CITY OF ALBUQUERQUE  
PUBLIC WORKS DEPARTMENT  
ENGINEERING GROUP


APPROVALS	ENGINEER	DATE	APPROVALS	ENGINEER	DATE
DRC CHAIRMAN	APPROVE		WATER		
TRANSPORTATION			WASTE WATER		
HYDROLOGY		MAR 31 1997	TRAF. OPER.	<i>[Signature]</i>	12/96

DRAWING NO. 5548.81		MAP NO. H-9-Z	SHEET 13	OF 16
---------------------	--	---------------	----------	-------

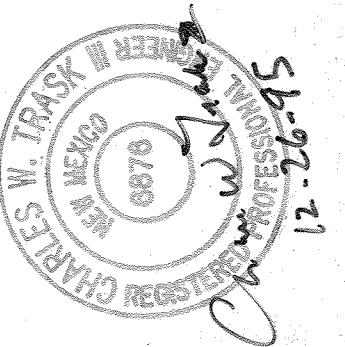[illegible]



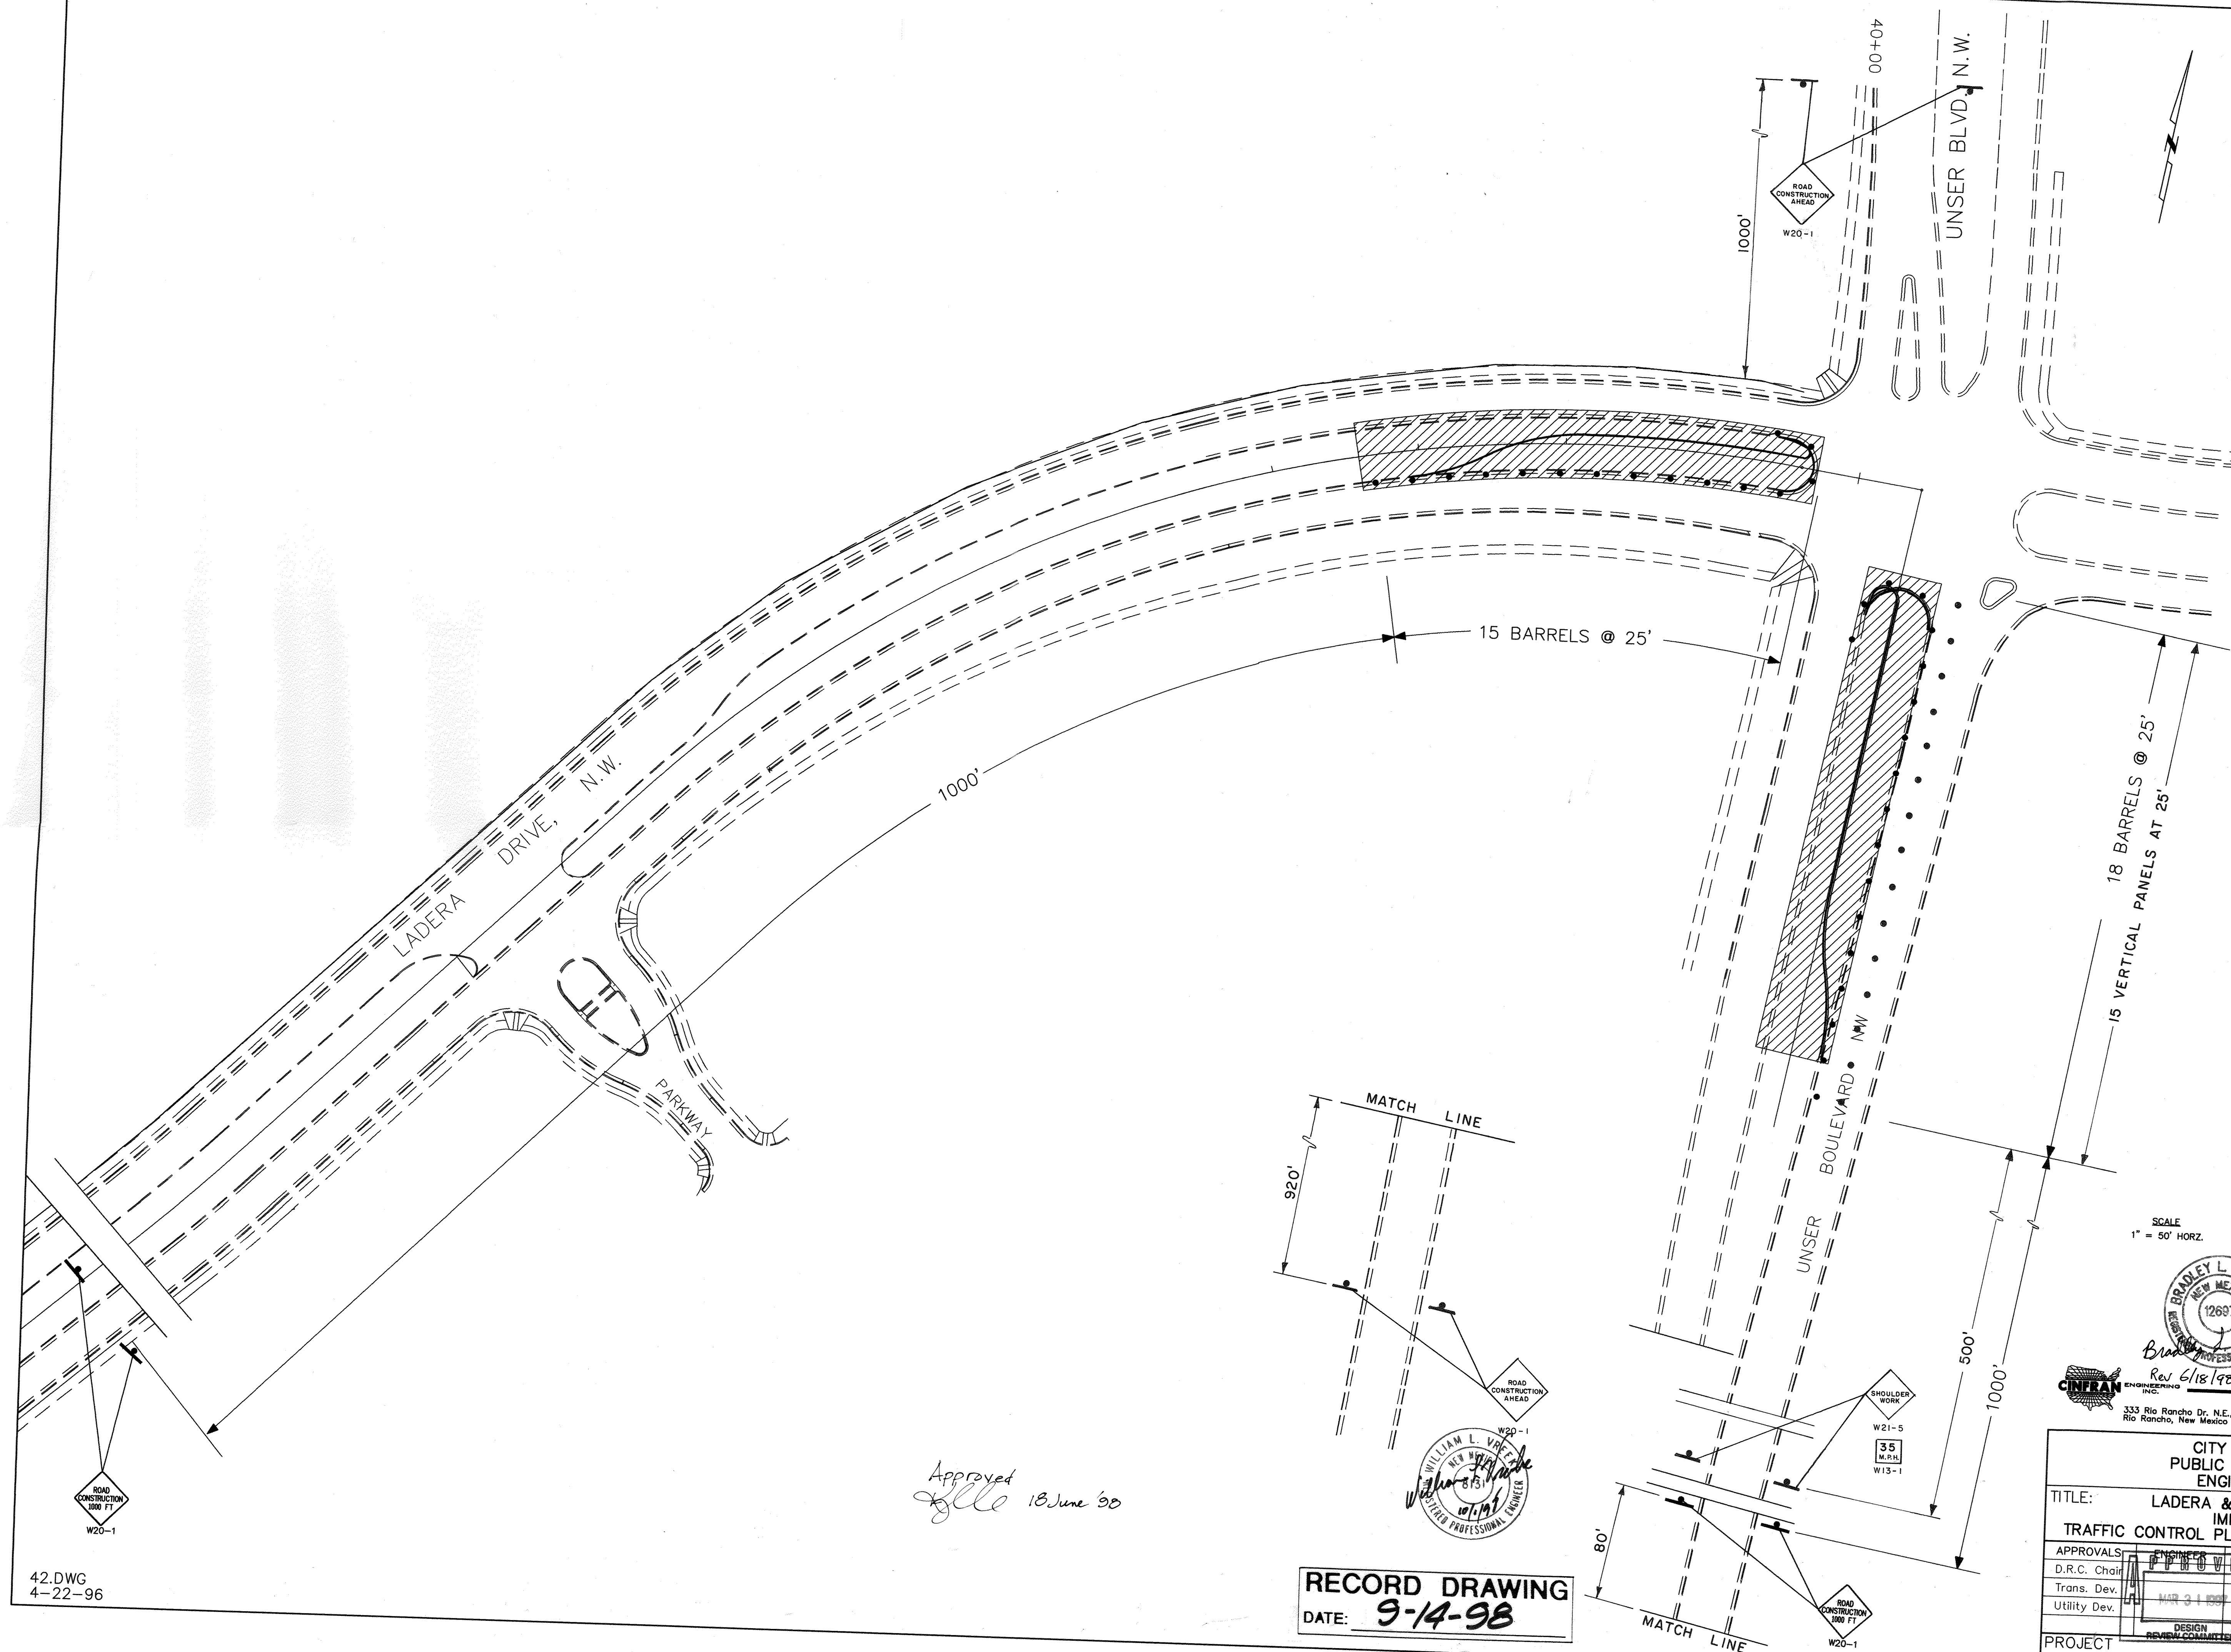

ENGINEER'S SEAL		SURVEY INFORMATION		BENCH MARKS		AS BUILT INFORMATION	
 5/23/96		FIELD NOTES		ALBUQUERQUE ACS MONUMENT "3-H10"		CONTRACTOR <i>Alb. Underground, Inc.</i>	
		NO.		BY		LOCATED NORTHEAST OF THE INTER-	
		REMARKS		DATE		SECTION OF UNSER BLVD. & LADERA	
		BY				DR. THE STATION MARK IS A STANDARD	
						ACS CAP SET FLUSH IN THE	
DESIGNED		BLB		DATE 3-19-96		FIELD LOCATION BY <i>BLH</i>	
DRAWN BY		BLB		DATE 3-19-96		DATE <i>9/98</i>	
CHECKED BY		WLB		DATE 3-19-96		DATE <i>9/98</i>	
						DRAWN CORRECTED BY <i>BLH</i>	
						MICRO-FILM INFORMATION	
						RECORDED BY	
						DATE	
						NO.	



# CONSTRUCTION TRAFFIC CONTROL GENERAL NOTES

1. CONTRACTOR MUST OBTAIN FROM CONSTRUCTION COORDINATION AN EXCAVATION/BARRICADING PERMIT BEFORE ENGAGING IN ANY CONSTRUCTION, MAINTENANCE OR REPAIR WORK IN ANY OF THE CITY OF ALBUQUERQUE'S RIGHTS-OF-WAY. EMERGENCY WORK THAT WOULD PRESERVE LIFE OR PROPERTY IS EXCLUDED WITH THE UNDERSTANDING, THAT A PERMIT SHALL BE OBTAINED WITHIN 24 TO 48 HOURS.

2. CONTRACTOR SHALL AT THE TIME OF PERMIT REQUEST, SUBMIT FOR APPROVAL BY CONSTRUCTION COORDINATION, A TRAFFIC CONTROL PLAN DETAILING ALL EXISTING TOPOGRAPHY SUCH AS LANE WIDTHS, DRIVEWAYS, AND BUSINESS/RESIDENTIAL ACCESSES. THE TRAFFIC CONTROL PLAN SHALL INCLUDE ALL PHASES OF WORK AND SCHEDULES INVOLVED IN THE CONSTRUCTION PROJECT. ANY SEPARATE PHASES OF A CONSTRUCTION PROJECT SHALL BE GIVEN AN INDIVIDUAL PERMIT EACH. BLANKET PERMITS WILL NOT BE ISSUED.

3. THESE TYPICAL TRAFFIC CONTROL PLANS DO NOT REFLECT THE EXISTING TOPOGRAPHY SUCH AS DRIVEWAYS, LANE WIDTHS, AND BUSINESS/RESIDENTIAL ACCESSES. EVERY LOCATION THAT REQUIRES CONSTRUCTION TRAFFIC CONTROL SHALL HAVE A DETAILED TRAFFIC CONTROL PLAN SHOWING ALL EXISTING TOPOGRAPHY.

4. CONSTRUCTION SHALL NOT BEGIN UNLESS A TRAFFIC CONTROL PLAN HAS BEEN APPROVED AND VERIFIED BY CONSTRUCTION COORDINATION.

5. CONSTRUCTION COORDINATION SHALL BE NOTIFIED 48 HOURS PRIOR TO ANY TRAFFIC CONTROL CHANGES NEEDED BY CONTRACTOR, THAT WERE NOT PREVIOUSLY APPROVED. THESE TRAFFIC CONTROL CHANGES SHALL BE REQUESTED IN WRITING ACCOMPANIED WITH A TRAFFIC CONTROL PLAN REFLECTING SUCH CHANGES.

6. ALL CONSTRUCTION TRAFFIC CONTROL DEVICES SHALL COMPLY TO THE MANUAL ON UNIFORM TRAFFIC CONTROL DEVICES (MUTCD), LATEST EDITION. IT IS THE RESPONSIBILITY OF THE CONTRACTOR TO INSTALL, SERVICE AND MAINTAIN ALL TRAFFIC CONTROL DEVICES. TRAFFIC CONTROL DEVICES SHALL NOT BE REMOVED OR ALTERED IN ANY WAY WITHOUT THE APPROVAL OF CONSTRUCTION COORDINATION, PER SECTION 6A-4 OF THE MUTCD, LATEST EDITION.

7. THE CONSTRUCTION TRAFFIC CONTROL INITIAL SET-UP SHALL BE BY AN AMERICAN TRAFFIC SAFETY SERVICES ASSOCIATION (ATSSA) CERTIFIED WORKSITE TRAFFIC SUPERVISOR. THE MAINTENANCE AND SERVICING SHALL ALSO BE DONE BY AN ATSSA CERTIFIED WORKSITE TRAFFIC SUPERVISOR OR EQUIVALENT.

8. CONTRACTOR IS RESPONSIBLE TO MAINTAIN AND SERVICE ALL TRAFFIC CONTROL DEVICES 24 HOURS A DAY, 7 DAYS A WEEK THROUGHOUT LENGTH OF PROJECT. CONTRACTOR IS RESPONSIBLE THAT ALL TRAFFIC CONTROL DEVICES COMPLY WITH THE MUTCD, LATEST EDITION.

9. ALL ADVANCE WARNING SIGNS SHALL BE DOUBLE INDICATED WHENEVER THERE ARE MULTI-LANE TRAFFIC IN ANY ONE GIVEN DIRECTION AND THERE IS SUFFICIENT MEDIAN SPACE.

10. ALL BARRICADES IN ALL TAPERS AND TANGENTS SHALL BE PLACED APART, A DISTANCE MEASURED IN FEET, EQUAL TO THAT OF THE POSTED SPEED LIMIT. NO EXCEPTIONS UNLESS APPROVED BY CONSTRUCTION COORDINATION PER MUTCD SECTION 6A-4.

11. CONTRACTOR SHALL NOT BEGIN WORK BEFORE 8:30 A.M. OR END WORK AFTER 4:00 P.M. WITHOUT THE APPROVAL OF CONSTRUCTION COORDINATION.

12. CONTRACTOR IS RESPONSIBLE TO PROVIDE CONSTRUCTION COORDINATION, A WEEKLY LOG OF DAILY INSPECTIONS OF BARRICADE AND MAINTENANCE SCHEDULES ON PROJECTS THAT ARE OVER ONE WEEK DURATION.

13. EQUIPMENT OR MATERIALS SHALL NOT BE STORED WITHIN 15 FEET OF A TRAVELLED TRAFFIC LANE DURING NON-WORKING HOURS WITHOUT THE APPROVAL OF CONSTRUCTION COORDINATION.

14. CONTRACTOR SHALL PROVIDE AND MAINTAIN A SAFE AND ADEQUATE MEANS OF CHANNELIZING PEDESTRIAN TRAFFIC AROUND AND THROUGH THE CONSTRUCTION AREA.

15. CONTRACTOR IS RESPONSIBLE FOR OBLITERATION OF ANY CONFLICTING STRIPING AND RESPONSIBLE FOR ALL TEMPORARY STRIPING.

16. CONTRACTOR SHALL MAINTAIN ACCESS TO ALL FACILITIES, BUSINESSES AND/OR RESIDENTS AT ALL TIMES.

17. CONTRACTOR SHALL PROVIDE ACCESS SIGNS FOR BUSINESSES LOCATED WITHIN THE CONSTRUCTION AREA UNDER THE SUPERVISION OF CONSTRUCTION COORDINATION. EACH ACCESS SIGN SHALL HAVE 5 INCH, WHITE OPAQUE LETTERING ON BLUE REFLECTORIZED BACKGROUND. ACCESS SIGNS SHALL BE CONSIDERED INCIDENTAL TO THE BID AND NOT PART OF THE CONTRACT UNLESS OTHERWISE STATED. NO MORE THAN 3 BUSINESSES SHALL BE LISTED ON A ACCESS SIGN. SHOPPING CENTERS AND MALLS SHALL BE LISTED AS SUCH.

18. ALL ADVANCE WARNING SIGNS SHALL MEET THE MINIMUM REFLECTIVE INTENSITY REQUIREMENTS SET FORTH BY THE CITY OF ALBUQUERQUE. CONSTRUCTION COORDINATION SHALL DETERMINE ALL REQUIREMENTS AND APPROVE OR DISAPPROVE ANY ADVANCE WARNING SIGN PER SECTION 6A-4 OF THE MUTCD, LATEST EDITION.

19. 24 HOURS PRIOR TO OCCUPANCY OR CLOSING OF A RIGHT-OF-WAY, CONTRACTOR SHALL NOTIFY: POLICE, FIRE DEPARTMENT, SCHOOLS, HOSPITALS, TRANSIT AUTHORITY, BUSINESSES AND/OR RESIDENTS THAT WILL BE AFFECTED BY THE CONSTRUCTION.

20. ANY FIELD ADJUSTMENTS SHALL BE APPROVED BY CONSTRUCTION COORDINATION.

21. EXCAVATIONS SHALL BE PLATED, TEMPORARILY PATCHED OR RESURFACED PRIOR TO OPENING OF TRAFFIC. A MINIMUM OF 11 FEET SHALL BE PROVIDED FOR TRAFFIC IN ANY GIVEN DIRECTION. CONTRACTOR IS RESPONSIBLE FOR ANY WORK INVOLVED IN SATISFYING THESE REQUIREMENTS.

22. CONTRACTOR SHALL AT ALL TIMES COMPLY WITH THE FOLLOWING:


- STANDARDS AND REQUIREMENTS SET FORTH IN THE MANUAL ON UNIFORM TRAFFIC CONTROL DEVICES, LATEST EDITION.
- THE CITY OF ALBUQUERQUE TRAFFIC CODE, LATEST EDITION.
- SECTION 19 OF THE CITY OF ALBUQUERQUE'S STANDARD SPECIFICATIONS FOR PUBLIC WORK CONSTRUCTION, AS WELL AS OTHER SECTIONS.

23. FAILURE TO COMPLY WITH ANY OF THE ABOVE MENTIONED, WILL BE ADEQUATE CAUSE TO CEASE ALL WORK ON ANY CONSTRUCTION PROJECT. WORK WILL NOT RESUME UNTIL ALL REQUIREMENTS ARE ADDRESSED AND APPROVED BY CONSTRUCTION COORDINATION.


24. ALL TRAFFIC CONTROL DEVICES SHALL BE KEPT IN NEW-CLEAN CONDITION. WASHING OF EQUIPMENT IS INCIDENTAL TO ITS PLACEMENT AND MAINTENANCE.

25. TRAFFIC CONTROL STANDARDS APPLY ONLY WHERE THE CONSTRUCTION TRAFFIC CONTROL PLANS ARE NOT SPECIFIC.


## PROJECT CONSTRUCTION TRAFFIC CONTROL GENERAL NOTES

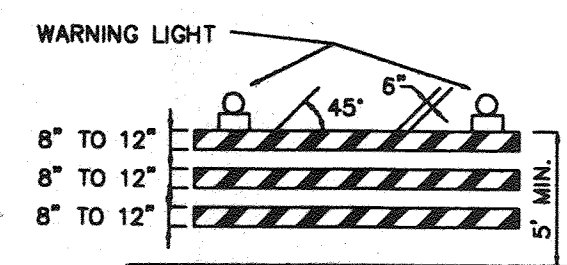


TYPE III BARRICADE

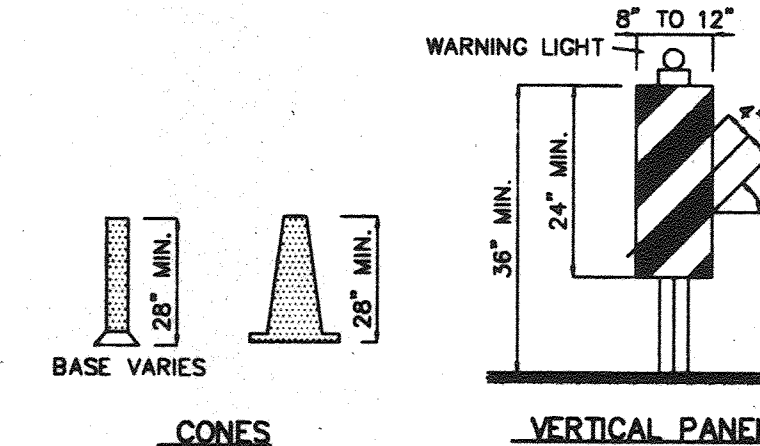


TYPE II BARRICADE

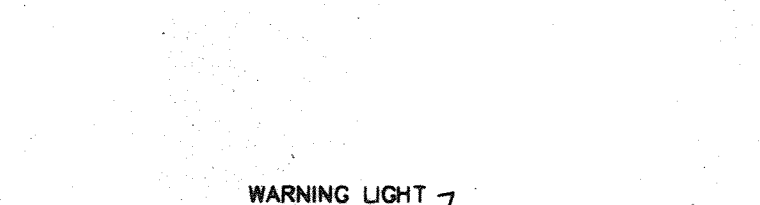


TYPE I BARRICADE

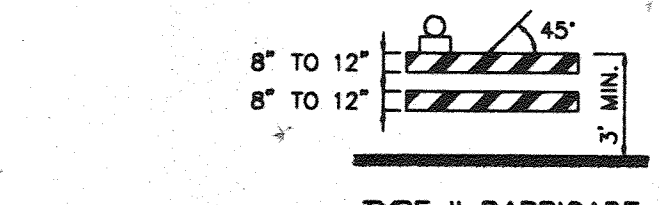


COLLAPSIBLE

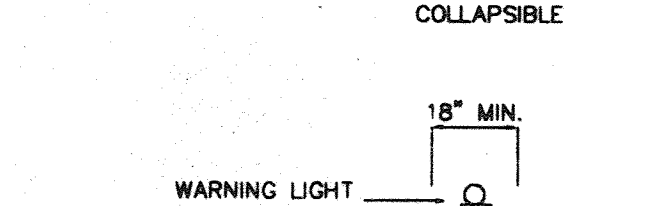


BARREL

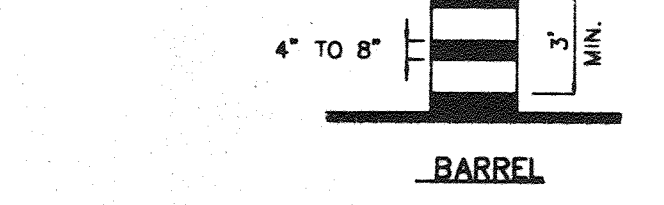


COLLAPSIBLE

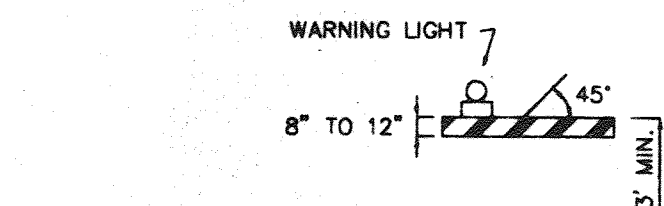


COLLAPSIBLE

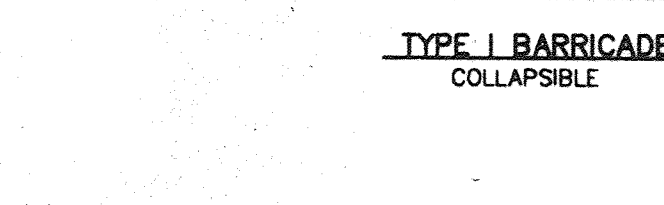


COLLAPSIBLE

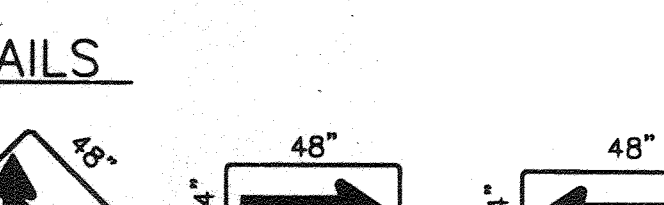


COLLAPSIBLE

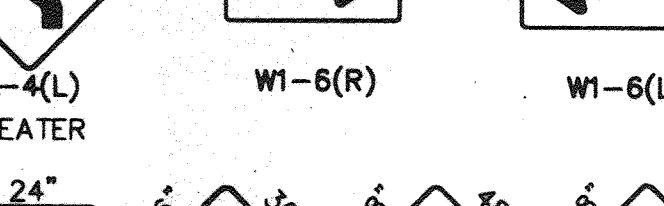


COLLAPSIBLE

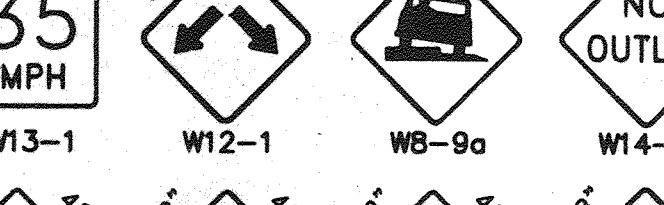


COLLAPSIBLE

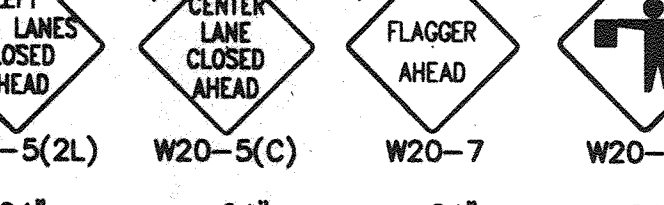


COLLAPSIBLE

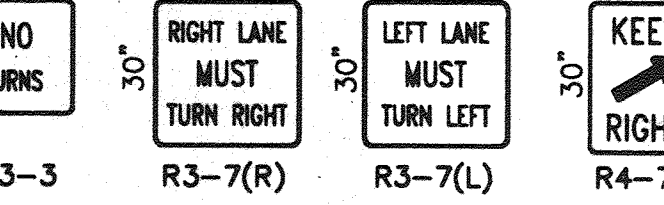

COLLAPSIBLE

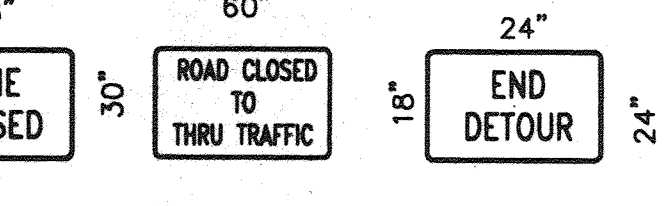


COLLAPSIBLE

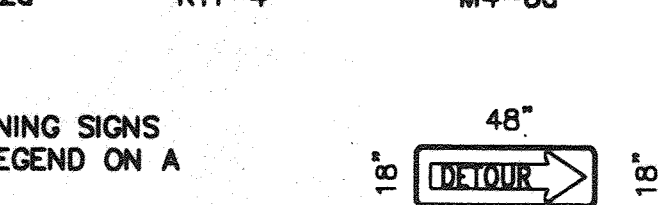

COLLAPSIBLE



COLLAPSIBLE

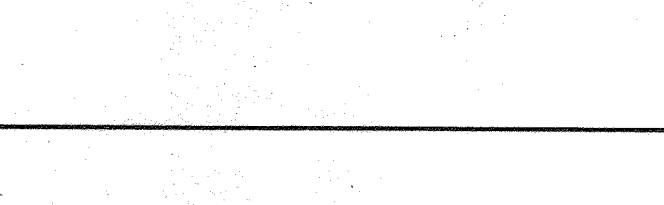

COLLAPSIBLE

## LEGEND

WORK AREA

BARRICADE - TYPE I, TYPE II, OR BARREL

BARRICADE - TYPE III

VERTICAL PANEL

WARNING SIGN

DISTANCE BETWEEN SIGNS - A DISTANCE MEASURED IN FEET EQUAL TO A VALUE OF TEN TIMES THE SPEED LIMIT OF THE STREET

FLAGMAN POSITION

SPACING BETWEEN BARRICADES - A DISTANCE MEASURED IN FEET EQUAL TO THE SPEED LIMIT OF THE STREET

TAPER LENGTH - SEE CHART BELOW

THE TANGENT LENGTH IS EQUAL TO THE TAPER LENGTH FOR A GIVEN STREET.

## TAPER REQUIREMENTS

SPEED LIMIT (MPH)	TAPER LENGTH (FEET)			MINIMUM NUMBER OF DEVICES FOR TAPER	MAXIMUM DEVICE SPACING IN FEET	
	10' LANE	11' LANE	12' LANE		ALONG TAPER	AFTER TAPER
20	70	75	80	5	20	20
25	105	115	125	6	25	25
30	150	165	180	7	30	30
35	205	225	245	8	35	35
40	270	295	320	9	40	40
45	450	495	540	13	45	45
50	500	550	600	13	50	50
55	550	605	660	13	55	55

## RECOMMENDED SIGN SPACING FOR ADVANCE WARNING SIGN SERIES

SPEED MILES PER HOUR	MINIMUM DISTANCE IN FEET	
	BETWEEN SIGNS	FROM LAST SIGN TO TAPER
0-20	10 X SPEED LIMIT	10 X SPEED LIMIT
25-30	10 X SPEED LIMIT	10 X SPEED LIMIT
30-35	10 X SPEED LIMIT	10 X SPEED LIMIT
40-45	10 X SPEED LIMIT	10 X SPEED LIMIT
50-60	10 X SPEED LIMIT	10 X SPEED LIMIT


## TAPER CRITERIA

TYPE OF TAPER	TAPER LENGTH
UPSTREAM TAPER:	
MERGING TAPER	L MINIMUM
SHIFTING TAPER	1/2 L MINIMUM
SHOULDER TAPER	1/2 L MINIMUM
TWO-WAY TRAFFIC TAPER	100 FEET MAXIMUM
DOWNSTREAM TAPERS	100 FEET PER LANE

## TAPER LENGTH COMPUTATION

SPEED LIMIT	
40 MPH OR LESS	$L = \frac{WS^2}{60}$
45 MPH OR GREATER	$L = W \times S$
L = TAPER LENGTH	
W = WIDTH OF OFFSET IN FEET	
S = POSTED SPEED OR OFF-PEAK 85-PERCENTILE SPEED IN MPH	

## SIGN FACE DETAILS

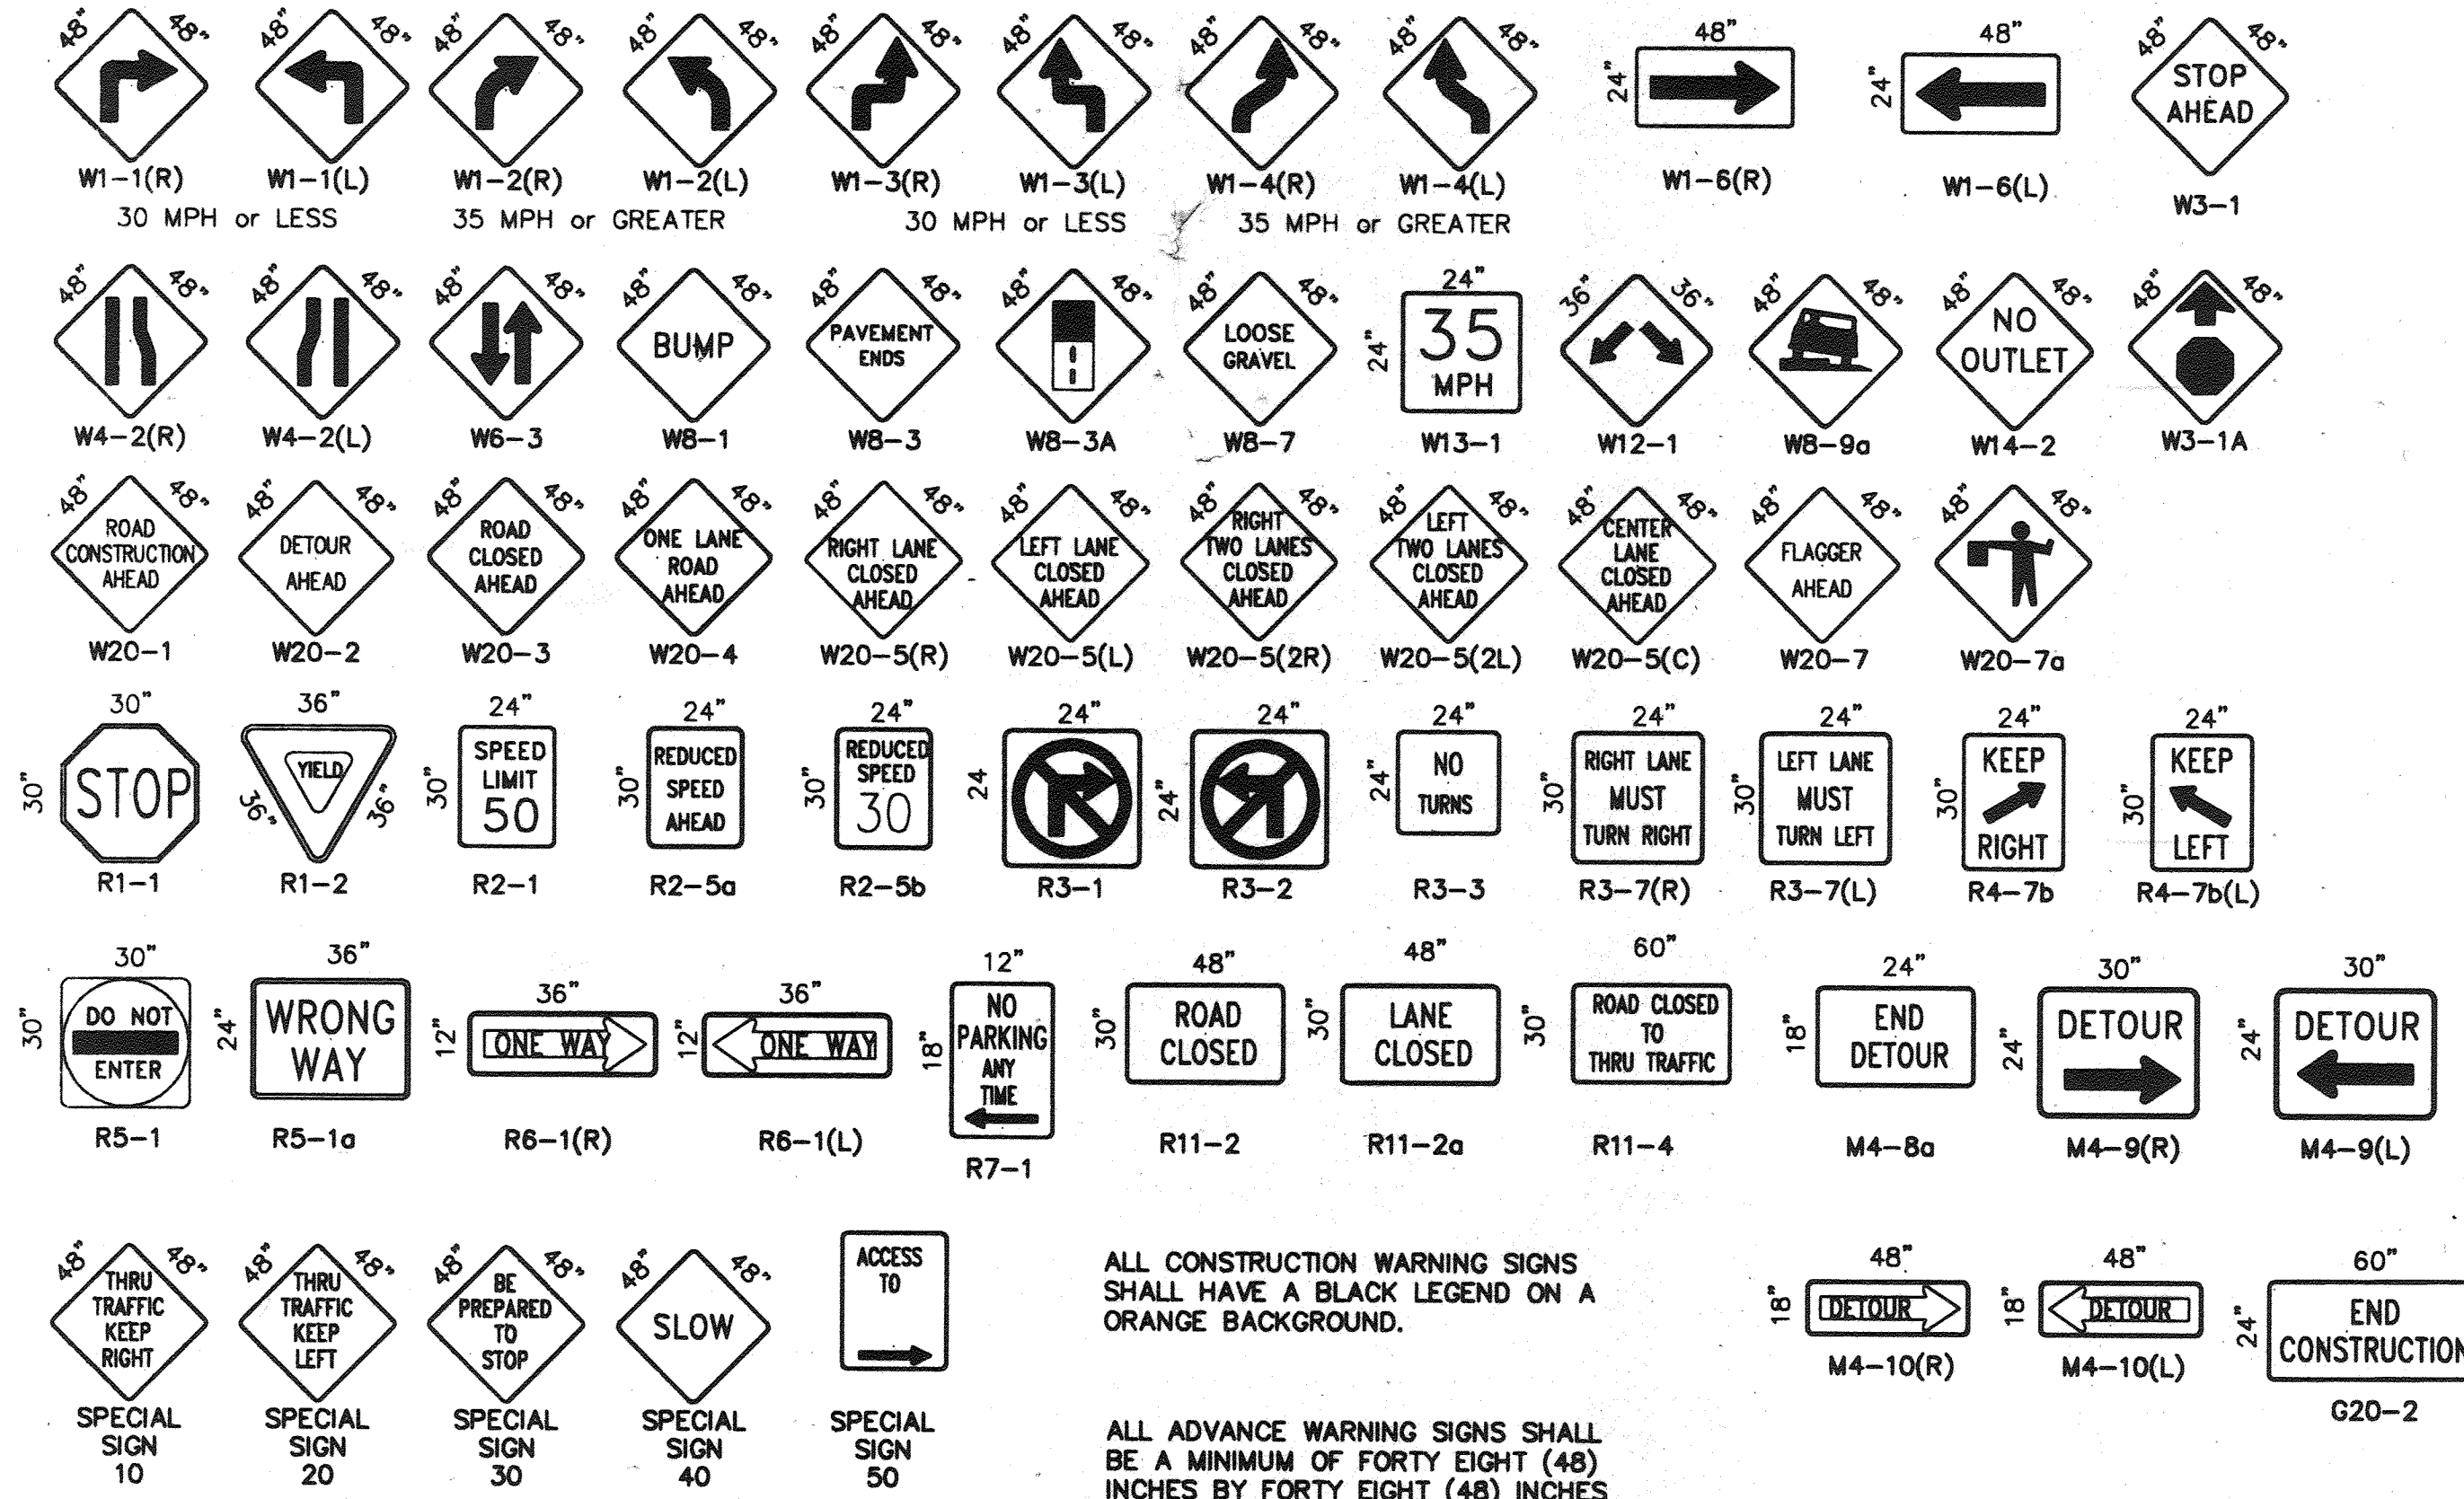

ALL CONSTRUCTION WARNING SIGNS SHALL HAVE A BLACK LEGEND ON A ORANGE BACKGROUND.

ALL ADVANCE WARNING SIGNS SHALL BE A MINIMUM OF FORTY EIGHT (48) INCHES BY FORTY EIGHT (48) INCHES IN SIZE AND SHALL HAVE ONE WARNING LIGHT.

## RECORD DRAWING

DATE: 9-14-98

## CITY OF ALBUQUERQUE PUBLIC WORKS DEPARTMENT ENGINEERING GROUP

TITLE:					
SIGNING AND CONSTRUCTION TRAFFIC CONTROL STANDARDS					
APPROVALS	ENGINEER	DATE	APPROVALS	ENGINEER	DATE
DRC CHAIRMAN			WATER		
TRANSPORTATION			WASTE WATER		
HYDROLOGY					
PROJECT NO. 5548.81		MAP NO. H-9-Z		SHEET 15 OF 16	



