
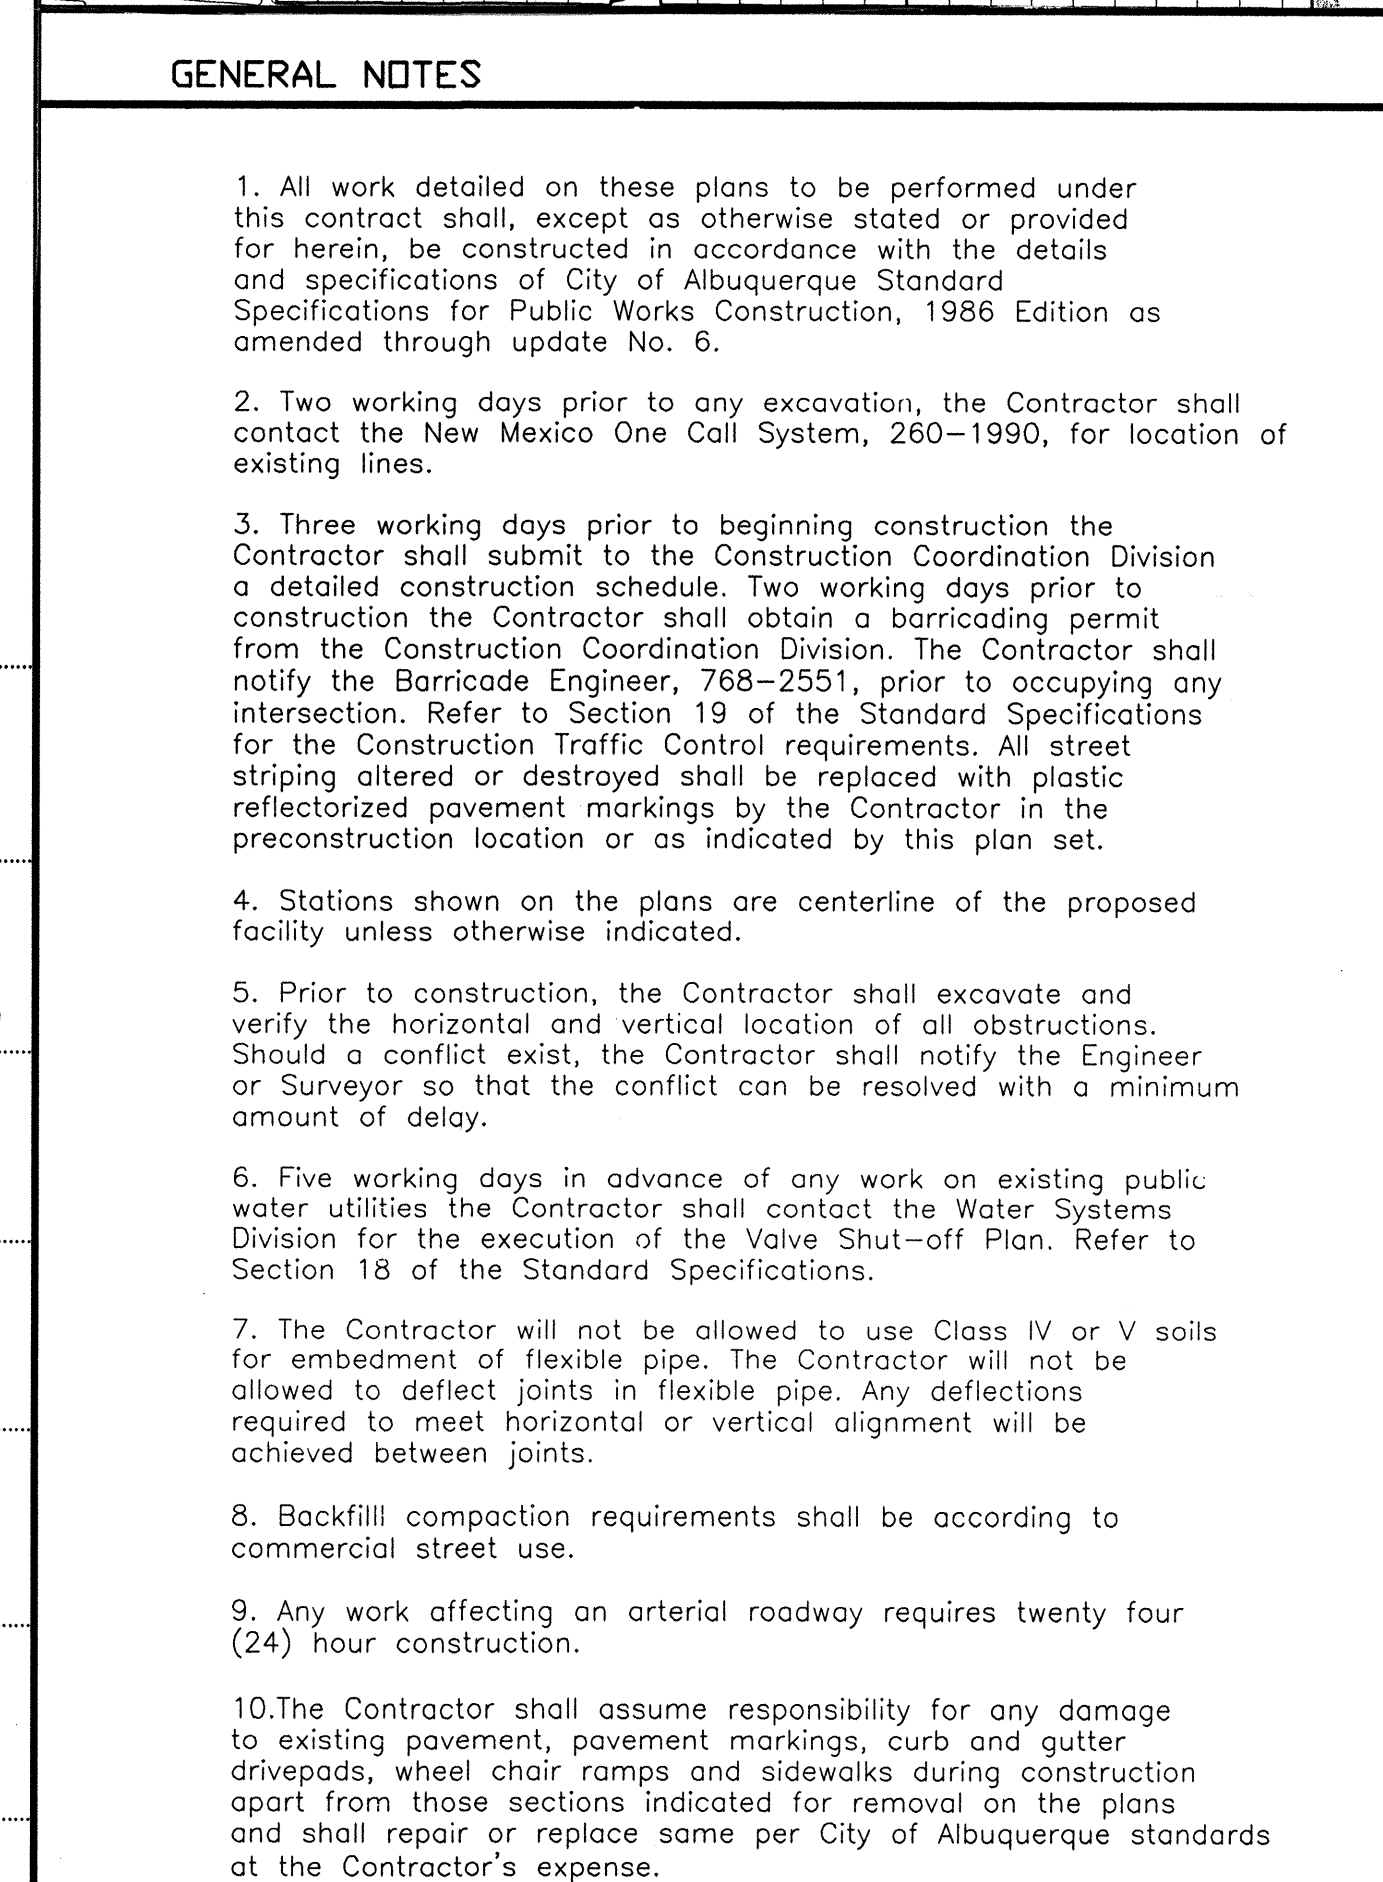


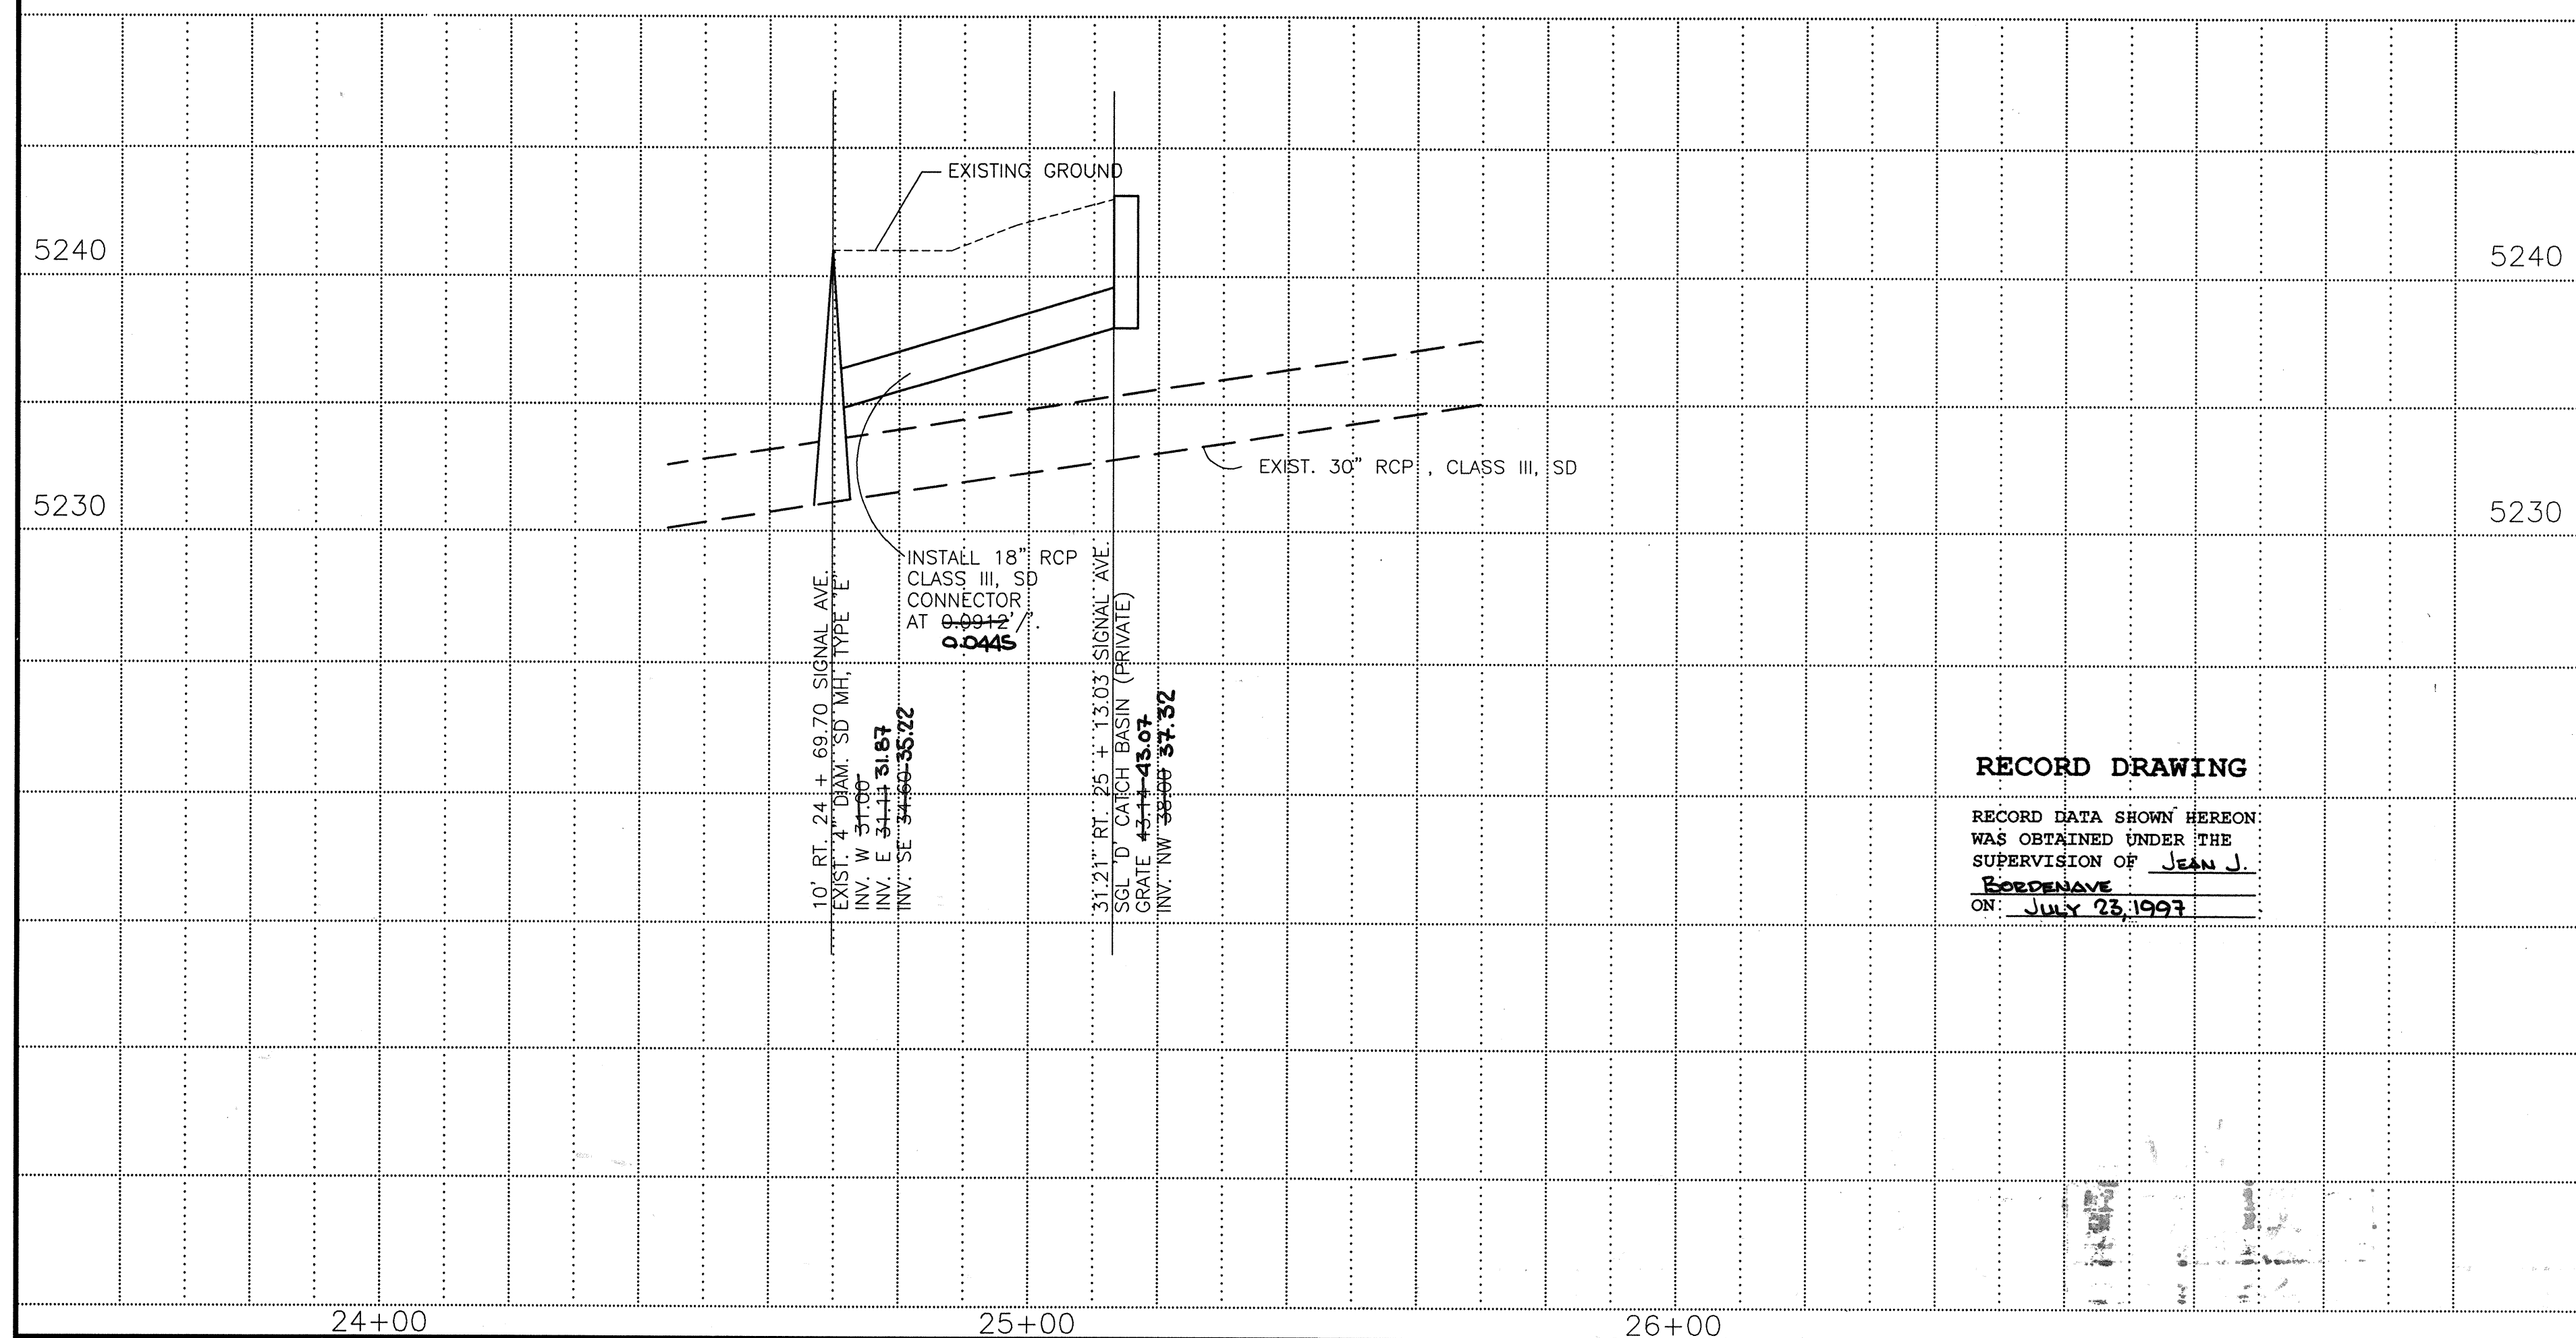

1	2	3	4	5	6	7	8	9	10	11	12	13	14	15
2	6	-	5	5	2	.	8	1			0	1	9	7