
SCANNED BY PLANNING

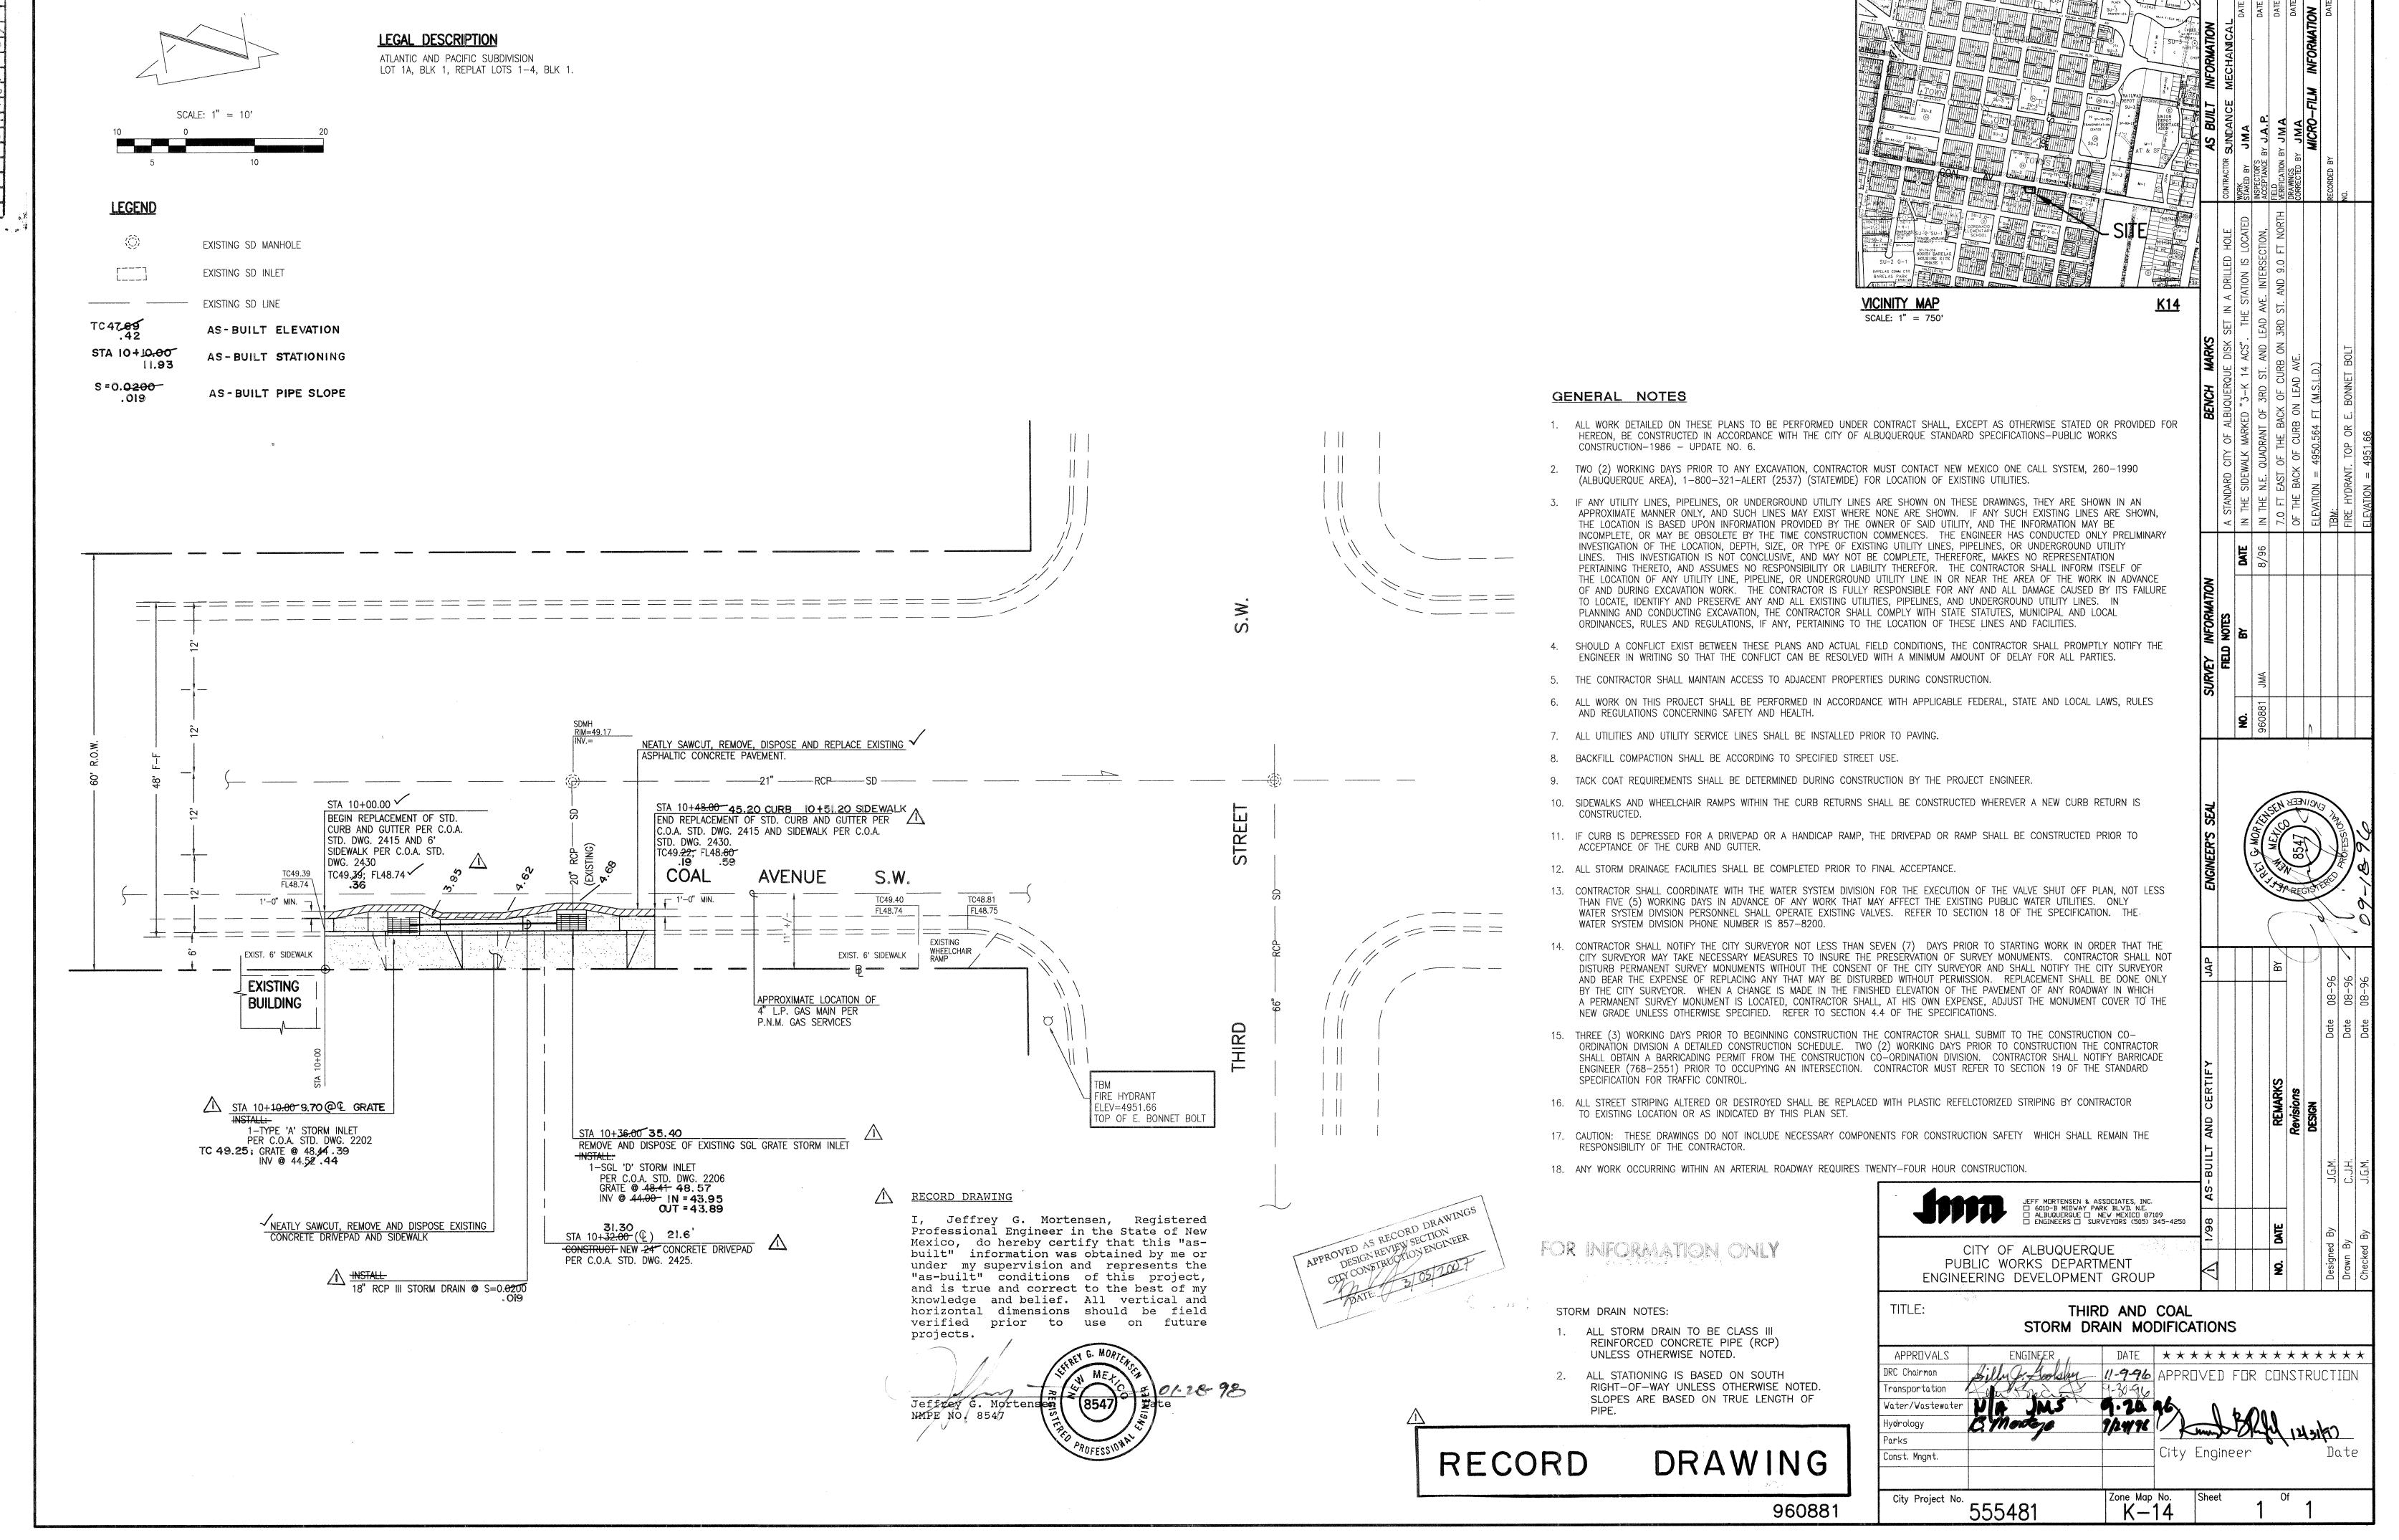

C:\DATA\ACADDWG\960881\960881 Wed Sep 18 10:57:55 1996 -TNT