


CITY OF ALBUQUERQUE, NEW MEXICO

CONSTRUCTION PLANS
FOR

VACUUM COLLECTION SYSTEM

FOR ELOISE PLACE

CITY PROJECT NO. 5565.81

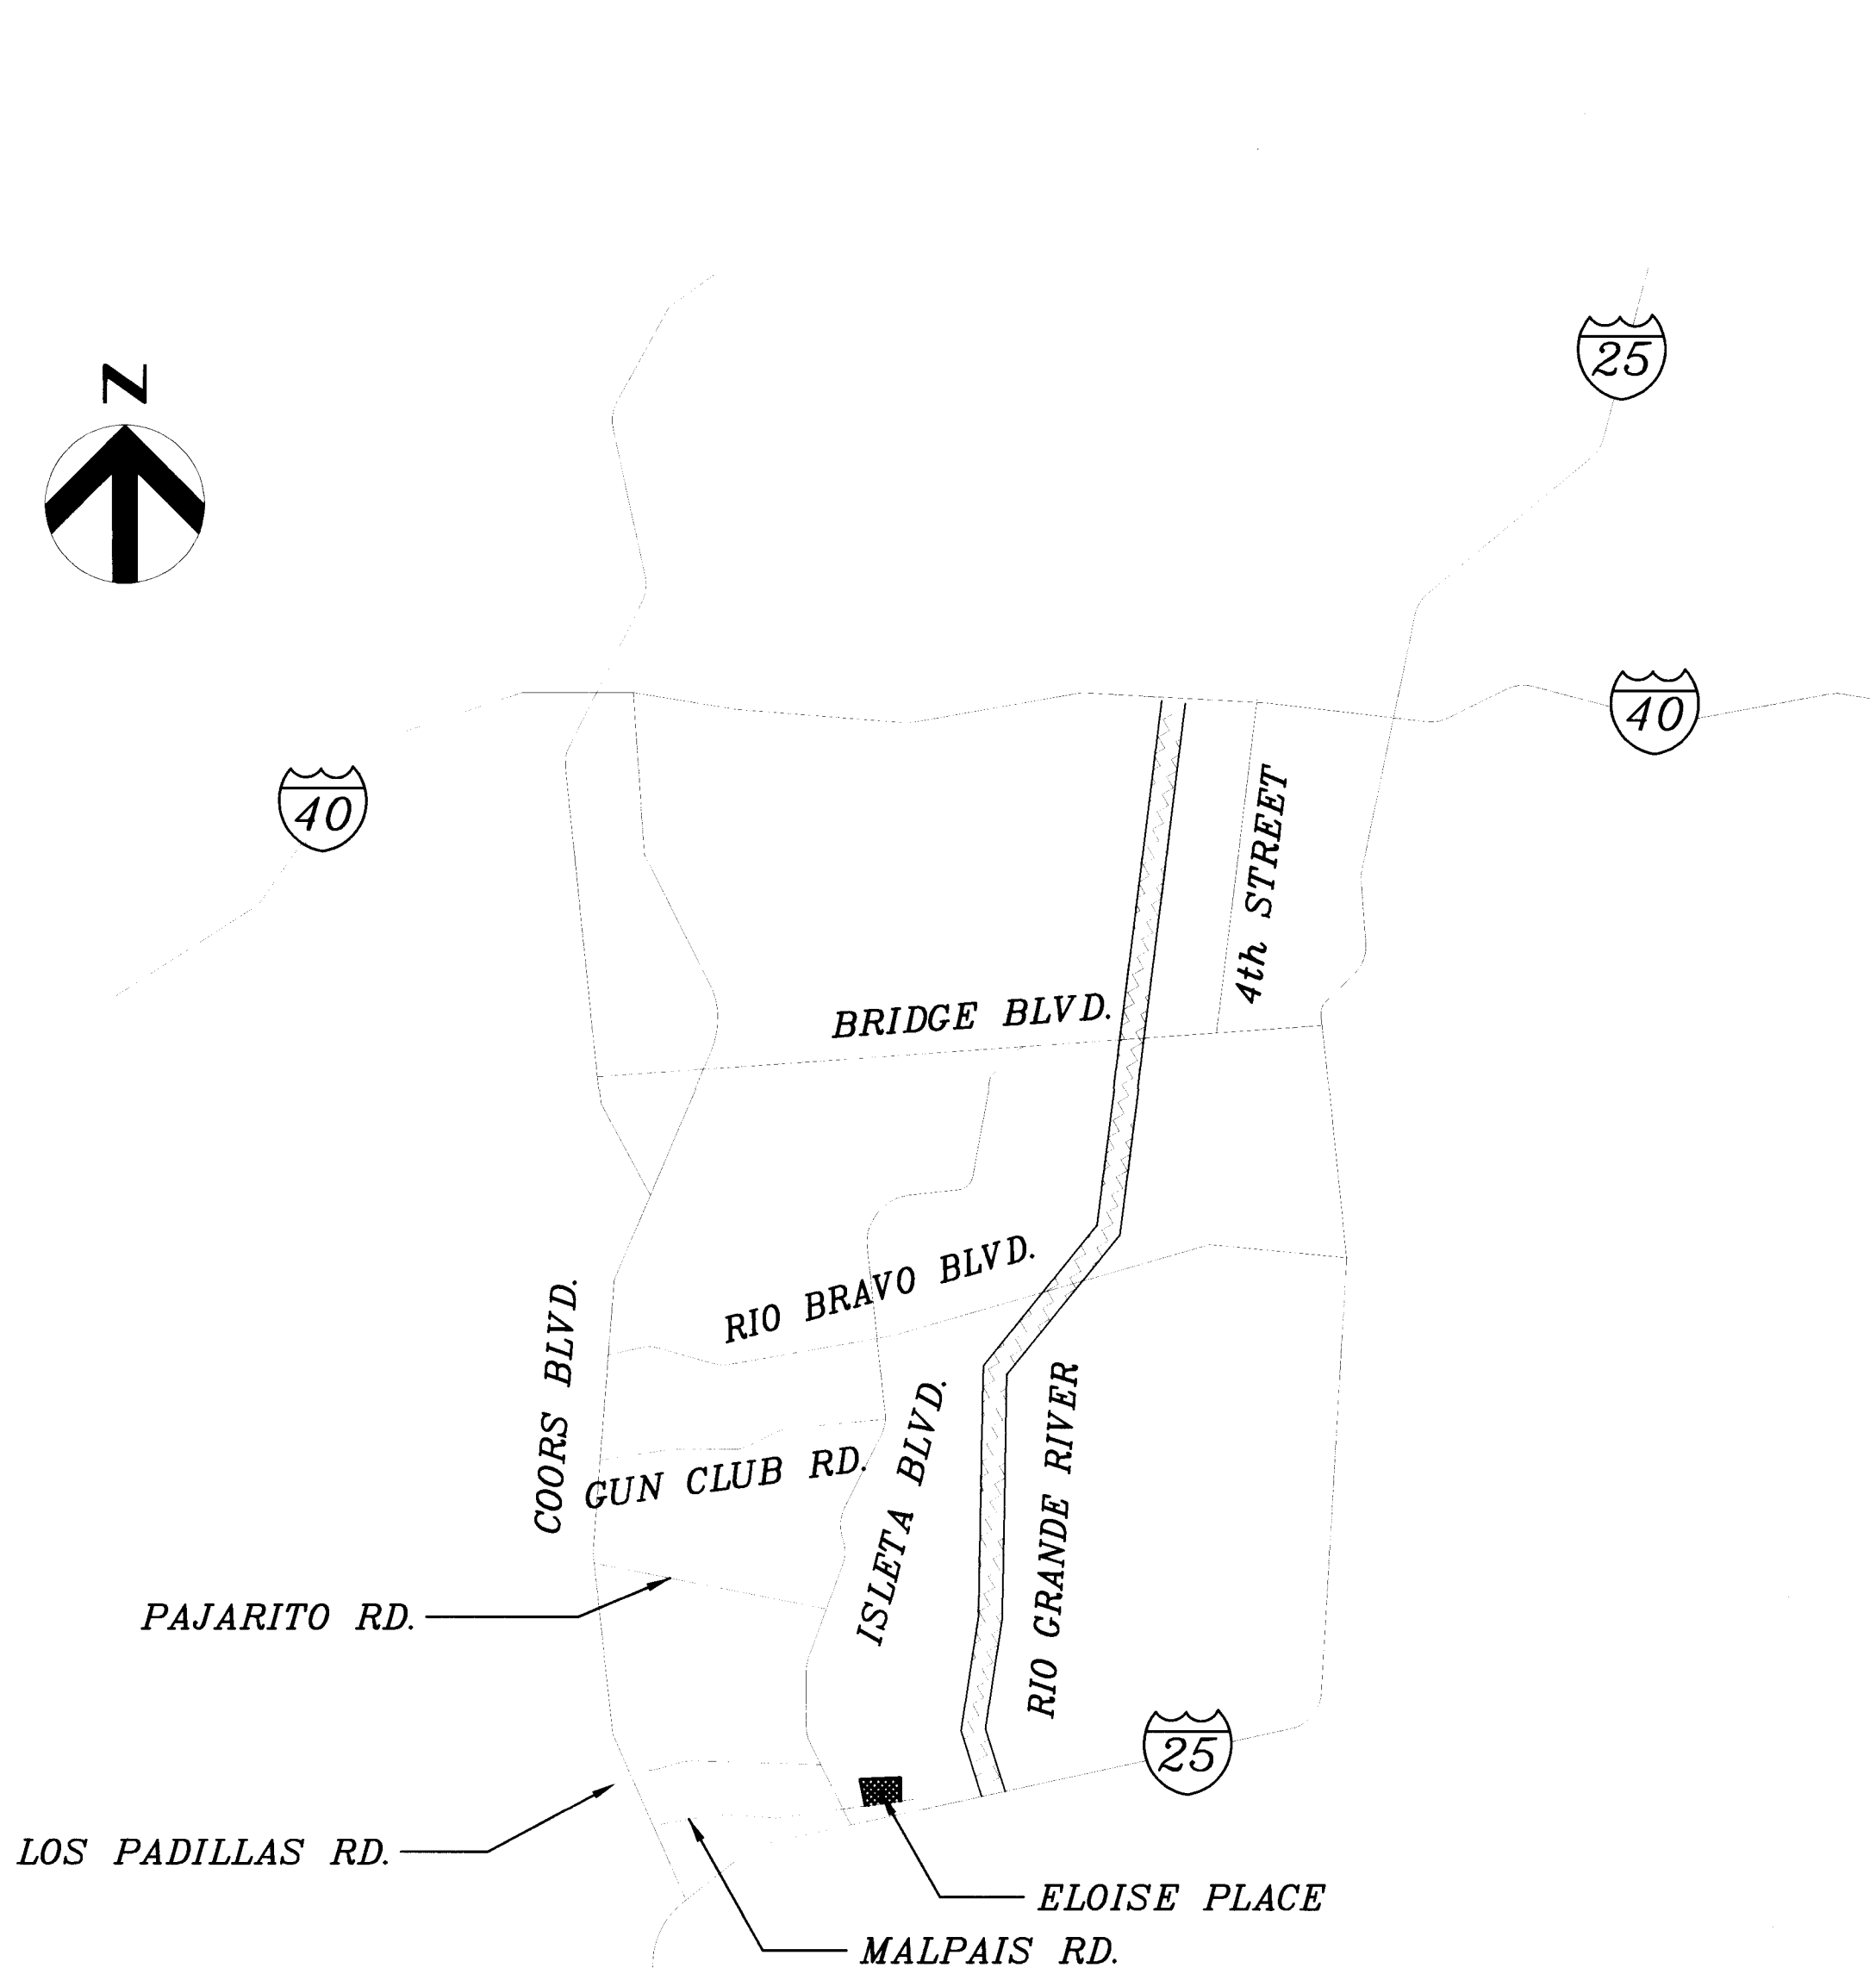

HDR
HDR Engineering, Inc.
6200 Uptown Boulevard N.E., Suite 220
Albuquerque, NM 87110-4142
(505) 884-6065; FAX: (505) 884-5969


APPROVAL OF AS BUILT DRAWINGS
CHIEF CONSTRUCTION ENGINEER
[Signature]
DATE 5-17-97

"AS RECORDED"
From Information
provided by the
contractors
By *[Signature]* Date 1/29/97

REV.	SHEETS	CITY ENGINEER	DATE	USER DEPARTMENT	DATE	USER DEPARTMENT	DATE
ENGINEER'S STAMP & SIGNATURE		APPROVALS		ENGINEER		DATE	
		DRC Chairman		<i>Billy G. [Signature]</i>		12/10/96	
		Transportation		See SH			
		Water/Wastewater		# 2			
		Hydrology					
		Parks					
Construction Management							
City Project No.		5565.81		APPROVED FOR CONSTRUCTION			
				County Engineer		DATE	
				<i>[Signature]</i>		3/4/97	
				City Engineer		DATE	
				Sheet 1		Of 5	


SCANNED BY
BY LASON

2 3 4 5 6 7 8 9 10 11 12 13 14
26-5565-181 01 97

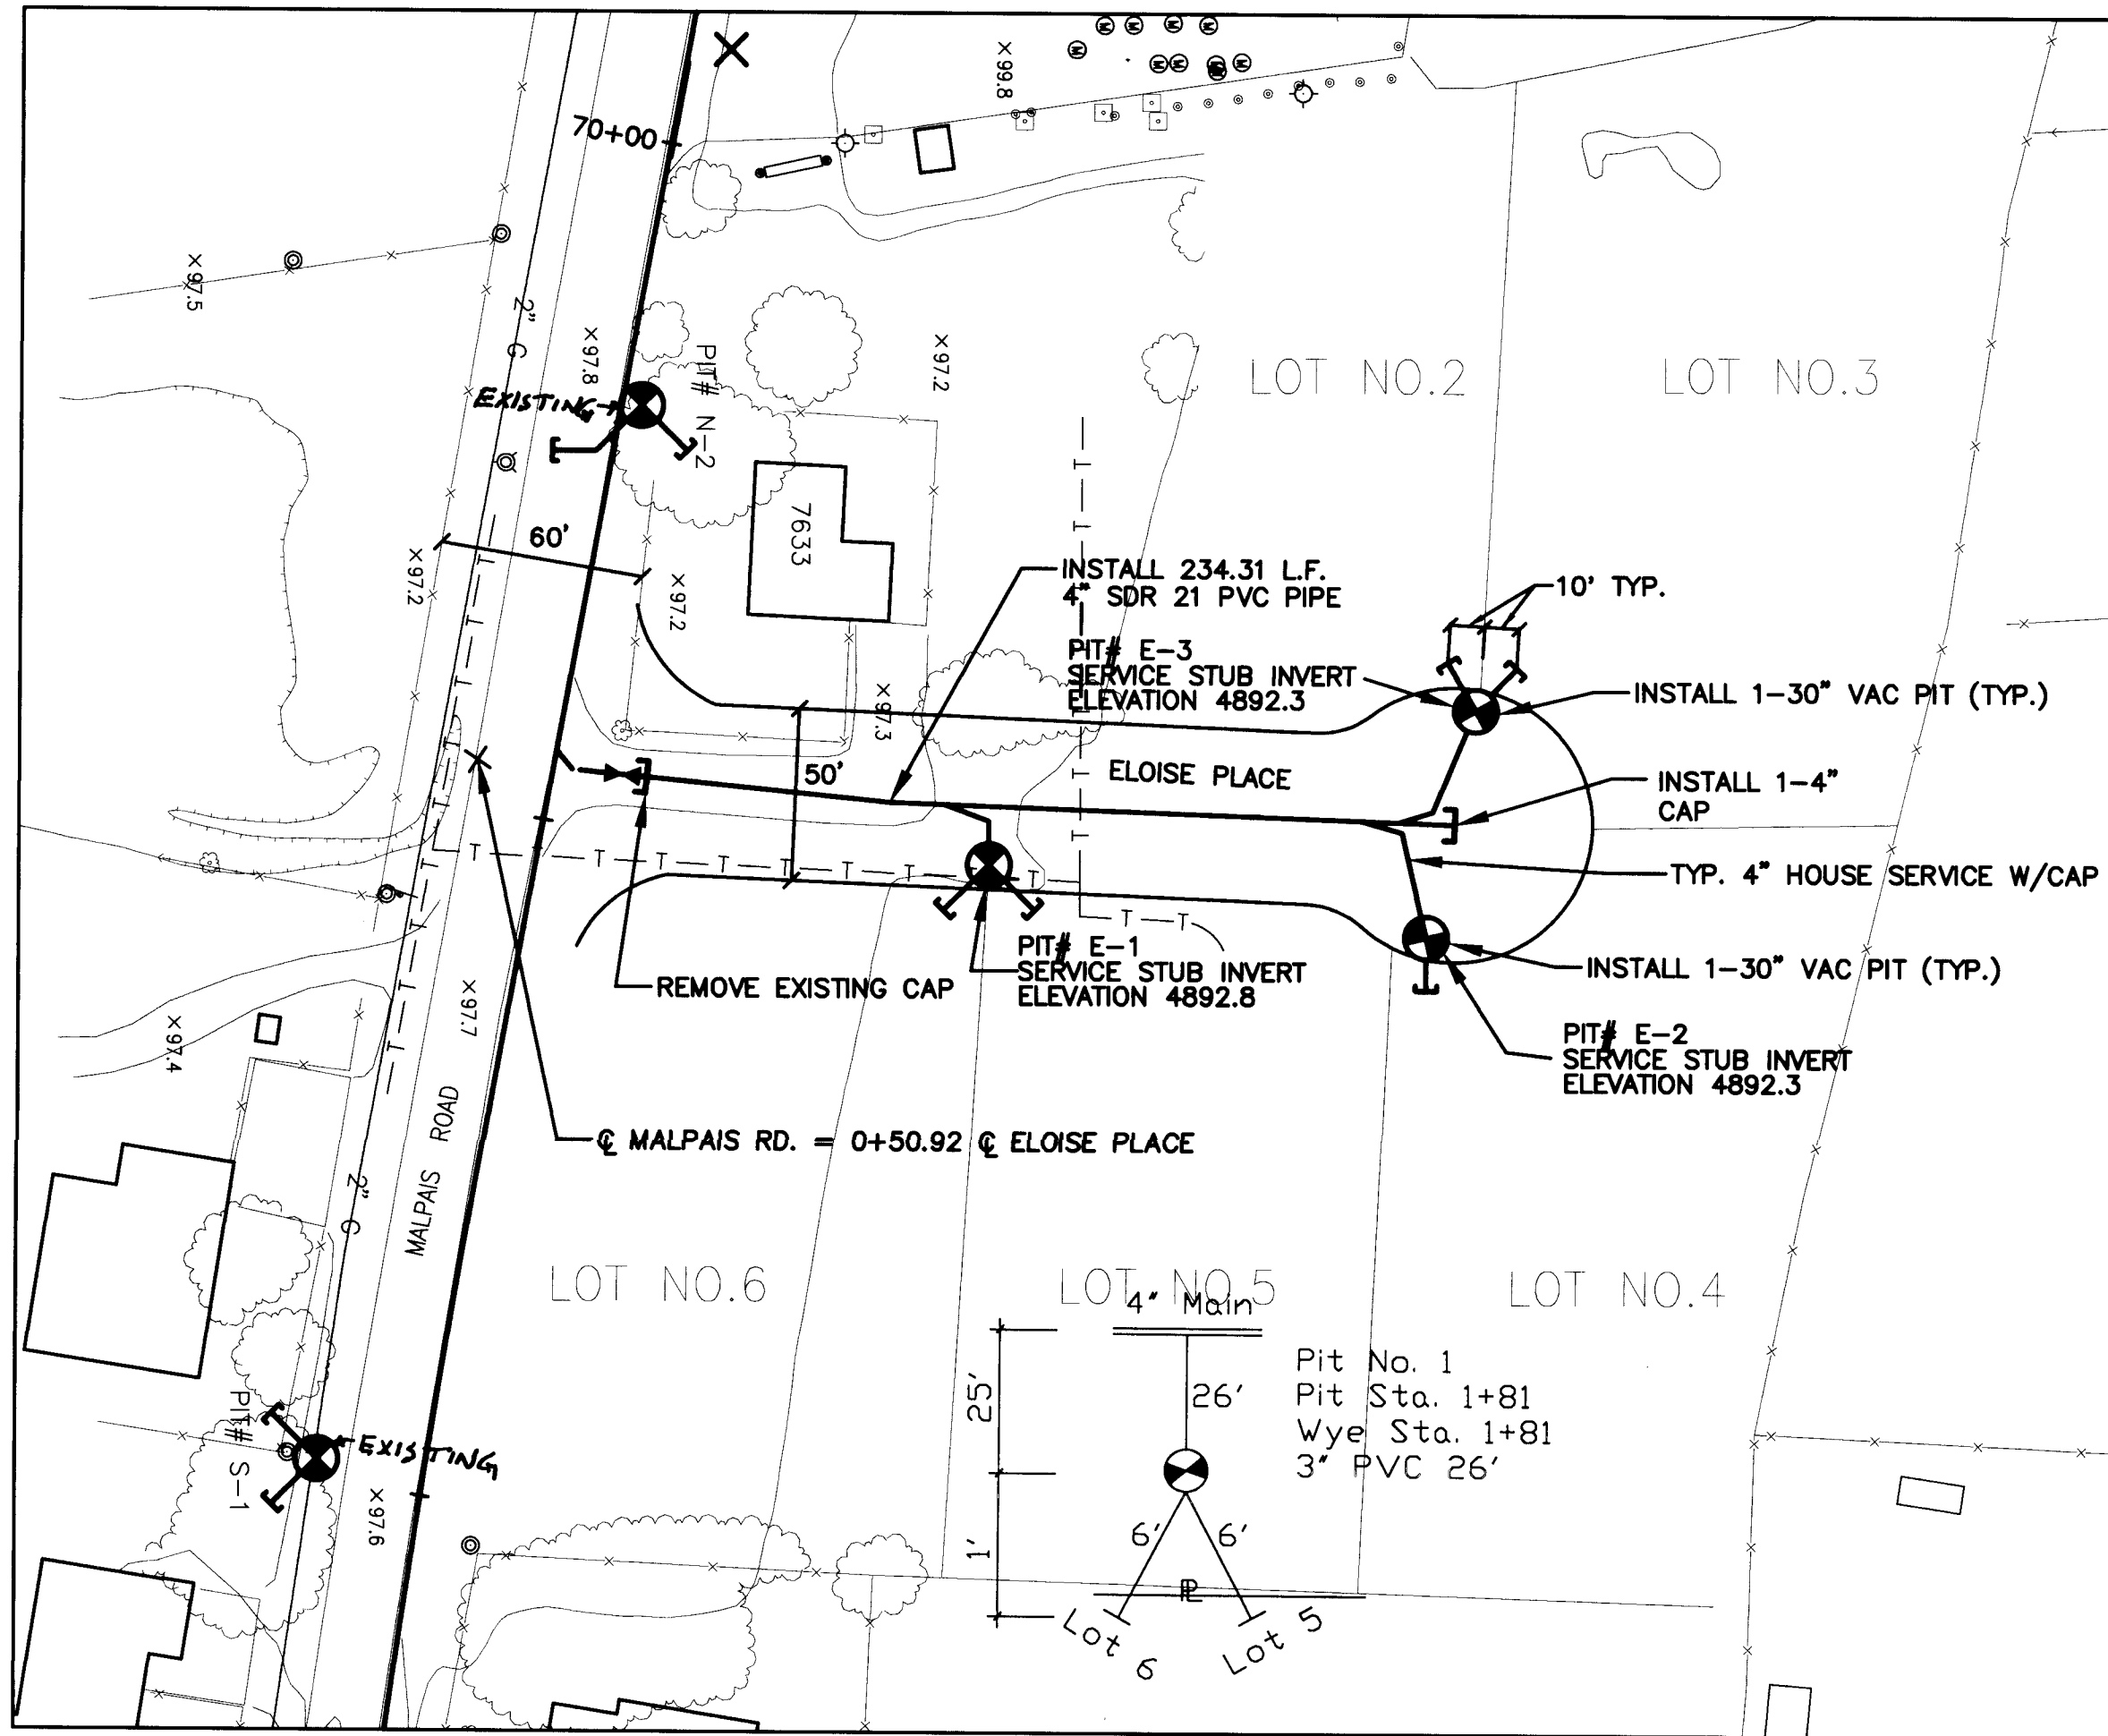


GENERAL NOTES:

- REFERENCE LOS PADILLAS PHASE IIA CITY PROJECT NO. 4686.90.
- ALL WORK DETAILED ON THESE PLANS TO BE PERFORMED UNDER THIS CONTRACT SHALL, EXCEPT AS OTHERWISE STATED OR PROVIDED FOR HEREON, BE CONSTRUCTED IN ACCORDANCE WITH THE CITY OF ALBUQUERQUE STANDARD SPECIFICATIONS FOR PUBLIC WORKS CONSTRUCTION, 1986 AS AMENDED THROUGH UPDATE #6 (REFERRED TO HEREAFTER AS THE STANDARD SPECIFICATIONS), THE LATEST VERSION OF THE BERNALILLO COUNTY PUBLIC WORKS STANDARDS, OR AS MODIFIED BY THE PROJECT SPECIFICATIONS TITLED LOS PADILLAS VACUUM COLLECTION SYSTEM, WHICHEVER IS MORE STRINGENT.
- TWO (2) WORKING DAYS PRIOR TO ANY EXCAVATION, CONTRACTOR MUST CONTACT N.M. ONE-CALL SYSTEM, 260-1990, FOR LOCATION OF EXISTING UTILITIES.
- THE CONTRACTOR SHALL EXERCISE CARE TO AVOID DISTURBING EXISTING UNDERGROUND UTILITIES. IT SHALL BE HIS RESPONSIBILITY TO COORDINATE WITH THE UTILITY COMPANIES IN ORDER TO PREVENT ANY SERVICE DISRUPTION.
- PRIOR TO CONSTRUCTION, THE CONTRACTOR SHALL EXCAVATE AND VERIFY THE HORIZONTAL AND VERTICAL LOCATIONS OF ALL OBSTRUCTIONS. SHOULD A CONFLICT EXIST, THE CONTRACTOR SHALL NOTIFY THE CITY/COUNTY ENGINEER SO THAT THE CONFLICT CAN BE RESOLVED WITH MINIMUM AMOUNT OF DELAY.
- PROJECT IS SUBJECT TO THE REQUIREMENTS OF COUNTY ORDINANCE NO. 95-12 AND ORDINANCE NO. 83-28. THE CONTRACTOR IS RESPONSIBLE FOR ACQUIRING ALL PERMITS NECESSARY. CONTRACTOR SHALL CALL 848-1500 FOR MORE INFORMATION.
- THE CONTRACTOR SHALL SUBMIT A TRAFFIC CONTROL PLAN TO THE COUNTY TRAFFIC CONTROL MANAGER AND TO THE NEW MEXICO STATE HIGHWAY AND TRANSPORTATION DEPARTMENT AT LEAST 48 HOURS PRIOR TO COMMENCEMENT OF WORK. TRAFFIC CONTROL PLANS SHALL BE PREPARED IN ACCORDANCE WITH MUTCD REQUIREMENTS AND BY CERTIFIED PERSONNEL AND MUST BE APPROVED PRIOR TO COMMENCEMENT OF WORK ON THE PROJECT. CALL 848-1504 FOR FURTHER INFORMATION.
- SURVEY MONUMENTS DISTURBED BY CONTRACTOR SHALL BE RESTORED AT CONTRACTOR'S EXPENSE.
- SEE STANDARD CITY VACUUM DETAILS.
Contractor shall install a 3" thick gravel surface 12' wide, this gravel surfacing shall be spread on the existing grade surface and back-dragged with the blade of a loader. This surface is only intended to serve as a temporary access.

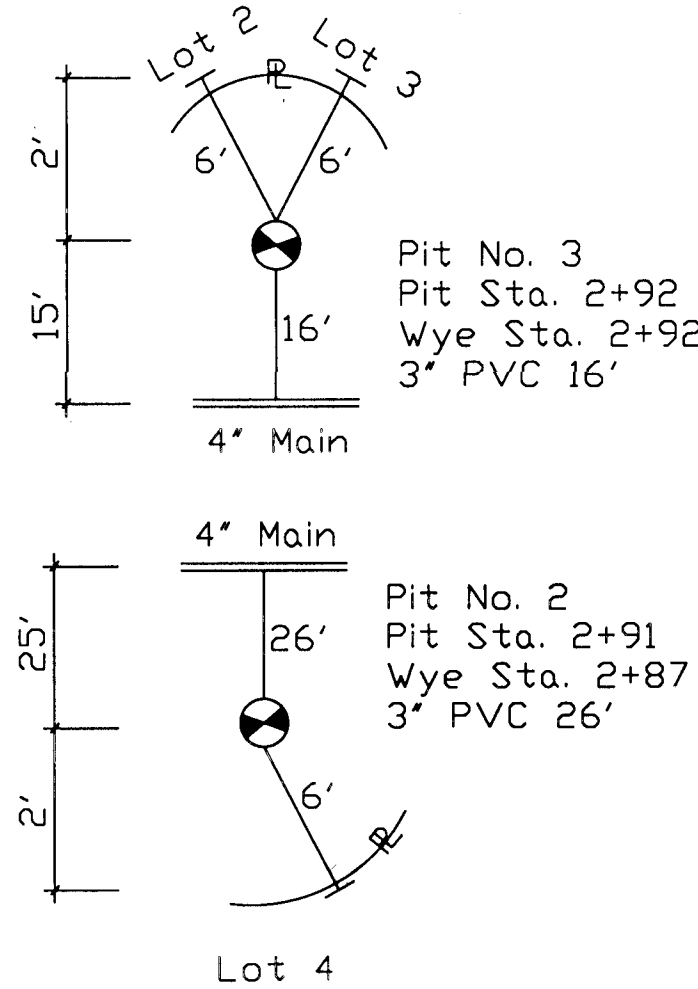

VICINITY MAP

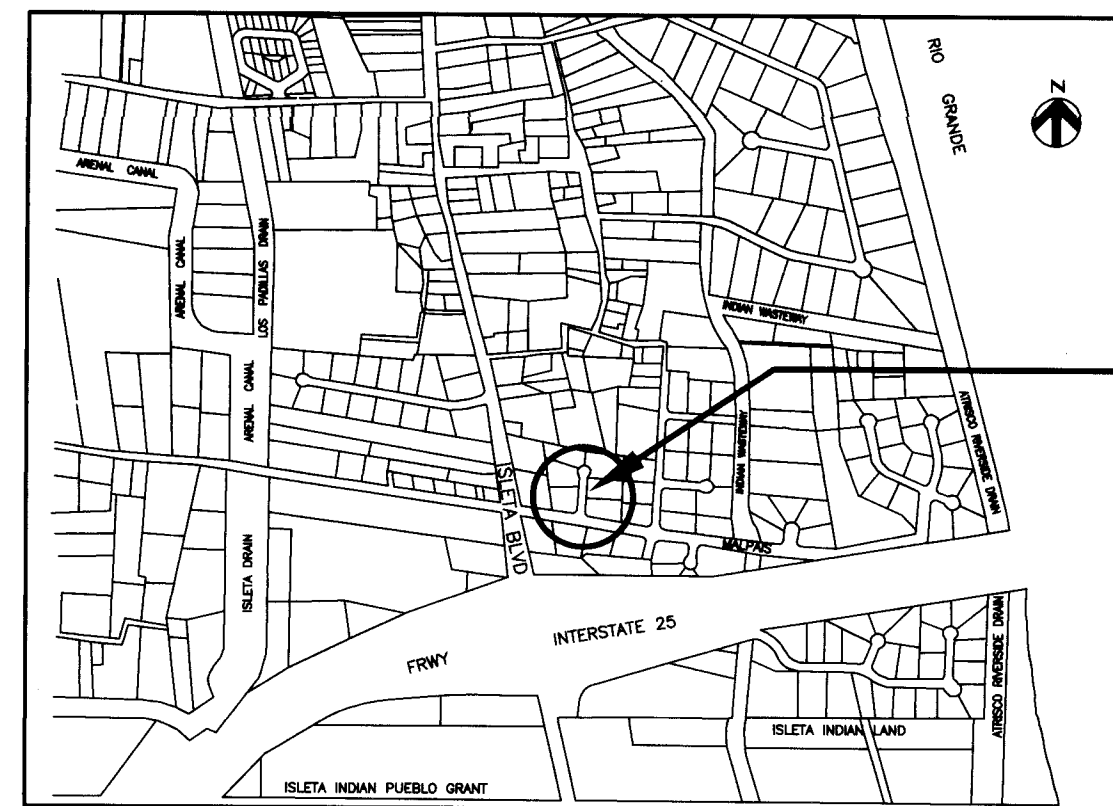

PLAN PROFILE

SCALE: 1"=50' SCALE: 1"=50' HOR 1"=5' VERT




LEGEND


PLAN VIEW



PROFILE VIEW

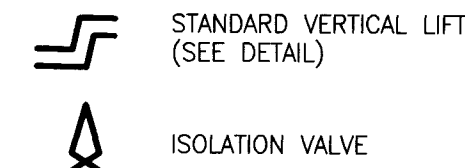


PLAN/PROFILE VIEWS

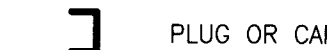

ELOISE PLACE

PAGE U-12-Z

* NOTE: ALL ELEVATIONS IN PROFILE ARE AT T.O.P. (TOP OF PIPE). LENGTHS SHOWN ON PROFILE REFER TO INSTALLED PIPE LENGTHS.

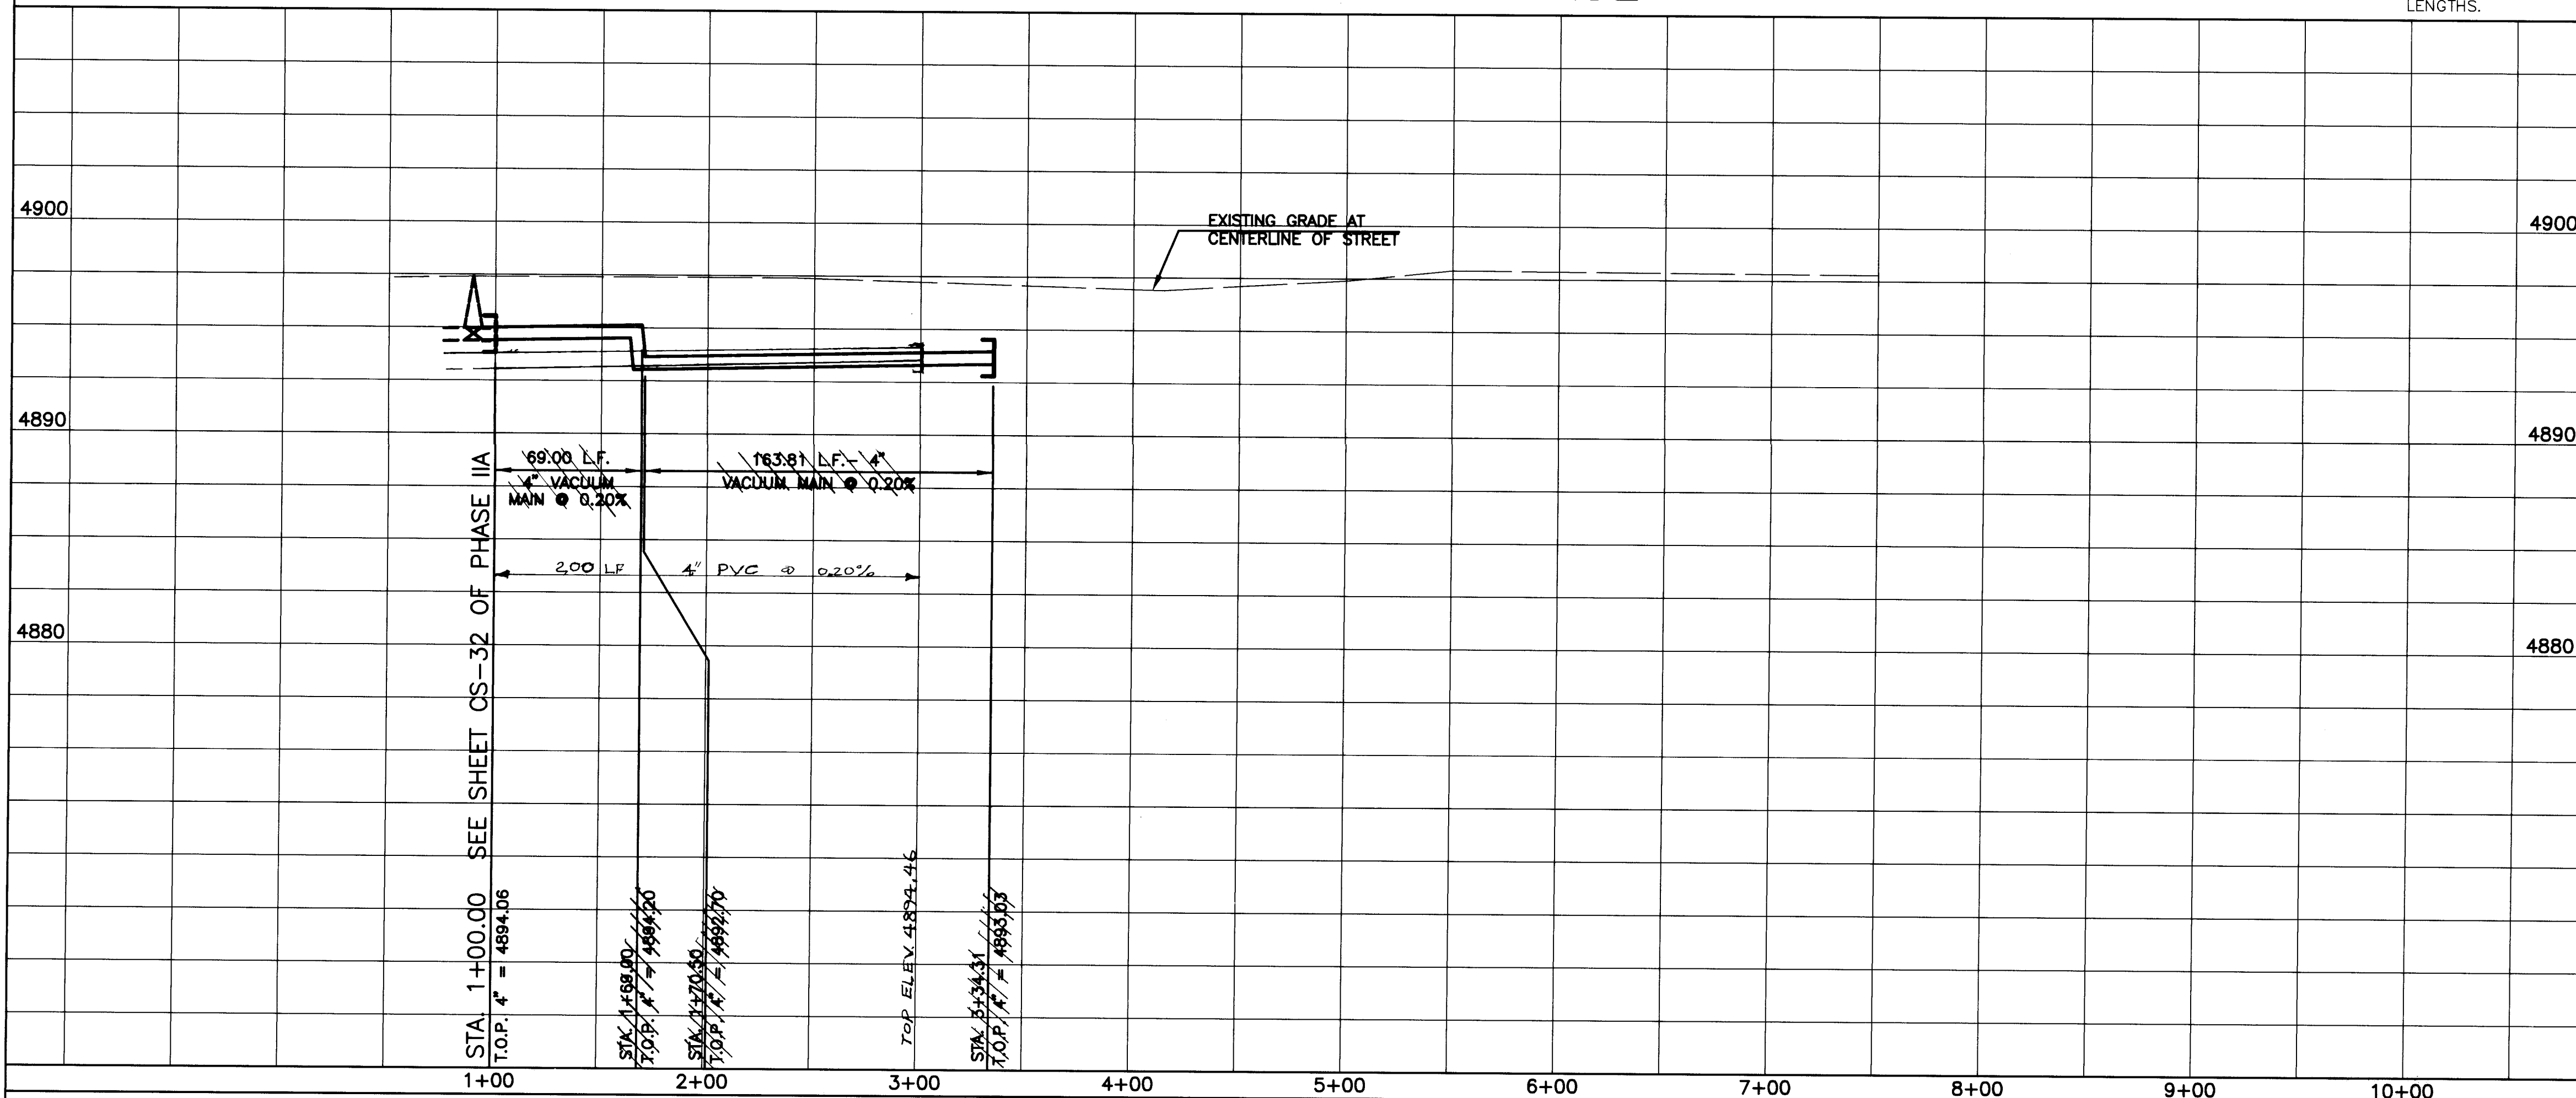

SEWER SERVICE SCHEDULE

STATION	ADDRESS	PIT NO.
2+00	ELOISE PLACE	E-1
3+29	ELOISE PLACE	E-2
3+39	ELOISE PLACE	E-3

"AS RECORDED"

From Information provided by the contractors

By *[Signature]* Date *4/29/97*



HDR

HDR Engineering, Inc.
6200 Uptown Boulevard N.E., Suite 220
Albuquerque, NM 87110-4142
(505) 884-6065; FAX: (505) 884-5969


REV.	SHEETS	CITY ENGINEER	DATE	USER DEPARTMENT	DATE	USER DEPARTMENT	DATE
ENGINEER'S STAMP & SIGNATURE	APPROVALS	ENGINEER	DATE	*****	APPROVED FOR CONSTRUCTION	DATE	
<i>[Signature]</i>	DRG Chairman						
	Transportation	<i>[Signature]</i>	10-3-96				
	Water/Wastewater	<i>[Signature]</i>	10-3-96				
	Hydrology	<i>[Signature]</i>	11/1/96				
	Parks						
	Construction Management						
City Project No. 5565.81				City Engineer DATE			
				Sheet 2 Of 5			

SCANNED BY LASON



2 3 4 5 6 7 8 9 10 11 12 13 14
26-15565-81 10/2/97

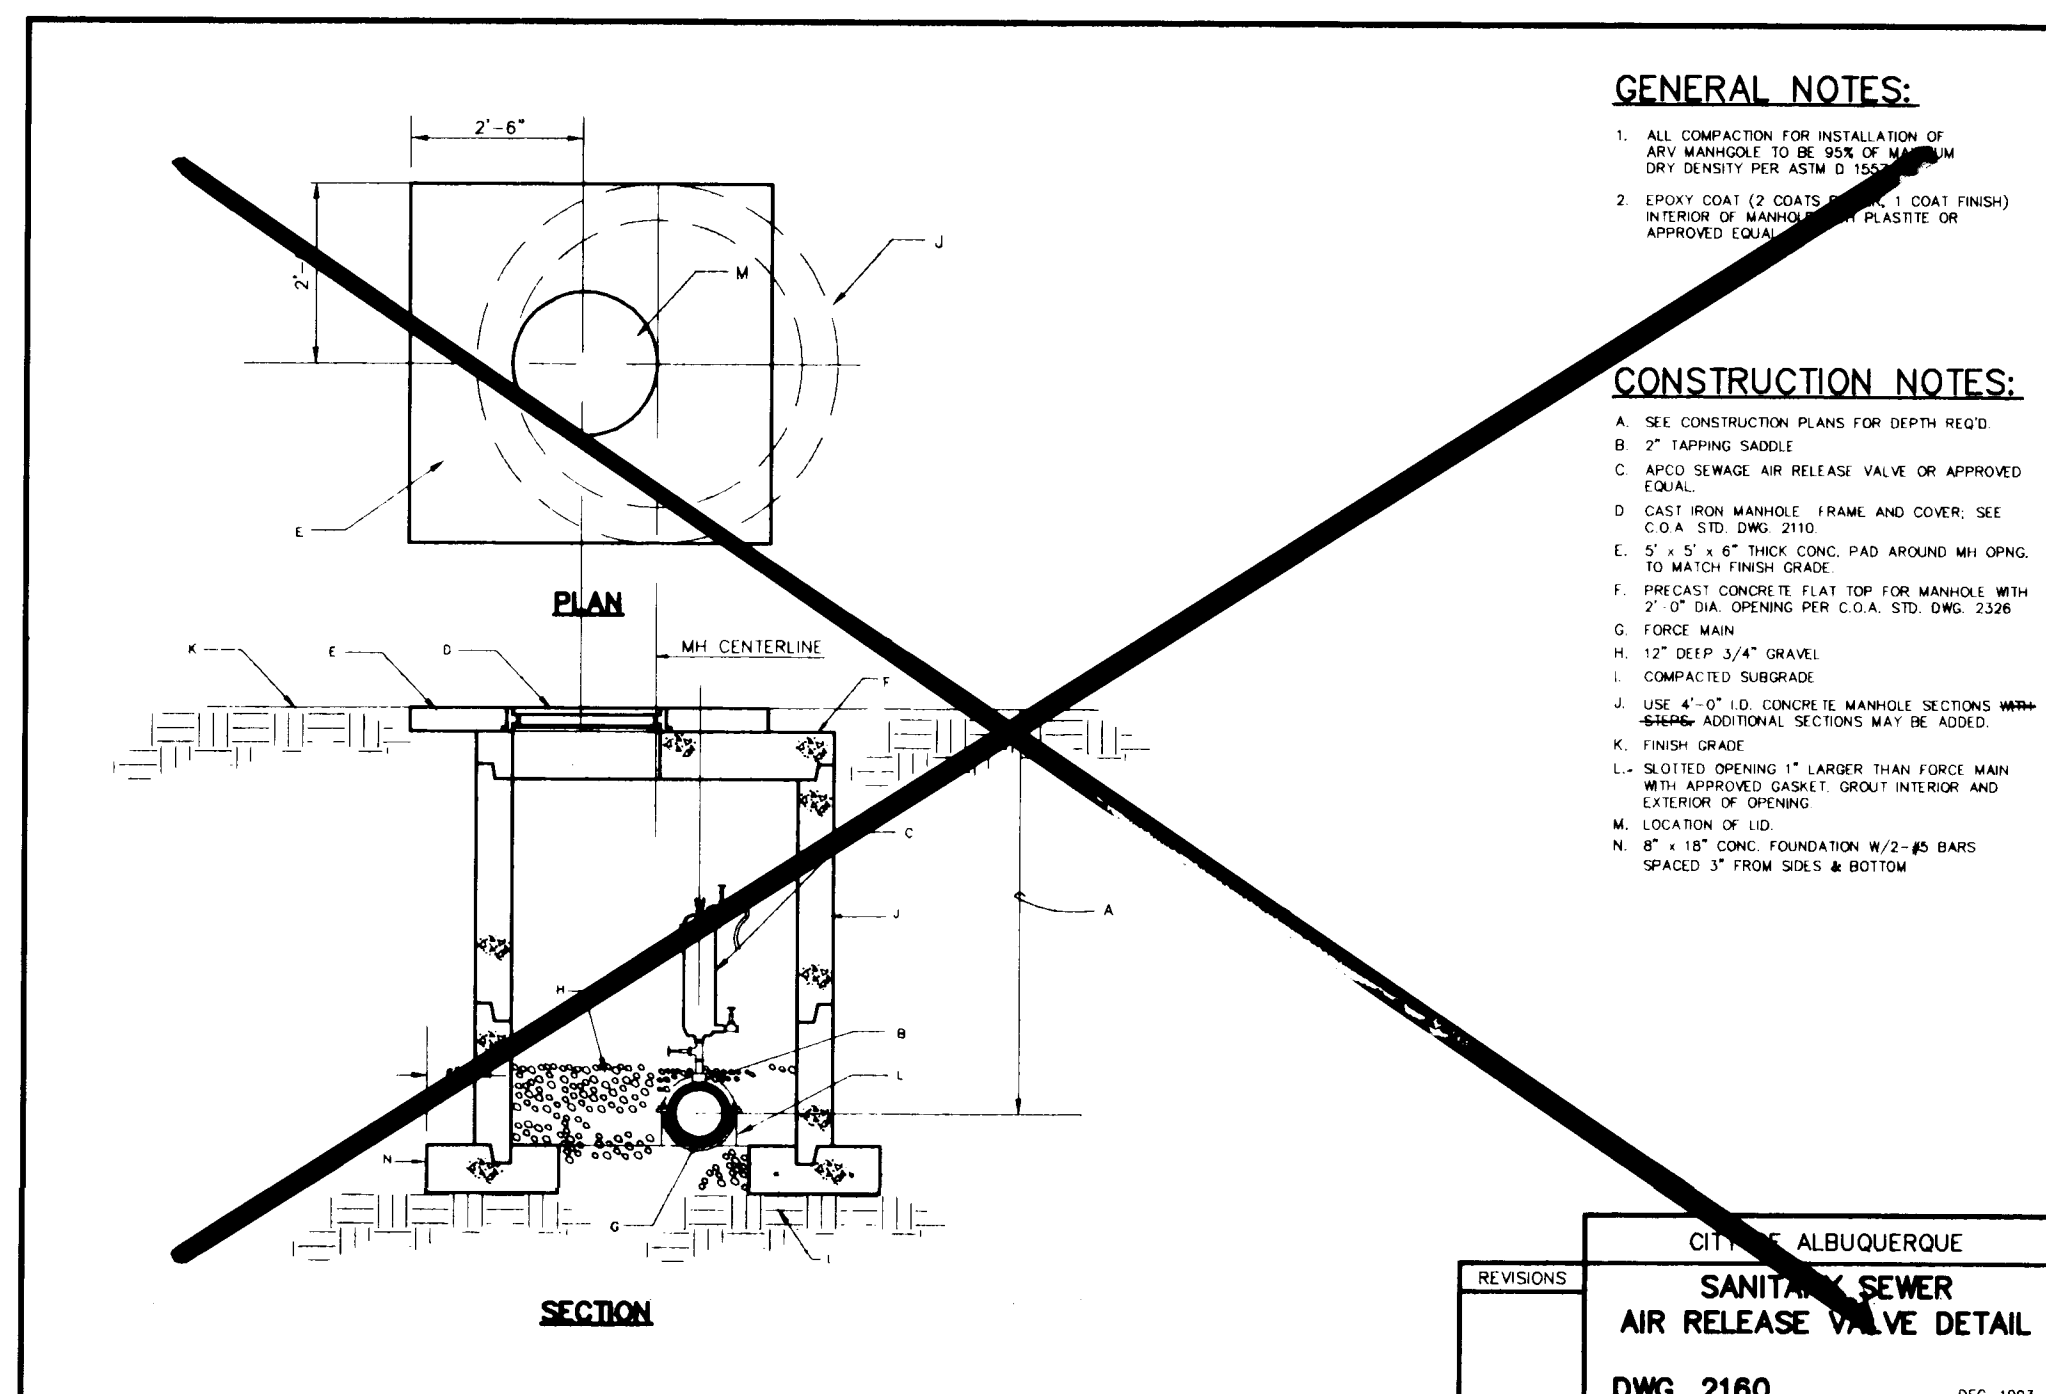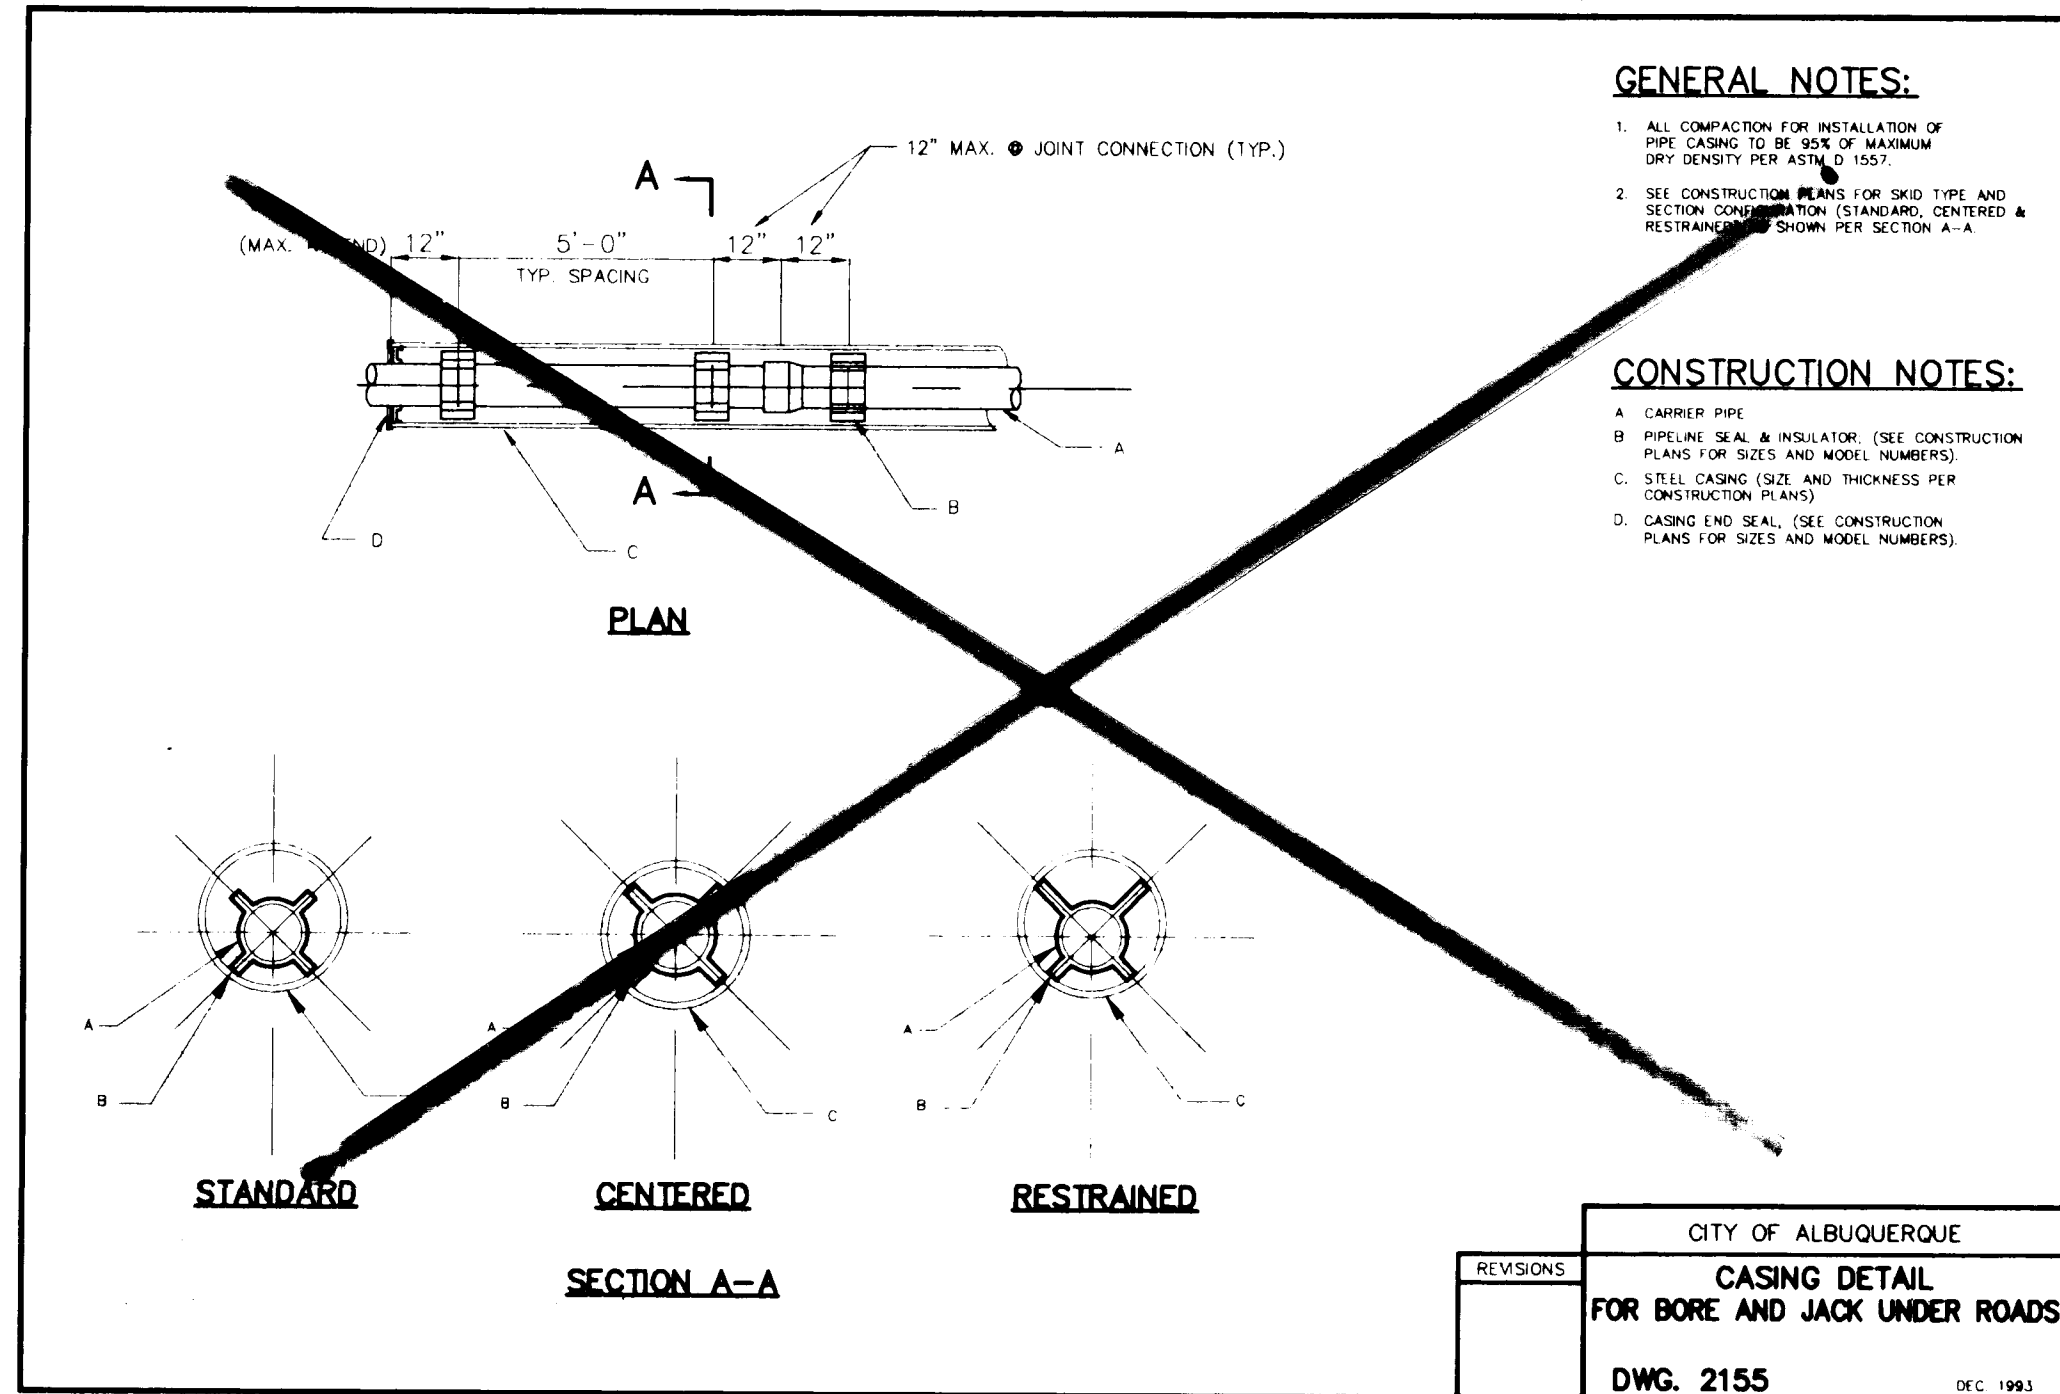

NOT USED IN THIS CONTRACT.





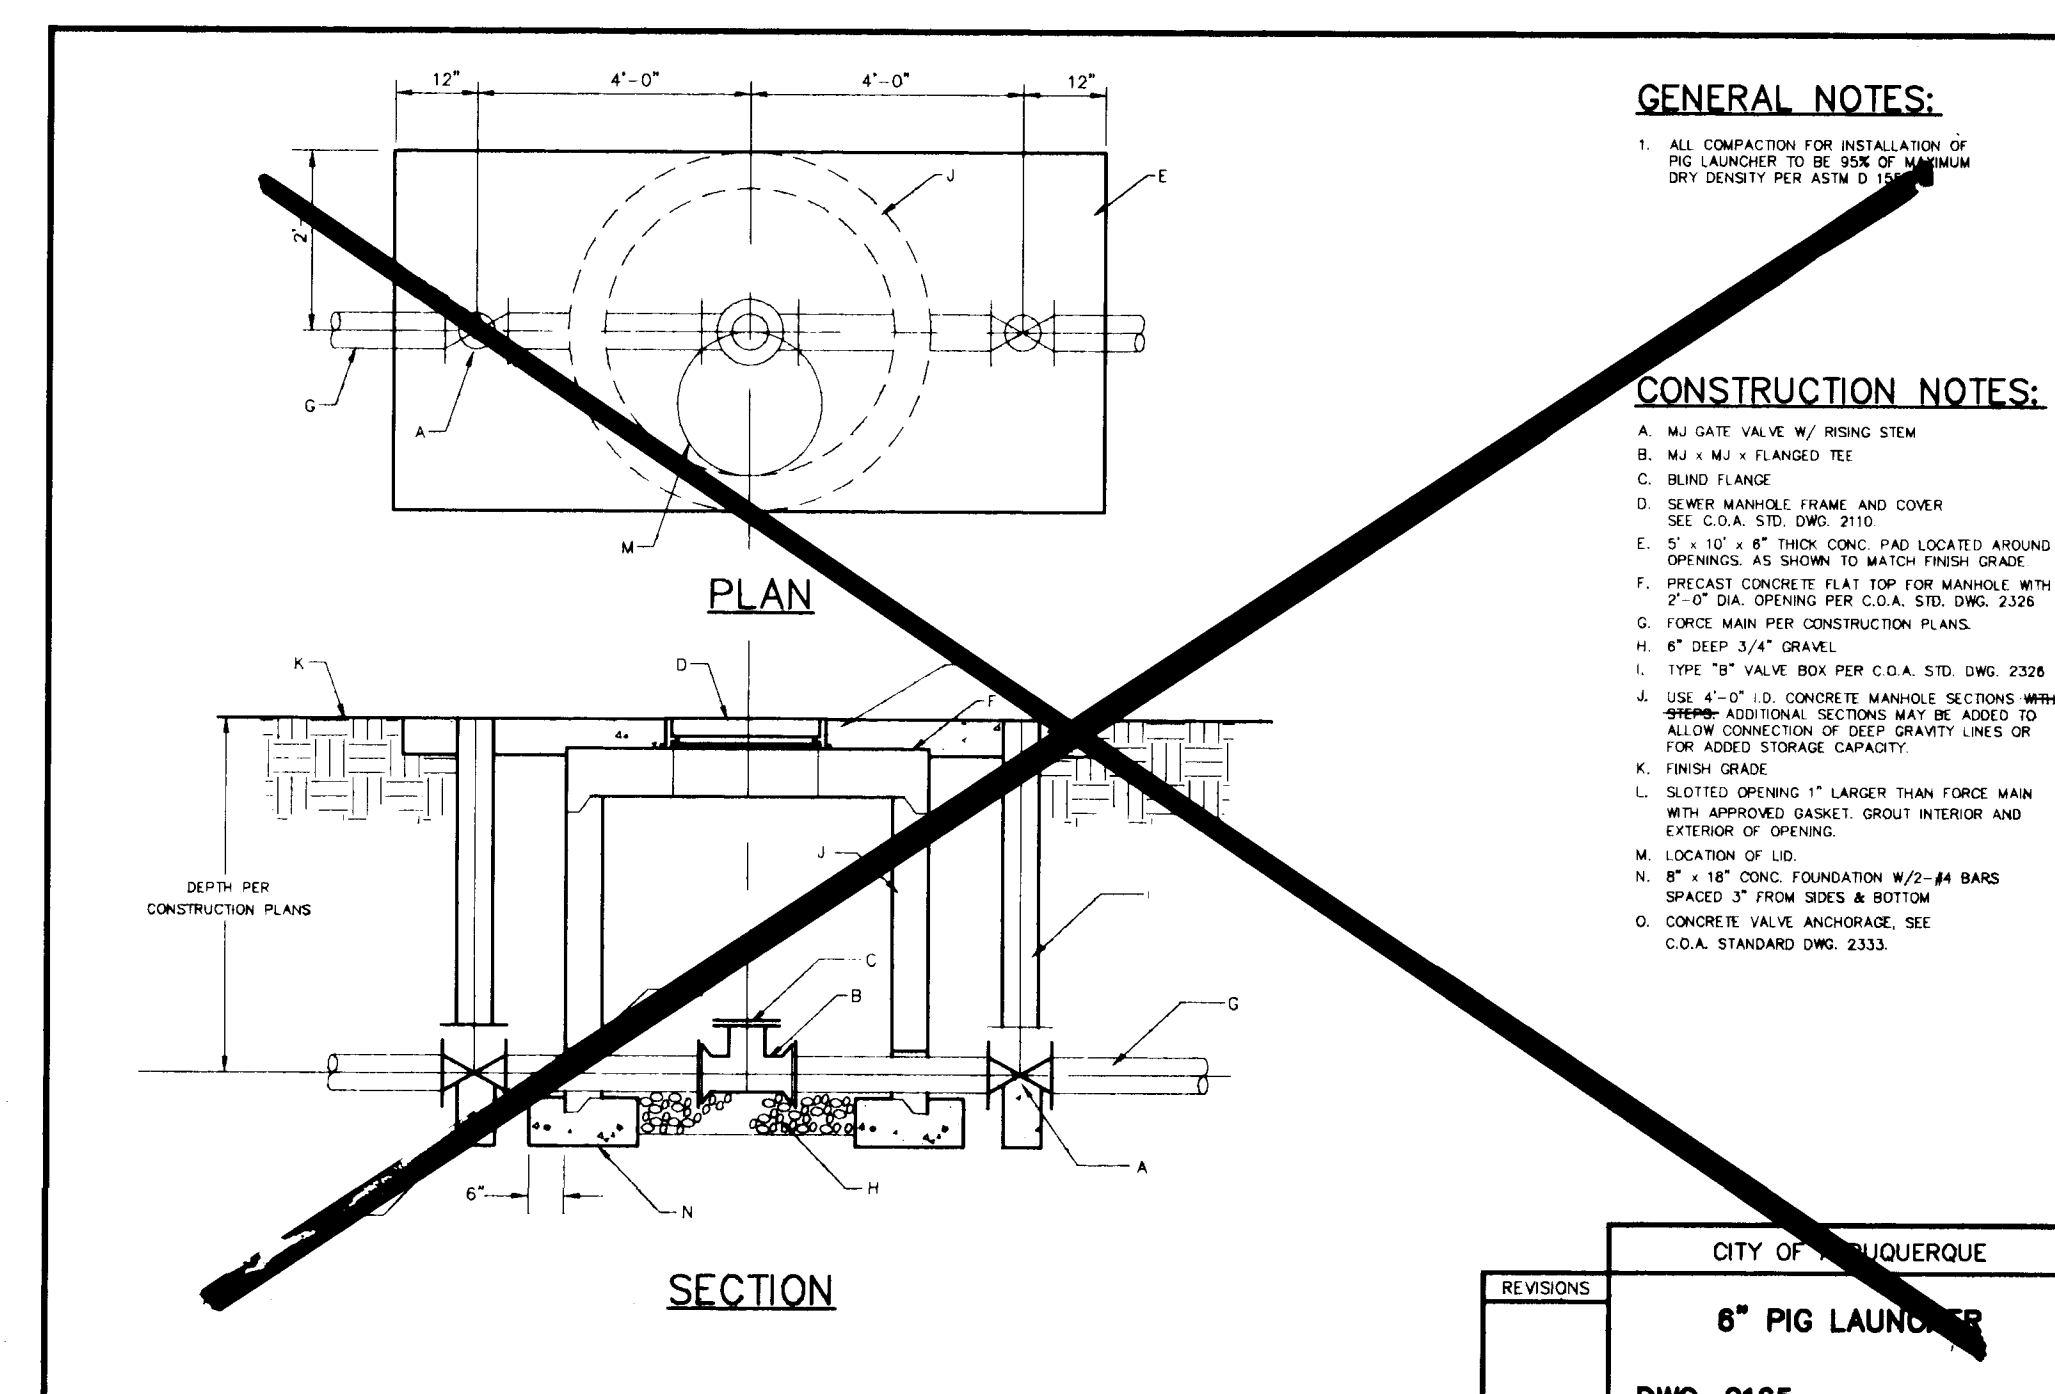


NOT USED IN THIS CONTRACT.

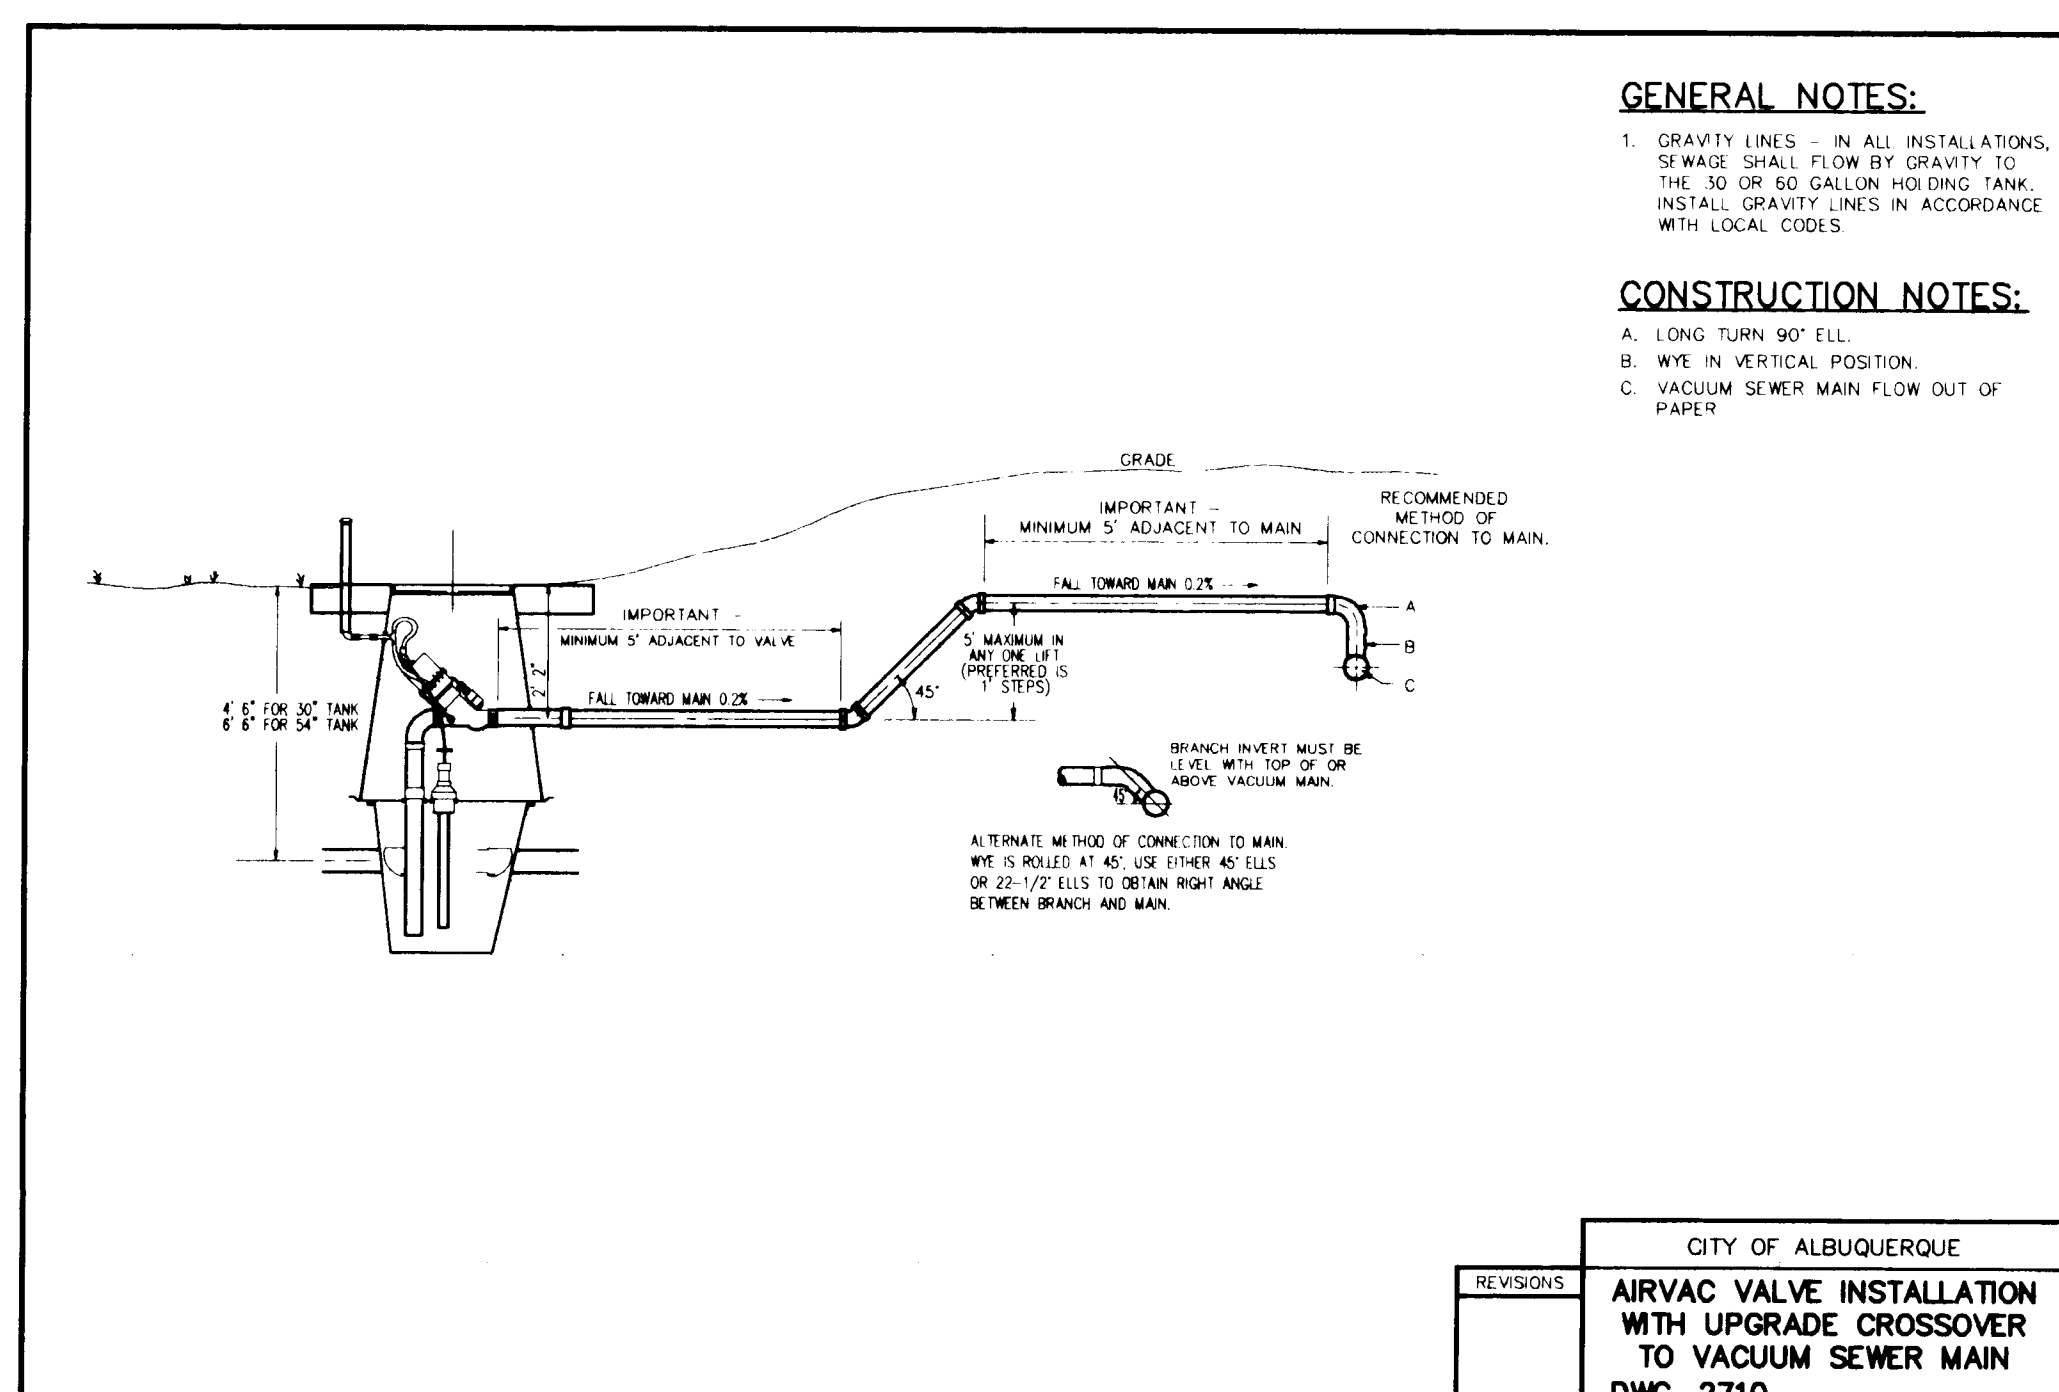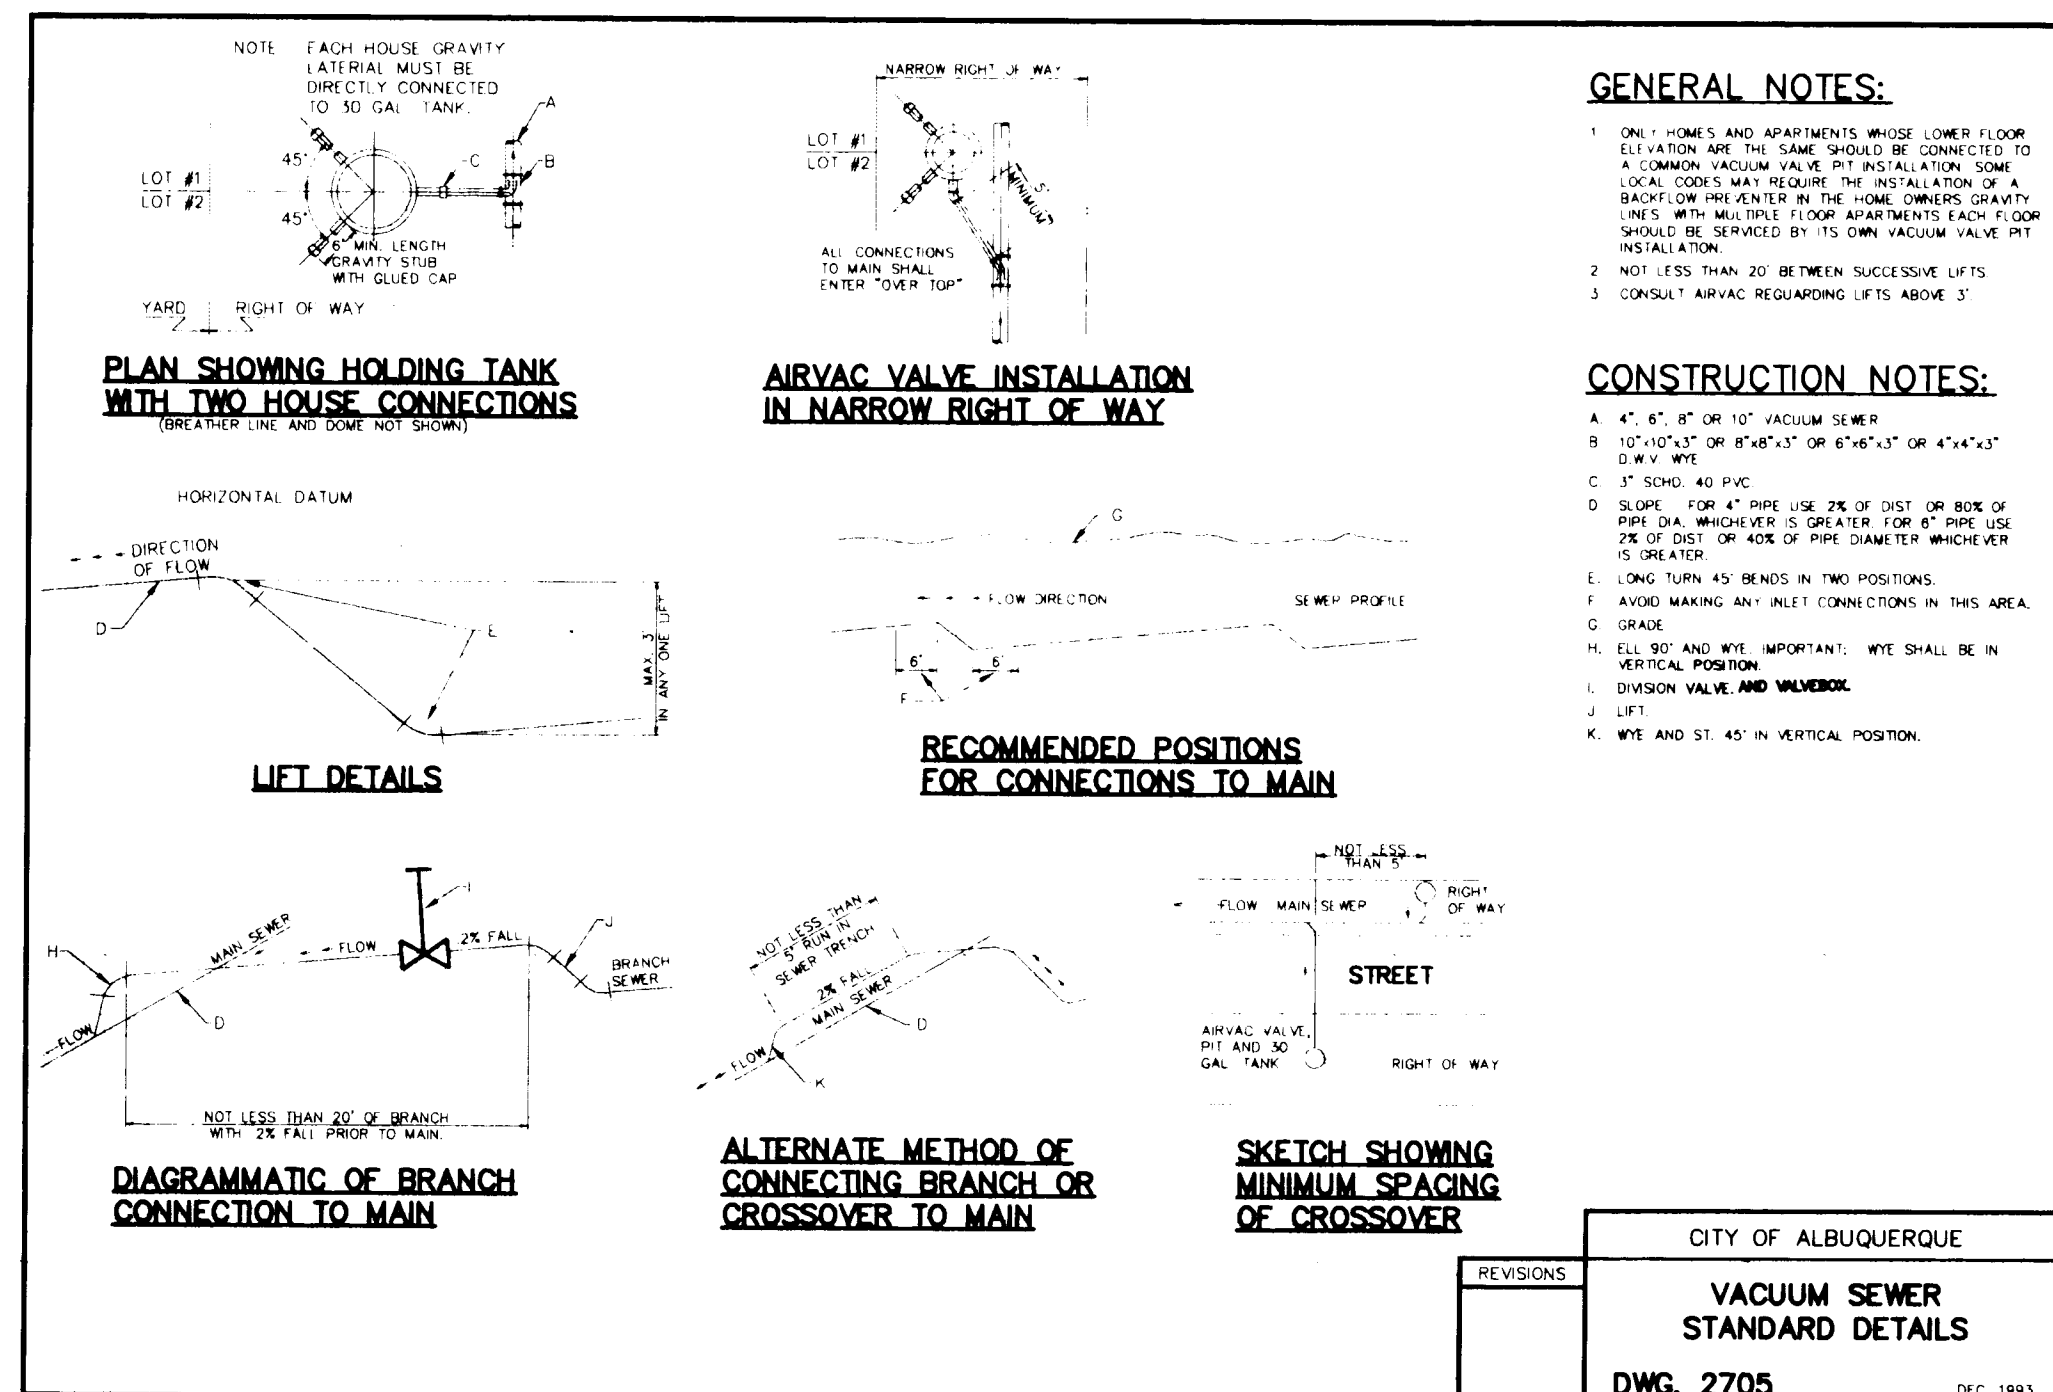

CITY OF ALBUQUERQUE PUBLIC WORKS DEPARTMENT ENGINEERING GROUP			
STANDARD DETAILS FOR VACUUM SEWER			
Design Review Committee	City Engineer Approval	Mo./Day/Yr.	Mo./Day/Yr.
City Project No.	MAP NO.	SHEET 3 OF 5	
NO. 5565.81			

2 3 4 5 6 7 8 9 10 11 12 13 14
26-5565.81 05.97

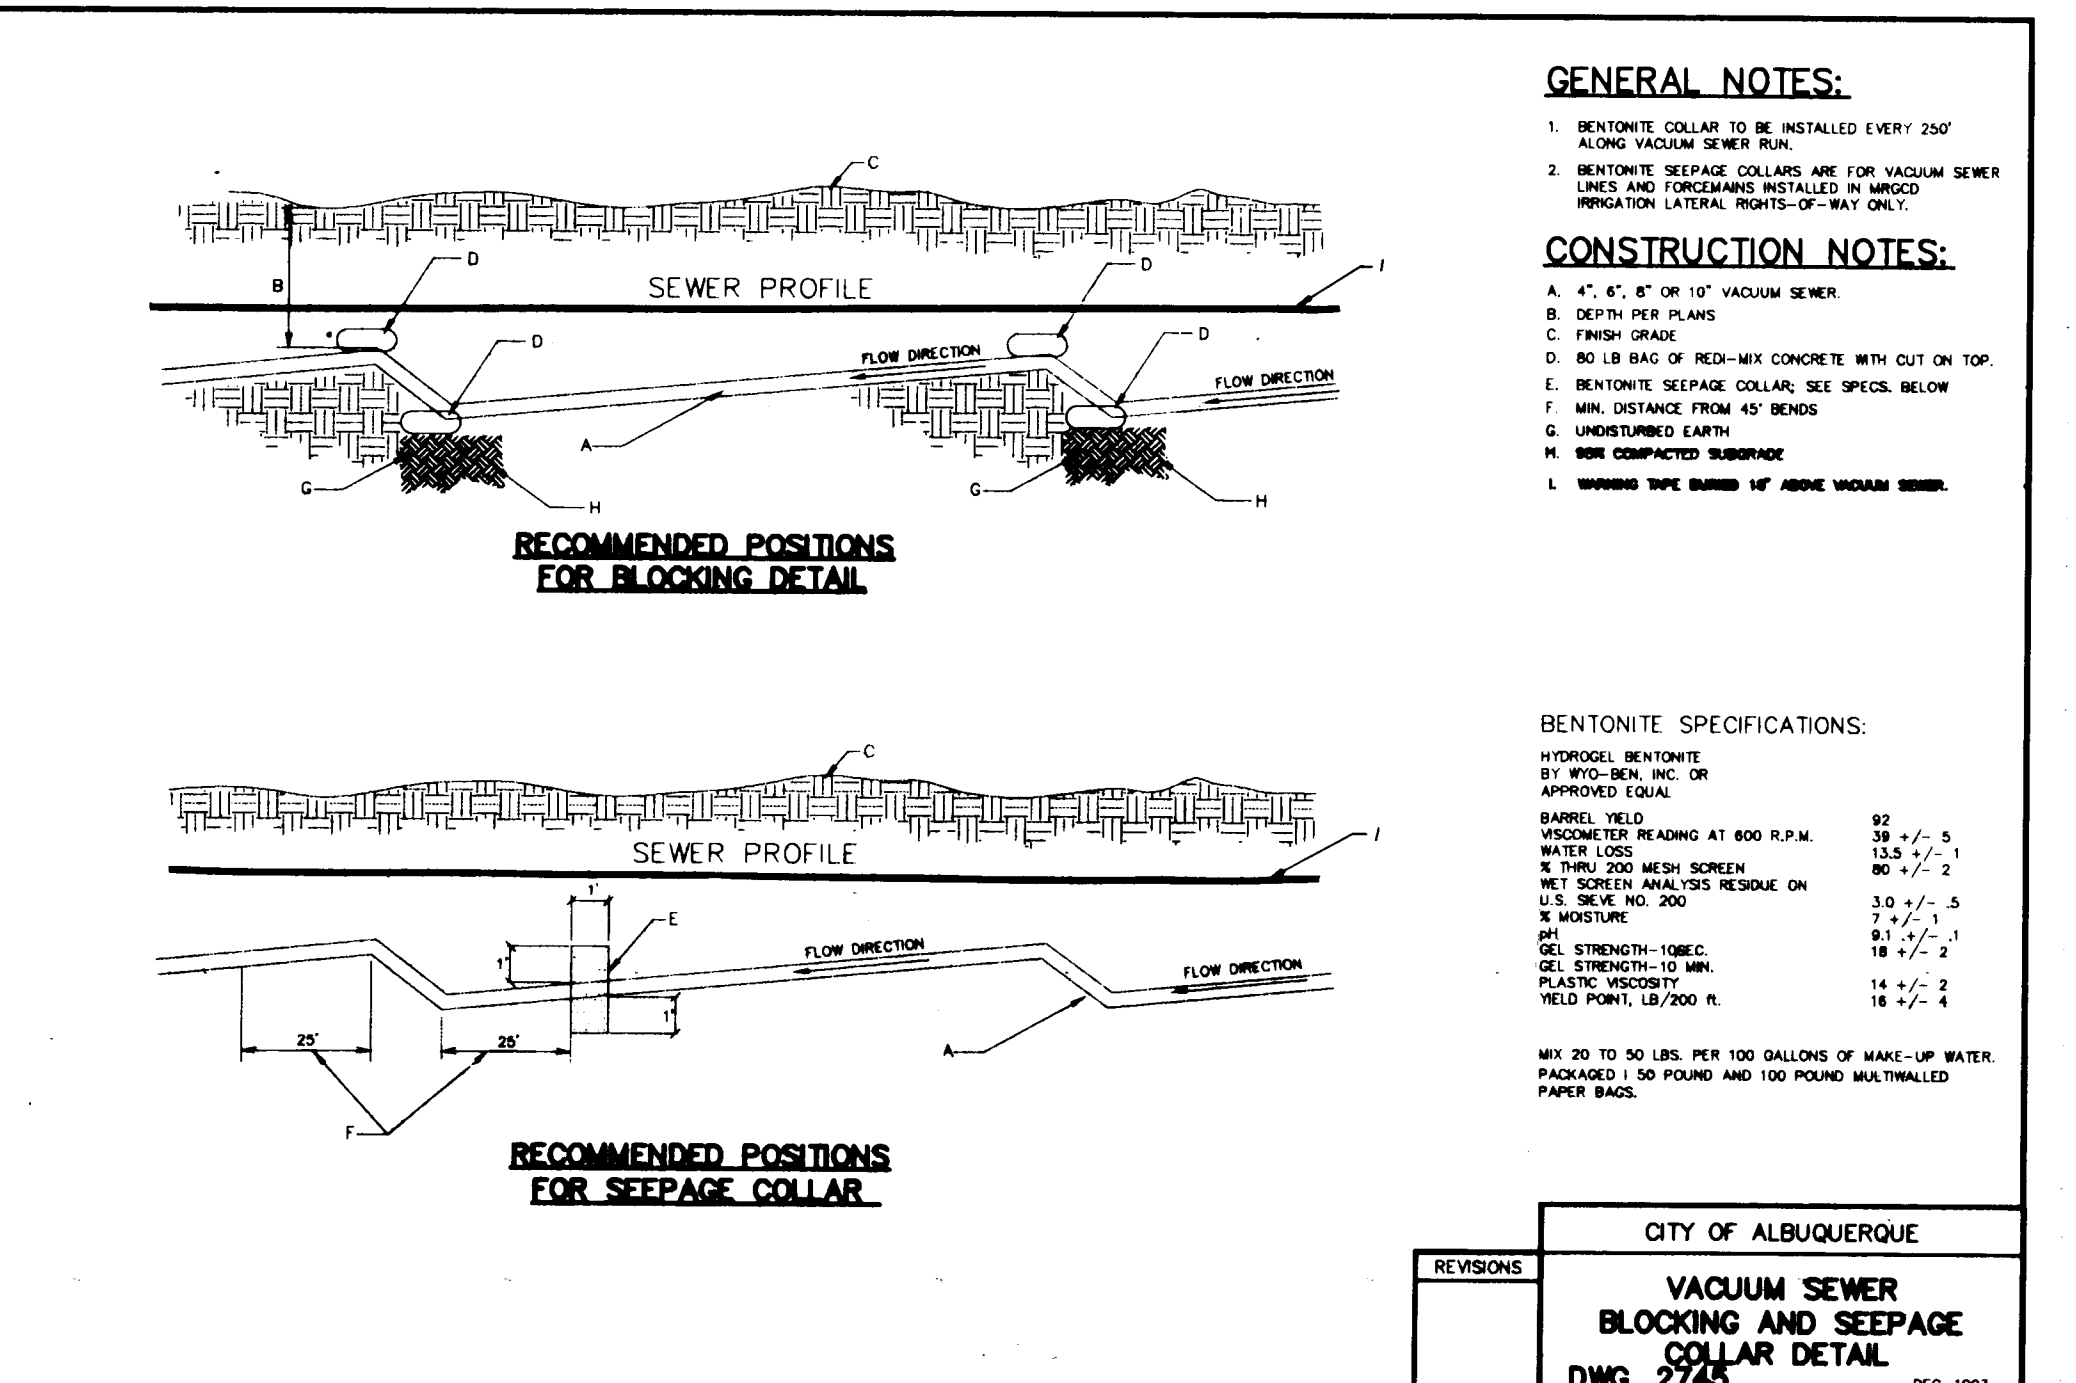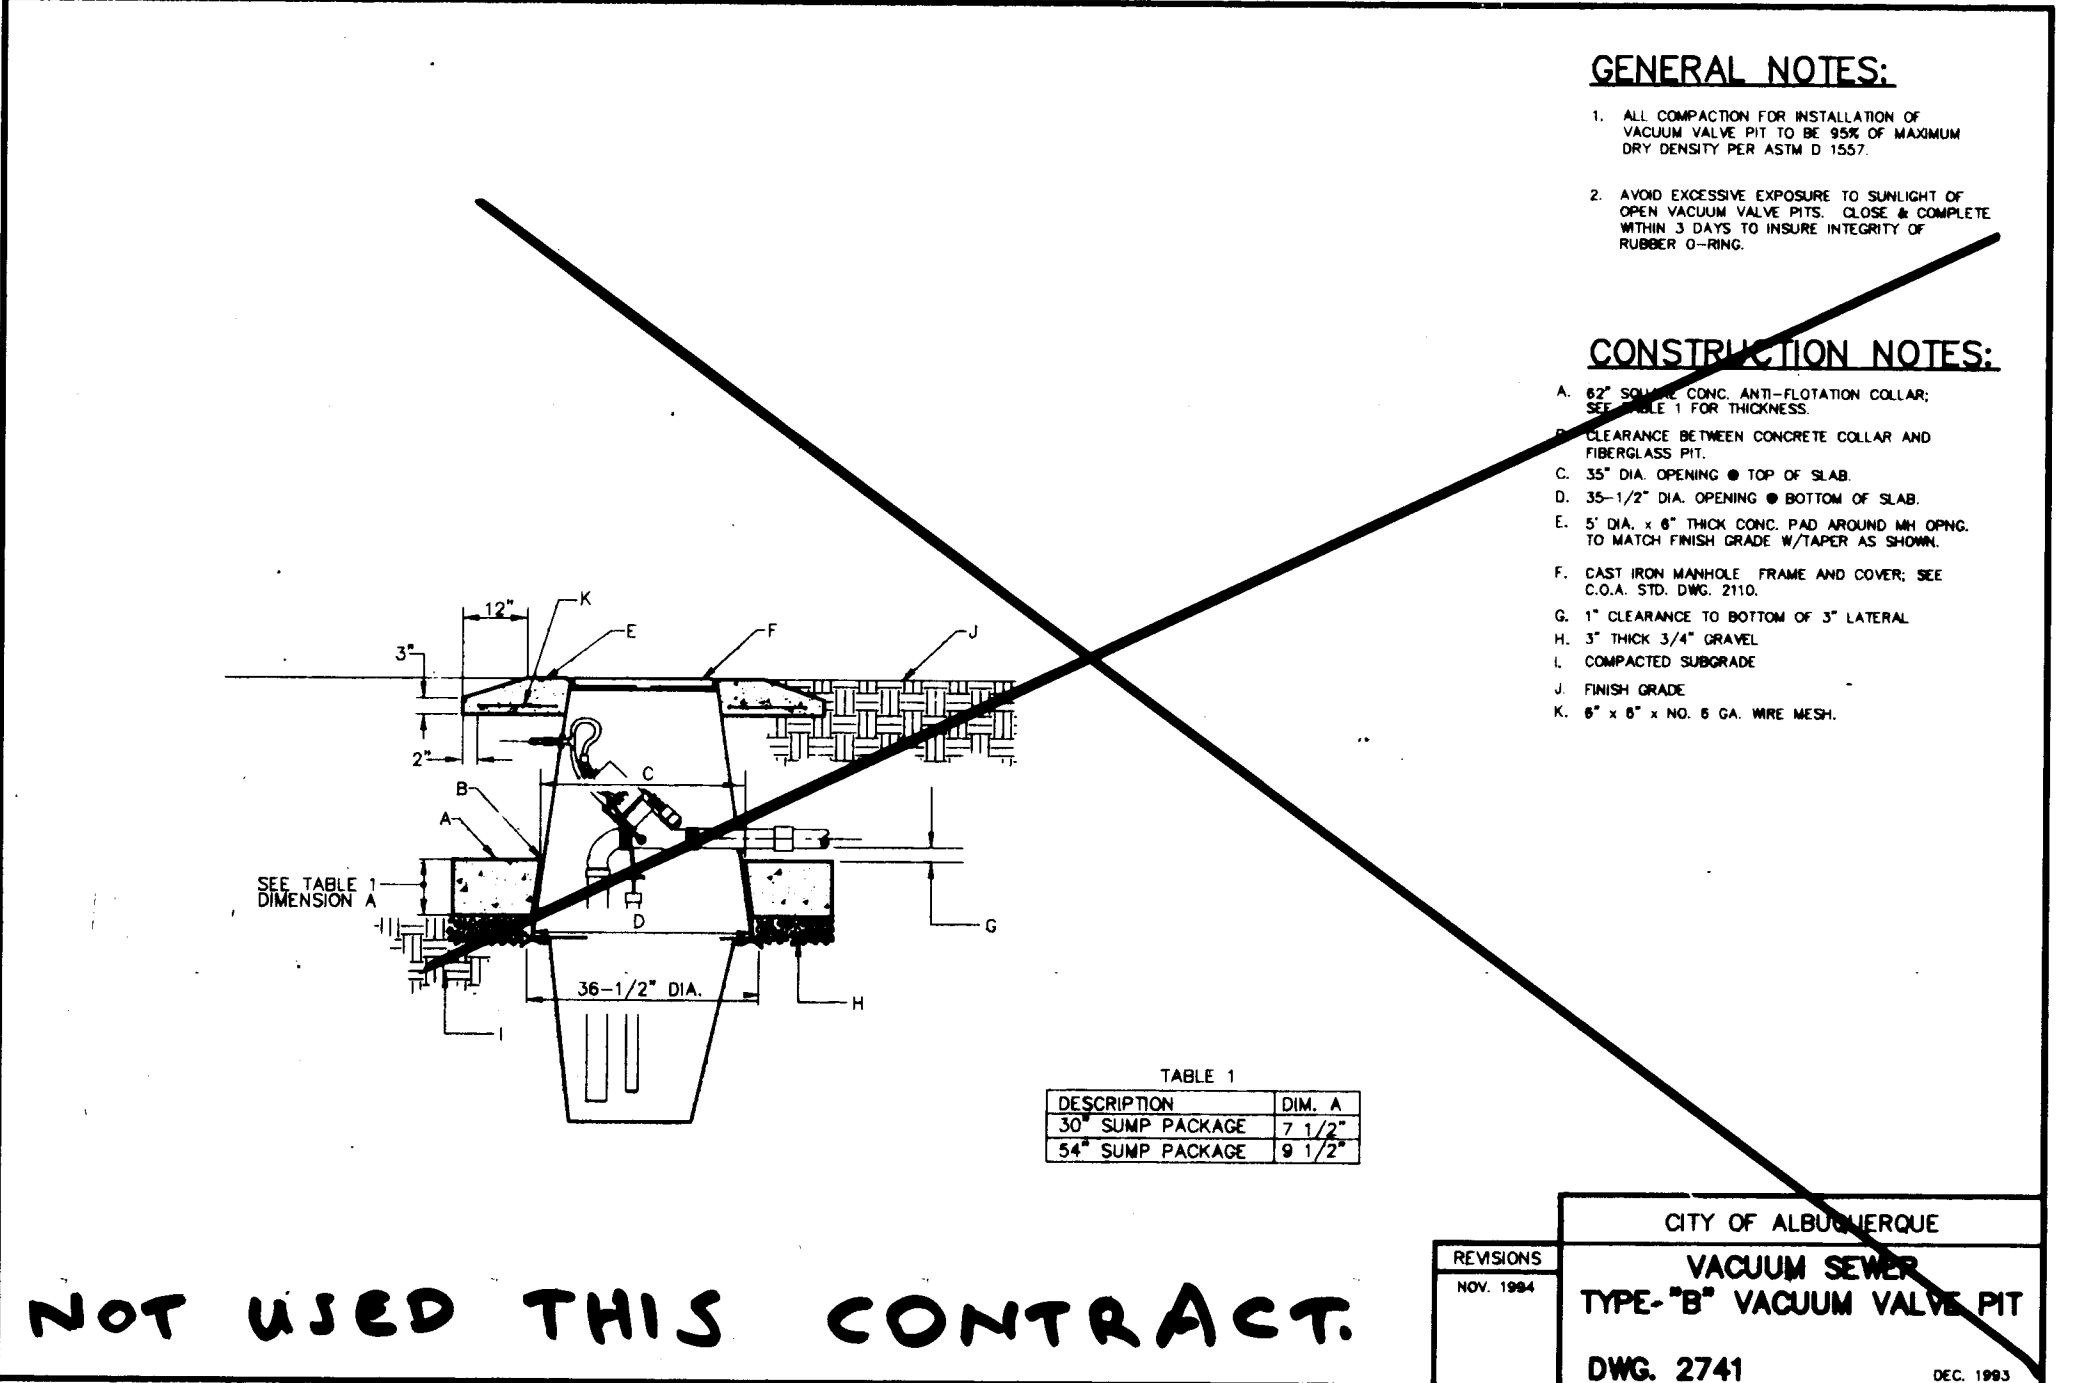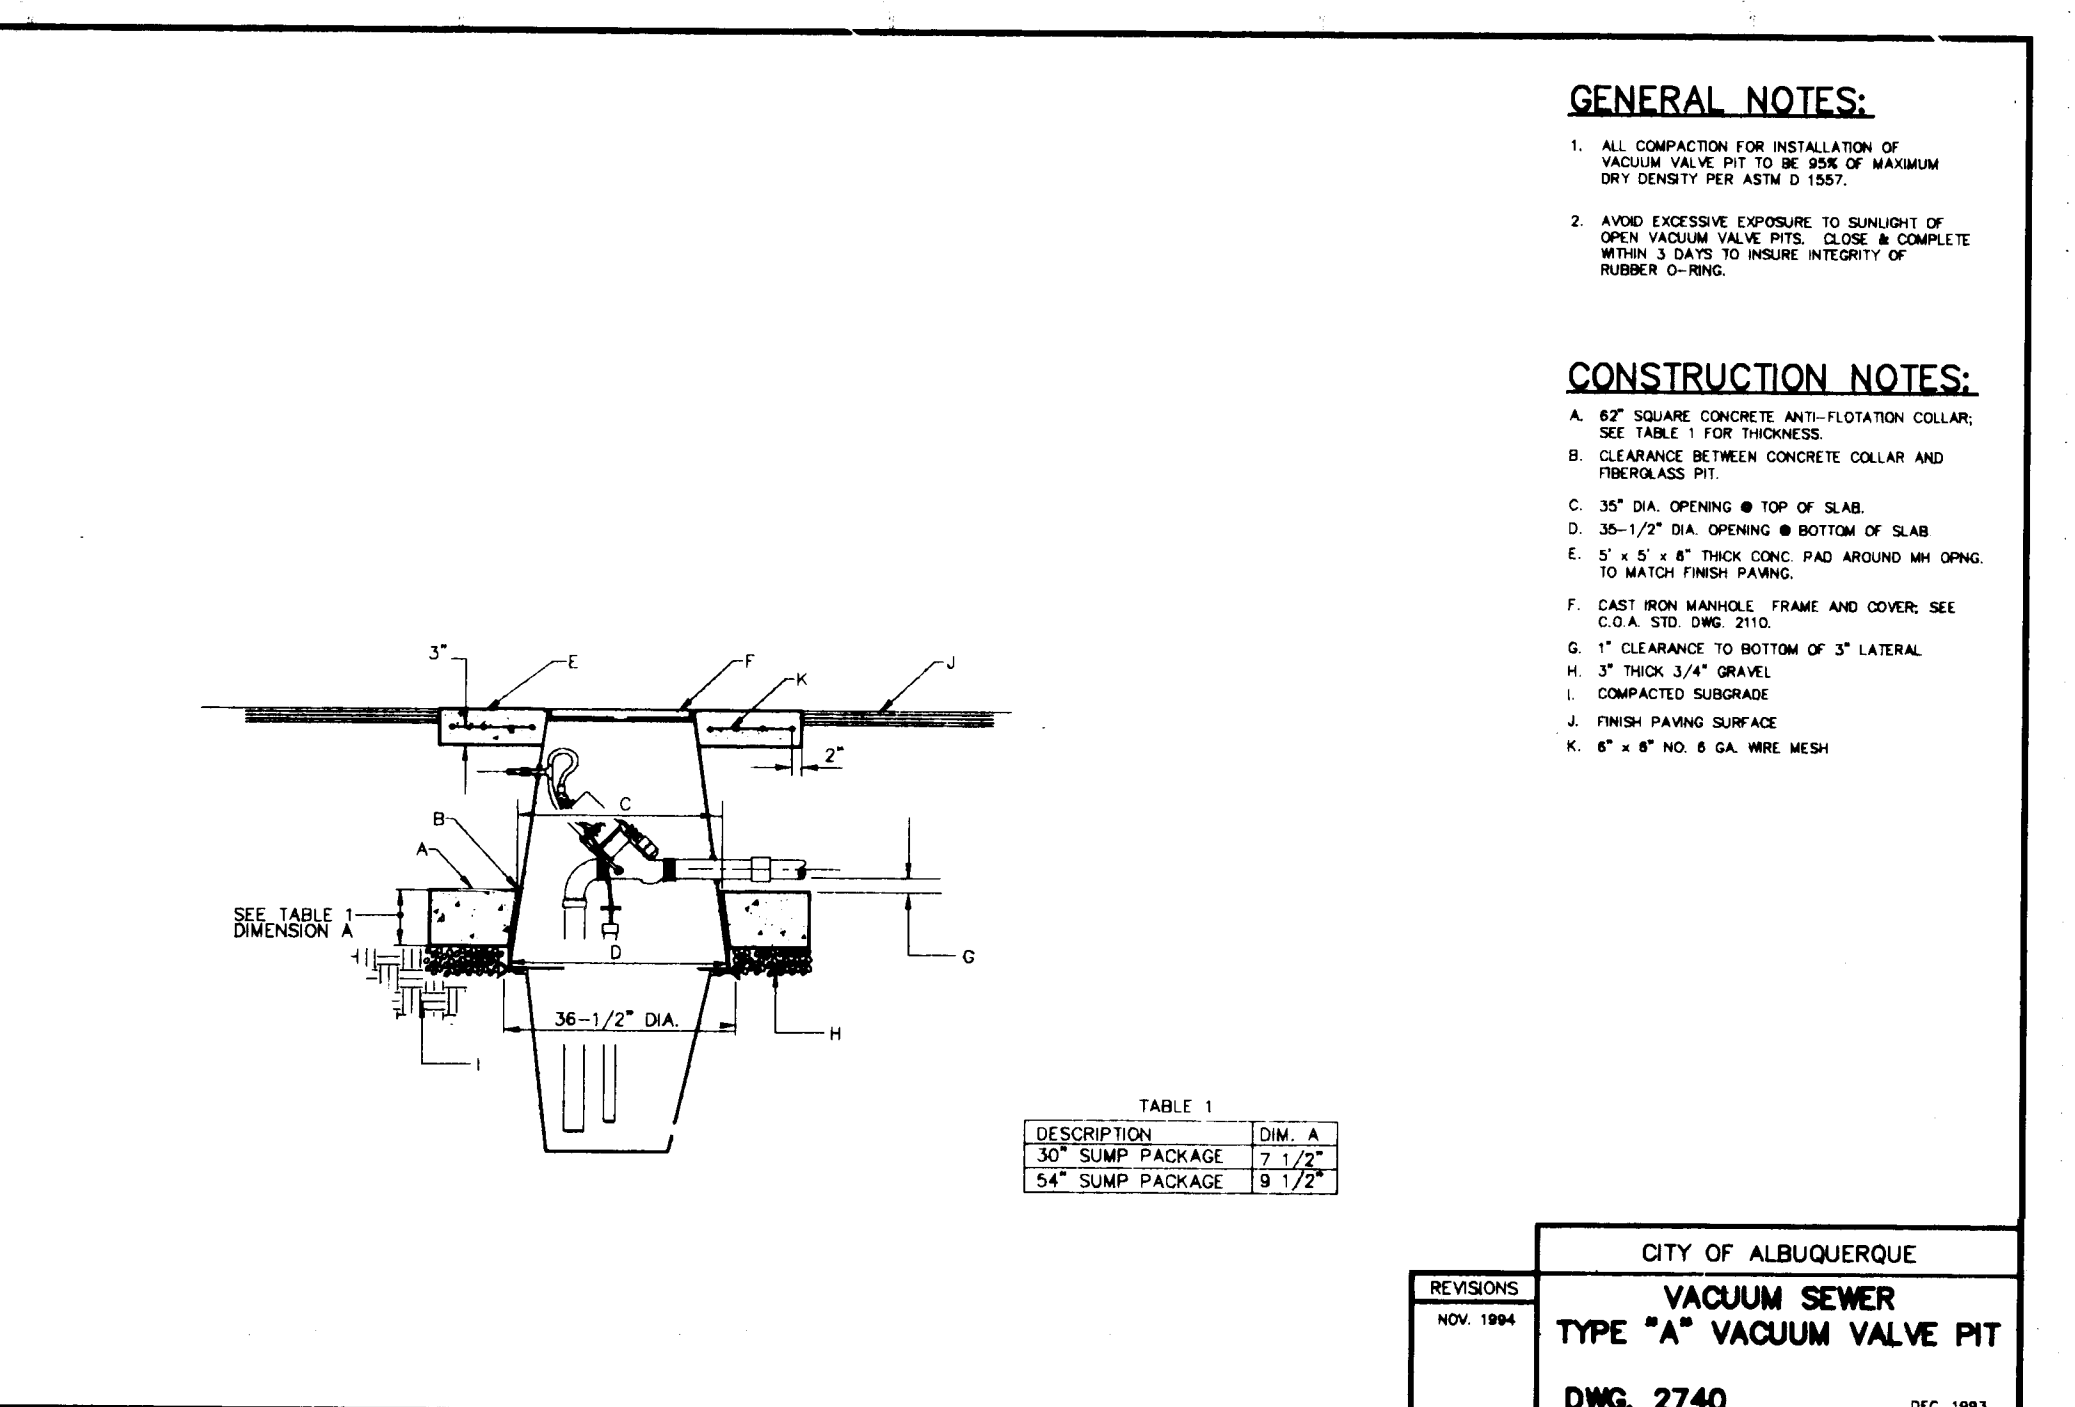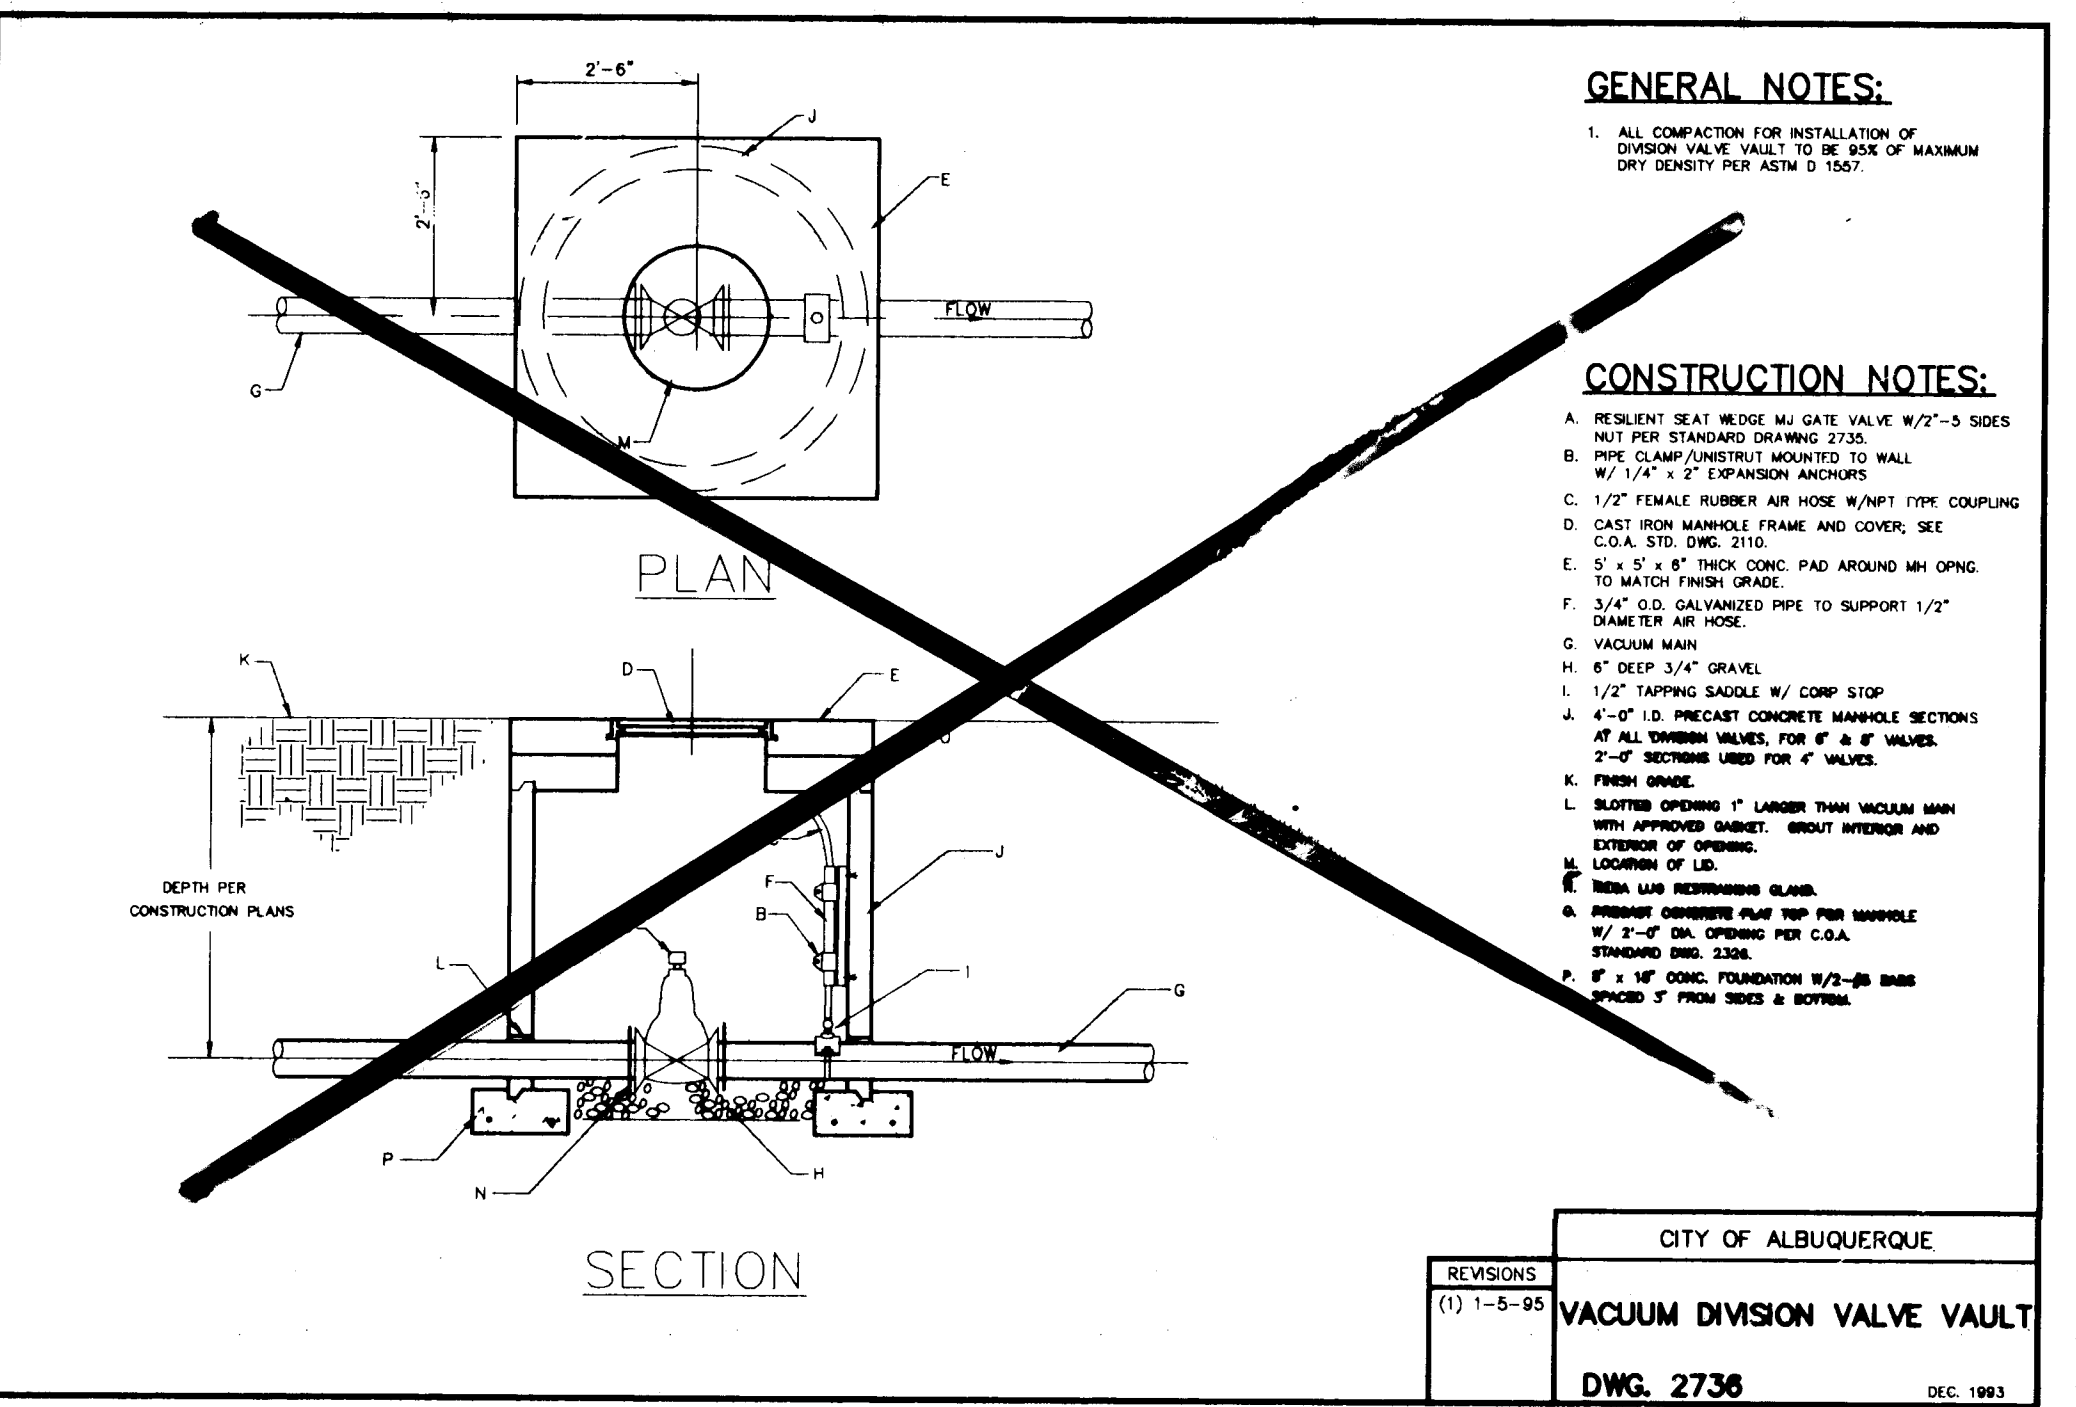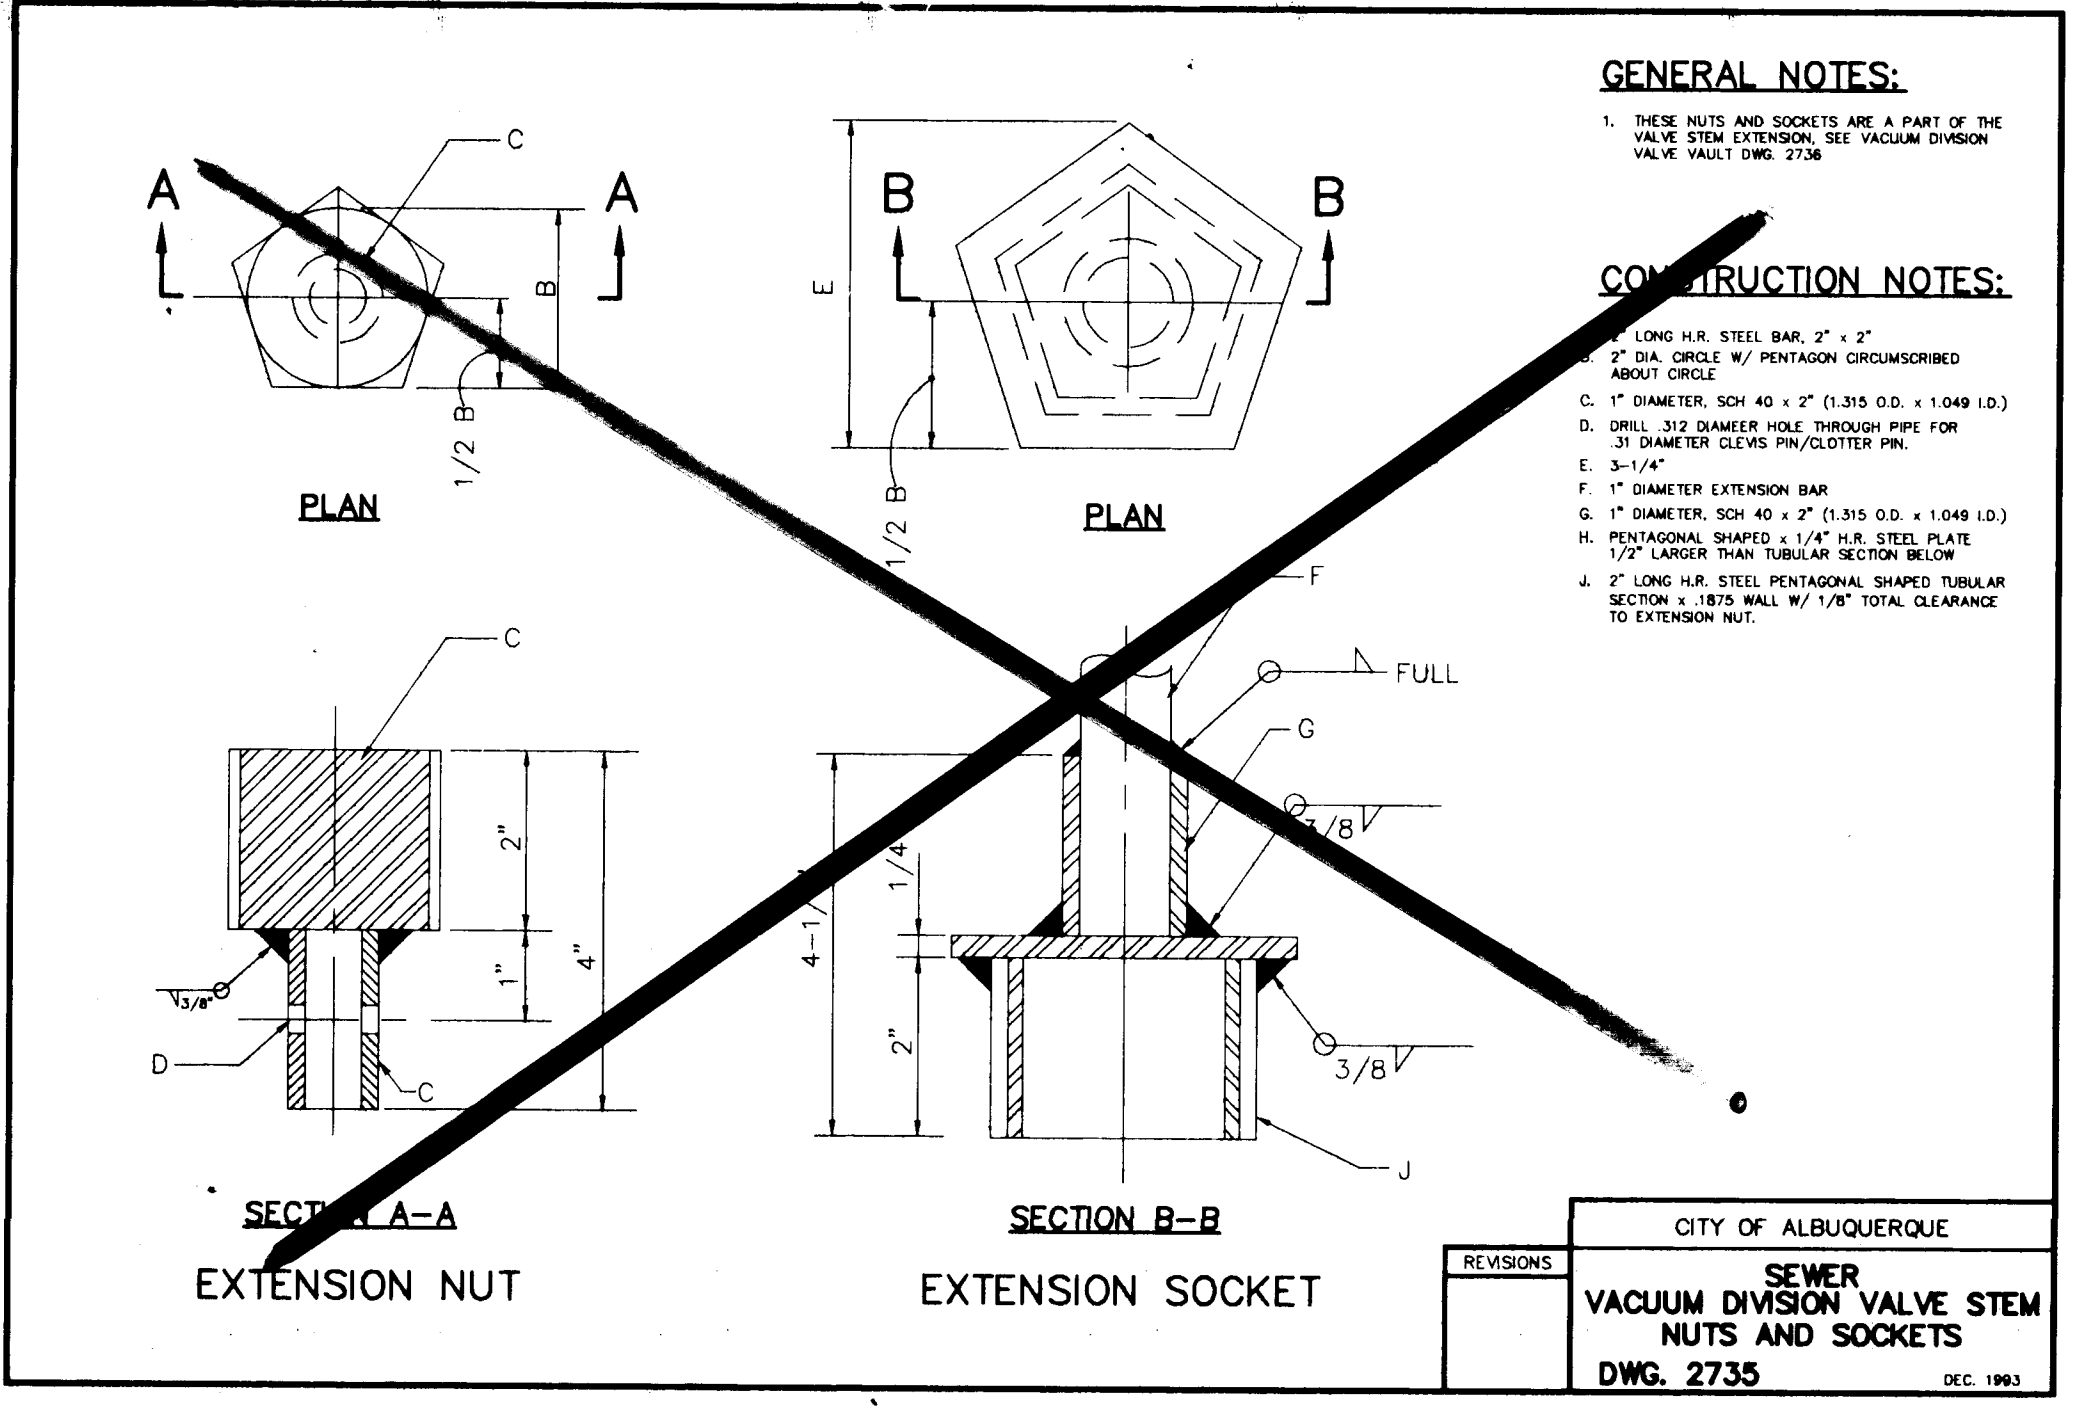

CITY OF ALBUQUERQUE

PUBLIC WORKS DEPARTMENT

ENGINEERING GROUP

STANDARD DETAILS FOR VACUUM SEWER

DESIGN	REVIEW	APPROVE	DATE	Mo./Day/Yr.	Mo./Day/Yr.
DESIGN	REVIEW	APPROVE	DATE	Mo./Day/Yr.	Mo./Day/Yr.

City Project No. 5565.81

MAP NO.

SHEET 5 OF 5

"AS RECORDED"

From Information provided by the contractors

By *[Signature]* Date *4/29/97*

SCANNED BY BYLASON

26-5565.81 6597