



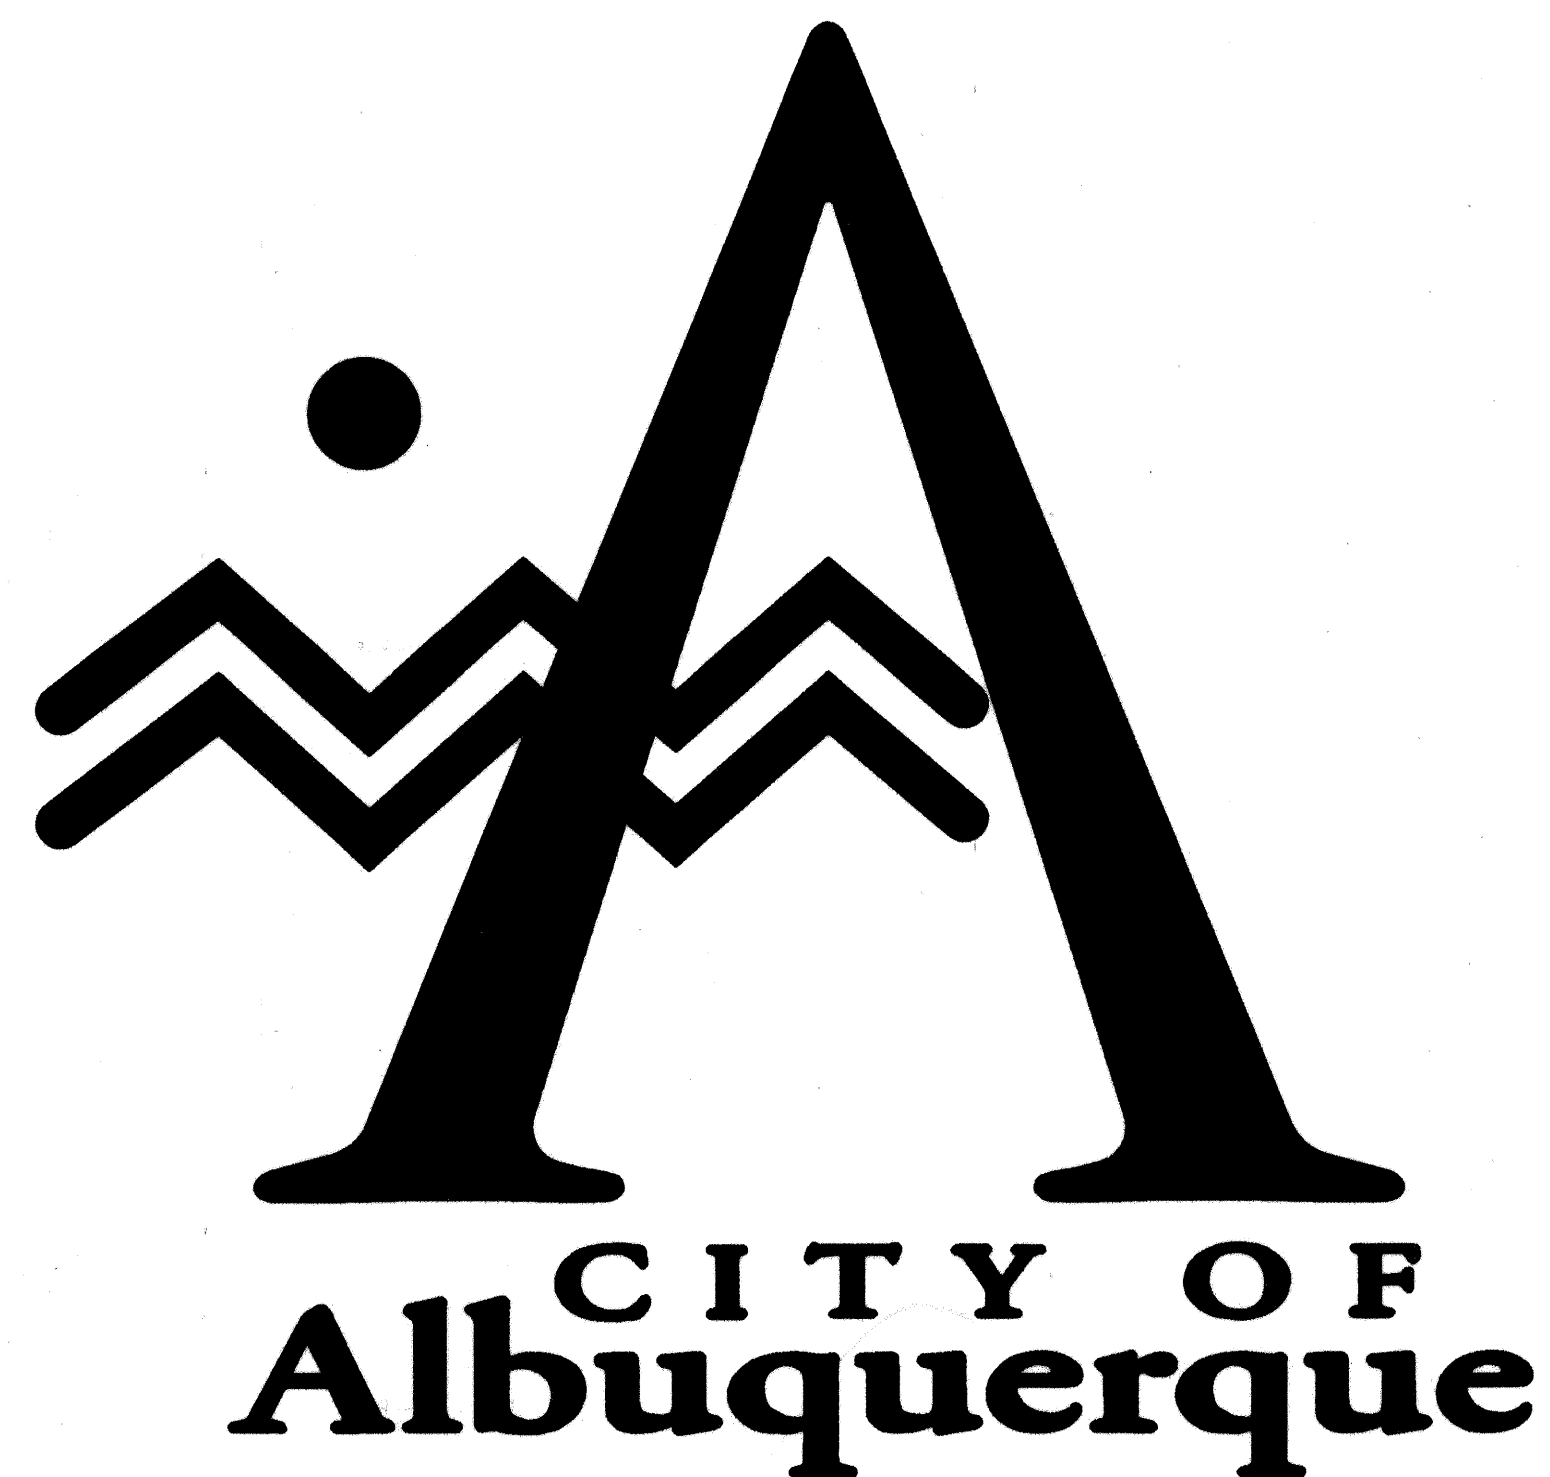

RENOVATION AND ADDITION TO TAFT MIDDLE SCHOOL

WATER LINE LOOP EXTENSION

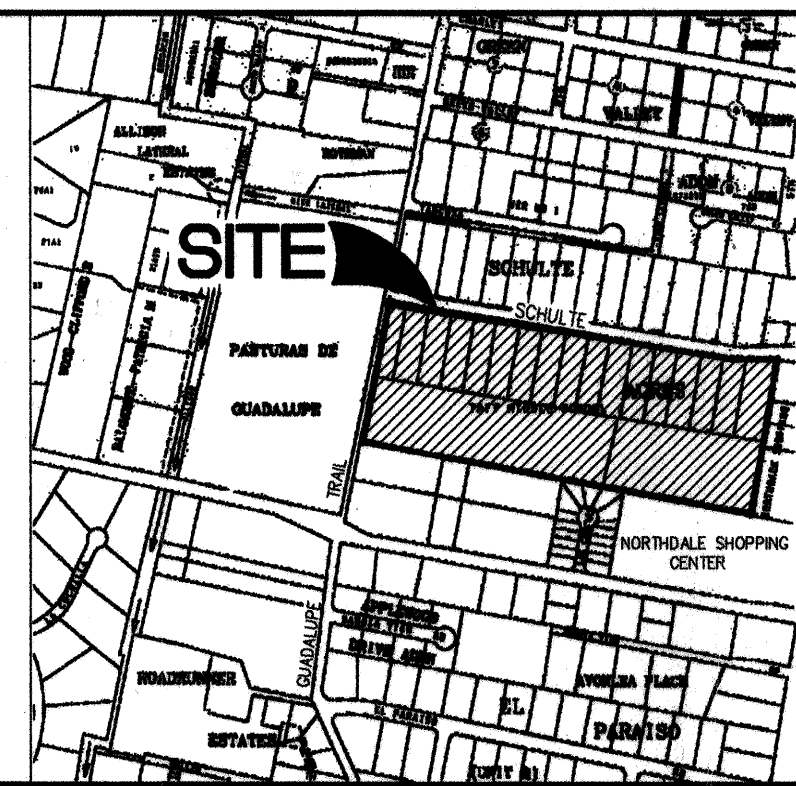

VICINITY MAP E-14-Z

GENERAL NOTES


1. AN EXCAVATION/CONSTRUCTION PERMIT WILL BE REQUIRED BEFORE BEGINNING ANY WORK WITHIN CITY RIGHT-OF-WAY. AN APPROVED COPY OF THESE PLANS MUST BE SUBMITTED AT THE TIME OF APPLICATION FOR THIS PERMIT.
2. ALL WORK DETAILED ON THESE PLANS TO BE PERFORMED, EXCEPT AS OTHERWISE STATED OR PROVIDED HEREON, SHALL BE CONSTRUCTED IN ACCORDANCE WITH CITY OF ALBUQUERQUE STANDARD SPECIFICATIONS FOR PUBLIC WORKS CONSTRUCTION, 1986 EDITION AS REVISED THROUGH UPDATE #6.
3. TWO WORKING DAYS PRIOR TO ANY EXCAVATION, CONTRACTOR MUST CONTACT LINE LOCATING SERVICE, (260-1990) FOR LOCATION OF EXISTING UTILITIES.
4. PRIOR TO CONSTRUCTION, THE CONTRACTOR SHALL EXCAVATE AND VERIFY THE HORIZONTAL AND VERTICAL LOCATIONS OF ALL PERTINENT EXISTING UTILITIES. SHOULD A CONFLICT EXIST, THE CONTRACTOR SHALL NOTIFY THE ENGINEER SO THAT THE CONFLICT CAN BE RESOLVED WITH A MINIMUM AMOUNT OF DELAY.
5. THREE WORKING DAYS PRIOR TO BEGINNING CONSTRUCTION THE CONTRACTOR SHALL SUBMIT TO THE CONSTRUCTION COORDINATION DIVISION A DETAILED CONSTRUCTION SCHEDULE. TWO WORKING DAYS PRIOR TO CONSTRUCTION, THE CONTRACTOR SHALL OBTAIN A BARRICADING PERMIT FROM THE CONSTRUCTION COORDINATION DIVISION. CONTRACTOR SHALL NOTIFY BARRICADE ENGINEER (765-2551) PRIOR TO OCCUPYING PUBLIC RIGHT-OF-WAY. SEE SECTION 19 OF THE SPECIFICATIONS.
6. ALL STREET STRIPING ALTERED OR DESTROYED SHALL BE REPLACED WITH PLASTIC REFLECTORIZED PAVEMENT MARKINGS BY CONTRACTOR TO SAME LOCATION AS EXISTING OR AS INDICATED BY THIS PLAN SET.
7. CONTRACTOR SHALL COORDINATE WITH WATER SYSTEMS DIVISION (857-8200) FIVE WORKING DAYS IN ADVANCE OF ANY WORK THAT MAY AFFECT EXISTING PUBLIC WATER OR SEWER UTILITIES. EXISTING VALVES TO BE OPERATED BY CITY PERSONNEL ONLY.
8. CONTRACTOR SHALL RECORD DATA ON ALL UTILITY LINES AND ACCESSORIES AS REQUIRED BY THE CITY OF ALBUQUERQUE FOR THE PREPARATION OF "AS CONSTRUCTED" DRAWINGS. CONTRACTOR SHALL NOT COVER UTILITY LINES AND ACCESSORIES UNTIL ALL DATA HAS BEEN RECORDED.
9. CONTRACTOR SHALL NOTIFY THE ENGINEER NOT LESS THAN SEVEN (7) DAYS PRIOR TO STARTING WORK IN ORDER THAT THE CITY SURVEYOR MAY TAKE NECESSARY MEASURES TO INSURE THE PRESERVATION OF SURVEY MONUMENTS. CONTRACTOR SHALL NOT DISTURB PERMANENT SURVEY MONUMENTS WITHOUT THE CONSENT OF THE CITY SURVEYOR AND SHALL NOTIFY THE CITY SURVEYOR AND BEAR THE EXPENSE OF REPLACING ANY THAT MAY BE DISTURBED.

LEGEND

DESCRIPTION	EXISTING	NEW
ASPHALT PATCH		
WATER LINE	---W---	---W---
FIRE HYDRANT		
WATER METER		
WATER VALVE		

ABBREVIATIONS

LF = LINEAR FEET	STA = STATION
LT = LEFT	TYP = TYPICAL
RT = RIGHT	TA = TOP OF ASPHALT
TC = TOP OF CURB	TP = TOP OF PIPE
FL = FLOWLINE	EXIST = EXISTING
LF = LINEAR FEET	W = WATER LINE

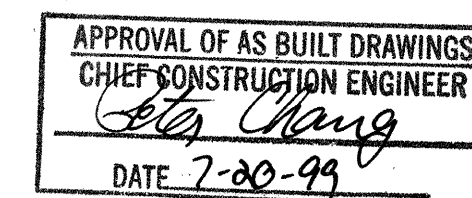



INDEX OF DRAWINGS

SHEET	TITLE
1	TITLE SHEET, INDEX, GENERAL NOTES, LEGEND, AND ABBREVIATIONS
2	WATER LINE PLAN AND PROFILE
3	WATER LINE PLAN AND PROFILE

CERTIFICATION
THESE DRAWINGS HAVE BEEN REVISED IN
ACCORDANCE WITH INFORMATION FURNISHED
BY JEFF MOXTENSEN & ASSOC.
TO REFLECT THE CONSTRUCTION AS
ACTUALLY COMPLETED.
DATE 4/9/98


RECORD DRAWING
DATE 4-9-98

REV.	SHEETS	CITY ENGINEER	DATE	USER DEPARTMENT	DATE	USER DEPARTMENT	DATE
ENGINEER'S STAMP & SIGNATURE		APPROVALS		ENGINEER		DATE	
		DRC Chairman		Billy P. Ambrey		2-13-97	
		Transportation		N/A		1-7-96	
		Water/Wastewater		John A. Grogan		1-7-97	
		Hydrology		N/A		1-21-97	
Const. Mngmt.		C.I.P.		S.M.		1-21-97	
City Project No.				558681			
Sheet				Of			
1				3			

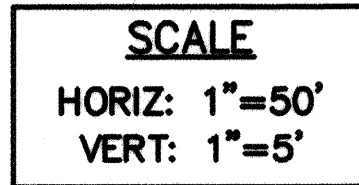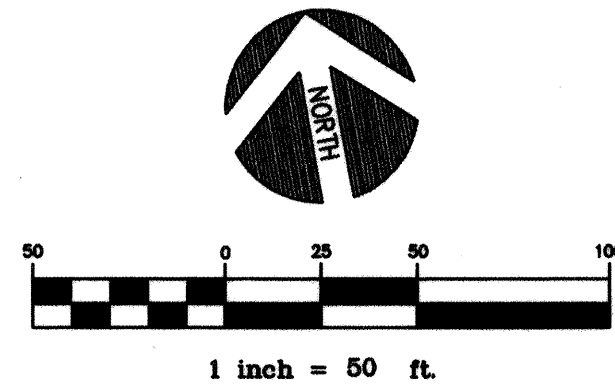


MATCHLINE - STA: 22+00.00
SEE NEXT SHEET

MATCHLINE - STA: 22+00.00
SEE NEXT SHEET

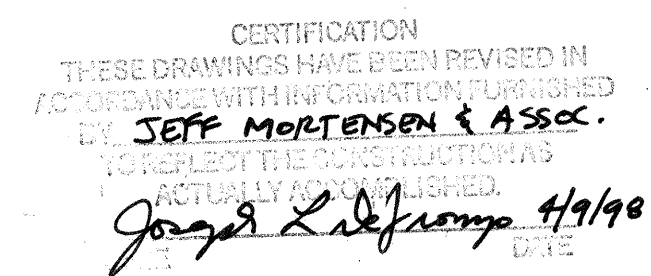

RECORD DRAWING
DATE 4-9-98

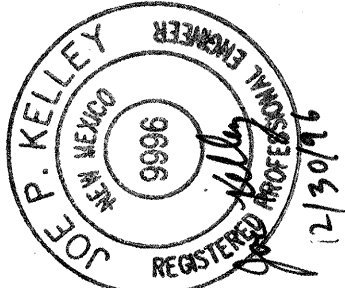[illegible]

 **CHAVEZ • GRIEVES**
CONSULTING ENGINEERS, INC.
5639 JEFFERSON STREET N.E. • ALBUQUERQUE, NEW MEXICO 87109
PHONE (505) 344-4080 • FAX (505) 343-8759

CITY OF ALBUQUERQUE
PUBLIC WORKS DEPARTMENT
ENGINEERING DEVELOPMENT GROUP

**TITLE: RENOVATION AND ADDITION TO TAFT MIDDLE SCHOOL
WATER LINE PLAN & PROFILE**

Design Review Committee
APPROVED
FEB 13 1997
DESIGN
REVIEW COMMITTEE

City Engineer Approval

Fast Design Update




Mo./Day/Yr.	Mo./Day/Yr.

City Project No.

558681

Zone Map No.
E-14-Z

Sheet 2 of 3

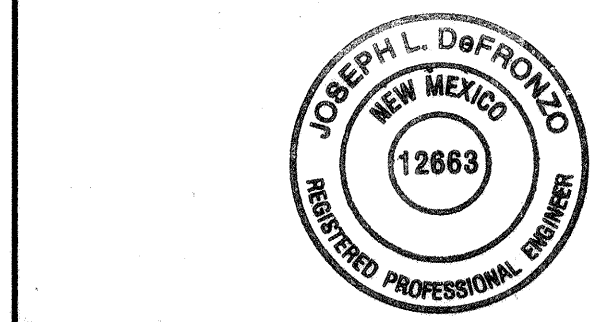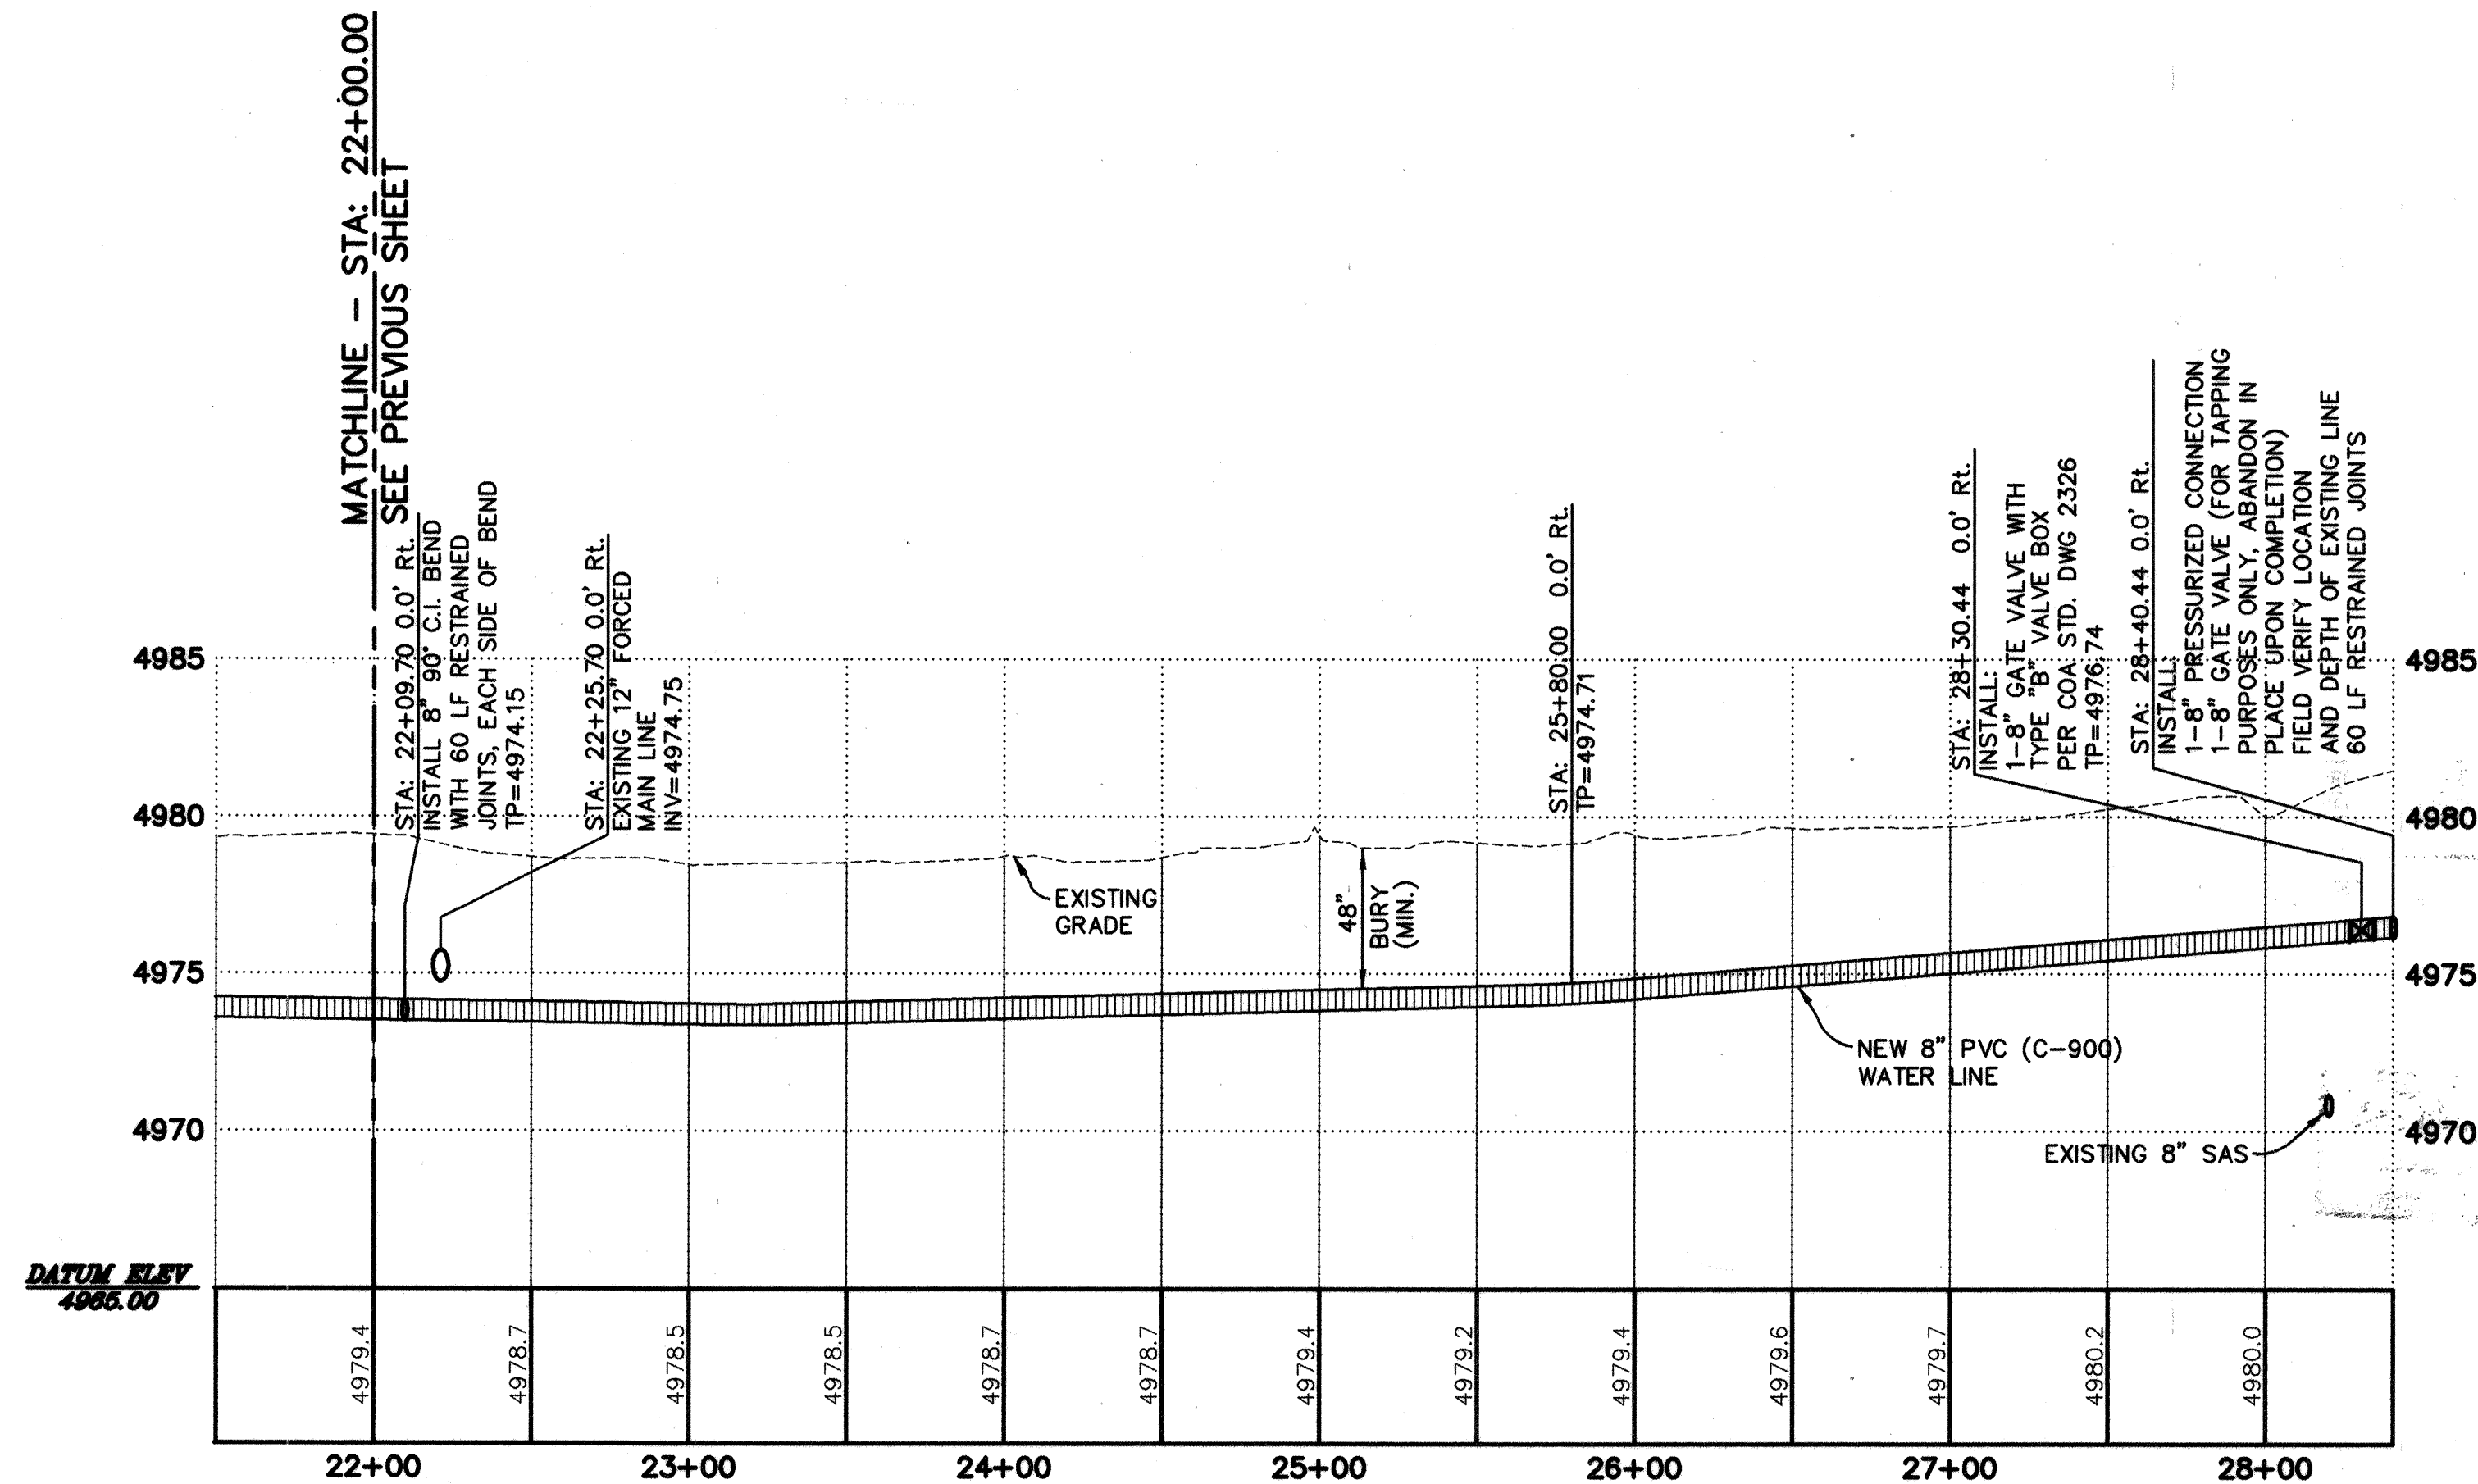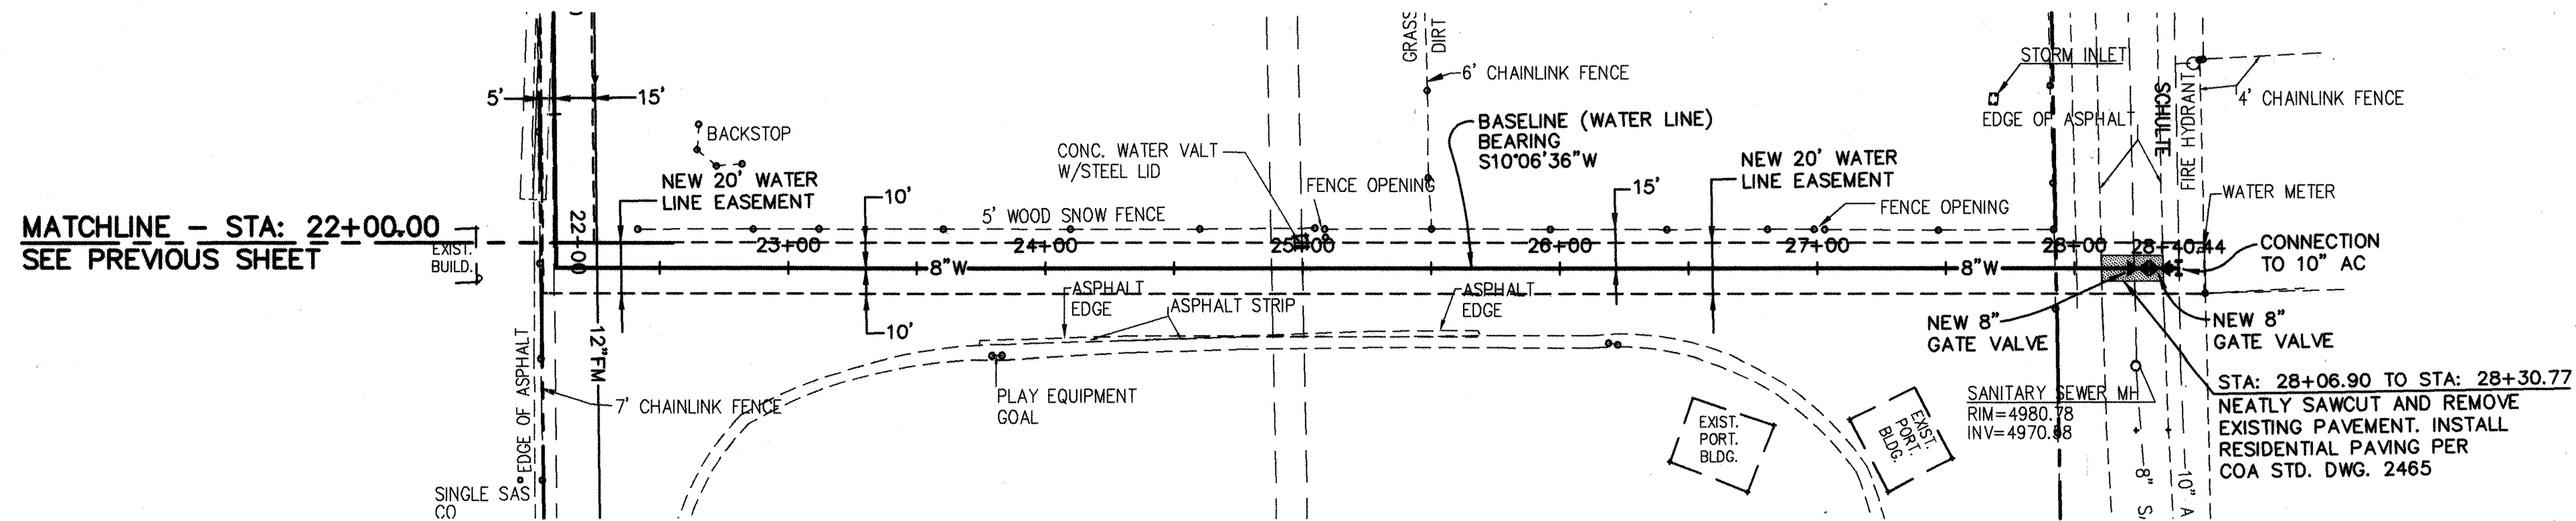

CERTIFICATION
THESE DRAWINGS HAVE BEEN REVIEWED BY
JEFF MORTENSEN & ASSOC.
DATE: 4-9-98

RECORD DRAWING
DATE: 4-9-98



CITY OF ALBUQUERQUE
PUBLIC WORKS DEPARTMENT
ENGINEERING DEVELOPMENT GROUP

TITLE: RENOVATION AND ADDITION TO TAFT MIDDLE SCHOOL
WATER LINE PLAN & PROFILE

Design Review Committee APPROVE FEB 13 1997	City Engineer Approval	Mo./Day/Yr.	Mo./Day/Yr.
DESIGN REVIEW COMMITTEE			
City Project No. 558681	Zone Map No. E-14-Z	Sheet 3 of 3	

ENGINEER'S SEAL		SURVEY INFORMATION		BENCH MARKS		AS BUILT INFORMATION	
NO.	DATE	BY	DATE	BENCHMARK 16-115: A "X" CUT ON THE NORTHEAST CORNER OF AN ABANDONED CONCRETE SIGN BASE	CONTRACTOR	DATE	DATE
	07/95	JEFF MORTENSEN	07/95	LOCATED AT THE SOUTHEAST QUADRANT OF THE INTERSECTION OF FORTH ST. AND SHULTE ROAD N.W.	INSPECTOR'S FIELD VERIFICATION BY	DATE	DATE
		AND ASSOCIATES		ELEVATION = 4984.02 FEET (M.S.L.D.)	CONTRACTOR'S FIELD VERIFICATION BY	DATE	DATE
					RECORDED BY	DATE	DATE
					NO.		