

CONSTRUCTION PLANS FOR QUAIL SPRINGS ESTATES

ROADWAY & UTILITY DESIGN

JANUARY 1997

TW


INDEX TO DRAWINGS

- | | |
|--|--|
| 1. TITLE SHEET & INDEX TO DRAWINGS | 15. UTILITY IMPROVEMENTS-GROUSE RIDGE DRIVE
STA 10+00.00 TO 12+74.00 |
| 2. PLAT-A | 16. UTILITY IMPROVEMENTS-SIGNAL AVENUE (OFF-SITE)
STA 1+00.00 TO 13+30.42 |
| 3. PLAT-B | 17. UTILITY IMPROVEMENTS-LOUISIANA BOULEVARD (OFF-SITE)
STA 13+30.42 TO 24+30.32 |
| 4. GRADING AND DRAINAGE PLAN-A | 18. UTILITY IMPROVEMENTS-OAKLAND AVENUE
STA 1+00.00 TO 11+50.00 |
| 5. GRADING AND DRAINAGE PLAN-B | 19. UTILITY IMPROVEMENTS-OAKLAND AVENUE
STA 11+50.00 TO 19+25.00 |
| 6. MASTER PAVING PLAN | 20. STORM SEWER IMPROVEMENTS-OAKLAND AVE.
STA 1+00.00 TO 11+89.50 |
| 7. PAVING IMPROVEMENTS-QUAIL SPRINGS PLACE
STA 10+00.00 TO 18+68.31 | 21. STORM SEWER IMPROVEMENTS
OAKLAND AVE. / QUAIL SPRINGS PLACE |
| 8. PAVING IMPROVEMENTS-QUAIL SPRINGS PLACE
STA 18+68.31 TO 25+22.94 | 22. RETAINING WALL
LOTS 57-59 AND LOTS 39-48 |
| 9. PAVING IMPROVEMENTS-GROUSE RIDGE DRIVE
STA 10+00.00 TO 12+64.00 | 23. RETAINING WALL
LOTS 29-38 AND LOTS 27-29 |
| 10. PAVING IMPROVEMENTS-OAKLAND AVENUE
STA 10+00.00 TO 18+85.00 | 16A PAVING IMPROVEMENTS - SIGNAL AVENUE (OFF-SITE) 
STA 1+00.00 TO 13+30.42 |
| 11. PAVING IMPROVEMENTS-OAKLAND AVENUE
STA 18+85.00 TO 27+36.67 | 17A UTILITY IMPROVEMENTS - LOUISIANA BLVD (OFF-SITE) 
STA 1+00.00 TO 6+15.11 |
| 12. MASTER UTILITY PLAN SHEET "A" | |
| 12A. MASTER UTILITY PLAN SHEET "B" | |
| 13. UTILITY IMPROVEMENTS-QUAIL SPRINGS PLACE
STA 1+00.00 TO 10+00.50 | |
| 14. UTILITY IMPROVEMENTS-QUAIL SPRINGS PLACE
STA 10+00.50 TO 16+35.13 | |

SCANNED BY
BY LASON

DRB NO. 96-215

30/950057/9557T.DWG/JDN/01-19-97

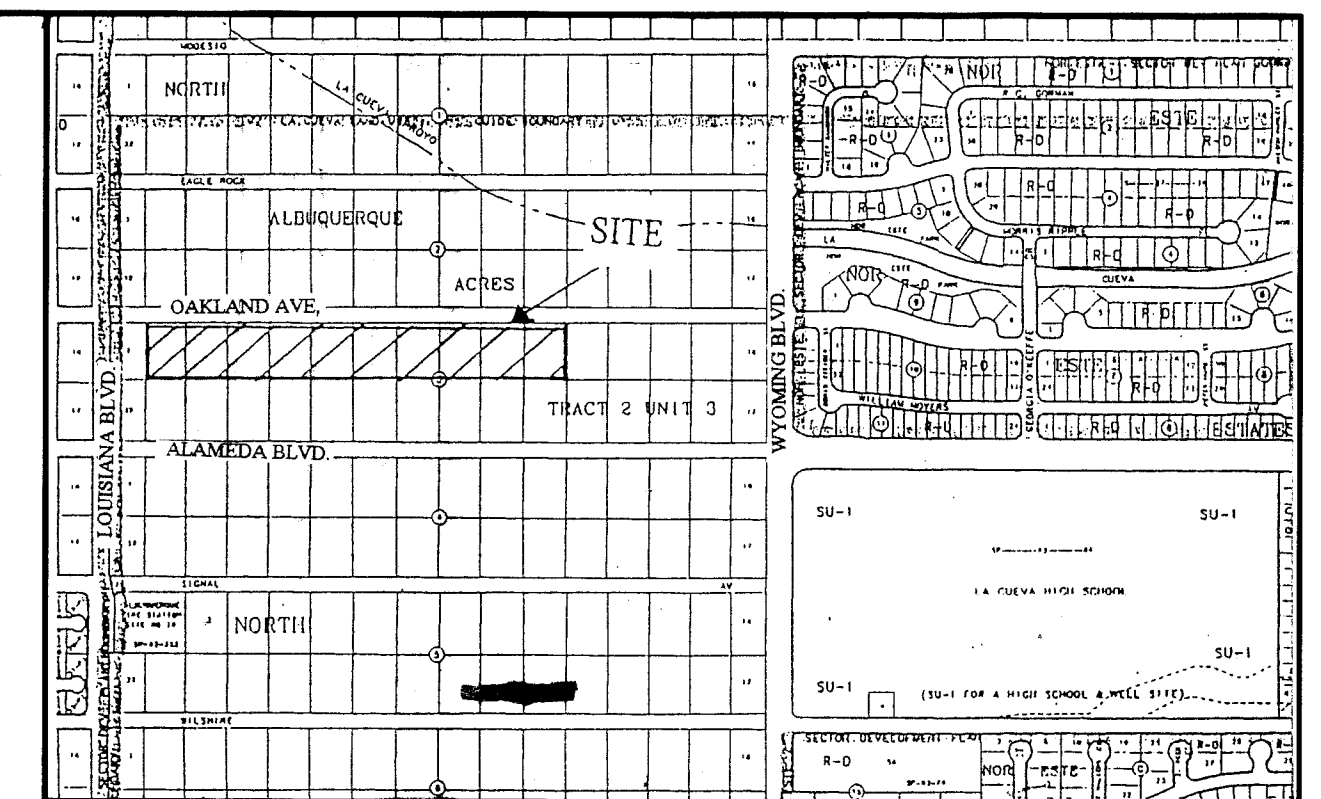

VICINITY MAP

C-19-Z

SCALE NONE

NOTICE TO CONTRACTORS

1. ALL WORK DETAILED ON THESE PLANS TO BE PERFORMED UNDER CONTRACT SHALL, EXCEPT AS OTHERWISE STATED OR PROVIDED FOR HEREON, BE CONSTRUCTED IN ACCORDANCE WITH THE CITY OF ALBUQUERQUE STANDARD SPECIFICATIONS FOR PUBLIC WORKS CONSTRUCTION, 1986 EDITION (UPDATE #6)

2. TWO WORKING DAYS PRIOR TO ANY EXCAVATION, THE CONTRACTOR MUST CONTACT NEW MEXICO ONE CALLS SYSTEM (260-1990) FOR LOCATION OF EXISTING UTILITIES.

3. ANY WORK AFFECTING AN ARTERIAL ROADWAY REQUIRES 24-HOUR CONSTRUCTION.

4. PRIOR TO CONSTRUCTION, THE CONTRACTOR SHALL EXCAVATE AND VERIFY THE HORIZONTAL AND VERTICAL LOCATIONS OF ALL OBSTRUCTIONS. SHOULD A CONFLICT EXIST, THE CONTRACTOR SHALL NOTIFY THE ENGINEER OR SURVEYOR IMMEDIATELY SO THAT THE CONFLICT CAN BE RESOLVED WITH A MINIMUM AMOUNT OF DELAY.

5. THREE(3) WORKING DAYS PRIOR TO BEGINNING OF CONSTRUCTION, THE CONTRACTOR SHALL SUBMIT TO CONSTRUCTION COORDINATIONS DIVISION A DETAILED CONSTRUCTION SCHEDULE. TWO(2) WORKING DAYS PRIOR TO CONSTRUCTION, THE CONTRACTOR SHALL OBTAIN A BARRICADING PERMIT FROM THE CONST. COORDINATION DIVISION. CONTRACTOR SHALL NOTIFY BARRICADE ENGINEER (768-2551) PRIOR TO OCCUPYING AN INTERSECTION. REFER TO STANDARD SPECIFICATIONS.

6. ALL STREET STRIPING ALTERED OR DESTROYED SHALL BE REPLACED WITH PLASTIC REFLECTORIZED PAVEMENT MARKINGS BY CONTRACTOR TO LOCATION AS EXISTING OR AS INDICATED BY THIS PLAN SET.

7. CONTRACTOR SHALL NOTIFY THE ENGINEER NOT LESS THAN SEVEN(7) DAYS PRIOR TO STARTING WORK IN ORDER THAT THE ENGINEER MAY TAKE NECESSARY MEASURES TO INSURE THE PRESERVATION OF SURVEY MONUMENTS. CONTRACTOR SHALL NOT DISTURB PERMANENT SURVEY MONUMENTS WITHOUT THE CONSENT OF THE ENGINEER AND SHALL NOTIFY THE ENGINEER AND BEAR THE EXPENSE OF REPLACING ANY THAT MAY BE DISTURBED WITHOUT PERMISSION. REPLACEMENT SHALL BE DONE ONLY BY THE CITY SURVEYOR. WHEN A CHANGE IS MADE IN THE FINISHED ELEVATIONS OF THE PAVEMENT OF ANY ROADWAY IN WHICH A PERMANENT SURVEY MONUMENT IS LOCATED, CONTRACTOR SHALL, AT HIS OWN EXPENSE, ADJUST THE MONUMENT COVER TO THE NEW GRADE UNLESS OTHERWISE SPECIFIED. REFER TO SECTION 4.4 OF THE GENERAL CONDITIONS OF THE STANDARD SPECIFICATIONS. ANY PERMANENT SURVEY MONUMENT LOCATED WITHIN 50' OF THIS PROJECT THAT IS NOT SHOWN ON THE PLAN AND IS DESTROYED DURING CONSTRUCTION WILL BE REPLACED AT THE DESIGNERS EXPENSE.

THE FOLLOWING NOTES ALSO APPLY WHEN CHECKED

☒ ALL UTILITIES AND UTILITY SERVICE LINES SHALL BE INSTALLED PRIOR TO PAVING.

☒ BACKFILL COMPACTION SHALL BE ACCORDING TO SPECIFIED STREET USE.

☐ TACK COAT REQUIREMENTS SHALL BE DETERMINED BY THE CITY ENGINEER.

☒ SIDEWALKS AND WHEELCHAIR RAMPS WITHIN THE CURB RETURNS SHALL BE CONSTRUCTED WHEREVER A NEW CURB RETURN IS CONSTRUCTED.

☐ IF CURB IS DEPRESSED FOR A DRIVEPAD, THE DRIVEPAD SHALL BE CONSTRUCTED PRIOR TO ACCEPTANCE OF CURB AND GUTTER.


☒ ALL STORM DRAINAGE FACILITIES SHALL BE COMPLETED PRIOR TO FINAL ACCEPTANCE.


RECORD DRAWING	
DATE: 8-21-97	DRAFTED BY: RW
TIERRA WEST DEV.	
THESE RECORD DRAWINGS HAVE BEEN PREPARED, IN PART, ON THE BASIS OF INFORMATION COMPILED AND FURNISHED BY OTHERS. THE ENGINEER WILL NOT BE RESPONSIBLE FOR ANY ERRORS OR OMISSIONS WHICH HAVE BEEN INCORPORATED INTO THE DOCUMENT AS A RESULT.	

TIERRA WEST DEVELOPMENT MANAGEMENT SERVICES EXPRESSLY RESERVES THE COMMON LAW COPYRIGHT AND OTHER PROPERTY RIGHTS IN THESE PLANS. THESE PLANS ARE NOT TO BE REPRODUCED, CHANGED OR COPIED IN ANY MANNER WHATSOEVER, NOR ARE THEY TO BE ASSIGNED TO ANY THIRD PARTY WITHOUT OBTAINING THE EXPRESS WRITTEN PERMISSION AND CONSENT OF TIERRA WEST DEVELOPMENT MANAGEMENT SERVICES.

TIERRA WEST DEVELOPMENT MANAGEMENT SERVICES	
4421 McLEOD ROAD, N.E., SUITE D ALBUQUERQUE, NEW MEXICO 87109 (505)883-7592	

16, 16A, 17A	1, 17	Billy G. Amodeo 5/26/97	R.W. Kane 5-1-97	Am. Budak 5-12-97
--------------	-------	-------------------------	------------------	-------------------

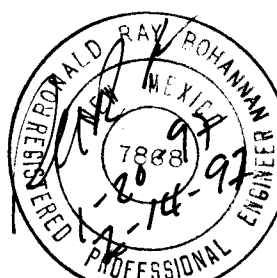REV	SHEETS	CITY ENGINEER	DATE	USER DEPT.	DATE	USER DEPT.	DATE
ENGINEERS STAMP & SIGNATURE		APPROVALS	ENGINEER	DATE	*****		
		DRC Chairman	Billy G. Amodeo	2-26-97	APPROVED FOR CONSTRUCTION		
		Transportation	R.W. Kane	2-26-97			
		Water/Wastewater	John Coleman	2-26-97			
		Hydrology					
		Parks					
		Constr. Mngmt.					
CITY PROJECT NO. 559081					SHEET 1 OF 23		

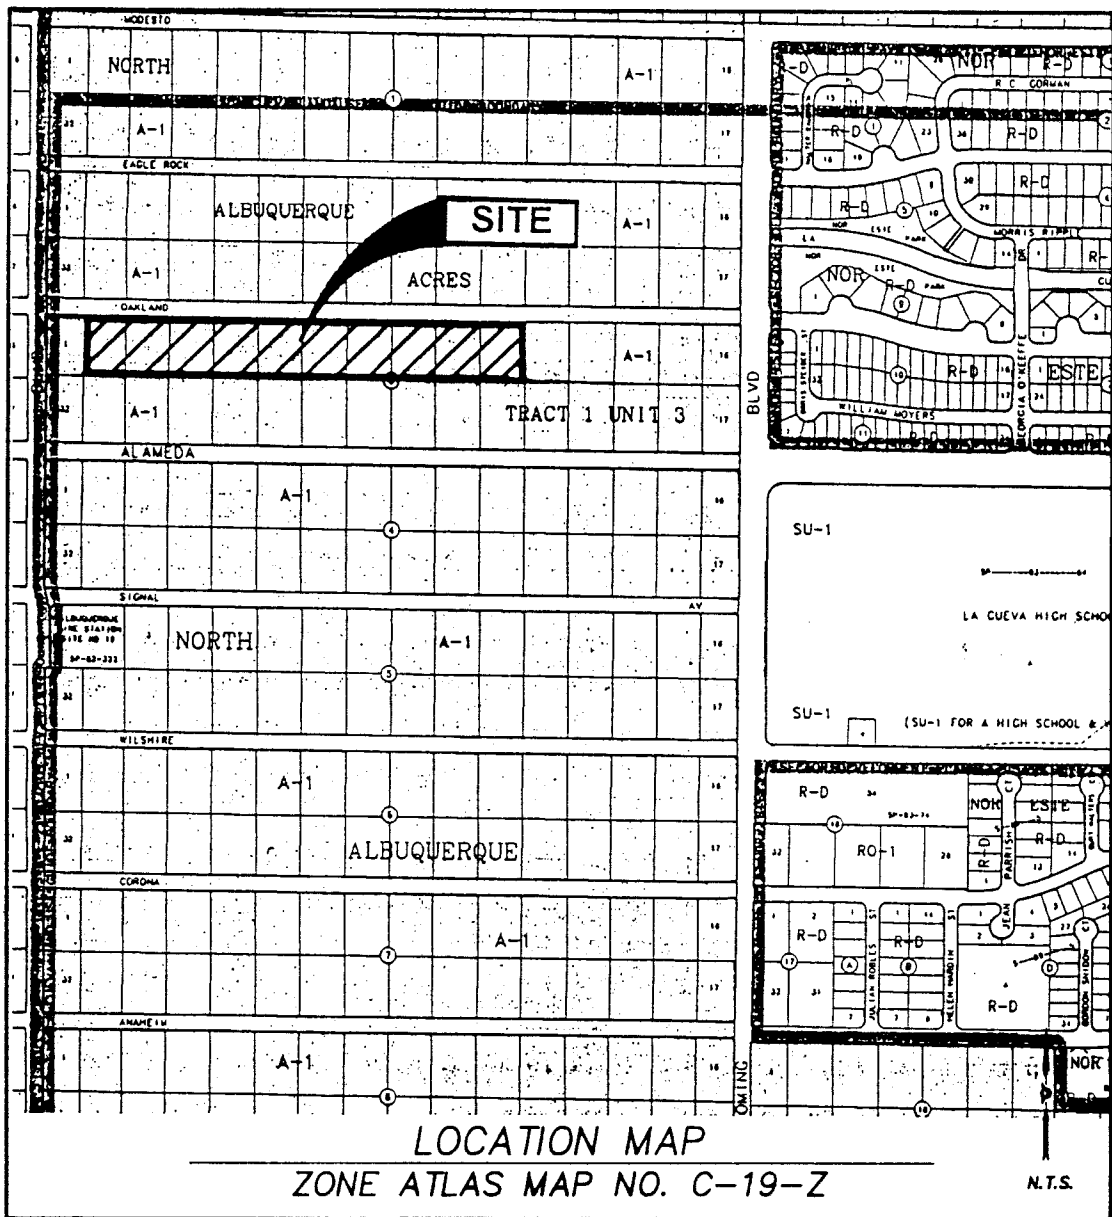

LEGAL DESCRIPTION

A TRACT OF LAND COMPRISING OF LOTS NUMBERED TWO (2) THROUGH ELEVEN (11) INCLUSIVE, IN BLOCK NUMBERED THREE (3) OF NORTH ALBUQUERQUE ACRES, TRACT 2 UNIT 3, AS THE SAME ARE SHOWN AND DESIGNATED ON THE PLAT THEREOF FILED IN THE OFFICE OF THE COUNTY CLERK OF BERNALILLO COUNTY, NEW MEXICO ON SEPTEMBER 10, 1931 IN VOLUME D1, FOLIO 20, SITUATE WITHIN PROJECTED SECTION 18, TOWNSHIP 11 NORTH, RANGE 4 EAST, N.M.P.M., ELENA GALLEGOS GRANT, BEING MORE PARTICULARLY DESCRIBED AS FOLLOWS:

BEGINNING AT THE NORTHWEST CORNER OF SAID TRACT LYING ON THE SOUTH RIGHT OF WAY LINE OF OAKLAND AVENUE, N.E., MARKED BY A FOUND REBAR WITH CAP "LS 6446" FROM WHENCE A TIE TO ACS MONUMENT "10C-18" BEARS N 69°15'45" W, A DISTANCE OF 2,964.48 FEET;

THENCE FROM SAID BEGINNING POINT S 89°38'30" E ALONG SAID RIGHT OF WAY LINE, A DISTANCE OF 1,649.07 FEET TO THE NORTHEAST CORNER OF SAID TRACT, MARKED BY A FOUND NO. 4 REBAR FROM WHENCE A TIE TO ACS MONUMENT "11C-18" BEARS N 65°38'08" W, A DISTANCE OF 2,026.38 FEET;

THENCE LEAVING SAID RIGHT OF WAY LINE S 00°13'03" W, A DISTANCE OF 235.34 FEET TO THE SOUTHEAST CORNER OF SAID TRACT MARKED BY A SET REBAR WITH CAP "PS 11993" FROM WHENCE A TIE TO ACS MONUMENT "HEAVEN" BEARS S 04°25'30" E, A DISTANCE OF 4,041.18 FEET;

THENCE N 89°40'10" W, A DISTANCE OF 1,649.48 FEET TO THE SOUTHWEST CORNER OF SAID TRACT MARKED BY A SET REBAR WITH CAP "PS 11993" FROM WHENCE A TIE TO ACS MONUMENT "10C-19" BEARS S 02°10'03" W, A DISTANCE OF 3,932.74 FEET;

THENCE N 00°19'02" E, A DISTANCE OF 236.14 FEET TO THE POINT OF BEGINNING CONTAINING 8.926 ACRES MORE OR LESS, NOW COMPRISING LOTS 1 THROUGH 60, QUAIL SPRINGS ESTATES.

EASEMENTS

THIS PLAT SHOWS EXISTING RECORDED AND APPARENT EASEMENTS AS NOTED.

PUBLIC UTILITY EASEMENTS SHOWN ON THIS PLAT ARE GRANTED FOR THE COMMON AND JOINT USE OF:

1. PNM ELECTRIC SERVICES FOR THE INSTALLATION, MAINTENANCE, AND SERVICE OF OVERHEAD AND UNDERGROUND ELECTRICAL LINES, TRANSFORMERS, POLES AND ANY OTHER EQUIPMENT, FIXTURES, STRUCTURES AND RELATED FACILITIES REASONABLY NECESSARY TO PROVIDE ELECTRICAL SERVICE.
2. PNM GAS SERVICES FOR INSTALLATION, MAINTENANCE, AND SERVICE OF NATURAL GAS LINES, VALVES AND OTHER EQUIPMENT AND FACILITIES REASONABLY NECESSARY TO PROVIDE NATURAL GAS.
3. U.S. WEST FOR THE INSTALLATION, MAINTENANCE AND SERVICE OF ALL BURIED AND AERIAL COMMUNICATION LINES AND OTHER RELATED EQUIPMENT AND FACILITIES REASONABLY NECESSARY TO PROVIDE COMMUNICATION SERVICES, INCLUDING BUT NOT LIMITED TO ABOVE GROUND PEDESTALS AND CLOSURES.
4. JONES INTERCABLE FOR THE INSTALLATION, MAINTENANCE, AND SERVICE OF SUCH LINES, CABLE, AND OTHER RELATED EQUIPMENT AND FACILITIES REASONABLY NECESSARY TO PROVIDE CABLE TV SERVICE.

INCLUDED IS THE RIGHT TO BUILD, REBUILD, CONSTRUCT, RECONSTRUCT, LOCATE, RELOCATE, CHANGE, REMOVE, MODIFY, RENEW, OPERATE, AND MAINTAIN FACILITIES FOR THE PURPOSES DESCRIBED ABOVE, TOGETHER WITH FREE ACCESS TO, FROM, AND OVER SAID EASEMENTS, INCLUDING SUFFICIENT WORKING AREA SPACE FOR ELECTRIC TRANSFORMERS, WITH THE RIGHT AND PRIVILEGE TO TRIM AND REMOVE TREES, SHRUBS OR BUSHES WHICH INTERFERE WITH THE PURPOSES SET FORTH HEREIN, NO BUILDING, SIGN, POOL (ABOVEGROUND OR SUBSURFACE), HOT TUB, CONCRETE OR WOOD POOL DECKING, OR OTHER STRUCTURE SHALL BE ERECTED OR CONSTRUCTED ON SAID EASEMENTS, NOR SHALL ANY WELL BE DRILLED OR OPERATED THEREON, PROPERTY OWNERS SHALL BE SOLELY RESPONSIBLE FOR CORRECTING ANY VIOLATIONS OF NATIONAL ELECTRICAL SAFETY CODE CAUSED BY CONSTRUCTION OR POOLS, DECKING, OR ANY STRUCTURES ADJACENT TO WITHIN OR NEAR EASEMENTS SHOWN ON THIS PLAT.

FREE CONSENT AND DEDICATION

THE REPLAT SHOWN HEREON IS WITH THE FREE CONSENT AND IN ACCORDANCE WITH THE DESIRES OF THE UNDERSIGNED OWNER AND/OR PROPRIETOR, EXISTING PUBLIC UTILITY EASEMENTS SHOWN HEREON FOR THE COMMON AND JOINT USE OF GAS, ELECTRICAL POWER AND COMMUNICATION SERVICES FOR BURIED DISTRIBUTION LINES, CONDUITS, AND PIPES FOR UNDERGROUND UTILITIES WHERE SHOWN OR INDICATED, AND INCLUDING THE RIGHT OF INGRESS AND EGRESS FOR CONSTRUCTION AND MAINTENANCE, AND THE RIGHT TO TRIM INTERFERING TREES AND SHRUBS, SAID OWNER AND/OR PROPRIETOR DOES HEREBY CERTIFY THAT THIS SUBDIVISION IS THEIR FREE ACT AND DEED, SAID OWNER AND/OR PROPRIETOR DOES HEREBY DEDICATE ALL STREETS AND PUBLIC RIGHTS OF WAY SHOWN HEREON TO THE CITY OF ALBUQUERQUE IN FEE SIMPLE WITH WARRANTY COVENANTS. EASEMENTS GRANTED AS SHOWN HEREON.

Ron Spradlin
CLARENCE O. ANDERSON AND JUDY ANDERSON
BY RON SPRADLIN, THEIR ATTORNEY IN FACT

9-25-96
DATE

ACKNOWLEDGEMENT

STATE OF NEW MEXICO)
COUNTY OF BERNALILLO)
THIS INSTRUMENT WAS ACKNOWLEDGED BEFORE ME THIS 25th DAY OF September, 1996
BY CLARENCE O. ANDERSON AND JUDY ANDERSON, BY RON SPRADLIN, THEIR ATTORNEY IN FACT.

Diana B. Baran
NOTARY PUBLIC
MY COMMISSION EXPIRES: 3-26-2000

PLAT OF LOTS 1 THRU 60 QUAIL SPRING ESTATES ALBUQUERQUE, BERNALILLO COUNTY, NEW MEXICO DECEMBER 1996

APPROVALS

CITY PLANNER, ALBUQUERQUE PLANNING DIVISION	DATE
CITY ENGINEER	DATE
A.M.A.F.C.A.	DATE
TRAFFIC ENGINEER	DATE
CITY SURVEYOR	DATE
PROPERTY MANAGEMENT	DATE
WATER RESOURCES DEPARTMENT	DATE
DESIGN AND DEVELOPMENT, CIP	DATE
PNM ELECTRIC SERVICES	DATE
PNM GAS SERVICES	DATE
U.S. WEST COMMUNICATIONS	DATE
JONES INTERCABLE, INC.	DATE

SUBDIVISION DATA:

GROSS SUBDIVISION ACREAGE: 8.926 ACRES±
ZONE ATLAS INDEX NO.: C-19-2
NO. OF TRACTS CREATED: 0
NO. OF LOTS CREATED: 60
MILES OF FULL-WIDTH STREETS CREATED: 0.321 MILE
DATE OF SURVEY: AUGUST 13, 1996 AND SEPTEMBER 10, 1996

NOTES:


1. MISC. DATA: ZONING A-1
2. BEARINGS SHOWN ARE GRID BEARINGS.
3. ALL DISTANCES ARE GROUND DISTANCES.
4. THIS PROPERTY LIES WITHIN PROJECTED SECTION 18, TOWNSHIP 11 NORTH, RANGE 4 EAST, N.M.P.M., ELENA GALLEGOS GRANT, BERNALILLO COUNTY, NEW MEXICO.
5. THE PURPOSE OF THIS PLAT IS TO REPLAT THE EXISTING TEN LOTS INTO 60 NEW LOTS, GRANT EASEMENTS AND DEDICATE RIGHT OF WAY.
6. PLAT SHOWS ALL EASEMENTS OF RECORD.
7. SP NO. 96021610570350

SURVEYOR'S CERTIFICATE

I, LARRY W. MEDRANO, A REGISTERED PROFESSIONAL SURVEYOR UNDER THE LAWS OF THE STATE OF NEW MEXICO, HEREBY CERTIFY THAT THIS PLAT WAS PREPARED FROM FIELD NOTES OF AN ACTUAL SURVEY MEETING THE MINIMUM REQUIREMENTS FOR MONUMENTATION AND SURVEYS OF THE CITY OF ALBUQUERQUE SUBDIVISION ORDINANCE AND OF STANDARDS FOR LAND SURVEYS OF THE N.M. BOARD OF REGISTRATION FOR ENGINEERS AND SURVEYORS AND IS TRUE AND CORRECT TO THE BEST OF MY KNOWLEDGE AND BELIEF, AND THAT NO ENCROACHMENTS EXIST EXCEPT AS NOTED ABOVE AND THAT ALL IMPROVEMENTS ARE SHOWN IN THEIR CORRECT LOCATION RELATIVE TO RECORD BOUNDARIES AS LOCATED BY THIS SURVEY.

Larry W. Medrano
LARRY W. MEDRANO
R.N.M.S. No. 11993

9/25/96
DATE

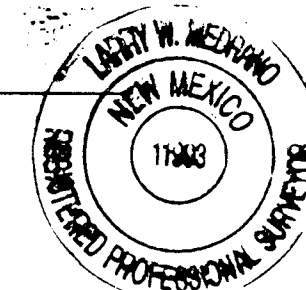


PRECISION SURVEYS, INC.

2829 COORS BLVD NW, SUITE 106
ALBUQUERQUE, NEW MEXICO 87120
PHONE 505 838 0569
FAX 505 838 4153


DRB CASE NO. 96-215
SHEET 1 OF 3

961365P

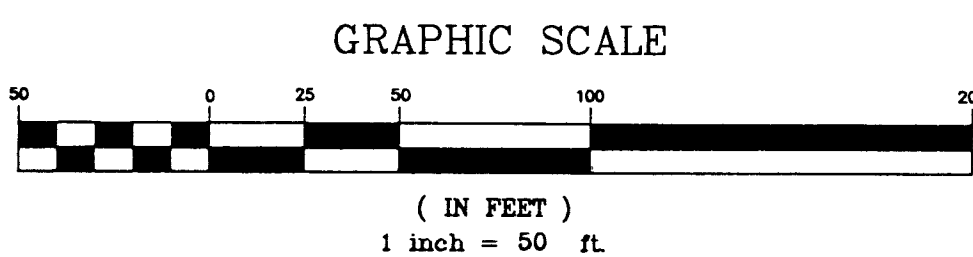

PLAT OF LOTS 1 THRU 60 QUAIL SPRING ESTATES ALBUQUERQUE, BERNALILLO COUNTY, NEW MEXICO DECEMBER 1996

ACS MONUMENT "10C-18"
NM STATE PLANE COORDINATES
CENTRAL ZONE - NAD 1927
X=402,316.45
Y=1,524,061.42
DELTA ALPHA=-0°11'18"
DELTA ALPHA=-0°11'18"
DELTA ALPHA=-0°11'18"

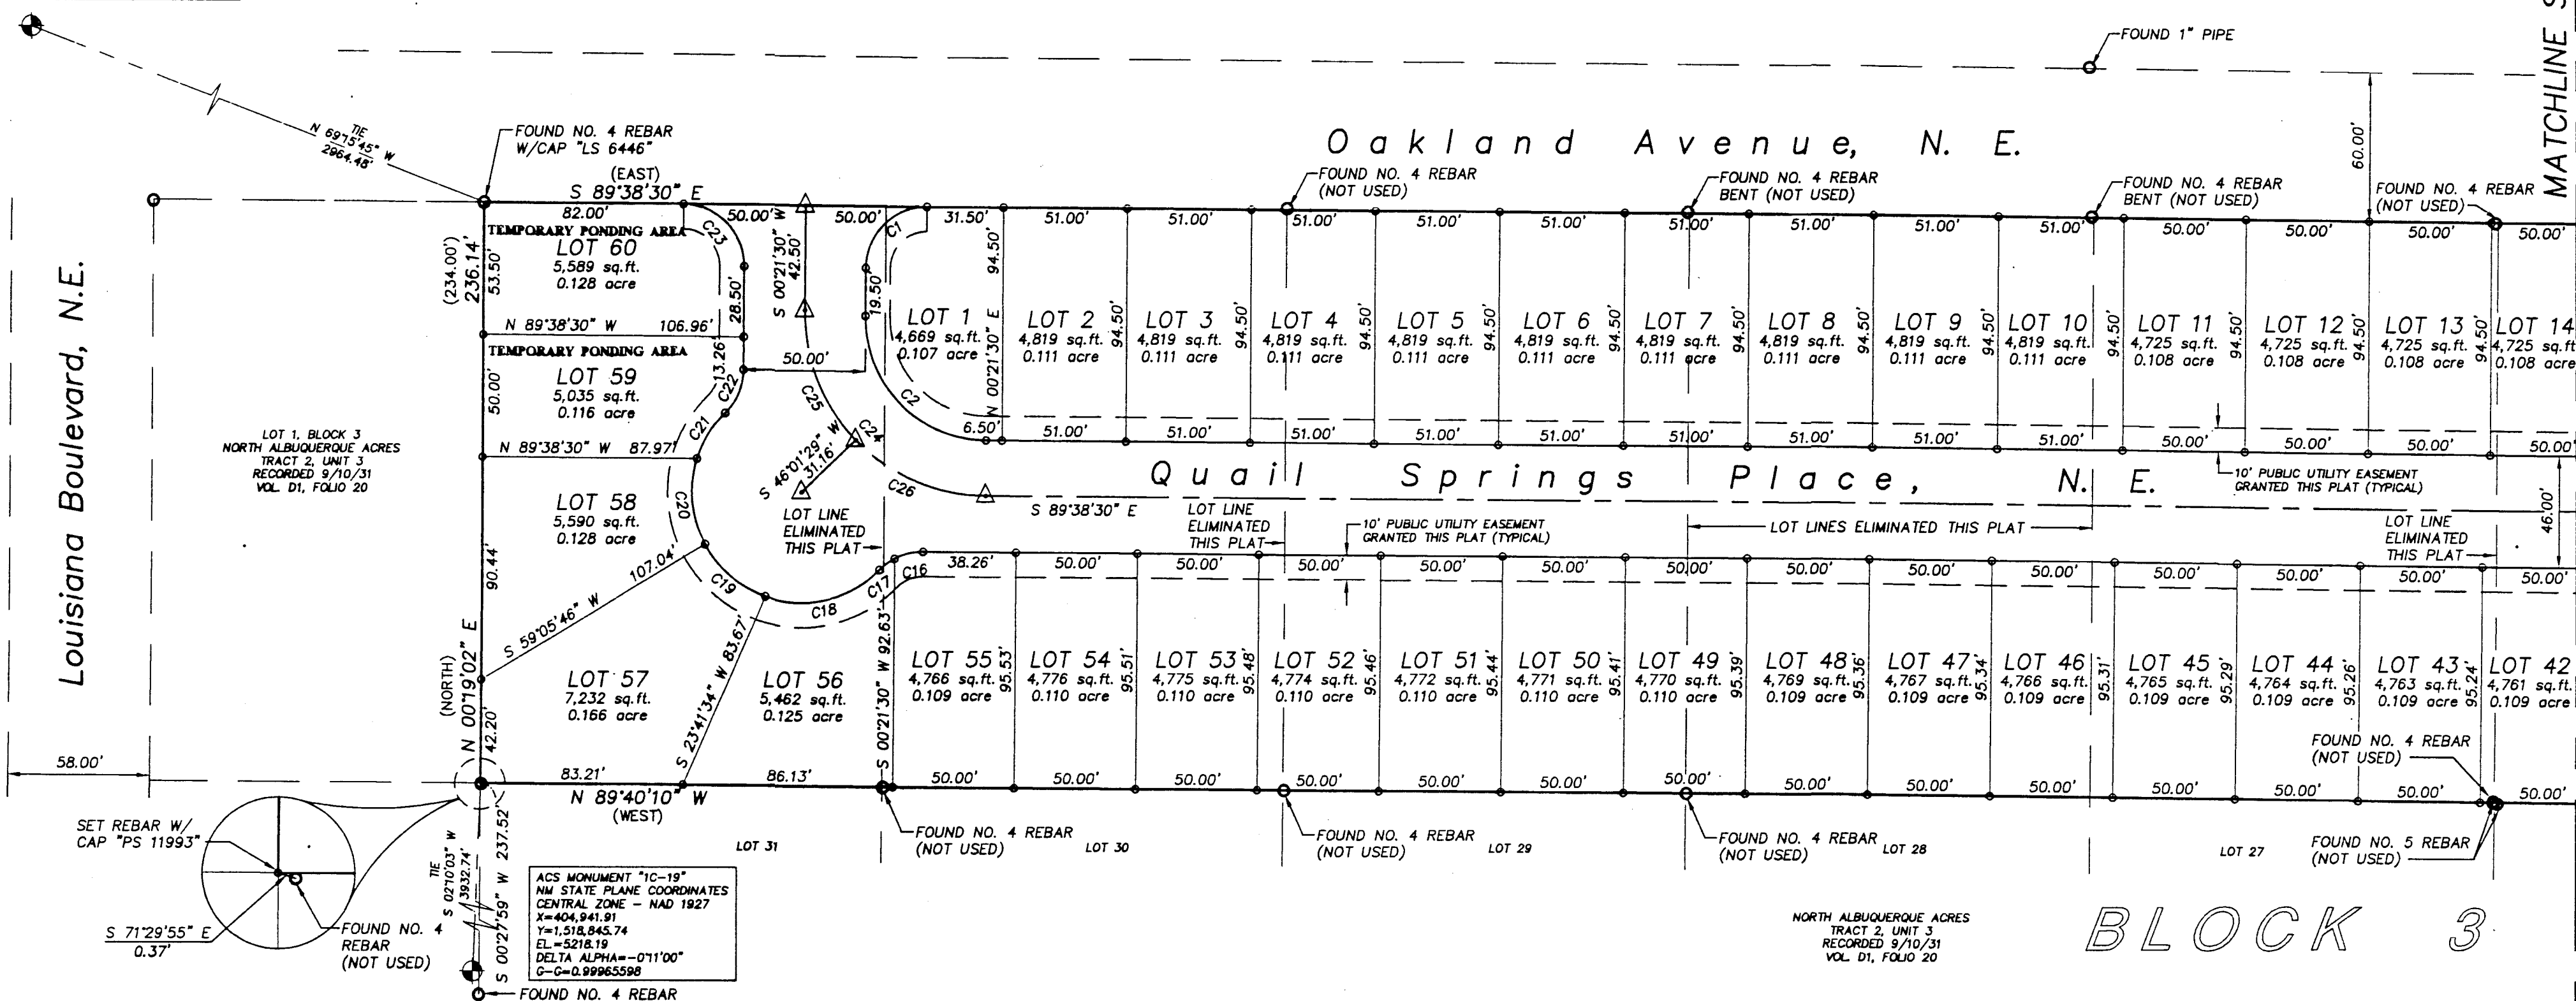

CURVE	RADIUS	LENGTH	TANGENT	CHORD	BEARING	DELTA
C1	25.00'	39.27'	25.00'	35.36'	S 45°21'30" W	90°00'00"
C2	50.00'	78.54'	50.00'	70.71'	N 44°38'30" W	90°00'00"
C3	25.00'	39.27'	25.00'	35.36'	N 45°21'30" E	90°00'00"
C4	25.00'	39.27'	25.00'	35.36'	N 44°38'30" W	90°00'00"
C5	25.00'	39.27'	25.00'	35.36'	N 45°21'30" E	90°00'00"
C6	25.00'	39.27'	25.00'	35.36'	N 44°38'30" E	90°00'00"
C7	25.00'	18.50'	9.70'	18.08'	N 69°09'31" E	42°23'58"
C8	40.00'	61.5'	3.08'	6.14'	S 52°21'42" W	08°48'20"
C9	40.00'	37.83'	20.46'	36.43'	S 83°51'23" W	54°11'03"
C10	40.00'	31.28'	16.49'	30.49'	N 46°38'49" W	44°48'34"
C11	40.00'	34.35'	18.31'	33.30'	N 00°21'30" E	49°12'02"
C12	40.00'	31.28'	16.49'	30.49'	S 47°21'49" W	44°48'34"
C13	40.00'	37.83'	20.46'	36.43'	S 83°08'23" E	54°11'03"
C14	40.00'	61.5'	3.08'	6.14'	S 51°38'42" E	08°48'20"
C15	25.00'	18.50'	9.70'	18.08'	S 68°26'31" E	42°23'58"
C16	25.00'	12.22'	6.23'	12.10'	N 76°21'17" E	28°00'25"
C17	25.00'	7.76'	3.91'	7.73'	S 53°27'32" W	17°47'06"
C18	45.00'	50.78'	28.48'	48.13'	N 76°53'36" E	64°39'15"
C19	45.00'	33.23'	17.41'	32.48'	N 49°37'29" W	42°18'35"
C20	45.00'	36.03'	19.04'	35.07'	N 05°31'58" W	45°52'27"
C21	45.00'	22.35'	11.41'	22.12'	N 31°37'55" E	26°27'18"
C22	25.00'	19.85'	10.48'	19.34'	N 23°06'32" E	45°30'04"
C23	25.00'	39.27'	25.00'	35.36'	N 44°38'30" W	90°00'00"
C24	75.00'	117.81'	75.00'	106.07'	N 44°38'30" W	90°00'00"
C25	75.00'	58.03'	30.56'	56.60'	N 21°43'51" W	44°20'01"
C26	75.00'	59.78'	31.58'	58.21'	N 66°48'31" W	45°39'59"

LEGEND

- POINT FOUND AND USED AS SHOWN
- POINT SET BY THIS SURVEY - REBAR W/CAP "PS 11993"
- △ CENTERLINE (IN LIEU OF R/W MONUMENTATION) TO BE INSTALLED AT ALL CENTERLINE P.C.'S, P.T.'S, ANGLE POINTS AND STREET INTERSECTIONS PRIOR TO ACCEPTANCE OF SUBDIVISION STREET IMPROVEMENTS AND WILL CONSIST OF A STANDARD FOUR-INCH (4") ALUMINUM ALLOY CAP STAMPED "CITY OF ALBUQUERQUE", "CENTERLINE MONUMENTATION", "SURVEY MARKER", "DO NOT DISTURB", "7-24-11993"


PRECISION SURVEYS, INC.

2829 COORS BLVD NW, SUITE 106
ALBUQUERQUE, NEW MEXICO 87120
PHONE 505 838 0569
FAX 505 838 4153

DRB CASE NO. 96-215
SHEET 2 OF 3


961365P

PLAT OF
LOTS 1 THRU 60
QUAIL SPRING ESTATES
ALBUQUERQUE, BERNALILLO COUNTY, NEW MEXICO
DECEMBER 1996

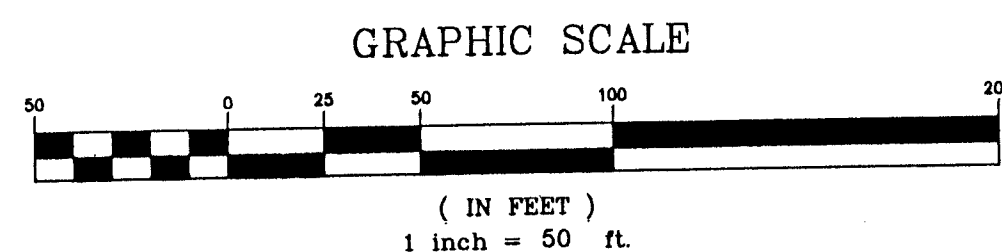

ACS MONUMENT "11C-18"
NM STATE PLANE COORDINATES
CENTRAL ZONE - NAD 1927
X=404,894.49
Y=1,323,837.39
EL.=5306.0
DELTA ALPHA=-0°11'00"
G=0.9996556

MATCHLINE SEE SHEET 2 OF 3

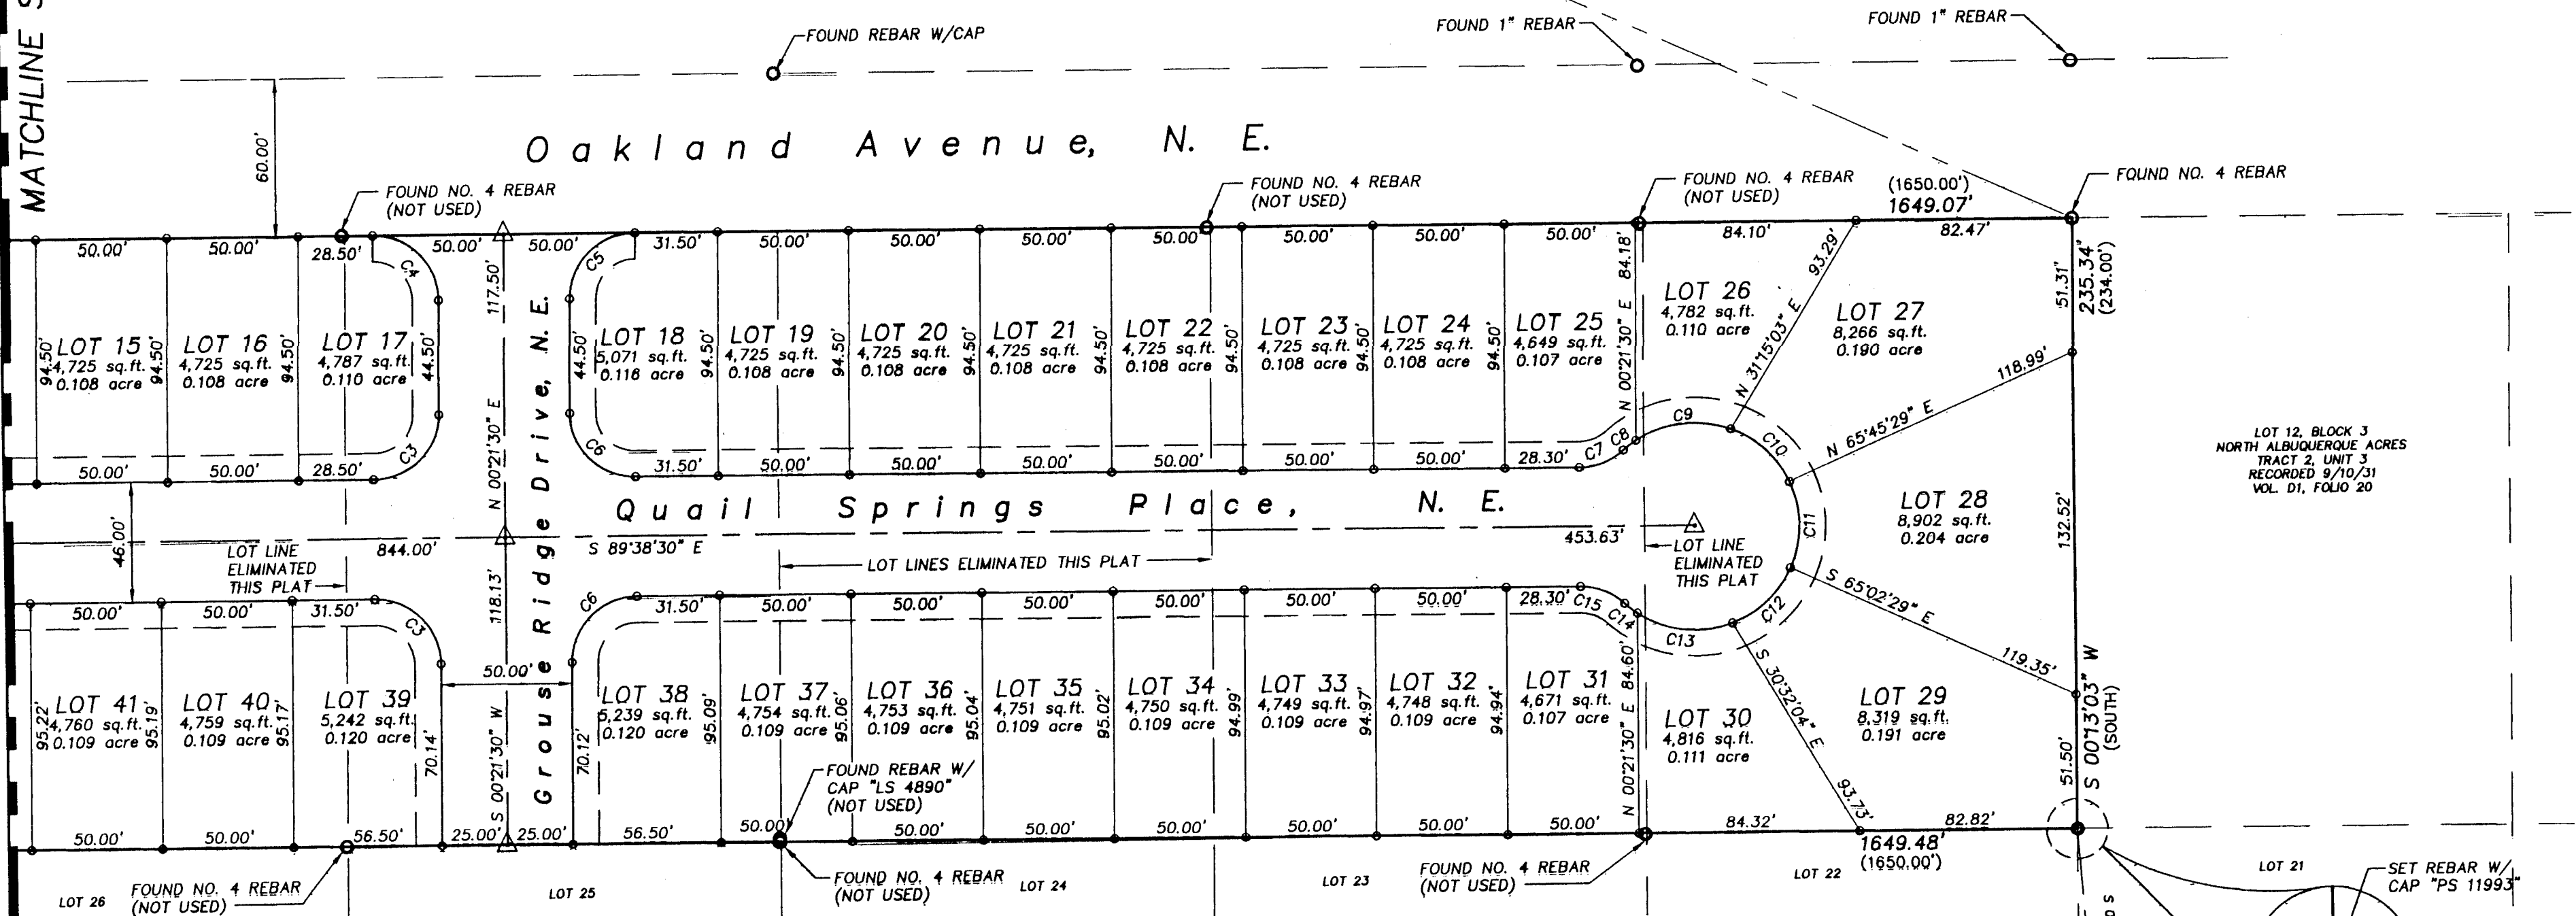

NORTH ALBUQUERQUE ACRES
TRACT 2, UNIT 3
RECORDED 9/10/31
VOL. D1, FOLIO 20

BLOCK 3

CURVE	RADIUS	LENGTH	TANGENT	CHORD	BEARING	DELTA
C1	25.00'	39.27'	25.00'	35.36'	S 45°21'30" W	90°00'00"
C2	50.00'	78.54'	50.00'	70.71'	N 44°38'30" W	90°00'00"
C3	25.00'	39.27'	25.00'	35.36'	N 45°21'30" E	90°00'00"
C4	25.00'	39.27'	25.00'	35.36'	N 44°38'30" W	90°00'00"
C5	25.00'	39.27'	25.00'	35.36'	N 45°21'30" E	90°00'00"
C6	25.00'	39.27'	25.00'	35.36'	S 44°38'30" E	90°00'00"
C7	25.00'	18.50'	9.70'	18.08'	N 69°09'11" E	42°23'58"
C8	40.00'	6.15'	3.08'	6.14'	S 52°21'42" W	08°48'20"
C9	40.00'	37.83'	20.46'	36.43'	S 83°51'23" W	54°11'03"
C10	40.00'	31.28'	16.49'	30.49'	N 46°38'49" W	44°46'54"
C11	40.00'	34.35'	18.31'	33.30'	N 00°21'50" E	46°12'02"
C12	40.00'	31.28'	16.49'	30.49'	S 47°21'48" W	44°46'54"
C13	40.00'	37.83'	20.46'	36.43'	S 83°08'23" E	54°11'03"
C14	40.00'	6.15'	3.08'	6.14'	S 51°38'42" E	08°48'20"
C15	25.00'	18.50'	9.70'	18.08'	S 68°28'51" E	42°23'58"
C16	25.00'	12.22'	6.23'	12.10'	N 76°21'12" E	28°00'25"
C17	25.00'	7.76'	3.91'	7.73'	S 53°27'32" W	17°47'06"
C18	45.00'	50.78'	28.48'	48.13'	N 76°53'36" E	64°39'15"
C19	45.00'	33.23'	17.41'	32.48'	N 49°37'29" W	42°18'35"
C20	45.00'	36.03'	19.04'	35.07'	N 05°31'58" W	45°52'27"
C21	45.00'	22.35'	11.41'	22.12'	N 51°37'55" E	28°27'18"
C22	25.00'	19.85'	10.48'	19.34'	N 23°06'32" E	45°30'04"
C23	25.00'	39.27'	25.00'	35.36'	N 44°38'30" W	90°00'00"
C24	75.00'	117.81'	75.00'	106.07'	N 44°38'30" W	90°00'00"
C25	75.00'	58.03'	30.58'	58.80'	N 21°48'31" W	44°20'01"
C26	75.00'	59.78'	31.58'	58.21'	N 66°48'31" W	45°39'59"

LEGEND
 ○ POINT FOUND AND USED AS SHOWN
 ○ POINT SET BY THIS SURVEY - REBAR W/CAP
 "PS 11993"
 △ CENTERLINE (IN LIEU OF R/W MONUMENTATION)
 TO BE INSTALLED AT ALL CENTERLINE P.C.'S,
 P.T.'S, ANGLE POINTS AND STREET INTERSECTIONS
 PRIOR TO ACCEPTANCE OF SUBMISSION STREET
 IMPROVEMENTS AND WILL CONSIST OF A STANDARD
 FOUR-INCH (4") ALUMINUM ALLOY CAP STAMPED
 "CITY OF ALBUQUERQUE," "CENTERLINE
 MONUMENTATION," "SURVEY MARKER," "DO NOT
 DISTURB," "PLS# 11993"

ACS MONUMENT "HEAVEN"
NM STATE PLANE COORDINATES
CENTRAL ZONE - NAD 1927
X=407,051.31
Y=1,518,737.03
EL.=5378.787
DELTA ALPHA=-0°10'45"
G=0.99965283



PRECISION SURVEYS, INC.




2828 COORS BLVD NW, SUITE 106
ALBUQUERQUE, NEW MEXICO 87120
PHONE 505 836 0500
FAX 505 836 4153

DRB CASE NO. 96-215
SHEET 3 OF 3

Z:\PUBLIC\PS-SER\PLATS\96\9625P Med Sep 18 07:08:23 1996

18 08/24/96
MOBA

CPN 559081

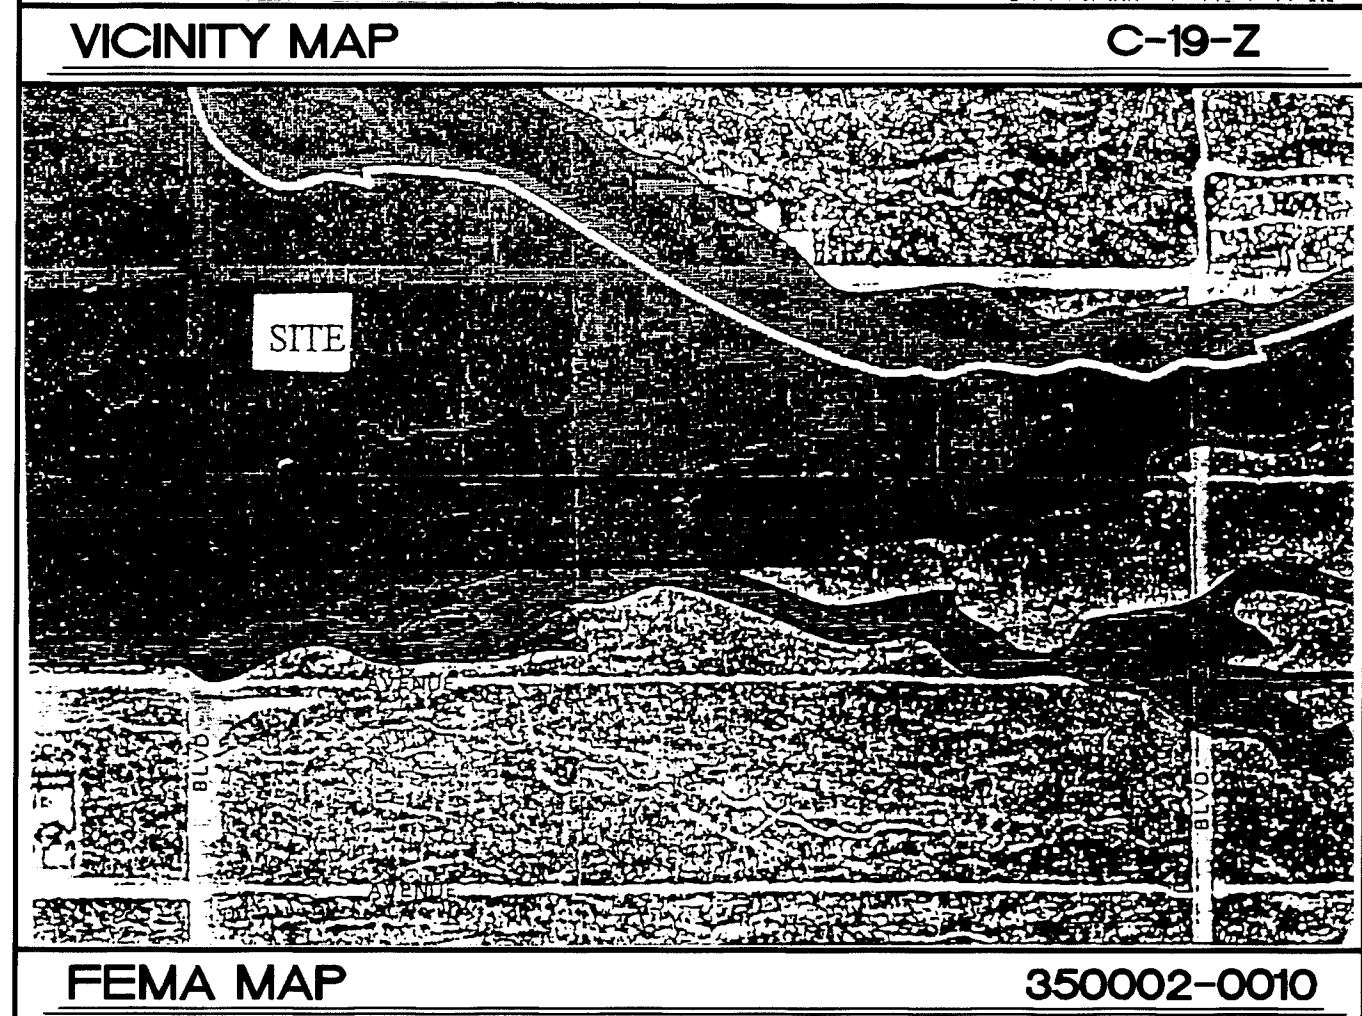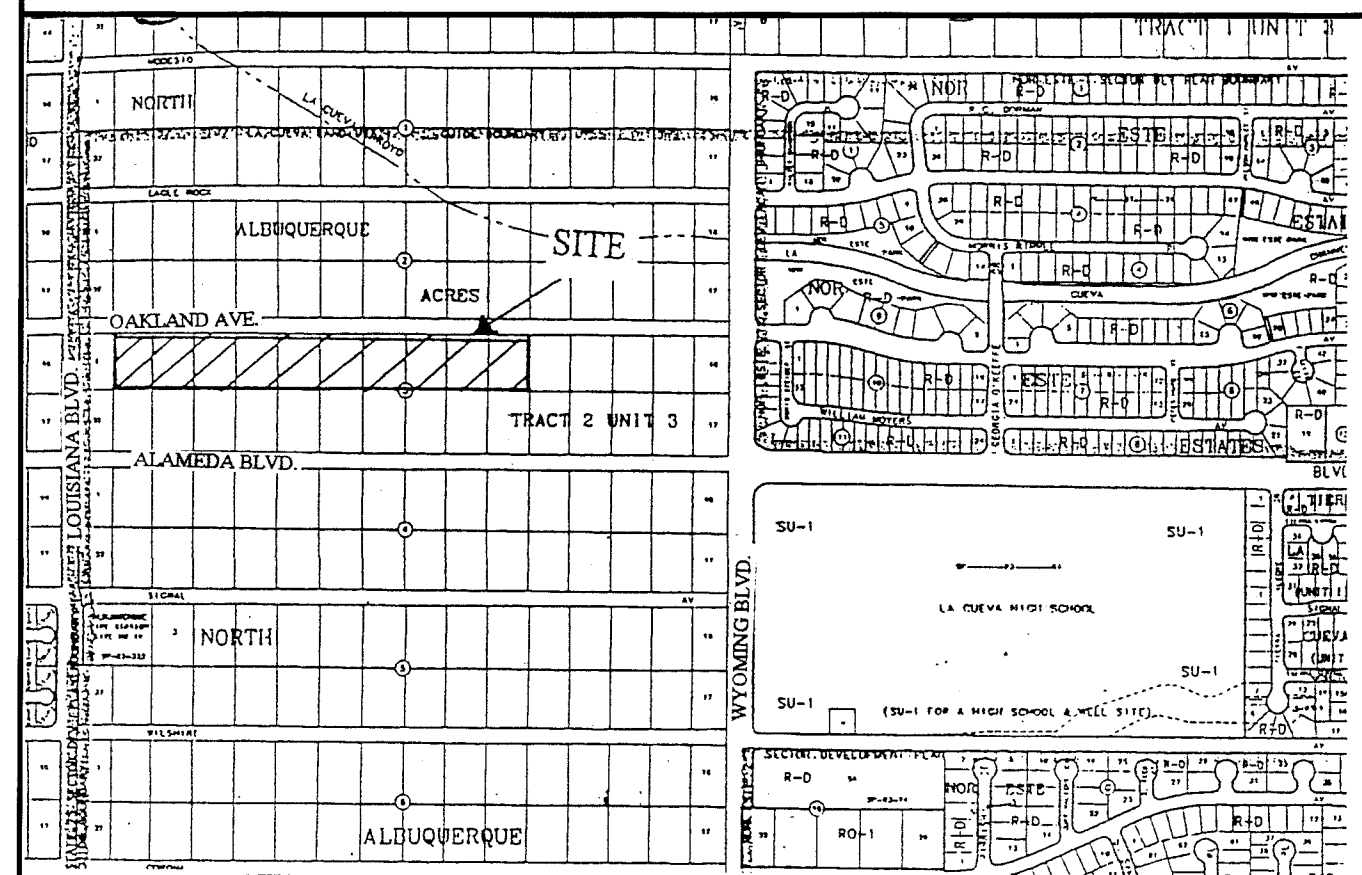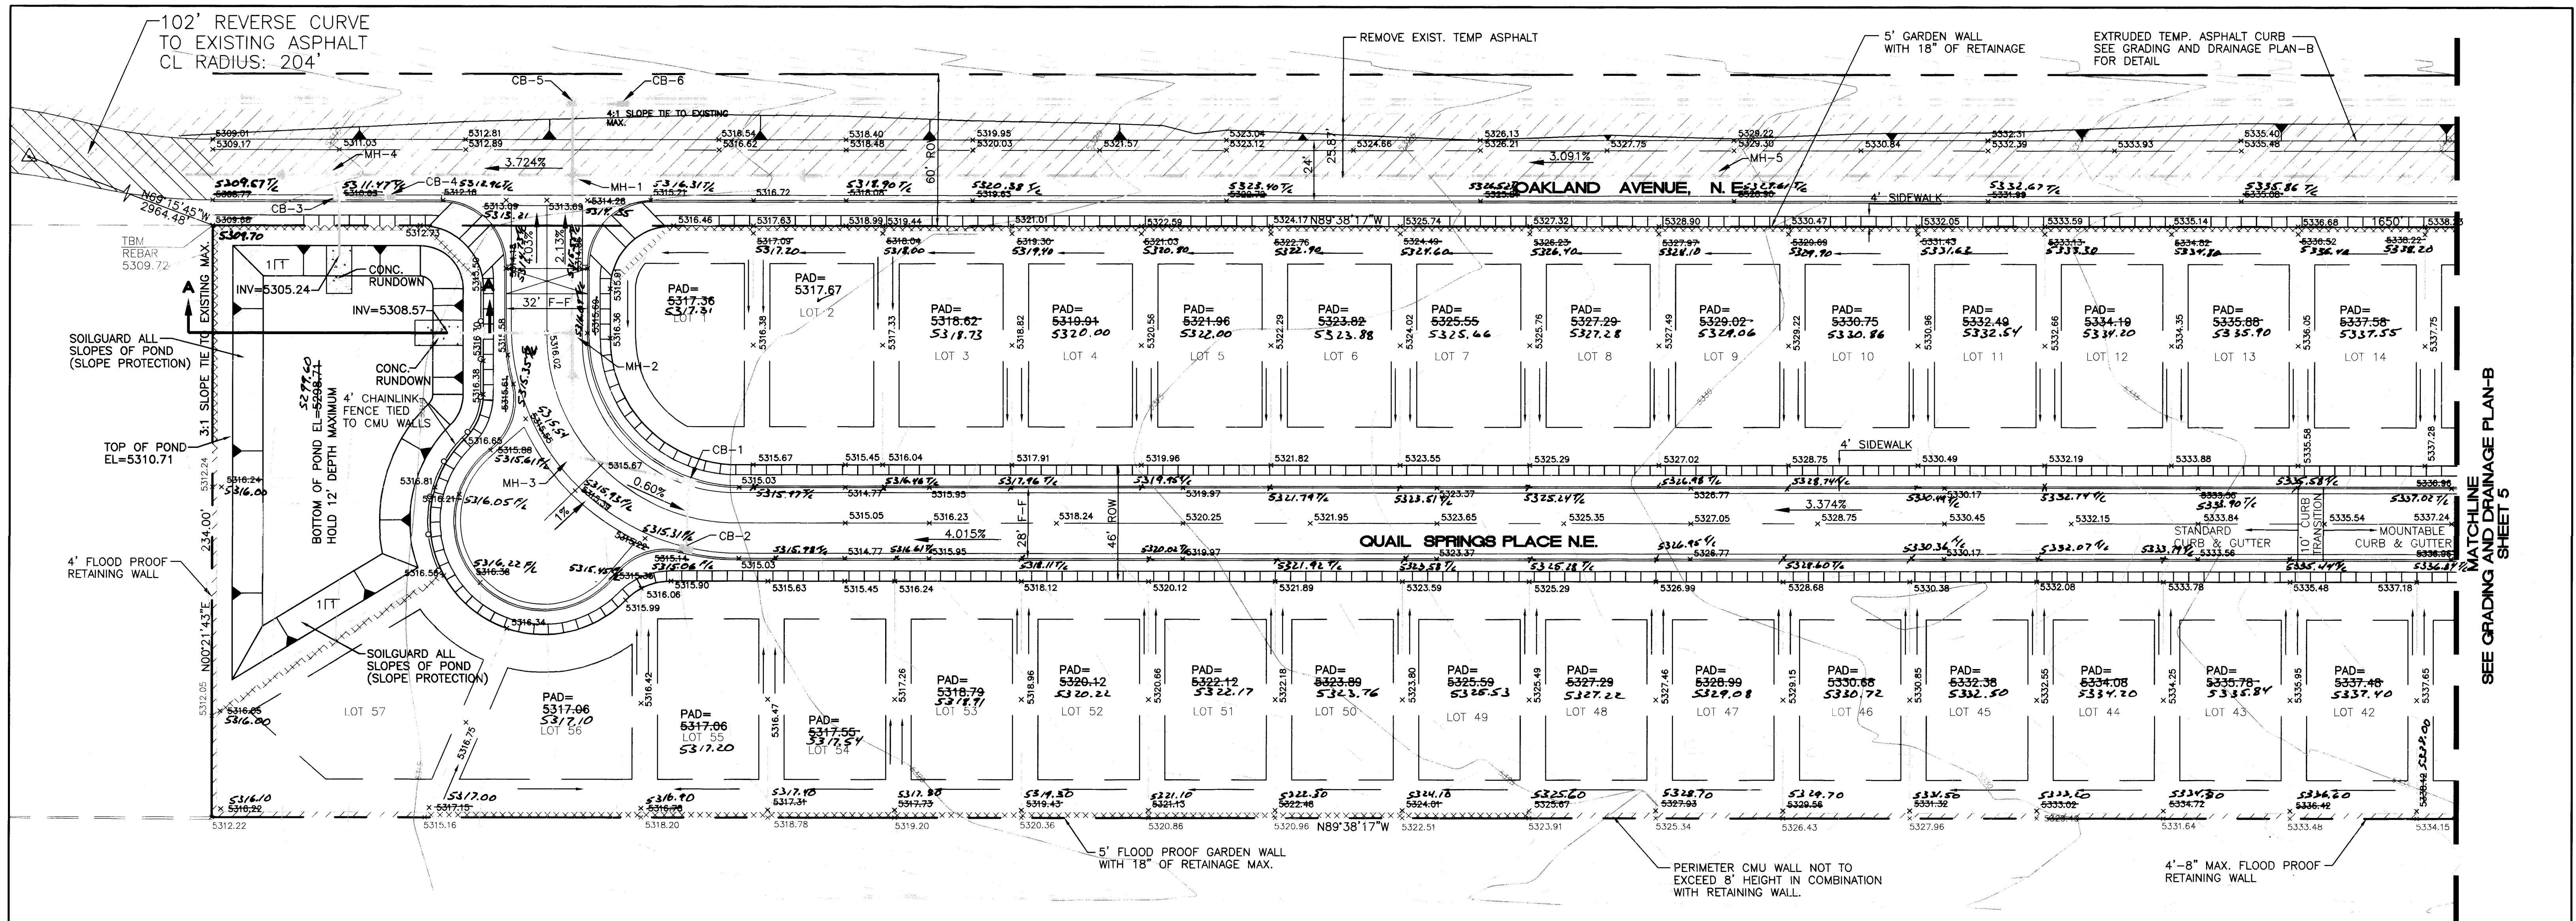

LEGAL DESCRIPTION:
LOTS 1 THRU 62, BLOCK 3 QUAIL SPRINGS, ALBUQUERQUE, BERNALILLO COUNTY, NEW MEXICO

BENCH MARK
ACS MONUMENT "10C-18", NM STATE PLANE COORDINATES, CENTRAL ZONE, NAD 1927, X=402,319.45, Y=1,524,061.42, EL=5219.41, DELTA ALPHA=-00°11'18" G-G=0.9996613, TIES TO THE NORTHEAST CORNER OF PROPERTY BEARING S69°15'45"E, 2964.48'

NOTES:


1. ALL SPOT ELEVATIONS INDICATE THE FLOWLINE ELEVATION UNLESS OTHERWISE NOTED.
2. SEE GRADING AND DRAINAGE PLAN-B FOR RETAINING WALL AND GARDEN WALL DETAILS.
3. SEE GRADING AND DRAINAGE PLAN-B FOR TYPICAL LOT LAYOUT DETAIL.
4. THIS PROJECT FALLS WITHIN A 100 YEAR FLOOD PLAIN, A LOMR HAS BEEN PREPARED BY AMFCA AND SENT TO FEMA FOR APPROVAL. GOVERNMENTAL AGENCIES WILL MAINTAIN THE UPLAND FACILITIES ENSURING THE PROPERTY IS OUT OF THE FLOOD PLAIN. FLOOD INSURANCE WILL BE REQUIRED UNTIL THE NEW FLOOD MAP HAS BEEN ISSUED BY FEMA.
5. THE SITE GRADING WAS PREPARED FROM INFORMATION SUPPLIED BY PRECISION SURVEYING. THE LAND HAS BEEN INSPECTED AND REPRESENTS THE GRADES AS SHOWN. NO GRADING, FILLING, OR EXCAVATION HAS OCCURRED FROM THE TIME OF SUBMITTAL.

EROSION CONTROL PLAN NOTES

1. CONTRACTOR IS RESPONSIBLE FOR OBTAINING A TOPSOIL DISTURBANCE PERMIT PRIOR TO BEGINNING WORK.
2. CONTRACTOR IS RESPONSIBLE FOR CLEANING ALL SEDIMENT OUT OF EXISTING RIGHT-OF-WAY.
3. CONTRACTOR IS RESPONSIBLE FOR CLEANING UP ANY SEDIMENT THAT GETS INTO EXISTING RIGHT-OF-WAY.
4. REPAIR OF DAMAGED FACILITIES AND CLEANUP OF SEDIMENT ACCUMULATION ON ADJACENT PROPERTIES AND IN PUBLIC FACILITIES IS THE RESPONSIBILITY OF THE CONTRACTOR.
5. ALL EXPOSED EARTH SURFACES MUST BE PROTECTED FROM WIND AND WATER EROSION PRIOR TO FINAL ACCEPTANCE OF ANY PROJECT.
6. SITE EXCEEDS FIVE ACRE MINIMUM WHICH WILL REQUIRE AN NPDES PERMIT BY THE CONTRACTOR.

ROUGH GRADING APPROVAL ± 1 **DATE**

STORM SEWER INFORMATION					
MH/CB	RIM/GRATE	INVERT IN	INVERT OUT	TYPE	
MH-1	5314.26	5307.36	5307.26	6" TYPE "E"	
MH-2	5315.73	5308.96	5308.86	4" TYPE "E"	
MH-3	5315.61	5309.58	5309.48	4" TYPE "E"	
MH-4	5310.64	5304.74	5304.64	4" TYPE "C"	
MH-5	5328.85	5322.95	5322.85	4" TYPE "C"	
CB-1	5315.11	5310.35	5310.25	DOUBLE "A"	
CB-2	5315.14	-----	5310.77	DOUBLE "A"	
CB-3	5310.63	5306.73	5306.63	SINGLE "A"	
CB-4	5311.37	-----	5307.37	SINGLE "A"	
CB-5	5314.05	5308.15	5308.05	SINGLE "A"	
CB-6	5314.79	-----	5310.79	SINGLE "A"	
PIPE LOCATION		TYPE	BEARING	LENGTH	SLOPE
CB-2 TO CB-1	24" RCP	S02°31'40"W		26.66'	1.58%
CB-1 TO MH-3	30" RCP	N77°00'29"W		47.26'	1.57%
MH-3 TO MH-2	30" RCP	N00°21'43"E		48.47'	1.07%
MH-2 TO POND	30" RCP	N89°38'17"W		49.00'	0.60%
MH-2 TO MH-1	30" RCP	N00°21'43"E		62.89'	2.39%
MH-1 TO MH-4	36" RCP	N89°38'17"W		100.00'	2.52%
MH-4 TO CAP	36" RCP	N89°38'17"W		52.81'	3.52%
CB-4 TO CB-3	18" RCP	N89°38'17"W		20.00'	3.70%
CB-3 TO POND	15" RCP	N00°21'43"E		23.61'	2.96%
CB-3 TO MH-4	18" RCP	S31°19'31"E		9.50'	19.89%
CB-6 TO CB-5	18" RCP	N89°38'17"W		20.00'	13.20%
CB-5 TO MH-1	18" RCP	S00°21'43"W		30.00'	2.30%
MH-5 TO MH-1	24" RCP	N89°38'17"W		450.00'	3.44%

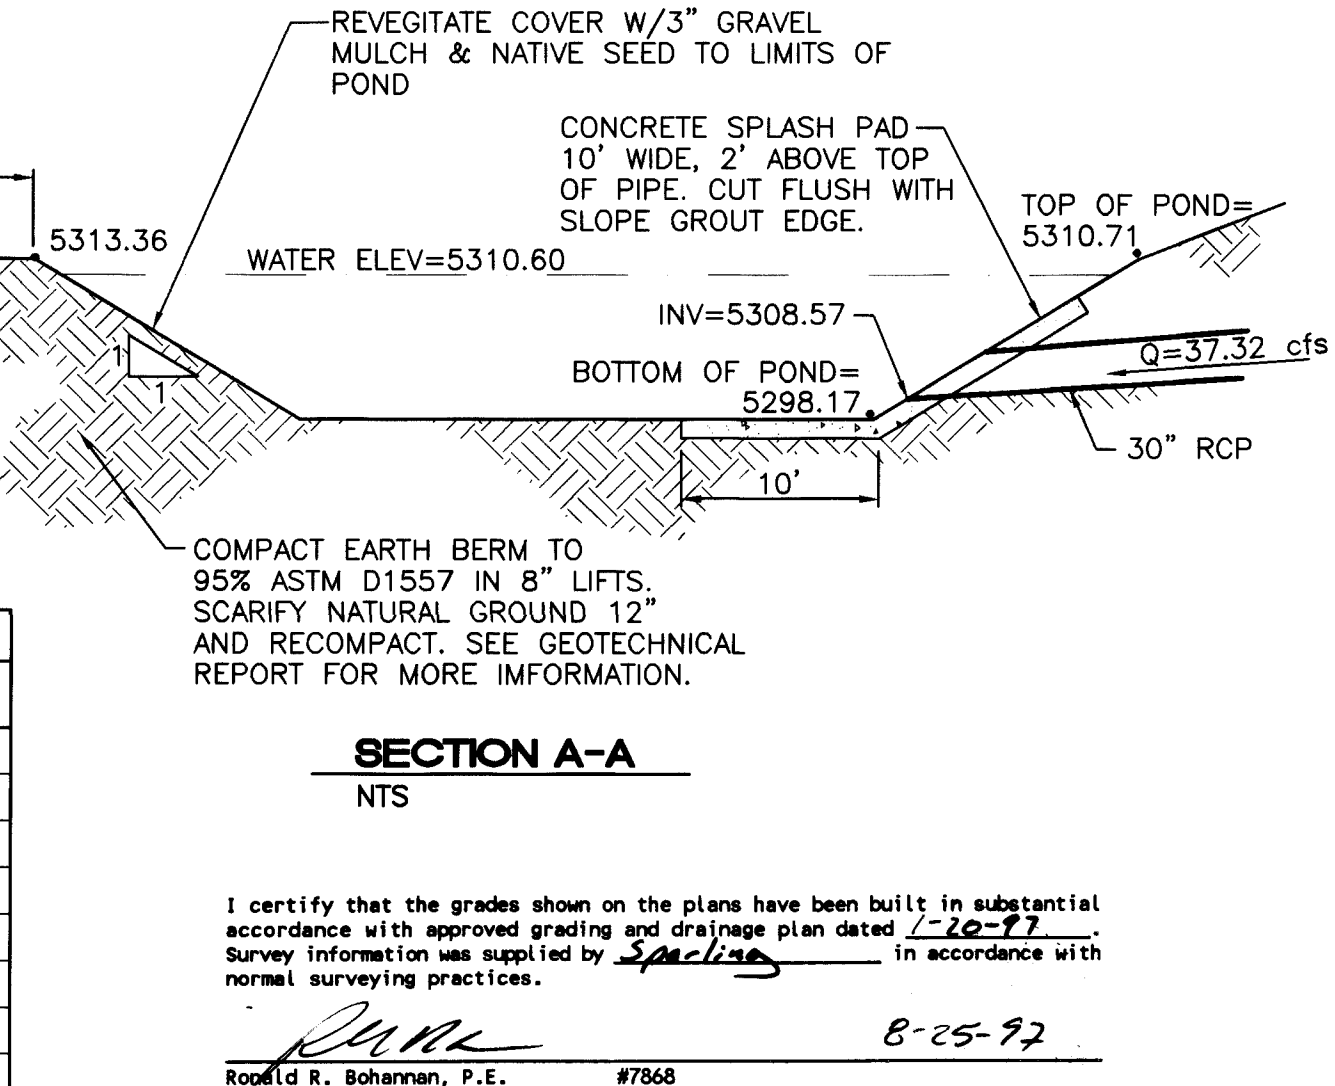


SECTION A-A
NTS

I certify that the grades shown on the plans have been built in substantial accordance with approved grading and drainage plan dated 1-10-77. Survey information was supplied by Precision in accordance with normal surveying practices.

Ronald B. Bohannan, P.E. 8-25-72

RECORD DRAWING
DATE: 8-21-77
DRAFTED BY: J.W. TIERRA WEST DEV.

THESE RECORD DRAWINGS HAVE BEEN PREPARED, IN PART, ON THE BASIS OF INFORMATION COMPILED AND FURNISHED BY OTHERS. THE ENGINEER WILL NOT BE RESPONSIBLE FOR ANY ERRORS OR OMISSIONS WHICH HAVE BEEN INCORPORATED INTO THE DOCUMENT AS A RESULT.

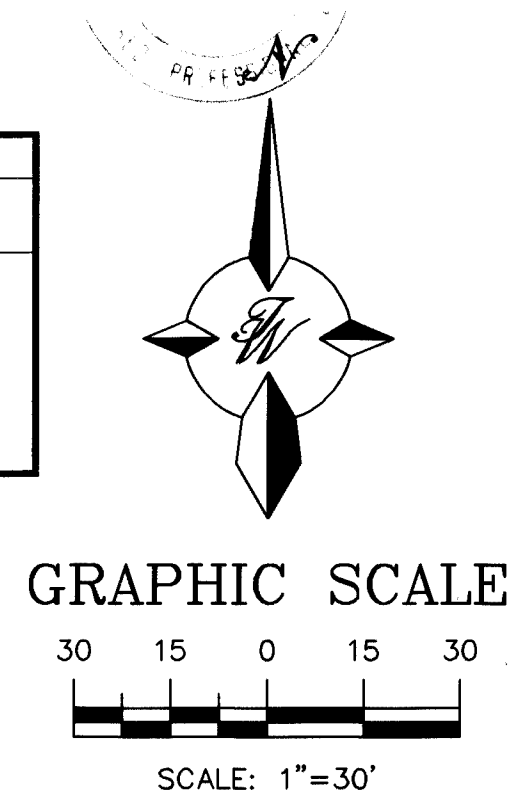


LEGEND			
BOUNDARY			
LOT			
SETBACK			
ROAD			
CURB AND GUTTER			
CENTER LINE			
EXISTING ROAD			
EXISTING LOT			
PROPOSED RETAINING WALL			
PROPOSED 3' GARDEN WALL			
PROPOSED SD			
PROPOSED SD INLETS			
PROPOSED SD MANHOLE			
DIRECTION OF FLOW			
PROPOSED SPOT ELEVATION	x 5334.72		
EXISTING SPOT ELEVATION	x 5320.98		
LIMITS OF EXISTING ASPHALT			

REVISIONS			
NO.	DATE	REMARKS	BY
ENGINEER'S SEAL			
QUAIL SPRINGS ESTATES			
GRADING AND DRAINAGE PLAN-A			
TERRA WEST DEVELOPMENT MANAGEMENT SERVICES			
4421 McLEOD ROAD, N.E., SUITE D ALBUQUERQUE, NEW MEXICO 87109 (505)883-7592			
DRAWN BY JDN			
DATE 10-12-96			
9557GRA1.DWG			
SHEET # 4 OF 23			
JOB # 950057			

CPN 559081

MATCHLINE SEE GRADING AND DRAINAGE PLAN-A SHEET 4

87' REVERSE CURVE TO EXISTING ASPHALT CL RADIUS: 204'

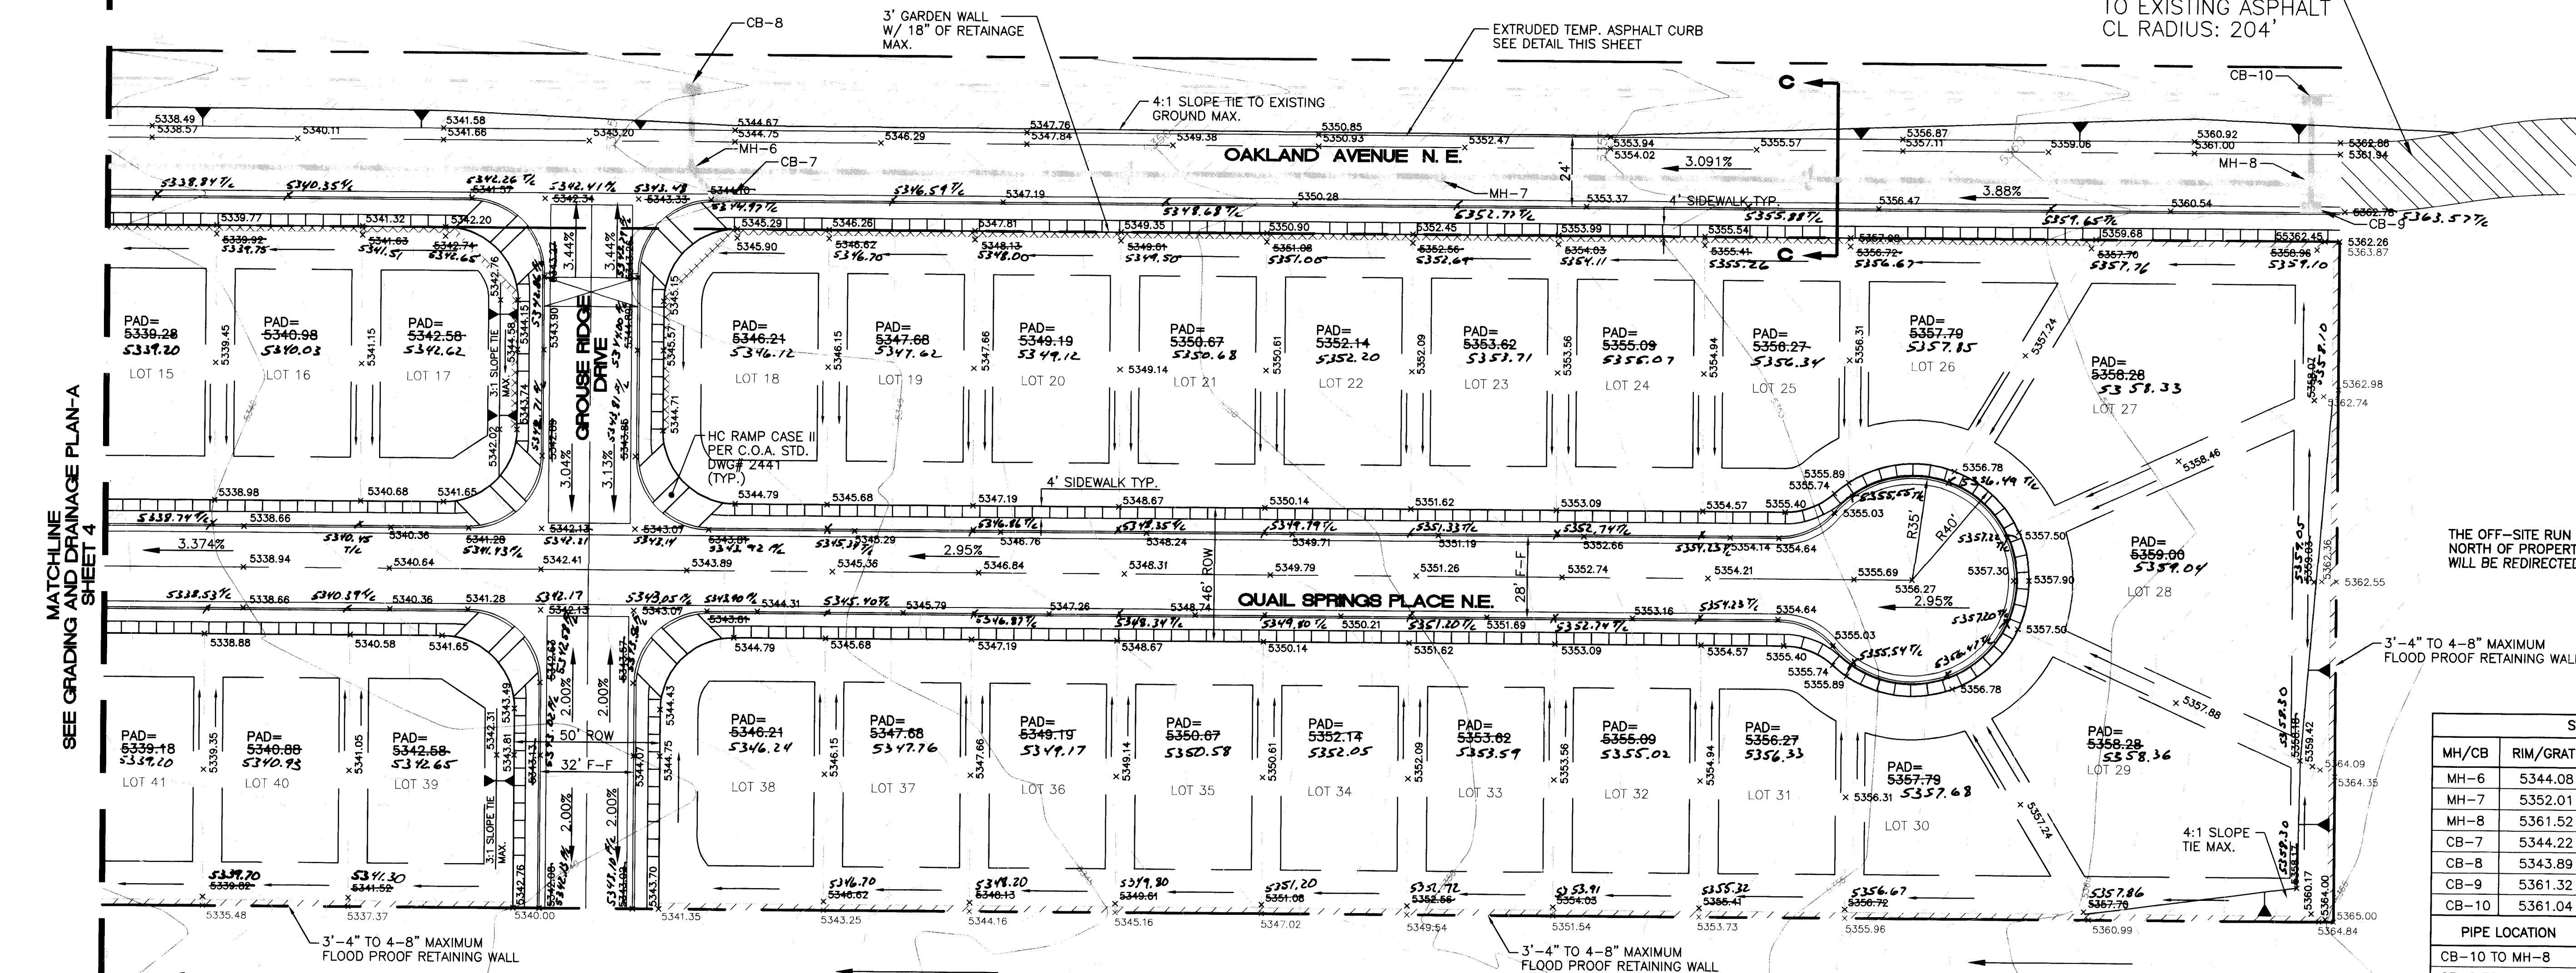

THE OFF-SITE RUN OFF FLOWS TO THE NORTH OF PROPERTY. THE UPLAND FLOWS WILL BE REDIRECTED UPON DEVELOPMENT.

3'-4" TO 4'-8" MAXIMUM FLOOD PROOF RETAINING WALL

STORM SEWER INFORMATION				
MH/CB	RIM/GRATE	INVERT IN	INVERT OUT	TYPE
MH-6	5344.08	5336.18	5336.08	6" TYPE "E"
MH-7	5352.01	5346.11	5346.01	4" TYPE "C"
MH-8	5361.52	5355.62	5355.52	4" TYPE "C"
CB-7	5344.22	-----	5340.22	SINGLE "A"
CB-8	5343.89	-----	5337.89	SINGLE "A"
CB-9	5361.32	-----	5357.32	SINGLE "A"
CB-10	5361.04	-----	5356.04	SINGLE "A"
PIPE LOCATION				
PIPE LOCATION	TYPE	BEARING	LENGTH	SLOPE
CB-10 TO MH-8	12" RCP	S00°21'43"W	30.00'	1.40%
CB-9 TO MH-8	12" RCP	N00°21'43"E	10.00'	17.00%
MH-8 TO MH-7	15" RCP	N89°38'17"W	298.50'	3.15%
MH-7 TO MH-6	15" RCP	N89°38'17"W	256.47'	3.84%
CB-7 TO MH-6	18" RCP	N41°32'11"W	11.00'	36.73%
CB-8 TO MH-6	18" RCP	S00°21'43"W	30.00'	5.70%
MH-6 TO MH-5	24" RCP	N89°38'17"W	492.03'	2.69%

SITE VOLUME TABLE: ADJUSTED


Site	Stratum	Surf1	Surf2	Cut	Fill	Net	Method
Vol2	Vol2	EX	FG				
Cut Factor for Shrinkage	0.70			11907.06	11871.53	35.53 (C)	Grid
Fill Factor for Compaction	0.95			11944.04	11922.84	21.19 (C)	End area
N Size 2.00'				11954.21	11917.35	36.86 (C)	Prismoidal
M Size 2.00'							
Average Excess Cut = 31.19 yards							

8 INCH REINFORCED CONCRETE MASONRY WALL							
H	A	B	T	Y-BARS	X-BARS		
ft.-in.	in.	ft.-in.	in.				
3'-4"	8"	2'-4"	9"	#3 @ 32" O.C.	#3 @ 27" O.C.		
4'-0"	10"	2'-8"	9"	#3 @ 32" O.C.	#3 @ 27" O.C.		
4'-8"	12"	3'-4"	10"	#3 @ 32" O.C.	#3 @ 27" O.C.		
5'-4"	14"	3'-8"	10"	#3 @ 32" O.C.	#3 @ 27" O.C.		
6'-0"	16"	4'-2"	12"	#3 @ 24" O.C.	#4 @ 25" O.C.		

12 INCH REINFORCED CONCRETE MASONRY WALL							
H	A	B	T	Y-BARS	X-BARS		
ft.-in.	in.	ft.-in.	in.				
5'-4"	14"	3'-8"	10"	#4 @ 24" O.C.	#3 @ 25" O.C.		
6'-0"	15"	4'-2"	12"	#4 @ 16" O.C.	#4 @ 30" O.C.		
6'-8"	16"	4'-6"	12"	#6 @ 24" O.C.	#4 @ 30" O.C.		
7'-4"	18"	4'-10"	12"	#5 @ 16" O.C.	#5 @ 26" O.C.		
8'-0"	20"	5'-4"	12"	#7 @ 24" O.C.	#5 @ 21" O.C.		


GENERAL CONSTRUCTION NOTES:

- ALL CONCRETE IS TO BE 4000 PSI @ 28 DAYS.
- MINIMUM COMPACTION UNDER FOOTINGS IS TO BE 95% PER ASTM. D 1557 FOR A DEPTH OF 12" MOISTURE CONTENT IS TO BE $\pm$ 2.0%.
- BACK FILL AGAINST WALLS IS TO BE HAND-PLACED AND COMPACTED.
- ALL BARS ARE TO BE GRADE 60, ASTM 615.
- TRUSS TYPE DUR-O-WALL EVERY OTHER COURSE.
- DOWELS SHALL BE AT LEAST EQUAL IN SIZE AND SPACING TO V-BARS, SHALL PROJECT A MINIMUM OF 30 BAR DIA. INTO THE FILLED BLOCK CORES, AND SHALL EXTEND TO THE TOE OF THE FOOTING.
- JOINT REINFORCEMENT CONSISTING OF 9GA. LONGITUDINAL WIRE AND 3/16" CROSS RODS SHALL BE PROVIDED AT 8" CENTERS VERTICALLY.
- PROVIDE KEY FOR 8" AND 12" WALLS WHERE H EXCEEDS 6'-0".
- USE EITHER EXPANSION JOINTS ON 20' CENTERS OR PILASTERS EVERY 16'.

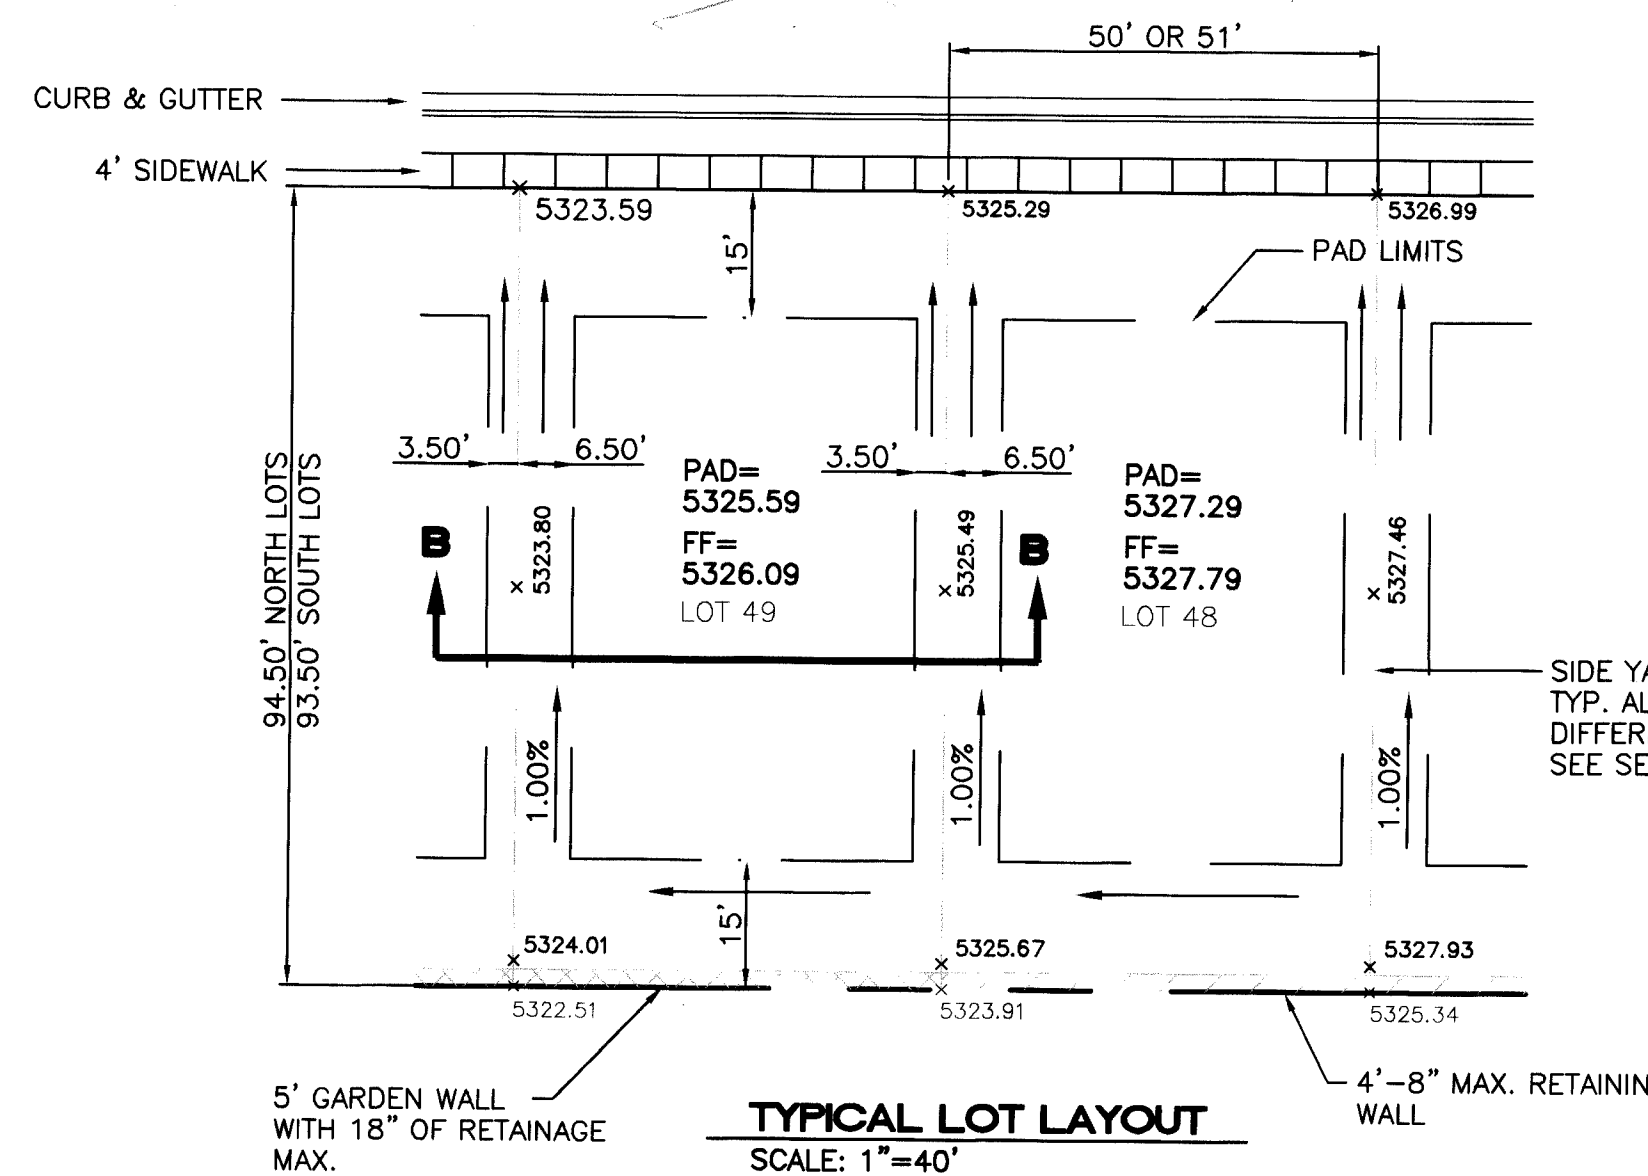

I certify that the grades shown on the plans have been built in substantial accordance with approved grading and drainage plan dated 7-26-92. Survey information was supplied by Spa-Land in accordance with normal surveying practices.

Ronald R. Bohannon, P.E. #7868 8-25-92

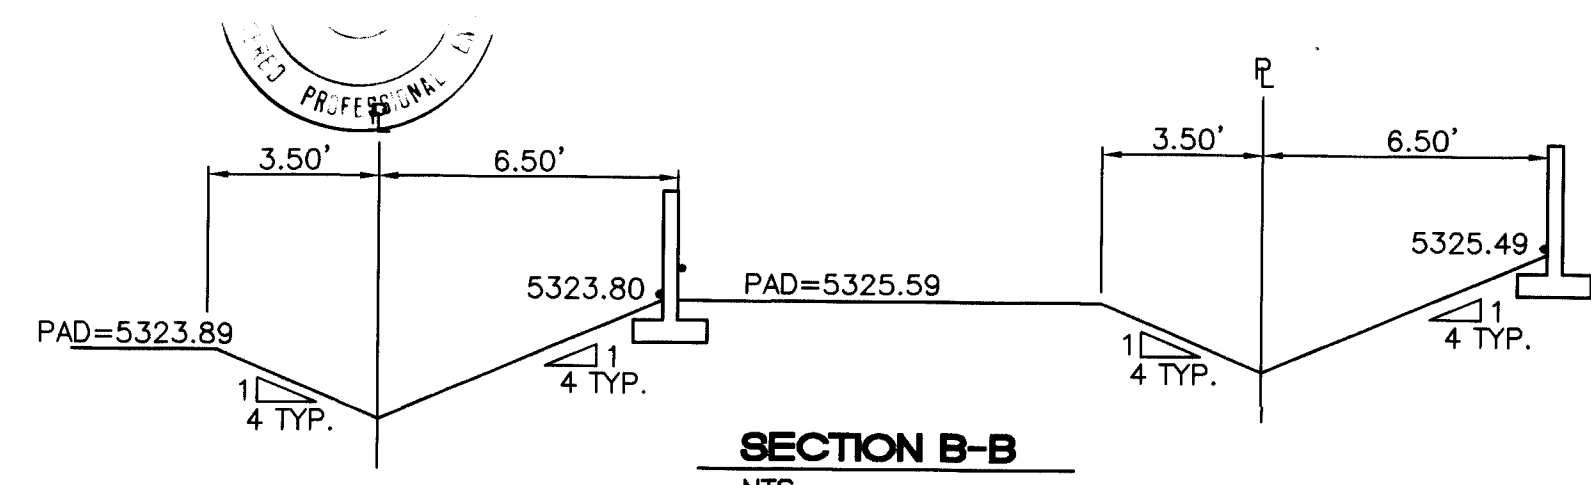


SECTION B-B NTS

RECORD DRAWING
DATE: 8-26-97 DRAFTED BY: JAM
TIERRA WEST DEV.


THESE RECORD DRAWINGS HAVE BEEN PREPARED, IN PART, ON THE BASIS OF INFORMATION COMPILED AND FURNISHED BY OTHERS. THE ENGINEER WILL NOT BE RESPONSIBLE FOR ANY ERRORS OR OMISSIONS WHICH HAVE BEEN INCORPORATED INTO THE DOCUMENT AS A RESULT.

NOTES:

- ALL SPOT ELEVATIONS INDICATE THE FLOWLINE ELEVATION UNLESS OTHERWISE NOTED.
- SEE GRADING AND DRAINAGE PLAN-A FOR TYPICAL LOT LAYOUT DETAIL AND LEGEND.
- SEE GRADING AND DRAINAGE PLAN-A FOR BENCH MARK AND EROSION CONTROL NOTES.

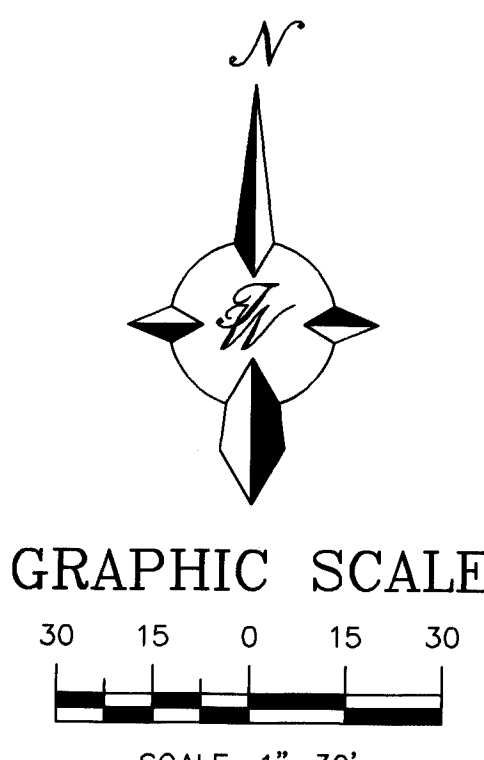

SECTION C-C OAKLAND AVENUE N.E. N.T.S.


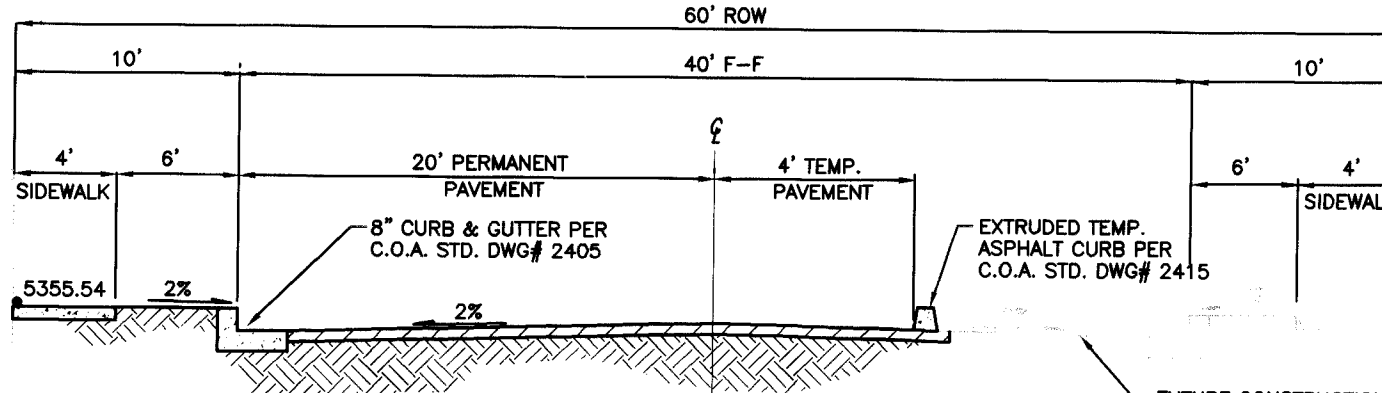


SCANNED BY BY LASON

30/950057/9557GRB.DWG/JDN/1-17-97

NO.	DATE	REMARKS	BY
REVISIONS			
ENGINEER'S SEAL			
QUAIL SPRINGS ESTATES			DRAWN BY BDG
GRADING AND DRAINAGE PLAN-B			DATE 9-10-95
TIERRA WEST DEVELOPMENT MANAGEMENT SERVICES			9557GRB.DWG
4421 McLEOD ROAD, N.E., SUITE D ALBUQUERQUE, NEW MEXICO 87109 (505)883-7592			SHEET # 5 OF 23
RONALD R. BOHANNAN P.E. #7868			JOB # 950057

CPN 559081

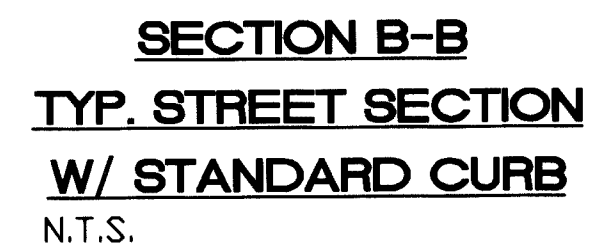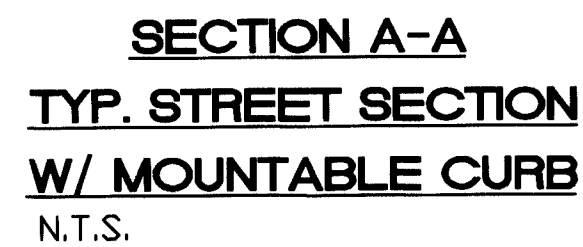


NOTE: ALL (LOT FRONT) INTERIOR SIDEWALKS HAVE BEEN DEFERRED




NOTE: ALL (LOT FRONT) INTERIOR SIDEWALKS HAVE BEEN DEFERRED




RECORD DRAWING	
DATE: 8-26-97	DRAFTED BY: RW TIERRA WEST DEV.
THESE RECORD DRAWINGS HAVE BEEN PREPARED, IN PART, ON THE BASIS OF INFORMATION COMPLIED AND FURNISHED BY OTHERS. THE ENGINEER WILL NOT BE RESPONSIBLE FOR ANY ERRORS OR OMISSIONS WHICH HAVE BEEN INCORPORATED INTO THE DOCUMENT AS A RESULT.	

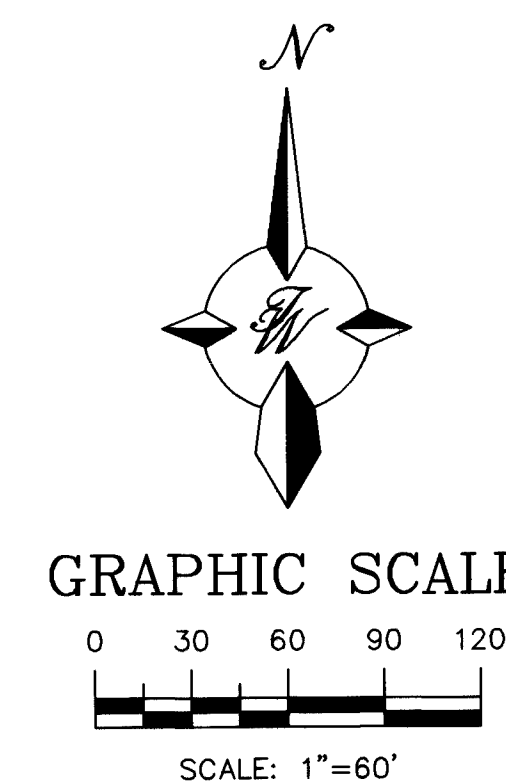

ENGINEER'S SEAL		SURVEY INFORMATION		BENCH MARKS		AS BUILT INFORMATION	
		FIELD NOTES		AC8 "100'-18" CENTRAL STATION DATA NM STATE PLANE COORDINATES Central Zone X=402,319.45 Y=1,524,061.42 G-G=0.9996613 DELTA=-00'11"18" ELEV.=5219.41		CONTRACTOR <i>SPARKLING #26899</i>	
		NO. BY REMARKS REVISIONS DESIGN				STARTED BY <i>SPARKLING</i> DATE INSPECTOR'S FIELD TANG BY <i>TIGER</i> DATE VERIFICATION BY <i>TIGER</i> DATE DRAWN BY <i>TIGER</i> DATE MICRO-FILM INFORMATION RECORDED BY DATE NO.	
DESIGNED BY	DATE 09-96						
DRAWN BY	DATE 09-96						

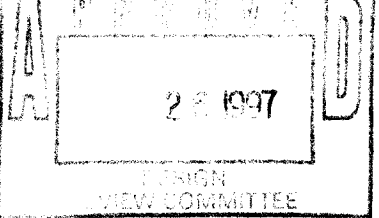TIERRA WEST DEVELOPMENT MANAGEMENT SERVICES											
4421 McLEOD ROAD, N.E., SUITE D ALBUQUERQUE, NEW MEXICO 87109 (505)683-7592						NO.		DATE		DESIGNED BY DRAWN BY	
CITY OF ALBUQUERQUE PUBLIC WORKS DEPARTMENT ENGINEERING GROUP											
TITLE:		<i>QUAL SPRINGS ESTATES MASTER PAVING PLAN</i>									
DESIGN REVIEW COMMITTEE 		CITY ENGINEER APPROVAL				LAST DESIGN UPDATE	MO./DAY./YR.		MO./DAY./YR.		
CITY PROJECT NO.				ZONE MAP NO. <i>C-19-Z</i>		SHEET		OF		<i>6 23</i>	

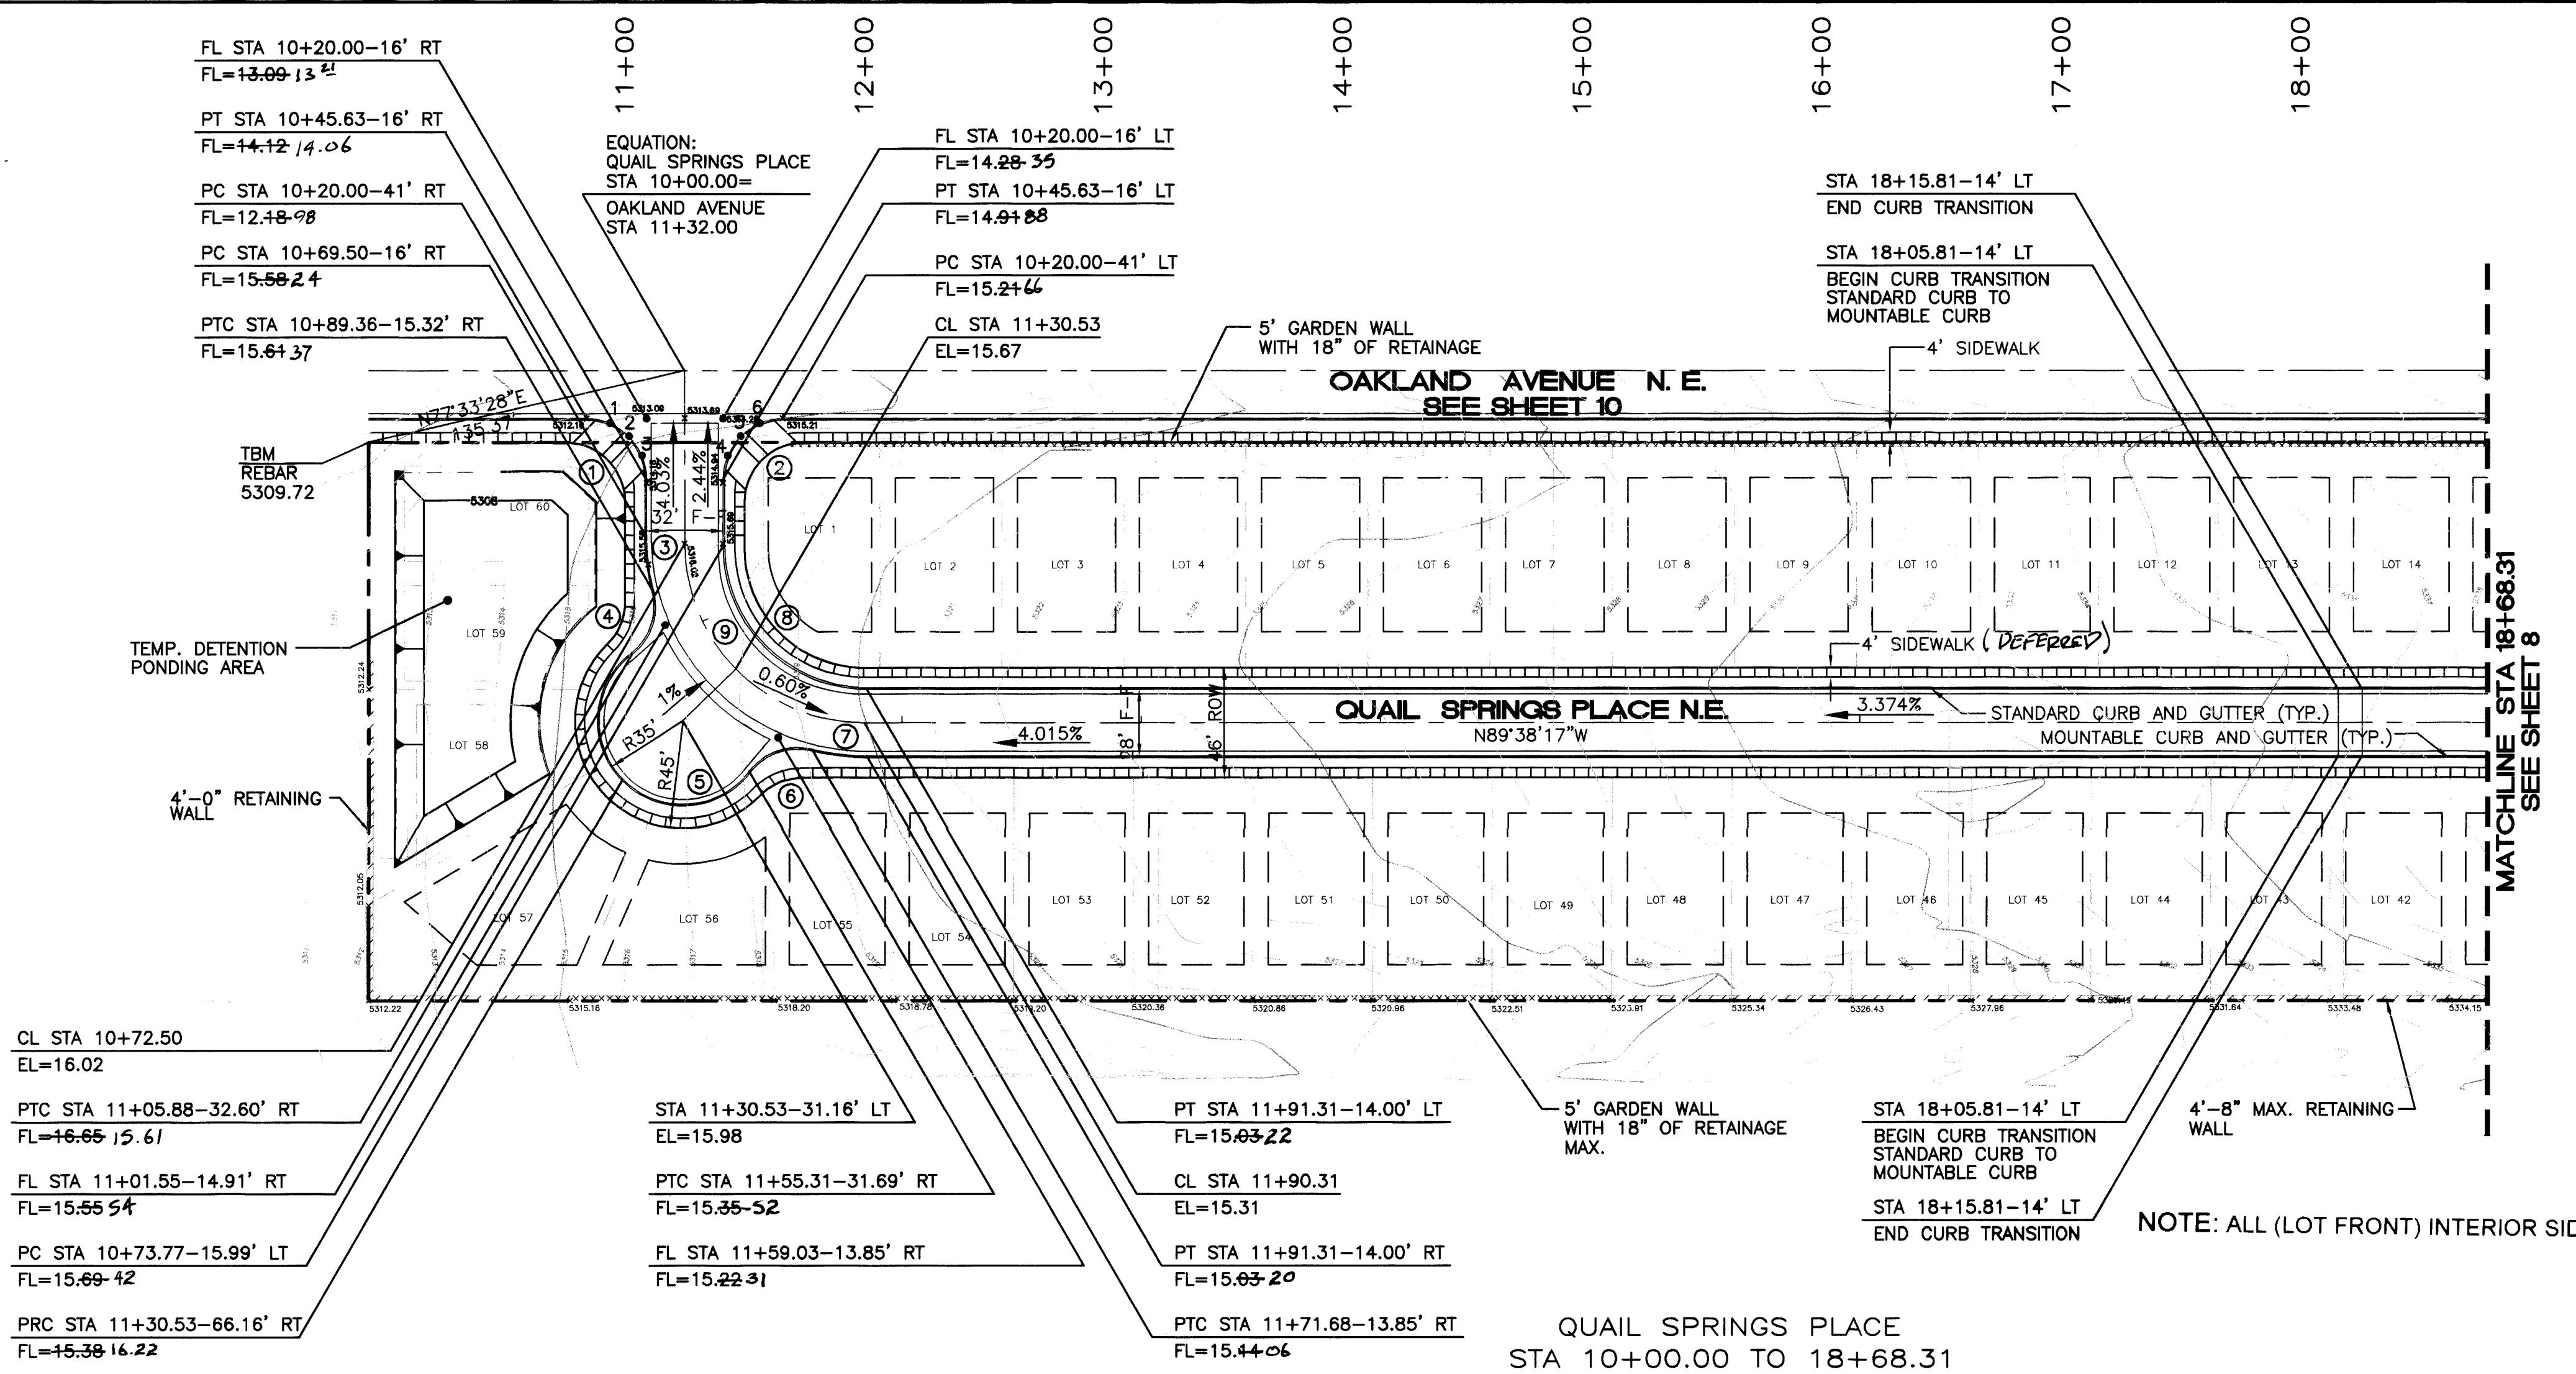

CURVE DATA (DESCRIBES FACE OF CURB)


① R = 25.00' Δ = 90°00'01" L = 39.27' T = 40.50'	② R = 25.00' Δ = 90°00'01" L = 39.27' T = 40.50'	③ R = 92.00' Δ = 14°33'38" L = 23.38' T = 142.38'	④ R = 25.00' Δ = 67°20'02" L = 29.38' T = --
⑤ R = 35.00' Δ = 195°43'21" L = 119.56' T = 17.56'	⑥ R = 25.00' Δ = 67°20'02" L = 29.38' T = --	⑦ R = 92.00' Δ = 14°22'26" L = 23.08' T = 116.82'	⑧ R = 60.00' Δ = 90°00'08" L = 94.25' T = 97.42'

CURVE DATA (DESCRIBES CENTERLINE)

⑨ R = 75.00' Δ = 90°00'01" L = 117.81' T = 121.51'


CURB RETURN QUARTER POINTS

FL	ELEV	FL	ELEV
1	12.66	4	15.01
2	13.16	5	15.07
3	13.66	6	15.14

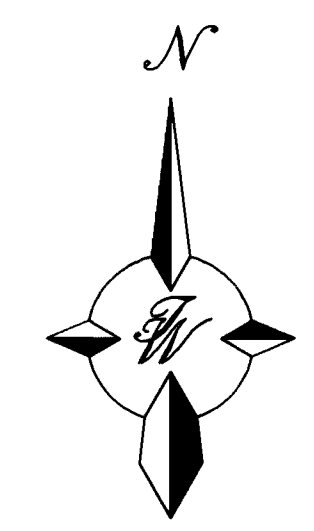

NOTE: SEE MASTER PAVING PLAN FOR STREET SECTIONS AND WHEELCHAIR RAMP TYPES.

SCALE: HORIZ. 1"=50'
VERT. 1"=5'

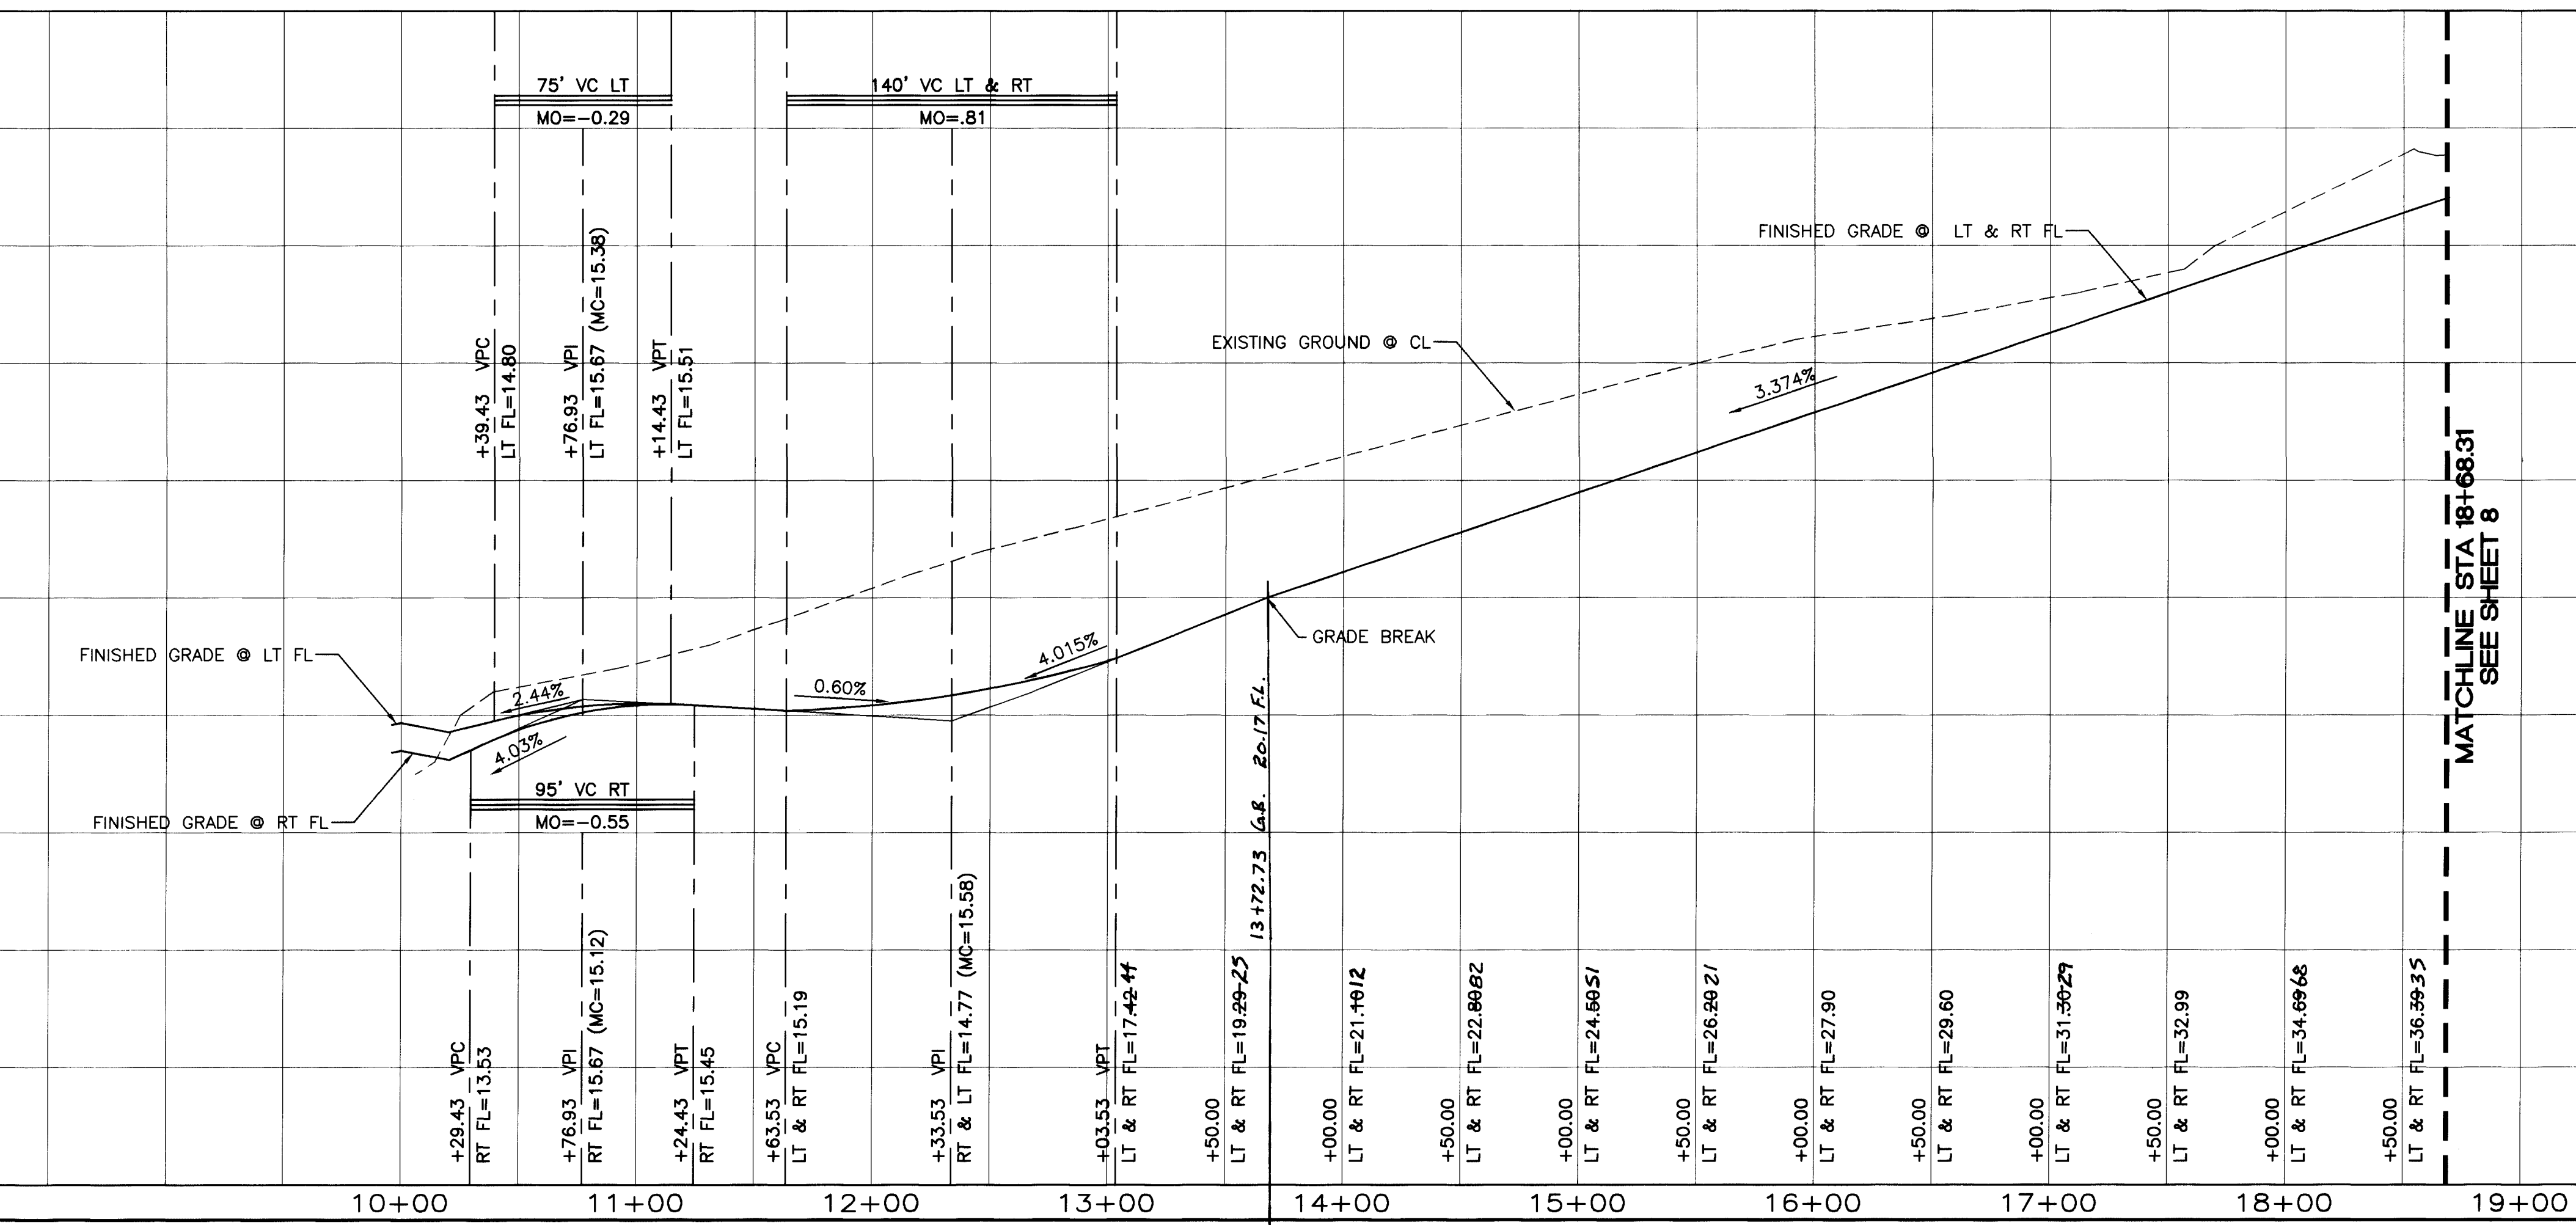


RECORD DRAWING
DATE: 8-28-97 DRAFTED BY: RRB
TERRA WEST DEV.
THESE RECORD DRAWINGS HAVE BEEN PREPARED
IN PART, ON THE BASIS OF INFORMATION COMPILED
AND FURNISHED BY OTHERS. THE ENGINEER WILL
NOT BE RESPONSIBLE FOR ANY ERRORS OR OMISSIONS
WHICH HAVE BEEN INCORPORATED INTO THE
DOCUMENT AS A RESULT.

TERRA WEST DEVELOPMENT
MANAGEMENT SERVICES
4421 McLEOD ROAD, N.E., SUITE D
ALBUQUERQUE, NEW MEXICO 87109
(505)883-7592

CITY OF ALBUQUERQUE
PUBLIC WORKS DEPARTMENT
ENGINEERING GROUP
TITLE: **QUAL SPRINGS ESTATES
PAVING IMPROVEMENTS
QUAIL SPRINGS PLACE STA 10+00.00 TO 18+68.31**
DESIGN REVIEW COMMITTEE
CITY ENGINEER APPROVAL
LAST DESIGN UPDATE
CITY PROJECT NO. 559081
ZONE MAP NO. C-19-Z
SHEET 7 OF 23

AS BUILT INFORMATION				BENCH MARKS				SURVEY INFORMATION				ENGINEER'S SEAL			
CONTRACTOR	SPRINT	DATE	8/28/97	ACS "100-18"	CENTRAL STATION DATA	DATE		NO.	BY	DATE					
WORKED BY	Joe Clauson	DATE	9/7	NM STATE PLANE COORDINATES											
INSPECTOR'S	Terra West	DATE	9/7	Control Zone											
FIELD	Terra West	DATE	9/7	X=402,319.45											
VERIFICATION BY	Terra West	DATE	9/7	Y=1,524,061.42											
CORRECTED BY	Terra West	DATE	9/7	G-G=0.9996613											
MICRO-FILM INFORMATION				DELTA=-001118"											
RECORDED BY				ELEV=5219.41											
NO.															

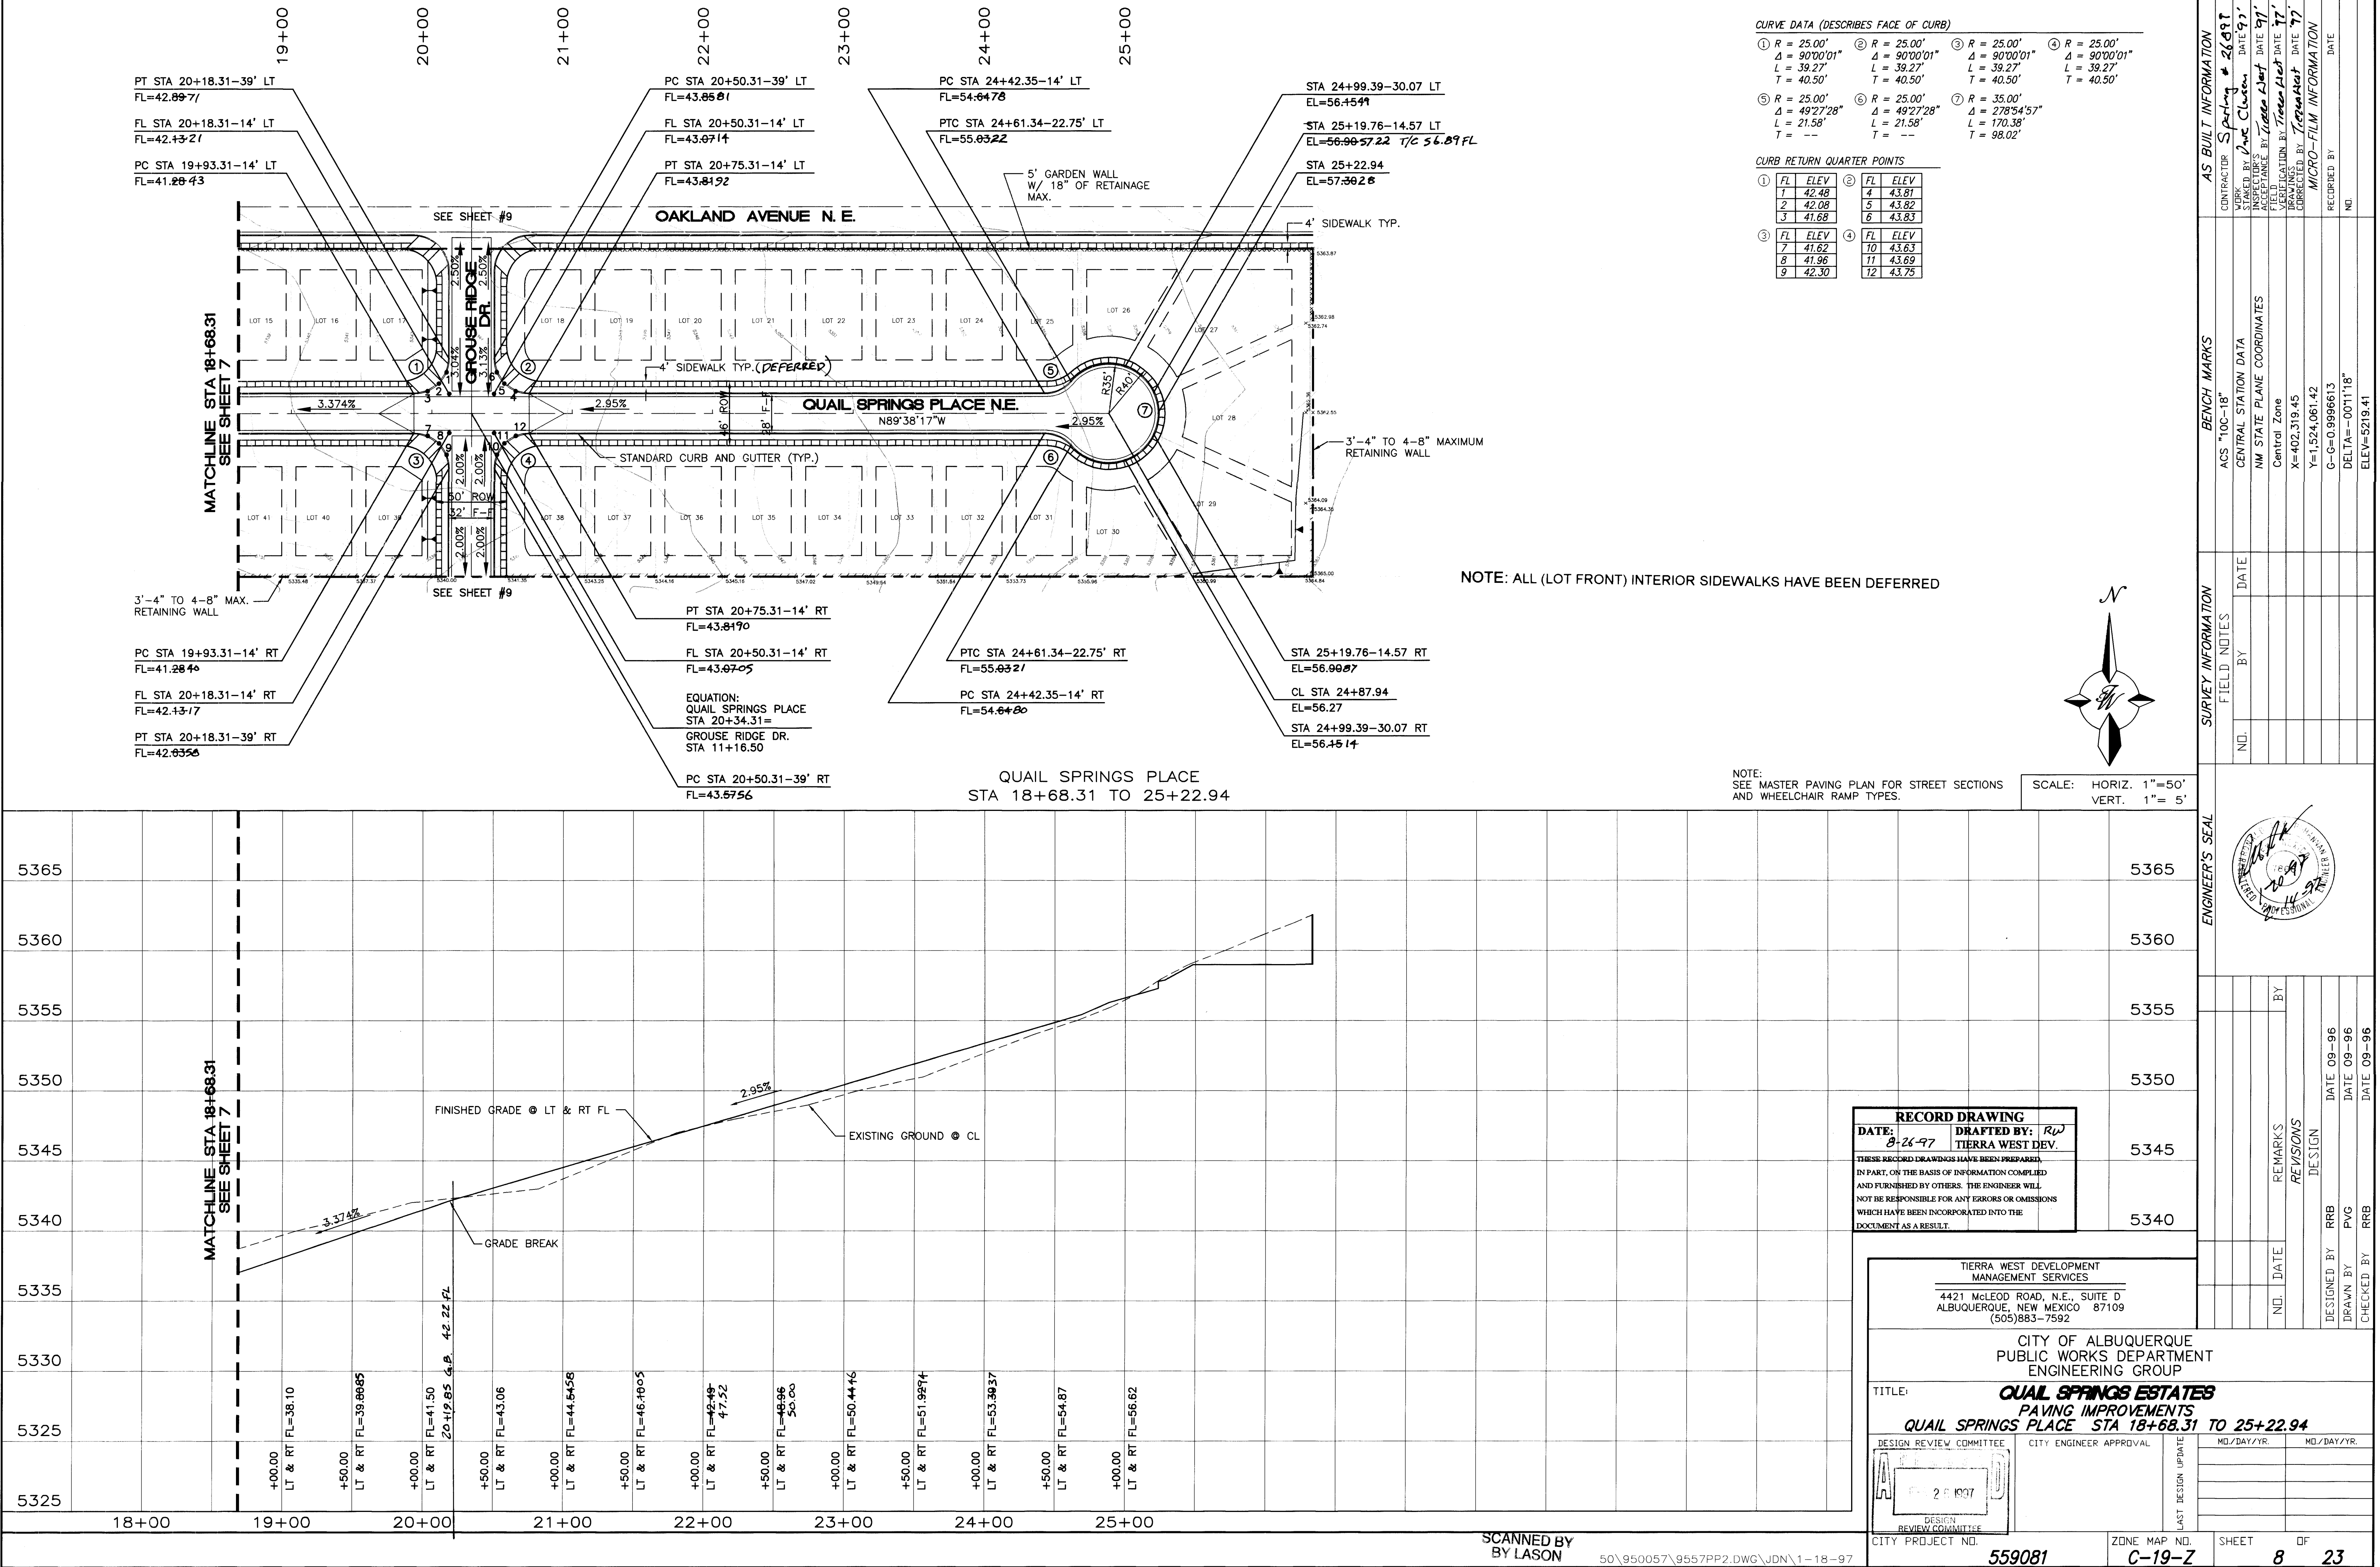

CURVE DATA (DESCRIBES FACE OF CURB)

① R = 25.00' Δ = 90°00'01" L = 39.27' T = 40.50'	② R = 25.00' Δ = 90°00'01" L = 39.27' T = 40.50'	③ R = 25.00' Δ = 90°00'01" L = 39.27' T = 40.50'	④ R = 25.00' Δ = 90°00'01" L = 39.27' T = 40.50'
⑤ R = 25.00' Δ = 49°27'28" L = 21.58' T = --	⑥ R = 25.00' Δ = 49°27'28" L = 21.58' T = --	⑦ R = 35.00' Δ = 278°54'57" L = 170.38' T = 98.02'	



CURB RETURN QUARTER POINTS

① FL ELEV 1 42.48 2 42.08 3 41.68	② FL ELEV 4 43.81 5 43.82 6 43.83	③ FL ELEV 7 41.62 8 41.96 9 42.30	④ FL ELEV 10 43.63 11 43.69 12 43.75
--	--	--	---

NOTE: ALL (LOT FRONT) INTERIOR SIDEWALKS HAVE BEEN DEFERRED

NOTE:
SEE MASTER PAVING PLAN FOR STREET SECTIONS
AND WHEELCHAIR RAMP TYPES.

SCALE: HORIZ. 1"=50'
VERT. 1"= 5'

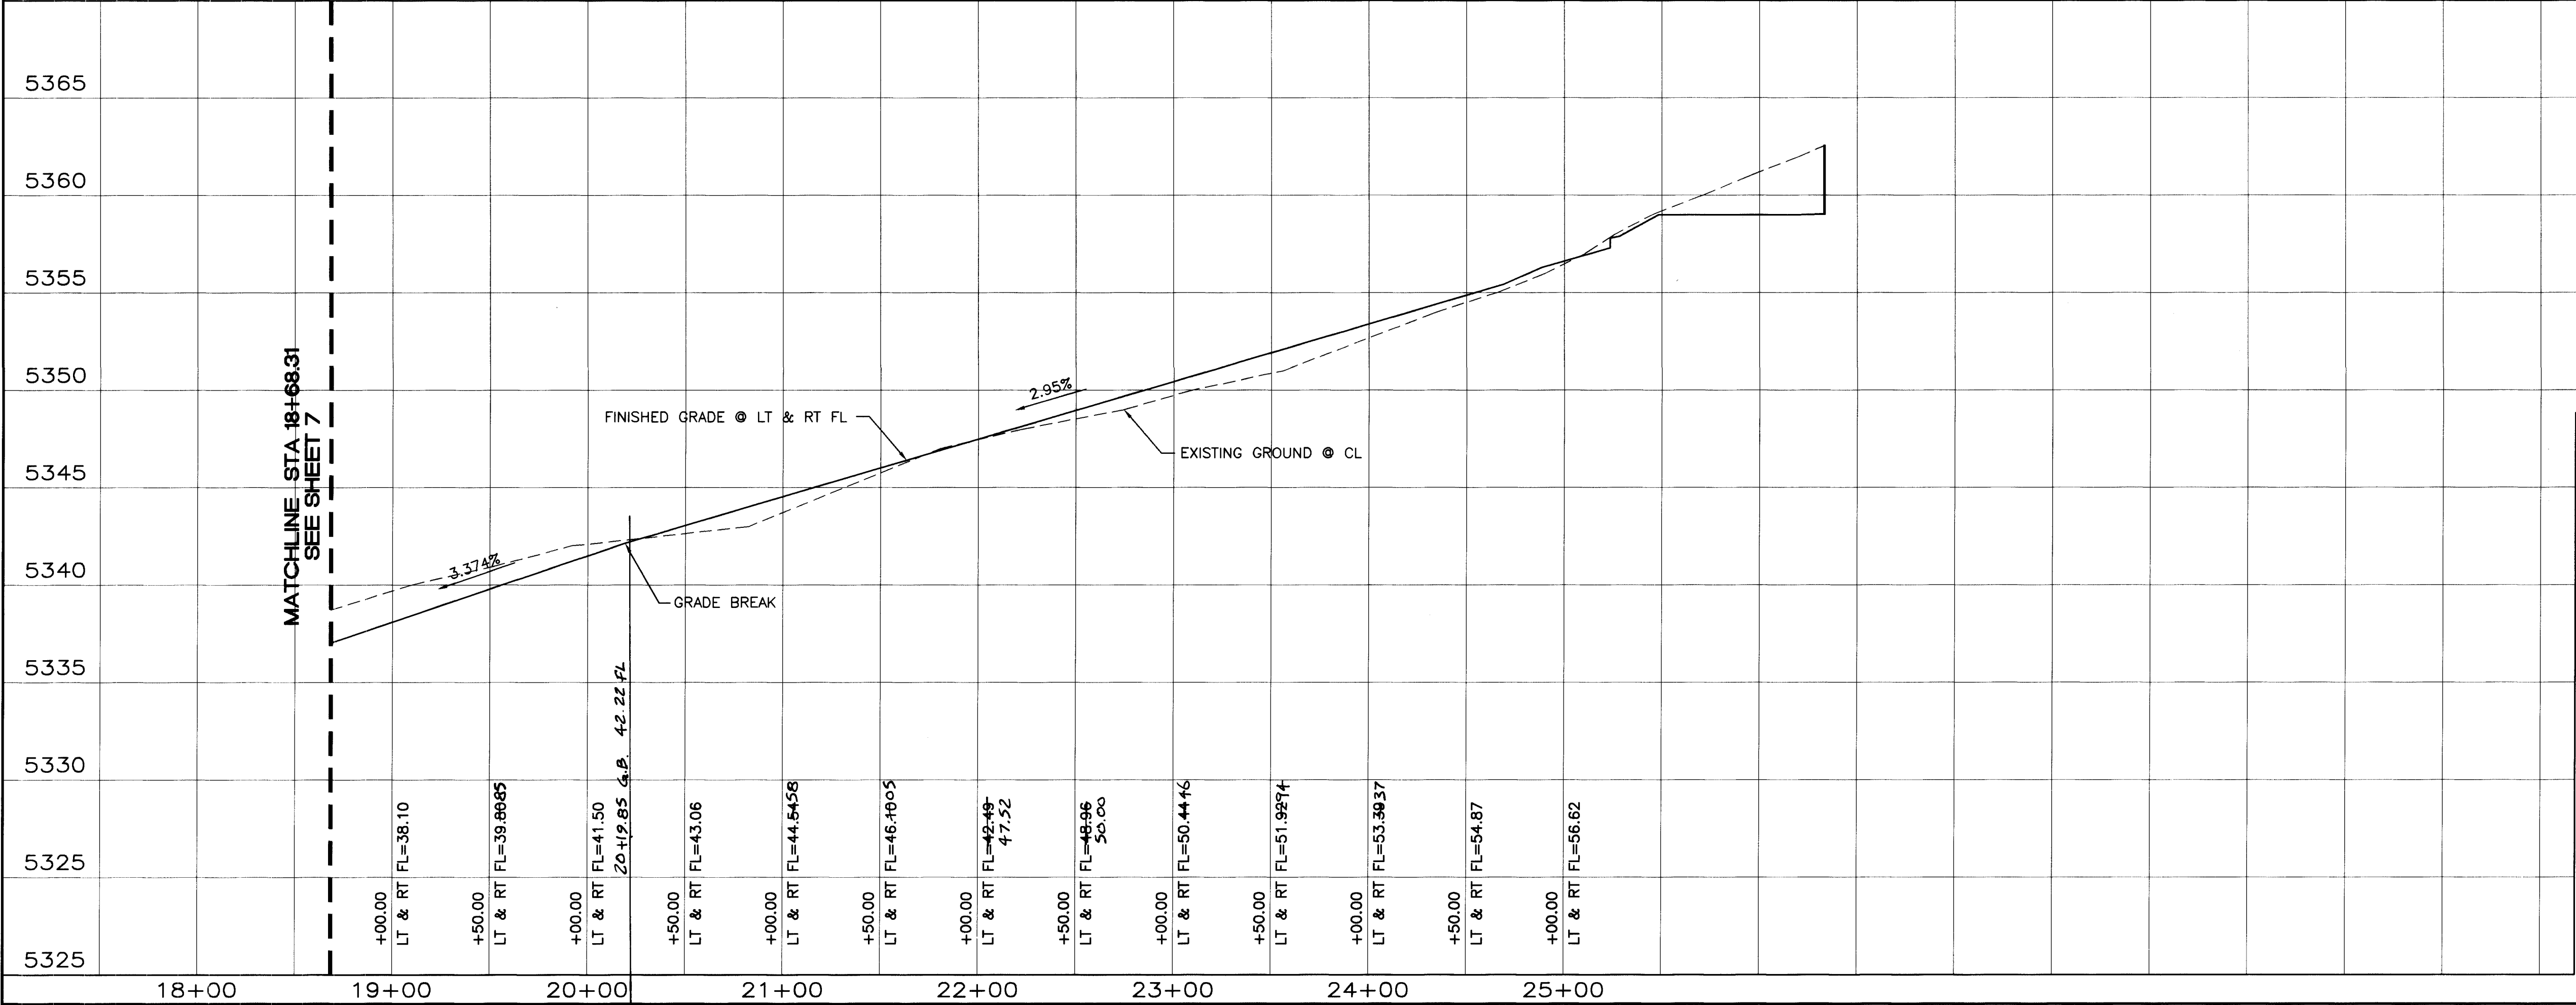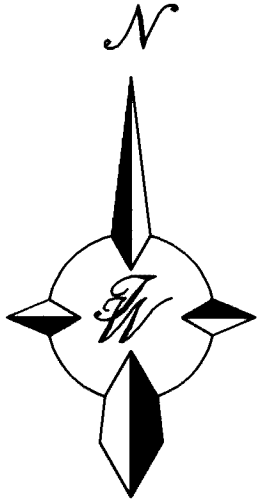

RECORD DRAWING


DATE: 8-26-97	DRAFTED BY: R.W.
TIERRA WEST DEV.	
THESE RECORD DRAWINGS HAVE BEEN PREPARED, IN PART, ON THE BASIS OF INFORMATION COMPLIED AND FURNISHED BY OTHERS. THE ENGINEER WILL NOT BE RESPONSIBLE FOR ANY ERRORS OR OMISSIONS WHICH HAVE BEEN INCORPORATED INTO THE DOCUMENT AS A RESULT.	

TIERRA WEST DEVELOPMENT
MANAGEMENT SERVICES
4421 McLEOD ROAD, N.E., SUITE D
ALBUQUERQUE, NEW MEXICO 87109
(505)883-7592


CITY OF ALBUQUERQUE
PUBLIC WORKS DEPARTMENT
ENGINEERING GROUP
TITLE: **QUAL SPRINGS ESTATES**
PAVING IMPROVEMENTS
QUAIL SPRINGS PLACE STA 18+68.31 TO 25+22.94

DESIGN REVIEW COMMITTEE	CITY ENGINEER APPROVAL	MO/DAY/YR.	MO/DAY/YR.
DESIGN REVIEW COMMITTEE			
DESIGN REVIEW COMMITTEE			
CITY PROJECT NO. 559081 ZONE MAP NO. C-19-Z SHEET 8 OF 23

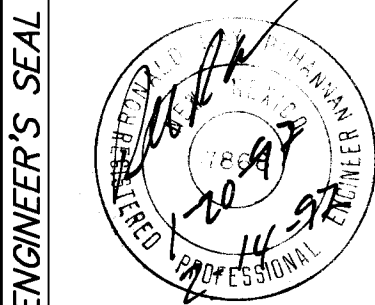


SURVEY INFORMATION				BENCH MARKS				AS BUILT INFORMATION			
FIELD NOTES		DATE		ACS "100-18"		CENTRAL STATION DATA		CONTRACTOR		Spring # 26897	
BY						NM STATE PLANE COORDINATES		STARTED BY		Dave Chuen	
NO.						Central Zone		INSPECTOR'S		DATE	
						X=402,319.45		FIELD NAME		Terra West	
						Y=1,524,061.42		VERIFICATION BY		Terra West	
								CORRECTED BY		Terra West	
								MICRO-FILM INFORMATION			
								RECORDED BY			
								DATE			
								DELTA		-001118"	
								ELEV		5219.41	

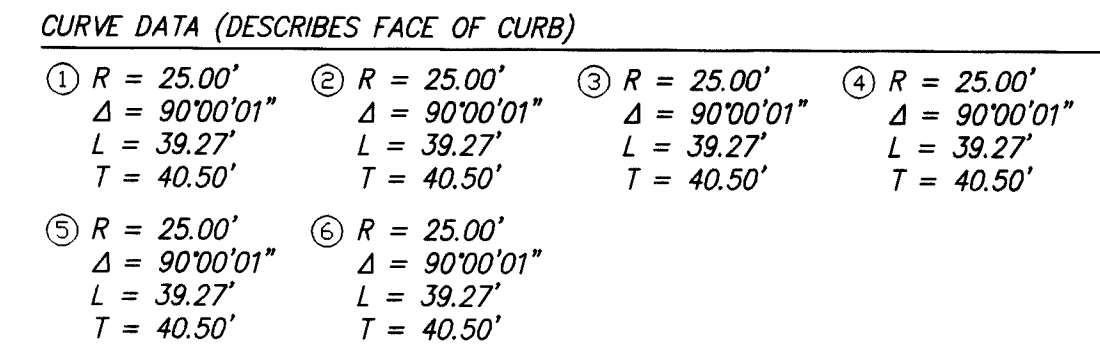

CURB RETURN QUARTER POINTS

①	FL	ELEV	②	FL	ELEV	③	FL	ELEV
	1	41.62		4	42.48		7	43.63
	2	41.96		5	42.08		8	43.69
	3	42.30		6	41.68		9	43.75


④	FL	ELEV	⑤	FL	ELEV	⑥	FL	ELEV
	10	43.27		13	42.58		16	44.08
	11	43.47		14	42.74		17	44.12
	12	43.67		15	42.90		18	44.16

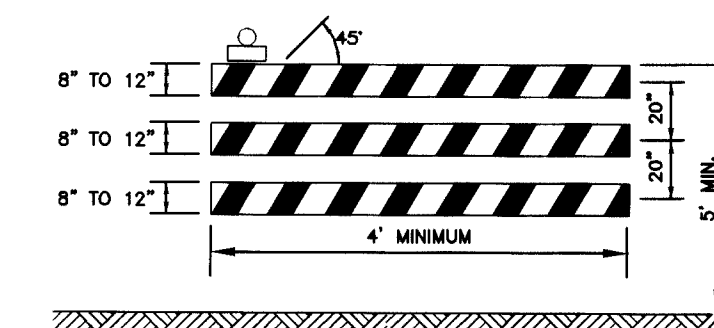

TYPE III BARRICADE


NOTE: FLASHING OR STEADY BURN WARNING LIGHTS SHOULD BE USED ON BARRICADES, PANELS, AND DRUMS AS NEEDED.

NOTE: ALL (LOT FRONT) INTERIOR SIDEWALKS HAVE BEEN DEFERRED

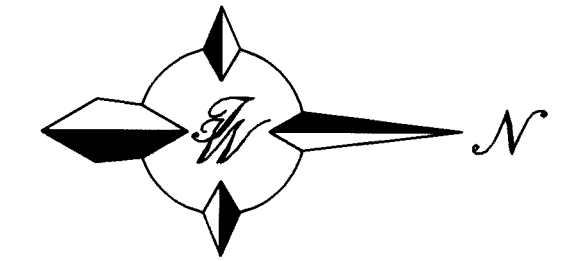

NOTE:
SEE MASTER PAVING PLAN FOR STREET SECTIONS
AND WHEELCHAIR RAMP TYPES.

SCALE: HORIZ. 1"=50'
VERT. 1"= 5'

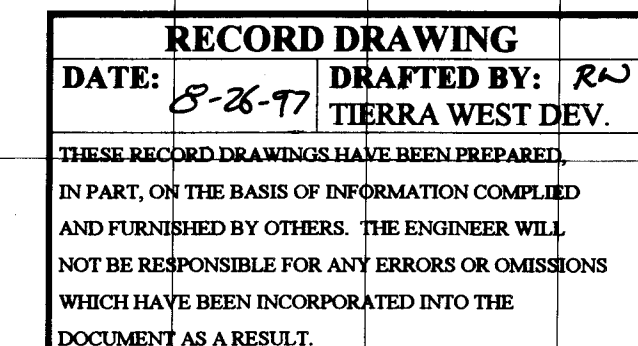

TIERRA WEST DEVELOPMENT
MANAGEMENT SERVICES
4421 McLEOD ROAD, N.E., SUITE D
ALBUQUERQUE, NEW MEXICO 87109
(505)883-7592

CITY OF ALBUQUERQUE
PUBLIC WORKS DEPARTMENT
ENGINEERING GROUP

TITLE: **QUAIL SPRINGS ESTATES**
PAVING IMPROVEMENTS
GROUSE RIDGE DRIVE STA 10+00.00 TO 12+64.00

DESIGN REVIEW COMMITTEE

APPROVED

26 1997

DESIGN REVIEW COMMITTEE

CITY ENGINEER APPROVAL

MO./DAY/YR.	MO./DAY/YR.


SCANNED BY
BY LASON

50\950057\9557PP3.DWG\JDN\1-18-97

CITY PROJECT NO.

ZONE MAP NO.
C-19-Z

SHEET	OF
9	23

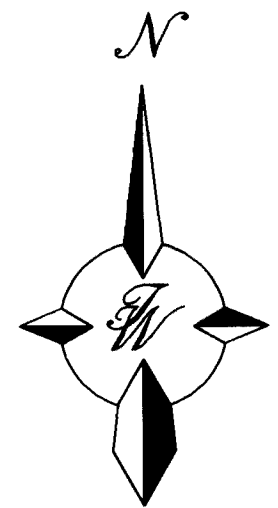

RECORD DRAWING	
DATE: 8-26-97	DRAFTED BY: RW TIERRA WEST DEV.
THESE RECORD DRAWINGS HAVE BEEN PREPARED IN PART, ON THE BASIS OF INFORMATION COMPILED AND FURNISHED BY OTHERS. THE ENGINEER WILL NOT BE RESPONSIBLE FOR ANY ERRORS OR OMISSIONS WHICH HAVE BEEN INCORPORATED INTO THE DOCUMENT AS A RESULT.	

TIERRA WEST DEVELOPMENT
MANAGEMENT SERVICES
4421 MCLEOD ROAD, N.E., SUITE D
ALBUQUERQUE, NEW MEXICO 87109
(505)883-7592

CITY OF ALBUQUERQUE
PUBLIC WORKS DEPARTMENT
ENGINEERING GROUP

TITLE: **QUAIL SPRINGS ESTATES**
PAVING IMPROVEMENTS
OAKLAND AVENUE STA 10+00.00 TO 18+85.00

DESIGN REVIEW COMMITTEE

A P P R O V E D

2007

DESIGN
REVIEW COMMITTEE

CITY PROJECT NO


	CITY ENGINEER APPROVAL
--	------------------------

ZONE MAP NO.


SHEET 12 OF 22

50\950057\9557PP4.DWG\BDG\2-03-9

SCANNED BY
BY LASON

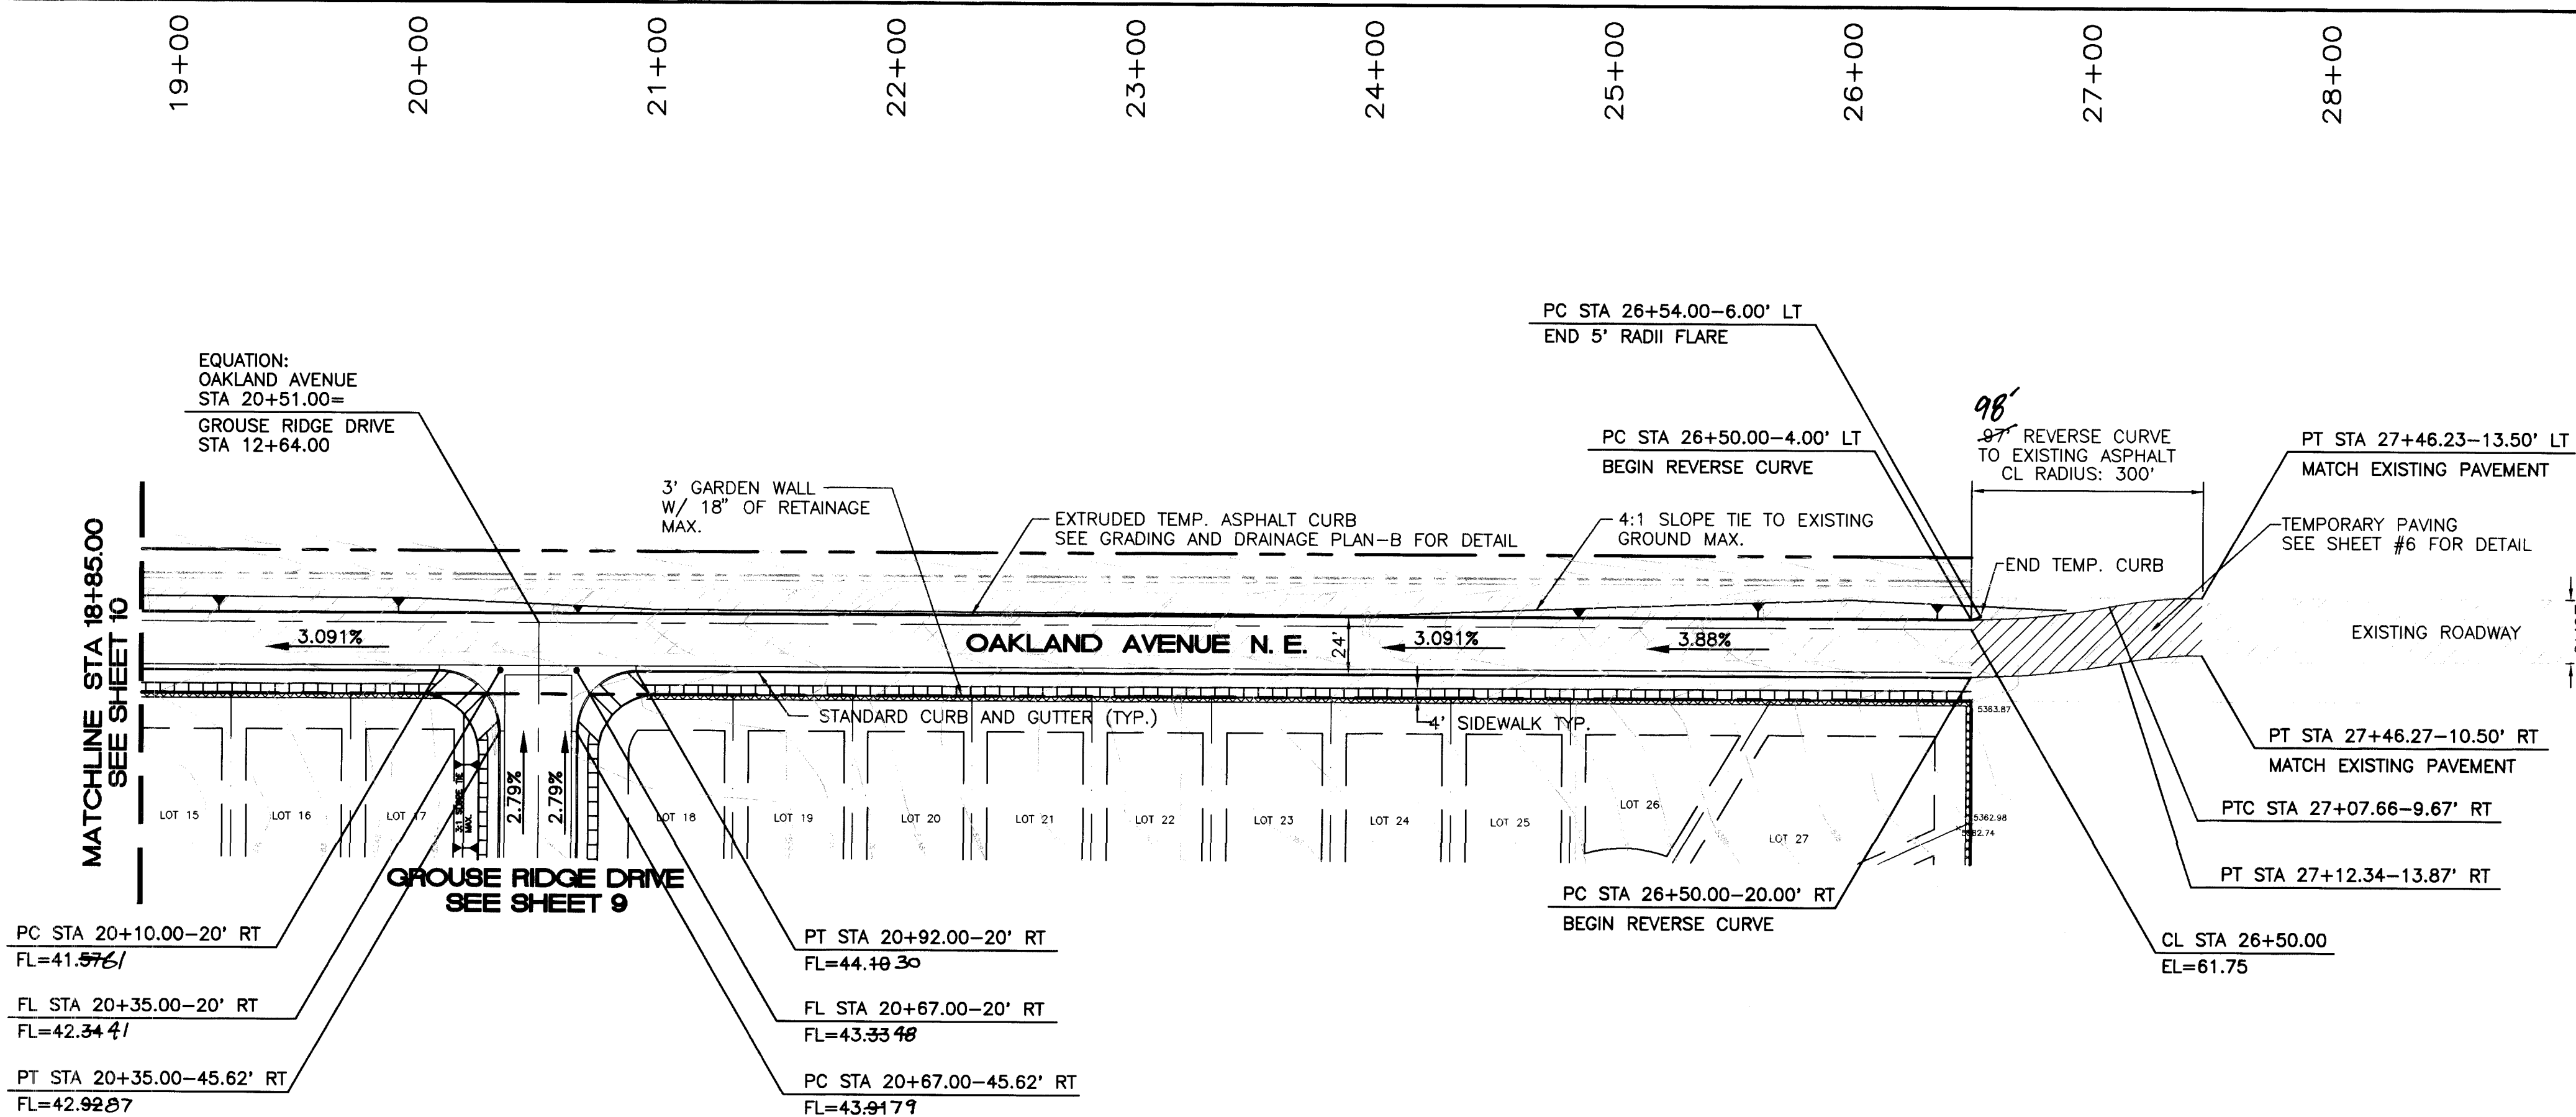


NOTE: ALL (LOT FRONT) INTERIOR SIDEWALKS HAVE BEEN DEFERRED

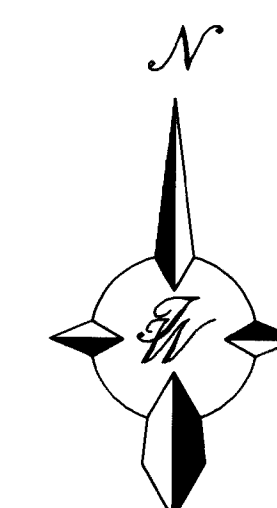

OAKLAND AVENUE
STA 18+85.00 TO 27+36.67

NOTE:
SEE MASTER PAVING PLAN FOR STREET SECTIONS
AND WHEELCHAIR RAMP TYPES.

SCALE: HORIZ. 1"=50'
VERT. 1"= 5'

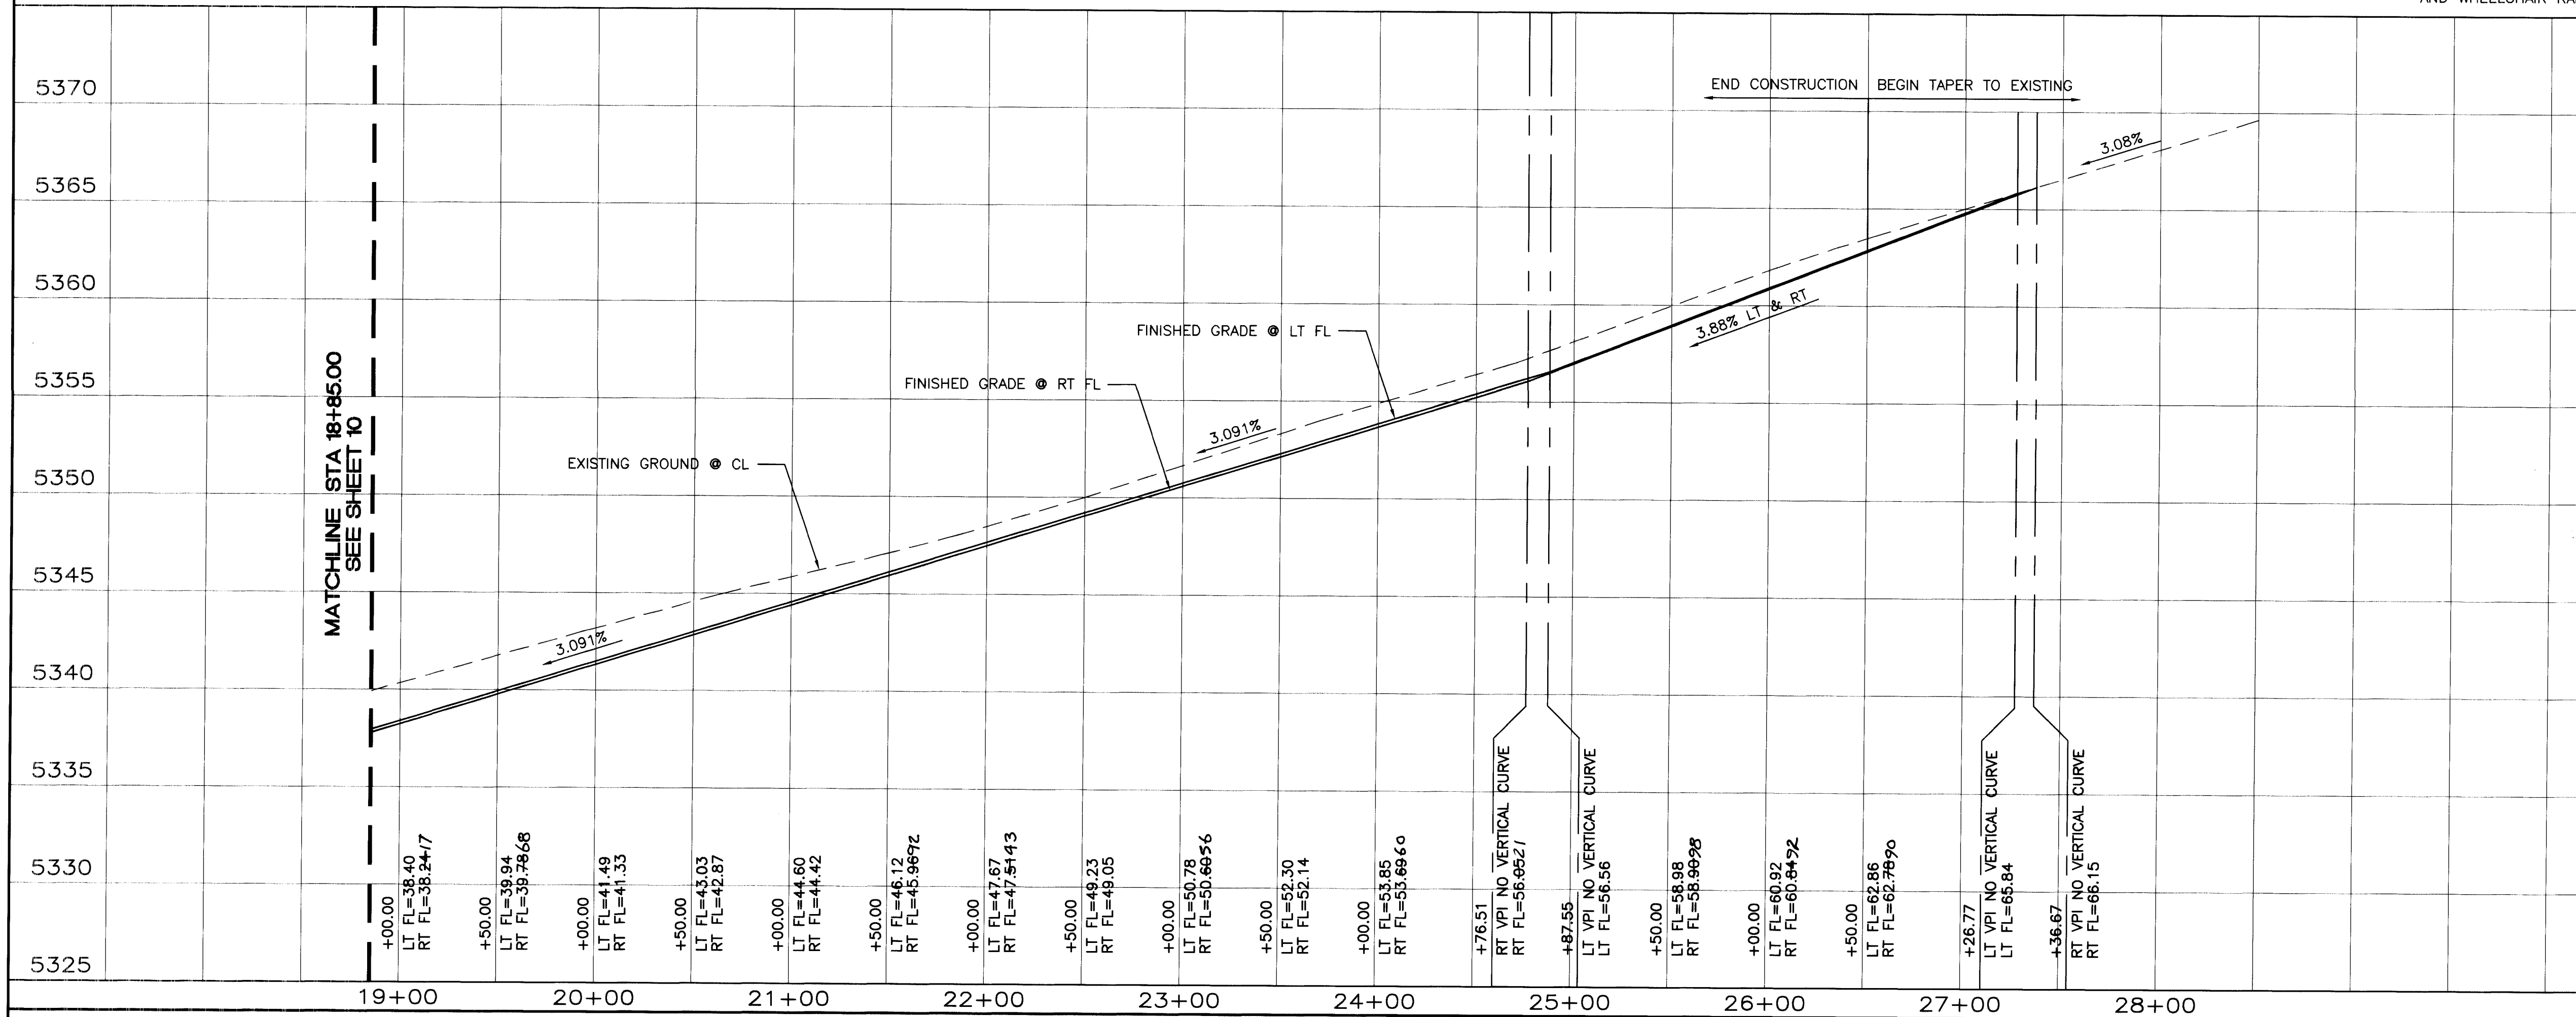

RECORD DRAWING
DATE: 8-25-97 DRAFTED BY: RJS
TERRA WEST DEV.
THESE RECORD DRAWINGS HAVE BEEN PREPARED
IN PART, ON THE BASIS OF INFORMATION COMPILED
AND FURNISHED BY OTHERS. THE ENGINEER WILL
NOT BE RESPONSIBLE FOR ANY ERRORS OR OMISSIONS
WHICH HAVE BEEN INCORPORATED INTO THE
DOCUMENT AS A RESULT.

TERRA WEST DEVELOPMENT
MANAGEMENT SERVICES
4421 McLEOD ROAD, N.E., SUITE D
ALBUQUERQUE, NEW MEXICO 87109
(505)883-7592

CITY OF ALBUQUERQUE
PUBLIC WORKS DEPARTMENT
ENGINEERING GROUP

TITLE: **QUAL SPRINGS ESTATES**
PAVING IMPROVEMENTS
OAKLAND AVENUE STA 18+85.00 TO 27+36.67

APPROVED: 2-14-97


CITY ENGINEER APPROVAL

DESIGNED BY: RRB DATE 09-96
DRAWN BY: PVG DATE 09-96
CHECKED BY: RRB DATE 09-96


NO. DATE REMARKS REVISIONS

NO. DATE REMARKS

SURVEY INFORMATION		BENCH MARKS		AS BUILT INFORMATION	
NO.	BY	DATE	ACS "10C-18"	CONTRACTOR	SPAWLING #26879
			CENTRAL STATION DATA	INSPECTED BY	JOE CLASSEN
			NM STATE PLANE COORDINATES	ACCEPTANCE DATE	97
			Central Zone	VERIFICATION BY	TERRA WEST
			X=402,319.45	DATE	97
			Y=1,524,061.42	DRIVEN BY	JOE CLASSEN
			G-G=0.998613	DATE	97
			DELTA=-001118"	MICRO-FILM INFORMATION	
			ELEV=5219.41	RECORDED BY	
				DATE	

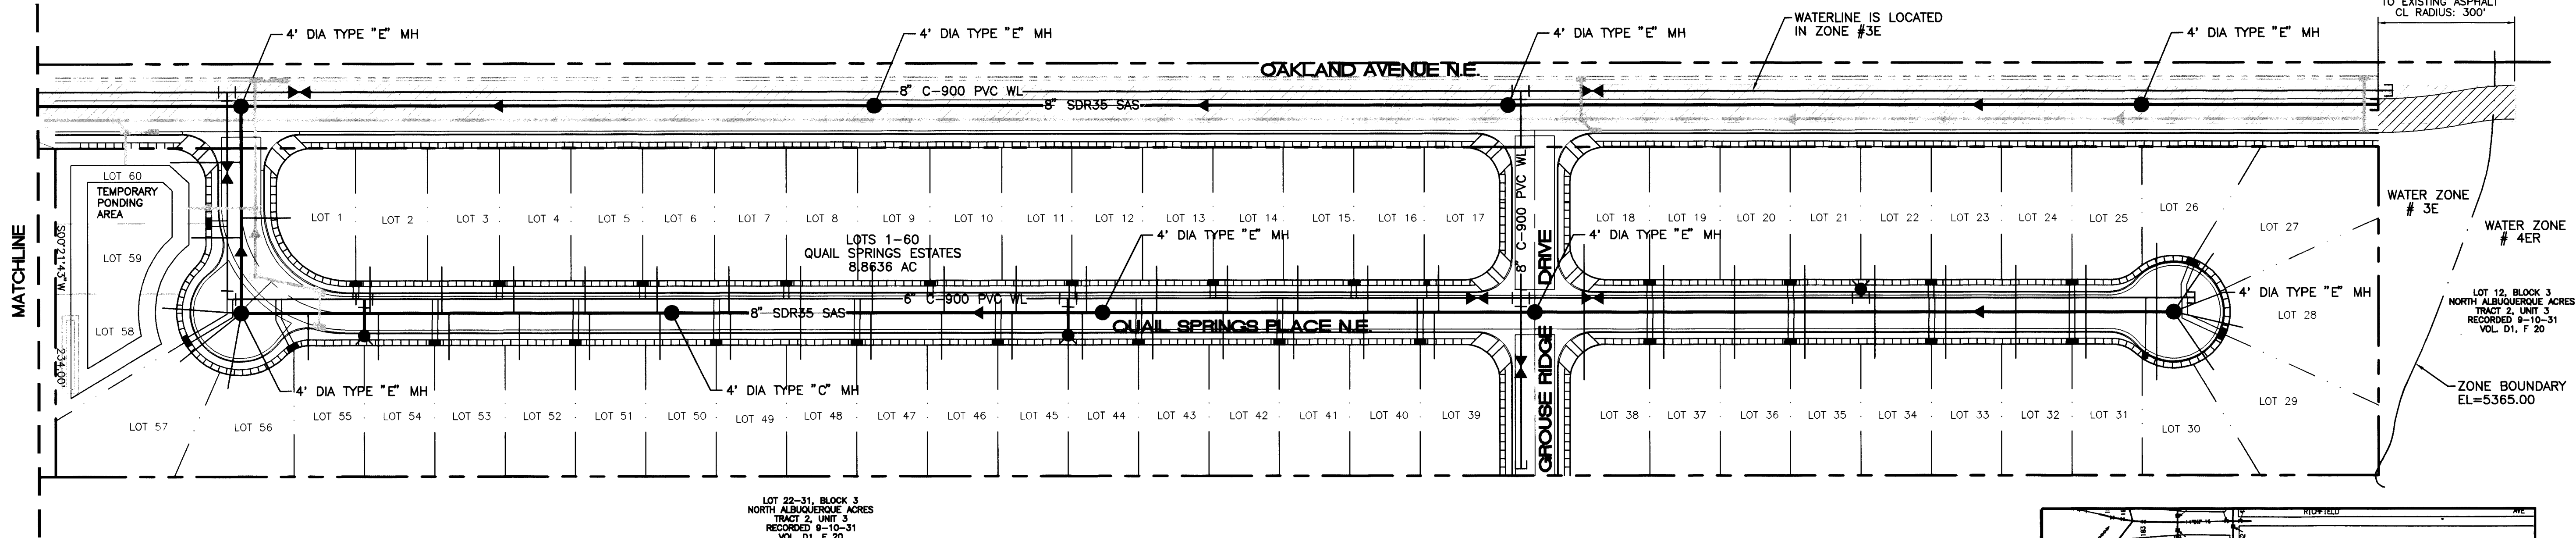


LOT 22-31, BLOCK 3
NORTH ALBUQUERQUE ACRES
TRACT 2, UNIT 3
RECORDED 8-10-31
VOL. D1, F. 20

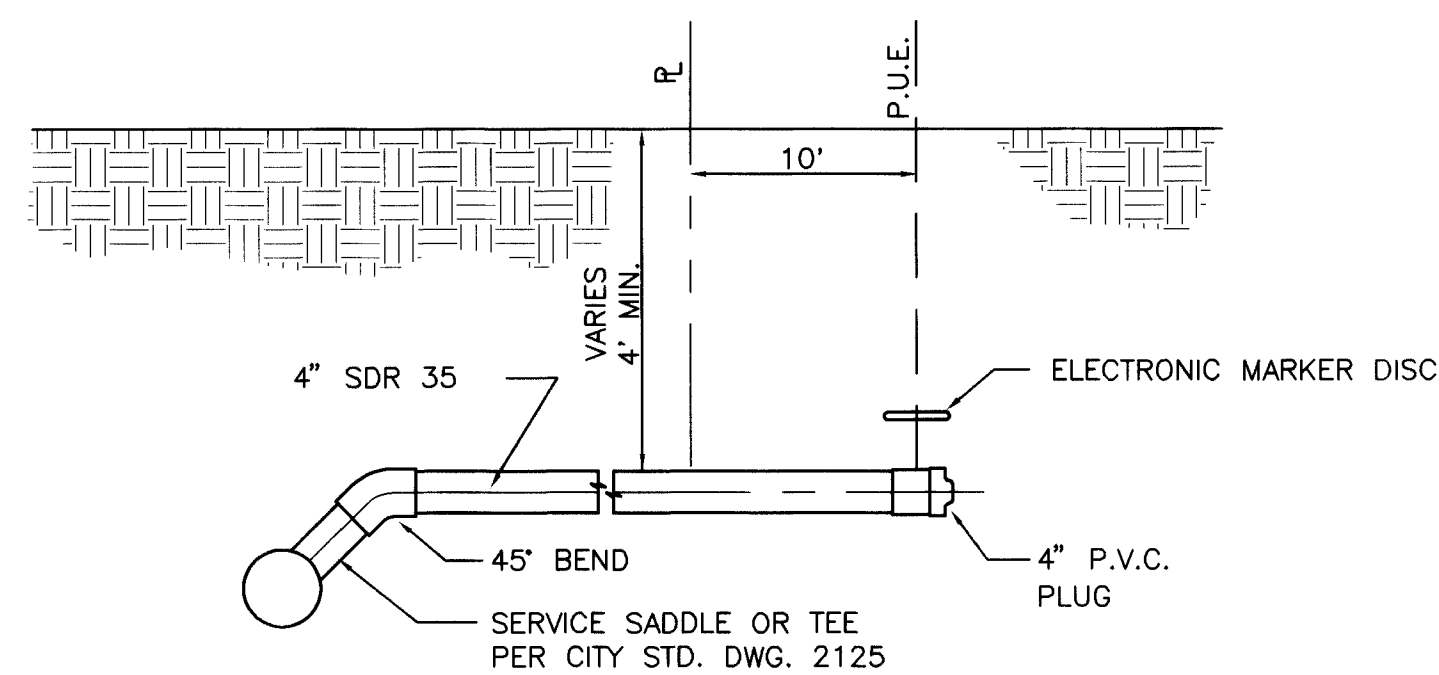


TYP. SANITARY SYSTEM SERVICE CONNECTION

PER COA STD. DWG. 2125
NO SCALE

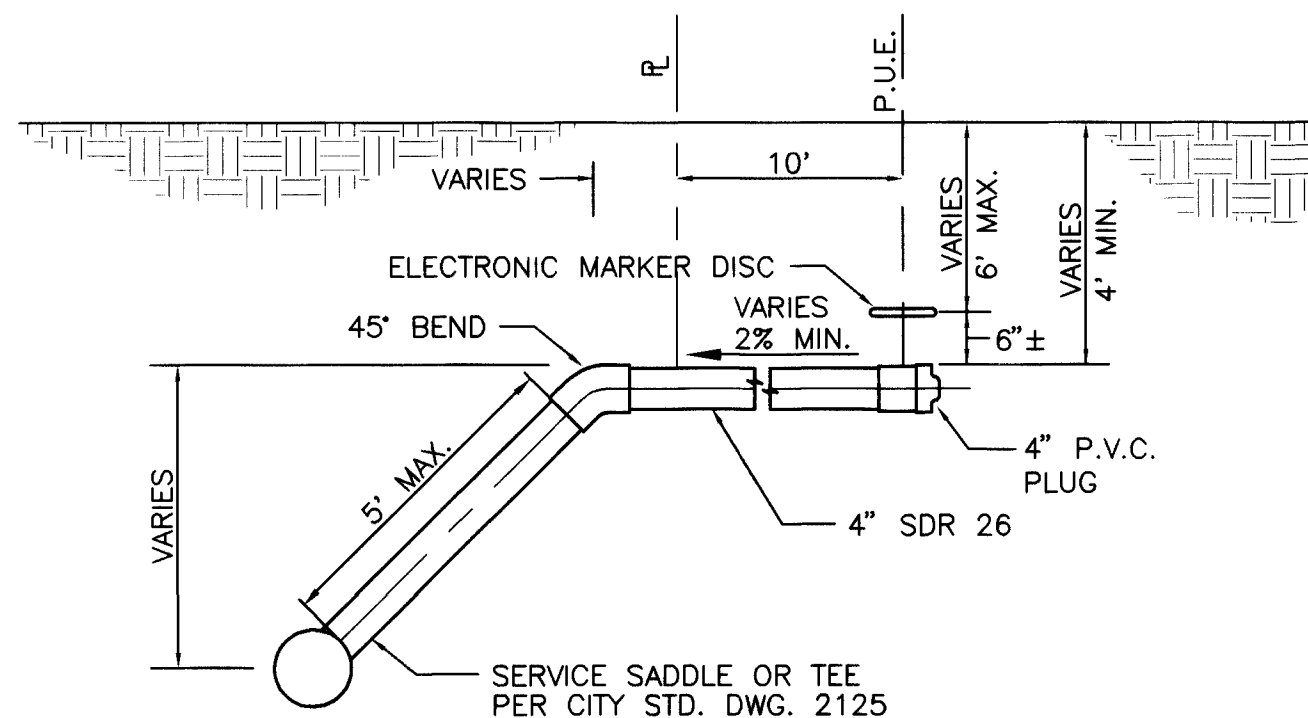

TYP. SANITARY SYSTEM SERVICE CONNECTION FOR DEEP SANITARY SEWERS

NO SCALE

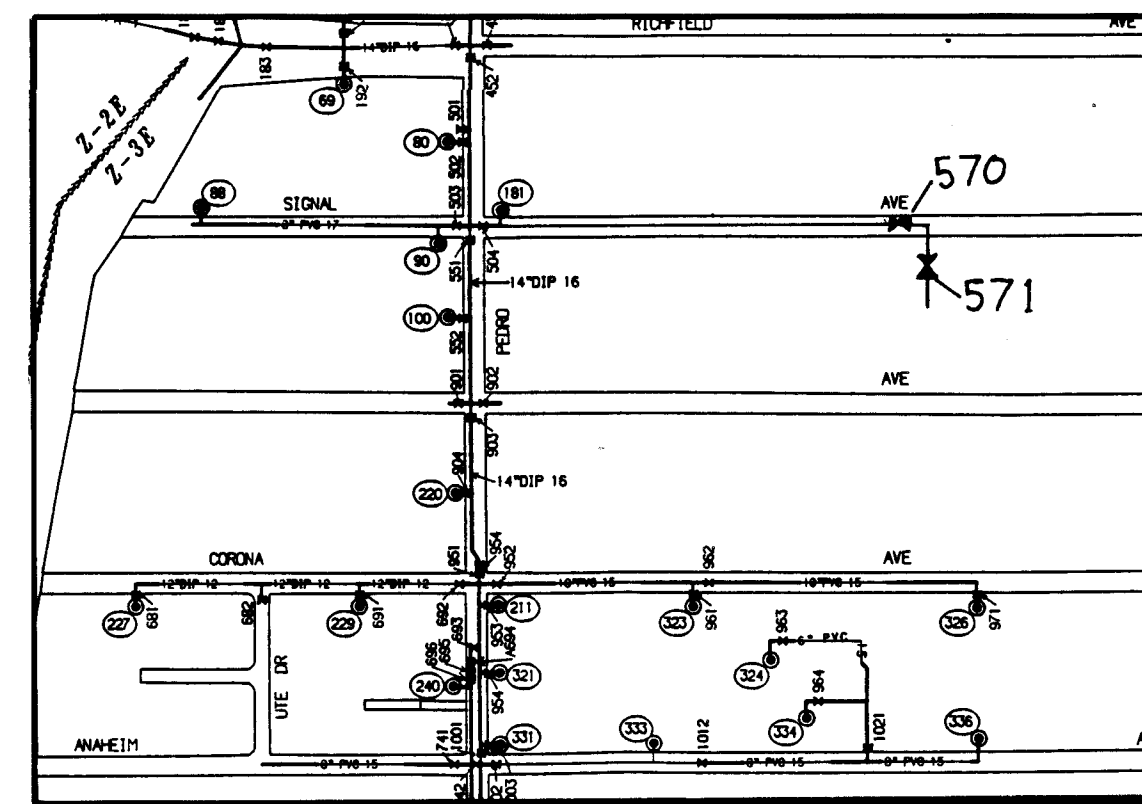

WATER SHUT-OFF PLAN

- NOTES:
- ONLY WATER SYSTEMS PERSONNEL ARE AUTHORIZED TO OPERATE VALVES
 - NOTIFY CITY OF ALBUQUERQUE, WATER SYSTEMS DIVISION (PHONE) 857-8200 FIVE (5) WORKING DAYS IN ADVANCE OF NEEDING EXECUTION OF THE WATER SHUT OFF PLAN
 - APPROXIMATE SHUT OFF TIME WILL BE 24 HOURS
 - SHUTOFF VALVES INDICATED IN THE ABOVE PLAN

BENCH MARK


ACS MONUMENT "10C-18", NM STATE PLANE COORDINATES, CENTRAL ZONE, NAD, 1927, X=402,319.45, Y=1,524,061.42, EL=5219.41, DELTA ALPHA=-0°11'18" G-G=0.9996613, TIES TO THE NORTHEAST CORNER OF PROPERTY BEARING S69°15'45"E, 2964.48'

LEGAL DESCRIPTION:

LOTS 1 THRU 60, BLOCK 3 QUAIL SPRINGS, ALBUQUERQUE, BERNALILLO COUNTY, NEW MEXICO


GENERAL NOTES:

- 4.5' MIN. BURY REQUIRED FOR ALL UTILITIES UNLESS OTHERWISE NOTED.
- ALL STUBS AND UTILITY LOCATIONS MUST BE FIELD VERIFIED PRIOR TO CONSTRUCTION.
- CLEAN OUTS TO BE BUILT PER UNIFORM PLUMBING CODE STANDARDS.
- ALL WATERLINE SERVICES ARE TO BE COPPER PIPING.

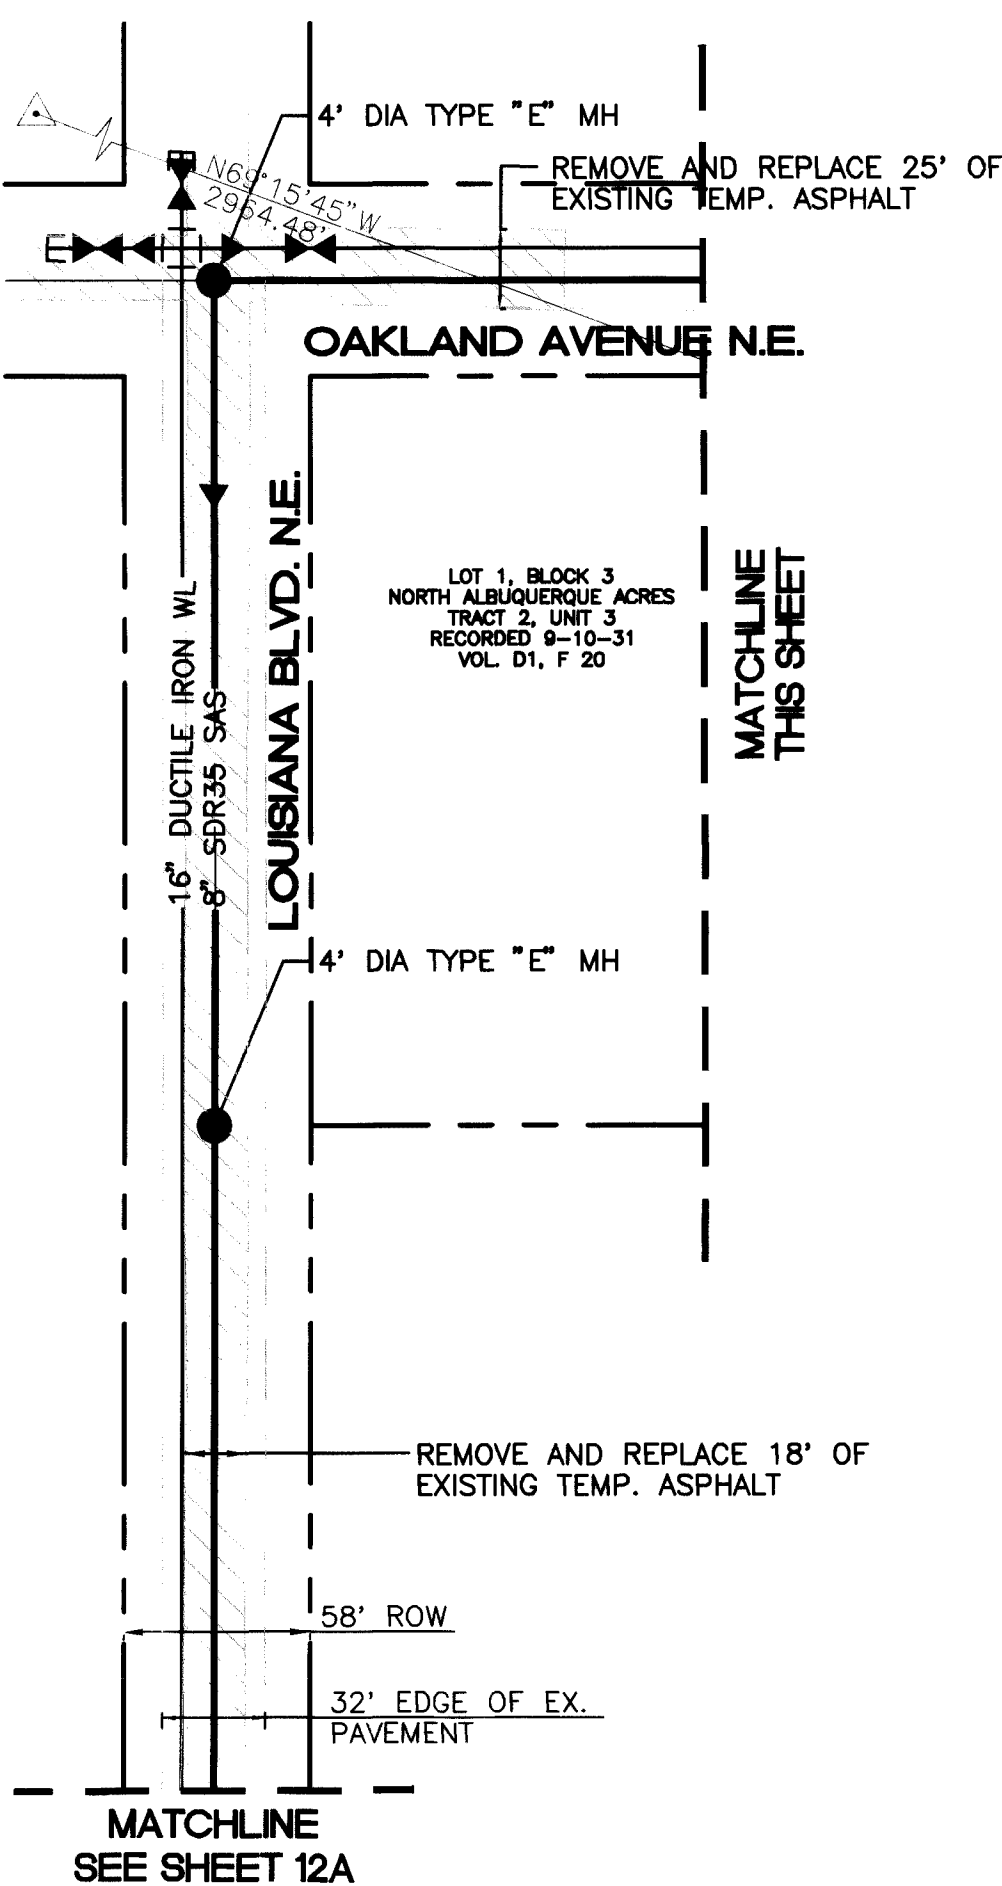

LEGEND


BOUNDARY	---
LOT	---
ROAD	---
CURB AND GUTTER	---
CENTER LINE	---
SIDEWALK	---
EXIST. ROAD	---
PROPOSED RETAINING WALL	---
PROPOSED 3' GARDEN WALL	---
LIMITS OF EXISTING ASPHALT	---
PROPOSED SAS LINE	---
EXISTING SAS LINE	---
PROPOSED WATER LINE	---
EXISTING WATER LINE	---
PROPOSED SD LINE	---
EXISTING SD LINE	---
SAS SERVICE	---
SINGLE WATER SERVICE	---
DOUBLE WATER SERVICE	---
SANITARY SEWER MANHOLE	●
CROSS	+
TEE	+
90° BEND	+
CAP	+
GATE VALVE	+
REDUCER	+
STORM SEWER MANHOLE	●
DROP INLET	+

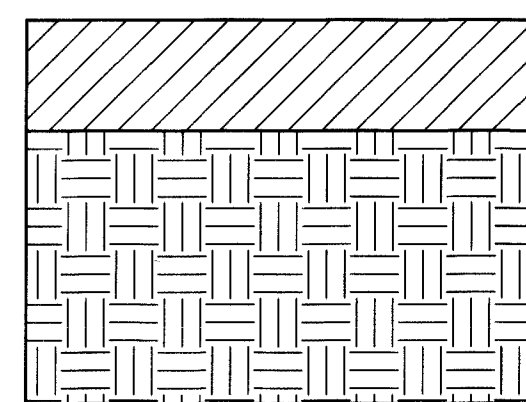


TEMP. PAVING SECTION

NO SCALE

RECORD DRAWING	
DATE: 8-28-97	DRAFTED BY: RLB
	TIERRA WEST DEV.
THESE RECORD DRAWINGS HAVE BEEN PREPARED, IN PART, ON THE BASIS OF INFORMATION COMPLIED AND FURNISHED BY OTHERS. THE ENGINEER WILL NOT BE RESPONSIBLE FOR ANY ERRORS OR OMISSIONS WHICH HAVE BEEN INCORPORATED INTO THE DOCUMENT AS A RESULT.	

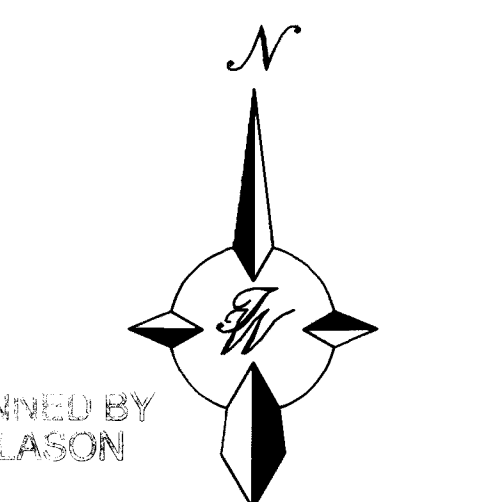

GRAPHIC SCALE

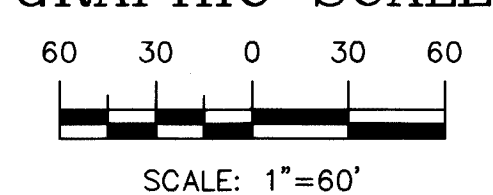


TIERRA WEST DEVELOPMENT MANAGEMENT SERVICES 4421 McLEOD ROAD, N.E., SUITE D ALBUQUERQUE, NEW MEXICO 87109 (505)883-7592		CITY OF ALBUQUERQUE PUBLIC WORKS DEPARTMENT ENGINEERING GROUP	
TITLE: QUAIL SPRINGS ESTATES MASTER UTILITY PLAN SHEET 'A'			
DESIGNED BY: RRB	CITY ENGINEER APPROVAL:	DATE: 09-96	
DRAWN BY: PVG		DATE: 09-96	
CHECKED BY: RRB		DATE: 09-96	
CITY PROJECT NO. 559081	ZONE MAP NO. C-19-Z	SHEET 12	OF 23

AS BUILT INFORMATION		BENCH MARKS		SURVEY INFORMATION	
CONTRACTOR: Spilling, #26879	WORK: By Dave Clavner	ACS "10C-18"	DATE: 09-97	NO.	BY
INSPECTOR: By Terra West Dev.	ACCEPTANCE: By Terra West Dev.	NM STATE PLANE COORDINATES	DATE: 09-97		
DRAWING: By Terra West Dev.	CORRECTION: By Terra West Dev.	Central Zone	DATE: 09-97		
MICRO-FILM INFORMATION		X=402,319.45	Y=1,524,061.42		
		G-G=0.9996613	DELTA=-0°11'18"		
		ELEV=5219.41			

RRB
2-14-97

LEGEND

BOUNDARY	---
LOT	- - - - -
ROAD	=====
CURB AND GUTTER	=====
CENTER LINE	=====
SIDEWALK	=====
EXIST. ROAD	=====
PROPOSED RETAINING WALL	=====
PROPOSED 3' GARDEN WALL	=====
LIMITS OF EXISTING ASPHALT	=====
PROPOSED SAS LINE	=====
EXISTING SAS LINE	=====
PROPOSED WATER LINE	=====
EXISTING WATER LINE	=====
PROPOSED SD LINE	=====
EXISTING SD LINE	=====
SAS SERVICE	=====
SINGLE WATER SERVICE	=====
DOUBLE WATER SERVICE	=====
SANITARY SEWER MANHOLE	=====
CROSS	=====
TEE	=====
90° BEND	=====
CAP	=====
GATE VALVE	=====
REDUCER	=====
STORM SEWER MANHOLE	=====
DROP INLET	=====

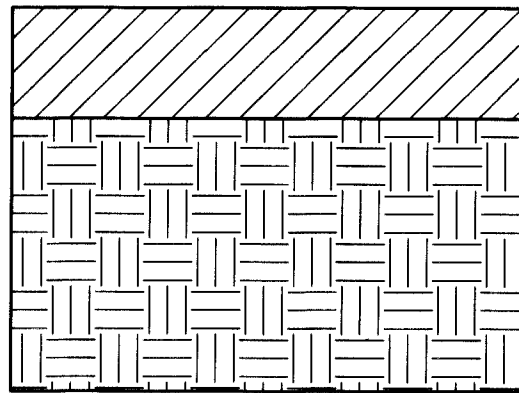

TEMP. PAVING SECTION
NO SCALE

- NOTES:
1. ALL WATERLINE SERVICES ARE COPPER PIPING.
 2. ALL WATERLINE STUBS ARE 8"

BENCH MARK

ACS MONUMENT "10C-18", NM STATE PLANE COORDINATES, CENTRAL ZONE, NAD 1927, X=402,319.45, Y=1,524,061.42, EL=5219.41, DELTA ALPHA=-00°11'18" G-G=0.9996613, TIES TO THE NORTHEAST CORNER OF PROPERTY BEARING S69°15'46" E, 2964.48'

LEGAL DESCRIPTION:

LOTS 1 THRU 60, BLOCK 3 QUAIL SPRINGS, ALBUQUERQUE, BERNALILLO COUNTY, NEW MEXICO

RECORD DRAWING



DATE: 8-28-97 DRAFTED BY: RRB
TERRA WEST DEV.

THESE RECORD DRAWINGS HAVE BEEN PREPARED, IN PART, ON THE BASIS OF INFORMATION COMPILED AND FURNISHED BY OTHERS. THE ENGINEER WILL NOT BE RESPONSIBLE FOR ANY ERRORS OR OMISSIONS WHICH HAVE BEEN INCORPORATED INTO THE DOCUMENT AS A RESULT.


TERRA WEST DEVELOPMENT
MANAGEMENT SERVICES
4421 McLEOD ROAD, N.E., SUITE D
ALBUQUERQUE, NEW MEXICO 87109
(505)883-7592

CITY OF ALBUQUERQUE PUBLIC WORKS DEPARTMENT ENGINEERING GROUP			
TITLE: QUAIL SPRINGS ESTATES MASTER UTILITY PLAN SHEET "B"			
DESIGN REVIEW COMMITTEE	CITY ENGINEER APPROVAL	MO./DAY/YR.	MO./DAY/YR.
APPROVED 2-19-97			
DESIGN COMMITTEE			
CITY PROJECT NO. P.E. #7868	559081	ZONE MAP NO. C-19-Z	SHEET OF 12A 23

SCANNED BY
BY LASON

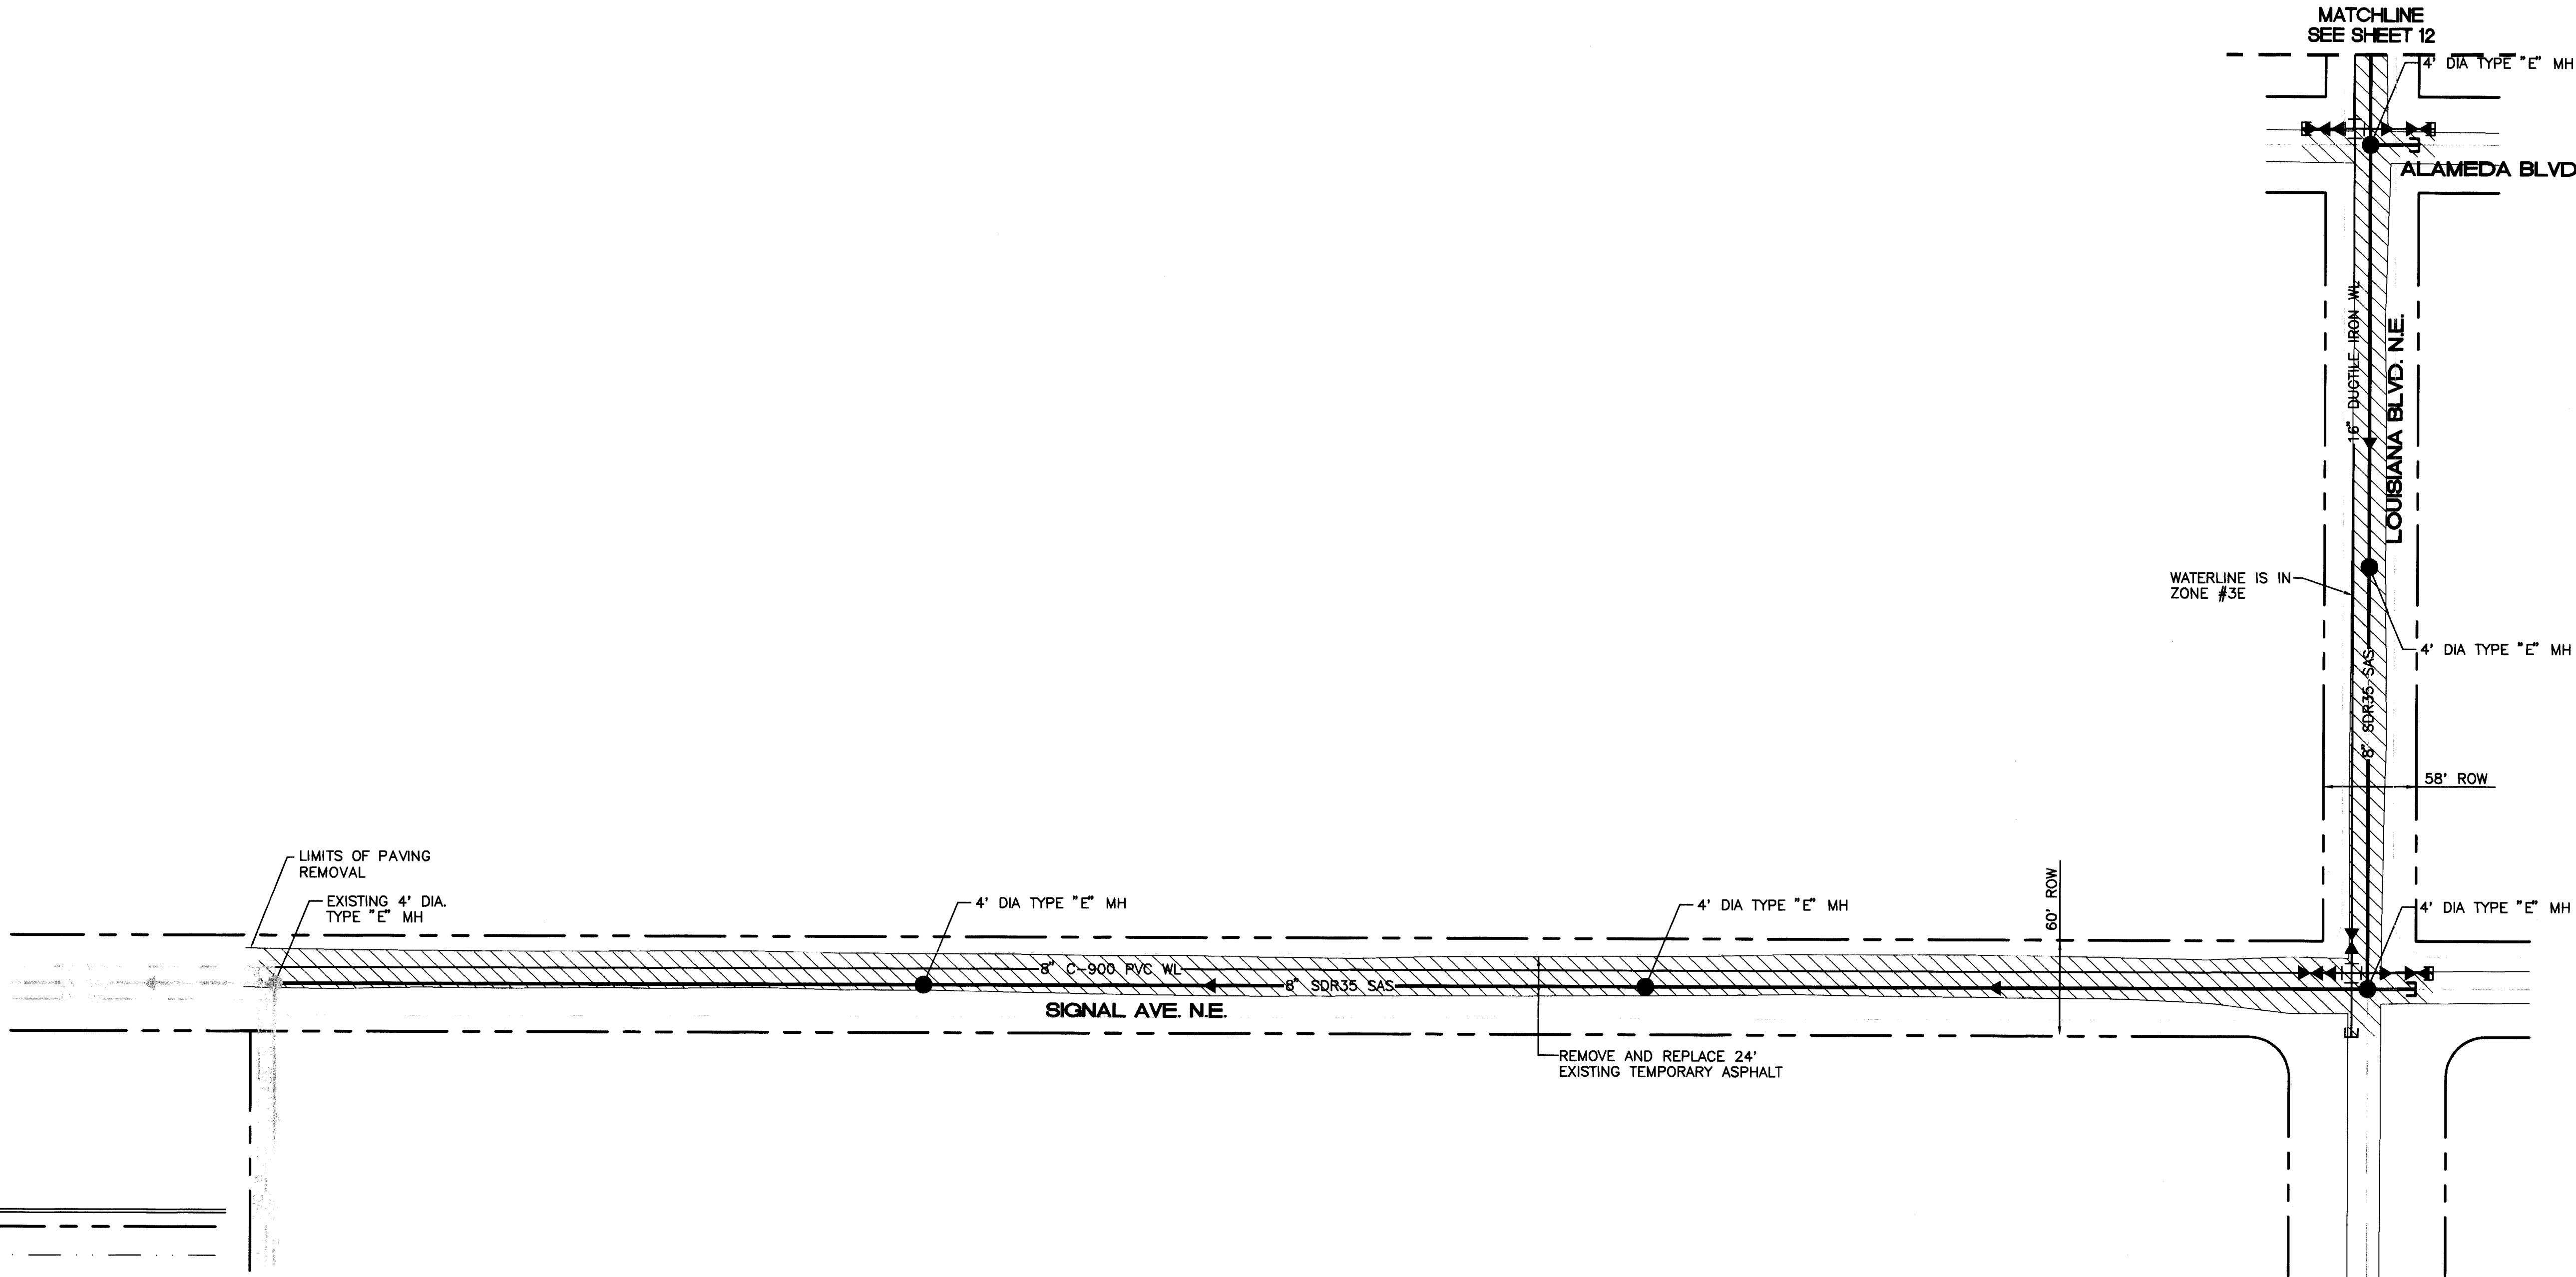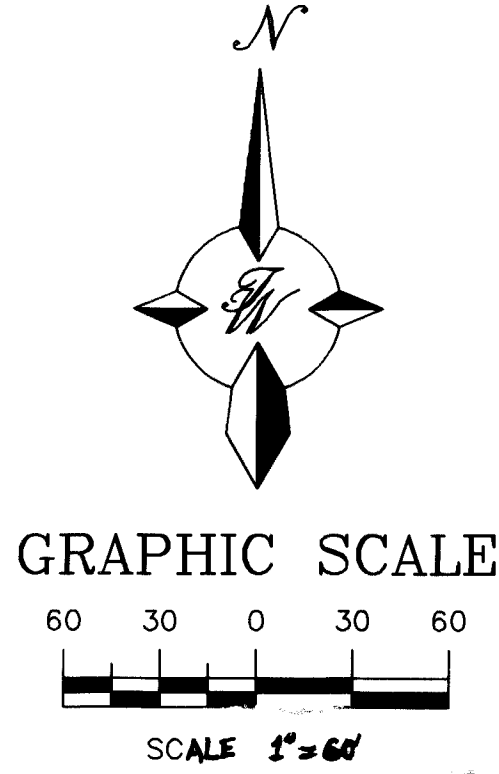


AS BUILT INFORMATION		BENCH MARKS		SURVEY INFORMATION		ENGINEER'S SEAL	
CONTRACTOR	SPARKLING #26999	ACS "10C-18"	CENTRAL STATION DATA	NO.	BY	DATE	NO.
WORKS	Done Check		NM STATE PLANE COORDINATES				
STARTED BY	Done Check		Central Zone				
ACCEPTANCE BY	Terra West		X=402,319.45				
FIELD	Done Check		Y=1,524,061.42				
DRAWINGS	Done Check		G-G=0.9996613				
CORRECTED BY	Terra West		DELTA=-00°11'18"				
RECORDED BY			ELEV=5219.41				
NO.							

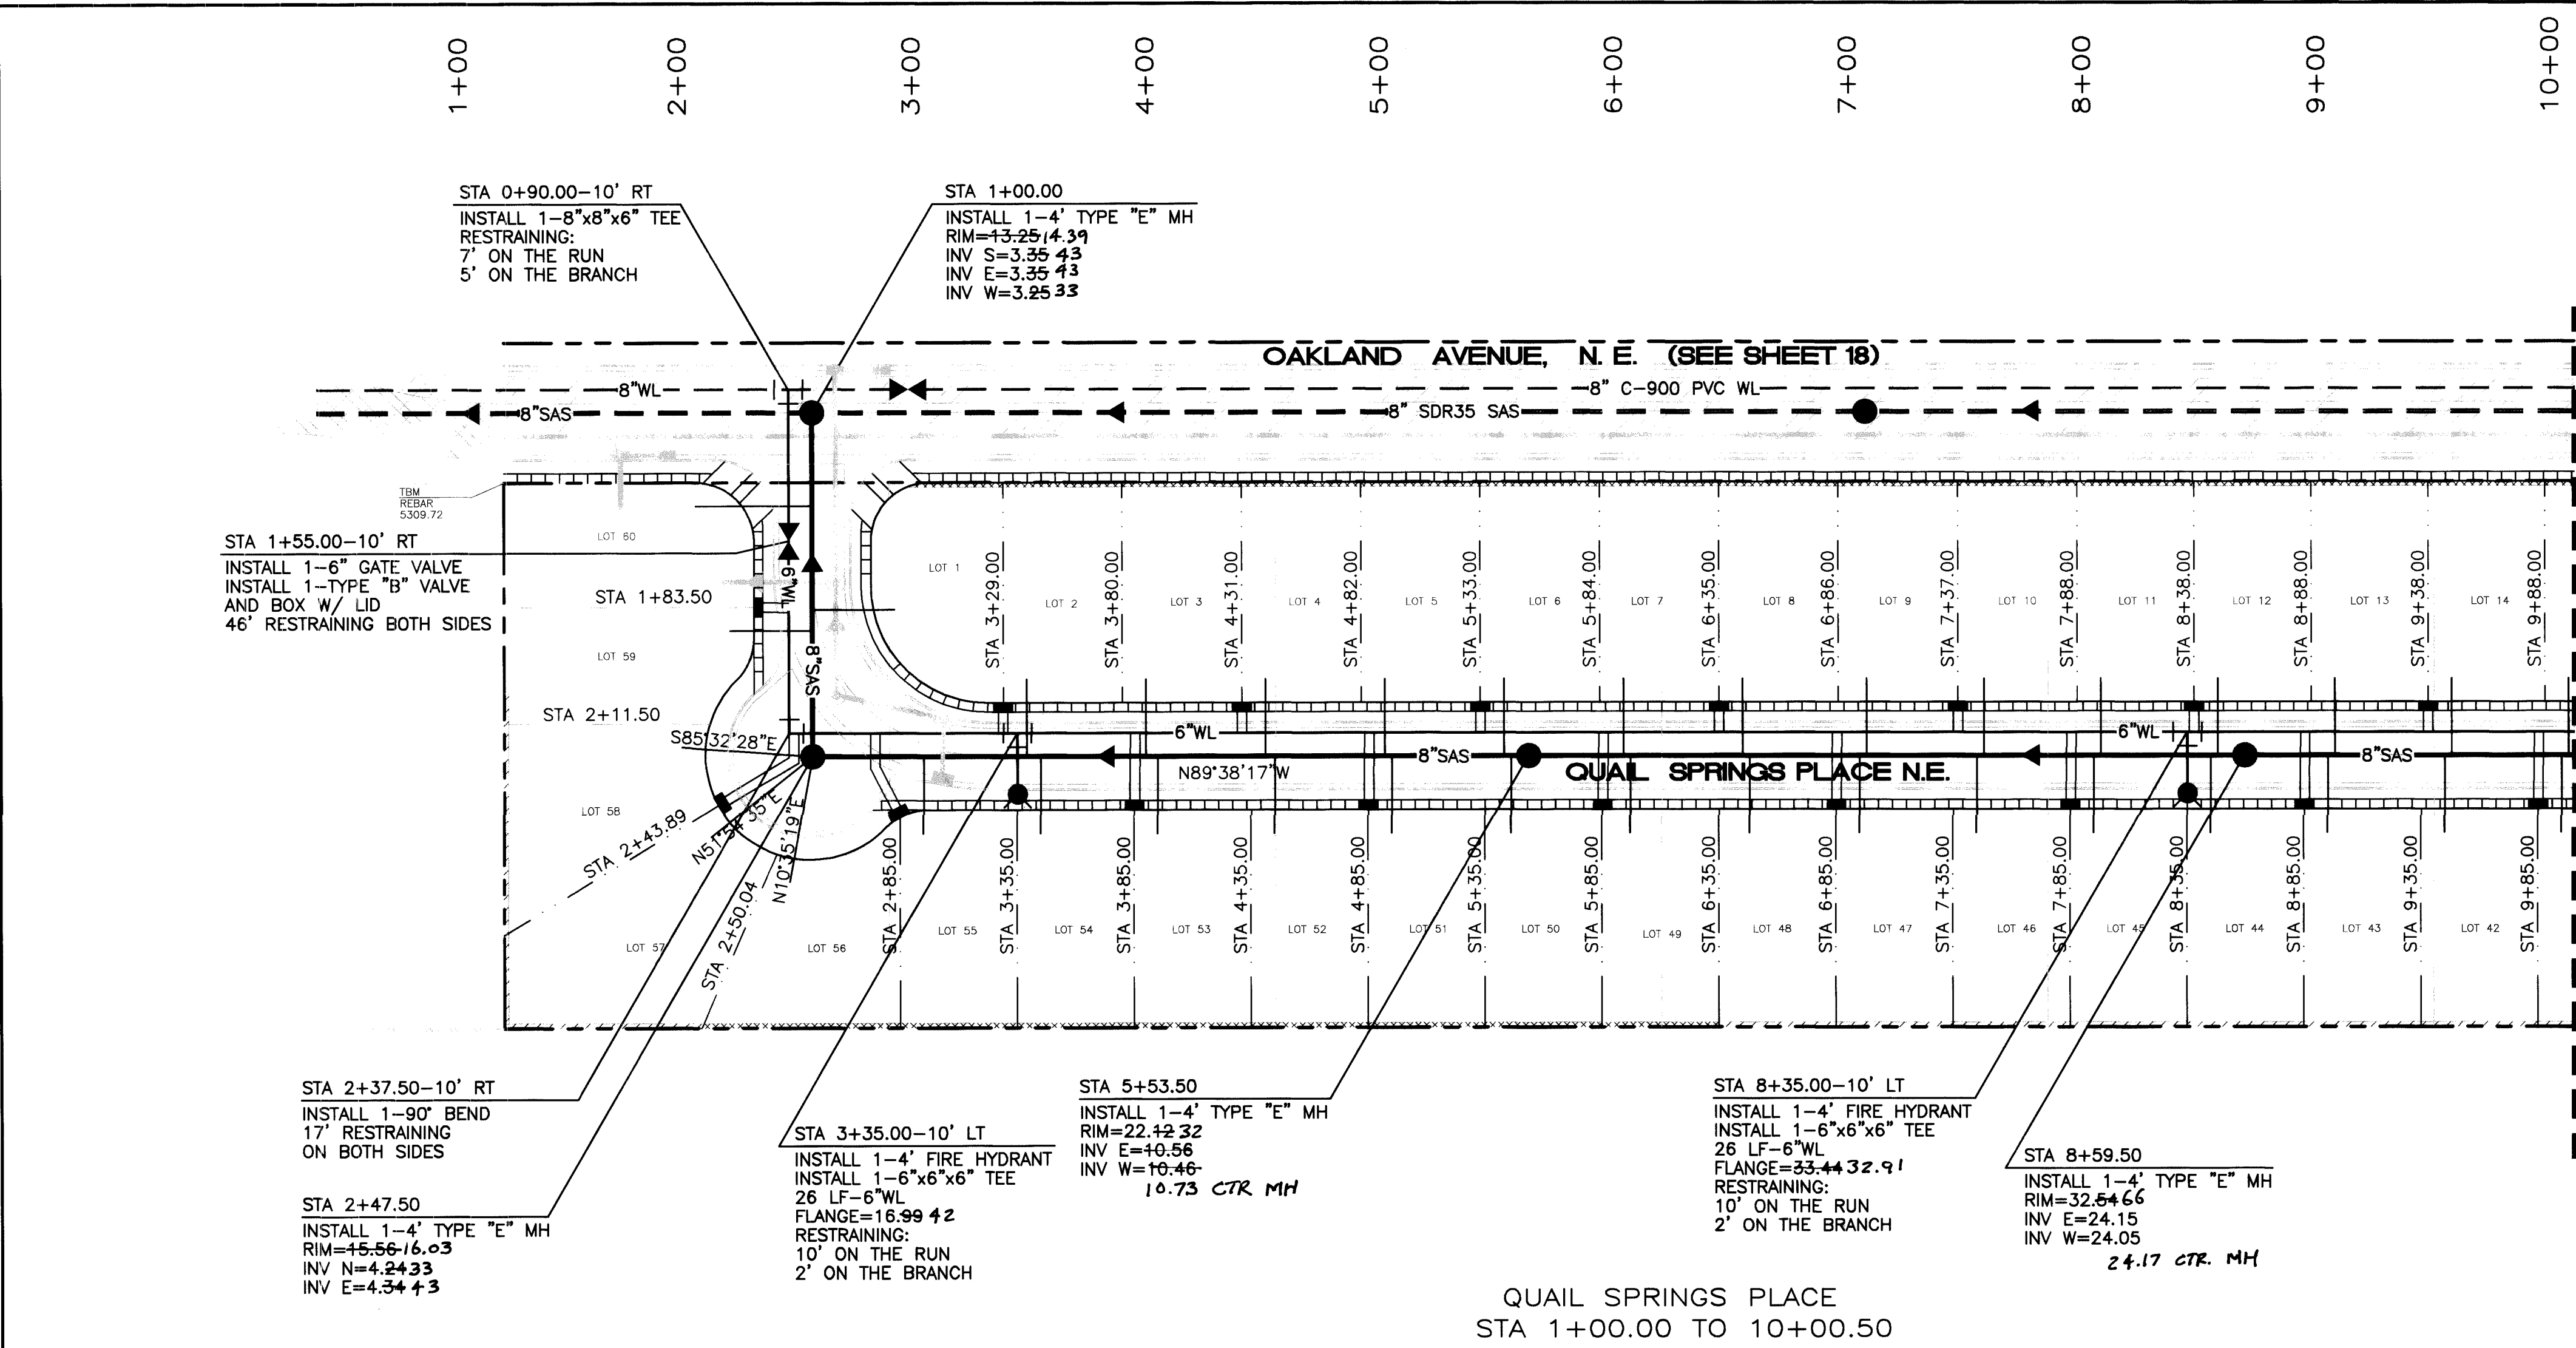


WL TABLE		
LOT #	STATION	SERVICE
1&2	3+29.00	DOUBLE
3&4	4+31.00	DOUBLE
5&6	5+33.00	DOUBLE
7&8	6+35.00	DOUBLE
9&10	7+36.00	DOUBLE
11&12	8+37.00	DOUBLE
13&14	9+37.00	DOUBLE
41&42	9+85.00	DOUBLE
43&44	9+45.00	DOUBLE
45&46	7+85.00	DOUBLE
47&48	6+85.00	DOUBLE
49&50	5+85.00	DOUBLE
51&52	4+85.00	DOUBLE
53&54	3+85.00	DOUBLE
55&56	2+85.00	DOUBLE
57&58	2+43.89	DOUBLE
59&60	1+83.50	DOUBLE

SAS TABLE				
LOT #	STATION	LF	INV. @ PL	EL. @ P
1	1+84.50	35	10.86	16.36
2	3+39.00	33	10.17	15.67
3	3+90.00	33	10.54	16.04
4	4+41.00	33	12.41	17.91
5	4+92.00	33	14.46	19.96
6	5+43.00	33	16.32	21.82
7	5+94.00	33	18.05	23.55
8	6+45.00	33	19.79	25.29
9	6+98.00	33	21.52	27.02
10	7+48.00	33	23.25	28.75
11	7+98.00	33	24.99	30.49
12	8+48.00	33	26.69	32.19
13	8+98.00	33	28.38	33.88
14	9+48.00	33	30.08	35.58
15	9+98.00	33	31.78	37.28
41	9+95.00	33	31.68	37.18
42	9+45.00	33	29.98	35.48
43	8+95.00	33	28.28	33.78
44	8+45.00	33	26.58	32.08
45	7+95.00	33	24.88	30.38
46	7+45.00	33	23.18	28.68
47	6+95.00	33	21.49	26.99
48	6+48.00	33	19.79	25.29
49	5+97.00	33	18.09	23.59
50	5+46.00	33	16.39	21.89
51	4+95.00	33	14.62	20.12
52	4+45.00	33	12.62	18.12
53	3+95.00	33	10.74	16.24
54	3+45.00	33	10.13	15.63
55	2+95.00	33	10.40	15.90
56	SEE DWG	55	10.56	16.06
57	SEE DWG	55	10.84	16.34
58	SEE DWG	56	11.06	16.56
59	1+93.50	35	10.80	16.30
60	1+40.00	50	10.00	15.50

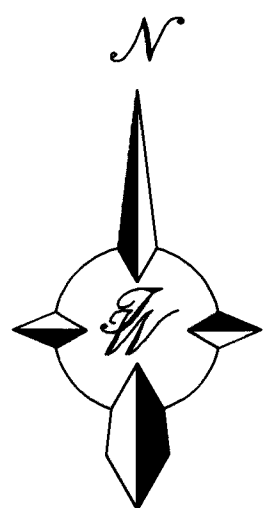

NOTE:
SEE MASTER UTILITY PLAN FOR
SANITARY SEWER SERVICE CONNECTION DETAILS.

SCALE: HORIZ. 1"=50'
VERT. 1"= 5'

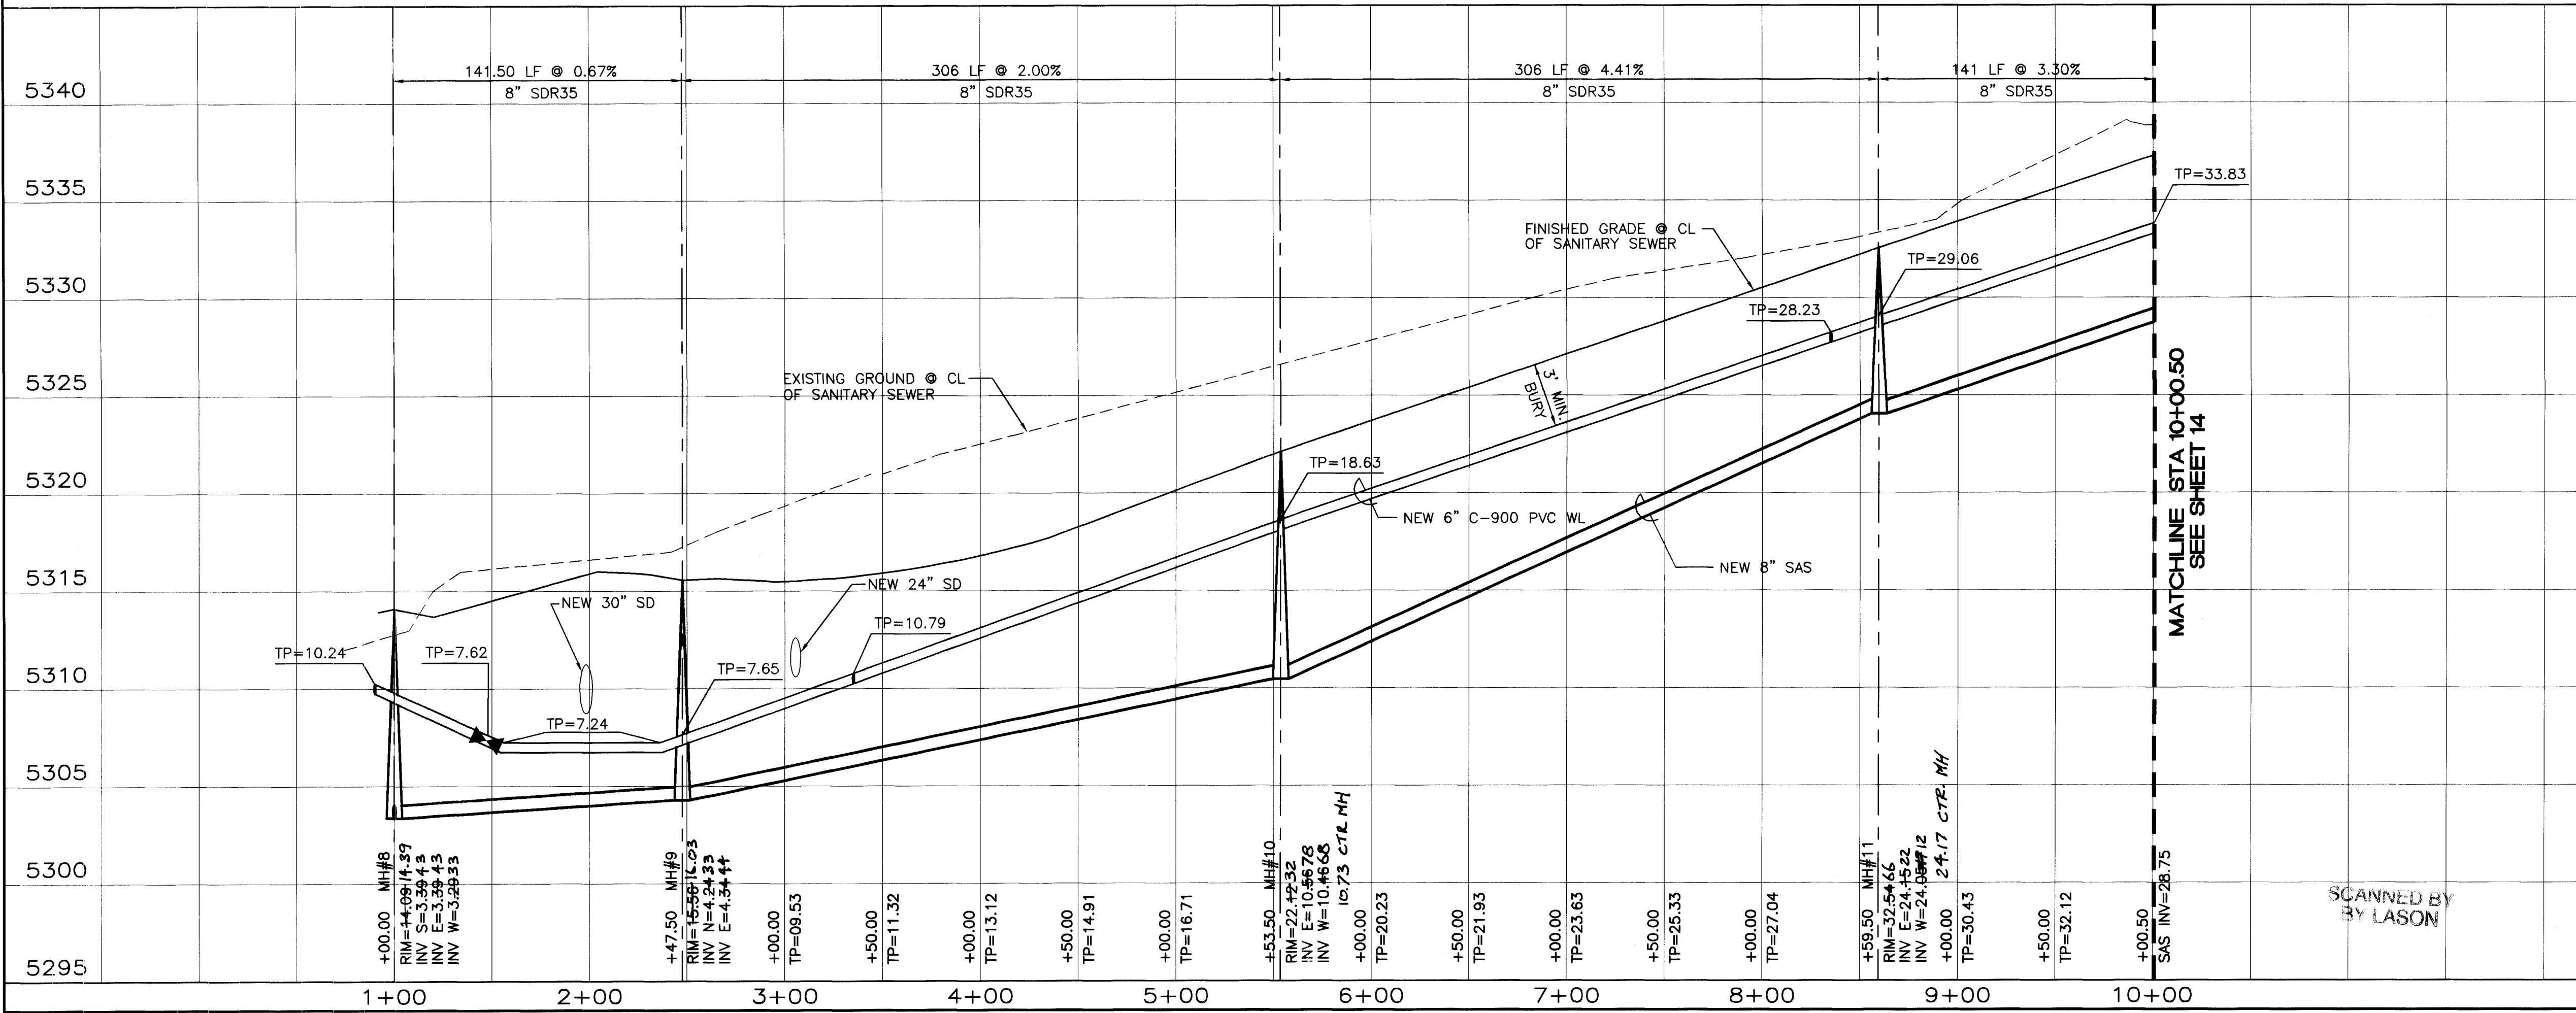

RECORD DRAWING

DATE: 0-26-97 DRAFTED BY: RRB
TERRA WEST DEV.

THESE RECORD DRAWINGS HAVE BEEN PREPARED
IN PART, ON THE BASIS OF INFORMATION COMPILED
AND FURNISHED BY OTHERS. THE ENGINEER WILL
NOT BE RESPONSIBLE FOR ANY ERRORS OR OMISSIONS
WHICH HAVE BEEN INCORPORATED INTO THE
DOCUMENT AS A RESULT.

TERRA WEST DEVELOPMENT
MANAGEMENT SERVICES
4421 McLEOD ROAD, N.E., SUITE D
ALBUQUERQUE, NEW MEXICO 87109
(505)883-7592

CITY OF ALBUQUERQUE
PUBLIC WORKS DEPARTMENT
ENGINEERING GROUP


TITLE: **QUAIL SPRINGS ESTATES**
UTILITY IMPROVEMENTS
QUAIL SPRINGS PLACE STA 1+00.00 TO 10+00.50



DESIGN REVIEW COMMITTEE
APPROVED
DATE: 2-6-1997

CITY ENGINEER APPROVAL
LAST DESIGN UPDATE


DESIGNED BY: RRB DATE: 09-96
DRAWN BY: PVG DATE: 09-96
CHECKED BY: RRB DATE: 09-96

CITY PROJECT NO. 559081
ZONE MAP NO. C-19-Z
SHEET 13 OF 23

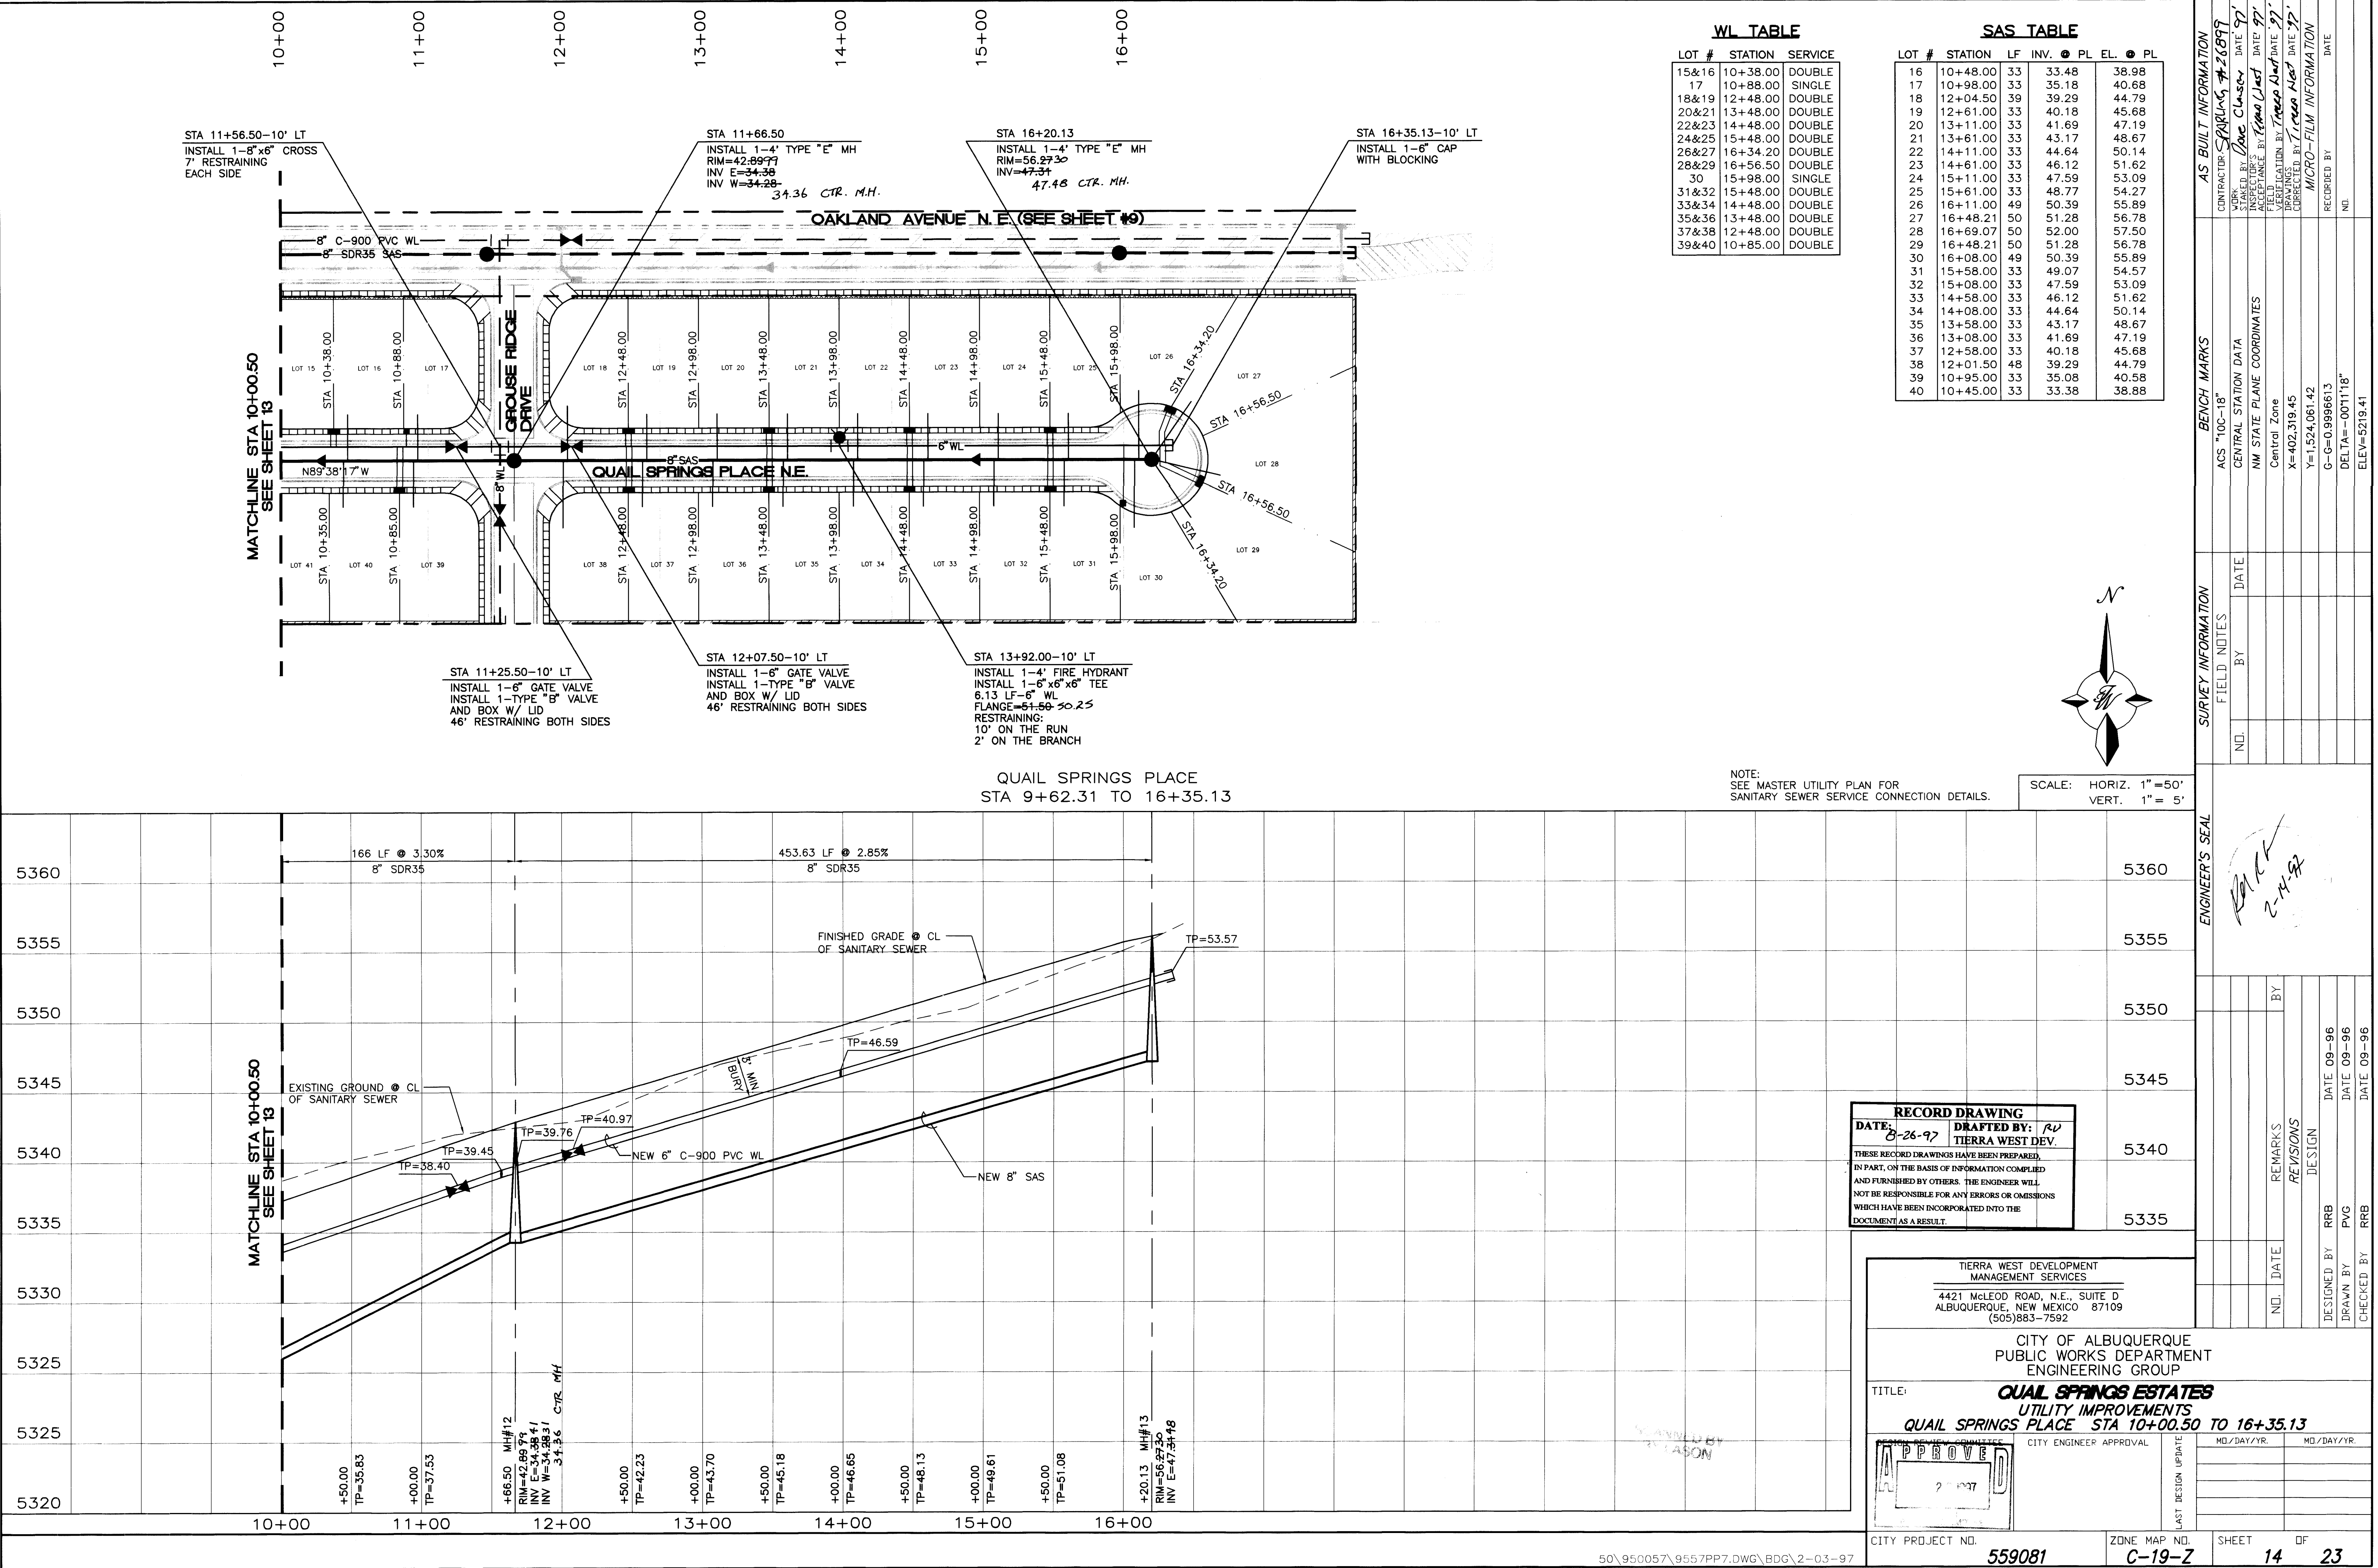

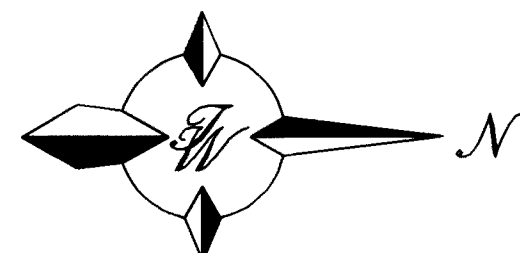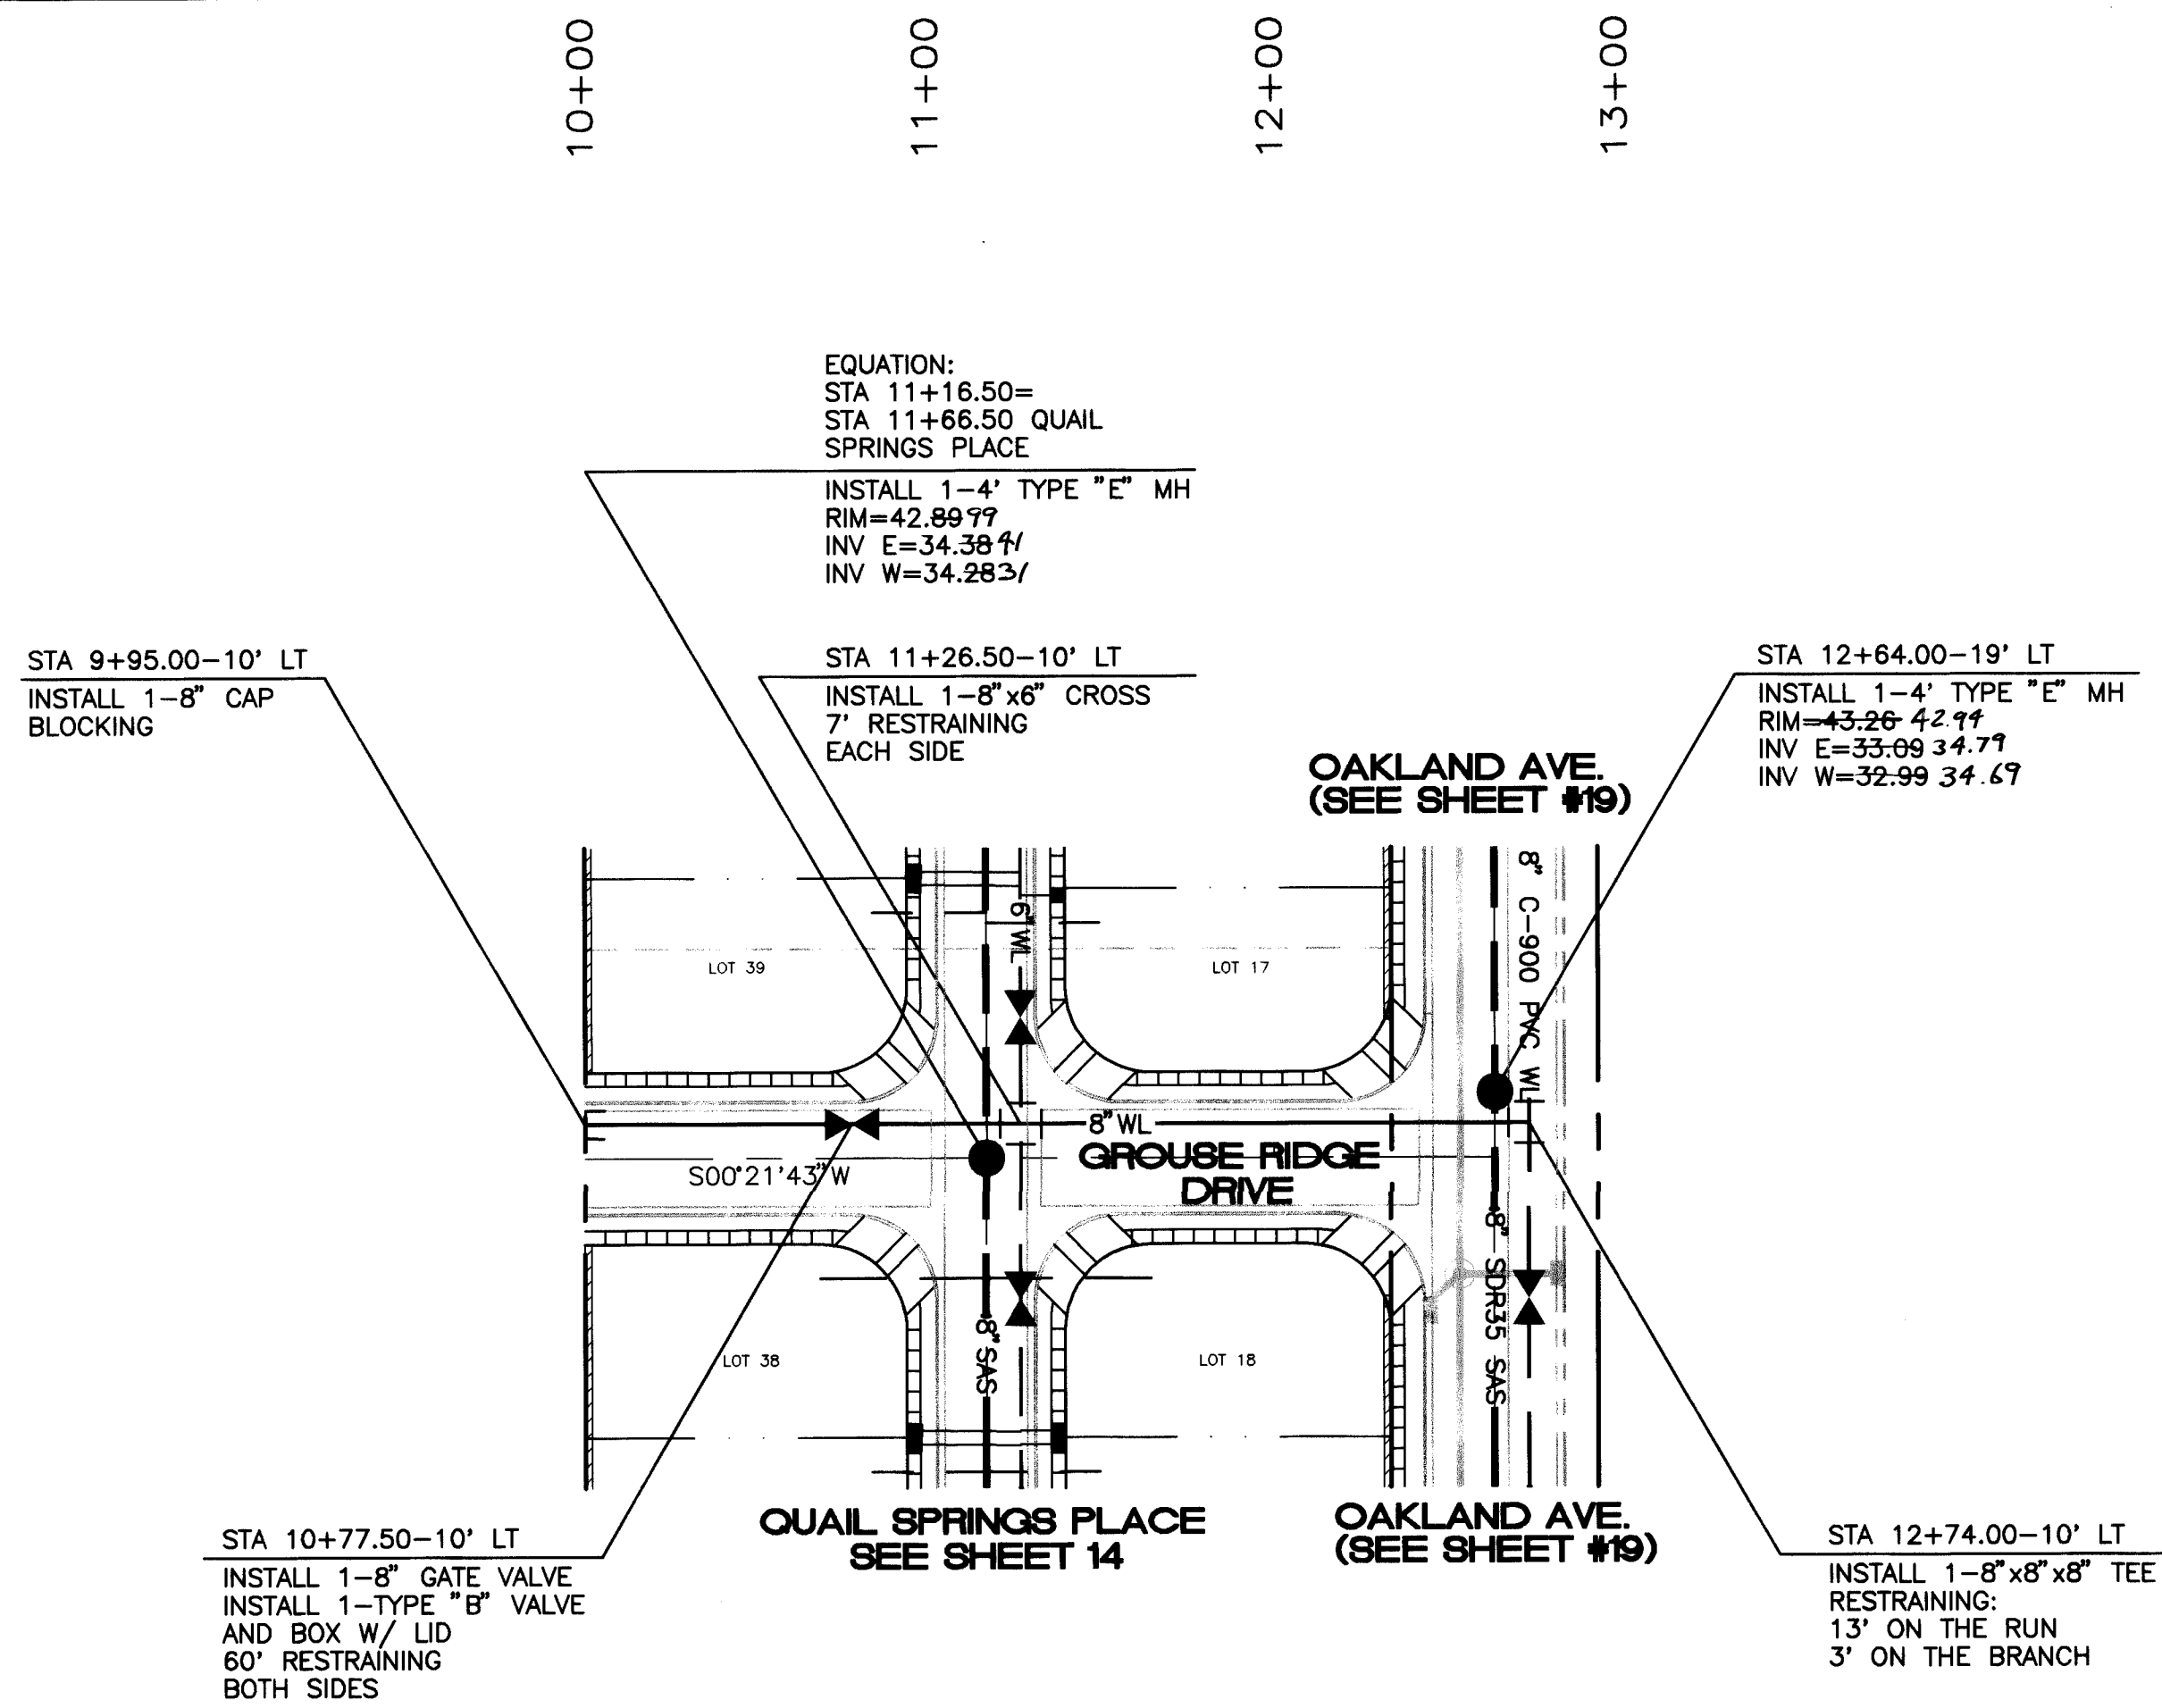

SCALE: HORIZ. 1" = 50'
VERT. 1" = 5'

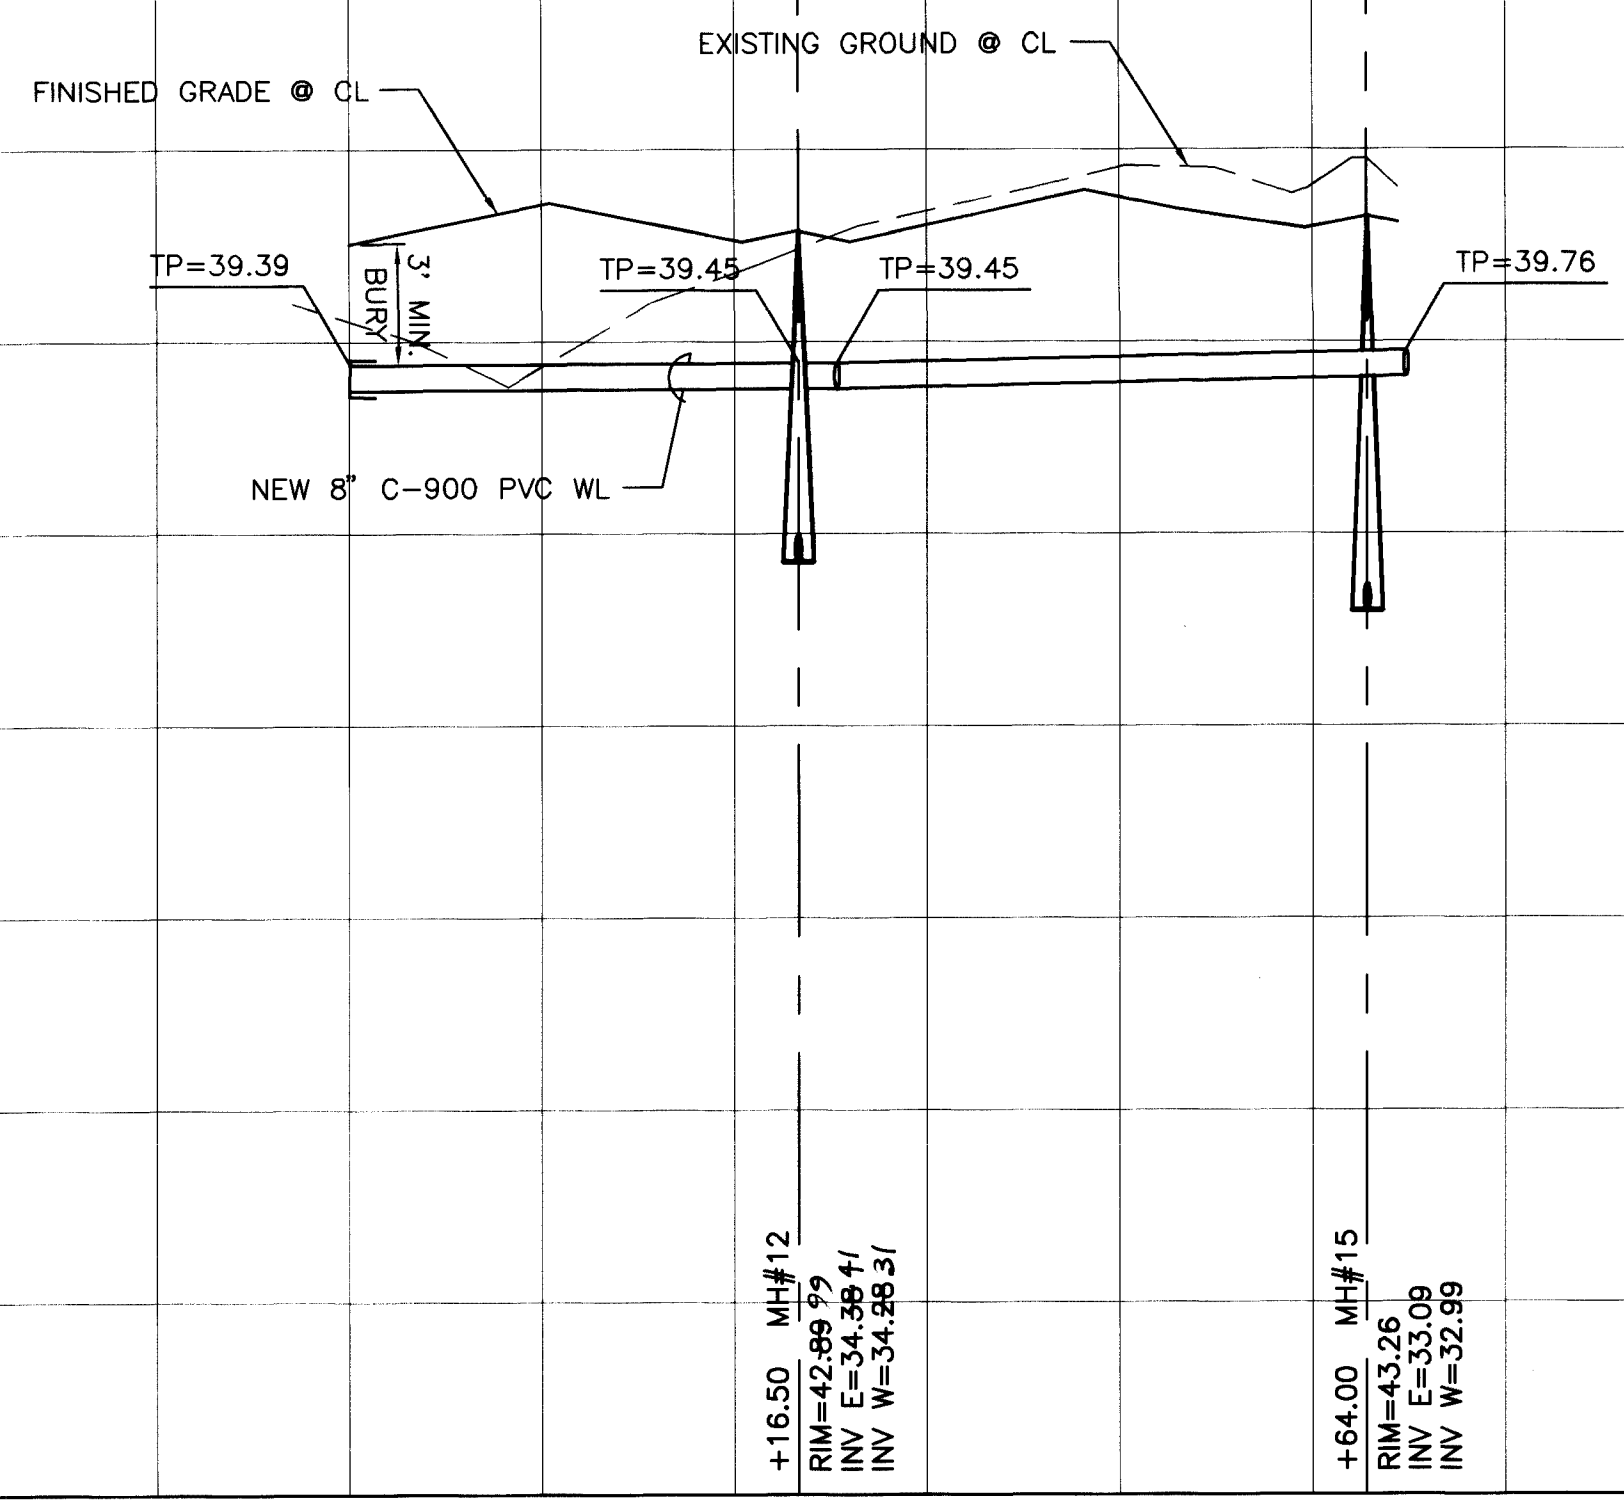



RECORD DRAWING
DATE: 8-26-97
DRAFTED BY: RRB
TIERRA WEST DEV.
THESE RECORD DRAWINGS HAVE BEEN PREPARED
IN PART, ON THE BASIS OF INFORMATION COMPLIED
AND FURNISHED BY OTHERS. THE ENGINEER WILL
NOT BE RESPONSIBLE FOR ANY ERRORS OR OMISSIONS
WHICH HAVE BEEN INCORPORATED INTO THE
DOCUMENT AS A RESULT.


TIERRA WEST DEVELOPMENT
MANAGEMENT SERVICES
4421 McLEOD ROAD, N.E., SUITE D
ALBUQUERQUE, NEW MEXICO 87109
(505)883-7592

CITY OF ALBUQUERQUE PUBLIC WORKS DEPARTMENT ENGINEERING GROUP	
TITLE: QUAL SPRINGS ESTATES UTILITY IMPROVEMENTS GROUSE RIDGE DRIVE STA 10+00.00 TO 12+74.00	
DESIGN REVIEW COMMITTEE	CITY ENGINEER APPROVAL
LAST DESIGN UPDATE	MO/DAY/YR.
CITY PROJECT NO. 559081	ZONE MAP NO. C-19-Z
SHEET 15 OF 23	

SCANNED BY
RY LASON

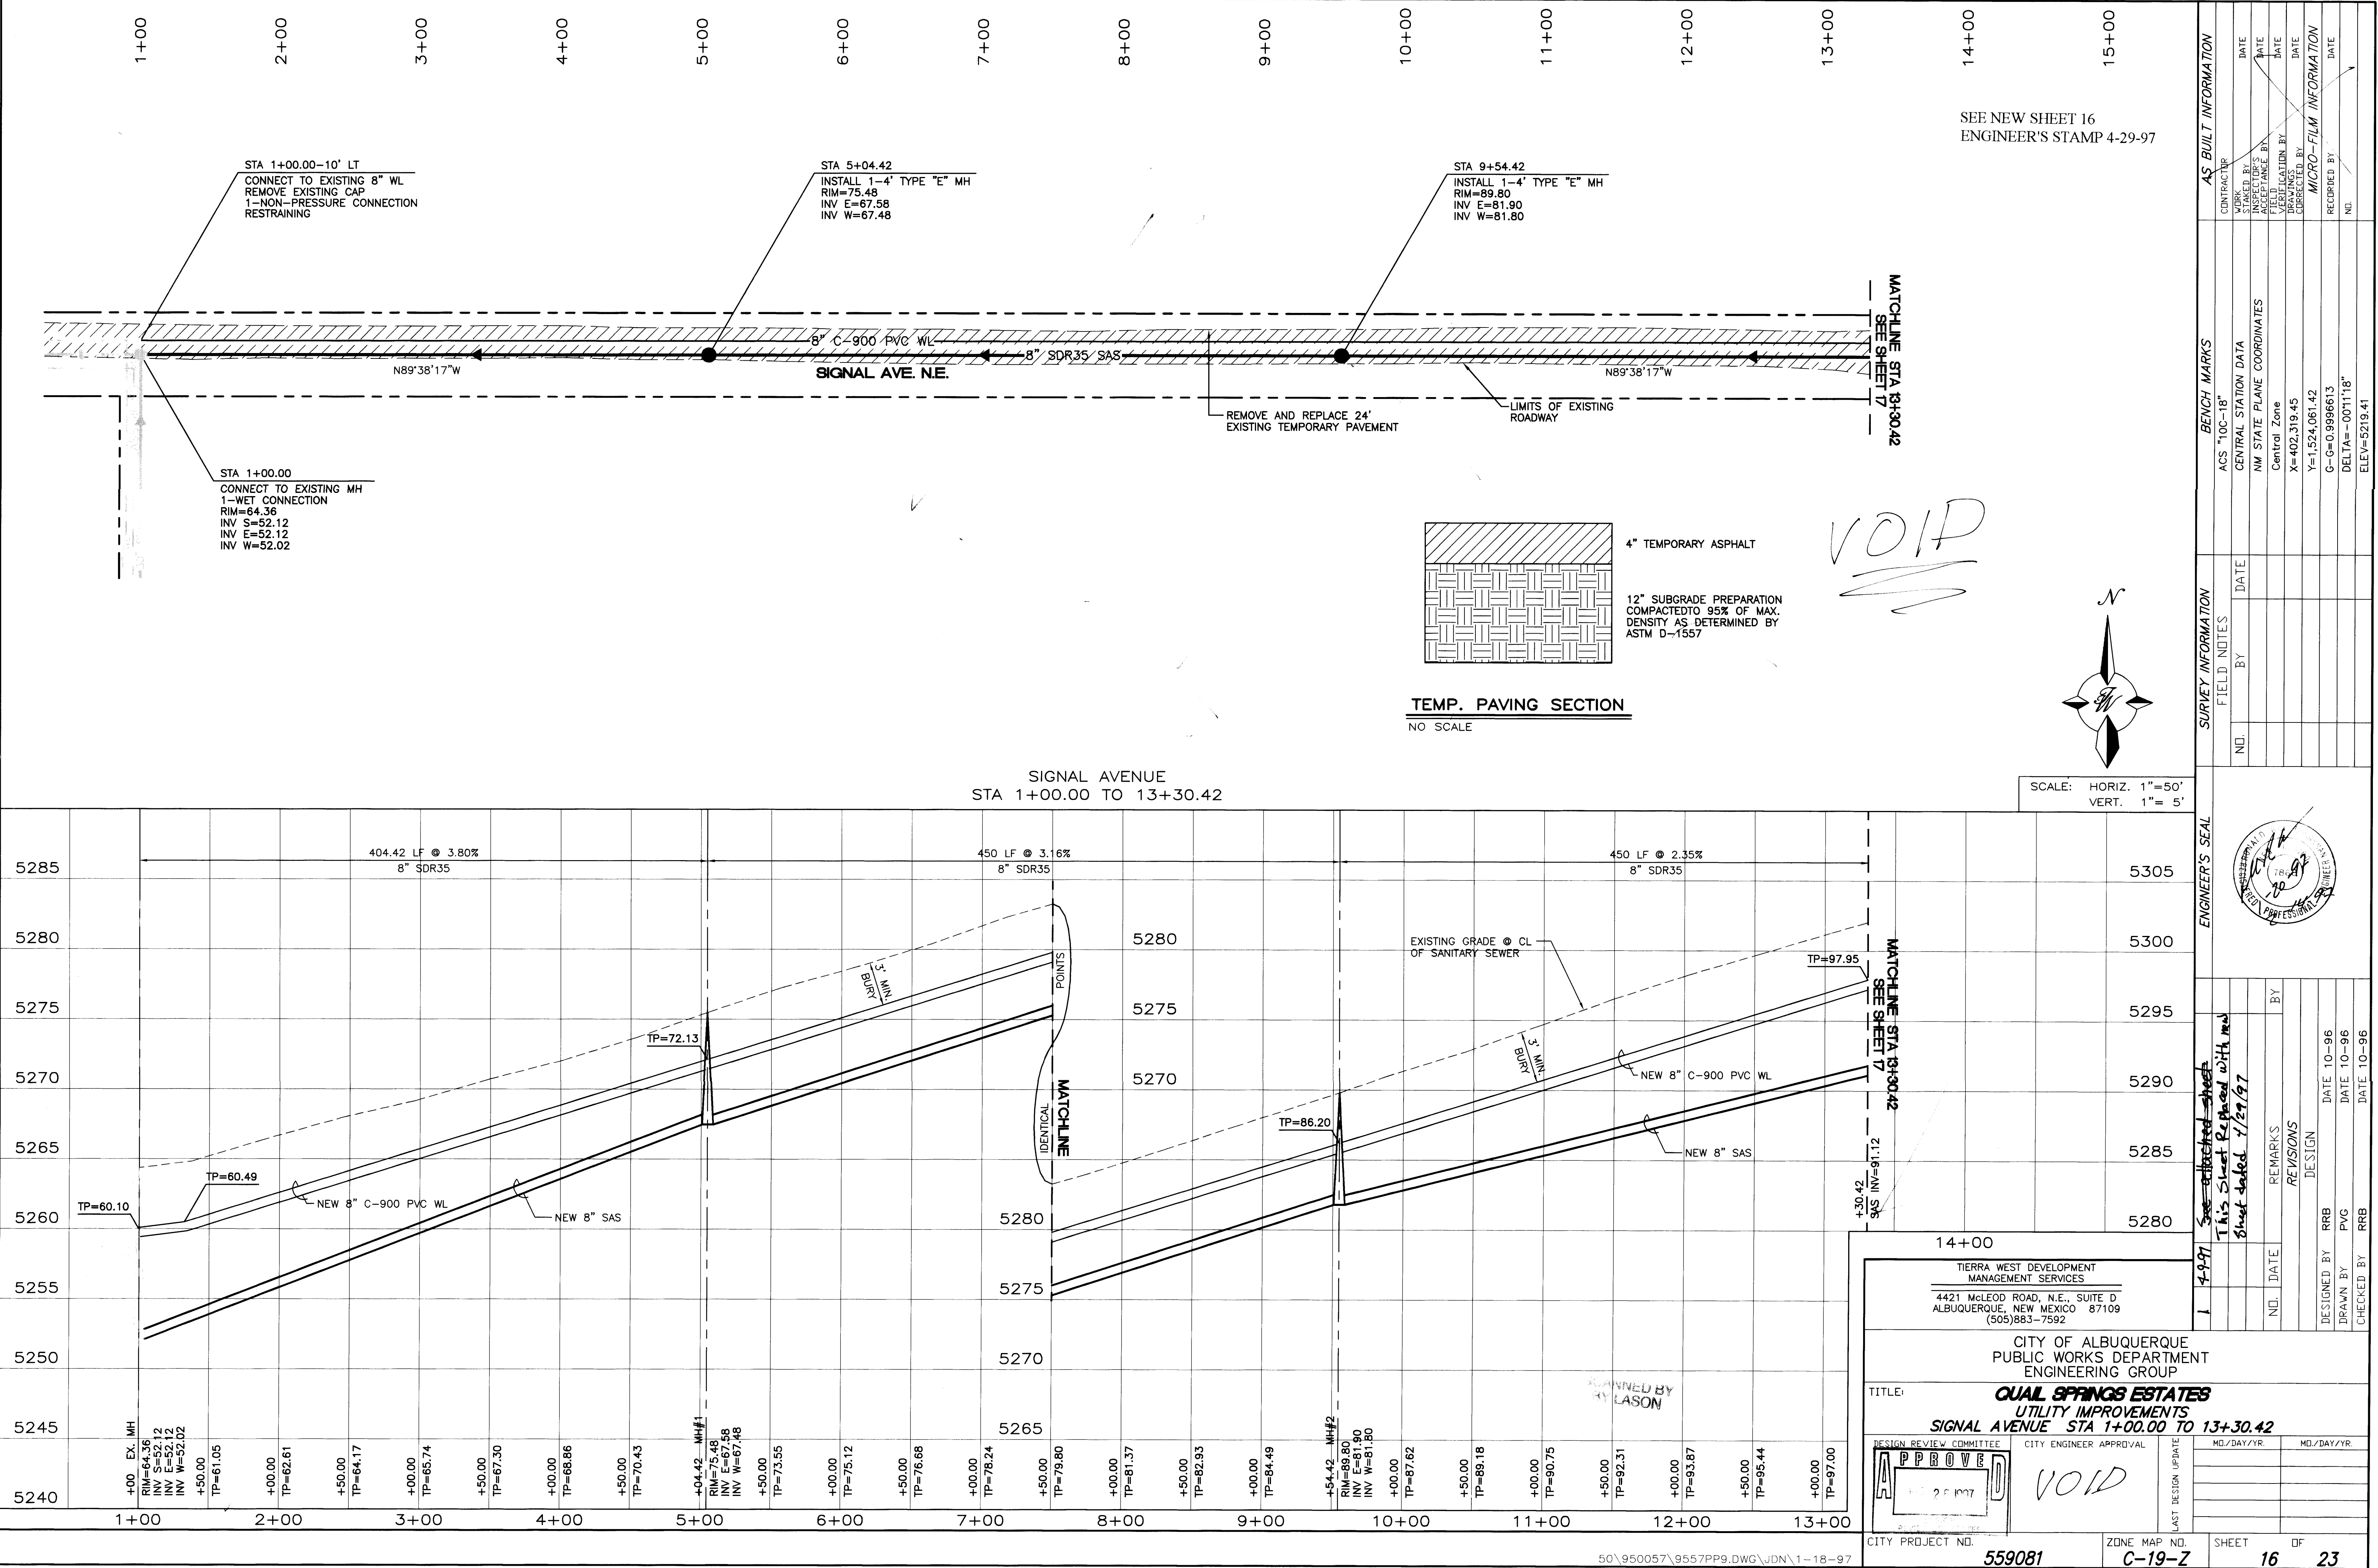

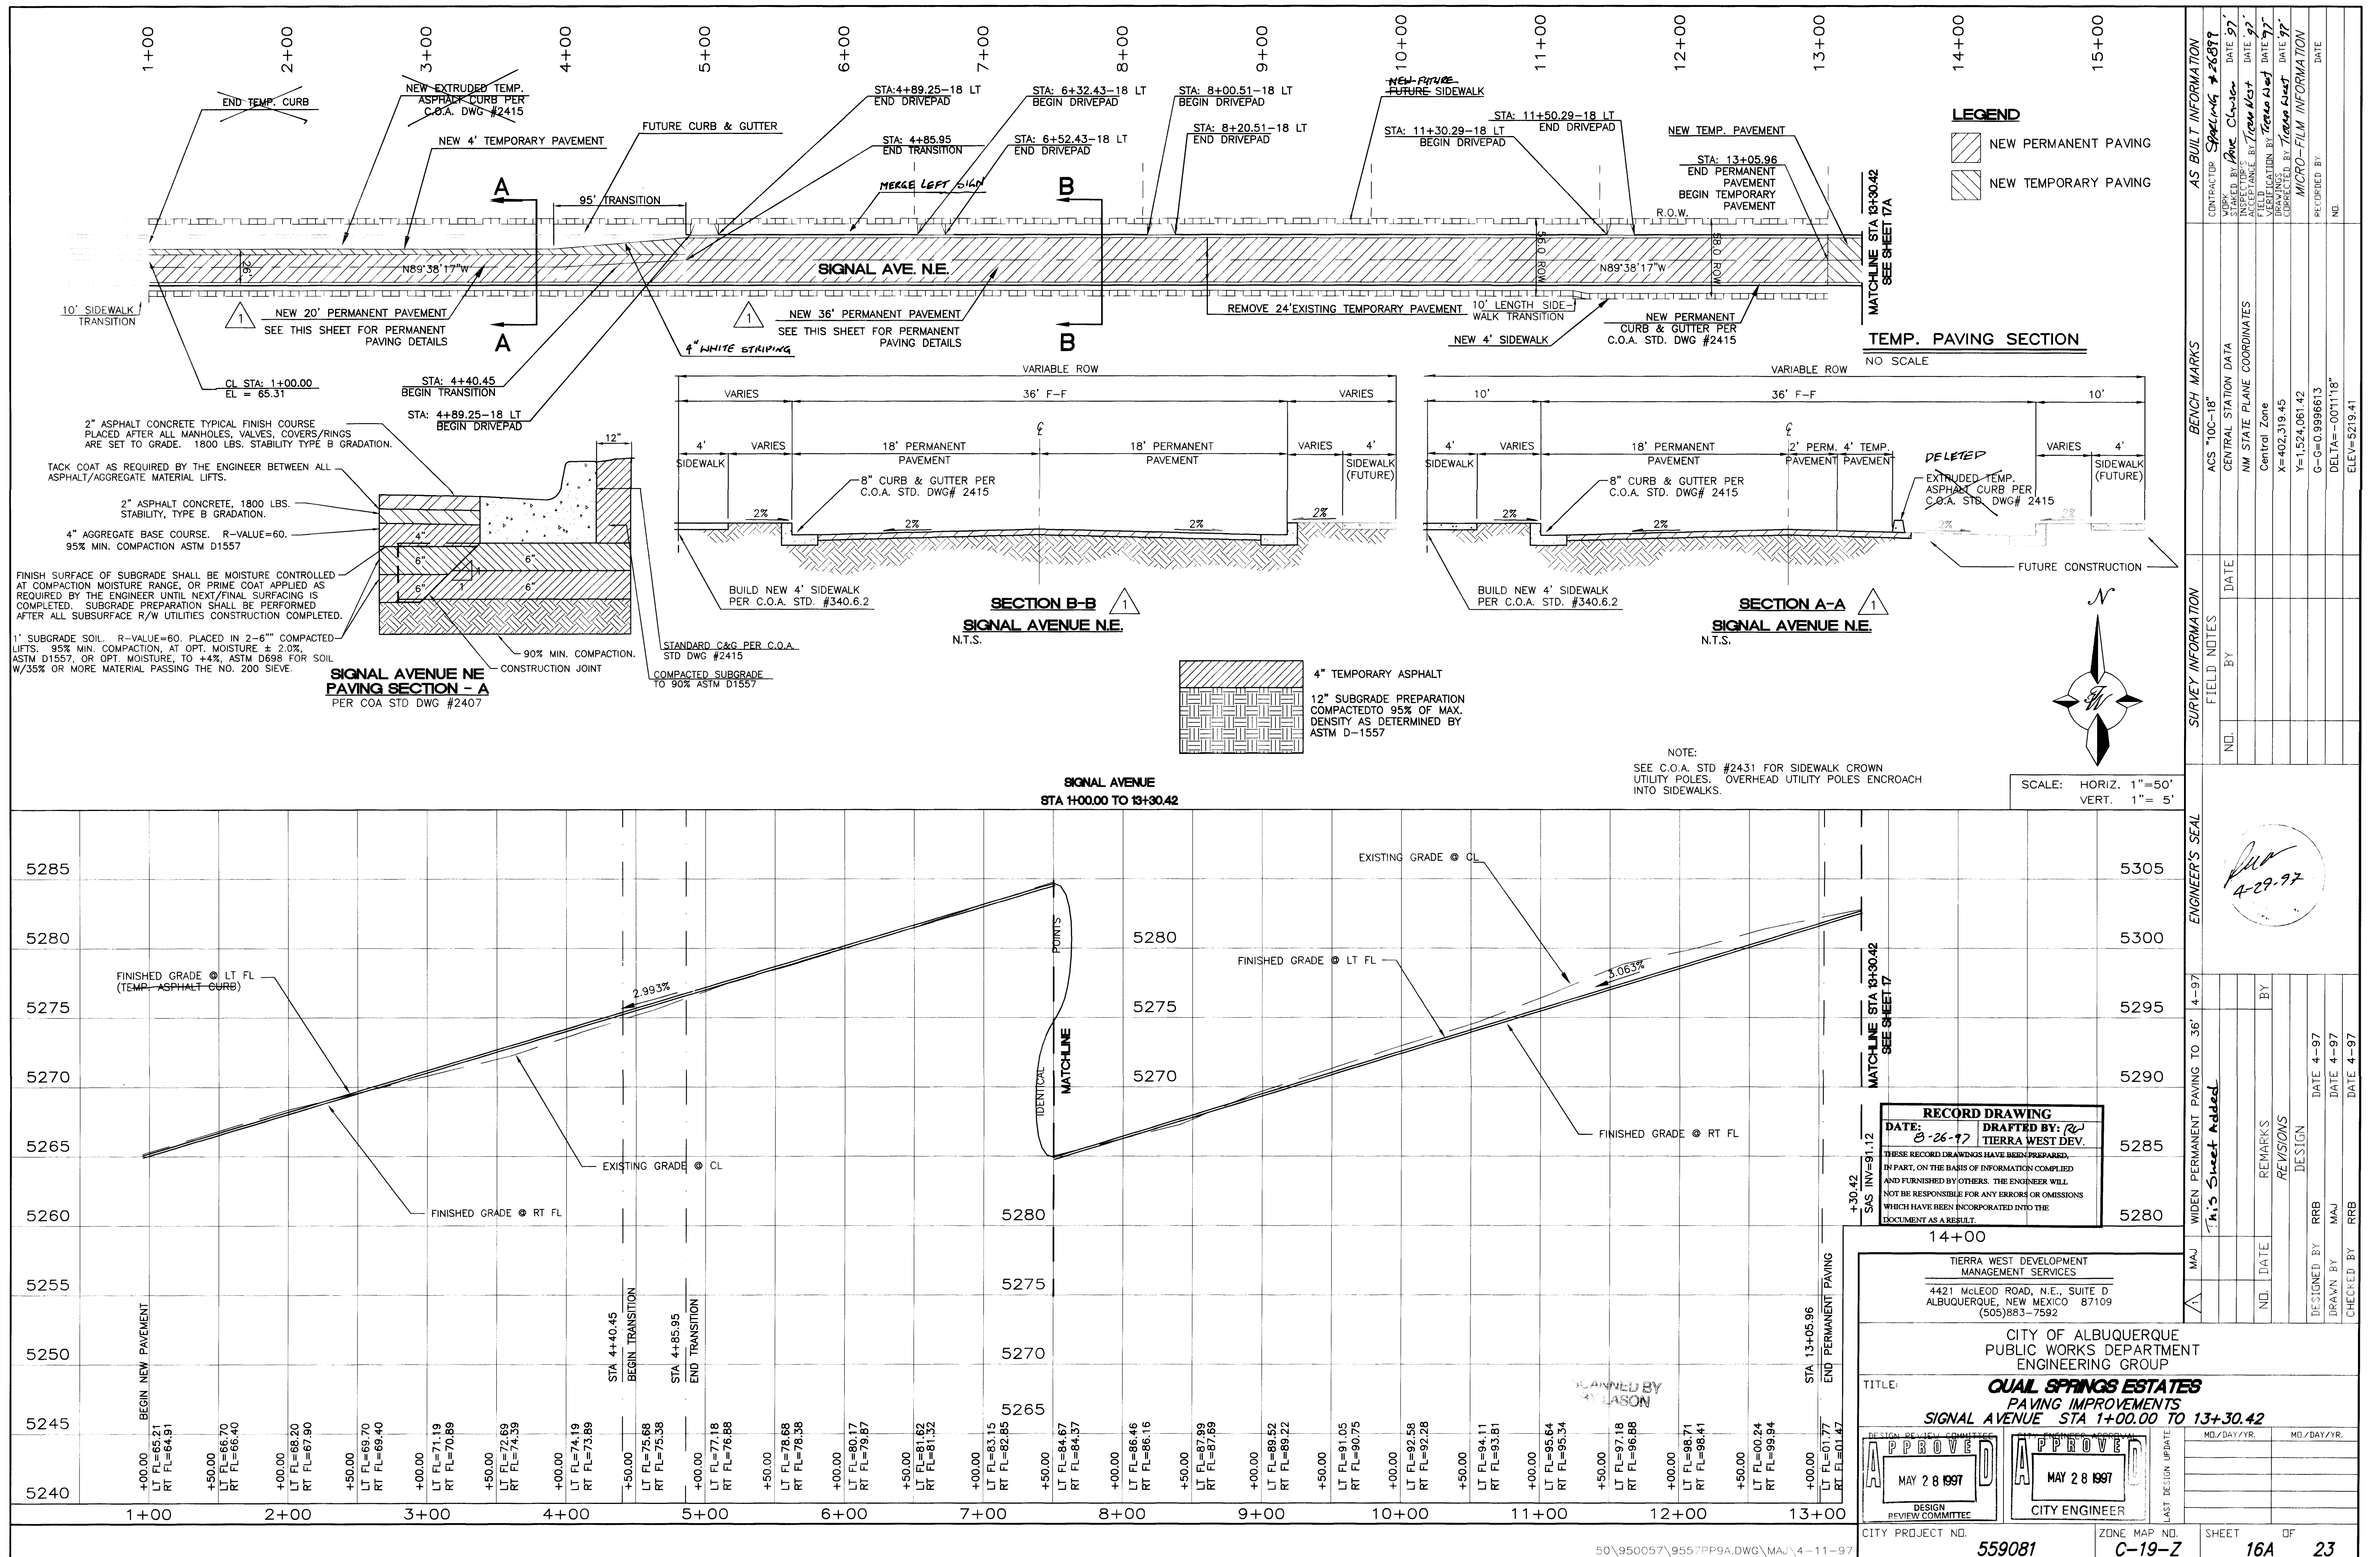

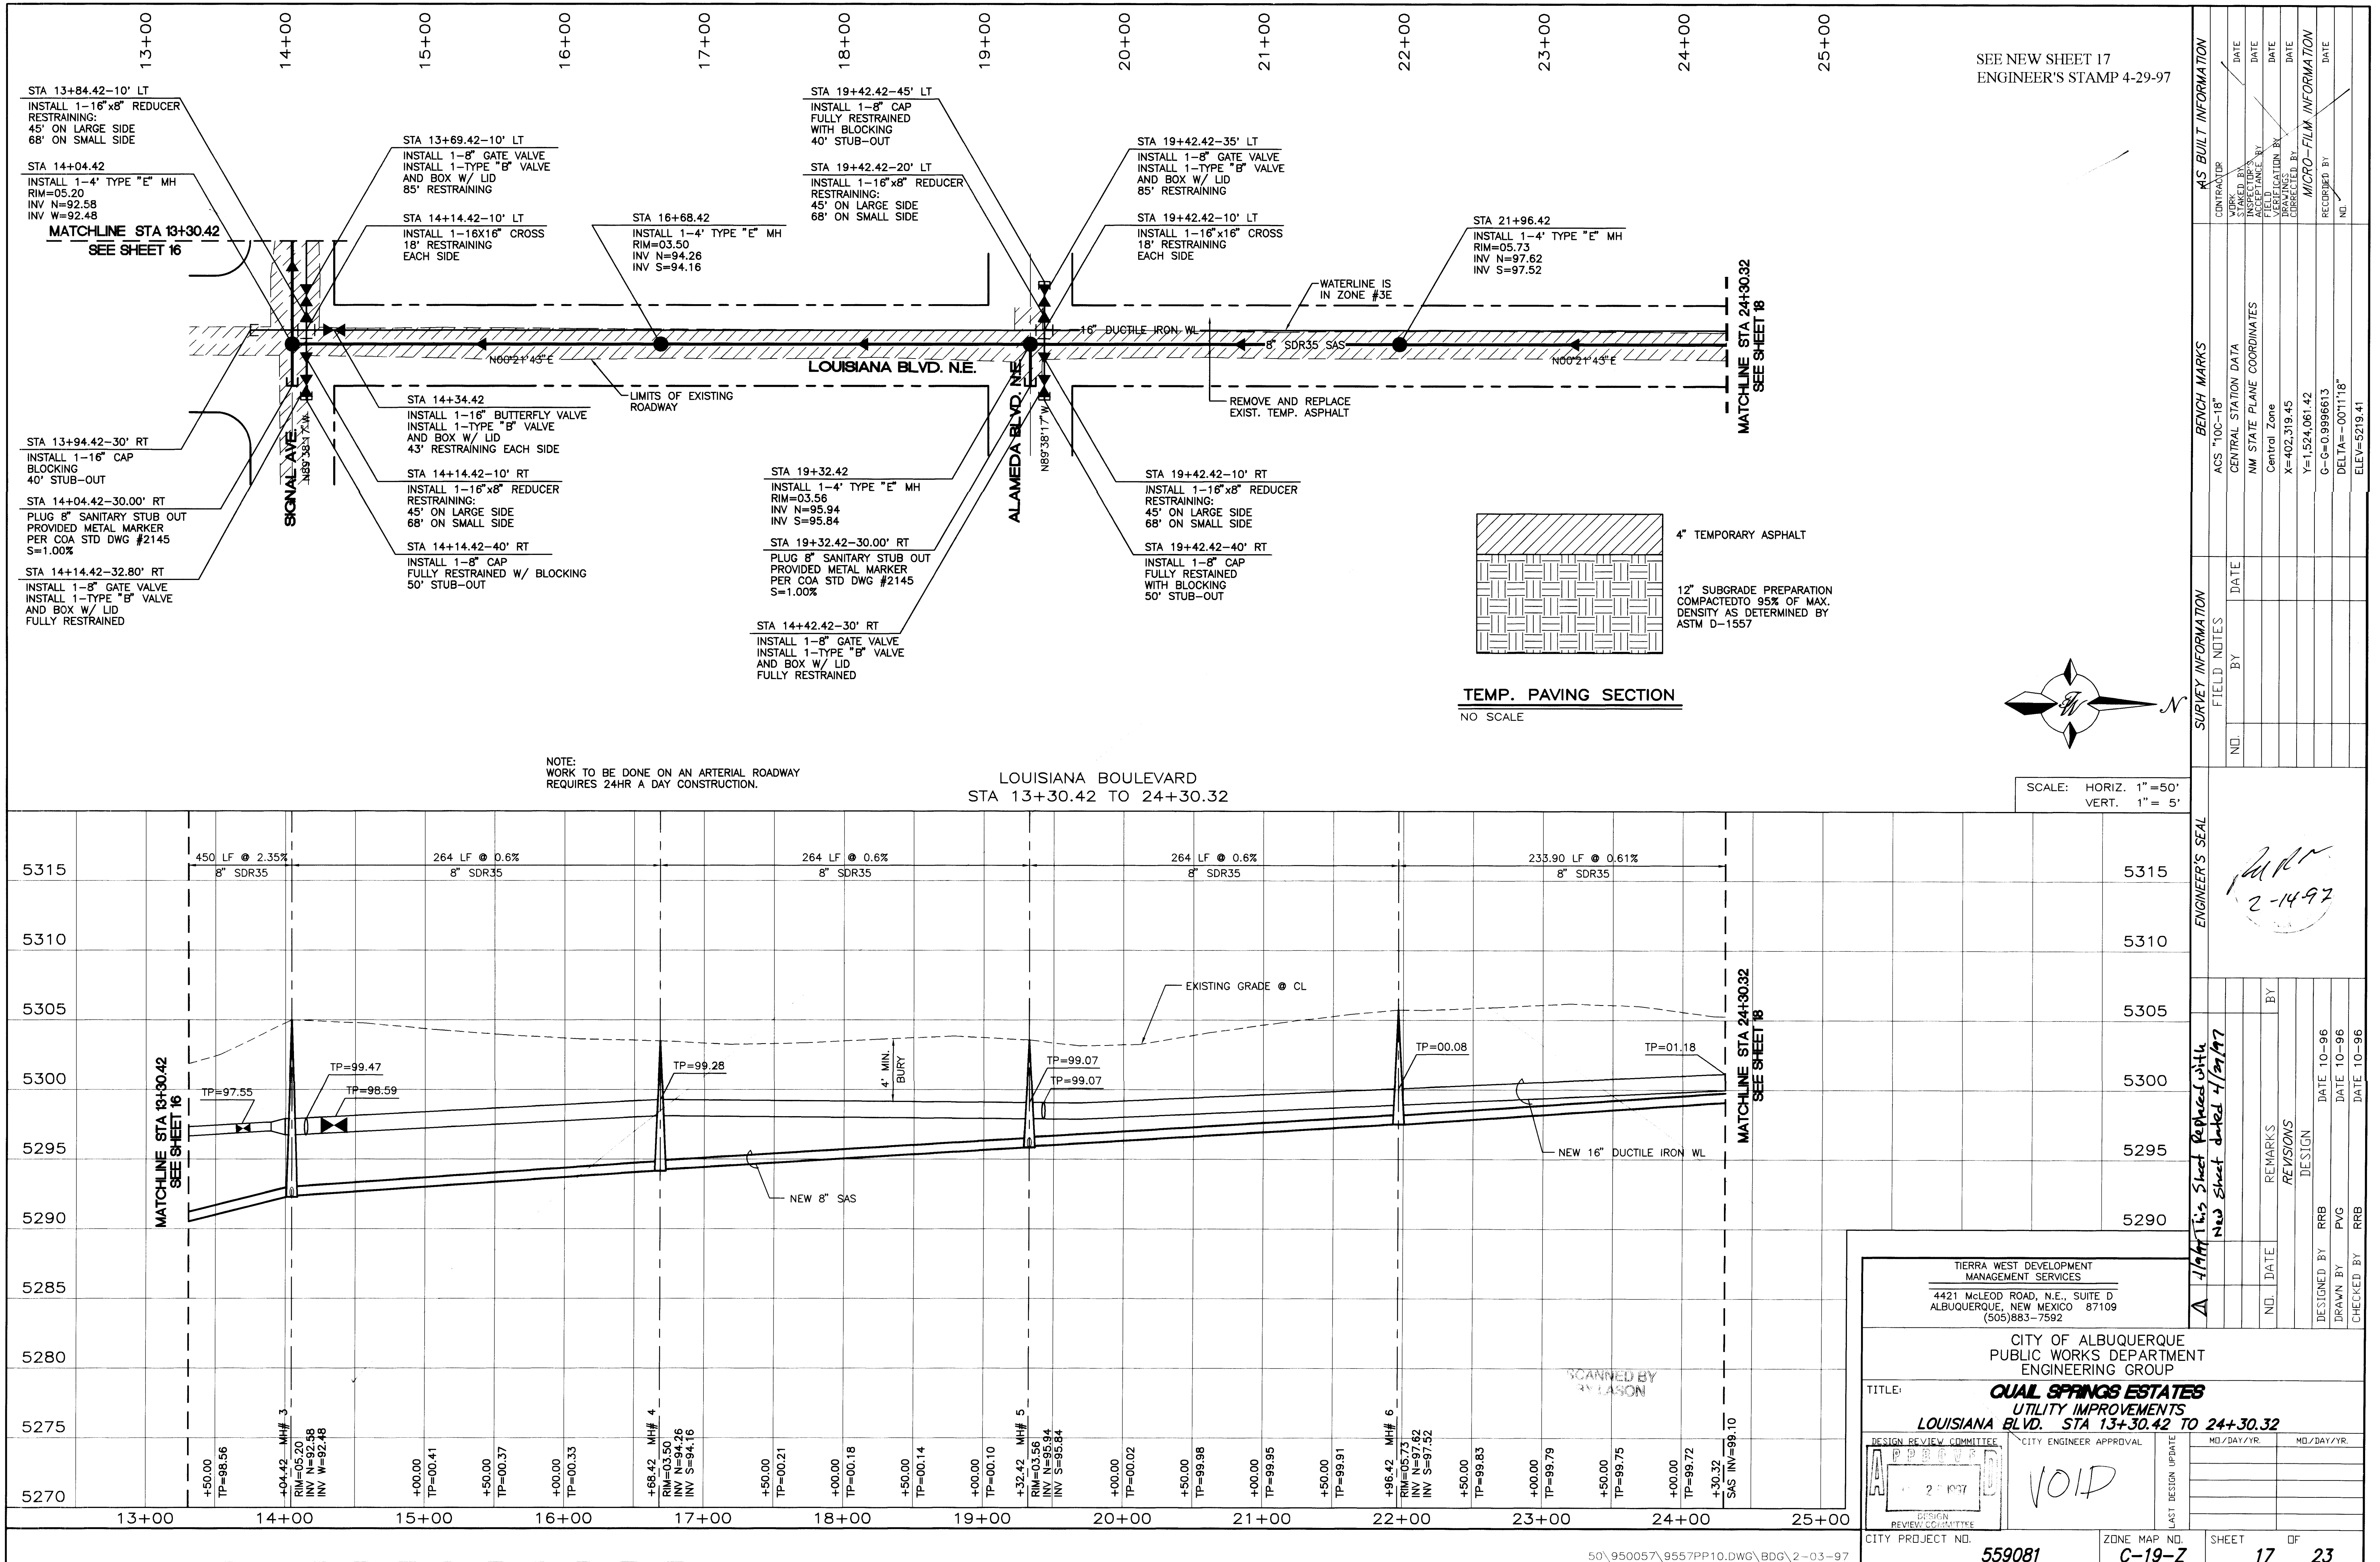

SEE NEW SHEET 17
ENGINEER'S STAMP 4-29-97

SURVEY INFORMATION			BENCH MARKS			AS BUILT INFORMATION		
NO.	BY	DATE	ACS "10C-18"			CONTRACTOR		
			CENTRAL STATION DATA			WORK STARTED BY		
			NM STATE PLANE COORDINATES			INSPECTED BY		
			Central Zone			FIELD CHANGE BY		
			X=402,319.45			DELEGATION BY		
			Y=1,524,061.42			DATE		
			G-G=0.9996613			DATE		
			DELTA=-001118"			DATE		
			ELEV=5219.411"			MICRO-FILM INFORMATION		
						RECORDED BY		
						NO.		

ENGINEER'S SEAL			
2-14-97			
NO.	DATE	REMARKS	BY
NO.	DATE	DESIGNED BY	DATE

TIERRA WEST DEVELOPMENT
MANAGEMENT SERVICES
4421 McLEOD ROAD, N.E., SUITE D
ALBUQUERQUE, NEW MEXICO 87109
(505)883-7592

CITY OF ALBUQUERQUE
PUBLIC WORKS DEPARTMENT
ENGINEERING GROUP

TITLE: **QUAL SPRINGS ESTATES
UTILITY IMPROVEMENTS
LOUISIANA BLVD. STA 13+30.42 TO 24+30.32**

DESIGN REVIEW COMMITTEE
CITY ENGINEER APPROVAL
LAST DESIGN UPDATE

DESIGNED BY: RRB
DRAWN BY: PVG
CHECKED BY: RRB

DATE: 10-96
DATE: 10-96
DATE: 10-96

CITY PROJECT NO. **559081**
ZONE MAP NO. **C-19-2**
SHEET **17** OF **23**

