



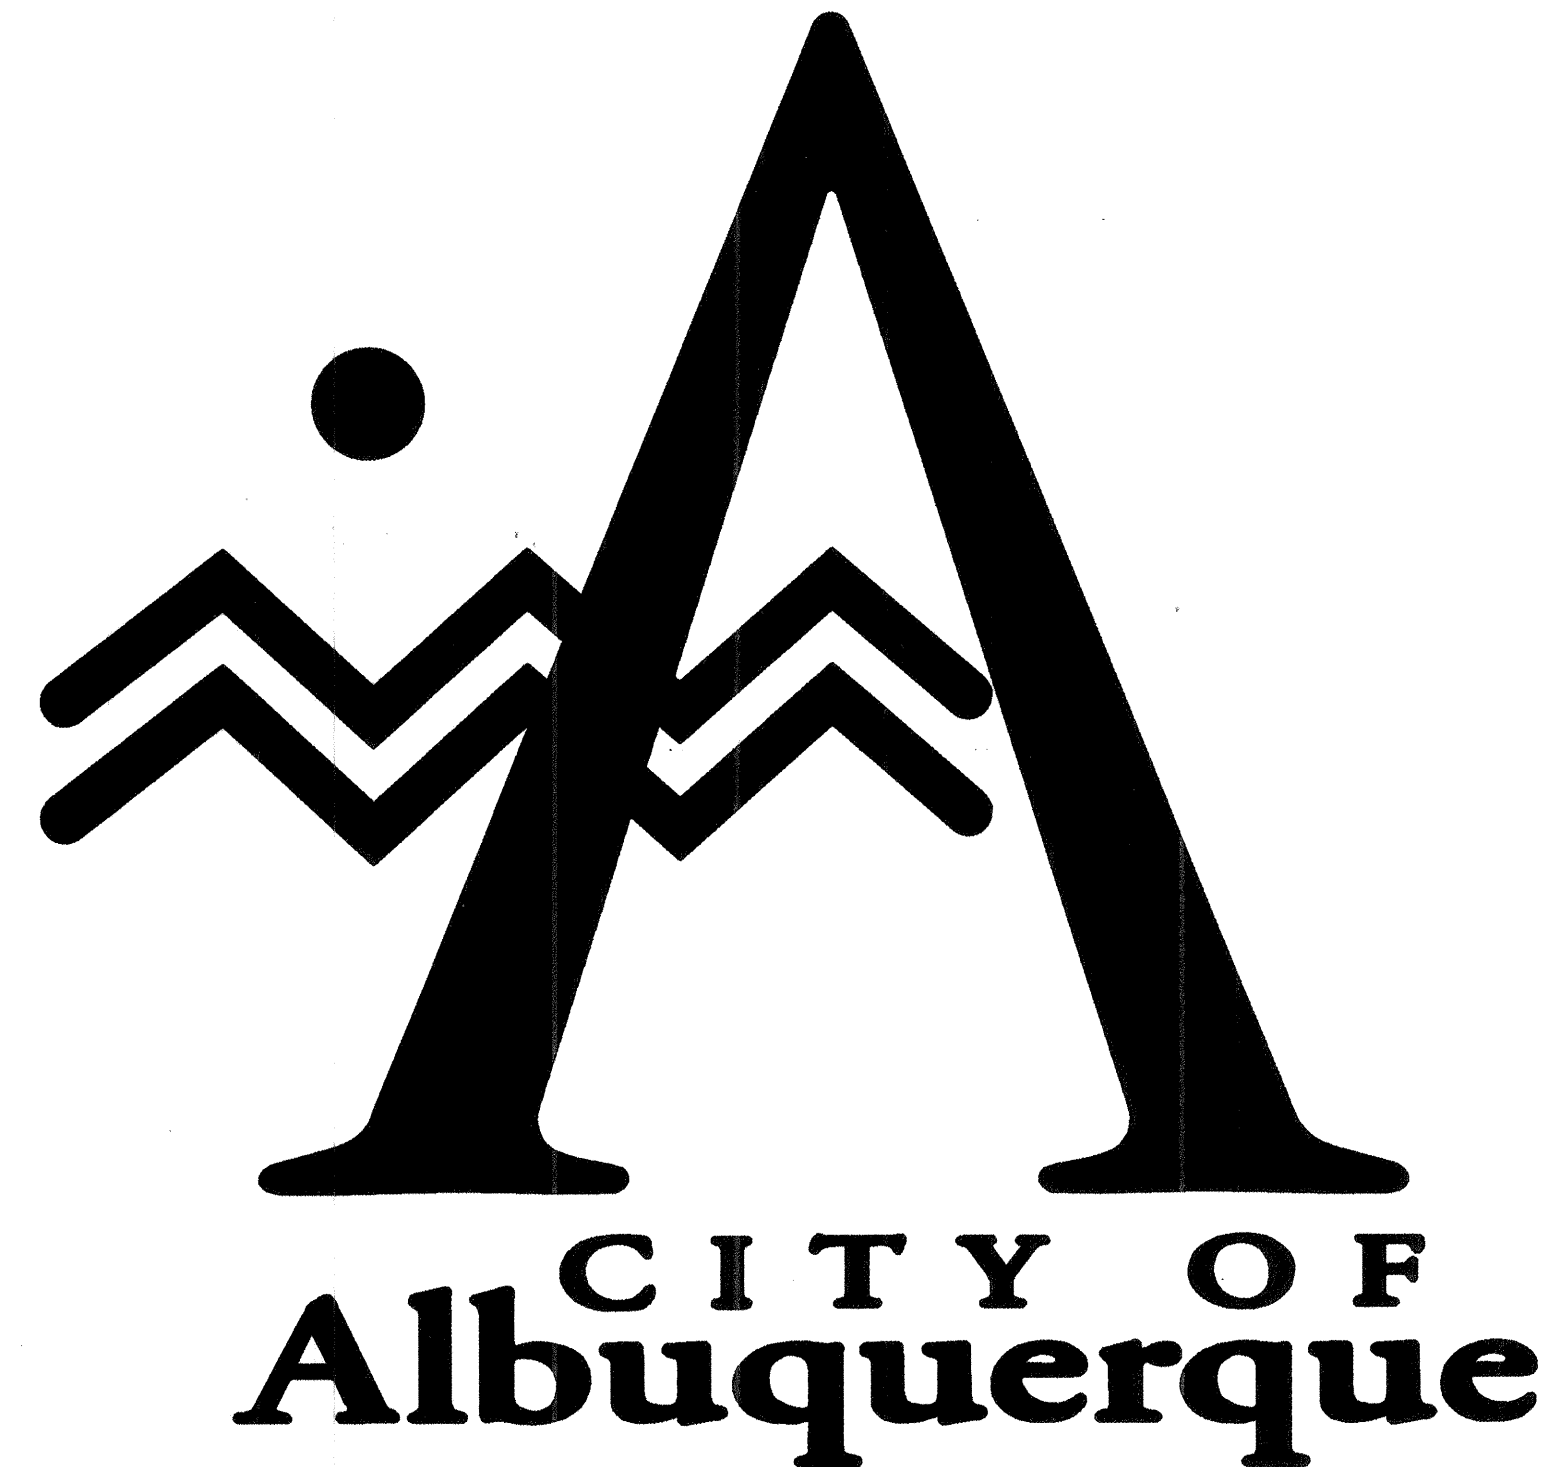


VILLA HERMOSA INFRASTRUCTURE IMPROVEMENTS UTILITIES AND PAVEMENT

INDEX OF DRAWINGS

SHEET	TITLE
1	TITLE SHEET, INDEX, GENERAL NOTES, LEGEND, AND ABBREVIATIONS
2	PLAT
3	COORS BOULEVARD LEFT TURN LANE EXTENSION
4	VILLA HERMOSA PUBLIC INFRASTRUCTURE SANITARY SEWER AND STORM DRAIN - PLAN AND PROFILE
5	VILLA HERMOSA PUBLIC INFRASTRUCTURE WATER - PLAN AND PROFILE
6	VILLA HERMOSA PUBLIC INFRASTRUCTURE WATER - PLAN AND PROFILE
7	VILLA HERMOSA OURAY ROAD IMPROVEMENTS ^Δ

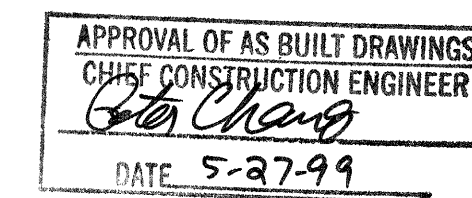

AS BUILT
DATE 6-2-98

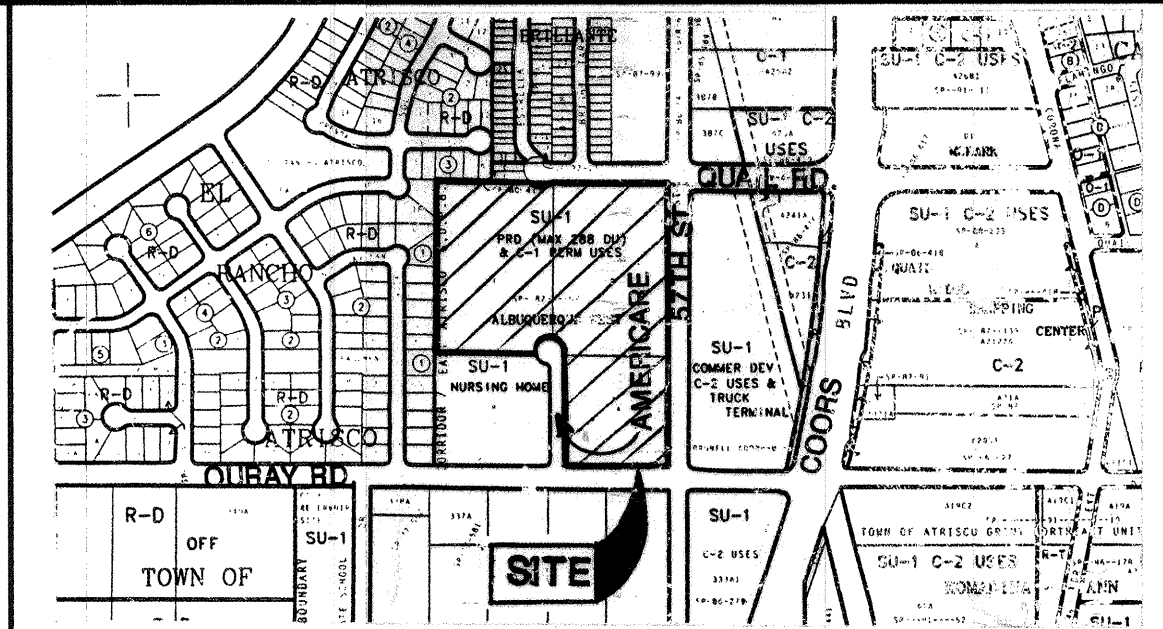

GENERAL NOTES

- AN EXCAVATION/CONSTRUCTION PERMIT WILL BE REQUIRED BEFORE BEGINNING ANY WORK WITHIN CITY RIGHT-OF-WAY.
- ALL WORK DETAILED ON THESE PLANS TO BE PERFORMED, EXCEPT AS OTHERWISE STATED OR PROVIDED HEREON, SHALL BE CONSTRUCTED IN ACCORDANCE WITH CITY OF ALBUQUERQUE STANDARD SPECIFICATIONS FOR PUBLIC WORKS CONSTRUCTION, 1986 EDITION AS REVISED THROUGH UPDATE #6.
- FIVE WORKING DAYS PRIOR TO ANY EXCAVATION, CONTRACTOR MUST CONTACT LINE LOCATING SERVICE, (260-1990) FOR LOCATION OF EXISTING UTILITIES.
- PRIOR TO CONSTRUCTION, THE CONTRACTOR SHALL EXCAVATE AND VERIFY THE HORIZONTAL AND VERTICAL LOCATIONS OF ALL PERTINENT EXISTING UTILITIES. SHOULD A CONFLICT EXIST, THE CONTRACTOR SHALL NOTIFY THE ENGINEER SO THAT THE CONFLICT CAN BE RESOLVED WITH A MINIMUM AMOUNT OF DELAY.
- TWO WORKING DAYS PRIOR TO BEGINNING CONSTRUCTION THE CONTRACTOR SHALL SUBMIT TO THE CONSTRUCTION COORDINATION DIVISION A DETAILED CONSTRUCTION SCHEDULE. TWO WORKING DAYS PRIOR TO CONSTRUCTION, THE CONTRACTOR SHALL OBTAIN A BARRICADING PERMIT FROM THE CONSTRUCTION COORDINATION DIVISION. CONTRACTOR SHALL NOTIFY BARRICADE ENGINEER (765-2551) PRIOR TO OCCUPYING PUBLIC RIGHT-OF-WAY. SEE SECTION 19 OF THE SPECIFICATIONS.
- ALL STREET STRIPING ALTERED OR DESTROYED SHALL BE REPLACED WITH PLASTIC REFLECTORIZED PAVEMENT MARKINGS BY CONTRACTOR TO SAME LOCATION AS EXISTING, OR AS INDICATED BY THIS PLAN SET.
- CONTRACTOR SHALL COORDINATE WITH WATER SYSTEMS DIVISION (857-8200) FIVE WORKING DAYS IN ADVANCE OF ANY WORK THAT MAY AFFECT EXISTING PUBLIC WATER OR SEWER UTILITIES. EXISTING VALVES TO BE OPERATED BY CITY PERSONNEL ONLY. CONTRACTOR SHALL CONTACT THE WATER SYSTEMS DIVISION.
- CONTRACTOR SHALL RECORD DATA ON ALL UTILITY LINES AND ACCESSORIES AS REQUIRED BY THE CITY OF ALBUQUERQUE FOR THE PREPARATION OF "AS CONSTRUCTED" DRAWINGS. CONTRACTOR SHALL NOT COVER UTILITY LINES AND ACCESSORIES UNTIL ALL DATA HAS BEEN RECORDED.
- CONTRACTOR SHALL NOTIFY THE ENGINEER NOT LESS THAN SEVEN (7) DAYS PRIOR TO STARTING WORK IN ORDER THAT THE CITY SURVEYOR MAY TAKE NECESSARY MEASURES TO INSURE THE PRESERVATION OF SURVEY MONUMENTS. CONTRACTOR SHALL NOT DISTURB PERMANENT SURVEY MONUMENTS WITHOUT THE CONSENT OF THE CITY SURVEYOR AND SHALL NOTIFY THE CITY SURVEYOR AND BEAR THE EXPENSE OF REPLACING ANY THAT MAY BE DISTURBED.
- ANY WORK AFFECTING AN ARTERIAL ROADWAY REQUIRES TWENTY FOUR (24) HOUR CONSTRUCTION.
- EXISTING PUBLIC OR PRIVATE IMPROVEMENTS WHICH ARE DAMAGED OR DISPLACED BY THE CONTRACTOR SHALL BE REPAIRED OR REPLACED BY THE CONTRACTOR AT THE CONTRACTOR'S OWN EXPENSE. REPAIRS SHALL BE APPROVED BY THE OWNER PRIOR TO CONSTRUCTION OF THE REPAIRS. REPAIRS SHALL BE ACCEPTED BY THE OWNER PRIOR TO FINAL PAYMENT.

LEGEND

DESCRIPTION	EXISTING	NEW
ASPHALT	///	///
CURB AND GUTTER	==	==
PROPERTY LINE	- - -	- - -
CONSTRUCTION BASE LINE		+

ABBREVIATIONS


LF = LINEAR FEET	STA = STATION
L = LEFT	RAD. = RADIUS
R = RIGHT	TYP. = TYPICAL
TC = TOP OF CURB	PC = POINT OF CURVATURE
FL = FLOWLINE	PT = POINT OF TANGENT
EXIST = EXISTING	TA = TOP OF ASPHALT



5639 JEFFERSON STREET N.E. • ALBUQUERQUE, NEW MEXICO 87109
PHONE (505) 344-4080 • FAX (505) 343-8759


REV.	7	DATE	6-2-98	USER	DATE	6-2-98	USER	DATE	6-2-98
ENGINEER'S STAMP & SIGNATURE	APPROVALS	ENGINEER	DATE	*****	APPROVED FOR CONSTRUCTION				
DRG Chairman	8-26-97								
Transportation	8-5-97								
Water/Wastewater	7-29-97								
Hydrology	8-11-97								
C.I.P.									
Constr. Mngmt.									
City Project No.	559481	Sheet	1	Of	7				

PLAT OF TRACTS A-1 & C-1
ALBUQUERQUE WEST
SITUATE WITHIN PROJECTED
SECTION 11, T. 10 N., R. 2 E., N.M.P.M.
ALBUQUERQUE, NEW MEXICO
MAY 1996
SHEET 2 OF 2



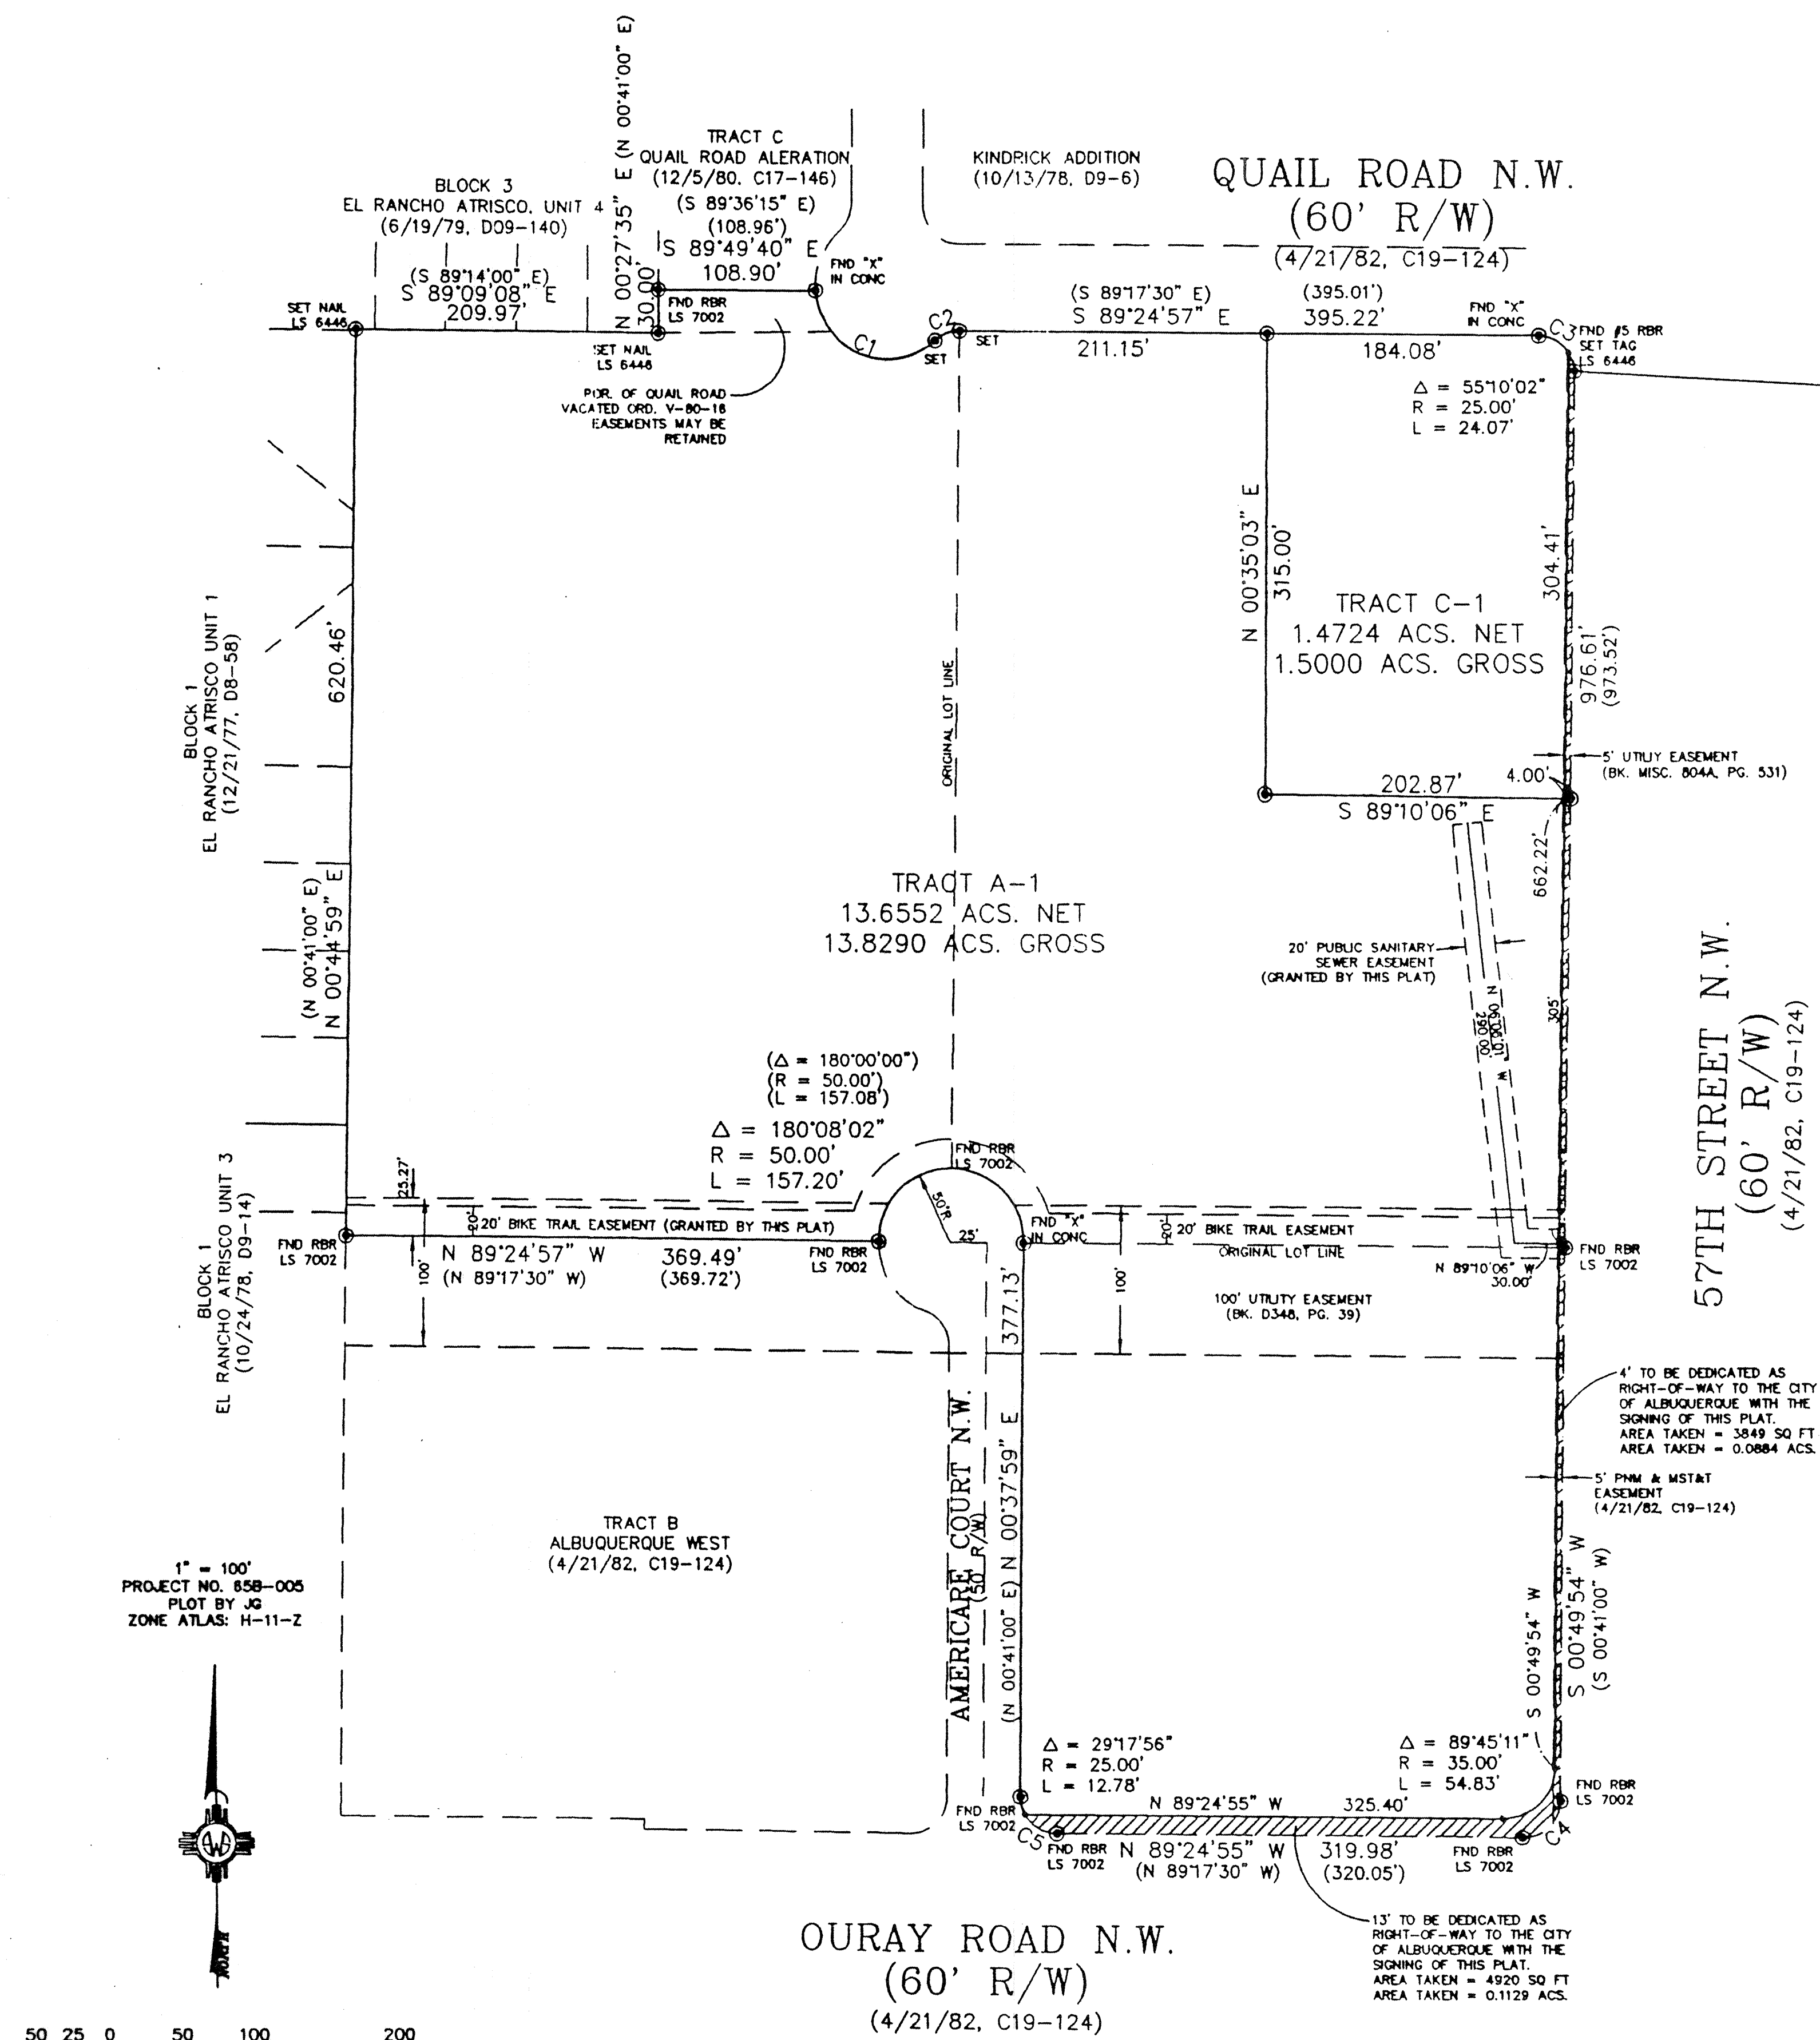


STATION: 12-H11
X = 365168.46
Y = 1497456.42
GROUND TO GRID = 0.99967688
DELTA ALPHA = -0°15'34"
NEW MEXICO STATE PLANE
COORDINATE SYSTEM
CENTRAL ZONE
NAD 1927

CURVE	RADIUS	DELTA	LENGTH	CHORD	BEARING
C1	50.00'	129°03'18"	112.62'	90.28'	N 67°43'18" W
	(50.00')	(132°48'39")	(115.90')		
C2	25.00'	42°50'00"	18.69'	18.26'	S 69°10'03" W
	(25.00')	(42°27'43")	(18.53')		
C3	25.00'	85°39'10"	37.37'	33.99'	S 44°28'03" E
	(25.00')	(89°58'30")	(39.26')		
C4	25.00'	91°40'54"	40.00'	35.87'	N 45°41'21" E
	(25.00')	(90°01'30")	(39.28')		
C5	25.00'	90°12'31"	39.36'	35.42'	S 43°54'17" E
	(25.00')	(89°58'30")	(39.26')		

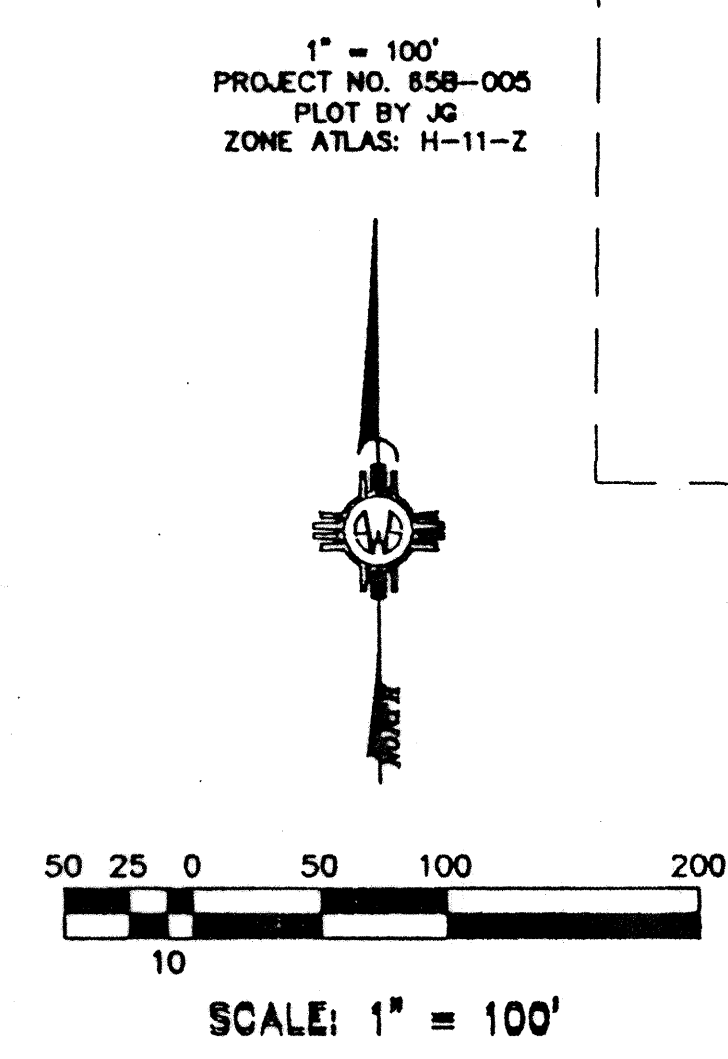

SOUTHWEST SURVEYING CO., INC.
333 LOMAS BLVD., N.E.
ALBUQUERQUE, NEW MEXICO 87102
PHONE: (505) 247-4444
FAX: (505) 242-8089

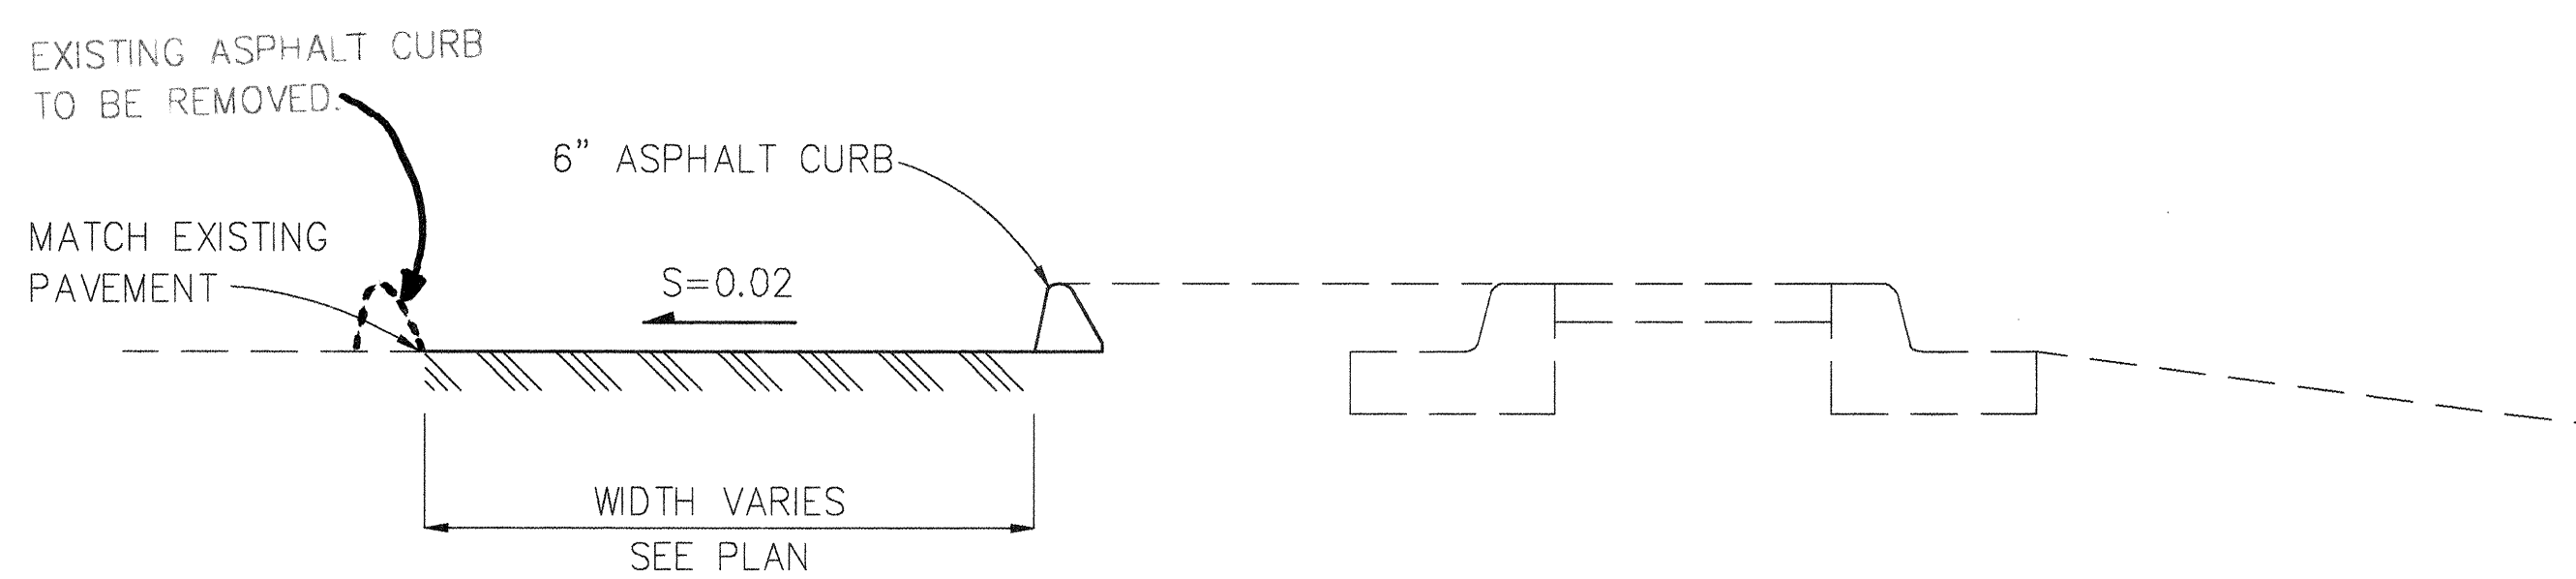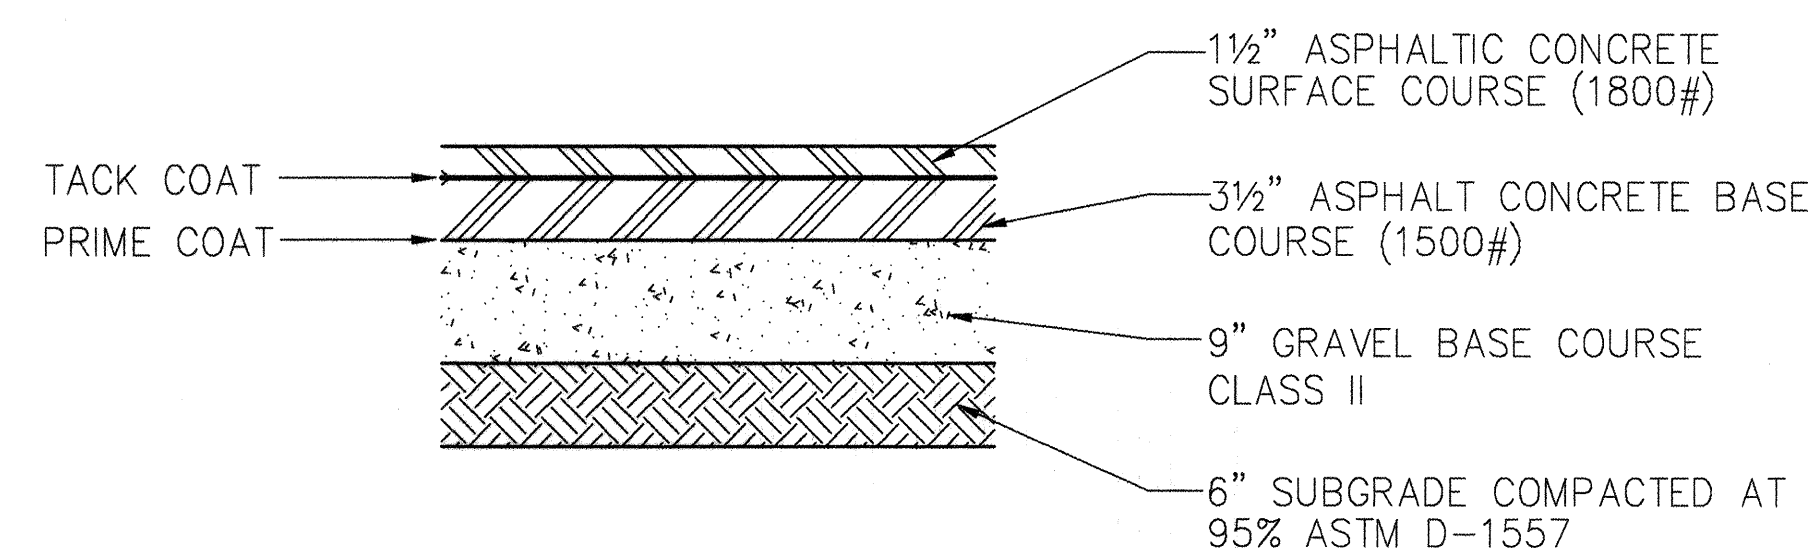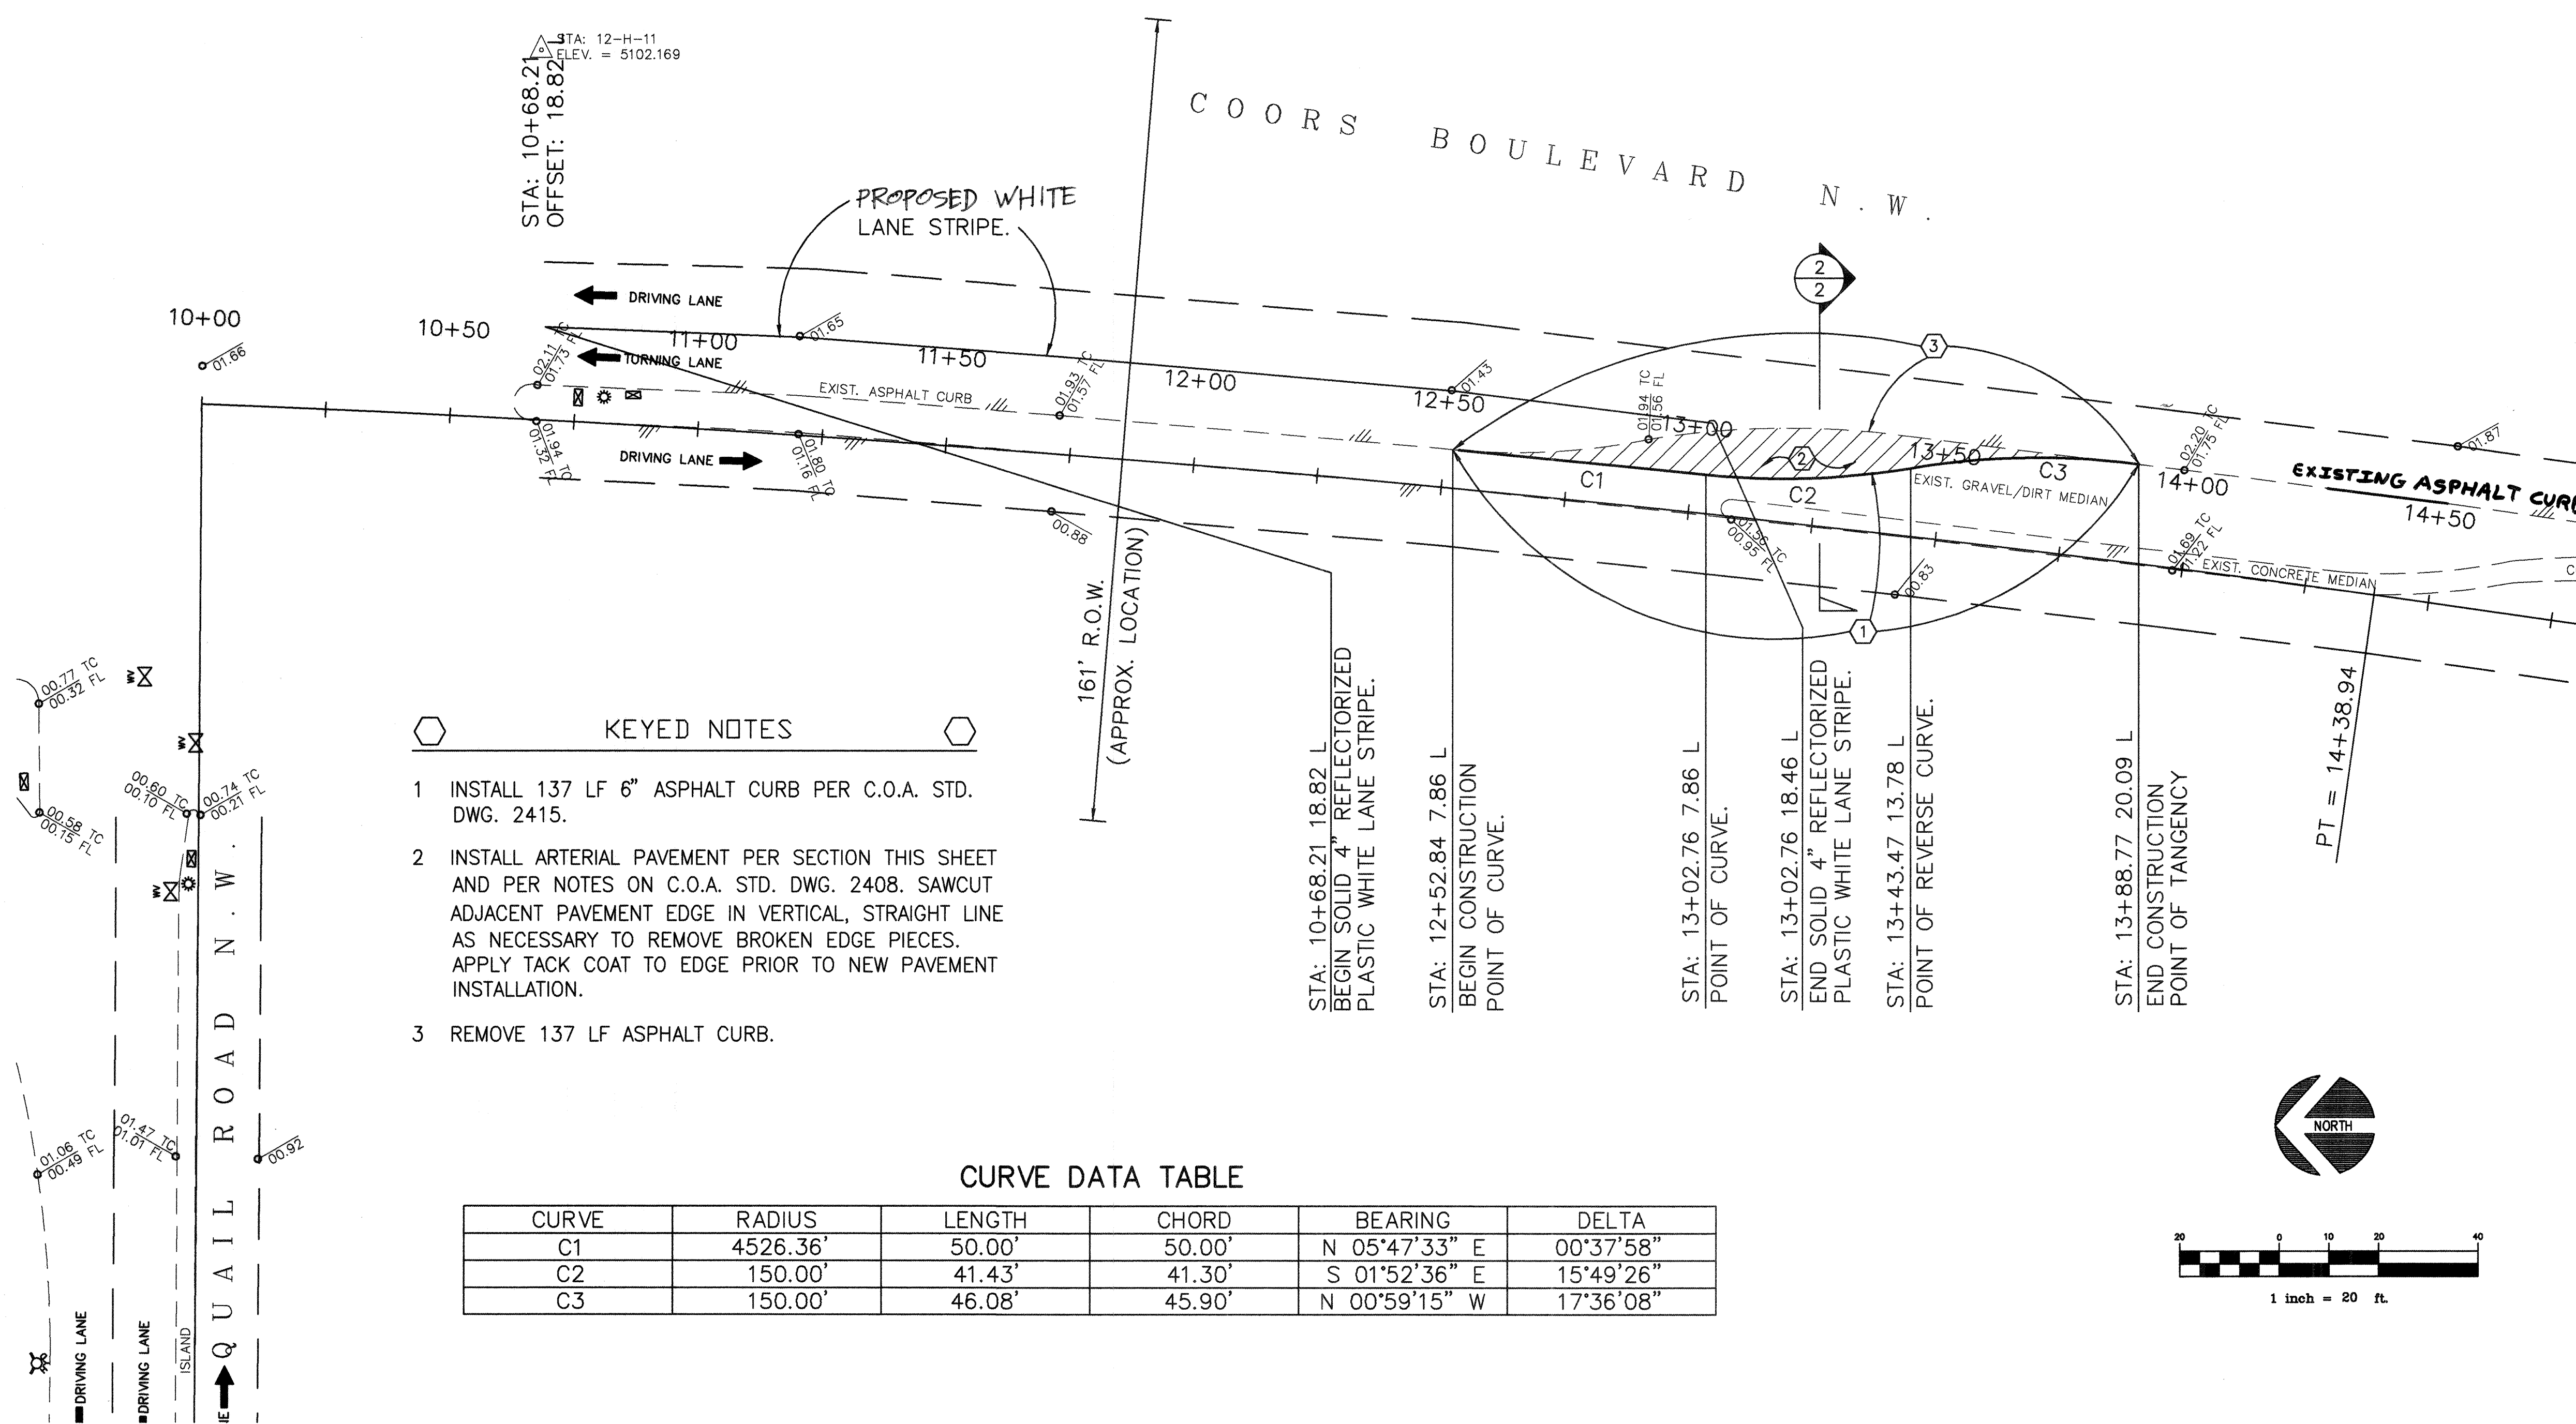


AS BUILT
DATE 6-2-98

CITY OF ALBUQUERQUE PUBLIC WORKS DEPARTMENT ENGINEERING DEVELOPMENT GROUP	
TITLE: COORS BOULEVARD LEFT TURN LANE EXTENSION	
APPROVED AUG 26 1997 DESIGN REVIEW COMMITTEE	
City Project No. 559481	Zone Map No. H-11
Sheet 3	Of 7

ENGINEER'S SEAL		SURVEY INFORMATION		BENCH MARKS		CONTRACTOR INFORMATION	
NO. DATE		FIELD NOTES		A 3-1/4" ALUMINUM CAP STAMPED "12-H11, 1989"		CONTRACTOR: Kometra Excavating	
BY		DATE		SET FLUSH IN THE TOP OF CURB LOCATED 84.2'		STAKED BY: J. A. Wolfenbarger	
REMARKS		DATE		SOUTHWEST SURVEYING 08/96		INSPECTED BY: J. A. Wolfenbarger	
DESIGN		DATE		CONSULTING SURVEYOR		FIELD INSPECTION BY: J. A. Wolfenbarger	
J. A. Wolfenbarger		DATE		ISLAND IN THE SOUTHEAST QUADRANT OF COORS BLVD.		CORRECTED BY: J. A. Wolfenbarger	
J. L. Martinez		DATE		AND QUAIL RD.		MICRO-FILM INFORMATION	
J. P. Kelley		DATE		ELEV. = 5102.169 FT.		RECORDED BY: J. P. Kelley	
DATE 05/97		DATE				NO. DATE	


JOB NO.: 008-113-5195
FILE: WPC-PP.DWG
ENG/TECH: JW/AM
REV: (08-04-97)

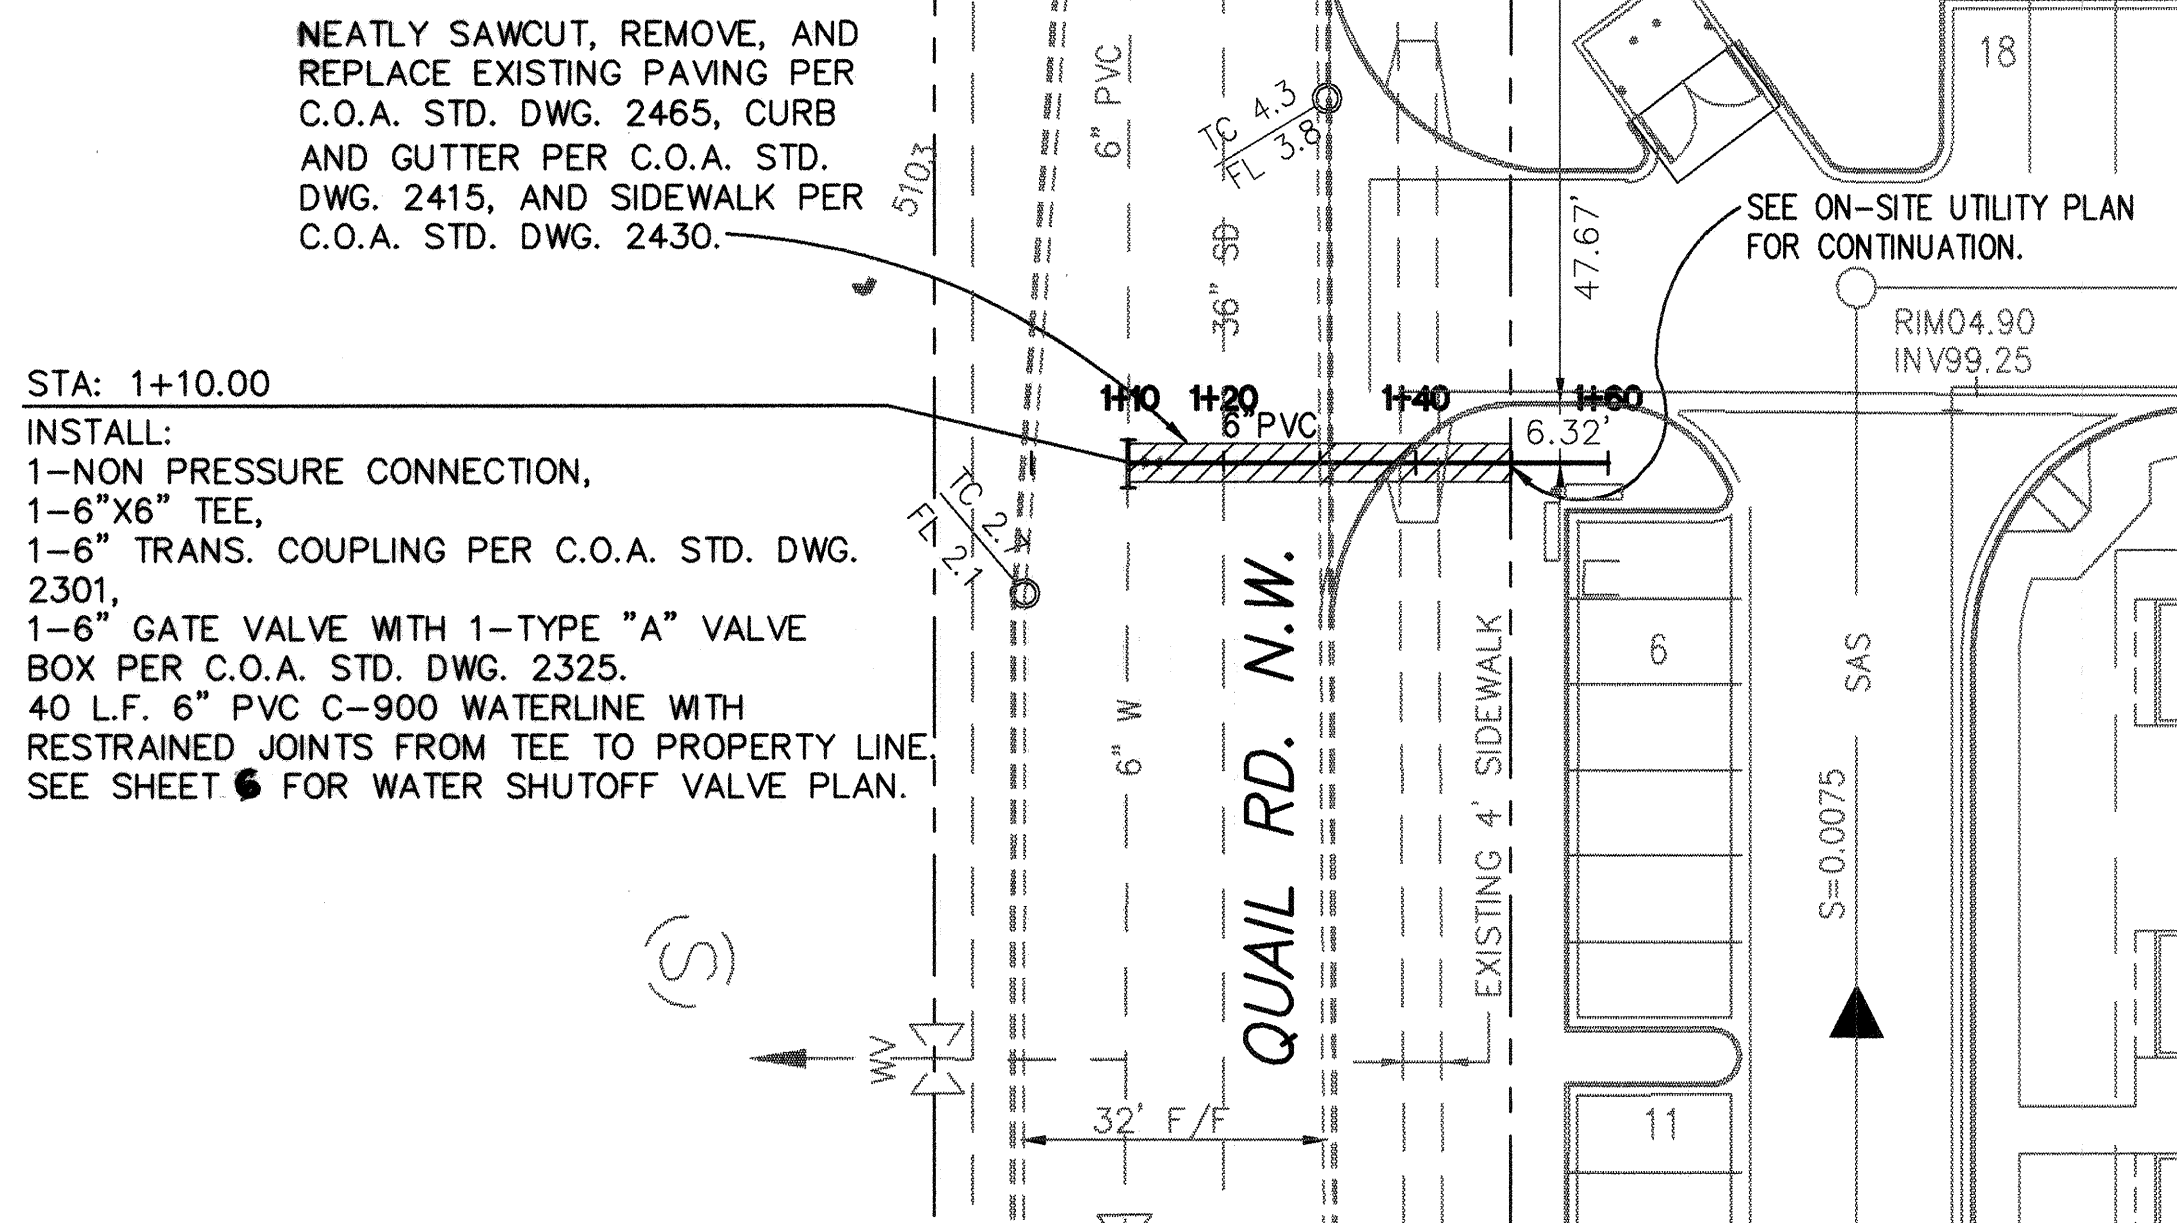

PLAN VIEW
AREA "B"


1 inch = 20 ft.

NORTH

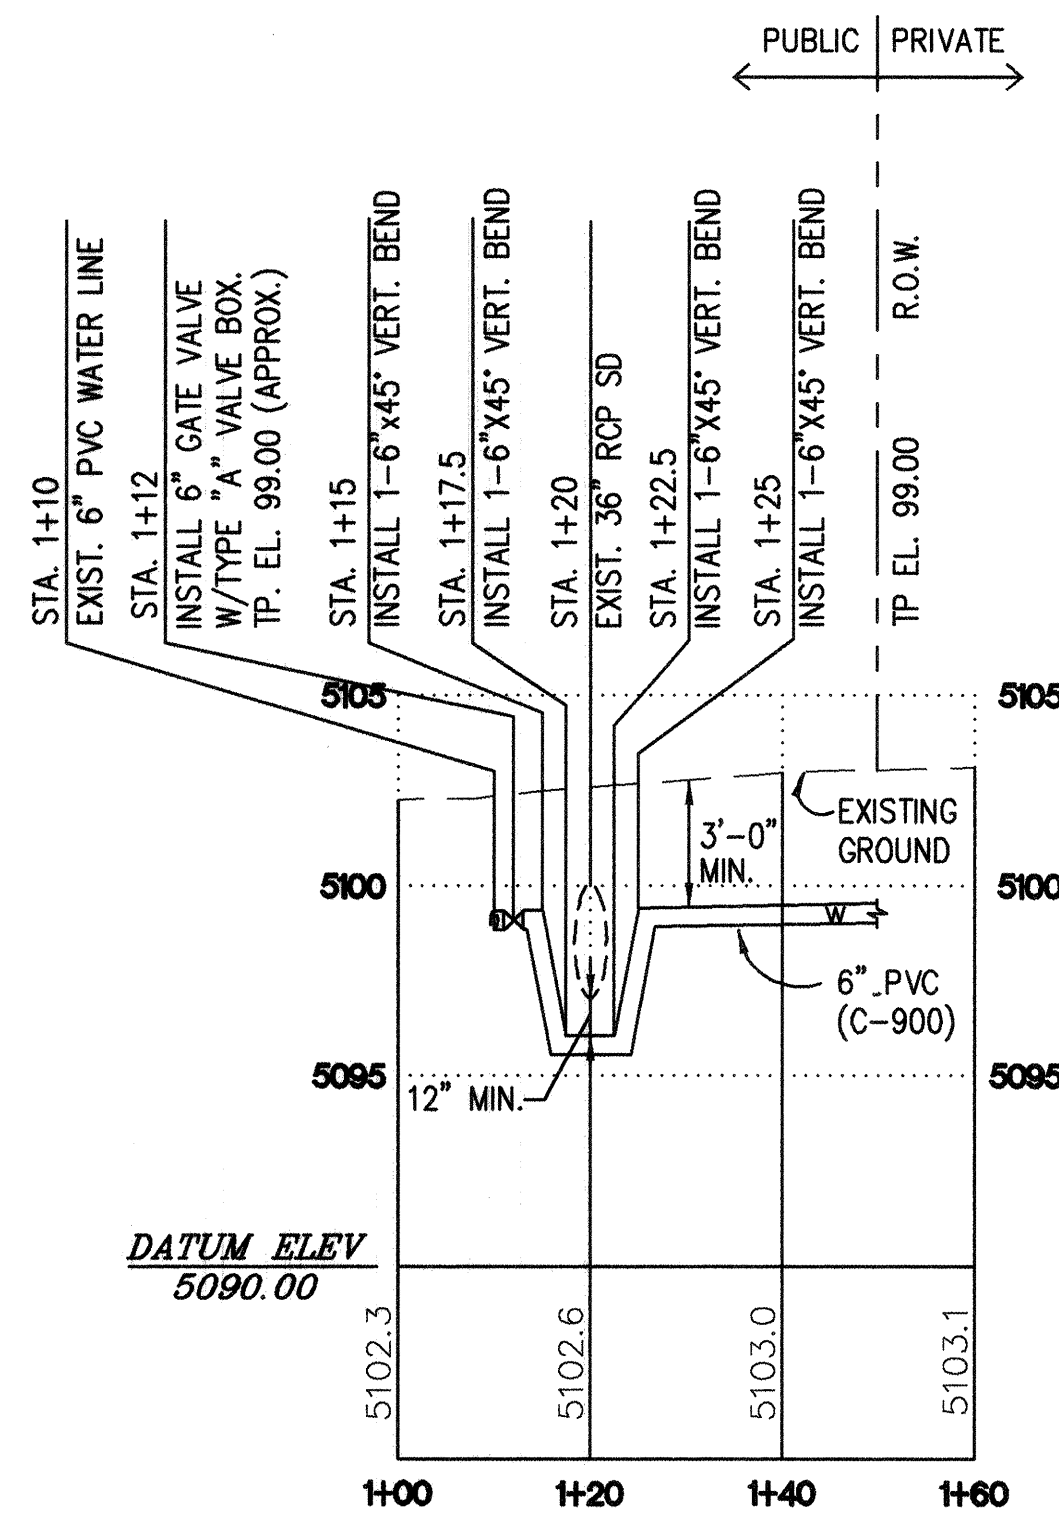

WATER PROFILE


SCALE:
HORIZ 1"=20'-0"
VERT 1"=5'-0"

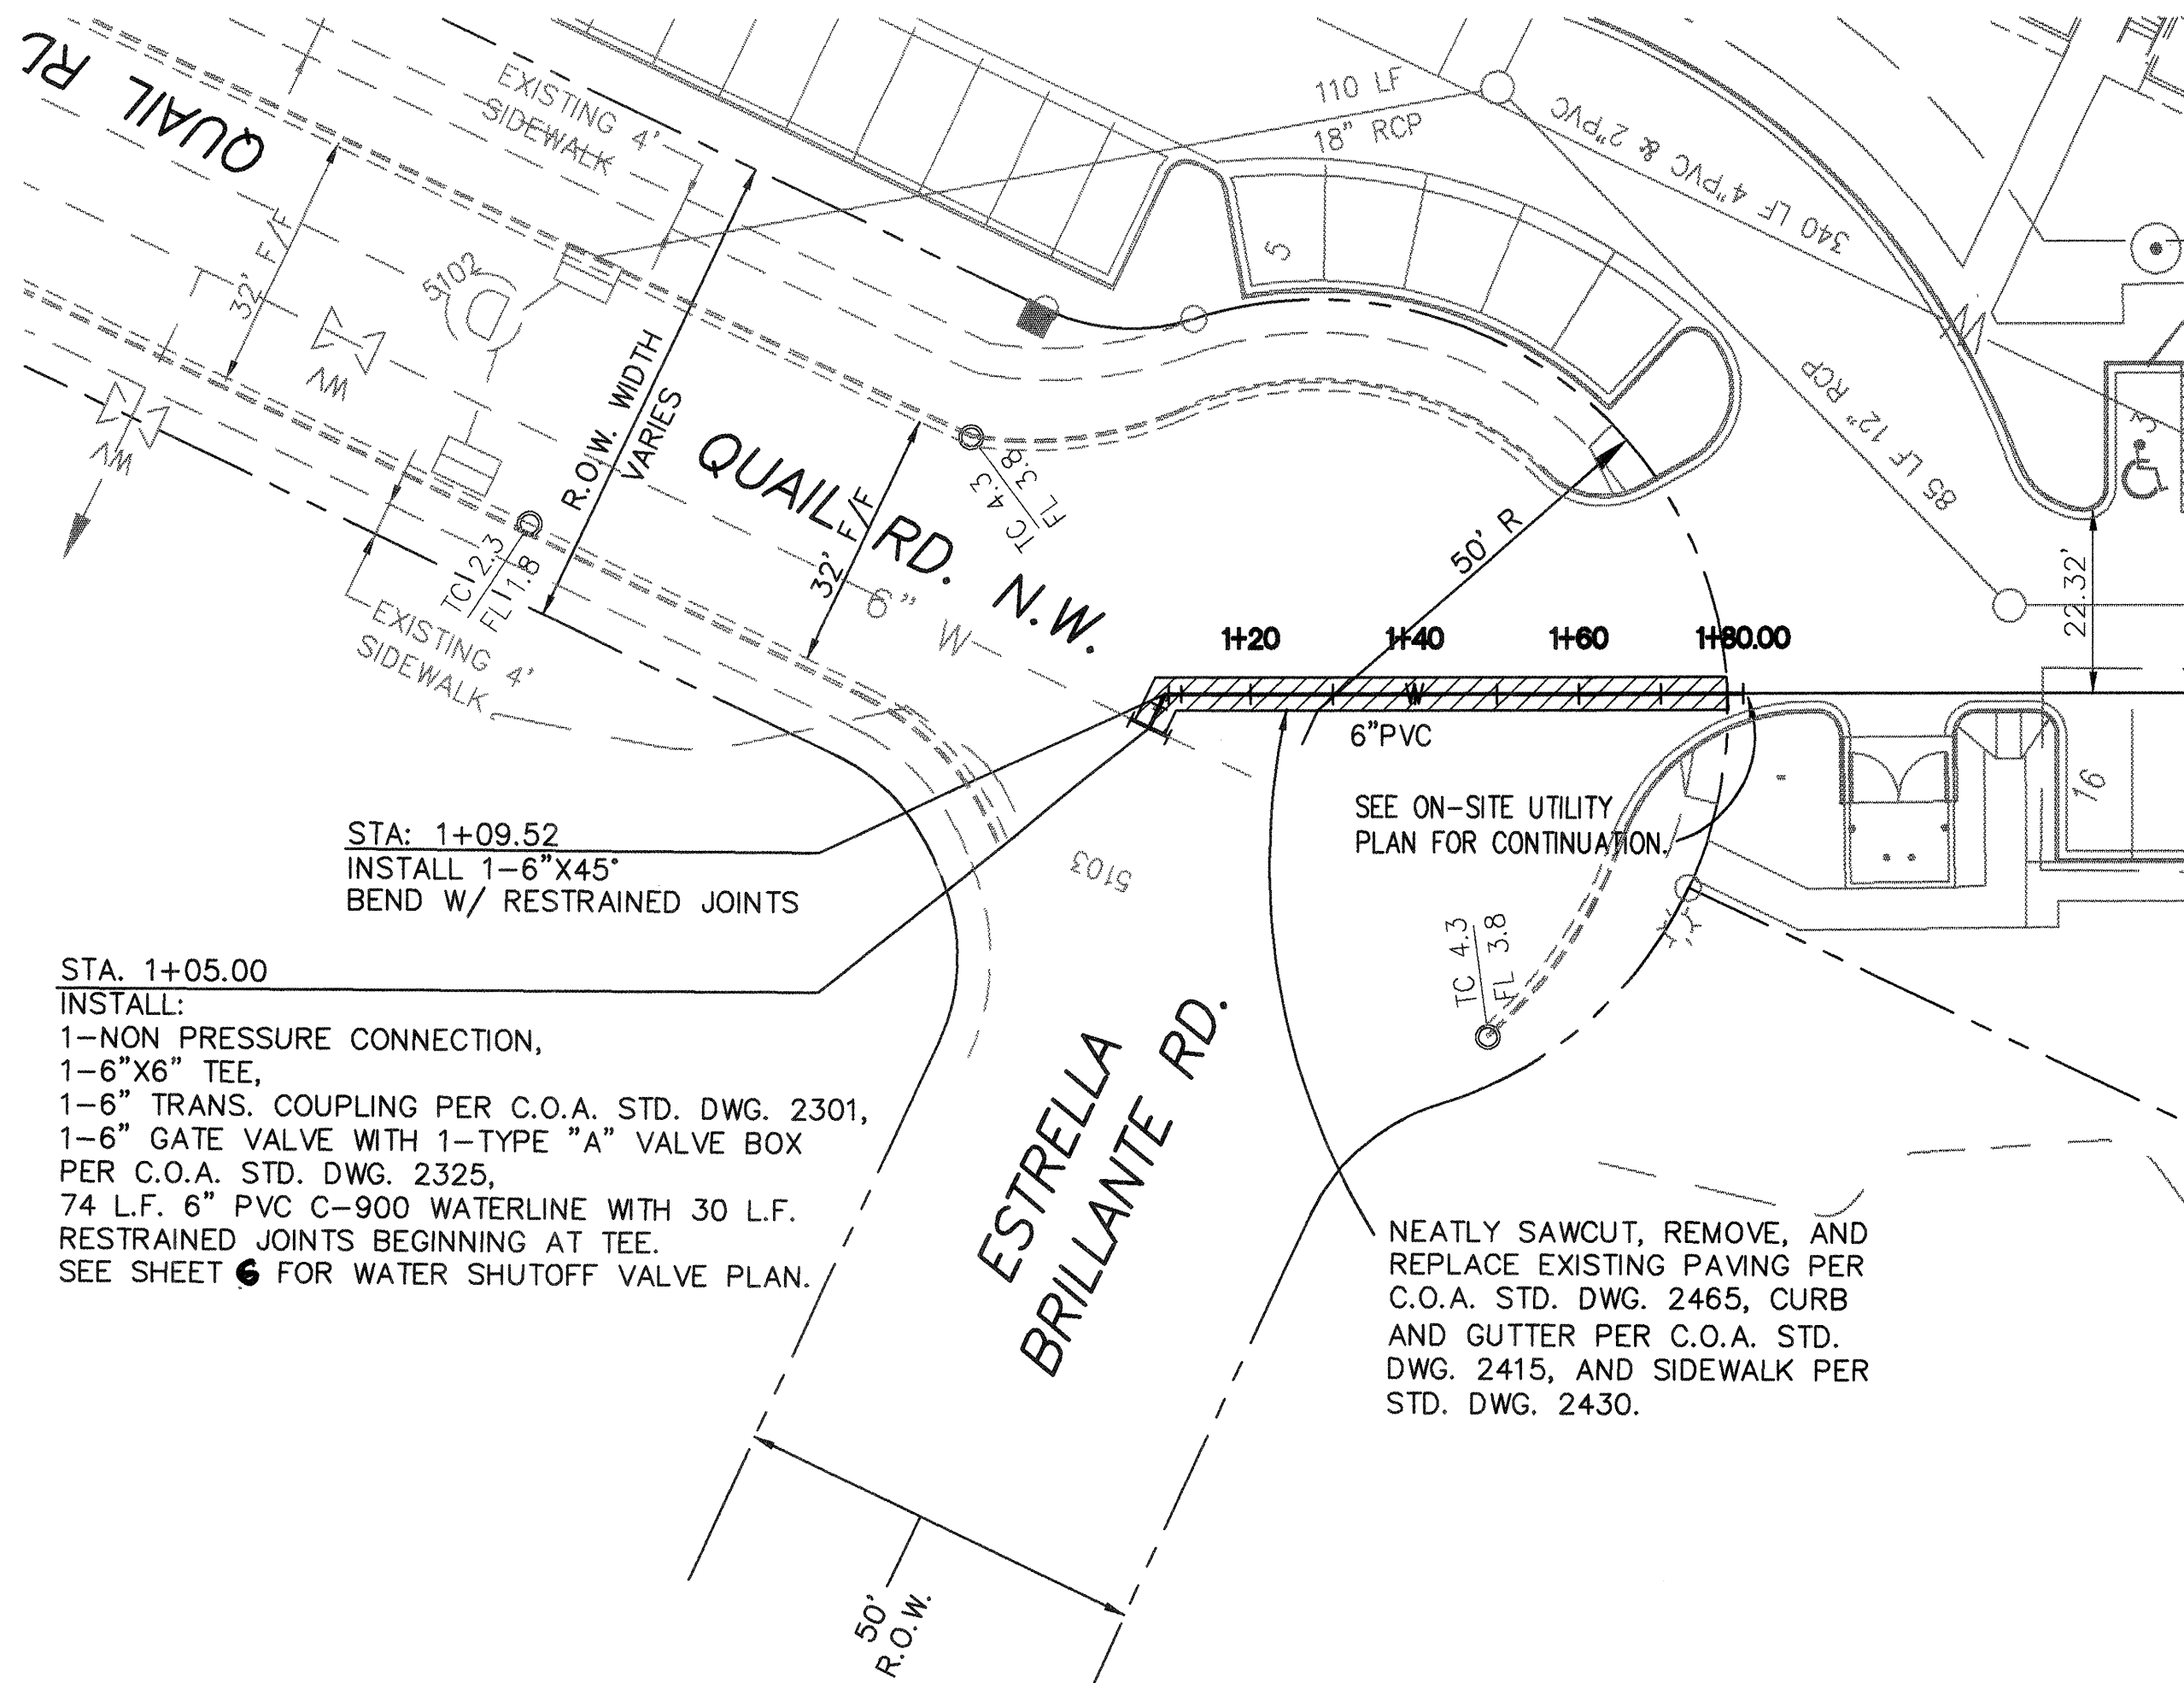


PLAN VIEW
AREA "C"

1 inch = 20 ft.

NORTH

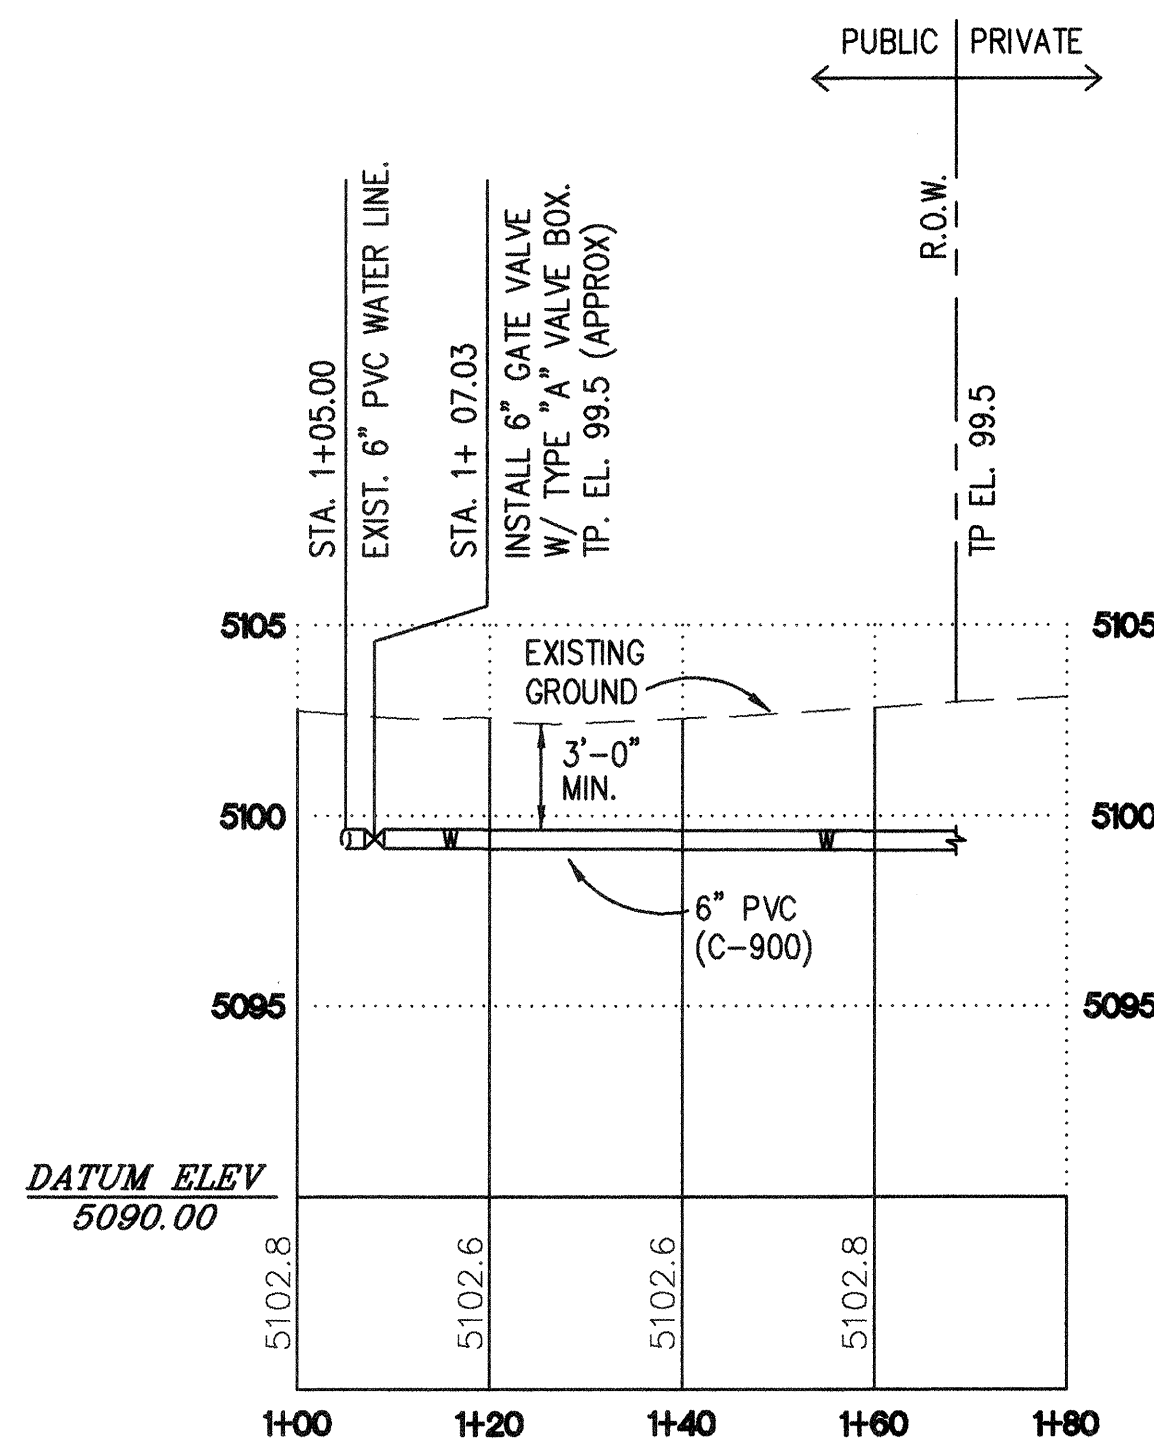


WATER PROFILE

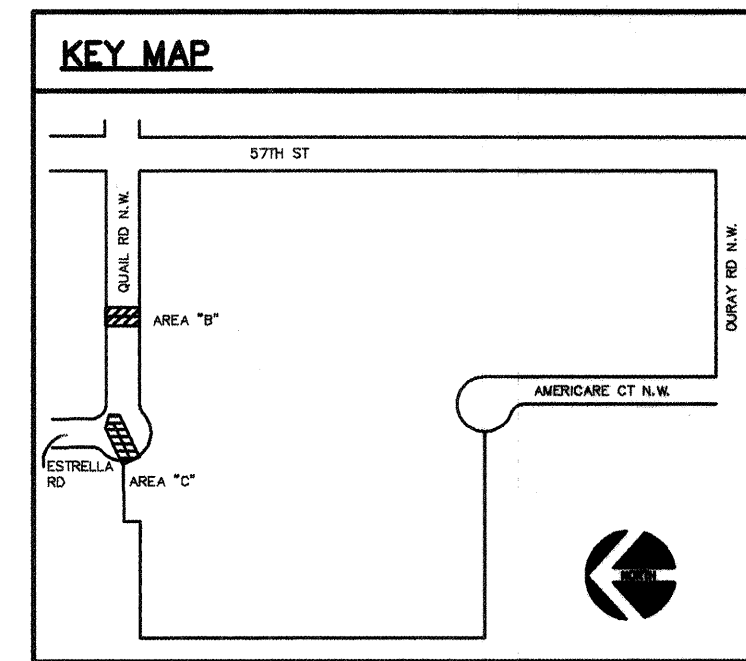

AS BUILT
DATE: 6-2-98

CITY OF ALBUQUERQUE PUBLIC WORKS DEPARTMENT ENGINEERING DEVELOPMENT GROUP	
TITLE: VILLA HERMOSA PUBLIC INFRASTRUCTURE WATER - PLAN AND PROFILE	
Design Review Committee APPROVED DESIGN REVIEW COMMITTEE	City Engineer Approval
City Project No. 559481	Zone Map No. H-11
Mo./Day/Yr. 10/26/97	Mo./Day/Yr. 10/26/97
DESIGNED BY J. A. WOLFENBARGER	DATE 05-97
DRAWN BY J. L. MARTINEZ	DATE 05-97
CHECKED BY J. P. KELLEY	DATE 05-97

SURVEY INFORMATION			BENCH MARKS		
FIELD NOTES					
NO.	BY	DATE			
	SOUTHWEST SURVEYING	5/96	A 1-3/4" ALUMINUM DISK STAMPED "ACS BM, 9-H11"		
	CONSULTING SURVEYOR		EXPLOXED TO THE TOP OF THE CONCRETE BASE OF THE FIRST GALVANIZED STEEL POWER POLE EAST OF COORS ROAD, 0.1 MILE NORTH OF OURAY ROAD NW ON THE WEST SIDE OF THE POLE.		
			ELEV. = 5101.518 FT.		
			MICRO-FILM INFORMATION		
			CONTRACTOR	WORK	DATE
			INSPECTOR'S	ACCEPTANCE BY	DATE
			VERIFICATION BY	DATE	
			DRAWINGS	CORRECTED BY	DATE
			RECORDED BY		
			DATE		
			NO.		

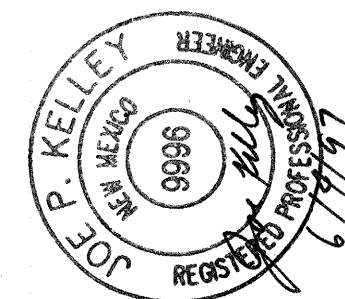





FOR CONNECTION:

1- CLOSE VALVES "23", "24", AND "31", AS INDICATED.

2- CLOSE VALVES "22", "24" AS INDICATED.

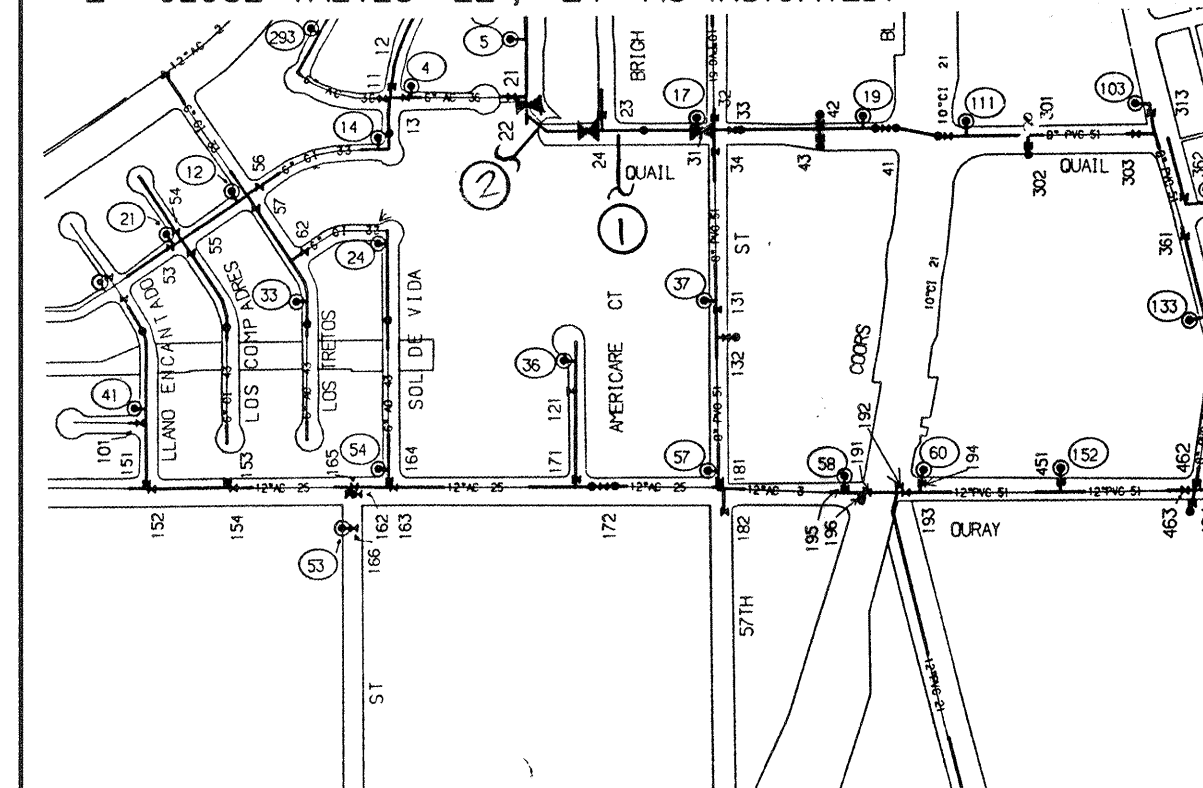

WATER VALVE SHUT-OFF PLAN H-11-Z

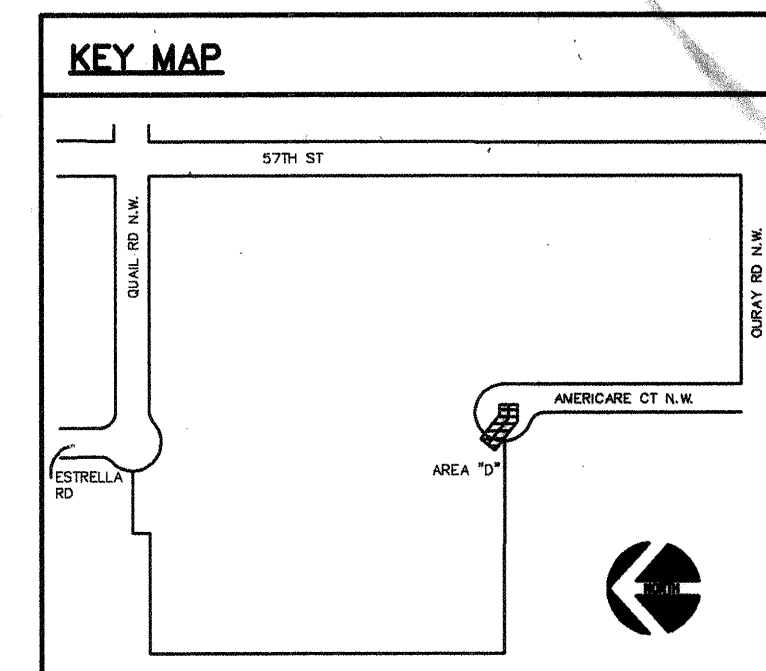

AS BUILT
DATE 6-2-98




CITY OF ALBUQUERQUE
PUBLIC WORKS DEPARTMENT
ENGINEERING DEVELOPMENT GROUP

TITLE: VILLA HERMOSA PUBLIC INFRASTRUCTURE
WATER - PLAN AND PROFILE

Design Review Committee  DESIGN REVIEW COMMITTEE	City Engineer Approval	Last Design Update	Mo./Day/Yr.	Mo./Day/Yr.
City Project No. 559481	Zone Map No. H-1	Sheet 6	Of 17	

SURVEY INFORMATION		BENCH MARKS		AS BUILT INFORMATION	
NO.	FIELD NOTES	DATE	CONTRACTOR	WORK DONE BY	DATE
	SOUTHWEST SURVEYING	5/96	EXPLOD TO THE TOP OF THE CONCRETE BASE OF	INSPECTOR'S ACCEPTANCE BY	DATE
	CONSULTING SURVEYOR		THE FIRST GALVANIZED STEEL POWER POLE EAST OF	VERIFICATION BY	DATE
			COORS ROAD, 0.1 MILE NORTH OF OURAY ROAD NW	DRAWINGS CORRECTED BY	DATE
			ON THE WEST SIDE OF THE POLE.	<i>MICRO-FILM INFORMATION</i>	
			ELEV = 5101.518 FT.	RECORDED BY	DATE
				NO.	

ENGINEER'S SEAL

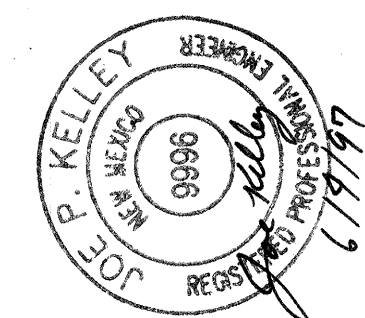

NO.	DATE	REMARKS	BY
REVISIONS			
DESIGN			
DESIGNED	J. A. WOLFENBARGER	DATE	05-97
DRAWN BY	J. L. MARTINEZ	DATE	05-97

