


CONSTRUCTION PLANS
FOR
AMERICAN SQUARE - J.C. PENNEY
UTILITY IMPROVEMENTS AND
OFF-SITE IMPROVEMENTS
ALBUQUERQUE, NEW MEXICO

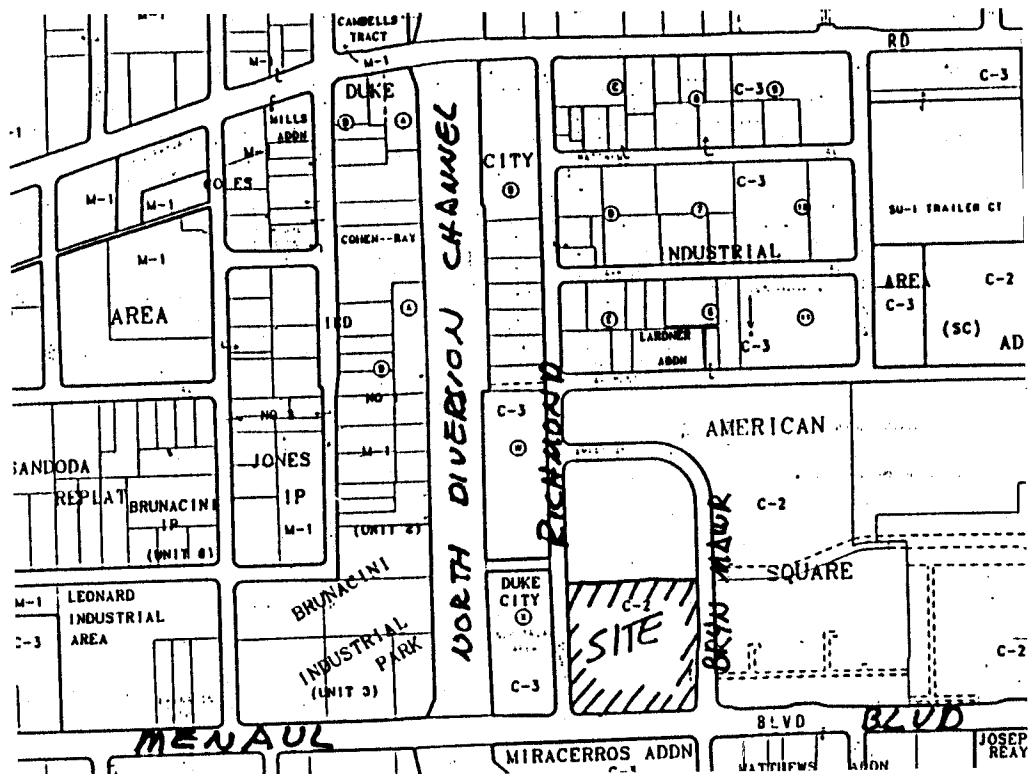

VICINITY MAP ZONE ATLAS H-16-Z
SCALE: NONE

GENERAL NOTES

NOTICE TO CONTRACTORS

- CITY OF ALBUQUERQUE SPECIFICATIONS FOR PUBLIC WORKS CONSTRUCTION, 1986 EDITION AS AMENDED THROUGH UPDATE 6, WILL BE REFERRED TO HEREIN AS THE "STANDARD SPECIFICATIONS".
- TWO WORKING DAYS PRIOR TO ANY EXCAVATION, CONTRACTOR MUST CONTACT NEW MEXICO ONE CALL SYSTEM (260-1990) AND DETERMINE LOCATION OF EXISTING UTILITIES.
- PRIOR TO ANY CONSTRUCTION, THE CONTRACTOR SHALL EXCAVATE AND VERIFY THE HORIZONTAL AND VERTICAL LOCATIONS OF ALL OBSTRUCTIONS. SHOULD A CONFLICT EXIST, THE CONTRACTOR SHALL NOTIFY THE ENGINEER OR THE SURVEYOR SO THAT THE CONFLICT CAN BE RESOLVED WITHOUT DELAY.
- ALL EXISTING SIGNS, MARKERS, DELINEATORS, ETC., WITHIN THE CONSTRUCTION LIMITS SHALL BE REMOVED, STORED AND RE-SET BY THE CONTRACTOR.
- THREE (3) WORKING DAYS PRIOR TO BEGINNING CONSTRUCTION THE CONTRACTOR SHALL SUBMIT TO THE CONSTRUCTION CO-ORDINATION DIVISION A DETAILED CONSTRUCTION SCHEDULE. TWO (2) WORKING DAYS PRIOR TO CONSTRUCTION THE CONTRACTOR SHALL OBTAIN A BARRICADING PERMIT FROM THE CONSTRUCTION CO-ORDINATION DIVISION. CONTRACTOR SHALL NOTIFY BARRICADE ENGINEER (768-2551) PRIOR TO OCCUPYING AN INTERSECTION. SEE SECTION 19 OF THE SPECIFICATIONS.
- ALL STREET STRIPING/REFLECTORIZED PAVEMENT MARKINGS ALTERED OR DESTROYED SHALL BE REPLACED WITH PLASTIC BY CONTRACTOR IN EXISTING OR NEW LOCATION AS INDICATED BY THIS SET.
- THE CONTRACTOR SHALL NOTIFY THE ENGINEER NOT LESS THAN SEVEN (7) DAYS PRIOR TO STARTING WORK IN ORDER THAT THE ENGINEER MAY TAKE NECESSARY MEASURES TO INSURE THE PRESERVATION OF SURVEY MONUMENTS. CONTRACTOR SHALL NOT DISTURB PERMANENT SURVEY MONUMENTS WITHOUT THE CONSENT OF THE ENGINEER AND SHALL NOTIFY THE ENGINEER AND BEAR THE EXPENSE OF REPLACING ANY THAT MAY BE DISTURBED WITHOUT PERMISSION. REPLACEMENT SHALL BE DONE ONLY BY THE CITY SURVEYOR. WHEN A CHANGE IS MADE IN THE FINISHED ELEVATIONS OF THE PAVEMENT OF ANY ROADWAY IN WHICH A PERMANENT SURVEY MONUMENT IS LOCATED, CONTRACTOR SHALL, AT HIS OWN EXPENSE, ADJUST THE MONUMENT COVER TO THE NEW GRADE UNLESS OTHERWISE SPECIFIED. REFER TO SECTION 4.4 OF THE GENERAL CONDITIONS OF THE STANDARD SPECIFICATIONS.
- ANY WORK OCCURRING WITHIN AN ARTERIAL ROADWAY REQUIRES 24 HOURS CONSTRUCTION.

THE FOLLOWING NOTES ALSO APPLY WHEN CHECKED

- ☒ ALL UTILITIES AND UTILITY SERVICE LINES SHALL BE INSTALLED PRIOR TO PAVING.
- ☒ BACKFILL COMPACTION SHALL BE ACCORDING TO SPECIFIED STREET USE.
- ☐ TACK COAT REQUIREMENTS SHALL BE DETERMINED BY THE CITY ENGINEER.
- ☒ SIDEWALK AND WHEELCHAIR RAMPS WITHIN THE CURB RETURNS SHALL BE CONSTRUCTED WHEREVER A NEW CURB RETURN IS CONSTRUCTED.
- ☐ IF CURB IS DEEPRESSED FOR A DRIVEPAD, THE DRIVEPAD SHALL BE CONSTRUCTED PRIOR TO ACCEPTANCE OF CURB AND GUTTER.
- ☐ ALL STORM DRAINAGE FACILITIES SHALL BE COMPLETED PRIOR TO FINAL ACCEPTANCE.

LEGEND			
	CURB AND GUTTER		WATER METER
	CONCRETE		CABLE T.V.
	ELECTRIC TRANSFORMER		POWER POLE
	ELECTRIC PANEL		ANCHOR
	SANITARY SEWER MANHOLE		LIGHT POLE
	TELEPHONE MANHOLE		TRAFFIC LIGHT
	ELECTRIC MANHOLE		CROSSWALK SIGNAL
	STORM SEWER MANHOLE		SPRINKLER CONTROL
	WATER VALVE		TRAFFIC CONTROL
	FIRE HYDRANT		LIGHTING BOX
	TELEPHONE BOX		SIGN
	SPOT ELEVATION		GRATE

INDEX TO DRAWINGS	
SHEET NO.	SHEET
1	TITLE SHEET
2-3	OFF-SITE PAVING IMPROVEMENT
4	MASTER UTILITY PLAN
5-6	UTILITY IMPROVEMENTS


SURVEYOR'S CERTIFICATION

"I, Timothy Aldrich, a duly qualified Registered Professional Land Surveyor under the Laws of the State of New Mexico, do hereby certify that the "as-built" information shown on these drawings was obtained from field construction and "as-built" surveys performed by me, or under my supervision, that the "as-built" information shown on these drawings was added by me, or under my supervision and that this "as-built" information is true and correct to the best of my knowledge and belief." Aldrich Land Surveying, Inc., is not responsible for any of the design concepts, calculations, engineering and/or intent of the record drawings.

Timothy Aldrich N.M.P.S. 7719

08-15-97

Date

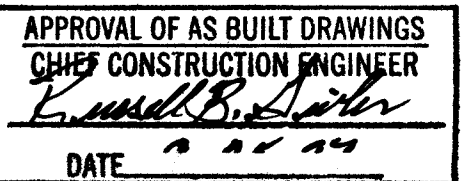


RECORD DRAWING
I hereby certify that the information contained on this drawing has been reviewed and is true and correct to the best of my knowledge and belief. This plan as constructed is in substantial compliance with the Approved Plan.
Gregory J. Krenk NMPE 11929

CAUTION:
NOTE THAT ALL EXISTING UTILITIES MAY NOT BE SHOWN. ALL EXISTING SERVICE CONNECTIONS ARE NOT SHOWN. ANY EXISTING UTILITIES THAT ARE SHOWN ARE APPROXIMATE LOCATION ONLY. IT SHALL BE THE SOLE RESPONSIBILITY OF THE CONTRACTOR TO CONTACT ALL THE UTILITY OWNERS AND TO CONDUCT ALL NECESSARY FIELD INVESTIGATIONS PRIOR TO ANY EXCAVATIONS TO DETERMINE THE ACTUAL LOCATION OF UTILITIES AND OTHER IMPROVEMENTS.

dmg D. MARK GOODWIN & ASSOCIATES, P.A.
CONSULTING ENGINEERS & SURVEYORS
P. O. BOX 90606
ALBUQUERQUE, NEW MEXICO 87199
(505) 348-2010

REV.	SHEETS	CITY ENGINEER	DATE	USER DEPARTMENT	DATE	USER DEPARTMENT	DATE
ENGINEERS STAMP & SIGNATURE		APPROVALS	ENGINEER	DATE	***** APPROVED FOR CONSTRUCTION *****		
		DRC CHAIRMAN	Silly & Associates	5-5-97			
		TRANSPORTATION	R. W. Kane	4-12-97			
		WATER/WASTEWATER	R. W. Kane	4-12-97			
		HYDROLOGY	C. J. P.	4-12-97			
		CONSTR. MGMT.	R. W. Kane	4-29-97	CITY ENGINEER DATE 5/12/97		
		CITY PROJECT NO.		566081		SHEET OF 1 6	

SCANNED BY
BY LASON

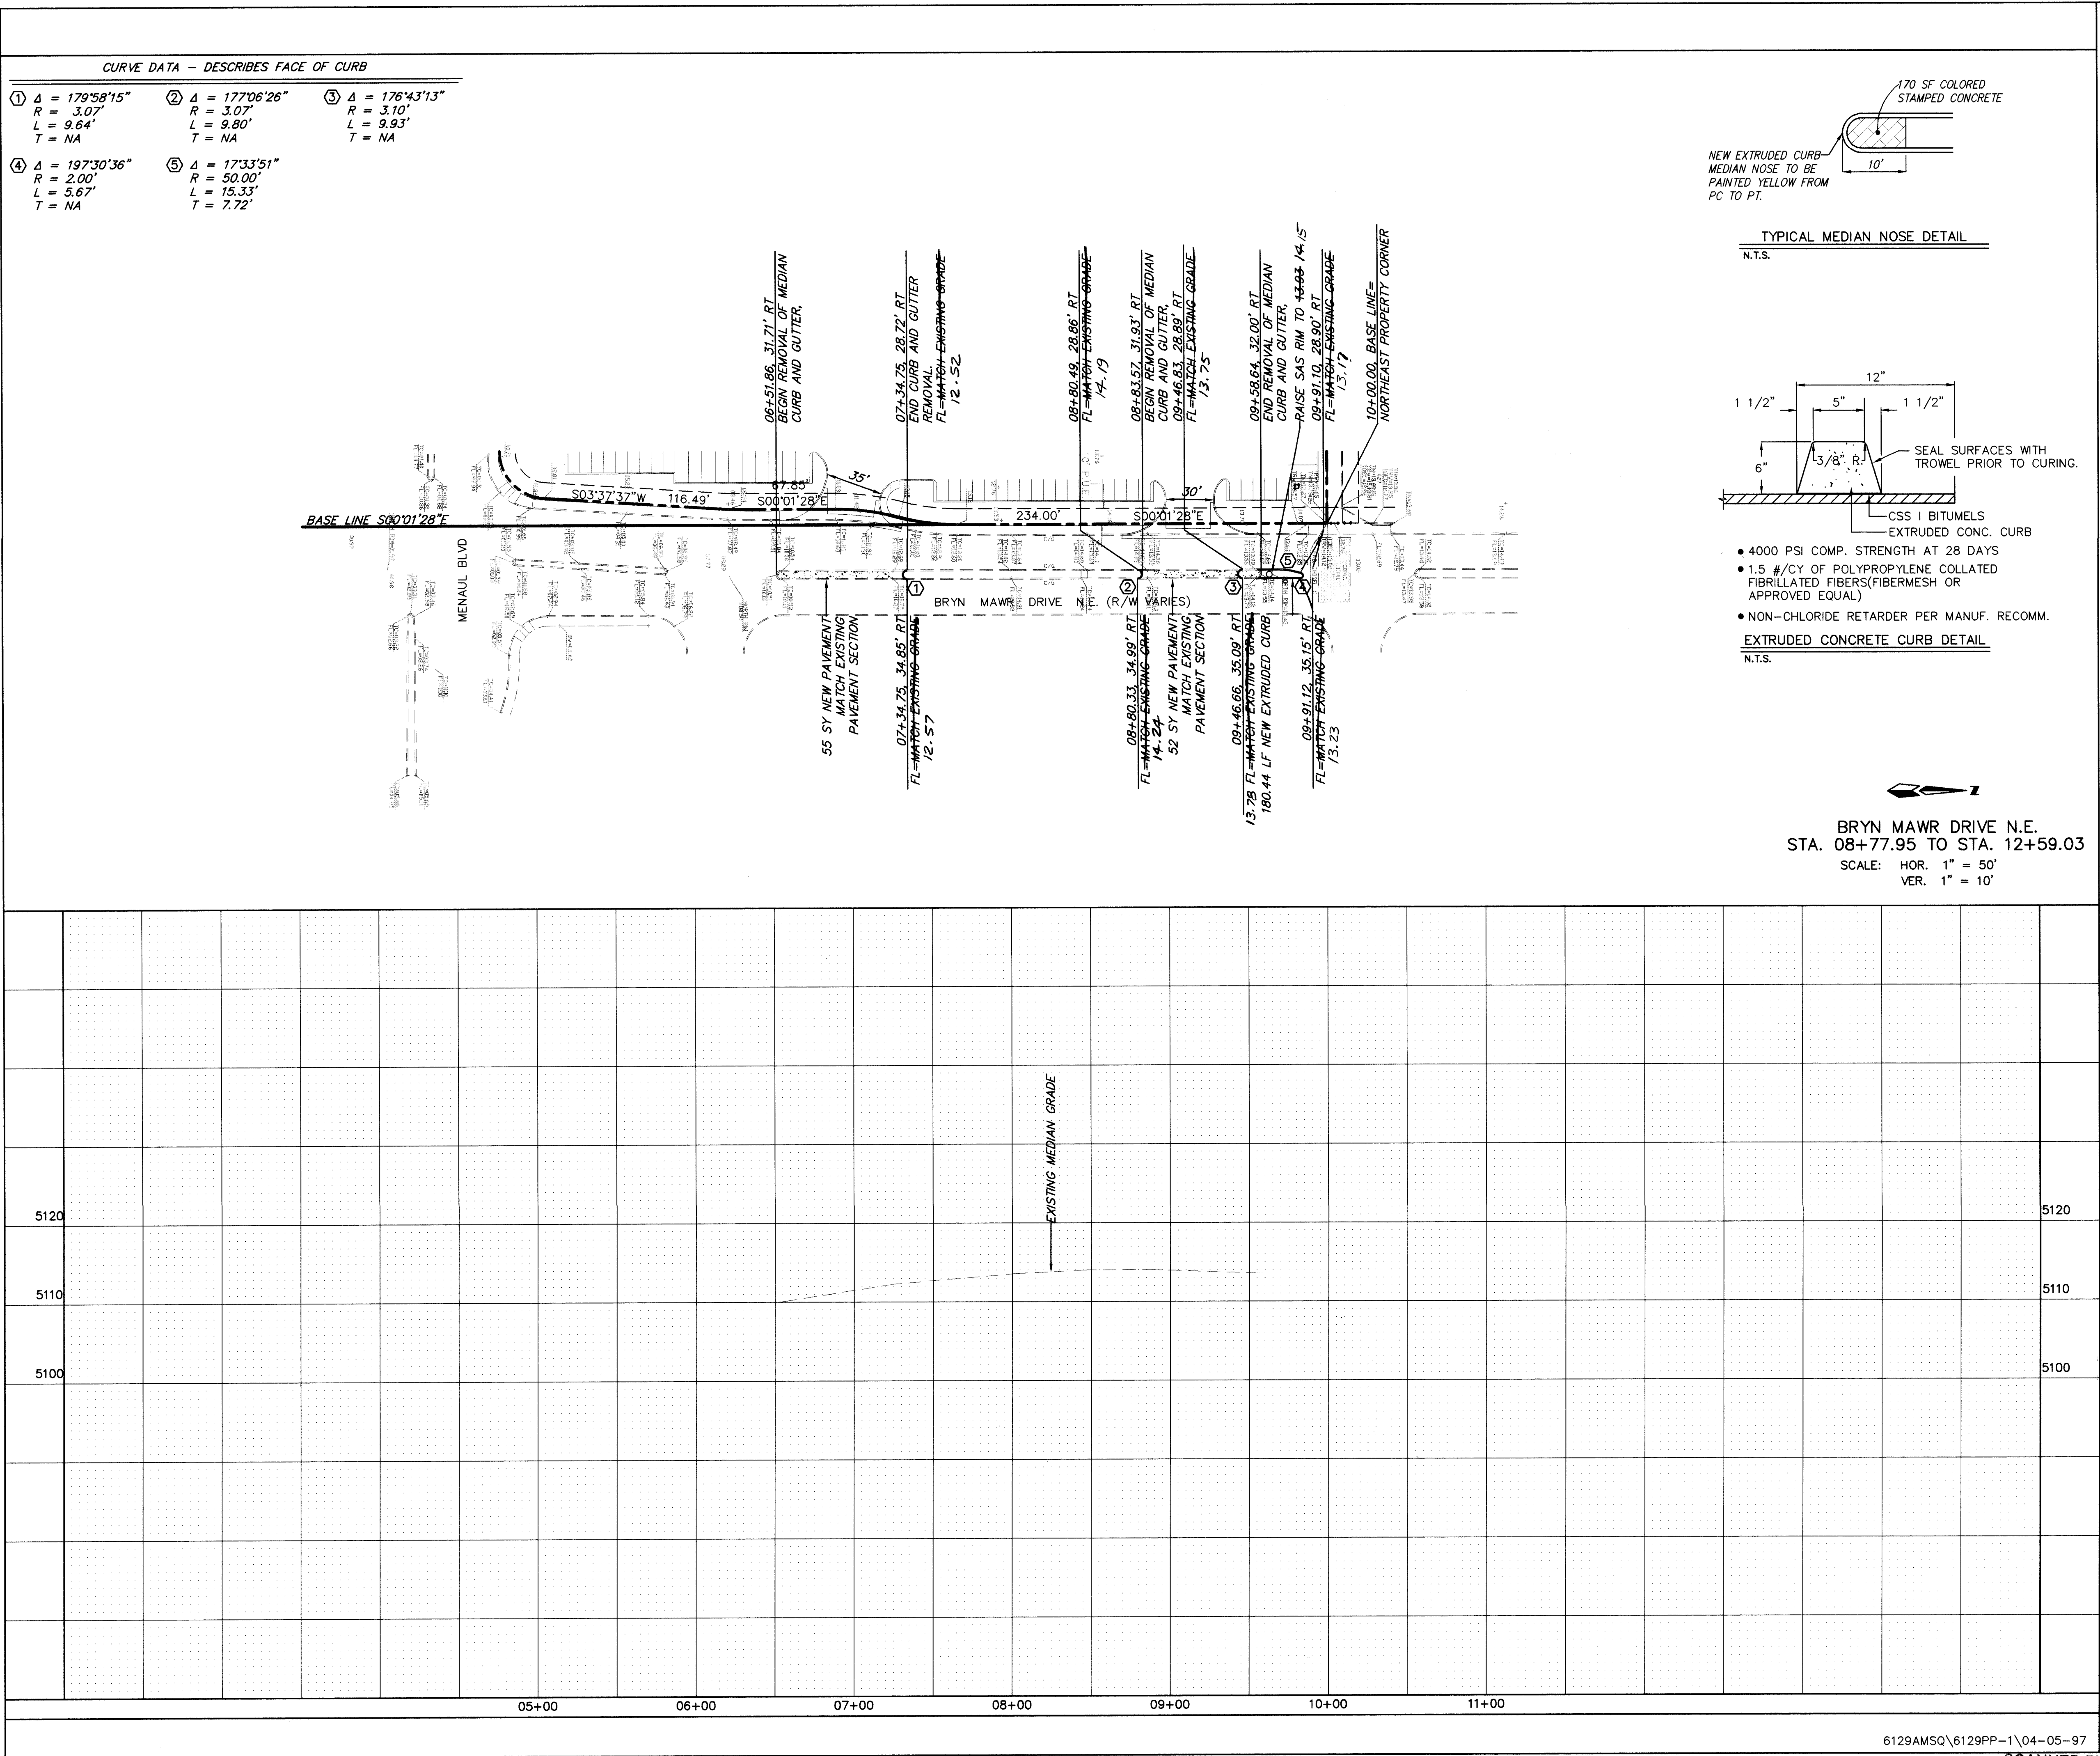

AS BUILT INFORMATION		BENCH MARKS		SURVEY INFORMATION		ENGINEER'S SEAL	
CONTRACTOR	GERALD MARKIN	MUSIC BRASS TABLET STA 1+40-12"		FIELD NOTES	NO.	NO.	
DATE	97	X = 391,771.83		BY	DATE	BY	
INSPECTOR'S	DATE	Y = 1,495,174.25					
FIELD	DATE	Z = 514,549					
VERIFICATION BY	DATE						
CORRECTED BY	DATE						
MICRO-FILM INFORMATION							
RECORDED BY	DATE						
NO.							

RECORD DRAWING

Gregory J. Krenk NMFE 11929

26-56600-811 0297

1 2 3 4 5 6 7 8 9 10 11 12 13 14 15

dmg D. MARK GOODWIN & ASSOCIATES, P.A.
CONSULTING ENGINEERS & SURVEYORS
P.O. BOX 90608
ALBUQUERQUE, NEW MEXICO 87199
(505) 345-2010

CITY OF ALBUQUERQUE
PUBLIC WORKS DEPARTMENT
ENGINEERING DEVELOPMENT GROUP

TITLE: AMERICAN SQUARE - J.C. PENNEY
PAVING IMPROVEMENTS

DESIGN REVIEW COMMITTEE

APPROVED

MAY - 5 1997

DESIGN REVIEW COMMITTEE

CITY ENGINEER APPROVAL

LAST DESIGN UPDATE

MO./DAY/YR.

MO./DAY/YR.


CITY PROJECT NO. 566081

ZONE MAP NO. H16


SHEET 2 OF 6

LENGTH OF RESTRAINED PIPE (FEET)							
PIPE SIZE	90	45	22.5	11.25	TEE	VALVE	REDUCER
6"	18'	7'	4'	2'	*	55'	35'
10"	27'	11'	5'	3'	*	72'	65'

* LENGTH OF RESTRAINED PIPE ON EACH SIDE OF THE BEND. RESTRAIN BRANCH AT FITTING ONLY. MINIMUM ATTACHED PIPE LENGTH, RUN SIDE OF TEE: 10.00 FEET.

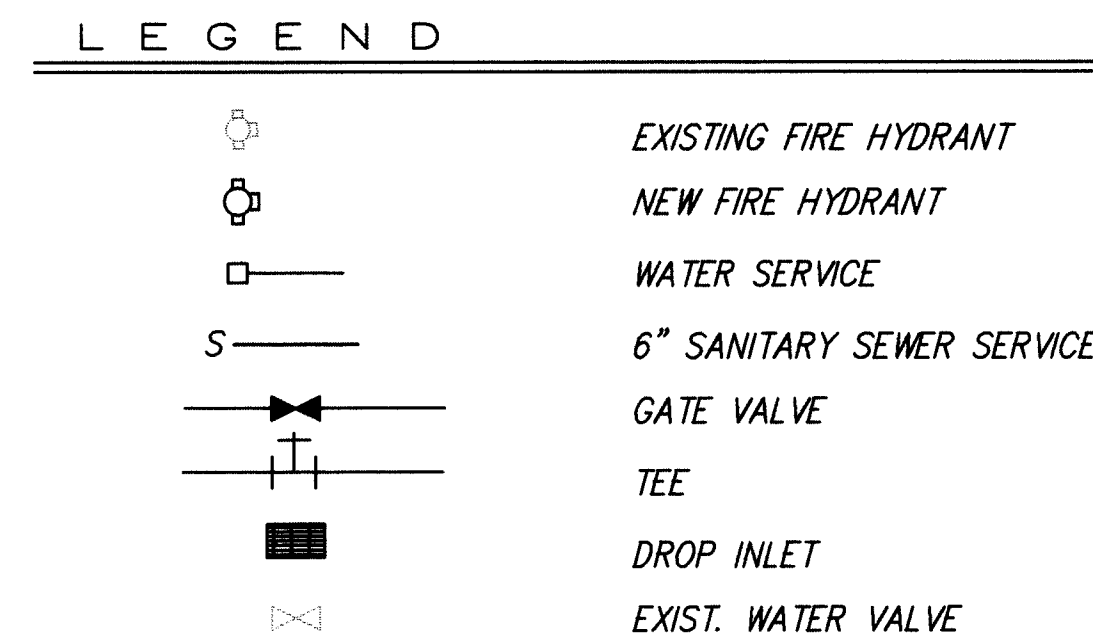


BUILDING	INV (5' FROM BLDG)
JC PENNY	04.46
MAJOR 2	05.00
PAD	03.80

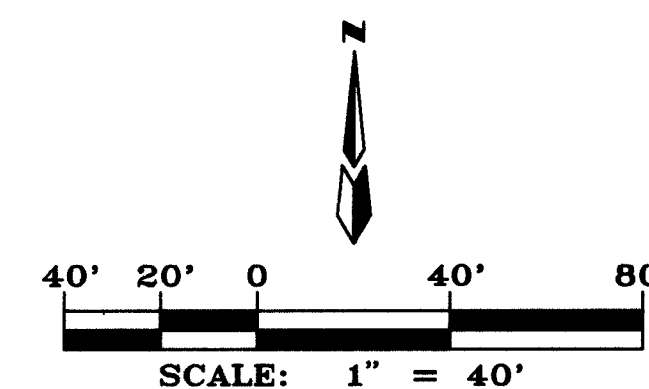

RECORD DRAWING

Gregory, J. Krenik NMPE 11929 8-19-97

[illegible]

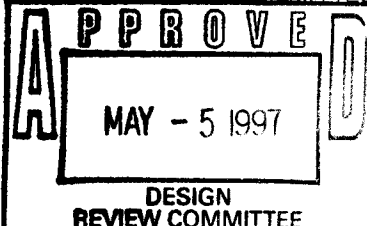 D. MARK GOODWIN & ASSOCIATES, P.A. CONSULTING ENGINEERS & SURVEYORS P.O. BOX 90606 ALBUQUERQUE, NEW MEXICO 87199 (505) 345-2010		NO. DA		DESIGNED BY DRAWN BY CHECKED BY	
 CITY OF ALBUQUERQUE PUBLIC WORKS DEPARTMENT ENGINEERING DEVELOPMENT GROUP					
TITLE: <i>MASTER SQUARE - J.C. PENNEY</i> <i>MASTER UTILITY PLAN</i>					
DESIGN REVIEW COMMITTEE  APPROVE MAY - 5 1997 DESIGN REVIEW COMMITTEE		CITY ENGINEER APPROVAL 		LAST DESIGN UPDATE 	
CITY PROJECT NO. 566081		ZONE MAP NO. H-16		SHEET OF 4 6	

15' PRIVATE WATERLINE EASEMENT
STA. 08+77.95 TO STA. 12+59.03
SCALE: HOR. 1" = 50'
VER. 1" = 10'

15' PRIVATE WATERLINE EASEMENT
STA. 08+77.95 TO STA. 12+59.03
SCALE: HOR. 1" = 50'
VER. 1" = 10'

15' PRIVATE WATERLINE EASEMENT
STA. 08+77.95 TO STA. 12+59.03
SCALE: HOR. 1" = 50'
VER. 1" = 10'

[illegible]

1.2.3 I hereby certify that the information contained on this drawing is in accordance with information furnished by the surveyor and that the construction is actually accomplished. This drawing is a substantial compliance with the Approved Plan.

RECORD DRAWING

dmg D. MARK GOODWIN & ASSOCIATES, P.A.
CONSULTING ENGINEERS & SURVEYORS
P.O. BOX 90606
ALBUQUERQUE, NEW MEXICO 87199
(505) 345-2010

 CITY OF ALBUQUERQUE
PUBLIC WORKS DEPARTMENT
ENGINEERING DEVELOPMENT GROUP

TITLE: AMERICAN SQUARE - J.C. PENNEY
PRIVATE UTILITY IMPROVEMENTS

DESIGN REVIEW COMMITTEE
APPROVE
MAY - 5 1997

DATE	CITY ENGINEER APPROVAL
------	------------------------

AST DESIGN UPDATE

MO./DAY/YR.	MO./DAY/YR.
-------------	-------------

CITY PROJECT NO.	ZONE MAP NO.	SHEET	OF
566081	H16	6	6

6129AMSQ\6129UP-1\04-07-97

4-07-97
SCANNED BY
BY LASON

SURVEY INFORMATION			BENCH MARKS	AS BUILT INFORMATION
NO.	FIELD NOTES	DATE		
			MUSHC BRASS TABLET "STA 1-40-12"	CONTRACTOR <i>GERALD MARTIN</i>
			<i>X = 391,771.93</i>	INSPECTOR'S BY <i>GERALD MARTIN</i> <i>97</i>
			<i>Y = 1,495,174.25</i>	DATE
			<i>Z = 5114.549</i>	FIELD
				FIELD LABEL BY <i>1, 2, 3</i>
				DATE <i>8/97</i>
				VERIFICATION BY <i>AKC, JMC</i>
				DATE <i>8/97</i>
				CORRECTED BY <i>AKC, JMC</i>
				DATE <i>8/97</i>
				MICRO-FILM INFORMATION
				RECORDED BY
				DATE
				NO.

REVISIONS			
NO.	DATE	REMARKS	BY
DESIGN			
DESIGNED BY	GAK	DATE	09/96
DRAWN BY	MCG	DATE	09/96
CHECKED BY	DMC	DATE	09/96