



**ABIEL CARRILLO, 75**

6/27/2011  
DATE

- GENERAL NOTES:
1. ALL WORK DETAILED ON THESE PLANS TO BE PERFORMED, EXCEPT AS OTHERWISE STATED OR PROVIDED HEREON, SHALL BE CONSTRUCTED IN ACCORDANCE WITH CITY OF ALBUQUERQUE STANDARD SPECIFICATIONS FOR PUBLIC WORKS CONSTRUCTION, 1986 EDITION THROUGH UPDATE #7, INCLUDING AMENDMENT NO. 1, AND WILL BE REFERRED TO HEREIN AS "STANDARD SPECIFICATIONS".
2. ALL CONSTRUCTION WITHIN CITY RIGHT-OF-WAY OR EASEMENTS MUST BE DONE FROM APPROVED WORK ORDER DOCUMENTS FROM THE CITY.
3. ALL WORK ON THIS PROJECT SHALL BE PERFORMED IN ACCORDANCE WITH APPLICABLE FEDERAL, STATE, AND LOCAL LAWS, ORDINANCES, RULES, AND REGULATIONS CONCERNING CONSTRUCTION SAFETY AND HEALTH.
4. CONTRACTOR AGREES THAT HE SHALL ASSUME THE SOLE AND COMPLETE RESPONSIBILITY FOR THE JOB SITE CONDITIONS DURING THE COURSE OF CONSTRUCTION OF THIS PROJECT, INCLUDING SAFETY OF ALL PERSONS AND PROPERTY. THIS REQUIREMENT SHALL APPLY CONTINUOUSLY AND NOT BE LIMITED TO NORMAL WORKING HOURS. CONTRACTOR SHALL DEFEND, INDEMNIFY, AND HOLD HARMLESS THE OWNER AND ENGINEER FROM ANY AND ALL LIABILITY, REAL OR ALLEGED, IN CONNECTION WITH THE PERFORMANCE OF WORK ON THIS PROJECT, EXCEPT LIABILITY ARISING FROM THE SOLE NEGLIGENCE OF THE OWNER OR ENGINEER.
5. ALL EXCAVATION, TRENCHING, AND SHORING ACTIVITIES MUST BE ACCOMPLISHED IN ACCORDANCE WITH OSHA 29CFR 1926.650 SUBPART P.
6. CONTRACTOR SHALL NOTIFY THE ENGINEER NOT LESS THAN SEVEN (7) DAYS PRIOR TO STARTING WORK IN ORDER THAT THE CITY SURVEYOR MAY TAKE NECESSARY MEASURES TO INSURE THE PRESERVATION OF SURVEY MONUMENTS. CONTRACTOR SHALL NOT DISTURB PERMANENT SURVEY MONUMENTS WITHOUT THE CONSENT OF THE CITY SURVEYOR AND SHALL NOTIFY THE CITY SURVEYOR AND BEAR THE EXPENSE OF REPLACING ANY THAT MAY BE DISTURBED WITHOUT PERMISSION. ONLY THE CITY SURVEYOR SHALL REPLACE SURVEY MONUMENTS. WHEN A CHANGE IS MADE IN THE FINISHED ELEVATION OF THE PAVEMENT OF ANY ROADWAY IN WHICH A PERMANENT SURVEY MONUMENT IS LOCATED, CONTRACTOR SHALL, AT HIS OWN EXPENSE, ADJUST THE MONUMENT COVER TO THE NEW GRADE UNLESS OTHERWISE SPECIFIED. REFER TO STANDARD SPECIFICATIONS SECTION 4.4.
7. SEVEN (7) WORKING DAYS PRIOR TO BEGINNING CONSTRUCTION, CONTRACTOR SHALL SUBMIT TO DMD, CONSTRUCTION COORDINATION DIVISION A DETAILED CONSTRUCTION SCHEDULE. TWO (2) WORKING DAYS PRIOR TO CONSTRUCTION, CONTRACTOR SHALL OBTAIN A BARRICADE PERMIT FROM THE DMD, CONSTRUCTION COORDINATION DIVISION. CONTRACTOR SHALL NOTIFY BARRICADE ENGINEER (824-3400) PRIOR TO OCCUPYING AN INTERSECTION. REFER TO SECTION 19 OF STANDARD SPECIFICATIONS.
8. TWO (2) WORKING DAYS PRIOR TO ANY EXCAVATION, CONTRACTOR MUST CONTACT NEW MEXICO ONE CALL SYSTEM (280-1980) FOR LOCATION OF EXISTING UTILITIES.
9. CONTRACTOR SHALL ASSIST THE ENGINEER IN THE RECORDING OF DATA ON ALL UTILITY LINES AND ACCESSORIES AS REQUIRED BY THE CITY OF ALBUQUERQUE FOR THE PREPARATION OF "AS CONSTRUCTED" DRAWINGS. CONTRACTOR SHALL NOT COVER UTILITY LINES AND ACCESSORIES UNTIL ALL DATA HAS BEEN RECORDED.
10. AT HIS OWN EXPENSE, CONTRACTOR SHALL ASSUME RESPONSIBILITY FOR ANY DAMAGE TO EXISTING PAVEMENT, PAVEMENT MARKINGS, CURB AND GUTTER, HANDICAP RAMPS, AND SIDEWALK DURING CONSTRUCTION APART FROM THOSE SECTIONS INDICATED FOR REMOVAL ON THE PLANS AND SHALL REPAIR OR REPLACE, PER STANDARD SPECIFICATIONS.
11. CONTRACTOR SHALL MAINTAIN A GRAFFITI-FREE WORK SITE. CONTRACTOR SHALL PROMPTLY REMOVE ANY AND ALL GRAFFITI FROM EQUIPMENT, WHETHER PERMANENT OR TEMPORARY.
12. CONTRACTOR SHALL BE RESPONSIBLE FOR PROVIDING AND MAINTAINING ALL CONSTRUCTION SIGNING UNTIL THE PROJECT HAS BEEN ACCEPTED BY THE CITY.
13. CONTRACTOR SHALL SECURE A "TOPSOIL DISTURBANCE PERMIT" PRIOR TO BEGINNING CONSTRUCTION.
14. CONTRACTOR SHALL DETERMINE IN ADVANCE OF HIS CONSTRUCTION IF OVERHEAD UTILITY LINES, SUPPORT STRUCTURES, POLES, GLYS, ETC. ARE AN OBSTRUCTION TO CONSTRUCTION OPERATIONS. IF ANY OBSTRUCTION TO CONSTRUCTION OPERATIONS IS EVIDENT, CONTRACTOR SHALL BE RESPONSIBLE FOR COORDINATING WITH THE APPROPRIATE UTILITY OWNER TO REMOVE OR SUPPORT THE UTILITY OBSTRUCTION. ANY COST ASSOCIATED WITH THIS EFFORT SHALL BE THE RESPONSIBILITY OF CONTRACTOR.
15. PRIOR TO CONSTRUCTION, CONTRACTOR SHALL EXCAVATE AND VERIFY THE HORIZONTAL AND VERTICAL LOCATIONS OF ALL PERTINENT EXISTING UTILITIES AND/OR OBSTRUCTIONS. SHOULD A CONFLICT EXIST, THE CONTRACTOR SHALL NOTIFY THE ENGINEER SO THE CONFLICT CAN BE RESOLVED WITH A MINIMUM AMOUNT OF DELAY.
16. CONTRACTOR SHALL SUPPORT ALL EXISTING, UNDERGROUND UTILITY LINES WHICH BECOME EXPOSED DURING CONSTRUCTION. PAYMENT FOR SUPPORTING WORK SHALL BE INCIDENTAL TO WATERLINE AND/OR SEWER LINE COSTS.
17. CONTRACTOR IS TO SUPPORT AND MAINTAIN THE INTEGRITY OF ALL UNDERGROUND TELEPHONE, ELECTRIC CABLES AND CABLE TELEVISION UTILITIES AT NO ADDITIONAL COST TO THE OWNER. CABLE IS TO BE SUPPORTED AT A MAXIMUM OF EVERY FIFTEEN (15) FEET. CONTRACTOR SHALL COORDINATE WITH AND MAKE NECESSARY PAYMENT (IF ANY) TO UTILITY OWNER FOR DE-ENERGIZATION OF CABLES OR SUPPORT OF CABLES BY THE UTILITY OWNER.
18. ALL BACKFILL FOR TRENCHES WITHIN THE COA RIGHT-OF-WAY SHALL BE COMPACTED TO A MINIMUM OF 95% MAXIMUM DENSITY PER ASTM D-1557 AND AS DIRECTED BY STANDARD SPECIFICATIONS SECTION 701.14.2 AND STANDARD DRAWING NUMBER 2465.
19. CONTRACTOR SHALL PROMPTLY CLEAN UP ANY MATERIAL EXCAVATED WITHIN THE PUBLIC RIGHT-OF-WAY OR PRIVATE ROADWAY EASEMENTS SO THAT THE EXCAVATED MATERIAL IS NOT SUSCEPTIBLE TO BEING WASHED DOWN THE STREET OR INTO ANY PUBLIC DRAINAGE FACILITY.
20. ALL EXISTING SIGNS, MARKERS, DELINEATORS, ETC., WITHIN THE CONSTRUCTION LIMITS SHALL BE REMOVED, STORED AND RE-SET BY THE CONTRACTOR. ANY PAVEMENT MARKINGS CONFLICTING WITH CONSTRUCTION SHALL BE REPLACED WHERE NECESSARY.
21. WHEN ABUTTING EXISTING PAVEMENT TO NEW, SAWCUT EXISTING PAVEMENT TO A STRAIGHT EDGE AND AT A RIGHT ANGLE, OR AS APPROVED BY THE FIELD ENGINEER, REMOVAL OF BROKEN OR CRACKED PAVEMENT WILL ALSO BE REQUIRED.
22. REMOVAL OF EXISTING CURB AND GUTTER OR SIDEWALK SHALL BE TO THE NEAREST JOINT OR SAW CUT.
23. AN EXCAVATION/CONSTRUCTION PERMIT WILL BE REQUIRED BEFORE BEGINNING ANY WORK WITHIN THE CITY RIGHT OF WAY.

|   |   |   |   |   |   |   |   |   |   |   |   |   |
|---|---|---|---|---|---|---|---|---|---|---|---|---|
| 2 | 6 | - | 5 | 6 | 6 | 5 | . | 8 | 6 | - | 1 | 1 |
|---|---|---|---|---|---|---|---|---|---|---|---|---|

|                                                                                                                                                                                                                                                                                  |                         |
|----------------------------------------------------------------------------------------------------------------------------------------------------------------------------------------------------------------------------------------------------------------------------------|-------------------------|
| RECORD DRAWING                                                                                                                                                                                                                                                                   |                         |
| DATE:<br><b>JUNE 2011</b>                                                                                                                                                                                                                                                        | DRAWN BY:<br><b>MCA</b> |
| THESE RECORD DRAWINGS HAVE BEEN<br>PREPARED, IN PART, ON THE BASIS ON<br>INFORMATION COMPILED AND FURNISHED BY<br>OTHERS. MOLZEN-CORBIN AND ASSOCIATES WILL<br>NOT BE RESPONSIBLE FOR ANY ERRORS OR<br>OMISSIONS WHICH HAVE BEEN INCORPORATED<br>INTO THIS DOCUMENT AS A RESULT. |                         |

2701 MILES RD SE  
ALBUQUERQUE, NM 87106  
TEL: 505.242-5700  
FAX: 505.242-0673

**MOLZEN-CORBIN** & Associates  
ENGINEERS/ARCHITECTS/PLANNERS



CITY OF ALBUQUERQUE  
DEPARTMENT OF MUNICIPAL DEVELOPMENT  
CIP DIVISION

TITLE: **AVENIDA CESAR CHAVEZ &  
UNIVERSITY BLVD  
MEDIAN ISLAND IMPROVEMENTS  
GENERAL NOTES**

|                            |                        |                    |             |             |
|----------------------------|------------------------|--------------------|-------------|-------------|
| Design Review Committee    | City Engineer Approval | Last Design Update | Mo./Day/Yr. | Mo./Day/Yr. |
|                            |                        |                    |             |             |
|                            |                        |                    |             |             |
| City Project No.<br>566586 | Zone Map No.<br>L-15   | Sheet 2            | Of 10       |             |

© COPYRIGHT

MCA JOB # UNM061-12

REDRAWN FOR RECORD PURPOSES

RECORD DRAWINGS

ABIEL CARRILLO

6/22/2011  
DATE

AVENIDA CESAR CHAVEZ  
HORIZONTAL ALIGNMENT DATA

| POINT     | STATION         | NORTHING        | EASTING     |
|-----------|-----------------|-----------------|-------------|
| CURVE #1  |                 |                 |             |
| PC        | 100+00.00       | 1480518.640     | 1525117.970 |
| PI        | 100+95.19       | 1480472.120     | 1525201.020 |
| PCC       | 101+89.66       | 1480444.160     | 1525292.010 |
| Radius:   | 892.32'         |                 |             |
| Delta:    | 12°10'41.3", LT |                 |             |
| Length:   | 189.66'         |                 |             |
| Tangent:  | 95.19'          |                 |             |
| External: | 5.06'           |                 |             |
| CURVE #2  |                 |                 |             |
| PCC       | 101+89.66       | 1480444.160     | 1525292.010 |
| PI        | 102+12.58       | 1480437.430     | 1525313.910 |
| PCC       | 102+35.47       | 1480432.390     | 1525336.270 |
| Radius:   | 600.00'         |                 |             |
| Delta:    | 4°22'27.6", LT  |                 |             |
| Length:   | 45.81'          |                 |             |
| Tangent:  | 22.92'          |                 |             |
| External: | 0.44'           |                 |             |
| CURVE #3  |                 |                 |             |
| PCC       | 102+35.47       | 1480432.390     | 1525336.270 |
| PI        | 103+06.52       | 1480416.770     | 1525405.580 |
| PCC       | 103+77.25       | 1480412.600     | 1525476.500 |
| Radius:   | 869.71'         |                 |             |
| Delta:    | 9°20'25.7", LT  |                 |             |
| Length:   | 141.78'         |                 |             |
| Tangent:  | 71.05'          |                 |             |
| External: | 2.90'           |                 |             |
| CURVE #4  |                 |                 |             |
| PCC       | 103+77.25       | 1480412.600     | 1525476.500 |
| PI        | 104+05.41       | 1480410.950     | 1525504.610 |
| PT        | 104+33.54       | 1480411.560     | 1525532.760 |
| Radius:   | 700.00'         |                 |             |
| Delta:    | 4°36'25.3", LT  |                 |             |
| Length:   | 56.29'          |                 |             |
| Tangent:  | 28.16'          |                 |             |
| External: | 0.57'           |                 |             |
| PT        | 104+33.54       | 1480411.560     | 1525532.760 |
| POE       | 116+87.85       | 1480438.760     | 1526786.780 |
|           |                 | N 88°45'25.7" E |             |

UNIVERSITY BLVD  
HORIZONTAL ALIGNMENT DATA

| POINT     | STATION        | NORTHING       | EASTING     |
|-----------|----------------|----------------|-------------|
| POB       | 98+81.79       | 1479055.250    | 1526397.180 |
| PC        | 100+00.00      | 1479171.840    | 1526416.730 |
|           |                | N 9°30'58.3" E |             |
| CURVE #1  |                |                |             |
| PC        | 100+00.00      | 1479171.840    | 1526416.730 |
| PI        | 101+33.19      | 1479303.190    | 1526438.750 |
| PT        | 102+65.76      | 1479436.380    | 1526438.750 |
| Radius:   | 1600.00'       |                |             |
| Delta:    | 9°31'00.5", LT |                |             |
| Length:   | 265.76'        |                |             |
| Tangent:  | 133.19'        |                |             |
| External: | 5.53'          |                |             |
| PT        | 102+65.76      | 1479436.380    | 1526438.750 |
| POE       | 118+25.73      | 1480996.350    | 1526438.730 |
|           |                | N 0°00'02.2" W |             |

AVENIDA CESAR CHAVEZ

AVE CESAR CHAVEZ STA 113+39.72 =  
UNIVERSITY BLVD STA 112+60.59  
N 1480431.214  
E 1526438.735

UNIVERSITY BLVD



1:1  
GABTC22X 4/8/10


|                                                                                                                                                                                                                                                                |               |
|----------------------------------------------------------------------------------------------------------------------------------------------------------------------------------------------------------------------------------------------------------------|---------------|
| RECORD DRAWING                                                                                                                                                                                                                                                 |               |
| DATE: JUNE 2011                                                                                                                                                                                                                                                | DRAWN BY: MCA |
| THESE RECORD DRAWINGS HAVE BEEN PREPARED, IN PART, ON THE BASIS OF INFORMATION COMPILED AND FURNISHED BY OTHERS. MOLZEN-CORBIN AND ASSOCIATES WILL NOT BE RESPONSIBLE FOR ANY ERRORS OR OMISSIONS WHICH HAVE BEEN INCORPORATED INTO THIS DOCUMENT AS A RESULT. |               |

2701 MILES RD SE  
ALBUQUERQUE, NM 87106  
TEL: 505.242-6700  
FAX: 505.242-6873  
**MOLZEN-CORBIN & Associates**  
ENGINEERS/ARCHITECTS/PLANNERS

CITY OF ALBUQUERQUE  
DEPARTMENT OF MUNICIPAL DEVELOPMENT  
CIP DIVISION




TITLE:  
**AVENIDA CESAR CHAVEZ &  
UNIVERSITY BLVD  
MEDIAN ISLAND IMPROVEMENTS  
HORIZONTAL ALIGNMENT PLAN**

|                         |                        |             |             |
|-------------------------|------------------------|-------------|-------------|
| Design Review Committee | City Engineer Approval | Mo./Day/Yr. | Mo./Day/Yr. |
|                         |                        |             |             |
|                         |                        |             |             |
|                         |                        |             |             |
|                         |                        |             |             |
| City Project No.        | Zone Map No.           | Sheet       | Of          |
| 566586                  | L-15                   | 3           | 10          |

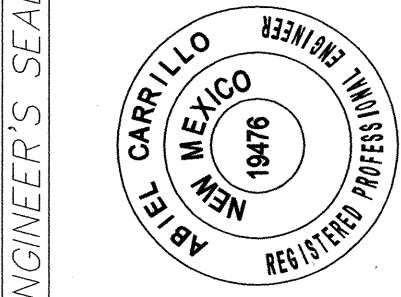




|             |           |           |      |
|-------------|-----------|-----------|------|
| NO.         | DATE      | REVISIONS | BY   |
|             |           | DESIGN    |      |
| DESIGNED BY | DATE      | DATE      | DATE |
| A. CARRILLO | JUNE 2010 |           |      |
| DRAWN BY    | DATE      | DATE      | DATE |
| B. BAILEY   | JUNE 2010 |           |      |
| CHECKED BY  | DATE      |           |      |

| SURVEY INFORMATION |             | BENCH MARKS |      | AS BUILT INFORMATION   |      |
|--------------------|-------------|-------------|------|------------------------|------|
| NO.                | FIELD NOTES | BY          | DATE | CONTRACTOR             | DATE |
|                    |             |             |      | STAMPED BY             | DATE |
|                    |             |             |      | INSPECTED BY           | DATE |
|                    |             |             |      | FIELD CHECKED BY       | DATE |
|                    |             |             |      | REVISION BY            | DATE |
|                    |             |             |      | CORRECTED BY           | DATE |
|                    |             |             |      | MICRO-FILM INFORMATION |      |
|                    |             |             |      | RECORDED BY            | DATE |
|                    |             |             |      | NO.                    |      |

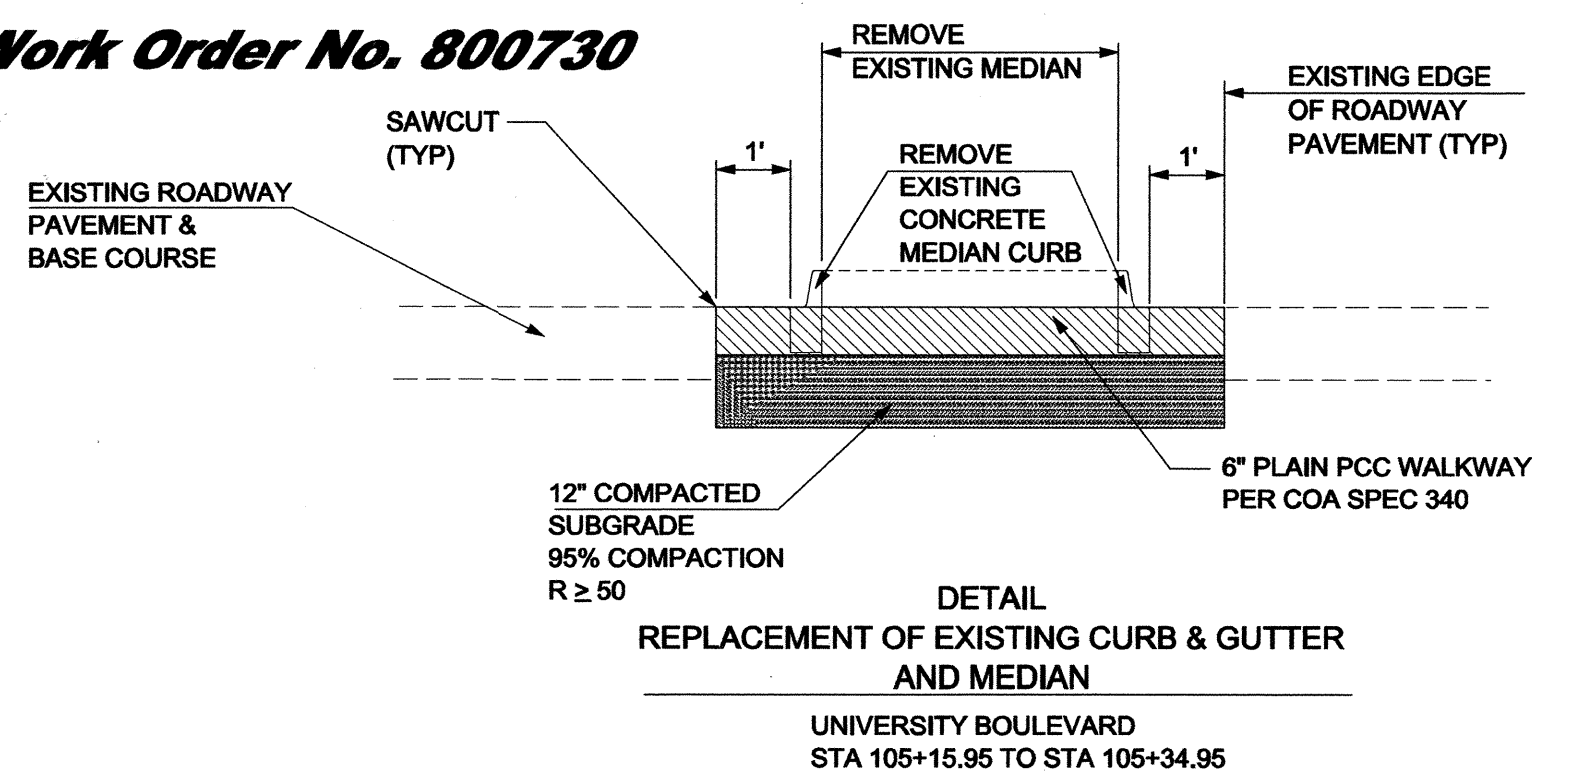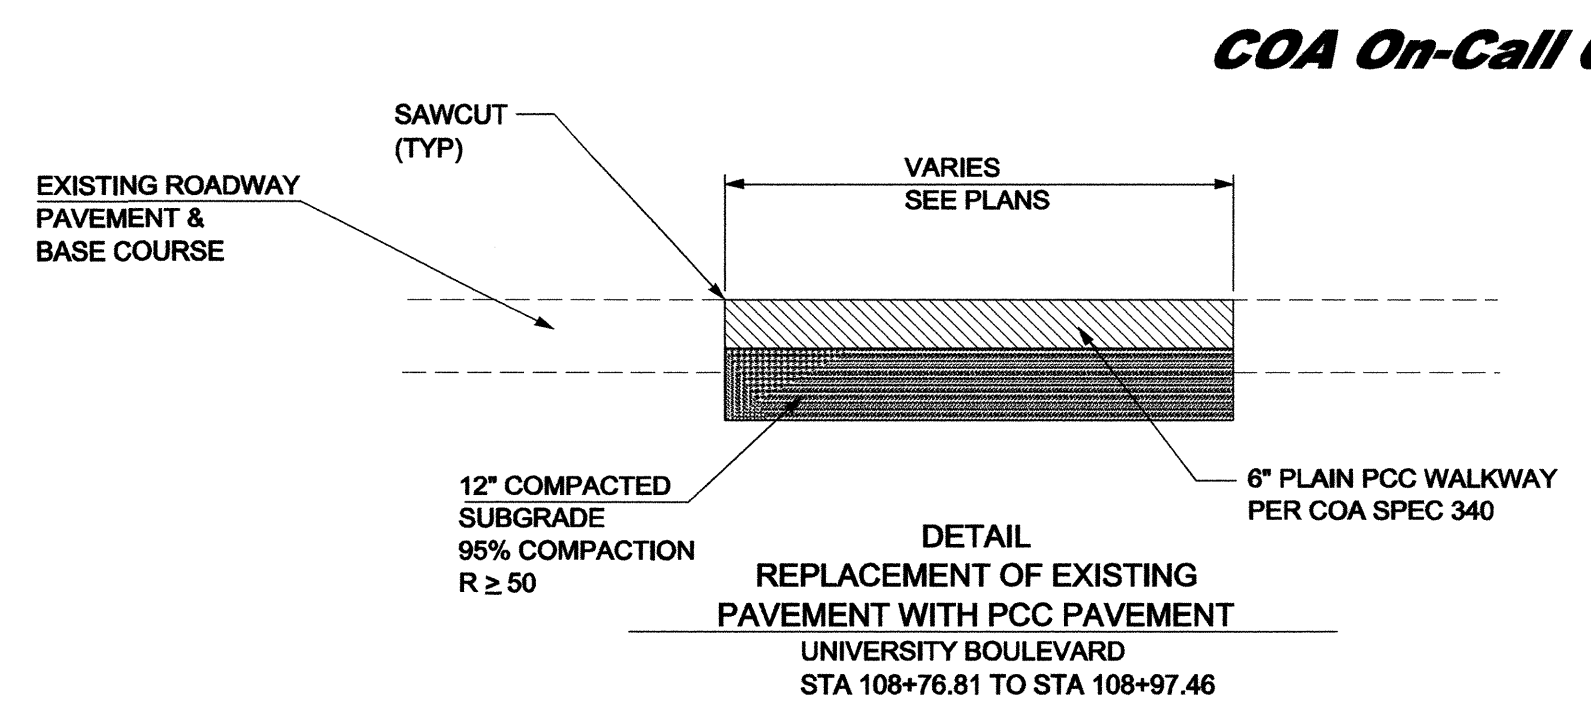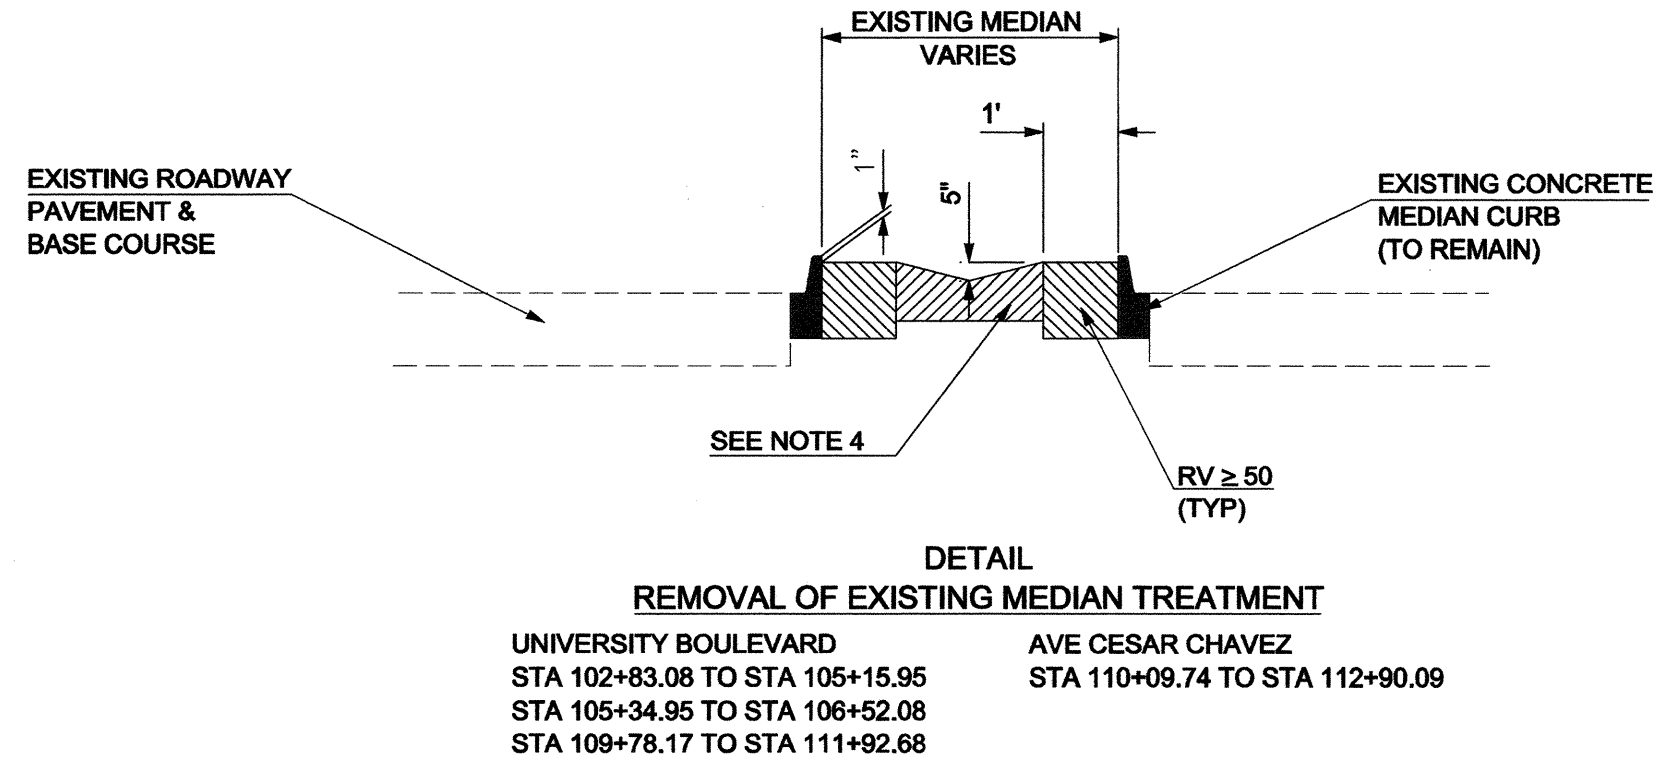

RECORD DRAWINGS




*[Signature]*  
DATE 6/24/2011

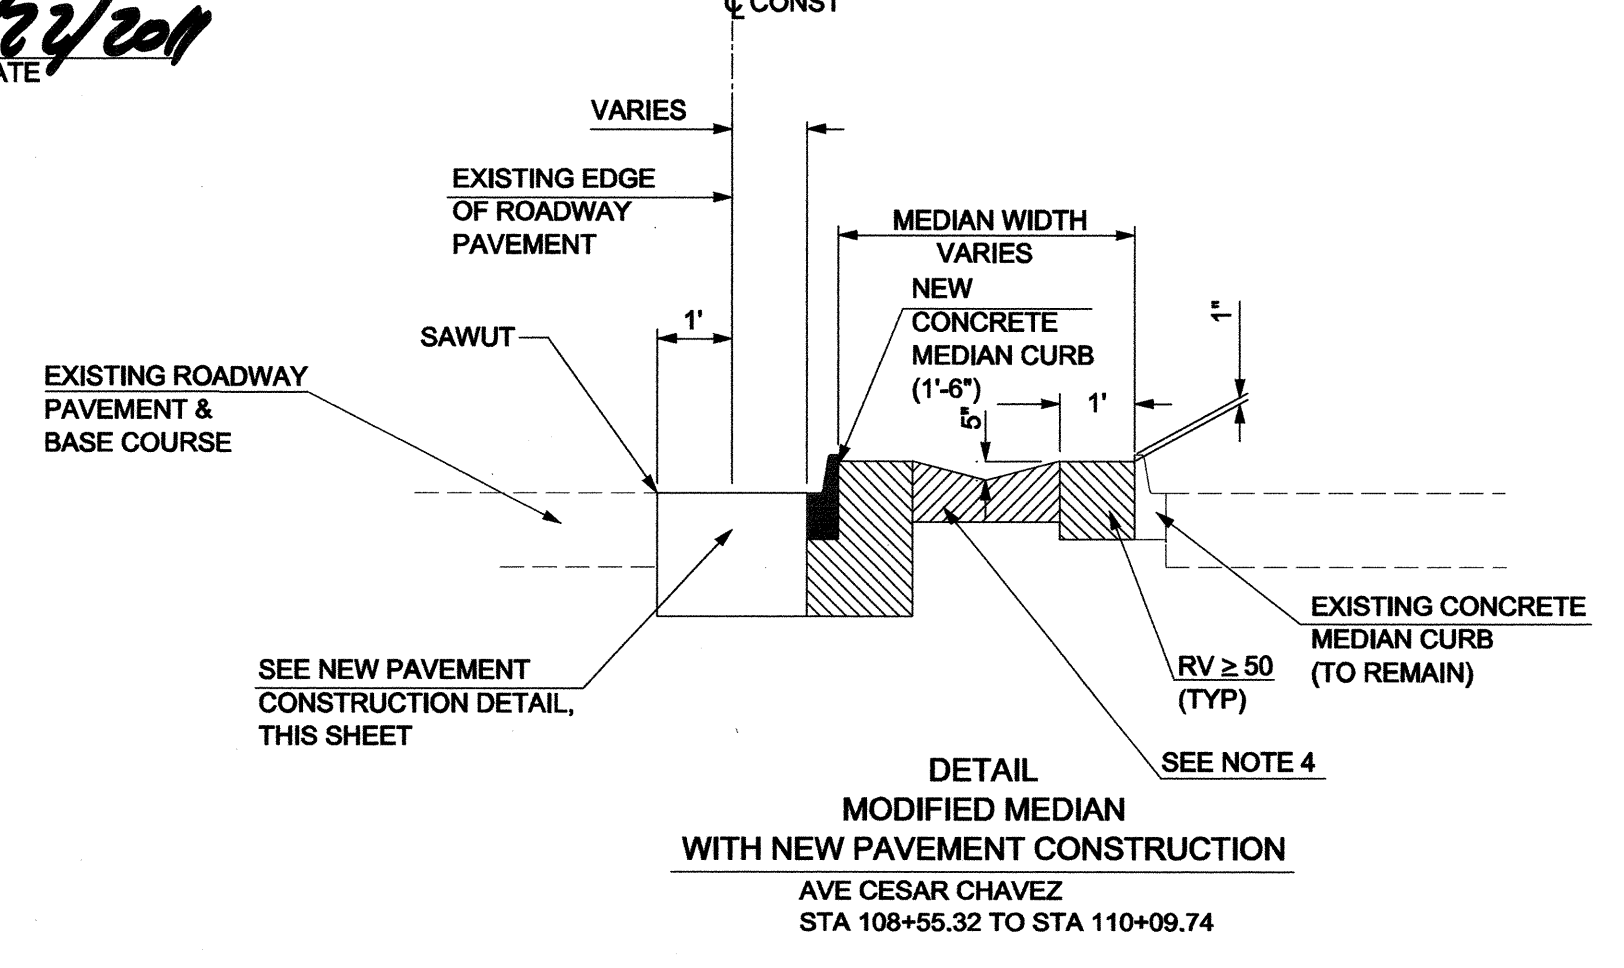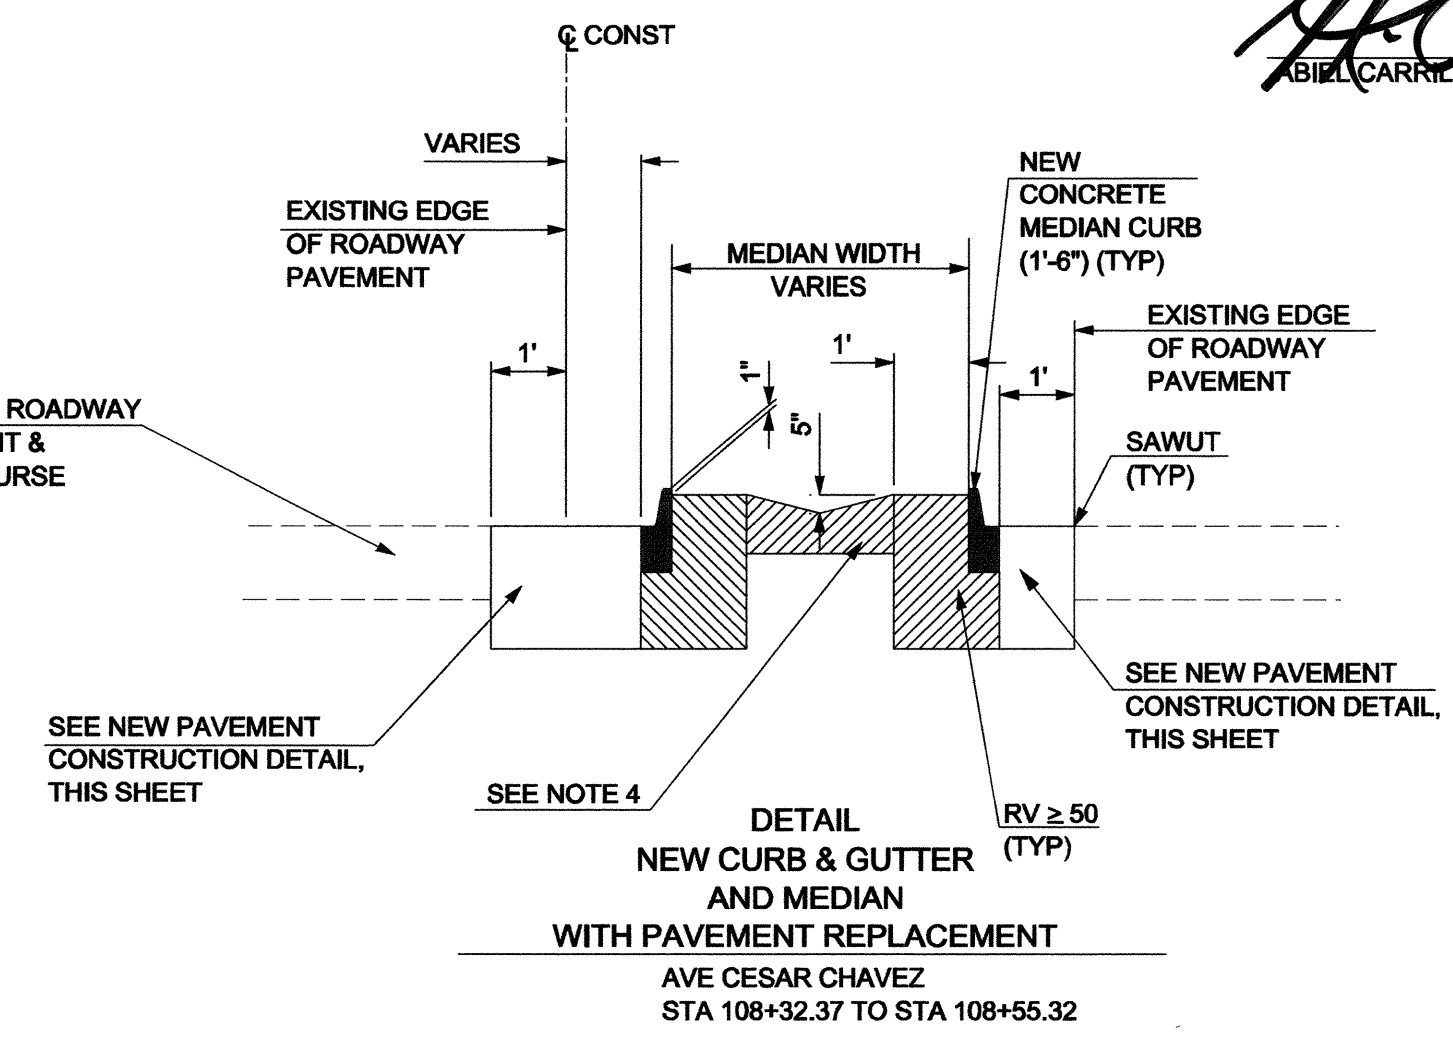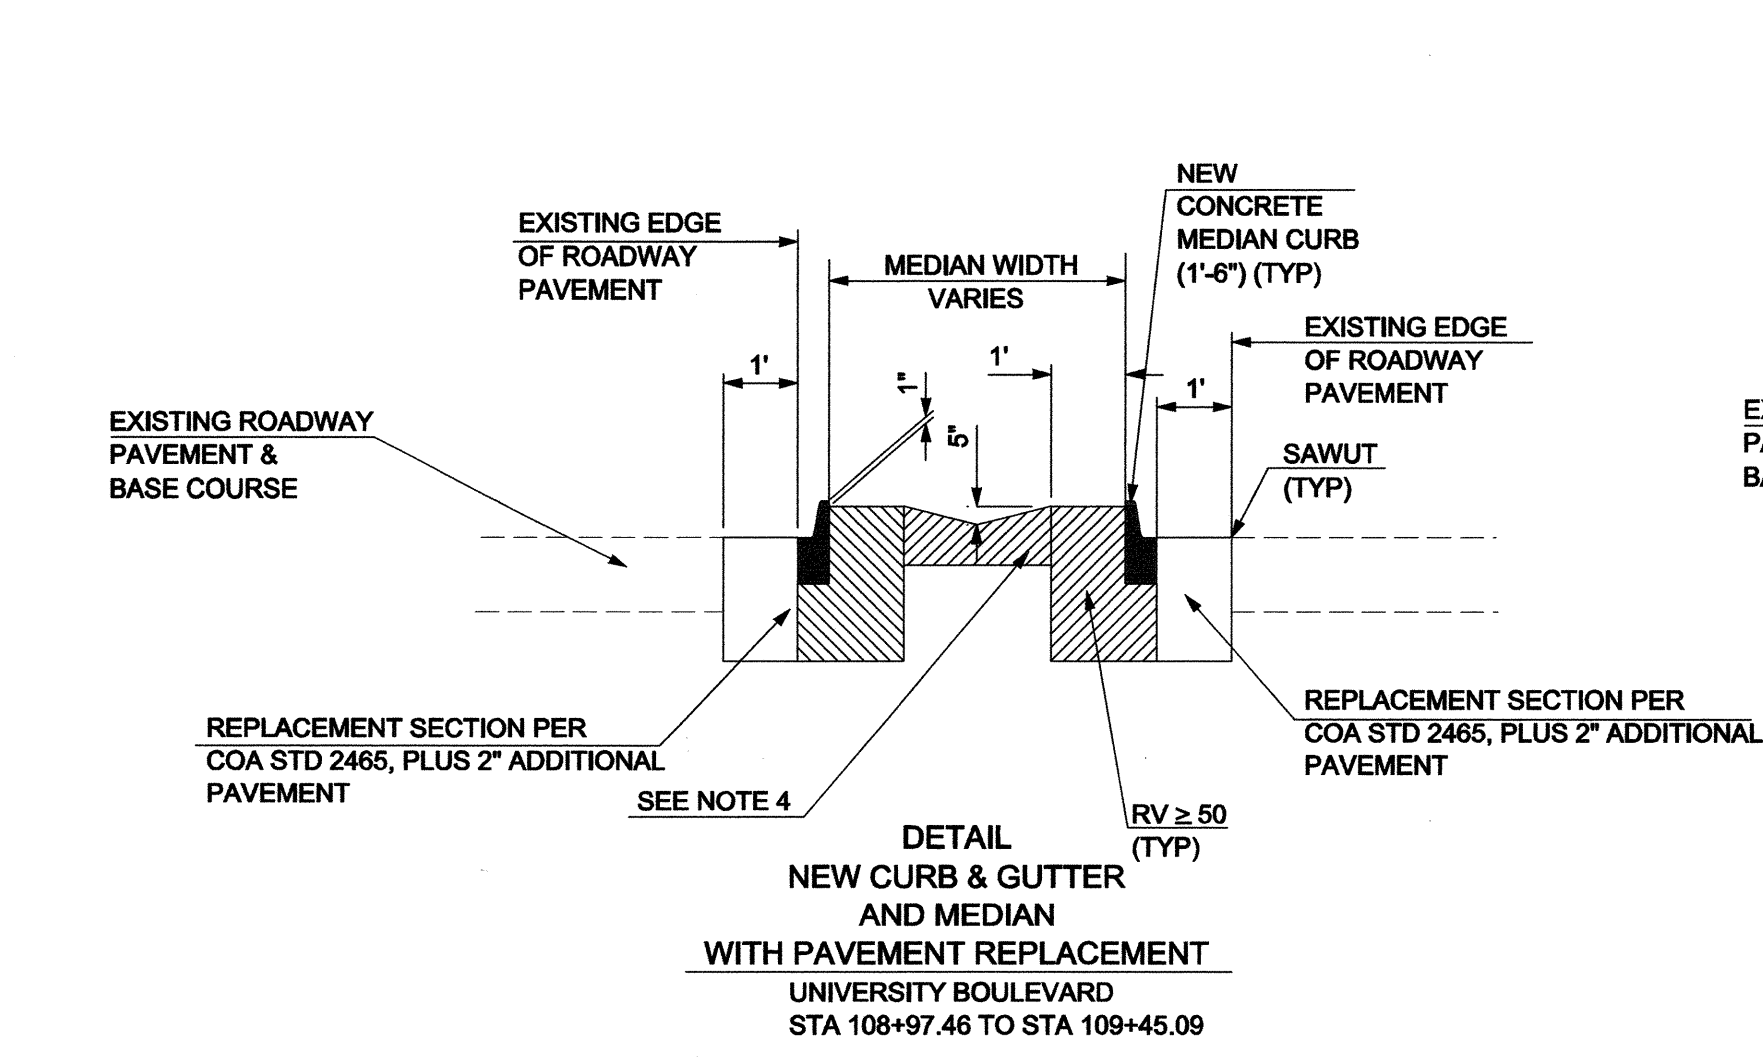

| RECORD DRAWING                                                                                                                                                                                                                                                 |           |
|----------------------------------------------------------------------------------------------------------------------------------------------------------------------------------------------------------------------------------------------------------------|-----------|
| DATE:                                                                                                                                                                                                                                                          | DRAWN BY: |
| JUNE 2011                                                                                                                                                                                                                                                      | MCA       |
| THESE RECORD DRAWINGS HAVE BEEN PREPARED, IN PART, ON THE BASIS ON INFORMATION COMPILED AND FURNISHED BY OTHERS. MOLZEN-CORBIN AND ASSOCIATES WILL NOT BE RESPONSIBLE FOR ANY ERRORS OR OMISSIONS WHICH HAVE BEEN INCORPORATED INTO THIS DOCUMENT AS A RESULT. |           |

- NOTES:
1. CONCRETE MEDIAN CURB & GUTTER COA DWG 2415B.
  2. ALIGN CROSSWALK BARS TO AVOID VEHICLE WHEEL PATH.
  3. UNM ATHLETICS IS RESPONSIBLE FOR MAINTENANCE AND REPAIR ASSOCIATED WITH CROSS WALK STRIPES WITH UNM LOGO.
  4. CONTRACTOR TO REMOVE DEBRIS (ROCK OVER 3", ASPHALT MILLINGS, CONCRETE, TRASH, WEEDS AND ROOTS) TO A DEPTH OF 8" BELOW FINISH GRADE OR AS NECESSARY TO REMOVE DEBRIS. EXISTING CLEAN DIRT CAN REMAIN. CLEAN DIRT TO BE ADDED OR REMOVED AS NECESSARY TO ACHIEVE FINISH GRADE. CURB MUST BE SUPPORTED. FINISH GRADE TO BE 1" BELOW TOP OF CURB AND EXTEND A MINIMUM DISTANCE OF 12" FROM BACK OF CURB. GRADE MAY THEN SLOPE TO 5" BELOW TOP OF CURB.

2701 MILES RD SE  
ALBUQUERQUE, NM 87106  
TEL: 505.242-6700  
FAX: 505.242-0673

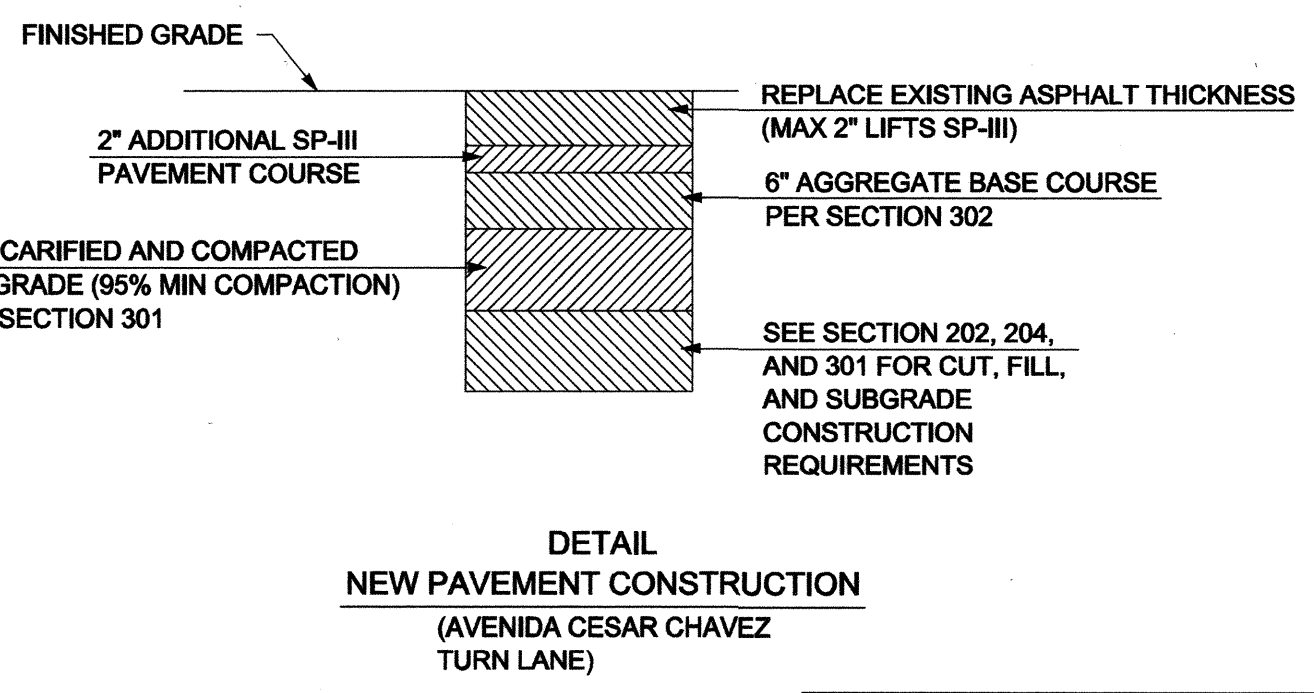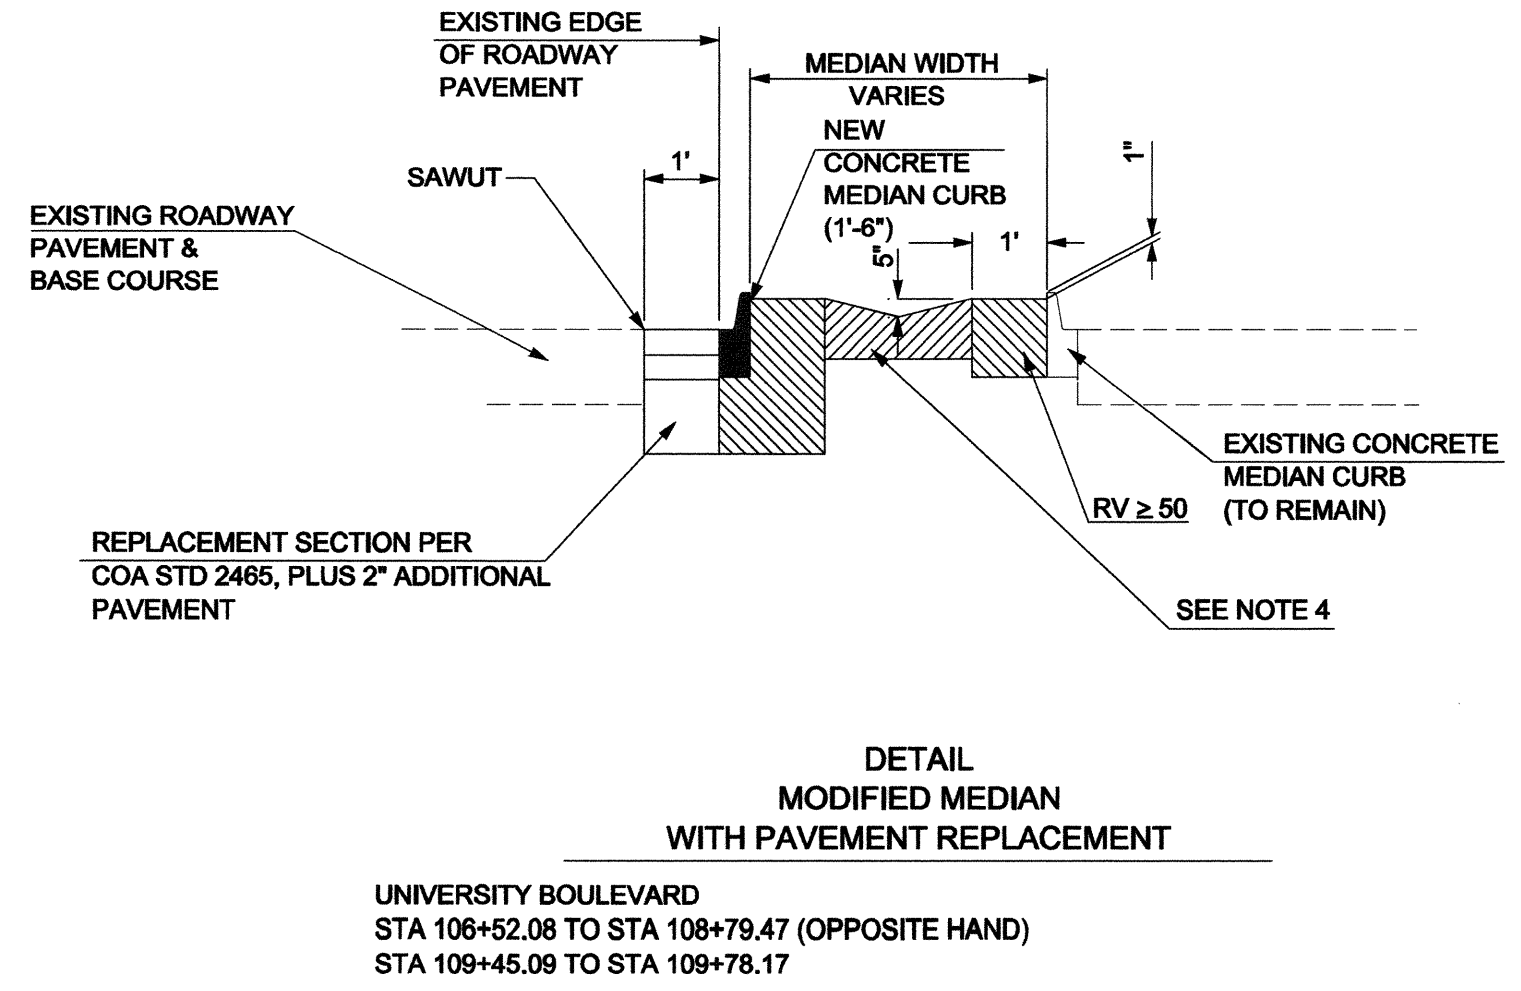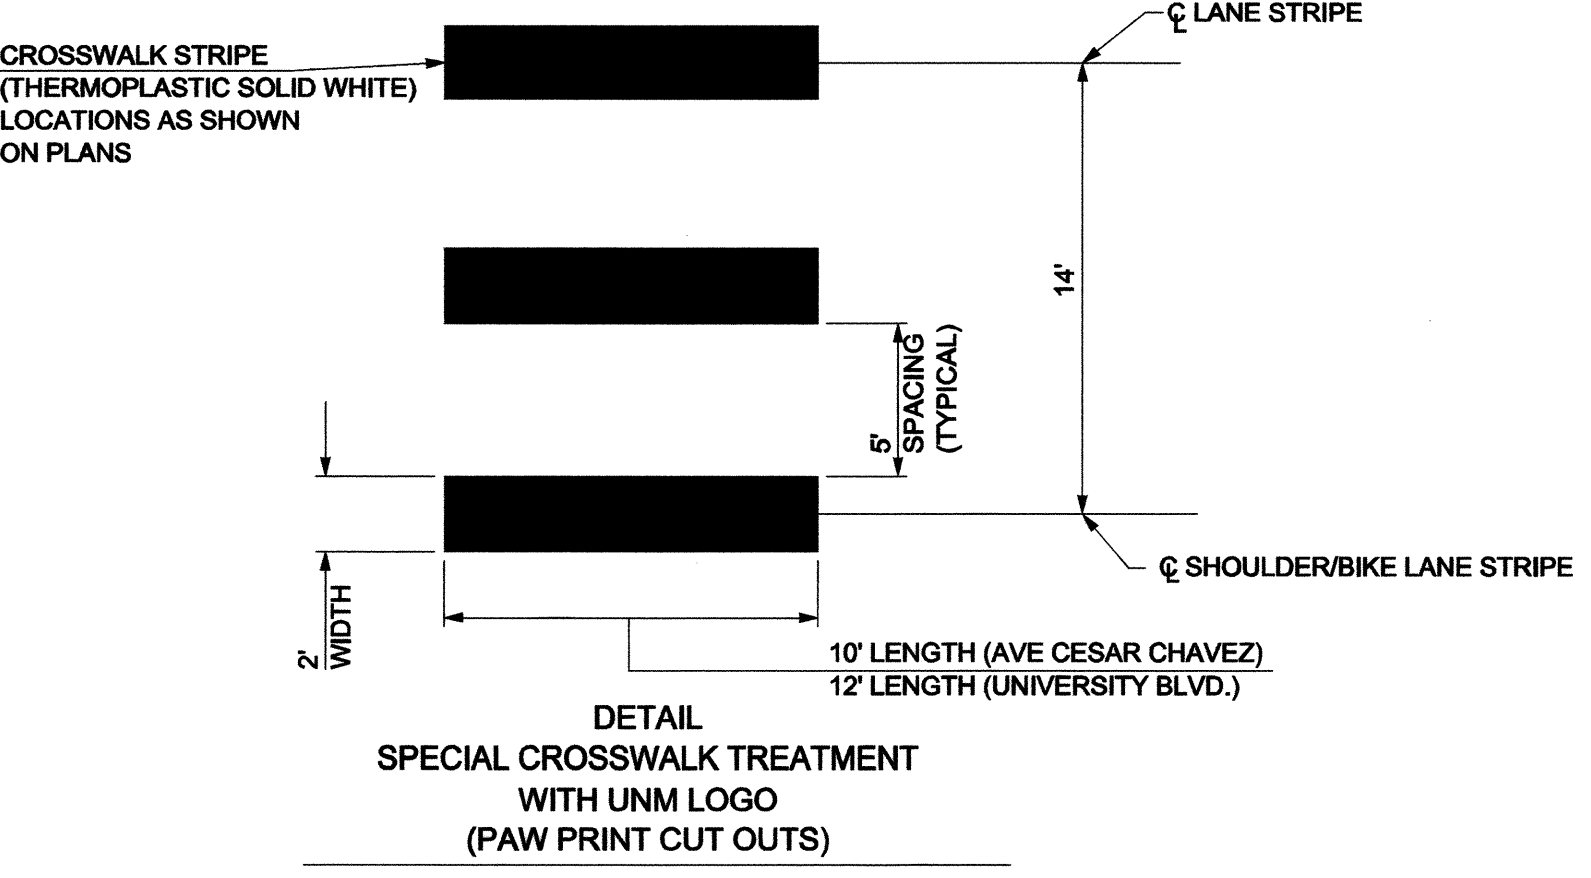

| CITY OF ALBUQUERQUE<br>DEPARTMENT OF MUNICIPAL DEVELOPMENT<br>CIP DIVISION                                           |                        |                    |    |
|----------------------------------------------------------------------------------------------------------------------|------------------------|--------------------|----|
| TITLE:<br><b>AVENIDA CESAR CHAVEZ &amp; UNIVERSITY BLVD<br/>MEDIAN ISLAND IMPROVEMENTS<br/>MISCELLANEOUS DETAILS</b> |                        |                    |    |
| Design Review Committee                                                                                              | City Engineer Approval | Last Design Update |    |
|                                                                                                                      |                        |                    |    |
| City Project No.                                                                                                     | Zone Map No.           | Sheet              | Of |
| 566586                                                                                                               | L-15                   | 4                  | 10 |

26-566586-86-11




A-XX

**= REMOVE EXISTING CONCRETE CURB AND GUTTER**

ABIEL CARRILLO


6/22/2011  
DATE

**Note:**  
***As Built Information Shown in "Italics"***

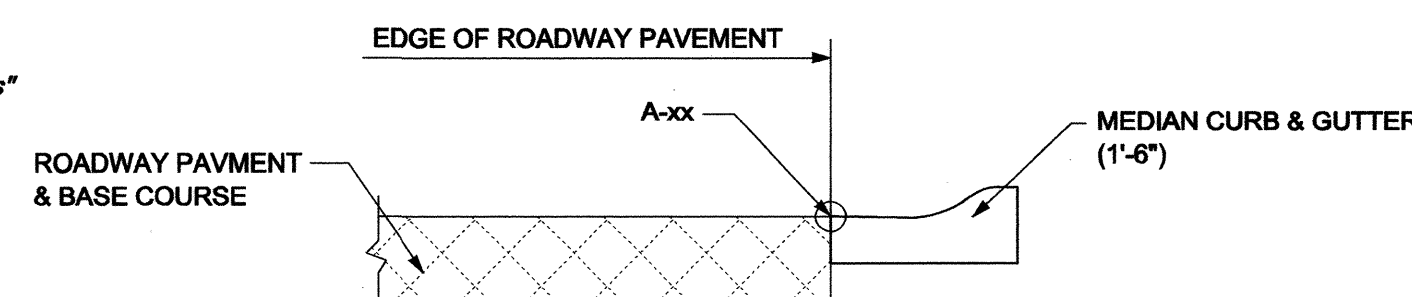

## DETAIL

### CURB LOCATION POINTS

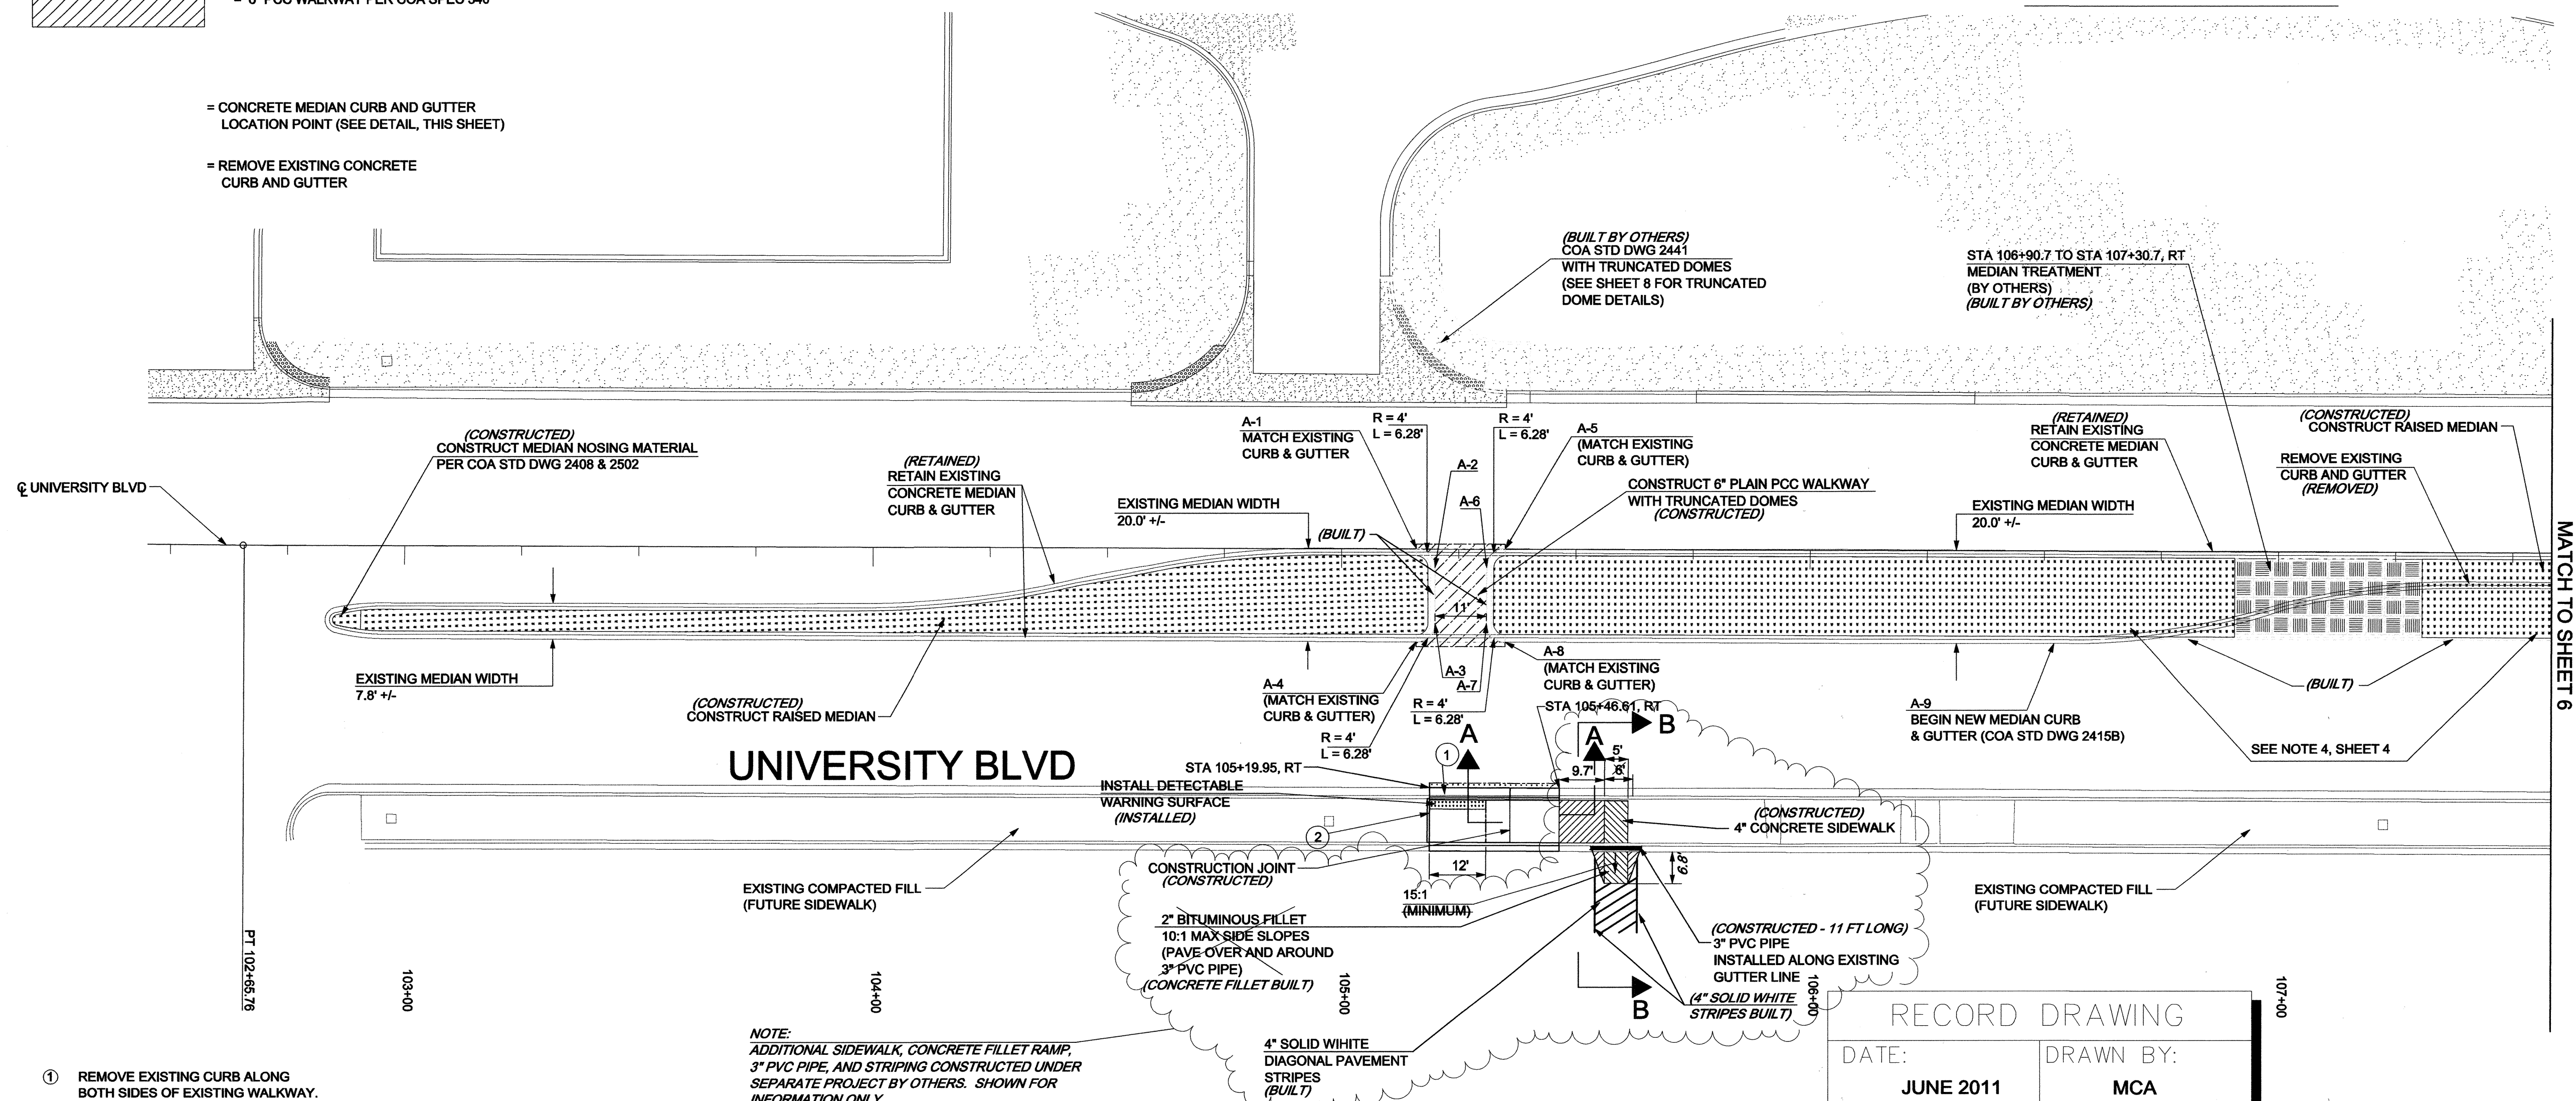

## UNIVERSITY BOULEVARD

**(NEW MEDIAN CURB AND GUTTER PER COA STD DWG 2415B)**

| POINT # | STATION   | OFFSET<br>(LT/RT) | DISTANCE | NORTHING    | EASTING     |
|---------|-----------|-------------------|----------|-------------|-------------|
| A-1     | 105+15.95 | LT                | 0.08'    | 1479686.568 | 1526438.662 |
| A-2     | 105+19.95 | RT                | 3.92'    | 1479690.569 | 1526442.662 |
| A-3     | 105+19.95 | RT                | 15.86'   | 1479690.569 | 1526454.599 |
| A-4     | 105+15.95 | RT                | 19.86'   | 1479686.574 | 1526458.599 |
| A-5     | 105+34.95 | LT                | 0.09'    | 1479705.568 | 1526438.655 |
| A-6     | 105+30.95 | RT                | 3.91'    | 1479701.569 | 1526442.654 |
| A-7     | 105+30.95 | RT                | 15.84'   | 1479701.569 | 1526454.577 |
| A-8     | 105+34.95 | RT                | 19.84'   | 1479705.574 | 1526458.577 |
| A-9     | 106+52.08 | RT                | 19.72'   | 1479822.702 | 1526458.460 |

**NOTE:**  
ADDITIONAL SIDEWALK, CONCRETE FILLET RAMP,  
3" PVC PIPE, AND STRIPING CONSTRUCTED UNDER  
SEPARATE PROJECT BY OTHERS. SHOWN FOR  
INFORMATION ONLY.

- ① REMOVE EXISTING CURB ALONG BOTH SIDES OF EXISTING WALKWAY.  
(*BUILT*)  
BUILD PEDESTRIAN CURB RAMP TYPE "C" WITH "STICK ON" DETECTABLE WARNING SURFACE. (*BUILT*)  
CONSTRUCT CONSTRUCTION JOINT, AS SHOWN.  
(*BUILT*)  
BUILD NEW VERTICAL CONCRETE CURB AND GUTTER, AND 4" CONCRETE SIDEWALK.
- ② BUILD VERTICAL CONCRETE HEADER CURB WITHIN EXISTING WALKWAY  
(*BUILT*)

RECORD DRAWING

DATE: **JUNE 2011**

|           |     |
|-----------|-----|
| DRAWN BY: | MCA |
|-----------|-----|

THESE RECORD DRAWINGS HAVE BEEN  
PREPARED, IN PART, ON THE BASIS ON  
INFORMATION COMPILED AND FURNISHED BY  
OTHERS. MOLZEN-CORBIN AND ASSOCIATES WILL  
NOT BE RESPONSIBLE FOR ANY ERRORS OR  
OMISSIONS WHICH HAVE BEEN INCORPORATED  
INTO THIS DOCUMENT AS A RESULT.

2701 MILES RD SE  
ALBUQUERQUE, NM 87106  
TEL: 505.242-5700  
FAX: 505.242.0673

**MOLZEN-CORBIN** & Associates  
ENGINEERS/ARCHITECTS/PLANNERS

CITY OF ALBUQUERQUE  
DEPARTMENT OF MUNICIPAL DEVELOPMENT  
CIP DIVISION

TITLE:

**AVENIDA CESAR CHAVEZ &  
UNIVERSITY BLVD  
MEDIAN ISLAND IMPROVEMENTS  
CURBING LAYOUT PLAN**

Design Review Committee

City Engineer Approval

Last Design Update

|             |             |
|-------------|-------------|
| Mo./Day/Yr. | Mo./Day/Yr. |
|-------------|-------------|

City Project No.

566586

Zone Map No.

Sheet 5 Of 10

REDRAWN FOR RECORD PURPOSES

**COA On-Call Contractor Work Order No. 800730**

**A-A**

|   |   |   |   |   |   |   |   |   |   |   |   |   |
|---|---|---|---|---|---|---|---|---|---|---|---|---|
| 2 | 6 | - | 5 | 6 | 6 | 5 | . | 8 | 6 | - | 1 | 1 |
|---|---|---|---|---|---|---|---|---|---|---|---|---|

© COPYRIGHT

MCA JOB # UNM061-12

Design File: I:\NIMPR\Expansion Phase I\Drawings\University Blvd & Avenida Cesar Chavez Median Realignments\Plans\Section 3\COA PIT MEDIAN\_CURB01(6-13-11).SHX  
6/24/2011 4:52:44 PM bbelley  
NIMDOT\_PDF\_MCA.plt

1

4/8/10

**GABTK22X**





ABIEL CARRILLO


6/22/2011  
DATE





RECORD DRAWING

DATE: JUNE 2011  
DRAWN BY: MCA


THESE RECORD DRAWINGS HAVE BEEN PREPARED, IN PART, ON THE BASIS ON INFORMATION COMPILED AND FURNISHED BY OTHERS. MOLZEN-CORBIN AND ASSOCIATES WILL NOT BE RESPONSIBLE FOR ANY ERRORS OR OMISSIONS WHICH HAVE BEEN INCORPORATED INTO THIS DOCUMENT AS A RESULT.

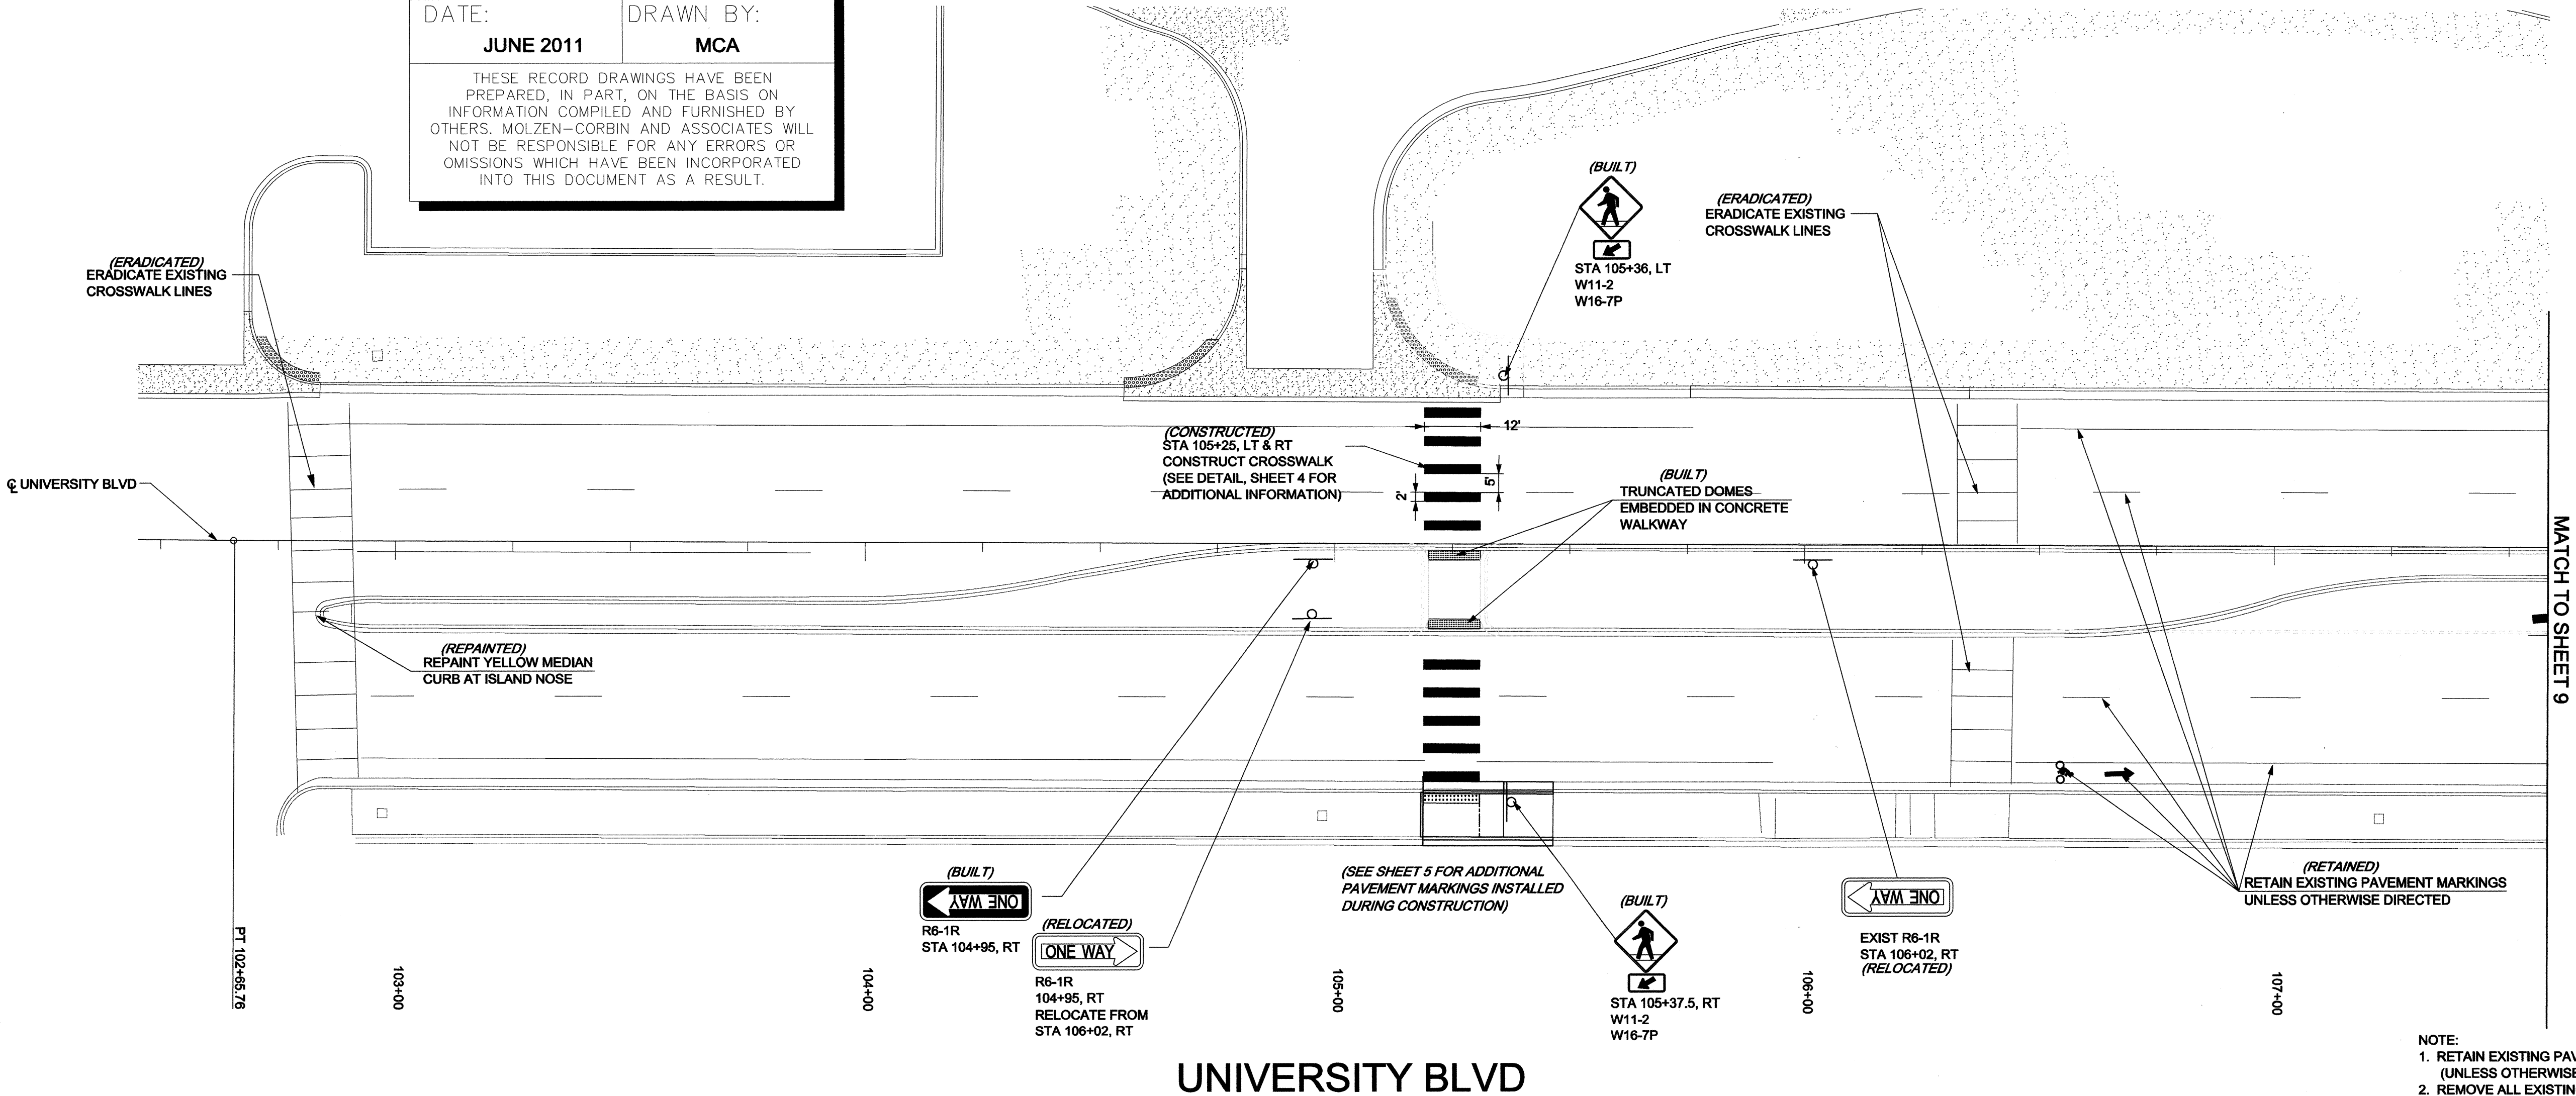

UNIVERSITY BLVD

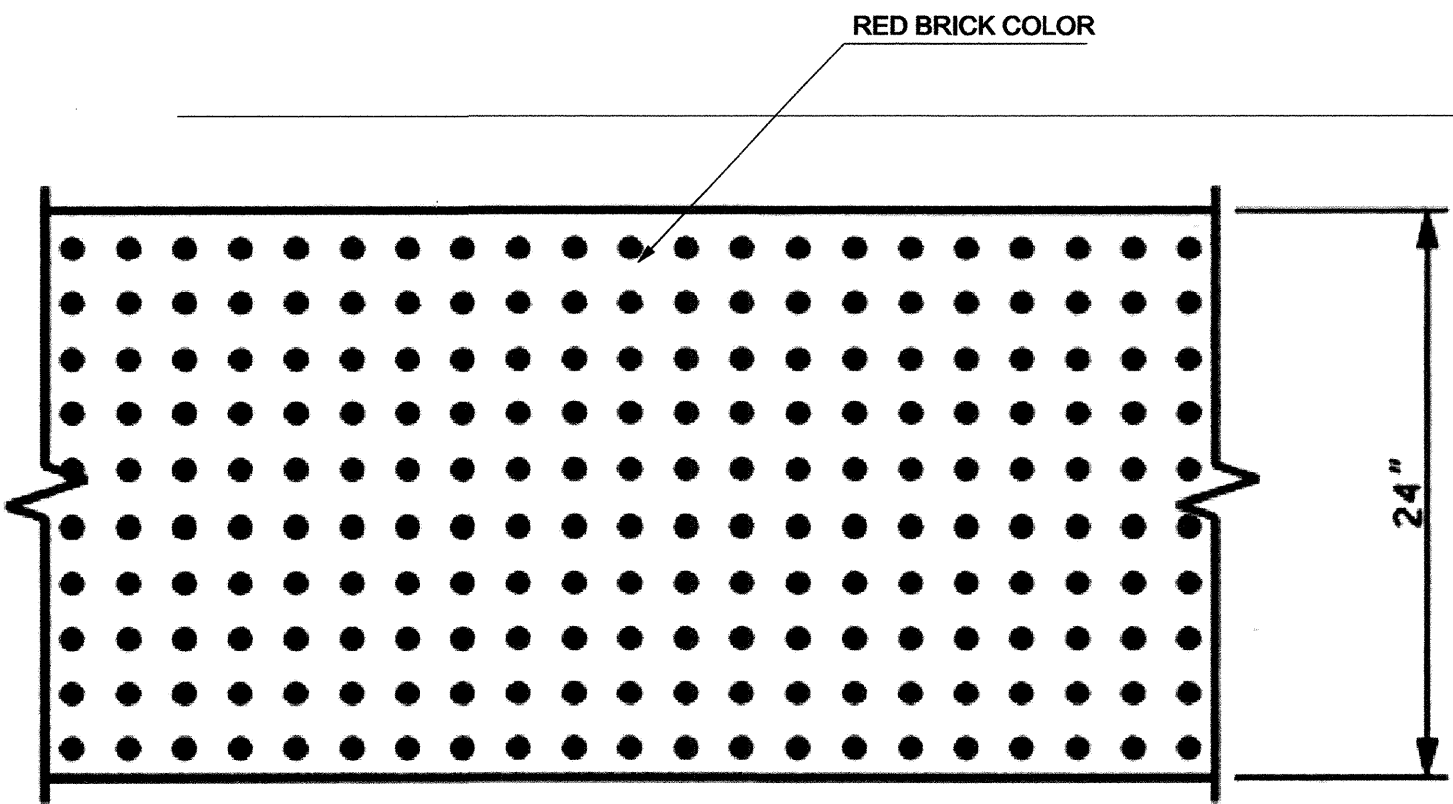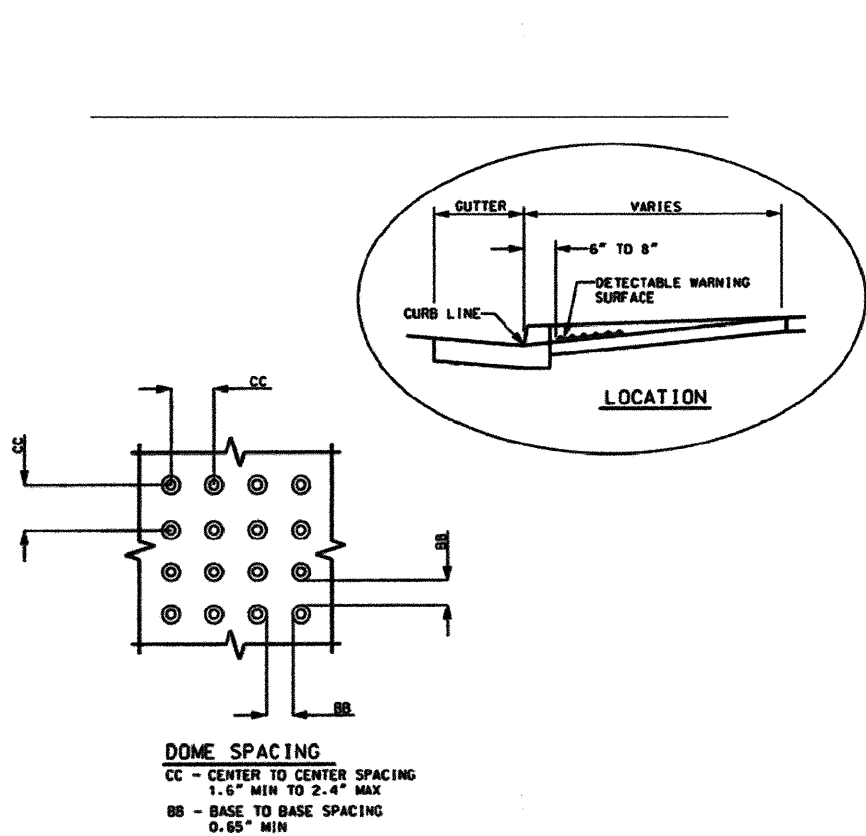

DETAILS  
TRUNCATED DOMES

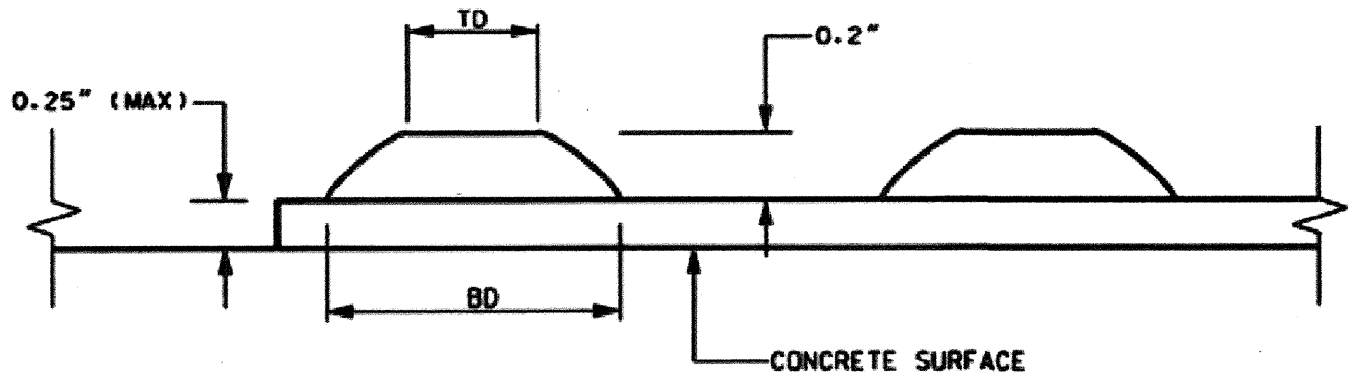

DOME SECTION

BD - BASE DIAMETER  
0.9\"/>



26-5665.86-11

- NOTE:
1. RETAIN EXISTING PAVEMENT MARKINGS (UNLESS OTHERWISE NOTED)
  2. REMOVE ALL EXISTING PAVEMENT MARKINGS AND PERMANENT SIGNING THAT CONFLICTS WITH NEW PAVEMENT MARKINGS AND SIGNING.
  3. ERADICATION OF EXISTING PAVEMENT MARKINGS SHALL BE PERFORMED USING WATER BLASTING METHOD. (COA STANDARD SPECIFICATIONS, SECTION 443)

2701 MILES RD SE  
ALBUQUERQUE, NM 87106  
TEL: 505.242-5700  
FAX: 505.242-6873

**MOLZEN-CORBIN & Associates**  
ENGINEERS/ARCHITECTS/PLANNERS


CITY OF ALBUQUERQUE  
DEPARTMENT OF MUNICIPAL DEVELOPMENT  
CIP DIVISION

TITLE:  
**AVENIDA CESAR CHAVEZ &  
UNIVERSITY BLVD  
MEDIAN ISLAND IMPROVEMENTS  
PERMANENT SIGNING & STRIPING PLAN**

|                         |                        |             |             |
|-------------------------|------------------------|-------------|-------------|
| Design Review Committee | City Engineer Approval | Mo./Day/Yr. | Mo./Day/Yr. |
|                         |                        |             |             |
|                         |                        |             |             |
| City Project No.        | Zone Map No.           | Sheet 8     | Of 10       |

566586

L-15

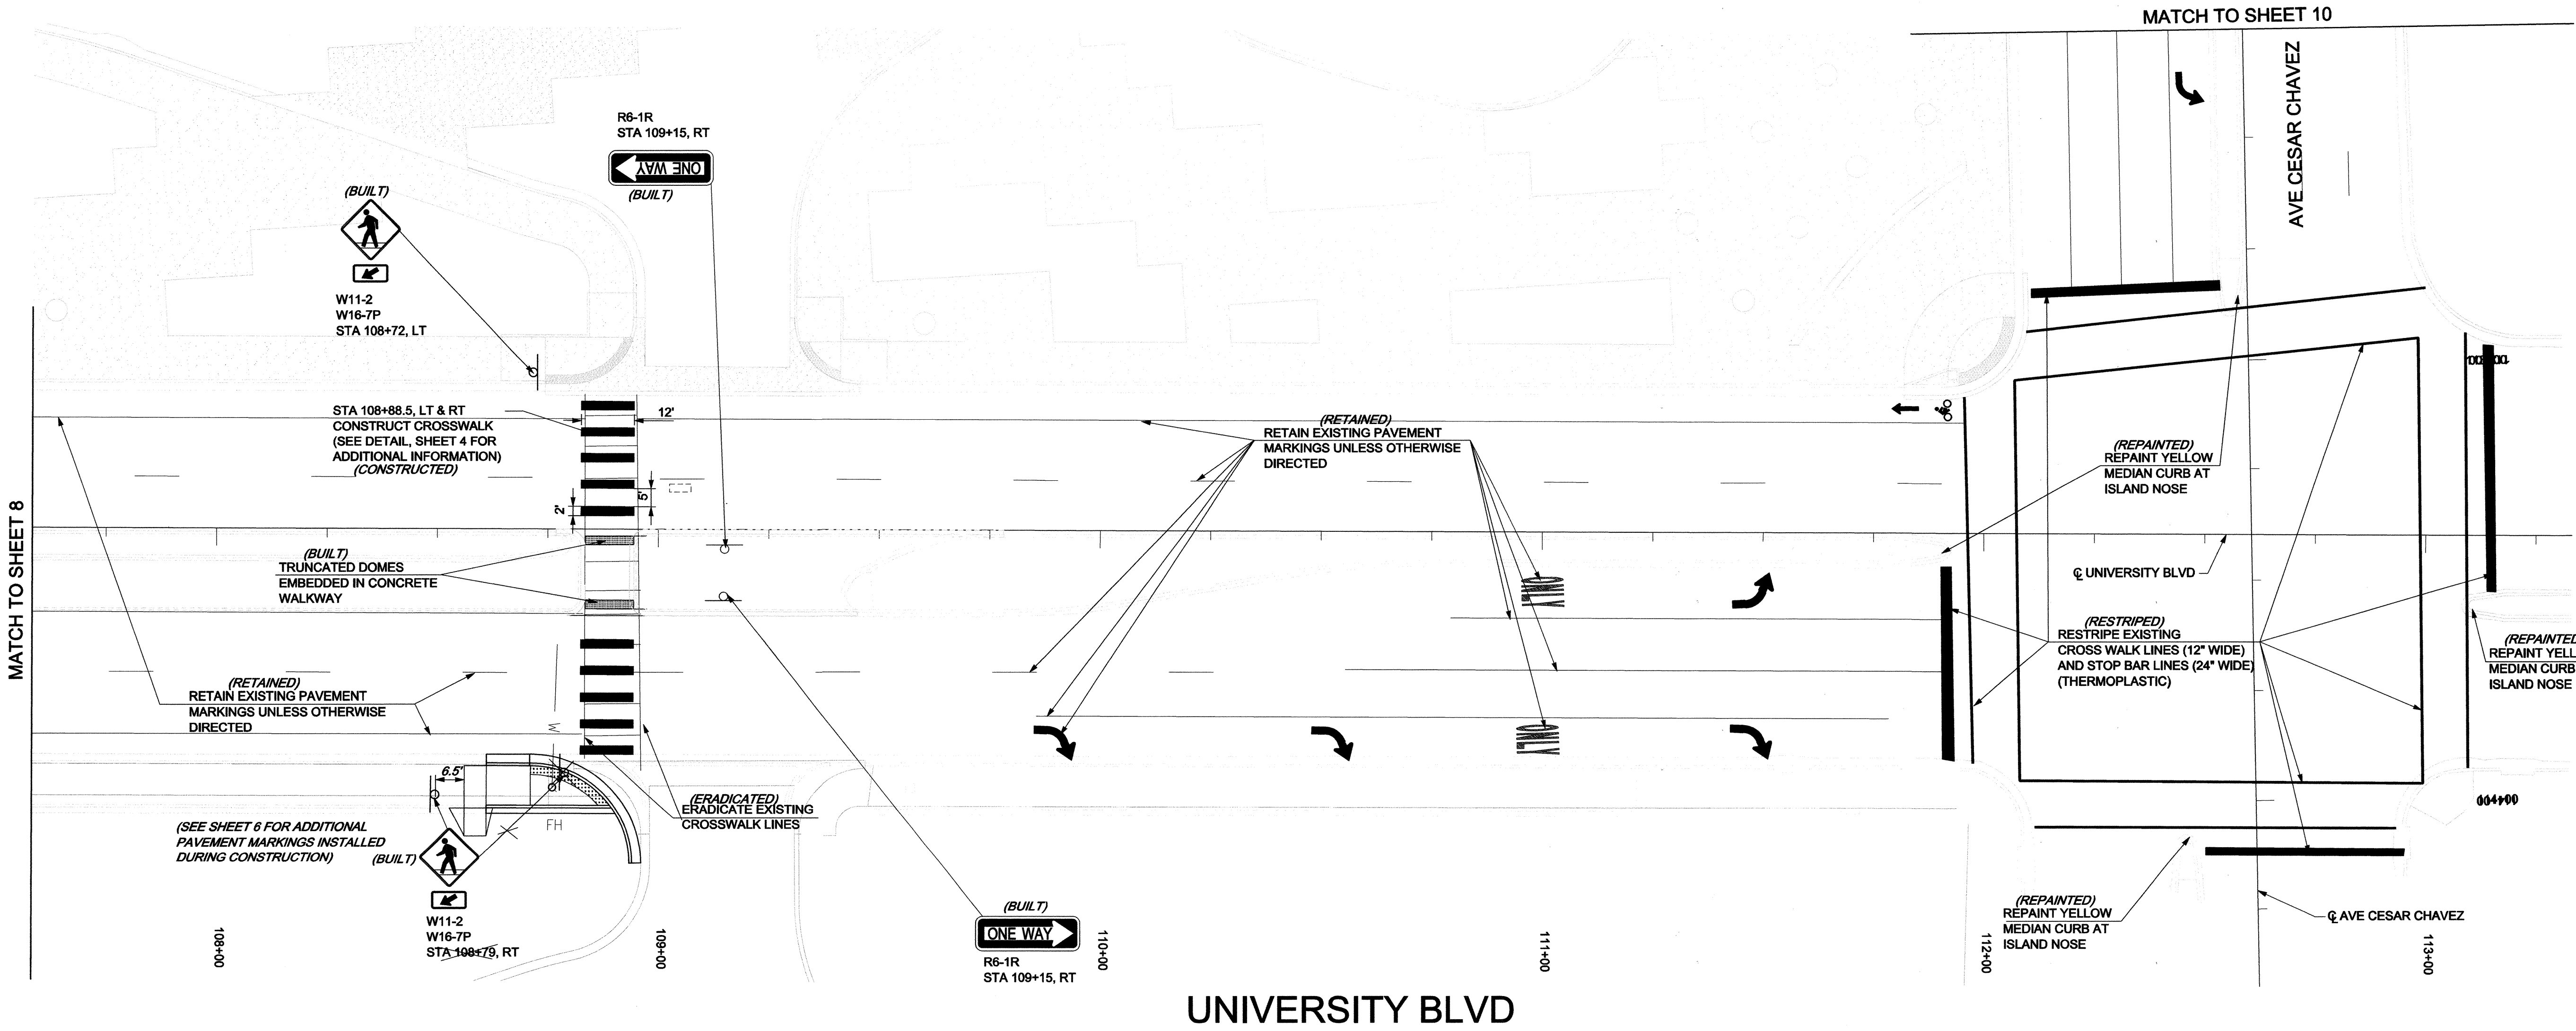

RECORD DRAWING

DATE: JUNE 2011

DRAWN BY: MCA

THESE RECORD DRAWINGS HAVE BEEN PREPARED, IN PART, ON THE BASIS ON INFORMATION COMPILED AND FURNISHED BY OTHERS. MOLZEN-CORBIN AND ASSOCIATES WILL NOT BE RESPONSIBLE FOR ANY ERRORS OR OMISSIONS WHICH HAVE BEEN INCORPORATED INTO THIS DOCUMENT AS A RESULT.

- NOTE:
1. RETAIN EXISTING PAVEMENT MARKINGS (UNLESS OTHERWISE NOTED)
  2. REMOVE ALL EXISTING PAVEMENT MARKINGS AND PERMANENT SIGNING THAT CONFLICTS WITH NEW PAVEMENT MARKINGS AND SIGNING.
  3. ERADICATION OF EXISTING PAVEMENT MARKINGS SHALL BE PERFORMED USING WATER BLASTING METHOD. (COA STANDARD SPECIFICATIONS, SECTION 443)

2701 MILES RD SE  
ALBUQUERQUE, NM 87106  
TEL: 505.242-6700  
FAX: 505.242-6873

MOLZEN-CORBIN & Associates

ENGINEERS/ARCHITECTS/PLANNERS

CITY OF ALBUQUERQUE  
DEPARTMENT OF MUNICIPAL DEVELOPMENT  
CIP DIVISION

TITLE:  
AVENIDA CESAR CHAVEZ &  
UNIVERSITY BLVD  
MEDIAN ISLAND IMPROVEMENTS  
PERMANENT SIGNING & STRIPING PLAN

|                         |                        |             |             |
|-------------------------|------------------------|-------------|-------------|
| Design Review Committee | City Engineer Approval | Mo./Day/Yr. | Mo./Day/Yr. |
|                         |                        |             |             |
|                         |                        |             |             |
|                         |                        |             |             |
|                         |                        |             |             |
| City Project No.        | Zone Map No.           | Sheet 9     | Of 10       |
| 566586                  | L-15                   |             |             |

REDRAWN FOR RECORD PURPOSES




26-5665-86-11

ABIEL CARRILLO

6/22/2011

|                                                                                                                                                                                                                                                                |                  |
|----------------------------------------------------------------------------------------------------------------------------------------------------------------------------------------------------------------------------------------------------------------|------------------|
| RECORD DRAWING                                                                                                                                                                                                                                                 |                  |
| DATE:<br>JUNE 2011                                                                                                                                                                                                                                             | DRAWN BY:<br>MCA |
| THESE RECORD DRAWINGS HAVE BEEN PREPARED, IN PART, ON THE BASIS ON INFORMATION COMPILED AND FURNISHED BY OTHERS. MOLZEN-CORBIN AND ASSOCIATES WILL NOT BE RESPONSIBLE FOR ANY ERRORS OR OMISSIONS WHICH HAVE BEEN INCORPORATED INTO THIS DOCUMENT AS A RESULT. |                  |

| AS BUILT INFORMATION   |      | BENCH MARKS                       |      | SURVEY INFORMATION |        | ENGINEER'S SEAL |      |
|------------------------|------|-----------------------------------|------|--------------------|--------|-----------------|------|
| CONTRACTOR             | DATE | A NMSHC BRASS DISC STAMPED        | DATE | NO.                | BY     |                 |      |
| INSPECTOR'S            | DATE | CONCRETE POST 0.2 FEET ABOVE      | DATE | REMARKS            | BY     |                 |      |
| FIELD                  | DATE | GROUND LOCATED AT THE NORTHWEST   | DATE | REVISIONS          | DESIGN | DESIGNED BY     | DATE |
| AS BUILT               | DATE | CORNER OF THE I-25 BRIDGE AND     | DATE | DESIGNED BY        | DATE   | DRAWN BY        | DATE |
| REVISIONS              | DATE | GIBSON BOULEVARD S.E. (NOT SHOWN) | DATE | CHECKED BY         | DATE   |                 |      |
| MICRO-FILM INFORMATION | DATE | ELEVATION = 5041.30 FEET          | DATE |                    |        |                 |      |
| RECORDED BY            | DATE | (NAVD 1988)                       | DATE |                    |        |                 |      |
| NO.                    |      |                                   |      |                    |        |                 |      |

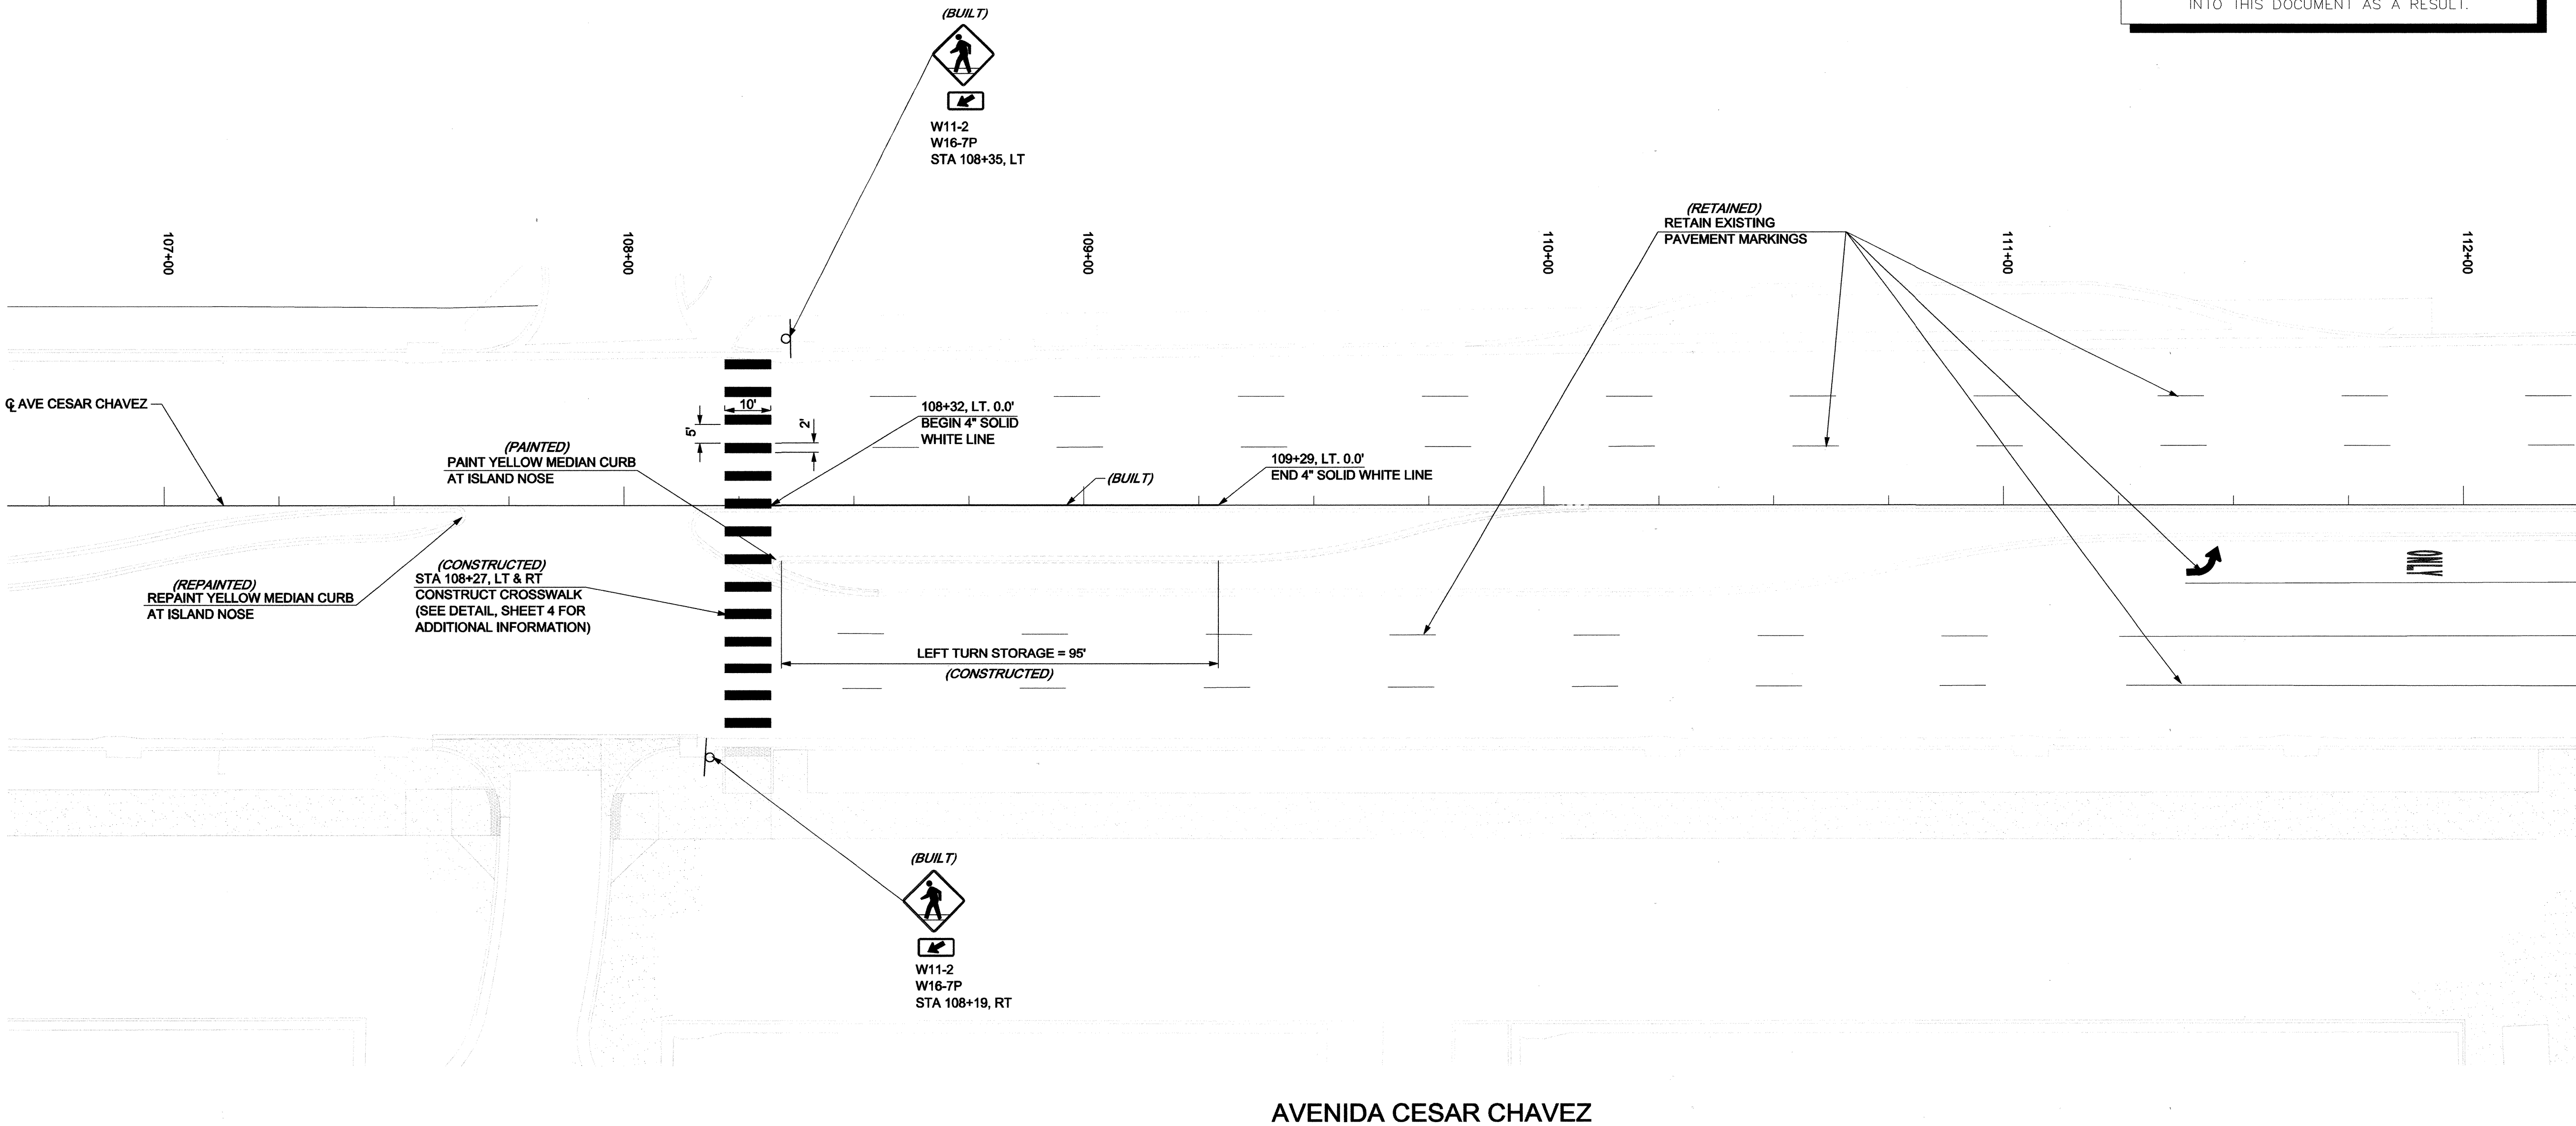

AVENIDA CESAR CHAVEZ

- NOTE:
1. RETAIN EXISTING PAVEMENT MARKINGS (UNLESS OTHERWISE NOTED)
  2. REMOVE ALL EXISTING PAVEMENT MARKINGS AND PERMANENT SIGNING THAT CONFLICTS WITH NEW PAVEMENT MARKINGS AND SIGNING.
  3. ERADICATION OF EXISTING PAVEMENT MARKINGS SHALL BE PERFORMED USING WATER BLASTING METHOD. (COA STANDARD SPECIFICATIONS, SECTION 443)

2701 MILES RD SE  
ALBUQUERQUE, NM 87108  
TEL: 505.242-6700  
FAX: 505.242-0873

**MOLZEN-CORBIN & Associates**  
ENGINEERS/ARCHITECTS/PLANNERS

|                                                                                                                                          |                        |             |             |
|------------------------------------------------------------------------------------------------------------------------------------------|------------------------|-------------|-------------|
| CITY OF ALBUQUERQUE<br>DEPARTMENT OF MUNICIPAL DEVELOPMENT<br>CIP DIVISION                                                               |                        |             |             |
| TITLE:<br><b>AVENIDA CESAR CHAVEZ &amp;<br/>UNIVERSITY BLVD<br/>MEDIAN ISLAND IMPROVEMENTS<br/>PERMANENT SIGNING &amp; STRIPING PLAN</b> |                        |             |             |
| Design Review Committee                                                                                                                  | City Engineer Approval | Mo./Day/Yr. | Mo./Day/Yr. |
|                                                                                                                                          |                        |             |             |
| City Project No.                                                                                                                         | Zone Map No.           | Sheet 10    | Of 10       |
| 566586                                                                                                                                   | L-15                   |             |             |



26-5665-86-11

© COPYRIGHT MCA JOB # UNM061-12

REDRAWN FOR RECORD PURPOSES