


CONSTRUCTION PLANS
FOR
DESERT HIGHLANDS AT HIGH DESERT
~~THE HIGHLANDS AT~~
~~HIGH DESERT - UNIT 4~~
ALBUQUERQUE, NEW MEXICO

INDEX	
SHEET NUMBER	DESCRIPTION
1	TITLE SHEET
2-3	PLAT
4	GENERAL NOTES
5-6	OVERALL GRADING
5A-6A	(OVERALL GRADING FOR INFORMATION ONLY)
7	MASTER PAVING PLAN
8	ROADWAY CROSS SECTIONS
9	PAVING PLAN AND PROFILE SHEETS
10	IMPERATA STREET (INCLUDING STORM DRAIN)
11	PINO CANYON PLACE STA. 1+00.00 - 9+87.67 (INCLUDING STORM DRAIN)
12	PINO CANYON PLACE STA. 9+87.67 -20+00.00
13	DESERT ZINNIA COURT STA. 1+00.00 - 9+48.17
14	DESERT ZINNIA COURT/QUAKING ASPEN PLACE STA. 9+48.17 - 15+00.00
15	MASTER UTILITY PLAN
16	UTILITY PLAN AND PROFILE SHEETS
17	IMPERATA STREET
18	PINO CANYON PLACE STA. 1+00.00 - 9+87.67
19	PINO CANYON PLACE STA. 9+87.67 - 20+00.00
20	DESERT ZINNIA COURT STA. 1+00.00 - 9+48.17
21	DESERT ZINNIA COURT/QUAKING ASPEN PLACE STA. 9+48.17 - 15+00.00
21A	SWALE PLAN AND PROFILE SHEETS
21B	COBBLE & BOULDER SWALE
22	SOUTH PINO TRIBUTARY STORM DRAIN PLAN & PROFILE (FOR INFORMATION ONLY)
23	SIGNING & CONSTRUCTION TRAFFIC CONTROL STANDARDS
24	TYPICAL TRAFFIC CONTROL & SIGNING EXAMPLES (REF. MUTCD)

AS BUILT
DRAWING

I hereby certify that the as-built drawings shown herein are true and correct to the best of my knowledge and belief.

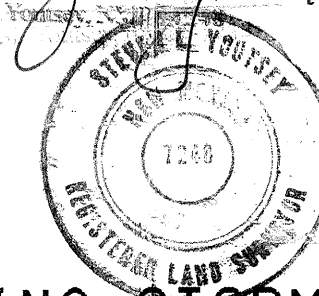


APPROVAL OF AS BUILT DRAWINGS
CHIEF CONSTRUCTION ENGINEER
DATE 6-10-99

COA INSPECTOR: RON RUTLEDGE

DRB No. 97-535
BHI JOB NO. C97416A03

BOHANNAN-HUSTON INC.
ENGINEERS • PLANNERS • PHOTOGRAMMETRISTS • SURVEYORS • LANDSCAPE ARCHITECTS
ALBUQUERQUE LAS CRUCES SANTA FE

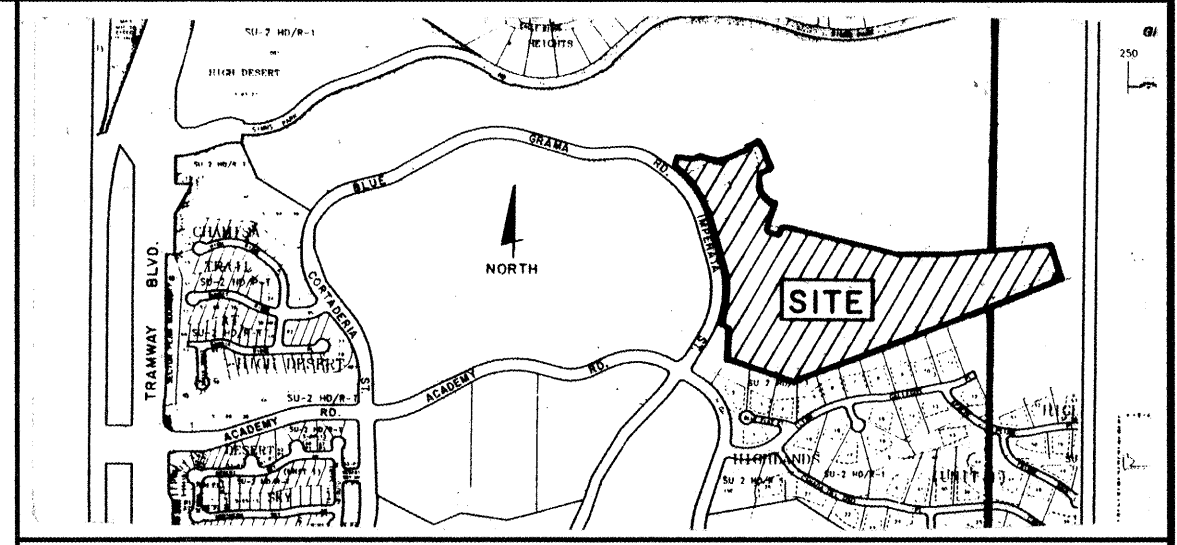

VICINITY MAP

NOT TO SCALE
E-23

NOTICE TO CONTRACTORS

- ALL WORK DETAILED ON THESE PLANS TO BE PERFORMED UNDER CONTRACT SHALL, EXCEPT AS OTHERWISE STATED OR PROVIDED FOR HEREON, BE CONSTRUCTED IN ACCORDANCE WITH THE CITY OF ALBUQUERQUE STANDARD SPECIFICATIONS FOR PUBLIC WORKS CONSTRUCTION, 1986 EDITION AND SHALL INCLUDE UPDATE No.6
- TWO WORKING DAYS PRIOR TO ANY EXCAVATION, THE CONTRACTOR MUST CONTACT NEW MEXICO ONE CALL SYSTEM (260-1990) FOR LOCATION OF EXISTING UTILITIES.
- PRIOR TO CONSTRUCTION, THE CONTRACTOR SHALL EXCAVATE AND VERIFY THE HORIZONTAL AND VERTICAL LOCATIONS OF ALL OBSTRUCTIONS. SHOULD A CONFLICT EXIST, THE CONTRACTOR SHALL NOTIFY THE ENGINEER OR SURVEYOR IMMEDIATELY SO THAT THE CONFLICT CAN BE RESOLVED WITH A MINIMUM AMOUNT OF DELAY.
- FIVE (5) WORKING DAYS PRIOR TO BEGINNING CONSTRUCTION, THE CONTRACTOR SHALL SUBMIT TO CONSTRUCTION COORDINATION DIVISION A DETAILED CONSTRUCTION SCHEDULE. TWO (2) WORKING DAYS PRIOR TO CONSTRUCTION, THE CONTRACTOR SHALL OBTAIN A BARRICADING PERMIT FROM THE CONST. COORDINATION DIVISION. CONTRACTOR SHALL NOTIFY BARRICADE ENGINEER (768-2551) PRIOR TO OCCUPYING AN INTERSECTION. REFER TO SECTION 19 OF THE GENERAL CONDITIONS OF THE STANDARD SPECIFICATIONS.
- ALL STREET STRIPING ALTERED OR DESTROYED SHALL BE REPLACED W/ PLASTIC REFLECTORIZED PAVEMENT MARKING BY CONTRACTOR TO LOCATION AS EXISTING OR AS INDICATED BY THIS PLAN SET.
- CONTRACTOR SHALL NOTIFY THE ENGINEER NOT LESS THAN SEVEN (7) DAYS PRIOR TO STARTING WORK IN ORDER THAT THE CITY SURVEYOR MAY TAKE NECESSARY MEASURES TO INSURE THE PRESERVATION OF SURVEY MONUMENTS. CONTRACTOR SHALL NOT DISTURB PERMANENT SURVEY MONUMENTS WITHOUT THE CONSENT OF THE CITY SURVEYOR AND SHALL NOTIFY THE CITY SURVEYOR AND BEAR THE EXPENSE OF REPLACING ANY THAT MAY BE DISTURBED WITHOUT PERMISSION. REPLACEMENT SHALL BE DONE ONLY BY THE CITY SURVEYOR. WHEN A CHANGE IS MADE IN THE FINISHED ELEVATIONS OF THE PAVEMENT OF ANY ROADWAY IN WHICH A PERMANENT SURVEY MONUMENT IS LOCATED, CONTRACTOR SHALL, AT HIS OWN EXPENSE, ADJUST THE MONUMENT COVER TO THE NEW GRADE UNLESS OTHERWISE SPECIFIED. REFER TO SECTION 4.4 OF THE GENERAL CONDITIONS OF THE STANDARD SPECIFICATIONS. ANY PERMANENT SURVEY MONUMENT LOCATED WITHIN 50' OF THE PROJECT LIMITS NOT SHOWN ON THE PLANS THAT IS DESTROYED DURING CONSTRUCTION WILL BE REPLACED AT DESIGNER'S EXPENSE.
- ANY WORK WITHIN AN ARTERIAL ROADWAY REQUIRES TWENTY-FOUR HOUR CONSTRUCTION.
- CONTRACTOR SHALL MAINTAIN A GRAFFITI-FREE WORK SITE. CONTRACTOR SHALL PROMPTLY REMOVE ANY AND ALL GRAFFITI FROM ALL EQUIPMENT WHETHER PERMANENT OR TEMPORARY.

THE FOLLOWING NOTES ALSO APPLY WHEN CHECKED


- ☒ ALL UTILITIES AND UTILITY SERVICE LINES SHALL BE INSTALLED PRIOR TO PAVING.
- ☐ BACKFILL COMPACTION SHALL BE ACCORDING TO SPECIFIED STREET USE.
- ☐ TACK COAT REQUIREMENTS SHALL BE DETERMINED BY THE CITY ENGINEER.
- ☐ SIDEWALKS AND WHEELCHAIR RAMPS WITHIN THE CURB RETURNS SHALL BE CONSTRUCTED WHEREVER A NEW CURB RETURN IS CONSTRUCTED.
- ☐ IF CURB IS DEEPRESSED FOR A DRIVEPAD, THE DRIVEPAD SHALL BE CONSTRUCTED PRIOR TO ACCEPTANCE OF CURB AND GUTTER.
- ☒ ALL STORM DRAINAGE FACILITIES SHALL BE COMPLETED PRIOR TO FINAL ACCEPTANCE.
- ☒ THE REQUESTOR OR DEVELOPER SHALL BE RESPONSIBLE FOR REPAIR OR REPLACEMENT OF ALL CURB AND GUTTER OR SIDEWALK DAMAGED AFTER APPROVAL BY THE CITY ENGINEER OF WORK COMPLETED BY THE CONTRACTOR.

REV.	SHEETS	CITY ENGINEER	DATE	USER DEPARTMENT	DATE	USER DEPARTMENT	DATE
1	5A, 6A, 7, 11						
2	15						
ENGINEERS STAMP & APPROVAL		APPROVALS	ENGINEER	DATE	APPROVED FOR CONSTRUCTION		
		DRC Chairman	Billings & Galt	5-11-98			
		Transportation	Billings & Galt	4-14-98			
		Water/Wastewater	Roger A. Shuman	4-14-98			
		Hydrology	Roger A. Shuman	4-14-98			
		CIP	Roger A. Shuman	4-14-98			
		Constr. Mngmt.	Roger A. Shuman	4-14-98			
		Const. Coord.	Roger A. Shuman	4-14-98			
		CITY PROJECT NO.		571283	SHEET 1 OF 21		

COPYRIGHT BOHANNAN-HUSTON 1998
DATE: FEBRUARY, 1998

SCANNED BY
MESA REPRO

SCANNED BY
MESA REPRO

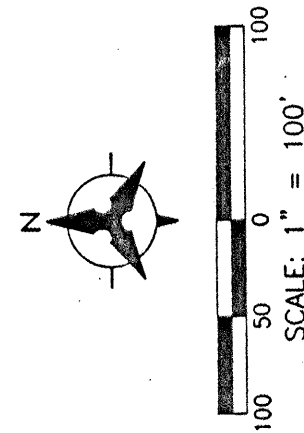

PLAT OF
UNIT 4 OF THE HIGHLANDS
AT HIGH DESERT
(REPLAT OF TRACT 15D-1A HIGH DESERT)
ALBUQUERQUE, NEW MEXICO
MARCH, 1998

EASEMENT (SOUTH PINO TRIBUTARY) GRANTED
TO AMAFCA AND HIGH DESERT RESIDENTIAL
OWNERS ASSOCIATION, INC.
FILED: NOVEMBER 12, 1993
BOOK 93-32, PAGES 3867-3893

EASEMENT (SOUTH PINO TRIBUTARY) GRANTED
TO AMAFCA AND HIGH DESERT RESIDENTIAL
OWNERS ASSOCIATION, INC.
FILED: NOVEMBER 12, 1993
BOOK 93-32, PAGES 3867-3893

TEMPORARY PUBLIC EASEMENT
TO BE GRANTED
BY PLAT FILED: MAR. 17, 1998
(98C-72) (4.9861 ACRES)
VACATED BY VACATION ACTION
(97C-182)

0.6399 ACRE
EASEMENT (SOUTH PINO TRIBUTARY) GRANTED
TO AMAFCA AND HIGH DESERT RESIDENTIAL
OWNERS ASSOCIATION, INC.
FILED: JUNE 11, 1997
(97C-182)

CURVE	BEARING	LENGTH	TANGENT	CHORD	CHORD BEARING	DELTA
C1	N89°49'44"E	42.72	21.60	42.49	N89°22'36"E	20°44'34"
C2	N82°03'43"E	43.55	79.68	52.05	N82°03'43"E	47°39'55"
C3	N80°00'00"E	150.28	344.32	N00°00'00"E	N00°00'00"E	360°00'00"
C4	N83°00'00"E	56.08	179.27	50.19	N83°00'00"E	42°11'54"
C5	N80°00'00"E	102.62	288.80	58.57	N80°00'00"E	54°45'31"
C6	N80°00'00"E	125.41	245.52	58.24	N80°00'00"E	54°45'31"
C7	N80°00'00"E	125.41	245.52	58.24	N80°00'00"E	54°45'31"
LOT NUMBER	SQUARE FOOTAGE
114	119,360.00 SQ. FT.
115	119,360.00 SQ. FT.
116	119,360.00 SQ. FT.
TANGENT	BEARING	DISTANCE
T1	N89°49'44"E	42.72
T2	N82°03'43"E	43.55
T3	N80°00'00"E	150.28
T4	N83°00'00"E	56.08
T5	N80°00'00"E	102.62
T6	N80°00'00"E	125.41
T7	N80°00'00"E	125.41
T8	N80°00'00"E	125.41
T49	N80°00'00"E	125.41

TANGENT	BEARING	DISTANCE
T1	N89°49'44"E	42.72
T2	N82°03'43"E	43.55
T3	N80°00'00"E	150.28
T4	N83°00'00"E	56.08
T5	N80°00'00"E	102.62
T6	N80°00'00"E	125.41
T7	N80°00'00"E	125.41
T8	N80°00'00"E	125.41
T49	N80°00'00"E	125.41

JOB NO. 97-416A-05

Bolman-Huston

Computed One 7500 JEFFERSON NE Albuquerque NEW MEXICO 87109

ENGINEERS PLANNERS PHOTOGRAMMETRISTS SURVEYORS SOFTWARE DEVELOPERS

SHEET 3 OF 4

TRACT 15D-1A-1
5.0107 AC.

EASEMENT (SOUTH PINO TRIBUTARY) GRANTED
TO AMAFCA AND HIGH DESERT RESIDENTIAL
OWNERS ASSOCIATION, INC.
FILED: NOVEMBER 12, 1993
BOOK 93-32, PAGES 3867-3893

TRACTS 4C-1, 15D-1A & 15D-1B
HIGH DESERT
FILED: MARCH 17, 1998
(98C-72)

EASEMENT (SOUTH PINO TRIBUTARY) GRANTED
TO AMAFCA AND HIGH DESERT RESIDENTIAL
OWNERS ASSOCIATION, INC.
FILED: NOVEMBER 12, 1993
BOOK 93-32, PAGES 3867-3893

EASEMENT (A PORTION OF HIGHLANDS
DENDRIC ARROYOS) GRANTED TO
AMAFCA, HIGH DESERT RESIDENTIAL
OWNERS ASSOCIATION, INC. AND
HIGH DESERT INVESTMENT CORPORATION
FILED: JULY 1, 1996
BOOK 96-18, PAGES 3732-3779

TRACT 15D-1A-1
5.0107 AC.

EASEMENT (SOUTH PINO TRIBUTARY) GRANTED
TO AMAFCA AND HIGH DESERT RESIDENTIAL
OWNERS ASSOCIATION, INC.
FILED: NOVEMBER 12, 1993
BOOK 93-32, PAGES 3867-3893

TRACTS 4C-1, 15D-1A & 15D-1B
HIGH DESERT
FILED: MARCH 17, 1998
(98C-72)

EASEMENT (SOUTH PINO TRIBUTARY) GRANTED
TO AMAFCA AND HIGH DESERT RESIDENTIAL
OWNERS ASSOCIATION, INC.
FILED: NOVEMBER 12, 1993
BOOK 93-32, PAGES 3867-3893

GENERAL NOTES:

1. WHEN CONFLICTS EXIST BETWEEN THE "STANDARD SPECIFICATIONS" AND THE "PLANS" ("PLANS" SHALL MEAN THE SHEETS NUMBERED 1 OF 21 THROUGH 21 OF 21 ENTITLED "CONSTRUCTION PLANS FOR THE HIGHLANDS AT HIGH DESERT, UNIT 4"), THE CONSTRUCTION OBSERVER SHALL BE NOTIFIED IMMEDIATELY FOR RESOLUTION. IN GENERAL, THE PLANS SHALL GOVERN.
2. ALL WORK ON THIS PROJECT SHALL BE PERFORMED IN ACCORDANCE WITH APPLICABLE FEDERAL, STATE, AND LOCAL LAWS, RULES AND REGULATIONS GOVERNING CONSTRUCTION SAFETY AND HEALTH.
3. PRIOR TO CONSTRUCTION, THE CONTRACTOR SHALL EXCAVATE AND VERIFY THE HORIZONTAL AND VERTICAL LOCATIONS OF ALL POTENTIAL OBSTRUCTIONS. SHOULD A CONFLICT EXIST, THE CONTRACTOR SHALL NOTIFY THE CONSTRUCTION OBSERVER SO THAT THE CONFLICT CAN BE RESOLVED WITH A MINIMUM AMOUNT OF DELAY.
4. FIVE (5) WORKING DAYS PRIOR TO ANY EXCAVATION, THE CONTRACTOR SHALL CONTACT LINE LOCATING SERVICE FOR LOCATION OF EXISTING UTILITIES.
5. ALL ELECTRICAL, TELEPHONE, CABLE TV, AND OTHER UTILITY LINES, CABLES, AND APPURTENANCES ENCOUNTERED DURING CONSTRUCTION THAT REQUIRE RELOCATION, SHALL BE COORDINATED WITH THAT UTILITY OWNER. THE CONTRACTOR SHALL BE RESPONSIBLE FOR COORDINATION OF ALL NECESSARY UTILITY ADJUSTMENTS.
6. IT WILL BE THE CONTRACTOR'S RESPONSIBILITY TO PROTECT AND MAINTAIN IN SERVICE, ALL EXISTING UTILITIES.
7. THE CONTRACTOR SHALL BE REQUIRED TO CONFINE ITS WORK WITHIN THE CONSTRUCTION LIMITS AND/OR PUBLIC RIGHT-OF-WAY TO PRESERVE EXISTING VEGETATION AND PRIVATE PROPERTY. THE CONTRACTOR SHALL AT ALL TIMES TRY TO MINIMIZE THE DISTURBANCE TO THE EXISTING VEGETATION. CONTRACTOR SHALL ERECT TEMPORARY FENCE AT 5' OFFSET FROM CONSTRUCTION LIMITS AS SHOWN USING 6-1/2' LONG 4' HIGH T-POST AT 40' ON CENTER. INSTALL ONE STRAND OF SMOOTH WIRE ON TOP OF POSTS WITH FLAGGING PLACED ALONG WIRE. CONTRACTOR SHALL CONFINE WORK AREA WITHIN LIMITS OF FENCING.
8. THE CONTRACTOR SHALL OBTAIN ALL THE NECESSARY PERMITS PRIOR TO COMMENCING CONSTRUCTION (I.E. BARRICADING, TOPSOIL DISTURBANCE AND EXCAVATION PERMITS, ETC.)
9. ALL TRENCHES AND EXCAVATIONS SHALL BE SLOPED, SHORED, SHEETED, BRACED, OR OTHERWISE SUPPORTED ACCORDING TO OSHA CONSTRUCTION SAFETY AND HEALTH STANDARDS. JOB SAFETY IS THE SOLE RESPONSIBILITY OF THE CONTRACTOR.
10. BLASTING USING EXPLOSIVES SHALL NOT BE PERMITTED. THE USE OF OTHER TECHNIQUES SHALL BE DONE IN ACCORDANCE WITH MANUFACTURER'S RECOMMENDATIONS AND APPROVED BY THE CONSTRUCTION OBSERVER AND THE CITY OF ALBUQUERQUE.
11. CONTRACTOR SHALL OBTAIN A COPY OF SOILS REPORT FROM THE CONSTRUCTION OBSERVER PRIOR TO BEGINNING CONSTRUCTION.
12. ALL STATIONING IS BASED ON STREET CENTERLINE, UNLESS OTHERWISE NOTED.
13. CONTRACTOR SHALL COORDINATE WITH PNM, ELECTRIC & GAS AND JONES INTERCABLE FOR THE INSTALLATION OF THEIR FACILITIES. CONTRACTOR SHALL SCHEDULE THOSE UTILITIES SO AS TO ALLOW WORK TO PROCEED IN A TIMELY MANNER BY THE CONTRACTOR AND THE UTILITY FIRMS.
14. IF THE CONTRACTOR DOES NOT CONFINE ITS WORK WITHIN THE CONSTRUCTION LIMITS, THE CONTRACTOR SHALL PROVIDE BARRICADING AND/OR LANDSCAPE ALL AREAS DISTURBED AT THE CONTRACTOR EXPENSE (SEE NOTE 7 ABOVE.)

WATERLINES REQUIREMENTS:

1. TEMPORARY WATERLINE CONNECTIONS FOR CONSTRUCTION PURPOSES SHALL BE INCIDENTAL TO THE PROJECT. THE CONTRACTOR SHALL MAKE ARRANGEMENTS WITH THE CITY OF ALBUQUERQUE FOR USE OF EXISTING FIRE HYDRANTS FOR CONSTRUCTION WATER. THE COST OF PERMITS, METERS, AND WATER USAGE SHALL BE INCIDENTAL TO OTHER BID ITEMS. THE FIRE HYDRANTS WITHIN THE THE HIGHLANDS SUBDIVISION MAY NOT BE USED FOR CONSTRUCTION WATER. CONTRACTOR SHALL ADVISE HIGH DESERT INVESTMENT CORPORATION OF WHICH HYDRANTS THEY PREFER TO USE FOR CONSTRUCTION WATER PRIOR TO OBTAINING PERMITS FROM THE CITY OF ALBUQUERQUE.

CONSTRUCTION SIGNING: UNLESS GOVERNED BY A SPECIFIC PLAN, THE FOLLOWING NOTES APPLY:

- A. ALL BARRICADES AND SIGNING SHALL CONFORM TO APPLICABLE SECTIONS OF THE "MANUAL ON UNIFORM TRAFFIC CONTROL DEVICES" (MUTCD), U.S. DEPARTMENT OF TRANSPORTATION, LATEST DIVISION EDITION.
- B. CONTRACTOR SHALL PREPARE A CONSTRUCTION SIGNING PLAN AND OBTAIN APPROVAL OF SUCH PLAN FROM THE CITY OF ALBUQUERQUE, TRAFFIC DIVISION, PRIOR TO BEGINNING ANY CONSTRUCTION WORK ON OR ADJACENT TO EXISTING STREETS.
- C. CONTRACTOR SHALL MAINTAIN ALL BARRICADES AND SIGNING AT ALL TIMES. THE CONTRACTOR SHALL VERIFY THE PROPER LOCATION OF ALL BARRICADES AT THE END AND BEGINNING OF EACH DAY.

SPECIAL NOTES FOR CONTRACTOR - CORPS 404 PERMIT REQUIREMENTS:

THE FOLLOWING CONDITIONS WERE PLACED ON THE PROJECT BY THE CORP OF ENGINEERS, SECTION 404, NATIONWIDE PERMIT:

1. AVOID DISTURBANCE TO THE GRAMA GRASS CACTUS WHEREVER POSSIBLE.
2. PROTECT FISH AND WILDLIFE RESOURCES
 - A. STORE FUELS, LUBRICANTS, HYDRAULIC FLUIDS AND OTHER PETROCHEMICALS OUTSIDE THE 100-YEAR FLOODPLAIN.
 - B. INSPECT CONSTRUCTION EQUIPMENT DAILY TO ENSURE THAT NO LEAKS OR DISCHARGES OR LUBRICANTS, HYDRAULIC FLUIDS OR FUELS OCCUR IN THE AQUATIC OR RIPARIAN ECOSYSTEM, AND
 - C. CONTAIN PETROCHEMICAL SPILLS, INCLUDING CONTAMINATED SOIL, AND DISPOSE AT AN UPLAND SITE.
3. CONSTRUCTION WITHIN 200 FEET OF ARCHEOLOGICAL SITES ELIGIBLE FOR THE NATIONAL REGISTER OF HISTORIC PLACES (LA 86078, LA 86079, LA 99727) WILL NOT BEGIN UNTIL AFTER THE CROPS HAS NOTIFIED YOU THAT COORDINATION WITH THE NEW MEXICO STATE HISTORIC PRESERVATION OFFICER IS COMPLETE.
4. THE CORPS WILL BE NOTIFIED IMMEDIATELY IF ANY PREVIOUSLY UNDISCOVERED CULTURAL RESOURCES ARE ENCOUNTERED DURING ANY CONSTRUCTION OPERATIONS. CONSTRUCTION WILL CEASE IN THE IMMEDIATE VICINITY OF THE RESOURCE UNTIL THE SIGNIFICANCE AND DISPOSITION OF THE RESOURCE HAS BEEN EVALUATED IN ACCORDANCE WITH CODE OF FEDERAL REGULATIONS 36 (CFR) 800.11.

MISCELLANEOUS NOTES:

1. ALL BOULDERS ENCOUNTERED DURING THE COURSE OF CONSTRUCTION SHALL BE PRESERVED AND STOCK PILED BY CONTRACTOR AT A LOCATION, ON SITE, DETERMINED BY OWNER.
2. CONTRACTOR SHALL MAINTAIN IN PLACE, AT ALL TIMES, ALL EXISTING AND TEMPORARY FENCES ON SITE.

RECLAMATION NOTES:

1. SEE SUPPLEMENT SPECIFICATION BOOKLET ENTITLED "HIGH DESERT COMMUNITY RESTORATION AND ENHANCEMENT PLAN" DATED NOVEMBER 1994 FOR RESTORATION AND ENHANCEMENT PLAN SPECIFICATIONS.
2. ALL DISTURBED AREAS SHALL BE RESTORED IN ACCORDANCE WITH THE SPECIFICATIONS PROVIDED IN THE ABOVE MENTIONED SPECIFICATION BOOKLET.
3. WORK AREAS SHALL BE LIMITED TO DESIGNATED ROAD RIGHT-OF-WAY AND EASEMENTS AS SHOWN ON THE PLANS. WORK OUTSIDE OF THE RIGHT-OF-WAY OR EASEMENTS IN HIGH DESERT PROPERTY IS NOT ALLOWED WITHOUT WRITTEN CONSENT FROM HIGH DESERT INVESTMENT CORPORATION.
4. COMMENTS OR QUESTIONS CONCERNING THE RESTORATION SPECIFICATIONS SHALL BE DIRECTED TO EITHER THE CONSTRUCTION OBSERVER OR THE LANDSCAPE ARCHITECT.
5. ANY SUBSTITUTION OF PLANT SEED MATERIAL MUST BE APPROVED IN WRITING BY THE CONSTRUCTION OBSERVER.
6. THE CONTRACTOR SHALL WARRANT THE RECLAMATION WORK FOR A PERIOD OF TWO (2) GROWING SEASONS, CONTINGENT UPON ACCEPTANCE BY HIGH DESERT.

CONSTRUCTION ACCESS:

1. THE HIGHLANDS SUBDIVISION-UNIT 4 CONTRACTOR SHALL TAKE ACCESS ONLY FROM THE ACADEMY /TRAMWAY OR SPAIN /TRAMWAY INTERSECTIONS. ACCESS THROUGH THE HIGH DESERT DEVELOPMENT MUST BE COORDINATED AND APPROVED BY THE HIGH DESERT INVESTMENT CORP. DIRECT ACCESS INTO THE HIGHLANDS PROJECT MAY BE TAKEN ONLY FROM THE INTERSECTION OF HIGH DESERT ST. AND IMPERATA ST.
2. THE HIGHLANDS SUBDIVISION CONTRACTOR SHALL COOPERATE IN ALLOWING ACCESS FOR OTHER PROJECTS UNDER CONSTRUCTION NEAR THE HIGHLANDS DEVELOPMENT. ACCESS PROBLEMS SHALL BE COORDINATED WITH HIGH DESERT INVESTMENT CORP. BY ALL CONTRACTORS WORKING WITHIN THE HIGH DESERT COMMUNITY.

EXISTING UTILITIES:


THESE DRAWINGS REFLECT INFORMATION ON UTILITIES GATHERED BY SITE INSPECTION, DISCUSSIONS WITH LOCAL UTILITIES, ENGINEERING OFFICIALS, AND PREVIOUS CONSTRUCTION DRAWINGS PROVIDED TO OR OBTAINED BY THE ENGINEER. IT IS POSSIBLE THAT THE EXACT LOCATION OF LINES IN THE IMMEDIATE VICINITY OF THE PROJECT MAY BE SLIGHTLY DIFFERENT FROM THE LOCATION SHOWN ON THIS DRAWING. IF ADDITIONAL LINES ARE ENCOUNTERED, THEY SHALL BE EXPOSED AND IDENTIFIED BY THIS CONTRACTOR. WHERE ADDITIONAL LINES AND/OR DIFFERING LOCATIONS ARE ENCOUNTERED, THIS CONTRACTOR SHALL REQUEST THAT THE ENGINEER MAKE A RULING AS TO ANY NECESSARY CHANGE OF MATERIALS, RE-ROUTING, ABANDONING OR RELOCATING OF SUCH LINES. GAS COMPANY, PNM, US WEST AND/OR CABLE TV SHALL BE THE SOLE AUTHORITY IN RULING ON THE DISPOSITION OF THEIR EXISTING LINES. ALL LINES ENCOUNTERED THAT INTERFERE WITH CONSTRUCTION SHALL BE RELOCATED TO CLEAR CONSTRUCTION (IF ACTIVE) AND SHALL BE REMOVED (IF INACTIVE) BY THIS CONTRACTOR UNDER THIS CONTRACT. ALL BIDDERS ARE CAUTIONED TO INVESTIGATE SITE CONDITIONS BEFORE SUBMITTING THEIR BIDS. ALL EXISTING PIPING SHALL HAVE A MINIMUM EARTH COVERAGE AND DEPTHS SHALL BE ADJUSTED AS REQUIRED TO PROVIDE MINIMUM COVERAGE DUE TO NEW GRADES OR CONSTRUCTION. CONTRACTOR SHALL PAY FOR ANY AND ALL COSTS OF PERMITS, LINE EXTENSIONS, FIRELINES, METER INSTALLATION, ETC., AS REQUIRED BY LOCAL GOVERNING UTILITIES ENGINEERING OFFICIALS.

EROSION CONTROL MEASURES:

1. THE CONTRACTOR SHALL ENSURE THAT NO SOIL ERODES FROM THE SITE INTO PUBLIC RIGHT-OF-WAY. THIS MAY BE ACHIEVED BY CONSTRUCTING TEMPORARY BERMS AT THE CONSTRUCTION LIMITS AND WETTING THE SOIL TO KEEP IT FROM BLOWING.
2. THE CONTRACTOR SHALL PROMPTLY CLEAN UP ANY MATERIAL EXCAVATED WITHIN THE PUBLIC RIGHT-OF-WAY SO THAT THE EXCAVATED MATERIAL IS NOT SUSCEPTIBLE TO BEING WASHED DOWN THE STREET.
3. THE CONTRACTOR SHALL SECURE "TOPSOIL DISTURBANCE PERMIT" PRIOR TO BEGINNING CONSTRUCTION. THE COST OF REQUIRED EROSION CONTROL MEASURES SHALL BE CONSIDERED INCIDENTAL TO THE PROJECT COST.
4. DURING THE MONTHS OF JULY, AUGUST, OR SEPTEMBER, ANY GRADING WITHIN OR ADJACENT OF A WATERCOURSE DEFINED AS A MAJOR FACILITY SHALL PROVIDE FOR EROSION CONTROL AND THE SAFE PASSAGE OF THE 10-YEAR DESIGN STORM RUNOFF DURING THE CONSTRUCTION PHASE.



SANITARY SEWER REQUIREMENTS:

1. THE CONTRACTOR SHALL EXCAVATE THE SANITARY SEWER SERVICES BY STARTING AT THE PLUG AND EXCAVATING BACK TO THE MAIN LINE SO AS TO MINIMIZE DISTURBANCE TO THE SURROUNDING VEGETATION.

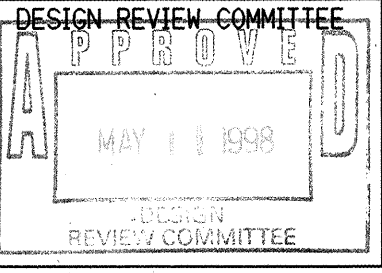 BOHANNAN-HUSTON INC. ENGINEERS • PLANNERS • PHOTOGRAMMETRISTS • SURVEYORS • LANDSCAPE ARCHITECTS ALBUQUERQUE LAS CRUCES SANTA FE			
 CITY OF ALBUQUERQUE PUBLIC WORKS DEPARTMENT ENGINEERING DEVELOPMENT GROUP DESERT HIGHLANDS AT HIGH DESERT THE HIGHLANDS AT HIGH DESERT UNIT 4			
GENERAL NOTES			
 DESIGN REVIEW COMMITTEE APPROVE MAY 1 1999 DESIGN REVIEW COMMITTEE	CITY ENGINEER APPROVAL	LAST DESIGN UPDATE	MO./DAY/YR.
			MO./DAY/YR.
CITY PROJECT NO.		ZONE MAP NO.	SHEET OF
571283		E23	4 21

BHI JOB NO. C97416A03

COPYRIGHT BOHANNAN-HUSTON, INC. 1998
DATE: FEBRUARY, 1998

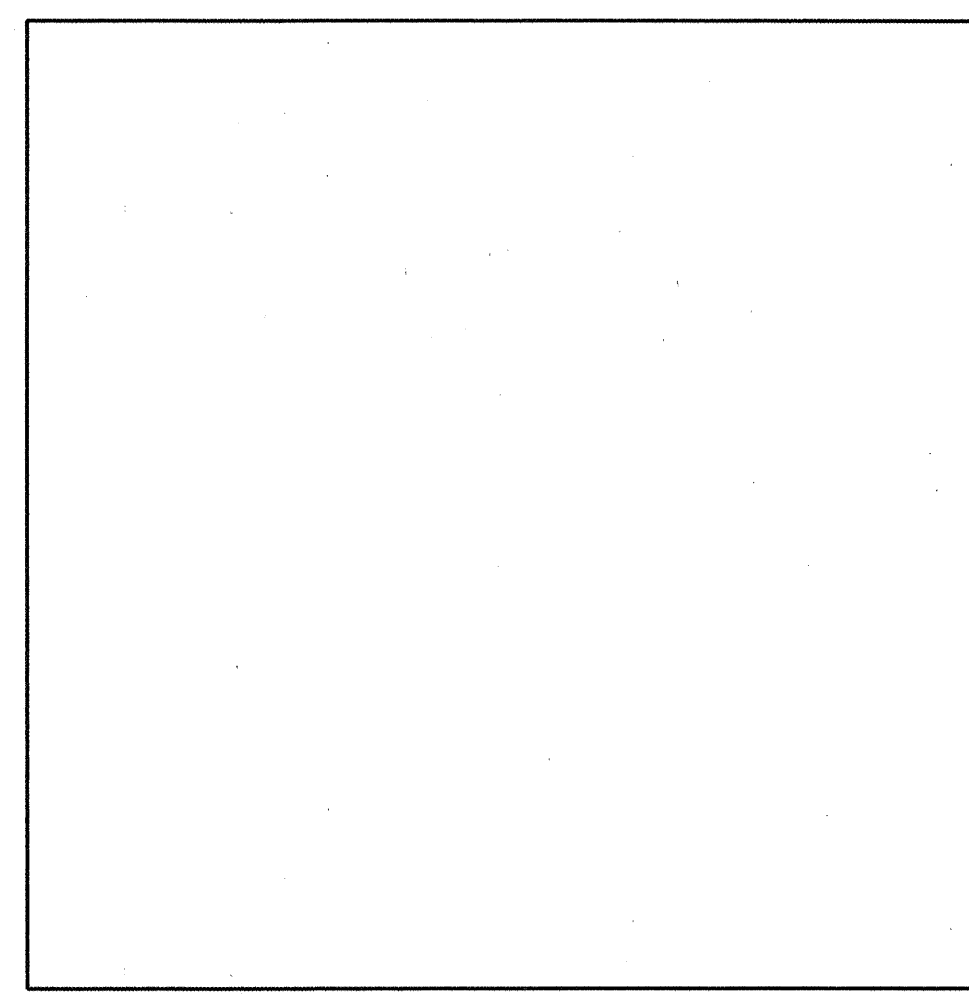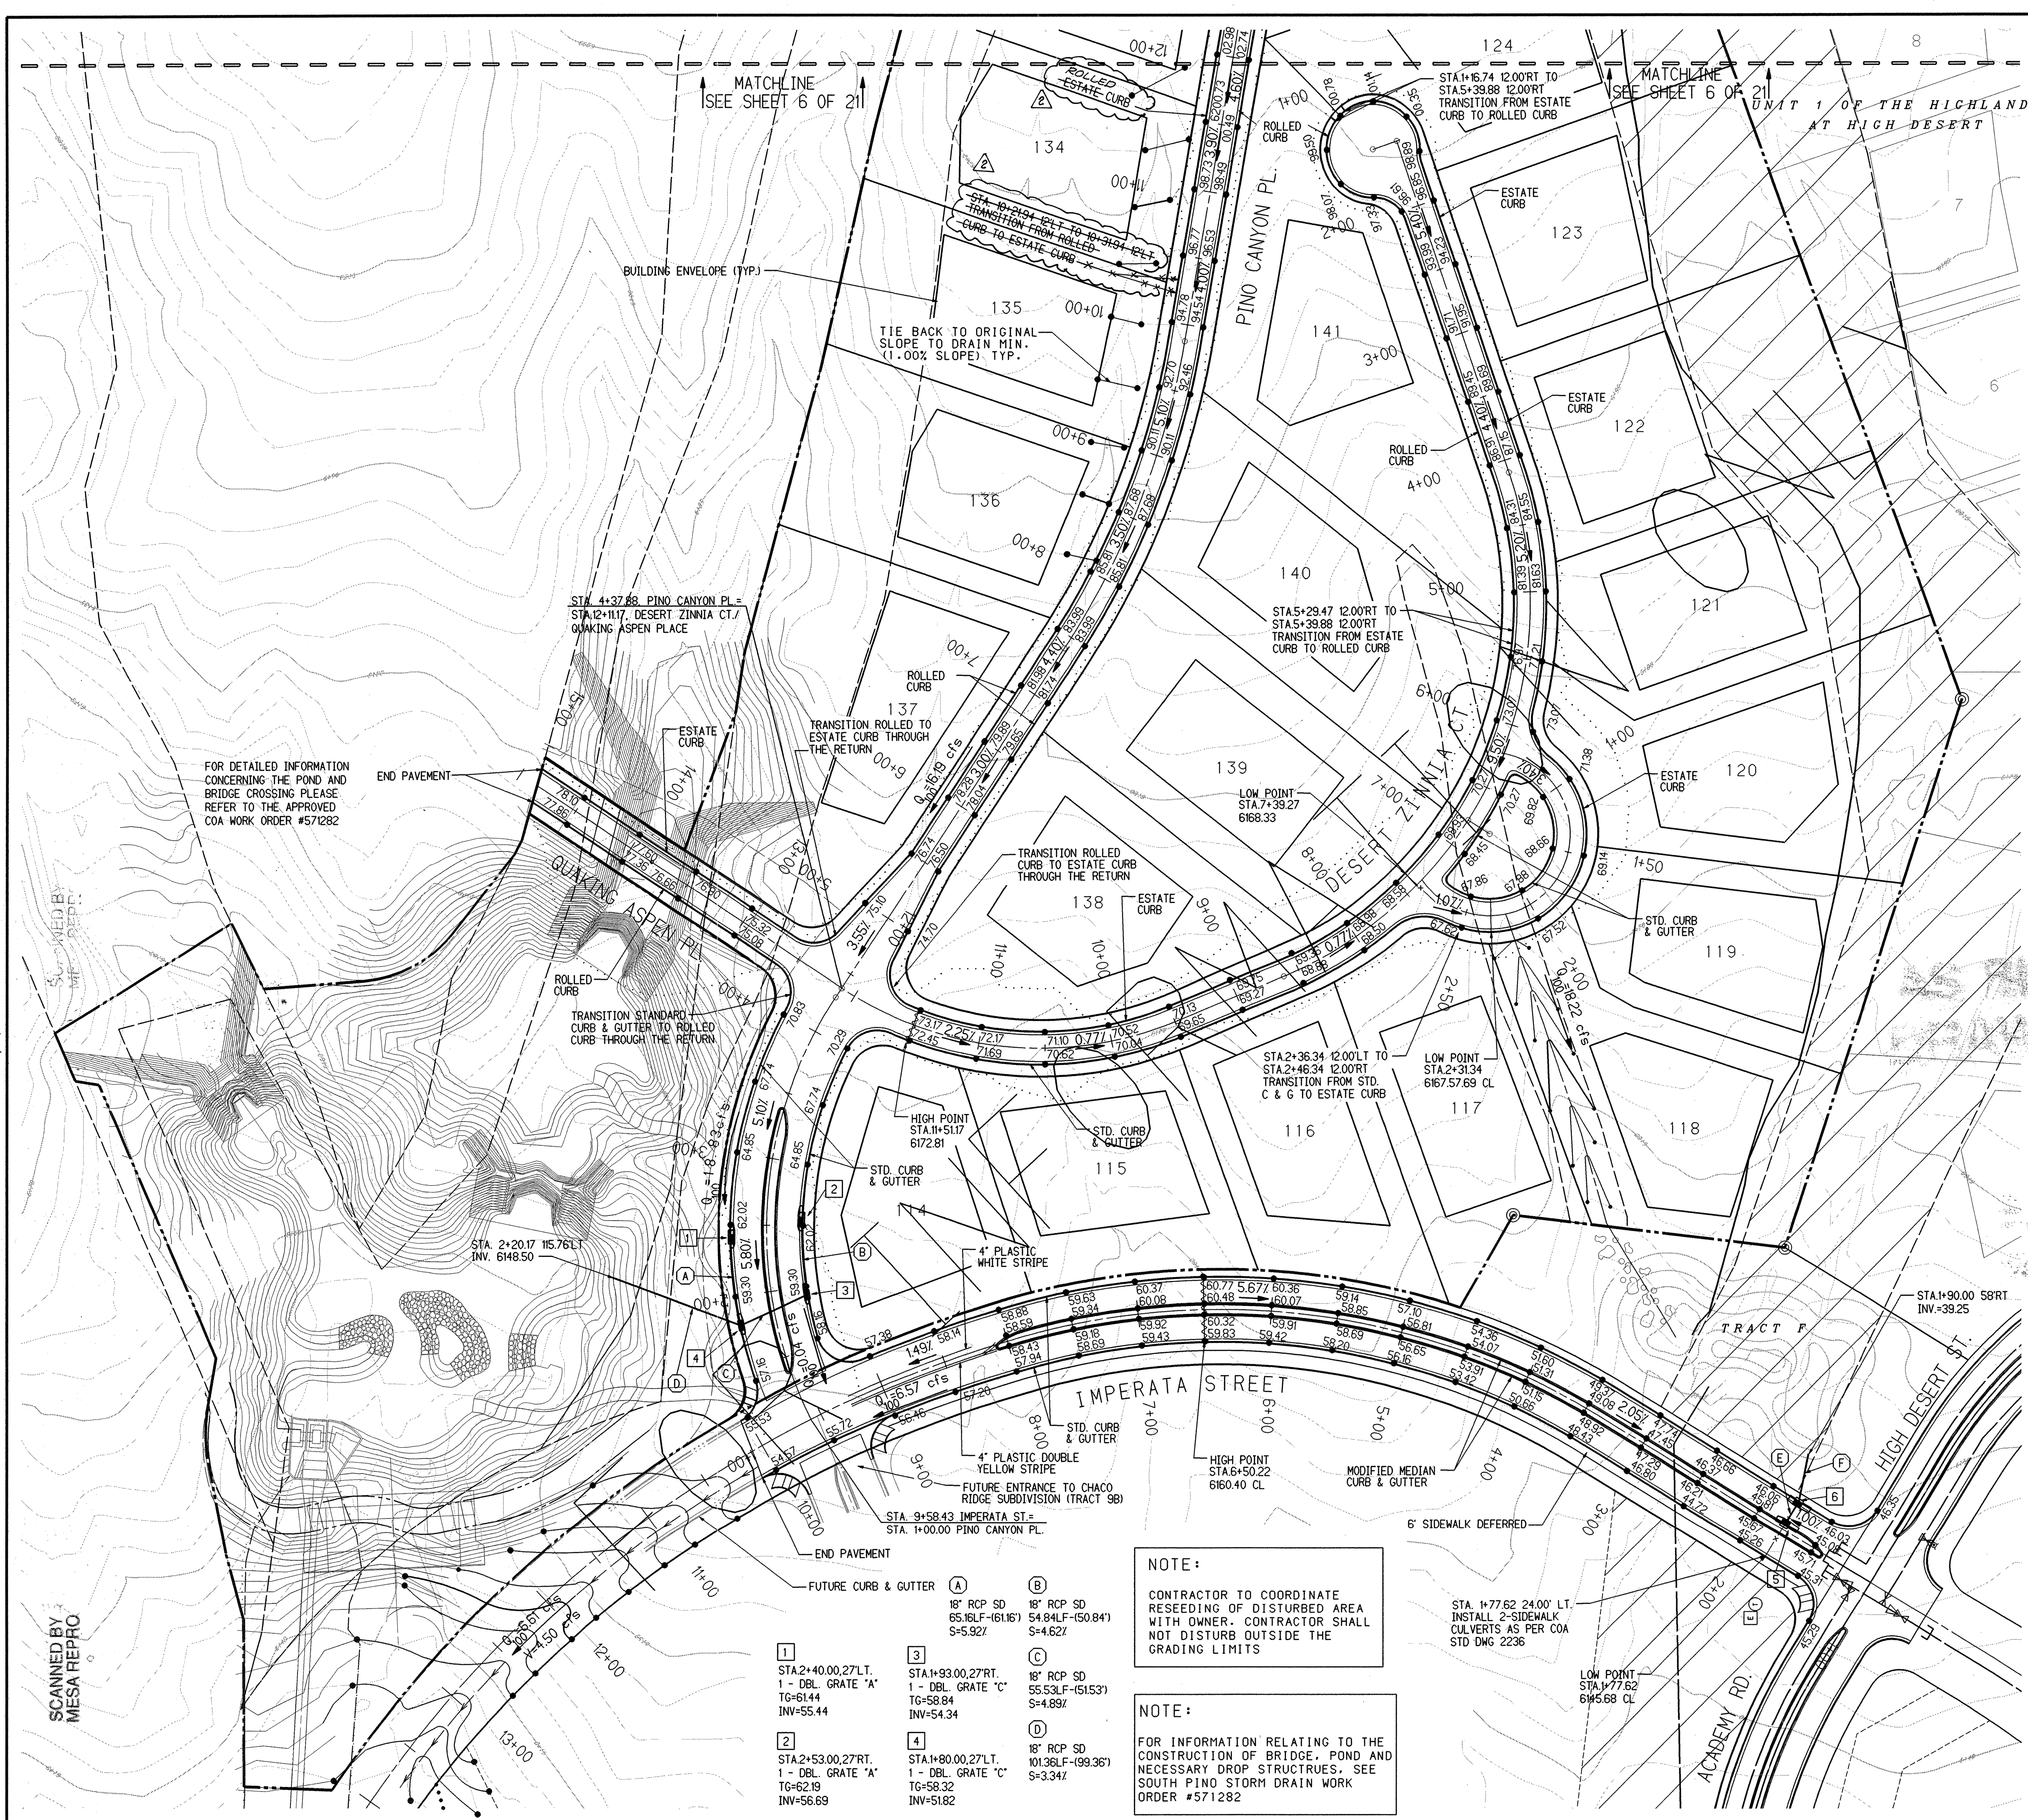


LOCATION MAP
ZONE ATLAS MAP NO. E-23
NO SCALE

GENERAL NOTES

1. CONTRACTOR MUST OBTAIN A TOPSOIL DISTURBANCE PERMIT FROM THE ENVIRONMENTAL HEALTH DIVISION PRIOR TO CONSTRUCTION.
2. THE CONTRACTOR IS TO REFER TO EARTHWORK SPECIFICATION AS NOTED IN THE SOILS REPORT PREPARED BY GEO-TEST, DATED FEBRUARY, 1998.
3. THE CONTRACTOR SHALL CONFORM TO ALL CITY, COUNTY, STATE, AND FEDERAL DUST CONTROL MEASURES AND REQUIREMENTS AND WILL BE RESPONSIBLE FOR PREPARING AND OBTAINING ALL NECESSARY APPLICATIONS AND APPROVALS.
4. ALL SPOT ELEVATIONS ARE TO FLOWLINE ELEV. UNLESS OTHERWISE NOTED.

LEGEND

- PROJECT BOUNDARY
- EXISTING CONTOUR (2' INTERVAL)
- EXISTING INDEX CONTOUR (2' INTERVAL)
- PROPOSED CONTOUR (VARIES)
- PROPOSED INDEX CONTOUR (VARIES)
- EXISTING SPOT ELEVATION
- PROPOSED SPOT ELEVATION
- DIRECTION OF FLOW
- GARDEN WALL
- PROPOSED RETAINING WALL
- EXISTING STORM DRAIN LINE
- EXISTING STORM DRAIN MANHOLE
- EXISTING STORM DRAIN INLET
- PROPOSED STORM DRAIN LINE
- PROPOSED STORM DRAIN MANHOLE
- PROPOSED STORM DRAIN INLET
- BACKYARD POND SYMBOL
- GRADING LIMITS
- PROPOSED CURB AND GUTTER

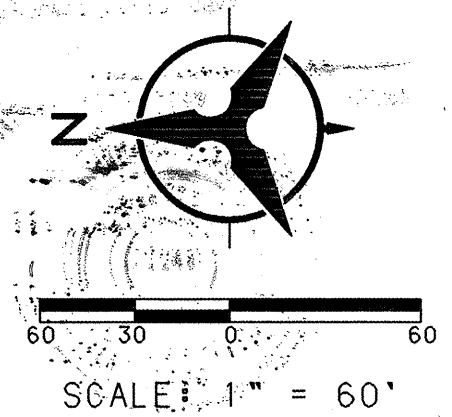

- 5 STA 1+77.62, 4' RT. 1-SINGLE GRATE "C" TG=45.74 INV=39.74
- 6 STA 1+77.62, 24 RT. 1-SINGLE GRATE "C" TG=46.06 INV=39.56
- 7 18" RCP SD 20.00LF (16.00') S=1.00%
- 8 18" RCP SD 36.18LF (34.18') S=0.97%

NOTE:
CONTRACTOR TO COORDINATE RESEEDING OF DISTURBED AREA WITH OWNER. CONTRACTOR SHALL NOT DISTURB OUTSIDE THE GRADING LIMITS

NOTE:
FOR INFORMATION RELATING TO THE CONSTRUCTION OF BRIDGE, POND AND NECESSARY DROP STRUCTURES, SEE SOUTH PINO CANYON DRAIN WORK ORDER #571282

- 1 STA 2+40.00, 27' LT. 1 - DBL. GRATE "A" TG=61.44 INV=55.44
- 2 STA 2+53.00, 27' RT. 1 - DBL. GRATE "A" TG=62.19 INV=56.69
- 3 STA 1+93.00, 27' RT. 1 - DBL. GRATE "C" TG=58.84 INV=54.34
- 4 STA 1+80.00, 27' LT. 1 - DBL. GRATE "C" TG=58.32 INV=51.82
- 5 18" RCP SD 65.16LF (61.16') S=5.92%
- 6 18" RCP SD 54.84LF (50.84') S=4.62%
- 7 18" RCP SD 55.53LF (51.53') S=4.89%
- 8 18" RCP SD 101.36LF (99.36') S=3.34%

AS-BUILT INFORMATION		BENCH MARKS		SURVEY INFORMATION		ENGINEER'S SEAL				
CONTRACTOR	SUNDANCE MECH.	STATION IS A STANDARD UCC & OS BRASS	NO.	BY	DATE		REMARKS DESIGN REVISIONS			
STAKED BY	Survey Co. Inc.	GEOLOGICAL SURVEY BENCH MARK, TOP	NO.	BY	DATE					
FIELD LOCATION BY	BH	TABLET STAMPED "TUMBLE 1969" SET IN CONCRETE PROJECTING 0.2 FEET ABOVE GROUND, LOCATED 489 FEET WEST OF THE INTERSECTION OF SAN ANTONIO DRIVE AND TENNYSON STREET, AND 35 FEET NORTH OF RIGHT-OF-WAY LINE OF SAN ANTONIO DR. ELEV. = 6009.155	NO.	BY	DATE					
CORRECTED BY	NW/SCI	MICRO-FILM INFORMATION	NO.	BY	DATE					
DESIGNED BY		KGP, TSG		DATE		1/98	CITY PROJECT NO. 571283			
DRAWN BY		BS		DATE		1/98				
CHECKED BY		KGP		DATE		1/98				
CITY PROJECT NO.		571283		ZONE MAP NO.		E-23	SHEET	5A	OF	21

APPROVED FOR ROUGH GRADING (± 1")

HYDROLOGY ENGINEER _____ DATE _____

BOHANNAN-HUSTON INC.
ENGINEERS • PLANNERS • PHOTOGRAMMETRISTS • SURVEYORS • LANDSCAPE ARCHITECTS
ALBUQUERQUE LAS CRUCES SANTA FE


CITY OF ALBUQUERQUE
PUBLIC WORKS DEPARTMENT
ENGINEERING DEVELOPMENT GROUP
DESERT HIGHLANDS AT HIGH DESERT
UNIT 4 OF THE HIGHLANDS AT HIGH DESERT
(OVERALL GRADING PLAN FOR INFORMATION ONLY)

DESIGN REVIEW BOARD NO. **97-535** APPROVAL DATE **1/1**

LAST DESIGN UPDATE



NOTE:
CONTRACTOR TO COORDINATE RESEEDING OF DISTURBED AREA WITH OWNER. CONTRACTOR SHALL NOT DISTURB OUTSIDE THE GRADING LIMITS

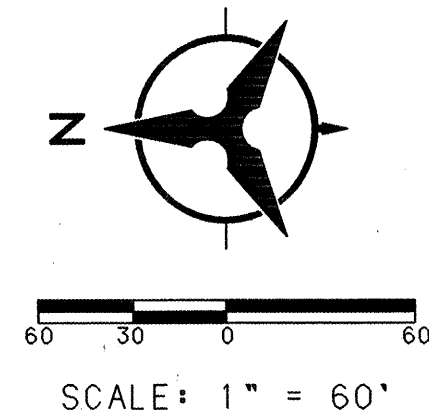

GENERAL NOTES

1. CONTRACTOR MUST OBTAIN A TOPSOIL DISTURBANCE PERMIT FROM THE ENVIRONMENTAL HEALTH DIVISION PRIOR TO CONSTRUCTION.
2. THE CONTRACTOR IS TO REFER TO EARTHWORK SPECIFICATION AS NOTED IN THE SOILS REPORT PREPARED BY GEO-TEST, DATED FEBRUARY, 1998.
3. THE CONTRACTOR SHALL CONFORM TO ALL CITY, COUNTY, STATE, AND FEDERAL DUST CONTROL MEASURES AND REQUIREMENTS AND WILL BE RESPONSIBLE FOR PREPARING AND OBTAINING ALL NECESSARY APPLICATIONS AND APPROVALS.
4. THE CONTRACTOR SHALL ENSURE THAT NO SOIL ERODES FROM THE LOTS INTO PUBLIC RIGHT-OF-WAY. THIS CAN BE ACHIEVED BY CONSTRUCTING TEMPORARY BERMS AS PER DETAIL THIS SHEET AND WETTING THE SOIL TO KEEP IT FROM BLOWING.
5. ALL SPOT ELEVATIONS ARE TO FLOWLINE ELEV. UNLESS OTHERWISE NOTED.


LEGEND

- PROJECT BOUNDARY: ———
- EXISTING CONTOUR (2' INTERVAL): ———
- EXISTING INDEX CONTOUR (2' INTERVAL): ———
- PROPOSED CONTOUR (1' INTERVAL): ———
- PROPOSED INDEX CONTOUR (1' INTERVAL): ———
- EXISTING SPOT ELEVATION: ○25.5
- PROPOSED SPOT ELEVATION: ●36.6
- DIRECTION OF FLOW: S=2.5642
- GARDEN WALL: ———
- PROPOSED RETAINING WALL: ———
- EXISTING STORM DRAIN LINE: ———
- EXISTING STORM DRAIN MANHOLE: ○
- EXISTING STORM DRAIN INLET: □
- PROPOSED STORM DRAIN LINE: ———
- PROPOSED STORM DRAIN MANHOLE: ○
- PROPOSED STORM DRAIN INLET: □
- BACKYARD POND SYMBOL: ○
- GRADING LIMITS: ———
- PROPOSED STD. CURB AND GUTTER: ———
- PROP. MOUNTABLE CURB ROLL TYPE: ———
- BASIN BOUNDARY: ———

AS BUILT
DRAWING

I hereby certify that the as-built data I have shown herein is true and correct to the best of my knowledge and belief.

[Signature] 10/18/98
ST. LOUIS, MISSOURI

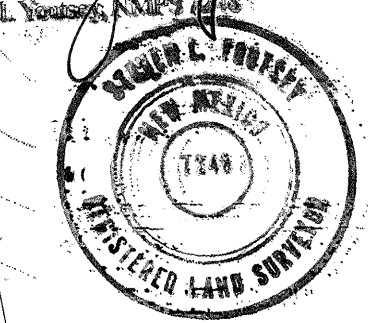


APPROVED FOR ROUGH GRADING (± 1')
[Signature] 4-1-98
HYDROLOGY ENGINEER DATE

BOHANNAN-HUSTON INC.
ENGINEERS • PLANNERS • PHOTOGRAMMETRISTS • SURVEYORS • LANDSCAPE ARCHITECTS
ALBUQUERQUE LAS CRUCES SANTA FE

CITY OF ALBUQUERQUE
PUBLIC WORKS DEPARTMENT
ENGINEERING DEVELOPMENT GROUP
DESERT HIGHLANDS AT HIGH DESERT
UNIT 1 OF THE HIGHLANDS AT HIGH DESERT
OVERALL GRADING PLAN

REVIEW BOARD NO. 97-535 XX-XXX	APPROVAL DATE _/_/_	MO./DAY/YR. _/_/_	MO./DAY/YR. _/_/_
CITY PROJECT NO. 571283	ZONE MAP NO. E-23	SHEET 6	OF 21




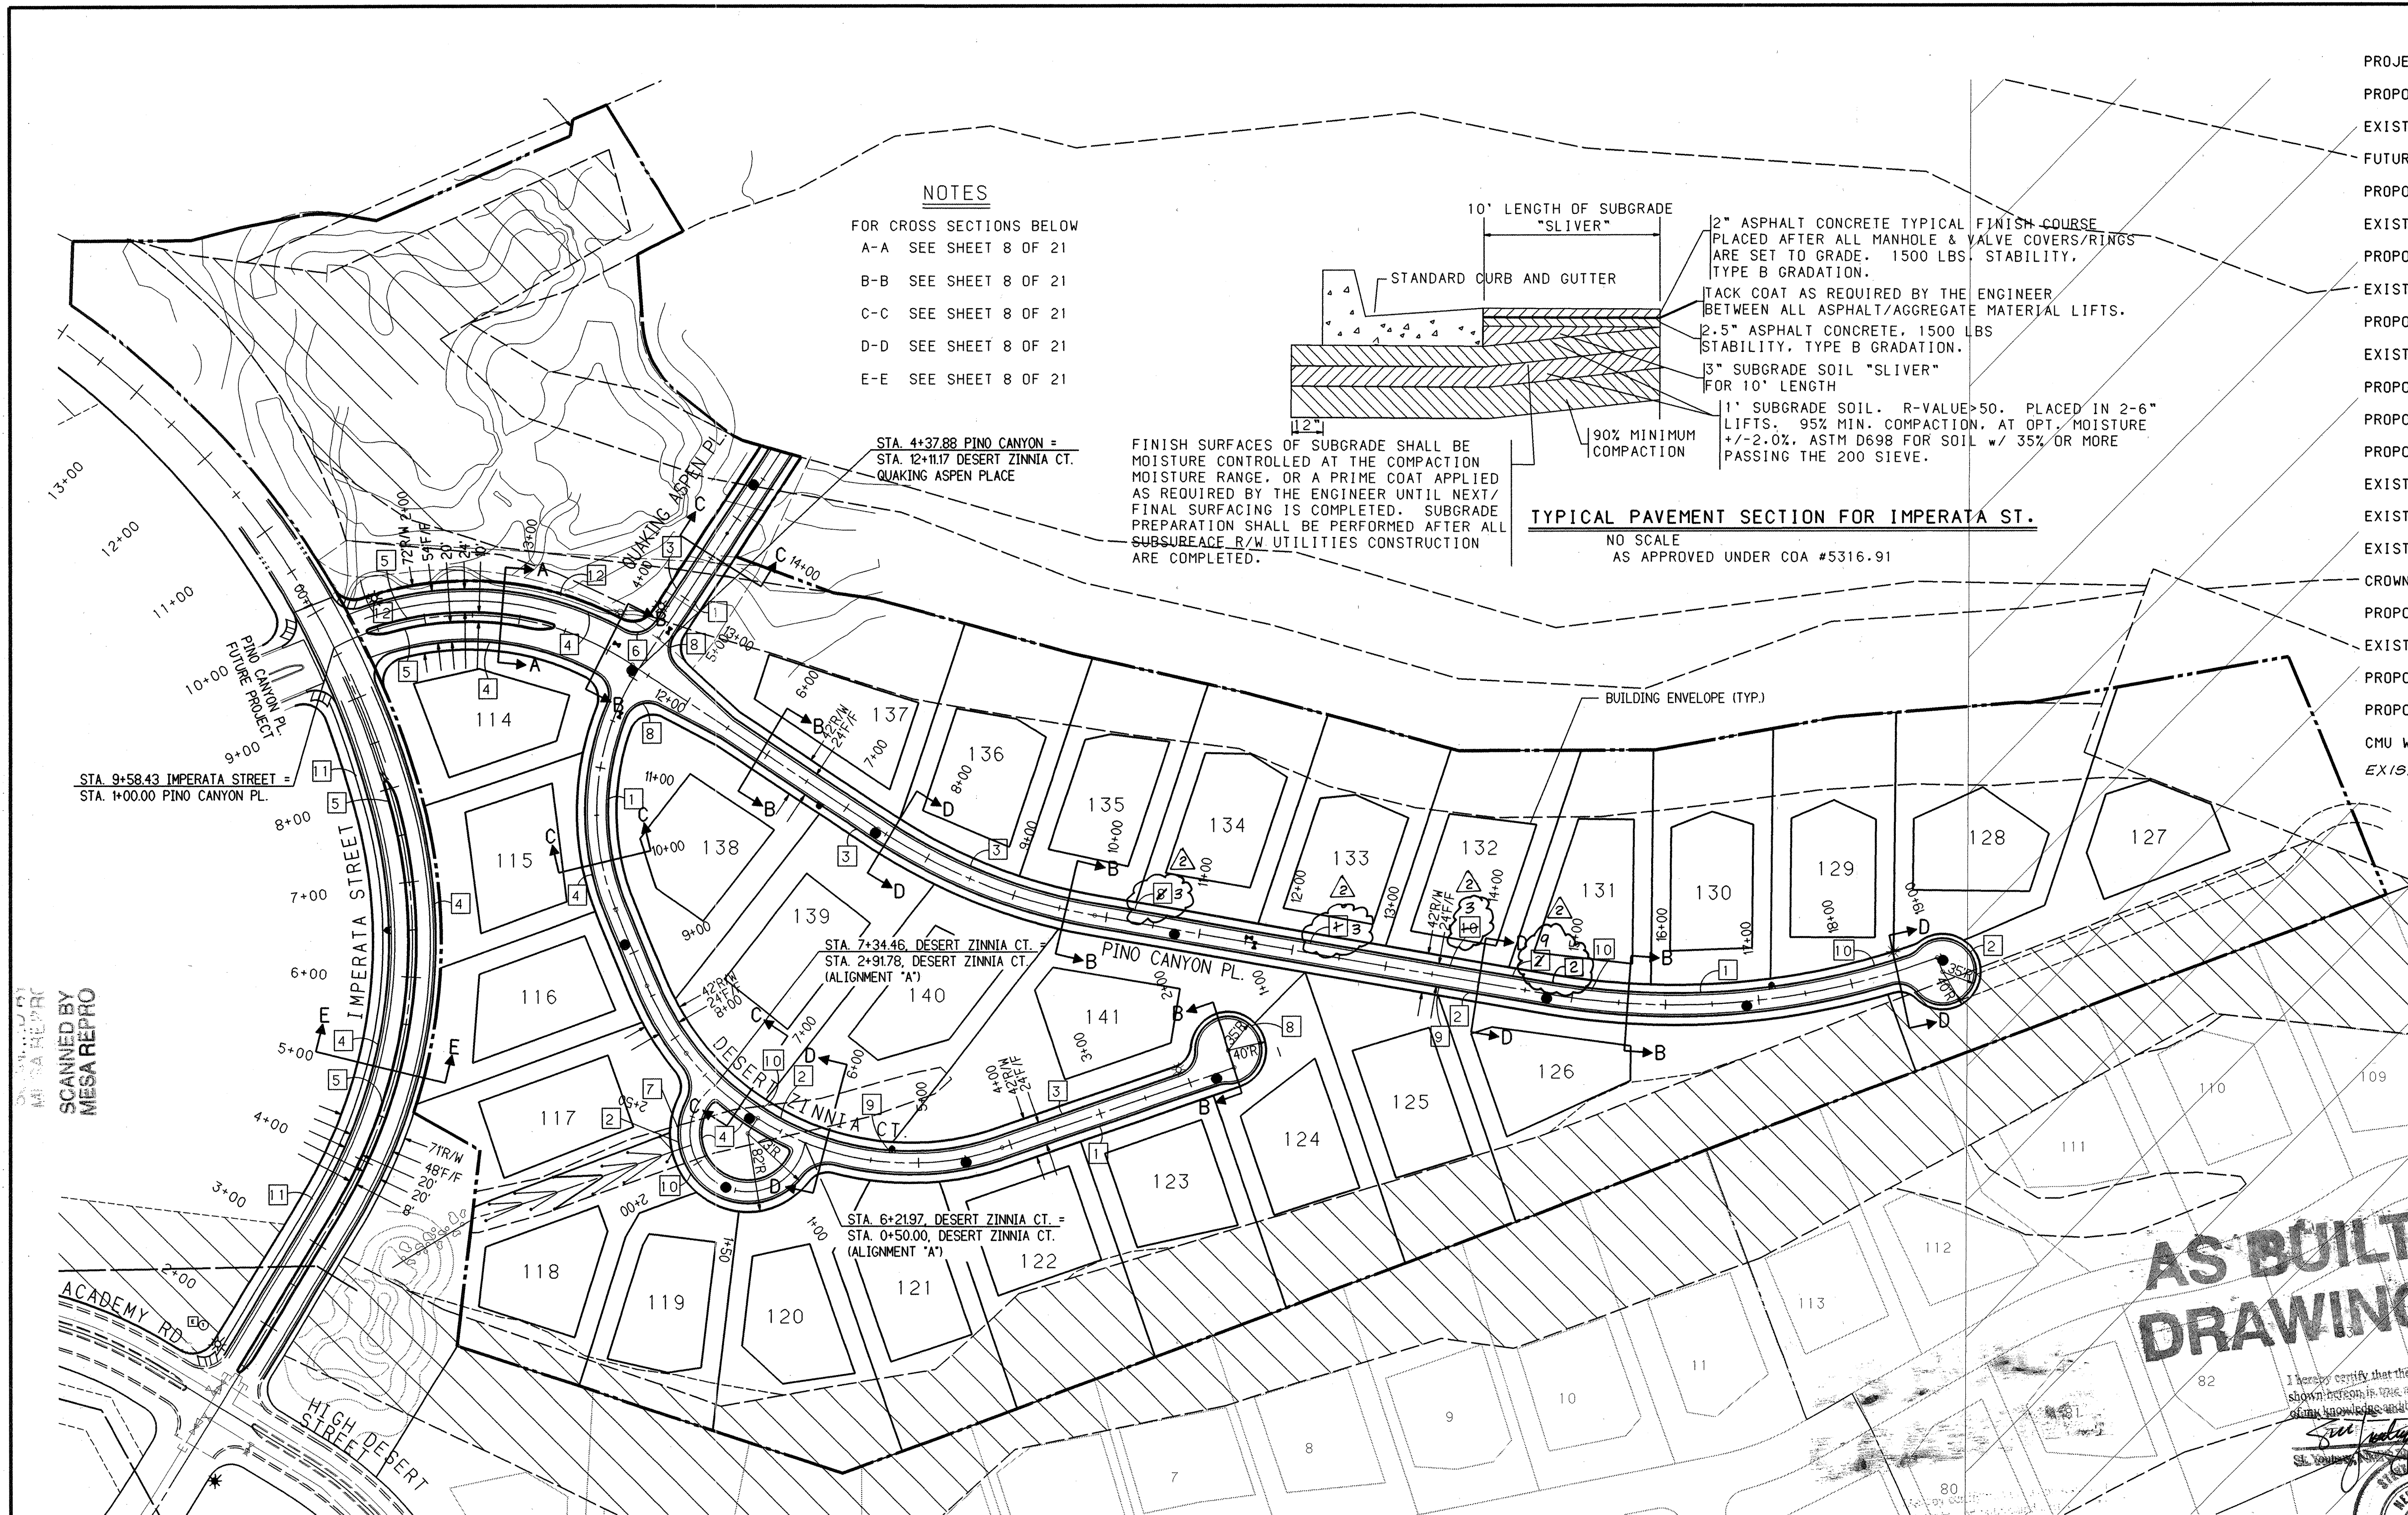

NOTES
FOR CROSS SECTIONS BELOW
A-A SEE SHEET 8 OF 21
B-B SEE SHEET 8 OF 21
C-C SEE SHEET 8 OF 21
D-D SEE SHEET 8 OF 21
E-E SEE SHEET 8 OF 21

STA 4+37.88 PINO CANYON PL. =
STA 12+11.7 DESERT ZINNIA CT.
QUAKING ASPEN PLACE


FINISH SURFACES OF SUBGRADE SHALL BE MOISTURE CONTROLLED AT THE COMPACTION MOISTURE RANGE, OR A PRIME COAT APPLIED AS REQUIRED BY THE ENGINEER UNTIL NEXT/ FINAL SURFACING IS COMPLETED. SUBGRADE PREPARATION SHALL BE PERFORMED AFTER ALL SUBSURFACE R/W UTILITIES CONSTRUCTION ARE COMPLETED.

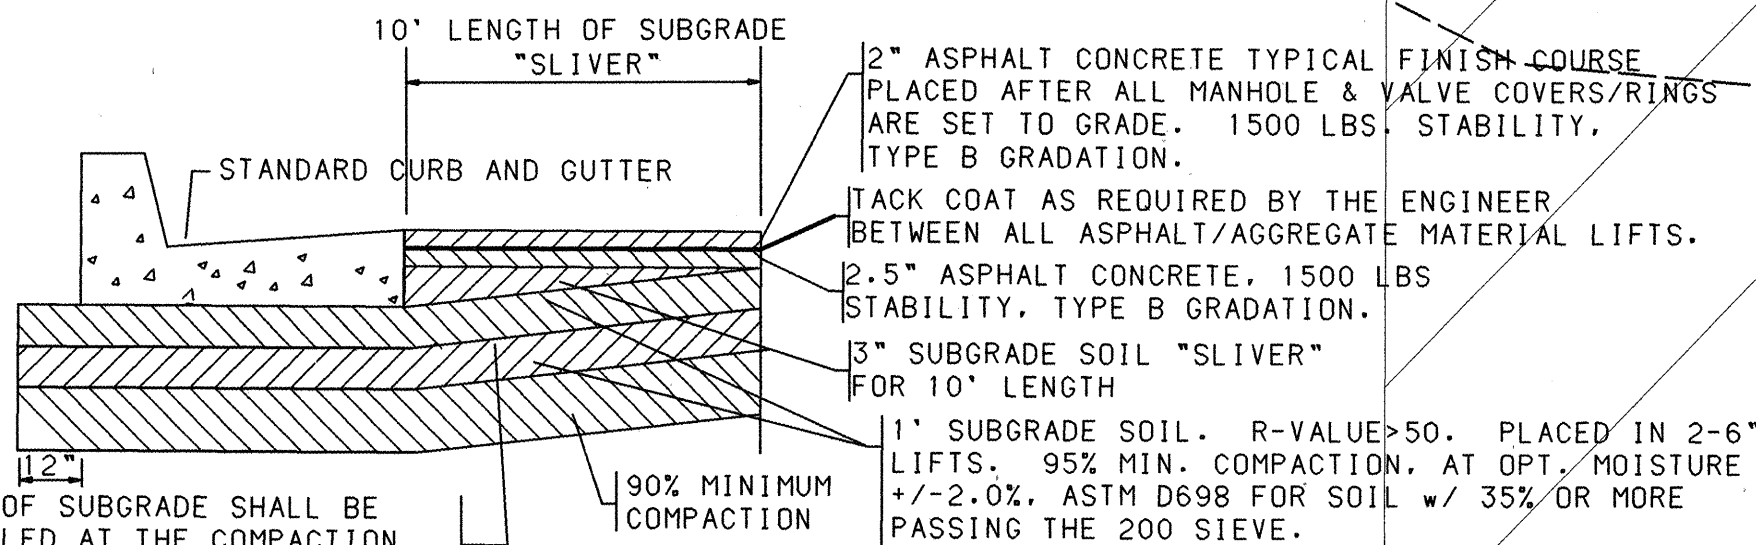

TYPICAL PAVEMENT SECTION FOR IMPERATA ST.
NO SCALE
AS APPROVED UNDER COA #5316.91



LEGEND

PROJECT BOUNDARY	---
PROPOSED CURB & GUTTER	---
EXISTING CURB & GUTTER	---
FUTURE SIDEWALK	---
PROPOSED SANITARY SEWER MANHOLE	●
EXISTING SANITARY SEWER MANHOLE	○
PROPOSED FIRE HYDRANT	●
EXISTING FIRE HYDRANT	○
PROPOSED GATE VALVE	×
EXISTING GATE VALVE	×
PROPOSED STORM DRAIN LINE	SD
PROPOSED STORM DRAIN MANHOLE	●
EXISTING STORM DRAIN LINE	SD
EXISTING STORM DRAIN MANHOLE	○
EXISTING STORM DRAIN INLET	□
CROWN FLATTENING	---
PROPOSED CONDUIT PIPE	---
EXISTING CONDUIT PIPE	---
PROPOSED STREET LIGHT	*
PROPOSED RETAINING WALL	---
CMU WALL	---
EXISTING STREET LIGHT	*

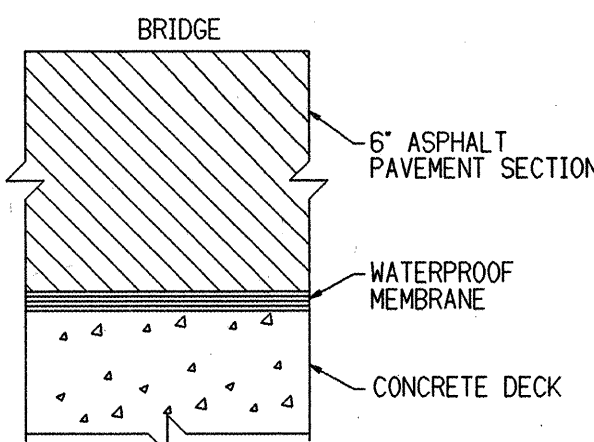


TYPICAL BRIDGE PAVEMENT SECTION
NO SCALE
(REFER TO COA STD DWG 2406)

AS BUILT DRAWING

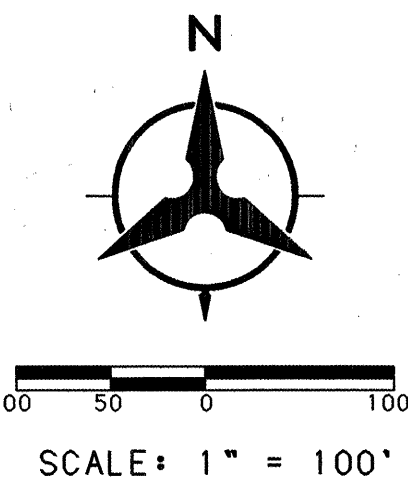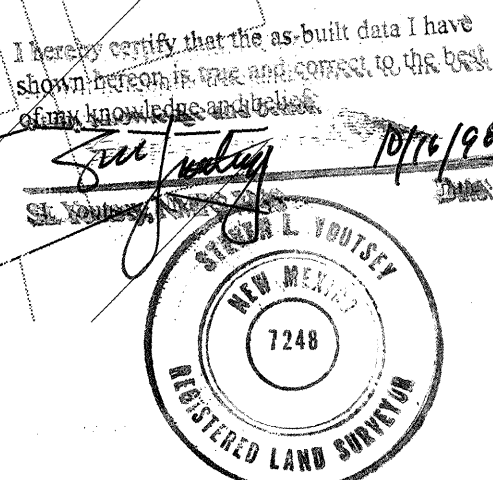


- KEYED NOTES**
- 1 DEPRESSED GUTTER TYPE CURB (MODIFIED) SEE SHEET 8 OF 21
 - 2 RUNDOWN CURB TYPE AS PER STD. DWG. 2415
 - 3 MOUNTABLE CURB ROLL TYPE AS PER STD. DWG. 2415
 - 4 STD. CURB AND GUTTER AS PER STD. DWG. 2415
 - 5 MOUNTABLE MEDIAN CURB (MODIFIED) SEE SHEET 8 OF 21
 - 6 TRANSITION FROM STD. CURB & GUTTER TO MOUNTABLE CURB ROLL TYPE THROUGH THE RETURN.
 - 7 TRANSITION FROM STD. CURB & GUTTER TO RUNDOWN CURB TYPE IN 10 LF.
 - 8 TRANSITION FROM MOUNTABLE CURB ROLL TYPE TO DEPRESSED GUTTER TYPE CURB (MODIFIED) IN 10 LF OR THROUGH THE RETURN
 - 9 TRANSITION FROM MOUNTABLE CURB ROLL TYPE TO RUNDOWN CURB TYPE IN 10 LF.
 - 10 CURB TRANSITION TO MATCH LENGTH OF ROADWAY TRANSITION SEE SHEET 8 OF 21
 - 11 6" SIDEWALK TO BE BUILT WITH SEPARATE LANDSCAPE PLAN
 - 12 BUILD 4" MEANDERING SIDEWALK

NOTE:
SEE PLAN AND PROFILE SHEETS FOR EXACT CURB TYPES & TRANSITIONS

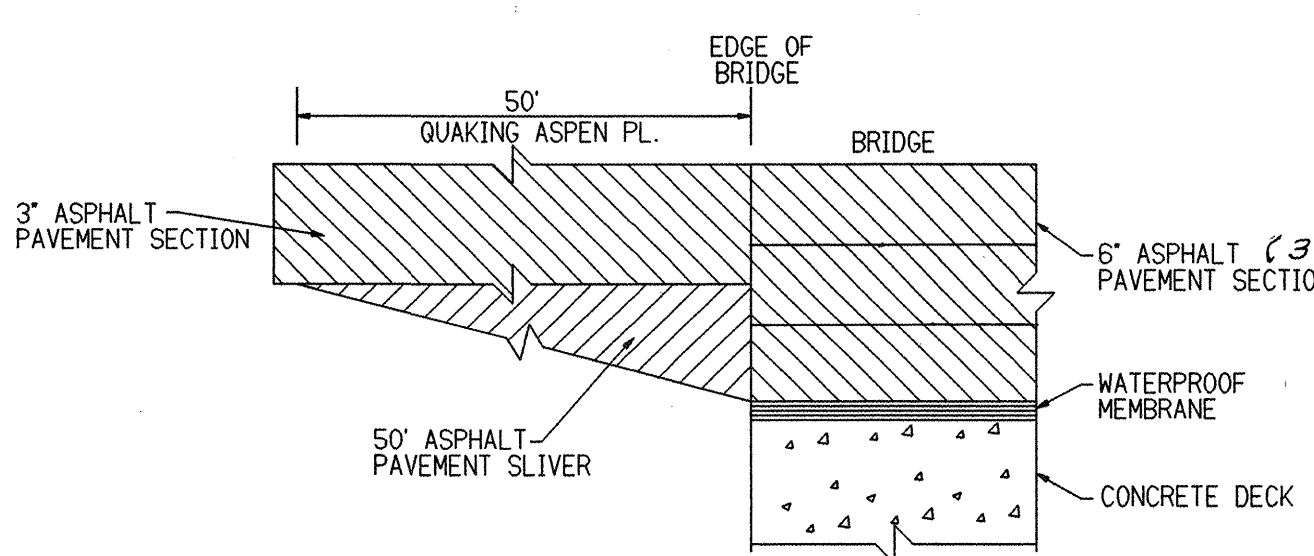

TYPICAL BRIDGE / QUAKING ASPEN PL. PAVEMENT SECTION TRANSITION
NO SCALE
(REFER TO COA STD DWG 2406)

NOTE:
IF THE R-VALUE IS LESS THAN 50 THE CONTRACTOR SHALL NOTIFY THE ENGINEER IMMEDIATELY AT 823-1000 FOR A REVISED PAVEMENT SECTION.

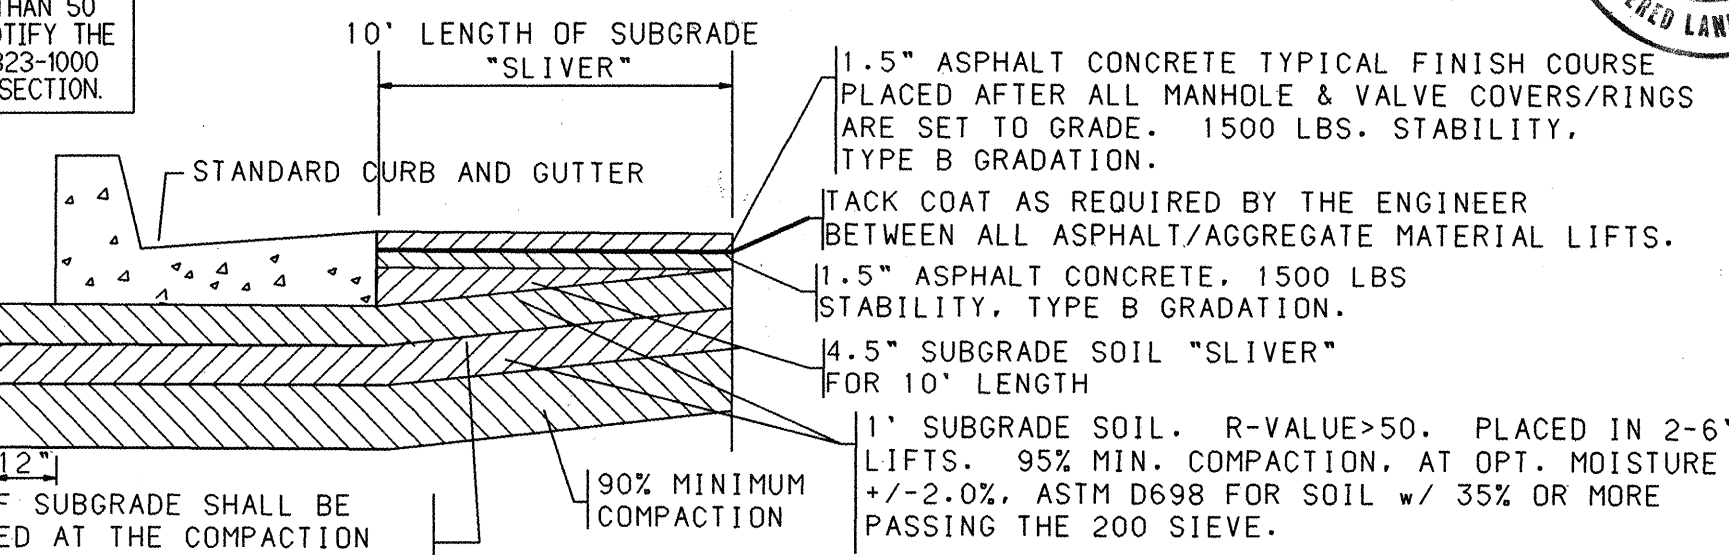


TYPICAL PAVEMENT SECTION
NO SCALE (REFER TO COA STD DWG 2405)

BOHANNAN-HUSTON INC.
ENGINEERS • PLANNERS • PHOTOGRAMMETRISTS • SURVEYORS • LANDSCAPE ARCHITECTS
ALBUQUERQUE LAS CRUCES SANTA FE

CITY OF ALBUQUERQUE
PUBLIC WORKS DEPARTMENT
ENGINEERING DEVELOPMENT GROUP
DESERT HIGHLANDS AT HIGH DESERT
UNIT 4 OF THE HIGHLANDS AT HIGH DESERT
MASTER PAVING PLAN

DESIGN REVIEW COMMITTEE	CITY ENGINEER APPROVAL	MO/DAY/YR.	MO/DAY/YR.
APPROVED MAY 11 1998			
DESIGN REVIEW COMMITTEE			
CITY PROJECT NO.	ZONE MAP NO.	SHEET	OF
571283	E-23	7	21

DESIGNED BY KGP DATE 2/98
DRAWN BY BS, JAOG DATE 2/98
CHECKED BY KGP DATE 2/98

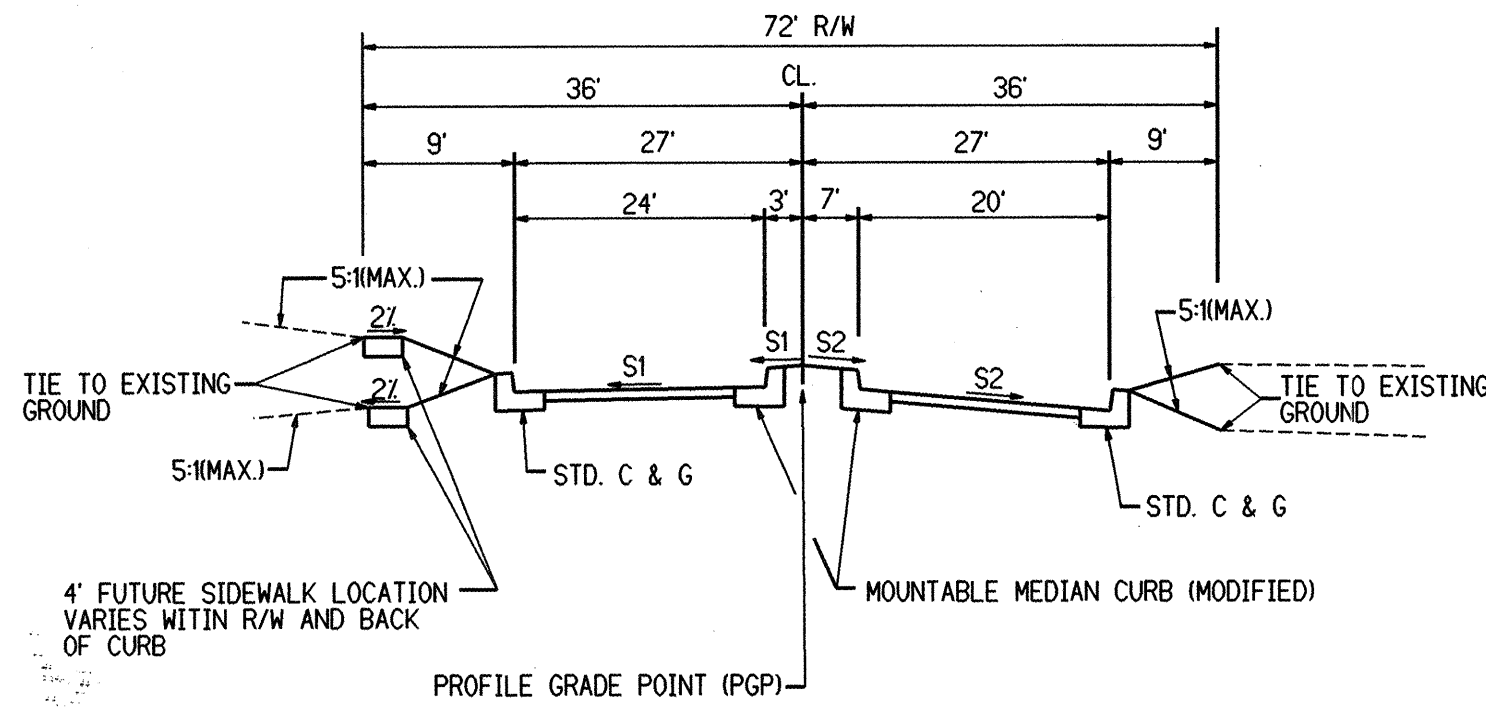


RESIDENTIAL STREET SECTION A - A

NOT TO SCALE

PINO CANYON PLACE
STA 1+30.00 TO 2+10.00
STA 2+10.00 TO 3+25.00
STA 3+25.00 TO 3+50.00
STA 3+50.00 TO 3+75.00
STA 3+75.00 TO 4+25.00

TRANSITION S1=S2=-14% TO S1=-2.00% & S2=2.00%
S1=-2.00% & S2=2.00%
TRANSITION FROM S1=-2.00% & S2=2.00% TO S1=-1.00% & S2=1.00% (FLATTEN MEDIAN)
S1=-1.00% & S2=1.00%
TRANSITION TO SECTION B-B

NOTE
CONTRACTOR SHALL COORDINATE AND VERIFY ALL DATA WITH PAVING PLAN AND PROFILE SHEETS.

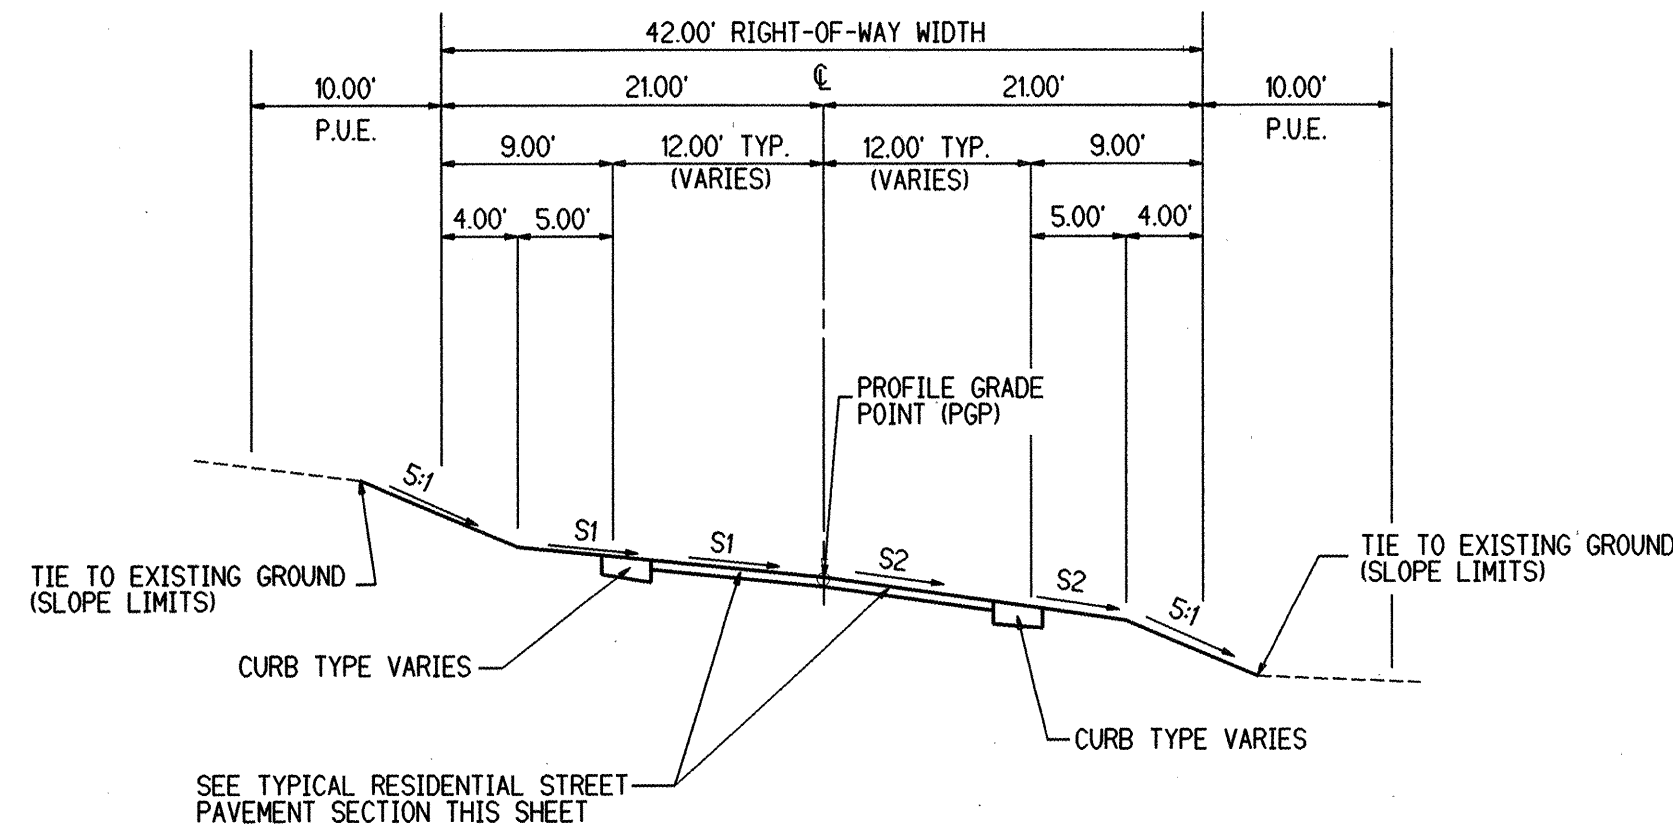

RESIDENTIAL STREET SECTION B - B

NOT TO SCALE


PINO CANYON PLACE
STA 4+00.00 TO 5+50.00
STA 4+25.00 TO 7+25.00
STA 7+25.00 TO 7+50.00
STA 9+50.00 TO 13+75.00
STA 13+75.00 TO 14+00.00
STA 15+50.00 TO 18+25.00
STA 18+25.00 TO 18+50.00

TRANSITION FROM 72.00' R/W TO 42.00' R/W
S1=S2=-1.00%
TRANSITION TO SECTION D-D
S1=S2=-1.00%
TRANSITION TO SECTION D-D
S1=S2=-1.00%
TRANSITION TO SECTION D-D

DESERT ZINNIA COURT
END CUL-DE-SAC TO STA 5+75.00
STA 5+75.00 TO 6+00.00

S1=S2=-1.00%
TRANSITION TO SECTION D-D

NOTE
CONTRACTOR SHALL COORDINATE AND VERIFY ALL DATA WITH PAVING PLAN AND PROFILE SHEETS.

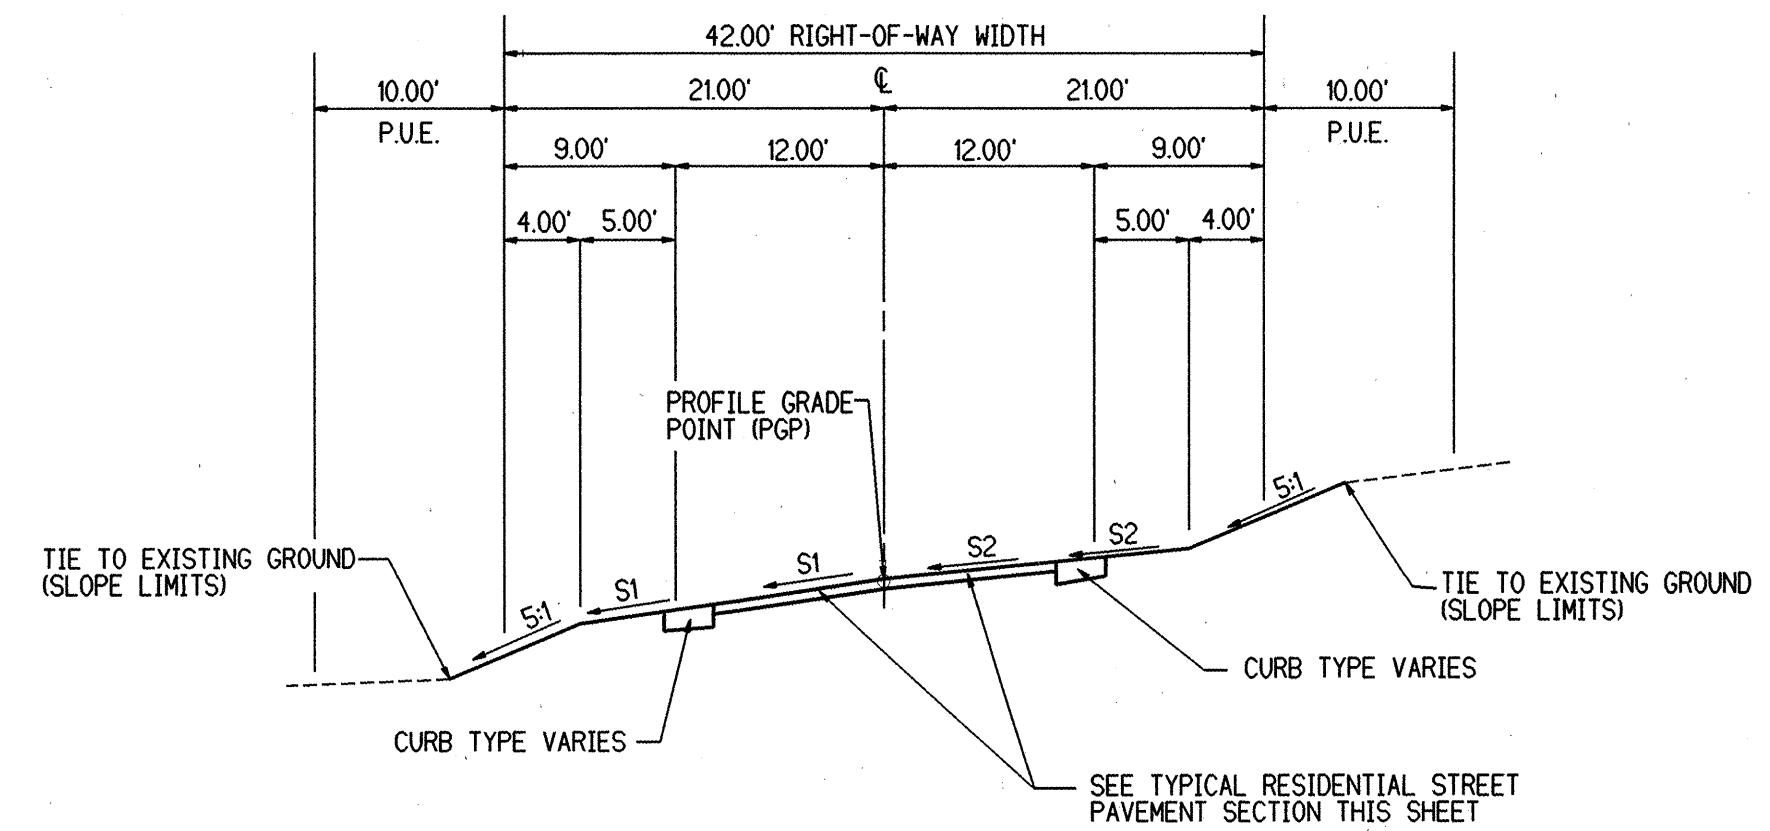


RESIDENTIAL STREET SECTION C - C

NOT TO SCALE

DESERT ZINNIA COURT
STA 7+00.00 TO 11+25.00
STA 11+25.00 TO 11+85.00
STA 11+85.00 TO 12+40.00
STA 12+40.00 TO 13+25.00
QUAKING ASPEN PLACE
STA 13+25.00 TO END OF PAVEMENT

S1=S2=2.00%
TRANSITION S1 & S2 FROM 2.00% TO 4.40%
S1=S2=4.40%
TRANSITION S1 & S2 FROM 4.40% TO 1.00%
S1=S2=1.00%

NOTE
CONTRACTOR SHALL COORDINATE AND VERIFY ALL DATA WITH PAVING PLAN AND PROFILE SHEETS.

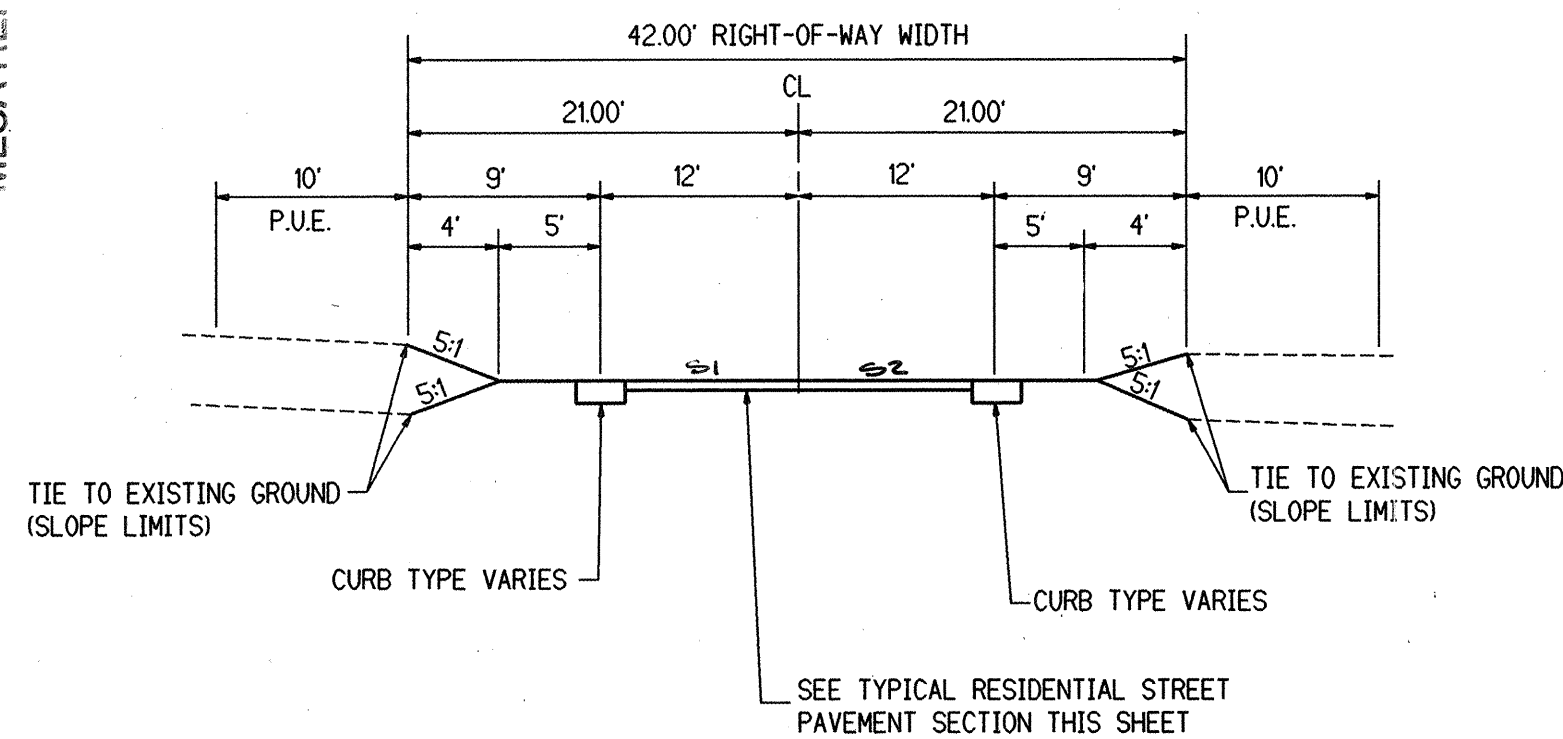

RESIDENTIAL STREET SECTION D - D

NOT TO SCALE


PINO CANYON PLACE
STA 7+50.00 TO 9+25.00
STA 9+25.00 TO 9+50.00
STA 14+00.00 TO 15+25.00
STA 15+25.00 TO 15+50.00
STA 18+50.00 TO END CUL-DE-SAC

S1=S2=0.00%
TRANSITION TO SECTION B-B
S1=S2=0.00%
TRANSITION TO SECTION B-B
S1=S2=0.00%

DESERT ZINNIA COURT
STA 6+00.00 TO 6+50.00
STA 6+50.00 TO 7+00.00

S1=S2=0.00%
TRANSITION TO SECTION C-C

NOTE
CONTRACTOR SHALL COORDINATE AND VERIFY ALL DATA WITH PAVING PLAN AND PROFILE SHEETS.

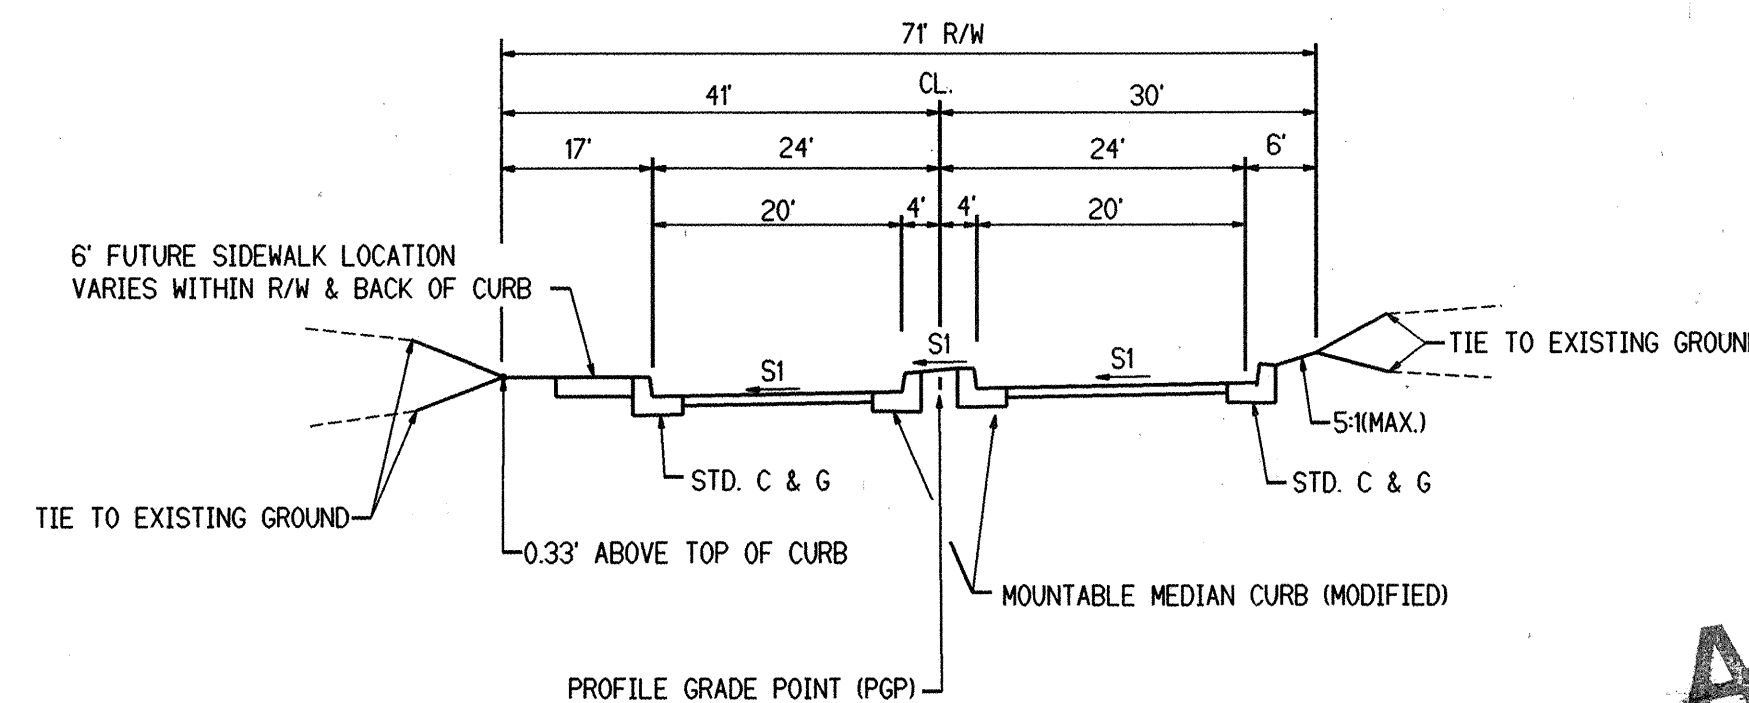


TYPICAL STREET SECTION E - E

NOT TO SCALE

IMPERATA STREET - DIVIDED LOCAL
STA 1+24.00 TO 2+50.00
STA 2+50.00 TO 10+11.63


TRANSITION S1 FROM 15.0% TO 2.00%
S1=2.00%

NOTE
CONTRACTOR SHALL COORDINATE AND VERIFY ALL DATA WITH PAVING PLAN AND PROFILE SHEETS.

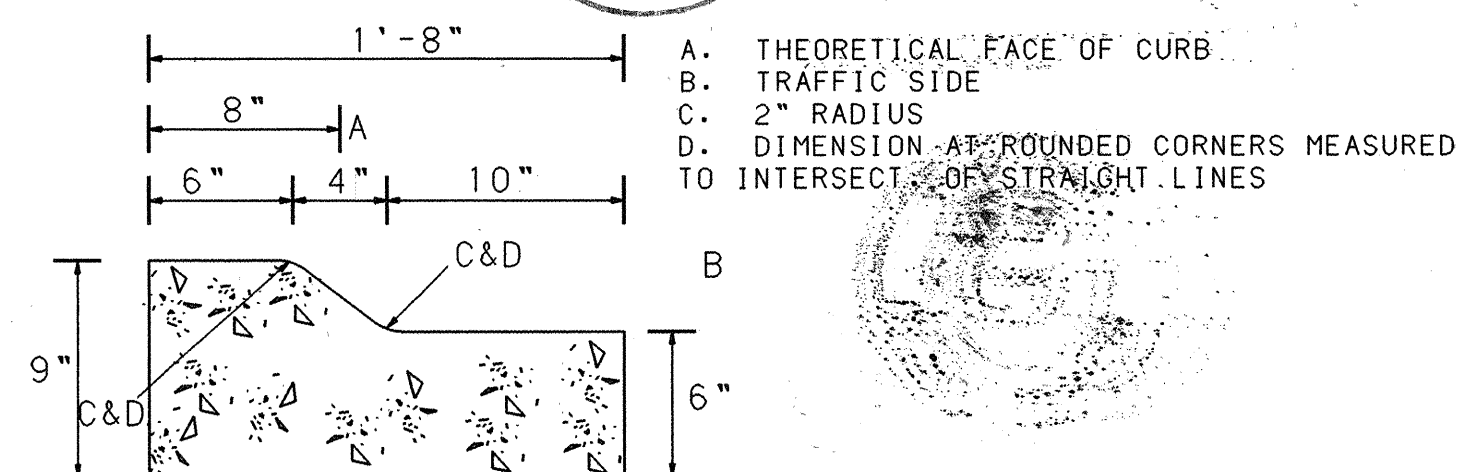

MODIFIED MEDIAN CURB & GUTTER

NO SCALE

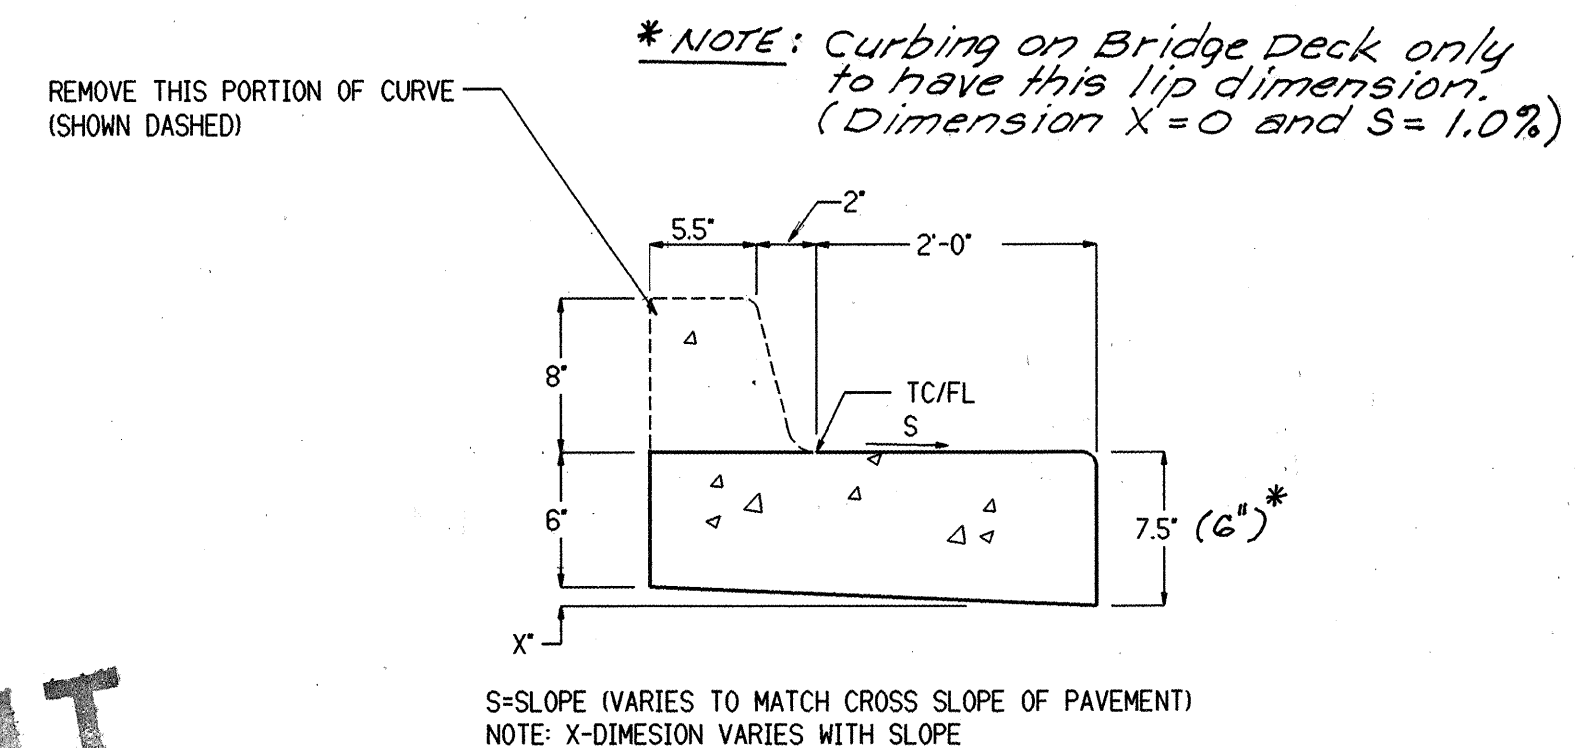

DEPRESSED GUTTER (MODIFIED)

NOTE:
FOR EXACT CURB TYPES AND TRANSITIONING SEE PAVING
PLAN & PROFILE SHEETS

**AS BUILT
DRAWING**

I hereby certify that the as-built data I have shown herein is true and correct to the best of my knowledge and belief.

10/16/98
10/16/98
10/16/98

REGISTERED LAND SURVEYOR

1248


CONSTRUCTION NOTES

- THEORETICAL FACE OF CURB
- TRAFFIC SIDE
- 2" RADIUS
- DIMENSION AT ROUNDED CORNERS MEASURED TO INTERSECT OF STRAIGHT LINES



BOHANNAN-HUSTON INC. ENGINEERS • PLANNERS • PHOTOGRAMMETRISTS • SURVEYORS • LANDSCAPE ARCHITECTS ALBUQUERQUE LAS CRUCES SANTA FE	
CITY OF ALBUQUERQUE PUBLIC WORKS DEPARTMENT ENGINEERING DEVELOPMENT GROUP DESERT HIGHLANDS AT HIGH DESERT UNIT 4 OF THE HIGHLANDS AT HIGH DESERT ROADWAY CROSS SECTIONS	
APPROVED MAY 11 1998 DESIGN REVIEW COMMITTEE	CITY ENGINEER APPROVAL LAST DESIGN UPDATE MO/DAY/YR. MO/DAY/YR.
CITY PROJECT NO. 571283	ZONE MAP NO. E-23
SHEET 8	OF 21

CENTERLINE CURVE DATA TABLE					
NUMBER	PI STA.	DELTA	TANGENT	ARC	RADIUS
C3	16+89.79	30°10'45.4"	215.70'	421.38'	800.00'

CENTERLINE TANGENT DATA		
NUMBER	BEARING	DISTANCE
T2	S80°11'09"E	486.42'
T3	S20°21'55"E	16.05'

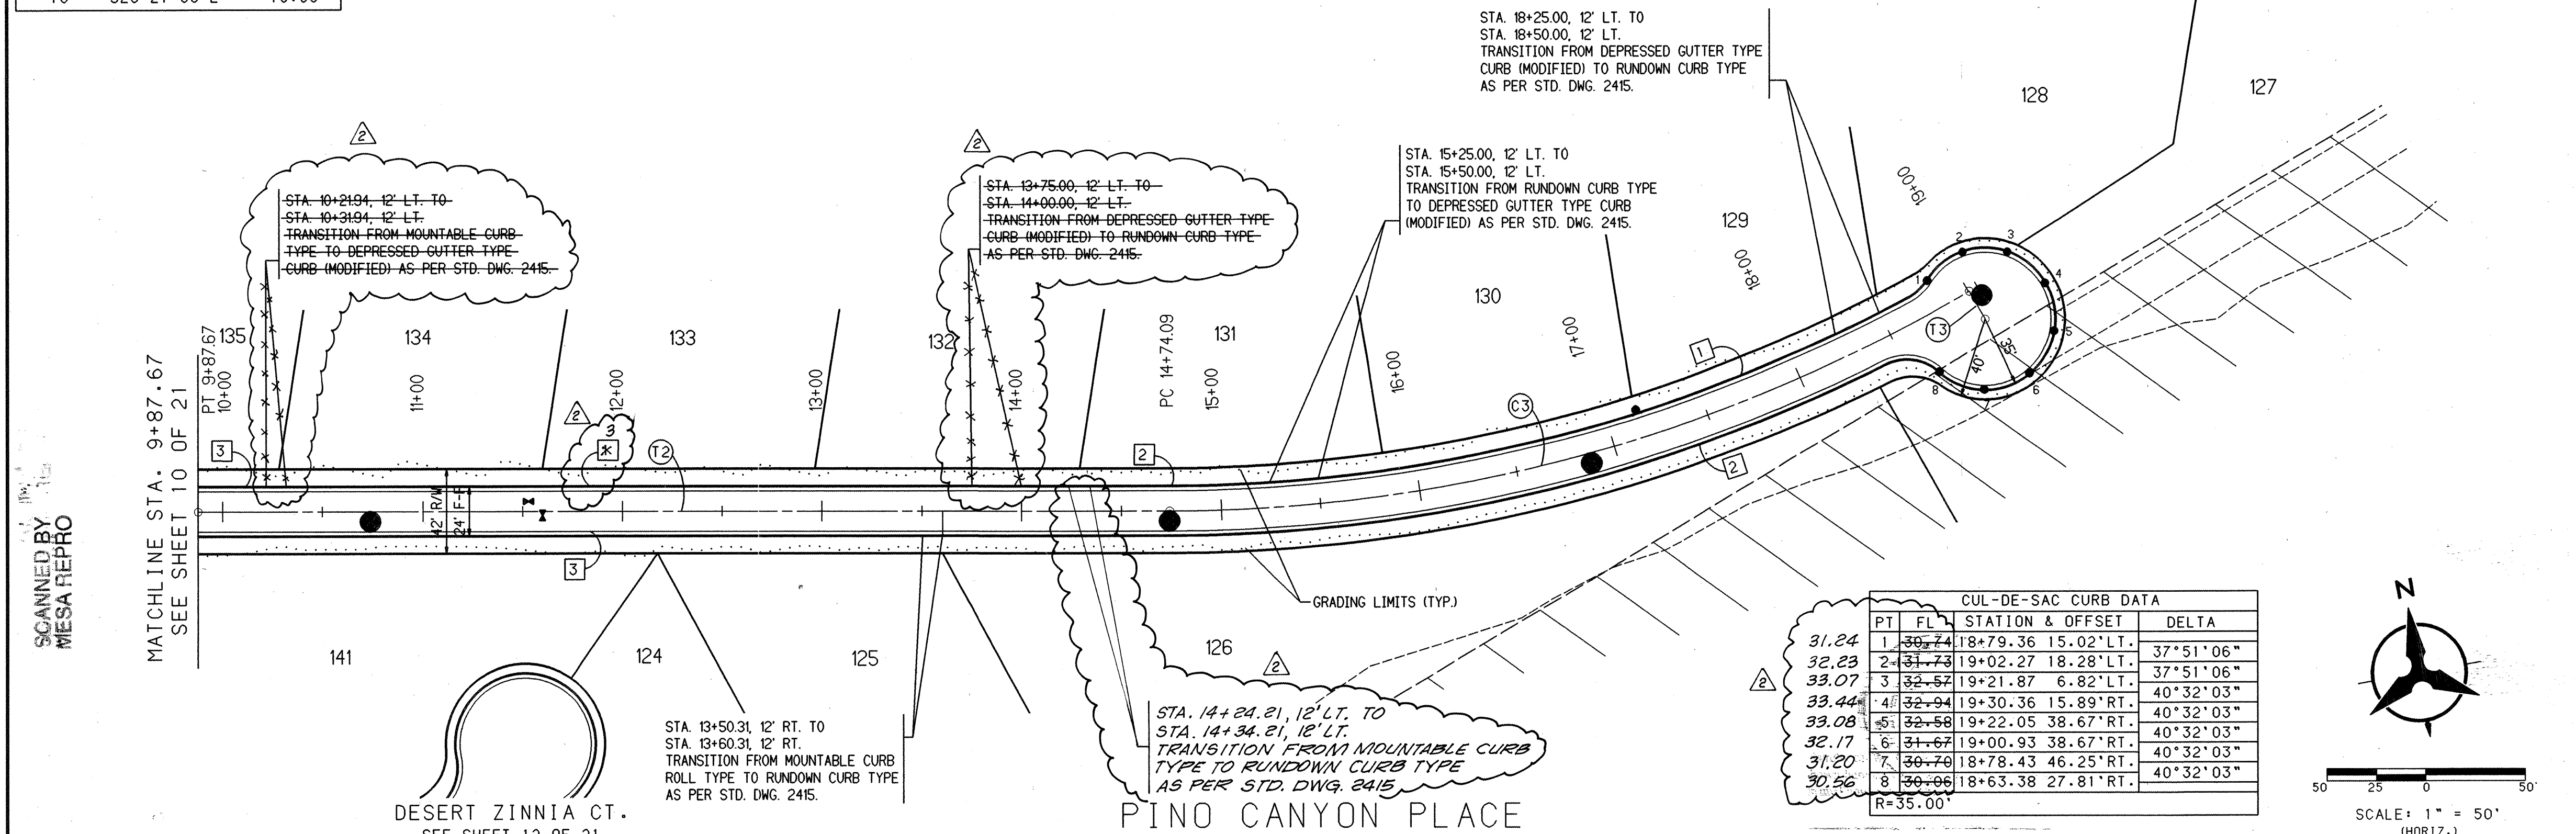

CUL-DE-SAC CURB DATA			
PT	FL	STATION & OFFSET	DELTA
31.24	1	18+79.36 15.02' LT.	37°51'06"
32.23	2	19+02.27 18.28' LT.	37°51'06"
33.07	3	19+21.87 6.82' LT.	40°32'03"
33.44	4	19+30.36 15.89' RT.	40°32'03"
33.08	5	19+22.05 38.67' RT.	40°32'03"
32.17	6	19+00.93 38.67' RT.	40°32'03"
31.20	7	18+78.43 46.25' RT.	40°32'03"
30.56	8	18+63.38 27.81' RT.	40°32'03"
R=35.00'			

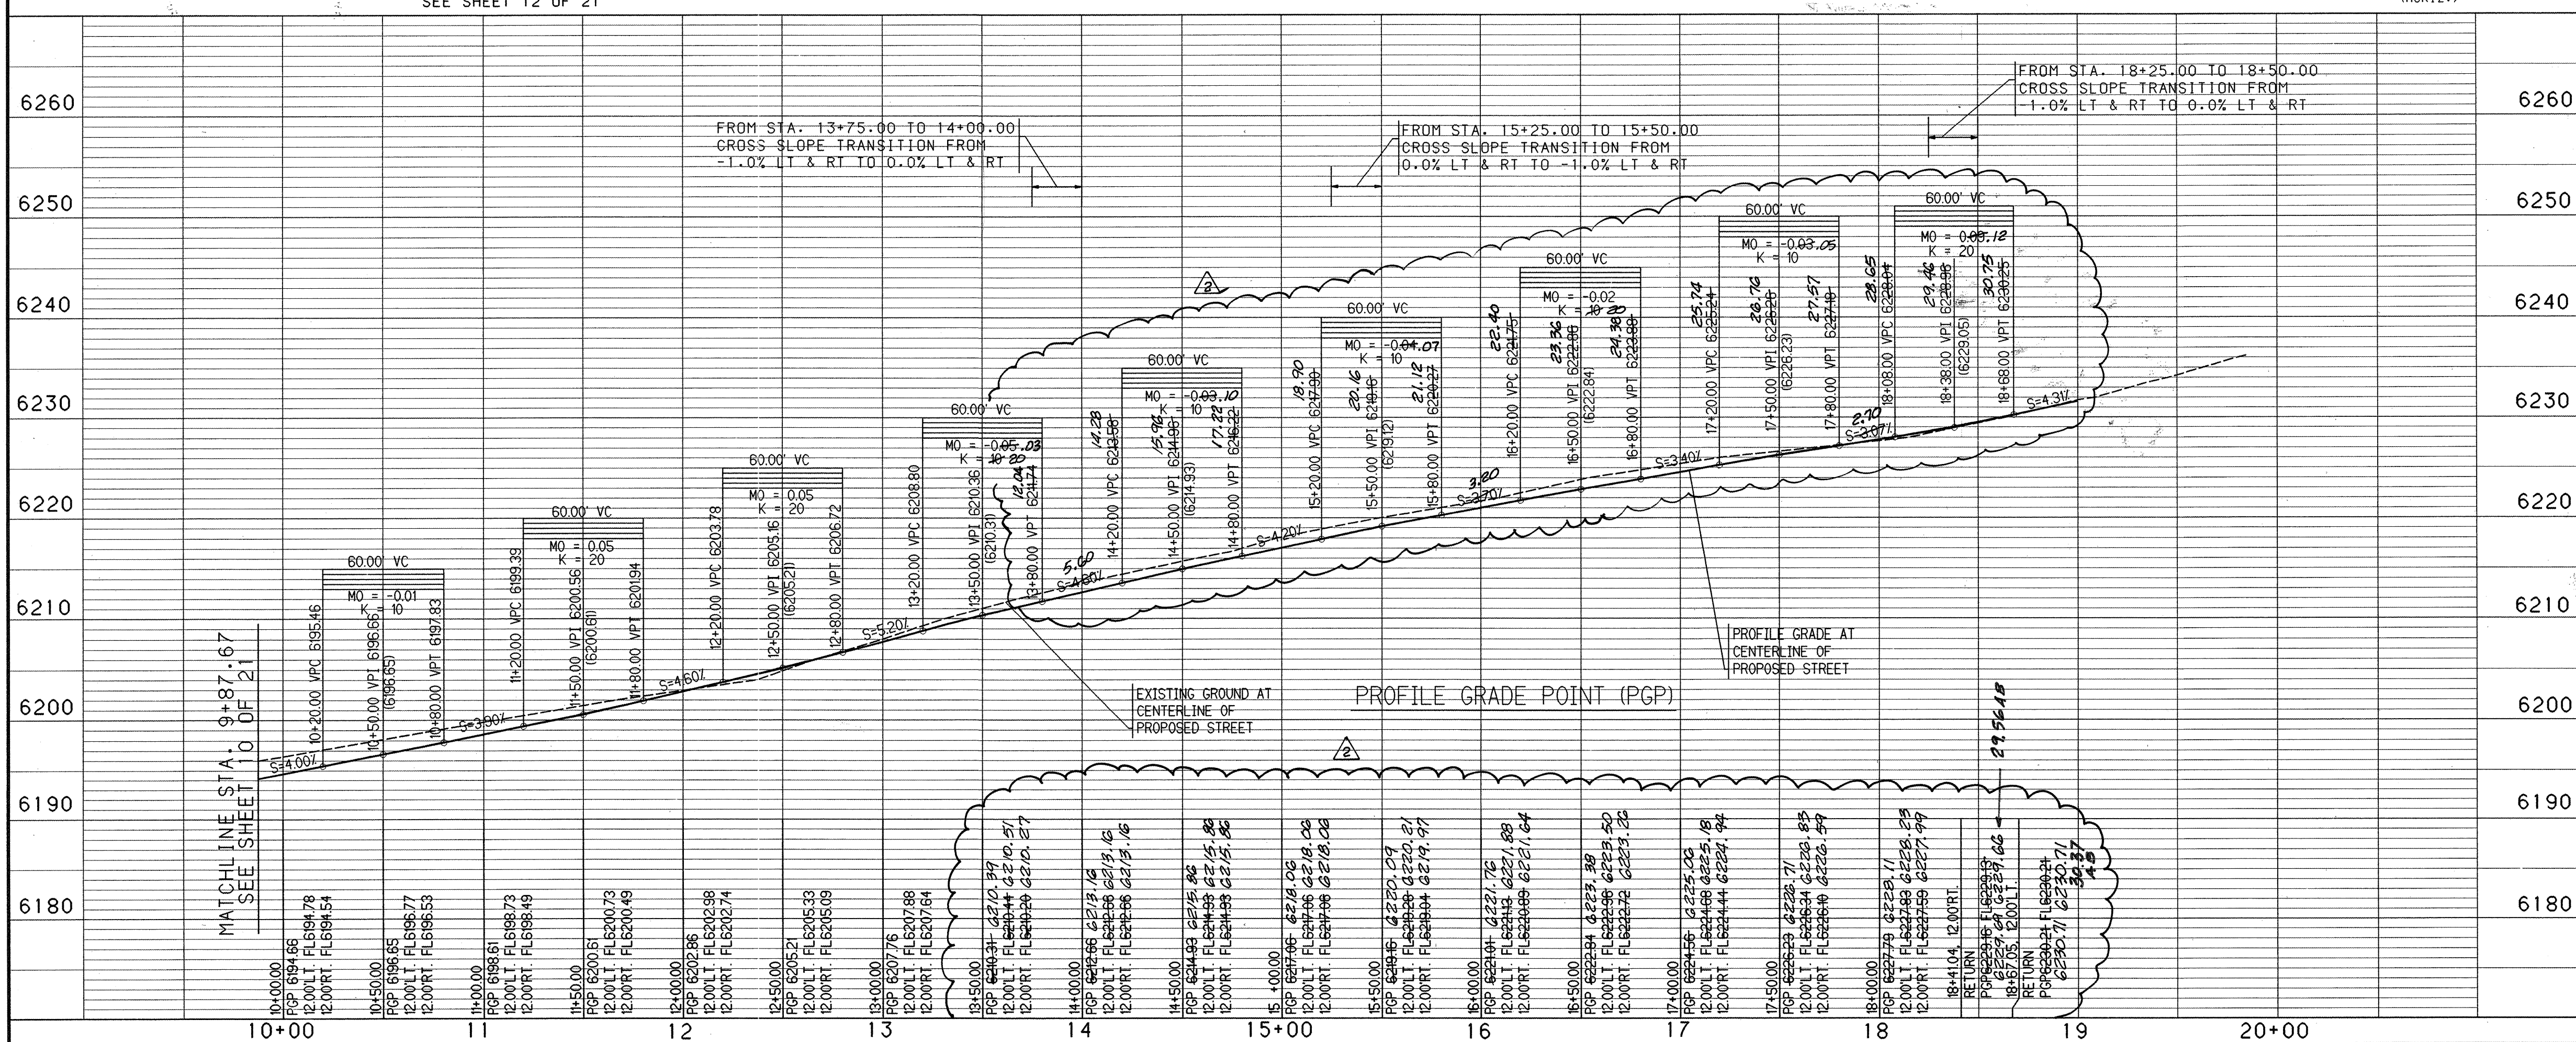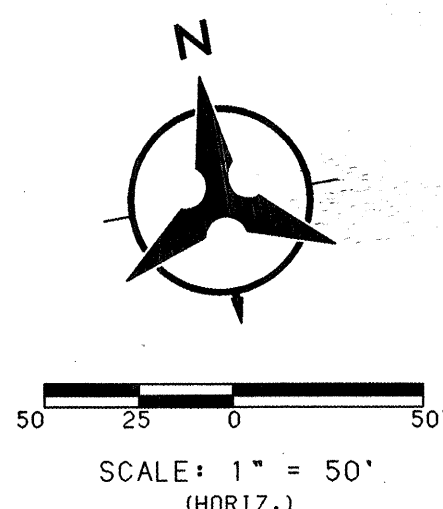


- NOTES**
1. THE CONTRACTOR SHALL FIELD VERIFY ALL EXISTING UTILITY LOCATIONS AND NOTIFY THE ENGINEER IMMEDIATELY OF ANY DISCREPANCIES.
 2. ALL CURB RETURN RADII SHALL BE 25' TO FACE OF CURB UNLESS OTHERWISE SPECIFIED.
 3. ALL CURVE DATA AND DIMENSIONS REFER TO FACE OF CURB UNLESS OTHERWISE SPECIFIED.
 4. GRADE ELEVATIONS, WHERE NOTED, ARE FOR FLOWLINE UNLESS OTHERWISE SPECIFIED.
 5. CONTRACTOR IS TO INSTALL A 4"x4"x5" POST AND EMD AT THE END OF EACH SANITARY SEWER SERVICE.
 6. CONTRACTOR IS RESPONSIBLE FOR REPAIR AND/OR REPLACEMENT OF ALL UTILITY CONDUITS AND EXISTING LINES.
 7. ANY ADDITIONAL GRADING REQUIRED TO MATCH PROPOSED STREET GRADES SHALL BE INCIDENTAL TO PAVING ITEMS.
 8. CONTRACTOR SHALL PROVIDE THE INSPECTORS, (CITY AND PRIVATE) WITH THE PROPOSED HYDROSTATIC TESTING PLAN. THE PLAN MUST BE APPROVED BEFORE TESTING OPERATIONS BEGIN.
 9. CONTRACTOR SHALL PARK EQUIPMENT AND VEHICLES AS NOT TO INTERFERE WITH NORMAL ACTIVITIES OF RESIDENTS OR OTHER CONTRACTORS ON SITE.
 10. ANY DAMAGE TO THE EXISTING FACILITIES (CURB AND GUTTER, PAVEMENT, CONDUITS, LANDSCAPING, UTILITY LINES, ETC.) DURING CONSTRUCTION SHALL BE REPLACED AT THE CONTRACTORS EXPENSE.
 11. REMOVAL OF THE EXISTING CURB AND GUTTER SHALL BE AS PER COA STD. DWG. 2415 (SAWCUT ONLY).
 12. WHEEL CHAIR RAMPS SHALL BE CONSTRUCTED PRIOR TO ACCEPTANCE OF CURB AND GUTTER.

- KEYED GENERAL NOTES**
- 1 DEPRESSED GUTTER TYPE CURB (MODIFIED) SEE SHEET 8 OF 21
 - 2 RUNDOWN CURB TYPE AS PER STD. DWG. 2415
 - 3 MOUNTABLE CURB ROLL TYPE AS PER STD. DWG. 2415

I hereby certify that the as-built data I have shown herein is true and correct to the best of my knowledge and belief.

[Signature] 9/20/98

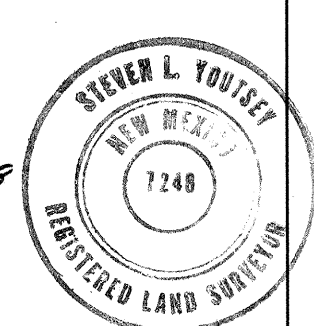

AS BUILT DRAWING

BOHANNAN-HUSTON INC.
ENGINEERS • PLANNERS • PHOTOGRAMMETRISTS • SURVEYORS • LANDSCAPE ARCHITECTS
ALBUQUERQUE LAS CRUCES SANTA FE


CITY OF ALBUQUERQUE
PUBLIC WORKS DEPARTMENT
ENGINEERING DEVELOPMENT GROUP
DESERT HIGHLANDS AT HIGH DESERT
UNIT 4 OF THE HIGHLANDS AT HIGH DESERT
PAVING PLAN & PROFILE
PINO CANYON PLACE STA. 9+87.67 - 20+00.00

DESIGN REVIEW COMMITTEE	CITY ENGINEER APPROVAL	MO./DAY/YR.	MO./DAY/YR.
APPROVED MAY 11 1998 DESIGN REVIEW COMMITTEE			

CITY PROJECT NO.	ZONE MAP NO.	SHEET	OF
571283	E-23	11	21

CENTERLINE CURVE DATA TABLE					
NUMBER	PI STA.	DELTA	TANGENT	ARC	RADIUS
C1	6+91.47	86°26'56.5"	281.96'	452.65'	300.00'
C2	0+89.95	227°06'07.3"	139.95'	241.78'	61.00'


CENTERLINE TANGENT DATA		
NUMBER	BEARING	DISTANCE
T1	S18°51'57"E	19.00'
T2	N71°08'03"E	259.51'
T3	N32°27'13"E	19.12'
T4	S22°25'00"E	86.01'

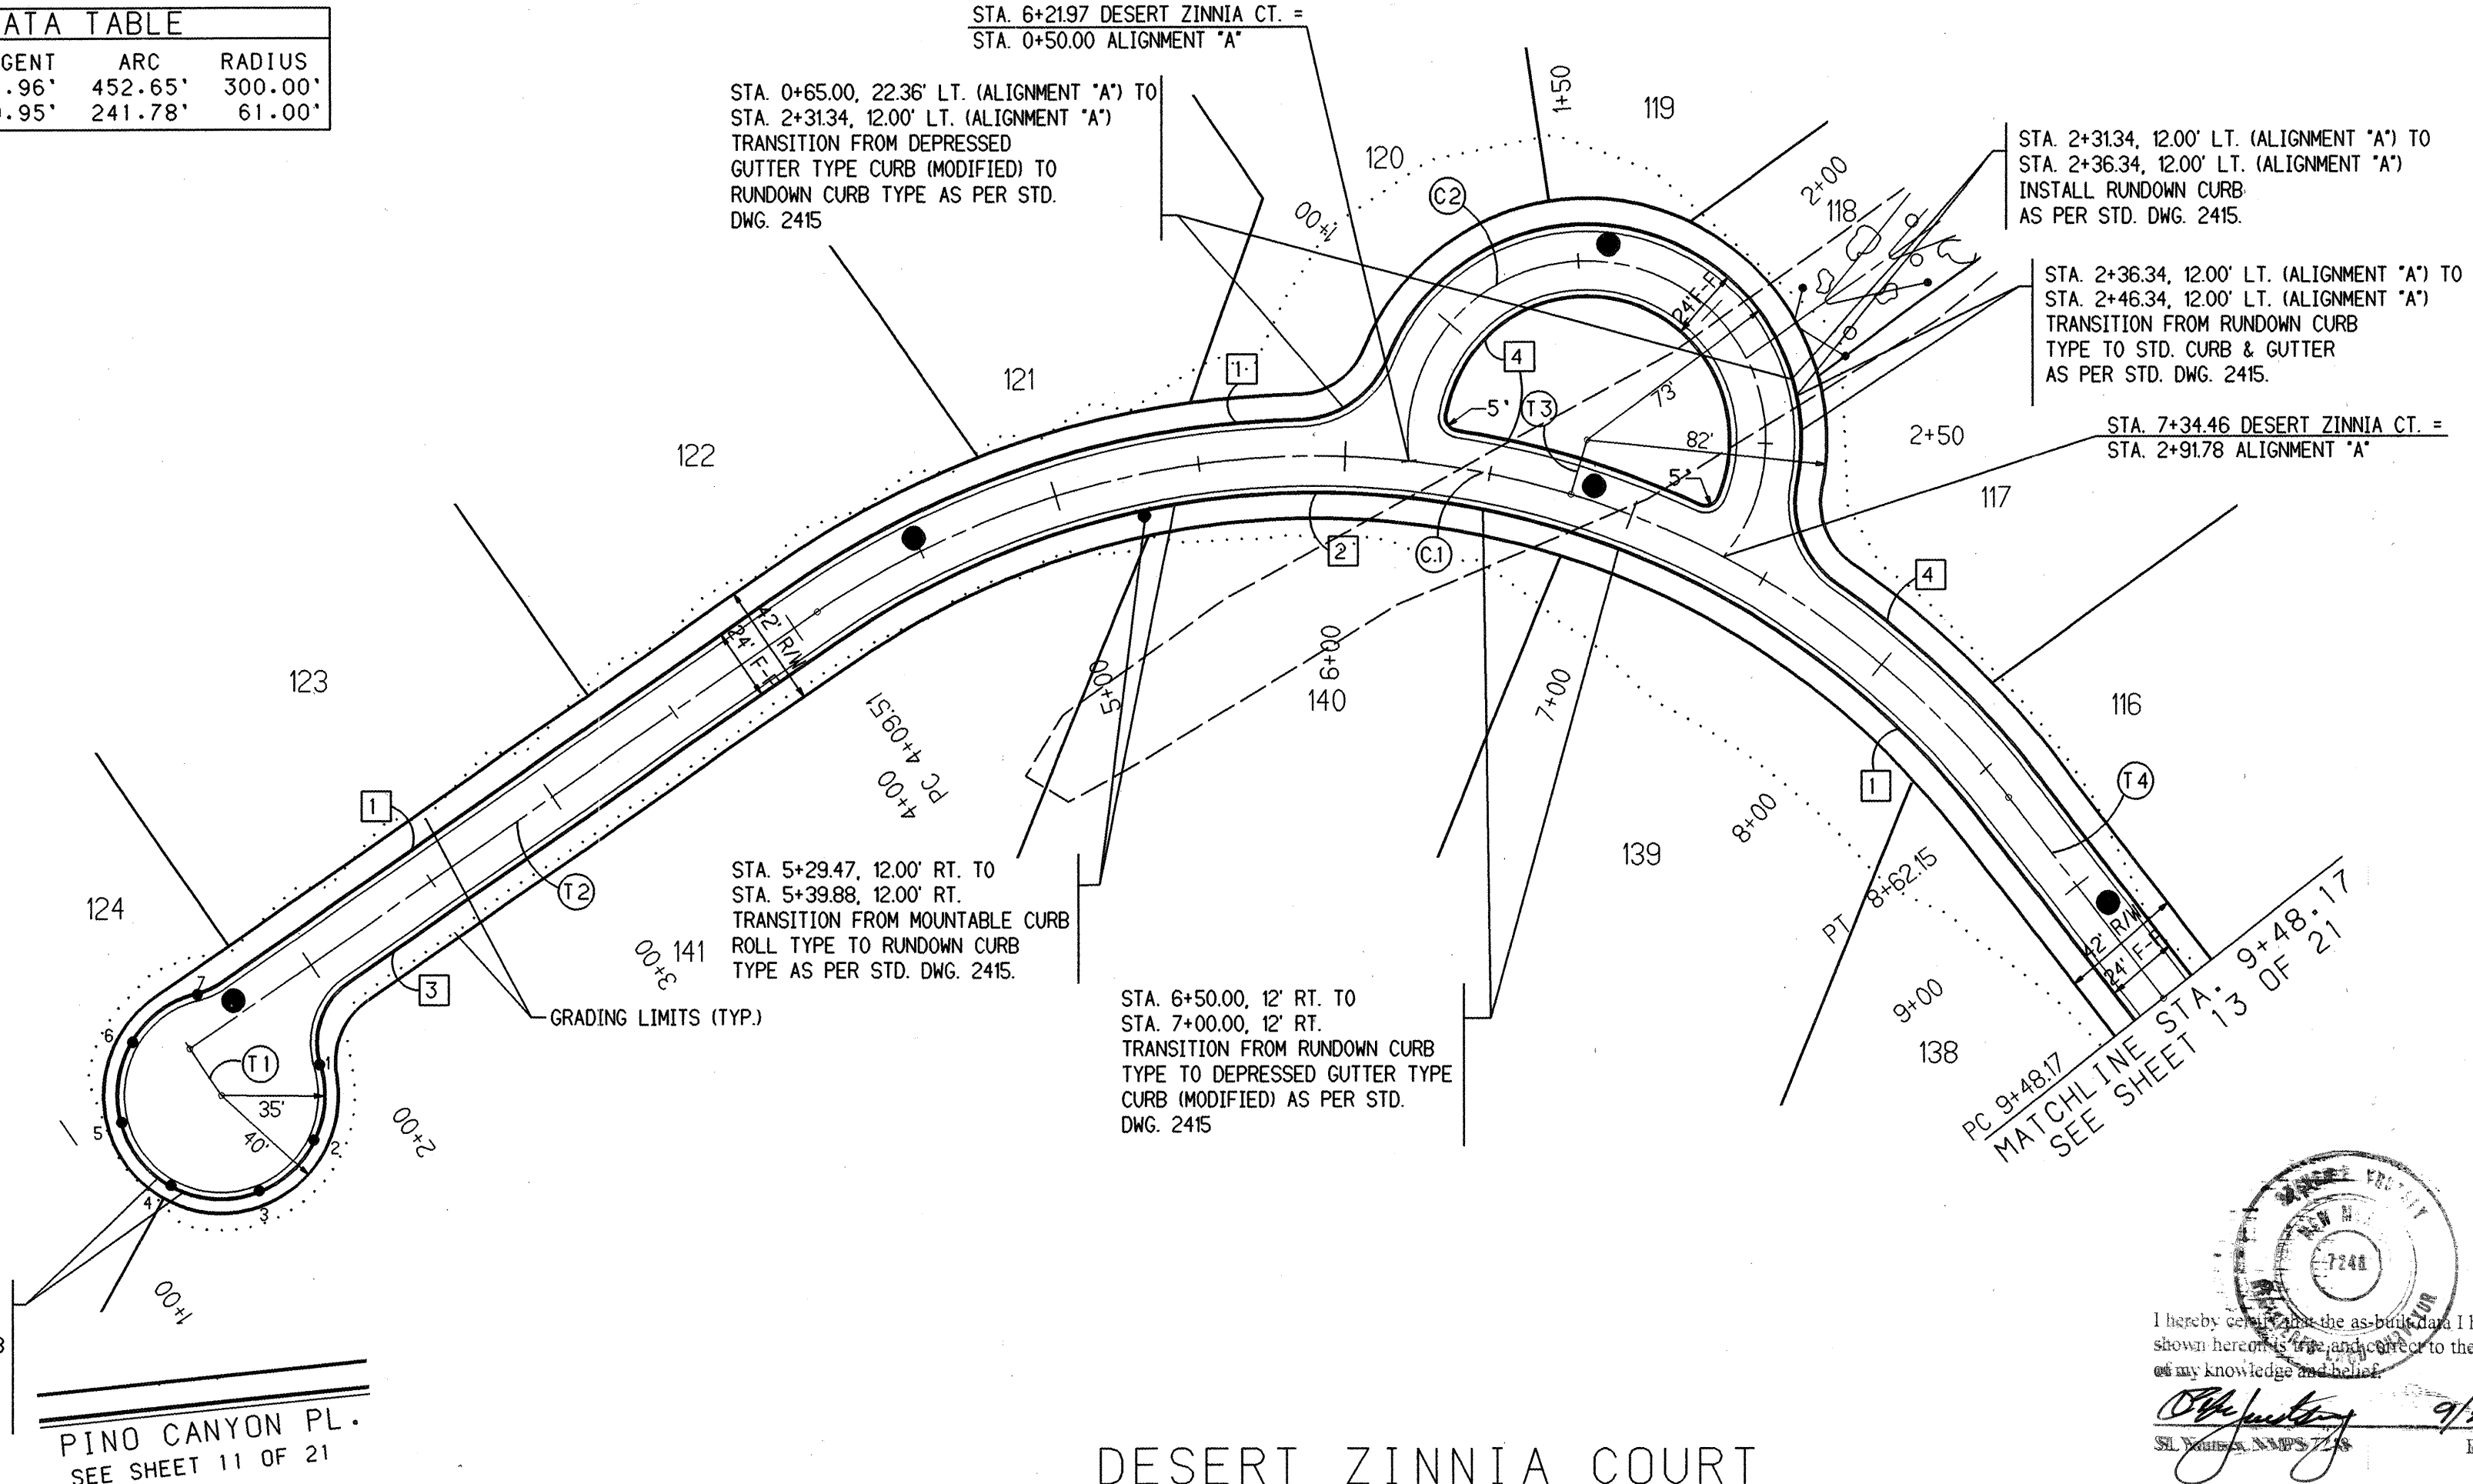

CUL-DE-SAC CURB DATA			
PT	FL	STATION & OFFSET	DELTA
1	97.33	1+83.39, 29.50' RT.	45°24'01"
2	98.07	1+65.97, 50.15' RT.	45°24'01"
3	99.50	1+39.03, 52.24' RT.	45°24'01"
4	100.78	1+18.63, 34.53' RT.	45°24'01"
5	01.14	1+17.00, 7.34' RT.	45°47'38"
6	00.35	1+35.34, 12.78' LT.	45°47'38"
7	98.89	1+62.57, 13.67' LT.	45°47'38"
R=35.00'			

- NOTES**
1. THE CONTRACTOR SHALL FIELD VERIFY ALL EXISTING UTILITY LOCATIONS AND NOTIFY THE ENGINEER IMMEDIATELY OF ANY DISCREPANCIES.
 2. ALL CURB RETURN RADI SHALL BE 25' TO FACE OF CURB UNLESS OTHERWISE SPECIFIED.
 3. ALL CURVE DATA AND DIMENSIONS REFER TO FACE OF CURB UNLESS OTHERWISE SPECIFIED.
 4. GRADE ELEVATIONS, WHERE NOTED, ARE FOR FLOWLINE UNLESS OTHERWISE SPECIFIED.
 5. CONTRACTOR IS TO INSTALL A 4"x4"x5" POST AND END AT THE END OF EACH SANITARY SEWER SERVICE.
 6. CONTRACTOR IS RESPONSIBLE FOR REPAIR AND/OR REPLACEMENT OF ALL UTILITY CONDUITS AND EXISTING LINES.
 7. ANY ADDITIONAL GRADING REQUIRED TO MATCH PROPOSED STREET GRADES SHALL BE INCIDENTAL TO PAVING ITEMS.
 8. CONTRACTOR SHALL PROVIDE THE INSPECTORS, (CITY AND PRIVATE) WITH THE PROPOSED HYDROSTATIC TESTING PLAN. THE PLAN MUST BE APPROVED BEFORE TESTING OPERATIONS BEGIN.
 9. CONTRACTOR SHALL PARK EQUIPMENT AND VEHICLES AS NOT TO INTERFERE WITH NORMAL ACTIVITIES OF RESIDENTS OR OTHER CONTRACTORS ON SITE.
 10. ANY DAMAGE TO THE EXISTING FACILITIES (CURB AND GUTTER, PAVEMENT, CONDUITS, LANDSCAPING, UTILITY LINES, ETC.) DURING CONSTRUCTION SHALL BE REPLACED AT THE CONTRACTORS EXPENSE.
 11. REMOVAL OF THE EXISTING CURB AND GUTTER SHALL BE AS PER COA STD. DWG. 2415 (SAWCUT ONLY).
 12. WHEEL CHAIR RAMPS SHALL BE CONSTRUCTED PRIOR TO ACCEPTANCE OF CURB AND GUTTER.

- KEYED GENERAL NOTES**
- 1 DEPRESSED GUTTER TYPE CURB (MODIFIED) SEE SHEET 8 OF 21
 - 2 ROUNDOFF CURB TYPE AS PER STD. DWG. 2415
 - 3 MOUNTABLE CURB ROLL TYPE AS PER STD. DWG. 2415
 - 4 STD. CURB & GUTTER AS PER STD. DWG. 2415

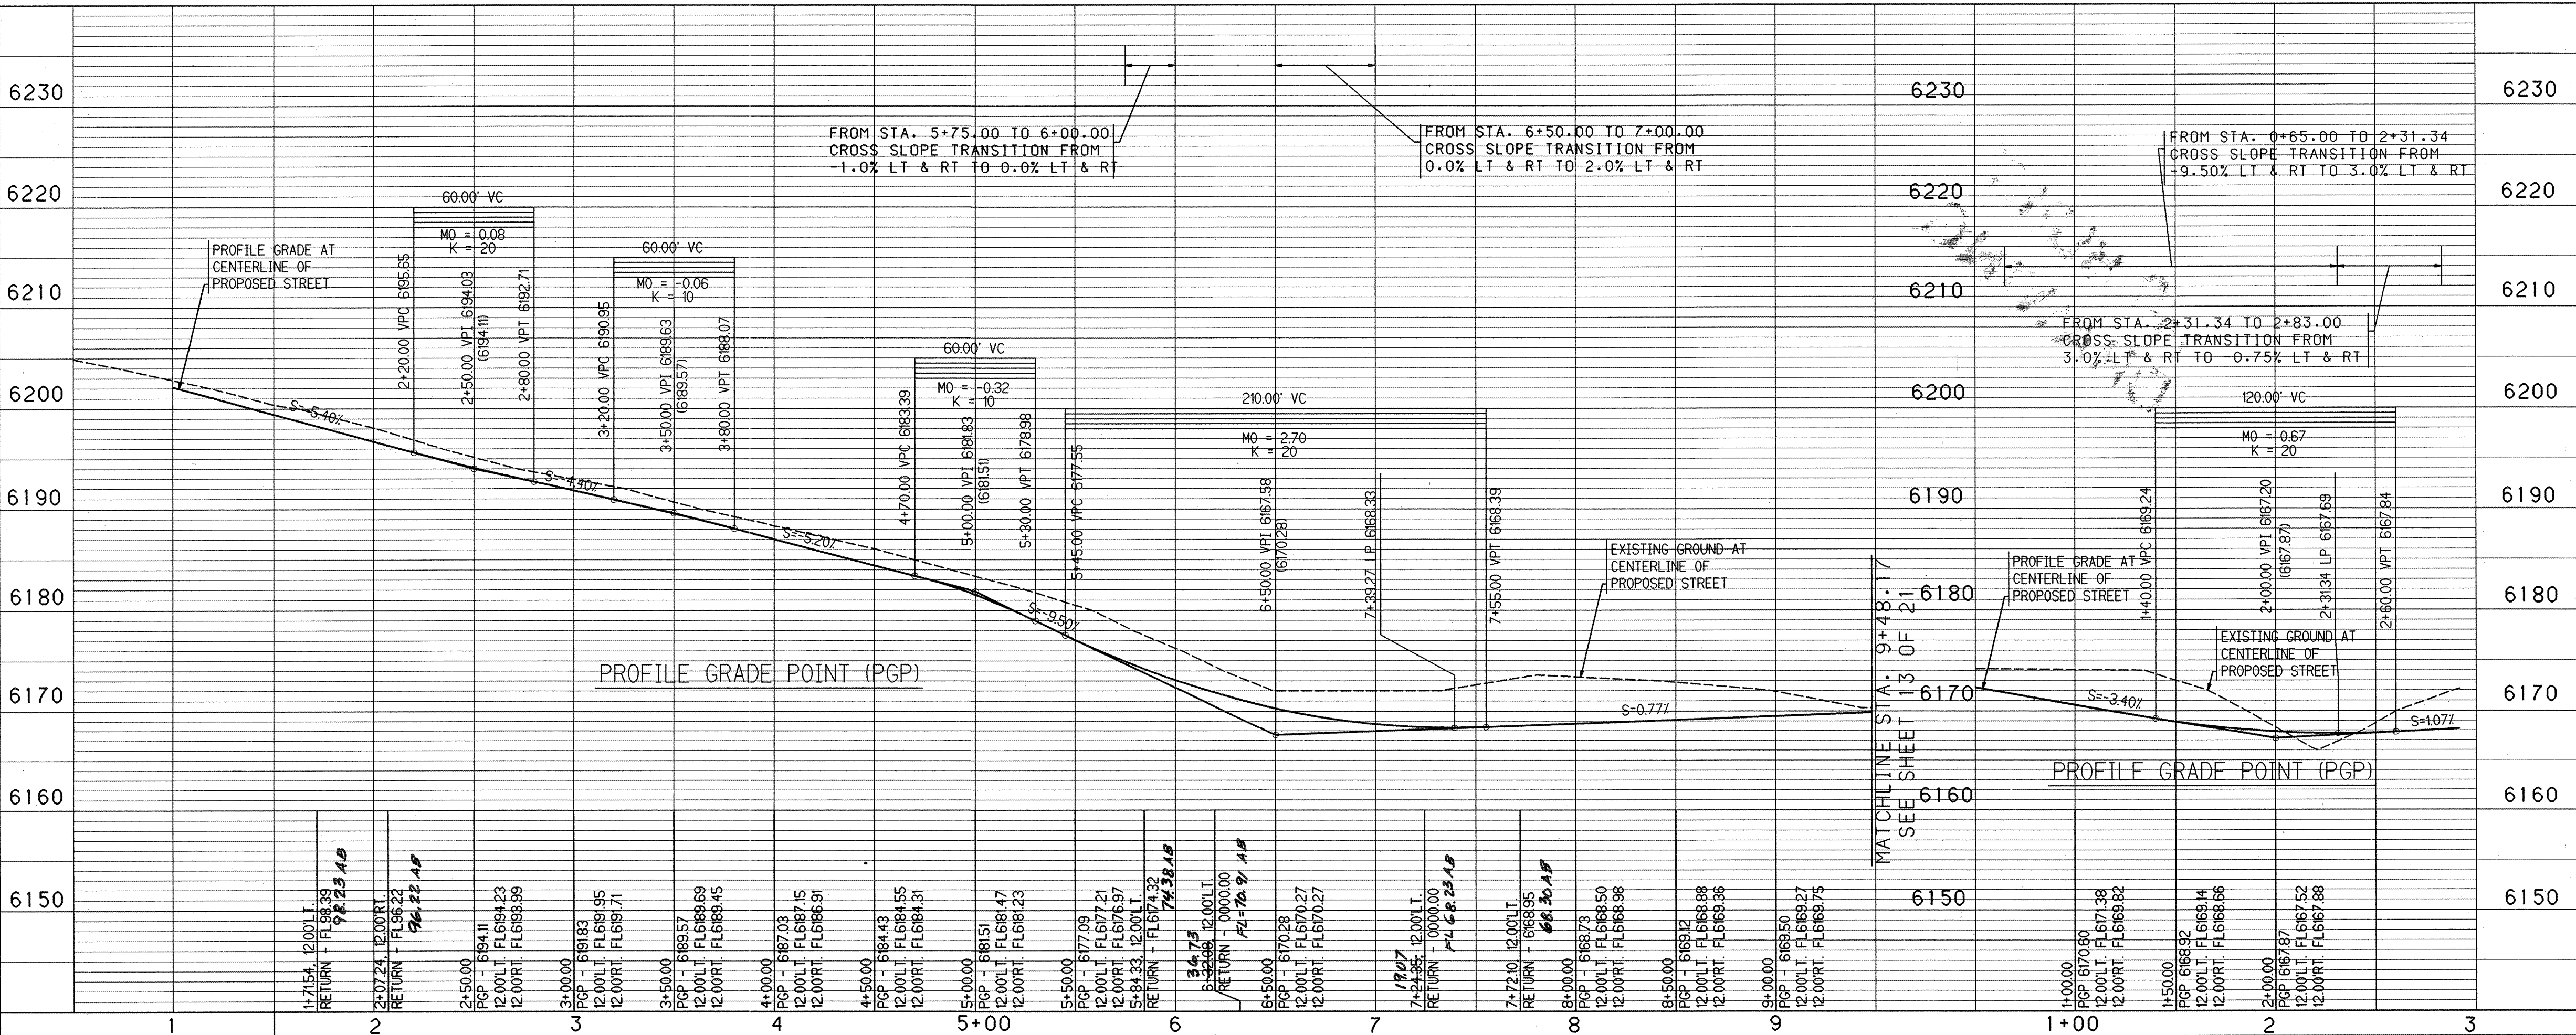


USERNAME: CDP\c97416a03.FWP\DESERT11.GRF

ENGINEER'S SEAL				AS-BUILT INFORMATION							
CONTRACTOR		CONTRACTOR		CONTRACTOR		CONTRACTOR					
BOHANNAN-HUSTON INC.		BOHANNAN-HUSTON INC.		BOHANNAN-HUSTON INC.		BOHANNAN-HUSTON INC.					
ENGINEERS • PLANNERS • PHOTOGRAMMETRISTS • SURVEYORS • LANDSCAPE ARCHITECTS		ENGINEERS • PLANNERS • PHOTOGRAMMETRISTS • SURVEYORS • LANDSCAPE ARCHITECTS		ENGINEERS • PLANNERS • PHOTOGRAMMETRISTS • SURVEYORS • LANDSCAPE ARCHITECTS		ENGINEERS • PLANNERS • PHOTOGRAMMETRISTS • SURVEYORS • LANDSCAPE ARCHITECTS					
ALBUQUERQUE		ALBUQUERQUE		ALBUQUERQUE		ALBUQUERQUE					
SANTA FE		SANTA FE		SANTA FE		SANTA FE					
CITY OF ALBUQUERQUE				CITY OF ALBUQUERQUE							
PUBLIC WORKS DEPARTMENT				PUBLIC WORKS DEPARTMENT							
ENGINEERING DEVELOPMENT GROUP				ENGINEERING DEVELOPMENT GROUP							
DESERT HIGHLANDS AT HIGH DESERT				DESERT HIGHLANDS AT HIGH DESERT							
UNIT 4 OF THE HIGHLANDS AT HIGH DESERT				UNIT 4 OF THE HIGHLANDS AT HIGH DESERT							
PAVING PLAN & PROFILE				PAVING PLAN & PROFILE							
DESERT ZINNIA COURT STA. 1+00.00 - 9+48.17				DESERT ZINNIA COURT STA. 1+00.00 - 9+48.17							
DESIGN REVIEW COMMITTEE				DESIGN REVIEW COMMITTEE							
CITY ENGINEER APPROVAL				CITY ENGINEER APPROVAL							
LAST DESIGN UPDATE				LAST DESIGN UPDATE							
CITY PROJECT NO.				CITY PROJECT NO.							
571283				571283							
ZONE MAP NO.				ZONE MAP NO.							
E-23				E-23							
SHEET				SHEET							
12				12							
OF				OF							
21				21							

BHI JOB NO. C97416A03

COPYRIGHT BOHANNAN HUSTON 1998
DATE: FEBRUARY, 1998


CENTERLINE TANGENT DATA		
NUMBER	BEARING	DISTANCE
T5	S33°25'35"W	320.05'

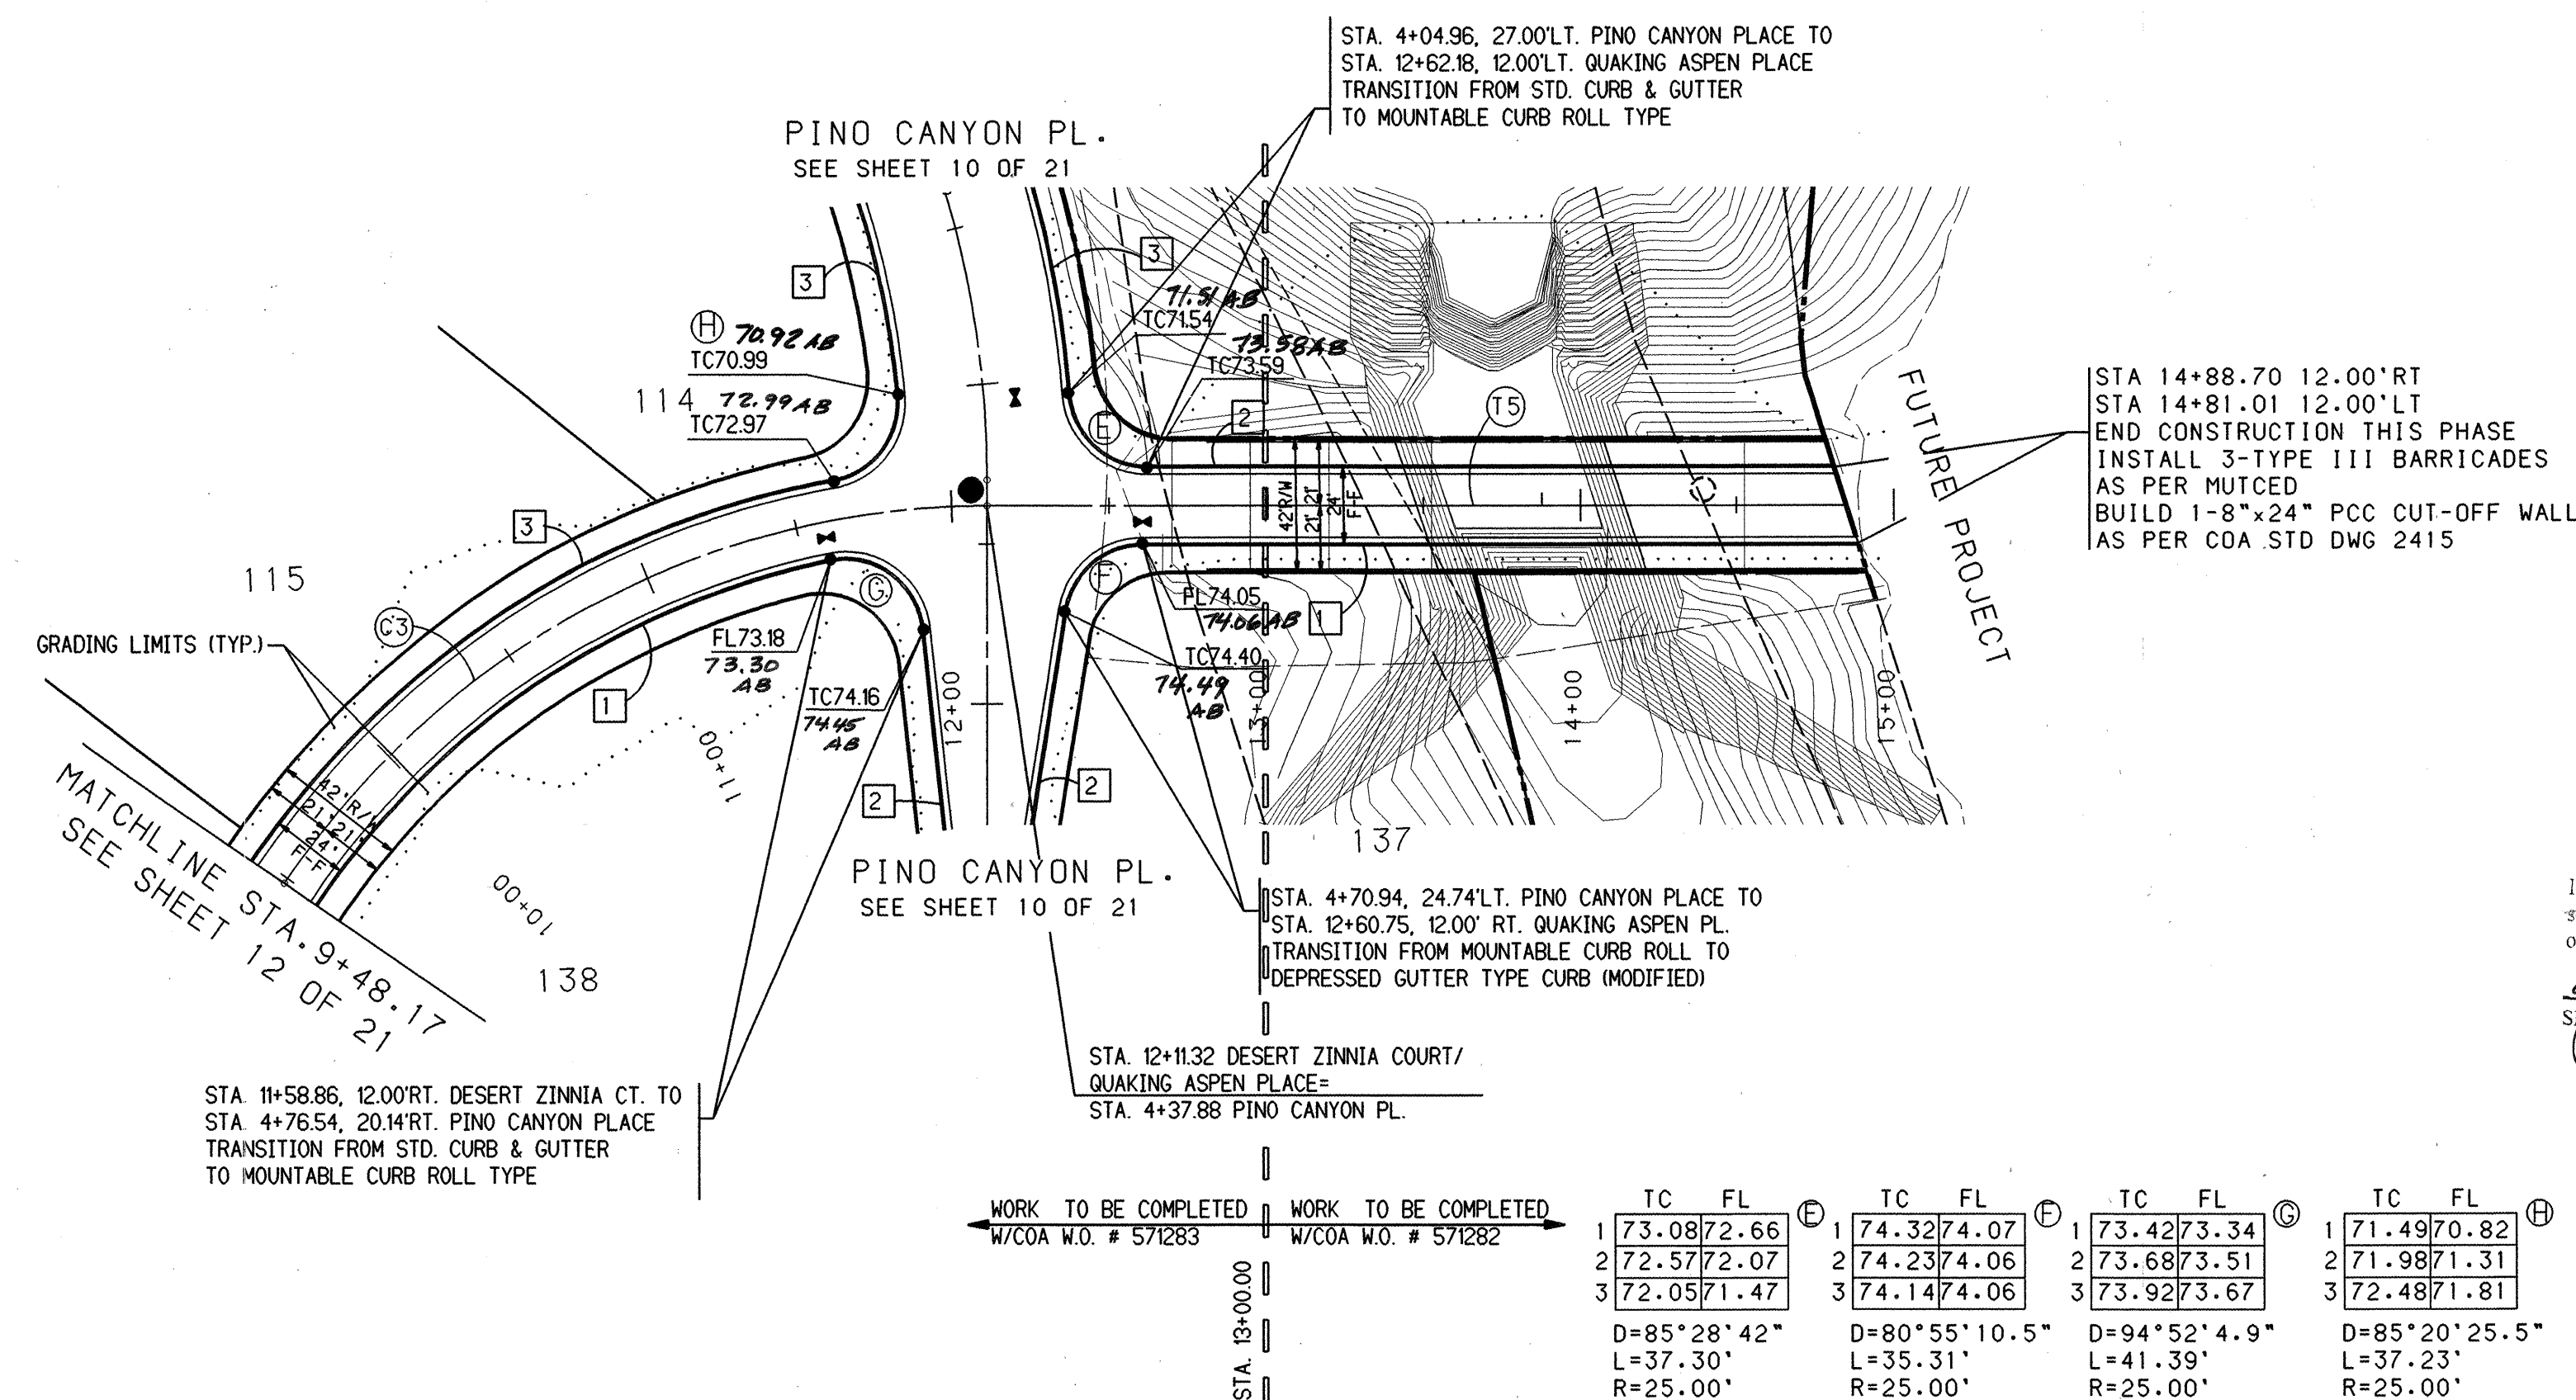


I hereby certify that the above data I have shown hereon is true and correct to the best of my knowledge and belief.

[Signature] 9/28/84

St. Yousef, NMPS 7248 Date:

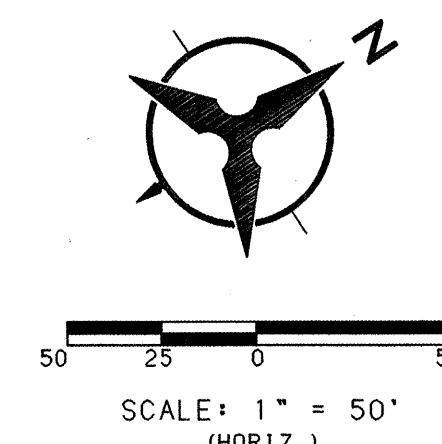

DESERT ZINNIA COURT/QUAKING ASPEN PLACE

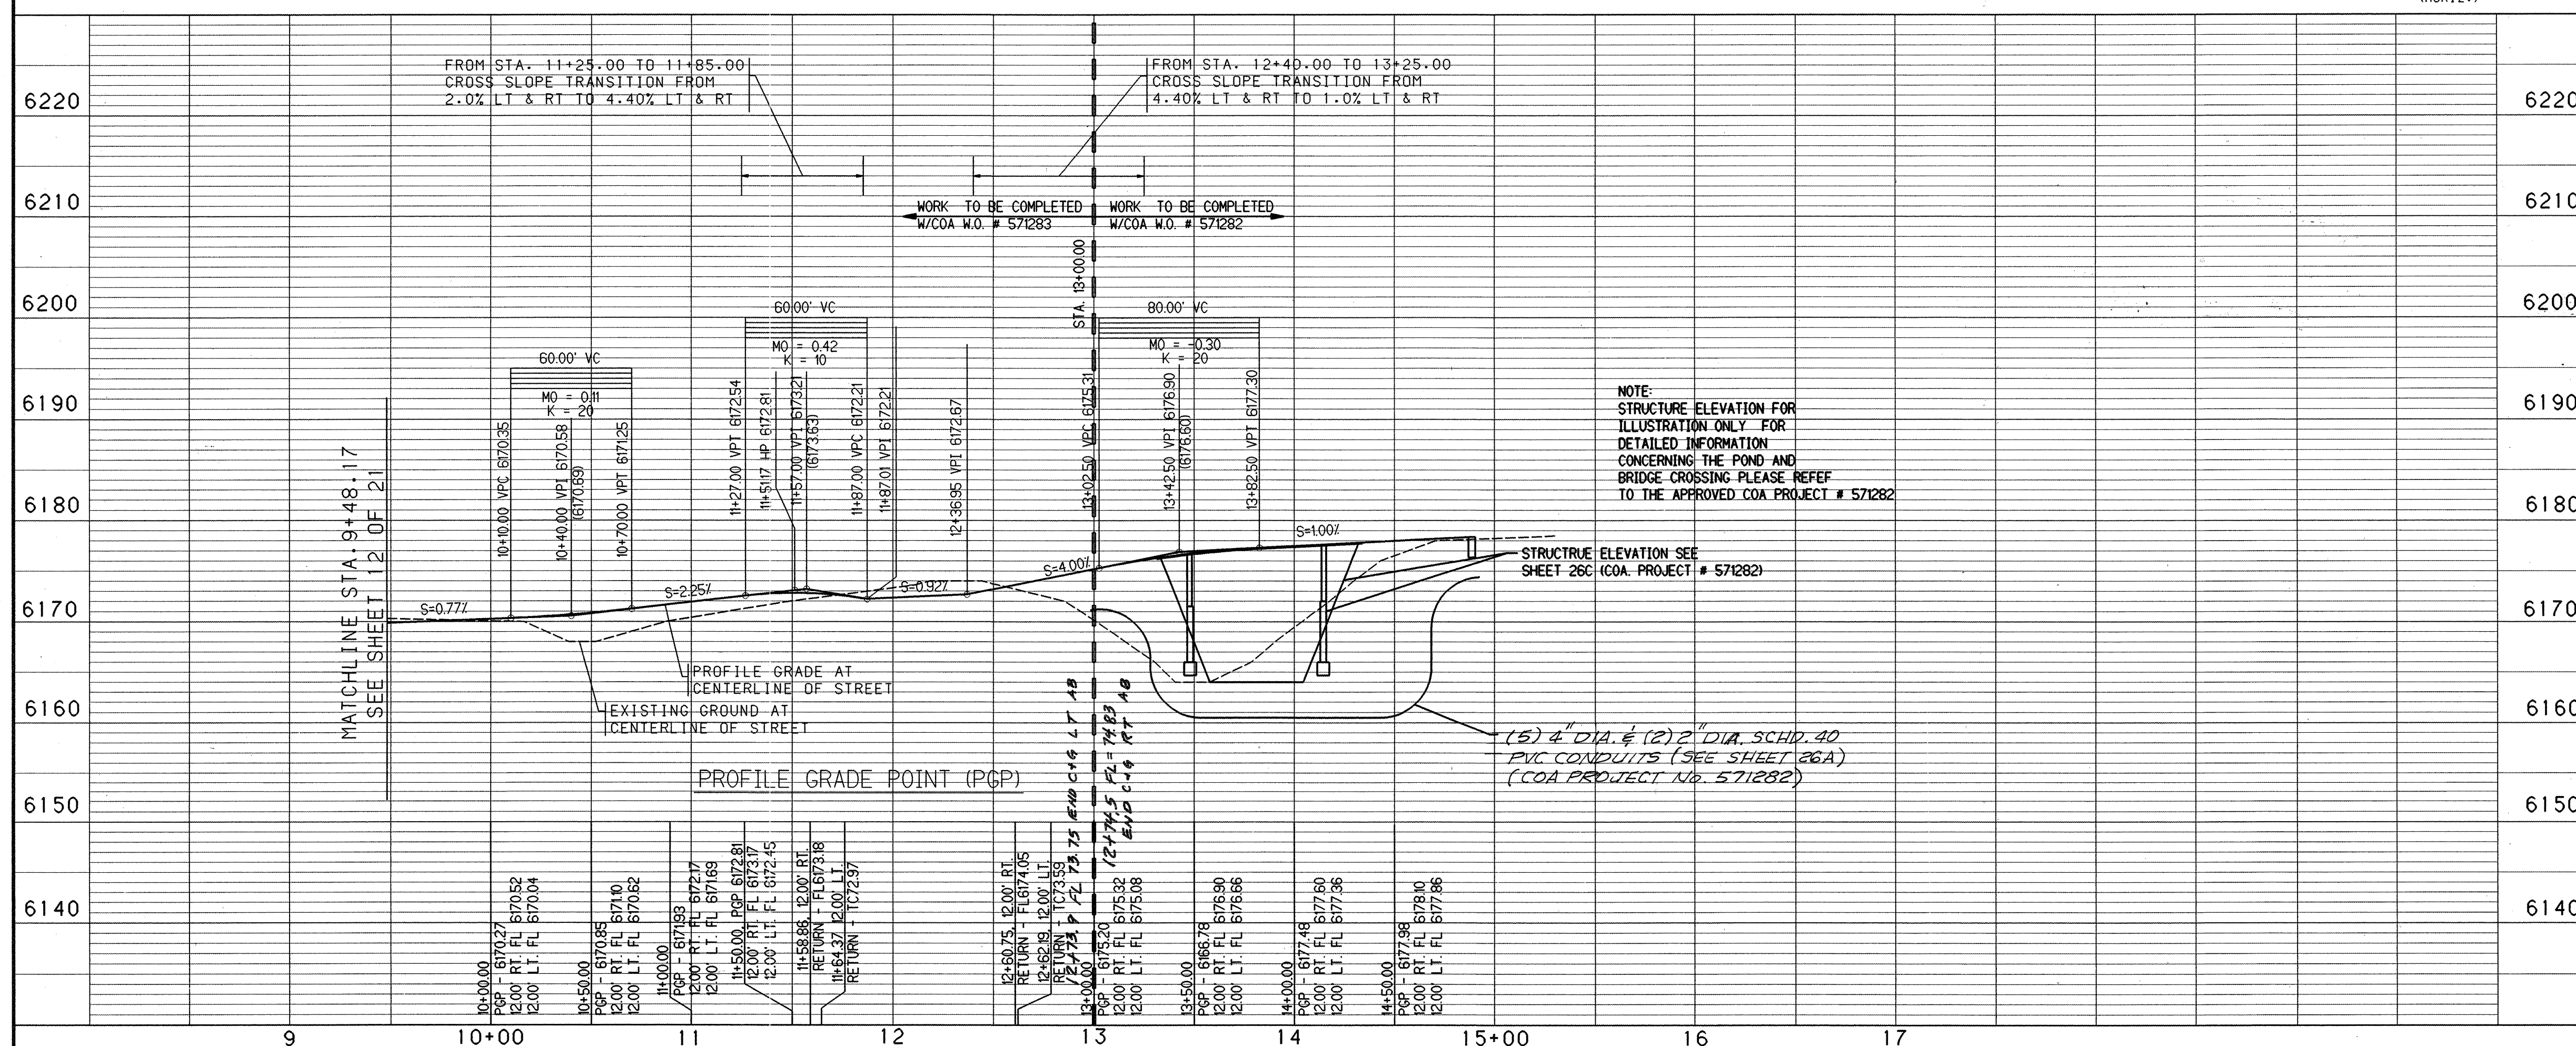

SCALE: 1" = 50' (HORIZ.)
1" = 10' (VERT.)

```
USERNAME: CDP:[C97416A03.PNP]NEW-DESERT2.GRE
```


BHI JOB NO. C97416A01

NOTES

1. THE CONTRACTOR SHALL FIELD VERIFY ALL EXISTING UTILITY LOCATIONS AND NOTIFY THE ENGINEER IMMEDIATELY OF ANY DISCREPANCIES.
2. ALL CURB RETURN RADII SHALL BE 25' TO FACE OF CURB UNLESS OTHERWISE SPECIFIED.
3. ALL CURVE DATA AND DIMENSIONS REFER TO FACE OF CURB UNLESS OTHERWISE SPECIFIED.
4. GRADE ELEVATIONS, WHERE NOTED, ARE FOR FLOWLINE UNLESS OTHERWISE SPECIFIED.
5. CONTRACTOR IS TO INSTALL A 4"x4"x5' POST AND END AT THE END OF EACH SANITARY SEWER SERVICE.
6. CONTRACTOR IS RESPONSIBLE FOR REPAIR AND/OR REPLACEMENT OF ALL UTILITY CONDUITS AND EXISTING LINES.
7. ANY ADDITIONAL GRADING REQUIRED TO MATCH PROPOSED STREET GRADES SHALL BE INCIDENTAL TO PAYING ITEMS.
8. CONTRACTOR SHALL PROVIDE THE INSPECTORS, (CITY AND PRIVATE) WITH THE PROPOSED HYDROSTATIC TESTING PLAN. THE PLAN MUST BE APPROVED BEFORE TESTING OPERATIONS BEGIN.
9. CONTRACTOR SHALL PARK EQUIPMENT AND VEHICLES AS NOT TO INTERFERE WITH NORMAL ACTIVITIES OF RESIDENTS OR OTHER CONTRACTORS ON SITE.
10. ANY DAMAGE TO THE EXISTING FACILITIES (CURB AND GUTTER, PAVEMENT, CONDUITS, LANDSCAPING, UTILITY LINES, ETC.) DURING CONSTRUCTION SHALL BE REPLACED AT THE CONTRACTORS EXPENSE.
11. REMOVAL OF THE EXISTING CURB AND GUTTER SHALL BE AS PER COA STD. DWG. 2415 (SAWCUT ONLY).
12. WHEEL CHAIR RAMPS SHALL BE CONSTRUCTED PRIOR TO ACCEPTANCE OF CURB AND GUTTER.

KEYED GENERAL NOTES

- 1 DEPRESSED GUTTER TYPE CURB
(MODIFIED) SEE SHEET 8 OF 21
- 2 MOUNTABLE CURB ROLL TYPE AS PER
STD. DWG. 2415 (See Detail Below)
- 3 STD. CURB & GUTTER AS PER STD.
DWG. 2415

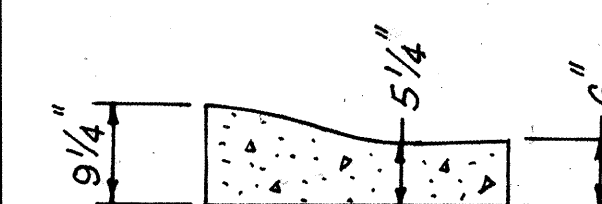

STD. DWG. 2415 (Modified)

NTS
Curbing on Bridge Deck only
to have these dimensions.

AS BUILT DRAWING



BOHANNAN-HUSTON INC.
ENGINEERS • PLANNERS • PHOTOGRAMMETRISTS • SURVEYORS • LANDSCAPE ARCHITECTS
ALBUQUERQUE LAS CRUCES SANTA FE

 CITY OF ALBUQUERQUE
PUBLIC WORKS DEPARTMENT
ENGINEERING DEVELOPMENT GROUP
DESERT HIGHLANDS AT HIGH DESERT
~~UNIT 4 OF THE HIGHLANDS AT HIGH DESERT~~
PAVING PLAN & PROFILE

DESERT ZINNIA CT./QUAKING ASPEN PL. STA. 9+48.17-15+00.00			
DESIGN REVIEW COMMITTEE	CITY ENGINEER APPROVAL	MO./DAY/YR	MO./DAY/YR

DESIGN REVIEW COMMITTEE

APPROVED


MAY 11 1998

DESIGN REVIEW COMMITTEE

CITY ENGINEER APPROVAL	MO./DAY/YB.	MO./DAY/YB.
------------------------	-------------	-------------

AP NO.	SHEET	OF
-23	13	2

COPYRIGHT BOHANNAN HUSTON 1998
DATE: FEBRUARY, 1998

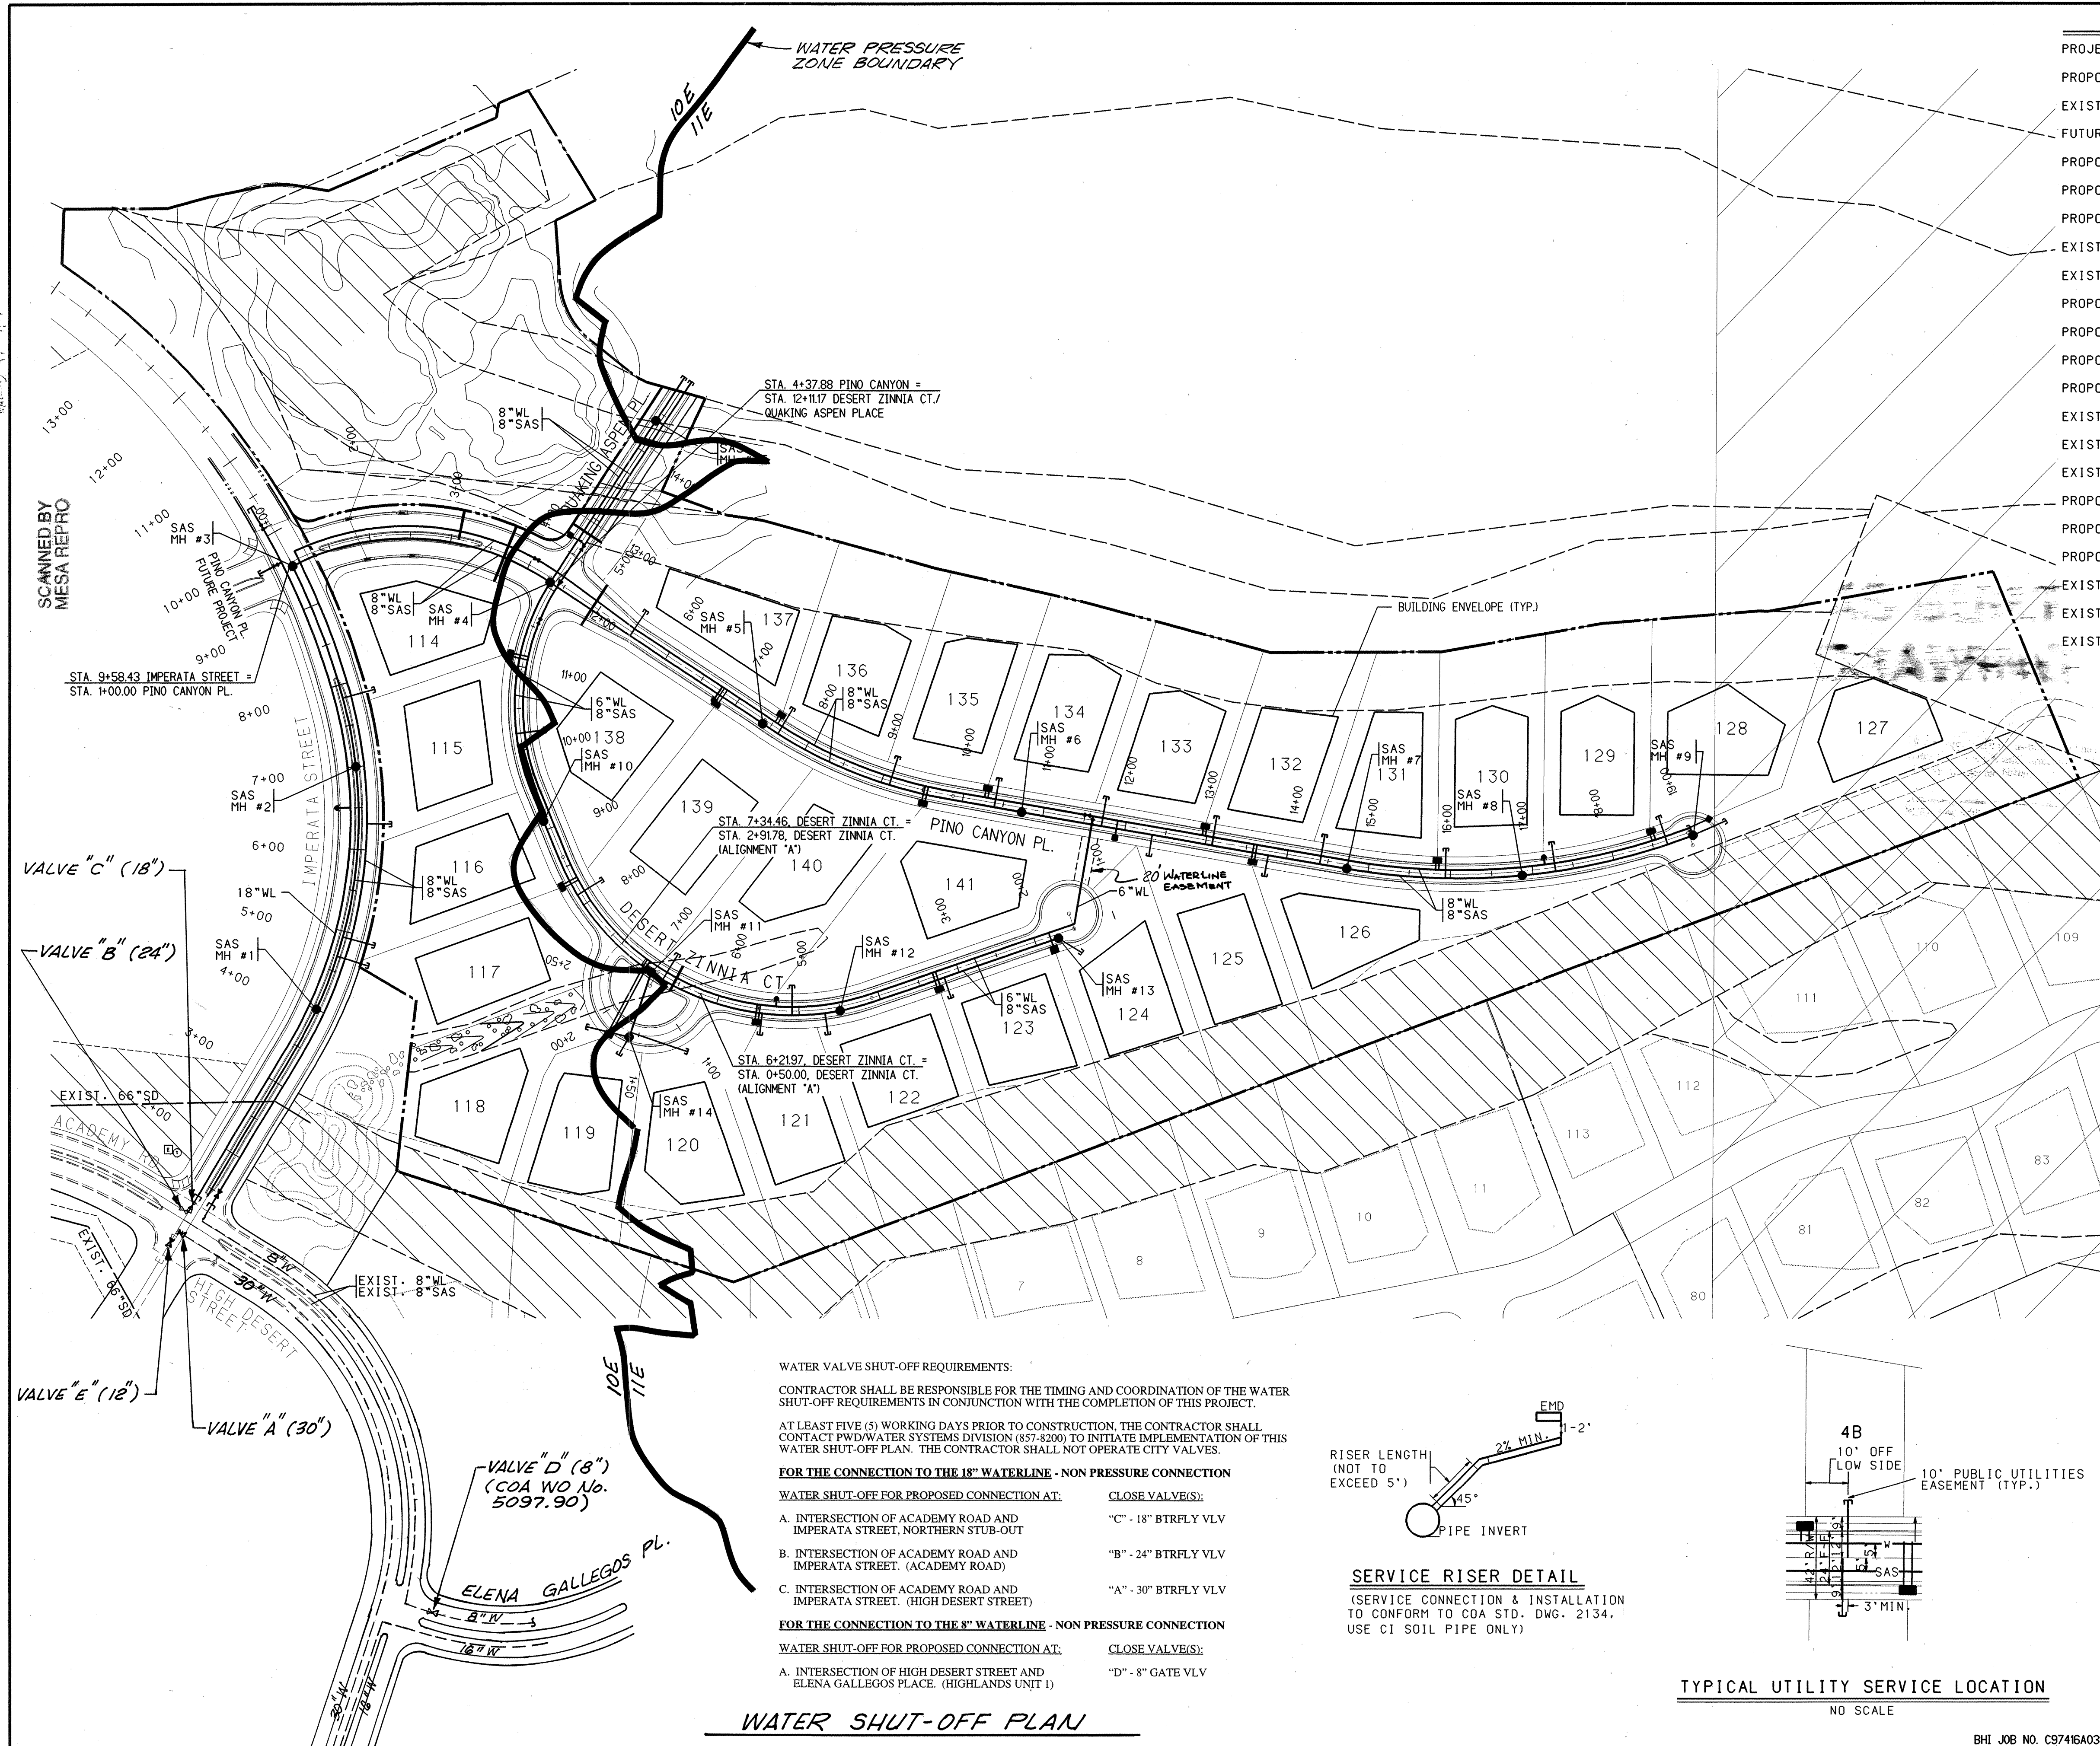


LEGEND	
PROJECT BOUNDARY	---
PROPOSED CURB & GUTTER	---
EXISTING CURB & GUTTER	---
FUTURE SIDEWALK	---
PROPOSED SANITARY SEWER LINE	SAS
PROPOSED SANITARY SEWER MANHOLE	●
PROPOSED SANITARY SEWER SERVICE	---
EXISTING SANITARY SEWER LINE	SAS
EXISTING SANITARY SEWER MANHOLE	○
PROPOSED WATER LINE	W
PROPOSED GATE VALVE	⌵
PROPOSED FIRE HYDRANT	●
PROPOSED WATER METER SERVICE	---
EXISTING WATER LINE	W
EXISTING GATE VALVE	⌵
EXISTING FIRE HYDRANT	●
PROPOSED STORM DRAIN LINE	SD
PROPOSED STORM DRAIN MANHOLE	⊙
PROPOSED STORM DRAIN INLET	■
EXISTING STORM DRAIN LINE	SD
EXISTING STORM DRAIN MANHOLE	⊙
EXISTING STORM DRAIN INLET	■

I hereby certify that the as-built data I have shown herein is true and correct to the best of my knowledge and belief.

[Signature]
SL Yonkers, N.Y. 10556-1000



**AS BUILT
DRAWING**

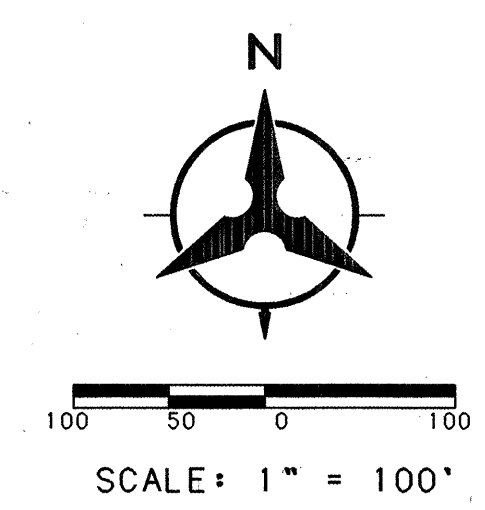

WATER VALVE SHUT-OFF REQUIREMENTS:
CONTRACTOR SHALL BE RESPONSIBLE FOR THE TIMING AND COORDINATION OF THE WATER SHUT-OFF REQUIREMENTS IN CONJUNCTION WITH THE COMPLETION OF THIS PROJECT.


AT LEAST FIVE (5) WORKING DAYS PRIOR TO CONSTRUCTION, THE CONTRACTOR SHALL CONTACT PWD/WATER SYSTEMS DIVISION (857-8200) TO INITIATE IMPLEMENTATION OF THIS WATER SHUT-OFF PLAN. THE CONTRACTOR SHALL NOT OPERATE CITY VALVES.

FOR THE CONNECTION TO THE 18" WATERLINE - NON PRESSURE CONNECTION


WATER SHUT-OFF FOR PROPOSED CONNECTION AT:	CLOSE VALVE(S):
A. INTERSECTION OF ACADEMY ROAD AND IMPERATA STREET, NORTHERN STUB-OUT	"C" - 18" BTRFLY VLV
B. INTERSECTION OF ACADEMY ROAD AND IMPERATA STREET. (ACADEMY ROAD)	"B" - 24" BTRFLY VLV
C. INTERSECTION OF ACADEMY ROAD AND IMPERATA STREET. (HIGH DESERT STREET)	"A" - 30" BTRFLY VLV

FOR THE CONNECTION TO THE 8" WATERLINE - NON PRESSURE CONNECTION

WATER SHUT-OFF FOR PROPOSED CONNECTION AT:	CLOSE VALVE(S):
A. INTERSECTION OF HIGH DESERT STREET AND ELENA GALLEGOS PLACE. (HIGHLANDS UNIT 1)	"D" - 8" GATE VLV

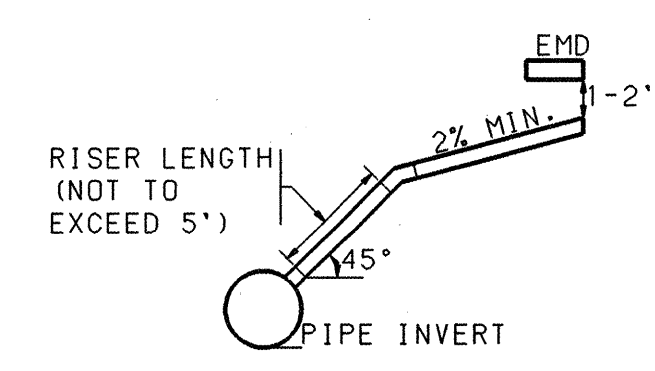

SERVICE RISER DETAIL
(SERVICE CONNECTION & INSTALLATION TO CONFORM TO COA STD. DWG. 2134. USE CI SOIL PIPE ONLY)

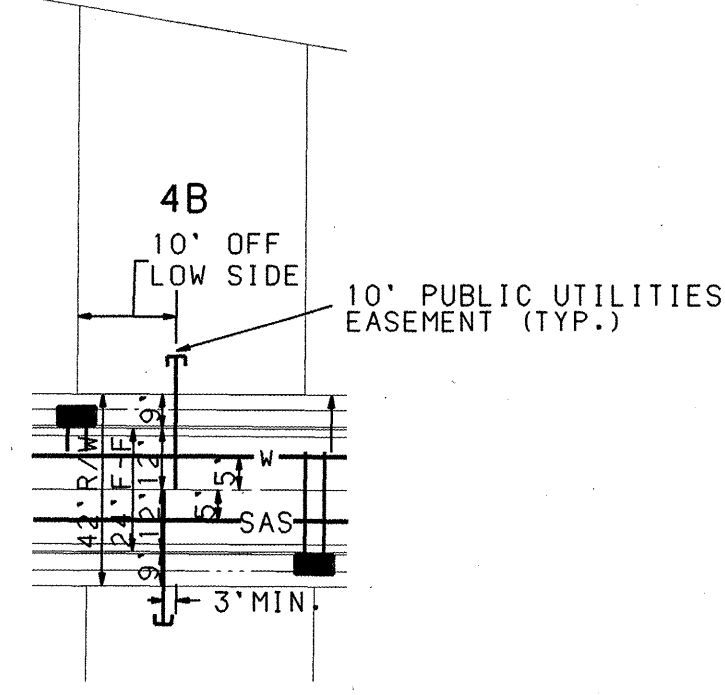

TYPICAL UTILITY SERVICE LOCATION
NO SCALE

BOHANNAN-HUSTON INC.
ENGINEERS • PLANNERS • PHOTOGRAMMETRISTS • SURVEYORS • LANDSCAPE ARCHITECTS
ALBUQUERQUE LAS CRUCES SANTA FE

CITY OF ALBUQUERQUE
PUBLIC WORKS DEPARTMENT
ENGINEERING DEVELOPMENT GROUP
DESERT HIGHLANDS AT HIGH DESERT
UNIT 4 OF THE HIGHLANDS AT HIGH DESERT
MASTER UTILITY PLAN

DESIGN REVIEW COMMITTEE

CITY PROJECT NO. 571283

CITY ENGINEER APPROVAL

ZONE MAP NO. E-23

LAST DESIGN UPDATE

SHEET 14 OF 21

MO/DAY/YR
MO/DAY/YR
MO/DAY/YR
MO/DAY/YR

SAS CURVE DATA TABLE					
NUMBER	PI STA.	DELTA	TANGENT	ARC	RADIUS
C3	3+67.98	6°40'42.0"	32.09'	64.11'	550.00'
C4	5+53.83	31°15'8.1"	153.83'	300.00'	550.00'
C5	7+48.82	10°8'39.0"	48.82'	97.38'	550.00'
C6	8+75.58	10°2'59.5"	78.26'	156.11'	890.00'

SAS TANGENT DATA		
NUMBER	BEARING	DISTANCE
T2	N31°27'18"E	196.89'


18" WATERLINE CURVE DATA TABLE					
NUMBER	PI STA.	DELTA	TANGENT	ARC	RADIUS
C7	5+76.74	48°4'29.1"	240.85'	453.09'	540.00'
C8	9+18.07	15°37'22.3"	120.72'	239.95'	880.00'

18" WATERLINE TANGENT DATA		
NUMBER	BEARING	DISTANCE
T3	N31°27'18"E	201.89'

UTILITY CROSSING DATA TABLE					
POINT	STATION	WL T.P.	SAS INV.	CLEARANCE	
#1	9+53.34	6153.04	6149.38	2.38'	
#2	1+77.62	6142.74	6139.58	0.78'	

8" WATERLINE CURVE DATA TABLE					
NUMBER	PI STA.	DELTA	TANGENT	ARC	RADIUS
C1	5+85.66	48°4'29.1"	249.77'	469.88'	560.00'
C2	8+83.94	10°59'52.5"	86.64'	172.75'	900.00'

8" WATERLINE TANGENT DATA		
NUMBER	BEARING	DISTANCE
T1	N31°27'18"E	201.90'

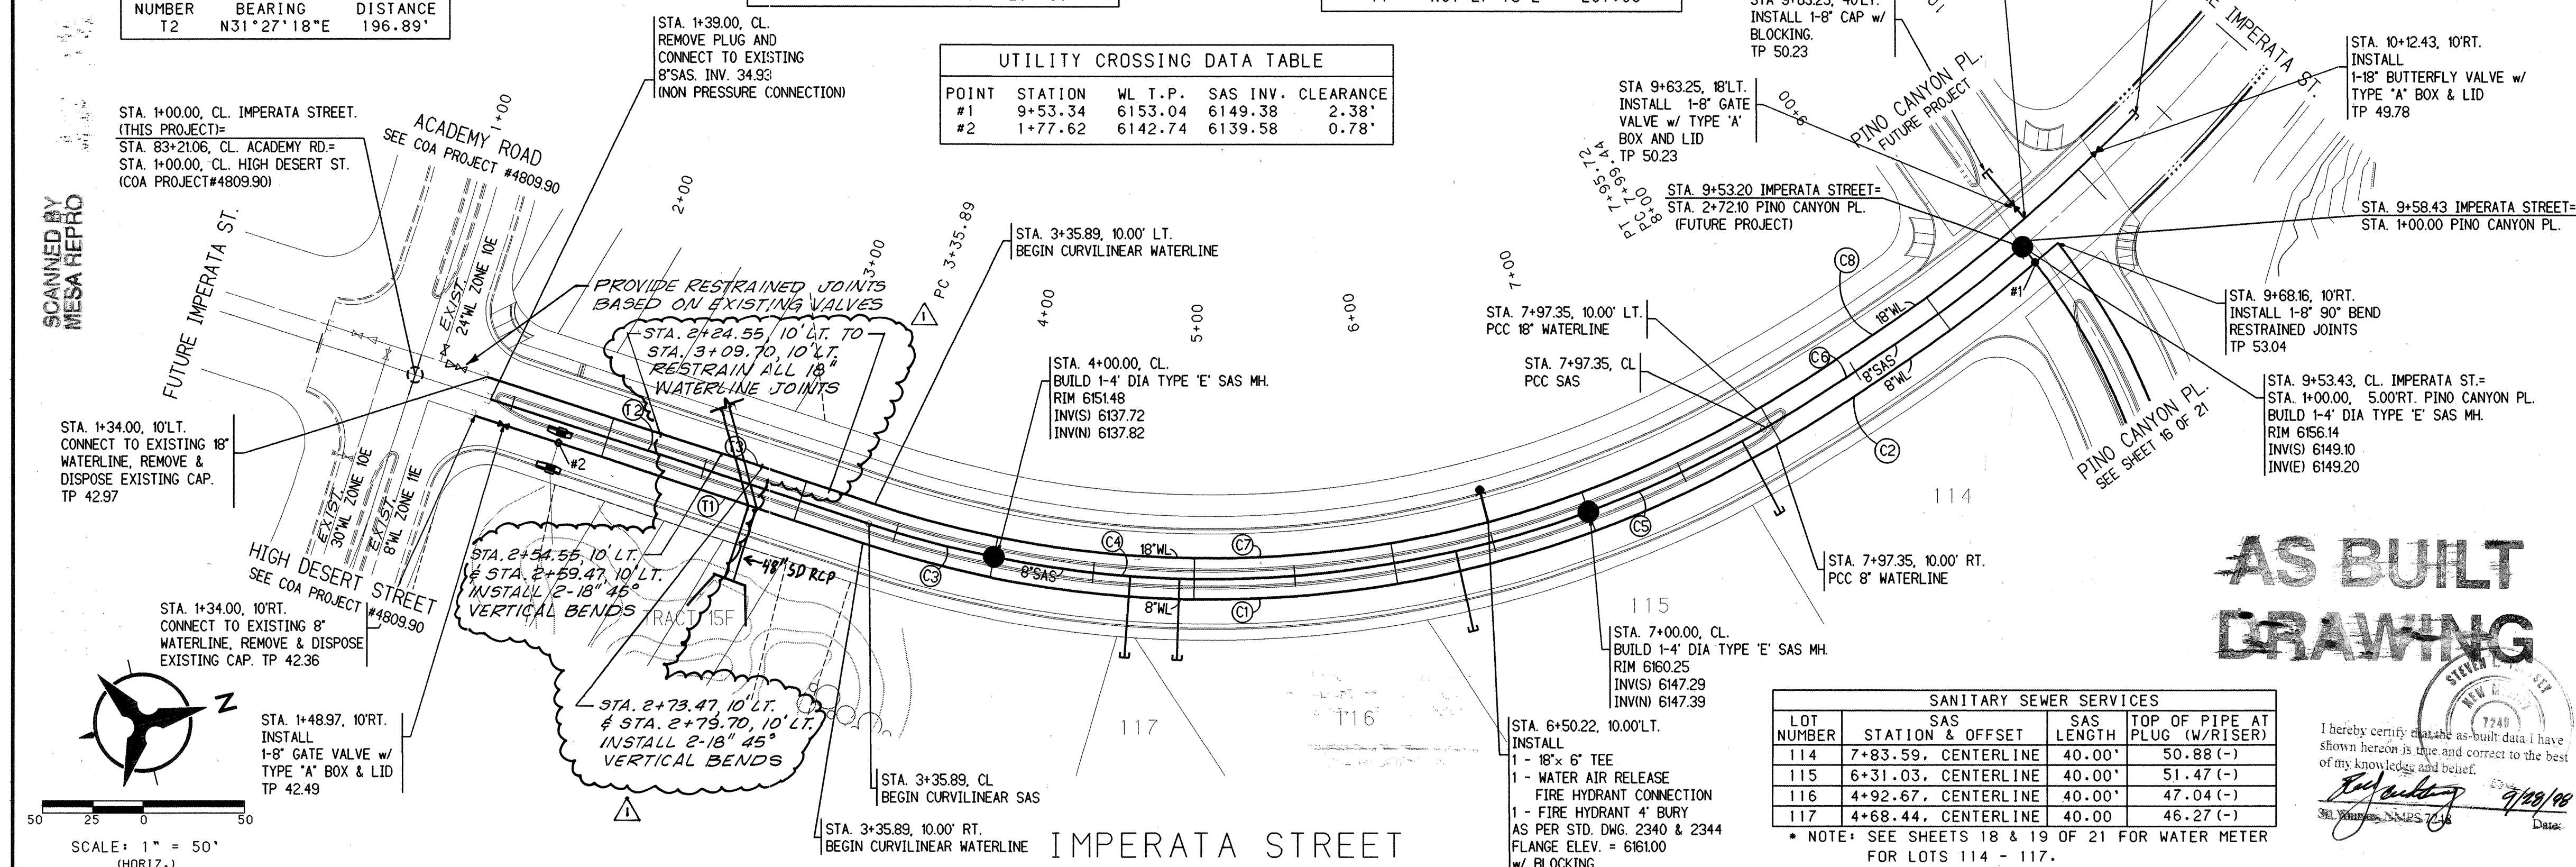

**AS BUILT
DRAWING**


SANITARY SEWER SERVICES				
LOT NUMBER	SAS STATION & OFFSET	SAS LENGTH	TOP OF PIPE AT PLUG (W/RISE)	
114	7+83.59, CENTERLINE	40.00'	50.88 (-)	
115	6+31.03, CENTERLINE	40.00'	51.47 (-)	
116	4+92.67, CENTERLINE	40.00'	47.04 (-)	
117	4+68.44, CENTERLINE	40.00'	46.27 (-)	

NOTE: SEE SHEETS 18 & 19 OF 21 FOR WATER METER FOR LOTS 114 - 117.

- NOTES**
1. THE CONTRACTOR SHALL FIELD VERIFY ALL EXISTING UTILITY LOCATIONS AND NOTIFY THE ENGINEER IMMEDIATELY OF ANY DISCREPANCIES.
 2. ALL CURB RETURN RADIUS SHALL BE 25' TO FACE OF CURB UNLESS OTHERWISE SPECIFIED.
 3. ALL CURVE DATA AND DIMENSIONS REFER TO FACE OF CURB UNLESS OTHERWISE SPECIFIED.
 4. GRADE ELEVATIONS, WHERE NOTED, ARE FOR FLOWLINE UNLESS OTHERWISE SPECIFIED.
 5. CONTRACTOR IS TO INSTALL A 4"x4"x5" POST AND EMD AT THE END OF EACH SANITARY SEWER SERVICE.
 6. CONTRACTOR IS RESPONSIBLE FOR REPAIR AND/OR REPLACEMENT OF ALL UTILITY CONDUITS AND EXISTING LINES.
 7. ANY ADDITIONAL GRADING REQUIRED TO MATCH PROPOSED STREET GRADES SHALL BE INCIDENTAL TO PAVING ITEMS.
 8. CONTRACTOR SHALL PROVIDE THE INSPECTORS (CITY AND PRIVATE) WITH THE PROPOSED HYDROSTATIC TESTING PLAN. THE PLAN MUST BE APPROVED BEFORE TESTING OPERATIONS BEGIN.
 9. CONTRACTOR SHALL PARK EQUIPMENT AND VEHICLES AS NOT TO INTERFERE WITH NORMAL ACTIVITIES OF RESIDENTS OR OTHER CONTRACTORS ON SITE.
 10. ANY DAMAGE TO THE EXISTING FACILITIES (CURB AND GUTTER, PAVEMENT, CONDUITS, LANDSCAPING, UTILITY LINES, ETC.) DURING CONSTRUCTION SHALL BE REPLACED AT THE CONTRACTORS EXPENSE.
 11. REMOVAL OF THE EXISTING CURB AND GUTTER SHALL BE AS PER COA STD. DWG. 2415 (SACUT ONLY).
 12. WHEEL CHAIR RAMPS SHALL BE CONSTRUCTED PRIOR TO ACCEPTANCE OF CURB AND GUTTER.

RESTRAINED JOINT TABLE			
MECHANICAL JOINTS	LENGTH OF RESTRAINED JOINTS FROM EACH SIDE OF MJ LISTED (6") (8") (10")		
11.25" H BEND	2'	3'	N/A
22.50" H BEND	4'	5'	N/A
45" H BEND	8'	11'	N/A
90" H BEND	20'	26'	N/A
GATE VALVE	55'	72'	N/A
BTFLY VALVE	---	---	18" 72'
REDUCER (8"x6")	30'	30'	N/A

- NOTE:**
1. ALL MECHANICAL JOINTS SHALL BE RESTRAINED AT THE FITTING.
 2. THE CONTRACTOR SHALL PROVIDE A MINIMUM PIPE LENGTH OF 20 LF FROM ALL MECHANICAL JOINTS. ALL PIPE JOINTS WITHIN 20 LF OF A MJ SHALL BE RESTRAINED AT THE CONTRACTORS EXPENSE.
 3. THE CONTRACTOR SHALL RESTRAIN ALL PIPE JOINTS IN THE SPECIFIED DISTANCE LISTED IN THE TABLE ABOVE. (SEE NOTE 2 ABOVE)
 4. THE CONTRACTOR SHALL RESTRAIN ALL FIRE HYDRANTS JOINTS FROM THE TEE ON THE MAIN TO THE FIRE HYDRANT FLANGE.
 5. ALL CAPS SHALL UTILIZE PCC BLOCKING

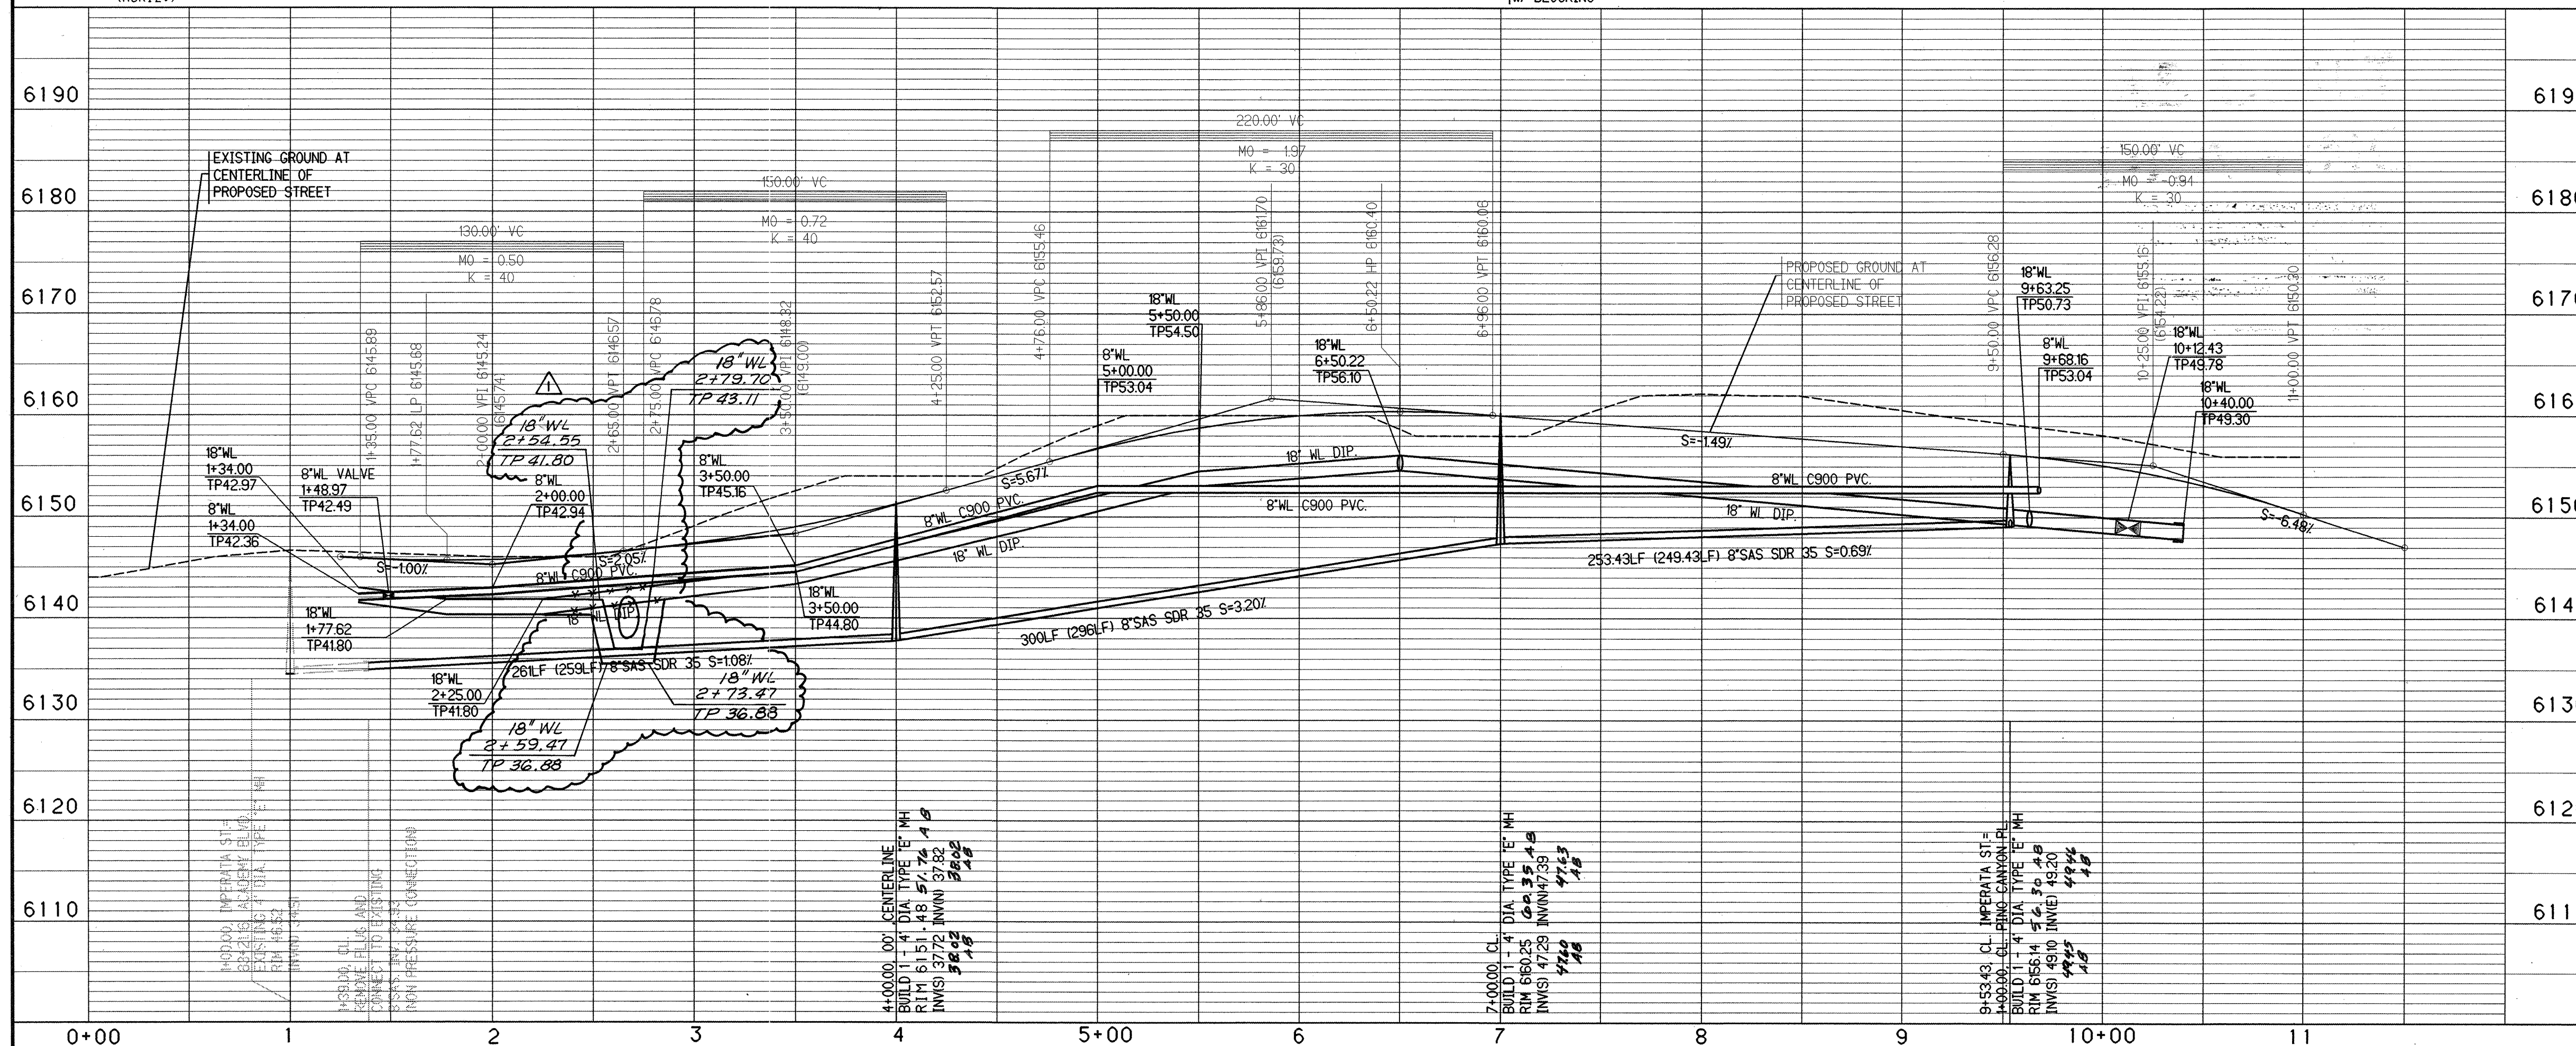

SCALE: 1" = 50' (HORIZ.)
1" = 10' (VERT.)

BOHANNAN-HUSTON INC.
ENGINEERS • PLANNERS • PHOTOGRAMMETRISTS • SURVEYORS • LANDSCAPE ARCHITECTS
ALBUQUERQUE LAS CRUCES SANTA FE

CITY OF ALBUQUERQUE
PUBLIC WORKS DEPARTMENT
ENGINEERING DEVELOPMENT GROUP
DESERT HIGHLANDS AT HIGH DESERT
IMPERATA STREET EXTENSION AT HIGH DESERT
UTILITY PLAN & PROFILE
IMPERATA STREET


DESIGN REVIEW COMMITTEE CITY ENGINEER APPROVAL MO/DAY/YR MO/DAY/YR

LAST DESIGN UPDATE

CITY PROJECT NO. **571283** ZONE MAP NO. **E-23** SHEET **15** OF **21**

COPYRIGHT BOHANNAN-HUSTON, INC. 1997
DATE: FEB., 1998

ENGINEER'S SEAL		SURVEY INFORMATION		BENCH MARKS		AS-BUILT INFORMATION	
NO.	DATE	NO.	DATE	NO.	DATE	NO.	DATE
1	6-17-98	1	6-17-98	1	6-17-98	1	6-17-98
2		2		2		2	
3		3		3		3	
4		4		4		4	
5		5		5		5	
6		6		6		6	
7		7		7		7	
8		8		8		8	
9		9		9		9	
10		10		10		10	
11		11		11		11	
12		12		12		12	
13		13		13		13	
14		14		14		14	
15		15		15		15	
16		16		16		16	
17		17		17		17	
18		18		18		18	
19		19		19		19	
20		20		20		20	
21		21		21		21	
22		22		22		22	
23		23		23		23	
24		24		24		24	
25		25		25		25	
26		26		26		26	
27		27		27		27	
28		28		28		28	
29		29		29		29	
30		30		30		30	

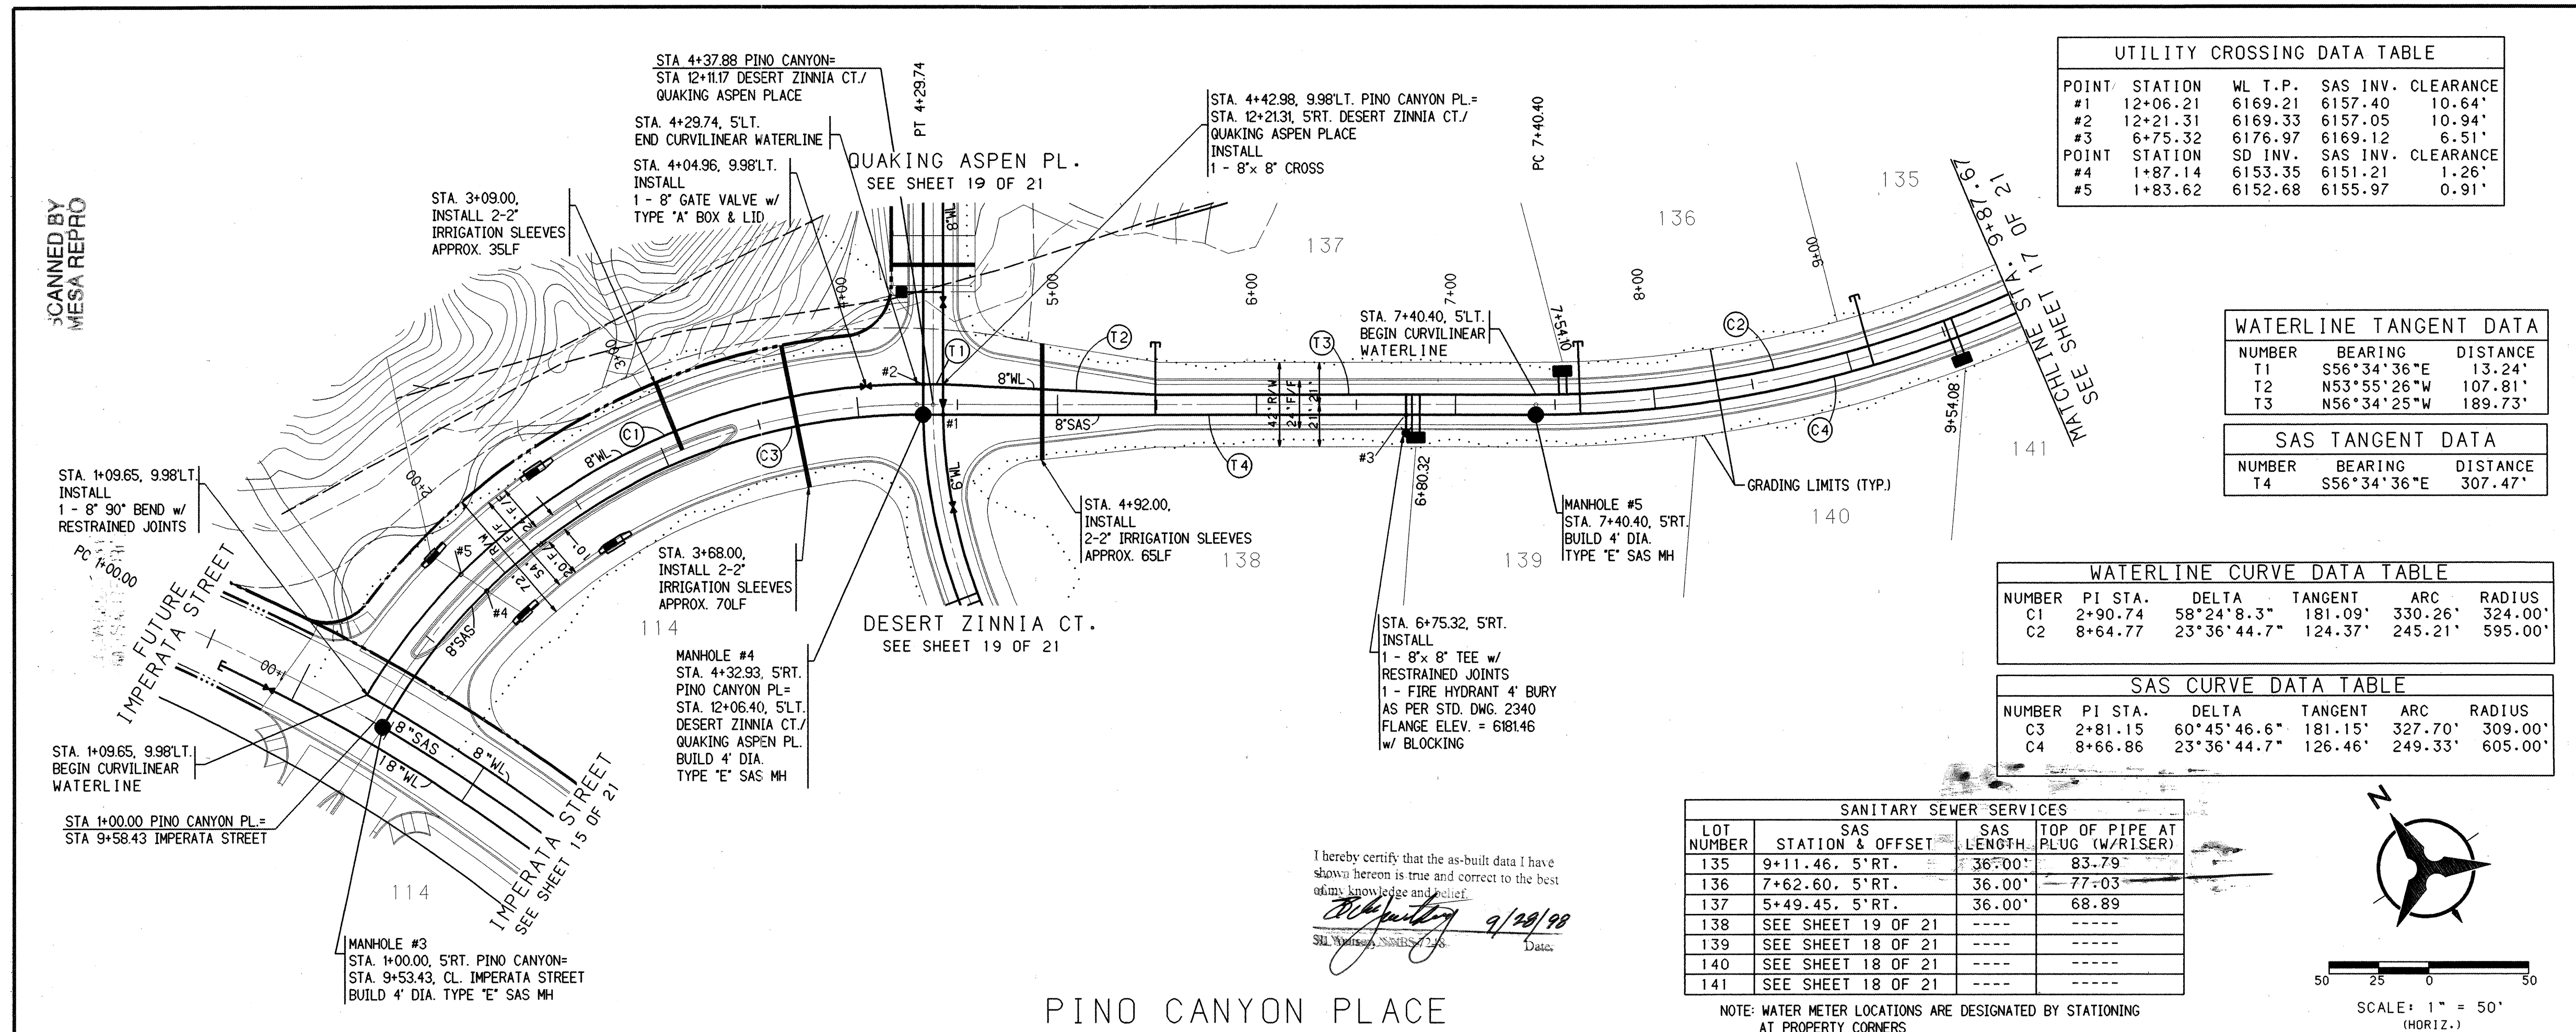

NOTES

- THE CONTRACTOR SHALL FIELD VERIFY ALL EXISTING UTILITY LOCATIONS AND NOTIFY THE ENGINEER IMMEDIATELY OF ANY DISCREPANCIES.
- ALL CURB RETURN RADII SHALL BE 25' TO FACE OF CURB UNLESS OTHERWISE SPECIFIED.
- ALL CURVE DATA AND DIMENSIONS REFER TO FACE OF CURB UNLESS OTHERWISE SPECIFIED.
- GRADE ELEVATIONS, WHERE NOTED, ARE FOR FLOWLINE UNLESS OTHERWISE SPECIFIED.
- CONTRACTOR IS TO INSTALL A 4"x4"x5" POST AND END AT THE END OF EACH SANITARY SEWER SERVICE.
- CONTRACTOR IS RESPONSIBLE FOR REPAIR AND/OR REPLACEMENT OF ALL UTILITY CONDUITS AND EXISTING LINES.
- ANY ADDITIONAL GRADING REQUIRED TO MATCH PROPOSED STREET GRADES SHALL BE INCIDENTAL TO PAVING ITEMS.
- CONTRACTOR SHALL PROVIDE THE INSPECTORS, (CITY AND PRIVATE) WITH THE PROPOSED HYDROSTATIC TESTING PLAN. THE PLAN MUST BE APPROVED BEFORE TESTING OPERATIONS BEGIN.
- CONTRACTOR SHALL PARK EQUIPMENT AND VEHICLES AS NOT TO INTERFERE WITH NORMAL ACTIVITIES OF RESIDENTS OR OTHER CONTRACTORS ON SITE.
- ANY DAMAGE TO THE EXISTING FACILITIES (CURB AND GUTTER, PAVEMENT, CONDUITS, LANDSCAPING, UTILITY LINES, ETC.) DURING CONSTRUCTION SHALL BE REPLACED AT THE CONTRACTORS EXPENSE.
- REMOVAL OF THE EXISTING CURB AND GUTTER SHALL BE AS PER COA STD. DWG. 2415 (SAWCUT ONLY).
- WHEEL CHAIR RAMPS SHALL BE CONSTRUCTED PRIOR TO ACCEPTANCE OF CURB AND GUTTER.

RESTRAINED JOINT TABLE

MECHANICAL JOINTS	LENGTH OF RESTRAINED JOINTS FROM EACH SIDE OF MJ LISTED (6") (8")
11.25" H BEND	2' 3'
22.50" H BEND	4' 5'
45" H BEND	8' 11'
90" H BEND	20' 26'
GATE VALVE	55' 72'
BIRFLY VALVE	---
REDUCER (8"x6")	30' 30'

NOTE:

- ALL MECHANICAL JOINTS SHALL BE RESTRAINED AT THE FITTING.
- THE CONTRACTOR SHALL PROVIDE A MINIMUM PIPE LENGTH OF 20 LF FROM ALL MECHANICAL JOINTS. ALL PIPE JOINTS WITHIN 20 LF OF A MJ SHALL BE RESTRAINED AT THE CONTRACTORS EXPENSE.
- THE CONTRACTOR SHALL RESTRAIN ALL PIPE JOINTS IN THE SPECIFIED DISTANCE LISTED IN THE TABLE ABOVE. (SEE NOTE 2 ABOVE)
- THE CONTRACTOR SHALL RESTRAIN ALL FIRE HYDRANTS JOINTS FROM THE TEE ON THE MAIN TO THE FIRE HYDRANT FLANGE.
- ALL CAPS SHALL UTILIZE PCC BLOCKING

BOHANNAN-HUSTON INC.
ENGINEERS • PLANNERS • PHOTOGRAMMETRISTS • SURVEYORS • LANDSCAPE ARCHITECTS
ALBUQUERQUE LAS CRUCES SANTA FE

CITY OF ALBUQUERQUE
PUBLIC WORKS DEPARTMENT
DESIGN DEVELOPMENT GROUP
DESERT HIGHLANDS AT HIGH DESERT
UNIT 4 OF THE HIGHLANDS AT HIGH DESERT
UTILITY PLAN & PROFILE
PINO CANYON PLACE STA. 1+00.00 - 9+87.67

APPROVE
MAY 11 1998
DESIGN REVIEW COMMITTEE

CITY ENGINEER APPROVAL

LAST DESIGN UPDATE

MO/DAY/YR


MO/DAY/YR

CITY PROJECT NO. 571283

ZONE MAP NO. E-23

SHEET 16 OF 21

DATE: FEBRUARY, 1998

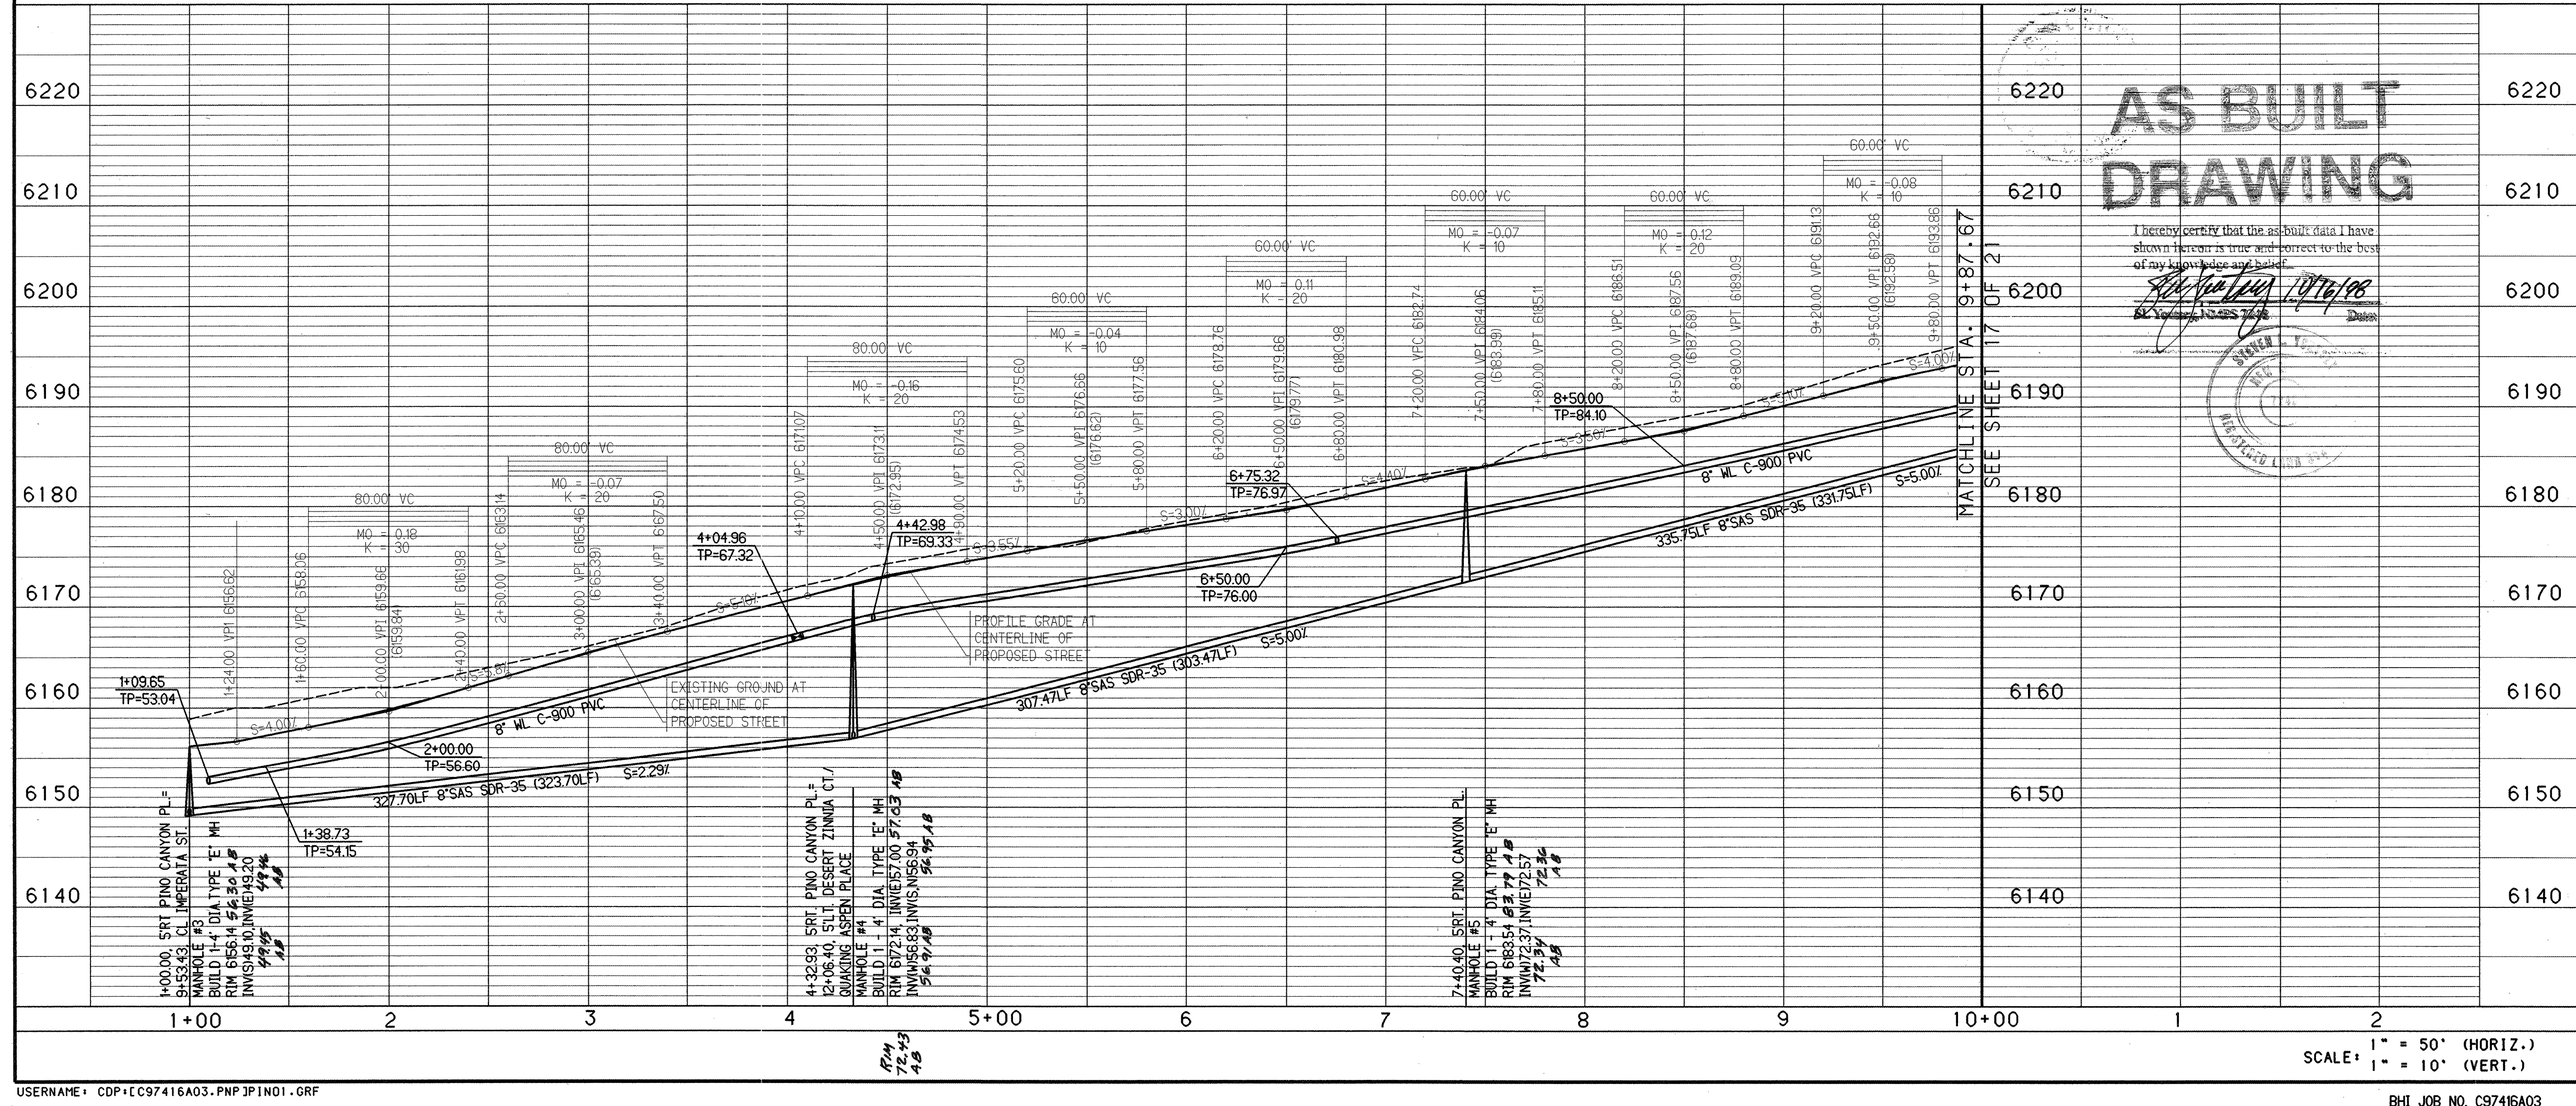

SAS CURVE DATA TABLE					
NUMBER	PI STA.	DELTA	TANGENT	ARC	RADIUS
C5	15+81.87	15°15'07.0"	107.78	214.29	805.00'
C6	17+94.82	15°15'07.0"	107.78	214.29	805.00'

SAS TANGENT DATA		
NUMBER	BEARING	DISTANCE
T5	S80°11'09"E	86.42'
T6	S80°11'09"E	400.00'



UTILITY CROSSING DATA TABLE				
POINT	STATION	WL T.P.	SAS INV.	CLEARANCE
#3	11+60.00	6197.63	6193.50	2.79'

SANITARY SEWER SERVICES				
LOT NUMBER	SAS	LENGTH	TOP OF PIPE AT PLUG (W/RISER)	
125	12+34.39, 5.00' RT.	26.00'	98.94 (-)	
126	13+77.25, 5.00' RT.	26.00'	05.51 (-)	
127	19+00.00, 5.00' RT.	43.55'	25.09 (-)	
128	18+67.36, 5.00' RT.	36.00'	23.98 (-)	
129	17+27.77, 5.00' RT.	36.00'	19.77 (-)	
130	15+94.09, 5.00' RT.	36.00'	14.92 (-)	
131	14+40.90, 5.00' RT.	36.00'	08.74 (-)	
132	13+08.30, 5.00' RT.	36.00'	02.64 (-)	
133	11+71.64, 5.00' RT.	36.00'	96.36 (-)	
134	10+40.05, 5.00' RT.	36.00'	90.33 (-)	

NOTE: WATER METER LOCATIONS ARE DESIGNATED BY STATIONING AT PROPERTY CORNERS.

WATERLINE CURVE DATA TABLE					
NUMBER	PI STA.	DELTA	TANGENT	ARC	RADIUS
C7	16+90.86	30°30'14.0"	216.77'	423.25'	795.00'

WATERLINE TANGENT DATA		
NUMBER	BEARING	DISTANCE
T7	S80°11'09"E	172.33'
T8	S80°11'09"E	314.09'
T9	S09°48'51"W	131.70'

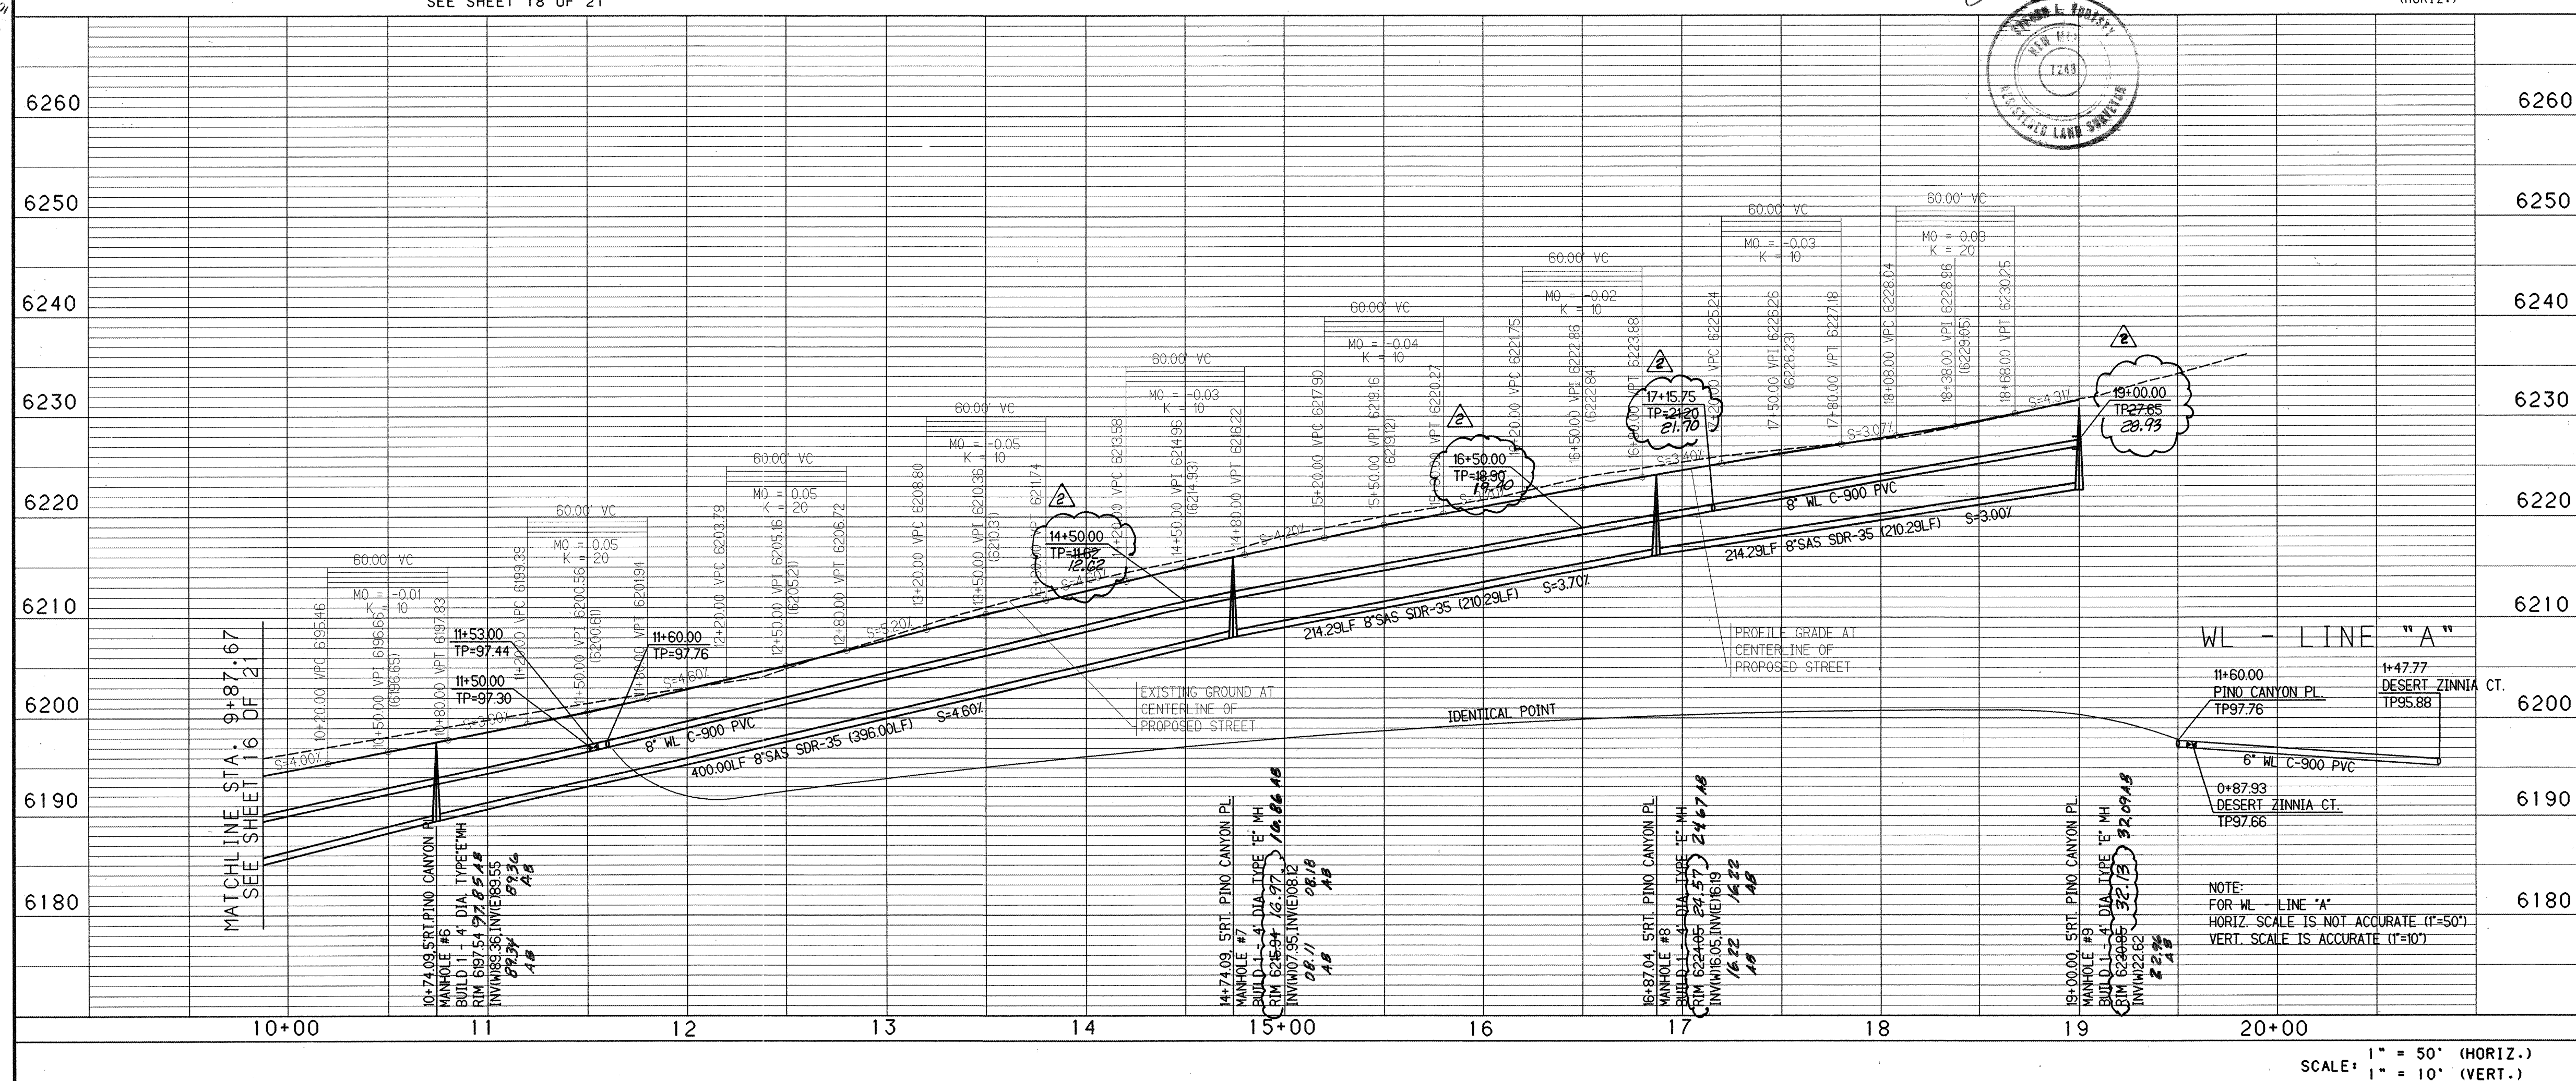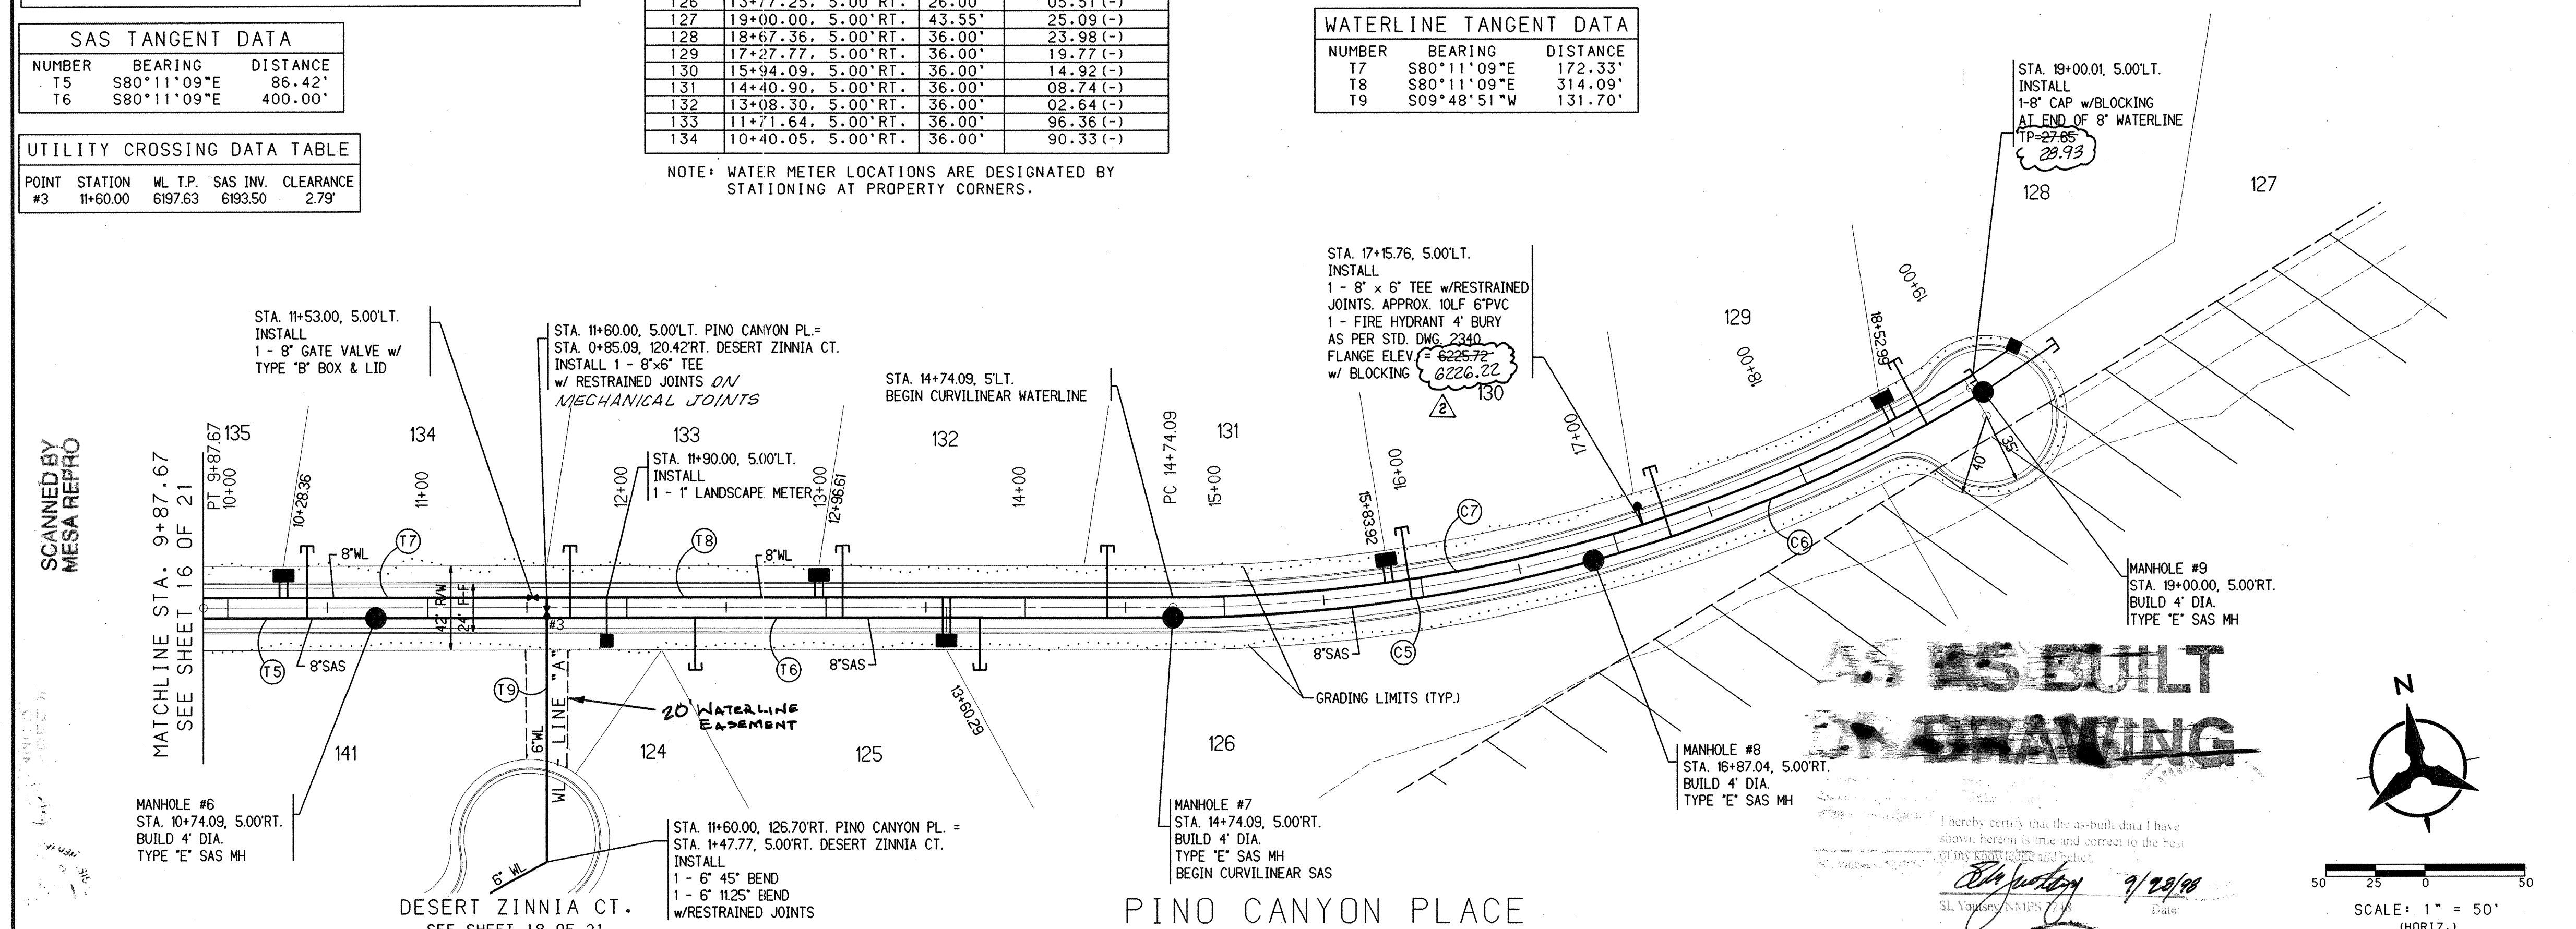

NOTES

- THE CONTRACTOR SHALL FIELD VERIFY ALL EXISTING UTILITY LOCATIONS AND NOTIFY THE ENGINEER IMMEDIATELY OF ANY DISCREPANCIES.
- ALL CURB RETURN RADI SHALL BE 25' TO FACE OF CURB UNLESS OTHERWISE SPECIFIED.
- ALL CURVE DATA AND DIMENSIONS REFER TO FACE OF CURB UNLESS OTHERWISE SPECIFIED.
- GRADE ELEVATIONS, WHERE NOTED, ARE FOR FLOWLINE UNLESS OTHERWISE SPECIFIED.
- CONTRACTOR IS TO INSTALL A 4"x4"x5" POST AND EMD AT THE END OF EACH SANITARY SEWER SERVICE.
- CONTRACTOR IS RESPONSIBLE FOR REPAIR AND/OR REPLACEMENT OF ALL UTILITY CONDUITS AND EXISTING LINES.
- ANY ADDITIONAL GRADING REQUIRED TO MATCH PROPOSED STREET GRADES SHALL BE INCIDENTAL TO PAVING ITEMS.
- CONTRACTOR SHALL PROVIDE THE INSPECTORS, (CITY AND PRIVATE) WITH THE PROPOSED HYDROSTATIC TESTING PLAN. THE PLAN MUST BE APPROVED BEFORE TESTING OPERATIONS BEGIN.
- CONTRACTOR SHALL PARK EQUIPMENT AND VEHICLES AS NOT TO INTERFERE WITH NORMAL ACTIVITIES OF RESIDENTS OR OTHER CONTRACTORS ON SITE.
- ANY DAMAGE TO THE EXISTING FACILITIES (CURB AND GUTTER, PAVEMENT, CONDUITS, LANDSCAPING, UTILITY LINES, ETC.) DURING CONSTRUCTION SHALL BE REPLACED AT THE CONTRACTORS EXPENSE.
- REMOVAL OF THE EXISTING CURB AND GUTTER SHALL BE AS PER COA STD. DWG. 2415 (SAWCUT ONLY).
- WHEEL CHAIR RAMPS SHALL BE CONSTRUCTED PRIOR TO ACCEPTANCE OF CURB AND GUTTER.

RESTRAINED JOINT TABLE

MECHANICAL JOINTS	LENGTH OF RESTRAINED JOINTS FROM EACH SIDE OF MJ LISTED (6") (8")	
11-25" H BEND	2'	3'
22-50" H BEND	4'	5'
45" H BEND	8'	11'
90" H BEND	20'	26'
GATE VALVE	55'	72'
BTFLY VALVE	---	---
REDUCER (8"x6")	30'	30'

REVISIONS

NO.	DATE	BY	REMARKS
1	7-16-98	KGP	REVISED ELEVATIONS
2	9-11-98	KGP	DESIGN

ENGINEER'S SEAL

BOHANNAN-HUSTON INC.

ENGINEERS • PLANNERS • PHOTOGRAMMETRISTS • SURVEYORS • LANDSCAPE ARCHITECTS

ALBUQUERQUE LAS CRUCES SANTA FE

CITY OF ALBUQUERQUE

PUBLIC WORKS DEPARTMENT

DESERT HIGHLANDS AT HIGH DESERT

UNIT 4 OF THE HIGHLANDS AT HIGH DESERT

UTILITY PLAN & PROFILE

PINO CANYON PLACE STA. 9+87.67 - 20+00.00

DESIGN REVIEW COMMITTEE

CITY ENGINEER APPROVAL

MO/DAY/YR.

MO/DAY/YR.

DESIGN REVIEW COMMITTEE

CITY PROJECT NO.

ZONE MAP NO.

SHEET

OF


SAS CURVE DATA TABLE						
NUMBER	PI STA.	DELTA	TANGENT	ARC	RADIUS	
C1	4+30.12	7°44'00.1"	20.61'	41.17'	305.00'	
C2	5+75.97	44°52'54.1"	125.97'	238.92'	305.00'	
C3	7+77.76	33°50'02.3"	92.76'	180.11'	305.00'	

WATERLINE CURVE DATA TABLE						
NUMBER	PI STA.	DELTA	TANGENT	ARC	RADIUS	
C4	6+86.77	86°26'56.5"	277.26'	445.10'	295.00'	


WATERLINE TANGENT DATA		
NUMBER	BEARING	DISTANCE
T5	S71°08'03"W	261.74'
T6	S22°25'00"E	86.01'

SAS TANGENT DATA		
NUMBER	BEARING	DISTANCE
T1	S71°08'03"W	238.01'
T2	N19°01'05"E	82.32'
T3	S22°25'00"E	49.00'
T4	S22°25'00"E	37.01'

STA. 1+47.77, 5.00'RT. DESERT ZINNIA CT. =
STA. 1+60.00, 126.70'RT. PINO CANYON PLACE
INSTALL
1 - 6" 45° BEND
1 - 6" 11.25° BEND
W/RESTRAINED JOINTS

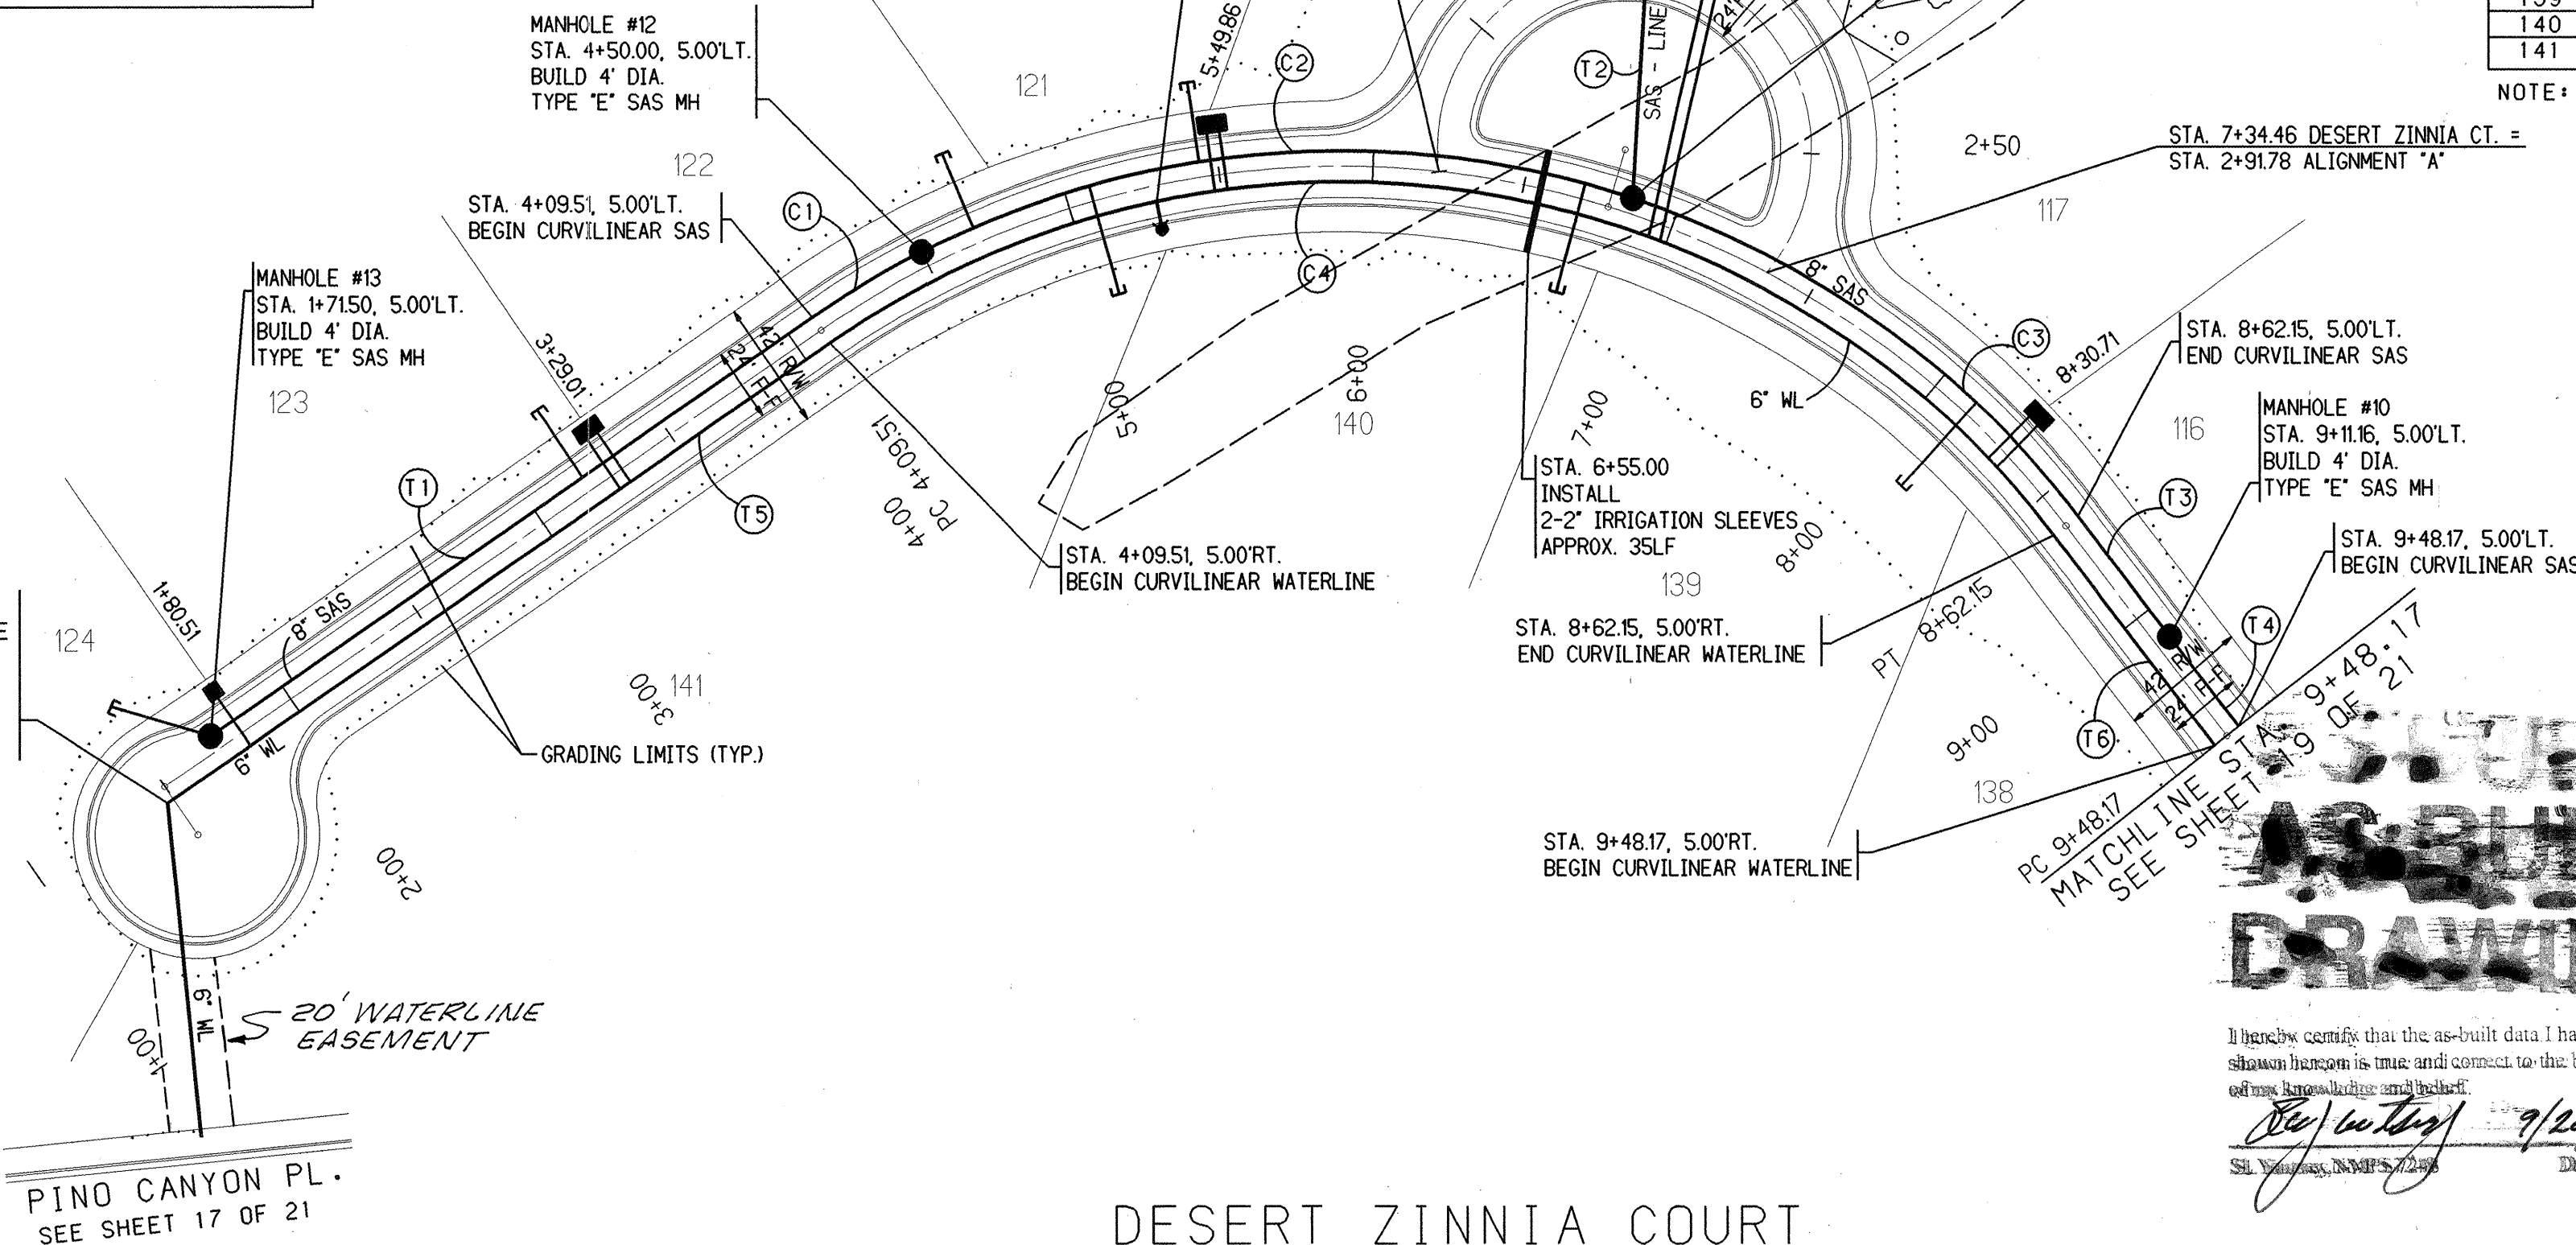

UTILITY CROSSING DATA TABLE				
POINT	STATION	WL T.P.	SAS INV.	CLEARANCE
#1	12+06.21	6169.21	6157.40	10.64'
#2	12+21.31	6169.33	6157.05	10.94'



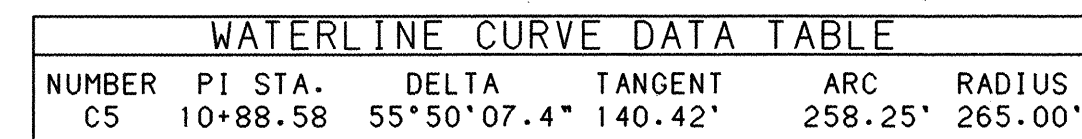


WATERLINE TANGENT DATA		
NUMBER	BEARING	DISTANCE
T7	N33°24'35"E	73.70'
T7A	N33°24'35"E	212.20'

SAS CURVE DATA TABLE					
NUMBER	PI STA.	DELTA	TANGENT	ARC	RADIUS
C6	10+90.71	54°47'52.7"	142.54'	263.01'	275.00'


SAS TANGENT DATA		
NUMBER	BEARING	DISTANCE
T8	N33°25'06"W	83.69'
T8A	N33°25'06"E	149.53'
T9	N33°25'06"E	62.67'

AS BUILT DRAWING

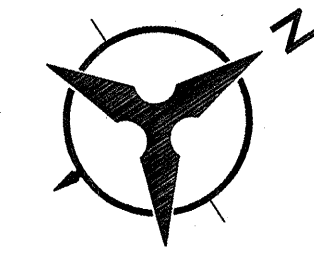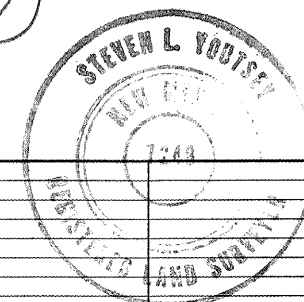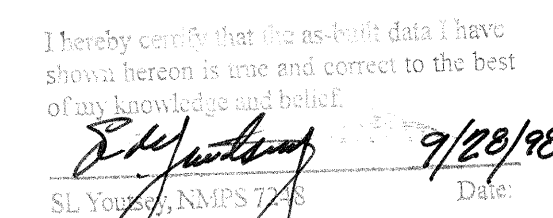

25 0
SCALE: 1" = 50'
(HORIZ.)

DESERT ZINNIA COURT/QUAKING ASPEN PLACE

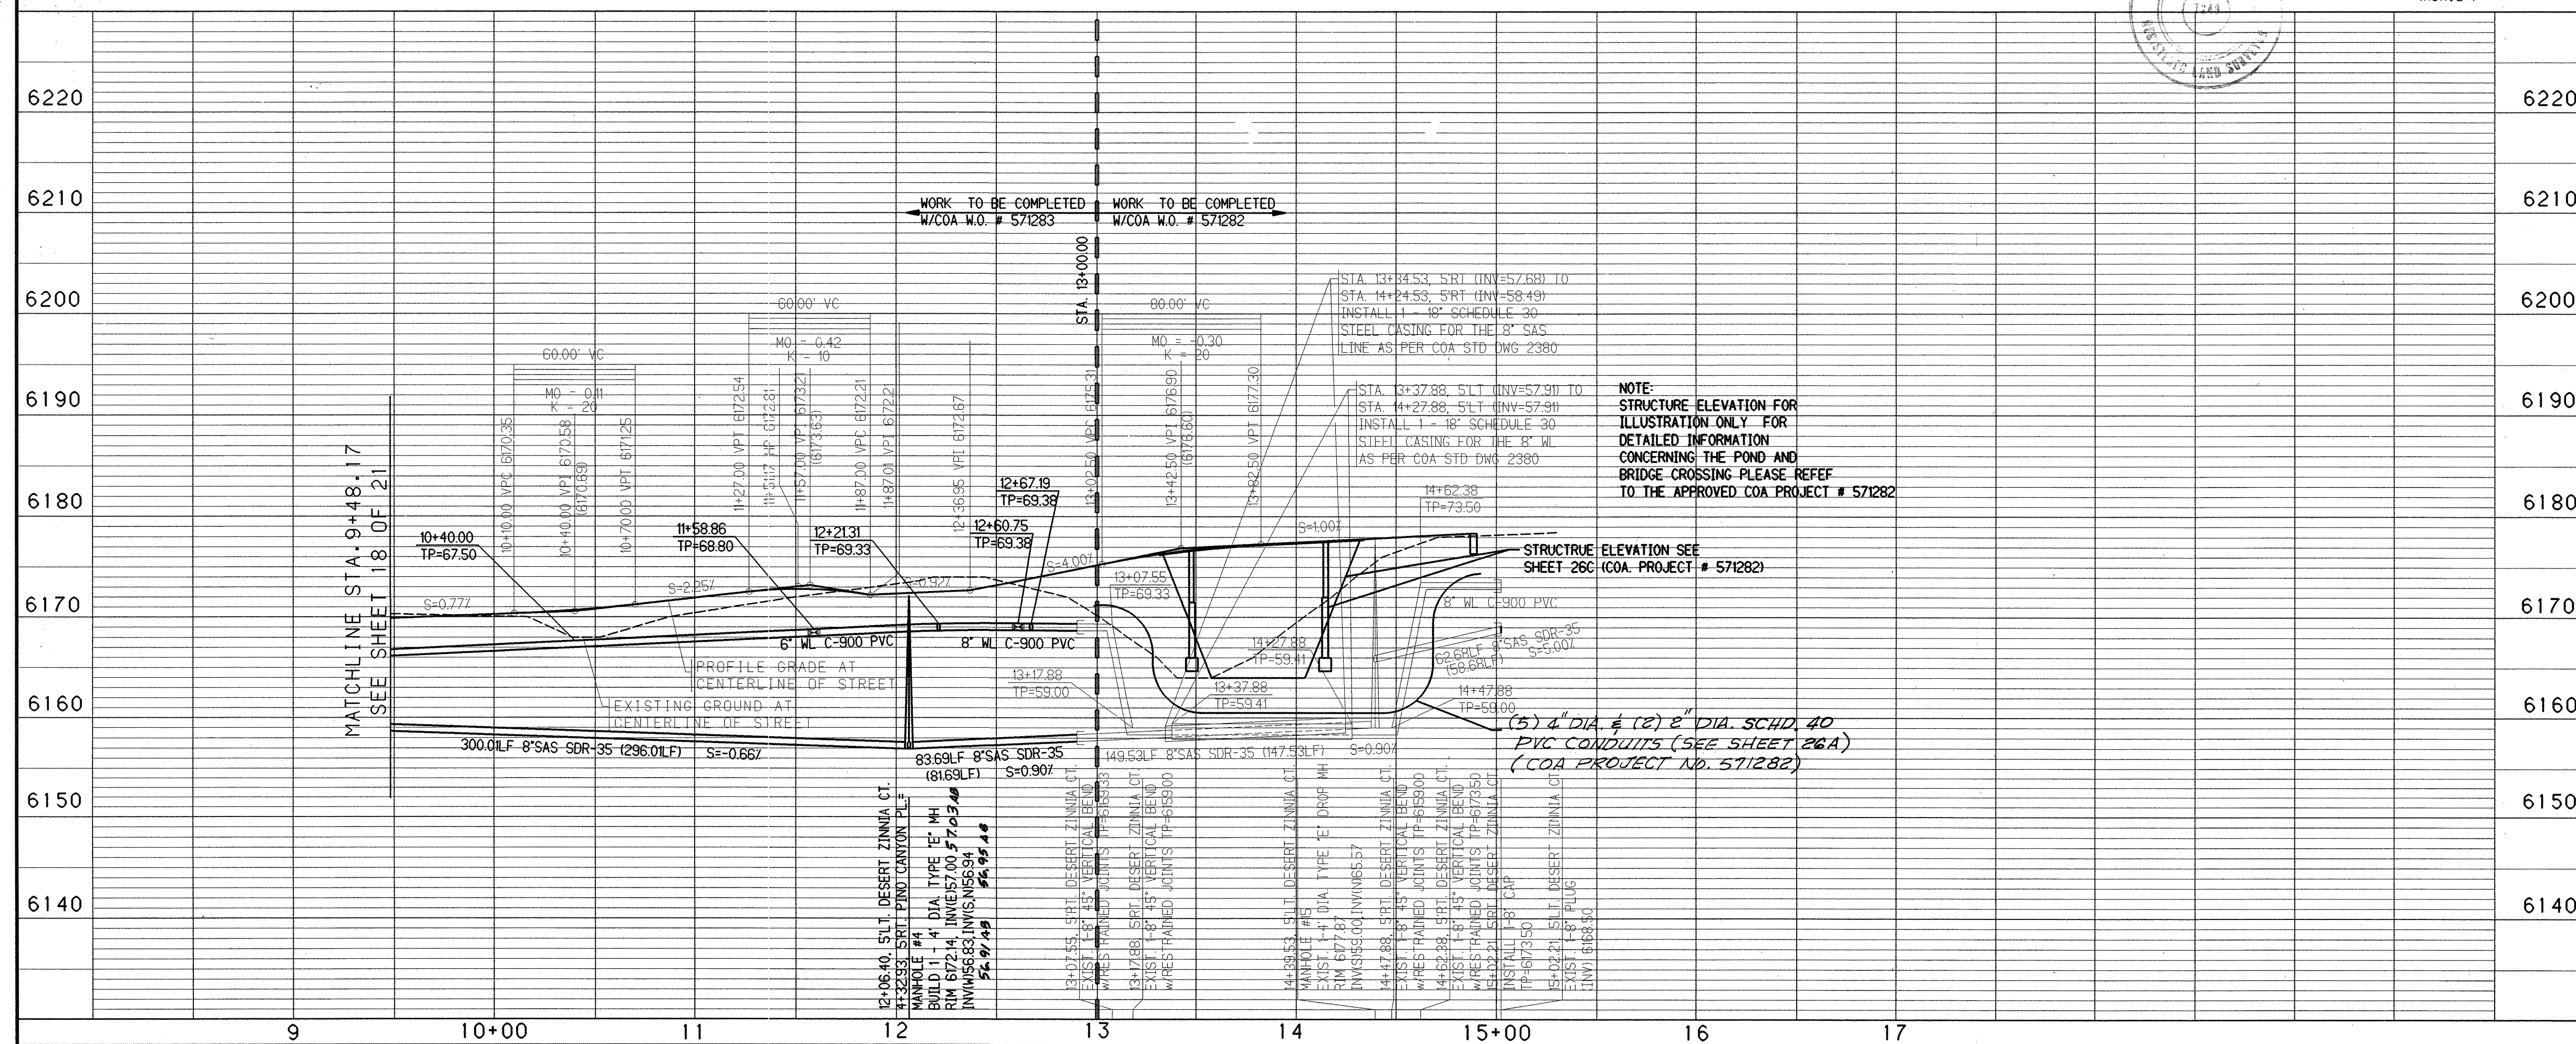

SCALE: 1" = 50' (HORIZ.)
1" = 10' (VERT.)

NOTES

1. THE CONTRACTOR SHALL FIELD VERIFY ALL EXISTING UTILITY LOCATIONS AND NOTIFY THE ENGINEER IMMEDIATELY OF ANY DISCREPANCIES.
2. ALL CURB RETURN RADII SHALL BE 25' TO FACE OF CURB UNLESS OTHERWISE SPECIFIED.
3. ALL CURVE DATA AND DIMENSIONS REFER TO FACE OF CURB UNLESS OTHERWISE SPECIFIED.
4. GRADE ELEVATIONS, WHERE NOTED, ARE FOR FLOWLINE UNLESS OTHERWISE SPECIFIED.
5. CONTRACTOR IS TO INSTALL A 4"x4"x5' POST AND END AT THE END OF EACH SANITARY SEWER SERVICE.
6. CONTRACTOR IS RESPONSIBLE FOR REPAIR AND/OR REPLACEMENT OF ALL UTILITY CONDUITS AND EXISTING LINES.
7. ANY ADDITIONAL GRADING REQUIRED TO MATCH PROPOSED STREET GRADES SHALL BE INCIDENTAL TO PAVING ITEMS.
8. CONTRACTOR SHALL PROVIDE THE INSPECTORS. (CITY AND PRIVATE) WITH THE PROPOSED HYDROSTATIC TESTING PLAN. THE PLAN MUST BE APPROVED BEFORE TESTING OPERATIONS BEGIN.
9. CONTRACTOR SHALL PARK EQUIPMENT AND VEHICLES AS NOT TO INTERFERE WITH NORMAL ACTIVITIES OF RESIDENTS OR OTHER CONTRACTORS ON SITE.
10. ANY DAMAGE TO THE EXISTING FACILITIES (CURB AND GUTTER, PAVEMENT, CONDUITS, LANDSCAPING, UTILITY LINES, ETC.) DURING CONSTRUCTION SHALL BE REPLACED AT THE CONTRACTORS EXPENSE.
11. REMOVAL OF THE EXISTING CURB AND GUTTER SHALL BE AS PER COA STD. DWG. 2415 (SAWCUT ONLY).
12. WHEEL CHAIR RAMPS SHALL BE CONSTRUCTED PRIOR TO ACCEPTANCE OF CURB AND GUTTER.

RESTRAINED JOINT TABLE		
MECHANICAL JOINTS	LENGTH OF RESTRAINED JOINTS FROM EACH SIDE OF MJ LISTED	
	(6")	(8")
11.25" H BEND	2'	3'
22.50" H BEND	4'	5'
45° H BEND	8'	11'
90° H BEND	20'	26'
GATE VALVE	55'	72'
BTFLY VALVE	---	---
REDUCER (12" - 6")	30'	30'

NOTE:

1. ALL MECHANICAL JOINTS SHALL BE RESTRAINED AT THE FITTING.
2. THE CONTRACTOR SHALL PROVIDE A MINIMUM PIPE LENGTH OF 20' LF FROM ALL MECHANICAL JOINTS. ALL PIPE JOINTS WITHIN 20 LF OF A MJ SHALL BE RESTRAINED AT THE CONTRACTORS EXPENSE.
3. THE CONTRACTOR SHALL RESTRAIN ALL PIPE JOINTS IN THE SPECIFIED DISTANCE LISTED IN THE TABLE ABOVE. (SEE NOTE 2 ABOVE)
4. THE CONTRACTOR SHALL RESTRAIN ALL FIRE HYDRANTS' JOINTS FROM THE TEE ON THE MAIN TO THE FIRE HYDRANT FLANGE.
5. ALL CAPS SHALL UTILIZE PCC BLOCKING



BOHANNAN-HUSTON INC.
ENGINEERS • PLANNERS • PHOTOGRAMMETRISTS • SURVEY
 ALBUQUERQUE LAS CRUCES


 CITY OF ALBUQUERQUE
 PUBLIC WORKS DEPARTMENT
 UTILITY PLANNING & DESIGN GROUP
~~UNIT 4 OF THE HIGHLANDS AT HIGH DESERT~~
 UTILITY PLAN & PROFILE
 DESERT ZINNIA CT./QUAKING ASPEN PL. STA. 9+48.17-15+00.00

DESIGN REVIEW COMMITTEE	CITY ENGINEER APPROVAL	MO./DAY/YR.	MO./DAY/YR.
-------------------------	------------------------	-------------	-------------

CITY ENGINEER APPROVAL	LAST DESIGN UPDATE	MO./DAY/YR.	MO./DAY/YR.


CITY PROJECT NO.	ZONE MAP NO.	SHEET	OF
571283	E-23	19	21

USERNAME: CDP:[C97416A03.PNP]NEW-DESERT2.GRF

PWT IOR NO C97416A03


COPYRIGHT BOHANNAN HUSTON 1998
DATE: FEBRUARY 1998

SCANNED BY
MESA REPRO

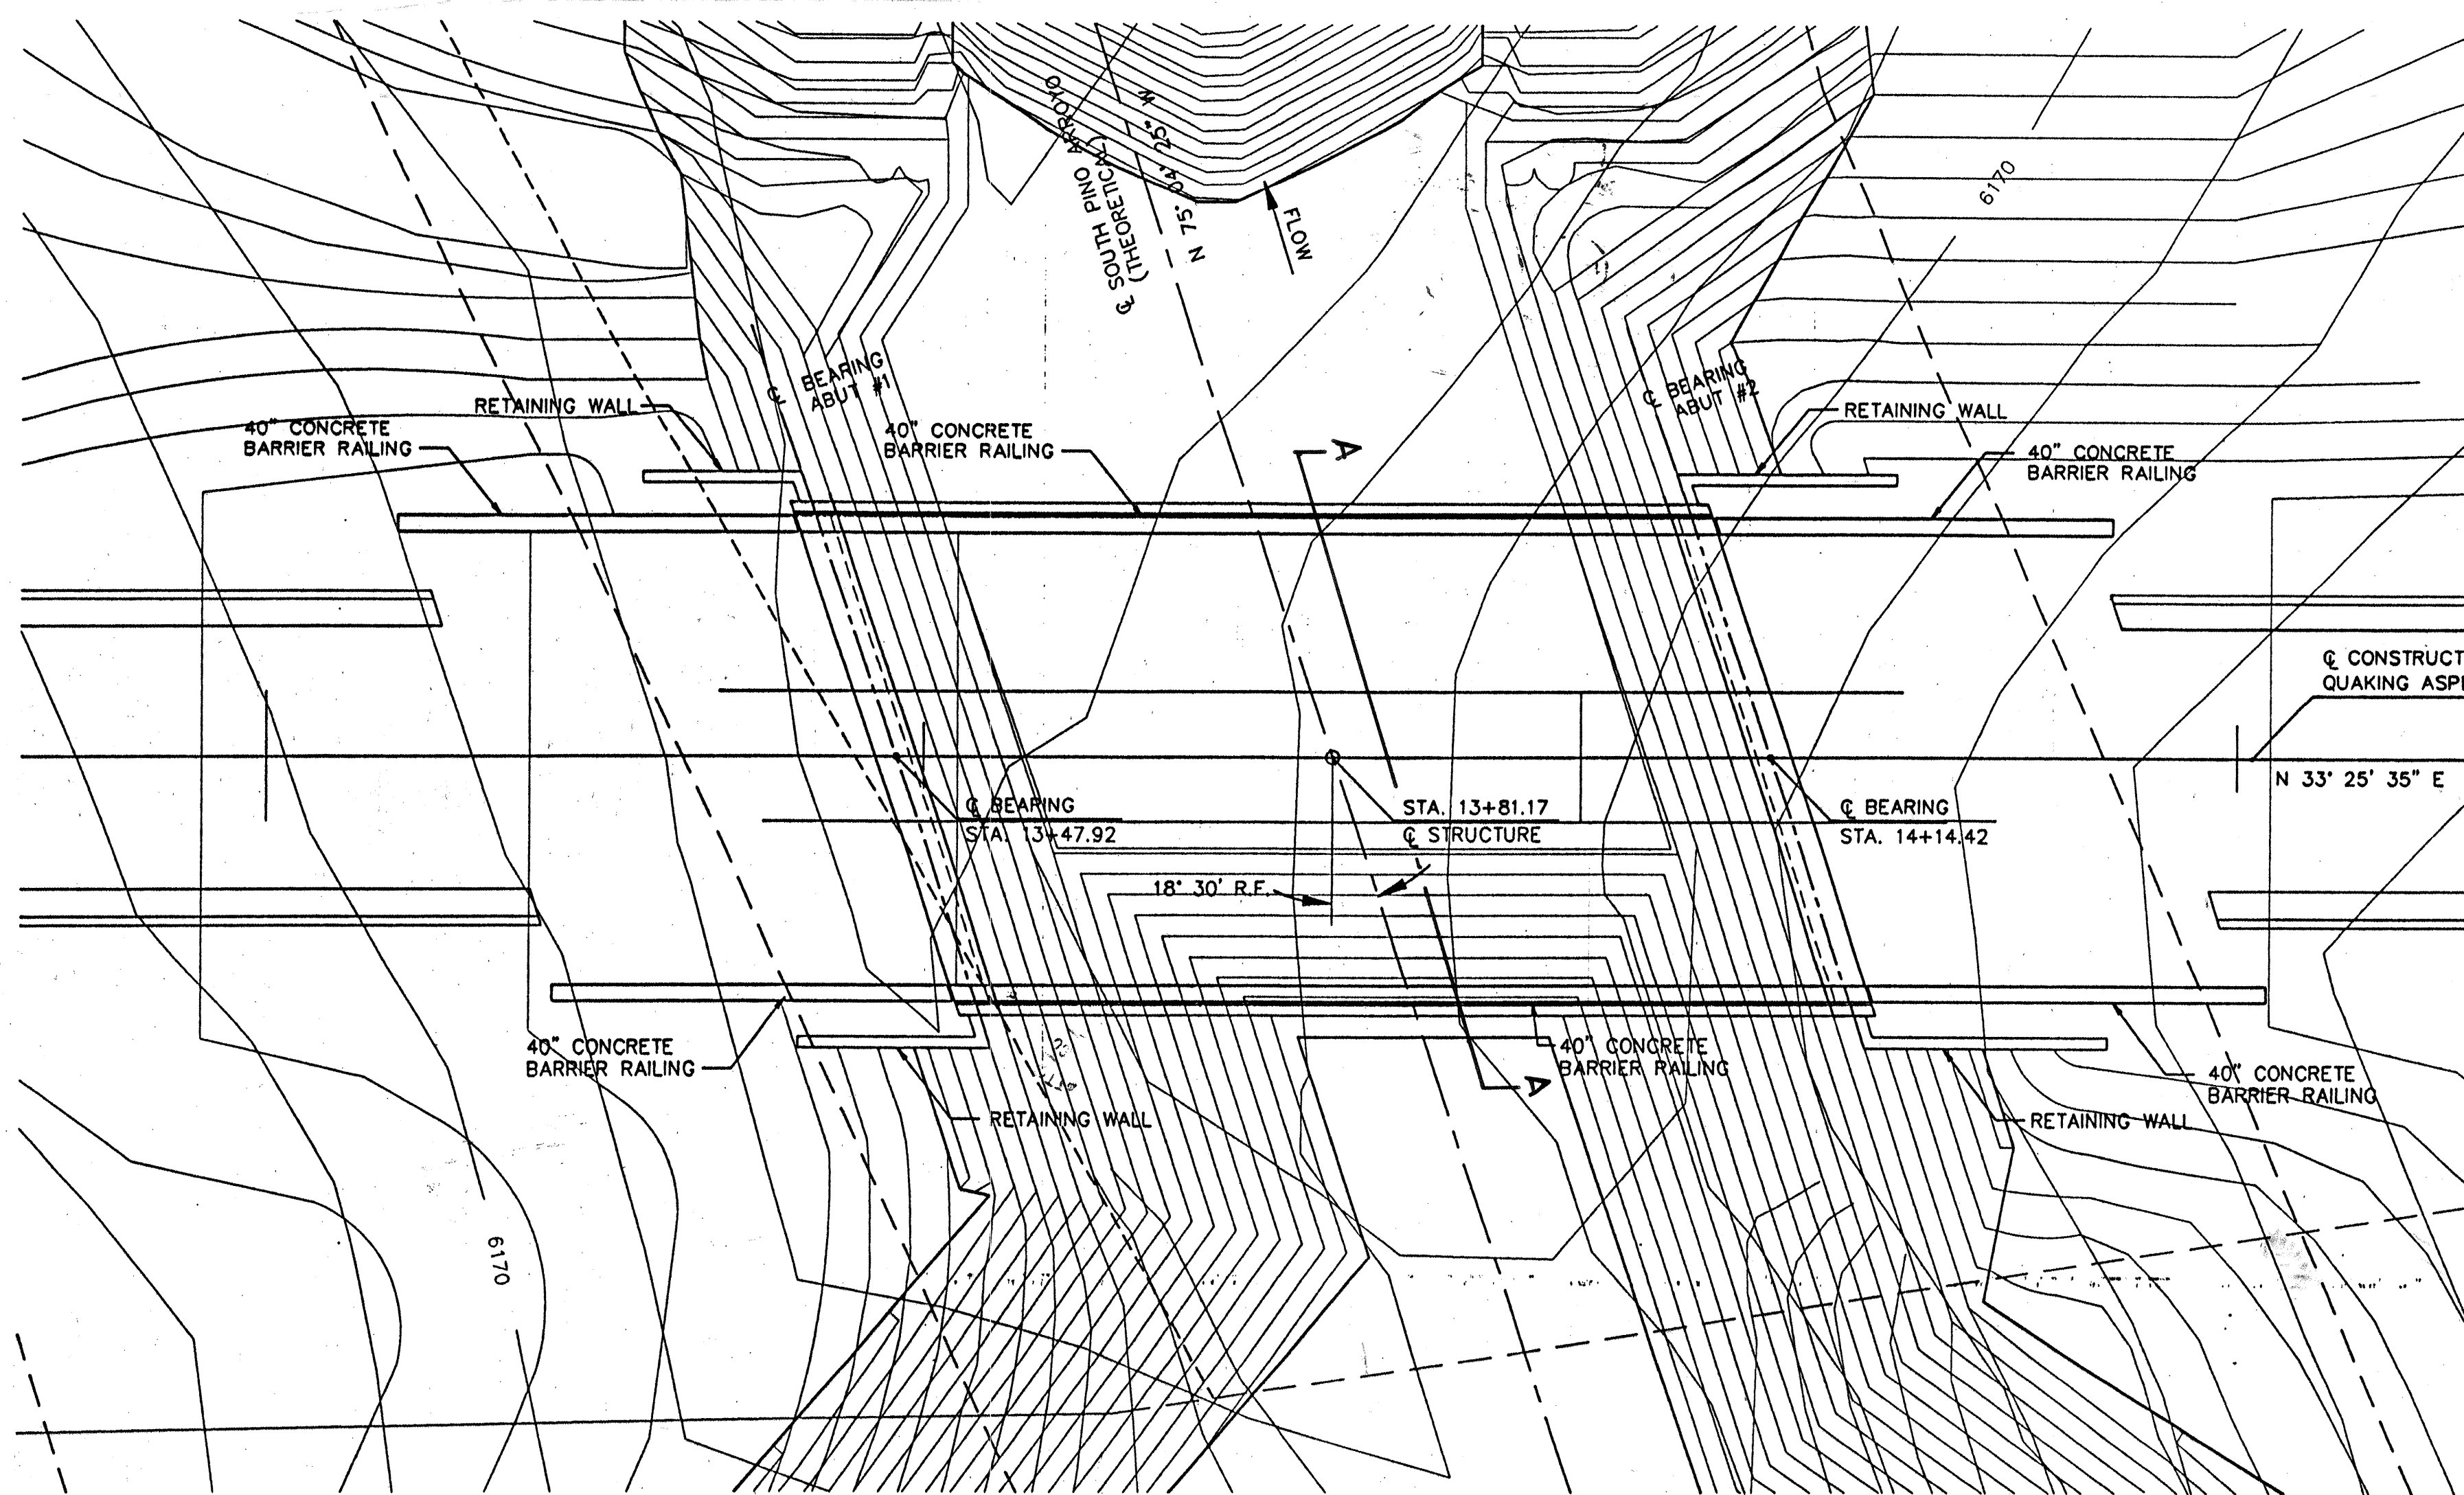



STRUCTURE LOCATION PLAN - QUAKING ASPEN PLACE

SCALE: 1" = 10'-0"

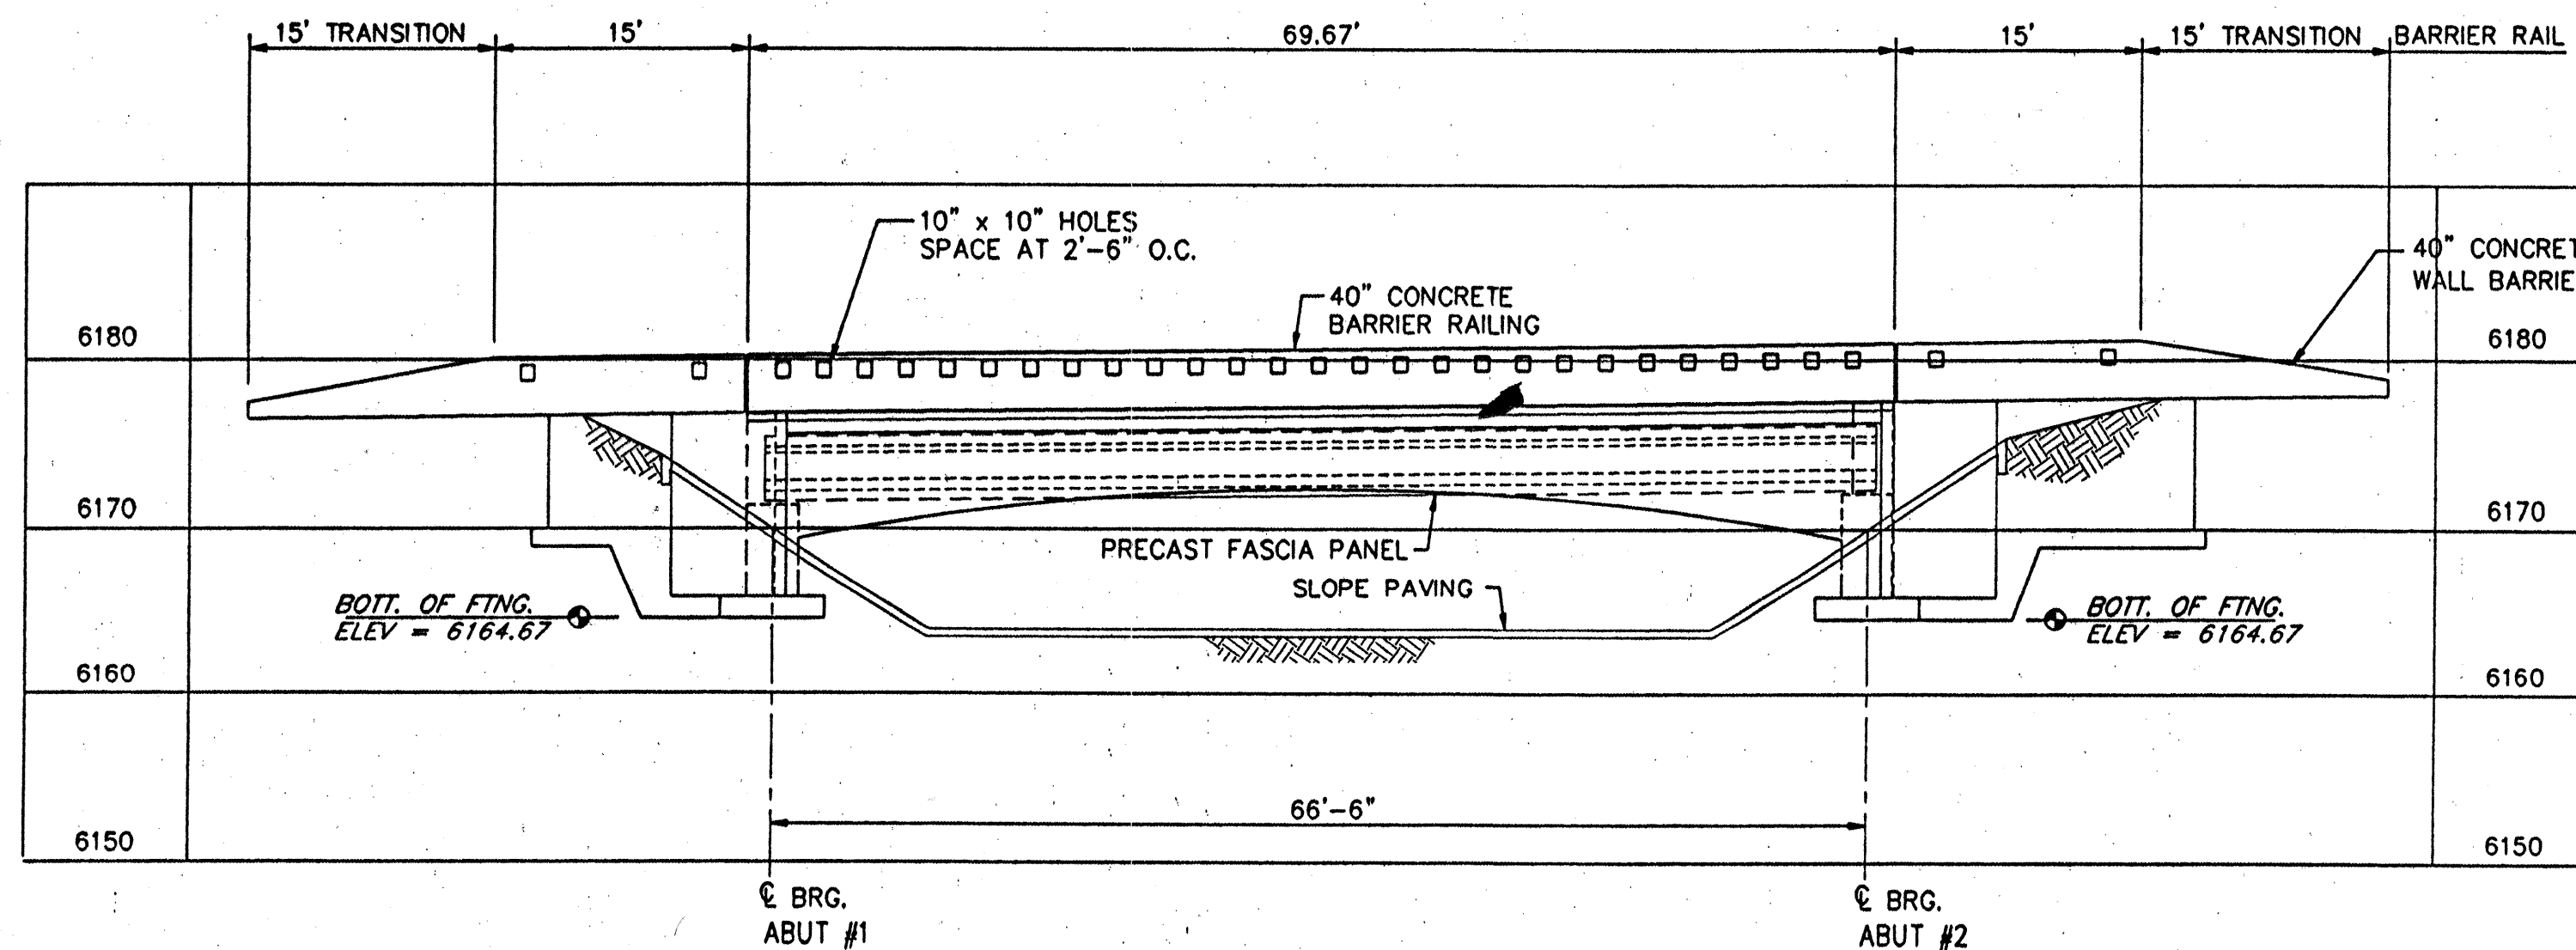

STRUCTURE ELEVATION


SCALE: 1" = 10'-0" HORIZ. & VERT.

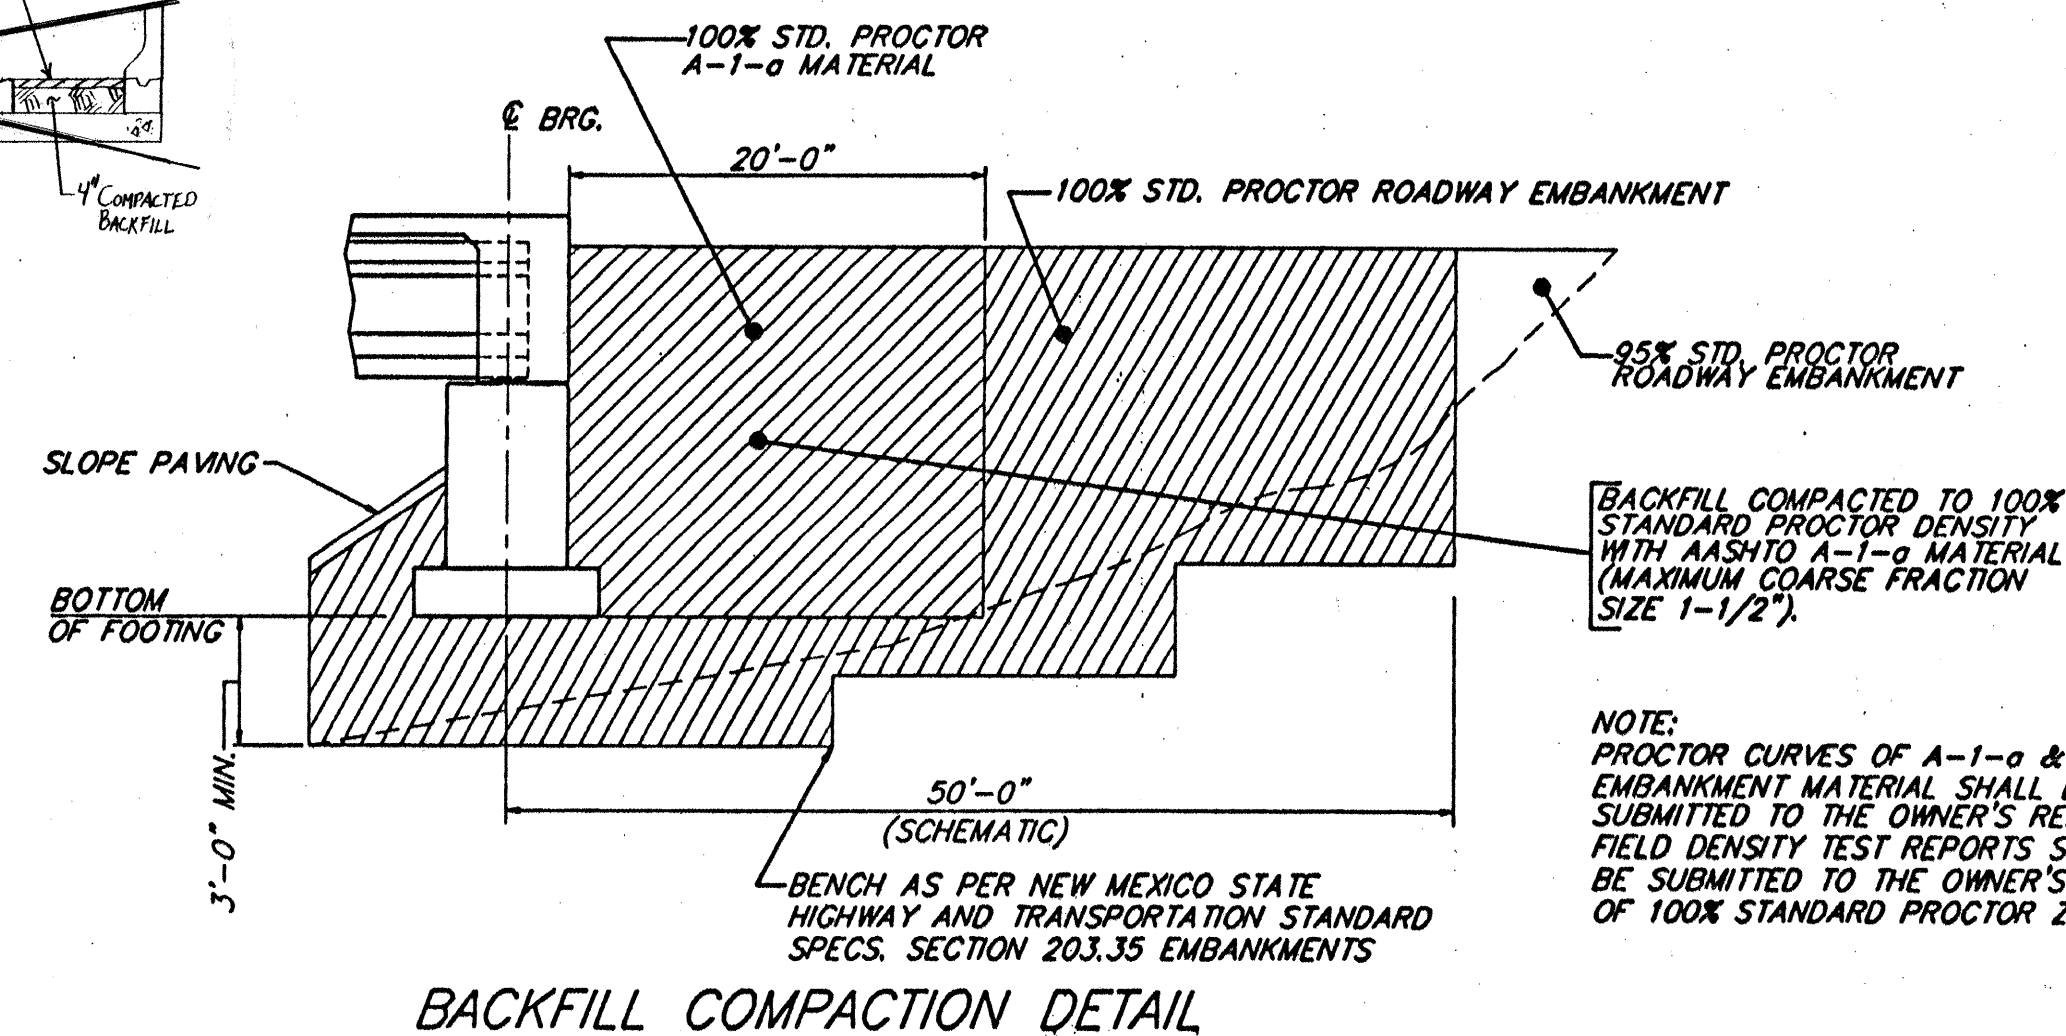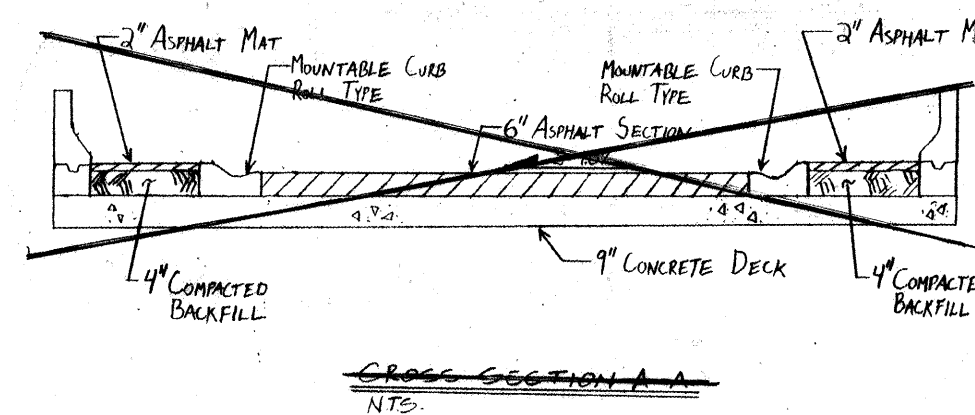

BACKFILL COMPACTION DETAIL

NO SCALE

ESTIMATED QUANTITIES - QUAKING ASPEN PLACE		
ITEM	UNIT	TOTAL
40" BRIDGE BARRIER RAILING	LF	X
40" CONCRETE WALL BARRIER	LF	X
6'-0" PRECAST CULVERTS	LF	X
PRECAST FACIA PANEL	SF	X
0510.11 STR. CONC. 4000 RPPG, FORM	CY	X

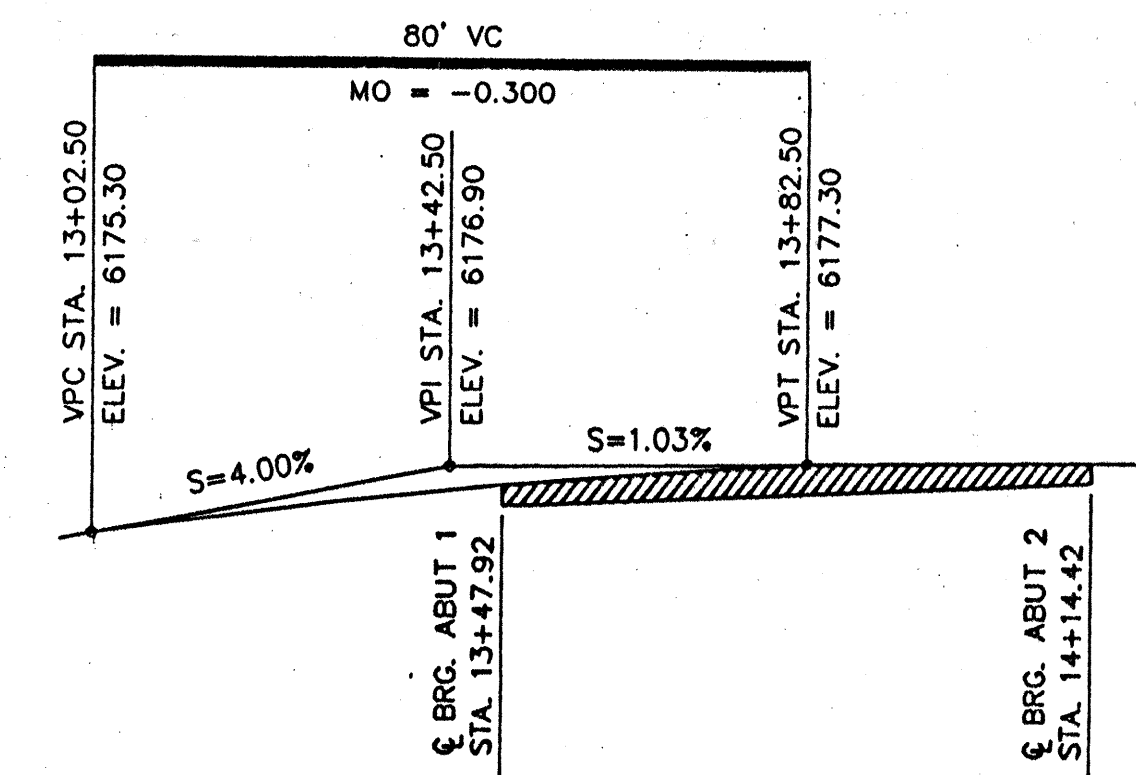

QUAKING ASPEN PLACE PROFILE
GRADE @ CONSTRUCTION

NO SCALE

LIMITS OF 40" BRIDGE BARRIER RAILING

OFFSET	BEGIN	END
A	X+	Y+
B	X+	Y+

NOTES

1. CONSTRUCT 40" CONCRETE WALL BARRIER. SEE DETAIL SHEET 26L.

EXCAVATION AND BACKFILL NOTES

1. SHALLOW SOILS BELOW THE ABUTMENT FOOTINGS SHALL BE OVEREXCAVATED A MINIMUM OF 3 FEET.
2. THE OVEREXCAVATED AREA TO REGIEVE FILL SHALL BE MOISTURE CONDITIONED TO OPTIMUM MOISTURE CONTENT $\pm 2\%$ FOR A MINIMUM DEPTH OF 5 FEET AND COMPACTED TO ACHIEVE 95% OF THE ASTM D-1557 MAXIMUM DRY DENSITY WITH A MINIMUM OF 20 PASSES WITH A HEAVY (20 TON MIN.) VIBRATORY ROLLER.
3. ALL BACKFILL SOILS AND STRUCTURAL FILL FOR ROADWAY EMBANKMENT SHALL BE NON-EXPANSIVE, FREE OF VEGETATION AND DEBRIS AND CONTAIN ROCKS NO LARGER THAN 1 1/2" GRADATION SHALL BE ACCORDING TO ASTM D-422 AS FOLLOWS:

SIEVE SIZE	PERCENT PASSING
3 INCH	0
NO 4	60-100
NO 200	5-50
4. THE OVEREXCAVATION AREA SHALL EXTEND A MINIMUM OF 5 FEET FROM EACH END OF THE FOOTING.

FOR INFORMATION ONLY

AS-BUILT INFORMATION		BENCH MARKS		SURVEY INFORMATION		ENGINEER'S SEAL		REVISIONS		DESIGN	
CONTRACTOR	W.M. Survey Co., Inc.	THE BENCH MARK IS A STANDARD USC&GS BRASS	TABLET STAMPED "TUMBLE 1969" SET IN CONCRETE	DATE	BY	NO.	BY	NO.	DATE	BY	DATE
WORK	SPWED 8/11/11	LOCATED APPROXIMATELY 35 FEET NORTH AND 489 FEET WEST OF THE INTERSECTION OF TENNYSON STREET AND SAN ANTONIO DRIVE	FIELD BOOK BY	DATE	BY	NO.	BY	NO.	DATE	BY	DATE
APPROVED BY	MM/SCI	PLANE COORDINATES: X=425,465.55 Y=1,513,470.01	GROUND-TO-GRID FACTOR 0.99961970	DATE	BY	NO.	BY	NO.	DATE	BY	DATE
RECORDED BY	MM/SCI	ELEVATION = 6009.155 FEET		DATE	BY	NO.	BY	NO.	DATE	BY	DATE

CITY OF ALBUQUERQUE PUBLIC WORKS DEPARTMENT ENGINEERING DEVELOPMENT GROUP DESERT HIGHLANDS AT HIGH DESERT	
TITLE: SOUTH PINO TRIBUTARY STORM DRAIN	
PLAN & ELEVATION	
Design Review Committee	City Engineer Approval
Mo./Day/Yr.	Mo./Day/Yr.
City Project No.	Zone Map No.
571283	E-23
Sheet	Of
21	21

CONSTRUCTION TRAFFIC CONTROL GENERAL NOTES

1. CONTRACTOR MUST OBTAIN FROM CONSTRUCTION COORDINATION AN EXCAVATION/BARRICADING PERMIT BEFORE ENGAGING IN ANY CONSTRUCTION, MAINTENANCE OR REPAIR WORK IN ANY OF THE CITY OF ALBUQUERQUE'S RIGHTS-OF-WAY. EMERGENCY WORK THAT WOULD PRESERVE LIFE OR PROPERTY IS EXCLUDED WITH THE UNDERSTANDING, THAT A PERMIT SHALL BE OBTAINED WITHIN 24 TO 48 HOURS.

2. CONTRACTOR SHALL AT THE TIME OF PERMIT REQUEST, SUBMIT FOR APPROVAL BY CONSTRUCTION COORDINATION, A TRAFFIC CONTROL PLAN DETAILING ALL EXISTING TOPOGRAPHY SUCH AS LANE WIDTHS, DRIVEWAYS, AND BUSINESS/RESIDENTIAL ACCESSES. THE TRAFFIC CONTROL PLAN SHALL INCLUDE ALL PHASES OF WORK AND SCHEDULES INVOLVED IN THE CONSTRUCTION PROJECT. ANY SEPARATE PHASES OF A CONSTRUCTION PROJECT SHALL BE GIVEN AN INDIVIDUAL PERMIT EACH. BLANKET PERMITS WILL NOT BE ISSUED.

3. THESE TYPICAL TRAFFIC CONTROL PLANS DO NOT REFLECT THE EXISTING TOPOGRAPHY SUCH AS DRIVEWAYS, LANE WIDTHS, AND BUSINESS/RESIDENTIAL ACCESSES. EVERY LOCATION THAT REQUIRES CONSTRUCTION TRAFFIC CONTROL SHALL HAVE A DETAILED TRAFFIC CONTROL PLAN SHOWING ALL EXISTING TOPOGRAPHY.

4. CONSTRUCTION SHALL NOT BEGIN UNLESS A TRAFFIC CONTROL PLAN HAS BEEN APPROVED AND VERIFIED BY CONSTRUCTION COORDINATION.

5. CONSTRUCTION COORDINATION SHALL BE NOTIFIED 48 HOURS PRIOR TO ANY TRAFFIC CONTROL CHANGES NEEDED BY CONTRACTOR, THAT WERE NOT PREVIOUSLY APPROVED. THESE TRAFFIC CONTROL CHANGES SHALL BE REQUESTED IN WRITING ACCOMPANIED WITH A TRAFFIC CONTROL PLAN REFLECTING SUCH CHANGES.

6. ALL CONSTRUCTION TRAFFIC CONTROL DEVICES SHALL COMPLY TO THE MANUAL ON UNIFORM TRAFFIC CONTROL DEVICES (MUTCD), LATEST EDITION. IT IS THE RESPONSIBILITY OF THE CONTRACTOR TO INSTALL, SERVICE AND MAINTAIN ALL TRAFFIC CONTROL DEVICES. TRAFFIC CONTROL DEVICES SHALL NOT BE REMOVED OR ALTERED IN ANY WAY WITHOUT THE APPROVAL OF CONSTRUCTION COORDINATION, PER SECTION 6A-4 OF THE MUTCD, LATEST EDITION.

7. THE CONSTRUCTION TRAFFIC CONTROL INITIAL SET-UP SHALL BE BY AN AMERICAN TRAFFIC SAFETY SERVICES ASSOCIATION (ATSSA) CERTIFIED WORKSITE TRAFFIC SUPERVISOR. THE MAINTENANCE AND SERVICING SHALL ALSO BE DONE BY AN ATSSA CERTIFIED WORKSITE TRAFFIC SUPERVISOR OR EQUIVALENT.

8. CONTRACTOR IS RESPONSIBLE TO MAINTAIN AND SERVICE ALL TRAFFIC CONTROL DEVICES 24 HOURS A DAY, 7 DAYS A WEEK THROUGHOUT LENGTH OF PROJECT. CONTRACTOR IS RESPONSIBLE THAT ALL TRAFFIC CONTROL DEVICES COMPLY WITH THE MUTCD, LATEST EDITION.

9. ALL ADVANCE WARNING SIGNS SHALL BE DOUBLE INDICATED WHENEVER THERE ARE MULTI-LANE TRAFFIC IN ANY ONE GIVEN DIRECTION AND THERE IS SUFFICIENT MEDIAN SPACE.

10. ALL BARRICADES IN ALL TAPERS AND TANGENTS SHALL BE PLACED APART, A DISTANCE MEASURED IN FEET, EQUAL TO THAT OF THE POSTED SPEED LIMIT. NO EXCEPTIONS UNLESS APPROVED BY CONSTRUCTION COORDINATION PER MUTCD SECTION 6A-4.

11. ALL WORK IN ARTERIAL ROADWAYS SHALL BE ON A CONTINUOUS 24 HOUR PER DAY BASIS UNTIL COMPLETED.

12. CONTRACTOR IS RESPONSIBLE TO PROVIDE CONSTRUCTION COORDINATION, A WEEKLY LOG OF DAILY INSPECTIONS OF BARRICADE AND MAINTENANCE SCHEDULES ON PROJECTS THAT ARE OVER ONE WEEK DURATION.

13. EQUIPMENT OR MATERIALS SHALL NOT BE STORED WITHIN 15 FEET OF A TRAVELLED TRAFFIC LANE DURING NON-WORKING HOURS WITHOUT THE APPROVAL OF CONSTRUCTION COORDINATION.

14. CONTRACTOR SHALL PROVIDE AND MAINTAIN A SAFE AND ADEQUATE MEANS OF CHANNELIZING PEDESTRIAN TRAFFIC AROUND AND THROUGH THE CONSTRUCTION AREA.

15. CONTRACTOR IS RESPONSIBLE FOR OBLITERATION OF ANY CONFLICTING STRIPING AND RESPONSIBLE FOR ALL TEMPORARY STRIPING.

16. CONTRACTOR SHALL MAINTAIN ACCESS TO ALL FACILITIES, BUSINESSES AND/OR RESIDENTS AT ALL TIMES.

17. CONTRACTOR SHALL PROVIDE ACCESS SIGNS FOR BUSINESSES LOCATED WITHIN THE CONSTRUCTION AREA UNDER THE SUPERVISION OF CONSTRUCTION COORDINATION. EACH ACCESS SIGN SHALL HAVE 5 INCH, WHITE OPAQUE LETTERING ON BLUE REFLECTORIZED BACKGROUND. ACCESS SIGNS SHALL BE CONSIDERED INCIDENTAL TO THE BID AND NOT PART OF THE CONTRACT UNLESS OTHERWISE STATED. NO MORE THAN 3 BUSINESSES SHALL BE LISTED ON A ACCESS SIGN. SHOPPING CENTERS AND MALLS SHALL BE LISTED AS SUCH.

18. ALL ADVANCE WARNING SIGNS SHALL MEET THE MINIMUM REFLECTIVE INTENSITY REQUIREMENTS SET FORTH BY THE CITY OF ALBUQUERQUE. CONSTRUCTION COORDINATION SHALL DETERMINE ALL REQUIREMENTS AND APPROVE OR DISAPPROVE ANY ADVANCE WARNING SIGN PER SECTION 6A-4 OF THE MUTCD, LATEST EDITION.

19. 48 HOURS PRIOR TO OCCUPANCY OR CLOSING OF A RIGHT-OF-WAY, CONTRACTOR SHALL NOTIFY: POLICE, FIRE DEPARTMENT, SCHOOLS, HOSPITALS, TRANSIT AUTHORITY, BUSINESSES AND/OR RESIDENTS THAT WILL BE AFFECTED BY THE CONSTRUCTION.

20. ANY FIELD ADJUSTMENTS SHALL BE APPROVED BY CONSTRUCTION COORDINATION.

SCANNED BY
MESA REPRO

21. EXCAVATIONS SHALL BE PLATED, TEMPORARILY PATCHED OR RESURFACED PRIOR TO OPENING OF TRAFFIC. A MINIMUM OF 11 FEET SHALL BE PROVIDED FOR TRAFFIC IN ANY GIVEN DIRECTION. CONTRACTOR IS RESPONSIBLE FOR ANY WORK INVOLVED IN SATISFYING THESE REQUIREMENTS.

22. CONTRACTOR SHALL AT ALL TIMES COMPLY WITH THE FOLLOWING:
1. STANDARDS AND REQUIREMENTS SET FORTH IN THE MANUAL ON UNIFORM TRAFFIC CONTROL DEVICES, LATEST EDITION.
2. THE CITY OF ALBUQUERQUE TRAFFIC CODE, LATEST EDITION.
3. SECTION 19 OF THE CITY OF ALBUQUERQUE'S STANDARD SPECIFICATIONS FOR PUBLIC WORK CONSTRUCTION, AS WELL AS OTHER SECTIONS.


23. FAILURE TO COMPLY WITH ANY OF THE ABOVE MENTIONED, WILL BE ADEQUATE CAUSE TO CEASE ALL WORK ON ANY CONSTRUCTION PROJECT. WORK WILL NOT RESUME UNTIL ALL REQUIREMENTS ARE ADDRESSED AND APPROVED BY CONSTRUCTION COORDINATION.

24. ALL TRAFFIC CONTROL DEVICES SHALL BE KEPT IN NEW-CLEAN CONDITION. WASHING OF EQUIPMENT IS INCIDENTAL TO ITS PLACEMENT AND MAINTENANCE.


25. TRAFFIC CONTROL STANDARDS APPLY ONLY WHERE THE CONSTRUCTION TRAFFIC CONTROL PLANS ARE NOT SPECIFIC.

26. ADVANCE WARNING SIGNS SHALL BE 36"x36" MIN. WITH SUPER ENGINEERING GRADE SHEETING OR BETTER. MOUNTING HEIGHT AT TOP OF SIGN SHALL BE THE SAME AS FOR A 48" SIGN AS INDICATED IN THE M.U.T.C.D.


27. CONTRACTOR SHALL MAINTAIN A GRAFFITI-FREE WORKSITE. ALL GRAFFITI SHALL BE PROMPTLY REMOVED FROM ALL EQUIPMENT, BOTH PERMANENT AND TEMPORARY.

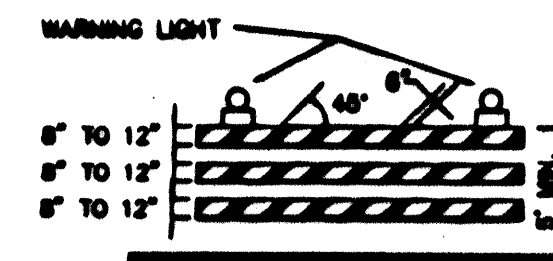


TYPE II BARRICADE

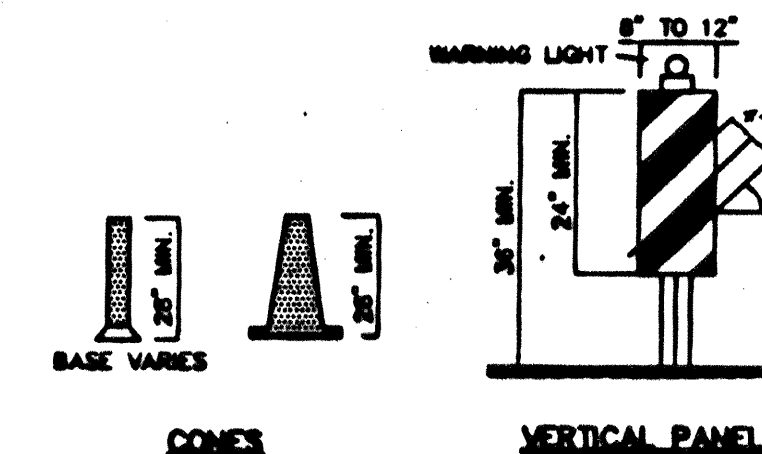


CONES VERTICAL PANEL HIGH LEVEL WARNING DEVICE

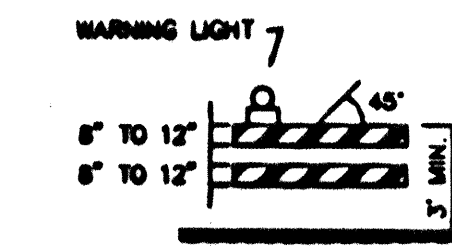


TYPE I BARRICADE COLLAPSIBLE

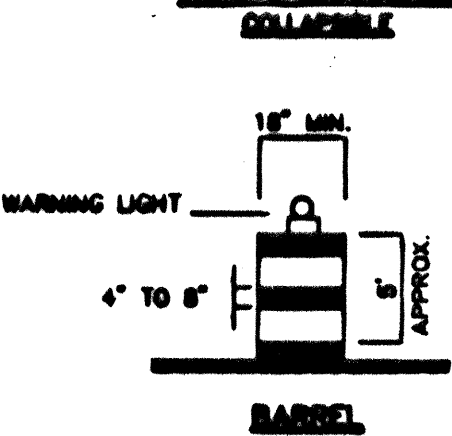

TYPE I BARRICADE COLLAPSIBLE

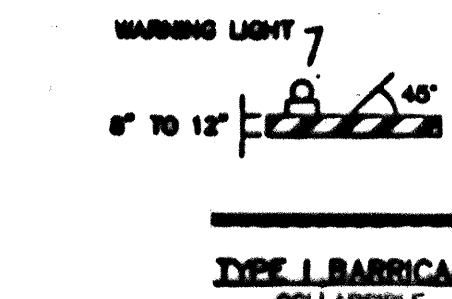

TYPE I BARRICADE COLLAPSIBLE

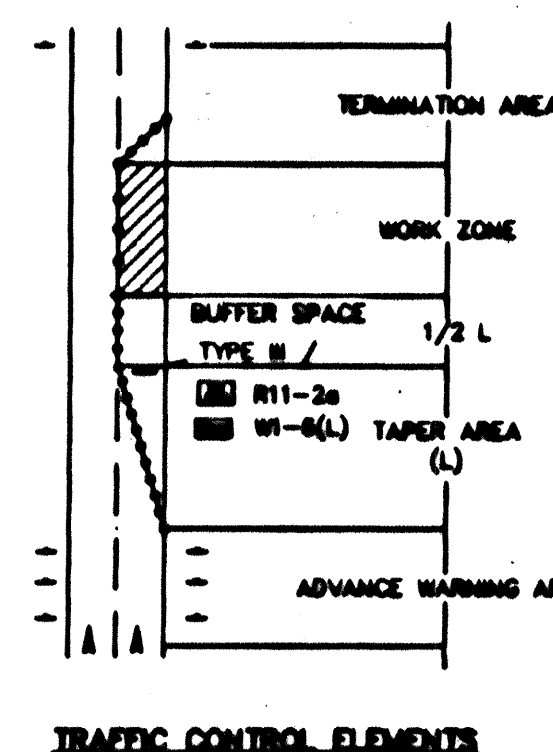

TRAFFIC CONTROL ELEMENTS

LEGEND

WORK AREA
BARRICADE - TYPE I, TYPE II, OR BARREL
BARRICADE - TYPE III
VERTICAL PANEL
WARNING SIGN
DISTANCE BETWEEN SIGNS - A DISTANCE MEASURED IN FEET EQUAL TO A VALUE OF TEN TIMES THE SPEED LIMIT OF THE STREET
FLAGMAN POSITION
SPACING BETWEEN BARRICADES - A DISTANCE MEASURED IN FEET EQUAL TO THE SPEED LIMIT OF THE STREET
TAPER LENGTH - SEE CHART BELOW
THE TANGENT LENGTH IS EQUAL TO THE TAPER LENGTH FOR A GIVEN STREET.

TAPER REQUIREMENTS

SPEED LIMIT (MPH)	TAPER LENGTH (L) (FEET)			MINIMUM NUMBER OF DEVICES FOR TAPER	MAXIMUM DEVICE SPACING IN FEET	
	10' LANE	11' LANE	12' LANE		BEFORE TAPER	AFTER TAPER
20	70	75	80	5	20	20
25	105	115	125	6	25	25
30	150	165	180	7	30	30
35	205	225	245	8	35	35
40	270	295	320	9	40	40
45	450	495	540	13	45	45
50	500	550	600	13	50	50
55	550	605	660	13	55	55

RECOMMENDED SIGN SPACING (D) FOR ADVANCE WARNING SIGN SERIES

SPEED LIMIT (MPH)	MINIMUM DISTANCE BETWEEN SIGNS	MINIMUM DISTANCE FROM LAST SIGN TO TAPER
0-20	10 X SPEED LIMIT	10 X SPEED LIMIT
25-30	10 X SPEED LIMIT	10 X SPEED LIMIT
30-35	10 X SPEED LIMIT	10 X SPEED LIMIT
40-45	10 X SPEED LIMIT	10 X SPEED LIMIT
50-60	10 X SPEED LIMIT	10 X SPEED LIMIT

TAPER CRITERIA


TYPE OF TAPER	TAPER LENGTH
UPSTREAM TAPER:	
MERGING TAPER	1 MINIMUM
SHIFTING TAPER	1/2 L MINIMUM
SHOULDER TAPER	1/2 L MINIMUM
TWO-WAY TRAFFIC TAPER	100 FEET MAXIMUM
DOWNSTREAM TAPERS	100 FEET PER LANE

TAPER LENGTH COMPUTATION

SPEED LIMIT	L =
40 MPH OR LESS	$L = \frac{W^2}{S}$
45 MPH OR GREATER	$L = W \times S$

L = TAPER LENGTH
W = WIDTH OF OFFSET IN FEET
S = POSTED SPEED OR OFF-PEAK 85-PERCENTILE SPEED IN MPH

SIGN FACE DETAILS

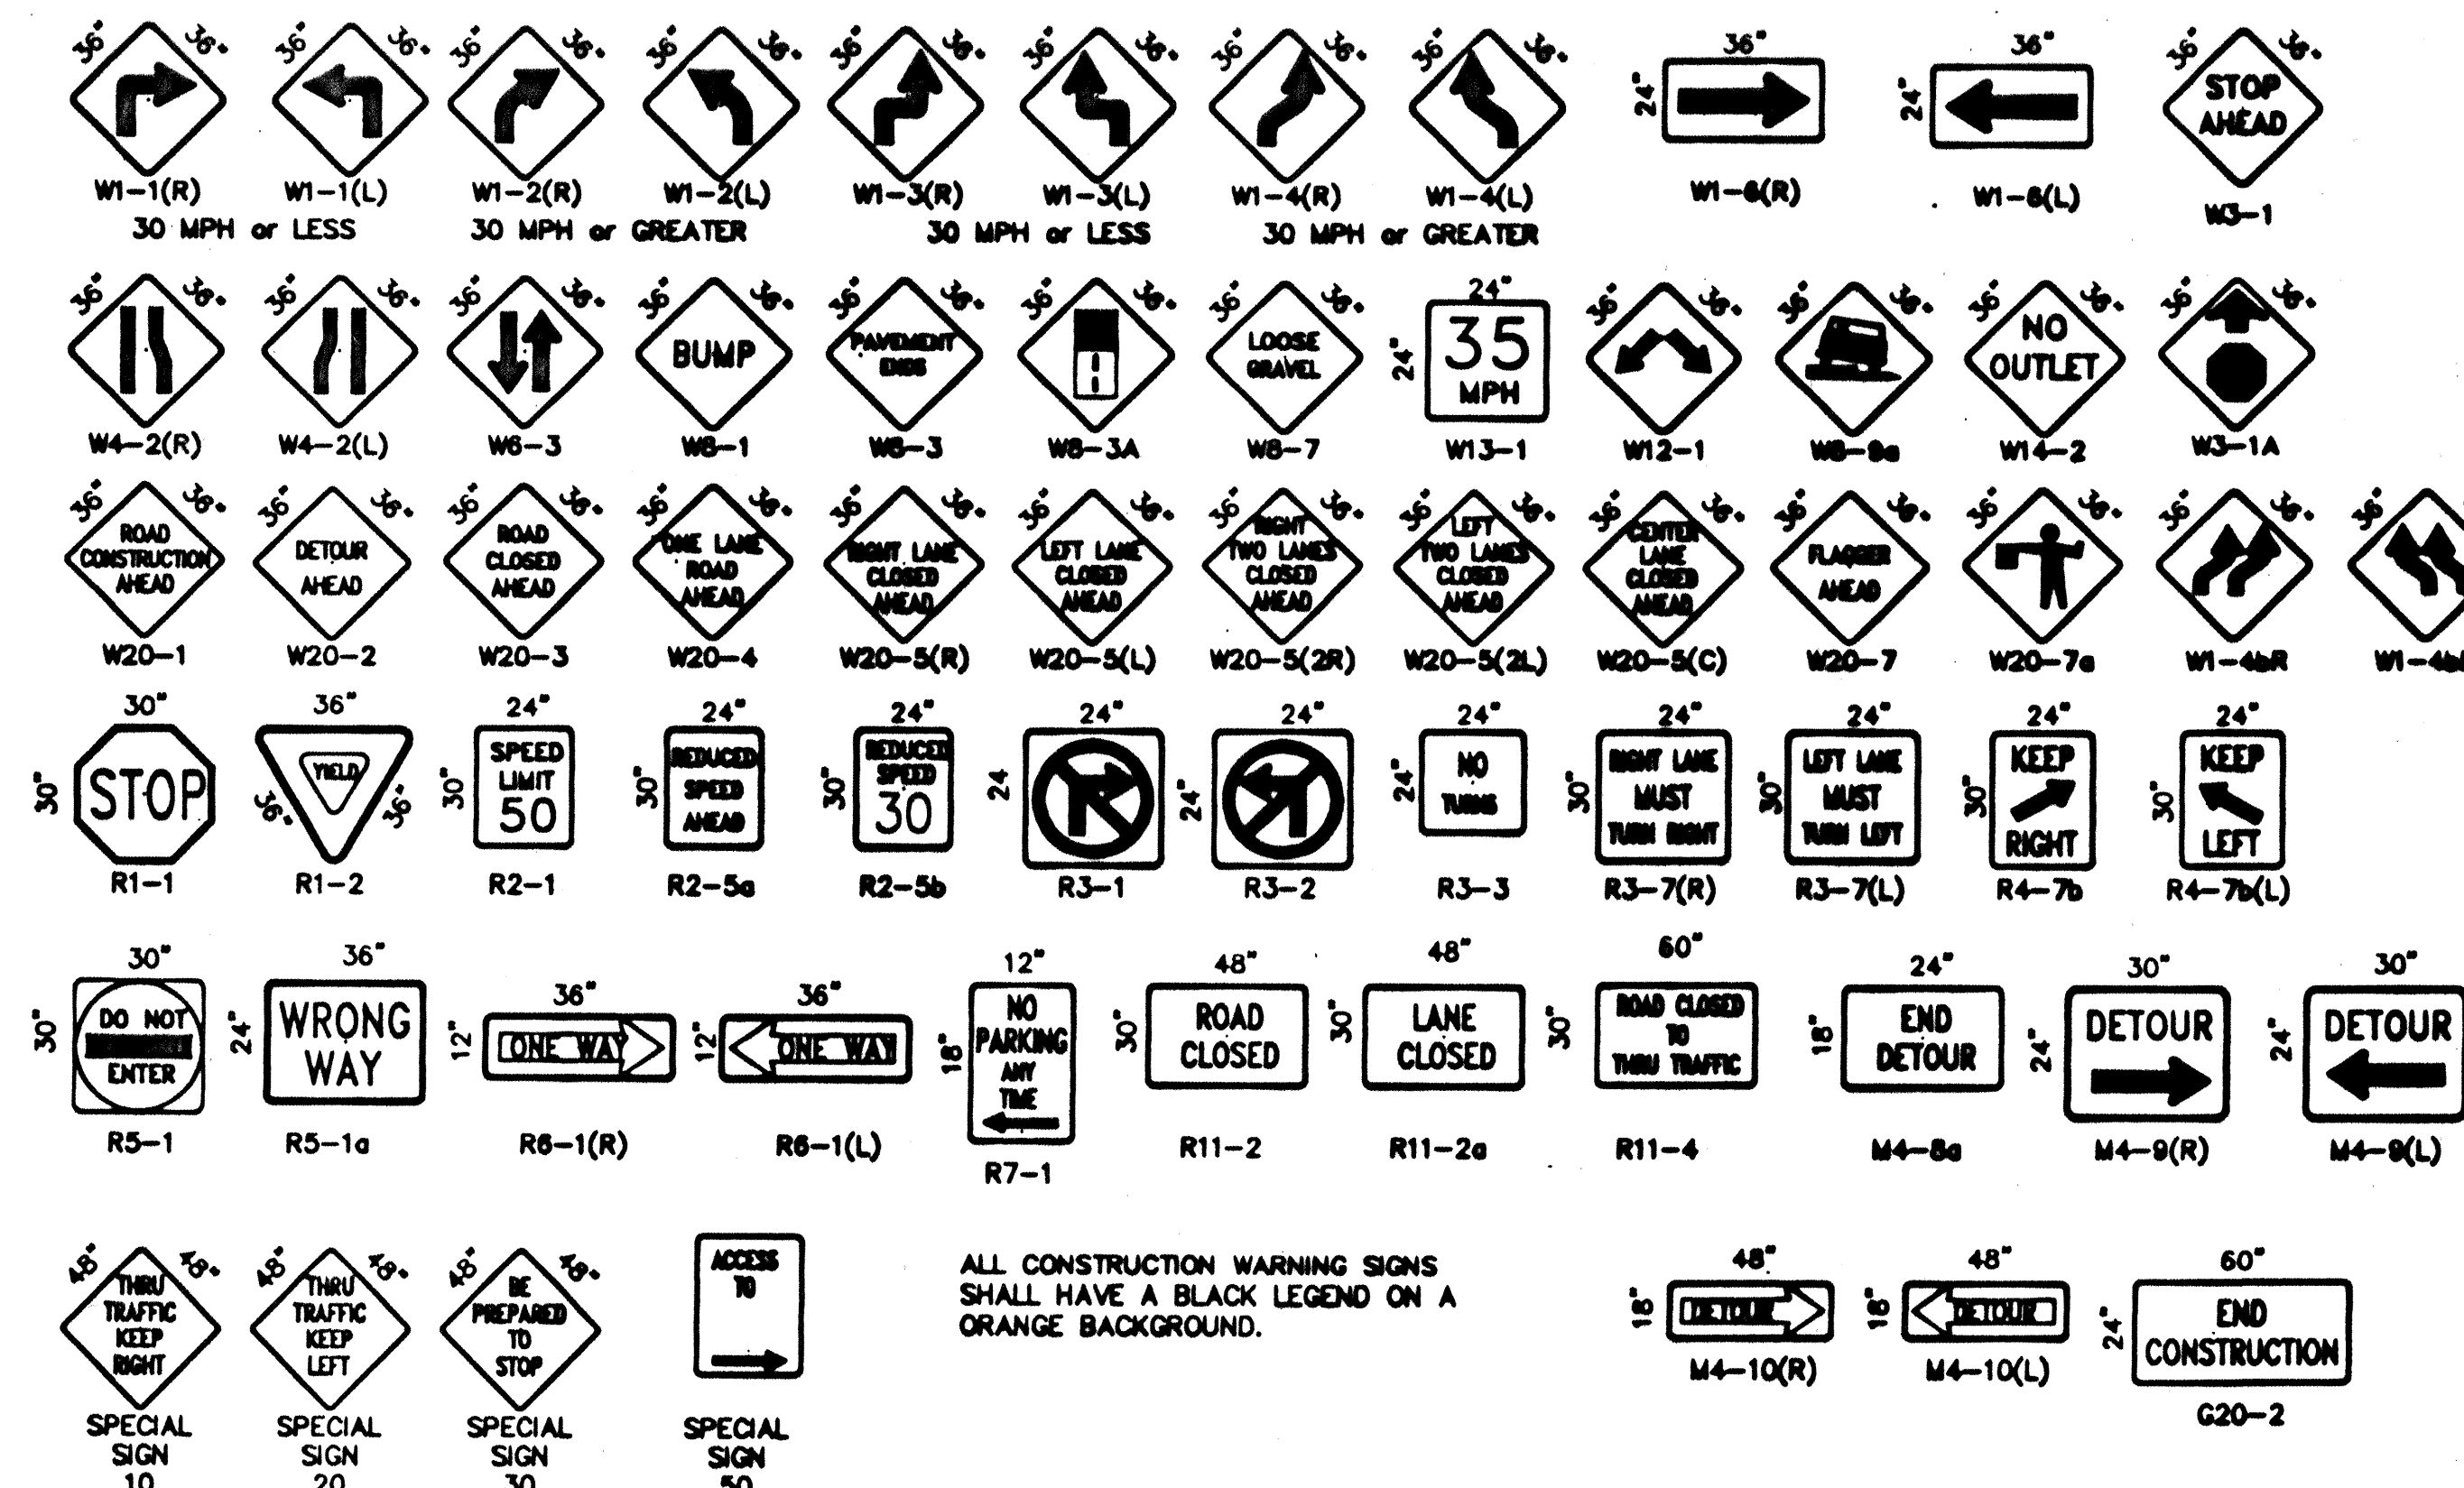

ALL CONSTRUCTION WARNING SIGNS SHALL HAVE A BLACK LEGEND ON A ORANGE BACKGROUND.

AS BUILT INFORMATION
DATE: 12/1/18
BY: [Signature]
CHECKED BY: [Signature]

BENCH MARKS
DATE: 12/1/18
BY: [Signature]
CHECKED BY: [Signature]

SURVEY INFORMATION
FIELD NOTES
DATE: 12/1/18
BY: [Signature]
CHECKED BY: [Signature]

ENGINEER'S SEAL
[Seal]
DATE: 12/1/18
BY: [Signature]
CHECKED BY: [Signature]

REVISIONS
DATE: 12/1/18
BY: [Signature]
CHECKED BY: [Signature]

CITY OF ALBUQUERQUE
PUBLIC WORKS DEPARTMENT
ENGINEERING DEVELOPMENT GROUP
TITLE: DESERT HIGHLANDS AT HIGH DESERT
SIGNING AND CONSTRUCTION TRAFFIC CONTROL STANDARDS
DESIGN REVIEW COMMITTEE: [Signature]
CITY ENGINEER APPROVAL: [Signature]
PROJECT NO: 571283
MAP NO: E-23
SHEET 21A OF 21

