

NOT TO SCALE

ED ON THESE PLANS TO BE

1. ALL WORK DETAILED ON THESE PLANS TO BE PERFORMED UNDER CONTRACT SHALL, EXCEPT AS OTHERWISE STATED OR PROVIDED FOR HEREON, BE CONSTRUCTED IN ACCORDANCE WITH THE CITY OF ALBUQUERQUE STANDARD SPECIFICATIONS FOR PUBLIC WORKS CONSTRUCTION, 1986 EDITION AND SHALL INCLUDE UPDATE No. 6.
2. TWO WORKING DAYS PRIOR TO ANY EXCAVATION, THE CONTRACTOR MUST CONTACT NEW MEXICO ONE CALL SYSTEM (263-1990) FOR LOCATION OF EXISTING UTILITIES.
3. PRIOR TO CONSTRUCTION, THE CONTRACTOR SHALL EXCAVATE AND VERIFY THE HORIZONTAL AND VERTICAL LOCATIONS OF ALL OBSTRUCTIONS. SHOULD A CONFLICT EXIST, THE CONTRACTOR SHALL NOTIFY THE ENGINEER OR SURVEYOR IMMEDIATELY SO THAT THE CONFLICT CAN BE RESOLVED WITH A MINIMUM AMOUNT OF DELAY.
4. FIVE (5) WORKING DAYS PRIOR TO BEGINNING CONSTRUCTION, THE CONTRACTOR SHALL SUBMIT TO CONSTRUCTION COORDINATION DIVISION A CONSTRUCTION SCHEDULE. TWO (2) WORKING DAYS PRIOR TO CONSTRUCTION, THE CONTRACTOR SHALL OBTAIN A BARRICADING PERMIT FROM THE CONST. COORDINATION DIVISION. CONTRACTOR SHALL NOTIFY BARRICADE ENGINEER (768-2551) PRIOR TO OCCUPYING AN INTERSECTION. REFER TO SECTION 19 OF THE GENERAL CONDITIONS OF THE STANDARD SPECIFICATIONS.
5. ALL STREET STRIPING ALTERED OR DESTROYED SHALL BE REPLACED W/ PLASTIC REFLECTORIZED PAVEMENT MARKING BY CONTRACTOR TO LOCATION AS EXISTING OR AS INDICATED BY THIS PLAN SET.
6. CONTRACTOR SHALL NOTIFY THE ENGINEER NOT LESS THAN SEVEN (7) DAYS PRIOR TO STARTING WORK IN ORDER THAT THE CITY SURVEYOR MAY TAKE NECESSARY MEASURES TO INSURE THE PRESERVATION OF SURVEY MONUMENTS. CONTRACTOR SHALL NOT DISTURB PERMANENT SURVEY MONUMENTS WITHOUT THE CONSENT OF THE CITY SURVEYOR AND SHALL NOTIFY THE CITY SURVEYOR AND BEAR THE EXPENSE OF REPLACING ANY THAT MAY BE DISTURBED WITHOUT PERMISSION. REPLACEMENT SHALL BE DONE ONLY BY THE CITY SURVEYOR. WHEN A CHANGE IS MADE IN THE FINISHED ELEVATIONS OF THE PAVEMENT OF ANY ROADWAY IN WHICH A PERMANENT SURVEY MONUMENT IS LOCATED, CONTRACTOR SHALL, AT HIS OWN EXPENSE, ADJUST THE MONUMENT COVER TO THE NEW GRADE UNLESS OTHERWISE SPECIFIED. REFER TO SECTION 4.4 OF THE GENERAL CONDITIONS OF THE STANDARD SPECIFICATIONS. ANY PERMANENT SURVEY MONUMENT LOCATED WITHIN 50' OF THE PROJECT LIMITS NOT SHOWN ON THE PLANS THAT IS DESTROYED DURING CONSTRUCTION WILL BE REPLACED AT DESIGNER'S EXPENSE.
7. ANY WORK WITHIN AN ARTERIAL ROADWAY REQUIRES TWENTY-FOUR HOUR CONSTRUCTION.

THE FOLLOWING NOTES ALSO APPLY WHEN CHECKED


- ☒ ALL UTILITIES AND UTILITY SERVICE LINES SHALL BE INSTALLED PRIOR TO PAVING.
- ☐ BACKFILL COMPACTION SHALL BE ACCORDING TO SPECIFIED STREET USE.
- ☐ TACK COAT REQUIREMENTS SHALL BE DETERMINED BY THE CITY ENGINEER.
- ☐ SIDEWALKS AND WHEELCHAIR RAMPS WITHIN THE CURB RETURNS SHALL BE CONSTRUCTED WHEREVER A NEW CURB RETURN IS CONSTRUCTED.
- ☒ IF CURB IS DEPRESSIONED FOR A DRIVEPAD, THE DRIVEPAD SHALL BE CONSTRUCTED PRIOR TO ACCEPTANCE OF CURB AND GUTTER.
- ☒ ALL STORM DRAINAGE FACILITIES SHALL BE COMPLETED PRIOR TO FINAL ACCEPTANCE.
- ☒ THE REQUESTOR OR DEVELOPER SHALL BE RESPONSIBLE FOR REPAIR OR REPLACEMENT OF ALL CURB AND GUTTER OR SIDEWALK DAMAGED AFTER APPROVAL BY THE CITY ENGINEER OF WORK COMPLETED BY THE CONTRACTOR.

DATE: 5-3-99

[illegible]

DRB #98-169

FBI HQ NO 699237AD

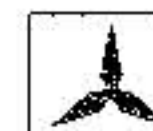

BOHANNAN-HUSTON INC

ENGINEERS • PLANNERS • PHOTOGRAMMETRISTS • SURVEYORS • LANDSCAPE ARCHITECTS

GENERAL NOTES:

- EXISTING ZONING: SU-2HD/R-LT
PROPOSED ZONING: SU-2HD/R-LT
- PROPOSED DEVELOPMENT: LOW-DENSITY SINGLE FAMILY DETACHED
- DESCRIPTION: TRACT 14A AT HIGH DESERT
- TOTAL ACREAGE: 36.01 ACRES
NET ACREAGE: 36.01 ACRES
- TOTAL NUMBER OF LOTS: 67
- PROPOSED DENSITY: 1.76 D.U./AC
- MINIMUM NET LOT AREA: 0.30 ACRE
- LOTS SHALL HAVE A FLOOR AREA RATIO OF: 0.30 MAXIMUM
- BUILDING ENVELOPES SHALL BE: 10,000 SF (OR LESS)
- DISTANCE BETWEEN BUILDING ENVELOPES AND LOT LINES: 10' MINIMUM
RIGHT-OF-WAY: 20' MINIMUM

- NO MORE THAN ONE WOOD BURNING FIREPLACE IS PERMITTED PER LOT. ALL OTHER FIREPLACES MUST BE GAS FIRED USING ARTIFICIAL LOGS.
- ALL STREETS AND DRAINAGE IMPROVEMENTS ARE TO BE PUBLIC, TO BE DEDICATED FOR MAINTENANCE TO THE CITY OF ALBUQUERQUE.
- ALL SANITARY AND PUBLIC EASEMENTS AND WATER UTILITIES IN THE STREET R/W ARE TO BE PUBLIC, AND TO BE DEDICATED FOR MAINTENANCE TO THE CITY OF ALBUQUERQUE.
- THIS SUBDIVISION LIES WITHIN THE CITY OF ALBUQUERQUE. WATER AND SANITARY SEWER CAPABILITIES ARE BASED ON THE CITY OF ALBUQUERQUE'S FACILITIES. WATER AND SANITARY SEWER INFRASTRUCTURE IMPROVEMENTS MUST BE APPROVED BY THE CITY OF ALBUQUERQUE.
- A PRIVATE CROSS-LOT DRAINAGE EASEMENT ACROSS THE ENTIRE TRACT, EXCEPT WITHIN THE BUILDING ENVELOPES AND THE RIGHTS-OF-WAY SHALL BE GRANTED WITH THE FILING OF THE FINAL PLAT.

OWNER: *Douglas H. Collier* 7-10-98
HIGH DESERT INVESTMENT CORP. PRESIDENT DATE
DOUGLAS H. COLLIER



SURVEY NOTES:

- UNLESS OTHERWISE NOTED, ALL BOUNDARY CORNERS SHOWN THUS (●) SHALL BE MARKED BY A 2" REBAR STAMPED "WEAVER LS 6544".
- FOUND 3" ALUM. CAP ON 2.5"x30" ALUM. ROD CORNERS SHOWN THUS (□) STAMPED LS 6544 AND DATED 1983.
- ALL STREET CENTERLINE MONUMENTATION SHALL BE INSTALLED AT ALL CENTERLINE P.C.'S, P.T.'S, ANGLE POINTS AND STREET INTERSECTIONS AND SHOWN THUS (▲) WILL BE MARKED BY A FOUR (4") ALUMINUM CAP STAMPED "CITY OF ALBUQUERQUE CENTERLINE MONUMENTATION MARKED, DO NOT DISTURB, P.L.S. 6544".
- THE SUBDIVISION BOUNDARY WILL BE TIED TO THE NEW MEXICO STATE PLANE COORDINATE SYSTEM AS SHOWN.
- BASIS OF BEARINGS WILL BE NEW MEXICO STATE PLANE GRID BEARINGS.
- DISTANCES SHALL BE GROUND DISTANCES.
- MANHOLE'S WILL BE OFFSET AT ALL POINTS OF CURVATURE, POINTS OF TANGENCY, STREET INTERSECTIONS AND ALL OTHER ANGLE POINTS TO ALLOW THE USE OF CENTERLINE MONUMENTATION.

APPROVED FOR MONUMENTATION AND STREET NAMES:
[Signature] 072796
CITY SURVEYOR DATE

N.T.S. STATION "TUMBLE"
N.M. State Plane Coordinates (Central Zone)
X = 425,465.55 Y = 1,513,470.03
Easting to Grid Factor = 0.9999197
Zone = 10N
Elev. = 6059.155


A.C.S. STATION "1-024" - PROJECTED SECTION CORNER
Geographic Position (NAD 1983)
X = 421,318.55 Y = 1,513,365.05
Easting to Grid Factor = 0.9999059
Zone = 10N
Elev. = 6059.155

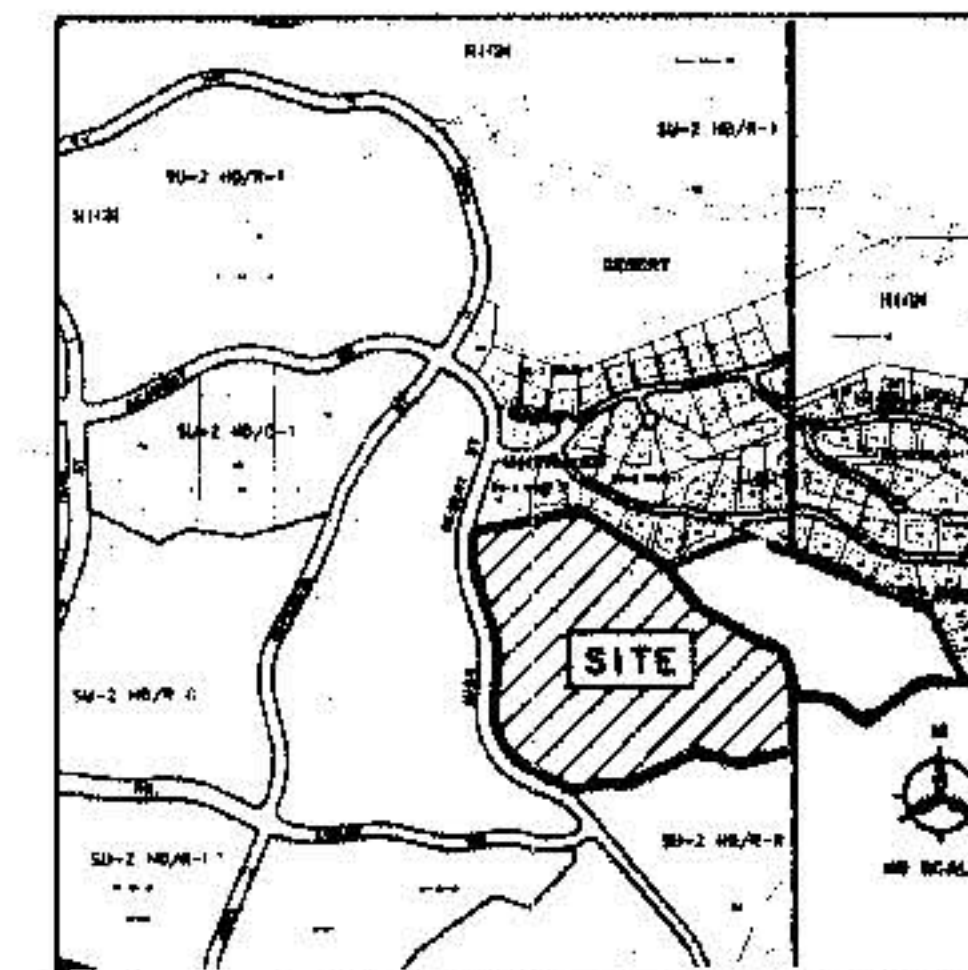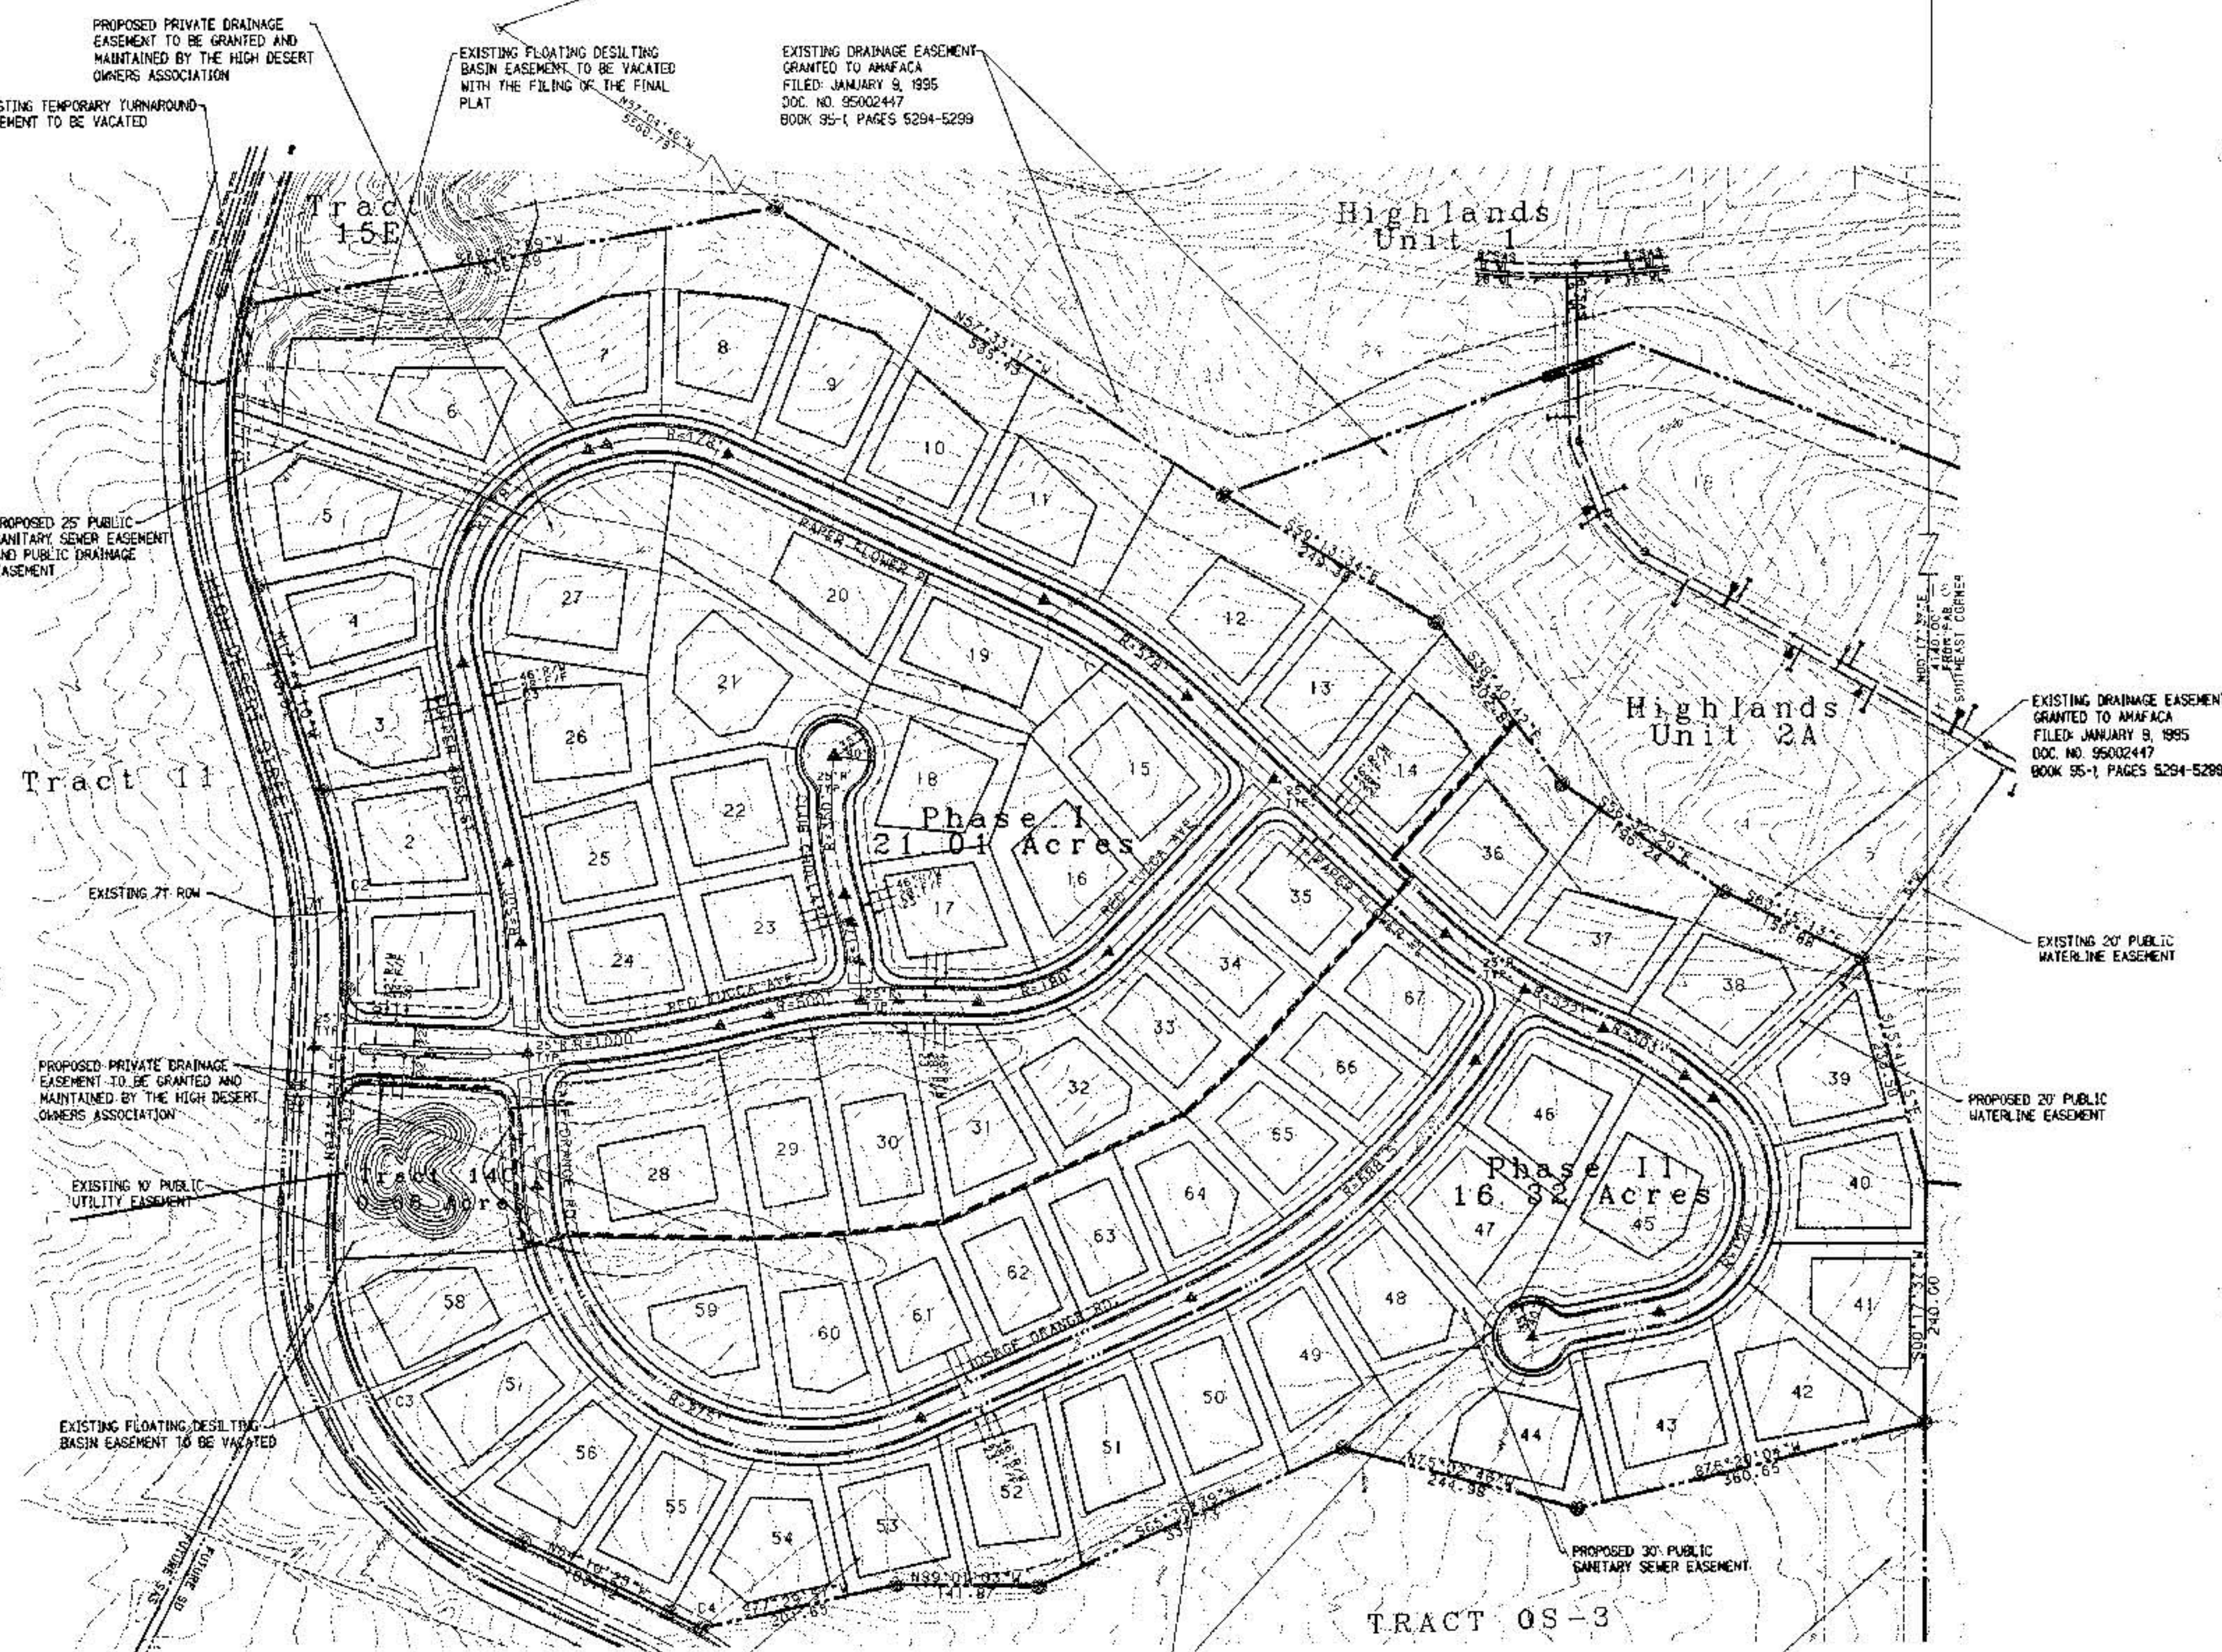

LOCATION MAP
ZONE ATLAS MAP NO. E-23
NO SCALE


PRELIMINARY PLAT (TRACT 14A) THE OVERLOOK AT HIGH DESERT JULY, 1998

NUMBER	DELTA	DEGREE	TANGENT	ARC	RADIUS
C1	31°54'44"	11°13'45"	145.89'	284.19'	510.24'
C2	21°01'41"	10°17'04"	103.40'	204.47'	557.12'
C3	67°27'56"	16°58'03"	225.48'	397.62'	337.68'
C4	4°55'26"	13°39'53"	18.03'	36.03'	419.30'

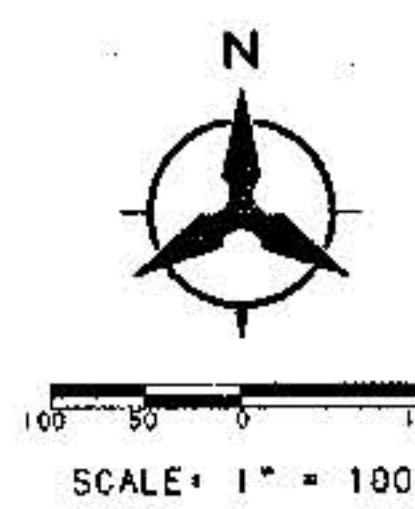


RECORD DRAWING
DATE: 5-3-99

BOHANNAN-HUSTON INC.
ENGINEERS • PLANNERS • PHOTOGRAMMETRISTS • SURVEYORS • LANDSCAPE ARCHITECTS
ALBUQUERQUE, NEW MEXICO

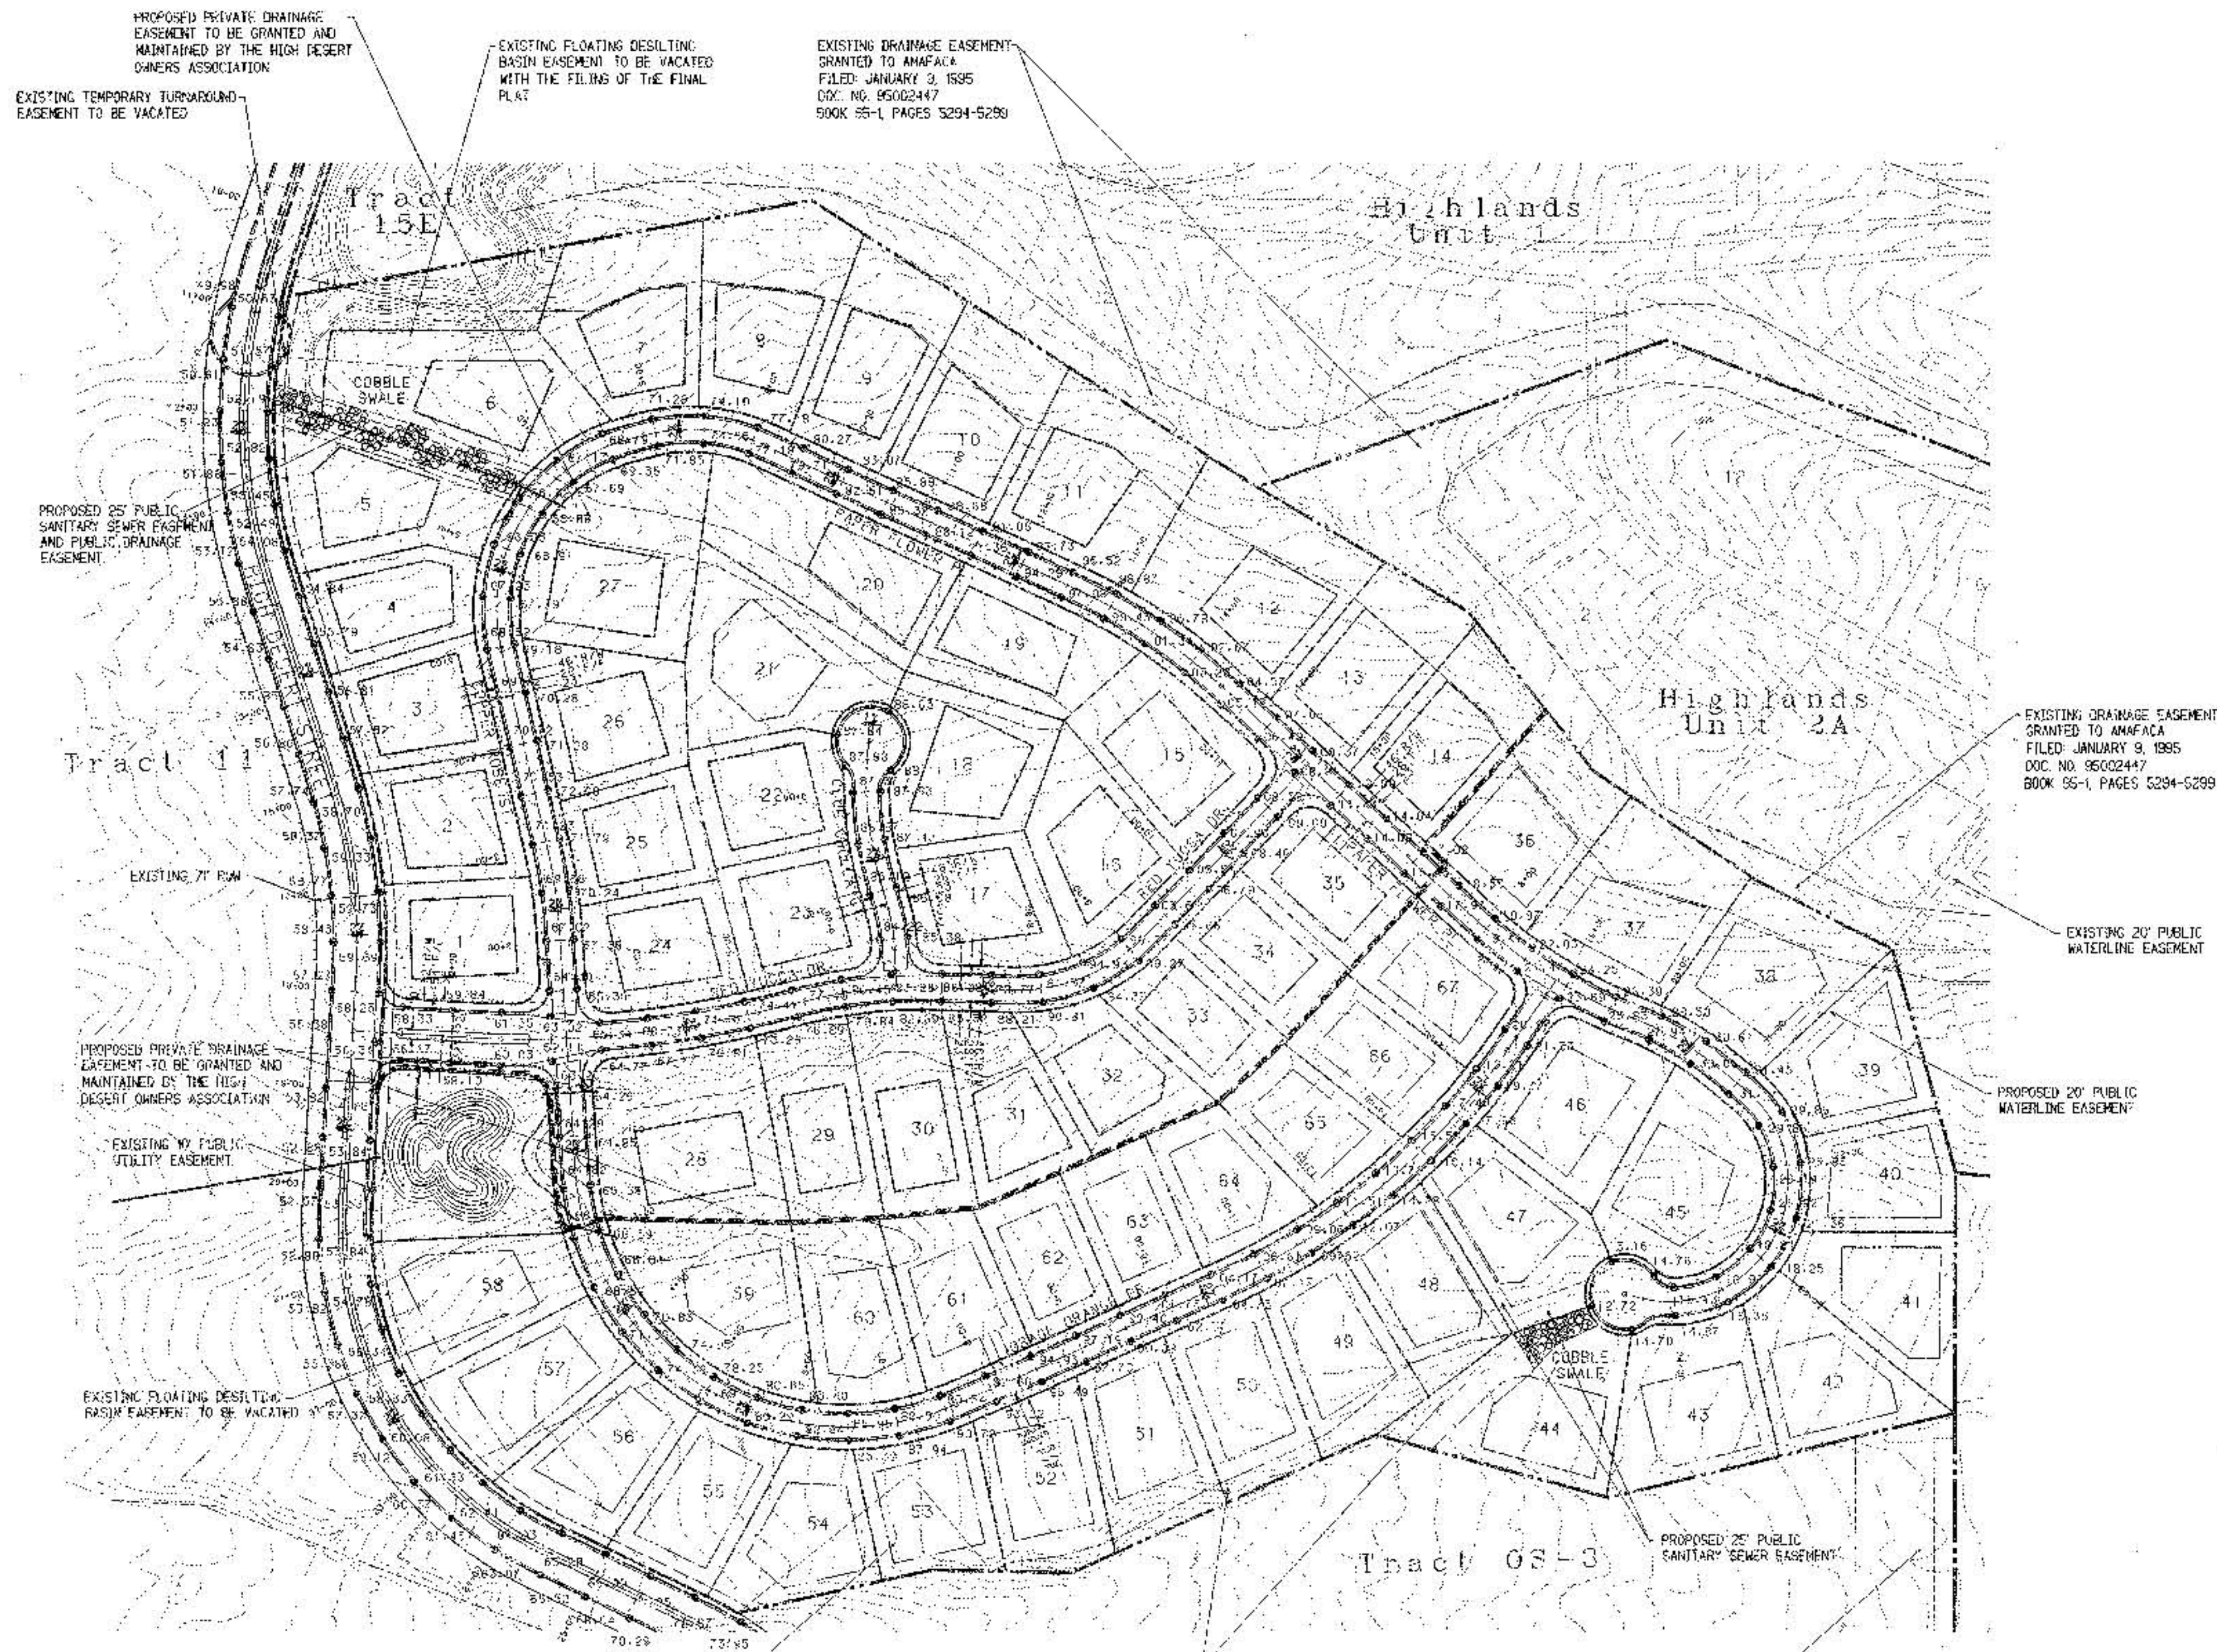

GENERAL NOTES

1. CONTRACTOR MUST OBTAIN A TOPSOIL DISTURBANCE PERMIT FROM THE ENVIRONMENTAL HEALTH DIVISION PRIOR TO CONSTRUCTION.
2. THE CONTRACTOR IS TO REFER TO EAR-TWORK SPECIFICATION AS NOTED IN THE SOILS REPORT PREPARED BY GEO-TEST, DATED JANUARY 9, 1998.
3. THE CONTRACTOR SHALL CONFORM TO ALL CITY, COUNTY, STATE, AND FEDERAL DUST CONTROL MEASURES AND REQUIREMENTS AND WILL BE RESPONSIBLE FOR PREPARING AND OBTAINING ALL NECESSARY APPLICATIONS AND APPROVALS.
4. THE CONTRACTOR SHALL ENSURE THAT NO SOIL ERODES FROM THE LOTS INTO PUBLIC RIGHT-OF-WAY. THIS CAN BE ACHIEVED BY CONSTRUCTING TEMPORARY BERMS AS PER DETAIL THIS SHEET AND WEETING THE SOIL TO KEEP IT FROM BLOWING.
5. ALL SPOT ELEVATIONS ARE FLOWLINE UNLESS OTHERWISE NOTED. VALLEY GUTTER ELEVATIONS ARE SHOWN AT FLOWLINE.

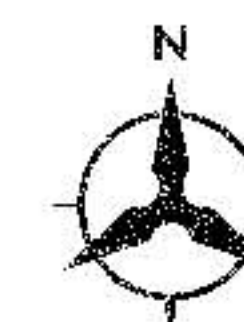

SCALE: 1" = 100'

LEGEND

PROJECT BOUNDARY	---
EXISTING CONTOUR	---
EXISTING SPOT ELEVATION	0.00
PROPOSED SPOT ELEVATION	0.00
DIRECTION OF FLOW	→
BASIN BOUNDARY	---
SUB-BASIN BOUNDARY	---
PROPOSED 2'-0" FILLED CURB WALL	---
EXISTING GARDEN WALL	---
EXISTING STORM DRAIN LINE	---
EXISTING STORM DRAIN HANCOLE	---
EXISTING STORM DRAIN INLET	---
PROPOSED STORM DRAIN LINE	---
PROPOSED STORM DRAIN HANCOLE	---
PROPOSED STORM DRAIN INLET	---
TOE OF SLOPE	---
EROSION CONTROL BERM	---

AS-BUILT INFORMATION		BENCH MARKS		SURVEY INFORMATION		FIELD NOTES	
CONTRACTOR: [blank]		STATION: [blank]		NO. [blank]		DATE [blank]	
DRAWN BY: [blank]		GEOLOGICAL SURVEY BEACH MARK: 100'		NO. [blank]		DATE [blank]	
CHECKED BY: [blank]		CONCRETE PROTECTING 0.2 FEET ABOVE GROUND - OCCURRED 489 FEET WEST OF THE INTERSECTION OF SAN ANTONIO DRIVE AND TENNISON STREET, AND 35 FEET NORTH OF RIGHT-OF-WAY LINE OF SAN ANTONIO DR. CLEV. 6509.155		NO. [blank]		DATE [blank]	
DATE: [blank]		DATE: [blank]		NO. [blank]		DATE [blank]	



APPROVED FOR ROUGH GRADING (1:1)





HYDROLOGY ENGINEER DATE

BOHANNAN-HUSTON INC.
ENGINEERS • PLANNERS • PHOTOGRAMMETRISTS • SURVEYORS • LANDSCAPE ARCHITECTS
ALBUQUERQUE, NEW MEXICO

CITY OF ALBUQUERQUE
PUBLIC WORKS DEPARTMENT
ENGINEERING DEVELOPMENT GROUP

HIGH DESERT TRACT-14A OVERALL GRADING AND DRAINAGE PLAN

DESIGN REVIEW BOARD NO.	APPROVAL DATE	NO. 571285	DATE 5-3-99
LAST DESIGN UPDATE	NO. 571285	DATE 5-3-99	DATE 5-3-99
CITY PROJECT NO.	ZONE MAP NO.	SHEET	OF
571285	E-23	3	20

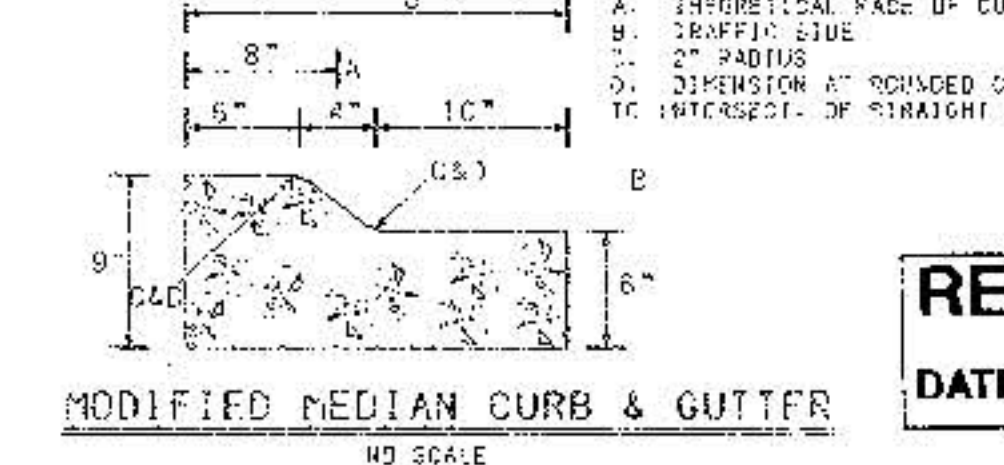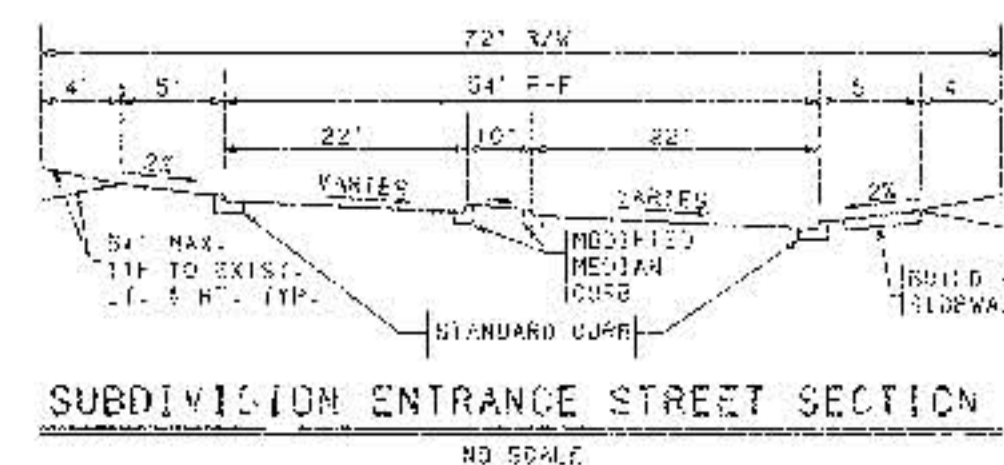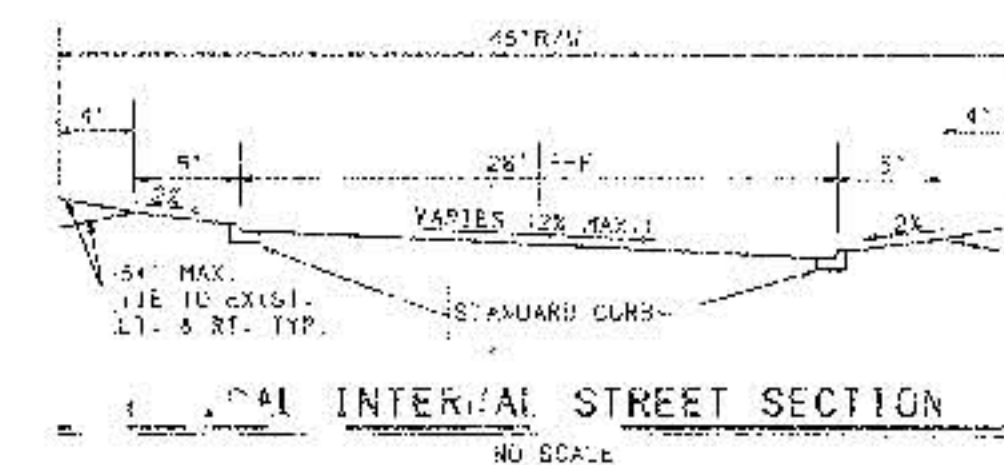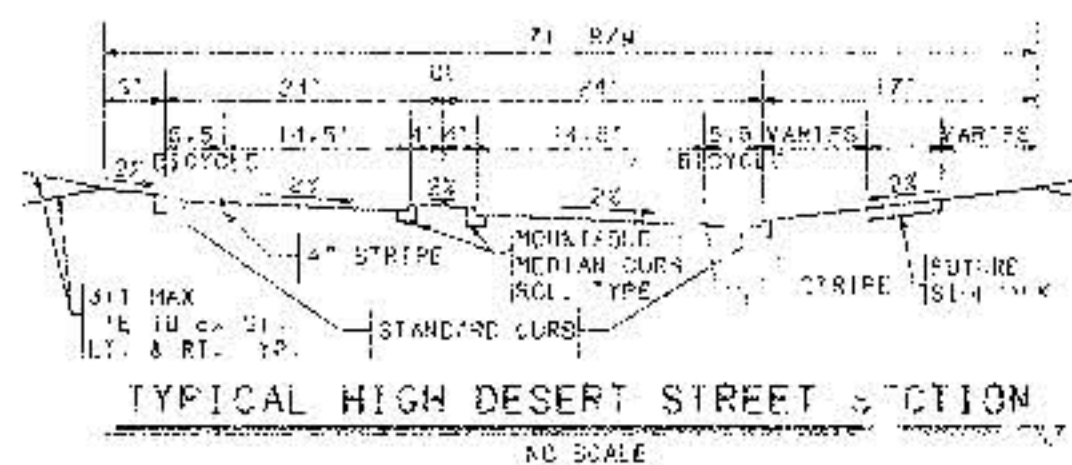

RECORD DRAWING
DATE: 5-3-99


BHI JOB NO. 99237A03

PROPOSED PRIVATE DRAINAGE EASEMENT TO BE GRANTED AND MAINTAINED BY THE HIGH DESERT OWNERS ASSOCIATION

EXISTING TEMPORARY TURNAROUND EASEMENT TO BE VACATED

EXISTING FLOATING DESILTING BASIN EASEMENT TO BE VACATED WITH THE FILING OF THE FINAL PLAN


EXISTING DRAINAGE EASEMENT GRANTED TO AMAFACA FILED JANUARY 9, 1995 DOC. NO. 95002447 BOOK 95-1, PAGES 5294-5299

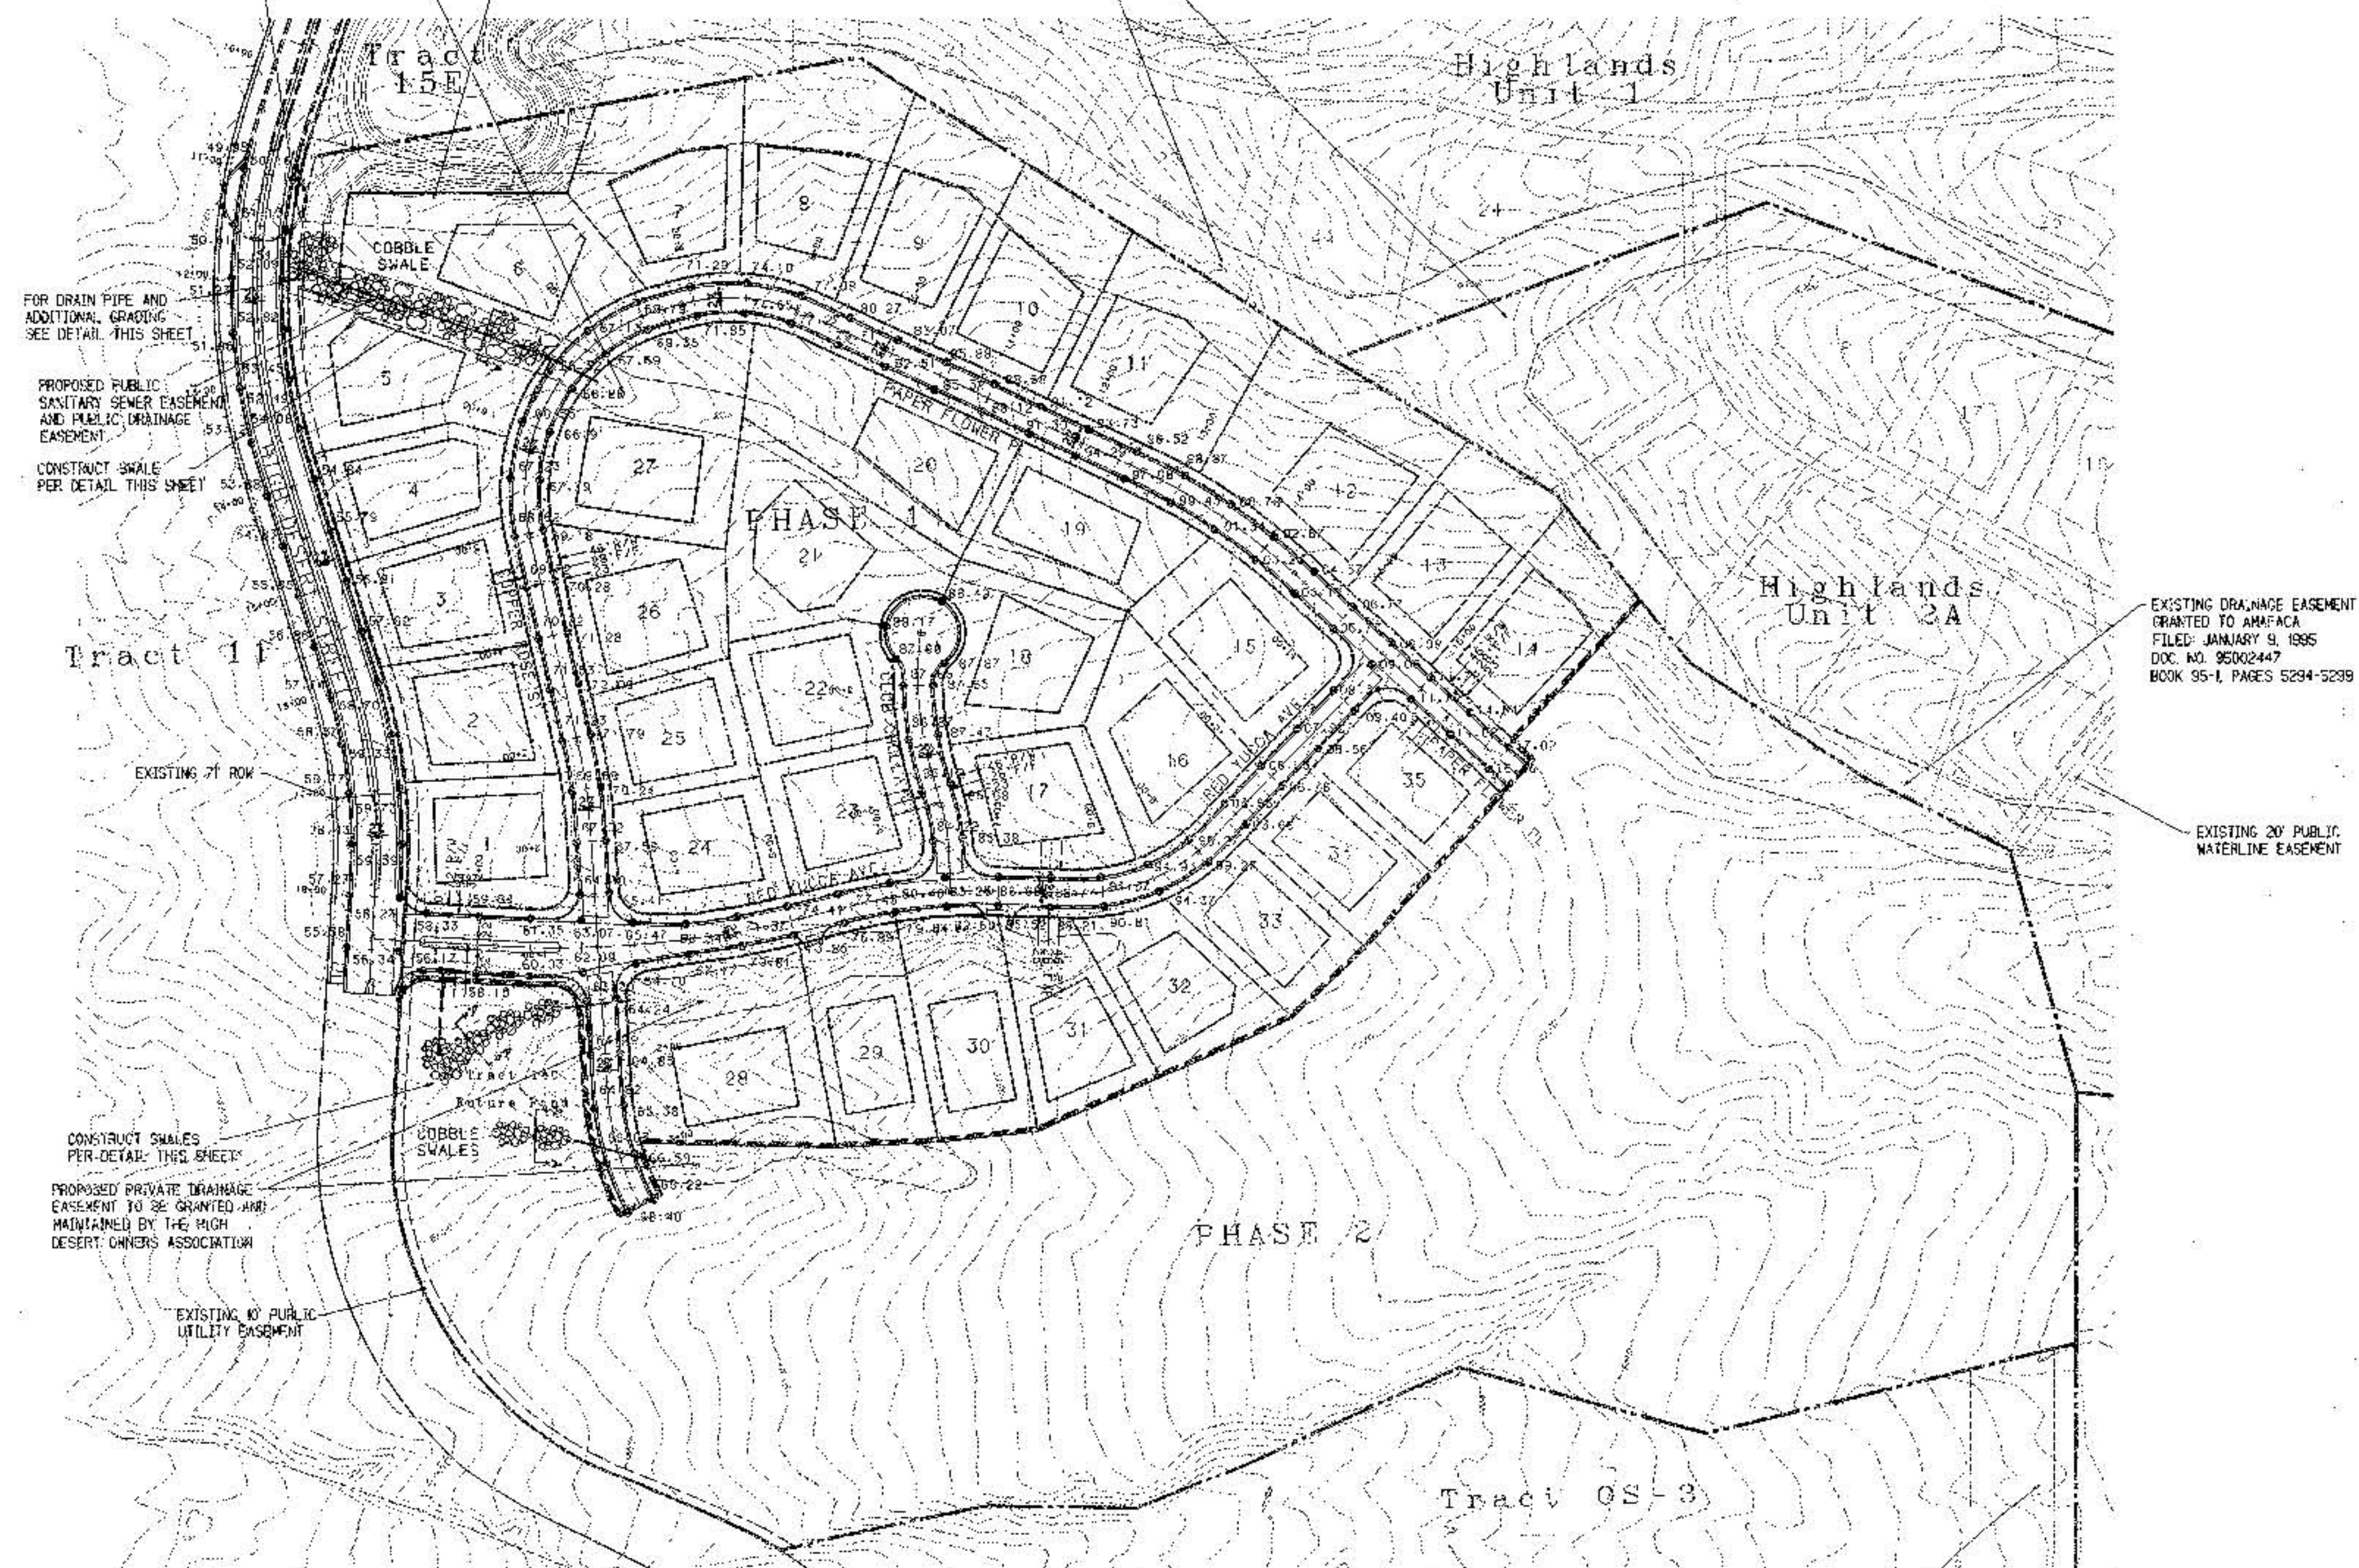

EXISTING DRAINAGE EASEMENT GRANTED TO AMAFACA FILED JANUARY 9, 1995 DOC. NO. 95002447 BOOK 95-1, PAGES 5294-5299



EXISTING 20' PUBLIC WATERLINE EASEMENT

- ### GENERAL NOTES
1. CONTRACTOR MUST OBTAIN A TOPSOIL DISTURBANCE PERMIT FROM THE ENVIRONMENTAL HEALTH DIVISION PRIOR TO CONSTRUCTION.
 2. THE CONTRACTOR IS TO REFER TO EAR-TWORK SPECIFICATION AS NOTED IN THE SOILS REPORT PREPARED BY GED - TEST, DATED JANUARY 19, 1998.
 3. THE CONTRACTOR SHALL CONFORM TO ALL CITY, COUNTY, STATE, AND FEDERAL DUST CONTROL MEASURES AND REQUIREMENTS AND WILL BE RESPONSIBLE FOR PREPARING AND OBTAINING ALL NECESSARY APPLICATIONS AND APPROVALS.
 4. THE CONTRACTOR SHALL ENSURE THAT NO SOIL BRUISES FROM THE LOTS INTO PUBLIC RIGHT-OF-WAY. THIS CAN BE ACHIEVED BY CONSTRUCTING TEMPORARY BERM AS PER DETAIL THIS SHEET AND WEAVING THE SOIL TO KEEP IT FROM BLOWING.
 5. ALL SPOT ELEVATIONS ARE FLOWLINE UNLESS OTHERWISE NOTED. VALLEY CUTTER ELEVATIONS ARE SHOWN AT FLOWLINE.

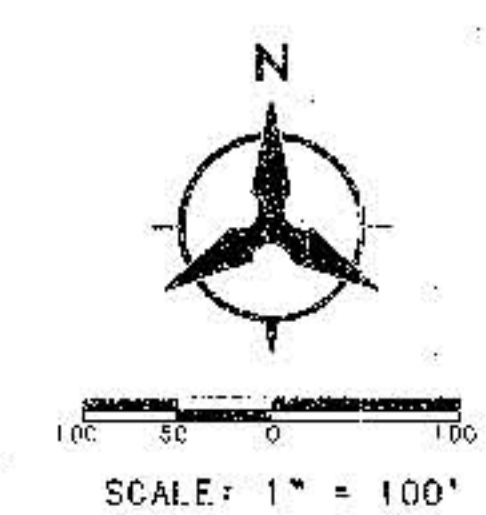

LEGEND

PROJECT BOUNDARY	---
EXISTING CONDUIT	---
EXISTING SPOT ELEVATION	0.255
PROPOSED SPOT ELEVATION	0.568
DIRECTION OF FLOW	→ S-2.5642
BASIN BOUNDARY	---
SUB-BASIN BOUNDARY	---
PROPOSED 2.5' FILLED CHU WALL	---
EXISTING GARDEN WALL	---
EXISTING STORM DRAIN LINE	---
EXISTING STORM DRAIN MANHOLE	---
EXISTING STORM DRAIN INLET	---
PROPOSED STORM DRAIN LINE	---
PROPOSED STORM DRAIN MANHOLE	---
PROPOSED STORM DRAIN INLET	---
TOP OF SLOPE	---
EROSION CONTROL BERM	---

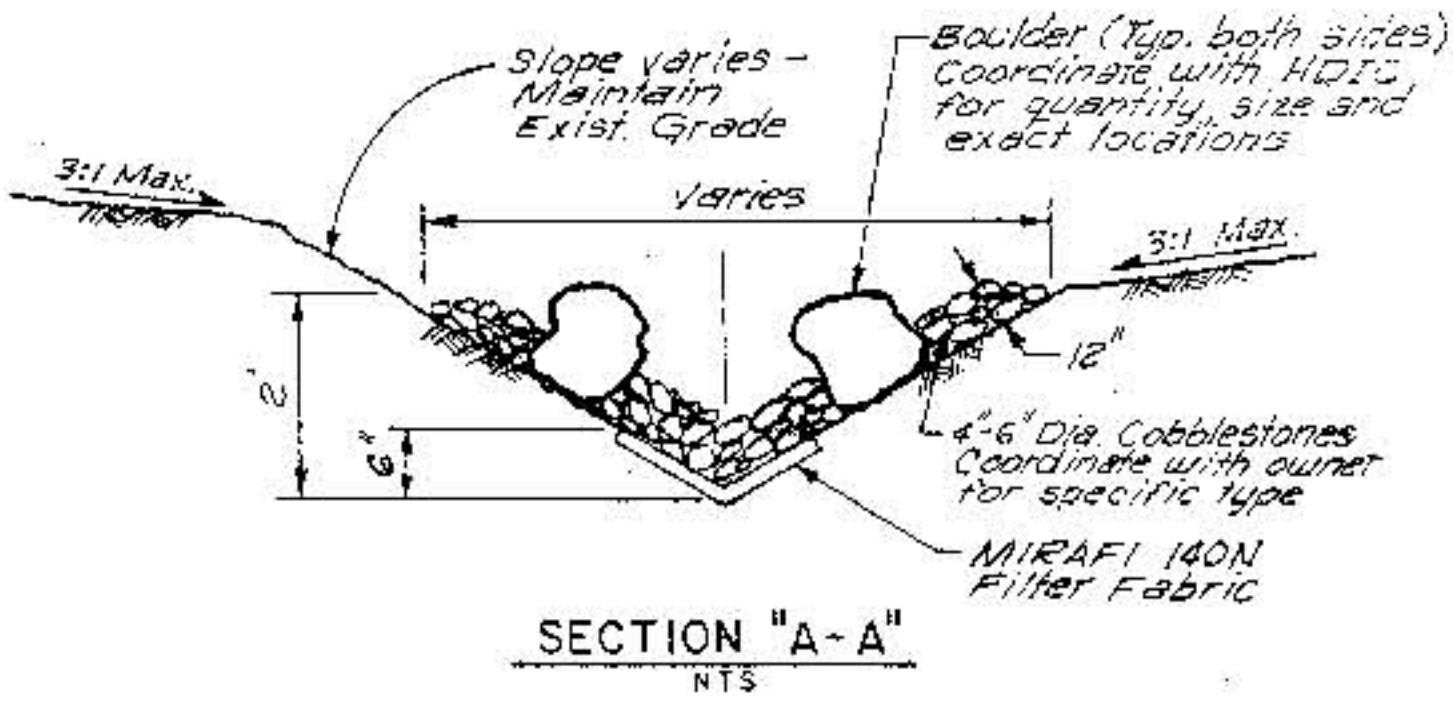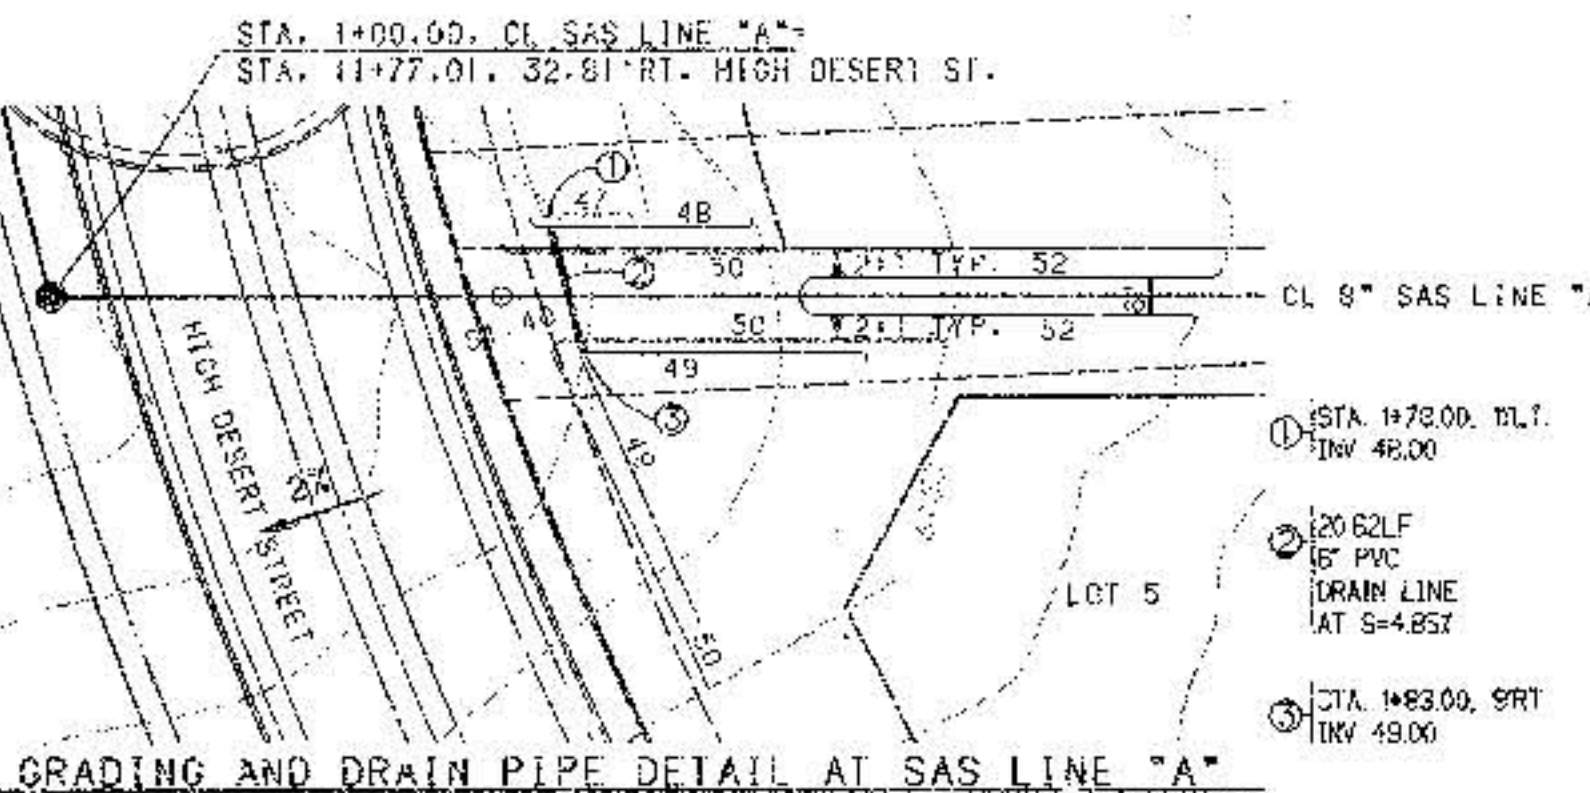

EXISTING 20' PUBLIC WATERLINE AND 80' TEMPORARY CONSTRUCTION EASEMENT FILED JUNE 29, 1992 (C19-183)

RECORD DRAWING
DATE: **5-3-99**

APPROVED FOR ROUGH GRADING (1")
[Signature] 9-22-98
HYDROLOGY ENGINEER DATE

BOHANNAN-HUSTON INC.
ENGINEERS • PLANNERS • PHOTOGRAMMETRISTS • SURVEYORS • LANDSCAPE ARCHITECTS
ALBUQUERQUE LAS CRUCES SANTA FE

CITY OF ALBUQUERQUE
PUBLIC WORKS DEPARTMENT
ENGINEERING DEVELOPMENT GROUP

HIGH DESERT TRACT 14A
PHASE 1 - GRADING AND DRAINAGE PLAN

DESIGN REVIEW BOARD NO.	APPROVAL DATE	NO./DAY/YR	NO./DAY/YR


CITY PROJECT NO.	ZONE MAP NO.	SHEET	OF
571285	E-23	4	20

ENGINEER'S SEAL	SURVEY INFORMATION	FIELD NOTES	AS-BUILT INFORMATION



NO.	DATE	REVISIONS	DESIGN

DESIGNED BY	APPROVED BY	DATE	DATE

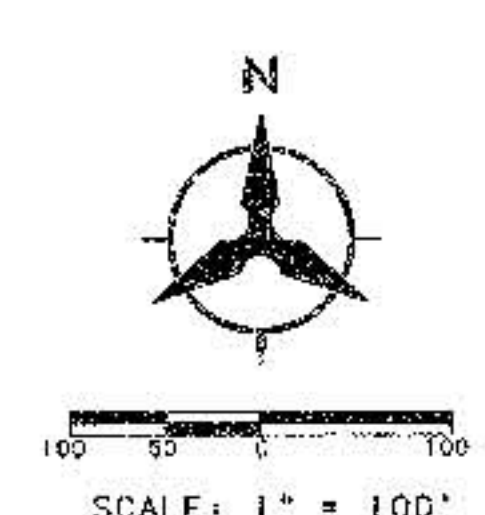


NOTE: CONTRACTOR SHALL INSTALL A SMOOTH WIRE FENCE 5' BEYOND GRADING LIMITS TO CONFINES ITS WORK WITHIN THE CONSTRUCTION LIMITS. TO MINIMIZE THE DISTURBANCE TO THE EXISTING VEGETATION, THE CONTRACTOR SHALL CONFINED WORK WITHIN LINES OF FENCING.

KEYED GENERAL NOTES


1. INSTALL CONCRETE VALLEY GUTTER AS PER STD. DWG. 2420 (ALT. 5)
2. INSTALL CONCRETE VALLEY GUTTER AS PER STD. DWG. 2421
3. INSTALL WHEEL CHAIR RAMP AS PER STD. DWG. 2441, CASE 1
4. INSTALL WHEEL CHAIR RAMP AS PER ADA STANDARDS. SEE THIS SHEET
5. STD. CURB & GUTTER AS PER STD. DWG. 2415
6. MOUNTABLE CURB ROLL TYPE AS PER STD. DWG. 2415
7. MODIFIED MEDIAN CURB & GUTTER AS PER DETAIL THIS SHEET
8. FUTURE SIDEWALK
9. BUILD 4' SIDEWALK
10. MEANDERING ASPHALT TRAIL TO BE BUILT IN CONJUNCTION WITH LANDSCAPING PLAN

CURB CONSTRUCTION NOTES

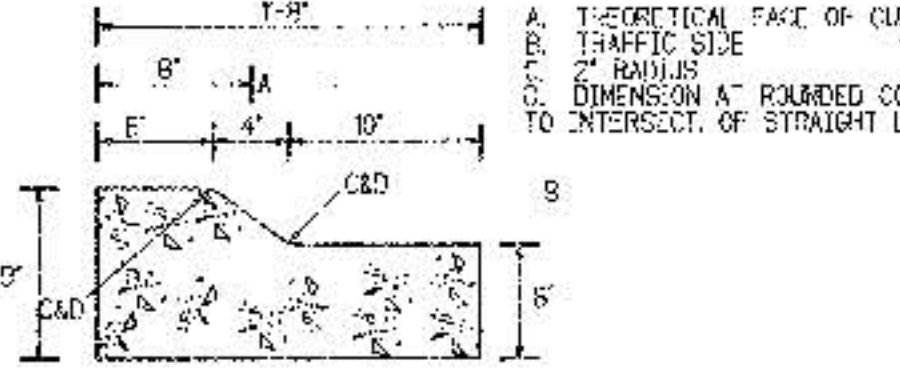


MODIFIED MEDIAN CURB & GUTTER
NO SCALE

PROPOSED PRIVATE DRAINAGE EASEMENT TO BE GRANTED AND MAINTAINED BY THE HIGH DESERT OWNERS ASSOCIATION

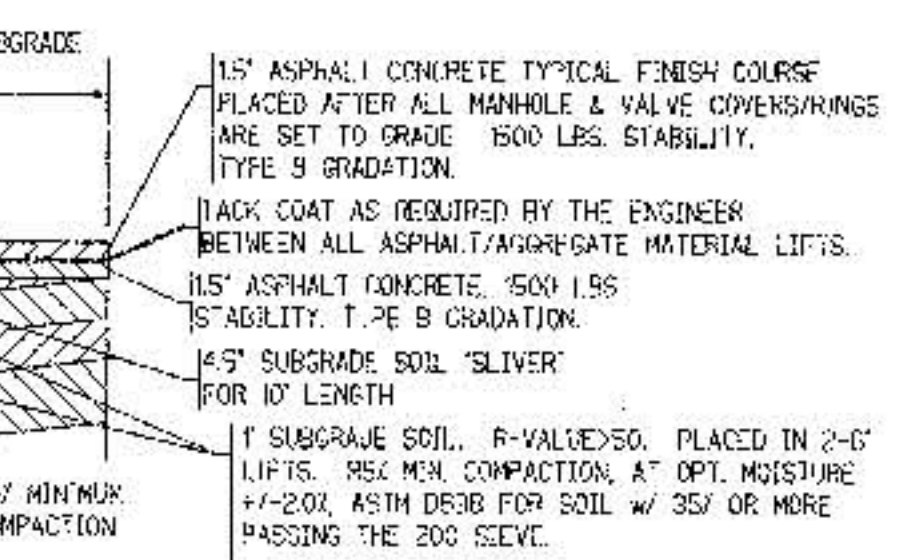


TYPICAL PAVEMENT SECTION
NO SCALE (REFER TO CDA STD DWG 2405)

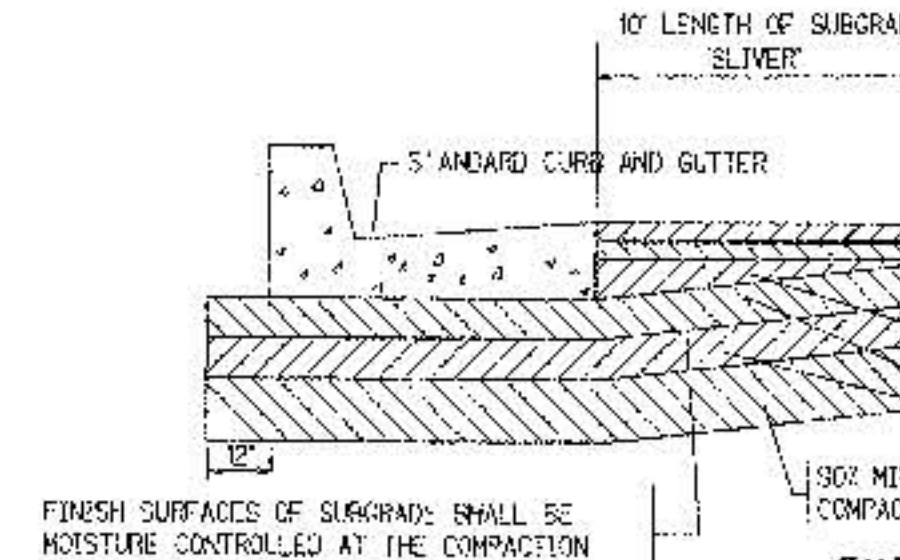

ENTRANCE PAVEMENT SECTION
RED YUCCA AVE. - STA. 1+00.00 TO 3+51.85
AND HIGH DESERT STREET
NO SCALE


HIGHLANDS UNIT 1

EXISTING DRAINAGE EASEMENT GRANTED TO AMAFACA
FILED: JANUARY 9, 1995
DOC. NO. 95002447
BOOK 95-1, PAGES 5294-5299

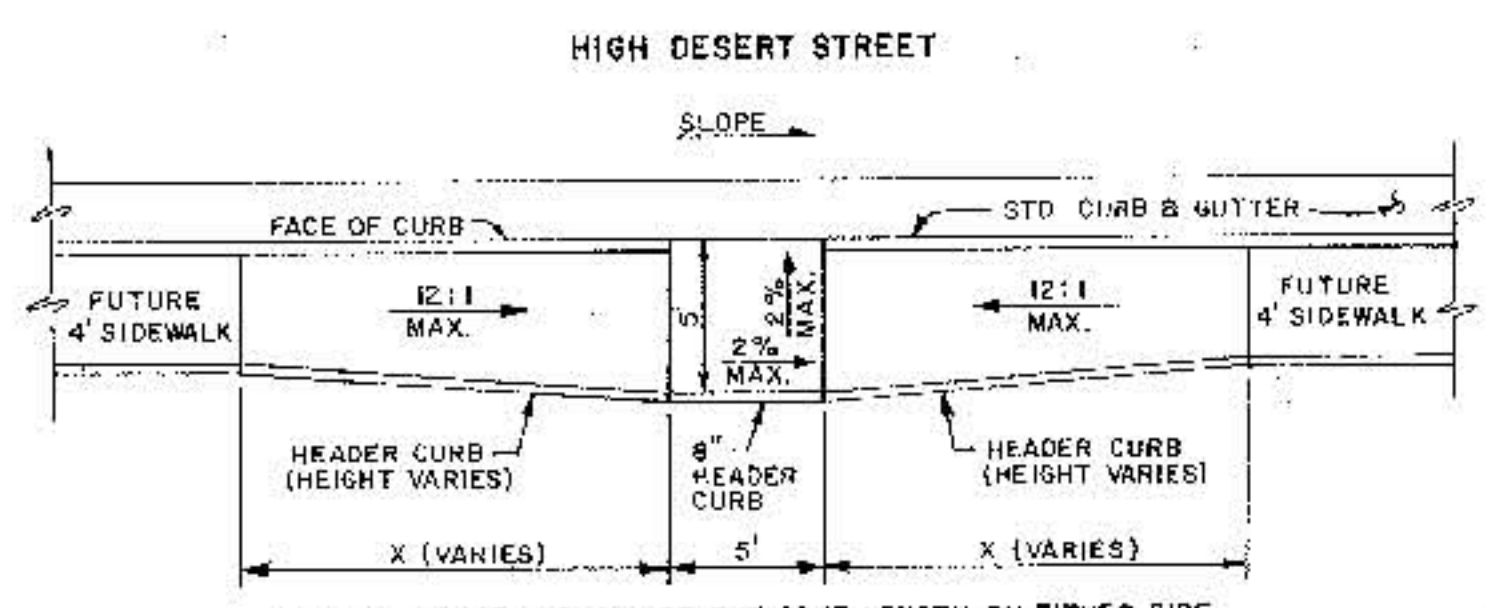


WHEELCHAIR RAMP DETAIL
NO SCALE


NOTE: DISTANCE X SHALL BE THE SAME LENGTH ON EITHER SIDE OF THE RAMP.

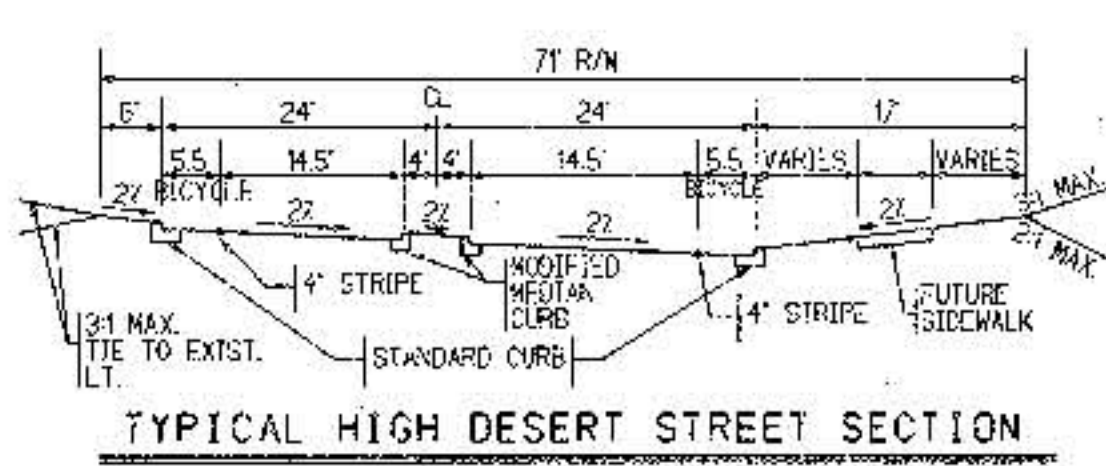

TYPICAL HIGH DESERT STREET SECTION
NO SCALE

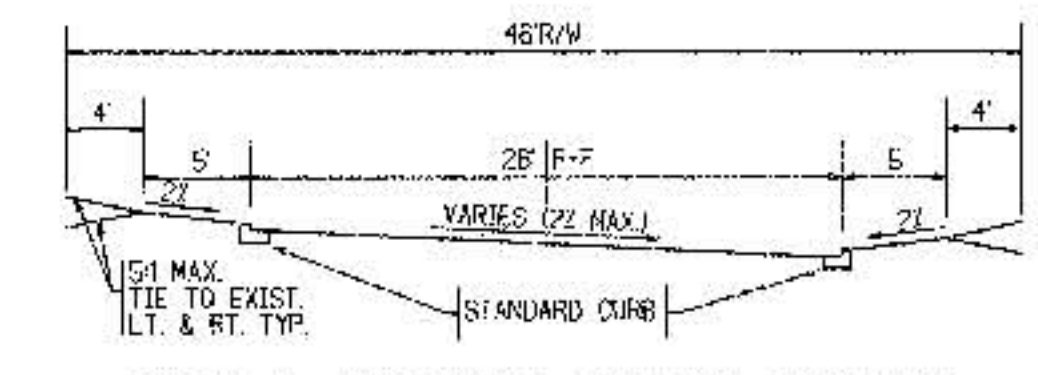

TYPICAL INTERNAL STREET SECTION
NO SCALE

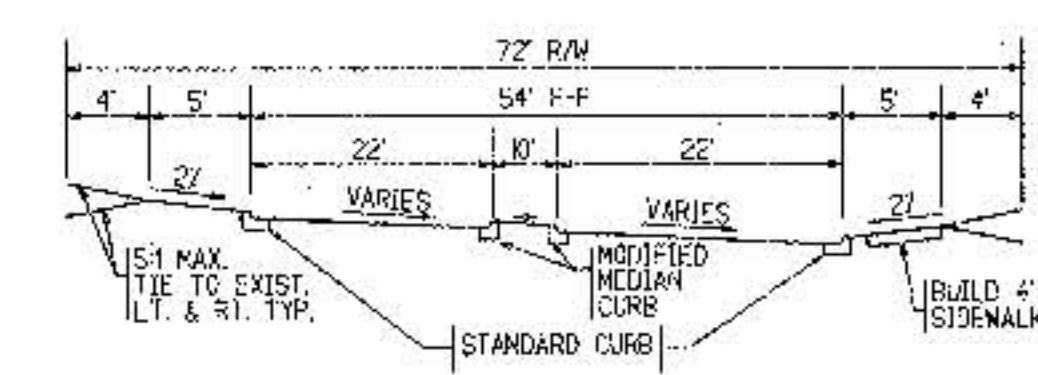

SUBDIVISION ENTRANCE STREET SECTION
NO SCALE

LEGEND

- PROJECT BOUNDARY
- PROPOSED CURB & GUTTER
- EXISTING CURB & GUTTER
- FUTURE SIDEWALK
- PROPOSED SANITARY SEWER MANHOLE
- EXISTING SANITARY SEWER MANHOLE
- PROPOSED FIRE HYDRANT
- EXISTING FIRE HYDRANT
- PROPOSED GATE VALVE
- EXISTING GATE VALVE
- PROPOSED STORM DRAIN LINE
- PROPOSED STORM DRAIN MANHOLE
- PROPOSED STORM DRAIN INLET
- EXISTING STORM DRAIN LINE
- EXISTING STORM DRAIN MANHOLE
- EXISTING STORM DRAIN INLET
- TRANSITION AREA
- PROPOSED CONDUIT PIPE
- EXISTING CONDUIT PIPE
- PROPOSED STREET LIGHT
- PROPOSED RETAINING WALL
- PHASE BOUNDARY

Tract OS-3

EXISTING 20' PUBLIC WATERLINE AND 30' TEMPORARY CONSTRUCTION EASEMENT
FILED: JUNE 22, 1982 (C19-163)

RECORD DRAWING
DATE: 5-3-99

NOTE: PT. 3 ELEV. IS AT TOP OF HEADER CURB

RAMP	PT. 1	PT. 2	PT. 3	PT. 4	PT. 5
B	55.78	56.09	56.64	56.79	56.90
D	61.99	62.74	63.29	62.84	63.19

ADA WHEEL CHAIR RAMP DETAIL
NO SCALE

- A = CURB RETURN POINT
- B = QUARTER POINTS
- C = 6' BEHIND FACE OF CURB RETURN
- D = RIGHT OF WAY RETURN POINT

NOTE: ALL HANDICAP RAMPS AND GUTTER POINT TABLES IDENTIFIED BY LETTER ON THE P & P SHEETS (CORRESPONDING TO THE LETTERS IN THE TABLE ABOVE)

BOHANNAN-HUSTON INC.
ENGINEERS • PLANNERS • PHOTOGRAPHERS • SURVEYORS • LANDSCAPE ARCHITECTS
ALBUQUERQUE LAS CRUCES SANTA FE

CITY OF ALBUQUERQUE
PUBLIC WORKS DEPARTMENT
ENGINEERING DEVELOPMENT GROUP

THE OVERLOOK AT HIGH DESERT
MASTER PAVING PLAN

DESIGN REVIEW DRAWING NO. 100 DAY/7R 100 DAY/7R

CITY PROJECT NO. 571285 ZONE MAP NO. E-23 SHEET 5 OF 20

DATE: AUGUST 25, 1998

ENGINEER'S SEAL SURVEY INFORMATION

NO. 101 BY DATE 5/3/99

REVISIONS

NO.	DATE	REMARKS
1	5/3/99	DESIGN

DESIGNED BY: NP, C DATE: 8/98
DRAWN BY: SAR DATE: 8/98
CHECKED BY: KP DATE: 8/98

AS-BUILT INFORMATION

CONTRACTOR: Universal
INSPECTOR: BH
FILED: BH
DATE: 5/99
FILED: BH
DATE: 5/99
FILED: BH
DATE: 5/99
FILED: BH
DATE: 5/99

CENTERLINE CURVE DATA TABLE					
NUMBER	PJ STA.	DELTA	TANGENT	ARC	RADIUS
C1	12+14.50	35°50'35.2"	174.72'	337.96'	540.24'

CENTERLINE TANGENT TABLE		
NUMBER	BEARING	DISTANCE
11	S18°06'25"W	289.79'
12	S17°44'10"E	210.01'

NOTE: CONTRACTOR SHALL COORDINATE WITH DTD (823-9360) PRIOR TO ANY CONSTRUCTION OR REMOVALS WITHIN HIGH DESERT STREET.

STA. 8+00.36, 54RT. = 4+32.58, 27LT. FUTURE STREET PL=48.91

STA. 8+64.36, 54RT. = 4+32.58, 27RT. FUTURE STREET PL=48.91

TC FL
1 48.60
2 48.29
3 48.58
D=90°00'00"
L=47.12'
R=30.00'

TC FL
1 48.61
2 48.35
3 48.01
D=90°00'00"
L=47.12'
R=30.00'

STA. 10+72.85, 4LT. TO 4RT. SAWCUT, REMOVE & DISPOSE OF MEDIAN NOSE CURB & GUTTER AND BOWMATE PAVEMENT ON MEDIAN NOSE. MATCH EXISTING MODIFIED CURB ELEVATIONS.

STA. 10+72.85, 24LT. TO 24RT. SAWCUT, REMOVE & DISPOSE OF ASPHALT PAVEMENT, PCC CURB & GUTTER AND ASPHALT CURB PER EXISTING TEMPORARY CUL-DE-SAC. MATCH EXISTING PAVEMENT AND ROLL CURB ELEVATIONS.

STA. 10+72.85, 24LT. AND 24RT. BEGIN 10' TRANSITION FROM ROLL CURB TO STANDARD CURB

PROPOSED PUBLIC SANITARY SEWER EASEMENT AND PUBLIC DRAINAGE EASEMENT


NEW BICYCLE PAVEMENT MARKINGS. SEE DIAGRAMS

STA. 10+72.85 TO 12+15.00 CROSS SLOPE TRANSITION FROM NORMAL CROWN TO -2.00% LT. RT

HIGH DESERT STREET

STA. 12+15.00 TO END OF PHASE ONE ROADWAY -2% CROSS SLOPE (RCP=1.48' -57' = FL-RT)

STA. 10+72.85 TO 12+15.00 CROSS SLOPE TRANSITION FROM NORMAL CROWN TO -2.00% LT. RT

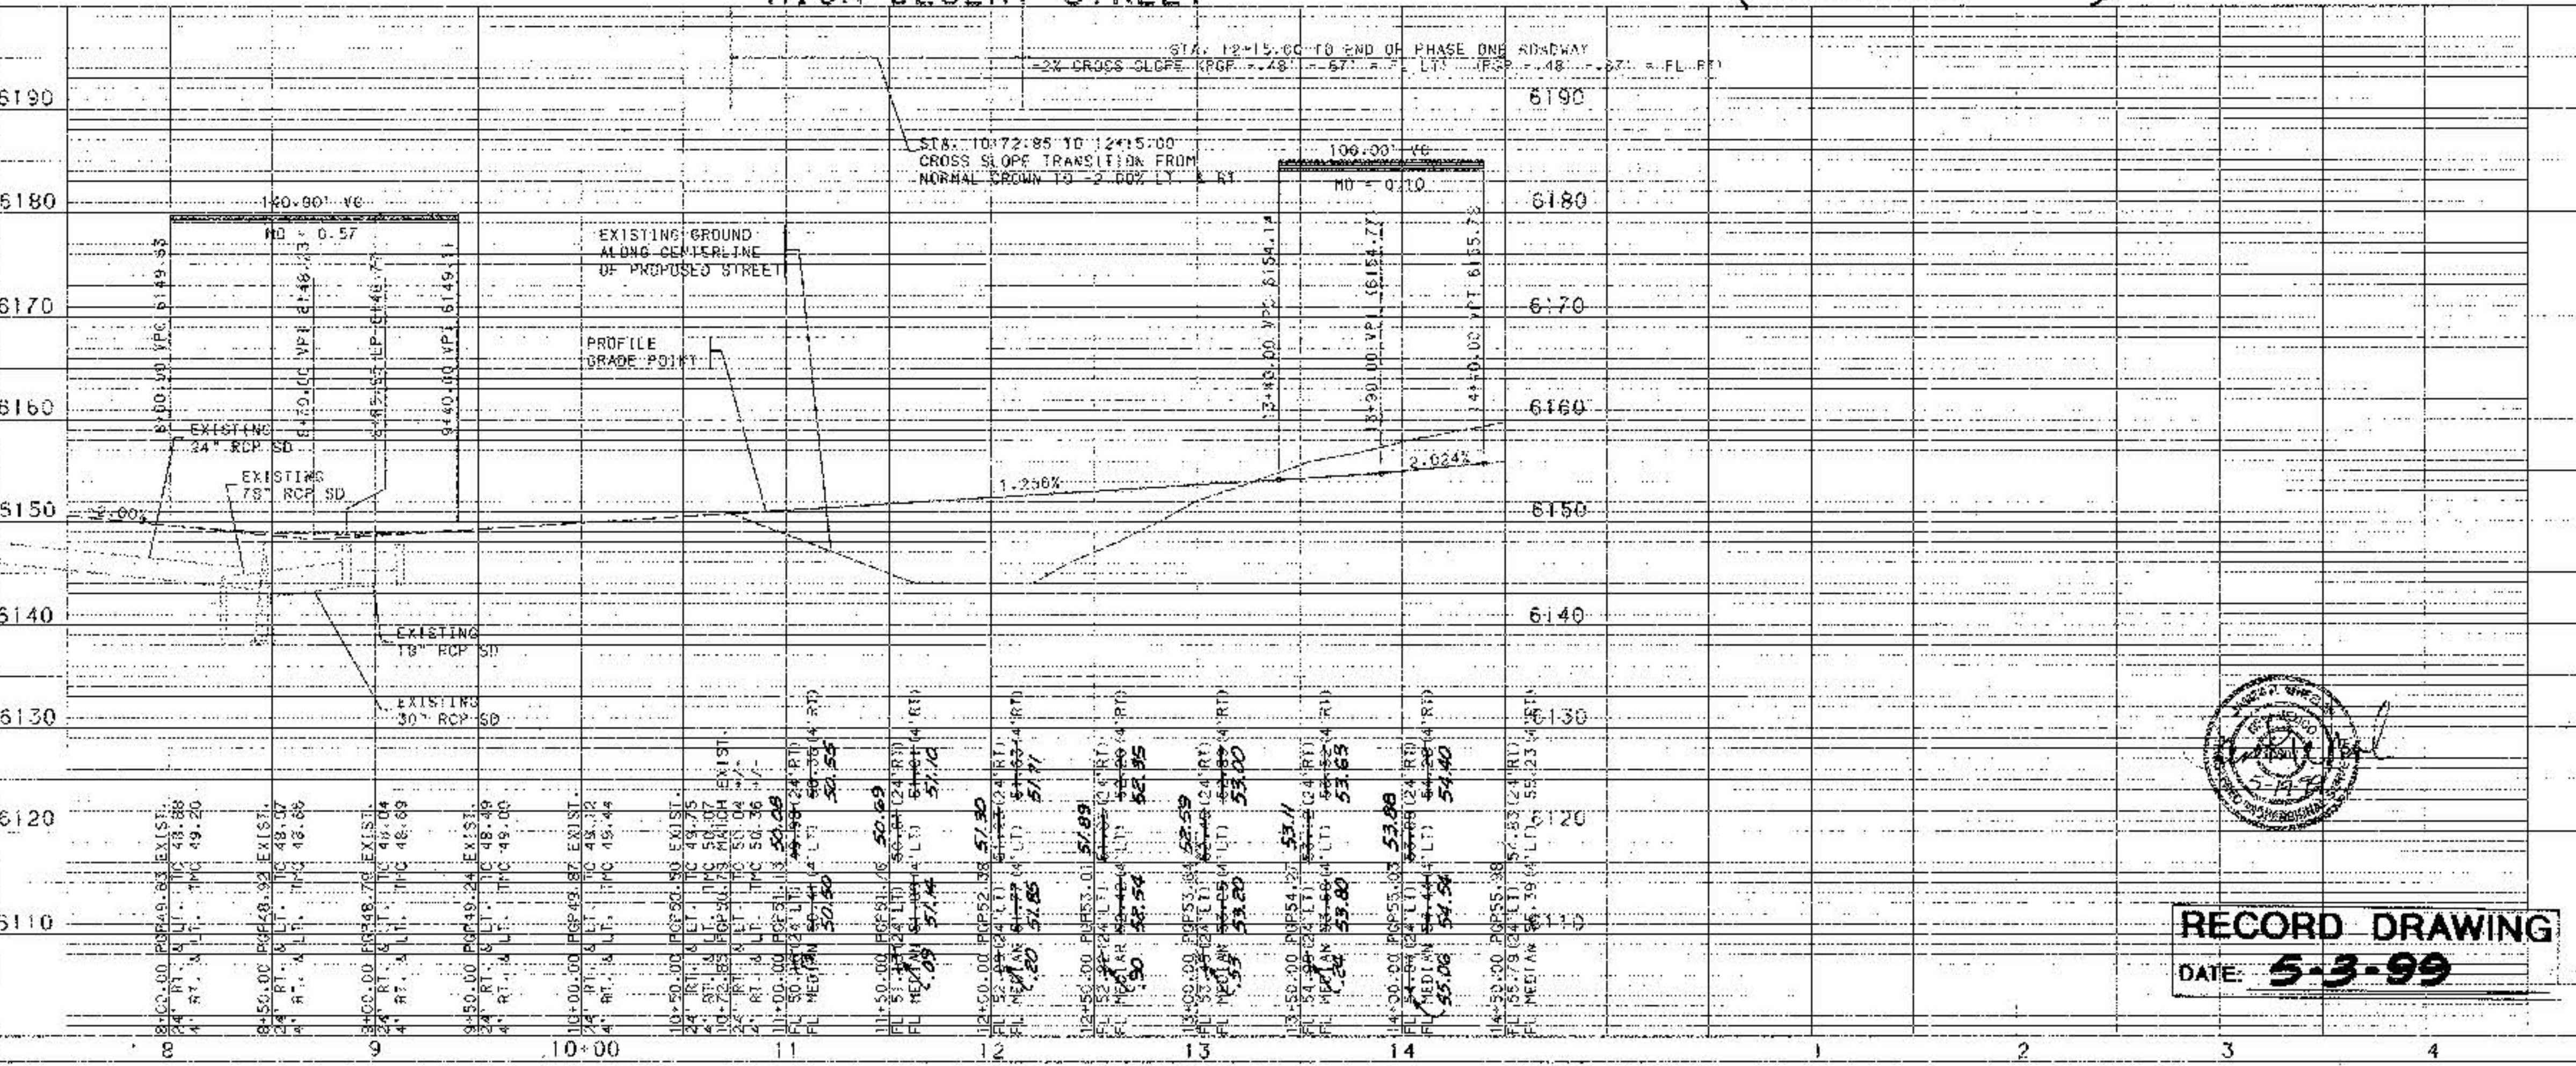

MEDIAN CURB CURVE DATA TABLE					
NUMBER	PI STA.	DELTA	TANGENT	ARC	RADIUS
C10	7+89.56	23°33'26.9"	10.43'	20.58'	50.00'
C11	8+08.37	157°33'49.8"	10.08'	5.50'	2.00'
C12	9+77.54	160°42'17.9"	11.77'	5.61'	2.00'
C13	9+75.99	23°33'41.0"	10.43'	20.56'	50.00'

ADDITIONAL CONSTRUCTION NOTES:

STA. 8+64.36, 4LT. TO STA. 9+46.36, 4LT. INSTALL 4" SOLID WHITE REFLECTIVE PLASTIC STRIPE

STA. 8+64.36, 4RT. TO STA. 9+46.36, 4RT. INSTALL 4" DOUBLE SOLID YELLOW REFLECTIVE PLASTIC STRIPE

PAVE MEDIAN NOSE W/ 4" BOWMATE CONCRETE 10' FROM HOSE TYP. COORDINATE PATTERN W/ HIGH DESERT INVESTMENT CORP.

STA. 7+79.14, 4LT. TO STA. 9+46.55, 4LT. REMOVE EXIST. MEDIAN CURB & GUTTER. MATCH EXIST. TC AND FL

STA. 7+98.28, 4RT. TO STA. 9+46.32, 4RT. REMOVE EXIST. MEDIAN CURB & GUTTER. MATCH EXIST. TC AND FL

STA. 7+79.14, 583LT. TO STA. 8+85.55, 583LT. AND STA. 7+98.28, 583RT. TO STA. 9+46.32, 583RT. SAWCUT REMOVE AND DISPOSE OF ASPHALT PAVEMENT. COMPACT THIS AREA IN ADDITION TO THE AREA OF EXISTING MEDIAN REMOVAL AND REPLACE WITH ASPHALT PAVEMENT SECTION PER DETAIL SHEET 5 OF 20.

STA. 7+77.13, 22RT. & LT. TO STA. 10+72.85, 22RT. & LT. MILL EXISTING ASPHALT SURFACE. RE-APPLY BICYCLE STRIPING AND PAVEMENT MARKINGS AS OBLITERATED. RELOCATE ANY SIGNS IF DISRUPTED.


STA. 8+85.95, 24RT. REMOVE AND DISPOSE OF EXISTING INLET. RETURN EXISTING INLET GRATE TO HIGH DESERT INVESTMENT CORP. REPLACE EXISTING INLET WITH TYPE 'D' TOP OF GRATE TO MATCH EXIST. FLOWLINE ELEV. MATCH INLET OF OLD INLET.

MEDIAN CURB DATA					
PT	TC=	FL	STATION & OFFSET	DESC.	
1	49.63	49.38	7+79.14 4.00' LT.	PC	
2	49.32	49.07	7+98.12 0.17' RT.	PCC	
3	49.25	49.00	7+98.28 4.00' RT.	PT	
4	49.04	48.79	9+46.32 4.00' RT.	PC	
5	49.11	48.86	9+46.56 0.17' RT.	PCC	
6	49.28	49.03	9+85.55 4.00' LT.	PT	

* TC ELEV. ARE APPROXIMATE. CONTRACTOR SHALL MATCH EXIST. TC ELEV.



CONTRACTOR SHALL INSTALL NEW SIGNS, SIGN POST AND BASE POST AT LOCATIONS SHOWN ABOVE.

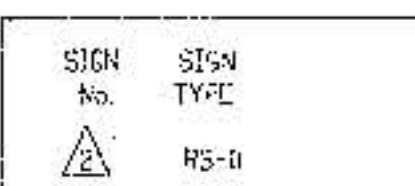

SCALE: 1" = 50' (HORIZ.)
1" = 10' (VERT.)

- NOTES**
1. THE CONTRACTOR SHALL FIELD VERIFY ALL EXISTING UTILITY LOCATIONS AND NOTIFY THE ENGINEER IMMEDIATELY OF ANY DISCREPANCIES.
 2. ALL CURB RETURN RADIUS SHALL BE 25' TO FACE OF CURB UNLESS OTHERWISE SPECIFIED.
 3. ALL CURVE DATA AND DIMENSIONS REFER TO FACE OF CURB UNLESS OTHERWISE SPECIFIED.
 4. GRADE ELEVATIONS, WHERE NOTED, ARE FOR TOP OF STANDARD CURB UNLESS OTHERWISE SPECIFIED.
 5. CONTRACTOR IS TO INSTALL A 4"x4"x5" POST AND END AT THE END OF EACH SANITARY SEWER SERVICE.
 6. CONTRACTOR IS RESPONSIBLE FOR REPAIR AND/OR REPLACEMENT OF UTILITY CONDUITS AND EXISTING LINES.
 7. ANY ADDITIONAL GRADING REQUIRED TO MATCH PROPOSED STREET GRADES SHALL BE INCIDENTAL TO PAVING ITEMS.
 8. CONTRACTOR SHALL PROVIDE THE INSPECTORS, (CITY AND PRIVATE) WITH THE PROPOSED HYDROSTATIC TESTING PLAN. THE PLAN MUST BE APPROVED BEFORE TESTING OPERATIONS BEGIN.
 9. CONTRACTOR SHALL PARK EQUIPMENT AND VEHICLES AS NOT TO INTERFERE WITH NORMAL ACTIVITIES OF RESIDENTS OR OTHER CONTRACTORS ON SITE.
 10. ANY DAMAGE TO THE EXISTING FACILITIES (CURB AND GUTTER, PAVEMENT, CONDUITS, LANDSCAPING, UTILITY LINES, ETC.) DURING CONSTRUCTION SHALL BE REPLACED AT THE CONTRACTORS EXPENSE.
 11. REMOVAL OF THE EXISTING CURB AND GUTTER SHALL BE AS PER COA STD. DWG. 2415 (SAW CUT ONLY).
 12. WHEEL CHAIR RAMPS SHALL BE CONSTRUCTED PRIOR TO ACCEPTANCE OF CURB AND GUTTER.
 13. CONTRACTOR SHALL COORDINATE WITH DTD (823-9360) PRIOR TO ANY CONSTRUCTION OR REMOVALS WITHIN HIGH DESERT STREET.

- KEYED GENERAL NOTES**
1. INSTALL CONCRETE VALLEY GUTTER AS PER STD. DWG. 2420 (ALT. B)
 2. INSTALL CONCRETE VALLEY GUTTER AS PER STD. DWG. 2421
 3. INSTALL WHEEL CHAIR RAMP AS PER STD. DWG. 2441, CASE 1
 4. INSTALL WHEEL CHAIR RAMP AS PER ADA STANDARDS (SEE SHEET 5 OF 20)
 5. STD. CURB & GUTTER AS PER STD. DWG. 2415
 6. MOUNTABLE CURB ROLL TYPE AS PER STD. DWG. 2415
 7. MEDIAN CURB & GUTTER (MODIFIED) AS PER DETAIL SHEET 5 OF 20
 8. FUTURE 4' SIDEWALK
 9. BUILD 4' SIDEWALK
 10. 10' MEANDERING ASPHALT TRAIL TO BE BUILT IN CONJUNCTION WITH LANDSCAPING PLAN



RECORD DRAWING
DATE: 5-3-99

BOHANNAN-HUSTON, INC.
ENGINEERS • PLANNERS • PHOTOGRAMMETRISTS • SURVEYORS • LANDSCAPE ARCHITECTS
ALBUQUERQUE LAS CRUCES SANTA FE

CITY OF ALBUQUERQUE
PUBLIC WORKS DEPARTMENT
ENGINEERING DEVELOPMENT GROUP

THE OVERLOOK AT HIGH DESERT
PAYING PLAN & PROFILE
HIGH DESERT STREET - STA. 7+50.00 TO 14+50.00


DESIGN-BUILD COMMITTEE: [Signature]
CITY ENGINEER APPROVAL: [Signature]
LAST DESIGN UPDATE: [Signature]

CITY PROJECT NO.: 571285
ZONE MAP NO.: E-23
SHEET 6 OF 20

DESIGNED BY: KP, TS
DRAWN BY: SAR
CHECKED BY: KP

DATE: 8/98
DATE: 8/98
DATE: 8/98

DATE: AUGUST 25, 1998

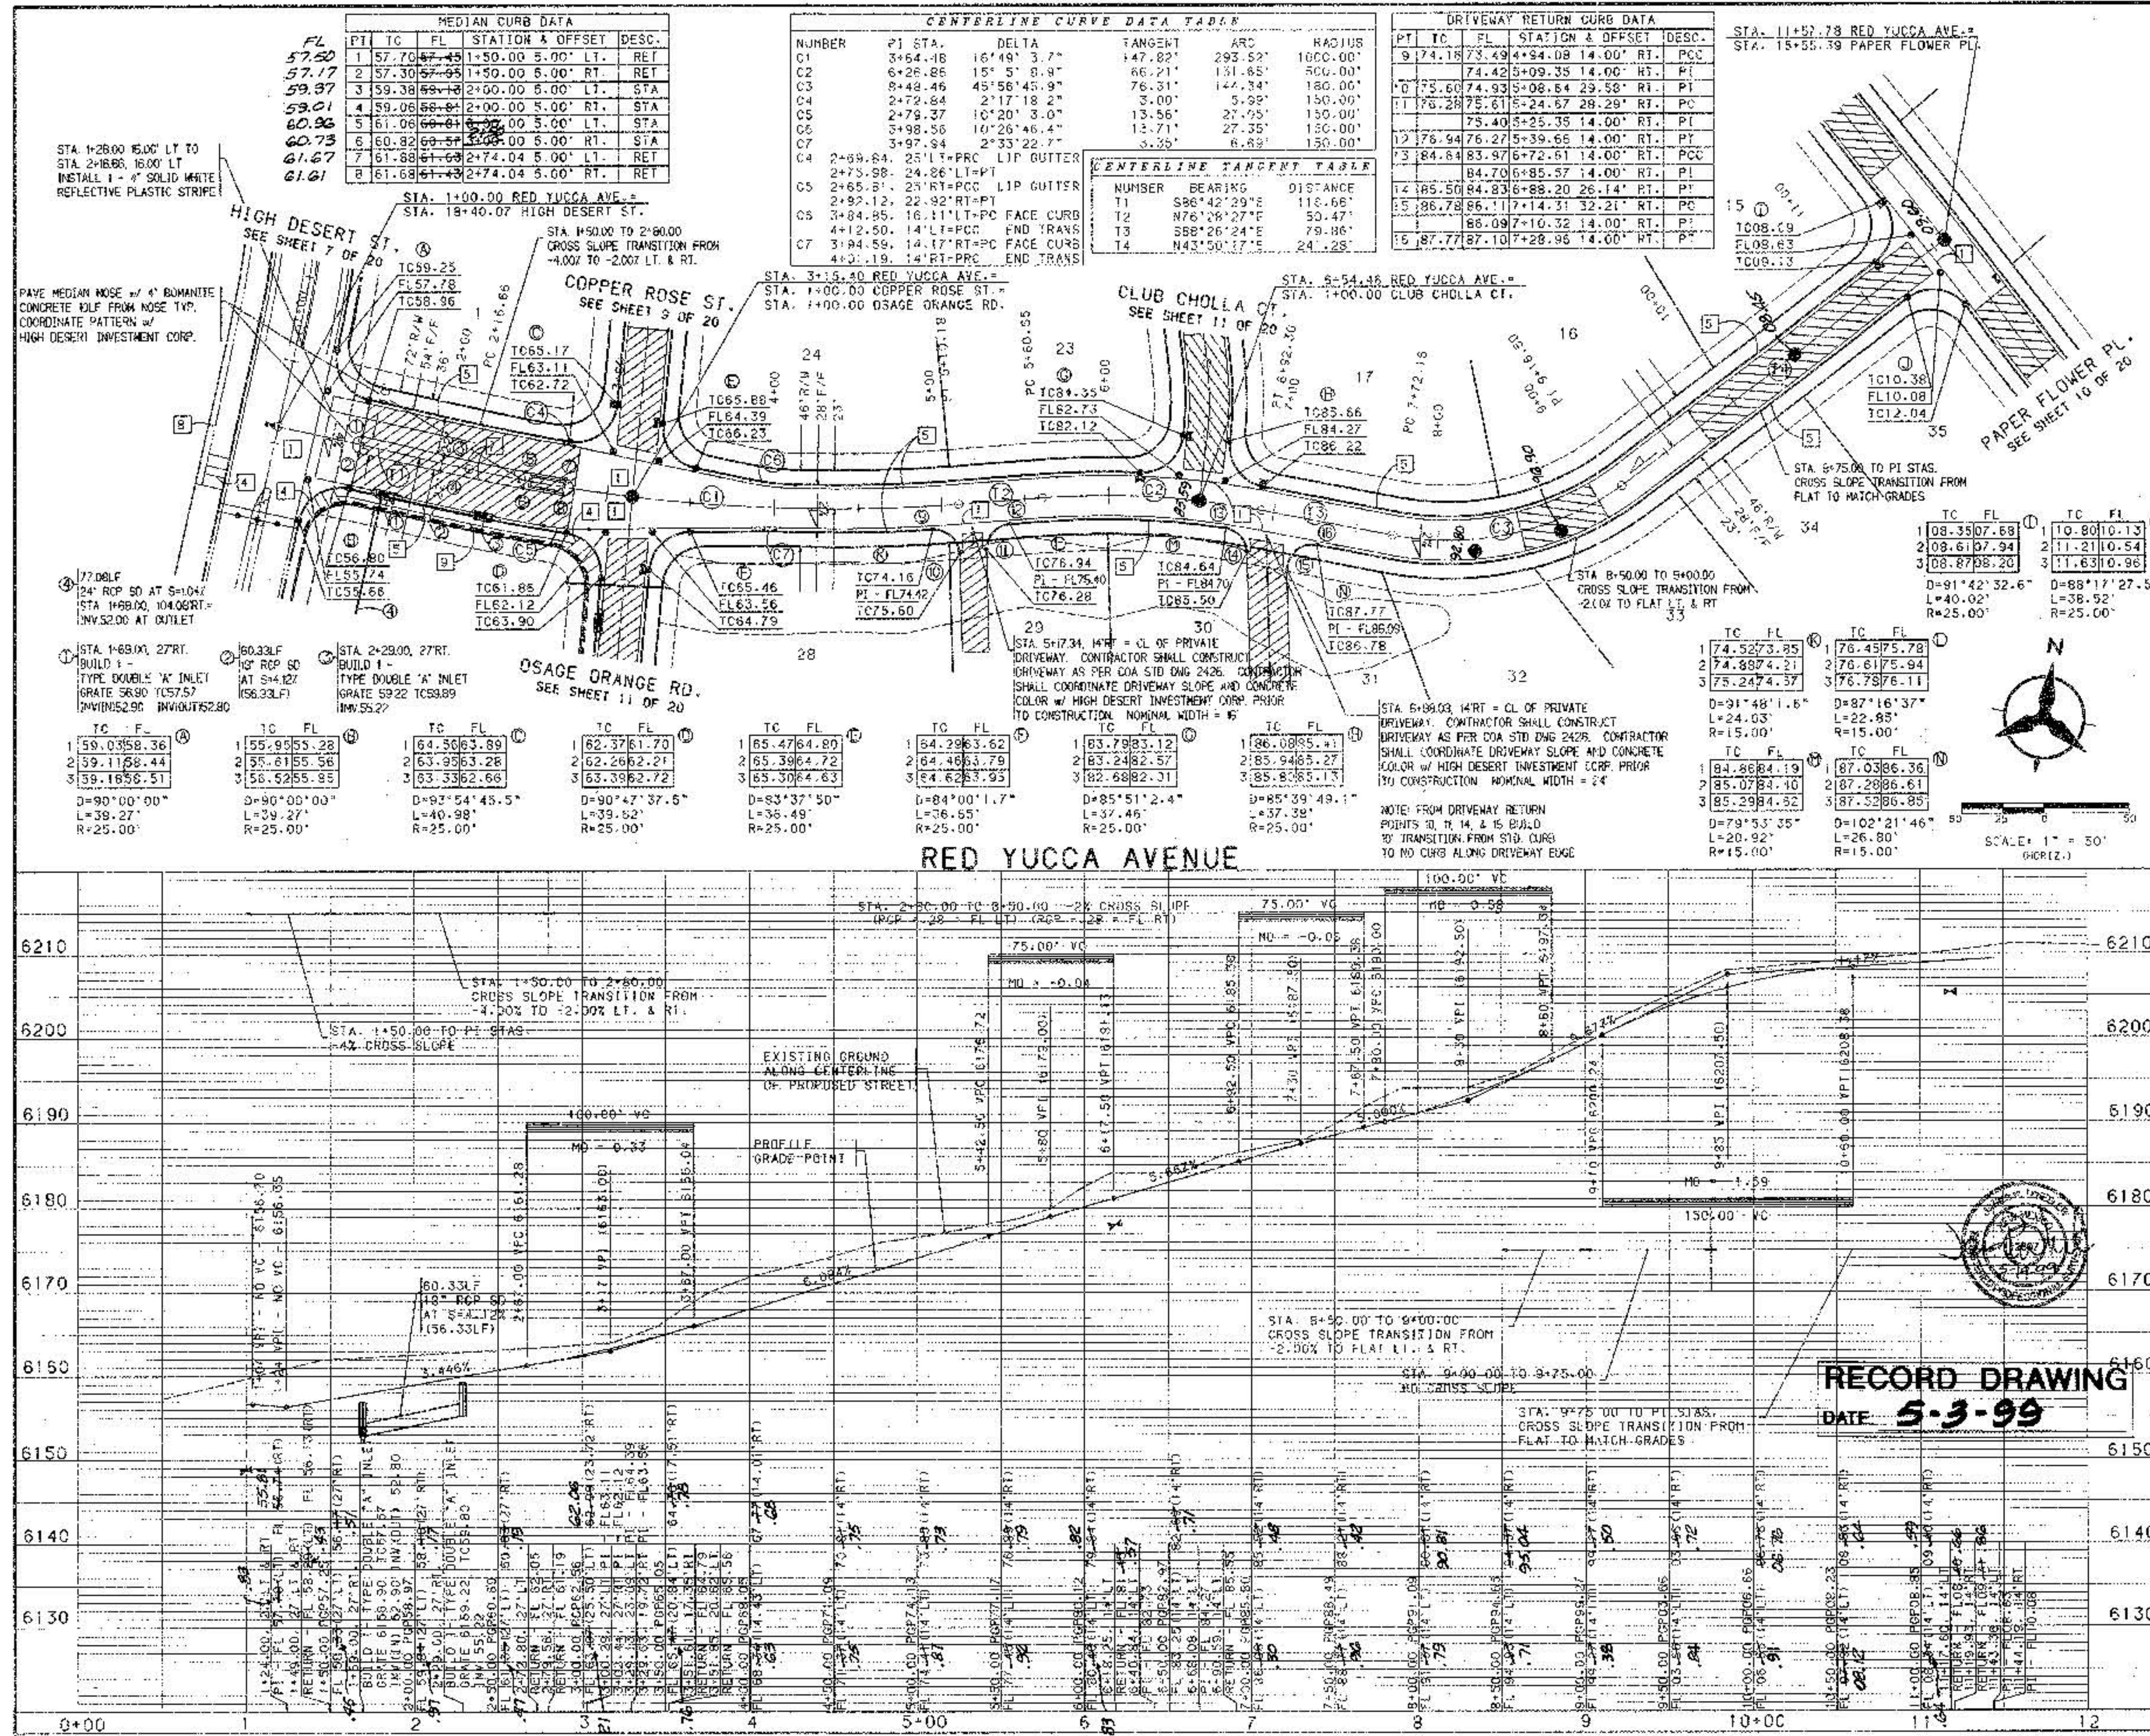

NOTES

- THE CONTRACTOR SHALL FIELD VERIFY ALL EXISTING UTILITY LOCATIONS AND NOTIFY THE ENGINEER IMMEDIATELY OF ANY DISCREPANCIES.
- ALL CURB RETURN RADIUS SHALL BE 25' TO FACE OF CURB UNLESS OTHERWISE SPECIFIED.
- ALL CURVE DATA AND DIMENSIONS REFER TO FACE OF CURB UNLESS OTHERWISE SPECIFIED.
- GRADE ELEVATIONS, WHERE NOTED, ARE FOR TOP OF STANDARD CURB UNLESS OTHERWISE SPECIFIED.
- CONTRACTOR IS TO INSTALL A 4"x4"x5' POST AND END AT THE END OF EACH SANITARY SEWER SERVICE.
- CONTRACTOR IS RESPONSIBLE FOR REPAIR AND/OR REPLACEMENT OF ALL UTILITY CONDUITS AND EXISTING LINES.
- ANY ADDITIONAL GRADING REQUIRED TO MATCH PROPOSED STREET GRADES SHALL BE INCIDENTAL TO PAVING ITEMS.
- CONTRACTOR SHALL PROVIDE THE INSPECTORS (CITY AND PRIVATE) WITH THE PROPOSED HYDROSTATIC TESTING PLAN. THE PLAN MUST BE APPROVED BEFORE TESTING OPERATIONS BEGIN.
- CONTRACTOR SHALL PARK EQUIPMENT AND VEHICLES AS NOT TO INTERFERE WITH NORMAL ACTIVITIES OF RESIDENTS OR OTHER CONTRACTORS ON SITE.
- ANY DAMAGE TO THE EXISTING FACILITIES (CURB AND GUTTER, PAVEMENT, CONDUITS, LANDSCAPING, UTILITY LINES, ETC.) DURING CONSTRUCTION SHALL BE REPLACED AT THE CONTRACTORS EXPENSE.
- REMOVAL OF THE EXISTING CURB AND GUTTER SHALL BE AS PER COA STD. DWG. 2415 (SAWCUT ONLY).
- WHEEL CHAIR RAMPS SHALL BE CONSTRUCTED PRIOR TO ACCEPTANCE OF CURB AND GUTTER.
- MEDIAN NOSES SHALL BE PAINTED REFLECTIVE YELLOW.

KEYED GENERAL NOTES

- INSTALL CONCRETE VALLEY GUTTER AS PER STD. DWG. 2420 (ALT. B)
- INSTALL CONCRETE VALLEY GUTTER AS PER STD. DWG. 2421
- INSTALL WHEEL CHAIR RAMP AS PER STD. DWG. 2441, CASE I
- INSTALL WHEEL CHAIR RAMP AS PER ADA STANDARDS
- STD. CURB & GUTTER AS PER STD. DWG. 2415
- MOUNTABLE CURB ROLL TYPE AS PER STD. DWG. 2415
- MEDIAN CURB & GUTTER AS PER STD. DWG. 2415
- FUTURE 4' SIDEWALK
- BUILD 4' SIDEWALK
- 10' MEANDERING ASPHALT TRAIL TO BE BUILT IN CONJUNCTION WITH LANDSCAPING PLAN

RECORD DRAWING
DATE 5-3-99

BOHANNAN-HUSTON INC.
ENGINEERS • PLANNERS • PHOTOGRAPHERS • SURVEYORS • LANDSCAPE ARCHITECTS
ALBUQUERQUE LAS CRUCES SANTA FE

CITY OF ALBUQUERQUE
PUBLIC WORKS DEPARTMENT
ENGINEERING DEVELOPMENT GROUP

THE OVERLOOK AT HIGH DESERT
PAVING PLAN & PROFILE
RED YUCCA AVENUE

DESIGN REVIEW COMMITTEE
LAST DESIGN UPDATE

NO. DATE
REVISIONS
DESIGN

DESIGNED BY KP, TG
DRAWN BY SAR
CHECKED BY KP


DATE 8/98
DATE 8/98
DATE 8/98

CITY PROJECT NO. 571285
ZONE MAP NO. E-23
SHEET 8 OF 20



BOHANNAN-HUSTON, INC.
DATE: AUGUST 25, 1998

CENTERLINE CURVE DATA TABLE					
NUMBER	PI STA.	DELTA	TANGENT	ARC	RADIUS
C4	13+50.93	17°15'0.2"	87.75'	174.10'	578.00'

CENTERLINE TANGENT TABLE		
NUMBER	BEARING	DISTANCE
T4	N85°08'16"W	349.54'
T5	R47°52'15"W	351.90'

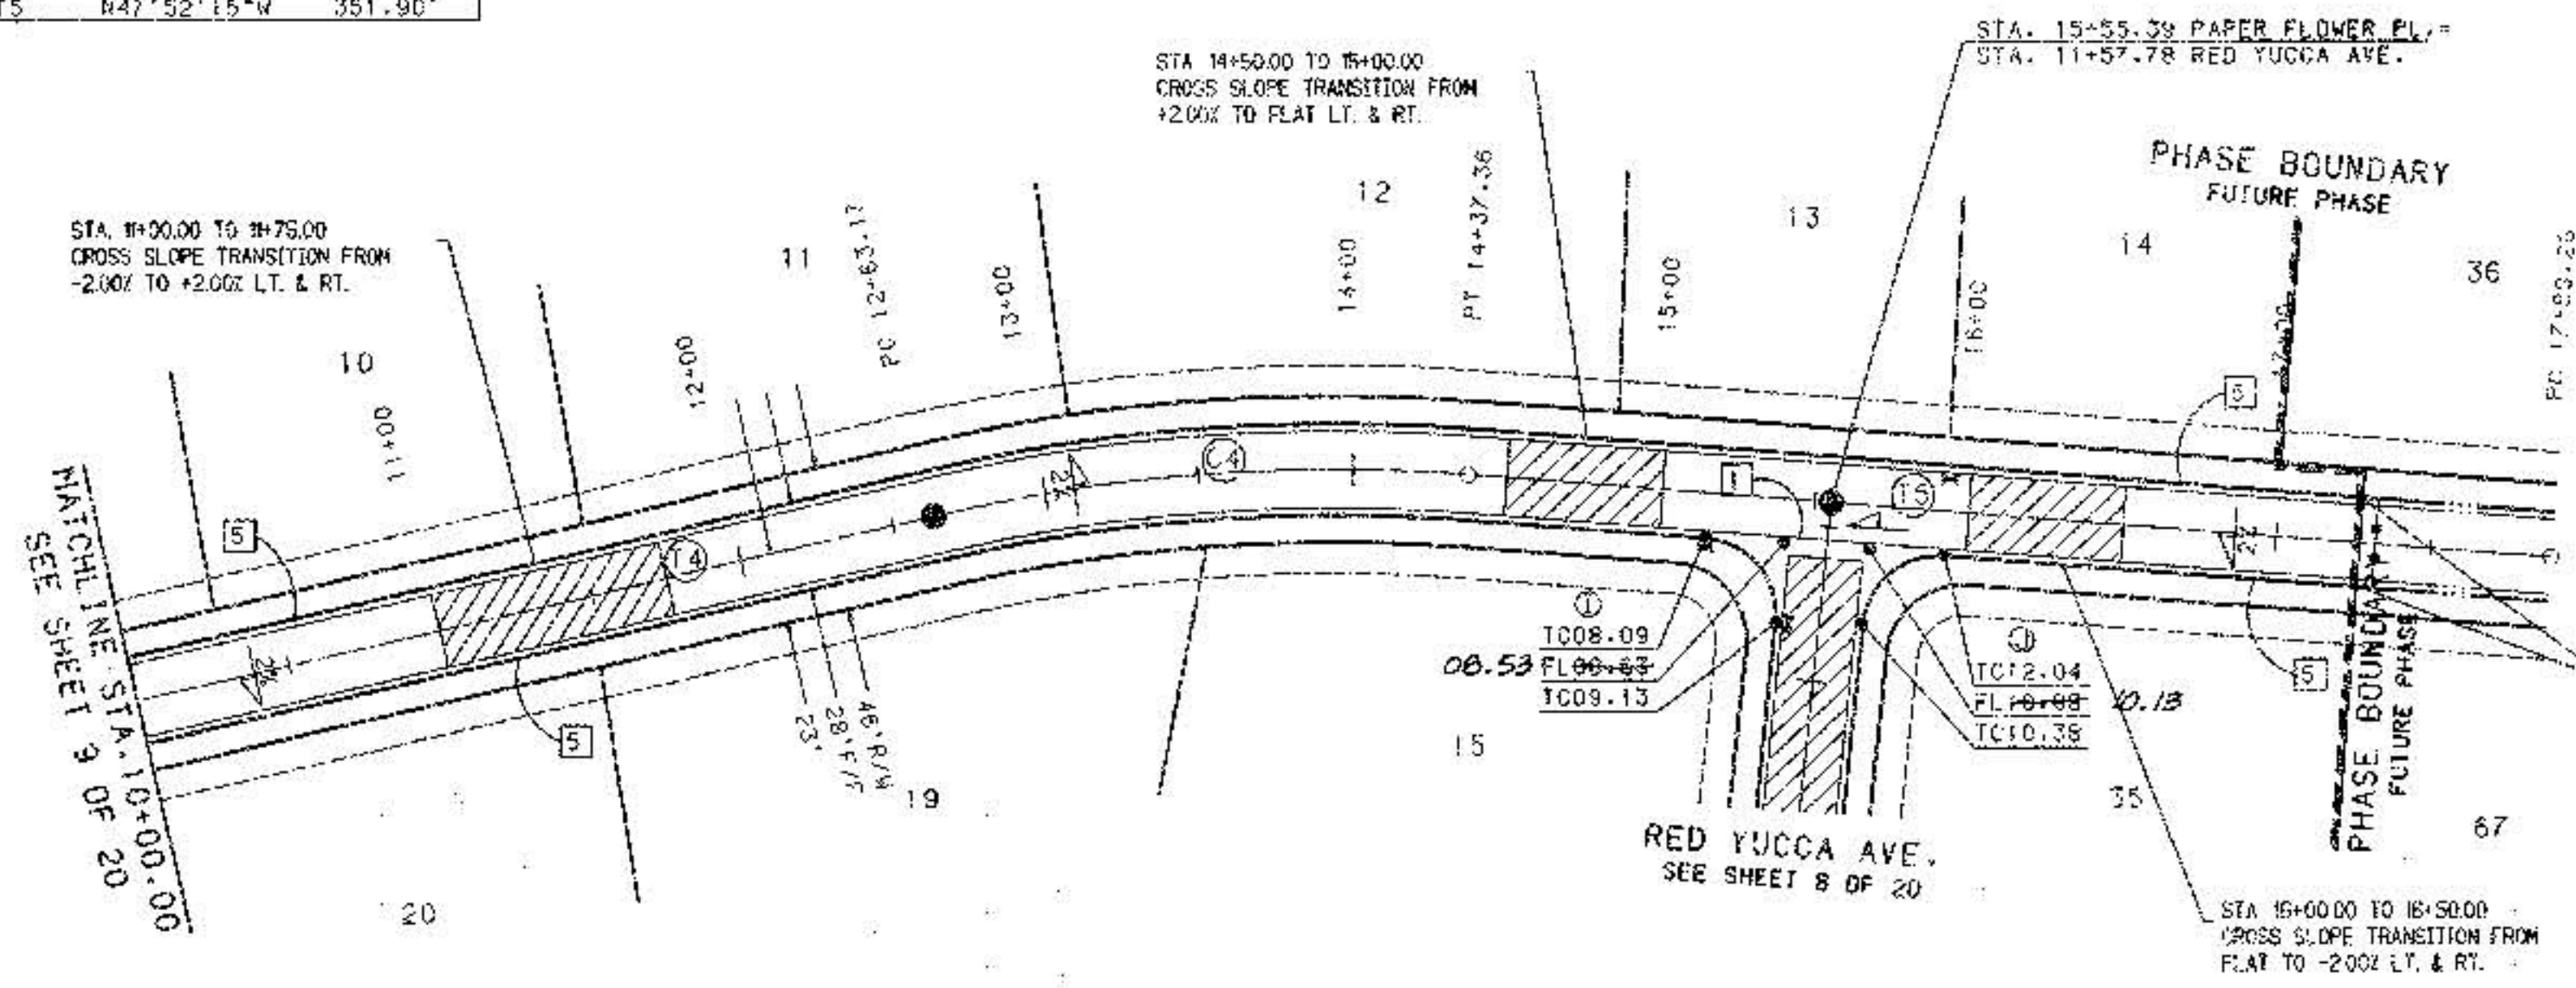

IC	FL
108.3507.68	110.8010.13
208.6107.94	211.2110.34
308.8718.20	311.6310.86
D=91°42'32.6"	
L=40.02'	
R=25.00'	

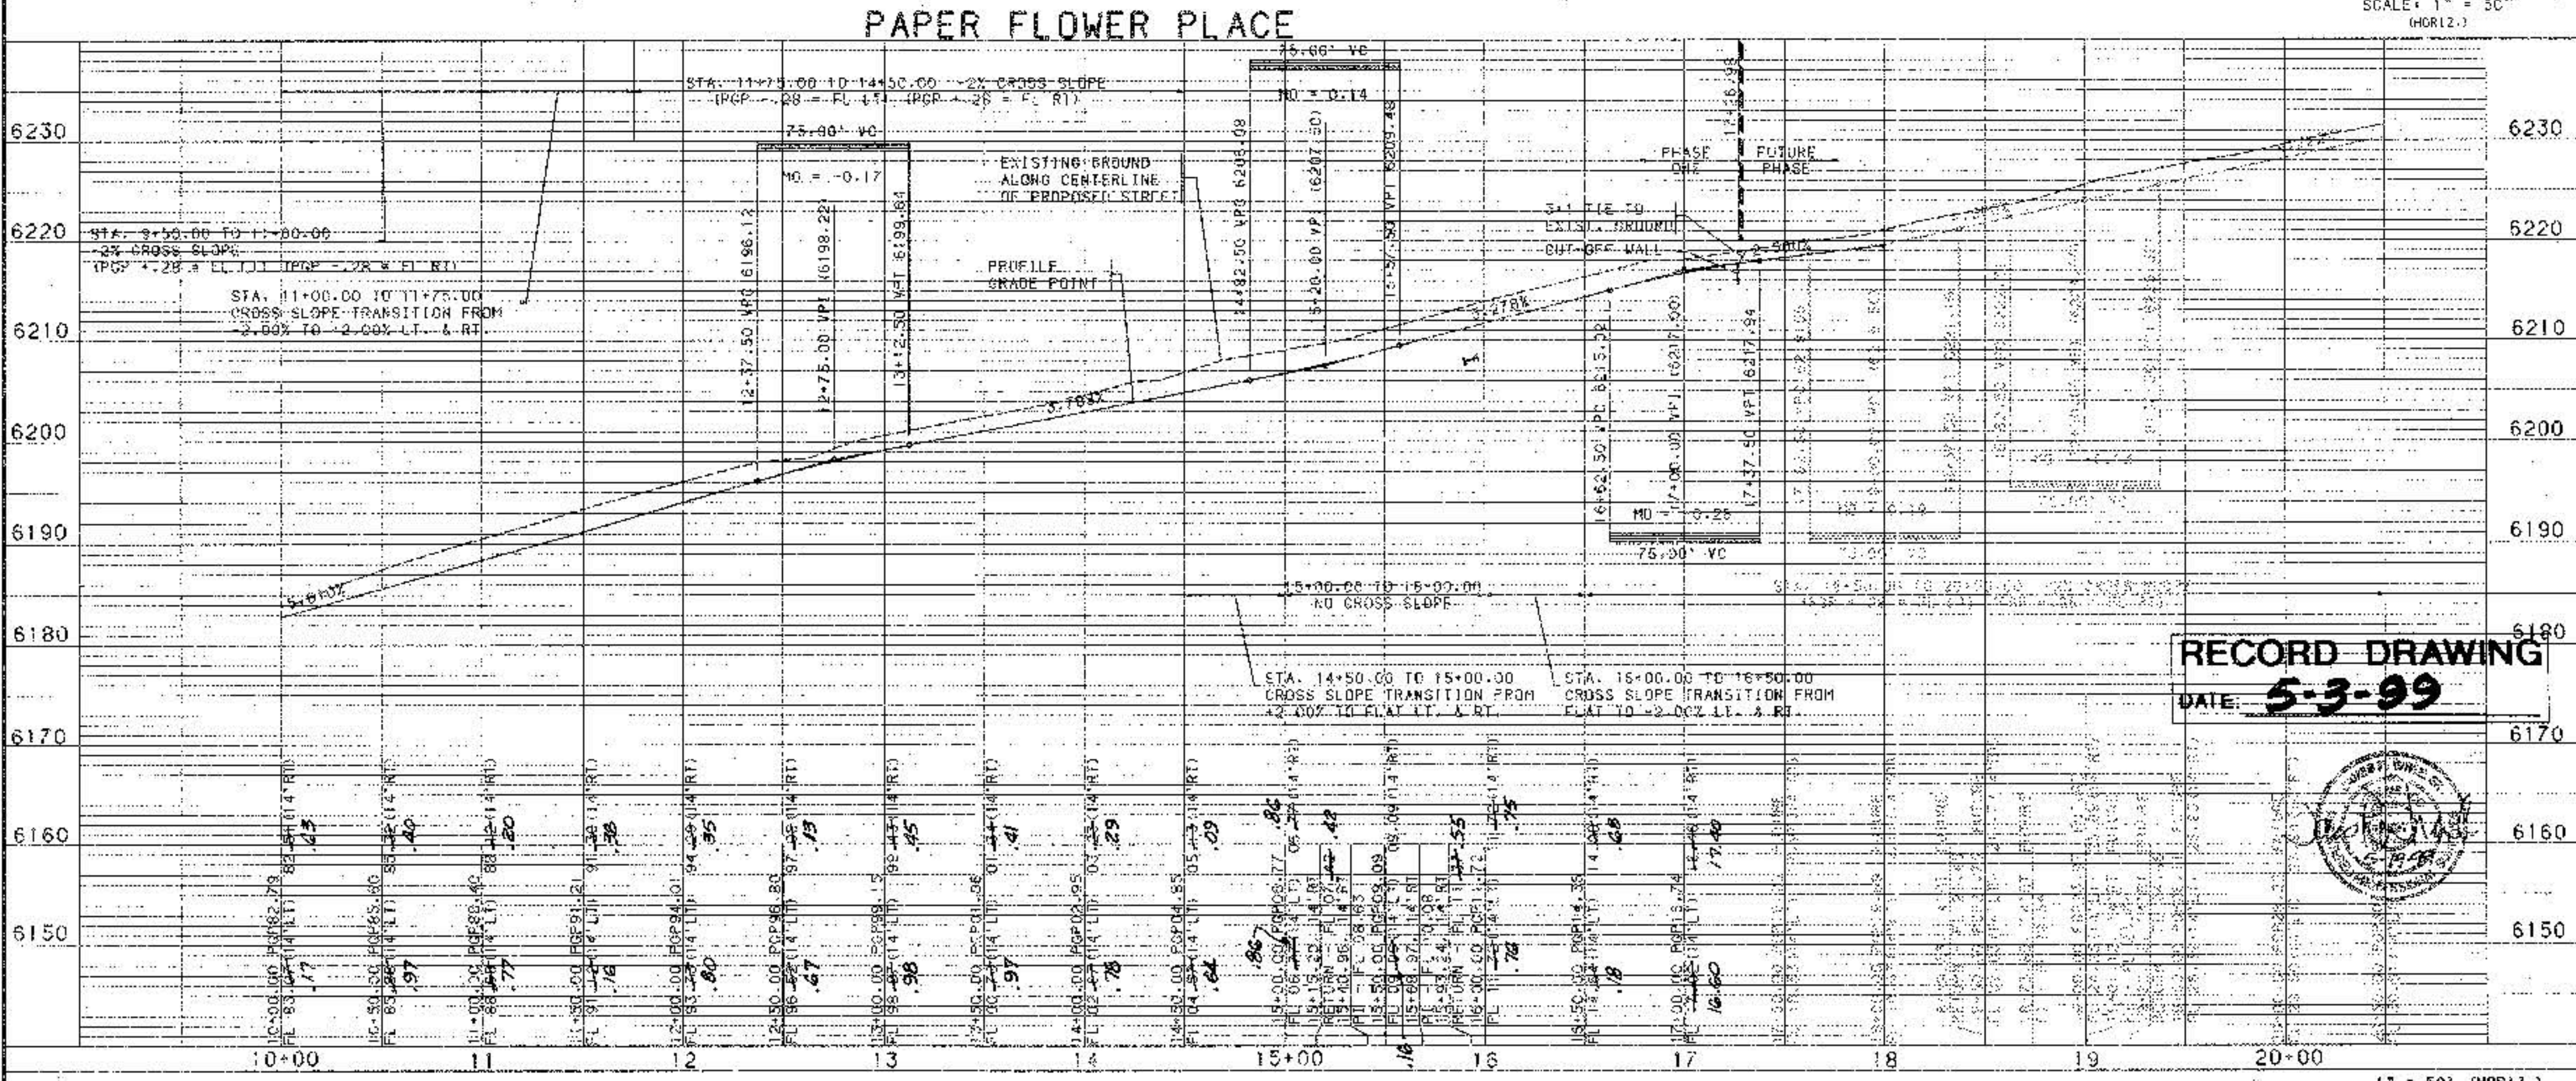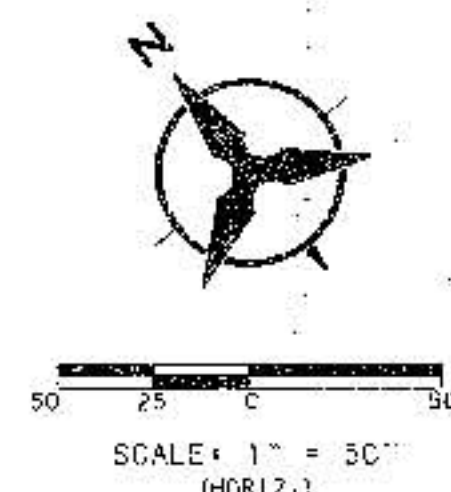

RECORD DRAWING
DATE: 5-3-99

- NOTES**
1. THE CONTRACTOR SHALL FIELD VERIFY ALL EXISTING UTILITY LOCATIONS AND NOTIFY THE ENGINEER IMMEDIATELY OF ANY DISCREPANCIES.
 2. ALL CURB RETURN RADII SHALL BE 25' TO FACE OF CURB UNLESS OTHERWISE SPECIFIED.
 3. ALL CURVE DATA AND DIMENSIONS REFER TO FACE OF CURB UNLESS OTHERWISE SPECIFIED.
 4. GRADE ELEVATIONS, WHERE NOTED, ARE FOR TOP OF STANDARD CURB UNLESS OTHERWISE SPECIFIED.
 5. CONTRACTOR IS TO INSTALL A 4"x4"x5' POST AND END AT THE END OF EACH SANITARY SEWER SERVICE.
 6. CONTRACTOR IS RESPONSIBLE FOR REPAIR AND/OR REPLACEMENT OF ALL UTILITY CONDUITS AND EXISTING LINES.
 7. ANY ADDITIONAL GRADING REQUIRED TO MATCH PROPOSED STREET GRADES SHALL BE INCIDENTAL TO PAVING ITEMS.
 8. CONTRACTOR SHALL PROVIDE THE INSPECTORS, (CITY AND PRIVATE) WITH THE PROPOSED HYDROSTATIC TESTING PLAN. THE PLAN MUST BE APPROVED BEFORE TESTING OPERATIONS BEGIN.
 9. CONTRACTOR SHALL PARK EQUIPMENT AND VEHICLES AS NOT TO INTERFERE WITH NORMAL ACTIVITIES OF RESIDENTS OR OTHER CONTRACTORS ON SITE.
 10. ANY DAMAGE TO THE EXISTING FACILITIES (CURB AND GUTTER, UTILITY LINES, ETC.) DURING CONSTRUCTION SHALL BE REPLACED AT THE CONTRACTORS EXPENSE.
 11. REMOVAL OF THE EXISTING CURB AND GUTTER SHALL BE AS PER COA STD. DWG. 2415 (SAND) ONLY).
 12. WHEEL CHAIR RAMPS SHALL BE CONSTRUCTED PRIOR TO ACCEPTANCE OF CURB AND GUTTER.

- KEYED GENERAL NOTES**
1. INSTALL CONCRETE VALLEY GUTTER AS PER STD. DWG. 2420 (ALV. B)
 2. INSTALL CONCRETE VALLEY GUTTER AS PER STD. DWG. 2421
 3. INSTALL WHEEL CHAIR RAMP AS PER STD. DWG. 2441, CASE I
 4. INSTALL WHEEL CHAIR RAMP AS PER ADA STANDARDS (SEE SHEET 5 OF 20)
 5. STD. CURB & GUTTER AS PER STD. DWG. 2415
 6. MOUNTABLE CURB ROLL TYPE AS PER STD. DWG. 2415
 7. MEDIAN CURB & GUTTER AS PER STD. DWG. 2415
 8. FUTURE 4' SIDEWALK
 9. BUILD 4' SIDEWALK
 10. 10' MEANDERING ASPHALT TRAIL TO BE BUILT IN CONJUNCTION WITH LANDSCAPING PLAN

BOHANNAN-HUSTON INC.
ENGINEERS • PLANNERS • PHOTOGRAMMETRISTS • SURVEYORS • LANDSCAPE ARCHITECTS
ALBUQUERQUE LAS CRUCES SANTA FE

CITY OF ALBUQUERQUE
PUBLIC WORKS DEPARTMENT
ENGINEERING DEVELOPMENT GROUP

THE OVERLOOK AT HIGH DESERT
PAVING PLAN & PROFILE
PAPER FLOWER PLACE



DESIGN REVIEW COMMITTEE: CITY ENGINEER APPROVAL: _____
LAST DESIGN UPDATE: _____

CITY PROJECT NO. 571285 ZONE MAP NO. E-23 SHEET 10 OF 20
DESIGNED BY: K.P. TC DATE: 8/98
DRAWN BY: SAR DATE: 8/98
CHECKED BY: KP DATE: 8/98

CENTERLINE CURVE DATA TABLE					
NUMBER	PI STA.	DELTA	TANGENT	ARC	RADIUS
C1	6+26.34	109°57'35.2"	392.45'	527.77'	275.00'
C2	1+61.56	13°20'8.8"	21.04'	41.80'	180.00'
C3	2+81.95	22°43'36.7"	70.36'	138.86'	330.00'

CENTERLINE TANGENT TABLE		
NUMBER	BEARING	DISTANCE
T1	S03°50'16"E	133.89'
T2	N02°46'35"W	40.52'
T3	N16°05'43"W	28.88'
T4	N83°22'47"W	2.02'

CUL-DE-SAC CURB DATA			
PT	TC	STATION & OFFSET	DELTA
1	88.57	3+24.72, 21.28' LT.	34°47'26"
2	88.73	3+41.54, 31.81' LT.	34°47'26"
3	88.93	3+60.73, 31.21' LT.	34°47'26"
4	89.09	3+76.99, 19.65' LT.	34°47'26"
5	89.17	3+85.16, 0.48' LT.	34°47'26"
6	89.13	3+81.14, 20.06' RT.	34°47'26"
7	88.96	3+64.47, 34.28' RT.	34°47'26"
8	88.73	3+41.28, 36.00' RT.	34°47'26"
9	88.54	3+22.19, 24.42' RT.	34°47'26"
R=35.00', L=21.25' (BETWEEN POINTS)			

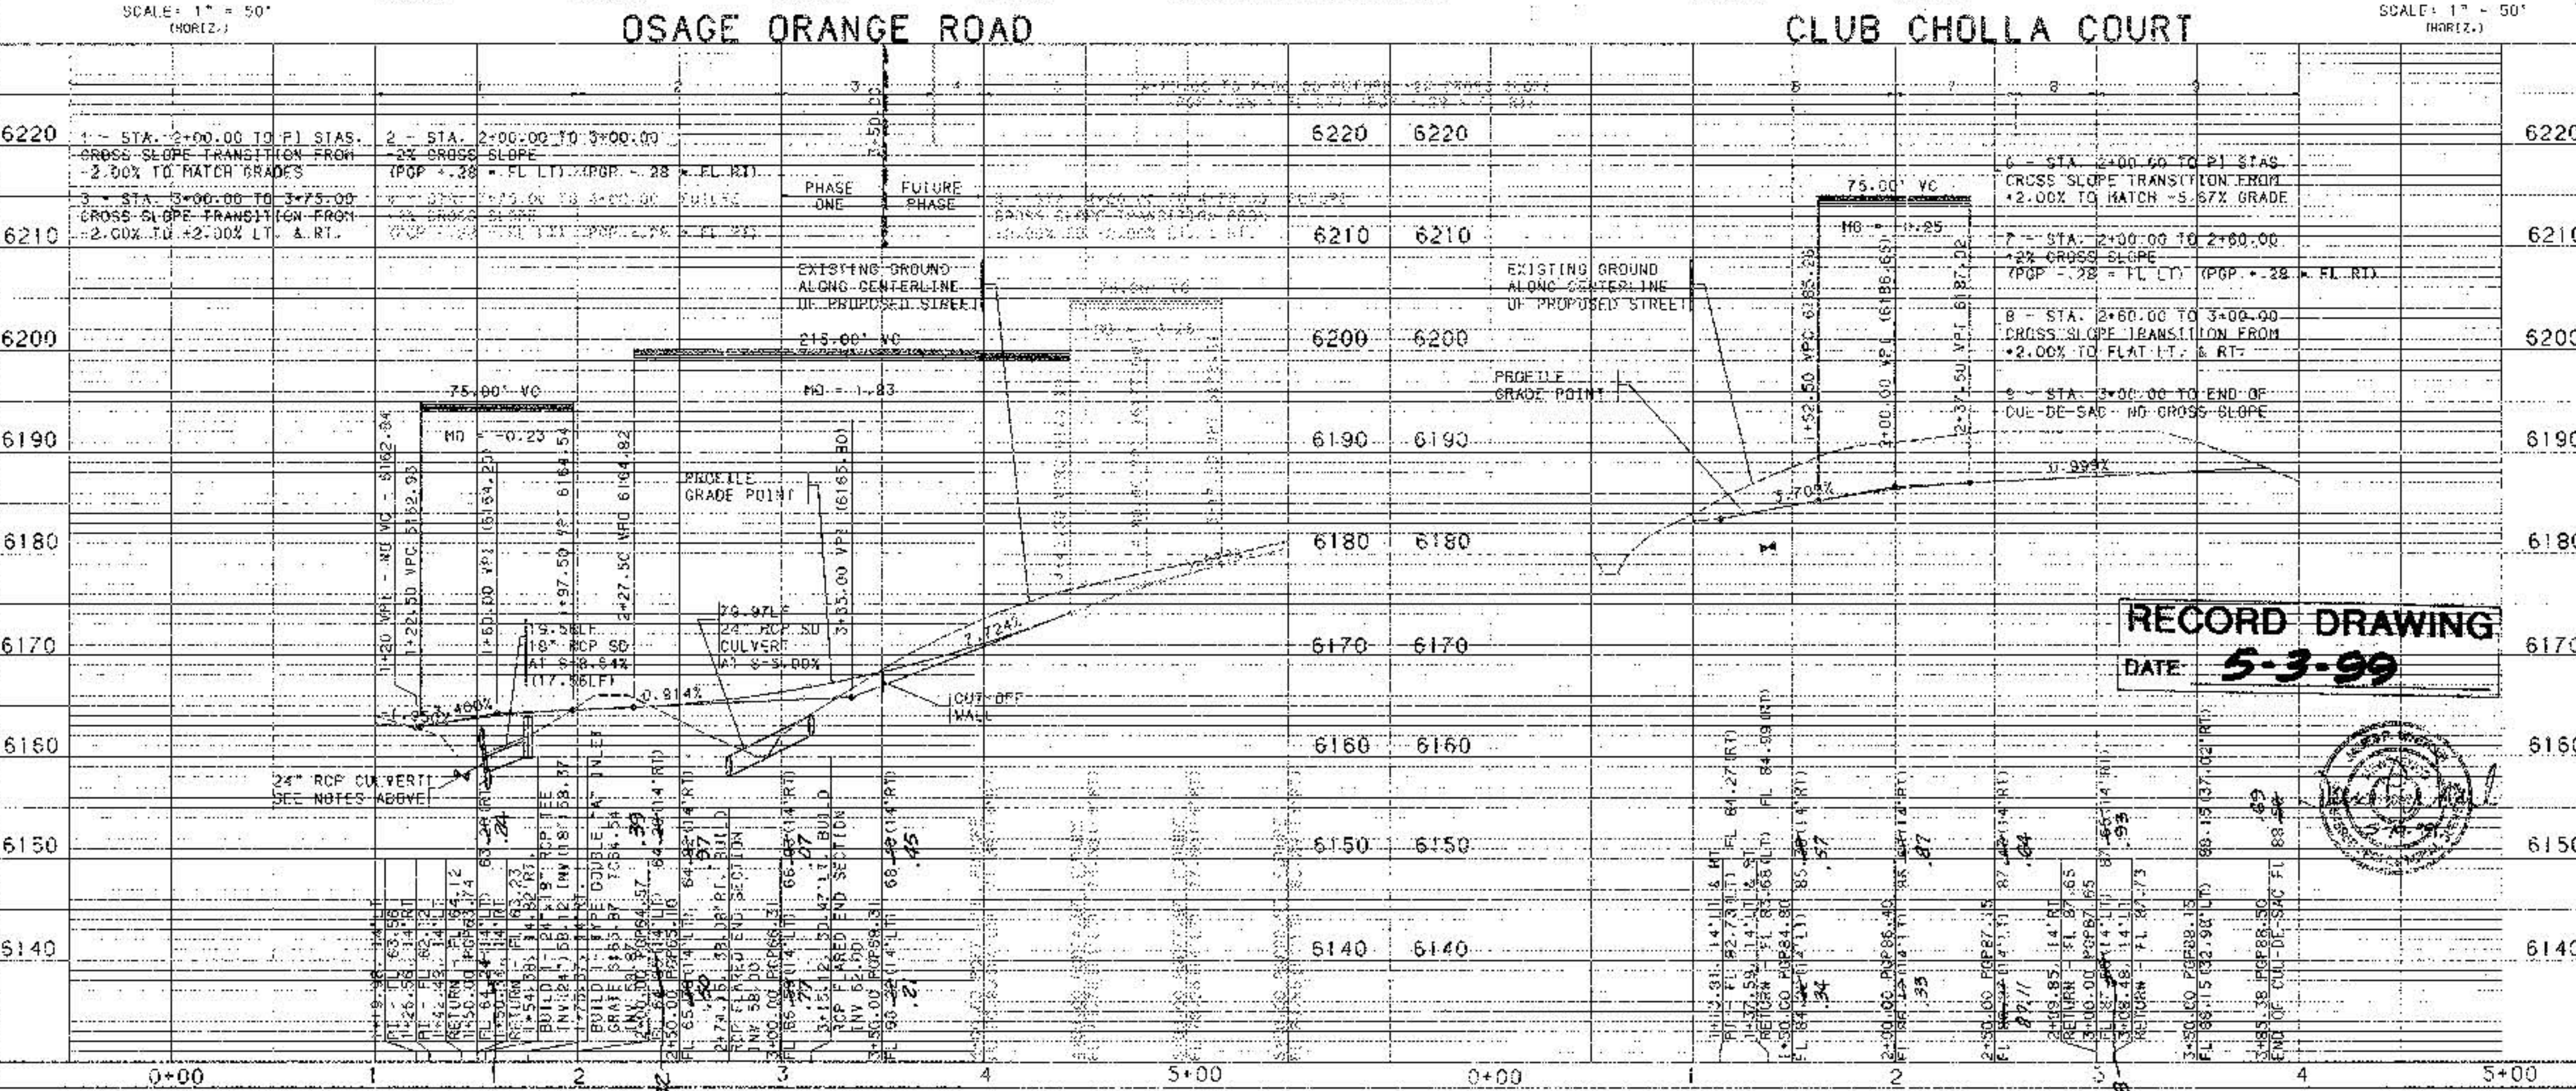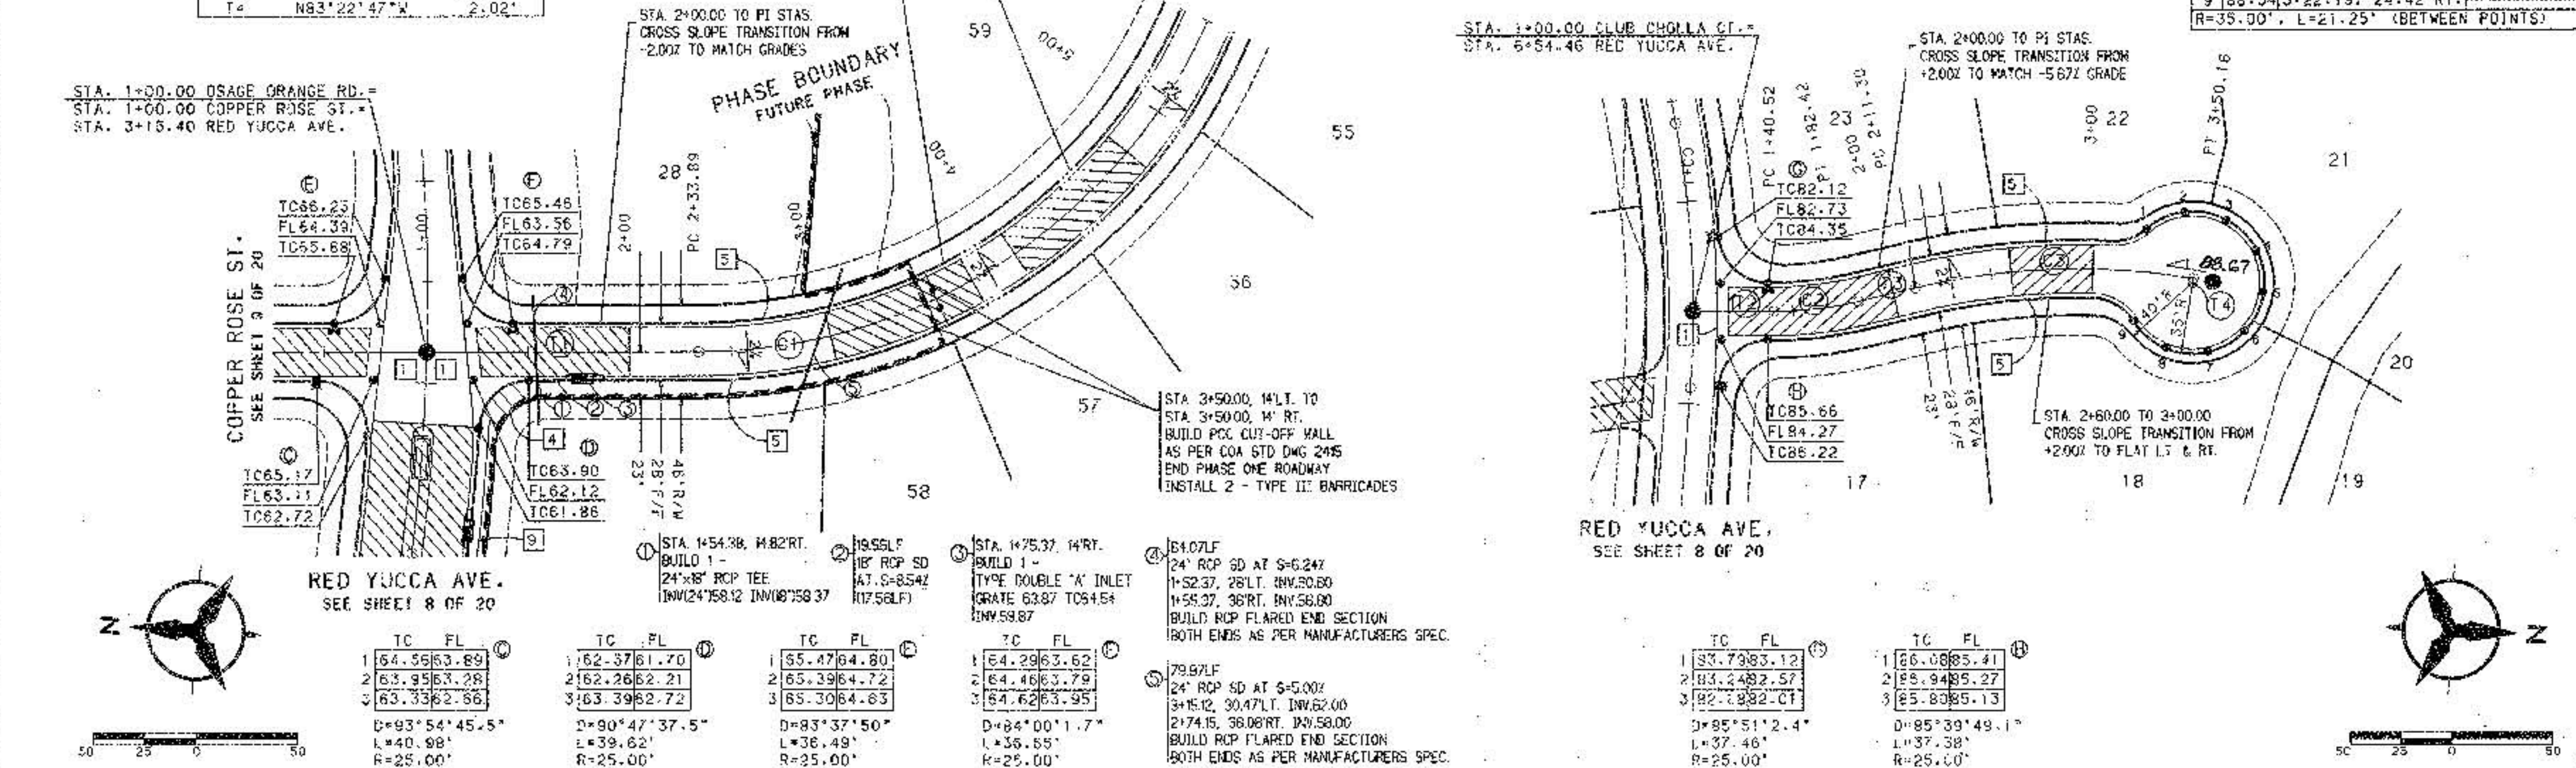

RECORD DRAWING
DATE: 5-3-99

NOTES

- THE CONTRACTOR SHALL FIELD VERIFY ALL EXISTING UTILITY LOCATIONS AND NOTIFY THE ENGINEER IMMEDIATELY OF ANY DISCREPANCIES.
- ALL CURB RETURN RADIUS SHALL BE 25' TO FACE OF CURB UNLESS OTHERWISE SPECIFIED.
- ALL CURVE DATA AND DIMENSIONS REFER TO FACE OF CURB UNLESS OTHERWISE SPECIFIED.
- GRADE ELEVATIONS, WHERE NOTED, ARE FOR TOP OF STANDARD CURB UNLESS OTHERWISE SPECIFIED.
- CONTRACTOR IS TO INSTALL A 4"x4"x5" POST AND END AT THE END OF EACH SANITARY SEWER SERVICE.
- CONTRACTOR IS RESPONSIBLE FOR REPAIR AND/OR REPLACEMENT OF ALL UTILITY CONDUITS AND EXISTING LINES.
- ANY ADDITIONAL GRADING REQUIRED TO MATCH PROPOSED STREET GRADES SHALL BE INCIDENTAL TO PAVING ITEMS.
- CONTRACTOR SHALL PROVIDE THE INSPECTORS, (CITY AND PRIVATE) WITH THE PROPOSED HYDROSTATIC TESTING PLAN. THE PLAN MUST BE APPROVED BEFORE TESTING OPERATIONS BEGIN.
- CONTRACTOR SHALL PARK EQUIPMENT AND VEHICLES AS NOT TO INTERFERE WITH NORMAL ACTIVITIES OF RESIDENTS OR OTHER CONTRACTORS ON SITE.
- ANY DAMAGE TO THE EXISTING FACILITIES (CURB AND GUTTER, PAVEMENT, CONDUITS, LANDSCAPING, UTILITY LINES, ETC.) DURING CONSTRUCTION SHALL BE REPLACED AT THE CONTRACTORS' EXPENSE.
- REMOVAL OF THE EXISTING CURB AND GUTTER SHALL BE AS PER COA STD. DWG. 2415 (SANITARY ONLY).
- WHEEL CHAIR RAMPS SHALL BE CONSTRUCTED PRIOR TO ACCEPTANCE OF CURB AND GUTTER.

KEYED GENERAL NOTES

- INSTALL CONCRETE VALLEY GUTTER AS PER STD. DWG. 2420 (ALT. B)
- INSTALL CONCRETE VALLEY GUTTER AS PER STD. DWG. 2421
- INSTALL WHEEL CHAIR RAMP AS PER STD. DWG. 2441, CASE 1
- INSTALL WHEEL CHAIR RAMP AS PER ADA STANDARDS (SEE SHEET 5 OF 20)
- STD. CURB & GUTTER AS PER STD. DWG. 2415
- MOUNTABLE CURB ROLL TYPE AS PER STD. DWG. 2415
- MEDIAN CURB & GUTTER AS PER STD. DWG. 2415
- FUTURE 4' SIDEWALK
- BUILD 4' SIDEWALK
- 10' MEANDERING ASPHALT TRAIL TO BE BUILT IN CONJUNCTION WITH LANDSCAPING PLAN

BOHANNAN-HUSTON INC.
ENGINEERS • PLANNERS • PHOTOGRAMMETRISTS • SURVEYORS • LANDSCAPE ARCHITECTS
ALBUQUERQUE LAS CRUCES SANTA FE

CITY OF ALBUQUERQUE
PUBLIC WORKS DEPARTMENT
ENGINEERING DEVELOPMENT GROUP

THE OVERLOOK AT HIGH DESERT
PAVING PLAN & PROFILE
OSAGE ORANGE ROAD - CLUB CHOLLA COURT


CITY PROJECT NO. 571285 ZONE MAP NO. E-23 SHEET 11 OF 20

DESIGNED BY: K.P. TC DRAWN BY: SAR CHECKED BY: KP



DATE: 8/98 DATE: 8/98 DATE: 8/98

REVISIONS

NO. DATE REMARKS

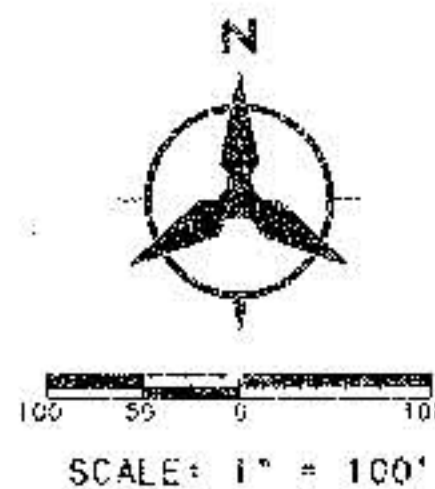

NOTE: CONTRACTOR SHALL INSTALL A SMOOTH WIRE FENCE 5' BEYOND GRADING LIMITS TO CONFINED ITS WORK WITHIN THE CONSTRUCTION LIMITS. TO MINIMIZE THE DISTURBANCE TO THE EXISTING VEGETATION, THE CONTRACTOR SHALL CONFINED WORK WITHIN LIMITS OF FENCING.

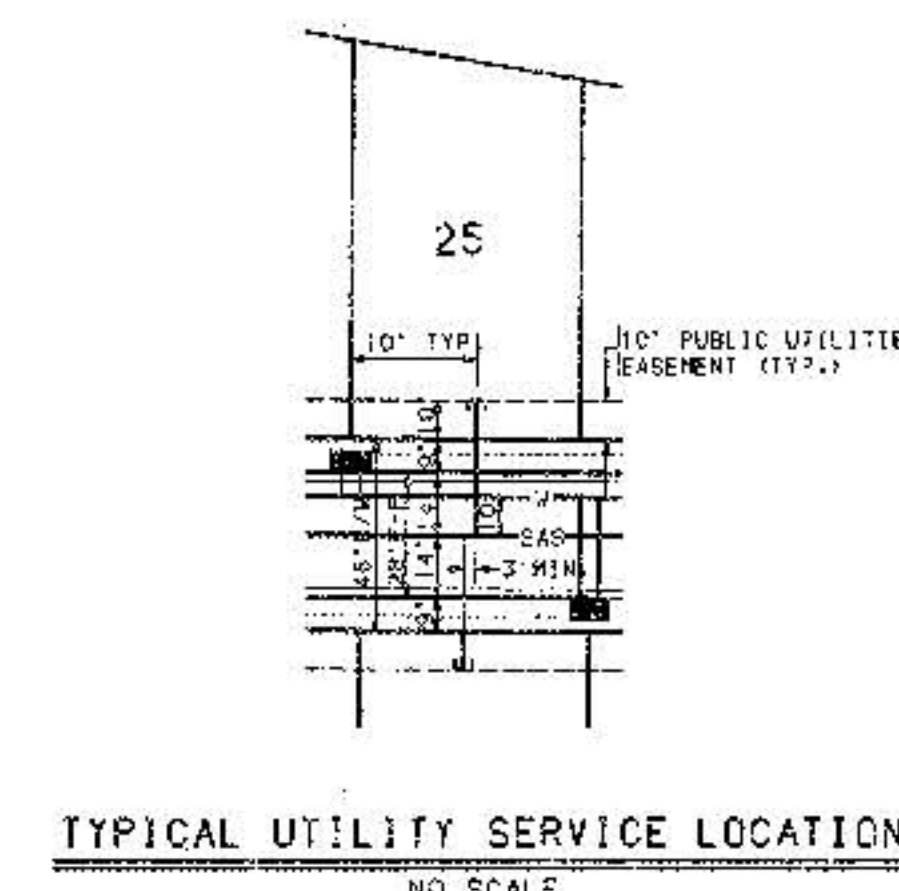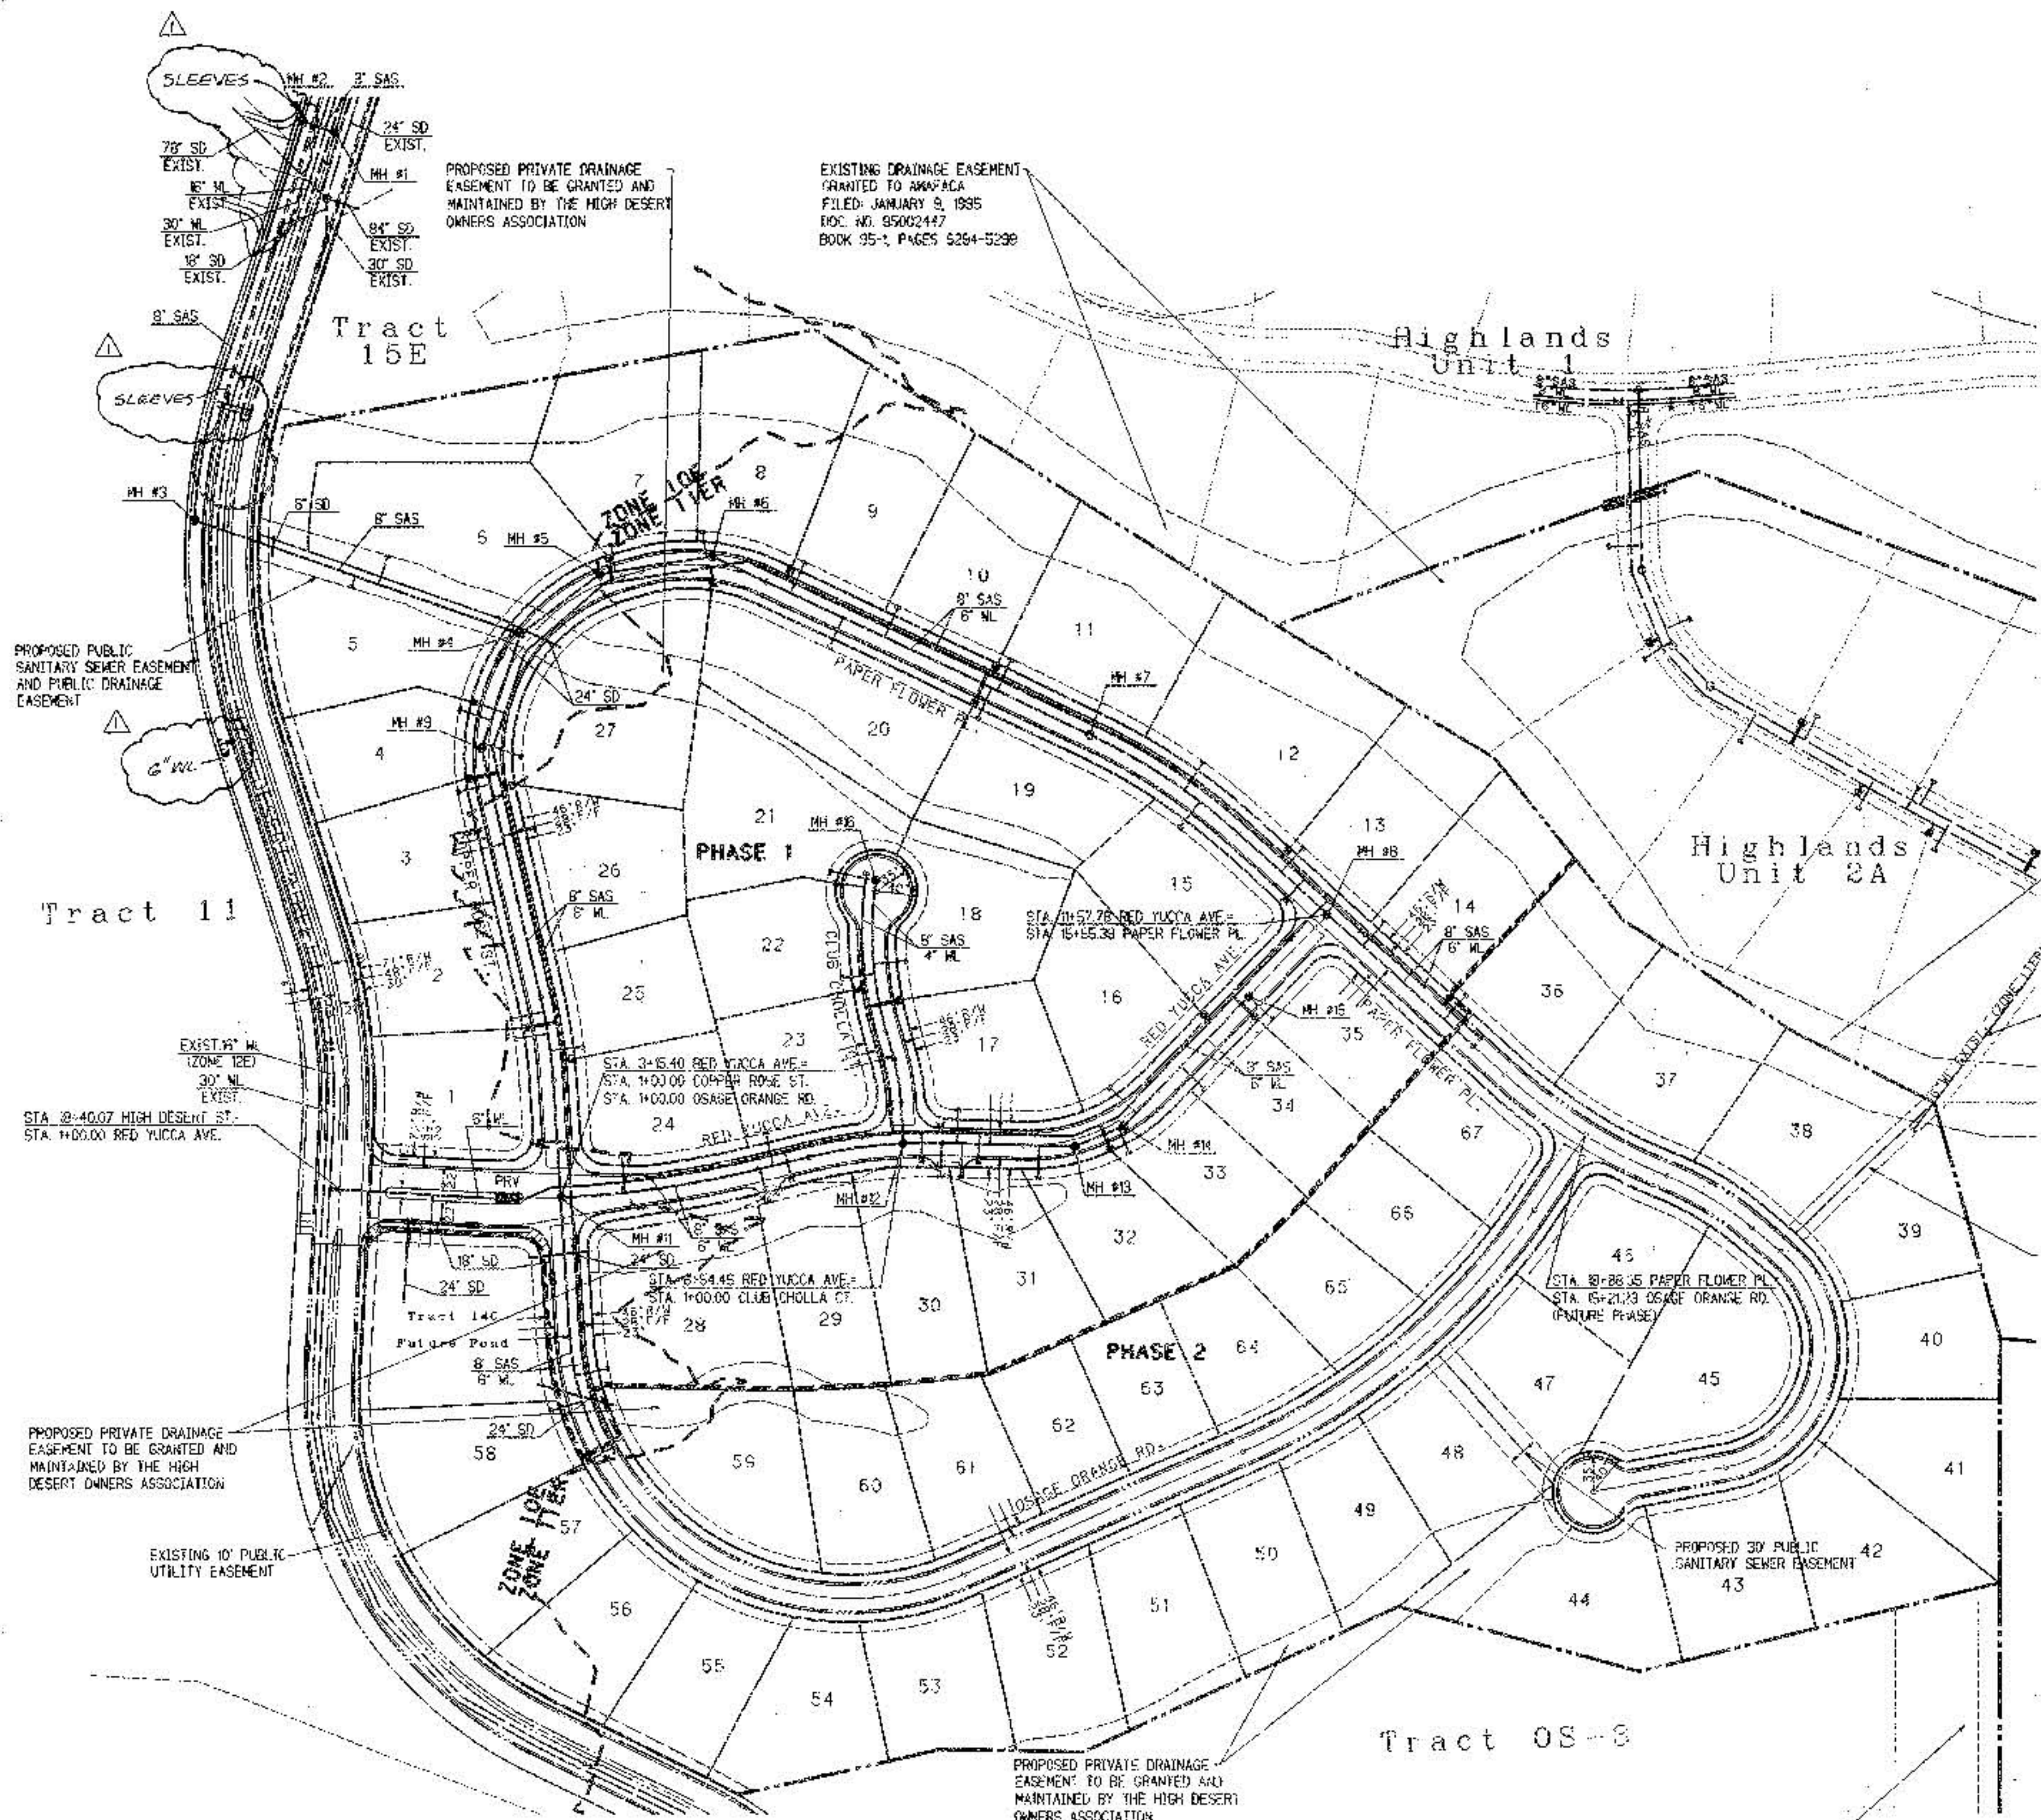

LEGEND	
PROJECT BOUNDARY	---
PROPOSED CURB & GUTTER	---
EXISTING CURB & GUTTER	---
FUTURE SIDEWALK	---
PROPOSED SANITARY SEWER MANHOLE	●
EXISTING SANITARY SEWER MANHOLE	○
PROPOSED FIRE HYDRANT	●
EXISTING FIRE HYDRANT	○
PROPOSED GATE VALVE	●
EXISTING GATE VALVE	○
PROPOSED STORM DRAIN LINE	---
PROPOSED STORM DRAIN MANHOLE	●
PROPOSED STORM DRAIN INLET	○
EXISTING STORM DRAIN LINE	---
EXISTING STORM DRAIN MANHOLE	●
EXISTING STORM DRAIN INLET	○
TRANSITION AREA	---
PROPOSED CONDUIT PIPE	---
EXISTING CONDUIT PIPE	---
PROPOSED STREET LIGHT	*
PROPOSED RETAINING WALL	---
PHASE BOUNDARY	---
PRESSURE ZONE BOUNDARY	---

WATER SHUT-OFF REQUIREMENTS:
NO WATER SHUT-OFF PLAN IS NECESSARY DUE TO THE PRESSURE CONNECTION TO THE EXISTING 16" WATERLINE IN HIGH DESERT STREET.

RECORD DRAWING
DATE: **5-3-99**

BOHANNAN-HUSTON INC.
ENGINEERS • PLANNERS • PHOTOGRAMMETRISTS • SURVEYORS • LANDSCAPE ARCHITECTS
ALBUQUERQUE LAS CRUCES SANTA FE

CITY OF ALBUQUERQUE
PUBLIC WORKS DEPARTMENT
ENGINEERING DEVELOPMENT GROUP

THE OVERLOOK AT HIGH DESERT
MASTER UTILITY PLAN

DESIGN REVIEW BOARD NO.	APPROVAL DATE	W/DATE	W/DATE
1			
2			
CITY PROJECT NO.	ZONE MAP NO.	SHEET	OF
571285	E-23	12	20

DESIGNED BY: K.P. TC
DRAWN BY: SAR
CHECKED BY: KP

DATE: 8/98
DATE: 8/98
DATE: 8/98

SAS CURVE DATA TABLE				
NUMBER	PI STA.	DELTA	TANGENT	ARC
1	11+12.96	14°33'12.4"	73.17'	145.55'
2				573.05'

SAS TANGENT TABLE		
NUMBER	BEARING	DISTANCE
1	N71°53'35"W	32.8'
2	N18°06'25"E	254.66'
3	N70°54'09"W	336.80'

MANHOLE #4
STA. 4+36.80, CL SAS LINE "A"
STA. 8+57.82, 9" LT. COPPER ROSE ST.
BUILD 4" DIA. TYPE "C" SAS MH

ALL SANITARY SEWER LINES SHALL BE PVC UNLESS OTHERWISE NOTED.
ALL WATER LINES SHALL BE PVC UNLESS OTHERWISE NOTED.
ALL STORM DRAIN LINES SHALL BE RCP UNLESS OTHERWISE NOTED.

NOTE: CONTRACTOR SHALL COORDINATE WITH HDIC (823-9360) PRIOR TO ANY CONSTRUCTION OR REMOVALS WITHIN HIGH DESERT STREET.

STA. 7+71.36, 36" RT. TO 9+03.36, 36" RT. INSTALL 1-4" PVC SCH. 40 SLEEVE 1-6" PVC SCH. 40 SLEEVE

STA. 10+70.00, CL TO STA. 10+70.00, 29" RT. INSTALL 2-4" PVC LANDSCAPE SLEEVES

STA. 7+77.83 TO 7+93.13 RIGHT SIDE SAWCUT, REMOVE, DISPOSE & REPLACE MODIFIED MEDIAN CURB, ROLLED CURB & ASPHALT, MATCH EXISTING PAVEMENT AND CURB ELEVATIONS.

STA. 11+78.27 HIGH DESERT ST. = STA. 1+00.00 CL SAS EASEMENT

STA. 7+87.13, 32" RT. TO 8+26.35, 32" RT. BUILD VERTICAL CURVILINEAR SEWER SEE DETAIL THIS SHEET

STA. 7+95.13, CL TO 9+5.00, CL CONTRACTOR SHALL FILL ABANDONED PIPE WITH GROUT AND CAP ENDS

STA. 7+05.10, CL BUILD 4" DIA. TYPE "C" SAS IN EXISTING 5" SAS LINE MANHOLE #1

MANHOLE #2
STA. 7+65.13, 32" RT. BUILD 4" DIA. TYPE "C" SAS MH

STA. 10+39.79, 32" RT. BEGIN CURVILINEAR SAS

STA. 11+77.01, 32" RT. END CURVILINEAR SAS

STA. 13+86.04, 4" RT. INSTALL 1-6" CAP W/ PDC BLOCKING AT END OF 25' 0" LF WL STUBOUT TP44.68


MANHOLE #3
STA. 11+77.01, 32" RT. HIGH DESERT ST. = STA. 1+00.00, CL SAS LINE "A" BUILD 4" DIA. TYPE "C" SAS MH

HIGH DESERT STREET

WATER & SANITARY SEWER SERVICES					
LOT NUMBER	STATION & OFFSET	WL TYPE	SAS STATION & OFFSET	SAS LENGTH	TOP OF PIPE AT PLUG
5	SEE SHEET 15 OF 20		2+66.75, CL SAS "A"	11.78'	49.93'
6	SEE SHEET 15 OF 20		2+90.89, CL SAS "A"	29.43'	50.59'

NOTES:

- CONTRACTOR SHALL BUILD VERTICAL CURVILINEAR SEWER IN ACCORDANCE WITH COA STD. DWG. 2117 WITH THE EXCEPTION OF THE REPLACEMENT OF NOTE E WITH NOTE 1.
- CONTRACTOR SHALL FIELD VERIFY THE CLEARANCE OF THE EXISTING 78" STORM DRAIN AND THE PROPOSED 8" SEWER CROSSING AND CONTACT THE ENGINEER OF ANY DISCREPANCIES.

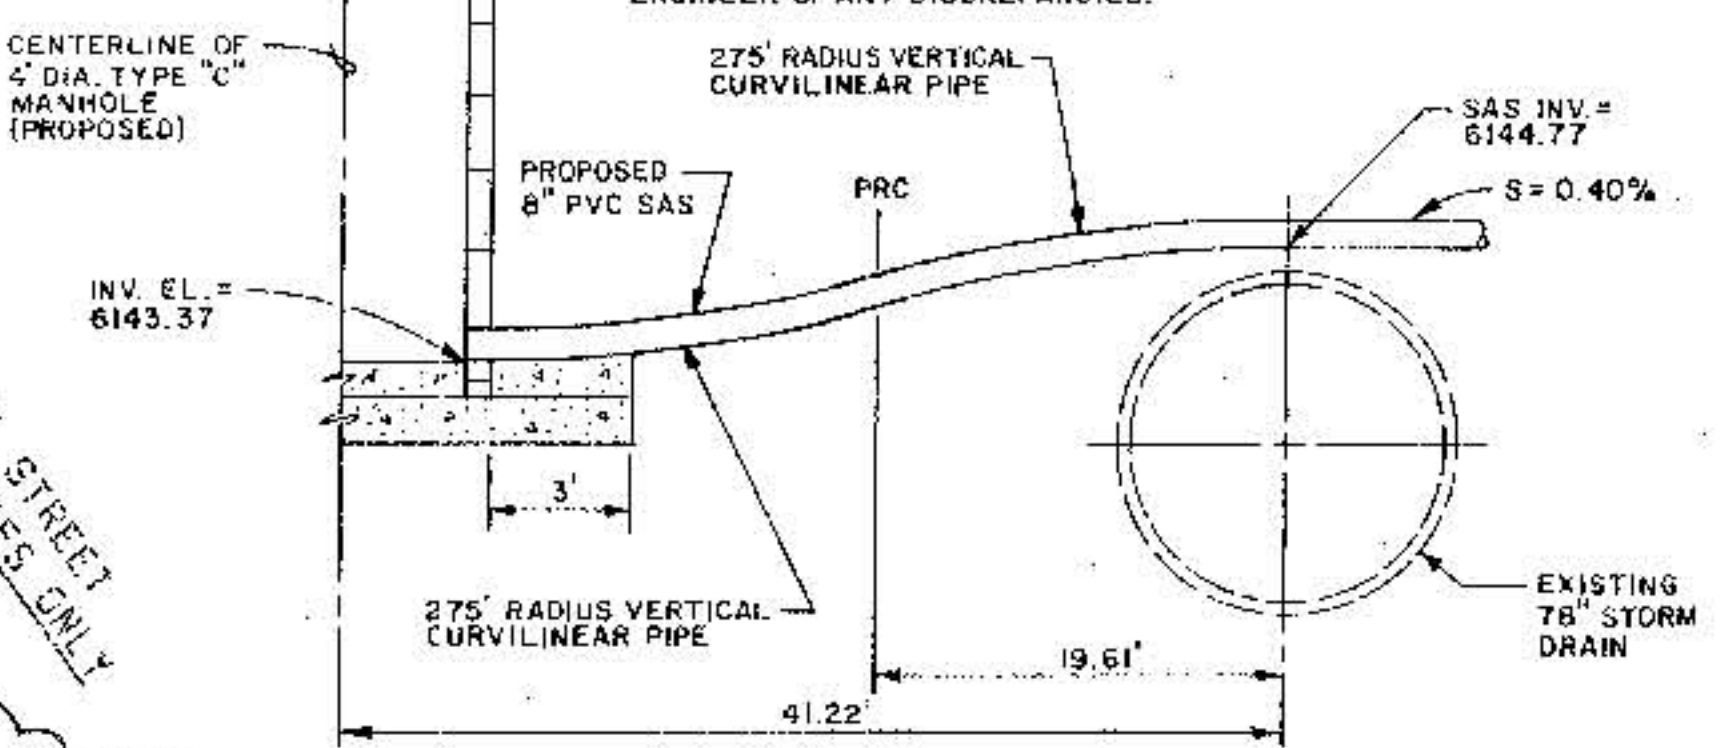


VERTICAL CURVILINEAR SEWER PIPE DETAIL

NO SCALE

UTILITY CROSSING & CLEARANCE		
#1	WATERLINE TP 5141.04 SAS INV. 6142.92	CLEARANCE = 1.98'
#2	WATERLINE TP 5141.04 SAS INV. 6143.02	CLEARANCE = 1.98'
#3	SD TP 6144.35 SAS INV. 6144.77	CLEARANCE = 0.42'
#4	WATERLINE TP 6139.81 SAS INV. 6146.49	CLEARANCE = 6.58'
#5	WATERLINE TP 6138.84 SAS INV. 6146.57	CLEARANCE = 7.93'



SCALE: 1" = 50' (HORIZ.)
1" = 10' (VERT.)

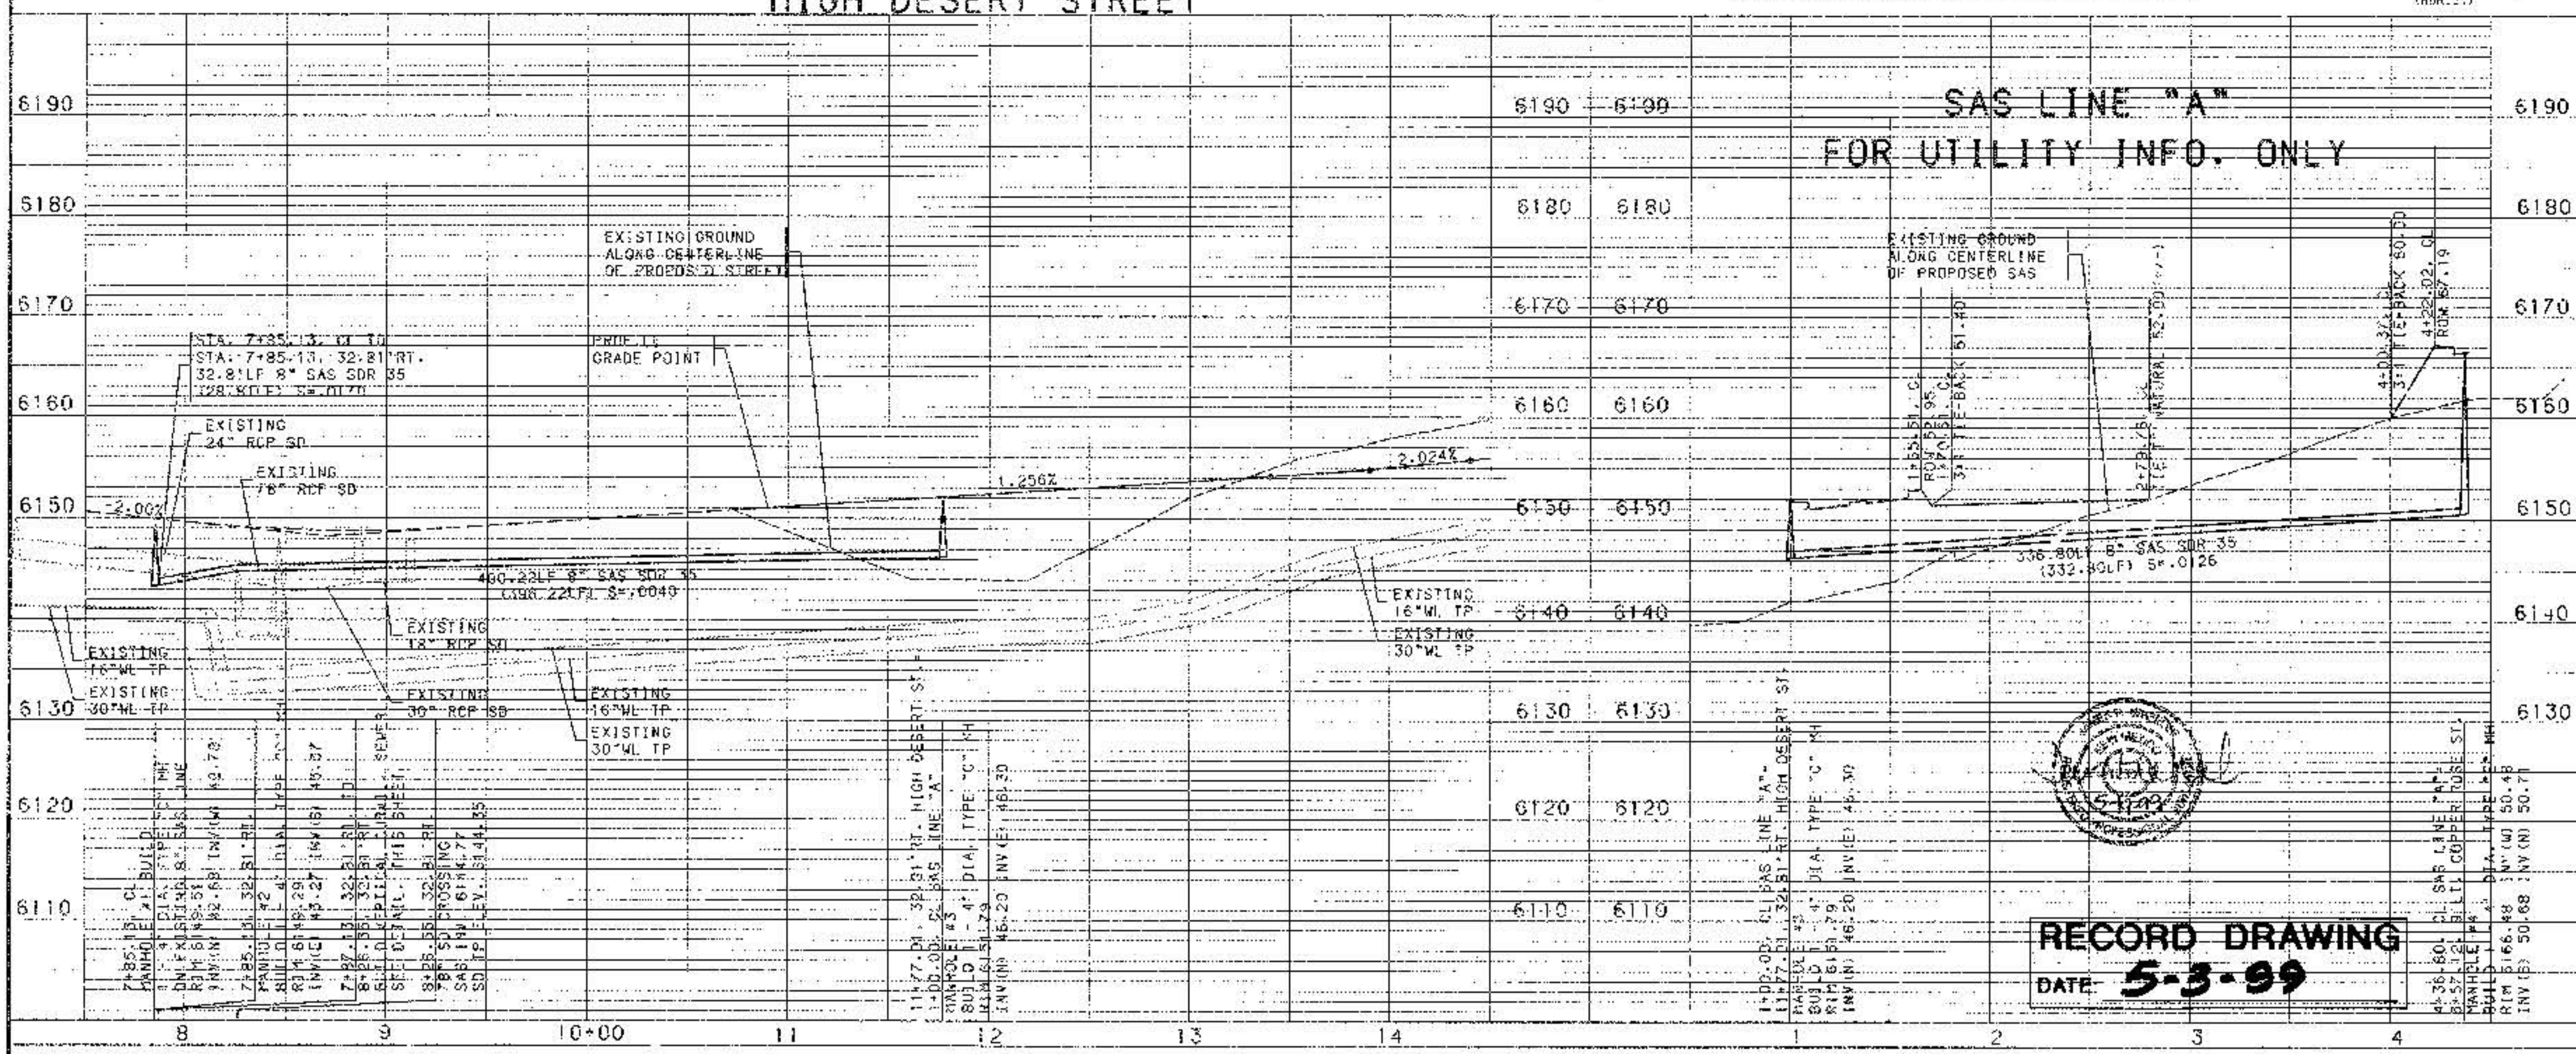

RECORD DRAWING
DATE: 5-3-99

NOTES

- THE CONTRACTOR SHALL FIELD VERIFY ALL EXISTING UTILITY LOCATIONS AND NOTIFY THE ENGINEER IMMEDIATELY OF ANY DISCREPANCIES.
- ALL CURB RETURN RADII SHALL BE 25' TO FACE OF CURB UNLESS OTHERWISE SPECIFIED.
- ALL CURVE DATA AND DIMENSIONS REFER TO FACE OF CURB UNLESS OTHERWISE SPECIFIED.
- GRADE ELEVATIONS, WHERE NOTED, ARE FOR TOP OF STANDARD CURB UNLESS OTHERWISE SPECIFIED.
- CONTRACTOR IS TO INSTALL A 4"x4"x5' POST AND END AT THE END OF EACH SANITARY SEWER SERVICE.
- CONTRACTOR IS RESPONSIBLE FOR REPAIR AND/OR REPLACEMENT OF ALL UTILITY CONDUITS AND EXISTING LINES.
- ANY ADDITIONAL GRADING REQUIRED TO MATCH PROPOSED STREET GRADES SHALL BE INCIDENTAL TO PAVING ITEMS.
- CONTRACTOR SHALL PROVIDE THE INSPECTORS (CITY AND PRIVATE) WITH THE PROPOSED HYDROSTATIC TESTING PLAN. THE PLAN MUST BE APPROVED BEFORE TESTING OPERATIONS BEGIN.
- CONTRACTOR SHALL PARK EQUIPMENT AND VEHICLES AS NOT TO INTERFERE WITH NORMAL ACTIVITIES OF RESIDENTS OR OTHER CONTRACTORS ON SITE.
- ANY DAMAGE TO THE EXISTING FACILITIES (CURB AND GUTTER, PAVEMENT, CONDUITS, LANDSCAPING, UTILITY LINES, ETC.) DURING CONSTRUCTION SHALL BE REPLACED AT THE CONTRACTORS EXPENSE.
- REMOVAL OF THE EXISTING CURB AND GUTTER SHALL BE AS PER COA STD. DWG. 2415 (SAWCUT ONLY).
- WHEEL CHAIR RAMPS SHALL BE CONSTRUCTED PRIOR TO ACCEPTANCE OF CURB AND GUTTER.
- CONTRACTOR SHALL COORDINATE WITH HDIC (823-9360) PRIOR TO ANY CONSTRUCTION OR REMOVALS WITHIN HIGH DESERT STREET.

RESTRAINED JOINT TABLE

MECHANICAL JOINTS	LENGTH OF RESTRAINED JOINTS FROM EACH SIDE OF MJ LISTED (4")			
	(16")	(24")	(36")	(48")
1" 25" H BEND	1'	2'	3'	5'
22.50" H BEND	3'	4'	5'	10'
45" H BEND	6'	8'	11'	21'
90" H BEND	15'	20'	26'	50'
GATE VALVE	46'	55'	72'	108'
BRICK VALVE	---	---	---	---
CAP	46'	55'	72'	108'

NOTES:

- ALL MECHANICAL JOINTS SHALL BE RESTRAINED AT THE FITTING.
- THE CONTRACTOR SHALL PROVIDE A MIN. PIPE LENGTH OF 20LF FROM ALL MECHANICAL JOINTS. ALL PIPE JOINTS WITHIN 20LF OF A MJ SHALL BE RESTRAINED AT THE CONTRACTORS EXPENSE.
- THE CONTRACTOR SHALL RESTRAIN ALL PIPE JOINTS IN THE SPECIFIED DISTANCE LISTED IN THE TABLE ABOVE. (SEE NOTE 2 ABOVE).
- THE CONTRACTOR SHALL RESTRAIN ALL FIRE HYDRANT JOINTS FROM THE TEE ON THE MAIN TO THE FIRE HYDRANT FLANGE.

BOHANNAN-HUSTON INC.
ENGINEERS • PLANNERS • PHOTOGRAPHICISTS • SURVEYORS • LANDSCAPE ARCHITECTS
ALBUQUERQUE • LAS CRUCES • SANTA FE

CITY OF ALBUQUERQUE
PUBLIC WORKS DEPARTMENT
ENGINEERING DEVELOPMENT GROUP

THE OVERLOOK AT HIGH DESERT
UTILITY PLAN & PROFILE
HIGH DESERT STREET - STA. 7+50.00 TO 14+50.00


DESIGN REVIEW COMMITTEE	CITY ENGINEER APPROVAL	NO. DAY/HR.	NO. DAY/HR.
DESIGNER	DATE	DATE	DATE
LAST DESIGN UPDATE			

CITY PROJECT NO. 571285 ZONE MAP NO. E-23 SHEET 13 OF 20

NUMBER	PI STA.	DELTA	TANGENT	ARC	RADIUS
C1	4+13.10	11° 9' 35.9"	97.70'	194.28'	1000.00'
C2	6+07.69	10° 44' 58.0"	47.04'	93.80'	500.00'
C3	6+72.39	4° 26' 10.9"	18.93'	37.84'	500.00'

NUMBER	PI STA.	DELTA	TANGENT	ARC	RADIUS
C4	2+31.30	11° 40' 40.1"	14.64'	29.28'	1000.00'
C5	4+09.22	11° 36' 26.6"	100.63'	200.56'	990.00'
C6	6+28.18	15° 5' 8.9"	67.53'	134.28'	510.00'

LOT NUMBER	STATION & OFFSET	PIPE TYPE	STATION & OFFSET	SAS LENGTH	TOP OF PIPE AT PLUG
28	SEE SHEET 17 OF 20	SEE SHEET 17 OF 20	SEE SHEET 17 OF 20	SEE SHEET 17 OF 20	SEE SHEET 17 OF 20
29	5+39.66 10.00' LT.	SINGLE	5+12.44 CL	33.00'	88.40'
30	5+72.61 10.00' LT.	SINGLE	5+91.94 CL	33.00'	77.79'
31	7+28.96 10.00' LT.	SINGLE	7+12.43 CL	33.00'	79.19'
32	8+52.47 4.78' LT.	DOUBLE	7+87.66 0.57' RT.	32.43'	84.62'
33	8+52.47 4.78' LT.	DOUBLE	8+67.24 6.32' RT.	26.83'	90.78'
34	10+35.41 10.00' LT.	DOUBLE	9+50.67 CL	33.00'	97.72'
35	10+35.41 10.00' LT.	DOUBLE	10+45.71 CL - NH	33.00'	95.02'
15	10+02.51 10.00' LT.	DOUBLE	SEE SHEET 15 OF 20	SEE SHEET 15 OF 20	SEE SHEET 15 OF 20
16	10+02.51 10.00' LT.	DOUBLE	8+07.43 CL	33.00'	73.34'
17	SEE SHEET 17 OF 20	SEE SHEET 17 OF 20	SEE SHEET 17 OF 20	SEE SHEET 17 OF 20	SEE SHEET 17 OF 20
23	SEE SHEET 17 OF 20	SEE SHEET 17 OF 20	SEE SHEET 17 OF 20	SEE SHEET 17 OF 20	SEE SHEET 17 OF 20
24	SEE SHEET 15 OF 20	SEE SHEET 15 OF 20	5+25.87 CL	33.00'	70.12'
			3+75.77 CL	35.24'	65.11'

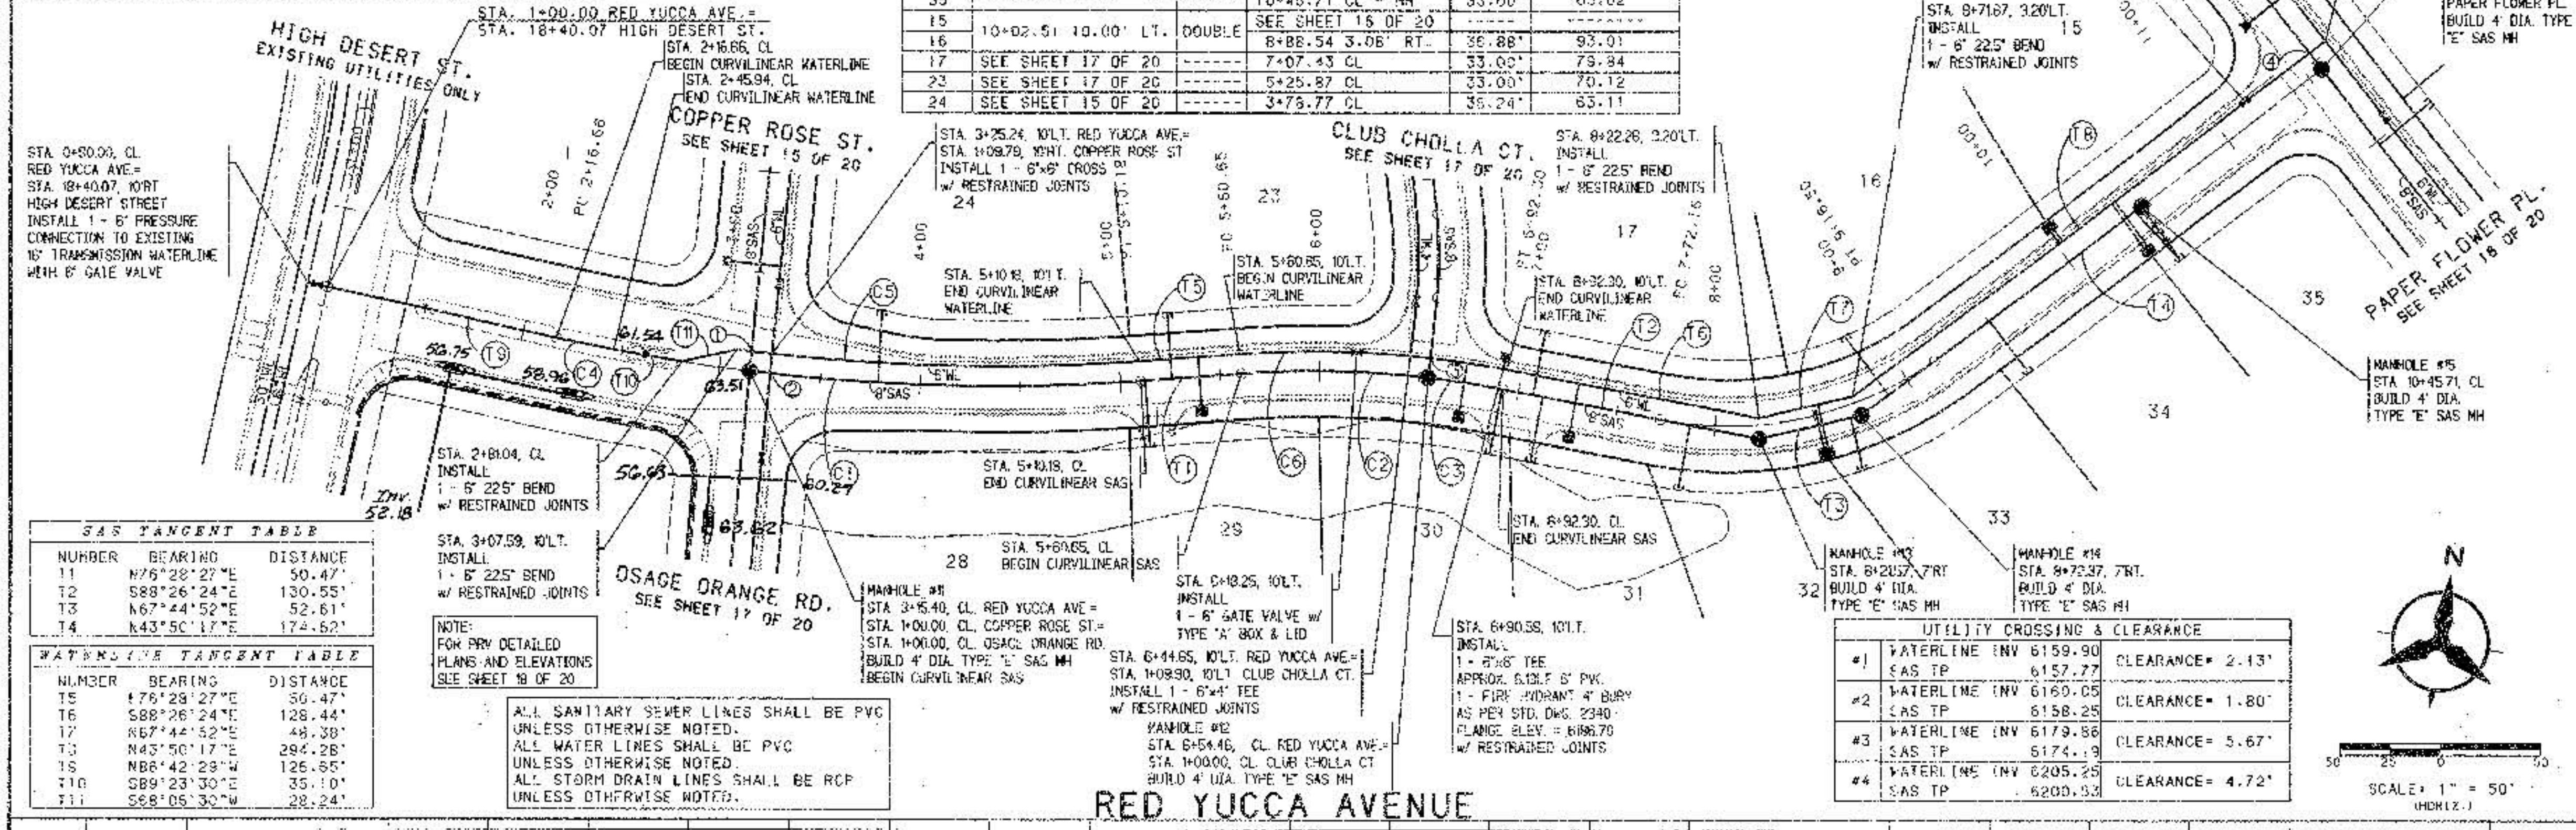

NUMBER	BEARING	DISTANCE
T1	N76°29'27"E	50.47'
T2	S88°26'24"E	130.55'
T3	N67°44'52"E	52.61'
T4	N43°50'17"E	174.52'

NUMBER	BEARING	DISTANCE
T5	N76°29'27"E	50.47'
T6	S88°26'24"E	128.44'
T7	N67°44'52"E	48.38'
T8	N43°50'17"E	294.28'
T9	N68°42'23"W	126.55'
T10	S69°23'30"E	35.10'
T11	S68°05'30"W	28.24'


NOTE:
FOR PLY DETAIL
PLANS AND ELEVATIONS
SEE SHEET 18 OF 20

ALL SANITARY SEWER LINES SHALL BE PVC
UNLESS OTHERWISE NOTED.
ALL WATER LINES SHALL BE PVC
UNLESS OTHERWISE NOTED.
ALL STORM DRAIN LINES SHALL BE RCP
UNLESS OTHERWISE NOTED.

NO.	WATERLINE INV	SAS TP	CLEARANCE
#1	6159.90	6157.77	CLEARANCE = 2.13'
#2	6160.05	6158.25	CLEARANCE = 1.80'
#3	6179.56	6174.19	CLEARANCE = 5.37'
#4	6205.25	6200.93	CLEARANCE = 4.32'



- NOTES**
1. THE CONTRACTOR SHALL FIELD VERIFY ALL EXISTING UTILITY LOCATIONS AND NOTIFY THE ENGINEER IMMEDIATELY OF ANY DISCREPANCIES.
 2. ALL CURB RETURN RADI SHALL BE 25' TO FACE OF CURB UNLESS OTHERWISE SPECIFIED.
 3. ALL CURVE DATA AND DIMENSIONS REFER TO FACE OF CURB UNLESS OTHERWISE SPECIFIED.
 4. GRADE ELEVATIONS, WHERE NOTED, ARE FOR TOP OF STANDARD CURB UNLESS OTHERWISE SPECIFIED.
 5. CONTRACTOR IS TO INSTALL A 4"x4"x5' POST AND END AT THE END OF EACH SANITARY SEWER SERVICE.
 6. CONTRACTOR IS RESPONSIBLE FOR REPAIR AND/OR REPLACEMENT OF ALL UTILITY CONDUITS AND EXISTING LINES.
 7. ANY ADDITIONAL GRADING REQUIRED TO MATCH PROPOSED STREET GRADES SHALL BE INCIDENTAL TO PAVING ITEMS.
 8. CONTRACTOR SHALL PROVIDE THE INSPECTORS, (CITY AND PRIVATE) WITH THE PROPOSED HYDROSTATIC TESTING PLAN. THE PLAN MUST BE APPROVED BEFORE TESTING OPERATIONS BEGIN.
 9. CONTRACTOR SHALL PARK EQUIPMENT AND VEHICLES AS NOT TO INTERFERE WITH NORMAL ACTIVITIES OF RESIDENTS OR OTHER CONTRACTORS ON SITE.
 10. ANY DAMAGE TO THE EXISTING FACILITIES, (CURBS, AND GUTTER, PAVEMENT, CONDUITS, LANDSCAPING, UTILITY LINES, ETC.) DURING CONSTRUCTION SHALL BE REPLACED AT THE CONTRACTOR'S EXPENSE.
 11. REMOVAL OF THE EXISTING CURB AND GUTTER SHALL BE AS PER COA STD. DWG. 2415 (SAW CUT ONLY).
 12. WHEEL CHAIR RAMPS SHALL BE CONSTRUCTED PRIOR TO ACCEPTANCE OF CURB AND GUTTER.

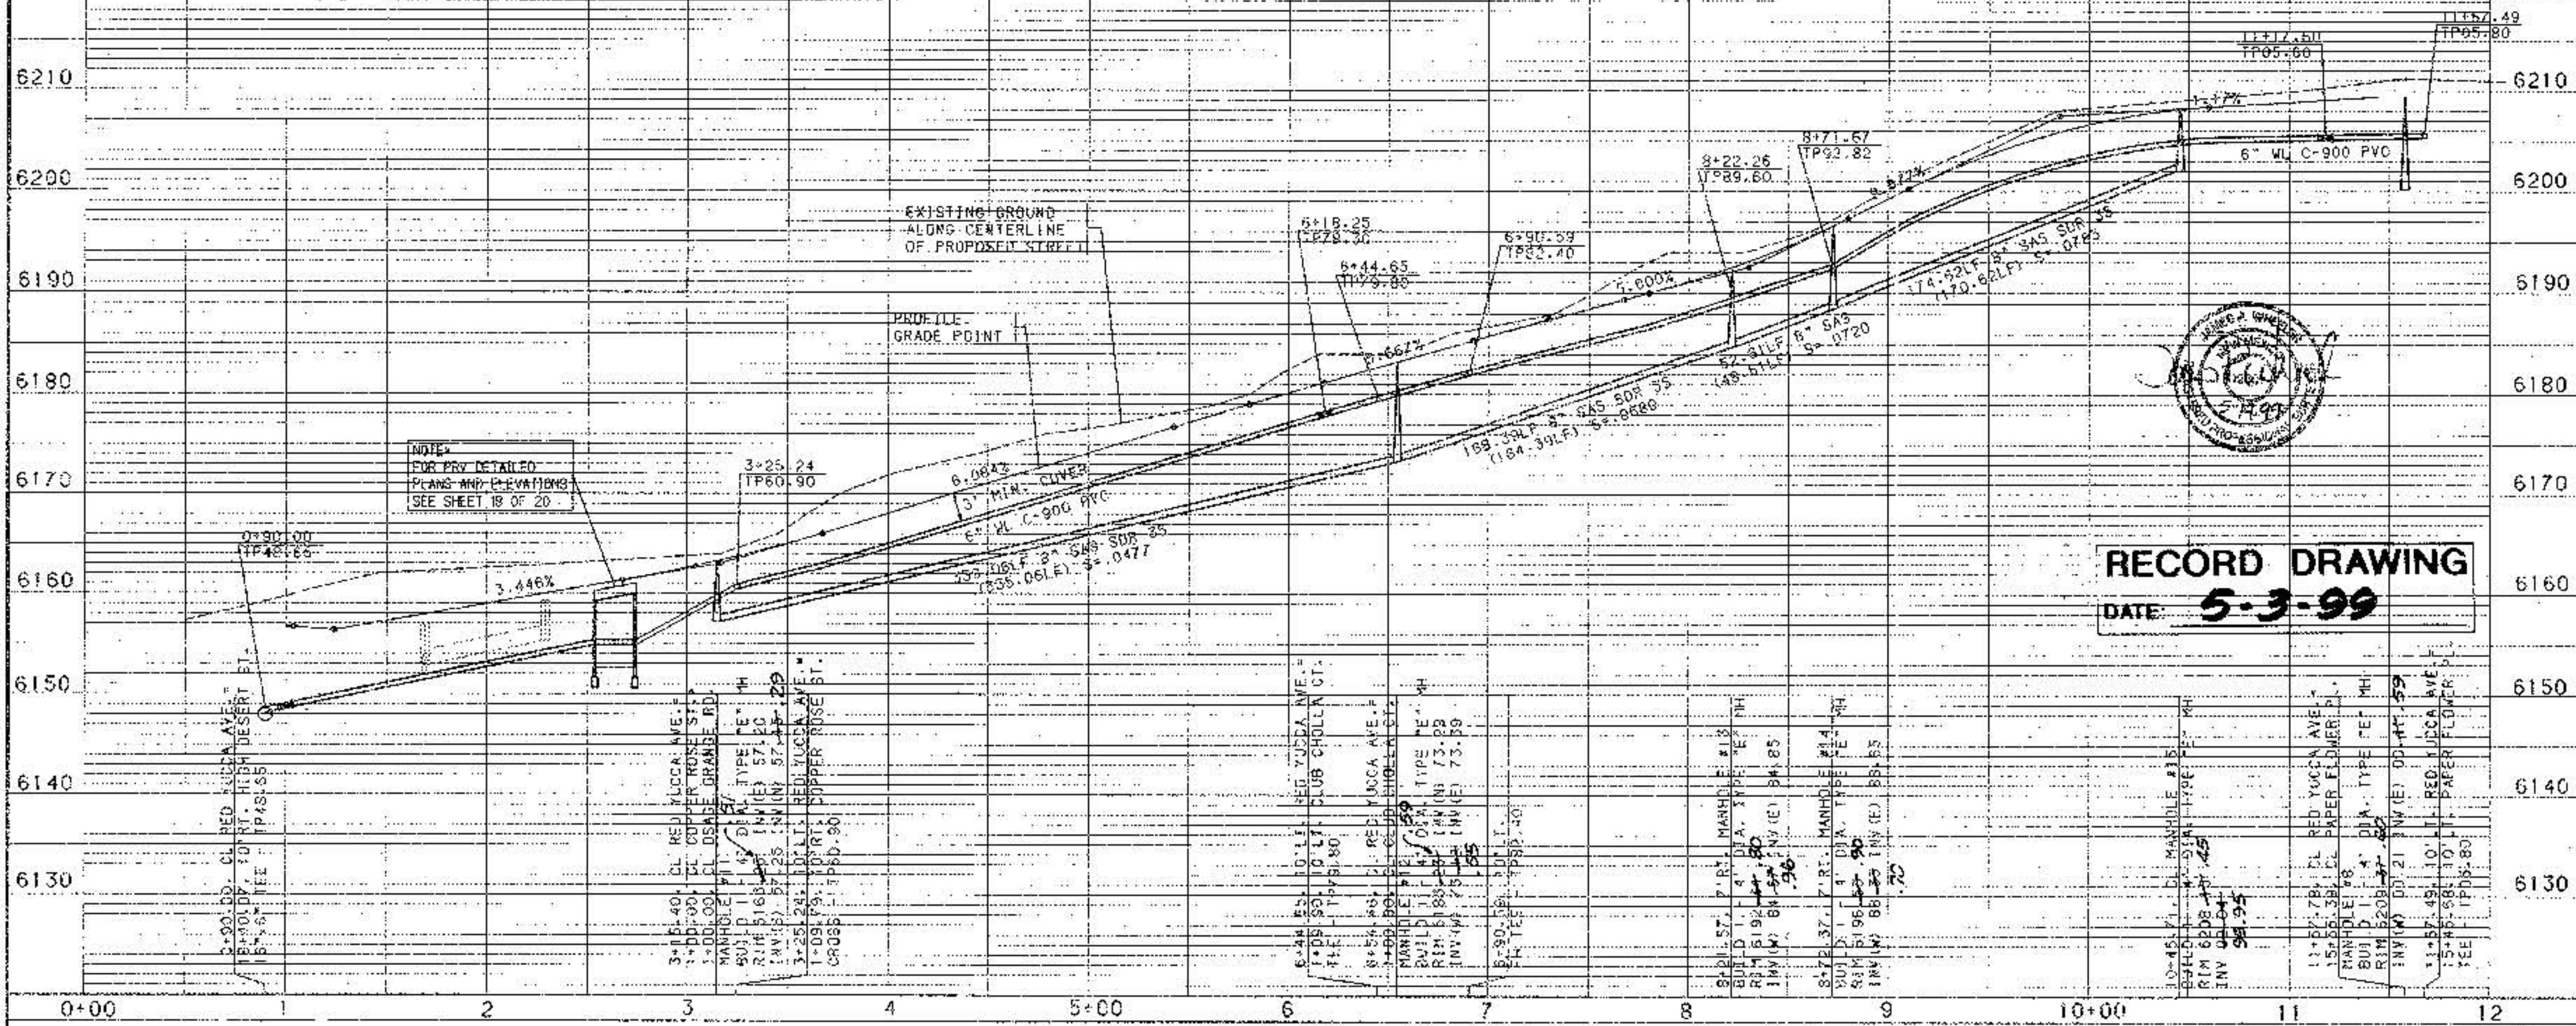

RECORD DRAWING
DATE: 5-3-99

MECHANICAL JOINTS	LENGTH OF RESTRAINED JOINTS FROM EACH SIDE OF JOINT LISTED (4") (6") (8") (16")
11.25" H BEND	1' 2' 3' 5'
22.50" H BEND	3' 4' 5' 10'
45" H BEND	5' 8' 11' 21'
90" H BEND	15' 20' 26' 50'
GATE VALVE	46' 55' 72' ---
BUTTERFLY VALVE	--- --- --- 108'
CAP	46' 55' 72' 108'

- NOTES:**
1. ALL MECHANICAL JOINTS SHALL BE RESTRAINED AT THE FITTING.
 2. THE CONTRACTOR SHALL PROVIDE A MIN. PIPE LENGTH OF 20' FROM ALL MECHANICAL JOINTS. ALL PIPE JOINTS WITHIN 20' OF A MJ SHALL BE RESTRAINED AT THE CONTRACTOR'S EXPENSE.
 3. THE CONTRACTOR SHALL RESTRAIN ALL PIPE JOINTS IN THE SPECIFIED DISTANCE LISTED IN THE TABLE ABOVE. (SEE NOTE 2 ABOVE).
 4. THE CONTRACTOR SHALL RESTRAIN ALL FIRE HYDRANT JOINTS FROM THE TEE ON THE MAIN TO THE FIRE HYDRANT FLANGE.


BOHANNAN-HUSTON INC.
ENGINEERS • PLANNERS • PHOTOGRAPHICISTS • SURVEYORS • LANDSCAPE ARCHITECTS
ARCHITECTS • LANDSCAPE ARCHITECTS

CITY OF ALBUQUERQUE
PUBLIC WORKS DEPARTMENT
ENGINEERING DEVELOPMENT GROUP

THE OVERLOOK AT HIGH DESERT
UTILITY PLAN & PROFILE
RED YUCCA AVENUE

DESIGNED BY: [Signature] DATE: 8/98
DRAWN BY: [Signature] DATE: 8/98
CHECKED BY: [Signature] DATE: 8/98

CITY PROJECT NO. 571285
ZONE MAP NO. E-23
SHEET 14 OF 20

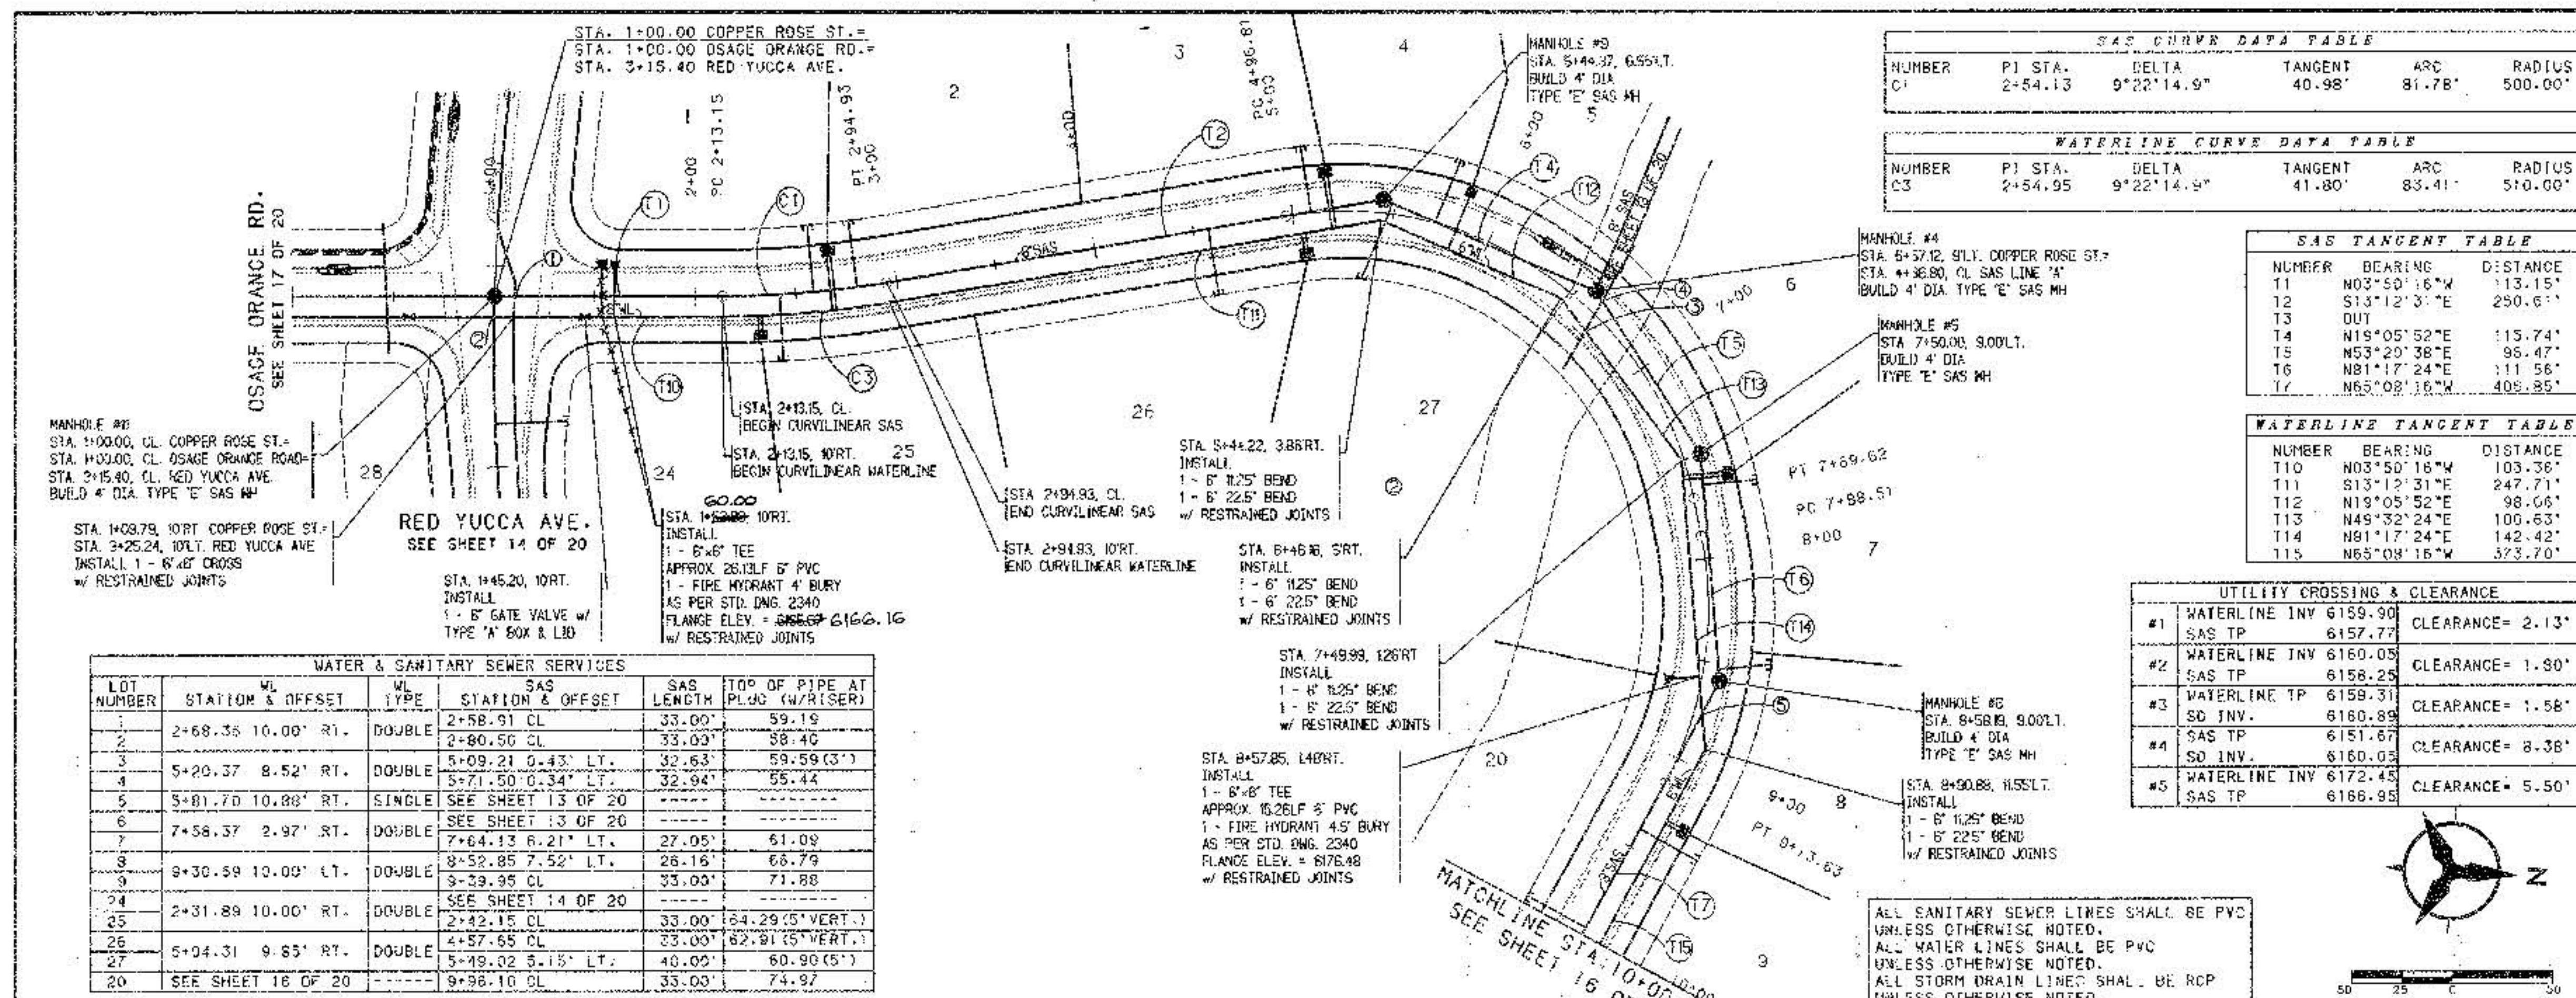


SAS CURVE DATA TABLE				
NUMBER	PI STA.	DELTA	TANGENT	ARC RADIUS
C1	2+54.13	9°22'14.9"	40.98'	81.78'
C2	2+54.95	9°22'14.9"	41.80'	83.41'

WATERLINE CURVE DATA TABLE				
NUMBER	PI STA.	DELTA	TANGENT	ARC RADIUS
C3	2+54.95	9°22'14.9"	41.80'	83.41'

SAS TANGENT TABLE		
NUMBER	BEARING	DISTANCE
11	N03°50'16"W	113.15'
12	S13°12'3"E	250.6'
13	OUT	
14	N19°05'52"E	115.74'
15	N53°20'38"E	95.47'
16	N81°17'24"E	111.56'
17	N65°08'16"W	408.85'


WATERLINE TANGENT TABLE		
NUMBER	BEARING	DISTANCE
110	N03°50'16"W	103.36'
111	S13°12'31"E	247.71'
112	N19°05'52"E	98.06'
113	N49°32'24"E	100.63'
114	N81°17'24"E	142.42'
115	N65°08'16"W	373.70'

UTILITY CROSSING & CLEARANCE		
#1	WATERLINE INV 6159.90 SAS TP 6157.77	CLEARANCE = 2.13'
#2	WATERLINE INV 6160.05 SAS TP 6158.25	CLEARANCE = 1.80'
#3	WATERLINE TP 6158.31 SD INV. 6160.89	CLEARANCE = 1.58'
#4	SAS TP 6151.67 SD INV. 6160.05	CLEARANCE = 8.38'
#5	WATERLINE INV 6172.45 SAS TP 6166.95	CLEARANCE = 5.50'

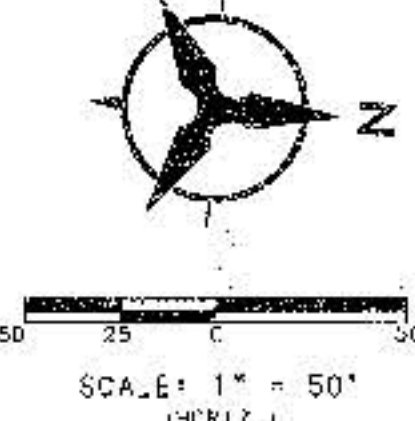

WATER & SANITARY SEWER SERVICES				
LOT NUMBER	STATION & OFFSET	W. TYPE	SAS STATION & OFFSET	TOP OF PIPE AT PLUG (W/RISER)
2	2+68.35 10.00' RT.	DOUBLE	2+58.91 CL	33.00' 59.19'
3	5+20.37 8.52' RT.	DOUBLE	2+80.50 CL	33.03' 58.40'
4	5+81.70 10.88' RT.	SINGLE	5+09.21 0.43' LT.	33.63' 59.59(3')
5	7+58.37 2.97' RT.	DOUBLE	5+71.50 0.34' LT.	32.94' 55.44'
6	9+30.59 10.00' LT.	DOUBLE	SEE SHEET 13 OF 20	
7	2+31.89 10.00' RT.	DOUBLE	7+64.13 6.21' LT.	27.05' 61.09'
8	5+04.31 9.83' RT.	DOUBLE	8+52.85 7.52' LT.	28.16' 66.79'
9	9+98.10 CL	---	9+23.35 CL	33.03' 71.88'
24	2+31.89 10.00' RT.	DOUBLE	SEE SHEET 14 OF 20	
25	5+04.31 9.83' RT.	DOUBLE	2+42.15 CL	33.00' 54.29(5' VERT.)
26	5+04.31 9.83' RT.	DOUBLE	4+57.65 CL	33.00' 62.91(5' VERT.)
27	5+04.31 9.83' RT.	DOUBLE	5+49.02 5.15' LT.	40.02' 60.90(5')
28	SEE SHEET 16 OF 20	---	9+98.10 CL	33.03' 74.97'

COPPER ROSE STREET

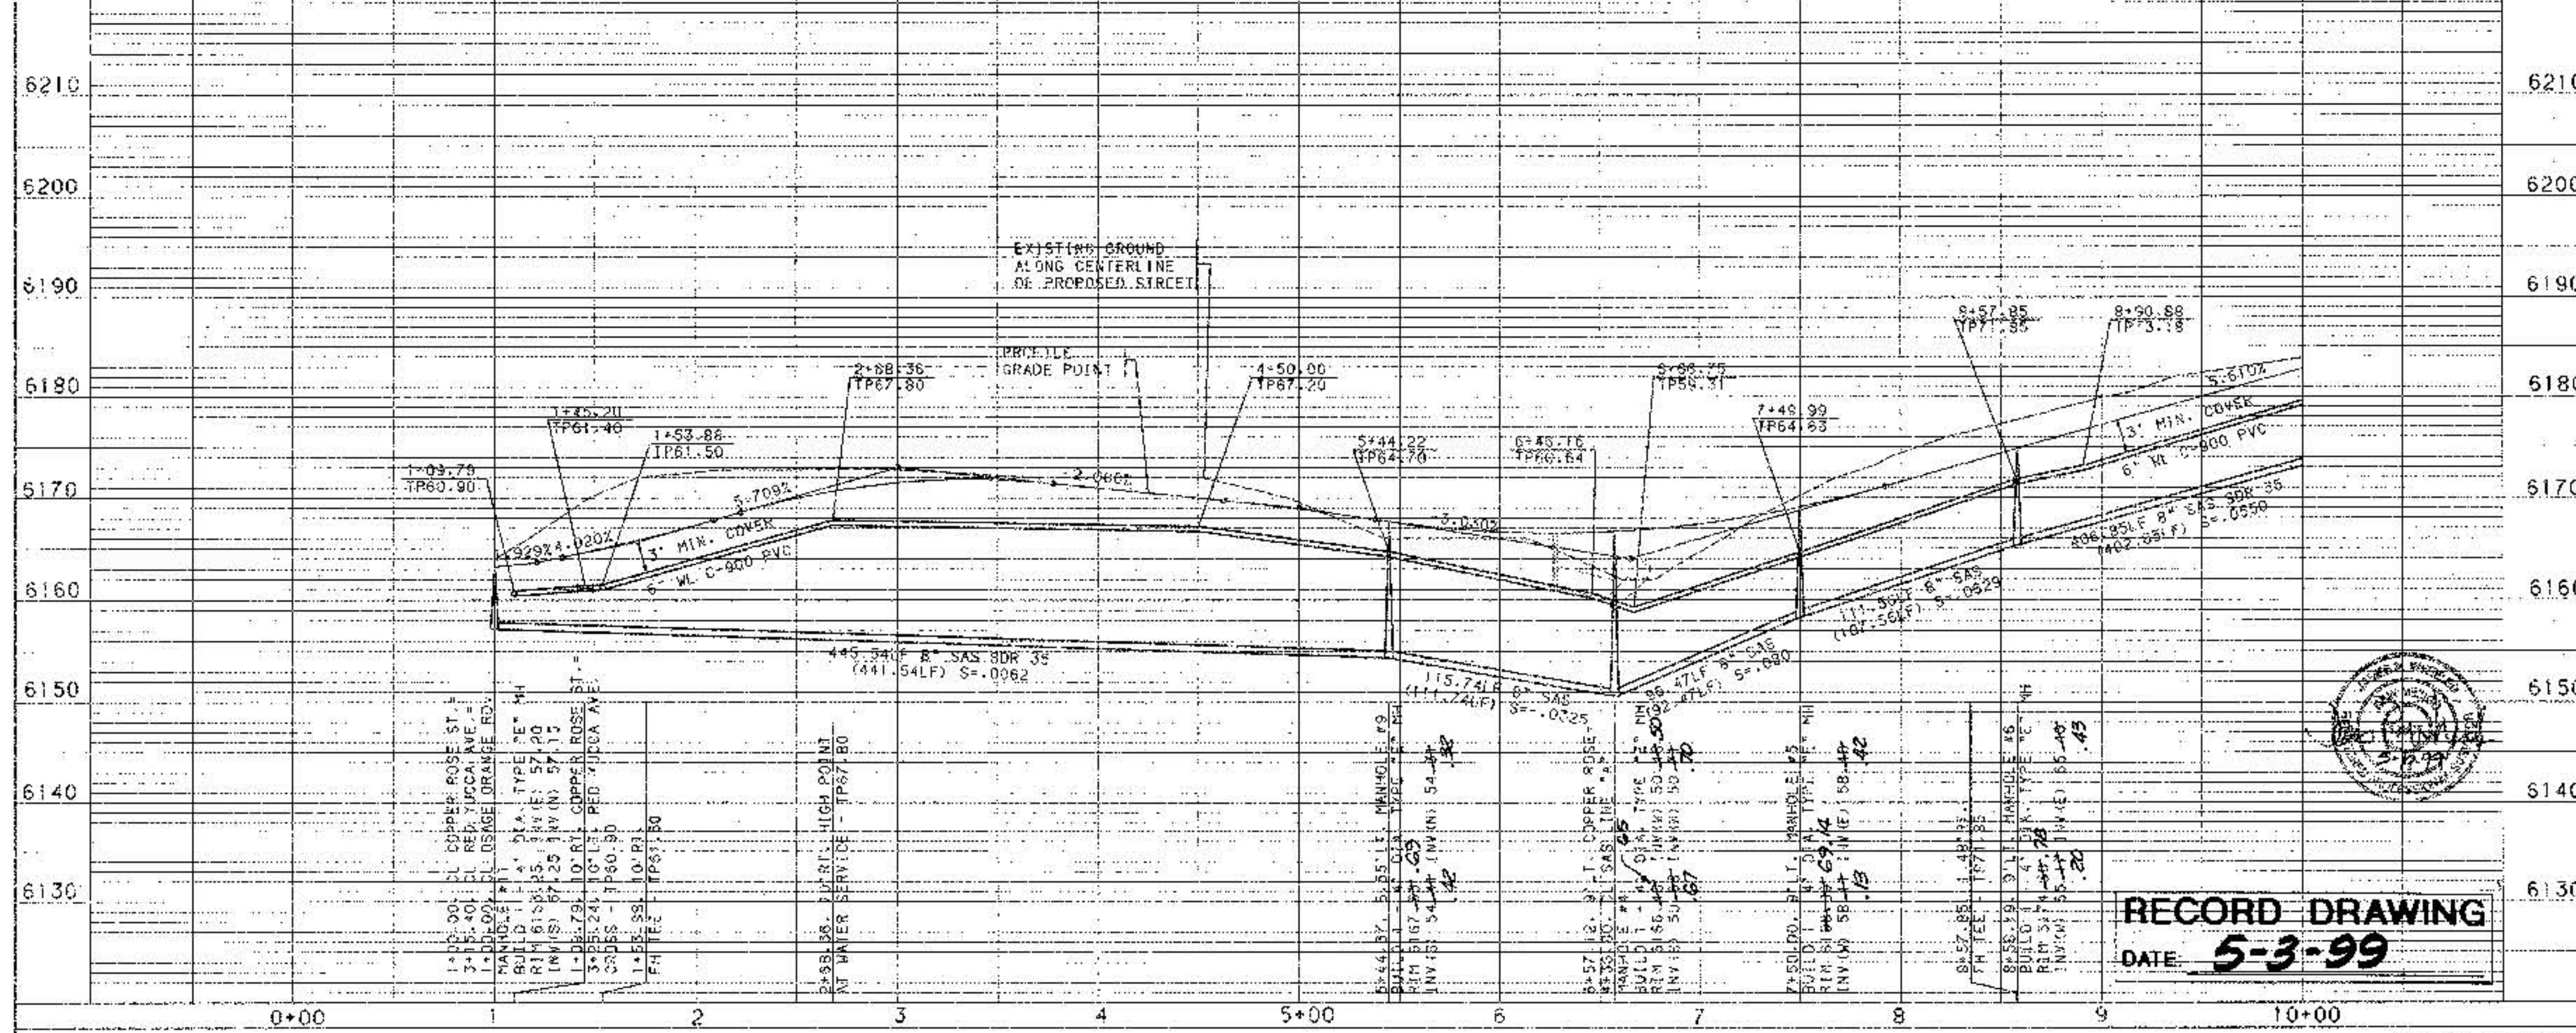

- NOTES**
- THE CONTRACTOR SHALL FIELD VERIFY ALL EXISTING UTILITY LOCATIONS AND NOTIFY THE ENGINEER IMMEDIATELY OF ANY DISCREPANCIES.
 - ALL CURB RETURN RADII SHALL BE 25' TO FACE OF CURB UNLESS OTHERWISE SPECIFIED.
 - ALL CURVE DATA AND DIMENSIONS REFER TO FACE OF CURB UNLESS OTHERWISE SPECIFIED.
 - GRADE ELEVATIONS, WHERE NOTED, ARE FOR TOP OF STANDARD CURB UNLESS OTHERWISE SPECIFIED.
 - CONTRACTOR IS TO INSTALL A 4"x4"x5' POST AND END AT THE END OF EACH SANITARY SEWER SERVICE.
 - CONTRACTOR IS RESPONSIBLE FOR REPAIR AND/OR REPLACEMENT OF ALL UTILITY CONDUITS AND EXISTING LINES.
 - ANY ADDITIONAL GRADING REQUIRED TO MATCH PROPOSED STREET GRADES SHALL BE INCIDENTAL TO PAVING ITEMS.
 - CONTRACTOR SHALL PROVIDE THE INSPECTORS, CITY AND PRIVATE, WITH THE PROPOSED HYDROSTATIC TESTING PLAN. THE PLAN MUST BE APPROVED BEFORE TESTING OPERATIONS BEGIN.
 - CONTRACTOR SHALL PARK EQUIPMENT AND VEHICLES AS NOT TO INTERFERE WITH NORMAL ACTIVITIES OF RESIDENTS OR OTHER CONTRACTORS ON SITE.
 - ANY DAMAGE TO THE EXISTING FACILITIES (CURB AND GUTTER, PAVEMENT, CONDUITS, LANDSCAPING, UTILITY LINES, ETC.) DURING CONSTRUCTION SHALL BE REPLACED AT THE CONTRACTORS EXPENSE.
 - REMOVAL OF THE EXISTING CURB AND GUTTER SHALL BE AS PER CGA STD. DWG. 2415 (SCAUCUT ONLY).
 - WHEEL CHAIR RAMPS SHALL BE CONSTRUCTED PRIOR TO ACCEPTANCE OF CURB AND GUTTER.

RESTRAINED JOINT TABLE				
MECHANICAL JOINTS	LENGTH OF RESTRAINED JOINTS FROM EACH SIDE OF M. LISTED (4") (6") (8") (16")			
11.25" F BEND	1'	2'	3'	5'
22.50" H BEND	3'	4'	5'	10'
45" H BEND	6'	8'	11'	21'
90" H BEND	13'	23'	26'	50'
GATE VALVE	46'	55'	72'	---
HYDRA VALVE	---	---	---	108'
CAP	46'	55'	72'	108'

NOTES:

- ALL MECHANICAL JOINTS SHALL BE RESTRAINED AT THE FITTING.
- THE CONTRACTOR SHALL PROVIDE A MIN. PIPE LENGTH OF 20LF FROM ALL MECHANICAL JOINTS. ALL PIPE JOINTS WITHIN 20LF OF A MJ SHALL BE RESTRAINED AT THE CONTRACTORS EXPENSE.
- THE CONTRACTOR SHALL RESTRAIN ALL PIPE JOINTS IN THE SPECIFIED DISTANCE LISTED IN THE TABLE ABOVE. (SEE NOTE 2 ABOVE).
- THE CONTRACTOR SHALL RESTRAIN AT FIRE HYDRANT JOINTS FROM THE TEE ON THE MAIN TO THE FIRE HYDRANT FLANGE.

BOHANNAN-HUSTON INC.
ENGINEERS • PLANNERS • PHOTOGRAPHERS • SURVEYORS • LANDSCAPE ARCHITECTS
ALBUQUERQUE LAS CRUCES SANTA FE

CITY OF ALBUQUERQUE
PUBLIC WORKS DEPARTMENT
ENGINEERING DEVELOPMENT GROUP

THE OVERLOOK AT HIGH DESERT
UTILITY PLAN & PROFILE
COPPER ROSE STREET

DESIGN-BUILD COMMITTEE	CITY ENGINEER APPROVAL	NO. DATE	REVISIONS
		BY	DATE
		DESIGNED BY	DATE
		DRAWN BY	DATE
		CHECKED BY	DATE

CITY PROJECT NO. 571285 ZONE MAP NO. E-23 SHEET 15 OF 20

DATE: AUGUST 25, 1998

WATER & SANITARY SEWER SERVICES					
LOT NUMBER	STATION & OFFSET	WL TYPE	SAS STATION & OFFSET	SAS LENGTH	TOP OF PIPE AT PLUS
10	11+52.14 10.00' LT.	DOUBLE	10+46.97 CL	33.00'	77.44
11	11+52.14 10.00' LT.	DOUBLE	11+62.58 CL	33.00'	84.13
12	14+84.29 10.00' LT.	DOUBLE	13+69.90 CL	33.00'	94.27
13	14+84.29 10.00' LT.	DOUBLE	14+93.90 CL	33.00'	99.83
14	16+99.84 10.00' LT.	DOUBLE	16+02.07 CL	33.00'	04.71
15	16+99.84 10.00' LT.	DOUBLE	17+09.93 CL	33.00'	10.29
16	11+47.36 10.00' LT.	DOUBLE	11+56.74 CL	33.00'	84.80
17	11+47.36 10.00' LT.	DOUBLE	13+88.64 CL	33.00'	95.08


SAS CURVE DATA TABLE					
NUMBER	PI STA.	DELTA	TANGENT	ARC	RADIUS
C2	13+50.93	17°16'0.2"	87.76'	174.19'	578.00'

WATERLINE CURVE DATA TABLE					
NUMBER	PI STA.	DELTA	TANGENT	ARC	RADIUS
C4	13+52.45	17°16'0.2"	89.28'	177.20'	588.00'

SAS TANGENT TABLE				WATERLINE TANGENT TABLE	
NUMBER	BEARING	DISTANCE		NUMBER	BEARING
T7	N65°08'16"W	406.25'		T15	N55°08'16"W
T8	N47°52'15"W	118.03'		T16	N47°52'15"W
T9	N47°52'15"W	194.51'			

UTILITY CROSSING & CLEARANCE		
#1	WATERLINE INV 6205.25	CLEARANCE= 4.72'
	SAS TP	6200.53

- NOTES**
- THE CONTRACTOR SHALL FIELD VERIFY ALL EXISTING UTILITY LOCATIONS AND NOTIFY THE ENGINEER IMMEDIATELY OF ANY DISCREPANCIES.
 - ALL CURB RETURN RADI(SHALL BE 25' TO FACE OF CURB UNLESS OTHERWISE SPECIFIED.
 - ALL CURVE DATA AND DIMENSIONS REFER TO FACE OF CURB UNLESS OTHERWISE SPECIFIED.
 - GRADE ELEVATIONS, WHERE NOTED, ARE FOR TOP OF STANDARD CURB UNLESS OTHERWISE SPECIFIED.
 - CONTRACTOR IS TO INSTALL A 4"x4"x5' POST AND END AT THE END OF EACH SANITARY SEWER SERVICE.
 - CONTRACTOR IS RESPONSIBLE FOR REPAIR AND/OR REPLACEMENT OF ALL UTILITY CONDUITS AND EXISTING LINES.
 - ANY ADDITIONAL GRADING REQUIRED TO MATCH PROPOSED STREET GRADES SHALL BE INCIDENTAL TO PAVING ITEMS.
 - CONTRACTOR SHALL PROVIDE THE INSPECTORS, (CITY AND PRIVATE) WITH THE PROPOSED HYDROSTATIC TESTING PLAN. THE PLAN MUST BE APPROVED BEFORE TESTING OPERATIONS BEGIN.
 - CONTRACTOR SHALL PARK EQUIPMENT AND VEHICLES, AS NOT TO INTERFERE WITH NORMAL ACTIVITIES OF RESIDENTS OR OTHER CONTRACTORS ON SITE.
 - ANY DAMAGE TO THE EXISTING FACILITIES (CURB AND GUTTER, PAVEMENT, CONDUITS, LANDSCAPING, UTILITY LINES, ETC.) DURING CONSTRUCTION SHALL BE REPLACED AT THE CONTRACTORS EXPENSE.
 - REMOVAL OF THE EXISTING CURB AND GUTTER SHALL BE AS PER COA STD. DWG. 2415 (S&WCUT ONLY).
 - WHEEL CHAIR RAMPS SHALL BE CONSTRUCTED PRIOR TO ACCEPTANCE OF CURB AND GUTTER.

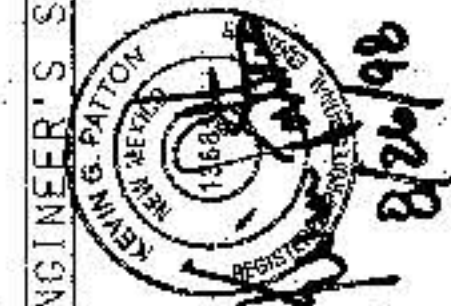

RESTRAINED JOINT TABLE				
MECHANICAL JOINTS	LENGTH OF RESTRAINED JOINTS FROM EACH SIDE OF MJ LISTED			
	(4")	(6")	(8")	(16")
11.25" H BEND	1'	2'	3'	5'
22.50" H BEND	2'	4'	5'	10'
45" H BEND	6'	8'	11'	21'
90" H BEND	15'	20'	26'	50'
DATE VALVE	46'	55'	72'	---
DIRTY VALVE	---	---	---	108'
CAP	46'	55'	72'	108'

- NOTES:**
- ALL MECHANICAL JOINTS SHALL BE RESTRAINED AT THE FITTING.
 - THE CONTRACTOR SHALL PROVIDE A MIN. PIPE LENGTH OF 20' FROM ALL MECHANICAL JOINTS. ALL PIPE JOINTS WITHIN 20' OF A MJ SHALL BE RESTRAINED AT THE CONTRACTORS EXPENSE.
 - THE CONTRACTOR SHALL RESTRAIN ALL PIPE JOINTS IN THE SPECIFIED DISTANCE LISTED IN THE TABLE ABOVE. (SEE NOTE 2 ABOVE).
 - THE CONTRACTOR SHALL RESTRAIN ALL FIRE HYDRANT JOINTS FROM THE TEE ON THE MAIN TO THE FIRE HYDRANT FLANGE.


BOHANNAN-HUSTON INC.
ENGINEERS • PLANNERS • PHOTOGRAMMETRISTS • SURVEYORS • LANDSCAPE ARCHITECTS
ALBUQUERQUE LAS CRUCES SANTA FE

CITY OF ALBUQUERQUE
PUBLIC WORKS DEPARTMENT
ENGINEERING DEVELOPMENT GROUP

THE OVERLOOK AT HIGH DESERT
UTILITY PLAN & PROFILE
PAPER FLOWER PLACE

DESIGN REVIEW COMMITTEE	CITY ENGINEER APPROVAL	NO. DATE/YY	NO. DATE/YY
LAST DESIGN UPDATE			

CITY PROJECT NO.	571285	ZONE MAP NO.	E-23	SHEET	16	OF	20
------------------	--------	--------------	------	-------	----	----	----

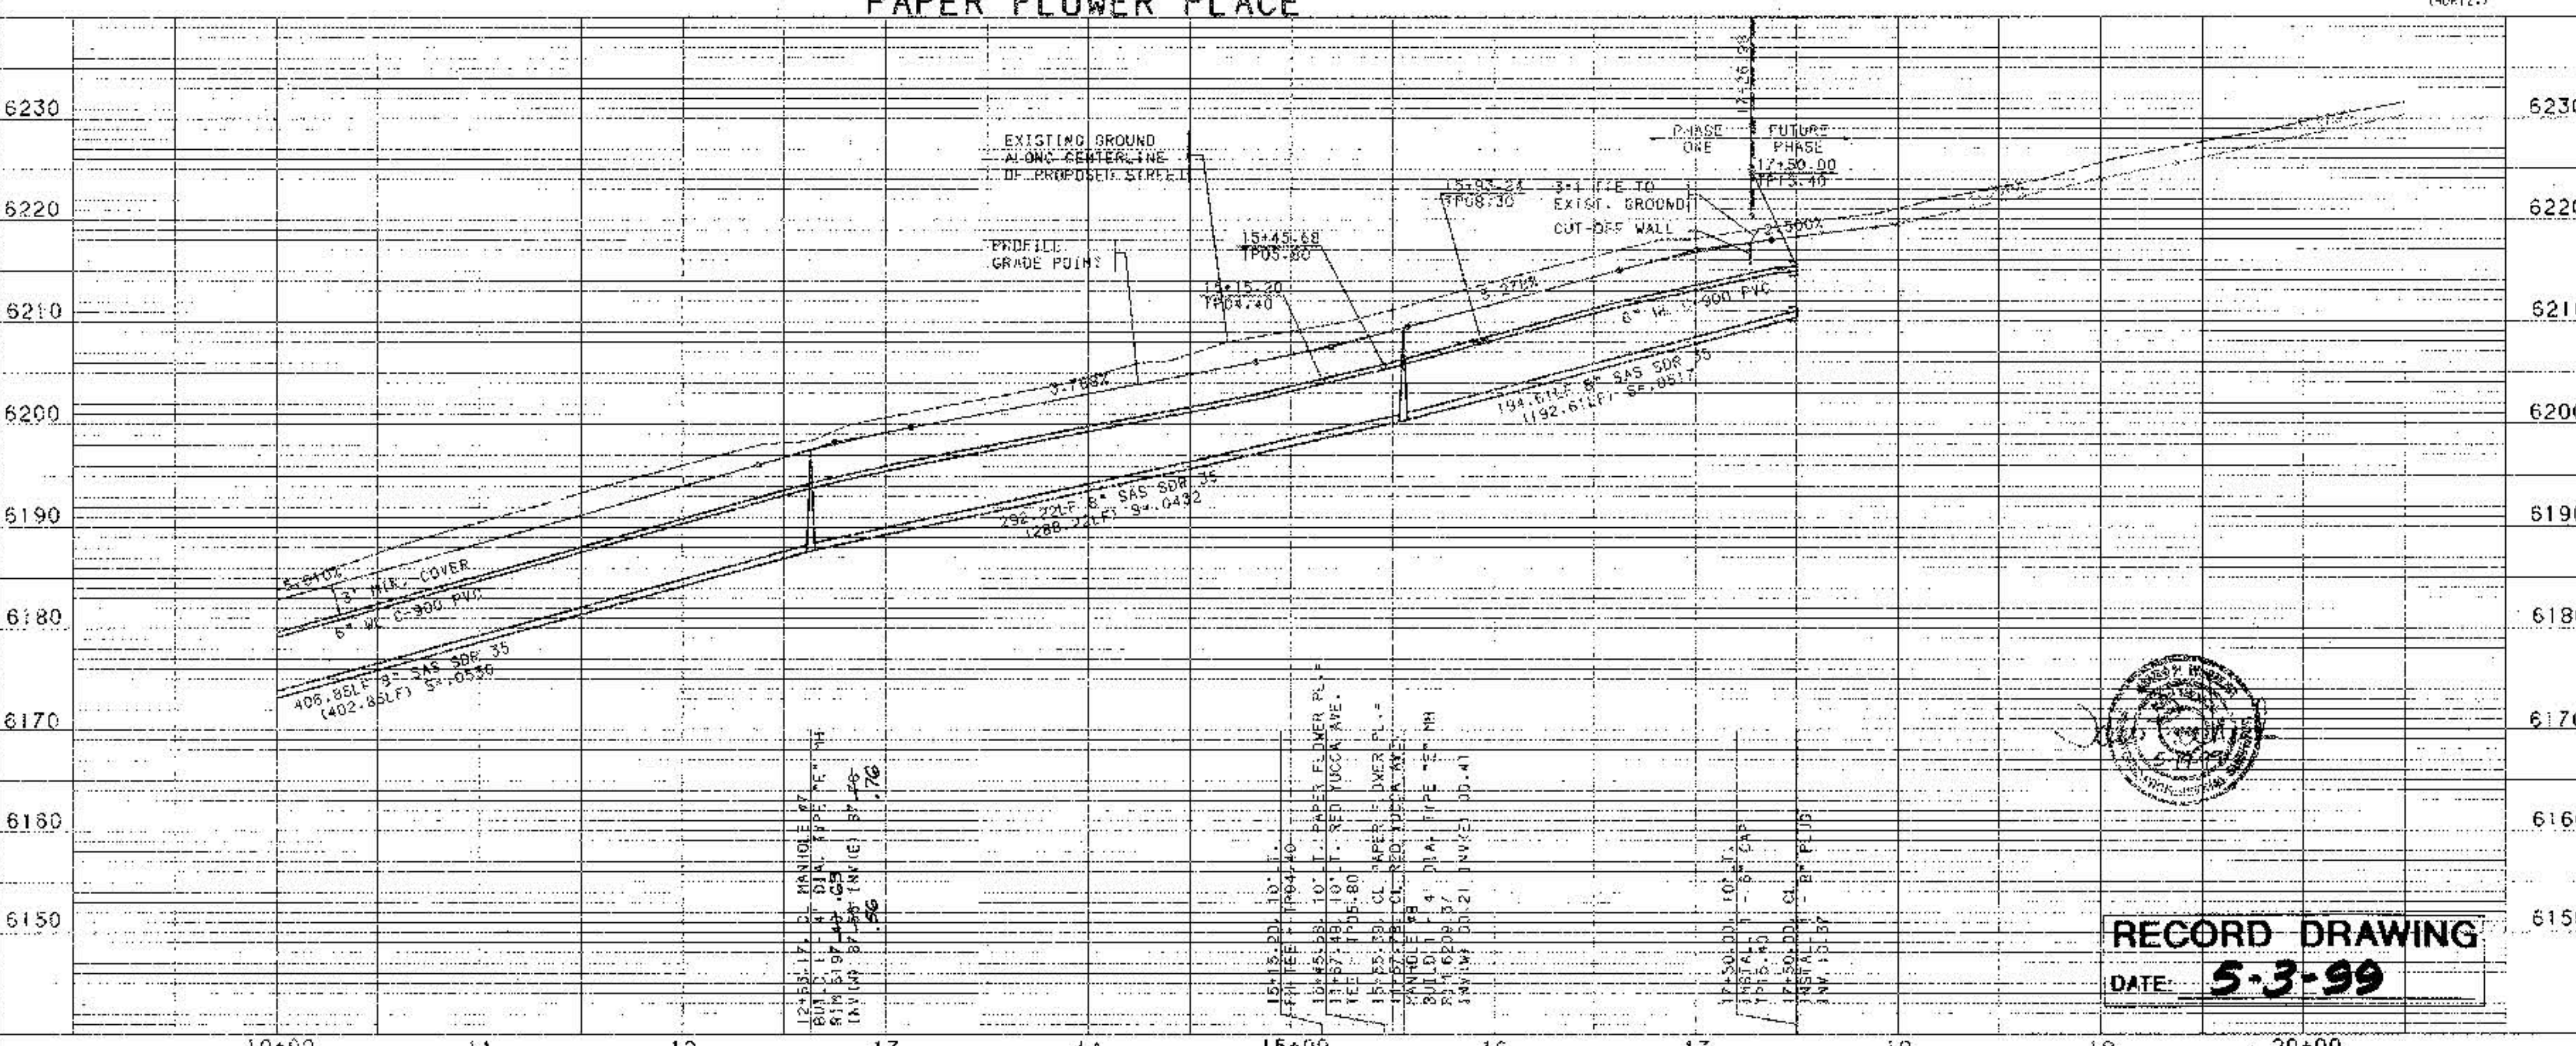

RECORD DRAWING
DATE: 5-3-99

NUMBER	PI STA.	DELTA	TANGENT	ARC	RADIUS
C1	2+98.07	26°16'27.4"	64.18'	126.11'	275.00'
C3	1+01.56	13°20'8.9"	32.15'	64.01'	275.00'
C4	2+69.79	24°26'26.0"	75.48'	148.65'	350.00'


NUMBER	BEARING	DISTANCE
T1	N03°50'16"W	133.89'
T3	S02°46'33"E	29.42'
T4	N16°06'43"W	17.77'

NUMBER	BEARING	DISTANCE
T2	N03°50'16"W	143.69'
T5	S02°46'33"E	19.51'
T6	N16°06'43"W	17.77'

NUMBER	PI STA.	DELTA	TANGENT	ARC	RADIUS
C2	2+95.74	26°16'27.4"	61.85'	121.52'	285.00'
C5	1+50.39	13°20'8.9"	30.96'	61.66'	285.00'
C6	2+92.16	25°18'15.0"	60.87'	159.10'	289.00'

LOT	STATION & OFFSET	TYPE	STATION & OFFSET	SAS LENGTH	TOP OF PIPE AT PLUG
28	2+91.74 TO 10.00' LT.	SINGLE	2+72.91 CL	33.00'	61.93
58	3+53.85 TO 10.00' LT.	SINGLE	2+99.06 CL	33.00'	60.42

LOT	STATION & OFFSET	TYPE	STATION & OFFSET	SAS LENGTH	TOP OF PIPE AT PLUG (W/RISER)
17	2+37.47 TO 10.00' LT.	DOUBLE	SEE SHEET 14 OF 20	33.00'	84.05 (4')
18	3+52.59 TO 10.00' LT.	SINGLE	3+59.98 CL - MH	46.43'	82.89
22	2+55.42 TO 10.00' LT.	DOUBLE	2+67.55 CL	33.00'	80.09
23			SEE SHEET 14 OF 20		

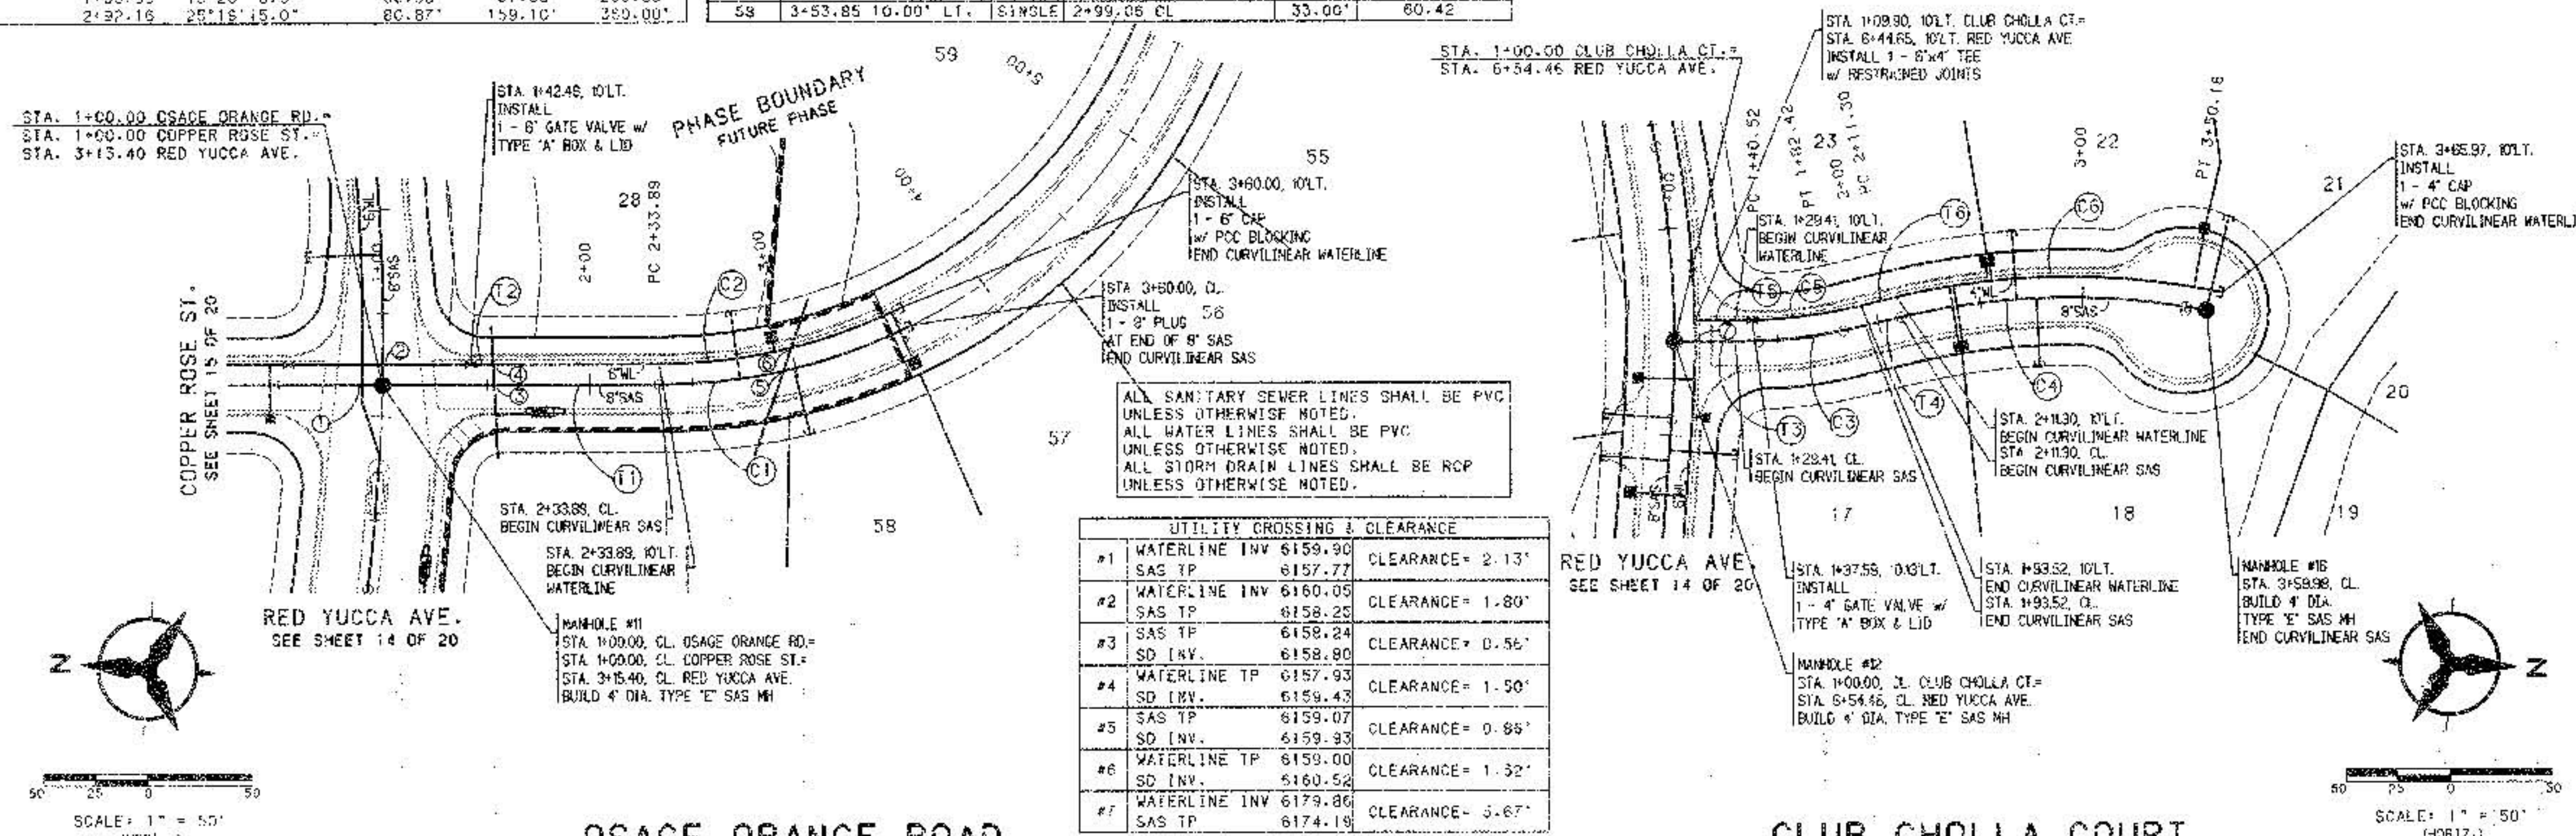

NUMBER	WATERLINE INV	SAS TP	CLEARANCE
#1	6159.90	6157.77	CLEARANCE = 2.13'
#2	6160.05	6158.25	CLEARANCE = 1.80'
#3	6158.24	6158.90	CLEARANCE = 0.56'
#4	6157.93	6159.43	CLEARANCE = 1.50'
#5	6159.93	6159.93	CLEARANCE = 0.85'
#6	6159.00	6160.52	CLEARANCE = 1.32'
#7	6179.86	6174.19	CLEARANCE = 3.67'

- NOTES**
1. THE CONTRACTOR SHALL FIELD VERIFY ALL EXISTING UTILITY LOCATIONS AND NOTIFY THE ENGINEER IMMEDIATELY OF ANY DISCREPANCIES.
 2. ALL CURB RETURN RADII SHALL BE 25' TO FACE OF CURB UNLESS OTHERWISE SPECIFIED.
 3. ALL CURVE DATA AND DIMENSIONS REFER TO FACE OF CURB UNLESS OTHERWISE SPECIFIED.
 4. GRADE ELEVATIONS, WHERE NOTED, ARE FOR TOP OF STANDARD CURB UNLESS OTHERWISE SPECIFIED.
 5. CONTRACTOR IS TO INSTALL A 4"x4"x5" POST AND END AT THE END OF EACH SANITARY SEWER SERVICE.
 6. CONTRACTOR IS RESPONSIBLE FOR REPAIR AND/OR REPLACEMENT OF ALL UTILITY CONDUITS AND EXISTING LINES.
 7. ANY ADDITIONAL GRADING REQUIRED TO MATCH PROPOSED STREET GRADES SHALL BE INCIDENTAL TO PAVING ITEMS.
 8. CONTRACTOR SHALL PROVIDE THE INSPECTORS (CITY AND PRIVATE) WITH THE PROPOSED HYDROSTATIC TESTING PLAN. THE PLAN MUST BE APPROVED BEFORE TESTING OPERATIONS BEGIN.
 9. CONTRACTOR SHALL PARK EQUIPMENT AND VEHICLES AS NOT TO INTERFERE WITH NORMAL ACTIVITIES OF RESIDENTS OR OTHER CONTRACTORS ON SITE.
 10. ANY DAMAGE TO THE EXISTING FACILITIES (CURB AND GUTTER, PAYMENT, CONDUITS, LANDSCAPING, UTILITY LINES, ETC.) DURING CONSTRUCTION SHALL BE REPLACED AT THE CONTRACTORS EXPENSE.
 11. REMOVAL OF THE EXISTING CURB AND GUTTER SHALL BE AS PER CDA STD. DWG. 2415 (S&M CUT DML).
 12. WHEEL CHAIR RAMPS SHALL BE CONSTRUCTED PRIOR TO ACCEPTANCE OF CURB AND GUTTER.

MECHANICAL JOINTS	LENGTH OF RESTRAINED JOINTS FROM EACH SIDE OF MJ LISTED (4")	(8")	(16")
11.25" H BEND	1'	2'	3'
22.50" H BEND	2'	4'	5'
45" H BEND	4'	8'	11'
90" H BEND	15'	20'	26'
GATE VALVE	48'	55'	72'
BTRFLY VALVE	48'	55'	72'
CAP	48'	55'	72'

- NOTES:**
1. ALL MECHANICAL JOINTS SHALL BE RESTRAINED AT THE FITTING.
 2. THE CONTRACTOR SHALL PROVIDE A MIN. PIPE LENGTH OF 20' FROM ALL MECHANICAL JOINTS. ALL PIPE JOINTS WITHIN 20' OF A MJ SHALL BE RESTRAINED AT THE CONTRACTORS EXPENSE.
 3. THE CONTRACTOR SHALL RESTRAIN ALL PIPE JOINTS IN THE SPECIFIED DISTANCE LISTED IN THE TABLE ABOVE. (SEE NOTE 2 ABOVE).
 4. THE CONTRACTOR SHALL RESTRAIN ALL FIRE HYDRANT JOINTS FROM THE IEE ON THE MAIN TO THE FIRE HYDRANT FLANGE.

RECORD DRAWING
DATE: 5-3-99


BOHANNAN-HUSTON INC.
ENGINEERS • PLANNERS • PHOTOGRAMMETRISTS • SURVEYORS • LANDSCAPE ARCHITECTS
ALBUQUERQUE LAS CRUCES SANTA FE

CITY OF ALBUQUERQUE
PUBLIC WORKS DEPARTMENT
ENGINEERING DEVELOPMENT GROUP

THE OVERLOOK AT HIGH DESERT
UTILITY PLAN & PROFILE
OSAGE ORANGE ROAD - CLUB CHOLLA COURT


DESIGN REVIEW COMMITTEE	CITY ENGINEER APPROVAL	NO. DATE	REMARKS	BY

CITY PROJECT NO.	ZONE MAP NO.	SHEET	OF
571285	E-23	17	20

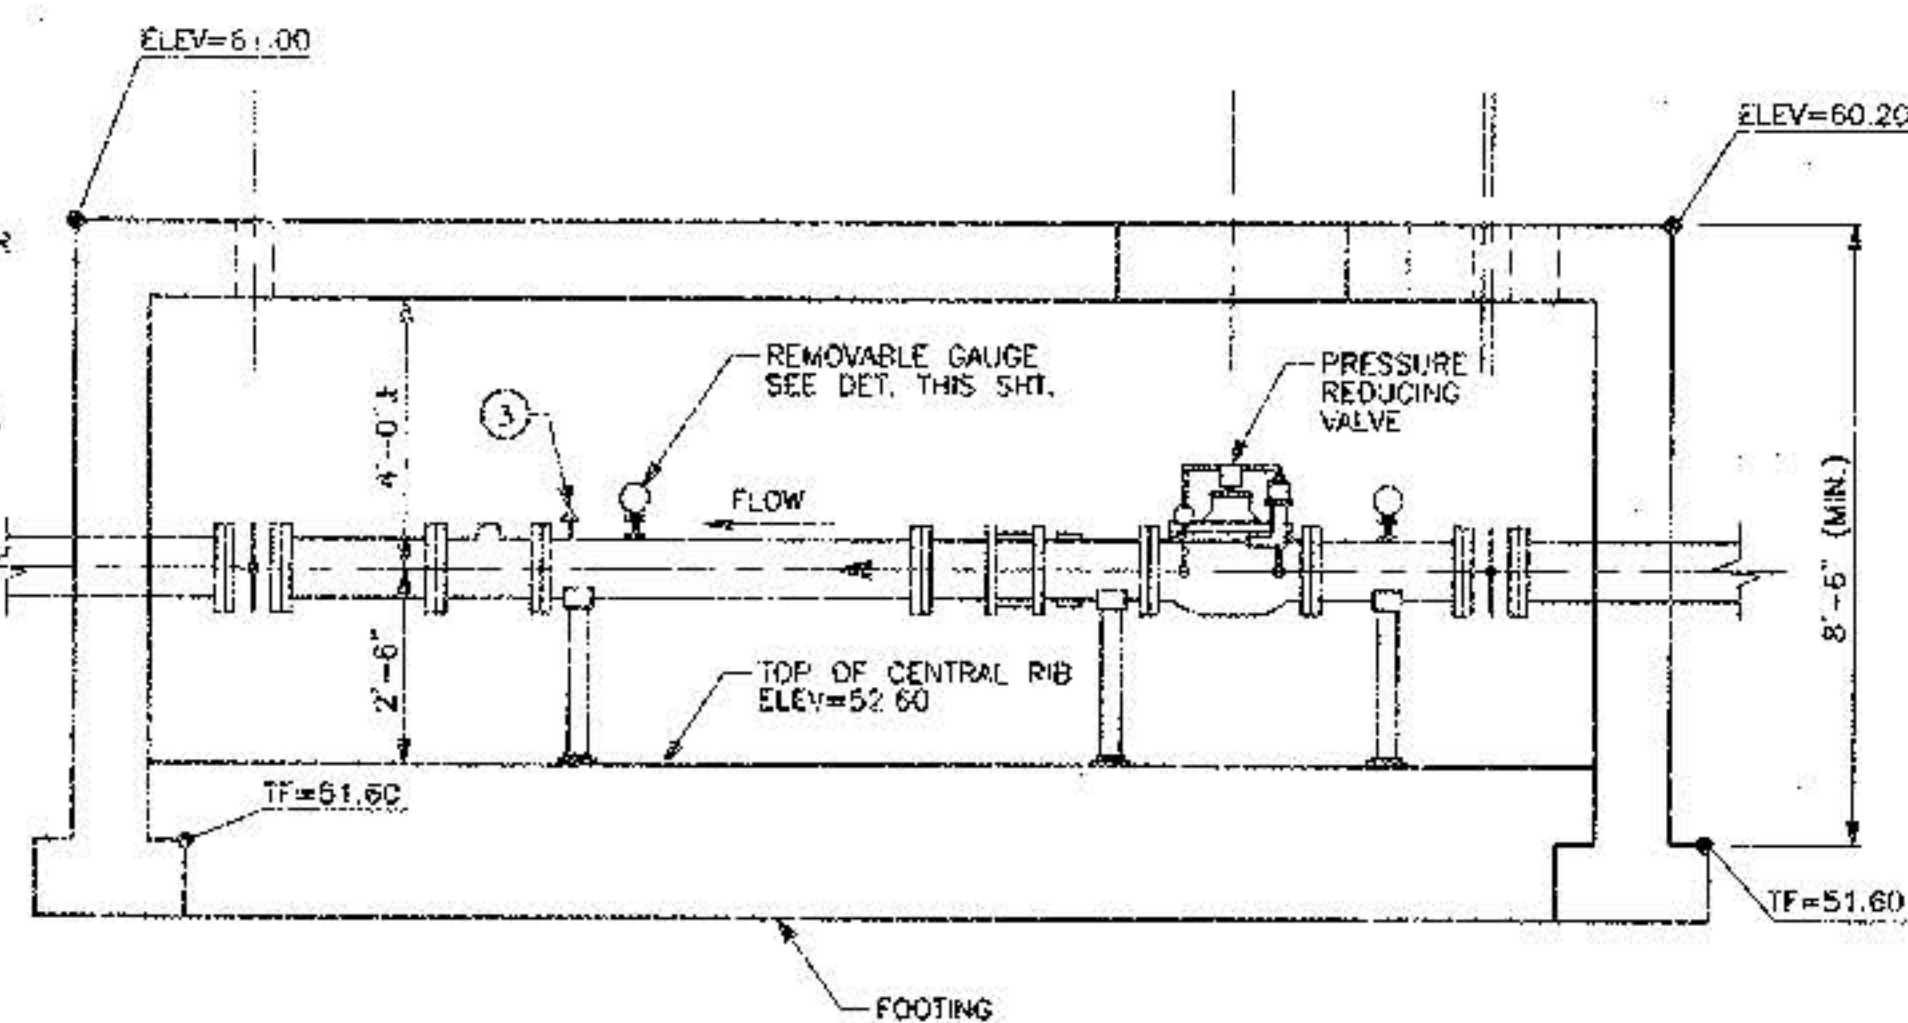


MECHANICAL PLAN
NOT TO SCALE


MECHANICAL SECTION "A-A"

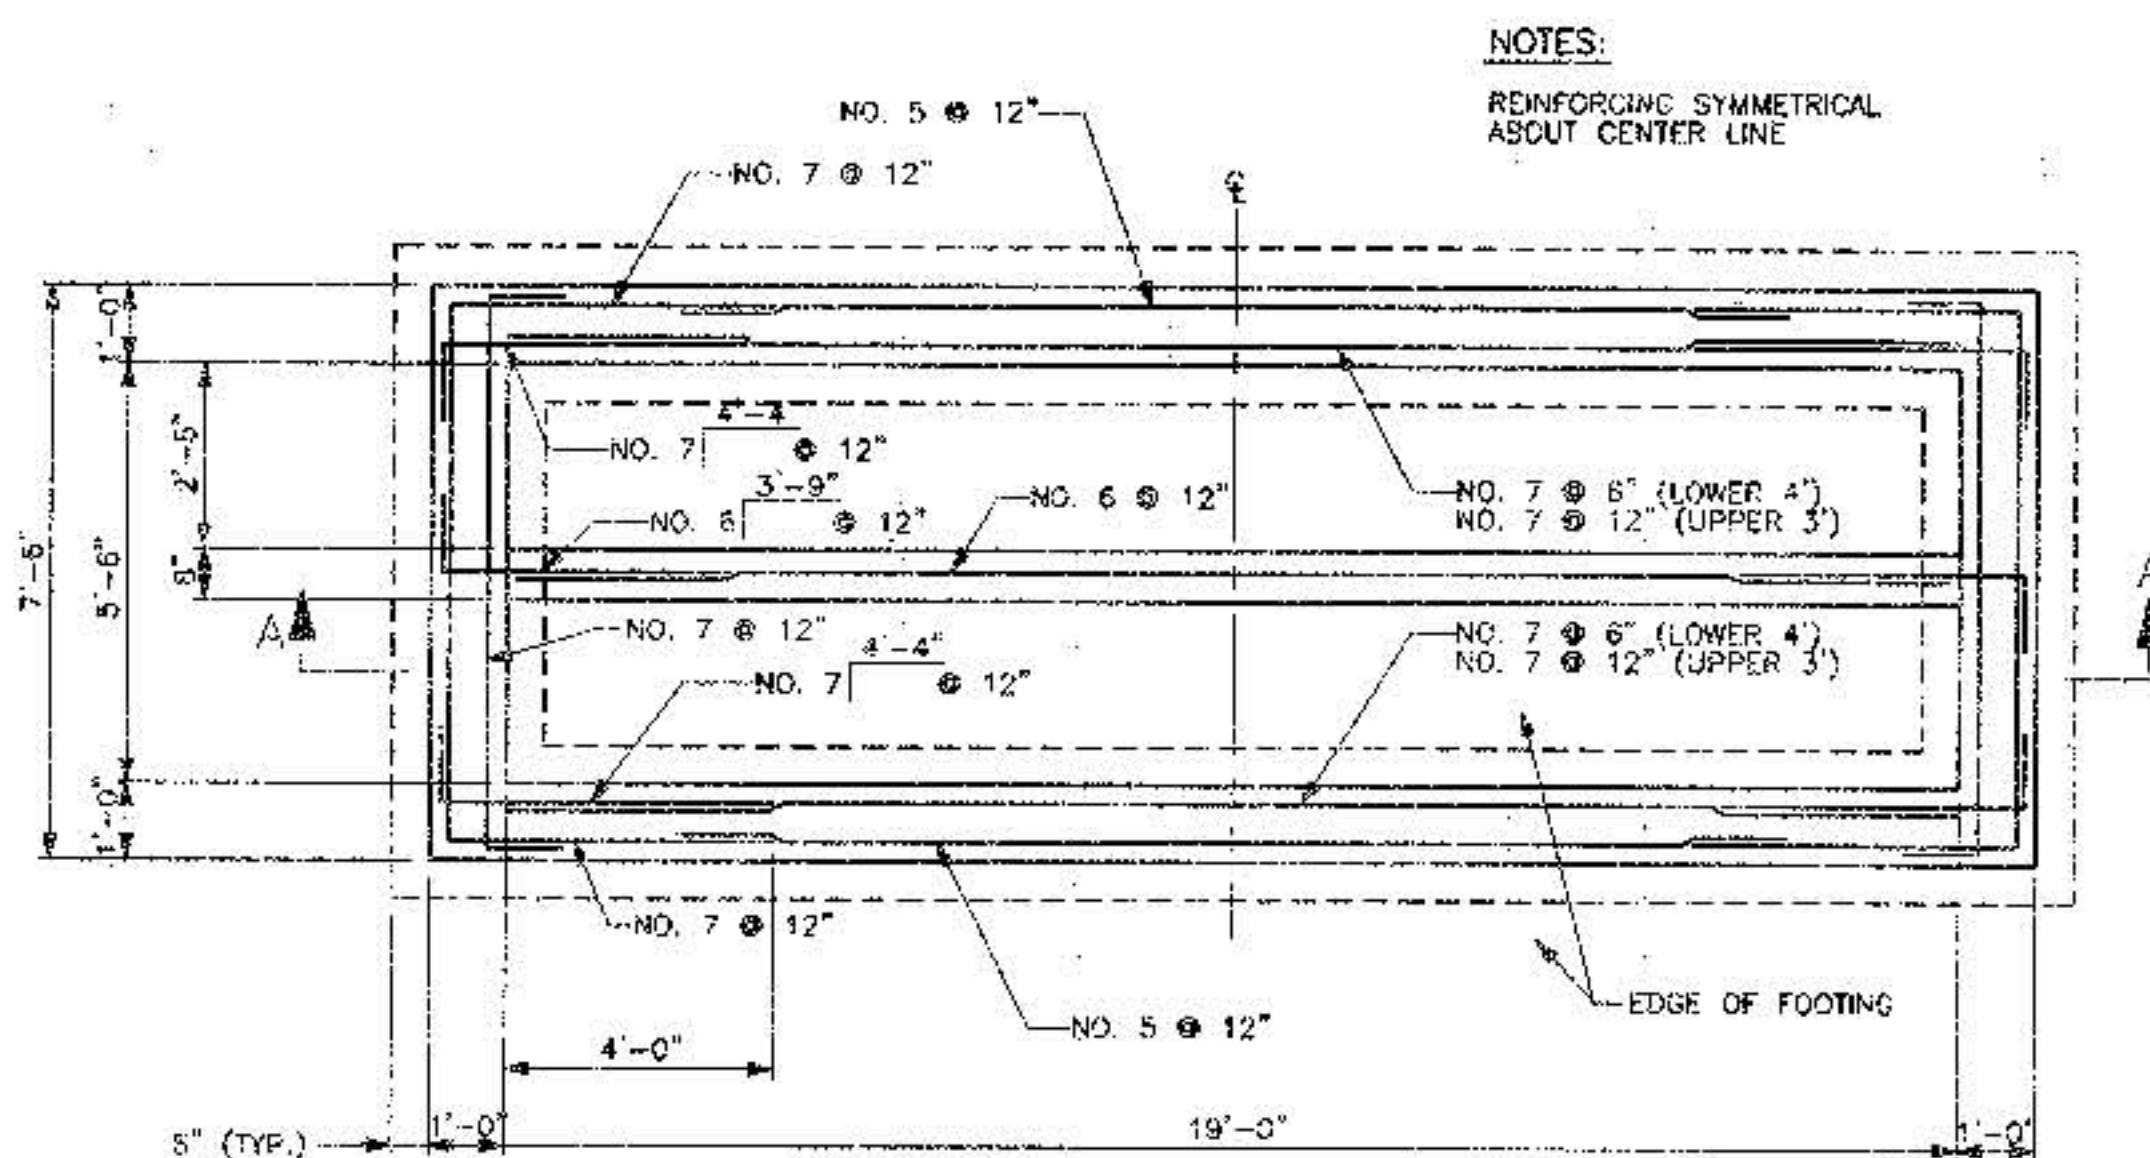


FLOOR PLAN
NOT TO SCALE

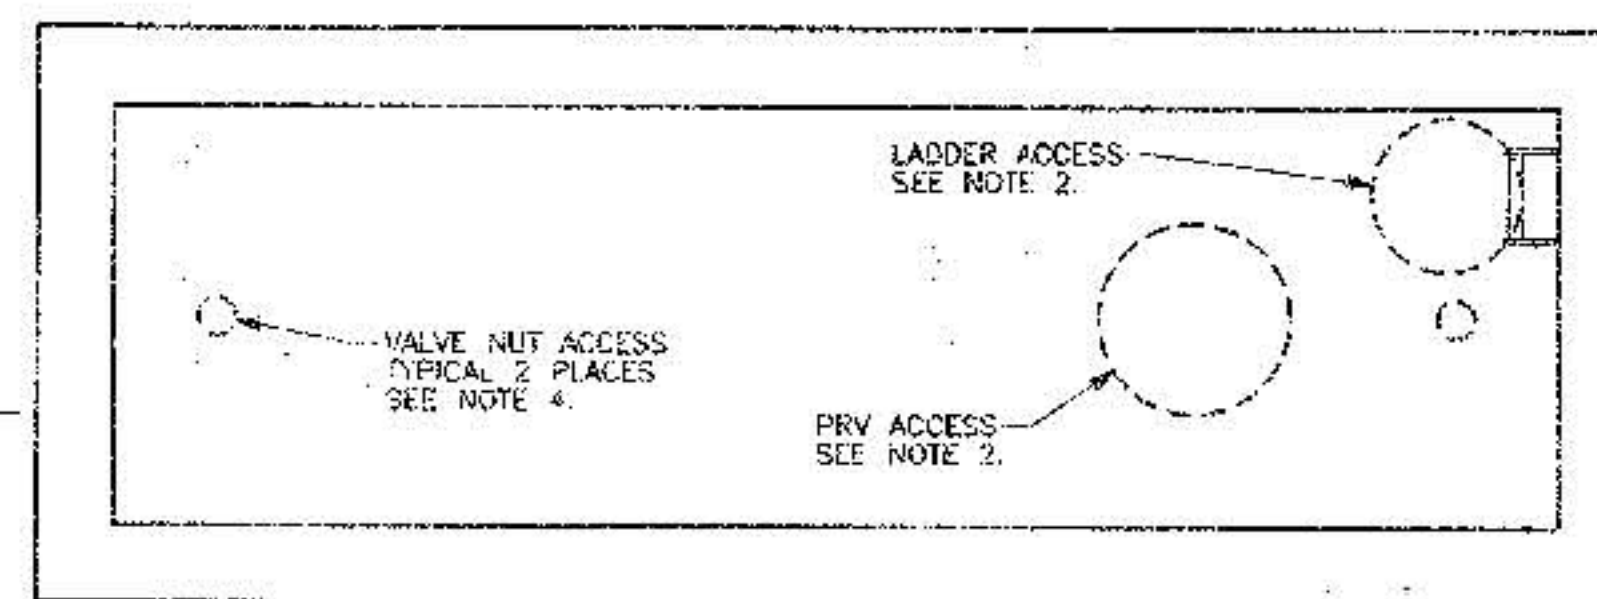

ROOF PLAN
NOT TO SCALE

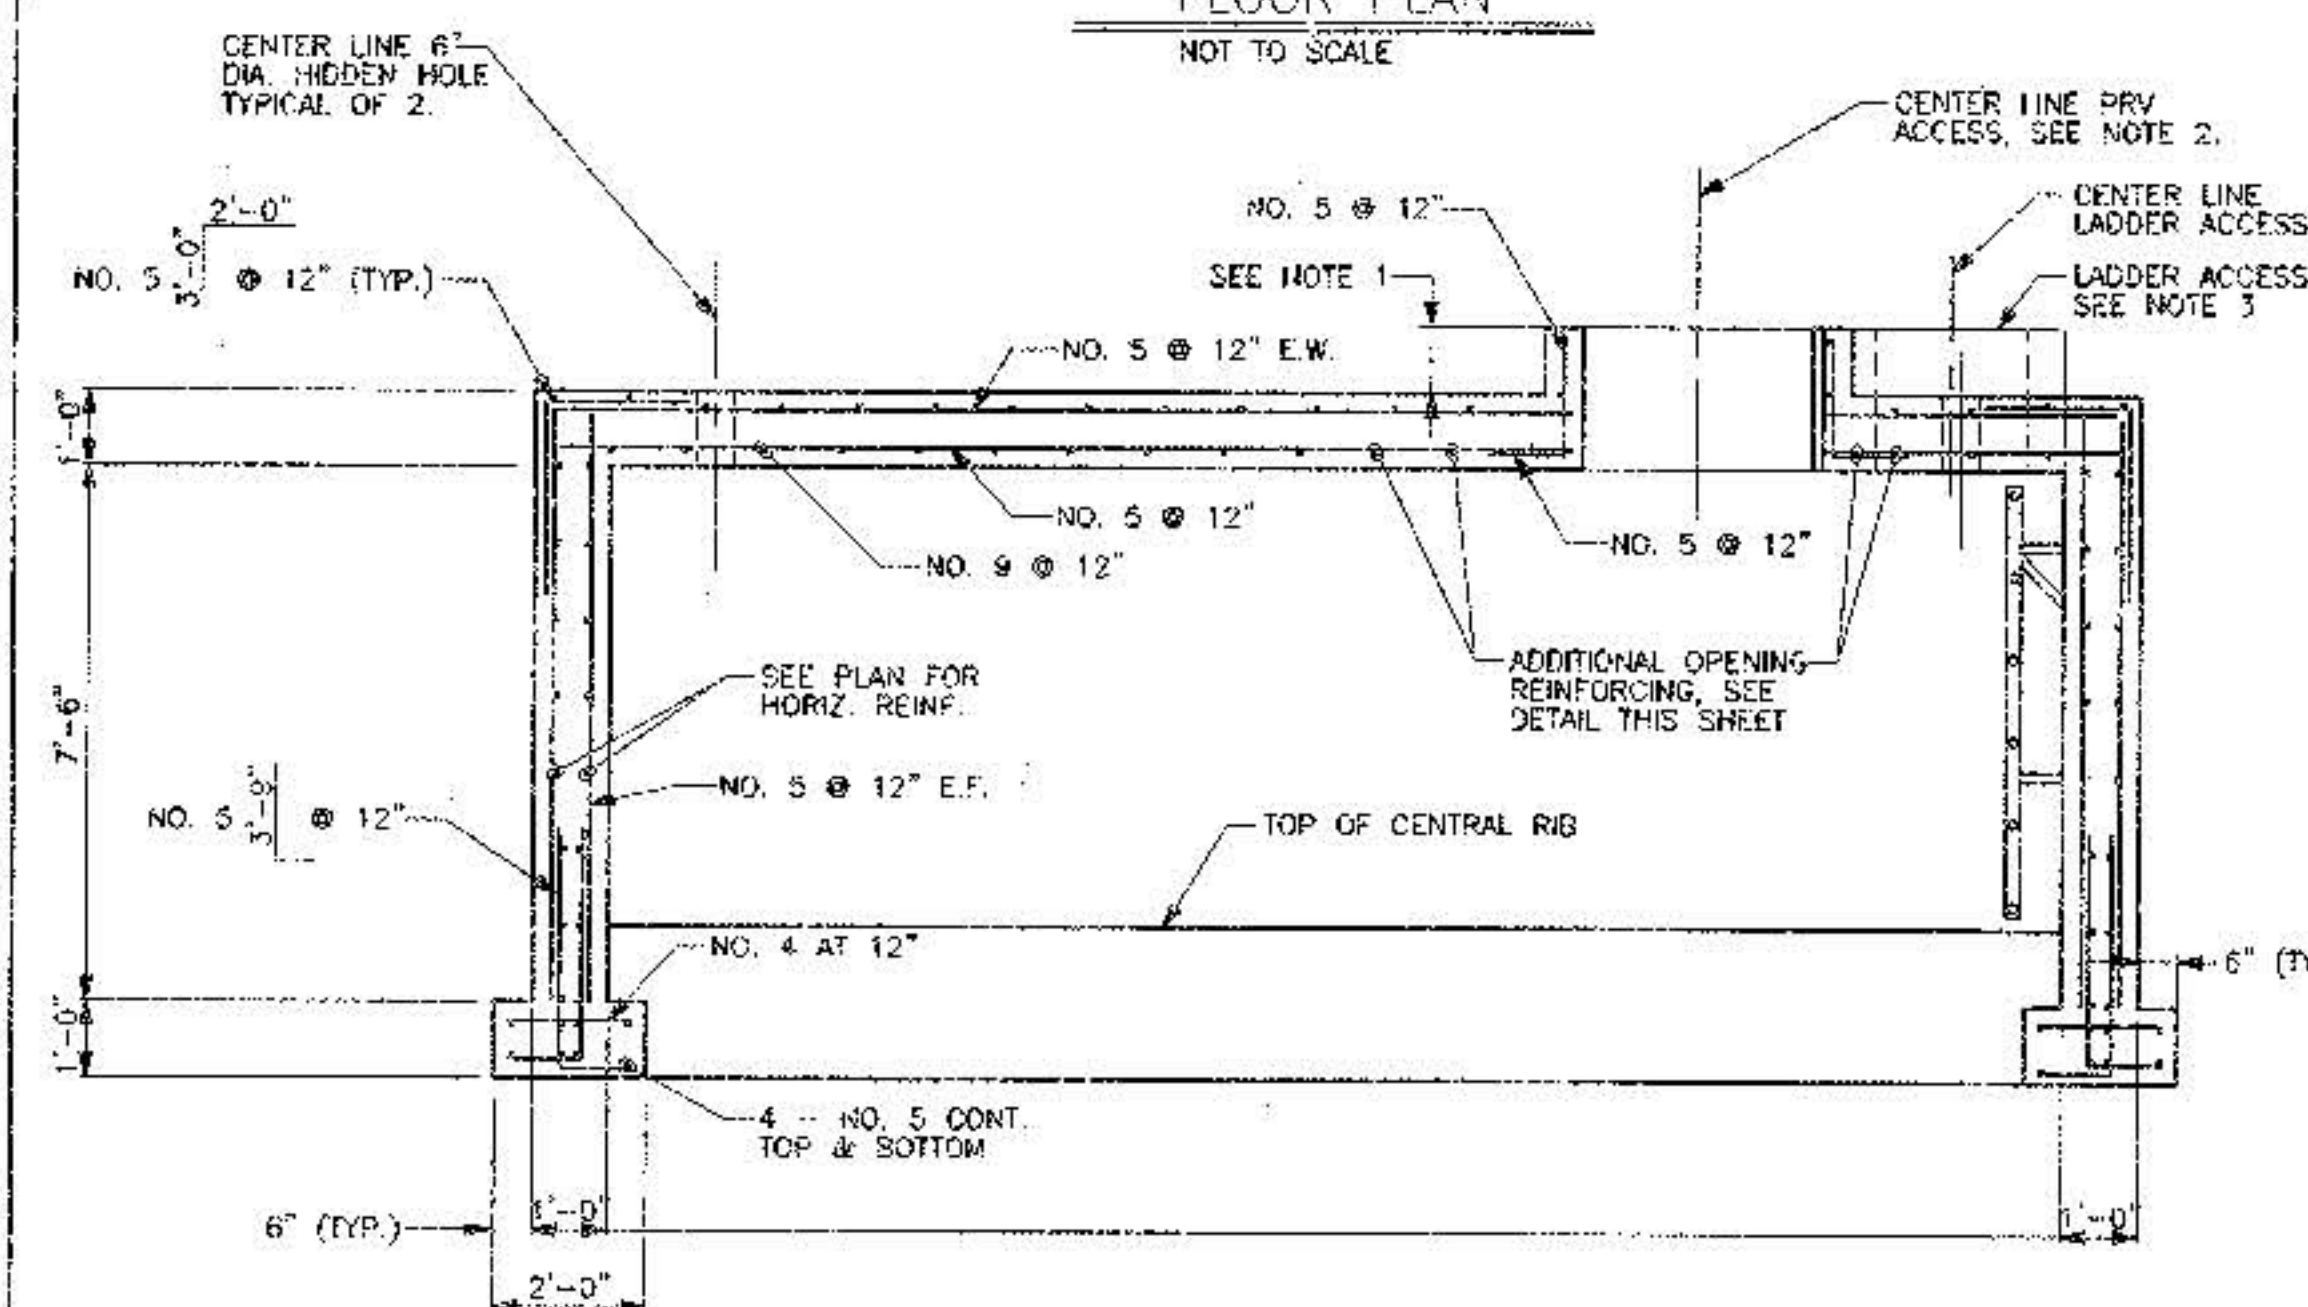


STRUCTURAL SECTION "A-A"
NOT TO SCALE

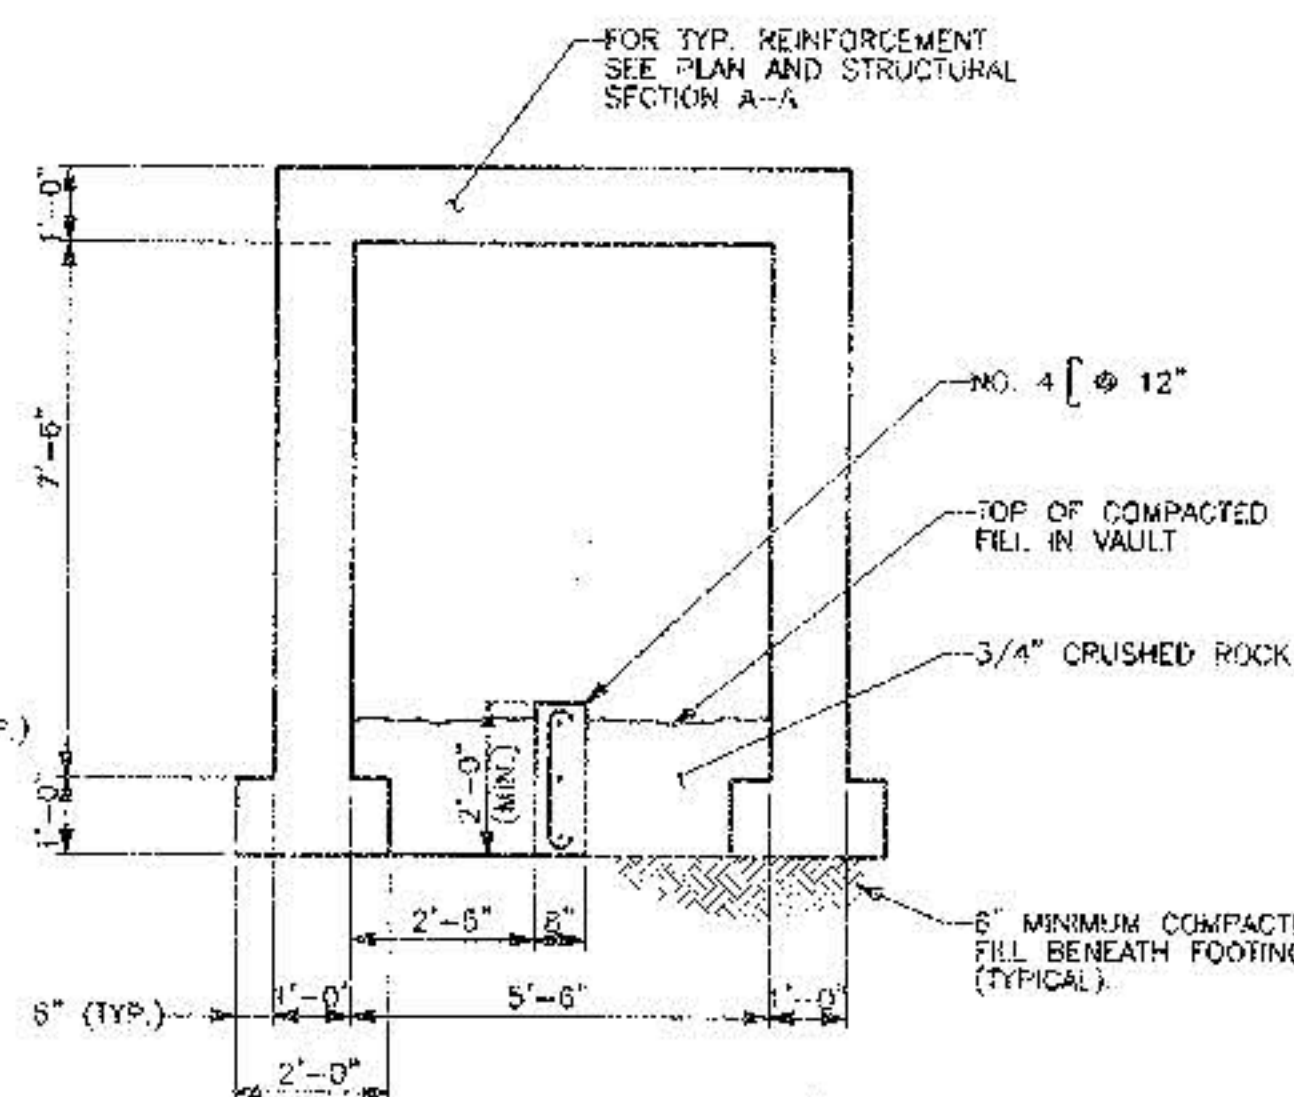

SECTION "B-B"


NOT TO SCALE

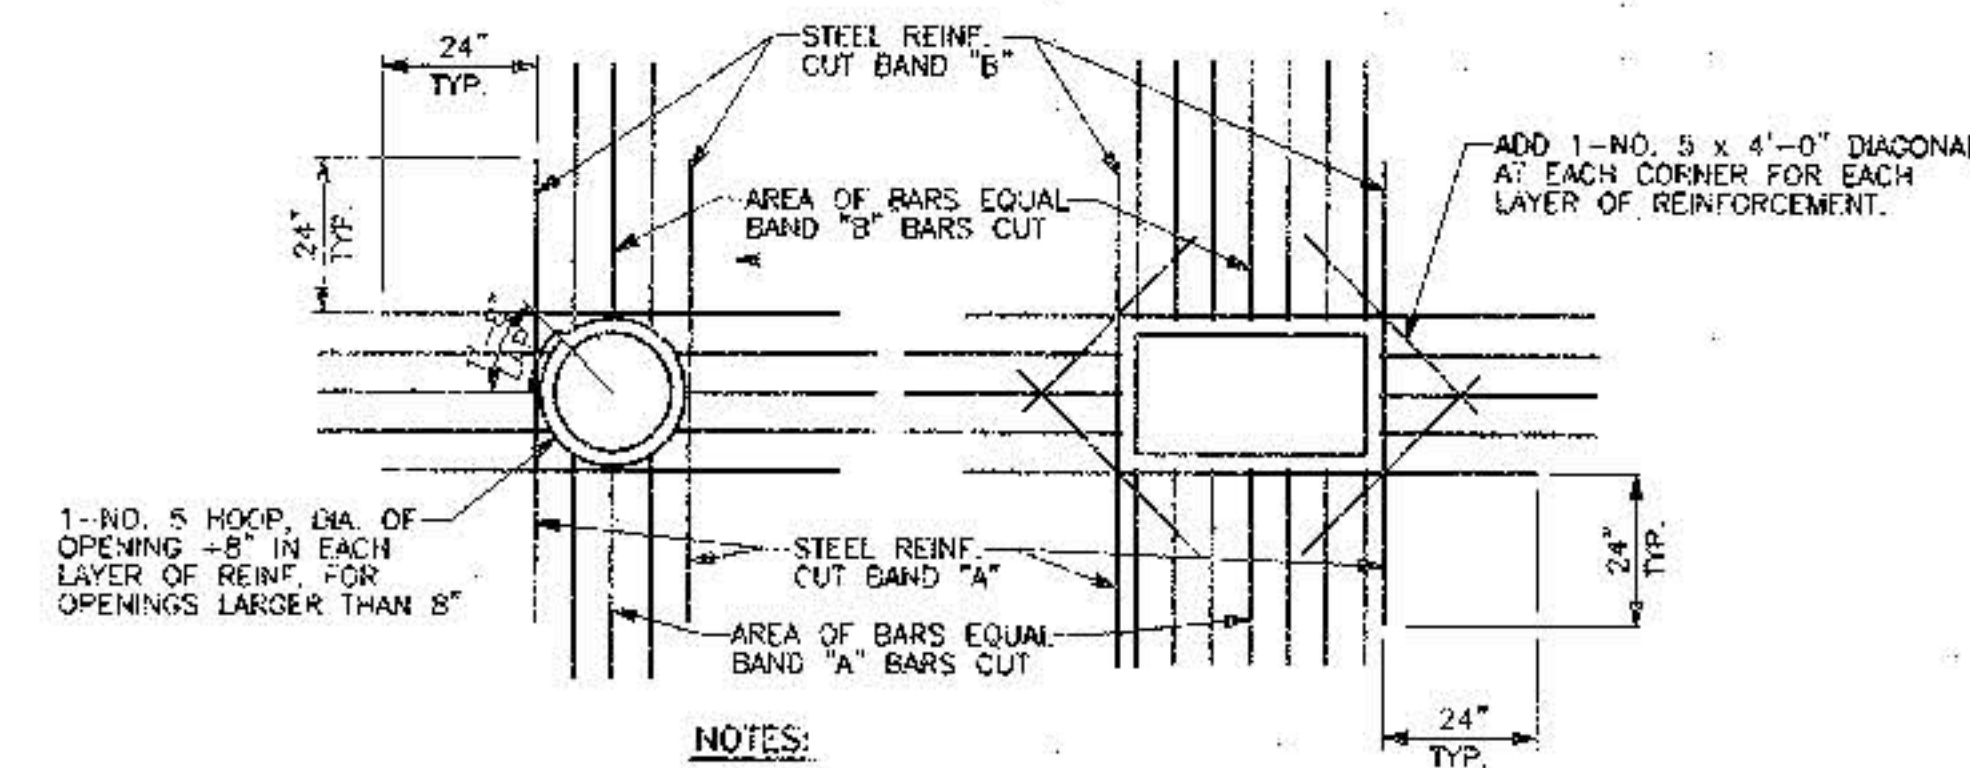

NOTES:

1. TYPICAL FOR ALL OPENINGS IN CONCRETE WALLS AND SLABS UNLESS INDICATED OTHERWISE ON PLANS.
2. DO NOT WELD REINFORCEMENT TO PIPE SLEEVES OR INSERTS.

OPENING REINFORCING DETAIL
NOT TO SCALE

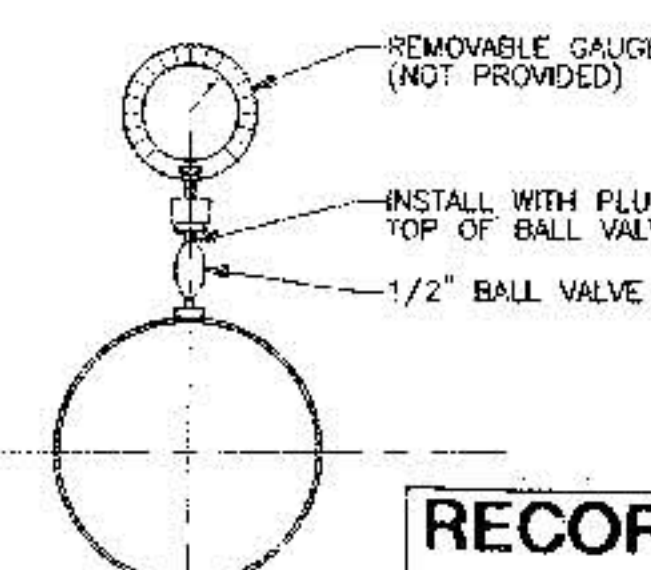



REMOVABLE GAUGE DETAIL
NOT TO SCALE

- 1 CONTRACTOR SHALL SET VAULT ROOF ELEVATION SUCH THAT WHEN USING PRECAST CONCRETE MANHOLE RINGS, THE MANHOLE COVER MATCHES EXISTING PAVEMENT GRADE.
- 2 PRE ACCESS OPENING SHALL BE 36" WITH PRECAST CONCRETE MANHOLE RINGS AND NEENAH R-1795-M MANHOLE BASE AND LID. EQUAL INSTALLATION OF ADJUSTMENT RINGS AND COLLAR SHALL BE SIMILAR TO CITY STD. DWG. 2101. MANHOLE TYPE "C". OPENING SHALL BE DIRECTLY OVER CENTER OF PREV.
- 3 LADDER ACCESS OPENING SHALL BE 24" WITH NEENAH R-1795-H MANHOLE BASE AND LID, OR EQUAL. INSTALL ACCORDING TO NOTE 2.
- 4 VALVE HUT ACCESS SHALL CONSIST OF CITY STD. VALVE BOX AND RING, MATCHING FINAL GRADE, MOUNTED ON 6" DIA. CORRUGATED GALV. PIPE, EXTENDING TO TOP OF ROOF. 6" DIA. CORRUGATED GALV. PIPE TO BE EMBEDDED IN ROOF, CENTER MATCHING CENTER OF 12" PIPE. OPENING SHALL BE DIRECTLY OVER VALVE OPERATING NUT.
- 5 CONTRACTOR AT HIS OPTION, MAY ELECT TO USE PRECAST CONCRETE ELEMENTS IN VAULT CONSTRUCTION. THESE VAULT ELEMENTS SHALL BE DESIGNED FOR THE FOLLOWING LOADS:
H-20 TRAFFIC LOADING AND 2 FT. OF SOIL LOAD ON ROOF SLAB.
72 PCF EQUIVALENT LOADING ON CENTRAL RIB.
PIPE AND VALVING LOADING ON CENTRAL RIB.
2000 PSF FOOTING LOAD.
- 6 BEFORE FABRICATION, VAULT MFR. SHOP DRAWINGS WITH COMPLETE STRUCTURAL AND FOUNDATION CALCULATIONS SHALL BE SUBMITTED TO THE ENGINEER AS SPECIFIED IN THE GENERAL CONDITIONS. VAULT DESIGN SHALL BE IN ACCORDANCE WITH AGC COMMITTEE REPORT 350.

1. VALVE DIMENSIONS AS REQUIRED BY MANUFACTURER. PRATT BFV 4" LAYING LENGTH SHALL BE ACCORDING TO AWWA STANDARDS.
2. FLOW DIMENSIONS AS REQUIRED BY MANUFACTURER. CLA-VAL MODEL 90-48 W/ LOW FLOW BY-PASS.
3. AIR / VAC VALVE SHALL BE ATTACHED TO HIGHEST POINT IN PIPE PROFILE.
4. FLOW METERS SHALL BE FLANGED TUBE, PROPELLER TYPE. LIQUID FLOW METERS, AND SHALL INCLUDE INTEGRALLY MOUNTED SIX- (OR MORE) DIGIT TOTALING REGISTERS READING IN GALLONS. METER ACCURACY SHALL BE WITHIN 2 PERCENT OF FLOW. MINIMUM OVER A 10:1 FLOW RANGE. MINIMUM METER DIMENSION AS REQUIRED BY MANUFACTURER. SPARKLING MODEL PDS-102. LAYING LENGTH 28".

ENGINEER'S SEAL	SURVEY INFORMATION		BENCH MARKS		AS-BUILT INFORMATION	
	FIELD NOTES					
	NO.	BY	DATE			
NO.	DATE	REMARKS				
		REVISIONS				
		DESIGN				
DESIGNED BY: K.G.P.		DATE: 8/08				
DRAWN BY: B.S.		DATE: 8/08				
			MICRO-FILM INFORMATION			
			RECORDED BY		DATE	
					NO.	

BHI PROJECT NUMBER: 005;[C95307A2440.ACAD
FILENAME PRV_DT1.S.DWG

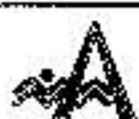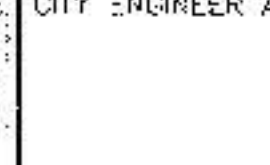BOHANNAN-HUSTON INC.		SURVEYORS LANDSCAPE ARCHITECTS	
ENGINEERS PLANNERS PHOTOGRAMMETRISTS		ALBUQUERQUE LAB CRUCES SANTA FE	
 CITY OF ALBUQUERQUE PUBLIC WORKS DEPARTMENT ENGINEERING DEVELOPMENT GROUP			
TITLE: THE OVERLOOK AT HIGH DESERT			
PRV DETAIL SHEET			
DESIGN REVIEW COMMITTEE	CITY ENGINEER APPROVAL	LAST DESIGN UPDATE	ML/DAY/YR
			ML/DAY/YR
			ML/DAY/YR
CITY PROJECT NO.	ZONE MAP NO.	SHEET	OF
571285	E-23	18	20

CONSTRUCTION TRAFFIC CONTROL GENERAL NOTES

- CONTRACTOR MUST OBTAIN FROM CONSTRUCTION COORDINATION AN EXCAVATION/BARRICADING PERMIT BEFORE ENGAGING IN ANY CONSTRUCTION, MAINTENANCE OR REPAIR WORK IN ANY OF THE CITY OF ALBUQUERQUE'S RIGHTS-OF-WAY. EMERGENCY WORK THAT WOULD PRESERVE LIFE OR PROPERTY IS EXCLUDED WITH THE UNDERSTANDING THAT A PERMIT SHALL BE OBTAINED WITHIN 24 TO 48 HOURS.
- CONTRACTOR SHALL AT THE TIME OF PERMIT REQUEST, SUBMIT FOR APPROVAL BY CONSTRUCTION COORDINATION, A TRAFFIC CONTROL PLAN DETAILING ALL EXISTING TOPOGRAPHY SUCH AS LANE WIDTHS, DRIVEWAYS, AND BUSINESS/RESIDENTIAL ACCESSES. THE TRAFFIC CONTROL PLAN SHALL INCLUDE ALL PHASES OF WORK AND SCHEDULES INVOLVED IN THE CONSTRUCTION PROJECT. ANY SEPARATE PHASES OF A CONSTRUCTION PROJECT SHALL BE GIVEN AN INDIVIDUAL PERMIT EACH. BLANKET PERMITS WILL NOT BE ISSUED.
- THESE TYPICAL TRAFFIC CONTROL PLANS DO NOT REFLECT THE EXISTING TOPOGRAPHY SUCH AS DRIVEWAYS, LANE WIDTHS, AND BUSINESS/RESIDENTIAL ACCESSES. EVERY LOCATION THAT REQUIRES CONSTRUCTION TRAFFIC CONTROL SHALL HAVE A DETAILED TRAFFIC CONTROL PLAN SHOWING ALL EXISTING TOPOGRAPHY.
- CONSTRUCTION SHALL NOT BEGIN UNLESS A TRAFFIC CONTROL PLAN HAS BEEN APPROVED AND VERIFIED BY CONSTRUCTION COORDINATION.
- CONSTRUCTION COORDINATION SHALL BE NOTIFIED 48 HOURS PRIOR TO ANY TRAFFIC CONTROL CHANGES NEEDED BY CONTRACTOR, THAT WERE NOT PREVIOUSLY APPROVED. THESE TRAFFIC CONTROL CHANGES SHALL BE REQUESTED IN WRITING ACCOMPANIED WITH A TRAFFIC CONTROL PLAN REFLECTING SUCH CHANGES.
- ALL CONSTRUCTION TRAFFIC CONTROL DEVICES SHALL COMPLY TO THE MANUAL ON UNIFORM TRAFFIC CONTROL DEVICES (MUTCD), LATEST EDITION. IT IS THE RESPONSIBILITY OF THE CONTRACTOR TO INSTALL, SERVICE AND MAINTAIN ALL TRAFFIC CONTROL DEVICES. TRAFFIC CONTROL DEVICES SHALL NOT BE REMOVED OR ALTERED IN ANY WAY WITHOUT THE APPROVAL OF CONSTRUCTION COORDINATION, PER SECTION 6A-4 OF THE MUTCD, LATEST EDITION.
- THE CONSTRUCTION TRAFFIC CONTROL INITIAL SET-UP SHALL BE BY AN AMERICAN TRAFFIC SAFETY SERVICES ASSOCIATION (ATSSA) CERTIFIED WORKSITE TRAFFIC SUPERVISOR. THE MAINTENANCE AND SERVICING SHALL ALSO BE DONE BY AN ATSSA CERTIFIED WORKSITE TRAFFIC SUPERVISOR OR EQUIVALENT.
- CONTRACTOR IS RESPONSIBLE TO MAINTAIN AND SERVICE ALL TRAFFIC CONTROL DEVICES 24 HOURS A DAY, 7 DAYS A WEEK THROUGHOUT LENGTH OF PROJECT. CONTRACTOR IS RESPONSIBLE THAT ALL TRAFFIC CONTROL DEVICES COMPLY WITH THE MUTCD, LATEST EDITION.
- ALL ADVANCE WARNING SIGNS SHALL BE DOUBLE INDICATED WHENEVER THERE ARE MULTI-LANE TRAFFIC IN ANY ONE GIVEN DIRECTION AND THERE IS SUFFICIENT MEDIAN SPACE.
- ALL BARRICADES IN ALL TAPER AND TANGENTS SHALL BE PLACED APART A DISTANCE MEASURED IN FEET, EQUAL TO THAT OF THE POSTED SPEED LIMIT. NO EXCEPTIONS UNLESS APPROVED BY CONSTRUCTION COORDINATION PER MUTCD SECTION 6A-4.
- ALL WORK IN ARTERIAL ROADWAYS SHALL BE ON A CONTINUOUS 24 HOUR PER DAY BASIS UNTIL COMPLETED.
- CONTRACTOR IS RESPONSIBLE TO PROVIDE CONSTRUCTION COORDINATION, A WEEKLY LOG OF DAILY INSPECTIONS OF BARRICADE AND MAINTENANCE SCHEDULES ON PROJECTS THAT ARE OVER ONE WEEK DURATION.
- EQUIPMENT OR MATERIALS SHALL NOT BE STORED WITHIN 15 FEET OF A TRAVELED TRAFFIC LANE DURING NON-WORKING HOURS WITHOUT THE APPROVAL OF CONSTRUCTION COORDINATION.
- CONTRACTOR SHALL PROVIDE AND MAINTAIN A SAFE AND ADEQUATE MEANS OF CHANNELIZING PEDESTRIAN TRAFFIC AROUND AND THROUGH THE CONSTRUCTION AREA.
- CONTRACTOR IS RESPONSIBLE FOR OBSERVATION OF ANY CONFLICTING STRIPING AND RESPONSIBLE FOR ALL TEMPORARY STRIPING.
- CONTRACTOR SHALL MAINTAIN ACCESS TO ALL FACILITIES, BUSINESSES AND/OR RESIDENTS AT ALL TIMES.
- CONTRACTOR SHALL PROVIDE ACCESS SIGNS FOR BUSINESSES LOCATED WITHIN THE CONSTRUCTION AREA UNDER THE SUPERVISION OF CONSTRUCTION COORDINATION. EACH ACCESS SIGN SHALL HAVE 5 INCH, WHITE OPAQUE LETTERING ON BLUE REFLECTORIZED BACKGROUND. ACCESS SIGNS SHALL BE CONSIDERED INCIDENTAL TO THE BID AND NOT PART OF THE CONTRACT UNLESS OTHERWISE STATED. NO MORE THAN 3 BUSINESSES SHALL BE LISTED ON A ACCESS SIGN. SHOPPING CENTERS AND WALLS SHALL BE LISTED AS SUCH.
- ALL ADVANCE WARNING SIGNS SHALL MEET THE MINIMUM REFLECTIVE INTENSITY REQUIREMENTS SET FORTH BY THE CITY OF ALBUQUERQUE. CONSTRUCTION COORDINATION SHALL DETERMINE ALL REQUIREMENTS AND APPROVE OR DISAPPROVE ANY ADVANCE WARNING SIGN PER SECTION 6A-4 OF THE MUTCD, LATEST EDITION.
- 48 HOURS PRIOR TO OCCUPANCY OR CLOSING OF A RIGHT-OF-WAY, CONTRACTOR SHALL NOTIFY POLICE, FIRE DEPARTMENT, SCHOOLS, HOSPITALS, TRANSIT AUTHORITY, BUSINESSES AND/OR RESIDENTS THAT WILL BE AFFECTED BY THE CONSTRUCTION.
- ANY FIELD ADJUSTMENTS SHALL BE APPROVED BY CONSTRUCTION COORDINATION.

21. EXCAVATIONS SHALL BE PLATED, TEMPORARILY PATCHED OR RESURFACED PRIOR TO OPENING OF TRAFFIC. A MINIMUM OF 11 FEET SHALL BE PROVIDED FOR TRAFFIC IN ANY GIVEN DIRECTION. CONTRACTOR IS RESPONSIBLE FOR ANY WORK INVOLVED IN SATISFYING THESE REQUIREMENTS.

22. CONTRACTOR SHALL AT ALL TIMES COMPLY WITH THE FOLLOWING:
1. STANDARDS AND REQUIREMENTS SET FORTH IN THE MANUAL ON UNIFORM TRAFFIC CONTROL DEVICES, LATEST EDITION.
2. THE CITY OF ALBUQUERQUE TRAFFIC CODE, LATEST EDITION.
3. SECTION 19 OF THE CITY OF ALBUQUERQUE'S STANDARD SPECIFICATIONS FOR PUBLIC WORK CONSTRUCTION, AS WELL AS OTHER SECTIONS.


23. FAILURE TO COMPLY WITH ANY OF THE ABOVE MENTIONED, WILL BE ADEQUATE CAUSE TO CEASE ALL WORK ON ANY CONSTRUCTION PROJECT. WORK WILL NOT RESUME UNTIL ALL REQUIREMENTS ARE ADDRESSED AND APPROVED BY CONSTRUCTION COORDINATION.

24. ALL TRAFFIC CONTROL DEVICES SHALL BE KEPT IN NEW-CLEAN CONDITION, WASHING OF EQUIPMENT IS INCIDENTAL TO ITS PLACEMENT AND MAINTENANCE.

25. TRAFFIC CONTROL STANDARDS APPLY ONLY WHERE THE CONSTRUCTION TRAFFIC CONTROL PLANS ARE NOT SPECIFIC.

26. ADVANCE WARNING SIGNS SHALL BE 36"x36" MIN. WITH SUPER ENGINEERING GRADE SHEETING OR BETTER. MOUNTING HEIGHT AT TOP OF SIGN SHALL BE THE SAME AS FOR A 48" SIGN AS INDICATED IN THE M.U.T.C.D.

27. CONTRACTOR SHALL MAINTAIN A GRAFFITI-FREE WORKSITE. ALL GRAFFITI SHALL BE PROMPTLY REMOVED FROM ALL EQUIPMENT, BOTH PERMANENT AND TEMPORARY.

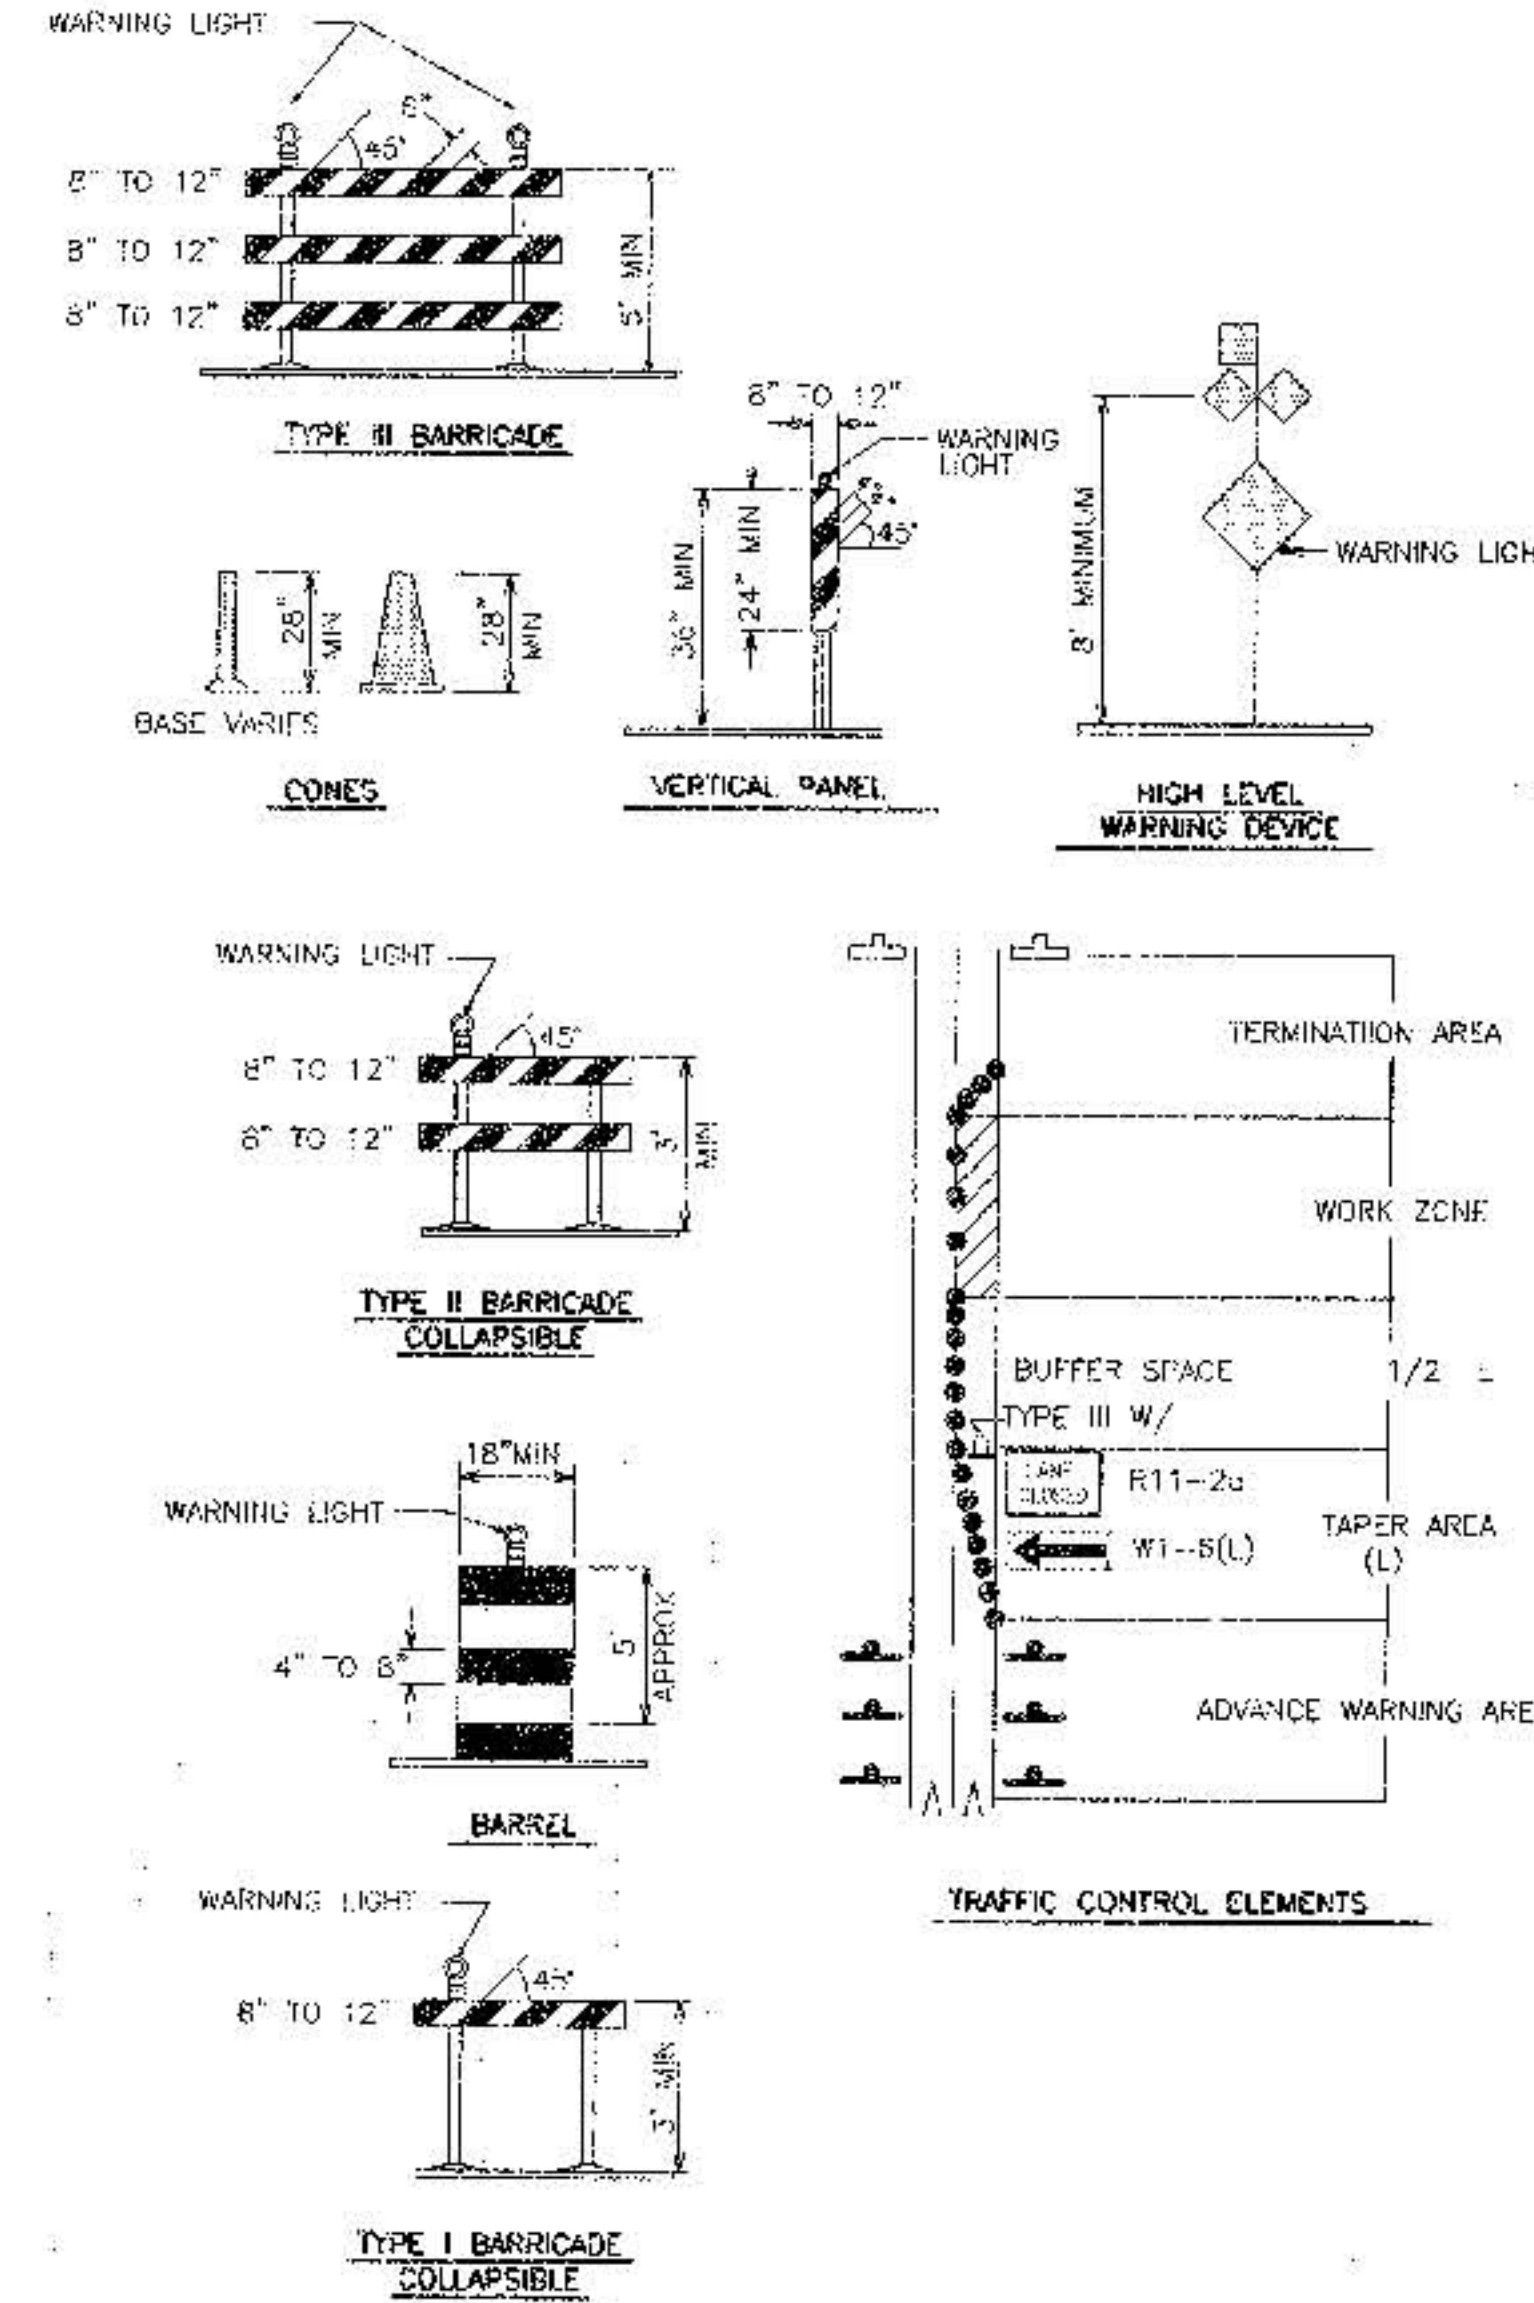

LEGEND

- WORK AREA
- BARRICADE - TYPE I, TYPE II, OR BARREL
- BARRICADE - TYPE III
- VERTICAL PANEL
- WARNING SIGN
- DISTANCE BETWEEN SIGNS - A DISTANCE MEASURED IN FEET EQUAL TO A VALUE OF TEN TIMES THE SPEED LIMIT OF THE STREET
- FLAGMAN POSITION
- SPACING BETWEEN BARRICADES - A DISTANCE MEASURED IN FEET EQUAL TO THE STREET LIMIT OF THE STREET
- TAPER LENGTH - SEE CHART BELOW

THE TANGENT LENGTH IS EQUAL TO THE TAPER LENGTH FOR A GIVEN STREET.

TAPER REQUIREMENT

SPEED LIMIT (MPH)	TAPER LENGTH (L) (FEET)			MINIMUM NUMBER OF DEVICES FOR TAPER	MAXIMUM DEVICE SPACING IN FEET	
	10' LANE	11' LANE	12' LANE		ALONG TAPER	AFTER TAPER
20	70	75	80	5	20	20
25	105	115	125	6	25	25
30	150	165	180	7	30	30
35	205	225	245	8	35	35
40	270	295	320	9	40	40
45	450	495	540	13	45	45
50	500	550	600	13	50	50
55	550	605	660	13	55	55

RECOMMENDED SIGN SPACING (D) FOR ADVANCE WARNING SIGN SERIES

SPEED LIMIT (MPH)	MINIMUM DISTANCE BETWEEN SIGNS	FROM LAST SIGN TO TAPER
0-20	10 X SPEED LIMIT	10 X SPEED LIMIT
25-30	10 X SPEED LIMIT	10 X SPEED LIMIT
30-35	10 X SPEED LIMIT	10 X SPEED LIMIT
40-45	10 X SPEED LIMIT	10 X SPEED LIMIT
50-60	10 X SPEED LIMIT	10 X SPEED LIMIT

TAPER CRITERIA


TYPE OF TAPER	TAPER LENGTH
UPSTREAM TAPER:	L MINIMUM
MERCING TAPER:	1/2 L MINIMUM
SHIFTING TAPER:	1/2 L MINIMUM
SHOULDER TAPER:	100 FEET MAXIMUM
TWO-WAY TRAFFIC TAPER:	100 FEET PER LANE
DOWNSTREAM TAPERS:	100 FEET PER LANE

TAPER LENGTH COMPUTATION

SPEED LIMIT	L = WS ² / 60
40 MPH OR LESS	L = WS ² / 60
40 MPH OR GREATER	L = W x S

L = TAPER LENGTH
W = WIDTH OF OFFSET IN FEET
S = POSTED SPEED OR OFF-PEAK 85-PERCENTILE SPEED IN MPH

SIGN FACE DETAILS

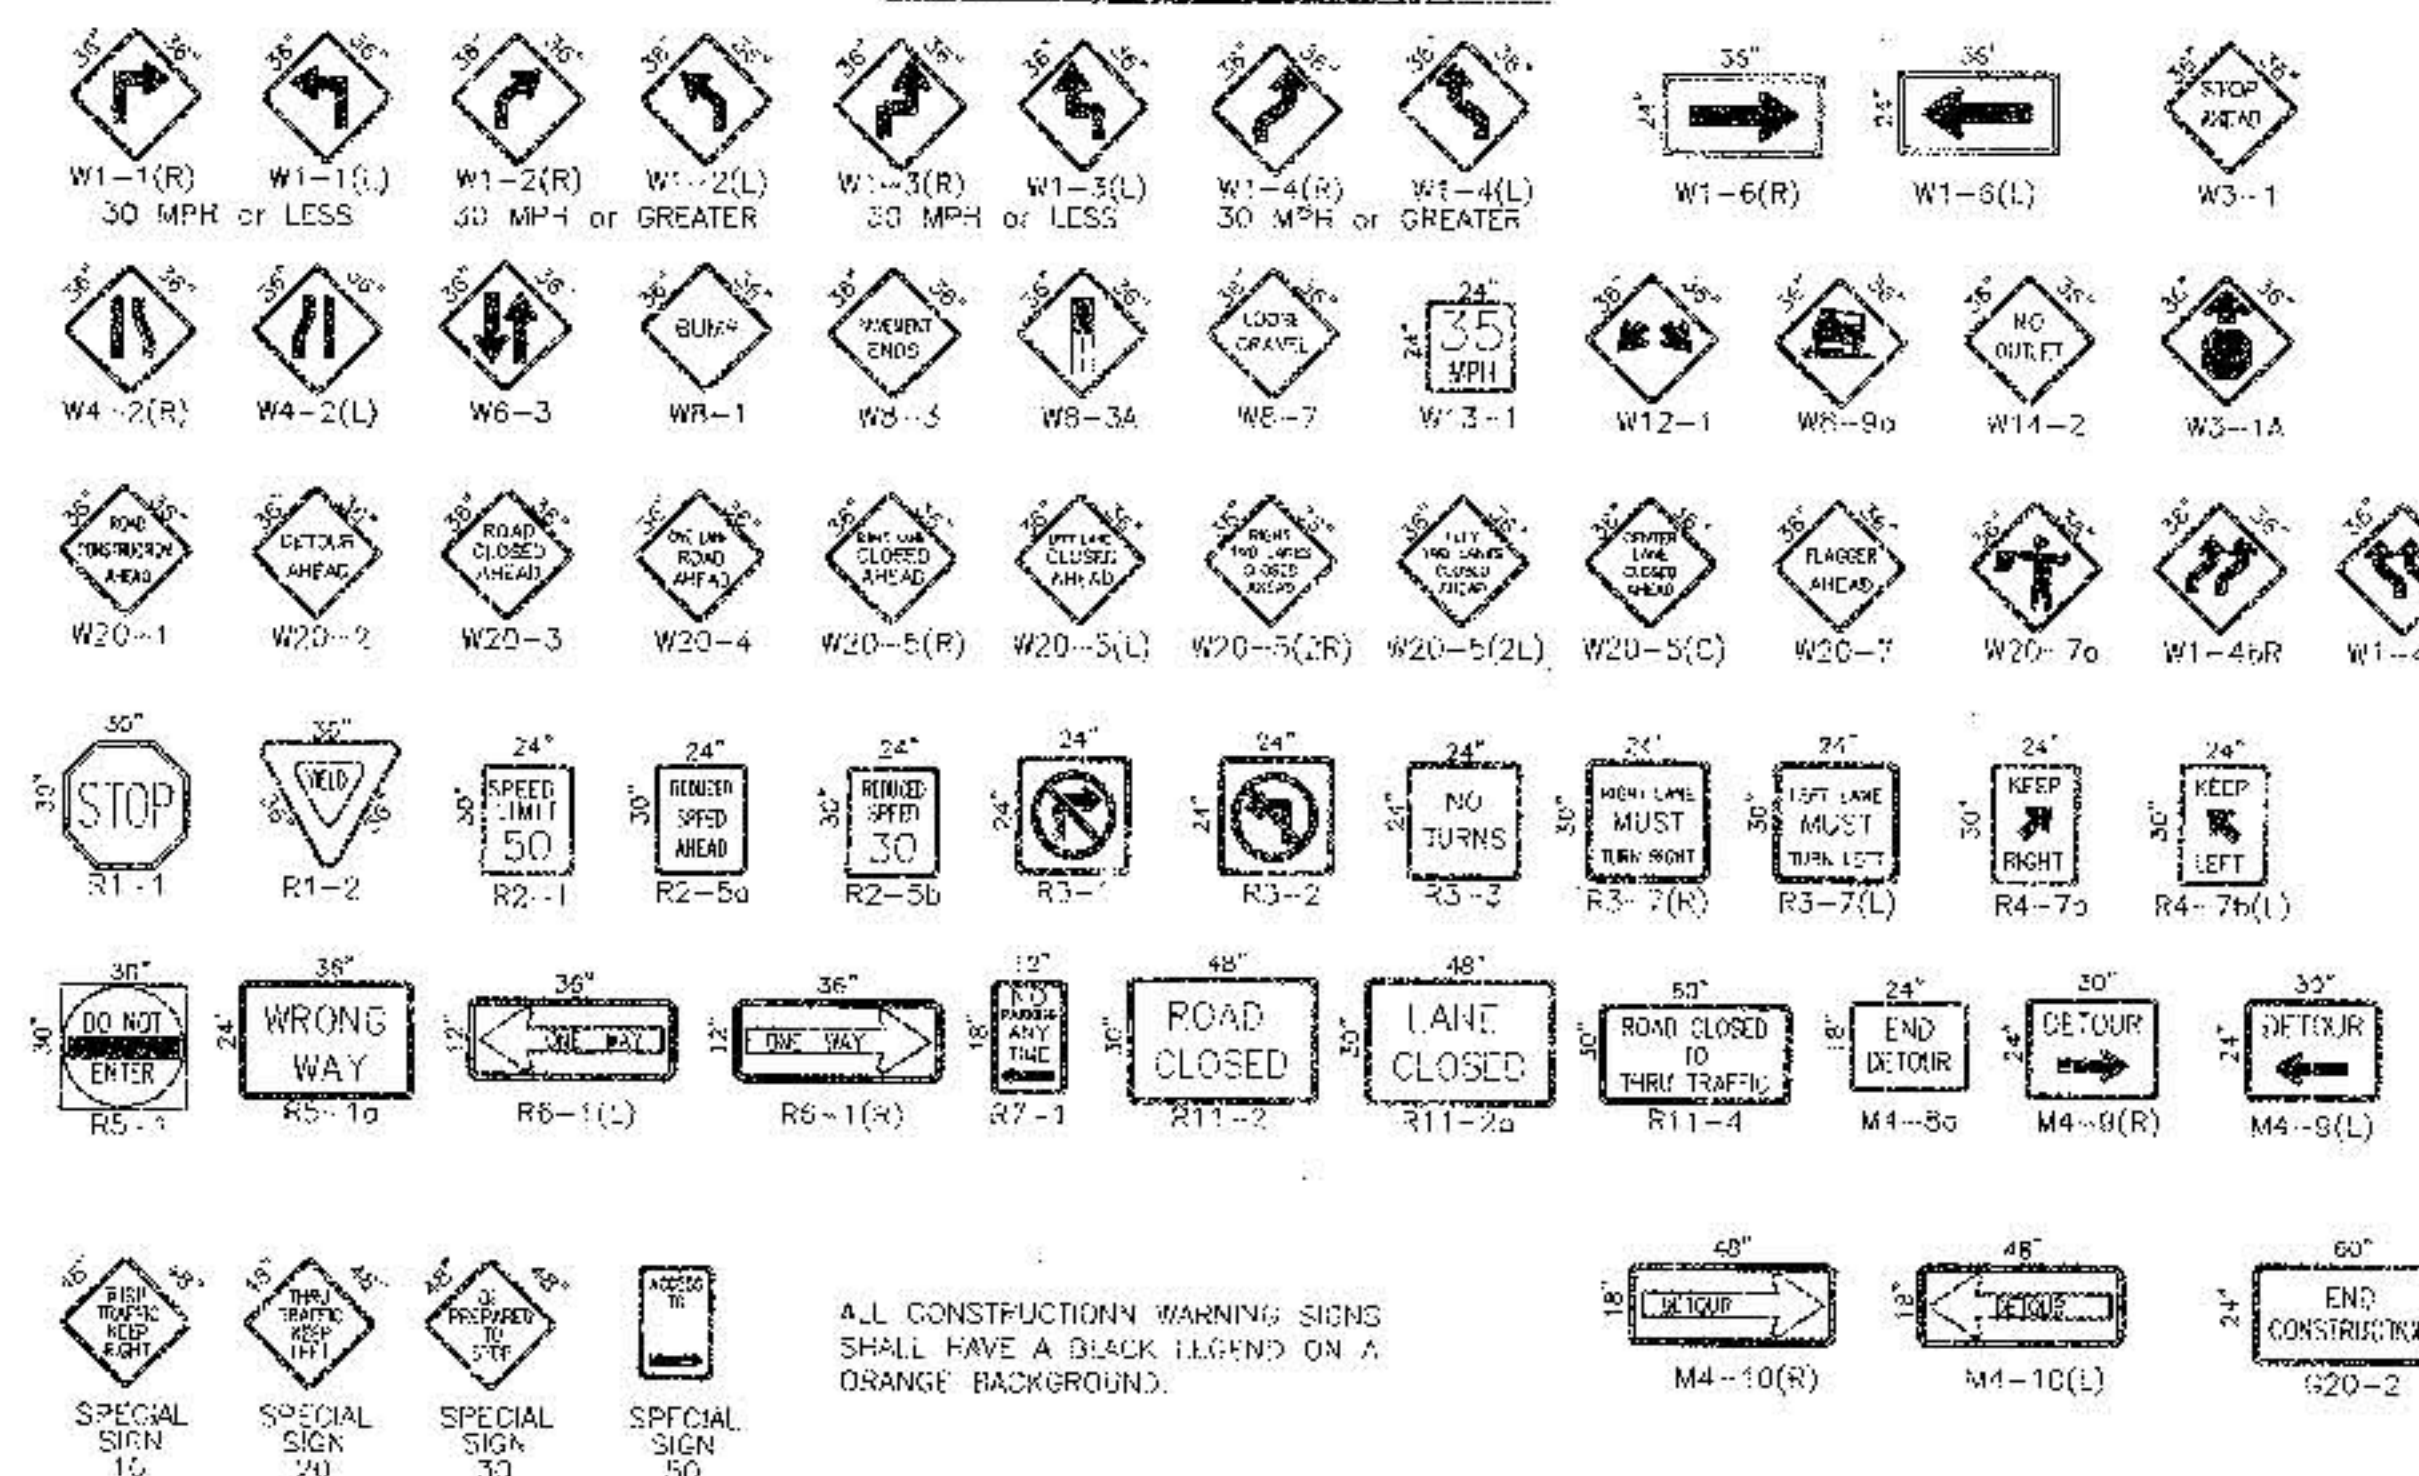

ALL CONSTRUCTION WARNING SIGNS SHALL HAVE A BLACK LEGEND ON A ORANGE BACKGROUND.

RECORD DRAWING
DATE: 5-3-99






CITY OF ALBUQUERQUE
PUBLIC WORKS DEPARTMENT
ENGINEERING DEVELOPMENT GROUP

TITLE: **TRAFFIC CONTROL**
SIGNING AND CONSTRUCTION TRAFFIC CONTROL STANDARDS


DESIGNED BY: BOHANNAN HUSTON
DRAWN BY: BOHANNAN HUSTON
CHECKED BY: BOHANNAN HUSTON

DATE: 5-97
DATE: 5-97
DATE: 5-97

CITY PROJECT NO.: 571285
ZONE MAP NO.: E-23
SHEET: 19 OF 20

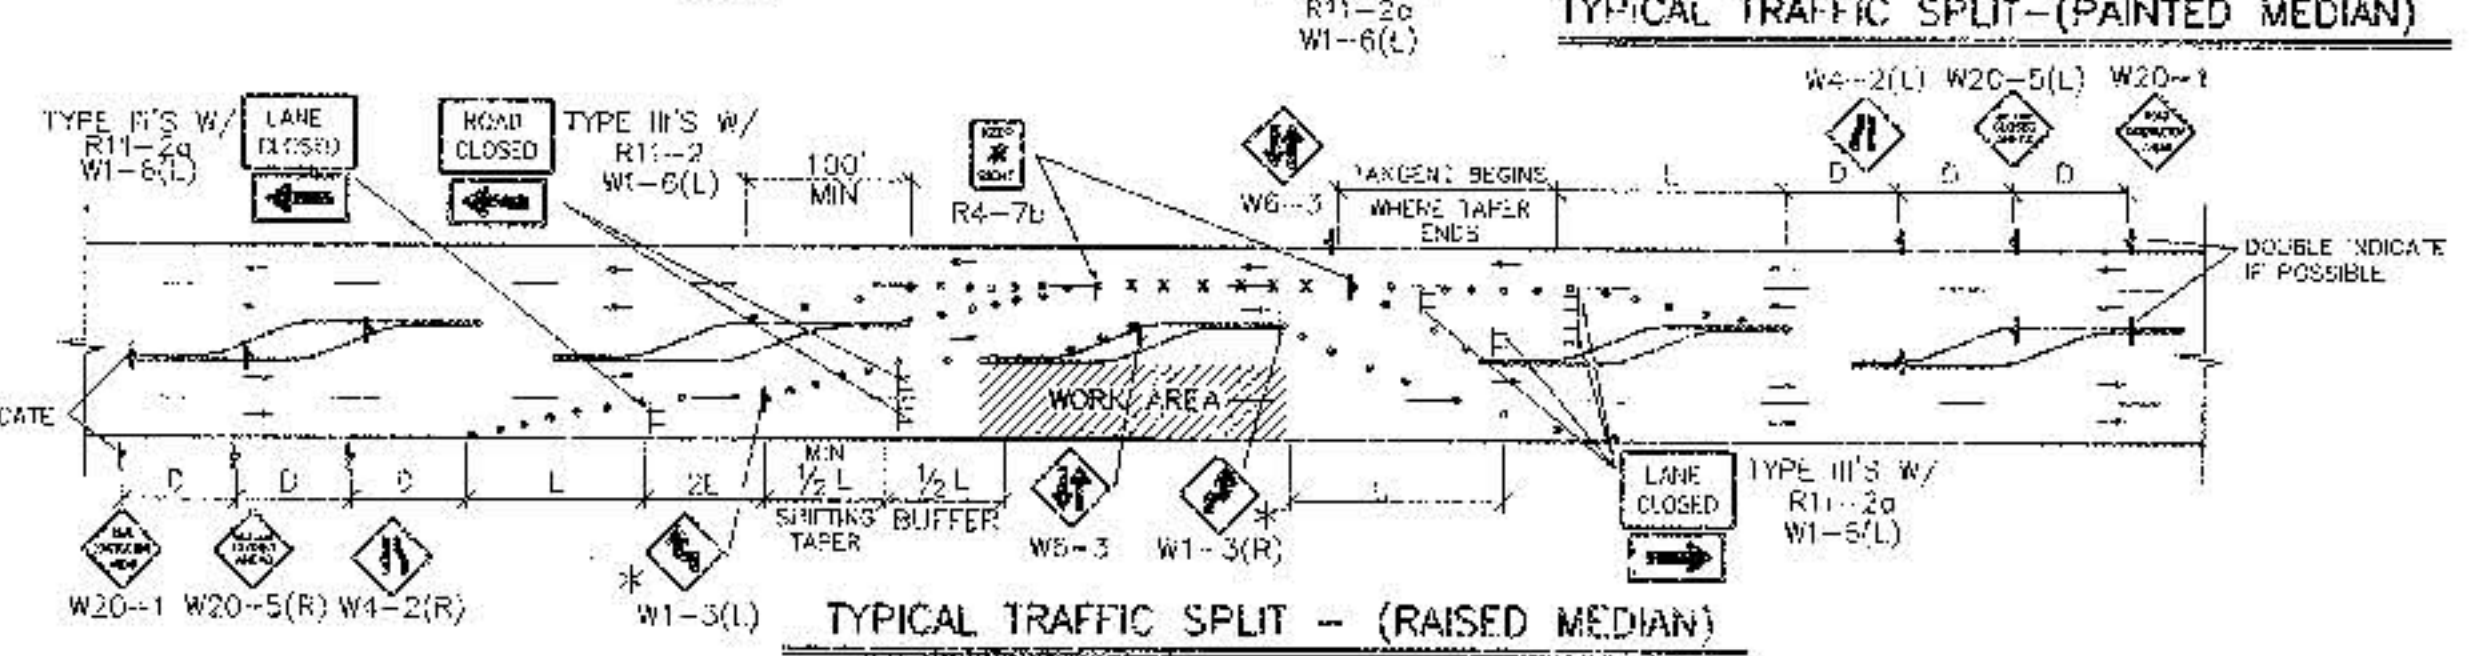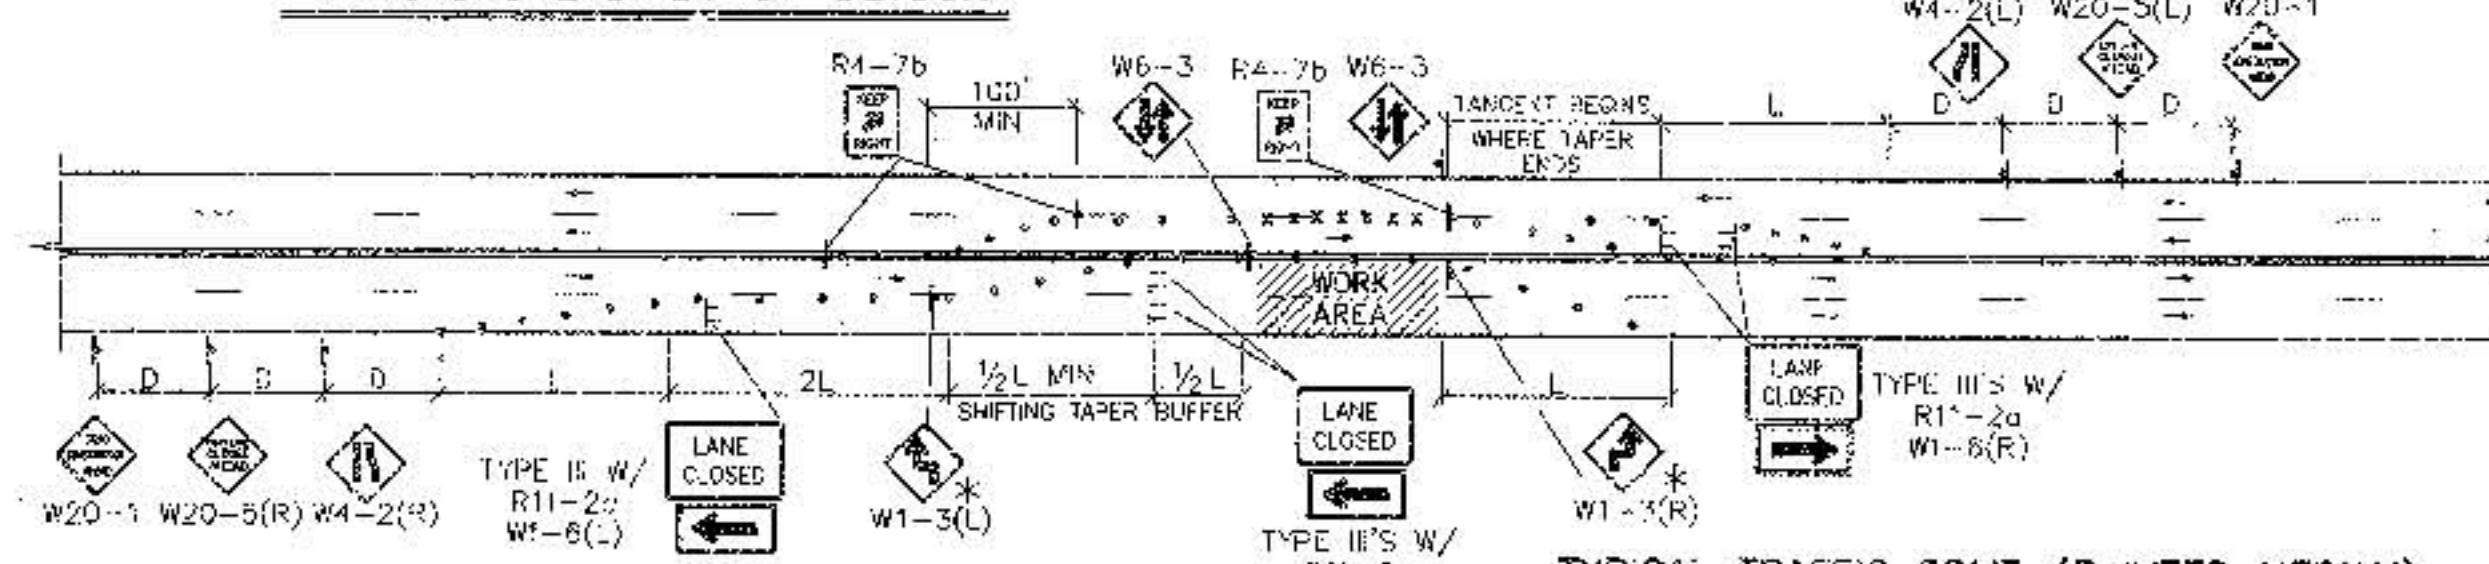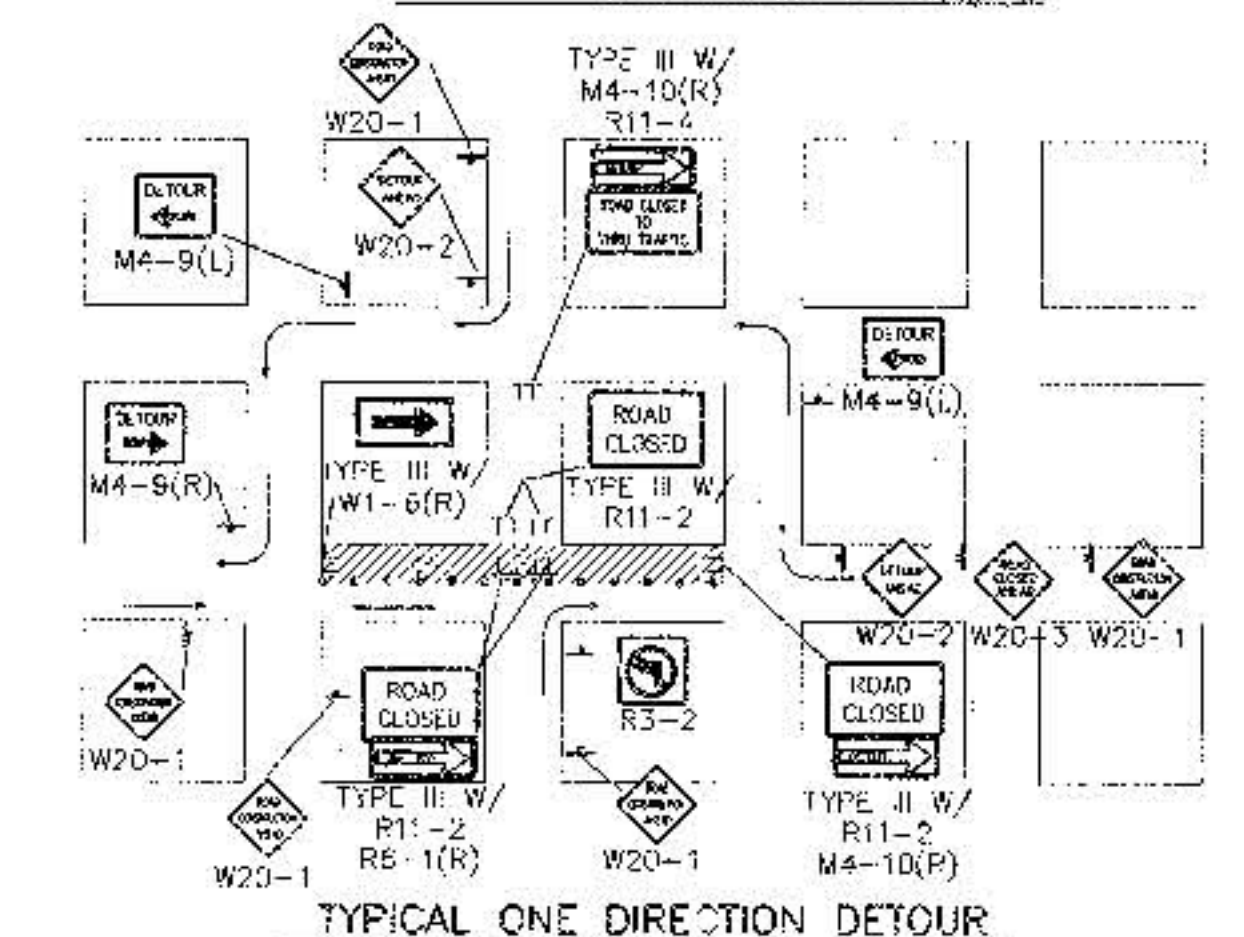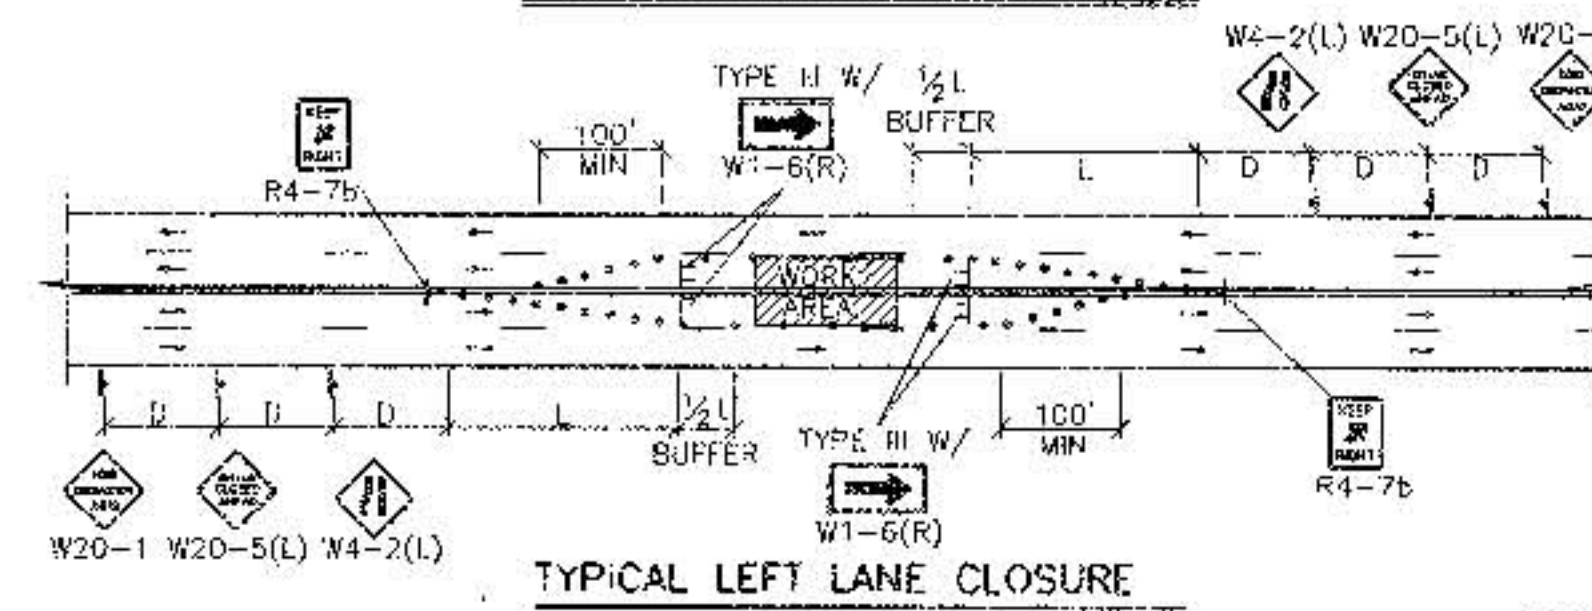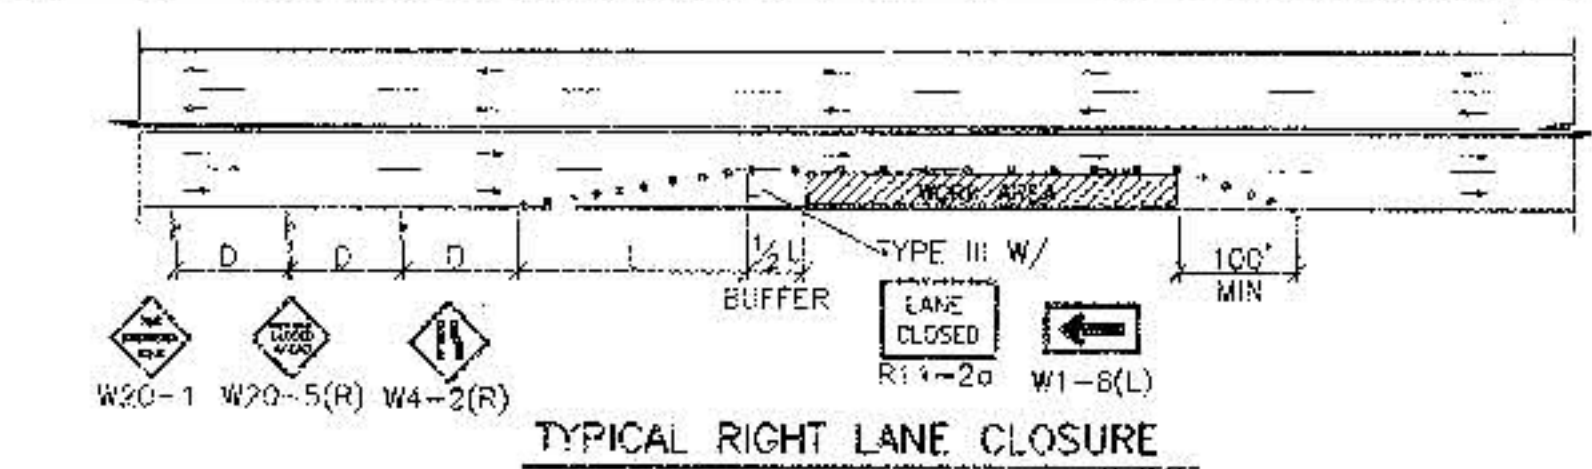

- TRAFFIC SPLIT NOTES:**
1. THE OFFSET DISTANCE MUST BE CALCULATED IN ALL SHIFTING TAPERS. THE OFFSET DISTANCE SHALL INCLUDE LANE WIDTHS PLUS MEDIAN WIDTHS.
 2. 1/2 L IS THE MINIMUM DISTANCE FOR SHIFTING TAPERS.
 3. REVERSE CURVES MAY BE IMPLEMENTED. ALL CURVE DATA SHALL BE CALCULATED.
 4. MEDIAN REMOVAL SHALL BE REQUIRED IF 1/2 L OR REVERSE CURVE IS NOT SUFFICIENT. MEDIAN REMOVAL SHALL TAKE PLACE BEFORE SPLIT.
 5. REDUCED SPEED MAY BE CONSIDERED.
 6. * USE W1-3 FOR 30 MPH OR LESS, W1-4 FOR SPEED 35 MPH OR GREATER.

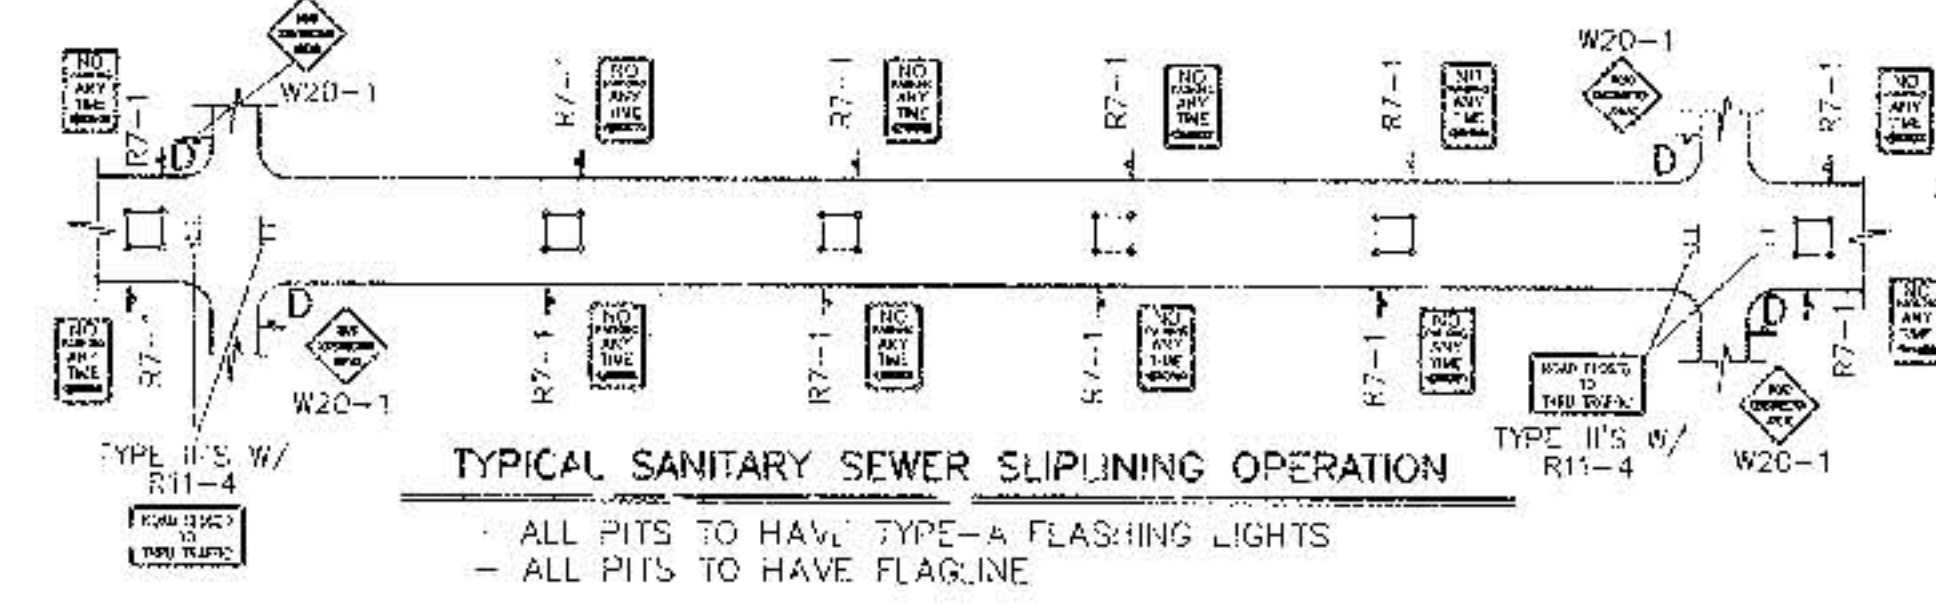

- ALL PITS TO HAVE TYPE-A FLASHING LIGHTS
- ALL PITS TO HAVE FLAGLINE


GENERAL NOTE:

ALL CONSTRUCTION WARNING SIGNS SHALL HAVE A BLACK LEGEND ON AN ORANGE BACKGROUND.


ALL ADVANCE WARNING SIGNS SHALL BE A MINIMUM OF 36" THIRTY SIX INCHES BY 36" THIRTY SIX INCHES IN SIZE AND SHALL HAVE ONE WARNING LIGHT.

NOTE:


MAY REQUIRE LEFT LANE CLOSURE DEPENDING ON FIELD CONDITIONS.

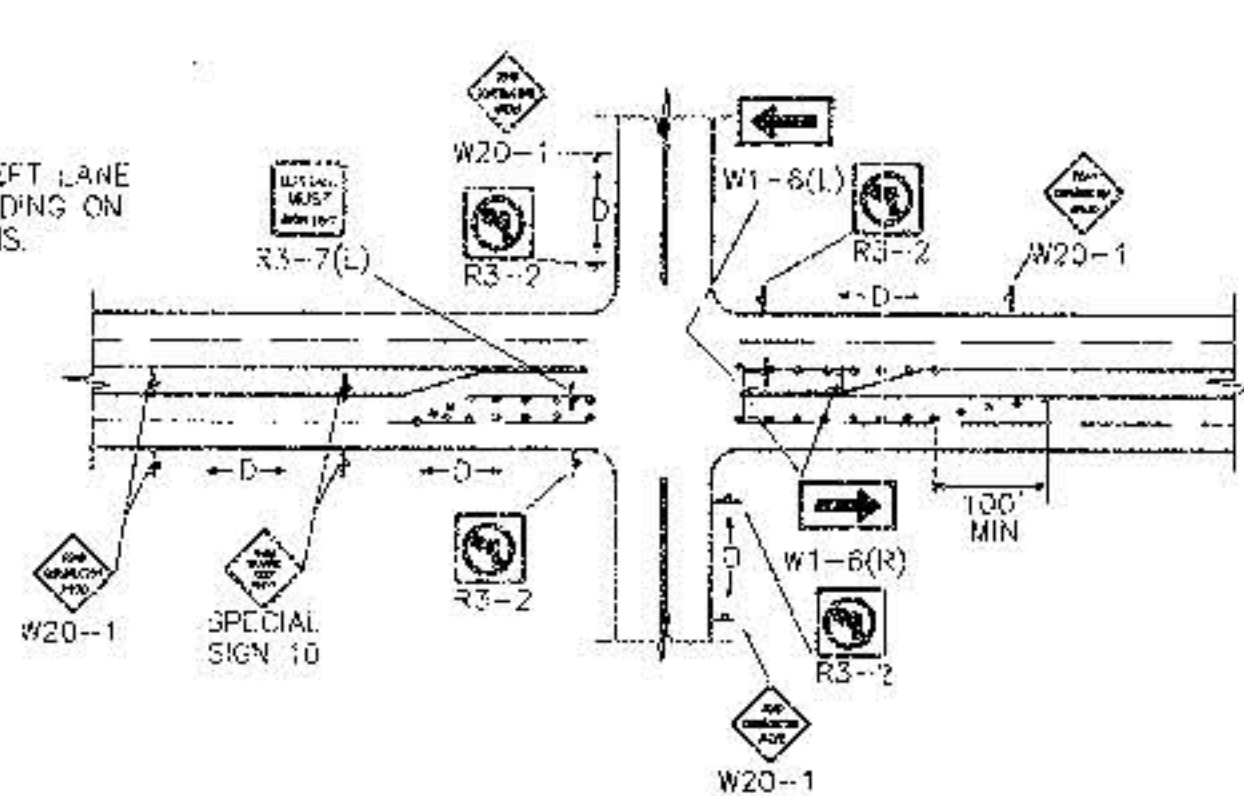





NOTE: DEPENDING ON WORK ZONE LOCATION.

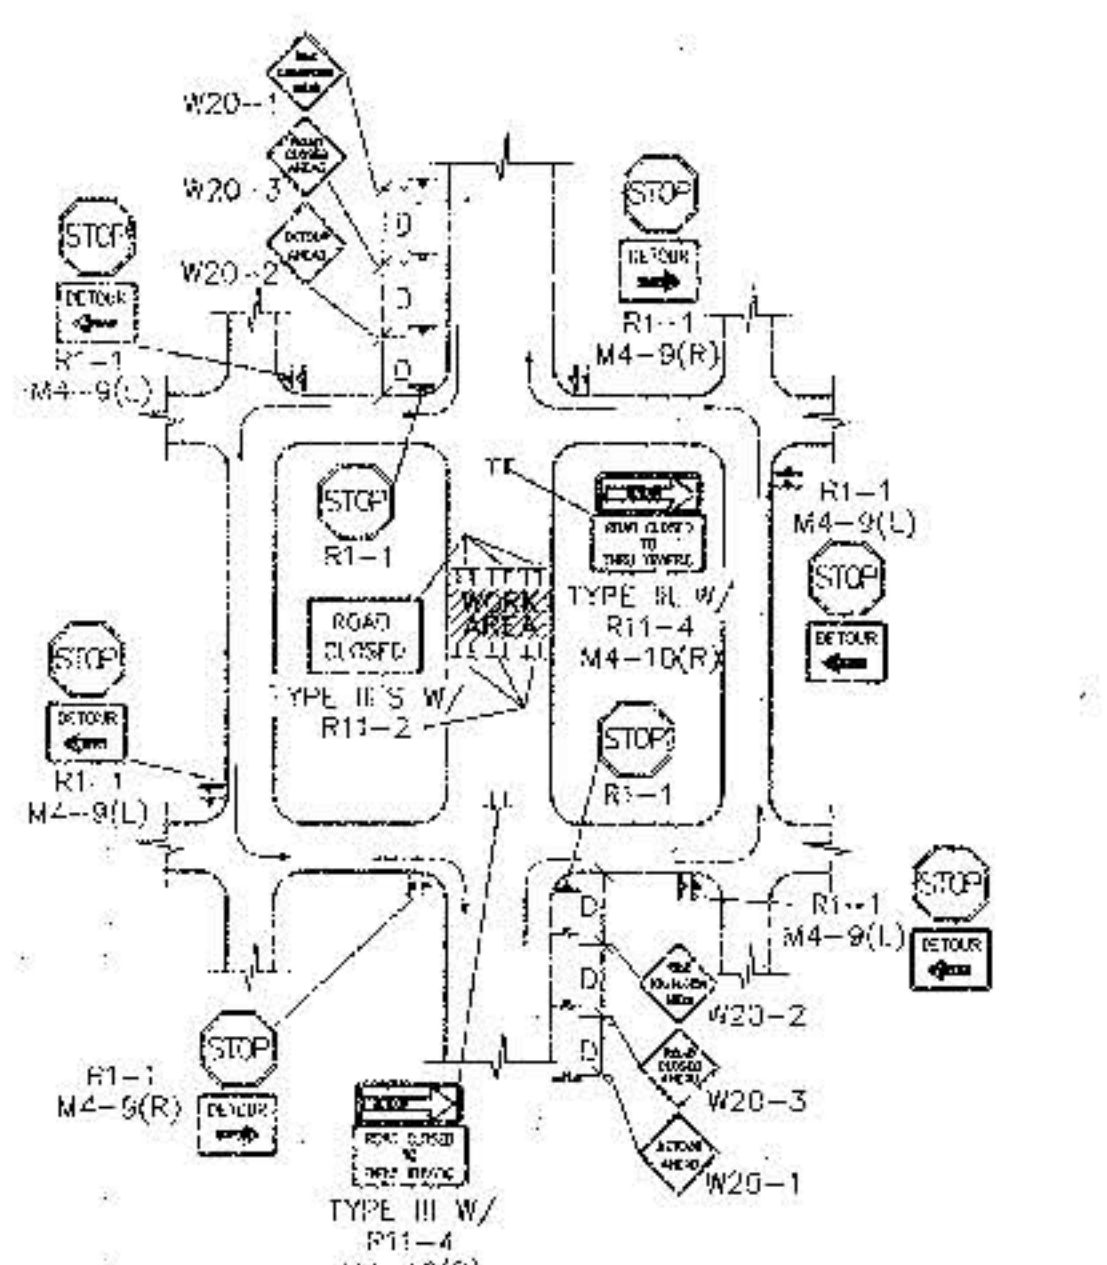

NOTE: (R1-1) BASED ON FIELD CONDITIONS.

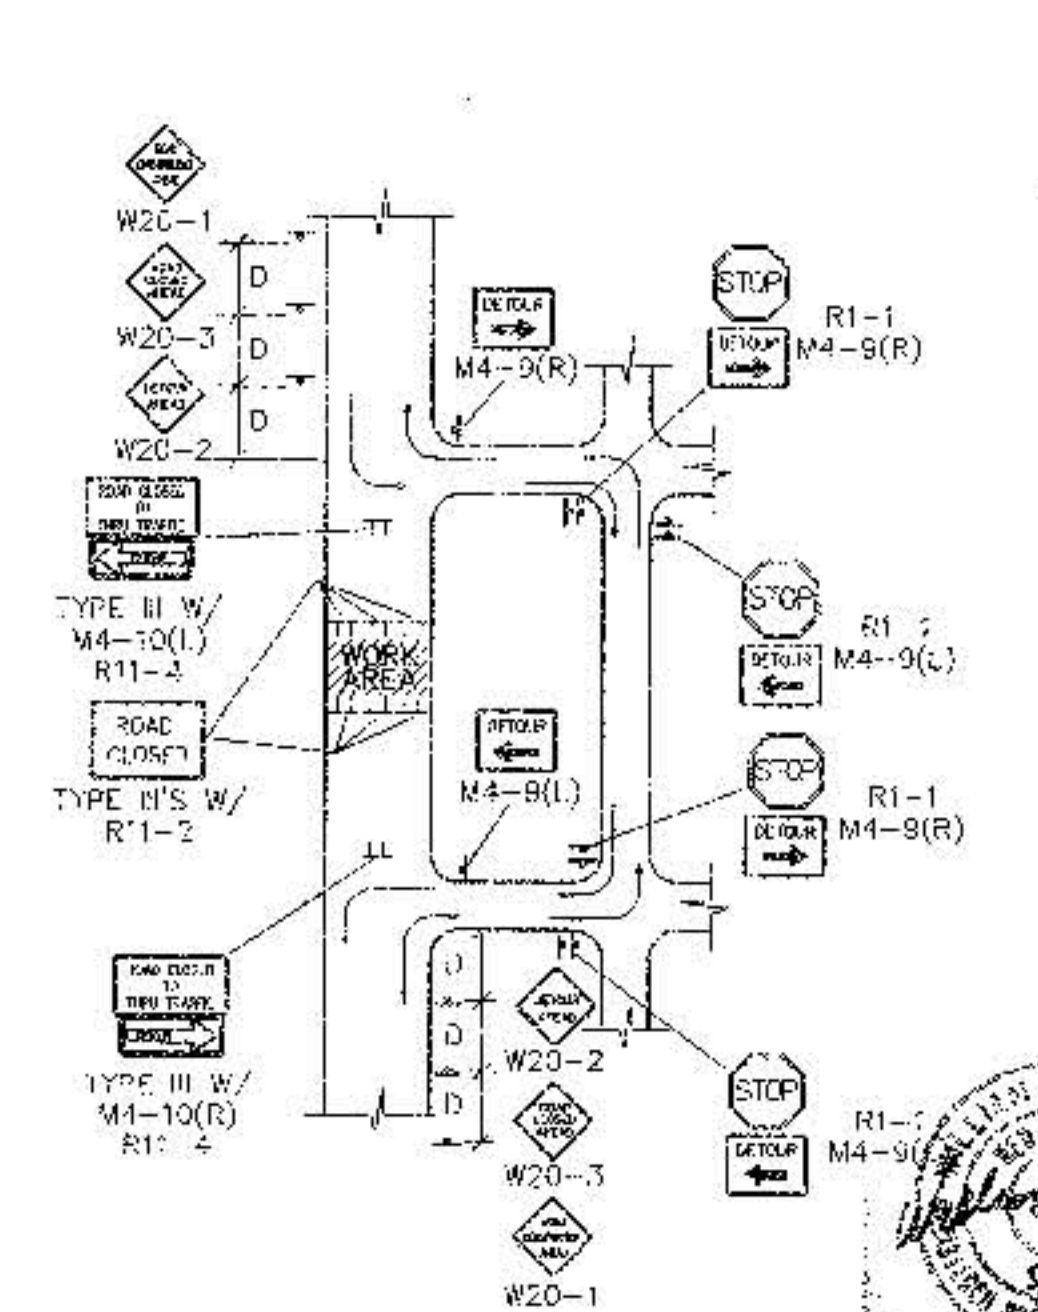

NOTE: (R1-1) BASED ON FIELD CONDITIONS.

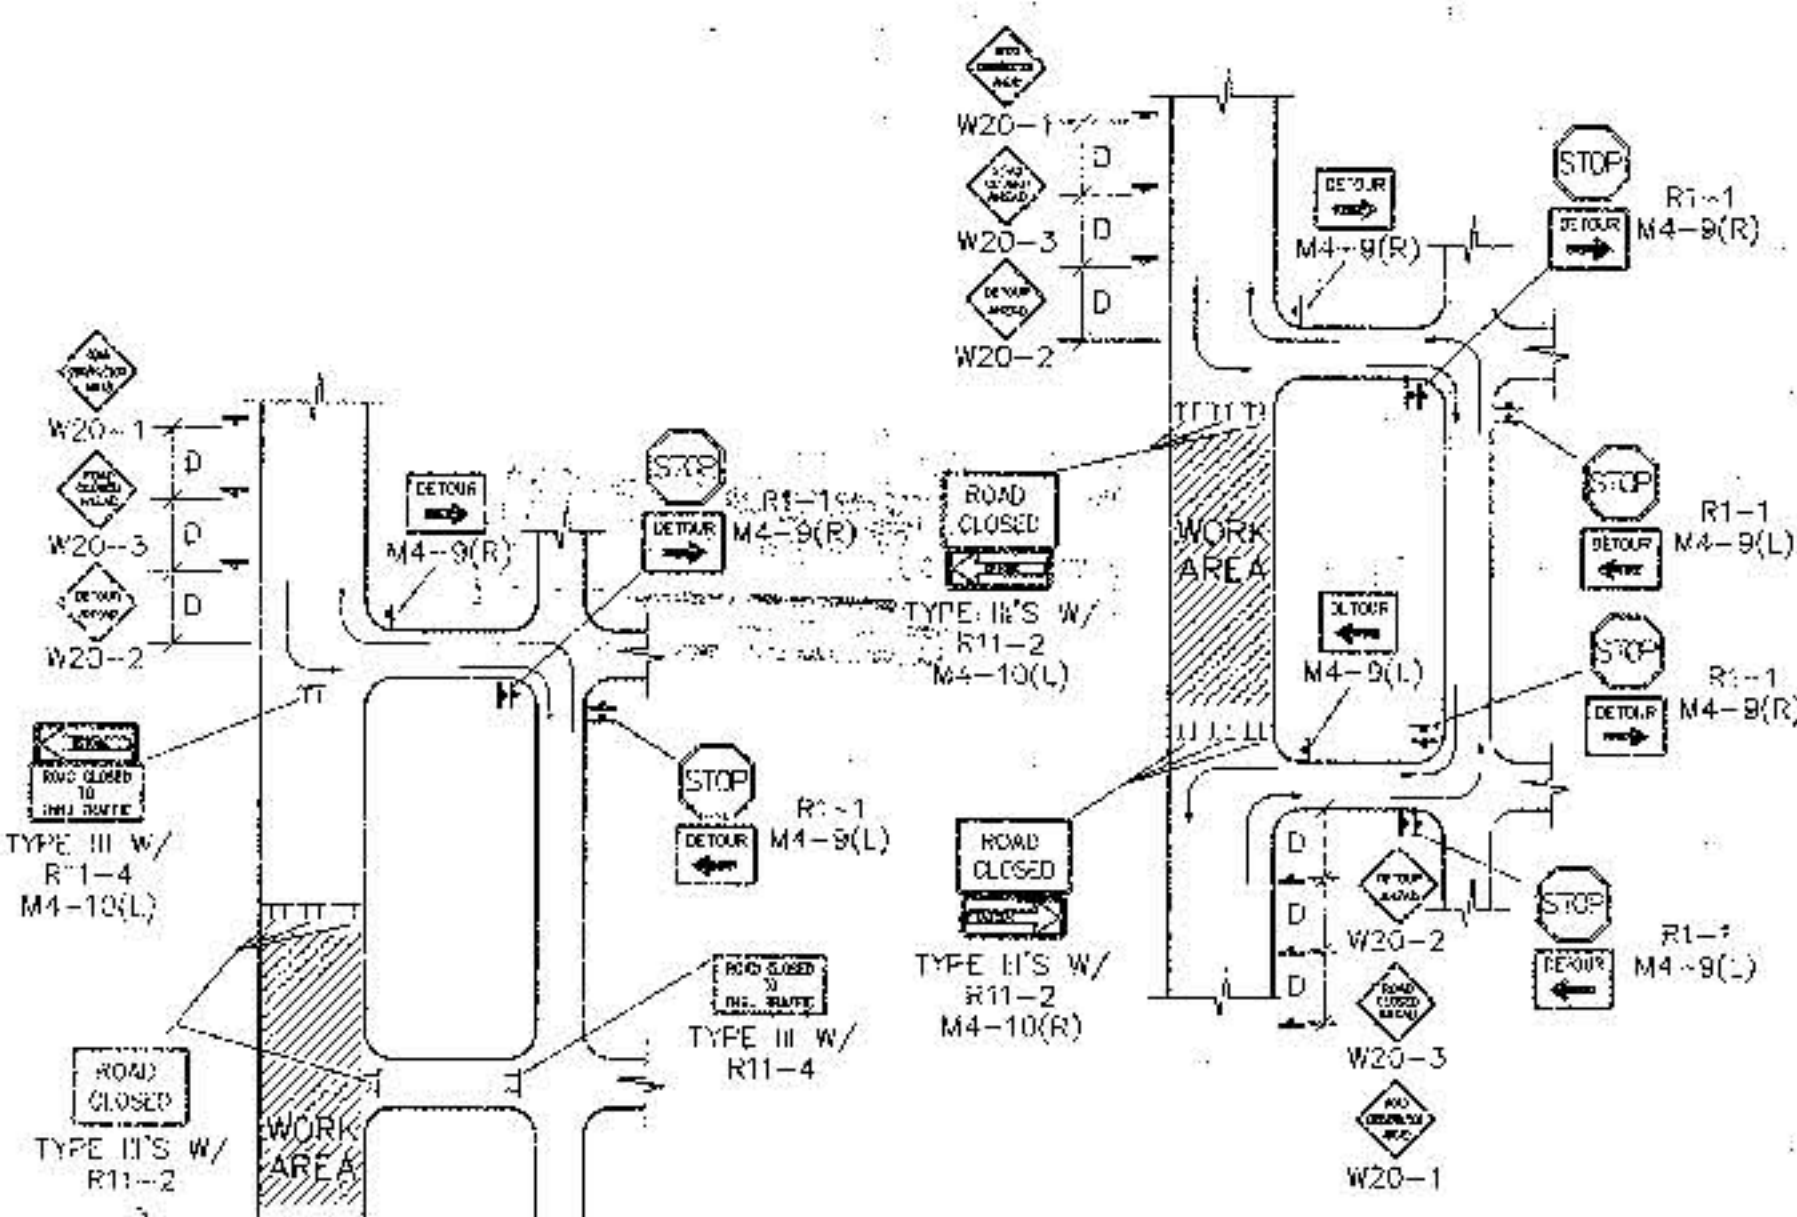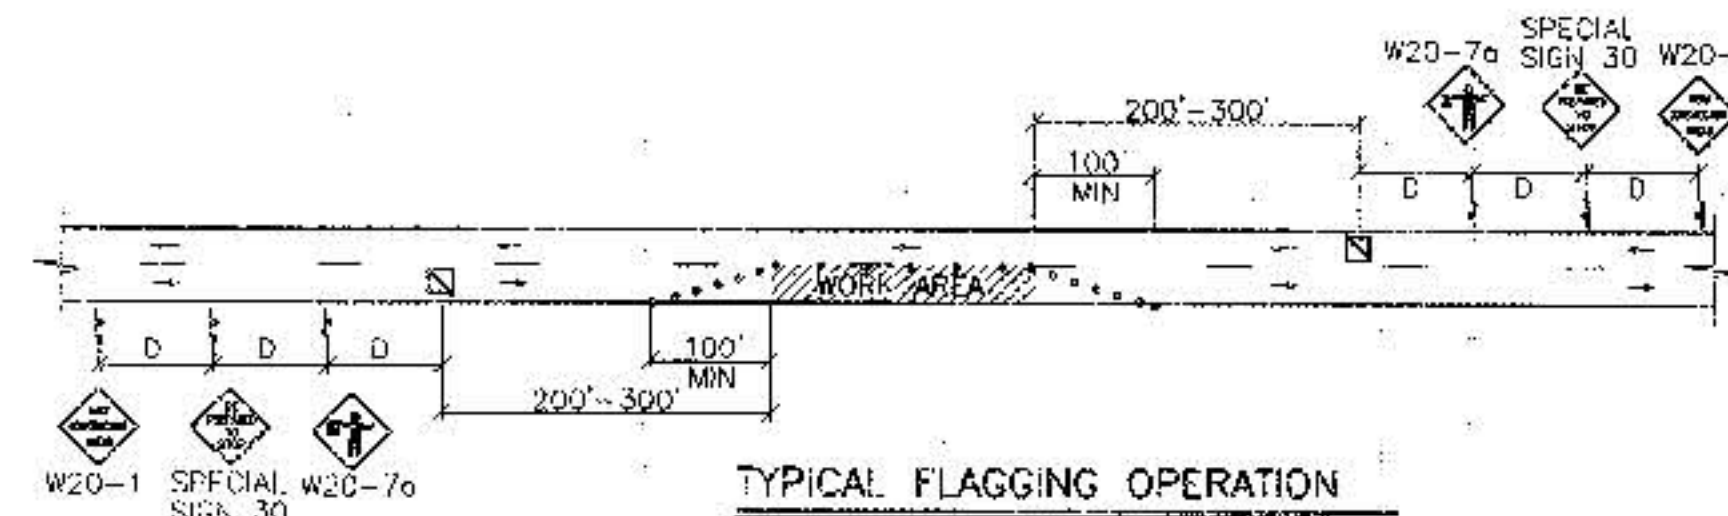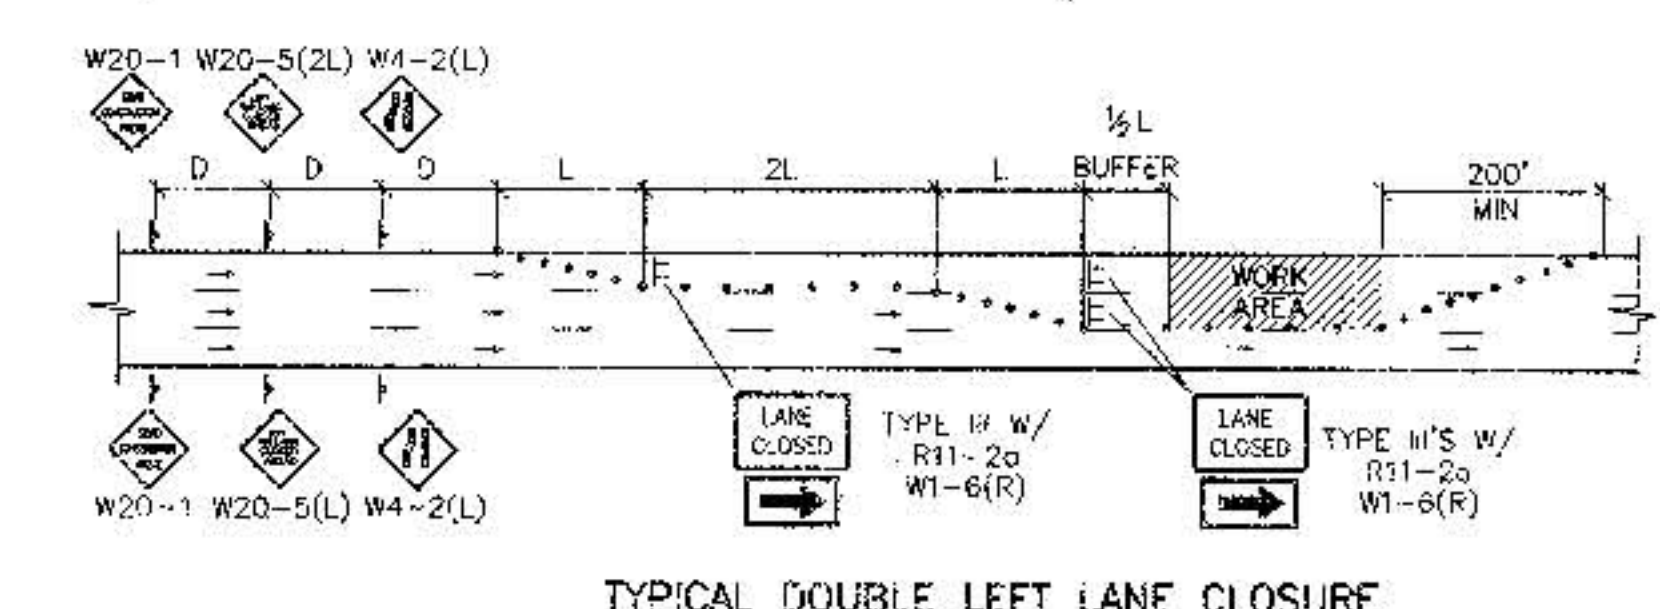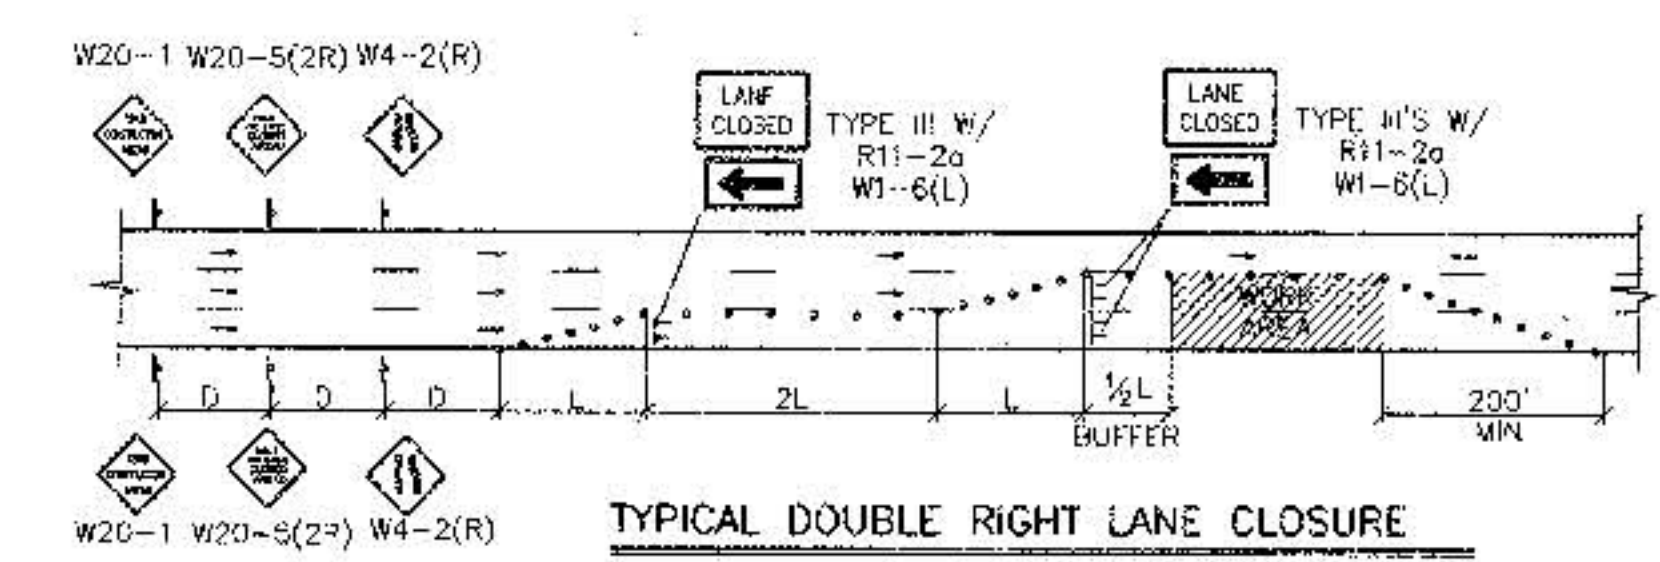

NOTE: (R1-1) BASED ON FIELD CONDITIONS.

RECORD DRAWING

DATE: **5-3-99**

TYPICAL STREET CLOSURE

NOTE: (R1-1) BASED ON FIELD CONDITIONS.

CITY OF ALBUQUERQUE PUBLIC WORKS DEPARTMENT ENGINEERING DEVELOPMENT GROUP	
FILE: _____ CITY ENGINEER APPROVAL: _____ CITY PROJECT NO.: 571285	TYPICAL TRAFFIC CONTROL & SIGNING EXAMPLES (REF M.U.T.C.D.) NO. DATE: _____ DESIGNED BY: BOHANNAN, HUSTON DRAWN BY: BOHANNAN, HUSTON CHECKED BY: BOHANNAN, HUSTON
SHEET 20 OF 20	ZONE MAP NO. E-23