

PUBLIC IMPROVEMENT PLANS
FOR
DESERT FLOWER SUBDIVISION
UNIT ONE
ALBUQUERQUE, NEW MEXICO

SEPTEMBER 1997

PREPARED FOR:
CURB, INC
6301 INDIAN SCHOOL RD, NE
SUITE 680
ALBUQUERQUE, NM 87110

PREPARED BY:
ISAACSON & ARFMAN, P.A.
128 MONROE ST. NE
ALBUQUERQUE, NM 87108

INDEX TO DRAWINGS


SHEET NO.	TITLE
1	TITLE SHEET
2-3	PLAT
4	GRADING & DRAINAGE PLAN
5	MASTER PAVING PLAN
	<u>PAVING & STORM DRAINAGE PLAN & PROFILE SHEETS</u>
6	APRIL FLOWER RD & NATIVE FLOWER PL
7	PURPLE CONE RD & SALTBRUSH PL
8	PURPLE FRINGE RD & DESERTWOOD DR
9	NATIVE FLOWER DR
10	FRESHWATER RD
11	DESERT SPRINGS DR
12-13	UNSER BLVD
13A	UNSER BLVD
14	MASTER UTILITY PLAN
14A	OFFSITE MASTER UTILITY PLAN
	<u>UTILITY PLAN & PROFILE SHEETS</u>
15	APRIL FLOWER RD & NATIVE FLOWER PL
16	PURPLE CONE RD & SALTBRUSH PL
17	PURPLE FRINGE RD & DESERTWOOD DR
18	NATIVE FLOWER DR
19	FRESHWATER RD
20	DESERT SPRINGS DR
21	OFFSITE WATERLINE CONNECTION
22-23	OFFSITE SAS CONNECTION
24	DRAINAGE DETAILS

APPROVAL OF AS BUILT DRAWINGS
CHIEF CONSTRUCTION ENGINEER
[Signature]
DATE 8/26/98

GENERAL NOTES

- ALL WORK DETAILED ON THESE PLANS TO BE PERFORMED UNDER CONTRACT SHALL, EXCEPT AS OTHERWISE STATED OR PROVIDED FOR HEREON, BE CONSTRUCTED IN ACCORDANCE WITH THE CITY OF ALBUQUERQUE STANDARD SPECIFICATIONS FOR PUBLIC WORKS CONSTRUCTION 1986 EDITION AS AMENDED WITH UPDATE NO. 6.
- ALL WORK ON THIS PROJECT SHALL BE PERFORMED IN ACCORDANCE WITH APPLICABLE FEDERAL, STATE, AND LOCAL LAWS, RULES, AND REGULATIONS CONCERNING CONSTRUCTION SAFETY AND HEALTH.
- PRIOR TO CONSTRUCTION, THE CONTRACTOR SHALL EXCAVATE & VERIFY THE HORIZONTAL AND VERTICAL LOCATIONS OF ALL OBSTRUCTIONS. SHOULD A CONFLICT EXIST, THE CONTRACTOR SHALL NOTIFY THE ENGINEER SO THAT THE CONFLICT CAN BE RESOLVED WITH MINIMUM DELAY.
- TWO (2) WORKING DAYS PRIOR TO ANY EXCAVATION, CONTRACTOR MUST CONTACT LINE LOCATING SERVICE @ 260-1990 FOR LOCATION OF EXISTING UTILITIES.
- CONTRACTOR SHALL CONDUCT HIS OPERATIONS IN A MANNER WHICH WILL MINIMIZE INTERFERENCE WITH LOCAL TRAFFIC. CONTRACTOR SHALL COMPLY WITH ALL APPLICABLE LAWS, ORDINANCES, RULES, REGULATIONS, AND ORDERS OF ANY PUBLIC BODY HAVING JURISDICTION FOR THE SAFETY OF PERSONS OR PROPERTY, AND TO PROTECT THEM FROM DAMAGE, INJURY, OR LOSS. CONTRACTOR SHALL ERECT AND MAINTAIN, AS REQUIRED BY THE CONDITIONS AND PROGRESS OF THE WORK, ALL NECESSARY SAFEGUARDS FOR SAFETY CONTINUOUSLY AND NOT LIMITED TO NORMAL WORKING HOURS, THROUGHOUT THE DURATION OF THE PROJECT. CONTRACTOR SHALL ADHERE TO SECTION 19 OF THE GENERAL CONDITIONS OF THE CITY OF ALBUQUERQUE STANDARD SPECIFICATIONS FOR PUBLIC WORKS CONSTRUCTION, 1986, AS AMENDED WITH UPDATE NO. 6.
- THE CONTRACTOR AGREES THAT HE SHALL ASSUME THE SOLE AND COMPLETE RESPONSIBILITY FOR THE JOB SITE CONDITIONS DURING THE COURSE OF CONSTRUCTION OF THIS PROJECT, INCLUDING SAFETY OF ALL PERSONS AND PROPERTY; THAT THIS REQUIREMENT SHALL APPLY CONTINUOUSLY AND NOT BE LIMITED TO NORMAL WORKING HOURS; AND THAT THE CONTRACTOR SHALL DEFEND, INDEMNIFY, AND HOLD HARMLESS THE OWNER & ENGINEER FROM ANY AND ALL LIABILITY REAL OR ALLEGED, IN CONNECTION WITH THE PERFORMANCE OF WORK ON THIS PROJECT, EXCEPTING LIABILITY ARISING FROM THE SOLE NEGLIGENCE OF THE OWNER OR ENGINEER.
- TRAFFIC CONTROL: FIVE (5) WORKING DAYS PRIOR TO BEGINNING CONSTRUCTION THE CONTRACTOR SHALL SUBMIT TO THE CONSTRUCTION COORDINATION DIVISION A DETAILED CONSTRUCTION SCHEDULE. TWO (2) WORKING DAYS PRIOR TO CONSTRUCTION, THE CONTRACTOR SHALL OBTAIN A BARRICADING PERMIT FROM THE CONSTRUCTION COORDINATION DIVISION. CONTRACTOR SHALL NOTIFY BARRICADE ENGINEER (768-2551) PRIOR TO OCCUPYING AN INTERSECTION. SEE SECTION 19 OF THE SPECIFICATIONS. ALL STREET STRIPING ALTERED OR DESTROYED SHALL BE REPLACED WITH PLASTIC REFLECTORIZED PAVEMENT MARKINGS BY CONTRACTOR TO LOCATION AS EXISTING OR AS SHOWN IN THIS PLAN SET.
- WHEN ABUTTING EXISTING PAVEMENT TO NEW, SAWCUT EXISTING PAVEMENT TO A STRAIGHT EDGE AND AT A RIGHT ANGLE, OR AS APPROVED BY THE FIELD ENGINEER. REMOVAL OF BROKEN OR CRACKED PAVEMENT WILL ALSO BE REQUIRED.
- EXISTING CURB AND GUTTER NOT TO BE REMOVED UNDER THE CONTRACT WHICH IS DAMAGED OR DISPLACED BY THE CONTRACTOR SHALL BE REMOVED AND REPLACED BY THE CONTRACTOR AT HIS EXPENSE.
- ALL FINAL BACKFILL FOR TRENCHES SHALL BE COMPACTED TO A MINIMUM 90% MAXIMUM DENSITY PER ASTM D-1557 AND AS DIRECTED BY SECTION 701.14.2 AND STANDARD DRAWING NUMBER 2315.
- THE CONTRACTOR SHALL PROMPTLY CLEAN UP ANY MATERIAL EXCAVATED WITHIN THE PUBLIC RIGHT-OF-WAY OR PRIVATE ROADWAY EASEMENTS SO THAT THE EXCAVATED MATERIAL IS NOT SUSCEPTIBLE TO BEING WASHED DOWN THE STREET OR INTO ANY PUBLIC DRAINAGE FACILITY.
- PROPOSED WATERLINE MATERIALS SHALL BE EITHER PVC PIPE MEETING AWWA C900 REQUIREMENTS (6"-12") OR DUCTILE IRON PIPE, THICKNESS CLASS 50 (6"-16").
- ALL SANITARY SEWER LINE STATIONING REFERS TO SANITARY SEWER CENTERLINE STATIONING.
- ALL FITTINGS ON WATERLINES SHALL HAVE RESTRAINED JOINTS AS NOTED ON THE PLANS.
- CONTRACTOR SHALL SUPPORT ALL EXISTING, UNDERGROUND UTILITY LINES WHICH BECOME EXPOSED DURING CONSTRUCTION. PAYMENT FOR SUPPORTING WORK SHALL BE INCIDENTAL TO WATER-LINE AND/OR SEWERLINE COSTS.
- CONTRACTOR SHALL ASSIST THE ENGINEER/INSPECTOR IN THE RECORDING OF DATA ON ALL UTILITY LINES AND ACCESSORIES AS REQUIRED BY THE CITY OF ALBUQUERQUE FOR THE PREPARATION OF RECORD DRAWINGS. CONTRACTOR SHALL NOT COVER UTILITY LINES AND ACCESSORIES UNTIL ALL DATA HAS BEEN RECORDED.
- THE CONTRACTOR IS RESPONSIBLE FOR PROTECTING AND MAINTAINING ALL EXISTING MONUMENTATION CONTROLS. IN THE EVENT OF IN-ADVERTENT DESTRUCTION OR ALTERATION, THE CONTRACTOR MUST IMMEDIATELY NOTIFY THE CITY CHIEF SURVEYOR.
- PNM WILL PROVIDE AT NO COST TO THE CITY OR THE CONTRACTOR THE REQUIRED PERSONNEL FOR INSPECTION OR OBSERVATION DEEMED NECESSARY BY PNM WHILE THE CONTRACTOR IS EXPOSING PNM'S CABLES. HOWEVER, THE CONTRACTOR SHALL BE CHARGED THE TOTAL COST ASSOCIATED WITH REPAIRS TO ANY DAMAGED CABLES OR FOR ANY COST ASSOCIATED WITH SUPPORTING OR RELOCATING THE POLES AND CABLES DURING CONSTRUCTION.
- WARNING--EXISTING UTILITY LINE LOCATIONS ARE SHOWN IN AN APPROXIMATE MANNER ONLY, AND SUCH LINES MAY EXIST WHERE NONE ARE SHOWN. THE LOCATION OF ANY SUCH EXISTING LINES IS BASED UPON INFORMATION PROVIDED BY THE UTILITY COMPANY, THE OWNER, OR BY OTHERS, AND THE INFORMATION MAY BE INCOMPLETE OR MAY BE OBSOLETE BY THE TIME CONSTRUCTION COMMENCES.


THE ENGINEER HAS UNDERTAKEN NO FIELD VERIFICATION OF THE LOCATION, DEPTH, SIZE, OR TYPE OF EXISTING UNDERGROUND UTILITY LINES, MAKES NO REPRESENTATION PERTAINING THERETO, AND ASSUMES NO RESPONSIBILITY OR LIABILITY THEREFOR. THE CONTRACTOR SHALL INFORM ITSELF OF THE LOCATION OF ANY UTILITY LINE IN OR NEAR THE AREA OF THE WORK IN ADVANCE OF AND DURING EXCAVATION WORK. THE CONTRACTOR IS FULLY RESPONSIBLE FOR ANY AND ALL DAMAGE CAUSED BY ITS FAILURE TO LOCATE, IDENTIFY, AND PRESERVE ANY AND ALL EXISTING UTILITIES. THE CONTRACTOR SHALL COMPLY WITH STATE STATUTES, MUNICIPAL AND LOCAL ORDINANCES, RULES AND REGULATIONS PERTAINING TO THE LOCATION OF THESE LINES AND FACILITIES, IN PLANNING AND CONDUCTING EXCAVATION, WHETHER BY CALLING OR NOTIFYING THE UTILITIES, COMPLYING WITH "BLUE STAKES" PROCEDURES, OR OTHERWISE.
- ANY WORK OCCURRING WITHIN AN ARTERIAL ROADWAY REQUIRES 24 HR. CONSTRUCTION.
- ALL EXCAVATION, TRENCHING AND SHORING ACTIVITIES MUST BE ACCOMPLISHED IN ACCORDANCE WITH OSHA 29CFR 1926.650 SUBPART P.

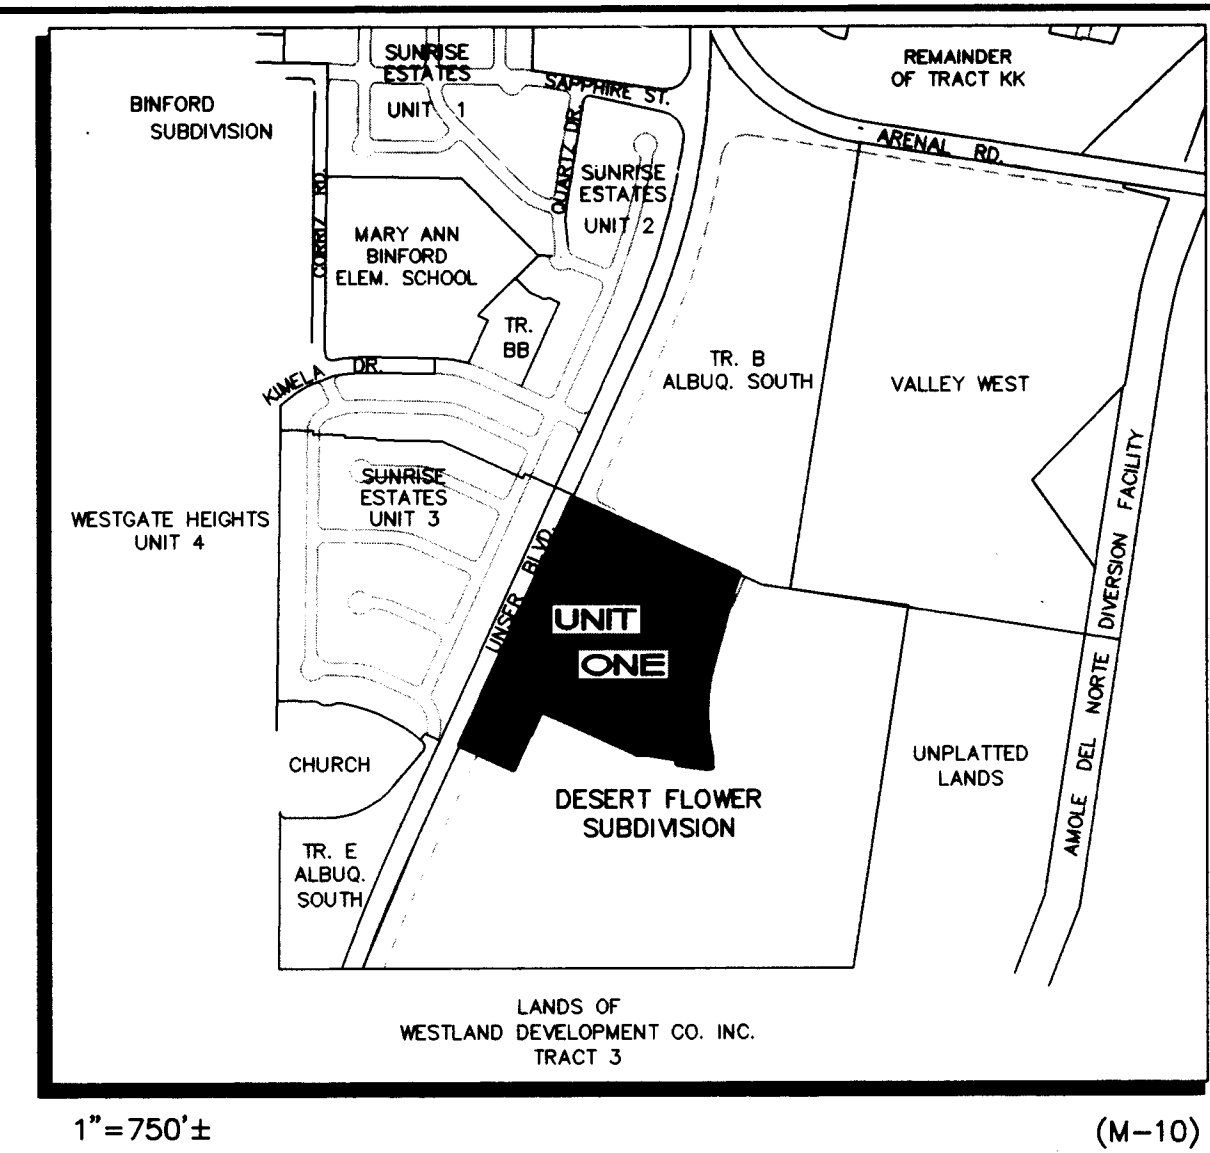

VICINITY MAP

DRB NO. 96-532
ISAACSON & ARFMAN, P.A.
Consulting Engineering Associates
128 Monroe Street N.E.
Albuquerque, New Mexico 87102
930CVR.DWG
10/28/97

REV.	SHEETS	CITY ENGINEER	DATE	USER DEPARTMENT	DATE	USER DEPARTMENT	DATE
ENGINEERS STAMP & SIGNATURE		APPROVALS		ENGINEER		DATE	
		DRC Chairman		<i>[Signature]</i>		1-16-98	
		Transportation		<i>[Signature]</i>		11-25-97	
		Water/Wastewater		<i>[Signature]</i>		11-18-97	
		Hydrology		<i>[Signature]</i>		11-18-97	
CIP							
Constr. Mngmt.							
City Project No.				5739 81			
APPROVED FOR CONSTRUCTION				<i>[Signature]</i> City Engineer Date			
Sheet				1 Of 24			

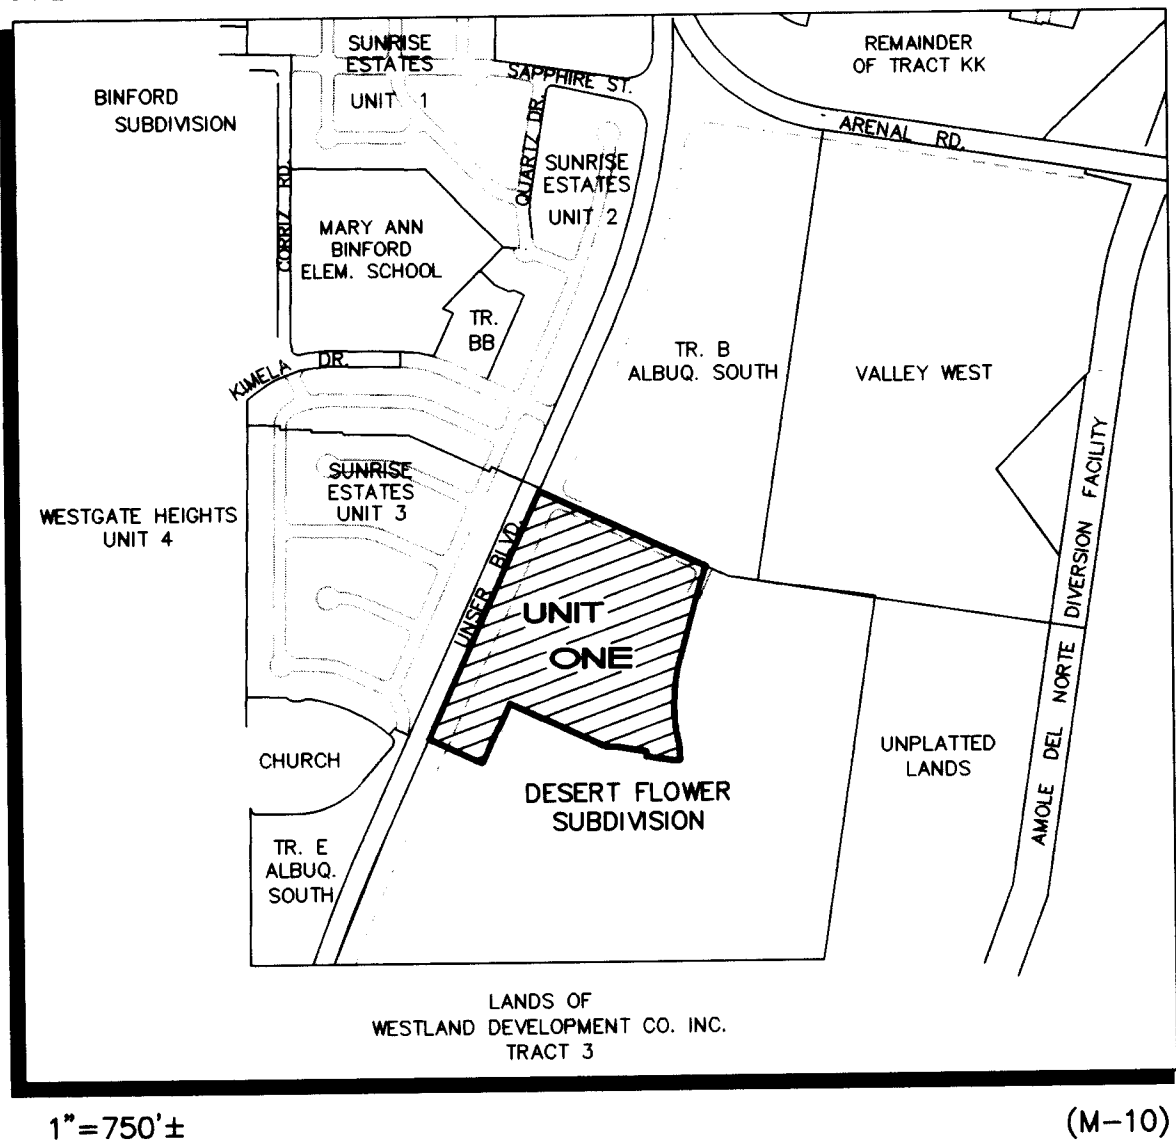

VICINITY MAP

SUBDIVISION DATA / NOTES

- Total Number of Existing Tracts: 1
- Total Number of Lots created: 85
- Total Number of Tracts created: 0
- Gross Subdivision Acreage: 15.7766 Ac.
- Total Mileage of Full Width Streets Created: 1.034
- Bearings are grid based on the New Mexico State Plane Coordinate System (Central Zone).
- Distances are ground distances.
- Basis of boundary are the following plats of record entitled:
"DESERT FLOWER SUBDIVISION, UNIT 1", (06-05-97, 97C-175)
"SUNRISE ESTATES, UNIT 2", (5-21-97, 97C-162)
"ALBUQUERQUE SOUTH, UNIT 1", (08-03-87, C34-74)
"VALLEY WEST", (04-17-80, C16-144)
"LANDS OF WESTLAND DEVELOPMENT CO. INC.", (09-08-83, C22-21)
- WARRANTY DEED "MESA ENTERPRISES, LIMITED", (04-23-80, BK. D118A-PG. 945)

all being records of Bernalillo County, New Mexico.

- Field Survey performed November, 1996.
- Unless otherwise noted all points are "SET 5/8" REBAR with cap "ALS LS 7719".
- City Standard Utility Note II:
"City of Albuquerque Water and Sanitary Sewer Service to Desert Flower Subdivision, Unit One, must be verified and coordinated with the Public Works Department, City of Albuquerque."
- △ = Set four inch (4") aluminum alloy cap stamped "City of Albuquerque", "Centerline Monumentation", "Survey Marker", "Do Not Disturb", PLS #7719.

LEGAL DESCRIPTION

A tract of land situate within the Town of Atrisco Grant, projected Section 34, Township 10 North, Range 2 East, New Mexico Principal Meridian, City of Albuquerque, Bernalillo County, New Mexico being all of TRACT A, DESERT FLOWER SUBDIVISION, as the same is shown and designated on said plat filed for record in the office of the County Clerk of Bernalillo County, New Mexico on June 5, 1997, in Volume 97C, Folio 175, and being more particularly described as follows:

BEGINNING at the northwest corner of the herein described tract, said point being common with the northwest corner of said TRACT A, and further being common with the southwest corner of TRACT B, ALBUQUERQUE SOUTH, UNIT 1, as the same is shown and designated on said plat filed for record in the office of the County Clerk of Bernalillo County, New Mexico on August 3, 1987, in Volume C34, Folio 74, from whence the Albuquerque Control Survey Monument "1-M10" bears N 08°07'14" E, 3304.87 feet;

THENCE S 65°23'58" E, 712.00 feet along a line common with the northerly line of said TRACT A to a point of non-tangent curvature;

LEGAL DESCRIPTION CONTINUED ON SHEET 3

DISCLOSURE STATEMENT

The purpose of this plat is to subdivide said Tract A of the Desert Flower Subdivision into 85 residential lots (Unit One), to dedicate public rights-of-way to the City of Albuquerque, and to grant those easements necessary to serve the residential development.

FREE CONSENT AND DEDICATION

The subdivision shown hereon is with the free consent and in accordance with the desires of the undersigned Owner(s) and/or Proprietor(s) thereof and said Owner(s) and/or Proprietor(s) do hereby dedicate all streets and public rights-of-way shown hereon to the City of Albuquerque in fee simple with warranty covenants and do hereby grant: all access, utility and drainage easements shown hereon including the right to construct, operate, inspect, and maintain facilities therein; and all public utility easements shown hereon for the common and joint use of gas, electrical power and communication services for overhead and buried distribution lines, conduits, and pipes for underground and/or overhead utilities where shown or indicated, and including the right of ingress and egress for construction and maintenance, and the right to trim interfering trees and shrubs. Said Owner(s) and/or Proprietor(s) do hereby consent to all of the foregoing and do hereby certify that this subdivision is their free act and deed.

OWNER

CURB INC.

BY:

Charles A. Hoegelin, President
Curb Inc.

Date

ACKNOWLEDGMENT

STATE OF NEW MEXICO } SS
COUNTY OF BERNALILLO }

This instrument was acknowledged before me on _____ 1997, by Charles A. Hoegelin, President of Curb Inc., a New Mexico Corporation, on behalf of said corporation.

My Commission Expires: _____

Notary Public

APPROVALS S- DRB NO. 96-532

PUBLIC SERVICE CO. OF NM--ELECTRIC SERVICES DIV. DATE

PUBLIC SERVICE CO. OF NM--GAS SERVICES DIV. DATE

US WEST COMMUNICATIONS DATE

JONES INTERCABLE DATE

CITY SURVEYOR, ENGR. DIV., P.W.D. DATE

TRAFFIC ENGINEERING, TRANS. DEV. DIV., P.W.D. DATE

PARKS DESIGN & DEVELOPMENT / CIP DATE

UTILITY DEVELOPMENT DIV., P.W.D. DATE

REAL PROPERTY DIVISION, D.F.M. DATE

A.M.A.F.C.A. DATE

CITY ENGINEER, PUBLIC WORKS DEPT. DATE

APPROVAL AND CONDITIONAL ACCEPTANCE AS SPECIFIED BY THE ALBUQUERQUE SUBDIVISION ORDINANCE, ARTICLE XI OF THE REVISED ORDINANCES OF ALBUQUERQUE, N.M.

CITY PLANNER, ALBUQUERQUE PLANNING DIVISION DATE

SURVEYOR'S CERTIFICATION

"I, Timothy Aldrich, a duly qualified Registered Professional Land Surveyor under the laws of the State of New Mexico, do hereby certify that this plat and description were prepared by me or under my supervision, shows all easements as shown on the plat of record or made known to me by the owners and/or proprietors of the subdivision shown hereon, utility companies and other parties expressing an interest and meets the minimum requirements for monumentation and surveys of the Albuquerque Subdivision Ordinance, and further meets the Minimum Standards for Land Surveying in the State of New Mexico (Effective November 1, 1989 and revisions effective December 25, 1991 and February 2, 1994), and is true and correct to the best of my knowledge and belief."

Timothy Aldrich, P.S. No. 7719


Date

SHEET 1 OF 3

PLAT FOR DESERT FLOWER SUBDIVISION UNIT ONE

BEING A REPLAT OF
TRACT A, DESERT FLOWER SUBDIVISION
WITHIN THE
TOWN OF ATRISCO GRANT
PROJECTED SECTION 34, T. 10 N. R. 2 E. NMPM
CITY OF ALBUQUERQUE
BERNALILLO COUNTY, NEW MEXICO
OCTOBER 1997

LOT AREA TABLE																																																																																																																																																																																																																																																																																																																																																																																																																																																																																																																																																																																																																																																																																																																																																																																																																																																																																																																																																																																																																																																																																																																														
BLOCK			LOT			AREA (SF)			BLOCK			LOT			AREA (SF)			BLOCK			LOT			AREA (SF)			BLOCK			LOT			AREA (SF)																																																																																																																																																																																																																																																																																																																																																																																																																																																																																																																																																																																																																																																																																																																																																																																																																																																																																																																																																																																																																																																																																													
A	1	5698	B	16	4974	C	1	5195	D	16	4725	E	11	6941	F	3	5250																																																																																																																																																																																																																																																																																																																																																																																																																																																																																																																																																																																																																																																																																																																																																																																																																																																																																																																																																																																																																																																																																																													
	2	4801		17	5446		2	4725		17	4725		12	8631																																																																																																																																																																																																																																																																																																																																																																																																																																																																																																																																																																																																																																																																																																																																																																																																																																																																																																																																																																																																																																																																																																																
	3	4800		18	4901		3	4725		18	4725		13	5512																																																																																																																																																																																																																																																																																																																																																																																																																																																																																																																																																																																																																																																																																																																																																																																																																																																																																																																																																																																																																																																																																																																
	4	4800		19	5808		4	4725		19	4725		14	4759																																																																																																																																																																																																																																																																																																																																																																																																																																																																																																																																																																																																																																																																																																																																																																																																																																																																																																																																																																																																																																																																																																																
	5	4801		20	5641		5	4725		20	5641		15	4725																																																																																																																																																																																																																																																																																																																																																																																																																																																																																																																																																																																																																																																																																																																																																																																																																																																																																																																																																																																																																																																																																																																
	6	4801	G	6	4725	H	1	5641	I	16	4725	J	4	6299																																																																																																																																																																																																																																																																																																																																																																																																																																																																																																																																																																																																																																																																																																																																																																																																																																																																																																																																																																																																																																																																																																																
	7	4801		2	4816		2	4725		17	4725		1	6299																																																																																																																																																																																																																																																																																																																																																																																																																																																																																																																																																																																																																																																																																																																																																																																																																																																																																																																																																																																																																																																																																																																
	8	4801		3	4725		3	4725		18	4725		2	4865																																																																																																																																																																																																																																																																																																																																																																																																																																																																																																																																																																																																																																																																																																																																																																																																																																																																																																																																																																																																																																																																																																																
	9	4801		4	4725		4	4725		19	4725		3	5538																																																																																																																																																																																																																																																																																																																																																																																																																																																																																																																																																																																																																																																																																																																																																																																																																																																																																																																																																																																																																																																																																																																
	10	4802		5	4725		5	4725		20	4725		2	4725																																																																																																																																																																																																																																																																																																																																																																																																																																																																																																																																																																																																																																																																																																																																																																																																																																																																																																																																																																																																																																																																																																																
	11	4802		6	4725		6	4725		21	4725		K	1	6376																																																																																																																																																																																																																																																																																																																																																																																																																																																																																																																																																																																																																																																																																																																																																																																																																																																																																																																																																																																																																																																																																																															
	12	4802		7	4725		7	4725		22	4725			L	2	7188																																																																																																																																																																																																																																																																																																																																																																																																																																																																																																																																																																																																																																																																																																																																																																																																																																																																																																																																																																																																																																																																																																														
	13	4802		8	4723		8	4725		23	5641																																																																																																																																																																																																																																																																																																																																																																																																																																																																																																																																																																																																																																																																																																																																																																																																																																																																																																																																																																																																																																																																																																																			
	14	4802		9	4669		9	5250		M	1		5641																																																																																																																																																																																																																																																																																																																																																																																																																																																																																																																																																																																																																																																																																																																																																																																																																																																																																																																																																																																																																																																																																																																	
	15	4803		10	5073		10	5250			2		4972																																																																																																																																																																																																																																																																																																																																																																																																																																																																																																																																																																																																																																																																																																																																																																																																																																																																																																																																																																																																																																																																																																																	

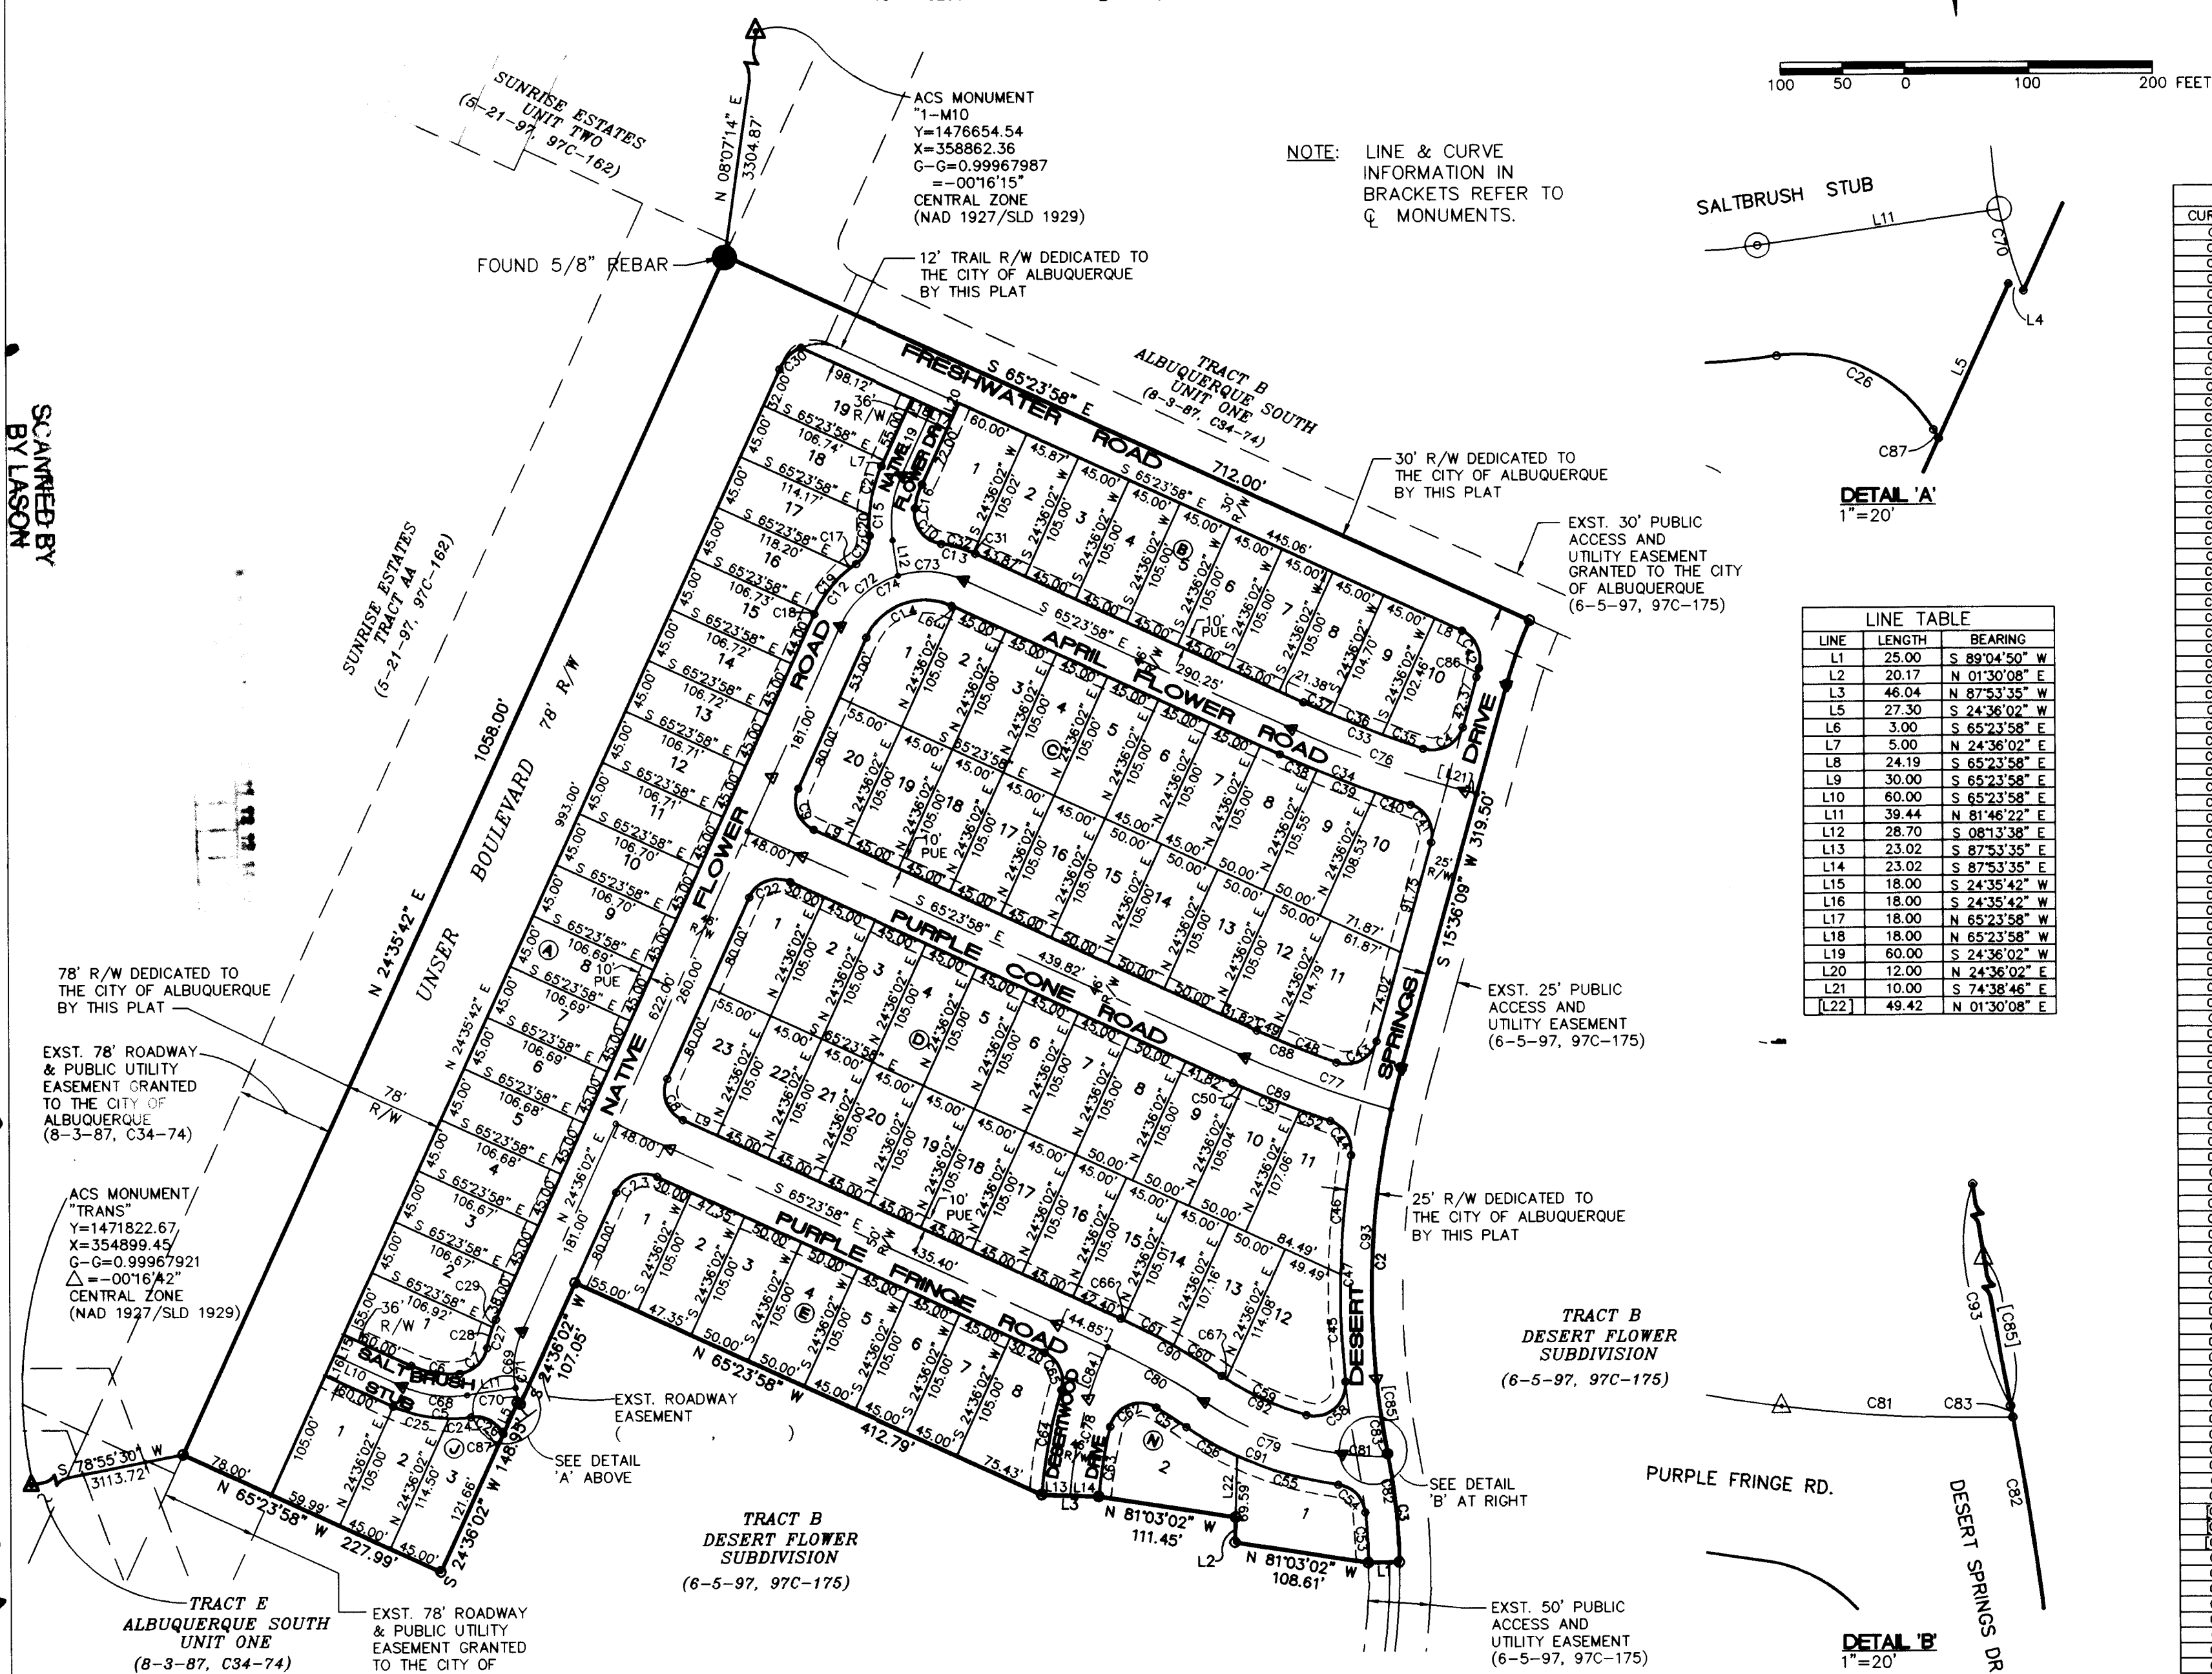

PLAT FOR DESERT FLOWER SUBDIVISION UNIT ONE

BEING A REPLAT OF
TRACT A, DESERT FLOWER SUBDIVISION
WITHIN THE
TOWN OF ATRISCO GRANT
PROJECTED SECTION 34, T. 10 N. R. 2 E. NMPM
CITY OF ALBUQUERQUE
BERNALILLO COUNTY, NEW MEXICO
OCTOBER 1997

CURVE TABLE			
CURVE	LENGTH	RADIUS	DELTA
C1	313.06	675.00	26°34'23"
C2	87.71	500.00	10°03'03"
C3	40.40	25.00	92°35'31"
C4	64.22	111.30	33°03'43"
C5	38.86	75.30	30°18'52"
C6	32.22	25.00	73°00'28"
C7	39.27	25.00	90°00'00"
C8	36.27	25.00	90°00'00"
C9	39.82	25.00	91°29'13"
C10	26.52	25.00	60°46'44"
C11	35.34	98.00	31°11'17"
C12	28.48	98.00	16°30'10"
C13	81.68	52.00	90°00'00"
C14	57.48	111.30	29°35'42"
C15	24.70	63.30	15°09'57"
C16	18.93	75.30	15°08'27"
C17	8.46	98.00	03°10'37"
C18	1.00	98.00	00°30'00"
C19	46.88	98.00	27°24'36"
C20	18.57	111.30	08°21'40"
C21	40.92	111.30	21°03'47"
C22	39.27	25.00	90°00'00"
C23	39.27	25.00	90°00'00"
C24	17.90	111.30	09°12'49"
C25	46.33	111.30	23°50'54"
C26	29.64	25.00	67°50'11"
C27	24.24	98.00	14°10'21"
C28	17.23	98.00	10°04'36"
C29	7.01	98.00	04°05'30"
C30	25.10	35.00	41°05'16"
C31	2.00	98.00	01°10'10"
C32	15.48	98.00	15°29'00"
C33	103.55	927.00	06°24'02"
C34	112.94	973.00	06°39'02"
C35	34.87	927.00	02°09'20"
C36	43.06	927.00	02°47'06"
C37	23.62	927.00	01°27'36"
C38	35.80	973.00	01°50'37"
C39	50.09	973.00	02°56'59"
C40	30.09	973.00	01°46'18"
C41	13.68	25.00	87°00'00"
C42	35.82	25.00	82°05'32"
C43	40.97	75.30	33°38'33"
C44	45.09	25.00	80°05'43"
C45	86.07	700.00	07°02'42"
C46	86.63	700.00	07°36'12"
C47	182.70	700.00	14°57'14"
C48	51.07	777.00	03°45'58"
C49	18.18	777.00	01°02'26"
C50	5.18	823.00	00°54'10"
C51	50.05	823.00	02°29'03"
C52	25.89	823.00	01°48'10"
C53	40.89	475.00	04°54'28"
C54	33.54	25.00	76°31'58"
C55	82.07	275.00	17°43'29"
C56	46.93	275.00	09°46'40"
C57	28.87	475.00	03°28'57"
C58	46.58	25.00	111°19'50"
C59	71.01	225.00	18°05'00"
C60	45.87	525.00	05°00'23"
C61	25.07	525.00	04°05'08"
C62	46.62	25.00	106°51'08"
C63	56.93	327.00	09°36'33"
C64	85.80	373.00	13°10'46"
C65	36.12	25.00	82°46'59"
C66	2.60	525.00	00°17'02"
C67	1.49	225.00	01°10'30"
C68	53.46	93.30	32°49'40"
C69	46.68	75.30	35°39'28"
C70	84.40	75.30	18°05'51"
C71	60.35	75.30	46°06'20"
C72	63.69	75.30	48°39'42"
C73	24.12	75.30	41°20'30"
C74	117.81	75.30	90°00'00"
C75	84.40	93.30	32°49'40"
C76	158.31	850.00	04°24'53"
C77	125.48	800.00	06°59'13"
C78	123.76	350.00	20°15'34"
C79	120.00	25.00	27°30'08"
C80	89.09	500.00	10°12'30"
C81	87.72	250.00	08°08'28"
C82	85.84	500.00	09°30'10"
C83	1.87	500.00	00°12'33"
C84	44.09	350.00	07°13'29"
C85	61.13	875.00	05°11'20"
C86	7.14	375.00	01°05'24"
C87	1.44	98.00	00°00'00"
C88	69.25	777.00	05°06'24"
C89	84.12	823.00	05°51'23"
C90	132.00	275.00	27°30'08"
C91	75.63	225.00	19°15'35"
C92	217.44	875.00	18°27'28"

PLAT
FOR
DESERT FLOWER SUBDIVISION
UNIT ONE
BEING A REPLAT OF
TRACT A, DESERT FLOWER SUBDIVISION
WITHIN THE
TOWN OF ATRISCO GRANT
PROJECTED SECTION 34, T. 10 N., R. 2 E., NMPM
CITY OF ALBUQUERQUE
BERNALILLO COUNTY, NEW MEXICO
OCTOBER 1997

LEGAL DESCRIPTION (Cont. from Sht. 1)

THENCE along a line common with the easterly line of said TRACT A, 54.93 feet along a curve to the left, whose radius is 350.00 feet through a central angle of 08°59'33" and whose chord bears S 20°05'56" W, 54.88 feet to a point of tangency;

THENCE continuing along the easterly line of said TRACT A, S 15°36'09" W, 319.50 feet to a point of tangent curvature;

THENCE along said easterly line 313.06 feet along a curve to the left, whose radius is 675.00 feet through a central angle of 26°34'23" and whose chord bears S 02°18'58" W, 310.26 feet to a point of tangent reverse curvature;

THENCE continuing along said easterly line 87.71 feet along a curve to the right, whose radius is 500.00 feet through a central angle of 10°03'03" and whose long chord bears S 05°56'52" E, 87.60 feet to a point of non-tangency, said point being common with the southeast corner of said TRACT A;

THENCE leaving said easterly line S 89°04'50" W, 25.00 feet to a point;

THENCE N 81°03'02" W, 108.61 feet to a point;

THENCE N 01°30'08" E, 20.17 feet to a point;

THENCE N 81°03'02" W, 111.45 feet to a point;

THENCE N 87°53'35" W, 46.04 feet to a point;

THENCE N 65°23'58" W, 412.79 feet to a point;

THENCE S 24°36'02" W, 107.05 feet to a point;

THENCE N 65°23'58" W, 2.66 feet to a point;

THENCE S 24°36'02" W, 148.95 feet to a point;

THENCE N 65°23'58" W, 227.99 feet to a point, said point being common with the southwest corner of said TRACT A;


THENCE N 24°35'42" E, 1058.00 feet to the point of beginning and containing 15.7766 acres more or less.

PUBLIC UTILITY EASEMENTS

PUBLIC UTILITY EASEMENTS SHOWN ON THIS PLAT ARE GRANTED FOR THE COMMON AND JOINT USE OF:


1. THE PUBLIC SERVICE CO. OF NM--ELECTRIC SERVICES DIVISION FOR THE INSTALLATION, MAINTENANCE, AND SERVICE OF UNDERGROUND/OVERHEAD ELECTRICAL LINES, TRANSFORMERS, AND ANY OTHER EQUIPMENT, FIXTURES, STRUCTURES, AND RELATED FACILITIES REASONABLY NECESSARY TO PROVIDE ELECTRICAL SERVICE.
2. U.S. WEST FOR THE INSTALLATION, MAINTENANCE AND SERVICE OF ALL BURIED COMMUNICATION LINES AND OTHER RELATED EQUIPMENT AND FACILITIES REASONABLY NECESSARY TO PROVIDE COMMUNICATION SERVICES, INCLUDING BUT NOT LIMITED TO ABOVE GROUND PEDESTALS AND CLOSURES.
3. JONES INTERCABLE FOR THE INSTALLATION, MAINTENANCE, AND SERVICE OF SUCH LINES, CABLE, AND OTHER RELATED EQUIPMENT AND FACILITIES REASONABLY NECESSARY TO PROVIDE CABLE TV SERVICE.
4. THE PUBLIC SERVICE CO. OF NM--GAS SERVICES DIVISION FOR THE INSTALLATION, MAINTENANCE, AND SERVICE OF SUCH DISTRIBUTION AND SERVICE LINES AND FACILITIES REASONABLY NECESSARY TO PROVIDE GAS SERVICE.

INCLUDED IS THE RIGHT TO BUILD, REBUILD, CONSTRUCT, RECONSTRUCT, LOCATE, RELOCATE, CHANGE, REMOVE, MODIFY, RENEW, OPERATE, AND MAINTAIN FACILITIES FOR THE PURPOSES DESCRIBED ABOVE, TOGETHER WITH FREE ACCESS TO, FROM, AND OVER SAID EASEMENT, INCLUDING SUFFICIENT WORKING AREA SPACE FOR ELECTRIC TRANSFORMERS, WITH THE RIGHT AND PRIVILEGE TO TRIM AND REMOVE TREES, SHRUBS, OR BUSHES WHICH INTERFERE WITH THE PURPOSES SET FORTH HEREIN. NO BUILDING, SIGN, OR OTHER STRUCTURE SHALL BE ERECTED OR CONSTRUCTED ON SAID EASEMENTS, NOR SHALL ANY WELL BE DRILLED OR OPERATED THEREON. PROPERTY OWNERS SHALL BE SOLELY RESPONSIBLE FOR CORRECTING ANY VIOLATIONS OF NATIONAL ELECTRICAL SAFETY CODE CAUSED BY CONSTRUCTION OF POOLS, DECKING, OR ANY STRUCTURES ADJACENT TO OR NEAR EASEMENTS SHOWN ON THIS PLAT.

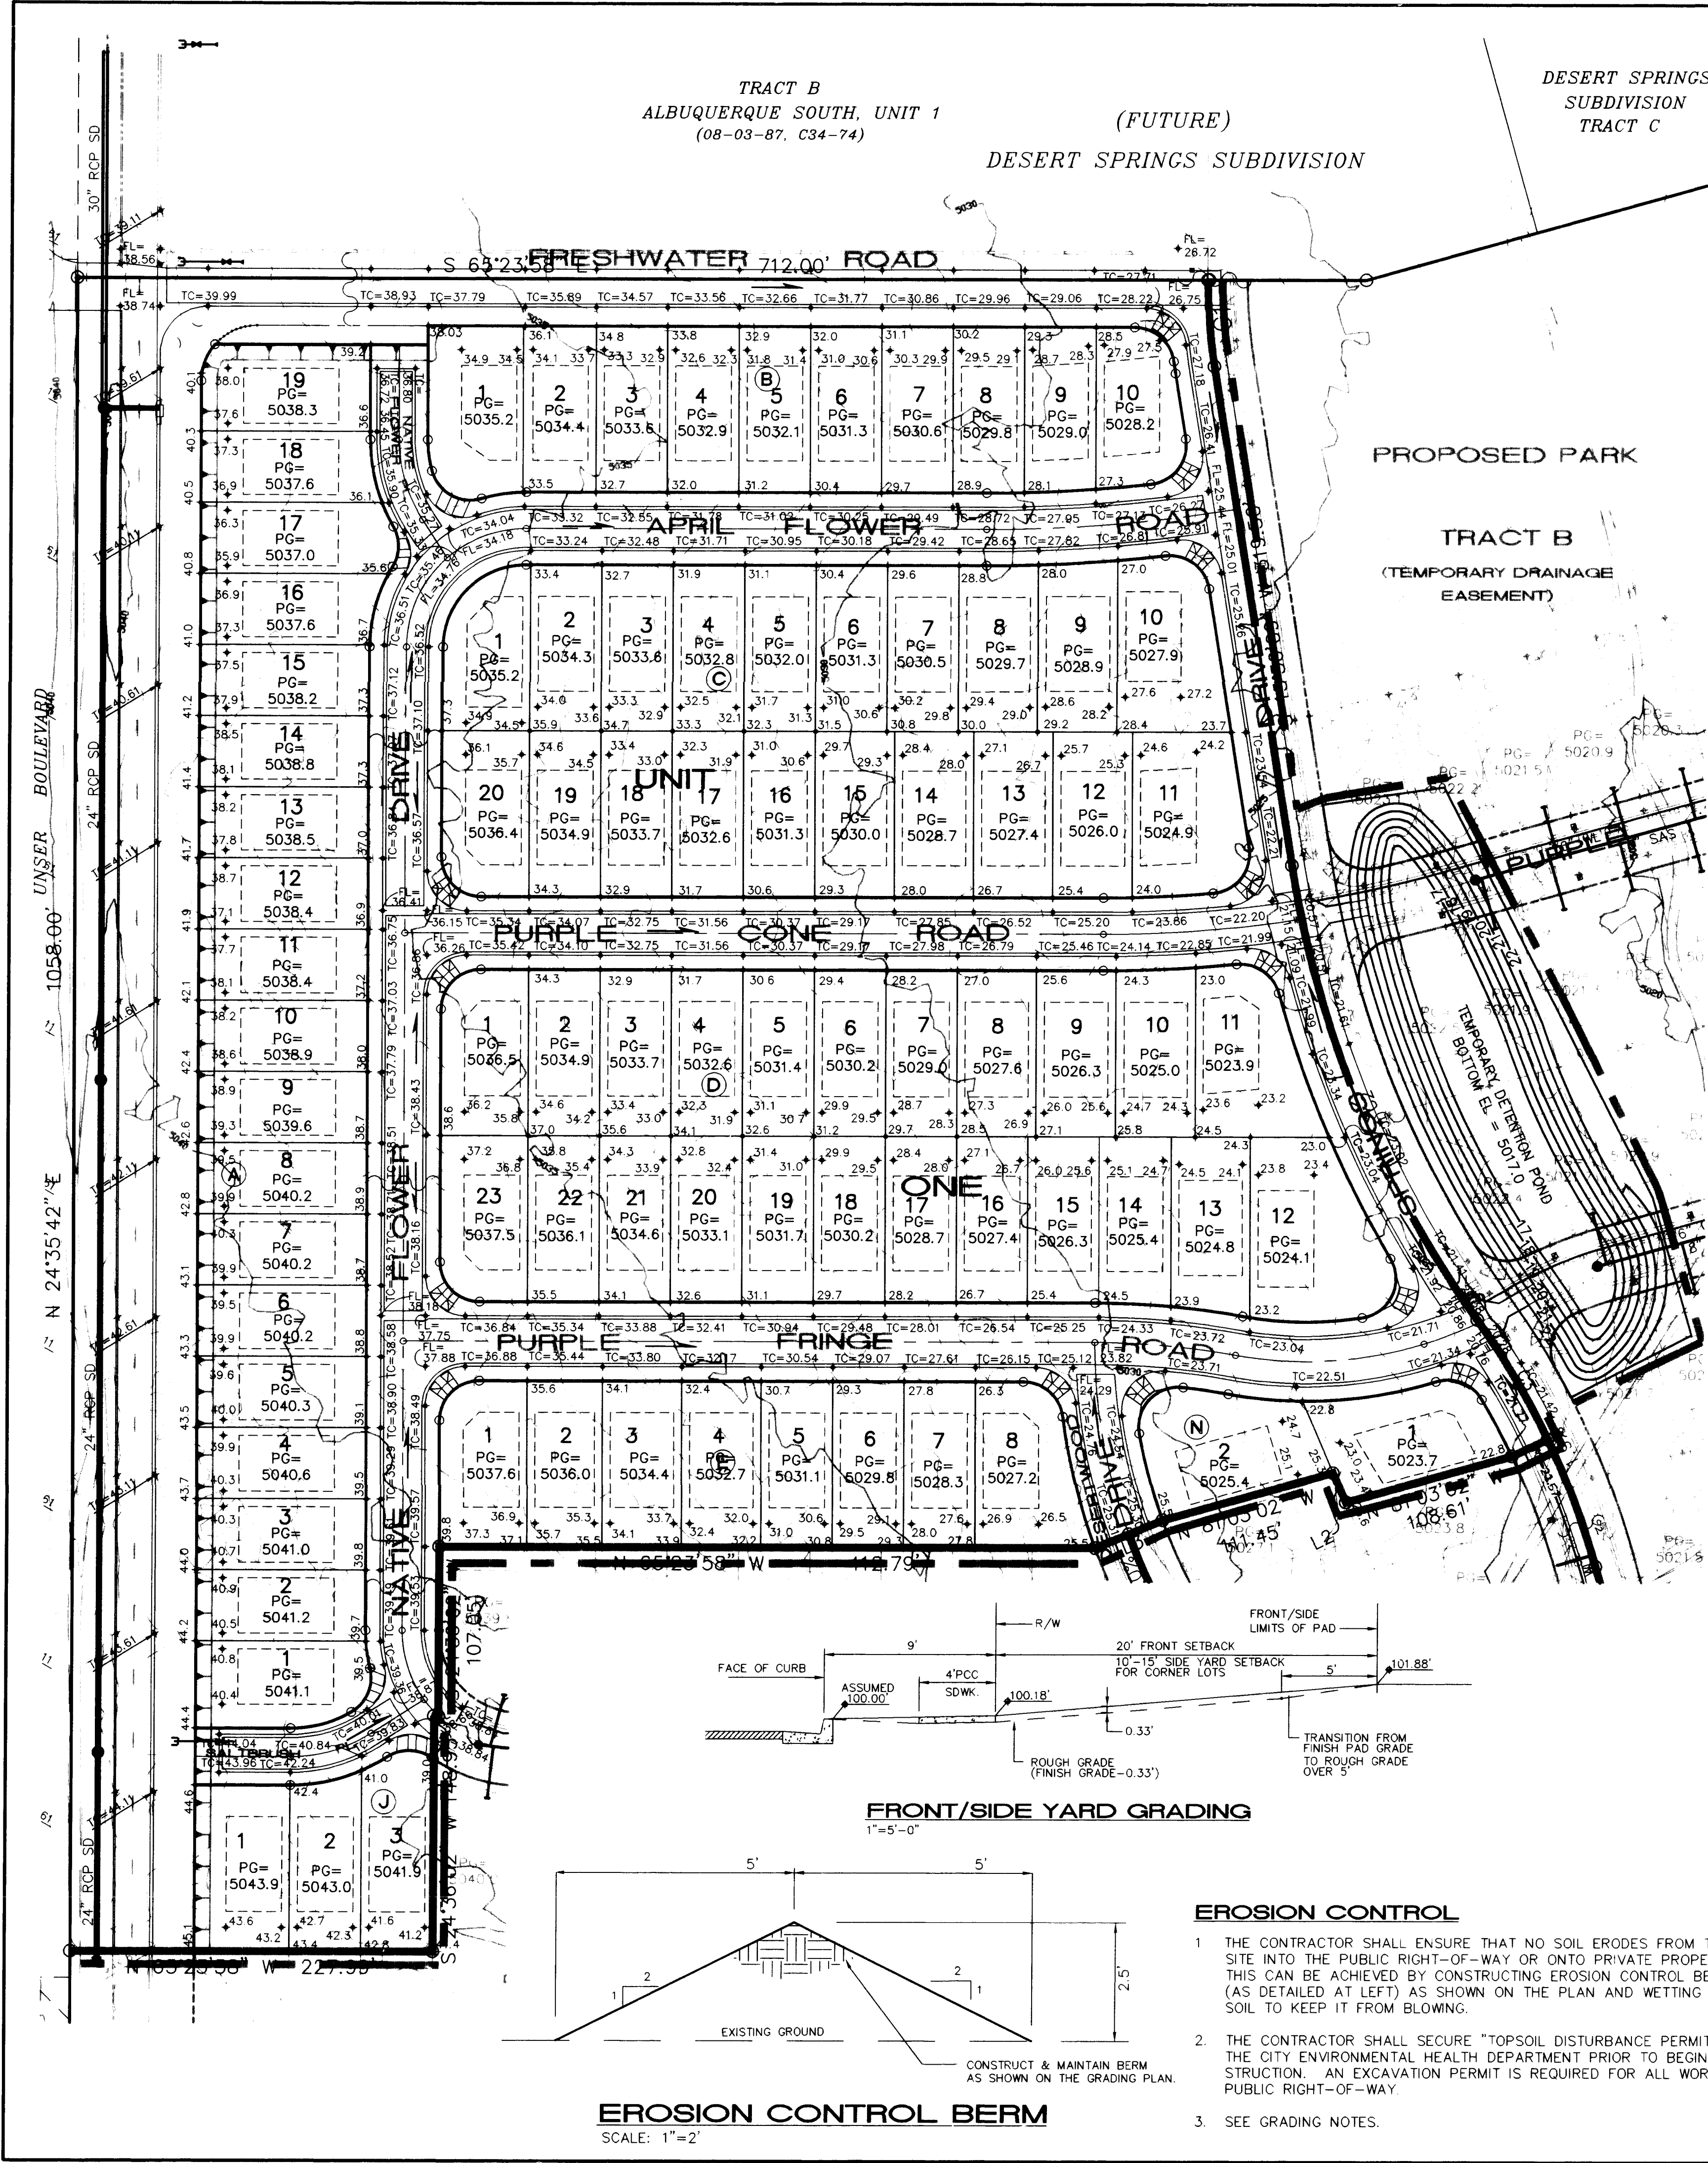

- LEGEND**
- 5012 EXISTING CONTOUR
 - 15 PROPOSED CONTOUR
 - 78.3 PROPOSED SPOT ELEVATION
 - FLOW ARROW
 - PG= 5022.0 PAD GRADE ELEVATION
 - PG= 25.74 PROPOSED TOP OF CURB ELEVATION
 - PG= 24.07 PROPOSED FLOW LINE ELEVATION
 - UNIT BOUNDARY
 - EROSION CONTROL BERM

- GRADING NOTES:**
- ALL TRASH, DEBRIS, & SURFACE VEGETATION SHALL BE CLEARED AND LEGALLY DISPOSED OFFSITE.
 - ALL SUBGRADE AND FILL SHALL BE COMPACTED TO A MINIMUM OF 90% ASTM D-1557.
 - EXCAVATION IS UNCLASSIFIED AND INCLUDES EXCAVATION TO SUBGRADE ELEVATIONS INDICATED, REGARDLESS OF CHARACTER OF MATERIALS ENCOUNTERED.
 - CONFORM TO ELEVATIONS AND DIMENSIONS SHOWN ON PLANS WITHIN A TOLERANCE OF 0.3± FEET.
 - SCARIFY AND COMPACT SUBGRADE FOR FILLS. PLACE FILL MATERIALS IN LAYERS NOT MORE THAN 8" IN LOOSE DEPTH. MOISTEN AS NECESSARY TO PROVIDE OPTIMUM MOISTURE (±2%) CONTENT.
 - UNIFORMLY GRADE AREAS WITHIN LIMITS OF GRADING AS SHOWN ON PLAN. SMOOTH FINISHED SURFACE WITHIN SPECIFIED TOLERANCE, COMPACT WITH UNIFORM SLOPES BETWEEN POINTS WHERE ELEVATIONS ARE INDICATED.
 - MAXIMUM SLOPES SHALL BE 3:1; MINIMUM SLOPES SHALL BE 1%.
 - TWO (2) WORKING DAYS PRIOR TO ANY EXCAVATION, CONTRACTOR MUST CONTACT NEW MEXICO ONE CALL SYSTEM, 260-1990, FOR LOCATION OF EXISTING UTILITIES.
 - IF ANY UTILITY LINES, PIPELINES, OR UNDERGROUND UTILITY LINES ARE SHOWN ON THESE DRAWINGS, THEY ARE SHOWN IN AN APPROXIMATE MANNER ONLY, AND SUCH LINES MAY EXIST WHERE NONE ARE SHOWN. IF ANY SUCH EXISTING LINES ARE SHOWN, THE LOCATION IS BASED UPON INFORMATION PROVIDED BY THE OWNER OF SAID UTILITY, AND THE INFORMATION MAY BE INCOMPLETE, OR MAY BE OBSOLETE BY THE TIME CONSTRUCTION COMMENCES. THE ENGINEER HAS CONDUCTED ONLY A PRELIMINARY INVESTIGATION OF THE LOCATION, DEPTH, SIZE OR TYPE OF EXISTING UTILITY LINES, PIPELINES, OR UNDERGROUND UTILITY LINES. THIS INVESTIGATION IS NOT CONCLUSIVE, AND MAY NOT BE COMPLETE, THEREFORE, MAKES NO REPRESENTATION PERTAINING THERETO, AND ASSUMES NO RESPONSIBILITY OR LIABILITY THEREFOR. THE CONTRACTOR SHALL INFORM ITSELF OF THE LOCATION OF ANY UTILITY LINE, PIPELINE, OR UNDERGROUND UTILITY LINE IN OR NEAR THE AREA OF THE WORK IN ADVANCE OF AND DURING EXCAVATION WORK. THE CONTRACTOR IS FULLY RESPONSIBLE FOR ANY AND ALL DAMAGE CAUSED BY ITS FAILURE TO LOCATE, IDENTIFY AND PRESERVE ANY AND ALL EXISTING UTILITIES, PIPELINES, AND UNDERGROUND UTILITY LINES. IN PLANNING AND CONDUCTING EXCAVATION, THE CONTRACTOR SHALL COMPLY WITH STATE STATUTES, MUNICIPAL AND LOCAL ORDINANCES, RULES AND REGULATIONS, IF ANY, PERTAINING TO THE LOCATION OF THESE LINES AND FACILITIES.
 - THE CONTRACTOR SHALL PROMPTLY CLEAN UP ANY MATERIAL EXCAVATED WITHIN THE PUBLIC RIGHT-OF-WAY SO THAT THE EXCAVATED MATERIAL IS NOT ERODED AND WASHED DOWN THE STREET.
 - OWNER WILL PROVIDE SOIL TESTING AND INSPECTION SERVICES DURING EARTHWORK OPERATIONS. ALLOW TESTING SERVICE TO INSPECT AND APPROVE COMPACTED SUBGRADES AND FILL LAYERS BEFORE FURTHER CONSTRUCTION WORK IS DONE. SHALL COMPACTION TESTS INDICATE INADEQUATE DENSITY, CONTRACTOR SHALL PROVIDE ADDITIONAL COMPACTION AND TESTING AT NO ADDITIONAL EXPENSE.
 - OWNER HAS ESTABLISHED SUBDIVISION BOUNDARY CORNERS. CONTRACTOR SHALL LOCATE AND PRESERVE ALL BOUNDARY CORNERS AND REPLACE ANY LOST OR DISTURBED CORNERS.
 - ISAACSON & ARFMAN, P.A. (THE ENGINEER) HAS PREPARED THIS GRADING PLAN TO ESTABLISH FINAL SURFACE GRADES FOR BOTH THE PROPOSED INDIVIDUAL RESIDENTIAL LOTS AND THE PUBLIC RIGHTS-OF-WAY.
 - THE EARTHWORK CONTRACTOR (CONTRACTOR) IS REQUIRED TO REVIEW THE FOLLOWING: GEOTECHNICAL ENGINEERING EVALUATION FOR TRACT 3B HIGH DESERT DEVELOPMENT, PREPARED BY GEO-TEST, DATED DECEMBER 19, 1994, FOR CHAMA DEVELOPMENT CORP. COPIES OF THIS DOCUMENT MAY BE REVIEWED AT THE OFFICE OF ISAACSON & ARFMAN, P.A., 128 MONROE STREET NE, ALBUQUERQUE, NEW MEXICO, (505) 268-8828. THE EARTHWORK CONTRACTOR'S BID SHALL INCLUDE ALL COSTS ASSOCIATED WITH THE IMPLEMENTATION OF ALL RECOMMENDATIONS CONTAINED IN THESE STUDIES.

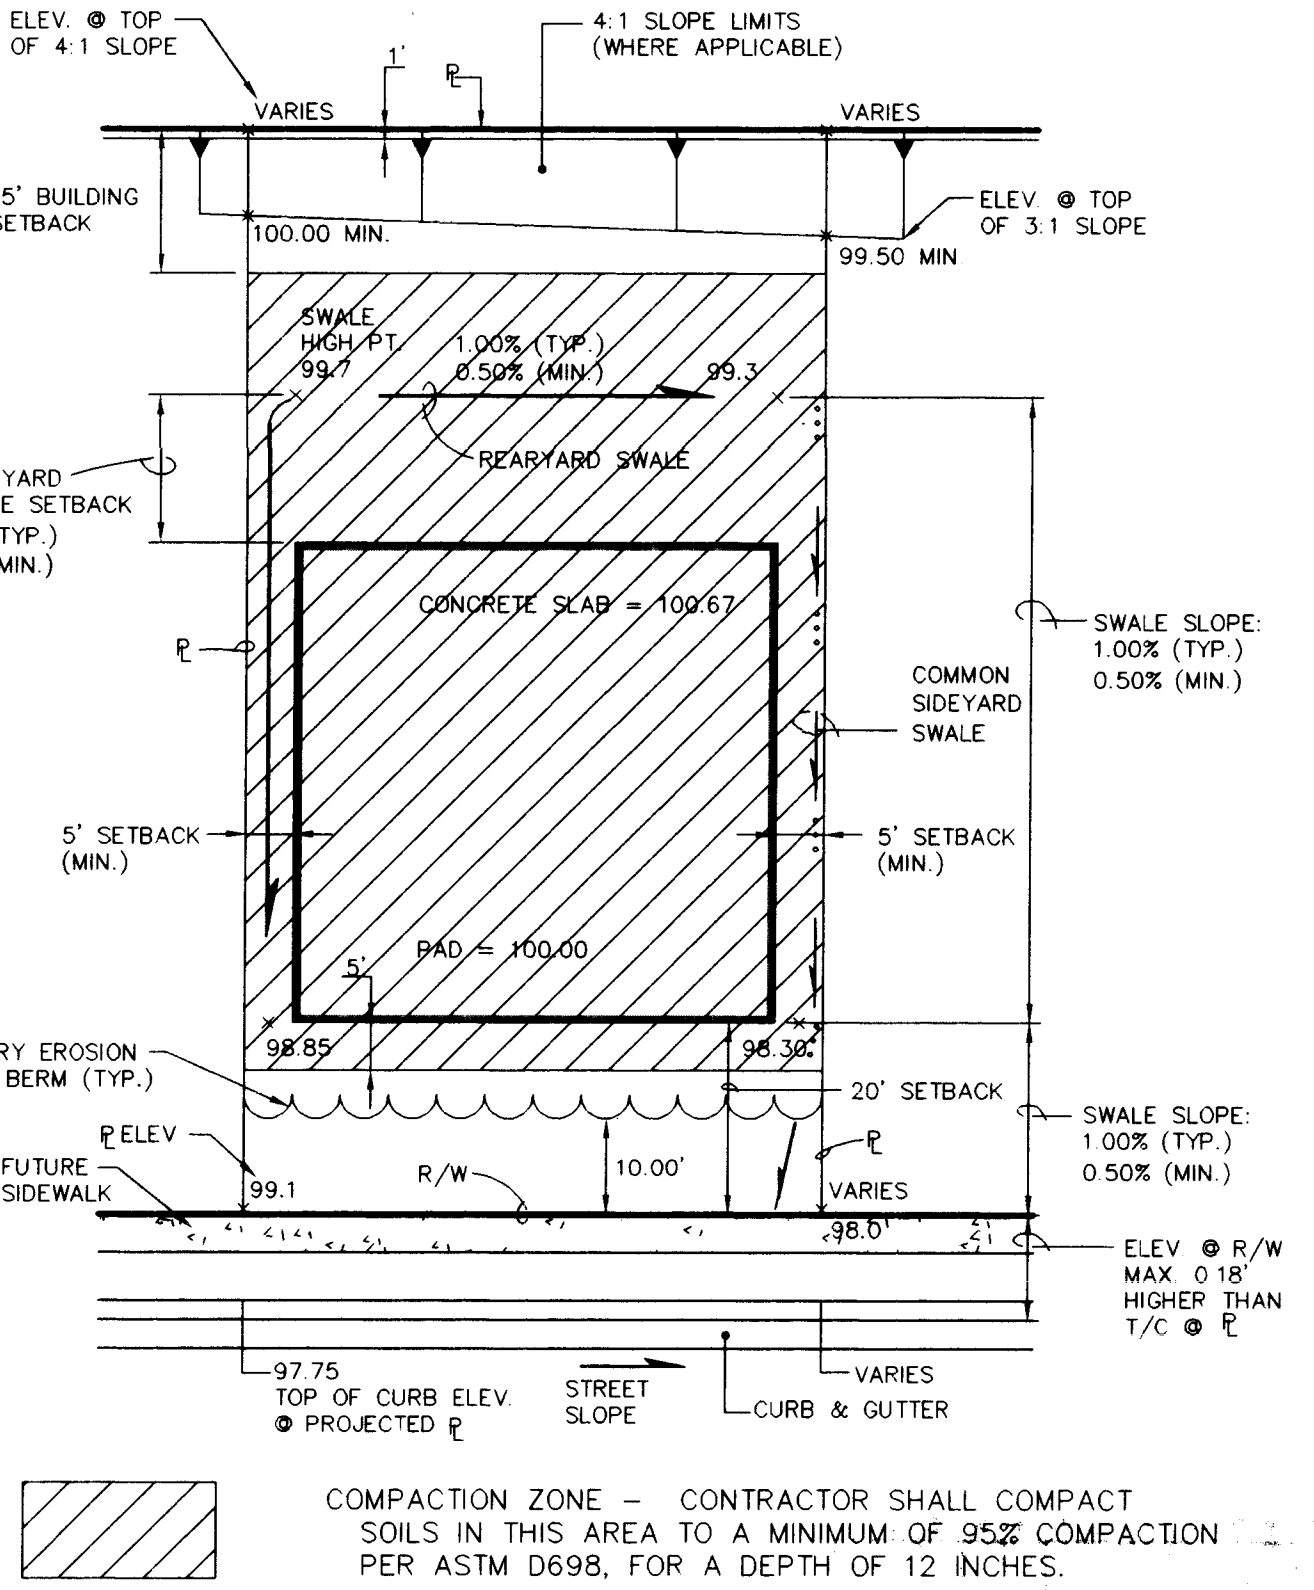

- NOTES**
- LEGAL DESCRIPTION: TRACT A, DESERT FLOWER SUBDIVISION, filed June 5, 1997, Vol. 97C, Folio 175.
 - BENCHMARK: ACS MONUMENT "1-M10" ELEV = 5079.88
 - ENGINEER: ISAACSON & ARFMAN, P.A. 128 Monroe Street NE, Albuquerque, NM Attn: Fred Arfman
 - SURVEYOR: ALS, Inc. P.O. Box 30701, Albuquerque, NM Attn: Tim Aldrich
 - FLOOD HAZARD STATEMENT: No part of this development is affected nor contributes to a flood hazard area as determined by Panel No. (35001C03360-3371) of the September 20, 1996 Edition of the F.E.M.A. Maps.
 - SOILS: From the SCS Soil Survey of Bernalillo County site soils are identified as Bluepoint Lomay Fine Sands which are classified as hydrologic group "A" soils.











ISAACSON & ARFMAN, P.A.
Consulting Engineering Associates
128 Monroe Street N.E.
Albuquerque New Mexico
930GR01.DWGems 10/29/97

CITY OF ALBUQUERQUE
PUBLIC WORKS DEPARTMENT
ENGINEERING GROUP

TITLE: DESERT FLOWER SUBDIVISION--UNIT ONE
GRADING & DRAINAGE PLAN

Design Review Committee	City Engineer Approval	Mo./Day/Yr.	Mo./Day/Yr.
City Project No. 5739.81	Zone Map No. M-10	Sheet 4	Of 24

AS-BUILT INFORMATION		BENCH MARKS		SURVEY INFORMATION		ENGINEER'S SEAL	
CONTRACTOR	DATE	WORK	DATE	FIELD	DATE	REVISIONS	BY
ACS MONUMENT "1-M10" LOCATED AT THE SOUTHEAST CORNER OF SAGE RD. & UNSER BLVD	DATE	5/96	1	ALS	DATE	DESIGN	JUN
ELEV. = 5079.88	DATE	5/97	DATE	DATE	DATE	DESIGN	ANW
TBM: RIM OF SOUTHWESTERLY MANHOLE AT SAPPHIRE ST & UNSER BLVD	DATE	5/97	DATE	DATE	DATE	DESIGN	FCA
ELEV. = 5035.84	DATE	5/97	DATE	DATE	DATE	DESIGN	

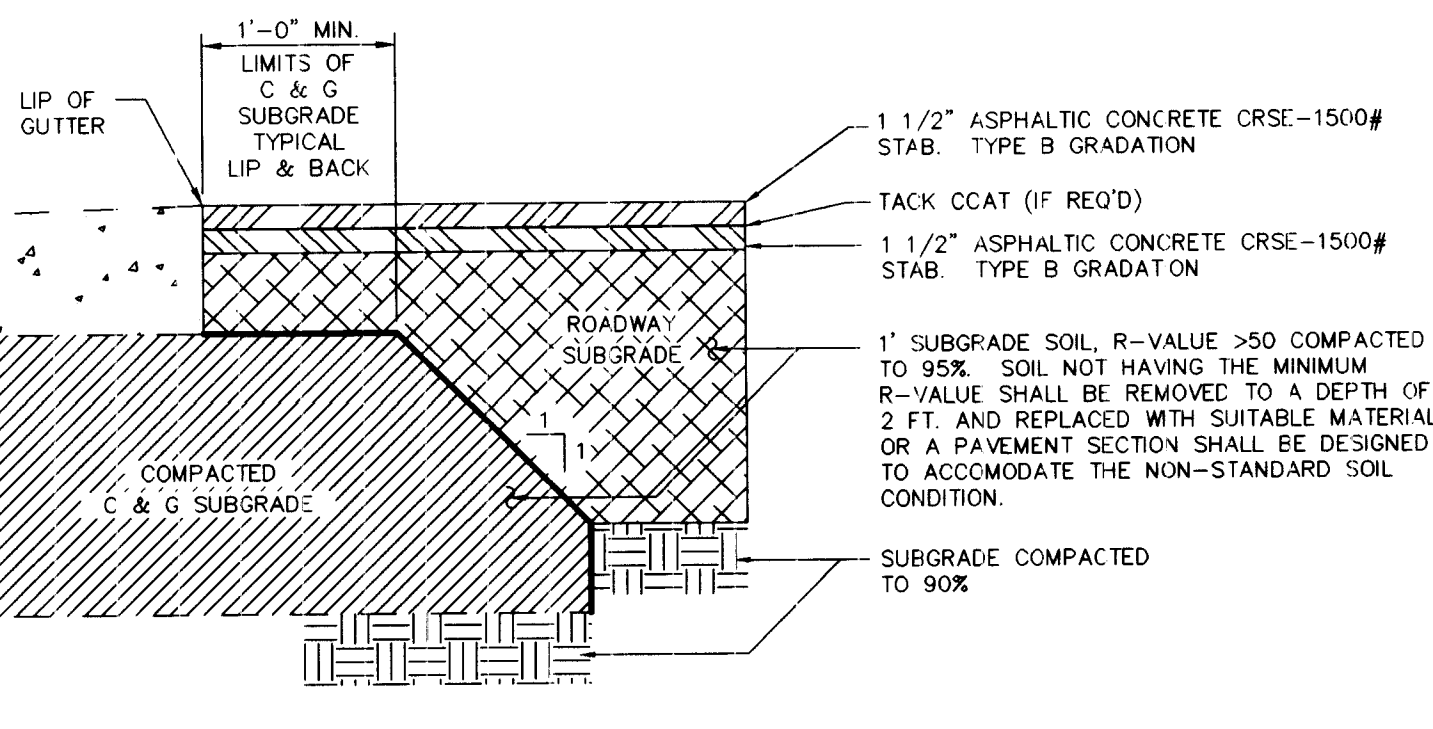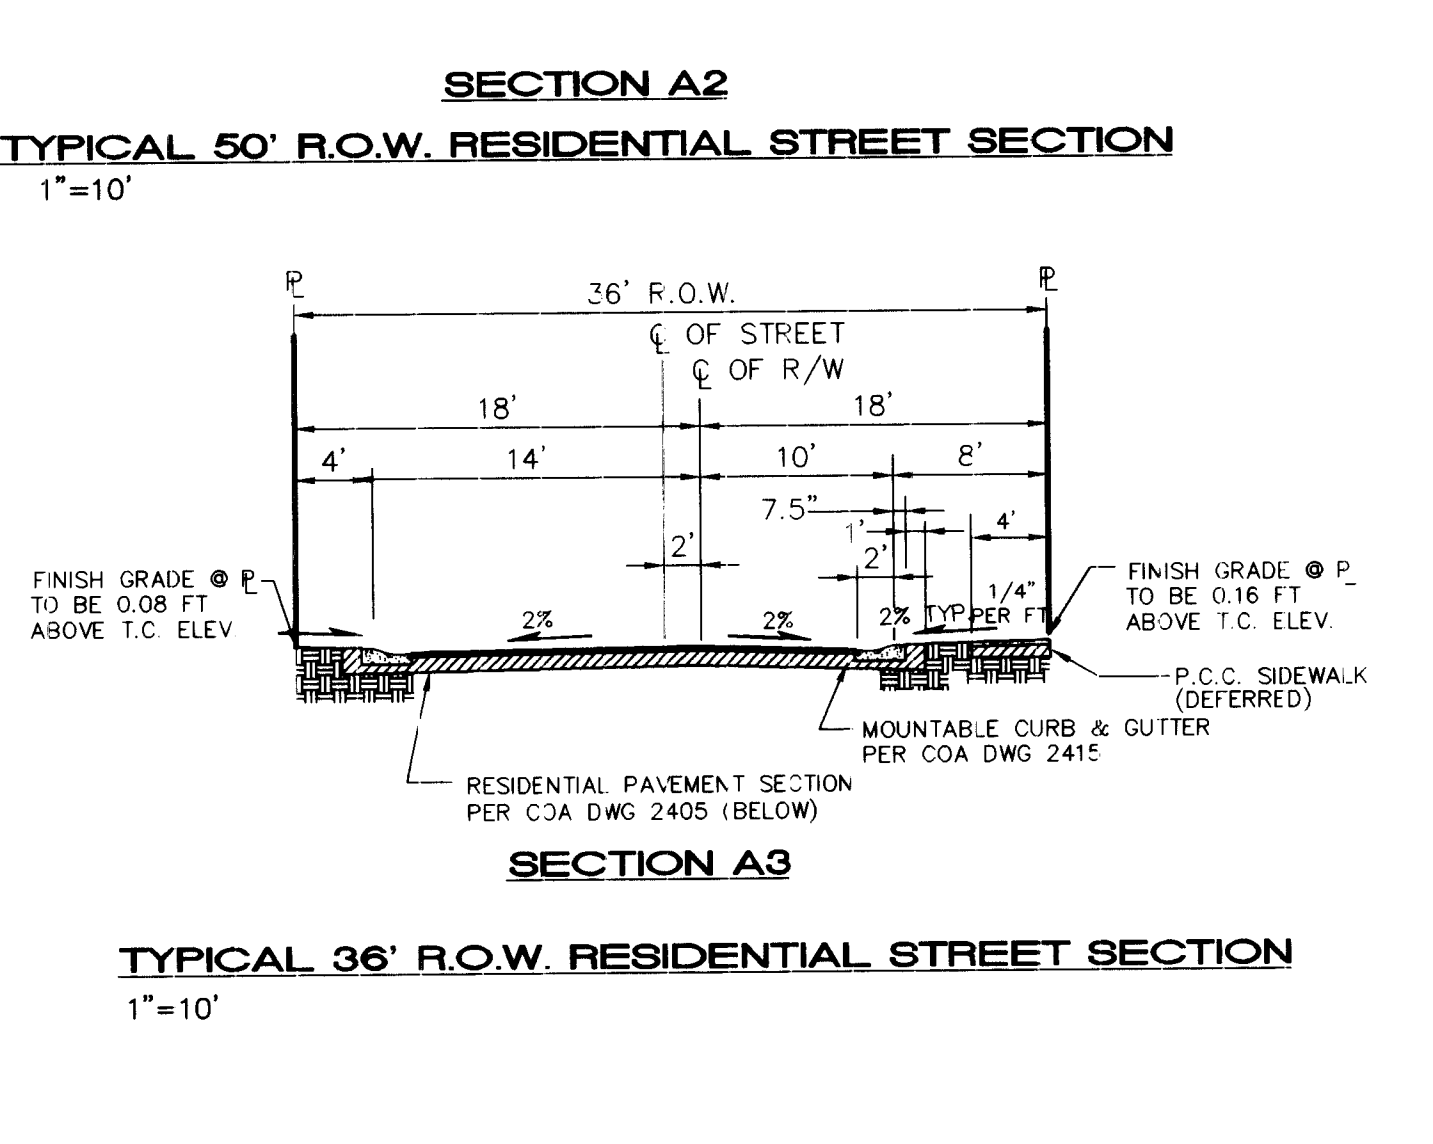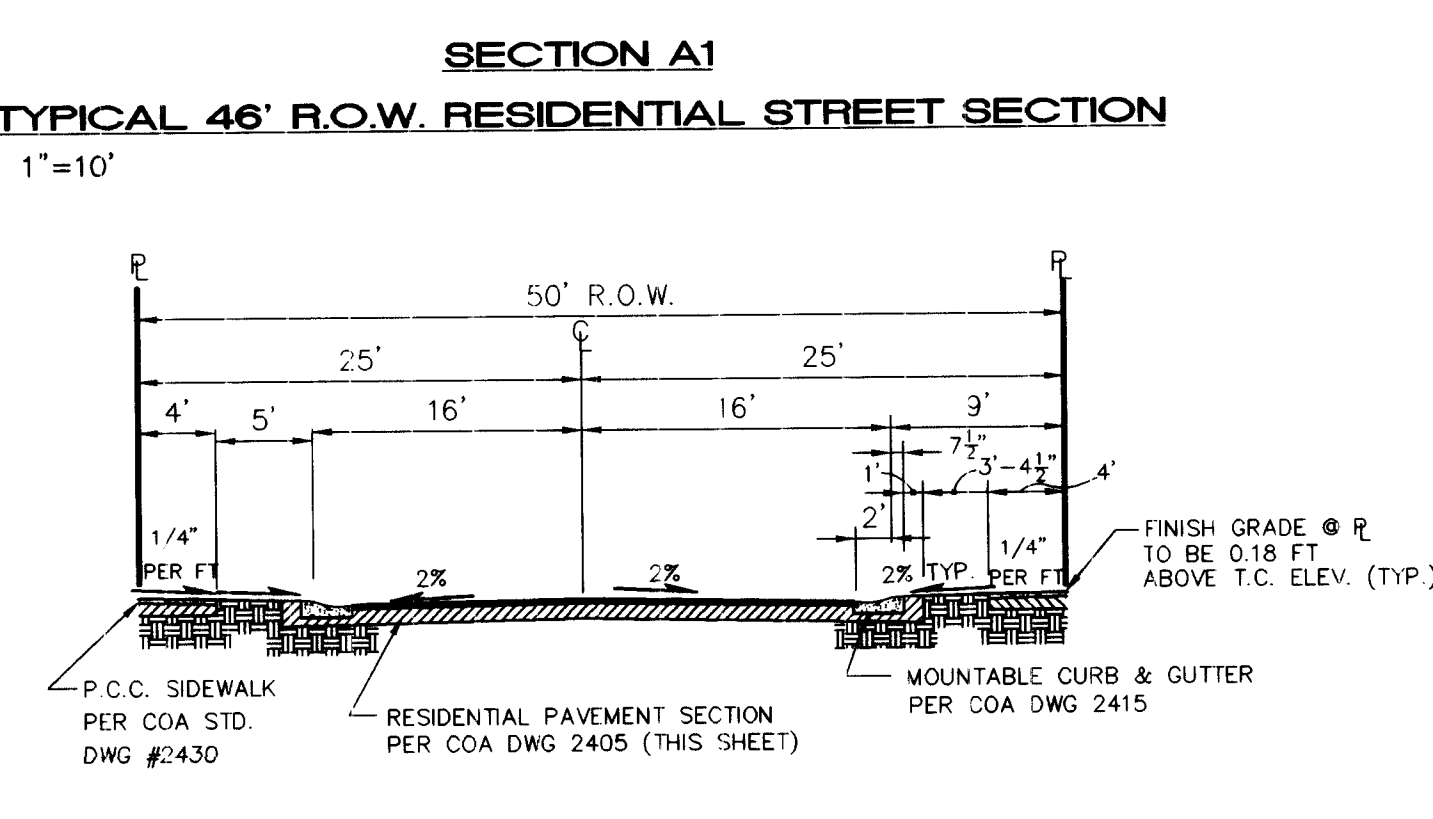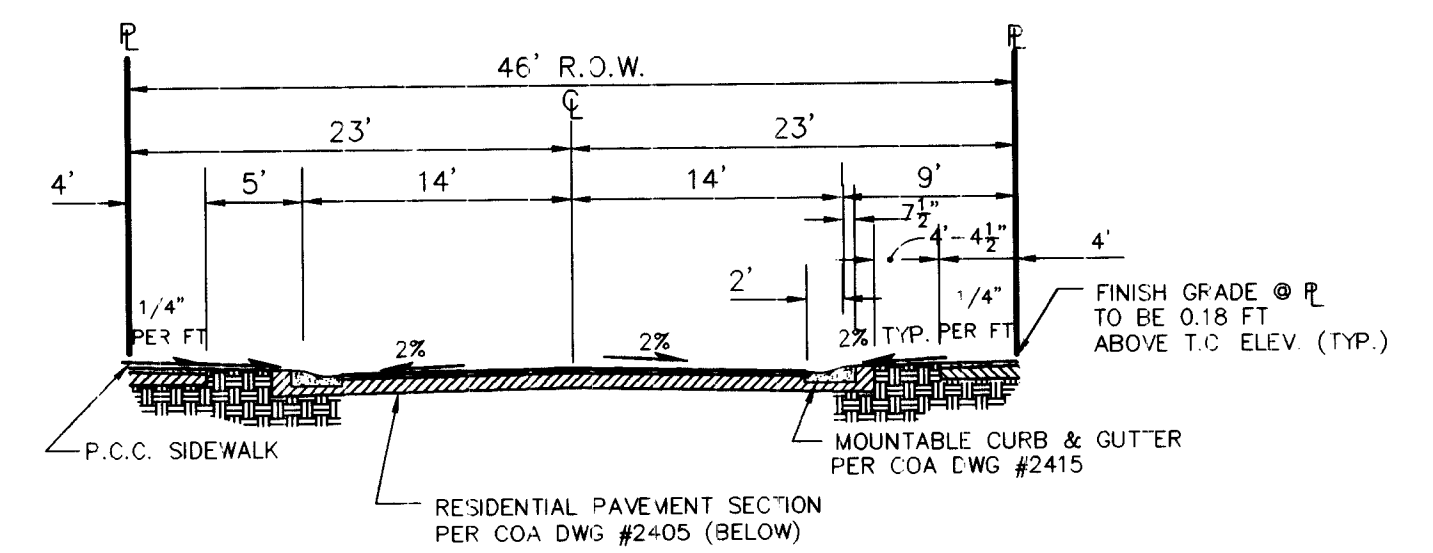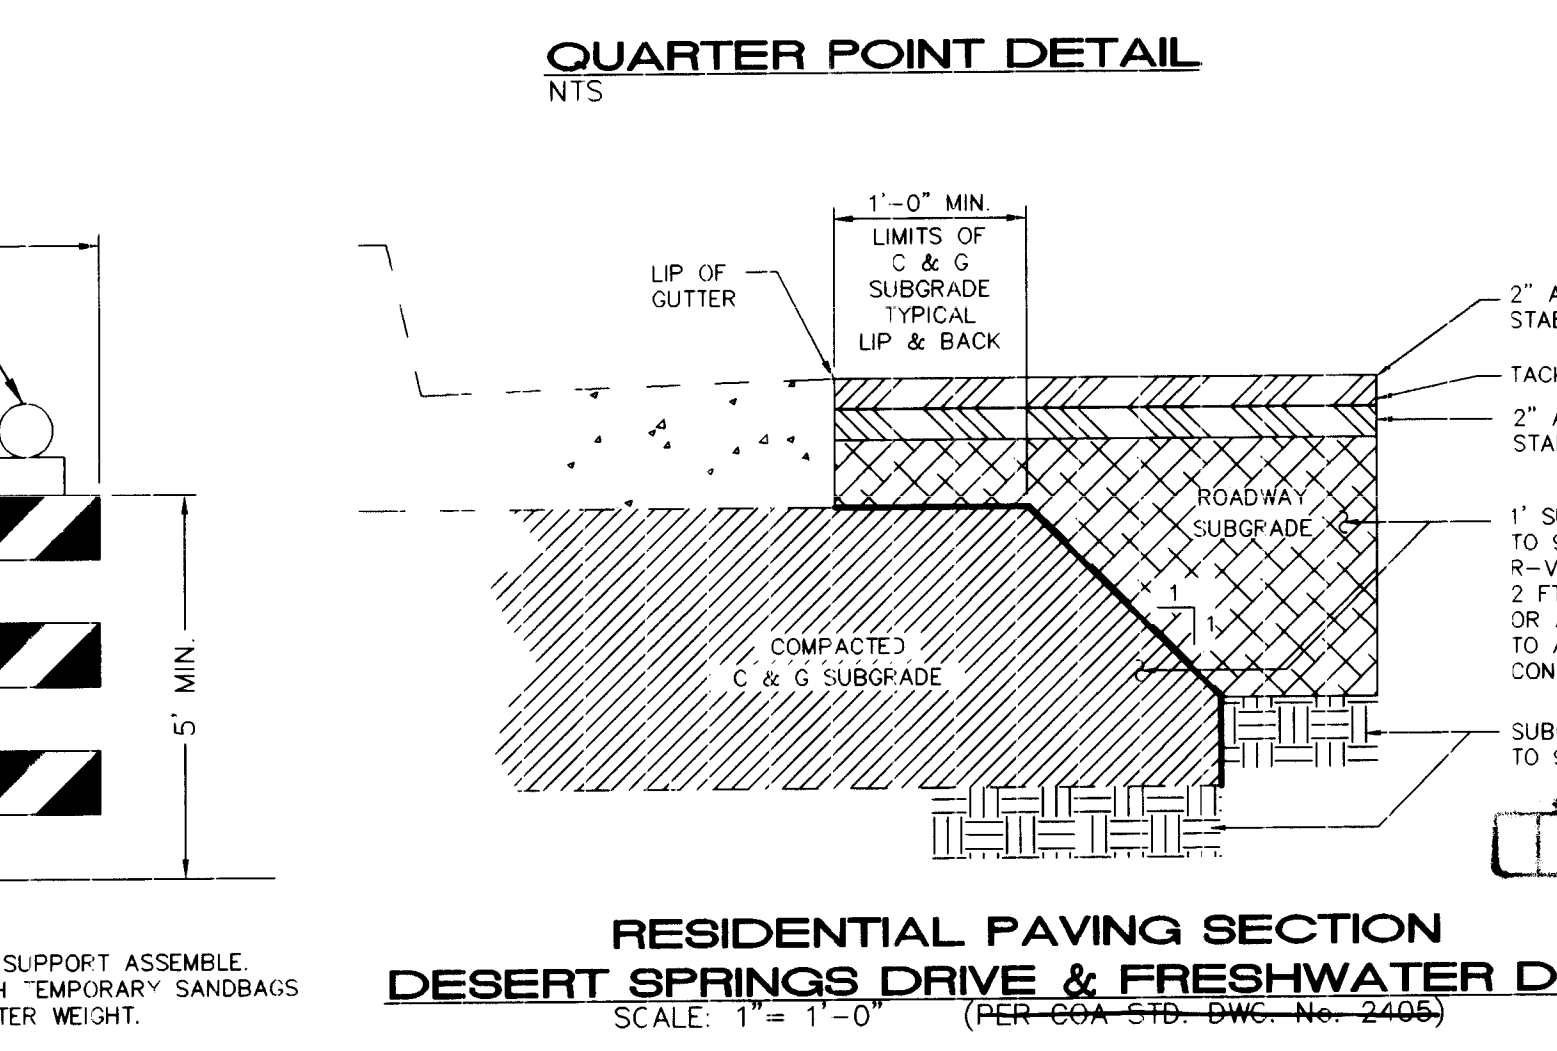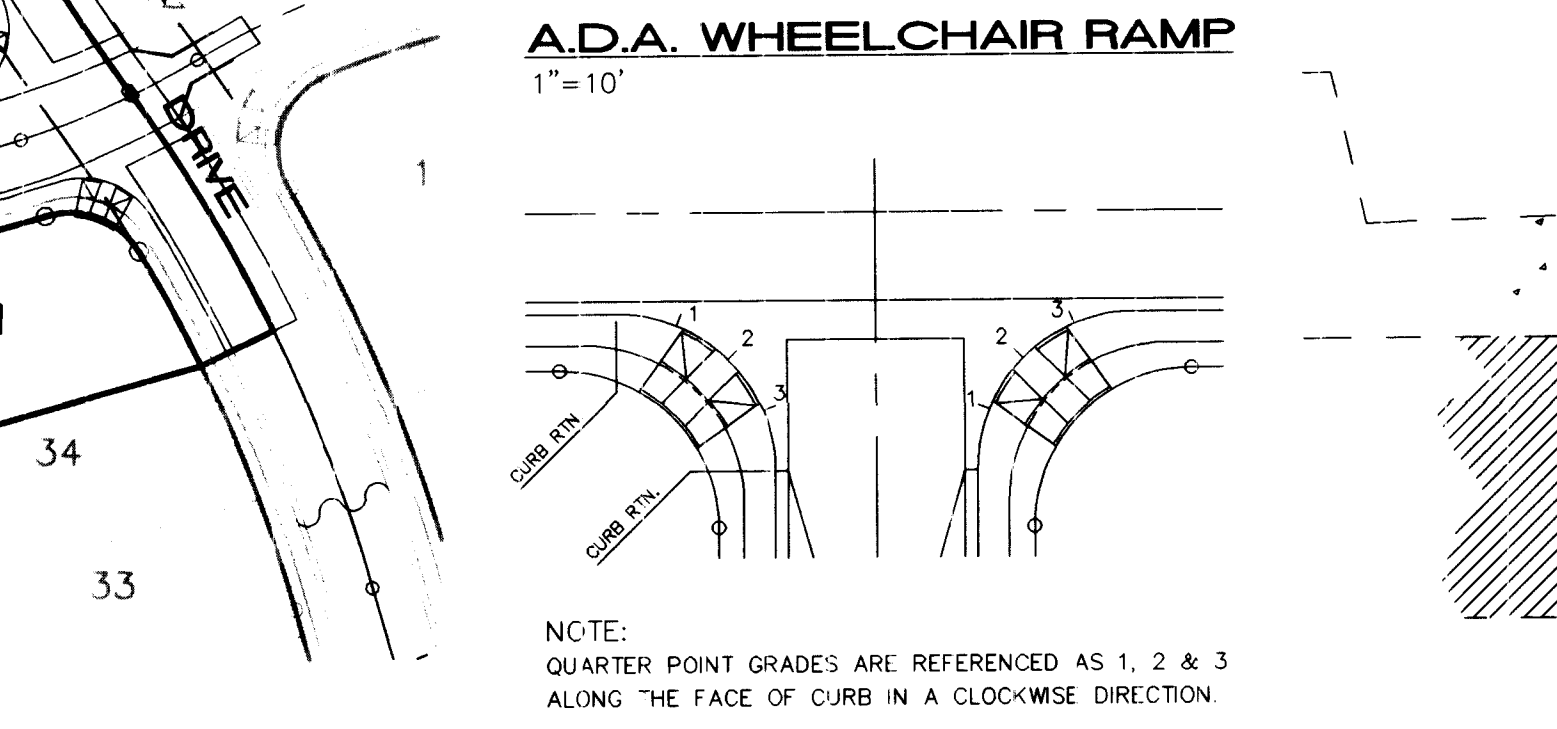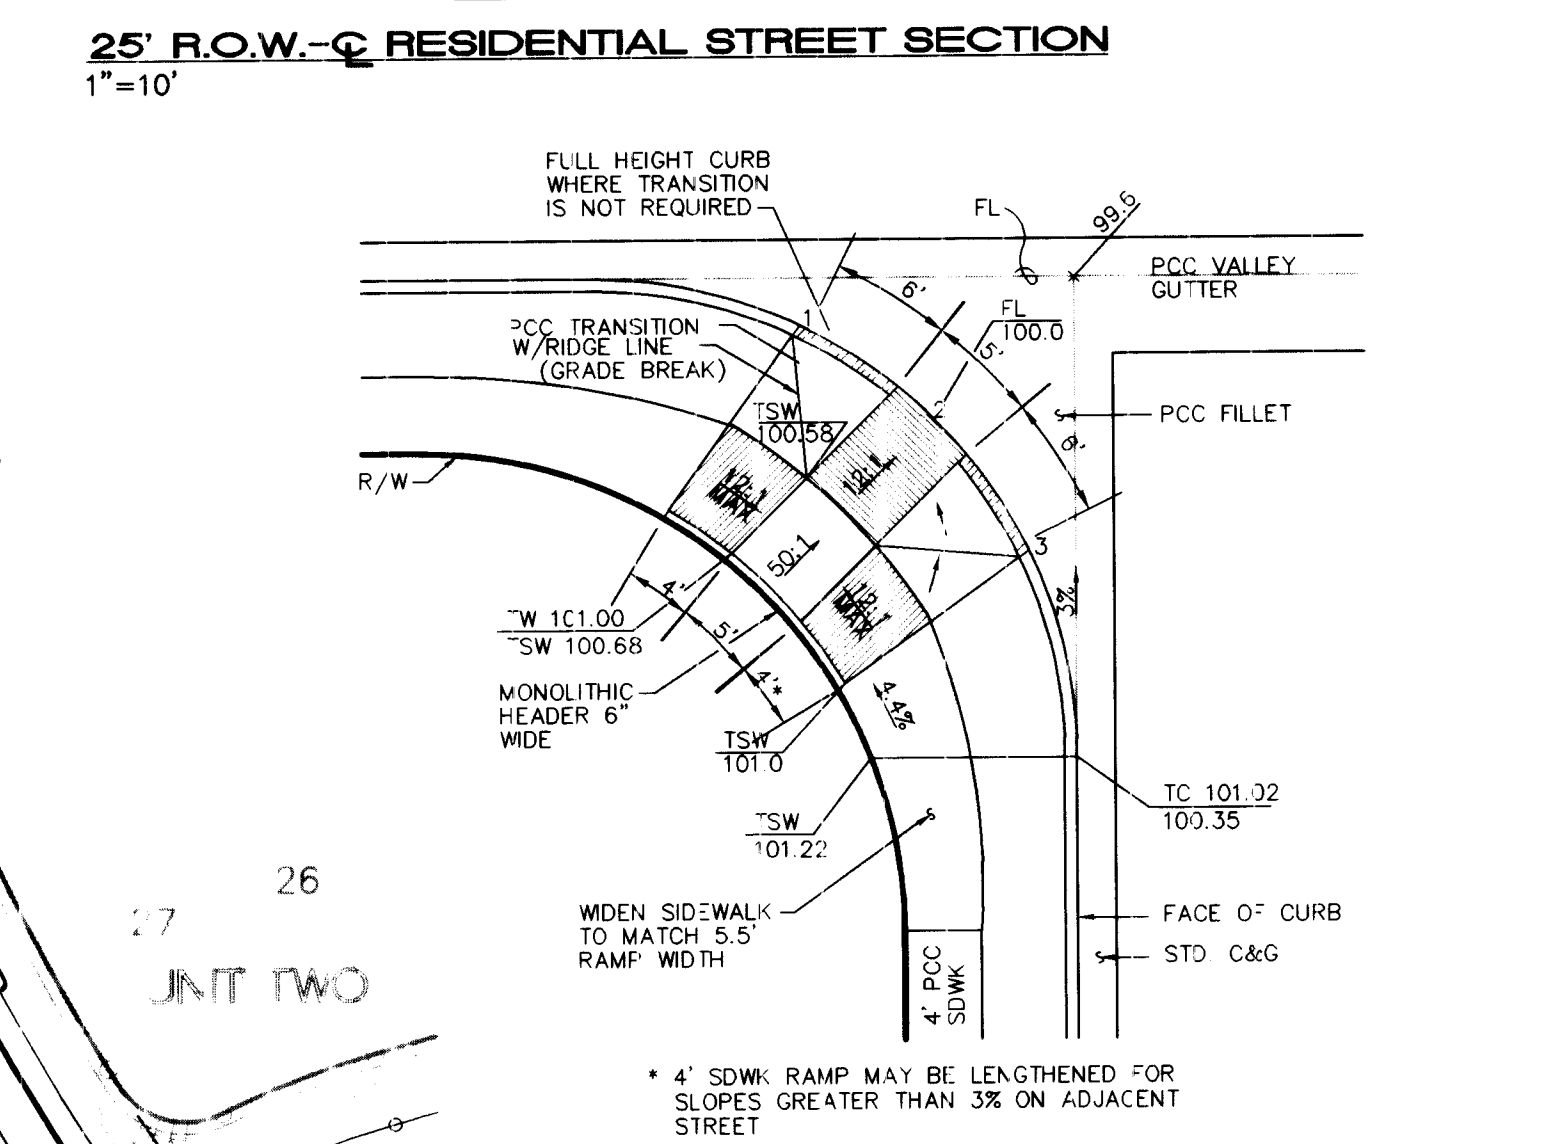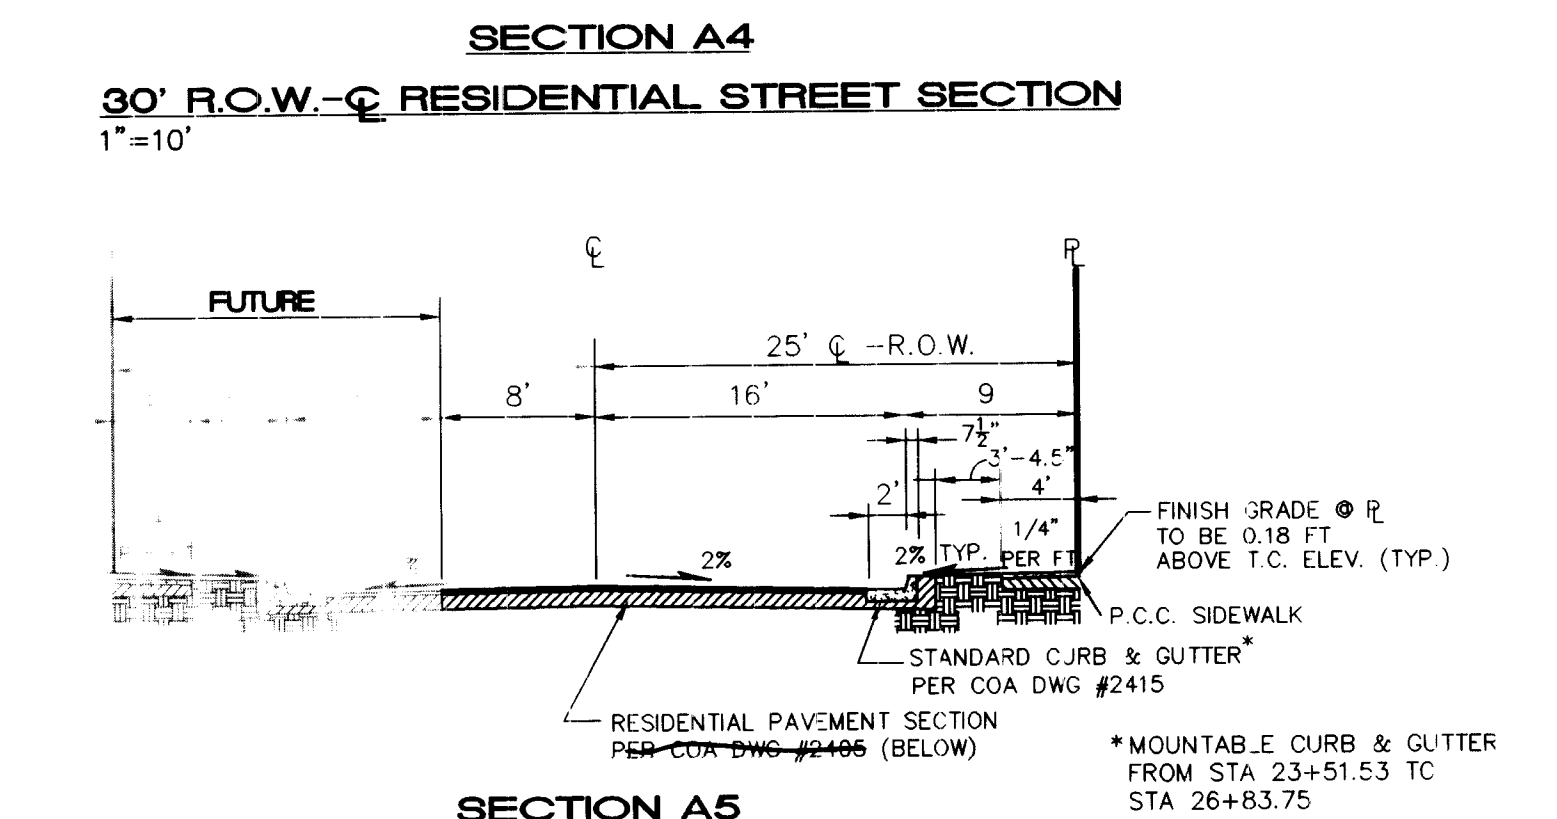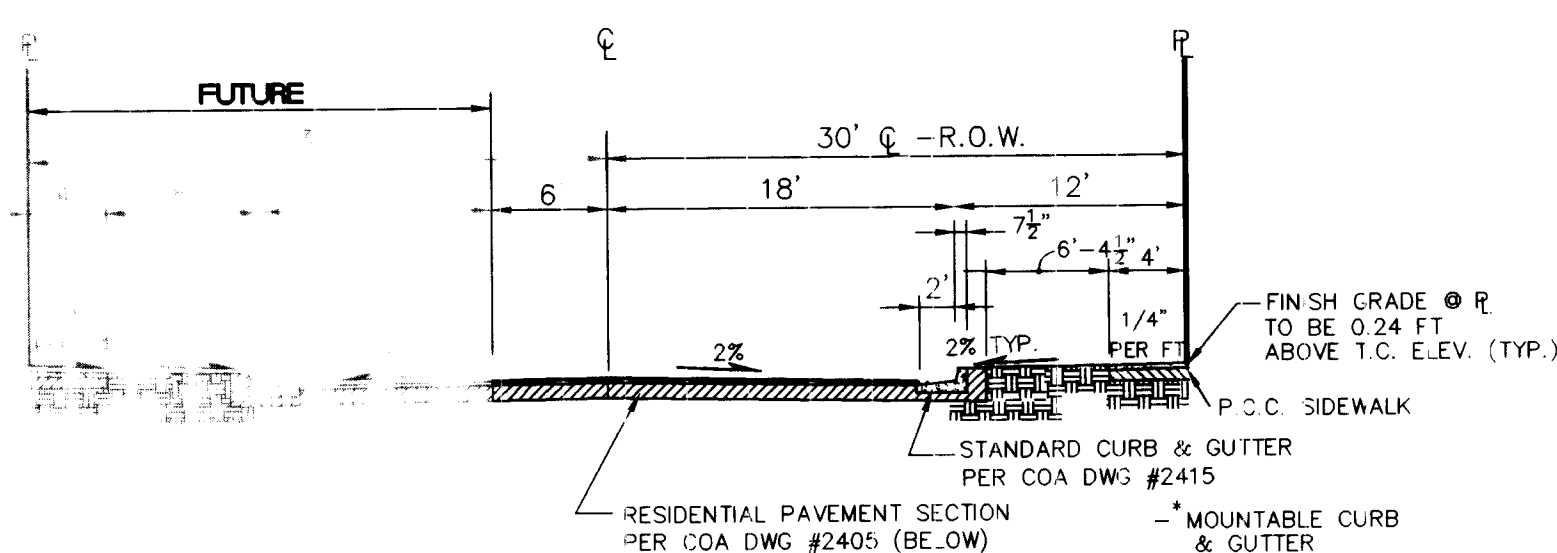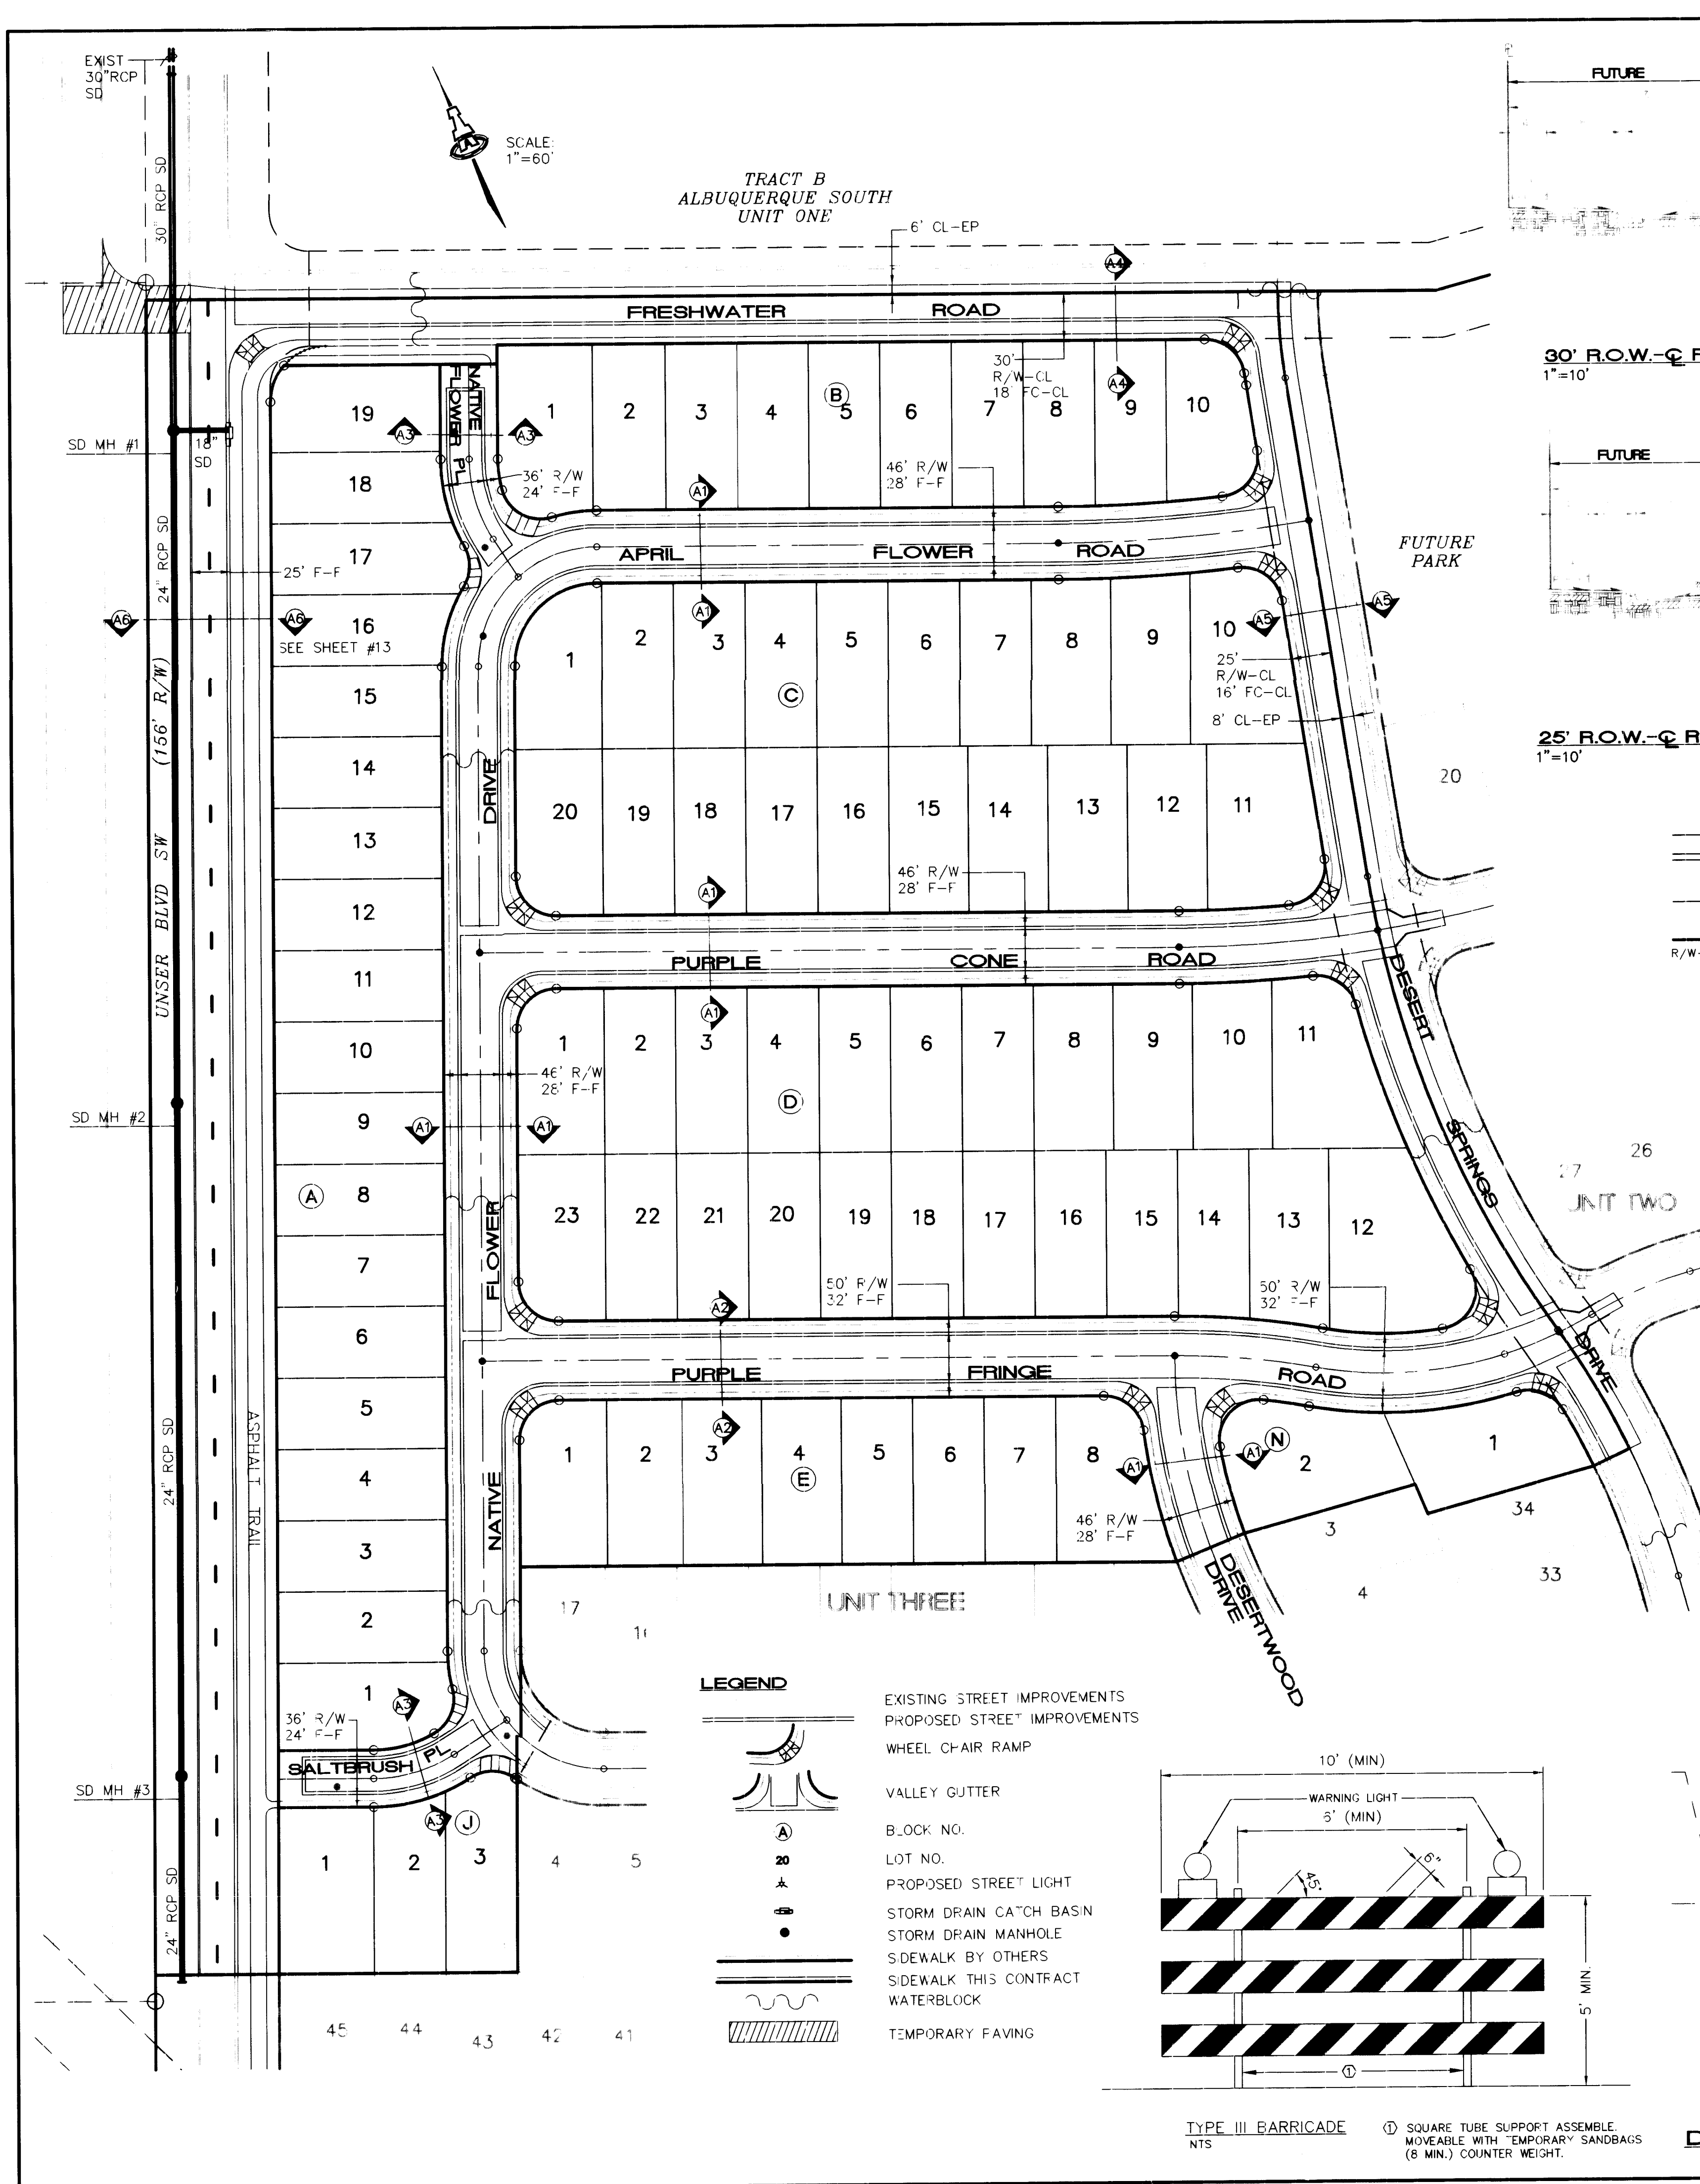

AS-BUILT INFORMATION		CONCEPTS		BENCH MARKS		SURVEY INFORMATION		FIELD NOTES		ENGINEER'S SEAL	
CONTRACTOR	ISAACSON & ARFMAN, P.A.	DATE	11/18/97	ACS MONUMENT "1-MIO" LOCATED AT THE SOUTHEAST CORNER OF SAGE RD. & UNSER BLVD.	5/96	1	ALS				NO. DATE BY REMARKS REVISIONS DESIGN
WORK BY	C.C.A.	DATE	11/18/97	ELEV. = 5079.88							
INSPECTOR	C.C.A.	DATE	11/18/97	TBM: RM. OF SOUTHWESTERLY MANHOLE AT SAPPHIRE ST & UNSER BLVD.						DESIGNED BY	JUN
ACCEPTANCE BY	C.C.A.	DATE	11/18/97	ELEV. = 5035.84						DRAWN BY	ANW
VERIFICATION BY	C.C.A.	DATE	11/18/97							CHECKED BY	FCA
RECORDED BY		DATE									


ISAACSON & ARFMAN, P.A.
 Consulting Engineering Associates
 128 Monroe Street N.E.
 Albuquerque New Mexico
 930PMSTR.DWGms 11/18/97

CITY OF ALBUQUERQUE
 PUBLIC WORKS DEPARTMENT
 ENGINEERING GROUP

TITLE: DESERT FLOWER SUBDIVISION--UNIT ONE
 MASTER PAVING PLAN

Design Review Committee City Engineer Approval

City Project No. 5739.81 Zone Map No. M-10 Sheet 5 of 24

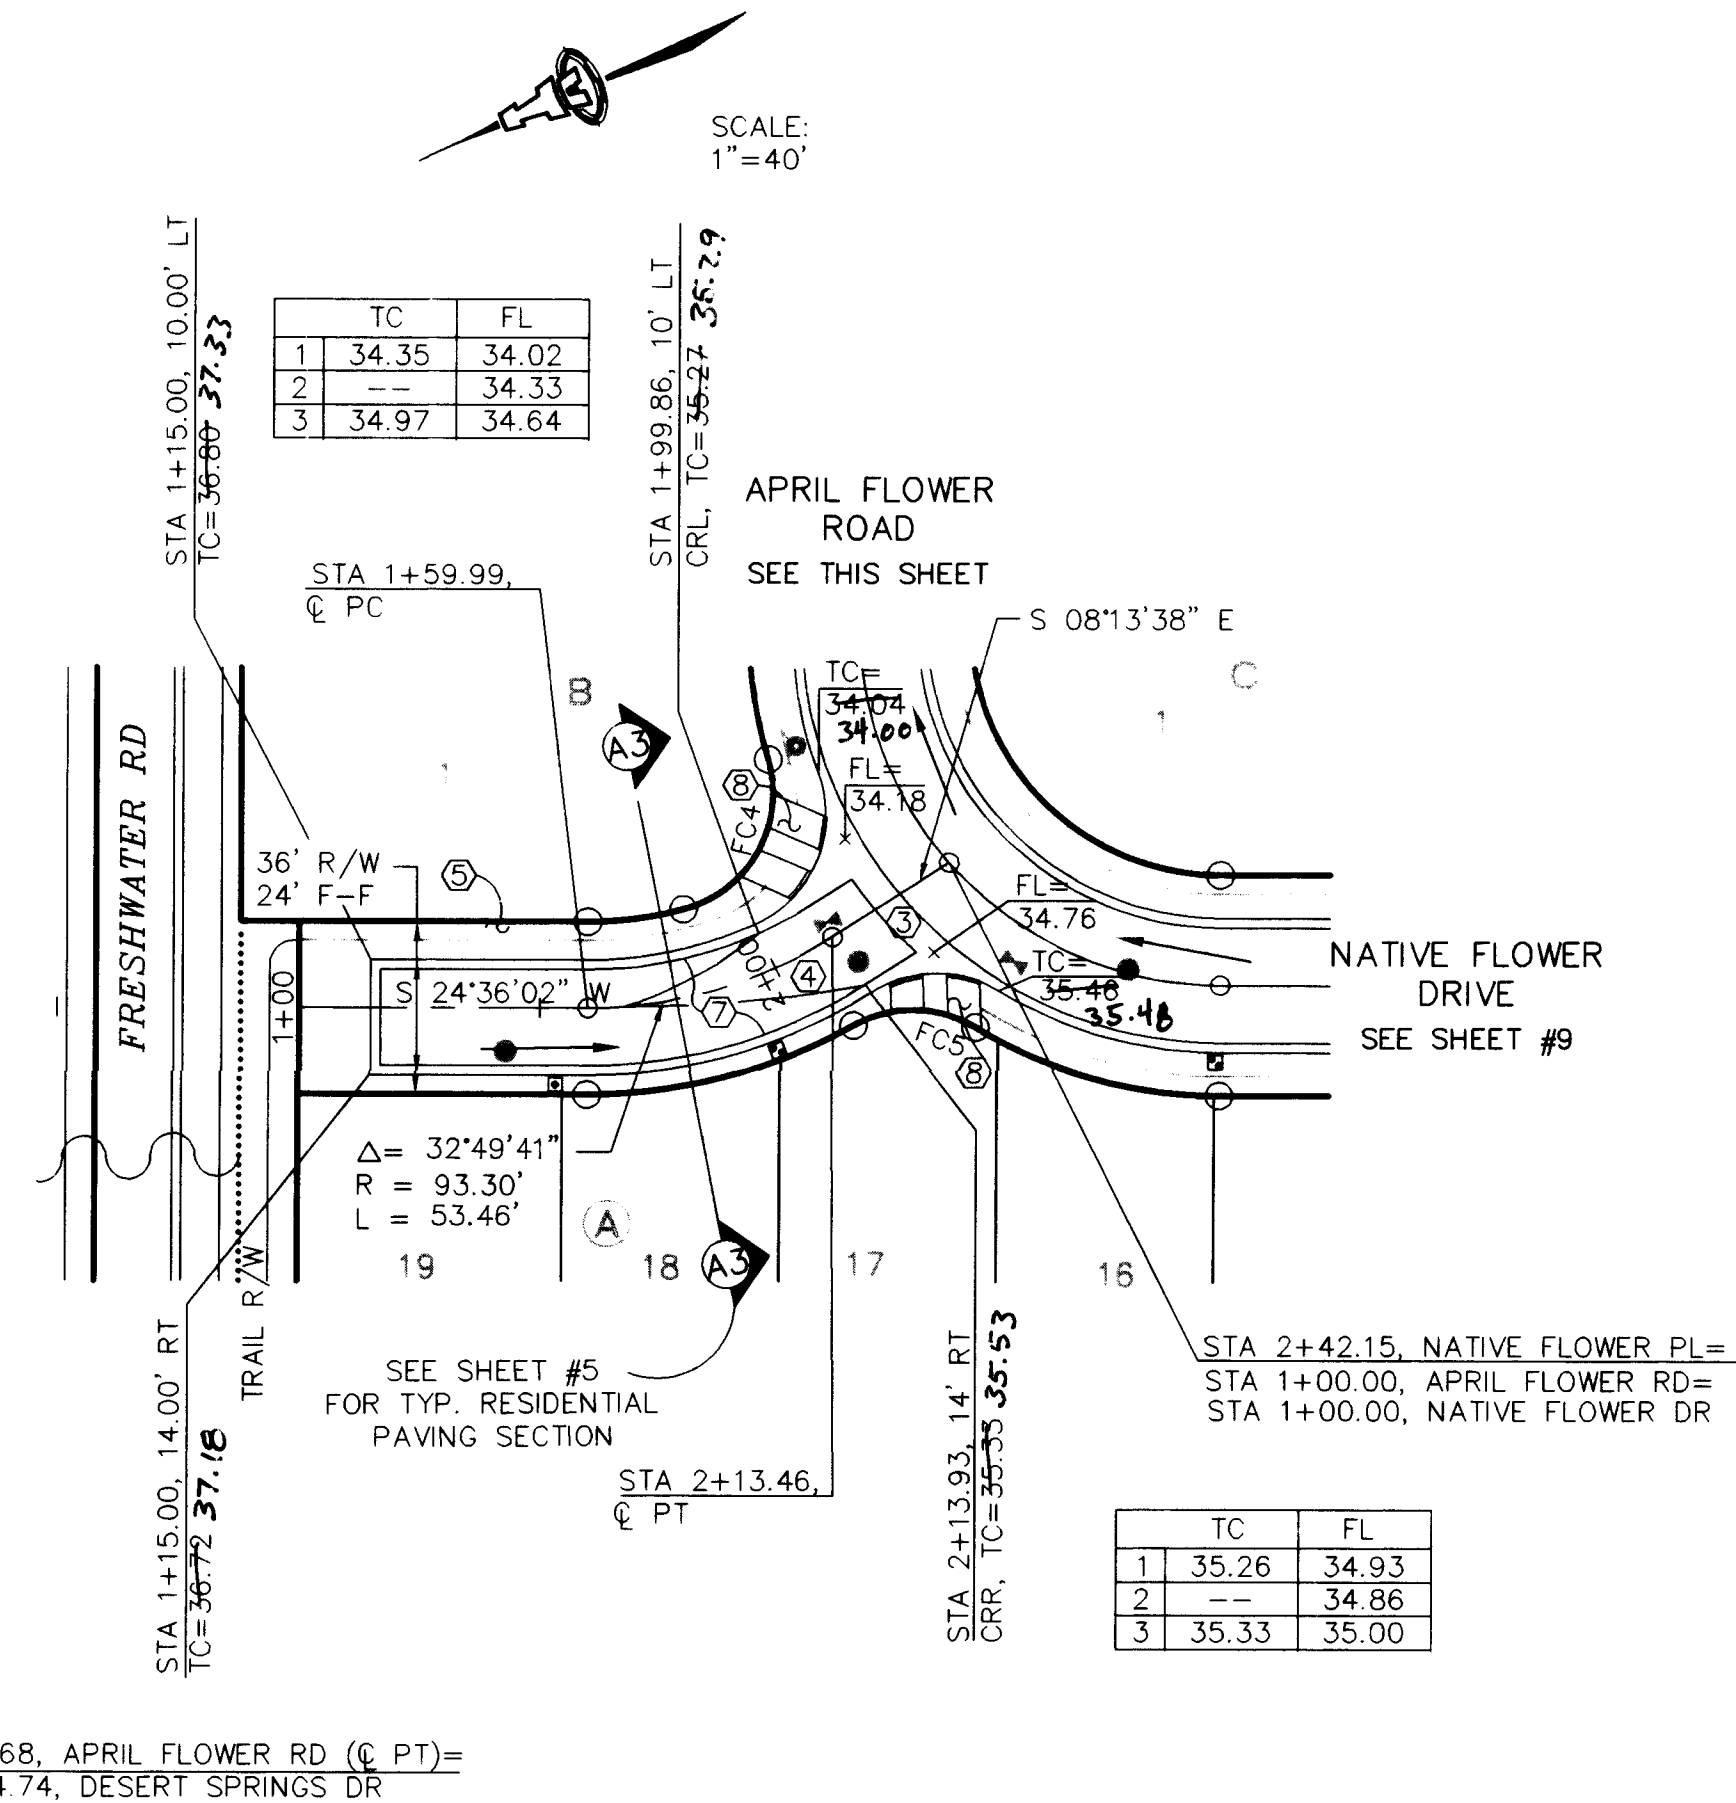


NATIVE FLOWER PLACE

KEYED CONSTRUCTION NOTES

1. CONSTRUCT HANDICAP RAMP PER
DETAIL ON SHEET #5.
2. STANDARD CURB & GUTTER PER COA
STD DWG #2415.
3. CONSTRUCT PCC VALLEY GUTTER
6" WIDE, 1 1/2" INVERT PER COA STD
DWG #2420.
4. CROWN TO NO CROWN TRANSITION
50' MIN LENGTH.
5. FUTURE 4' SIDEWALK PER COA STD
DWG #2430.
6. TRANSITION FROM MOUNTABLE TO STANDARD
CURB PER COA STD DWG #2418.
7. MOUNTABLE CURB & GUTTER PER COA
STD DWG #2415.
8. CONSTRUCT HANDICAP RAMP PER
COA STD DWG #2441, CASE I.

FACE OF CURB CURVE TABLE

CURVE	RADIUS	LENGTH	DELTA
FC4	25.00'	37.49'	85°55'52"
FC5	25.00'	27.89'	63°55'34"
FC6	25.00'	40.14'	92°00'19"
FC7	25.00'	38.46'	88°09'10"

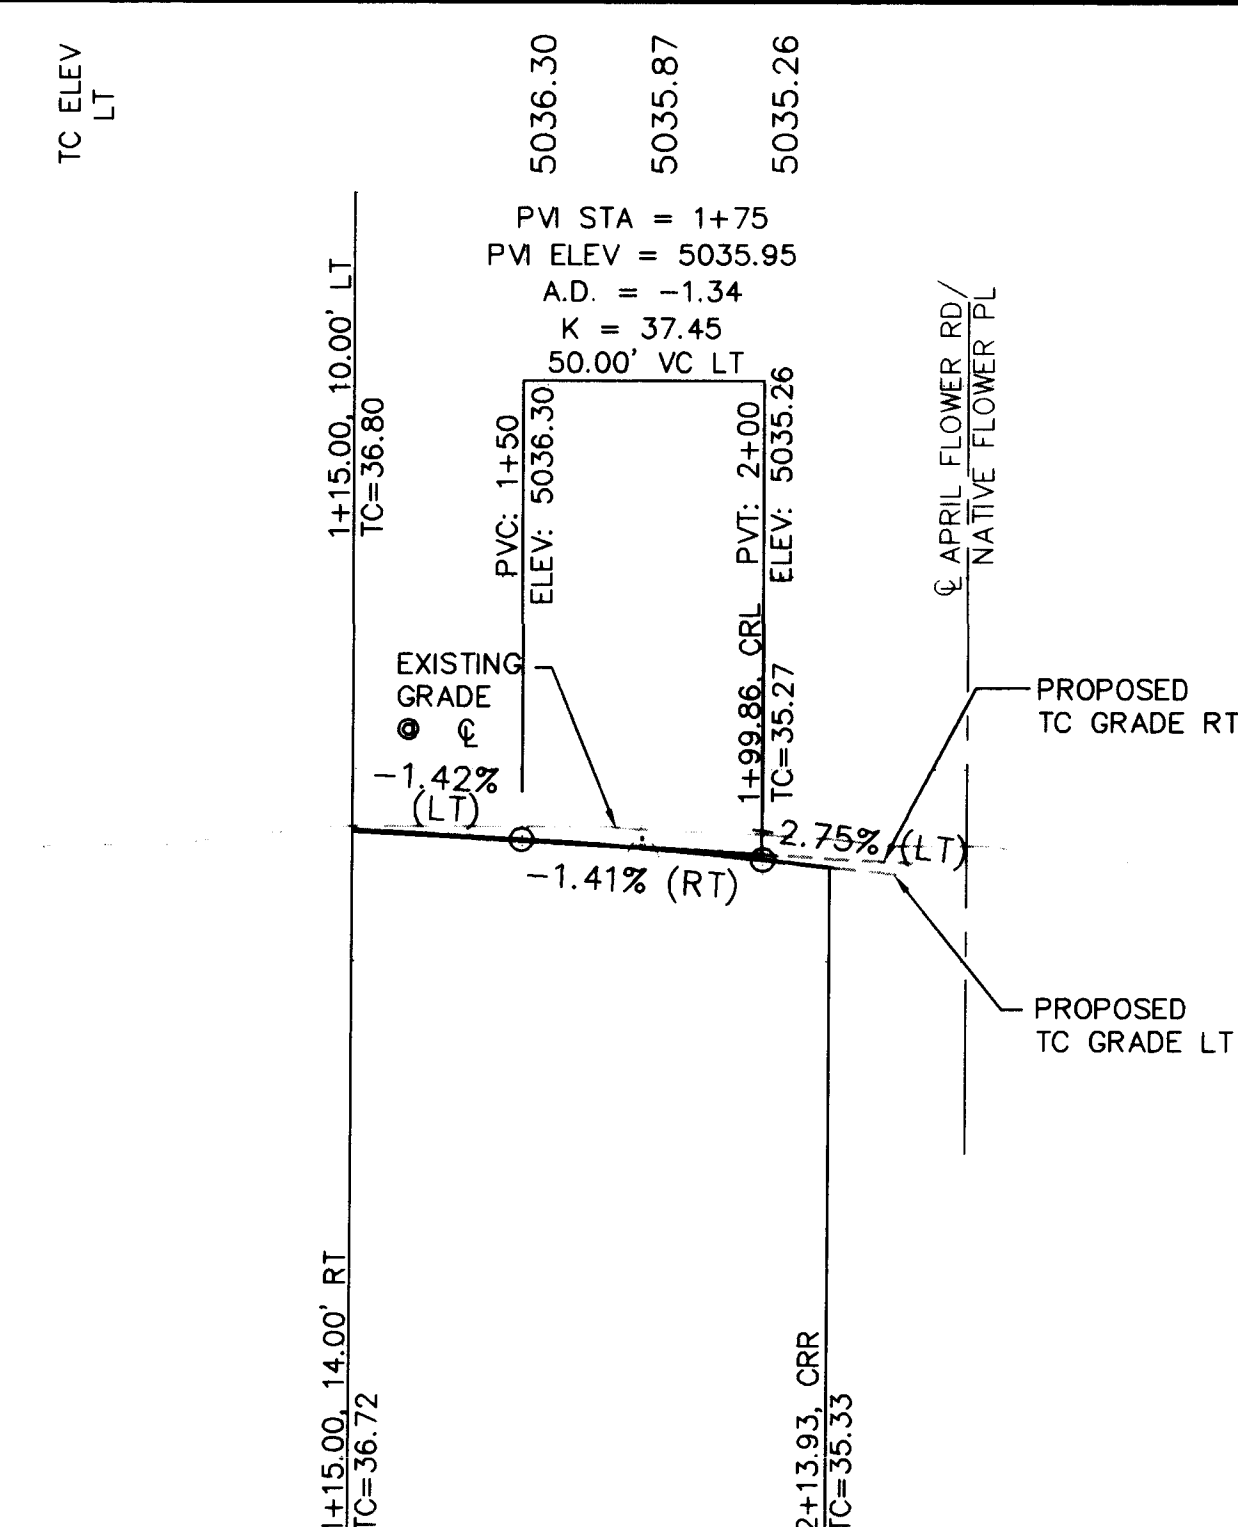

ISAACSON & ARFMAN, P.A.
Consulting Engineering Associates
128 Monroe Street N.E.
Albuquerque New Mexico
930PV1 DWGanw 10/28/97


CITY OF ALBUQUERQUE
PUBLIC WORKS DEPARTMENT
ENGINEERING GROUP

TITLE: DESERT FLOWER SUBDIVISION--UNIT ONE
APRIL FLOWER RD & NATIVE FLOWER PLACE
PAYING PLAN & PROFILE

Design Review Committee	City Engineer Approval	Last Design Update _____	Mo./Day/Yr.	Mo./Day/Yr.

City Project No.	Zone Map No.	Sheet	Of
5739.81	M-10	6	24

SCANNED BY
BY LASON

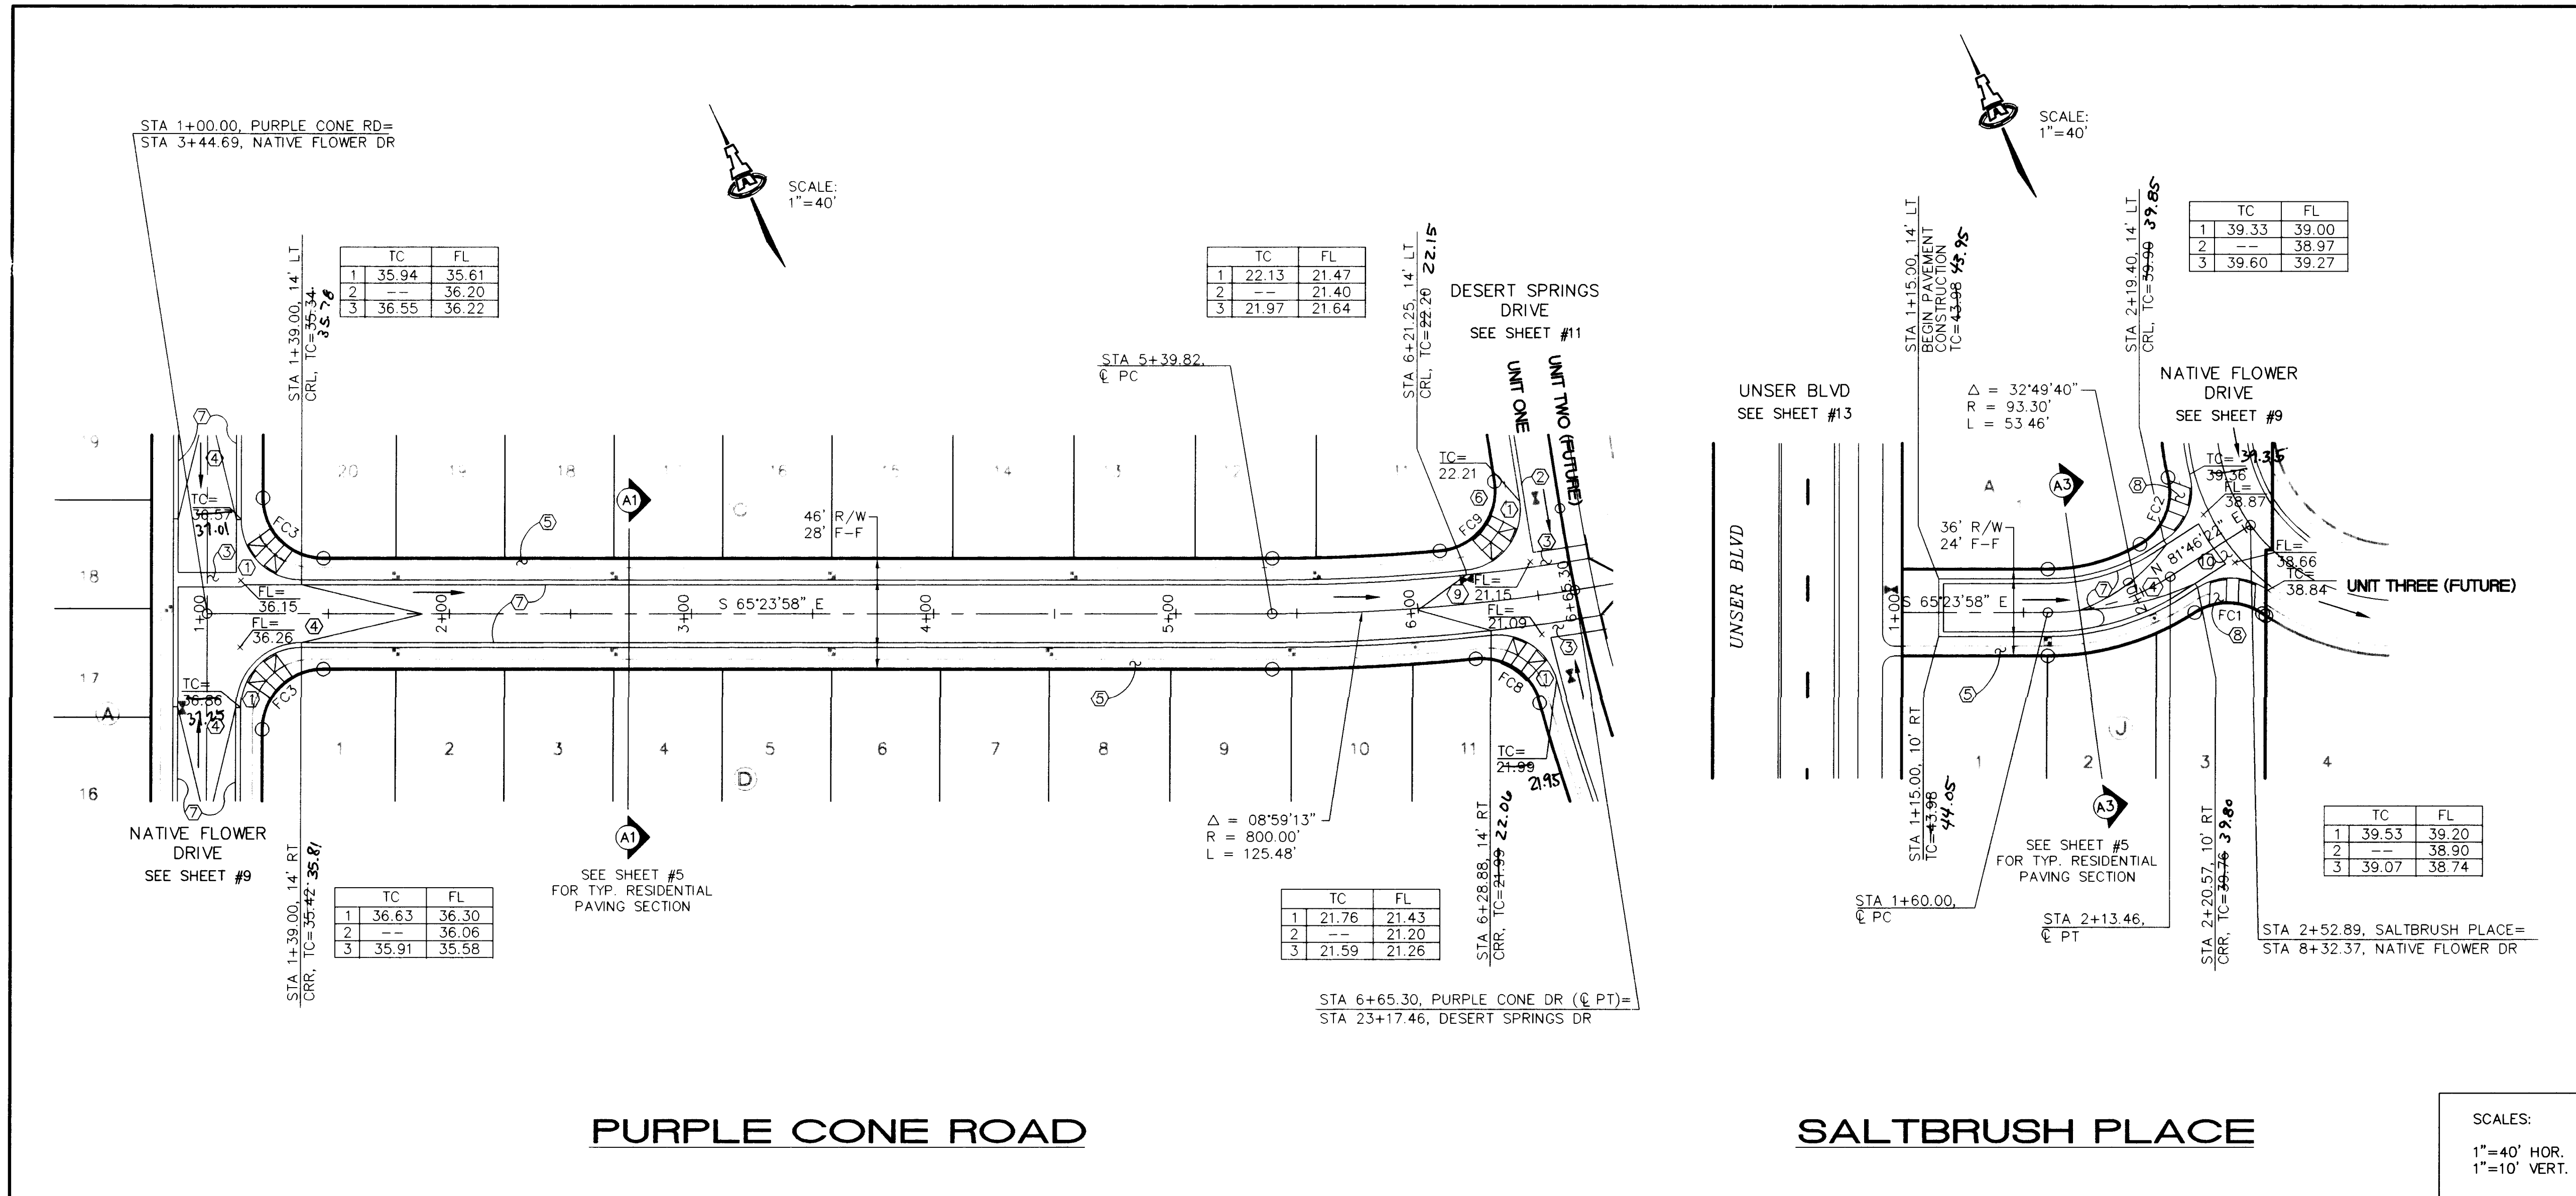


KEYED CONSTRUCTION NOTES

1. CONSTRUCT HANDICAP RAMP PER DETAIL ON SHEET #5.
2. STANDARD CURB & GUTTER PER COA STD DWG #2415.
3. CONSTRUCT PCC VALLEY GUTTER 10' WIDE, 3/4" INVERT PER COA STD DWG #2422.
4. CROWN TO NO CROWN TRANSITION 50' MIN. LENGTH.
5. FUTURE 4' SIDEWALK PER COA STD DWG #2430.
6. TRANSITION FROM MOUNTABLE TO STANDARD CURB PER COA STD DWG #2418.
7. MOUNTABLE CURB & GUTTER PER COA STD DWG #2415.
8. CONSTRUCT HANDICAP RAMP PER COA STD DWG #2441, CASE I.
9. CROWN TO HALF CROWN TRANSITION 25' MIN. LENGTH.
10. CONSTRUCT PCC VALLEY GUTTER 6' WIDE, 1 1/2" INVERT PER COA STD DWG #2420.

FACE OF CURB CURVE TABLE

CURVE	RADIUS	LENGTH	DELTA
FC1	25.00'	30.61'	70°09'14"
FC2	25.00'	31.40'	71°57'49"
FC3	25.00'	39.27'	90°00'00"
FC8	25.00'	35.59'	81°33'42"
FC9	25.00'	40.65'	93°09'59"

AS-BUILT INFORMATION				BENCH MARKS				SURVEY INFORMATION				ENGINEER'S SEAL			
CONTRACTOR				INSPECTOR'S				FIELD NOTES				BY			
STANDARD BY				DATE				1				REMARKS			
DATE				ELEV.				DESIGN				DATE			
DATE				DATE				DATE				DATE			
DATE				DATE				DATE				DATE			

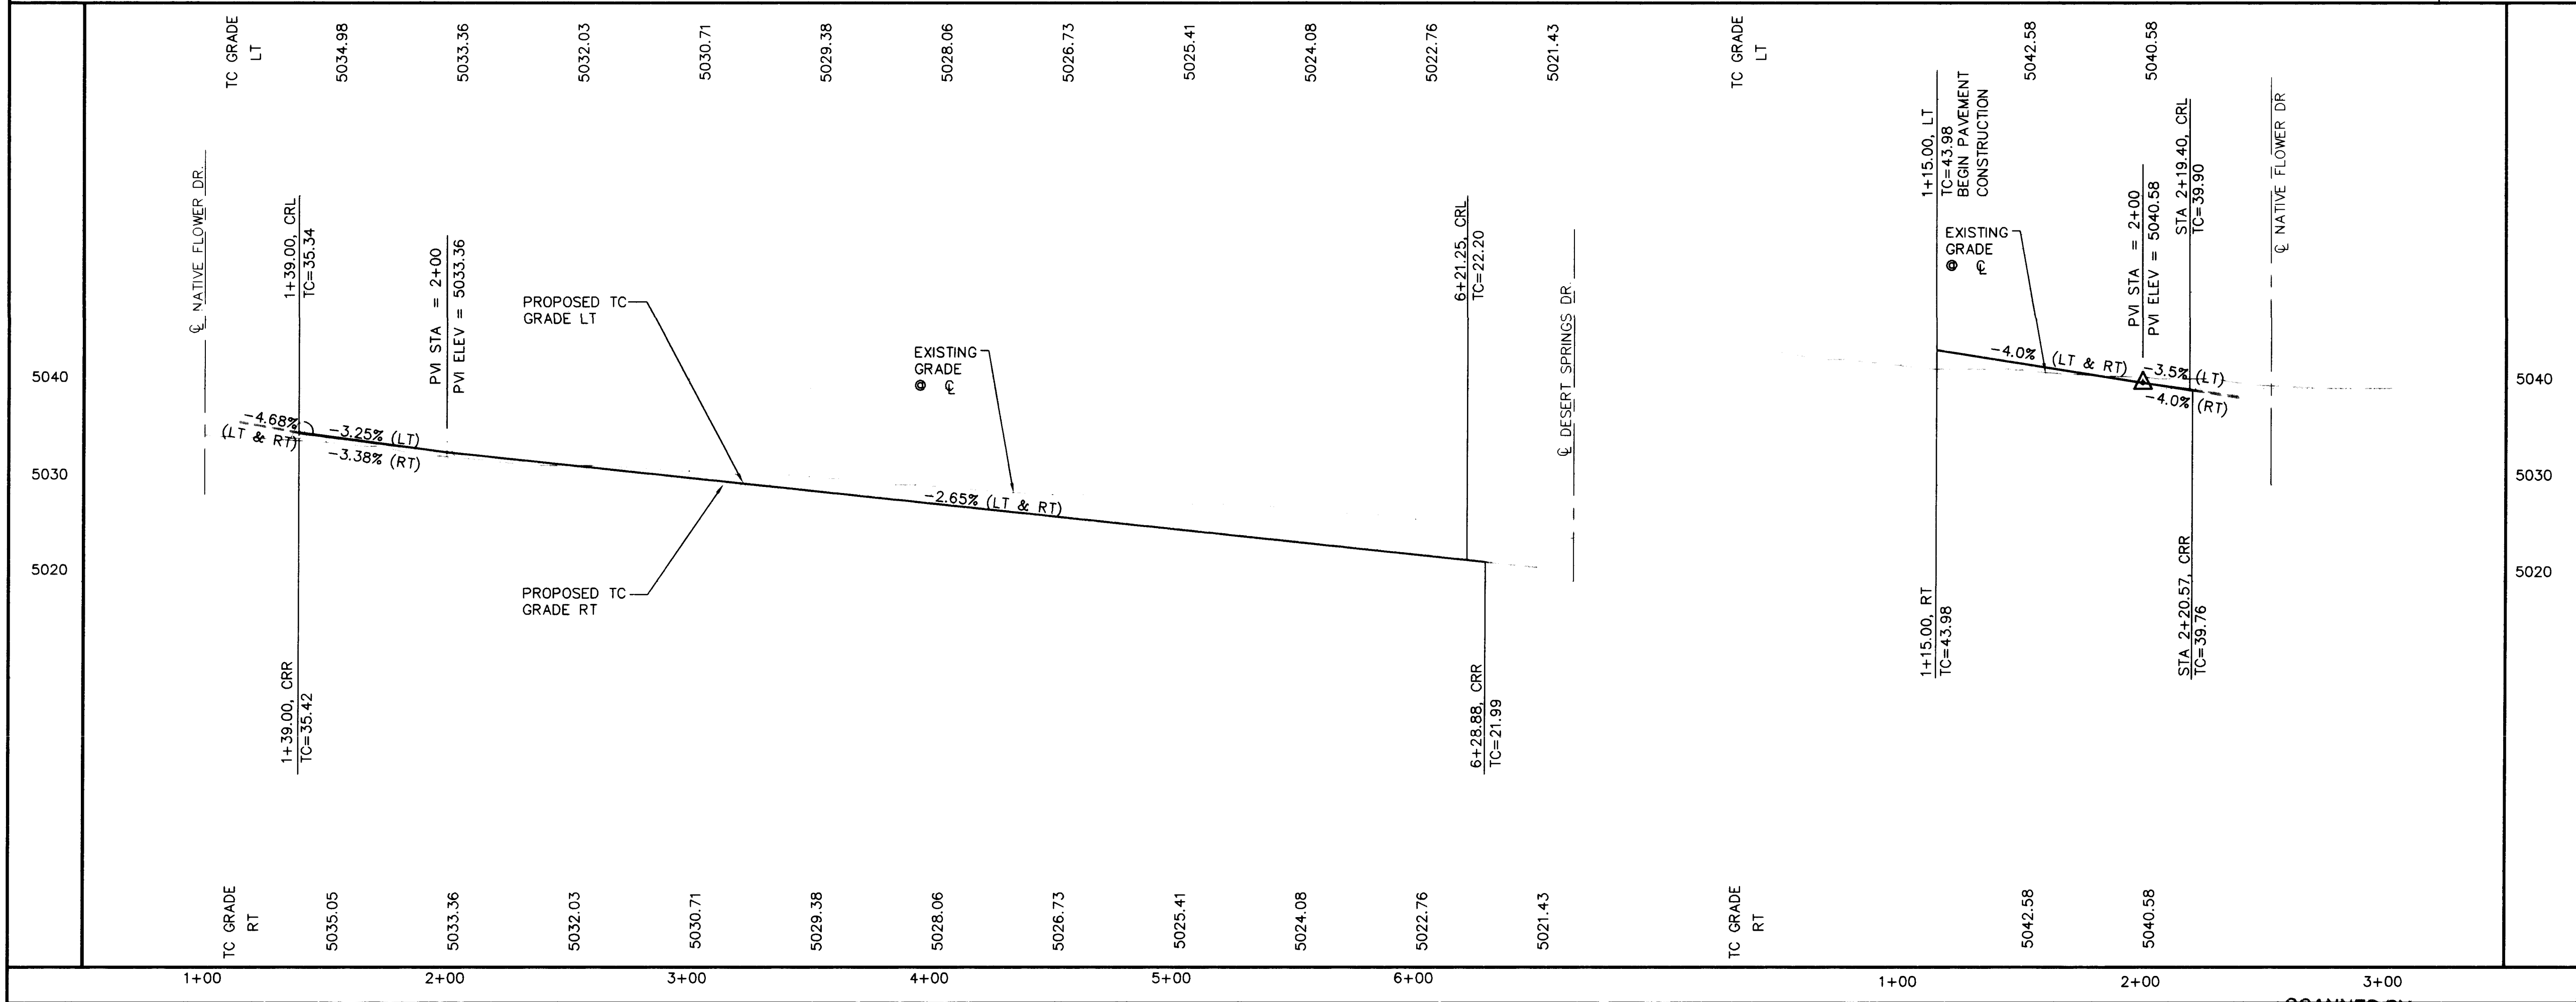



ISAACSON & ARFMAN, P.A.
Consulting Engineering Associates
128 Monroe Street N.E.
Albuquerque New Mexico
930PV2.DWGems 10/22/97


CITY OF ALBUQUERQUE
PUBLIC WORKS DEPARTMENT
ENGINEERING GROUP

TITLE: DESERT FLOWER SUBDIVISION--UNIT ONE
PURPLE CONE RD & SALTBRUSH PLACE
PAVING PLAN & PROFILE

Design Review Committee	City Engineer Approval	Mo./Day/Yr.	Mo./Day/Yr.

City Project No. 5739.81 Zone Map No. M-10 Sheet 7 Of 24

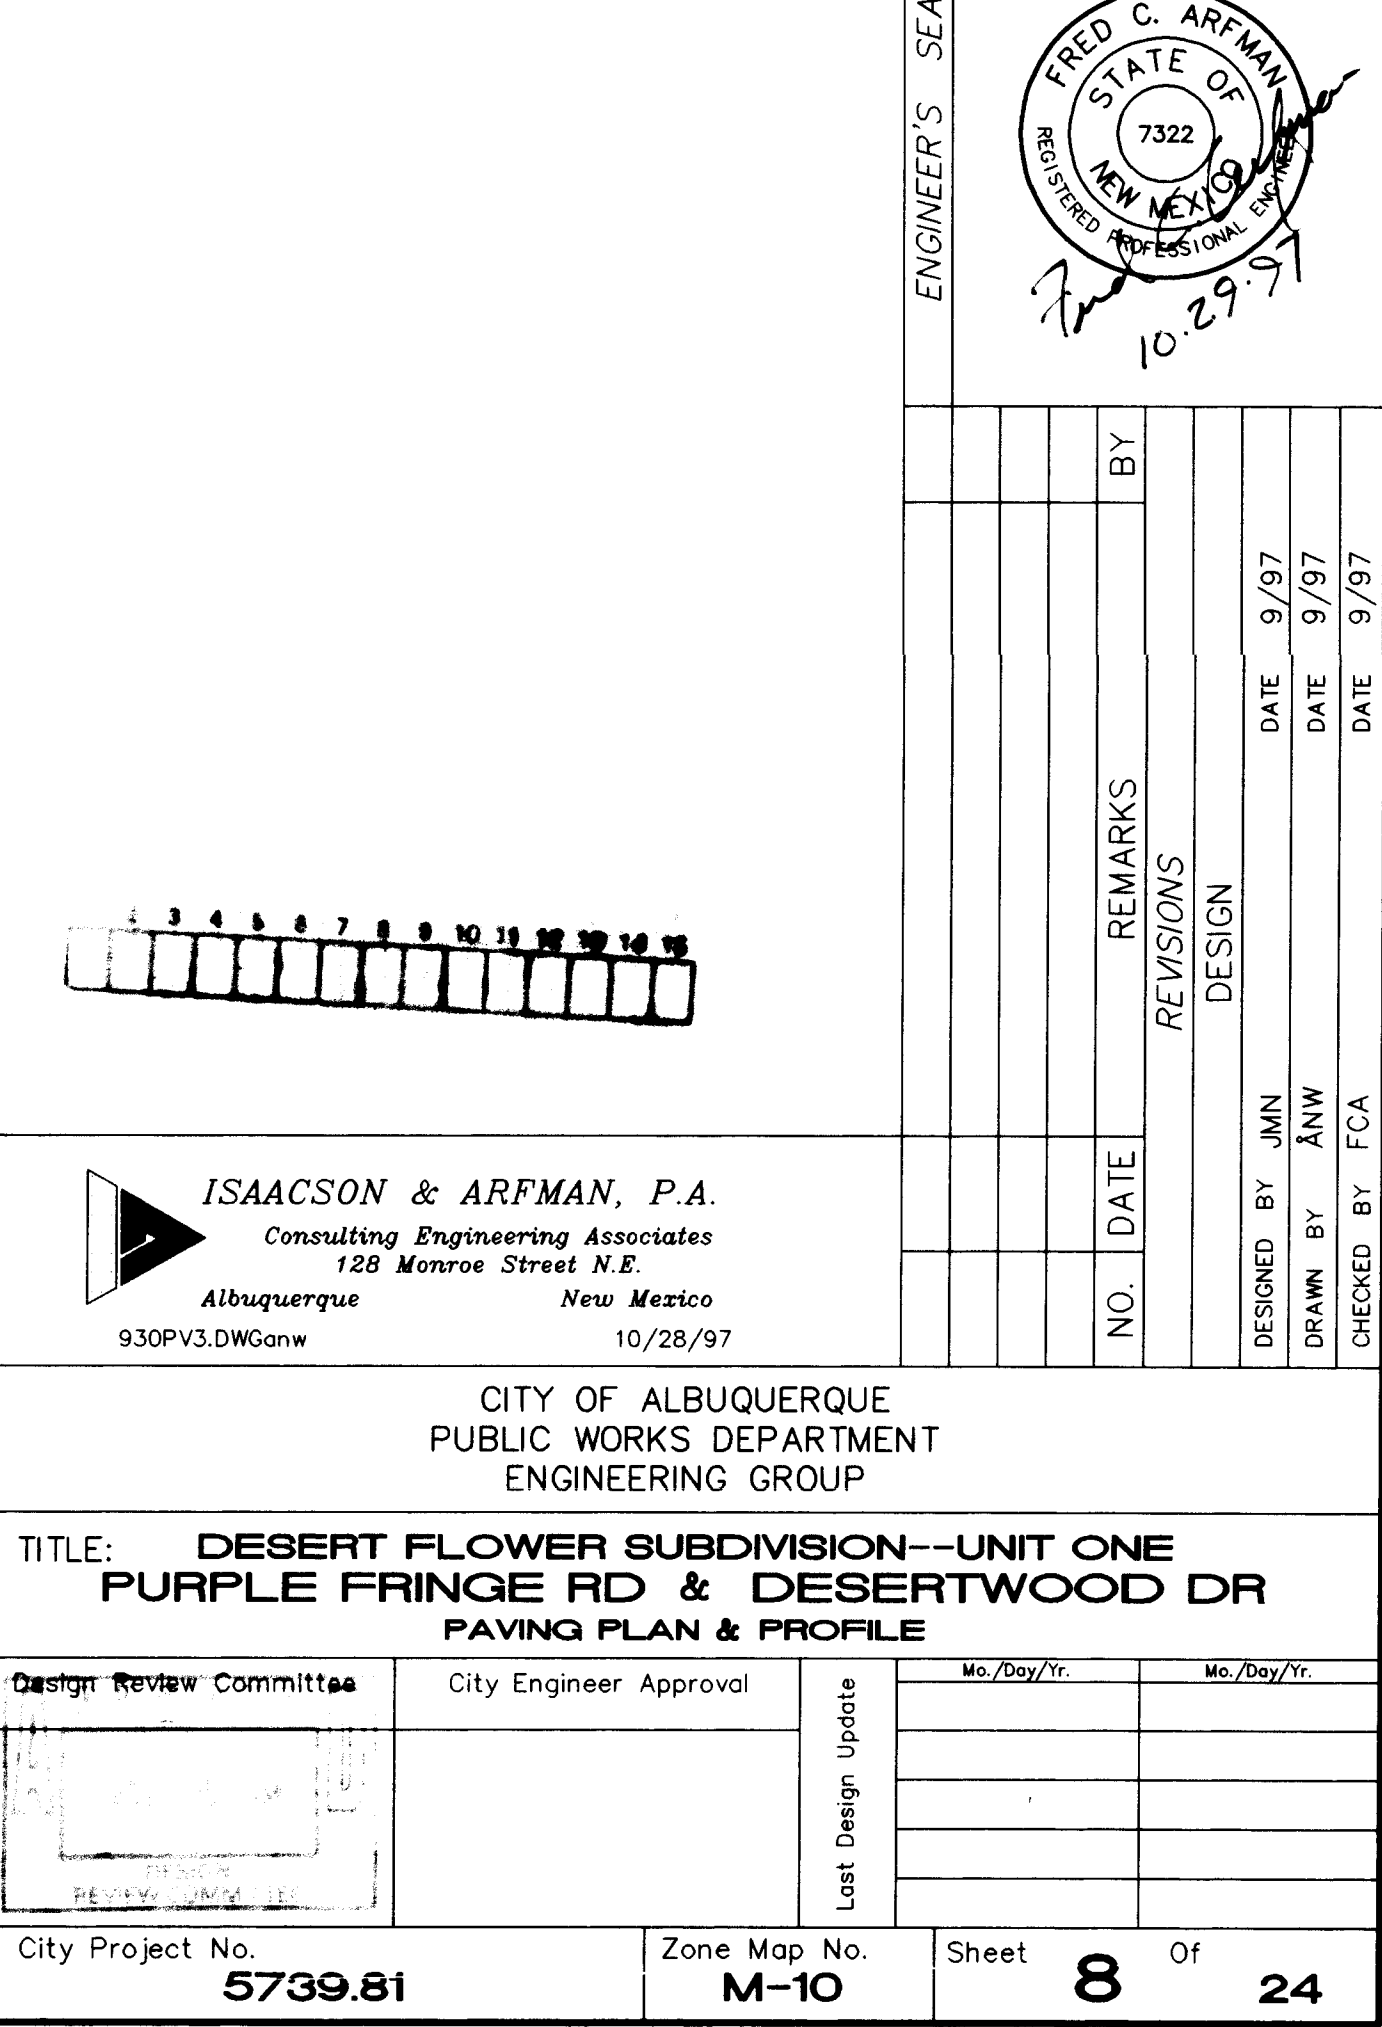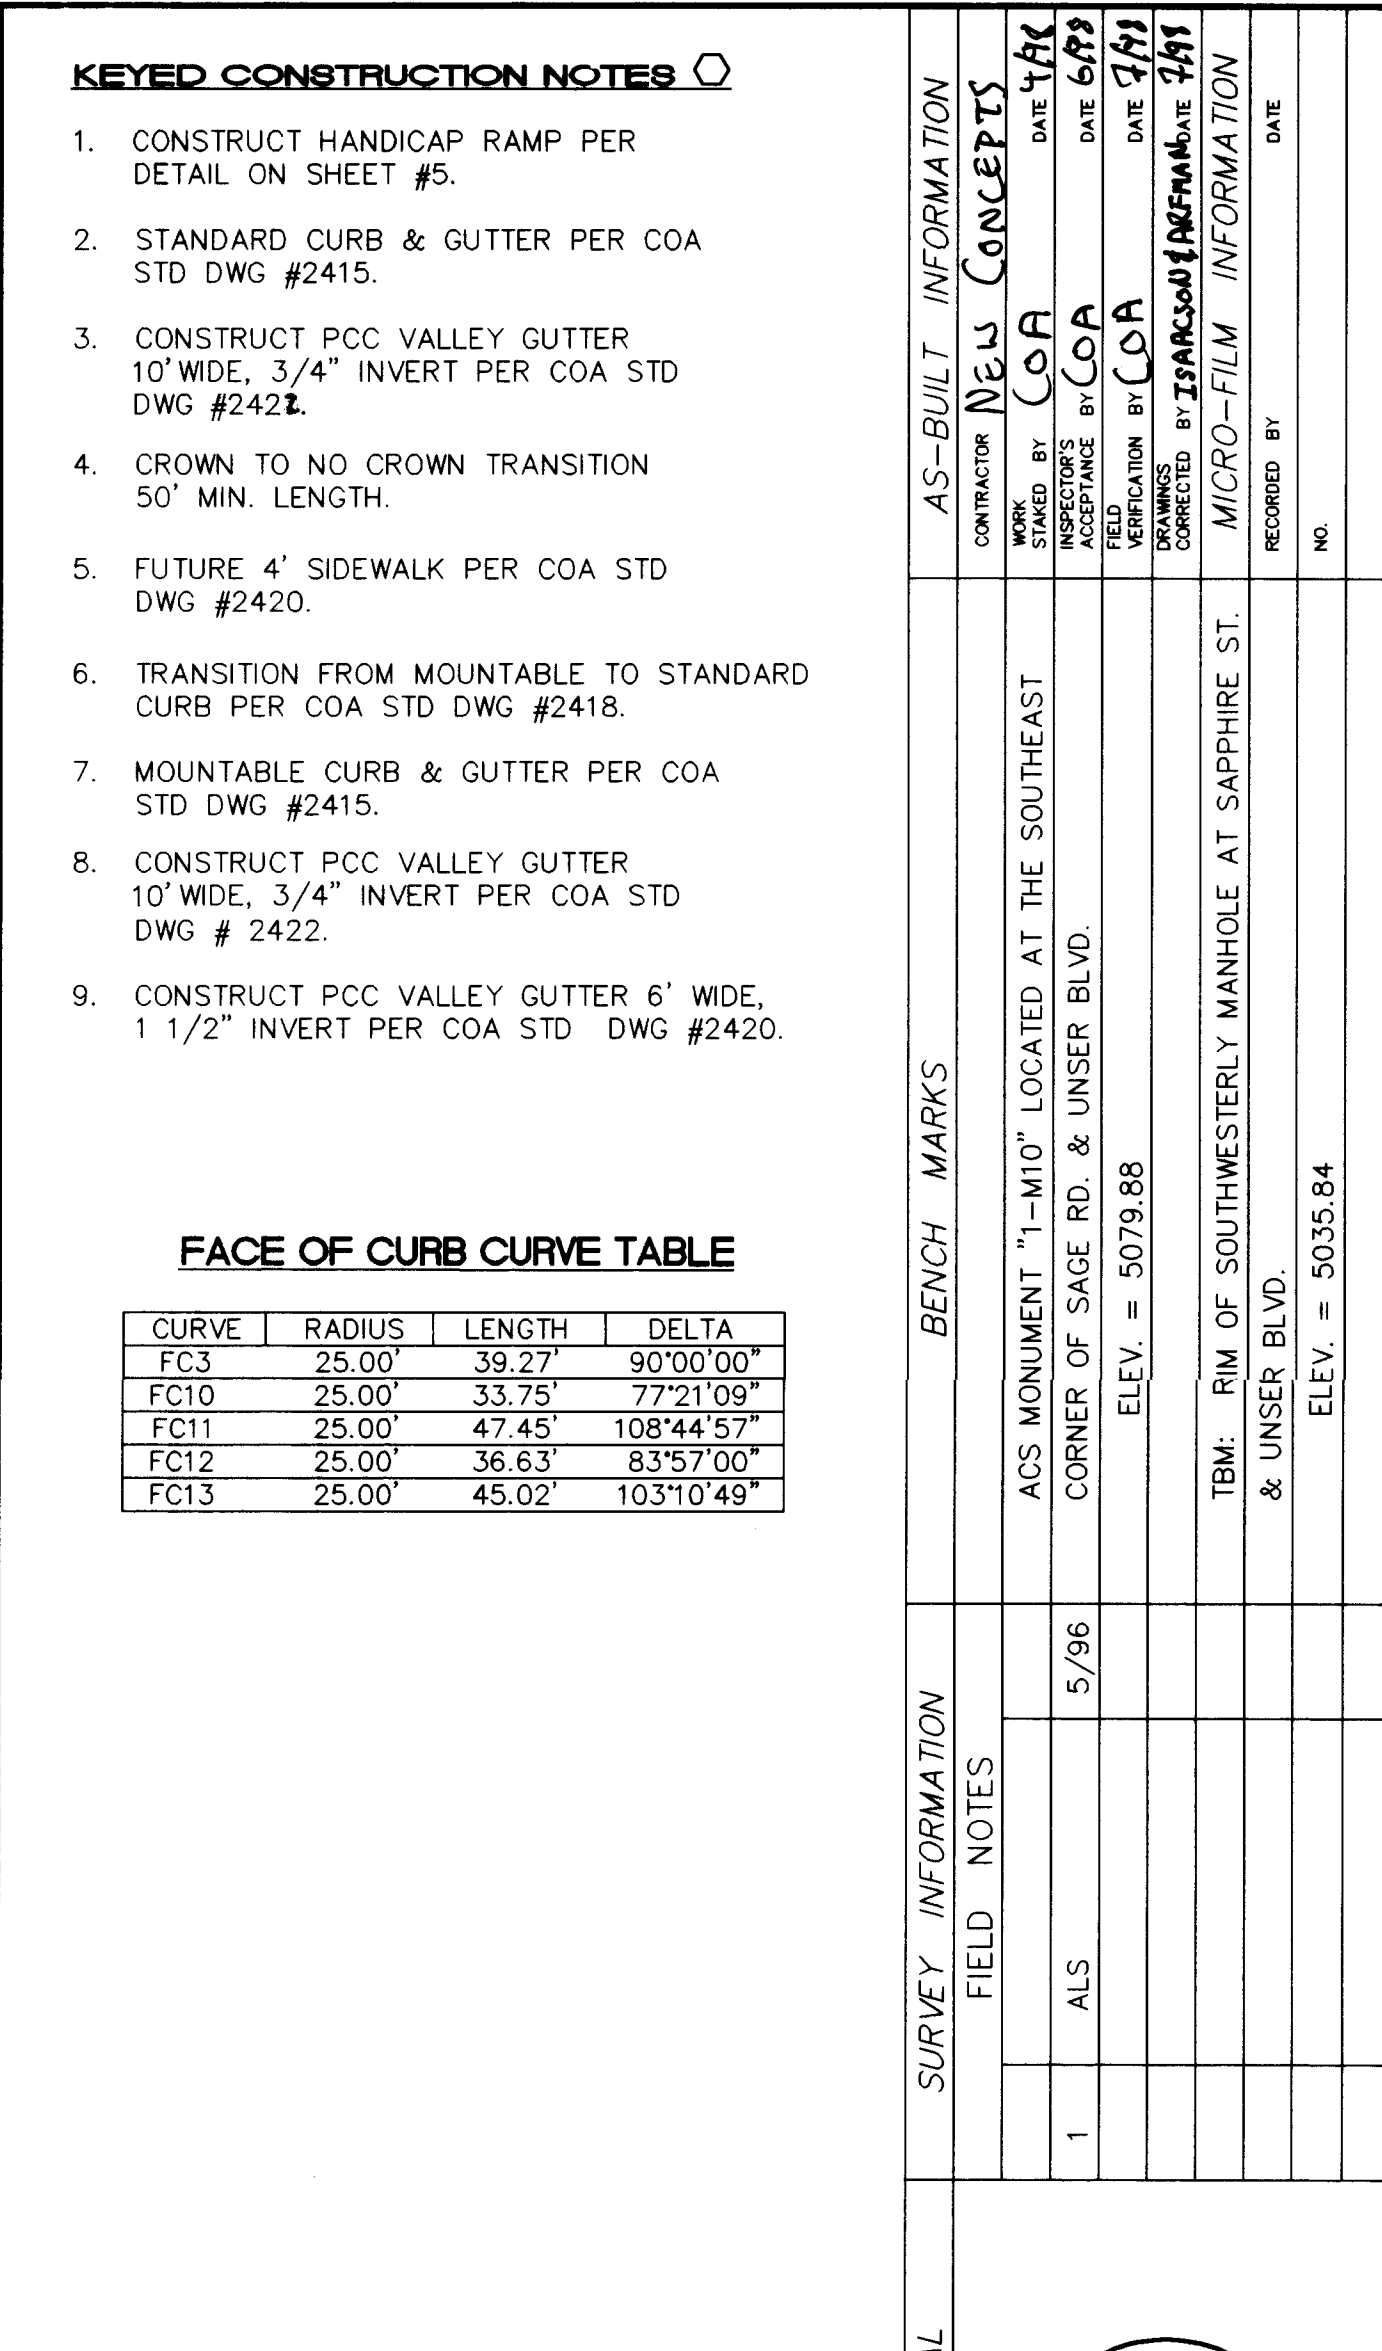

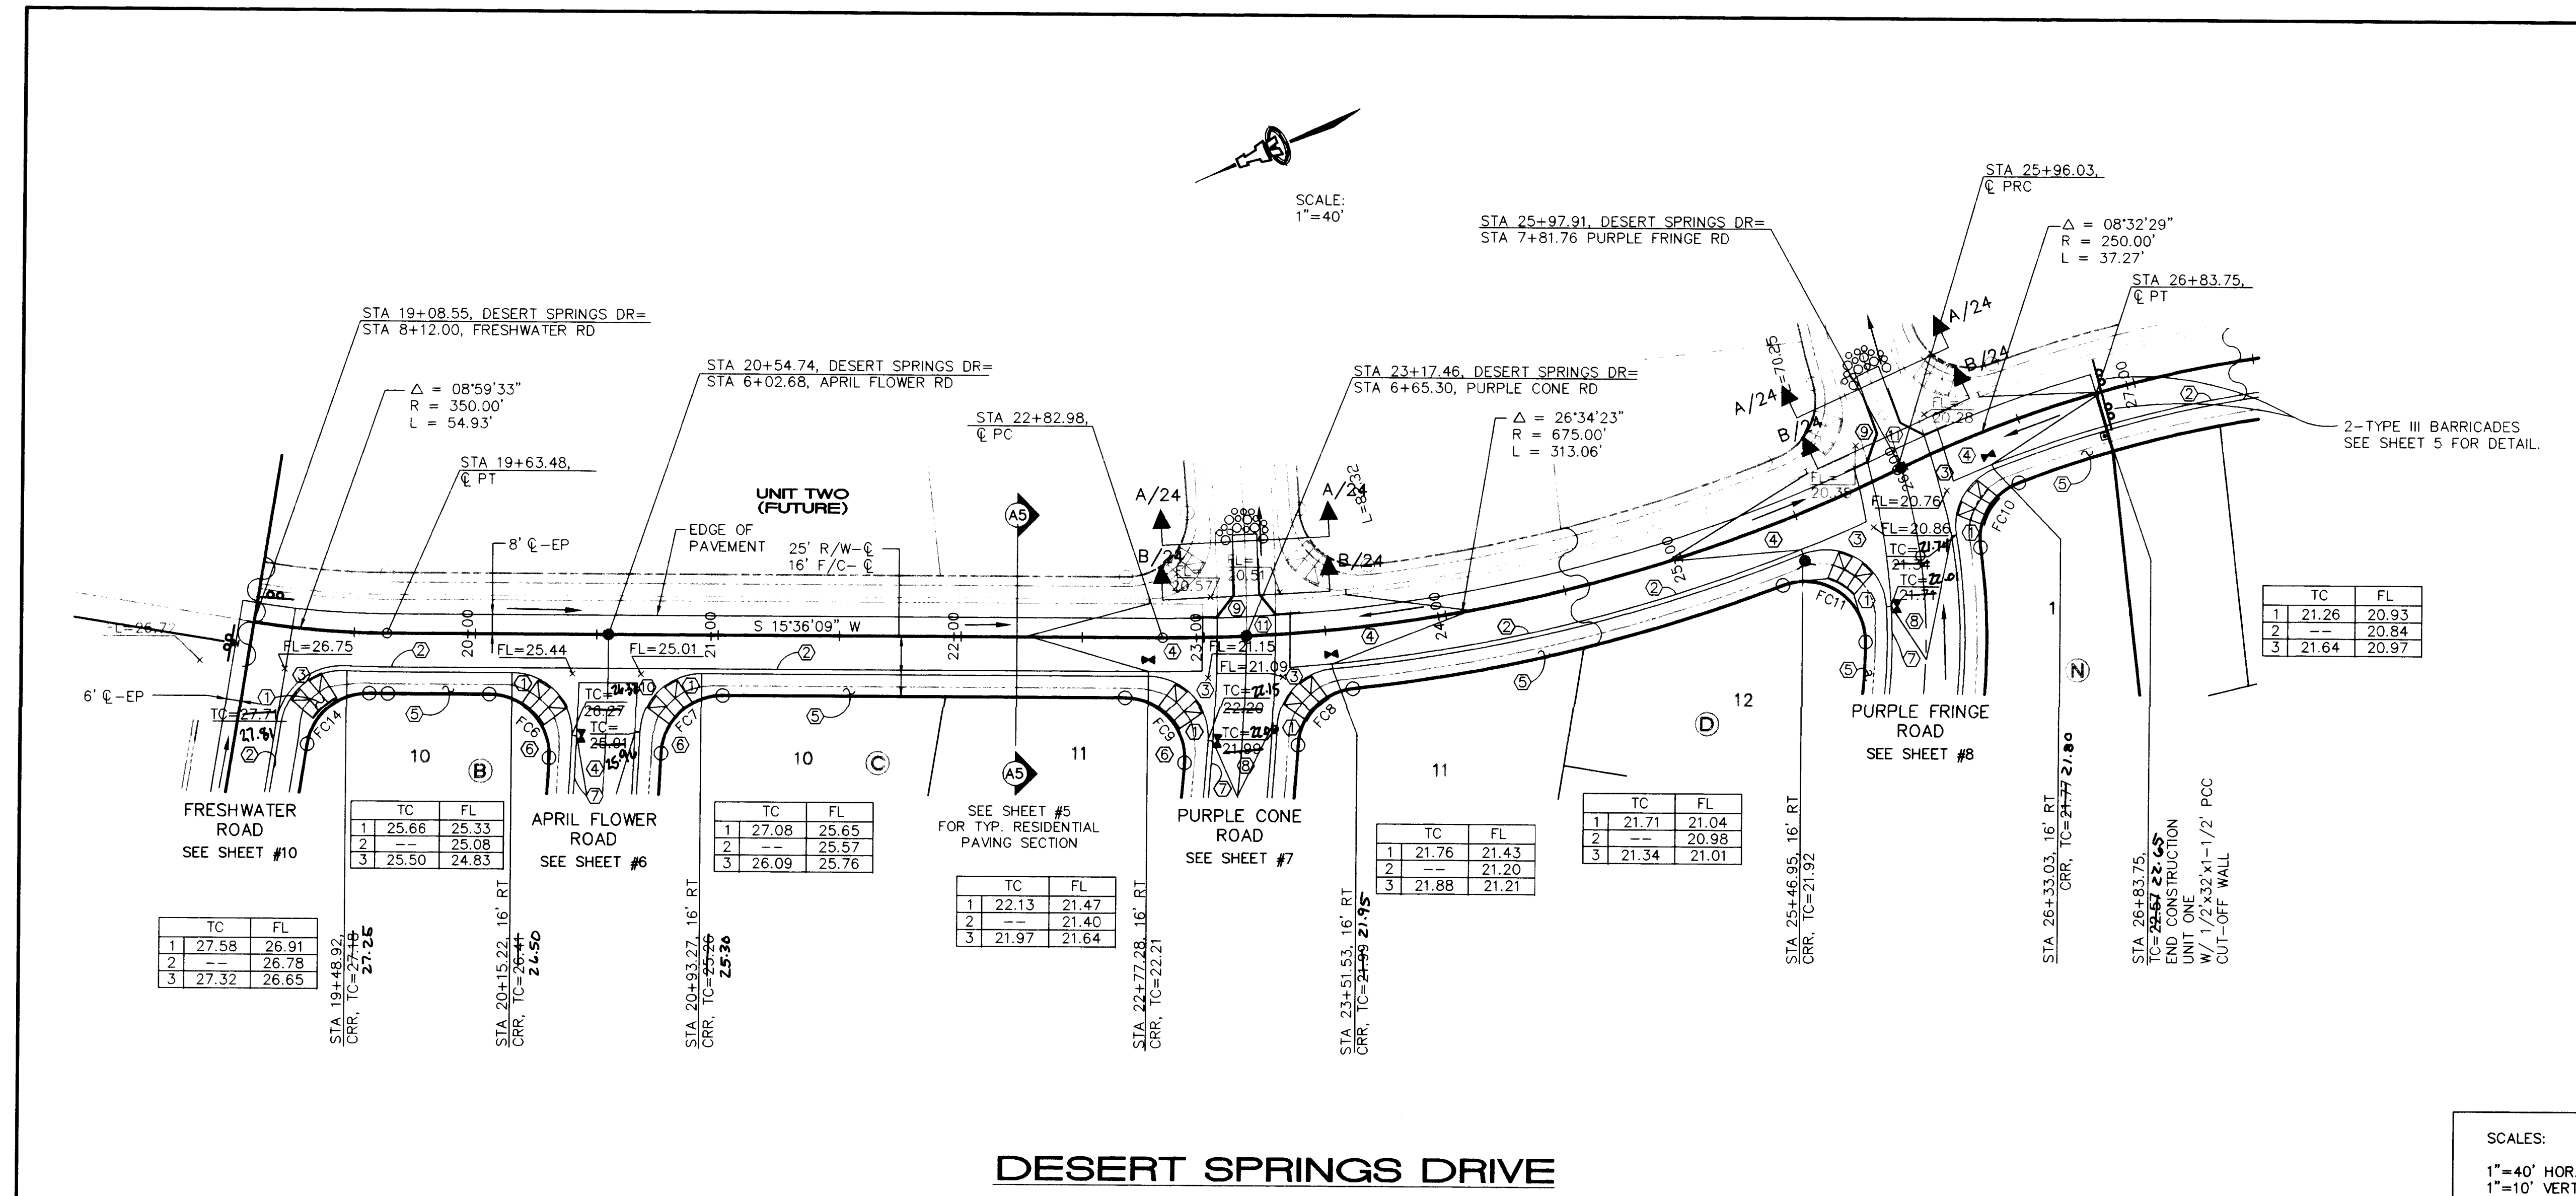

KEYED CONSTRUCTION NOTES

1. CONSTRUCT HANDICAP RAMP PER DETAIL ON SHEET #5.

2. STANDARD CURB & GUTTER PER COA STD DWG #2415.

3. CONSTRUCT PCC VALLEY GUTTER 10' WIDE, 3/4" INVERT PER COA STD DWG #2422.

4. CROWN TO NO CROWN TRANSITION 50' MIN. LENGTH.

5. FUTURE 4' SIDEWALK PER COA STD DWG #2430.

6. TRANSITION FROM MOUNTABLE TO STANDARD CURB PER COA STD DWG #2418.

7. MOUNTABLE CURB & GUTTER PER COA STD DWG #2415.

8. CROWN TO HALF CROWN TRANSITION 25' MIN. LENGTH.

9. 10' MIN LENGTH TEMPORARY 6" ASPHALT HEADER CURB.

10. CONSTRUCT PCC VALLEY GUTTER 6" WIDE, 1 1/2" INVERT, PER COA STD DWG 2420.

11. PLACE WOODEN BOLLARDS WITH REFLECTORIZED RED DELINEATORS @ 5' O.C.

FACE OF CURB CURVE TABLE

CURVE	RADIUS	LENGTH	DELTA
FC6	25.00'	40.14'	92°00'19"
FC7	25.00'	38.46'	88°09'10"
FC8	25.00'	35.59'	81°33'42"
FC9	25.00'	40.65'	93°09'59"
FC10	25.00'	33.75'	77°21'09"
FC11	25.00'	47.45'	108°44'57"
FC14	25.00'	36.51'	83°40'54"


AS-BUILT INFORMATION
CONTRACTOR: **ISAACSON & ARFMAN**
WORK: **DESERT SPRINGS DR**
DATE: **9/97**
STAMPED BY: **COA**
ACCEPTANCE BY: **COA**
FIELD CHECK BY: **COA**
DRAWINGS CORRECTED BY: **ISAACSON & ARFMAN**
MICRO-FILM INFORMATION
RECORDED BY: **NO**
DATE: **NO**

BENCH MARKS
ACS MONUMENT "1-M10" LOCATED AT THE SOUTHEAST CORNER OF SAGE RD. & UNSER BLVD.
ELEV = 5079.88
TBM: RIM OF SOUTHWESTERLY MANHOLE AT SAPHIRE ST. & UNSER BLVD.
ELEV = 5035.84

SURVEY INFORMATION
FIELD NOTES
1 ALS 5/96

ENGINEER'S SEAL

REVISIONS
NO. DATE BY
DESIGN
JUN 9/97
ANW
FCA
DATE 9/97

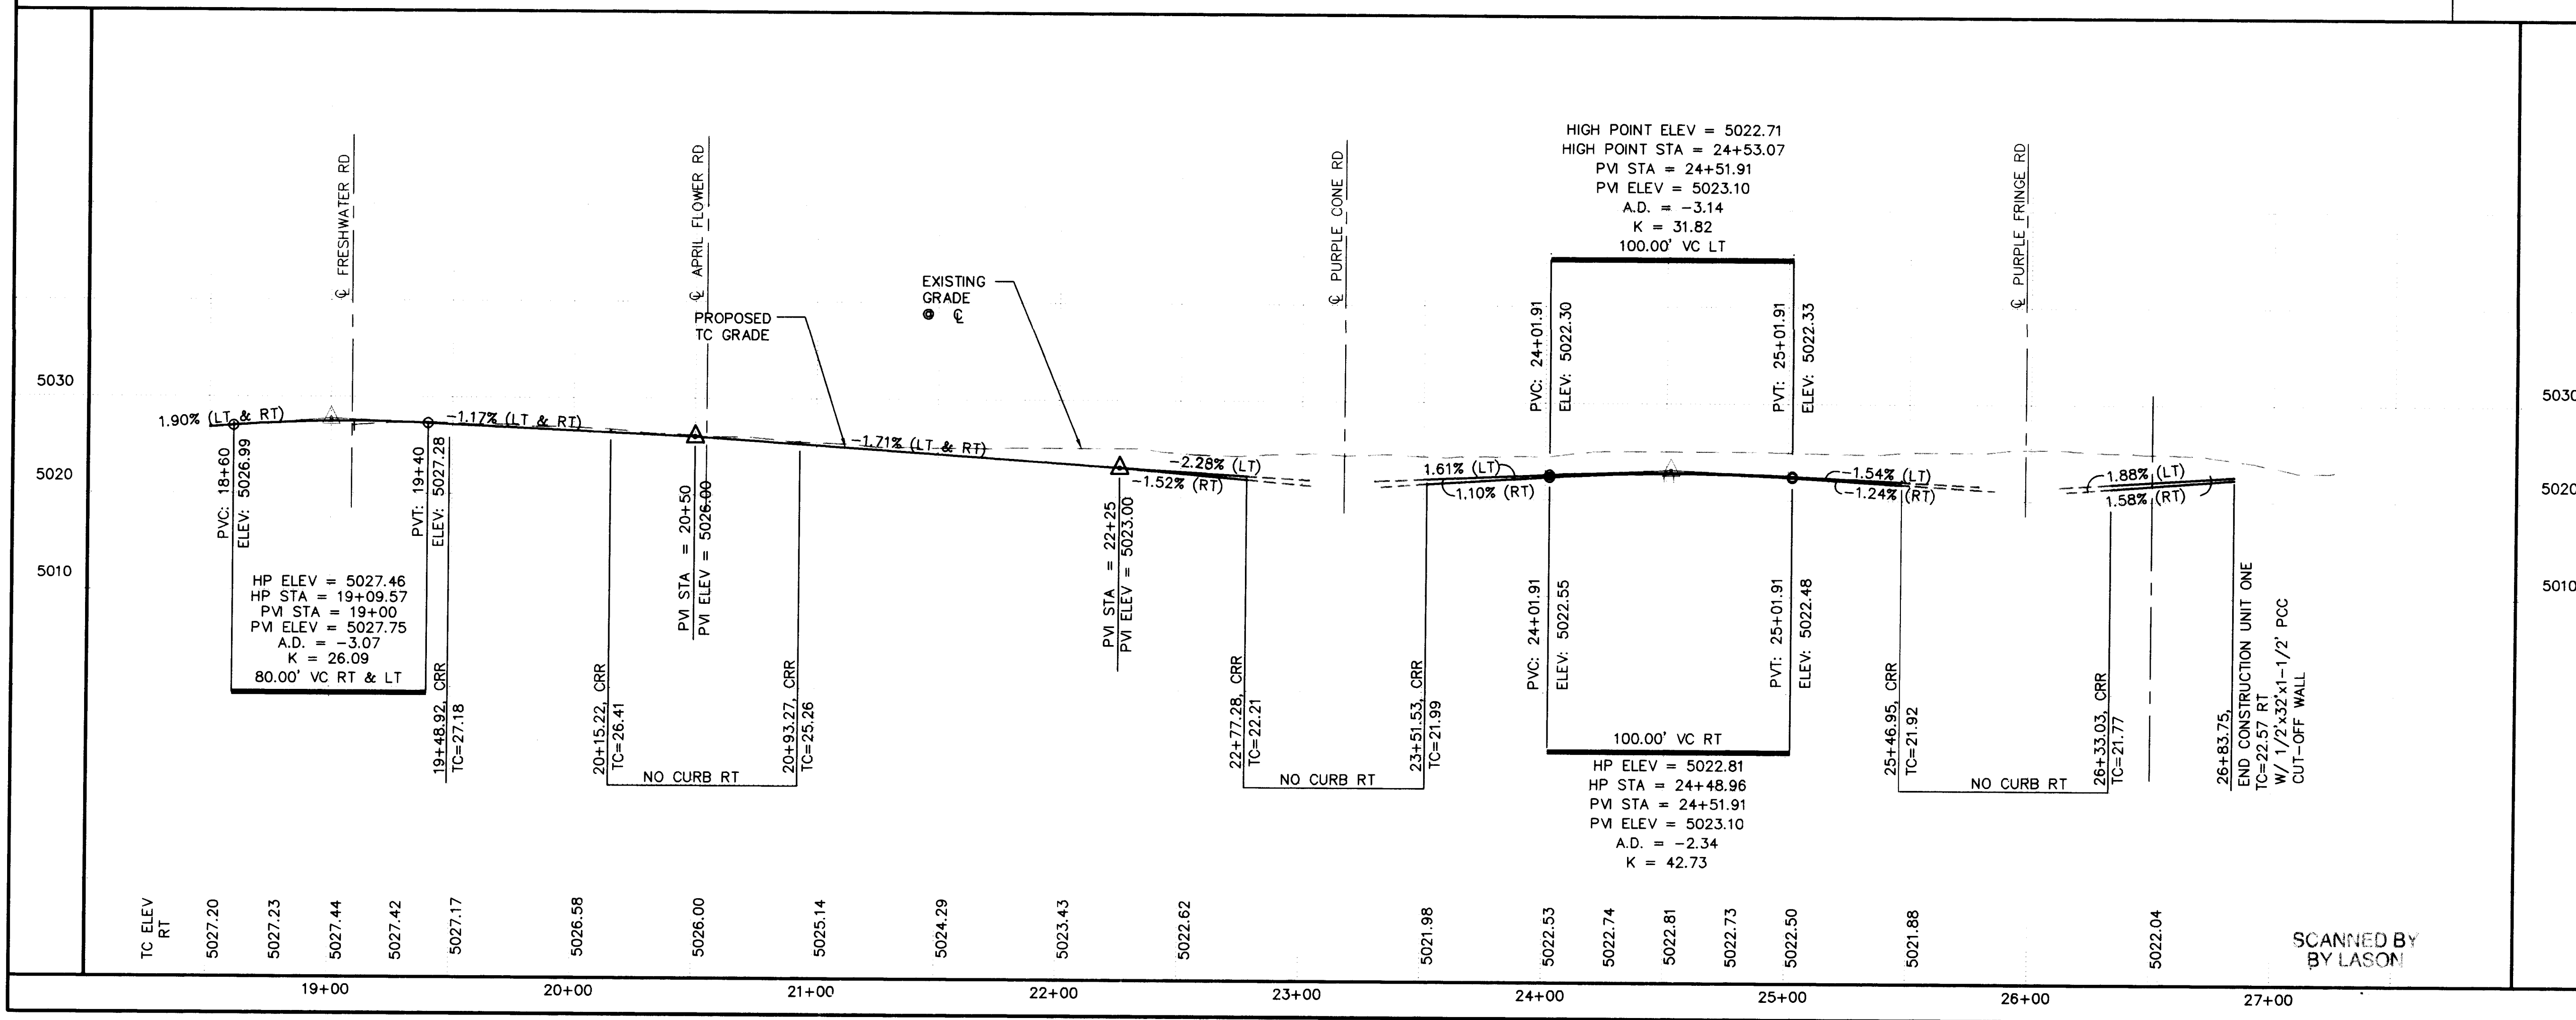

ISAACSON & ARFMAN, P.A.
Consulting Engineering Associates
128 Monroe Street N.E.
Albuquerque New Mexico 87102
930PV6.DWGems 10/28/97

CITY OF ALBUQUERQUE
PUBLIC WORKS DEPARTMENT
ENGINEERING GROUP

TITLE: DESERT FLOWER SUBDIVISION--UNIT ONE
DESERT SPRINGS DR
PAVING PLAN PROFILE

City Engineer Approval

City Project No. **5739.81**

Zone Map No. **M-10**


Sheet **11** Of **24**

City Engineer Approval

City Project No. **5739.81**

Zone Map No. **M-10**

Sheet **11** Of **24**

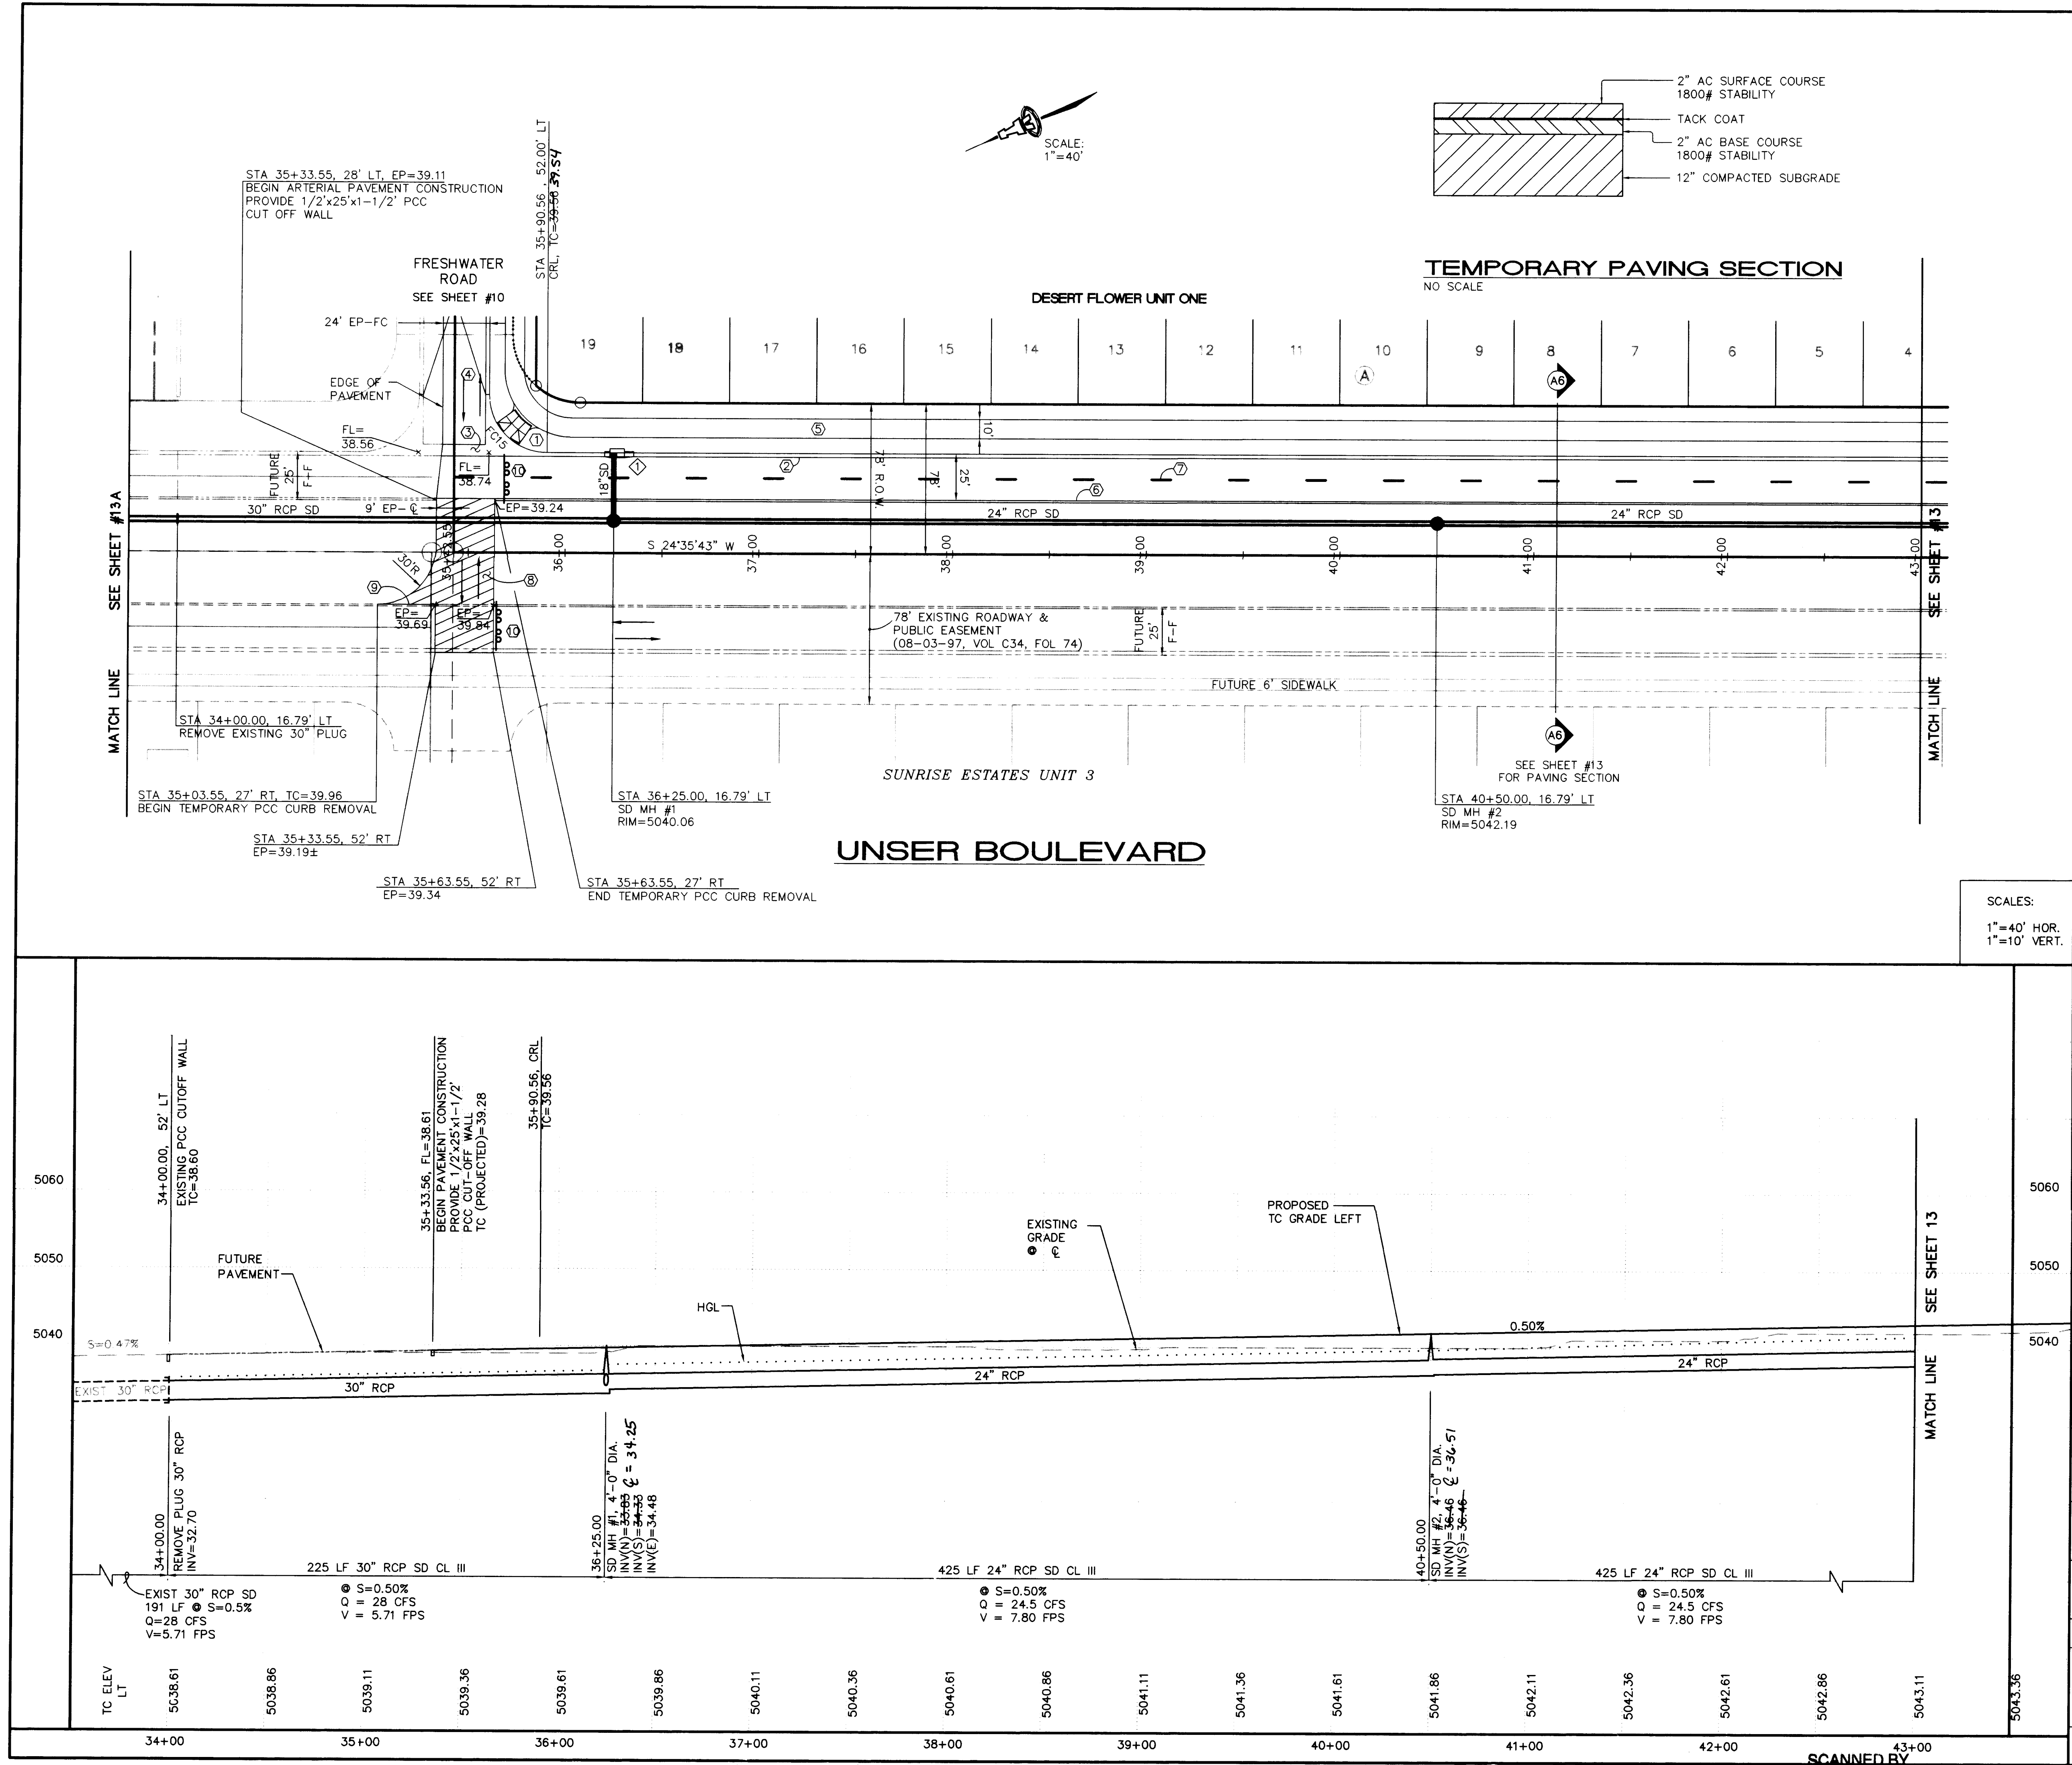

KEYED CONSTRUCTION NOTES

- CONSTRUCT HANDICAP RAMP PER DETAIL ON SHEET #5.
- STANDARD CURB & GUTTER PER COA STD DWG #2415.
- CONSTRUCT PCC VALLEY GUTTER 6' WIDE, 3/4" INVERT PER COA STD DWG #2420.
- CROWN TO NO CROWN TRANSITION 50' MIN. LENGTH.
- 10' ASPHALT TRAIL.
- TEMPORARY ASPHALT EXTRUDED CURB PER COA STD DWG #2415.
- DASHED 4" WHITE PLASTIC REFLECTORIZED PAVEMENT STRIPING PER MUTCD. 10' STRIPE W/30' GAP BETWEEN STRIPES.
- 288 SY TEMPORARY PAVING FOR TEMPORARY CONNECTION TO UNSER BOULEVARD. SEE DETAIL THIS SHEET.
- REMOVE AND DISPOSE OF 28 LF TEMPORARY PCC EXTRUDED CURB.
- PLACE TYPE III BARRICADES PER DETAIL ON SHEET 5.

FACE OF CURB CURVE TABLE

CURVE	RADIUS	LENGTH	DELTA
FC15	30.00'	47.13'	90°00'19"

STORM DRAIN INLET INFORMATION

INLET NO.	INLET TYPE	STATION* & OFFSET	TOP GR. EL.	INV. OUT
1	A, SG	36+25.00, 52' LT	38.83	34.86

*STATIONING IS TO MIDPOINT OF GRATE • FACE OF CURB

CONNECTOR PIPE INFORMATION

FROM INLET NO.	DIA. (IN)	LENGTH (FT)	SLOPE (FT/FT)
1	18	32	0.01

ENGINEER'S SEAL



ISAACSON & ARFMAN, P.A.
Consulting Engineering Associates
128 Monroe Street N.E.
Albuquerque, New Mexico 87102
930PV7.DWGnvw VIEW: 1 10/23/97

CITY OF ALBUQUERQUE
PUBLIC WORKS DEPARTMENT
ENGINEERING GROUP


TITLE: DESERT FLOWER SUBDIVISION--UNIT ONE
UNSER BOULEVARD
PAVING & STORM DRAIN PLAN & PROFILE

DESIGN COMMITTEE


City Project No. 5739.81 **Zone Map No. M-10** **Sheet 12 Of 24**

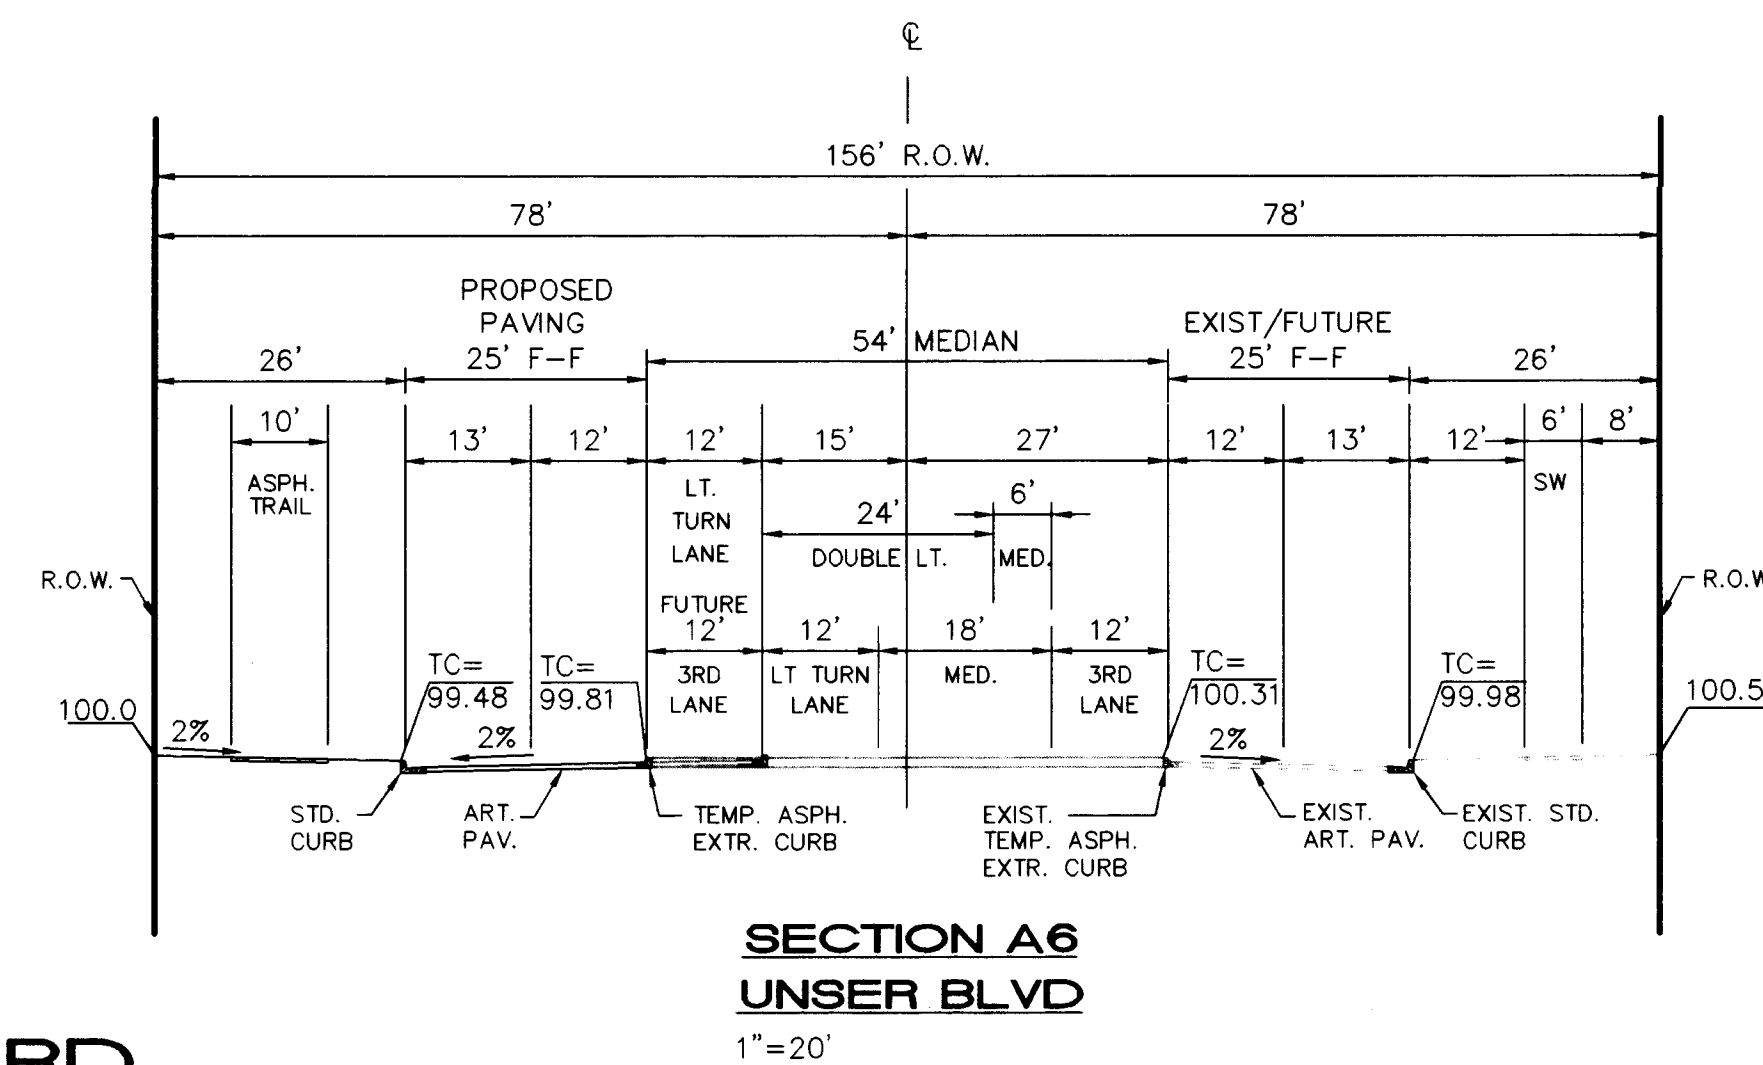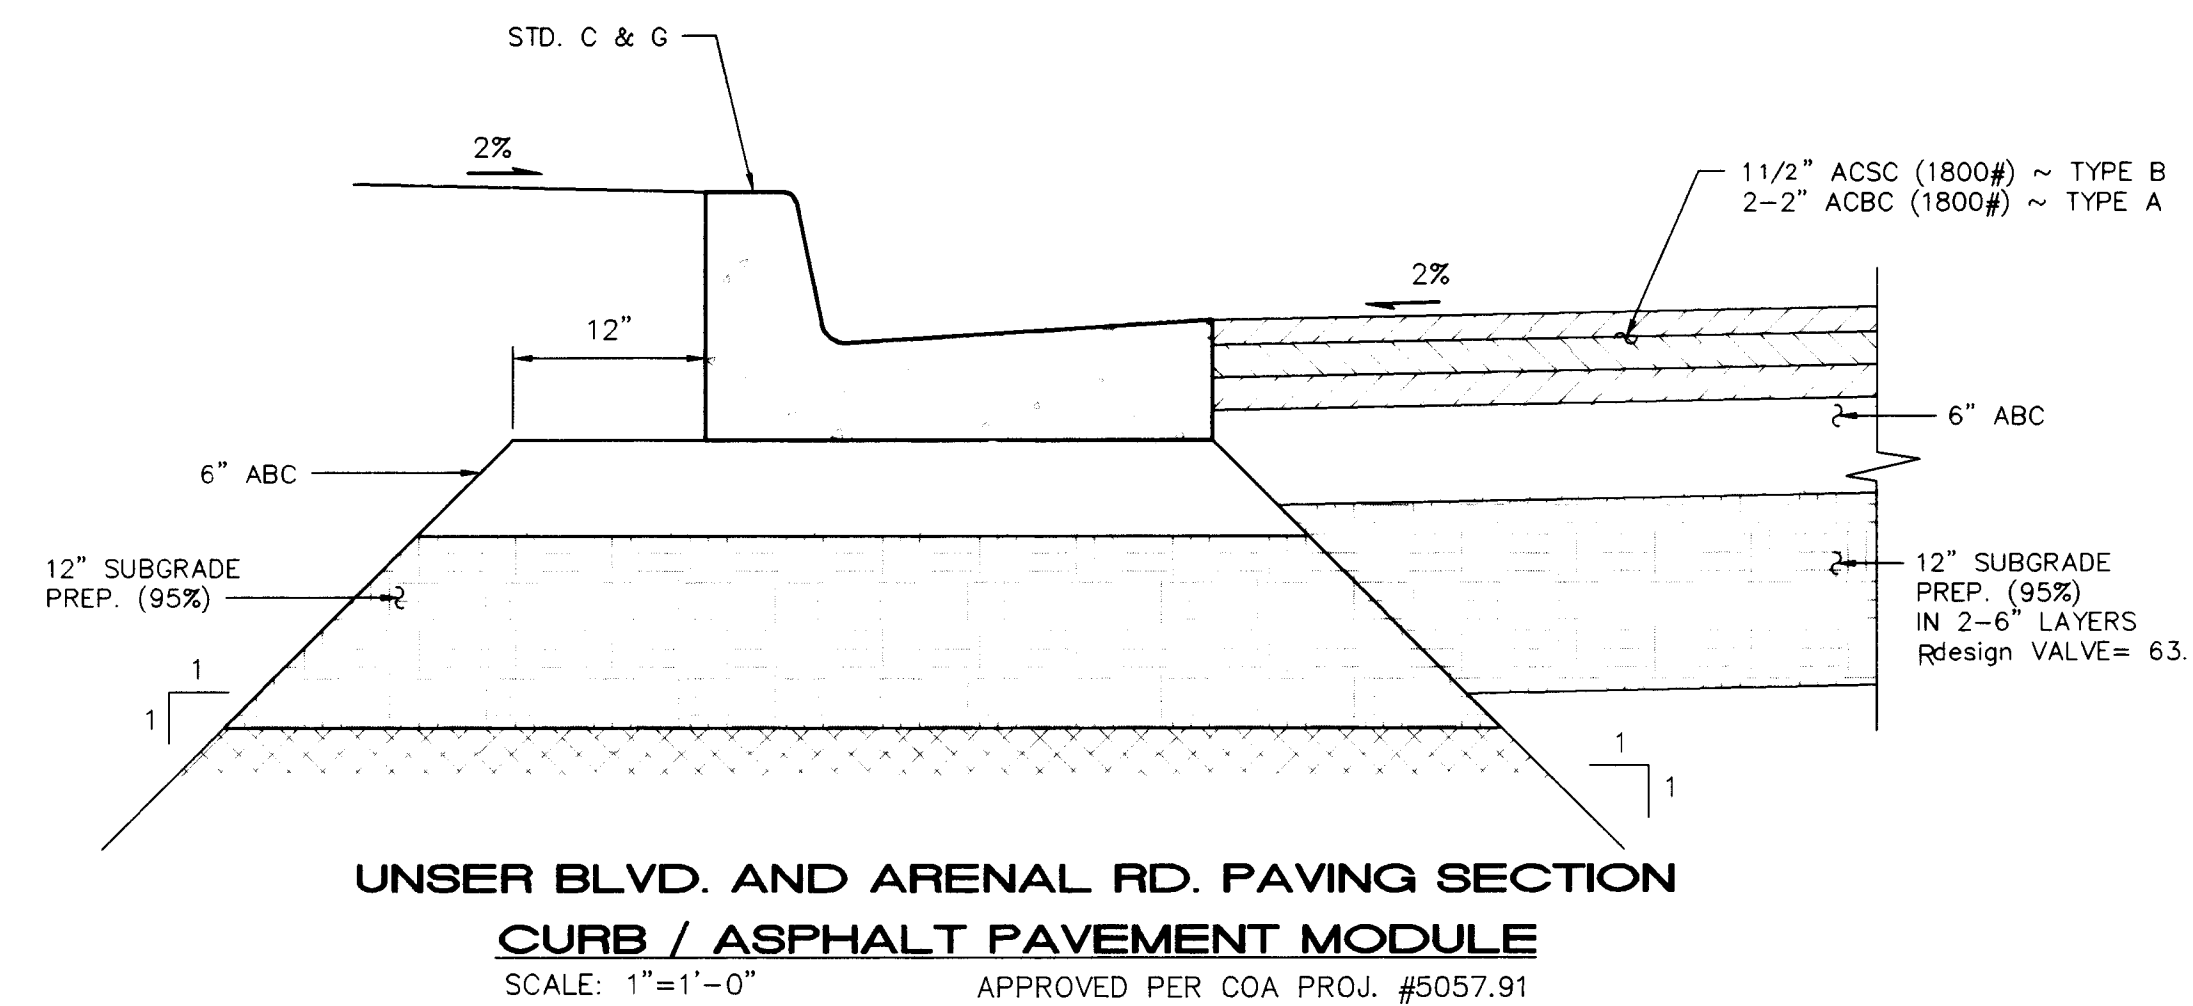

UNSER BOULEVARD

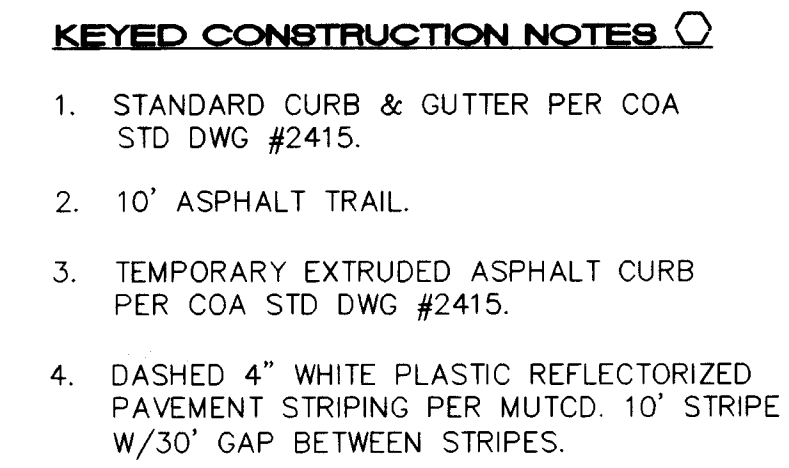


SURVEY INFORMATION			BENCH MARKS	AS-BUILT INFORMATION	
FIELD NOTES				CONTRACTOR'S	INFORMATION
1	ALS	5/96	ACS MONUMENT "1-M10" LOCATED AT THE SOUTHEAST CORNER OF SAGE RD. & UNSER BLVD. ELEV. = 5079.88	WORK STARTED BY: C&A INSPECTOR'S DATE: 6/18 FIELD VERIFICATION BY: C&A DATE CORRECTED BY: 6/18	9/13 CONCEPTS DATE BY DATE BY
			TBM: RIM OF SOUTHWESTERLY MANHOLE AT SAPHIRE ST. & UNSER BLVD. ELEV. = 5035.84	9/13 CONCEPTS DATE BY	9/13 CONCEPTS DATE BY

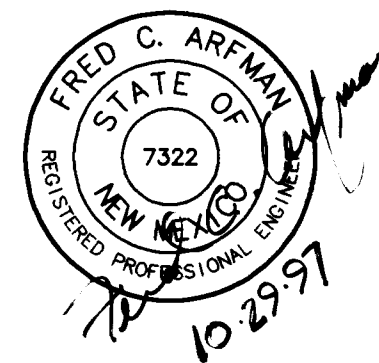[illegible]

 **ISAACSON & ARFMAN, P.A.**
Consulting Engineering Associates
128 Monroe Street N.E.
Albuquerque New Mexico
930PV7.DWGanw VIEW: 2 10/23/97

CITY OF ALBUQUERQUE
PUBLIC WORKS DEPARTMENT
ENGINEERING GROUP

TITLE: DESERT FLOWER SUBDIVISION--UNIT ONE
UNSER BOULEVARD
PAVING & STORM DRAIN PLAN & PROFILE

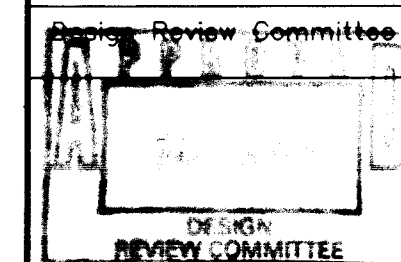

City Engineer Approval

Last Design Update

Mo./Day/Yr.	Mo./Day/Yr.

City Project No. **5739.81**

Zone Map No.
M-10

Sheet **13** Of **24**

SCANNED BY
BY LASON



SUNRISE ESTATES UNIT 2

SCALES:
1"=40' HOR.
1"=10' VERT.




AS FURTHER DRAWING

CITY OF ALBUQUERQUE
PUBLIC WORKS DEPARTMENT
ENGINEERING GROUP

Design Review Committee	City Engineer Approval	Last Design Update	Mo./Day/Yr.	Mo./Day/Yr.

City Project No. 5739.81	Zone Map No. M-10	Sheet 13A Of 24
------------------------------------	-----------------------------	-------------------------------

[illegible]

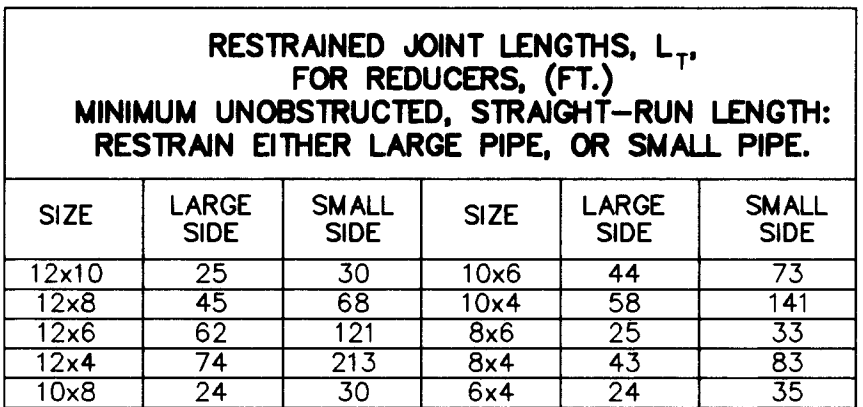

DEPTH OF BURY	3.0 FT. MINIMUM
FACTOR OF SAFETY	1.25
MATERIAL	PVC PIPE
SOIL TYPE:	GM/SM - SILTY GRAVELS AND SILTY SANDS, GRAVEL-SAND-SILT MIXTURES.
TEST PRESSURE	150 PSI
TRENCH TYPE 4:	PIPE BEDDED IN SAND, GRAVEL, OR CRUSHED STONE TO DEPTH OF 1/8 PIPE DIAMETER, 4 INCH MINIMUM; BACKFILL COMPACTED TO TOP OF PIPE.

DIFFERENT CRITERIA, E.G., DUCTILE IRON PIPE, GREATER DEPTH OF BURY, ETC., WILL REQUIRE DIFFERENT RESTRAINED LENGTHS. THESE MUST BE CALCULATED BY A QUALIFIED PROFESSIONAL ENGINEER AND APPROVED BY THE PUBLIC WORKS DEPARTMENT.


WATER SHUT-OFF PLAN

IF THE 30" MPWL IS OPERATIONAL, SHUT OFF VALVES [1] & [2] TO PROVIDE NON-PRESSURE CONNECTION. IF TEMPORARY CONNECTIONS NEED TO BE MADE, SHUT OFF VALVES [3] (KIMELA DR AT SUMMERFIELD PL) & [4] (DESERT SPRINGS @ DESERT CANYON PL) TO PROVIDE A NON-PRESSURE CONNECTION. THE CONTRACTOR SHALL CONTACT WATER SYSTEMS DIVISION (857-8200) 3 WORKING DAYS PRIOR TO SHUT-OFF OR TURN-ON AT VALVES. ONLY CITY PERSONNEL ARE ALLOWED TO OPERATE VALVES.

- | | |
|---|----------------------------------|
|  | SINGLE WATER METER & BOX |
|  | DOUBLE WATER METER & BOX |
|  | GATE VALVE W/ TYPE 'A' VALVE BOX |
|  | FIRE HYDRANT |
|  | SAS MANHOLE |
|  | WATER LINE W/ FITTING |
|  | WATER PRESSURE RELIEF VALVE |


SCANNED BY
BY LASON

	ISAACSON & ARFMAN, P.A.						
	<i>Consulting Engineering Associates</i>						
	<i>128 Monroe Street N.E.</i>						
	<i>Albuquerque New Mexico</i>						
930UMSTR.DWGems	VIEW: 1	10/27/97				NO. DATE	DESIGNED BY JH DRAWN BY A CHECKED BY F
CITY OF ALBUQUERQUE PUBLIC WORKS DEPARTMENT ENGINEERING GROUP							
TITLE: DESERT FLOWER SUBDIVISION--UNIT ONE MASTER UTILITY PLAN							
Design Review Committee	City Engineer Approval	Last Design Update	Mo./Day/Yr.		Mo./Day/Yr.		
City Project No. 5739.81	Zone Map No. M-10	Sheet 14	Of 24				

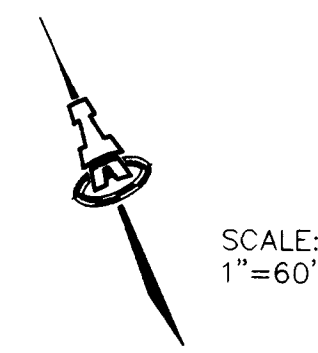

SCALE:
1"=60'


	SINGLE WATER METER & BOX
	DOUBLE WATER METER & BOX
	GATE VALVE W/ TYPE 'A' VALVE BOX
	FIRE HYDRANT
	SAS MANHOLE
	WATER LINE W/ FITTING
	WATER PRESSURE RELIEF VALVE

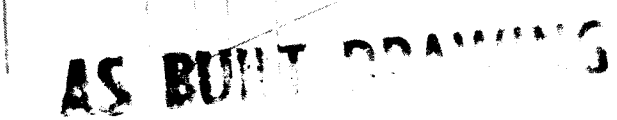

Design Review Committee	City Engineer Approval	Last Design Update	Mo./Day/Yr.	Mo./Day/Yr.
City Project No. 5739.81	Zone Map No. M-10	Sheet 14A Of 24		

SURVEY INFORMATION		BENCH MARKS	AS-BUILT INFORMATION	
FIELD NOTES			CONTRACTOR	NEW CONCEPTS
1	ALS 5/96	ACS MONUMENT "1-110" LOCATED AT THE SOUTHEAST CORNER OF SAGE RD. & UNSER BLVD. ELEV. = 5079.88	WORK STARTED BY ACCEPTANCE BY FIELD MEASUREMENT BY DRAWINGS CORRECTED BY	COA COA COA COA COA
		TBM: RIM OF SOUTHWESTERLY MANHOLE AT SAPPHERE ST. & UNSER BLVD. ELEV. = 5035.84	DATE DATE DATE DATE DATE	5/98 6/98 7/98 8/98 8/98
			MICRO-FILM INFORMATION	
			RECORDED BY	DATE
			NO.	

NO.	DATE	REMARKS
<i>REVISES</i>		
<i>DESIGN</i>		
DESIGNED BY	JMN	DATE 9/97
DRAWN BY	ANW	DATE 9/97
CHECKED BY	FCA	DATE 9/97

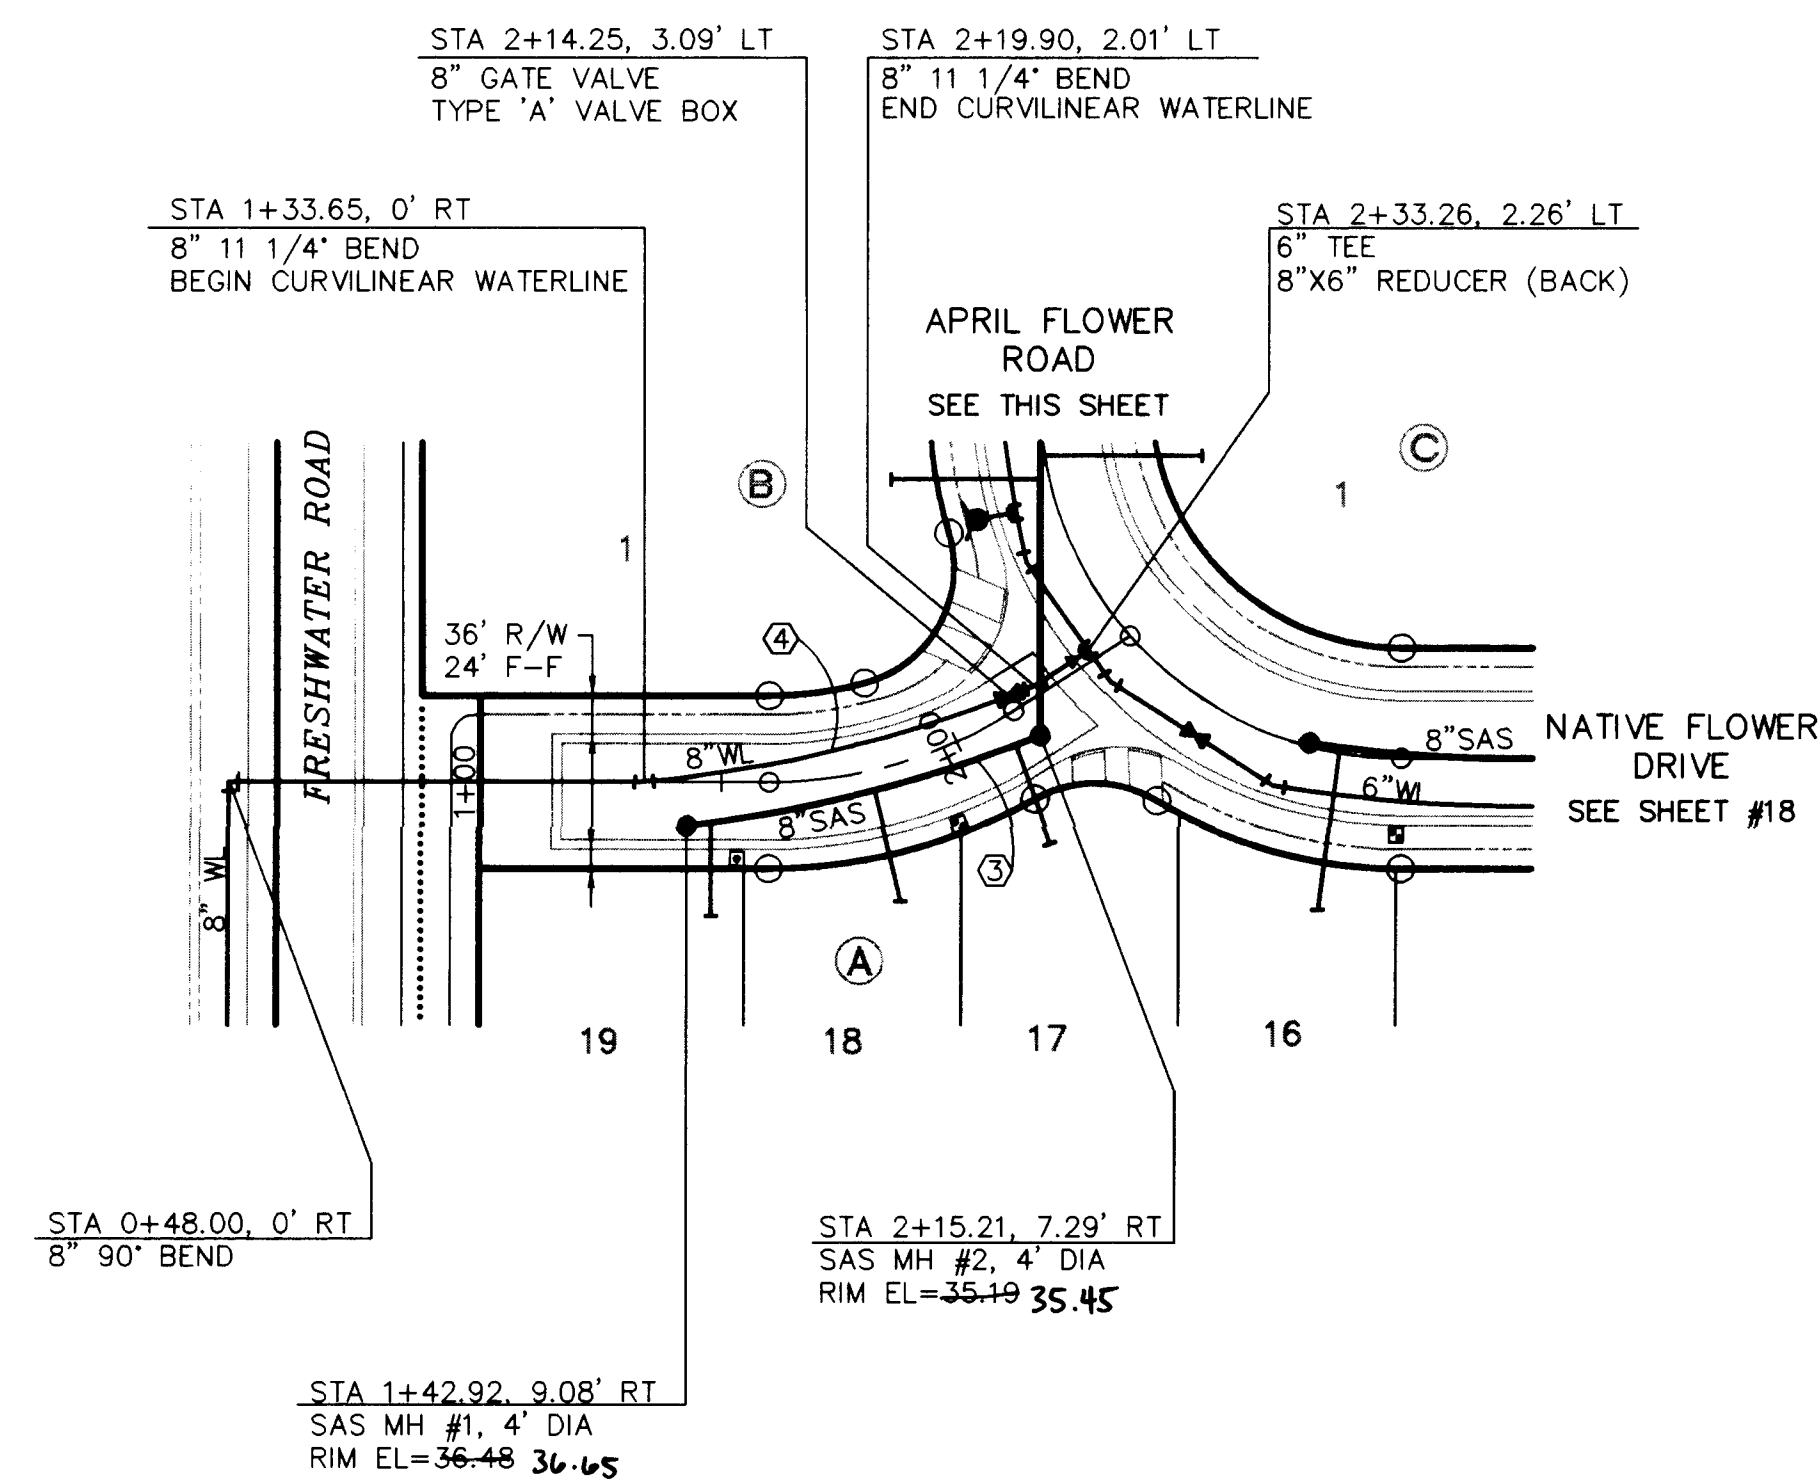


NATIVE FLOWER PLACE

UTILITY SERVICE TABLE

BLOCK/ LOT NO.	STATION		
	WATER, LENGTH	SAS, LENGTH	
A 17		2+08.18, 20'	
A 18	1+94.30, 22'	1+81.14, 24'	
A 19	1+55.00, 19' (S)	1+48.00, 22'	
B 1	1+52.69, 7'	1+37.40, 33'	
B 2		1+82.99, 33'	
B 3	2+42.99, 6'	2+27.99, 33'	
B 4		2+72.99, 33'	
B 5	3+32.99, 6'	3+17.99, 33'	
B 6		3+62.99, 33'	
B 7	4+22.99, 6'	4+07.99, 33'	
B 8		4+53.20, 33'	
B 9	5+14.75, 6'	4+93.25, 33'	
B 10		5+40.25, 33'	
C 1	1+57.12, 26'	1+42.22, 33'	
C 2		1+87.12, 33'	
C 3	2+47.12, 26'	2+32.12, 33'	
C 4		2+77.12, 33'	
C 5	3+37.12, 26'	3+22.12, 33'	
C 6		3+67.12, 33'	
C 7	4+27.12, 26'	4+12.12, 33'	
C 8		4+62.12, 33'	
C 9	5+25.26, 26'	5+10.57, 33'	
C 10		5+49.52, 33'	

SURVEY INFORMATION		BENCH MARKS	AS-BUILT INFORMATION	
FIELD NOTES			CONTRACTOR	NEW CONCEPTS
1	ALS	ACS MONUMENT "1-M10" LOCATED AT THE SOUTHEAST CORNER OF SAGE RD. & UNSER BLVD. ELEV. = 5079.88	WORK STAMPED BY: COA ACCEPTANCE BY: COA FIELD LOCATION BY: COA DRAWINGS CORRECTED BY: COA	DATE: 5/98 DATE: 6/78 DATE: 7/78 DATE: 7/99
		TBM: RM OF SOUTHWESTERLY MANHOLE AT SAPPHIRE ST. & UNSER BLVD.	MICRO-FILM	DATE
		ELEV. = 5035.84	RECORDED BY:	DATE
			NO.	

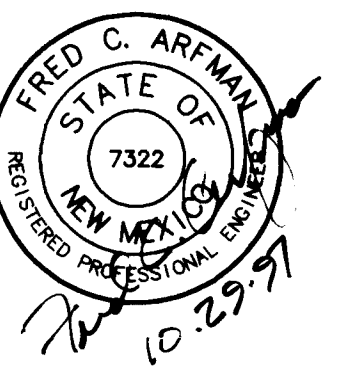


AS-BUILT DRAWING


	SINGLE WATER METER & BOX
	DOUBLE WATER METER & BOX
	GATE VALVE W/ TYPE 'A' VALVE BOX
	FIRE HYDRANT
	SAS MANHOLE
	WATER LINE W/ FITTING

City Engineer Approval	Last Design Update	Mo./Day/Yr.	Mo./Day/Yr.


Sheet **15** Of **24**

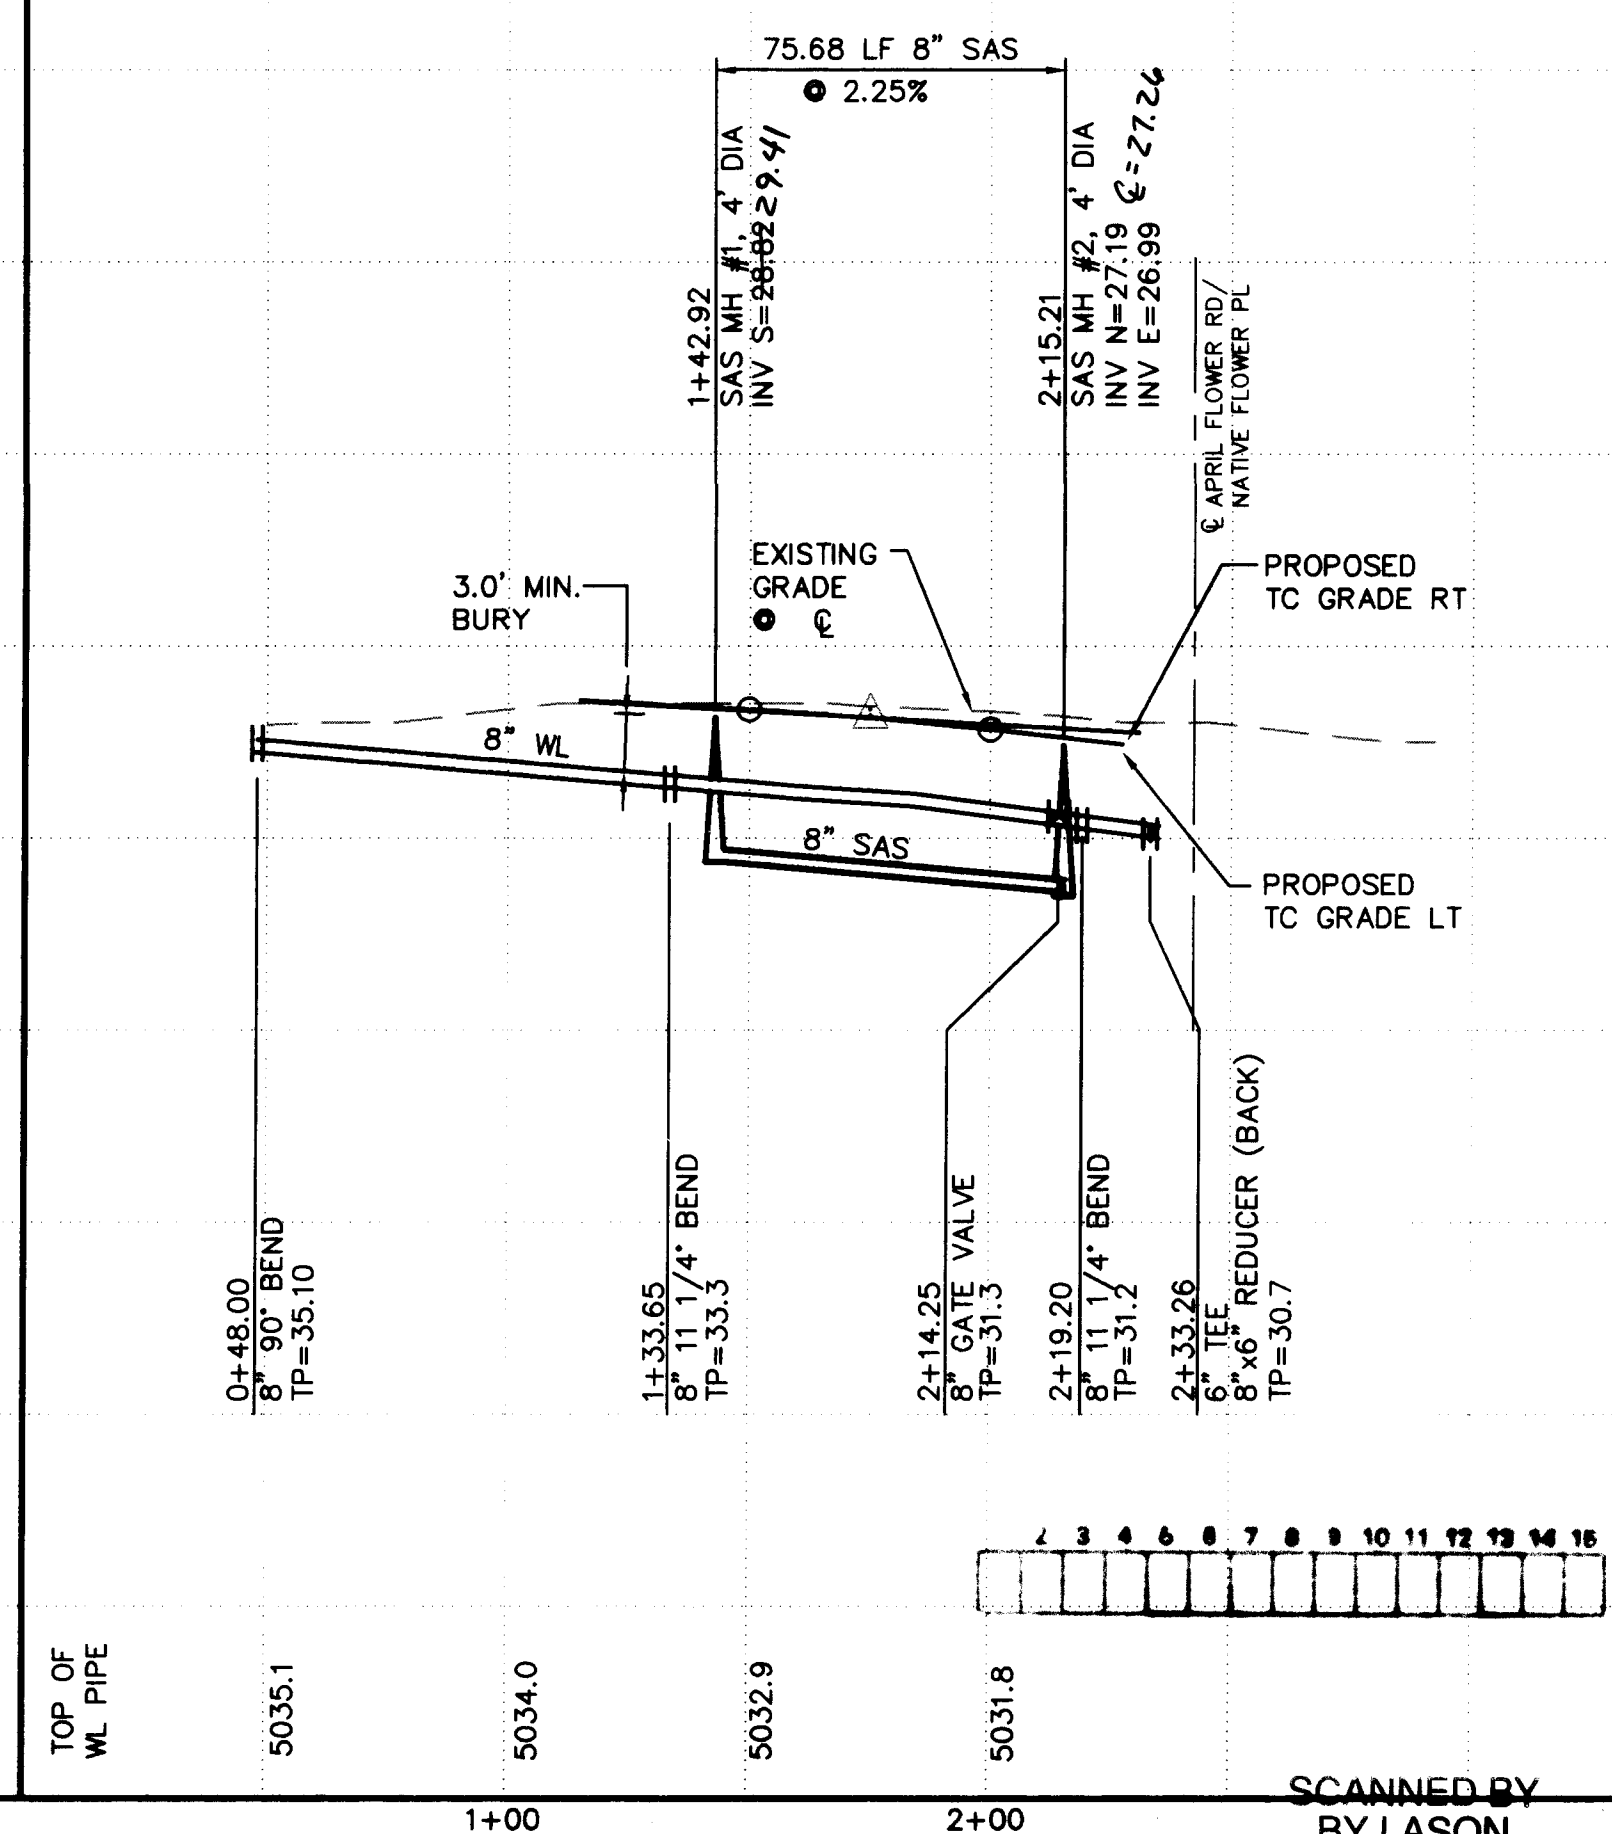


- LEGEND**
- SINGLE WATER METER & BOX
 - DOUBLE WATER METER & BOX
 - GATE VALVE W/ TYPE 'A' VALVE BOX
 - FIRE HYDRANT
 - SAS MANHOLE
 - WATER LINE W/ FITTING

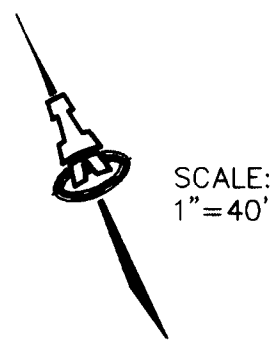

SCALE:
1"=40'

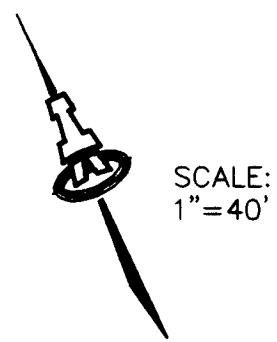

SCALE:
1"=40'

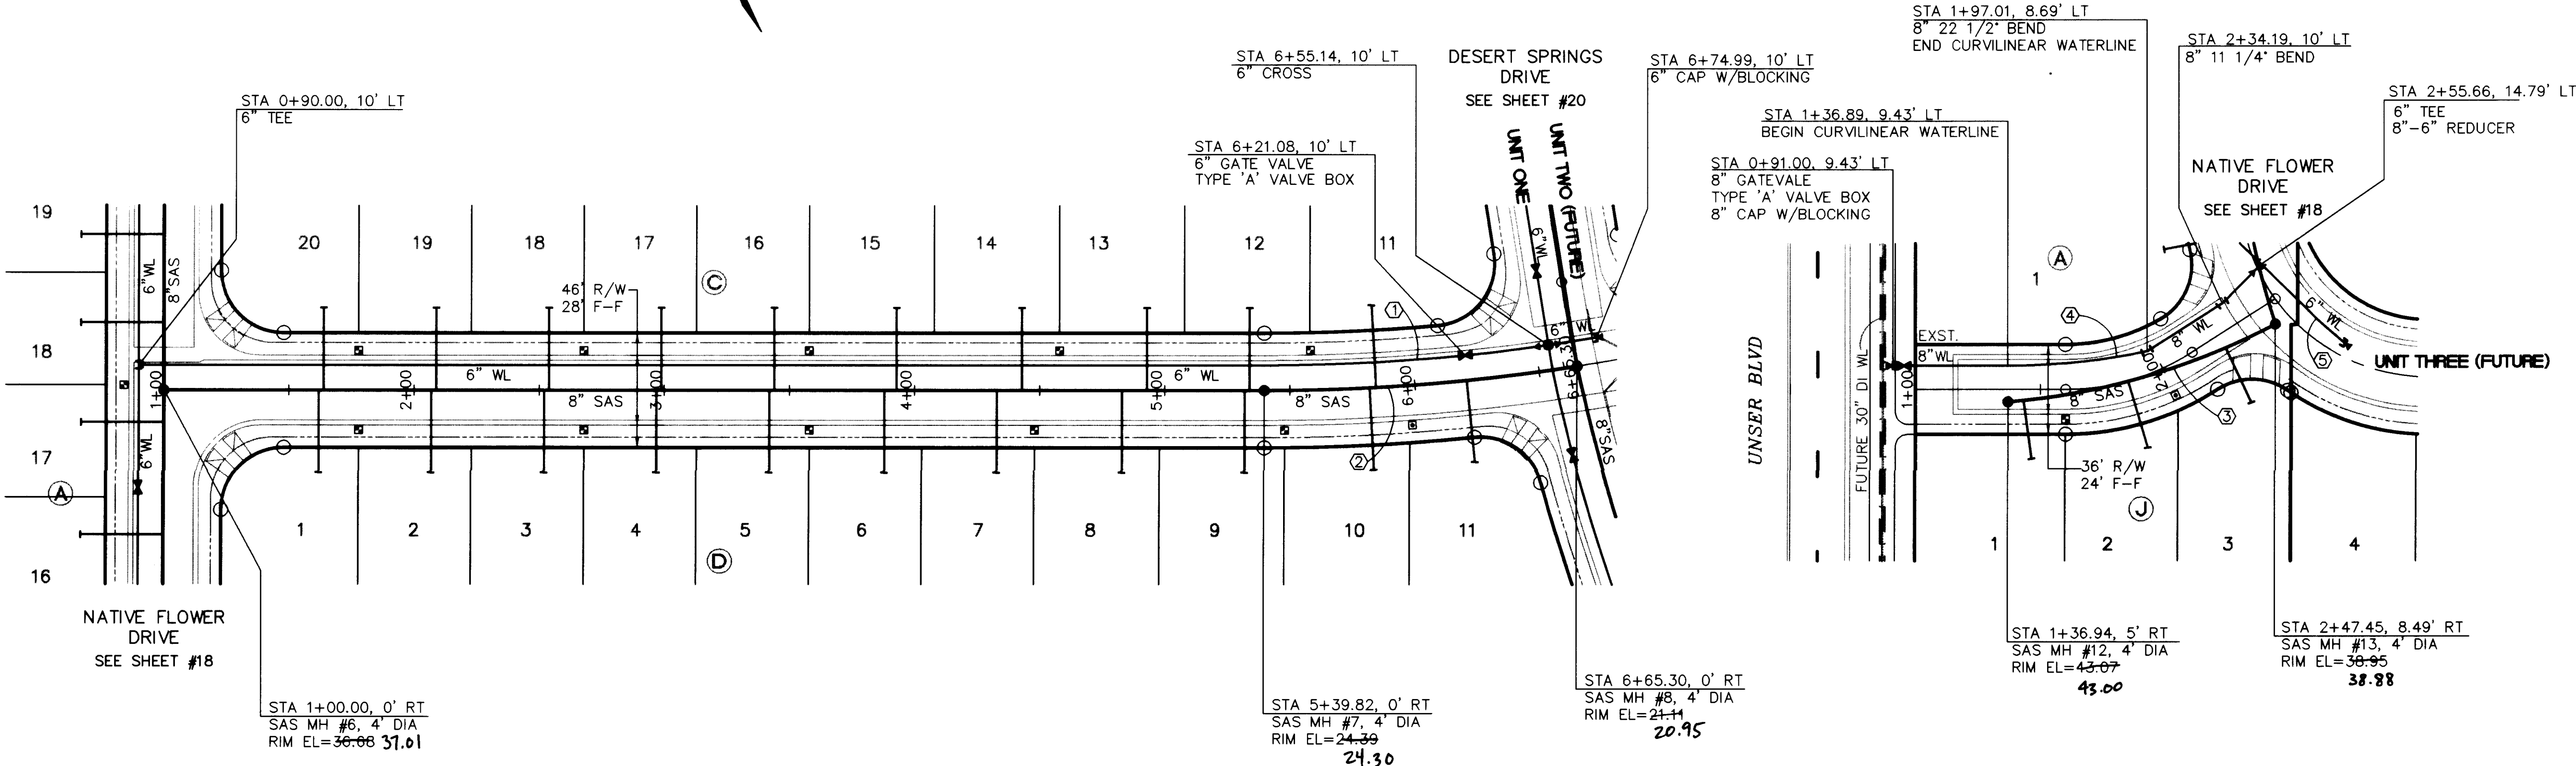

PURPLE CONE ROAD

SALTBRUSH PLACE

SCALES:
1"=40' HOR.
1"=10' VERT.

GENERAL NOTES

1. CONSTRUCT SAS SERVICES PER COA STD DWG #2125.
2. CONSTRUCT ALL SINGLE & DOUBLE WATER SERVICES PER COA STD DWG'S #2361, #2362, & #2363.
3. SEE SHEET #14 FOR WATER SHUT-OFF PLAN.
4. SEE SHEET #14 FOR RESTRAINED JOINT LENGTHS FOR WATER LINE FITTINGS.
5. CONSTRUCT FIRE HYDRANTS PER DESIGNATED DEPTHS & LENGTHS PER COA STD DWG #2340.

KEYED NOTES

1. INSTALL CURVILINEAR WATERLINE FROM STA 5+39.82 TO 6+55.14 AS FOLLOWS:
 $\Delta = 08'15''33''$
 $R = 790.00'$
 $L = 113.88'$
2. INSTALL CURVILINEAR SANITARY SEWER BETWEEN MH 7 & 8 AS FOLLOWS:
 $\Delta = 08'59''13''$
 $R = 800.00'$
 $L = 125.48'$
3. INSTALL CURVILINEAR SANITARY SEWER BETWEEN MH 12 & 13 AS FOLLOWS:
 $\Delta = 23'19''54''$
 $R = 275.00'$
 $L = 111.98'$
4. INSTALL CURVILINEAR WATERLINE FROM STA 1+36.89, 9.43' LT TO STA 1+97.01, 8.69' LT AS FOLLOWS:
 $\Delta = 11'57''10''$
 $R = 270.00'$
 $L = 56.33'$
5. INSTALL CURVILINEAR WATERLINE FROM STA 8+45.41, 7.00' LT TO STA 8+66.80, 5.07' RT AS FOLLOWS:
 $\Delta = 05'38''40''$
 $R = 200.00'$
 $L = 19.70'$

UTILITY SERVICE TABLE


BLOCK / LOT NO.	STATION		SAS INV @ END
	WATER, LENGTH	SAS, LENGTH	
C 11	5+58.54, 6'	5+84.34, 33'	18.2
C 12		5+34.00, 33'	19.5
C 13	4+58.00, 6'	4+93.00, 33'	20.6
C 14		4+43.00, 33'	21.9
C 15	3+58.00, 6'	3+93.00, 33'	23.2
C 16		3+44.00, 33'	24.5
C 17		2+99.00, 33'	25.7
C 18	2+68.00, 6'	2+54.00, 33'	26.9
C 19		2+09.00, 33'	28.1
C 20	1+78.00, 6'	1+64.00, 33'	29.5
D 1	1+78.00, 26'	1+62.00, 33'	29.6
D 2		2+07.00, 33'	28.2
D 3	2+68.00, 26'	2+52.00, 33'	27.0
D 4		2+97.00, 33'	25.8
D 5	3+58.00, 26'	3+42.00, 33'	24.6
D 6		3+88.00, 33'	23.4
D 7	4+48.00, 26'	4+33.00, 33'	22.2
D 8		4+83.00, 33'	20.9
D 9	5+47.77, 26'	5+32.00, 33'	19.6
D 10		5+81.81, 33'	18.2
D 11	5+96.42, 26' (S)	6+20.75, 33'	17.2
J 1	1+60.00, 21'	1+43.15, 24'	30.2
J 2	1+98.83, 21' (S)	1+85.17, 29'	28.8
J 3		2+26.01, 27'	27.7

ALL WATER SERVICES ARE DOUBLE EXCEPT WHERE NOTED AS (S) SINGLE.



ISAACSON & ARFMAN, P.A.
Consulting Engineering Associates
128 Monroe Street N.E.
Albuquerque New Mexico 87102
9300TL2.DWGems 10/28/97

CITY OF ALBUQUERQUE
PUBLIC WORKS DEPARTMENT
ENGINEERING GROUP

TITLE: **DESERT FLOWER SUBDIVISION--UNIT ONE**
PURPLE CONE RD & SALTBRUSH PLACE
UTILITY PLAN & PROFILE

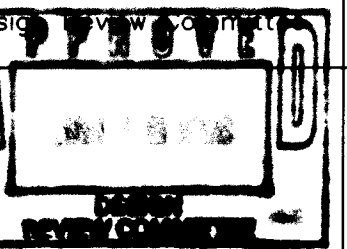

City Engineer Approval	Mo./Day/Yr.	Mo./Day/Yr.
Last Design Update		

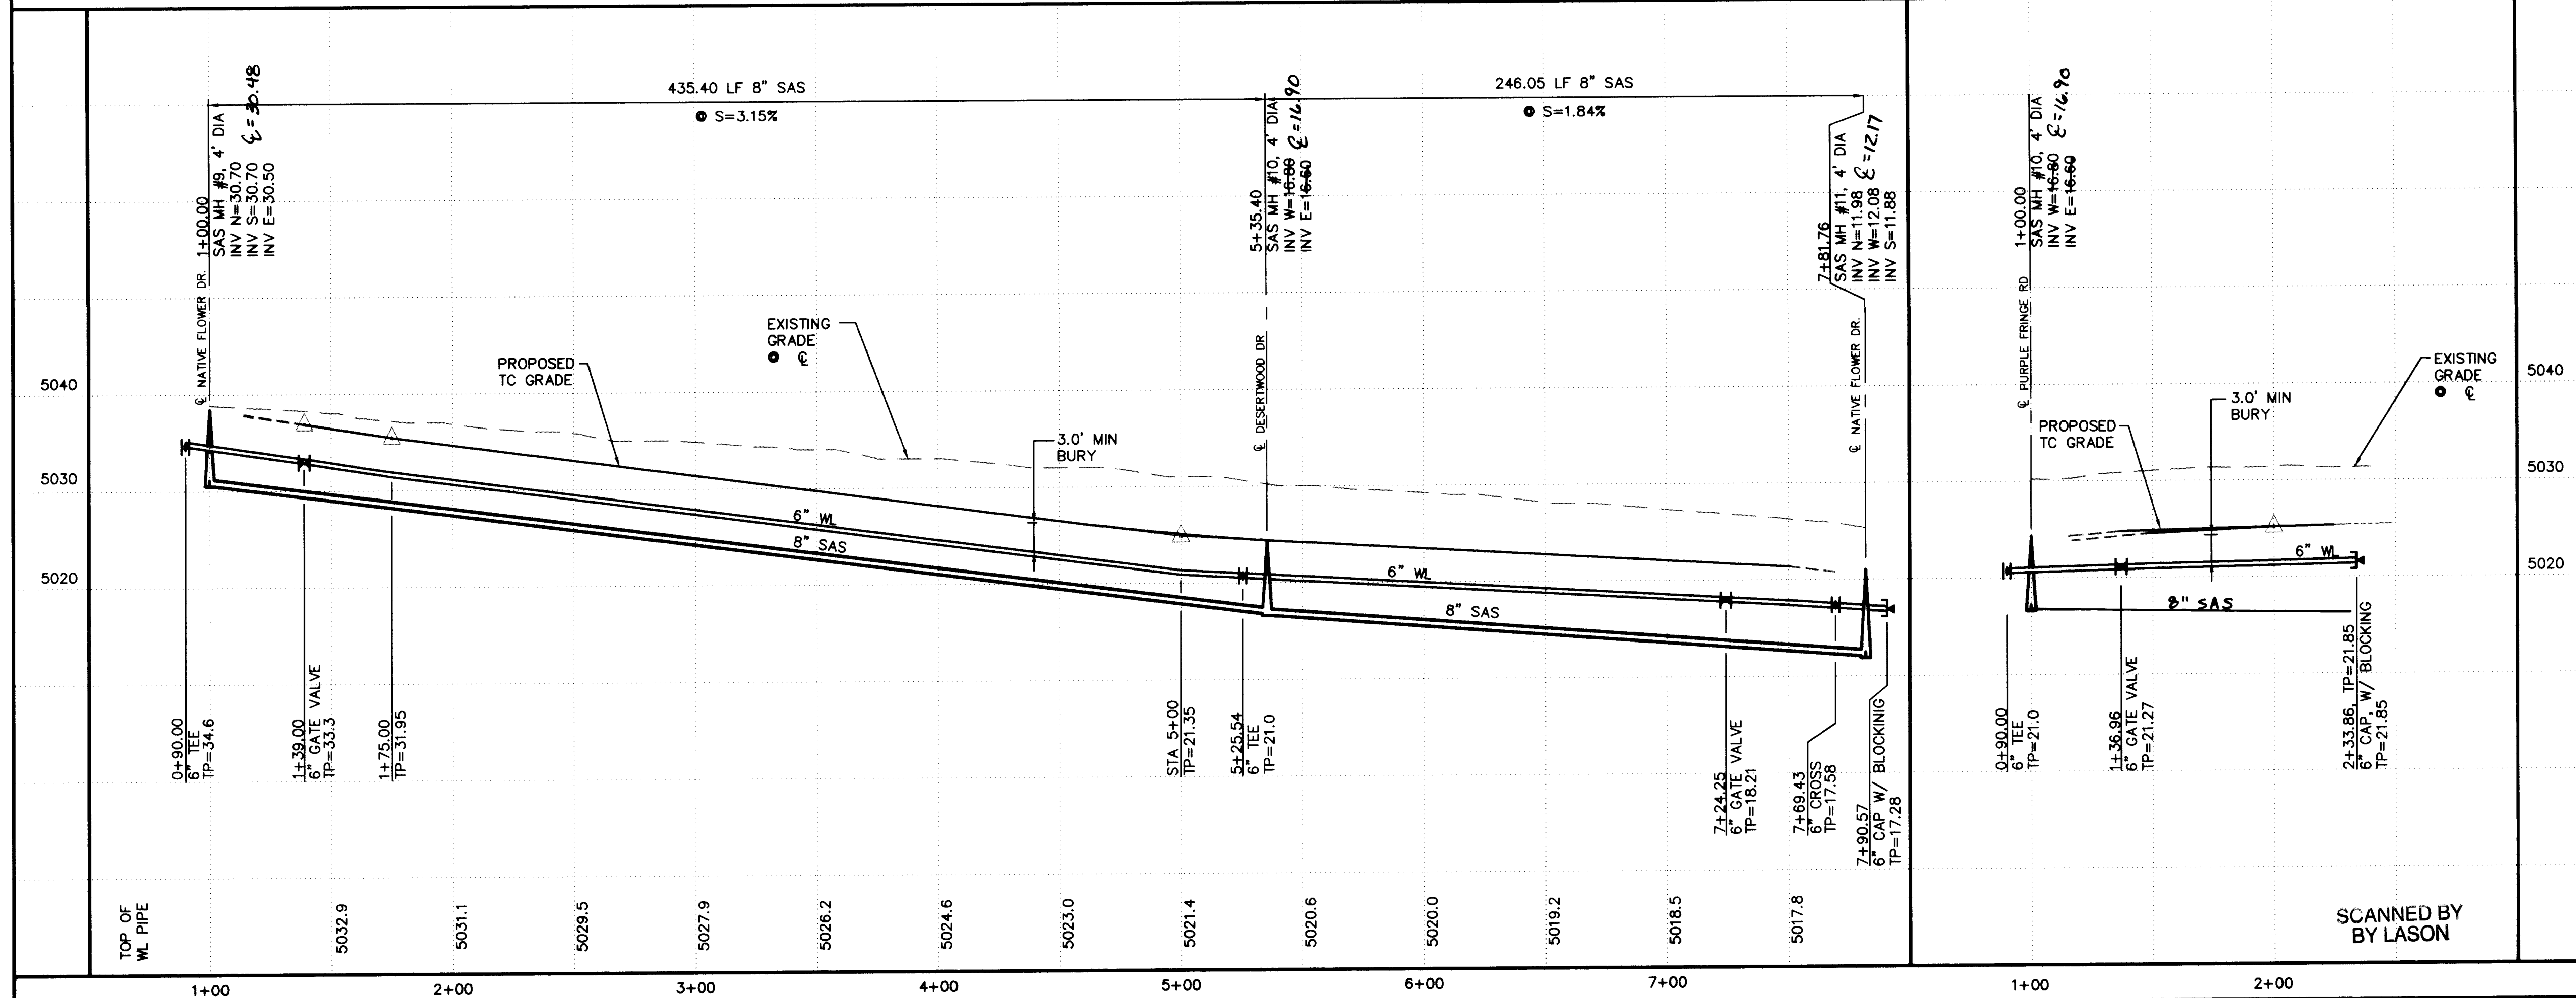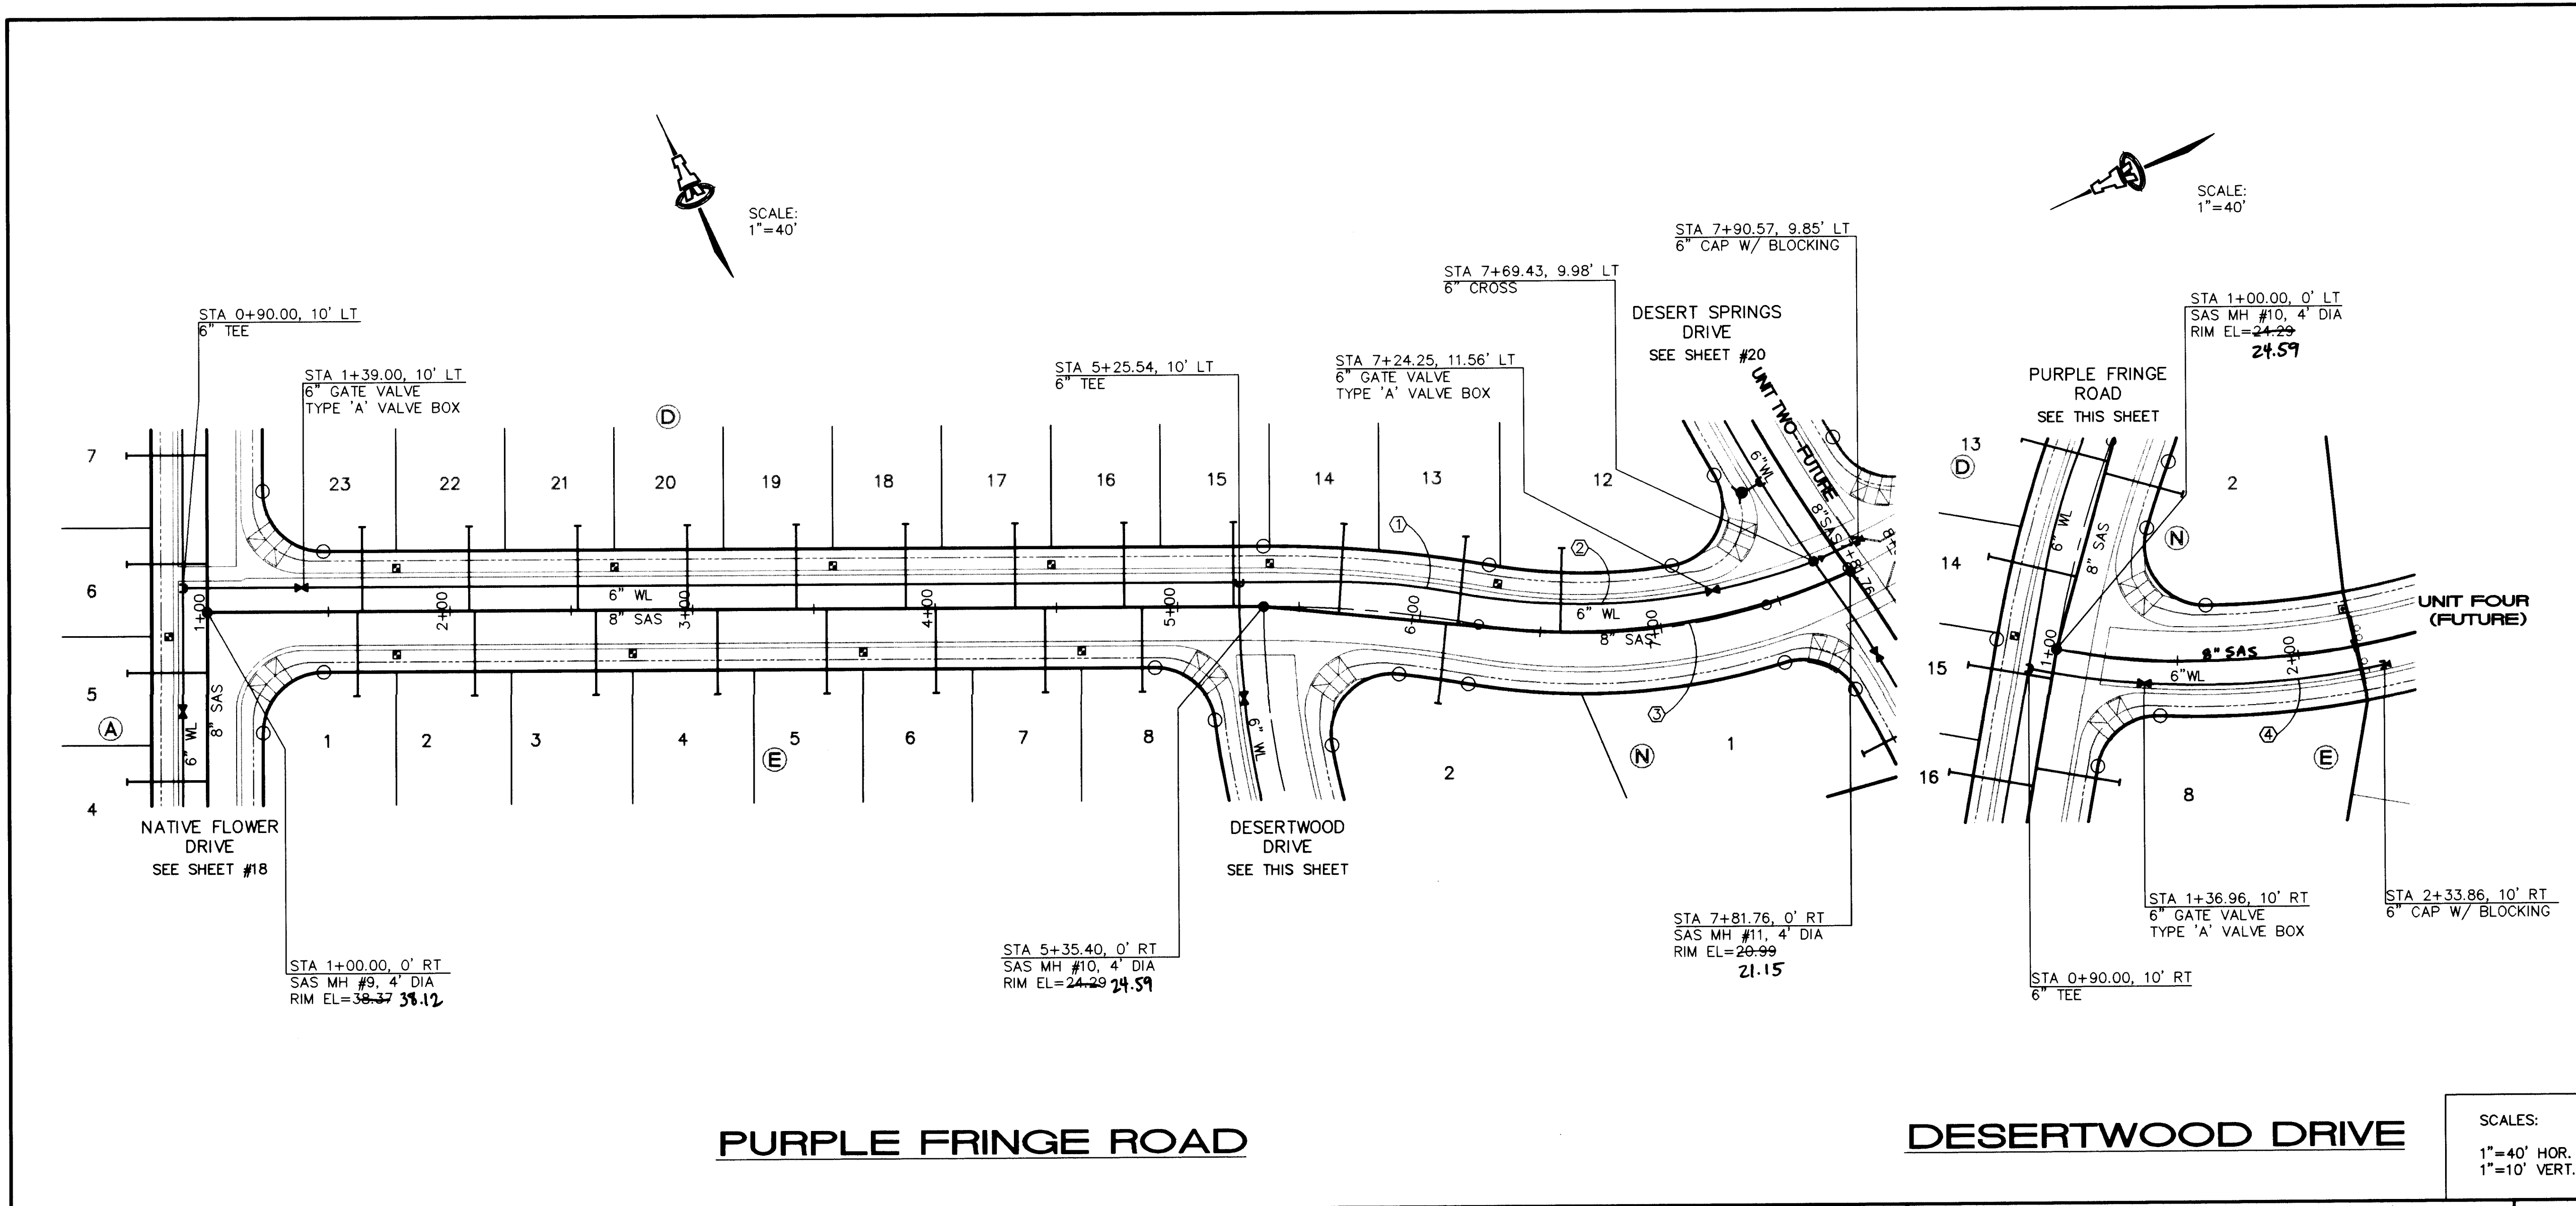

GENERAL NOTES

- CONSTRUCT SAS SERVICES PER COA STD DWG #2125.
- CONSTRUCT ALL SINGLE & DOUBLE WATER SERVICES PER COA STD DWG'S #2361, #2362, & #2363.
- SEE SHEET #14 FOR WATER SHUT-OFF PLAN.
- SEE SHEET #14 FOR RESTRAINED JOINT LENGTHS FOR WATER LINE FITTINGS.
- CONSTRUCT FIRE HYDRANTS PER DESIGNATED DEPTHS & LENGTHS PER COA STD DWG #2340.

KEYED NOTES

- INSTALL CURVILINEAR WATERLINE FROM STA 5+62.94, 10.77' LT TO 6+13.76, 11.36' LT AS FOLLOWS:
 $\Delta = 10^{\circ}50'09"$
 $R = 275.00'$
 $L = 52.01'$
- INSTALL CURVILINEAR WATERLINE FROM STA 6+13.76, 11.36' LT TO 7+69.43, 9.98' LT AS FOLLOWS:
 $\Delta = 31^{\circ}05'49"$
 $R = 275.00'$
 $L = 149.25'$
- INSTALL CURVILINEAR SANITARY SEWER FROM STA 6+37.33 TO 7+81.76 AS FOLLOWS:
 $\Delta = 30^{\circ}01'41"$
 $R = 275.00'$
 $L = 144.12'$
- INSTALL CURVILINEAR WATERLINE FROM STA 0+90.00, 10' RT TO 2+33.86, 10' RT AS FOLLOWS:
 $\Delta = 23^{\circ}30'19"$
 $R = 360.00'$
 $L = 147.69'$

BLOCK/ LOT NO.	STATION		SAS INV @ END
	WATER, LENGTH	SAS, LENGTH	
D 12	6+29.62, 8'	6+58.11, 35'	17.6
D 13	6+15.97, 37'	6+15.97, 37'	18.2
D 14	5+37.88, 8'	5+66.40, 35'	18.9
D 15	5+23.00, 35'	5+23.00, 35'	19.6
D 16	4+48.00, 8'	4+78.00, 35'	20.6
D 17	4+33.00, 35'	4+33.00, 35'	22.0
D 18	3+58.00, 8'	3+88.00, 35'	23.5
D 19	3+43.00, 35'	3+43.00, 35'	25.0
D 20	2+98.00, 35'	2+98.00, 35'	26.4
D 21	2+53.00, 35'	2+53.00, 35'	27.9
D 22	2+08.00, 35'	2+08.00, 35'	29.3
D 23	1+78.00, 8'	1+64.00, 35'	30.9
E 1	1+62.00, 35'	1+62.00, 35'	30.9
E 2	1+78.00, 28'	2+10.35, 35'	29.3
E 3	2+60.35, 35'	2+60.35, 35'	27.7
E 4	2+75.35, 28'	3+10.35, 35'	26.0
E 5	3+55.35, 35'	3+55.35, 35'	24.6
E 6	4+00.35, 35'	4+00.35, 35'	23.1
E 7	4+45.35, 35'	4+45.35, 35'	21.6
E 8	4+60.35, 28'	4+85.35, 35'	20.4
N 2	2+22.80, 26' (S)	6+11.04, 35'	20.3

LEGEND

- SINGLE WATER METER & BOX
- DOUBLE WATER METER & BOX
- GATE VALVE W/ TYPE 'A' VALVE
- FIRE HYDRANT
- SAS MANHOLE
- WATER LINE W/ FITTING

ISAACSON & ARFMAN, P.A.

Consulting Engineering Associates
128 Monroe Street N.E.
Albuquerque, New Mexico
930UTL3.DWG Date 10/28/97

CITY OF ALBUQUERQUE

PUBLIC WORKS DEPARTMENT
ENGINEERING GROUP

TITLE: DESERT FLOWER SUBDIVISION--UNIT ONE

PURPLE FRINGE RD & DESERTWOOD DR
UTILITY PLAN & PROFILE

City Project No. **5739.81**

Zone Map No. **M-10**

Sheet **17** Of **24**

DESIGNED BY JMN DATE 9/97

DRAWN BY ANW DATE 9/97

CHECKED BY FCA DATE 9/97

REVISIONS

NO. DATE

REMARKS



BY

DATE


DESIGNED BY JMN DATE 9/97

DRAWN BY ANW DATE 9/97

CHECKED BY FCA DATE 9/97

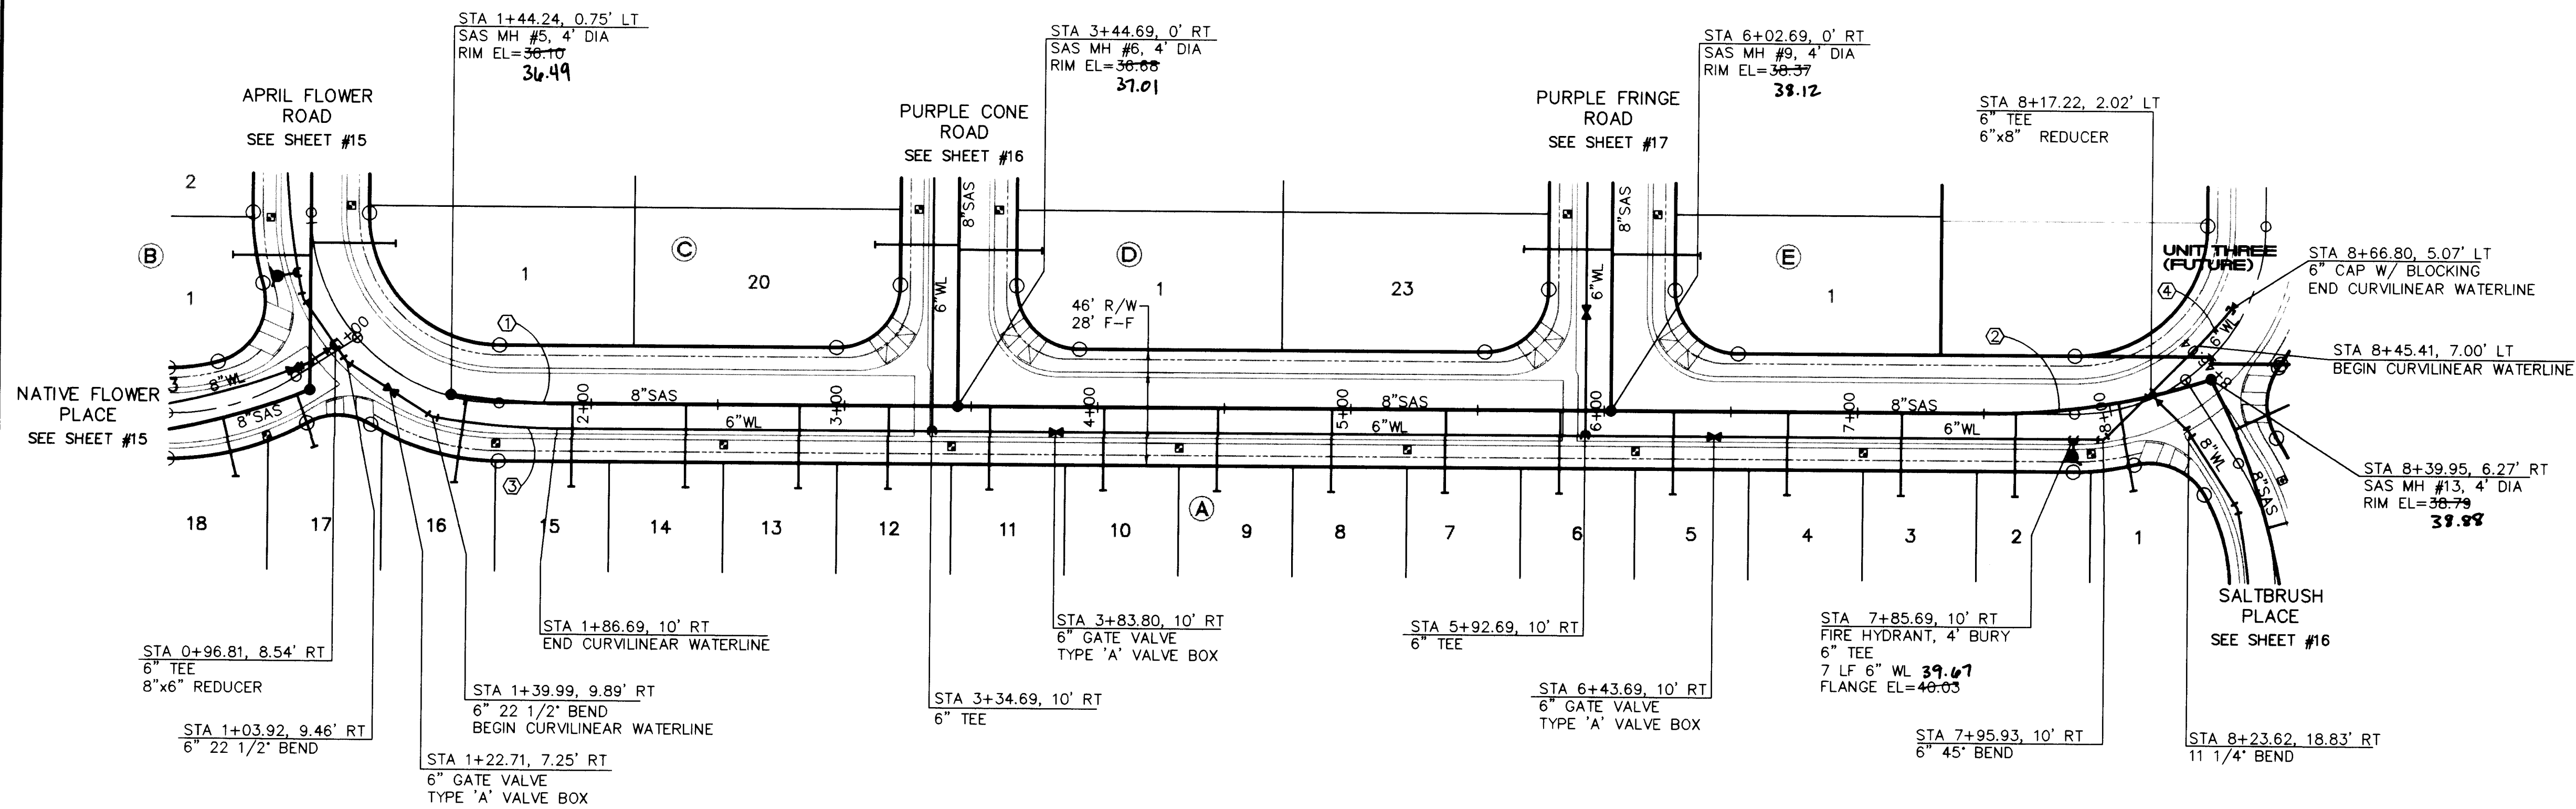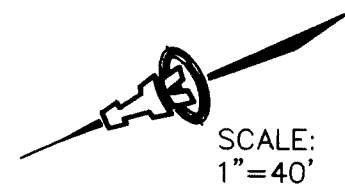

NATIVE FLOWER DRIVE

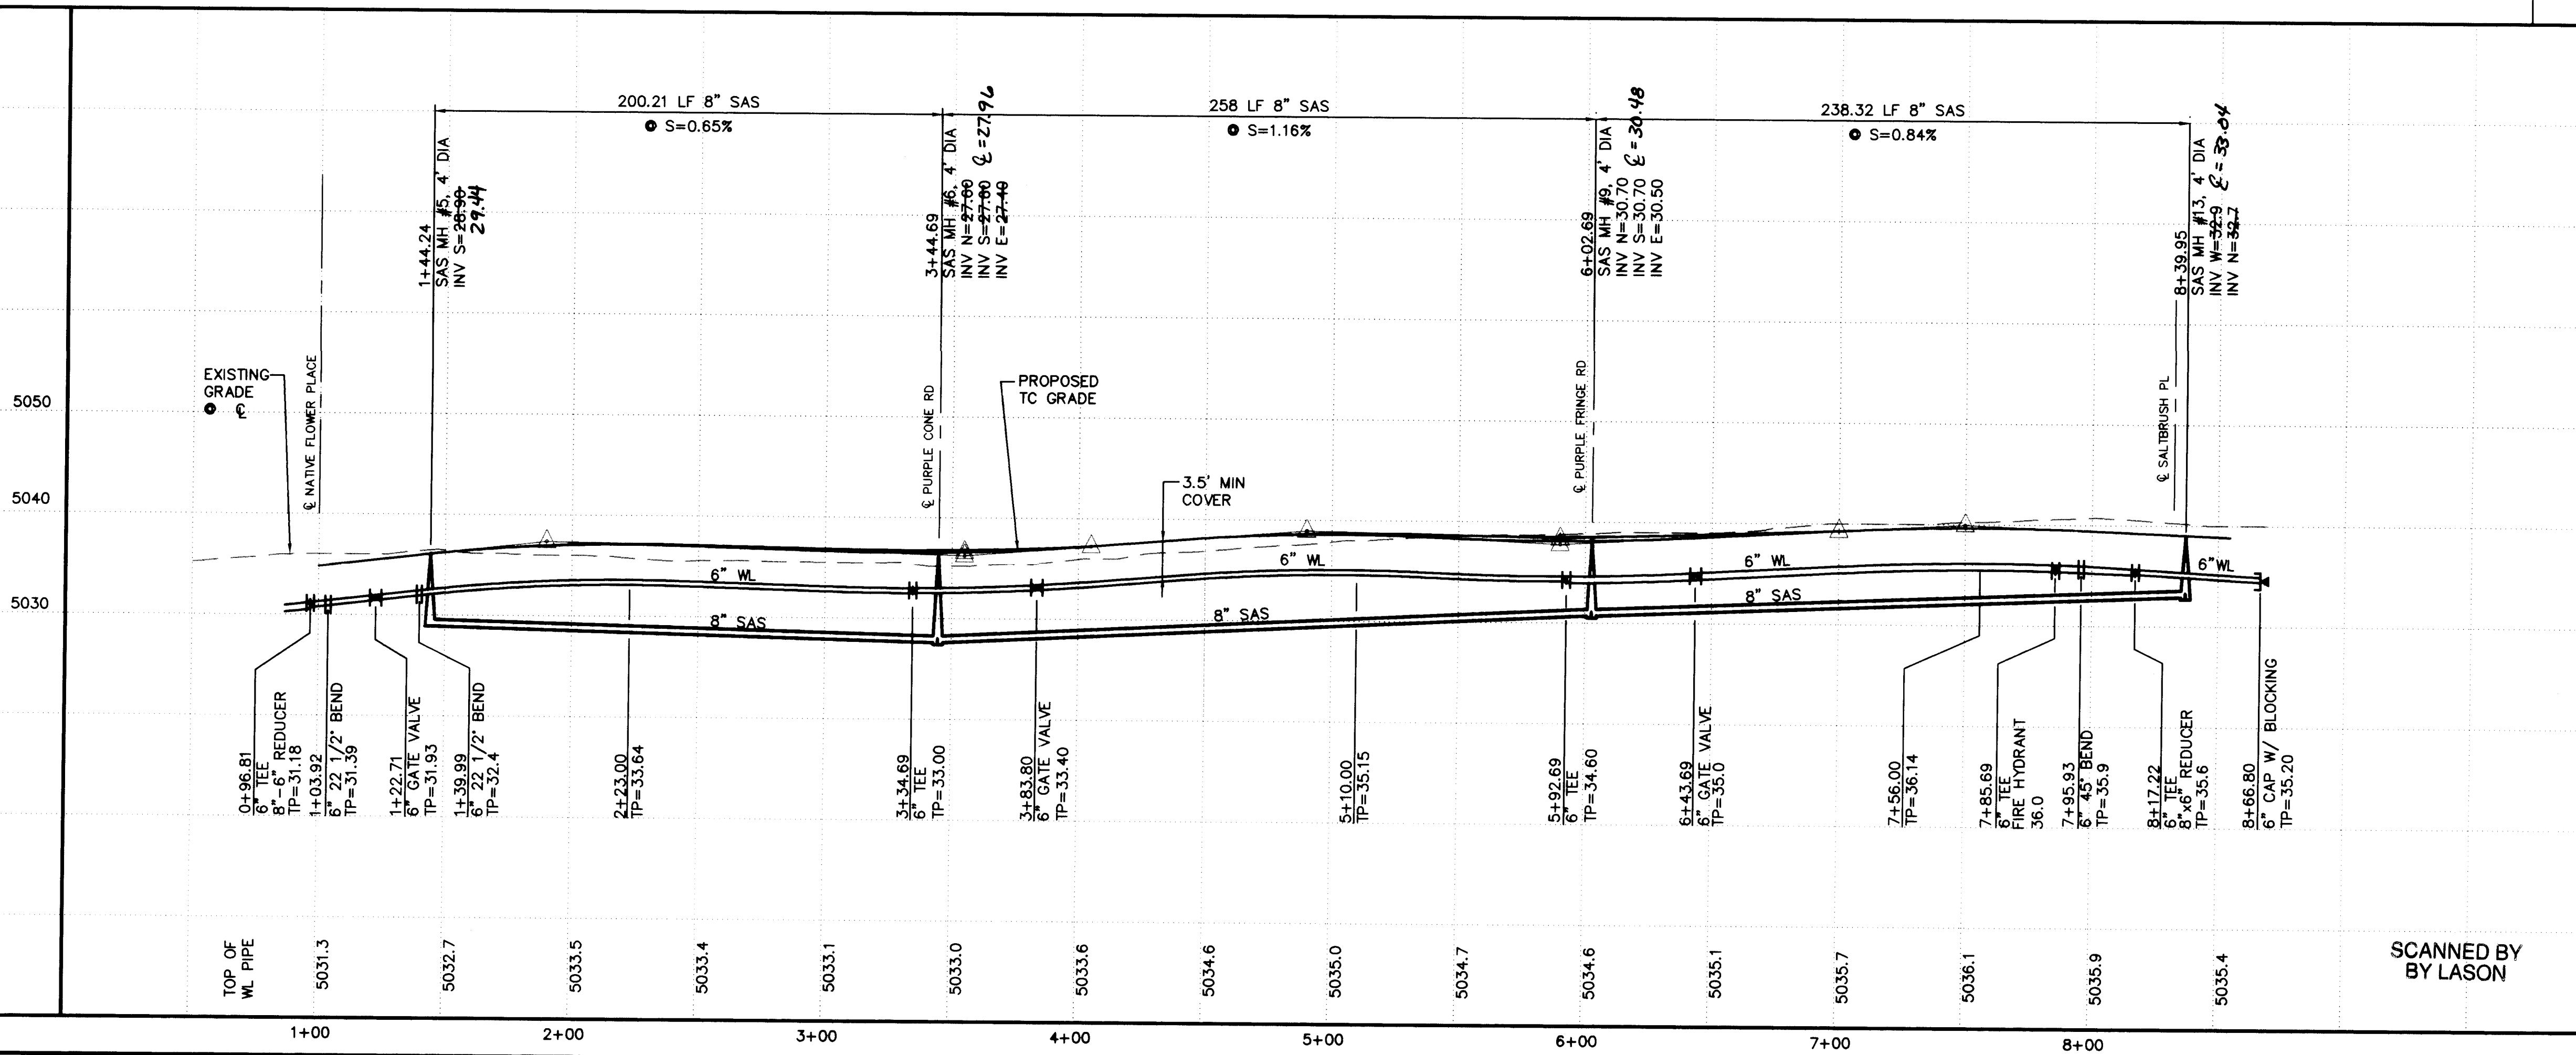

GENERAL NOTES

1. CONSTRUCT SAS SERVICES PER COA STD DWG #2125.
2. CONSTRUCT ALL SINGLE & DOUBLE WATER SERVICES PER COA STD DWG'S #2361, #2362, & #2363.
3. SEE SHEET #14 FOR WATER SHUT-OFF PLAN.
4. SEE SHEET #14 FOR RESTRAINED JOINT LENGTHS FOR WATER LINE FITTINGS.
5. CONSTRUCT FIRE HYDRANTS PER DESIGNATED DEPTHS & LENGTHS PER COA STD DWG #2340.

KEYED NOTES

1. INSTALL CURVILINEAR SANITARY SEWER FROM STA 1+44.24, 0.75' LT TO 1+86.69, 0' LT AS FOLLOWS:
Δ = 08'47'37"
R = 275.00'
L = 42.21'
2. INSTALL CURVILINEAR SANITARY SEWER FROM STA 7+52.60, 0' RT TO 8+39.95, 6.27' RT AS FOLLOWS:
Δ = 18'25'09"
R = 275.00'
L = 88.41'
3. INSTALL CURVILINEAR WATERLINE FROM STA 1+39.99, 9.89' RT TO 1+86.69, 10' RT AS FOLLOWS:
Δ = 09'58'40"
R = 285.00'
L = 49.63'
4. INSTALL CURVILINEAR WATERLINE FROM STA 8+45.41, 7.00' LT TO 8+66.80, 5.07' RT AS FOLLOWS:
Δ = 05'38'40"
R = 200.00'
L = 19.70'

UTILITY SERVICE TABLE

BLOCK / LOT NO.	STATION		SAS INV @ END
	WATER, LENGTH	SAS, LENGTH	
A 1	7+91.05, 7'	8+02.67, 35'	34.4
A 2		7+62.69, 33'	34.6
A 3	7+02.69, 6'	7+17.69, 33'	34.4
A 4		6+72.69, 33'	39.0
A 5	6+12.69, 6'	6+27.69, 33'	33.7
A 6		5+82.69, 33'	33.5
A 7	5+22.69, 6'	5+37.69, 33'	33.6
A 8		4+92.69, 33'	33.6
A 9	4+32.69, 6'	4+47.69, 33'	33.1
A 10		4+02.69, 33'	32.2
A 11	3+42.69, 6'	3+57.69, 33'	31.8
A 12		3+17.69, 33'	31.8
A 13	2+52.69, 6'	2+82.36, 33'	31.9
A 14		2+37.64, 33'	32.1
A 15	1+62.93, 6'	1+92.69, 33'	32.0
A 16		1+51.39, 34'	31.2

ALL WATER SERVICES ARE DOUBLE EXCEPT WHERE NOTED AS (S) SINGLE.

LEGEND

- SINGLE WATER METER & BOX
- DOUBLE WATER METER & BOX
- GATE VALVE W/ TYPE 'A' VALVE BOX
- FIRE HYDRANT
- SAS MANHOLE
- WATER LINE W/ FITTING


ISAACSON & ARFMAN, P.A.
Consulting Engineering Associates
128 Monroe Street N.E.
Albuquerque New Mexico 87102
930UTLS.DWGens 10/27/97

CITY OF ALBUQUERQUE
PUBLIC WORKS DEPARTMENT
ENGINEERING GROUP


TITLE: **DESERT FLOWER SUBDIVISION--UNIT ONE
NATIVE FLOWER DR
UTILITY PLAN & PROFILE**

DESIGN REVIEW COMMITTEE	City Engineer Approval	Mo./Day/Yr.	Mo./Day/Yr.
REVISIONS	NO. DATE	REMARKS	BY
DESIGN	1 9/97		
DESIGNED BY	JUN	DATE	9/97
DRAWN BY	ANW	DATE	9/97
CHECKED BY	FCA	DATE	9/97


SCANNED BY
BY LASON

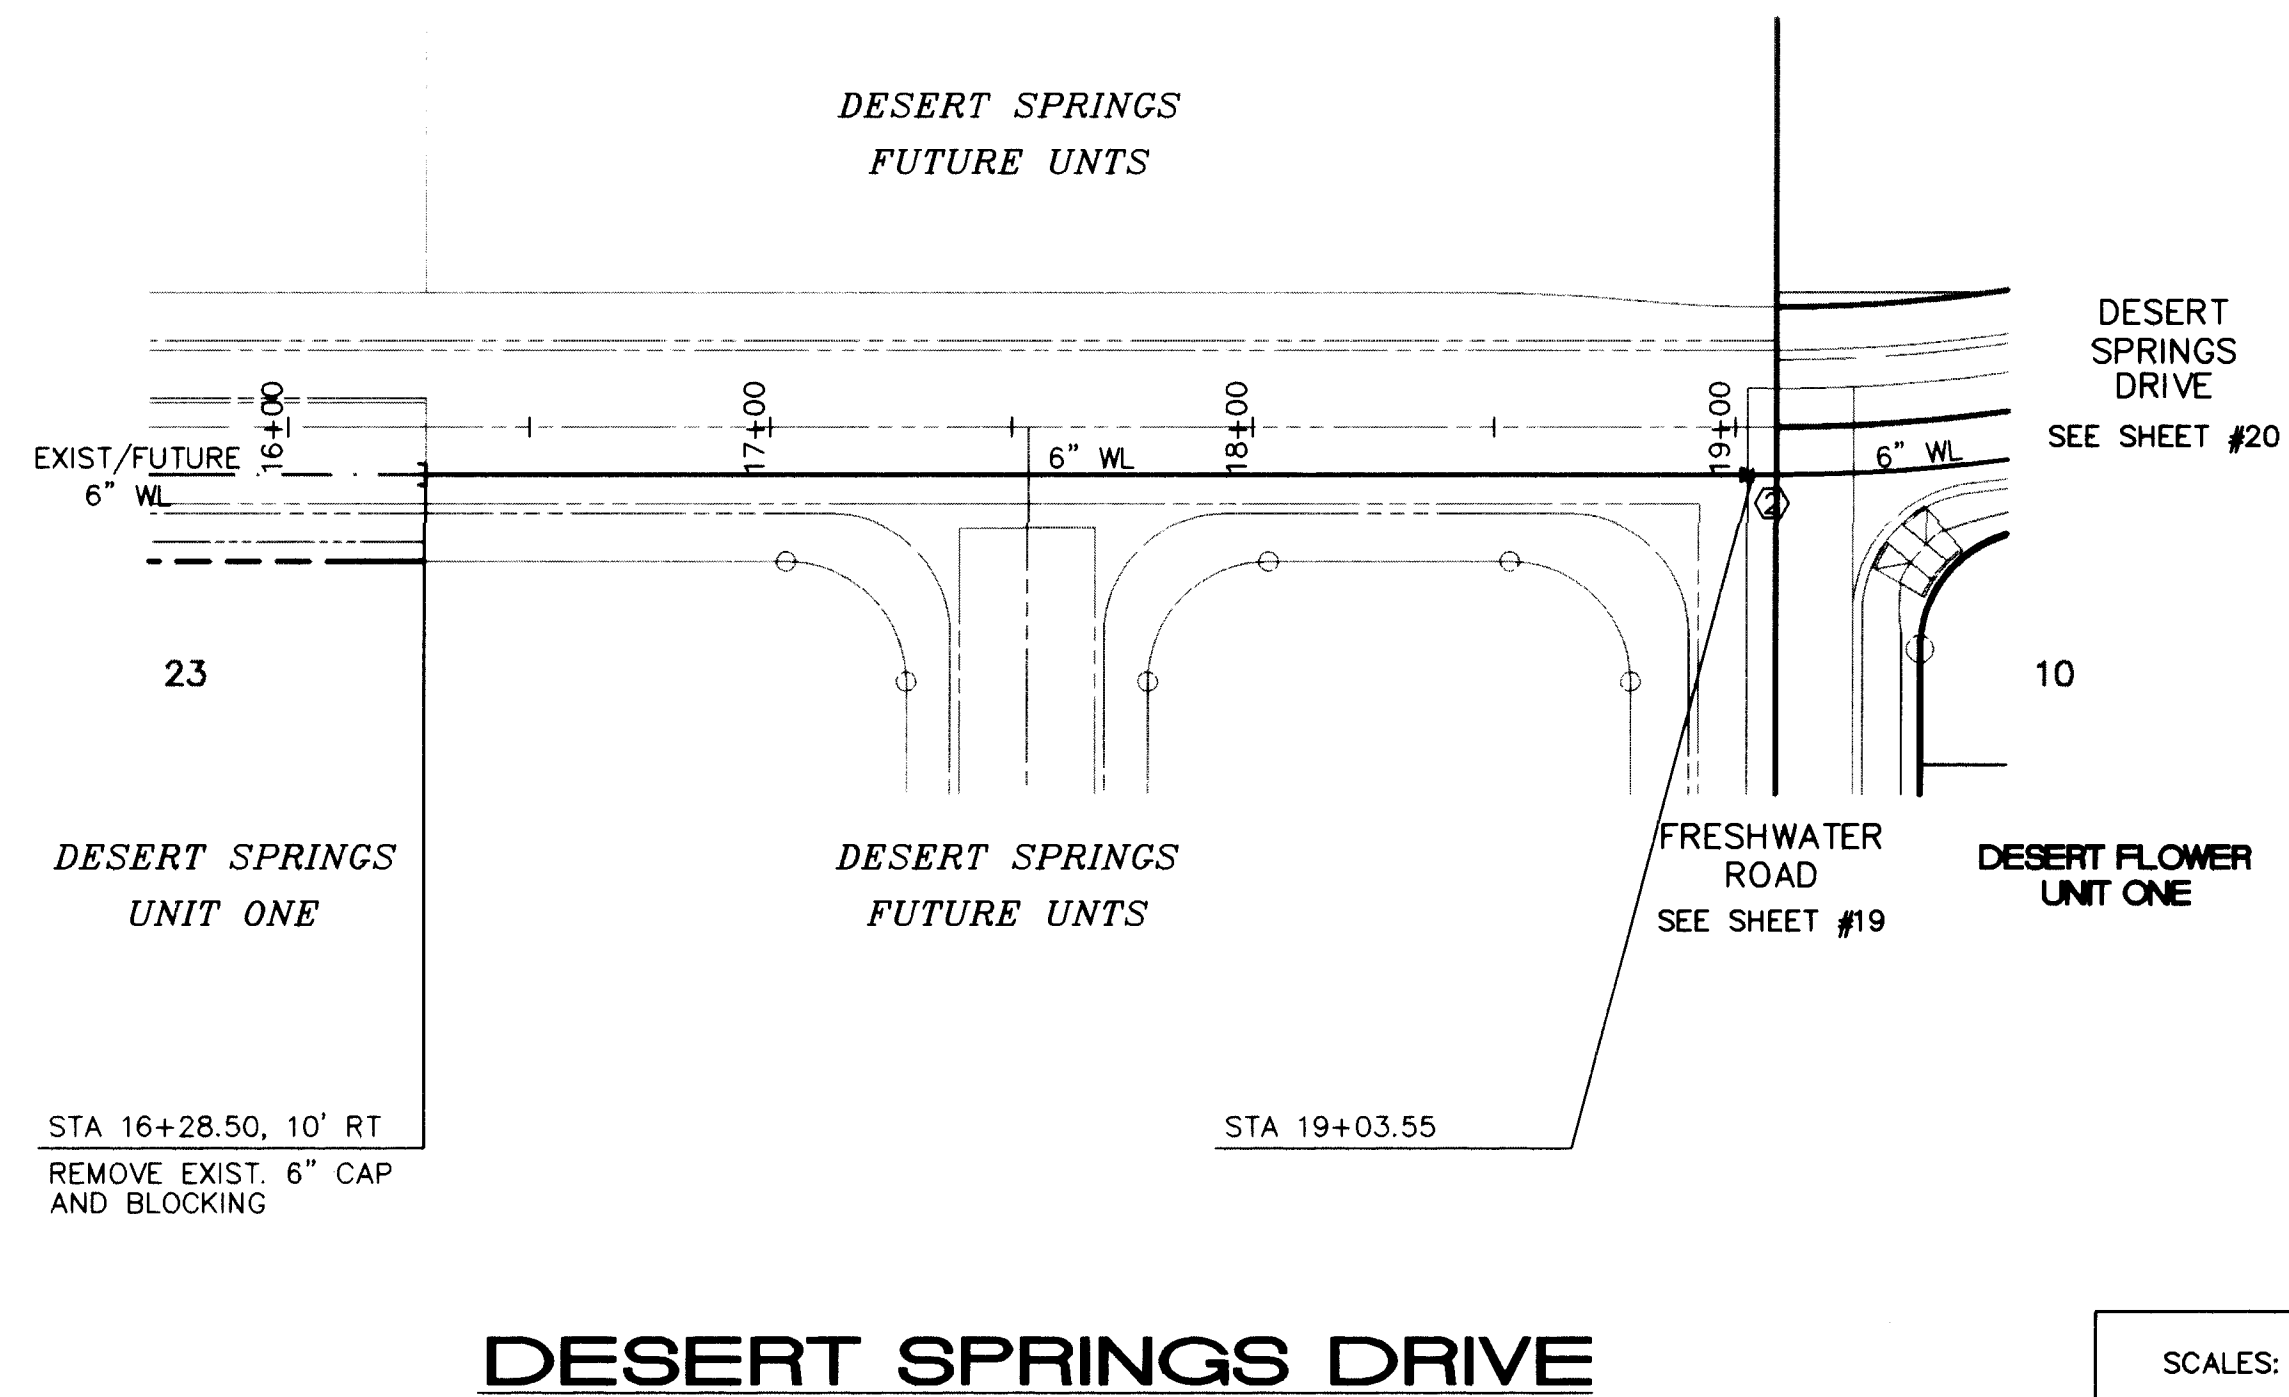

1. STA 33+73.46, 0' RT
4' MH TEMPORARY PRV.
SEE DETAIL THIS SHEET.
2. IF TEMPORARY CONNECTION DOES NOT NEED
TO BE INSTALLED, PLACE A 6" CAP WITH
BLOCKING AT STA 19+03.55.
3. IF THE TEMPORARY CONNECTION TO ZONE
2WR WATER MUST BE MADE AND DESERT
FLOWER PROCEEDS DESERT SPRINGS
IN DEVELOPMENT, THEN PROVIDE THE
CONNECTION FROM STA 33+89.87, 0' RT
TO STA 32+46.36, 18' RT.

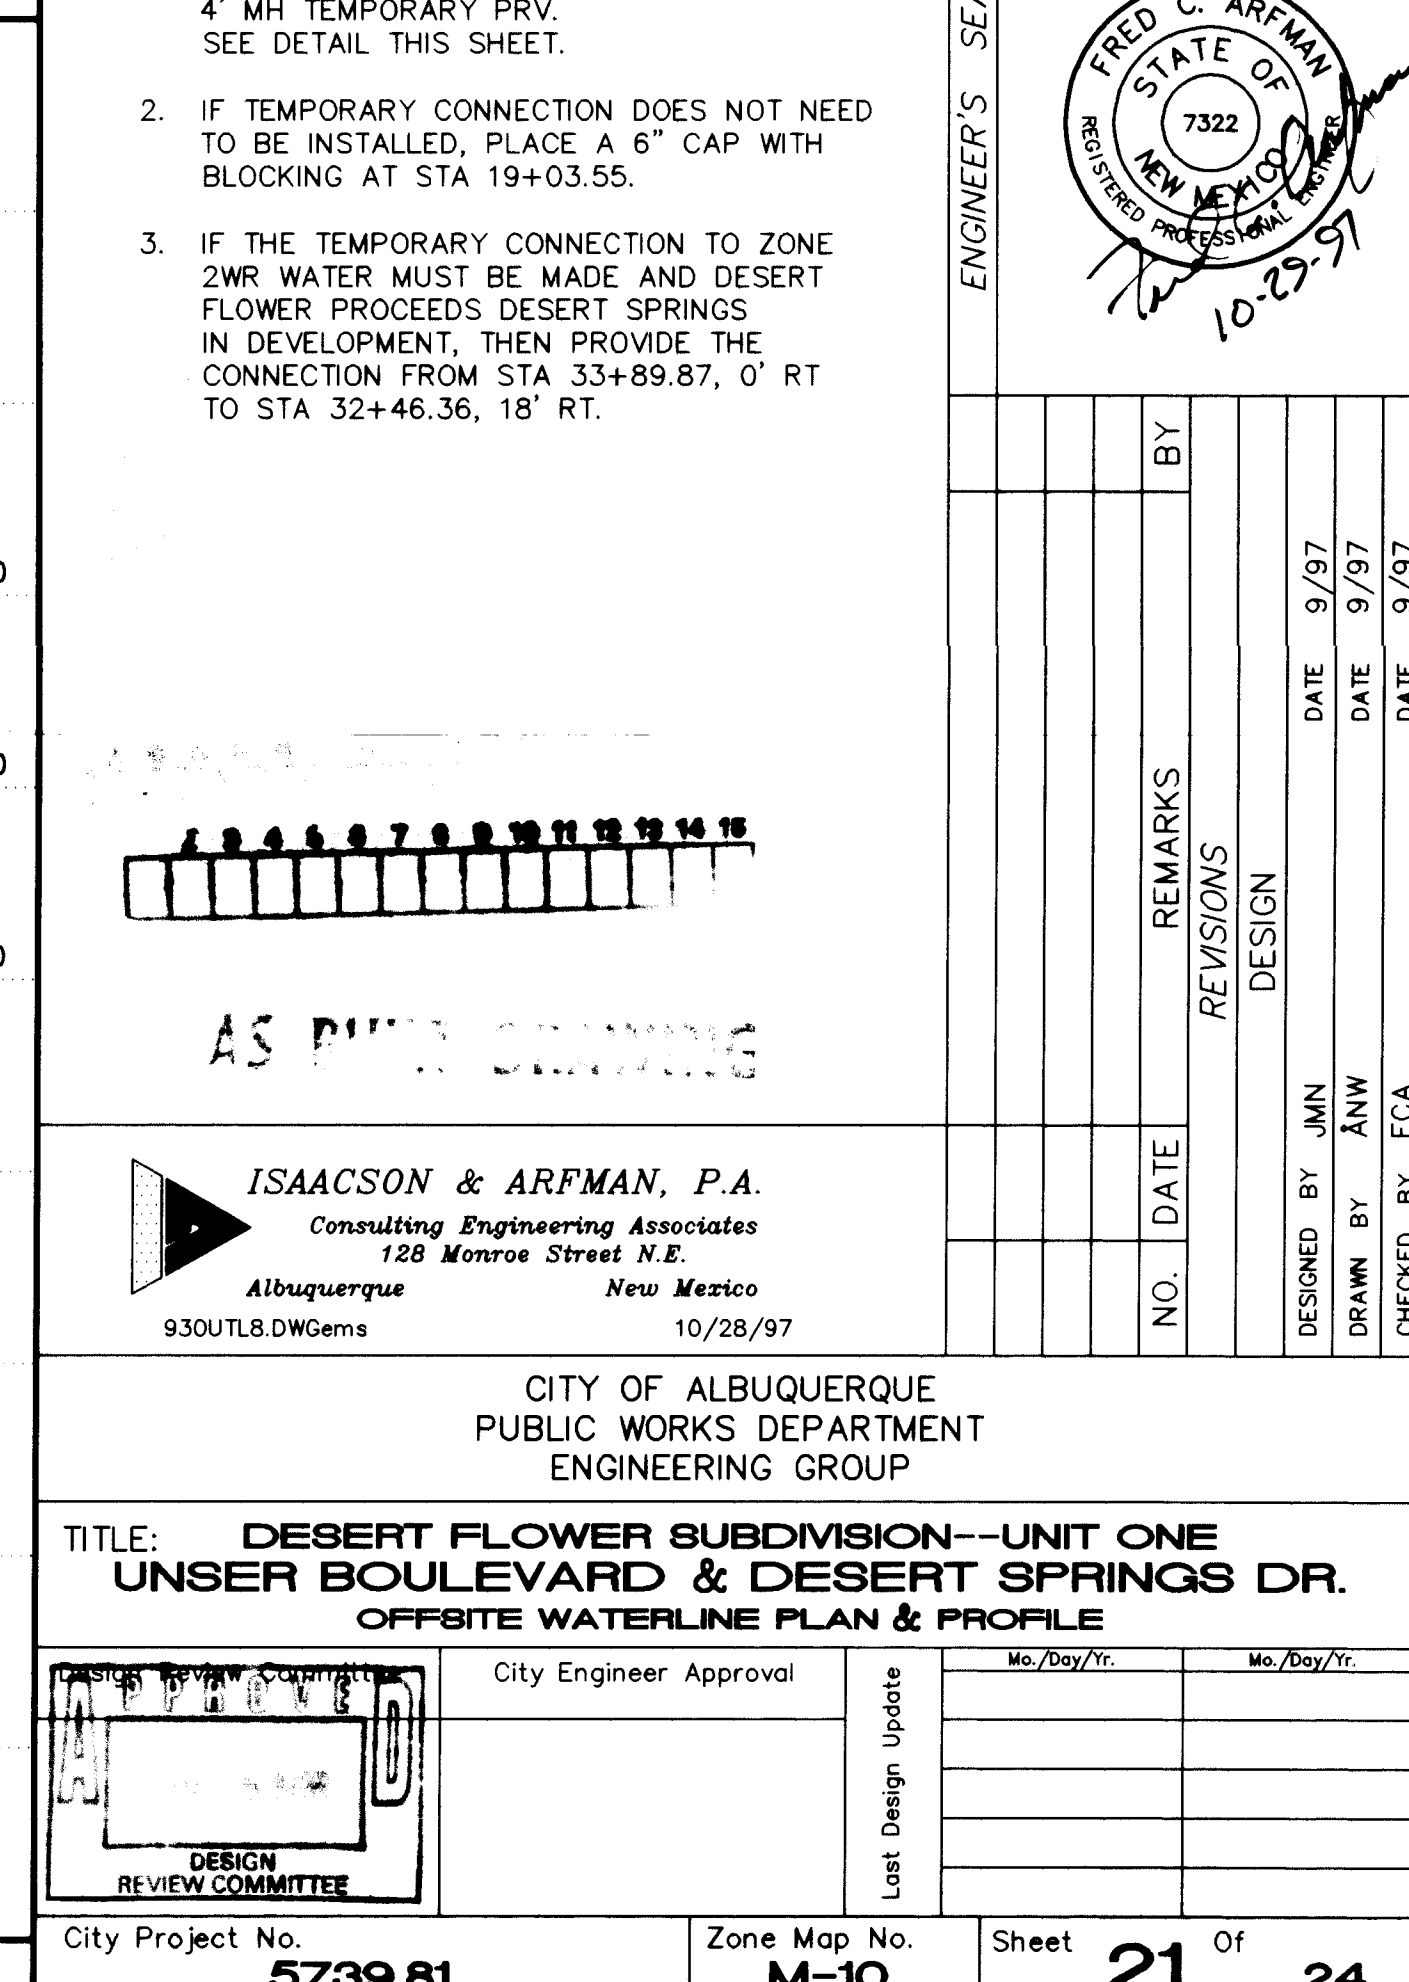


SCANNED BY
BY LASON

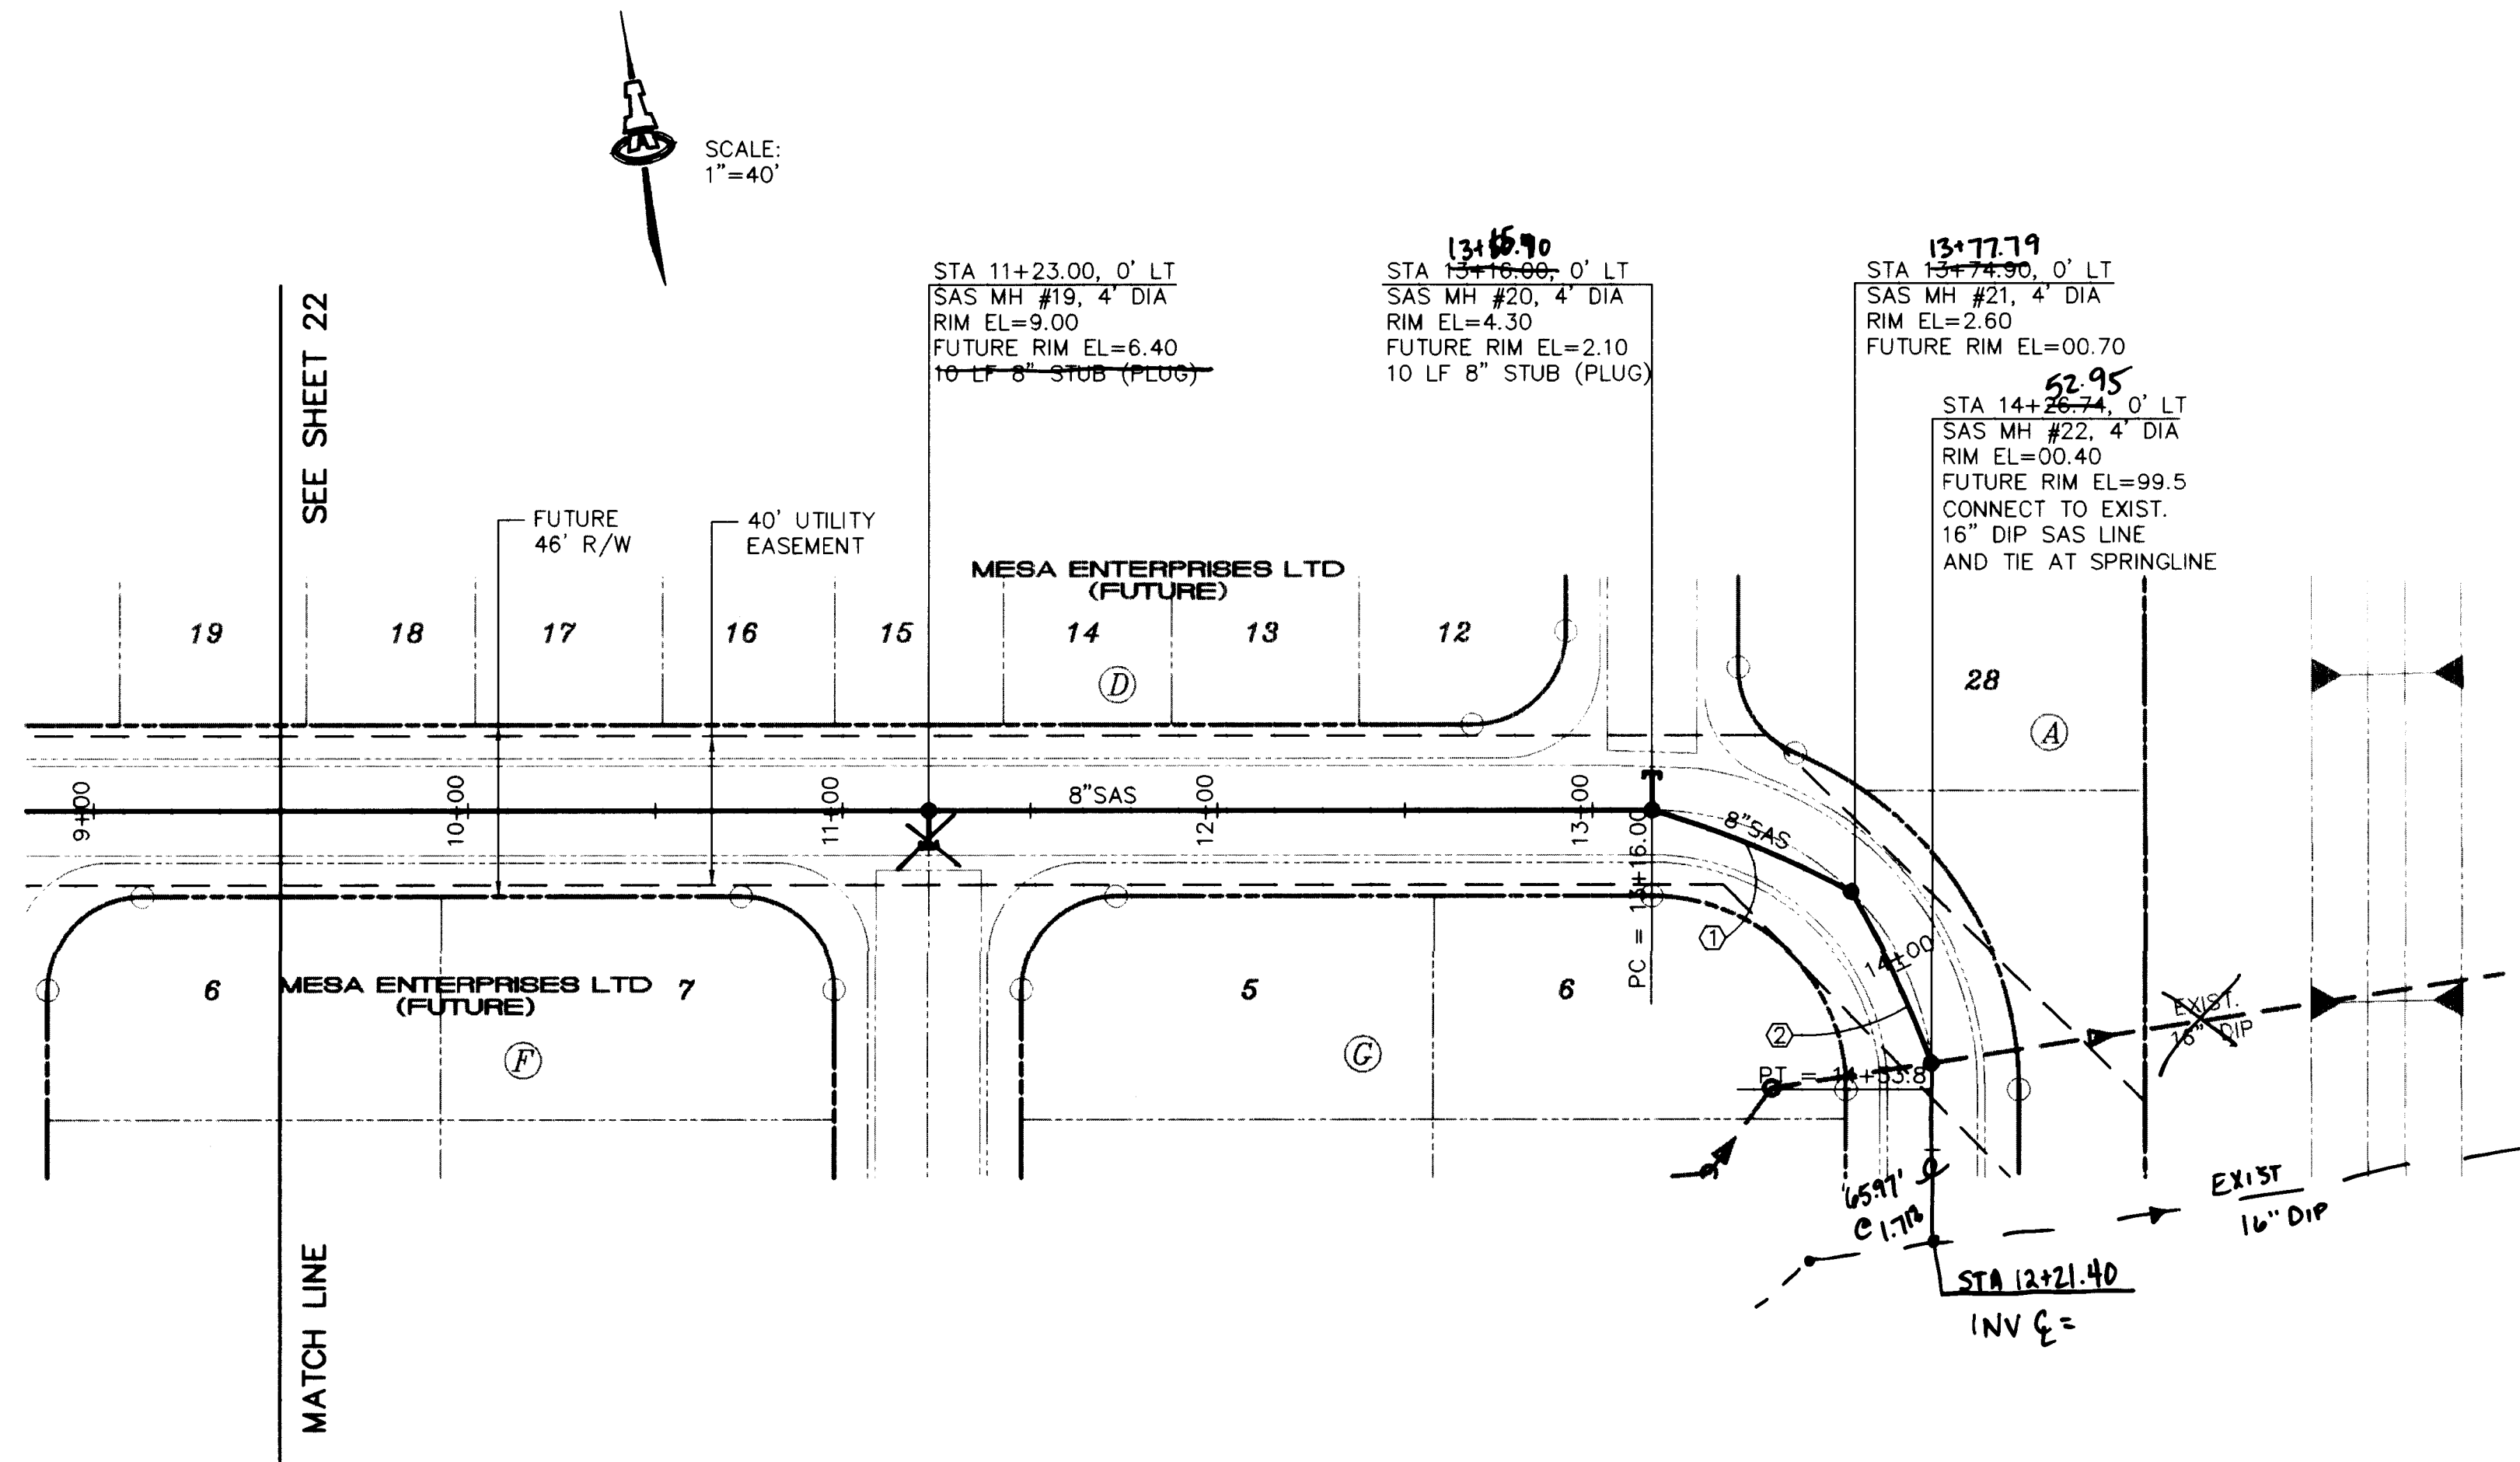

OFFSITE SANITARY SEWER

SCALES:
1"=40' HOR.
1"=10' VERT.

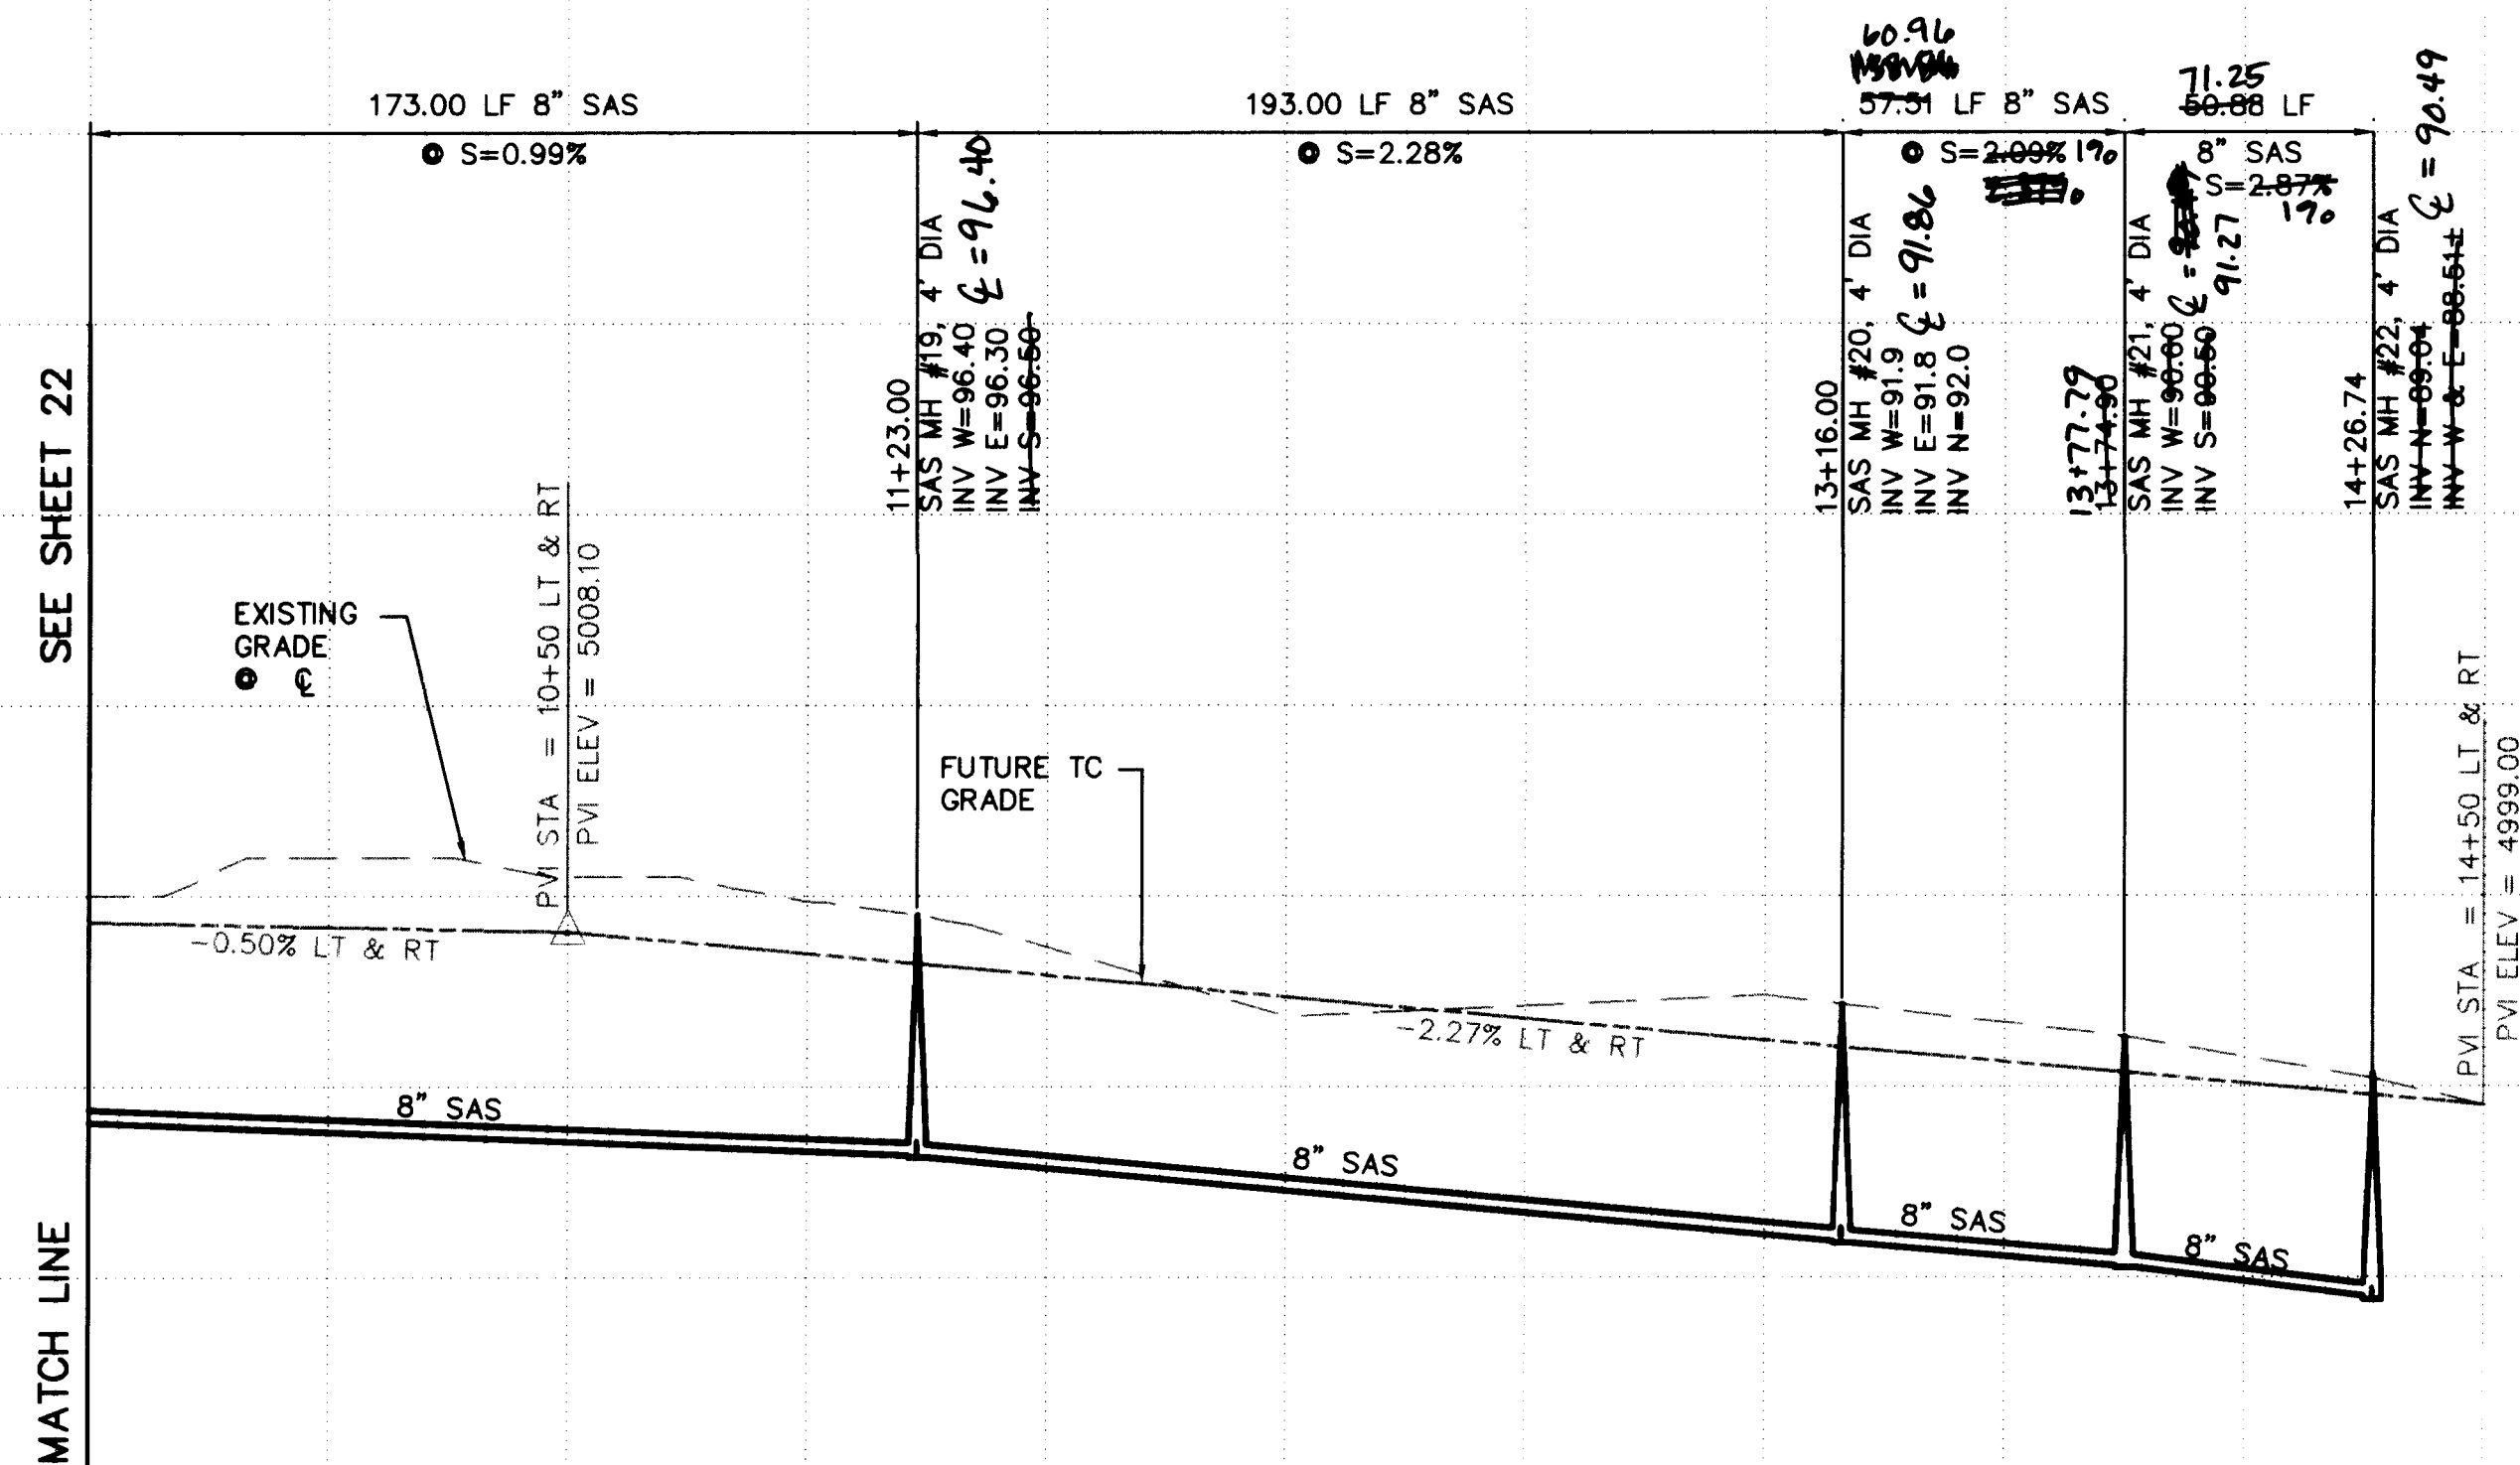

GENERAL NOTES


1. CONSTRUCT SAS SERVICES PER COA STD DWG #2125.
2. CONSTRUCT ALL SINGLE & DOUBLE WATER SERVICES PER COA STD DWG'S #2361, #2362, & #2363.
3. SEE SHEET #14 FOR WATER SHUT-OFF PLAN.
4. SEE SHEET #14 FOR RESTRAINED JOINT LENGTHS FOR WATER LINE FITTINGS.
5. CONSTRUCT FIRE HYDRANTS PER DESIGNATED DEPTHS & LENGTHS PER COA STD DWG #2340.

KEYED NOTES

1. INSTALL CURVILINEAR SANITARY SEWER FROM STA 13+16.00, 0' LT TO 13+74.90, 0' LT AS FOLLOWS:
 $\Delta = 11'58.53"$
 $R = 275.00'$
 $L = 57.51'$
2. INSTALL CURVILINEAR SANITARY SEWER FROM STA 13+74.90, 0' LT TO 14+26.74 0' LT AS FOLLOWS:
 $\Delta = 10'36.03"$
 $R = 275.00'$
 $L = 50.88'$

LEGEND


- SINGLE WATER METER & BOX
- DOUBLE WATER METER & BOX
- GATE VALVE W/ TYPE 'A' VALVE BOX
- FIRE HYDRANT
- SAS MANHOLE
- WATER LINE W/ FITTING

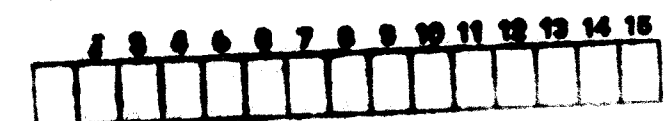

ISAACSON & ARFMAN, P.A.
Consulting Engineering Associates
128 Monroe Street N.E.
Albuquerque New Mexico
930UTL7.DWG Date: 10/28/97

CITY OF ALBUQUERQUE
PUBLIC WORKS DEPARTMENT
ENGINEERING GROUP

TITLE: **DESERT FLOWER SUBDIVISION--UNIT ONE
OFFSITE SAS CONNECTION
UTILITY PLAN & PROFILE**

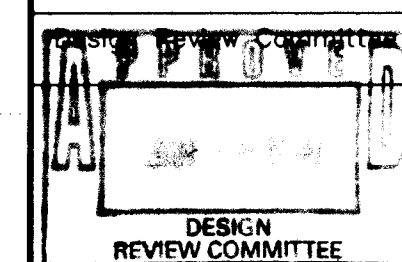

City Engineer Approval

Last Design Update

Mo./Day/Yr. Mo./Day/Yr.


City Project No. **5739.81**

Zone Map No. **M-10**




Sheet **23** Of **24**

SURVEY INFORMATION			BENCH MARKS		AS-BUILT INFORMATION	
FIELD NOTES					CONTRACTOR NEW CONCEPTS	
1	ALS	5/96	ACS MONUMENT "1-M10" LOCATED AT THE SOUTHEAST CORNER OF SAGE RD. & UNSER BLVD. ELEV. = 5079.88		WORKED BY COA	DATE 5/7/99
					INSPECTOR'S ACCEPTANCE BY COA	DATE 6/1/99
					VERIFICATION BY COA	DATE 6/2/99
			TBM: RIM OF SOUTHWESTERLY MANHOLE AT SAPHIRE ST. & UNSER BLVD. ELEV. = 5035.84		DRAWINGS CORRECTED BY ISAKSON/STANLEY	DATE 6/2/99
					MICRO-FILM INFORMATION	
					RECORDED BY	DATE
					NO.	


SCANNED BY
BY LASON

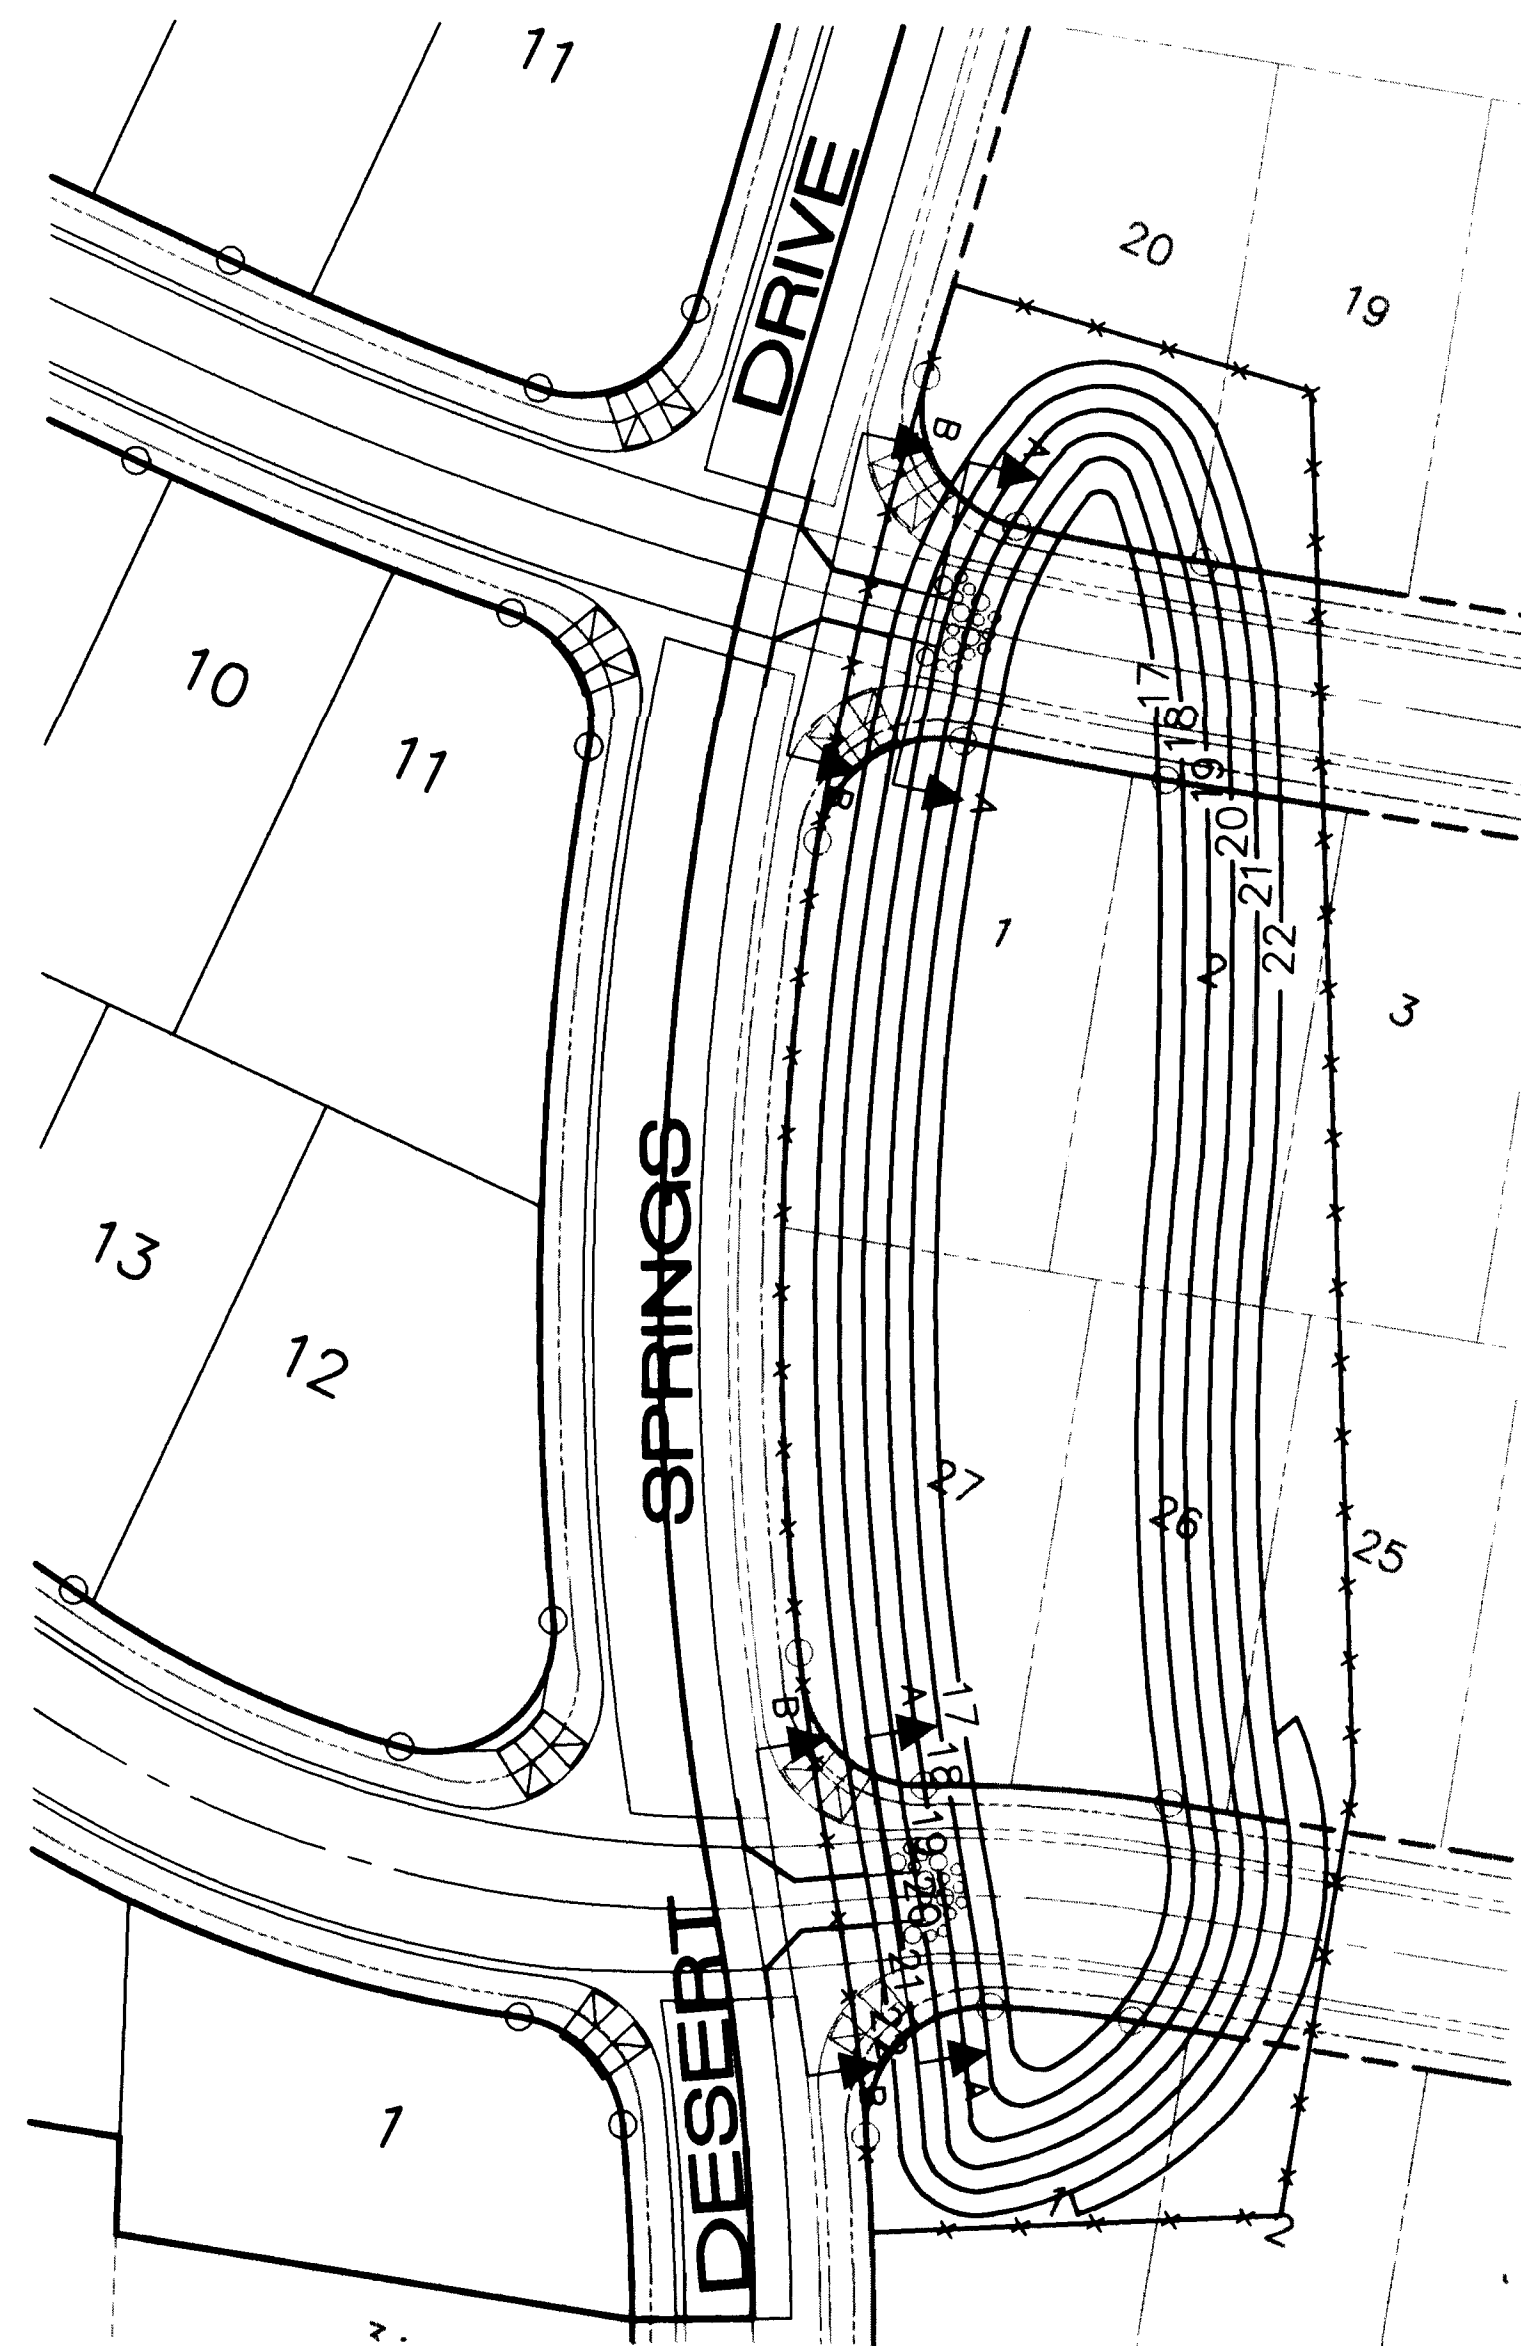

POND DETAIL
SCALE: 1"=40'

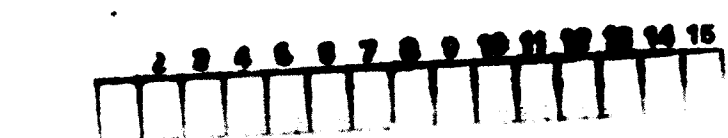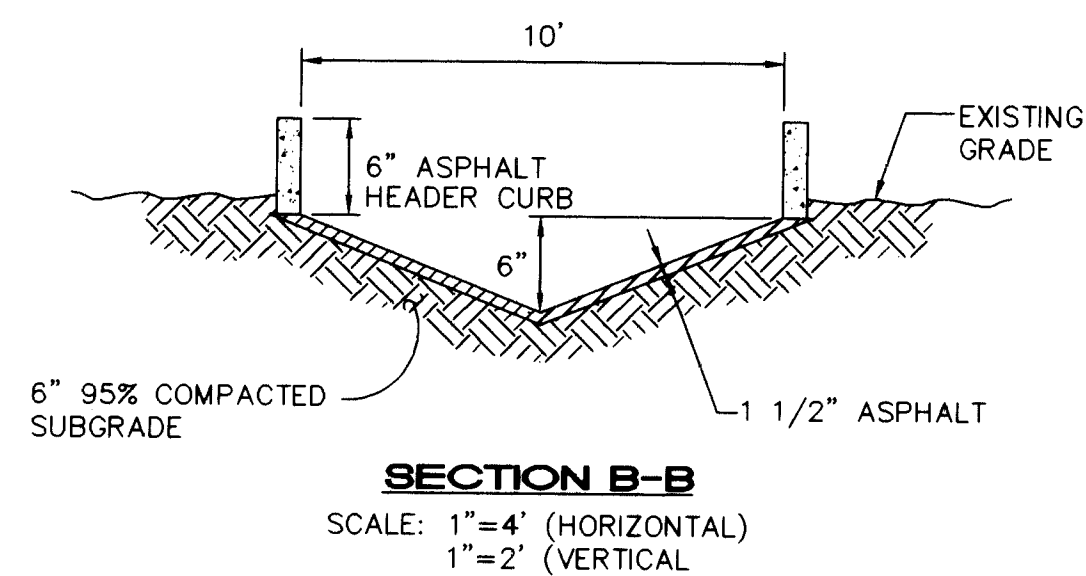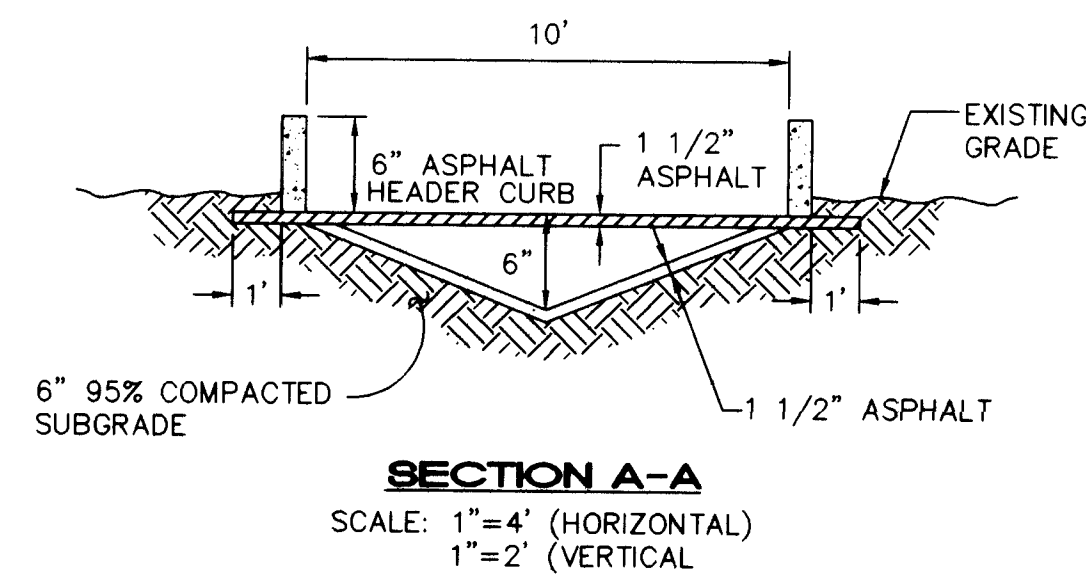

AS BUILT RECORD

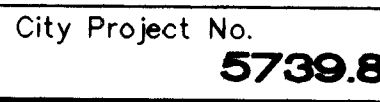ISAACSON & ARFMAN, P.A. Consulting Engineering Associates 128 Monroe Street N.E. Albuquerque, New Mexico 9300TLDWGems 10/28/97		CITY OF ALBUQUERQUE PUBLIC WORKS DEPARTMENT ENGINEERING GROUP	
TITLE: DESERT FLOWER SUBDIVISION--UNIT ONE DRAINAGE DETAILS			
City Project No. 5739.81	Zone Map No. M-10	Sheet 24	Of 24
City Engineer Approval 	Last Design Update Mo./Day/Yr. _____	Mo./Day/Yr. _____	Mo./Day/Yr. _____
DESIGN REVIEW COMMITTEE 	DESIGNED BY: JMN DATE: 9/97	DRAWN BY: ANW DATE: 9/97	CHECKED BY: FCA DATE: 9/97

SCANNED BY
BY LASON

SURVEY INFORMATION		BENCH MARKS		AS-BUILT INFORMATION	
FIELD	NOTES				
1	ALS			CONTRACTOR: NEW CONCEPTS	
				DRAWN BY: CoA	DATE: 1/98
				INSPECTOR'S: CoA	DATE: 6/98
				FIELD: CoA	DATE: 7/98
				REVISIONS: CoA	DATE: 7/98
				CORRECTED BY: CoA	DATE: 7/98
				MICRO-FILM INFORMATION	
				RECORDED BY:	DATE:
				NO.	

