

CONSTRUCTION PLANS
FOR
WHISTLER AT SEVEN BAR NORTH
UNIT I
ALBUQUERQUE, NEW MEXICO

INDEX

SHEET NUMBER	DESCRIPTION
1	TITLE SHEET
2	FINAL-PLAT
3	GRADING PLAN UNIT I
4	GRADING DETAILS
5	OVERALL PAVING PLAN
6	PAVING PLAN AND PROFILE SHEETS
7	AMARANTH AVENUE
8	SNOWBIRD DRIVE
9	WHISTLER AVENUE & FUTURE ALTA DRIVE
10	CORTO COURT & WILLOWBROOK PLACE
11	OVERALL UTILITY PLAN
12	UTILITY PLAN AND PROFILE SHEETS
13	AMARANTH AVENUE
14	SNOWBIRD DRIVE
15	WHISTLER AVENUE & FUTURE ALTA DRIVE
16	CORTO COURT & WILLOWBROOK PLACE
17	WATERLINE EASEMENT
18	STORM DRAIN & SAS PLAN AND PROFILE SHEET
19	STORM DRAIN & SANITARY SEWER EXTENSIONS
20	MISCELLANEOUS DETAILS
21-25	TRAFFIC CONTROL STANDARDS

SURVEYOR'S CERTIFICATION

"I, Timothy Aldrich, a duly qualified Registered Professional Land Surveyor under the laws of the State of New Mexico, do hereby certify that the 'as-built' information shown on these drawings was obtained from field construction and 'as-built' surveys performed by me or under my supervision, that the 'as-built' information shown on these drawings was added by me or under my supervision, and that this 'as-built' information is true and correct to the best of my knowledge and belief." Aldrich Land Surveying is not responsible for any of the design concepts, calculations, engineering or intent of the record drawings.

Timothy Aldrich 06-07-99
Timothy Aldrich, P.S. No. 7719 Date


APPROVAL OF AS BUILT DRAWINGS
CHIEF CONSTRUCTION ENGINEER
John C. Alexander
DATE 8/26/99

DRB# 98-186

Bohannon & Huston


Courtyard One 7500 JEFFERSON NE ALBUQUERQUE NEW MEXICO 87109

ENGINEERS PLANNERS PHOTOGRAMMETRISTS SURVEYORS LANDSCAPE ARCHITECTS

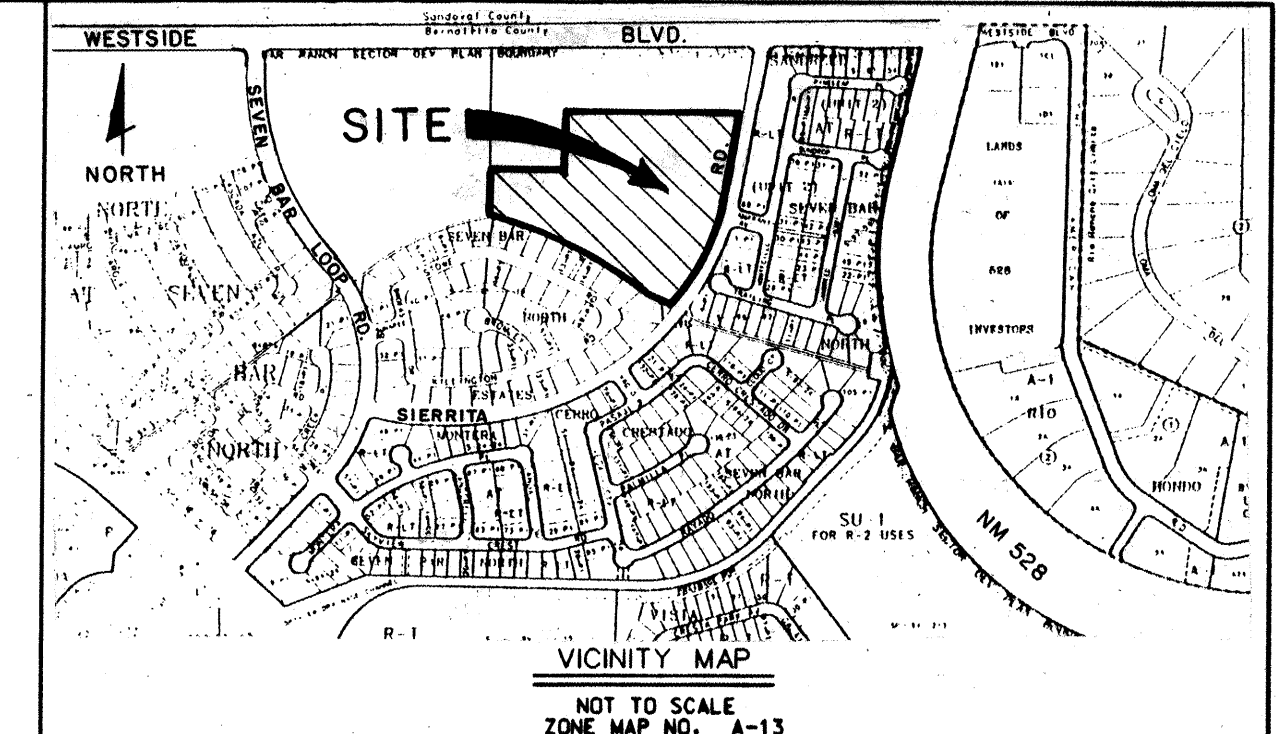

- NOTICE TO CONTRACTORS
1. ALL WORK DETAILED ON THESE PLANS TO BE PERFORMED UNDER CONTRACT SHALL EXCEPT AS OTHERWISE STATED OR PROVIDED FOR HEREON, BE CONSTRUCTED IN ACCORDANCE WITH THE CITY OF ALBUQUERQUE STANDARD SPECIFICATIONS FOR PUBLIC WORKS CONSTRUCTION, 1986 EDITION AND SHALL INCLUDE UPDATE No. 6.
 2. TWO WORKING DAYS PRIOR TO ANY EXCAVATION, THE CONTRACTOR MUST CONTACT NEW MEXICO ONE CALL SYSTEM (260-1090) FOR LOCATION OF EXISTING UTILITIES.
 3. PRIOR TO CONSTRUCTION, THE CONTRACTOR SHALL EXCAVATE AND VERIFY THE HORIZONTAL AND VERTICAL LOCATIONS OF ALL OBSTRUCTIONS. SHOULD A CONFLICT EXIST, THE CONTRACTOR SHALL NOTIFY THE ENGINEER OR SURVEYOR IMMEDIATELY SO THAT THE CONFLICT CAN BE RESOLVED WITH A MINIMUM AMOUNT OF DELAY.
 4. FIVE (5) WORKING DAYS PRIOR TO BEGINNING CONSTRUCTION, THE CONTRACTOR SHALL SUBMIT TO CONSTRUCTION COORDINATION DIVISION A DETAILED CONSTRUCTION SCHEDULE. TWO (2) WORKING DAYS PRIOR TO CONSTRUCTION, THE CONTRACTOR SHALL OBTAIN A BARRICADING PERMIT FROM THE CONST. COORDINATION DIVISION. CONTRACTOR SHALL NOTIFY BARRICADE ENGINEER (768-2551) PRIOR TO OCCUPYING AN INTERSECTION. REFER TO SECTION 19 OF THE GENERAL CONDITIONS OF THE STANDARD SPECIFICATIONS.
 5. ALL STREET STRIPING ALTERED OR DESTROYED SHALL BE REPLACED W/ PLASTIC REFLECTORIZED PAVEMENT MARKING BY CONTRACTOR TO LOCATION AS EXISTING OR AS INDICATED BY THIS PLAN SET.
 6. CONTRACTOR SHALL NOTIFY THE ENGINEER NOT LESS THAN SEVEN (7) DAYS PRIOR TO STARTING WORK IN ORDER THAT THE CITY SURVEYOR MAY TAKE NECESSARY MEASURES TO INSURE THE PRESERVATION OF SURVEY MONUMENTS. CONTRACTOR SHALL NOT DISTURB PERMANENT SURVEY MONUMENTS WITHOUT THE CONSENT OF THE CITY SURVEYOR AND SHALL NOTIFY THE CITY SURVEYOR AND BEAR THE EXPENSE OF REPLACING ANY THAT MAY BE DISTURBED WITHOUT PERMISSION. REPLACEMENT SHALL BE DONE ONLY BY THE CITY SURVEYOR. WHEN A CHANGE IS MADE IN THE FINISHED ELEVATIONS OF THE PAVEMENT OF ANY ROADWAY IN WHICH A PERMANENT SURVEY MONUMENT IS LOCATED, CONTRACTOR SHALL, AT HIS OWN EXPENSE, ADJUST THE MONUMENT COVER TO THE NEW GRADE UNLESS OTHERWISE SPECIFIED. REFER TO SECTION 4.4 OF THE GENERAL CONDITIONS OF THE STANDARD SPECIFICATIONS. ANY PERMANENT SURVEY MONUMENT LOCATED WITHIN 50' OF THE PROJECT LIMITS NOT SHOWN ON THE PLANS THAT IS DESTROYED DURING CONSTRUCTION WILL BE REPLACED AT DESIGNER'S EXPENSE.
 7. ANY WORK WITHIN AN ARTERIAL ROADWAY REQUIRES TWENTY-FOUR HOUR CONSTRUCTION.
 8. ALL UTILITY WORK SHALL BE CONSTRUCTED IN ACCORDANCE WITH NEW MEXICO UTILITIES, INC. SPECIFICATIONS FOR WATER AND WASTEWATER FACILITIES (MOST RECENT REVISIONS).
 9. THE CONTRACTOR SHALL NOTIFY NEW MEXICO UTILITIES (898-2661) THREE WORKING DAYS PRIOR TO BEGINNING THE CONSTRUCTION OF THE UTILITIES.
 10. CONTRACTOR SHALL MAINTAIN A GRAFFITI-FREE WORK SITE. CONTRACTOR SHALL PROMPTLY REMOVE ANY GRAFFITI FROM ALL EQUIPMENT, WHETHER PERMANENT OR TEMPORARY.
- THE FOLLOWING NOTES ALSO APPLY WHEN CHECKED
- ☒ ALL UTILITIES AND UTILITY SERVICE LINES SHALL BE INSTALLED PRIOR TO PAVING.
 - ☒ BACKFILL COMPACTION SHALL BE ACCORDING TO SPECIFIED STREET USE.
 - ☐ TACK COAT REQUIREMENTS SHALL BE DETERMINED BY THE CITY ENGINEER.
 - ☒ SIDEWALKS AND WHEELCHAIR RAMPS WITHIN THE CURB RETURNS SHALL BE CONSTRUCTED WHEREVER A NEW CURB RETURN IS CONSTRUCTED.
 - ☐ IF CURB IS DEPRESSIONED FOR A DRIVEPAD, THE DRIVEPAD SHALL BE CONSTRUCTED PRIOR TO ACCEPTANCE OF CURB AND GUTTER.
 - ☒ ALL STORM DRAINAGE FACILITIES SHALL BE COMPLETED PRIOR TO FINAL ACCEPTANCE.
 - ☒ THE REQUESTOR OR DEVELOPER SHALL BE RESPONSIBLE FOR REPAIR OR REPLACEMENT OF ALL CURB AND GUTTER OR SIDEWALK DAMAGED AFTER APPROVAL BY THE CITY ENGINEER OF WORK COMPLETED BY THE CONTRACTOR.

REV.	SHEETS	CITY ENGINEER	DATE	USER DEPARTMENT	DATE	USER DEPARTMENT	DATE
ENGINEERS STAMP & SIGNATURE	APPROVALS	ENGINEER	DATE	*****			
	DRC Chairman	<i>John C. Alexander</i>	9-24-98	APPROVED FOR CONSTRUCTION			
	Transportation	<i>R. W. Kane</i>	9-16-98				
	Water/Wastewater	<i>John C. Alexander</i>	9-16-98				
	Hydrology	<i>John C. Alexander</i>	9-16-98				
	Construction coord.	<i>John C. Alexander</i>	9-16-98				
	Const. Mngmt.	<i>John C. Alexander</i>	9-16-98				
	N.M.U.I.	<i>John C. Alexander</i>	9-16-98				
City Project No.		5752.82		Sheet	1	Of	19

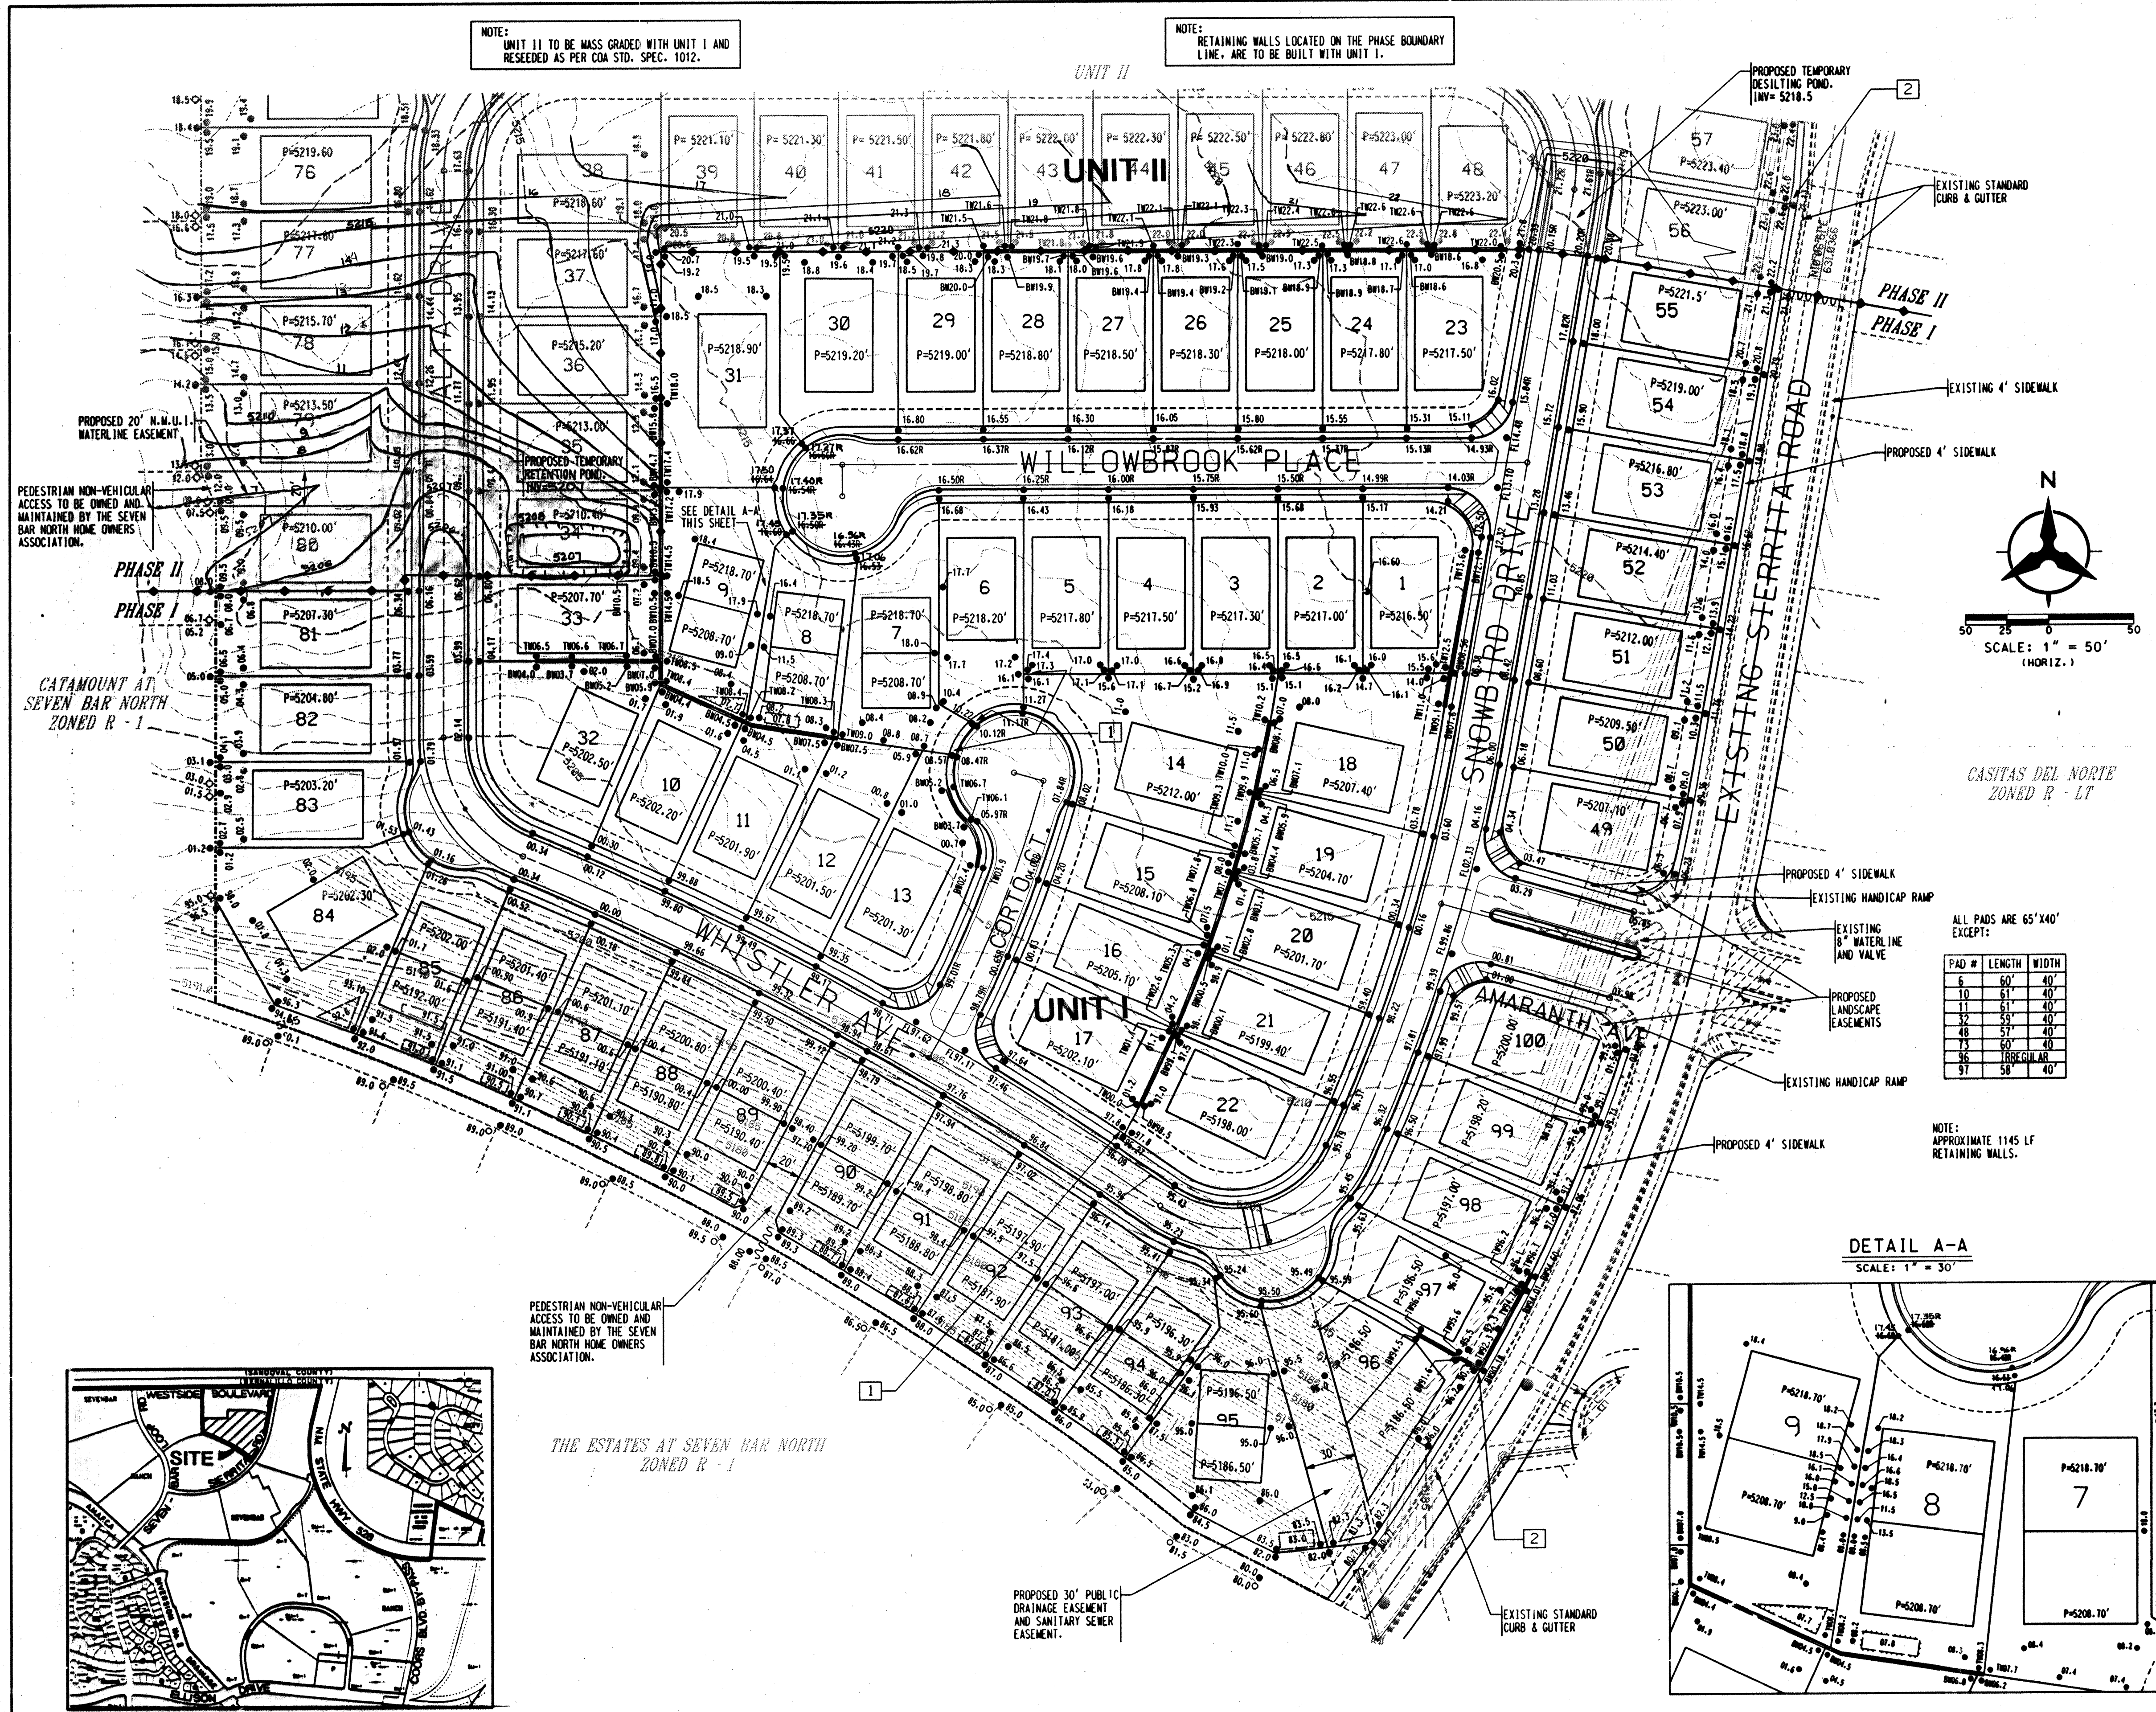

- GENERAL NOTES**
1. CONTRACTOR MUST OBTAIN A TOPSOIL DISTURBANCE PERMIT FROM THE ENVIRONMENTAL HEALTH DIVISION PRIOR TO CONSTRUCTION.
 2. THE CONTRACTOR IS TO REFER TO EARTHWORK SPECIFICATION AS NOTED IN THE SOILS REPORT PREPARED BY VINYARD AND ASSOCIATES DATED AUG. 31, 1994.
 3. THE CONTRACTOR SHALL CONFORM TO ALL CITY, COUNTY, STATE AND FEDERAL DUST CONTROL MEASURES AND REQUIREMENTS AND WILL BE RESPONSIBLE FOR PREPARING AND OBTAINING ALL NECESSARY APPLICATIONS AND APPROVALS.
 4. THE CONTRACTOR SHALL ENSURE THAT NO SOIL ERODES FROM THE LOTS INTO PUBLIC RIGHT-OF-WAY. THIS CAN BE ACHIEVED BY CONSTRUCTING TEMPORARY BERMS AS PER THE DETAIL ON SHEET 4, AND WETTING THE SOIL TO KEEP IT FROM BLOWING.
 5. ALL STREET SPOT ELEVATIONS ARE TO TOP OF CURB UNLESS OTHERWISE NOTED. VALLEY GUTTER ELEVATIONS ARE SHOWN AT FLOWLINE ELEVATION.
 6. ALL SIDE WALLS SHOWN ARE TO BE PLACED ALONG PROPERTY LINE.

LEGAL DESCRIPTION
TRACT D-2
SEVEN BAR NORTH
SUBDIVISION, UNIT I

NOTE:
FOR GRADING DETAILS
SEE SHEET 4 OF 19

NOTE:
FOR BACKYARD POND
DIMENSIONS SHEET 4 OF 19

KEYED NOTES

1. GARDEN WALL BUILDER:
TO INSTALL ONE TURNED OUT BLOCK AT LOWEST POINT IN LOT JUST ABOVE GRADE.
2. GARDEN WALL BUILDER:
TO INSTALL ONE TURNED OUT CONCRETE MASONRY UNIT AT LOWEST POINT IN CORNER TO DRAIN TO SIERRITA ROAD RIGHT OF WAY.

LEGEND

PROPOSED RETAINING WALL	• 5235.25
PROPOSED SPOT ELEVATION	• 5235.25R
TOP OF ROLL CURB ELEVATION	• 5235.25
EXISTING SPOT ELEVATION	• 5235.25
FUTURE SPOT ELEVATION	• 5235.25
PROPOSED CONTOUR	---
EXISTING CONTOUR	---
DIRECTION OF FLOW	→
EXISTING STORM DRAIN LINE	---
EXISTING STORM DRAIN MANHOLE	○
PROPOSED STORM DRAIN INLET	■
PROPOSED STORM DRAIN LINE	---
PROPOSED STORM DRAIN MANHOLE	○
PROPOSED WATER BLOCK	■
PROPOSED BACKYARD POND	■
EXISTING SAS MANHOLE	○
PHASING BOUNDARY	---


SPOT ELEVATIONS CONTAINING AN "R" DENOTES TOP OF ADJUSTABLE ROLL TYPE CURB. 1.0' - 32.5' X 20"

Bohannon & Huston
Countywide One 7500 JEFFERSON NE ALBUQUERQUE NEW MEXICO 87109
ENGINEERS PLANNERS PHOTOGRAMMETRISTS SURVEYORS SOFTWARE DEVELOPERS

CITY OF ALBUQUERQUE
PUBLIC WORKS DEPARTMENT
ENGINEERING DEVELOPMENT GROUP
WHISTLER AT SEVEN BAR NORTH
GRADING PLAN UNIT I


DESIGN REVIEW BOARD NO. 128	APPROVAL DATE	98 / 04 / 98
CITY PROJECT NO. 5752.82	ZONE MAP NO. A-13	SHEET 3 OF 19
DESIGNED BY JCA	DATE 7/98	DRAWN BY PEG
CHECKED BY JCA	DATE 7/98	

FOR INFORMATION ONLY

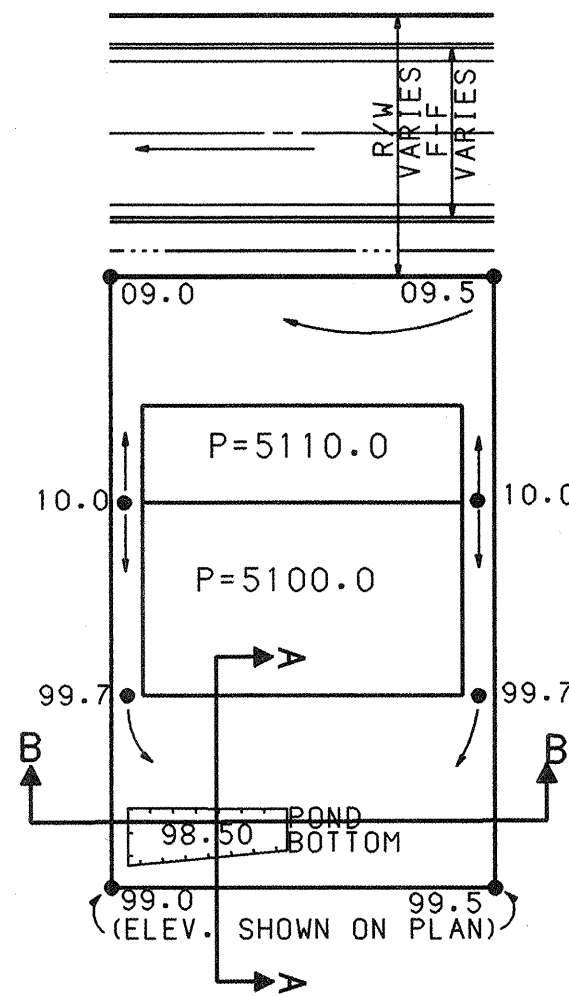

**TYPICAL SPLIT LOT GRADING PLAN
FOR LOTS WITH BACKYARD PONDING**

NO SCALE
NOTE: ALL AREAS FROM THE REAR OF THE UPPER PAD TO THE STREET TO DRAIN TO THE STREET. POND IS DESIGNED FOR BACKYARD, SIDEYARD AND LOWER PAD RUNOFF.


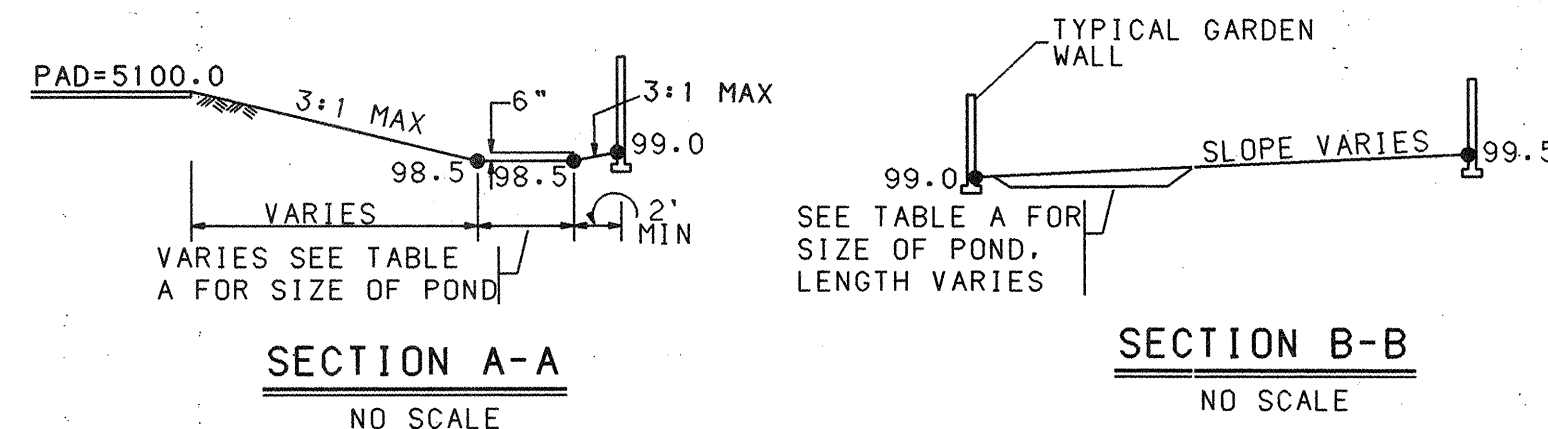


SECTION A-A
NO SCALE

SECTION B-B
NO SCALE


TABLE A
BACKYARD POND DIMENSIONS
REFER TO SHEET 3 OF 19 FOR POND LOCATIONS

LOT #	BACKYARD AREA (SQ. FT.)	REQUIRED V (100) (CU. FT.)	POND DIMENSION (FT.)	ACTUAL POND VOLUME (CU. FT.)
UNIT B-9	(SQ. FT.)	(CU. FT.)	L W1 W2 D	(CU. FT.)
1280	117	32	14 6 0.0	120
2002	167	47	11 7 0.0	169
1790	152	40	10 7 0.0	153
2500	201	55	13 10 0.0	201
1400	384	23	19.4 0.0 0.0	394
5150	129	11	11 0.0 0.0	125
1567	157	15	12 0.0 0.0	142
1640	142	11	10 0.0 0.0	140
1563	142	11	10 0.0 0.0	140
1563	136	11	10 0.0 0.0	140
1552	139	11	10 0.0 0.0	140
1595	142	11	10 0.0 0.0	140
1615	146	11	10 0.0 0.0	140
1660	143	11	10 0.0 0.0	140
5391	401	42	18 14.4 0.6	408

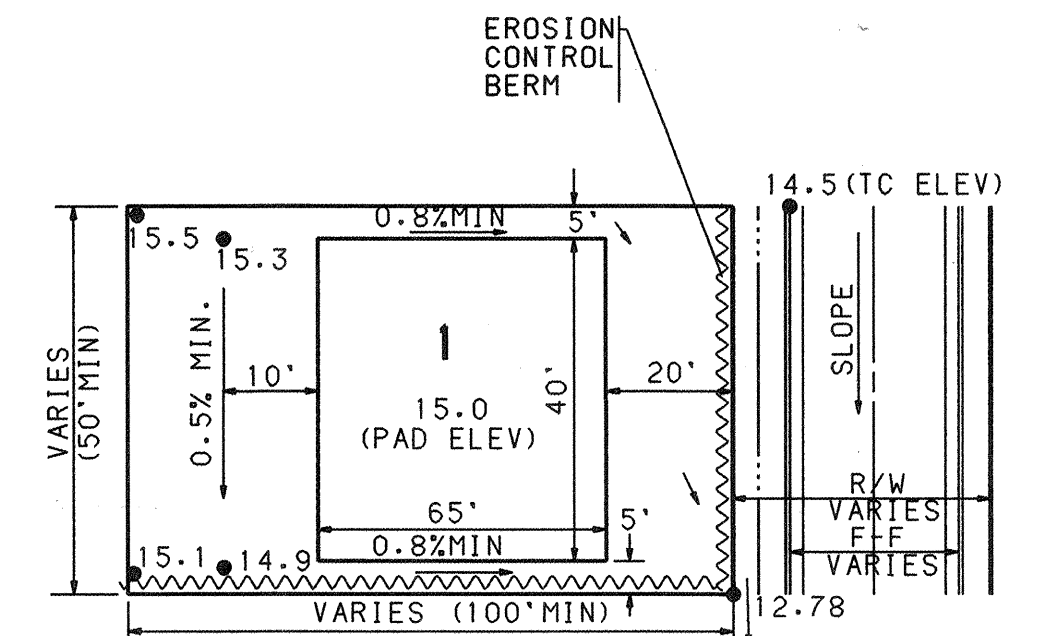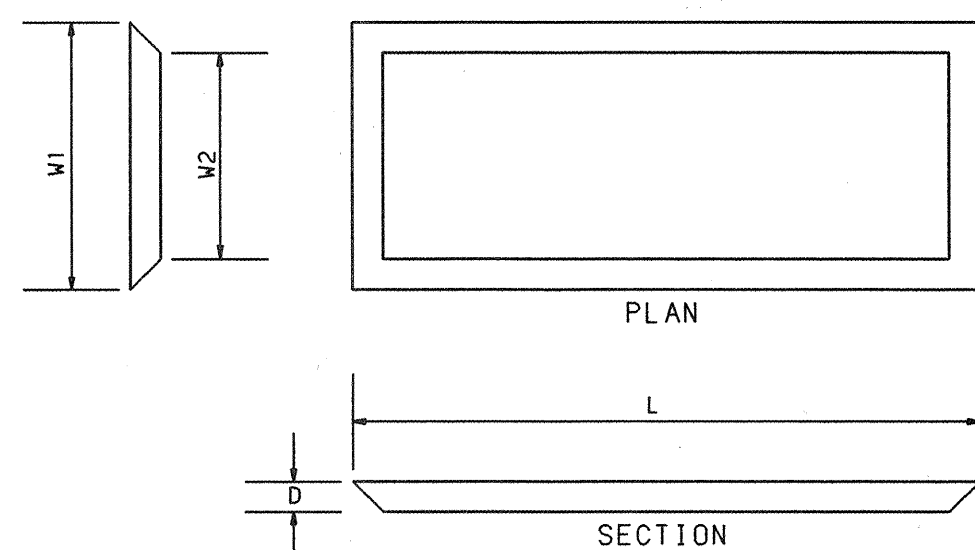


TYPICAL LOT GRADING PLAN

NO SCALE
FOR LOTS WITHOUT PONDS
(SEE SHEET 3 OF 19 FOR REQUIRED SPOT ELEVATIONS.)

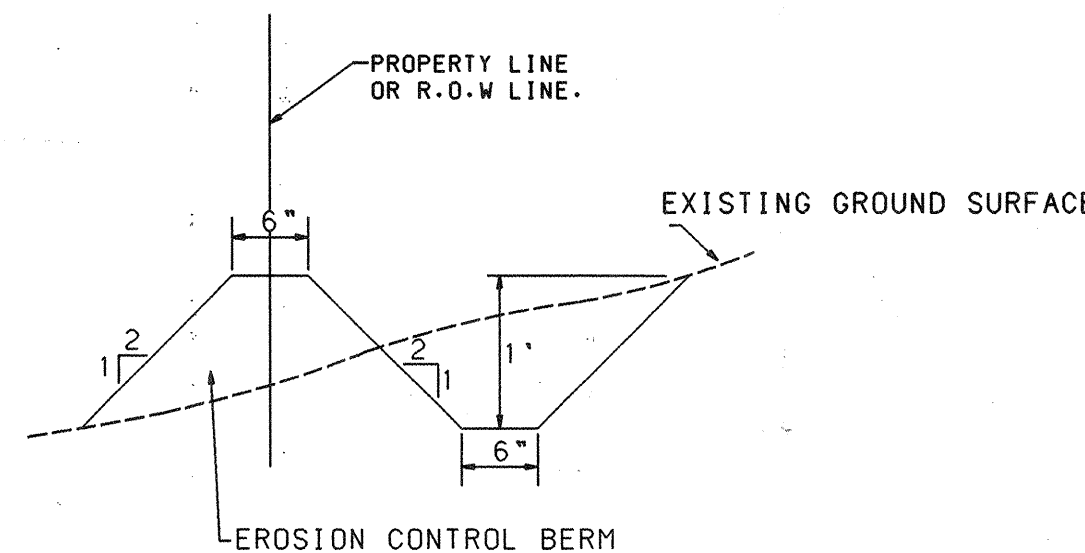

EROSION CONTROL PLAN


NO SCALE
A BERM WITH THE DIMENSIONS SHOWN SHALL BE MAINTAINED DURING CONSTRUCTION UNTIL COMPLETION OF INDIVIDUAL HOMES WITHIN THE PROJECT. SEE TYPICAL LOT GRADING PLAN THIS SHEET FOR LOCATION.

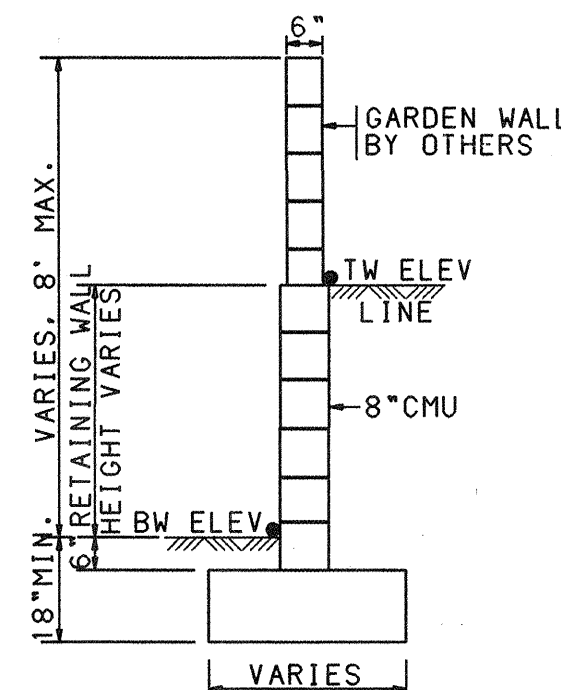

TW=FINISHED GRADE ELEVATION AT TOP OF RETAINING WALL
BW=FINISHED GRADE ELEVATION AT BOTTOM OF RETAINING WALL


TYPICAL RETAINING WALL NOMENCLATURE

NO SCALE
(RETAINAGE HEIGHT IS TAKEN TO BE DIFFERENCE IN FINISHED GRADES ON LEFT AND RIGHT SIDE OF WALL)

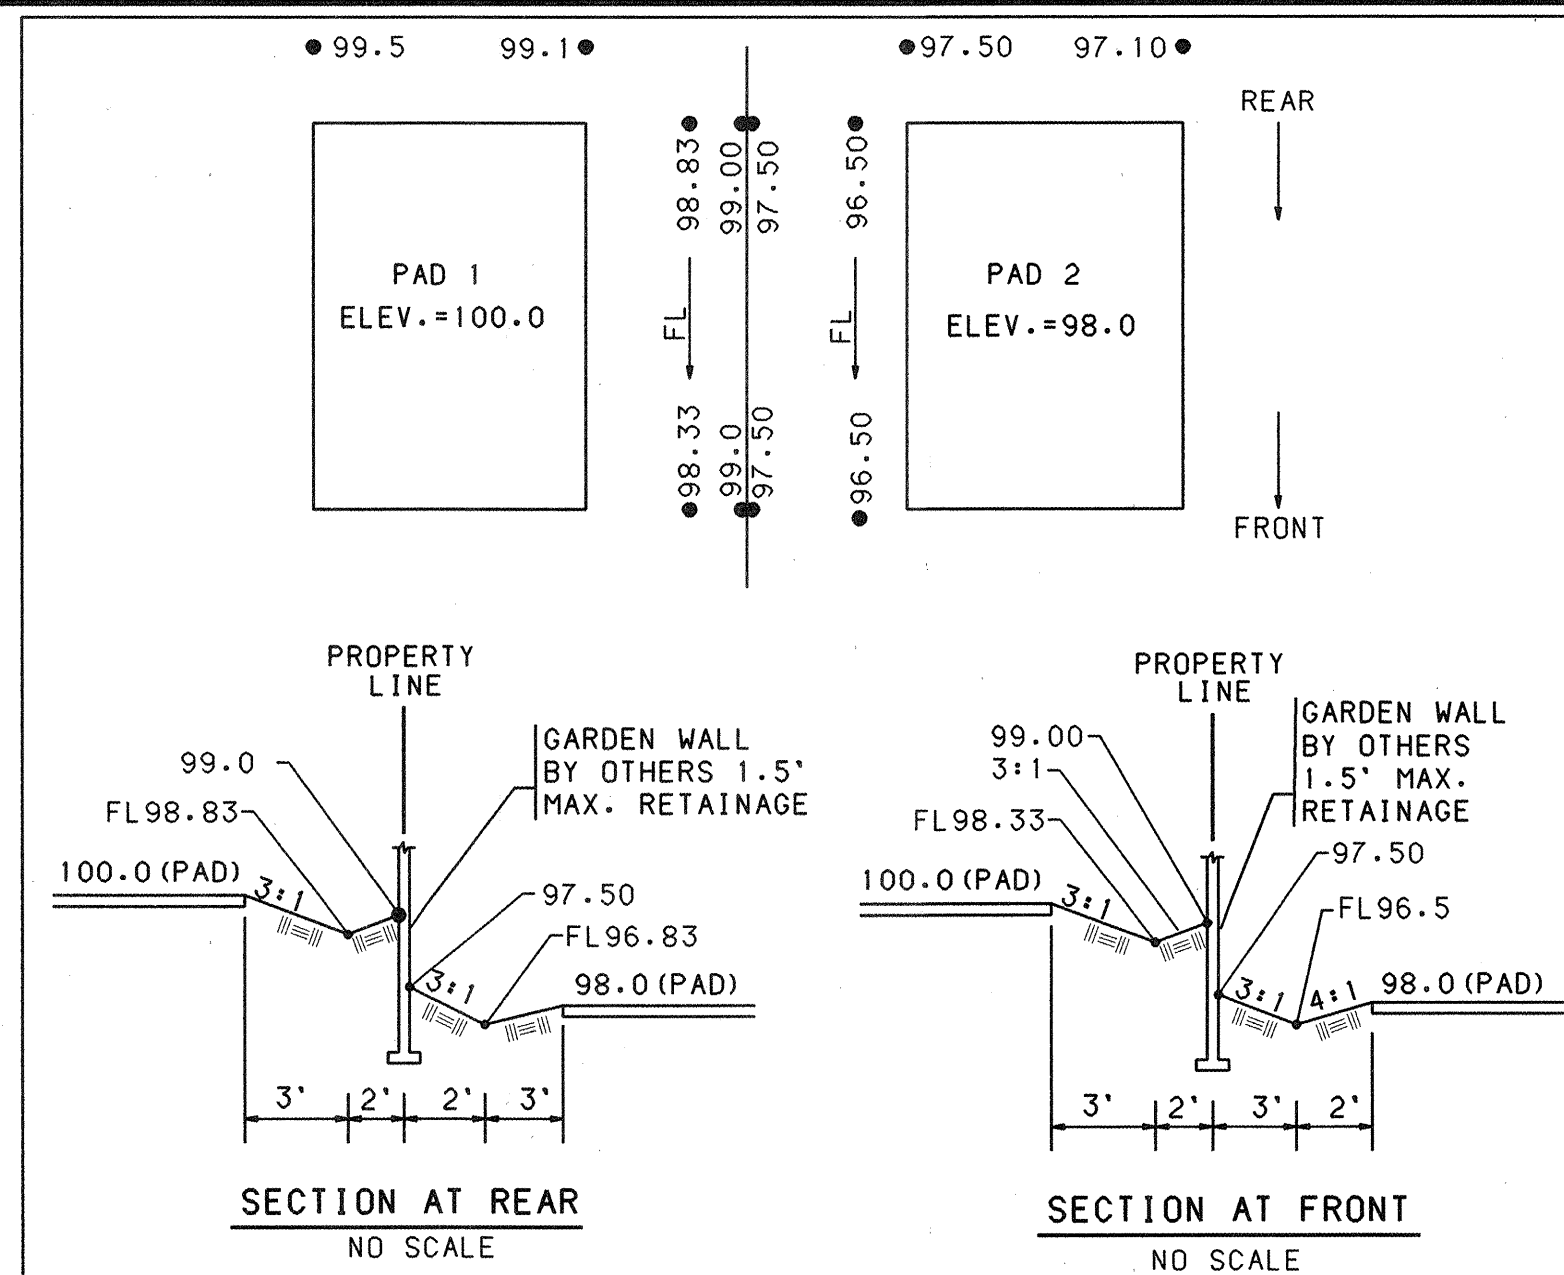

**SIDE LOT GRADING
(AFTER GARDEN WALL INSTALLATION)**

NOTE: TYPICAL FOR LOTS WITHOUT SIDE LOT RETAINING WALLS. LOTS WITH RETAINING WALLS USE THE SAME GEOMETRY FOR DRAINAGE BUT A GREATER RETAINED DIFFERENCE (GREATER THAN 1.5').

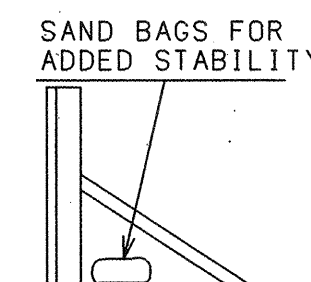


TYPE "III" BARRICADE FRAMING AND SUPPORTS SHALL BE 2"x 2" MIN. -12Ga.. SQUARE METAL TUBING OR DRIVEDOWN

**TYPICAL
MOVABLE TYPE "III" BARRICADE**

BARRICADE - CHARACTERISTICS	
WIDTH OF RAIL	8"min.-12"max.
LENGTH OF RAIL	6'or8'
WIDTH OF STRIPES	6ins.
HEIGHT	5ft. min.
TYPE OF FRAME	Posts or skids

BARRICADE DETAILS

NO SCALE

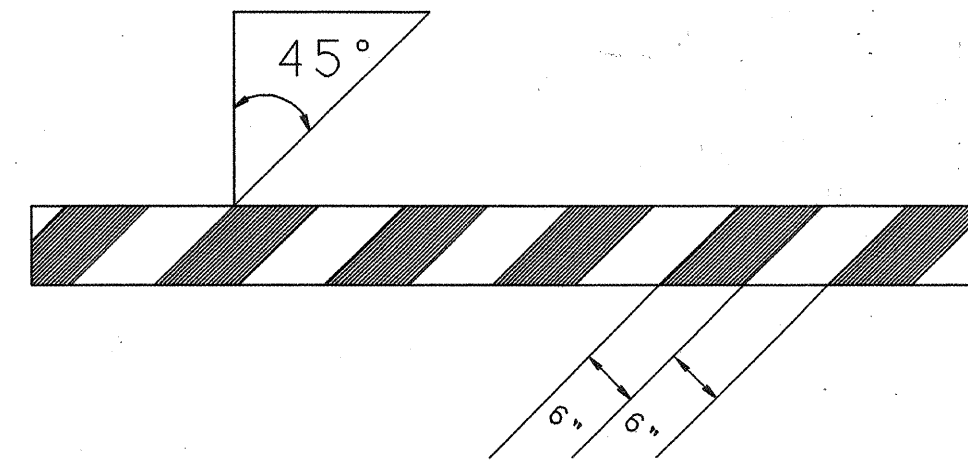

RAIL SHALL BE 1/2" MIN. 5 PLY SIGN GRADE PLYWOOD OR 2"x 8" S&S QUALITY WOOD. STRIPES SHALL SLANT DOWNWARD AT 45° TOWARD THE SIDE WHICH TRAFFIC IS TO PASS.

**DETAIL OF BARRICADE
RAIL STRIPING**

FOR BARRICADES LOCATION
SEE SHEET 5 OF 19

GENERAL NOTES


- CONTRACTOR MUST OBTAIN A TOPSOIL DISTURBANCE PERMIT FROM THE ENVIRONMENTAL HEALTH DIVISION PRIOR TO CONSTRUCTION.
- THE CONTRACTOR IS TO REFER TO EARTHWORK SPECIFICATION AS NOTED IN THE SOILS REPORT PREPARED BY VINYARD AND ASSOCIATES DATED AUGUST 31, 1994.
- THE CONTRACTOR SHALL CONFORM TO ALL CITY, COUNTY, STATE, AND FEDERAL DUST CONTROL MEASURES AND REQUIREMENTS AND WILL BE RESPONSIBLE FOR PREPARING AND OBTAINING ALL NECESSARY APPLICATIONS AND APPROVALS.
- THE CONTRACTOR SHALL ENSURE THAT NO SOIL ERODES FROM THE LOTS INTO PUBLIC RIGHT-OF-WAY. THIS CAN BE ACHIEVED BY CONSTRUCTING TEMPORARY BERMS AS PER DETAIL THIS SHEET AND WETTING THE SOIL TO KEEP IT FROM BLOWING.

AS-BUILT INFORMATION		BENCH MARKS		SURVEY INFORMATION		ENGINEER'S SEAL		NO. DATE		BY		REMARKS		NO. DATE		BY		REMARKS		NO. DATE		BY		REMARKS	
CONTRACTOR: BOHANNAN HUSTON		TBM NO. 205		CHISLED "X" LOCATED APPROXIMATELY 459 FEET SOUTH OF THE BLACK'S DIVERSION INLET STRUCTURE ON THE EAST WALL.		DATE: 09/98		NO. 13478		BY: JOHN C. ALEXANDER		REMARKS: RELATIONS DESIGN		NO. 13478		DATE: 09/98		BY: JOHN C. ALEXANDER		REMARKS: RELATIONS DESIGN		NO. 13478		DATE: 09/98	
INSPECTOR'S SIGNATURE: JOHN C. ALEXANDER		DATE: 09/98		DATE: 09/98		DATE: 09/98		DATE: 09/98		DATE: 09/98		DATE: 09/98		DATE: 09/98		DATE: 09/98		DATE: 09/98		DATE: 09/98		DATE: 09/98		DATE: 09/98	
MICRO-FILM INFORMATION		RECORDED BY: JOHN C. ALEXANDER		NO. 5110.55		DATE: 09/98		DATE: 09/98		DATE: 09/98		DATE: 09/98		DATE: 09/98		DATE: 09/98		DATE: 09/98		DATE: 09/98		DATE: 09/98		DATE: 09/98	

BOHANNAN HUSTON
ENGINEERS • PLANNERS • PHOTOGRAMMETRISTS • SURVEYORS • LANDSCAPE ARCHITECTS
ALBUQUERQUE LAS CRUCES SANTA FE

CITY OF ALBUQUERQUE
PUBLIC WORKS DEPARTMENT
ENGINEERING DEVELOPMENT GROUP



WHISTLER AT SEVEN BAR NORTH UNIT I
GRADING DETAILS

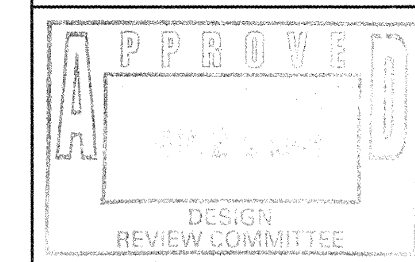

CITY ENGINEER APPROVAL	MO/DAY/YR	MO/DAY/YR
LAST DESIGN UPDATE		
DESIGN REVIEW COMMITTEE		

COA PROJECT No. **5752.82** ZONE MAP NO. **A-13** SHEET **4** OF **19**

BHI JOB NO. 98161A05

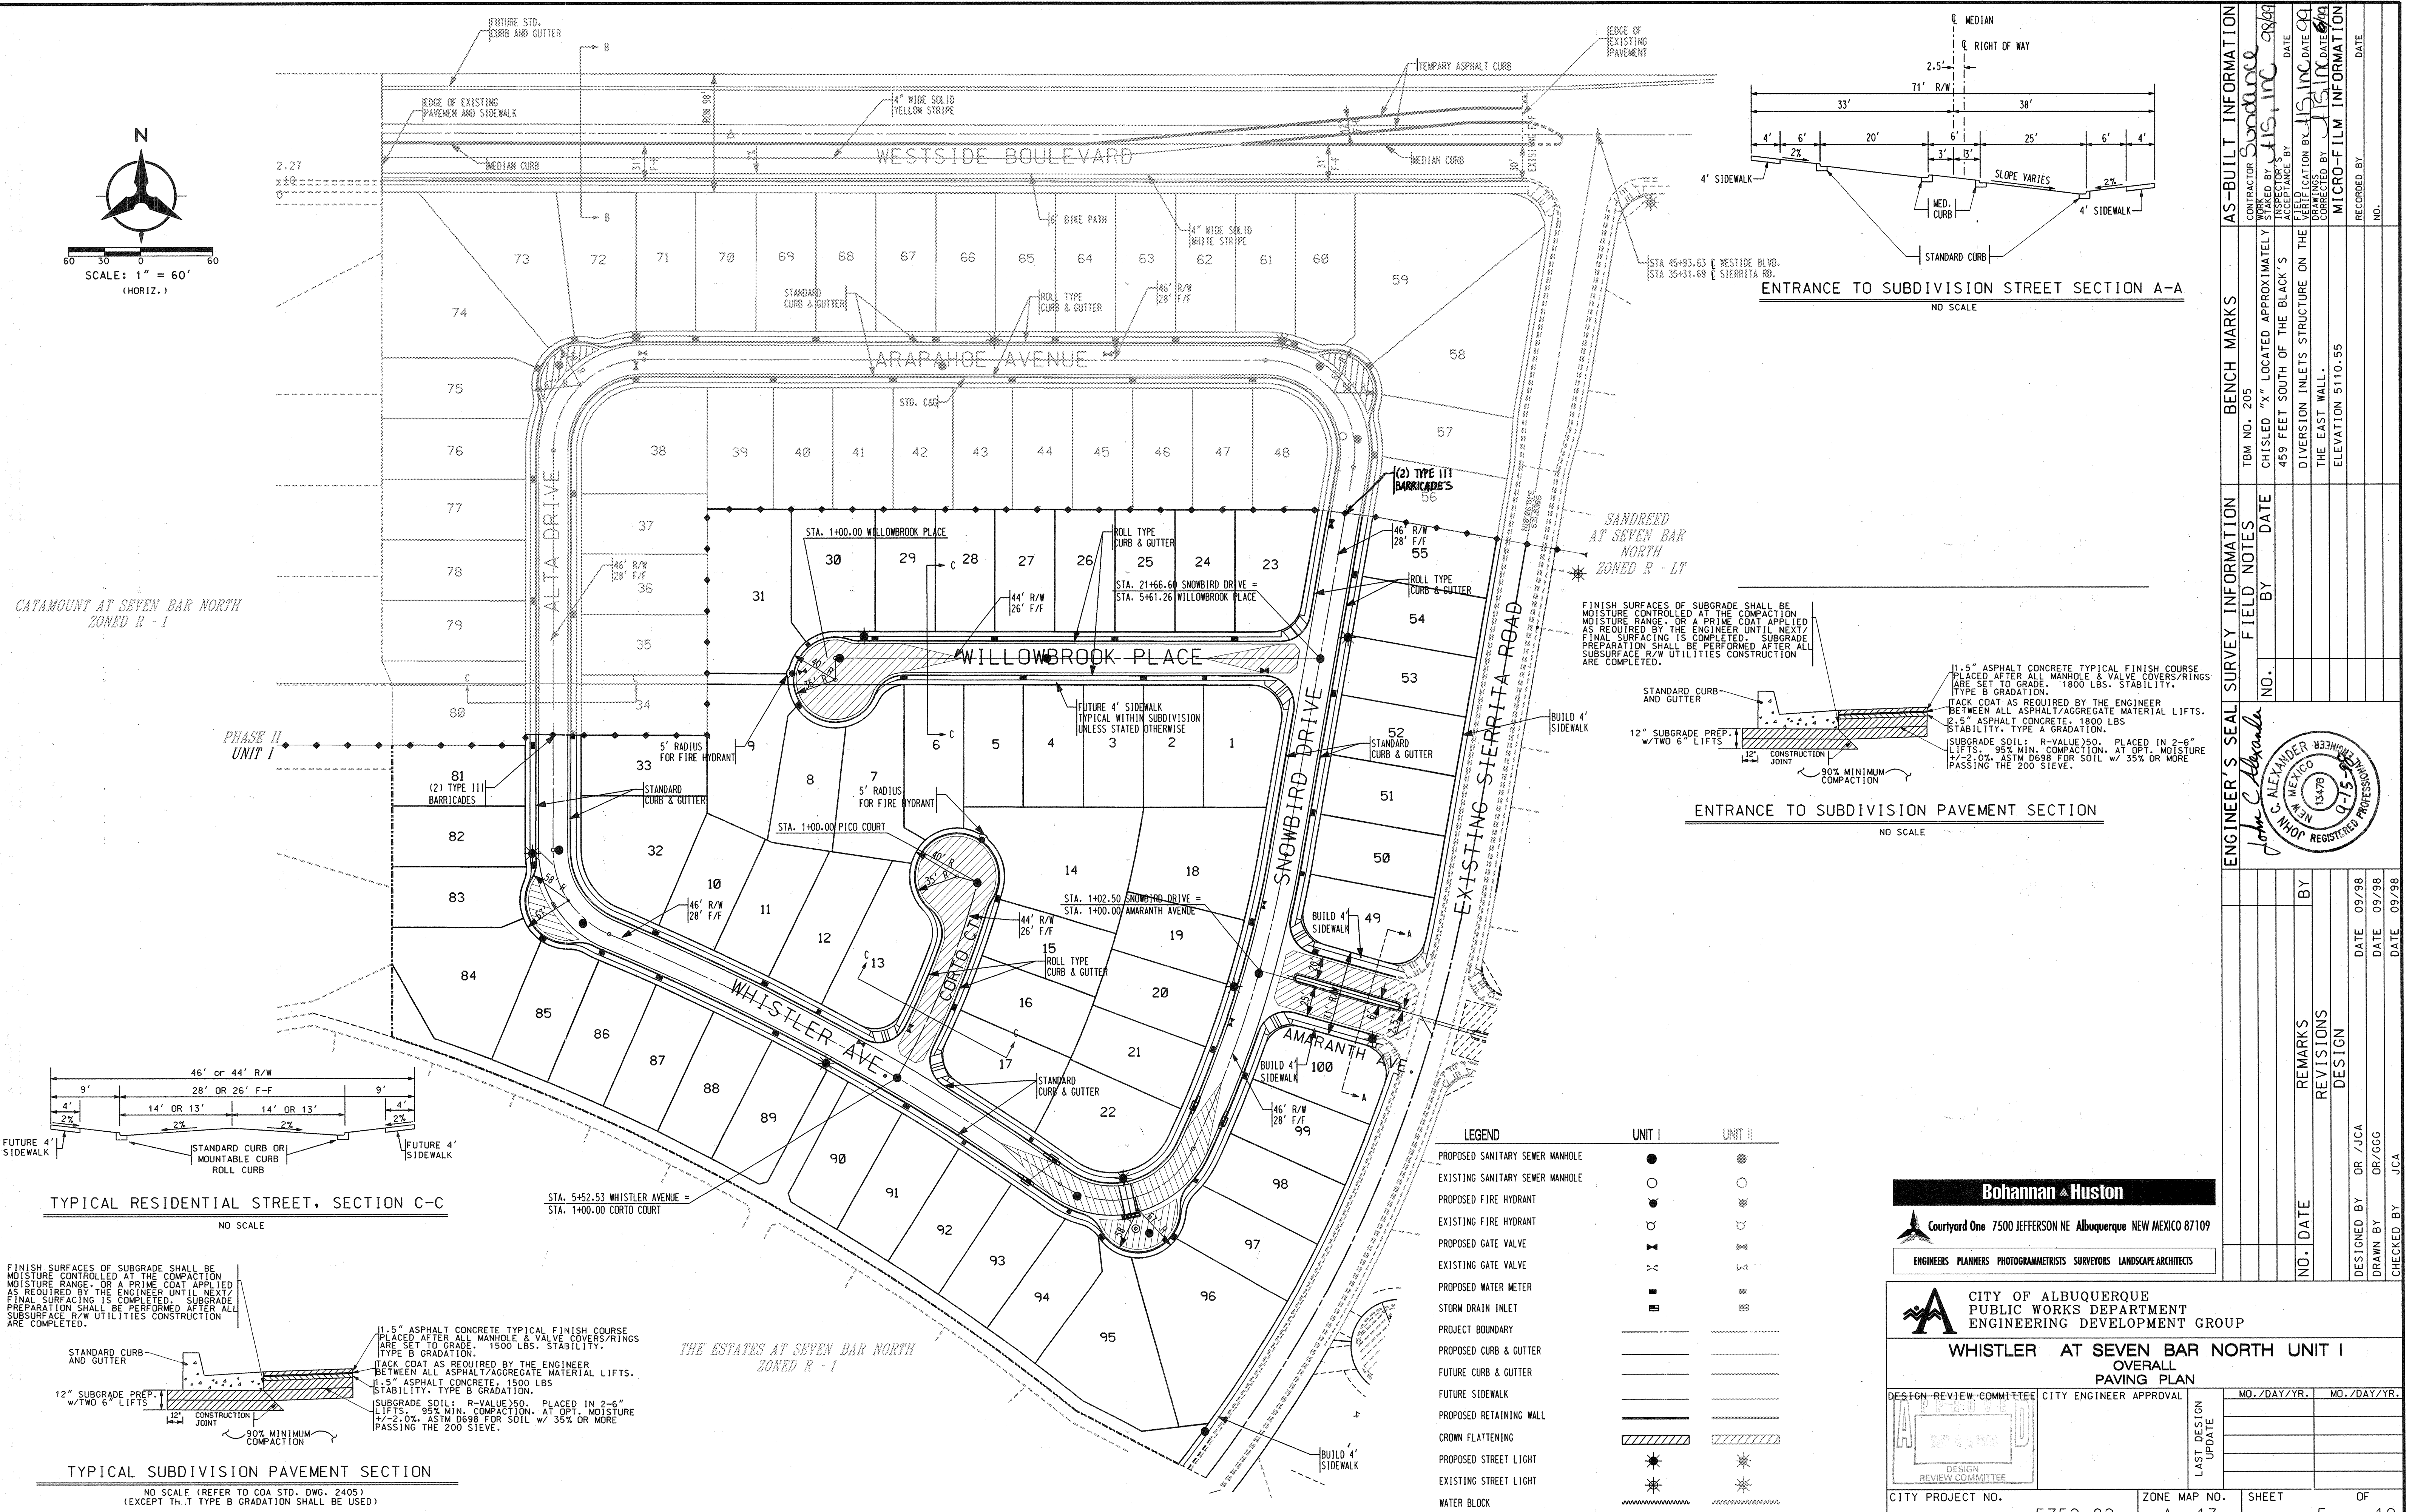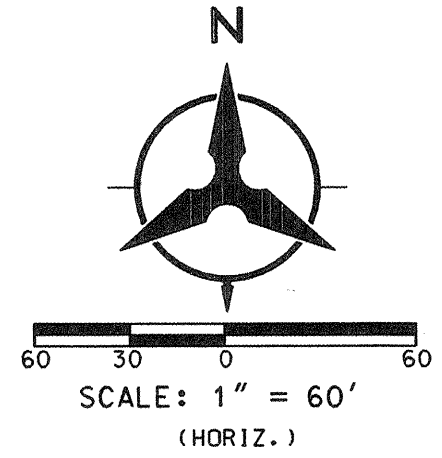


CENTERLINE TANGENT DATA		
NUMBER	BEARING	DISTANCE
T1	S74°09'05"E	153.00'

04.00	03.39
03.40	03.38
04.09	03.43

TC	FL
1	51
2	3.06
3	2.85
4	3.27
5	2.85
6	3.06
7	51


STA. 2+10.53, 25.50' LT.
TIE TO EXISTING STD.
CURB AND GUTTER
MATCH EXISTING ELEVATION
TC=5205.85

EXISTING SIERRITA ROAD
COA PROJECT 4982.97

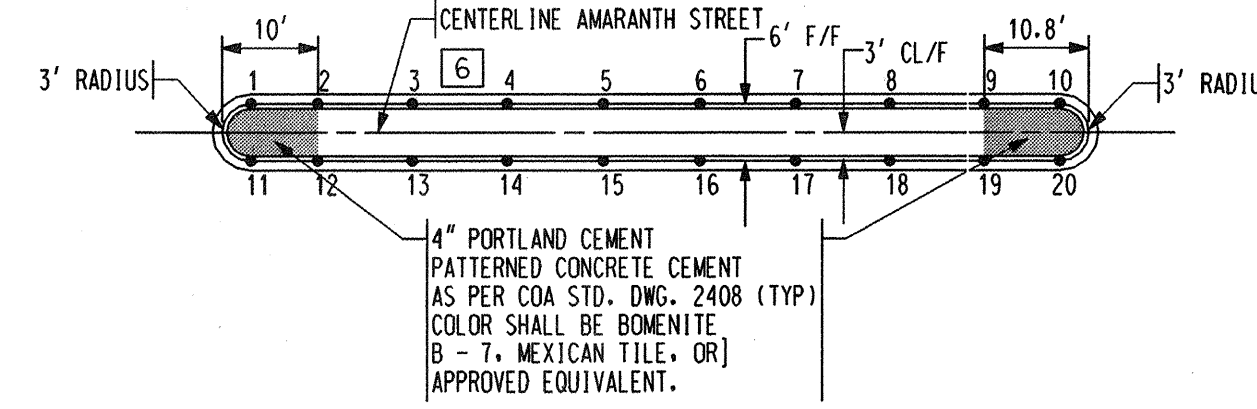

MEDIAN CURB DETAIL
(NO SCALE)

PT	FL	STATION & OFFSET	PT	FL	STATION & OFFSET
1	2.28	1+33.00, 5.50' LT.	11	1.96	1+33.00, 0.50' RT.
2	2.56	1+40.00, 5.50' LT.	12	2.24	1+40.00, 0.50' RT.
3	2.95	1+50.00, 5.50' LT.	13	2.64	1+50.00, 0.50' RT.
4	3.35	1+60.00, 5.50' LT.	14	3.04	1+60.00, 0.50' RT.
5	3.75	1+70.00, 5.50' LT.	15	3.44	1+70.00, 0.50' RT.
6	4.07	1+80.00, 5.50' LT.	16	3.75	1+80.00, 0.50' RT.
7	4.29	1+90.00, 5.50' LT.	17	3.98	1+90.00, 0.50' RT.
8	4.41	2+00.00, 5.50' LT.	18	4.69	2+00.00, 0.50' RT.
9	4.91	2+10.00, 5.50' LT.	19	4.14	2+10.00, 0.50' RT.
10	4.35	2+18.00, 5.50' LT.	20	4.10	2+18.00, 0.50' RT.

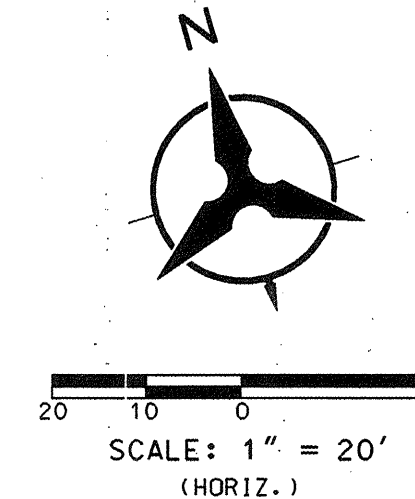

NOTES

- THE CONTRACTOR SHALL FIELD VERIFY ALL EXISTING UTILITY LOCATIONS AND NOTIFY THE ENGINEER IMMEDIATELY OF ANY DISCREPANCIES.
- ALL CURB RETURN RADIUS SHALL BE 25' UNLESS OTHERWISE SPECIFIED.
- ALL CURVE DATA AND DIMENSIONS REFER TO FACE OF CURB UNLESS OTHERWISE SPECIFIED.
- GRADE ELEVATIONS, WHERE NOTED, ARE FOR FLOWLINE UNLESS OTHERWISE SPECIFIED.
- CONTRACTOR IS TO INSTALL A 4" X 4" X 5' POST AND END AT THE END OF EACH SANITARY SEWER SERVICE.
- CONTRACTOR IS RESPONSIBLE FOR REPAIR AND/OR REPLACEMENT OF ALL UTILITY CONDUITS AND EXISTING LINES.
- ANY ADDITIONAL GRADING REQUIRED TO MATCH PROPOSED STREET GRADES SHALL BE INCIDENTAL TO PAVING ITEMS.
- CONTRACTOR SHALL PROVIDE THE INSPECTORS, (CITY AND PRIVATE) WITH THE PROPOSED HYDROSTATIC TESTING PLAN. THE PLAN MUST BE APPROVED BEFORE TESTING OPERATIONS BEGIN.
- CONTRACTOR SHALL PARK EQUIPMENT AND VEHICLES AS NOT TO INTERFERE WITH NORMAL ACTIVITIES OF RESIDENTS OR OTHER CONTRACTORS ON SITE.
- ANY DAMAGE TO THE EXISTING FACILITIES (CURB & GUTTER, PAVEMENT, CONDUITS, LANDSCAPING, UTILITY LINES, ETC.) DURING CONSTRUCTION SHALL BE REPLACED AT THE CONTRACTORS' EXPENSE.
- REMOVAL OF THE EXISTING CURB AND GUTTER SHALL BE AS PER COA STD. DWG. 2415 (SAWCUT ONLY).
- WHEELCHAIR RAMP SHALL BE CONSTRUCTED PRIOR TO ACCEPTANCE OF CURB & GUTTER.

* NOT APPLICABLE THIS SHEET

KEYED GENERAL NOTES

- INSTALL CONCRETE VALLEY GUTTER AS PER COA STD. DWG. 2421
- INSTALL CONCRETE VALLEY GUTTER AS PER COA STD. DWG. 2420
- INSTALL WHEELCHAIR RAMP AS PER COA STD. DWG. 2441, CASE I
- INSTALL WHEELCHAIR RAMP AS PER COA STD. DWG. 2441, CASE II
- STANDARD CURB & GUTTER AS PER COA STD. DWG. 2415
- MEDIAN CURB & GUTTER AS PER COA STD. DWG. 2415
- FUTURE 4' SIDEWALK
- BUILD 6' SIDEWALK
- BUILD 4' SIDEWALK


Bohannon & Huston
 Courtyard One 7500 JEFFERSON NE Albuquerque NEW MEXICO 87109
 ENGINEERS PLANNERS PHOTOGRAMMETRISTS SURVEYORS LANDSCAPE ARCHITECTS



CITY OF ALBUQUERQUE
 PUBLIC WORKS DEPARTMENT
 ENGINEERING DEVELOPMENT GROUP

WHISLER AT SEVEN BAR NORTH UNIT I
 PAVING PLAN & PROFILE
 AMARANTH AVENUE

DESIGN REVIEW COMMITTEE	CITY ENGINEER APPROVAL	MO./DAY/YR.	MO./DAY/YR.
APPROVED			
DESIGN REVIEW COMMITTEE			

CITY PROJECT NO.	ZONE MAP NO.	SHEET	OF
5752.82	A-13	6	19

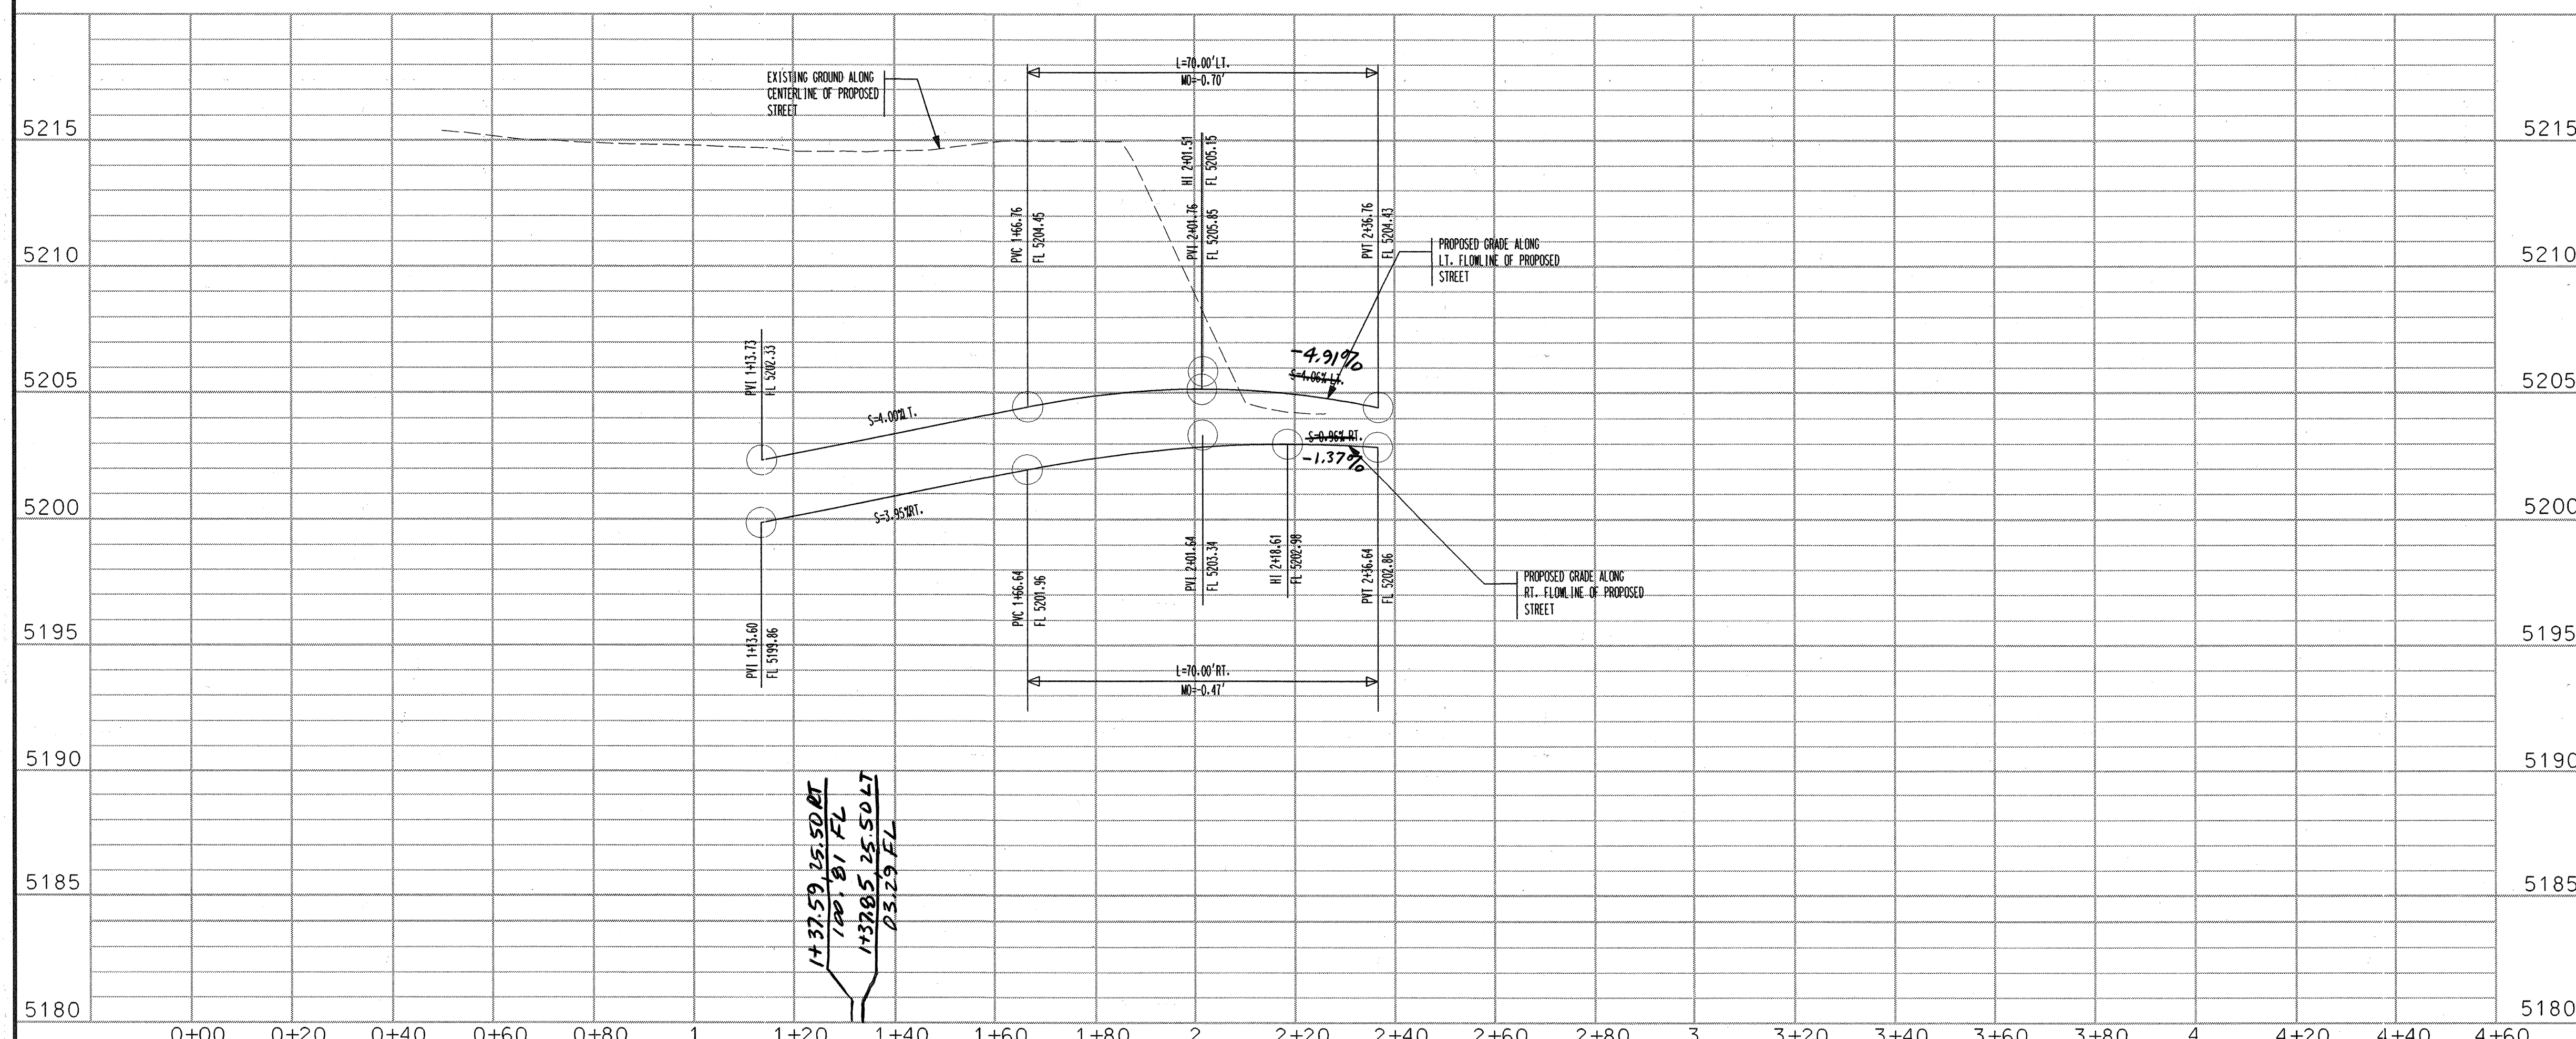


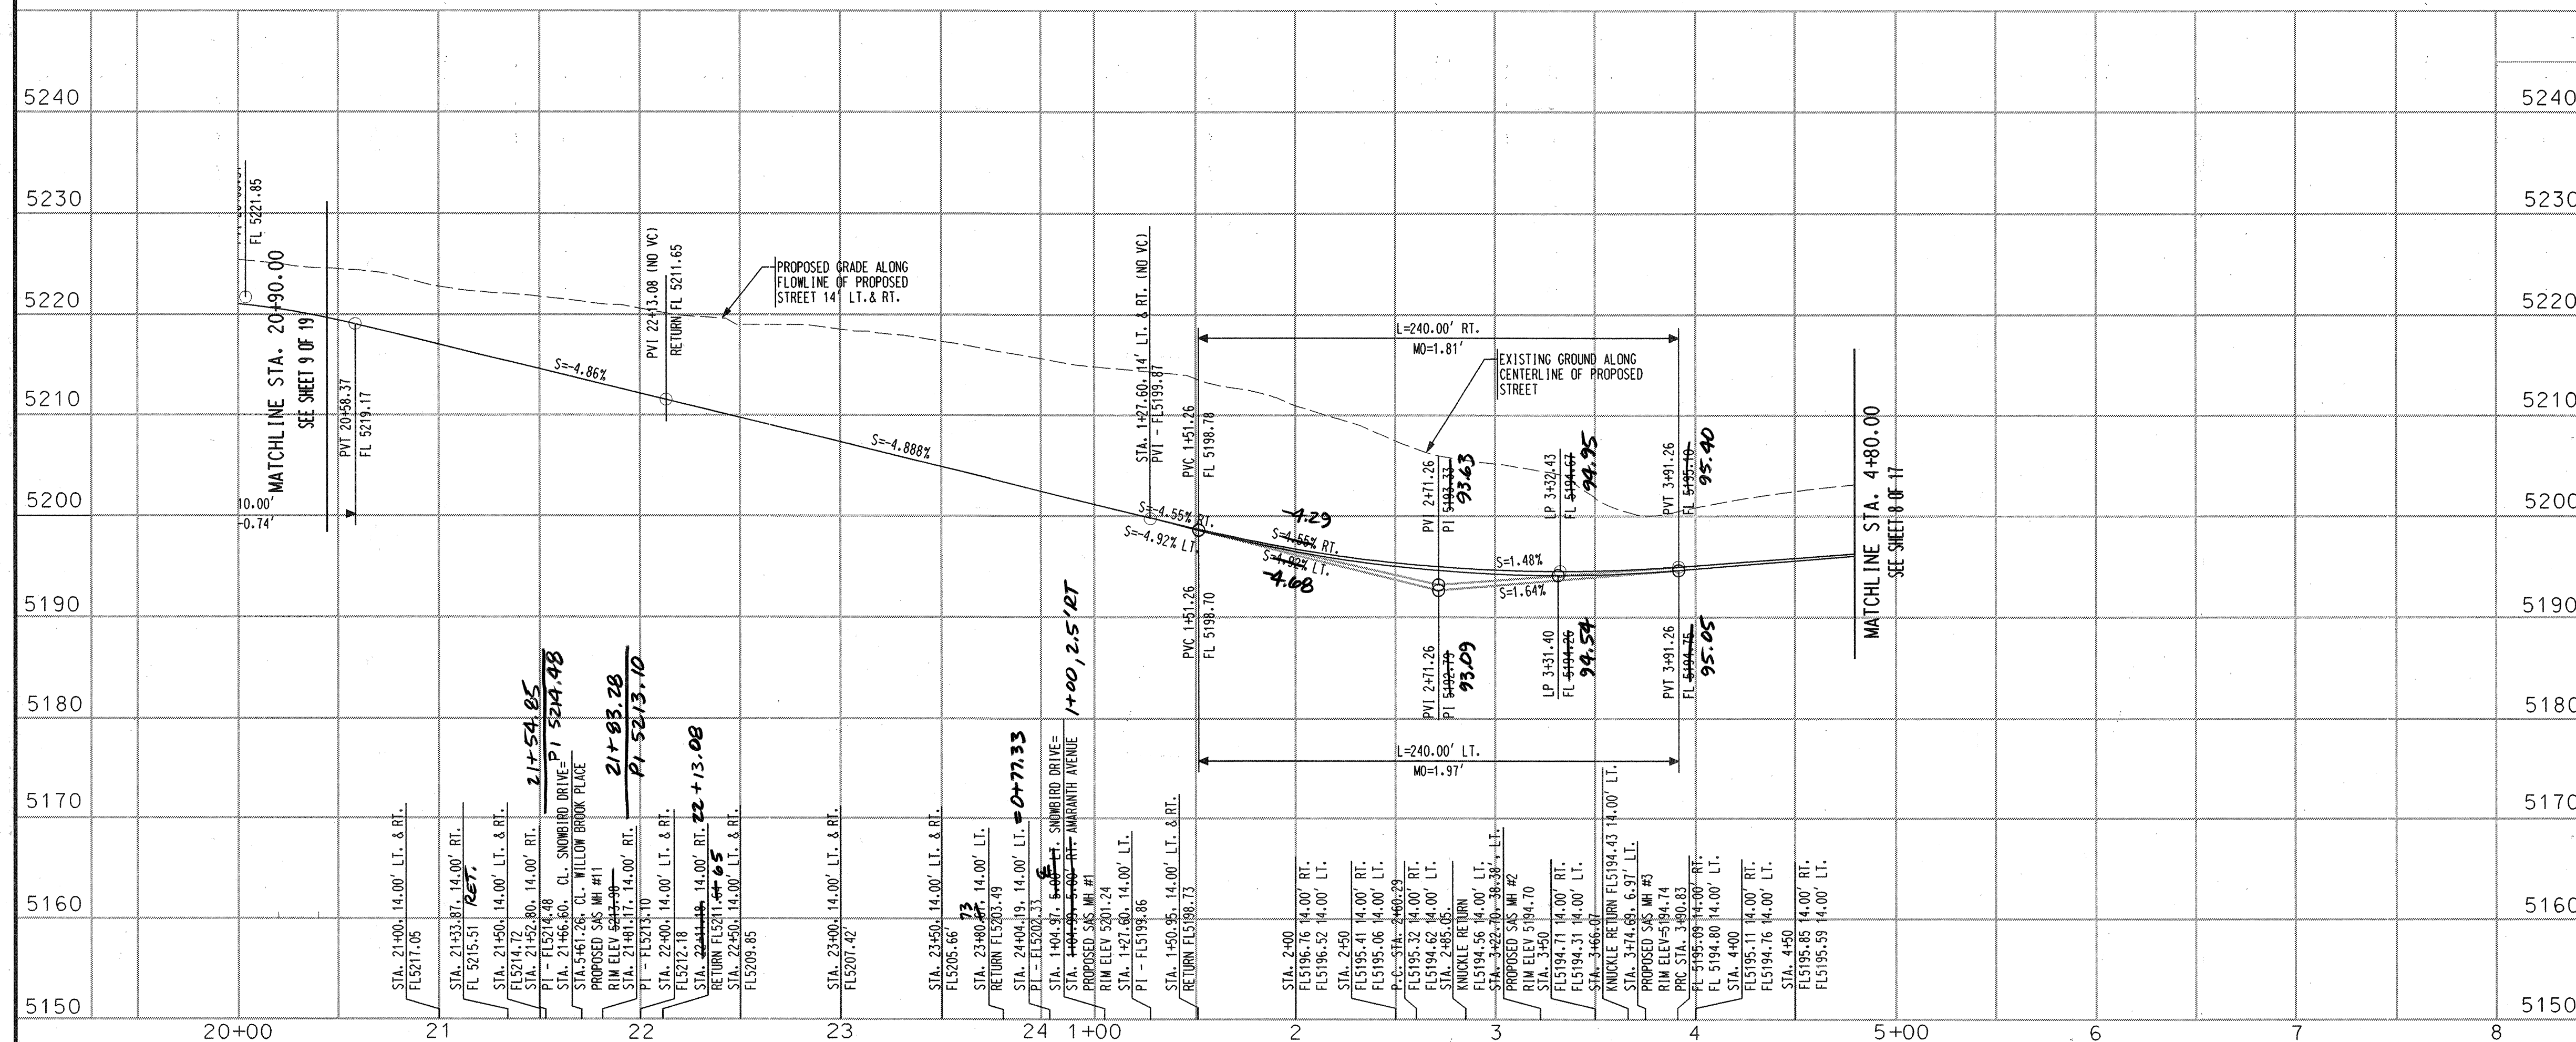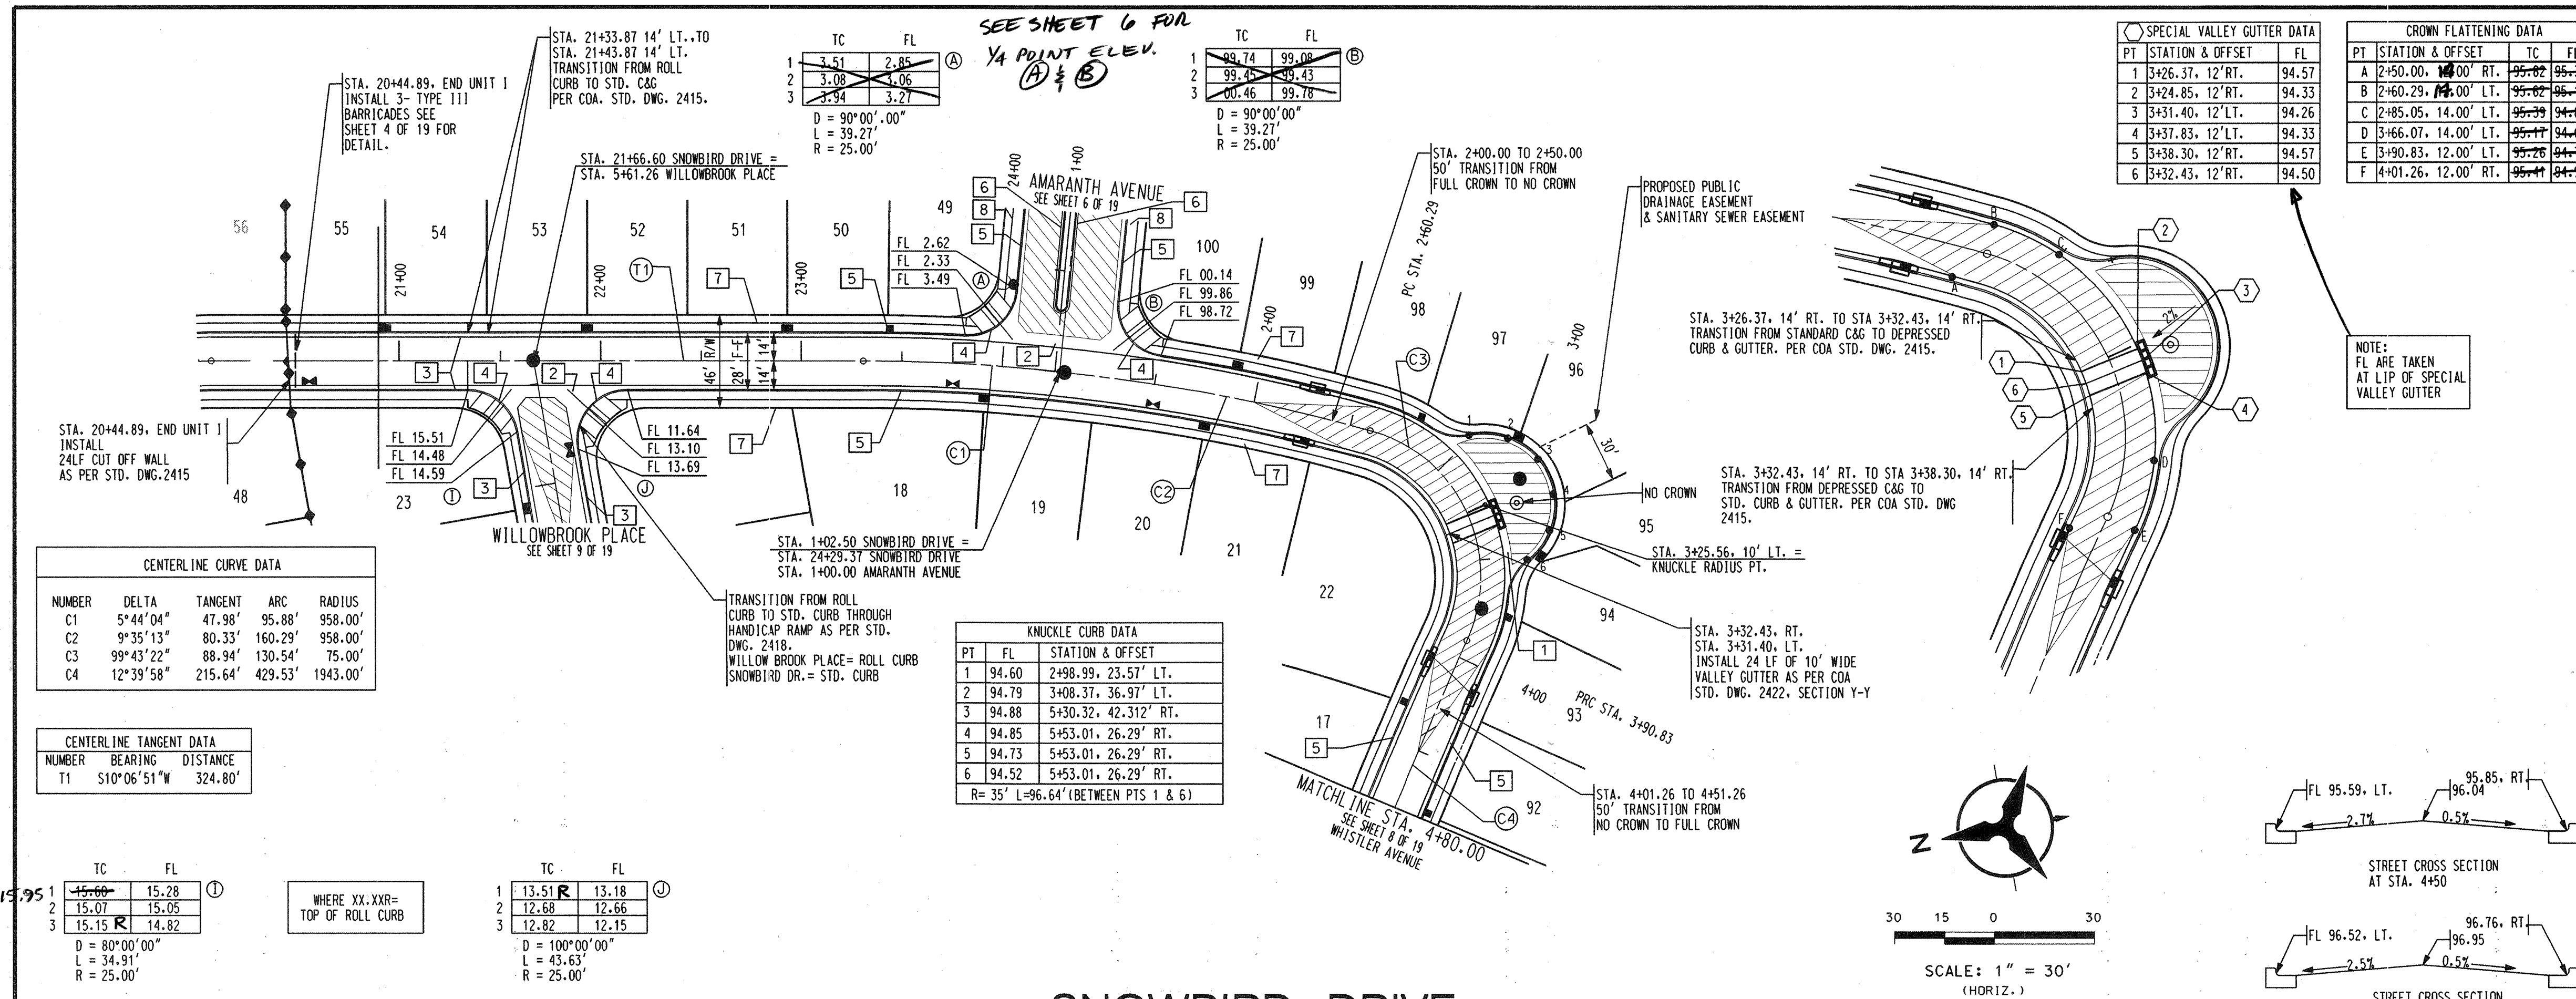

P:\BHI-MAIN\PROJECTS\94250\CDP\PNP\UNIT
94250PPNP02.DGN

BH1 JOB NO.98161A05

COPYRIGHT BOHANNAN HUSTON 1998
DATE: SEPTEMBER, 1998

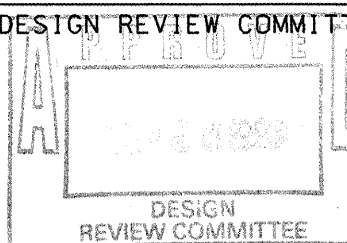FL NOTES 95.40 THE CONTRACTOR SHALL FIELD VERIFY ALL EXISTING UTILITY LOCATIONS AND NOTIFY THE ENGINEER IMMEDIATELY OF ANY DISCREPANCIES. 94.82 94.44 94.31 94.75 ALL CURB RETURN RADII SHALL BE 25' UNLESS OTHERWISE SPECIFIED. - ALL CURVE DATA AND DIMENSIONS REFER TO FACE OF CURB UNLESS OTHERWISE SPECIFIED. - GRADE ELEVATIONS, WHERE NOTED, ARE FOR FLOWLINE UNLESS OTHERWISE SPECIFIED. - CONTRACTOR IS TO INSTALL A 4" X 4" X 5' POST AND END AT THE END OF EACH SANITARY SEWER SERVICE. - CONTRACTOR IS RESPONSIBLE FOR REPAIR AND/OR REPLACEMENT OF ALL UTILITY CONDUITS AND EXISTING LINES. - ANY ADDITIONAL GRADING REQUIRED TO MATCH PROPOSED STREET GRADES SHALL BE INCIDENTAL TO PAVING ITEMS. - CONTRACTOR SHALL PROVIDE THE INSPECTORS, (CITY AND PRIVATE) WITH THE PROPOSED HYDROSTATIC TESTING PLAN. THE PLAN MUST BE APPROVED BEFORE TESTING OPERATIONS BEGIN. - CONTRACTOR SHALL PARK EQUIPMENT AND VEHICLES AS NOT TO INTERFERE WITH NORMAL ACTIVITIES OF RESIDENTS OR OTHER CONTRACTORS ON SITE. - ANY DAMAGE TO THE EXISTING FACILITIES (CURB & GUTTER, PAVEMENT, CONDUITS, LANDSCAPING, UTILITY LINES, ETC.) DURING CONSTRUCTION SHALL BE REPLACED AT THE CONTRACTORS' EXPENSE. - REMOVAL OF THE EXISTING CURB AND GUTTER SHALL BE AS PER COA STD. DWG. 2415 (SAWCUT ONLY). - WHEELCHAIR RAMPS SHALL BE CONSTRUCTED PRIOR TO ACCEPTANCE OF CURB & GUTTER. * NOT APPLICABLE THIS SHEET KEYED GENERAL NOTES - INSTALL CONCRETE VALLEY GUTTER AS PER COA STD. DWG. 2421 - INSTALL CONCRETE VALLEY GUTTER AS PER COA STD. DWG. 2420 - ROLL CURB AND GUTTER AS PER STD. DWG. 2415 - INSTALL WHEELCHAIR RAMP AS PER COA STD. DWG. 2441, CASE 11 - STANDARD CURB & GUTTER AS PER COA STD. DWG. 2415 - MEDIAN CURB & GUTTER AS PER COA STD. DWG. 2415 - FUTURE 4' SIDEWALK - BUILD 4' SIDEWALK						AS-BUILT INFORMATION CONTRACTOR: Sundance STARTED BY: JIS DATE: 08/99 INSPECTED BY: Cory Rocco DATE: 11/99 FIELD ACTION BY: JIS INC DATE: 01/00 DRAWINGS CORRECTED BY: JIS INC DATE: 01/00 MICRO-FILM INFORMATION RECORDED BY: _____ DATE: _____ NO. _____																																						
BENCH MARKS TBM NO. 205 CHISELED "X" LOCATED APPROXIMATELY 459 FEET SOUTH OF THE BLACK'S DIVERSION INLET STRUCTURE ON THE EAST WALL. ELEV. 5110.55						SURVEY INFORMATION FIELD NOTES <table border="1" style="width:100%;"> <thead> <tr> <th>NO.</th> <th>BY</th> <th>DATE</th> </tr> </thead> <tbody> <tr><td> </td><td> </td><td> </td></tr> <tr><td> </td><td> </td><td> </td></tr> <tr><td> </td><td> </td><td> </td></tr> <tr><td> </td><td> </td><td> </td></tr> <tr><td> </td><td> </td><td> </td></tr> <tr><td> </td><td> </td><td> </td></tr> <tr><td> </td><td> </td><td> </td></tr> <tr><td> </td><td> </td><td> </td></tr> <tr><td> </td><td> </td><td> </td></tr> <tr><td> </td><td> </td><td> </td></tr> </tbody> </table>						NO.	BY	DATE																														
NO.	BY	DATE																																										
ENGINEER'S SEAL 						<table border="1" style="width:100%;"> <thead> <tr> <th>REMARKS</th> <th>BY</th> <th>DATE</th> </tr> </thead> <tbody> <tr><td> </td><td> </td><td> </td></tr> <tr><td> </td><td> </td><td> </td></tr> <tr><td> </td><td> </td><td> </td></tr> <tr><td> </td><td> </td><td> </td></tr> <tr><td> </td><td> </td><td> </td></tr> <tr><td> </td><td> </td><td> </td></tr> <tr><td> </td><td> </td><td> </td></tr> <tr><td> </td><td> </td><td> </td></tr> <tr><td> </td><td> </td><td> </td></tr> <tr><td> </td><td> </td><td> </td></tr> </tbody> </table>						REMARKS	BY	DATE																														
REMARKS	BY	DATE																																										
Bohannon ▴ Huston  Courtyard One 7500 JEFFERSON NE Albuquerque NEW MEXICO 87109 ENGINEERS PLANNERS PHOTOGRAMMETRISTS SURVEYORS LANDSCAPE ARCHITECTS						DESIGNED BY: JCA DATE: 09/98 DRAWN BY: PEG/GGG DATE: 09/98 CHECKED BY: JCA DATE: 09/98																																						
CITY OF ALBUQUERQUE PUBLIC WORKS DEPARTMENT ENGINEERING DEVELOPMENT GROUP																																												
WHISTLER AT SEVEN BAR NORTH UNIT I PAVING PLAN & PROFILE SNOWBIRD DRIVE																																												
DESIGN REVIEW COMMITTEE 						CITY ENGINEER APPROVAL LAST DESIGN UPDATE <table border="1" style="width:100%;"> <tr><td> </td></tr> <tr><td> </td></tr> <tr><td> </td></tr> <tr><td> </td></tr> <tr><td> </td></tr> </table>																																						
CITY PROJECT NO. 5752.82						ZONE MAP NO. A-13																																						
SHEET 7						OF 19																																						

SCANNED BY
MESA REPRO

KNUCKLE CURB DATA		
PT	FL	STATION & OFFSET
1	95.94	8+38.72, 19.95' LT.
2	00.29	8+48.44, 29.45' LT.
3	00.56	8+59.13, 34.38' LT.
4	00.77	8+70.10, 34.38' LT.
5	00.90	8+80.79, 29.45' LT.
6	00.97	8+90.51, 19.95' LT.
R=35.00', L=79.69' (BETWEEN PTS 1 & 6)		

CENTERLINE CURVE DATA				
NUMBER	DELTA	TANGENT	ARC	RADIUS
C4	12°39'58"	215.64'	429.53'	1943.00'
C5	-67°37'19"	50.23'	88.52'	75.00'

CENTERLINE TANGENT DATA		
NUMBER	BEARING	DISTANCE
T1	N00°06'51"E	159.31'



CENTERLINE CURVE DATA				
NUMBER	DELTA	TANGENT	ARC	RADIUS
C1	90°00'00"	75.00'	117.81'	75.00'

CENTERLINE TANGENT DATA		
NUMBER	BEARING	DISTANCE
T1	N00°06'51"E	330.31'
T2	S89°53'09"E	518.29'

KNUCKLE CURB DATA		
PT	FL	STATION & OFFSET
1	18.11	12+73.15, 20.49' LT.
2	18.45	12+82.98, 29.92' LT.
3	18.67	12+93.42, 34.62' LT.
4	18.76	13+04.05, 34.62' LT.
5	18.71	13+14.47, 29.93' LT.
6	18.57	13+24.67, 20.01' LT.
R=35.00', L=81.46' (BETWEEN PTS 1 & 6)		


NOTES

- THE CONTRACTOR SHALL FIELD VERIFY ALL EXISTING UTILITY LOCATIONS AND NOTIFY THE ENGINEER IMMEDIATELY OF ANY DISCREPANCIES.
- ALL CURB RETURN RADI1 SHALL BE 25' UNLESS OTHERWISE SPECIFIED.
- ALL CURVE DATA AND DIMENSIONS REFER TO FACE OF CURB UNLESS OTHERWISE SPECIFIED.
- GRADE ELEVATIONS, WHERE NOTED, ARE FOR FLOWLINE UNLESS OTHERWISE SPECIFIED.
- CONTRACTOR IS TO INSTALL A 4" X 4" X 5' POST AND END AT THE END OF EACH SANITARY SEWER SERVICE.
- CONTRACTOR IS RESPONSIBLE FOR REPAIR AND/OR REPLACEMENT OF ALL UTILITY CONDUITS AND EXISTING LINES.
- ANY ADDITIONAL GRADING REQUIRED TO MATCH PROPOSED STREET GRADES SHALL BE INCIDENTAL TO PAVING ITEMS.
- CONTRACTOR SHALL PROVIDE THE INSPECTORS (CITY AND PRIVATE) WITH THE PROPOSED HYDROSTATIC TESTING PLAN. THE PLAN MUST BE APPROVED BEFORE TESTING OPERATIONS BEGIN.
- CONTRACTOR SHALL PARK EQUIPMENT AND VEHICLES AS NOT TO INTERFERE WITH NORMAL ACTIVITIES OF RESIDENTS OR OTHER CONTRACTORS ON SITE.
- ANY DAMAGE TO THE EXISTING FACILITIES (CURB & GUTTER, PAVEMENT, CONDUITS, LANDSCAPING, UTILITY LINES, ETC.) DURING CONSTRUCTION SHALL BE REPLACED AT THE CONTRACTORS' EXPENSE.
- REMOVAL OF THE EXISTING CURB AND GUTTER SHALL BE AS PER COA STD. DWG. 2415 (SAWCUT ONLY).
- WHEELCHAIR RAMP SHALL BE CONSTRUCTED PRIOR TO ACCEPTANCE OF CURB & GUTTER.

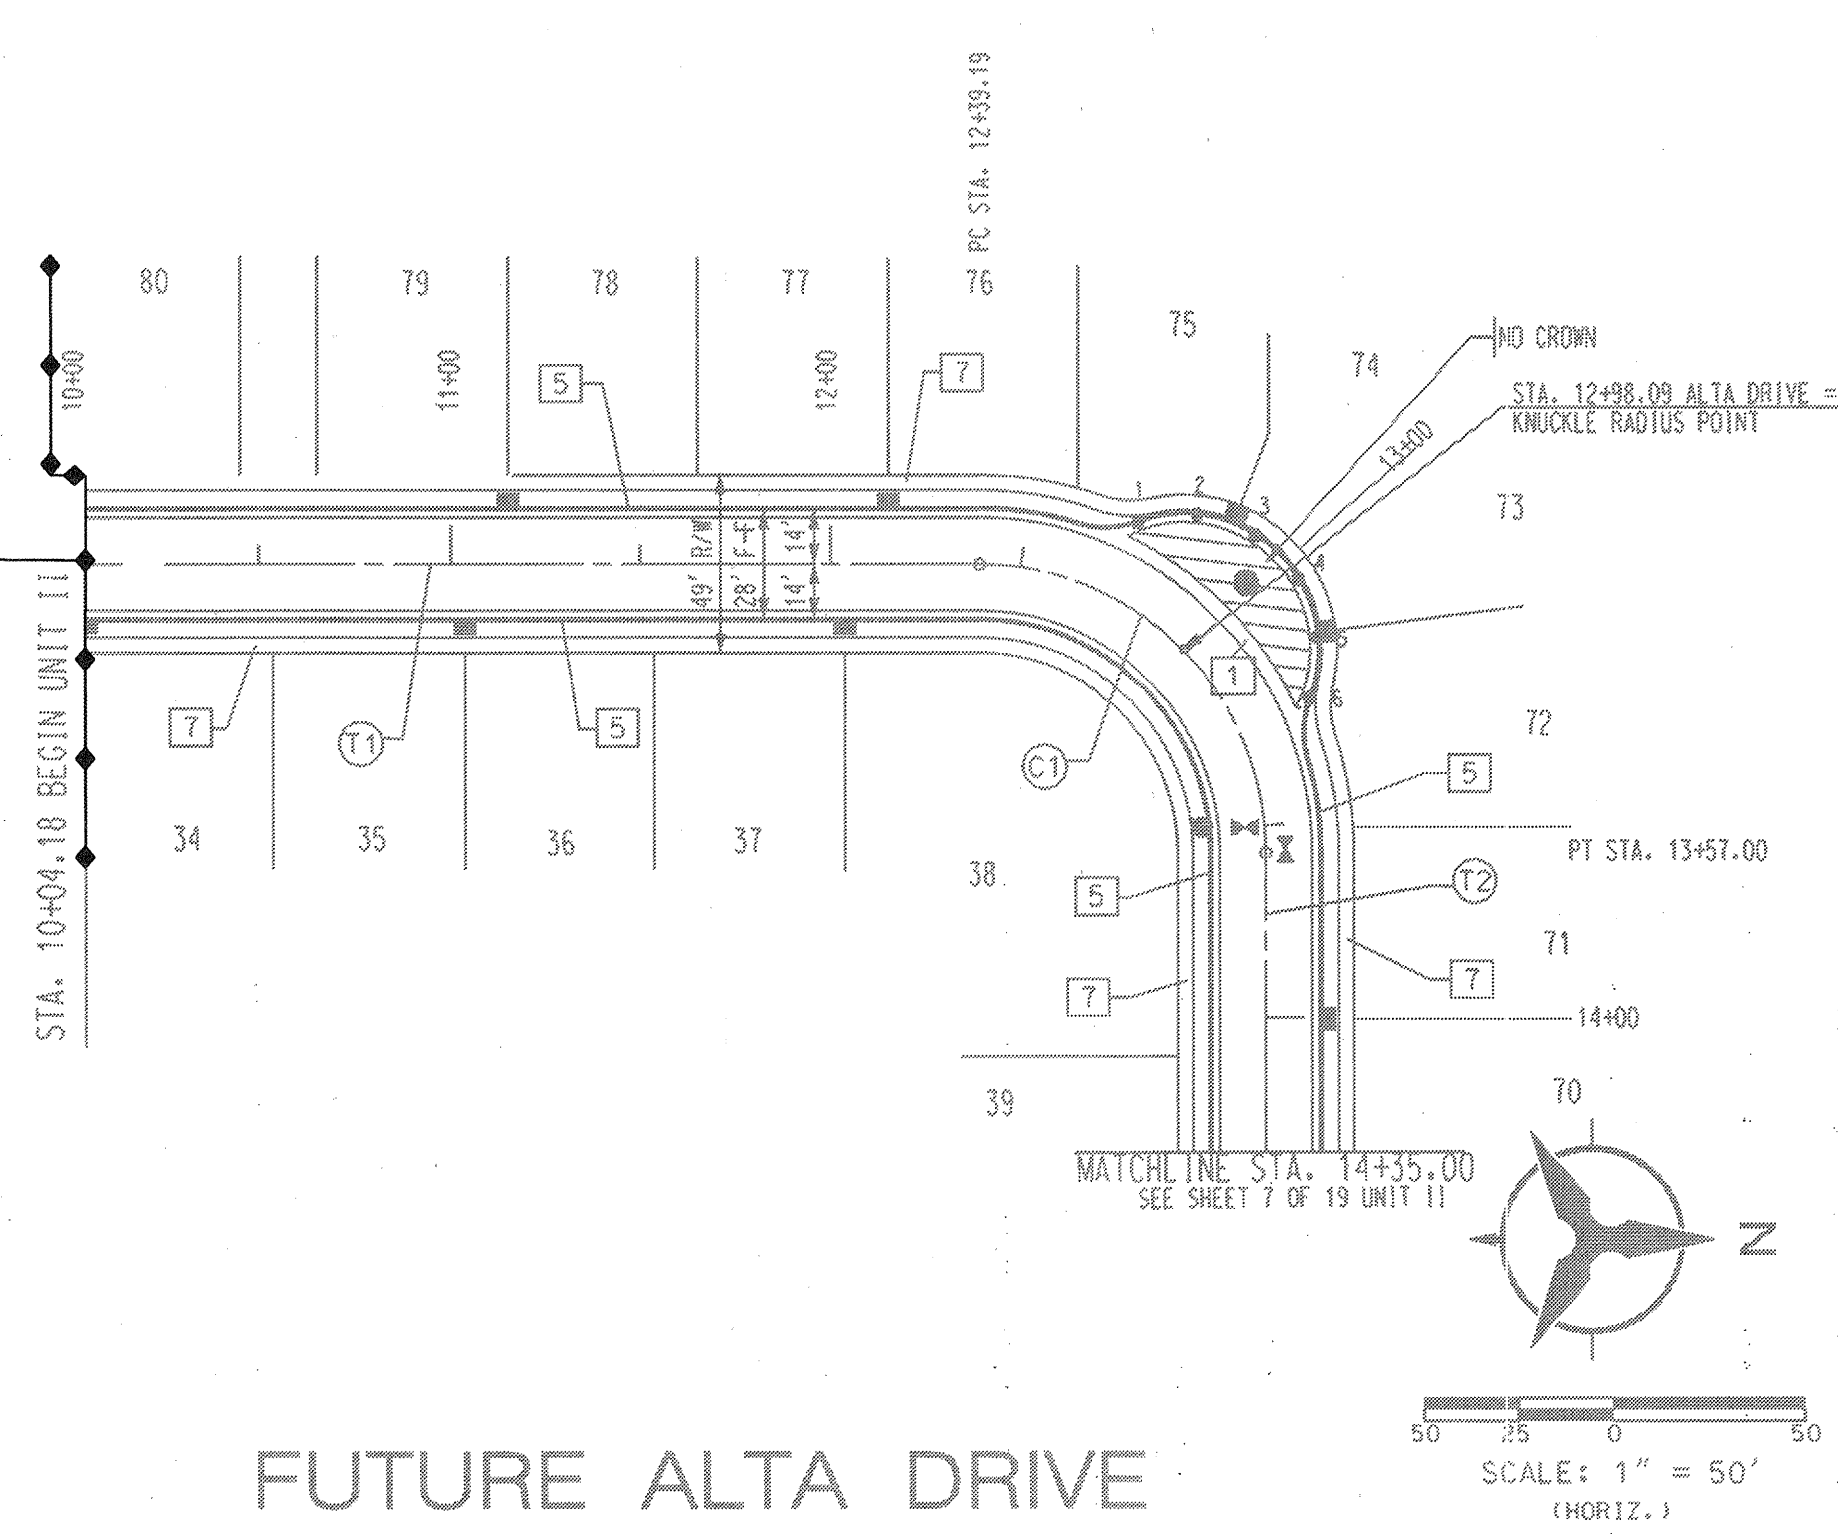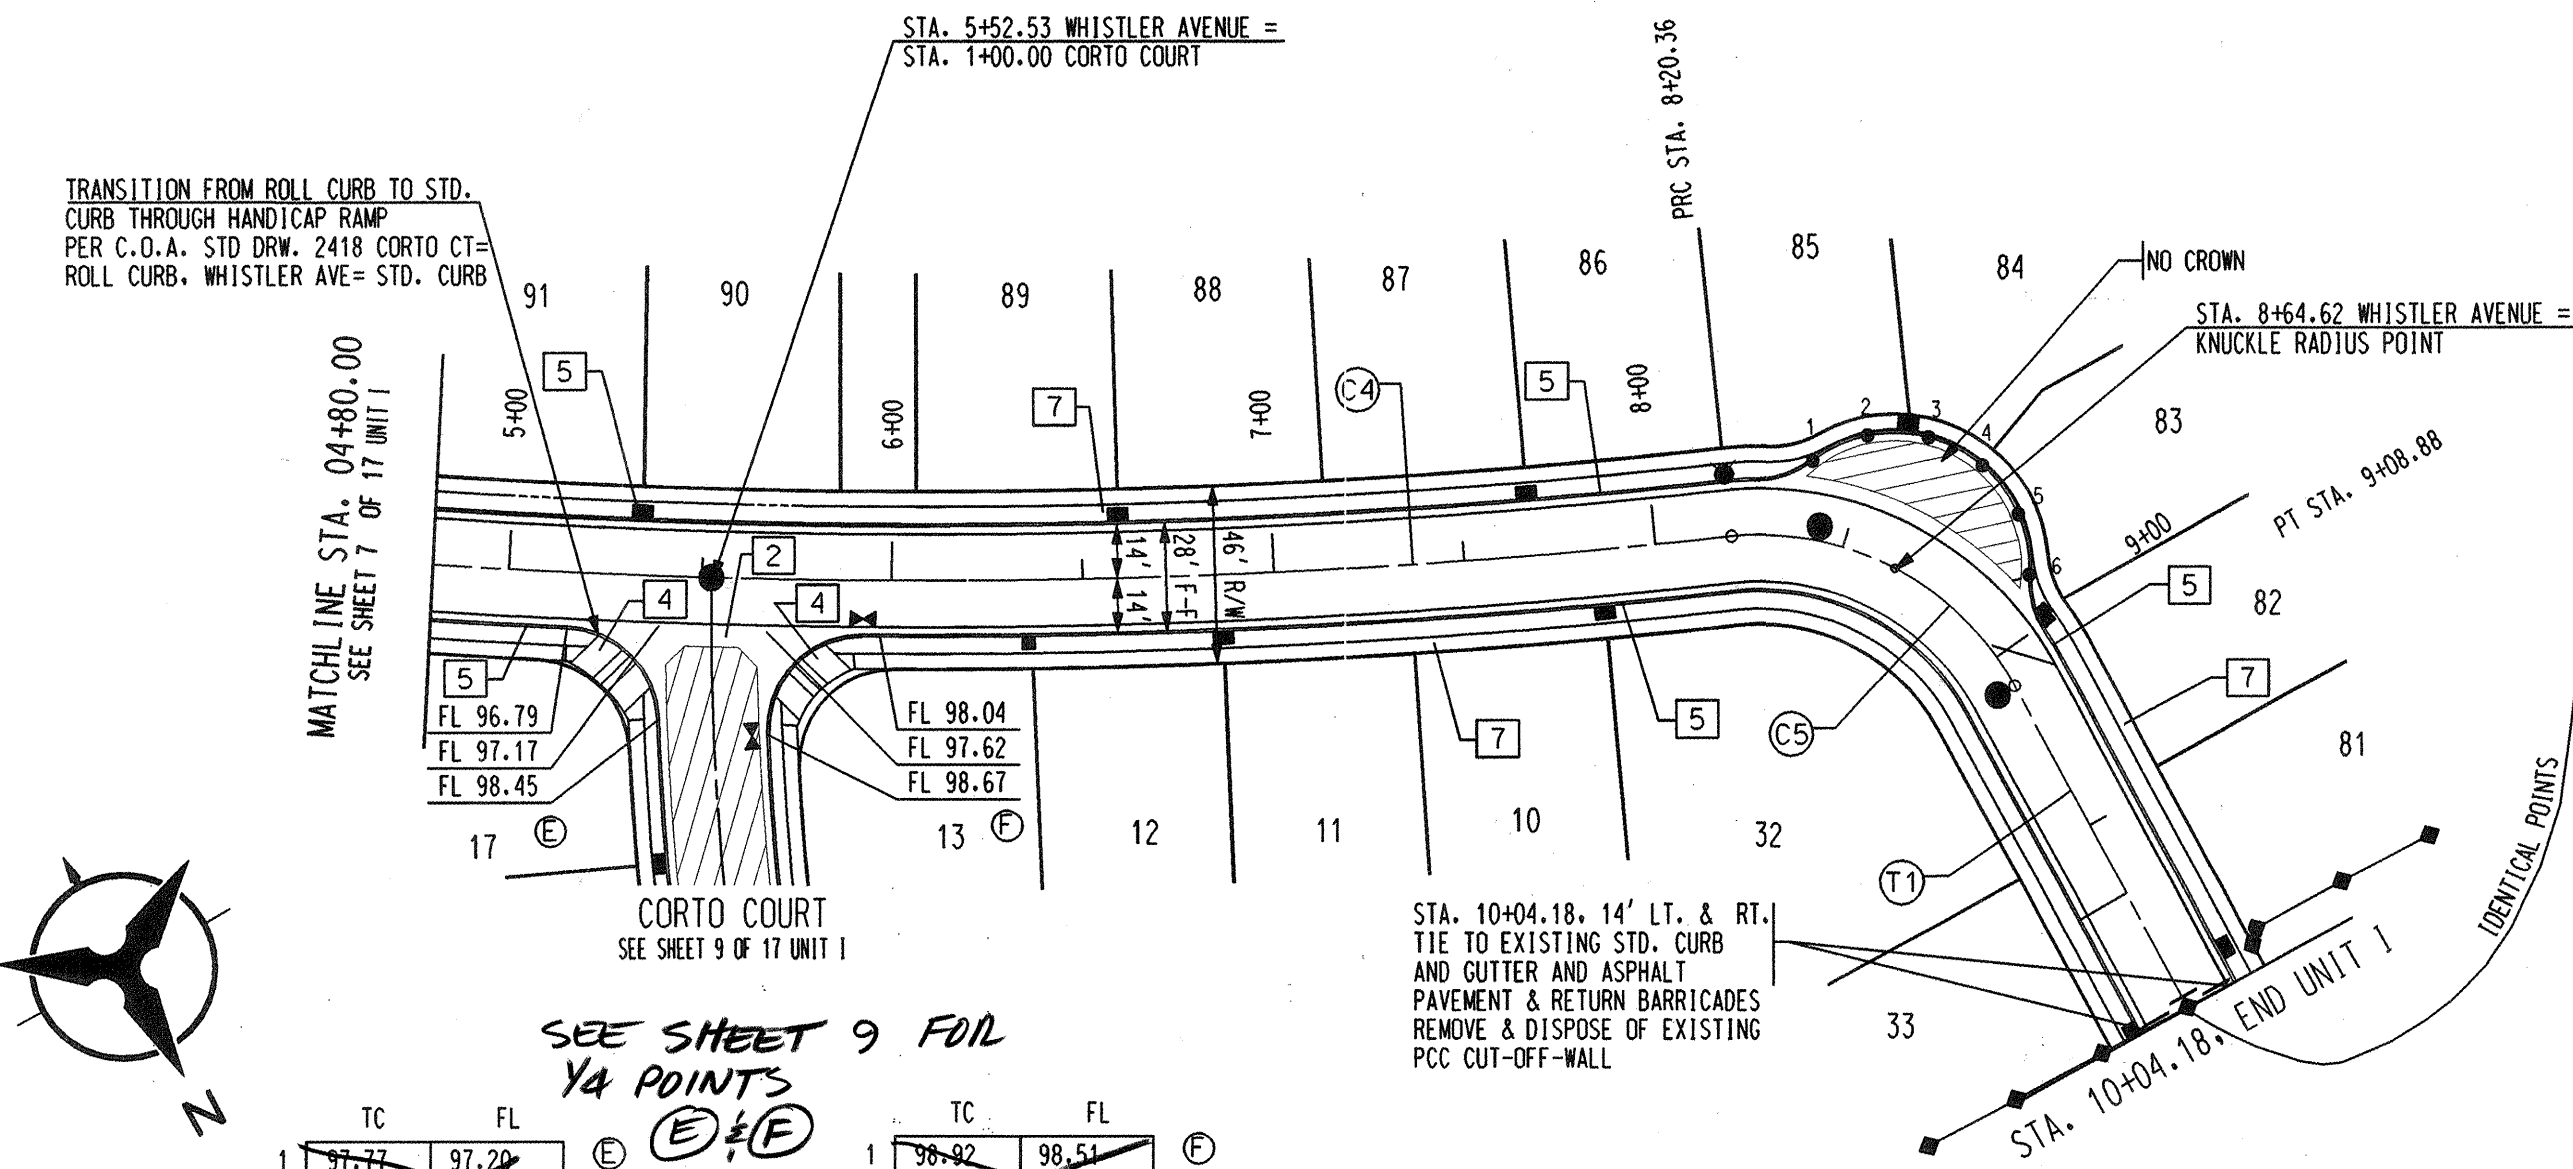

WHISTLER AVENUE

FUTURE ALTA DRIVE


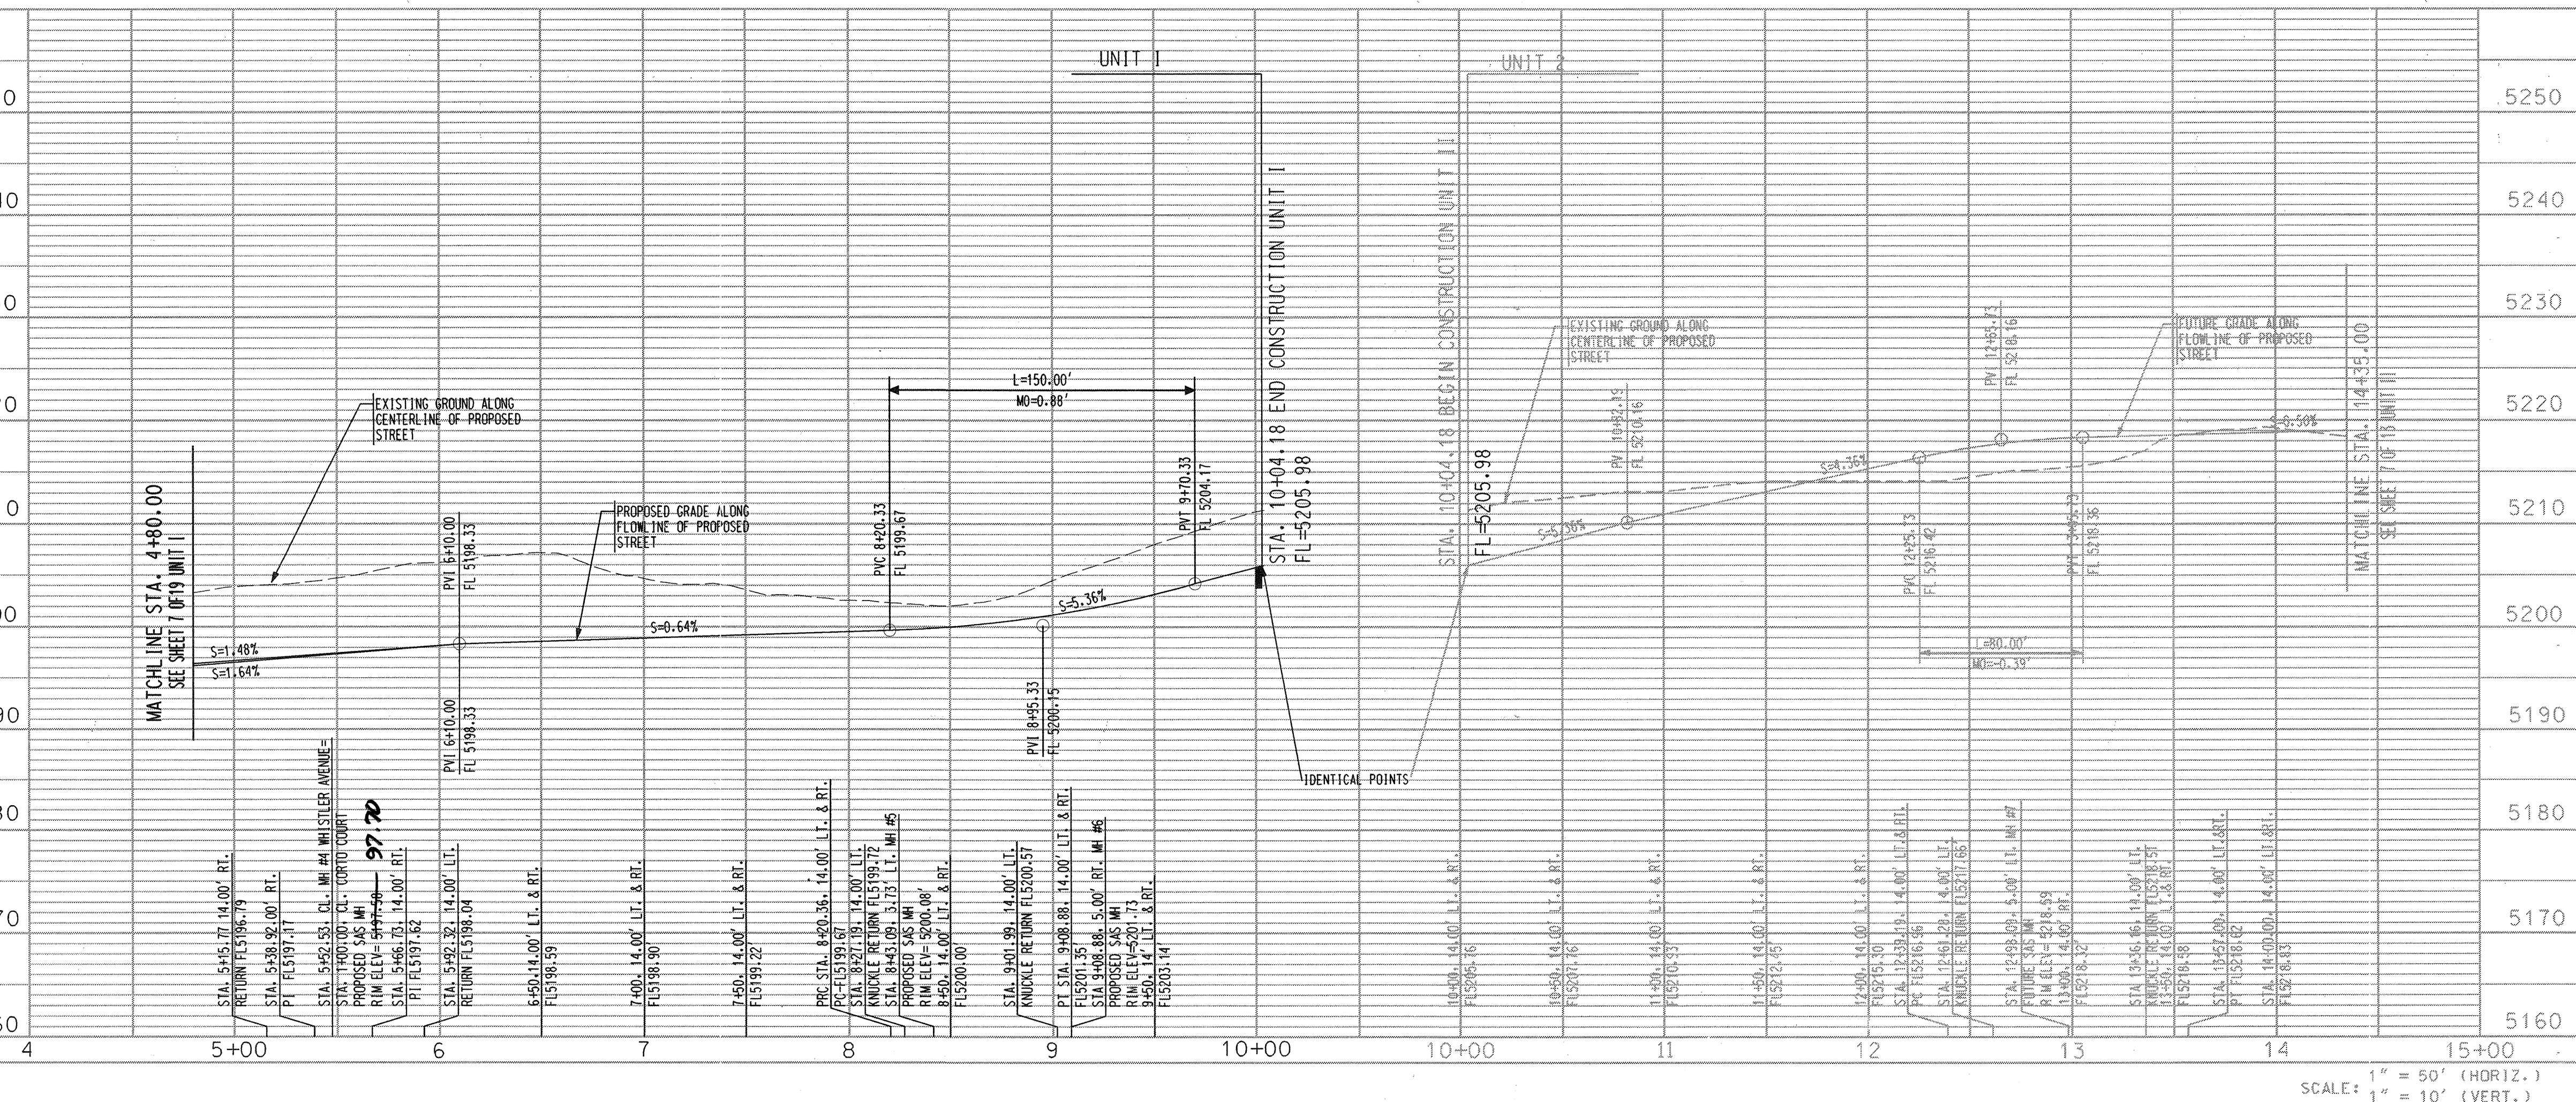


KEYED GENERAL NOTES

- INSTALL CONCRETE VALLEY GUTTER AS PER COA STD. DWG. 2421
 - INSTALL CONCRETE VALLEY GUTTER AS PER COA STD. DWG. 2420
 - INSTALL WHEELCHAIR RAMP AS PER COA STD. DWG. 2441, CASE 1
 - INSTALL WHEELCHAIR RAMP AS PER COA STD. DWG. 2441, CASE 11
 - STANDARD CURB & GUTTER AS PER COA STD. DWG. 2415
 - MEDIAN CURB & GUTTER AS PER COA STD. DWG. 2415
 - FUTURE 4' SIDEWALK
 - BUILD 6' SIDEWALK
- * NOT APPLICABLE THIS SHEET

Bohannon & Huston
Courtney One 7500 JEFFERSON NE ALBUQUERQUE NEW MEXICO 87109
ENGINEERS PLANNERS PHOTOGRAMMETRISTS SURVEYORS LANDSCAPE ARCHITECTS

CITY OF ALBUQUERQUE
PUBLIC WORKS DEPARTMENT
ENGINEERING DEVELOPMENT GROUP
WHISTLER AT SEVEN BAR NORTH UNIT I
PAVING PLAN & PROFILE
WHISTLER AVENUE & ALTA DRIVE
DESIGN REVIEW COMMITTEE CITY ENGINEER APPROVAL
LAST DESIGN UPDATE
CITY PROJECT NO. 5752.82
ZONE MAP NO. A-13
SHEET 8 OF 19
DESIGNED BY JCA
DRAWN BY PEG/GGG
CHECKED BY JCA
DATE 09/98
DATE 09/98
DATE 09/98

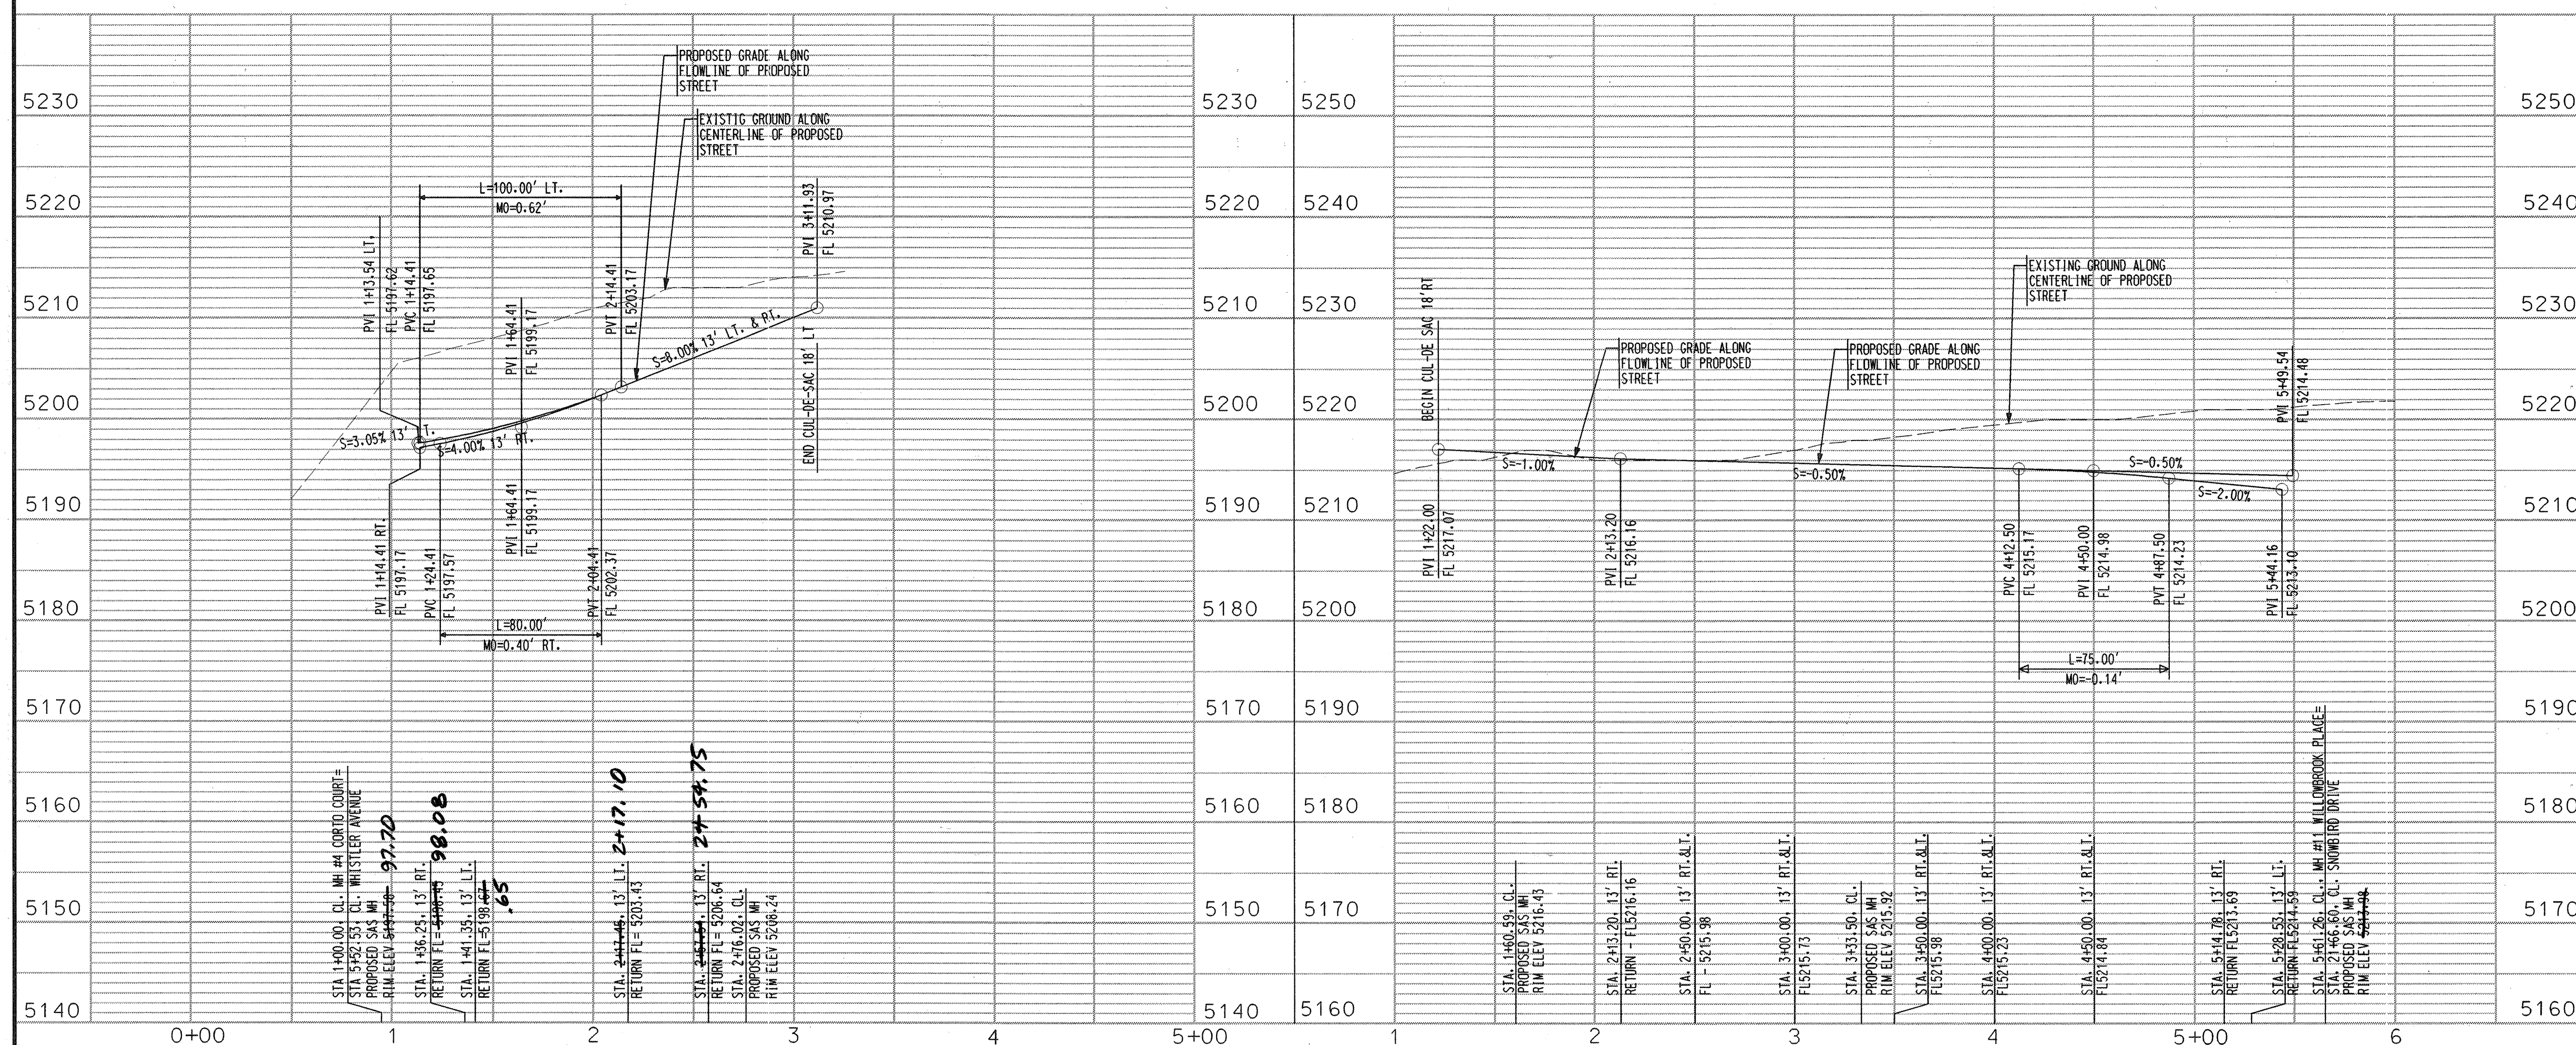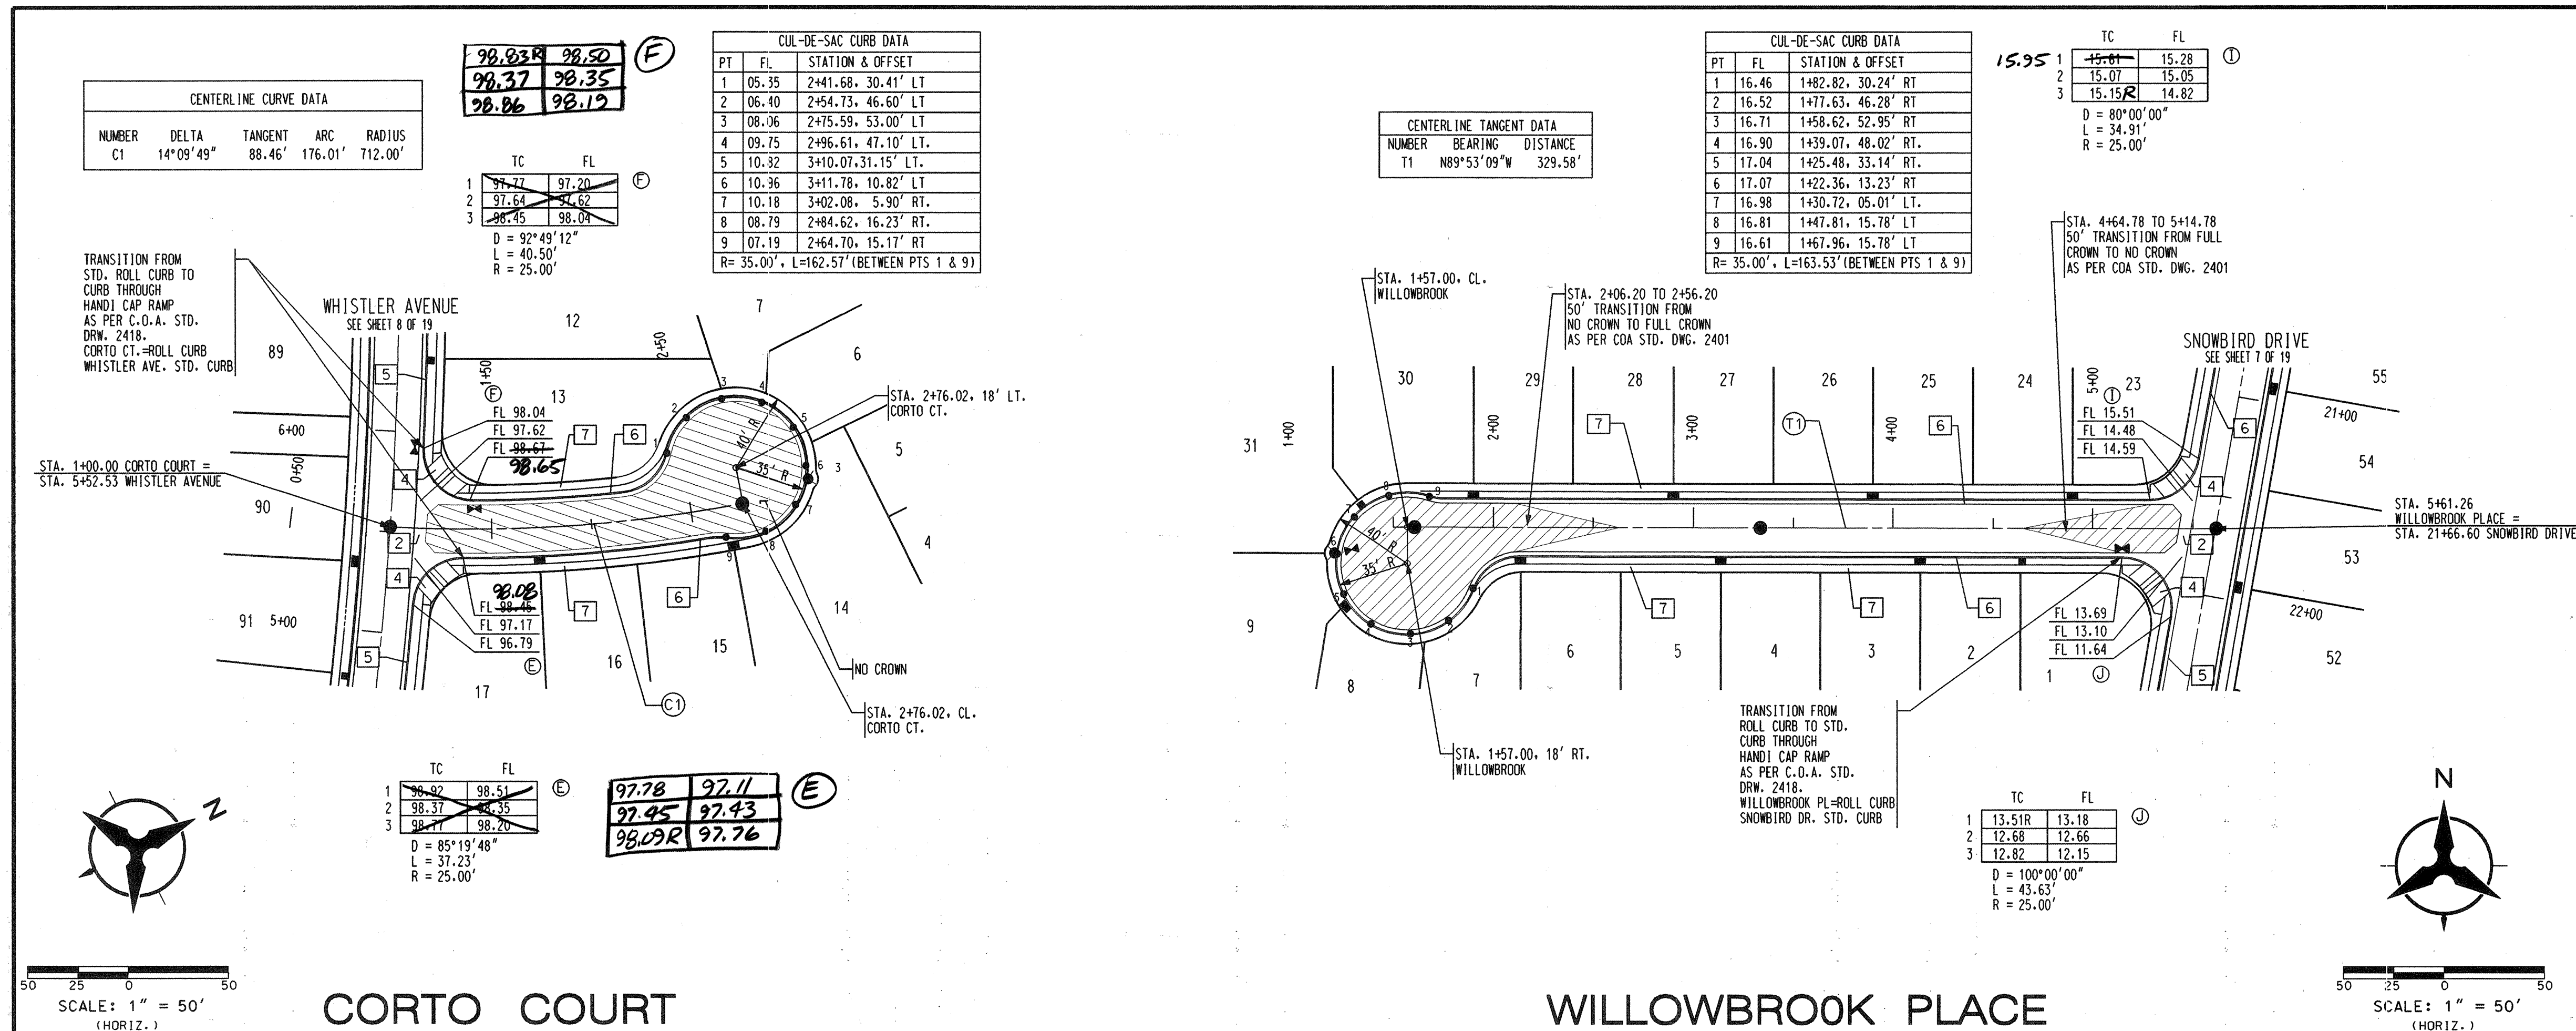

- NOTES
1. THE CONTRACTOR SHALL FIELD VERIFY ALL EXISTING UTILITY LOCATIONS AND NOTIFY THE ENGINEER IMMEDIATELY OF ANY DISCREPANCIES.
 2. ALL CURB RETURN RADII SHALL BE 25' UNLESS OTHERWISE SPECIFIED.
 3. ALL CURVE DATA AND DIMENSIONS REFER TO FACE OF CURB UNLESS OTHERWISE SPECIFIED.
 4. GRADE ELEVATIONS, WHERE NOTED, ARE FOR FLOWLINE UNLESS OTHERWISE SPECIFIED.
 5. CONTRACTOR IS TO INSTALL A 4" X 4" X 5' POST AND END AT THE END OF EACH SANITARY SEWER SERVICE.
 6. CONTRACTOR IS RESPONSIBLE FOR REPAIR AND/OR REPLACEMENT OF ALL UTILITY CONDUITS AND EXISTING LINES.
 7. ANY ADDITIONAL GRADING REQUIRED TO MATCH PROPOSED STREET GRADES SHALL BE INCIDENTAL TO PAVING ITEMS.
 8. CONTRACTOR SHALL PROVIDE THE INSPECTORS, (CITY AND PRIVATE) WITH THE PROPOSED HYDROSTATIC TESTING PLAN. THE PLAN MUST BE APPROVED BEFORE TESTING OPERATIONS BEGIN.
 9. CONTRACTOR SHALL PARK EQUIPMENT AND VEHICLES AS NOT TO INTERFERE WITH NORMAL ACTIVITIES OF RESIDENTS OR OTHER CONTRACTORS ON SITE.
 10. ANY DAMAGE TO THE EXISTING FACILITIES (CURB & GUTTER, PAVEMENT, CONDUITS, LANDSCAPING, UTILITY LINES, ETC.) DURING CONSTRUCTION SHALL BE REPLACED AT THE CONTRACTORS' EXPENSE.
 11. REMOVAL OF THE EXISTING CURB AND GUTTER SHALL BE AS PER COA STD. DWG. 2415 (SAWCUT ONLY).
 12. WHEELCHAIR RAMPS SHALL BE CONSTRUCTED PRIOR TO ACCEPTANCE OF CURB & GUTTER.

* NOT APPLICABLE THIS SHEET

KEYED GENERAL NOTES

- * **1** INSTALL CONCRETE VALLEY GUTTER
AS PER COA STD. DWG. 2421
- 2** INSTALL CONCRETE VALLEY GUTTER
AS PER COA STD. DWG. 2420
- * **3** INSTALL WHEELCHAIR RAMP AS
PER COA STD. DWG. 2441, CASE I
- 4** INSTALL WHEELCHAIR RAMP AS
PER COA STD. DWG. 2441, CASE II
- 5** STANDARD CURB & GUTTER
AS PER COA STD. DWG. 2415
- 6** ROLL CURB & GUTTER
AS PER COA STD. DWG. 2415
- 7** FUTURE 4' SIDEWALK
- * **8** BUILD 6' SIDEWALK

Bohannon ▲ Huston

 **Courtyard One** 7500 JEFFERSON NE Albuquerque NEW MEXICO 87109

ENGINEERS PLANNERS PHOTOGRAMMETRISTS SURVEYORS LANDSCAPE ARCHITECTS

 CITY OF ALBUQUERQUE
PUBLIC WORKS DEPARTMENT
ENGINEERING DEVELOPMENT GROUP

WHISTLER AT SEVEN BAR NORTH UNIT I
PAVING PLAN & PROFILE
CORTO COURT /WILLOWBROOK PLACE

DESIGN REVIEW COMMITTEE	CITY ENGINEER APPROVAL
-------------------------	------------------------




APPROVED
DESIGN
REVIEW COMMITTEE

	CITY PROJECT NO.
--	------------------



5752.82

ZONE MAP NO.	SHEET	OF
A-13	9	19

SCANNED BY
MESA REPRO

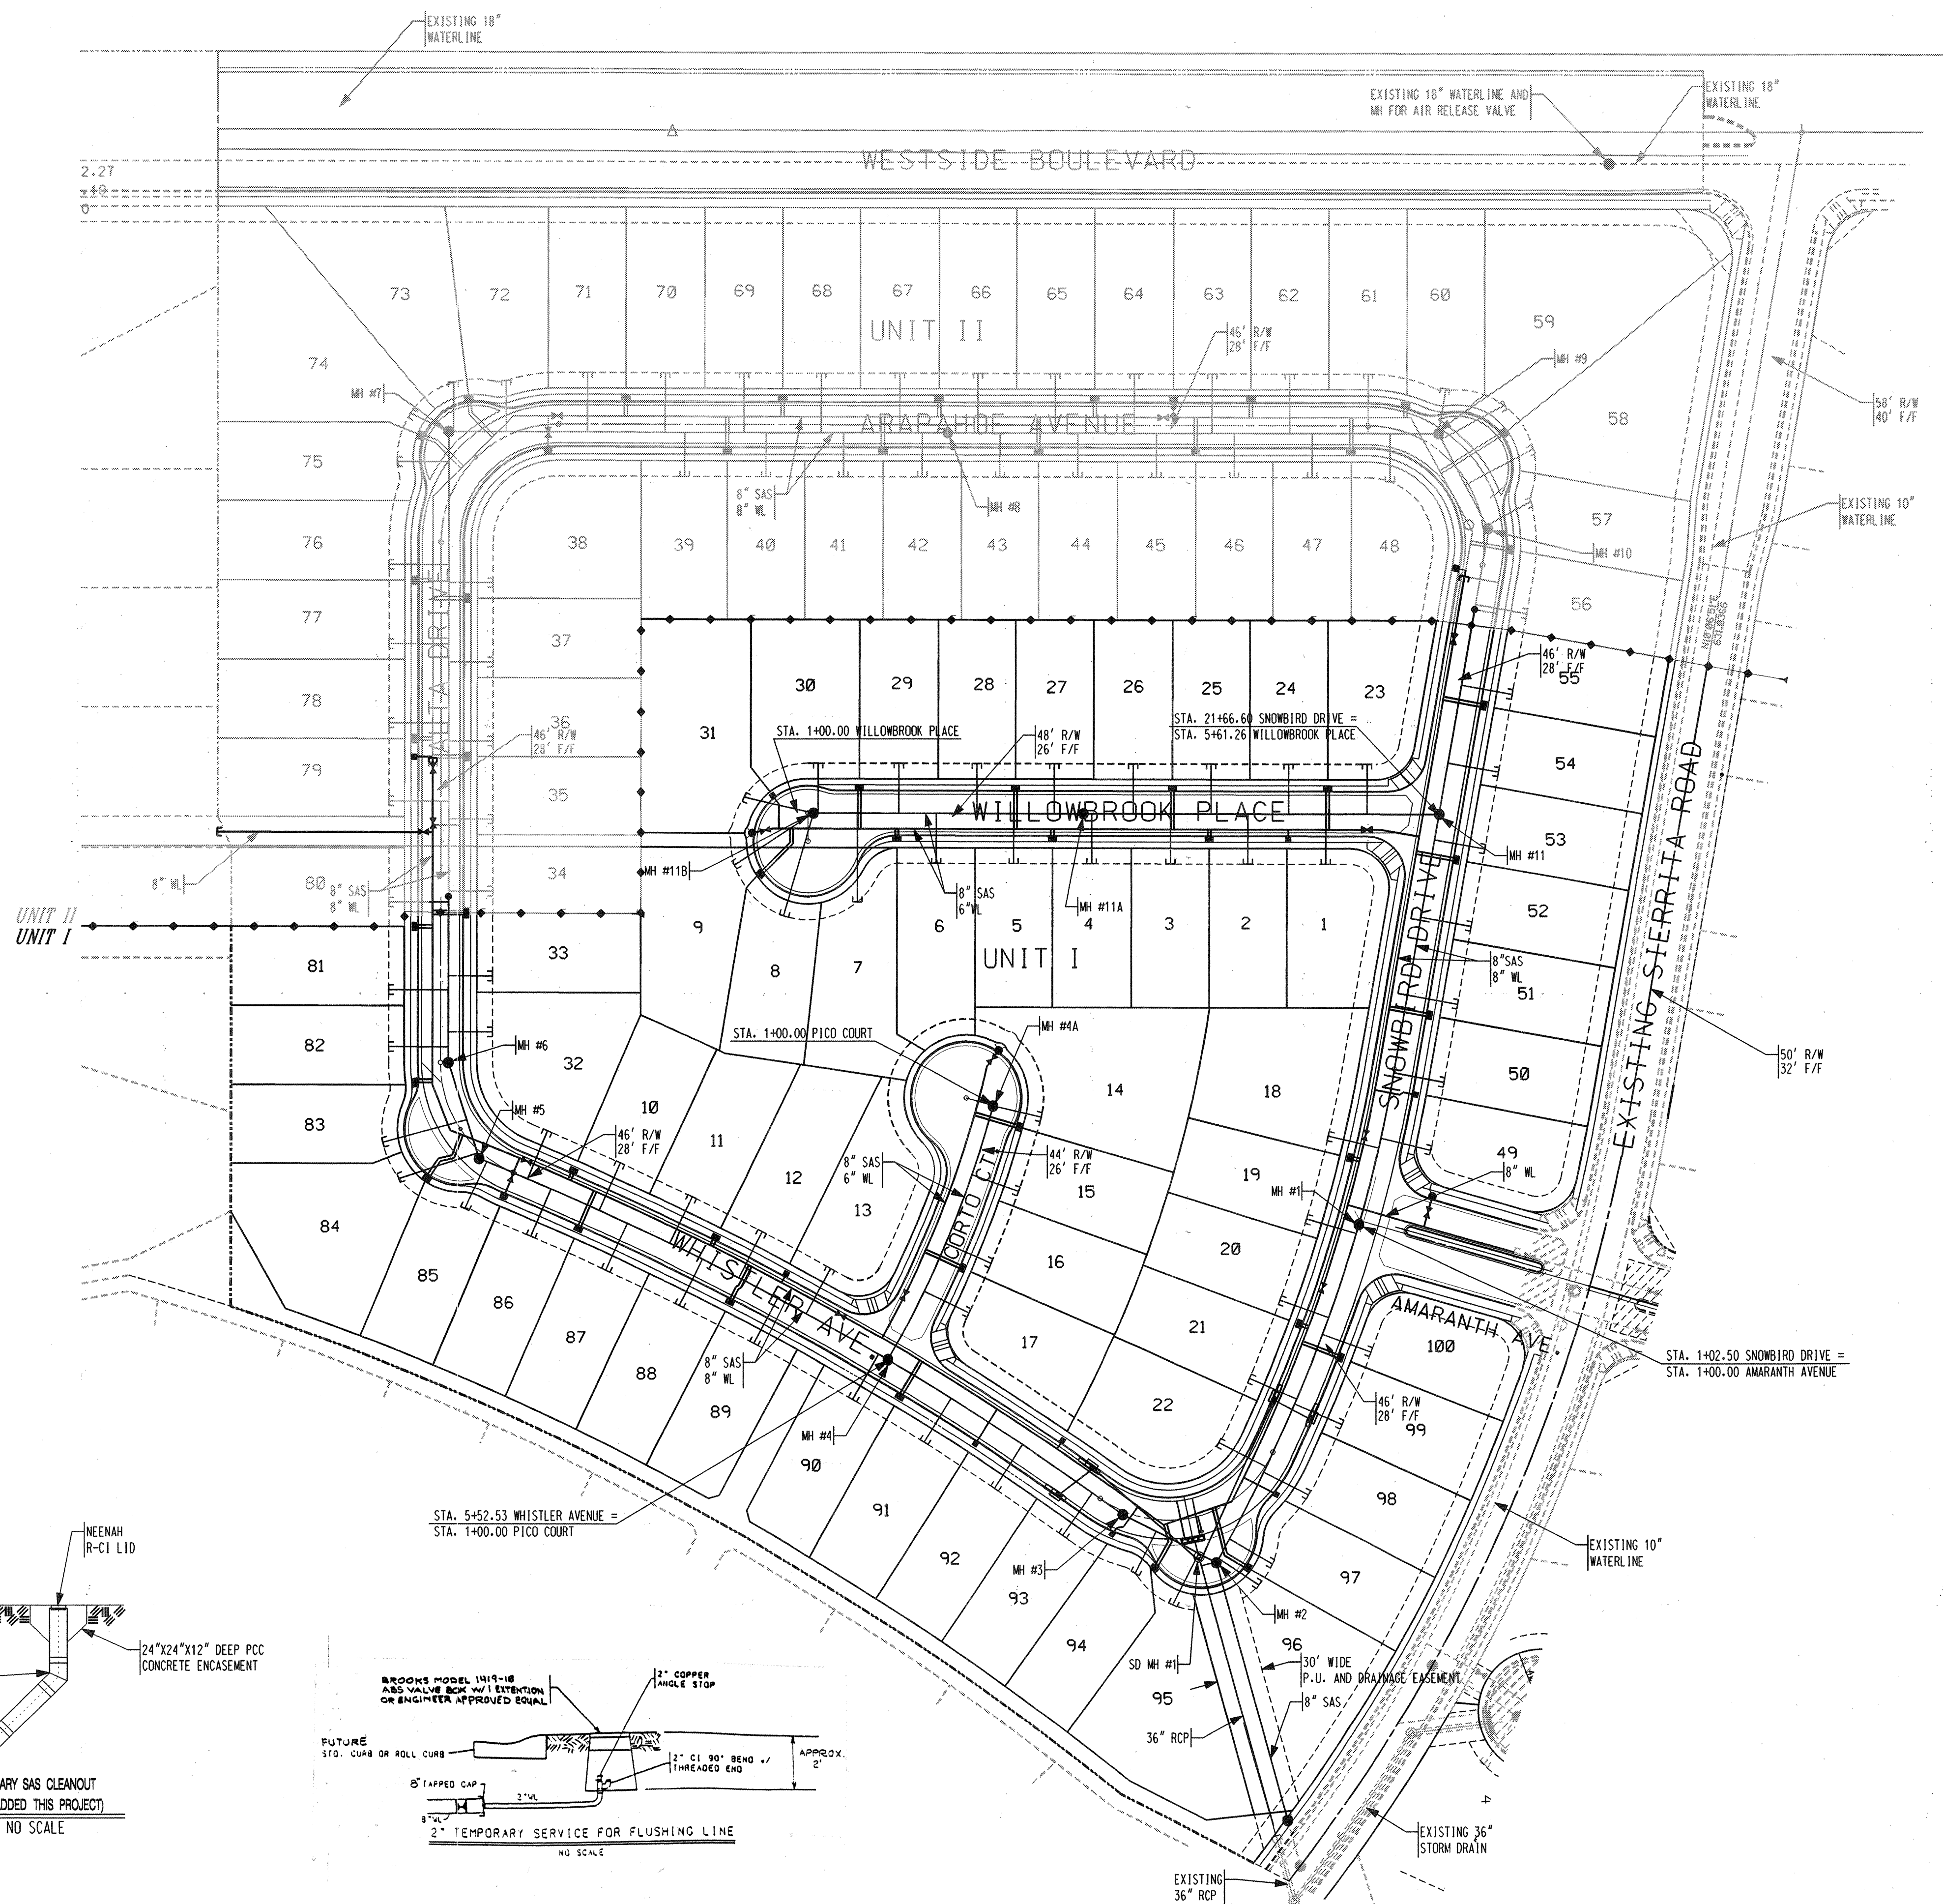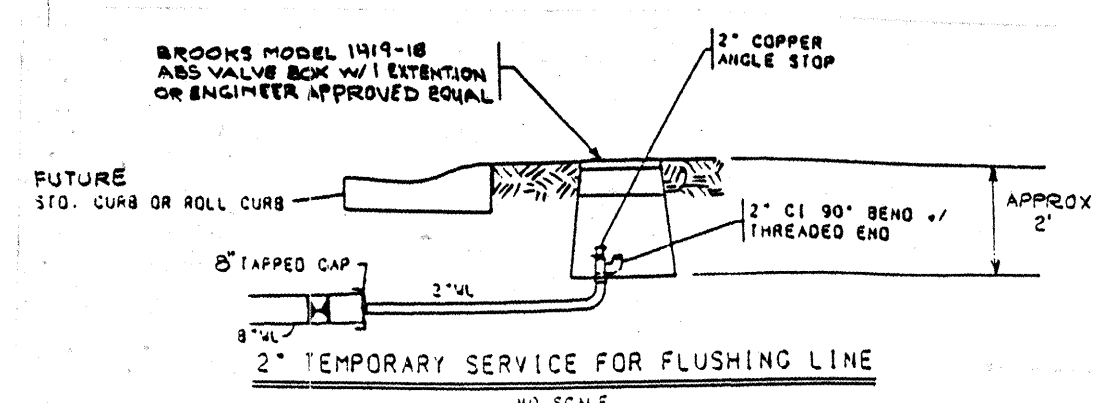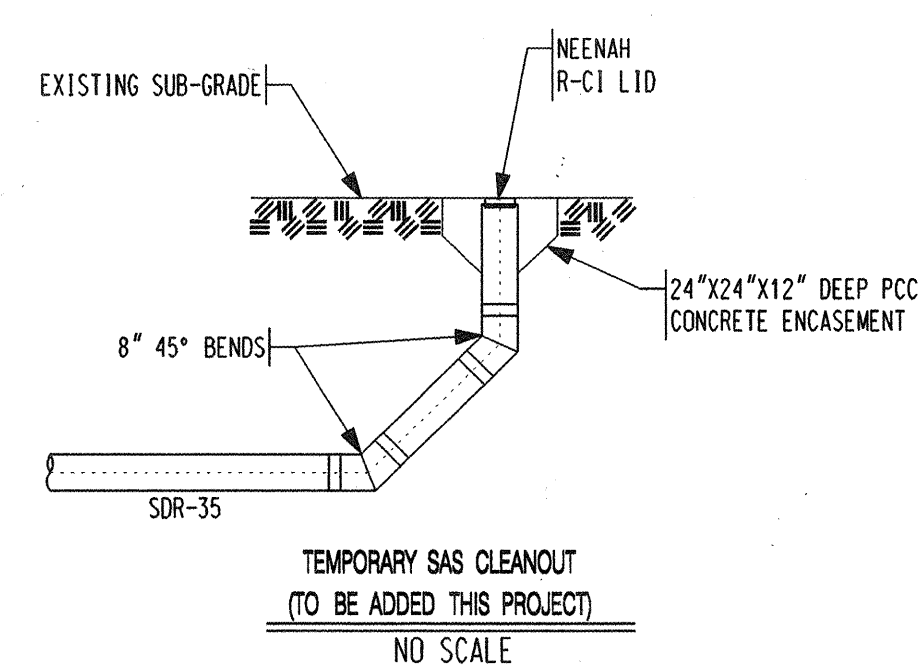


LEGEND	UNIT I	UNIT II
PROPOSED SANITARY SEWER MANHOLE		
EXISTING SANITARY SEWER MANHOLE		
PROPOSED FIRE HYDRANT		
EXISTING FIRE HYDRANT		
PROPOSED GATE VALVE		
EXISTING GATE VALVE		
PROPOSED SANITARY SEWER LINE	<u>SAS</u>	<u>SAS</u>
EXISTING SANITARY SEWER LINE	<u>SAS</u>	<u>SAS</u>
PROPOSED WATER LINE	<u>W</u>	<u>W</u>
EXISTING WATER LINE	<u>W</u>	<u>W</u>
PROPOSED SANITARY SEWER SERVICE		
PROPOSED WATER METER SERVICE		
UNIT BOUNDARY		

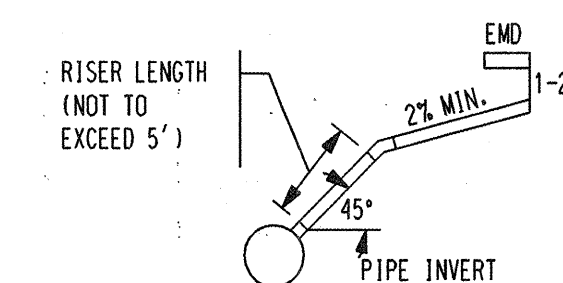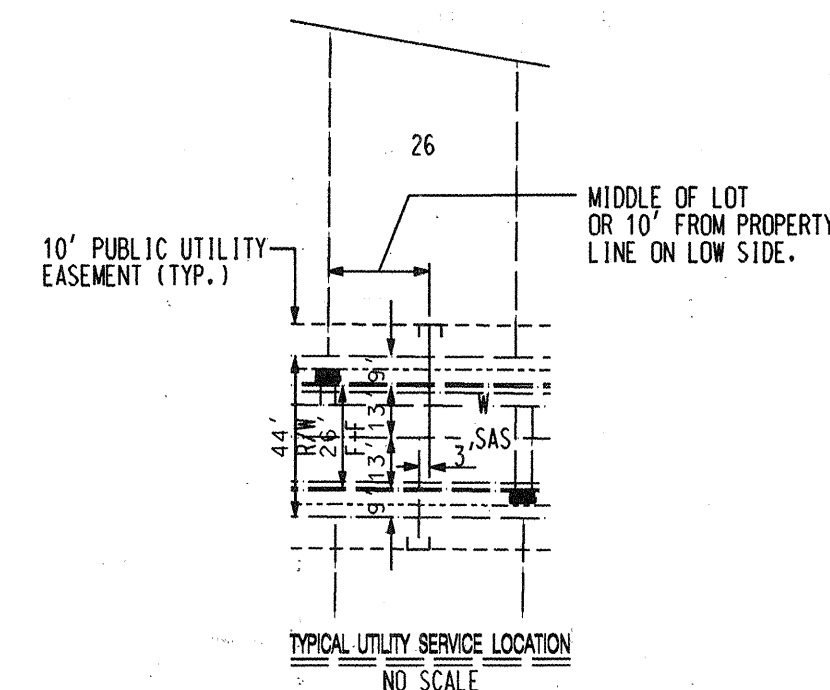

SERVICE RISER DETAIL

(SERVICE CONNECTION * INSTALLATION
TO CONFORM TO COA STD. DWG. 2134
USE C1 SOIL PIPE ONLY)

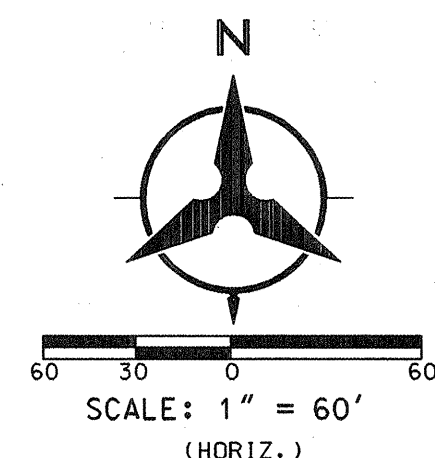

Bohannon ▲ Huston


 Courtyard One 7500 JEFFERSON NE Albuquerque NEW MEXICO 87109

ENGINEERS PLANNERS PHOTOGRAMMETRISTS SURVEYORS LANDSCAPE ARCHITECTS



CITY OF ALBUQUERQUE
PUBLIC WORKS DEPARTMENT
ENGINEERING DEVELOPMENT GROUP

WHISTLER AT SEVEN BAR NORTH UNIT I
OVERALL
UTILITY PLAN

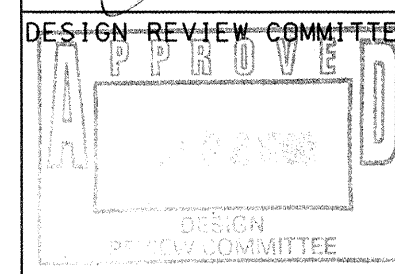

CITY ENGINEER APPROVAL

	MO./DAY/YR.	MO./DAY/YR.
--	-------------	-------------


CITY PROJECT NO.	5752.82	ZONE MAP NO.	A -13	SHEET	10	OF	19
------------------	---------	--------------	-------	-------	----	----	----

P:BHI-MAIN\PROJECTS\94250\DGN
94250OVLUTL1.DGN



BHI JOB NO. 98161A05

COPYRIGHT BOHANNAN HUSTON 1998
DATE: AUGUST, 1998

WATERLINE TANGENT DATA		
NUMBER	BEARING	LENGTH
T1	N74°09'05"W	148.00'

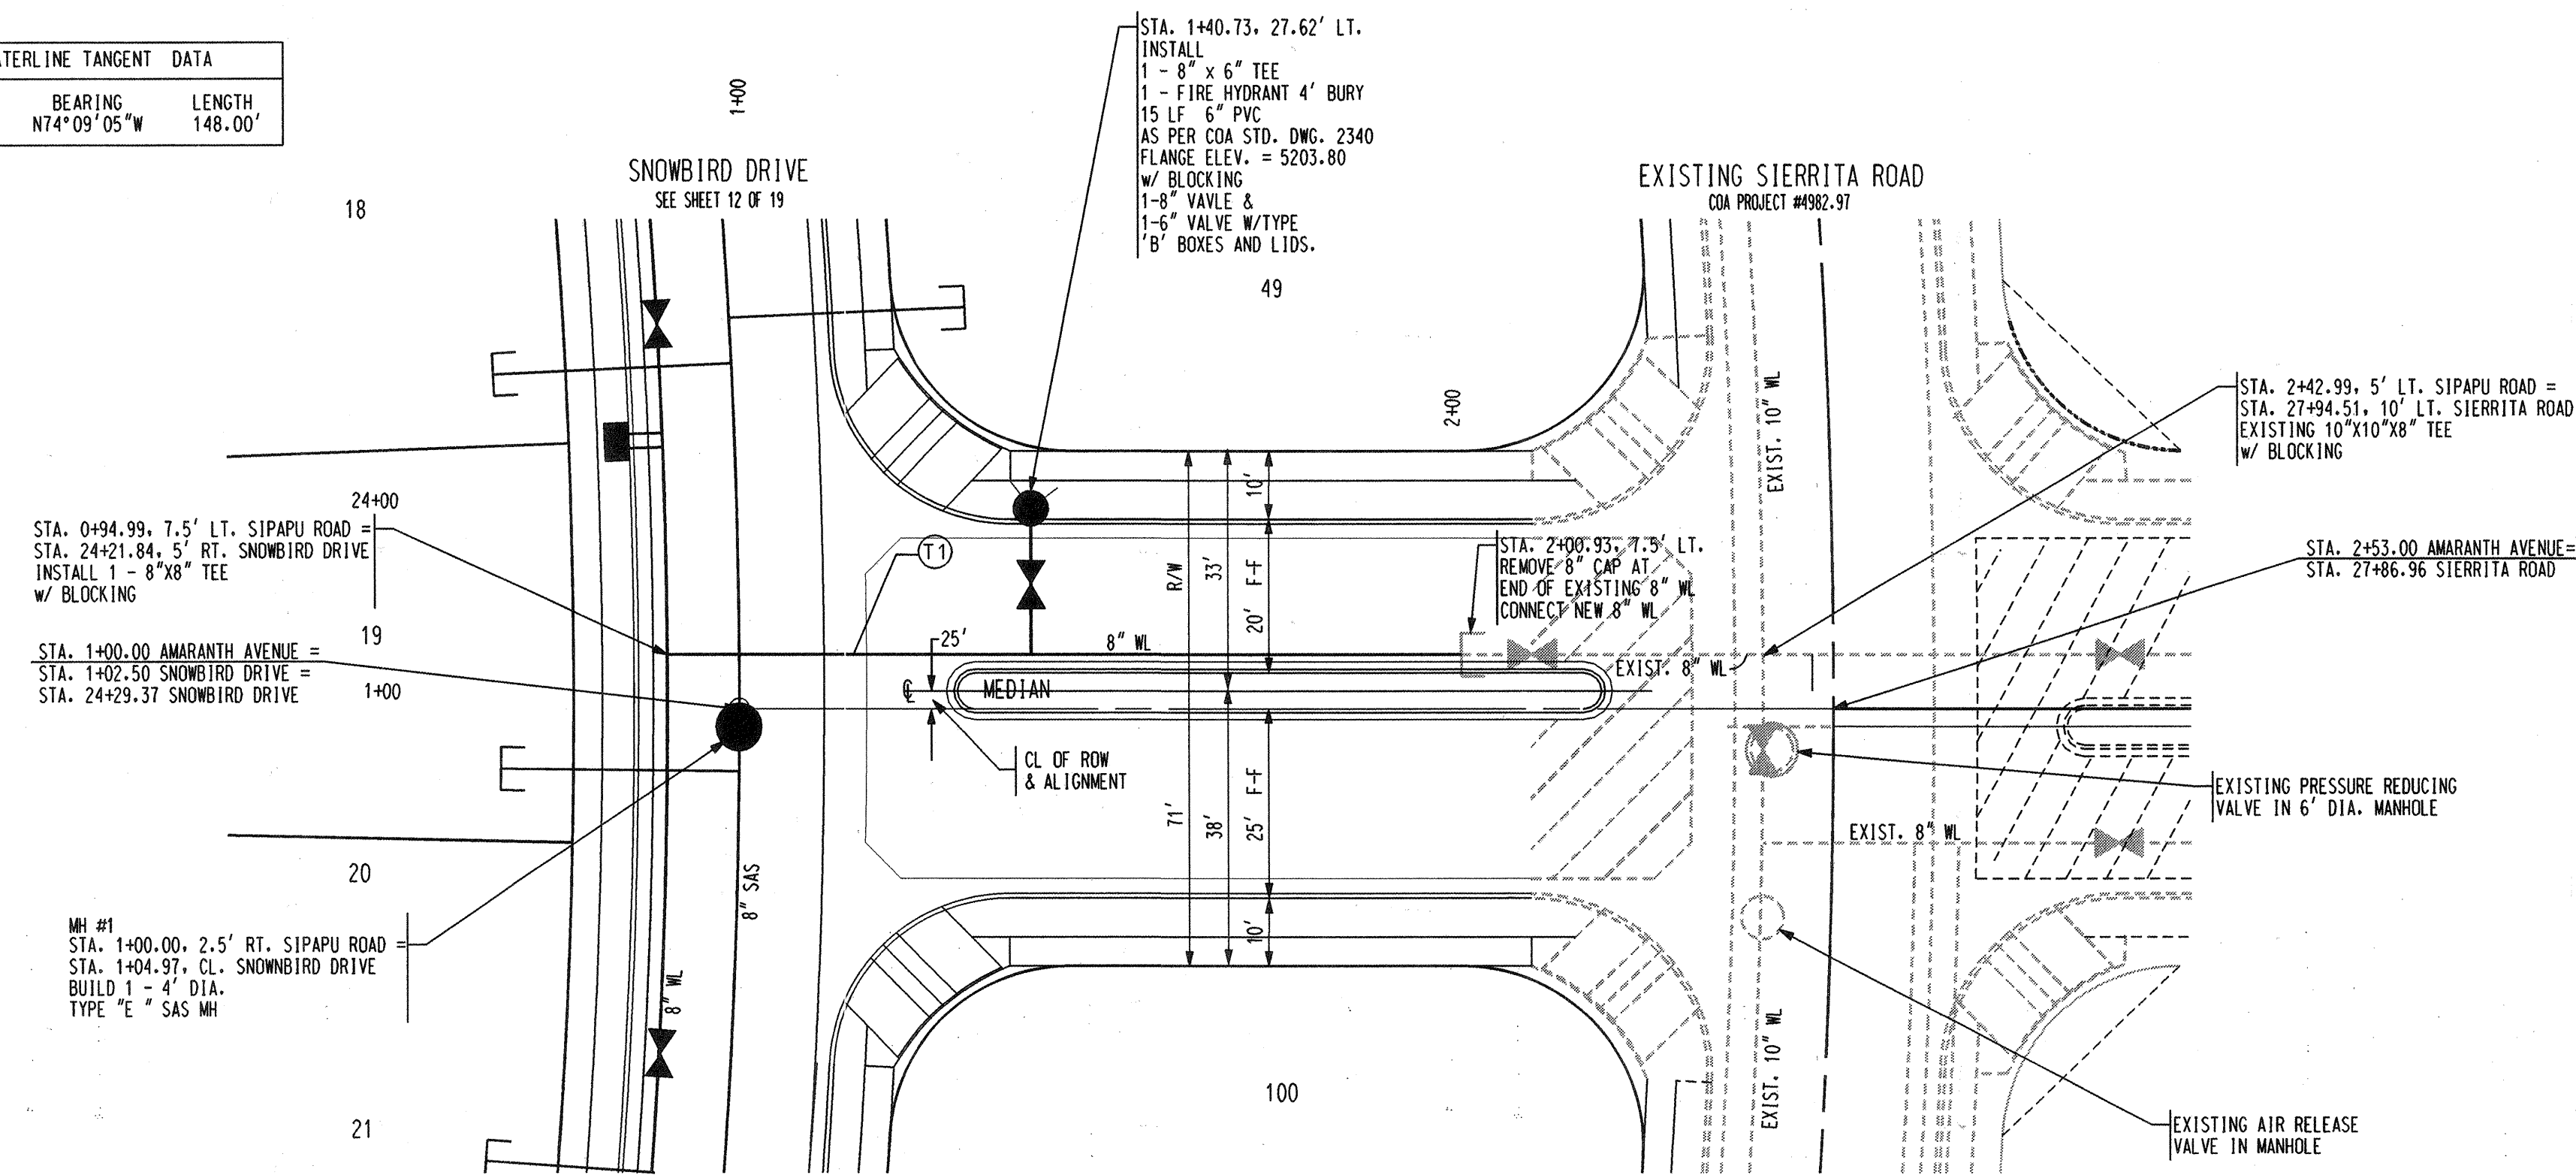


ALL SANITARY SEWER LINES SHALL BE
SDR 35 UNLESS OTHERWISE NOTED.
ALL WATER LINES SHALL BE C-900
UNLESS OTHERWISE NOTED.

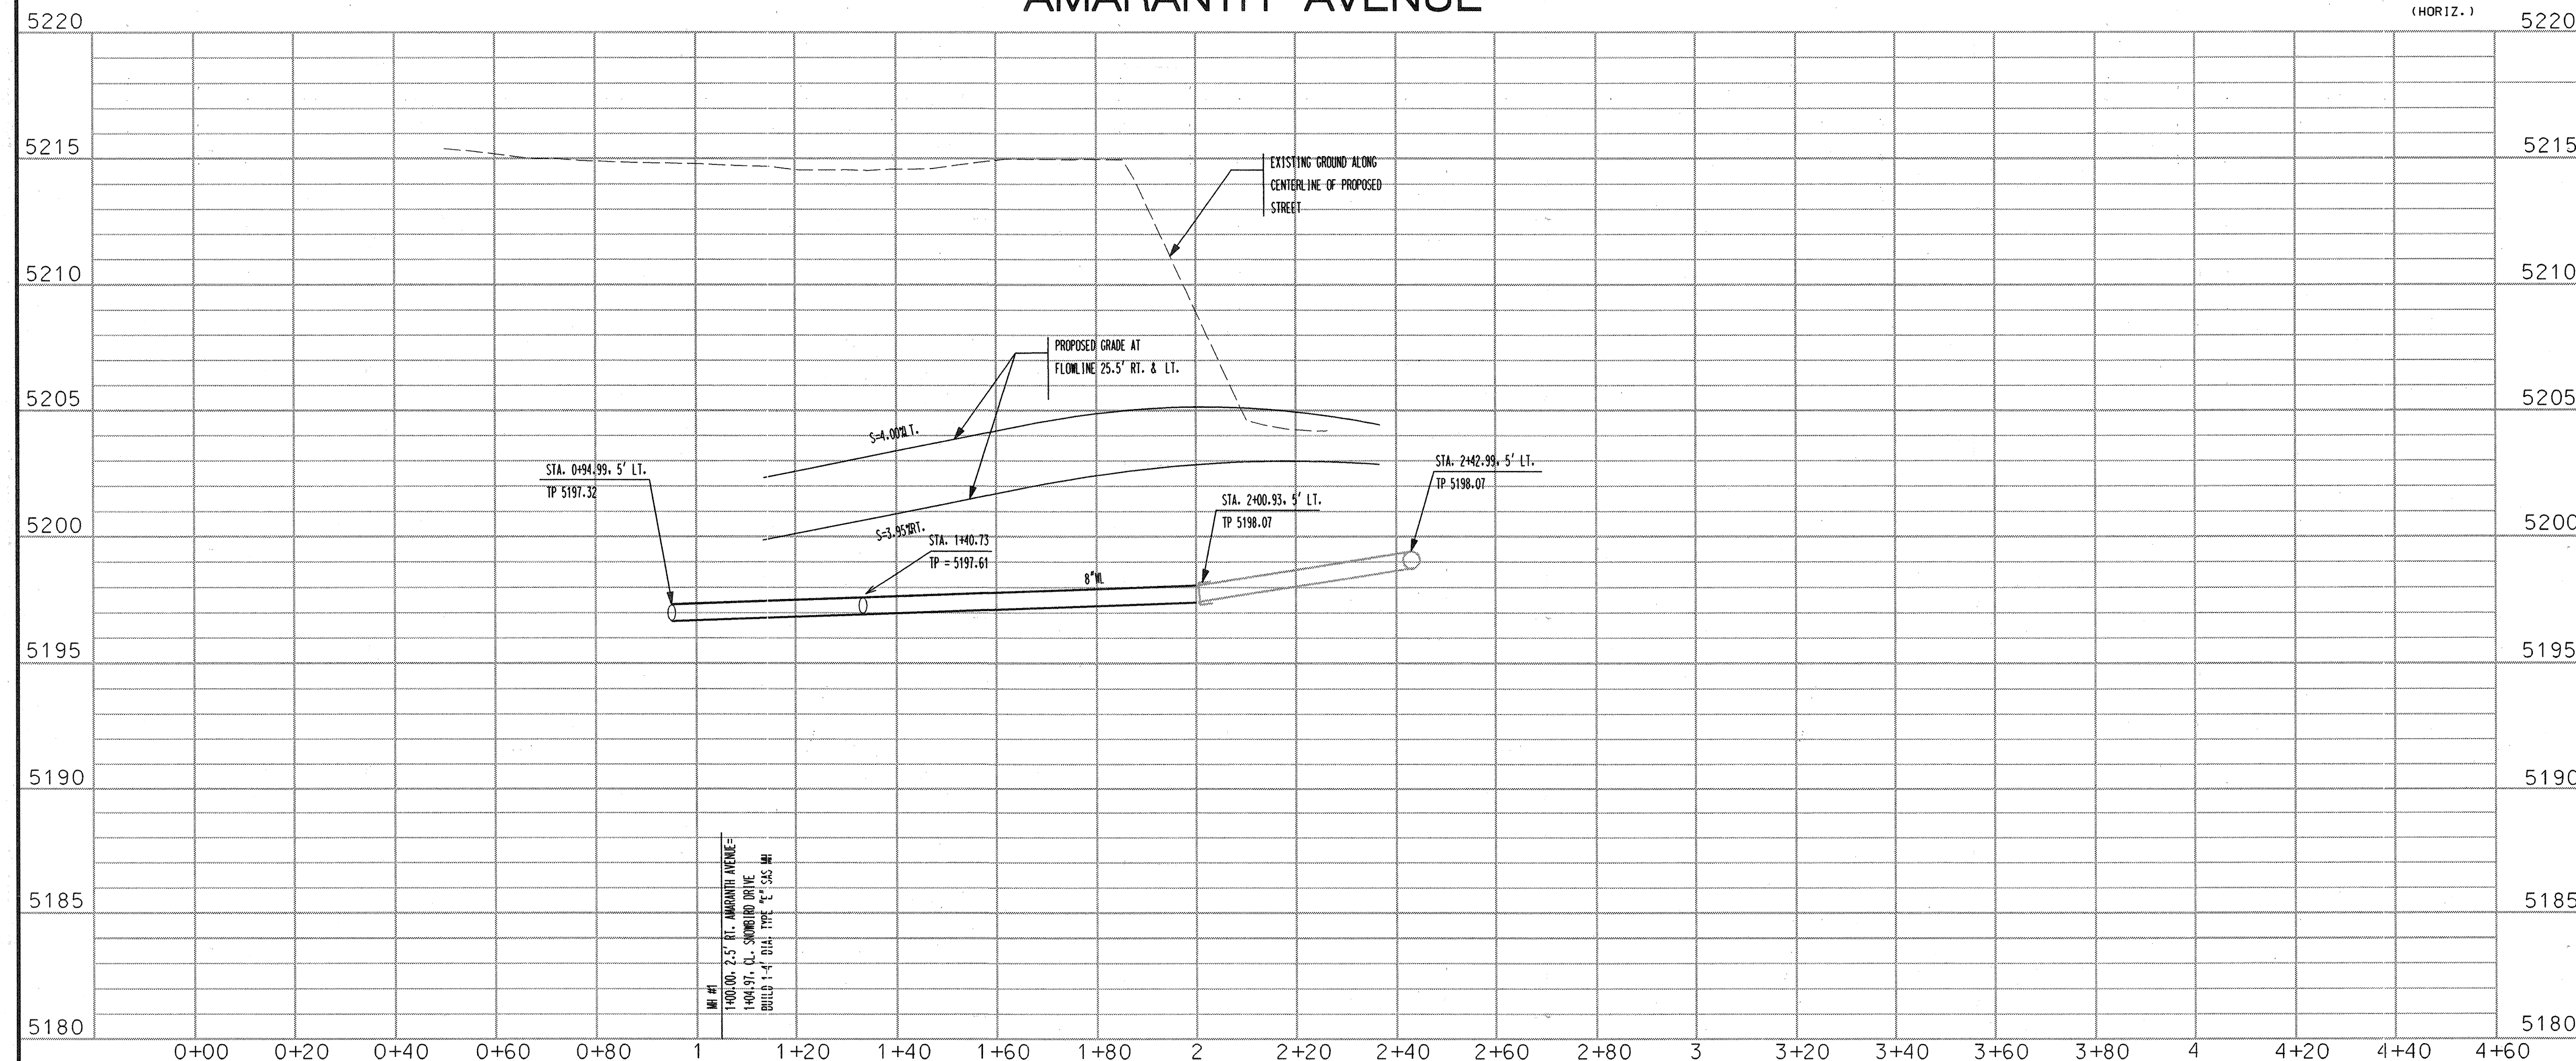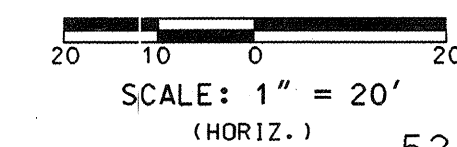

NOTES

1. THE CONTRACTOR SHALL FIELD VERIFY ALL EXISTING UTILITY LOCATIONS AND NOTIFY THE ENGINEER IMMEDIATELY OF ANY DISCREPANCIES.
2. ALL CURB RETURN RADIi SHALL BE 25' UNLESS OTHERWISE SPECIFIED.
3. ALL CURVE DATA AND DIMENSIONS REFER TO FACE OF CURB UNLESS OTHERWISE SPECIFIED.
4. GRADE ELEVATIONS, WHERE NOTED, ARE FOR FLOWLINE UNLESS OTHERWISE SPECIFIED.
5. CONTRACTOR IS TO INSTALL A 4" x 4" x 5' POST AND END AT THE END OF EACH SANITARY SEWER SERVICE.
6. CONTRACTOR IS RESPONSIBLE FOR REPAIR AND/OR REPLACEMENT OF ALL UTILITY CONDUITS AND EXISTING LINES.
7. ANY ADDITIONAL GRADING REQUIRED TO MATCH PROPOSED STREET GRADES SHALL BE INCIDENTAL TO PAVING ITEMS.
8. CONTRACTOR SHALL PROVIDE THE INSPECTORS, (CITY AND PRIVATE) WITH THE PROPOSED HYDROSTATIC TESTING PLAN. THE PLAN MUST BE APPROVED BEFORE TESTING OPERATIONS BEGIN.
9. CONTRACTOR SHALL PARK EQUIPMENT AND VEHICLES AS NOT TO INTERFERE WITH NORMAL ACTIVITIES OF RESIDENTS OR OTHER CONTRACTORS ON SITE.
10. ANY DAMAGE TO THE EXISTING FACILITIES (CURB & GUTTER, PAVEMENT, CONDUITS, LANDSCAPING, UTILITY LINES, ETC.) DURING CONSTRUCTION SHALL BE REPLACED AT THE CONTRACTORS' EXPENSE.
11. REMOVAL OF THE EXISTING CURB AND GUTTER SHALL BE AS PER COA STD. DWG. 2415 (SAWCUT ONLY).
12. WHEELCHAIR RAMPS SHALL BE CONSTRUCTED PRIOR TO ACCEPTANCE OF CURB & GUTTER.

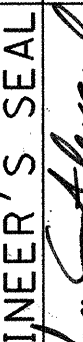ENGINEER'S SEAL		SURVEY INFORMATION		BENCH MARKS		AS-BUILT INFORMATION	
		FIELD NOTES		TMB NO. 205 CHISELED "X" LOCATED APPROXIMATELY 459 FEET SOUTH OF THE BLACK 'S DIVERSION INLET STRUCTURE ON THE EAST WALL ELEV. 5110.55		CONTRACTOR <u>Goodland</u> DESIGNED BY <u>CHS, Inc.</u> DATE <u>9/99</u> INSPECTED BY _____ DATE _____ ACCEPTANCE BY _____ DATE _____ FIELD LICATION BY <u>CHS, Inc.</u> DATE <u>9/99</u> DRAWINGS CORRECTED BY <u>CHS, Inc.</u> DATE <u>9/99</u> MICRO-FILM INFORMATION	
		NO.	BY				
NO.	DATE	REMARKS	BY				
REVISIONS							
DESIGN							
DESIGNED BY	JCA/CMG	DATE	09/98				
DRAWN BY	PEG/OGG	DATE	09/98				
CHECKED BY	JCA	DATE	09/98				

Bohannon ▲ Huston

 **Courtyard One** 7500 JEFFERSON NE ALBUQUERQUE NEW MEXICO 87110


ENGINEERS PLANNERS PHOTOGRAMMETRISTS SURVEYORS LANDSCAPE ARCHITECTS

A CITY OF ALBUQUERQUE
PUBLIC WORKS DEPARTMENT
ENGINEERING DEVELOPMENT GROUP

WHISLTER AT SEVEN BAR NORTH UNIT I
UTILITY PLAN & PROFILE
AMARANTH AVENUE

[illegible]

SCALE:	1" = 20' (HORIZ.) 1" = 4' (VERT.)	CITY PROJECT NO. 5752-82	ZONE MAP NO. A-13	SHEET 11	OF 19
--------	--------------------------------------	-----------------------------	----------------------	-------------	----------

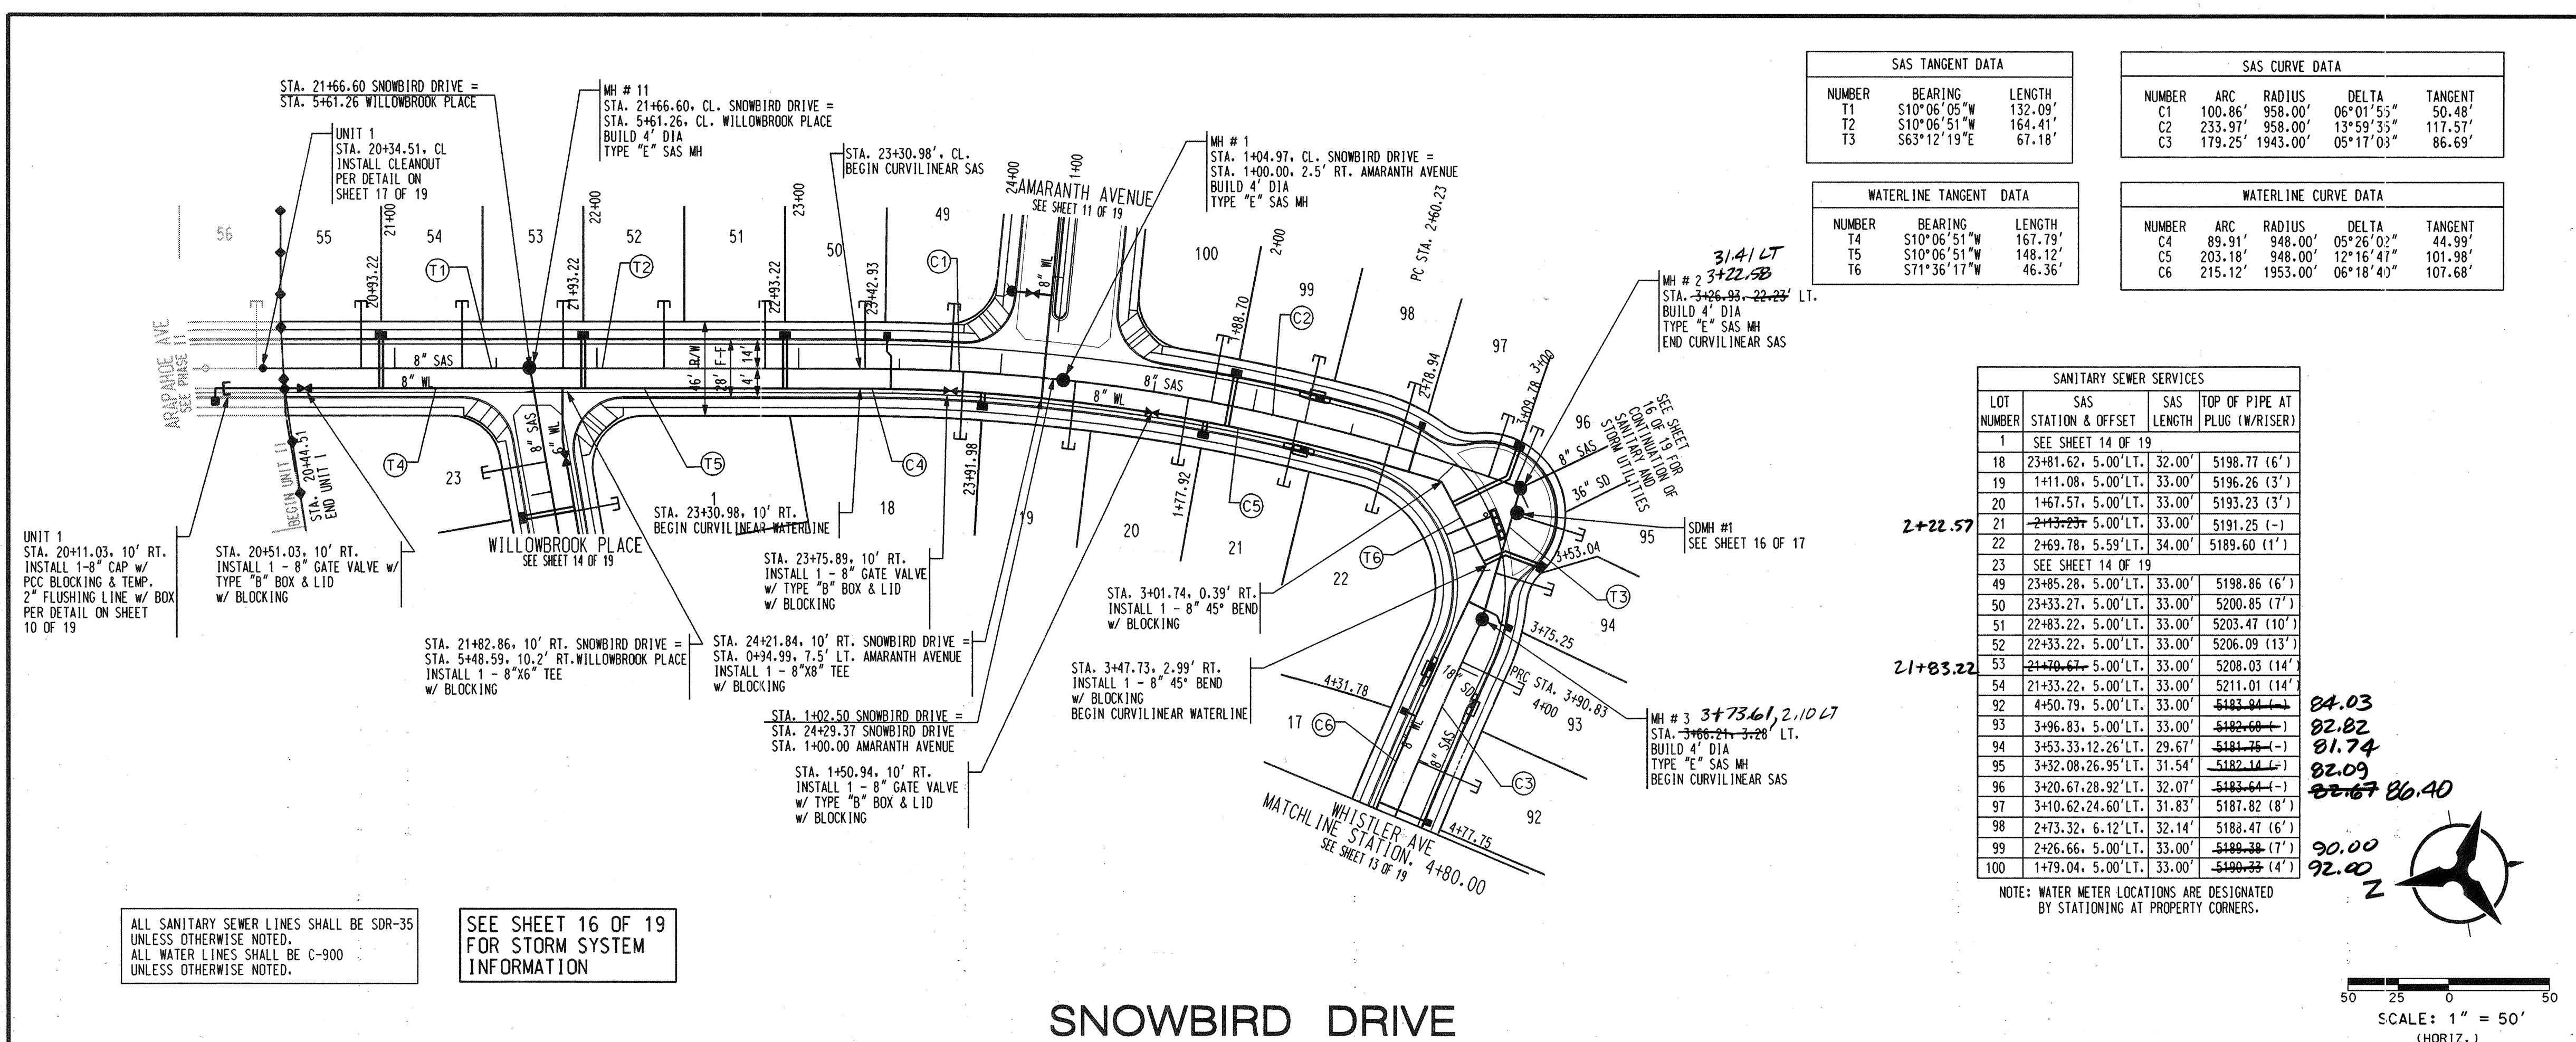

SAS TANGENT DATA		
NUMBER	BEARING	LENGTH
T1	S10°06'05"W	132.09'
T2	S10°06'51"W	164.41'
T3	S63°12'19"E	67.18'

SAS CURVE DATA			
NUMBER	ARC	RADIUS	DELTA
C1	100.86'	958.00'	06°01'55"
C2	233.97'	958.00'	13°59'35"
C3	179.25'	1943.00'	05°17'03"


WATERLINE TANGENT DATA		
NUMBER	BEARING	LENGTH
T4	S10°06'51"W	167.79'
T5	S10°06'51"W	148.12'
T6	S71°36'17"W	46.36'

WATERLINE CURVE DATA			
NUMBER	ARC	RADIUS	DELTA
C4	89.91'	948.00'	05°26'02"
C5	203.18'	948.00'	12°16'47"
C6	215.12'	1953.00'	06°18'40"

SANITARY SEWER SERVICES			
LOT NUMBER	SAS STATION & OFFSET	SAS LENGTH	TOP OF PIPE AT PLUG (W/RISE)
1	SEE SHEET 14 OF 19		
18	23+81.62, 5.00' LT.	32.00'	5198.77 (6')
19	1+11.08, 5.00' LT.	33.00'	5196.26 (3')
20	1+67.57, 5.00' LT.	33.00'	5193.23 (3')
21	2+43.23, 5.00' LT.	33.00'	5191.25 (-)
22	2+69.78, 5.59' LT.	34.00'	5189.60 (1')
23	SEE SHEET 14 OF 19		
49	23+85.28, 5.00' LT.	33.00'	5198.86 (6')
50	23+33.27, 5.00' LT.	33.00'	5200.85 (7')
51	22+83.22, 5.00' LT.	33.00'	5203.47 (10')
52	22+33.22, 5.00' LT.	33.00'	5206.09 (13')
53	21+10.67, 5.00' LT.	33.00'	5208.03 (14')
54	21+33.22, 5.00' LT.	33.00'	5211.01 (14')
92	4+50.79, 5.00' LT.	33.00'	5183.84 (-)
93	3+96.83, 5.00' LT.	33.00'	5182.68 (-)
94	3+53.33, 12.26' LT.	29.67'	5181.76 (-)
95	3+32.08, 26.95' LT.	31.54'	5182.14 (-)
96	3+20.67, 28.92' LT.	32.07'	5183.64 (-)
97	3+10.62, 24.60' LT.	31.83'	5187.82 (8')
98	2+73.32, 6.12' LT.	32.14'	5188.47 (6')
99	2+26.66, 5.00' LT.	33.00'	5189.38 (7')
100	1+79.04, 5.00' LT.	33.00'	5190.33 (4')

NOTE: WATER METER LOCATIONS ARE DESIGNATED BY STATIONING AT PROPERTY CORNERS.

- NOTES
- THE CONTRACTOR SHALL FIELD VERIFY ALL EXISTING UTILITY LOCATIONS AND NOTIFY THE ENGINEER IMMEDIATELY OF ANY DISCREPANCIES.
 - ALL CURB RETURN RADIUS SHALL BE 25' UNLESS OTHERWISE SPECIFIED.
 - ALL CURVE DATA AND DIMENSIONS REFER TO FACE OF CURB UNLESS OTHERWISE SPECIFIED.
 - GRADE ELEVATIONS, WHERE NOTED, ARE FOR FLOWLINE UNLESS OTHERWISE SPECIFIED.
 - CONTRACTOR IS TO INSTALL A 4" X 4" X 5' POST AND EMD AT THE END OF EACH SANITARY SEWER SERVICE.
 - CONTRACTOR IS RESPONSIBLE FOR REPAIR AND/OR REPLACEMENT OF ALL UTILITY CONDUITS AND EXISTING LINES.
 - ANY ADDITIONAL GRADING REQUIRED TO MATCH PROPOSED STREET GRADES SHALL BE INCIDENTAL TO PAVING ITEMS.
 - CONTRACTOR SHALL PROVIDE THE INSPECTORS, (CITY AND PRIVATE) WITH THE PROPOSED HYDROSTATIC TESTING PLAN. THE PLAN MUST BE APPROVED BEFORE TESTING OPERATIONS BEGIN.
 - CONTRACTOR SHALL PARK EQUIPMENT AND VEHICLES AS NOT TO INTERFERE WITH NORMAL ACTIVITIES OF RESIDENTS OR OTHER CONTRACTORS ON SITE.
 - ANY DAMAGE TO THE EXISTING FACILITIES (CURB & GUTTER, PAVEMENT, CONDUITS, LANDSCAPING, UTILITY LINES, ETC.) DURING CONSTRUCTION SHALL BE REPLACED AT THE CONTRACTORS' EXPENSE.
 - REMOVAL OF THE EXISTING CURB AND GUTTER SHALL BE AS PER COA STD. DWG. 2415 (SAWCUT ONLY).
 - WHEELCHAIR RAMPS SHALL BE CONSTRUCTED PRIOR TO ACCEPTANCE OF CURB & GUTTER.

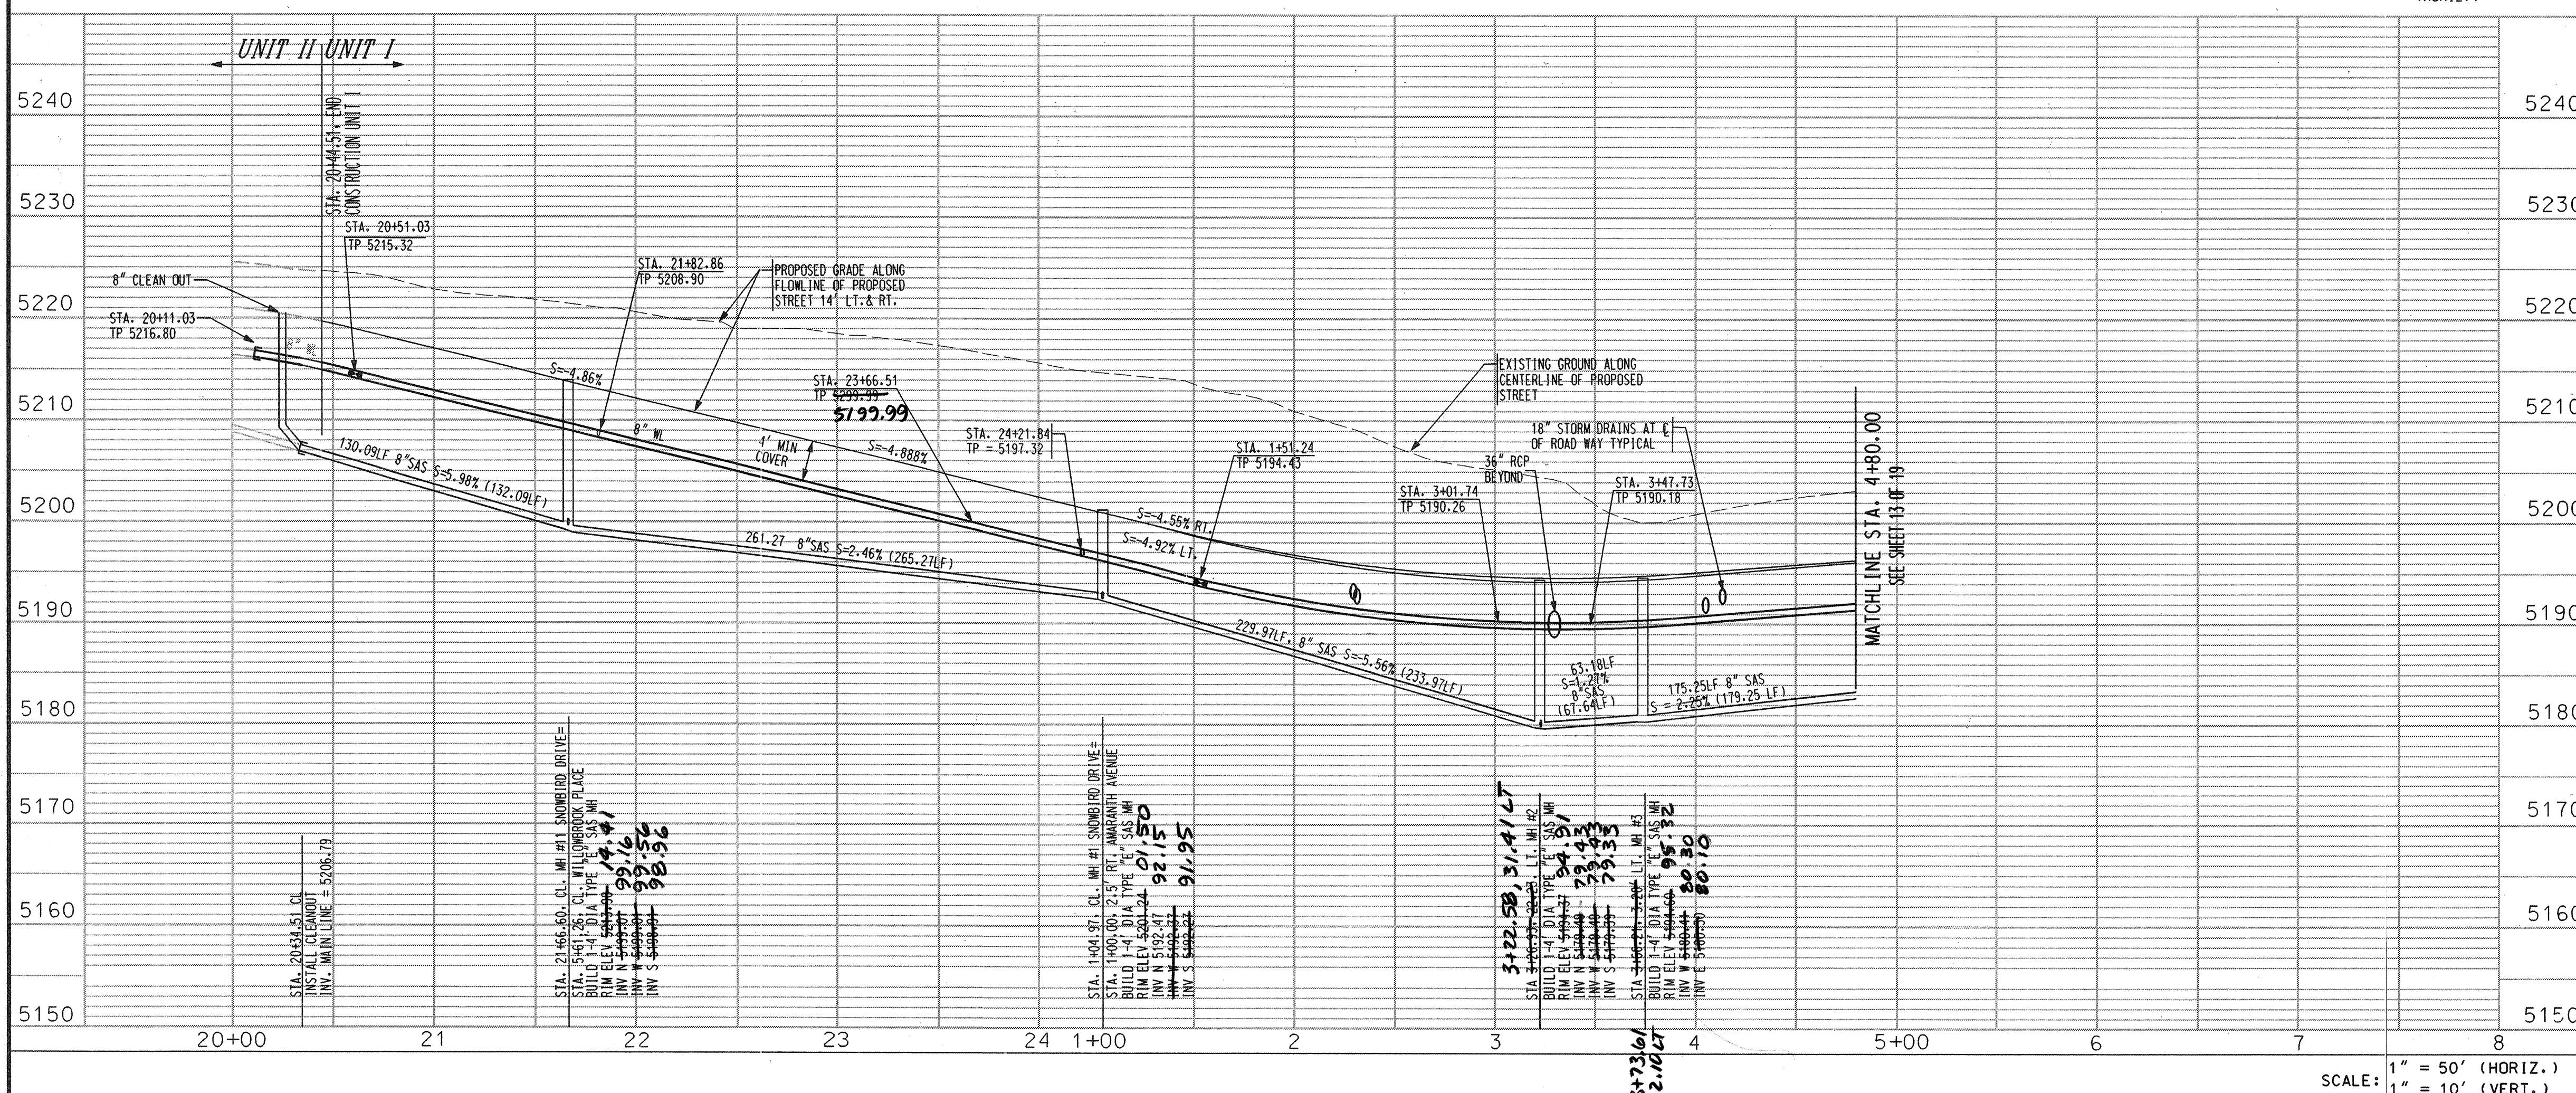

P:\BHI-MAIN\PROJECTS\94250\CDP\PNP 94250\PNP02.DGN

Bohannon & Huston

Courtyard One 7500 JEFFERSON NE Albuquerque NEW MEXICO 87109

ENGINEERS PLANNERS PHOTOGRAMMETRISTS SURVEYORS LANDSCAPE ARCHITECTS

CITY OF ALBUQUERQUE

PUBLIC WORKS DEPARTMENT

ENGINEERING DEVELOPMENT GROUP

WHISTLER AT SEVEN BAR NORTH UNIT I

UTILITY PLAN & PROFILE

SNOWBIRD DRIVE / WHISTLER AVENUE

DESIGN REVIEW COMMITTEE CITY ENGINEER APPROVAL

MO./DAY/YR. MO./DAY/YR.

LAST DESIGN UPDATE

CITY PROJECT NO. 5752.82

ZONE MAP NO. A-13

SHEET 12 OF 19

SANITARY SEWER SERVICES			
LOT NUMBER	SAS STATION & OFFSET	SAS LENGTH	TOP OF PIPE AT PLUG (W/RISE)
10	7460.10, 5.00' LT.	38.00'	5193.41(11')
11	7410.64, 5.00' LT.	38.00'	5193.03(11')
12	6461.56, 5.00' LT.	38.00'	5192.66(8')
13	6412.39, 5.00' LT.	38.00'	5192.72(9')
SEE SHEET 14 OF 19			
32	9428.60, 5.00' RT.	28.00'	5193.80(11')
33	9463.66, 5.00' RT.	28.00'	5193.41(7')
81	9455.07, 5.00' RT.	38.00'	5196.79(6')
82	9419.01, 5.00' RT.	38.00'	5196.55(7')

NOTE: WATER METER LOCATIONS ARE DESIGNATED
BY STATIONING AT PROPERTY CORNERS.

WATERLINE CURVE DATA				
NUMBER	ARC	RADIUS	DELTA	TANGENT
C3	215.12'	1953.00'	06°18'40"	107.67'
C4	306.34'	1952.99'	08°59'14"	153.48'



SAS CURVE DATA				
NUMBER	ARC	RADIUS	DELTA	TANGENT
C1	179.25'	1943.00'	05°17'08"	89.69'
C2	291.33'	1943.00'	08°35'27"	145.94'

SANITARY SEWER SERVICES				
LOT NUMBER	SAS STATION & OFFSET	SAS LENGTH	TOP OF PIPE AT PLUG (W/RISE)	
83	8+68.03, 4.78 'Rt.	53.38'	5194.6727'(+)	
84	8+53.23, 0.94 'Lt.	50.64'	5193.5527'(+)	
85	8+35.00, 8.50 'Lt.	29.27'	5188.31(-)	
86	7+94.00, 5.00 'Lt.	28.00'	5187.93(-)	
87	7+40.25, 5.00 'Lt.	28.00'	5187.52(-)	
88	6+87.62, 5.00 'Lt.	28.00'	5187.11(-)	
89	6+33.34, 5.00 'Lt.	28.00'	5186.70(-)	
90	5+59.32, 5.00 'Lt.	28.00'	5186.20(-)	
91	5+05.54, 2.64 'Lt.	28.00'	5185.21(-)	

NOTE: WATER METER LOCATIONS ARE DESIGNATED
BY STATIONING AT PROPERTY CORNERS.

SAS TANGENT DATA		
NUMBER	BEARING	LENGTH
T1	S17°52'37"E	63.65'
T2	S00°06'51"W	105.30'

WATERLINE TANGENT DATA		
NUMBER	BEARING	LENGTH
T3	S21°15'43"E	30.95'
T4	N00°06'51"E	159.00'

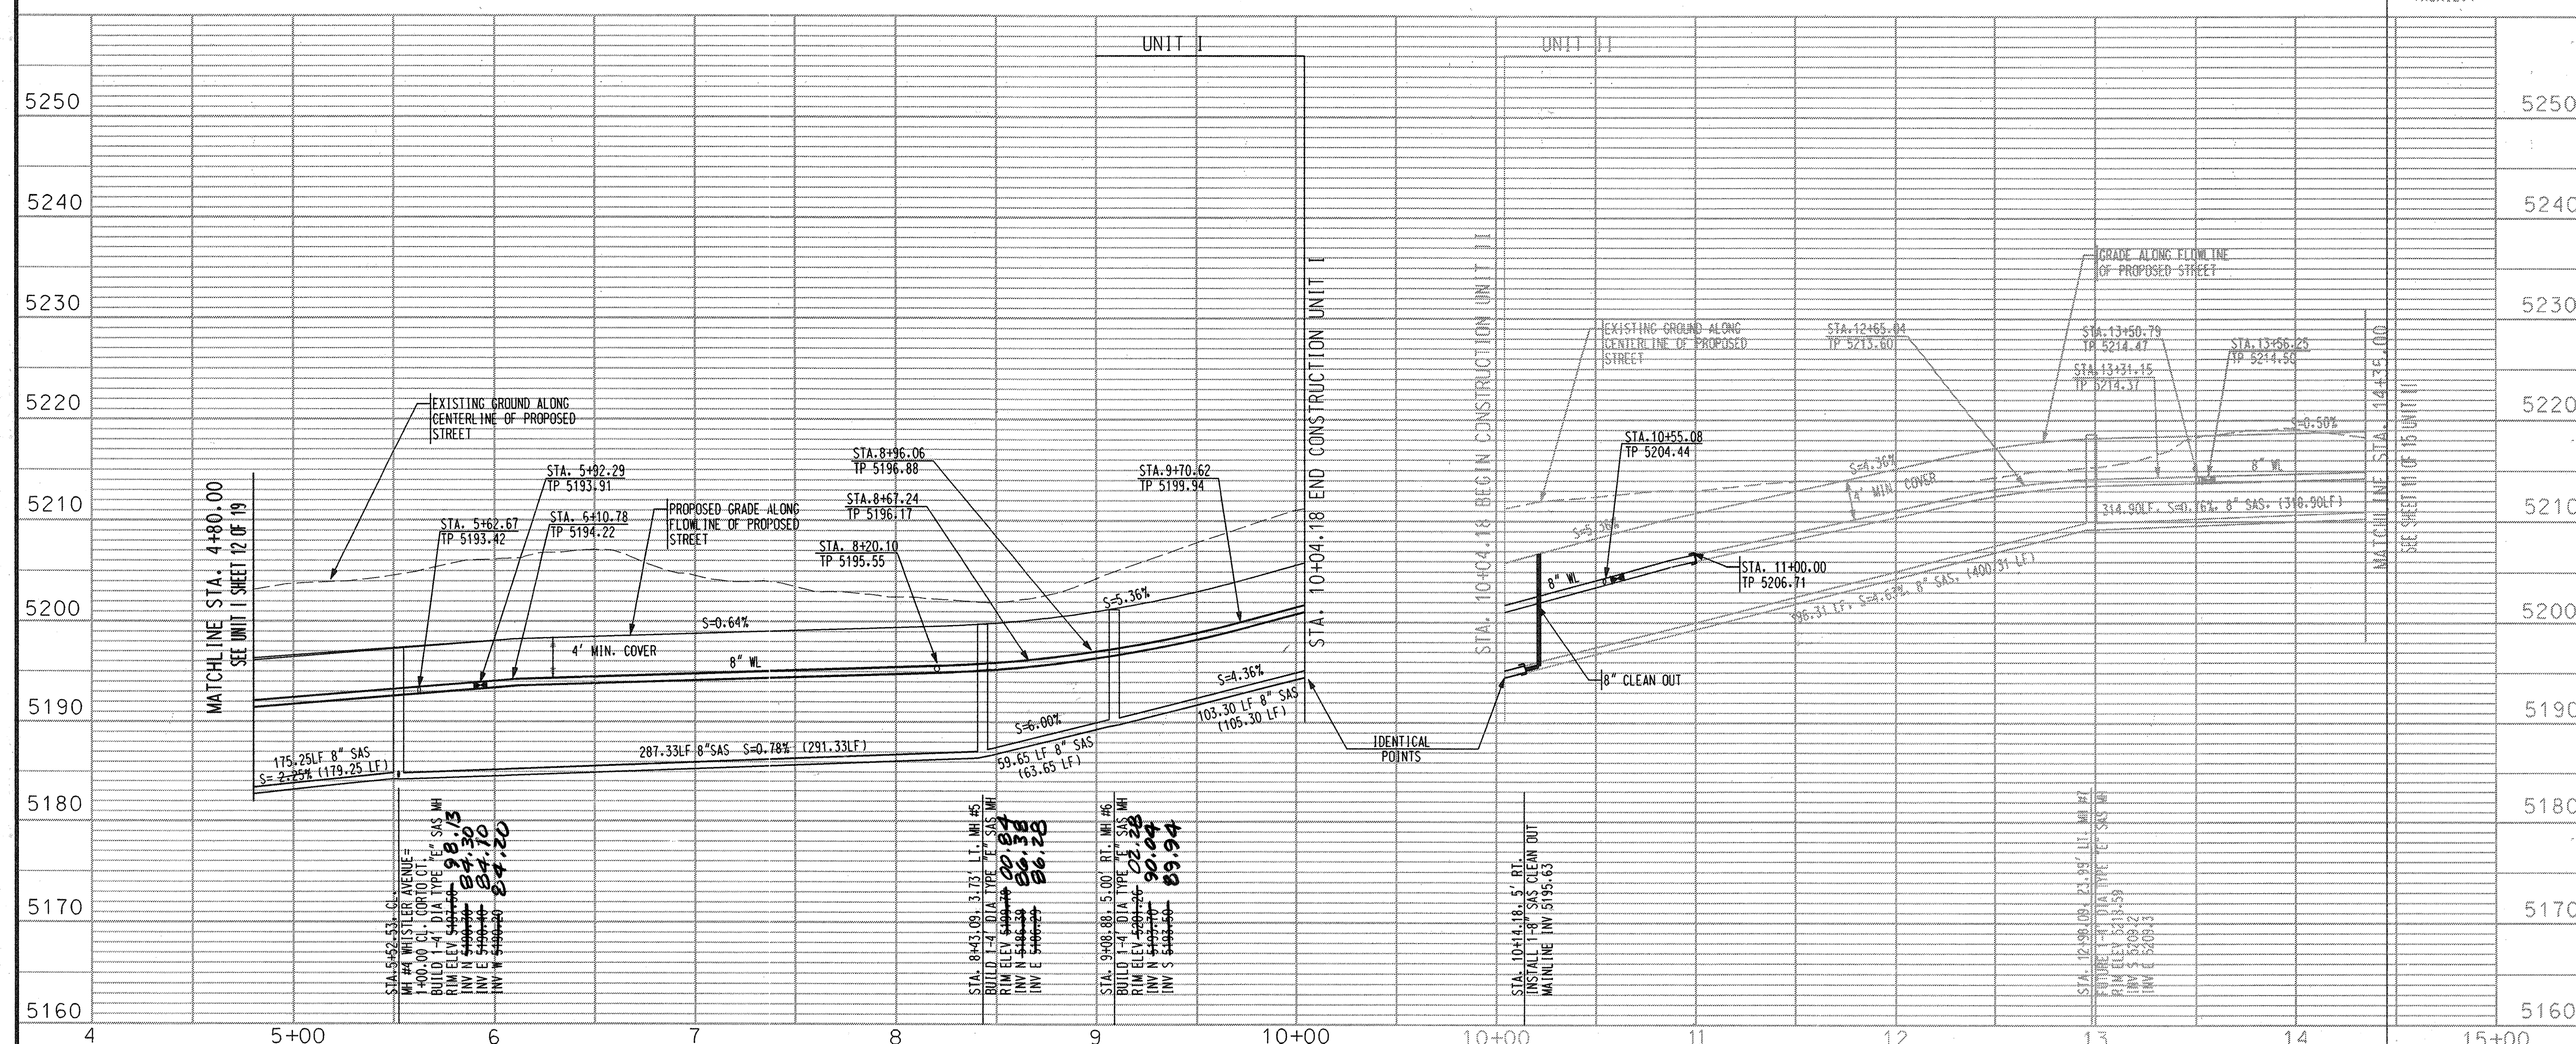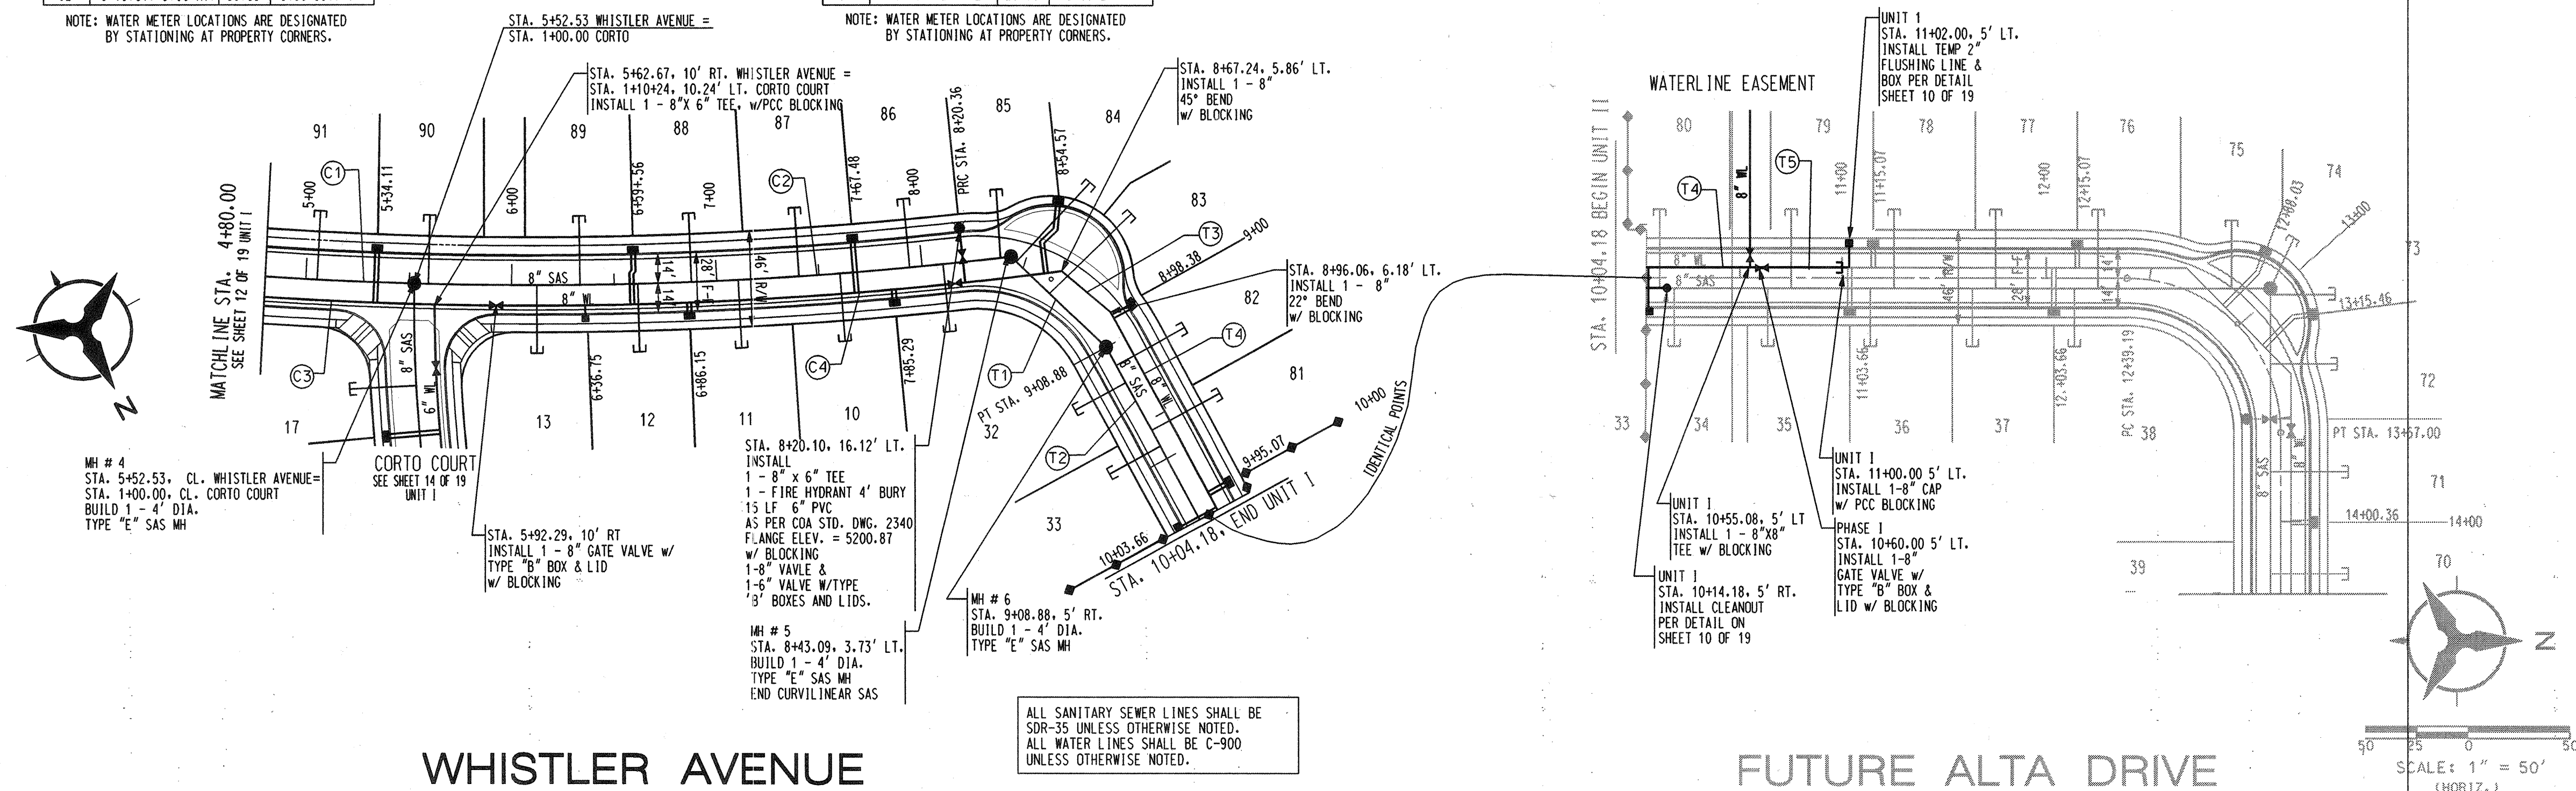

P:\BHI-MAIN\PROJECTS\94250\CDP\PNP
94250UPNP03.DGN

BHI IOB NO. 98161A05

COPYRIGHT BOHANNAN HUSTON 1998
DATE: SEPTEMBER, 1998

NOTES

1. THE CONTRACTOR SHALL FIELD VERIFY ALL EXISTING UTILITY LOCATIONS, AND NOTIFY THE ENGINEER IMMEDIATELY OF ANY DISCREPANCIES.
2. ALL CURB RETURN RADII SHALL BE 25' UNLESS OTHERWISE SPECIFIED.
3. ALL CURVE DATA AND DIMENSIONS REFER TO FACE OF CURB UNLESS OTHERWISE SPECIFIED.
4. GRADE ELEVATIONS, WHERE NOTED, ARE FOR FLOWLINE UNLESS OTHERWISE SPECIFIED.
5. CONTRACTOR IS TO INSTALL A 4" X 4" X 5' POST AND END AT THE END OF EACH SANITARY SEWER SERVICE.
6. CONTRACTOR IS RESPONSIBLE FOR REPAIR AND/OR REPLACEMENT OF ALL UTILITY CONDUITS AND EXISTING LINES.
7. ANY ADDITIONAL GRADING REQUIRED TO MATCH PROPOSED STREET GRADES SHALL BE INCIDENTAL TO PAVING ITEMS.
8. CONTRACTOR SHALL PROVIDE THE INSPECTORS, (CITY AND PRIVATE) WITH THE PROPOSED HYDROSTATIC TESTING PLAN. THE PLAN MUST BE APPROVED BEFORE TESTING OPERATIONS BEGIN.
9. CONTRACTOR SHALL PARK EQUIPMENT AND VEHICLES AS NOT TO INTERFERE WITH NORMAL ACTIVITIES OF RESIDENTS OR OTHER CONTRACTORS ON SITE.
10. ANY DAMAGE TO THE EXISTING FACILITIES (CURB & GUTTER, PAVEMENT, CONDUITS, LANDSCAPING, UTILITY LINES, ETC.) DURING CONSTRUCTION SHALL BE REPLACED AT THE CONTRACTORS EXPENSE.
11. REMOVAL OF THE EXISTING CURB AND GUTTER SHALL BE AS PER COA STD. DWG. 2415 (SAWCUT ONLY).
12. WHEELCHAIR RAMPS SHALL BE CONSTRUCTED PRIOR TO ACCEPTANCE OF CURB & GUTTER.

QUERQUE		ENGINEER'S SEAL		SURVEY INFORMATION		BENCH MARKS		AS-BUILT INFORMATION	
DEPARTMENT				FIELD NOTES		TBM NO. 205		CONTRACTOR	
PROJECT GROUP				NO. BY DATE		CHISLED "X" LOCATED APPROXIMATELY 459 FEET SOUTH OF THE BLACK'S		STARTED BY HIS, INC.	
NORTH UNIT I		NO. DATE		REMARKS		INSPECTOR'S		DATE	
FILE		BY		REVISIONS		ACCEPTANCE BY		DATE	
A DRIVE				DESIGN		DIVERSION INLET STRUCTURE ON THE EAST WALL.		DRAWING NO. 8499	
		DESIGNED BY JCA/CMG		DATE 09/98		ELEV. 5110.55		MICRO-FILM INFORMATION	
		DRAWN BY PEG/CGG		DATE 09/98		RECORDED BY		DATE	
								NO.	

SANITARY SEWER SERVICES				
LOT NUMBER	SAS STATION & OFFSET	SAS LENGTH	TOP OF PIPE AT PLUG (W/RISE)	
14	2+76.02-CL.	32.00'	5203.77 (14')	
15	2+30.08-CL.	32.00'	5200.41 (11')	
16	1+82.83-CL.	32.00'	5196.37 (10')	
17	1+49.61-CL.	32.00'	5193.37 (14')	

NOTE: WATER METER LOCATIONS ARE DESIGNATED BY STATIONING AT PROPERTY CORNERS.

WATERLINE CURVE DATA				
NUMBER	ARC	RADIUS	DELTA	TANGENT
C2	204.15'	702.00'	16°32'40"	102.79'

SAS CURVE DATA				
NUMBER	ARC	RADIUS	DELTA	TANGENT
C1	175.01'	712.00'	14°09'49"	88.46'

SANITARY SEWER SERVICES				
LOT NUMBER	SAS STATION & OFFSET	SAS LENGTH	TOP OF PIPE AT PLUG (W/RISE)	
1	3+88.71-CL.	32.00'	5208.11(13')	
2	2+88.70-CL.	32.00'	5208.46(13')	
3	2+88.70-CL.	32.00'	5208.81(13')	
4	2+38.70-CL.	32.00'	5209.16(13')	
5	1+88.70-CL.	32.00'	5210.19(13')	
6	1+38.70-CL.	32.00'	5210.54(13')	
7	0+88.70-CL.	49.66'	5204.59(-)	
8	1+53.37-CL.	68.23'	5205.30(-)	
9	1+53.37-CL.	58.27'	5205.12(-)	

NOTE: WATER METER LOCATIONS ARE DESIGNATED BY STATIONING AT PROPERTY CORNERS.

SANITARY SEWER SERVICES				
LOT NUMBER	SAS STATION & OFFSET	SAS LENGTH	TOP OF PIPE AT PLUG (W/RISE)	
23	4+14.93-CL.	32.00'	5209.01(14')	
24	3+64.93-CL.	32.00'	5209.36(14')	
25	3+14.93-CL.	32.00'	5209.03(13')	
26	2+64.93-CL.	32.00'	5209.38(13')	
27	2+14.93-CL.	32.00'	5210.40(13')	
28	1+64.93-CL.	32.00'	5210.35(13')	
29	1+14.93-CL.	32.00'	5210.42(11')	
30	1+53.37-CL.	32.01'	5210.79(11')	
31	1+53.37-CL.	43.01'	5211.24(11')	


NOTE: WATER METER LOCATIONS ARE DESIGNATED BY STATIONING AT PROPERTY CORNERS.

SAS TANGENT DATA		
NUMBER	BEARING	LENGTH
T1	S89°53'09"E	176.53'
T2	S89°53'09"E	228.14'



WATERLINE TANGENT DATA		
NUMBER	BEARING	LENGTH
T3	S89°53'09"E	396.41'
T4	N80°53'09"E	25.15'
T5	N78°03'09"E	13.85'

NOTES

- THE CONTRACTOR SHALL FIELD VERIFY ALL EXISTING UTILITY LOCATIONS AND NOTIFY THE ENGINEER IMMEDIATELY OF ANY DISCREPANCIES.
- ALL CURB RETURN RADIUS SHALL BE 25' UNLESS OTHERWISE SPECIFIED.
- ALL CURVE DATA AND DIMENSIONS REFER TO FACE OF CURB UNLESS OTHERWISE SPECIFIED.
- GRADE ELEVATIONS, WHERE NOTED, ARE FOR FLOWLINE UNLESS OTHERWISE SPECIFIED.
- CONTRACTOR IS TO INSTALL A 4" X 4" X 5' POST AND EMD AT THE END OF EACH SANITARY SEWER SERVICE.
- CONTRACTOR IS RESPONSIBLE FOR REPAIR AND/OR REPLACEMENT OF ALL UTILITY CONDUITS AND EXISTING LINES.
- ANY ADDITIONAL GRADING REQUIRED TO MATCH PROPOSED STREET GRADES SHALL BE INCIDENTAL TO PAVING ITEMS.
- CONTRACTOR SHALL PROVIDE THE INSPECTORS, (CITY AND PRIVATE) WITH THE PROPOSED HYDROSTATIC TESTING PLAN. THE PLAN MUST BE APPROVED BEFORE TESTING OPERATIONS BEGIN.
- CONTRACTOR SHALL PARK EQUIPMENT AND VEHICLES AS NOT TO INTERFERE WITH NORMAL ACTIVITIES OF RESIDENTS OR OTHER CONTRACTORS ON SITE.
- ANY DAMAGE TO THE EXISTING FACILITIES (CURB & GUTTER, PAVEMENT, CONDUITS, LANDSCAPING, UTILITY LINES, ETC.) DURING CONSTRUCTION SHALL BE REPLACED AT THE CONTRACTORS' EXPENSE.
- REMOVAL OF THE EXISTING CURB AND GUTTER SHALL BE AS PER COA STD. DWG. 2415 (SAWCUT ONLY).
- WHEELCHAIR RAMPS SHALL BE CONSTRUCTED PRIOR TO ACCEPTANCE OF CURB & GUTTER.

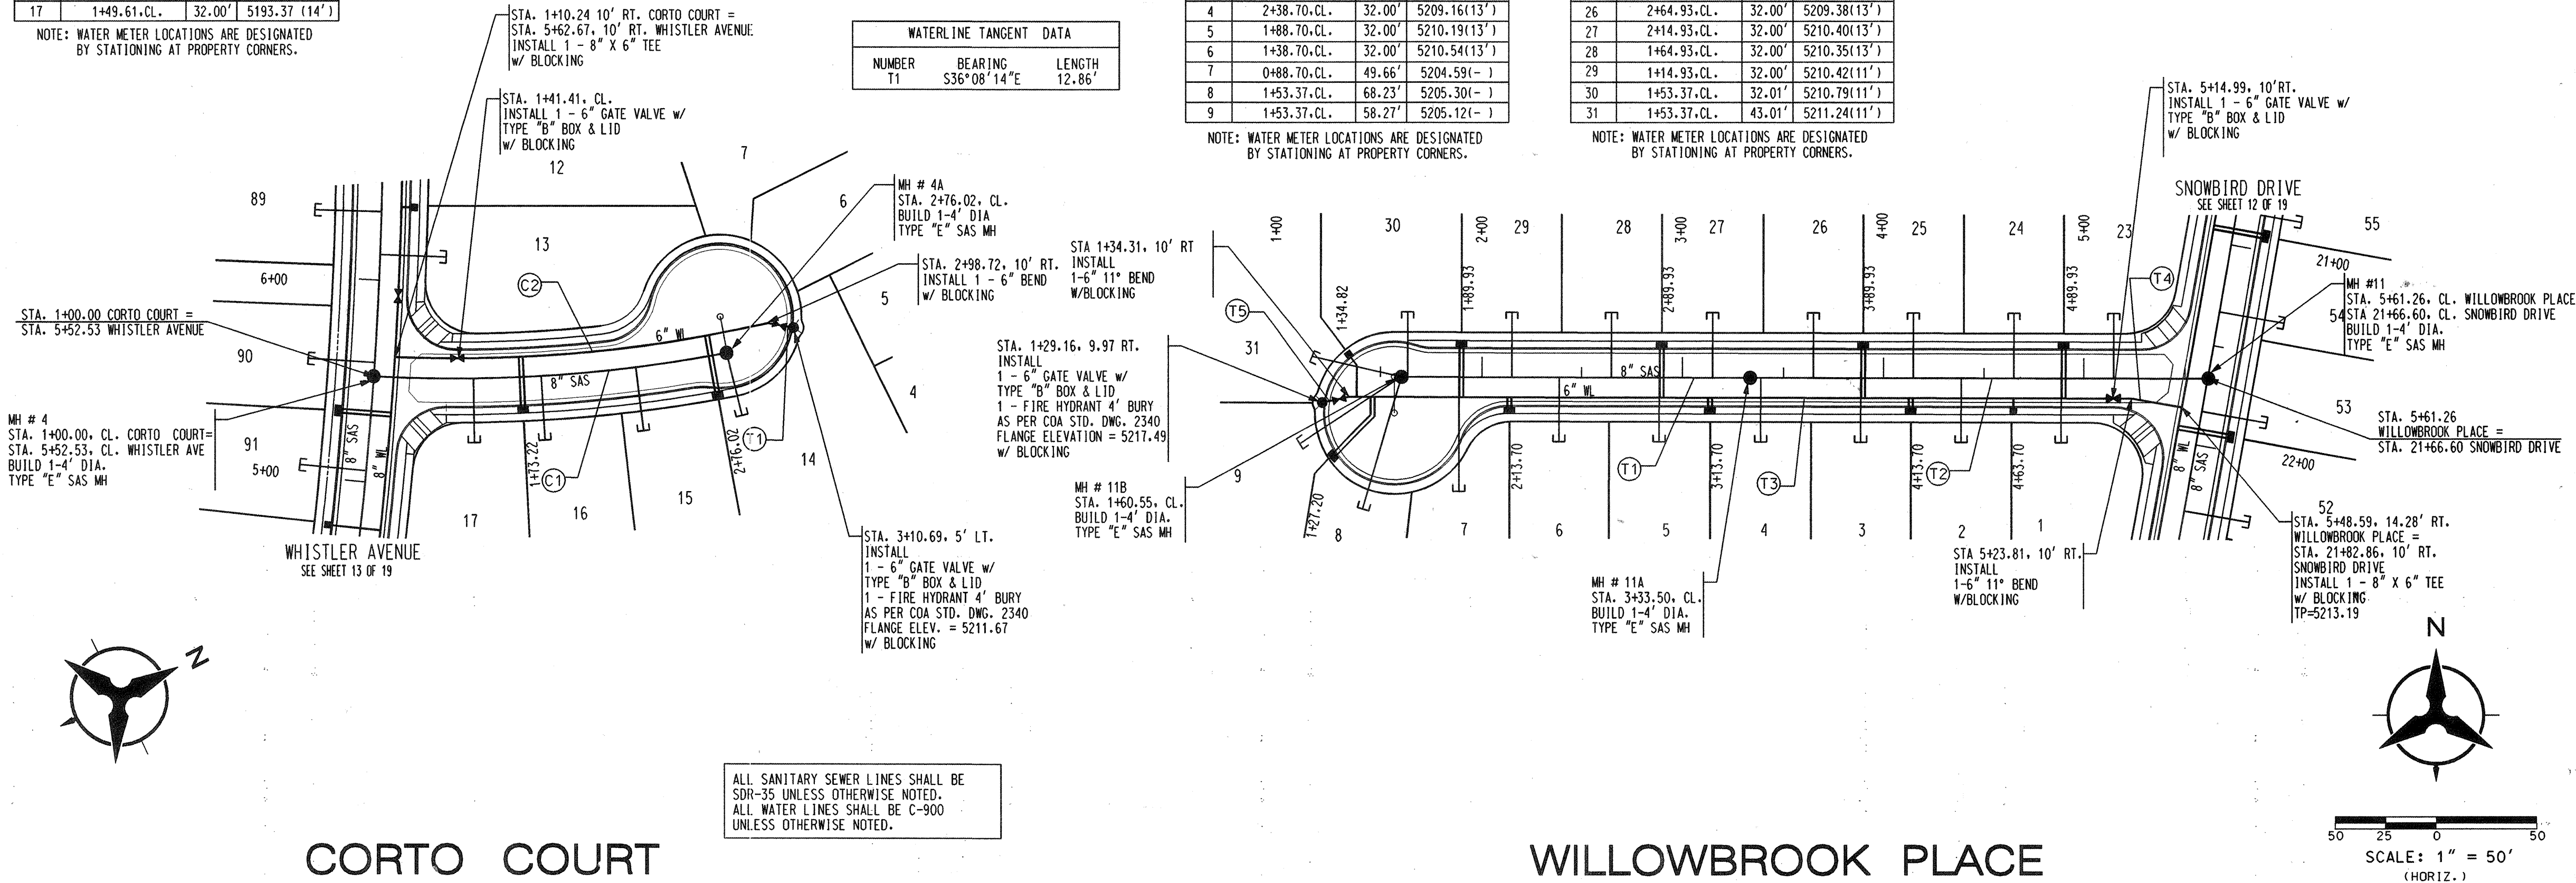

ALL SANITARY SEWER LINES SHALL BE SDR-35 UNLESS OTHERWISE NOTED.
ALL WATER LINES SHALL BE C-900 UNLESS OTHERWISE NOTED.

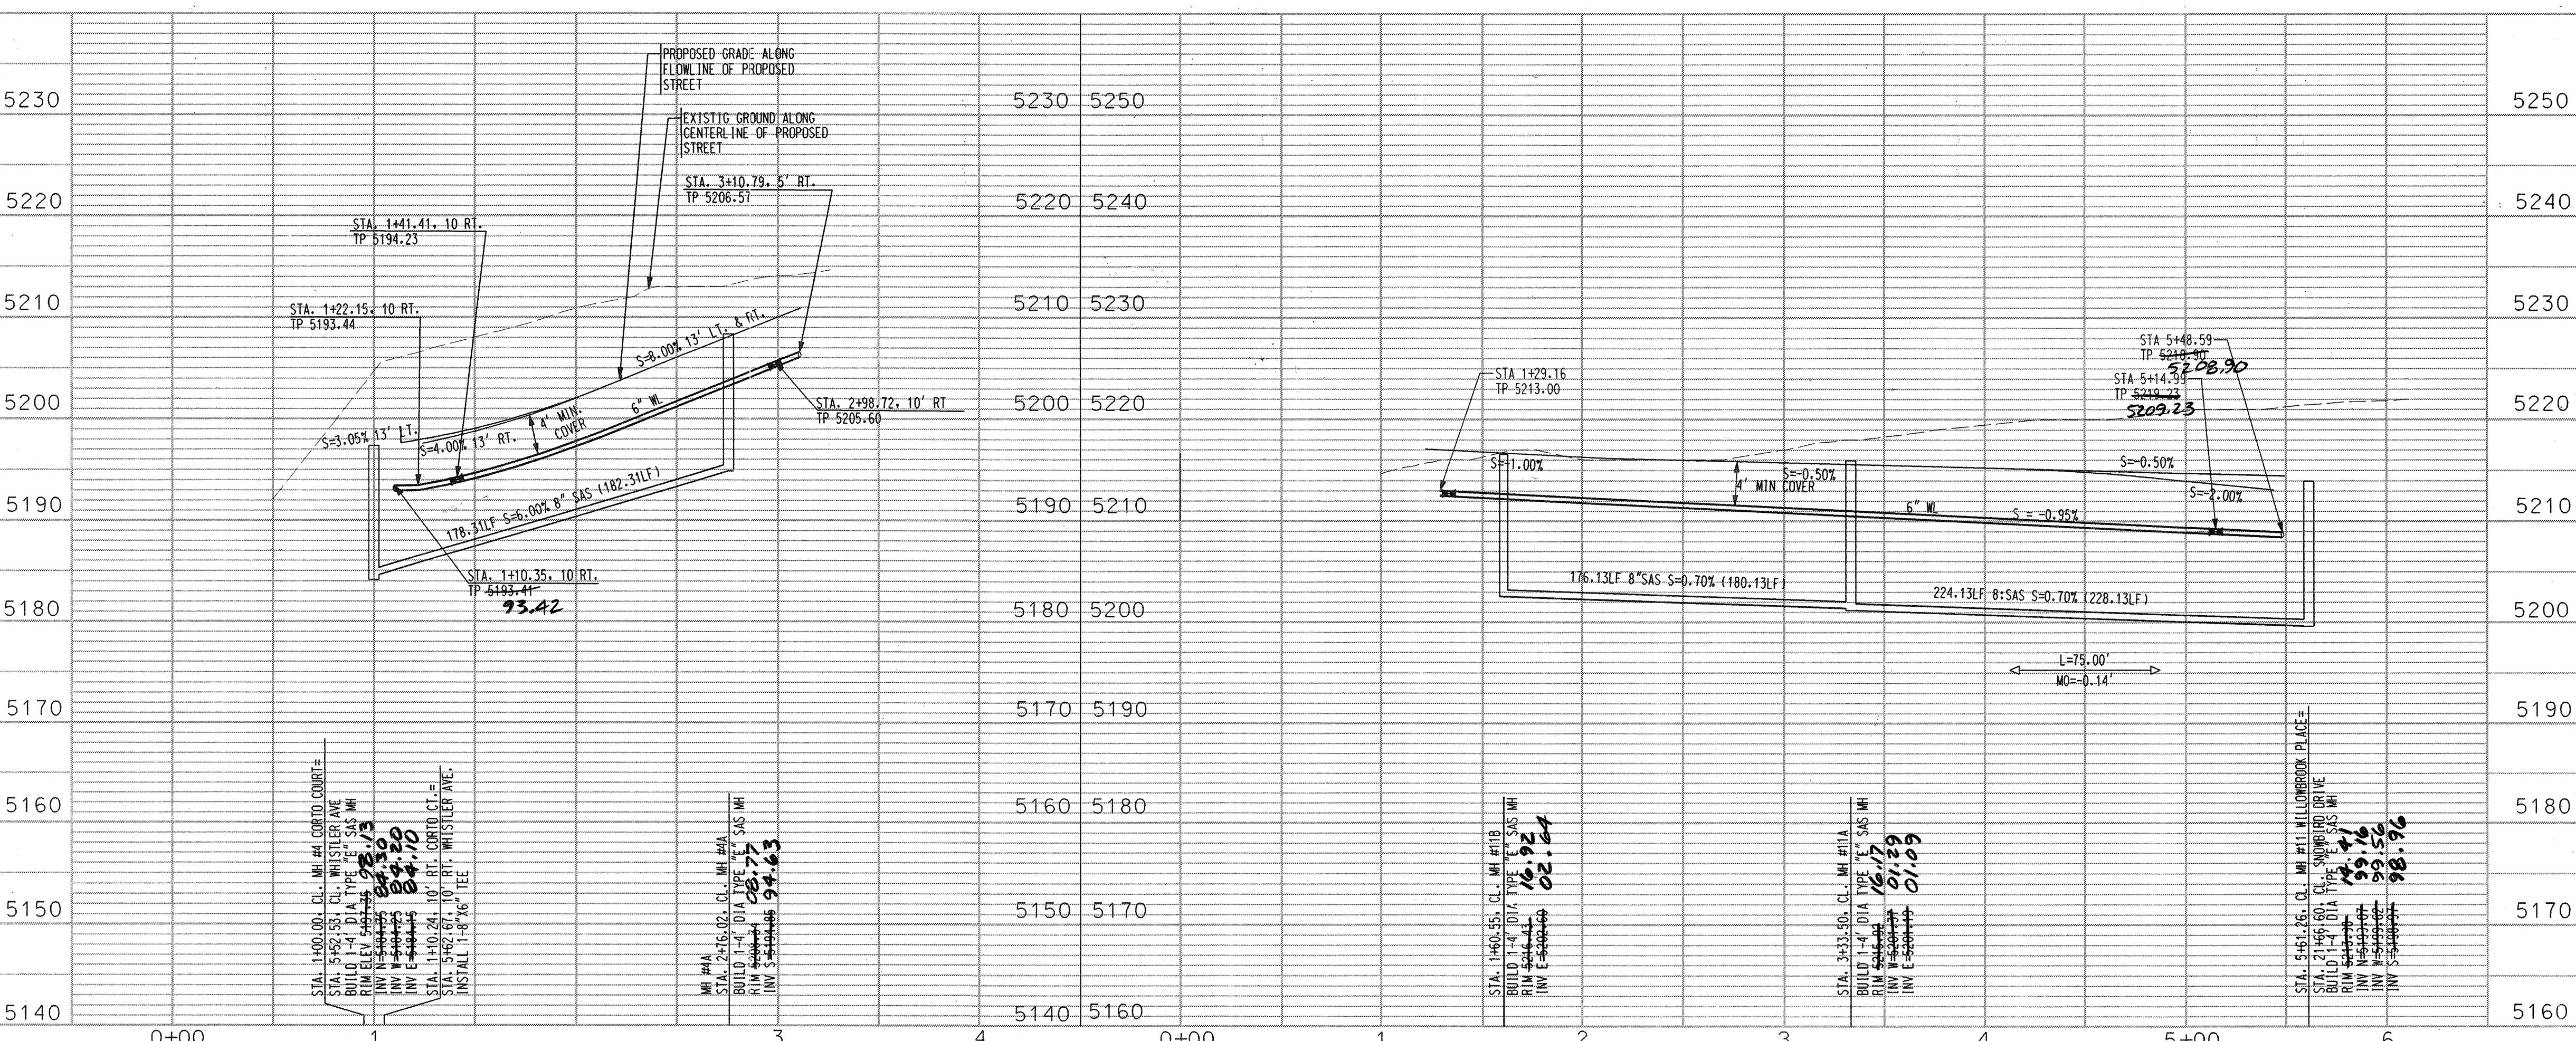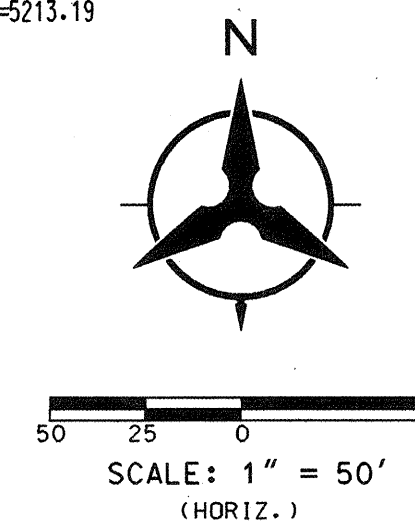

ENGINEER'S SEAL SURVEY INFORMATION

FIELD NOTES

DATE

BY

NO.

REMARKS

REVISIONS

DESIGN

DATE

BY

DATE

BY

DATE

BY

BOHANNAN & HUSTON

COURTYARD ONE 7500 JEFFERSON NE ALBUQUERQUE NEW MEXICO 87109

ENGINEERS PLANNERS PHOTOGRAMMETRISTS SURVEYORS LANDSCAPE ARCHITECTS

CITY OF ALBUQUERQUE

PUBLIC WORKS DEPARTMENT

ENGINEERING DEVELOPMENT GROUP

WHISTLER AT SEVEN BAR NORTH UNIT I

UTILITY PLAN & PROFILE

CORTO COURT /WILLOWBROOK PLACE

DESIGN REVIEW COMMITTEE CITY ENGINEER APPROVAL

MO./DAY/YR.

MO./DAY/YR.

CITY PROJECT NO.

5752.82

ZONE MAP NO.

A-13

SHEET



14

OF


19

SCANNED BY
MESA REPRO

WL TANGENT DATA		
NUMBER	BEARING	DISTANCE
T1	S89°53'09"E	140.00'
T2	S89°53'09"E	123.12'
T3	N80°35'35"E	17.52'

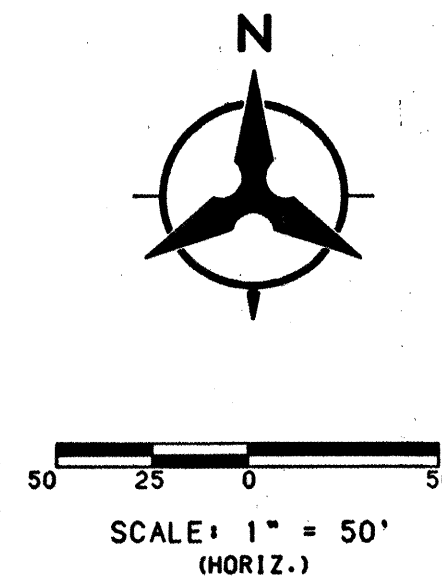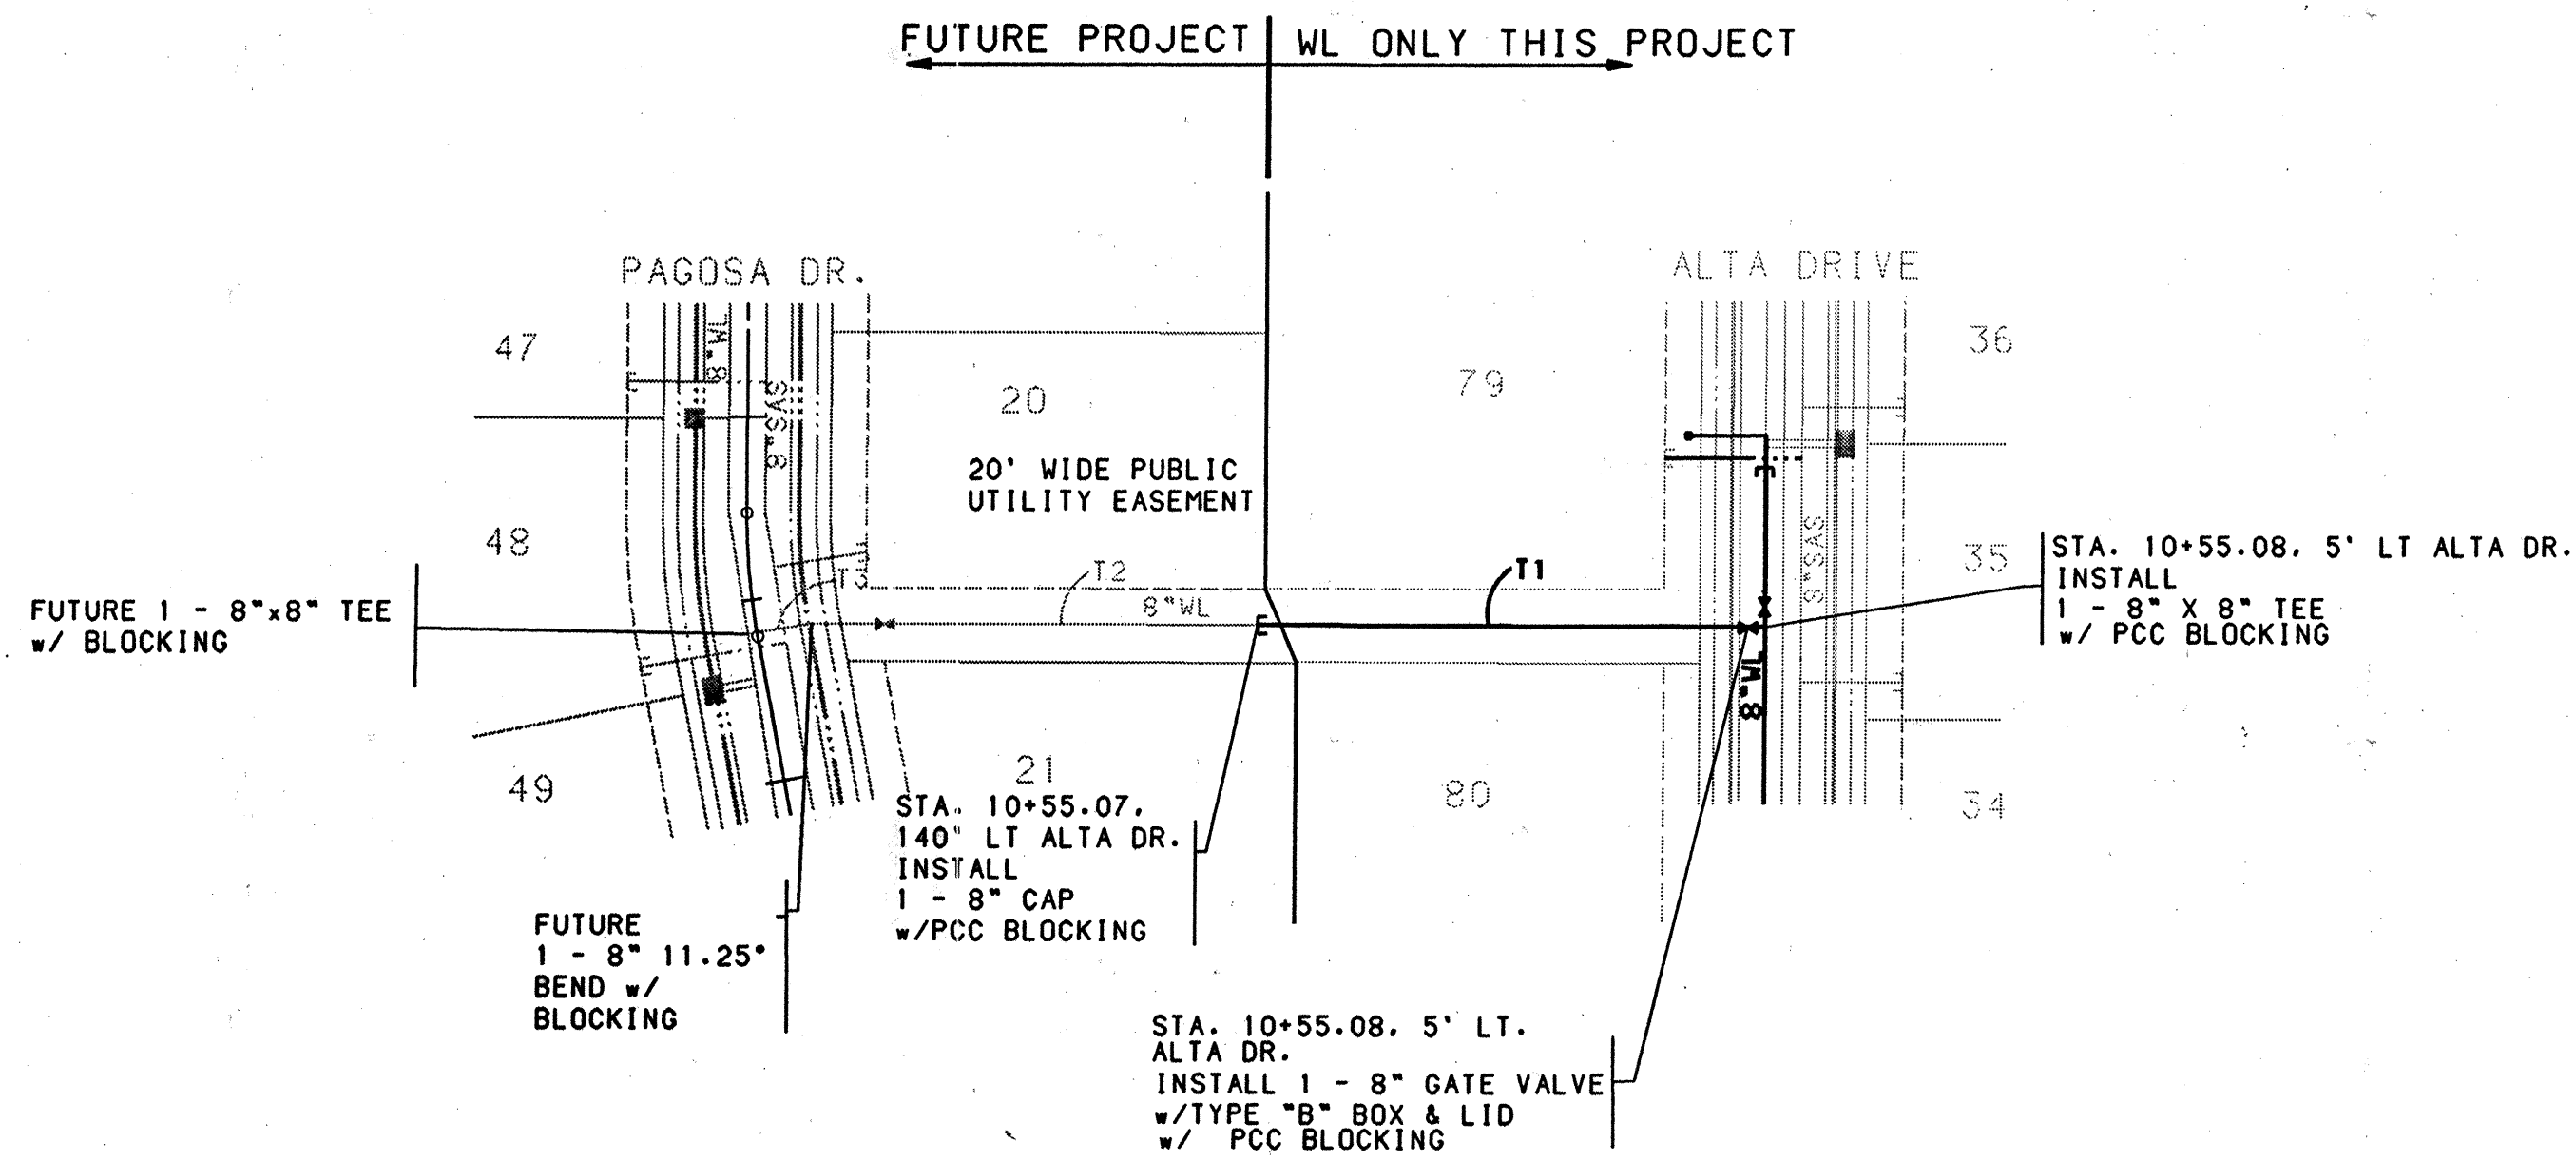


WATERLINE EASEMENT

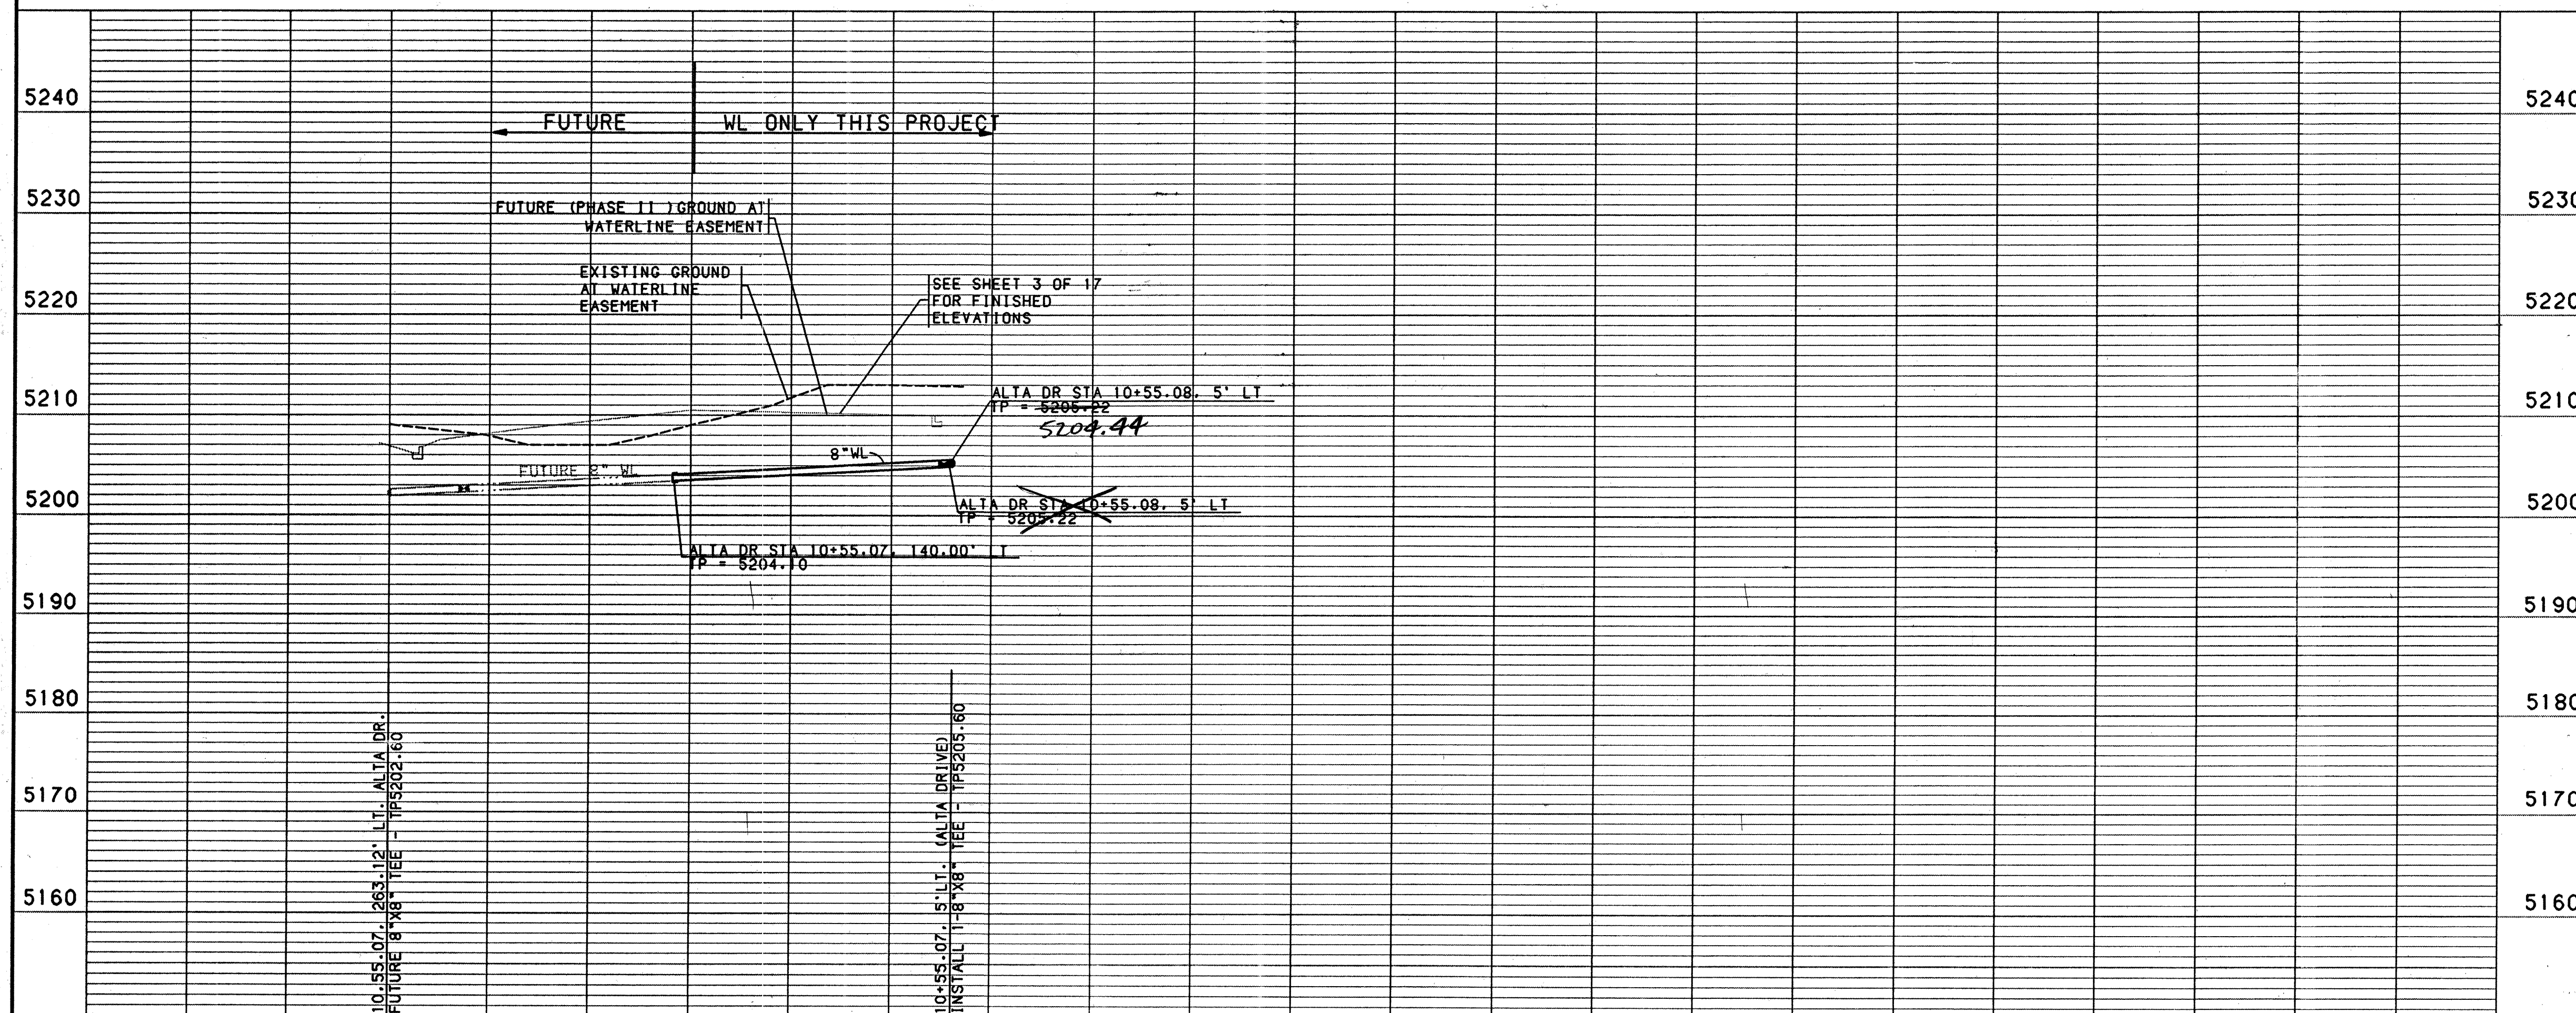

SCALE: 1" = 50' (HORIZ.)
1" = 10' (VERT.)

NOTES


1. THE CONTRACTOR SHALL FIELD VERIFY ALL EXISTING UTILITY LOCATIONS AND NOTIFY THE ENGINEER IMMEDIATELY OF ANY DISCREPANCIES.
2. ALL CURB RETURN RADII SHALL BE 25' TO FACE OF CURB UNLESS OTHERWISE SPECIFIED.
3. ALL CURVE DATA AND DIMENSIONS REFER TO FLOW LINE UNLESS OTHERWISE SPECIFIED.
4. GRADE ELEVATIONS, WHERE NOTED, ARE FOR TOP OF CURB UNLESS OTHERWISE SPECIFIED.
5. CONTRACTOR IS TO INSTALL A 4"x4"x5' POST AND END AT THE END OF EACH SANITARY SEWER SERVICE.
6. CONTRACTOR IS RESPONSIBLE FOR REPAIR AND/OR REPLACEMENT OF ALL UTILITY CONDUITS AND EXISTING LINES.
7. ANY ADDITIONAL GRADING REQUIRED TO MATCH PROPOSED STREET GRADES SHALL BE INCIDENTAL TO PAVING ITEMS.
8. CONTRACTOR SHALL PROVIDE THE INSPECTORS. (CITY AND PRIVATE) WITH THE PROPOSED HYDROSTATIC TESTING PLAN. THE PLAN MUST BE APPROVED BEFORE TESTING OPERATIONS BEGIN.
9. CONTRACTOR SHALL PARK EQUIPMENT AND VEHICLES AS NOT TO INTERFERE WITH NORMAL ACTIVITIES OF RESIDENTS OR OTHER CONTRACTORS ON SITE.
10. ANY DAMAGE TO THE EXISTING FACILITIES (CURB AND GUTTER, PAVEMENT, CONDUITS, LANDSCAPING, UTILITY LINES, ETC.) DURING CONSTRUCTION, SHALL BE REPLACED AT THE CONTRACTORS EXPENSE.

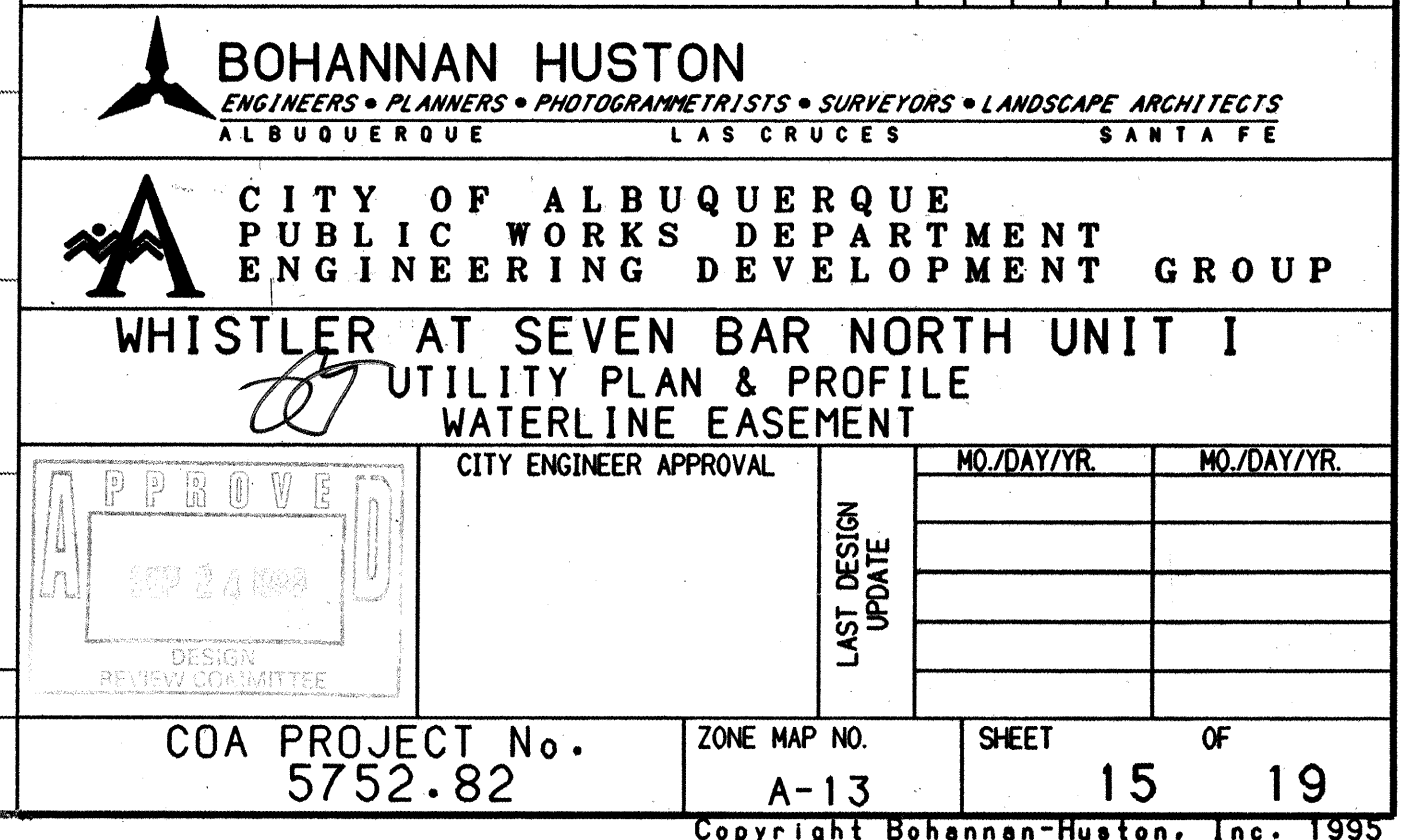[illegible]

NUMBER	BEARING	LENGTH
T1	S15°29'57"E	182.68'
T2	S15°29'57"E	88.80'
T3	S49°11'26"E	24.52'
T4	N52°47'22"E	110.83'
T5	S25°12'57"W	22.04'
T6	N62°12'00"W	8.20'

SAS TANGENT DATA		
NUMBER	BEARING	LENGTH
T7	S15°29'57"E	162.94'

NOTE:
STATIONING IS BASED ON CENTERLINE
STORM DRAIN EXTENSION LINE.

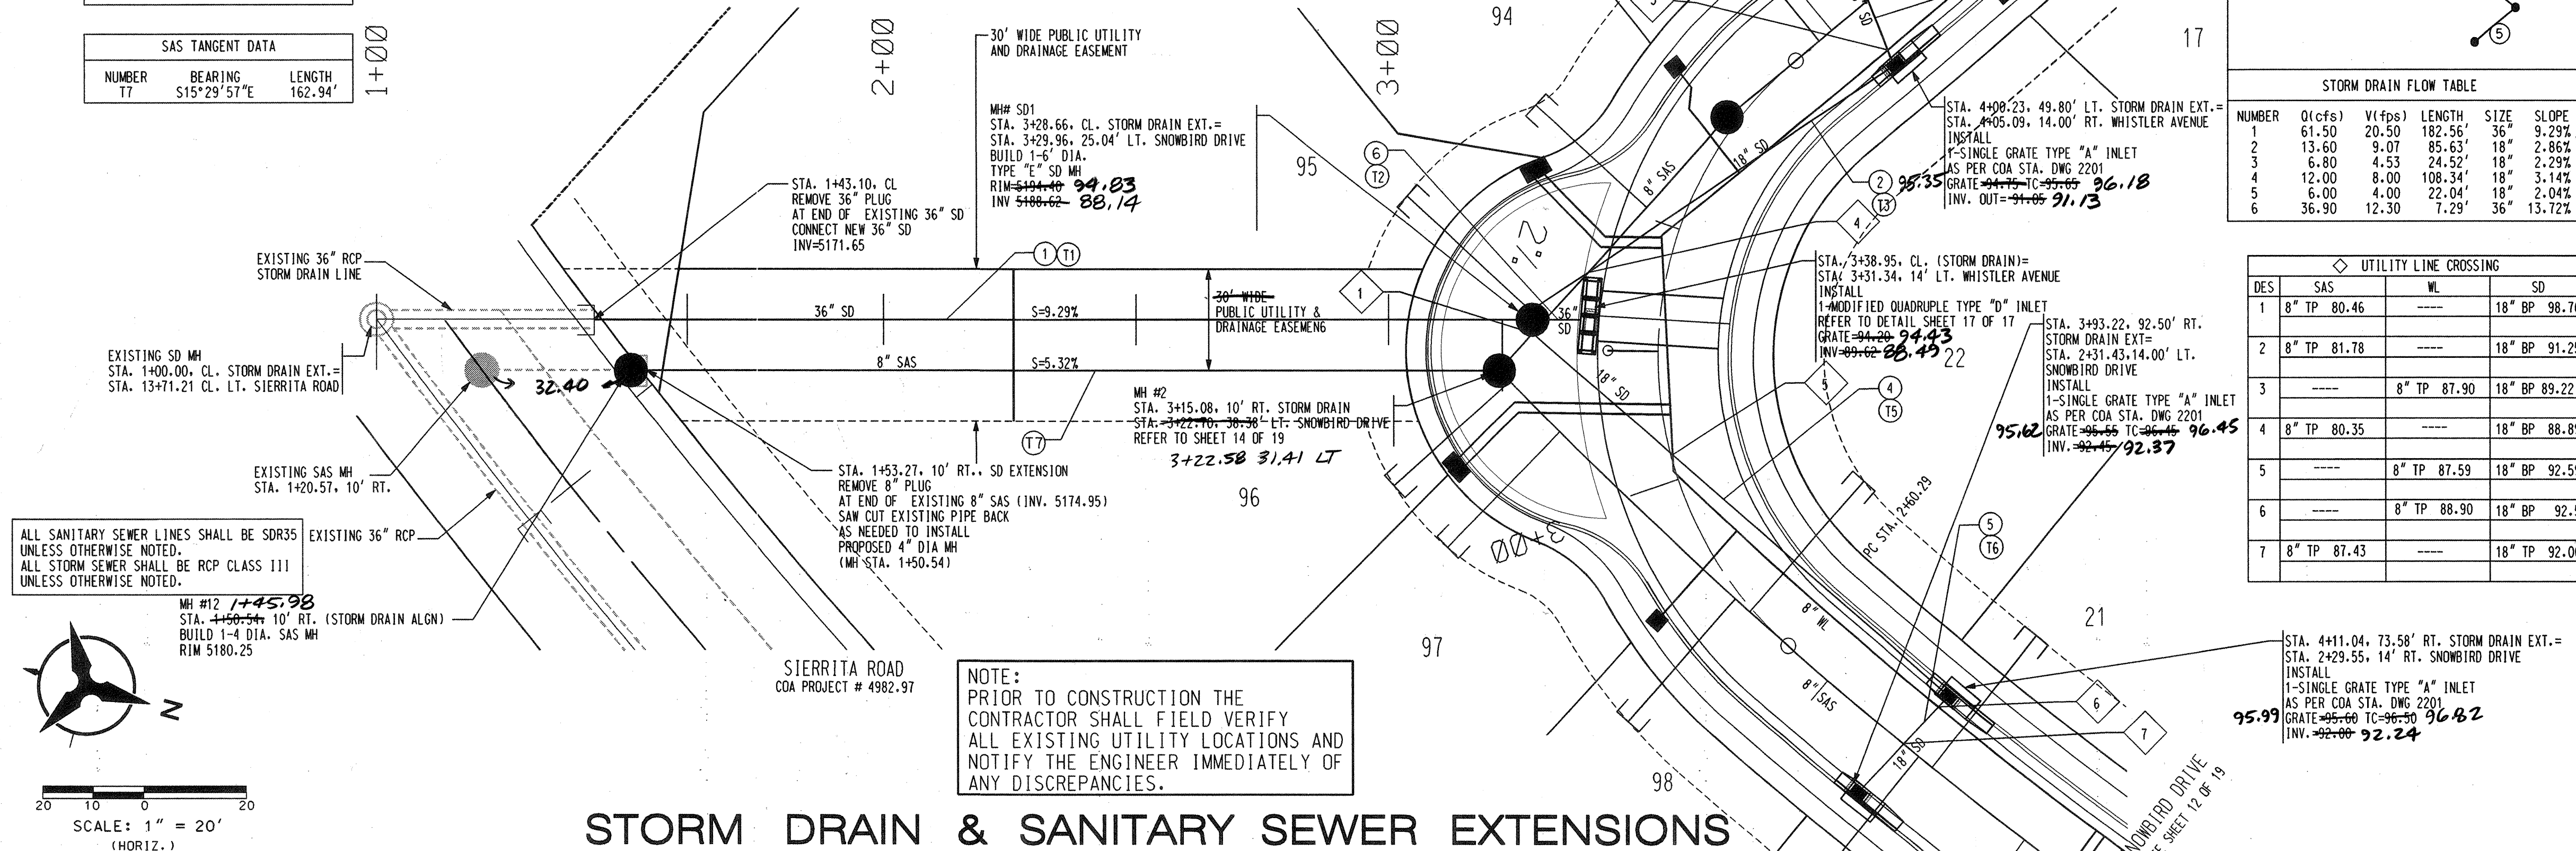


GENERAL NOTES

1. THE CONTRACTOR SHALL FIELD VERIFY ALL EXISTING UTILITY LOCATIONS, AND NOTIFY THE ENGINEER IMMEDIATELY OF ANY DISCREPANCIES.
2. ALL CURB RETURN RADII SHALL BE 25' UNLESS OTHERWISE SPECIFIED.
3. ALL CURVE DATA AND DIMENSIONS REFER TO FACE OF CURB UNLESS OTHERWISE SPECIFIED.
4. GRADE ELEVATIONS, WHERE NOTED, ARE FOR THE CURB UNLESS OTHERWISE SPECIFIED.
5. CONTRACTOR IS TO INSTALL A 4" X 4" X 5' POST AND END AT THE END OF EACH SANITARY SEWER SERVICE.
6. CONTRACTOR IS RESPONSIBLE FOR REPAIR AND/OR REPLACEMENT OF ALL UTILITY CONDUITS AND EXISTING LINES.
7. ANY ADDITIONAL GRADING REQUIRED TO MATCH PROPOSED STREET GRADES SHALL BE INCIDENTAL TO PAVING ITEMS.
8. CONTRACTOR SHALL PROVIDE THE INSPECTORS, (CITY AND PRIVATE) WITH THE PROPOSED HYDROSTATIC TESTING PLAN. THE PLAN MUST BE APPROVED BEFORE TESTING OPERATIONS BEGIN.
9. CONTRACTOR SHALL PARK EQUIPMENT AND VEHICLES AS NOT TO INTERFERE WITH NORMAL ACTIVITIES OF RESIDENTS OR OTHER CONTRACTORS ON SITE.
10. ANY DAMAGE TO THE EXISTING FACILITIES (CURB & GUTTER, PAVEMENT, CONDUITS, LANDSCAPING, UTILITY LINES, ETC.) DURING CONSTRUCTION SHALL BE REPLACED AT THE CONTRACTORS' EXPENSE.
11. REMOVAL OF THE EXISTING CURB AND GUTTER SHALL BE AS PER COA STD. DWG. 2415 (SAW CUT ONLY).
12. WHEELCHAIR RAMPS SHALL BE CONSTRUCTED PRIOR TO ACCEPTANCE OF CURB & GUTTER.
13. STATIONING AND OFFSETS GIVEN FOR DROP INLETS ARE GIVEN AT CENTER OF GRATE AT FLOWLINE.

STORM DRAIN FLOW TABLE					
NUMBER	Q(cfs)	V(fps)	LENGTH	SIZE	SLOPE
1	61.50	20.50	182.56'	36"	9.29%
2	13.60	9.07	85.63'	18"	2.86%
3	6.80	4.53	24.52'	18"	2.29%
4	12.00	8.00	108.34'	18"	3.14%
5	6.00	4.00	22.04'	18"	2.04%
6	36.90	12.30	7.29'	36"	13.72%

◇ UTILITY LINE CROSSING				
DES	SAS	WL	SD	
1	8" TP 80.46		18" BP	98.42
2	8" TP 81.78		18" BP	91.42
3		8" TP 87.90	18" BP	89.22
4	8" TP 80.35		18" BP	88.42
5		8" TP 87.59	18" BP	92.42
6		8" TP 88.90	18" BP	92.42
7	8" TP 87.43		18" TP	92.42

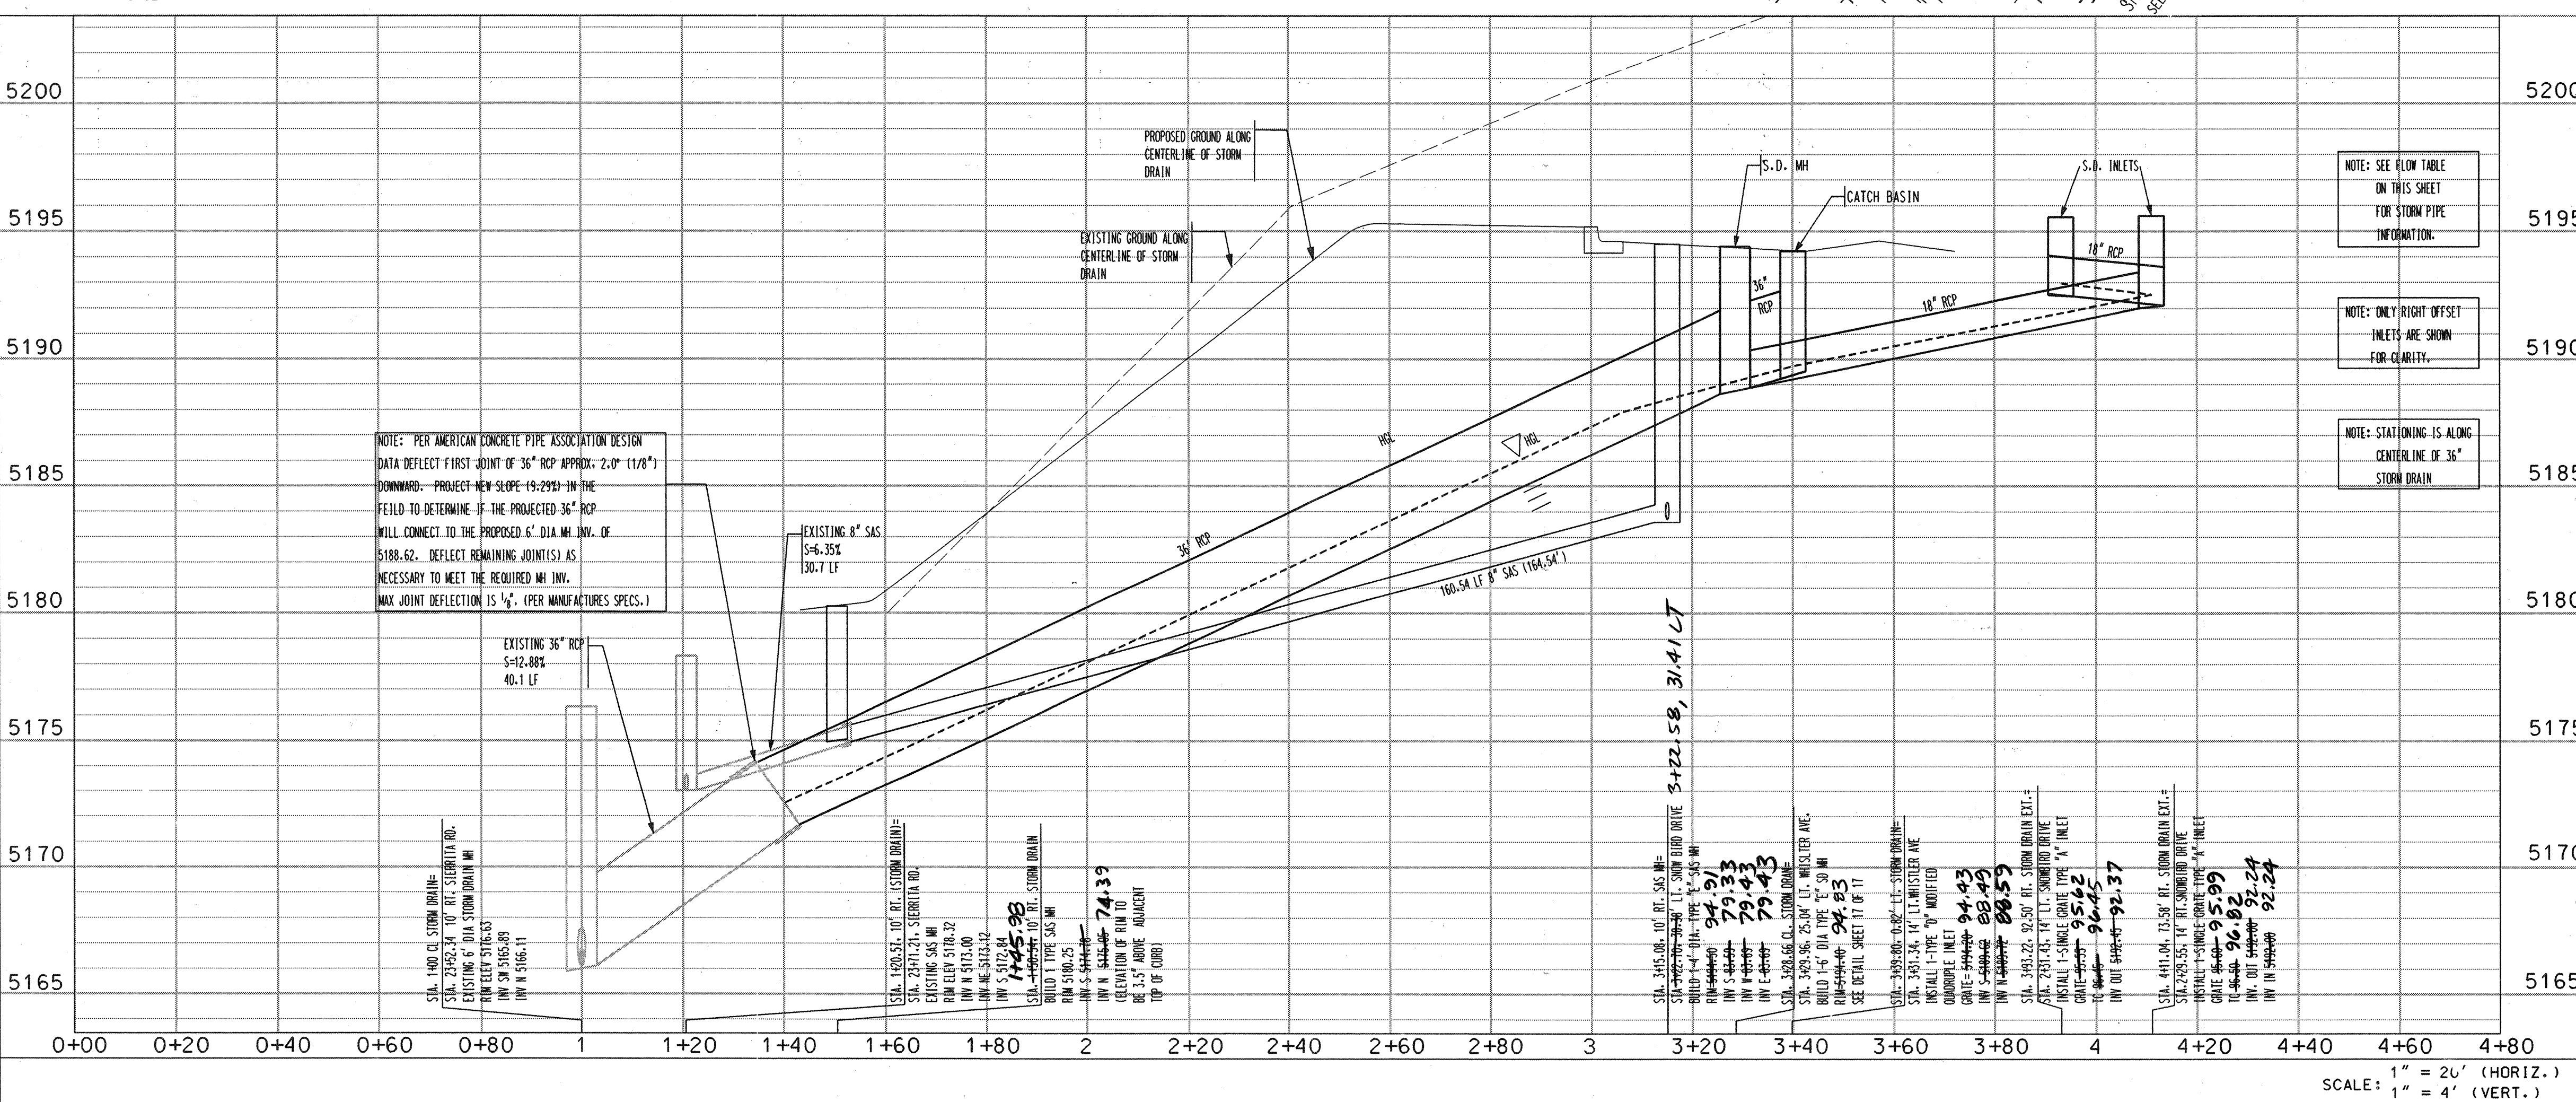

SCALE: $1'' = 20'$ (HORIZ.)
 $1'' = 4'$ (VERT.)

P:\BHI-MAIN\PROJECTS\94250\CDP\PNF
94250UPNP08.DGN

BHI JOB NO. 98161A05

COPYRIGHT BOHANNAN HUSTON 1998
DATE: SEPTEMBER, 1998

Bohannon ▲ Huston

 **Courtyard One** 7500 JEFFERSON NE Albuquerque NEW MEXICO 87109


ENGINEERS PLANNERS PHOTOGRAMMETRISTS SURVEYORS LANDSCAPE ARCHITECTS

 CITY OF ALBUQUERQUE
PUBLIC WORKS DEPARTMENT
ENGINEERING DEVELOPMENT GROUP

 WHISTLER AT SEVEN BAR NORTH UNIT I
UTILITY PLAN & PROFILE
STORM DRAIN & SANITARY SEWER EXTENSIONS



DESIGN REVIEW COMMITTEE CITY ENGINEER APPROVAL		MO./DAY/YR.	MO./DAY/YR.
 DESIGN REVIEW COMMITTEE	LAST DESIGN UPDATE		

CITY PROJECT NO.	5752.82	ZONE MAP NO.	A-13	SHEET	16	OF	19
------------------	---------	--------------	------	-------	----	----	----

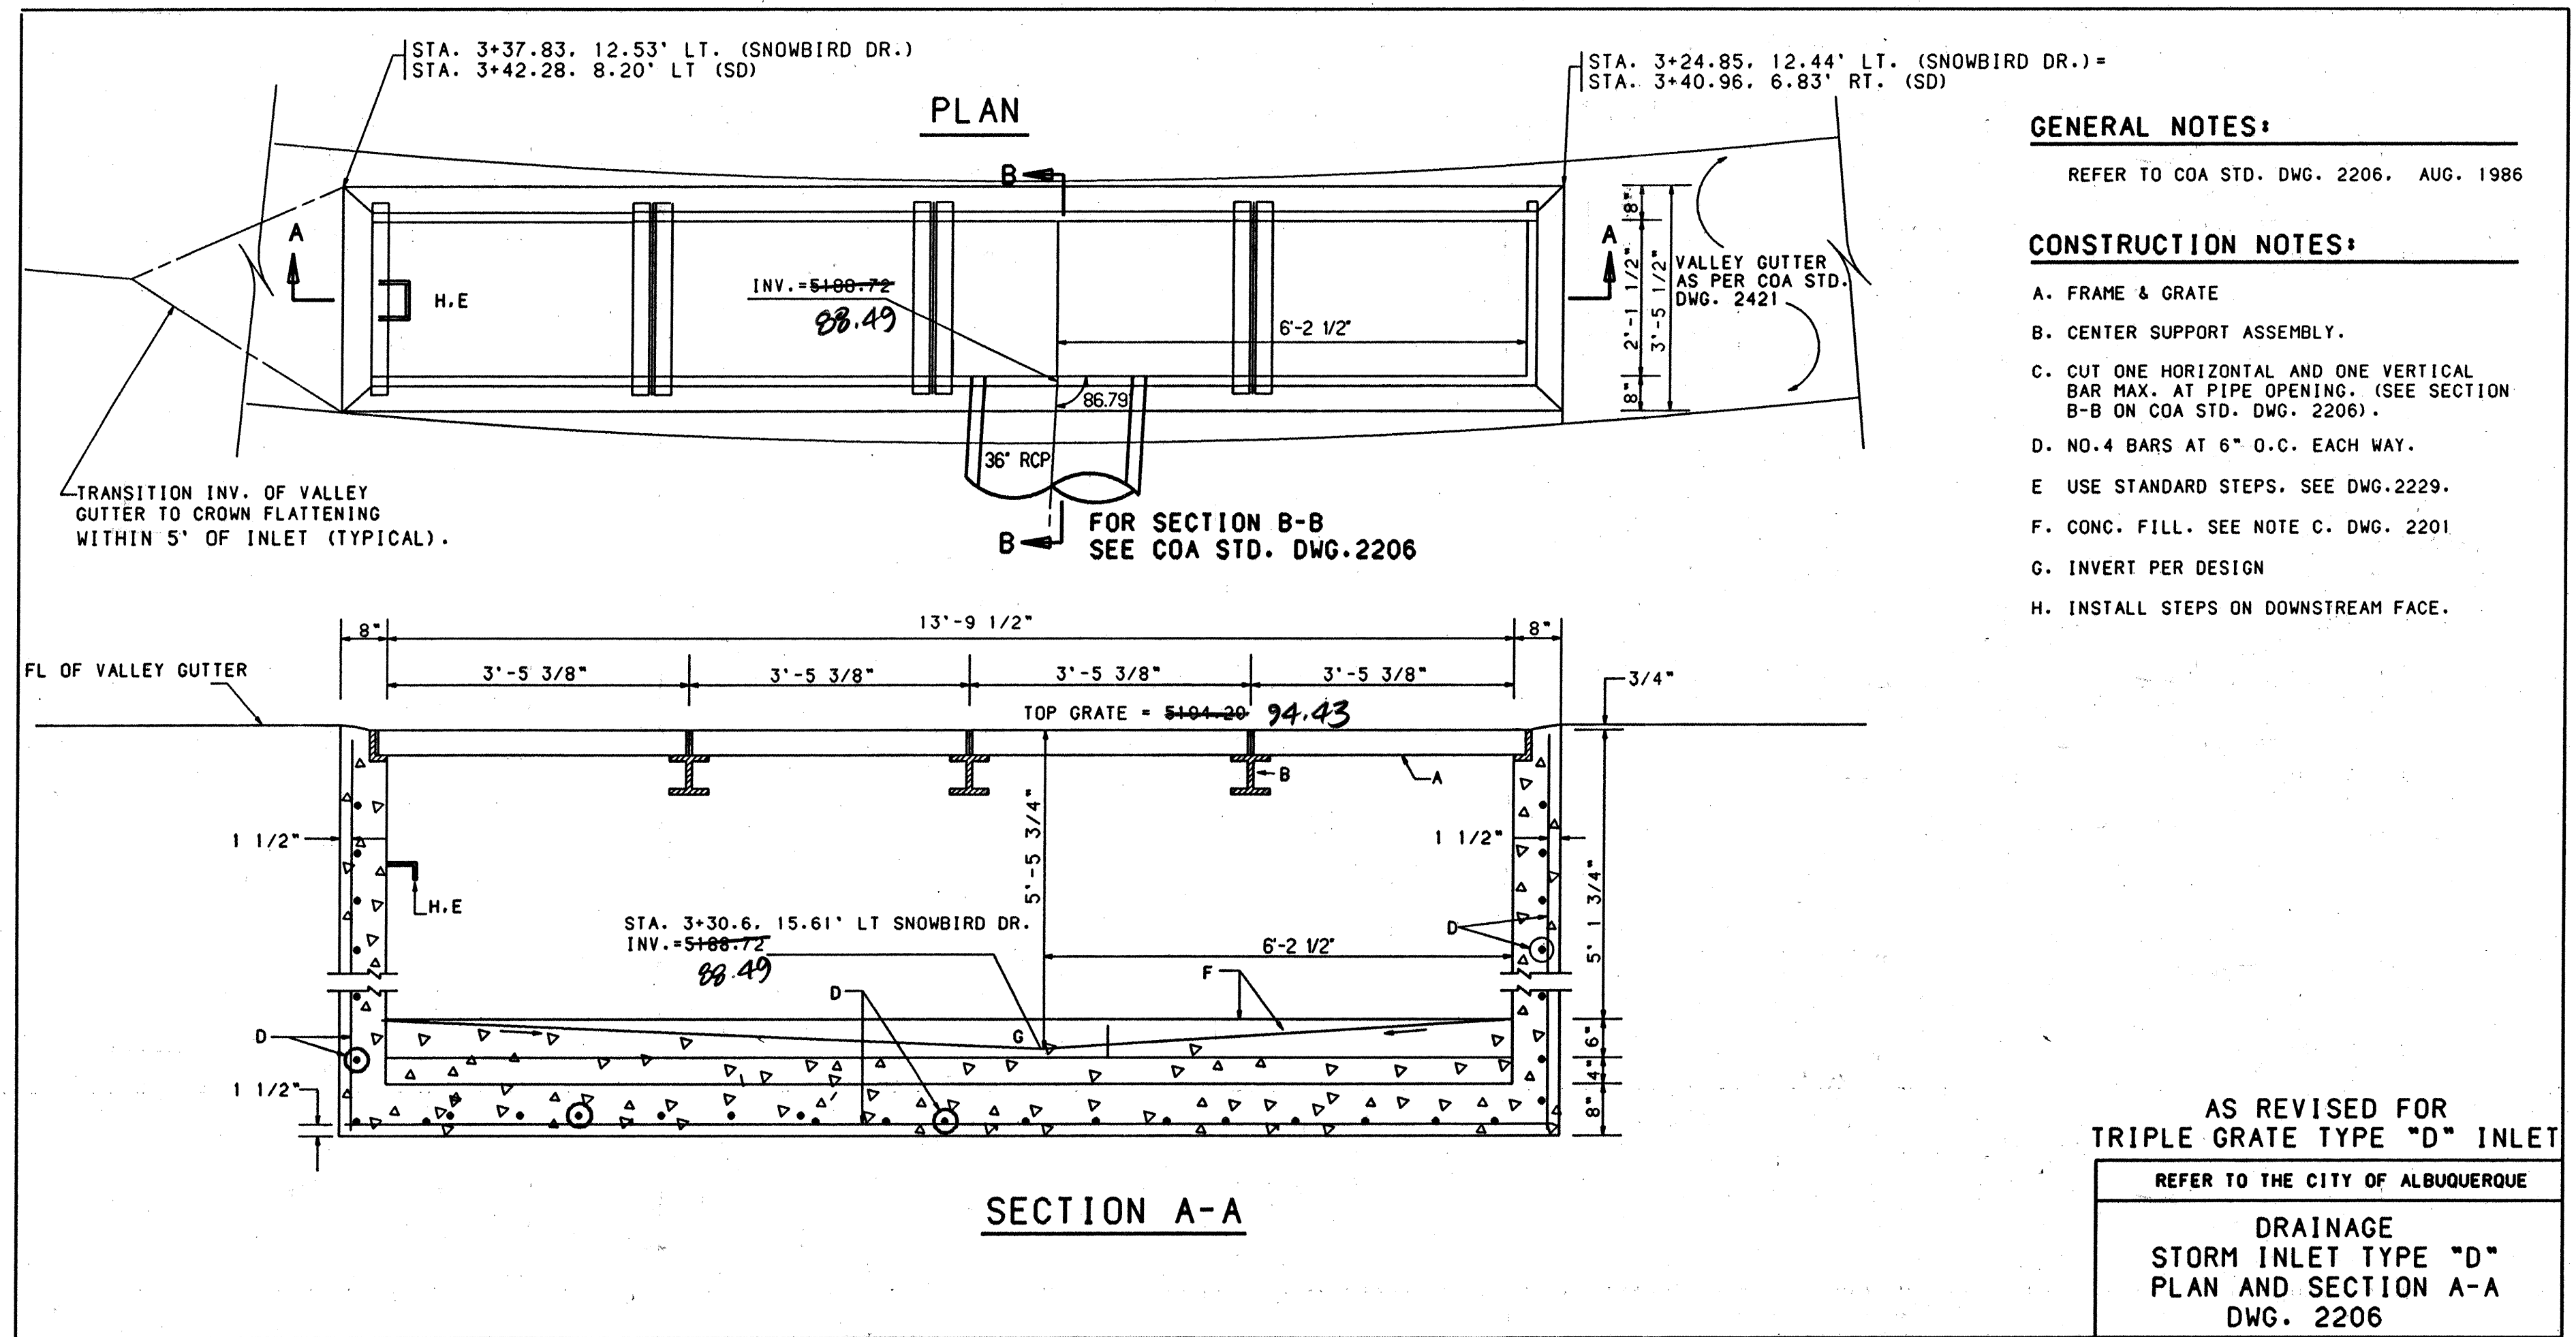

MODIFIED QUADRUPLE GRATE TYPE "D" INLET - (SNOWBIRD DR.)

NO SCALE

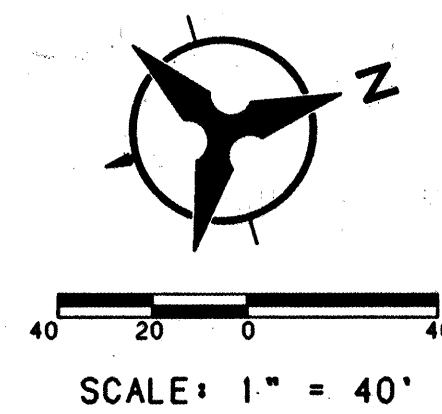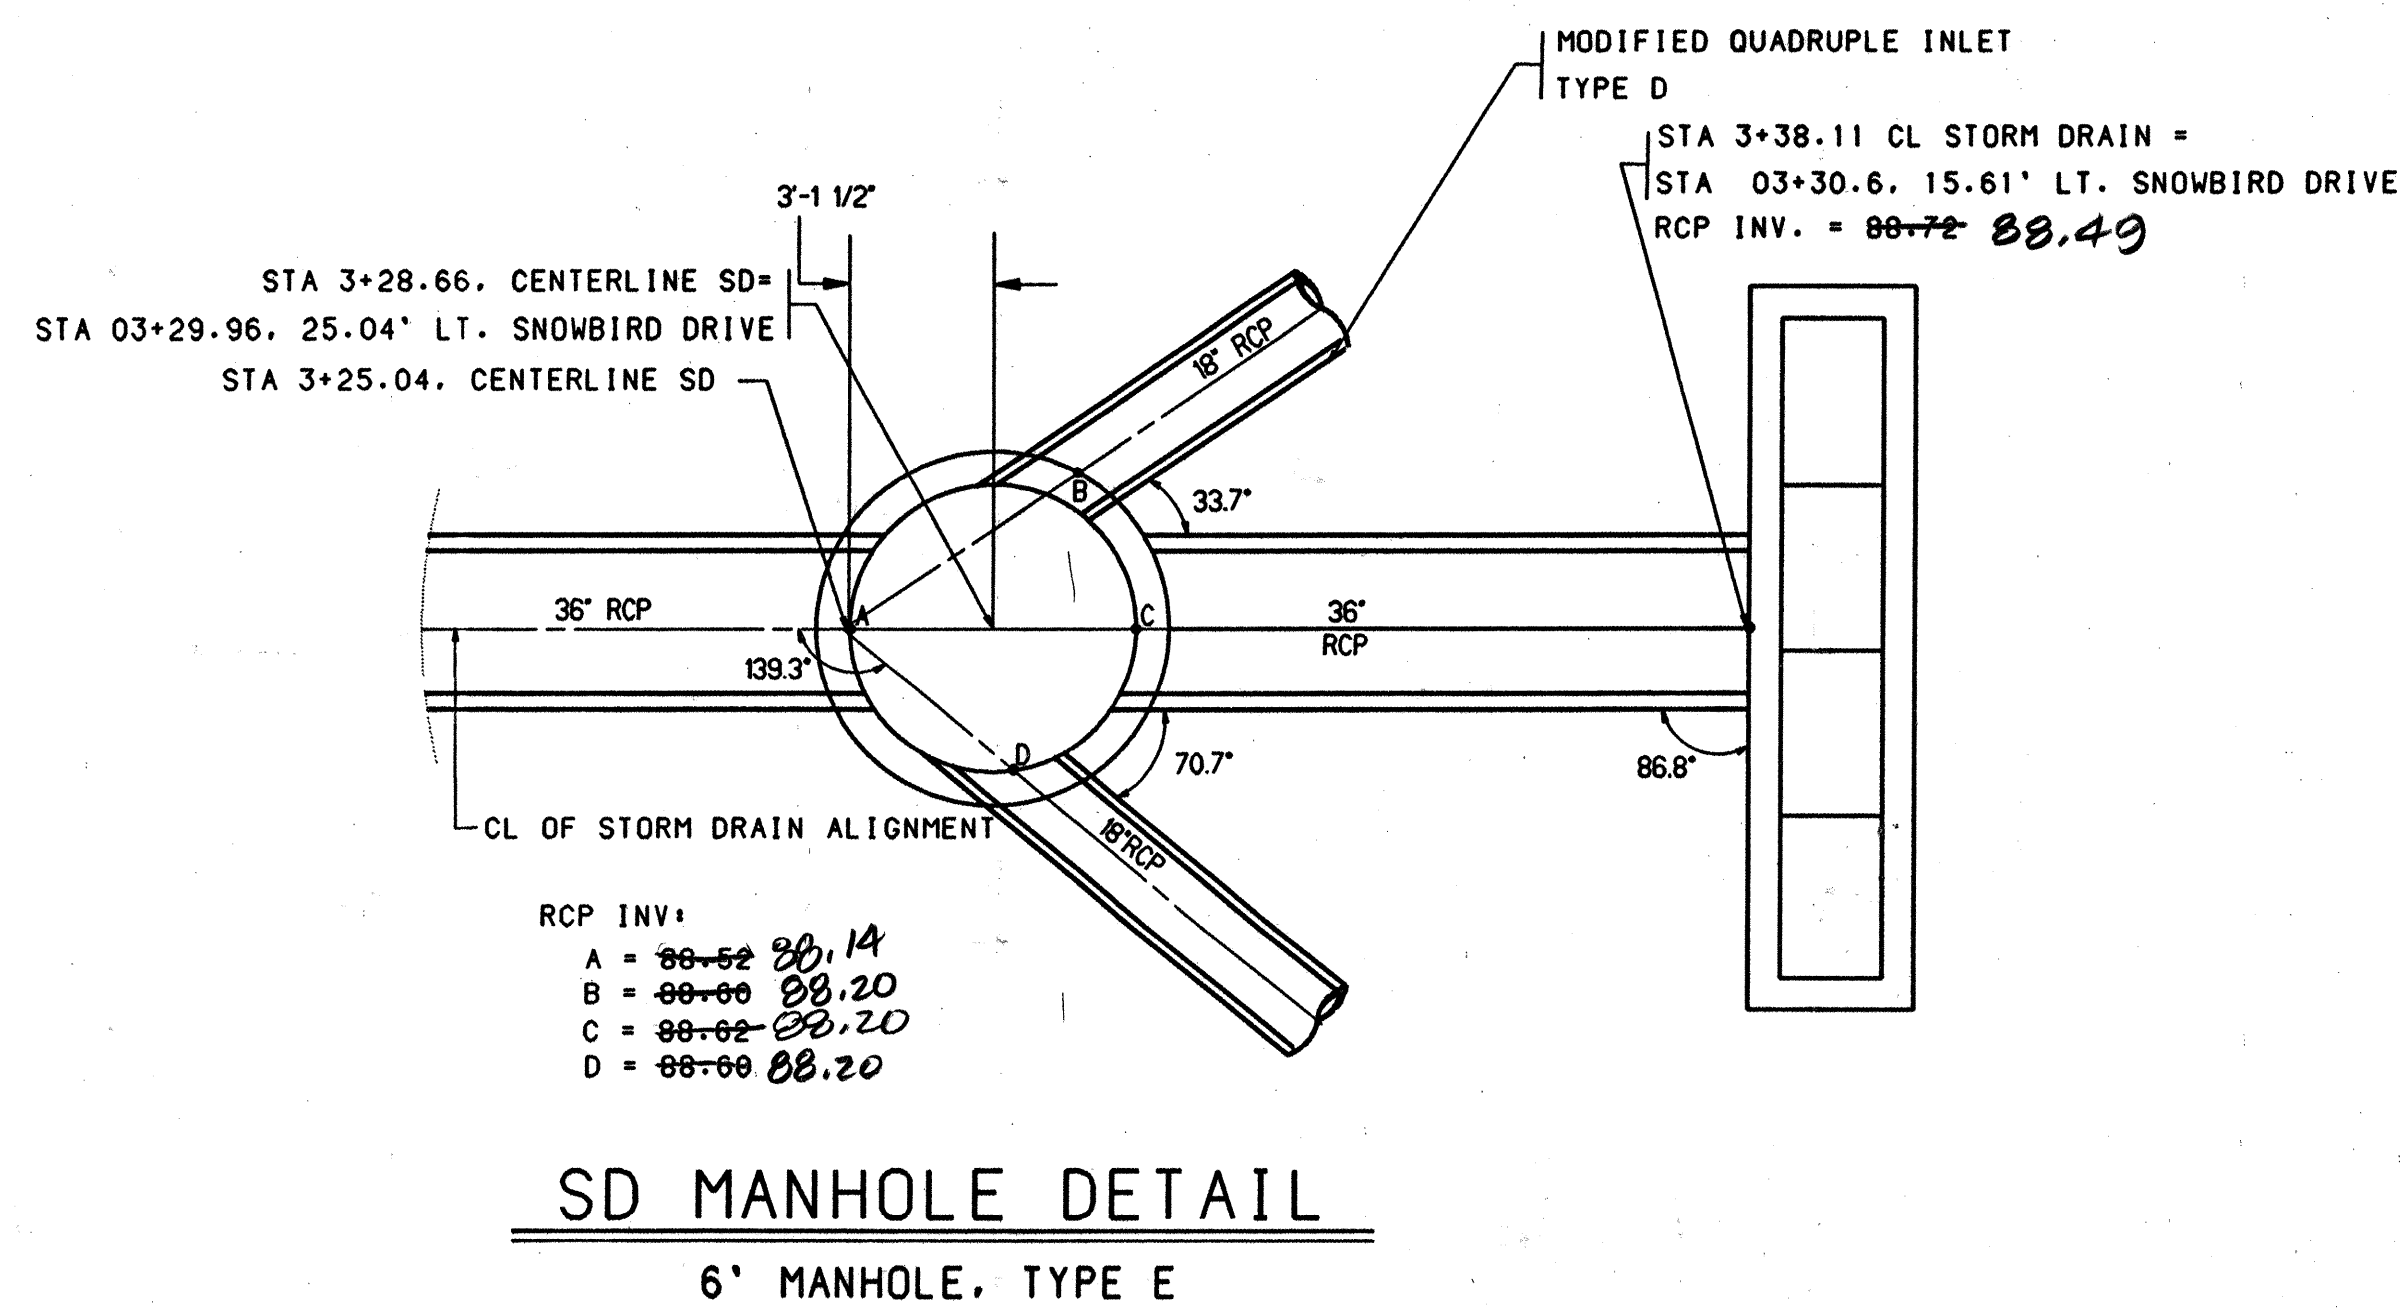

BOHANNAN HUSTON ENGINEERS • PLANNERS • PHOTOGRAMMETRISTS • SURVEYORS • LANDSCAPE ARCHITECTS ALBUQUERQUE LAS CRUCES SANTA FE			
CITY OF ALBUQUERQUE PUBLIC WORKS DEPARTMENT ENGINEERING DEVELOPMENT GROUP			
WHISTLER AT SEVEN BAR NORTH UNIT I MISC. DETAILS			
APPROVED SEP 24 1998 DESIGN REVIEW	CITY ENGINEER APPROVAL	NO./DAY/YR.	
		NO./DAY/YR.	NO./DAY/YR.
LAST DESIGN UPDATE		SHEET 17 OF 19	
COA PROJECT No. 5752.82		ZONE MAP NO. A-13	

BHI JOB NO. 98160A05

CONSTRUCTION TRAFFIC CONTROL GENERAL NOTES

1. CONTRACTOR MUST OBTAIN FROM CONSTRUCTION COORDINATION AN EXCAVATION/BARRICADING PERMIT BEFORE ENGAGING IN ANY CONSTRUCTION, MAINTENANCE OR REPAIR WORK IN ANY OF THE CITY OF ALBUQUERQUE'S RIGHTS-OF-WAY. EMERGENCY WORK THAT WOULD PRESERVE LIFE OR PROPERTY IS EXCLUDED WITH THE UNDERSTANDING, THAT A PERMIT SHALL BE OBTAINED WITHIN 24 TO 48 HOURS.

2. CONTRACTOR SHALL AT THE TIME OF PERMIT REQUEST, SUBMIT FOR APPROVAL BY CONSTRUCTION COORDINATION, A TRAFFIC CONTROL PLAN DETAILING ALL EXISTING TOPOGRAPHY SUCH AS LANE WIDTHS, DRIVEWAYS, AND BUSINESS/RESIDENTIAL ACCESSES. THE TRAFFIC CONTROL PLAN SHALL INCLUDE ALL PHASES OF WORK AND SCHEDULES INVOLVED IN THE CONSTRUCTION PROJECT. ANY SEPARATE PHASES OF A CONSTRUCTION PROJECT SHALL BE GIVEN AN INDIVIDUAL PERMIT EACH. BLANKET PERMITS WILL NOT BE ISSUED.

3. THESE TYPICAL TRAFFIC CONTROL PLANS DO NOT REFLECT THE EXISTING TOPOGRAPHY SUCH AS DRIVEWAYS, LANE WIDTHS, AND BUSINESS/RESIDENTIAL ACCESSES. EVERY LOCATION THAT REQUIRES CONSTRUCTION TRAFFIC CONTROL SHALL HAVE A DETAILED TRAFFIC CONTROL PLAN SHOWING ALL EXISTING TOPOGRAPHY.

4. CONSTRUCTION SHALL NOT BEGIN UNLESS A TRAFFIC CONTROL PLAN HAS BEEN APPROVED AND VERIFIED BY CONSTRUCTION COORDINATION.

5. CONSTRUCTION COORDINATION SHALL BE NOTIFIED 48 HOURS PRIOR TO ANY TRAFFIC CONTROL CHANGES NEEDED BY CONTRACTOR, THAT WERE NOT PREVIOUSLY APPROVED. THESE TRAFFIC CONTROL CHANGES SHALL BE REQUESTED IN WRITING ACCOMPANIED WITH A TRAFFIC CONTROL PLAN REFLECTING SUCH CHANGES.

6. ALL CONSTRUCTION TRAFFIC CONTROL DEVICES SHALL COMPLY TO THE MANUAL ON UNIFORM TRAFFIC CONTROL DEVICES (MUTCD), LATEST EDITION. IT IS THE RESPONSIBILITY OF THE CONTRACTOR TO INSTALL, SERVICE AND MAINTAIN ALL TRAFFIC CONTROL DEVICES. TRAFFIC CONTROL DEVICES SHALL NOT BE REMOVED OR ALTERED IN ANY WAY WITHOUT THE APPROVAL OF CONSTRUCTION COORDINATION, PER SECTION 6A-4 OF THE MUTCD, LATEST EDITION.

7. THE CONSTRUCTION TRAFFIC CONTROL INITIAL SET-UP SHALL BE BY AN AMERICAN TRAFFIC SAFETY SERVICES ASSOCIATION (ATSSA) CERTIFIED WORKSITE TRAFFIC SUPERVISOR. THE MAINTENANCE AND SERVICING SHALL ALSO BE DONE BY AN ATSSA CERTIFIED WORKSITE TRAFFIC SUPERVISOR OR EQUIVALENT.

8. CONTRACTOR IS RESPONSIBLE TO MAINTAIN AND SERVICE ALL TRAFFIC CONTROL DEVICES 24 HOURS A DAY, 7 DAYS A WEEK THROUGHOUT LENGTH OF PROJECT. CONTRACTOR IS RESPONSIBLE THAT ALL TRAFFIC CONTROL DEVICES COMPLY WITH THE MUTCD, LATEST EDITION.

9. ALL ADVANCE WARNING SIGNS SHALL BE DOUBLE INDICATED WHENEVER THERE ARE MULTI-LANE TRAFFIC IN ANY ONE GIVEN DIRECTION AND THERE IS SUFFICIENT MEDIAN SPACE.

10. ALL BARRICADES IN ALL TAPERS AND TANGENTS SHALL BE PLACED APART, A DISTANCE MEASURED IN FEET, EQUAL TO THAT OF THE POSTED SPEED LIMIT. NO EXCEPTIONS UNLESS APPROVED BY CONSTRUCTION COORDINATION PER MUTCD SECTION 6A-4.

11. ALL WORK IN ARTERIAL ROADWAYS SHALL BE ON A CONTINUOUS 24 HOUR PER DAY BASIS UNTIL COMPLETED.

12. CONTRACTOR IS RESPONSIBLE TO PROVIDE CONSTRUCTION COORDINATION, A WEEKLY LOG OF DAILY INSPECTIONS OF BARRICADE AND MAINTENANCE SCHEDULES ON PROJECTS THAT ARE OVER ONE WEEK DURATION.

13. EQUIPMENT OR MATERIALS SHALL NOT BE STORED WITHIN 15 FEET OF A TRAVELED TRAFFIC LANE DURING NON-WORKING HOURS WITHOUT THE APPROVAL OF CONSTRUCTION COORDINATION.

14. CONTRACTOR SHALL PROVIDE AND MAINTAIN A SAFE AND ADEQUATE MEANS OF CHANNELIZING PEDESTRIAN TRAFFIC AROUND AND THROUGH THE CONSTRUCTION AREA.

15. CONTRACTOR IS RESPONSIBLE FOR OBLITERATION OF ANY CONFLICTING STRIPING AND RESPONSIBLE FOR ALL TEMPORARY STRIPING.

16. CONTRACTOR SHALL MAINTAIN ACCESS TO ALL FACILITIES, BUSINESSES AND/OR RESIDENTS AT ALL TIMES.

17. CONTRACTOR SHALL PROVIDE ACCESS SIGNS FOR BUSINESSES LOCATED WITHIN THE CONSTRUCTION AREA UNDER THE SUPERVISION OF CONSTRUCTION COORDINATION. EACH ACCESS SIGN SHALL HAVE 5 INCH, WHITE OPAQUE LETTERING ON BLUE REFLECTORIZED BACKGROUND. ACCESS SIGNS SHALL BE CONSIDERED INCIDENTAL TO THE BID AND NOT PART OF THE CONTRACT UNLESS OTHERWISE STATED. NO MORE THAN 3 BUSINESSES SHALL BE LISTED ON A ACCESS SIGN. SHOPPING CENTERS AND MALLS SHALL BE LISTED AS SUCH.

18. ALL ADVANCE WARNING SIGNS SHALL MEET THE MINIMUM REFLECTIVE INTENSITY REQUIREMENTS SET FORTH BY THE CITY OF ALBUQUERQUE. CONSTRUCTION COORDINATION SHALL DETERMINE ALL REQUIREMENTS AND APPROVE OR DISAPPROVE ANY ADVANCE WARNING SIGN PER SECTION 6A-4 OF THE MUTCD, LATEST EDITION.

19. 48 HOURS PRIOR TO OCCUPANCY OR CLOSING OF A RIGHT-OF-WAY, CONTRACTOR SHALL NOTIFY: POLICE, FIRE DEPARTMENT, SCHOOLS, HOSPITALS, TRANSIT AUTHORITY, BUSINESSES AND/OR RESIDENTS THAT WILL BE AFFECTED BY THE CONSTRUCTION.

20. ANY FIELD ADJUSTMENTS SHALL BE APPROVED BY CONSTRUCTION COORDINATION.

21. EXCAVATIONS SHALL BE PLATED, TEMPORARILY PATCHED OR RESURFACED PRIOR TO OPENING OF TRAFFIC. A MINIMUM OF 11 FEET SHALL BE PROVIDED FOR TRAFFIC IN ANY GIVEN DIRECTION. CONTRACTOR IS RESPONSIBLE FOR ANY WORK INVOLVED IN SATISFYING THESE REQUIREMENTS.

22. CONTRACTOR SHALL AT ALL TIMES COMPLY WITH THE FOLLOWING:
1. STANDARDS AND REQUIREMENTS SET FORTH IN THE MANUAL ON UNIFORM TRAFFIC CONTROL DEVICES, LATEST EDITION.
2. THE CITY OF ALBUQUERQUE TRAFFIC CODE, LATEST EDITION.
3. SECTION 19 OF THE CITY OF ALBUQUERQUE'S STANDARD SPECIFICATIONS FOR PUBLIC WORK CONSTRUCTION, AS WELL AS OTHER SECTIONS.


23. FAILURE TO COMPLY WITH ANY OF THE ABOVE MENTIONED, WILL BE ADEQUATE CAUSE TO CEASE ALL WORK ON ANY CONSTRUCTION PROJECT. WORK WILL NOT RESUME UNTIL ALL REQUIREMENTS ARE ADDRESSED AND APPROVED BY CONSTRUCTION COORDINATION.

24. ALL TRAFFIC CONTROL DEVICES SHALL BE KEPT IN NEW-CLEAN CONDITION. WASHING OF EQUIPMENT IS INCIDENTAL TO IT'S PLACEMENT AND MAINTENANCE.

25. TRAFFIC CONTROL STANDARDS APPLY ONLY WHERE THE CONSTRUCTION TRAFFIC CONTROL PLANS ARE NOT SPECIFIC.

26. ADVANCE WARNING SIGNS SHALL BE 36"x36" MIN. WITH SUPER ENGINEERING GRADE SHEETING OR BETTER. MOUNTING HEIGHT AT TOP OF SIGN SHALL BE THE SAME AS FOR A 48" SIGN AS INDICATED IN THE M.U.T.C.D.

27. CONTRACTOR SHALL MAINTAIN A GRAFFITI-FREE WORKSITE. ALL GRAFFITI SHALL BE PROMPTLY REMOVED FROM ALL EQUIPMENT, BOTH PERMANENT AND TEMPORARY.

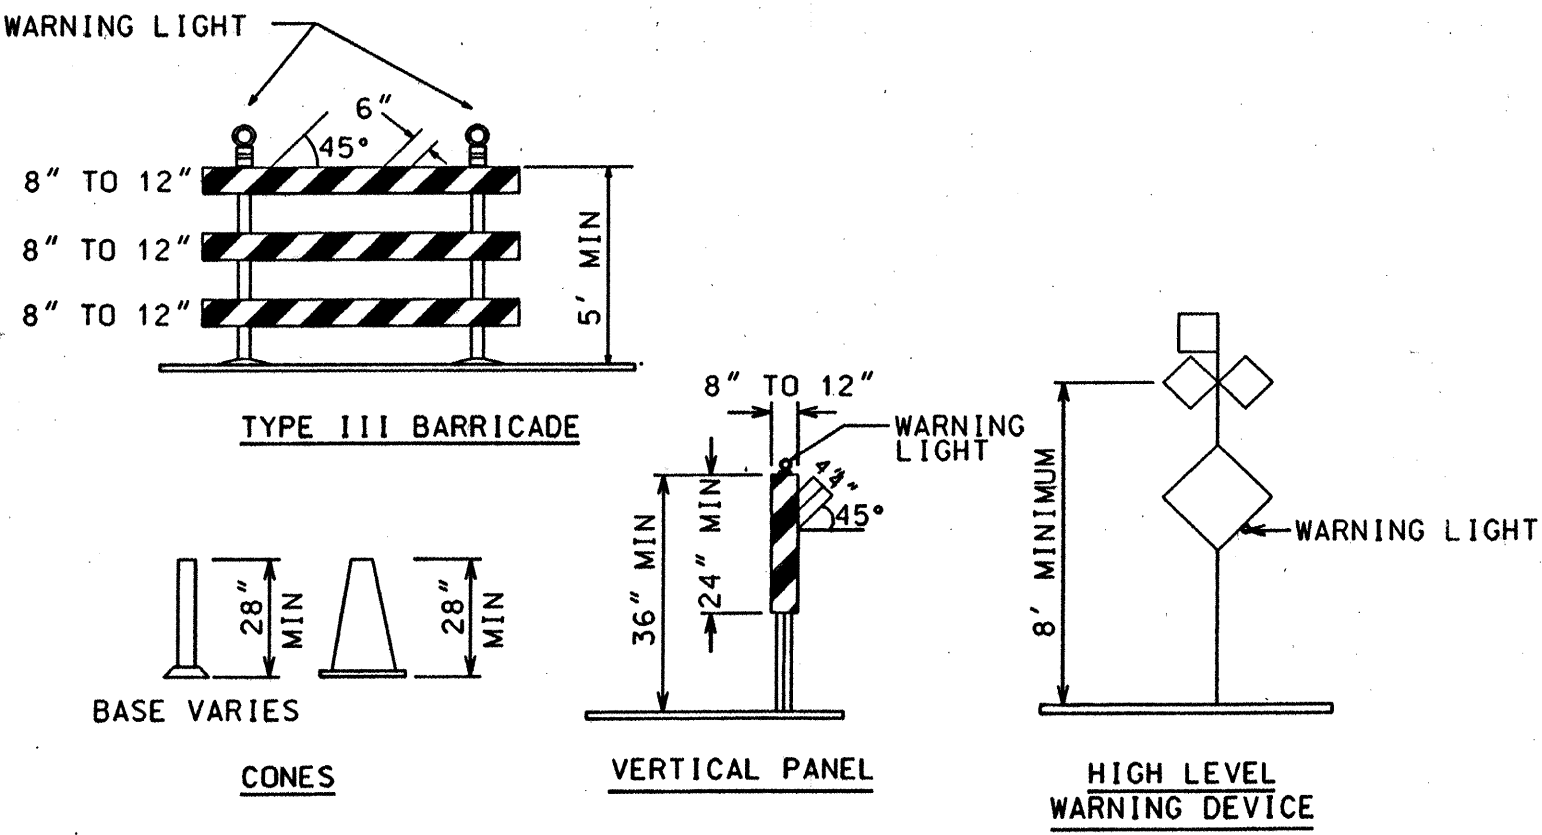

LEGEND

- WORK AREA
- BARRICADE - TYPE I, TYPE II, OR BARREL
- BARRICADE - TYPE III
- VERTICAL PANEL
- WARNING SIGN
- DISTANCE BETWEEN SIGNS - A DISTANCE MEASURED IN FEET EQUAL TO A VALUE OF TEN TIMES THE SPEED LIMIT OF THE STREET
- FLAGMAN POSITION
- SPACING BETWEEN BARRICADES - A DISTANCE MEASURED IN FEET EQUAL TO THE STREET LIMIT OF THE STREET
- L TAPER LENGTH - SEE CHART BELOW

THE TANGENT LENGTH IS EQUAL TO THE TAPER LENGTH FOR A GIVEN STREET.

TAPER REQUIREMENT

SPEED LIMIT (MPH)	TAPER LENGTH(L) (FEET)			MINIMUM NUMBER OF DEVICES FOR TAPER	MAXIMUM DEVICE SPACING IN FEET	
	10' LANE	11' LANE	12' LANE		ALONG TAPER	AFTER TAPER
20	70	75	80	5	20	20
25	105	115	125	6	25	25
30	150	165	180	7	30	30
35	205	225	245	8	35	35
40	270	295	320	9	40	40
45	450	495	540	13	45	45
50	500	550	600	13	50	50
55	550	605	660	13	55	55

RECOMMENDED SIGN SPACING(D) FOR ADVANCE WARNING SIGN SERIES

SPEED MILES PER HOUR	MINIMUM DISTANCE BETWEEN SIGNS	DISTANCE FROM LAST SIGN TO TAPER
0-20	10 X SPEED LIMIT	10 X SPEED LIMIT
25-30	10 X SPEED LIMIT	10 X SPEED LIMIT
30-35	10 X SPEED LIMIT	10 X SPEED LIMIT
40-45	10 X SPEED LIMIT	10 X SPEED LIMIT
50-60	10 X SPEED LIMIT	10 X SPEED LIMIT

TAPER CRITERIA


TYPE OF TAPER	TAPER LENGTH
UPSTREAM TAPER:	
MERGING TAPER	L MINIMUM
SHIFTING TAPER	1/2 L MINIMUM
SHOULDER TAPER	1/2 L MINIMUM
TWO-WAY TRAFFIC TAPER	100 FEET MAXIMUM
DOWNSTREAM TAPERS	100 FEET PER LANE

TAPER LENGTH COMPUTATION

SPEED LIMIT	L =
40 MPH OR LESS	$L = \frac{WS^2}{60}$
40 MPH OR GREATER	$L = W \times S$

L = TAPER LENGTH
W = WIDTH OF OFFSET IN FEET
S = POSTED SPEED OR OFF-PEAK 85-PERCENTILE SPEED IN MPH

SIGN FACE DETAILS

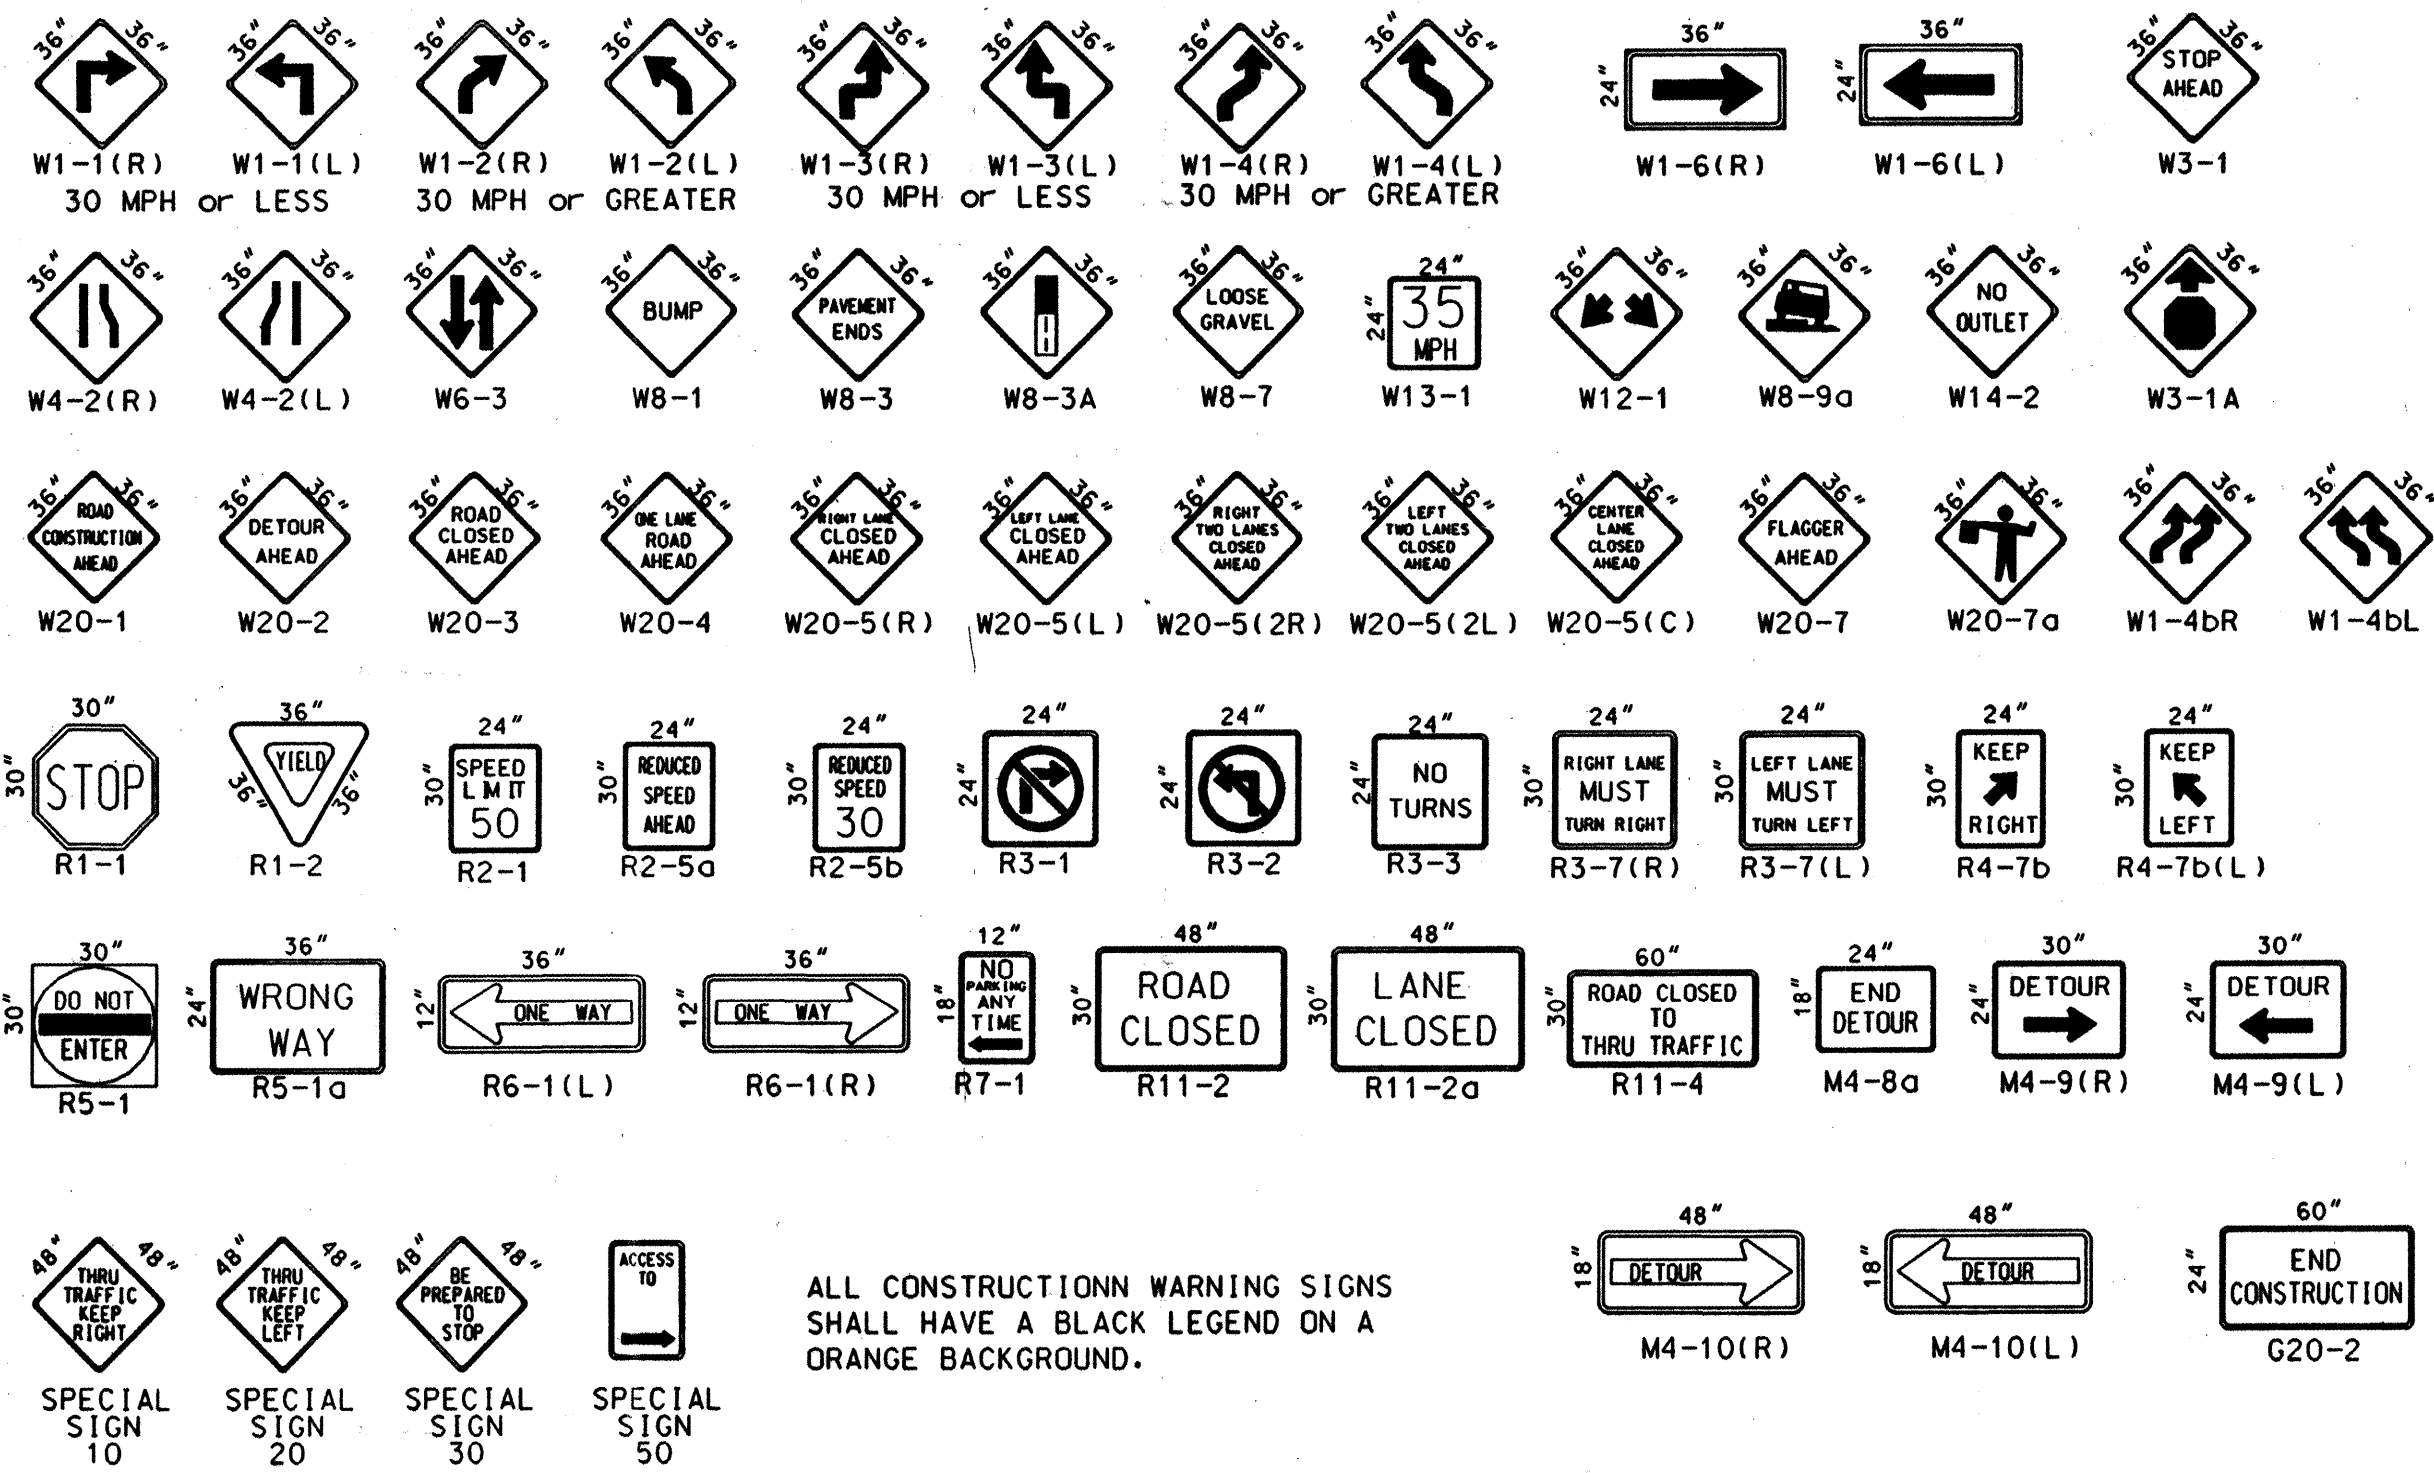

ALL CONSTRUCTION WARNING SIGNS SHALL HAVE A BLACK LEGEND ON A ORANGE BACKGROUND.

Bohannon & Huston

Courtyard One 7500 JEFFERSON NE ALBUQUERQUE NEW MEXICO 87109

ENGINEERS PLANNERS PHOTOGRAMMETRISTS SURVEYORS LANDSCAPE ARCHITECTS



















CITY OF ALBUQUERQUE
PUBLIC WORKS DEPARTMENT
ENGINEERING DEVELOPMENT GROUP

WHISTLER AT SEVEN BAR NORTH UNIT I
TRAFFIC CONTROL
SIGNING AND CONSTRUCTION TRAFFIC CONTROL STANDARDS

DESIGN REVIEW COMMITTEE	CITY ENGINEER APPROVAL	MO./DAY/YR.	MO./DAY/YR.
APPROVED			
DESIGN REVIEW COMMITTEE			

CITY PROJECT NO.	5752.82	ZONE MAP NO.	A -13	SHEET	18	OF	19
------------------	---------	--------------	-------	-------	----	----	----

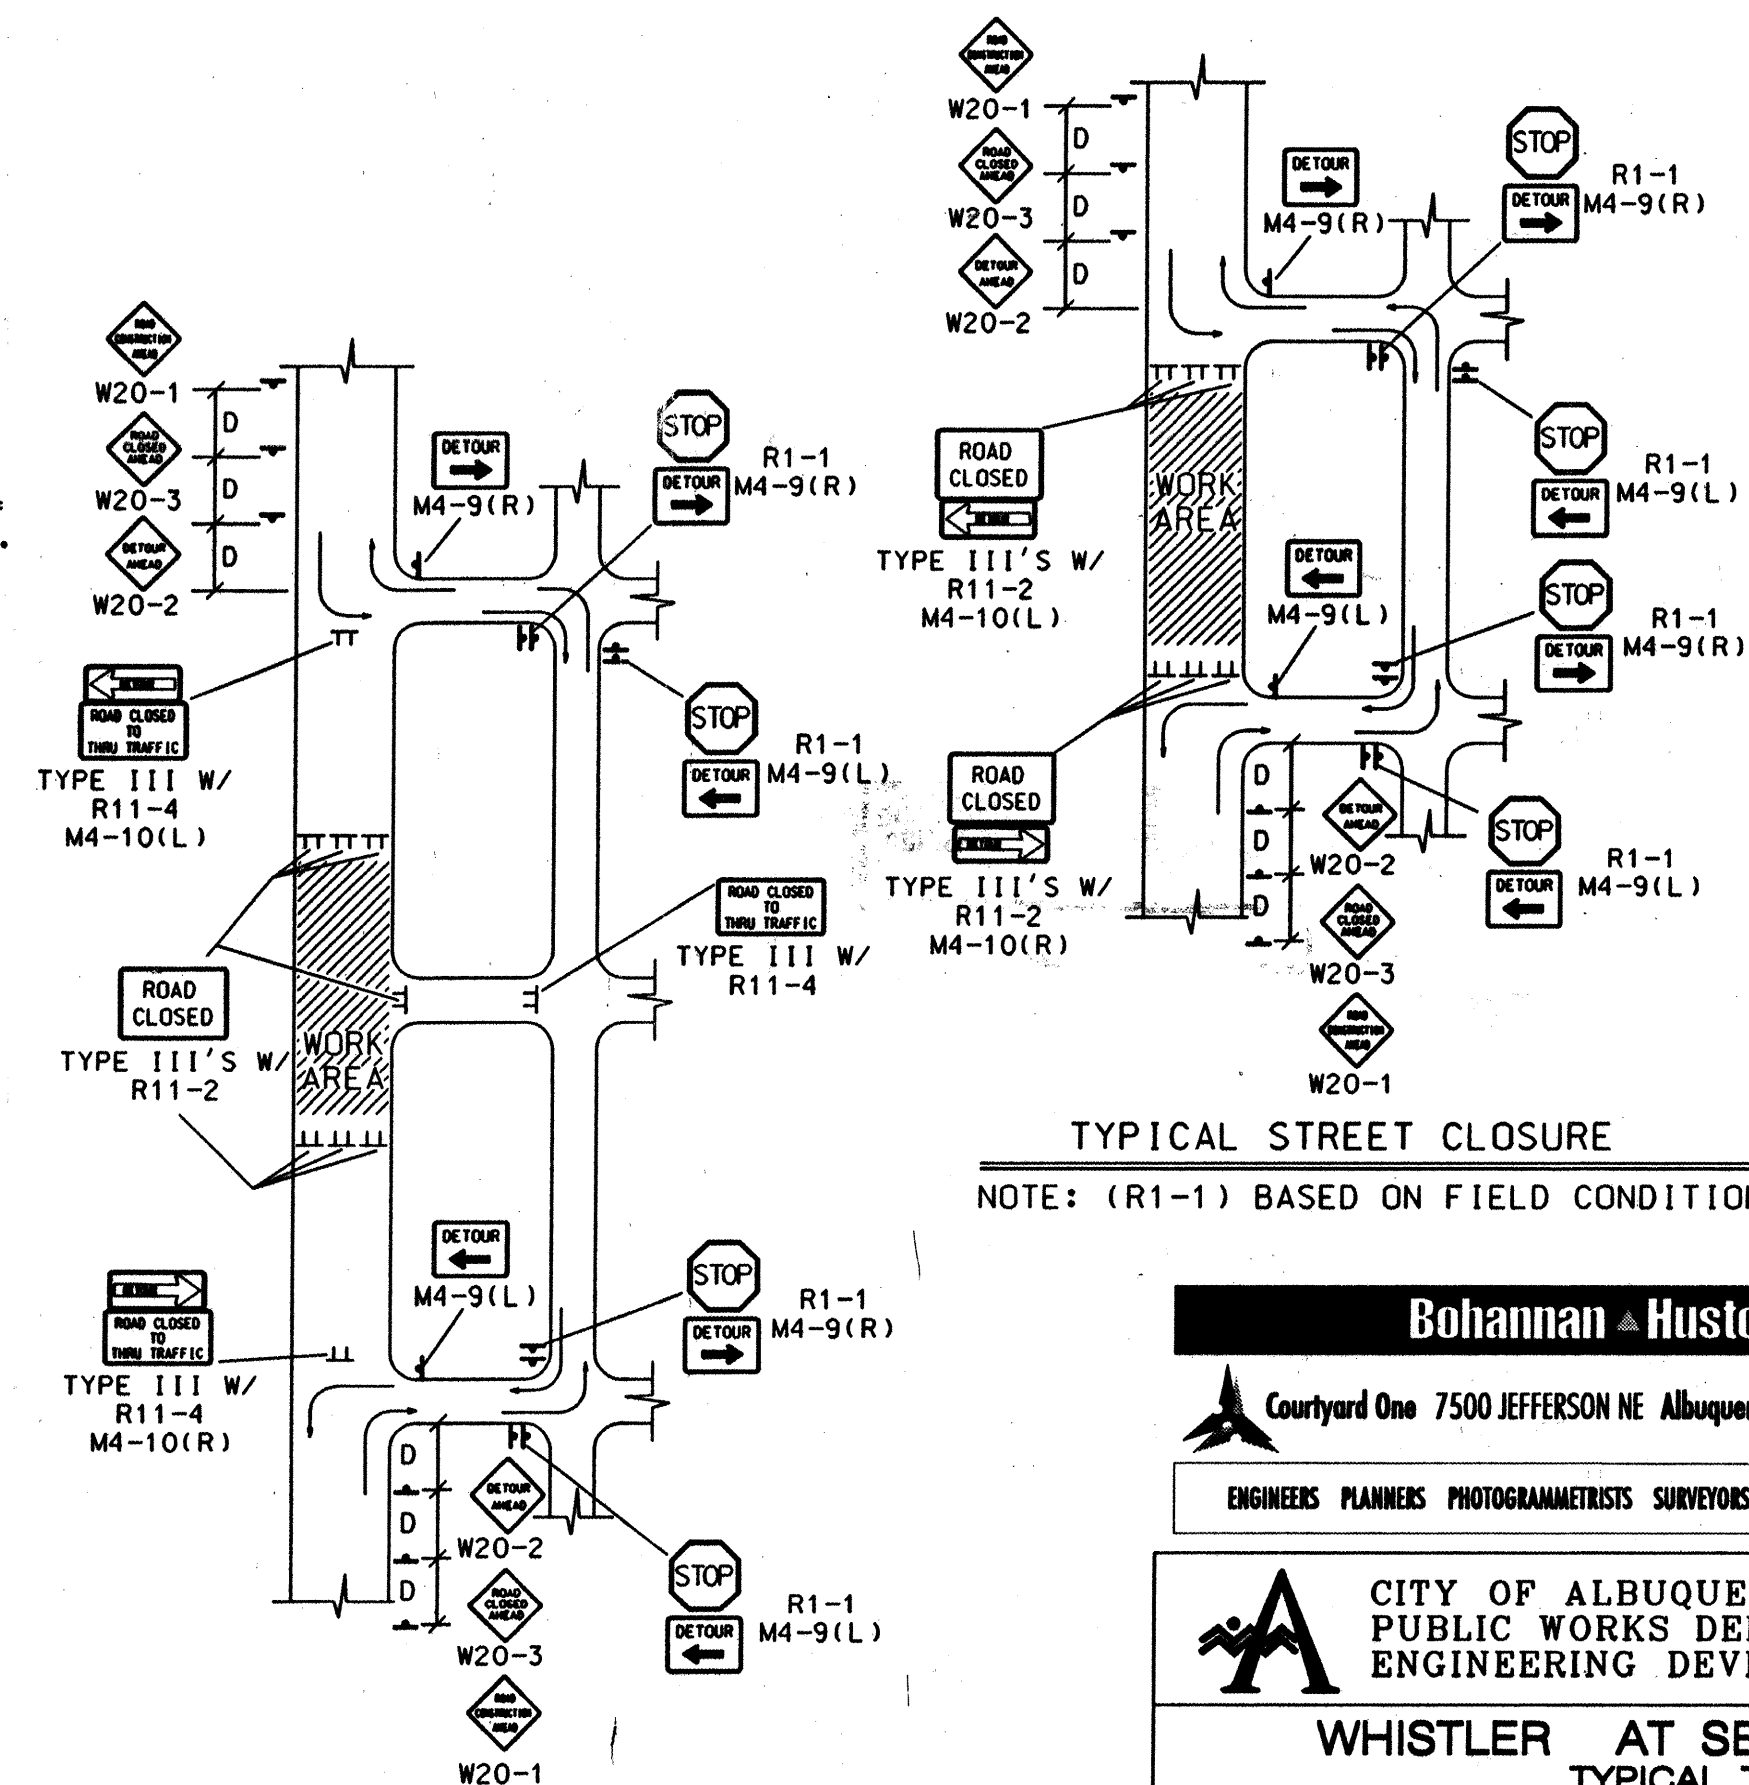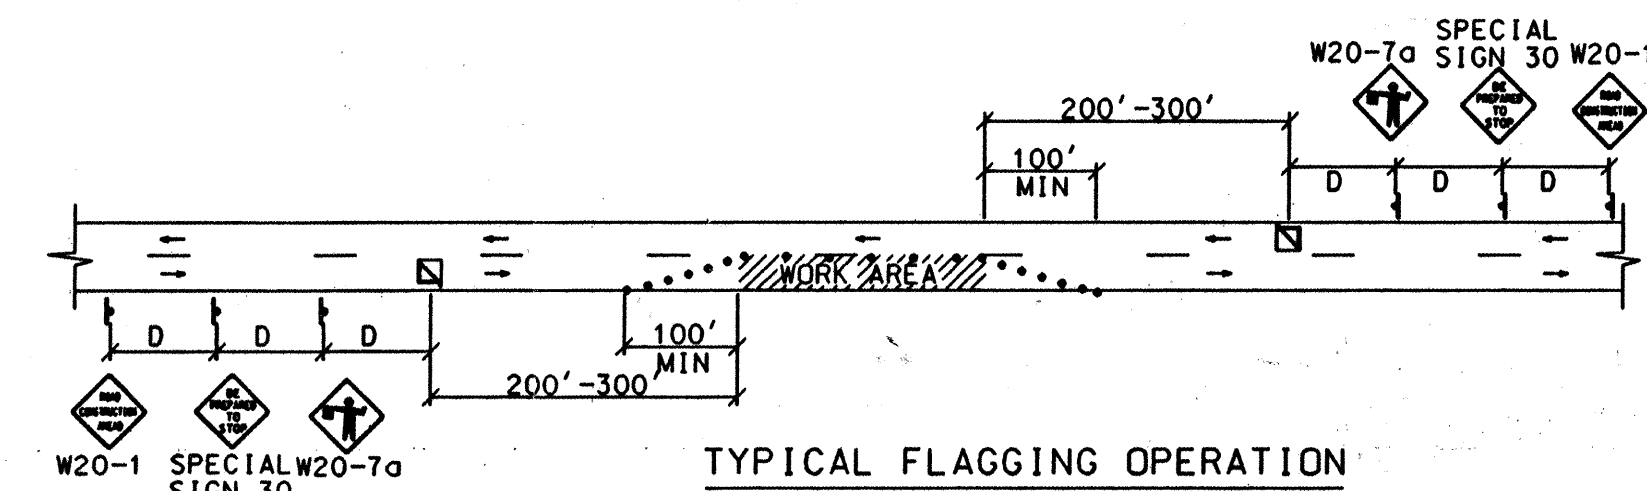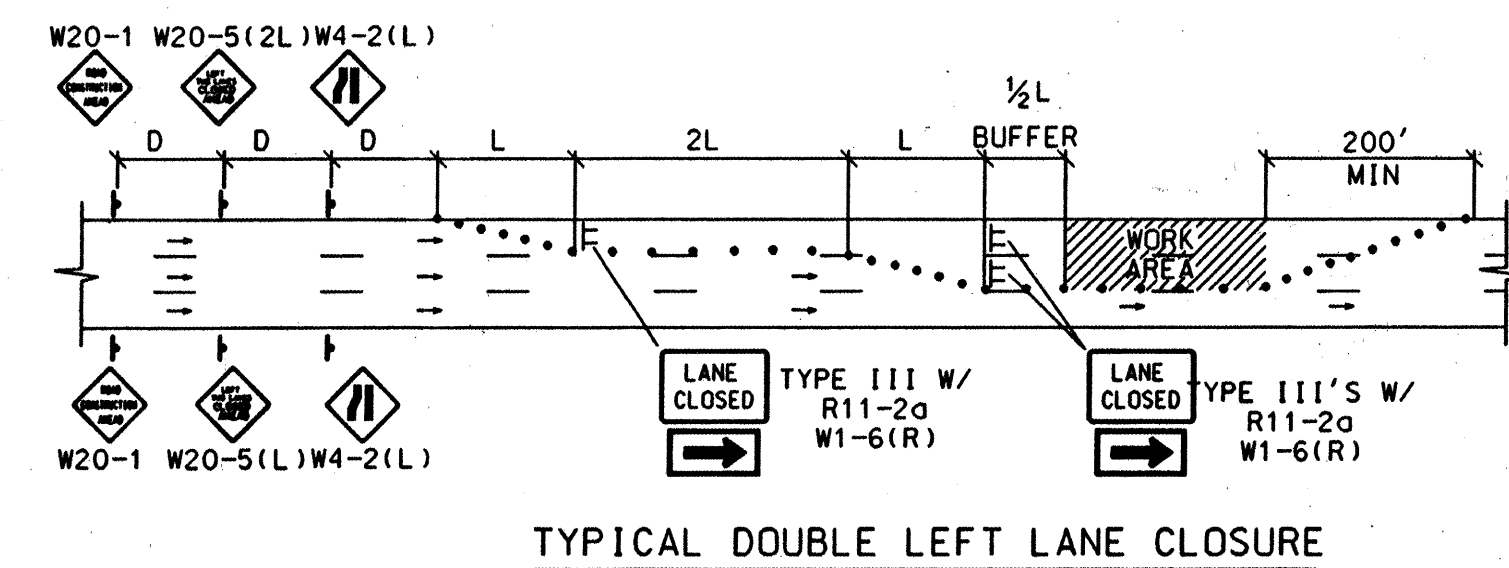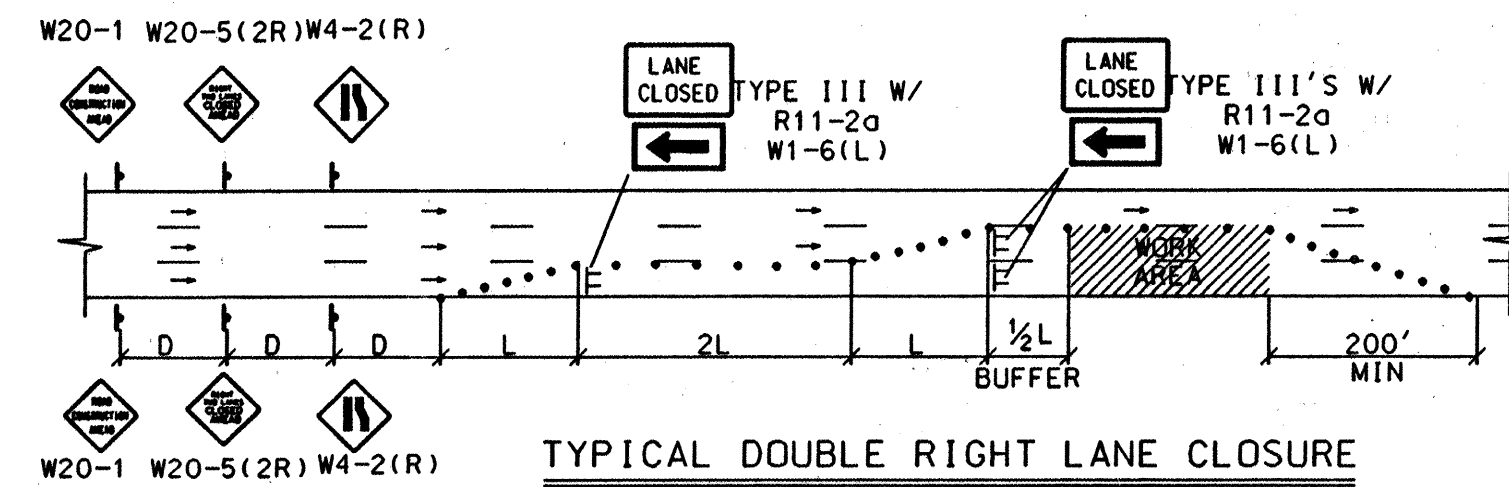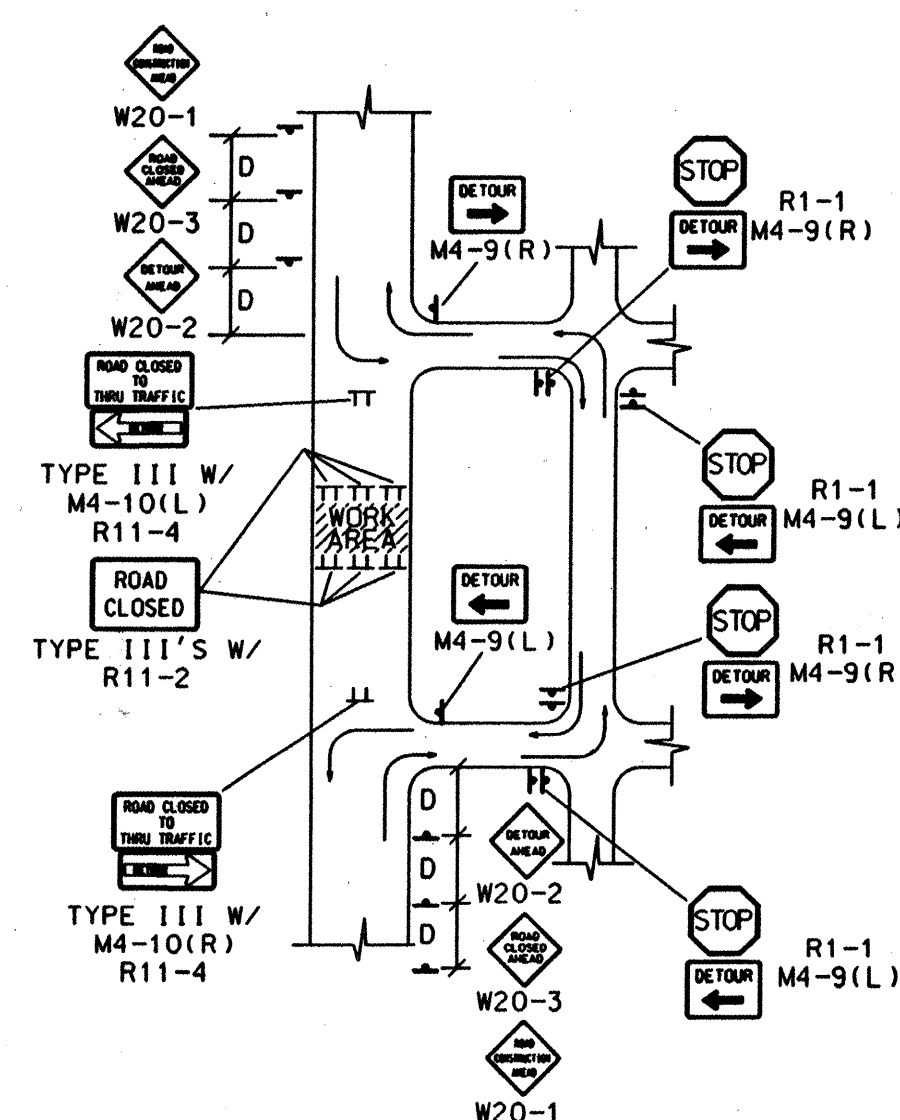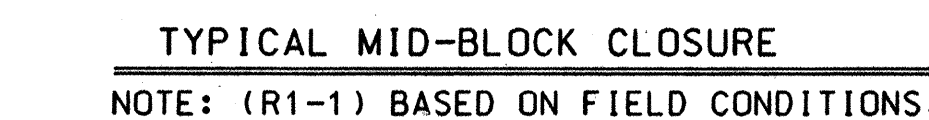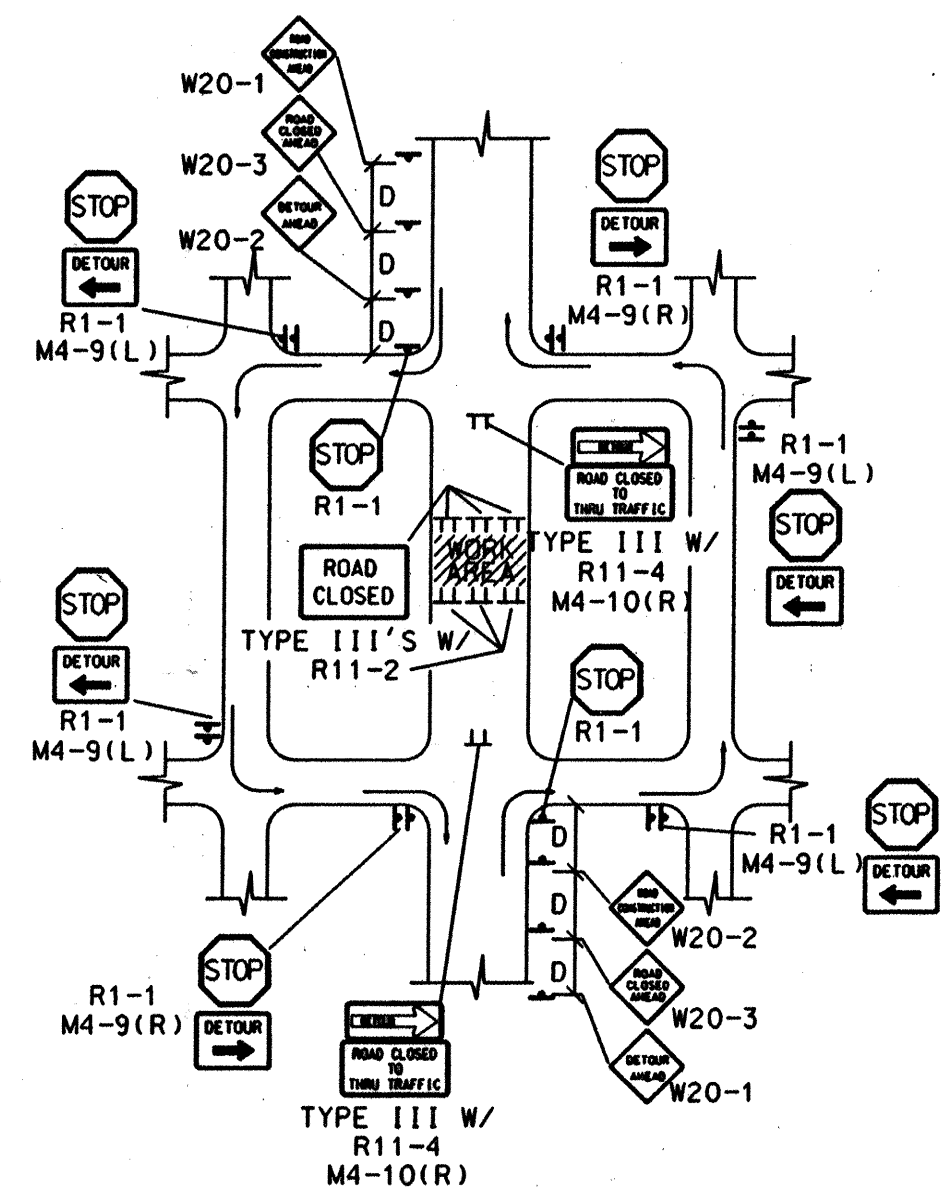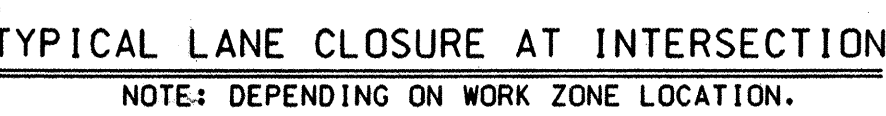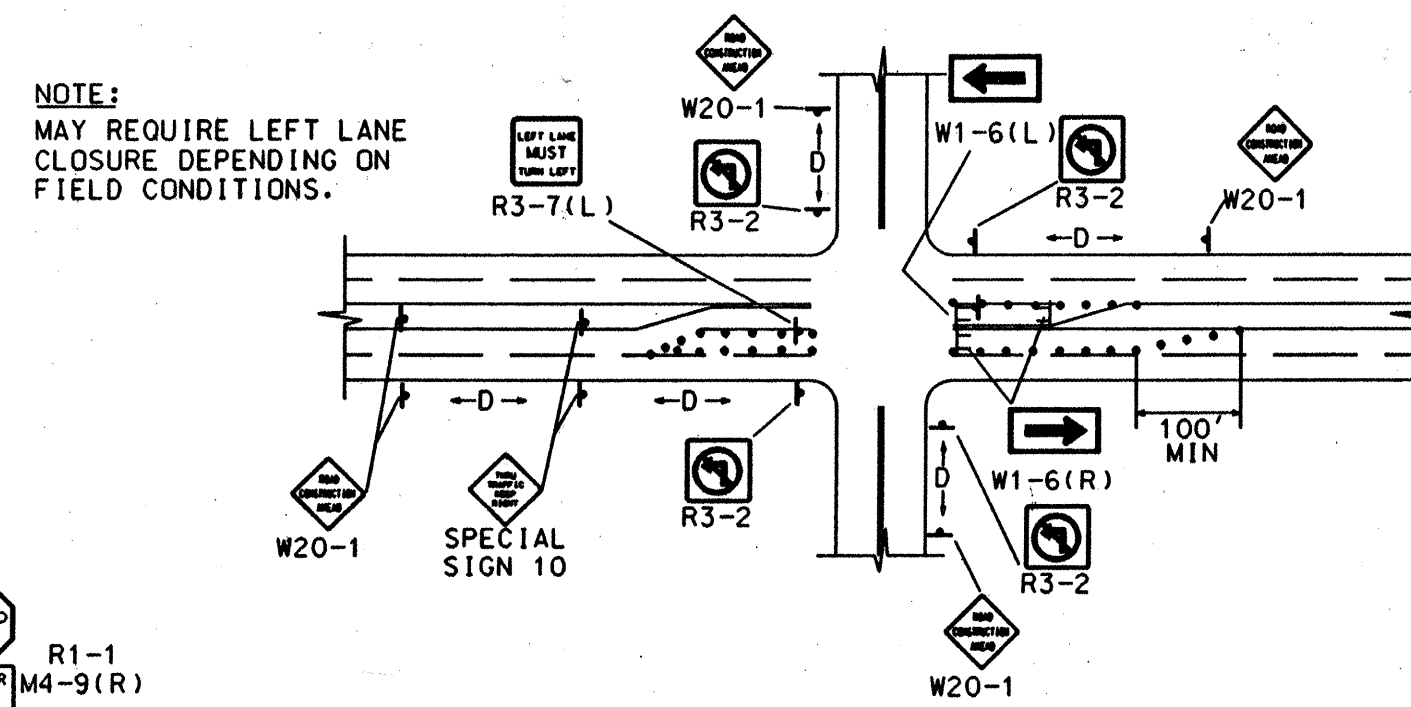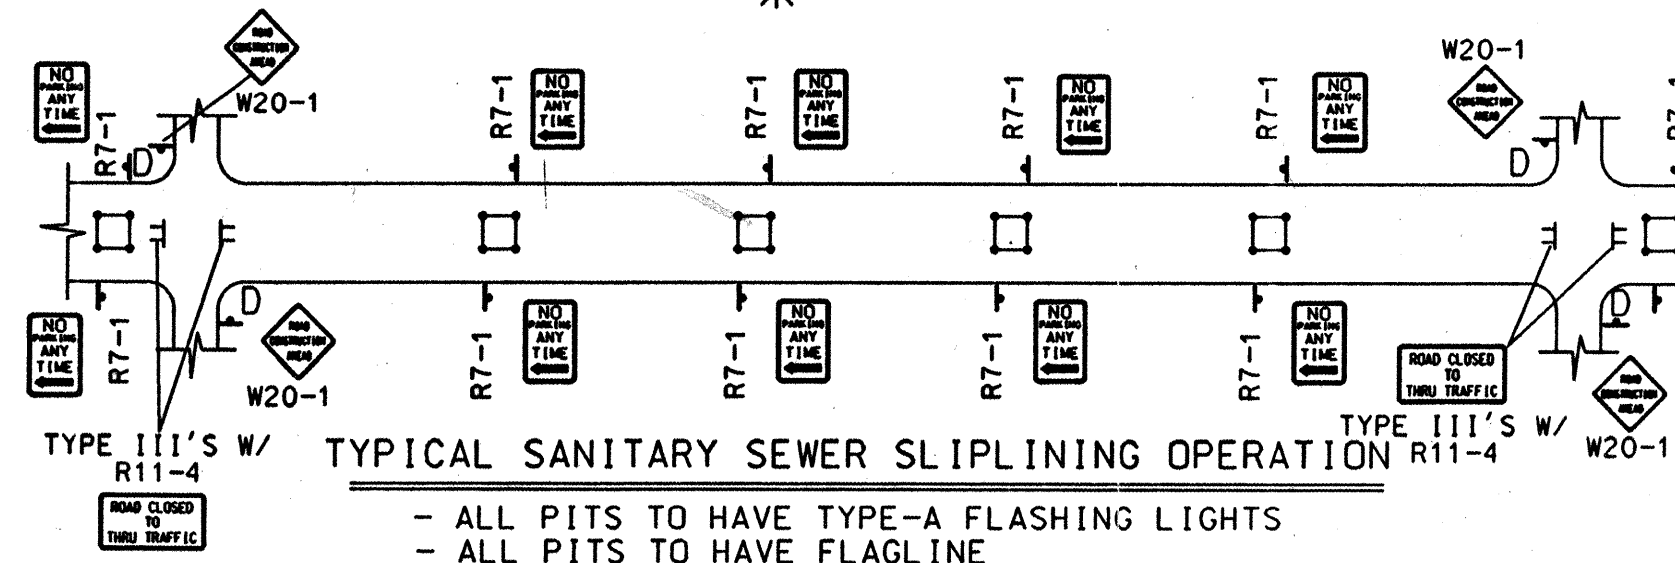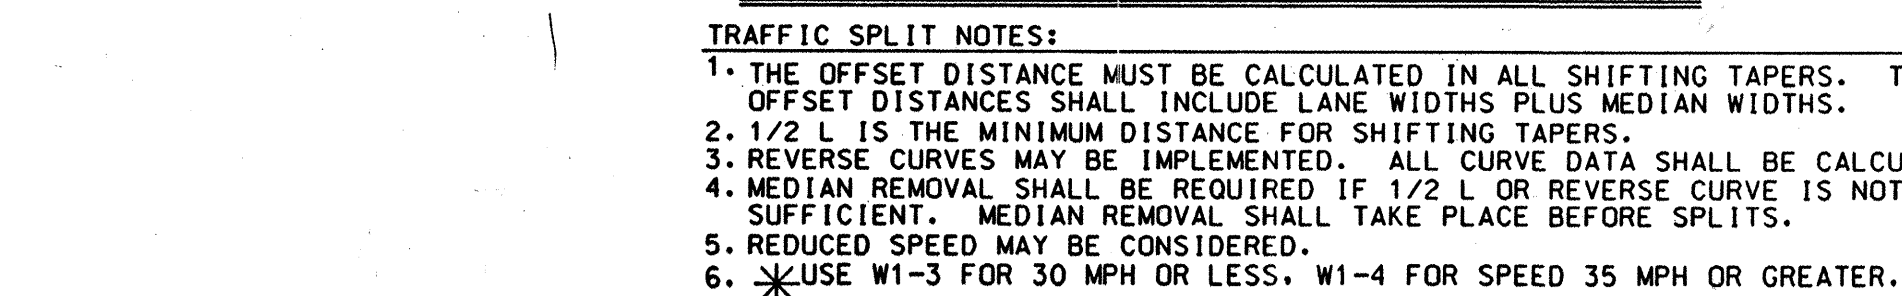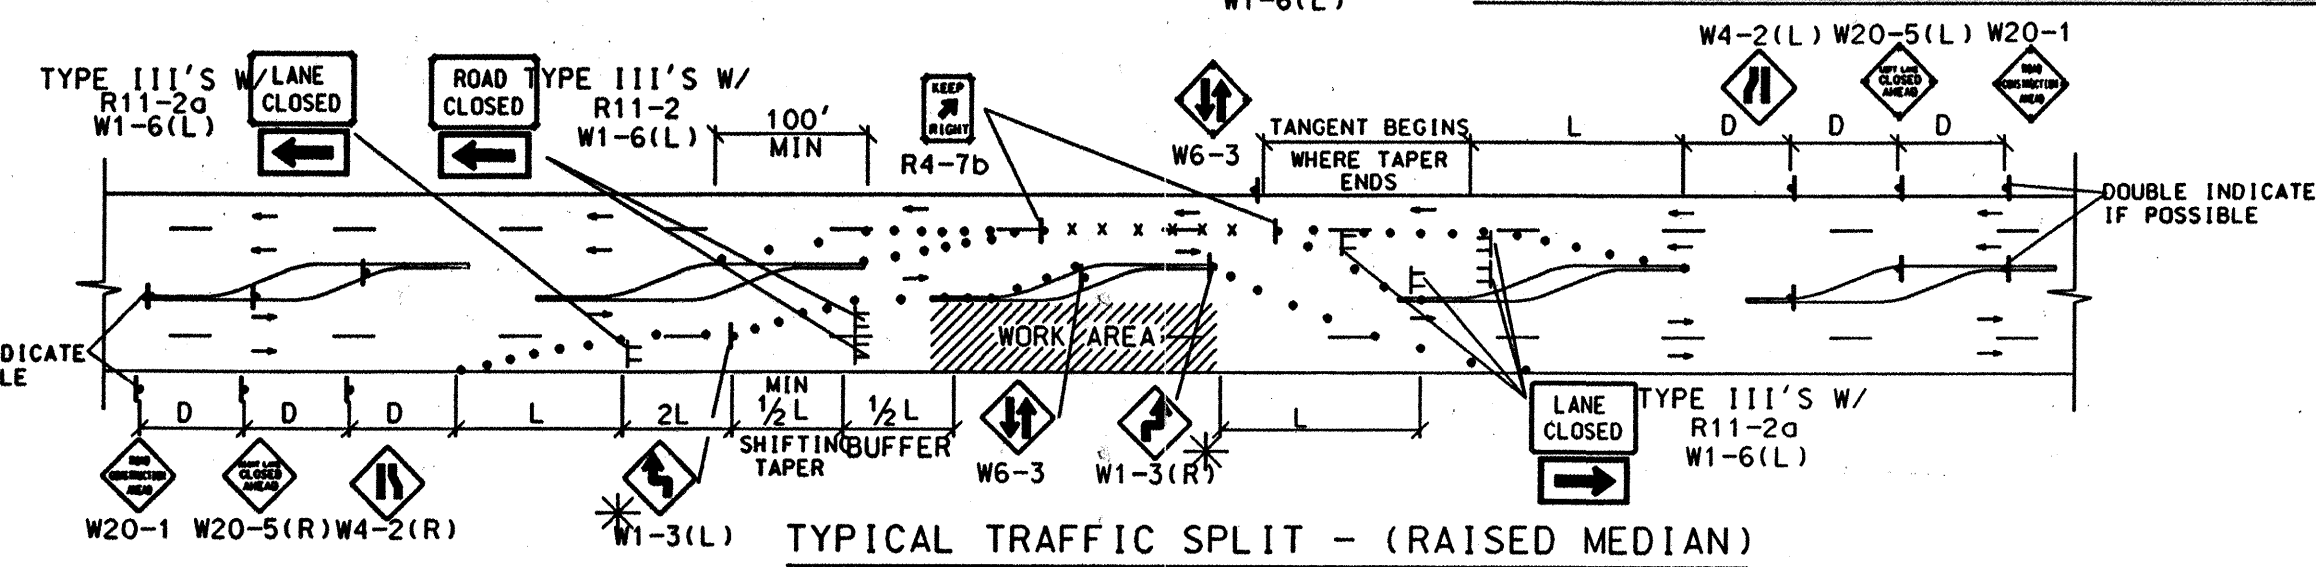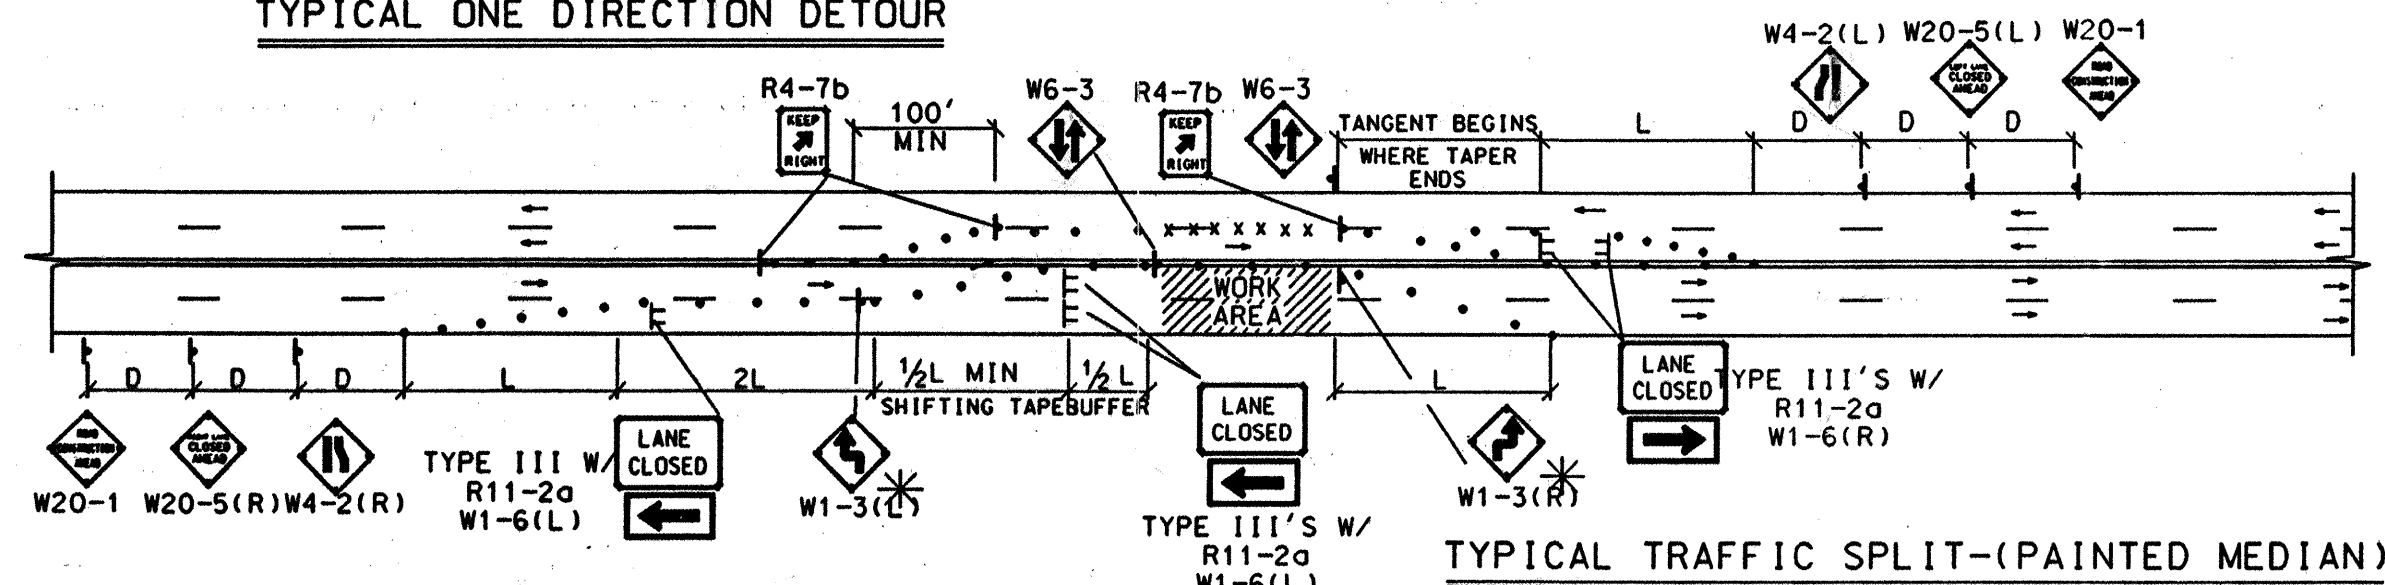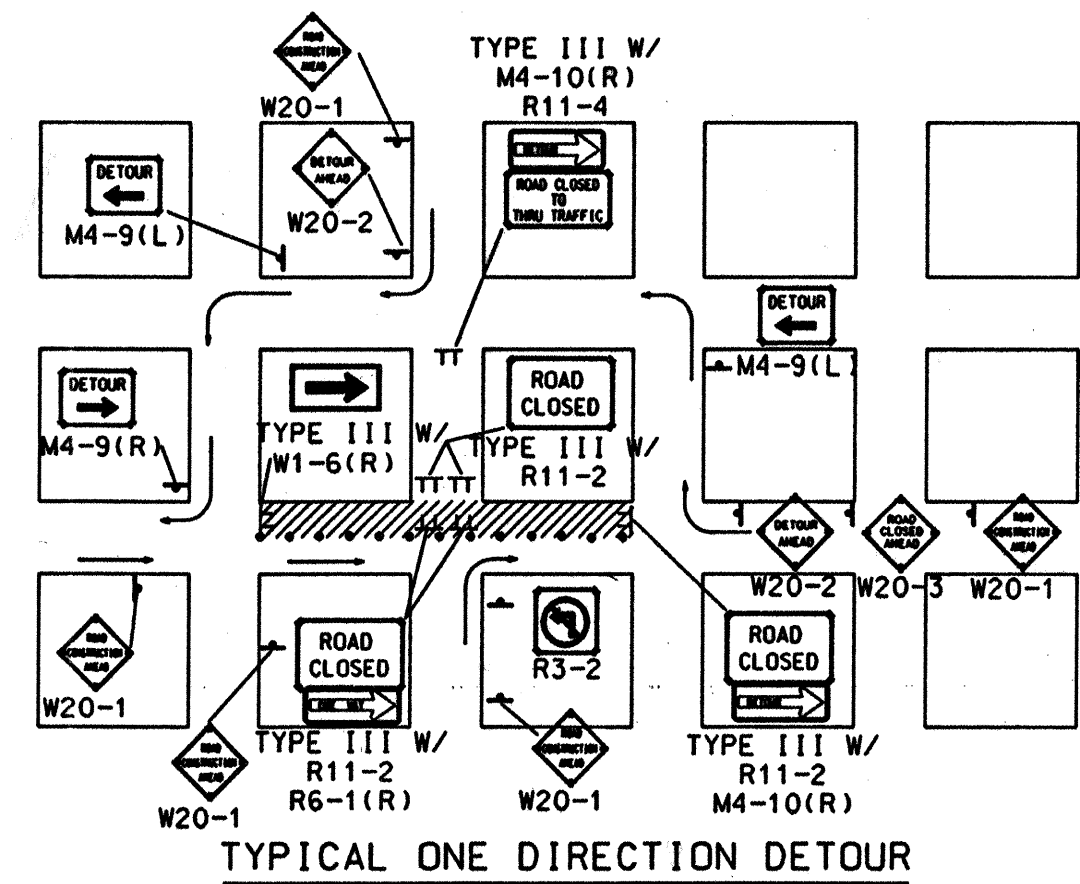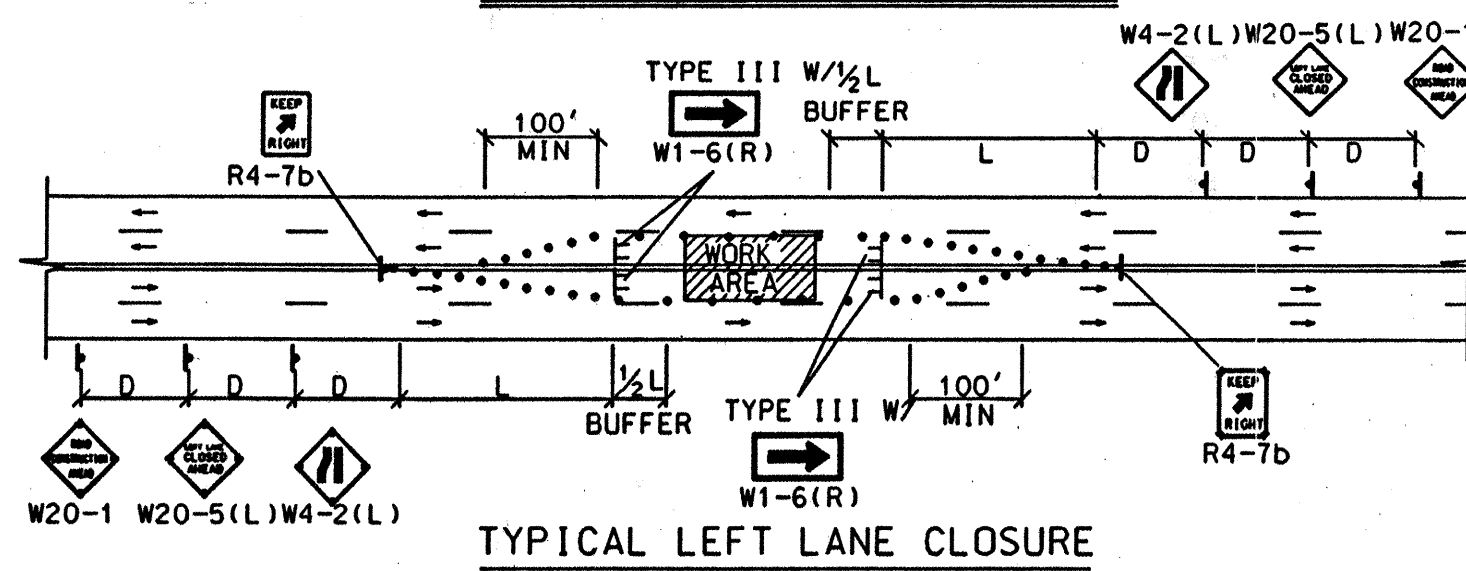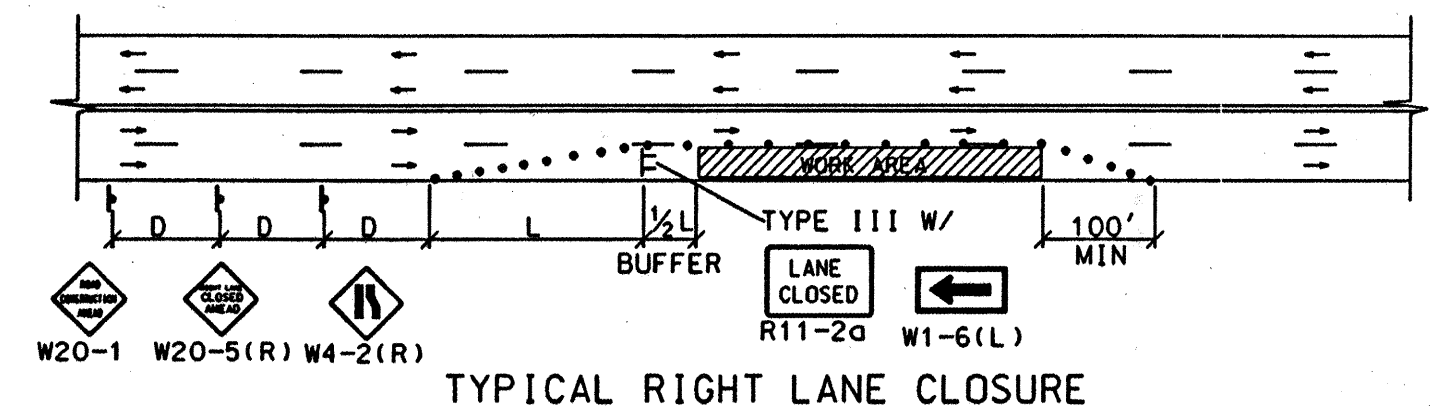[illegible]