

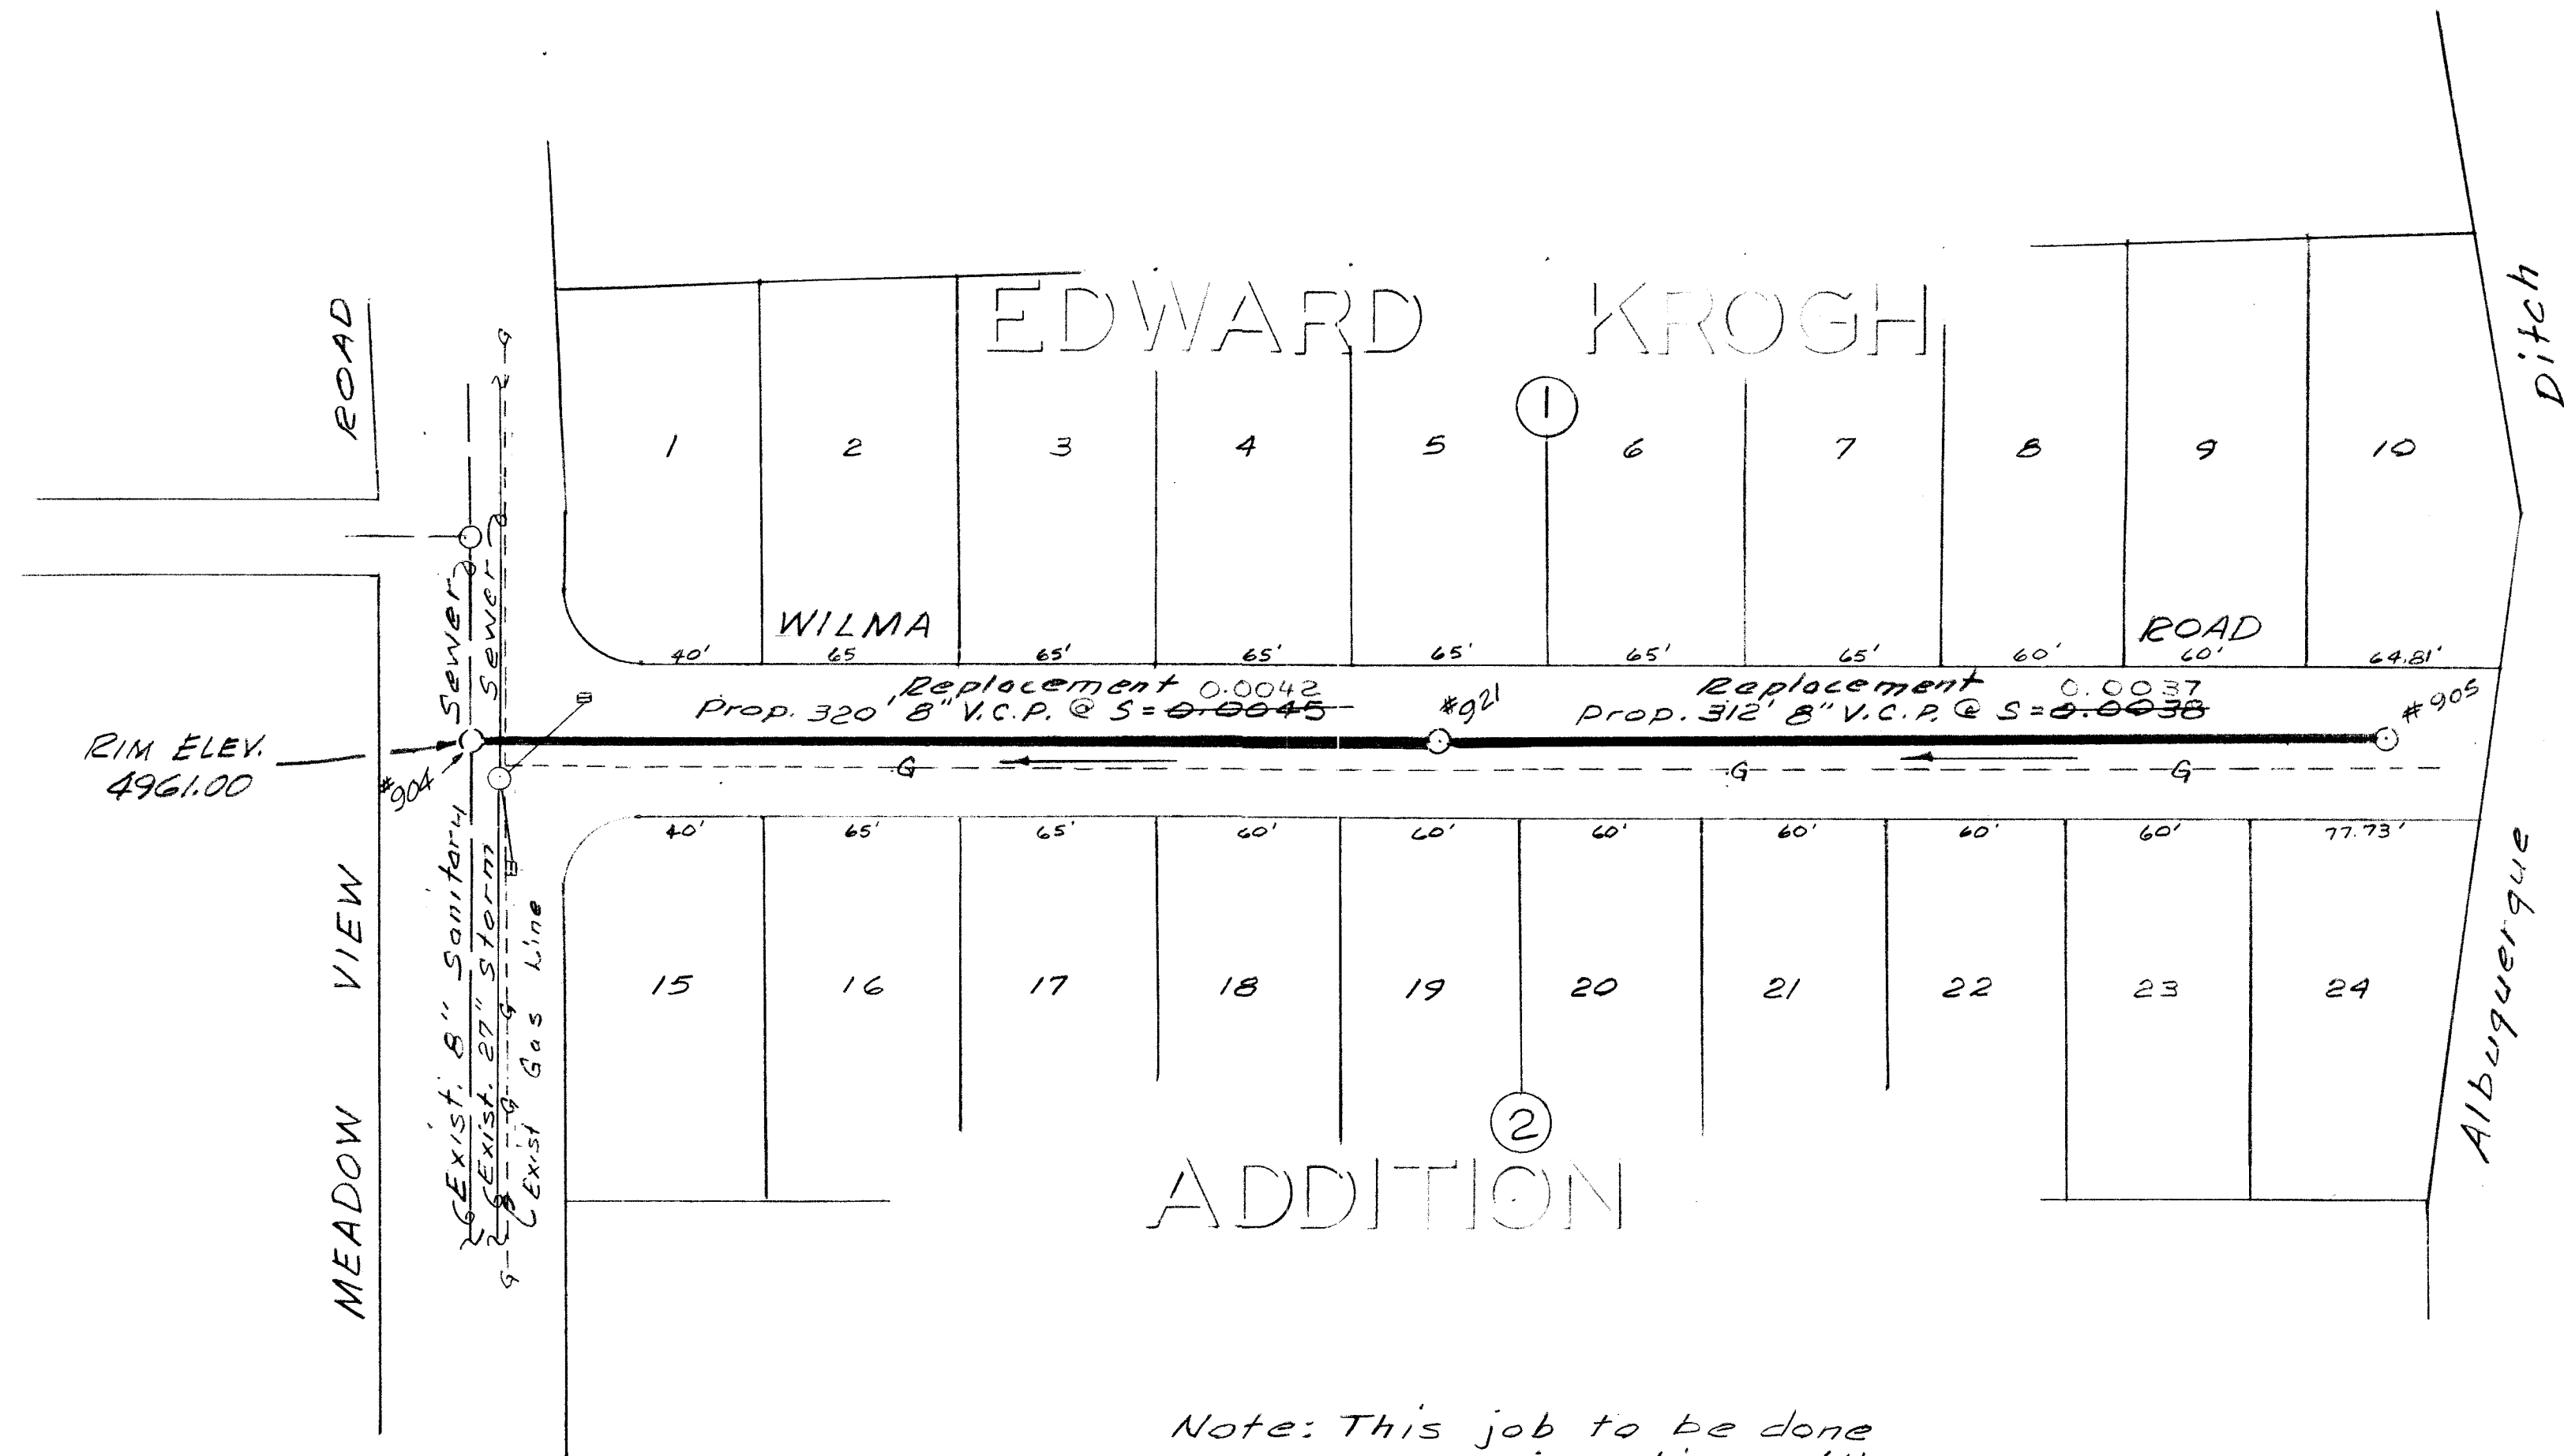


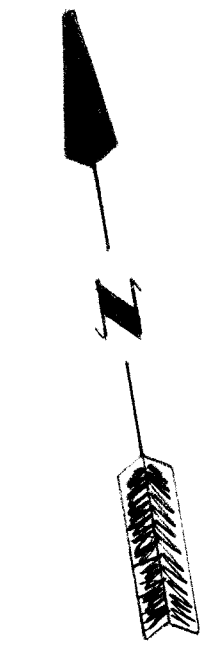

Note: This job to be done in conjunction with W-114-78.
old line to be removed
And New line to be laid at same slope.

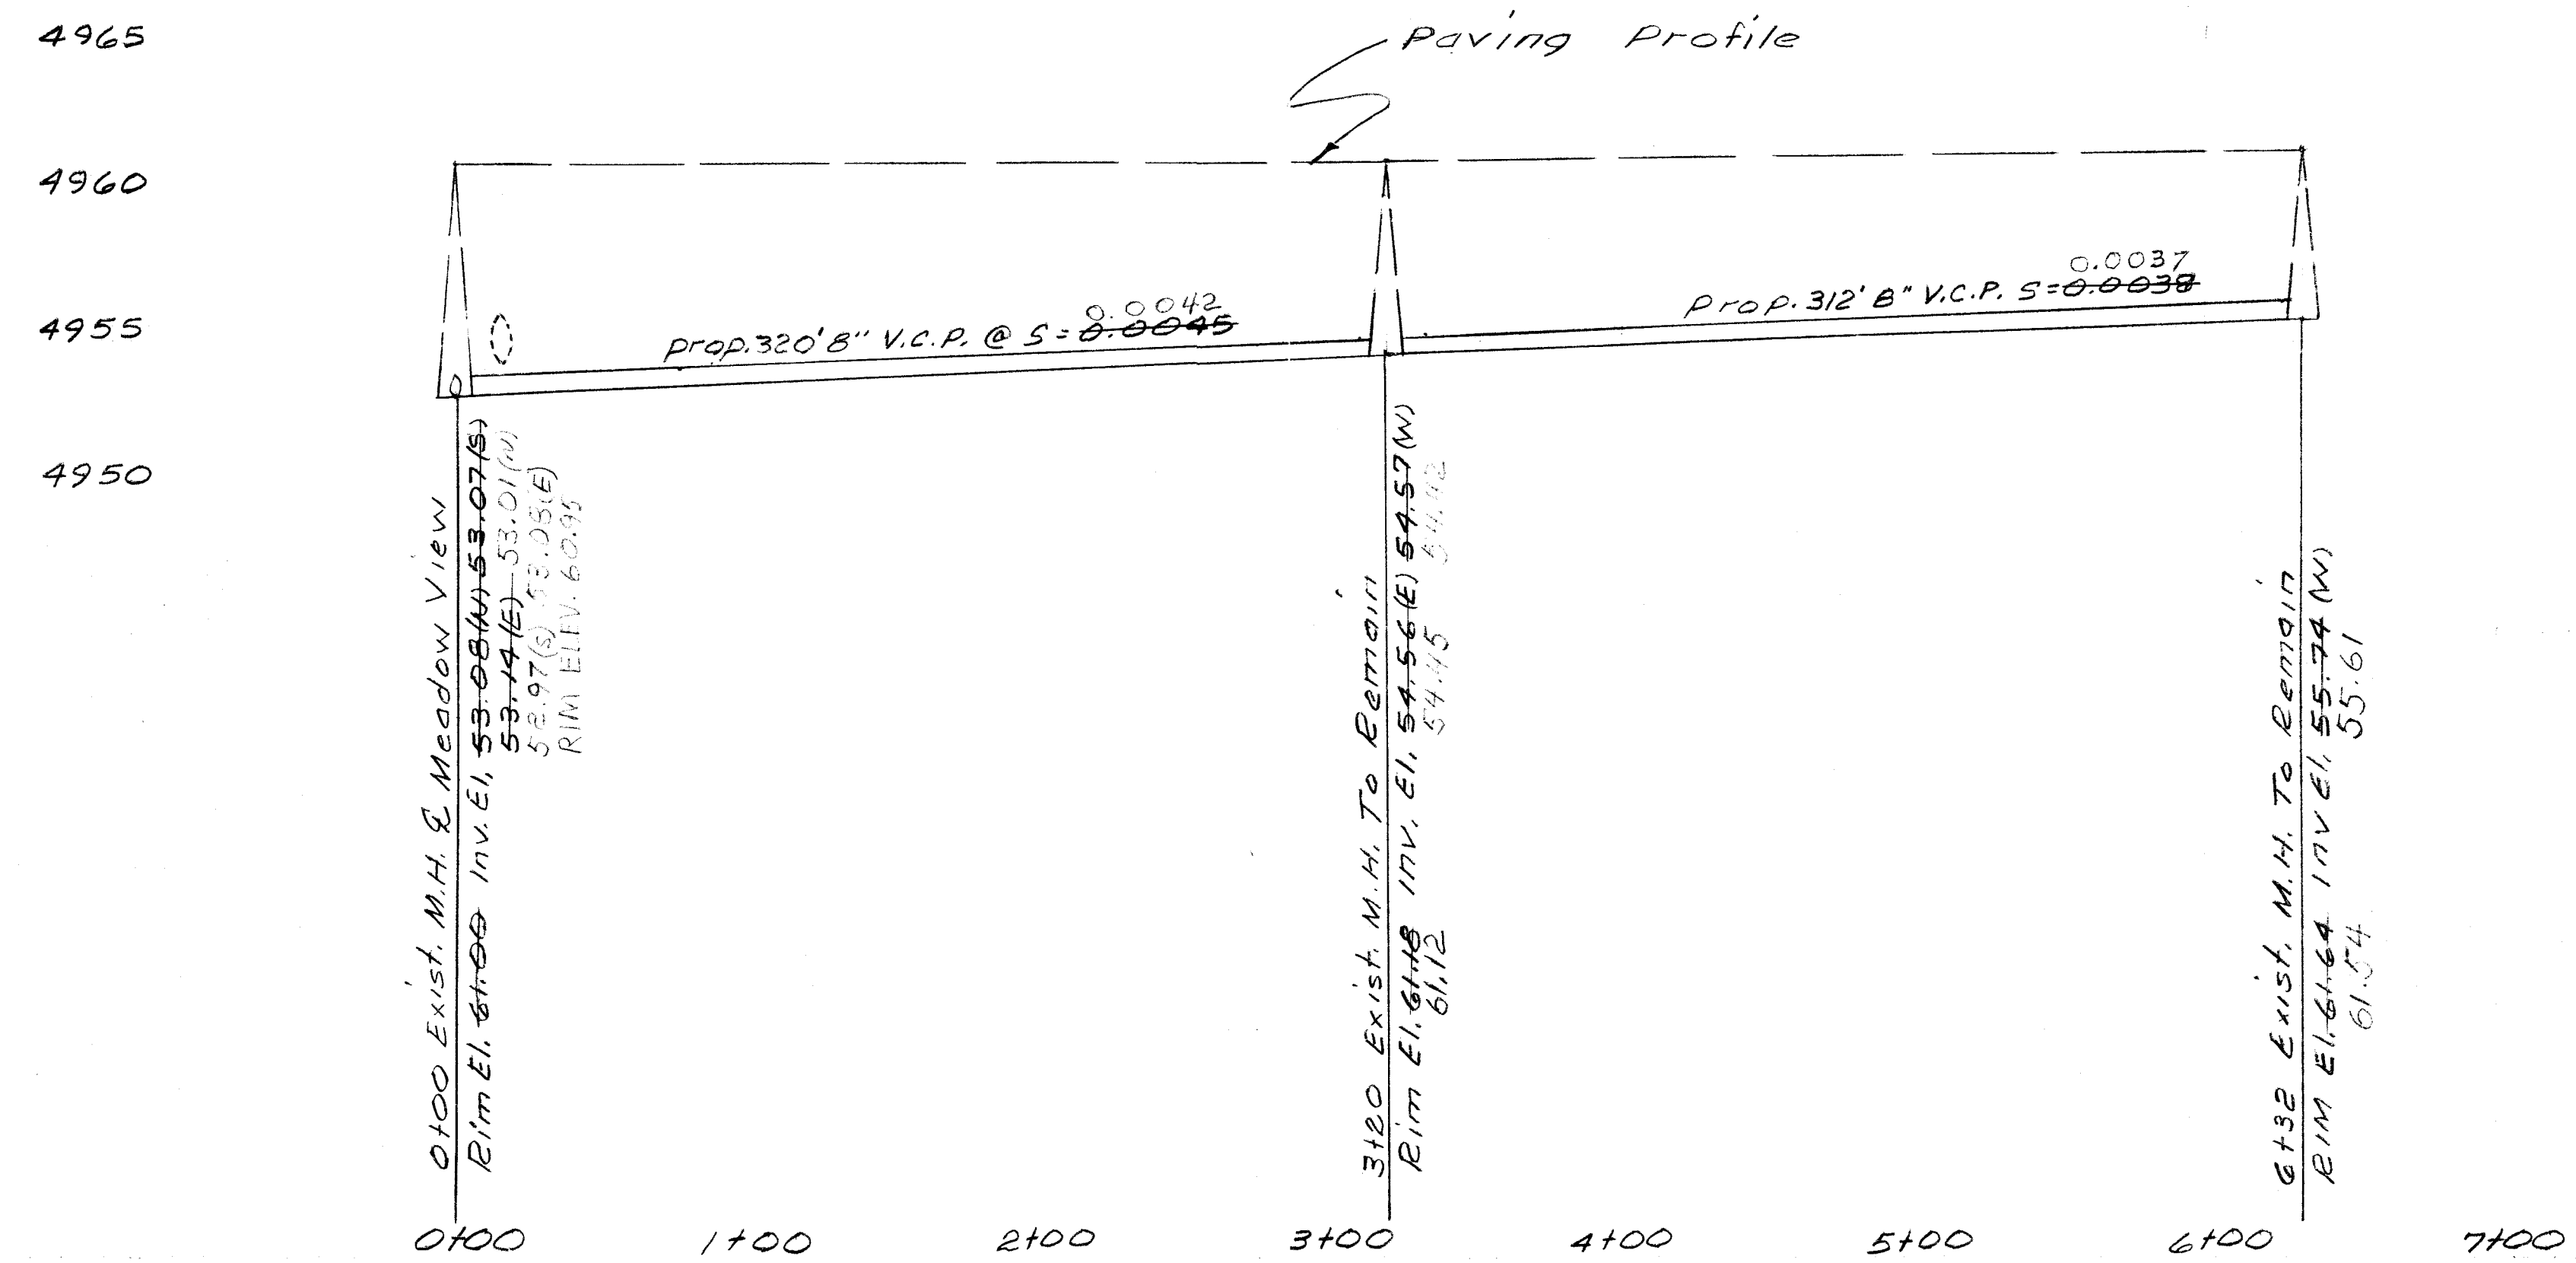

Scale: 1" = 50' Horiz.
1" = 5' Vert.

21 057 0178

WILMA ROAD FROM MEADOW VIEW ROAD EAST TO ALBUQUERQUE DITCH. 8" Sanitary Sewer Replacement.

dated 8/1/78
SAS-57-78
Fred Gomez
Dolly Herrera
7-20-78

H-13 AS
SAS-57-78 W.D.# 50
W-57-78
Cut T.C. W-S.W. Est.
Matthew Ave. NW. &
Meadow View Dr. NW.
ELEV. 4962.54
7-78
C. Lucero
R. Tofaya
D. Kerr

10/1/78
10/1/78