

PUBLIC IMPROVEMENT PLANS
FOR
DESERT SPRINGS SUBDIVISION
UNIT ONE

ALBUQUERQUE, NEW MEXICO

SEPTEMBER 1997

PREPARED FOR:
BUILDERS INVESTMENT INC.
c/o SIGNATURE J HOMES, INC.
7007 WYOMING BOULEVARD, NE, SUITE D-6
ALBUQUERQUE, NM 87109


PREPARED BY:
ISAACSON & ARFMAN, P.A.
128 MONROE ST. NE
ALBUQUERQUE, NM 87108

INDEX TO DRAWINGS

SHEET NO.	TITLE	SHEET NO.	TITLE
1	TITLE SHEET	19	UTILITY PLAN & PROFILE SHEETS
2-3	SUBDIVISION PLAT	20	UTILITY MASTER PLAN
4-5	GRADING & DRAINAGE PLAN	21	OFFSITE UTILITY MASTER PLAN
6	GRADING DETAILS	22	DESERT CANYON PLACE & DESERT SPRINGS COURT
	PAVING PLAN & PROFILE SHEETS	23	RAINWATER ROAD & SHADETREE STUB STREET
7	PAVING & STORM DRAIN MASTER PLAN	24	SILVERBERRY ROAD & SILVERBERRY STUB STREET
8	PAVING DETAILS & SECTIONS	25	SHADETREE DRIVE
8A	PAVING DETAILS	26	DESERT SPRINGS DRIVE
9	DESERT CANYON PLACE & DESERT SPRINGS COURT	27	DESERT SPRINGS DRIVE & OFFSITE SAS
10	RAINWATER ROAD & SHADETREE STUB STREET	28	UNSER BOULEVARD
11	SILVERBERRY ROAD & SILVERBERRY STUB STREET	29	UNSER BOULEVARD
12	SHADETREE DRIVE	30	OFFSITE SANITARY SEWER
13	DESERT SPRINGS DRIVE	31	OFFSITE SANITARY SEWER
14	DESERT SPRINGS DRIVE	32	POND DETAILS
15	ARENAL ROAD	32A	STRIPING PLAN
16	UNSER BOULEVARD TEMPORARY PAVING PLAN	32B	SIGNING & CONSTRUCTION TRAFFIC CONTROL STANDARDS
17	UNSER BOULEVARD		TYPICAL TRAFFIC CONTROL & SIGNING EXAMPLES
18	UNSER BOULEVARD		

I, David C. Clausen, New Mexico Professional Land Surveyor No. 6547, do hereby certify that the as-built information shown hereon is the result of a field survey performed by me or under my direct supervision, and that the same is true and correct.

David C. Clausen
N.M.L.S. # 6547

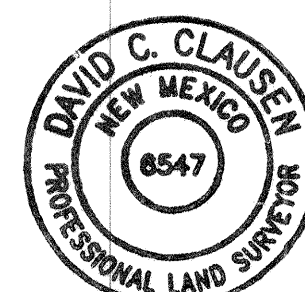


GENERAL NOTES

- ALL WORK DETAILED ON THESE PLANS TO BE PERFORMED UNDER CONTRACT SHALL, EXCEPT AS OTHERWISE STATED OR PROVIDED FOR HEREON, BE CONSTRUCTED IN ACCORDANCE WITH THE CITY OF ALBUQUERQUE STANDARD SPECIFICATIONS FOR PUBLIC WORKS CONSTRUCTION 1986 EDITION AS AMENDED WITH UPDATE NO. 6.
- ALL WORK ON THIS PROJECT SHALL BE PERFORMED IN ACCORDANCE WITH APPLICABLE FEDERAL, STATE, AND LOCAL LAWS, RULES, AND REGULATIONS CONCERNING CONSTRUCTION SAFETY AND HEALTH.
- PRIOR TO CONSTRUCTION, THE CONTRACTOR SHALL EXCAVATE & VERIFY THE HORIZONTAL AND VERTICAL LOCATIONS OF ALL OBSTRUCTIONS. SHOULD A CONFLICT EXIST, THE CONTRACTOR SHALL NOTIFY THE ENGINEER SO THAT THE CONFLICT CAN BE RESOLVED WITH MINIMUM DELAY.
- TWO (2) WORKING DAYS PRIOR TO ANY EXCAVATION, CONTRACTOR MUST CONTACT LINE LOCATING SERVICE @ 260-1990 FOR LOCATION OF EXISTING UTILITIES.
- CONTRACTOR SHALL CONDUCT HIS OPERATIONS IN A MANNER WHICH WILL MINIMIZE INTERFERENCE WITH LOCAL TRAFFIC. CONTRACTOR SHALL COMPLY WITH ALL APPLICABLE LAWS, ORDINANCES, RULES, REGULATIONS, AND ORDERS OF ANY PUBLIC BODY HAVING JURISDICTION FOR THE SAFETY OF PERSONS OR PROPERTY, AND TO PROTECT THEM FROM DAMAGE, INJURY, OR LOSS. CONTRACTOR SHALL ERECT AND MAINTAIN, AS REQUIRED BY THE CONDITIONS AND PROGRESS OF THE WORK, ALL NECESSARY SAFEGUARDS FOR SAFETY CONTINUOUSLY AND NOT LIMITED TO NORMAL WORKING HOURS, THROUGHOUT THE DURATION OF THE PROJECT. CONTRACTOR SHALL ADHERE TO SECTION 19 OF THE GENERAL CONDITIONS OF THE CITY OF ALBUQUERQUE STANDARD SPECIFICATIONS FOR PUBLIC WORKS CONSTRUCTION, 1986, AS AMENDED WITH UPDATE NO. 6.
- THE CONTRACTOR AGREES THAT HE SHALL ASSUME THE SOLE AND COMPLETE RESPONSIBILITY FOR THE JOB SITE CONDITIONS DURING THE COURSE OF CONSTRUCTION OF THIS PROJECT, INCLUDING SAFETY OF ALL PERSONS AND PROPERTY; THAT THIS REQUIREMENT SHALL APPLY CONTINUOUSLY AND NOT BE LIMITED TO NORMAL WORKING HOURS; AND THAT THE CONTRACTOR SHALL DEFEND, INDEMNIFY, AND HOLD HARMLESS THE OWNER & ENGINEER FROM ANY AND ALL LIABILITY REAL OR ALLEGED, IN CONNECTION WITH THE PERFORMANCE OF WORK ON THIS PROJECT, EXCEPTING LIABILITY ARISING FROM THE SOLE NEGLIGENCE OF THE OWNER OR ENGINEER.
- TRAFFIC CONTROL: FIVE (5) WORKING DAYS PRIOR TO BEGINNING CONSTRUCTION THE CONTRACTOR SHALL SUBMIT TO THE CONSTRUCTION COORDINATION DIVISION A DETAILED CONSTRUCTION SCHEDULE. TWO (2) WORKING DAYS PRIOR TO CONSTRUCTION, THE CONTRACTOR SHALL OBTAIN A BARRICADING PERMIT FROM THE CONSTRUCTION COORDINATION DIVISION. CONTRACTOR SHALL NOTIFY BARRICADE ENGINEER (768-2551) PRIOR TO OCCUPYING AN INTERSECTION. SEE SECTION 19 OF THE SPECIFICATIONS. ALL STREET STRIPING ALTERED OR DESTROYED SHALL BE REPLACED WITH PLASTIC REFLECTORIZED PAVEMENT MARKINGS BY CONTRACTOR TO LOCATION AS EXISTING OR AS SHOWN IN THIS PLAN SET AT NO ADDITIONAL COST TO THE OWNER.
- WHEN ABUTTING EXISTING PAVEMENT TO NEW, SAWCUT EXISTING PAVEMENT TO A STRAIGHT EDGE AND AT A RIGHT ANGLE, OR AS APPROVED BY THE FIELD ENGINEER. REMOVAL OF BROKEN OR CRACKED PAVEMENT WILL ALSO BE REQUIRED.
- EXISTING CURB AND GUTTER NOT TO BE REMOVED UNDER THE CONTRACT WHICH IS DAMAGED OR DISPLACED BY THE CONTRACTOR SHALL BE REMOVED AND REPLACED BY THE CONTRACTOR AT HIS EXPENSE.
- ALL FINAL BACKFILL FOR TRENCHES SHALL BE COMPACTED TO A MINIMUM 90% MAXIMUM DENSITY PER ASTM D-1557 AND AS DIRECTED BY SECTION 701.14.2 AND STANDARD DRAWING NUMBER 2315.
- CONTRACTOR SHALL MAINTAIN A GRAFFITI-FREE WORK SITE. CONTRACTOR SHALL PROMPTLY REMOVE ANY AND ALL GRAFFITI FROM EQUIPMENT, WHETHER PERMANENT OR TEMPORARY.
- THE CONTRACTOR SHALL PROMPTLY CLEAN UP ANY MATERIAL EXCAVATED WITHIN THE PUBLIC RIGHT-OF-WAY OR PRIVATE ROADWAY EASEMENTS SO THAT THE EXCAVATED MATERIAL IS NOT SUSCEPTIBLE TO BEING WASHED DOWN THE STREET OR INTO ANY PUBLIC DRAINAGE FACILITY.
- PROPOSED WATERLINE MATERIALS SHALL BE EITHER PVC PIPE MEETING AWWA C900 REQUIREMENTS (6"-12") OR DUCTILE IRON PIPE, THICKNESS CLASS 50 (6"-16").
- ALL SANITARY SEWER LINE STATIONING REFERS TO STREET CENTERLINE STATIONING UNLESS OTHERWISE NOTED.
- ALL FITTINGS ON WATERLINES SHALL HAVE RESTRAINED JOINTS AS NOTED ON THE PLANS.
- CONTRACTOR SHALL SUPPORT ALL EXISTING, UNDERGROUND UTILITY LINES WHICH BECOME EXPOSED DURING CONSTRUCTION. PAYMENT FOR SUPPORTING WORK SHALL BE INCIDENTAL TO WATER-LINE AND/OR SEWERLINE COSTS.
- CONTRACTOR SHALL ASSIST THE ENGINEER/INSPECTOR IN THE RECORDING OF DATA ON ALL UTILITY LINES AND ACCESSORIES AS REQUIRED BY THE CITY OF ALBUQUERQUE FOR THE PREPARATION OF RECORD DRAWINGS. CONTRACTOR SHALL NOT COVER UTILITY LINES AND ACCESSORIES UNTIL ALL DATA HAS BEEN RECORDED.
- THE CONTRACTOR IS RESPONSIBLE FOR PROTECTING AND MAINTAINING ALL EXISTING MONUMENTATION CONTROLS. IN THE EVENT OF IN-ADVERTENT DESTRUCTION OR ALTERATION, THE CONTRACTOR MUST IMMEDIATELY NOTIFY THE CITY CHIEF SURVEYOR.
- PNM WILL PROVIDE AT NO COST TO THE CITY OR THE CONTRACTOR THE REQUIRED PERSONNEL FOR INSPECTION OR OBSERVATION DEEMED NECESSARY BY PNM WHILE THE CONTRACTOR IS EXPOSING PNM'S CABLES. HOWEVER, THE CONTRACTOR SHALL BE CHARGED THE TOTAL COST ASSOCIATED WITH REPAIRS TO ANY DAMAGED CABLES OR FOR ANY COST ASSOCIATED WITH SUPPORTING OR RELOCATING THE POLES AND CABLES DURING CONSTRUCTION.
- WARNING--EXISTING UTILITY LINE LOCATIONS ARE SHOWN IN AN APPROXIMATE MANNER ONLY, AND SUCH LINES MAY EXIST WHERE NONE ARE SHOWN. THE LOCATION OF ANY SUCH EXISTING LINES IS BASED UPON INFORMATION PROVIDED BY THE UTILITY COMPANY, THE OWNER, OR BY OTHERS, AND THE INFORMATION MAY BE INCOMPLETE OR MAY BE OBSOLETE BY THE TIME CONSTRUCTION COMMENCES.

THE ENGINEER HAS UNDERTAKEN NO FIELD VERIFICATION OF THE LOCATION, DEPTH, SIZE, OR TYPE OF EXISTING UNDERGROUND UTILITY LINES, MAKES NO REPRESENTATION PERTAINING THERETO, AND ASSUMES NO RESPONSIBILITY OR LIABILITY THEREFOR. THE CONTRACTOR SHALL INFORM ITSELF OF THE LOCATION OF ANY UTILITY LINE IN OR NEAR THE AREA OF THE WORK IN ADVANCE OF AND DURING EXCAVATION WORK. THE CONTRACTOR IS FULLY RESPONSIBLE FOR ANY AND ALL DAMAGE CAUSED BY ITS FAILURE TO LOCATE, IDENTIFY, AND PRESERVE ANY AND ALL EXISTING UTILITIES. THE CONTRACTOR SHALL COMPLY WITH STATE STATUTES, MUNICIPAL AND LOCAL ORDINANCES, RULES AND REGULATIONS PERTAINING TO THE LOCATION OF THESE LINES AND FACILITIES, IN PLANNING AND CONDUCTING EXCAVATION, WHETHER BY CALLING OR NOTIFYING THE UTILITIES, COMPLYING WITH "BLUE STAKES" PROCEDURES, OR OTHERWISE.

- ANY WORK OCCURRING WITHIN AN ACCEPTED ARTERIAL ROADWAY REQUIRES 24 HR. CONSTRUCTION.
- ALL EXCAVATION, TRENCHING AND SHORING ACTIVITIES MUST BE ACCOMPLISHED IN ACCORDANCE WITH OSHA 29CFR 1926.650 SUBPART P.
- THE CONTRACTOR SHALL NOTIFY THE CONSTRUCTION COORDINATION DIVISION (768-2552) AT LEAST FIVE DAYS PRIOR TO ANY WORK EFFECTING TRAFFIC ON EITHER UNSER BOULEVARD OR ARENAL ROAD TO ARRANGE AN ON-SITE MEETING. THE CONTRACTOR'S SCHEDULE OF OPERATIONS ON THESE ROADWAYS MUST BE APPROVED BY THE CONSTRUCTION COORDINATION DIVISION.

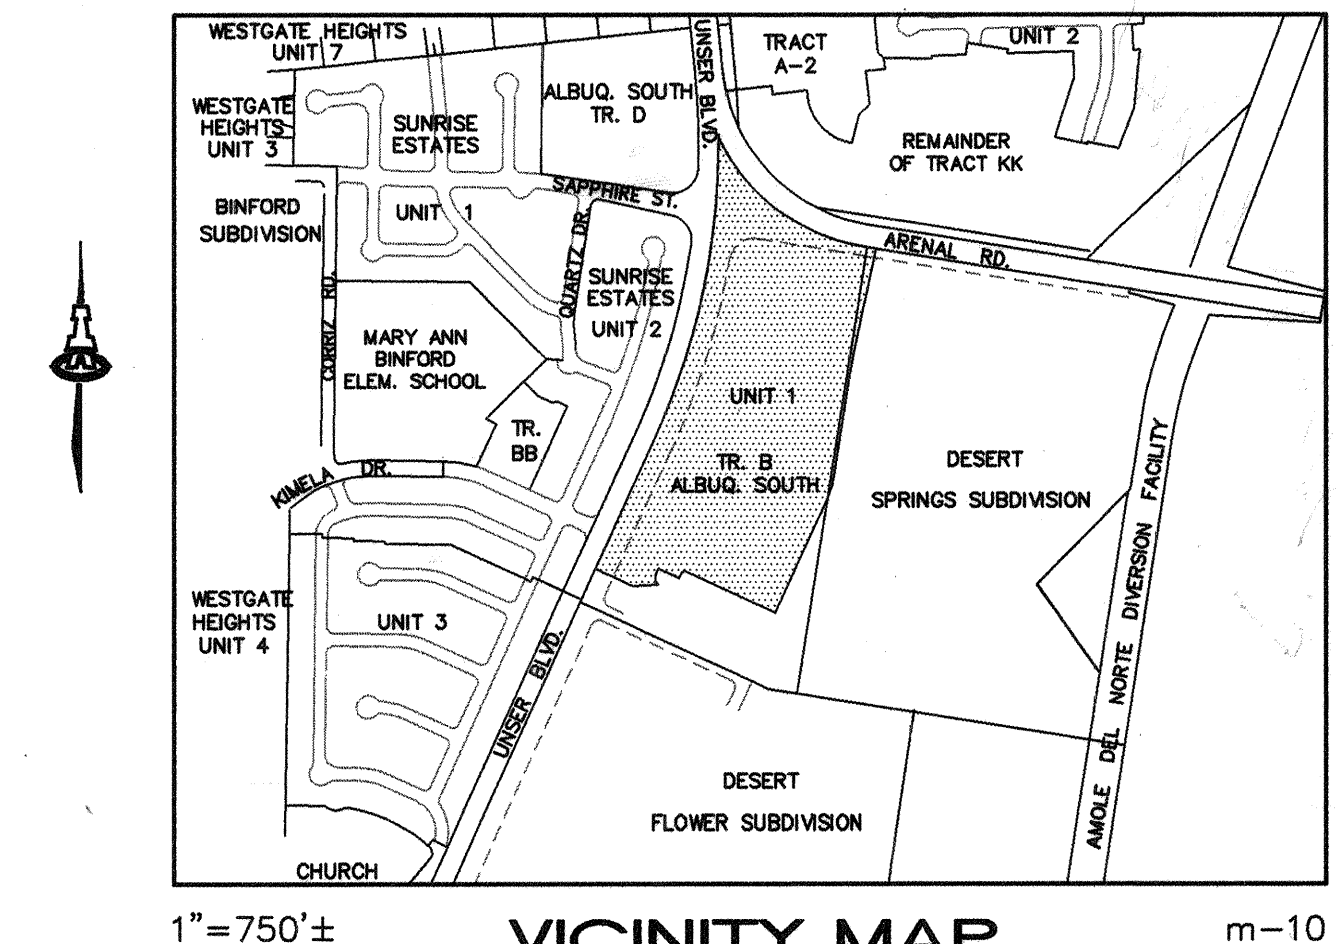


1"=750'± VICINITY MAP m-10

REV.	SHEETS	CITY ENGINEER	DATE	USER DEPARTMENT	DATE	USER DEPARTMENT	DATE
ENGINEERS STAMP & SIGNATURE		APPROVALS		ENGINEER		DATE	
		DRC Chairman		Billy G. Andaby		2-18-98	
		Transportation		R.W. Kane		1-9-98	
		Water/Wastewater		R.W. Kane		11-26-97	
		Hydrology		R.W. Kane		11-26-97	
		CIP		R.W. Kane		11-26-97	
Constr. Mngmt.		Constr. Coord.		J. B. B. B.		2-7-98	
City Project No.		5785.81		Sheet		1 Of 32	

DRB NO. 96-435

ISAACSON & ARFMAN, P.A.
Consulting Engineering Associates
128 Monroe Street N.E.
Albuquerque New Mexico
921CVR.DWGems 10/20/97

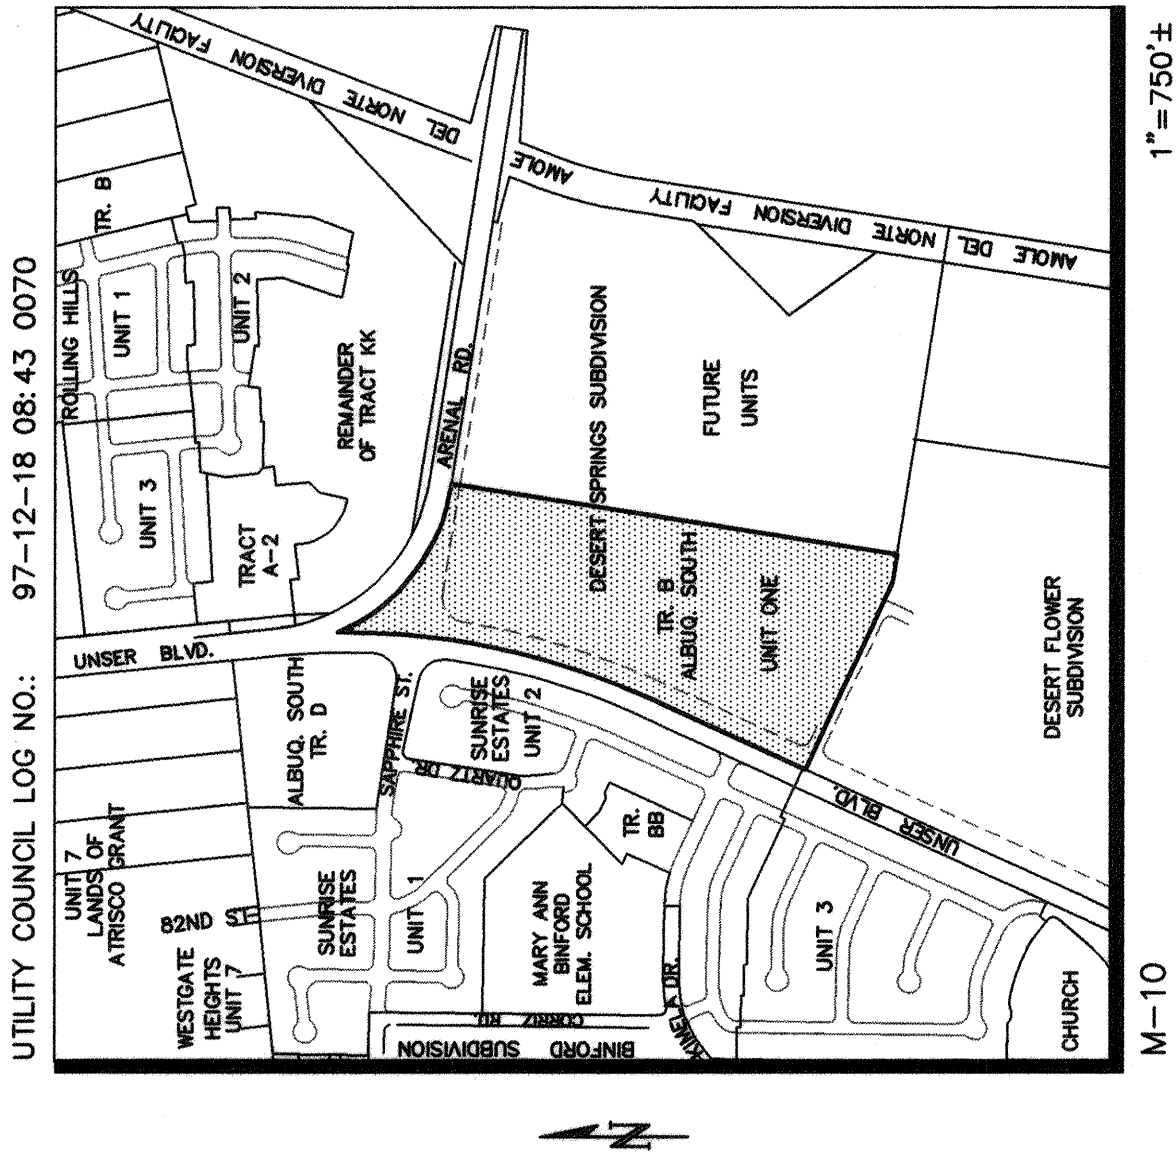

VICINITY MAP

SUBDIVISION DATA / NOTES

- Total Number of Existing Tracts: 1
- Total Number of Lots created: 99
- Total Number of Tracts created: 2
- Gross Subdivision Acreage: 28.8008 Ac.
- Total Mileage of Full Width Streets Created: 0.5486 mi.
- Bearings are grid based on the New Mexico State Plane Coordinate System (Central Zone).
- Distances are ground distances.
- Bearings and distances in parenthesis are record.
- Basis of boundary are the following plats (and documents) of record entitled:
"SUNRISE ESTATES, UNIT TWO", (05-21-97, 97C-162)
"ALBUQUERQUE SOUTH, UNIT 1", (08-03-87, C34-74)
"DESERT SPRINGS SUBDIVISION", (02-20-97, 97C-55)
"DESERT FLOWER SUBDIVISION", (06-05-97, 97C-175)
WARRANTY DEED "MESA ENTERPRISES, LIMITED", (04-23-80, BK. D118A-PG. 945)
WARRANTY DEED " PARCEL A-1-14, AMOLE DEL NORTE DIVERSION FACILITY", (07-13-82, BK. D165-A, PGS. 615-619)
WARRANTY DEED " PARCEL A-1-15, AMOLE DEL NORTE DIVERSION FACILITY", (07-13-82, BK. D165-A, PGS. 615-619)
WARRANTY DEED " PARCEL A-2-1, AMOLE DEL NORTE DIVERSION FACILITY", (07-13-82, BK. D165-A, PGS. 615-619)
all being records of Bernalillo County, New Mexico.
- Field Survey performed November, 1996.
- Title Report: Provided by Albuquerque Title Company Commitment No. 143189M, Effective Date: 09-17-96 (Portion of Valley West)
- Commitment No. 144484M, Effective Date: 08-07-96 (Tract B, Albuquerque South, Unit 1)
- This property is apparently affected by reservations, restrictions and memorandums contained within easements, documents and memorandums as listed within the above mentioned Title Report.
- Existing Temporary Blanket Drainage easement on all of TRACT B, ALBUQUERQUE SOUTH, UNIT 1 and A PORTION OF VALLEY WEST (04-24-95, BK. BCR95-3, PGS. 9716-9734)
(01-20-94, BK. BCR94-2, PGS. 9787-9794)

SUBDIVISION DATA/NOTES CONTINUED ON SHEET 2

CONTINUED-LEGAL DESCRIPTION

THENCE leaving said southerly right-of-way line S 08°59'07" W, 1762.56 feet along a line common with the westerly line of said DESERT SPRINGS SUBDIVISION to the southwest corner of said DESERT SPRINGS SUBDIVISION.

THENCE N 81°03'02" W, 111.88 feet along a line common with the northerly line of DESERT FLOWER SUBDIVISION to the southeast corner of said Bernalillo County, New Mexico on June 5, 1997 in Volume 97C, Folio 175 to a point.

THENCE N 65°23'58" W, 811.82 feet to the southwest corner, said point being common with the northwest corner of said DESERT FLOWER SUBDIVISION, also being on the easterly property line of TRACT AA, SUNRISE ESTATES, UNIT TWO, the same is shown and designated on said plat filed for record in the Office of the County Clerk of Bernalillo County, New Mexico on May 5, 1997 in Volume 97C, Folio 162.

THENCE N 24°35'42" E, 692.63 feet along a line common with the easterly property line of said TRACT AA and SUNRISE ESTATES, UNIT TWO, as the same is shown and designated on said plat filed for record in the office of the County Clerk of Bernalillo County, New Mexico on May 21, 1997, in Volume 97C, Folio 162 to a point of curvature;

THENCE continuing 929.46 feet along a curve to the left, whose radius is 2900.00 feet through a central angle of 19°01'10" and whose chord bears N 15°05'08" E, 925.20 feet to a point on curve, said point being common with the northeast corner of said SUNRISE ESTATES, UNIT TWO and further being common with the southeast corner of said TRACT D;

THENCE along a line common with the easterly line of said TRACT D 290.49 feet along a line common with the easterly line of said TRACT D through a central angle of 05°56'39" and whose chord bears N 02°34'50" E, 290.35 feet to the point of beginning and containing 28.8008 acres more or less.

These tracts are affected by a RIGHT-OF-WAY EASEMENT to American Telephone and Telegraph Company, dated December 13, 1929, recorded in Book 112, Page 290, said easement amended by a MODIFICATION EASEMENT, dated January 31, 1973, recorded in Book Misc. 298, Page 635, said easement assigned to the Mountain States Telephone and Telegraph Company by ASSIGNMENT dated December 26, 1974, recorded in Book Misc. 575, Page 928 all being records of Bernalillo County, New Mexico.

These tracts are affected by Special Agreement #72-2 (04-26-72, Bk. Misc.257, Pg. 708-734)

City of Albuquerque Water and Sanitary Sewer Service to XXX must be verified and coordinated with the Public Works Department, City of Albuquerque.

"Centerline Monumentation", Survey Marker, "Do Not Disturb", PLS #7719.

Unless otherwise noted all points are "SET 5/8" REBAR with cap "ALS LS 7719".

CONTINUED-SUBDIVISION DATA/NOTES

These tracts are affected by a RIGHT-OF-WAY EASEMENT to American Telephone and Telegraph Company, dated December 13, 1929, recorded in Book 112, Page 290, said easement amended by a MODIFICATION EASEMENT, dated January 31, 1973, recorded in Book Misc. 298, Page 635, said easement assigned to the Mountain States Telephone and Telegraph Company by ASSIGNMENT dated December 26, 1974, recorded in Book Misc. 575, Page 928 all being records of Bernalillo County, New Mexico.

These tracts are affected by Special Agreement #72-2 (04-26-72, Bk. Misc.257, Pg. 708-734)

City of Albuquerque Water and Sanitary Sewer Service to XXX must be verified and coordinated with the Public Works Department, City of Albuquerque.

"Centerline Monumentation", Survey Marker, "Do Not Disturb", PLS #7719.

Unless otherwise noted all points are "SET 5/8" REBAR with cap "ALS LS 7719".

LEGAL DESCRIPTION

A tract of land situate within the Town of Atrisco Grant, projected Section 34, Township 10 North, Range 2 East, New Mexico Principal Meridian, City of Albuquerque, Bernalillo County, New Mexico being all of TRACT B, ALBUQUERQUE SOUTH, UNIT 1 as the same is shown and designated on said plat filed for record in the Office of the County Clerk of Bernalillo County, New Mexico on August 3, 1987 in Volume C34, Folio 74 and further being on the southerly right-of-way line of Arenal Road S.W. from whence the Albuquerque Control Survey Monument "1-M10" bears N 02°57'20" W, 1460.50 feet;

BEGINNING at the northwest corner of the herein described tract, said point being on the easterly line of TRACT D, ALBUQUERQUE SOUTH, UNIT 1 as the same is shown and designated on said plat filed for record in the office of the County Clerk of Bernalillo County, New Mexico on August 3, 1987 in Volume C34, Folio 74 and further being on the southerly right-of-way line of Arenal Road S.W. from whence the Albuquerque Control Survey Monument "1-M10" bears N 02°57'20" W, 1460.50 feet;

THENCE along said southerly right-of-way line 738.27 feet along a curve to the left, whose radius is 759.20 through a central angle of 55°42'59" and whose chord bears S 53°09'44" E, 709.52 feet to a point of tangency;

THENCE continuing S 81°01'13" E, 14.10 feet to a point, said point being on the northeast corner of the herein described tract, said point being the northwest corner of DESERT SPRINGS SUBDIVISION as the same is shown and designated on said plat filed for record in the office of the County Clerk of Bernalillo County, New Mexico on February 20, 1997 in Volume 97C, Folio 35;

LEGAL DESCRIPTION CONTINUED ON SHEET 2

DISCLOSURE STATEMENT

The intent of this plat is to subdivide one (1) tract into 99 residential lots, including (19) lots (19A) for future residential development, to dedicate public rights-of-way, and to grant those easements necessary to serve the residential development.

FREE CONSENT AND DEDICATION

The subdivision shown hereon is with the free consent and in accordance with the desires of the undersigned Owner(s) and/or Proprietor(s) thereof and said Owner(s) and/or Proprietor(s) do hereby dedicate all streets and public rights-of-way shown hereon to the City of Albuquerque in fee simple with warranty covenants and do hereby grant: all access, utility and drainage easements, and all other rights and interests in and to the land shown hereon to maintain facilities therein; and all public utility easements shown hereon for the common and joint use of gas, electrical power and communication services for overhead and buried distribution lines, conduits, and pipes for underground and/or overhead utilities where shown or indicated, and including the right of ingress and egress for construction and maintenance, and the right to trim interfering trees and shrubs. Said Owner(s) and/or Proprietor(s) do hereby consent to all of the foregoing and do hereby certify that this subdivision is their free act and deed.

OWNER

BUILDERS INVESTMENT COMPANY OF NEW MEXICO, LTD, CO.

H. Griffin Pickard, Jr. Date

Managing Member, Trustee

ACKNOWLEDGEMENT

STATE OF NEW MEXICO }
COUNTY OF BERNALILLO }

This instrument was acknowledged before me on 1997, by H. Griffin Pickard, Jr., as Managing Member, Trustee of Builders Investment Company of New Mexico, Ltd, Co., a New Mexico Limited Company, on behalf of said Company.

My Commission Expires: _____

Notary Public

LOT AREA TABLE

BLOCK A			BLOCK B		
14	5624 SF	19	4481 SF		
15	4512 SF	20	5332 SF		
16	4500 SF	21	6008 SF		
17	4500 SF	22	5629 SF		
18	4500 SF	23	4725 SF		
19	4500 SF	24	4725 SF		
20	4500 SF	25	4725 SF		
21	4500 SF	26	4725 SF		
22	4500 SF	27	4725 SF		
23	4500 SF	28	4725 SF		
24	4500 SF	29	5215 SF		
25	4454 SF	30	5759 SF		
26	4454 SF	31	5591 SF		
27	4454 SF	32	5110 SF		
28	4454 SF	33	5060 SF		
29	4454 SF	34	5053 SF		
30	4454 SF	35	4578 SF		
31	4454 SF	36	4912 SF		
32	4454 SF				
33	4454 SF	BLOCK C			
34	4493 SF	1	4863 SF		
35	5354 SF	2	4500 SF		
36	4834 SF	3	4500 SF		
37	4567 SF	4	4500 SF		
38	6283 SF	5	4500 SF		
39	4987 SF	6	4500 SF		
40	4987 SF	7	4500 SF		
41	4725 SF	8	5366 SF		
42	4725 SF	9	5366 SF		
43	5250 SF	10	4500 SF		
44	4490 SF	11	4490 SF		
45	5526 SF	12	4270 SF		
46	7286 SF	13	4270 SF		
		14	7145 SF		
		15	6144 SF		
		16	6144 SF		
		17	7250 SF		
		18	4270 SF		
		19	4499 SF		
		20	4500 SF		
		21	5366 SF		
		22	4700 SF		
		23	4500 SF		
		24	4500 SF		
		39	4906 SF		

LINE	LINE	LINE	LINE	LINE	LINE
1	9.27	2	586.3174	3	586.3174
4	14.50	5	842.5524	6	842.5524
7	25.00	8	842.5524	9	842.5524
10	15.00	11	842.5524	12	842.5524
13	15.00	14	842.5524	15	842.5524
16	15.00	17	842.5524	18	842.5524
19	15.00	20	842.5524	21	842.5524
22	15.00	23	842.5524	24	842.5524
25	15.00	26	842.5524	27	842.5524
28	15.00	29	842.5524	30	842.5524
31	15.00	32	842.5524	33	842.5524
34	15.00	35	842.5524	36	842.5524
37	15.00	38	842.5524	39	842.5524
40	15.00	41	842.5524	42	842.5524
43	15.00	44	842.5524	45	842.5524
46	15.00	47	842.5524	48	842.5524
49	15.00	50	842.5524	51	842.5524
52	15.00	53	842.5524	54	842.5524
55	15.00	56	842.5524	57	842.5524
58	15.00	59	842.5524	60	842.5524
61	15.00	62	842.5524	63	842.5524
64	15.00	65	842.5524	66	842.5524
67	15.00	68	842.5524	69	842.5524
70	15.00	71	842.5524	72	842.5524
73	15.00	74	842.5524	75	842.5524
76	15.00	77	842.5524	78	842.5524
79	15.00	80	842.5524	81	842.5524
82	15.00	83	842.5524	84	842.5524
85	15.00	86	842.5524	87	842.5524
88	15.00	89	842.5524	90	842.5524
91	15.00	92	842.5524	93	842.5524
94	15.00	95	842.5524	96	842.5524
97	15.00	98	842.5524	99	842.5524

PLAT
FOR
DESERT SPRINGS SUBDIVISION
UNIT ONE
BEING A REPLAT OF
TRACT B, ALBUQUERQUE SOUTH, UNIT ONE
WITHIN THE
TOWN OF ATRISCO GRANT
PROJECTED SECTION 34, T. 10 N. R. 2 E. NMPM
CITY OF ALBUQUERQUE
BERNALILLO COUNTY, NEW MEXICO
DECEMBER 1997

APPROVALS S-97-12 DRB NO. 96-435

PUBLIC SERVICE CO. OF NM--ELECTRIC SERVICES DIV.	DATE
PUBLIC SERVICE CO. OF NM--GAS SERVICES DIV.	DATE
US WEST COMMUNICATIONS	DATE
JONES INTERCABLE	DATE
CITY SURVEYOR, ENGR. DIV., P.W.D.	DATE
TRAFFIC ENGINEERING, TRANS. DEV. DIV., P.W.D.	DATE
PARKS DESIGN & DEVELOPMENT / OIP	DATE
UTILITY DEVELOPMENT DIV., P.W.D.	DATE
REAL PROPERTY DIVISION, D.F.M.	DATE
A.M.A.F.C.A.	DATE
CITY ENGINEER, PUBLIC WORKS DEPT.	DATE

APPROVAL AND CONDITIONAL ACCEPTANCE AS SPECIFIED BY THE ALBUQUERQUE SUBDIVISION ORDNANCE, ARTICLE XI OF THE REVISED ORDINANCES OF ALBUQUERQUE, N.M.

CITY PLANNER, ALBUQUERQUE PLANNING DIVISION DATE

SURVEYORS CERTIFICATION

"I, Timothy Aldrich, a duly qualified Registered Professional Land Surveyor under the laws of the State of New Mexico, do hereby certify that this plat and description were prepared by me or under my supervision, shows all easements as shown on the plat of record and the survey was made in accordance with the provisions of the subdivision shown hereon, utility companies and other parties expressing an interest and meets the minimum requirements for monumentation and surveys of the Albuquerque Subdivision Ordinance, and further meets the Minimum Standards for Land Surveying in the State of New Mexico (Effective November 1, 1989 and revisions effective December 25, 1991 and February 2, 1994), and is true and correct to the best of my knowledge and belief".

Timothy Aldrich, P.S. No. 7719

PLAT
FOR
DESERT SPRINGS SUBDIVISION
UNIT ONE
BEING A REPLAT OF
TRACT B, ALBUQUERQUE SOUTH, UNIT ONE
WITHIN THE
TOWN OF ATRISCO GRANT
PROJECTED SECTION 34, T. 10 N. R. 2 E. NMPM
CITY OF ALBUQUERQUE
BERNALILLO COUNTY, NEW MEXICO
DECEMBER 1997

CURVE	BEARING	LENGTH	TRANSIT	CURVE	BEARING	DELTA
C1	S 88°10'00" E	26.21	13.58	C31	S 88°10'00" E	26.21
C2	S 88°10'00" E	26.21	13.58	C32	S 88°10'00" E	26.21
C3	S 88°10'00" E	26.21	13.58	C33	S 88°10'00" E	26.21
C70	S 88°10'00" E	26.21	13.58	C100	S 88°10'00" E	26.21

BOUNDARY DATA TABLES

LINE	DIRECTION	DISTANCE
BL1	S 81°01'13" E	14.10'
	(S 81°18'45" E)	(13.26')

CURVE	RADIUS	LENGTH	TANGENT	CHORD	BEARING	DELTA
BC1	759.20'	738.27'	401.27'	709.52'	S 53°09'44" E	55°42'59"
		(738.96')				(55.46 DE)
BC2	2800.00'	929.46'	469.05'	925.20'	N 15°05'08" E	19°01'10"
		(929.64')				(19°01'22")
BC3	2800.00'	290.48'	145.38'	280.36'	N 02°34'50" E	05°58'39"
		(291.05')				(05°57'20")

EASEMENT DATA TABLES

CURVE	RADIUS	LENGTH	TANGENT	CHORD	BEARING	DELTA
EC1	25.00'	198.18'	31.33'	40.33'	N 70°00'28" E	28°51'57"
		(200.00')				(29.00 DE)
EC2	25.00'	26.00'	10.68'	10.48'	S 08°05'28" W	57°22'00"
		(26.00')				(57.37 DE)
EC3	25.00'	20.00'	10.68'	10.48'	S 08°05'28" W	45°51'50"
		(20.00')				(46.00 DE)
EC4	30.00'	34.77'	19.63'	32.85'	N 47°49'15" W	66°23'56"
		(35.00')				(66.40 DE)

LINE	DISTANCE	BEARING
EL1	15.89'	N 86°31'32" E
EL2	15.12'	N 64°16'28" E
EL3	12.01'	N 08°59'07" E
EL4	2.51'	N 81°01'13" W

PLAT FOR
DESERT SPRINGS SUBDIVISION
UNIT ONE

BEING A REPLAT OF
TRACT B, ALBUQUERQUE SOUTH, UNIT ONE
WITHIN THE

TOWN OF ATRISCO GRANT
PROJECTED SECTION 34, T. 10 N., R. 2 E., NMPM
CITY OF ALBUQUERQUE
BERNALILLO COUNTY, NEW MEXICO

DECEMBER 1997

TRACT D
ALBUQUERQUE SOUTH
UNIT ONE
(08-03-87, C34-74)
BC3
TIE: N 02°57'20" W
1460.30'
ACS MONUMENT
T=100
X=176654.54
Y=1358862.36
G=0-0.99967987
G=0-0.99967987
CENTRAL ZONE
(NAD 1987/SLD 1929)
TIE: N 02°57'20" W
1460.30'
EXISTING 20' WATER UTILITY
EASEMENT (08-12-72,
BK MISC 327, PGS 336-339)
EXISTING 40' TEMPORARY
ROADWAY EASEMENT
(07-19-94, BK BCR4-21,
PGS 7033-7036)

EXISTING 20' PERMANENT
UTILITY EASEMENT
(10-03-86, MS 402A,
PGS 188-192)
156' R.O.W.
BC2
20' WIDE EXISTING PUBLIC
WATERLINE EASEMENT
PEDESTRIAN
ACCESS
12' R/W


SCALE: 1"=100'



SUNRISE ESTATES
UNIT 2
(05-21-97, 97C-162)




TRACT AA
SUNRISE ESTATES
UNIT 2
(05-21-97, 97C-162)
ACS MONUMENT
T=100
X=354889.45
Y=1354889.45
G=0-0.99967921
G=0-0.99967921
CENTRAL ZONE
(NAD 1987/SLD 1929)
TIE: S 65°56'15" W
3630.18'

78' EXISTING ROADWAY AND PUBLIC UTILITY
EASEMENT (08-03-87, C34-74)
(N 24°19'42" E)
(N 24°35'42" E)

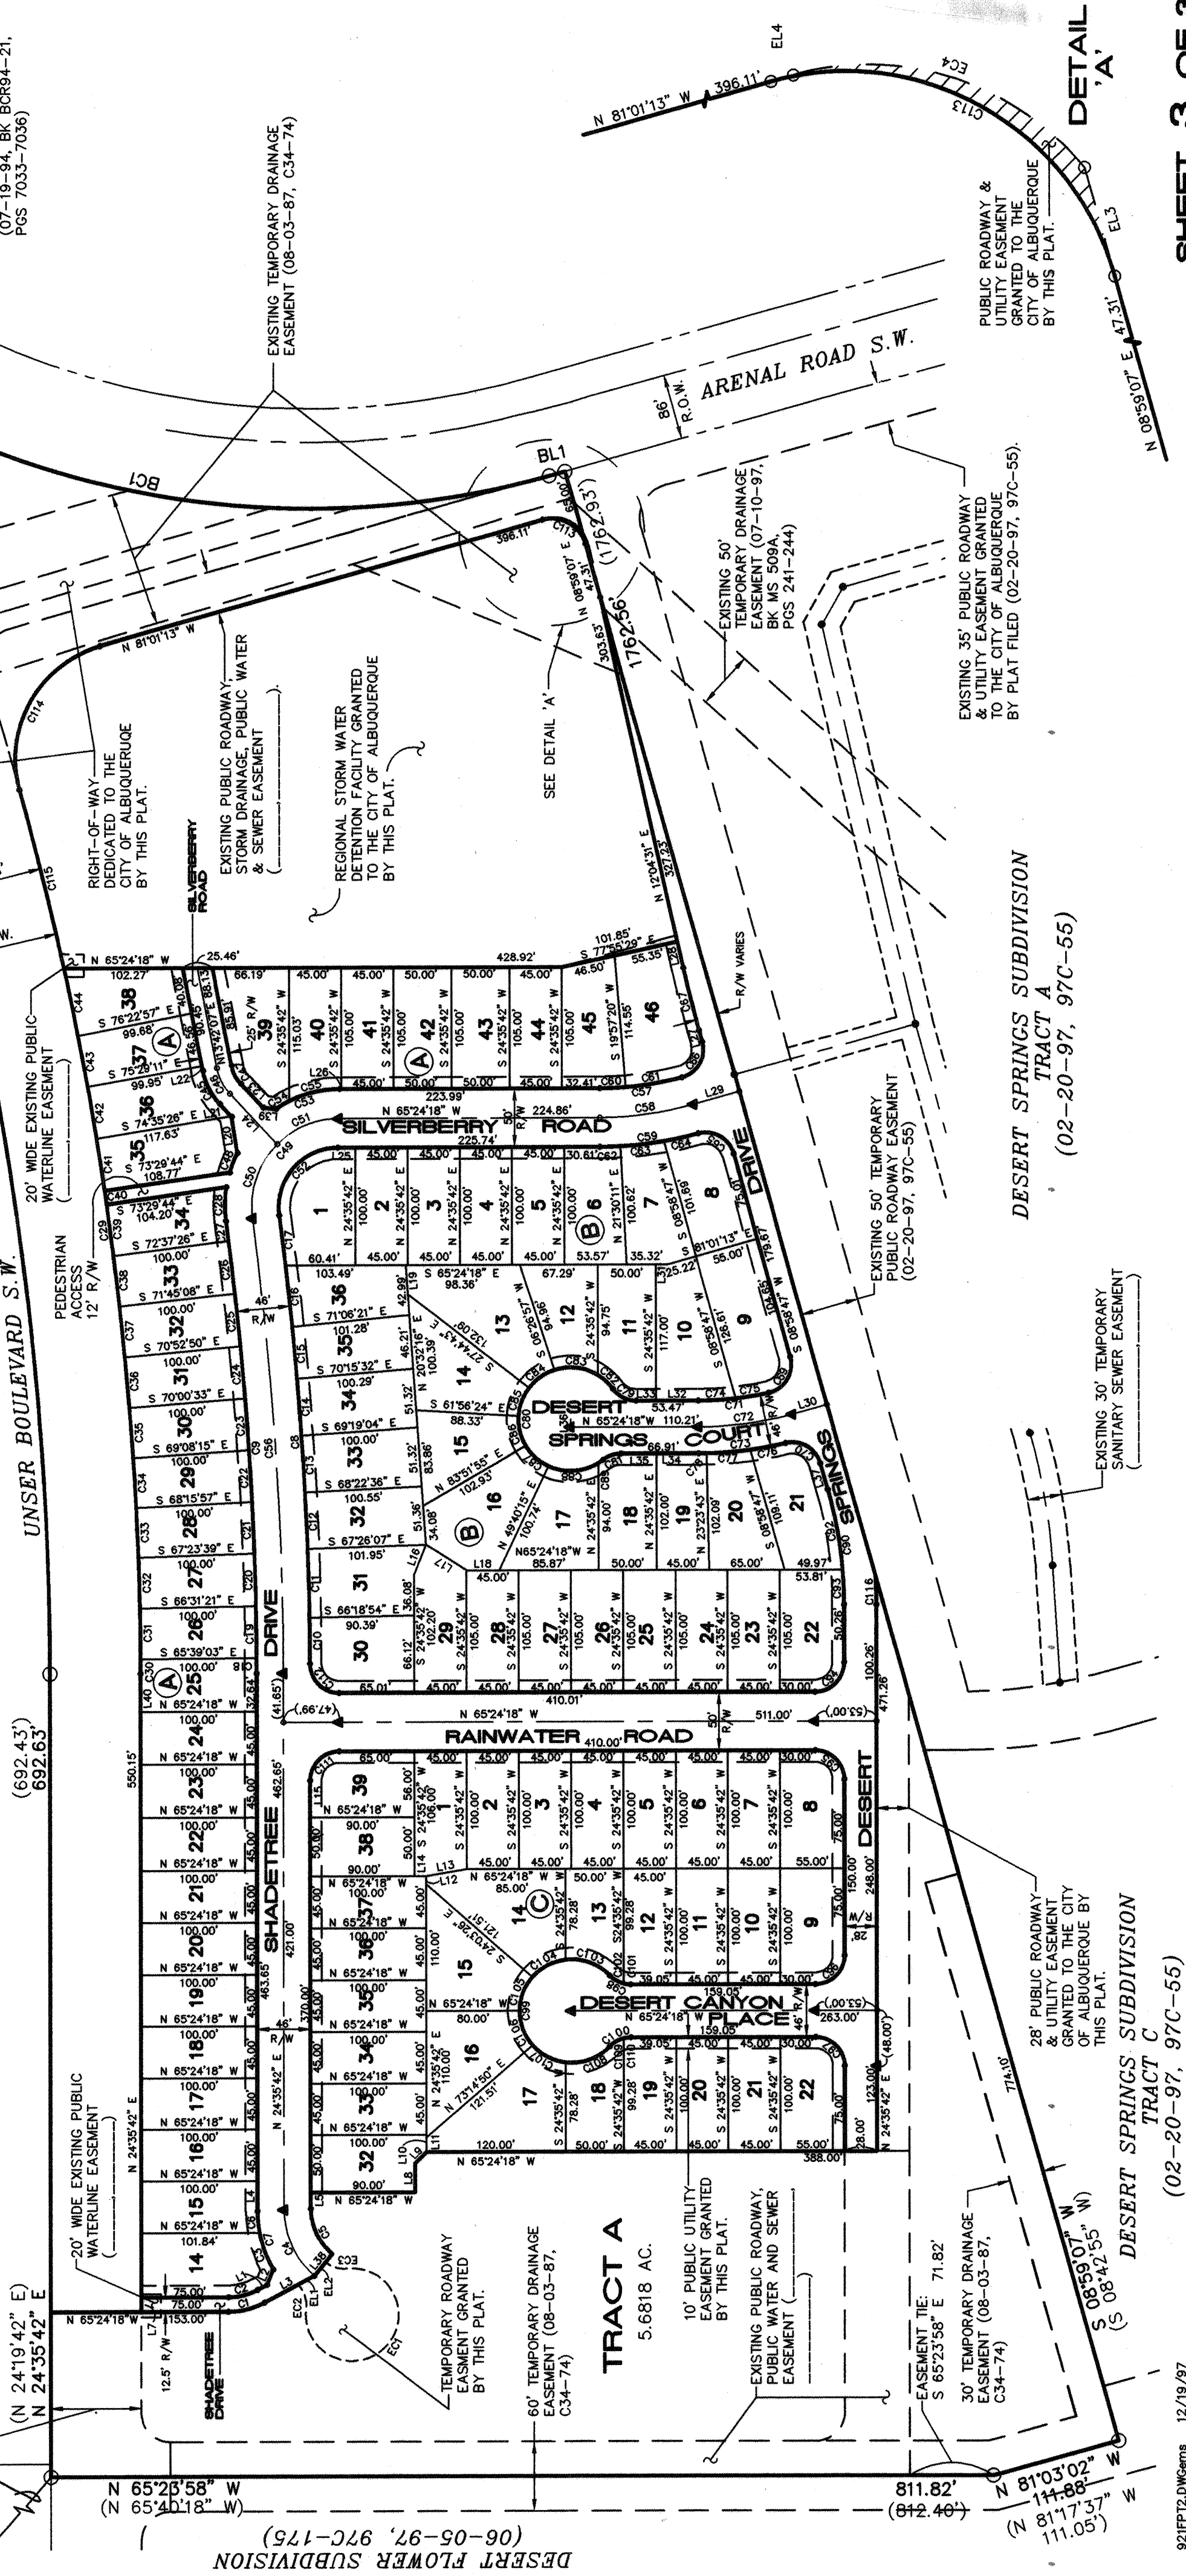


DESERT SPRINGS SUBDIVISION
TRACT A
(02-20-97, 97C-55)

DESERT SPRINGS SUBDIVISION
TRACT C
(02-20-97, 97C-55)

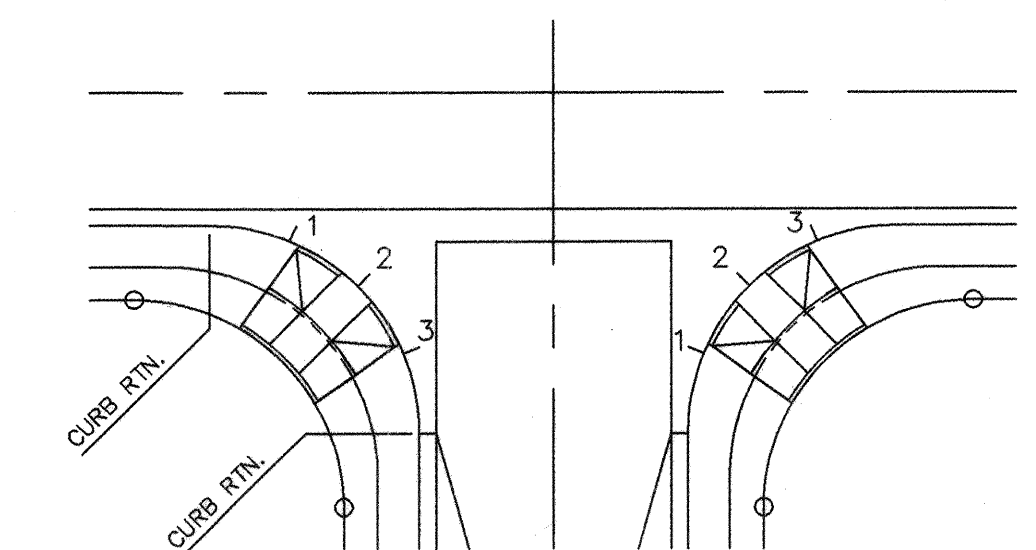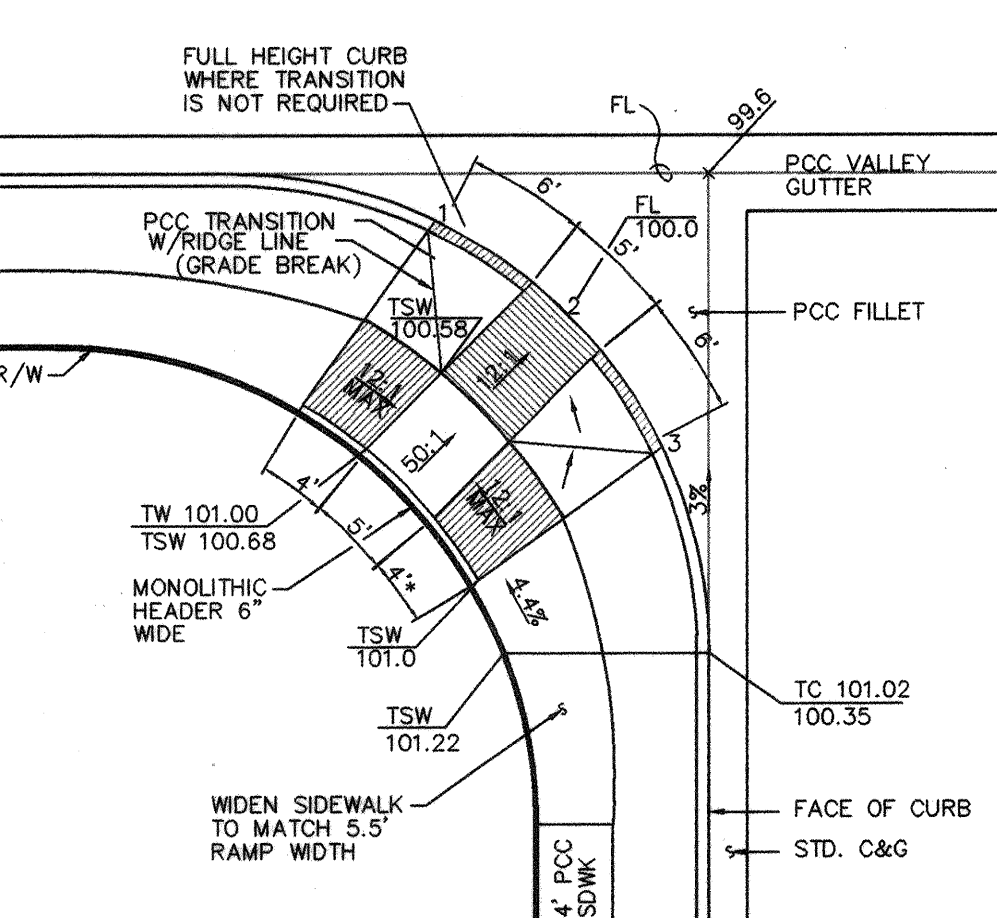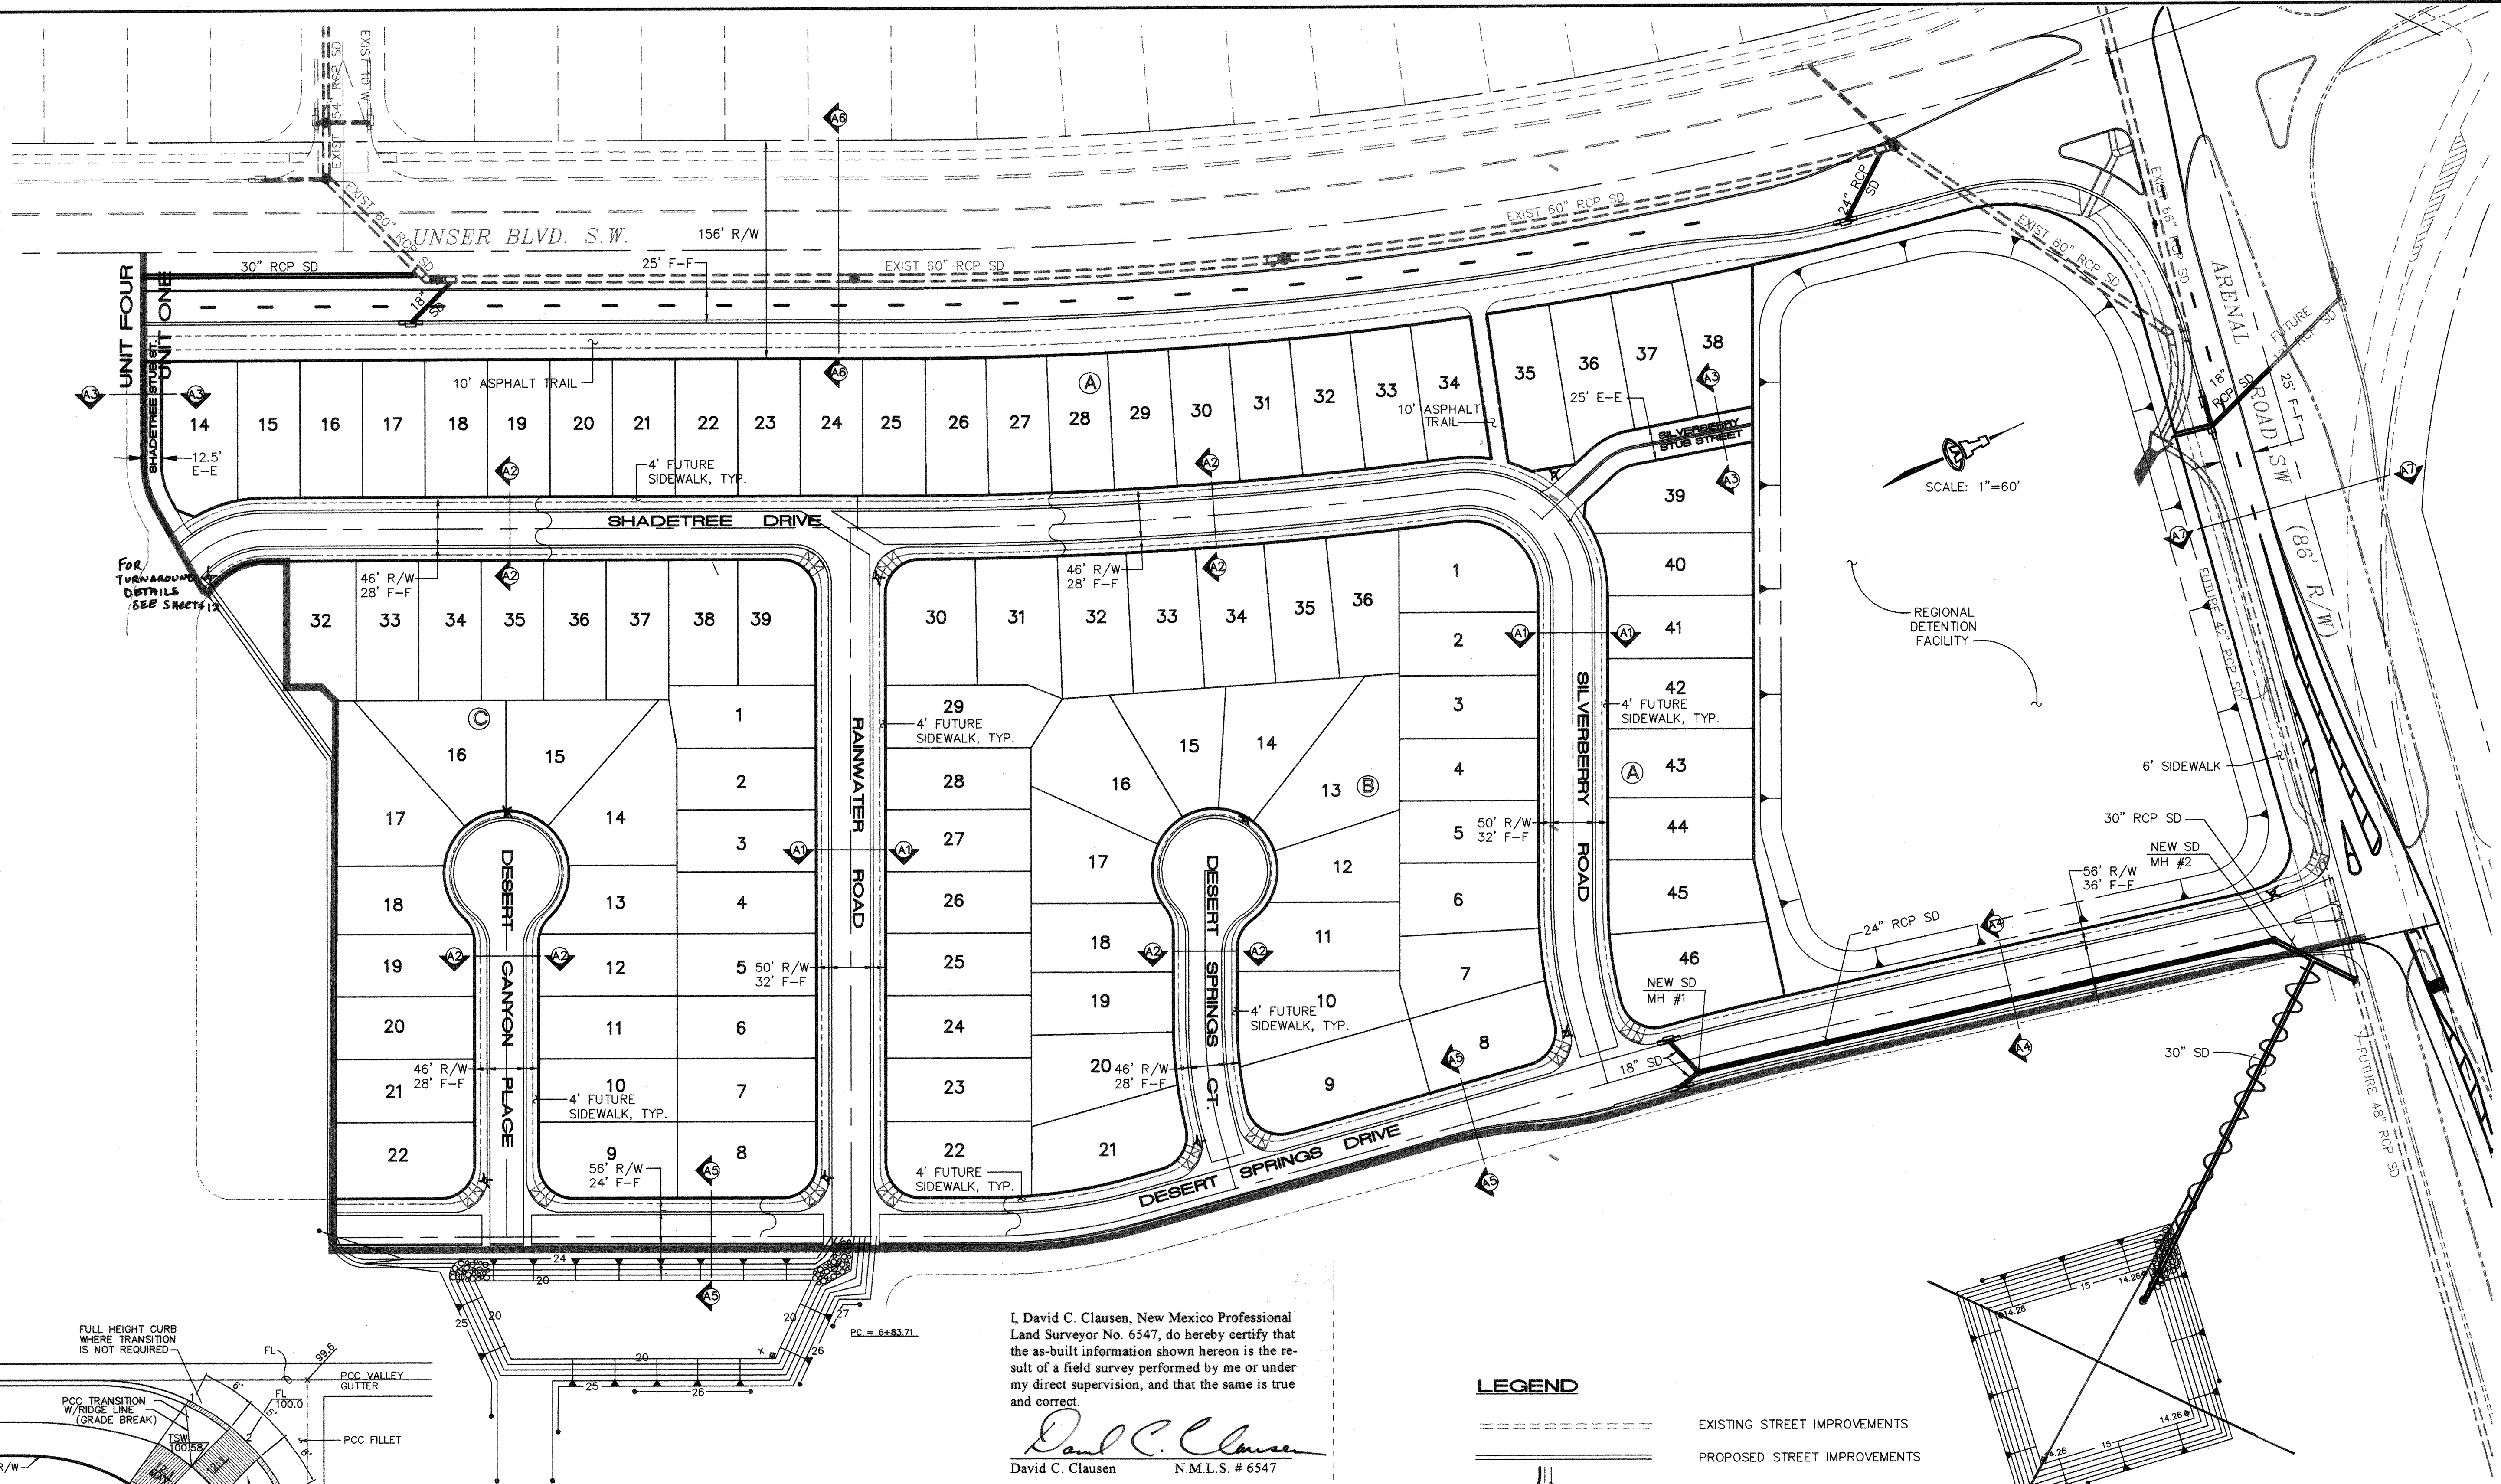

I, David C. Clausen, New Mexico Professional Land Surveyor No. 6547, do hereby certify that the as-built information shown hereon is the result of a field survey performed by me or under my direct supervision, and that the same is true and correct.

David C. Clausen
David C. Clausen N.M.L.S. # 6547

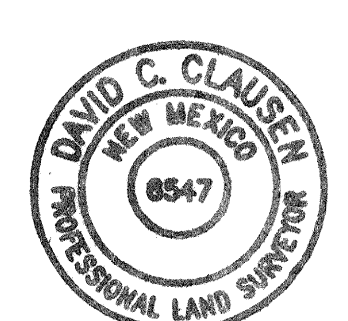


LEGEND


- EXISTING STREET IMPROVEMENTS
- PROPOSED STREET IMPROVEMENTS
- WHEEL CHAIR RAMP
- VALLEY GUTTER
- BLOCK NO.
- LOT NO.
- STORM DRAIN CATCH BASIN
- STORM DRAIN MANHOLE
- EXISTING STREET LIGHT
- SIDEWALK BY OTHERS
- SIDEWALK THIS CONTRACT

ISAACSON & ARFMAN, P.A. Consulting Engineering Associates 128 Monroe Street N.E. Albuquerque, New Mexico	
921PMSTR.DWGems 10/21/97	
CITY OF ALBUQUERQUE PUBLIC WORKS DEPARTMENT ENGINEERING GROUP	
TITLE: DESERT SPRINGS SUBDIVISION, UNIT ONE PAVING & STORM DRAIN MASTER PLAN	
Design Review Committee	City Engineer Approval
APPROVED FEB 10 1998 DESIGN REVIEW COMMITTEE	APPROVED FEB 10 1998 CITY ENGINEER
City Project No. 5785.81	Zone Map No. M-10
Sheet 7 Of 32	


ENGINEER'S SEAL		SURVEY INFORMATION		BENCH MARKS		AS-BUILT INFORMATION	
	REVISIONS	NO.	DATE	FIELD NOTES	ACS MONUMENT "1-M10" LOCATED AT THE SOUTHEAST CORNER OF SAGE RD. & UNSER BLVD. ELEV. = 5079.88	CONTRACTOR	AS-BUILT INFORMATION
DESIGNED BY MJC		DATE 7/11/97		TBM: RIM OF SOUTHWESTERLY MANHOLE AT SAPPHIRE ST. & UNSER BLVD. ELEV. = 5035.84		RECORDED BY	
DRAWN BY EMS		DATE 7/11/97				NO.	
CHECKED BY FCA		DATE 7/11/97					

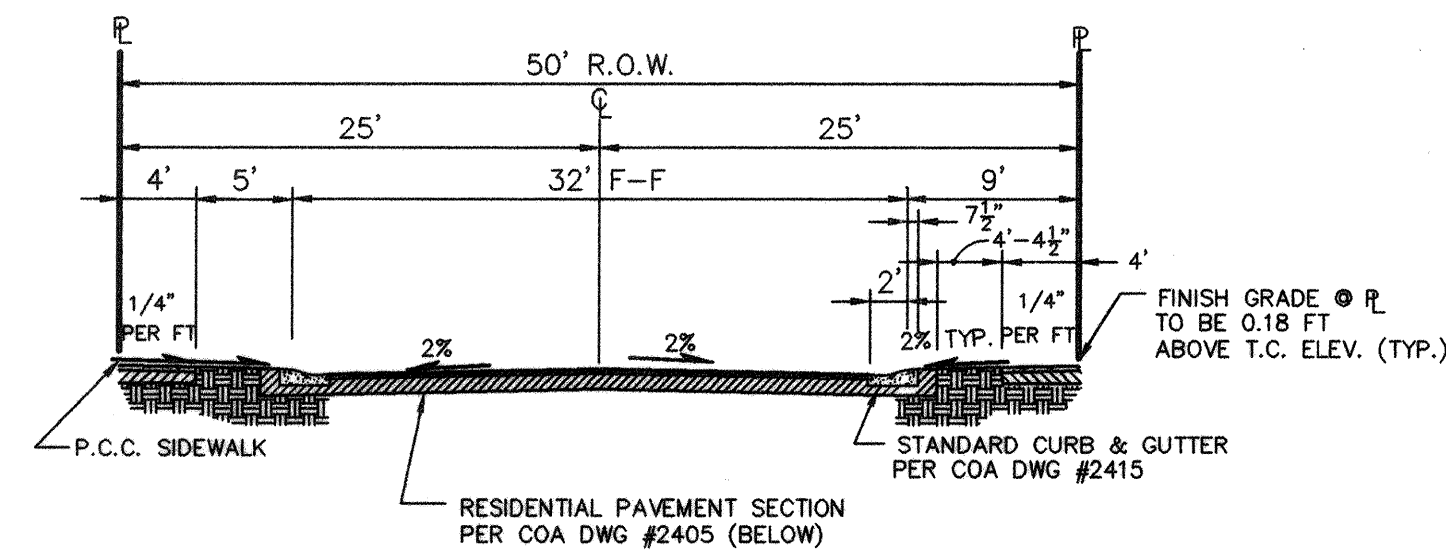


SECTION A1
TYPICAL 50' R.O.W. RESIDENTIAL STREET SECTION
1"=10'

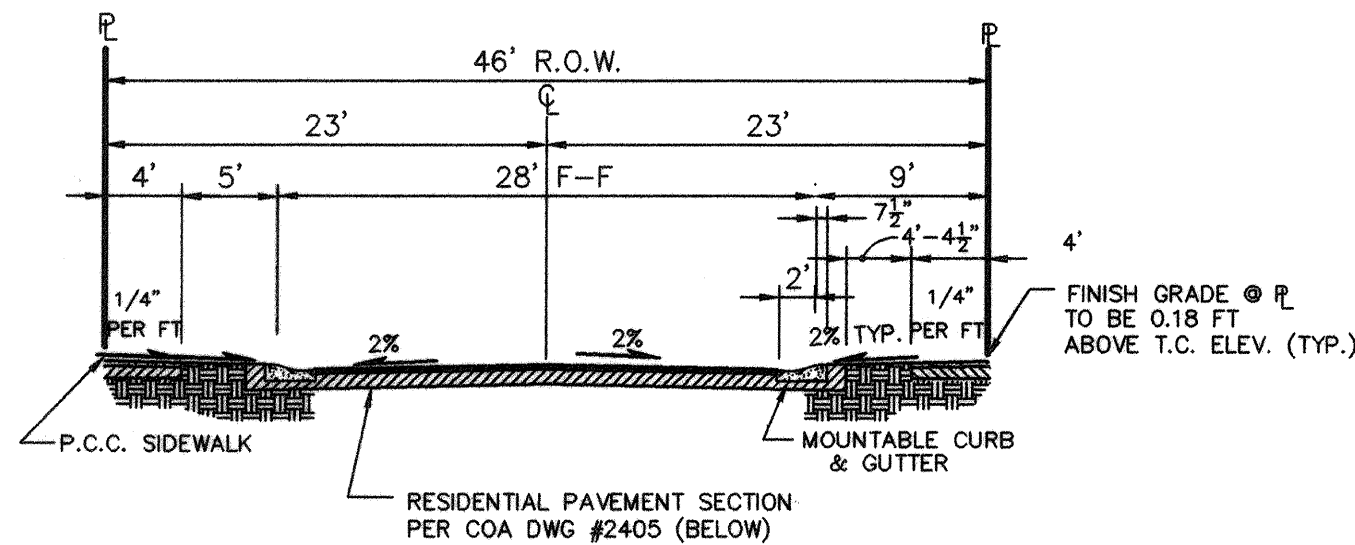


SECTION A2
TYPICAL 46' R.O.W. RESIDENTIAL STREET SECTION
1"=10'

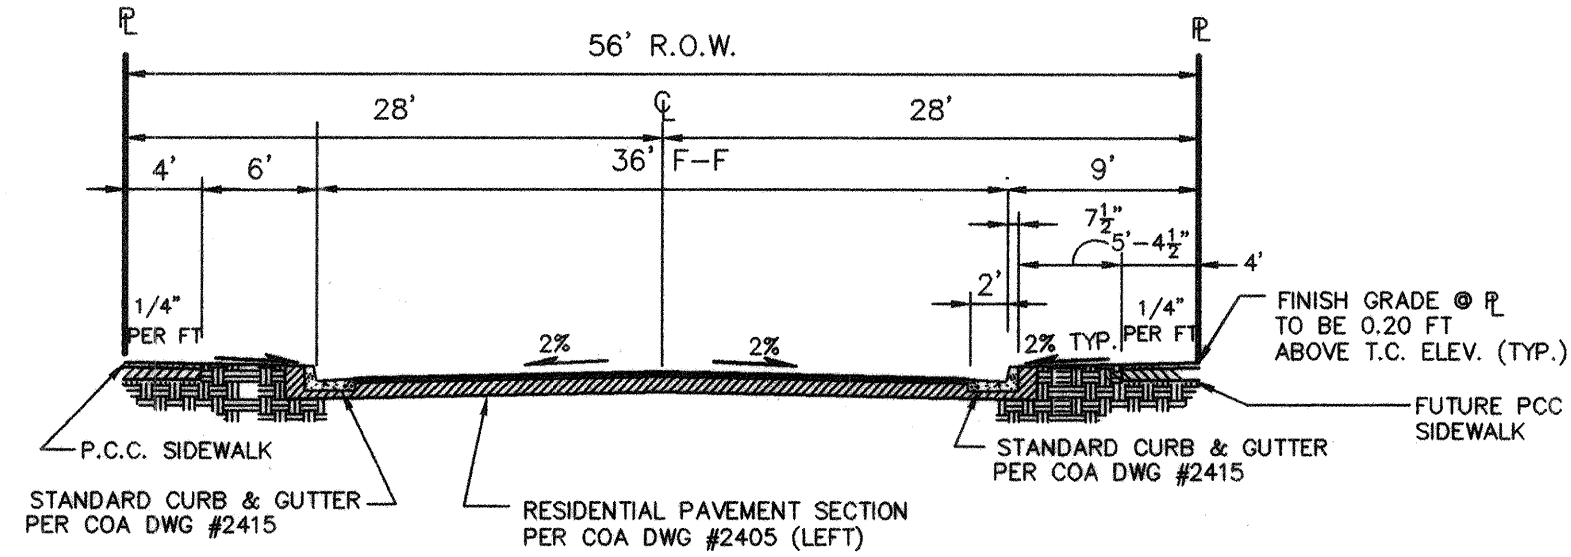


SECTION A4
TYPICAL 56' R.O.W. RESIDENTIAL STREET SECTION
1"=10'

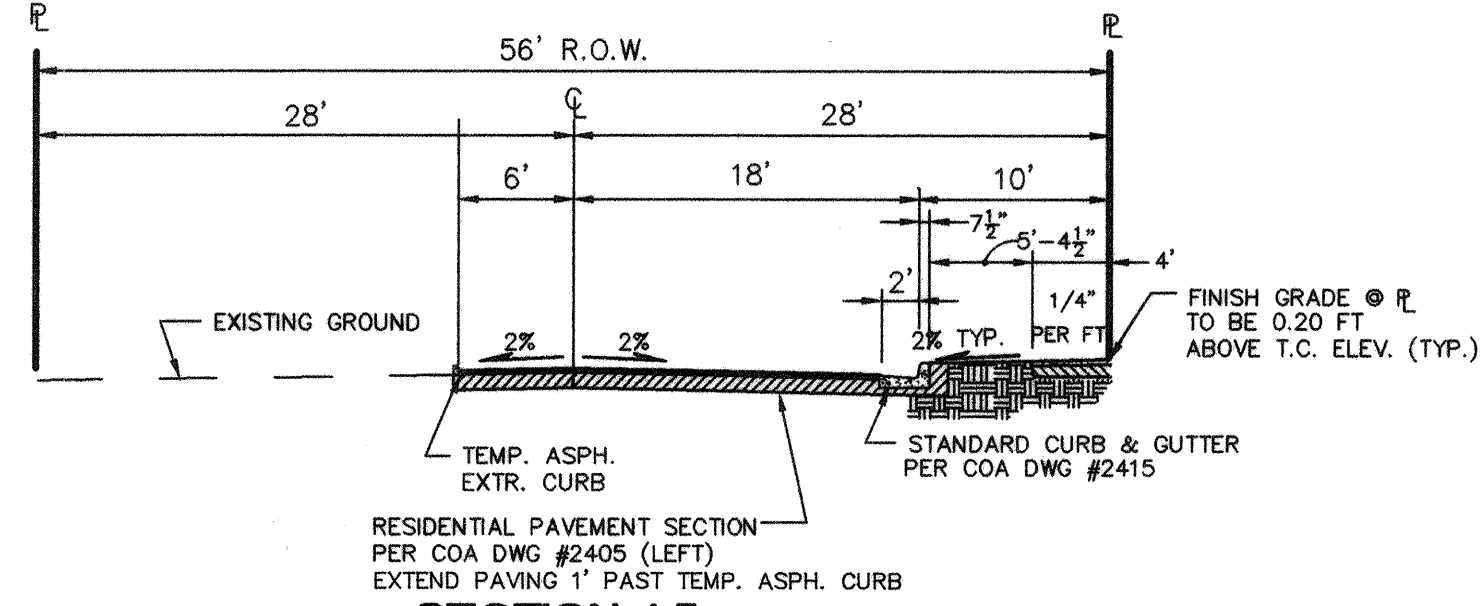


SECTION A5
TYPICAL 56' R.O.W. RESIDENTIAL STREET SECTION
1"=10'

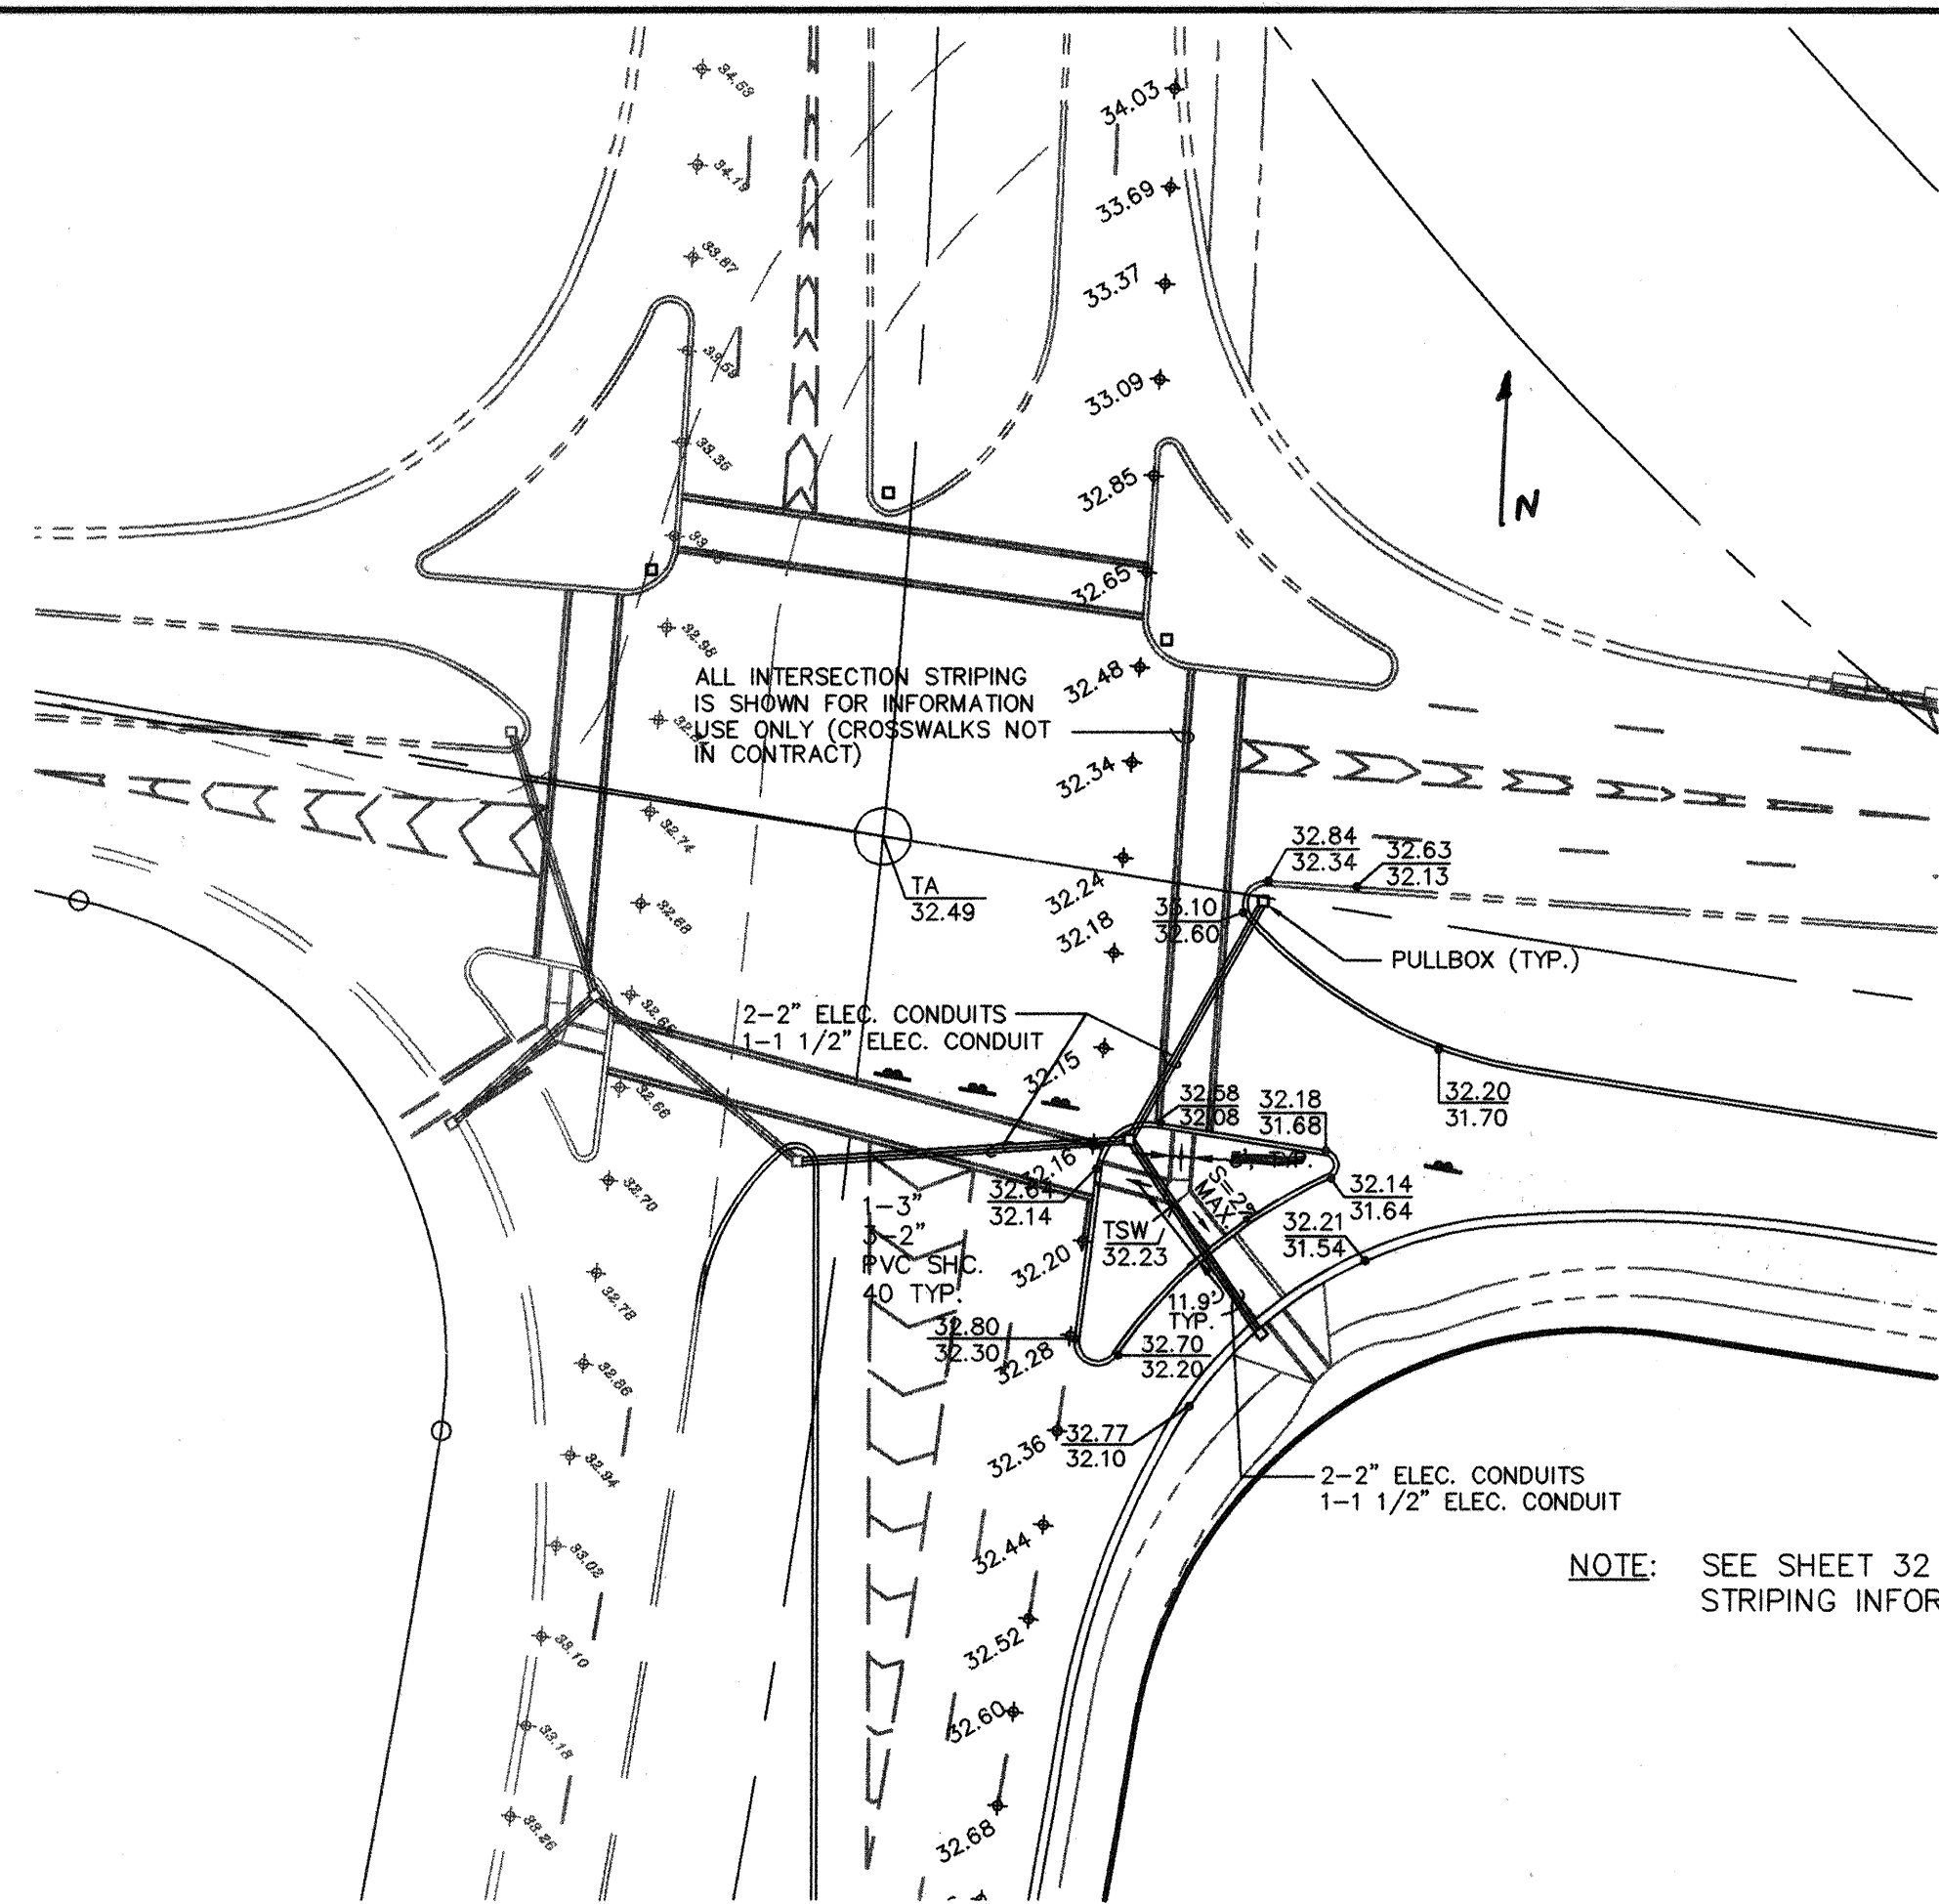


INTERSECTION MEDIAN DETAIL
SCALE: 1"=40'

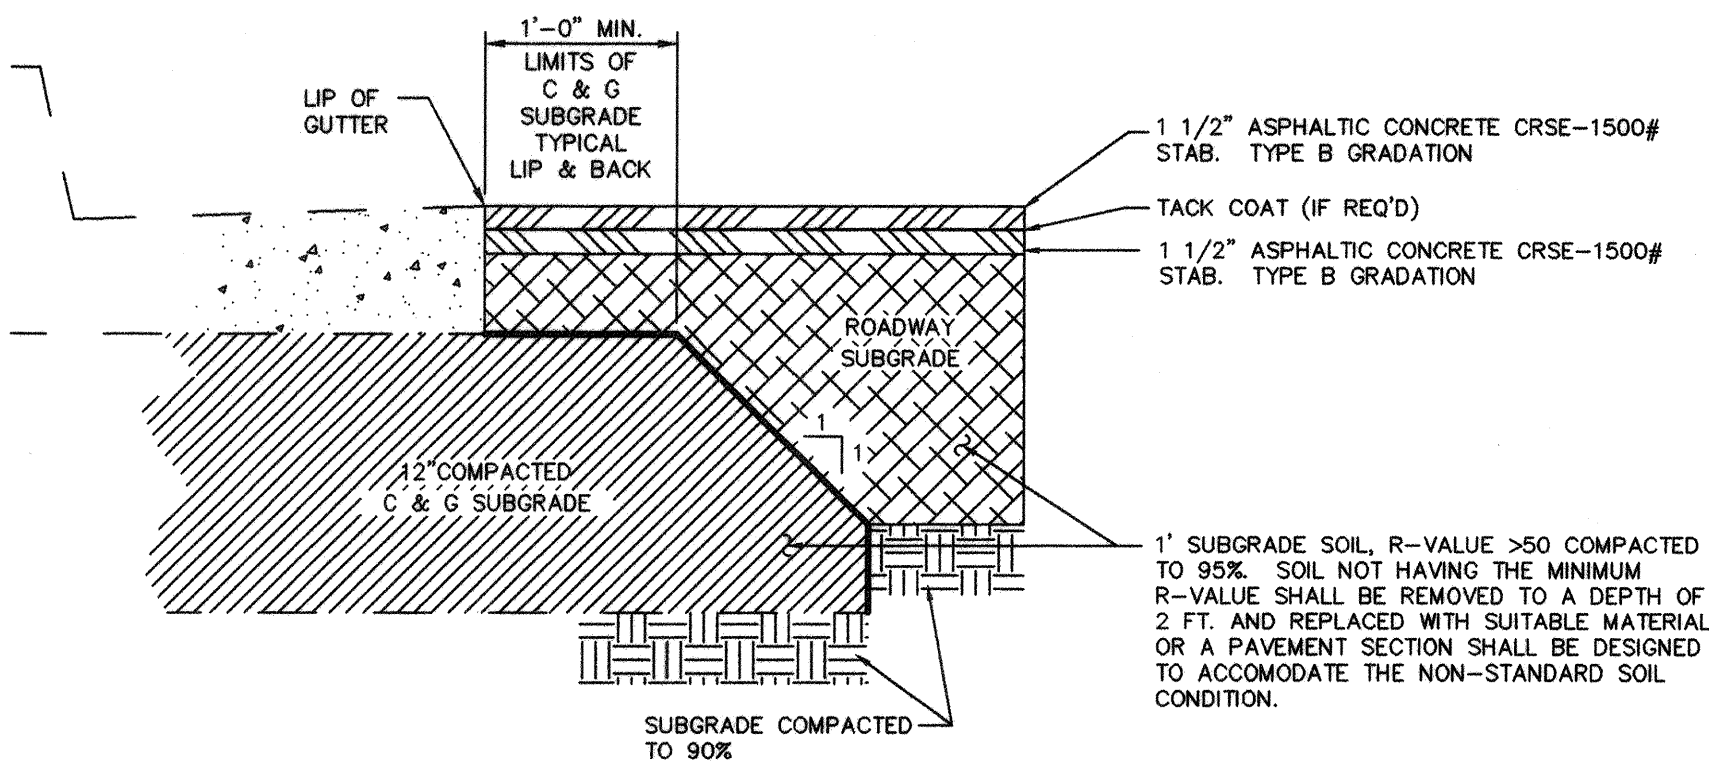


RESIDENTIAL PAVING SECTION
SCALE: 1"=1'-0" (PER COA STD. DWG. No. 2405)

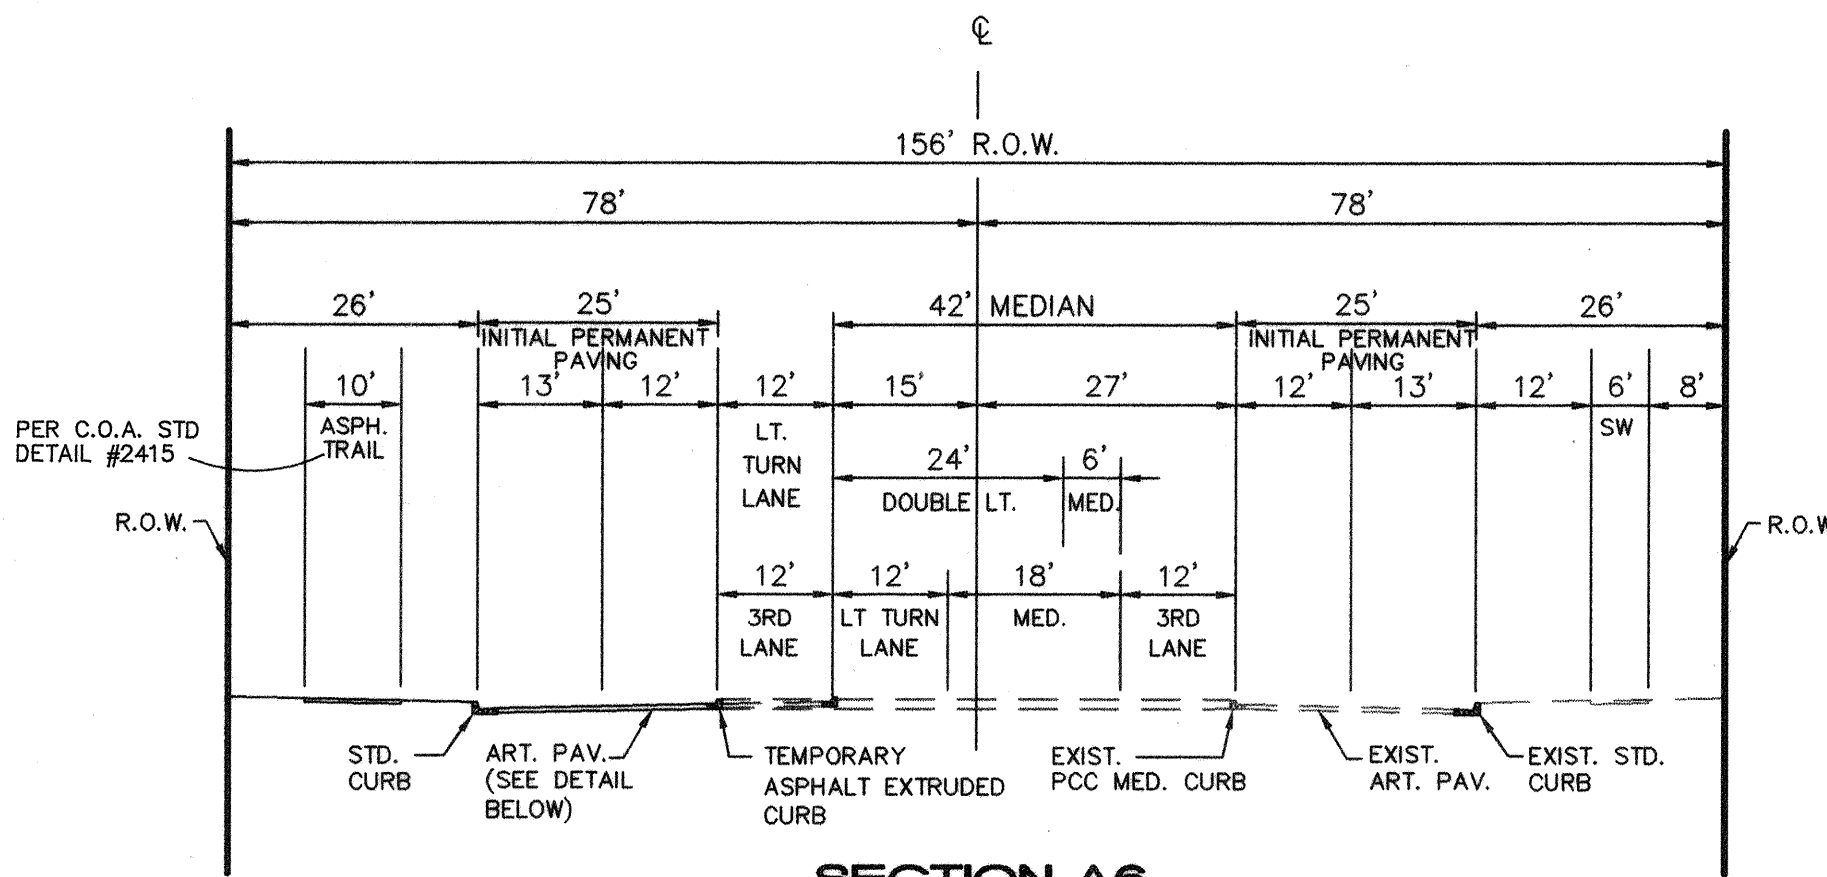


SECTION A6
UNSER BLVD
1"=20'

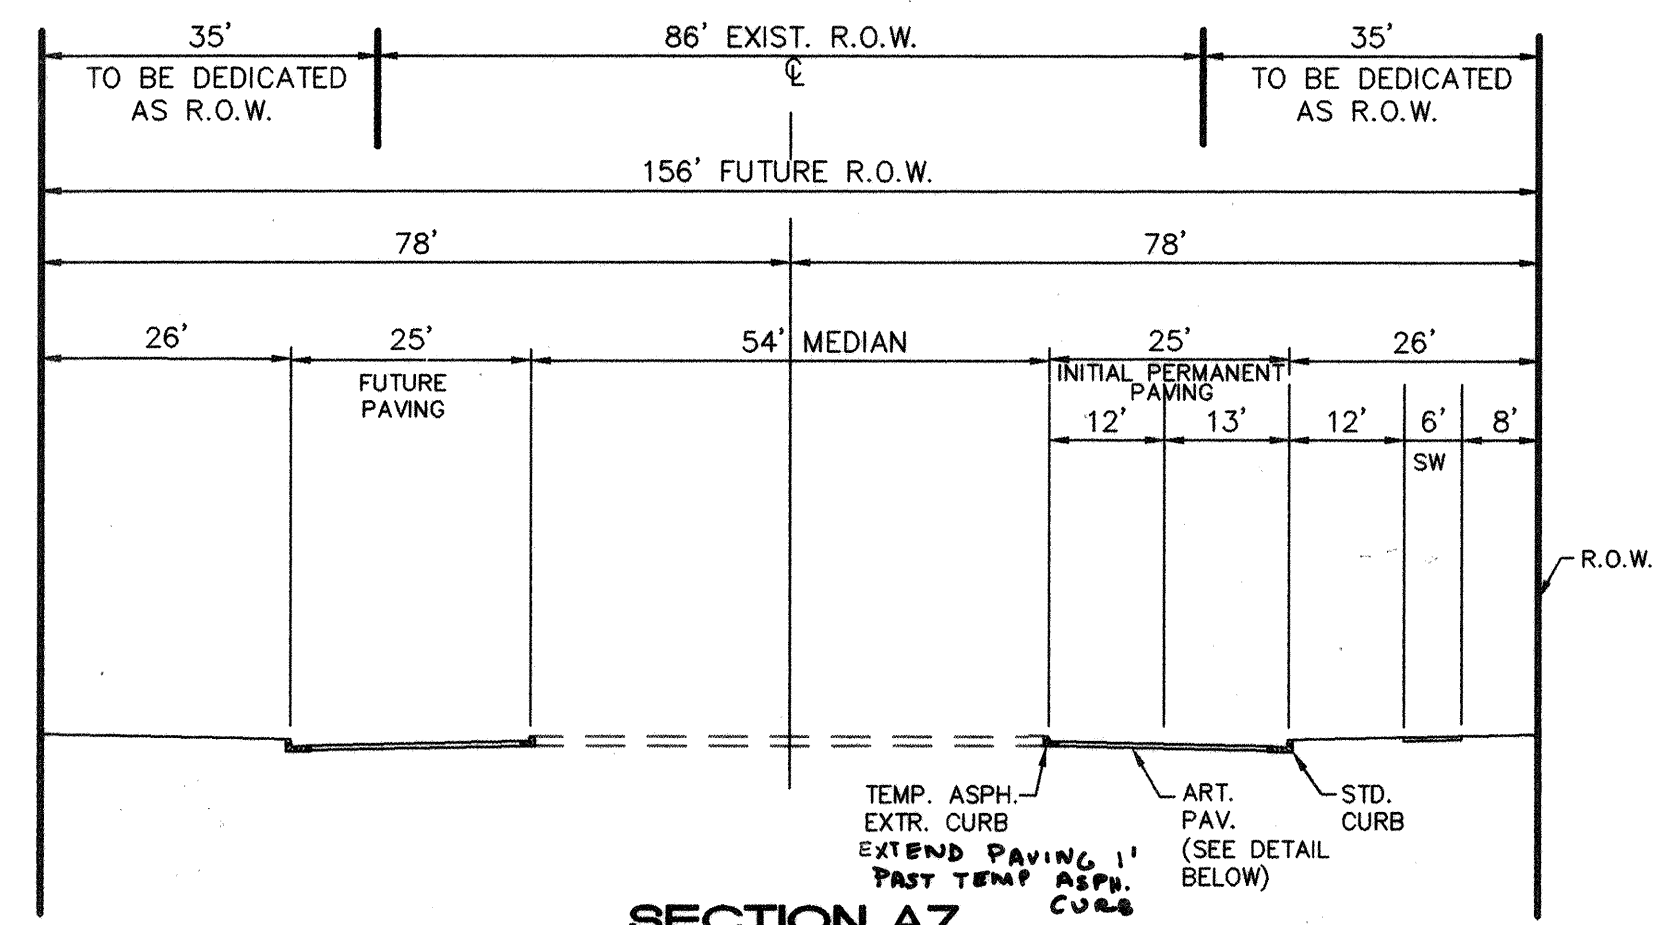


SECTION A7
ARENAL ROAD
1"=20'

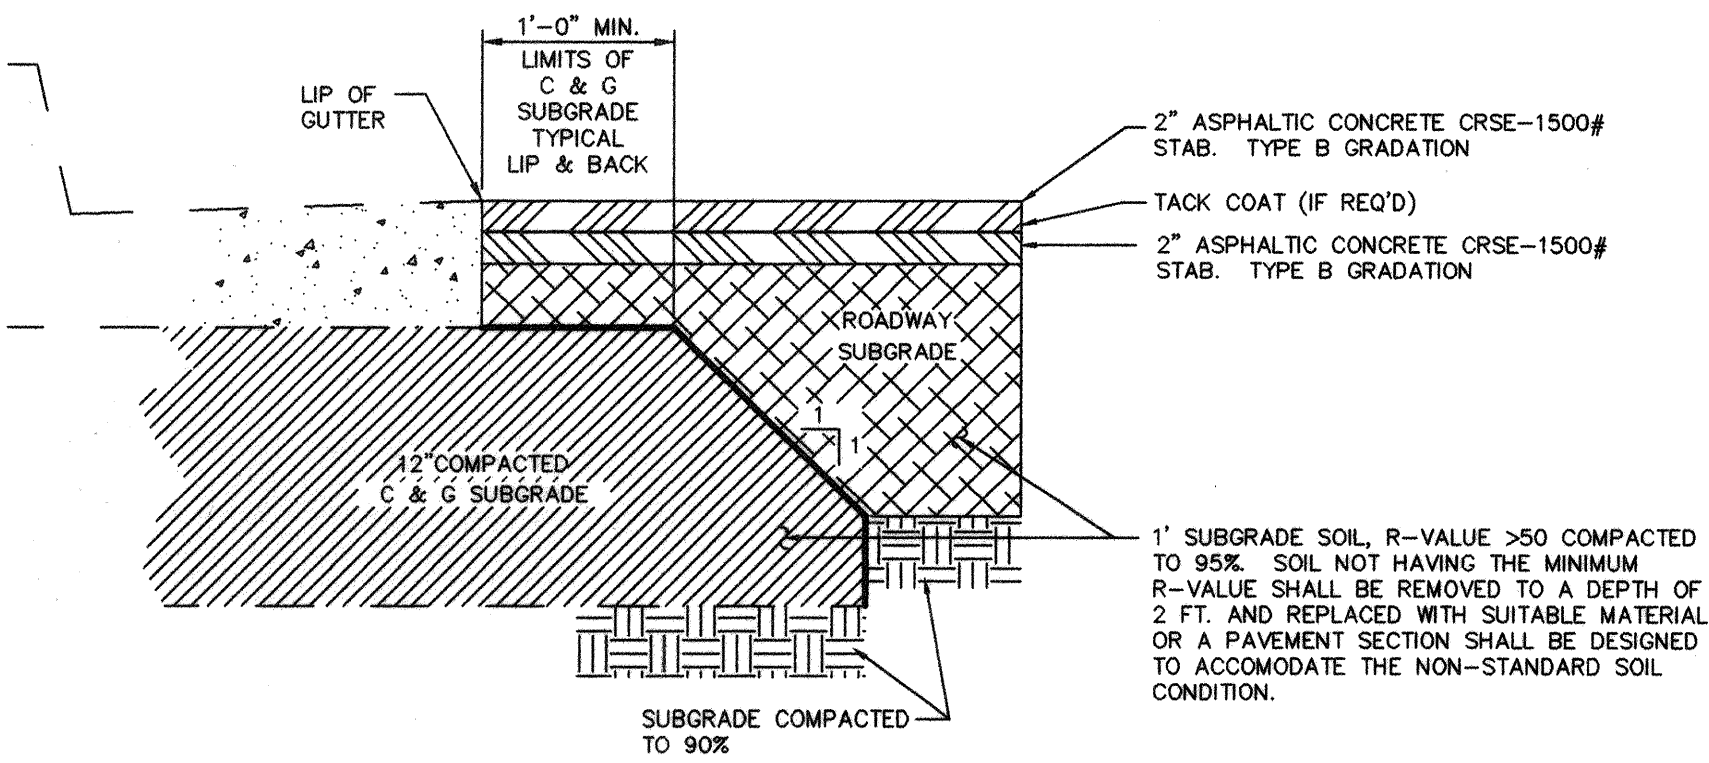

RESIDENTIAL PAVING SECTION
DESERT SPRINGS DRIVE
SCALE: 1"=1'-0" (PER COA STD. DWG. No. 2405)

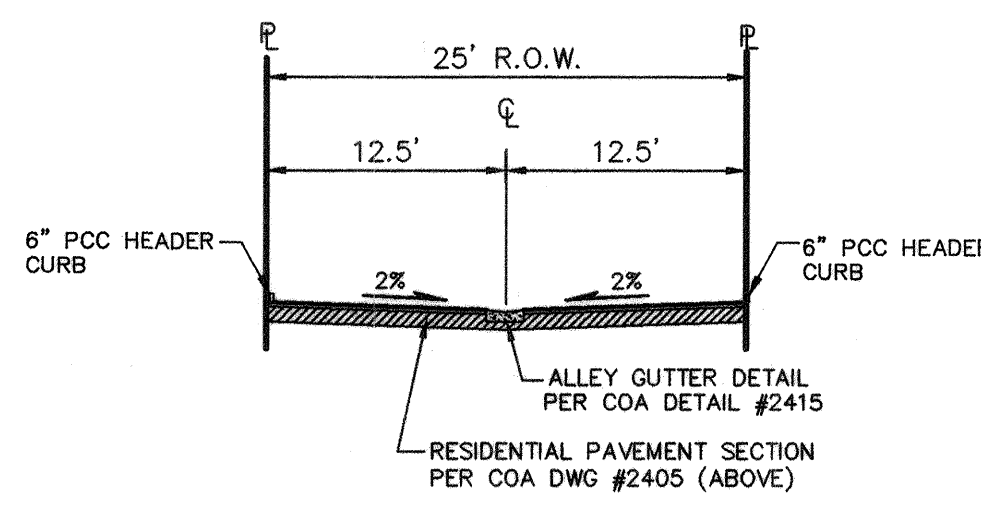

SECTION A3
TYPICAL 25' STUB STREET SECTION
1"=10'

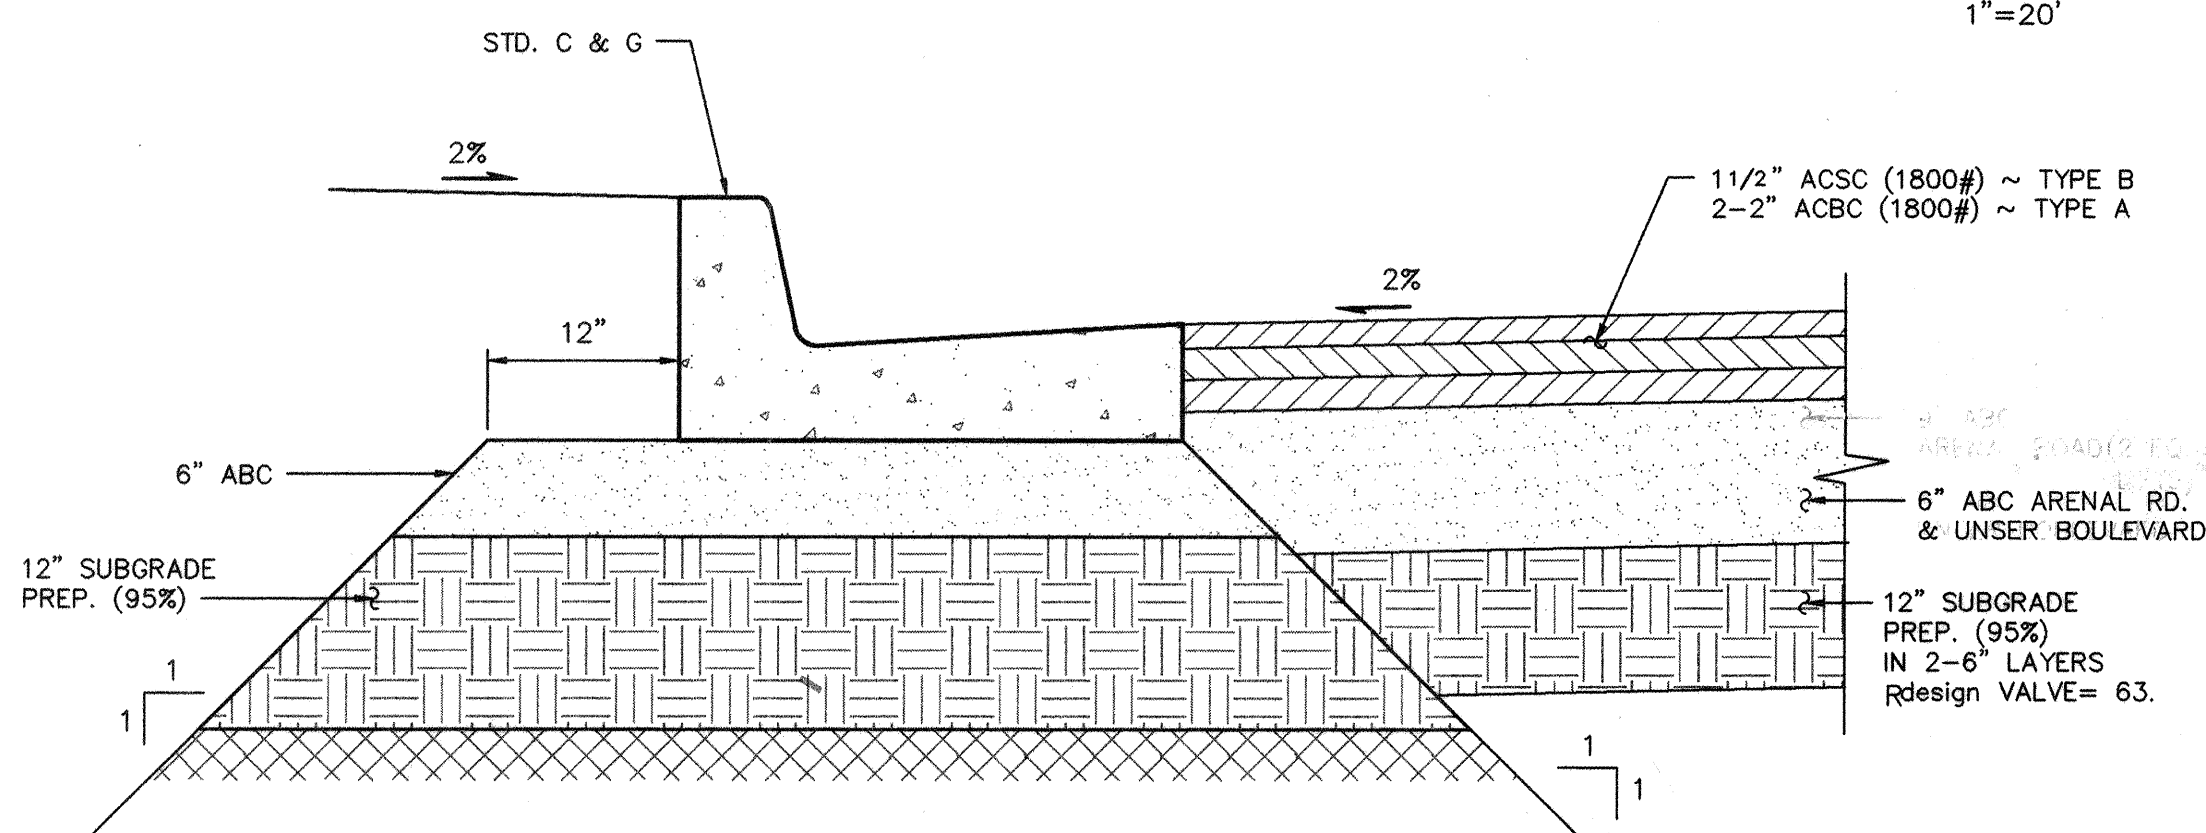

UNSER BLVD. AND ARENAL RD. PAVING SECTION
CURB / ASPHALT PAVEMENT MODULE
SCALE: 1"=1'-0"
UNSER BOULEVARD APPROVED
PER COA PROJ. #5057.91

ISAACSON & ARFMAN, P.A.
Consulting Engineering Associates
128 Monroe Street N.E.
Albuquerque, New Mexico


921PDTLS.DWGems 11/21/97

**CITY OF ALBUQUERQUE
PUBLIC WORKS DEPARTMENT
ENGINEERING GROUP**


**TITLE: DESERT SPRINGS SUBDIVISION, UNIT ONE
PAVING DETAILS & SECTIONS.**

DESIGN REVIEW COMMITTEE		CITY ENGINEER APPROVAL	
DESIGNED BY: MJC	DATE: 7/11/97	City Engineer	Update
DRAWN BY: EMS	DATE: 7/11/97		
CHECKED BY: FCA	DATE: 7/11/97		

City Project No. **5785.81** Zone Map No. **M-10** Sheet **8** Of **32**

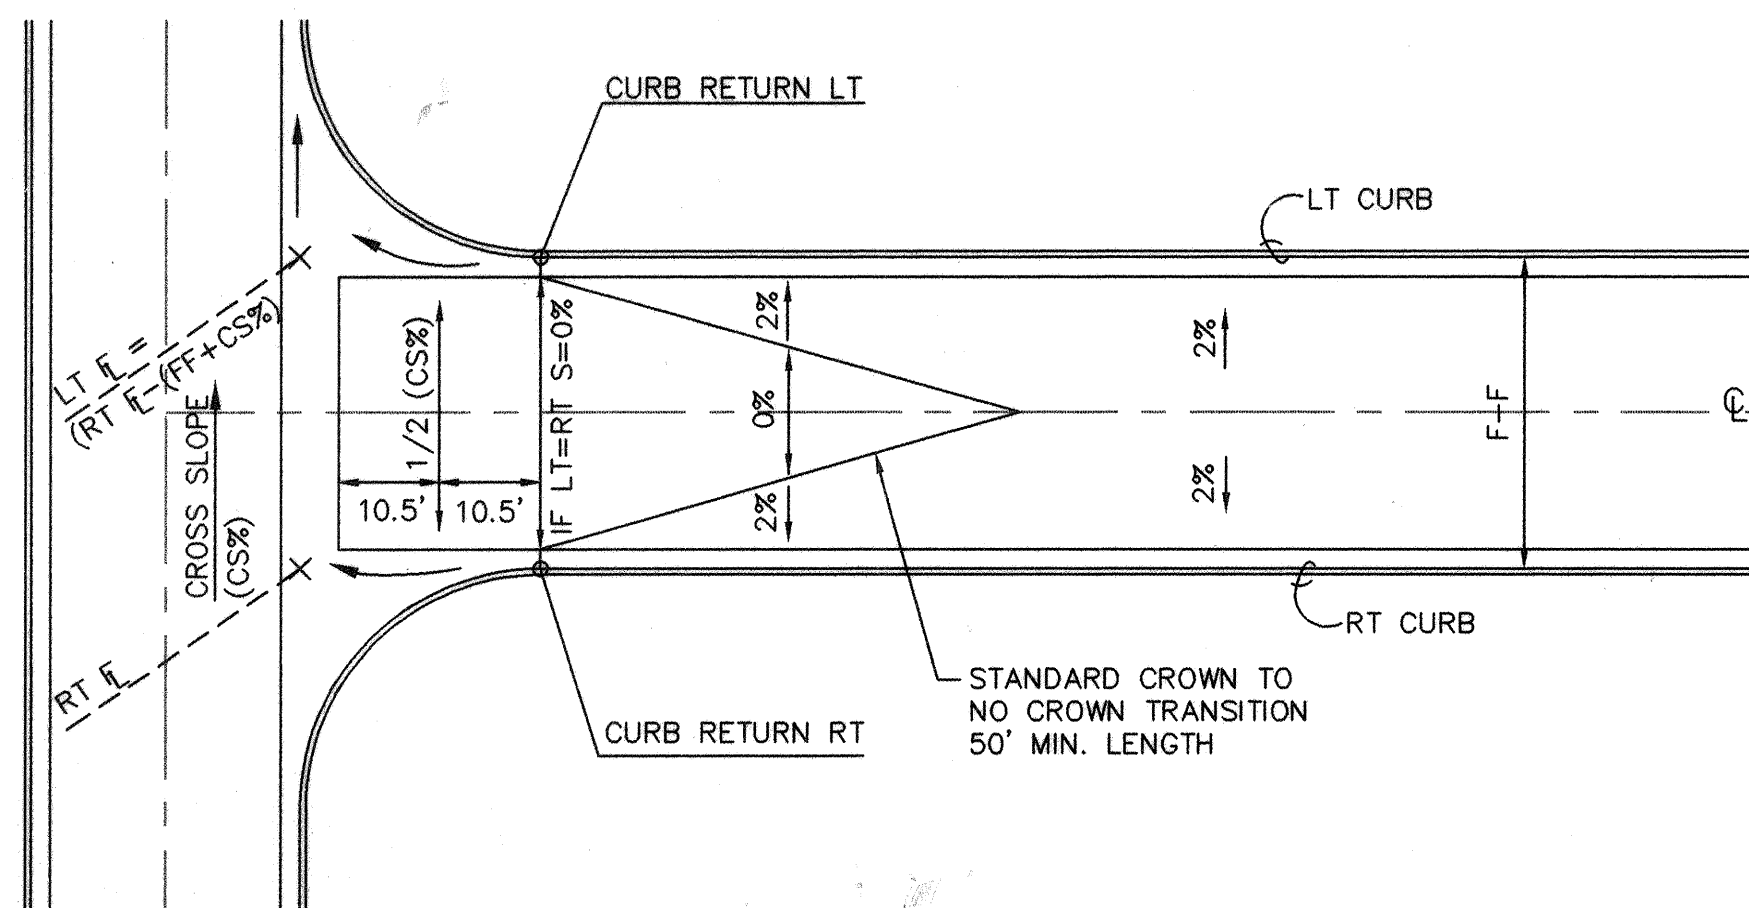


TYPICAL CROWN TO CROSS SLOPE TRANSITION
SCALE: 1"=20'

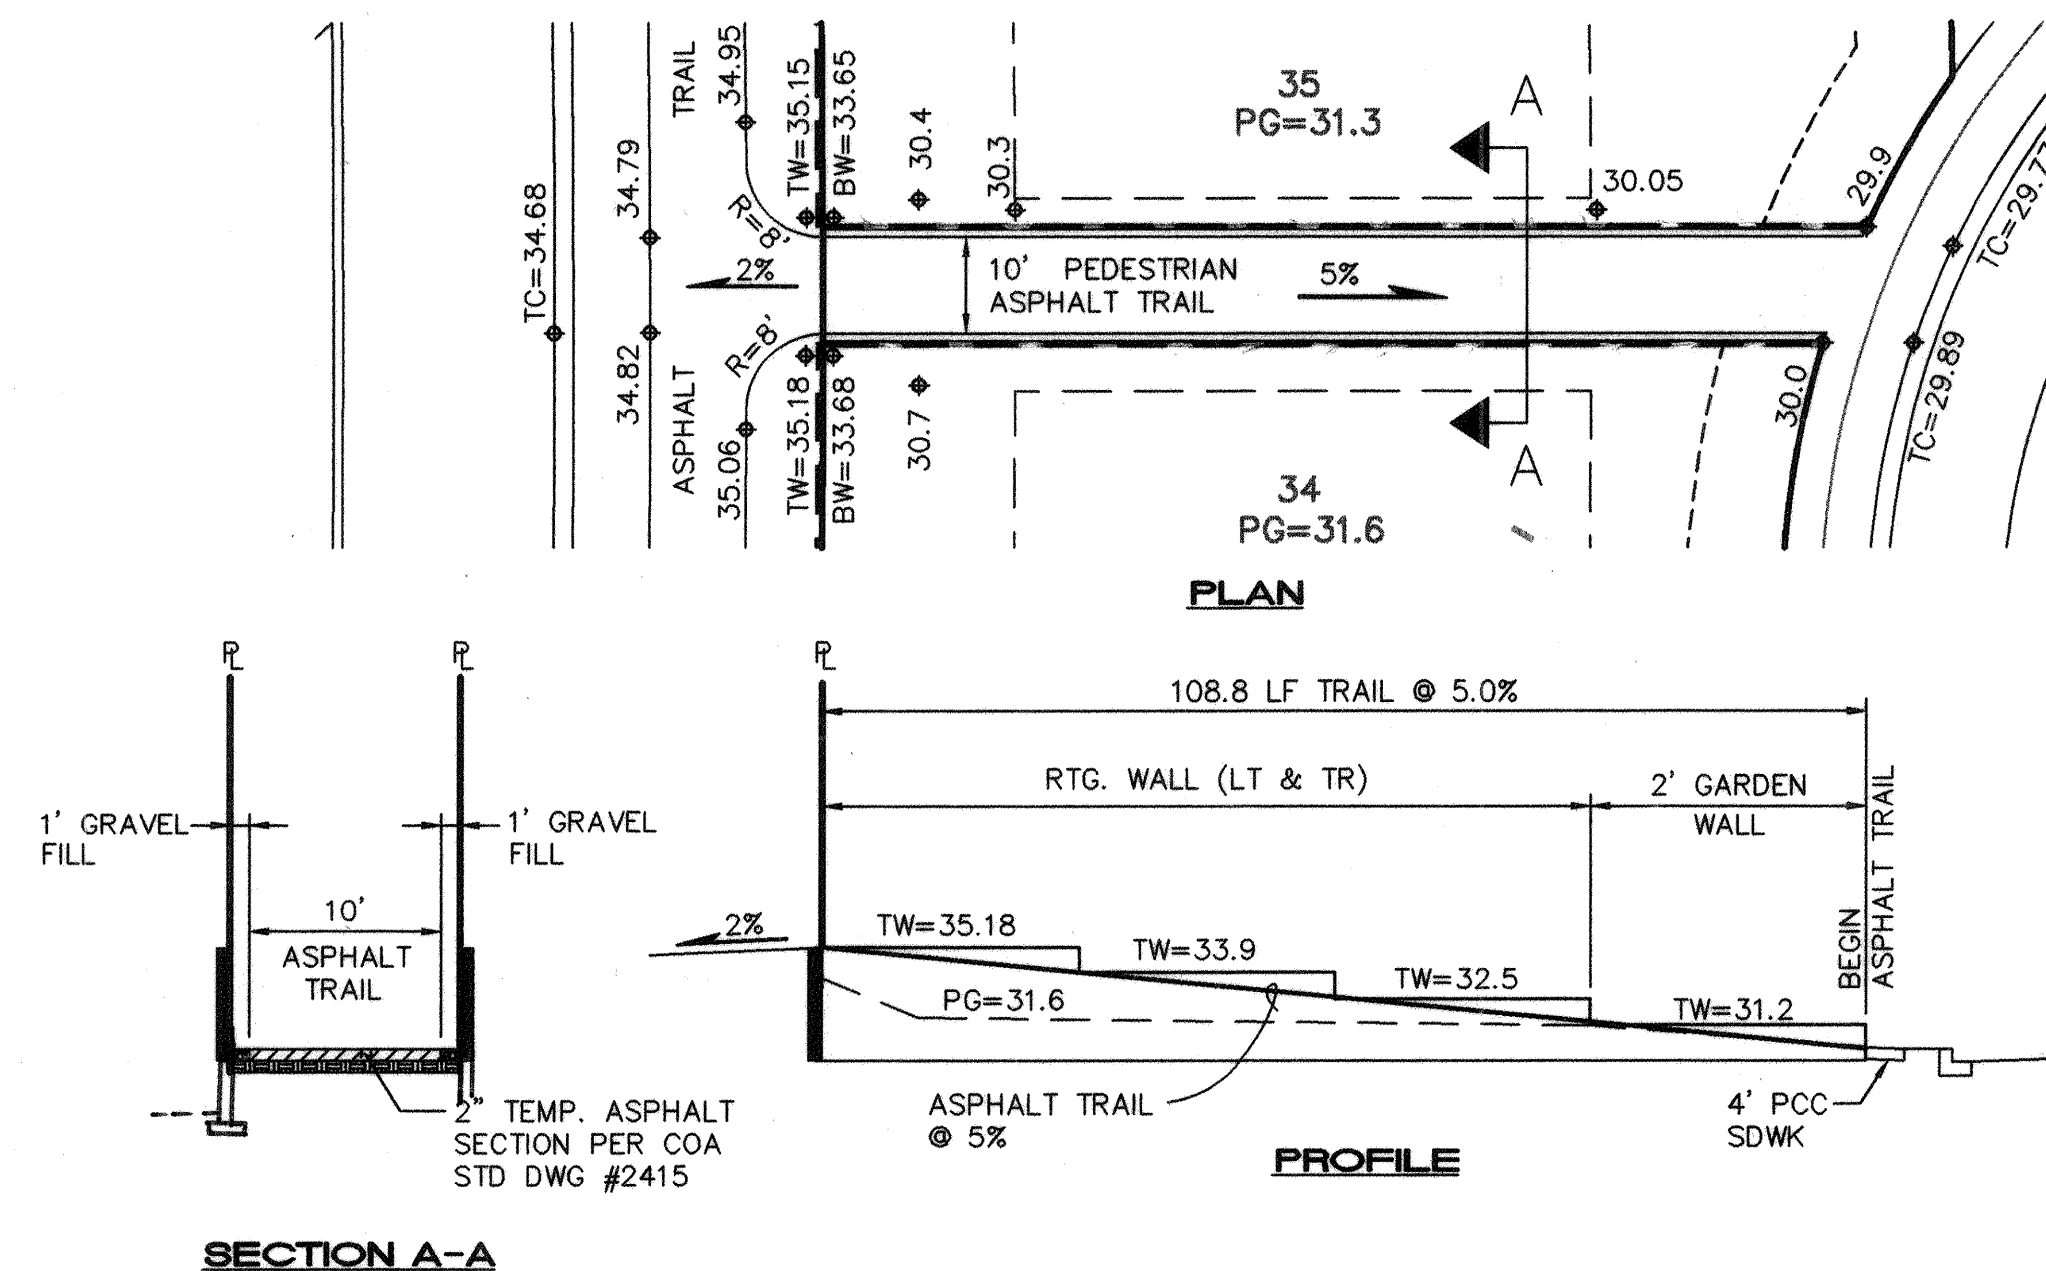


SECTION A-A

PEDESTRIAN ASPHALT TRAIL
SCALE: 1"=20'

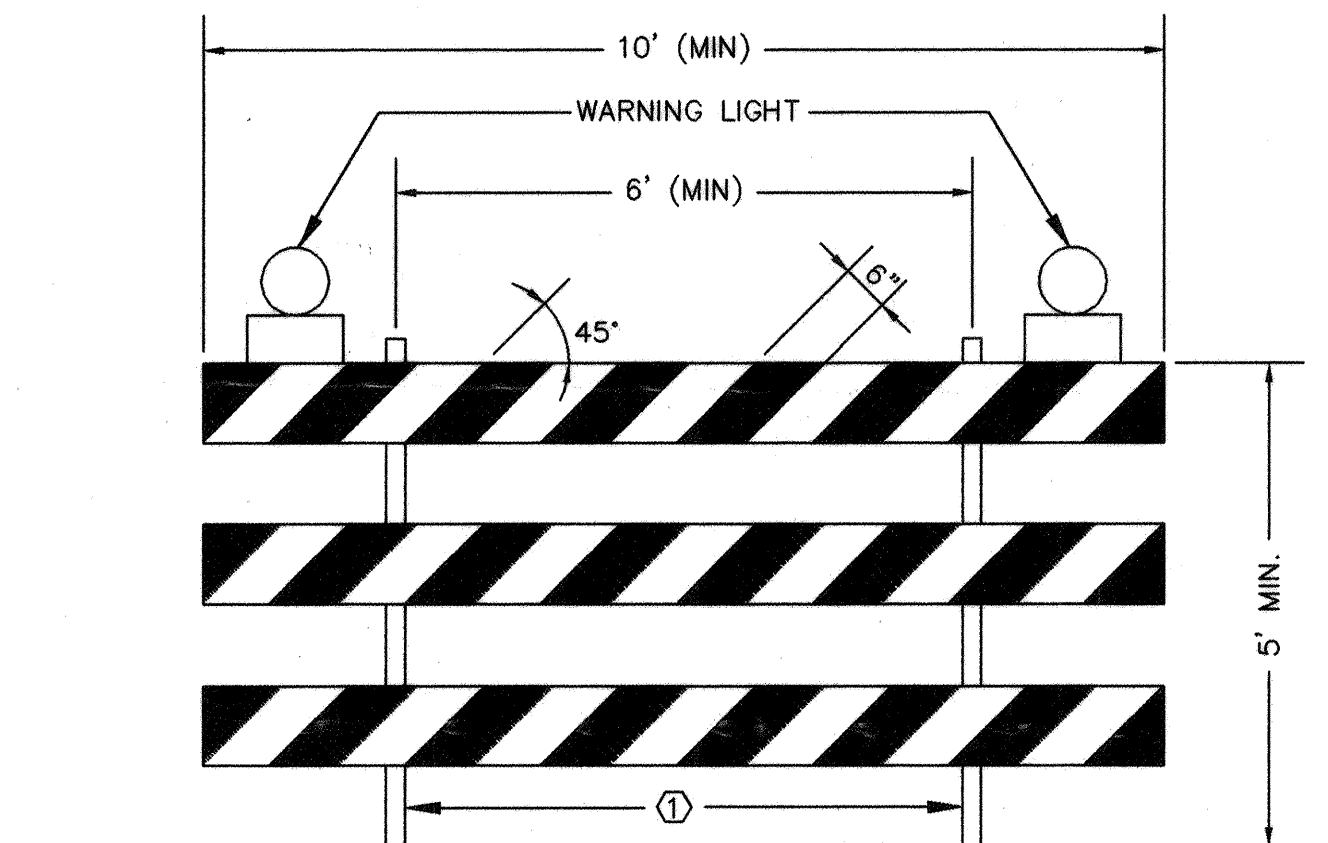


TYPE III BARRICADE
SCALE: 1"=2'

① SQUARE TUBE SUPPORT ASSEMBLY.
MOVEABLE WITH TEMPORARY SANDBAGS
(8 MIN.) COUNTER WEIGHT.

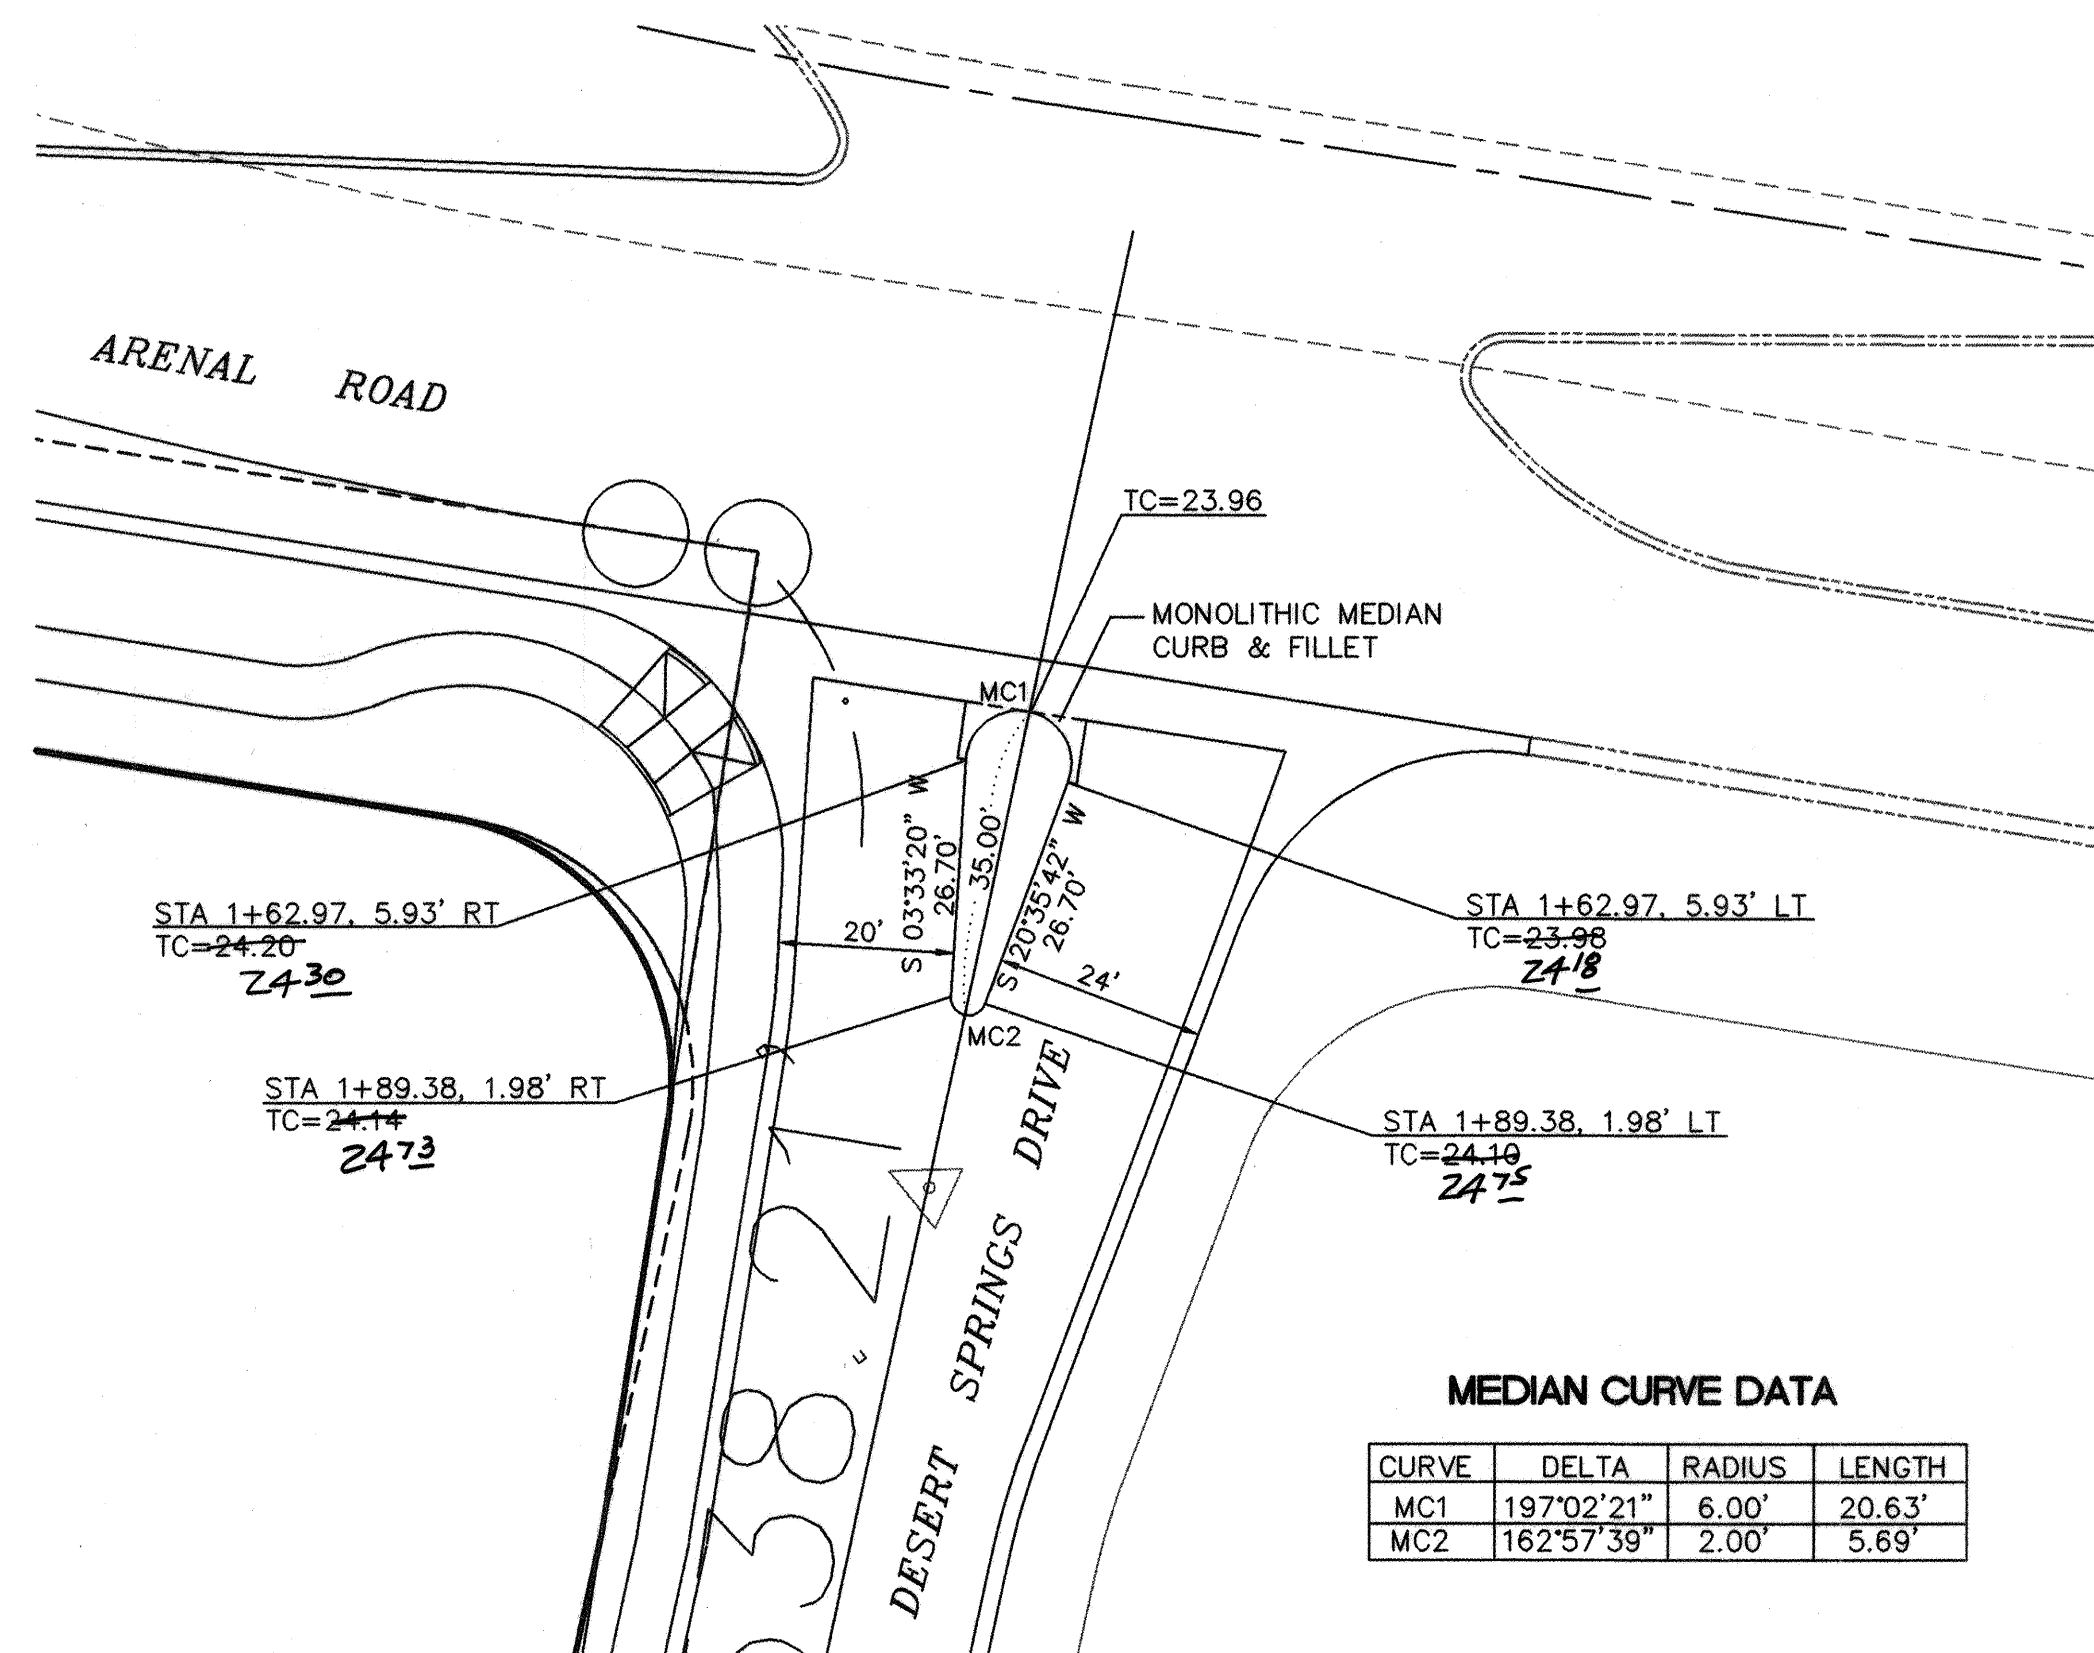


DESERT SPRINGS & ARENAL MEDIAN DETAIL
SCALE: 1"=20'

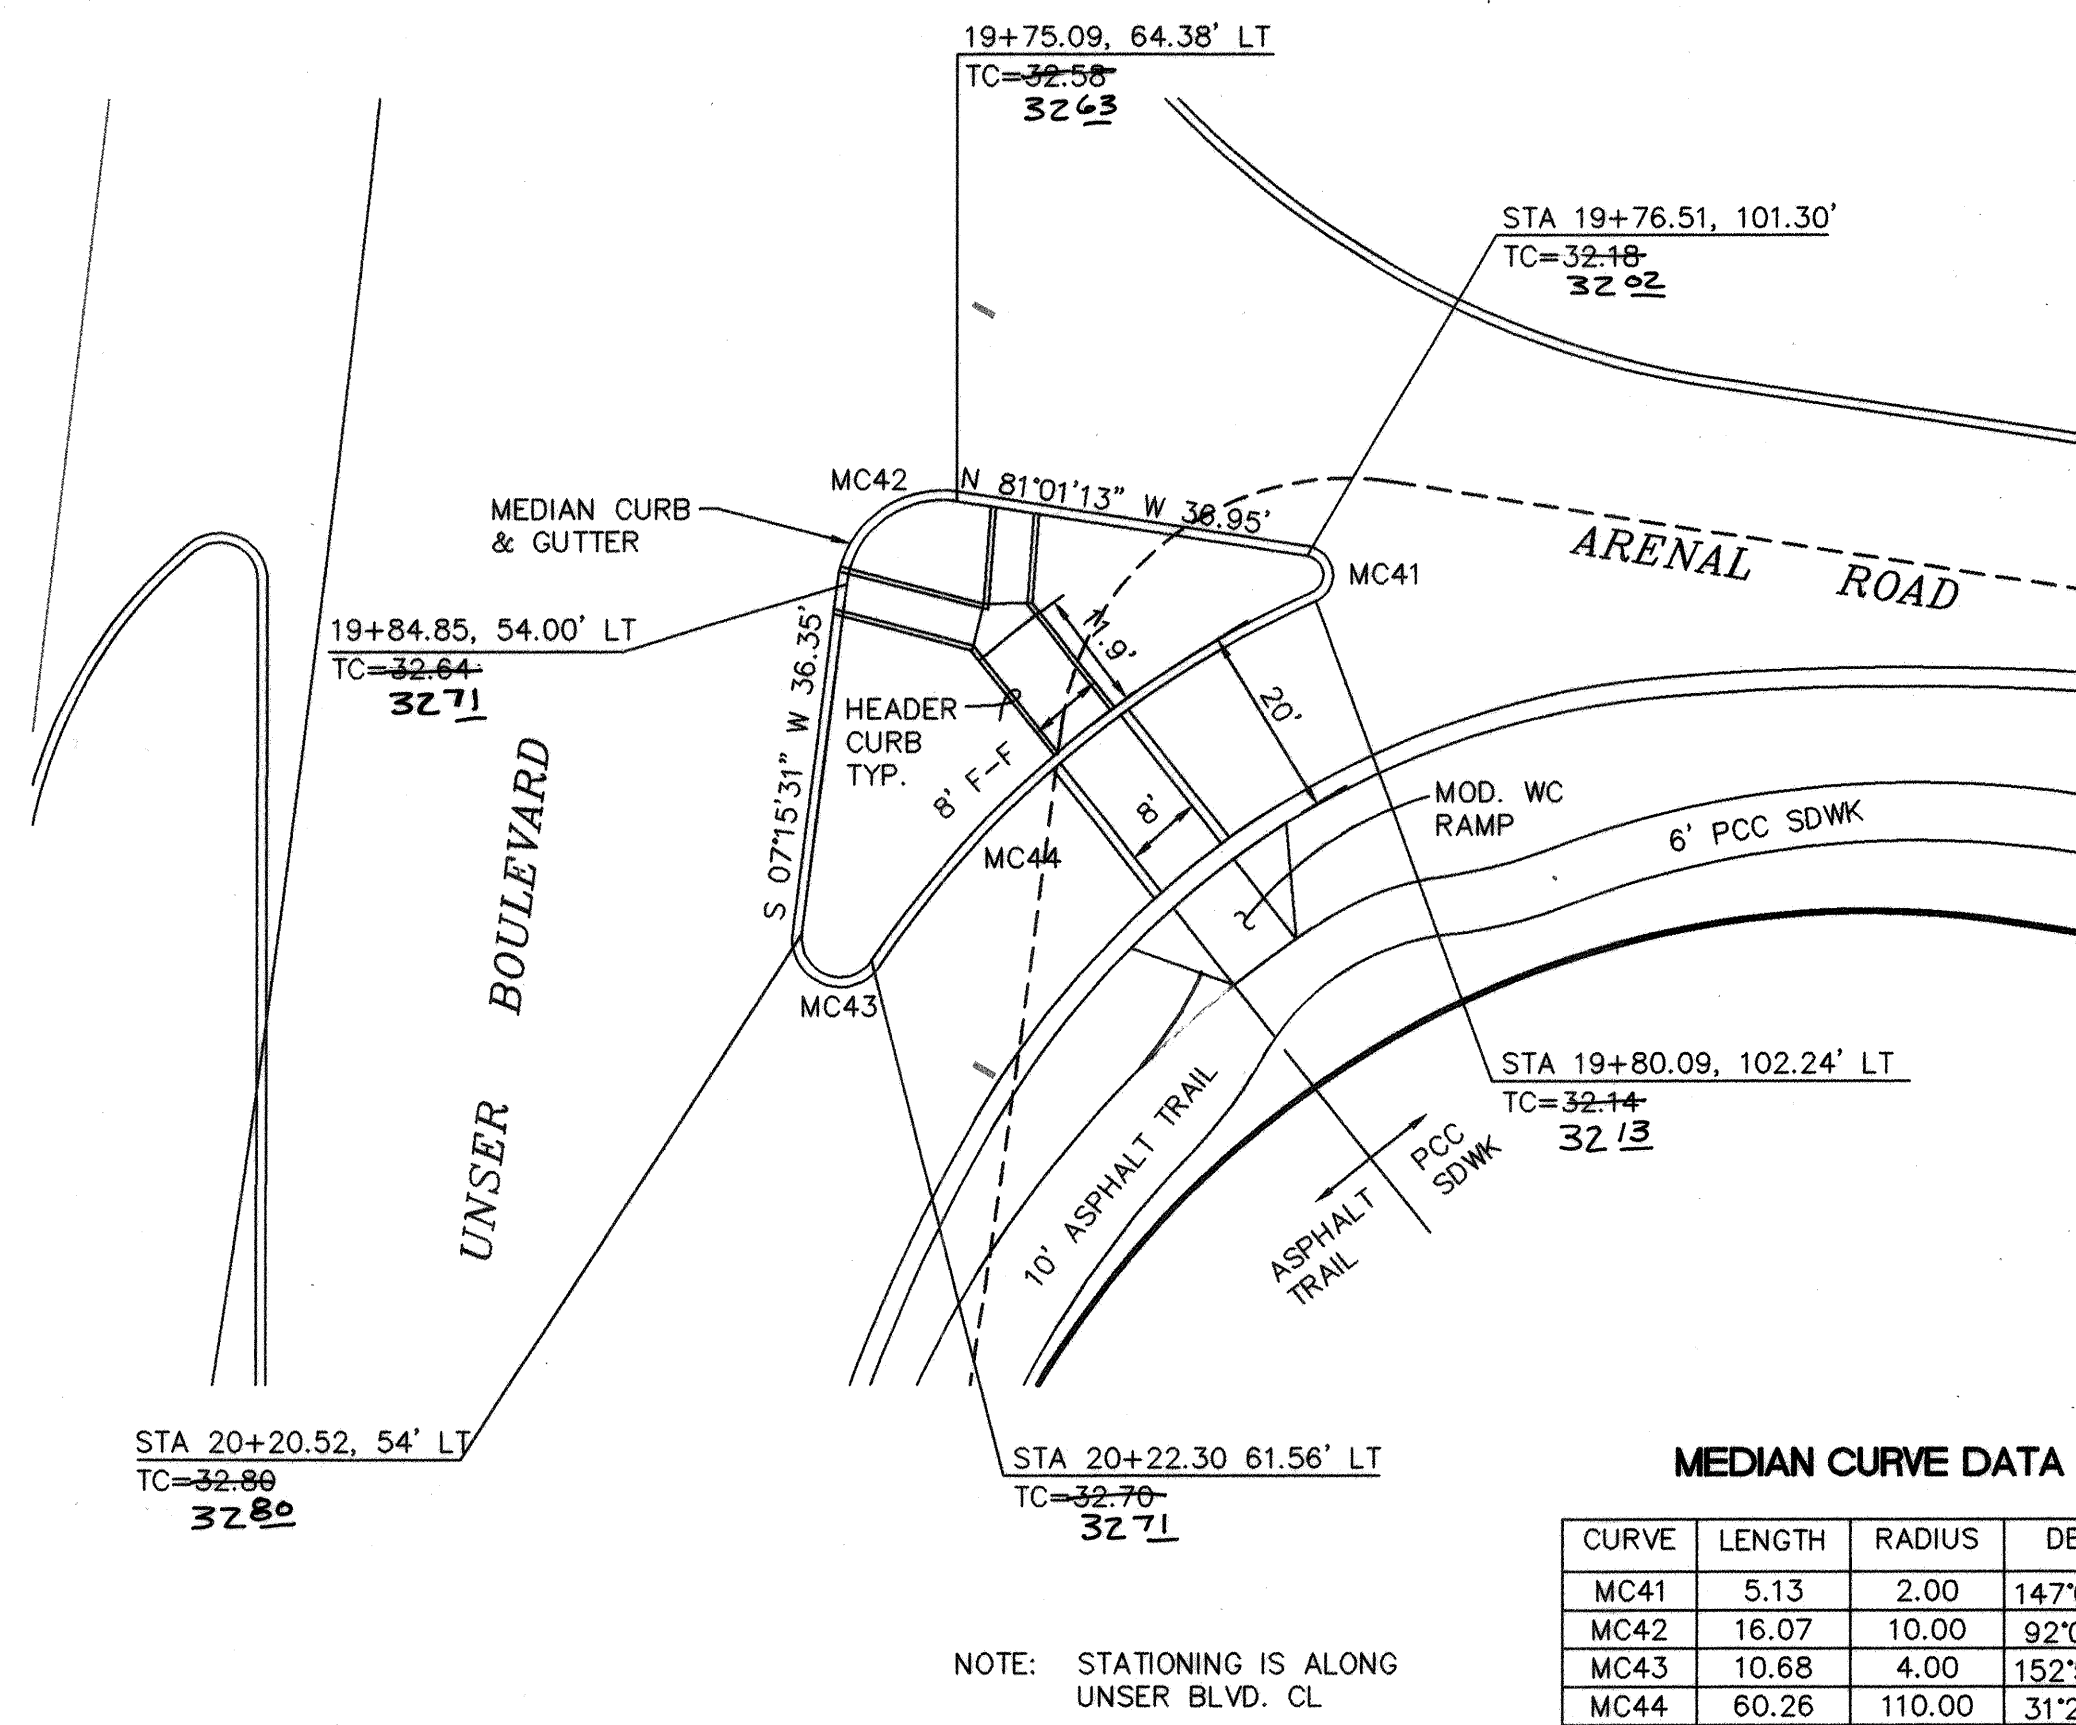

UNSER BOULEVARD & ARENAL MEDIAN DETAIL
SCALE: 1"=20'

I, David C. Clausen, New Mexico Professional Land Surveyor No. 6547, do hereby certify that the as-built information shown hereon is the result of a field survey performed by me or under my direct supervision, and that the same is true and correct.



David C. Clausen
David C. Clausen N.M.L.S. # 6547

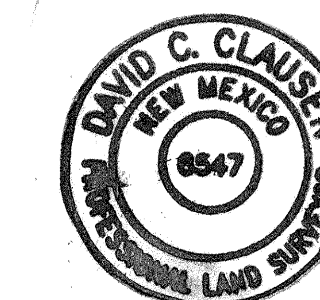

ISAACSON & ARFMAN, P.A.
Consulting Engineering Associates
128 Monroe Street N.E.
Albuquerque New Mexico
9210TL4.DWG 02/08/98

CITY OF ALBUQUERQUE PUBLIC WORKS DEPARTMENT ENGINEERING GROUP	
TITLE: DESERT SPRINGS SUBDIVISION, UNIT ONE PAVING DETAILS	
Design Review Committee	City Engineer Approval
APPROVED FEB 18 1998	
City Project No. 5785.81	Zone Map No. M-10
Sheet 8A	Of 32

AS-BUILT INFORMATION	
CONTRACTOR	ISAACSON & ARFMAN, P.A.
DATE	02/08/98
BENCH MARKS	
ACS MONUMENT "1-MIO" LOCATED AT THE SOUTHEAST CORNER OF SAGE RD. & UNSER BLVD.	
ELEV. = 5079.88	
SURVEY INFORMATION	
FIELD NOTES	1/97
ALS	
1	
ENGINEER'S SEAL	
DAVID C. CLAUSEN	REGISTERED LAND SURVEYOR
NO.	DATE
REVISIONS	DATE
DESIGN	7/11/97
DRAWN BY	DATE
7/11/97	
CHECKED BY	DATE
FCA	7/11/97

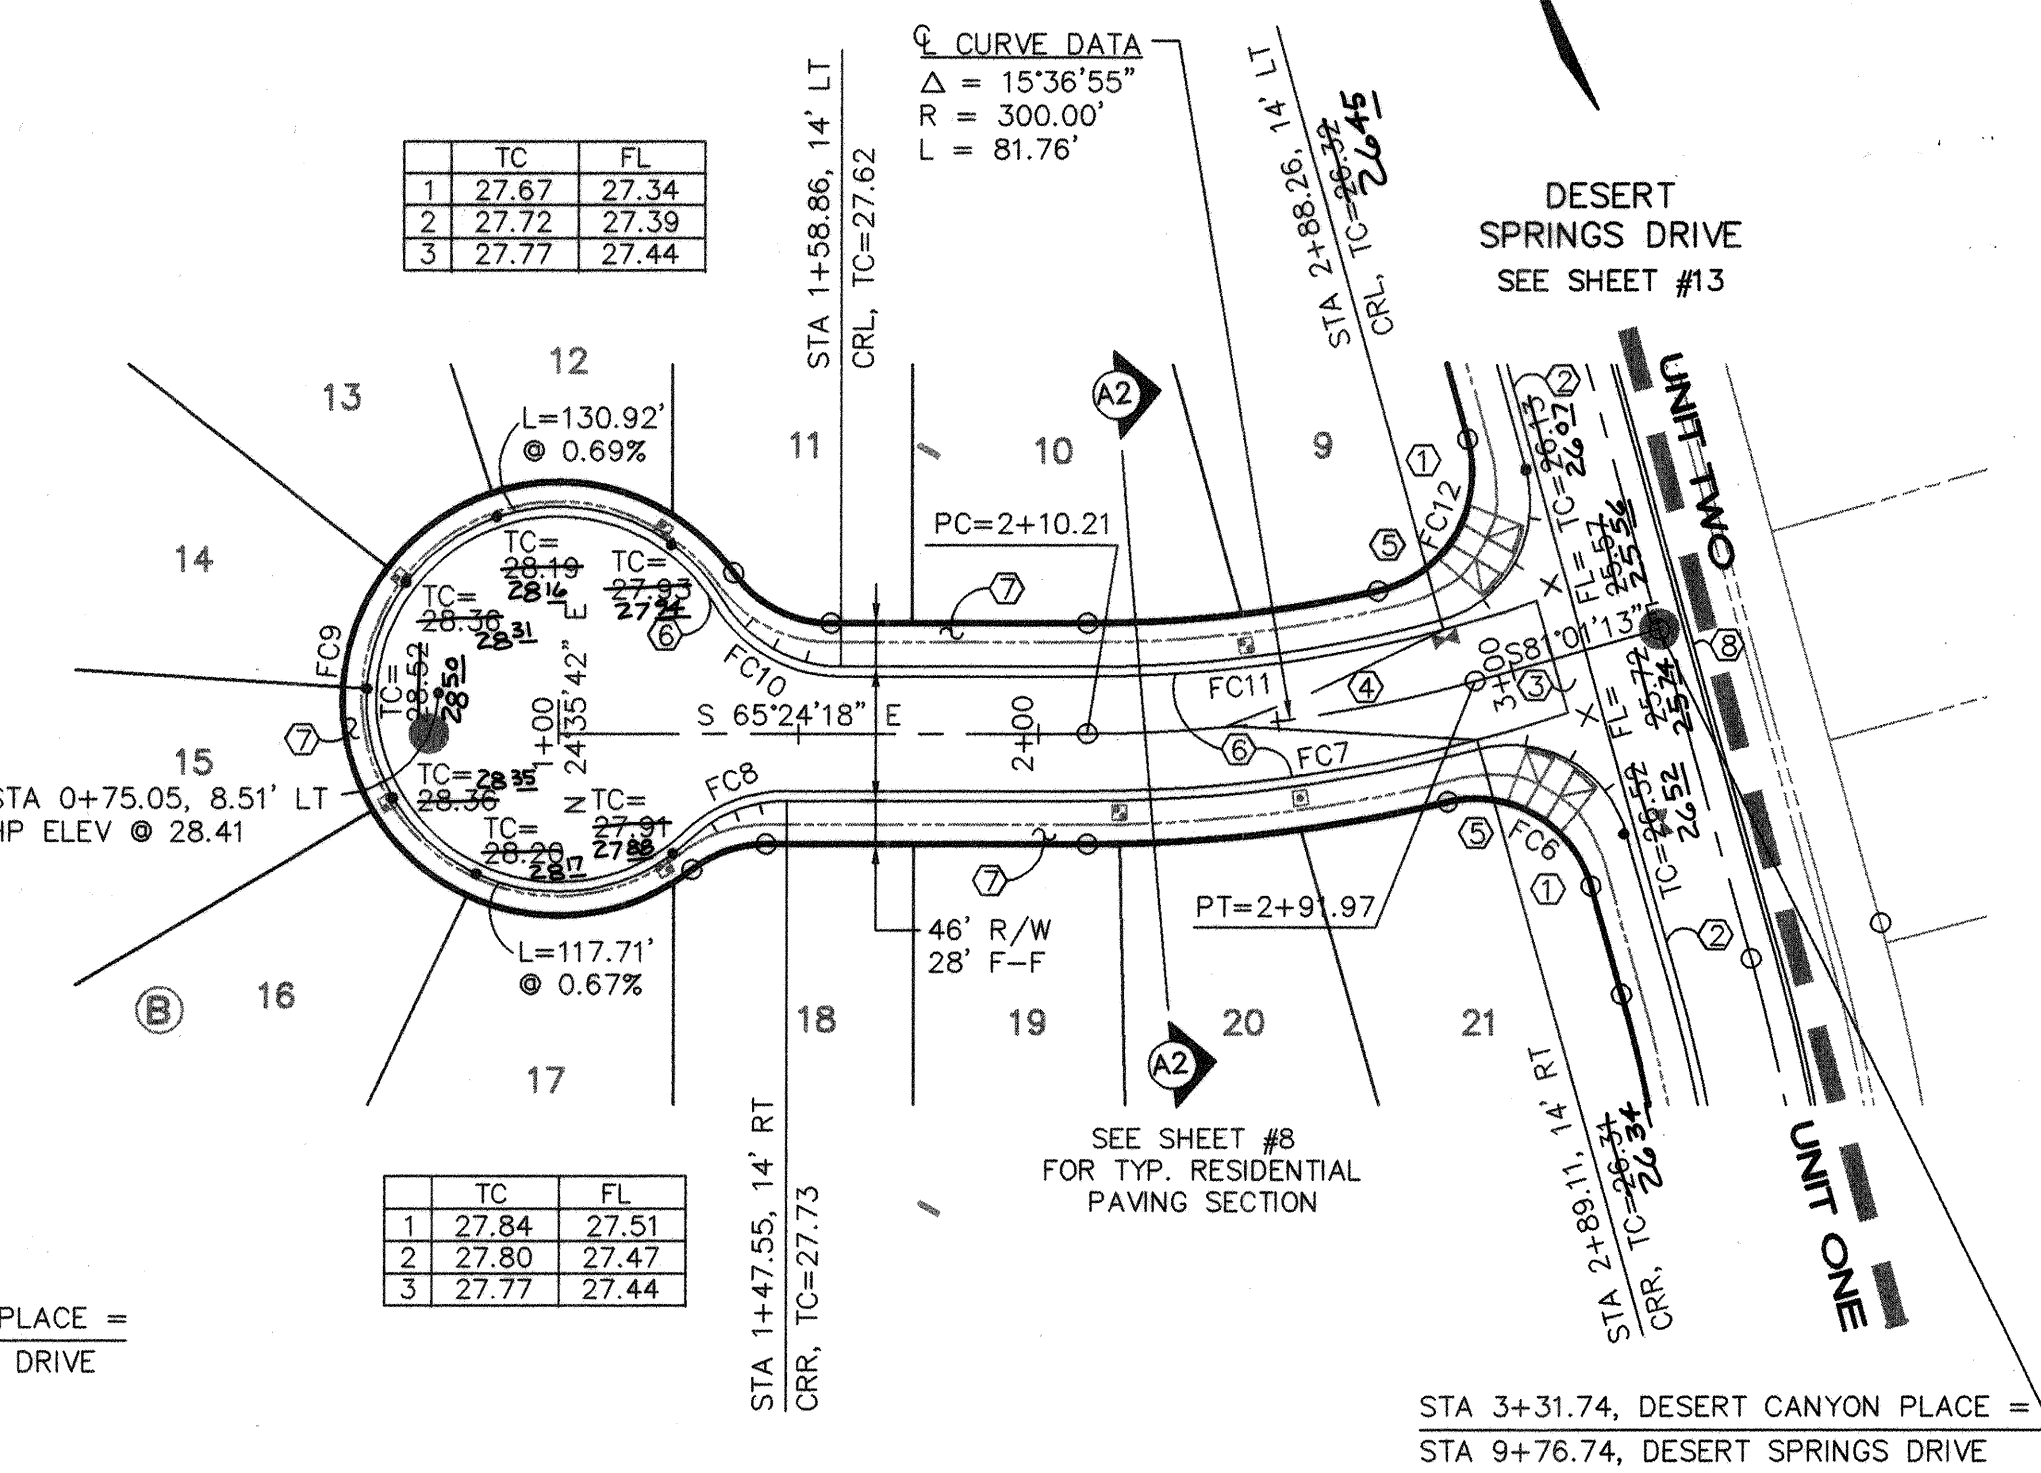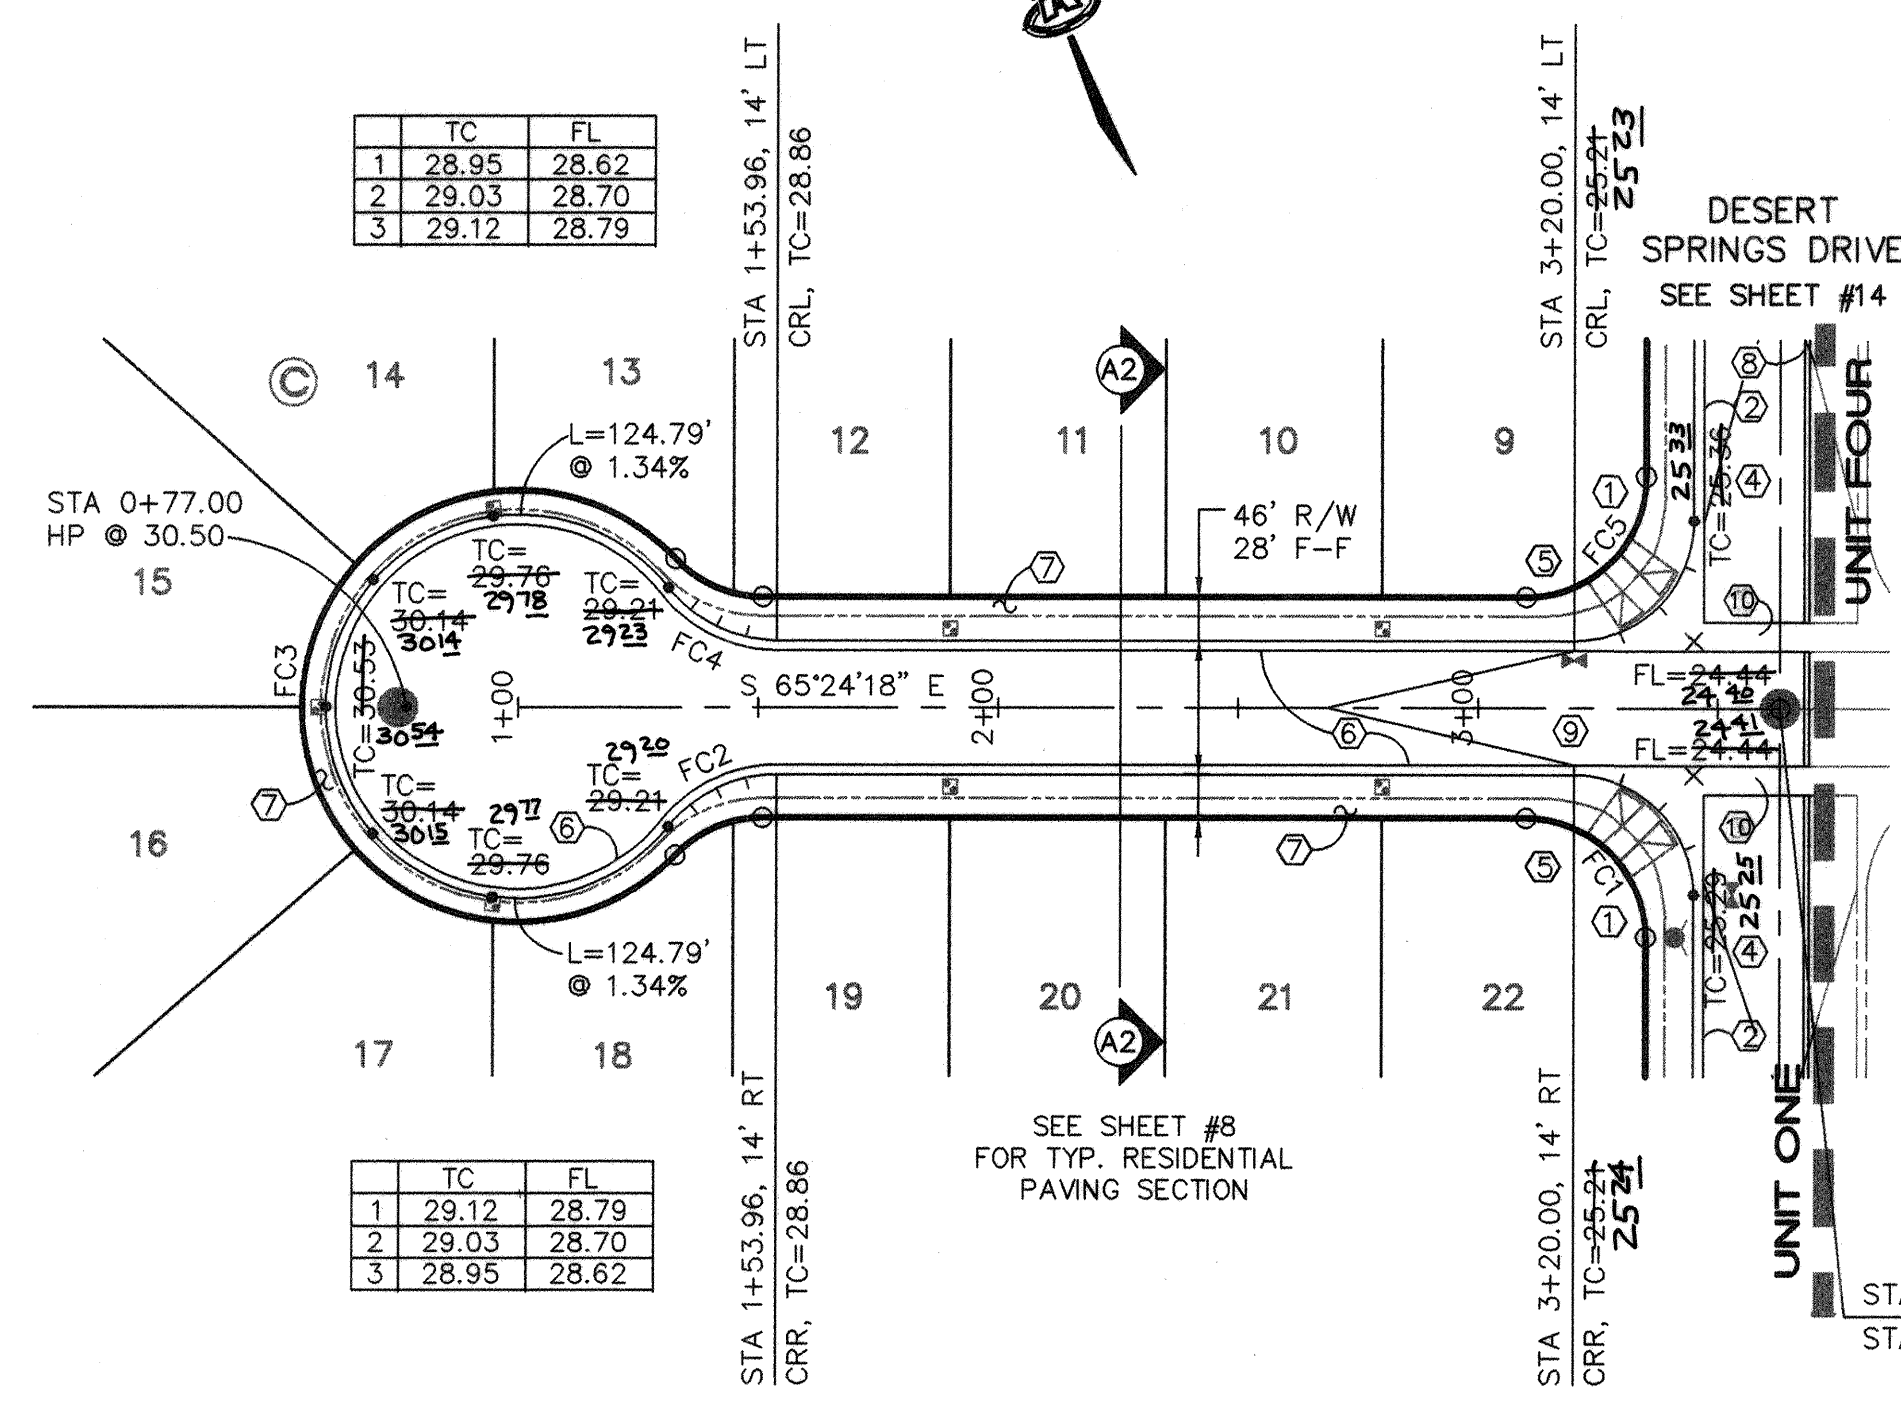


- KEYED CONSTRUCTION NOTES**
- CONSTRUCT HANDICAP RAMP PER DETAIL ON SHEET #7.
 - STANDARD CURB & GUTTER PER COA STD DWG #2415.
 - CONSTRUCT PCC VALLEY GUTTER 6' WIDE, 1 1/2" INVERT PER COA STD DWG #2420.
 - CROWN TO NO CROWN TRANSITION 50' MIN. LENGTH.
 - TRANSITION FROM MOUNTABLE TO STANDARD CURB PER COA STD DWG #2418.
 - MOUNTABLE CURB & GUTTER PER COA STD DWG #2415.
 - FUTURE 4' SIDEWALK PER COA STD DWG #2430.
 - TEMPORARY EXTRUDED ASPHALT CURB PER COA STD DWG #2415.
 - CROWN TO QUARTER CROWN TRANSITION 37.5' MIN. LENGTH. MAINTAIN 0.5% CROSS SLOPE THROUGH INTERSECTION.
 - CONSTRUCT PCC VALLEY GUTTER, 10' WIDE, 3/4" INVERT, PER COA STD DWG #2422.

FACE OF CURB CURVE TABLE

CURVE	RADIUS	LENGTH	DELTA
FC1	25.00'	39.27'	90°00'00"
FC2	29.00'	26.04'	51°27'02"
FC3	40.00'	197.50'	282°54'05"
FC4	29.00'	26.04'	51°27'02"
FC5	25.00'	39.27'	90°00'00"
FC6	25.00'	39.03'	89°27'16"
FC7	314.00'	81.66'	14°54'03"
FC8	29.00'	22.05'	43°33'41"
FC9	40.00'	196.95'	282°06'44"
FC10	29.00'	29.64'	58°33'04"
FC11	286.00'	73.31'	14°41'14"
FC12	25.00'	39.58'	90°42'31"

I, David C. Clausen, New Mexico Professional Land Surveyor No. 6547, do hereby certify that the as-built information shown hereon is the result of a field survey performed by me or under my direct supervision, and that the same is true and correct.

David C. Clausen
David C. Clausen N.M.L.S. # 6547

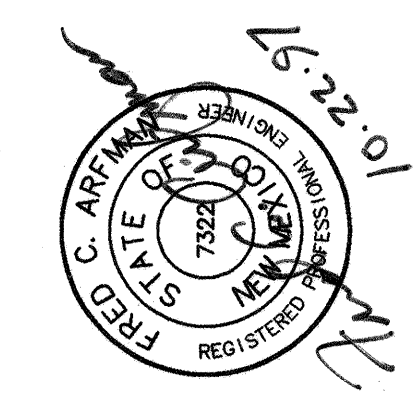

ISAACSON & ARFMAN, P.A.
Consulting Engineering Associates
128 Monroe Street N.E.
Albuquerque New Mexico
921PV1.DWGms 10/20/97

CITY OF ALBUQUERQUE
PUBLIC WORKS DEPARTMENT
ENGINEERING GROUP


**TITLE: DESERT SPRINGS SUBDIVISION, UNIT ONE
DESERT CANYON PL & DESERT SPRINGS CT
PAVING PLAN & PROFILE**


Design Review Committee	City Engineer Approval	Mo./Day/Yr.	Mo./Day/Yr.
APPROVED			
DESIGN REVIEW COMMITTEE			
City Project No.	5785.81	Zone Map No.	M-10
Sheet	9	Of	32

DESERT CANYON PLACE

DESERT SPRINGS COURT


SCALES:
1"=40' HOR.
1"=10' VERT.

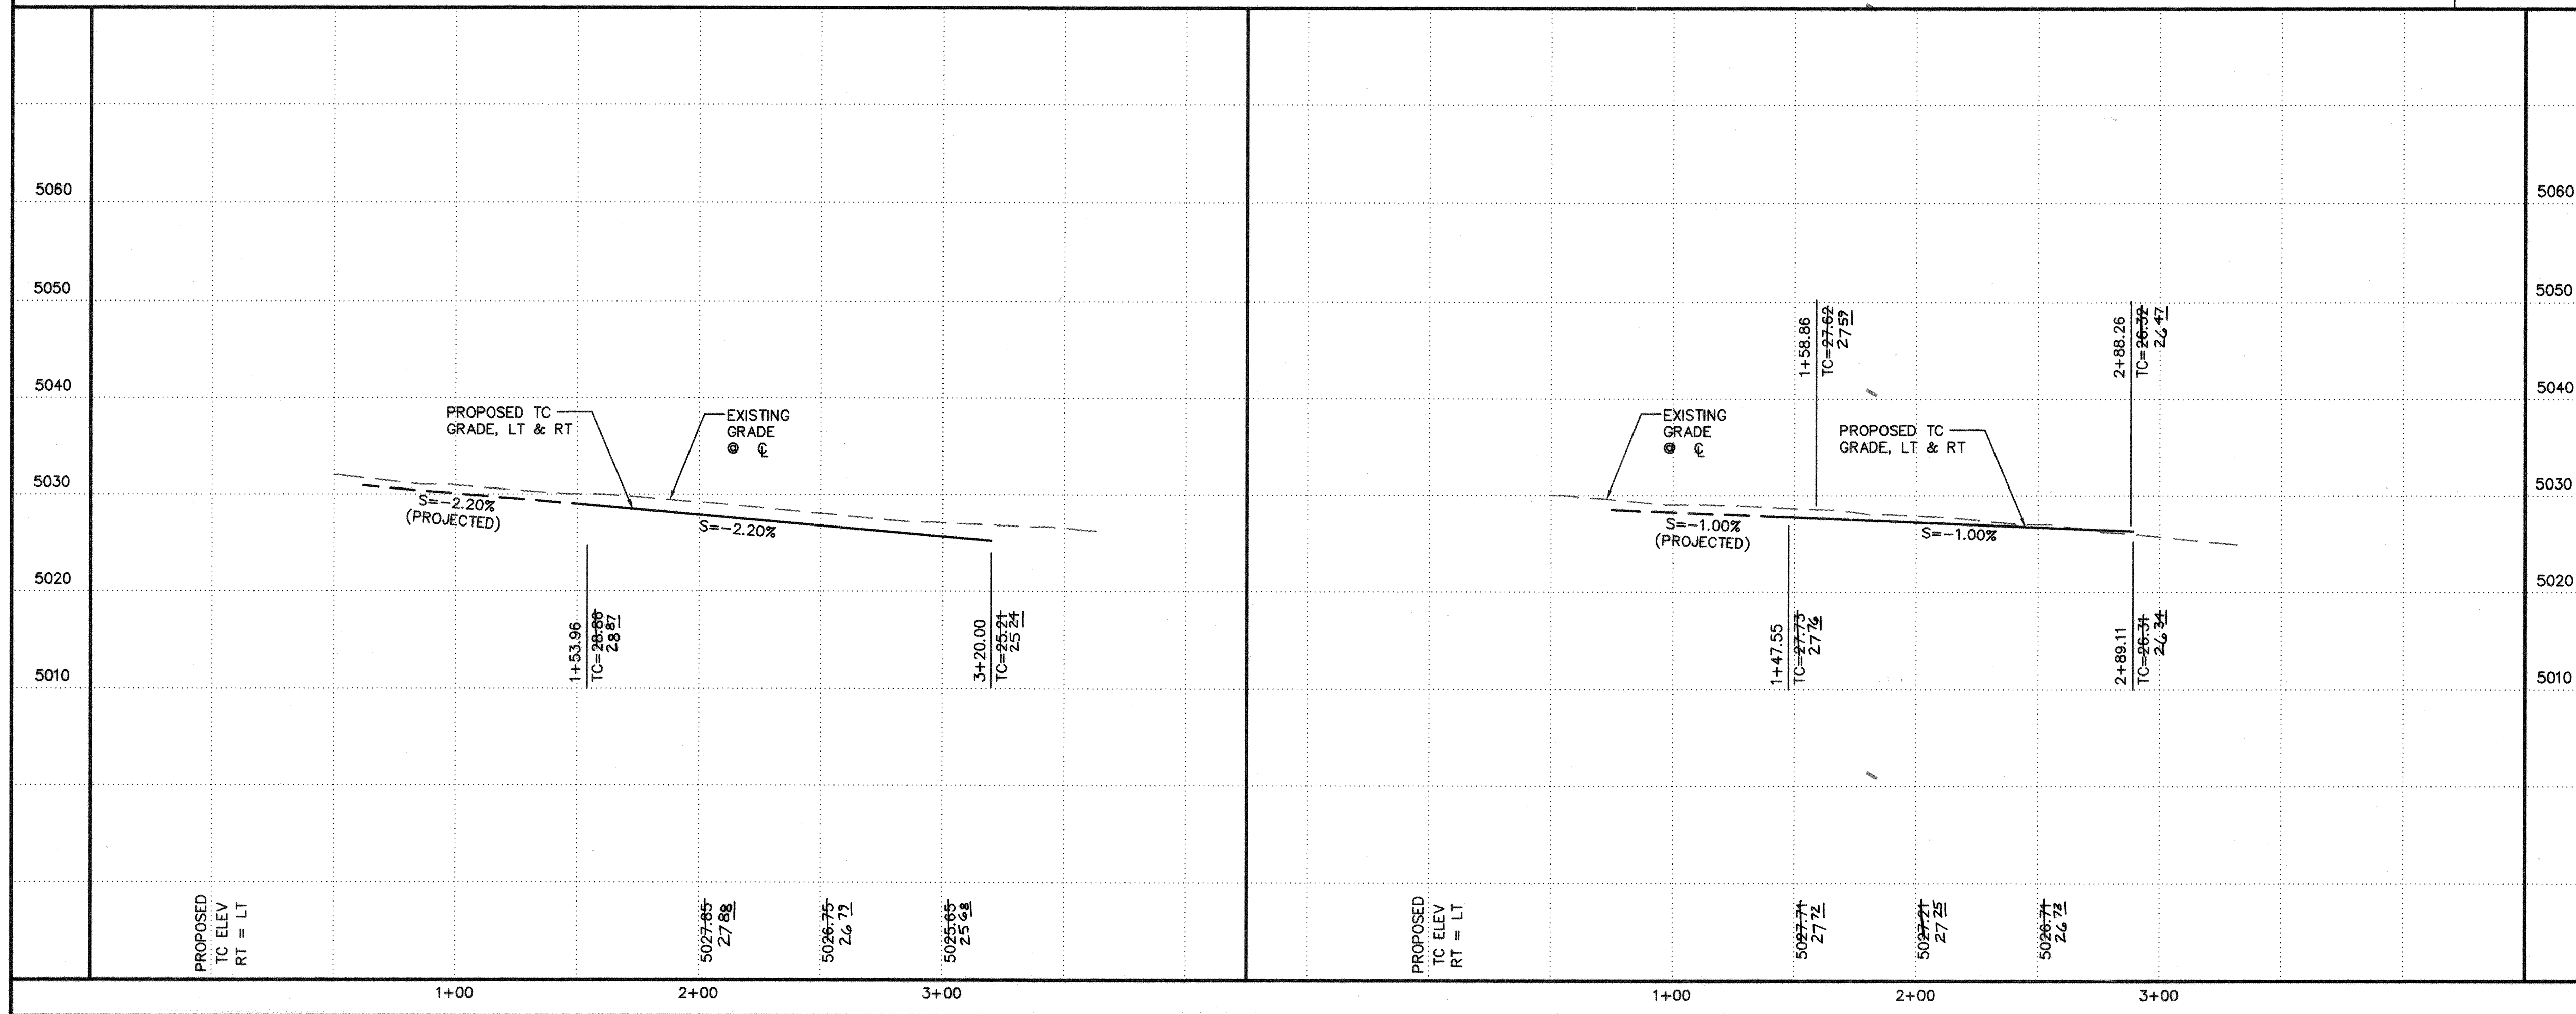


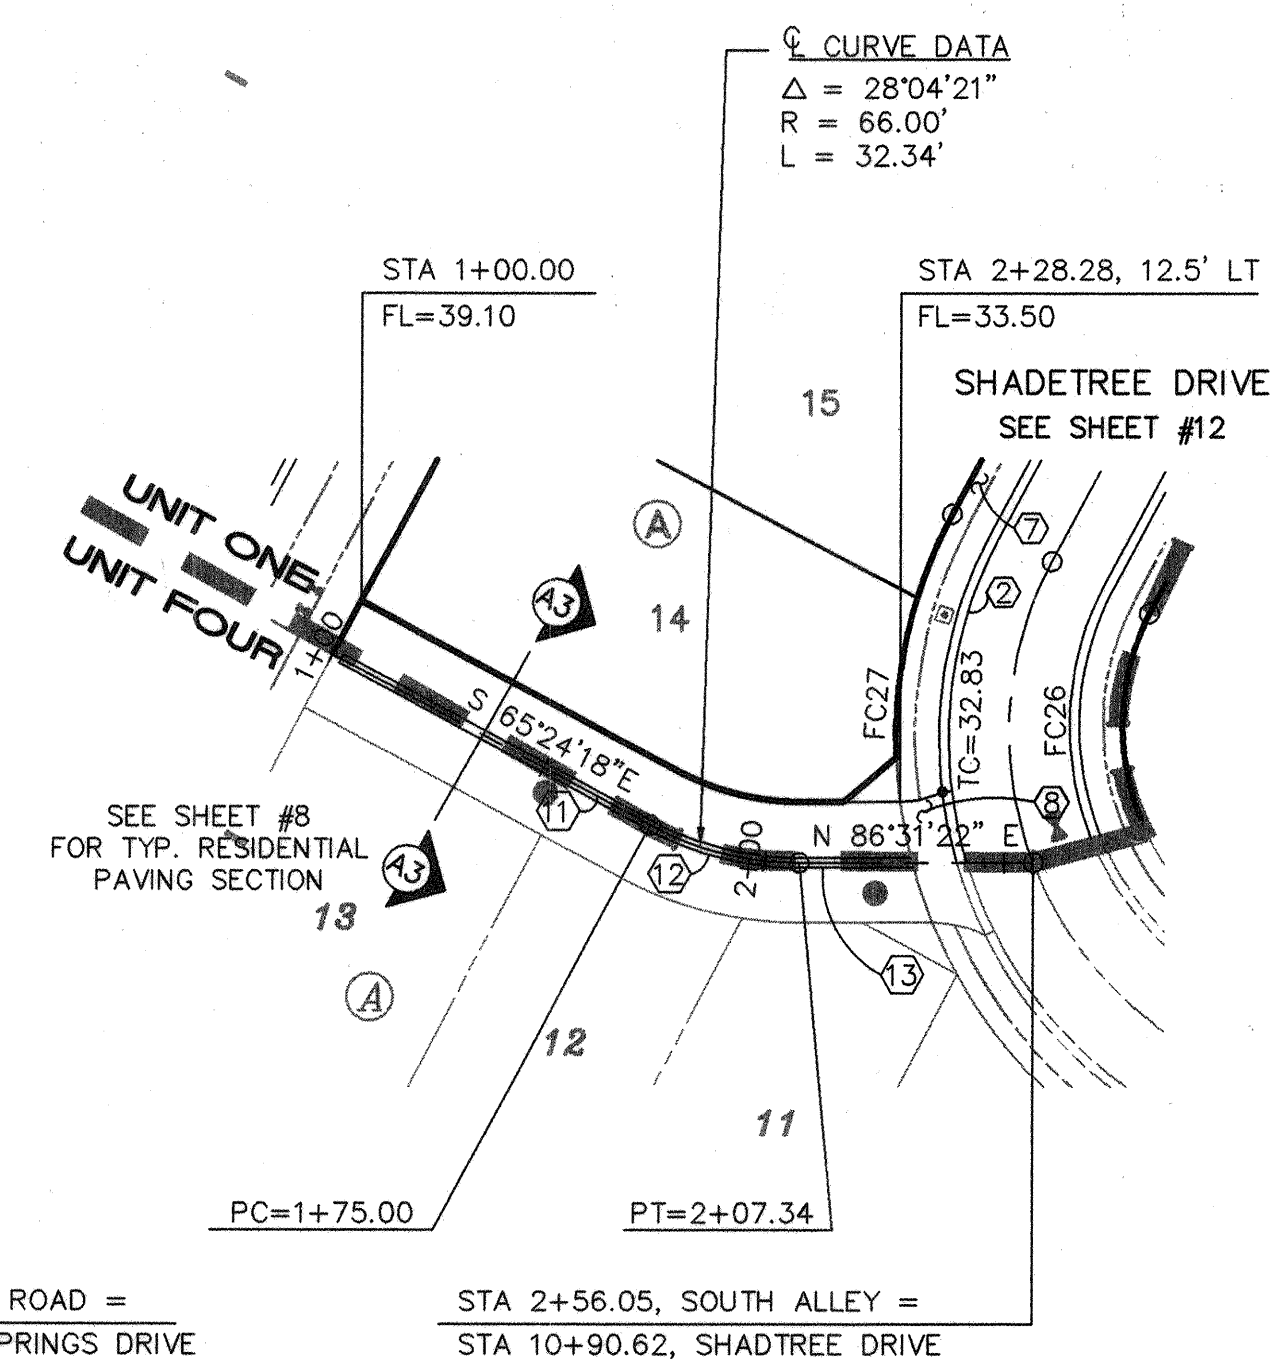

SHADETREE STUB STREET

I, David C. Clausen, New Mexico Professional Land Surveyor No. 6547, do hereby certify that the as-built information shown hereon is the result of a field survey performed by me or under my direct supervision, and that the same is true and correct.

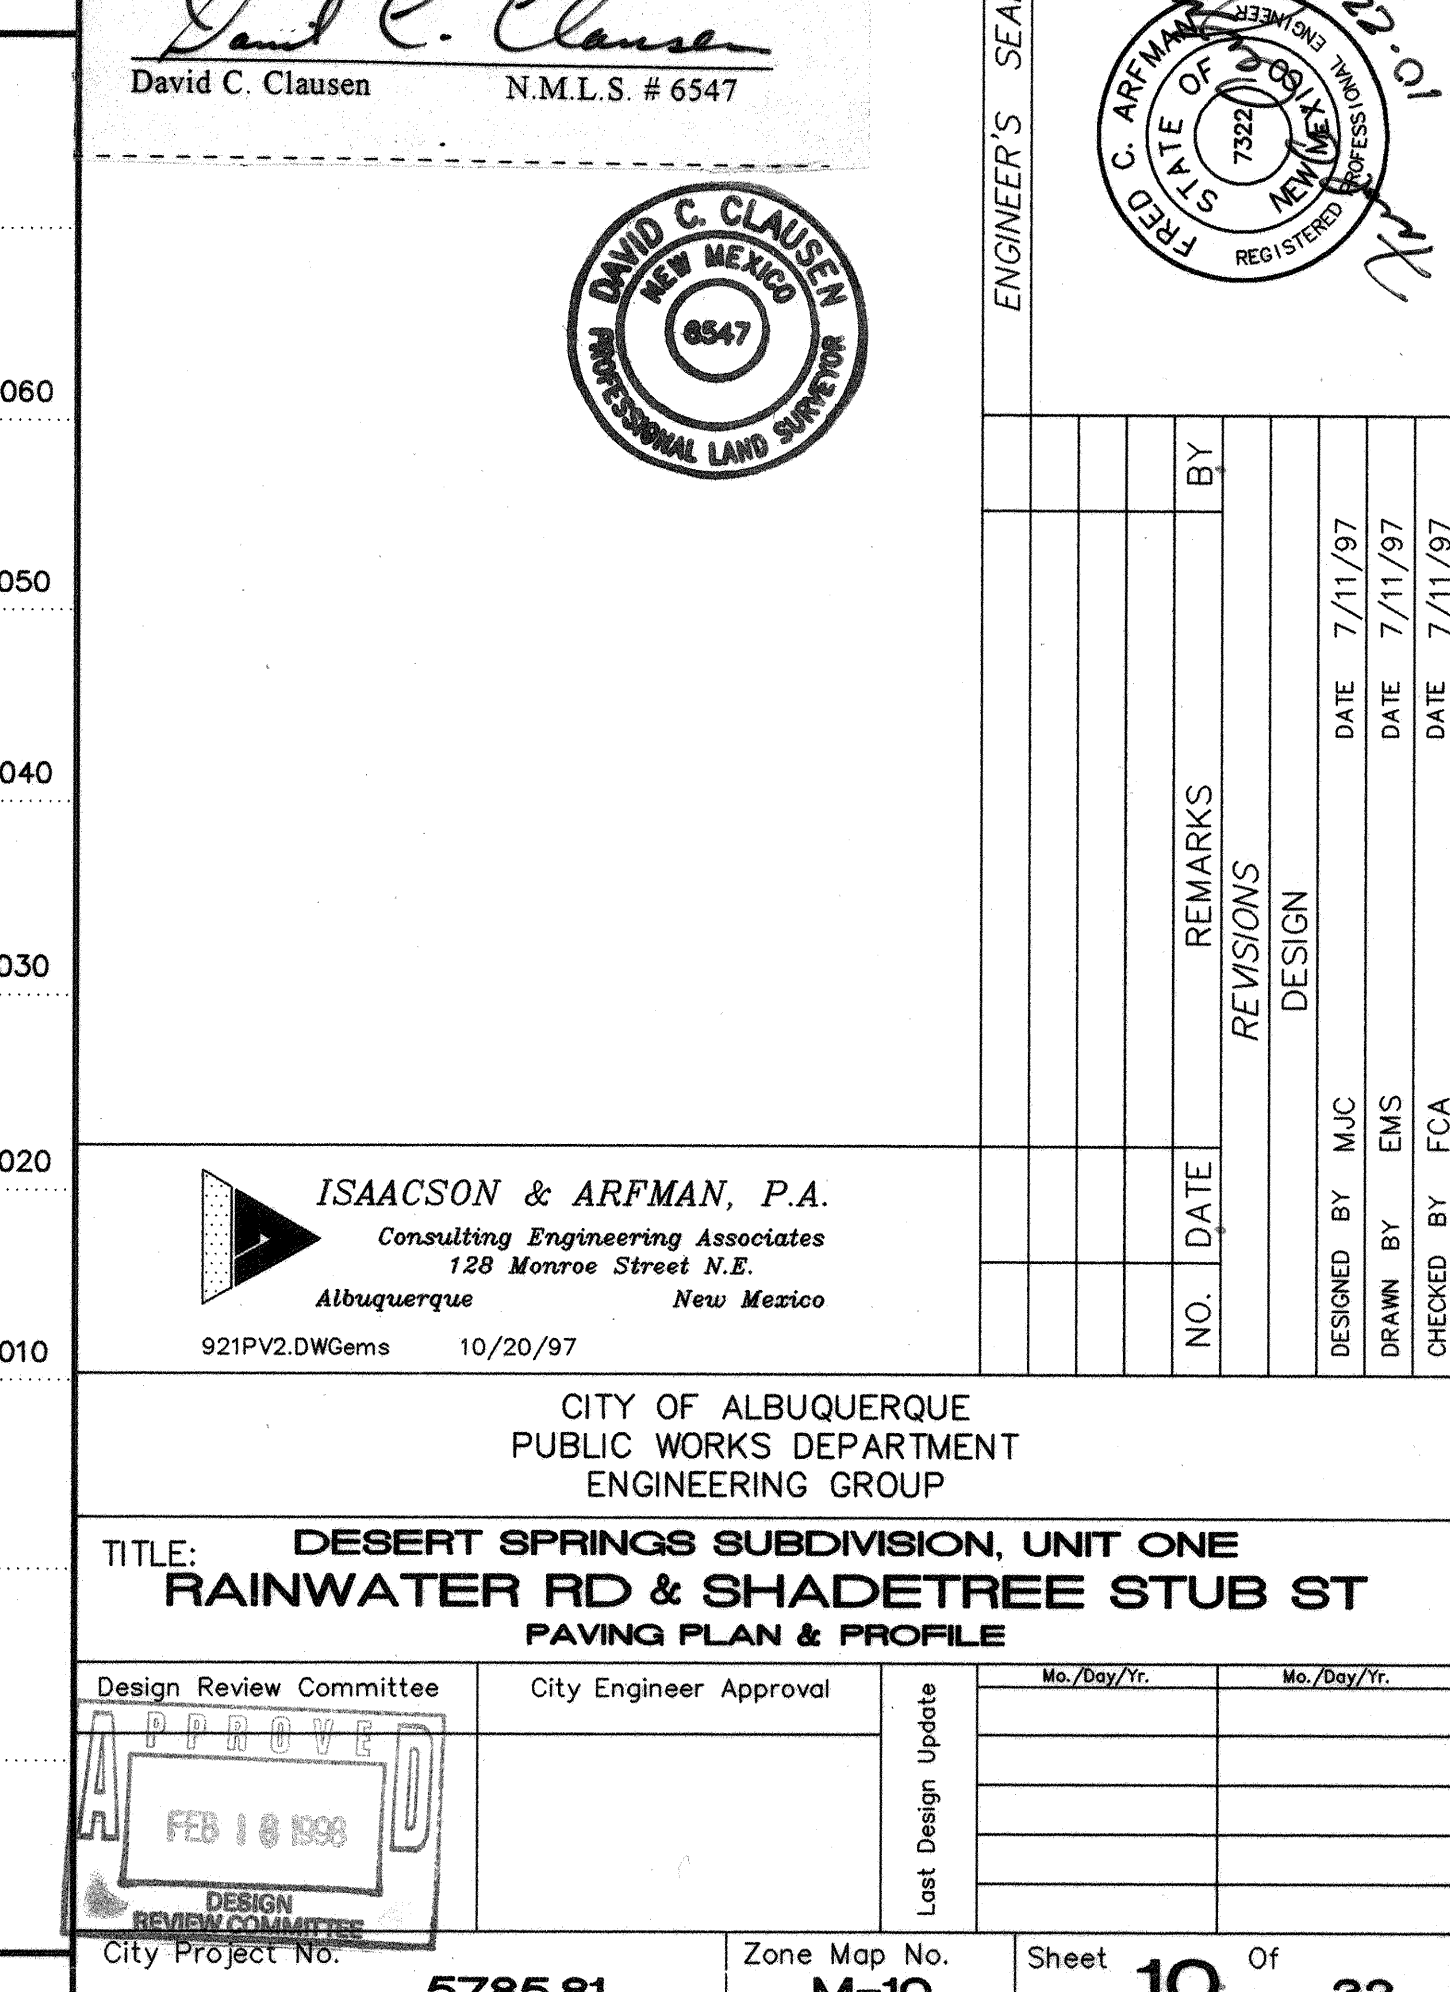

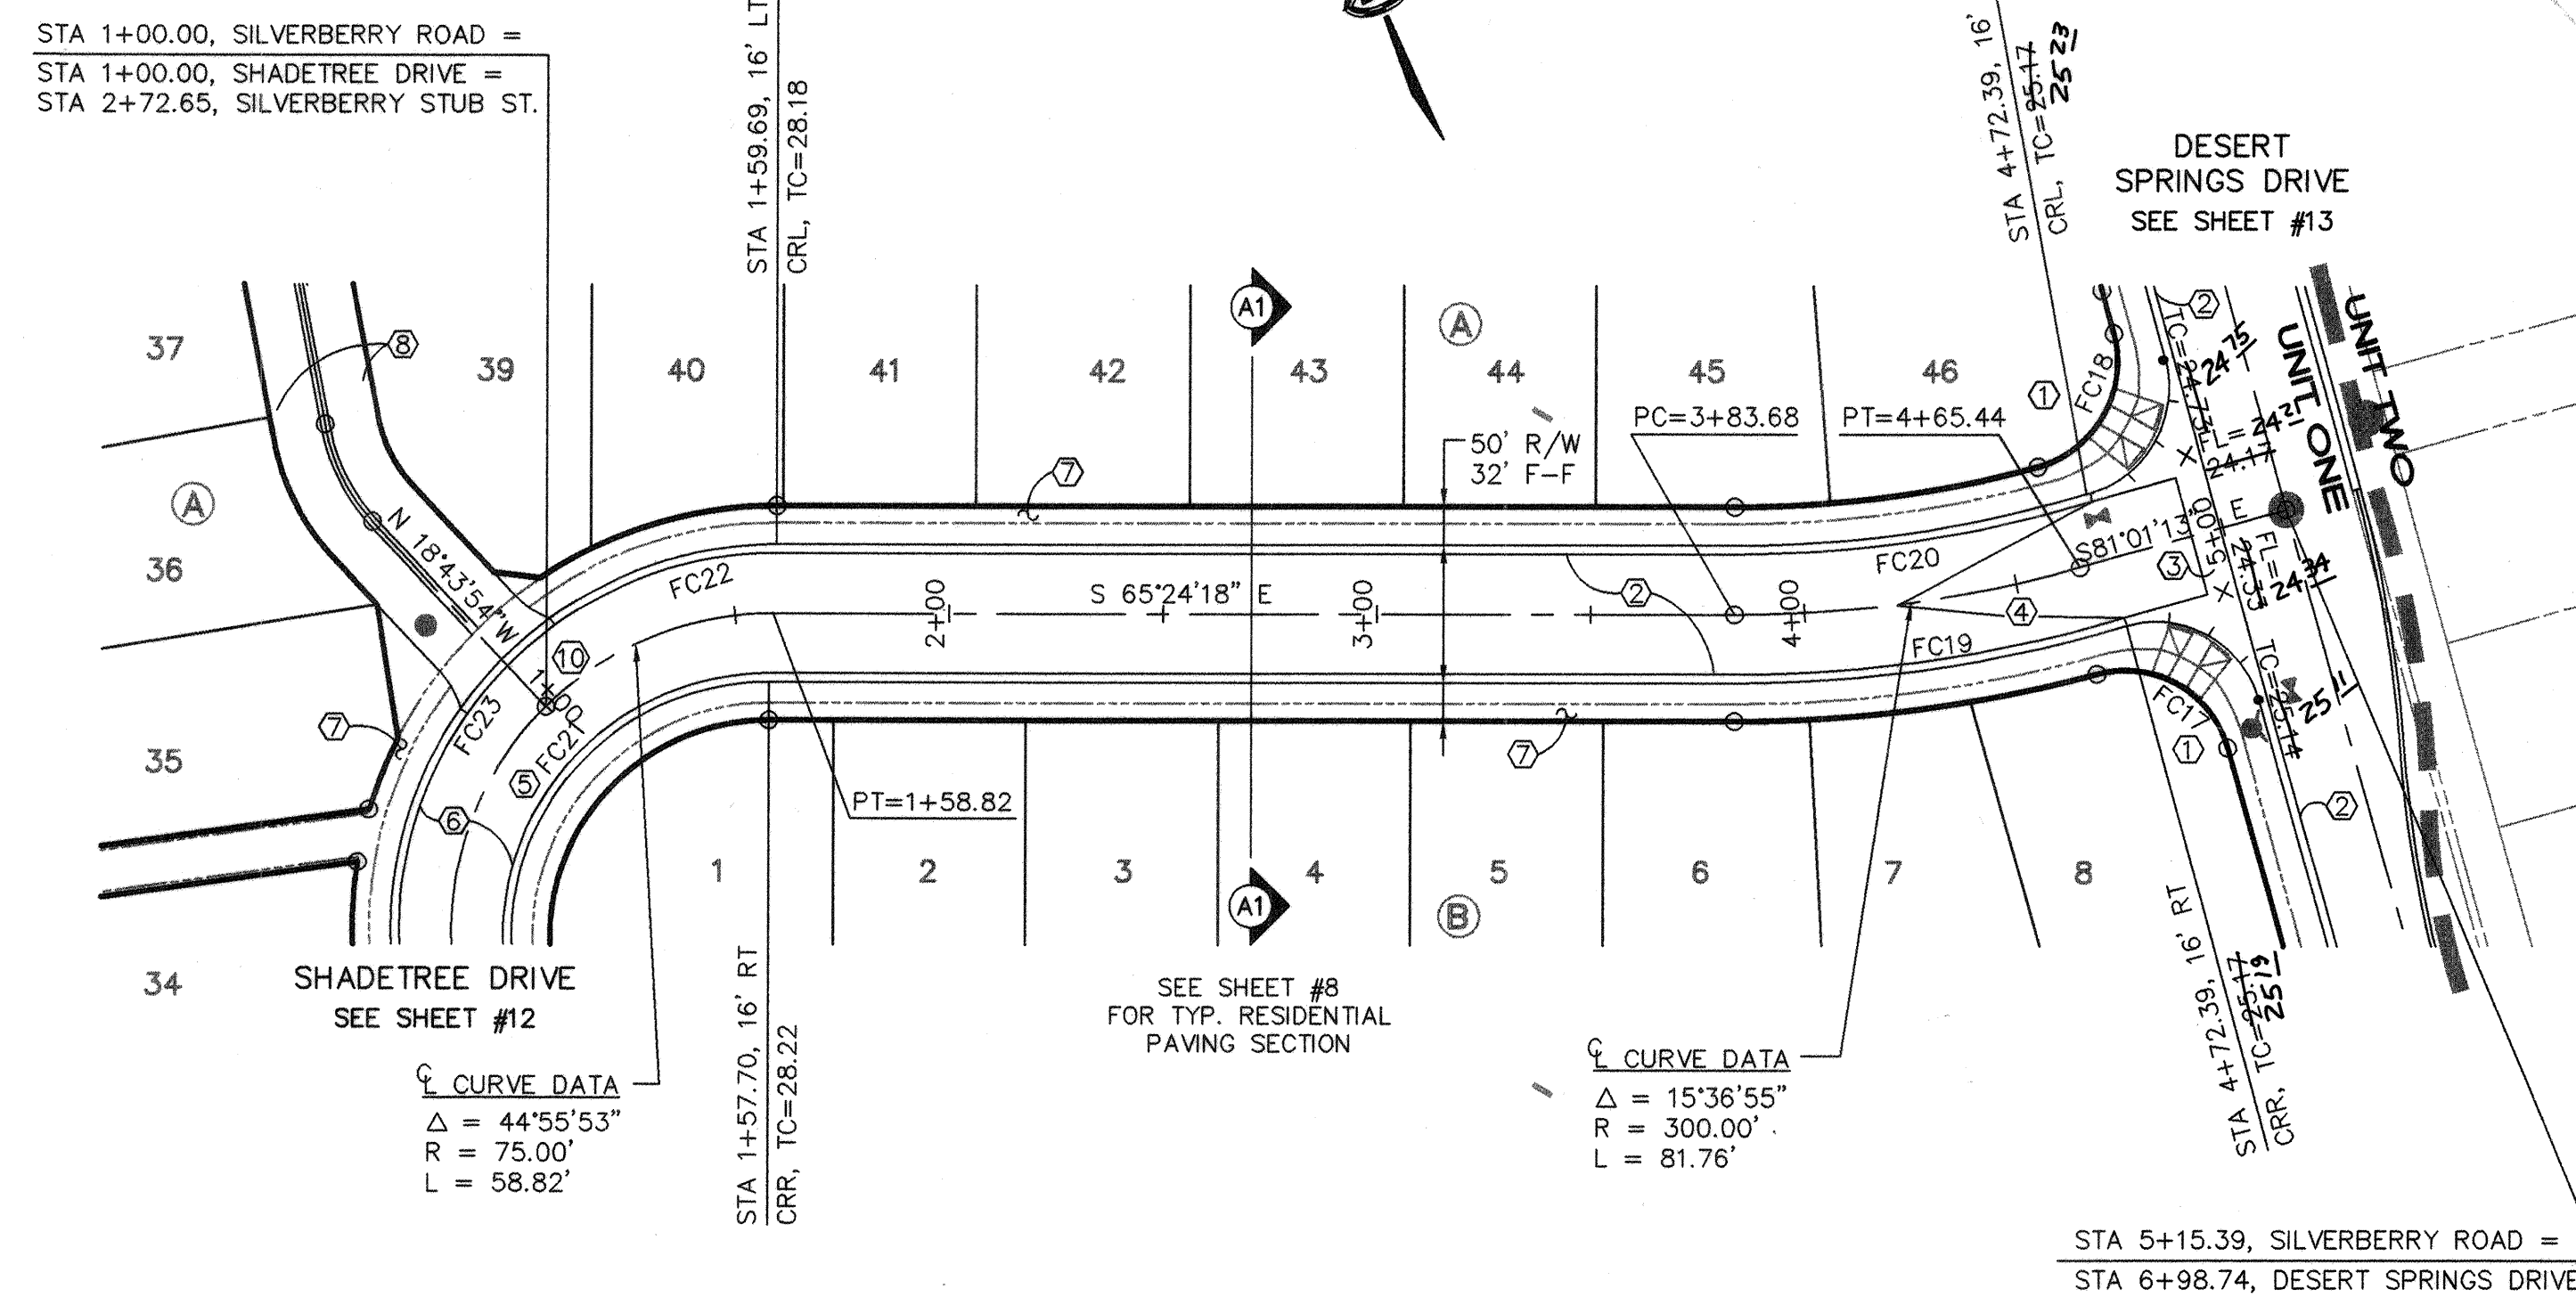


1. CONSTRUCT HANDICAP RAMP PER
DETAIL ON SHEET #7.
2. STANDARD CURB & GUTTER PER COA
STD DWG #2415.
3. CONSTRUCT PCC VALLEY GUTTER
6" WIDE, 1 1/2" INVERT PER COA STD
DWG #2420.
4. CROWN TO NO CROWN TRANSITION
50' MIN. LENGTH.
5. STA 0+93.78 TO STA 0+87.73,
TRANSITION FROM MOUNTABLE TO STANDARD
CURB.
6. MOUNTABLE CURB & GUTTER PER COA
STD DWG #2415.
7. FUTURE 4' SIDEWALK PER COA STD
DWG #2430.
8. ALLEY GUTTER PER COA STD DWG #2415.
9. CONSTRUCT CONCRETE DRIVEPAD PER COA
STD DWG #2425.
10. SEE SHEET #12 FOR PROJECTED VERTICAL
CURVE DATA.

CURVE	RADIUS	LENGTH	DELTA
FC17	25.00'	39.27'	90°00'00"
FC18	25.00'	39.27'	90°00'00"
FC19	316.00'	86.12'	15°36'55"
FC20	284.00'	77.40'	15°36'55"
FC21	60.00'	102.12'	97°31'06"
FC22	90.00'	71.48'	45°30'25"
FC23	90.00'	81.75'	52°02'39"

SILVERBERRY ROAD

I, David C. Clausen, New Mexico Professional Land Surveyor No. 6547, do hereby certify that the as-built information shown hereon is the result of a field survey performed by me or under my direct supervision, and that the same is true and correct.

David C. Clausen
David C. Clausen N.M.L.S. # 6547

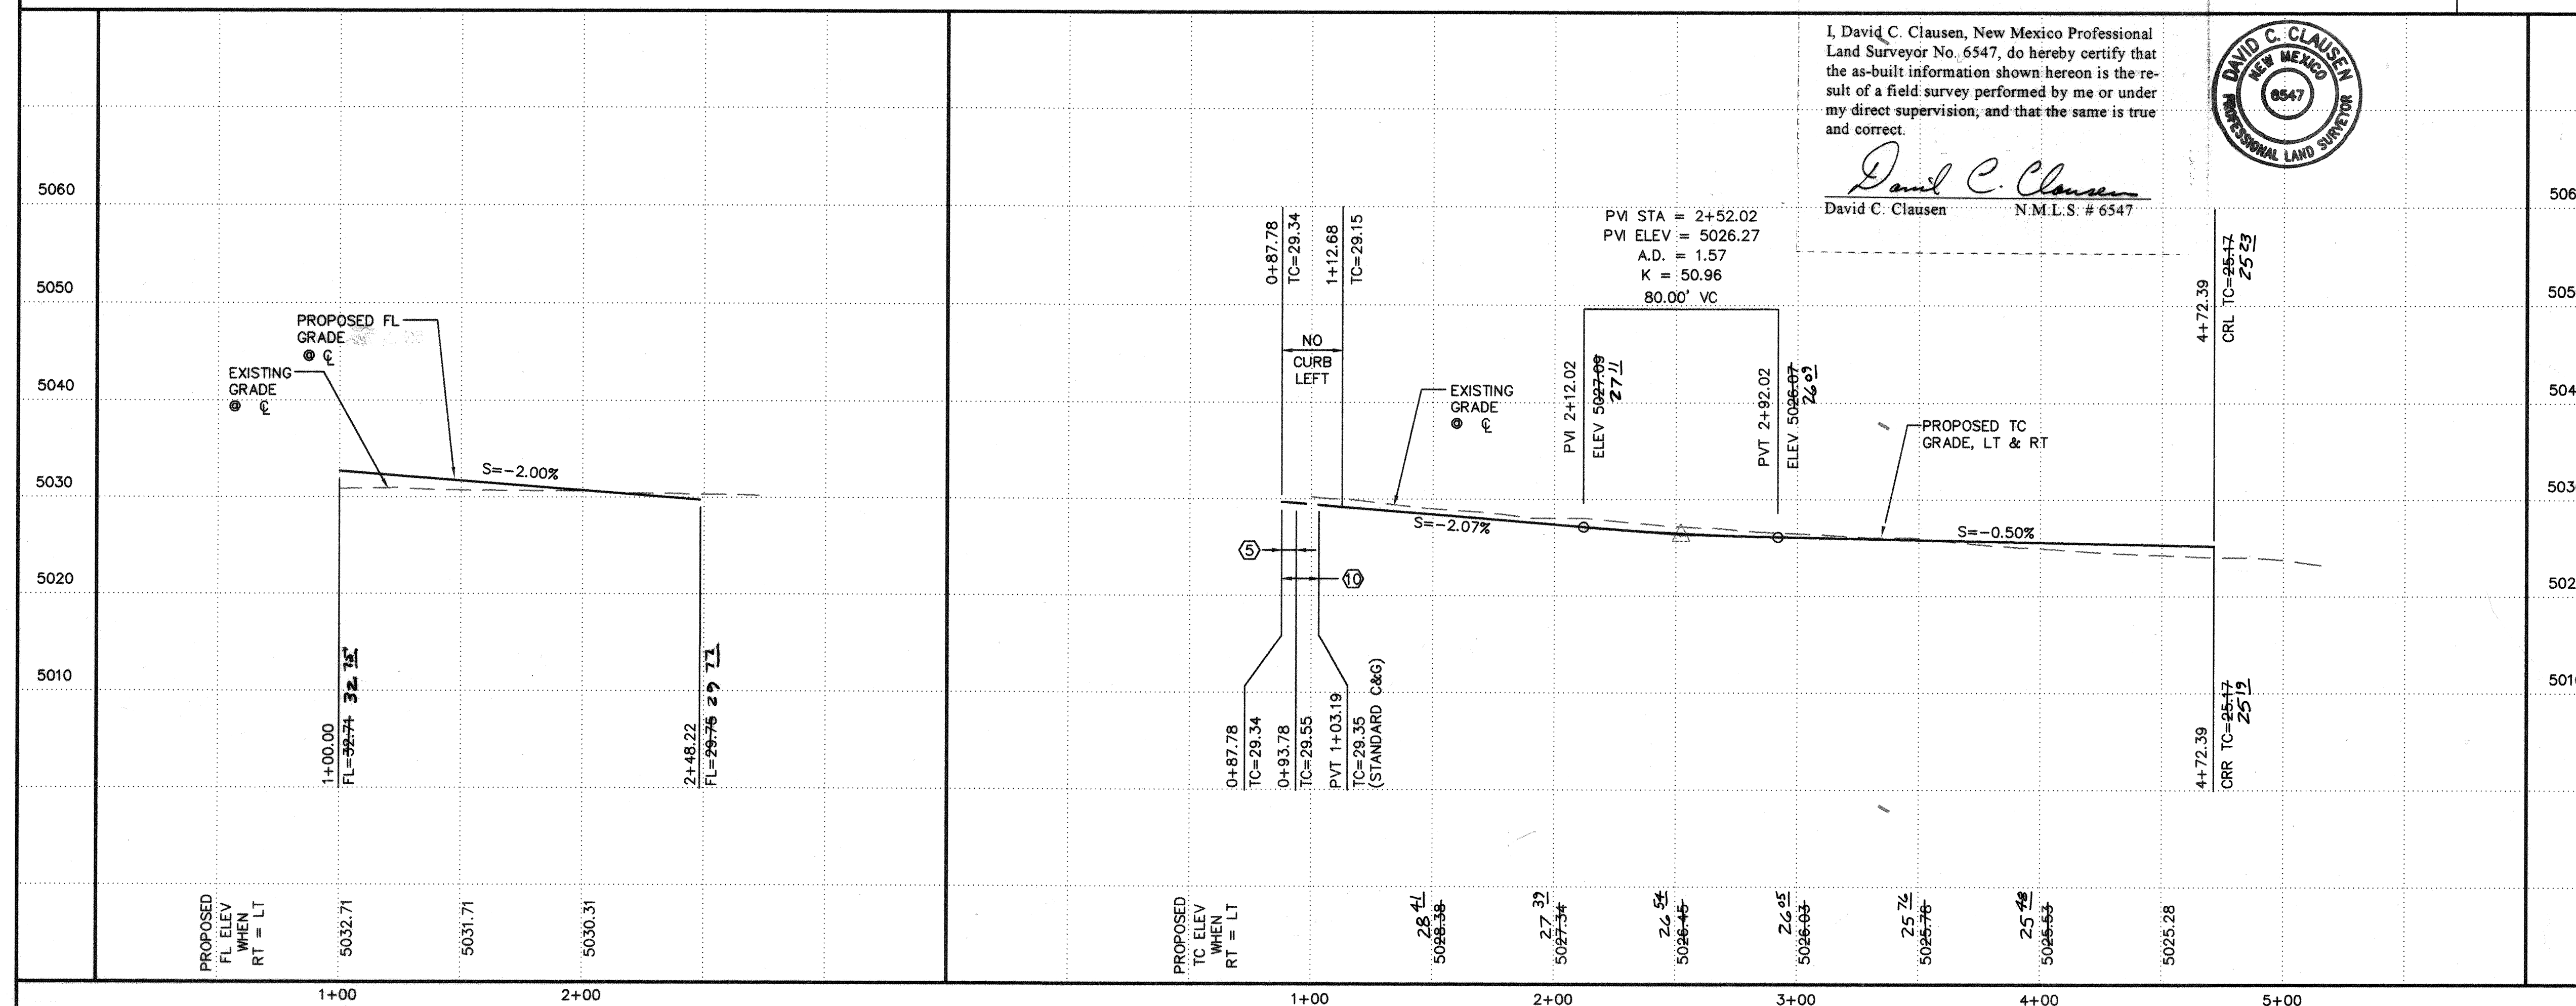

 **ISAACSON & ARFMAN, P.A.**
Consulting Engineering Associates
128 Monroe Street N.E.
Albuquerque New Mexico
921PV3.DWGems 10/20/97

CITY OF ALBUQUERQUE
PUBLIC WORKS DEPARTMENT
ENGINEERING GROUP

TITLE: DESERT SPRINGS SUBDIVISION, UNIT ONE
SILVERBERRY ROAD & STUB STREET
PAVING PLAN & PROFILE

Design Review Committee
APPROVED
FEB 18 1996
DESIGN REVIEW COMMITTEE

City Engineer Approval

②

pdatt

U
uf

Design

cast |

2

City Project No.

Zone Map No.	
--------------	--



Sheet 11 Of


5785.81

Zone Map No.
M-10

Sheet **11** Of

32

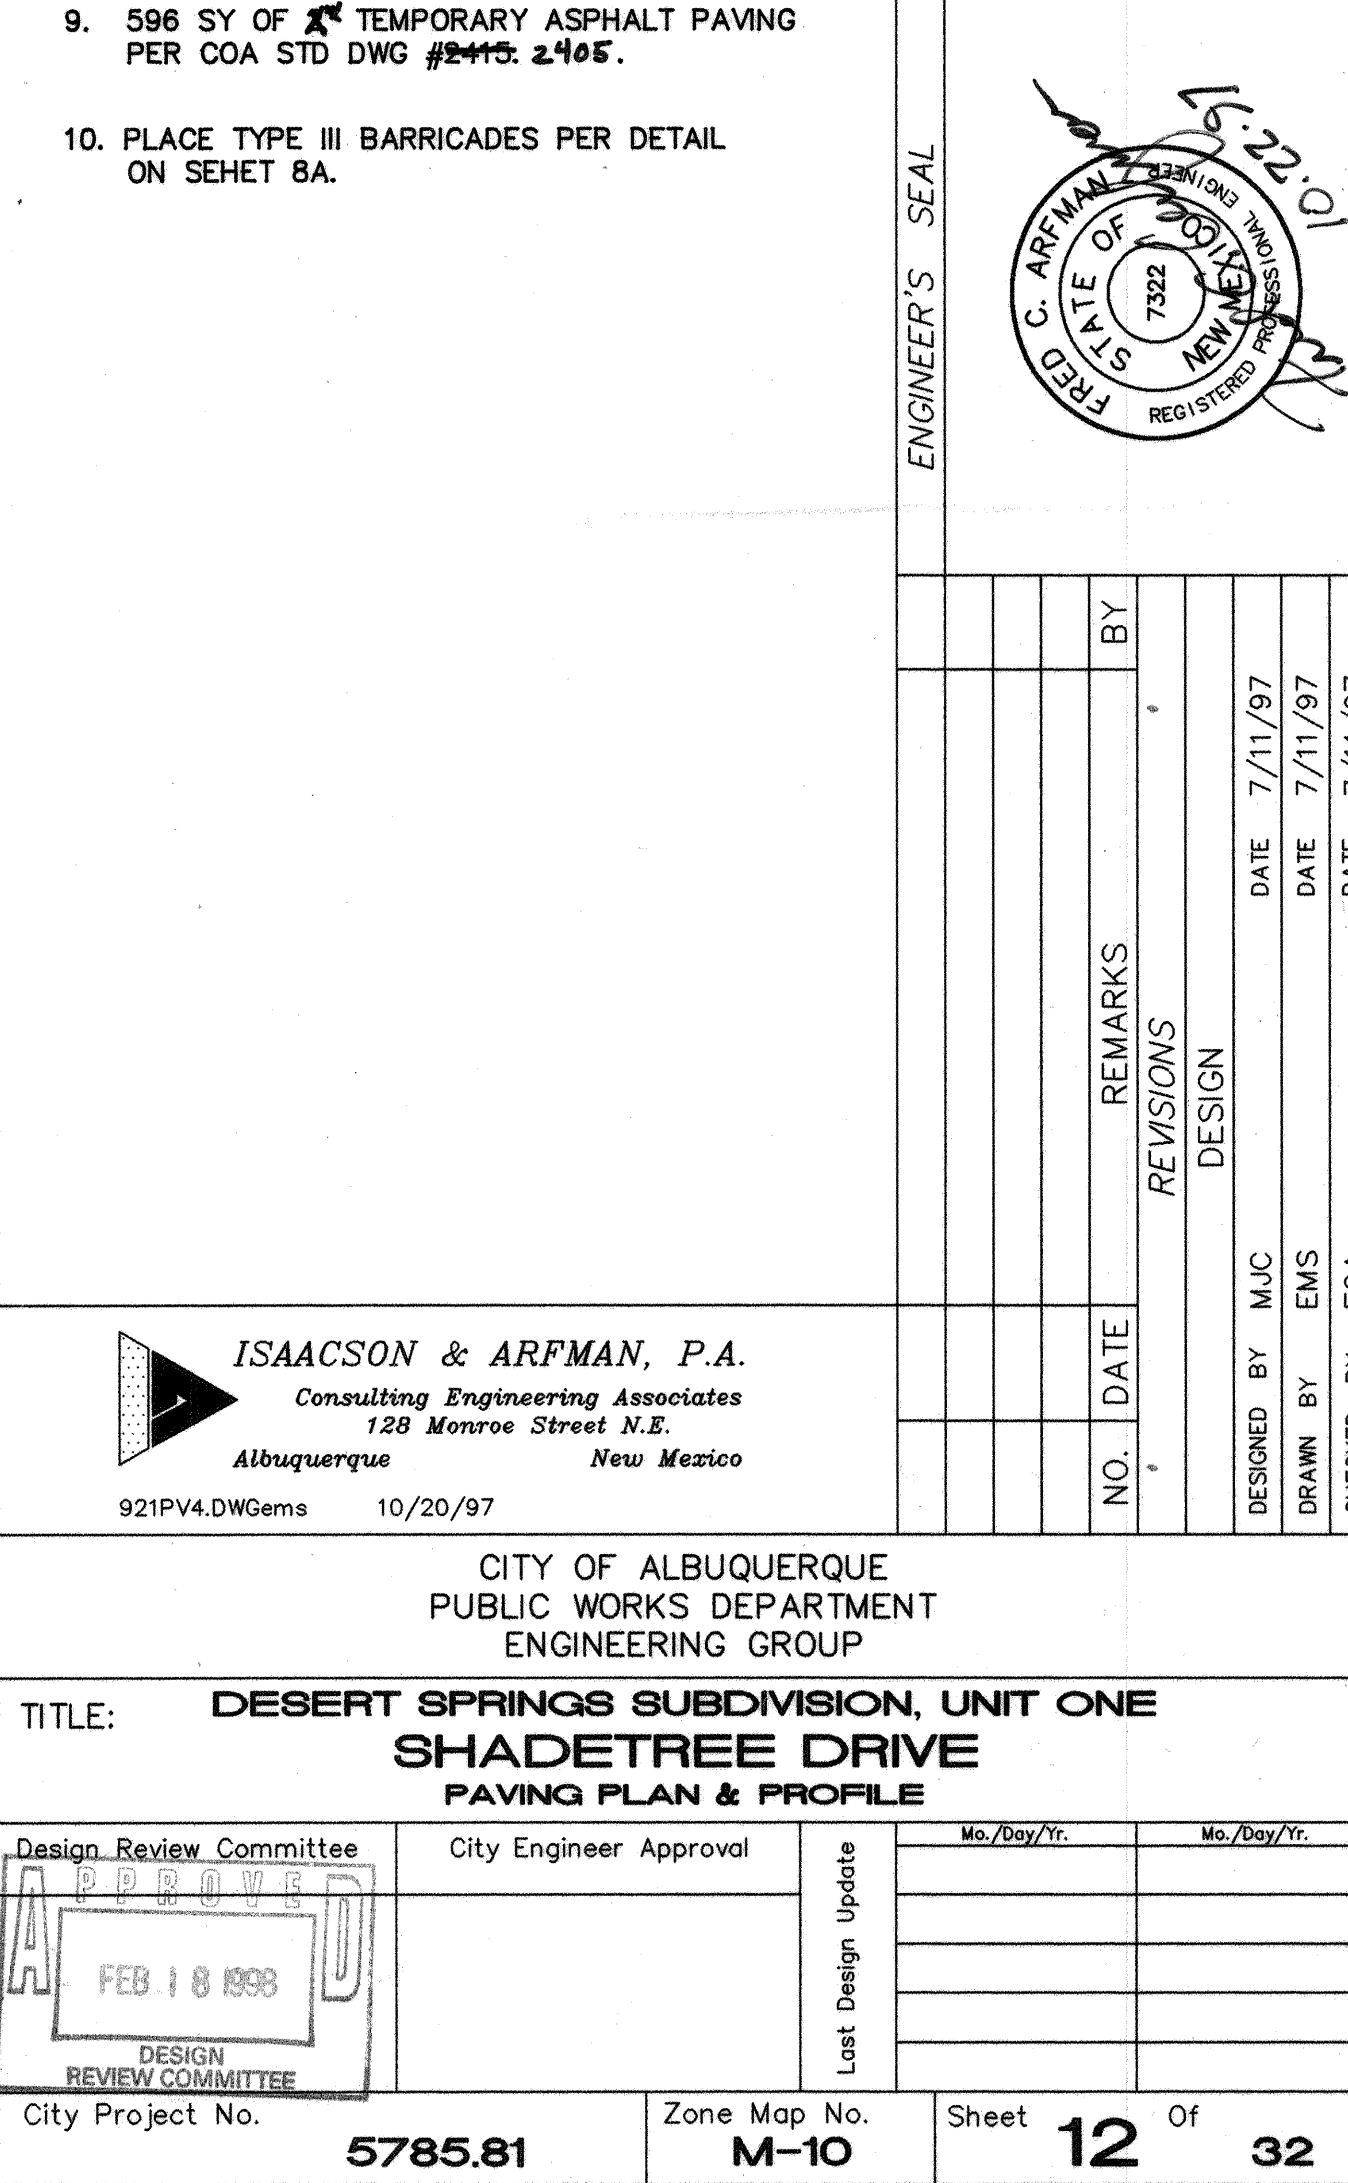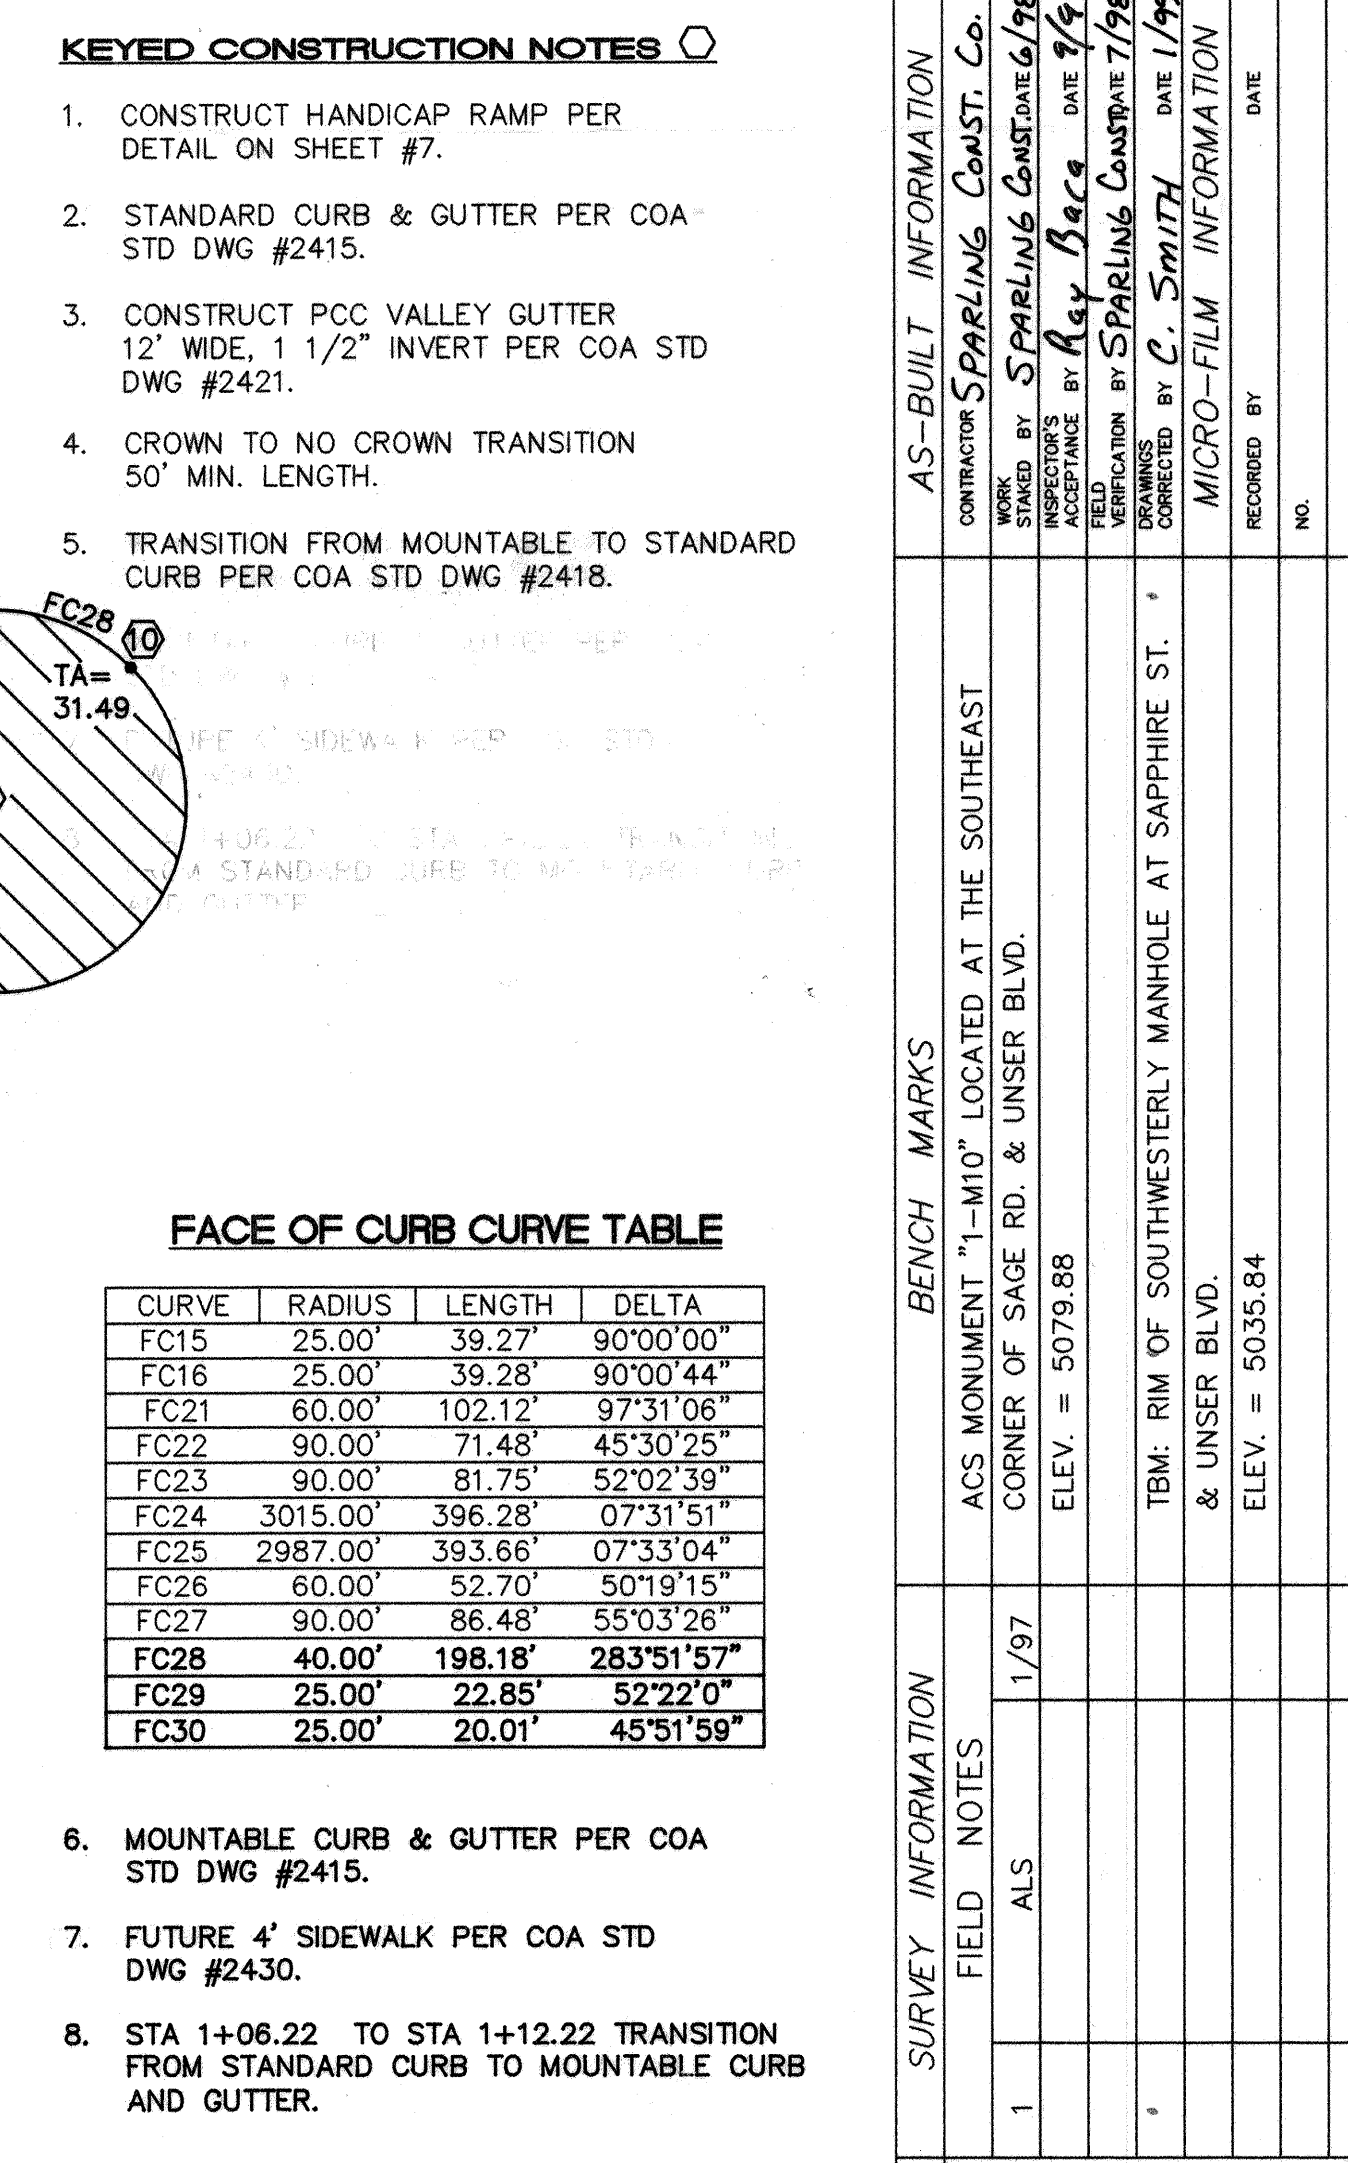

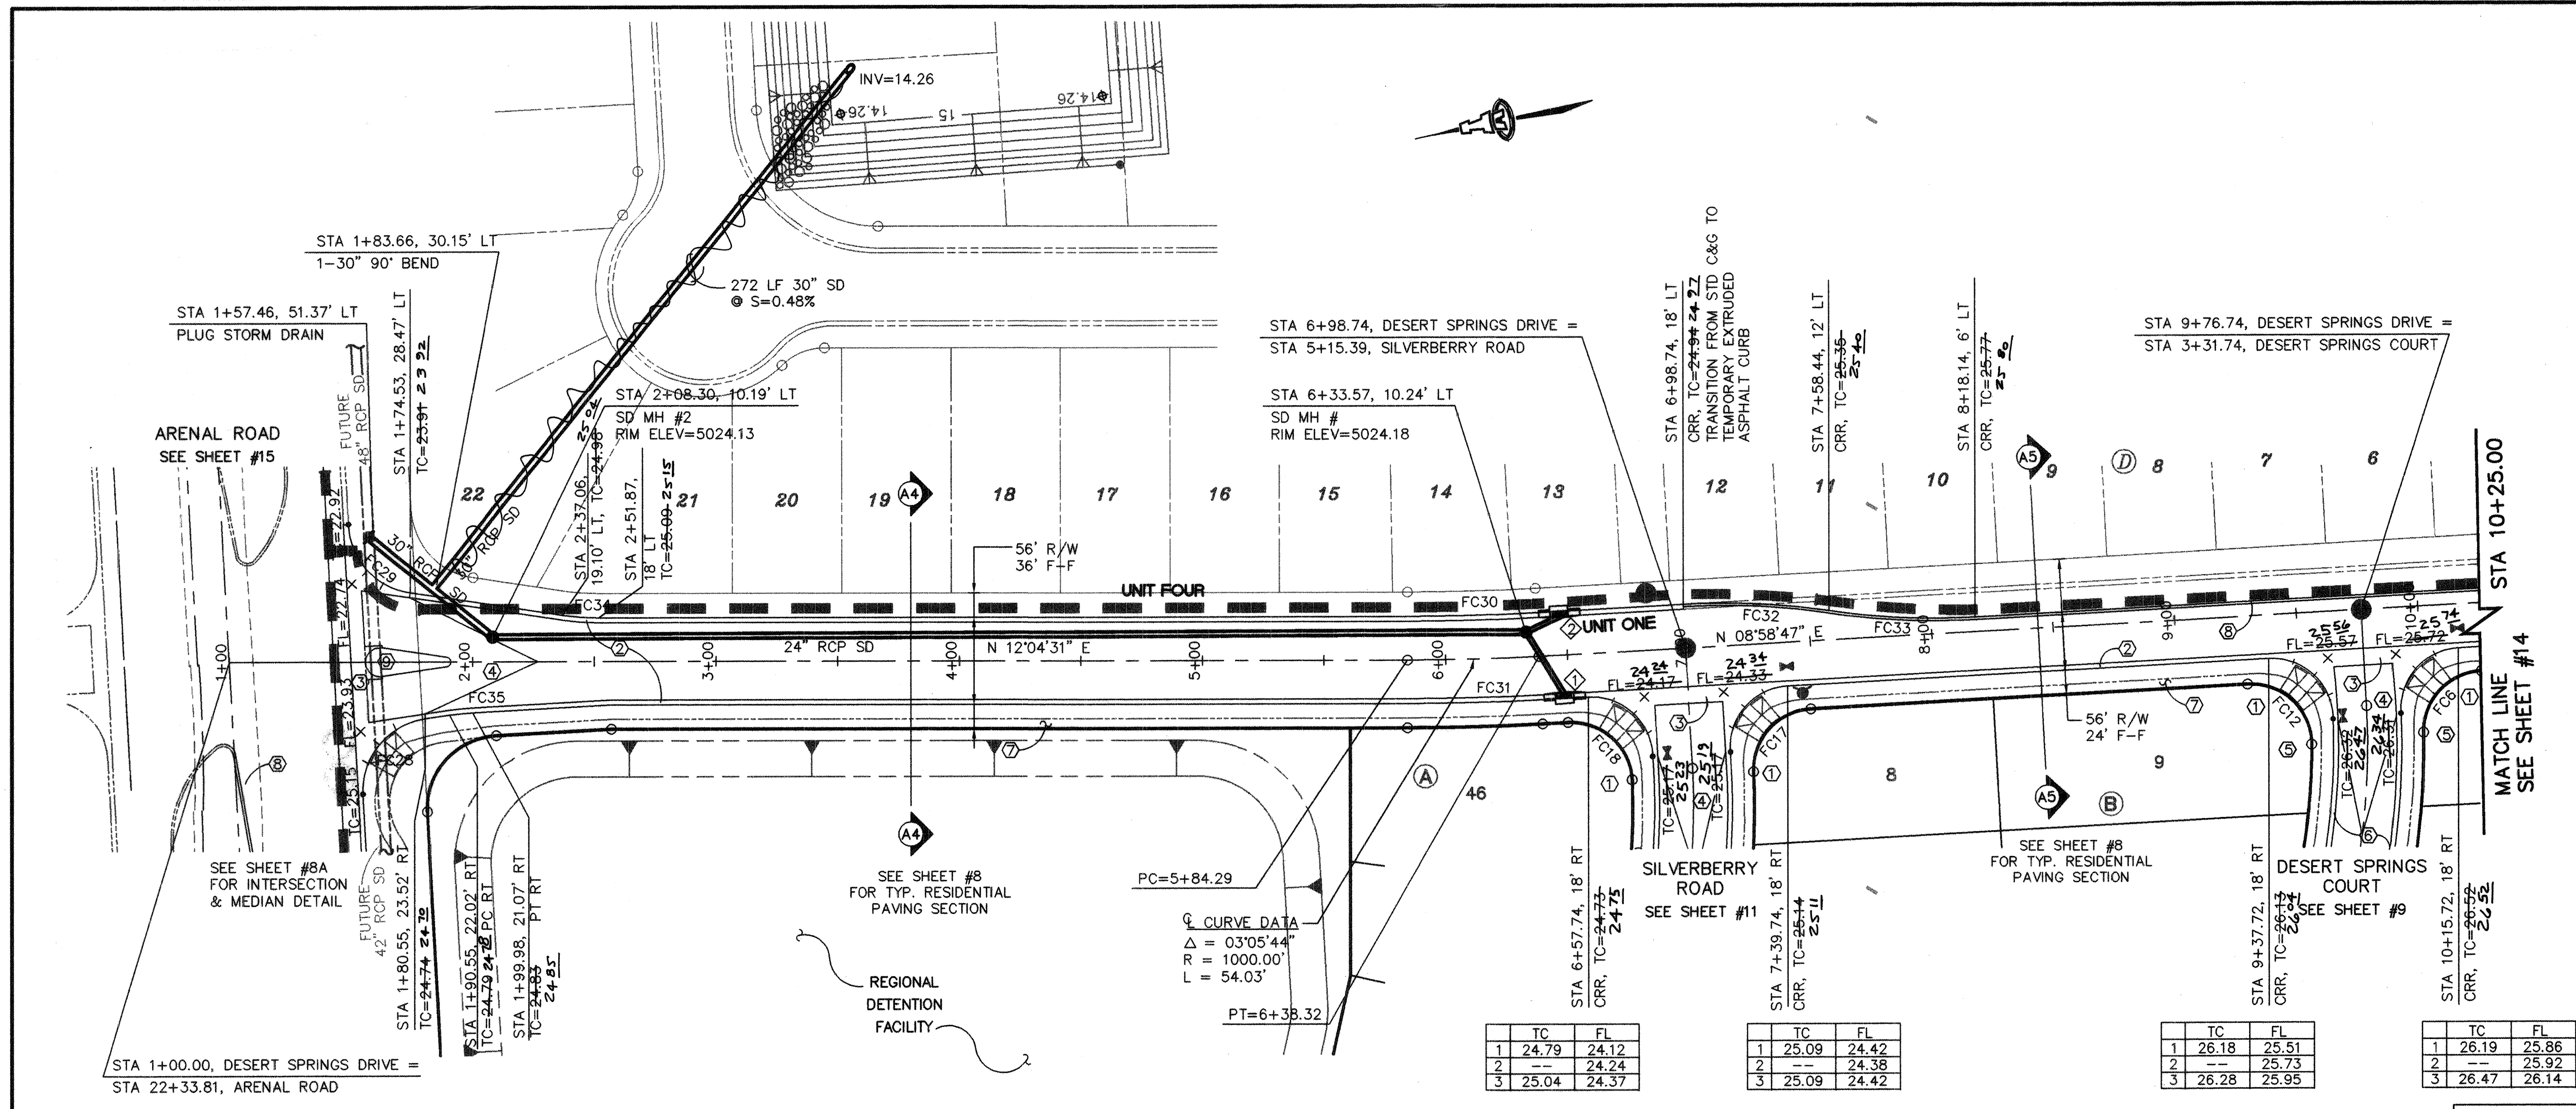

- KEYED CONSTRUCTION NOTES**
- CONSTRUCT HANDICAP RAMP PER DETAIL ON SHEET #7.
 - STANDARD CURB & GUTTER PER COA STD DWG #2415.
 - CONSTRUCT PCC VALLEY GUTTER 6' WIDE, 1 1/2" INVERT PER COA STD DWG #2420.
 - CROWN TO NO CROWN TRANSITION 50' MIN. LENGTH.
 - TRANSITION FROM MOUNTABLE TO STANDARD CURB PER COA STD DWG #2418.
 - MOUNTABLE CURB & GUTTER PER COA STD DWG #2415.
 - FUTURE 4' SIDEWALK PER COA STD DWG #2430.
 - TEMPORARY EXTRUDED ASPHALT CURB PER COA STD DWG #2415.
 - SEE MEDIAN DETAILS ON SHEET 8A.

FACE OF CURB CURVE TABLE

CURVE	RADIUS	LENGTH	DELTA
FC6	25.00'	39.03'	89°27'16"
FC12	25.00'	39.58'	90°42'31"
FC17	25.00'	39.27'	90°00'00"
FC18	25.00'	39.27'	90°00'00"
FC28	30.00'	44.28'	84°34'33"
FC29	30.00'	41.04'	78°23'05"
FC30	982.00'	53.06'	03°05'44"
FC31	1018.00'	55.00'	03°05'44"
FC32	300.00'	60.10'	11°28'42"
FC33	300.00'	60.10'	11°28'42"
FC34	100.00'	14.87'	08°31'11"
FC35	100.00'	9.48'	05°25'46"

STORM DRAIN INLET INFORMATION


INLET NO.	INLET TYPE	STATION* & OFFSET	TOP GR. EL.	INV. OUT
1	A, DBL THROAT	6+47.74, 16' RT	-23.78 -23.80	-20.60 -20.74
2	A, DBL THROAT	6+47.74, 16' LT	-23.78 -23.81	-20.60 -20.74

*STATIONING IS TO MIDPOINT OF GRATE @ FACE OF CURB

CONNECTOR PIPE INFORMATION


FROM INLET NO.	DIA. (IN)	LENGTH (FT)	SLOPE (FT/FT)
1	18	29.81'	1.61%
2	18	15.24'	3.15%

SCALES:
1"=40' HOR.
1"=10' VERT.

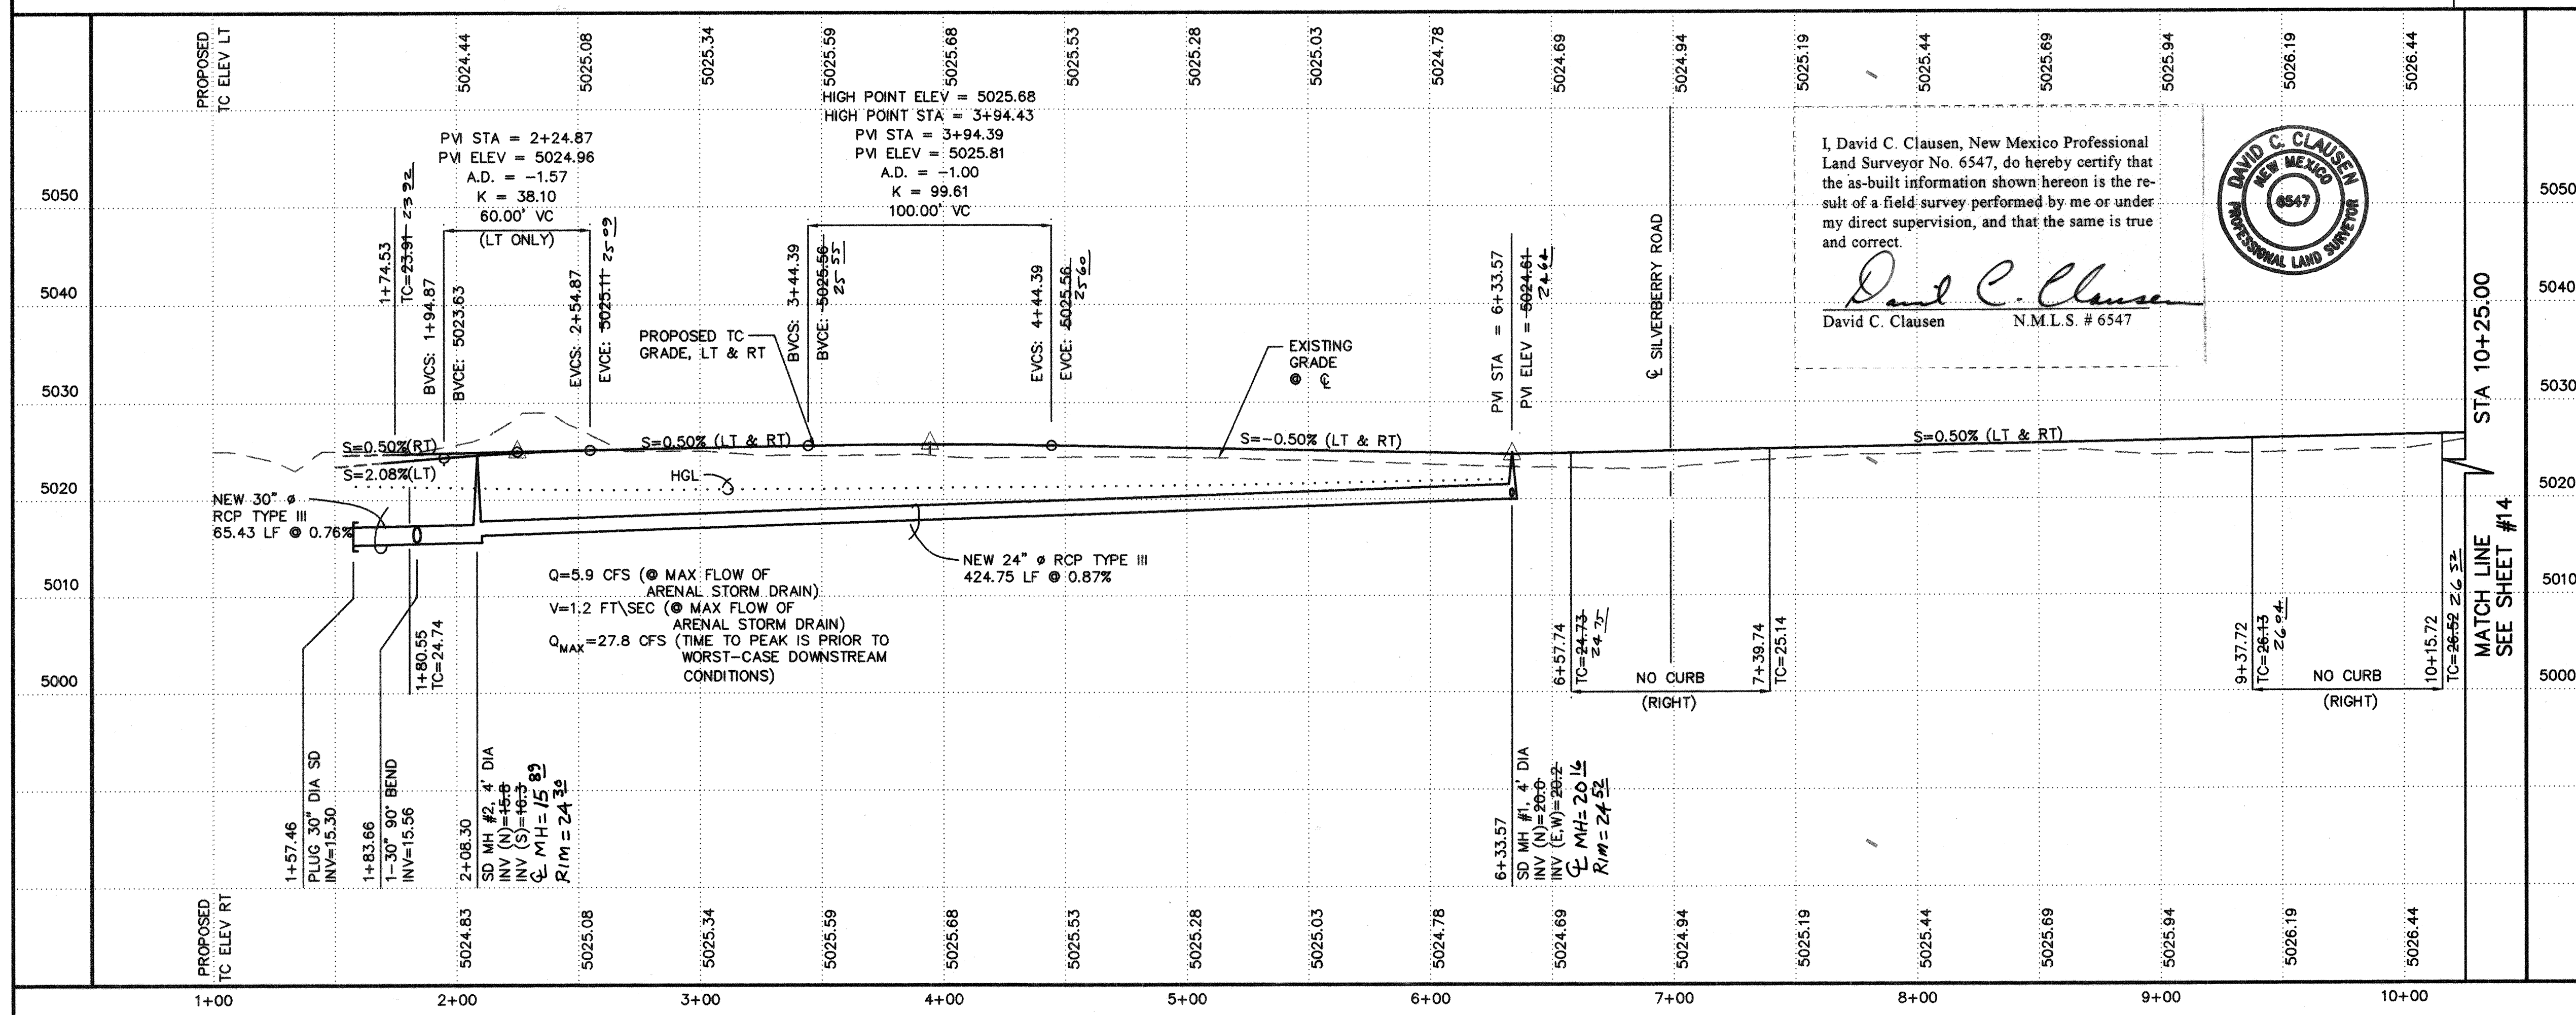

I, David C. Clausen, New Mexico Professional Land Surveyor No. 6547, do hereby certify that the as-built information shown herein is the result of a field survey performed by me or under my direct supervision, and that the same is true and correct.

David C. Clausen
David C. Clausen N.M.L.S. # 6547

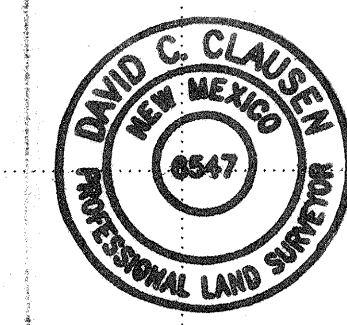

ISAACSON & ARFMAN, P.A.
Consulting Engineering Associates
128 Monroe Street N.E.
Albuquerque New Mexico
921PV5.DWGms 10/20/97

CITY OF ALBUQUERQUE
PUBLIC WORKS DEPARTMENT
ENGINEERING GROUP

TITLE: **DESERT SPRINGS SUBDIVISION, UNIT ONE
DESERT SPRINGS DRIVE
PAVING & STORM DRAIN PLAN & PROFILE**

Design Review Committee City Engineer Approval

APPROVED FEB 1 9 1998

DESIGN REVIEW COMMITTEE

City Project No. **5785.81** Zone Map No. **M-10** Sheet **13** Of **32**

AS-BUILT INFORMATION

CONTRACTOR: **SPARKLING CONST. CO.**
STARTED BY: **SPARKLING CONST. CO.** DATE: **7/97**
INSPECTED BY: **Ray Arca** DATE: **7/97**
FIELD VERIFICATION BY: **SPARKLING CONST. CO.** DATE: **1/99**
CORRECTED BY: **C. SMITH** DATE: **1/99**
MICRO-FILM INFORMATION
RECORDED BY: **NO.** DATE: **NO.**

BENCH MARKS


ACS MONUMENT "1-M10" LOCATED AT THE SOUTHEAST CORNER OF SAGE RD. & UNSER BLVD.
ELEV. = 5079.88

SURVEY INFORMATION

FIELD NOTES
1/97
ALS

ENGINEER'S SEAL


REVISIONS
NO. DATE
DESIGNED BY: **MJC** DATE: **7/11/97**
DRAWN BY: **EMS** DATE: **7/11/97**
CHECKED BY: **FCA** DATE: **7/11/97**

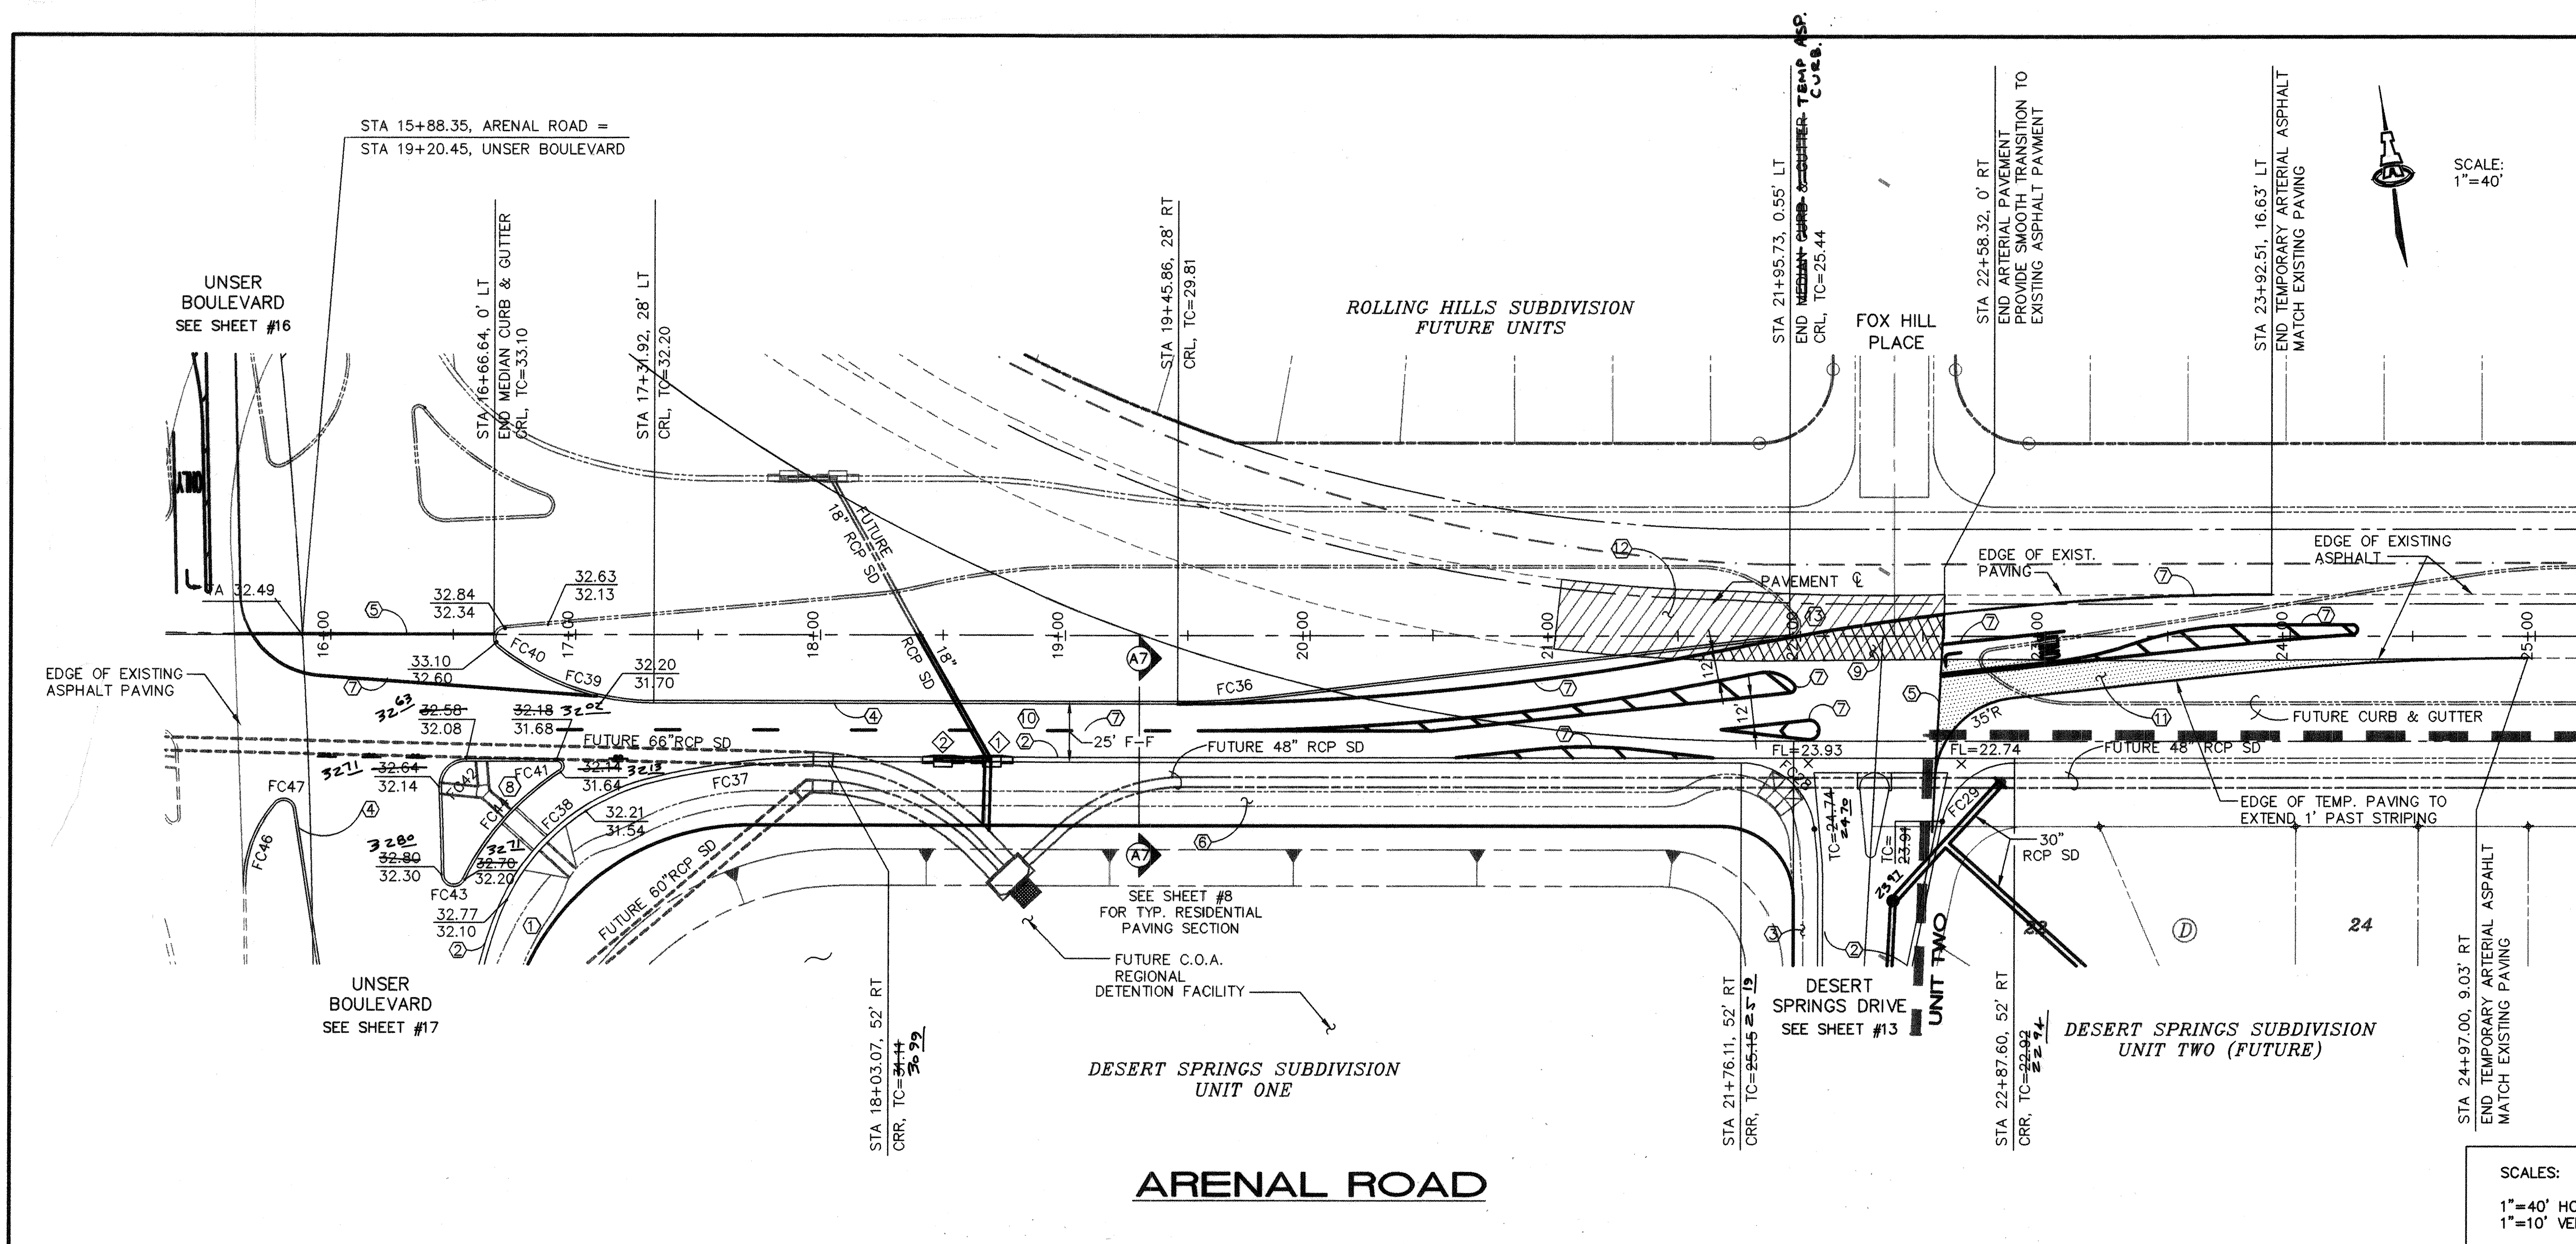

- ### KEYED CONSTRUCTION NOTES
- 10' ASPHALT TRAIL.
 - STANDARD CURB & GUTTER PER COA STD DWG #2415.
 - FUTURE 4' SIDEWALK PER COA STD DWG #2420.
 - TEMPORARY ~~EXTENDED~~ CONCRETE CURB PER COA STD DWG #2415.
 - EDGE OF ARTERIAL ASPHALT PAVING.
 - 6' SIDEWALK PER COA STD DWG #2430.
 - SEE SHEET #32 FOR STRIPING INFORMATION.
 - SEE SHEETS 8 & 8A FOR MEDIAN & INTERSECTION DETAILS.
 - REPLACE TEMPORARY PAVING WITH ARTERIAL PAVEMENT PER SHEET 8.
 - ARTERIAL PAVEMENT PER SECTION ON SHEET #8.
 - 207 SY TEMPORARY PAVING PER COA STD DWG #2415.
 - CUT AND REMOVE 477 SY EXISTING ASPHALT PAVING AND CONSTRUCT BERM AT STA 21+00.00.
 - EXTEND PCC CURB AROUND MEDIAN NOSE.

FACE OF CURB CURVE TABLE

CURVE	RADIUS	LENGTH	DELTA
FC28	30.00'	44.28'	84°34'33"
FC29	30.00'	41.04'	78°23'05"
FC36	299.00	35.18	06°44'31"
FC37	300.00	71.89	13°43'45"
FC38	90.00	86.82	55°16'27"
FC39	100.00	68.21	39°04'48"
FC40	4.00	4.79	68°38'08"
FC41	2.00	5.13	147°03'53"
FC42	10.00	16.07	92°05'10"
FC43	4.00	10.68	152°58'08"
FC44	110.00	60.26	31°23'23"
FC47	4.00	9.08	130°05'23"
FC48	2864.00	100.00	02°00'02"

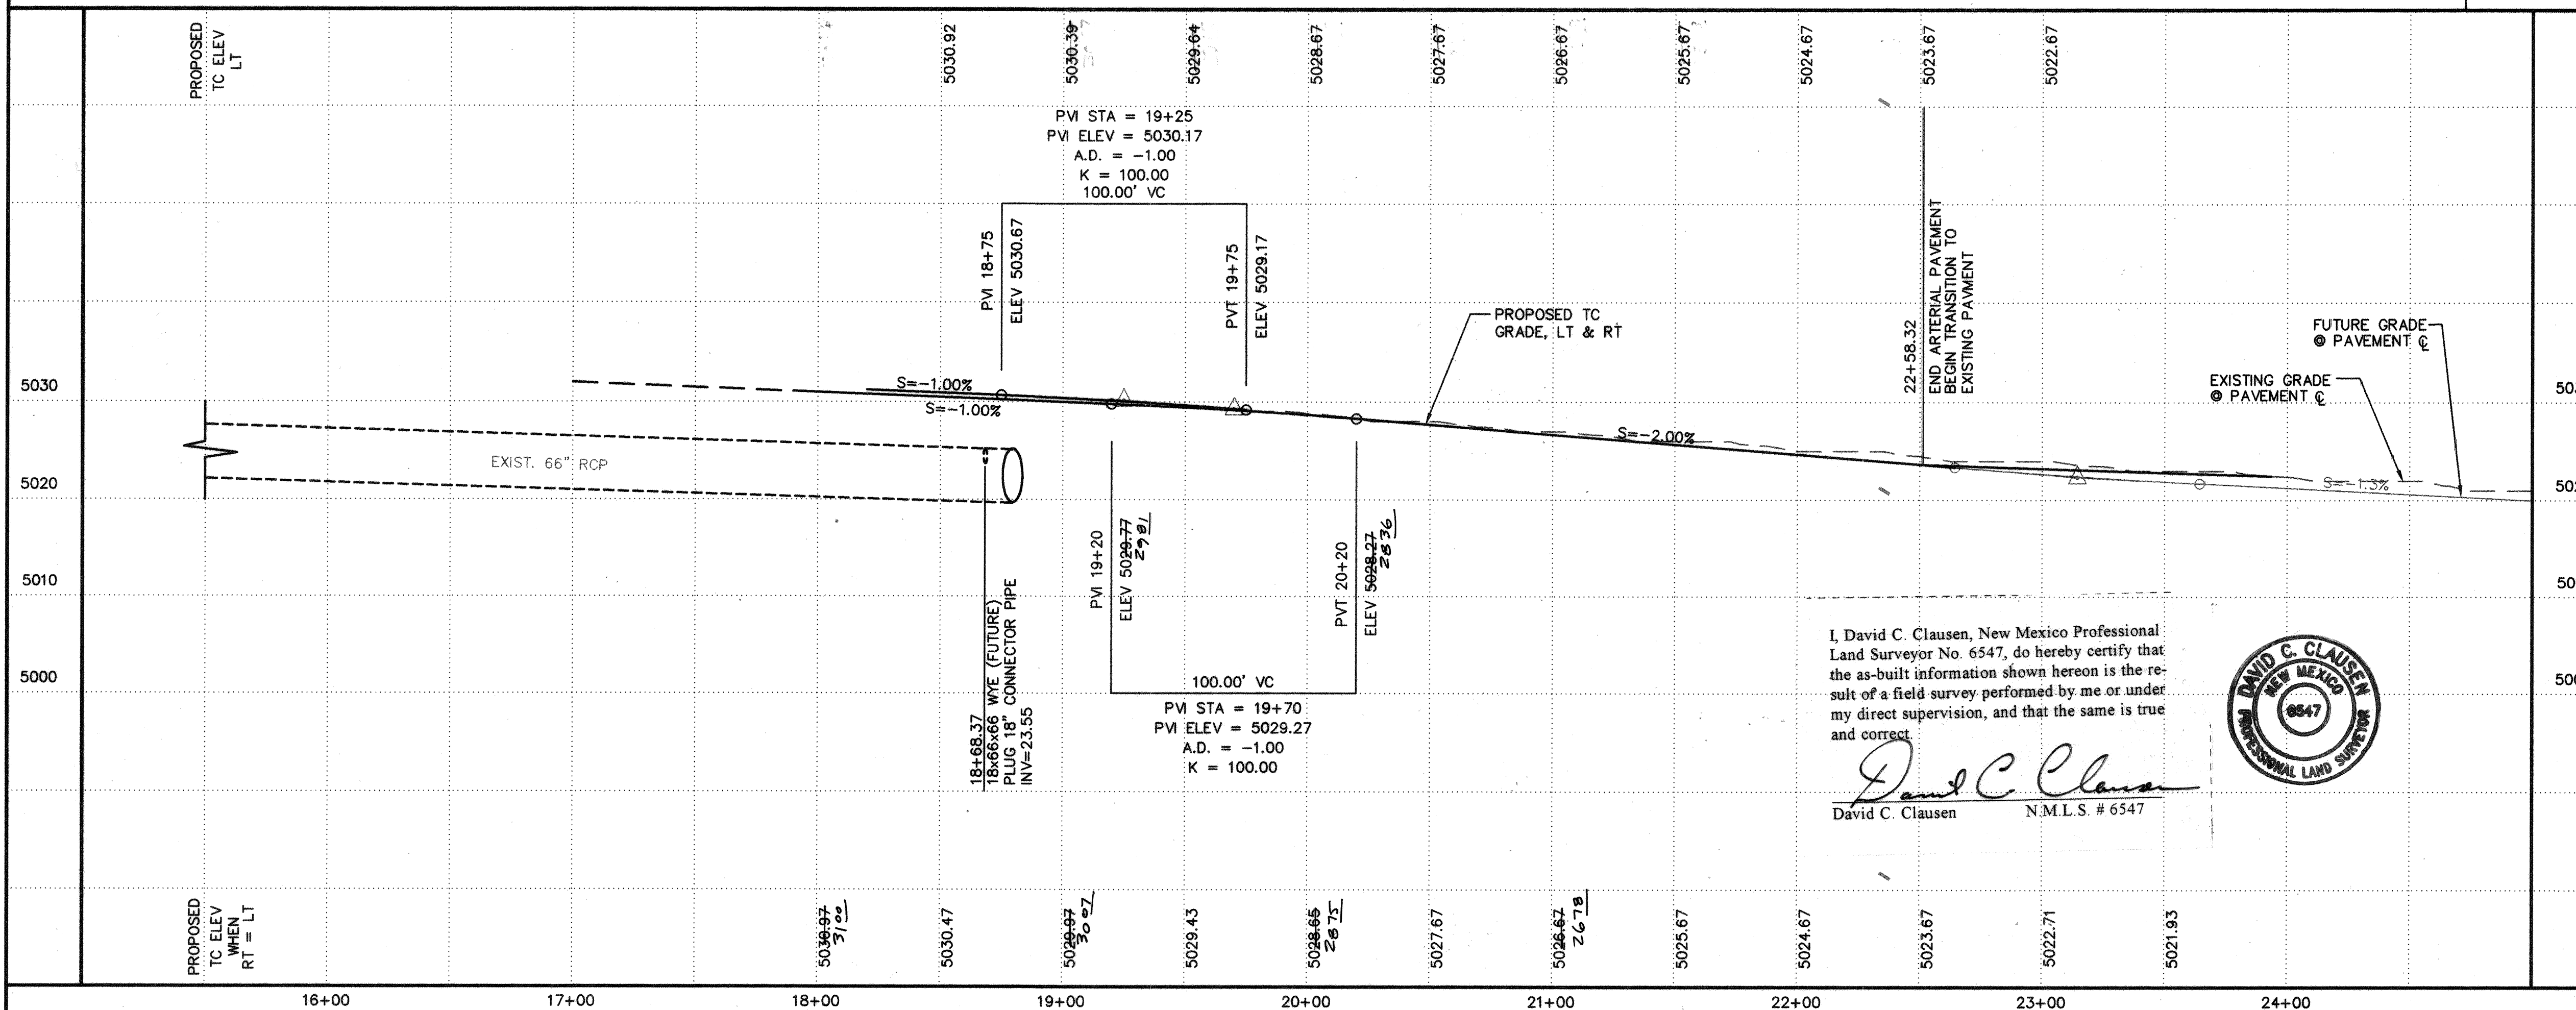

STORM DRAIN INLET INFORMATION

INLET NO.	INLET TYPE	STATION* & OFFSET	TOP GR. EL.	INV. OUT
1	A, SGL	18+68.37, 50' RT	29.84 29.43	25.26(N&W) 25.16(S)
2	A, SGL	18+48.37, 50' RT	30.04 29.33	25.67

*STATIONING IS TO MIDPOINT OF GRATE @ FACE OF CURB

CONNECTOR PIPE INFORMATION

FROM INLET NO.	DIA. (IN)	LENGTH (FT)	SLOPE (FT/FT)
1 (N)	18	54'	1.0%
1 (S)	18	27'	6.7%
2	18	20	2.0%

ISAACSON & ARFMAN, P.A.
Consulting Engineering Associates
128 Monroe Street N.E.
Albuquerque, New Mexico
921PV7.DWGens 01/09/98

**CITY OF ALBUQUERQUE
PUBLIC WORKS DEPARTMENT
ENGINEERING GROUP**

TITLE: **DESERT SPRINGS SUBDIVISION, UNIT ONE
ARENAL ROAD
PAVING & STORM DRAIN PLAN & PROFILE**

Design Review Committee

City Engineer Approval


Last Design Update

No./Day/Yr.	No./Day/Yr.

City Project No. **5785.81** Zone Map No. **M-10** Sheet **15** Of **32**

I, David C. Clausen, New Mexico Professional Land Surveyor No. 6547, do hereby certify that the as-built information shown hereon is the result of a field survey performed by me or under my direct supervision, and that the same is true and correct.

David C. Clausen
David C. Clausen N.M.L.S. # 6547

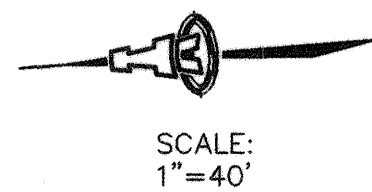

SCALE:
1"=40'

ROLLING HILLS SUBDIVISION
FUTURE UNITS

STA 19+20.45, UNSER BLVD. =
STA 15+88.35, ARENAL ROAD

ARNAL ROAD
SEE SHEET #15

REGIONAL
DETENTION
FACILITY

SEE SHEET #17

SUNRISE ESTATES SUBDIVISION
UNIT TWO

UNSER BLVD.


KEYED CONSTRUCTION NOTES

1. 1,103 SY TEMPORARY PAVING PER COA STD DWG #2415.
2. CUT AND REMOVE 770 SY EXISTING ASPHALT PAVING AND CONSTRUCT BERM AT STA 15+75.00 AND STA 18+00.00.
3. SEE SHEET #32 FOR STRIPING INFORMATION.
4. EDGE OF ARTERIAL ASPHALT PAVING.
5. INSTALL STOP SIGN PER MUTCD.

AS-BUILT INFORMATION			
CONTRACTOR	WORK	DATE	DATE
SPAVED BY	BY	DATE	DATE
ACCEPTANCE BY	BY	DATE	DATE
REVISION	BY	DATE	DATE
REVISION	BY	DATE	DATE
REVISION	BY	DATE	DATE
REVISION	BY	DATE	DATE

MICRO-FILM INFORMATION			
CONTRACTOR	WORK	DATE	DATE
SPAVED BY	BY	DATE	DATE
ACCEPTANCE BY	BY	DATE	DATE
REVISION	BY	DATE	DATE
REVISION	BY	DATE	DATE
REVISION	BY	DATE	DATE
REVISION	BY	DATE	DATE

SURVEY INFORMATION			
FIELD	NOTES	DATE	DATE
1	ALS	1/97	

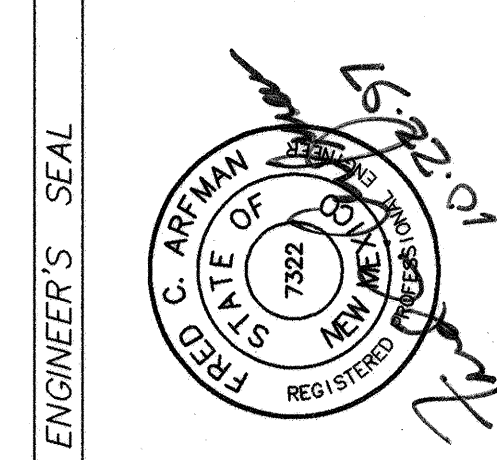

ENGINEER'S SEAL			
NO.	DATE	REVISIONS	BY
		DESIGN	
DESIGNED BY	MJC	DATE	7/11/97
DRAWN BY	EMS	DATE	7/11/97
CHECKED BY	FCA	DATE	7/11/97

ISAACSON & ARFMAN, P.A.
Consulting Engineering Associates
128 Monroe Street N.E.
Albuquerque, New Mexico
921PV8.DWGems VIEW: 3 10/21/97

CITY OF ALBUQUERQUE
PUBLIC WORKS DEPARTMENT
ENGINEERING GROUP

TITLE: **DESERT SPRINGS SUBDIVISION, UNIT ONE
UNSER BOULEVARD
TEMPORARY PAVING PLAN**

Design Review Committee
APPROVED
FEB 18 1998
DESIGN REVIEW COMMITTEE

City Engineer Approval



Least Design Update

Mo./Day/Yr.	Mo./Day/Yr.

City Project No. **5785.81**


Zone Map No. **M-10**

Sheet **16** Of **32**

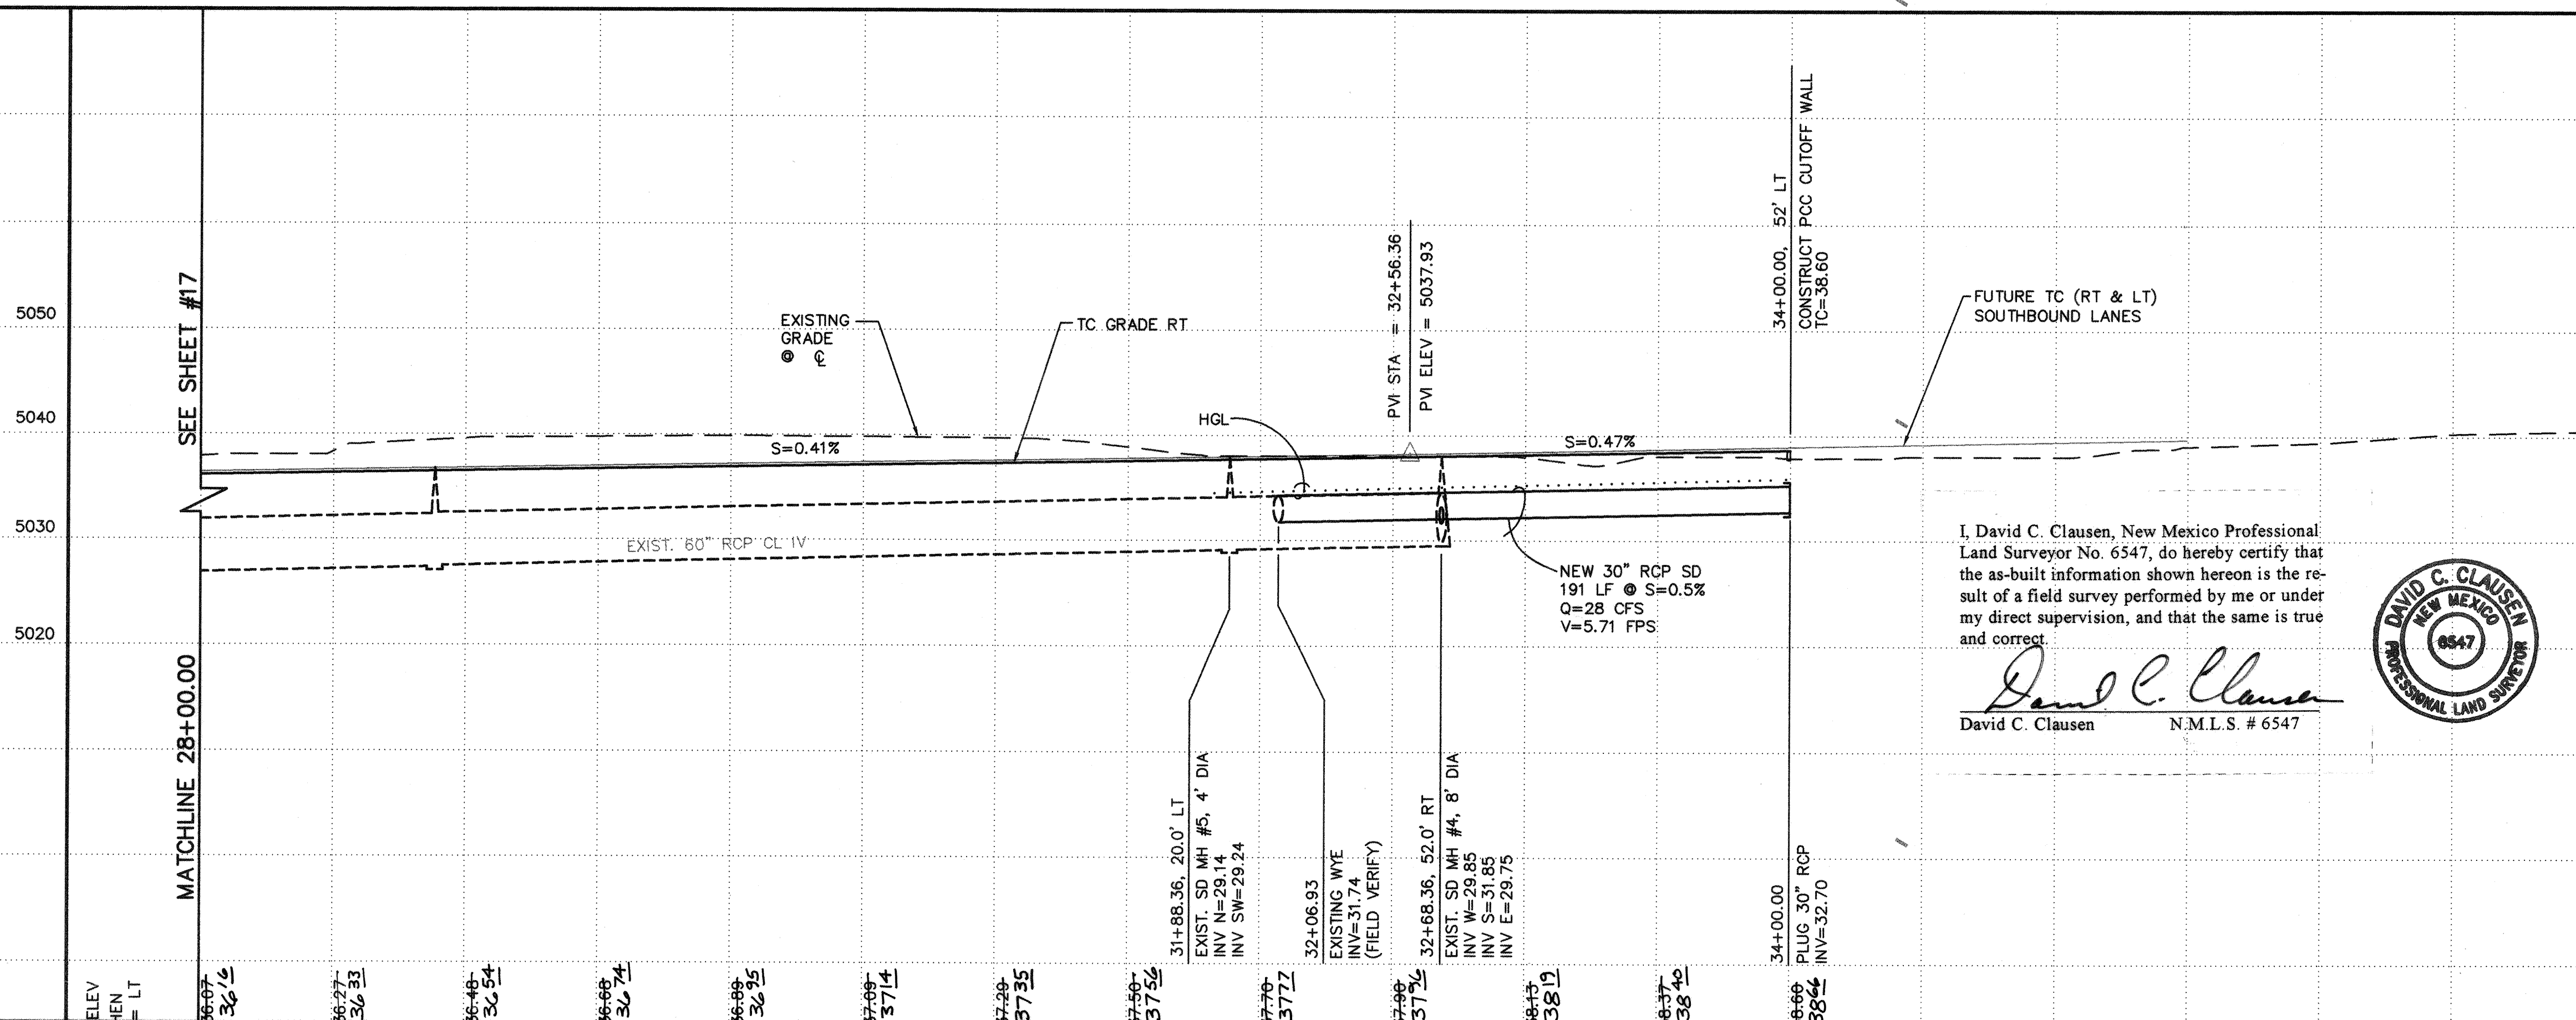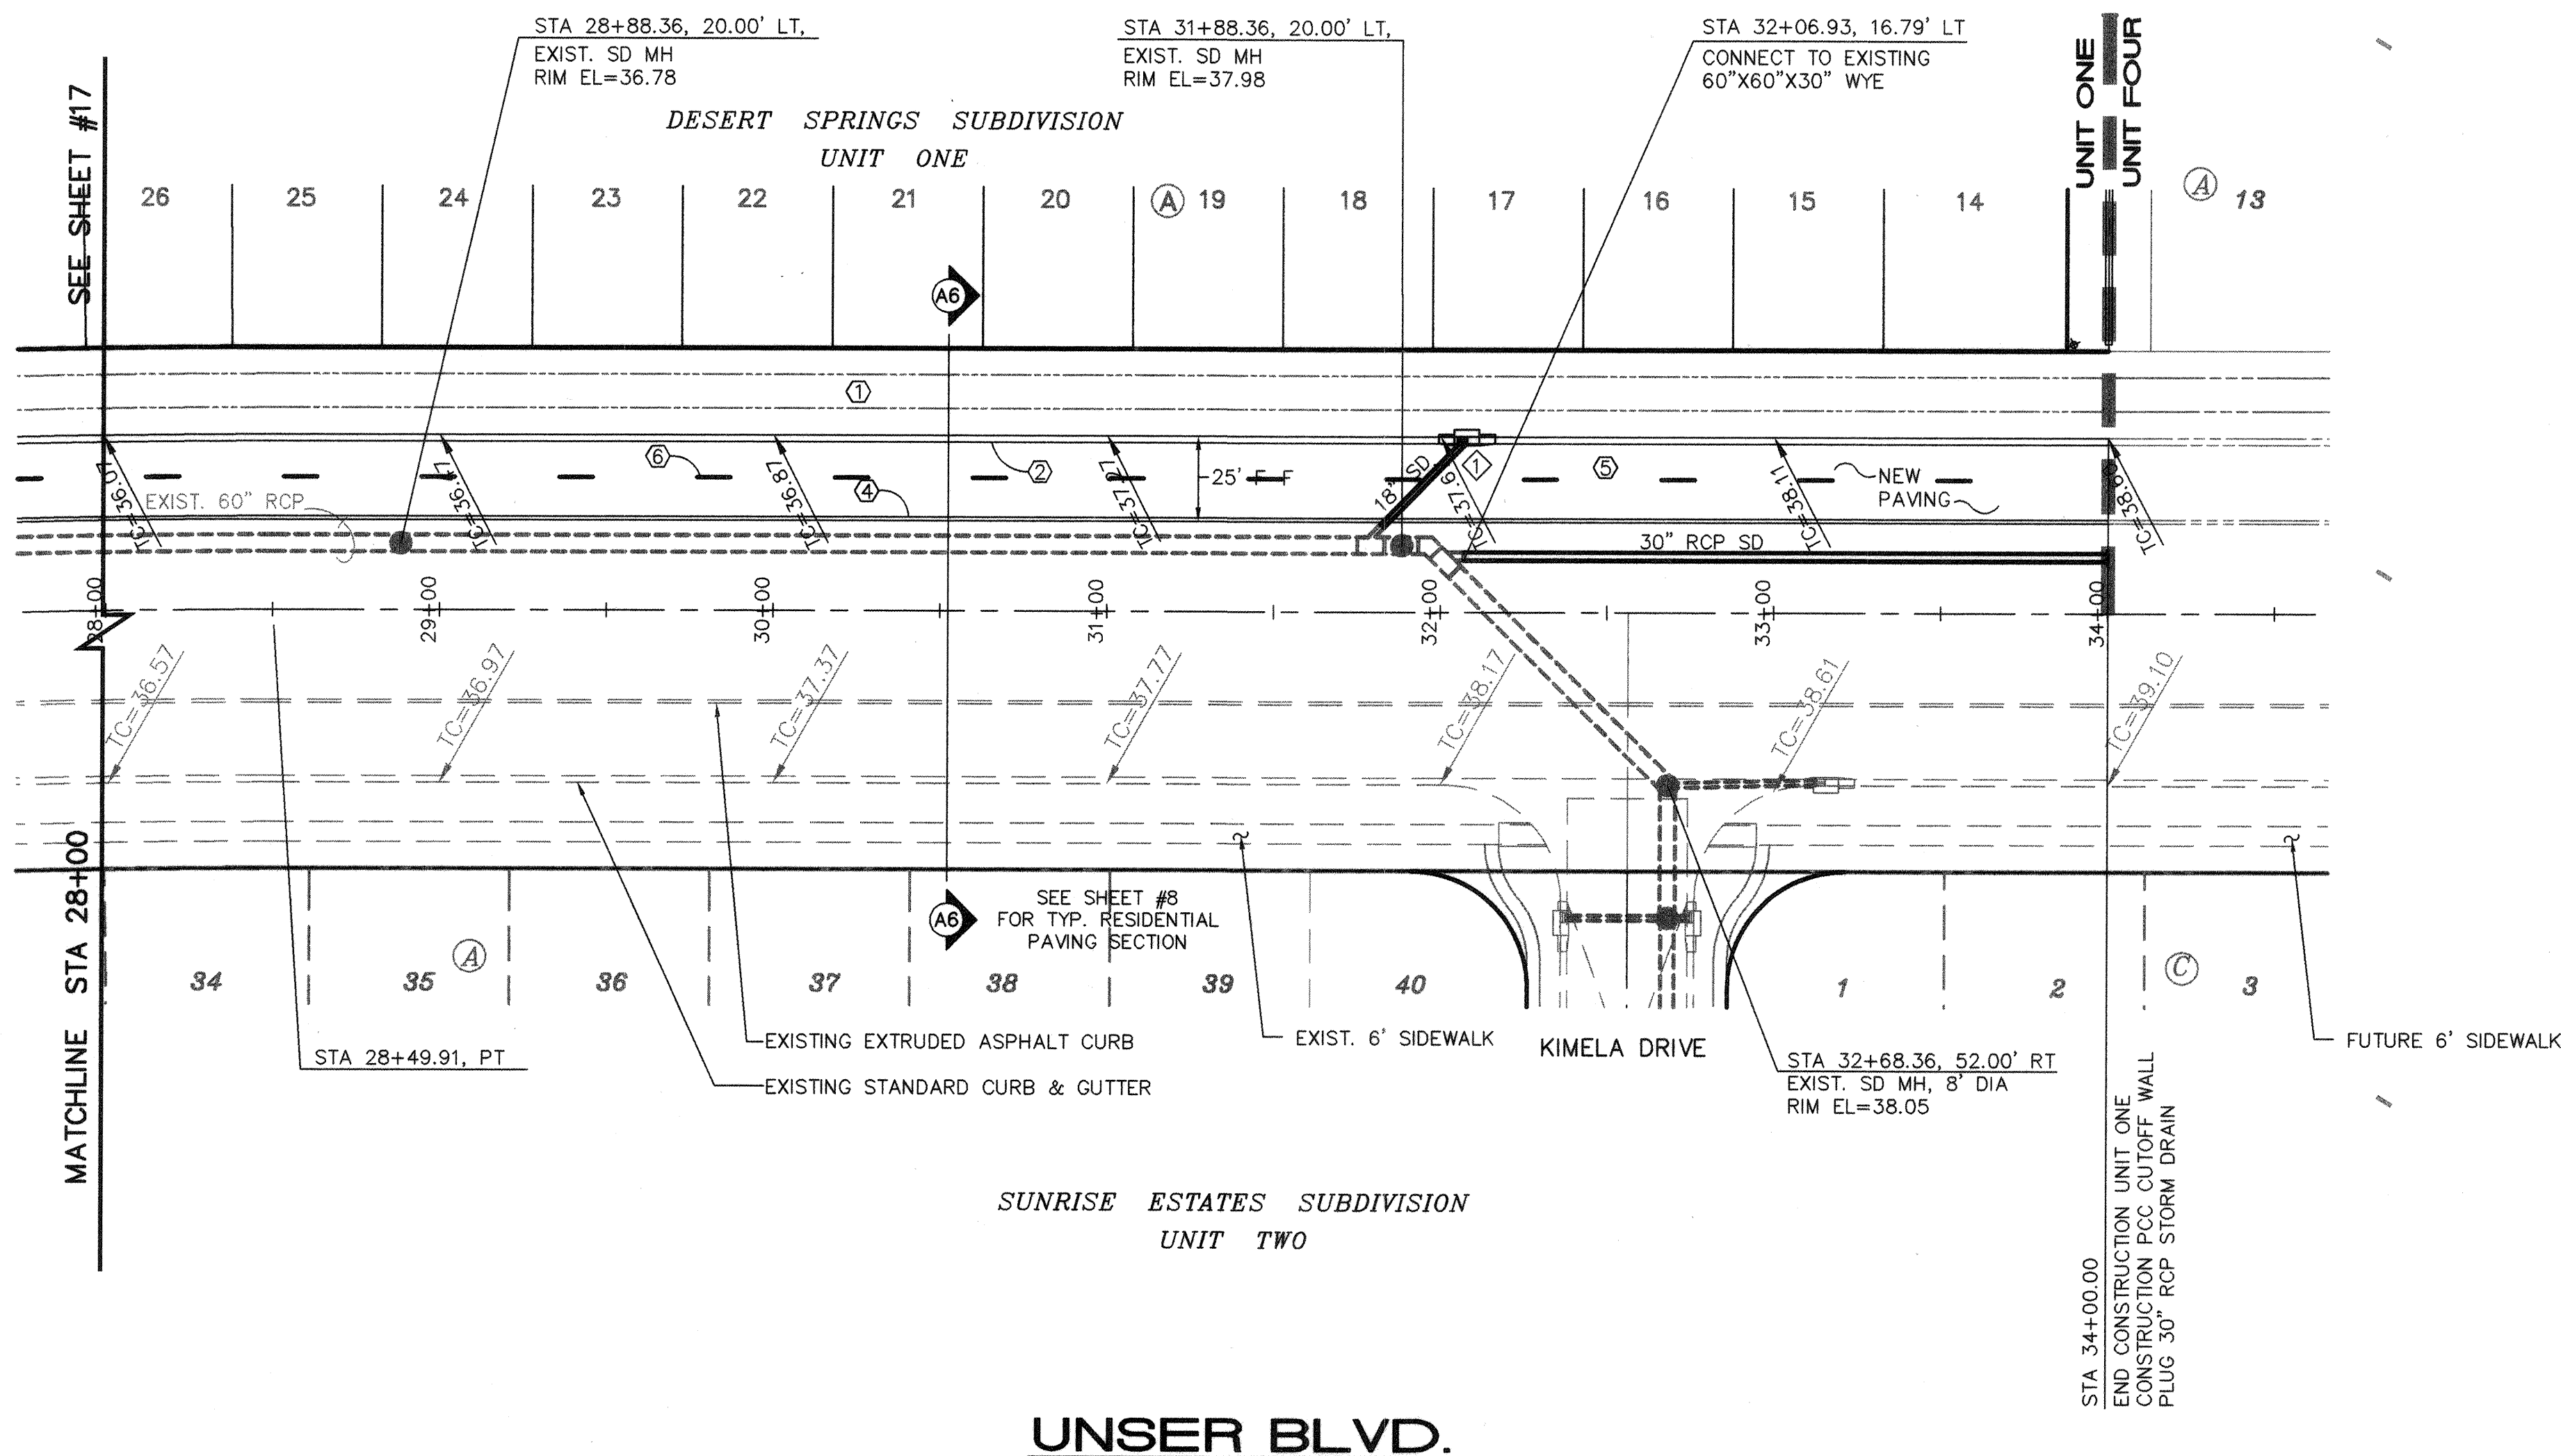

I, David C. Clausen, New Mexico Professional Land Surveyor No. 6547, do hereby certify that the as-built information shown hereon is the result of a field survey performed by me or under my direct supervision, and that the same is true and correct.

David C. Clausen
David C. Clausen N.M.L.S. # 6547

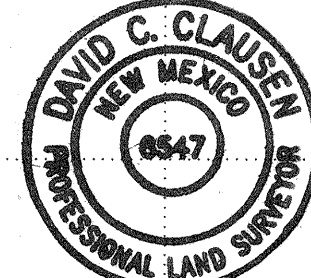

- KEYED CONSTRUCTION NOTES**
1. FUTURE 10' ASPHALT TRAIL.
 2. STANDARD CURB & GUTTER PER COA STD DWG #2415.
 3. FUTURE 4' SIDEWALK PER COA STD DWG #2420.
 4. TEMPORARY EXTRUDED ASPHALT CURB PER COA STD DWG #2415.
 5. ARTERIAL PAVING PER SECTION ON SHEET #8.
 6. SEE SHEET 32 FOR STRIPING INFORMATION.

STORM DRAIN INLET INFORMATION				
INLET NO.	INLET TYPE	STATION* & OFFSET	TOP GR. EL.	INV. OUT
1	A, SG	32+06.58, 50'LT	37.02	32.82

*STATIONING IS TO MIDPOINT OF GRATE @ FACE OF CURB

CONNECTOR PIPE INFORMATION			
FROM INLET NO.	DIA. (IN)	LENGTH (FT)	SLOPE (FT/FT)
1	18	35'	0.03

ENGINEER'S SEAL

STATE OF NEW MEXICO
FEB 10 2000
DAVID C. ARFMAN
REGISTERED PROFESSIONAL ENGINEER

NO.	DATE	REMARKS	BY
1	7/11/97	DESIGN	
2	7/11/97	REVISIONS	
3	7/11/97	DESIGN	

DESIGNED BY MJC
DRAWN BY EMS
CHECKED BY FCA


ISAACSON & ARFMAN, P.A.
Consulting Engineering Associates
128 Monroe Street N.E.
Albuquerque New Mexico
921PVB.DWGems VIEW: 2 10/21/97

CITY OF ALBUQUERQUE
PUBLIC WORKS DEPARTMENT
ENGINEERING GROUP

TITLE: **DESERT SPRINGS SUBDIVISION, UNIT ONE
UNSER BOULEVARD
PAVING PLAN & PROFILE**

Design Review Committee
City Engineer Approval
Mo./Day/Yr.
Mo./Day/Yr.

City Project No. **5785.81** Zone Map No. **M-10** Sheet **18** Of **32**

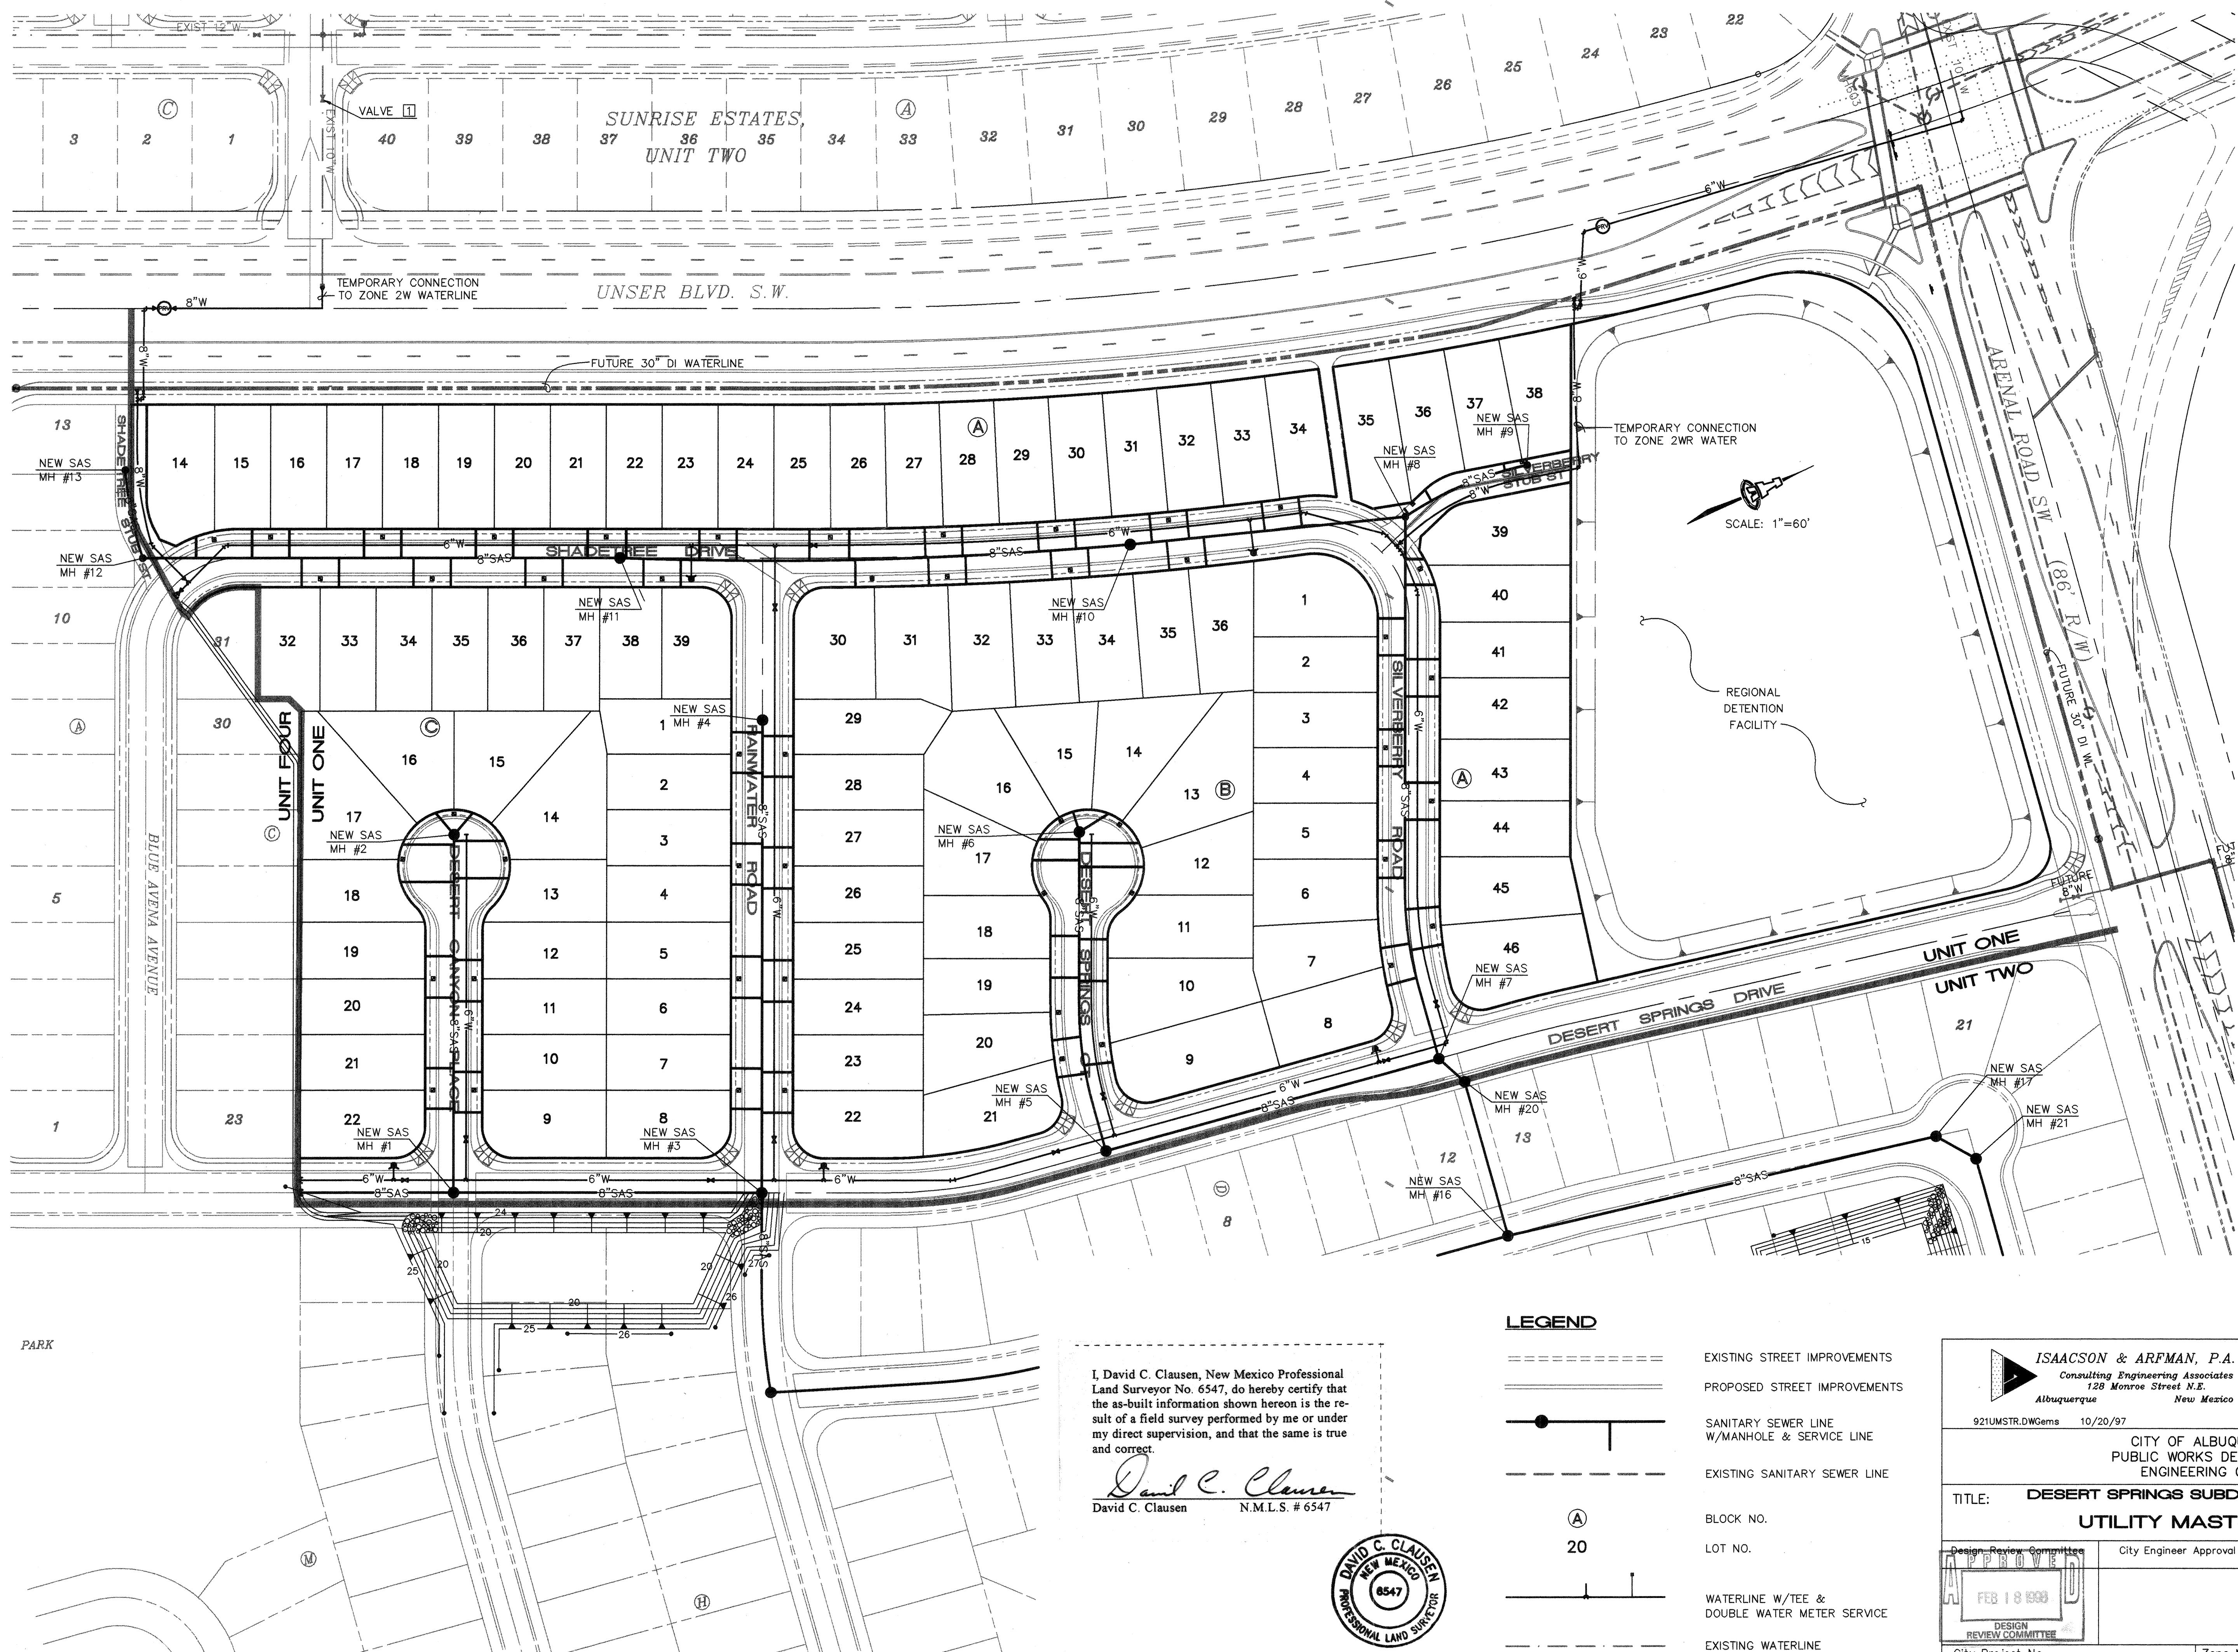

I, David C. Clausen, New Mexico Professional Land Surveyor No. 6547, do hereby certify that the as-built information shown hereon is the result of a field survey performed by me or under my direct supervision, and that the same is true and correct.

David C. Clausen
David C. Clausen N.M.L.S. # 6547



LEGEND


- EXISTING STREET IMPROVEMENTS
- PROPOSED STREET IMPROVEMENTS
- SANITARY SEWER LINE W/MANHOLE & SERVICE LINE
- EXISTING SANITARY SEWER LINE
- BLOCK NO.
- LOT NO.
- WATERLINE W/TEE & DOUBLE WATER METER SERVICE
- EXISTING WATERLINE

ISAACSON & ARFMAN, P.A. Consulting Engineering Associates 128 Monroe Street N.E. Albuquerque New Mexico 921UMSTR.DWG.ms 10/20/97	
CITY OF ALBUQUERQUE PUBLIC WORKS DEPARTMENT ENGINEERING GROUP	
TITLE: DESERT SPRINGS SUBDIVISION, UNIT ONE UTILITY MASTER PLAN	
DESIGNED BY: MJC	DATE: 7/11/97
DRAWN BY: EMS	DATE: 7/11/97
CHECKED BY: FCA	DATE: 7/11/97
REVISIONS	NO. DATE
DESIGN	1 7/11/97
City Project No. 5785.81 Zone Map No. M-10 Sheet 19 Of 32	

BENCH MARKS		SURVEY INFORMATION		ENGINEER'S SEAL	
ACS MONUMENT "1-M10" LOCATED AT THE SOUTHEAST CORNER OF SAGE RD. & UNSER BLVD.	1/97	FIELD NOTES	ALS		
ELEV. = 5079.88					
TBM: RIM OF SOUTHWESTERLY MANHOLE AT SAPPHIRE ST. & UNSER BLVD.					
ELEV. = 5035.84					

AS-BUILT INFORMATION		BENCH MARKS		SURVEY INFORMATION		ENGINEER'S SEAL	
CONTRACTOR: SPACIOUS CONST. CO.	DATE: 3-98	INSPECTOR: D. CLAUSEN	DATE: 3-98	FIELD NOTES	ALS		
FIELD VERIFICATION BY: D. CLAUSEN	DATE: 3-98	FIELD VERIFICATION BY: D. CLAUSEN	DATE: 3-98				
CONNECTED BY: D. CLAUSEN	DATE: 3-98	CONNECTED BY: D. CLAUSEN	DATE: 3-98				
MICRO-FILM INFORMATION		RECORDED BY:					

SCALE: 1"=60'

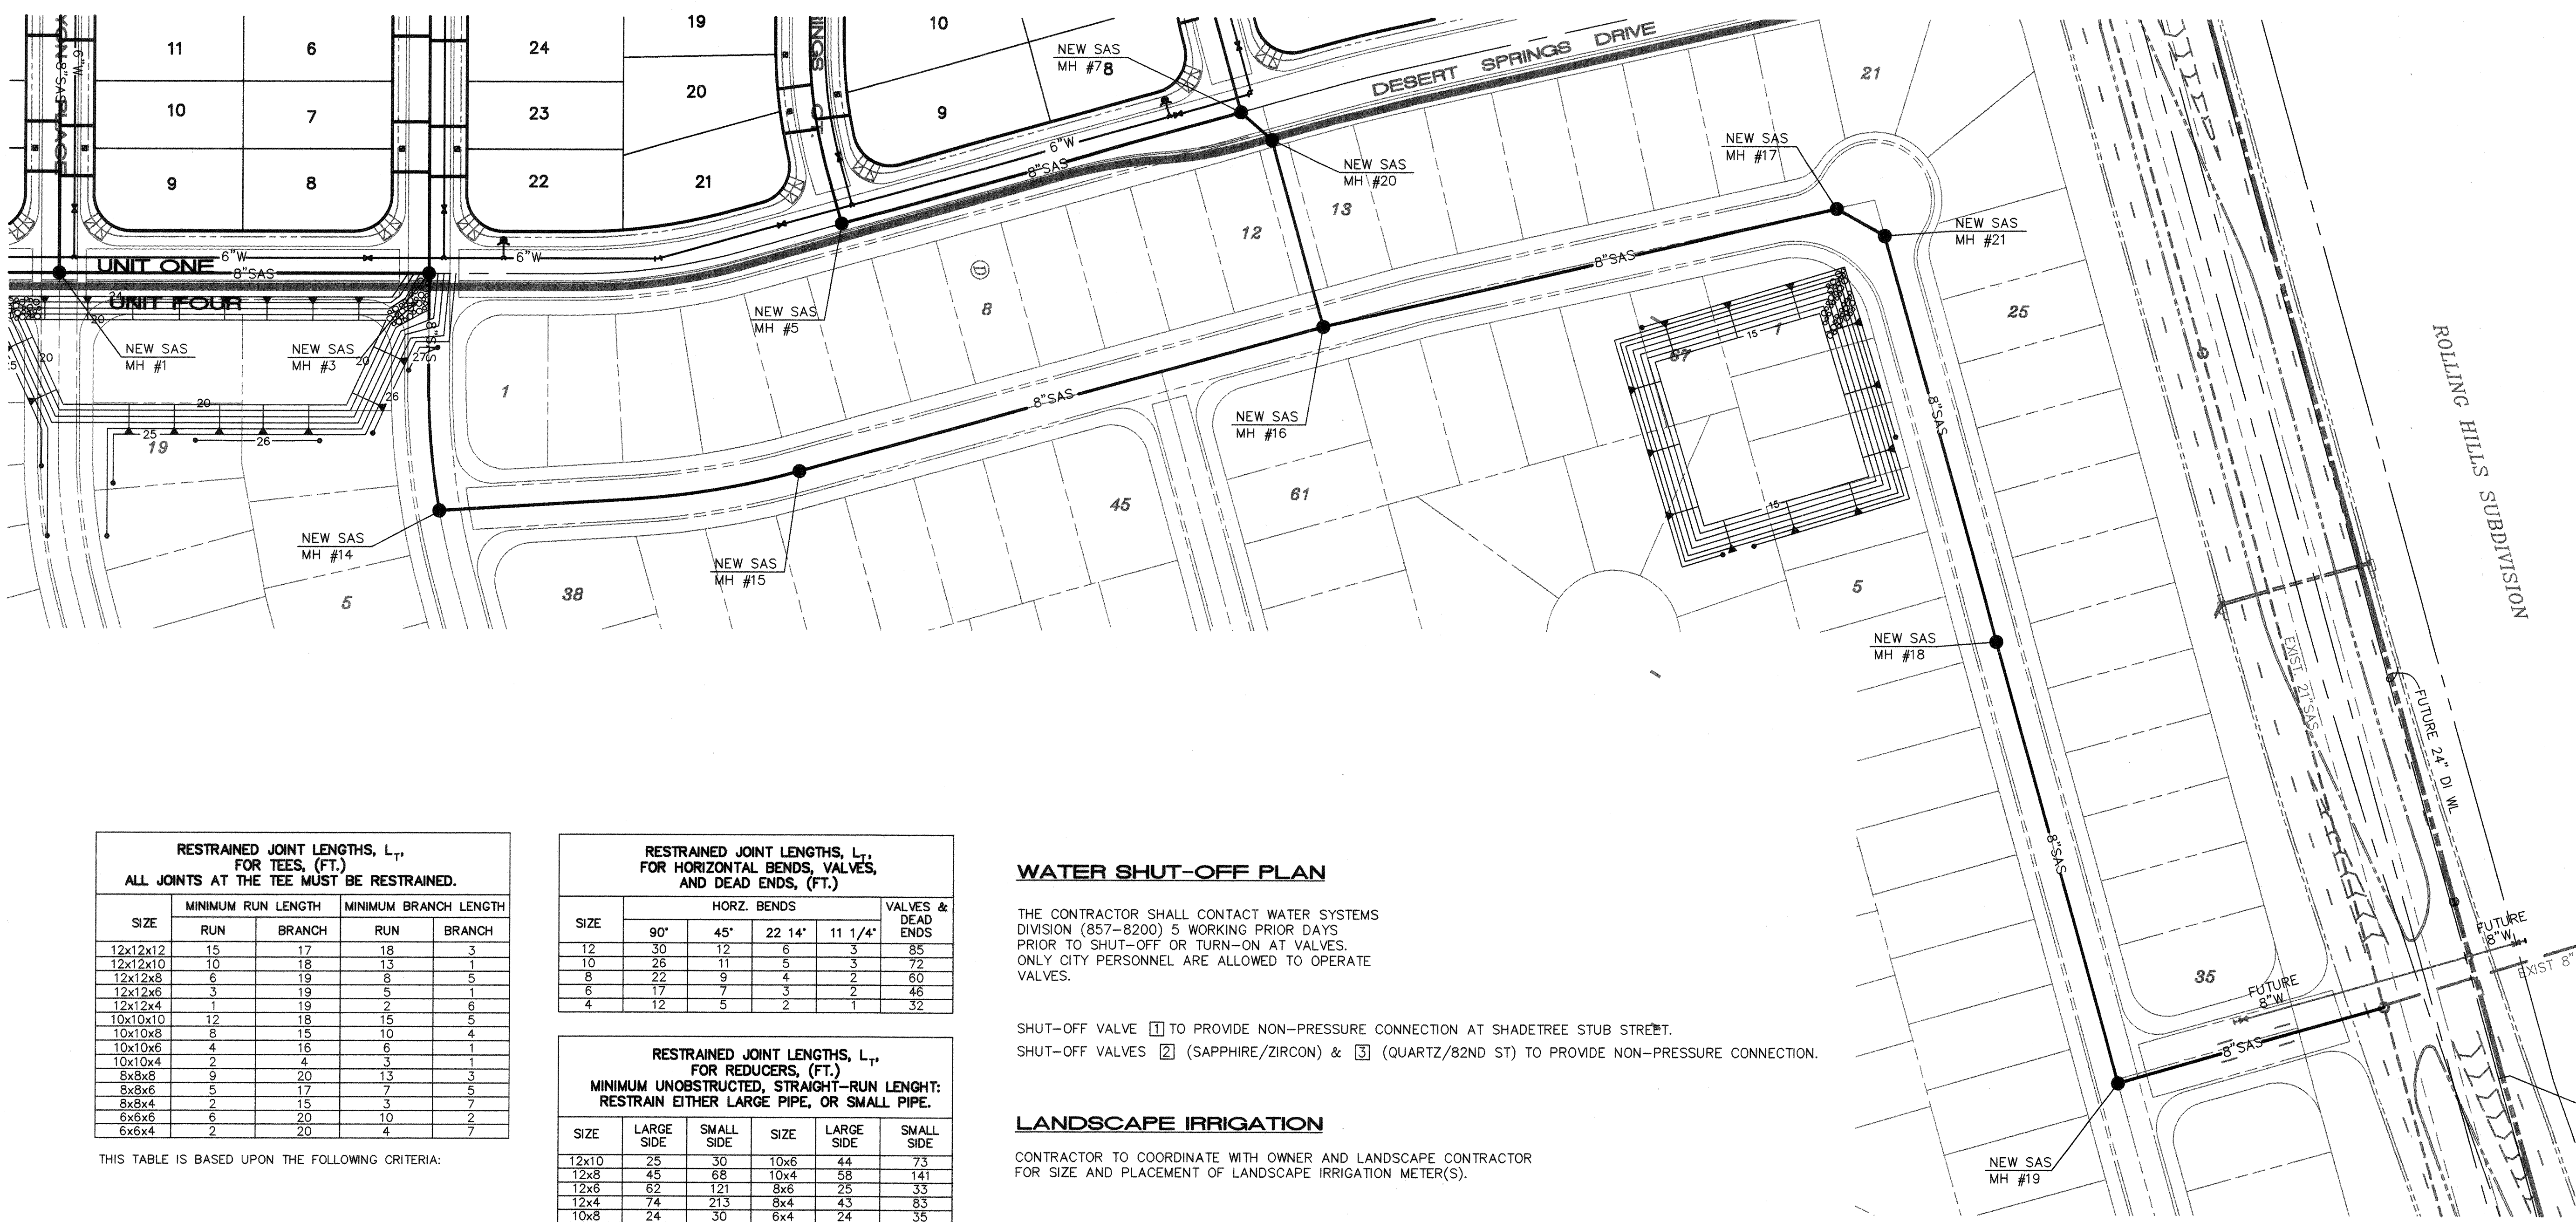

RESTRAINED JOINT LENGTHS, L _r , FOR TEES, (FT.) ALL JOINTS AT THE TEE MUST BE RESTRAINED.				
SIZE	MINIMUM RUN LENGTH		MINIMUM BRANCH LENGTH	
	RUN	BRANCH	RUN	BRANCH
12x12x12	15	17	18	3
12x12x10	10	18	13	1
12x12x8	6	19	8	5
12x12x6	3	19	5	1
12x12x4	1	19	2	6
10x10x10	12	18	15	5
10x10x8	8	15	10	4
10x10x6	4	16	6	1
10x10x4	2	4	3	1
8x8x8	9	20	13	3
8x8x6	5	17	7	5
8x8x4	2	15	3	7
6x6x6	6	20	10	2
6x6x4	2	20	4	7

THIS TABLE IS BASED UPON THE FOLLOWING CRITERIA:

DEPTH OF BURY 3.0 FT. MINIMUM
FACTOR OF SAFETY 1.25
MATERIAL PVC PIPE
SOIL TYPE GM/SW - SILTY GRAVELS AND SILTY SANDS,
GRAVEL-SAND-SILT MIXTURES.
TEST PRESSURE 150 PSI
TRENCH TYPE 4: PIPE BEDDED IN SAND, GRAVEL, OR CRUSHED
STONE TO DEPTH OF 1/8 PIPE DIAMETER, 4 INCH
MINIMUM; BACKFILL COMPACTED TO TOP OF PIPE.

DIFFERENT CRITERIA, E.G., DUCTILE IRON PIPE, GREATER DEPTH OF BURY,
ETC., WILL REQUIRE DIFFERENT RESTRAINED LENGTHS. THESE MUST BE
CALCULATED BY A QUALIFIED PROFESSIONAL ENGINEER AND APPROVED
BY THE PUBLIC WORKS DEPARTMENT.

RESTRAINED JOINT LENGTHS FOR WATERLINE FITTINGS

RESTRAINED JOINT LENGTHS, L _r , FOR HORIZONTAL BENDS, VALVES, AND DEAD ENDS, (FT.)					
SIZE	HORZ. BENDS				VALVES & DEAD ENDS
	90°	45°	22 1/4°	11 1/4°	
12	30	12	6	3	85
10	26	11	5	3	72
8	22	9	4	2	60
6	17	7	3	2	46
4	12	5	2	1	32

RESTRAINED JOINT LENGTHS, L _r , FOR REDUCERS, (FT.) MINIMUM UNOBSTRUCTED, STRAIGHT-RUN LENGTH: RESTRAIN EITHER LARGE PIPE, OR SMALL PIPE.					
SIZE	LARGE SIDE		SIZE	SMALL SIDE	
	SIZE	LENGTH		SIZE	LENGTH
12x10	25	30	10x6	44	73
12x8	45	68	10x4	58	141
12x6	62	121	8x6	25	33
12x4	74	213	8x4	43	83
10x8	24	30	6x4	24	35

WATER SHUT-OFF PLAN

THE CONTRACTOR SHALL CONTACT WATER SYSTEMS
DIVISION (857-8200) 5 WORKING PRIOR DAYS
PRIOR TO SHUT-OFF OR TURN-ON AT VALVES.
ONLY CITY PERSONNEL ARE ALLOWED TO OPERATE
VALVES.

SHUT-OFF VALVE 1 TO PROVIDE NON-PRESSURE CONNECTION AT SHADETREE STUB STREET.
SHUT-OFF VALVES 2 (SAPPHIRE/ZIRCON) & 3 (QUARTZ/82ND ST) TO PROVIDE NON-PRESSURE CONNECTION.

LANDSCAPE IRRIGATION

CONTRACTOR TO COORDINATE WITH OWNER AND LANDSCAPE CONTRACTOR
FOR SIZE AND PLACEMENT OF LANDSCAPE IRRIGATION METER(S).

LEGEND

- EXISTING STREET IMPROVEMENTS
- PROPOSED STREET IMPROVEMENTS
- SANITARY SEWER LINE
W/MANHOLE & SERVICE LINE
- EXISTING SANITARY SEWER LINE
- BLOCK NO.
- LOT NO.
- WATERLINE W/TEE &
DOUBLE WATER METER SERVICE
- EXISTING WATERLINE

I, David C. Clausen, New Mexico Professional
Land Surveyor No. 6547, do hereby certify that
the as-built information shown hereon is the re-
sult of a field survey performed by me or under
my direct supervision, and that the same is true
and correct.


David C. Clausen
David C. Clausen N.M.L.S. # 6547




ISAACSON & ARFMAN, P.A. Consulting Engineering Associates 128 Monroe Street N.E. Albuquerque New Mexico 921UMSTR.DWGms 10/20/97	
CITY OF ALBUQUERQUE PUBLIC WORKS DEPARTMENT ENGINEERING GROUP	
TITLE: DESERT SPRINGS SUBDIVISION, UNIT ONE OFFSITE UTILITY MASTER PLAN	
DESIGNED BY MJC DATE 7/11/97	REVISIONS
DRAWN BY EMS DATE 7/11/97	BY
CHECKED BY FCA DATE 7/11/97	NO. DATE
City Project No. 5785.81	Zone Map No. M-10
Sheet 20 Of 32	

I, David C. Clausen, New Mexico Professional Land Surveyor No. 6547, do hereby certify that the as-built information shown hereon is the result of a field survey performed by me or under my direct supervision, and that the same is true and correct.

David C. Clausen
David C. Clausen N.M.L.S. # 6547

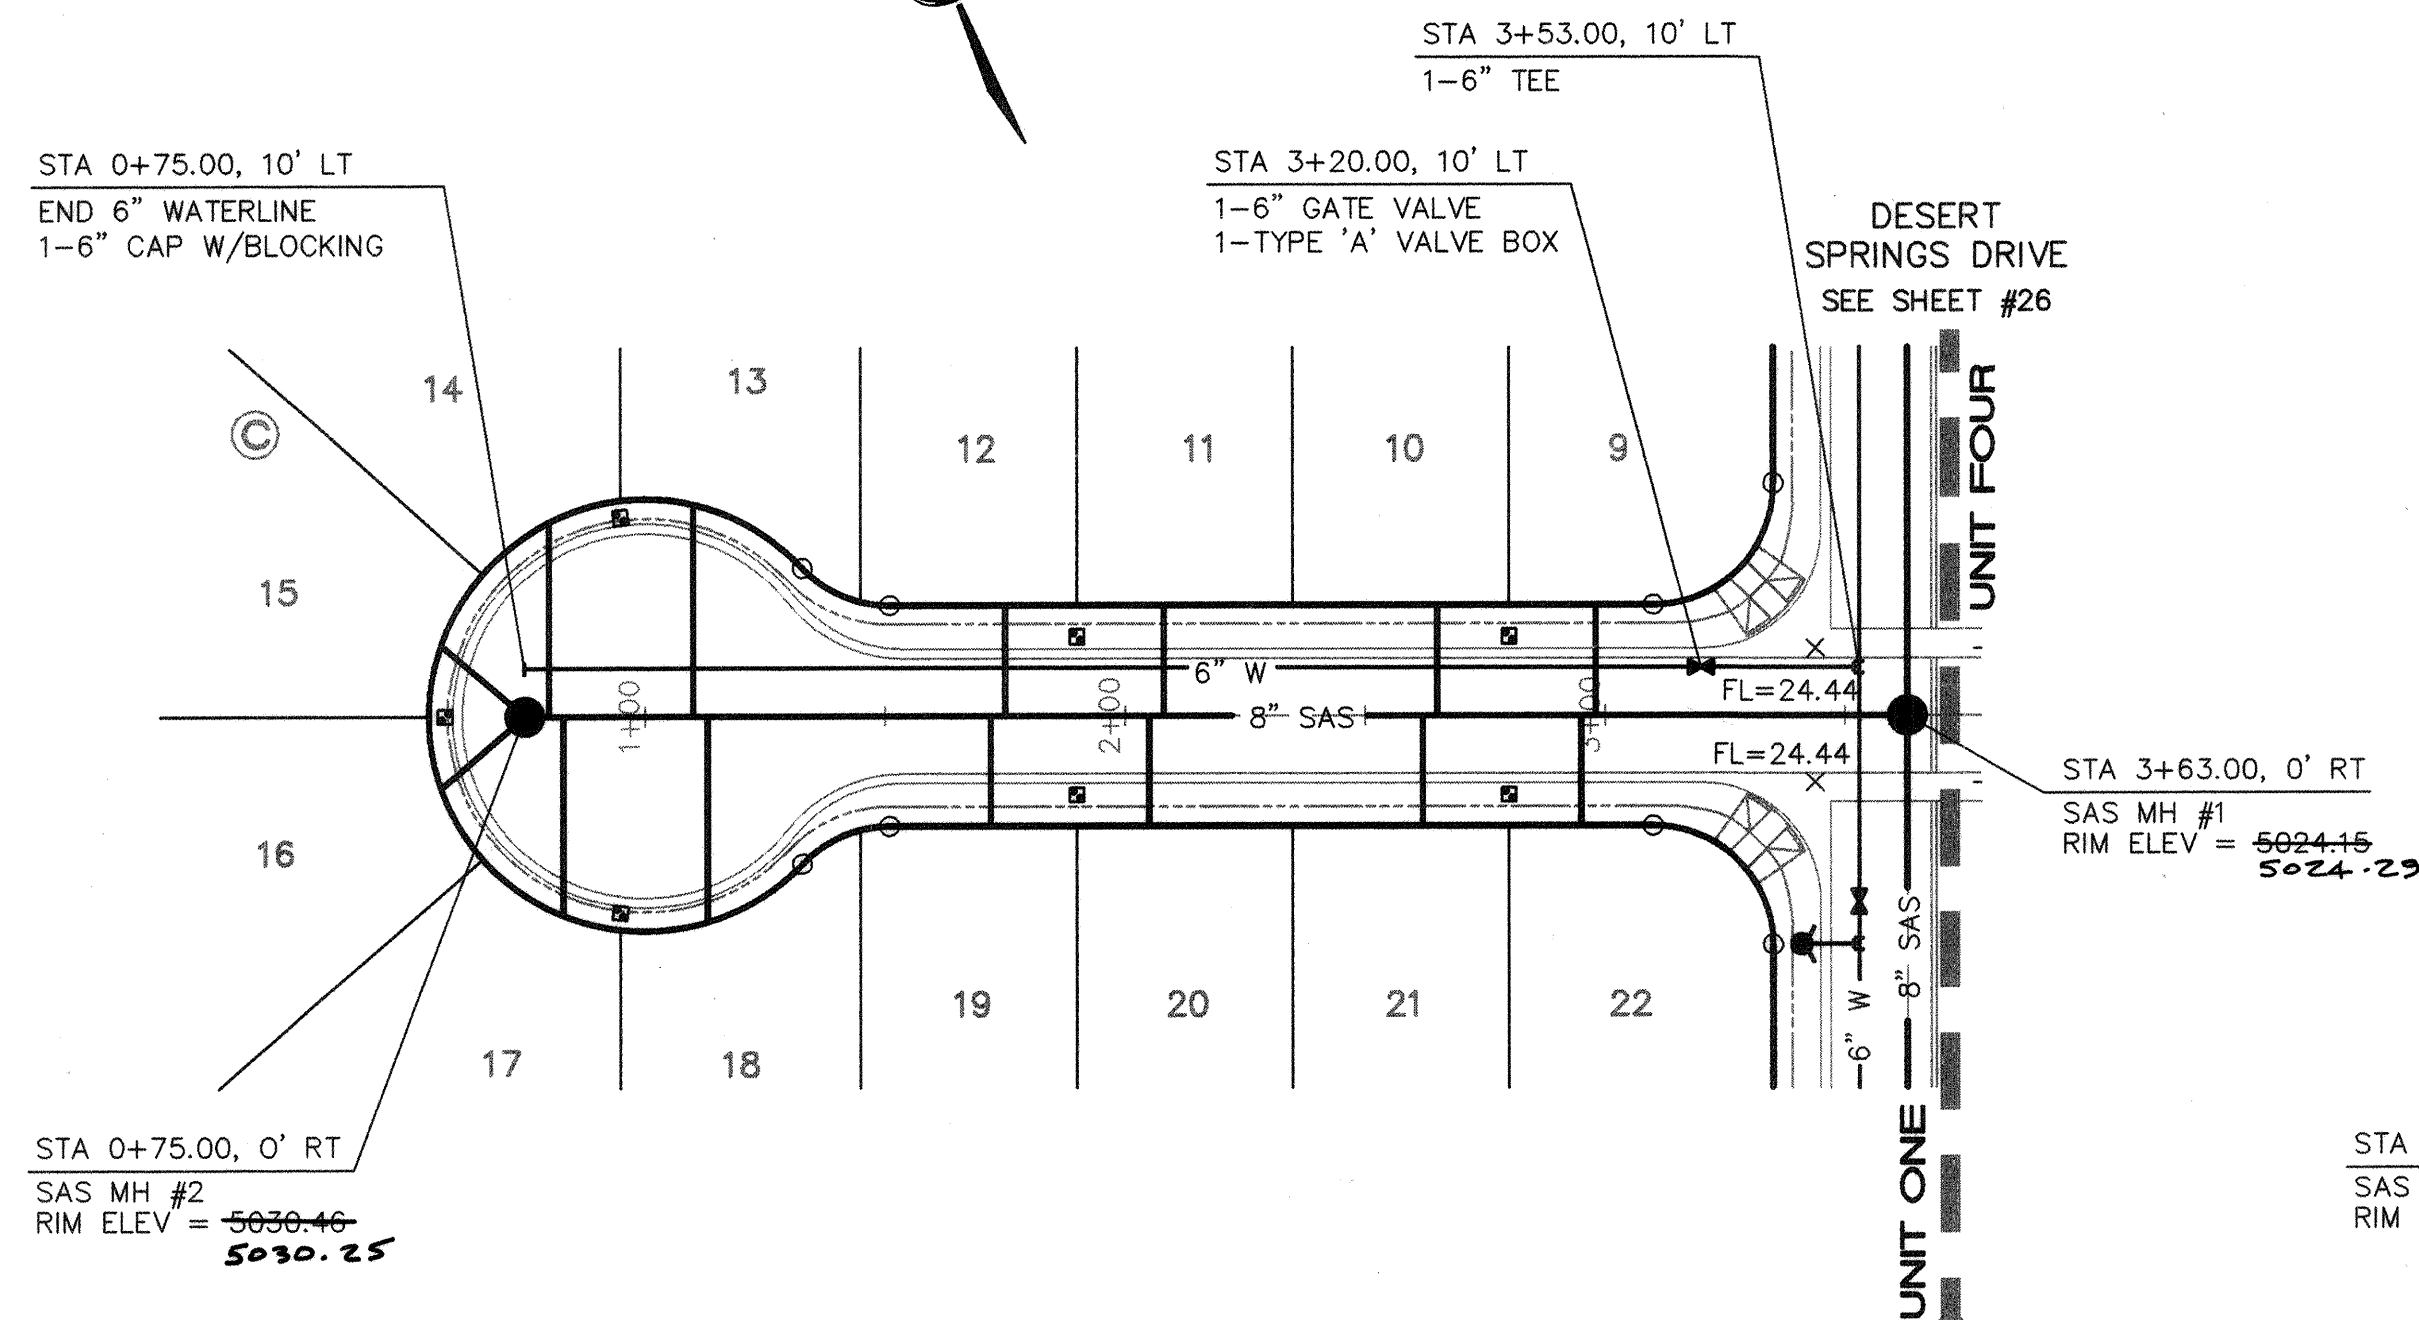

DESERT CANYON PLACE

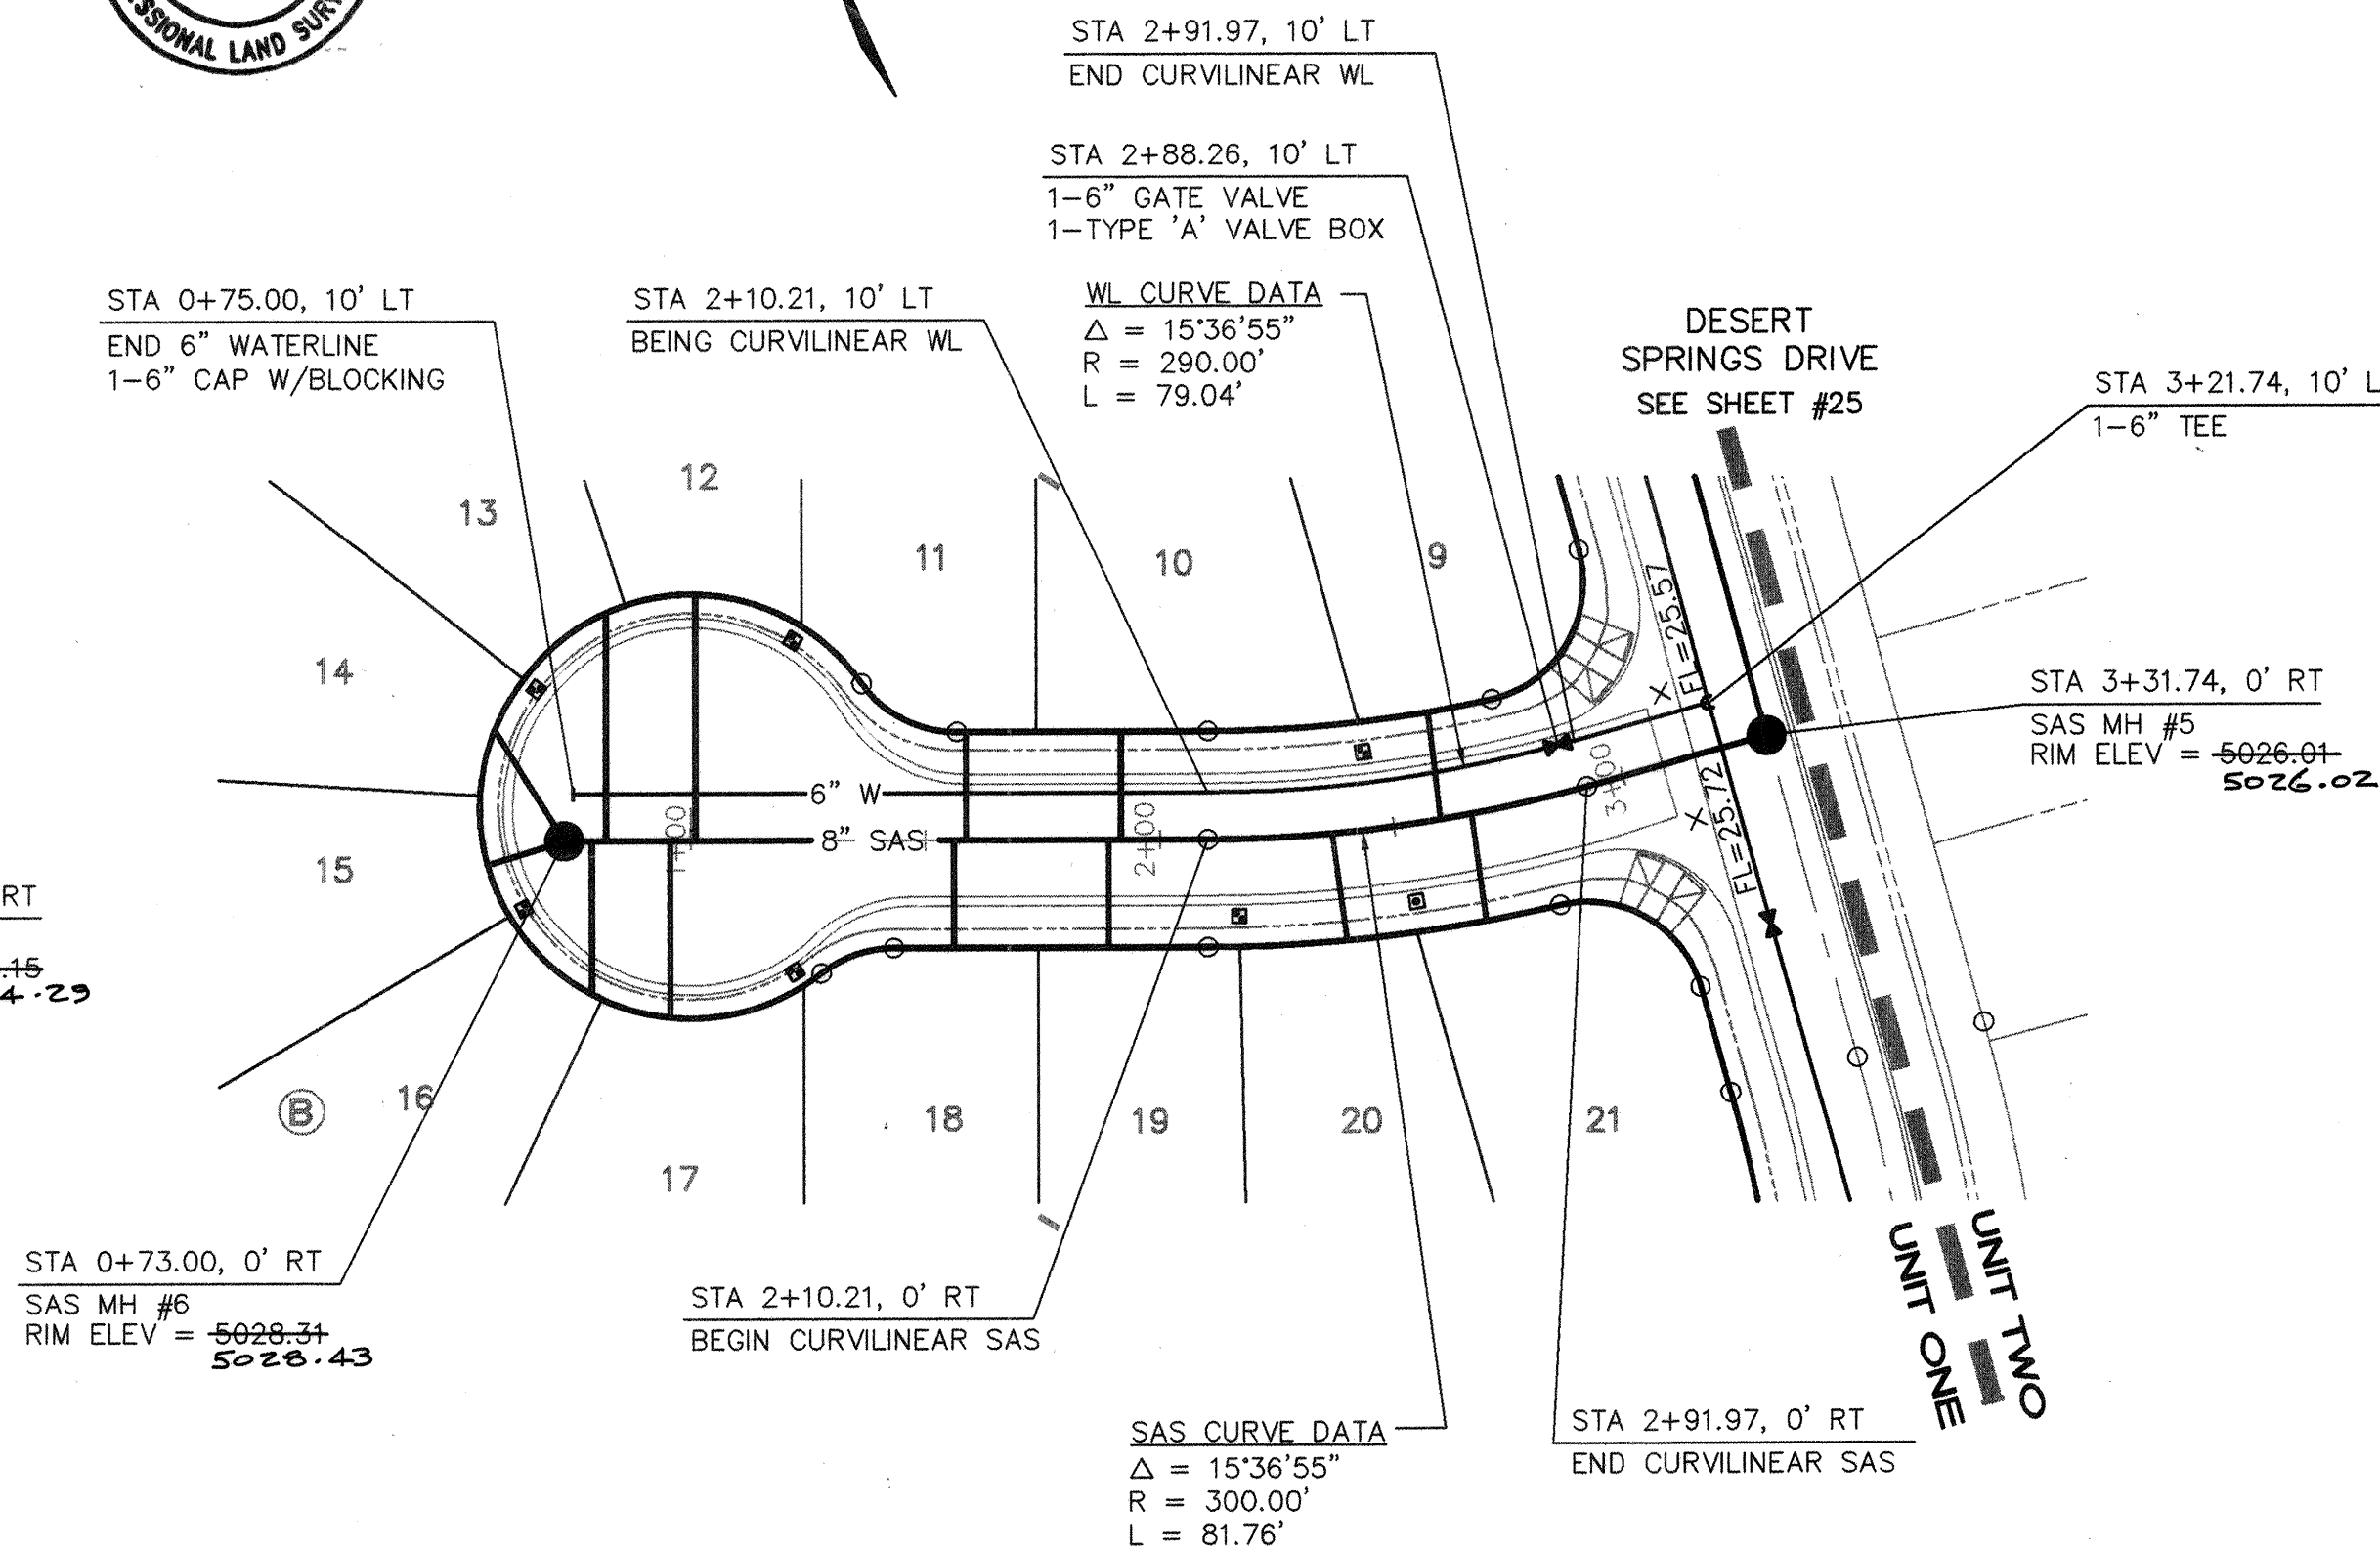

DESERT SPRINGS COURT

SCALES:
1"=40' HOR.
1"=10' VERT.

GENERAL NOTES

1. CONSTRUCT SAS SERVICES PER COA STD DWG #2125.
2. CONSTRUCT ALL SINGLE & DOUBLE WATER SERVICES PER COA STD DWG'S #2361, #2362, & #2363.
3. SEE SHEET #20 FOR WATER SHUT-OFF PLAN.
4. SEE SHEET #20 FOR RESTRAINED JOINT LENGTHS FOR WATER LINE FITTINGS.
5. CONSTRUCT FIRE HYDRANTS PER DESIGNATED DEPTHS & LENGTHS PER COA STD DWG #2340.

UTILITY SERVICE TABLE

LOT NO./BLOCK	STATION		SAS INV @ R/W
	WATER, LENGTH	SAS, LENGTH	
9/B	2+44.96, 6'	2+61.22, 23'	21.5 21.3
10/B		1+91.70, 23'	22.5 22.1
11/B		1+58.70, 23'	22.7 23.3
12/B	1+23.70, 32'	1+01.04, 52'	22.9 24.8
13/B		0+81.93, 48'	23.2 23.7
14/B	0+64.38, 26'	0+58.19, 28'	23.4 23.8
15/B	0+61.32, 45'	0+56.67, 17'	23.4 22.7
16/B		0+78.93, 33'	23.2 24.5
17/B	1+24.11, 38'	0+95.60, 38'	22.8 24.5
18/B		1+56.11, 23'	22.8 22.5
19/B		1+89.11, 23'	22.2 22.5
20/B	2+16.49, 27'	2+37.76, 23'	21.5 21.2
21/B	2+51.70, 27' S	2+65.64, 23'	21.8 22.5
9/C		2+98.00, 23'	20.7 21.3
10/C	2+80.00, 6'	2+65.00, 23'	21.4 21.3
11/C		2+08.00, 23'	22.7 22.5
12/C	1+90.00, 6'	1+75.00, 23'	23.3 22.3
13/C	0+95.00, 31'	1+10.00, 44'	24.6 24.1
14/C		0+80.00, 40'	25.3 24.5
15/C	0+55.00, 33'	0+57.57, 23'	25.8 23.5
16/C		0+57.57, 23'	25.8 23.5
17/C		0+83.00, 42'	26.4 24.5
18/C	0+95.00, 51'	1+13.00, 43'	24.2 23.5
19/C		1+72.00, 23'	23.4 22.7
20/C	1+90.00, 27'	2+05.00, 23'	22.7 22.3
21/C		2+62.00, 23'	21.4 21.3
22/C	2+80.00, 27'	2+95.00, 23'	20.7 20.3

ALL WATER SERVICES ARE DOUBLE EXCEPT WHERE NOTED AS (S) SINGLE.


LEGEND

- SINGLE WATER METER & BOX
- DOUBLE WATER METER & BOX
- GATE VALVE W/ TYPE 'A' VALVE BOX
- FIRE HYDRANT W/ VALVED LEG
- SAS MANHOLE
- WATER LINE W/ FITTING


ISAACSON & ARFMAN, P.A.
Consulting Engineering Associates
128 Monroe Street N.E.
Albuquerque New Mexico

921UTL1.DWGems 10/20/97

CITY OF ALBUQUERQUE PUBLIC WORKS DEPARTMENT ENGINEERING GROUP	
TITLE: DESERT SPRINGS SUBDIVISION, UNIT ONE DESERT CANYON PL & DESERT SPRINGS CT UTILITY PLAN & PROFILE	
Design Review Committee APPROVED FEB 18 1998 DESIGN REVIEW COMMITTEE	City Engineer Approval Mo./Day/Yr. Mo./Day/Yr.
City Project No. 5785.81	Zone Map No. M-10
Sheet 21	Of 32

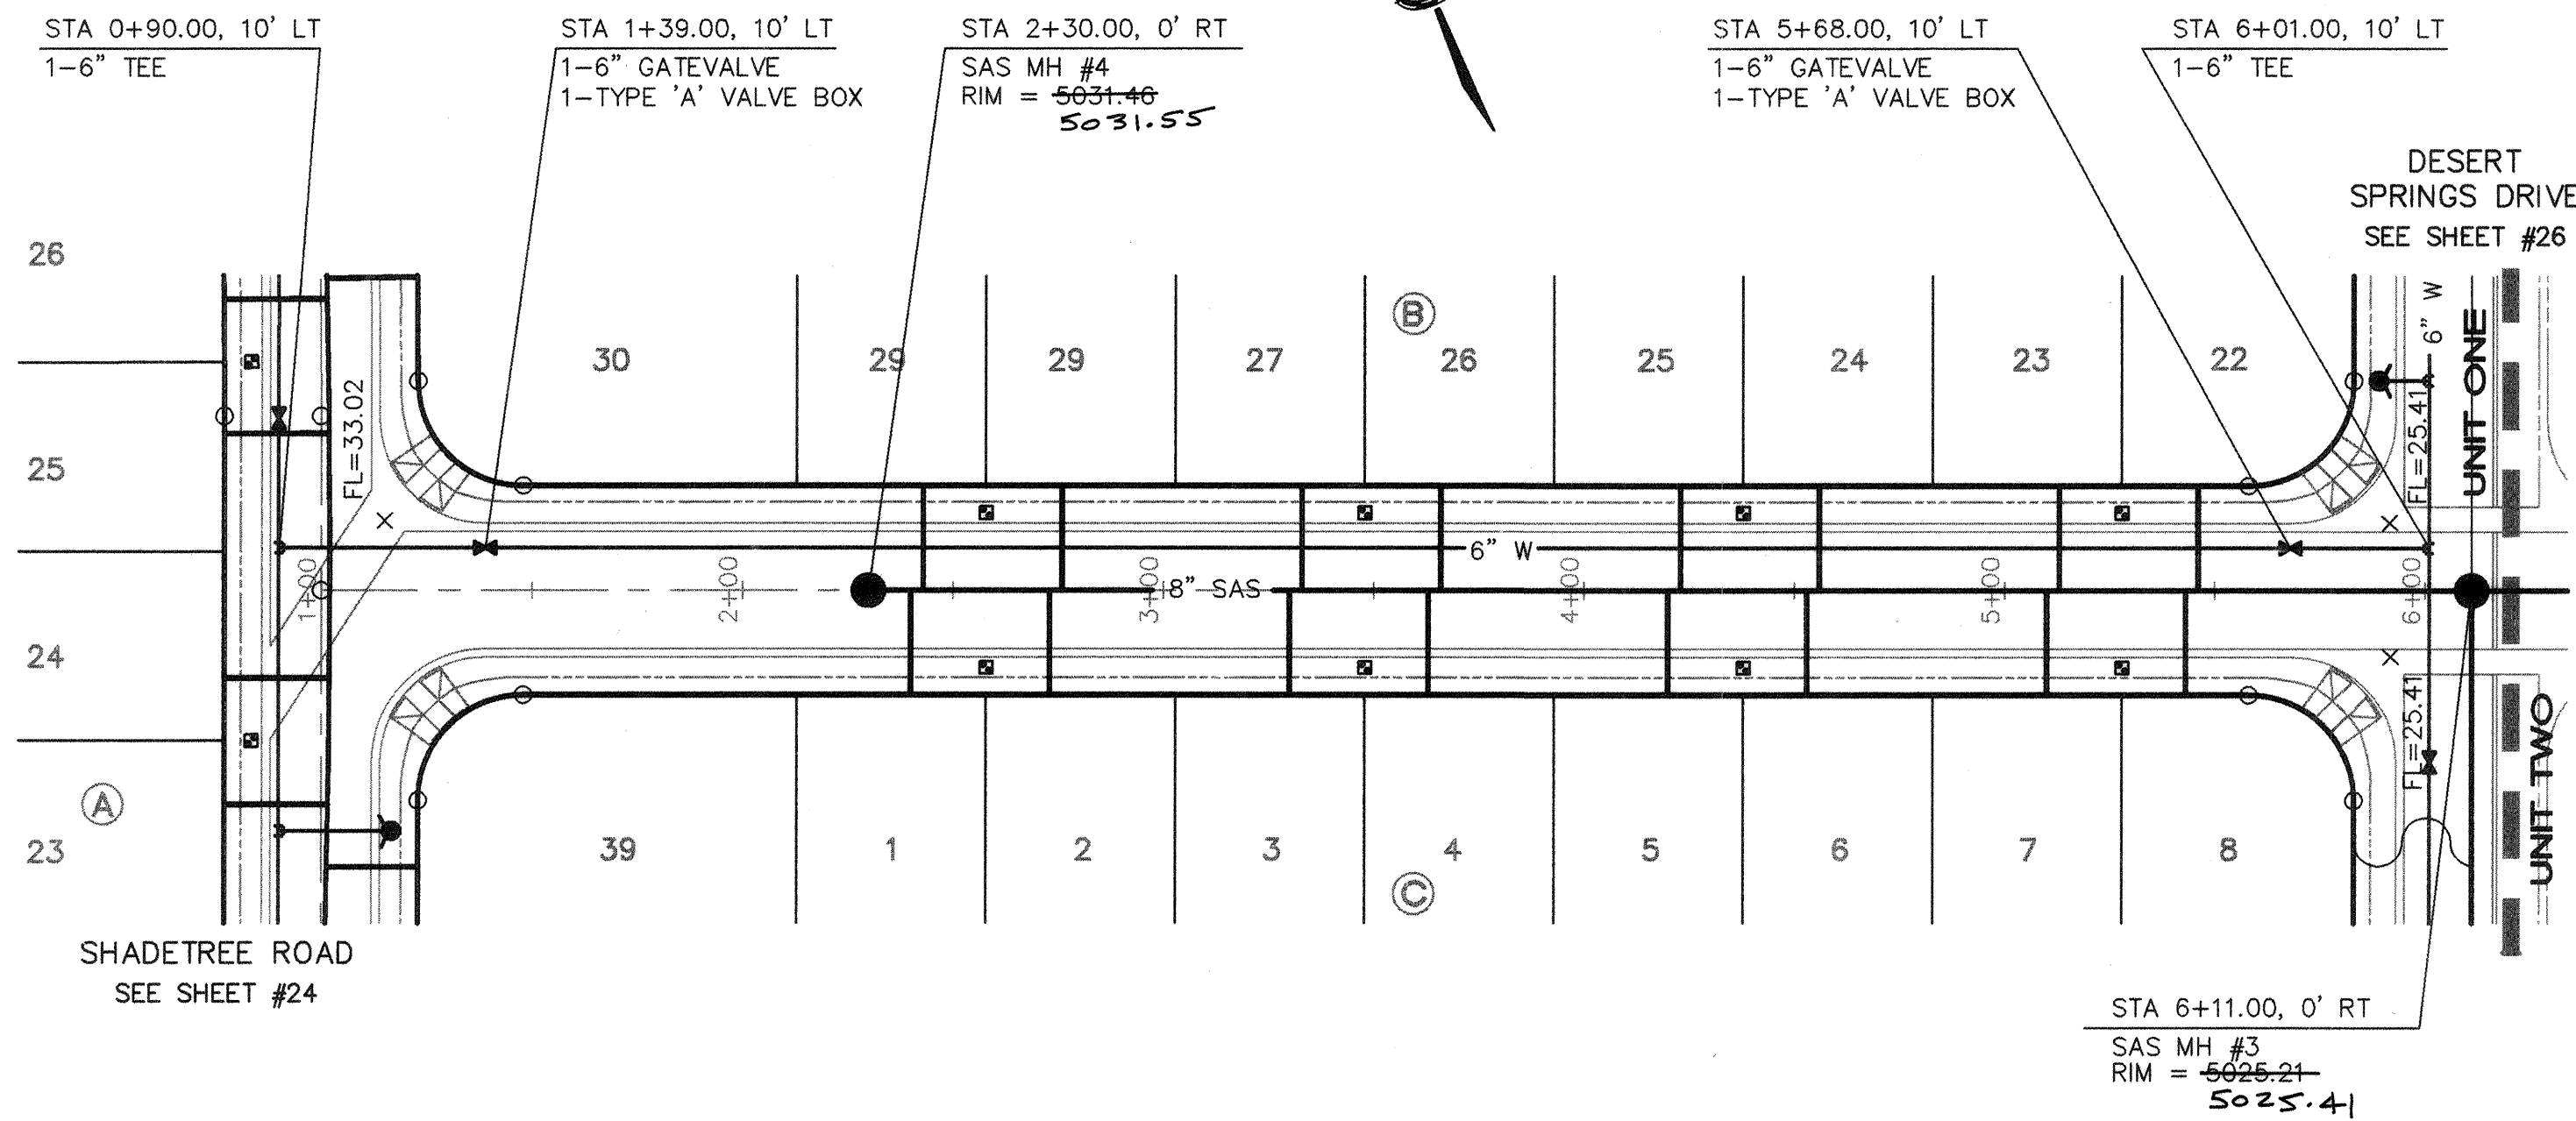

RAINWATER ROAD

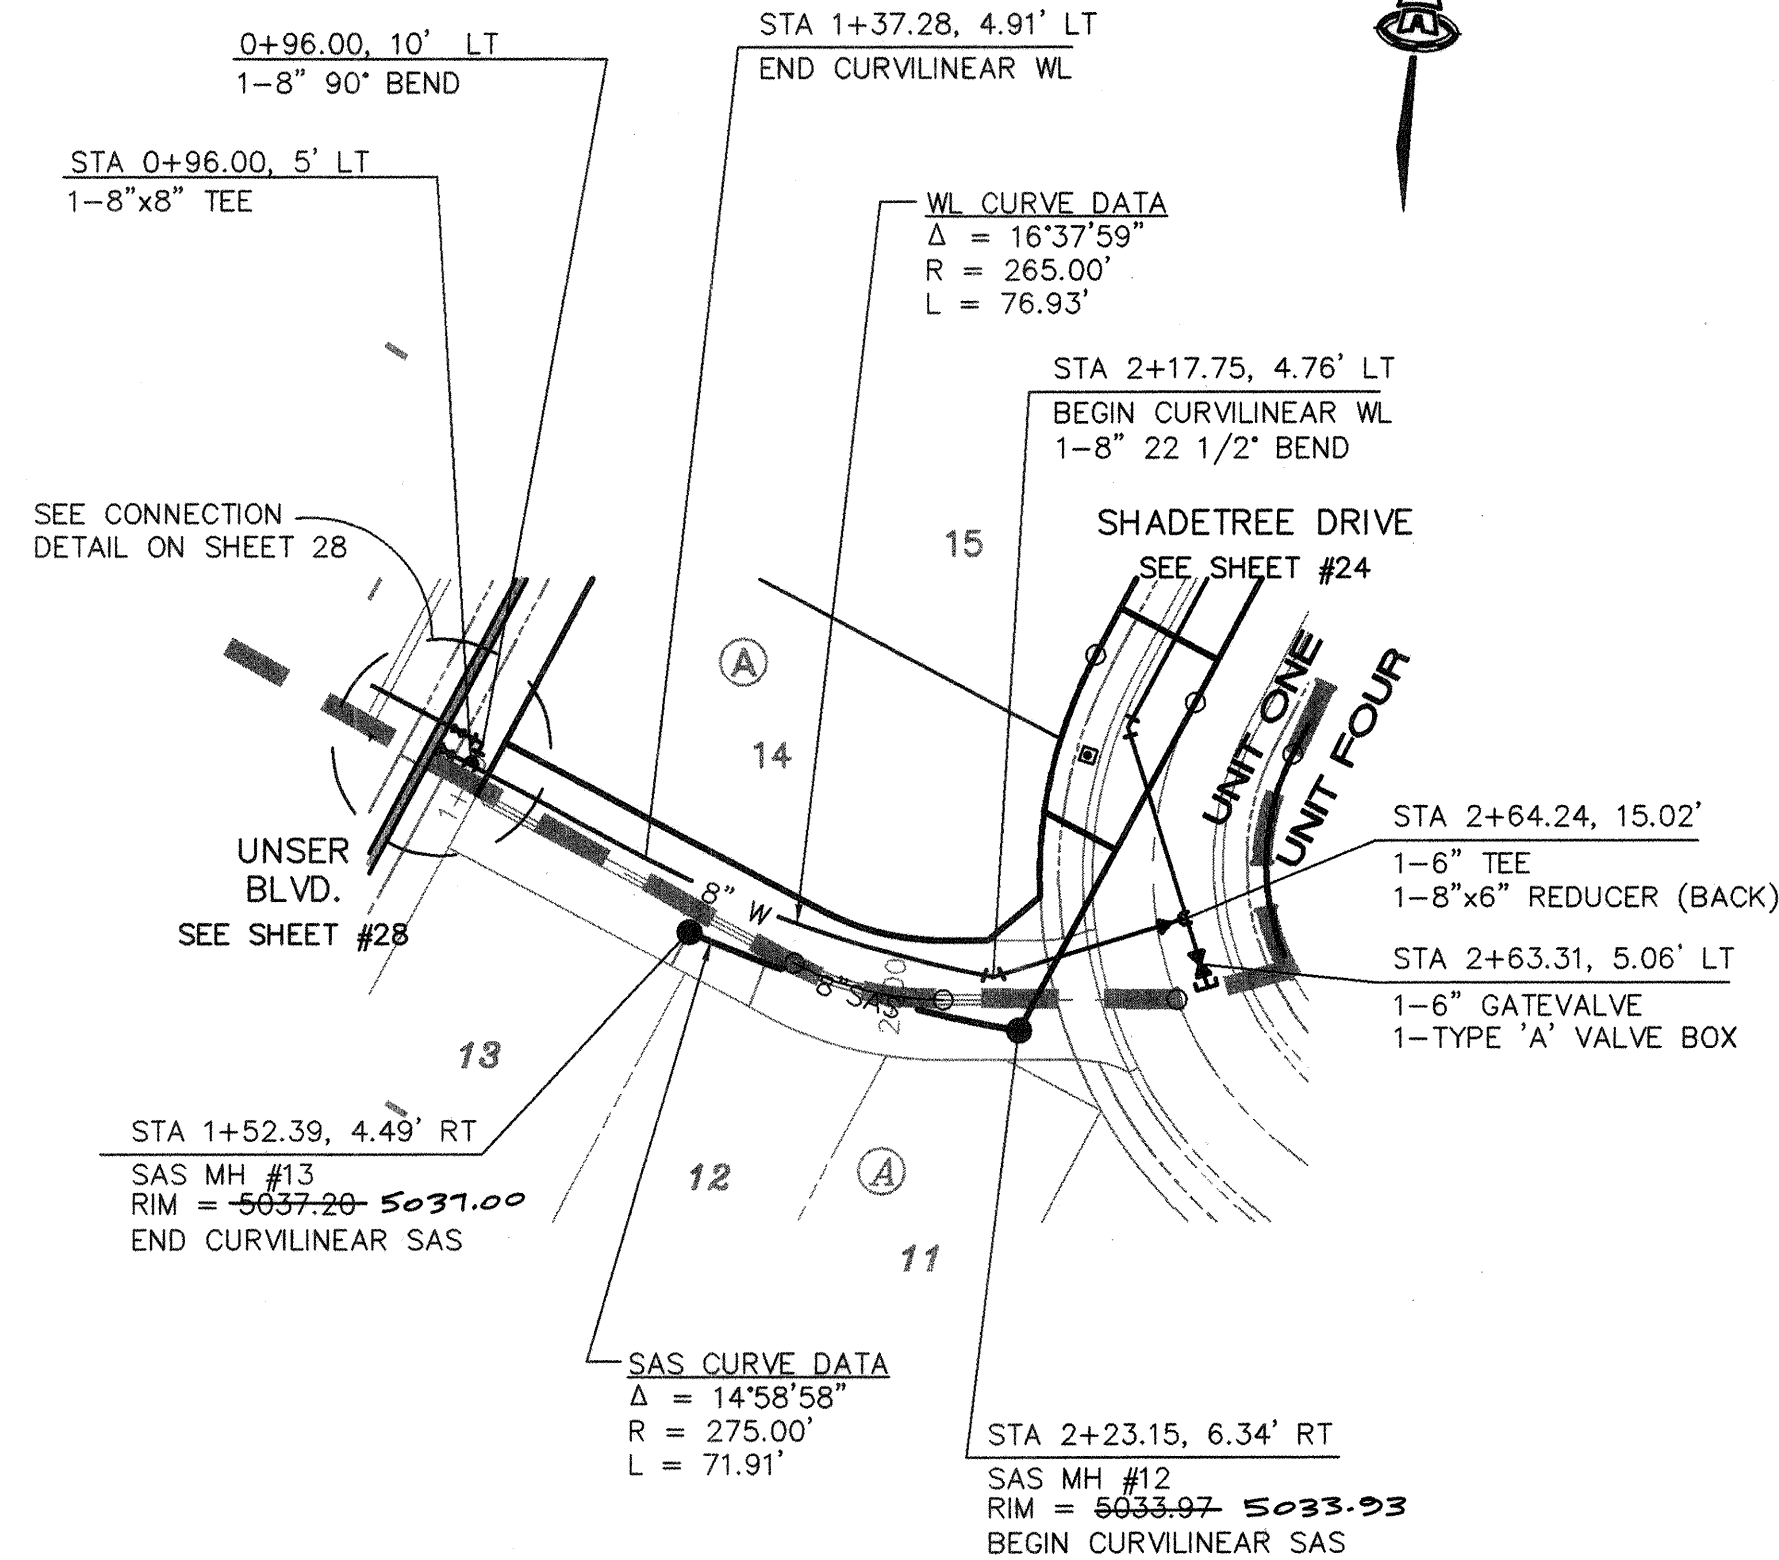

SHADETREE STUB STREET

SCALES:
1"=40' HOR.
1"=10' VERT.

GENERAL NOTES

- CONSTRUCT SAS SERVICES PER COA STD DWG #2125.
- CONSTRUCT ALL SINGLE & DOUBLE WATER SERVICES PER COA STD DWG'S #2361, #2362, & #2363.
- SEE SHEET #20 FOR WATER SHUT-OFF PLAN.
- SEE SHEET #20 FOR RESTRAINED JOINT LENGTHS FOR WATER LINE FITTINGS.
- CONSTRUCT FIRE HYDRANTS PER DESIGNATED DEPTHS & LENGTHS PER COA STD DWG #2340.

UTILITY SERVICE TABLE

LOT NO.	STATION		SAS INV @ R/W
	WATER, LENGTH	SAS, LENGTH	
22/B	5+28.00, 8'	5+46.00, 25'	22+22.2
23/B		5+13.00, 25'	22+6.218
24/B	4+38.00, 8'	4+56.00, 25'	23+2.228
25/B		4+23.00, 25'	23+6.228
26/B	3+48.00, 8'	3+66.00, 25'	23+6.228
27/B		3+33.00, 25'	23+6.228
28/B	2+58.00, 8'	2+76.00, 25'	23+6.228
29/B		2+43.00, 25'	23+6.228
1/C		2+40.00, 25'	23+6.228
2/C	2+58.00, 29'	2+73.00, 25'	23+6.228
3/C	3+48.00, 29'	3+63.00, 25'	23+6.228
4/C		4+20.00, 25'	23+6.228
5/C	4+38.00, 29'	4+53.00, 25'	23+6.228
6/C		5+10.00, 25'	23+6.228
7/C	5+28.00, 29'	5+43.00, 25'	23+6.228
8/C			23+6.228


ALL WATER SERVICES ARE DOUBLE EXCEPT WHERE NOTED AS (S) SINGLE.

LEGEND

- SINGLE WATER METER & BOX
- DOUBLE WATER METER & BOX
- GATE VALVE W/ TYPE 'A' VALVE BOX
- FIRE HYDRANT W/ VALVED LEG
- SAS MANHOLE
- WATER LINE W/ FITTING

I, David C. Clausen, New Mexico Professional Land Surveyor No. 6547, do hereby certify that the as-built information shown hereon is the result of a field survey performed by me or under my direct supervision, and that the same is true and correct.


David C. Clausen N.M.L.S. # 6547

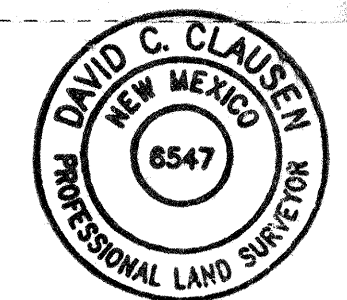

ISAACSON & ARFMAN, P.A.
Consulting Engineering Associates
128 Monroe Street N.E.
Albuquerque New Mexico
921UTL2.DWGms 10/20/97


CITY OF ALBUQUERQUE
PUBLIC WORKS DEPARTMENT
ENGINEERING GROUP

TITLE: DESERT SPRINGS SUBDIVISION, UNIT ONE
RAINWATER RD. & SHADEETREE STUB ST.
UTILITY PLAN & PROFILE

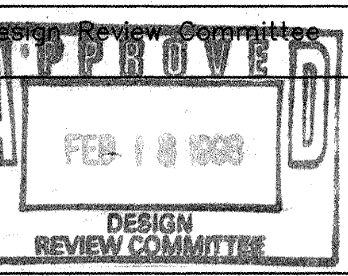

NO.	DATE	REVISIONS	BY
1		DESIGN	

City Project No. 5785.81 Zone Map No. M-10 Sheet 22 Of 32

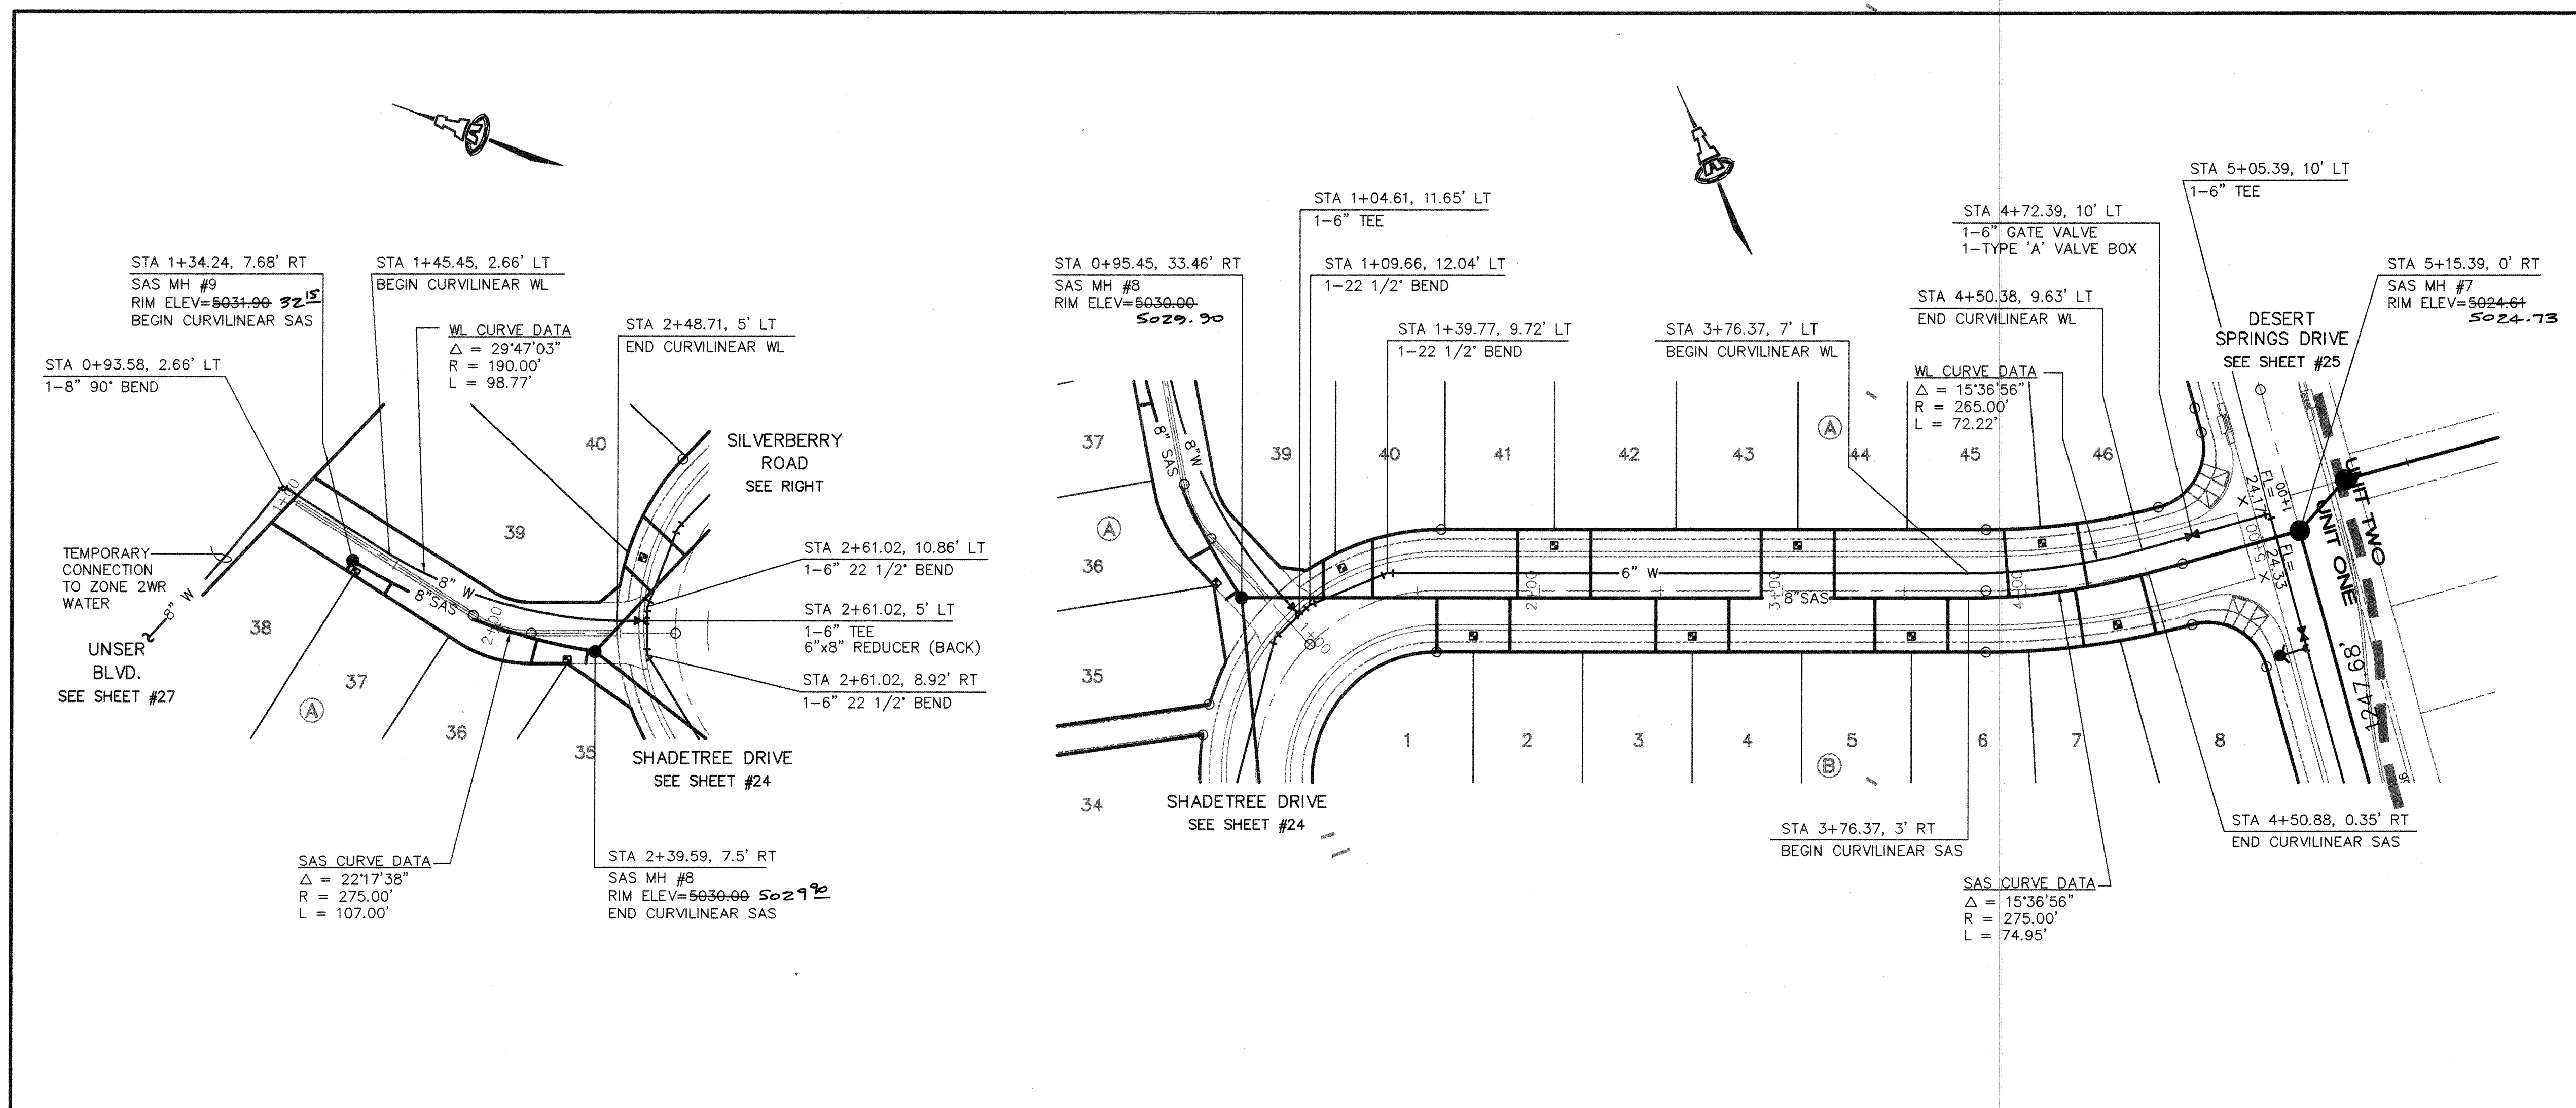


- GENERAL NOTES**
- CONSTRUCT SAS SERVICES PER COA STD DWG #2125.
 - CONSTRUCT ALL SINGLE & DOUBLE WATER SERVICES PER COA STD DWG'S #2361, #2362, & #2363.
 - SEE SHEET #20 FOR WATER SHUT-OFF PLAN.
 - SEE SHEET #20 FOR RESTRAINED JOINT LENGTHS FOR WATER LINE FITTINGS.
 - CONSTRUCT FIRE HYDRANTS PER DESIGNATED DEPTHS & LENGTHS PER COA STD DWG #2340.

UTILITY SERVICE TABLE

LOT NO.	STATION		SAS INV @ R/W
	WATER, LENGTH	SAS, LENGTH	
35/A	2+28.22, 17'	2+35.69, 6'	24.7
36/A	2+28.22, 17'	2+13.26, 10'	25.2
37/A	1+37.68, 14'	1+52.68, 6'	26.2
38/A	1+37.68, 14'	1+24.57, 5'	26.9
39/A	1+25.68, 9'	1+21.43, 16'	24.1
40/A	1+25.68, 9'	1+38.03, 24'	23.7
41/A	2+06.26, 11'	1+91.26, 28'	22.4
42/A	2+06.26, 11'	2+21.26, 28'	21.8
43/A	3+06.26, 11'	2+91.26, 28'	21.8
44/A	3+06.26, 11'	3+21.26, 28'	20.7
45/A	4+07.97, 6'	3+91.60, 28'	20.4
46/A	4+07.97, 6'	4+24.34, 27'	20.2
1/B	1+73.07, 26'	1+57.39, 22'	23.1
2/B	1+73.07, 26'	1+88.07, 22'	22.5
3/B	2+63.07, 26'	2+48.07, 22'	21.3
4/B	2+63.07, 26'	2+78.07, 22'	21.2
5/B	3+53.07, 26'	3+38.07, 22'	20.7
6/B	3+53.07, 26'	3+68.07, 22'	20.5
7/B	4+34.88, 26'	4+21.03, 23'	20.3
8/B	4+34.88, 26'	4+48.73, 24'	20.1

ALL WATER SERVICES ARE DOUBLE EXCEPT WHERE NOTED AS (S) SINGLE.

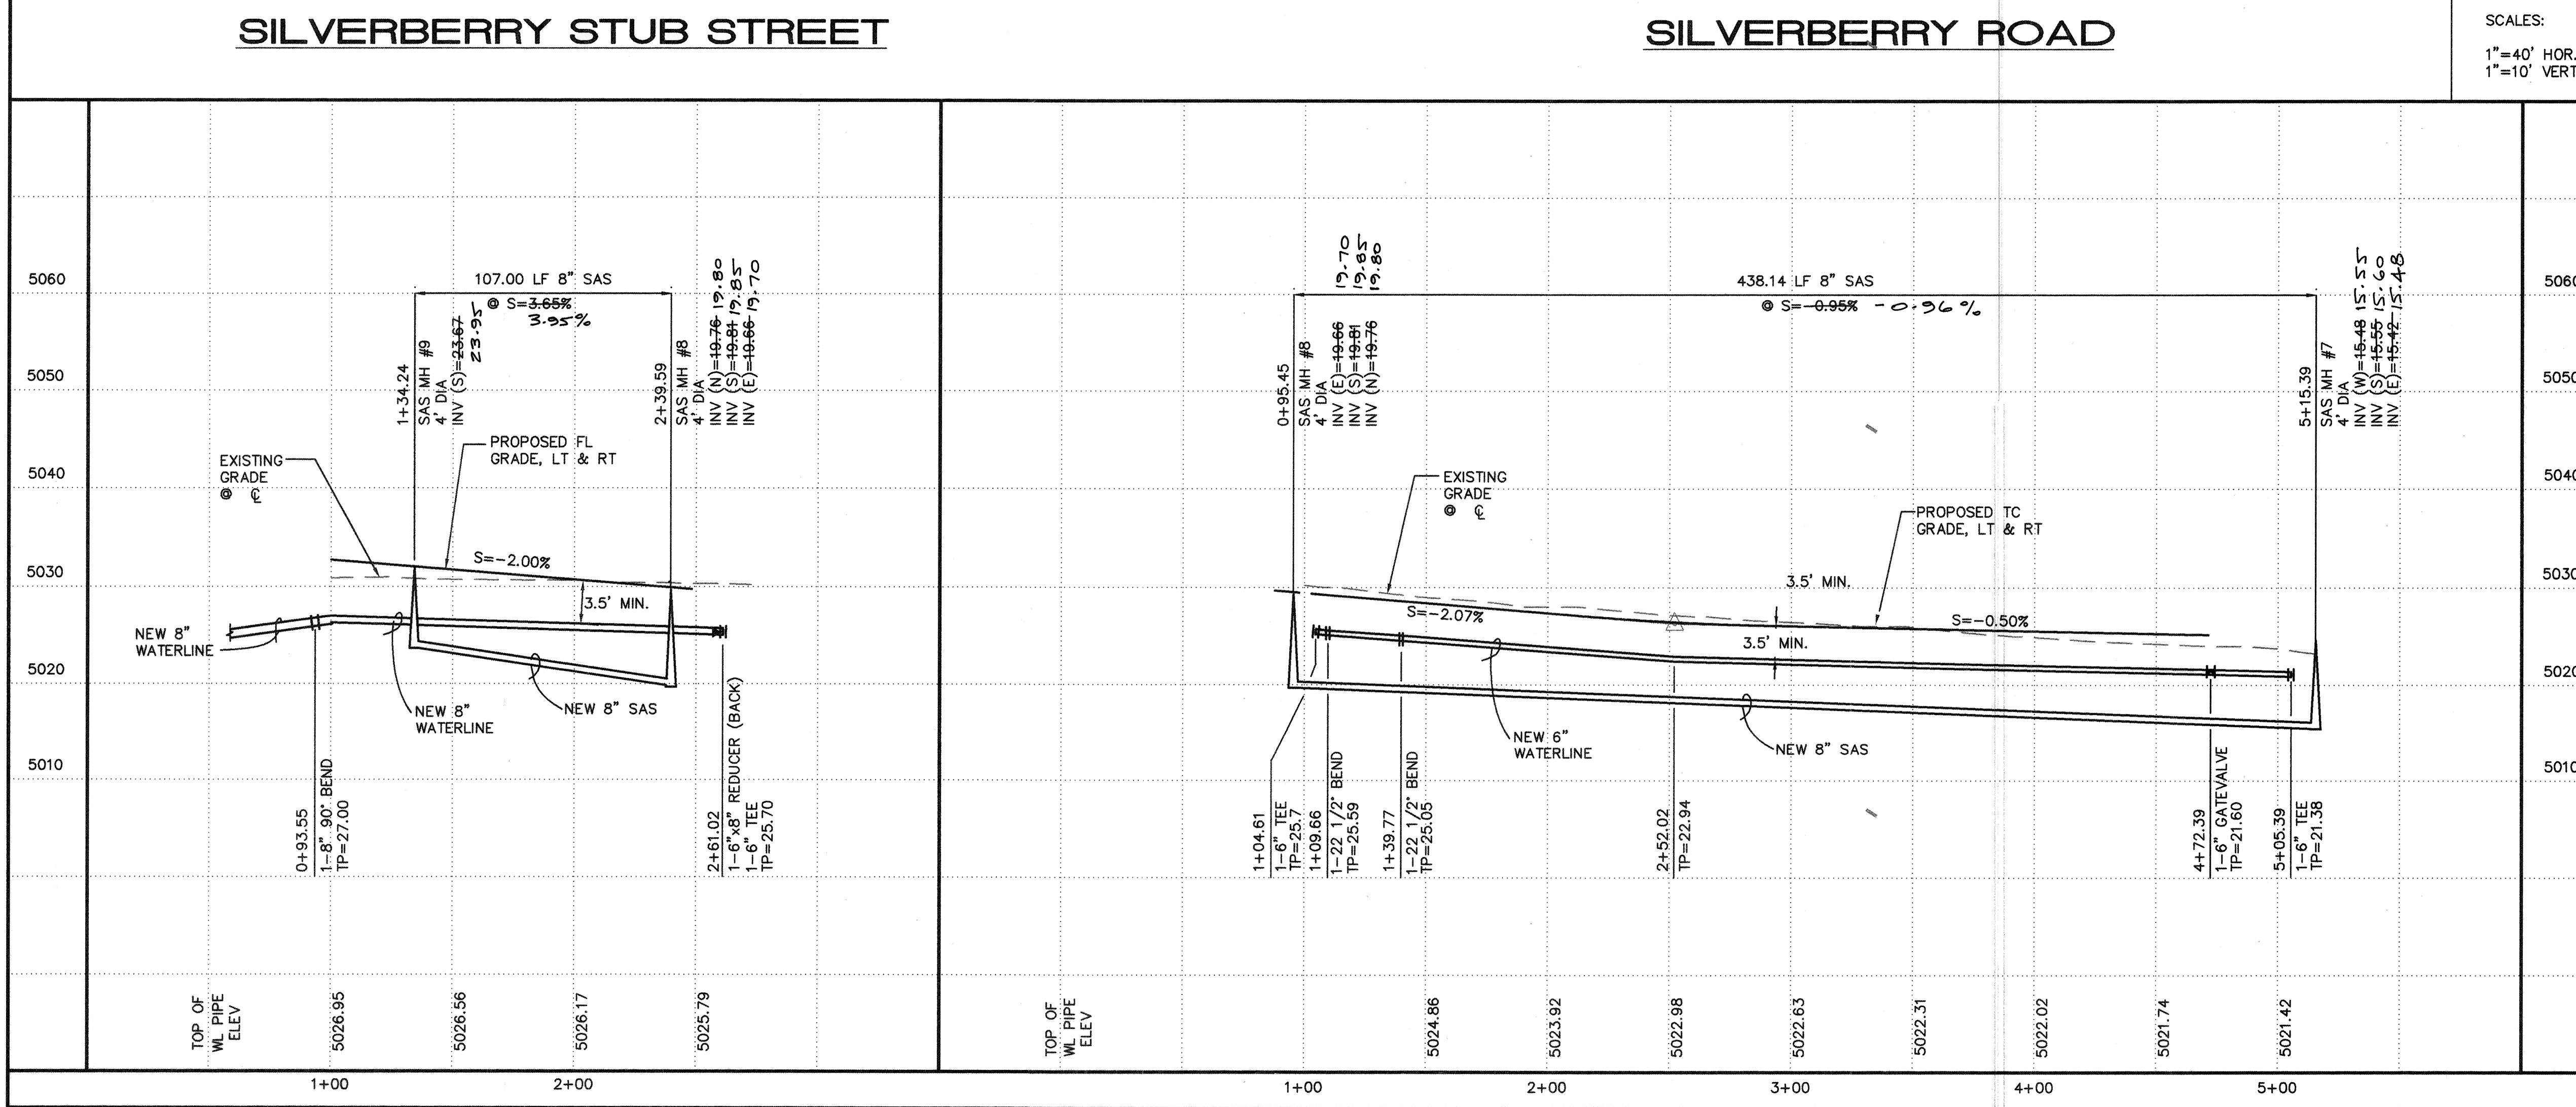

LEGEND

- SINGLE WATER METER & BOX
- DOUBLE WATER METER & BOX
- GATE VALVE W/ TYPE 'A' VALVE BOX
- FIRE HYDRANT W/ VALVED LEG
- SAS MANHOLE
- WATER LINE W/ FITTING

I, David C. Clausen, New Mexico Professional Land Surveyor No. 6547, do hereby certify that the as-built information shown hereon is the result of a field survey performed by me or under my direct supervision, and that the same is true and correct.


David C. Clausen

ISAACSON & ARFMAN, P.A.
Consulting Engineering Associates
128 Monroe Street N.E.
Albuquerque, New Mexico
921UTL3.DWG 10/20/97

CITY OF ALBUQUERQUE
PUBLIC WORKS DEPARTMENT
ENGINEERING GROUP

TITLE: DESERT SPRINGS SUBDIVISION, UNIT ONE
SILVERBERRY ROAD & STUB STREET
UTILITY PLAN & PROFILE

City Project No. 5785.81 Zone Map No. M-10 Sheet 23 Of 32

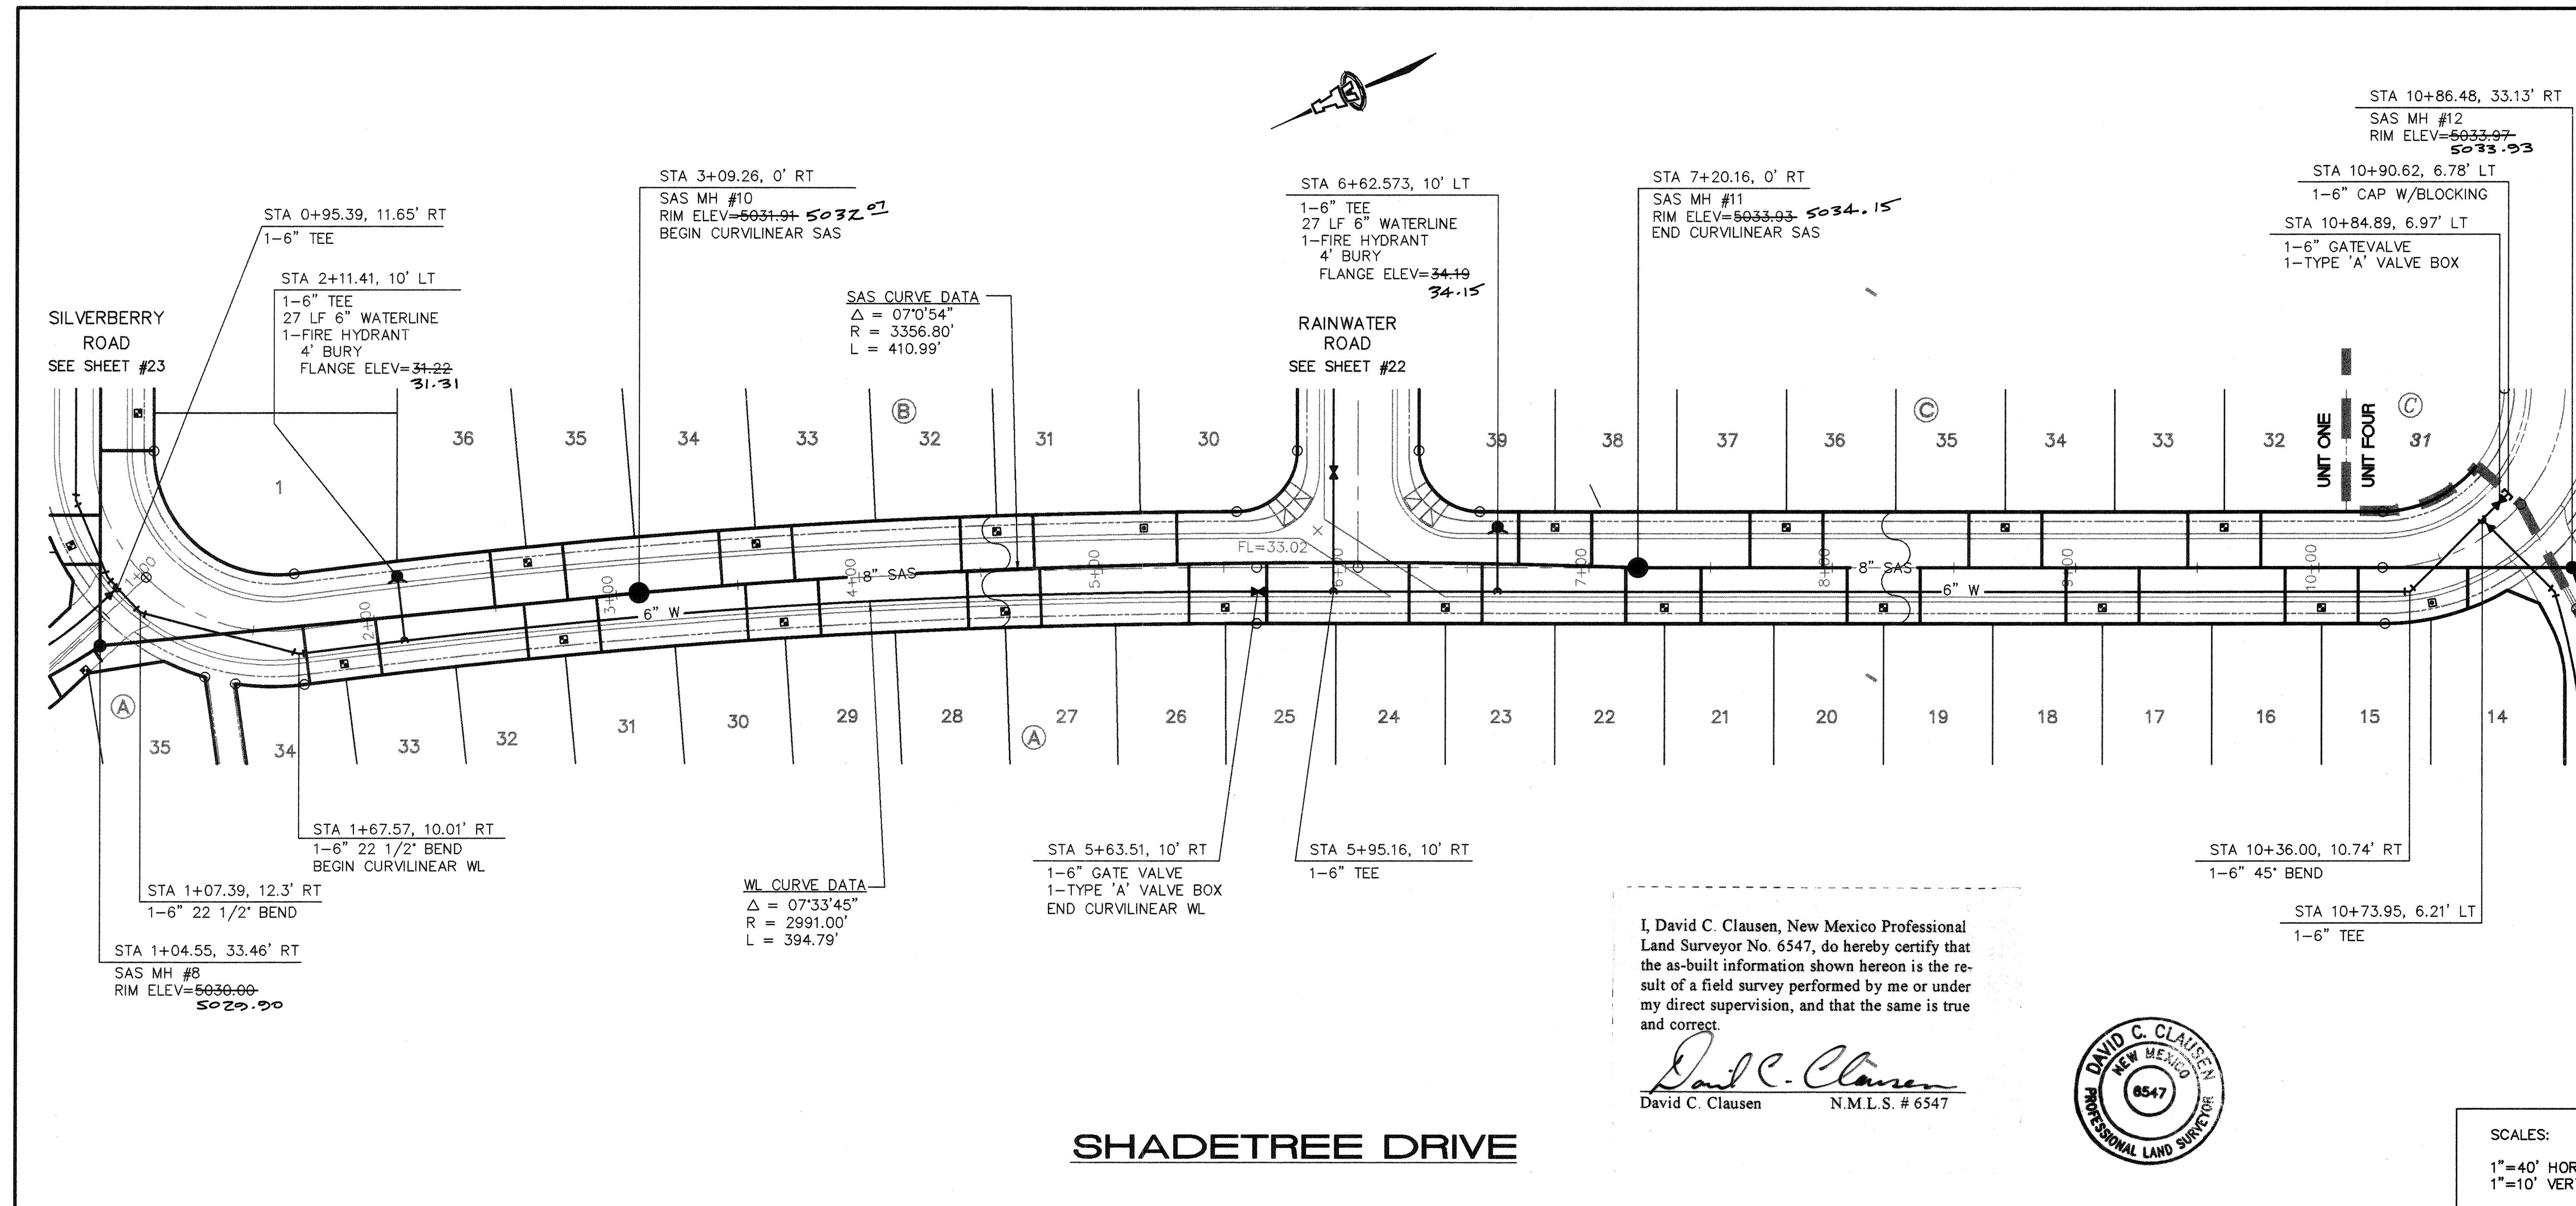

I, David C. Clausen, New Mexico Professional Land Surveyor No. 6547, do hereby certify that the as-built information shown hereon is the result of a field survey performed by me or under my direct supervision, and that the same is true and correct.

David C. Clausen
David C. Clausen N.M.L.S. # 6547



- GENERAL NOTES**
- CONSTRUCT SAS SERVICES PER COA STD DWG #2125.
 - CONSTRUCT ALL SINGLE & DOUBLE WATER SERVICES PER COA STD DWG'S #2361, #2362, & #2363.
 - SEE SHEET #20 FOR WATER SHUT-OFF PLAN.
 - SEE SHEET #20 FOR RESTRAINED JOINT LENGTHS FOR WATER LINE FITTINGS.
 - CONSTRUCT FIRE HYDRANTS PER DESIGNATED DEPTHS & LENGTHS PER COA STD DWG #2340.

STATION		SAS LENGTH		SAS INV @ R/W
LOT/BLOCK	WATER, LENGTH	SAS, LENGTH		
14/A	10+41.53, 10' S	10+53.42, 17'	28.4	28.4
15/A	10+01.15, 6'	10+16.15, 23'	28.6	28.6
16/A	9+86.15, 23'	9+86.15, 23'	28.7	28.7
17/A	9+86.15, 23'	9+86.15, 23'	28.7	28.7
18/A	9+11.15, 6'	8+96.15, 23'	28.7	28.7
19/A	8+21.15, 6'	8+36.15, 23'	28.7	28.7
20/A	8+21.15, 6'	8+06.15, 23'	28.7	28.7
21/A	7+46.15, 23'	7+46.15, 23'	28.7	28.7
22/A	7+31.15, 6'	7+15.16, 23'	28.7	28.7
23/A	6+41.15, 6'	6+56.15, 25'	28.8	28.8
24/A	6+41.15, 6'	6+26.15, 25'	28.8	28.8
25/A	5+50.62, 6'	5+67.72, 25'	28.8	28.8
26/A	5+50.62, 6'	5+35.51, 25'	28.8	28.8
27/A	4+59.31, 6'	4+74.43, 24'	28.8	28.8
28/A	4+59.31, 6'	4+44.20, 24'	28.8	28.8
29/A	3+68.01, 6'	3+83.12, 24'	28.8	28.8
30/A	3+68.01, 6'	3+52.89, 24'	28.8	28.8
31/A	2+76.70, 6'	2+91.81, 23'	28.9	28.9
32/A	2+76.70, 6'	2+61.58, 23'	28.9	28.9
33/A	1+85.39, 6'	2+00.51, 24'	28.9	28.9
34/A	1+85.39, 6'	1+70.27, 25'	28.9	28.9
30/B	5+15.84, 27' S	5+30.73, 22'	28.7	28.7
31/B	4+57.15, 27'	4+72.04, 23'	28.7	28.7
32/B	4+57.15, 27'	4+42.27, 23'	28.7	28.7
33/B	3+58.56, 27'	3+73.45, 23'	27.9	27.9
34/B	3+58.56, 27'	3+43.67, 23'	27.9	27.9
35/B	2+64.90, 27'	2+79.78, 23'	27.9	27.9
36/B	2+64.90, 27'	2+50.01, 23'	27.9	27.9
32/C	9+61.16, 27'	9+76.16, 23'	28.8	28.8
33/C	9+61.16, 27'	9+46.16, 23'	28.8	28.8
34/C	8+71.16, 27'	8+86.16, 23'	28.8	28.8
35/C	8+71.16, 27'	8+56.16, 23'	28.8	28.8
36/C	7+81.16, 27'	7+96.16, 23'	28.8	28.8
37/C	7+81.16, 27'	7+66.16, 23'	28.8	28.8
38/C	6+86.16, 27'	7+01.16, 23'	28.8	28.8
39/C	6+86.16, 27'	6+71.16, 22'	28.8	28.8

ALL WATER SERVICES ARE DOUBLE EXCEPT WHERE NOTED AS (S) SINGLE.


- LEGEND**
- SINGLE WATER METER & BOX
 - DOUBLE WATER METER & BOX
 - GATE VALVE W/ TYPE 'A' VALVE BOX
 - FIRE HYDRANT W/ VALVED LEG
 - SAS MANHOLE
 - WATER LINE W/ FITTING

ISAACSON & ARFMAN, P.A.
Consulting Engineering Associates
128 Monroe Street N.E.
Albuquerque New Mexico
921UTL4.DWGams 10/20/97

CITY OF ALBUQUERQUE
PUBLIC WORKS DEPARTMENT
ENGINEERING GROUP

TITLE: **DESERT SPRINGS SUBDIVISION, UNIT ONE SHADEETREE DRIVE UTILITY PLAN & PROFILE**


Design Review Committee	City Engineer Approval	Mo./Day/Yr.	Mo./Day/Yr.
APPROVED			
DESIGN REVIEW COMMITTEE			

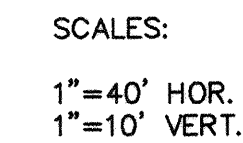

- I, David C. Clausen, New Mexico Professional Land Surveyor No. 6547, do hereby certify that the as-built information shown hereon is the result of a field survey performed by me or under my direct supervision, and that the same is true and correct.
- 
David C. Clausen N.M.L.S. # 6547




	SINGLE WATER METER & BOX
	DOUBLE WATER METER & BOX
	GATE VALVE W/ TYPE 'A' VALVE BOX
	FIRE HYDRANT W/ VALVED LEG
	SAS MANHOLE
	WATER LINE W/ FITTING

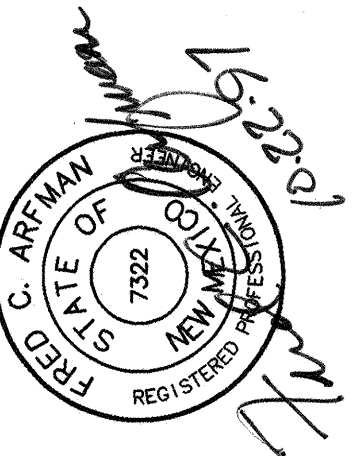

 **ISAACSON & ARFMAN, P.A.**
Consulting Engineering Associates
128 Monroe Street N.E.
Albuquerque New Mexico

CITY OF ALBUQUERQUE PUBLIC WORKS DEPARTMENT ENGINEERING GROUP	
TITLE:	DESERT SPRINGS SUBDIVISION, UNIT ONE DESERT SPRINGS DRIVE UTILITY PLAN & PROFILE

Design Review Committee APPROVE FEB 18 1998 DESIGN REVIEW COMMITTEE		City Engineer Approval	Last Design Update	Mo./Day/Yr.	Mo./Day/Yr.
City Project No. 5785.81	Zone Map No. M-10	Sheet 25 Of 32			

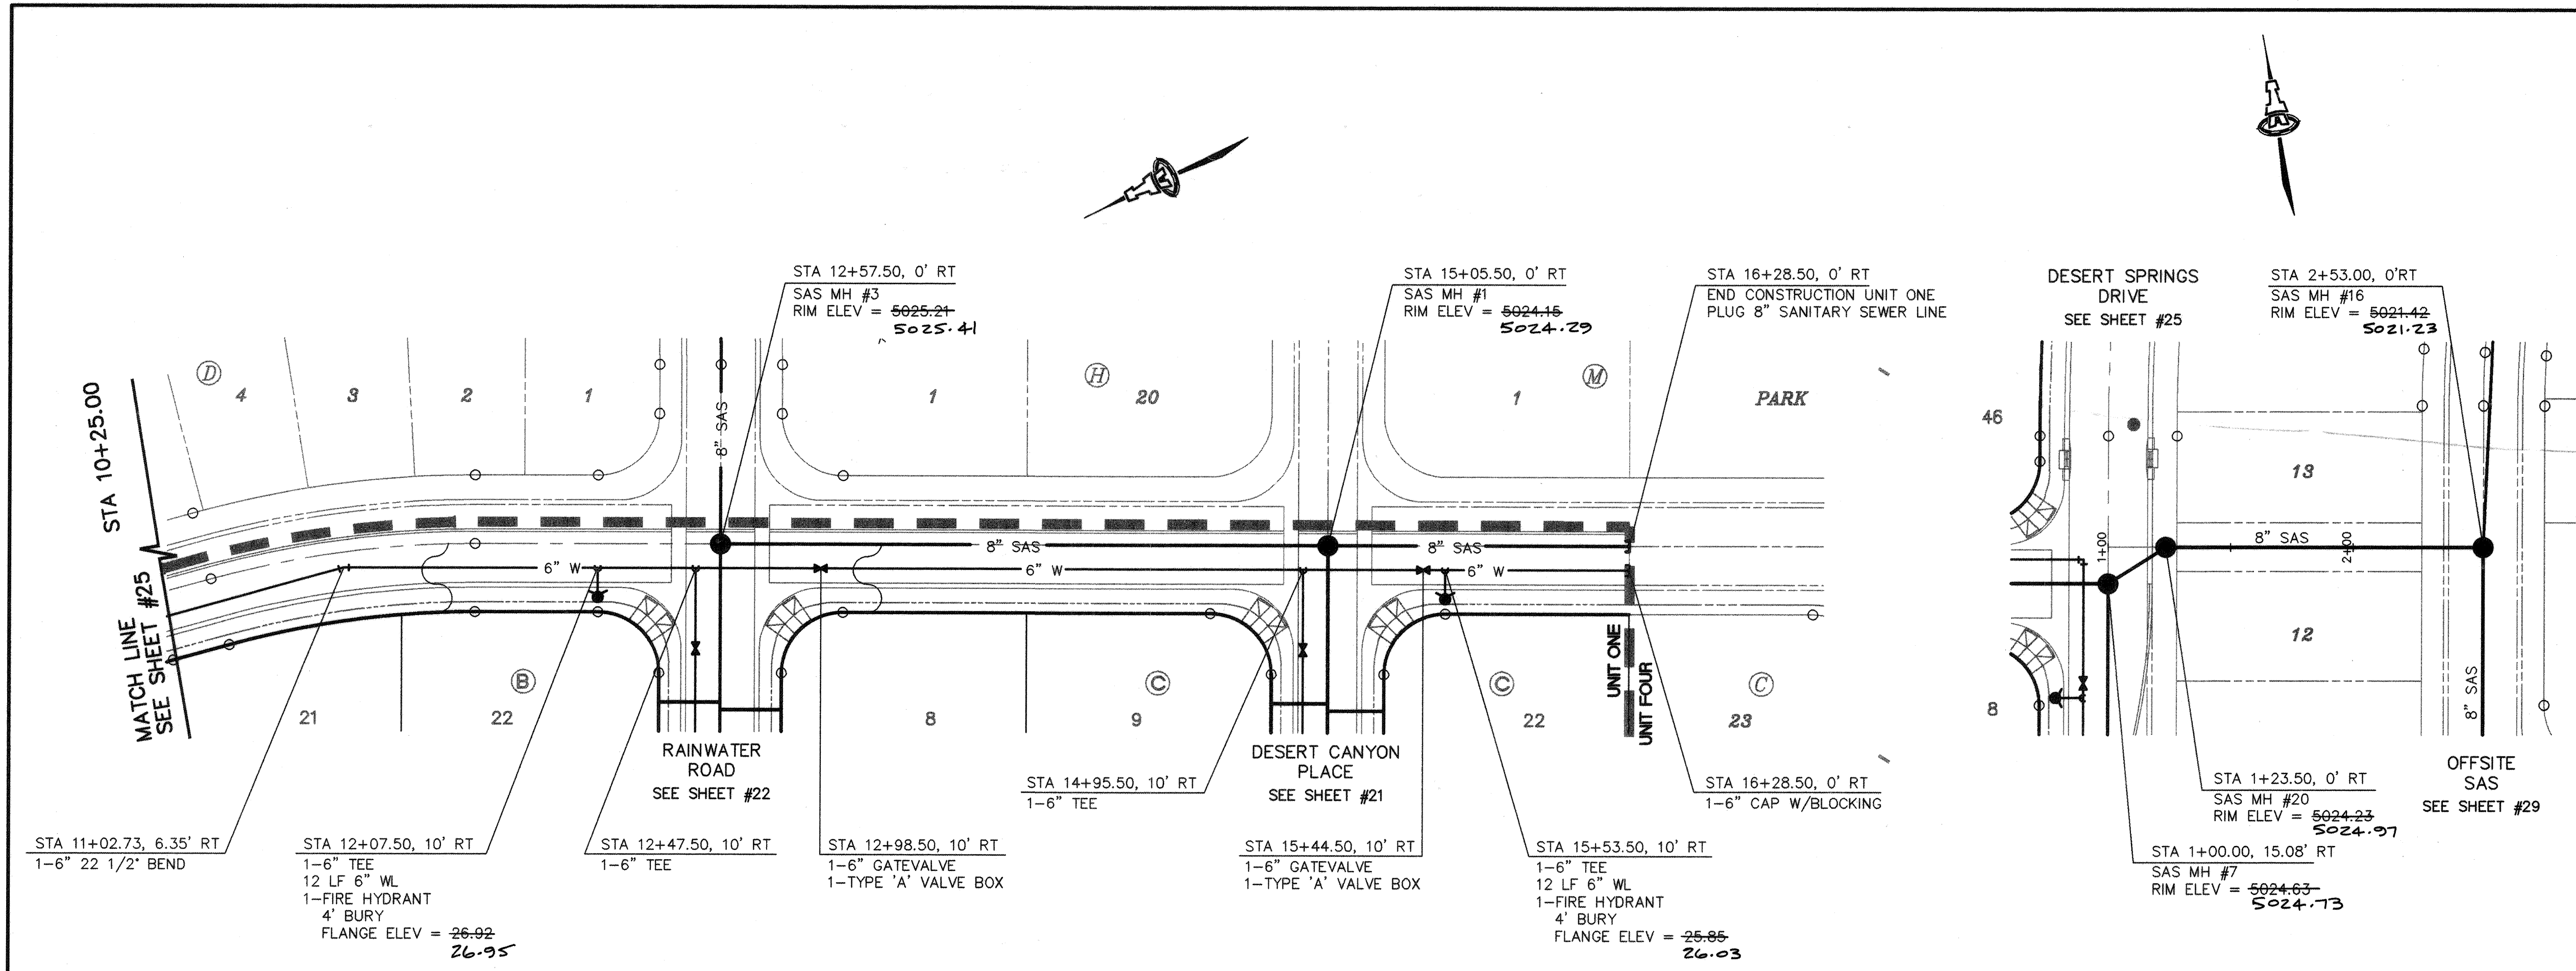


- GENERAL NOTES**
1. CONSTRUCT SAS SERVICES PER COA STD DWG #2125.
 2. CONSTRUCT ALL SINGLE & DOUBLE WATER SERVICES PER COA STD DWG'S #2361, #2362, & #2363.
 3. SEE SHEET #20 FOR WATER SHUT-OFF PLAN.
 4. SEE SHEET #20 FOR RESTRAINED JOINT LENGTHS FOR WATER LINE FITTINGS.
 5. CONSTRUCT FIRE HYDRANTS PER DESIGNATED DEPTHS & LENGTHS PER COA STD DWG #2340.

- LEGEND**
- SINGLE WATER METER & BOX
 - DOUBLE WATER METER & BOX
 - GATE VALVE W/ TYPE 'A' VALVE BOX
 - FIRE HYDRANT W/ VALVED LEG
 - SAS MANHOLE
 - WATER LINE W/ FITTING


SCALES:
1"=40' HOR.
1"=10' VERT.

**DESERT SPRINGS DRIVE
SANITARY SEWERLINE**

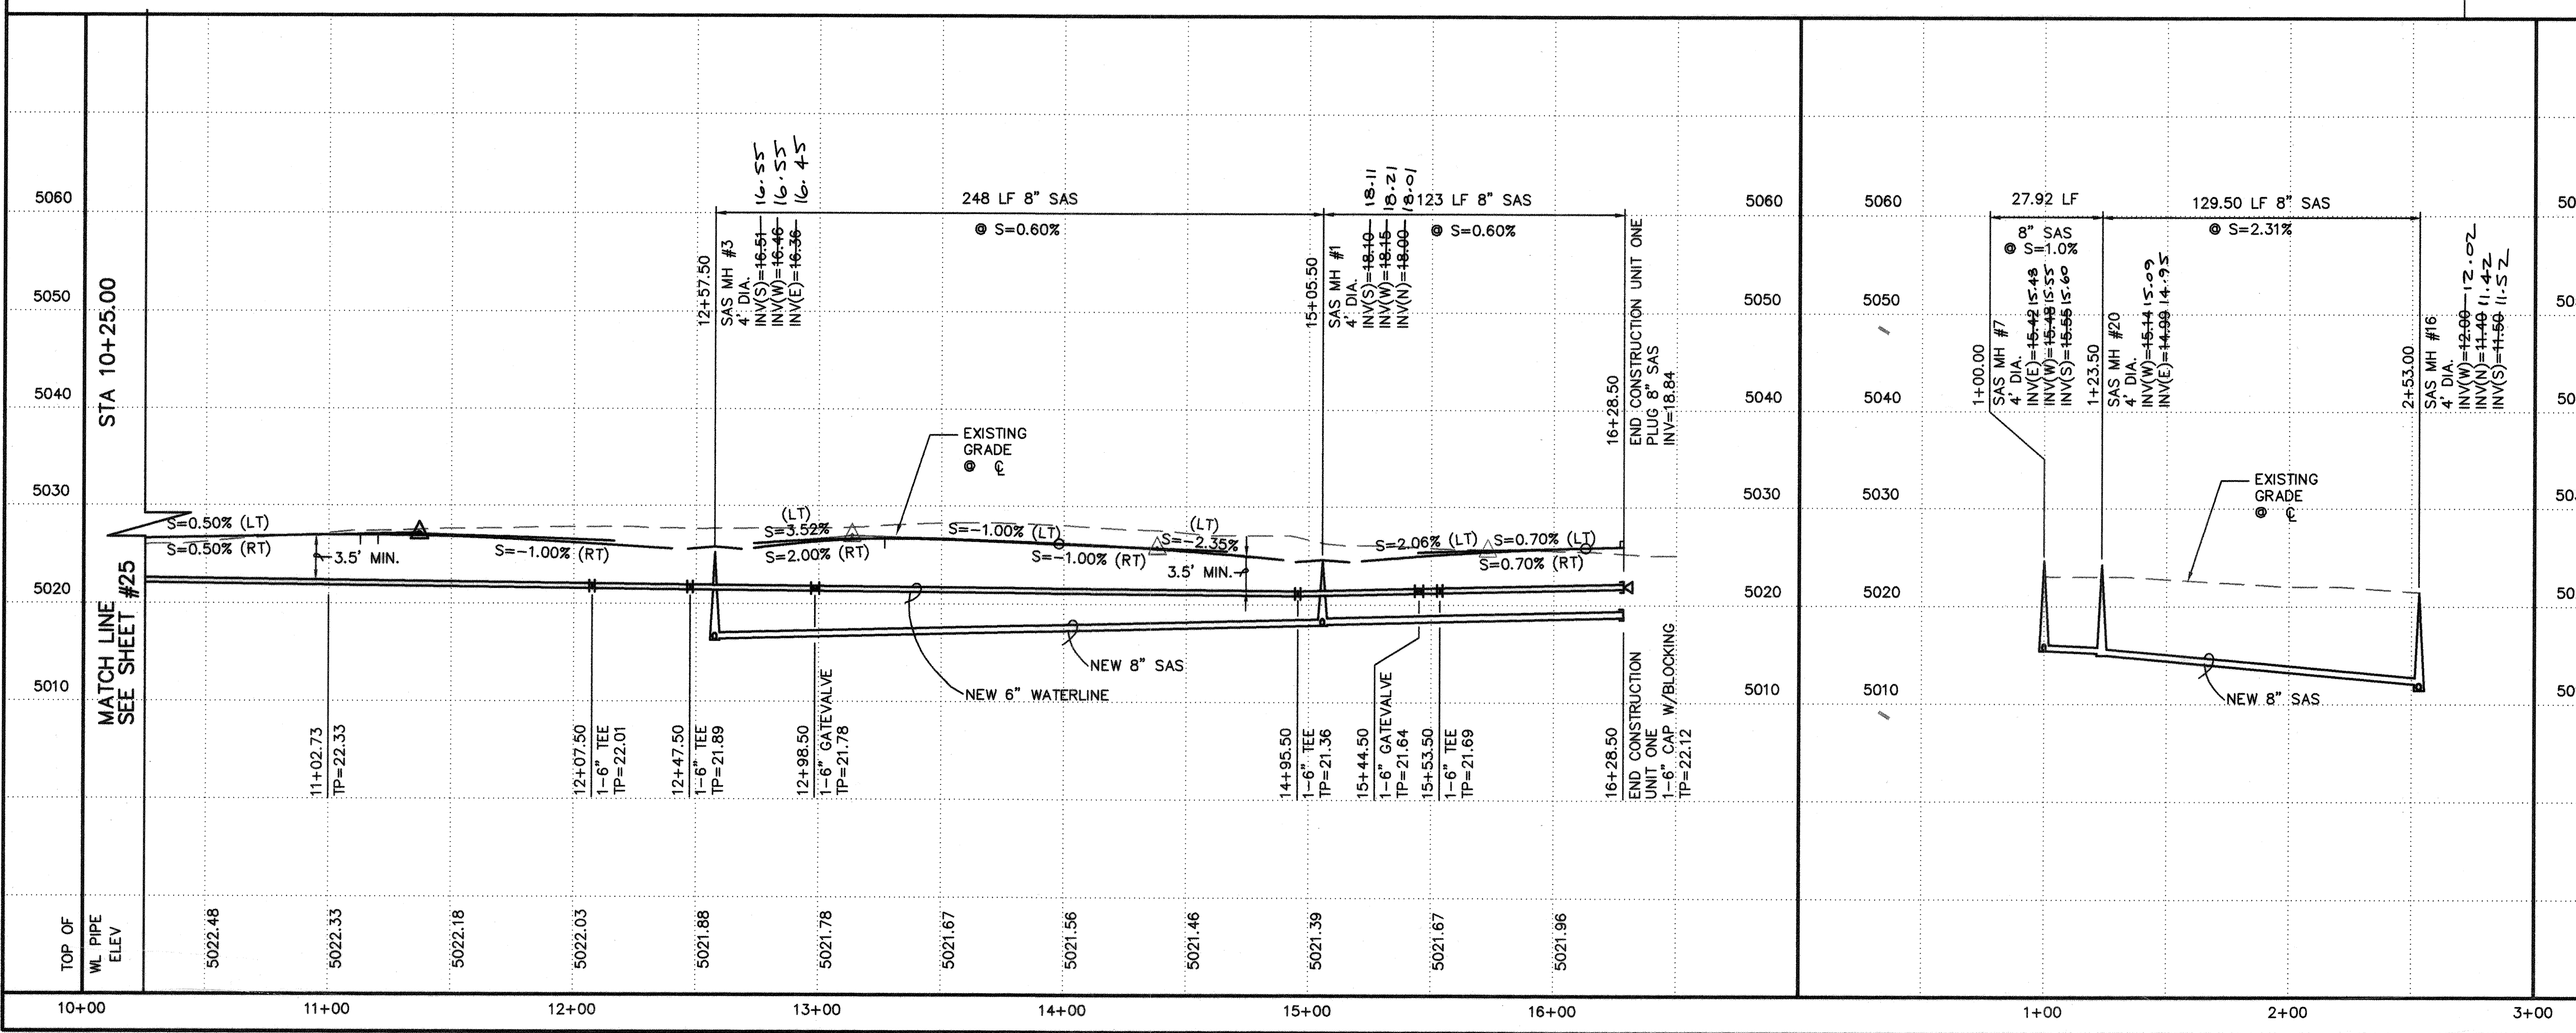

I, David C. Clausen, New Mexico Professional Land Surveyor No. 6547, do hereby certify that the as-built information shown hereon is the result of a field survey performed by me or under my direct supervision, and that the same is true and correct.

David C. Clausen
David C. Clausen N.M.L.S. # 6547

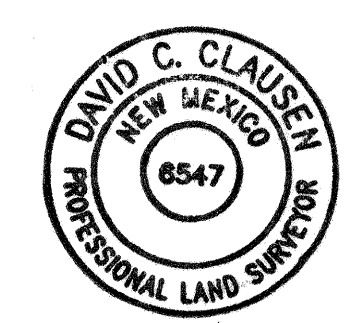

ISAACSON & ARFMAN, P.A.
Consulting Engineering Associates
128 Monroe Street N.E.
Albuquerque New Mexico
921UTL6.DWGms 10/20/97



CITY OF ALBUQUERQUE
PUBLIC WORKS DEPARTMENT
ENGINEERING GROUP

TITLE: **DESERT SPRINGS SUBDIVISION, UNIT ONE
DESERT SPRINGS DRIVE & OFFSITE SAS
UTILITY PLAN & PROFILE**


NO.	DATE	REVISIONS	BY

DESIGNED BY: MUC DATE: 7/11/97
DRAWN BY: EMS DATE: 7/11/97
CHECKED BY: FCA DATE: 7/11/97

City Project No. **5785.81** Zone Map No. **M-10** Sheet **26** Of **32**

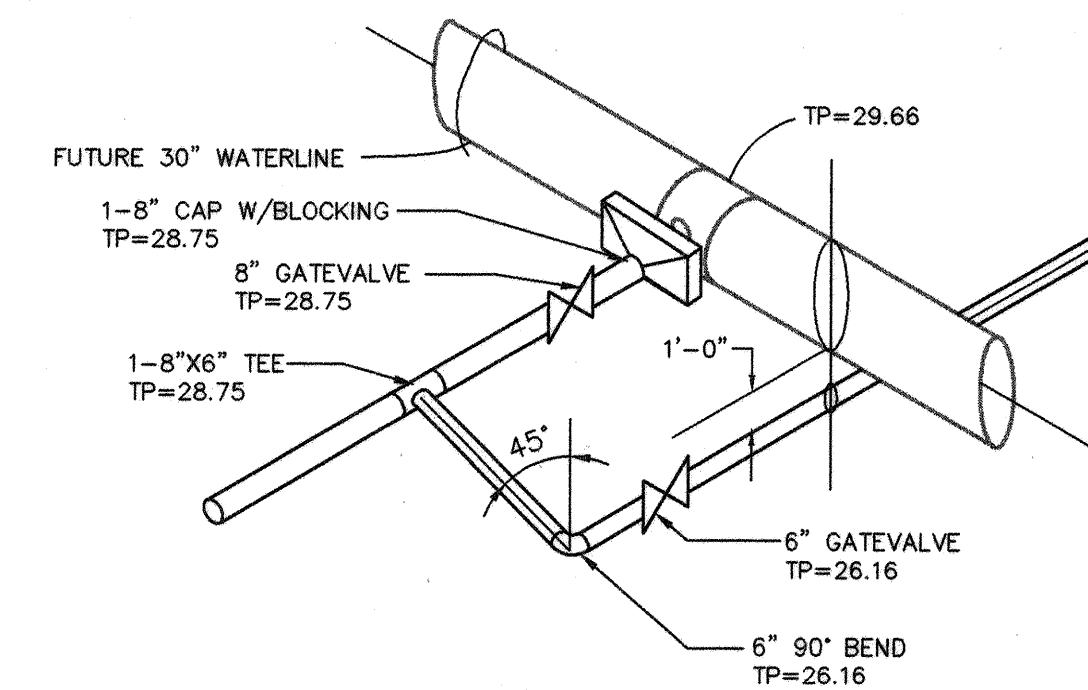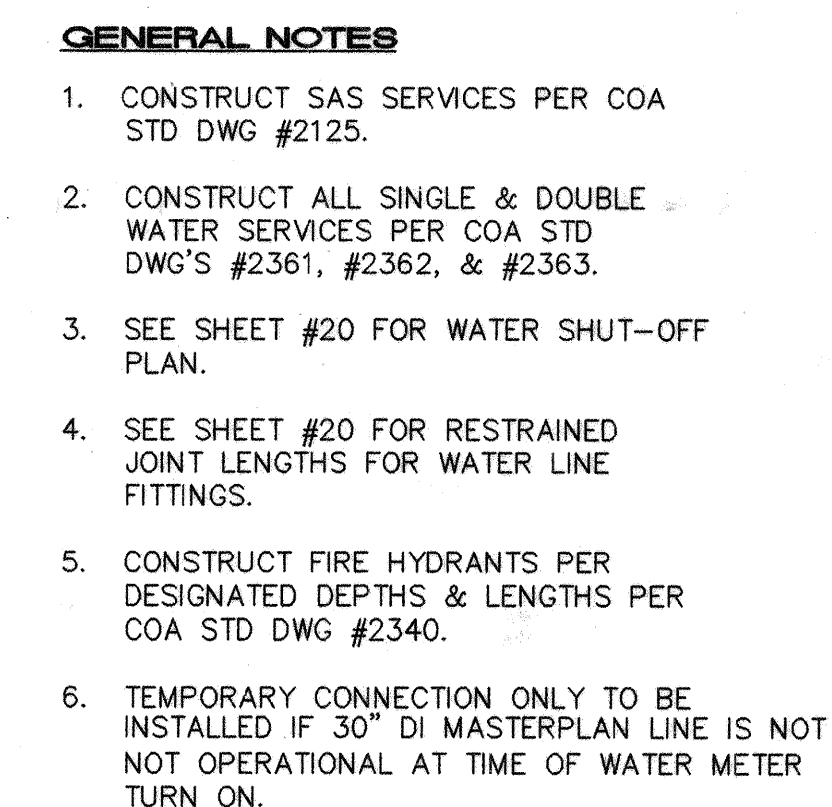


DETAIL 'A'
SCALE: 1"=5'

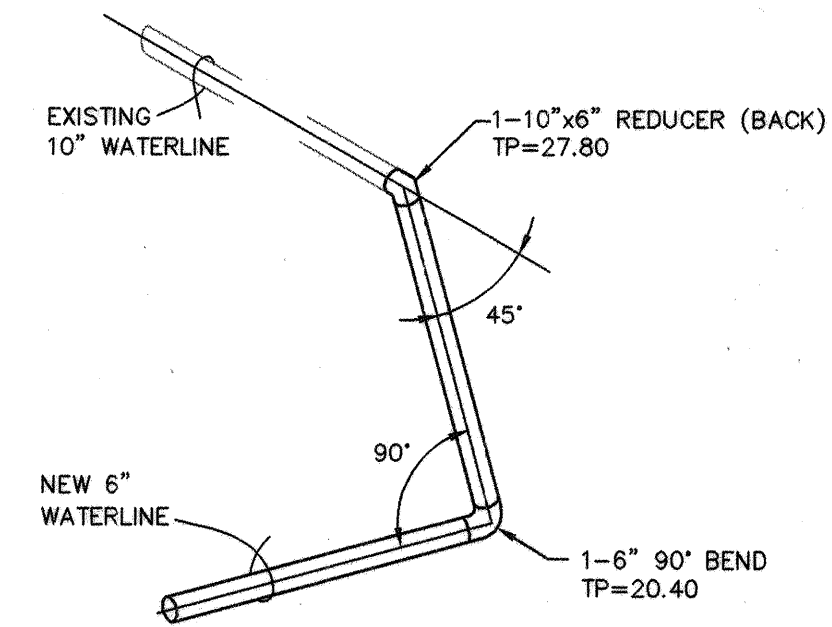

DETAIL 'E'
SCALE: 1"=5'

- ### LEGEND


- | | |
|---|----------------------------------|
|  | SINGLE WATER METER & BOX |
|  | DOUBLE WATER METER & BOX |
|  | GATE VALVE W/ TYPE 'A' VALVE BOX |
|  | FIRE HYDRANT W/ VALVED LEG |
|  | SAS MANHOLE |
|  | WATER LINE W/ FITTING |

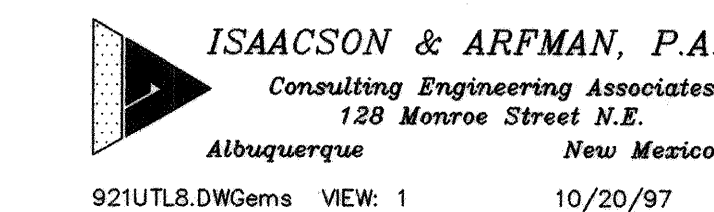


CITY OF ALBUQUERQUE
PUBLIC WORKS DEPARTMENT
ENGINEERING GROUP

TITLE: DESERT SPRINGS SUBDIVISION, UNIT ONE
UNSER BOULEVARD
UTILITY PLAN & PROFILE

Design Review Committee		City Engineer Approval		Mo./Day/Yr. Mo./Day/Yr.	
APPROVED FEB 18 1998 DESIGN REVIEW COMMITTEE		City Engineer Approval			
City Project No.				Zone Map No.	Sheet
5785.81		M-10	27	32	

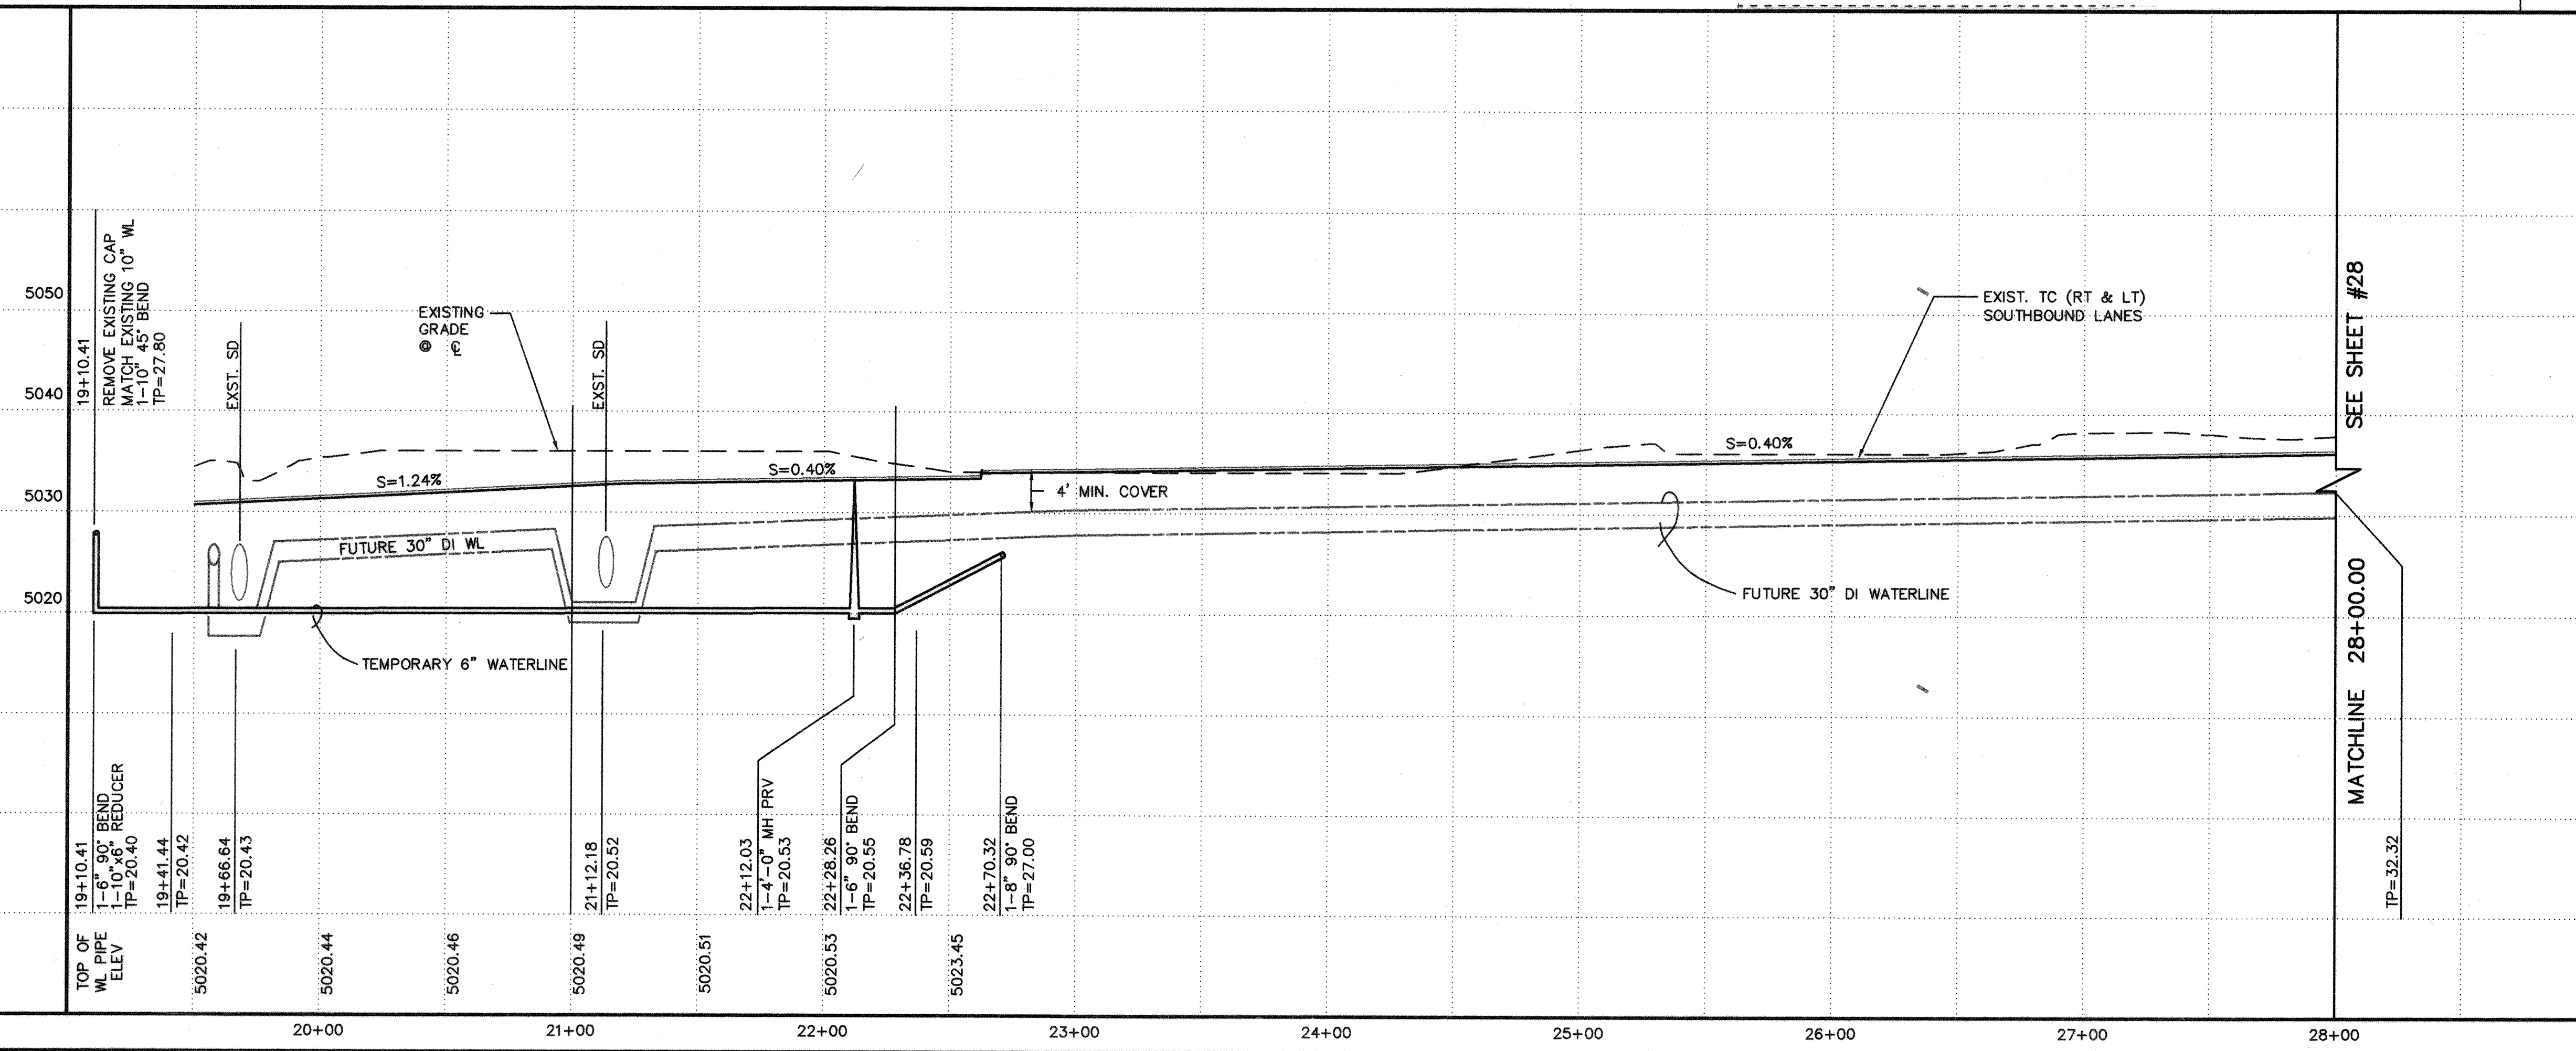

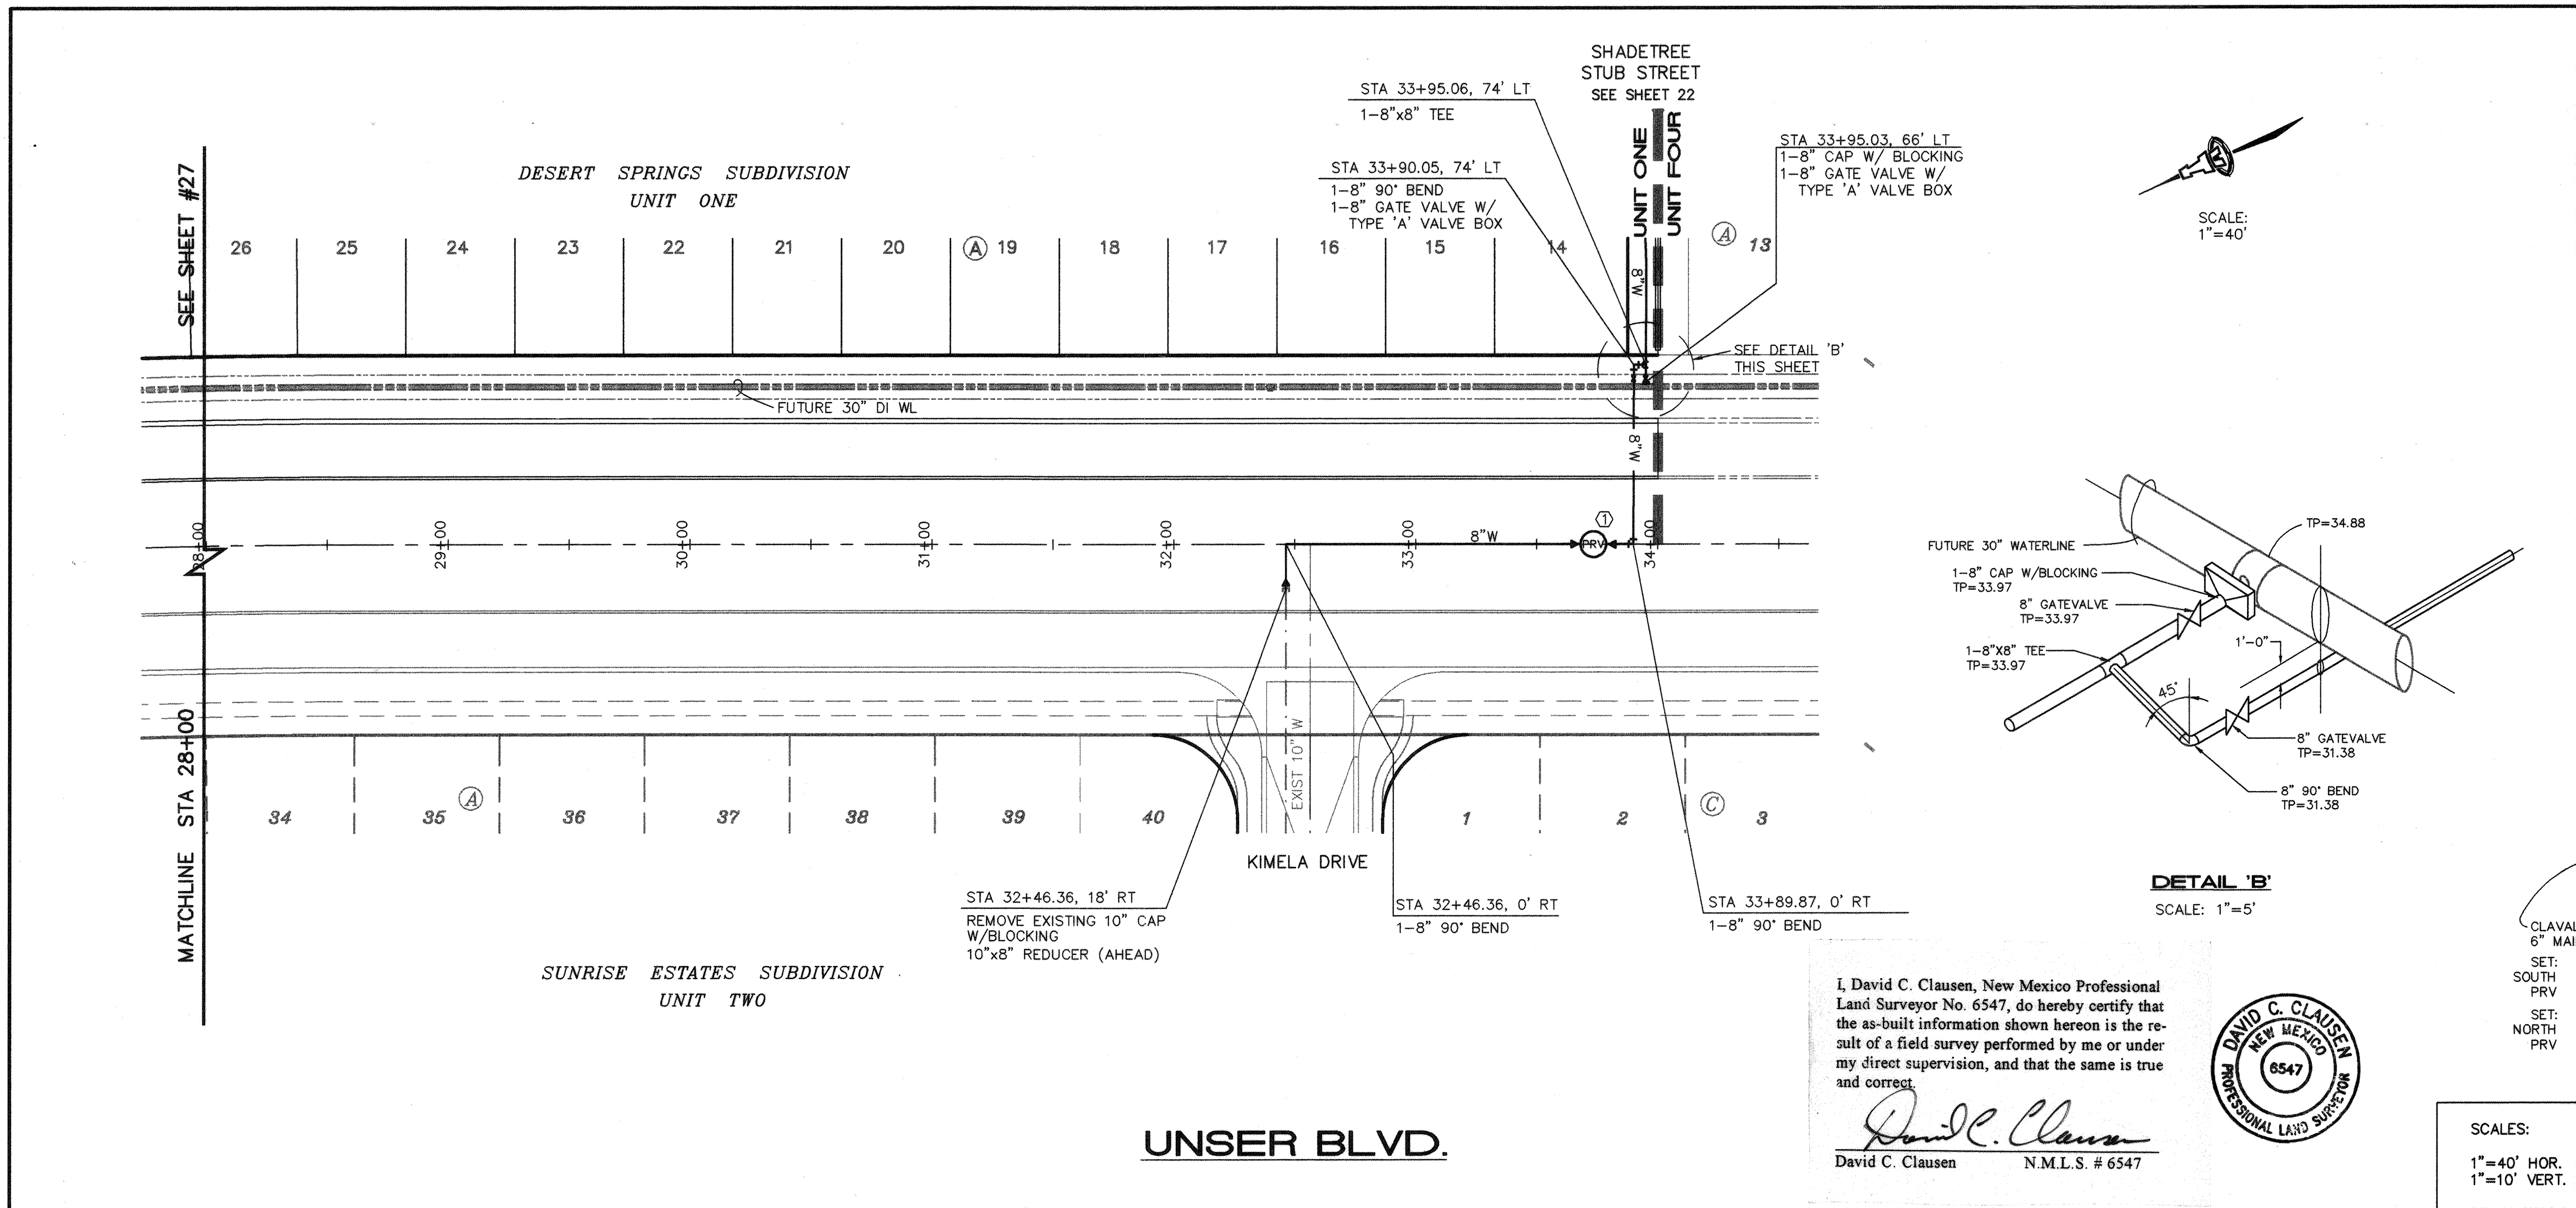


GENERAL NOTES

1. CONSTRUCT SAS SERVICES PER COA STD DWG #2125.
2. CONSTRUCT ALL SINGLE & DOUBLE WATER SERVICES PER COA STD DWG'S #2361, #2362, & #2363.
3. SEE SHEET #20 FOR WATER SHUT-OFF PLAN.
4. SEE SHEET #20 FOR RESTRAINED JOINT LENGTHS FOR WATER LINE FITTINGS.
5. CONSTRUCT FIRE HYDRANTS PER DESIGNATED DEPTHS & LENGTHS PER COA STD DWG #2340.
6. TEMPORARY CONNECTION ONLY TO BE INSTALLED IF 30" DI MASTERPLAN LINE IS NOT NOT OPERATIONAL AT TIME OF WATER METER TURN ON.

KEYED CONSTRUCTION NOTE

1. STA 33+73.46, 0' RT
4" MH TEMPORARY PRV.
SEE DETAIL THIS SHEET.

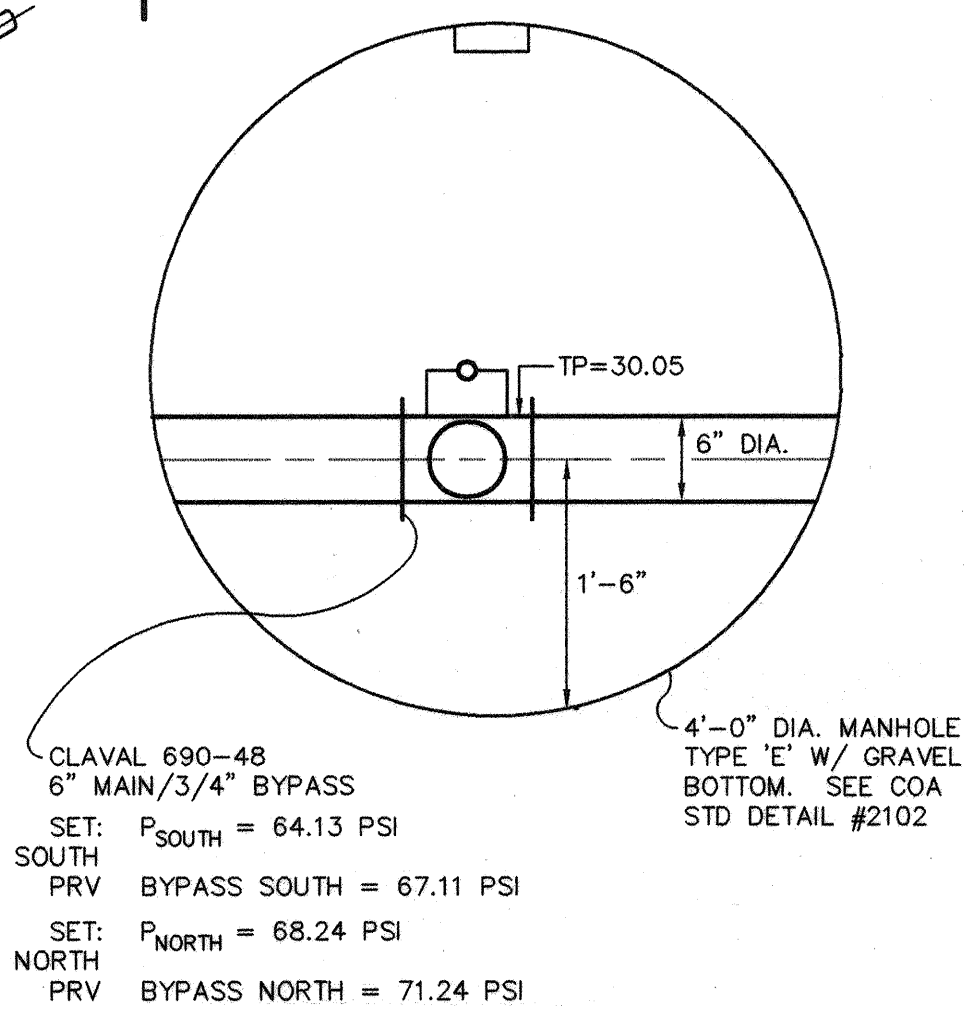


TEMPORARY PRV DETAIL

N.T.S.

LEGEND

- SINGLE WATER METER & BOX
- DOUBLE WATER METER & BOX
- GATE VALVE W/ TYPE 'A' VALVE BOX
- FIRE HYDRANT W/ VALVED LEG
- SAS MANHOLE
- WATER LINE W/ FITTING

SCALES:
1"=40' HOR.
1"=10' VERT.

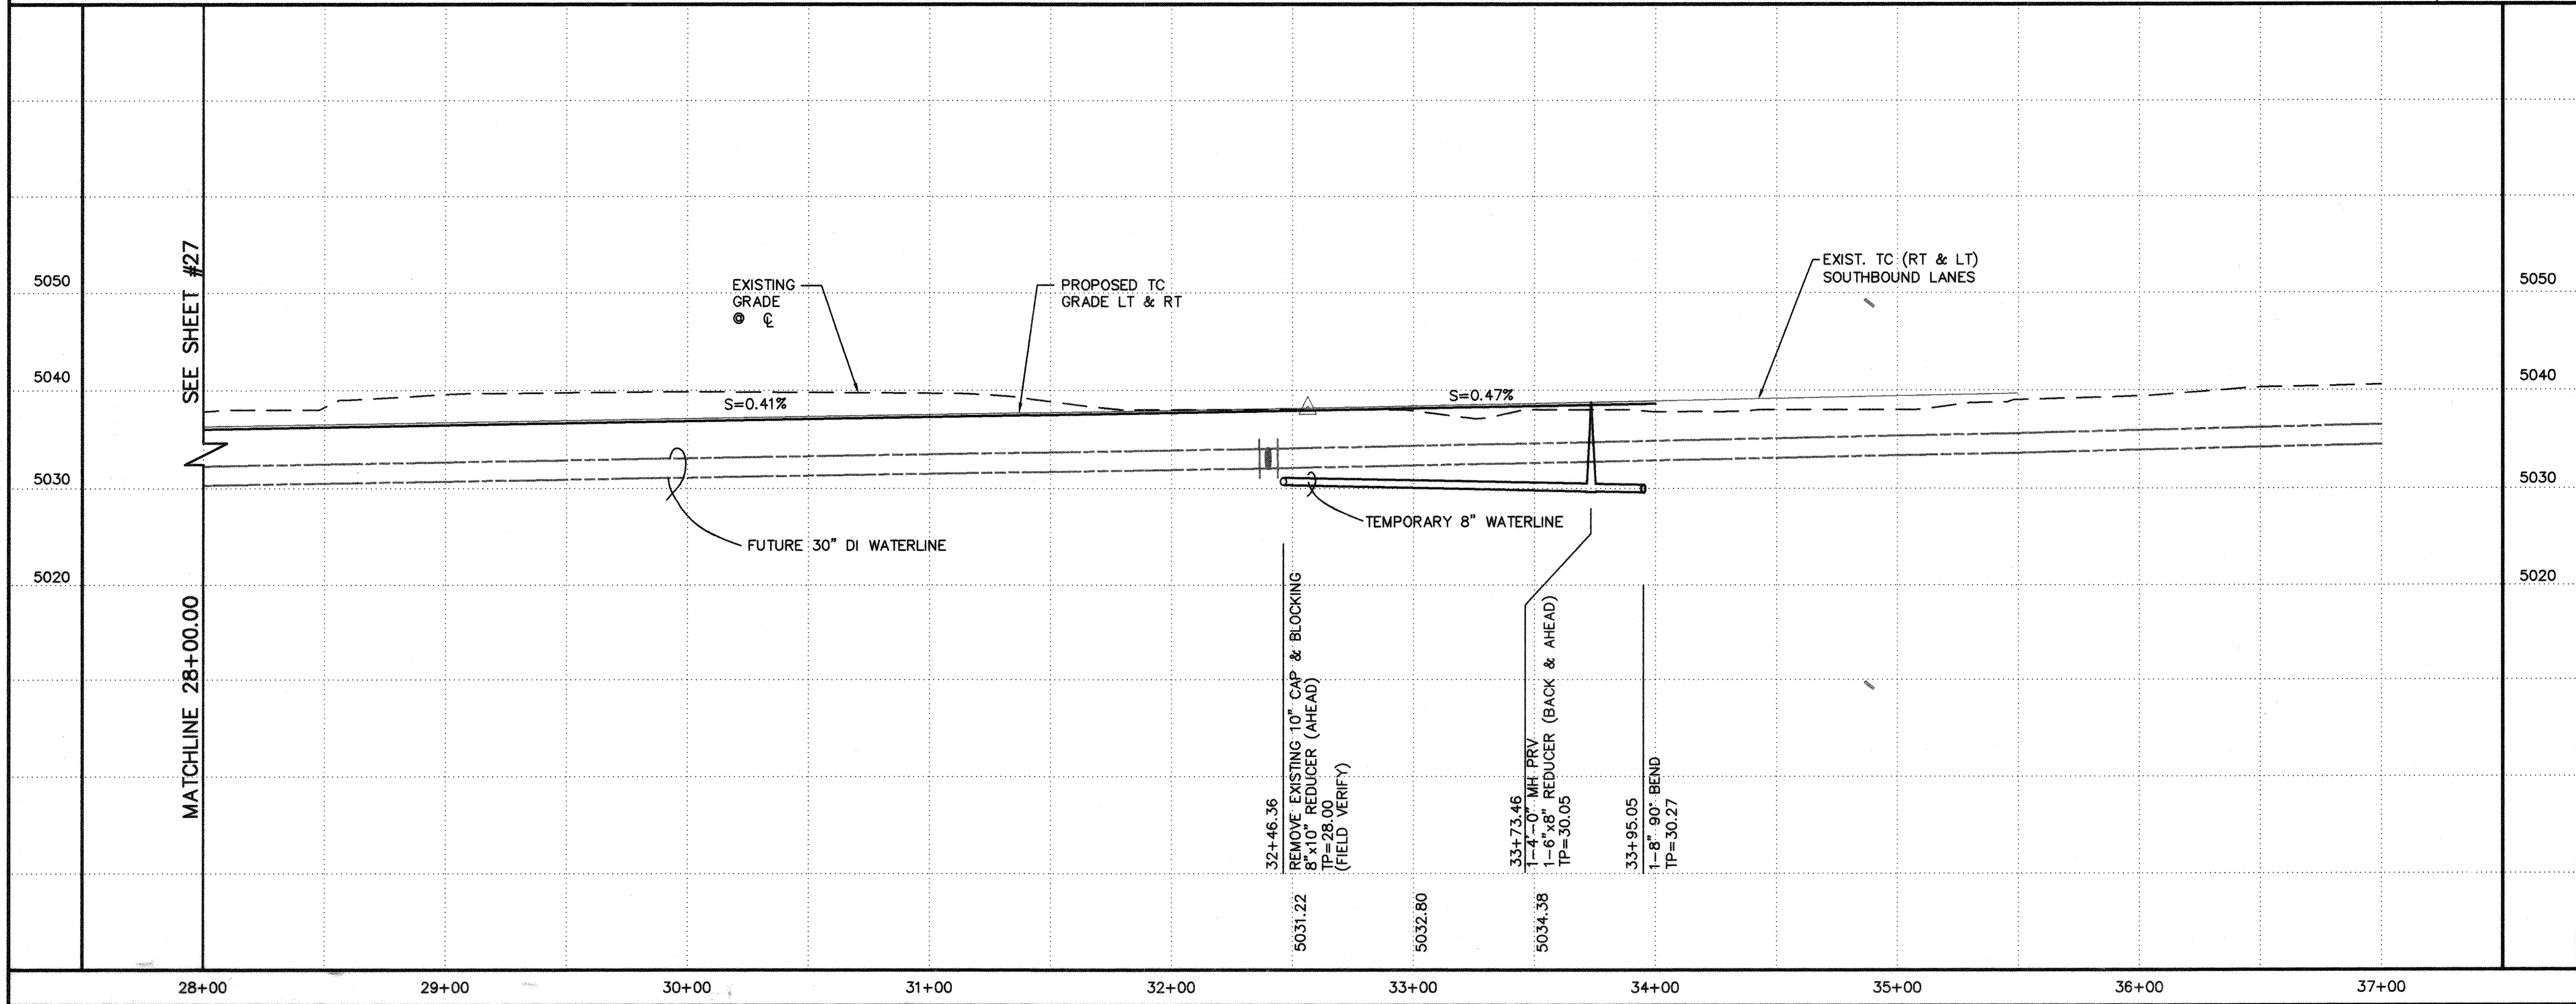

ISAACSON & ARFMAN, P.A.
Consulting Engineering Associates
128 Monroe Street N.E.
Albuquerque New Mexico
921UTL8.DWGms VIEW: 2 10/20/97

CITY OF ALBUQUERQUE
PUBLIC WORKS DEPARTMENT
ENGINEERING GROUP

TITLE: DESERT SPRINGS SUBDIVISION, UNIT ONE
UNSER BOULEVARD
UTILITY PLAN & PROFILE



City Engineer Approval

Last Design Update

City Project No.

5785.81

Zone Map No.

M-10


Sheet

28

Of


32

AS-BUILT INFORMATION		BENCH MARKS		SURVEY INFORMATION		ENGINEER'S SEAL	
CONTRACTOR	SPARKLING CONST. CO.	ACS MONUMENT "1-M10" LOCATED AT THE SOUTHEAST CORNER OF SAGE RD. & UNSER BLVD.	1/97	FIELD NOTES	ALS		
WORK STARTED BY	D. CLAUSEN	ELEV. = 5079.88					
DATE	5/98					REVISIONS	
ACCEPTANCE BY	D. CLAUSEN						
DATE	5/98					DESIGN	
REVISIONS BY	D. CLAUSEN						
DATE	5/98					CHECKED BY	
COMPLETED BY	D. CLAUSEN						
DATE	5/98					DRAWN BY	
MICRO-FILM INFORMATION							
RECORDED BY						DATE	
NO.							

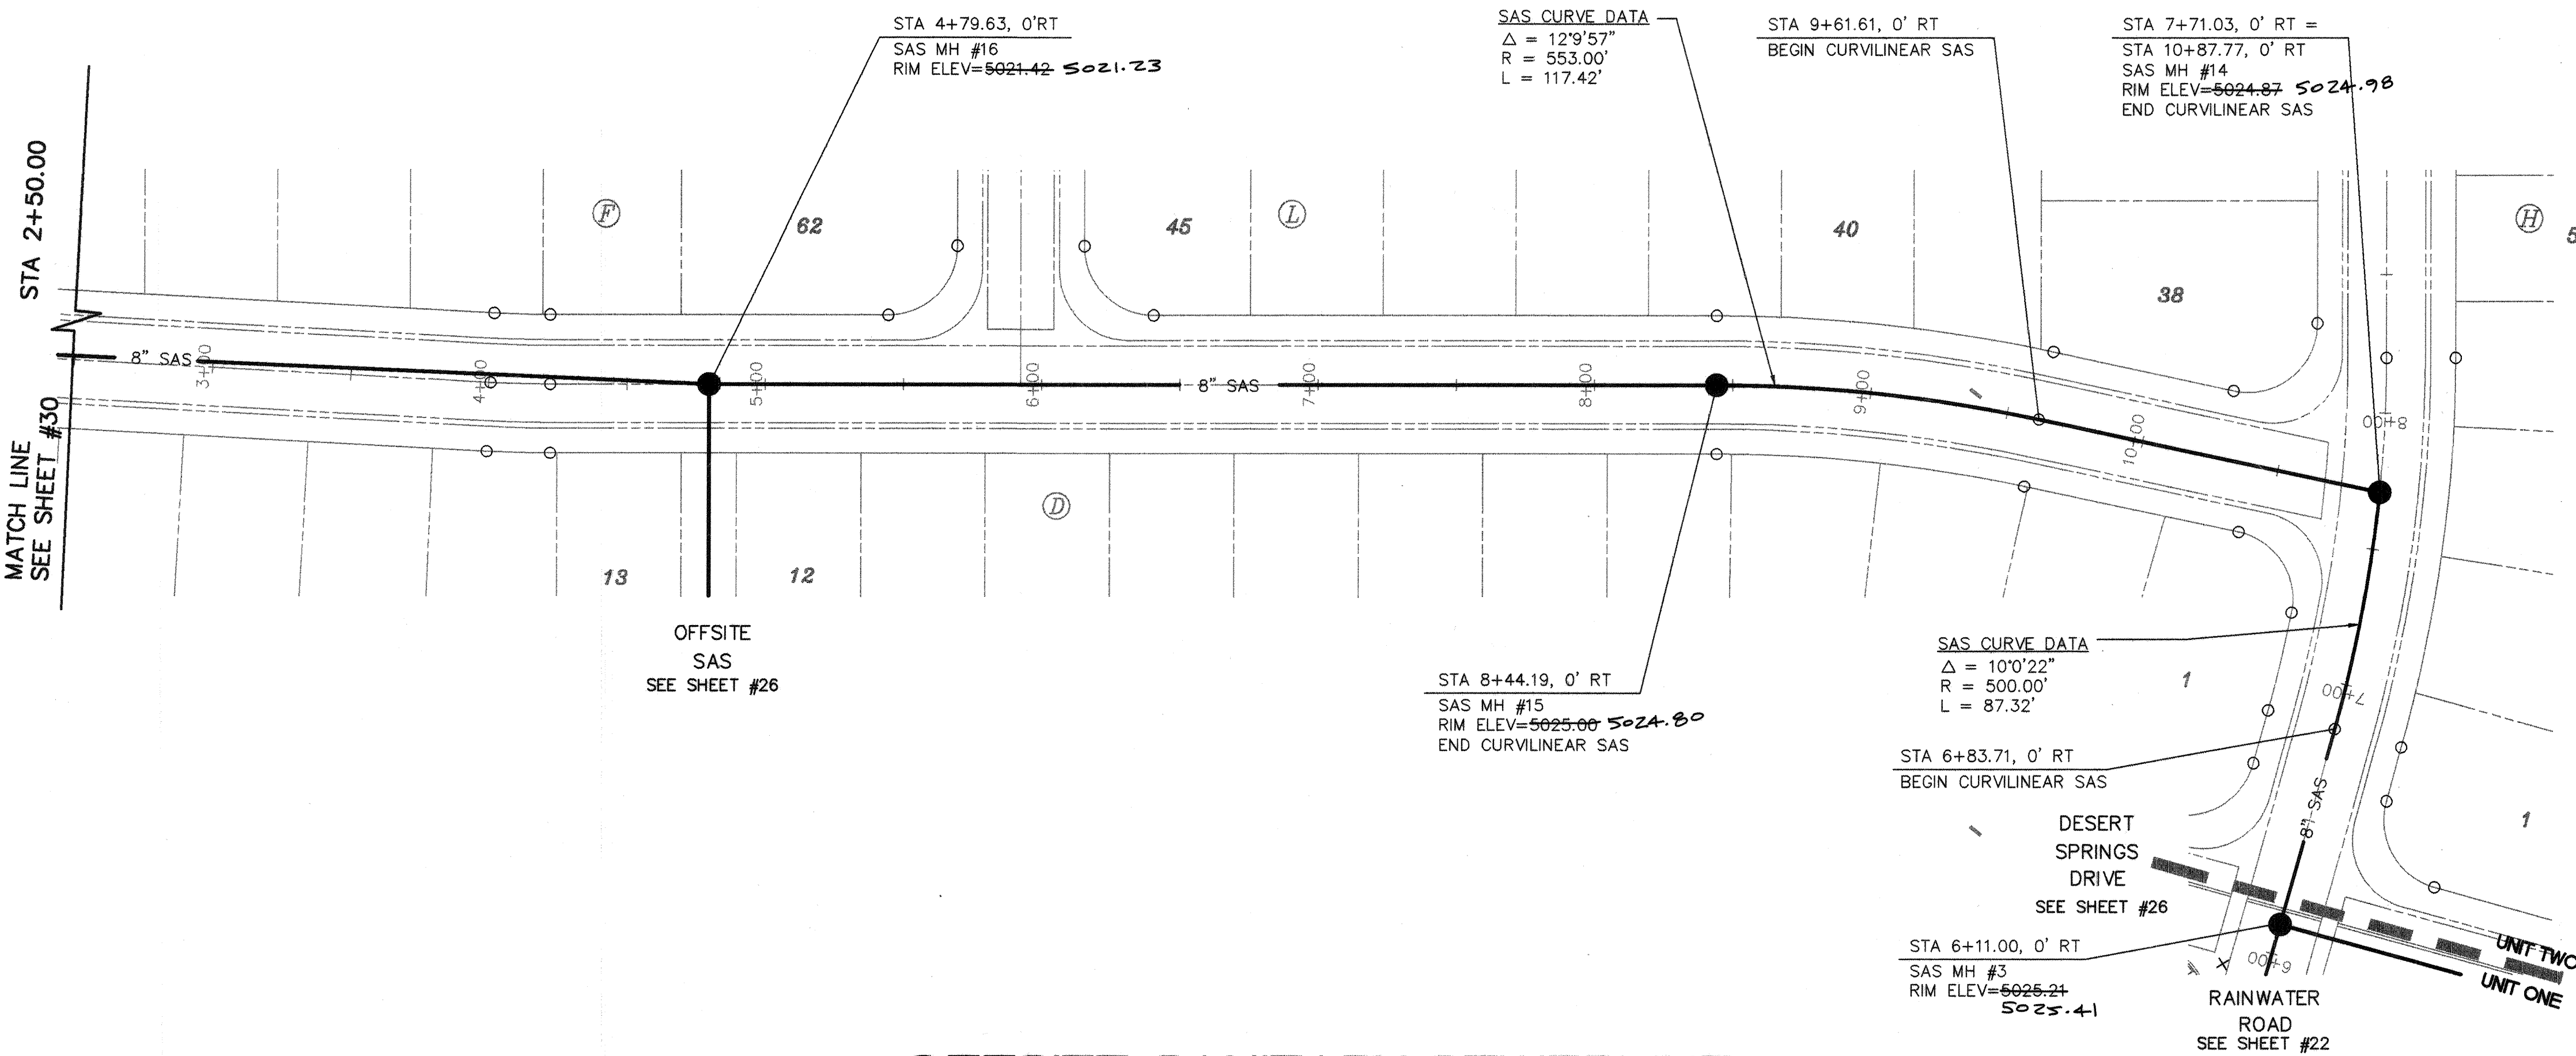

OFFSITE SANITARY SEWERLINE

SCALES:
1"=40' HOR.
1"=10' VERT.

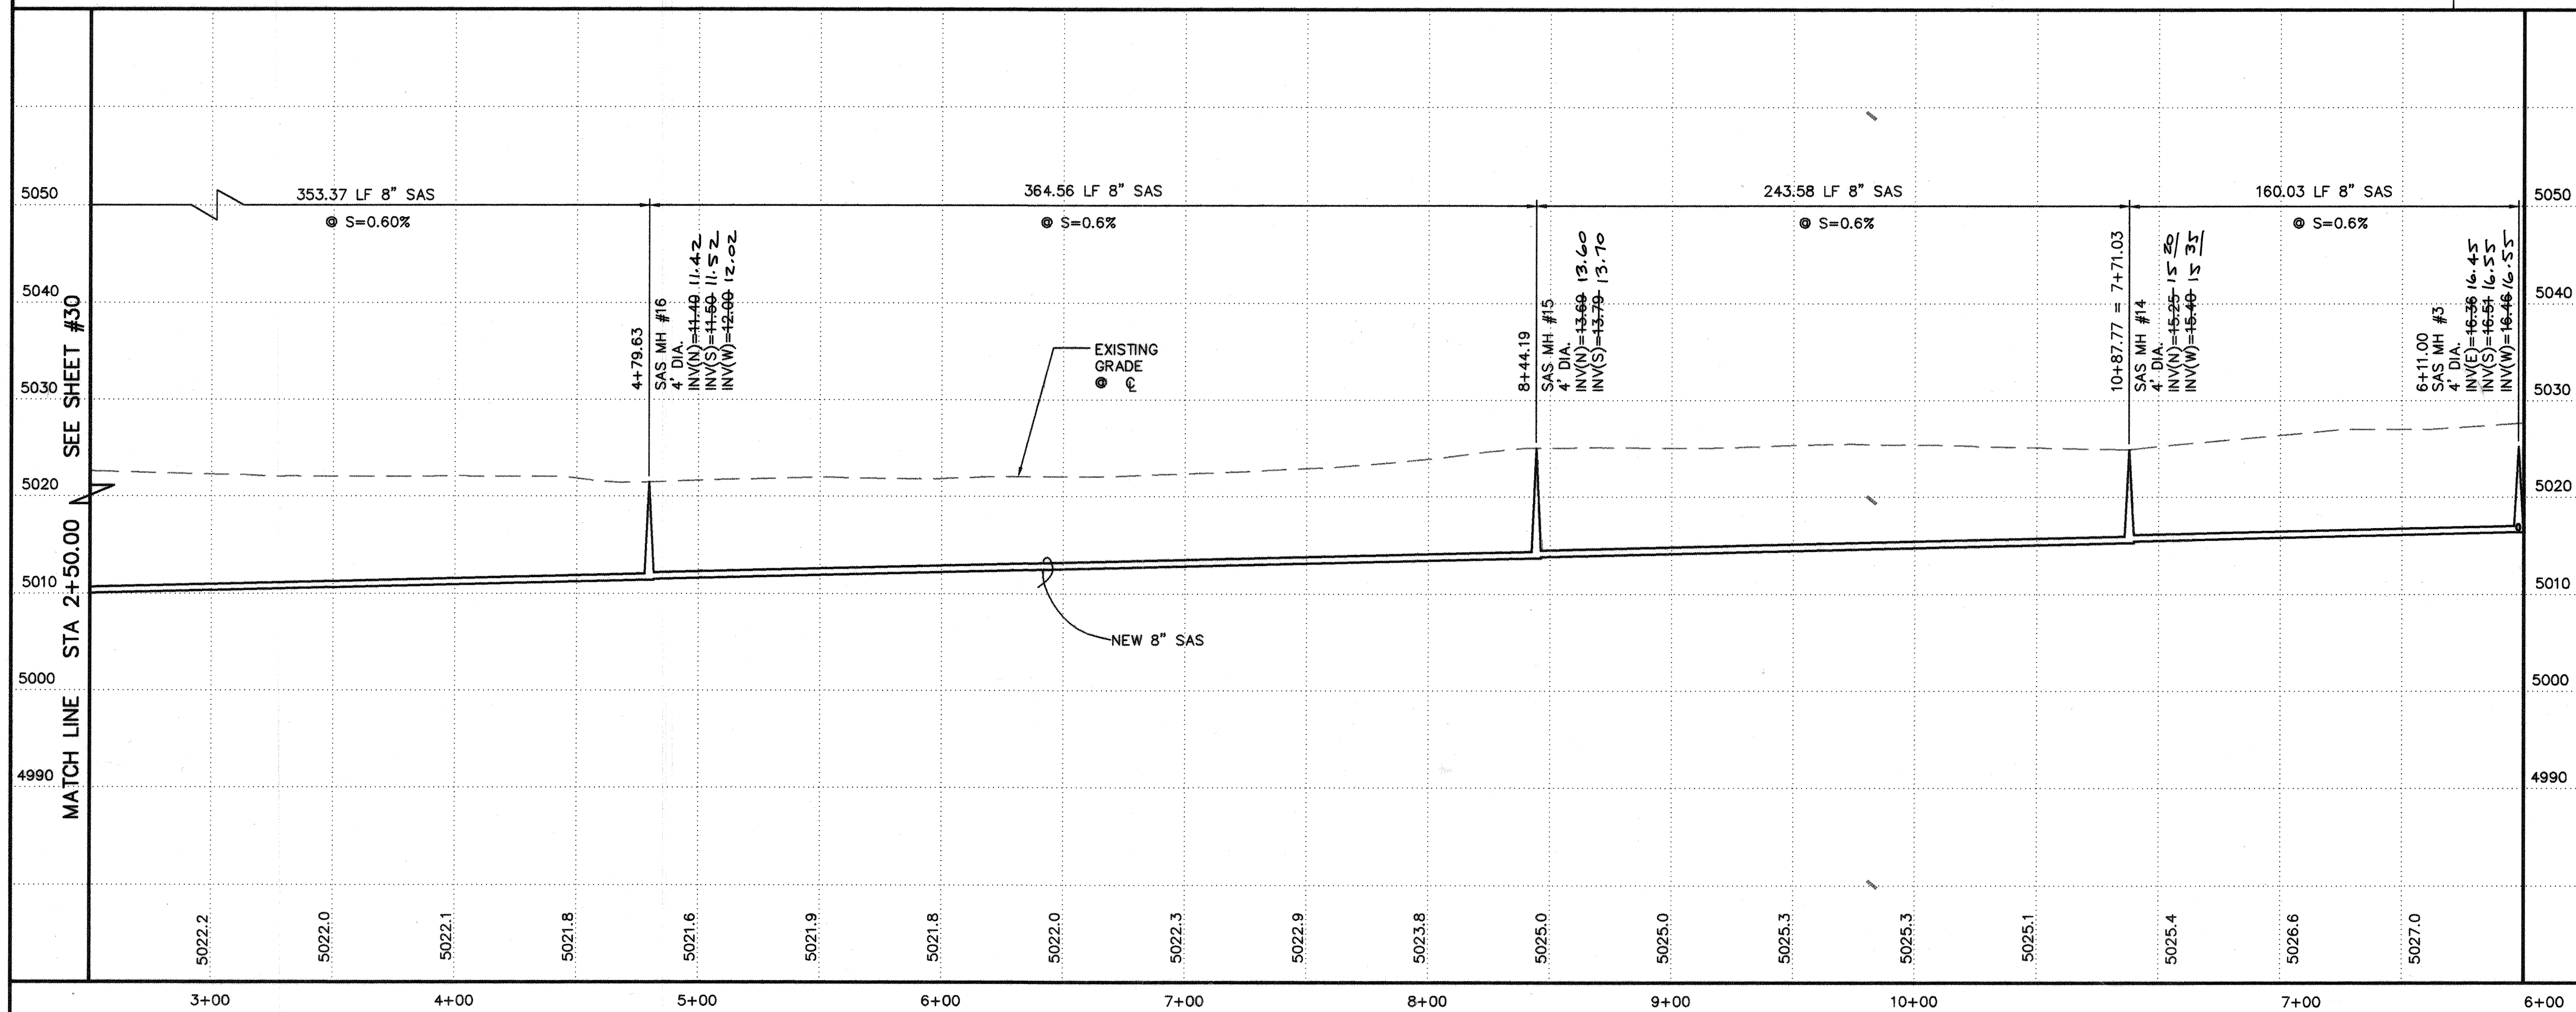

GENERAL NOTES

1. CONSTRUCT SAS SERVICES PER COA STD DWG #2125.
2. CONSTRUCT ALL SINGLE & DOUBLE WATER SERVICES PER COA STD DWG'S #2361, #2362, & #2363.
3. SEE SHEET #20 FOR WATER SHUT-OFF PLAN.
4. SEE SHEET #20 FOR RESTRAINED JOINT LENGTHS FOR WATER LINE FITTINGS.
5. CONSTRUCT FIRE HYDRANTS PER DESIGNATED DEPTHS & LENGTHS PER COA STD DWG #2340.

I, David C. Clausen, New Mexico Professional Land Surveyor No. 6547, do hereby certify that the as-built information shown hereon is the result of a field survey performed by me or under my direct supervision, and that the same is true and correct.

David C. Clausen
N.M.L.S. # 6547



LEGEND


- SINGLE WATER METER & BOX
- DOUBLE WATER METER & BOX
- GATE VALVE W/ TYPE 'A' VALVE BOX
- FIRE HYDRANT W/ VALVED LEG
- SAS MANHOLE
- WATER LINE W/ FITTING

ISAACSON & ARFMAN, P.A.
Consulting Engineering Associates
128 Monroe Street N.E.
Albuquerque New Mexico

CITY OF ALBUQUERQUE
PUBLIC WORKS DEPARTMENT
ENGINEERING GROUP


TITLE: DESERT SPRINGS SUBDIVISION, UNIT ONE
OFFSITE SANITARY SEWERLINE
UTILITY PLAN & PROFILE

Design Review Committee	City Engineer Approval	Mo./Day/Yr.	Mo./Day/Yr.
APPROVED			
DESIGN REVIEW COMMITTEE			

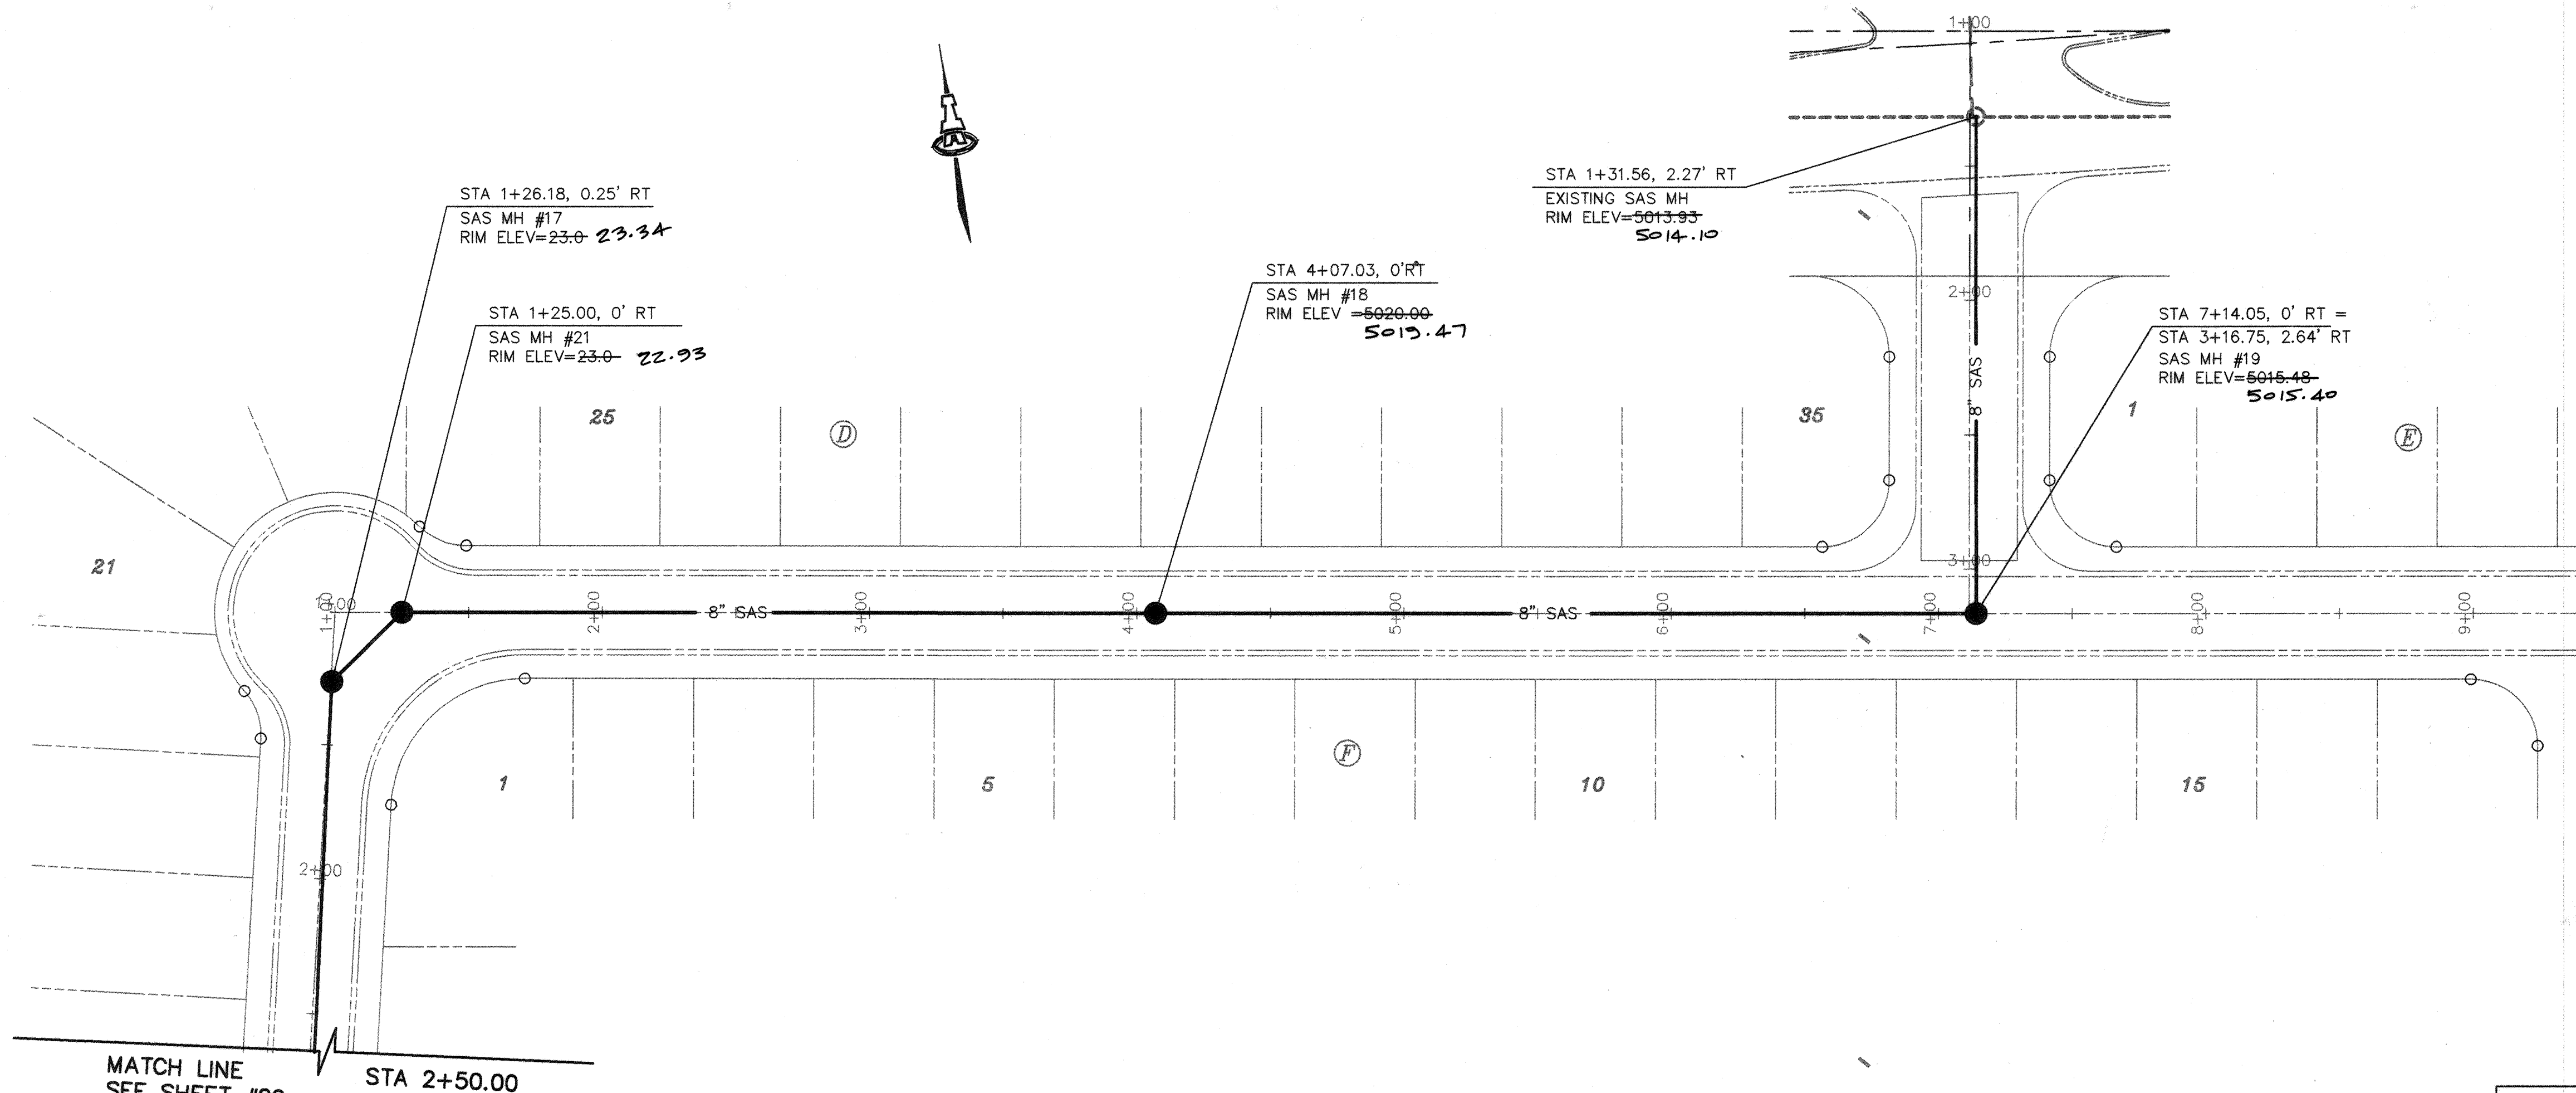

OFFSITE SANITARY SEWERLINE

SCALES:
1"=40' HOR.
1"=10' VERT.

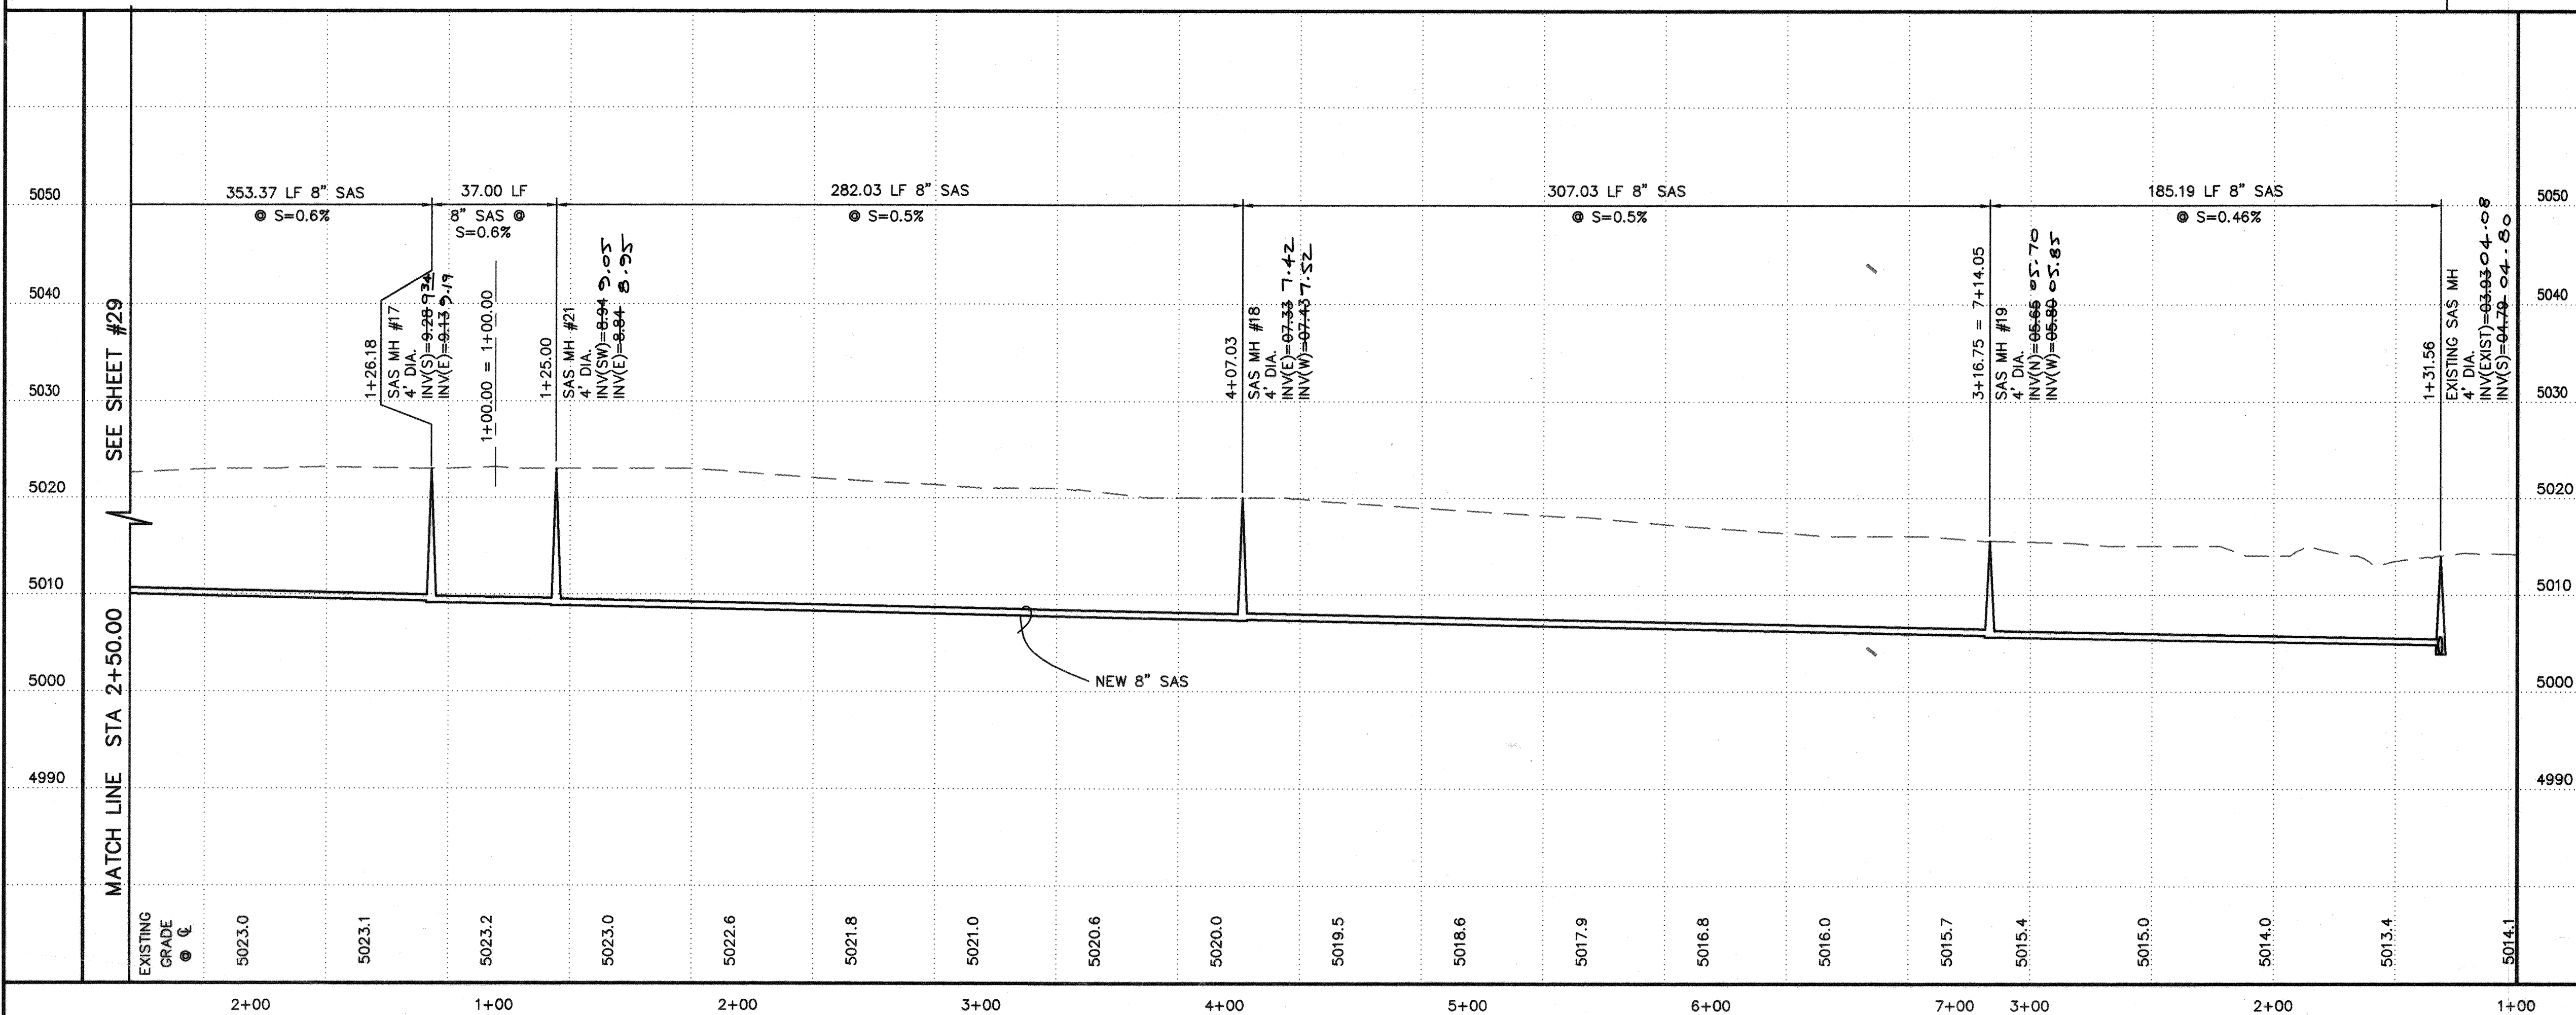


GENERAL NOTES

1. CONSTRUCT SAS SERVICES PER COA STD DWG #2125.
2. CONSTRUCT ALL SINGLE & DOUBLE WATER SERVICES PER COA STD DWG'S #2361, #2362, & #2363.
3. SEE SHEET #20 FOR WATER SHUT-OFF PLAN.
4. SEE SHEET #20 FOR RESTRAINED JOINT LENGTHS FOR WATER LINE FITTINGS.
5. CONSTRUCT FIRE HYDRANTS PER DESIGNATED DEPTHS & LENGTHS PER COA STD DWG #2340.

I, David C. Clausen, New Mexico Professional Land Surveyor No. 6547, do hereby certify that the as-built information shown hereon is the result of a field survey performed by me or under my direct supervision, and that the same is true and correct.

David C. Clausen
David C. Clausen N.M.L.S. # 6547

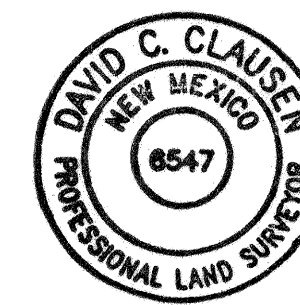


LEGEND

- SINGLE WATER METER & BOX
- DOUBLE WATER METER & BOX
- GATE VALVE W/ TYPE 'A' VALVE BOX
- FIRE HYDRANT W/ VALVED LEG
- SAS MANHOLE
- WATER LINE W/ FITTING


ISAACSON & ARFMAN, P.A.
Consulting Engineering Associates
128 Monroe Street N.E.
Albuquerque New Mexico
921UTL10.DWGems 10/20/97

CITY OF ALBUQUERQUE PUBLIC WORKS DEPARTMENT ENGINEERING GROUP	
TITLE: DESERT SPRINGS SUBDIVISION, UNIT ONE OFFSITE SANITARY SEWERLINE UTILITY PLAN & PROFILE	
DESIGN REVIEW COMMITTEE APPROVED FEB 10 1998 DESIGN REVIEW COMMITTEE	CITY ENGINEER APPROVAL _____ Ms./Day/Yr.
City Project No. 5785.81	Zone Map No. M-10
Sheet 30 Of 32	REVISIONS NO. DATE REMARKS BY 1 7/11/97 DESIGN DESIGNED BY MJC DATE 7/11/97 DRAWN BY EMS DATE 7/11/97 CHECKED BY FCA

AS-BUILT INFORMATION		BENCH MARKS		SURVEY INFORMATION	
CONTRACTOR	SPACIL & CLAYTON, CO.	ACS MONUMENT "1"-M10" LOCATED AT THE SOUTHEAST CORNER OF SAGE RD. & UNSER BLVD.	1/97	FIELD NOTES	ALS
WORK STAMPED BY	DATE 7/98	ELEV. = 5079.88		1	
ACCEPTANCE BY					
FIELD DRAWING BY	DATE 7/98	TBM: RIM OF SOUTHWESTERLY MANHOLE AT SAPPHIRE ST. & UNSER BLVD.			
CORRECTED BY	DATE 7/98	ELEV. = 5035.84			
MICRO-FILM INFORMATION					
RECORDED BY	DATE				
NO.					

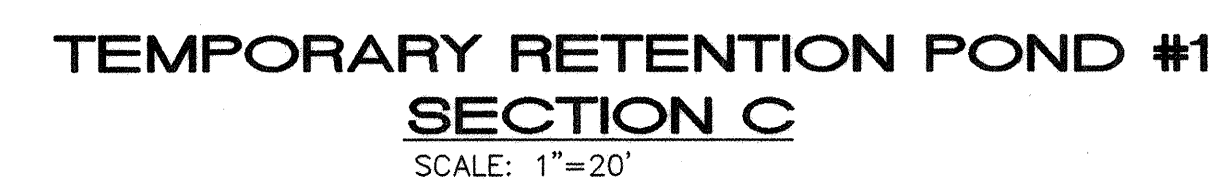

	ISAACSON & ARFMAN, P.A.								
	<i>Consulting Engineering Associates 128 Monroe Street N.E. Albuquerque New Mexico</i>								
921D.TL2.DWGans 10/20/97									
CITY OF ALBUQUERQUE PUBLIC WORKS DEPARTMENT ENGINEERING GROUP									
TITLE: DESERT SPRINGS SUBDIVISION, UNIT ONE POND DETAILS									
 Design Review Committee City Engineer Approval	Last Design Update	Mo./Day/Yr.		Mo./Day/Yr.					
City Project No. 5785.81		Zone Map No. M-10		Sheet 31		Of 32			

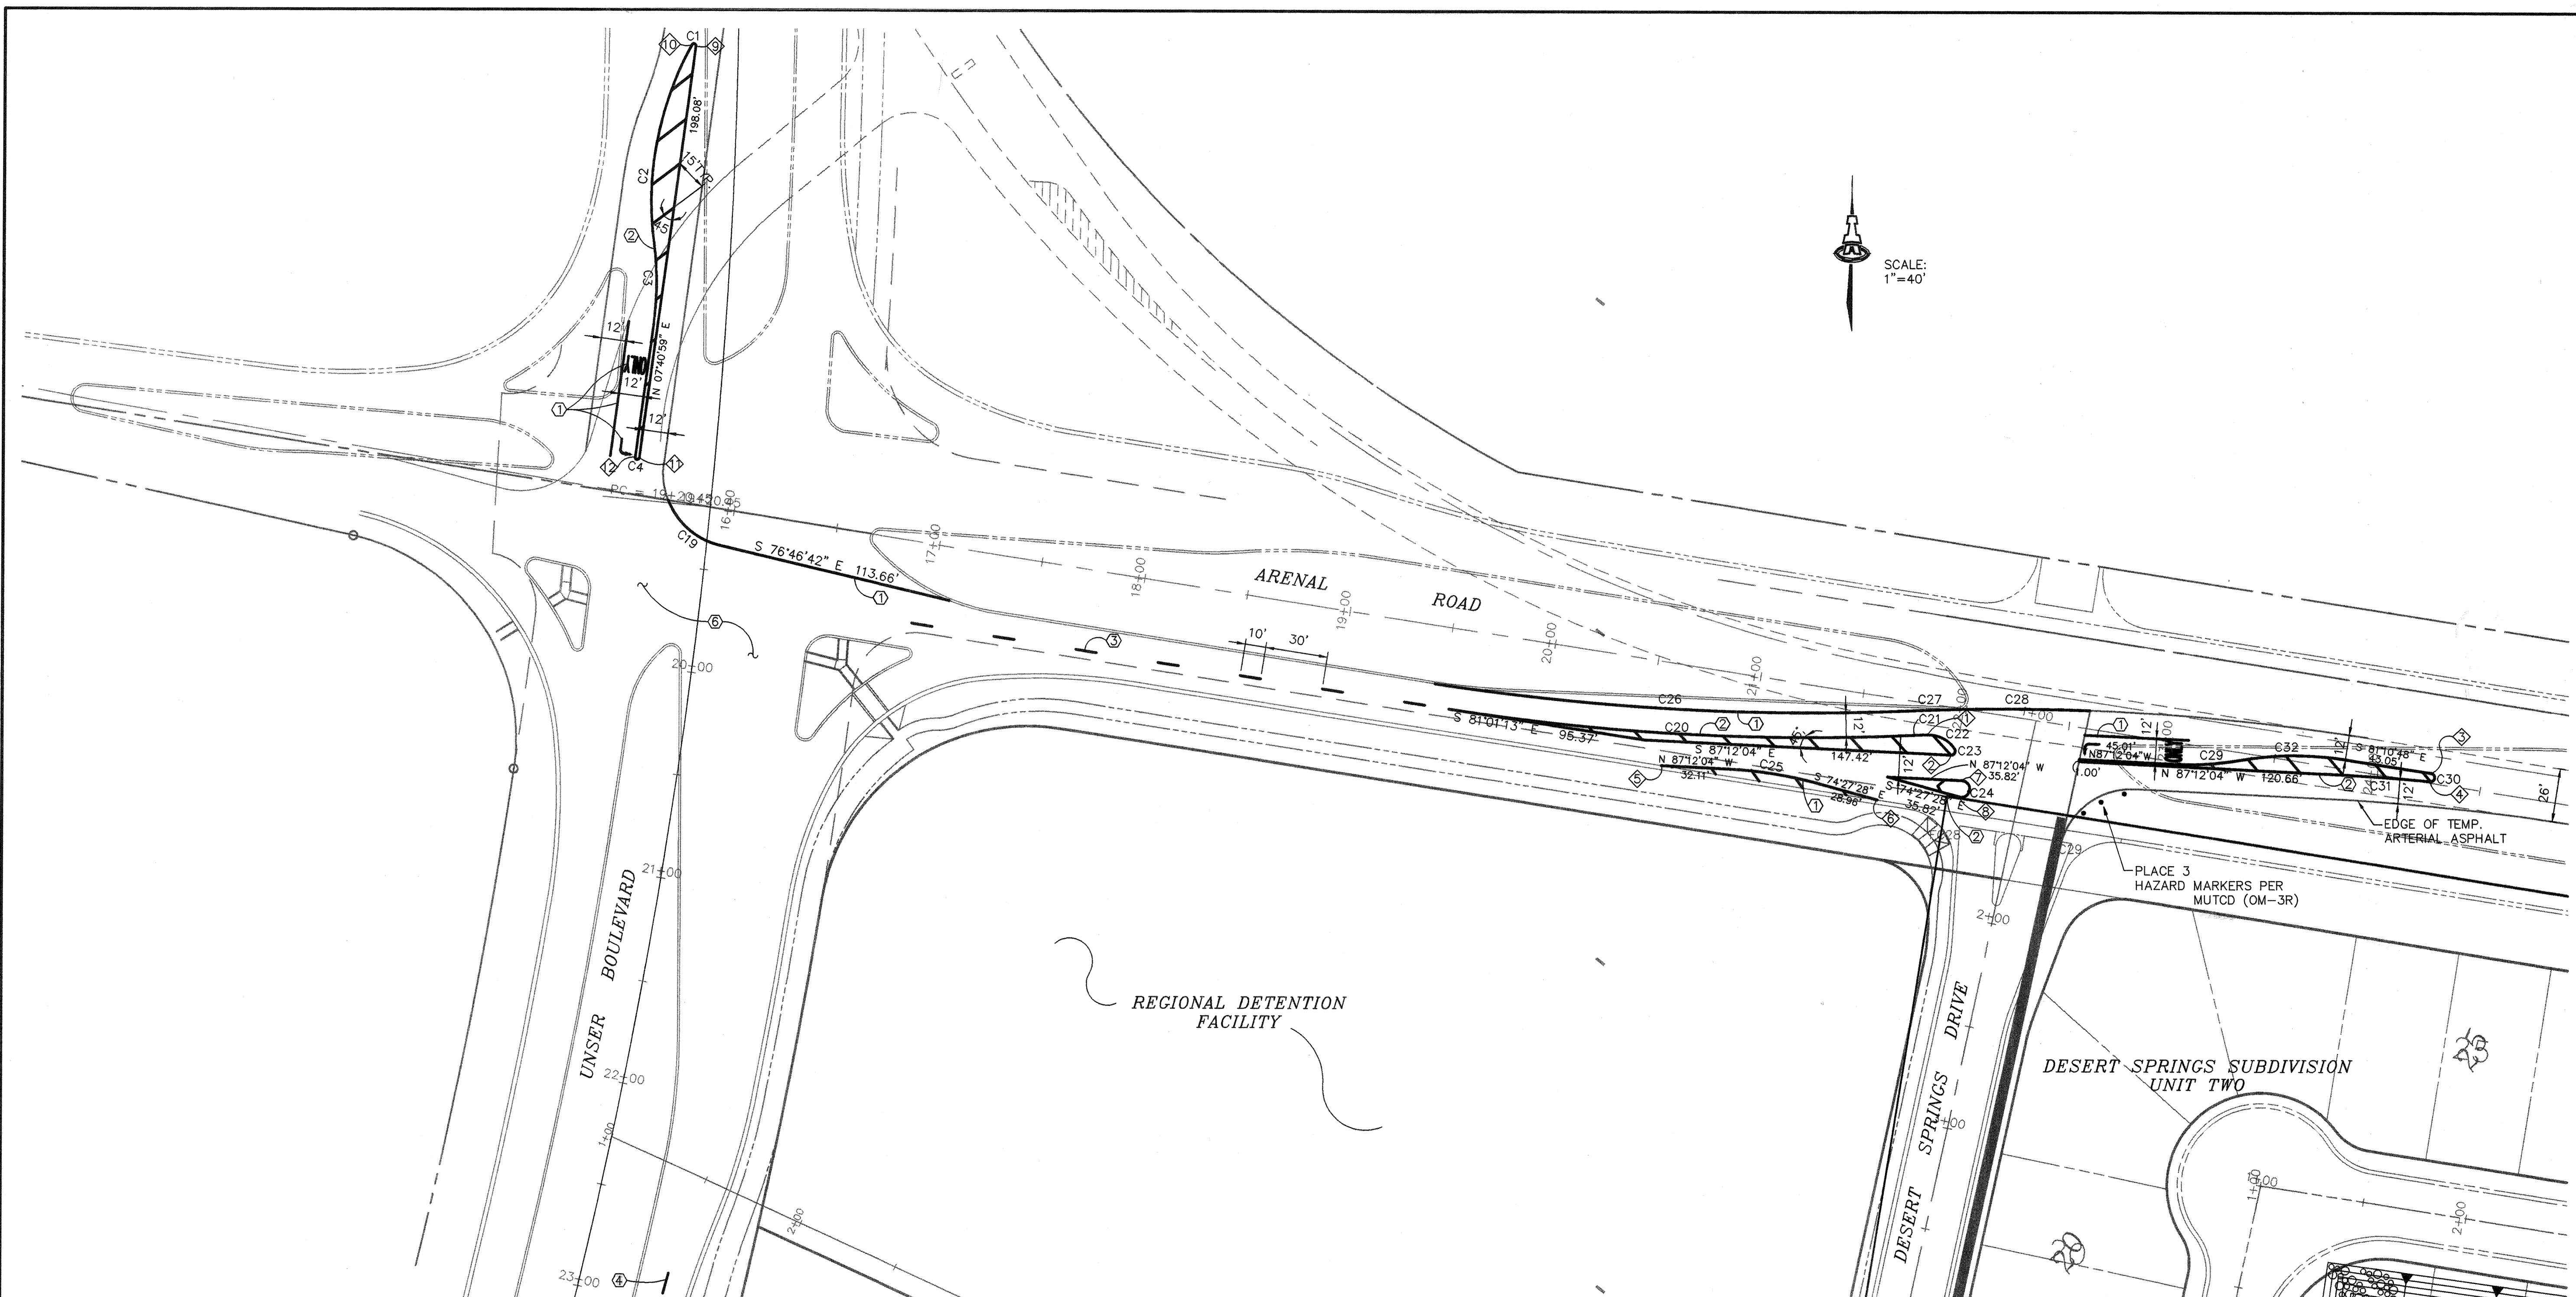

CURVE TABLE		
CURVE	LENGTH	RADIUS
C1	2.76	1.00
C2	96.80	150.00
C3	39.95	100.00
C4	3.14	1.00
C18	13.66	88.00
C19	33.43	35.00
C20	221.26	1106.00
C21	9.47	1082.00
C22	15.48	15.00
C23	4.29	2.00
C24	13.46	4.00
C25	44.48	200.00
C26	227.36	1187.19
C27	25.25	1094.00
C28	56.41	1094.00
C29	33.12	150.00
C30	6.16	2.00
C31	48.29	1112.00
C32	48.88	150.00

STATION TABLE	
STATION	OFFSET
21+83.40	15.10' RT
21+96.25	23.13' RT
24+25.55	4.66' LT
24+25.68	0.67' LT
20+59.57	50.00' RT
21+64.64	50.00' RT
22+03.39	34.42' RT
22+03.36	42.37' RT
17+42.45	14.93' RT
17+42.17	16.88' RT
19+00.00	36.31' RT
18+99.91	38.31' RT

STRIPING NOTES

1. TEMPORARY SOLID 4" WHITE PLASTIC REFLECTORIZED PAVEMENT STRIPING PER MUTCD.
2. TEMPORARY SOLID 4" YELLOW PLASTIC REFLECTORIZED PAVEMENT STRIPING PER MUTCD.
3. TEMPORARY DASHED 4" YELLOW PLASTIC REFLECTORIZED STRIPING PER MUTCD. 10' STRIPE W/ 30' GAP BETWEEN STRIPES.
4. DASHED 4" WHITE PLASTIC REFLECTORIZED PAVEMENT STRIPING PER MUTCD. 10' STRIPE W/ 30' GAP BETWEEN STRIPES.
5. SOLID 4" WHITE PLASTIC REFLECTORIZED PAVEMENT STRIPING PER MUTCD.
6. STRIPING OF THIS INTERSECTION WILL BE PROVIDED BY THE FUTURE SUBDIVISION WHICH FIRST UTILIZES THE EAST SIDE OF UNSER (DESERT FLOWER, ROLLING HILLS, OR FUTURE PHASES OF DESERT SPRINGS).

ISAACSON & ARFMAN, P.A.
Consulting Engineering Associates
128 Monroe Street N.E.
Albuquerque New Mexico

921DTL3.DWGems 10/22/97

CITY OF ALBUQUERQUE
PUBLIC WORKS DEPARTMENT
ENGINEERING GROUP

TITLE: **DESERT SPRINGS SUBDIVISION, UNIT ONE
STRIPING PLAN**

Design Review Committee

City Engineer Approval

Last Design Update

Mo./Day/Yr.

Mo./Day/Yr.

City Project No. **5785.81**

Zone Map No. **M-10**


Sheet **32** Of **32**

DESIGNED BY MJC DATE 7/11/97
DRAWN BY EMS DATE 7/11/97
CHECKED BY FCA DATE 7/11/97

ENGINEER'S SEAL		SURVEY INFORMATION		BENCH MARKS		AS-BUILT INFORMATION	
		FIELD NOTES		ACS MONUMENT "1-M10" LOCATED AT THE SOUTHEAST CORNER OF SAGE RD. & UNSER BLVD. ELEV. = 5079.88		CONTRACTOR	
		1 ALS				WORK STARTED BY	
						FIELD ACCEPTANCE BY	
						FIELD DRAWINGS BY	
						DRAWINGS CORRECTED BY	
						MICRO-FILM INFORMATION	
						RECORDED BY	
						NO.	

CITY OF ALBUQUERQUE				
PUBLIC WORKS DEPARTMENT				
ENGINEERING DEVELOPMENT GROUP				
TITLE: DESERT SPRINGS UNIT 1				
TYPICAL TRAFFIC CONTROL &				
SIGNING EXAMPLES (REF. M.U.T.C.D.)				
DESIGN REVIEW COMMITTEE		CITY ENGINEER APPROVAL		MO./DAY/YR.
 		LAST UPDATE		MO./DAY/YR.
				MO./DAY/YR.
				MO./DAY/YR.
				MO./DAY/YR.
PROJECT NO. 5785.81	MAP NO. M-10	SHEET 32B OF 32		

UTILITY COUNCIL LOG NO.: 97-12-18 08:43 0070

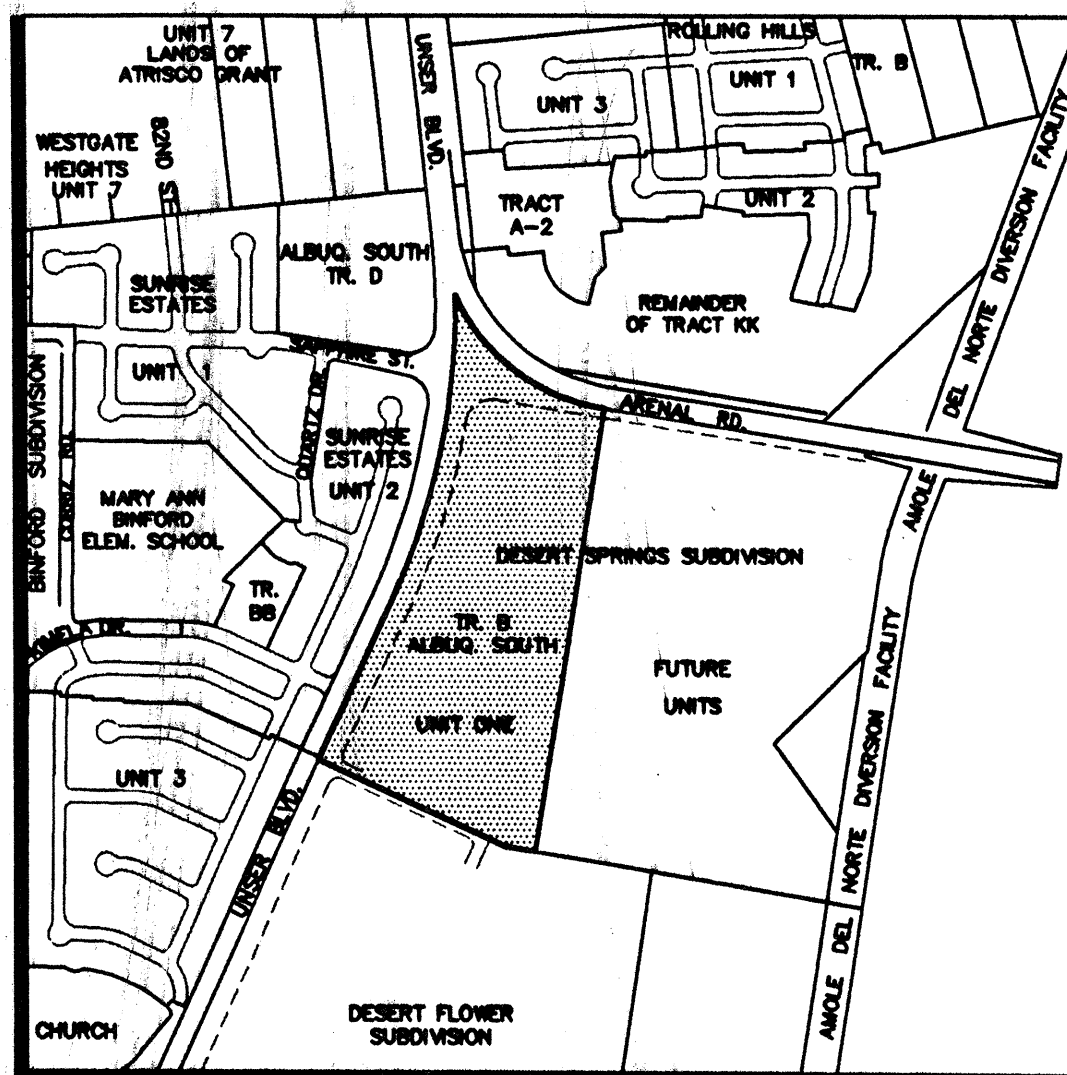

M-10

1"=750'

VICINITY MAP

SUBDIVISION DATA / NOTES

- Total Number of Existing Tracts: 1
- Total Number of Lots created: 99
- Total Number of Tracts created: 2
- Gross Subdivision Acreage: 28.8008 Ac.
- Total Mileage of Full Width Streets Created: 0.5486 mi.
- Bearings are grid based on the New Mexico State Plane Coordinate System (Central Zone).
- Distances are ground distances.
- Bearings and distances in parenthesis are record.
- Basis of boundary are the following plats (and documents) of record entitled:

"SUNRISE ESTATES, UNIT TWO", (05-21-97, 97C-162)

"ALBUQUERQUE SOUTH, UNIT 1", (08-03-87, C34-74)

"DESERT SPRINGS SUBDIVISION", (02-20-97, 97C-55)

"DESERT FLOWER SUBDIVISION", (06-05-97, 97C-175)

WARRANTY DEED "MESA ENTERPRISES, LIMITED",
(04-23-80, BK. D118A-PG. 945)WARRANTY DEED "PARCEL A-1-14, AMOLE DEL NORTE DIVERSION FACILITY",
(07-13-82, BK. D165-A, PGS. 615-619)WARRANTY DEED "PARCEL A-1-15, AMOLE DEL NORTE DIVERSION FACILITY",
(07-13-82, BK. D165-A, PGS. 615-619)WARRANTY DEED "PARCEL A-2-1, AMOLE DEL NORTE DIVERSION FACILITY",
(07-13-82, BK. D165-A, PGS. 615-619)

all being records of Bernalillo County, New Mexico.

- Field Survey performed November, 1996.
- Title Report: Provided by Albuquerque Title Company
Commitment No. 143188VM, Effective Date: 09-17-96
(Portion of Valley West)
Commitment No. 144484VM, Effective Date: 08-07-96
(Tract B, Albuquerque South, Unit 1))
- This property is apparently affected by reservations, restrictions and agreements contained within easements, documents and memorandums as listed within the above mentioned Title Report.
- Existing Temporary Blanket Drainage easement on all of TRACT B, ALBUQUERQUE SOUTH, UNIT 1 and A PORTION OF VALLEY WEST
(04-24-95, BK. BCR95-9, PGS. 9716-9734)
(01-20-94, BK. BCR94-2, PGS. 9787-9794)

SUBDIVISION DATA/NOTES CONTINUED ON SHEET 2

2 3 4 5 6 7 8 9 10 11 12 13 14 15
26-5785-81-2011

LEGAL DESCRIPTION

A tract of land situate within the Town of Atrisco Grant, projected Section 34, Township 10 North, Range 2 East, New Mexico Principal Meridian, City of Albuquerque, Bernalillo County, New Mexico being all of TRACT B, ALBUQUERQUE SOUTH, UNIT 1 as the same is shown and designated on said plat filed for record in the office of the County Clerk of Bernalillo County, New Mexico on August 3, 1987 in Volume C34, Folio 74 and being more particularly described as follows:

BEGINNING at the northwest corner of the herein described tract, said point being on the easterly line of TRACT D, ALBUQUERQUE SOUTH, UNIT 1 as the same is shown and designated on said plat filed for record in the office of the County Clerk of Bernalillo County, New Mexico on August 3, 1987 in Volume C34, Folio 74 and further being on the southerly right-of-way line of Arenal Road S.W. from whence the Albuquerque Control Survey Monument "1-M10" bears N 02°57'20" W, 1460.50 feet;

THENCE along said southerly right-of-way line 738.27 feet along a curve to the left, whose radius is 759.20 through a central angle of 55°42'59" and whose chord bears S 53°09'44" E, 709.52 feet to a point of tangency;

THENCE continuing S 81°01'13" E, 14.10 feet to a point, said point being on the northeast corner of the herein described tract, said point being the northwest corner of DESERT SPRINGS SUBDIVISION as the same is shown and designated on said plat filed for record in the office of the County Clerk of Bernalillo County, New Mexico on February 20, 1997 in Volume 97C, Folio 55;

LEGAL DESCRIPTION CONTINUED ON SHEET 2

DISCLOSURE STATEMENT

The intent of this plat is to subdivide one (1) tract into 99 residential lots, and a single tract (TRACT A) for future residential development, to dedicate public rights-of-way, and to grant those easements necessary to serve the residential development. A single tract (TRACT B) is being dedicated to the City of Albuquerque for a storm drainage management facility.

FREE CONSENT AND DEDICATION

The subdivision shown hereon is with the free consent and in accordance with the desires of the undersigned Owner(s) and/or Proprietor(s) thereof and said Owner(s) and/or Proprietor(s) do hereby dedicate all streets and public rights-of-way shown hereon to the City of Albuquerque in fee simple with warranty covenants and do hereby grant: all access, utility and drainage easements shown hereon including the right to construct, operate, inspect, and maintain facilities therein; and all public utility easements shown hereon for the common and joint use of gas, electrical power and communication services for overhead and buried distribution lines, conduits, and pipes for underground and/or overhead utilities where shown or indicated, and including the right of ingress and egress for construction and maintenance, and the right to trim interfering trees and shrubs. Said Owner(s) and/or Proprietor(s) do hereby consent to all of the foregoing and do hereby certify that this subdivision is their free act and deed.

OWNER

BUILDERS INVESTMENT COMPANY OF NEW MEXICO, LTD. CO.

Stanley G. Lane
Stanley G. Lane
Chief Executive Officer

2-5-98
Date


ACKNOWLEDGEMENT

STATE OF NEW MEXICO } SS
COUNTY OF BERNALILLO }

This instrument was acknowledged before me on February 5 1998, by Stanley G. Lane, Chief Executive Officer of Builders Investment Company of New Mexico, Ltd. Co., a New Mexico Limited Company, on behalf of said Company.

My Commission Expires: June 12, 2000

Melissa D. Guthals
Melissa D. Guthals
Notary Public

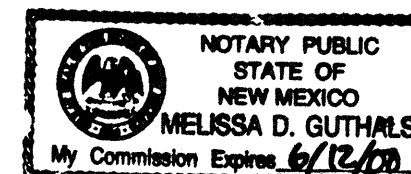

1998037346
Page: 1 of 3
03/30/1998 02:53P
Bk-58C Pg-86

PLAT FOR DESERT SPRINGS SUBDIVISION UNIT ONE

BEING A REPLAT OF
TRACT B, ALBUQUERQUE SOUTH, UNIT ONE
WITHIN THE
TOWN OF ATRISCO GRANT
PROJECTED SECTION 34, T. 10 N, R. 2 E, NMPM
CITY OF ALBUQUERQUE
BERNALILLO COUNTY, NEW MEXICO
JANUARY 1998

THIS IS TO CERTIFY THAT TAXES ARE CURRENT AND
PAID ON UP TO 010-055-202-275-30160
PROPERTY OWNERS RECORD
Albuquerque, South
BERNALILLO COUNTY TREASURER'S OFFICE
Joseph M. Serna 3-30-98

APPROVALS 98-16
S-9232 DRB NO. 96-435


<i>[Signature]</i> PUBLIC SERVICE CO. OF NM--ELECTRIC SERVICES DIV.	2-23-98 DATE
<i>[Signature]</i> PUBLIC SERVICE CO. OF NM--GAS SERVICES DIV.	2-23-98 DATE
<i>Catherine Schnur</i> US WEST COMMUNICATIONS	02-23-98 DATE
<i>Violet Watson</i> JONES INTERCABLE	2-24-98 DATE
<i>Neil Chuc</i> CITY SURVEYOR, ENGR. DIV., P.W.D.	02-23-98 DATE
<i>[Signature]</i> TRAFFIC ENGINEERING, TRANS. DEV. DIV., P.W.D.	2-17-98 DATE
<i>Edward A. Hwang</i> PARKS DESIGN & DEVELOPMENT, CIP	3-12-98 DATE
<i>Roger A. Green</i> UTILITY DEVELOPMENT DIV., P.W.D.	2-17-98 DATE
<i>[Signature]</i> REAL PROPERTY DIVISION, D.F.M.	3-20-98 DATE
<i>[Signature]</i> A.M.A.F.C.A.	3-18-98 DATE
<i>[Signature]</i> CITY ENGINEER, PUBLIC WORKS DEPT.	2-17-98 DATE

APPROVAL AND CONDITIONAL ACCEPTANCE AS SPECIFIED BY THE ALBUQUERQUE SUBDIVISION ORDINANCE, ARTICLE XI OF THE REVISED ORDINANCES OF ALBUQUERQUE, N.M.

[Signature]
CITY PLANNER, ALBUQUERQUE PLANNING DIVISION
3/30/98
DATE

SURVEYOR'S CERTIFICATION

"I, Timothy Aldrich, a duly qualified Registered Professional Land Surveyor under the laws of the State of New Mexico, do hereby certify that this plat and description were prepared by me or under my supervision, shows all easements as shown on the plat of record or made known to me by the owners and/or proprietors of the subdivision shown hereon, utility companies and other parties expressing an interest and meets the minimum requirements for monumentation and surveys of the Albuquerque Subdivision Ordinance, and further meets the Minimum Standards for Land Surveying in the State of New Mexico (Effective November 1, 1989 and revisions effective December 25, 1991 and February 2, 1994), and is true and correct to the best of my knowledge and belief."

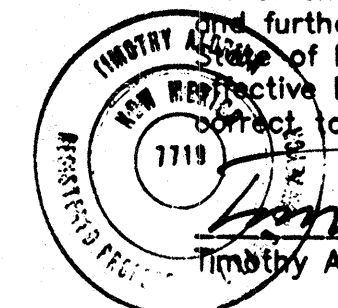

[Signature]
Timothy Aldrich, P.S. No. 7719
02-05-98
Date

SHEET 1 OF 3

CPN # 578581

Judith D. Woodward Bern. Co. PLAT R 17.00 1998037346 5626598 Page: 2 of 3 03/30/1998 02:53 Bk-98C Pg-86

THENCE along a line common with the easterly line of said TRACT D 290.49 feet along a curve to the left, whose radius is 2800.00 feet through a central angle of 05°56'39" and whose chord bears N 02°34'50" E, 290.36 feet to the point of beginning and containing 28.8008 acres more or less.

LINE TABLE		
LINE	LENGTH	BEARING
L1	9.27	S89.31°42'W
L2	14.20	N46.81°32'E
L3	48.71	S85.31°42'E
L4	26.01	N24°35'42"E
L5	14.00	N24°35'42"E
L7	12.90	N24°35'42"E
L8	25.00	S24°35'42"W
L9	14.14	S89.35°42'W
L10	15.00	N24°35'42"E
L11	13.00	N82°35'42"E
L12	7.00	N24°35'42"E
L13	38.51	N75°07'58"W
L14	10.00	N85°24'15"W
L15	31.00	N24°35'42"E
L16	27.12	N46°11'47"E
L17	41.57	S82°47'04"E
L18	27.96	S89.24°18'E
L19	24.67	S89.24°18'E
L20	31.62	N15°24'34"E
L21	14.63	S18°43'54"E
L22	38.01	N1°32'07"E
L23	28.01	S18°43'54"E
L24	58.26	N18°43'54"W
L25	15.13	S82°24'18'E
L26	1.57	S82°24'18'E
L27	10.40	N24°35'42"E
L28	15.67	N12°04'31"E
L29	41.08	N81°01'13"W
L30	30.67	N11°11'53"W
L31	10.15	S82°24'18'E
L32	36.51	S89.24°18'E
L33	16.97	S89.24°18'E
L34	36.10	S82°24'18'E
L35	30.81	S82°24'18'E
L36	7.00	S24°35'42"W
L37	23.74	S08°38'47"E
L38	24.12	N04°16'28"E
L39	10.98	N58°43'54"E
L40	35.64	N58°43'54"E

18. Unless otherwise noted all points are "SET 5/8" REBAR with cap "ALS LS 7719".

Professional Engineer Seal for Timothy A. Lacey, State of Missouri, No. 05-98, Mechanical Engineering.

CURVE	RADIUS	CURVE TABLE				CHORD	BEARING	DELTA
		LENGTH	TANGENT					
C1	66.00	32.34	16.50		32.01	S79°28'28"E	28°04'21"	
C2	53.50	26.21	13.36		25.85	S79°28'28"E	28°04'21"	
C3	96.00	33.51	16.91		33.35	S03°50'24"W	19°23'28"	
C4	75.00	64.46	34.37		82.50	S00°01'28"E	49°14'42"	
C5	51.00	44.79	23.96		43.37	S00°33'55"E	50°19'15"	
C6	99.00	19.11	9.58		19.06	S19°03'56"W	11°03'34"	
C7	96.00	52.82	26.84		52.00	S09°22'11"W	30°27'03"	
C8	3024.00	53.23	18.33		53.62	N12°12'42"E	07°21'22"	
C9	2978.00	392.47	196.82		392.19	N02°41'10"E	07°53'04"	
C10	3024.00	36.75	19.86		36.75	N24°03'42"E	06°45'12"	
C11	3024.00	59.14	29.57		59.14	N23°07'28"E	01°07'14"	
C12	3024.00	49.67	24.84		49.67	N22°05'39"E	00°58'28"	
C13	3024.00	49.67	24.84		49.67	N1°09'10"E	00°58'28"	
C14	3024.00	49.67	24.84		49.67	N12°23'42"E	00°58'28"	
C15	3024.00	44.71	21.99		44.71	N18°12'42"E	00°58'28"	
C16	3024.00	53.26	26.63		53.26	N18°23'22"E	01°03'36"	
C17	3024.00	42.66	21.33		42.66	N17°28'51"E	00°48'30"	
C18	2978.00	12.78	6.39		12.78	N24°28'20"E	00°14'46"	
C19	2978.00	45.30	22.65		45.30	N23°54'48"E	00°32'18"	
C20	2978.00	45.30	22.65		45.30	N23°02'30"E	00°32'18"	
C21	2978.00	45.30	22.65		45.30	N22°10'12"E	00°32'18"	
C22	2978.00	45.30	22.65		45.30	N21°17'54"E	00°32'18"	
C23	2978.00	45.30	22.65		45.30	N20°25'36"E	00°32'18"	
C24	2978.00	45.30	22.65		45.30	N19°33'18"E	00°32'18"	
C25	2978.00	45.30	22.65		45.30	N18°41'01"E	00°32'18"	
C26	2978.00	45.30	22.65		45.30	N17°48'43"E	00°32'18"	
C27	2978.00	17.25	8.63		17.25	N17°48'43"E	00°19'56"	
C28	99.00	26.48	14.34		26.38	S25°17'08"W	16°29'01"	
C29	2978.00	773.02	386.85		770.69	N16°54'02"E	15°23'22"	
C30	2978.00	12.36	6.18		12.36	N24°28'20"E	00°14'46"	
C31	2978.00	43.78	21.89		43.78	N23°54'48"E	00°32'18"	
C32	2978.00	43.78	21.89		43.78	N23°02'30"E	00°32'18"	
C33	2978.00	43.78	21.89		43.78	N22°10'12"E	00°32'18"	
C34	2978.00	43.78	21.89		43.78	N21°17'54"E	00°32'18"	
C35	2978.00	43.78	21.89		43.78	N20°25'36"E	00°32'18"	
C36	2978.00	43.78	21.89		43.78	N19°33'18"E	00°32'18"	
C37	2978.00	43.78	21.89		43.78	N18°41'01"E	00°32'18"	
C38	2978.00	43.78	21.89		43.78	N17°48'43"E	00°32'18"	
C39	2978.00	43.78	21.89		43.78	N16°56'25"E	00°32'18"	
C40	2978.00	12.00	6.00		12.00	N16°52'08"E	00°14'20"	
C41	2978.00	45.00	22.50		45.00	N15°49'03"E	00°33'45"	
C42	2978.00	45.00	22.50		45.00	N14°55'18"E	00°33'45"	
C43	2978.00	45.00	22.50		45.00	N14°01'33"E	00°33'45"	
C44	2978.00	59.58	29.78		59.58	N12°59'08"E	01°11'09"	
C45	56.00	32.43	16.68		31.96	S02°08'34"E	33°10'40"	
C46	33.50	26.17	13.09		25.82	S09°24'24"E	33°10'40"	
C47	31.00	18.01	9.26		17.75	S02°30'34"E	33°10'40"	
C48	99.00	18.01	9.03		17.99	S48°10'18"W	10°25'32"	
C49	75.00	127.67	85.57		112.81	S85°49'40"W	87°32'05"	
C50	75.00	66.86	37.07		66.46	S43°21'43"W	52°36'12"	
C51	75.00	58.82	31.01		57.32	N87°32'14"E	44°55'53"	
C52	51.00	86.80	58.17		76.70	S05°50'29"E	97°31'06"	
C53	99.00	58.66	30.22		57.80	N82°27'42"W	33°56'48"	
C54	99.00	13.76	6.86		13.66	S84°36'46"W	07°55'45"	
C55	3024.00	44.66	22.87		44.67	N24°04'50"W	28°01'05"	
C56	3001.00	396.65	197.61		394.36	N02°44'00"E	07°32'05"	
C57	275.00	71.59	36.00		71.39	S72°51'46"E	14°54'57"	
C58	300.00	81.76	41.14		81.51	S73°12'45"E	15°36'55"	
C59	325.00	85.74	43.12		85.49	S72°57'46"E	15°06'57"	
C60	275.00	22.27	11.14		22.26	S67°43'29"E	04°38'23"	
C61	275.00	49.32	24.73		49.26	S75°10'57"E	10°16'34"	
C62	325.00	17.54	8.77		17.54	S68°37'03"E	03°05'32"	
C63	325.00	37.63	18.96		37.50	S71°50'26"E	08°41'10"	
C64	325.00	30.28	15.19		30.26	S71°00'19"E	05°20'19"	
C65	25.00	25.00	24.78		25.00	S23°13'47"E	88°27'29"	
C66	25.00	36.56	25.31		35.57	N54°19'49"W	90°41'58"	
C67	1028.00	55.54	27.78		55.53	S10°31'39"E	03°05'44"	
C68	25.00	40.56	26.35		36.27	N55°29'03"E	93°00'32"	
C69	25.00	36.32	24.07		34.86	N34°55'52"W	87°46'18"	
C70	277.00	60.95	30.60		60.82	S71°42'29"E	12°38'23"	
C71	300.00	81.76	41.14		81.51	S73°12'45"E	15°36'55"	
C73	323.00	75.75	38.05		75.56	S72°07'24"E	13°28'13"	
C74	277.00	32.09	16.06		32.07	S68°43'25"E	08°36'14"	
C75	277.00	32.09	16.06		32.07	S67°19'36"E	08°56'06"	
C76	323.00	51.08	15.55		51.07	S67°03'21"E	08°56'06"	
C77	323.00	37.81	18.96		37.68	S69°50'50"E	08°56'28"	
C78	323.00	6.76	3.38		6.76	S68°00'17"E	01°11'56"	
C79	25.00	23.63	12.78		22.76	S38°19'54"E	54°08'46"	
C80	25.00	21.91	43.18		62.32	S32°33'42"W	27°21'35"	
C81	45.00	16.67	8.66		16.37	N84°30'11"E	36°14'46"	
C82	45.00	17.56	8.66		17.45	N22°26'22"E	22°21'44"	
C83	45.00	39.22	20.95		39.79	S56°35'08"W	48°59'49"	
C84	45.00	26.86	13.84		26.46	S79°21'10"E	34°11'41"	
C85	45.00	26.86	13.84		26.46	S45°09'26"W	34°11'41"	
C86	45.00	26.86	13.84		26.46	S10°57'46"W	34°11'41"	
C87	45.00	26.86	13.84		26.46	S23°13'55"E	34°11'41"	
C88	45.00	26.86	13.84		26.46	S69°56'52"E	34°11'41"	
C89	45.00	4.57	2.29		4.57	N78°12'12"E	05°48'56"	
C90	372.00	101.36	51.01		101.07	N18°47'15"E	15°36'55"	
C92	372.00	71.62	35.92		71.50	N14°28'41"E	11°01'49"	
C93	372.00	29.77	14.89		29.76	N22°18'09"E	04°35'07"	
C94	25.00	39.27	25.00		35.36	N89°35'42"E	90°00'00"	
C95	25.00	39.27	25.00		35.36	N20°24'18"E	90°00'00"	
C96	25.00	39.27	25.00		35.36	N89°35'42"E	90°00'00"	
C97	25.00	39.27	25.00		35.36	N20°24'18"E	90°00'00"	
C98	25.00	20.38	19.19		19.82	S44°33'03"E	48°27'29"	
C99	25.00	21.74	7.49		61.71	S24°58'42"E	27°12'29"	
C100	25.00	20.38	10.79		19.82	N88°32'32"E	48°42'29"	
C101	25.00	6.01	3.02		5.99	S56°31'10"E	13°46'15"	
C102	25.00	14.37	7.39		14.17	S33°06'55"E	32°36'15"	
C103	45.00	41.69	22.48		40.22	N45°14'26"E	53°05'15"	
C104	45.00	33.20	17.40		32.45	S87°04'54"E	42°16'22"	
C105	45.00	32.47	16.98		31.77	S45°06'08"W	41°20'52"	
C106	45.00	32.47	16.98		31.77	S03°55'16"E	41°20'52"	
C107	45.00	32.47	16.98		31.77	S02°04'24"E	41°20'52"	
C108	45.00	32.47	16.98		31.77	S02°04'24"E	41°20'52"	
C109	45.00	41.69	22.48		40.22	S85°34'08"E	53°05'15"	
C110	25.00	14.37	7.39		14.17	S45°12'00"E	32°36'15"	
C111	25.00	6.01	3.02		5.99	N72°17'25"E	13°46'15"	
C112	25.00	39.27	25.00		35.36	S89°35'42"E	90°00'00"	
C113	25.00	39.27	25.00		35.36	N20°24'00"E	89°30'35"	
C114	100.00	47.13	30.00		42.43	S36°01'19"E	90°00'21"	
C115	2678.00	180.05	80.04		180.02	S04°56'24"E	88°27'29"	
C116	400.00	24.42	12.21		24.42	N22°30'45"E	03°26'52"	

BEING A REPLAT OF
TRACT B, ALBUQUERQUE SOUTH, UNIT ONE
WITHIN THE
TOWN OF ATRISCO GRANT
PROJECTED SECTION 34, T. 10 N., R. 2 E., NMPM
CITY OF ALBUQUERQUE
BERNALILLO COUNTY, NEW MEXICO

JANUARY 1998

INCLUDED IS THE RIGHT TO BUILD, REBUILD, CONSTRUCT, RECONSTRUCT, LOCATE, RELOCATE, CHANGE, REMOVE, MODIFY, RENEW, OPERATE, AND MAINTAIN FACILITIES FOR THE PURPOSES DESCRIBED ABOVE, TOGETHER WITH FREE ACCESS TO, FROM, AND OVER SAID EASEMENT, INCLUDING SUFFICIENT WORKING AREA SPACE FOR ELECTRIC TRANSFORMERS, WITH THE RIGHT AND PRIVILEGE TO TRIM AND REMOVE TREES, SHRUBS, OR BUSHES WHICH INTERFERE WITH THE PURPOSES SET FORTH HEREIN. NO BUILDING, SIGN, OR OTHER STRUCTURE SHALL BE ERRECTED OR CONSTRUCTED ON SAID EASEMENTS, NOR SHALL ANY WELL BE DRILLED OR OPERATED THEREON. PROPERTY OWNERS SHALL BE SOLELY RESPONSIBLE FOR CORRECTING ANY VIOLATIONS OF NATIONAL ELECTRICAL SAFETY CODE CAUSED BY CONSTRUCTION OF POOLS, DECKING, OR ANY STRUCTURES ADJACENT TO OR NEAR EASEMENTS SHOWN ON THIS PLAN.

EASEMENT DATA TABLES

CURVE	RADIUS	LENGTH	TANGENT	CHORD	BEARING	DELTA
EC1	40.00'	198.18'	31.33'	49.33'	N 70°20'28" E	283°51'57"
EC2	25.00'	22.85'	12.29'	22.06'	S 06°05'26" W	52°22'0"
EC3	25.00'	20.01'	10.58'	19.48'	N 48°39'32" E	45°51'59"
EC4	30.00'	34.77'	19.63'	32.85'	N 47°49'15" W	66°23'56"

LINE	DISTANCE	BEARING
EL1	15.89'	N 86°31'32" E
EL2	15.12'	N 64°16'28" E
EL3	12.01'	N 08°59'07" E
E34	2.51'	N 81°01'13" W

BEING A REPLAT OF
TRACT B, ALBUQUERQUE SOUTH, UNIT ONE
WITHIN THE
TOWN OF ATRISCO GRANT
PROJECTED SECTION 34, T. 10 N., R. 2 E., NMPM
CITY OF ALBUQUERQUE
BERNALILLO COUNTY, NEW MEXICO

JANUARY 1998

ACS MONUMENT
"1-M10"
Y=1478654.54
X=358862.36
G-G=0.99967987
 $\Delta\alpha=-00^{\circ}16'15''$
CENTRAL ZONE
(NAD 1927/SLD 1929)
E: N 02°57'20" W
1460.50'

EXISTING 20' WATER UTILITY
EASEMENT (08-12-72,
BK MISC 327, PGS 336-339)

— EXISTING 40' TEMPORARY
ROADWAY EASEMENT
(07-19-94, BK BCR94-21,
PGS 7033-7036)

— EXISTING TEMPORARY DRAINAGE
EASEMENT (08-03-87, C34-74)

REGIONAL STORM WATER
DETENTION FACILITY GRANTED
TO THE CITY OF ALBUQUERQUE
BY THIS PLAT.

TRACT B
3.8996 AC.

SEE DETAIL 'A' —

EXISTING 50'
TEMPORARY DR
EASEMENT (07-
BK MS 509A,
PGS 241-244)

EXISTING 35' PUBLIC ROADWAY
& UTILITY EASEMENT GRANTED
TO THE CITY OF ALBUQUERQUE
BY PLAT FILED (02-20-97, 97C-55).

RIGHT-OF-WAY—
DEDICATED TO THE
CITY OF ALBUQUERQUE
BY THIS PLAT.

DETAIL

SHEET 3 OF 3

TRACT AA
SUNRISE ESTATES
UNIT 2
(05-21-97, 97C-162)

*THE WESTERLY 15 FT OF SHADETREE DR.
(STUB STREET ADJACENT TO UNSER BLVD,
A LIMITED ACCESS PRINCIPAL ARTERIAL) IS
LIMITED TO NON-VEHICULAR ACCESS ONLY.

**SUNRISE ESTATES
UNIT 2
(05-21-97, 97C-162)**

SCALE: 1"=100'

100 50 0 100 200 FEET

UNSER BOULEVARD S.W.

12' PEDESTRIAN ACCESS R.O.W.
DEDICATED TO THE CITY OF
ALBUQUERQUE BY THIS PLAT -

20' WIDE EXISTING PUBLIC
WATERLINE EASEMENT
(01-30-98, BK BCR98-3,
PGS 9662-9666)

RIGHT-OF-WAY
DEDICATED TO THE
CITY OF ALBUQUERQUE
BY THIS PLAT.

EXISTING PUBLIC ROADWAY, STORM DRAINAGE, PUBLIC WATER & SEWER EASEMENT
(11-13-97, BK BCR97-31, PGS 7633-7635)

TRACT A
5.6818 AC.

10' PUBLIC UTILITY-
EASEMENT GRANTED
BY THIS PLAT.

EXISTING PUBLIC ROADWAY,
PUBLIC WATER AND SEWER
EASEMENT (11-13-97,
BK BCR97-31,
PGS 7630-7632)

EASEMENT TIE:
S 65°23'58" E 71.82'

30' TEMPORARY DRAINAGE
EASEMENT (08-03-87,
C34-74)

28' PUBLIC ROADWAY—
& UTILITY EASEMENT
GRANTED TO THE CITY
OF ALBUQUERQUE BY
THIS PLAT.

**DESERT SPRINGS SUBDIVISION
TRACT C
(02-20-97, 97C-55)**

**DESERT SPRINGS SUBDIVISION
TRACT A
(02-20-97, 97C-55)**

—EXISTING 30' TEMPORARY
SANITARY SEWER EASEMENT
(12-04-97, BK BCR97-34,
PGS 338-339)

DESERT FLOWER SUBDIVISION
(06-05-97, 97C-175)

921FPT2.DWG 12/19/97