

This is a detailed plat map of a portion of the City of Los Angeles. The map shows several tracts, including 'SEVENBAR RANCH', 'SEVENBAR', 'BOARD', 'EDUCATION', 'WESTWOOD RANCH', and 'BLACK ARROYO'. A specific site is marked with a black dot and labeled 'SITE'. The map includes various lot numbers, street names, and a scale bar. The map is titled 'PLAT MAP' and 'CITY OF LOS ANGELES'.

GENERAL NOTES

NOTICE TO CONTRACTORS

1. CITY OF ALBUQUERQUE SPECIFICATIONS FOR PUBLIC WORKS CONSTRUCTION, 1986 EDITION AS AMENDED THROUGH UPDATE 6, WILL BE REFERRED TO HEREIN AS THE "STANDARD SPECIFICATIONS".
2. TWO WORKING DAYS PRIOR TO ANY EXCAVATION, CONTRACTOR MUST CONTACT NEW MEXICO ONE CALL SYSTEM (260-1990) AND DETERMINE LOCATION OF EXISTING UTILITIES.
3. PRIOR TO ANY CONSTRUCTION, THE CONTRACTOR SHALL EXCAVATE AND VERIFY THE HORIZONTAL AND VERTICAL LOCATIONS OF ALL OBSTRUCTIONS. SHOULD A CONFLICT EXIST, THE CONTRACTOR SHALL NOTIFY THE ENGINEER OR THE SURVEYOR SO THAT THE CONFLICT CAN BE RESOLVED WITHOUT DELAY.
4. ALL EXISTING SIGNS, MARKERS, DELINEATORS, ETC., WITHIN THE CONSTRUCTION LIMITS SHALL BE REMOVED, STORED AND RE-SET BY THE CONTRACTOR.
5. FIVE (5) WORKING DAYS PRIOR TO BEGINNING CONSTRUCTION THE CONTRACTOR SHALL SUBMIT TO THE CONSTRUCTION CO-ORDINATION DIVISION A DETAILED CONSTRUCTION SCHEDULE. TWO (2) WORKING DAYS PRIOR TO CONSTRUCTION THE CONTRACTOR SHALL OBTAIN A BARRICADING PERMIT FROM THE CONSTRUCTION CO-ORDINATION DIVISION. CONTRACTOR SHALL NOTIFY BARRICADE ENGINEER (788-5551) PRIOR TO OCCUPYING AN INTERSECTION.
SEE SECTION 19 OF THE SPECIFICATIONS
6. ALL STREET STRIPING ALTERED OR DESTROYED SHALL BE REPLACED WITH PLASTIC REFLECTORIZED PAVEMENT MARKINGS BY CONTRACTOR IN EXISTING OR NEW LOCATION AS INDICATED BY THIS SET.
7. THE CONTRACTOR SHALL NOTIFY THE ENGINEER NOT LESS THAN SEVEN (7) DAYS PRIOR TO STARTING WORK IN ORDER THAT THE ENGINEER MAY MEASURE AND LOCATE THE MONUMENTS. TO ENSURE THE PRESERVATION OF SURVEY MONUMENTS, CONTRACTOR SHALL NOT DISTURB PERMANENT SURVEY MONUMENTS WITHOUT THE CONSENT OF THE ENGINEER AND SHALL NOTIFY THE ENGINEER AND BEAR THE EXPENSE OF REPLACING ANY THAT MAY BE DISTURBED WITHOUT PERMISSION. REPLACEMENT SHALL BE DONE ONLY BY THE CITY SURVEYOR. WHEN A CHANGE IS MADE IN THE FINISHED ELEVATIONS OR THE PAVEMENT OF ANY ROADWAY IN WHICH A PERMANENT SURVEY MONUMENT IS LOCATED, CONTRACTOR SHALL, AT HIS OWN EXPENSE, ADJUST THE MONUMENT COVER TO THE NEW GRADE UNLESS OTHERWISE SPECIFIED. REFER TO SECTION 4.4 OF THE GENERAL CONDITIONS OF THE STANDARD SPECIFICATIONS.
8. ANY WORK OCCURRING WITHIN AN ARTERIAL ROADWAY REQUIRES 24 HOURS CONSTRUCTION.
9. WATER AND SEWER FACILITIES SHALL BE CONSTRUCTED PER NMUI SPECIFICATIONS, INSPECTION AND APPROVAL.
10. THE CONTRACTOR SHALL NOTIFY NMUI THREE (3) WORKING DAYS PRIOR TO BEGINNING WATER OR SEWER CONSTRUCTION AND SHALL COORDINATE SAID CONSTRUCTION WITH NMUI.
11. CONTRACTOR SHALL MAINTAIN A GRAFFITI-FREE WORK SITE. CONTRACTOR SHALL PROMPTLY REMOVE ANY AND ALL GRAFFITI FROM EQUIPMENT, WHETHER PERMANENT OR TEMPORARY.

THE FOLLOWING NOTES ALSO APPLY WHEN CHECKED


- ☒ ALL UTILITIES AND UTILITY SERVICE LINES SHALL BE
 INSTALLED PRIOR TO PAVING.
☒ BACKFILL COMPACTION SHALL BE ACCORDING TO SPECIFIED
 STREET USE.
☐ TACK COAT REQUIREMENTS SHALL BE DETERMINED BY THE
 CITY ENGINEER.
☒ SIDEWALK AND WHEELCHAIR RAMPS WITHIN THE CURB
 RETURNS SHALL BE CONSTRUCTED WHEREVER A NEW CURB
 RETURN IS CONSTRUCTED.
☐ IF CURB IS DERESSED FOR A DRIVEPAD, THE DRIVEPAD SHALL
 BE CONSTRUCTED PRIOR TO ACCEPTANCE OF CURB AND GUTTER.
☐ ALL STORM DRAINAGE FACILITIES SHALL BE COMPLETED PRIOR
 TO FINAL ACCEPTANCE.

CAUTION:
NOTE THAT ALL EXISTING UTILITIES MAY NOT BE SHOWN. ALL EXISTING SERVICE CONNECTIONS ARE NOT SHOWN. ANY EXISTING UTILITIES THAT ARE SHOWN ARE APPROXIMATE LOCATION ONLY.
IT SHALL BE THE SOLE RESPONSIBILITY OF THE CONTRACTOR TO CONTACT ALL THE UTILITY OWNERS AND TO CONDUCT ALL NECESSARY FIELD INVESTIGATIONS PRIOR TO ANY EXCAVATIONS TO DETERMINE THE ACTUAL LOCATION OF UTILITIES AND OTHER IMPROVEMENTS.

dmg D. MARK GOODWIN & ASSOCIATES, P.A.
CONSULTING ENGINEERS
P. O. BOX 90606
ALBUQUERQUE, NEW MEXICO 87199
(505) 828-2200

REV.	SHEETS	CITY ENGINEER	DATE	USER DEPARTMENT	DATE	USER DEPARTMENT	DATE
ENGINEERS STAMP & SIGNATURE		APPROVALS	ENGINEER	DATE	*****		
		DRC CHAIRMAN	<i>William G. Gooding</i>	4-24-98	APPROVED FOR CONSTRUCTION		
		TRANSPORTATION	<i>Paul Davis</i>	4-7-98			
		WATER/WASTEWATER	<i>P. W. Kane</i>	3-23-98			
		HYDROLOGY	<i>Paul H. Howell</i>	4-7-98			
		CIP			CITY ENGINEER	DATE	
		CONSTR. MNGMT.					
		F. NIMUE		3-12-98			
		CITY PROJECT NO.	<i>John Hardy</i>	4-15-98			
		578782			SHEET OF		
					1 12		

INDEX TO DRAWINGS

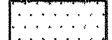	CURB AND GUTTER		WATER METER
	CONCRETE		CABLE T.V.
	ELECTRIC TRANSFORMER		POWER POLE
	ELECTRIC PANEL		ANCHOR
	SANITARY SEWER MANHOLE		LIGHT POLE
	TELEPHONE MANHOLE		TRAFFIC LIGHT
	ELECTRIC MANHOLE		CROSSWALK SIGNAL
	STORM SEWER MANHOLE		SPRINKLER CONTROL
	WATER VALVE		TRAFFIC CONTROL
	FIRE HYDRANT		LIGHTING BOX
	TELEPHONE BOX		SIGN
	SPOT ELEVATION		GRATE

<u>SHEET NO.</u>	<u>TITLE SHEET</u>
1	TITLE SHEET
2-3	PLAT
4	MASTER PAVING PLAN
5-6	PAVING IMPROVEMENTS
7	MASTER UTILITY PLAN
8-9	UTILITY IMPROVEMENTS
10-11	GRADING PLANS
12A-12B	TYPICAL TRAFFIC CONTROL


RECORD DRAWING

I hereby certify that the information contained on this drawing has been revised in accordance with information furnished by the contractor, Franklin's Earthmoving Inc., and by the surveyor, A.L.S. Inc., and reflects the construction as actually accomplished. This plan as constructed is in substantial compliance with the Approved Plan.

Mark Goodwin 8/5/98
Mark Goodwin NMPE 8948

DRB CASE NO. 97298

8021CRYS\8021-TTL\03-01-98

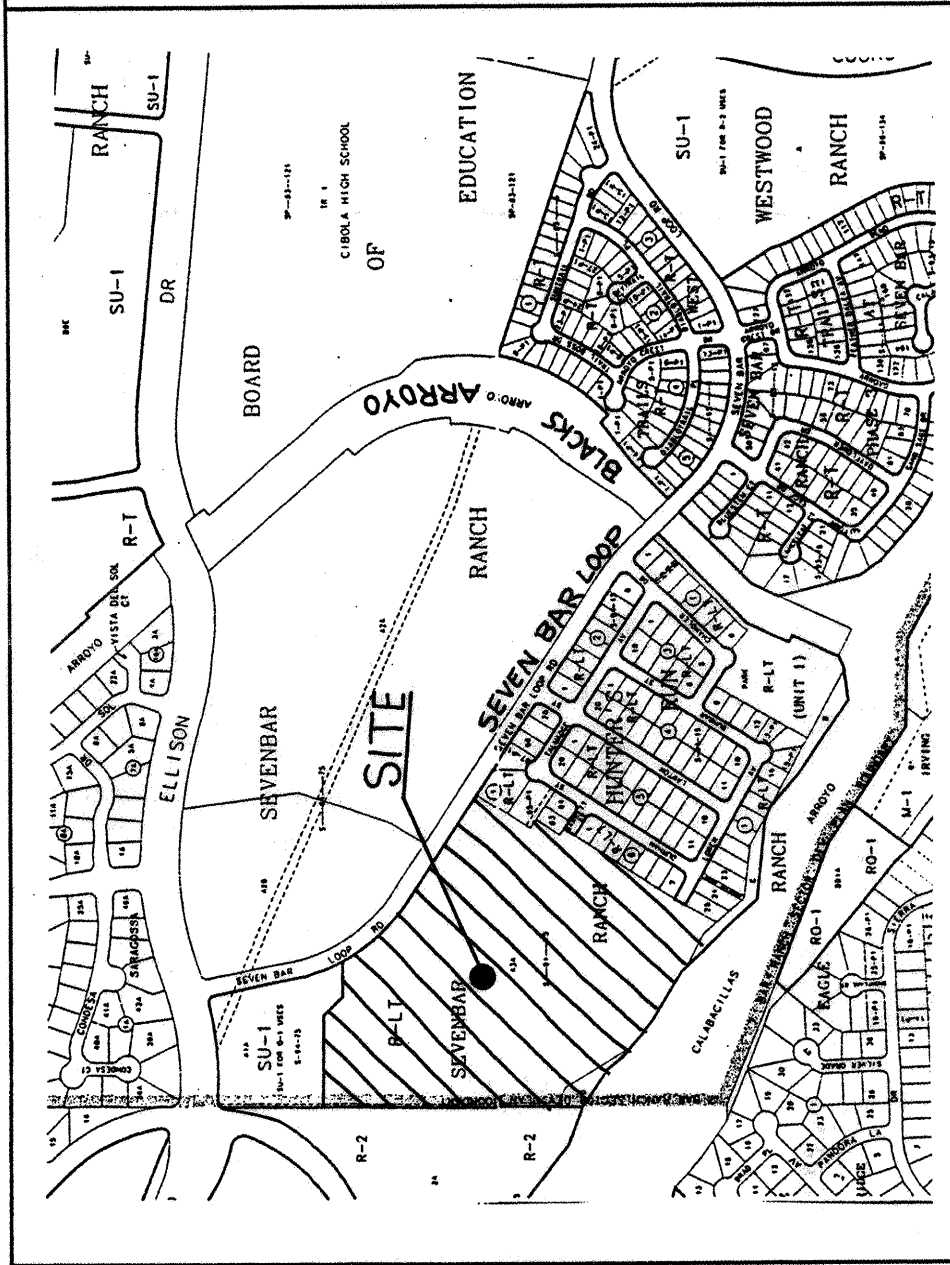

LOCATION MAP
ZONE ATLAS A-13B-13
SCALE: NONE

SUBDIVISION DATA			
PLAT CASE NO.	DRB. 97-298 S	V.	
GROSS ACREAGE	7.3425		
ZONE ATLAS NO.	A13B13		
NO. OF EXISTING TRACTS/LOTS	1 tract		
NO. OF TRACTS/LOTS CREATED	48 LOTS		
NO. OF TRACTS/LOTS ELIMINATED	1 tract		
MILES OF FULL WIDTH STREETS CREATED	0.2208		
AREA DEDICATED TO CITY OF ALBUQUERQUE	1.3075 AC		
DATE OF SURVEY	1-13-94		
UTILITY CONTROL LOCATION SYSTEM LOG NUMBER	9401171500322		

FREE CONSENT AND DEDICATION

The subdivision hereon described is with the free consent and in accordance with the desires of the undersigned owner(s) and/or proprietors thereof, and said owner(s) and/or proprietors thereof, to the City of Albuquerque in fee simple with warranty covenants and do hereby grant: all access, utility and drainage easements shown hereon including the right to construct, operate, inspect, and maintain facilities therein; and all public utility easements shown hereon for the common and joint use of gas, electrical power and communication services for buried distribution lines, conduits, and pipes for underground & overhead utilities where shown or indicated, and including the right of ingress and egress for construction and maintenance, and the right to trim interfering trees and shrubs. Said owner(s) and/or proprietors (s) do hereby, consent to all of the foregoing and do hereby certify that this subdivision is their free act and deed.

by: *John K. Murtagh*
JOHN K. MURTAGH, President
LONGFORD AT CRYSTAL RIDGE

OWNER'S ACKNOWLEDGMENT

STATE OF NEW MEXICO } ss
COUNTY OF BERNALILLO }
This instrument was acknowledged before me on _____
Notary Public
MY COMMISSION EXPIRES _____

LEGAL DESCRIPTION

A tract of land situate, within the Town of Alameda Grant, projected Sections 6 and 7, Township 11 North, Range 3 East, New Mexico Principal Meridian, City of Albuquerque, Bernalillo County, New Mexico being all of TRACT A-3A-2, CRYSTAL RIDGE SUBDIVISION as the same is shown and designated on said plat filed for record in the office of the County Clerk of Bernalillo County, New Mexico on September 30, 1997 in Volume 97C, Folio 298, and being more particularly described as follows:

BEGINNING at the northwest corner of the herein described tract, said point being common with the southwest corner of Block C1, A-3A-3, TRACTS A-1 THRU A-3, SEVEN-BAR RANCH, (10-17-89, C40-21) and the southwest corner of Block 1, Unit 1, HUNTERS RUN SUBDIVISION, as the same is shown and designated on said plat filed for record in the office of the County Clerk of Bernalillo County, New Mexico on September 30, 1997 in Volume 97C, Folio 298, from whence the National Geodetic Survey Monument "BLACK 2" bears N26707'35" W, 859.94 feet;

THENCE S 89°42'04" E, 271.62 feet along a line common with the south line of said TRACT A-3A-3 to the northeast corner, said point being common with the northwest corner of CRYSTAL RIDGE, UNIT 1 as the same is shown and designated on said plat filed for record in the office of the County Clerk of Bernalillo County, Mexico on December 18, 1997 in Volume 97C, Folio 356;

THENCE S 001°7'56" W, 115.08 feet along a line common with the westerly line of said CRYSTAL RIDGE, UNIT 1 to a point on curve;

THENCE continuing 4.12 feet along a curve to the left, whose radius is 143.00 feet through a central angle of 01°39'05" and whose chord bears N 88°52'31" W, 4.12 feet to a point on tangent;

THENCE continuing S 001°7'56" W, 46.00 feet to a point on curve;

THENCE continuing 21.35 feet along a curve to the right, whose radius is 97.00 feet through a central angle of 12°36'32" and whose chord bears S 83°23'48" E, 21.30 feet to a point on tangent;

THENCE continuing S 11°44'17" W, 63.93 feet to a point;

THENCE continuing S 001°7'56" W, 90.00 feet to a point;

THENCE continuing N 89°42'04" W, 15.00 feet to a point;

THENCE continuing S 001°7'56" W, 27.58 feet to a point;

THENCE continuing S 31°08'55" E, 109.85 feet to a point on curve;

THENCE continuing 35.29 feet along a curve to the left, whose radius is 143.00 feet through a central angle of 14°08'17" and whose chord bears S 65°55'14" W, 35.20 feet to a point on tangent;

THENCE continuing S 31°08'55" E, 152.16 feet to a point;

THENCE continuing N 58°51'05" E, 29.93 feet to a point;

THENCE continuing S 31°08'55" E, 55.94 feet to a point;

THENCE continuing S 33°05'53" E, 365.51 feet to a point;

THENCE continuing S 32°42'13" W, 93.96 feet to a point of tangency;

THENCE continuing 37.72 feet along a curve to the right, whose radius is 25.00 feet through a central angle of 86°26'39" and whose chord bears S 75°55'33" W, 34.24 feet to a point of tangency;

THENCE continuing N 60°51'08" W, 4.00 feet to a point;

THENCE continuing S 29°08'52" W, 46.00 feet to a point on curve;

THENCE continuing 20.69 feet along a curve to the right, whose radius is 127.00 feet through a central angle of 09°20'08" and whose chord bears S 56°11'03" E, 20.67 feet to a point of reverse curvature;

THENCE continuing 28.51 feet along a curve to the left, whose radius is 175.00 feet through a central angle of 09°20'08" and whose chord bears S 56°11'03" E, 28.48 feet to a point of tangency;

THENCE continuing S 60°51'08" E, 129.16 feet to a point, said point being common with the northwest corner of LOT 25, BLOCK 1, UNIT 1, HUNTERS RUN SUBDIVISION as the same is shown and designated on said plat filed for record in the office of the County Clerk of Bernalillo County, New Mexico on October 19, 1994 in Volume 94C, Folio 353;

THENCE S 29°08'52" W, 142.29 feet along a line common with the westerly line of said LOT 25 to the south-east corner, said point being on the westerly right-of-way line of the Arroyo de las Cañadas as the same is shown and designated on said RIGHT-OF-WAY MAP filed for record in the office of the County Clerk of Bernalillo County, New Mexico on June 8, 1981 in Volume C18, Folio 96;

THENCE along said northerly right-of-way line N 41°11'54" W, 67.35 feet to a point;

THENCE continuing N 62°11'51" W, 149.84 feet to a point;

THENCE continuing N 44°09'16" W, 28.27 feet to a point;

THENCE continuing N 58°45'33" W, 210.67 feet to a point;

THENCE continuing N 50°40'47" W, 142.31 feet to a point;

THENCE continuing N 31°08'55" W, 299.80 feet to a point;

THENCE continuing N 65°32'08" W, 86.00 feet to a point, said point being on the east line of TRACT 2-A, EAGLE RANCH as the same is shown and designated on said plat filed for record in the office of the County Clerk of Bernalillo County, New Mexico on October 11, 1985 in Volume C28, Folio 123;

THENCE leaving said northerly right-of-way line N 001°7'56" E, 489.08 feet along a line common with said east line of said TRACT 2-A to the point of beginning and containing 7.3425 acres more or less.

LEGAL DESCRIPTION (SEE SHEET 2)

NOTES (SEE SHEET 2)

PURPOSE OF PLAT

- SUBDIVIDE THE EXISTING TRACT A-3A-2, CRYSTAL RIDGE SUBDIVISION, INTO 48 RESIDENTIAL LOTS
- TO DEDICATE RIGHT-OF-WAY AND GRANT EASEMENTS AS SHOWN

PLAT OF
CRYSTAL RIDGE
SUBDIVISION
UNIT 2
WITHIN THE
TOWN OF ALAMEDA GRANT
PROJECTED SECTIONS 6 AND 7
T11 N, R 3 E, N4PM
CITY OF ALBUQUERQUE
BERNALILLO COUNTY, NEW MEXICO
FEBRUARY 1998

APPROVED AND ACCEPTED BY:

APPROVAL AND CONDITIONAL ACCEPTANCE as specified by the Albuquerque Subdivision Ordinance, Article XI of Chapter 7 of the Revised Ordinances of Albuquerque, New Mexico.

Subdivision Case No. _____

Planning Director, City of Albuquerque, N.M. _____ Date _____

City Engineer, City of Albuquerque, N.M. _____ Date _____

Albuquerque Metropolitan Arroyo Flood Control Authority _____ Date _____

Transportation Development, City of Albuquerque, N.M. _____ Date _____

Utility Development Division, City of Albuquerque, N.M. _____ Date _____

Parks Design and Development, C.I.P., City of Albuquerque, N.M. Date _____

W. J. Clark
City Surveyor, City of Albuquerque, N.M. **0225-98** Date _____

Property Management, City of Albuquerque, N.M. _____ Date _____

New Mexico Utilities, Inc. _____ Date _____
PNM GAS *Kelly Phil* **2-25-98** Date _____

Cathleen Strubbe
PNM Telecommunications _____ Date _____
Kyle Phil **2-28-98** Date _____

Robert Watson
PNM ELECTRIC **2-28-98** Date _____
Jones Intercable, Inc. **2-28-98** Date _____

dwg: 7055hw1 Scale: 1"=50' Drawn: B/G Date: 2-9-98 Checked: ALS Job: 97055 Sheet 1 of 3

NOTES

- Bearings are grid based on the New Mexico State Plane Coordinate System (Central Zone).
- Distances are ground distances.
- Bearings and distances in parenthesis are record.
- Basis of boundary are the following plats of record entitled:
"TRACTS A-1 THRU A-3, SEVEN-BAR RANCH" (10-17-89, C40-21)
"TRACTS N-2A-1 AND N-2A-2, SEVEN-BAR RANCH" (10-17-89, C40-22)
"TRACTS A-1, A-2, A-3, C28-123)
"SUMMARY PLAT, SEVEN-BAR RANCH" (6-8-81, C18-96)
"BULK LAND PLAT OF CRYSTAL RIDGE SUBDIVISION" (09-30-97, 97C.298)
"CRYSTAL RIDGE SUBDIVISION, UNIT 1" (12-18-97, 97C-356)
all being records of Bernalillo County, New Mexico.
- Field Survey performed January 13, 1994.
- This subdivision is within the New Mexico Utilities, Inc. franchise area. Water and sanitary sewer capabilities are based on New Mexico Utilities, Inc. facilities and not the City of Albuquerque's.

PLAT OF
CRYSTAL RIDGE
SUBDIVISION
UNIT 2
WITHIN THE
TOWN OF ALAMEDA GRANT
PROJECTED SECTIONS 6 AND 7
T11 N, R 3 E, N4PM
CITY OF ALBUQUERQUE
BERNALILLO COUNTY, NEW MEXICO
FEBRUARY 1998

PUBLIC UTILITY EASEMENTS


PUBLIC UTILITY EASEMENTS shown on this plat are granted for the common and joint use of:

- The PNM Electric Services Division for the installation, maintenance and service of overhead and underground electrical lines, transformers, poles and any other equipment, fixtures, structures and related facilities reasonably necessary to provide electrical services.
- The PNM Gas Services Division for installation, maintenance and service of natural gas lines, valves and other equipment and facilities reasonably necessary to provide natural gas.
- U.S. West for installation, maintenance and service of all buried and aerial communication lines and other related equipment and facilities reasonably necessary to provide communication services, including but not limited to above ground pedestals and closures.
- Jones Intercable for installation, maintenance and service of such lines, cable and other related equipment and facilities reasonably necessary to provide Cable TV service.
- The New Mexico Utilities, Inc. for the installation, maintenance and service of water and sanitary sewer lines and any other equipment, fixtures, structures and related facilities reasonably necessary to provide water and sewer services.


Included, is the right to build, rebuild, construct, reconstruct, locate, relocate, change, remove, modify, renew, operate and maintain facilities for the purposes described above, together with free access to, from and over said easement, including sufficient working area space for electric transformers, with the right and privilege to trim and remove trees, shrubs or other plants and structures which may interfere with the easement. No building, sign, pool (above ground or subsurface), hot tub, concrete or wood pool decking, or other structure shall be erected or constructed on said easements, nor shall any well be drilled or operated thereon. Property owners shall be solely responsible for correcting any violations of National Electrical Safety Code caused by construction of pools, decking or any structures adjacent to within or near easements shown on this plat.

In approving this plat, the utility companies did not conduct a Title Search of the properties shown hereon. Consequently, the utility companies do not waive or release any easement or easement rights which may have been granted by prior plat, replat or other document and which are not shown on this plat.

dwg: 7055hw2 Scale: 1"=50' Drawn: B/G Date: 2-9-98 Checked: ALS Job: 97055 Sheet 2 of 3

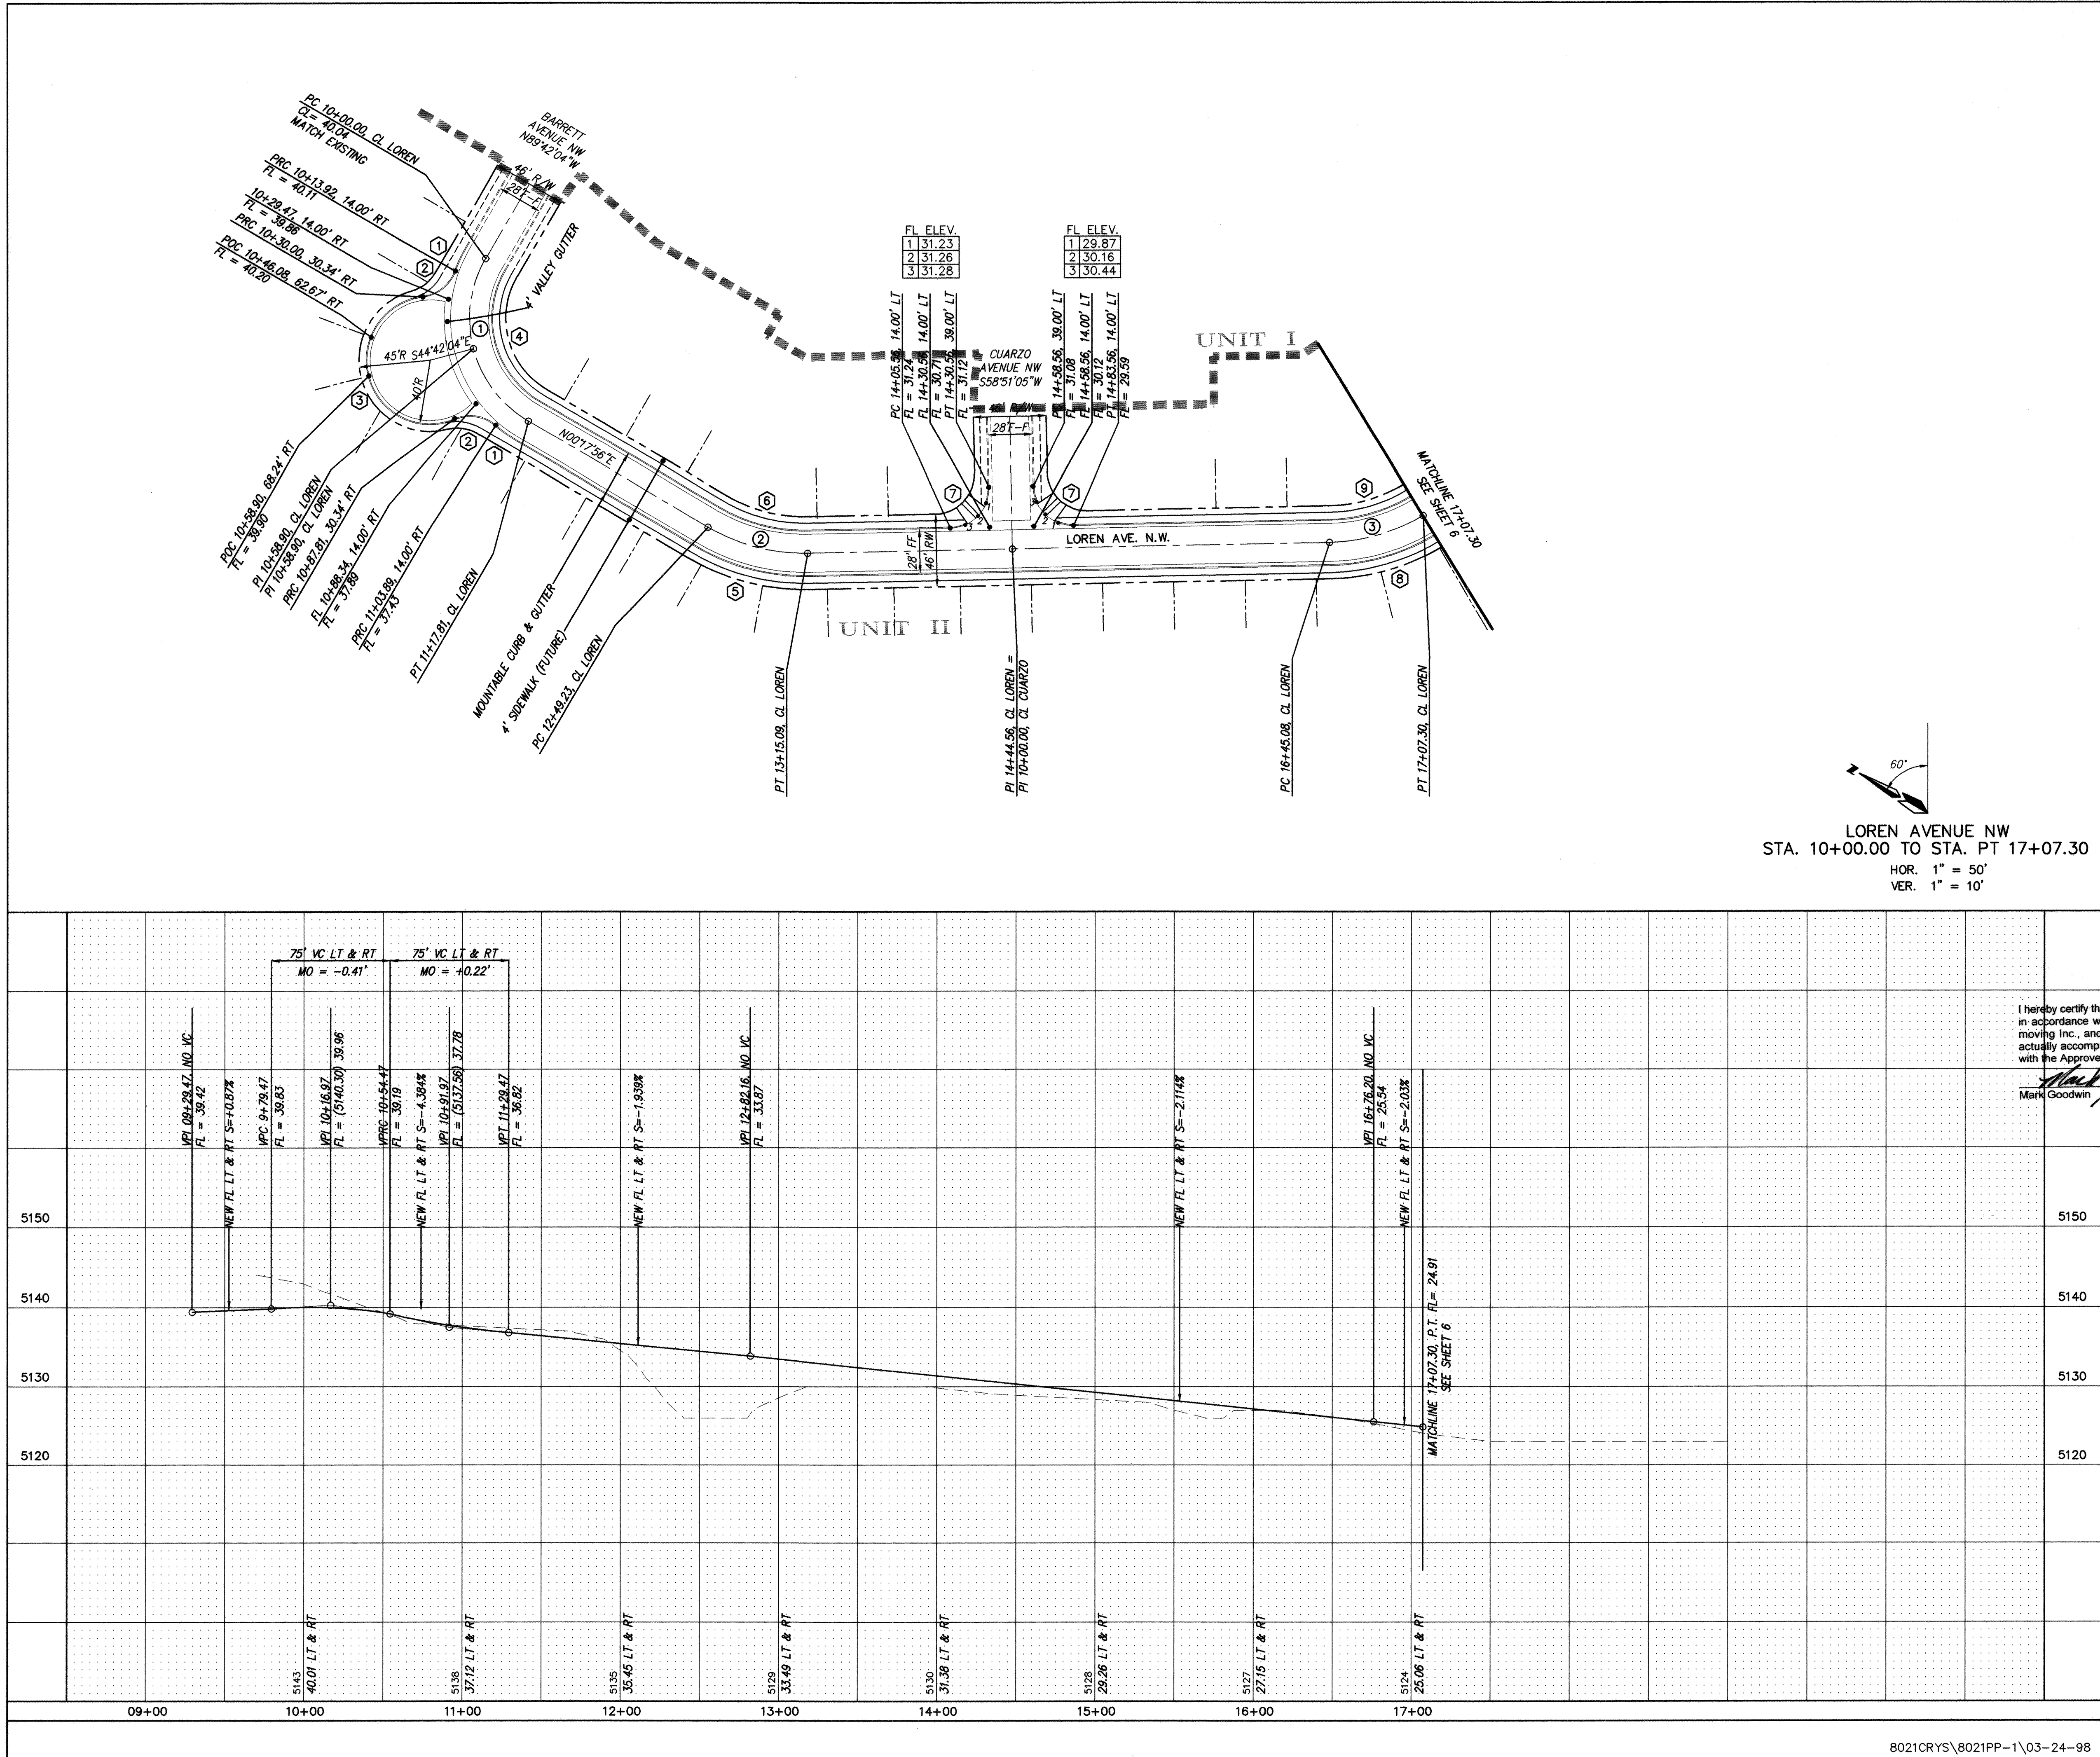

NOTES	
1. ALL STATIONING IS CENTERLINE STATIONING. 2. VALLEY GUTTERS ARE 6' UNLESS SPECIFIED OTHERWISE. 3. STANDARD TO MOUNTABLE CURB AND GUTTER PER CITY OF ALBUQUERQUE STANDARD DRAWING 241B.	
CURVE DATA - DESCRIBES FACE OF CURB	
① $\Delta = 10'37'54''$ $R = 89.00'$ $L = 16.51'$ $T = 8.28'$	② $\Delta = 6'34'25''$ $R = 25.00'$ $L = 27.80'$ $T = 15.54'$
③ $\Delta = 196'09'55''$ $R = 40.00'$ $L = 136.95'$ $T = N/A$	④ $\Delta = 90'00'00''$ $R = 61.00'$ $L = 95.82'$ $T = 61.00'$
⑤ $\Delta = 31'26'51''$ $R = 134.00'$ $L = 73.55'$ $T = 37.73'$	⑥ $\Delta = 31'26'51''$ $R = 106.00'$ $L = 58.18'$ $T = 29.84'$
⑦ $\Delta = 90'00'00''$ $R = 25.00'$ $L = 39.27'$ $T = 25.00'$	⑧ $\Delta = 29'42'33''$ $R = 134.00'$ $L = 69.48'$ $T = 35.54'$
⑨ $\Delta = 29'42'33''$ $R = 106.00'$ $L = 54.99'$ $T = 28.13'$	
CURVE DATA - DESCRIBES CENTERLINE	
① $\Delta = 90'00'00''$ $R = 75.00'$ $L = 117.81'$ $T = 75.00'$	② $\Delta = 31'26'51''$ $R = 120.00'$ $L = 65.86'$ $T = 33.78'$
③ $\Delta = 29'42'33''$ $R = 120.00'$ $L = 62.22'$ $T = 31.83'$	
AS BUILT INFORMATION	
CONTRACTOR: Franklin's	DATE: 6/98
INSPECTOR'S: ALS	DATE: 8/98
FIELD DISTANCE BY: ALS	DATE: 8/98
CORRECTED BY: ALS	DATE: 8/98
RECORDED BY: ALS	DATE: 8/98
STATION MARK IS A STANDARD MINGSHI BRASS TABLET, STAMPED "NM448-N12", SET IN TOP OF A CONCRETE TABLET, PROJECTING 0.3 FT. ABOVE GROUND. TO REACH THE STATION FROM THE INTERSECTION OF STATE RD. 448 AND CENTRAL AVE., GO NORTH ON STATE RD. 448, 9.30 MILES TO MOUNTAIN BELL TELE. SUB-STATION AND STATION ON LEFT (WEST).	
X=381,108.54 Y=1,528,910.94 Z=5023.411	
SURVEY INFORMATION	
FIELD NOTES	DATE
BY	
NO.	
ENGINEER'S SEAL	
RECORD DRAWING	
I hereby certify that the information contained on this drawing has been revised in accordance with information furnished by the contractor, Franklin's Earthmoving Inc., and by the surveyor, ALS, Inc., and reflects the construction as actually accomplished. This plan as constructed is in substantial compliance with the Approved Plan.	
Mark Goodwin NMPE 8948	
3/15/98	
REGISTERED PROFESSIONAL ENGINEER	
CITY OF ALBUQUERQUE PUBLIC WORKS DEPARTMENT ENGINEERING DEVELOPMENT GROUP	
TITLE: CRYSTAL RIDGE - UNIT II PAVING IMPROVEMENTS LOREN AVENUE NW	
DESIGN REVIEW COMMITTEE	
APR 24 1998	
CITY ENGINEER APPROVAL	
LAST DESIGN UPDATE	
MO./DAY/YR.	
MO./DAY/YR.	
CITY PROJECT NO. 578782	
ZONE MAP NO. A-13 & B-13	
SHEET 5 OF 11	

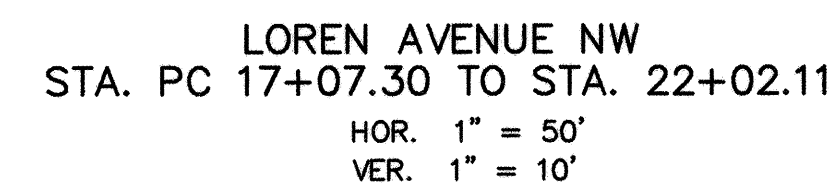

Mark Goodwin 8/5/98
Mark Goodwin NMPE 8948



1. ALL STATIONING IS CENTERLINE STATIONING.
2. VALLEY GUTTER ARE 6' UNLESS SPECIFIED OTHERWISE.
3. STANDARD TO MOUNTABLE CURB AND GUTTER PER CITY OF ALBUQUERQUE STANDARD DRAWING 2418.

⑧ $\Delta = 29'42''33''$
 $R = 134.00''$
 $L = 39.48''$
 $T = 35.54''$

⑨ $\Delta = 29'43''33''$
 $R = 106.00''$
 $L = 54.99''$
 $T = 28.13''$

⑩ $\Delta = 86'26''39''$
 $R = 25.00''$
 $L = 37.72''$
 $T = 23.49''$

⑪ $\Delta = 93'33''21''$
 $R = 25.00''$
 $L = 40.82''$
 $T = NA$

⑫ $\Delta = 09'22''00''$
 $R = 136.00''$
 $L = 22.23''$
 $T = 11.14''$

⑬ $\Delta = 09'22''00''$
 $R = 164.00''$
 $L = 26.81''$
 $T = 13.44''$

$$\begin{array}{ll} \textcircled{3} \Delta = 29^{\circ}42'33'' & \textcircled{4} \Delta = 06^{\circ}37'11'' \\ R = 120.00' & R = 150.00' \\ L = 62.22' & L = 17.33' \\ T = 31.83' & T = 8.67' \end{array}$$

[illegible]

dmg MARK GOODWIN & ASSOCIATES, P.A.
CONSULTING ENGINEERS
P.O. BOX 90606
ALBUQUERQUE, NEW MEXICO 87199
(505) 828-2200

 CITY OF ALBUQUERQUE
PUBLIC WORKS DEPARTMENT
ENGINEERING DEVELOPMENT GROUP

TITLE: CRYSTAL RIDGE - UNIT I
PAVING IMPROVEMENTS
LOREN AVENUE NW

DESIGN REVIEW COMMITTEE

APPROVED


APR 24 1998


DESIGN REVIEW COMMITTEE

CITY ENGINEER APPROVAL

CITY PROJECT NO.	578782	ZONE MAP NO.	A-13 & B-13
------------------	--------	--------------	-------------

SHEET 6 OF 11

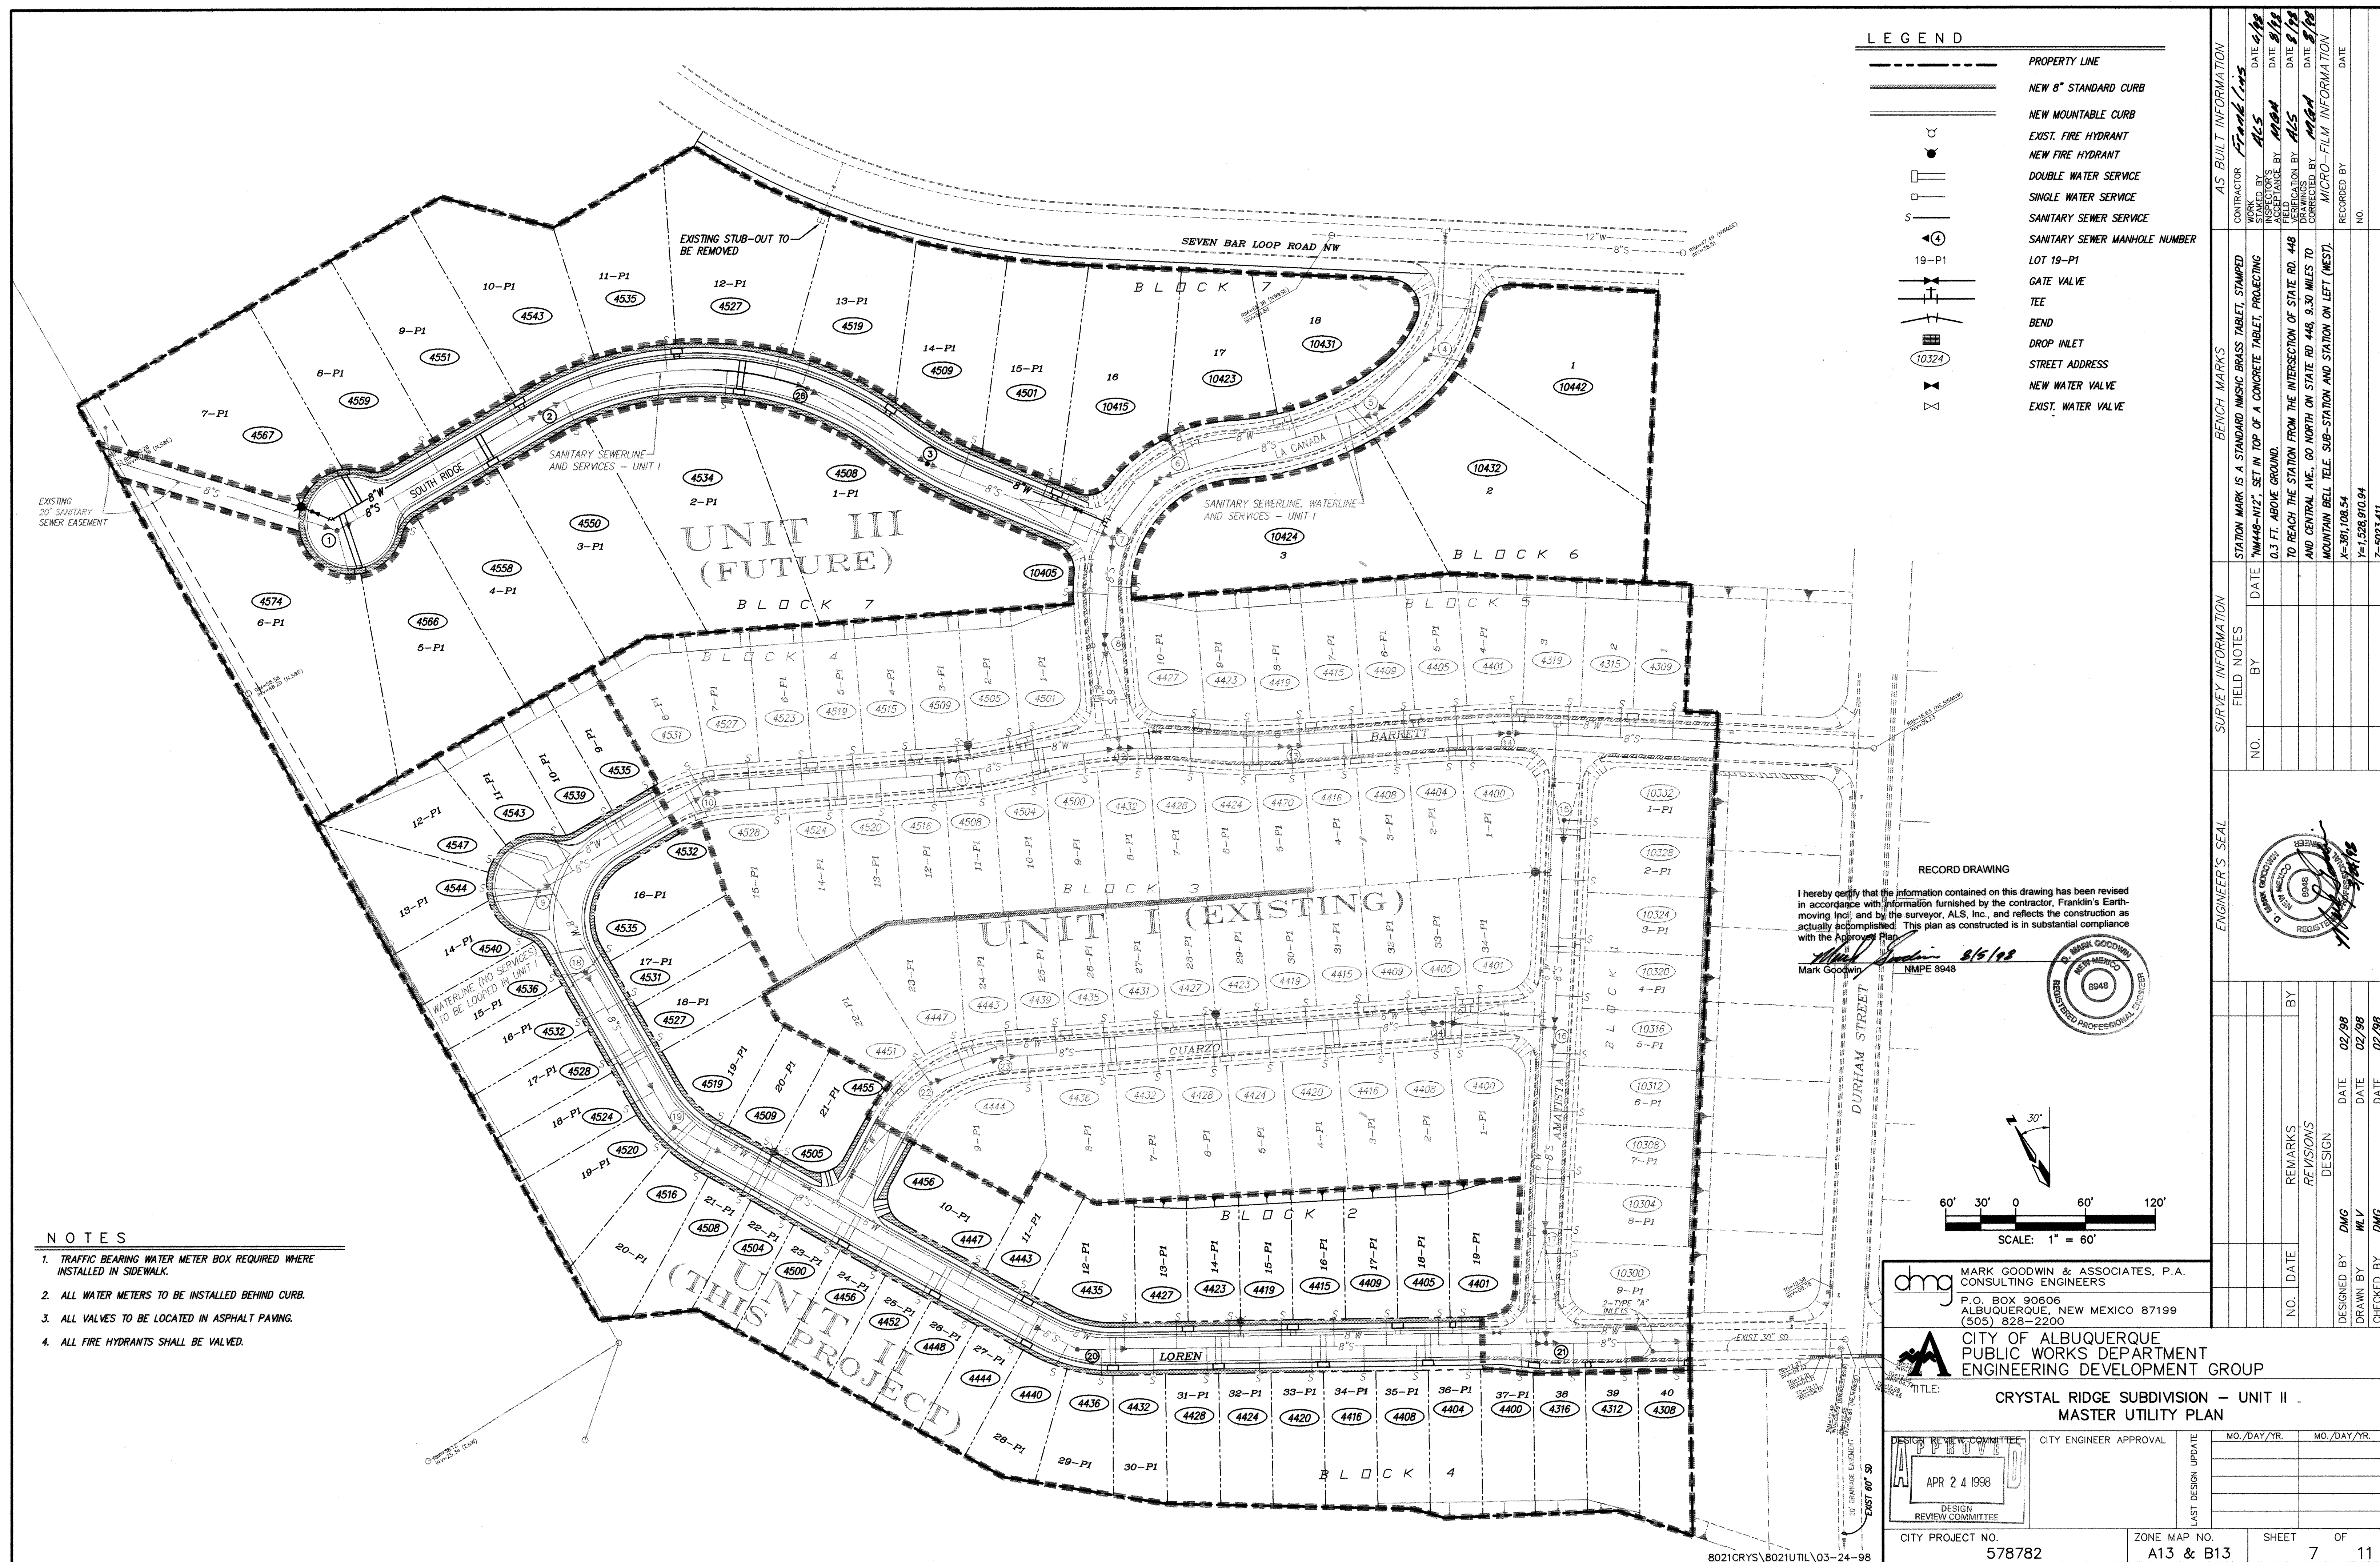

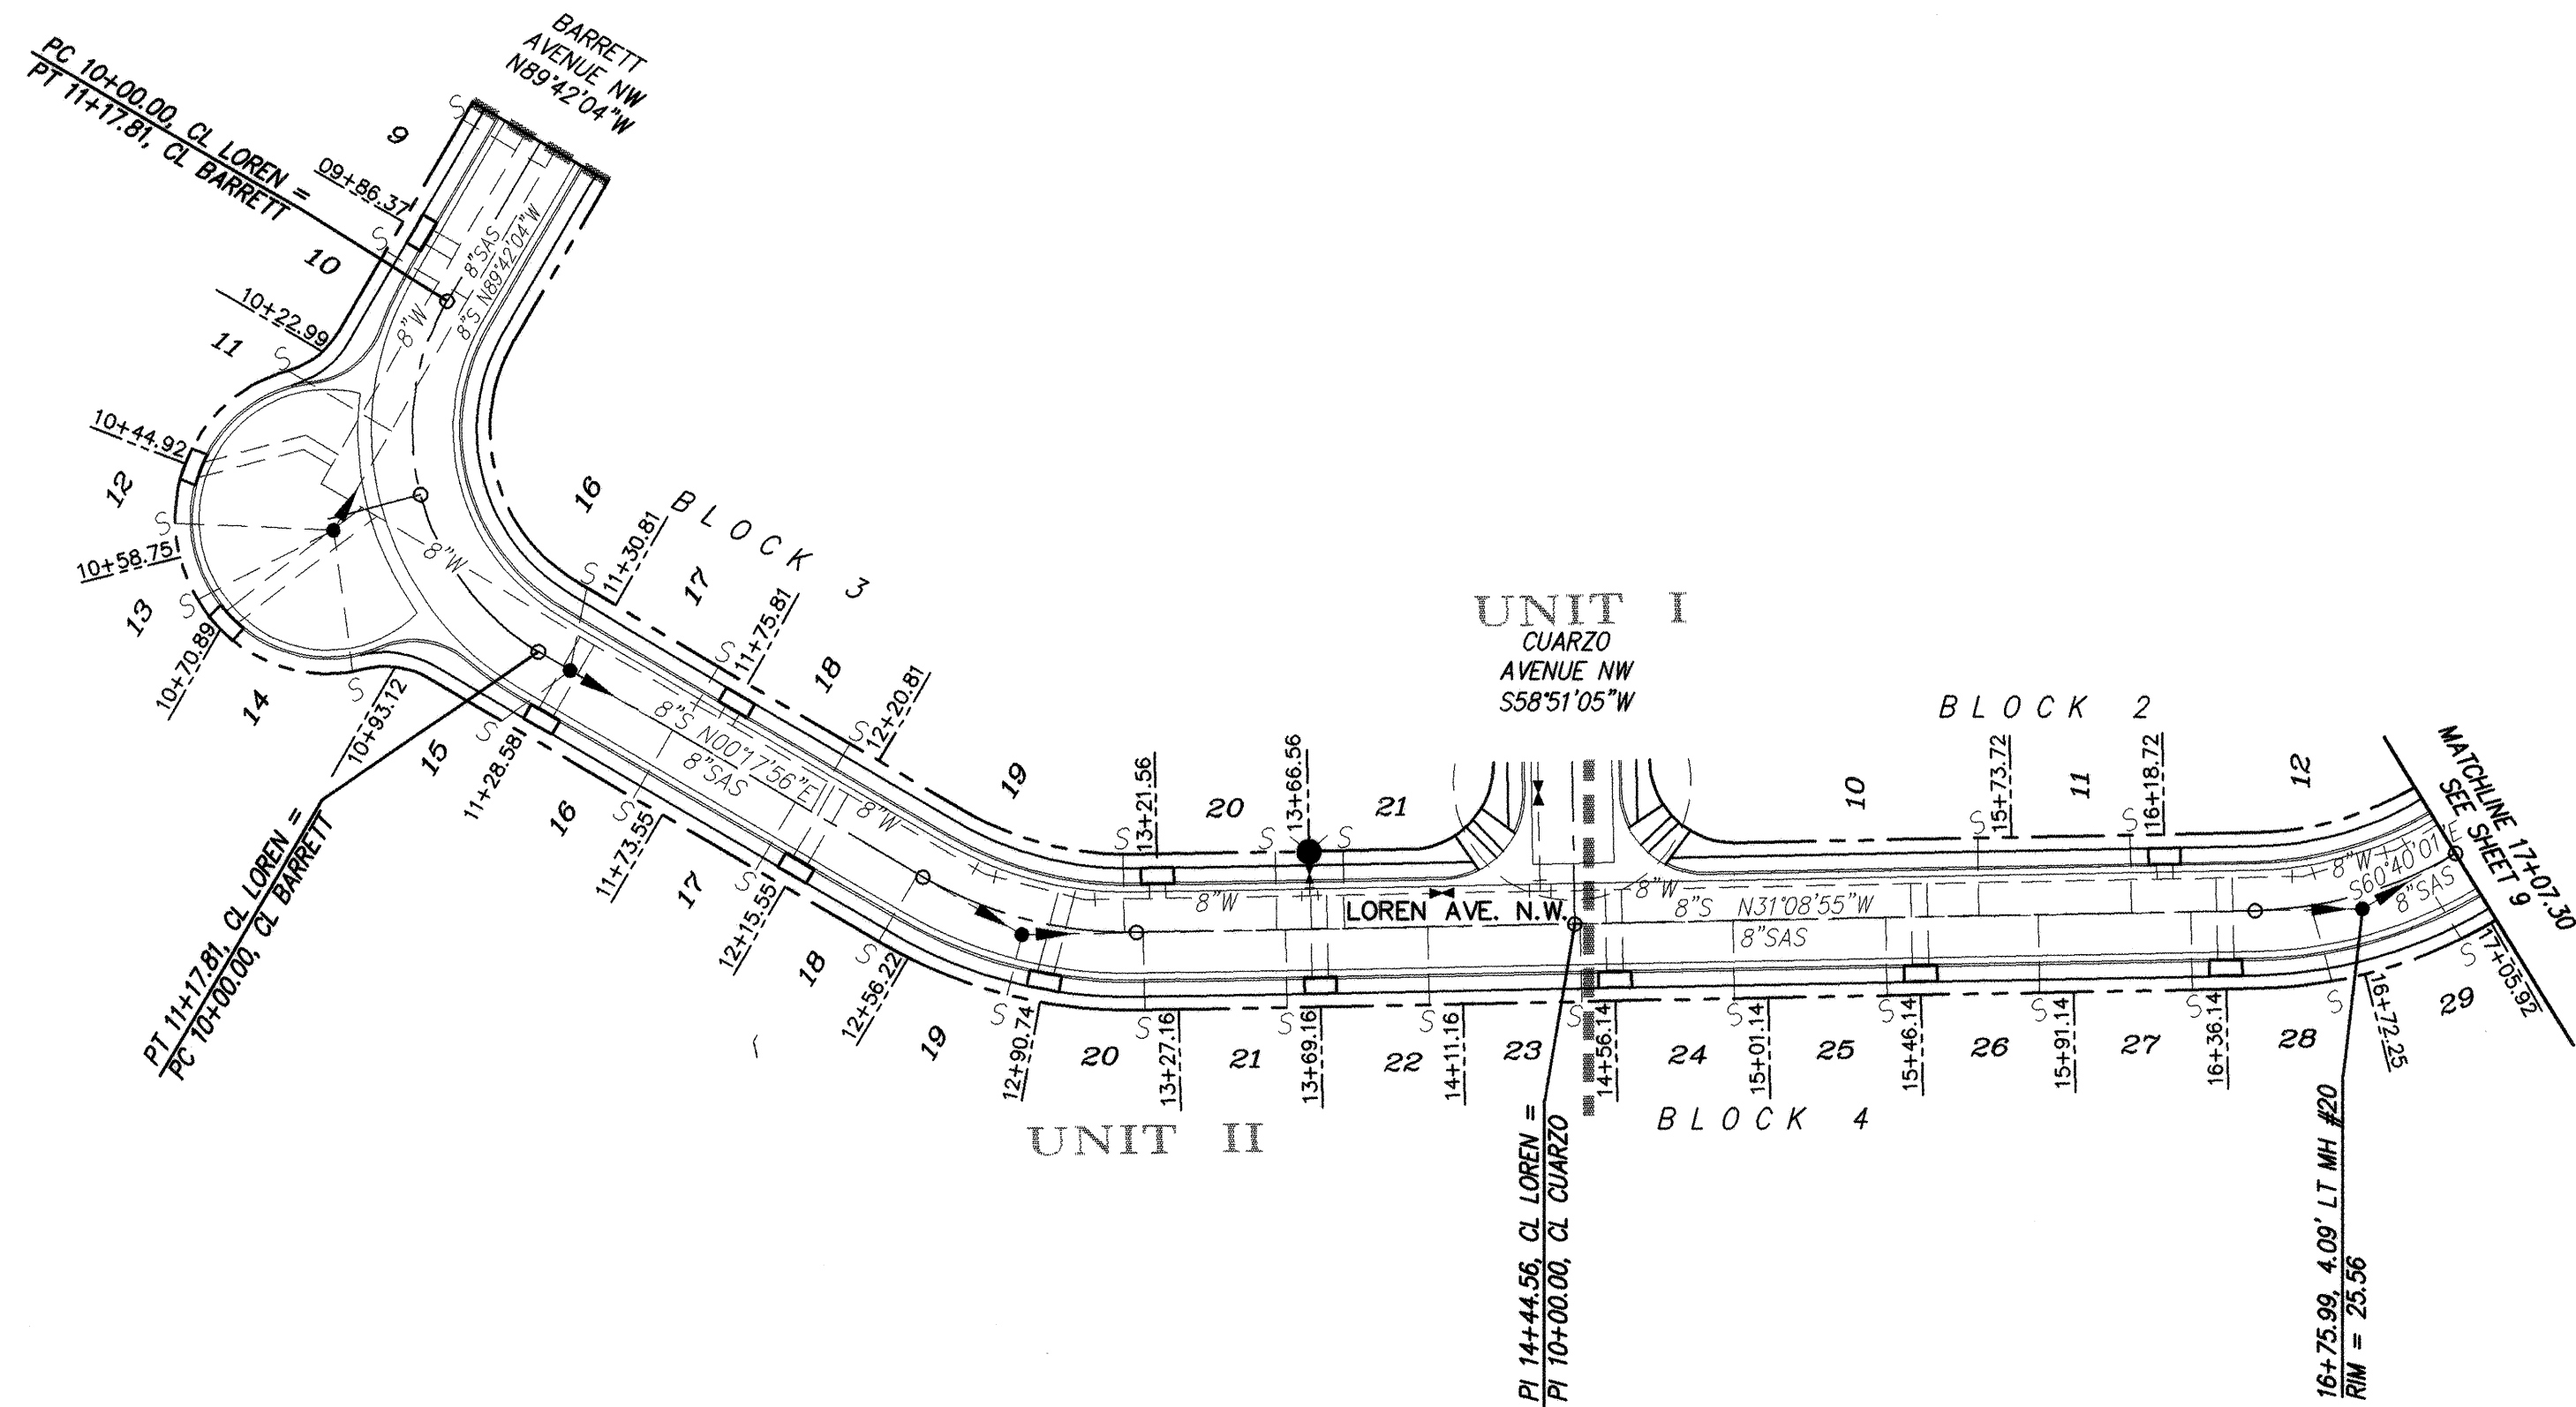

NOTE:
WATERLINES AND SERVICES SHOWN ON THIS PROJECT EXIST. INSTALL METER BOXES & SERVICE FITTINGS
SANITARY SEWER SHOWN FOR REFERENCE ONLY. SAS AND SERVICES EXIST.

EXIST. SANITARY SEWER SERVICES				
BLOCK	LOT	STATION AT PL	INV. ELEV. AT PL	LENGTH AT PL
2	10	15+63	24.00	23.00'
2	11	16+08	23.60	23.00'
3	16	11+20	35.20	24.28'
3	17	11+65	33.80	23.00'
3	18	12+10	32.20	23.00'
3	19	13+11	29.40	23.06'
3	20	13+56	28.40	23.00'
3	21	13+76	27.80	23.00'
4	9	09+51	37.00	28.00'
4	10	9+96	36.20	28.00'
4	11	10+32	36.80	35.01'
4	12	10+48	36.60	46.61'
4	13	10+60	36.60	44.80'
4	14	10+83	36.00	41.56'
4	15	11+18	35.20	25.08'
4	16	11+63	34.00	23.00'
4	17	12+05	32.40	23.00'
4	18	12+46	31.40	23.00'
4	19	12+80	30.40	18.34'
4	20	13+17	29.40	23.00'
4	21	13+59	28.40	23.00'
4	22	14+01	27.40	23.00'
4	23	14+46	26.40	23.00'
4	24	14+91	25.40	23.00'
4	25	15+36	24.20	23.00'
4	26	15+81	23.20	23.00'
4	27	16+26	22.40	23.00'
4	28	16+62	21.60	22.24'
4	29	16+95	21.00	22.56'


LOREN AVENUE NW
STA. PC 10+00.00 TO STA. PT 17+07.30
HOR. 1" = 50'
VER. 1" = 10'

NOTES

1. ALL STATIONING IS CENTERLINE STATIONING.

AS BUILT INFORMATION		BENCH MARKS		STATION MARK IS A STANDARD MMSHC BRASS TABLET STAMPED "MM448-N12" SET IN TOP OF A CONCRETE TABLET PROJECTING 0.3 FT. ABOVE GROUND. TO REACH THE STATION FROM THE INTERSECTION OF STATE RD. 448 AND CENTRAL AVE., GO NORTH ON STATE RD 448, 9.30 MILES TO MOUNTAIN BELL TELE. SUB-STATION AND STATION ON LEFT (WEST).	
CONTRACTOR	FRANKLIN'S	DATE	8/1/98	NO.	
WORK	AS	DATE	8/1/98	NO.	
INSPECTOR'S	ALB	DATE	8/1/98	NO.	
ACCEPTANCE BY	ALB	DATE	8/1/98	NO.	
VERIFICATION BY	ALB	DATE	8/1/98	NO.	
DRAWN BY	ALB	DATE	8/1/98	NO.	
RECORDED BY	ALB	DATE	8/1/98	NO.	
NO.					

RECORD DRAWING
I hereby certify that the information contained on this drawing has been revised in accordance with information furnished by the contractor, Franklin's Earthmoving, Inc., and by the surveyor, ALS, Inc., and reflects the construction as actually accomplished. This plan as constructed is in substantial compliance with the approved plan.
Mark Goodwin
NMPE 8948

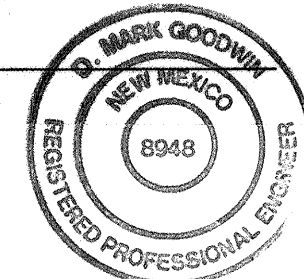

dmg MARK GOODWIN & ASSOCIATES, P.A.
CONSULTING ENGINEERS
P.O. BOX 90606
ALBUQUERQUE, NEW MEXICO 87199
(505) 828-2200

CITY OF ALBUQUERQUE
PUBLIC WORKS DEPARTMENT
ENGINEERING DEPARTMENT GROUP

TITLE: CRYSTAL RIDGE - UNIT II
UTILITY IMPROVEMENTS
LOREN AVENUE NW

APPROVED
APR 24 1998
DESIGN REVIEW COMMITTEE

CITY ENGINEER APPROVAL

LAST DESIGN UPDATE


MO./DAY/YR.	MO./DAY/YR.

CITY PROJECT NO.


578782

ZONE MAP NO.
A-13 & B-13


SHEET 8 OF 11

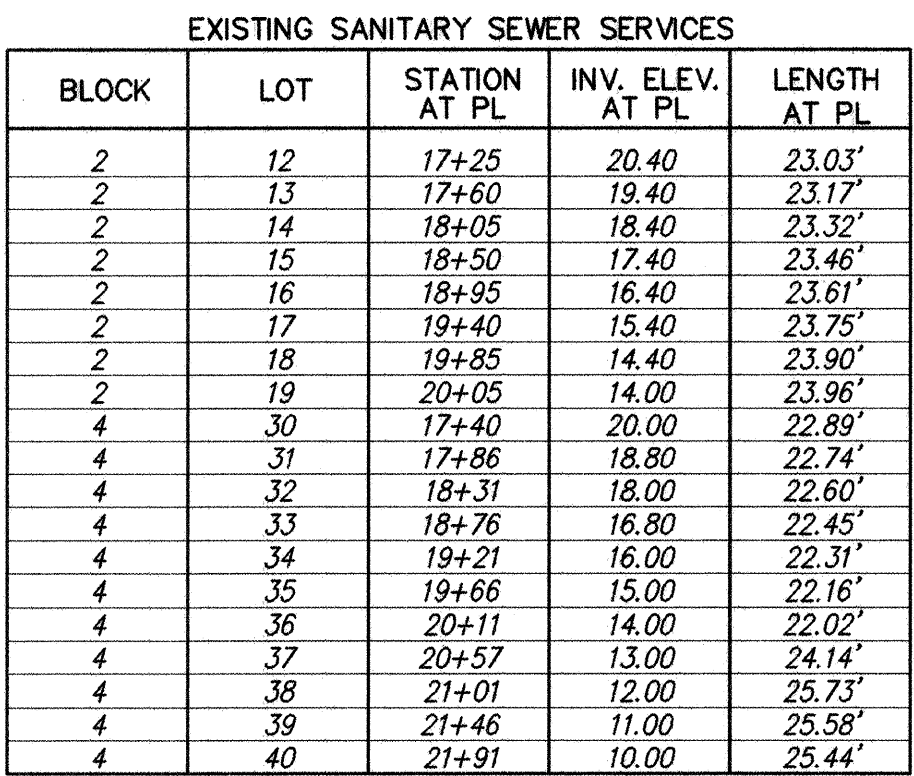

LOREN AVENUE NW
STA. PC 17+07.30 TO STA. 22+01.59
HOR. 1" = 50'
VER. 1" = 10'

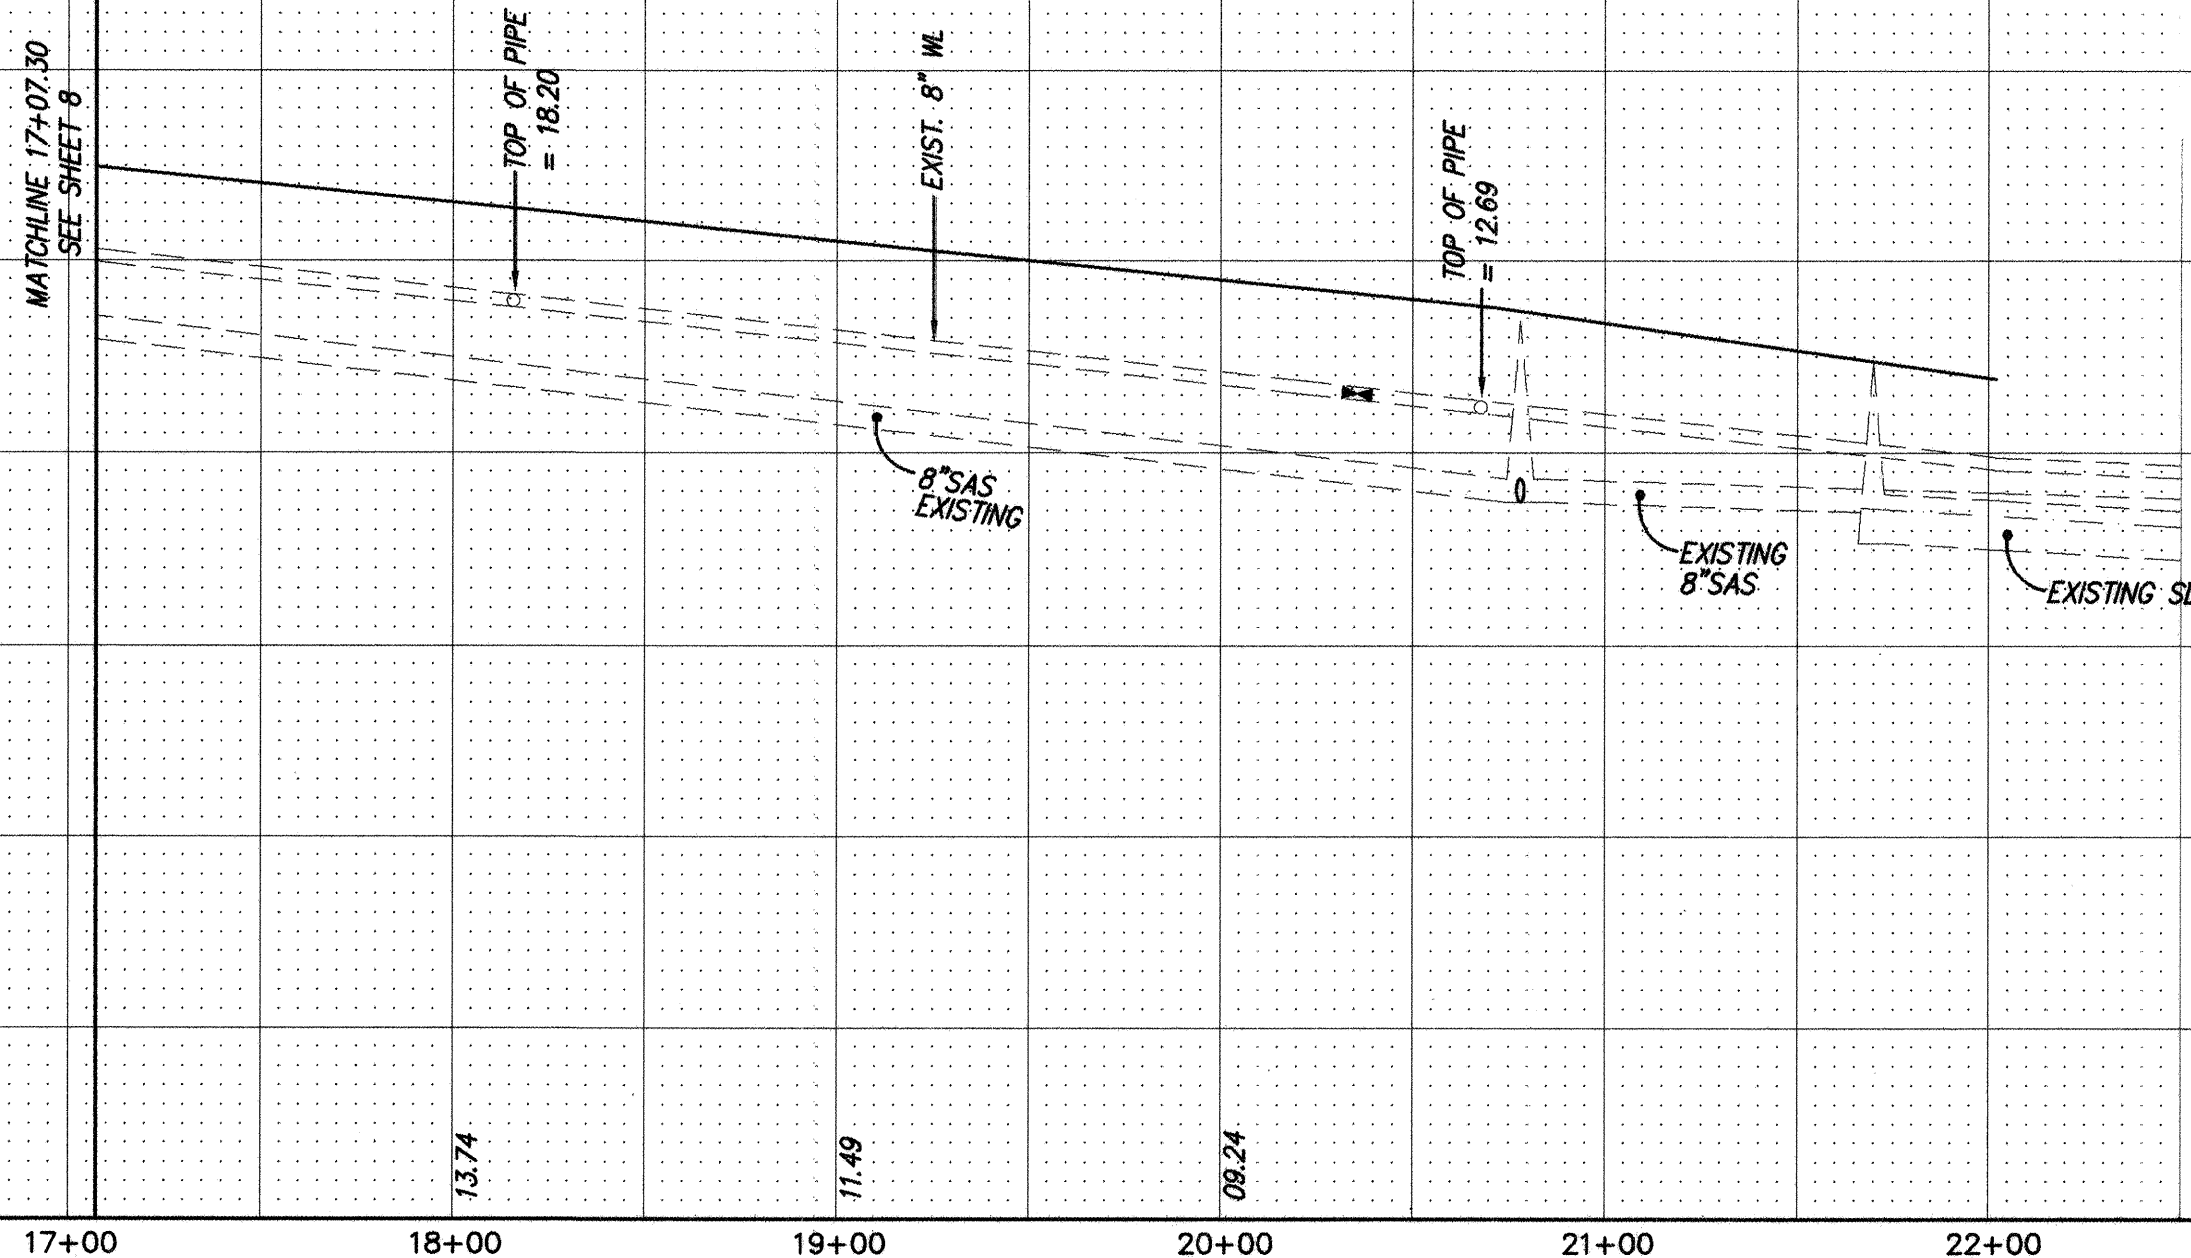

Mark Goodwin NMPE 8948

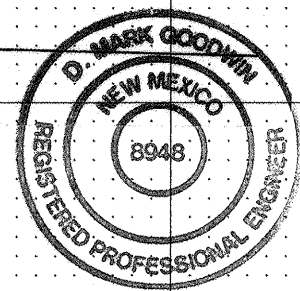

dmg MARK GOODWIN & ASSOCIATES, P.A.
CONSULTING ENGINEERS
P.O. BOX 90606
ALBUQUERQUE, NEW MEXICO 87199
(505) 828-2200

 CITY OF ALBUQUERQUE
PUBLIC WORKS DEPARTMENT
ENGINEERING DEVELOPMENT GROUP

TITLE: CRYSTAL RIDGE - UNIT II
UTILITY IMPROVEMENTS
LOREN AVENUE NW

DESIGN REVIEW COMMITTEE

APPROVE

APR 24 1998

DESIGN
REVIEW COMMITTEE

CITY ENGINEER APPROVAL

FAST DESIGN UPDATE

MO./DAY/YR.	MO./DAY/YR.
-------------	-------------

CITY PROJECT NO.

ZONE MAP NO.


SHEET OF

CITY PROJECT NO.

578782

A-13 & B-13

9 11

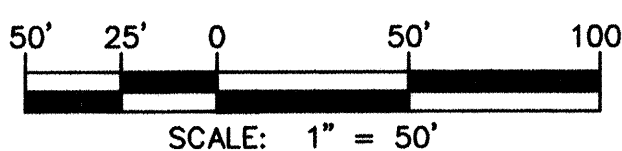

dmg D. MARK GOODWIN & ASSOCIATES, P.A.
CONSULTING ENGINEERS & SURVEYORS
P.O. BOX 90606
ALBUQUERQUE, NEW MEXICO 87199
(505) 828-2200



**CITY OF ALBUQUERQUE
PUBLIC WORKS DEPARTMENT
ENGINEERING DEVELOPMENT GROUP**

TITLE: CRYSTAL RIDGE SUBDIVISION
GRADING AND DRAINAGE PLAN

DESIGN REVIEW COMMITTEE	CITY ENGINEER APPROVAL
-------------------------	------------------------

Approved @
DRB

CITY PROJECT NO. 578782

ZONE MAP NO.
A13 & B13

SHEET 10 OF 1

DIVISION			
GE PLAN			
MO./DAY/YR.		MO./DAY/YR.	
SHEET		OF	
13		10	

