


SCANNED BY
MESA REPRO

CONSTRUCTION PLANS FOR *EAGLE ROCK ESTATES* *UNIT III* ALBUQUERQUE, NEW MEXICO

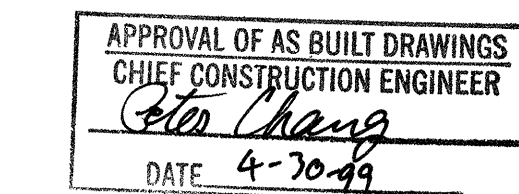

COA INSPECTOR: RUBEN ORTEGA


INDEX TO DRAWINGS

SHEET NO.	SHEET
1	TITLE SHEET
2-3	PLAT
4	GRADING AND DRAINAGE PLAN
5	MASTER PAVING PLAN
6-9	PAVING IMPROVEMENTS
10	MASTER UTILITY PLAN - ONSITE
11	MASTER UTILITY PLAN - OFFSITE
12-16	UTILITY IMPROVEMENTS
17	STORM DRAIN IMPROVEMENTS
18-19	TRAFFIC CONTROL

SURVEYOR'S CERTIFICATION

"I, Timothy Aldrich, a duly qualified Registered Professional Land Surveyor under the laws of the State of New Mexico, do hereby certify that the 'as-built' information shown on these drawings was obtained from field construction and 'as-built' surveys performed by me or under my supervision, that the 'as-built' information shown on these drawings was added by me or under my supervision, and that this 'as-built' information is true and correct to the best of my knowledge and belief." Aldrich Land Surveying is not responsible for any of the design concepts, calculations, engineering, or intent of the record drawings.

Timothy Aldrich, P.S. No. 7719
Date 02-23-99

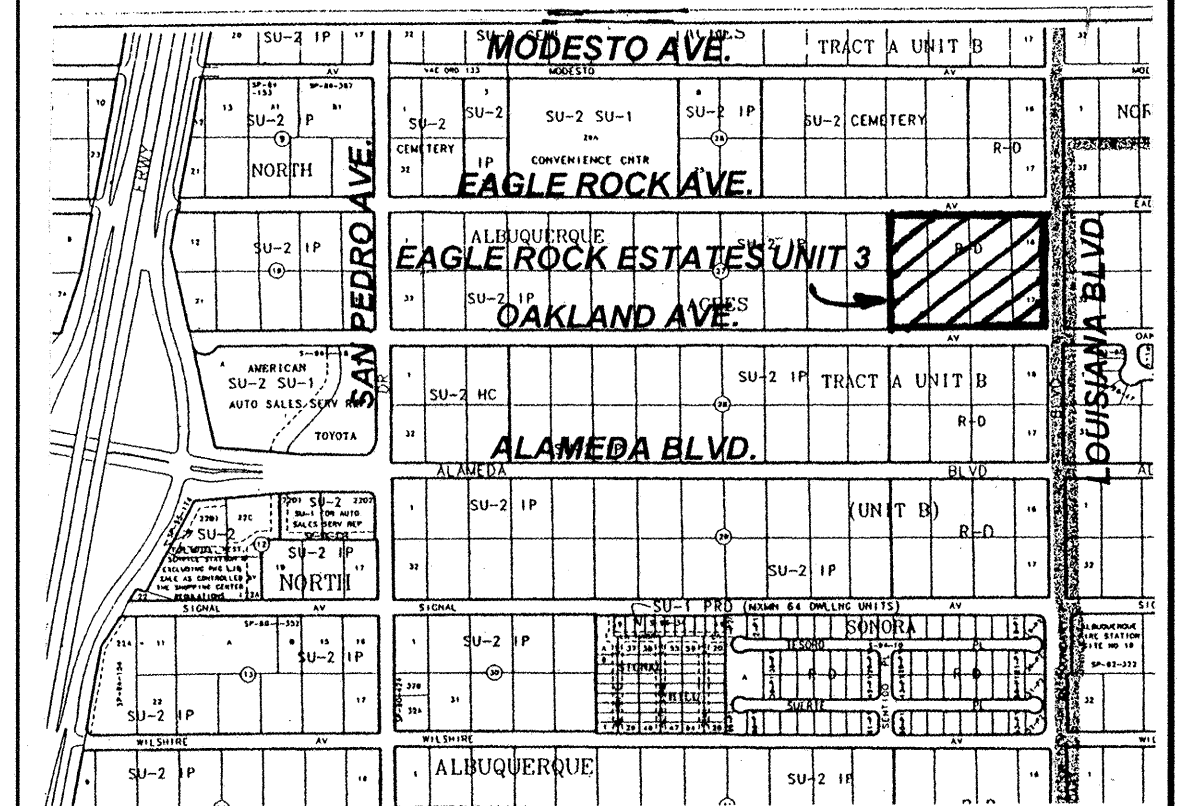

VICINITY MAP ZONE ATLAS C-18-Z
SCALE: NONE

GENERAL NOTES

NOTICE TO CONTRACTORS

- CITY OF ALBUQUERQUE SPECIFICATIONS FOR PUBLIC WORKS CONSTRUCTION, 1986 EDITION AS AMENDED THROUGH UPDATE 6, WILL BE REFERRED TO HEREIN AS THE "STANDARD SPECIFICATIONS".
- TWO WORKING DAYS PRIOR TO ANY EXCAVATION, CONTRACTOR MUST CONTACT NEW MEXICO ONE CALL SYSTEM (260-1990) AND DETERMINE LOCATION OF EXISTING UTILITIES.
- PRIOR TO ANY CONSTRUCTION, THE CONTRACTOR SHALL EXCAVATE AND VERIFY THE HORIZONTAL AND VERTICAL LOCATIONS OF ALL OBSTRUCTIONS. SHOULD A CONFLICT EXIST, THE CONTRACTOR SHALL NOTIFY THE ENGINEER OR THE SURVEYOR SO THAT THE CONFLICT CAN BE RESOLVED WITHOUT DELAY.
- ALL EXISTING SIGNS, MARKERS, DELINEATORS, ETC., WITHIN THE CONSTRUCTION LIMITS SHALL BE REMOVED, STORED AND RE-SET BY THE CONTRACTOR.
- FIVE (5) WORKING DAYS PRIOR TO BEGINNING CONSTRUCTION THE CONTRACTOR SHALL SUBMIT TO THE CONSTRUCTION CO-ORDINATION DIVISION A DETAILED CONSTRUCTION SCHEDULE. TWO (2) WORKING DAYS PRIOR TO CONSTRUCTION THE CONTRACTOR SHALL OBTAIN A BARRICADING PERMIT FROM THE CONSTRUCTION CO-ORDINATION DIVISION. CONTRACTOR SHALL NOTIFY BARRICADE ENGINEER (768-2551) PRIOR TO OCCUPYING AN INTERSECTION. SEE SECTION 19 OF THE SPECIFICATIONS.
- ALL STREET STRIPING ALTERED OR DESTROYED SHALL BE REPLACED WITH PLASTIC REFLECTORIZED PAVEMENT MARKINGS BY CONTRACTOR IN EXISTING OR NEW LOCATION AS INDICATED BY THIS SET.
- THE CONTRACTOR SHALL NOTIFY THE ENGINEER NOT LESS THAN SEVEN (7) DAYS PRIOR TO STARTING WORK IN ORDER THAT THE ENGINEER MAY TAKE NECESSARY MEASURES TO INSURE THE PRESERVATION OF SURVEY MONUMENTS. CONTRACTOR SHALL NOT DISTURB PERMANENT SURVEY MONUMENTS WITHOUT THE CONSENT OF THE ENGINEER AND SHALL NOTIFY THE ENGINEER AND BEAR THE EXPENSE OF REPLACING ANY THAT MAY BE DISTURBED WITHOUT PERMISSION. REPLACEMENT SHALL BE DONE ONLY BY THE CITY SURVEYOR. WHEN A CHANGE IS MADE IN THE FINISHED ELEVATIONS OF THE PAVEMENT OF ANY ROADWAY IN WHICH A PERMANENT SURVEY MONUMENT IS LOCATED, CONTRACTOR SHALL, AT HIS OWN EXPENSE, ADJUST THE MONUMENT COVER TO THE NEW GRADE UNLESS OTHERWISE SPECIFIED. REFER TO SECTION 4.4 OF THE GENERAL CONDITIONS OF THE STANDARD SPECIFICATIONS.
- ANY WORK OCCURRING WITHIN AN ARTERIAL ROADWAY REQUIRES 24 HOURS CONSTRUCTION.

THE FOLLOWING NOTES ALSO APPLY WHEN CHECKED


- ☒ ALL UTILITIES AND UTILITY SERVICE LINES SHALL BE INSTALLED PRIOR TO PAVING.
- ☒ BACKFILL COMPACTION SHALL BE ACCORDING TO SPECIFIED STREET USE.
- ☐ TACK COAT REQUIREMENTS SHALL BE DETERMINED BY THE CITY ENGINEER.
- ☒ SIDEWALK AND WHEELCHAIR RAMPS WITHIN THE CURB RETURNS SHALL BE CONSTRUCTED WHEREVER A NEW CURB RETURN IS CONSTRUCTED.
- ☐ IF CURB IS DEPRESSED FOR A DRIVEPAD, THE DRIVEPAD SHALL BE CONSTRUCTED PRIOR TO ACCEPTANCE OF CURB AND GUTTER.
- ☒ ALL STORM DRAINAGE FACILITIES SHALL BE COMPLETED PRIOR TO FINAL ACCEPTANCE.

CAUTION:
NOTE THAT ALL EXISTING UTILITIES MAY NOT BE SHOWN. ALL EXISTING SERVICE CONNECTIONS ARE NOT SHOWN. ANY EXISTING UTILITIES THAT ARE SHOWN ARE APPROXIMATE LOCATION ONLY. IT SHALL BE THE SOLE RESPONSIBILITY OF THE CONTRACTOR TO CONTACT ALL THE UTILITY OWNERS AND TO CONDUCT ALL NECESSARY FIELD INVESTIGATIONS PRIOR TO ANY EXCAVATIONS TO DETERMINE THE ACTUAL LOCATION OF UTILITIES AND OTHER IMPROVEMENTS.

dmg D. MARK GOODWIN & ASSOCIATES, P.A.
CONSULTING ENGINEERS
P. O. BOX 90606
ALBUQUERQUE, NEW MEXICO 87199
(505) 828-2200, FAX (505) 787-9539

REV.	SHEETS	CITY ENGINEER	DATE	USER DEPARTMENT	DATE	USER DEPARTMENT	DATE
ENGINEERS STAMP & SIGNATURE		APPROVALS		ENGINEER		DATE	
		DRC CHAIRMAN		B. J. J. J. J.		4-22-99	
		TRANSPORTATION		K. D. Kane		4-29-98	
		WATER/WASTEWATER		K. D. Kane		4-29-98	
		HYDROLOGY		K. D. Kane		4-29-98	
		CONST. COOR.		K. D. Kane		4-29-98	
CONST. MGMT.		K. D. Kane		K. D. Kane		4-29-98	
CITY PROJECT NO.				SHEET OF			
580183				1 19			

DRB NO.: 97-487

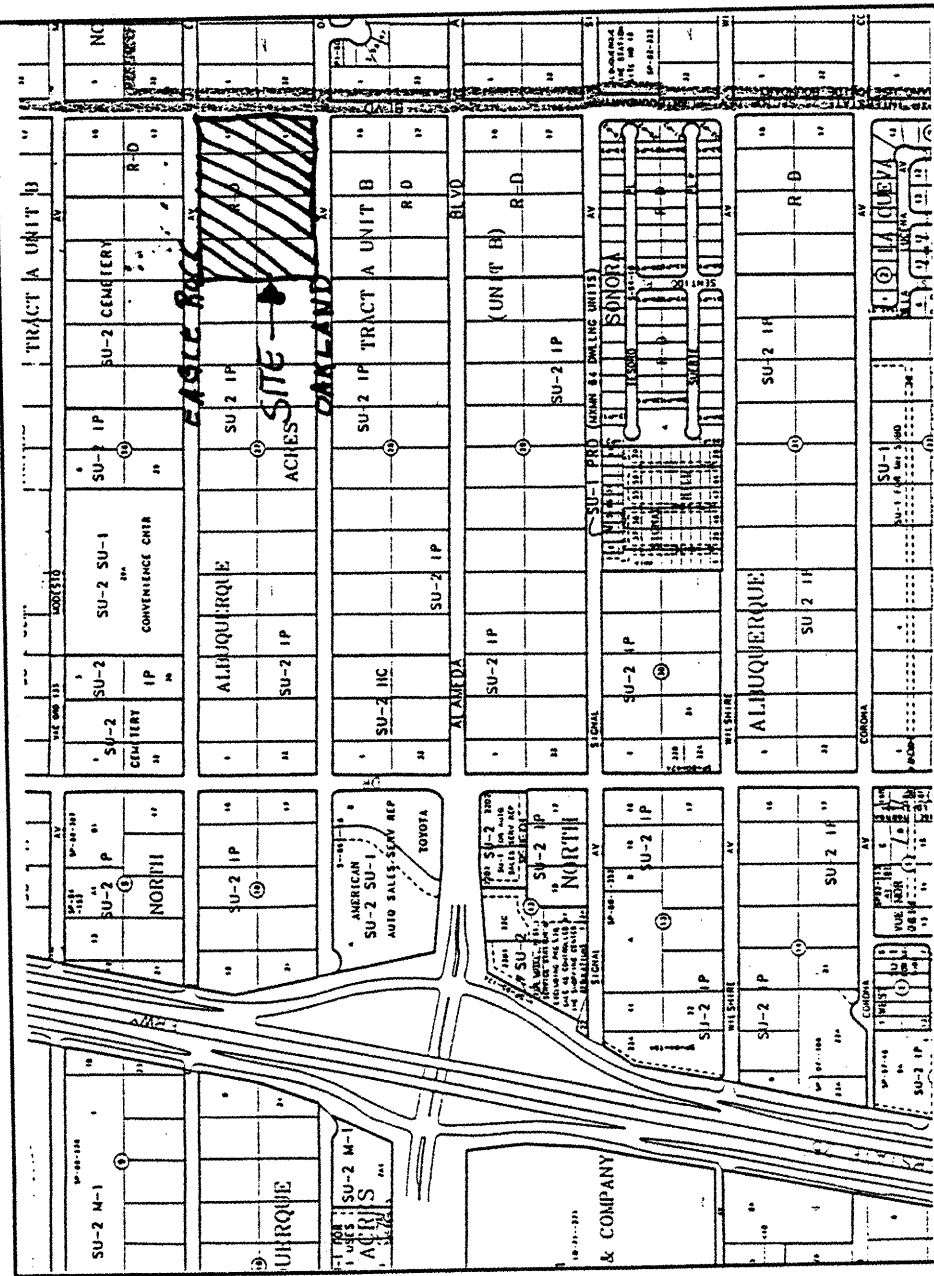

LOCATION MAP
ZONE ATLAS C-1B-Z
SCALE: NONE

SUBDIVISION DATA
PLAT CASE NOS. DRB. 97- S V
GROSS ACRES 7.9885
ZONE ATLAS NO. C18
NO. OF EXISTING TRACTS/LOTS 8 LOTS
NO. OF TRACTS/LOTS CREATED 36 LOTS
NO. OF TRACTS/LOTS ELIMINATED 8 LOTS
MILES OF FULL WIDTH STREETS CREATED 0.4608 mi.
AREA DEDICATED TO CITY OF ALBUQUERQUE 3.0133 ac

DATE OF SURVEY JULY 1997
UTILITY CONTROL LOCATION SYSTEM LOG NUMBER: 97071108100059

FREE CONSENT AND DEDICATION

The subdivision hereon described is with the free consent and in accordance with the desires of the undersigned owner(s) and/or proprietor(s) thereof and said owner(s) and/or proprietor(s) do hereby dedicate all streets and public right-of-ways shown hereon to the City of Albuquerque in fee simple with warranty covenants and do hereby grant: all access, utility easements and maintain facilities therein; and all poles, electrical power and communication services and buried distribution lines, conduits, and pipes for ingress and egress for construction and maintenance, and the right to trim interfering trees and shrubs. Said owner(s) and/or proprietor(s) do hereby consent to all of the foregoing and do hereby certify that this subdivision is their free act and deed.

SUNSET WEST, OWNER, by MARK F. PAGELS, SR., NM AGENT

OWNER'S ACKNOWLEDGMENT

STATE OF NEW MEXICO }
COUNTY OF BERNALILLO } ss
This instrument was acknowledged before me on 9/15/97
Notary Public
Barbara Strubbe
MY COMMISSION EXPIRES 30 August 2000

LEGAL DESCRIPTION

A tract of land situated within the Elena Gallegos Grant, Projected Section 13, Township 11 North, Range 3 East, New Mexico Principal Meridian, City of Albuquerque, Bernalillo County, New Mexico, being all of LOTS 13 thru 20, BLOCK 27, TRACT A, UNIT B, NORTH ALBUQUERQUE ACRES, as shown and designated on said plat filed for record in the office of the County Clerk of Bernalillo County, New Mexico on April 24, 1936 in Volume D, Folio 130 and being more particularly described as follows:

BEGINNING at the northeast corner of the herein described tract said point being the intersection of the centerline of Eagle Rock Avenue N.E. and the centerline of Louisiana Boulevard N.E. from whence the Albuquerque Control Survey Monument "11-C18" bears N 07°23'59" W, 268.99 feet;

THENCE leaving said centerline of Eagle Rock Avenue N.E. S 00°12'43" W, 527.28 feet along said centerline of Louisiana Boulevard N.E. to the southeast corner, said point being the intersection of said Louisiana Boulevard N.E. and the centerline of Oakland Avenue N.E.;

THENCE leaving said centerline of Louisiana Boulevard N.E. N 89°43'45" W, 659.81 feet along said centerline of Oakland Avenue N.E. to the southwest corner;

THENCE leaving said centerline of Oakland Avenue N.E. N 00°12'38" E, 527.46 feet along a line common with the east line of LOTS 21 and 12, BLOCK 27, TRACT A, UNIT B, NORTH ALBUQUERQUE ACRES as the same is shown and designated on said plat filed for record in the office of the County Clerk of Bernalillo County, New Mexico on April 24, 1936 in Volume D, Folio 130 to the northwest corner, said point being on said centerline of Eagle Rock Avenue N.E.;

THENCE along said centerline of Eagle Rock Avenue N.E. S 89°42'49" E, 659.82 feet to the point of beginning and containing 7.9883 acres more or less.

PURPOSE OF PLAT

1. SUBDIVIDE THE EXISTING TRACT A, UNIT B, BLOCK 27, LOTS 13 THRU 20 INTO 36 RESIDENTIAL LOTS.
2. TO GRANT NEW RIGHT-OF-WAY AND EASEMENTS AS SHOWN.

NOTES

1. Bearings are grid based on the New Mexico State Plane Grid Bearings (Central Zone).
2. Distances are ground distances.
3. Bearings and distances in parenthesis are record.
4. Basis of boundary are the following plats of record entitled:
"NORTH ALBUQUERQUE ACRES, TRACT A, UNIT B"
(04-24-36, D-130)
"NORTH ALBUQUERQUE ACRES, TRACT 2, UNIT 3"
(09-10-31, D1-20),
all being records of Bernalillo County, New Mexico.
5. Field Survey performed July, 1997.
6. Unless otherwise noted all points are "SET 5/8" REBAR with cap "ALS LS 7719".
7. Title Report: NONE PROVIDED.
Address of Property: NONE PROVIDED.
8. Bernalillo County, New Mexico Zone: RD (TRACT 2, UNIT 3)
9. City of Albuquerque Water and Sanitary Sewer Service to
EAGLE ROCK ESTATES UNIT III
must be verified and coordinated with the Public Works Department, City of Albuquerque.
10. Portions of the subject property lie within a designated Area of Special Flood Hazard as shown on the National Flood Insurance Programs "Flood Insurance Rate map" Panel No. 3500C0137 D1, dated September 20, 1986. Until such time that a LOMR is issued by FEMA, flood insurance may be required.

CPN 580183
Eagle Rock Estates Unit III Sht. 2 of 19

LEGAL DESCRIPTION
(SEE SHEET 2)
SCANNED BY
MESA REPRO
PURPOSE OF PLAT
(SEE SHEET 2)
NOTES
(SEE SHEET 2)

PLAT OF
EAGLE ROCK
ESTATES
UNIT III
WITHIN THE
ELENA GALLEGOS GRANT
PROJECTED SECTION 13
TOWNSHIP 11 NORTH, RANGE 3 EAST, NMPM
CITY OF ALBUQUERQUE
BERNALILLO COUNTY, NEW MEXICO
AUGUST 1997

APPROVED AND ACCEPTED BY:

APPROVAL AND CONDITIONAL ACCEPTANCE as specified by the Albuquerque Subdivision Ordinance, Article XI of Chapter 7 of the Revised Ordinances of Albuquerque, New Mexico.

Subdivision Case No. _____
Planning Director, City of Albuquerque, N.M. _____ Date _____
City Engineer, City of Albuquerque, N.M. _____ Date _____
Albuquerque Metropolitan Arroyo Flood Control Authority _____ Date _____
Transportation Development, City of Albuquerque, N.M. _____ Date _____
Utility Development Division, City of Albuquerque, N.M. _____ Date _____
Parks Design and Development, C.I.P., City of Albuquerque, N.M. Date 08/19/97
City Surveyor, City of Albuquerque, N.M. _____ Date _____
Property Management, City of Albuquerque, N.M. _____ Date _____

P.M. GAS 1-22-98 Date
Norman Carrillo 9-25-97 Date
U.S. West Telecommunications 1-22-98 Date
P.M. ELECTRIC 9-25-97 Date
Mick Watson 9-25-97 Date
Jones Intercable, Inc. _____ Date

EAGLE ROCK ESTATES UNIT III

dmg D. MARK GOODWIN & ASSOCIATES, P.A.
CONSULTING ENGINEERS & SURVEYORS
P.O. BOX 90606
ALBUQUERQUE, NEW MEXICO 87199
(505) 828-2200

dwg: 7058III Drawn: BJC Date: 9-9-97 Checked: ALS Sheet 1 of 4
Scale: 1"=50' Job: 97058

PLAT OF EAGLE ROCK ESTATES UNIT III

WITHIN THE
ELENA GALLEGOS GRANT
PROJECTED SECTION 13
TOWNSHIP 11 NORTH, RANGE 3 EAST, NMPM
CITY OF ALBUQUERQUE,
BERNALILLO COUNTY, NEW MEXICO
AUGUST 1997

PUBLIC UTILITY EASEMENTS

PUBLIC UTILITY EASEMENTS shown on this plat are granted for the common and joint use of:

1. The PNM Electric Services Division for the installation, maintenance and service of overhead and underground electrical lines, transformers, poles and any other equipment, structures and related facilities reasonably necessary to provide electrical services.
2. The PNM Gas Services Division for installation, maintenance and services of natural gas lines, valves and other equipment and facilities reasonably necessary to provide natural gas.
3. U.S. West for installation, maintenance and service of all buried and aerial communication lines and other related equipment and facilities reasonably necessary to provide communication services, including but not limited to above ground pedestals and closures.
4. Jones Intercable for installation, maintenance and service of such lines, cable and other related equipment and facilities reasonably necessary to provide Cable TV service.

Included, is the right to build, rebuild, construct, reconstruct, locate, relocate, change, remove, modify, repair, operate and maintain facilities for the purpose of the easement above, together with free access to, easements over said easement, including sufficient width and space for electric transformers, with this right and privilege to trim and remove trees, shrubs or any other vegetation which interfere with the purposes set forth herein. No building, sign, pool (above ground or subsurface), hot tub, concrete or wood pool decking, or other structure shall be erected or constructed on said easements, nor shall any well be drilled or operated thereon. Property owner shall be solely responsible for correcting any violation of National Electrical Safety Code caused by construction of pools, decking or any structures adjacent to within or near easements shown on this plat.

In approving this plat, the utility companies did not conduct a Title Search of the properties shown hereon. Consequently, the utility companies do not waive or release any easement or easement rights which may have been granted by prior plat, replat or other document and which are not shown on this plat.

EAGLE ROCK ESTATES UNIT III

dmg D. MARK GOODWIN & ASSOCIATES, P.A.
CONSULTING ENGINEERS & SURVEYORS
P.O. BOX 90606
ALBUQUERQUE, NEW MEXICO 87199
(505) 828-2200

dwg: 7058III Drawn: BJC Date: 9-18-97 Checked: ALS Sheet 2 of 4
Scale: 1"=50' Job: 97058



OPEN SPACE AREA TABLE

The RD useable open space requirement will be met on the lots with dwellings as follows:

TOTAL AREA	REQUIRED OPEN SPACE	BUILDABLE LOT AREA
1 6382 sf	2400 sf	3982 sf
2-4 5700	2400	3300
5 5764	2400	3364
6 5971	2400	3571
7 7556	2400	5156
8 6094	2400	3318
9 5818	2400	3360
10-12 5760	2400	3393
13 6393	2400	3982
1 6382	2400	3300
2-4 5700	2400	3364
5 5764	2400	3571
6 5971	2400	5156
7 7556	2400	3318
8 6094	2400	3360
9 5818	2400	3393
10-12 5760	2400	3982
13 6393	2400	3300
1 6165	2400	3221
2 5622	2400	3221
3-4 5621	2400	4146
5 6393	2400	3702
6 5621	2400	3221
7 5622	2400	3222
8 6565	2400	4165



NOTE: UNITS ARE SQUARE FEET

SCANNED BY
MESA REPRO

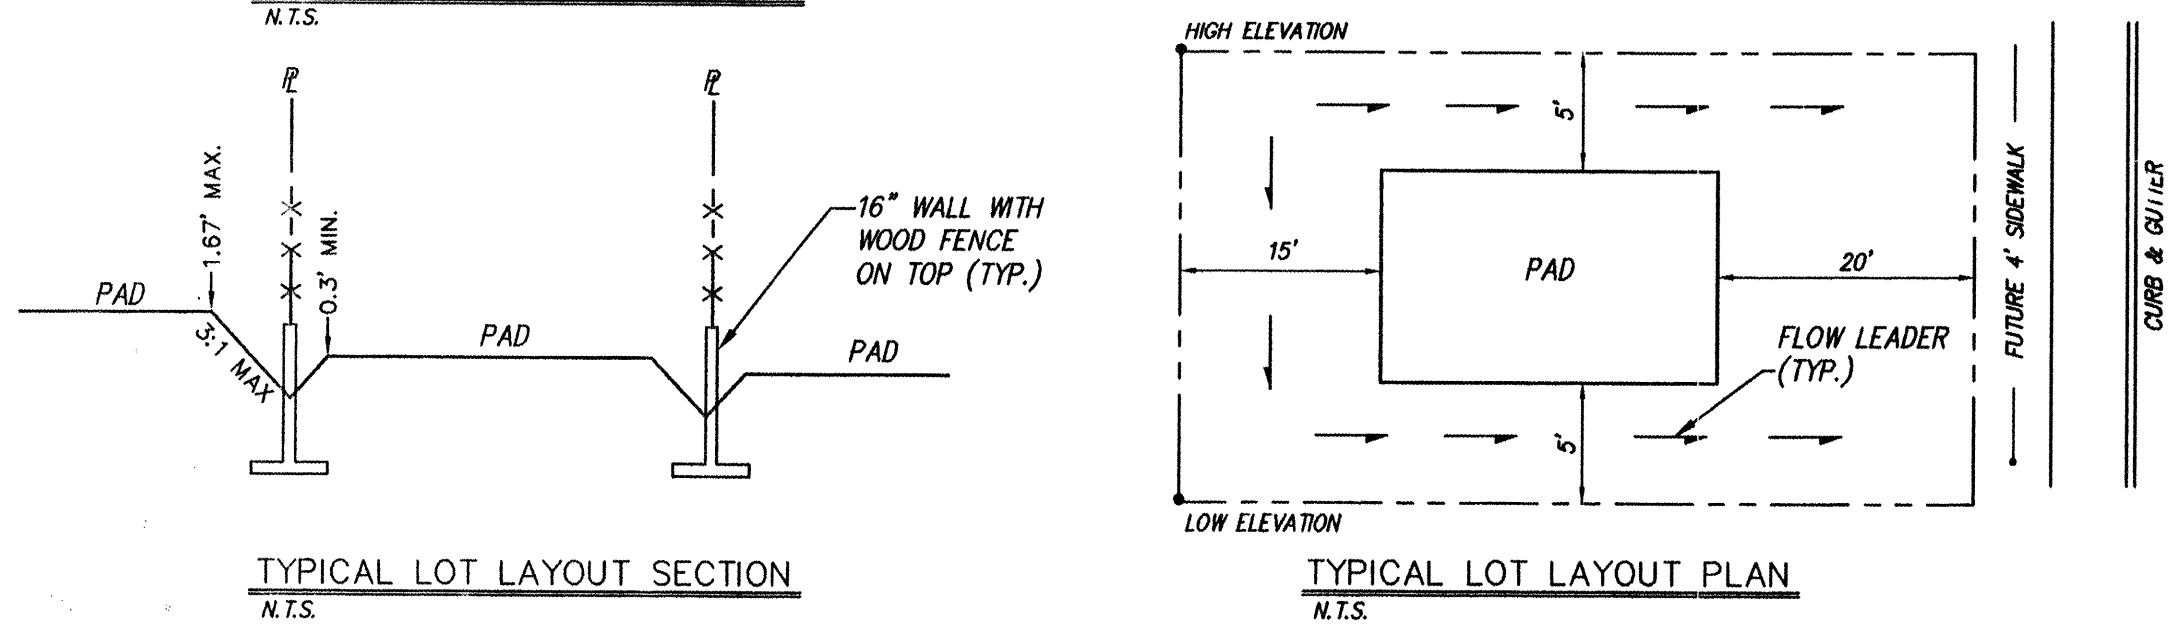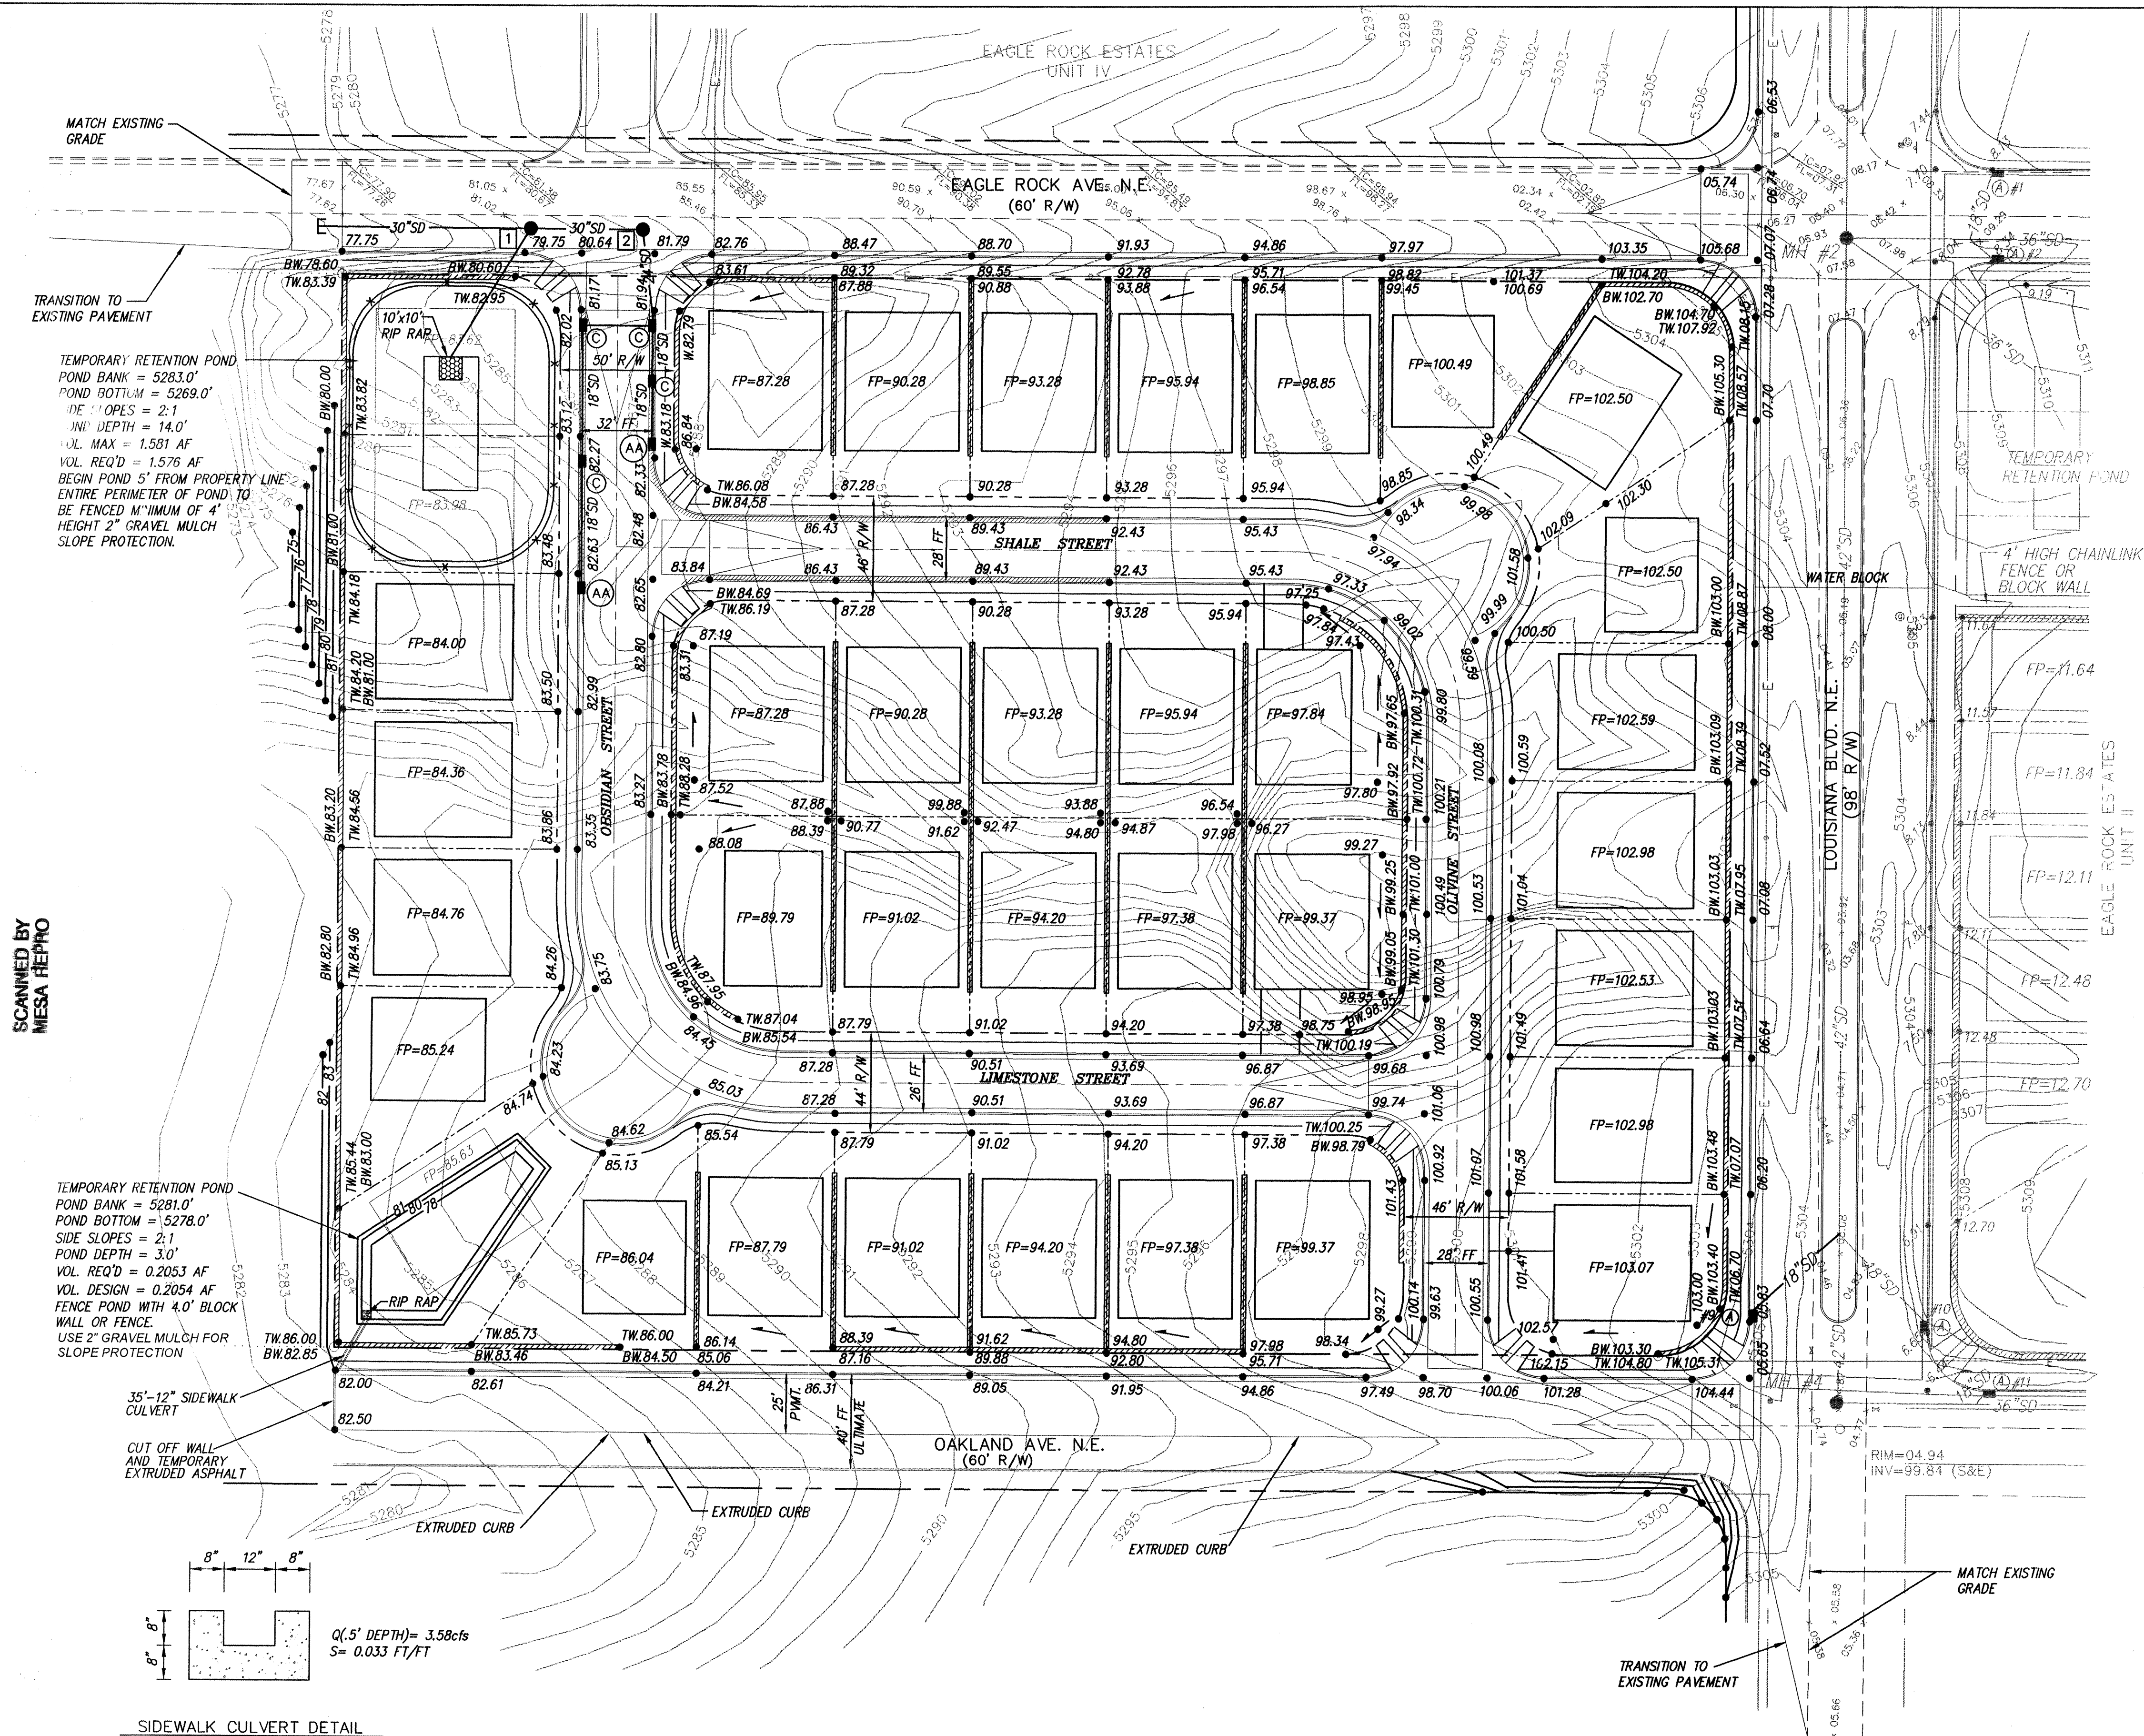

NOTES

1. CONTRACTOR MUST OBTAIN A TOPSOIL DISTURBANCE PERMIT FROM THE ENVIRONMENTAL HEALTH DIVISION PRIOR TO CONSTRUCTION.
2. CITY OF ALBUQUERQUE STANDARD SPECIFICATIONS FOR PUBLIC WORKS CONSTRUCTION, LATEST EDITION SHALL GOVERN ALL WORK.
3. THE CONTRACTOR SHALL CONFORM TO ALL CITY, COUNTY, STATE AND FEDERAL DUST CONTROL MEASURES AND REQUIREMENTS AND WILL BE RESPONSIBLE FOR PREPARING AND OBTAINING ALL NECESSARY APPLICATIONS AND APPROVALS.
4. THE CONTRACTOR SHALL ENSURE THAT NO SOIL ERODES FROM THE LOTS INTO PUBLIC RIGHT-OF-WAY. THIS CAN BE ACHIEVED BY CONSTRUCTING TEMPORARY BERMS AS PER DTL THIS SHT. AND WETTING THE SOIL TO KEEP IT FROM BLOWING.
5. THE EARTHWORK CONTRACTOR SHALL STOCKPILE ENOUGH MATERIAL ADJACENT TO RETAINING WALL LOCATIONS TO BE UTILIZED FOR WALL BACKFILL.

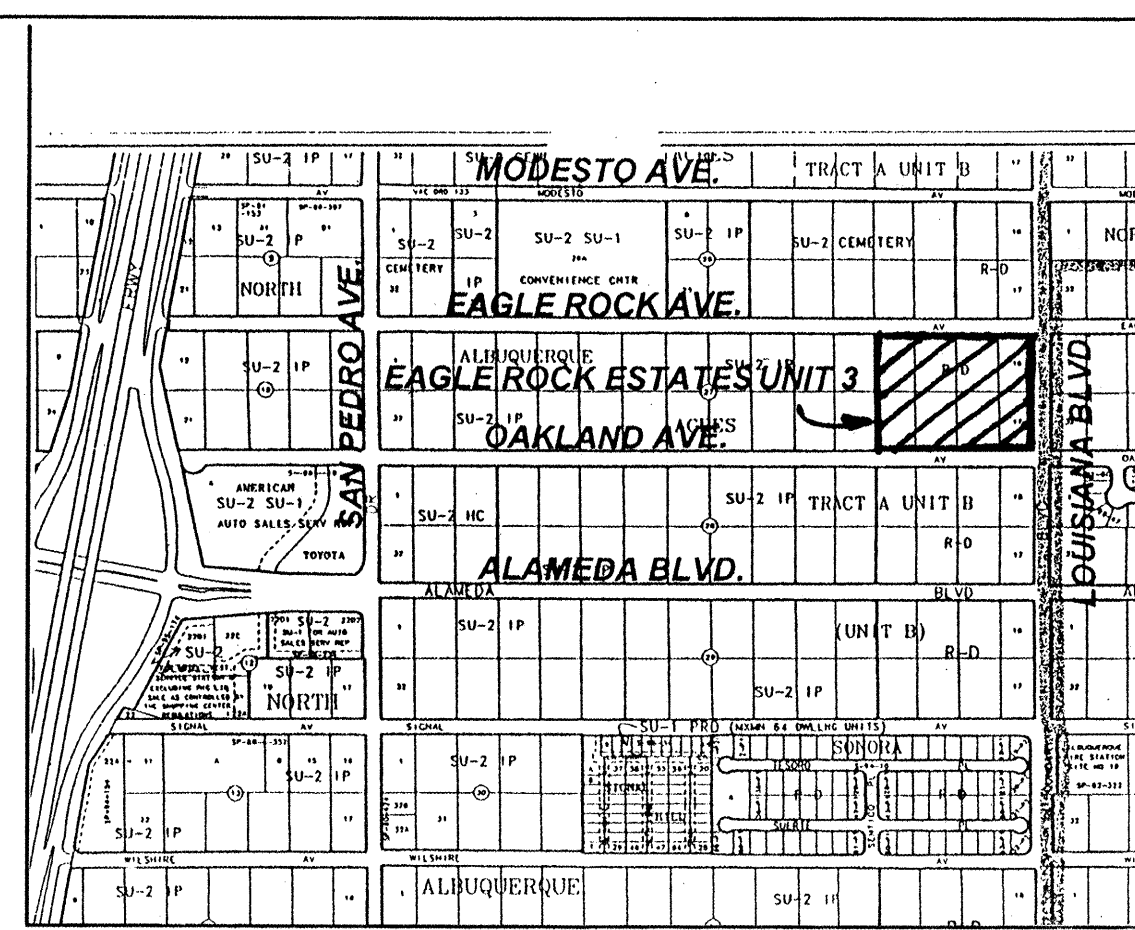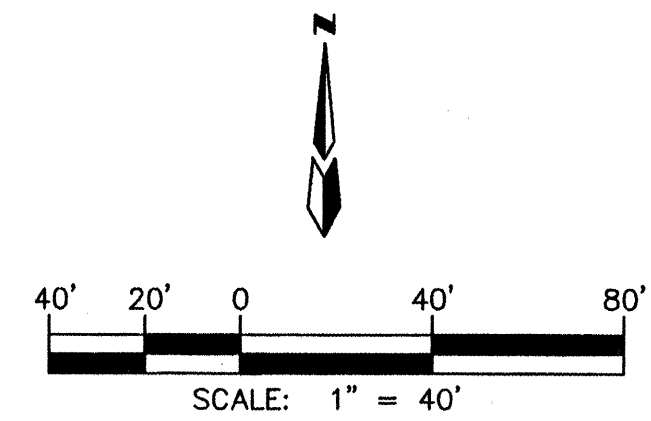


VICINITY MAP

ZONE MAP: C-18-Z

LEGAL DESCRIPTION

NORTH ALBUQUERQUE ACRES TRACT 2, UNIT 3, BLOCK 2
LOTS 1 THRU 4 AND LOTS 29 THRU 32.

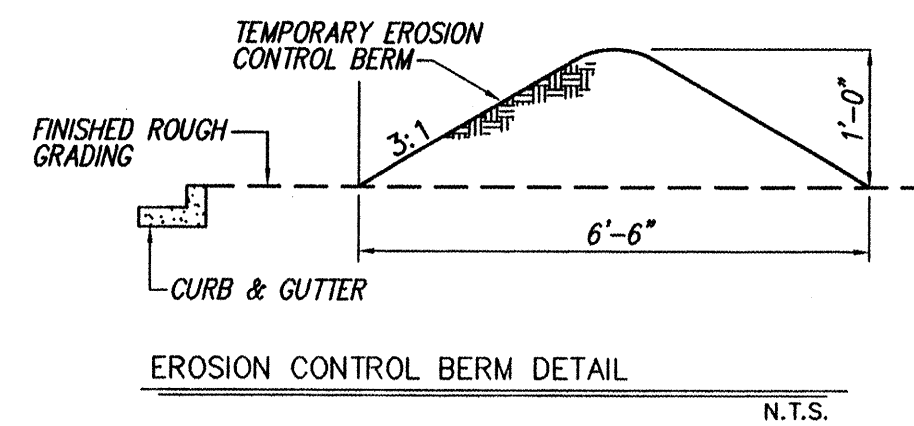

EROSION CONTROL NOTES

1. CONTRACTOR IS RESPONSIBLE FOR KEEPING ALL SEDIMENT OUT OF EXISTING RIGHT-OF-WAY.
2. CONTRACTOR IS RESPONSIBLE FOR CLEANING UP ANY SEDIMENT THAT GETS INTO EXISTING RIGHT-OF-WAY.
3. EROSION CONTROL BERMS ARE REQUIRED AROUND THE ENTIRE SITE.
4. ALL EROSION CONTROL BERMS MUST BE IN PLACE AND ENGINEER CERTIFIED PRIOR TO BUILDING PERMIT RELEASE.

LEGEND

PROPERTY LINE	—51.35—	EXIST. CONTOUR
NEW RETAINING WALL	TC=	EXIST. TOP OF CURB
NEW SPOT ELEVATION	FL=	EXIST. FLOWLINE
97.21	43.53 X	EXIST. SPOT ELEV.
TH.21.01		EXIST. CURB AND GUTTER
BW.18.31		EXIST. SAS MANHOLE
FP=48.72		EXIST. CABLE T.V. PEDESTAL
		EXIST. WATER VALVE
28.53	—E—	EXIST. OVERHEAD ELECTRIC LINE
PROPOSED SPOT ELEV.	—T—	EXIST. OVERHEAD TELEPHONE LINE
3:1 SLOPE		EXIST. P.P.
EXIST. SANITARY SEWER MANHOLE	⊗	EXIST. TEL. PEDESTAL
EXIST. WATER VALVE	× 00.00	SPOT ELEVATION
EXIST. FIRE HYDRANT	=====	CURB AND GUTTER
EXIST. STORM SEWER MANHOLE	—SD—	PROPOSED STORM DRAIN LINE
EXIST. DROP INLET	●	PROPOSED MANHOLE
EXIST. TOP OF CURB	←—	NEW FLOW ARROW
FLOWLINE	— — — —	EXISTING EDGE OF PAVEMENT
PROPOSED STORM DRAIN INLET	(AA)	DOUBLE GRATE TYPE "A" INLET
STORM DRAIN MANHOLE		
TYPE "C" INLET		

Hydrology Approved 3-17-98
APPROVED FOR ROUGH GRADING 1± DATE

dmg D. MARK GOODWIN & ASSOCIATES, P.A.
CONSULTING ENGINEERS
P.O. BOX 90606
ALBUQUERQUE, NEW MEXICO 87199
(505) 828-2200

 CITY OF ALBUQUERQUE
PUBLIC WORKS DEPARTMENT
ENGINEERING DEVELOPMENT GROUP

TITLE: EAGLE ROCK ETATES UNIT III
GRADING AND DRAINAGE PLAN

DESIGN REVIEW COMMITTEE	CITY ENGINEER APPROVAL
-------------------------	------------------------


Approved
@ DRB

CITY PROJECT NO.


580183

MAP NO.
C-18

OF
4 19

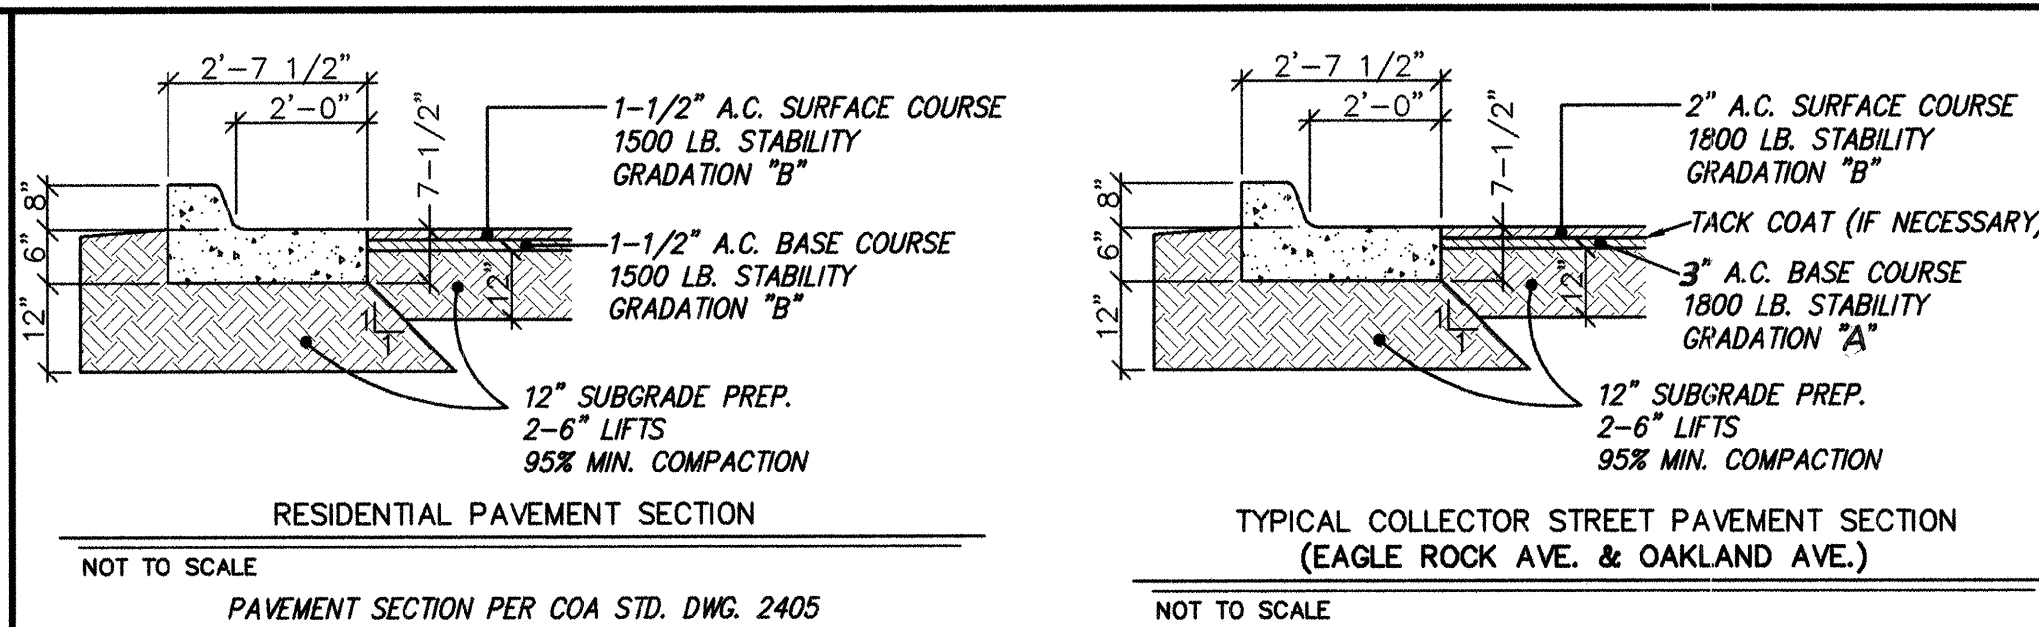


Soil not having the minimum R-Value of 50, shall be removed to a depth of 2 feet and replaced by the contractor, with suitable material or a pavement section. Shall be designed by consultant accommodating the existing R-value per COA Standard Specifications.

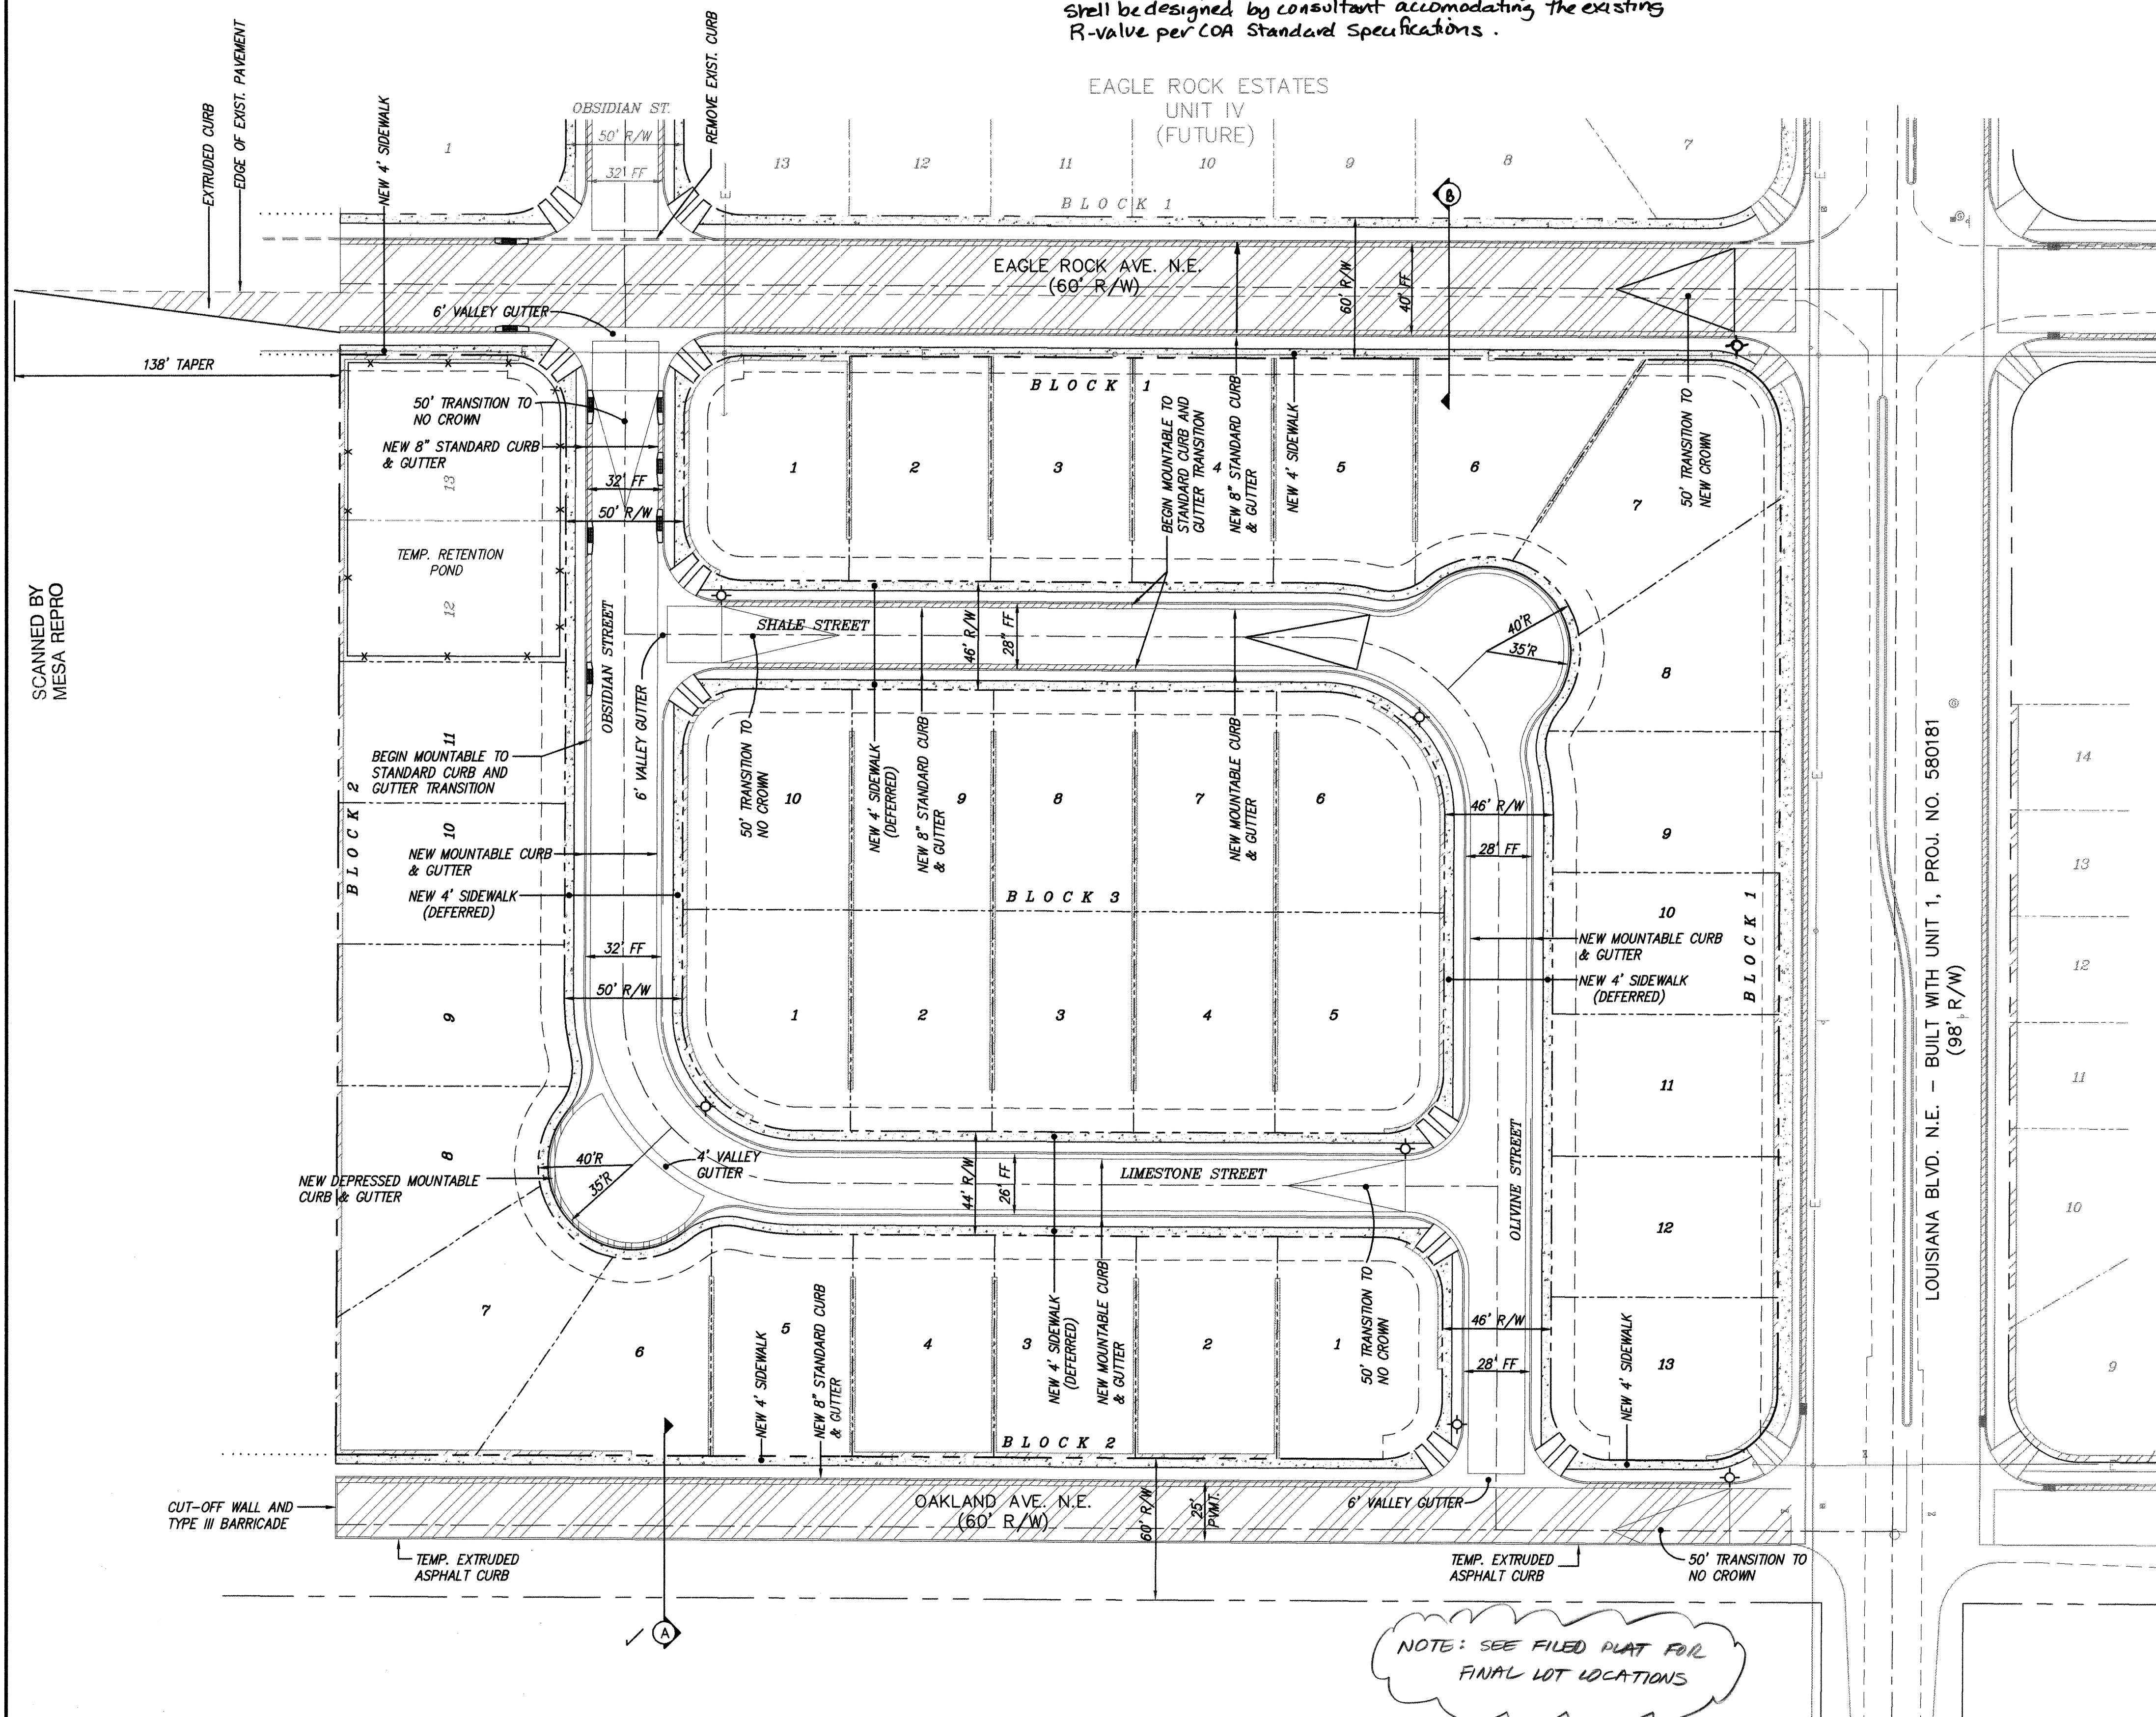


SCANNED BY
MESA REPRO

CURVE DATA - DESCRIBES FACE OF NEW CURB

- | | | |
|--|--|--|
| ① $\Delta = 89^{\circ}55'32''$
$R = 25.00'$
$L = 39.24'$
$T = 24.97'$ | ② $\Delta = 90^{\circ}04'28''$
$R = 25.00'$
$L = 39.30'$
$T = 25.03'$ | ③ $\Delta = 89^{\circ}55'32''$
$R = 30.00'$
$L = 47.08'$
$T = 29.96'$ |
| ④ $\Delta = 90^{\circ}01'00''$
$R = 25.00'$
$L = 39.28'$
$T = 25.01'$ | ⑤ $\Delta = 89^{\circ}59'00''$
$R = 25.00'$
$L = 39.26'$
$T = 24.99'$ | ⑥ $\Delta = 90^{\circ}07'00''$
$R = 30.00'$
$L = 47.18'$
$T = 30.02'$ |

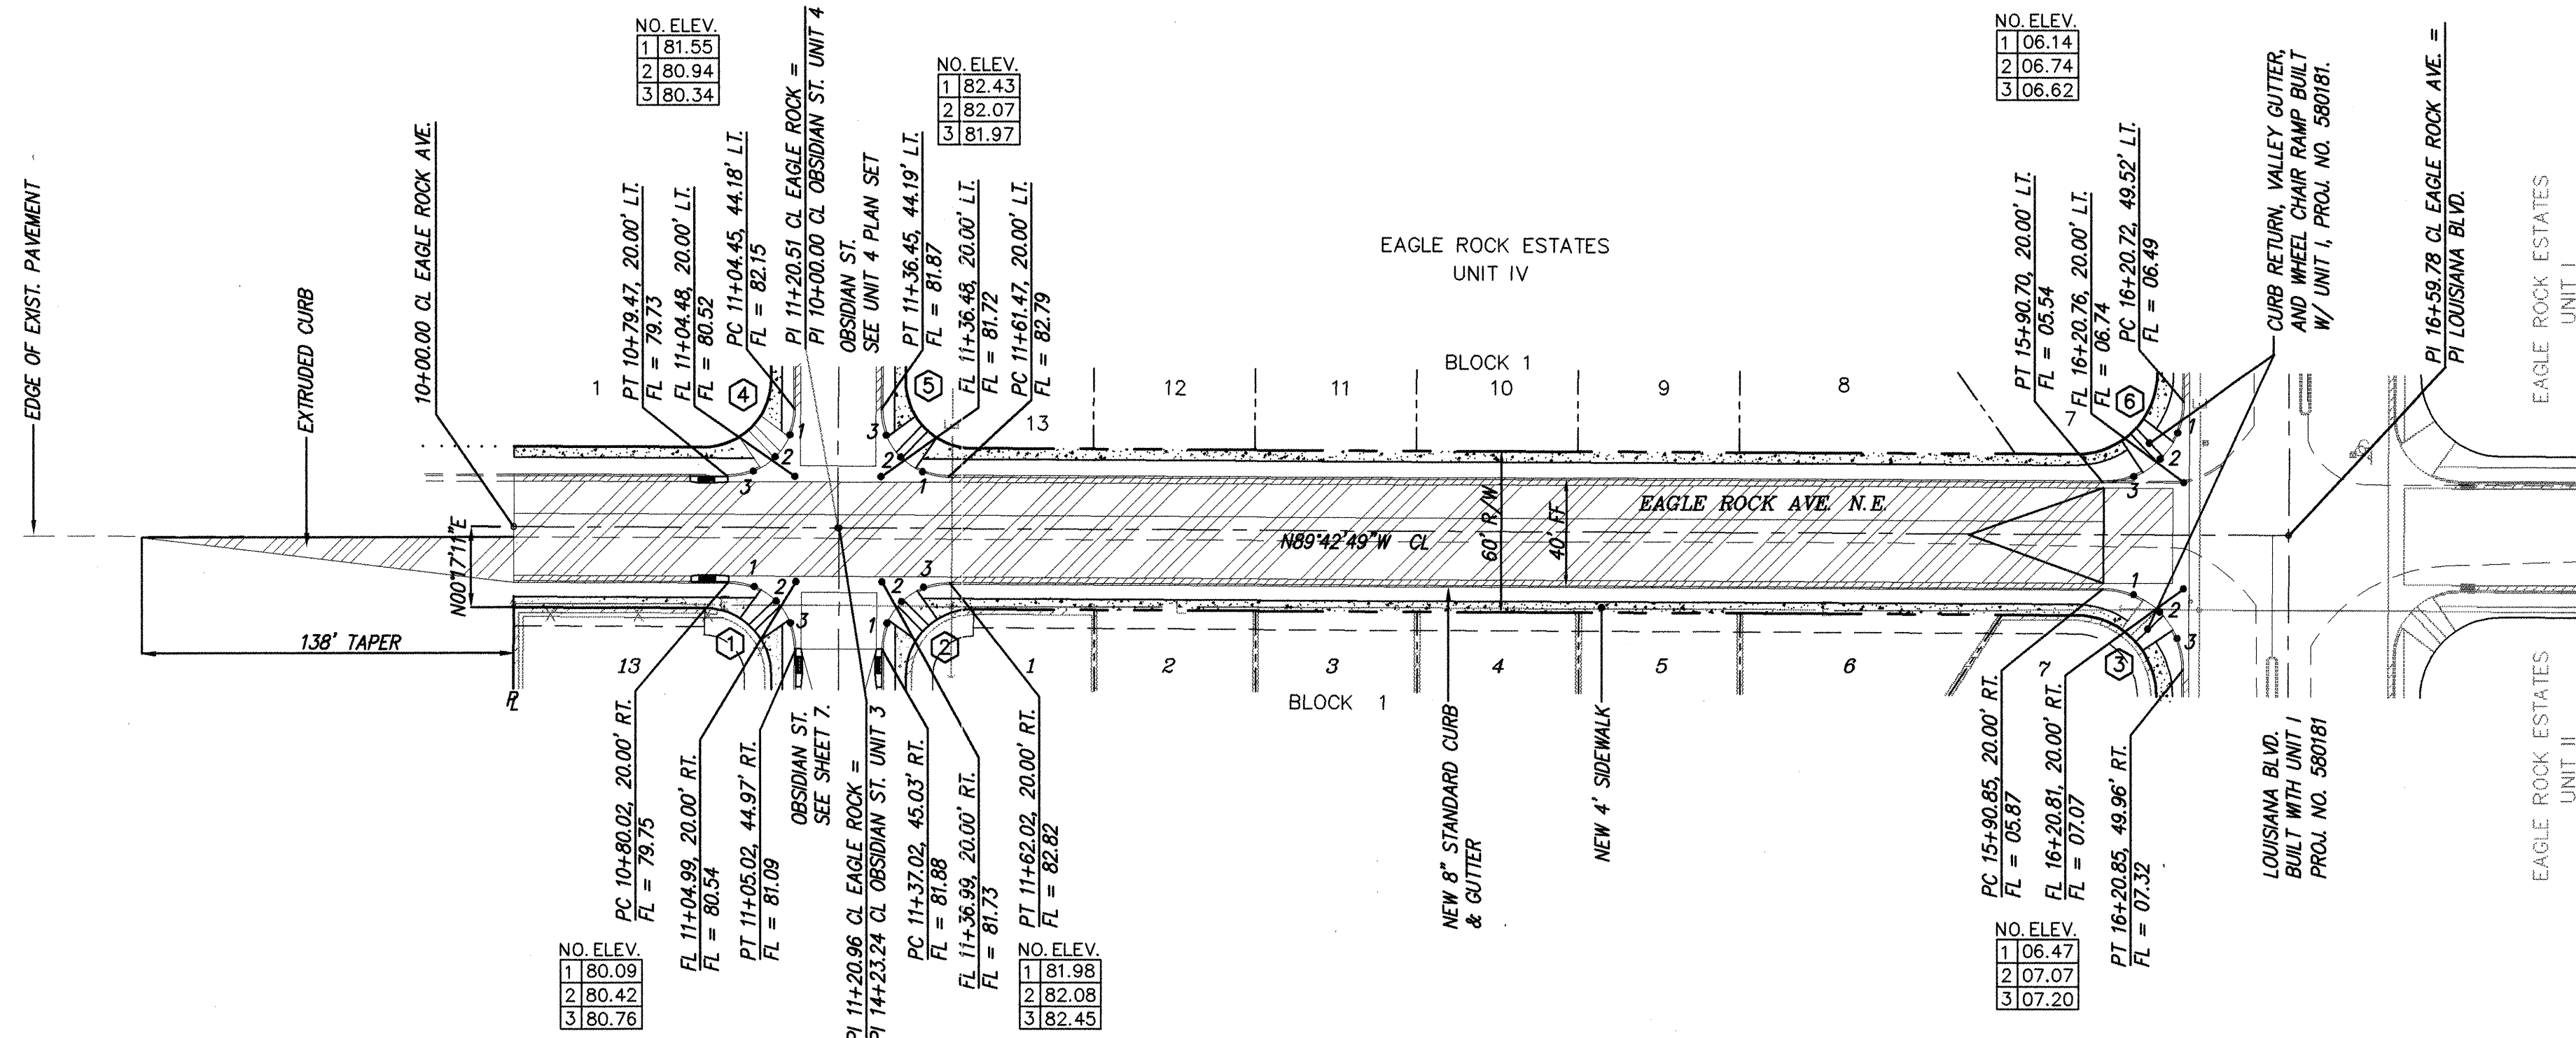

EAGLE ROCK AVE.
STA. 10+00.00 TO STA. 16+59.78
SCALE: HORIZ. 1" = 50'
VERT. 1" = 10'

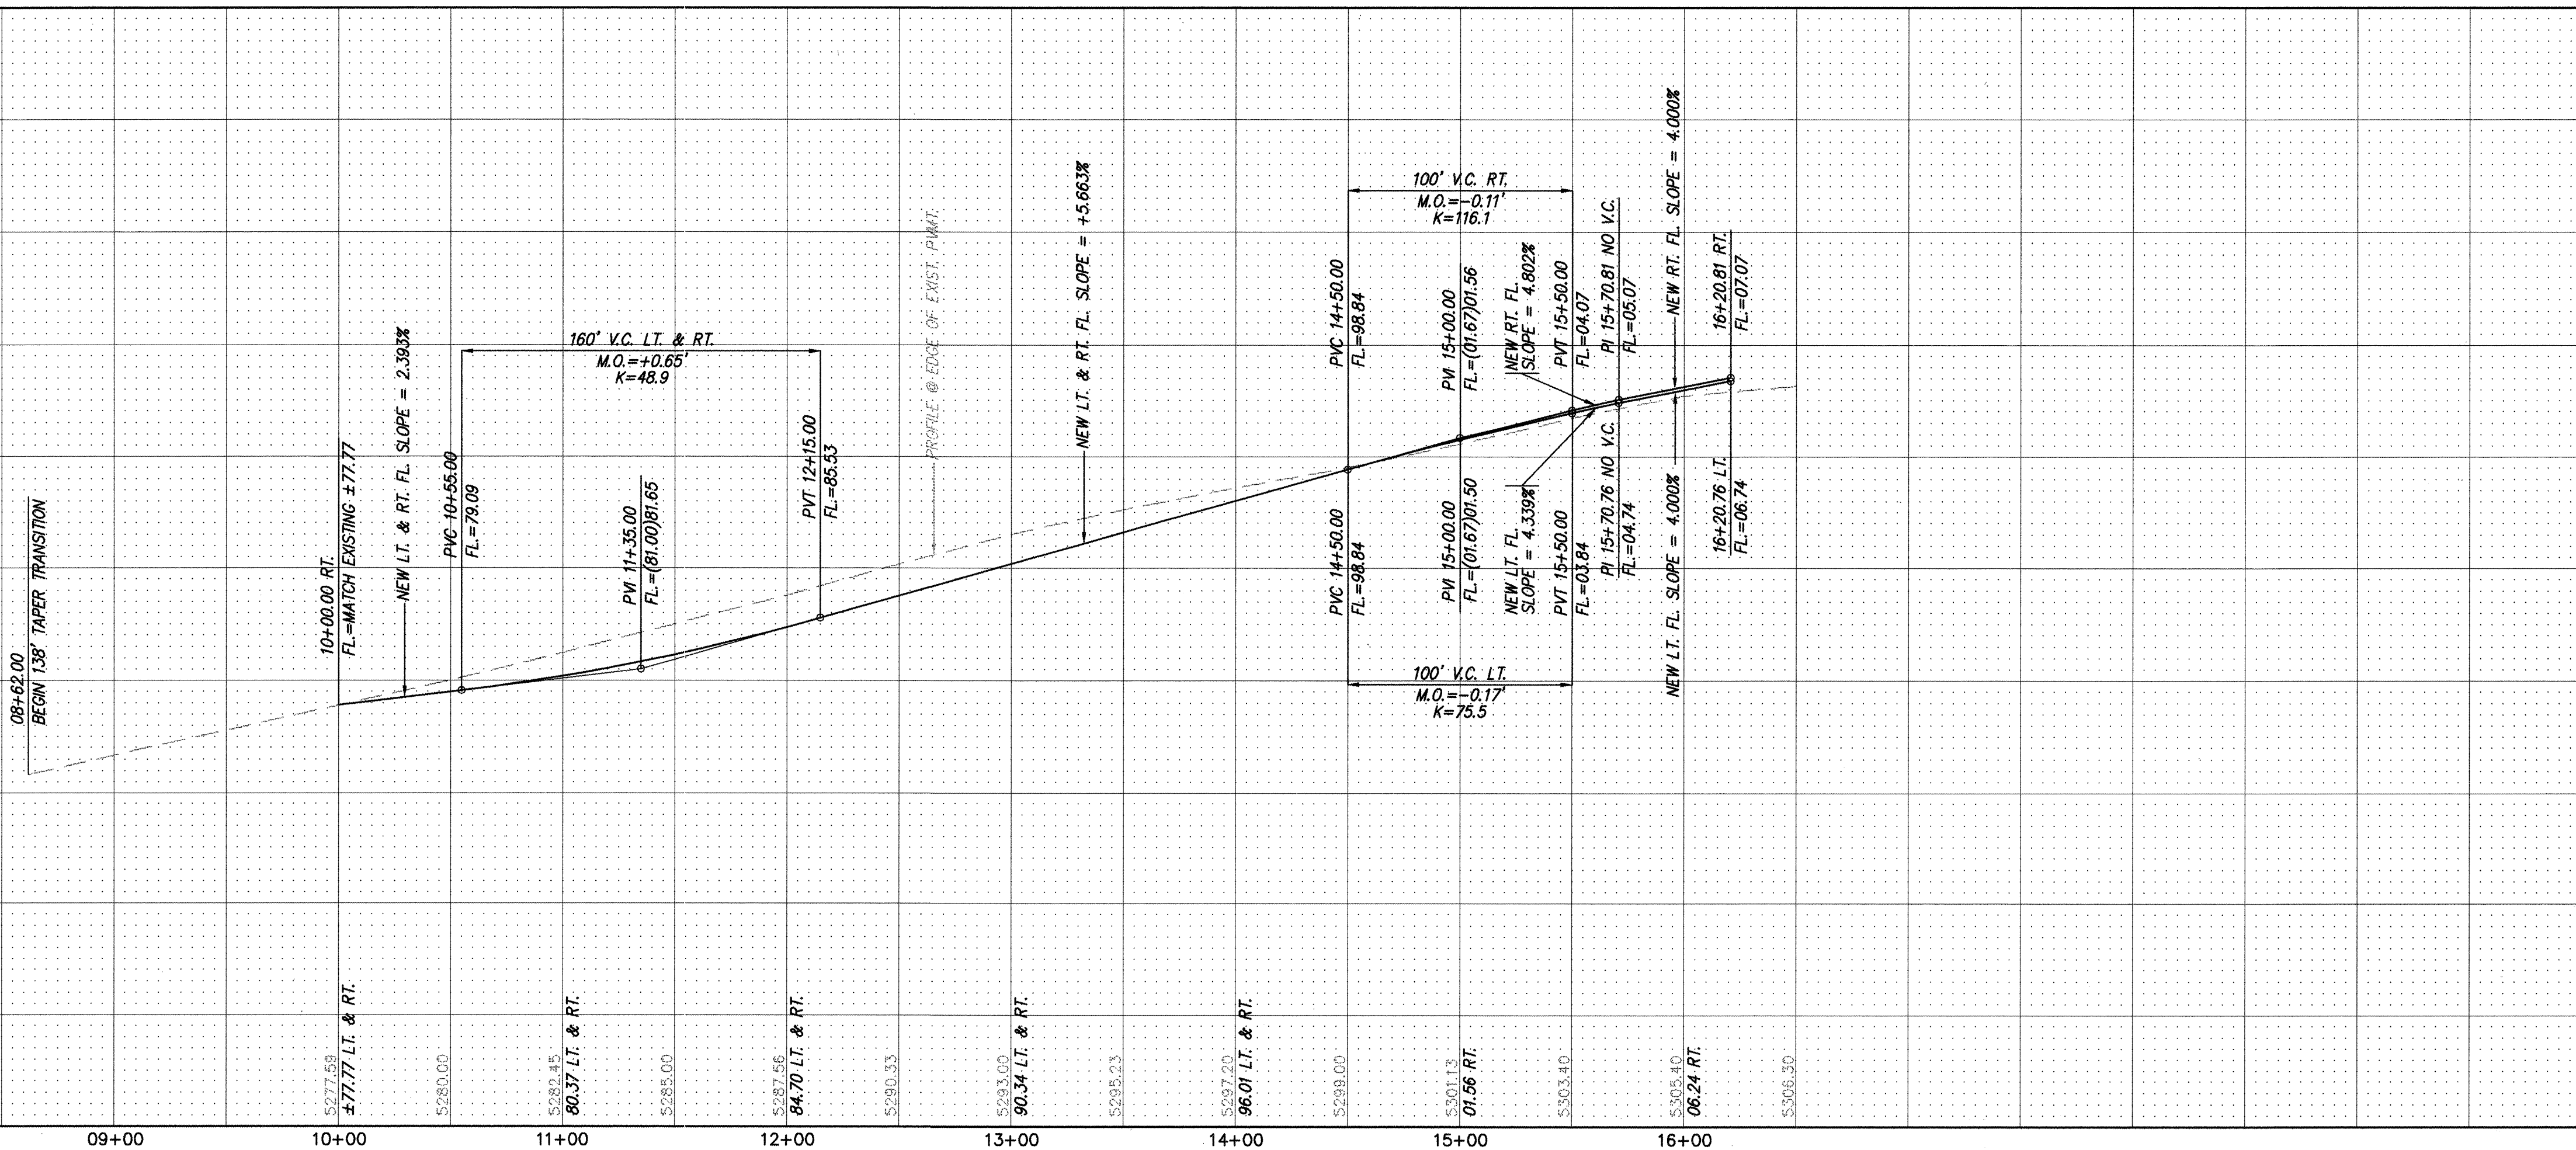

NOTES

1. ALL STATIONING IS CENTERLINE STATIONING.

NOTE: SEE FILED PLAT FOR
FINAL LOT LOCATIONS

dmg MARK GOODWIN & ASSOCIATES, P.A.
CONSULTING ENGINEERS
P.O. BOX 90606
ALBUQUERQUE, NEW MEXICO 87199
(505) 828-2200, FAX (505) 797-9539

CITY OF ALBUQUERQUE
PUBLIC WORKS DEPARTMENT
ENGINEERING DEVELOPMENT GROUP
TITLE: EAGLE ROCK ESTATES - UNIT III
PAVING IMPROVEMENTS
EAGLE ROCK AVENUE

DESIGN REVIEW COMMITTEE
APPROVED
APR 29 1998
DESIGN REVIEW COMMITTEE

CITY ENGINEER APPROVAL


CITY PROJECT NO.

580183 C-18

ZONE MAP NO.

SHEET 6 OF 19

AS BUILT INFORMATION		BENCH MARKS		SURVEY INFORMATION		ENGINEER'S SEAL	
CONTRACTOR	WORK	STANDARD	DATE	FIELD	NO.	DATE	NO.
BY	BY	X = 404.894.49	Y = 1,523,837.39	BY	BY	DATE	DATE
INSPECTOR'S	DATE						
FIELD	DATE						
ADJUSTMENT	DATE						
CORRECTED BY	DATE						
MICRO-FILM INFORMATION	DATE						
RECORDED BY	DATE						
NO.							

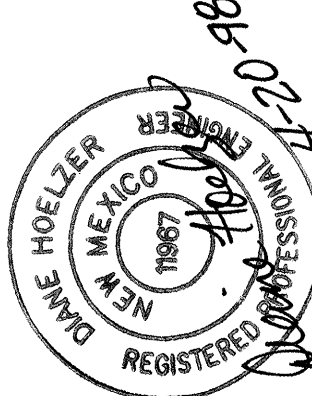


REVISIONS		DESIGN	
NO.	DATE	NO.	DATE
1	01/98	1	01/98
2	01/98	2	01/98

SCANNED BY
MESA REPRO

CURVE DATA - DESCRIBES FACE OF NEW CURB



① $\Delta = 89^{\circ}56'28''$ $R = 28.00'$ $L = 39.24'$ $T = 24.97'$	② $\Delta = 90^{\circ}03'32''$ $R = 25.00'$ $L = 39.30'$ $T = 25.03'$	③ $\Delta = 89^{\circ}56'28''$ $R = 25.00'$ $L = 39.24'$ $T = 24.97'$	④ $\Delta = 90^{\circ}03'32''$ $R = 25.00'$ $L = 39.30'$ $T = 25.03'$	⑤ $\Delta = 89^{\circ}55'32''$ $R = 25.00'$ $L = 95.74'$ $T = 60.92'$
⑥ $\Delta = 137^{\circ}24'41''$ $R = 89.00'$ $L = 20.52'$ $T = 10.31'$	⑦ $\Delta = 59^{\circ}15'44''$ $R = 25.00'$ $L = 25.86'$ $T = 14.22'$	⑧ $\Delta = 177^{\circ}58'23''$ $R = 89.00'$ $L = 111.19'$ $T = 1978.49'$	⑨ $\Delta = 59^{\circ}15'44''$ $R = 25.00'$ $L = 25.86'$ $T = 14.22'$	⑩ $\Delta = 137^{\circ}24'41''$ $R = 89.00'$ $L = 20.52'$ $T = 10.31'$

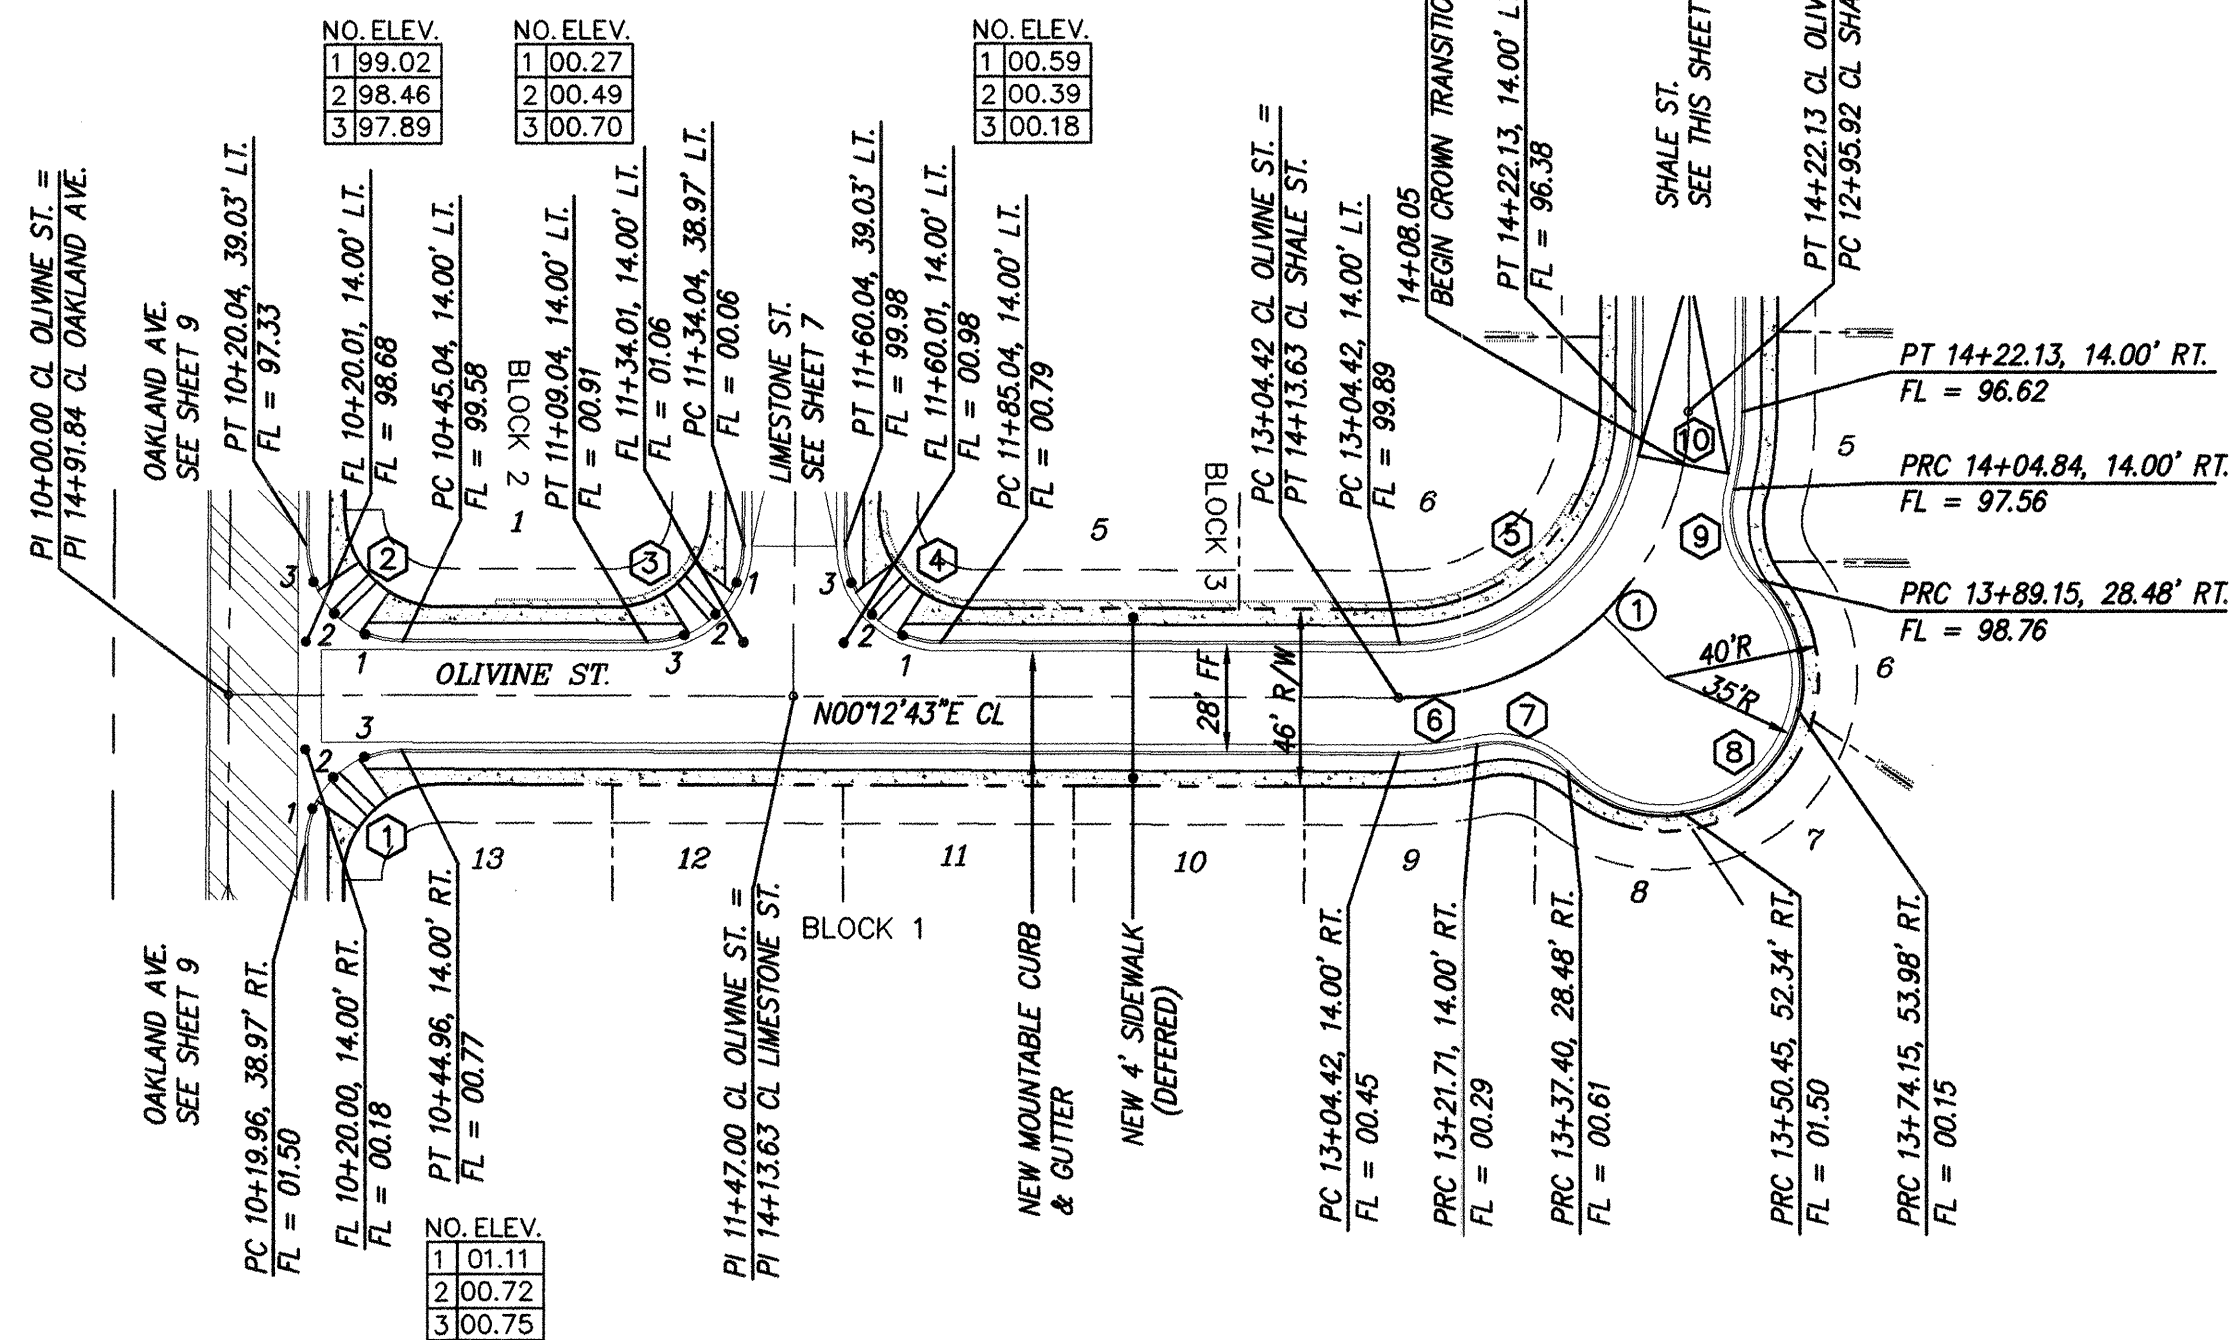

CURVE DATA - DESCRIBES CENTERLINE

① $\Delta = 89^{\circ}55'32''$
 $R = 75.00'$
 $L = 117.71'$
 $T = 74.90'$


OLIVINE STREET
STA. 10+20.00 TO STA. 14+22.13
SCALE: HORZ. 1" = 50'
VERT. 1" = 10'

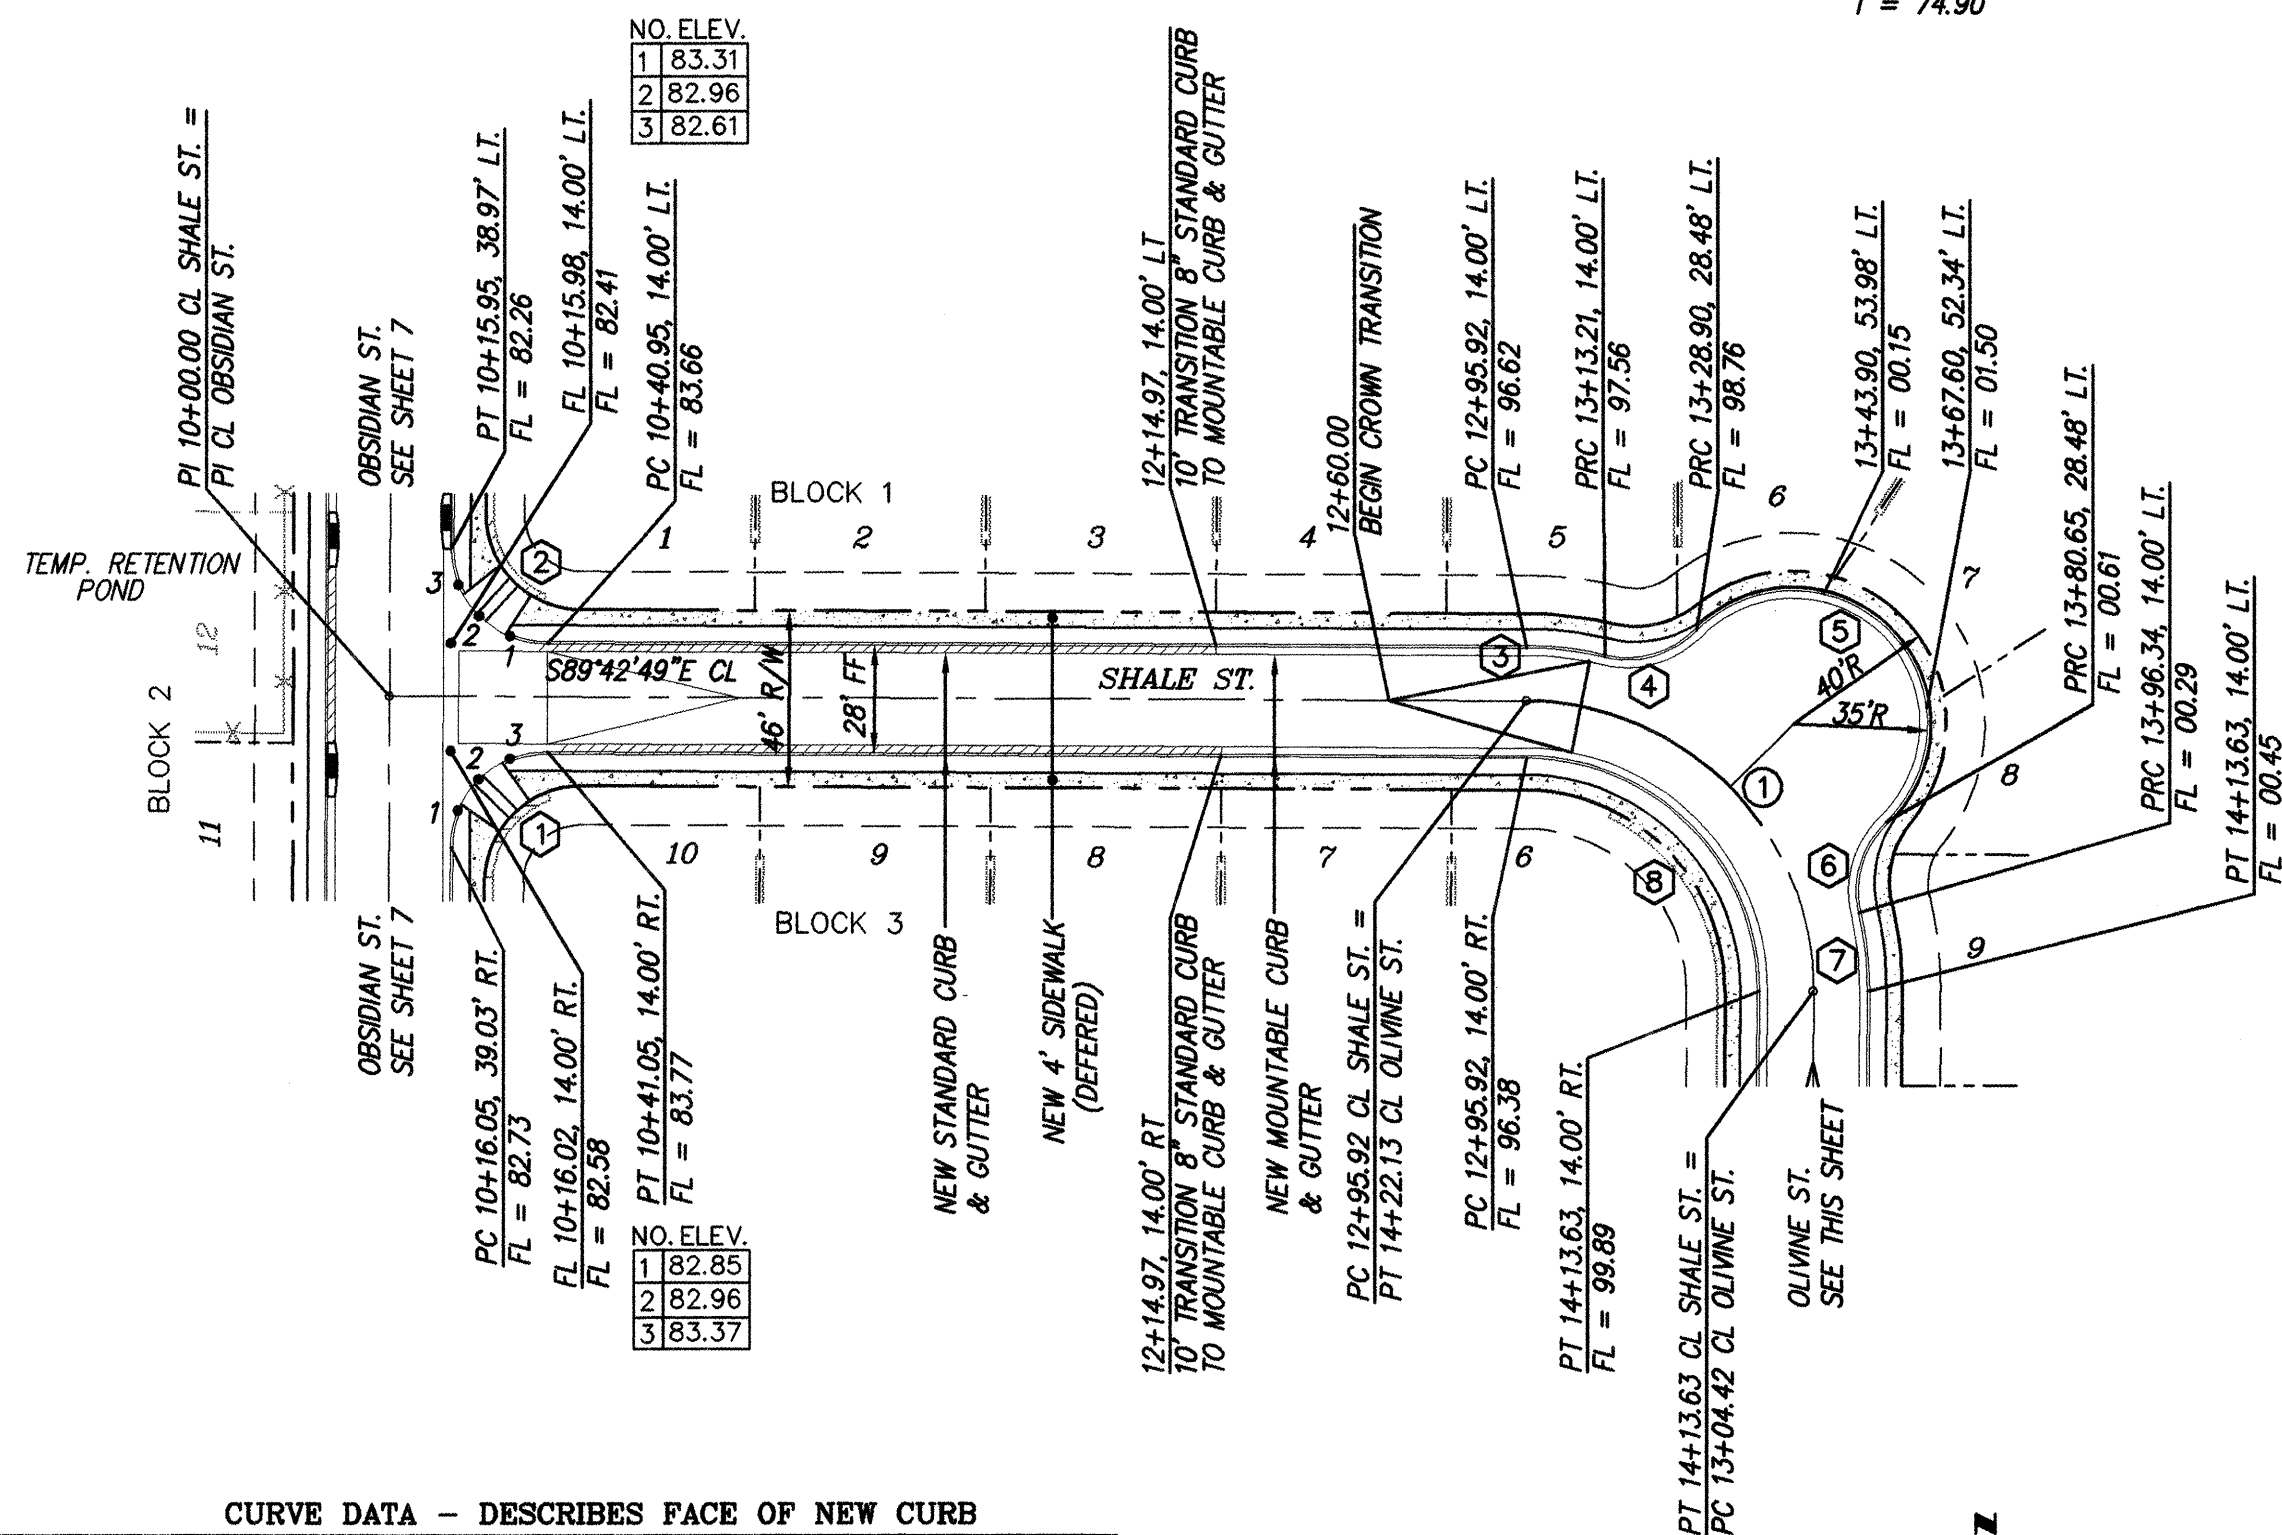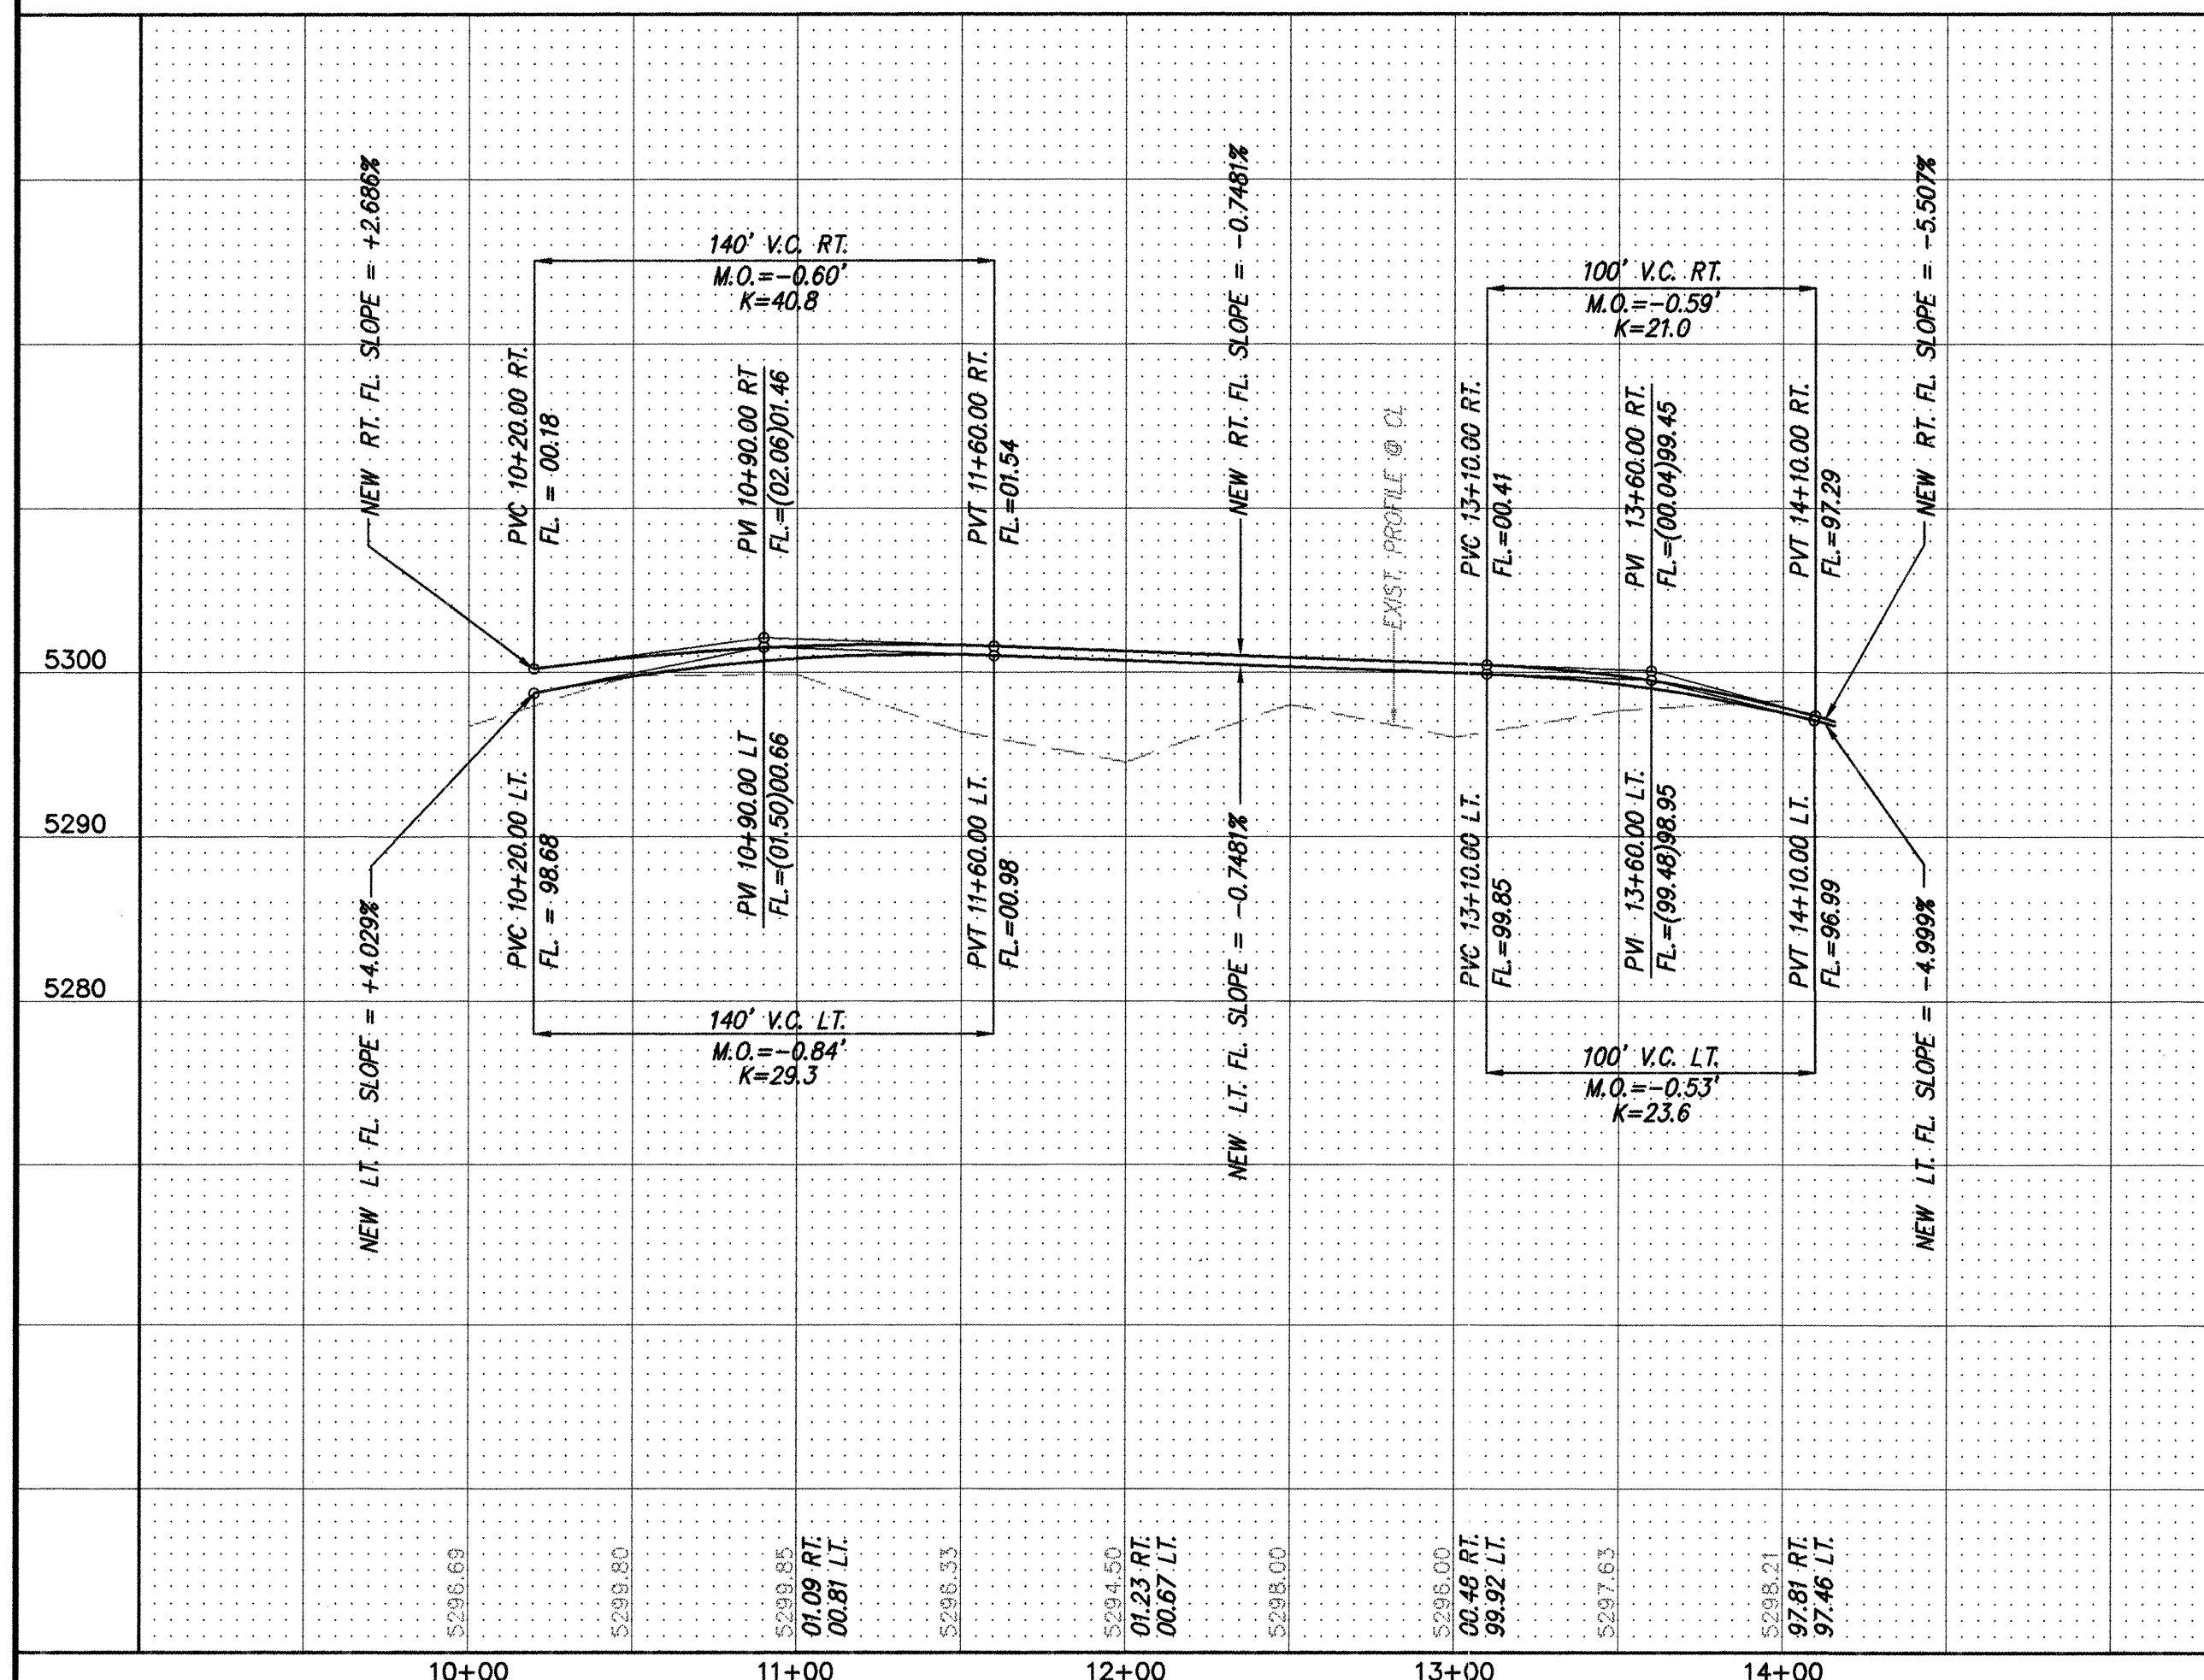

CURVE DATA - DESCRIBES FACE OF NEW CURB

① $\Delta = 90^{\circ}04'28''$ $R = 25.00'$ $L = 39.30'$ $T = 25.03'$	② $\Delta = 89^{\circ}55'32''$ $R = 25.00'$ $L = 39.24'$ $T = 24.97'$	③ $\Delta = 137^{\circ}2'41''$ $R = 89.00'$ $L = 20.52'$ $T = 10.31'$	④ $\Delta = 59^{\circ}15'44''$ $R = 25.00'$ $L = 25.86'$ $T = 14.22'$
⑤ $\Delta = 177^{\circ}58'23''$ $R = 35.00'$ $L = 111.19'$ $T = 1978.49'$	⑥ $\Delta = 59^{\circ}15'44''$ $R = 25.00'$ $L = 25.86'$ $T = 14.22'$	⑦ $\Delta = 137^{\circ}2'41''$ $R = 89.00'$ $L = 20.52'$ $T = 10.31'$	⑧ $\Delta = 89^{\circ}55'32''$ $R = 61.00'$ $L = 95.74'$ $T = 60.92'$

SHALE STREET
STA. 10+15.98 TO STA. 14+13.63
SCALE: HORZ. 1" = 50'
VERT. 1" = 10'

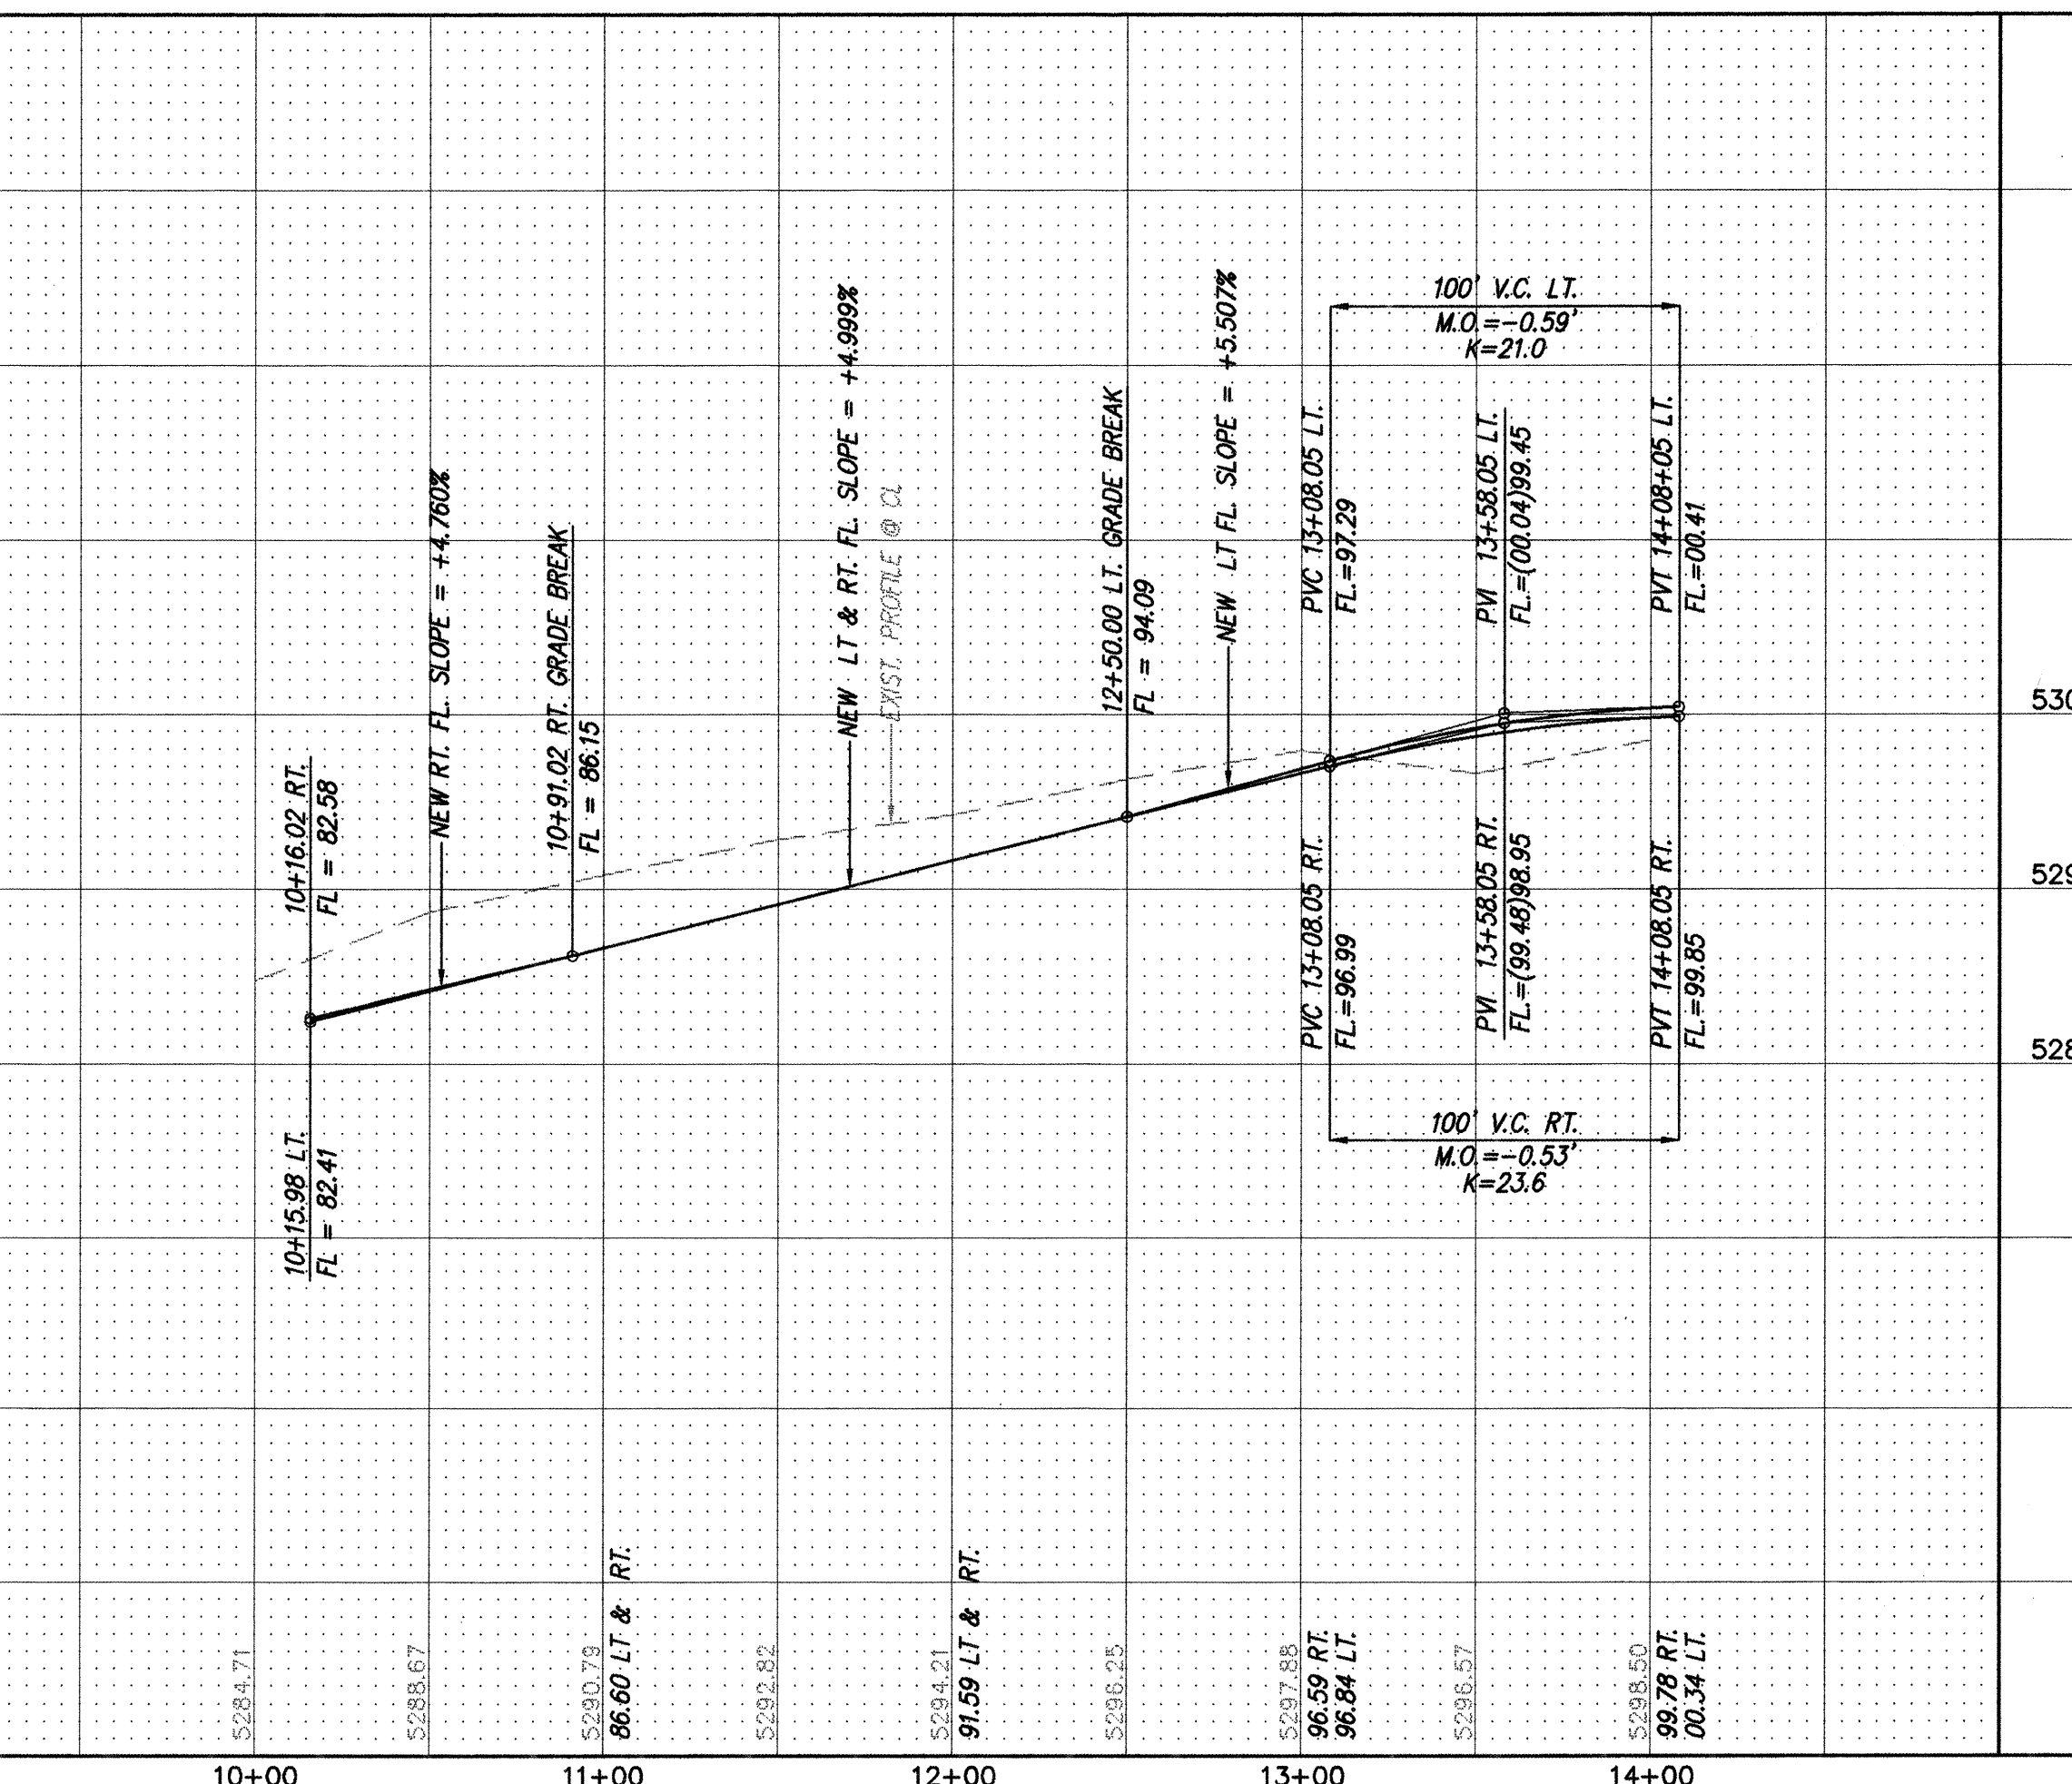

NOTES

1. ALL STATIONING IS CENTERLINE STATIONING.

ENGINEER'S SEAL		SURVEY INFORMATION		BENCH MARKS		AS BUILT INFORMATION	
		FIELD NOTES					
		NO.	BY	DATE		WORK STARTED BY	DATE
					STANDARD ACS ALUMINUM CAP STAMPED "11-C18"	CONTRACTOR	WOLKING
					X = 404,894.49	INSPECTOR	CHS, INC
					Y = 1,523,837.39	ACCEPTANCE BY	DATE 8/99
					Z = 5,305.00	FIELD	DATE 09/01
						REVISION BY	CHS, INC
						DRAWINGS	DATE 02/01
						CORRECTED BY	CHS, INC
						MICRO-FILM INFORMATION	
						RECORDED BY	DATE
							NO.

NOTE: SEE FILED PLAT FOR
FINAL LOT LOCATIONS.

dmg MARK GOODWIN & ASSOCIATES, P.A.
CONSULTING ENGINEERS
P.O. BOX 90606
ALBUQUERQUE, NEW MEXICO 87199
(505) 828-2200, FAX (505) 797-9539

	CITY OF ALBUQUERQUE PUBLIC WORKS DEPARTMENT ENGINEERING DEVELOPMENT GROUP
	TITLE: <i>EAGLE ROCK ESTATES - UNIT III PAVING IMPROVEMENTS OLIVINE STREET AND SHALE STREET</i>

DESIGN REVIEW COMMITTEE
APPROVED
APR 29 1998
DESIGN
REVIEW COMMITTEE

CITY ENGINEER APPROVAL _____

FAST DESIGN UPDATE

CITY PROJECT NO.

ZONE MAP NO

SHEET OF

7058\INI3\PP-OLIM\04-16-98

580183


C-18

87


SCANNED BY
MESA REPRO

CURVE DATA - DESCRIBES FACE OF NEW CURB

① $\Delta = 90^{\circ}03'32''$ $R = 25.00'$ $L = 39.30'$ $T = 25.03'$	② $\Delta = 89^{\circ}56'28''$ $R = 25.00'$ $L = 39.24'$ $T = 24.97'$	③ $\Delta = 90^{\circ}03'32''$ $R = 30.00'$ $L = 47.15'$ $T = 30.03'$
--	--	--

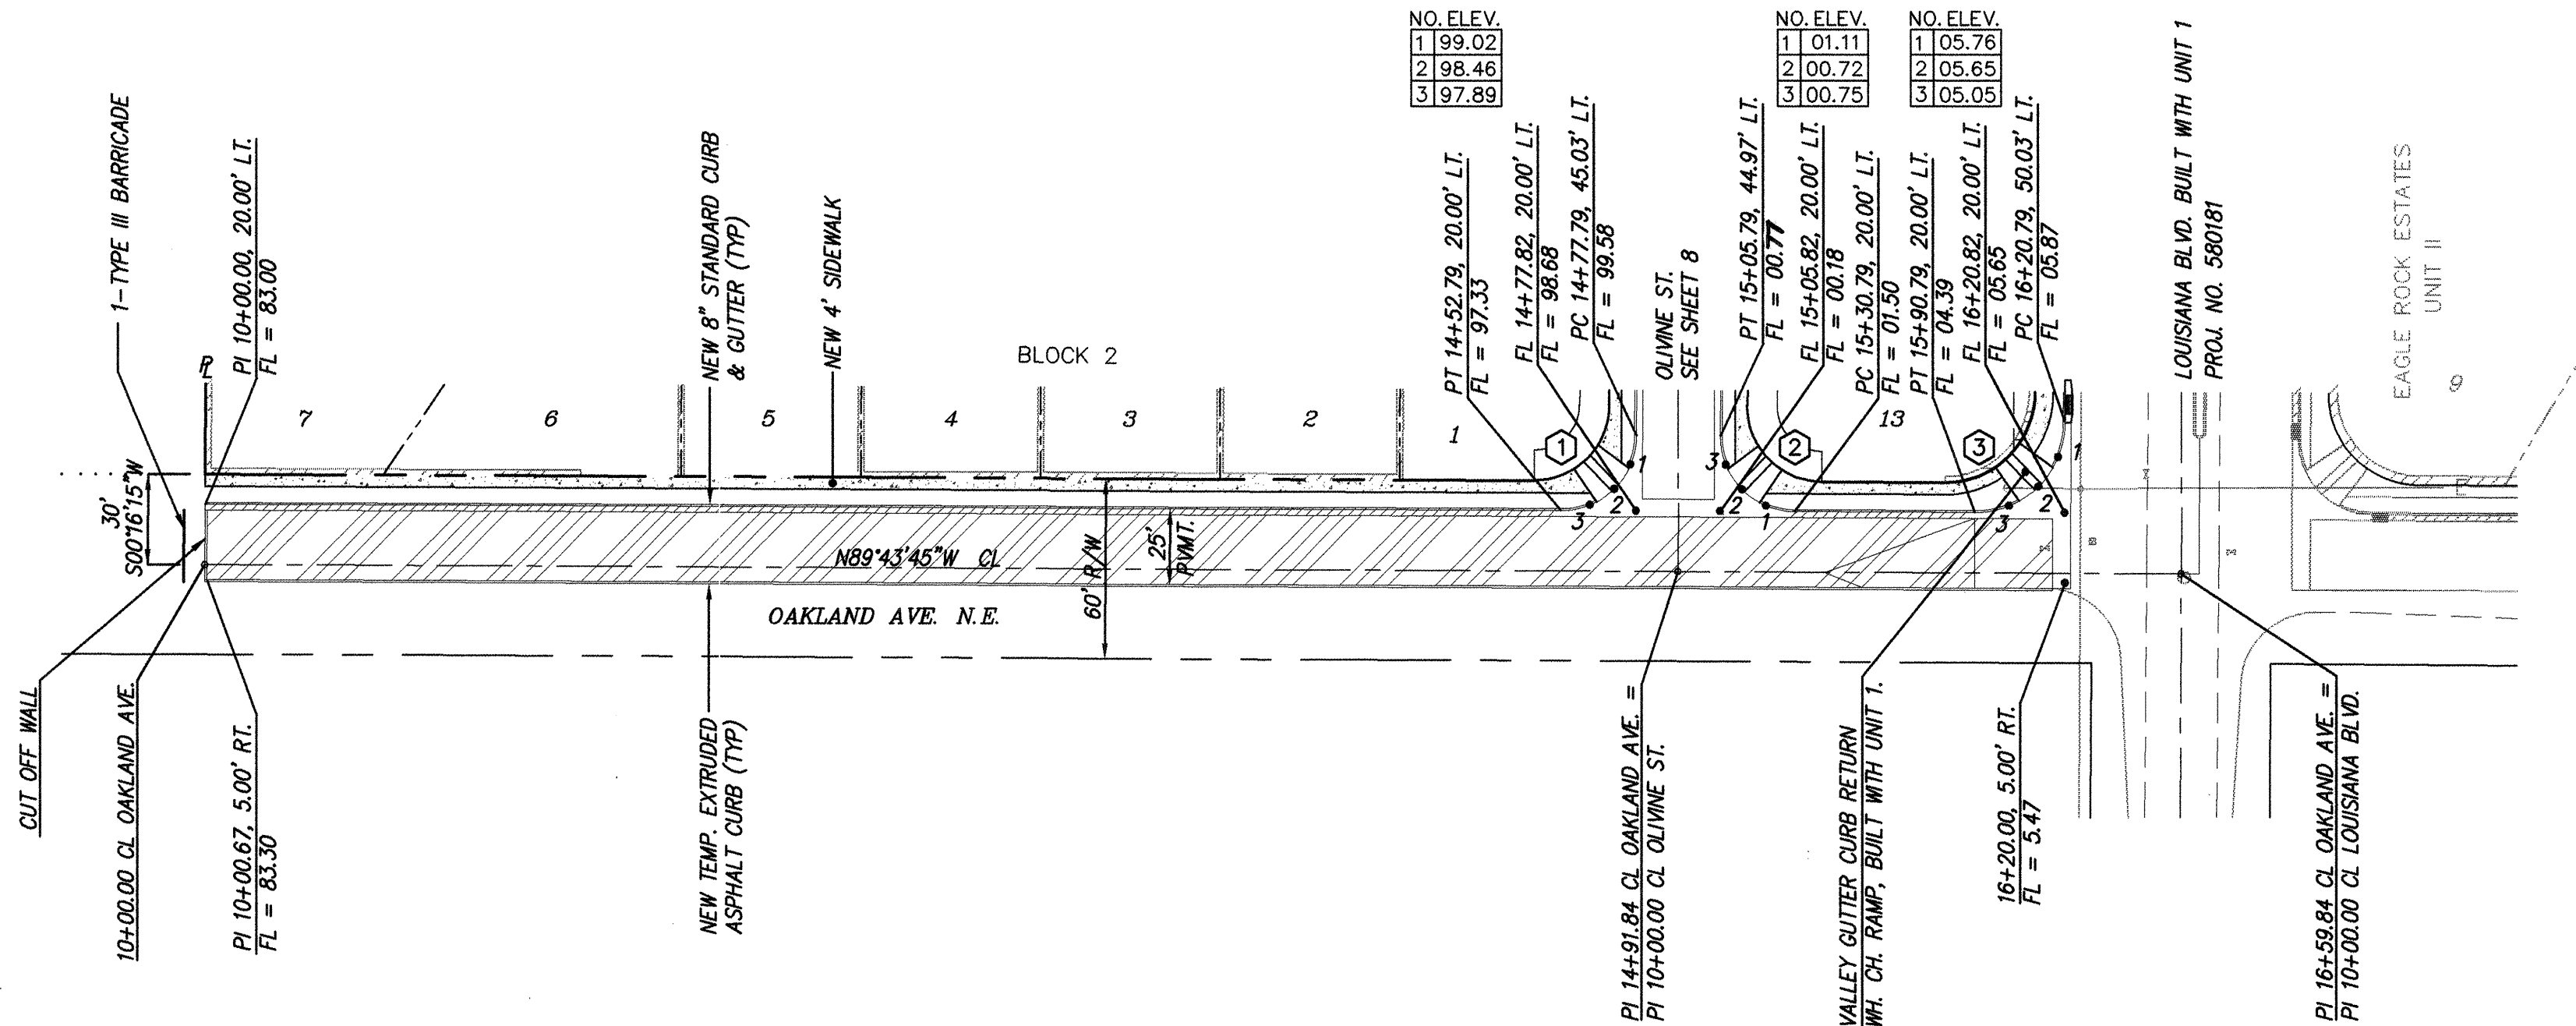

OAKLAND AVENUE
STA. 10+00.00 TO STA. 16+59.84
SCALE: HORIZ. 1" = 50'
VERT. 1" = 10'

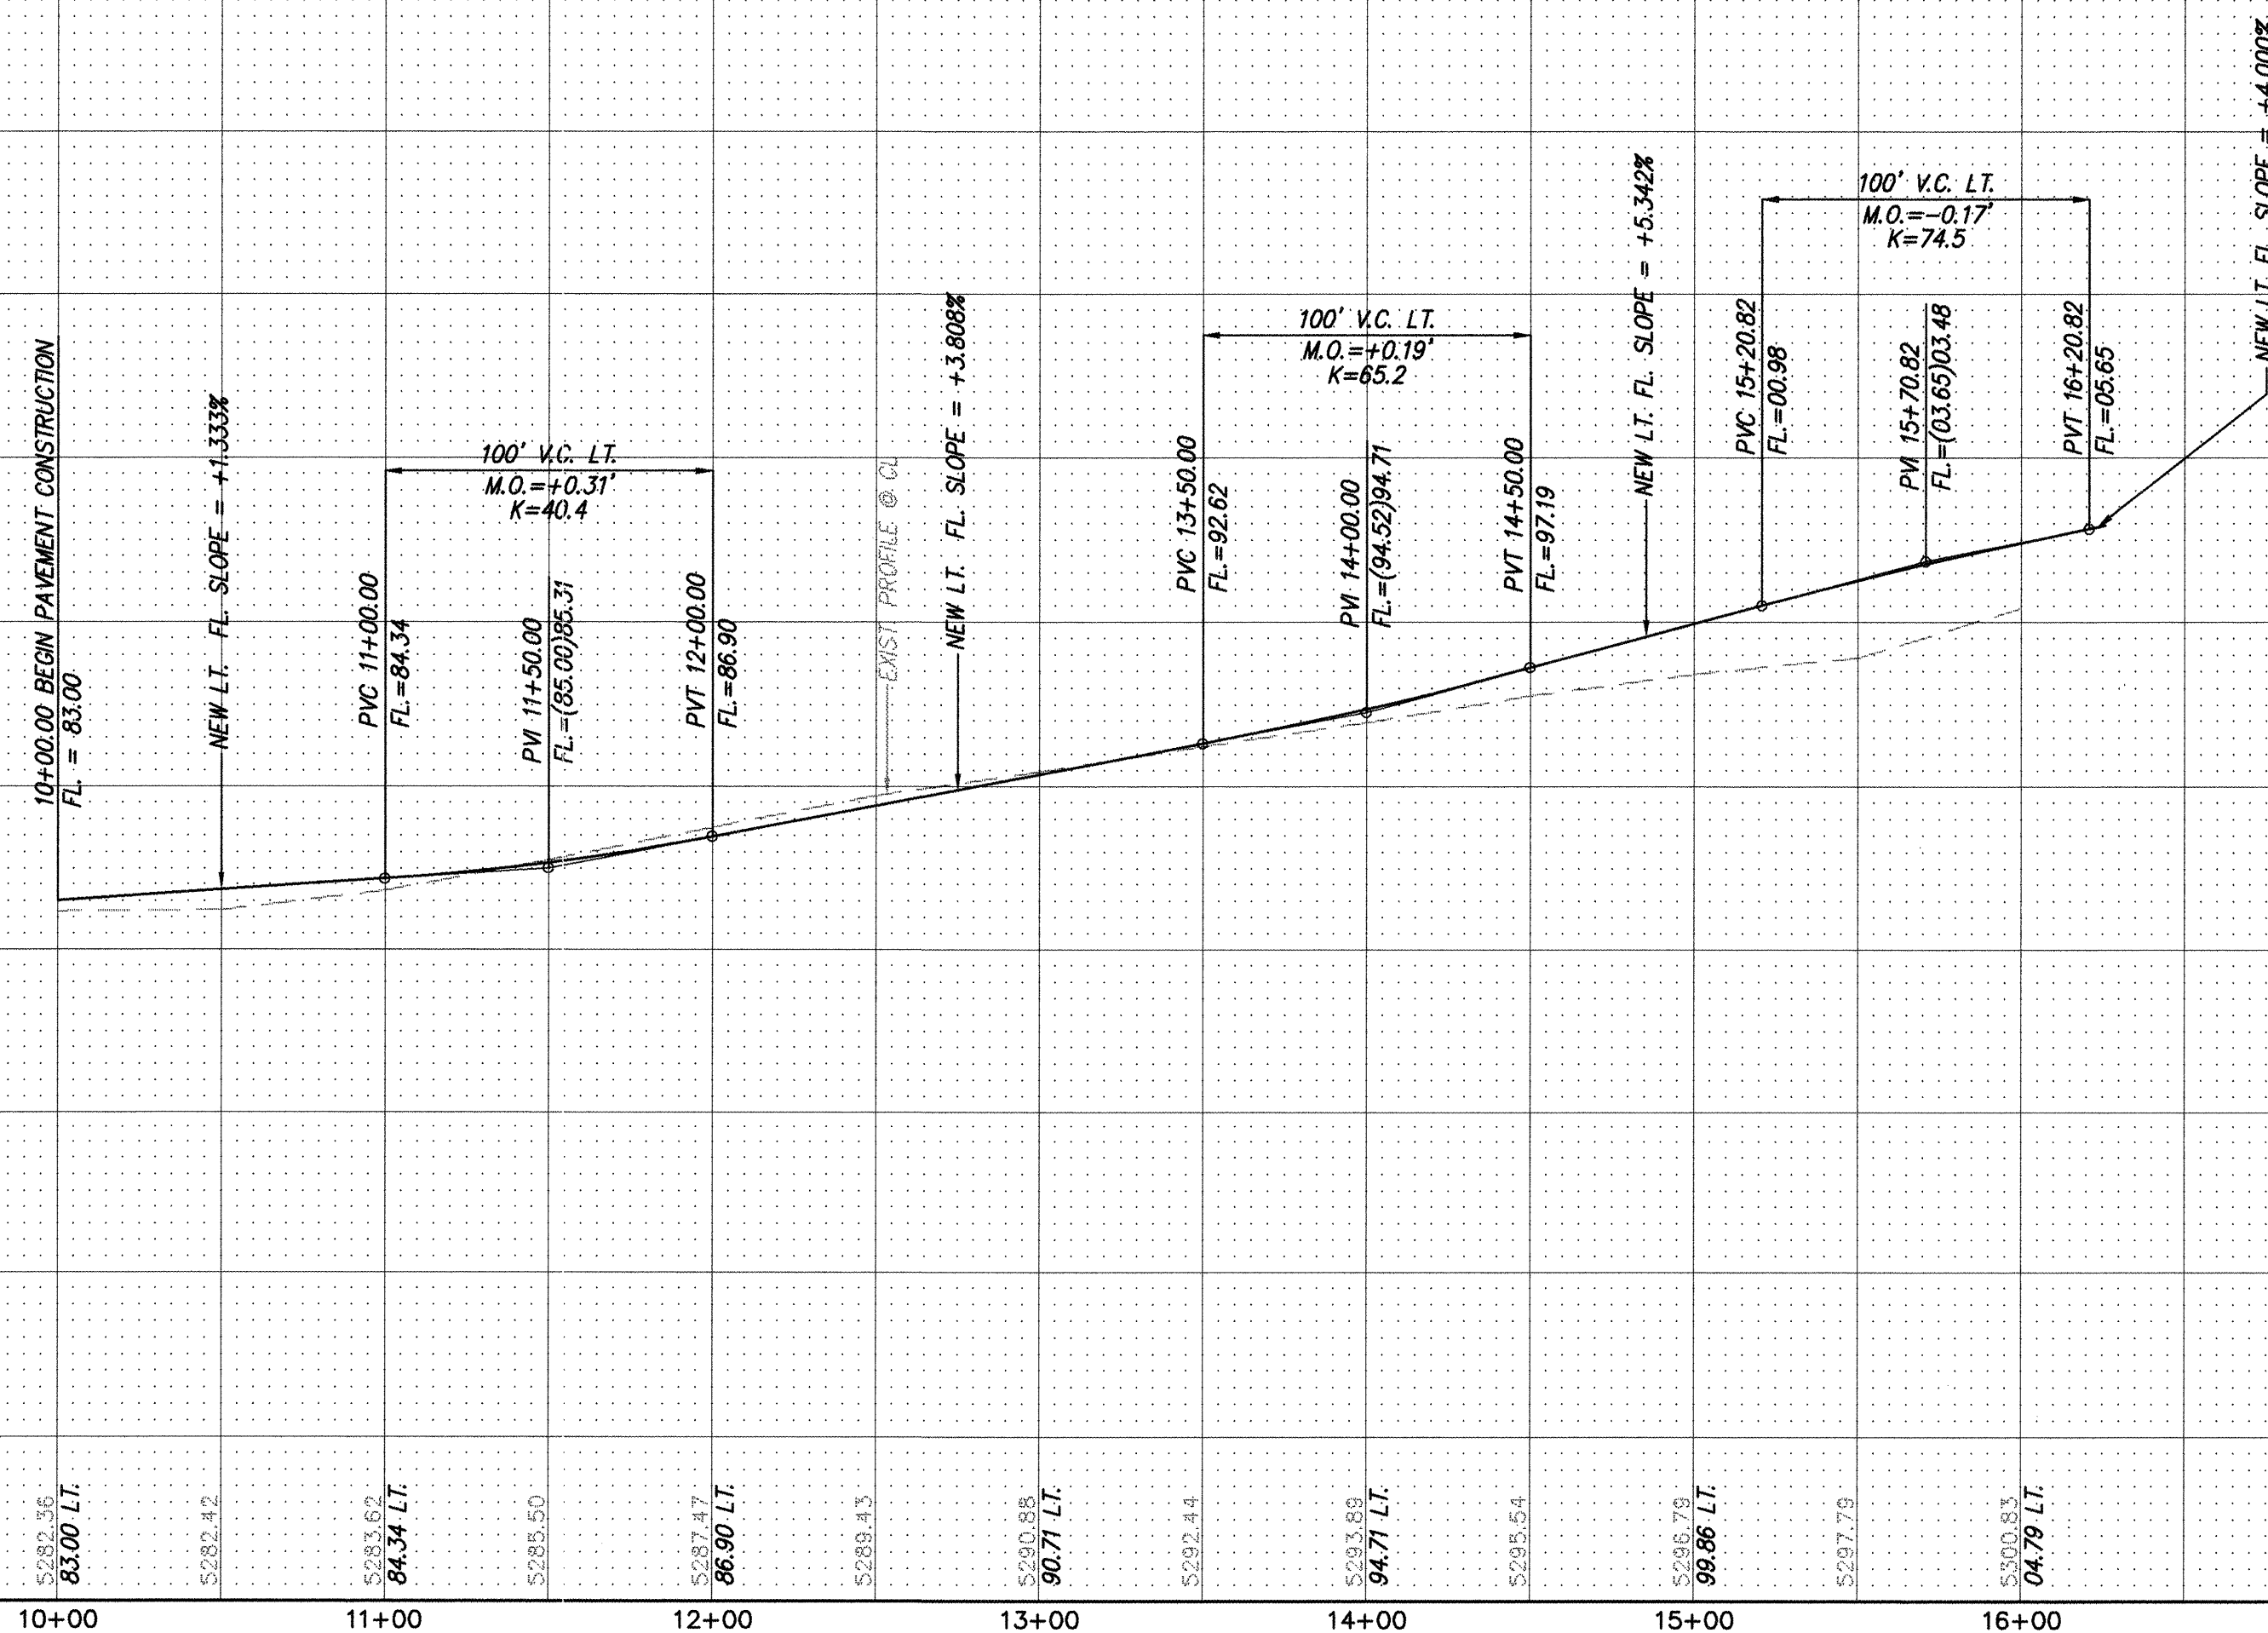

NOTES

1. ALL STATIONING IS CENTERLINE STATIONING.

NOTE:
SEE FILED PLAT FOR
FINAL LOT LOCATIONS

dmg MARK GOODWIN & ASSOCIATES, P.A.
CONSULTING ENGINEERS
P.O. BOX 90606
ALBUQUERQUE, NEW MEXICO 87199
(505) 828-2200, FAX (505) 797-9539

CITY OF ALBUQUERQUE
PUBLIC WORKS DEPARTMENT
ENGINEERING DEVELOPMENT GROUP
TITLE: EAGLE ROCK ESTATES - UNIT III
PAVING IMPROVEMENTS
OAKLAND AVENUE

DESIGN REVIEW COMMITTEE
APR 29 1998
DESIGN REVIEW COMMITTEE

CITY ENGINEER APPROVAL

LAST DESIGN UPDATE

CITY PROJECT NO.

580183

ZONE MAP NO.

C-18

SHEET OF

9 19

ENGINEER'S SEAL




SURVEY INFORMATION

STANDARD ACS ALUMINUM CAP STAMPED "11-C18"

AS BUILT INFORMATION

NO.	BY	DATE
1	DMG	01/98
2	DMG	01/98
3	DMG	01/98
SCANNED BY
MESA REPRO

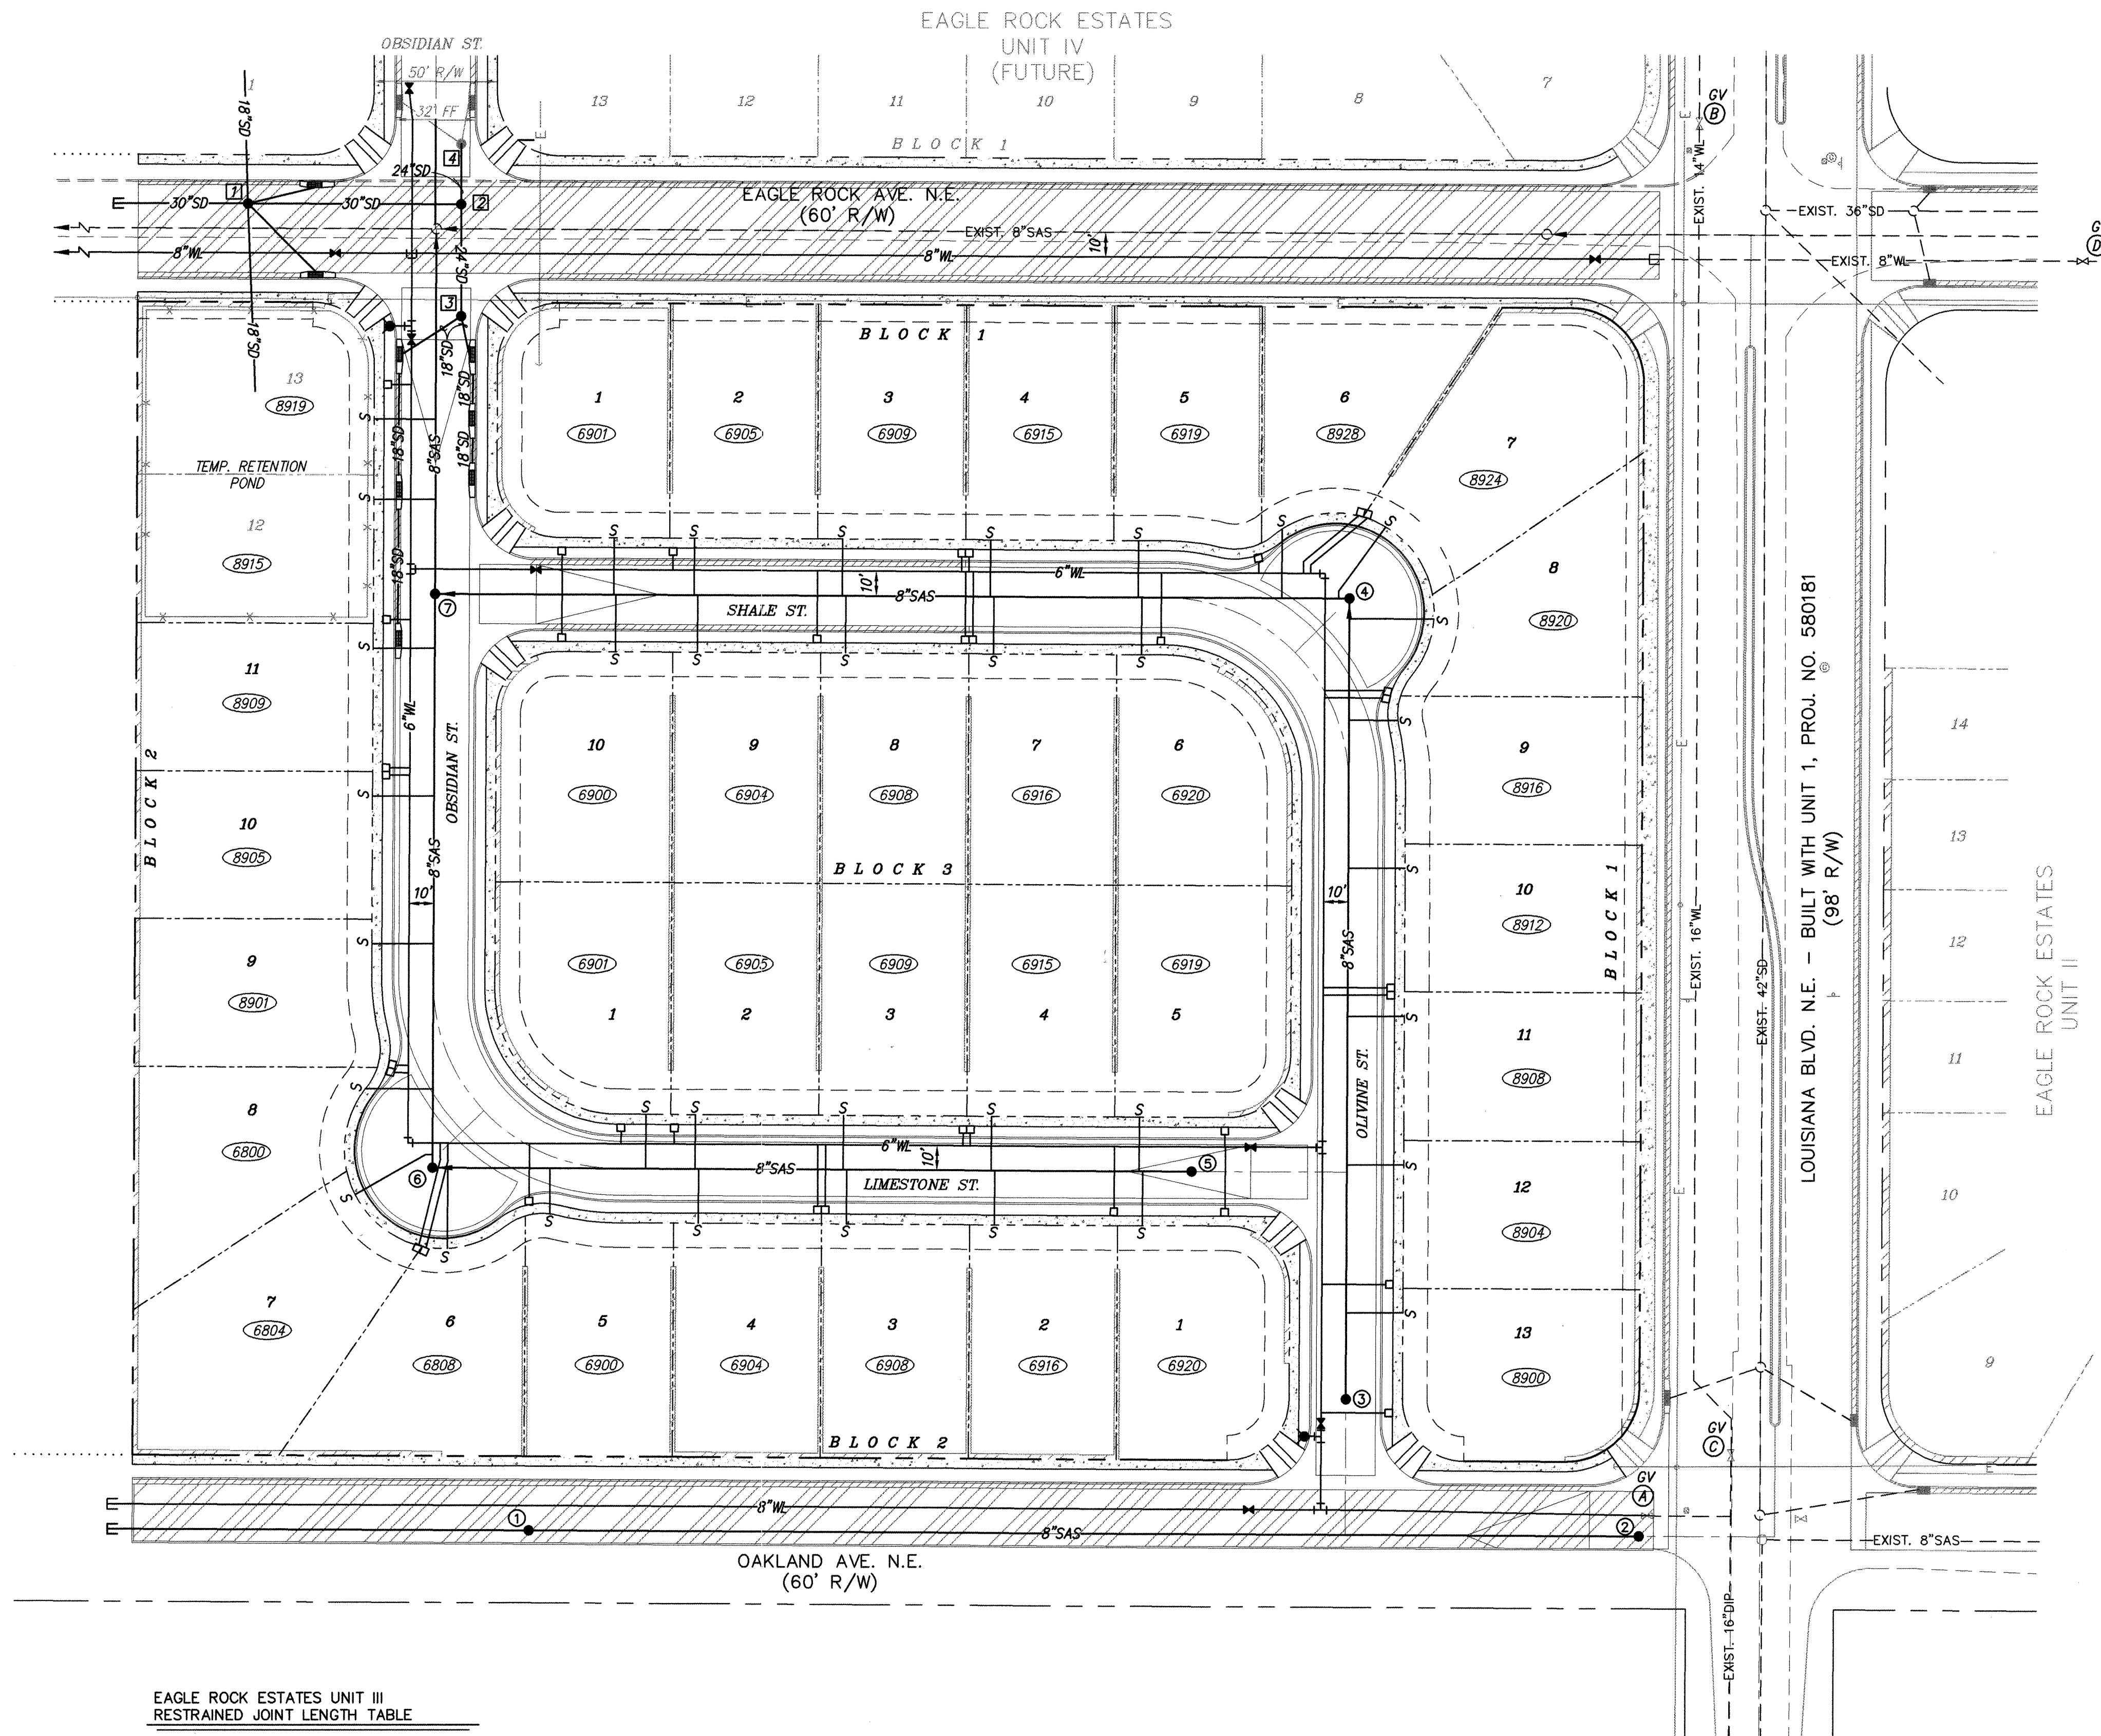EAGLE ROCK ESTATES UNIT III
RESTRAINED JOINT LENGTH TABLE

14"X8" TEE - (6' RUN, 4'BR)
8"X6" TEE - (5' RUN 17'BR) OR (7' RUN 5'BR)
6"X6" TEE - (6' RUN 4'BR) OR (10' RUN 2'BR)
8" DEAD END - 85'
14" DEAD END - 135'
16"X14" REDUCER - 35'
6" 90° BEND - 17'
16" 90° BEND - 18'

LEGEND


- PROPERTY LINE**
- NEW STANDARD CURB & GUTTER**
- NEW MOUNTABLE CURB & GUTTER**
- NEW WHEEL CHAIR RAMP
PER CITY STD. DWG. 2441 CASE II**
- NEW STORM DRAIN MANHOLE**
- NEW DROP INLET**
- NEW 30" STORM DRAIN**
- NEW 6" WATERLINE**
- NEW FIRE HYDRANT**
- NEW GATE VALVE**
- NEW WATERLINE TEE**
- NEW WATERLINE BEND**
- NEW DOUBLE WATER SERVICE**
- NEW SINGLE WATER SERVICE**
- NEW 8" SANITARY SEWER**
- NEW SANITARY SEWER MANHOLE NO. 1**
- NEW SANITARY SEWER SERVICE**
- STREET ADDRESS**
- NEW OFFSITE PAVEMENT**

NOTES

WATER SHUT-OFF PLAN (C-18, 19)

1. CONTRACTOR WILL CONTACT WATER SYSTEMS AT 857-8200, FIVE (5) DAYS PRIOR TO NECESSARY SHUT-OFF.
2. VALVES SHALL ONLY BE OPERATED BY CITY WATER EMPLOYEES.
3. A NON-PRESSURE CONNECTION TO THE EXISTING 8" WL STUBOUT WEST OF THE OAKLAND AVENUE/LOUISIANA BLVD. INTERSECTION WILL BE MADE AT GATE VALVE (A).
4. A NON-PRESSURE CONNECTION TO THE EXISTING 8" WL STUBOUT WEST OF EAGLE ROCK AVENUE/LOUISIANA BLVD. INTERSECTION WILL BE MADE BY SHUTTING OFF GV(B), GV(C) AND GV(D) AS DEPICTED ON THIS MASTER UTILITY PLAN.

NOTE: SEE FILED PLAT FOR
FINAL LOT LOCATIONS

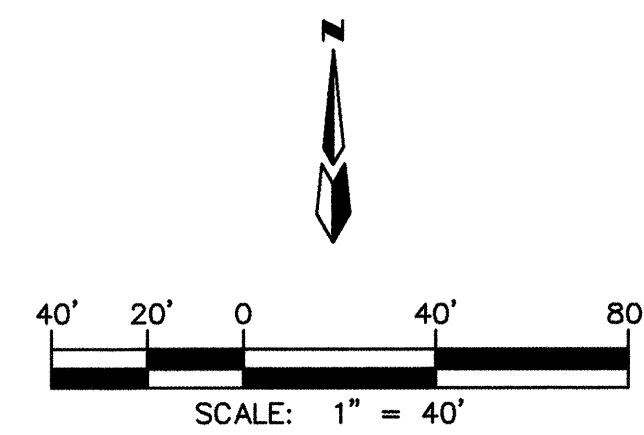

7058UNI3\MUTIL-U3\04-16-98

ENGINEER'S SEAL		SURVEY INFORMATION		BENCH MARKS		AS BUILT INFORMATION	
		FIELD NOTES					
		NO.	BY	DATE			
					STANDARD ACS ALUMINUM CAP STAMPED "11-C18"	CONTRACTOR	ALCOA ALUM
					X = 404,894.49	WORK STARTED BY	115 INC
					Y = 1,523,837.39	INSPECTOR'S FIELD LABEL BY	DATE 4/99
					Z = 5,305.00	FIELD VERIFICATION BY	DATE 4/99
						AS BUILT CORRECTED BY	DATE 11/99
						MICRO-FILM INFORMATION	
						RECORDED BY	DATE
						NO.	

DESIGNED BY **DLH** DATE **01/98**

DRAWN BY **DBC, BLN** DATE **01/98**

CHECKED BY **DMG** DATE **01/98**

dmg MARK GOODWIN & ASSOCIATES, P.A.
CONSULTING ENGINEERS
P.O. BOX 90606
ALBUQUERQUE, NEW MEXICO 87199
(505) 828-2200, FAX (505) 797-9539

	CITY OF ALBUQUERQUE PUBLIC WORKS DEPARTMENT ENGINEERING DEVELOPMENT GROUP
	TITLE: <i>EAGLE ROCK ESTATES - UNIT II</i> <i>MASTER UTILITY PLAN</i>

DESIGN REVIEW COMMITTEE		CITY ENGINEER APPROVAL		LAST DESIGN UPDATE		MO./DAY/YR.		MO./DAY/YR.	
									
CITY PROJECT NO.		ZONE MAP NO.		SHEET		OF			
580183		C-18		10		19			

Matchline see continuation below

CONNECT NEW 8" WATERLINE TO EXISTING 8" WATERLINE

EAGLE ROCK AVE. N.E.
(60' R/W)

EXIST. 8"SAS - (BUILT WITH UNIT 1)

8" ML

138' TAPER

Obsidian St.

TEMP. RETENTION POND

EAGLE ROCK ESTATES UNIT III

EAGLE ROCK ESTATES UNIT IV (FUTURE)

BLOCK 1

13 12

1 2

NOTE: SEE FILED PLAT FOR FINAL LOT LOCATION

SAN PEDRO DR. N.E.

EXIST. 24" SD

EXIST. 8" ML

EXIST. 8"SAS


EXIST. 24" SD

EXIST. 8" ML


14"x8" TEE - (6' RUN, 4'BR)
8"x6" TEE - (5' RUN 17'BR) OR (7' RUN 5'BR)
6"x6" TEE - (6' RUN 4'BR) OR (10' RUN 2'BR)
8" DEAD END - 85'
14" DEAD END - 135'
16"x14" REDUCER - 35'
6" 90° BEND - 17'
16" 90° BEND - 18'

	MARK GOODWIN & ASSOCIATES, P.A. CONSULTING ENGINEERS P.O. BOX 30606 ALBUQUERQUE, NEW MEXICO 87199 (505) 828-2200, FAX (505) 797-9539						NO.	DATE	DESIGNED BY	DRAWN BY	CHECKED BY
 CITY OF ALBUQUERQUE PUBLIC WORKS DEPARTMENT ENGINEERING DEVELOPMENT GROUP											
TITLE: <i>EAGLE ROCK ESTATES - UNIT III</i> <i>OFF-SITE MASTER UTILITY PLAN</i>											
DESIGN REVIEW COMMITTEE 		CITY ENGINEER APPROVAL		LAST DESIGN UPDATE		MO./DAY/YR.		MO./DAY/YR.			
CITY PROJECT NO. 580183				ZONE MAP NO. C-18		SHEET 11		OF 19			

SCANNED BY
MESA REPRO

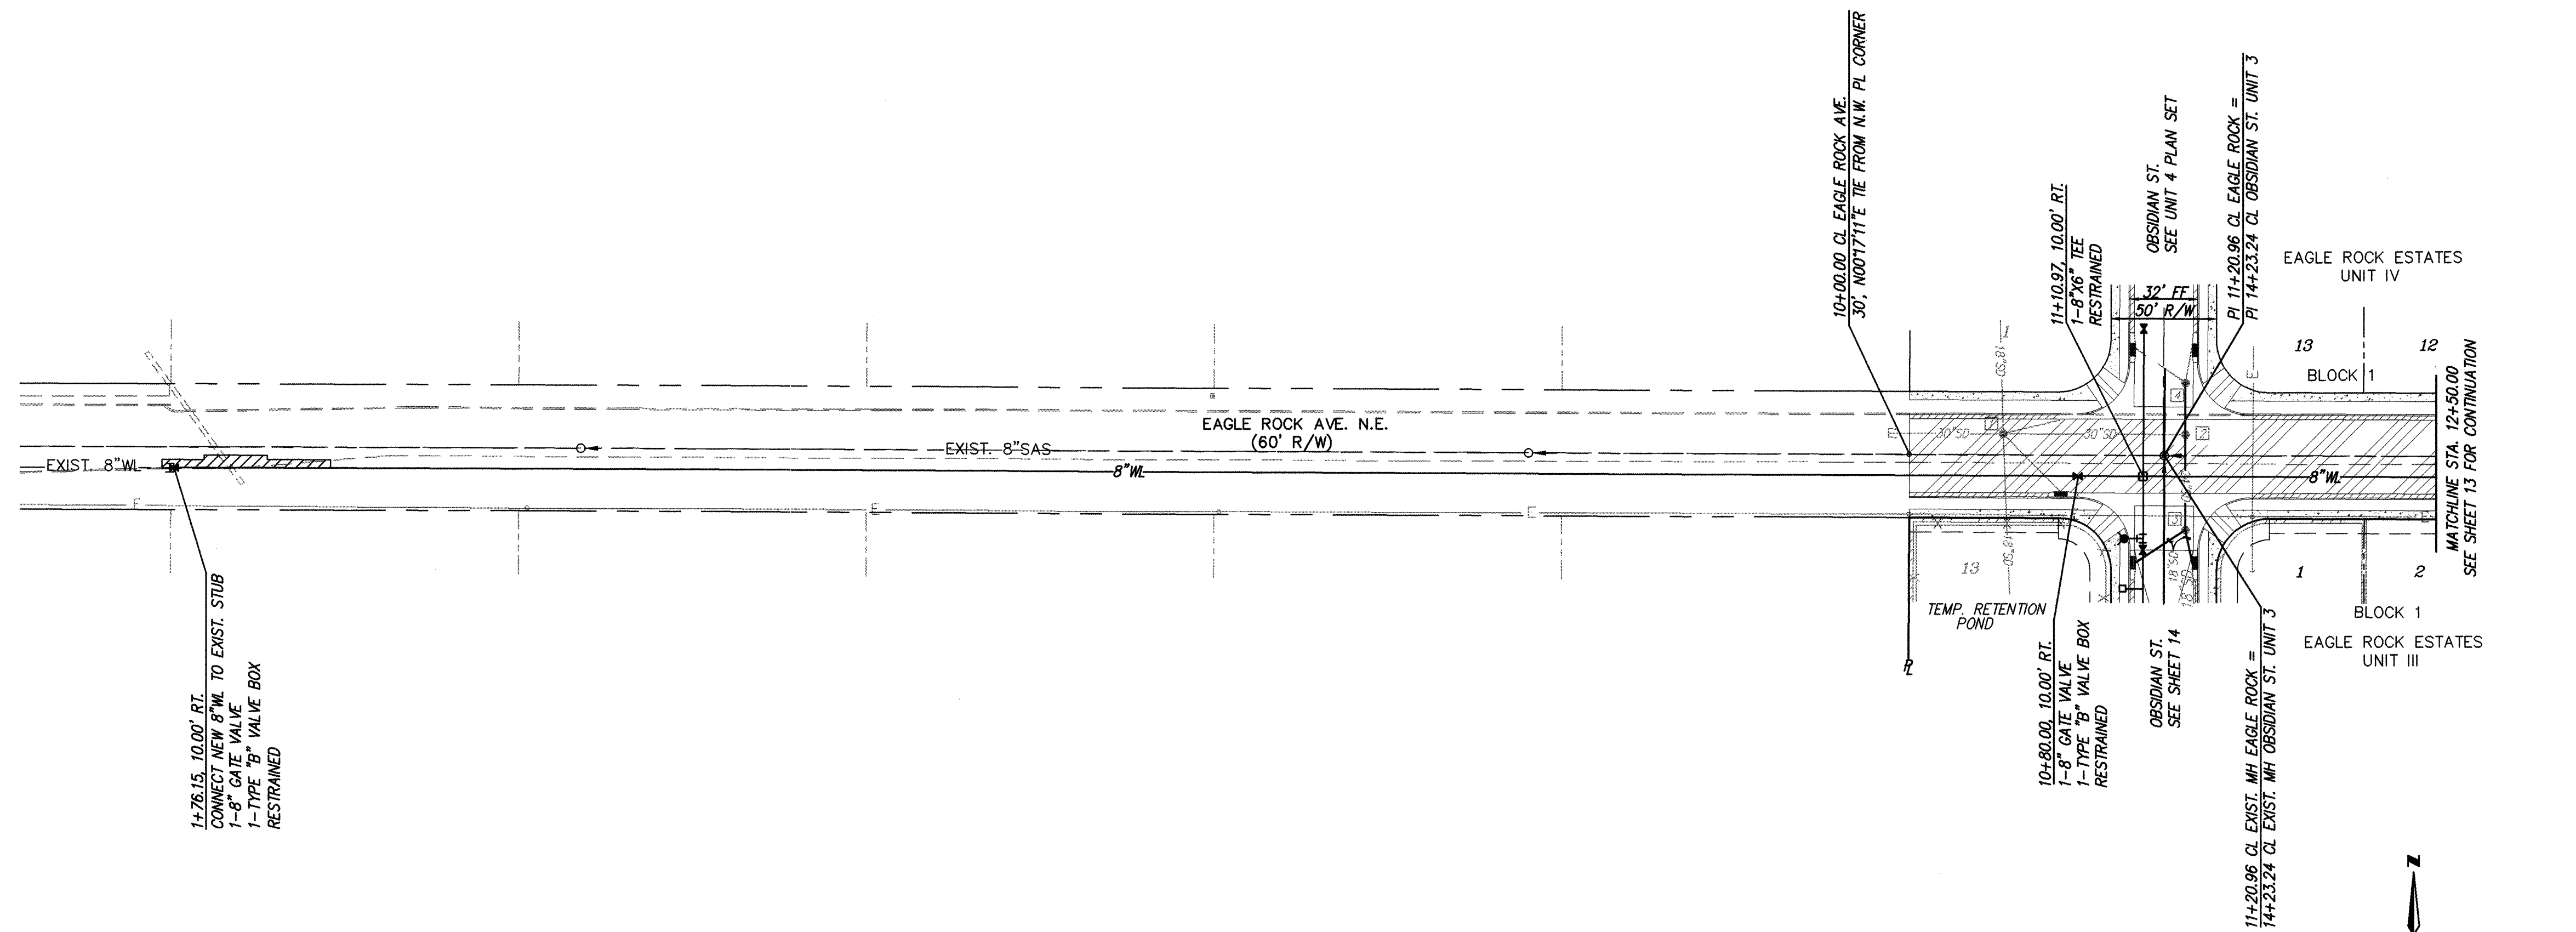

EAGLE ROCK AVE.
STA. 1+76.15 TO STA. 12+50.00
SCALE: HORZ. 1" = 50'
VERT. 1" = 10'

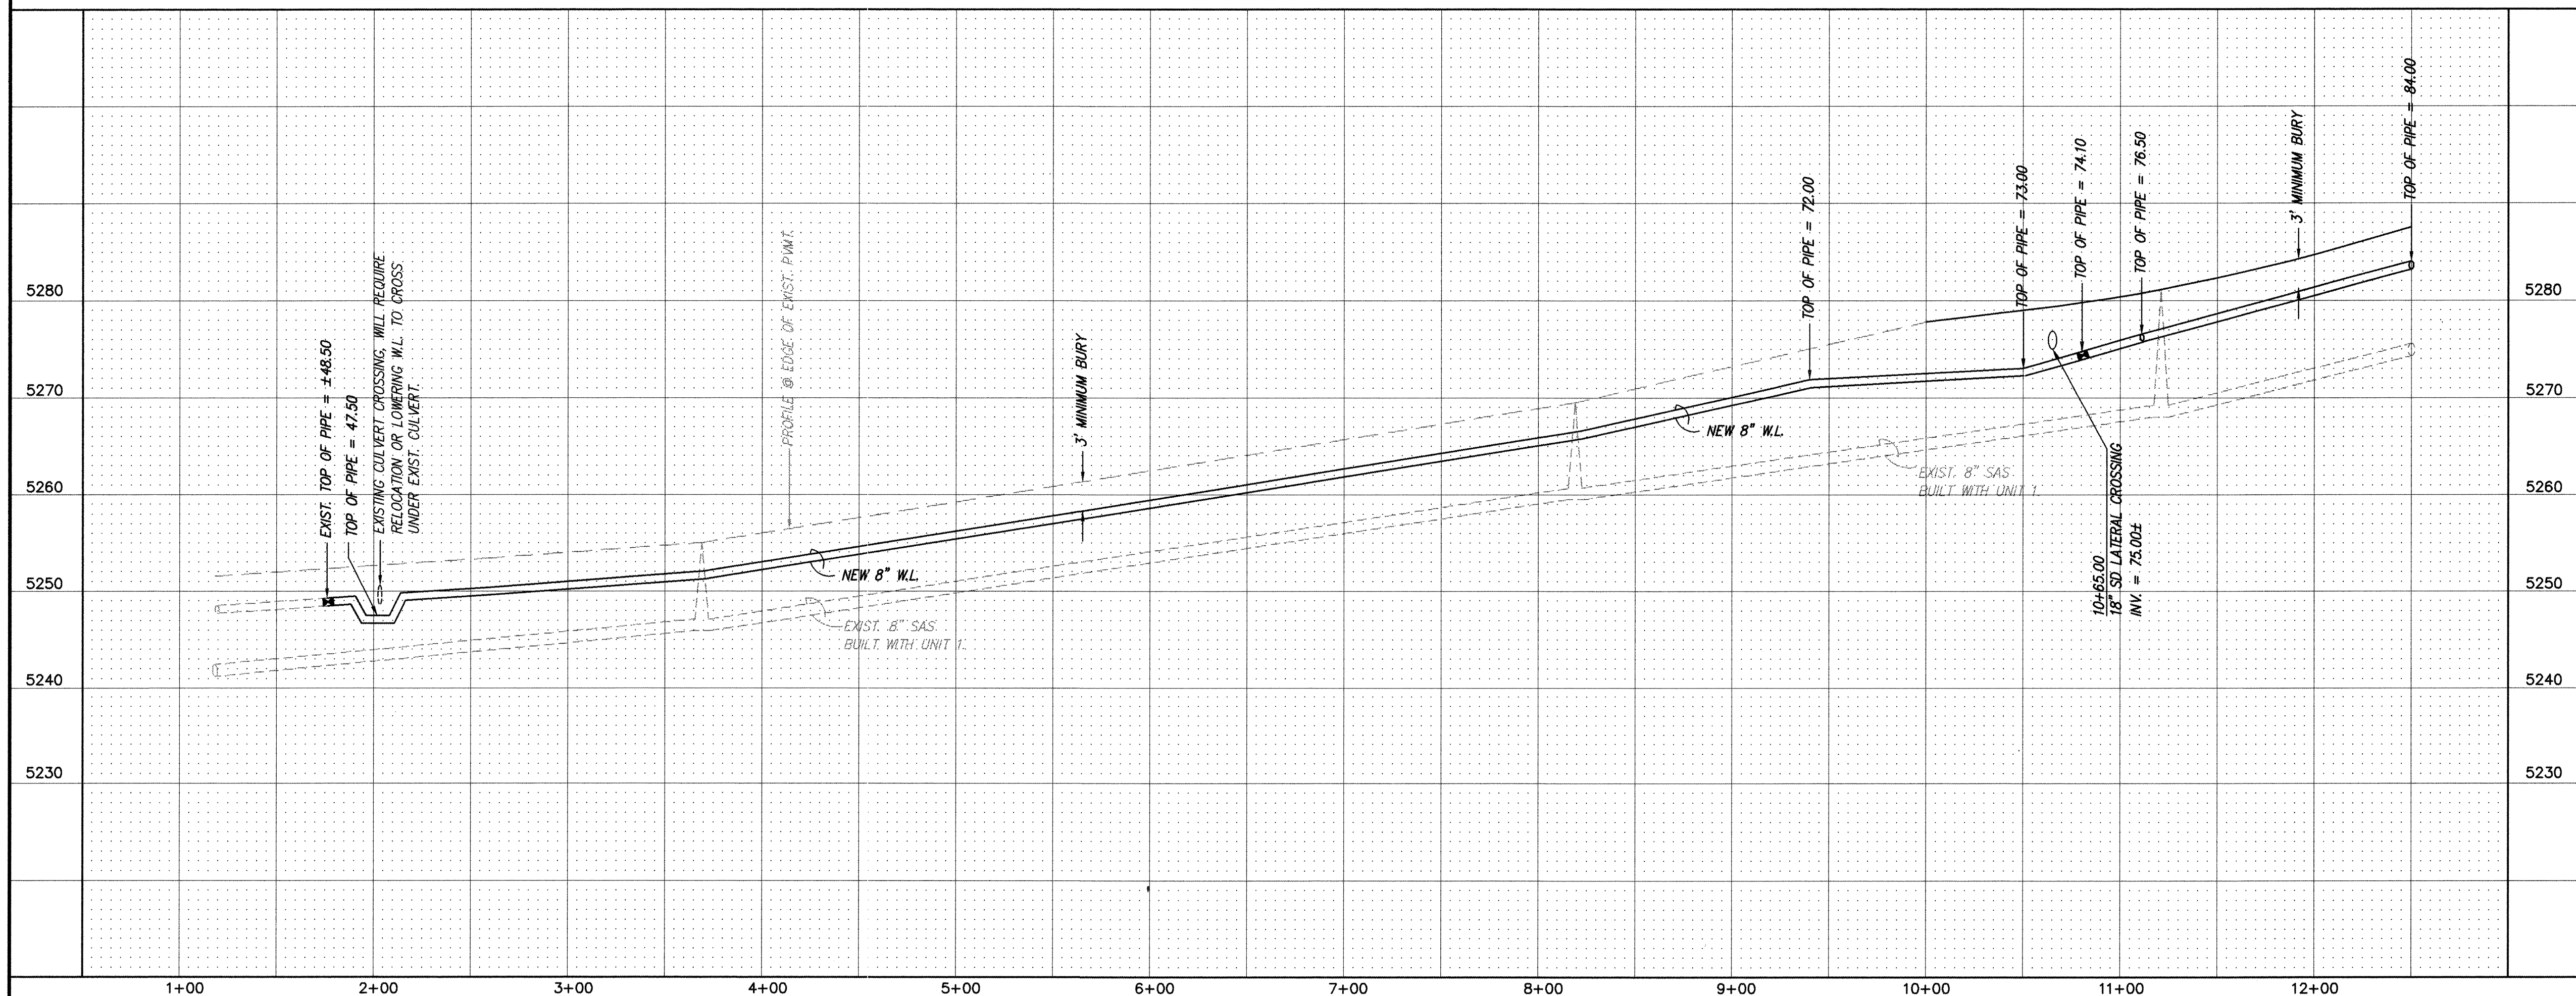

NOTES

1. ALL STATIONING IS CENTERLINE STATIONING.

[illegible]

NOTE:
SEE FILED PLAT FOR
FINAL LOT LOCATIONS

dmg MARK GOODWIN & ASSOCIATES, P.A.
CONSULTING ENGINEERS
P.O. BOX 90606
ALBUQUERQUE, NEW MEXICO 87199
(505) 828-2200, FAX (505) 797-9539

	CITY OF ALBUQUERQUE PUBLIC WORKS DEPARTMENT ENGINEERING DEVELOPMENT GROUP
	TITLE: <i>EAGLE ROCK ESTATES - UNIT III UTILITY IMPROVEMENTS EAGLE ROCK AVENUE</i>

DESIGN REVIEW COMMITTEE

APPROVED

APR 29 1998

DESIGN
REVIEW COMMITTEE

CITY ENGINEER APPROVAL

AST DESIGN UPDATE

MO./DAY/YR.

MO./DAY/YR

CITY PROJECT NO.

ZONE MAP NO	
-------------	--

SHEET OF


7058UNI3\UP-EAGL1\04-16-98

580183


C-18

12 15

SCANNED BY
MESA REPRO

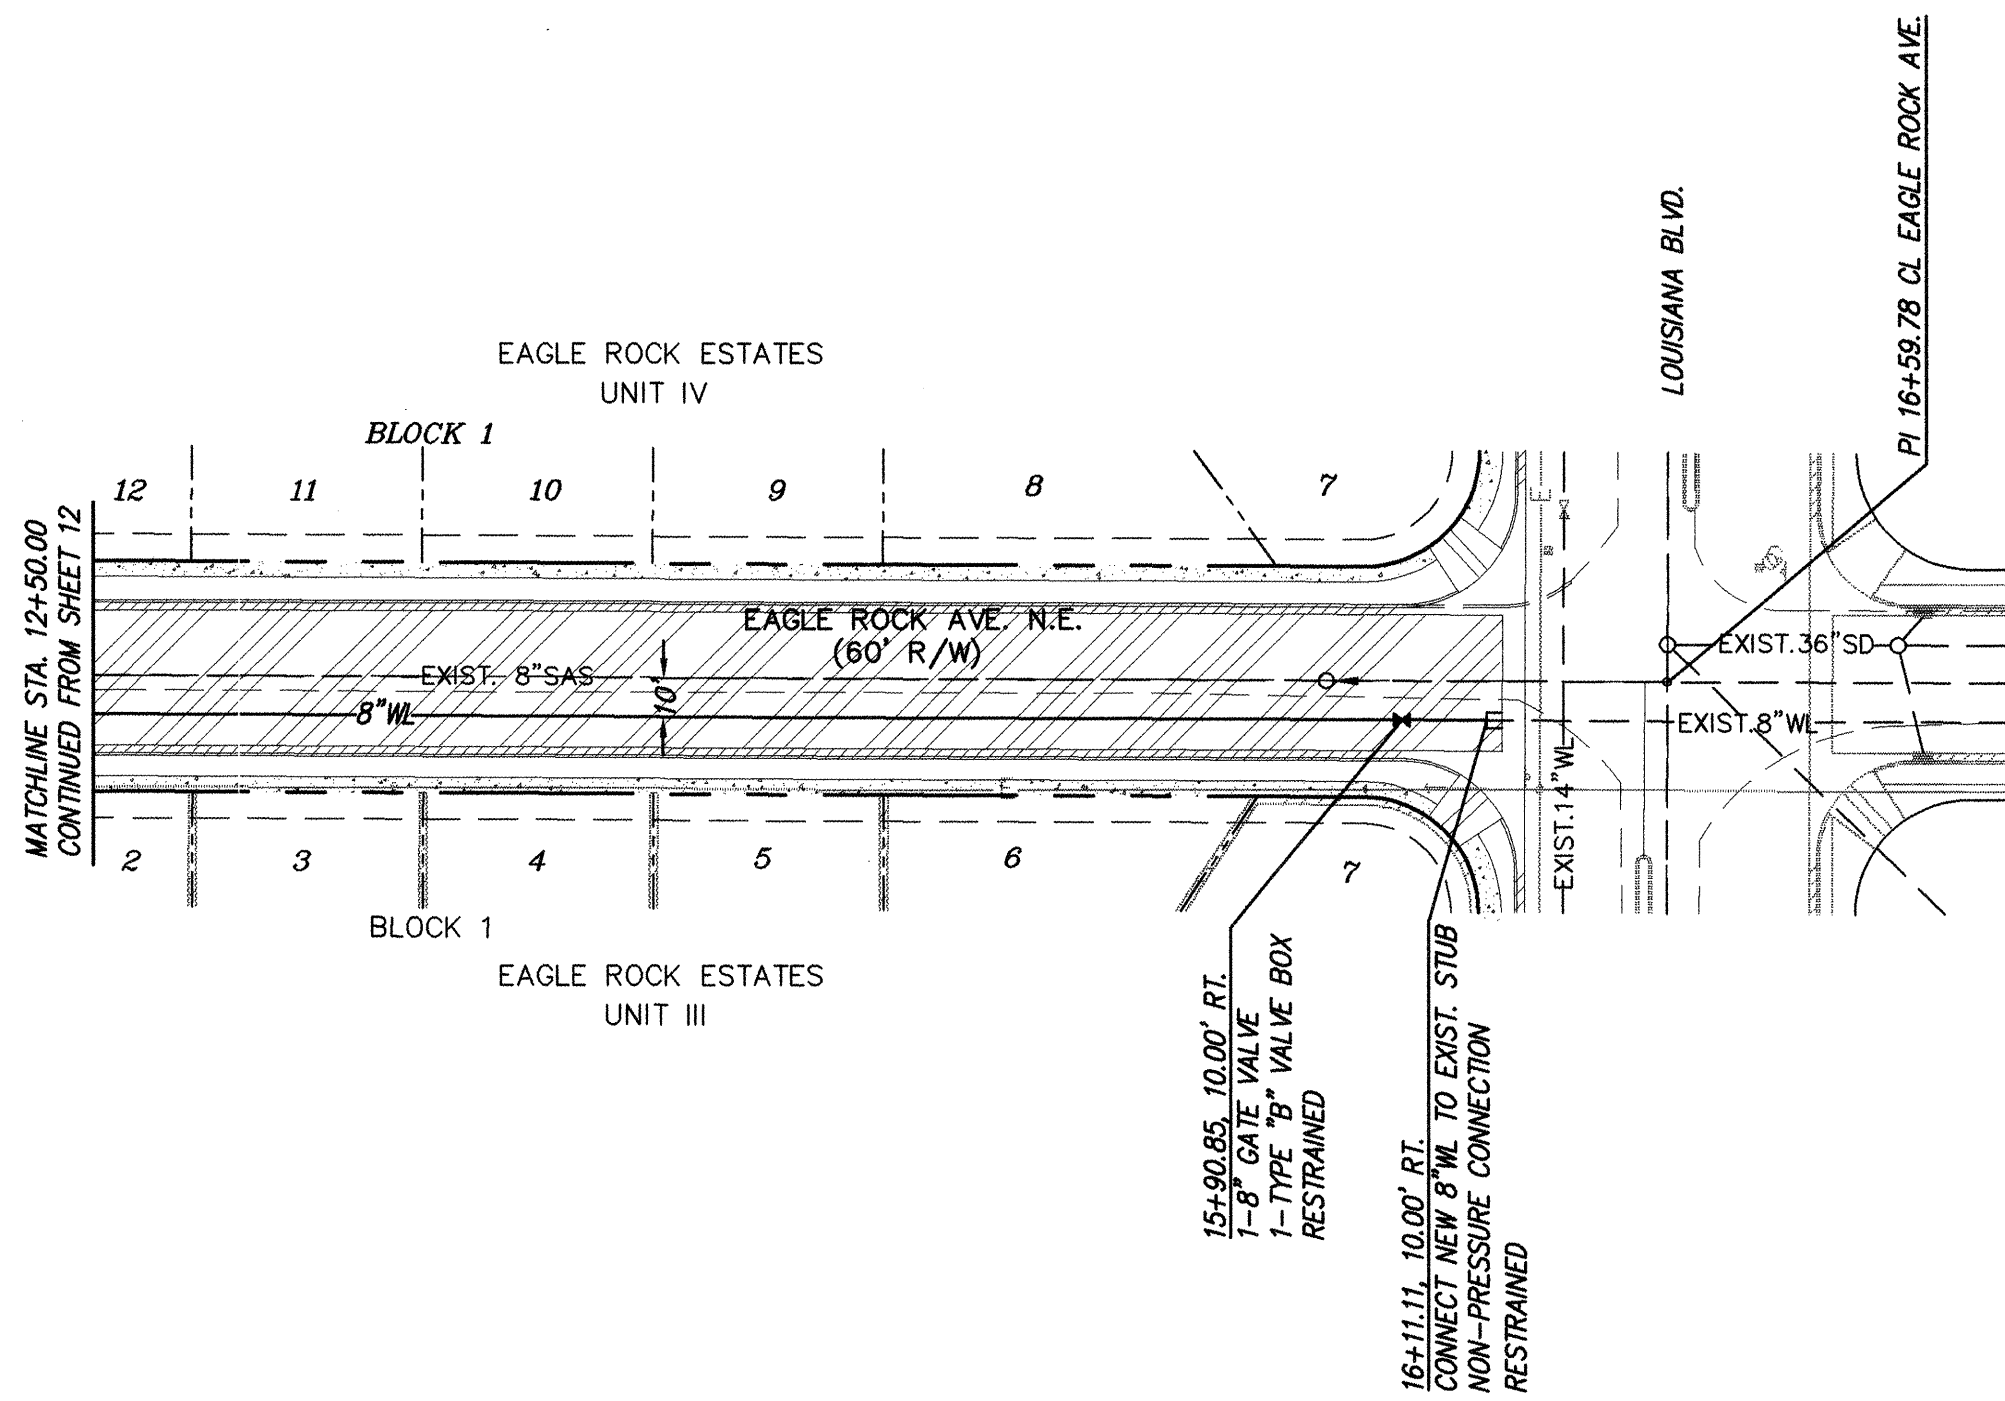

EAGLE ROCK AVE. CONTINUATION
STA. 12+50.00 TO STA. 16+59.78
SCALE: HORIZ. 1" = 50'
VERT. 1" = 10'

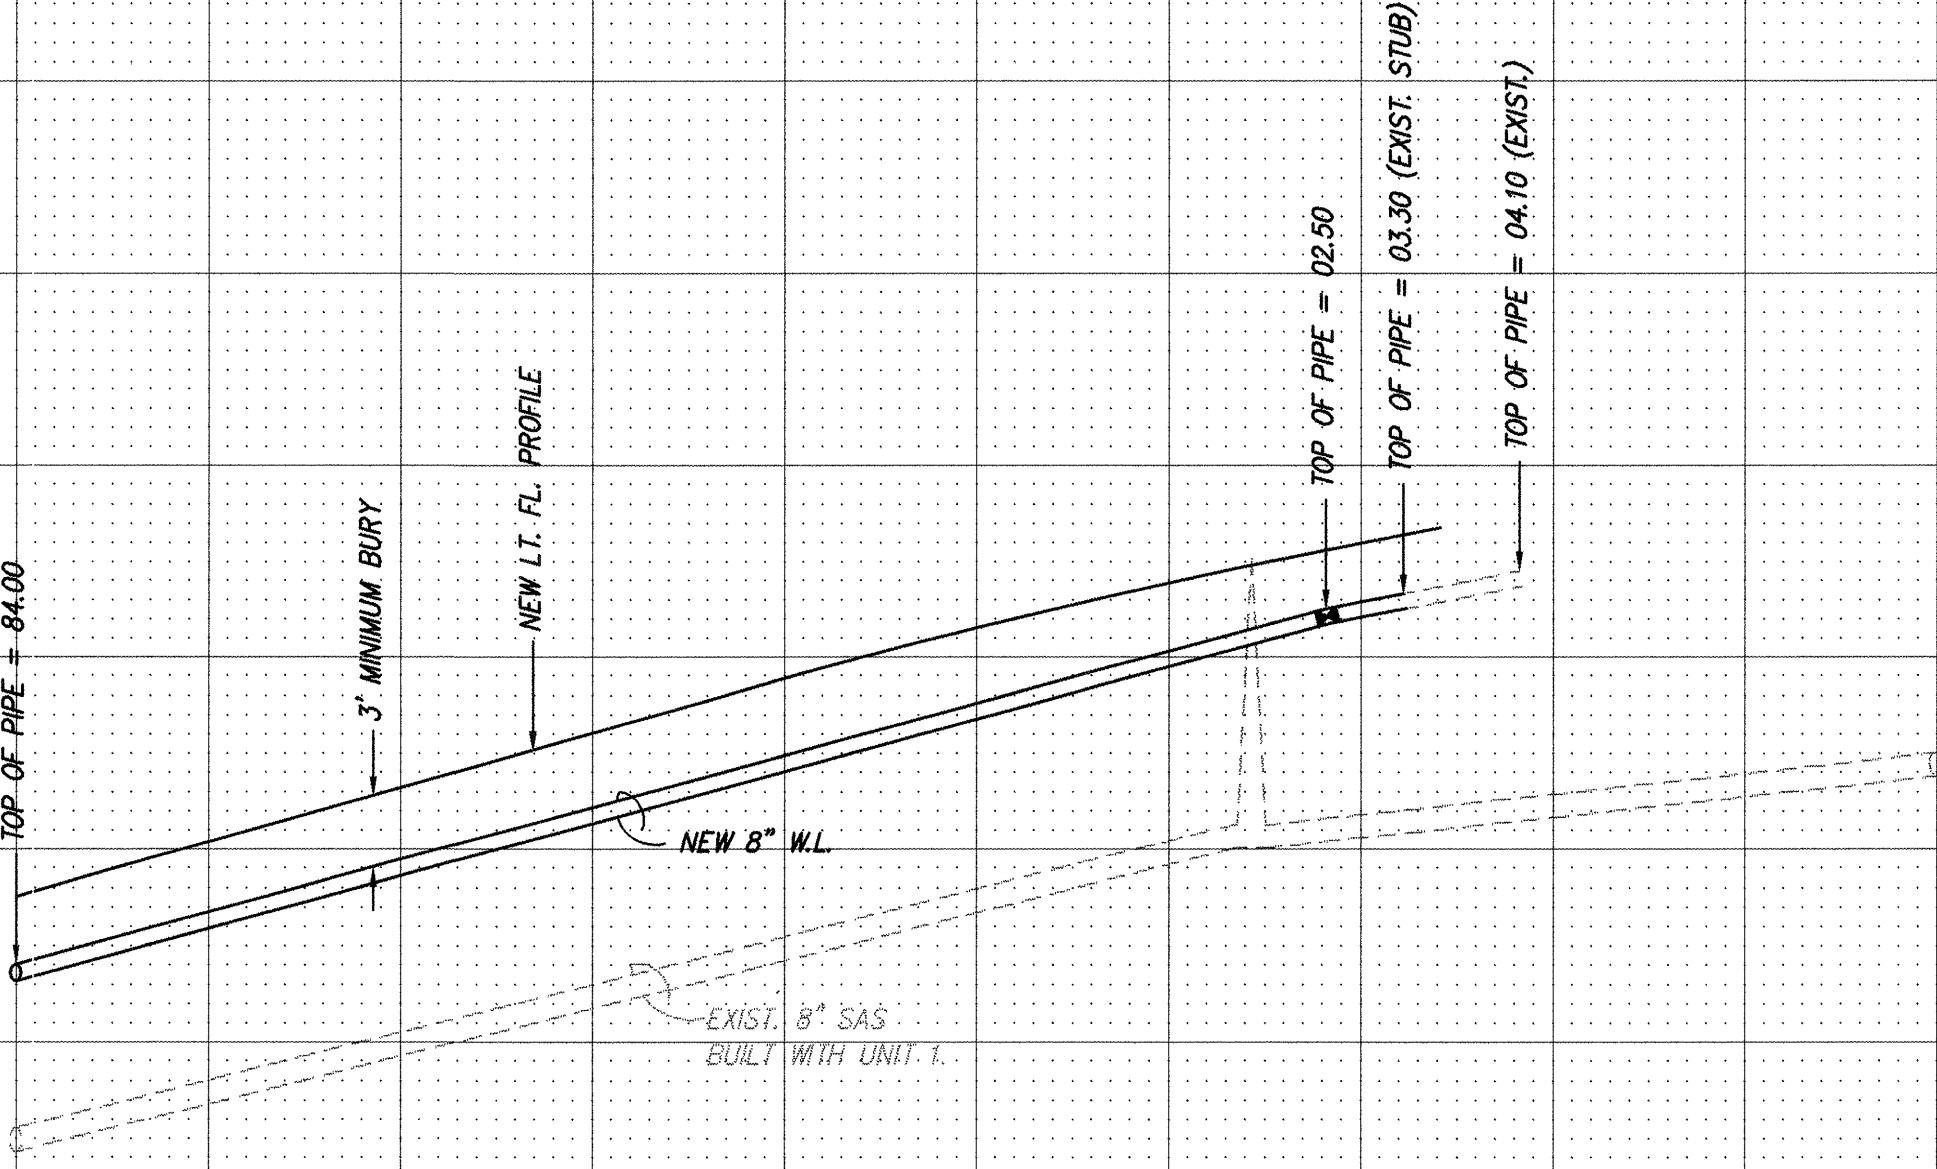

NOTES

1. ALL STATIONING IS CENTERLINE STATIONING.

AS BUILT INFORMATION				BENCH MARKS				SURVEY INFORMATION				ENGINEER'S SEAL			
CONTRACTOR	YOUKING	STANDARD ACS ALUMINUM CAP STAMPED "11-C18"		NO.	BY	DATE		NO.	BY	DATE					
WORK STARTED BY	J. S. INC.	X = 404,894.49													
INSPECTED BY	W. S. INC.	Y = 1,523,837.39													
FIELD NOTES BY	W. S. INC.	Z = 5305.00													
DESIGNED BY	J. S. INC.														
DRAWN BY	J. S. INC.														
CHECKED BY	J. S. INC.														
RECORDED BY															
NO.															

NOTE:
SEE FILED PLAT FOR
FINAL LOT LOCATIONS

dmg MARK GOODWIN & ASSOCIATES, P.A.
CONSULTING ENGINEERS
P.O. BOX 90606
ALBUQUERQUE, NEW MEXICO 87199
(505) 828-2200, FAX (505) 797-9539

CITY OF ALBUQUERQUE
PUBLIC WORKS DEPARTMENT
ENGINEERING DEVELOPMENT GROUP
TITLE: EAGLE ROCK ESTATES - UNIT III
UTILITY IMPROVEMENTS
EAGLE ROCK AVENUE CONTINUATION


APPROVED
APR 29 1998
DESIGN REVIEW COMMITTEE

CITY ENGINEER APPROVAL

LAST DESIGN UPDATE

MO./DAY/YR.	MO./DAY/YR.

SCANNED BY
MESA REPRO

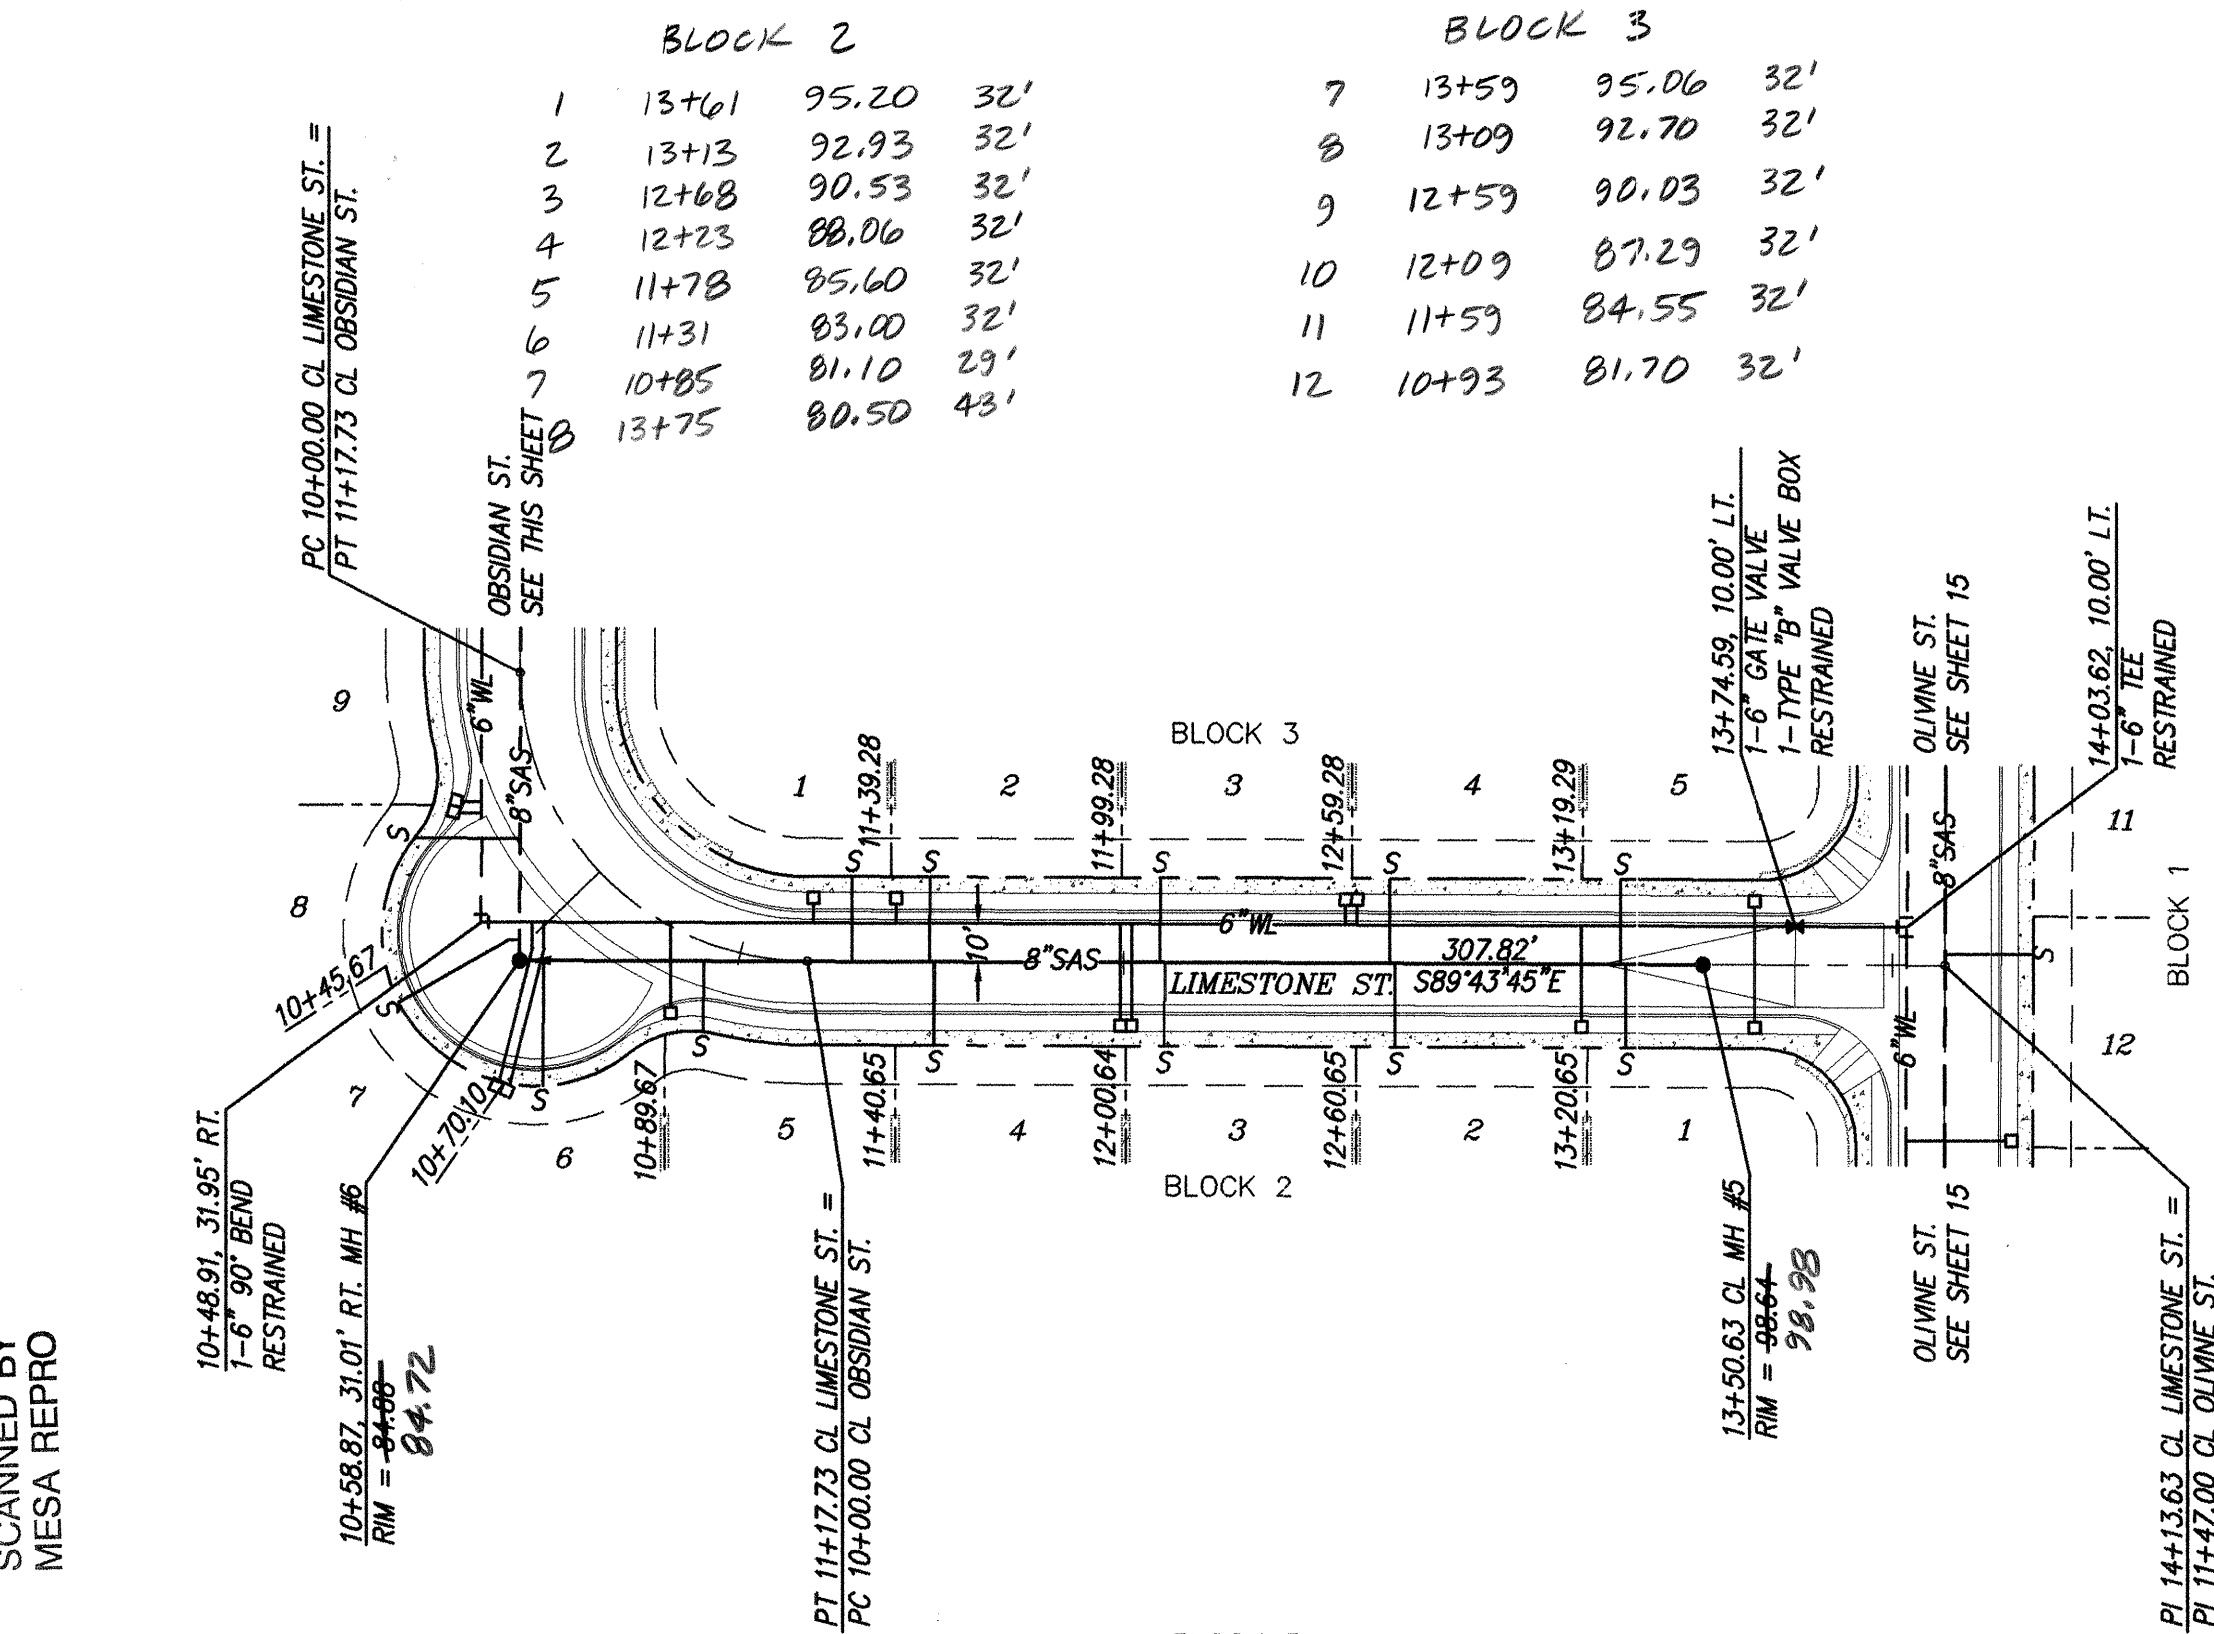




BLOCK 2
SANITARY SEWER SERVICES

LOT	STA.	INV. ELEV. @ PL	LENGTH @ PL	INV. ELEV. @ M.H.
1	13+30.5	93.94	22.00'	N/A
2	12+70.5	90.82	22.00'	N/A
3	12+10.5	87.53	22.00'	N/A
4	11+50.5	84.21	22.00'	N/A
5	10+90.5	81.68	18.53'	N/A
6	10+75.5	80.95	32.70'	N/A
7	10+50.5	80.26	32.70'	N/A
8	10+29.0	79.83	27.39'	N/A

BLOCK 3
SANITARY SEWER SERVICES

LOT	STA.	INV. ELEV. @ PL	LENGTH @ PL	INV. ELEV. @ M.H.
1	11+29.0	85.11	22.00'	N/A
2	11+49.0	84.11	22.00'	N/A
3	12+09.0	87.44	22.00'	N/A
4	12+69.0	90.73	22.00'	N/A
5	13+29.0	93.87	22.00'	N/A

LIMESTONE STREET
STA. 10+00.00 TO STA. 14+13.63
SCALE: HORIZ. 1" = 50'
VERT. 1" = 10'

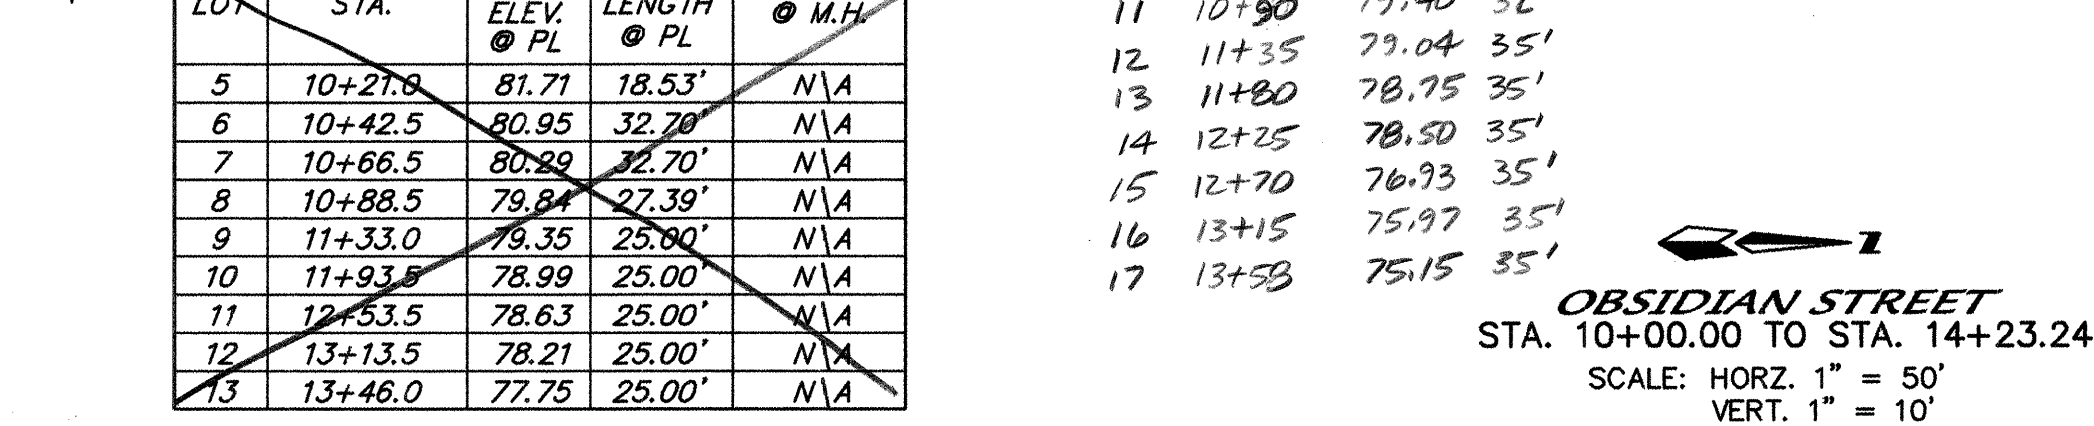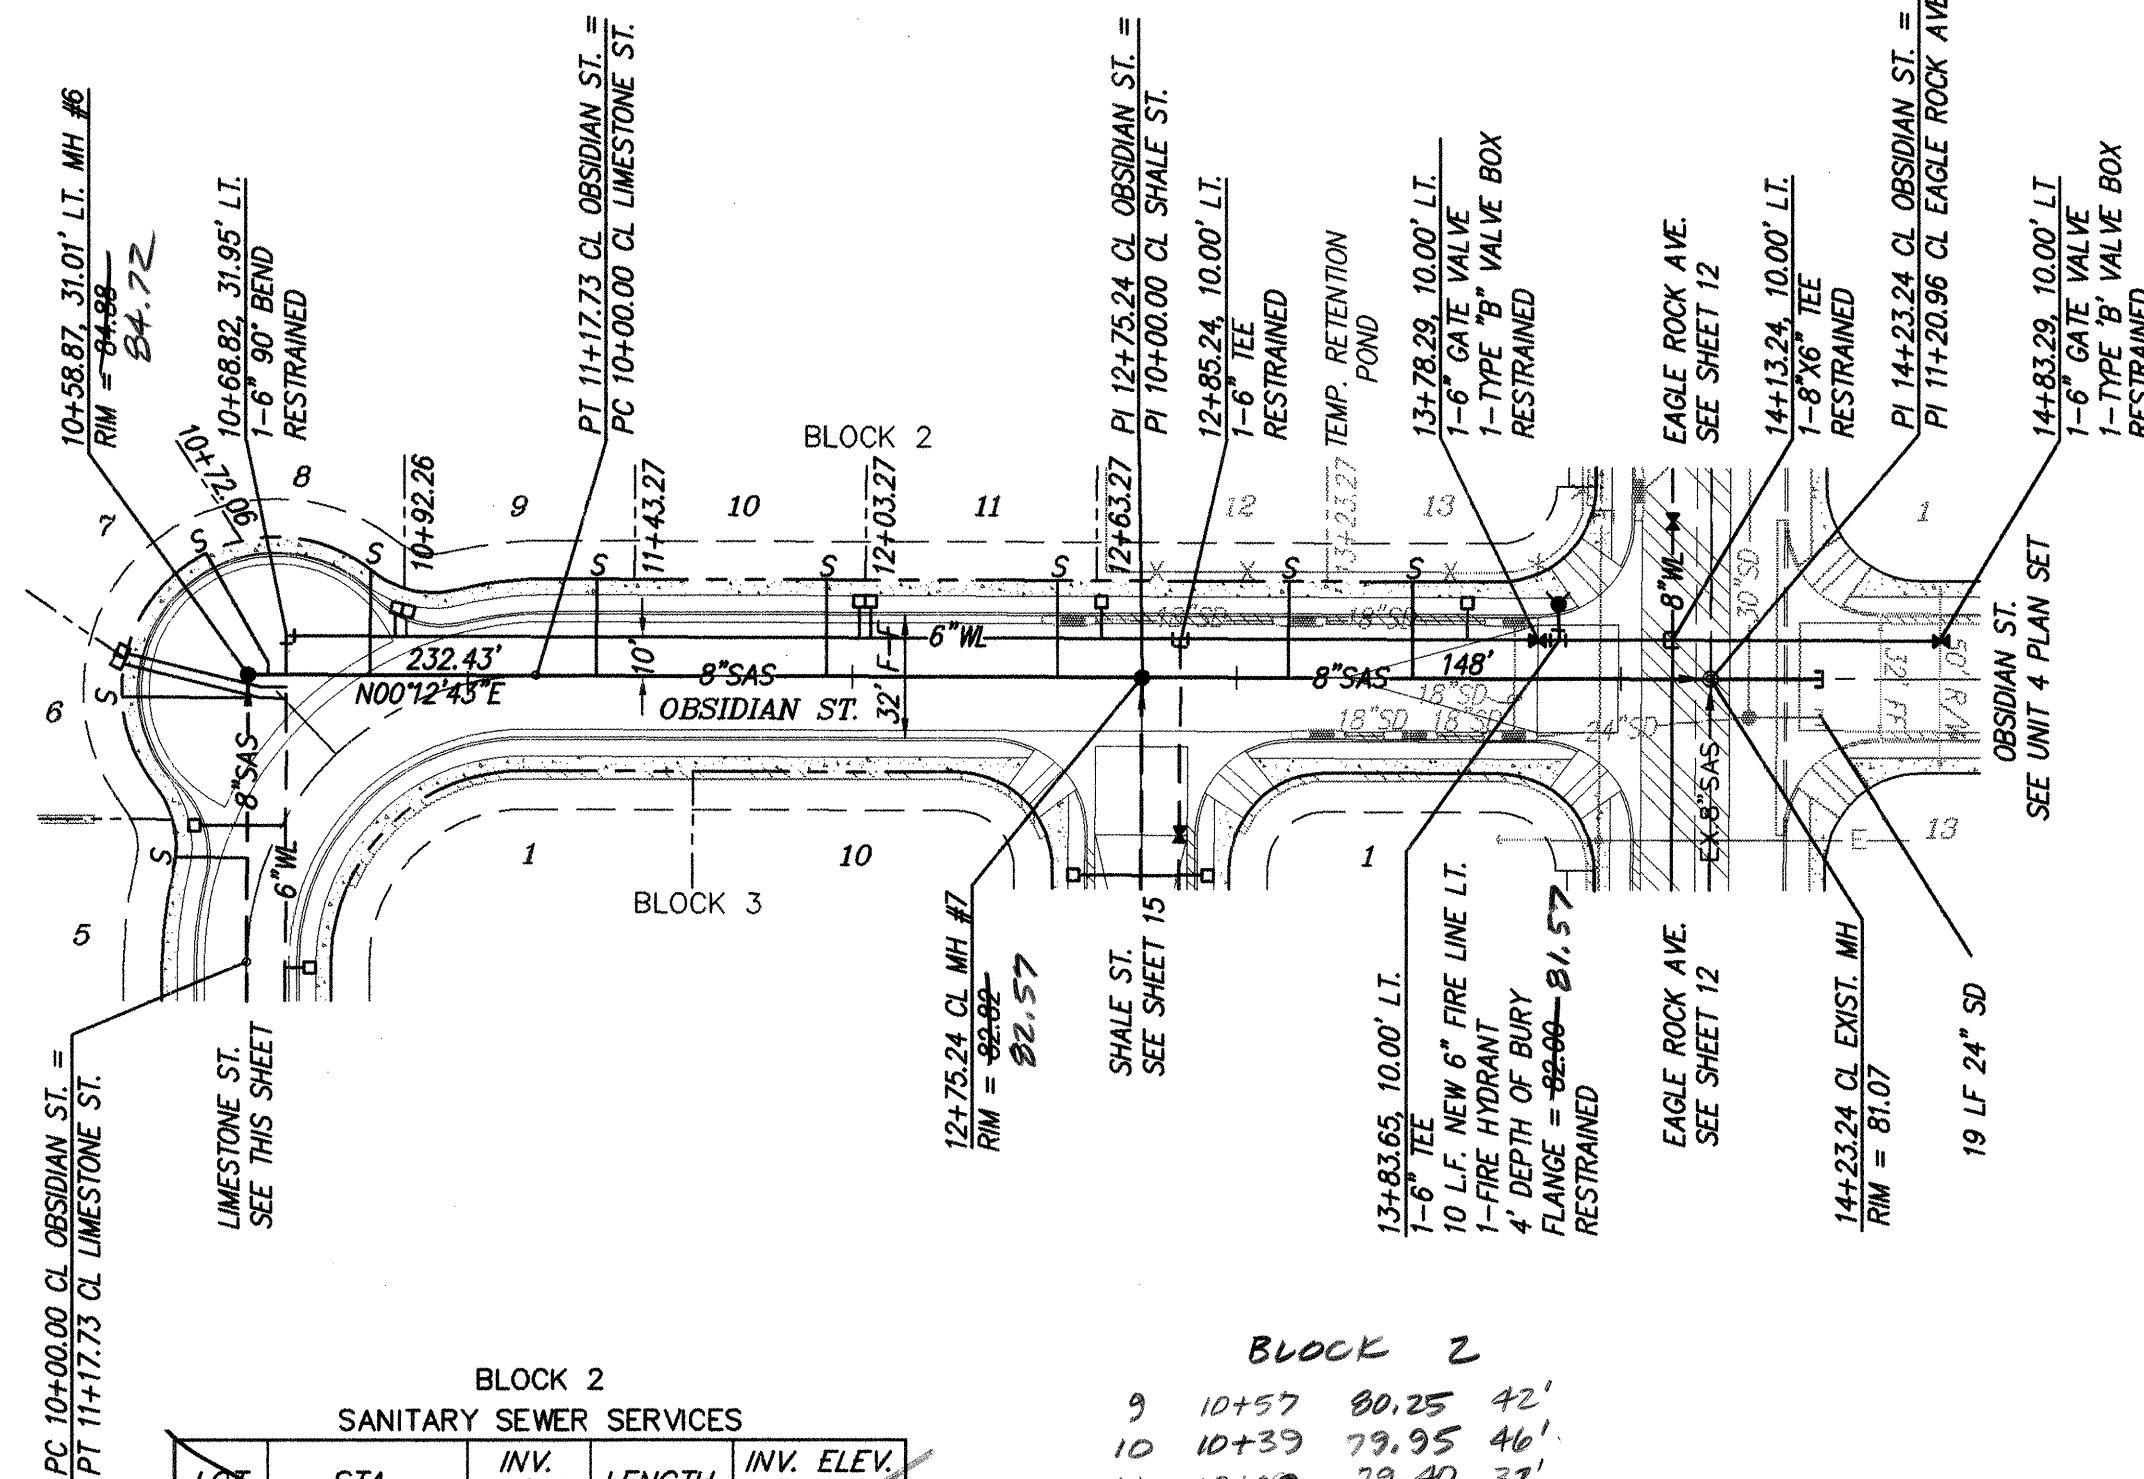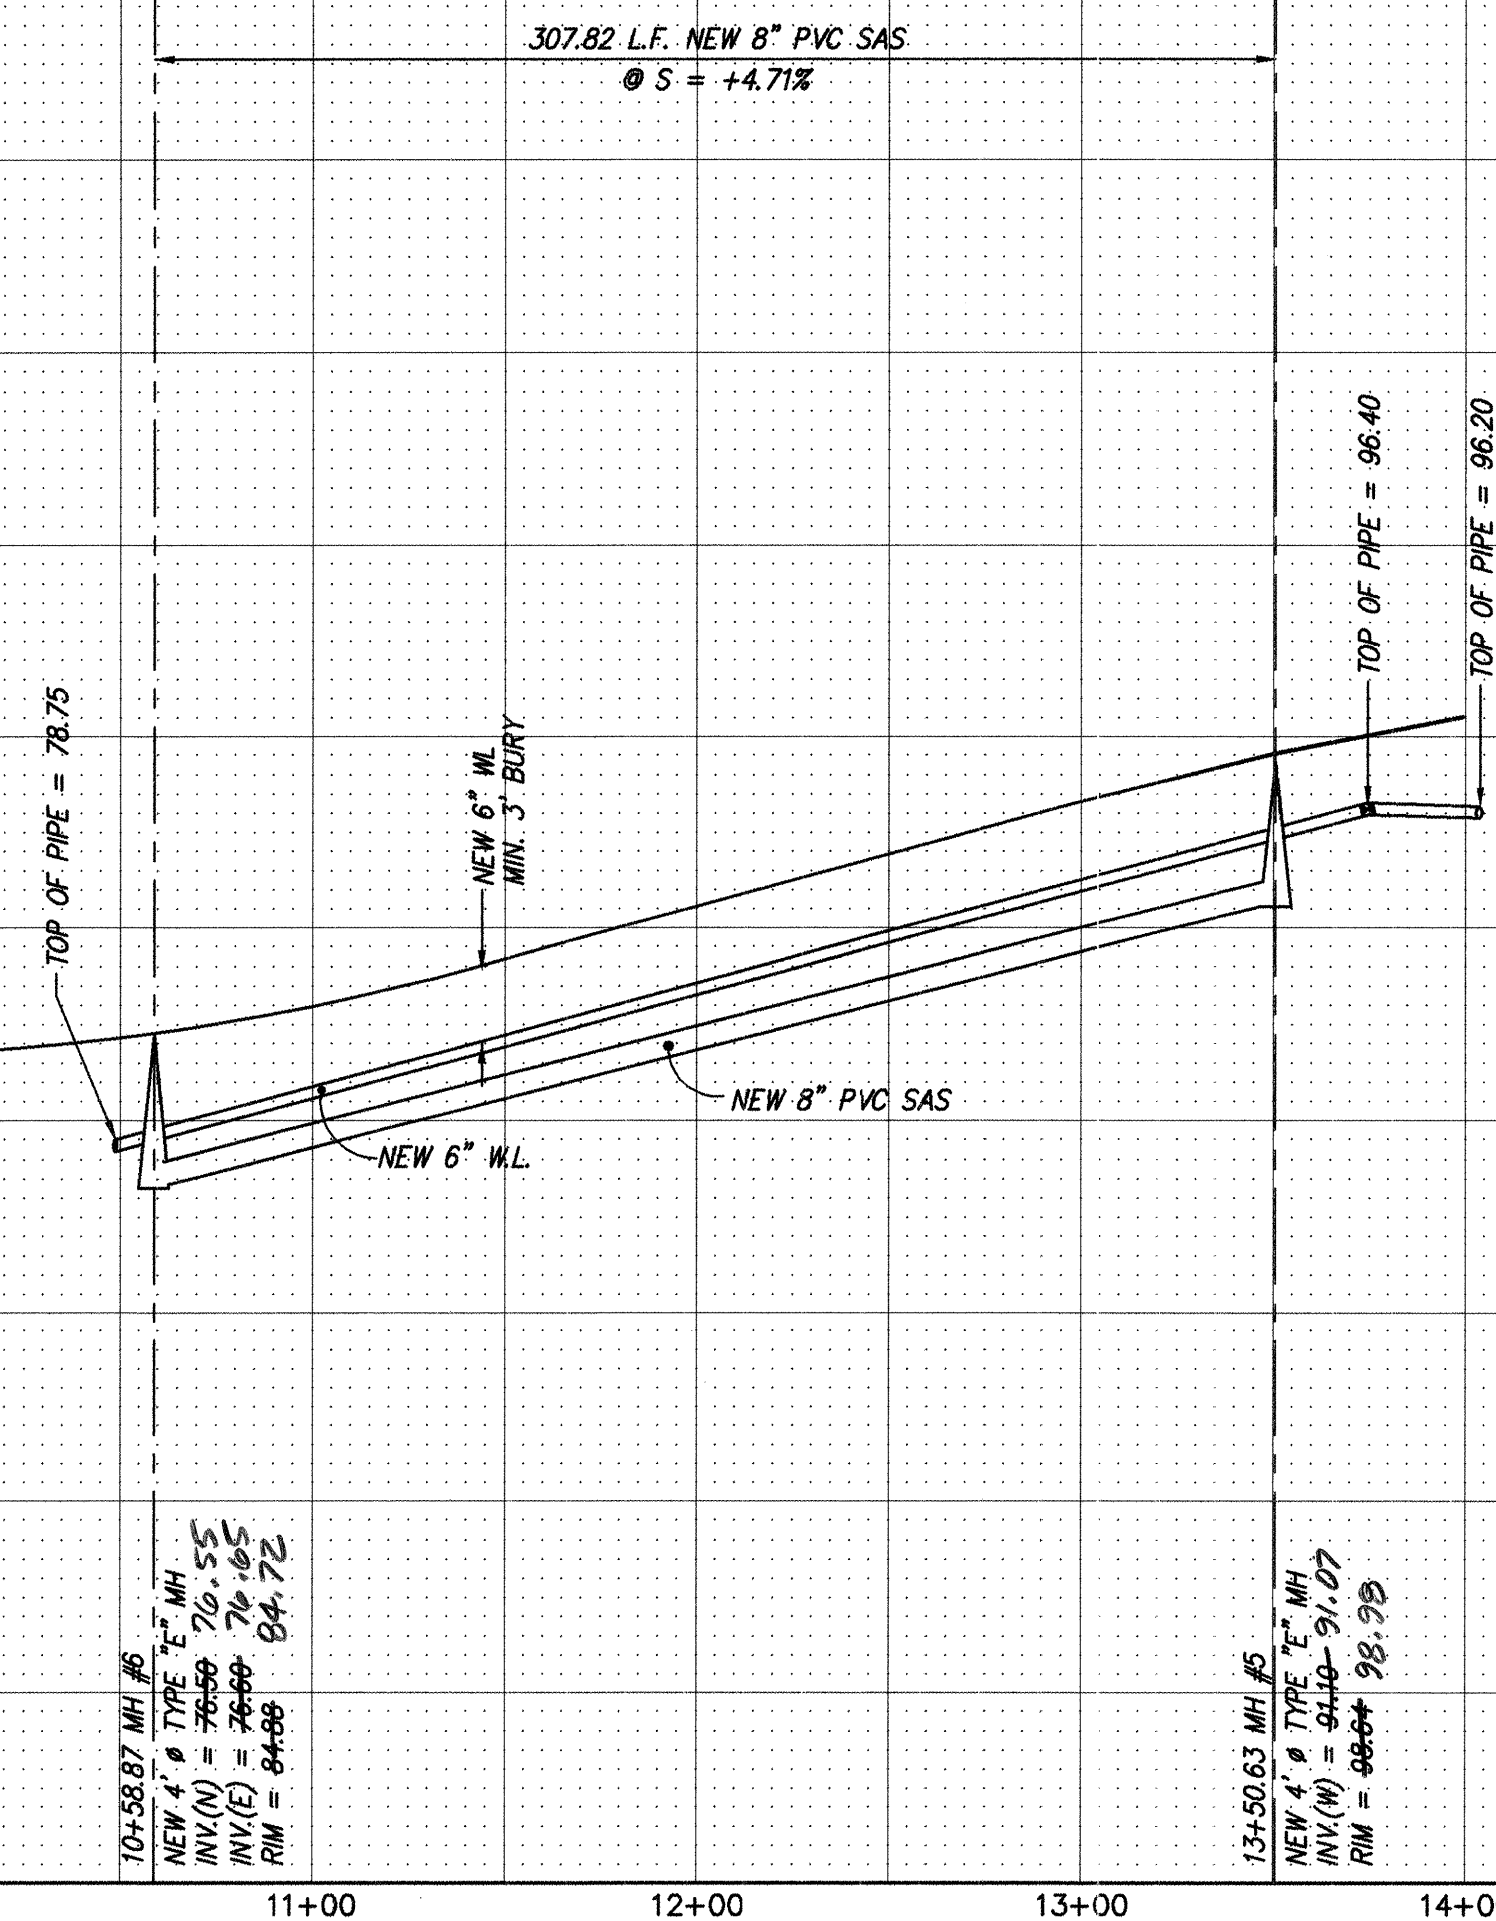

NOTES

1. ALL STATIONING IS CENTERLINE STATIONING.

NOTE: SEE FILED PLAT FOR FINAL LOT LOCATIONS

dmg MARK GOODWIN & ASSOCIATES, P.A.
CONSULTING ENGINEERS
P.O. BOX 90606
ALBUQUERQUE, NEW MEXICO 87199
(505) 828-2200, FAX (505) 797-9539


CITY OF ALBUQUERQUE
PUBLIC WORKS DEPARTMENT
ENGINEERING DEVELOPMENT GROUP
TITLE: EAGLE ROCK ESTATES - UNIT III
UTILITY IMPROVEMENTS
LIMESTONE STREET AND OBSIDIAN STREET

APPROVED
APR 29 1998
DESIGN REVIEW COMMITTEE

CITY ENGINEER APPROVAL

LAST DESIGN UPDATE
NO./DAY/YR.
MO./DAY/YR.

CITY PROJECT NO. 580183 ZONE MAP NO. C-18 SHEET 14 OF 19

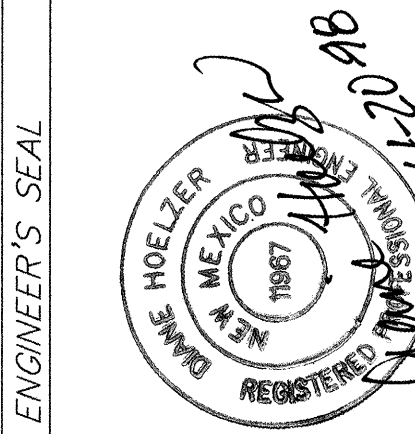

ENGINEER'S SEAL

REVISIONS
NO. DATE
REMARKS
BY
DATE
DESIGNED BY DLH DATE 02/98
DRAWN BY DBC, BLN, FSM, KJS DATE 02/98
CHECKED BY DMG DATE 02/98

AS BUILT INFORMATION

BENCH MARKS

SURVEY INFORMATION

FIELD NOTES

ENGINEER'S SEAL

REVISIONS

REVISIONS

SCANNED BY
MESA REPRO

SANITARY SEWER SERVICES
BLOCK 1

LOT	STA.	INV. ELEV. @ PL	LENGTH @ PL	INV. ELEV. @ M.H.
6	13+80.00	5294.22	27.81'	N/A
7	13+65.50	5294.74	35.05'	N/A
8	13+59.00	5294.94	34.25'	N/A
9	13+29.00	5295.63	19.86'	N/A
10	12+70.00	5296.16	23.00'	N/A
11	12+10.00	5296.61	23.00'	N/A
12	11+50.00	5297.03	23.00'	N/A
13	10+90.00	5296.65	23.00'	N/A

BLOCK 1

10	13+78	97.20	44'
11	13+34	95.50	30'
12	12+87	96.28	33'
13	12+43	96.61	33'
14	11+98	96.65	33'
15	11+53	97.27	33'
16	11+08	97.29	33'
17	10+55	96.70	33'


OLIVINE STREET
STA. 10+00.00 TO STA. 14+22.13
SCALE: HORZ. 1" = 50'
VERT. 1" = 10'

BLOCK 1

1	10+55	80.05	33'
2	11+02	82.40	33'
3	11+47	84.65	33'
4	11+92	86.90	33'
5	12+37	89.15	33'
6	12+82	91.40	33'
7	13+28	93.10	30'
8	13+67	95.30	44'
9	13+84	96.20	42'

BLOCK 3

1	10+56	80.18	33'
2	11+06	82.60	33'
3	11+56	85.10	33'
4	12+06	87.60	33'
5	12+56	90.10	33'
6	13+24	93.00	36'

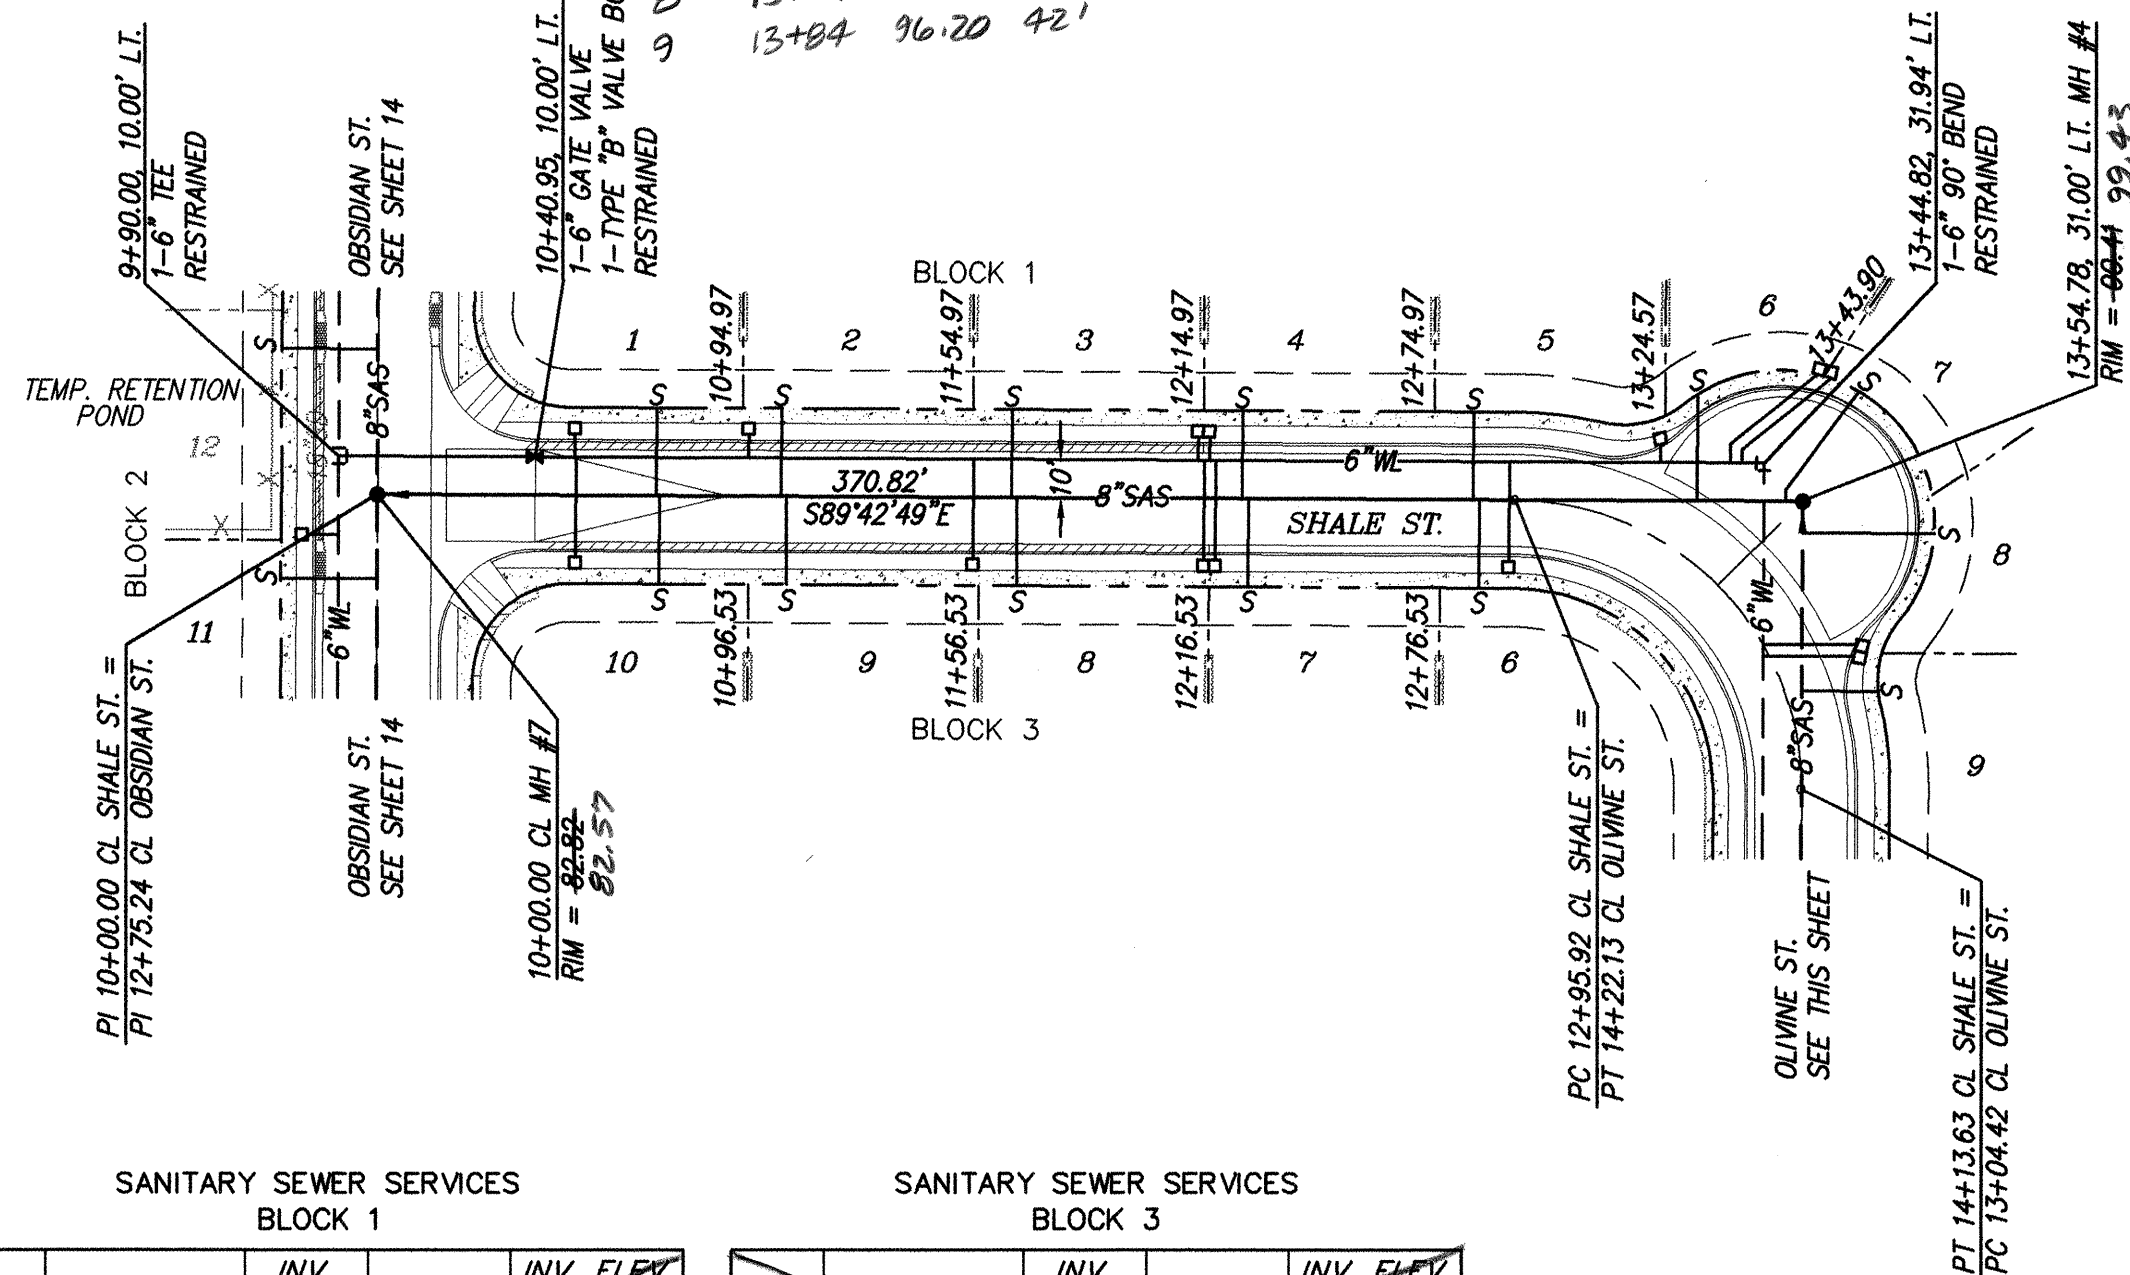

SANITARY SEWER SERVICES
BLOCK 1

LOT	STA.	INV. ELEV. @ PL	LENGTH @ PL	INV. ELEV. @ M.H.
1	10+72.50	5281.10	23.00'	N/A
2	11+05.00	5282.73	23.00'	N/A
3	11+65.00	5285.72	23.00'	N/A
4	12+25.00	5288.72	23.00'	N/A
5	12+86.50	5291.95	23.00'	N/A
6	13+38.00	5294.65	23.00'	N/A
7	13+52.50	5295.21	35.05'	N/A
8	13+59.00	5295.43	34.25'	N/A
9	13+89.00	5296.17	19.86'	N/A

SANITARY SEWER SERVICES
BLOCK 3

LOT	STA.	INV. ELEV. @ PL	LENGTH @ PL	INV. ELEV. @ M.H.
6	12+86.50	5291.95	23.00'	N/A
7	12+26.50	5288.78	23.00'	N/A
8	11+66.50	5285.80	23.00'	N/A
9	11+06.50	5282.80	23.00'	N/A
10	10+73.50	5281.54	23.00'	N/A

SHALE STREET
STA. 10+00.00 TO STA. 14+13.63
SCALE: HORZ. 1" = 50'
VERT. 1" = 10'

NOTES

1. ALL STATIONING IS CENTERLINE STATIONING.

AS BUILT INFORMATION

CONTRACTOR

STANDARD ACS ALUMINUM CAP STAMPED "11-C18"

DATE

BY

NO.

ENGINEER'S SEAL

REVISIONS

DATE

DESIGNED BY

DRAWN BY

CHECKED BY

CITY OF ALBUQUERQUE
PUBLIC WORKS DEPARTMENT
ENGINEERING DEVELOPMENT GROUP
TITLE: EAGLE ROCK ESTATES - UNIT III
UTILITY IMPROVEMENTS
OLIVINE STREET AND SHALE STREET


APPROVAL
APR 29 1998
DESIGN REVIEW COMMITTEE

CITY PROJECT NO. 580183


ZONE MAP NO. C-18

SHEET 15 OF 19

SCANNED BY
MESA REPRO

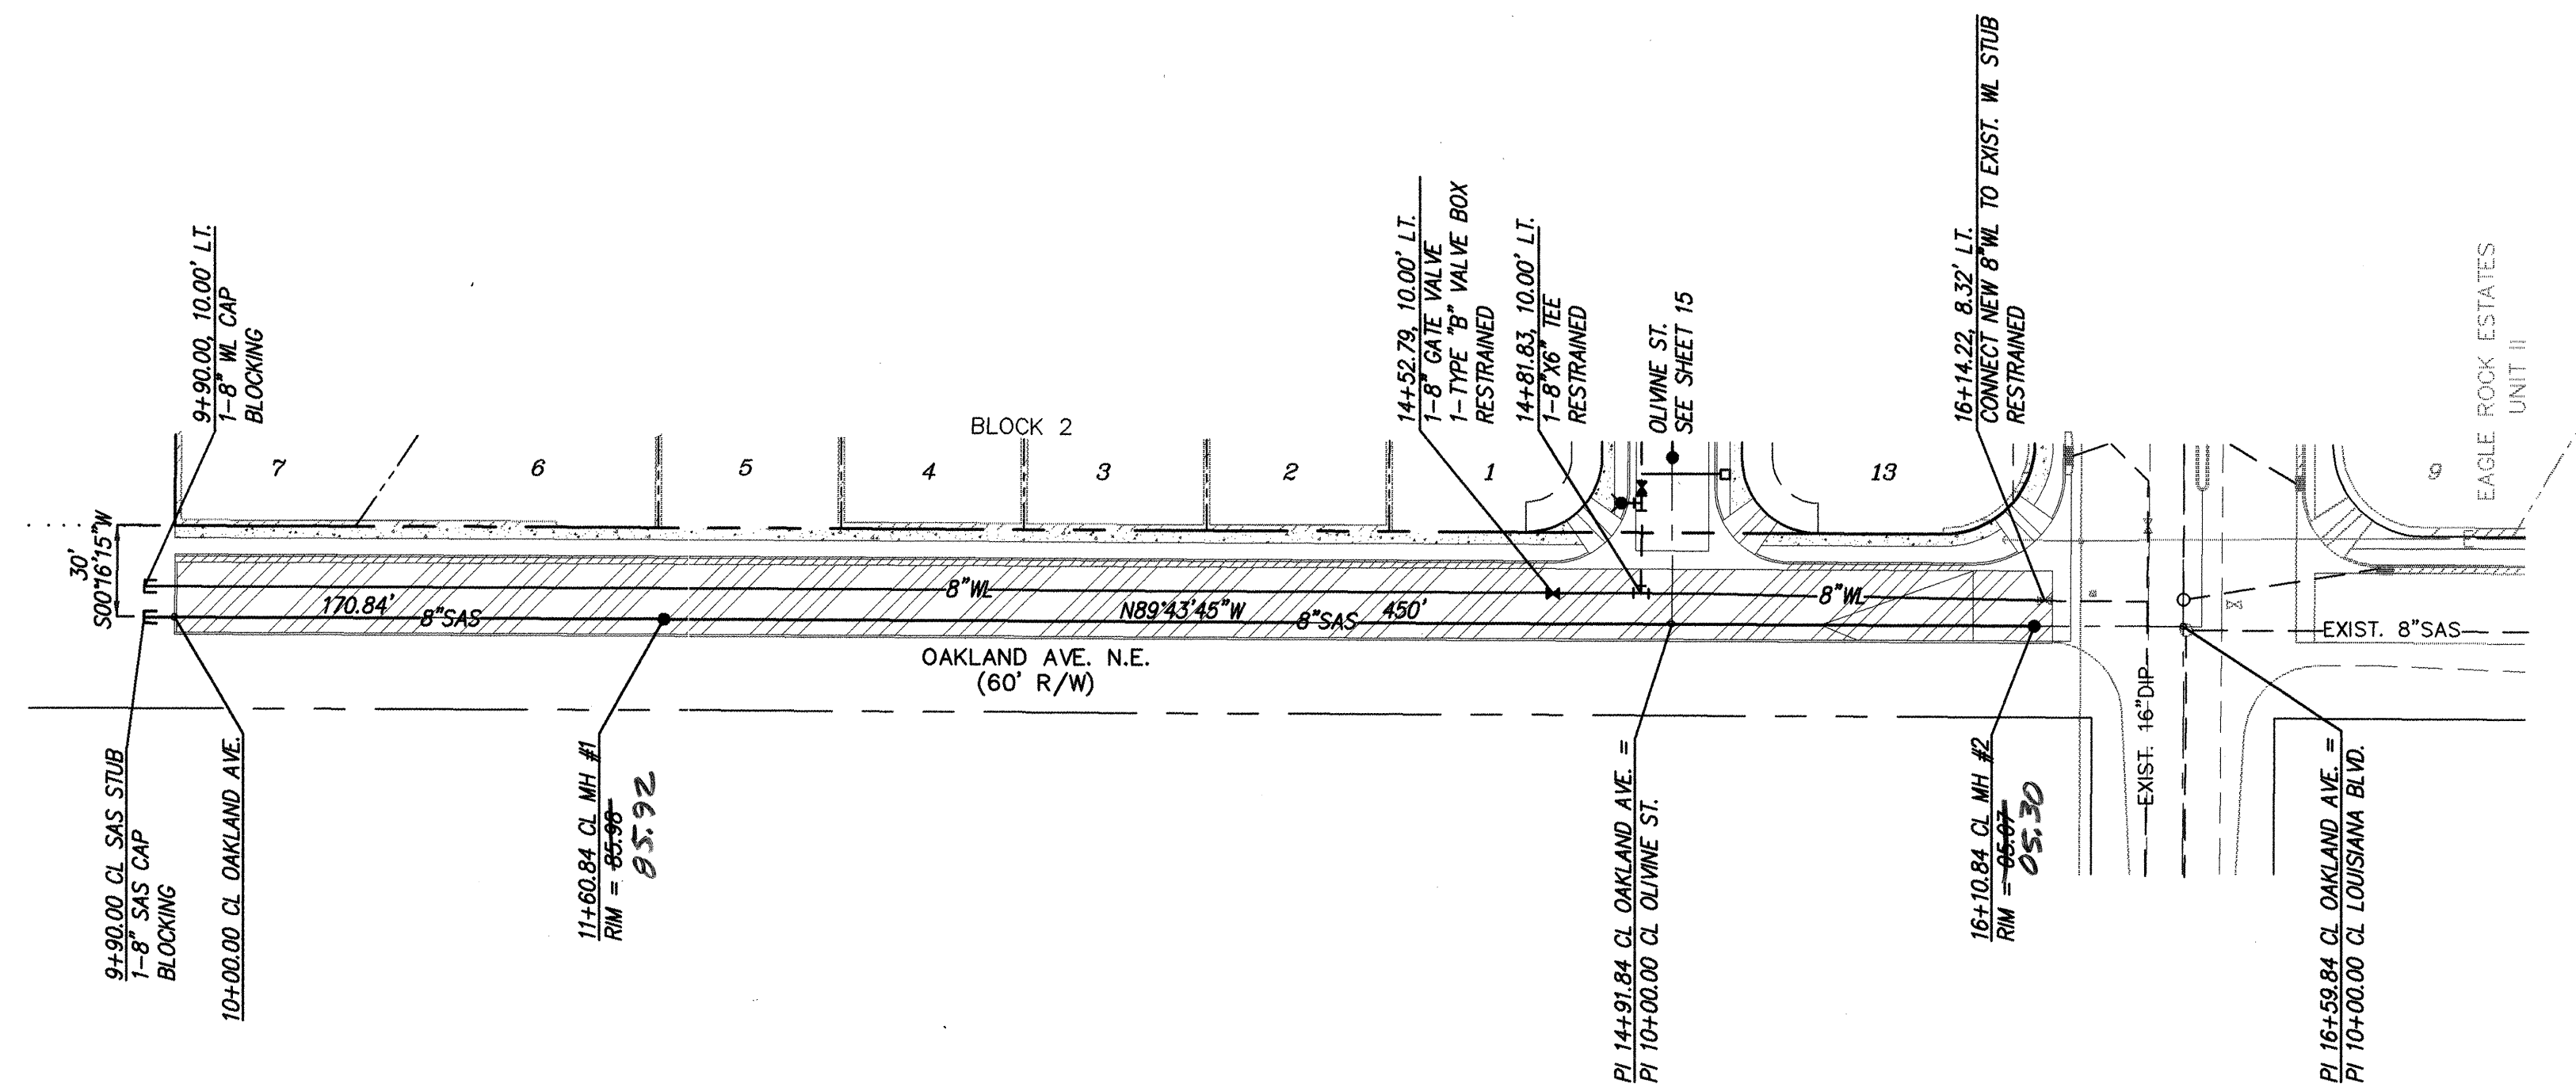



OAKLAND AVE.
 STA. 9+90.00 TO STA. 16+59.84
 SCALE: HORIZ. 1" = 50'
 VERT. 1" = 10'

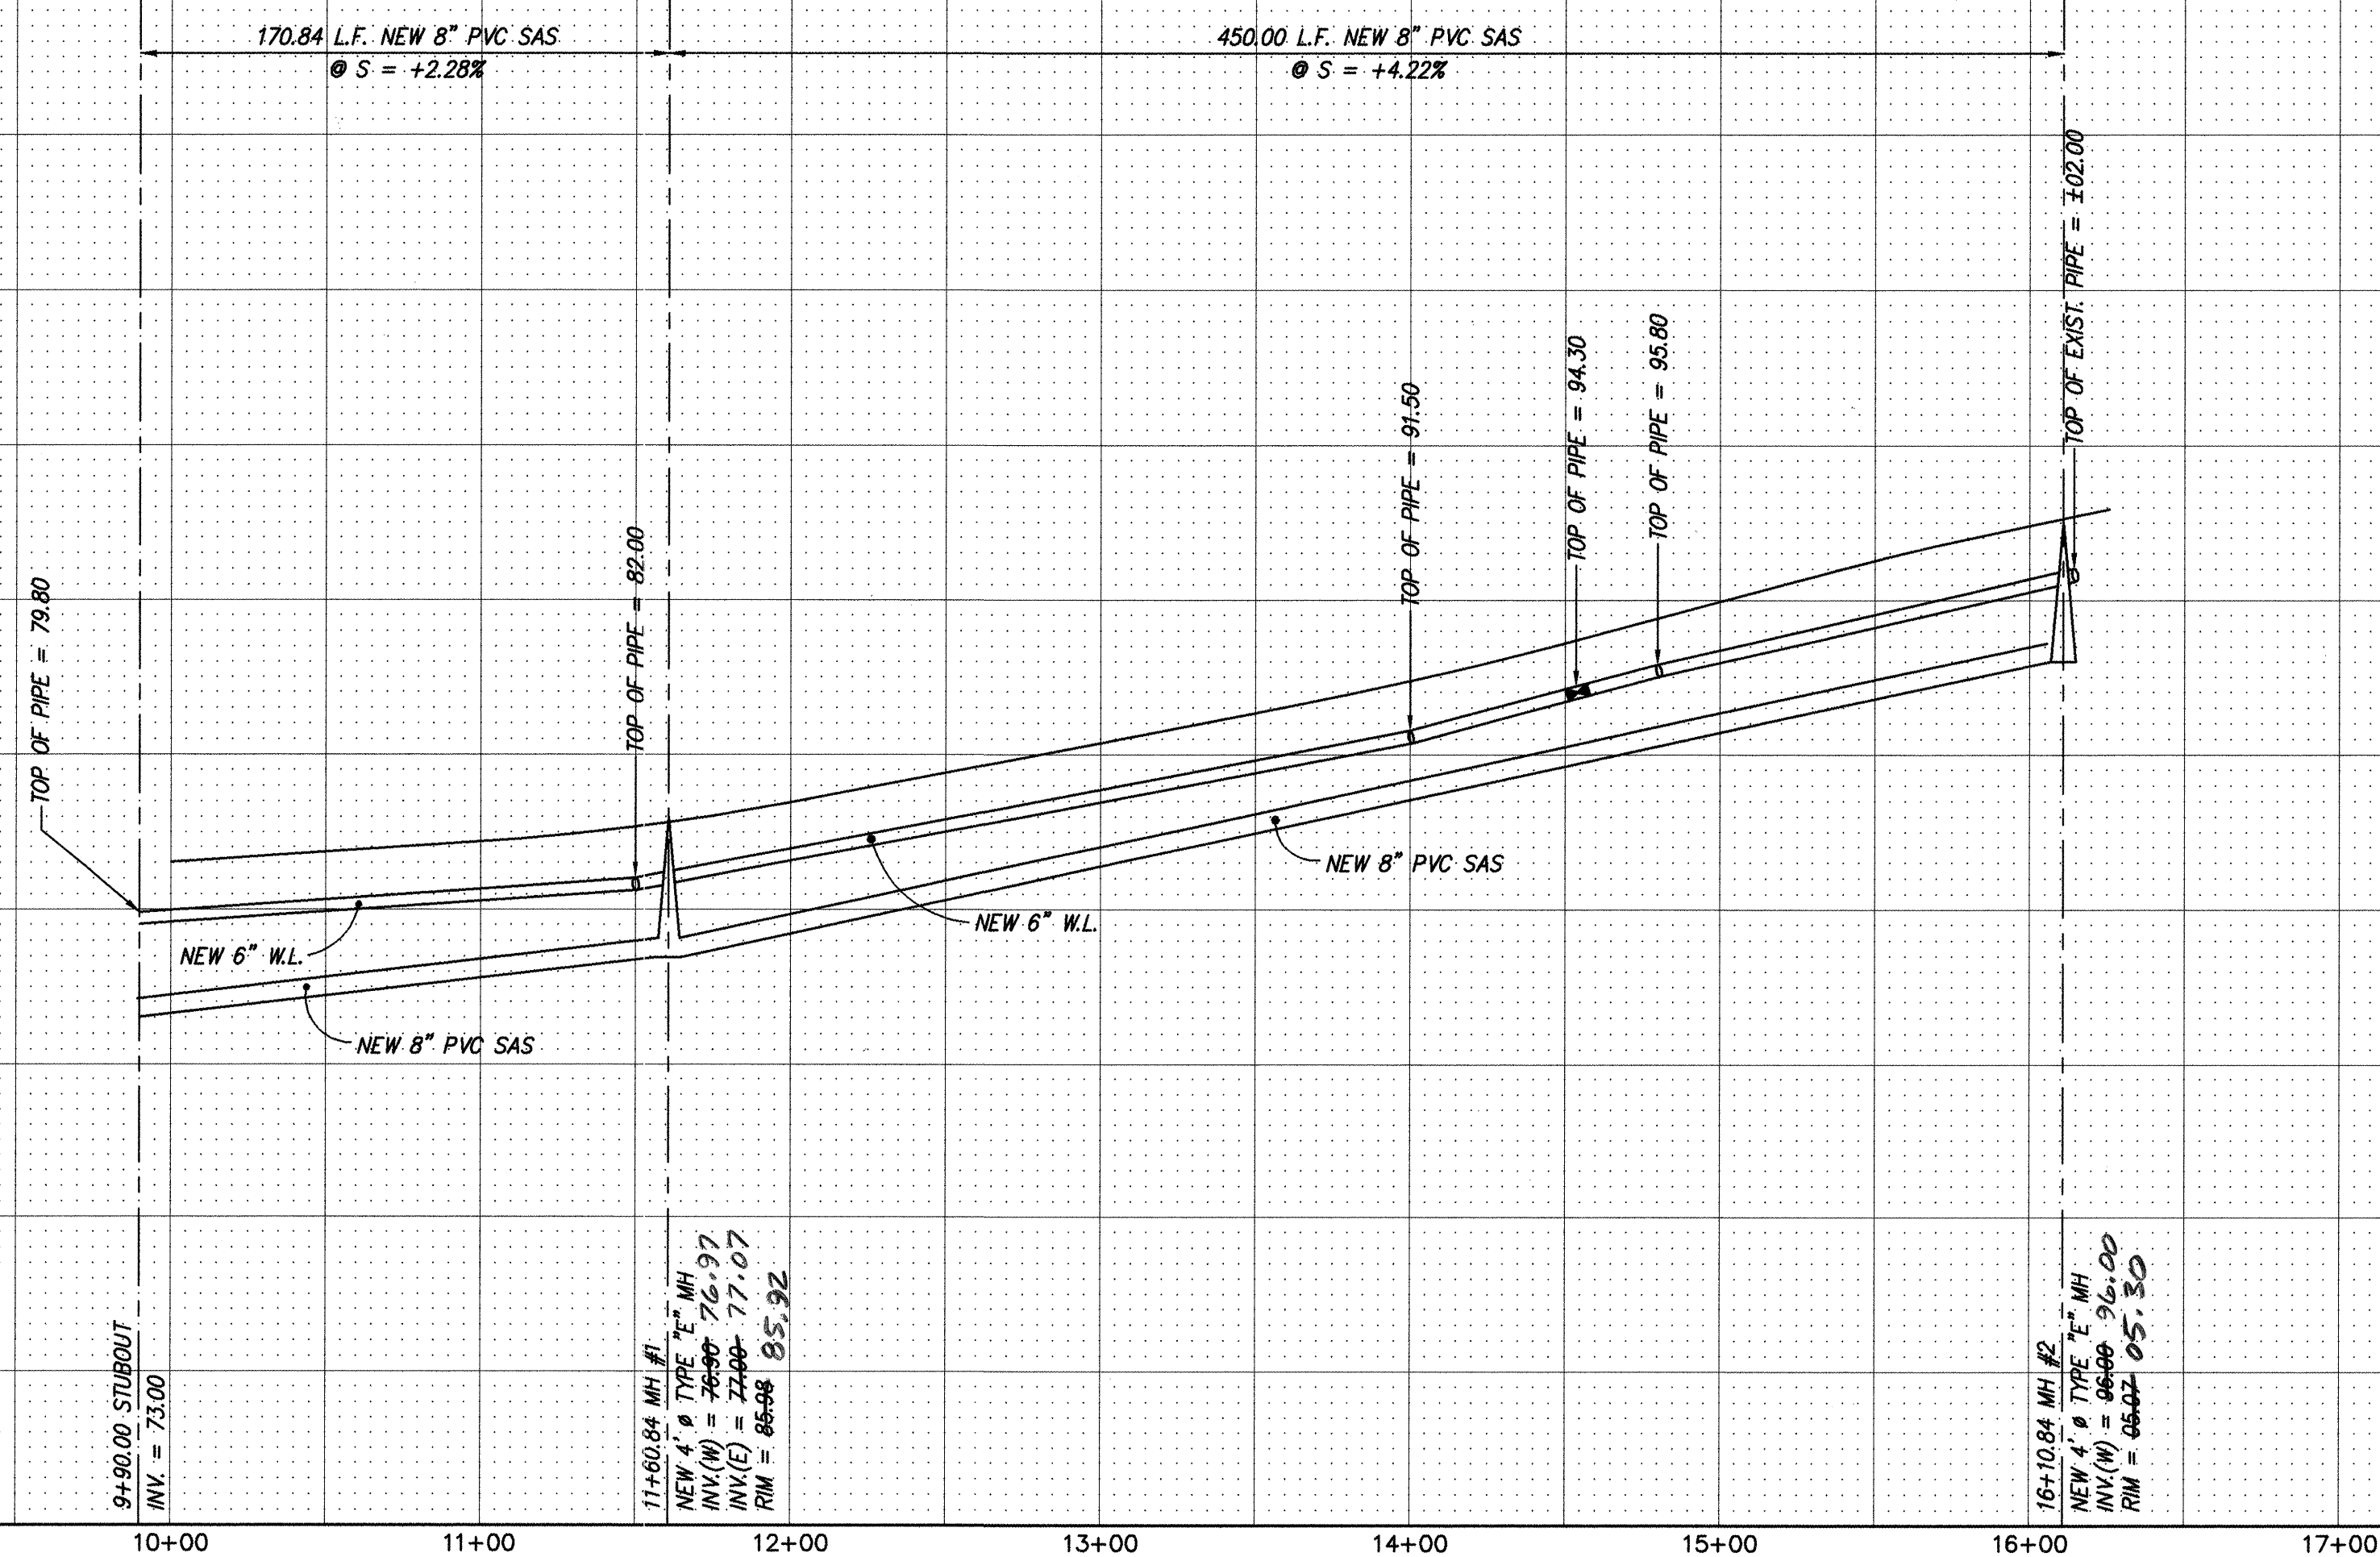

NOTES

1. ALL STATIONING IS CENTERLINE STATIONING.

DESIGNED BY		DLH	DATE	02/98
DRAWN BY		DBC, BLN	DATE	02/98
CHECKED BY		DMG	DATE	02/98

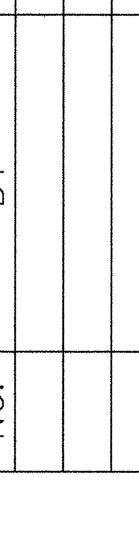ENGINEER'S SEAL		SURVEY INFORMATION		BENCH MARKS		AS BUILT INFORMATION		
		FIELD NOTES		STANDARD ACS ALUMINUM CAP STAMPED "11-018"		CONTRACTOR		
		NO.	BY	DATE	X = 404.894.49	WORK	Franklin	
					Y = 1,520.87.39	INSPECTED BY	JF	
					Z = 5305.00	INSPECTOR'S	DATE 4/99	
						ACCEPTANCE BY	DATE 4/99	
						VERIFICATION BY		
						DATE 4/99		
						DRAWINGS		
						CONTROL BY		
						DATE 4/99		
						MICRO-FILM INFORMATION		
						RECORDED BY		
						DATE		
						NO.		

NOTE: SEE FILED PLAT FOR
FINAL LOT LOCATIONS

dmg MARK GOODWIN & ASSOCIATES, P.A.
CONSULTING ENGINEERS
P.O. BOX 90606
ALBUQUERQUE, NEW MEXICO 87199
(505) 828-2200, FAX (505) 797-9539

	CITY OF ALBUQUERQUE PUBLIC WORKS DEPARTMENT ENGINEERING DEVELOPMENT GROUP
	TITLE: <i>EAGLE ROCK ESTATES - UNIT III</i> <i>UTILITY IMPROVEMENTS</i> <i>OAKLAND AVENUE</i>

DESIGN REVIEW COMMITTEE
APPROVED
APR 29 1998
DESIGN
REVIEW COMMITTEE

CITY ENGINEER APPROVAL

FAST DESIGN UPDATE


MO. / DAY / YR.

MO./DAY/YR.


CITY PROJECT NO.

LA	
ZONE MAP NO.	

SHEET		OF	
-------	--	----	--

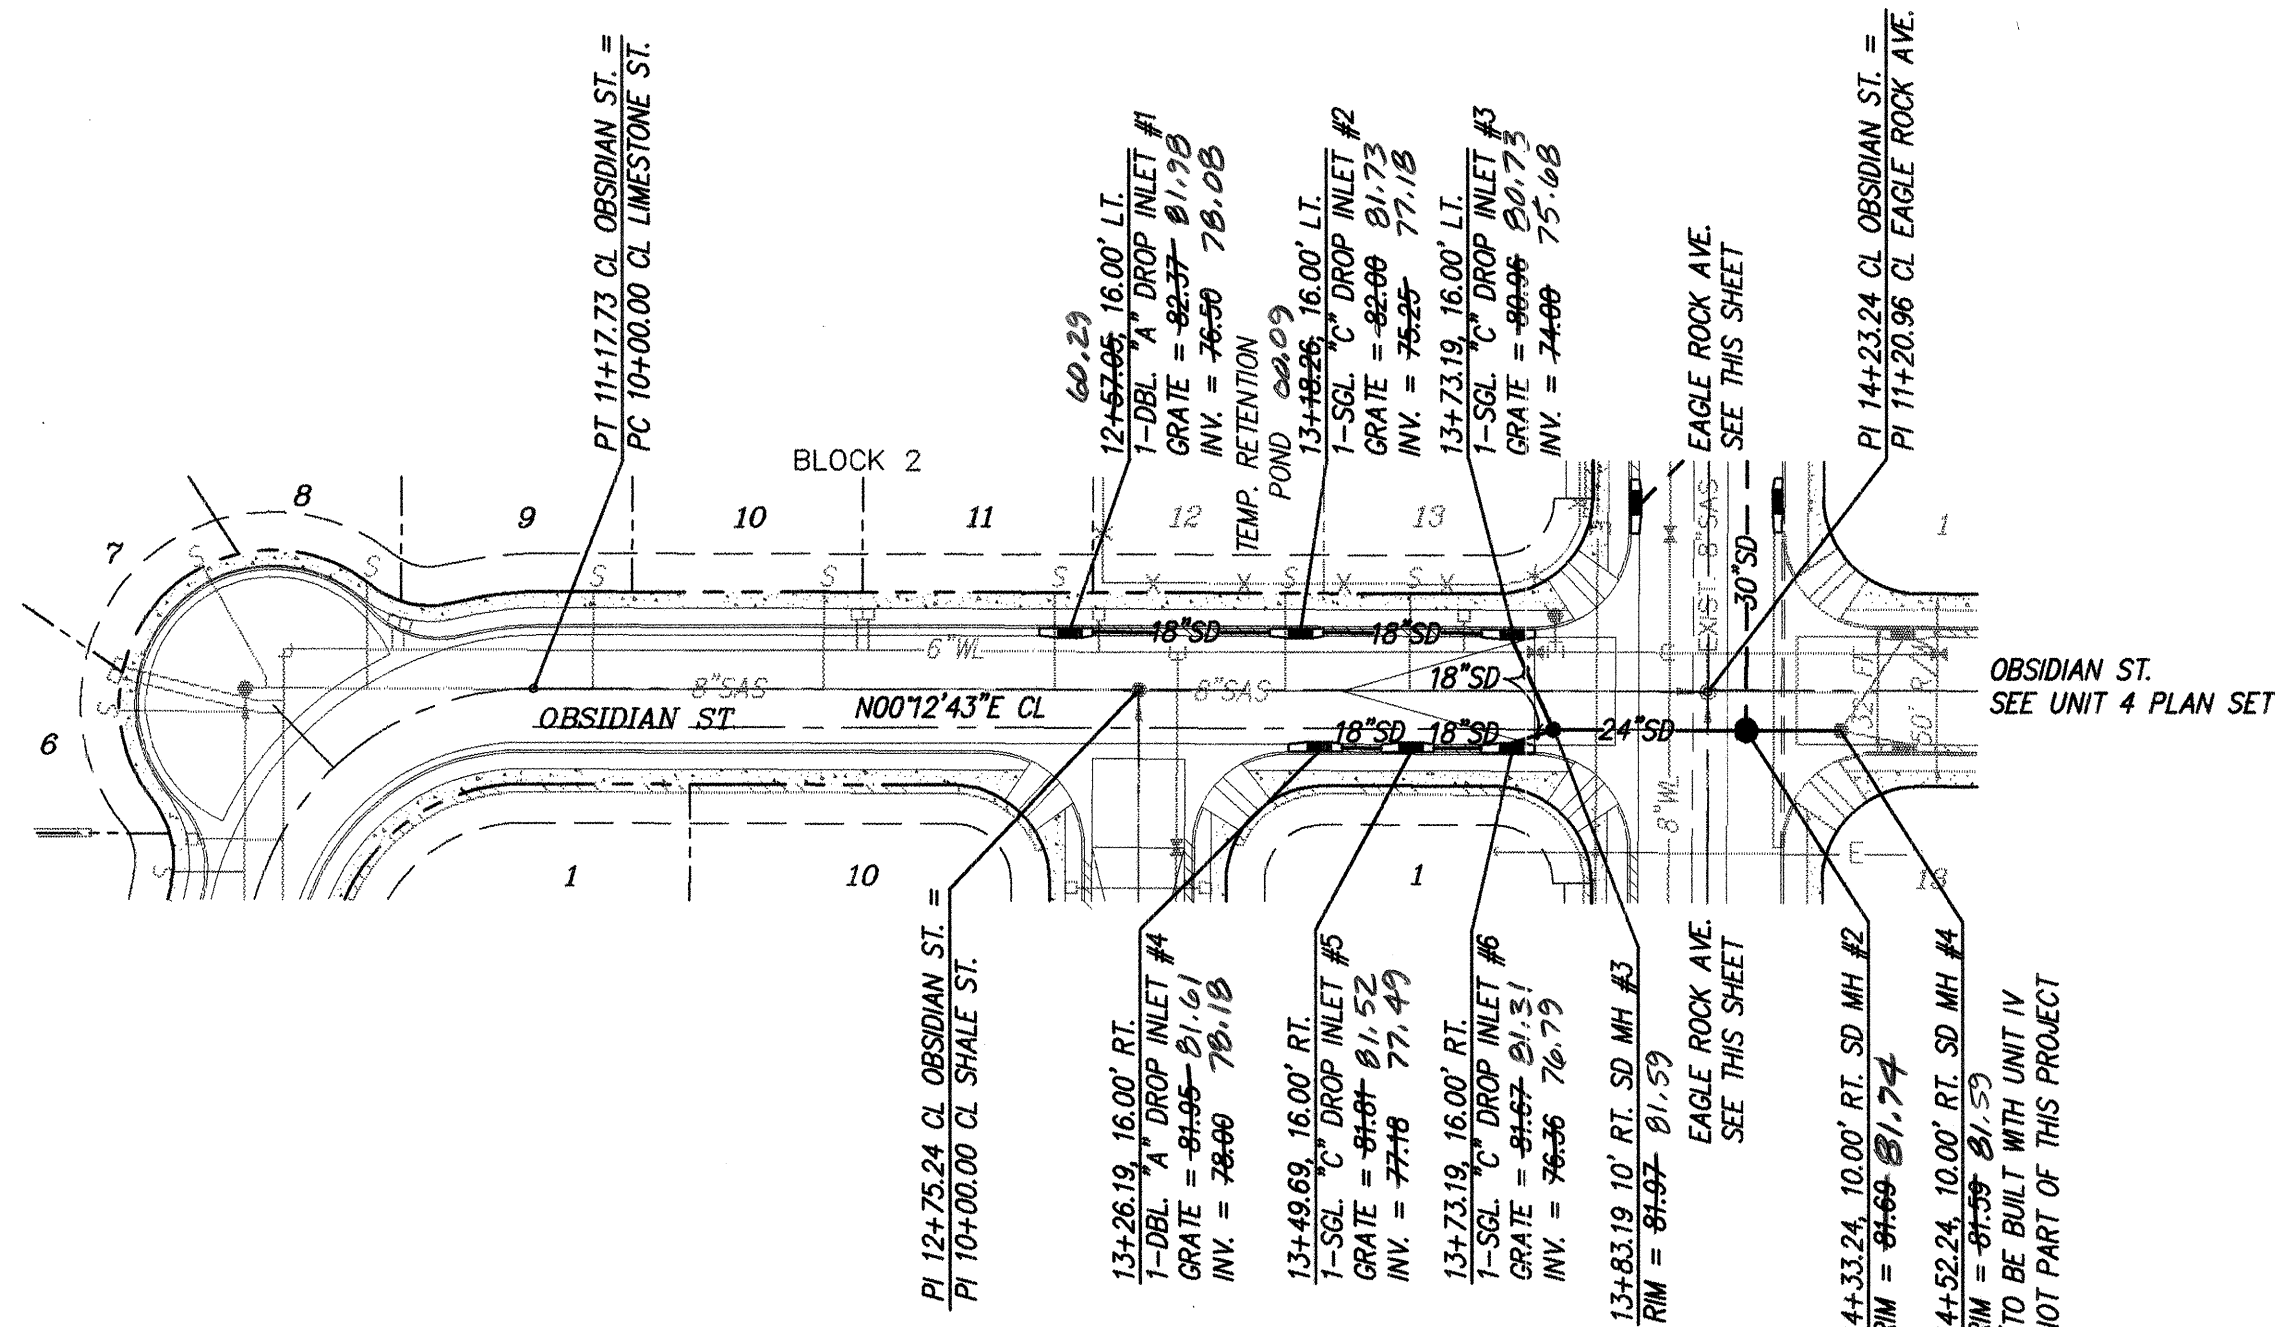

Obsidian Street
STA. 11+17.73 TO STA. 14+33.24
SCALE: HORZ. 1" = 50'
VERT. 1" = 10'

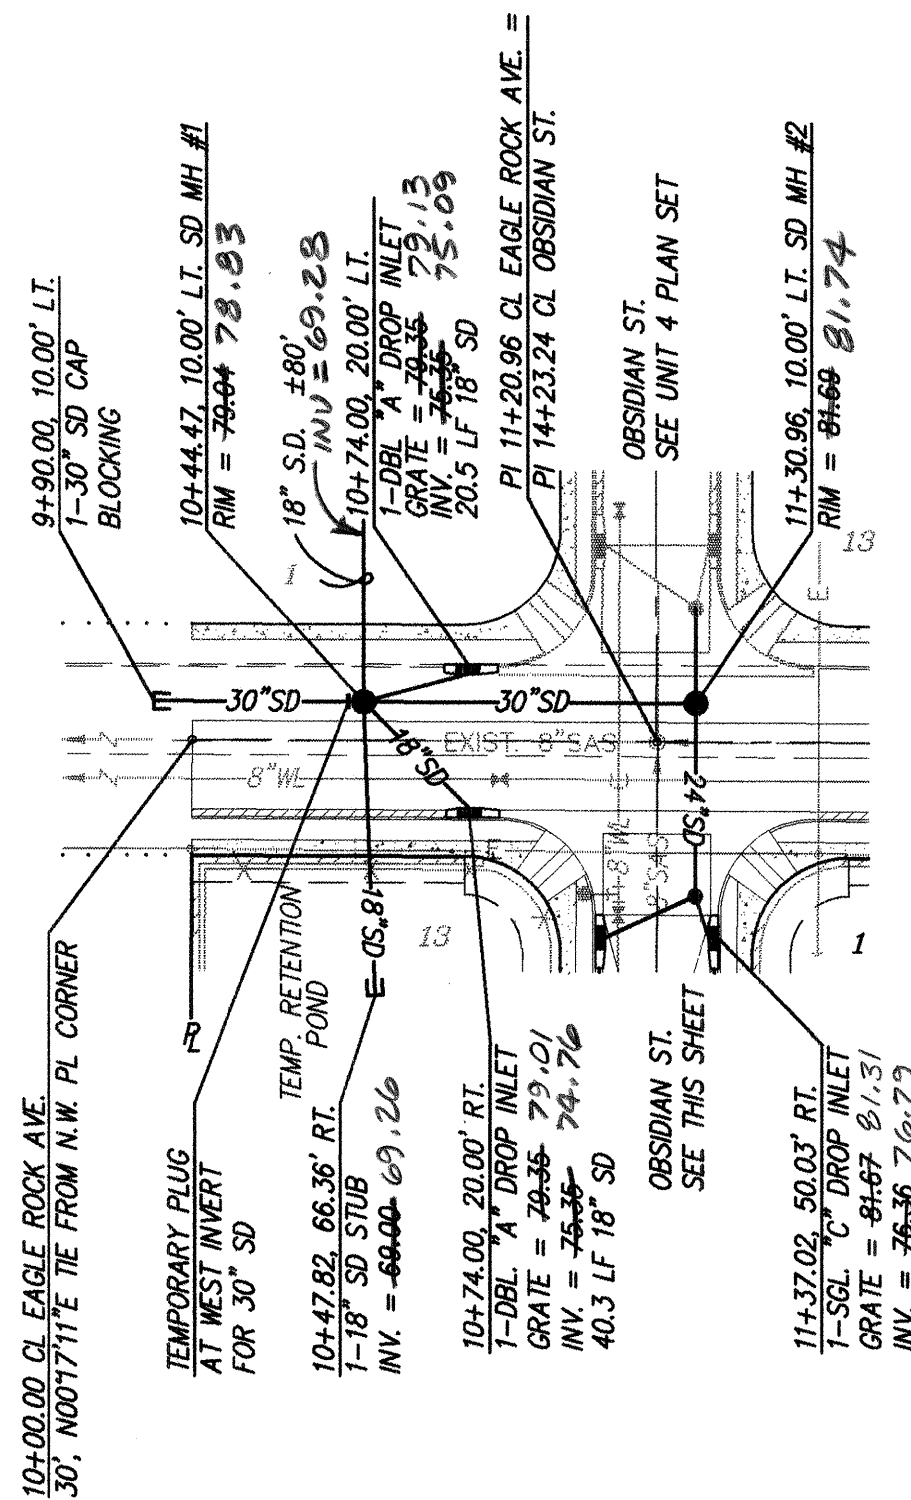

Eagle Rock Ave.
STA. 9+90.00 TO STA. 11+37.02
SCALE: HORZ. 1" = 50'
VERT. 1" = 10'

NOTES

1. ALL STATIONING IS CENTERLINE STATIONING.

NOTE: SEE FILED PLAT FOR FINAL LOT LOCATIONS

dmg MARK GOODWIN & ASSOCIATES, P.A.
CONSULTING ENGINEERS
P.O. BOX 90606
ALBUQUERQUE, NEW MEXICO 87199
(505) 828-2200, FAX (505) 797-9539

CITY OF ALBUQUERQUE
PUBLIC WORKS DEPARTMENT
ENGINEERING DEVELOPMENT GROUP
TITLE: **EAGLE ROCK ESTATES - UNIT III**
STORM DRAIN IMPROVEMENTS
Obsidian Street and Eagle Rock Ave.

DESIGN REVIEW COMMITTEE
APR 29 1998
DESIGN REVIEW COMMITTEE

CITY ENGINEER APPROVAL

LAST DESIGN UPDATE

MO./DAY/YR.
MO./DAY/YR.


CITY PROJECT NO. **580183** ZONE MAP NO. **C-18** SHEET **17** OF **19**

SURVEY INFORMATION		BENCH MARKS		AS BUILT INFORMATION	
NO.	BY	DATE	STANDARD ACS ALUMINUM CAP STAMPED "11-C18"	CONTRACTOR	DATE
			X = 404,894.49	STARTED BY	DATE
			Y = 1,529,873.39	INSPECTOR'S	DATE
			Z = 5305.00	FIELD	DATE
				VERIFICATION BY	DATE
				RECORDED BY	DATE
				MICRO-FILM INFORMATION	DATE
				RECORDED BY	DATE
				NO.	

ENGINEER'S SEAL		REVISIONS	
		NO.	DATE
		REMARKS	DATE
		DESIGN	DATE
		BY	DATE
		DMG	02/98
		DMG	02/98
		DMG	02/98

- SCANNED BY
MESA REPRO


- SIGN FACE DETAILS

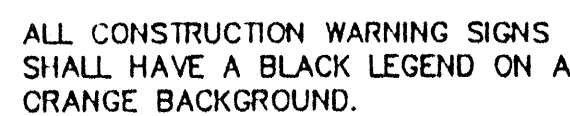


C-18

CTSD202.DWG


SCANNED BY
MESA REPRO

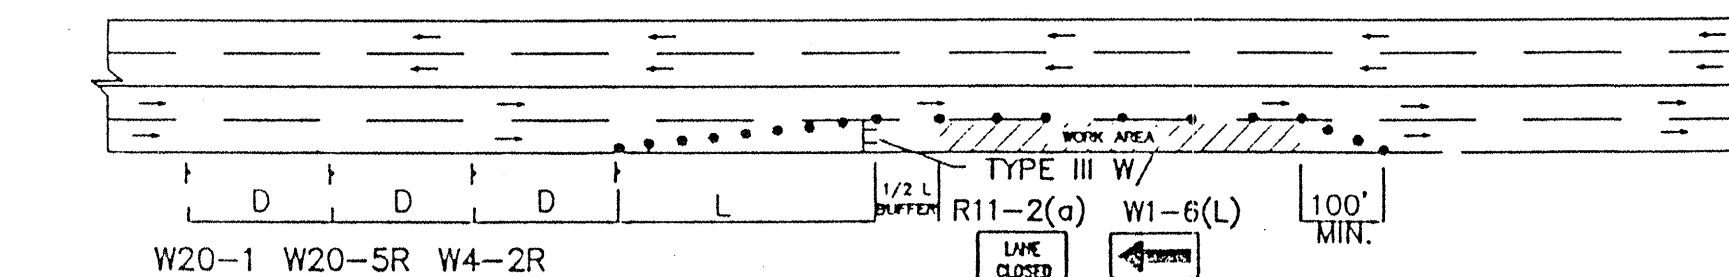


TYPICAL RIGHT LANE CLOSURE

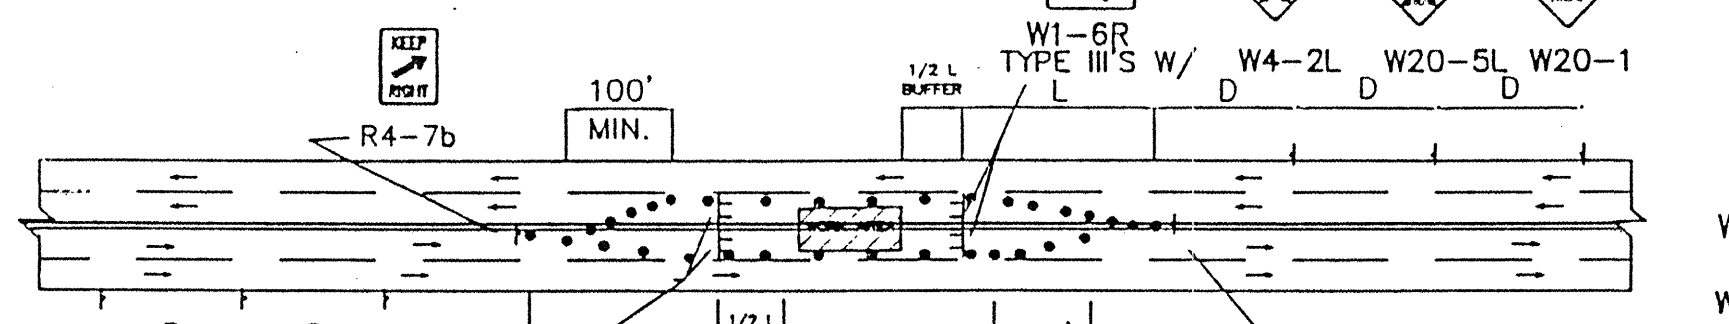


TYPICAL LEFT LANE CLOSURE

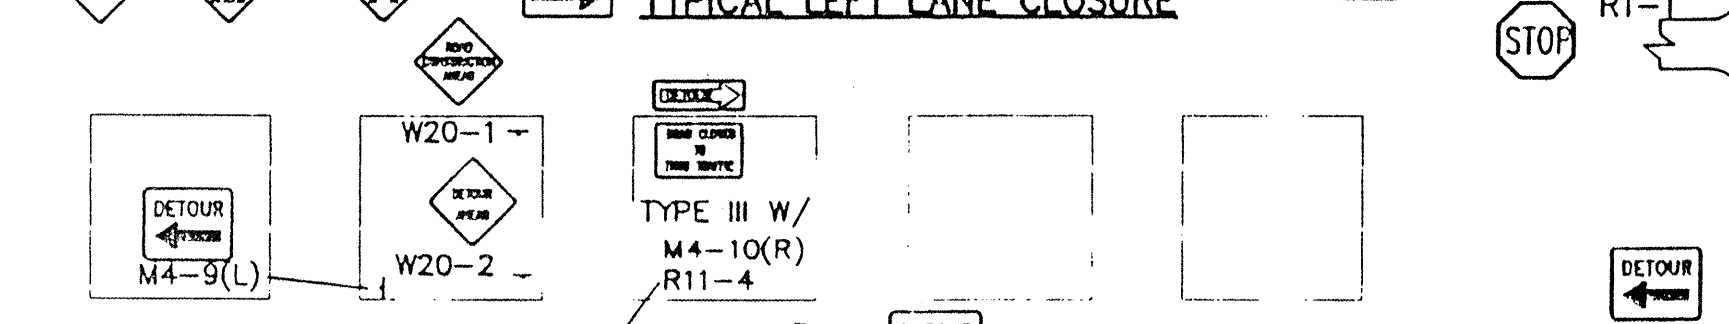


TYPICAL ONE DIRECTION DETOUR

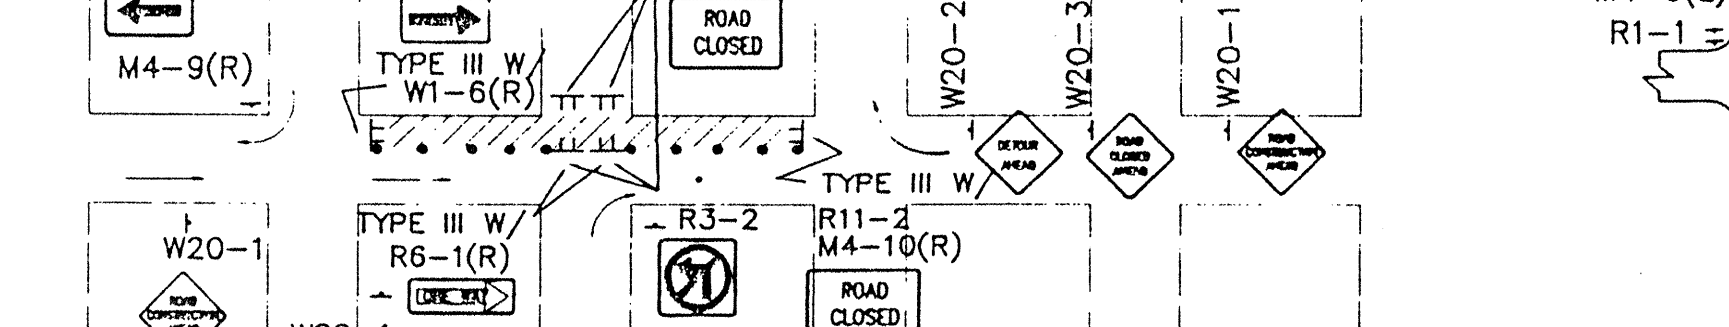


TYPICAL STREET CLOSURE

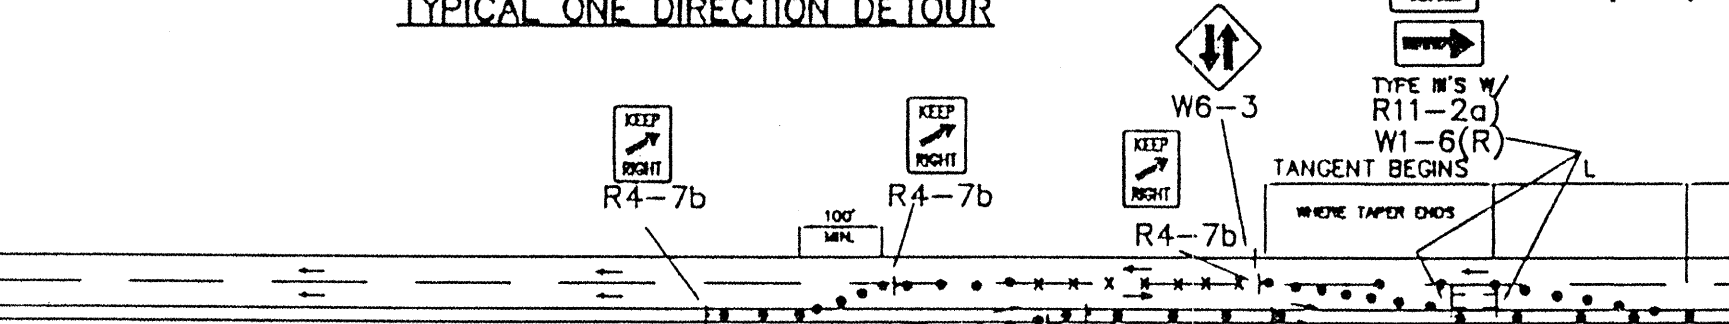


TYPICAL TRAFFIC SPLIT-(PAINTED MEDIAN)

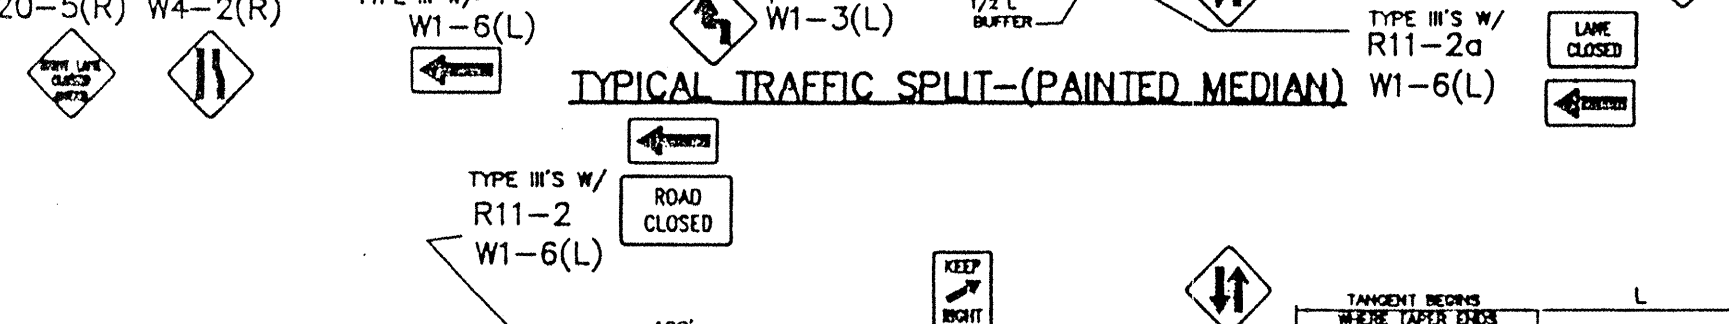


TYPICAL TRAFFIC SPLIT-(RAISED MEDIAN)

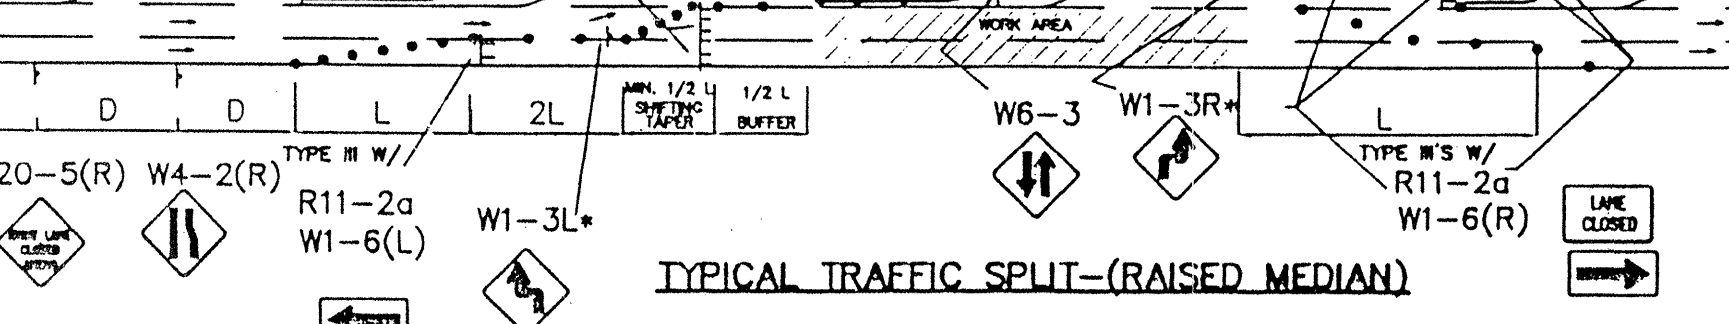


TYPICAL SANITARY SEWER SLIPLINING OPERATION

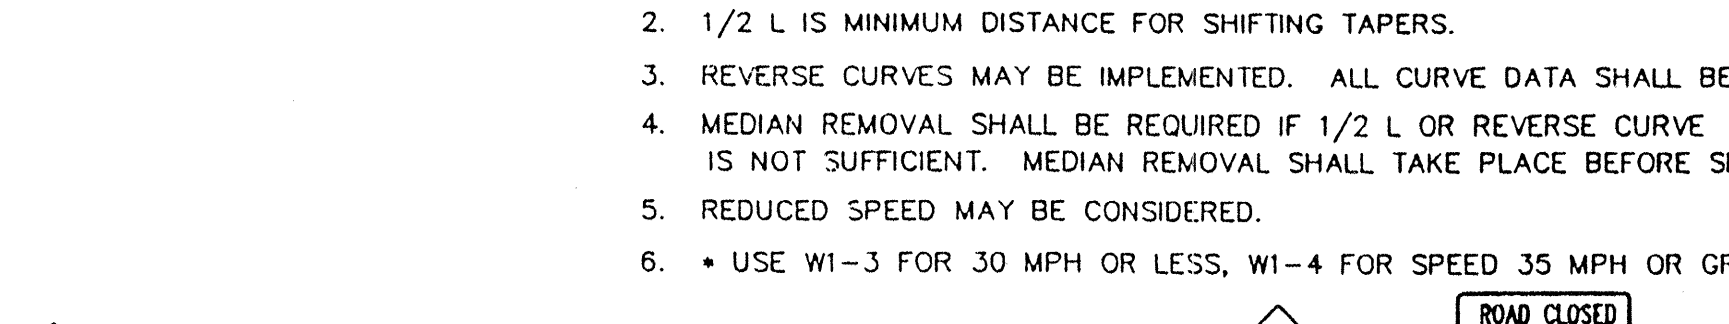

TYPICAL STREET CLOSURE

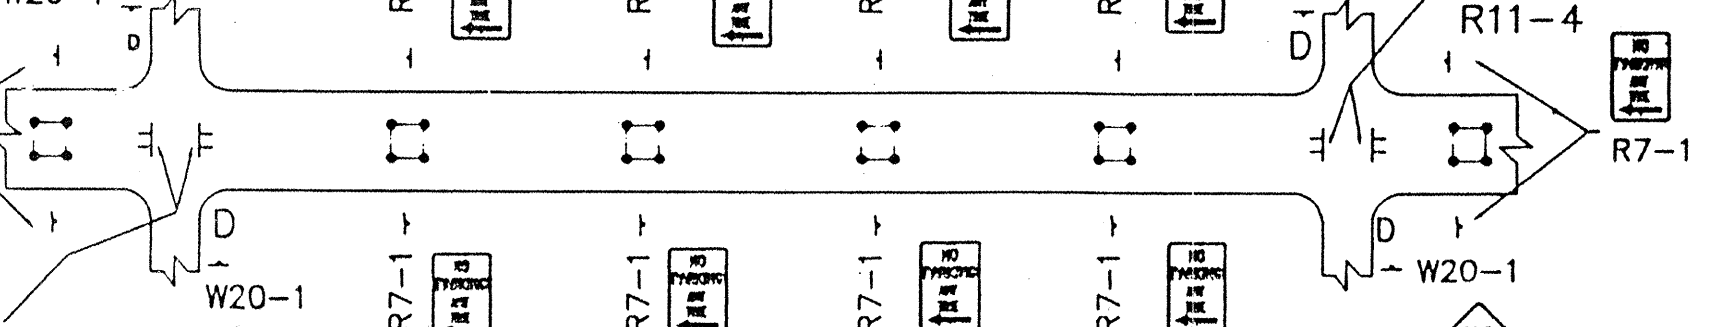


TYPICAL STREET CLOSURE

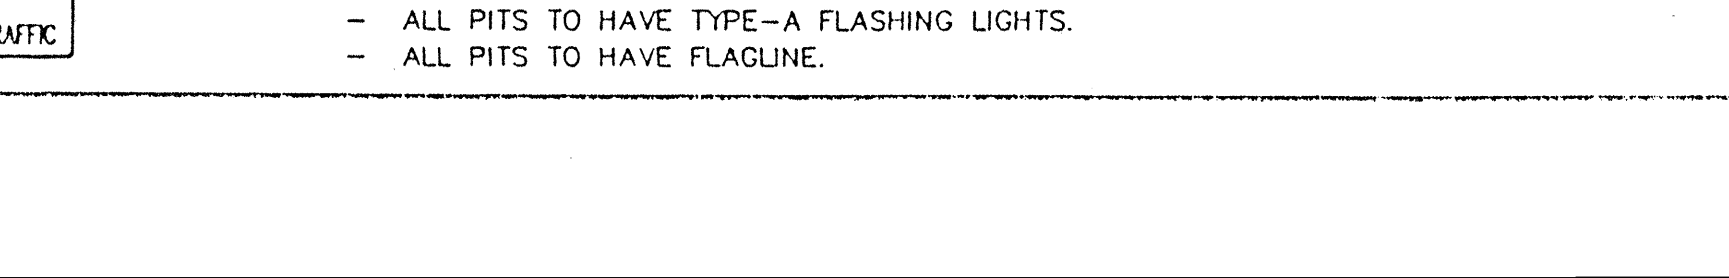


TYPICAL STREET CLOSURE


NOTE: MAY REQUIRE LEFT LANE CLOSURE DEPENDING ON FIELD CONDITIONS.

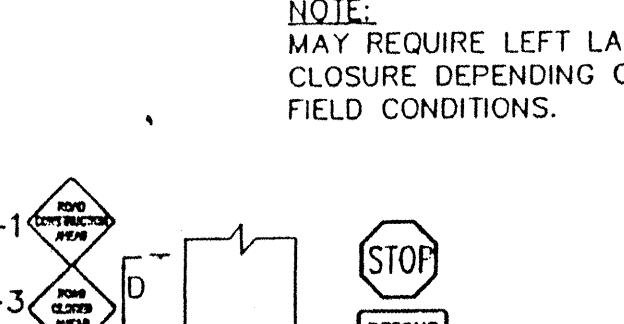


TYPICAL LANE CLOSURE AT INTERSECTION

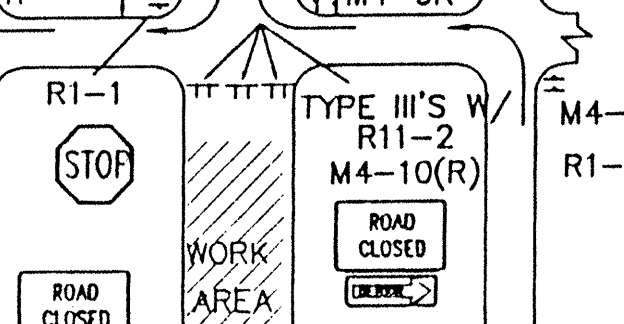


TYPICAL LANE CLOSURE AT INTERSECTION

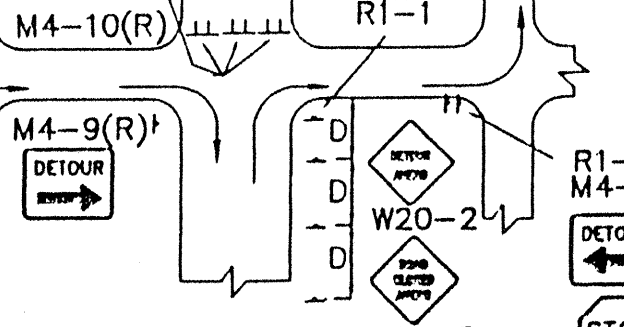


TYPICAL LANE CLOSURE AT INTERSECTION

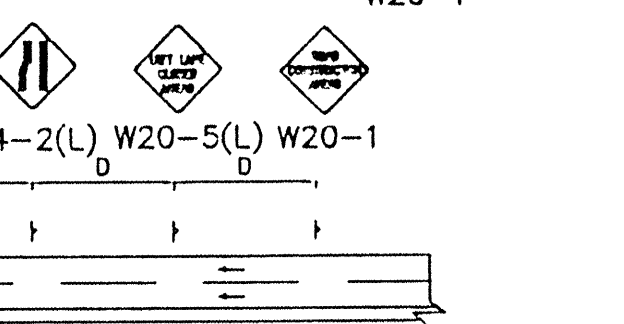


TYPICAL LANE CLOSURE AT INTERSECTION

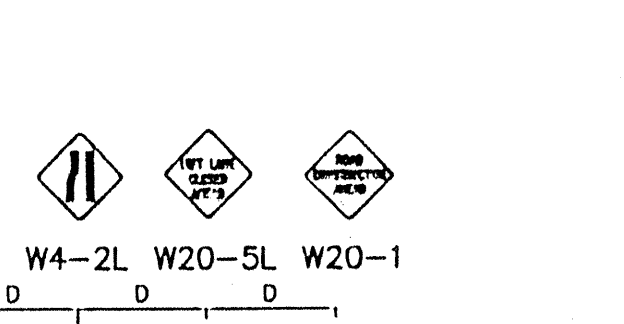


TYPICAL LANE CLOSURE AT INTERSECTION

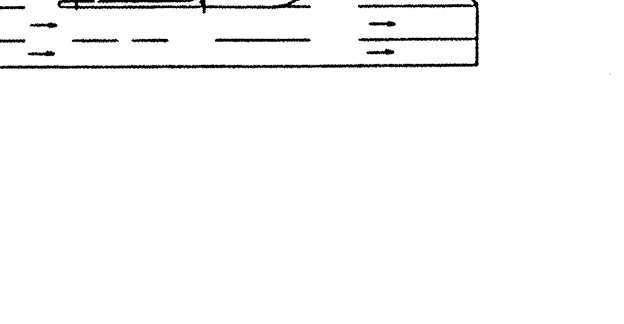


TYPICAL LANE CLOSURE AT INTERSECTION

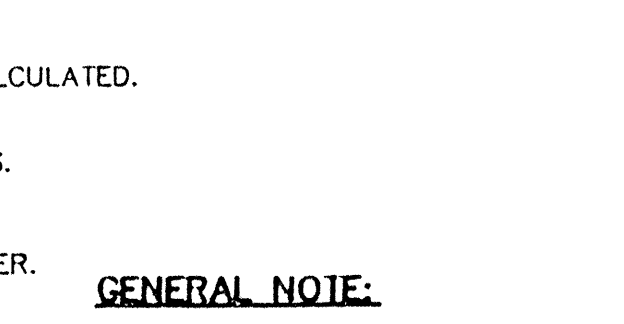

TYPICAL LANE CLOSURE AT INTERSECTION

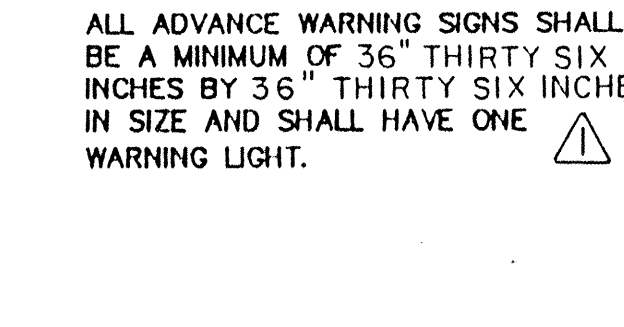


TYPICAL LANE CLOSURE AT INTERSECTION

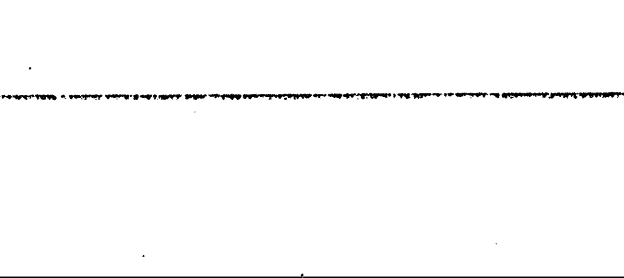


TYPICAL LANE CLOSURE AT INTERSECTION


NOTE: (R1-1) BASED ON FIELD CONDITIONS.

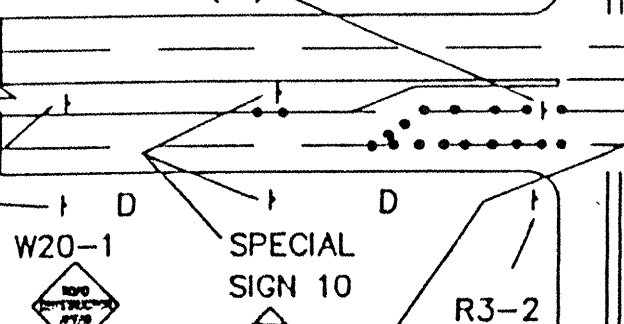


TYPICAL MID-BLOCK CLOSURE

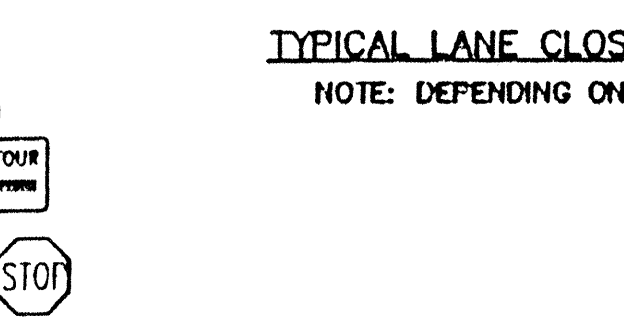


TYPICAL MID-BLOCK CLOSURE

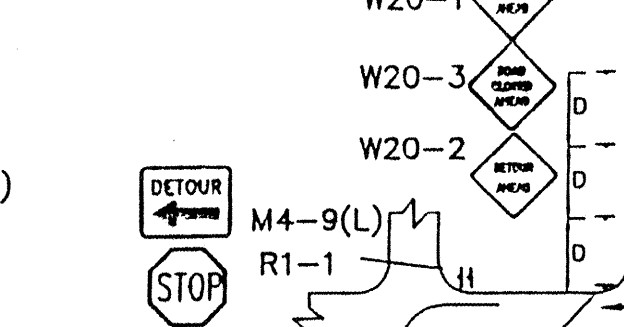


TYPICAL MID-BLOCK CLOSURE

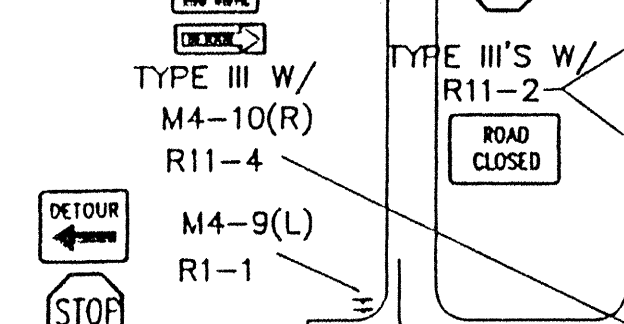


TYPICAL MID-BLOCK CLOSURE

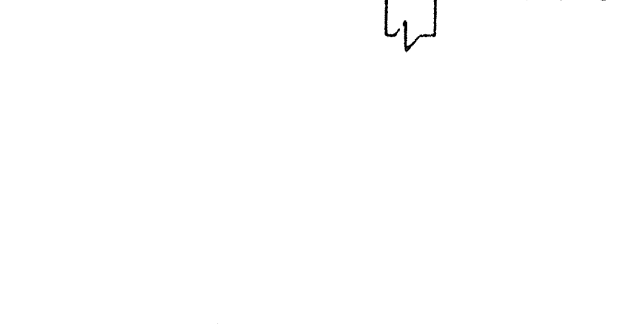


TYPICAL MID-BLOCK CLOSURE

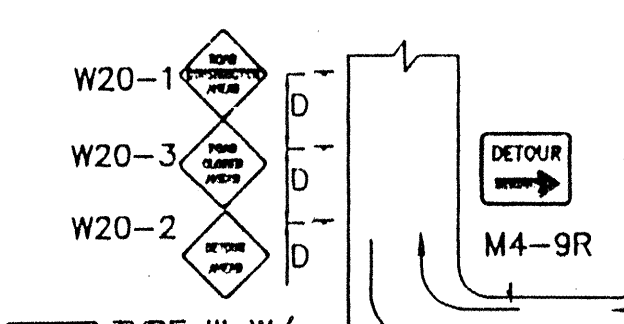


TYPICAL MID-BLOCK CLOSURE

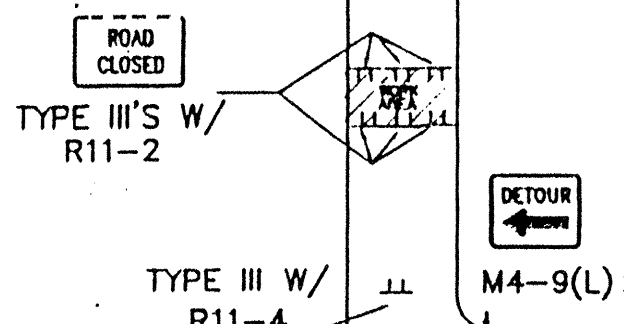

TYPICAL MID-BLOCK CLOSURE

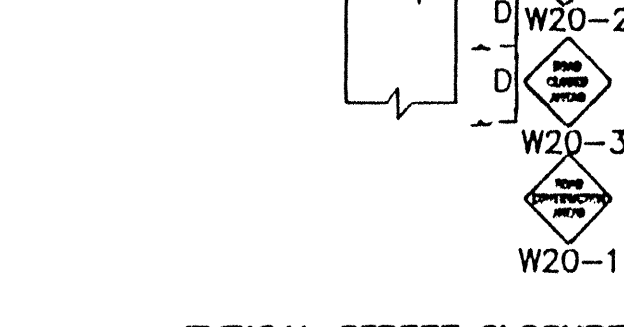


TYPICAL MID-BLOCK CLOSURE

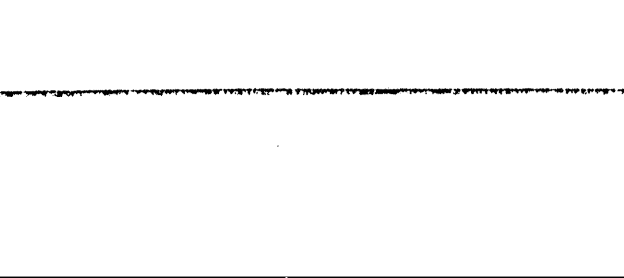


TYPICAL MID-BLOCK CLOSURE


NOTE: (R1-1) BASED ON FIELD CONDITIONS.

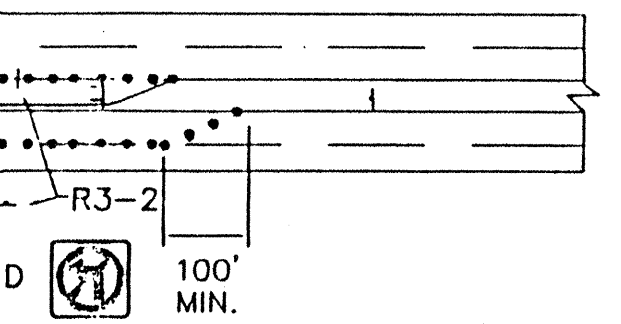


TYPICAL MID-BLOCK CLOSURE

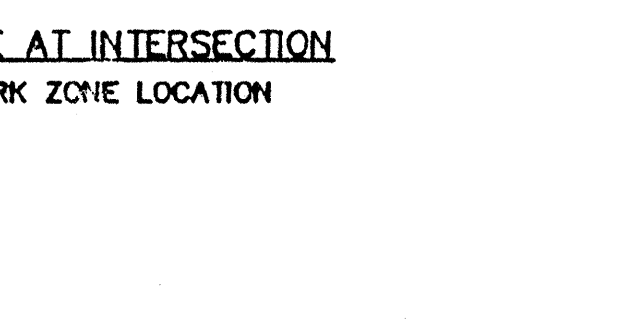


TYPICAL MID-BLOCK CLOSURE

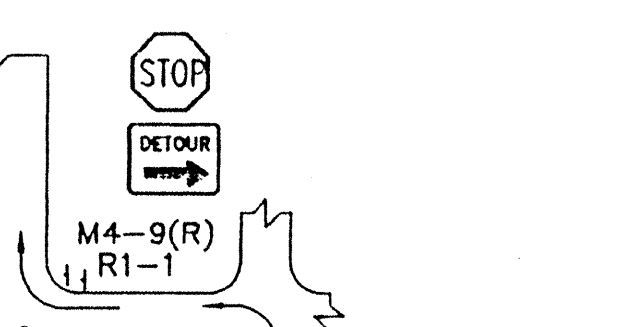


TYPICAL MID-BLOCK CLOSURE

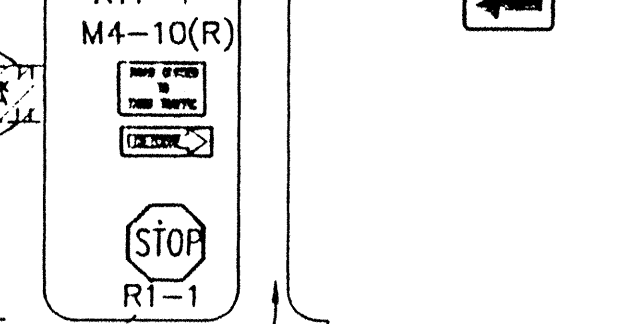


TYPICAL MID-BLOCK CLOSURE

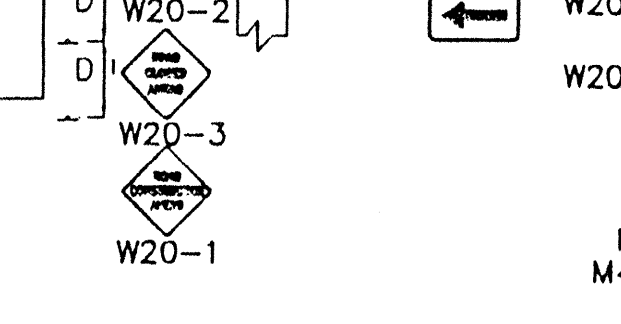


TYPICAL MID-BLOCK CLOSURE

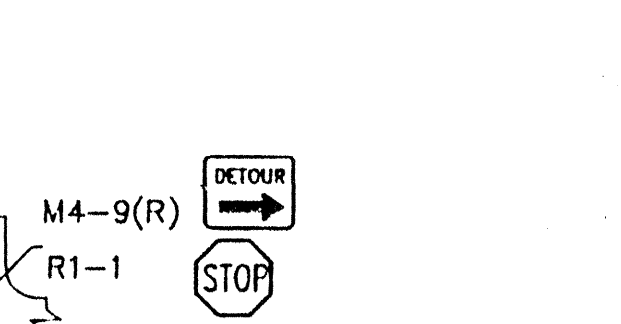


TYPICAL MID-BLOCK CLOSURE

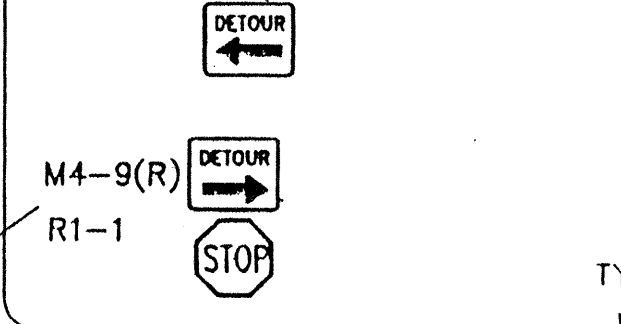

TYPICAL MID-BLOCK CLOSURE

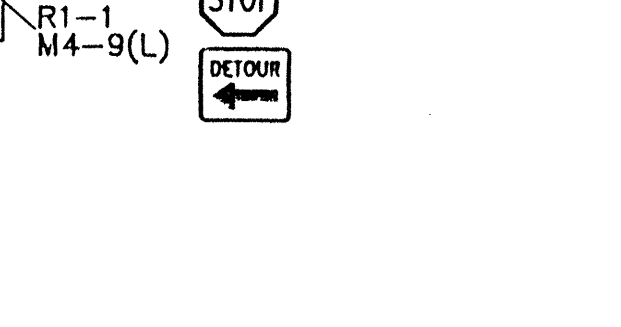


TYPICAL MID-BLOCK CLOSURE

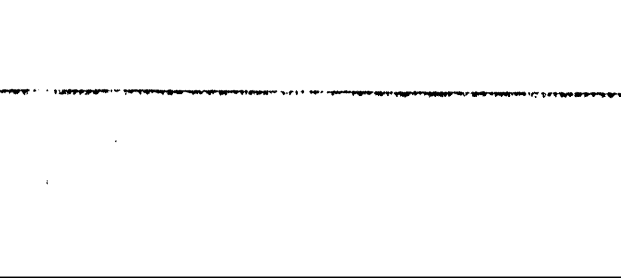


TYPICAL MID-BLOCK CLOSURE


NOTE: (R1-1) BASED ON FIELD CONDITIONS.

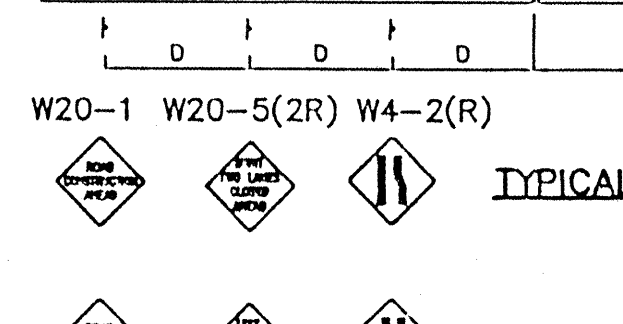


TYPICAL DOUBLE RIGHT LANE CLOSURE

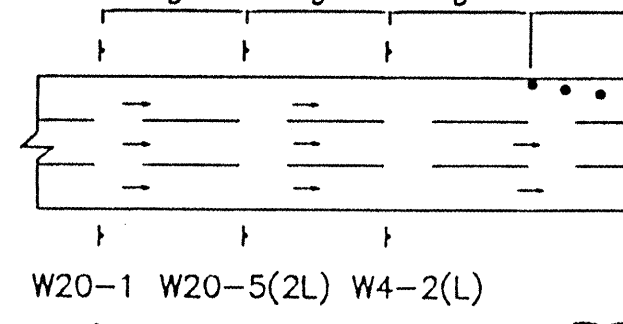


TYPICAL DOUBLE RIGHT LANE CLOSURE

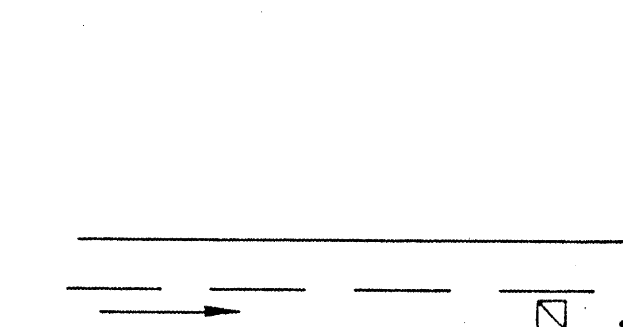


TYPICAL DOUBLE RIGHT LANE CLOSURE

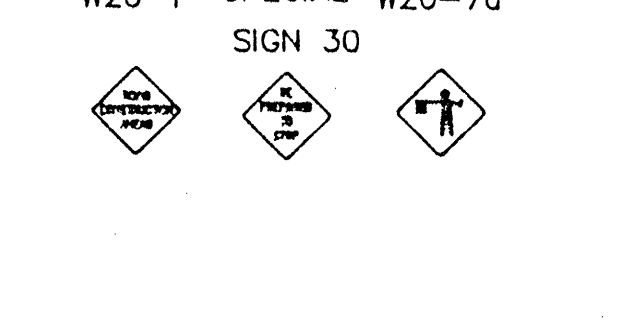


TYPICAL DOUBLE RIGHT LANE CLOSURE

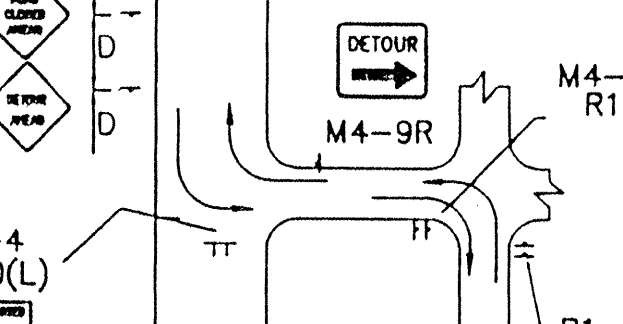


TYPICAL DOUBLE RIGHT LANE CLOSURE

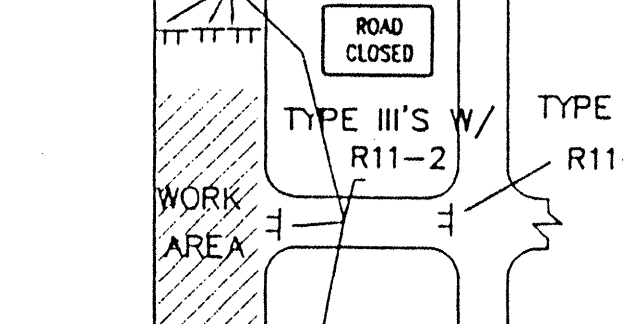


TYPICAL DOUBLE RIGHT LANE CLOSURE

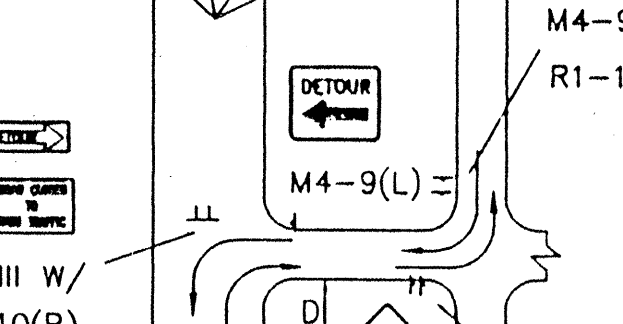

TYPICAL DOUBLE RIGHT LANE CLOSURE

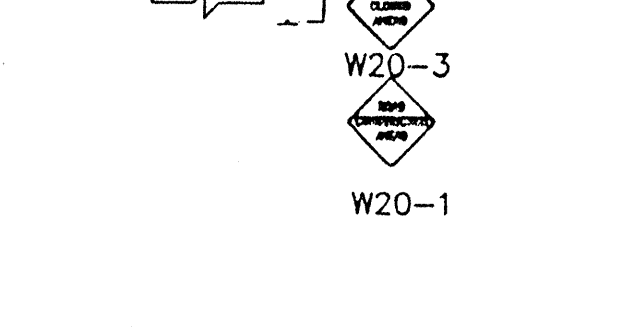


TYPICAL DOUBLE RIGHT LANE CLOSURE

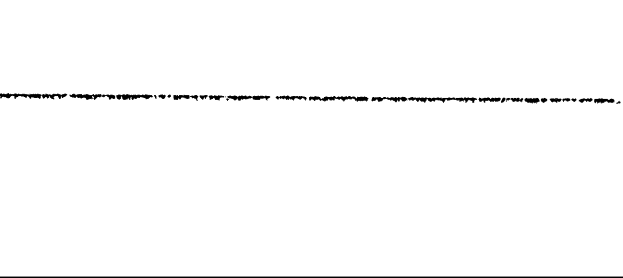


TYPICAL DOUBLE RIGHT LANE CLOSURE


NOTE: (R1-1) BASED ON FIELD CONDITIONS.

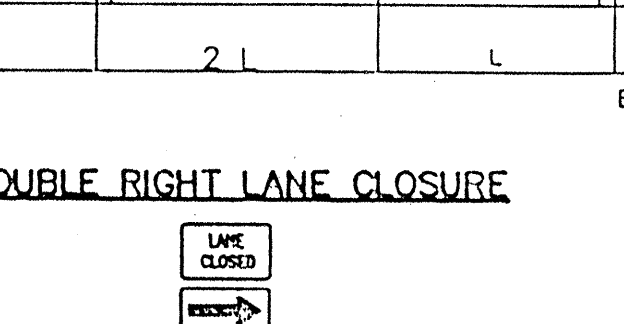


TYPICAL DOUBLE LEFT LANE CLOSURE

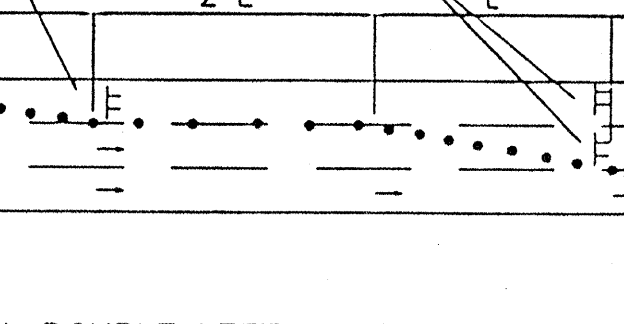


TYPICAL DOUBLE LEFT LANE CLOSURE

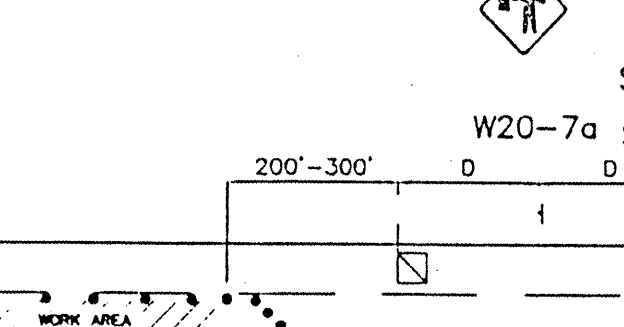


TYPICAL DOUBLE LEFT LANE CLOSURE

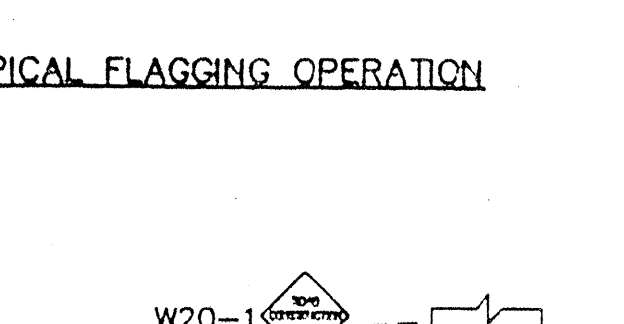


TYPICAL DOUBLE LEFT LANE CLOSURE

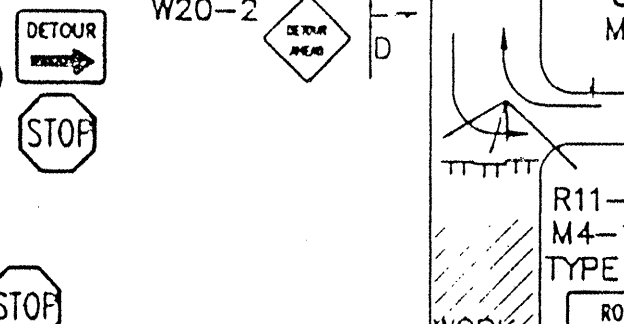


TYPICAL DOUBLE LEFT LANE CLOSURE

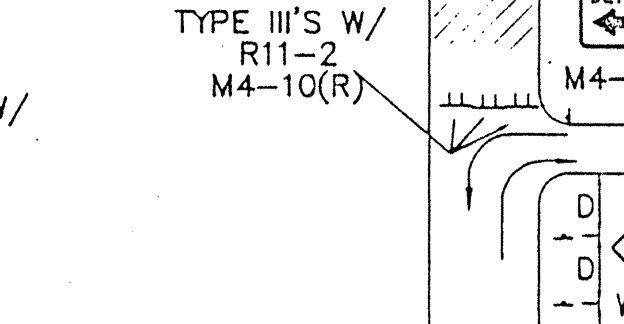


TYPICAL DOUBLE LEFT LANE CLOSURE

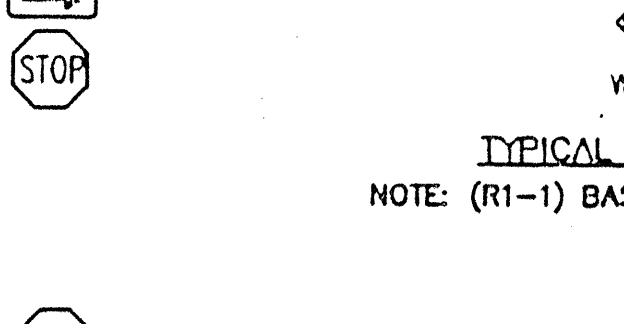

TYPICAL DOUBLE LEFT LANE CLOSURE

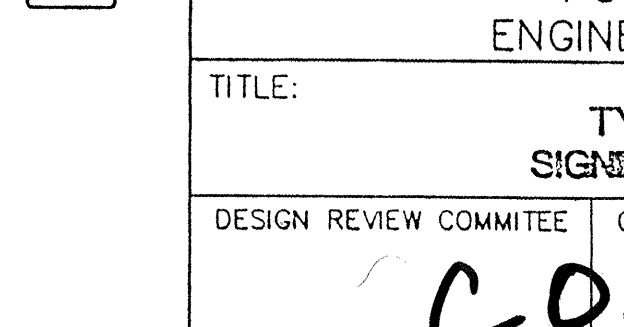


TYPICAL DOUBLE LEFT LANE CLOSURE

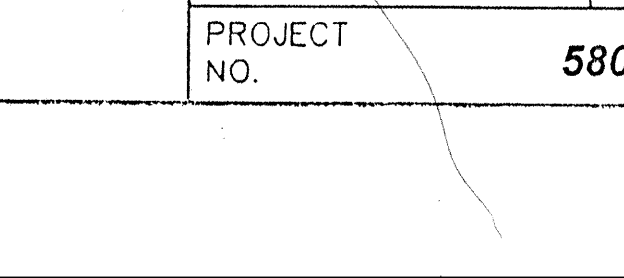


TYPICAL DOUBLE LEFT LANE CLOSURE


NOTE: (R1-1) BASED ON FIELD CONDITIONS.

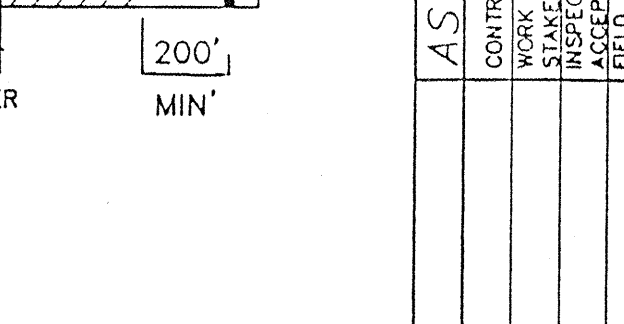


TYPICAL FLAGGING OPERATION

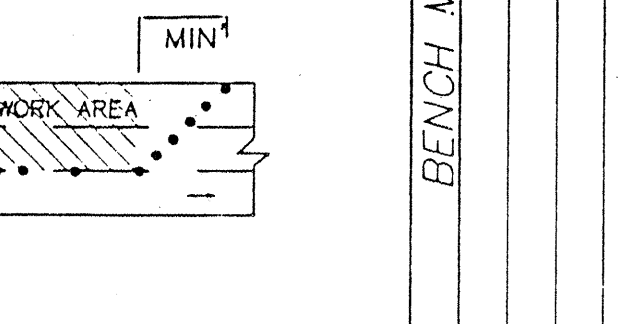


TYPICAL FLAGGING OPERATION

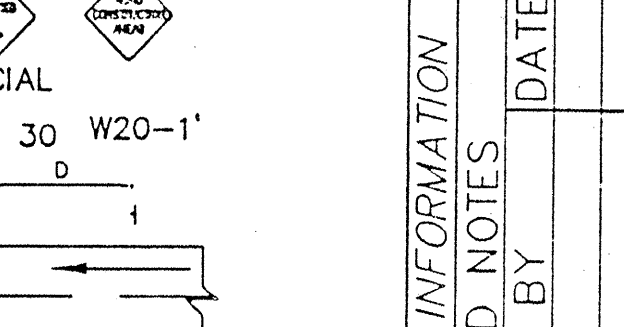


TYPICAL FLAGGING OPERATION

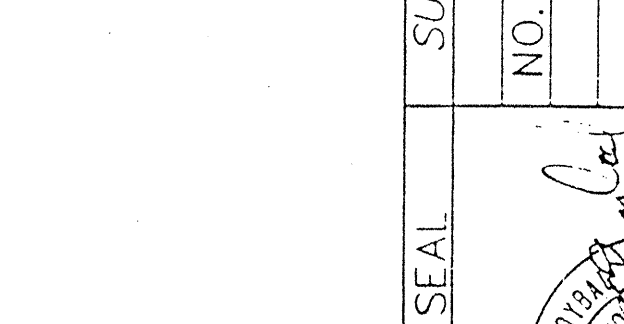


TYPICAL FLAGGING OPERATION

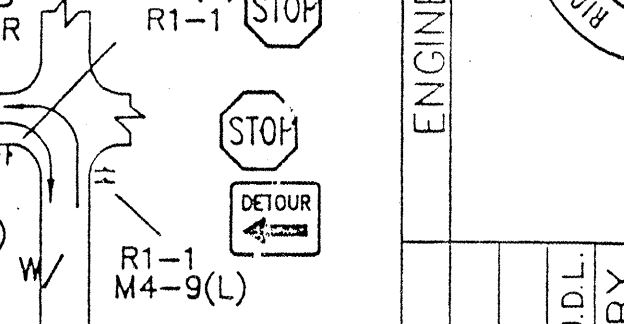

TYPICAL FLAGGING OPERATION

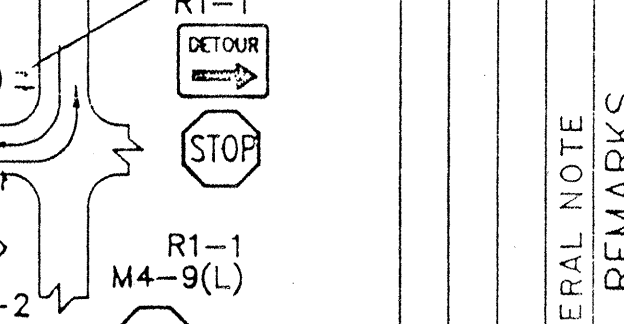


TYPICAL FLAGGING OPERATION

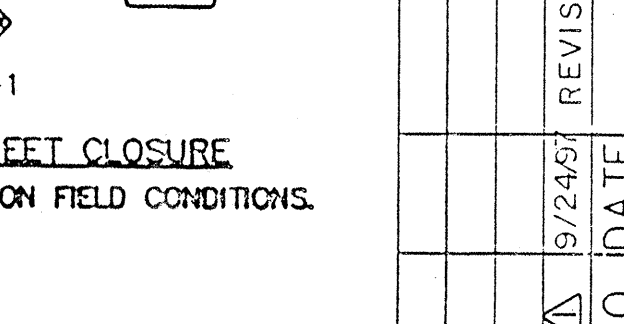

TYPICAL FLAGGING OPERATION




TYPICAL FLAGGING OPERATION

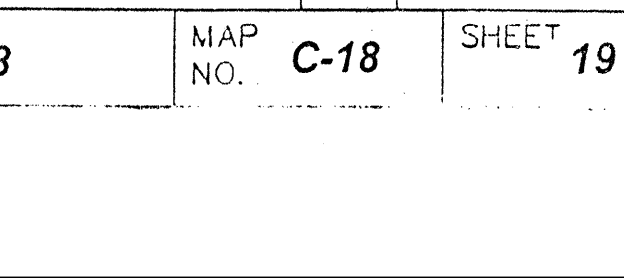


TYPICAL FLAGGING OPERATION


NOTE: (R1-1) BASED ON FIELD CONDITIONS.

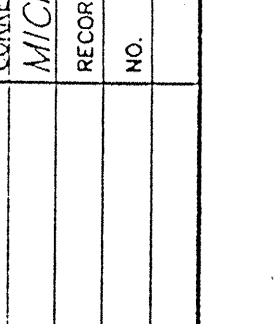


TYPICAL FLAGGING OPERATION

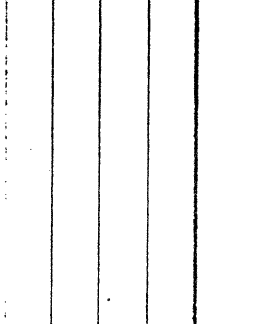


TYPICAL FLAGGING OPERATION

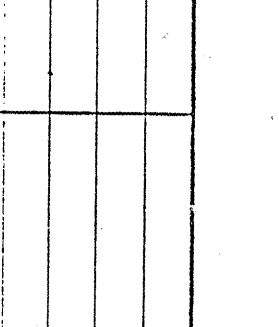


TYPICAL FLAGGING OPERATION

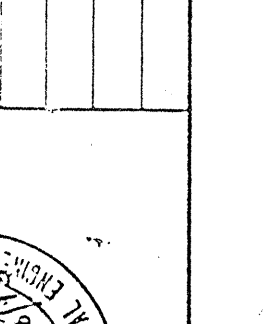


TYPICAL FLAGGING OPERATION

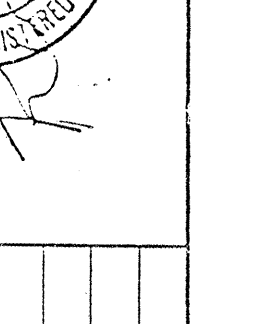


TYPICAL FLAGGING OPERATION

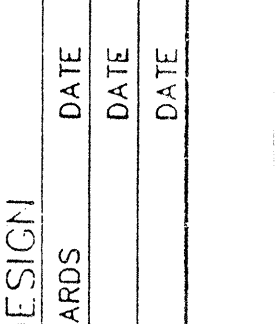


TYPICAL FLAGGING OPERATION

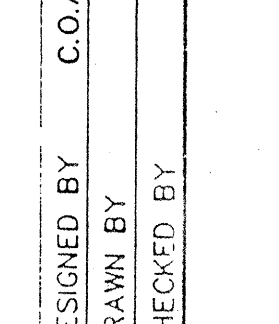

TYPICAL FLAGGING OPERATION

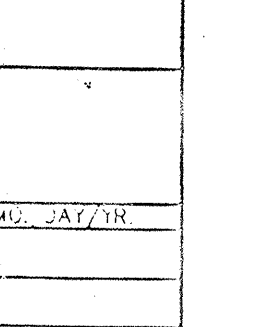

TYPICAL FLAGGING OPERATION

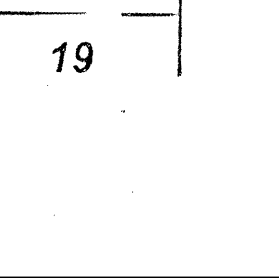

TYPICAL FLAGGING OPERATION