



SCANNED BY
PLANNING

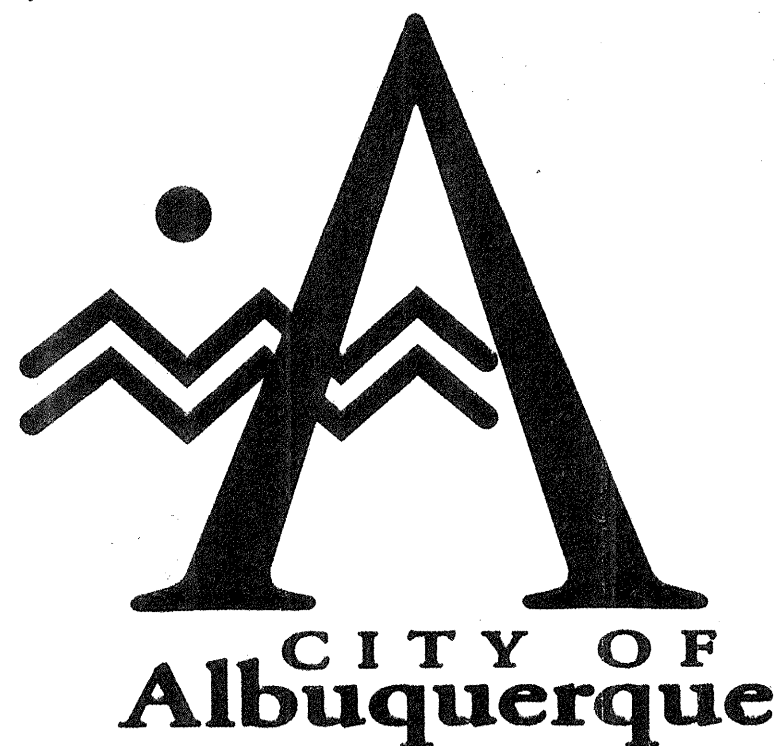

JAYNES CORP. BLDG. ADDITION

NEW FIRE HYDRANT

EDITH AND BROADWAY

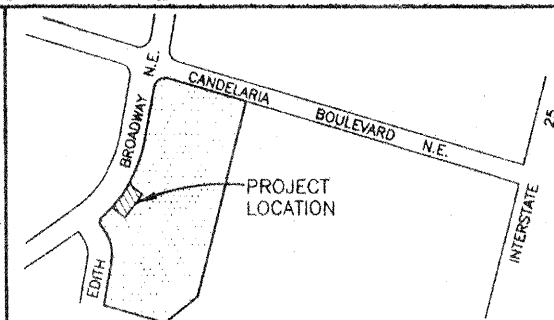

VICINITY MAP H-15-Z

GENERAL NOTES

1. AN EXCAVATION/CONSTRUCTION PERMIT WILL BE REQUIRED BEFORE BEGINNING ANY WORK WITHIN CITY RIGHT-OF-WAY.
2. ALL WORK DETAILED ON THESE PLANS TO BE PERFORMED, EXCEPT AS OTHERWISE STATED OR PROVIDED HEREON, SHALL BE CONSTRUCTED IN ACCORDANCE WITH CITY OF ALBUQUERQUE STANDARD SPECIFICATIONS FOR PUBLIC WORKS CONSTRUCTION, 1986 EDITION AS REVISED THROUGH UPDATE #6.
3. TWO WORKING DAYS PRIOR TO ANY EXCAVATION, CONTRACTOR MUST CONTACT LINE LOCATING SERVICE, (280-1990) FOR LOCATION OF EXISTING UTILITIES.
4. PRIOR TO CONSTRUCTION, THE CONTRACTOR SHALL EXCAVATE AND VERIFY THE HORIZONTAL AND VERTICAL LOCATIONS OF ALL PERTINENT EXISTING UTILITIES. SHOULD A CONFLICT EXIST, THE CONTRACTOR SHALL NOTIFY THE ENGINEER SO THAT THE CONFLICT CAN BE RESOLVED WITH A MINIMUM AMOUNT OF DELAY.
5. FIVE WORKING DAYS PRIOR TO BEGINNING CONSTRUCTION THE CONTRACTOR SHALL SUBMIT TO THE CONSTRUCTION COORDINATION DIVISION A DETAILED CONSTRUCTION SCHEDULE. TWO WORKING DAYS PRIOR TO CONSTRUCTION, THE CONTRACTOR SHALL OBTAIN A BARRICADING PERMIT FROM THE CONSTRUCTION COORDINATION DIVISION. CONTRACTOR SHALL NOTIFY BARRICADE ENGINEER (765-2561) PRIOR TO OCCUPYING PUBLIC RIGHT-OF-WAY. SEE SECTION 19 OF THE SPECIFICATIONS.
6. ALL STREET STRIPING ALTERED OR DESTROYED SHALL BE REPLACED WITH PLASTIC REFLECTORIZED PAVEMENT MARKINGS BY CONTRACTOR TO SAME LOCATION AS EXISTING, OR AS INDICATED BY THIS PLAN SET.
7. CONTRACTOR SHALL COORDINATE WITH WATER SYSTEMS DIVISION (857-8200) FIVE WORKING DAYS IN ADVANCE OF ANY WORK THAT MAY AFFECT EXISTING PUBLIC WATER OR SEWER UTILITIES. EXISTING VALVES TO BE OPERATED BY CITY PERSONNEL ONLY. CONTRACTOR SHALL CONTACT THE WATER SYSTEMS DIVISION.
8. CONTRACTOR SHALL RECORD DATA ON ALL UTILITY LINES AND ACCESSORIES AS REQUIRED BY THE CITY OF ALBUQUERQUE FOR THE PREPARATION OF "AS CONSTRUCTED" DRAWINGS. CONTRACTOR SHALL NOT COVER UTILITY LINES AND ACCESSORIES UNTIL ALL DATA HAS BEEN RECORDED.
9. CONTRACTOR SHALL NOTIFY THE ENGINEER NOT LESS THAN SEVEN (7) DAYS PRIOR TO STARTING WORK IN ORDER THAT THE CITY SURVEYOR MAY TAKE NECESSARY MEASURES TO INSURE THE PRESERVATION OF SURVEY MONUMENTS. CONTRACTOR SHALL NOT DISTURB PERMANENT SURVEY MONUMENTS WITHOUT THE CONSENT OF THE CITY SURVEYOR AND SHALL NOTIFY THE CITY SURVEYOR AND BEAR THE EXPENSE OF REPLACING ANY THAT MAY BE DISTURBED.
10. ANY WORK AFFECTING AN ARTERIAL ROADWAY REQUIRES TWENTY FOUR (24) HOUR CONSTRUCTION.

INDEX OF DRAWINGS


SHEET	TITLE
1	TITLE SHEET, INDEX, GENERAL NOTES, LEGEND, AND ABBREVIATIONS
2	NEW FIRE HYDRANT - PLAN

Field Verified 12/29/06
That it was constructed.
2/7/2007


CHAVEZ • GRIEVES
CONSULTING ENGINEERS, INC.

5639 JEFFERSON STREET N.E. • ALBUQUERQUE, NEW MEXICO 87109
PHONE (505) 344-4080 • FAX (505) 343-8759


REV.	SHEETS	CITY ENGINEER	DATE	USER	DEPARTMENT	DATE	USER	DEPARTMENT	DATE
ENGINEER'S STAMP & SIGNATURE		APPROVALS		ENGINEER		DATE		*****	
		DRG Chairman		B. R. R. R.		4-6-98		APPROVED FOR CONSTRUCTION	
		Transportation		R. W. R. R.		3-17-98			
		Water/Wastewater		R. W. R. R.		3-12-98			
		Hydrology		N/A					
		C.I.P.							
Constr. Mngmt.									
City Project No.				586381				Sheet 1 of 2	

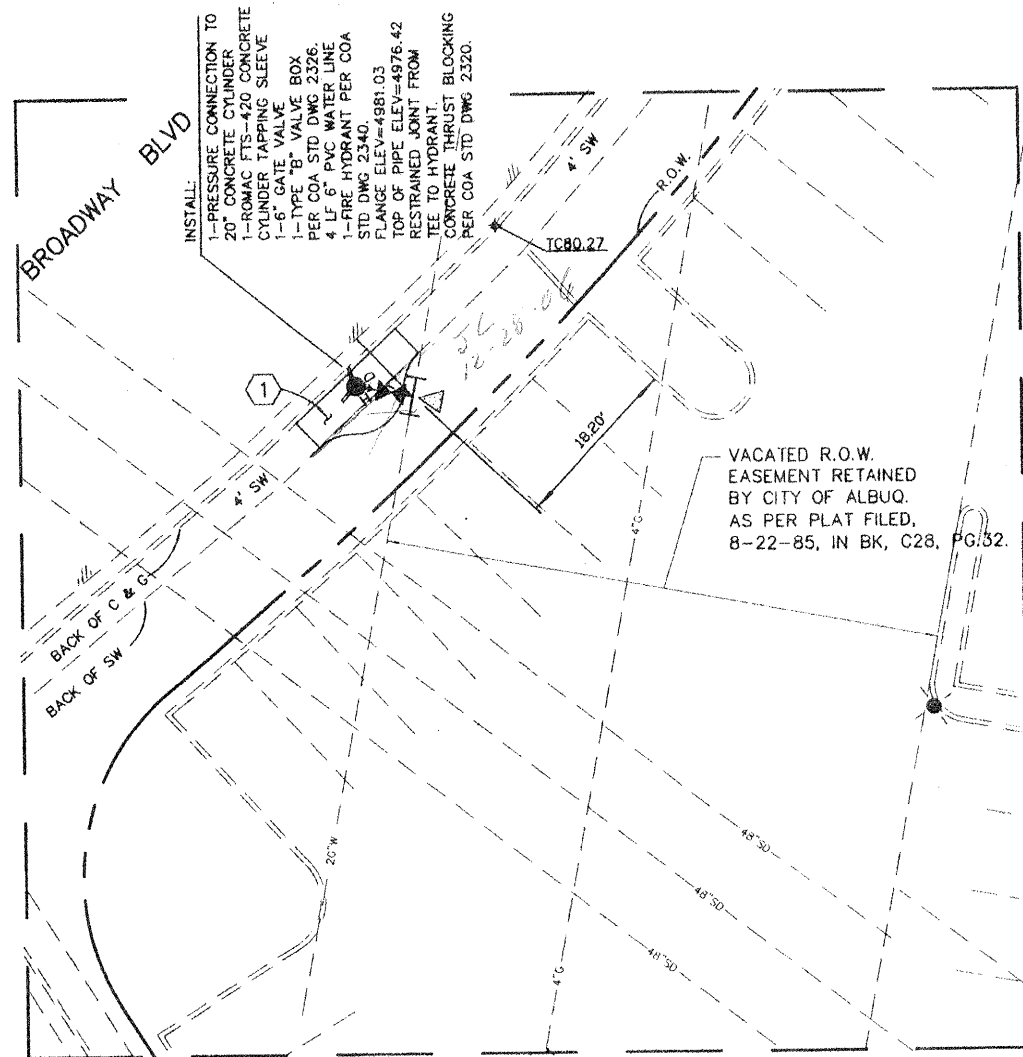

ENLARGED AREA

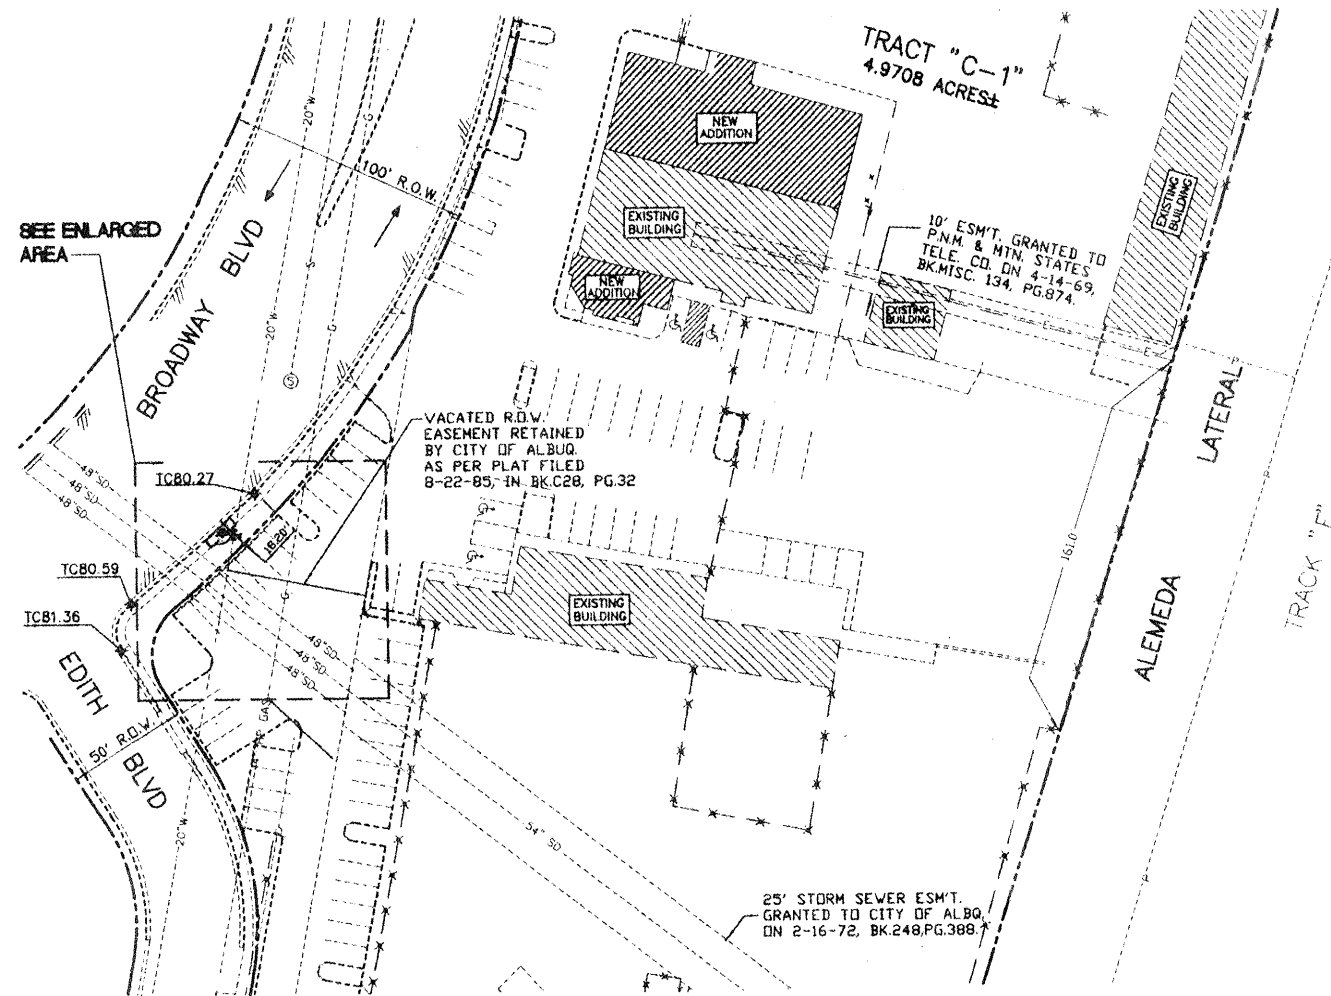

PLAN VIEW

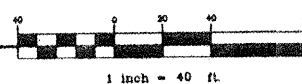

LEGEND

EXIST. CURB AND GUTTER	---
EXIST. WATER LINE	---
NEW WATER LINE	---
NEW WATER VALVE	⋈
EASEMENT LINE	---
BLOCKING	Δ
EXIST GAS LINE	---
EXIST SANITARY SEWER	---
EXIST MANHOLE	⊙
NEW FIRE HYDRANT	⋈
EDGE OF EXIST PAVEMENT	---
EXIST SIDEWALK	---
NEW SIDEWALK	---

- KEYED NOTES**
- REMOVE AND REPLACE EXISTING SIDEWALK PER COA STD DWG 2431 TO NEAREST JOINT. INSTALL 1/2" EXPANSION JOINT WHERE NEW SIDEWALK MEETS THE EXISTING SIDEWALK. MATCH EXISTING ELEVATION.

ABBREVIATIONS

- SAS = SANITARY SEWER
- LF = LINEAL FEET
- INV. = INVERT
- TP = TOP OF PIPE
- EXIST. = EXISTING
- ELEV. = ELEVATION
- W/ = WITH
- S = SLOPE
- PG = PAGE
- BK = BOOK
- R.O.W. = RIGHT OF WAY
- W = WATER
- SW = SIDEWALK



CITY OF ALBUQUERQUE
 PUBLIC WORKS DEPARTMENT
 ENGINEERING DEVELOPMENT GROUP

TITLE: BROADWAY AND EDITH
 NEW FIRE HYDRANT - PLAN

DESIGN REVIEW COMMITTEE	CITY ENGINEER APPROVAL	NO. DATE	REMARKS	BY
APR - 6 1998			DESIGN	
			REVISIONS	

City Project No. 586381 Zone Map No. H-15 Sheet 2 of 2

AS BUILT INFORMATION		BENCH MARKS		SURVEY INFORMATION		ENGINEER'S SEAL	
CONTRACTOR	DATE	EDIT OR ERASE THIS TEXT	DATE	FIELD NOTES	NO.		
DATE	DATE	TBM: NE PROPERTY CORNER, A 1" PIPE	DATE	BY	DATE		
DATE	DATE	ELEV = 4987.69'	DATE	CLINT SHERRILL & ASSOCIATES	DATE		
DATE	DATE		DATE		DATE		
MICRO-FILM INFORMATION							
DATE	DATE						
DATE	DATE						
DATE	DATE						