

STORM DRAIN INLET
2709 VASSAR PLACE NE

INDEX

- 1 TITLE SHEET
- 2 GRADING AND DRAINAGE PLAN
- 3 INLET DETAILS
- 4 TRAFFIC CONTROL STANDARDS
- 5 TRAFFIC CONTROL SIGNS AND EXAMPLES


APPROVAL OF AS BUILT DRAWINGS
CHIEF CONSTRUCTION ENGINEER
Geler Chang
DATE 11-4-98
TURNKEY / MARCIAL MARTINEZ

THESE DRAWINGS SHOW
AS-BUILT CONSTRUCTION
THE WORK IS IN SUBSTANTIAL
AGREEMENT WITH THE DESIGN



MARVIN R. KORTUM, P.E.
Civil Engineering
NM PE 6519

1605 Speakman Drive, S.E.
Albuquerque, New Mexico 87123
(505) 299-0774

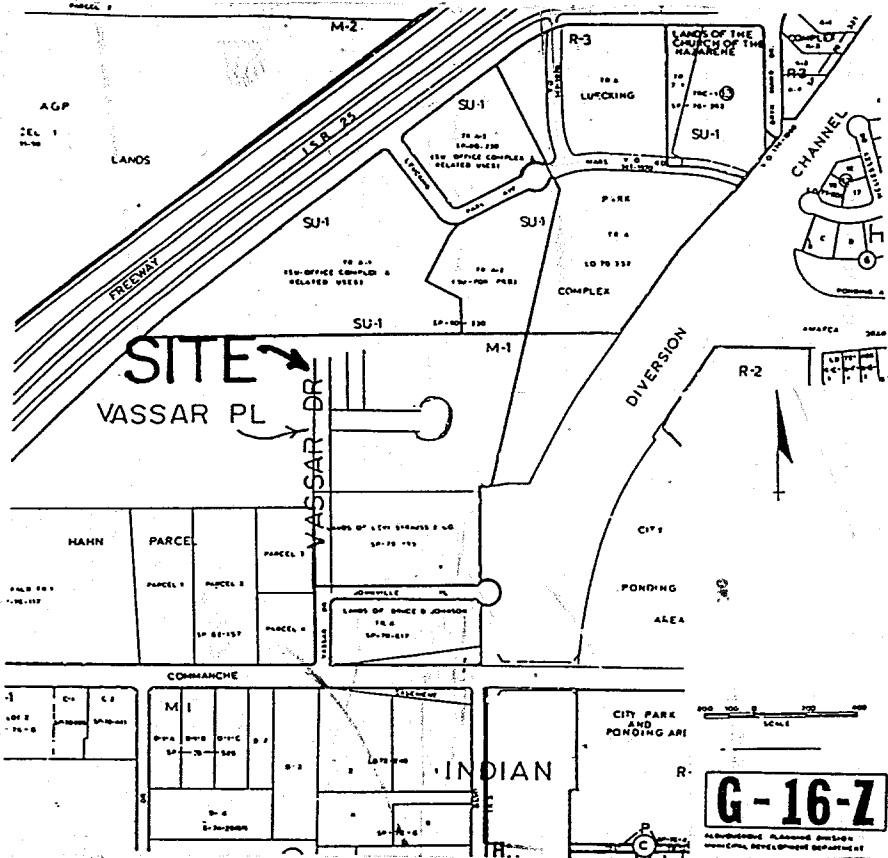

NOTICE TO CONTRACTORS

1. ALL WORK DETAILED ON THESE PLANS TO BE PERFORMED UNDER CONTRACT SHALL, EXCEPT AS OTHERWISE STATED OR PROVIDED FOR HEREON, BE CONSTRUCTED IN ACCORDANCE WITH THE CITY OF ALBUQUERQUE STANDARD SPECIFICATIONS FOR PUBLIC WORKS CONSTRUCTION, 1986 EDITION, AS AMENDED THROUGH AMENDMENT 6.
2. TWO (2) WORKING DAYS PRIOR TO ANY EXCAVATION, THE CONTRACTOR MUST CONTACT NEW MEXICO ONE-CALL SYSTEMS, 260-1990, FOR LOCATION OF EXISTING UTILITIES.
3. PRIOR TO CONSTRUCTION, THE CONTRACTOR SHALL EXCAVATE AND VERIFY THE HORIZONTAL AND VERTICAL LOCATIONS OF ALL OBSTRUCTIONS. SHOULD A CONFLICT EXIST, THE CONTRACTOR SHALL NOTIFY THE ENGINEER OR SURVEYOR SO THAT THE CONFLICT CAN BE RESOLVED WITH A MINIMUM AMOUNT OF DELAY.
4. CONTRACTOR SHALL NOTIFY THE ENGINEER NOT LESS THAN SEVEN (7) DAYS PRIOR TO STARTING WORK IN ORDER THAT THE ENGINEER MAY TAKE NECESSARY MEASURES TO INSURE THE PRESERVATION OF SURVEY MONUMENTS. CONTRACTOR SHALL NOT DISTURB PERMANENT SURVEY MONUMENTS WITHOUT THE CONSENT OF THE ENGINEER AND SHALL NOTIFY THE ENGINEER AND BEAR THE EXPENSE OF REPLACING ANY THAT MAY BE DISTURBED WITHOUT PERMISSSION. REPLACEMENT SHALL BE DONE ONLY BY THE CITY SURVEY SECTION. WHEN A CHANGE IS MADE IN THE FINISHED ELEVATION OF THE PAVEMENT OF ANY ROADWAY IN WHICH A PERMANENT SURVEY MONUMENT IS LOCATED, CONTRACTOR SHALL, AT HIS OWN EXPENSE, ADJUST THE MONUMENT COVER TO THE NEW GRADE UNLESS OTHERWISE SPECIFIED. REFER TO SECTION 4.4 OF GENERAL CONDITIONS OF STANDARD SPECIFICATIONS.
5. FIVE (5) WORKING DAYS PRIOR TO CONSTRUCTION, CONTRACTOR SHALL SUBMIT TO THE CONSTRUCTION COORDINATING DIVISION, A DETAILED CONSTRUCTION SCHEDULE. TWO (2) DAYS PRIOR TO CONSTRUCTION THE CONTRACTOR SHALL OBTAIN A BARRICADING PERMIT FROM THE CONSTRUCTION COORDINATING DIVISION. CONTRACTOR SHALL NOTIFY THE BARRICADING ENGINEER (768-2551) PRIOR TO OCCUPYING AN INTERSECTION. SEE SECTION 19 OF THE SPECIFICATION.
6. ALL STREET STRIPING ALTERED OR DESTROYED SHALL BE REPLACED WITH PLASTIC REFLECTORIZED PAVEMENT MARKINGS BY THE CONTRACTOR TO LOCATION AS EXISTED OR INDICATED BY THIS PLAN SET.


- ☐ ALL UTILITIES AND UTILITY SERVICE LINES SHALL BE INSTALLED PRIOR TO PAVING.
- ☐ BACKFILL COMPACTION SHALL BE ACCORDING TO SPECIFIED STREET USE.
- ☐ TACK COAT REQUIREMENTS SHALL BE DETERMINED BY THE CITY ENGINEER
- ☐ SIDEWALKS AND WHEELCHAIR RAMPS WITHIN THE CURB RETURNS SHALL BE CONSTRUCTED WHEREVER A NEW CURB RETURN IS CONSTRUCTED.
- ☐ IF CURB IS DEPRESSED FOR A DRIVEPAD OR A HANDICAP RAMP, THE DRIVEPAD OR RAMP SHALL BE CONSTRUCTED PRIOR TO ACCEPTANCE OF THE CURB AND GUTTER.
- ☐ ALL STORM DRAINAGE FACILITIES SHALL BE COMPLETED PRIOR TO FINAL ACCEPTANCE.

--	--	
BENCHMARK: The Comanche Business Park project benchmark is station M-6, located on Montgomery Boulevard, on the east abutment of the bridge crossing over the North Diversion Channel. The station is a brass marker located between the west bound and east bound bridges. Elevation 5110.492. There is a temporary bench mark located on the top of the curb on Vassar Drive, north of the intersection with Vassar Place, a painted mark on the east side of the street. Elevation: 5065.01.

Phase I includes the grading and drainage improvements shown for lot B-1-A-1 and that portion of the common access driveway and driveway along the common property line between lots B-1-A-1 and B-1-B-1. The unimproved portion of lot B-1-B-1 that is adjacent to the surfaced driveway will be sloped back from the edge of the pavement surface at a slope not to exceed 1 vertical to 3 horizontal in order to not create a hazardous cut bank.


LEGAL DESCRIPTION: Tracts B-1-A-1 and B-1-B-1, COMANCHE BUSINESS PARK, Albuquerque, Bernalillo County, New Mexico.

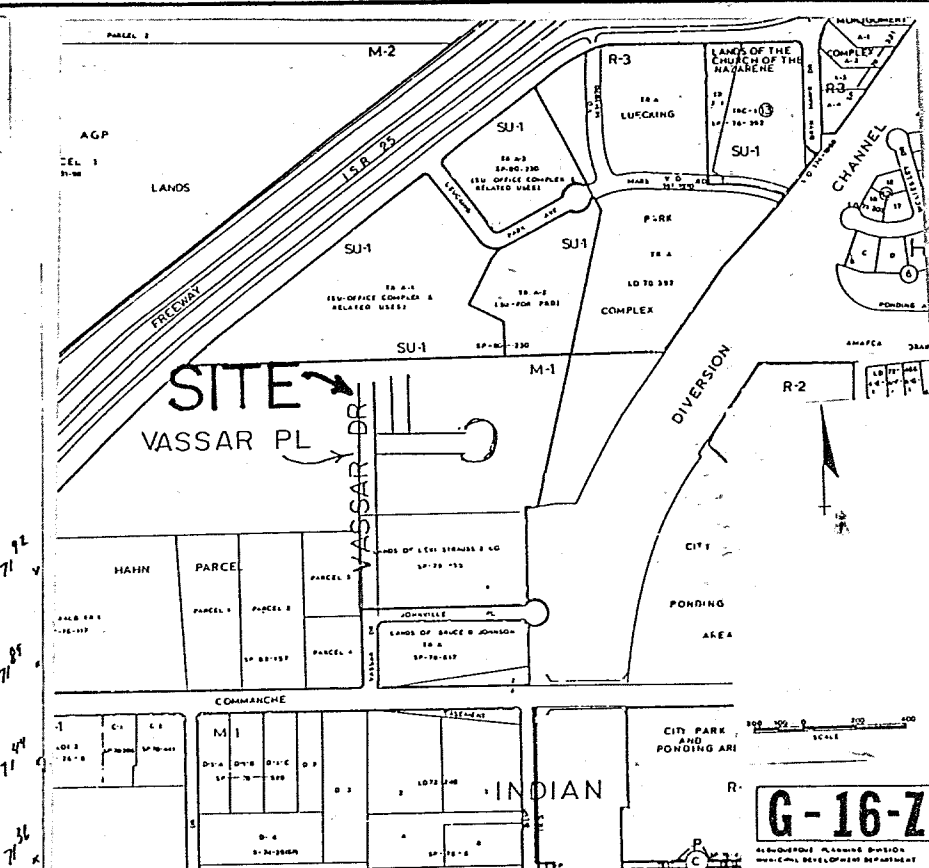

LEGEND	Existing	Proposed
Spot Elevation	64.25	TC
Top of Curb	TC	TC
Flow Line Invert	FL	FL
Finished Floor Elevation	FFE	FFE
Contour Line	64	64
Property Line		
Lot Number		
Structure		
Curb and Gutter		
Driveway		

VASSAR DRIVE, NE

VASSAR PLACE, NE

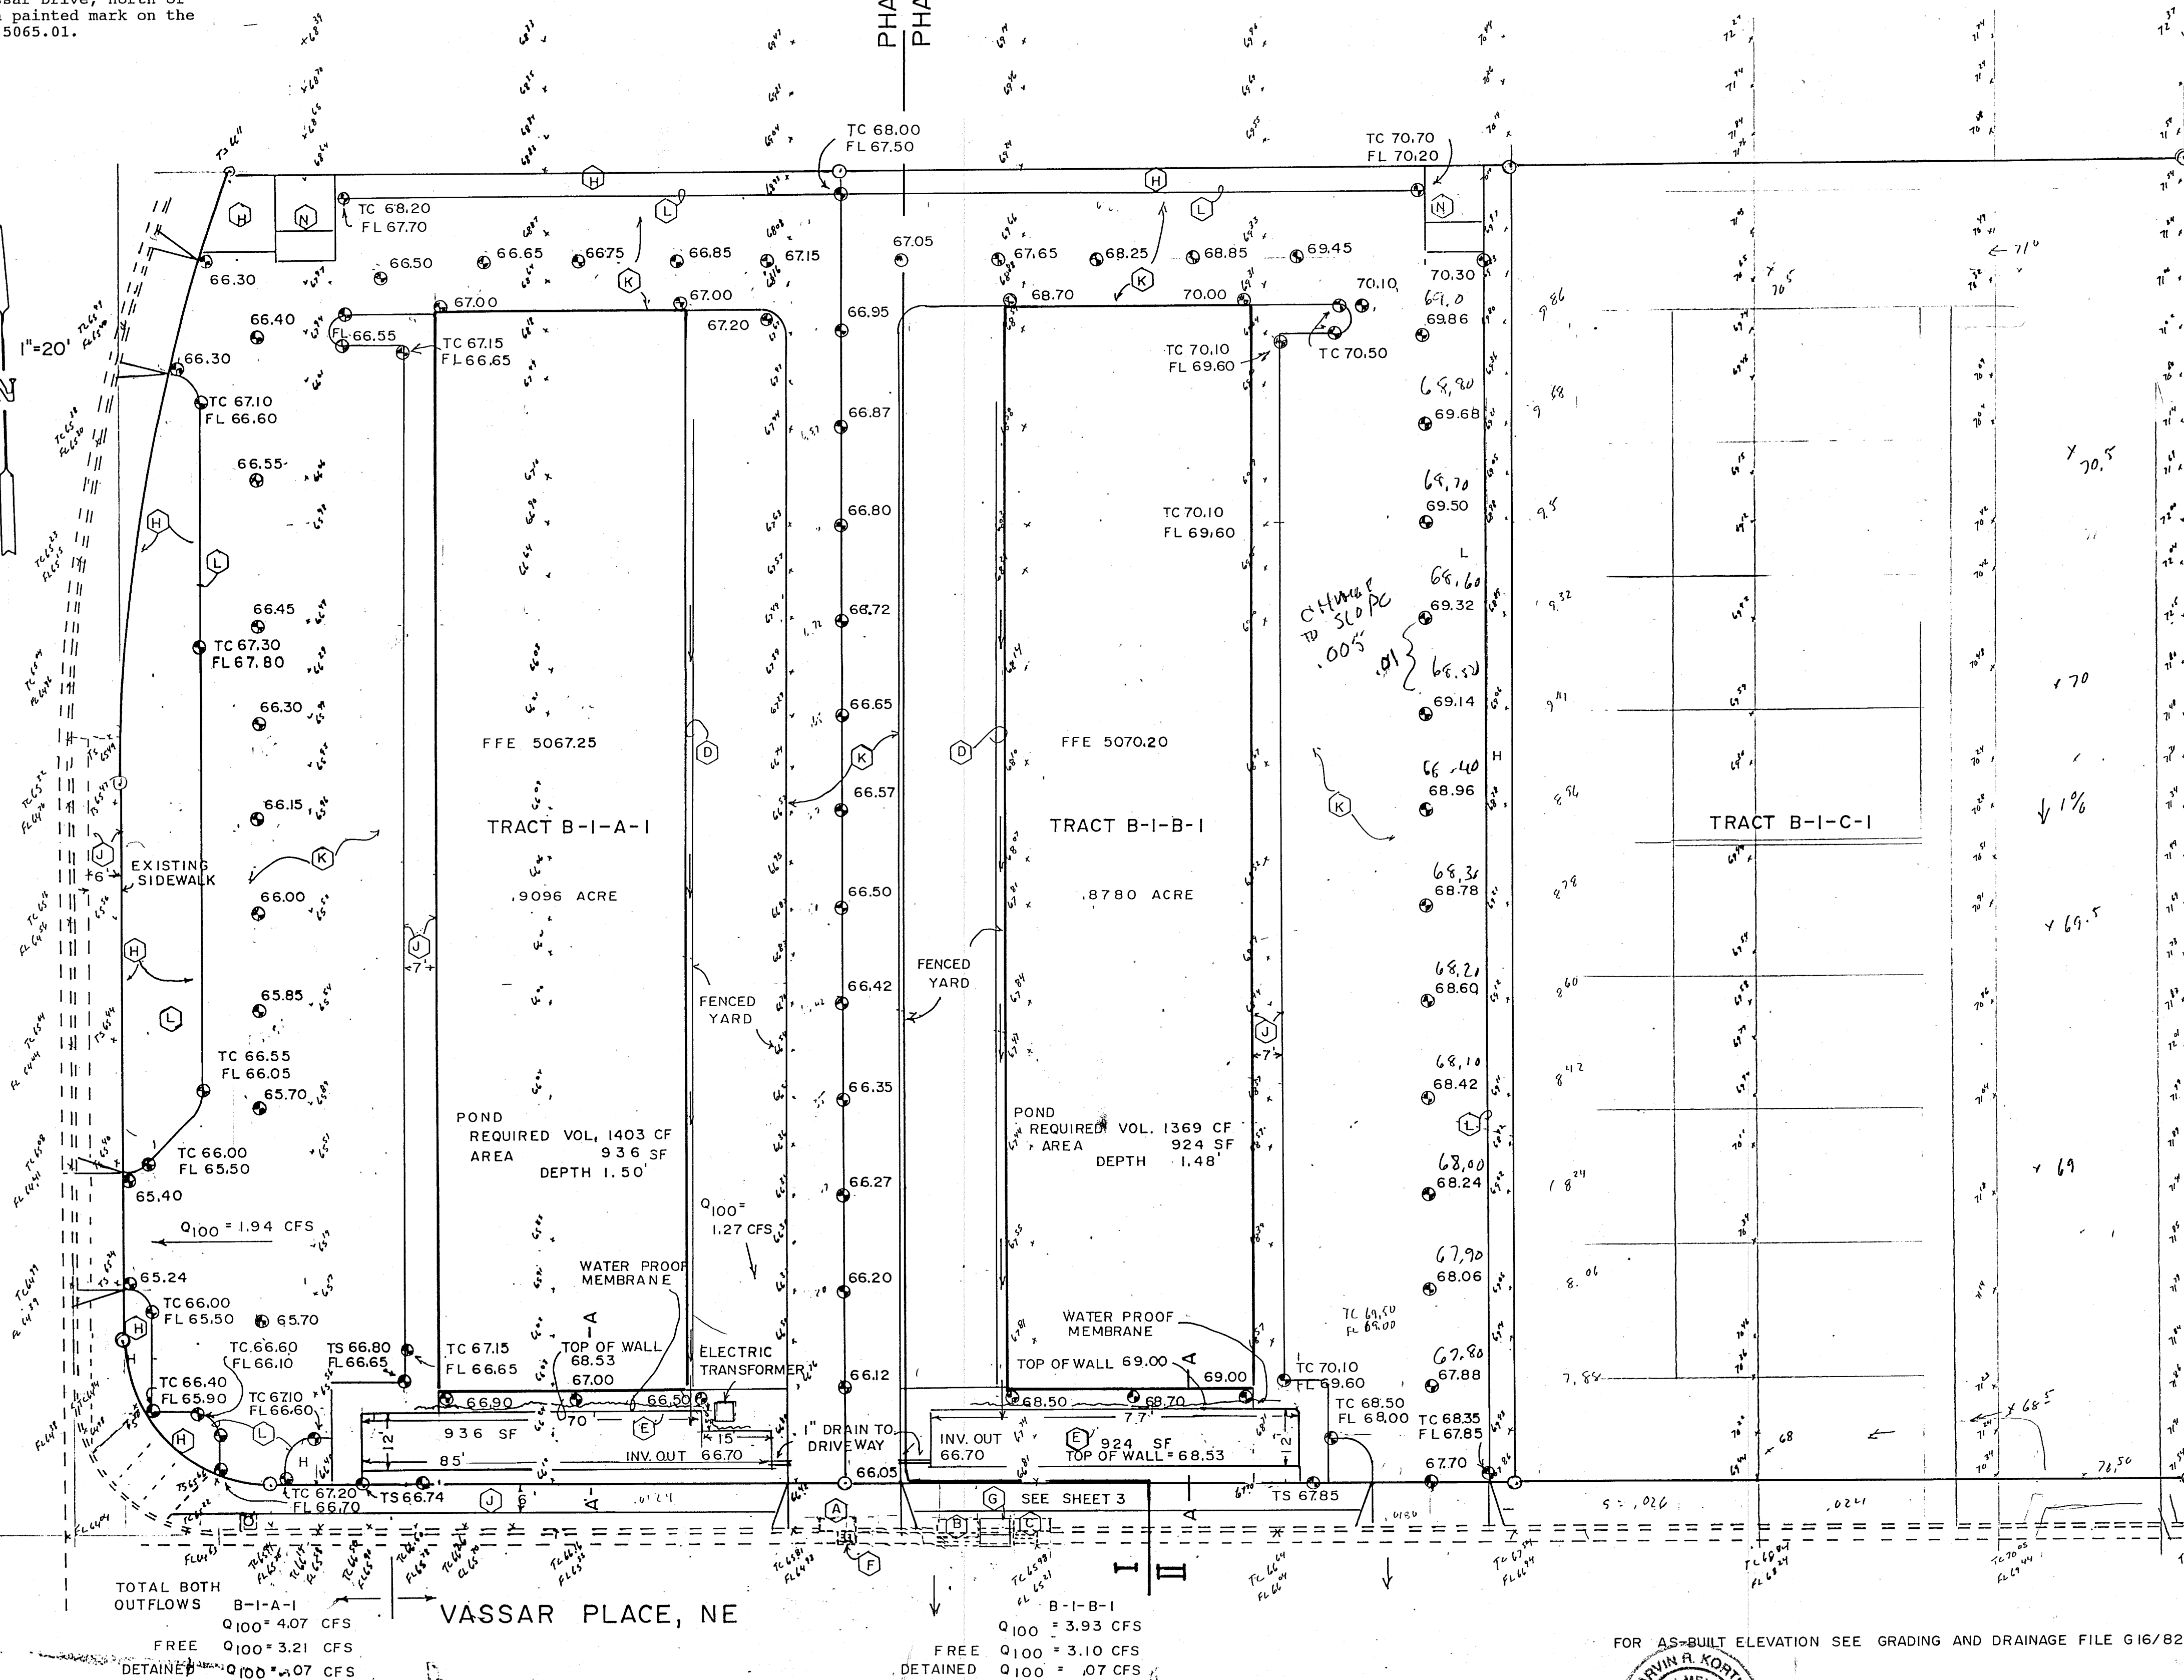

I certify that I have personally inspected the Tracts B-1-A-1 and B-1-B-1 site and the surrounding terrain. The representation of the land and the contours are as presented on these drawings and the accompanying text as of December 1997.

DATE 12/10/1997

MARVIN R. KORTUM


Topographic survey by Marvin R Kortum

NOTES

- EXISTING SINGLE "A" INLET
- EXISTING DOUBLE "C" INLET
- EXISTING SINGLE "A" INLET
- INSTALL ROOF GUTTER TO COLLECT AND DIRECT ROOF RUNOFF TO THE EAST POND. GUTTER SHALL BE 6 INCHES BY 6 INCHES OR LARGER, AND SHALL BE SET AT A 0.5% SLOPE (1/8 INCH PER FOOT) OR LARGER. THE GUTTER SHALL DIRECT THE FLOW TO A DOWNSPOUT, THEN INTO THE DETENTION POND.
- CONSTRUCT DETENTION POND.
- REMOVE EXISTING INLET A.
- CONSTRUCT NEW INLET, TYPE ~~SINGLE~~ DOUBLE "C"
- LANDSCAPING. IF A MEMBRANE IS USED, THE MEMBRANE WILL BE PERVIOUS.
- PCC SIDEWALK.
- Asphalt or PCC pavement.

- 6" WIDE BY REQUIRED DEPTH HEADER CURB. A PCC CURB AND GUTTER MAY BE USED.
- OFF-SITE FLOWS FROM ADJACENT UNDEVELOPED PROPERTY CAN BE ACCEPTED, PASSED THROUGH THE PROPERTY, AND DISPOSED OF IN ACCORDANCE WITH THE COMANCHE BUSINESS PARK MASTER DRAINAGE PLAN.
- TRASH COLLECTION BIN.
- ALL BERMS AND EARTHWORK SUPPORTING STRUCTURES MUST BE COMPACTED TO 95% OF MAXIMUM DRY DENSITY (MODIFIED PROCTOR TEST).
- ELEVATIONS OF BUILDING PADS ARE BASED ON SLAB ON GRADE.
- QUANTITATIVE EARTHWORK ESTIMATES SHOULD BE BASED ON MORE DETAILED TOPOGRAPHIC CROSS SECTIONS OF THE WORK AREA.

FOR AS-BUILT ELEVATION SEE GRADING AND DRAINAGE FILE G16/82B

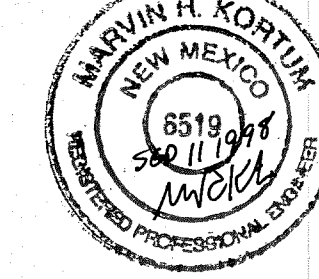

INCREASE POND AREA
RELOCATE INLET
ADD PHASE I, II LINE

MRK
MRK
MRK

MAR 16, 1998
FEB 20, 1998
JAN 13, 1998

Preliminary
APPROVALS, REVISIONS

Marvin R Kortum
BY

December 10, 1997
DATE



MARVIN R. KORTUM, P.E.
Civil Engineering
NM PE 6519
1605 Speakman Drive, S.E.
Albuquerque, New Mexico 87123
(505) 299-0774

GRADING AND DRAINAGE PLAN
TRACTS B-1-A-1 & B-1-B-1
COMANCHE BUSINESS PARK
SITE GRADING

CITY PROJECT NO.

590381

G-16/D82B

G-16 2/5

COMMON ACCESS GASEW
RECORDED JAN 15 1998
BK 98-2 P829-852
PROPERTY

VASSAR DRIVE NE

TRACT B-1-B-1
2709 VASSAR PLACE NE

$$\begin{aligned} H: I'' &= IO' \\ V: I'' &= I' \end{aligned}$$

A circular professional engineer seal for Marvin R. Kortum, State of New Mexico. The seal contains the text: MARVIN R. KORTUM, NEW MEXICO, 6519, SEP 1 1998, and REGISTERED PROFESSIONAL ENGINEER. There is a handwritten signature across the bottom half of the seal.



ENGINEER'S SEAL

BY	
----	--

REVISIONS
REMARKS

NO.	DATE
-----	------

NOTES FOR CLOSING OF EXISTING INLET AND CONSTRUCTION OF NEW INLET

J. FILL THE INLET "A" BOTTOM AND THE 18" RCP PIPE WHICH EXTENDS TO INLET "B" WITH CLEAN SAND (WET THE SAND TO OBTAIN MAXIMUM COMPACTION). PLACE A TEMPORARY FORM AT THE END OF THE PIPE IN INLET "B" WHILE PLACING AND COMPACTING THE SAND.

L. PLACE DRIVEPAD IN LOCATION AS SHOWN, REMOVING EXISTING CURB STONES TO THE NEAREST WHOLE STONE. BE SURE THAT THE FLOW LINE HAS A SLOPE FOR POSITIVE DRAINAGE.

N. SAW CUT EXISTING ASPHALT STREET SURFACE 12" BACK FROM THE CURB LINE IN THE CONSTRUCTION AREA, AND THEN REPLACE ASPHALT IN ACCORDANCE WITH NOTE 7, STANDARD DRAWING 2415

TITLE: STORM DRAIN INLET DETAILS

Design Review Committee
APPROVED
JUN - 2 1993
DESIGN
REVIEW COMMITTEE

City Engineer Approval

City Project No. 59038J

Zone	Map No.	Sheet	Of
	G-16	3	5

CONSTRUCTION TRAFFIC CONTROL GENERAL NOTES

1. CONTRACTOR MUST OBTAIN FROM CONSTRUCTION COORDINATION AN EXCAVATION/BARRICADING PERMIT BEFORE ENGAGING IN ANY CONSTRUCTION, MAINTENANCE OR REPAIR WORK IN ANY OF THE CITY OF ALBUQUERQUE'S RIGHTS-OF-WAY. EMERGENCY WORK THAT WOULD PRESERVE LIFE OR PROPERTY IS EXCLUDED WITH THE UNDERSTANDING, THAT A PERMIT SHALL BE OBTAINED WITHIN 24 TO 48 HOURS.

2. CONTRACTOR SHALL AT THE TIME OF PERMIT REQUEST, SUBMIT FOR APPROVAL BY CONSTRUCTION COORDINATION, A TRAFFIC CONTROL PLAN DETAILING ALL EXISTING TOPOGRAPHY SUCH AS LANE WIDTHS, DRIVEWAYS, AND BUSINESS/RESIDENTIAL ACCESSES. THE TRAFFIC CONTROL PLAN SHALL INCLUDE ALL PHASES OF WORK AND SCHEDULES INVOLVED IN THE CONSTRUCTION PROJECT. ANY SEPARATE PHASES OF A CONSTRUCTION PROJECT SHALL BE GIVEN AN INDIVIDUAL PERMIT EACH. BLANKET PERMITS WILL NOT BE ISSUED.

3. THESE TYPICAL TRAFFIC CONTROL PLANS DO NOT REFLECT THE EXISTING TOPOGRAPHY SUCH AS DRIVEWAYS, LANE WIDTHS, AND BUSINESS/RESIDENTIAL ACCESSES. EVERY LOCATION THAT REQUIRES CONSTRUCTION TRAFFIC CONTROL SHALL HAVE A DETAILED TRAFFIC CONTROL PLAN SHOWING ALL EXISTING TOPOGRAPHY.

4. CONSTRUCTION SHALL NOT BEGIN UNLESS A TRAFFIC CONTROL PLAN HAS BEEN APPROVED AND VERIFIED BY CONSTRUCTION COORDINATION.

5. CONSTRUCTION COORDINATION SHALL BE NOTIFIED 48 HOURS PRIOR TO ANY TRAFFIC CONTROL CHANGES NEEDED BY CONTRACTOR, THAT WERE NOT PREVIOUSLY APPROVED. THESE TRAFFIC CONTROL CHANGES SHALL BE REQUESTED IN WRITING ACCOMPANIED WITH A TRAFFIC CONTROL PLAN REFLECTING SUCH CHANGES.

6. ALL CONSTRUCTION TRAFFIC CONTROL DEVICES SHALL COMPLY TO THE MANUAL ON UNIFORM TRAFFIC CONTROL DEVICES (MUTCD), LATEST EDITION. IT IS THE RESPONSIBILITY OF THE CONTRACTOR TO INSTALL, SERVICE AND MAINTAIN ALL TRAFFIC CONTROL DEVICES. TRAFFIC CONTROL DEVICES SHALL NOT BE REMOVED OR ALTERED IN ANY WAY WITHOUT THE APPROVAL OF CONSTRUCTION COORDINATION, PER SECTION 6A-4 OF THE MUTCD, LATEST EDITION.

7. THE CONSTRUCTION TRAFFIC CONTROL INITIAL SET-UP SHALL BE BY AN AMERICAN TRAFFIC SAFETY SERVICES ASSOCIATION (ATSSA) CERTIFIED WORKSITE TRAFFIC SUPERVISOR. THE MAINTENANCE AND SERVICING SHALL ALSO BE DONE BY AN ATSSA CERTIFIED WORKSITE TRAFFIC SUPERVISOR OR EQUIVALENT.

8. CONTRACTOR IS RESPONSIBLE TO MAINTAIN AND SERVICE ALL TRAFFIC CONTROL DEVICES 24 HOURS A DAY, 7 DAYS A WEEK THROUGHOUT LENGTH OF PROJECT. CONTRACTOR IS RESPONSIBLE THAT ALL TRAFFIC CONTROL DEVICES COMPLY WITH THE MUTCD, LATEST EDITION.

9. ALL ADVANCE WARNING SIGNS SHALL BE DOUBLE INDICATED WHENEVER THERE ARE MULTI-LANE TRAFFIC IN ANY ONE GIVEN DIRECTION AND THERE IS SUFFICIENT MEDIAN SPACE.

10. ALL BARRICADES IN ALL TAPERS AND TANGENTS SHALL BE PLACED APART, A DISTANCE MEASURED IN FEET, EQUAL TO THAT OF THE POSTED SPEED LIMIT. NO EXCEPTIONS UNLESS APPROVED BY CONSTRUCTION COORDINATION PER MUTCD SECTION 6A-4.

11. ALL WORK IN ARTERIAL ROADWAYS SHALL BE ON A CONTINUOUS 24HOUR PER DAY BASIS UNTIL COMPLETED.

12. CONTRACTOR IS RESPONSIBLE TO PROVIDE CONSTRUCTION COORDINATION, A WEEKLY LOG OF DAILY INSPECTIONS OF BARRICADE AND MAINTENANCE SCHEDULES ON PROJECTS THAT ARE OVER ONE WEEK DURATION.

13. EQUIPMENT OR MATERIALS SHALL NOT BE STORED WITHIN 15 FEET OF A TRAVELLED TRAFFIC LANE DURING NON-WORKING HOURS WITHOUT THE APPROVAL OF CONSTRUCTION COORDINATION.

14. CONTRACTOR SHALL PROVIDE AND MAINTAIN A SAFE AND ADEQUATE MEANS OF CHANNELIZING PEDESTRIAN TRAFFIC AROUND AND THROUGH THE CONSTRUCTION AREA.

15. CONTRACTOR IS RESPONSIBLE FOR OBLITERATION OF ANY CONFLICTING STRIPING AND RESPONSIBLE FOR ALL TEMPORARY STRIPING.

16. CONTRACTOR SHALL MAINTAIN ACCESS TO ALL FACILITIES, BUSINESSES AND/OR RESIDENTS AT ALL TIMES.

17. CONTRACTOR SHALL PROVIDE ACCESS SIGNS FOR BUSINESSES LOCATED WITHIN THE CONSTRUCTION AREA UNDER THE SUPERVISION OF CONSTRUCTION COORDINATION. EACH ACCESS SIGN SHALL HAVE 5 INCH, WHITE OPAQUE LETTERING ON BLUE REFLECTORIZED BACKGROUND. ACCESS SIGNS SHALL BE CONSIDERED INCIDENTAL TO THE BID AND NOT PART OF THE CONTRACT UNLESS OTHERWISE STATED. NO MORE THAN 3 BUSINESSES SHALL BE LISTED ON A ACCESS SIGN. SHOPPING CENTERS AND MALLS SHALL BE LISTED AS SUCH.

18. ALL ADVANCE WARNING SIGNS SHALL MEET THE MINIMUM REFLECTIVE INTENSITY REQUIREMENTS SET FORTH BY THE CITY OF ALBUQUERQUE. CONSTRUCTION COORDINATION SHALL DETERMINE ALL REQUIREMENTS AND APPROVE OR DISAPPROVE ANY ADVANCE WARNING SIGN PER SECTION 6A-4 OF THE MUTCD, LATEST EDITION.

19. 48 HOURS PRIOR TO OCCUPANCY OR CLOSING OF A RIGHT-OF-WAY, CONTRACTOR SHALL NOTIFY: POLICE, FIRE DEPARTMENT, SCHOOLS, HOSPITALS, TRANSIT AUTHORITY, BUSINESSES AND/OR RESIDENTS THAT WILL BE AFFECTED BY THE CONSTRUCTION.

20. ANY FIELD ADJUSTMENTS SHALL BE APPROVED BY CONSTRUCTION COORDINATION.

21. EXCAVATIONS SHALL BE PLATED, TEMPORARILY PATCHED OR RESURFACED PRIOR TO OPENING OF TRAFFIC. A MINIMUM OF 11 FEET SHALL BE PROVIDED FOR TRAFFIC IN ANY GIVEN DIRECTION. CONTRACTOR IS RESPONSIBLE FOR ANY WORK INVOLVED IN SATISFYING THESE REQUIREMENTS.

22. CONTRACTOR SHALL AT ALL TIMES COMPLY WITH THE FOLLOWING:
1. STANDARDS AND REQUIREMENTS SET FORTH IN THE MANUAL ON UNIFORM TRAFFIC CONTROL DEVICES, LATEST EDITION.
2. THE CITY OF ALBUQUERQUE TRAFFIC CODE, LATEST EDITION.
3. SECTION 19 OF THE CITY OF ALBUQUERQUE'S STANDARD SPECIFICATIONS FOR PUBLIC WORK CONSTRUCTION, AS WELL AS OTHER SECTIONS.


23. FAILURE TO COMPLY WITH ANY OF THE ABOVE MENTIONED, WILL BE ADEQUATE CAUSE TO CEASE ALL WORK ON ANY CONSTRUCTION PROJECT. WORK WILL NOT RESUME UNTIL ALL REQUIREMENTS ARE ADDRESSED AND APPROVED BY CONSTRUCTION COORDINATION.

24. ALL TRAFFIC CONTROL DEVICES SHALL BE KEPT IN NEW-CLEAN CONDITION. WASHING OF EQUIPMENT IS INCIDENTAL TO IT'S PLACEMENT AND MAINTENANCE.


25. TRAFFIC CONTROL STANDARDS APPLY ONLY WHERE THE CONSTRUCTION TRAFFIC CONTROL PLANS ARE NOT SPECIFIC.

26. ADVANCE WARNING SIGNS SHALL BE 36"x36" MIN. WITH SUPER ENGINEERING GRADE SHEETING OR BETTER. MOUNTING HEIGHT AT TOP OF SIGN SHALL BE THE SAME AS FOR A 48" SIGN AS INDICATED IN THE M.U.T.C.D.

27. CONTRACTOR SHALL MAINTAIN A GRAFFITI-FREE WORKSITE. ALL GRAFFITI SHALL BE PROMPTLY REMOVED FROM ALL EQUIPMENT, BOTH PERMANENT AND TEMPORARY.

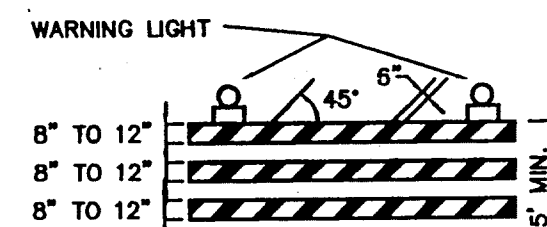


TYPE III BARRICADE

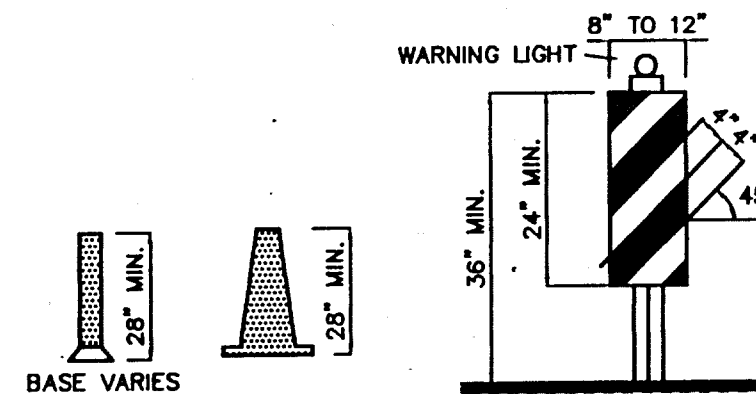


CONES

VERTICAL PANEL


HIGH LEVEL WARNING DEVICE

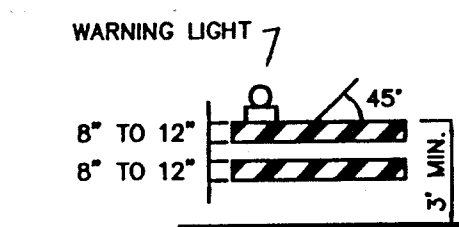


TYPE I BARRICADE

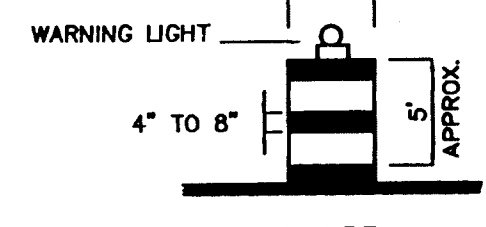

BARREL

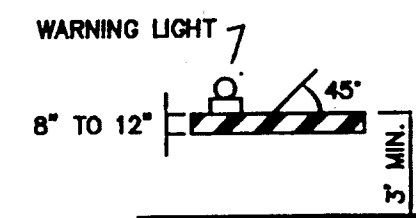


TYPE I BARRICADE

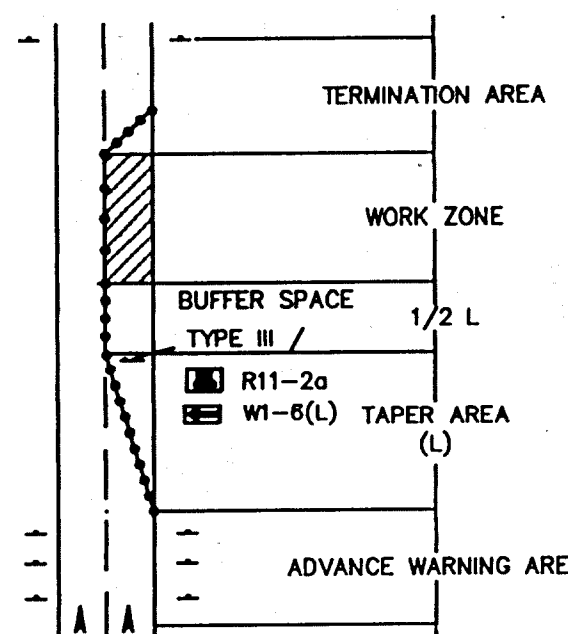

TRAFFIC CONTROL ELEMENTS

LEGEND

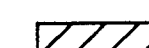


WORK AREA



BARRICADE - TYPE I, TYPE II, OR BARREL



BARRICADE - TYPE III

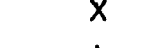

VERTICAL PANEL




WARNING SIGN



DISTANCE BETWEEN SIGNS - A DISTANCE MEASURED IN FEET EQUAL TO A VALUE OF TEN TIMES THE SPEED LIMIT OF THE STREET



FLAGMAN POSITION

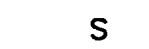

SPACING BETWEEN BARRICADES - A DISTANCE MEASURED IN FEET EQUAL TO THE SPEED LIMIT OF THE STREET



TAPER LENGTH - SEE CHART BELOW

THE TANGENT LENGTH IS EQUAL TO THE TAPER LENGTH FOR A GIVEN STREET.

TAPER REQUIREMENTS

SPEED LIMIT (MPH)	TAPER LENGTH (L) (FEET)			MINIMUM NUMBER OF DEVICES FOR TAPER	MAXIMUM DEVICE SPACING IN FEET	
	10' LANE	11' LANE	12' LANE		BEFORE TAPER	AFTER TAPER
20	70	75	80	5	20	20
25	105	115	125	6	25	25
30	150	165	180	7	30	30
35	205	225	245	8	35	35
40	270	295	320	9	40	40
45	450	495	540	13	45	45
50	500	550	600	13	50	50
55	550	605	660	13	55	55

RECOMMENDED SIGN SPACING(D) FOR ADVANCE WARNING SIGN SERIES

SPEED MILES PER HOUR	MINIMUM DISTANCE IN FEET	
	BETWEEN SIGNS	FROM LAST SIGN TO TAPER
0-20	10 X SPEED LIMIT	10 X SPEED LIMIT
25-30	10 X SPEED LIMIT	10 X SPEED LIMIT
30-35	10 X SPEED LIMIT	10 X SPEED LIMIT
40-45	10 X SPEED LIMIT	10 X SPEED LIMIT
50-60	10 X SPEED LIMIT	10 X SPEED LIMIT


TAPER CRITERIA

TYPE OF TAPER	TAPER LENGTH
UPSTREAM TAPER:	
MERGING TAPER	L MINIMUM
SHIFTING TAPER	1/2 L MINIMUM
SHOULDER TAPER	1/2 L MINIMUM
TWO-WAY TRAFFIC TAPER	100 FEET MAXIMUM
DOWNSTREAM TAPERS	100 FEET PER LANE


TAPER LENGTH COMPUTATION

SPEED LIMIT	L = WS ² / 60
40 MPH OR LESS	
45 MPH OR GREATER	L = W x S

L = TAPER LENGTH
W = WIDTH OF OFFSET IN FEET
S = POSTED SPEED OR OFF-PEAK 85-PERCENTILE SPEED IN MPH

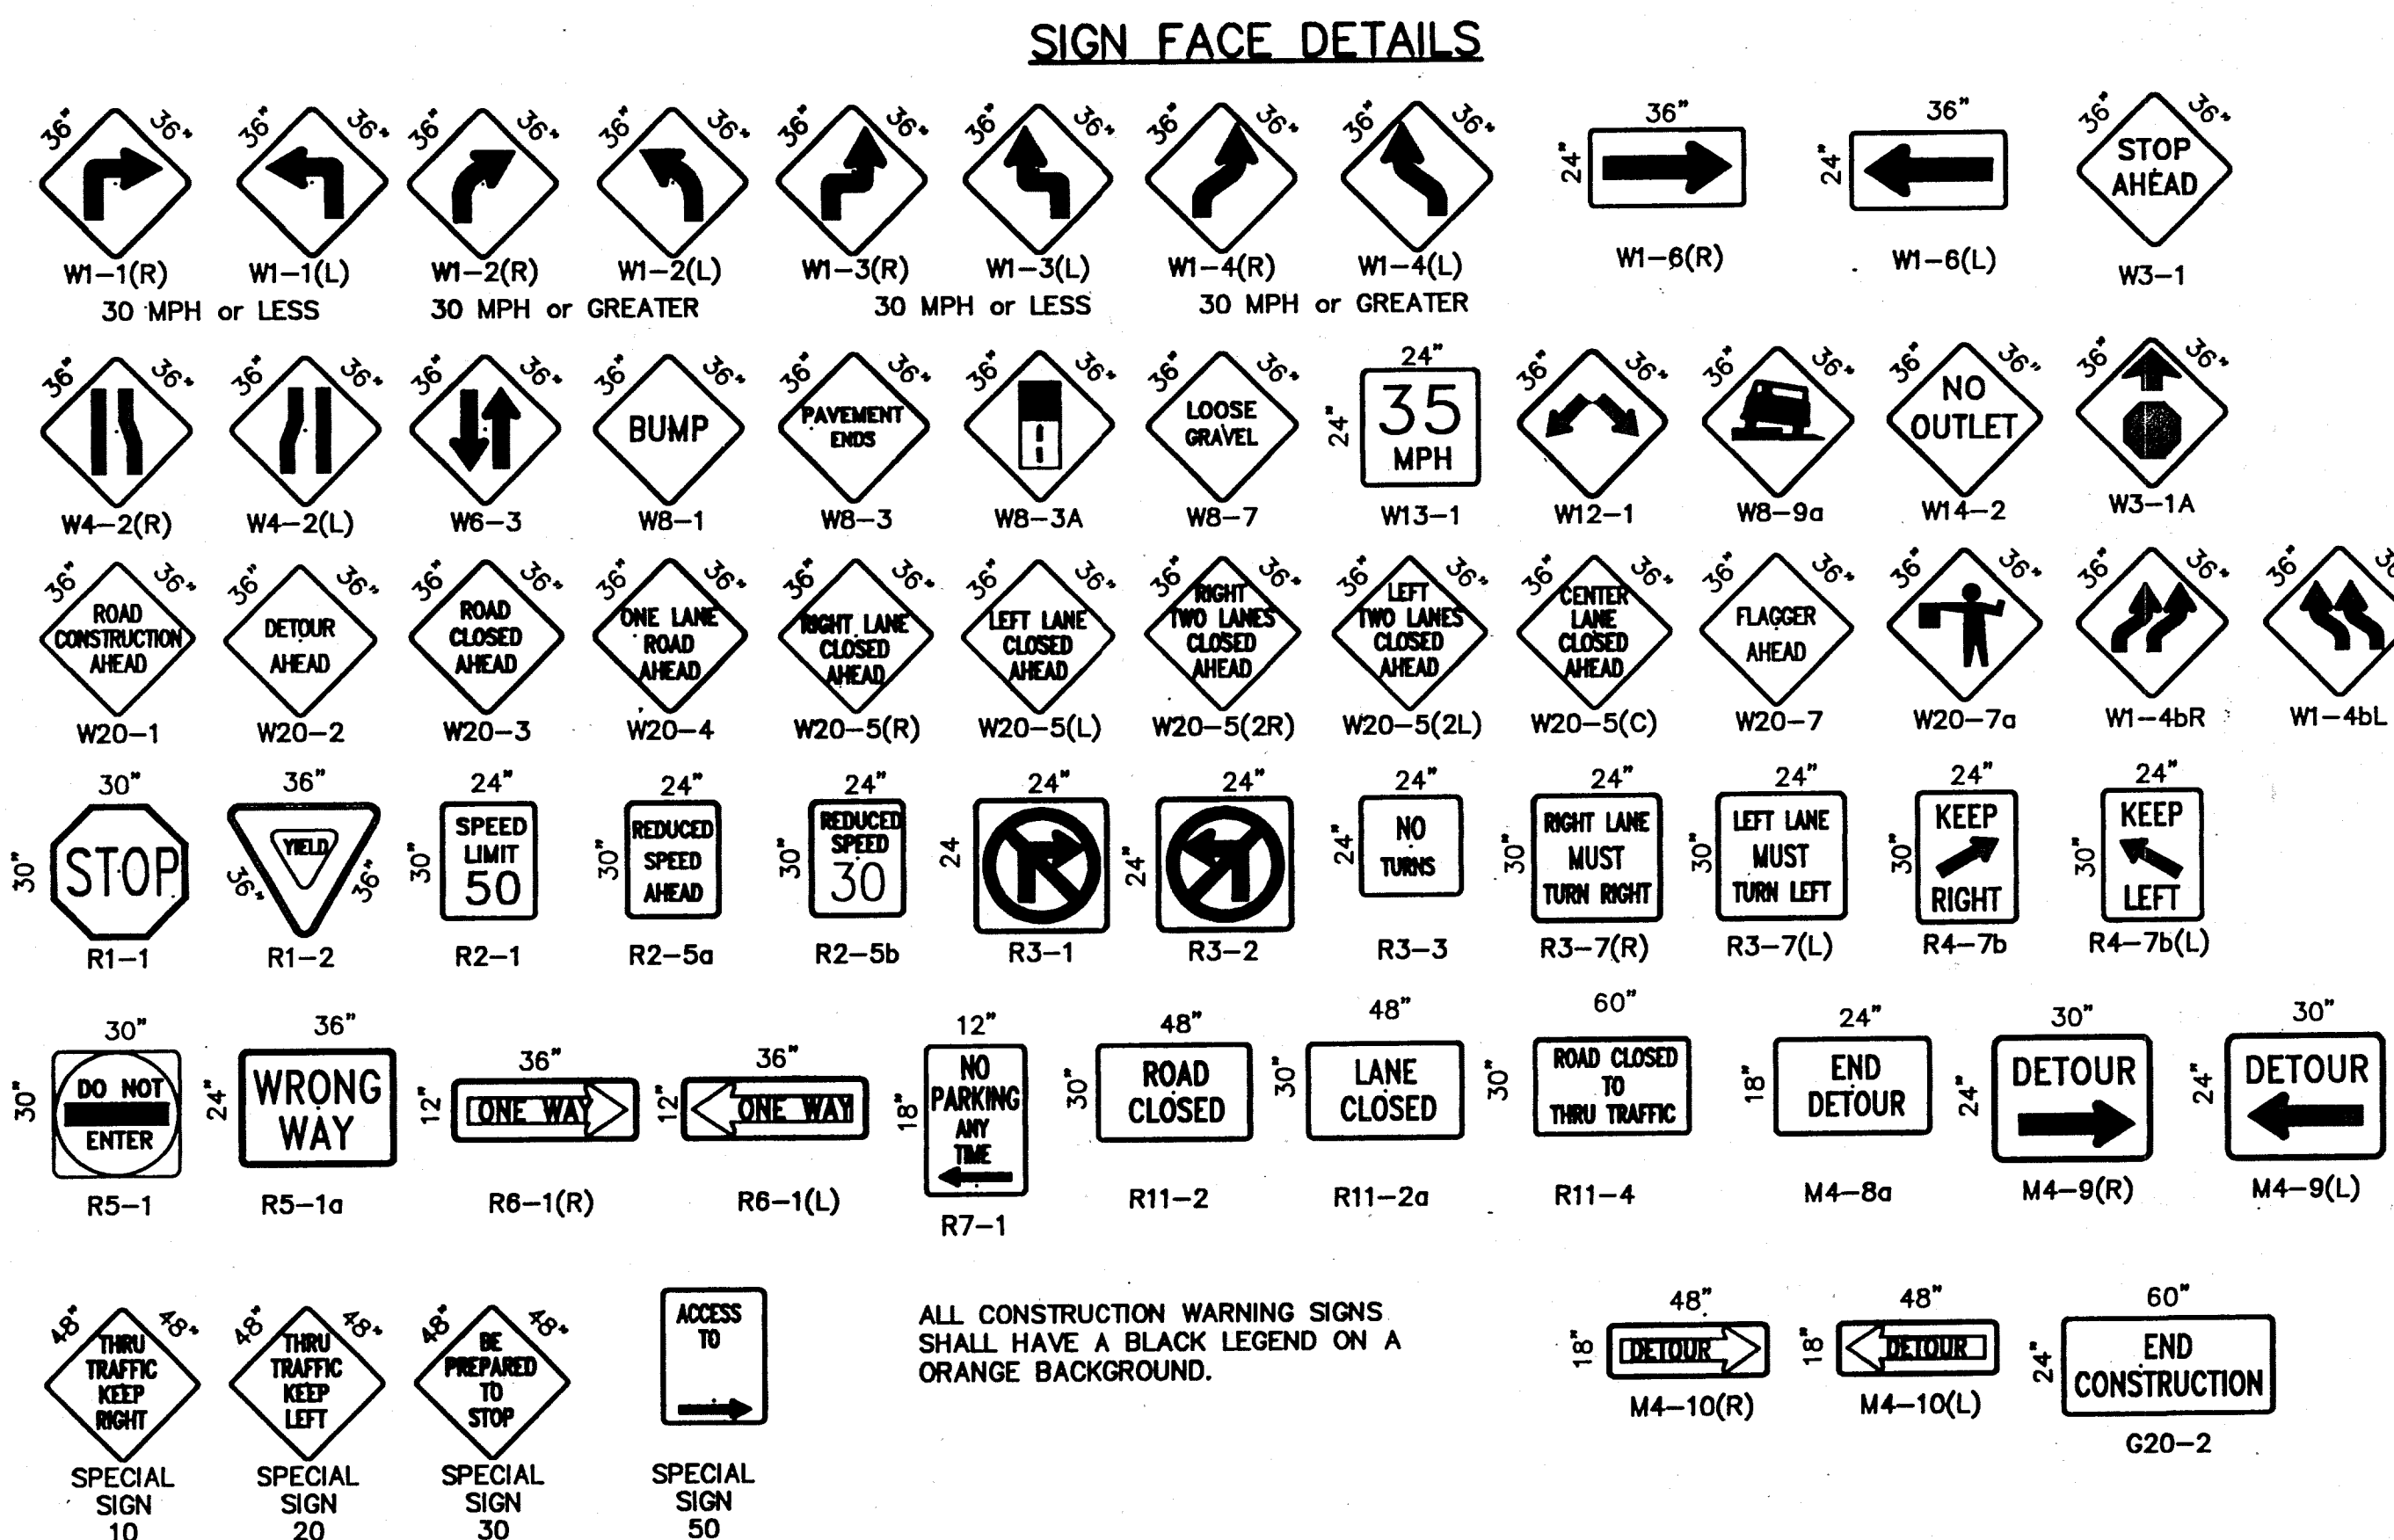

ALL CONSTRUCTION WARNING SIGNS SHALL HAVE A BLACK LEGEND ON A ORANGE BACKGROUND.

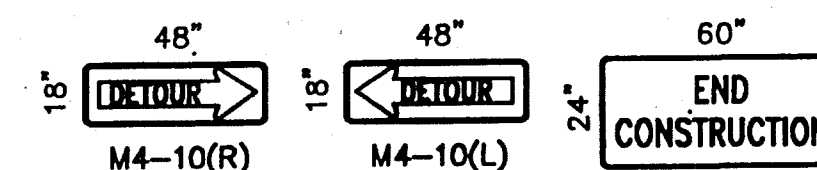

END CONSTRUCTION

