



APPROVAL OF AS BUILT DRAWINGS
CHIEF CONSTRUCTION ENGINEER
[Signature]
DATE 5-4-99

INDEX	
SHEET No.	DESCRIPTION
Sheet 1 of 6	Title Sheet
Sheet 2 of 6	Typ. Traffic Control & Signing
Sheet 3 of 6	Signing & Construction Traffic Control Standards
Sheet 4 of 6	Location of Alley Gates
Sheet 5 of 6	Plan and Profile
Sheet 6 of 6	Plan and Profile

[illegible]

1. CONTRACTOR MUST OBTAIN FROM CONSTRUCTION COORDINATION AN EXCAVATION/BARRICADING PERMIT BEFORE ENGAGING IN ANY CONSTRUCTION, MAINTENANCE OR REPAIR WORK IN ANY OF THE CITY OF ALBUQUERQUE'S RIGHTS-OF-WAY. EMERGENCY WORK THAT WOULD PRESERVE LIFE OR PROPERTY IS EXCLUDED WITH THE UNDERSTANDING, THAT A PERMIT SHALL BE OBTAINED WITHIN 24 TO 48 HOURS.

3. THESE TYPICAL TRAFFIC CONTROL PLANS DO NOT REFLECT THE EXISTING TOPOGRAPHY SUCH AS DRIVEWAYS, LANE WIDTHS, AND BUSINESS/RESIDENTIAL ACCESSES. EVERY LOCATION THAT REQUIRES CONSTRUCTION TRAFFIC CONTROL SHALL HAVE A DETAILED TRAFFIC CONTROL PLAN SHOWING ALL EXISTING TOPOGRAPHY.

5. CONSTRUCTION COORDINATION SHALL BE NOTIFIED 48 HOURS PRIOR TO ANY TRAFFIC CONTROL CHANGES NEEDED BY CONTRACTOR, THAT WERE NOT PREVIOUSLY APPROVED. THESE TRAFFIC CONTROL CHANGES SHALL BE REQUESTED IN WRITING ACCOMPANIED WITH A TRAFFIC CONTROL PLAN REFLECTING SUCH CHANGES.

7. THE CONSTRUCTION TRAFFIC CONTROL INITIAL SET-UP SHALL BE BY AN AMERICAN TRAFFIC SAFETY SERVICES ASSOCIATION (ATSSA) CERTIFIED WORKSITE TRAFFIC SUPERVISOR. THE MAINTENANCE AND SERVICING SHALL ALSO BE DONE BY AN ATSSA CERTIFIED WORKSITE TRAFFIC SUPERVISOR OR EQUIVALENT.

9. ALL ADVANCE WARNING SIGNS SHALL BE DOUBLE INDICATED WHENEVER THERE ARE MULTI-LANE TRAFFIC IN ANY ONE GIVEN DIRECTION AND THERE IS SUFFICIENT MEDIAN SPACE.

11. ALL WORK IN ARTERIAL ROADWAYS SHALL BE ON A CONTINUOUS 24 HOUR PER DAY BASIS UNTIL COMPLETED.

13. EQUIPMENT OR MATERIALS SHALL NOT BE STORED WITHIN 15 FEET OF A TRAVELLED TRAFFIC LANE DURING NON-WORKING HOURS WITHOUT THE APPROVAL OF CONSTRUCTION COORDINATION.

15. CONTRACTOR IS RESPONSIBLE FOR OBLITERATION OF ANY CONFLICTING STRIPING AND RESPONSIBLE FOR ALL TEMPORARY STRIPING.

17. CONTRACTOR SHALL PROVIDE ACCESS SIGNS FOR BUSINESSES LOCATED WITHIN THE CONSTRUCTION AREA UNDER THE SUPERVISION OF CONSTRUCTION COORDINATION. EACH ACCESS SIGN SHALL HAVE 5 INCH, WHITE OPAQUE LETTERING ON BLUE REFLECTORIZED BACKGROUND. ACCESS SIGNS SHALL BE CONSIDERED INCIDENTAL TO THE BID AND NOT PART OF THE CONTRACT UNLESS OTHERWISE STATED. NO MORE THAN 3 BUSINESSES SHALL BE LISTED ON A ACCESS SIGN. SHOPPING CENTERS AND MALLS SHALL BE LISTED AS SUCH.

19. ⁽²⁾ 48 HOURS PRIOR TO OCCUPYING OR CLOSING OF A RIGHT-OF-WAY, CONTRACTOR SHALL NOTIFY: POLICE, FIRE DEPARTMENT, SCHOOLS, HOSPITALS, TRANSIT AUTHORITY, BUSINESSES AND/OR RESIDENTS THAT WILL BE AFFECTED BY THE CONSTRUCTION.


21. EXCAVATIONS SHALL BE PLATED, TEMPORARILY PATCHED OR RESURFACED PRIOR TO OPENING OF TRAFFIC. A MINIMUM OF 11 FEET SHALL BE PROVIDED FOR TRAFFIC IN ANY GIVEN DIRECTION. CONTRACTOR IS RESPONSIBLE FOR ANY WORK INVOLVED IN SATISFYING THESE REQUIREMENTS.

23. FAILURE TO COMPLY WITH ANY OF THE ABOVE MENTIONED, WILL BE ADEQUATE CAUSE TO CEASE ALL WORK ON ANY CONSTRUCTION PROJECT. WORK WILL NOT RESUME UNTIL ALL REQUIREMENTS ARE ADDRESSED AND APPROVED BY CONSTRUCTION COORDINATION.


25. TRAFFIC CONTROL STANDARDS APPLY ONLY WHERE THE CONSTRUCTION TRAFFIC CONTROL PLANS ARE NOT SPECIFIC.

26. ADVANCE WARNING SIGNS SHALL BE 36"x36" MIN. WITH SUPER ENGINEERING GRADE SHEETING OR BETTER. MOUNTING HEIGHT AT TOP OF SIGN SHALL BE THE SAME AS FOR A 48" SIGN AS INDICATED IN THE M.U.T.C.D. 

27. CONTRACTOR SHALL MAINTAIN A GRAFFITI-FREE WORKSITE. ALL GRAFFITI SHALL BE PROMPTLY REMOVED FROM ALL EQUIPMENT, BOTH PERMANENT AND TEMPORARY. 4

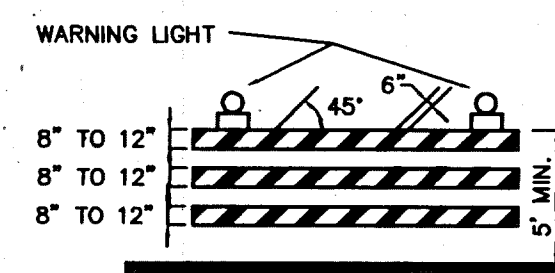


TYPE III BARRICADE

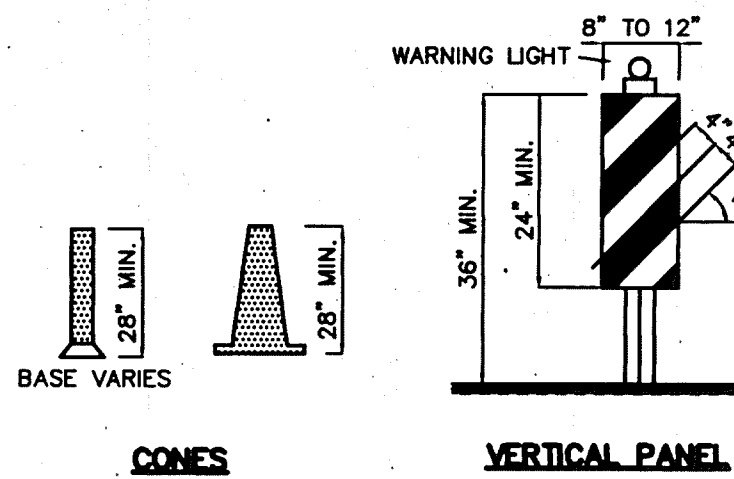



CONE

VERTICAL PANEL


HIGH LEVEL WARNING DEVICE

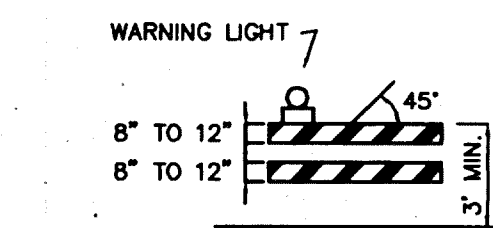

TYPE II BARRICADE
COLLAPSIBLE

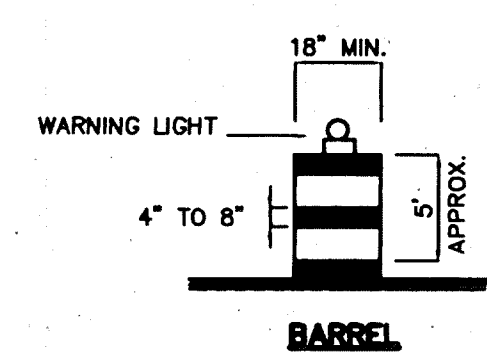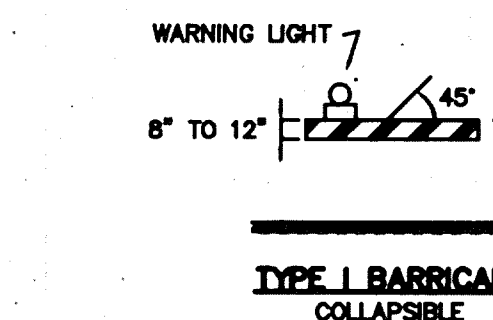**BARRE**

TYPE I BARRICADE
COLLAPSIBLE

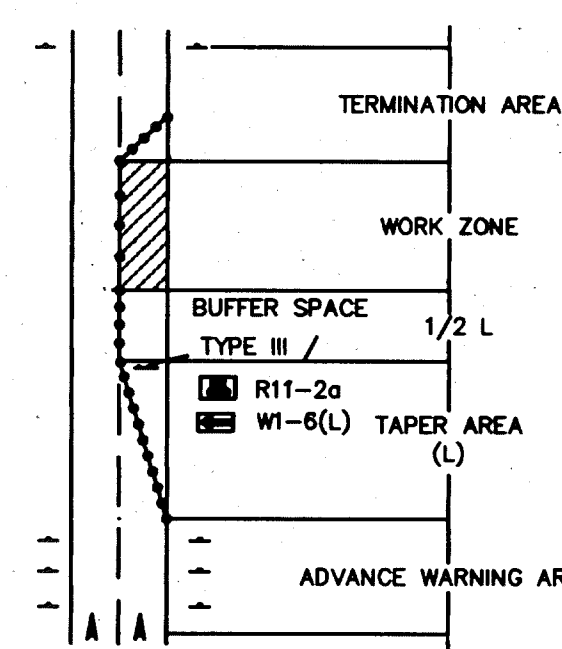

TRAFFIC CONTROL ELEMENTS

	WORK AREA
•	BARRICADE - TYPE I, TYPE II, OR BARREL
⊥	BARRICADE - TYPE III
X	VERTICAL PANEL
	WARNING SIGN
D	DISTANCE BETWEEN SIGNS - A DISTANCE MEASURED IN FEET EQUAL TO A VALUE OF TEN TIMES THE SPEED LIMIT OF THE STREET
	FLAGMAN POSITION
S	SPACING BETWEEN BARRICADES - A DISTANCE MEASURED IN FEET EQUAL TO THE SPEED LIMIT OF THE STREET
L	TAPER LENGTH - SEE CHART BELOW

THE TANGENT LENGTH IS EQUAL TO THE TAPER LENGTH FOR A GIVEN STREET.

SPEED LIMIT (MPH)	TAPER LENGTH (L) (FEET)			MINIMUM NUMBER	MAXIMUM SPACING IN FEET	DEVICES FOR TAPER	AFTER TAPER
	10' LANE	11' LANE	12' LANE	5	20	20	20
20	70	75	80	5	20	20	20
25	105	115	125	5	25	25	25
30	150	165	180	7	30	30	30
35	205	225	245	8	35	35	35
40	270	295	320	9	40	40	40
45	450	495	540	13	45	45	45
50	500	550	600	13	50	50	50
55	550	605	660	13	55	55	55

SPEED MILES PER HOUR	MINIMUM DISTANCE IN FEET	
	BETWEEN SIGNS	FROM LAST SIGN TO TAPER
0-20	10 X SPEED LIMIT	10 X SPEED LIMIT
25-30	10 X SPEED LIMIT	10 X SPEED LIMIT
30-35	10 X SPEED LIMIT	10 X SPEED LIMIT
40-45	10 X SPEED LIMIT	10 X SPEED LIMIT
50-60	10 X SPEED LIMIT	10 X SPEED LIMIT


<u>TYPE OF TAPER</u>	<u>TAPER LENGTH</u>
UPSTREAM TAPER:	
MERGING TAPER	L MINIMUM
SHIFTING TAPER	1/2 L MINIMUM
SHOULDER TAPER	1/2 L MINIMUM
TWO-WAY TRAFFIC TAPER	100 FEET MAXIMUM
DOWNSTREAM TAPERS	100 FEET PER LANE

SPEED LIMIT

40 MPH OR LESS $L = \frac{WS^2}{60}$


45 MPH OR GREATER $L = W \times S$







L = TAPER LENGTH
W = WIDTH OF OFFSET IN FEET
S = POSTED SPEED OR OFF-PEAK
85-PERCENTILE SPEED IN MPH

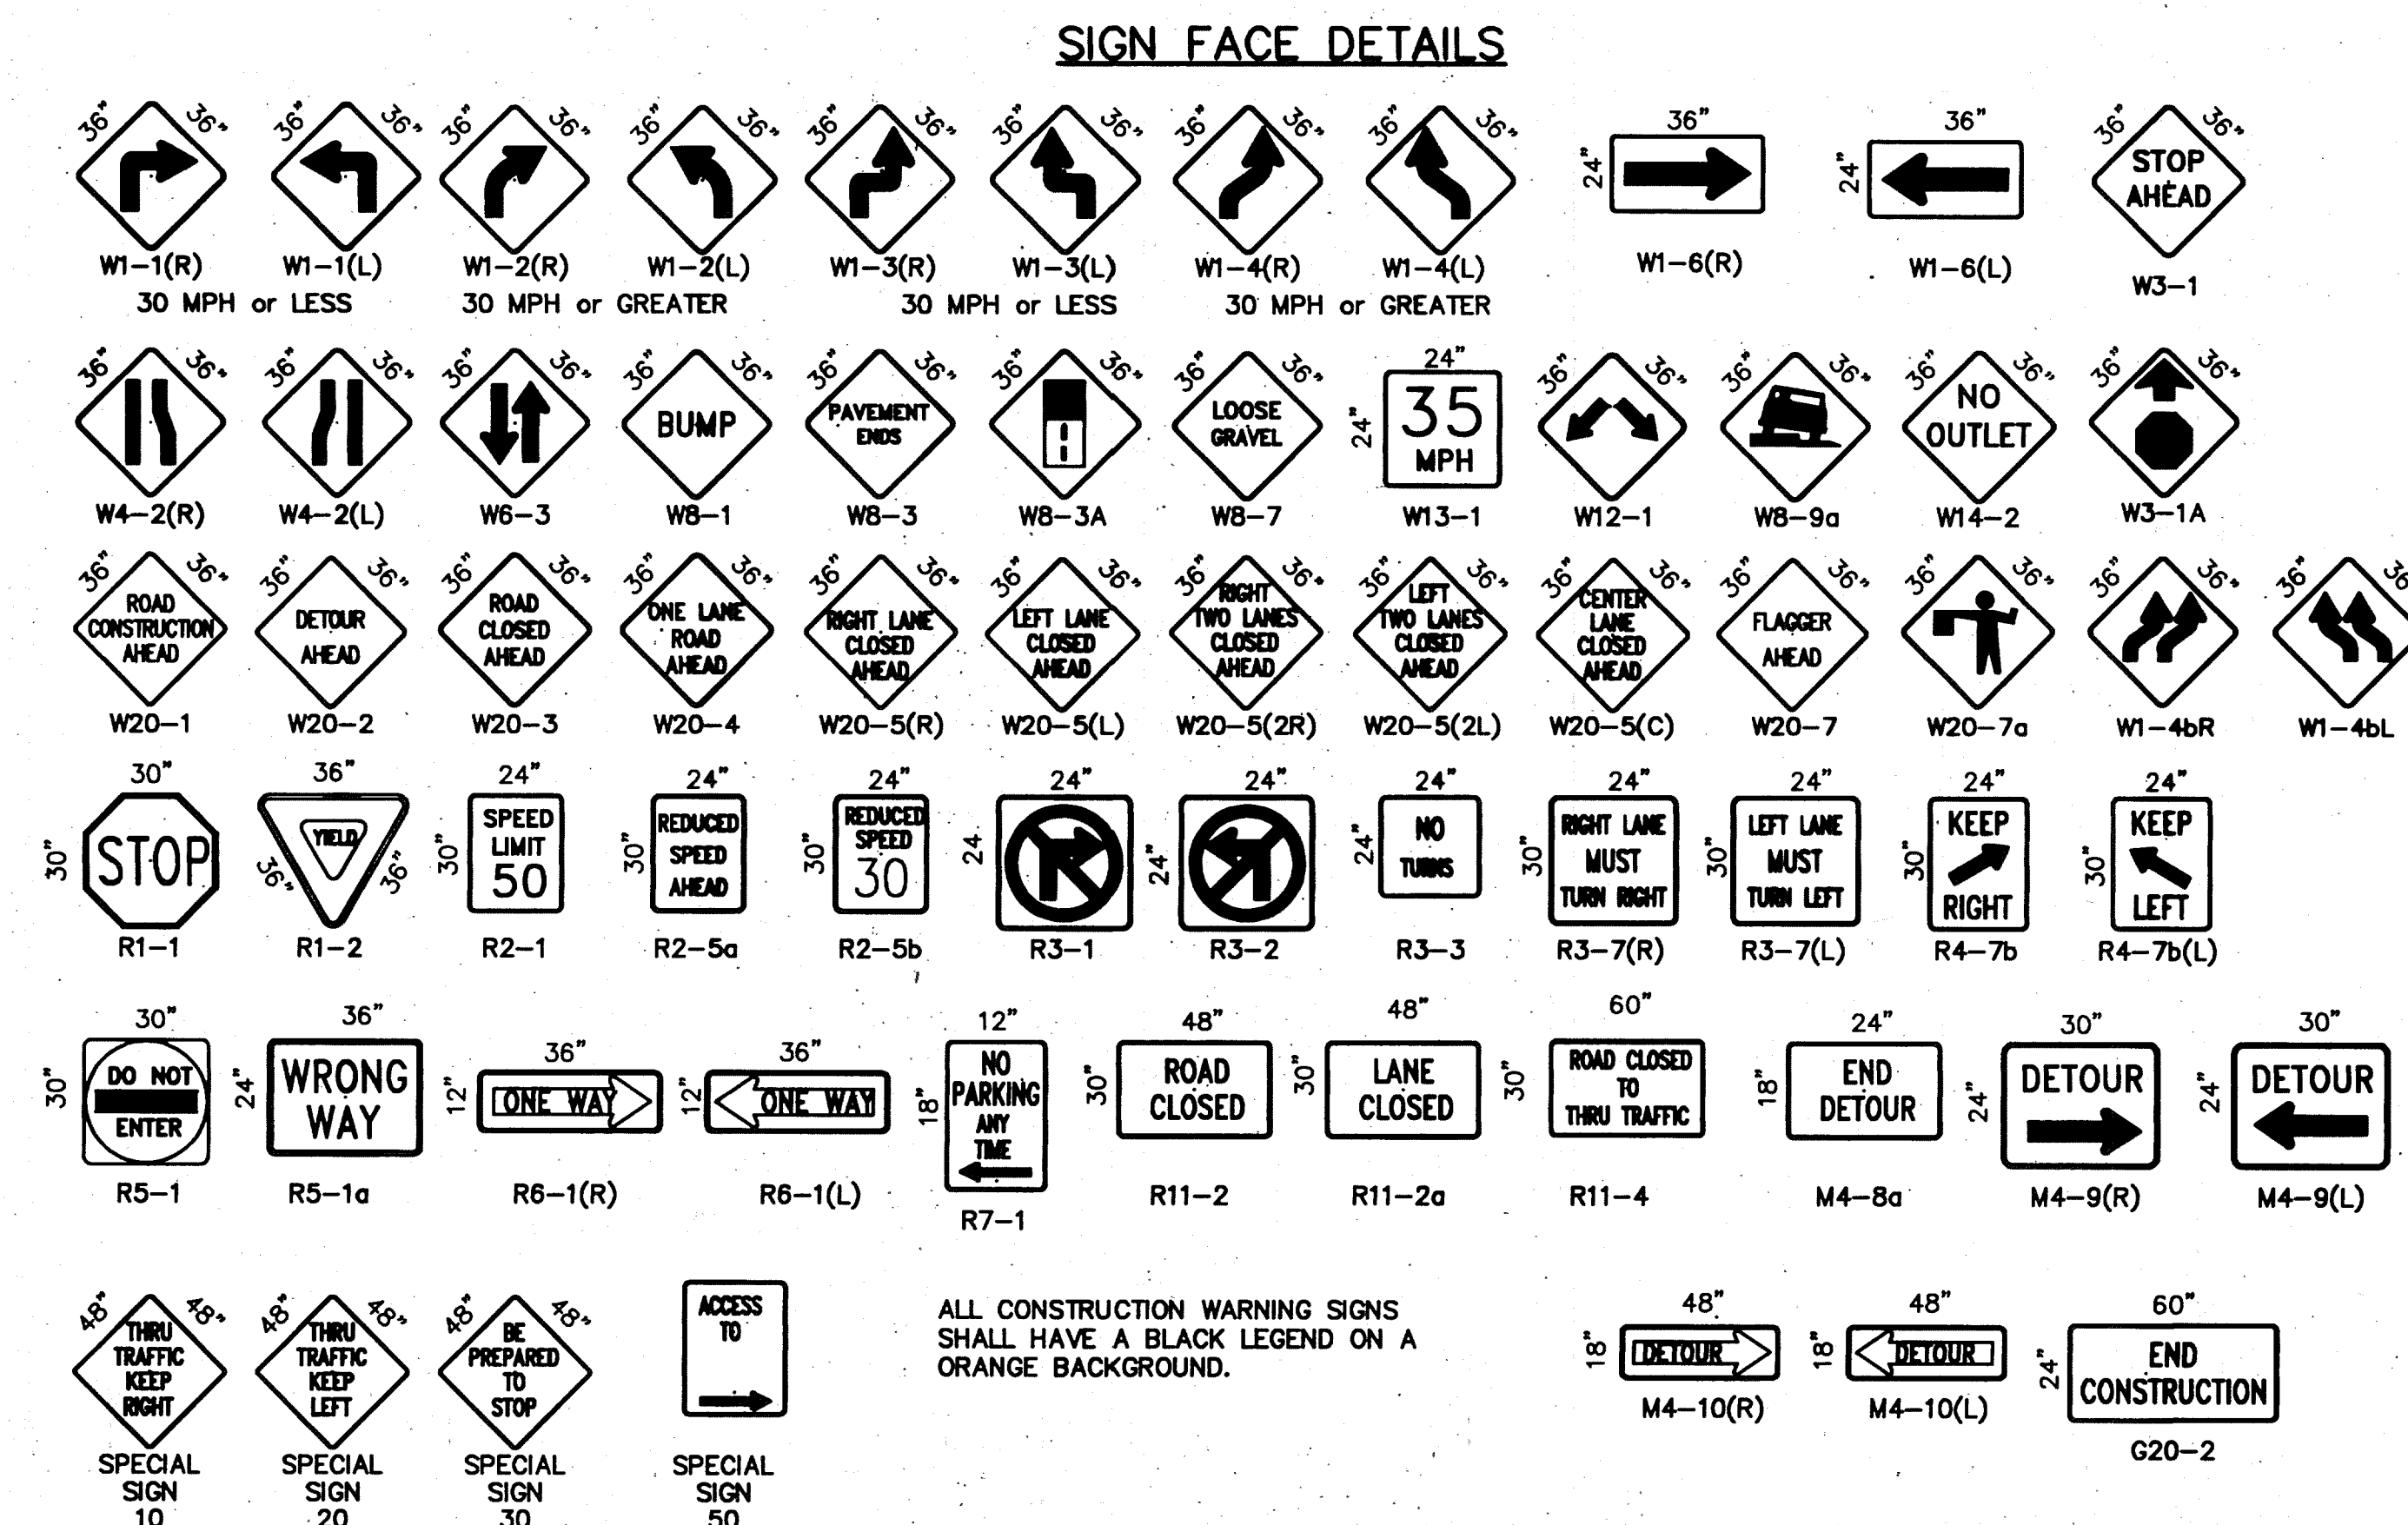


ALL CONSTRUCTION WARNING SIGNS
SHALL HAVE A BLACK LEGEND ON A
ORANGE BACKGROUND.

DESIGNED BY	DATE			ENGINEER'S SEAL	SURVEY INFORMATION	BENCH MARKS	AS BUILT INFORMATION
DRAWN BY C.O.A. STANDARDS	DATE						
CHECKED BY C.O.A.	DATE						
NO.	DATE	NO.	DATE	NO.	DATE	NO.	DATE
REVISIONS	REMARKS	BY	DATE	BY	DATE	BY	DATE
DESIGN							
ADD NOTE. 27	9/25/97	J.D.L.					
REVISED NOTE NO. 26	9/24/97	J.D.L.					
REVISED NOTE NO.19	9/24/97	J.D.L.					
REVISED NOTE NO. 11	9/24/97	J.D.L.					

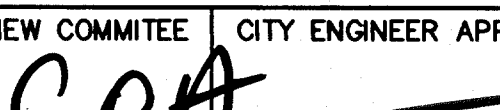
CITY OF ALBUQUERQUE PUBLIC WORKS DEPARTMENT ENGINEERING DEVELOPMENT GROUP															
TITLE: SIGNING AND CONSTRUCTION TRAFFIC CONTROL STANDARDS															
DESIGN REVIEW COMMITTEE		CITY ENGINEER APPROVAL													
		LAST UPDATE	<table border="1"> <thead> <tr> <th>MO./DAY/YR.</th> <th>MO./DAY/YR.</th> </tr> </thead> <tbody> <tr><td> </td><td> </td></tr> <tr><td> </td><td> </td></tr> <tr><td> </td><td> </td></tr> <tr><td> </td><td> </td></tr> <tr><td> </td><td> </td></tr> </tbody> </table>	MO./DAY/YR.	MO./DAY/YR.										
MO./DAY/YR.	MO./DAY/YR.														
PROJECT NO. 5911:91	MAP NO. J-13/ J-14	SHEET 2 OF 6													

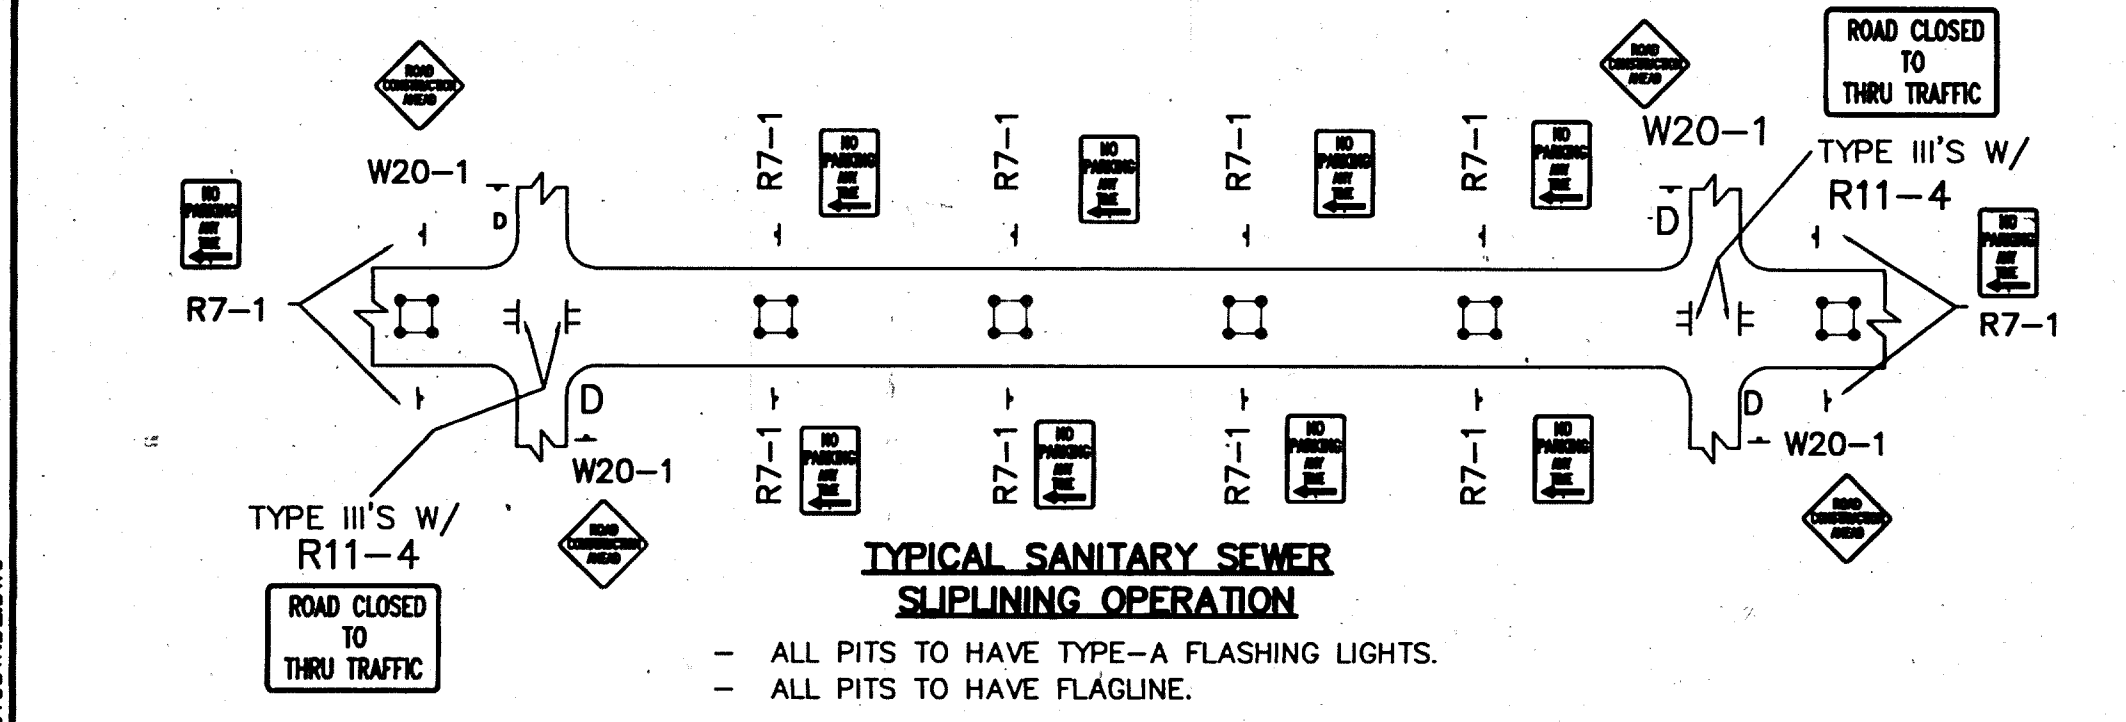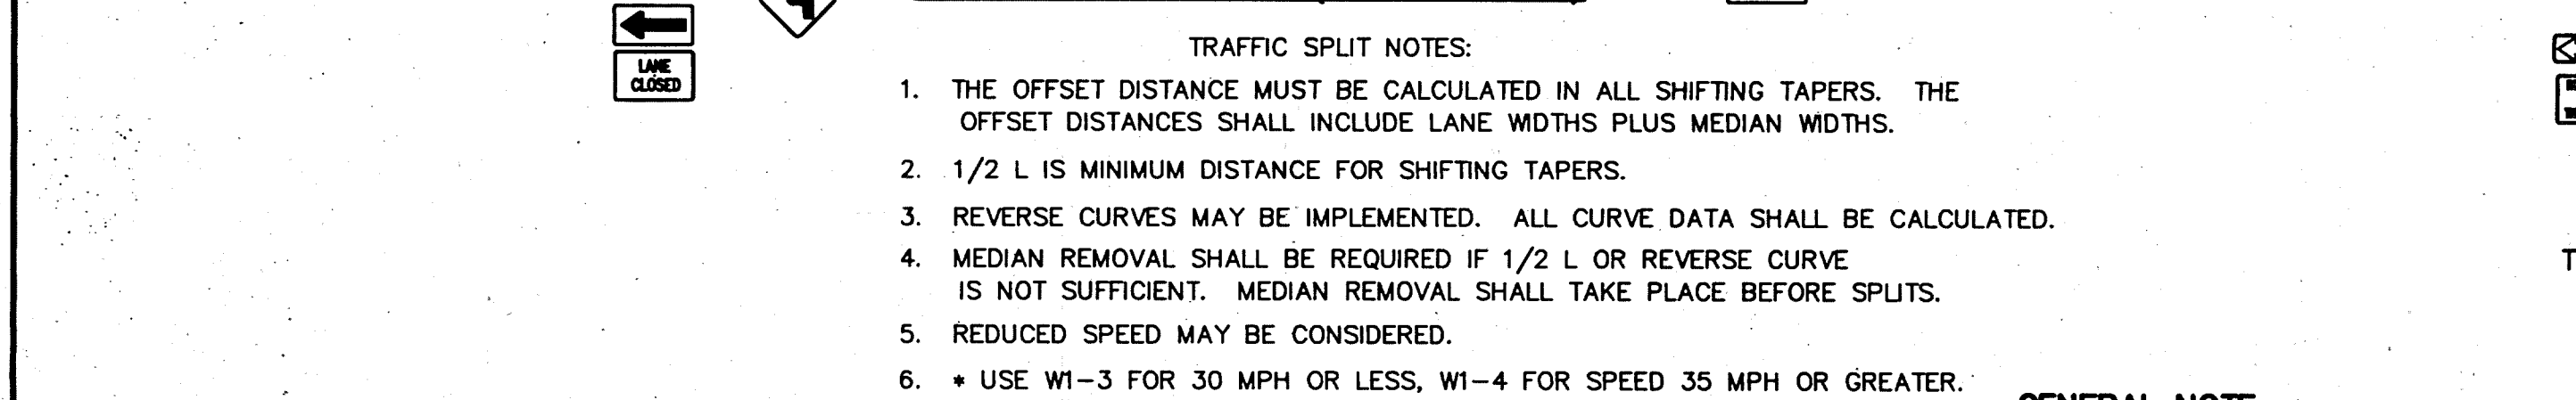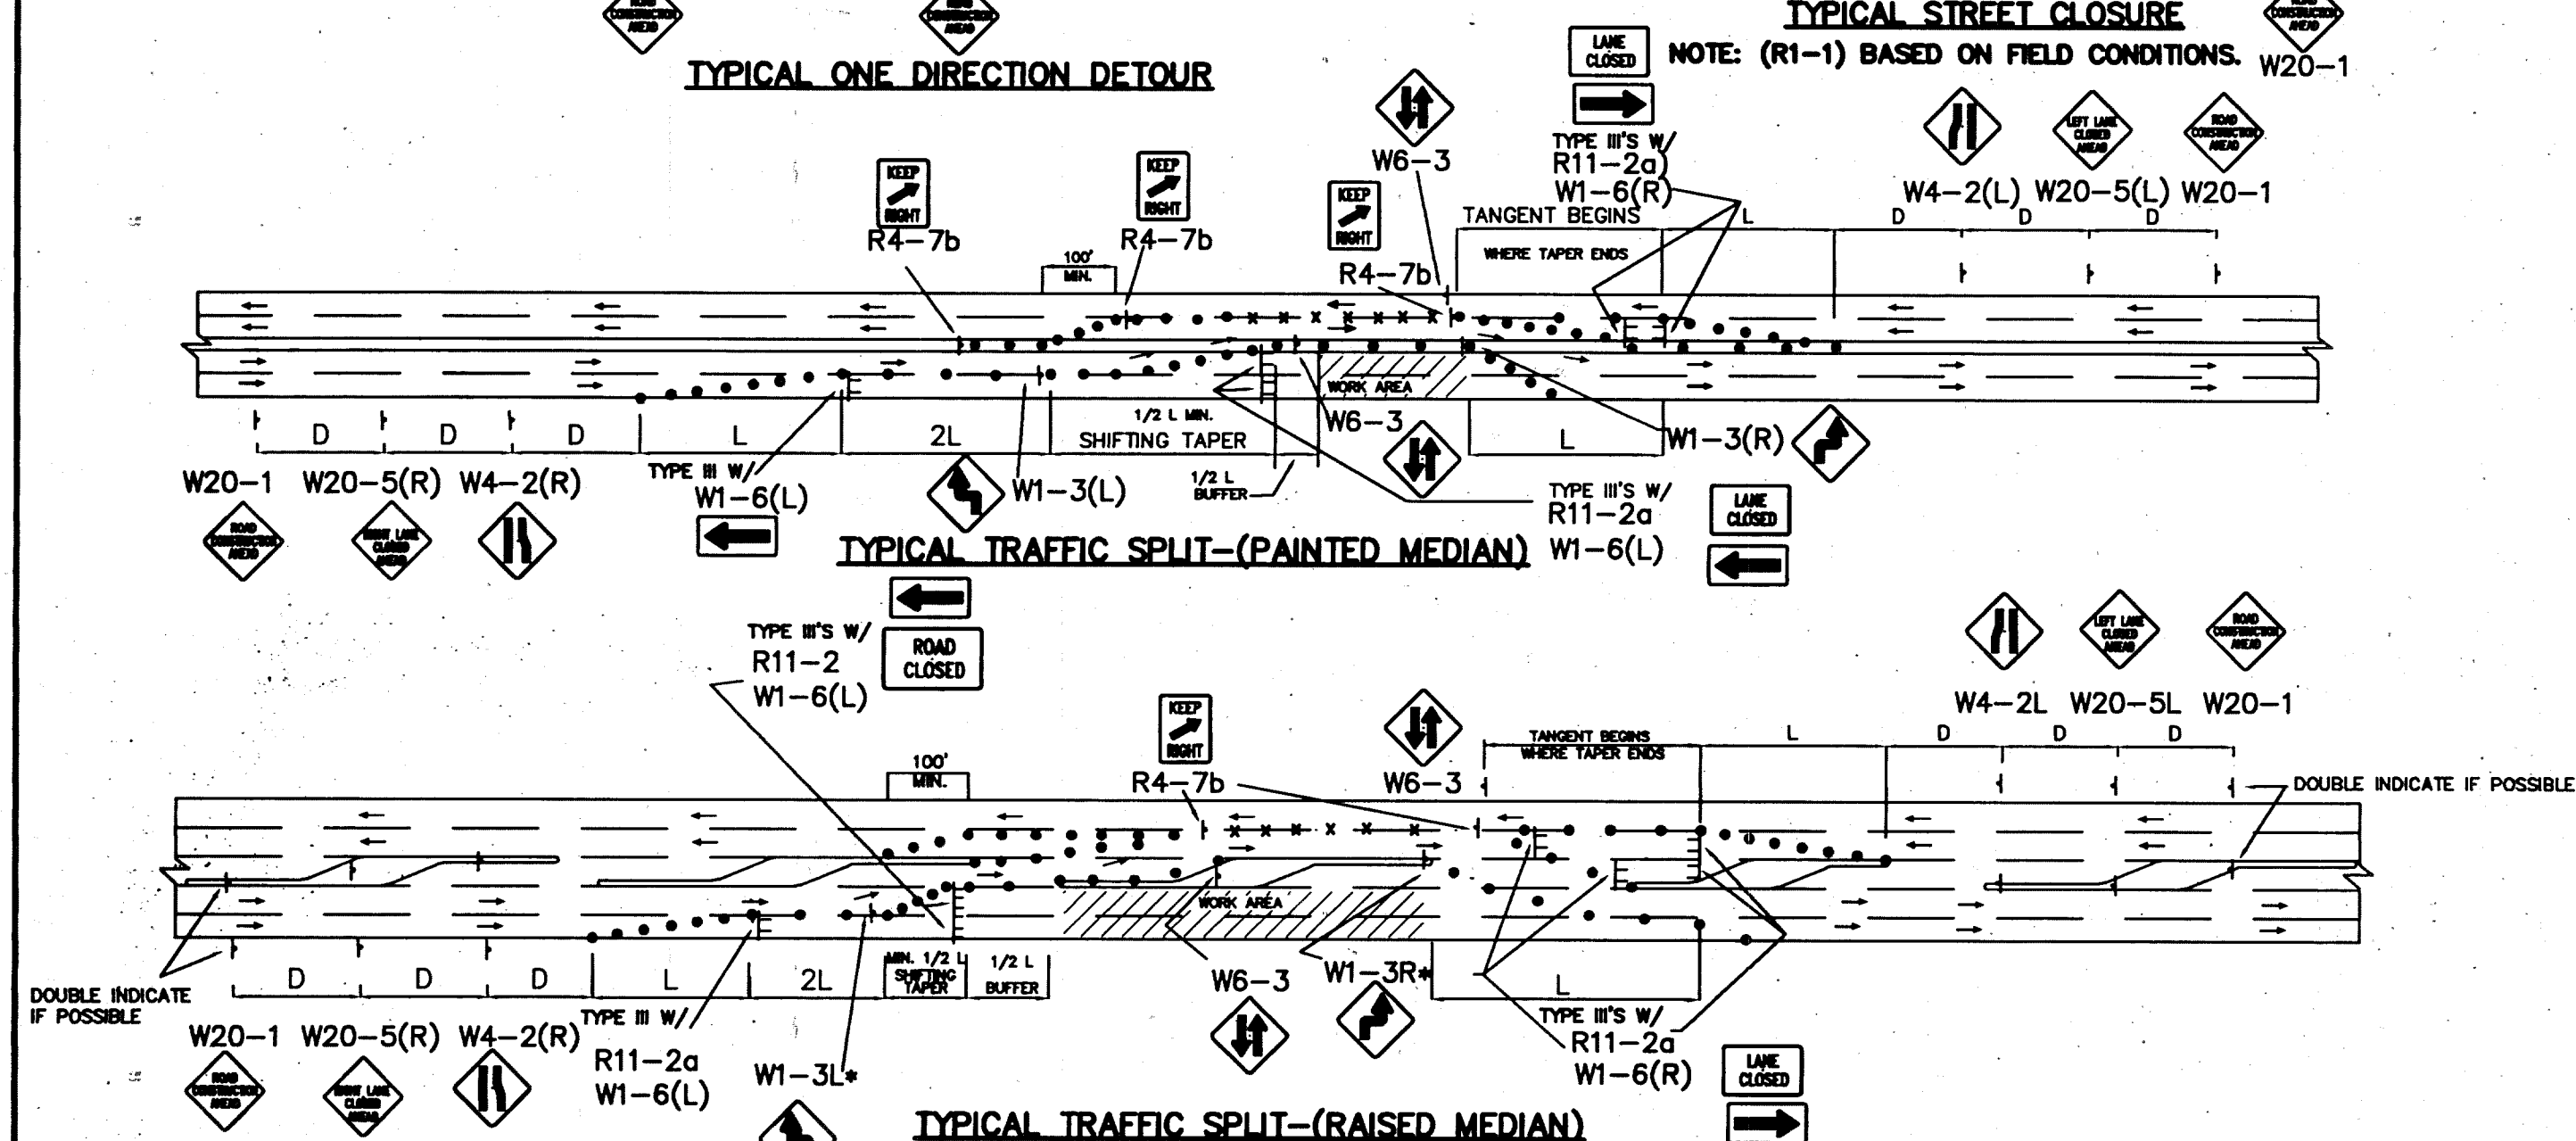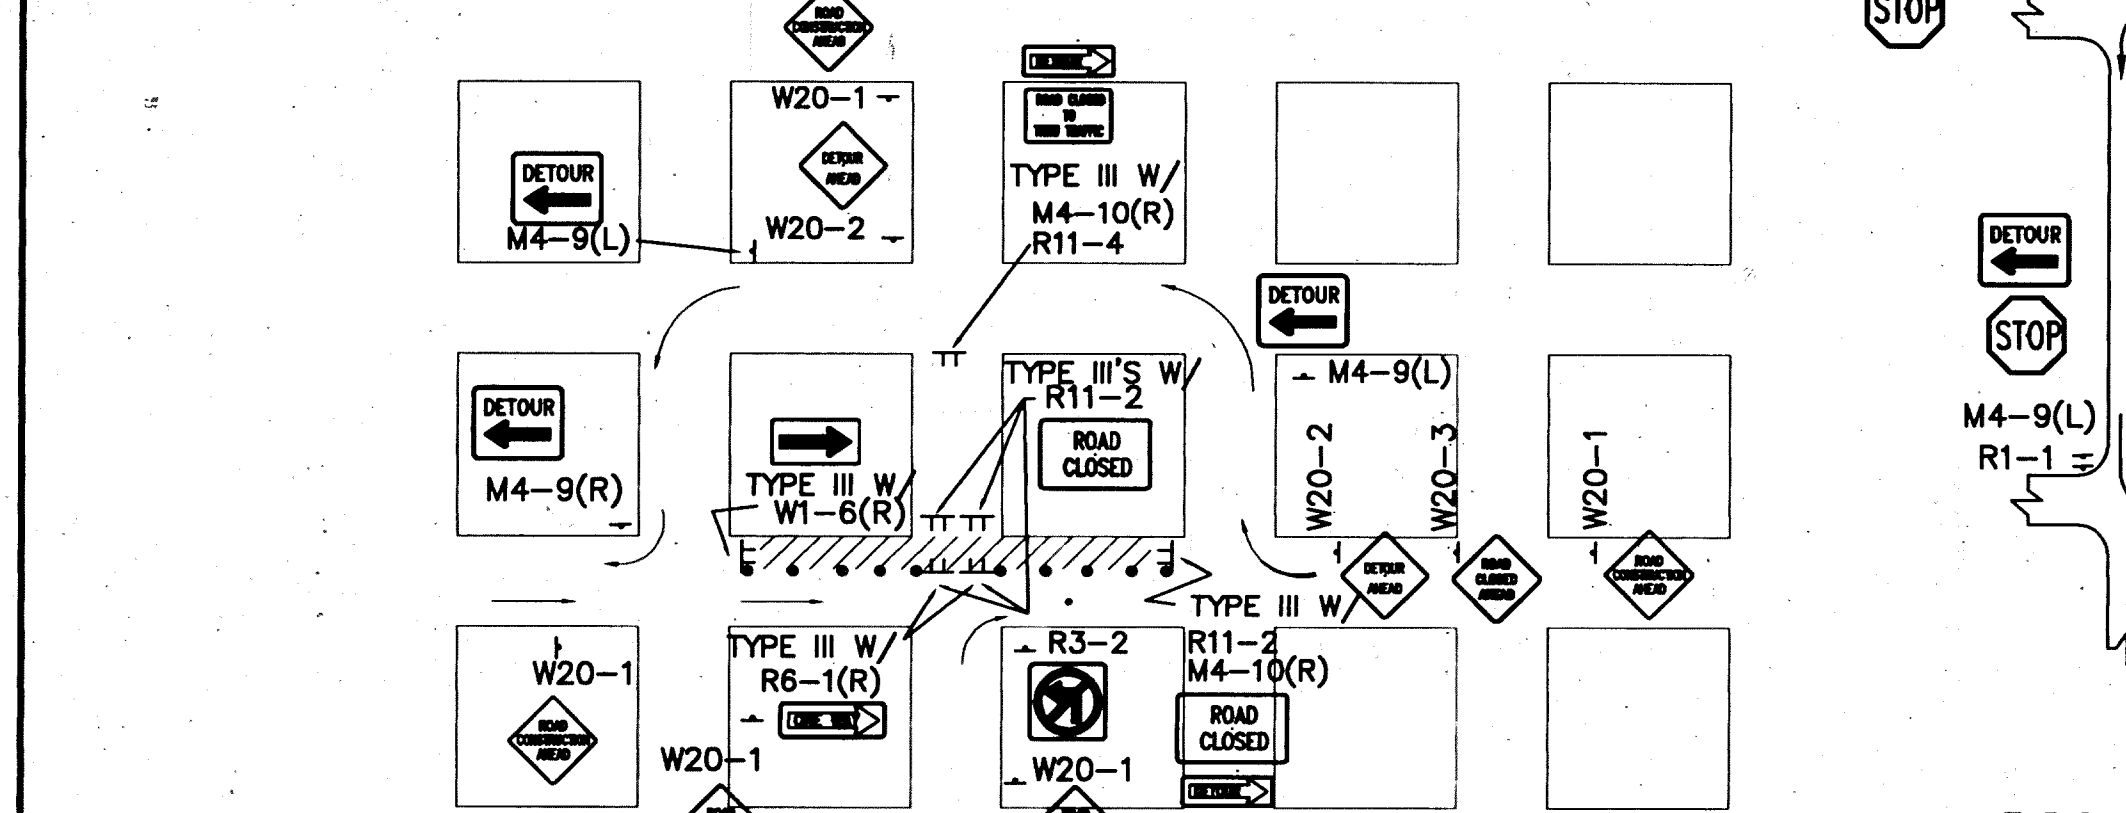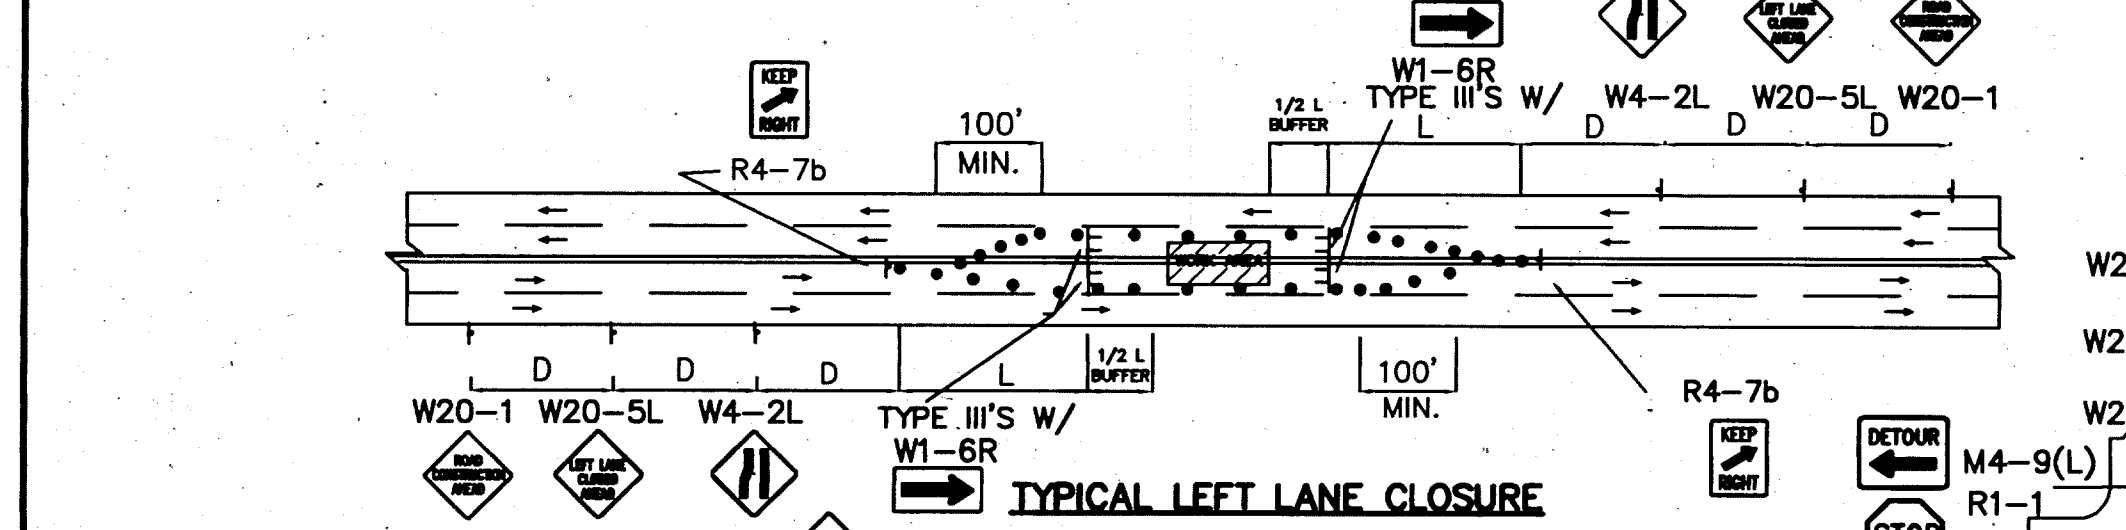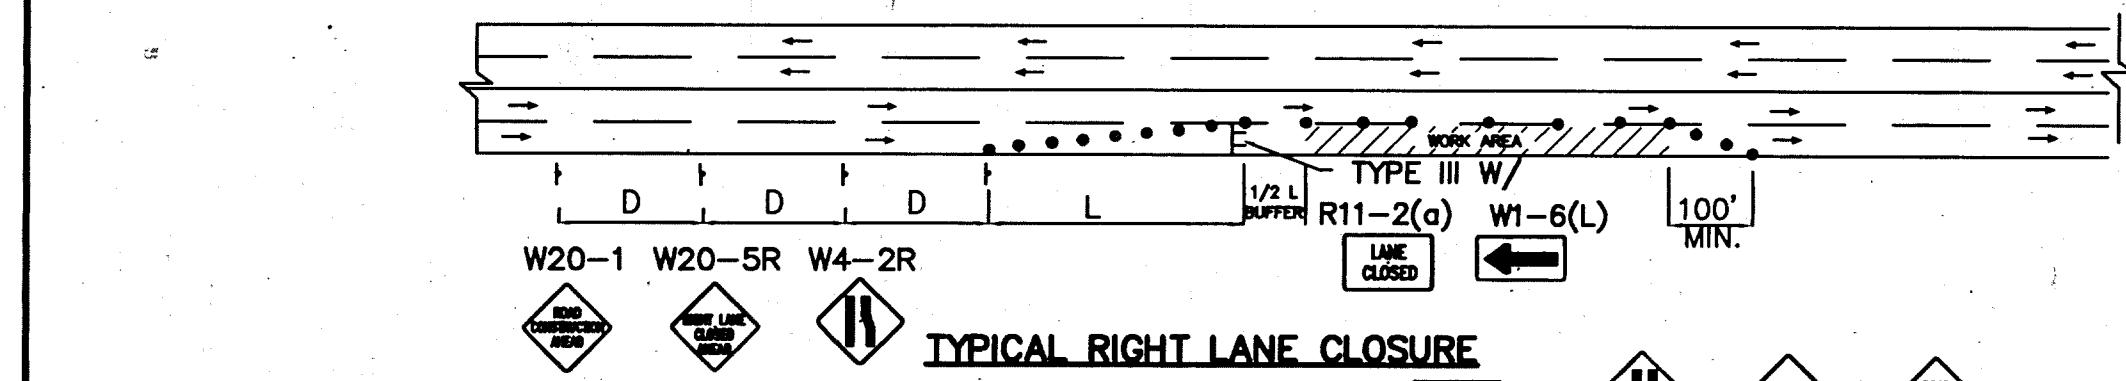


NOTE: MAY REQUIRE LEFT LANE CLOSURE DEPENDING ON FIELD CONDITIONS.

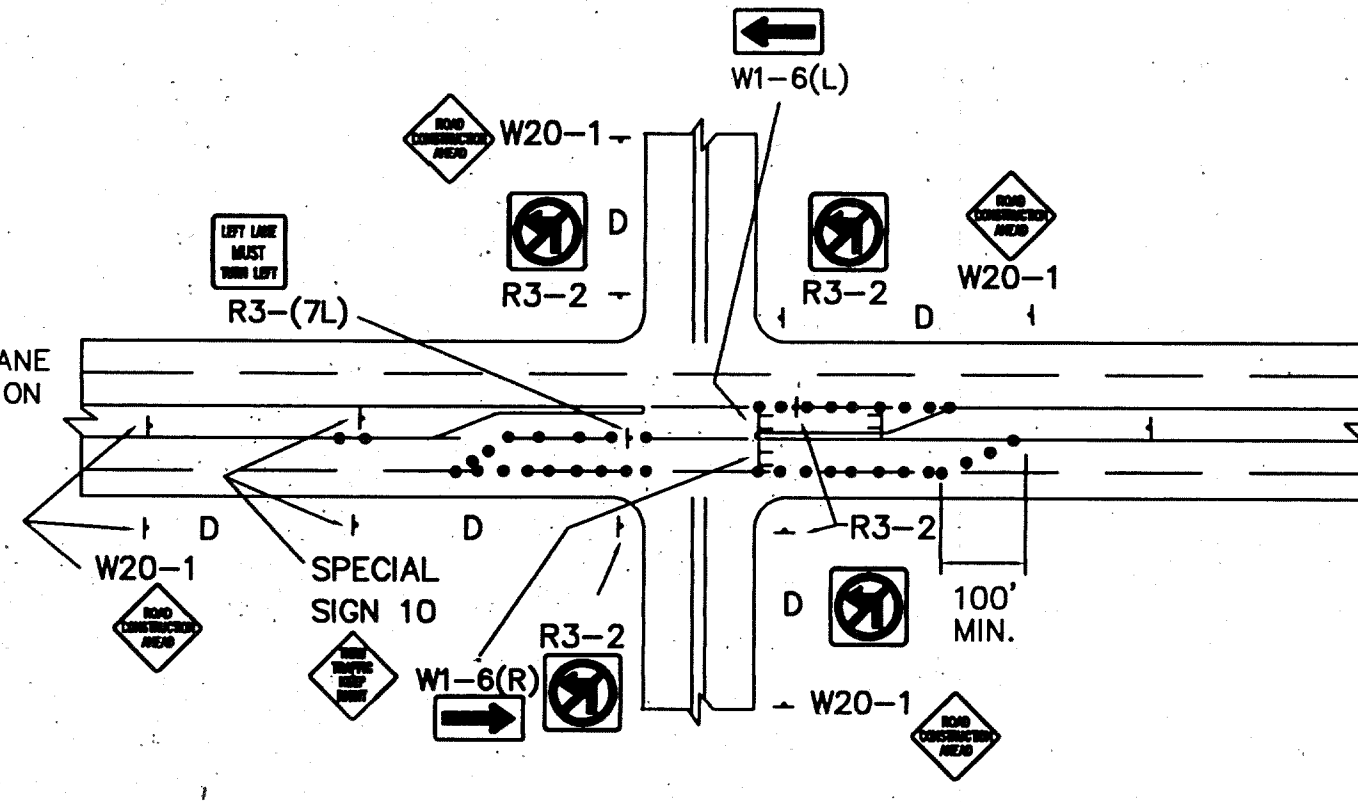





NOTE: DEPENDING ON WORK ZONE LOCATION

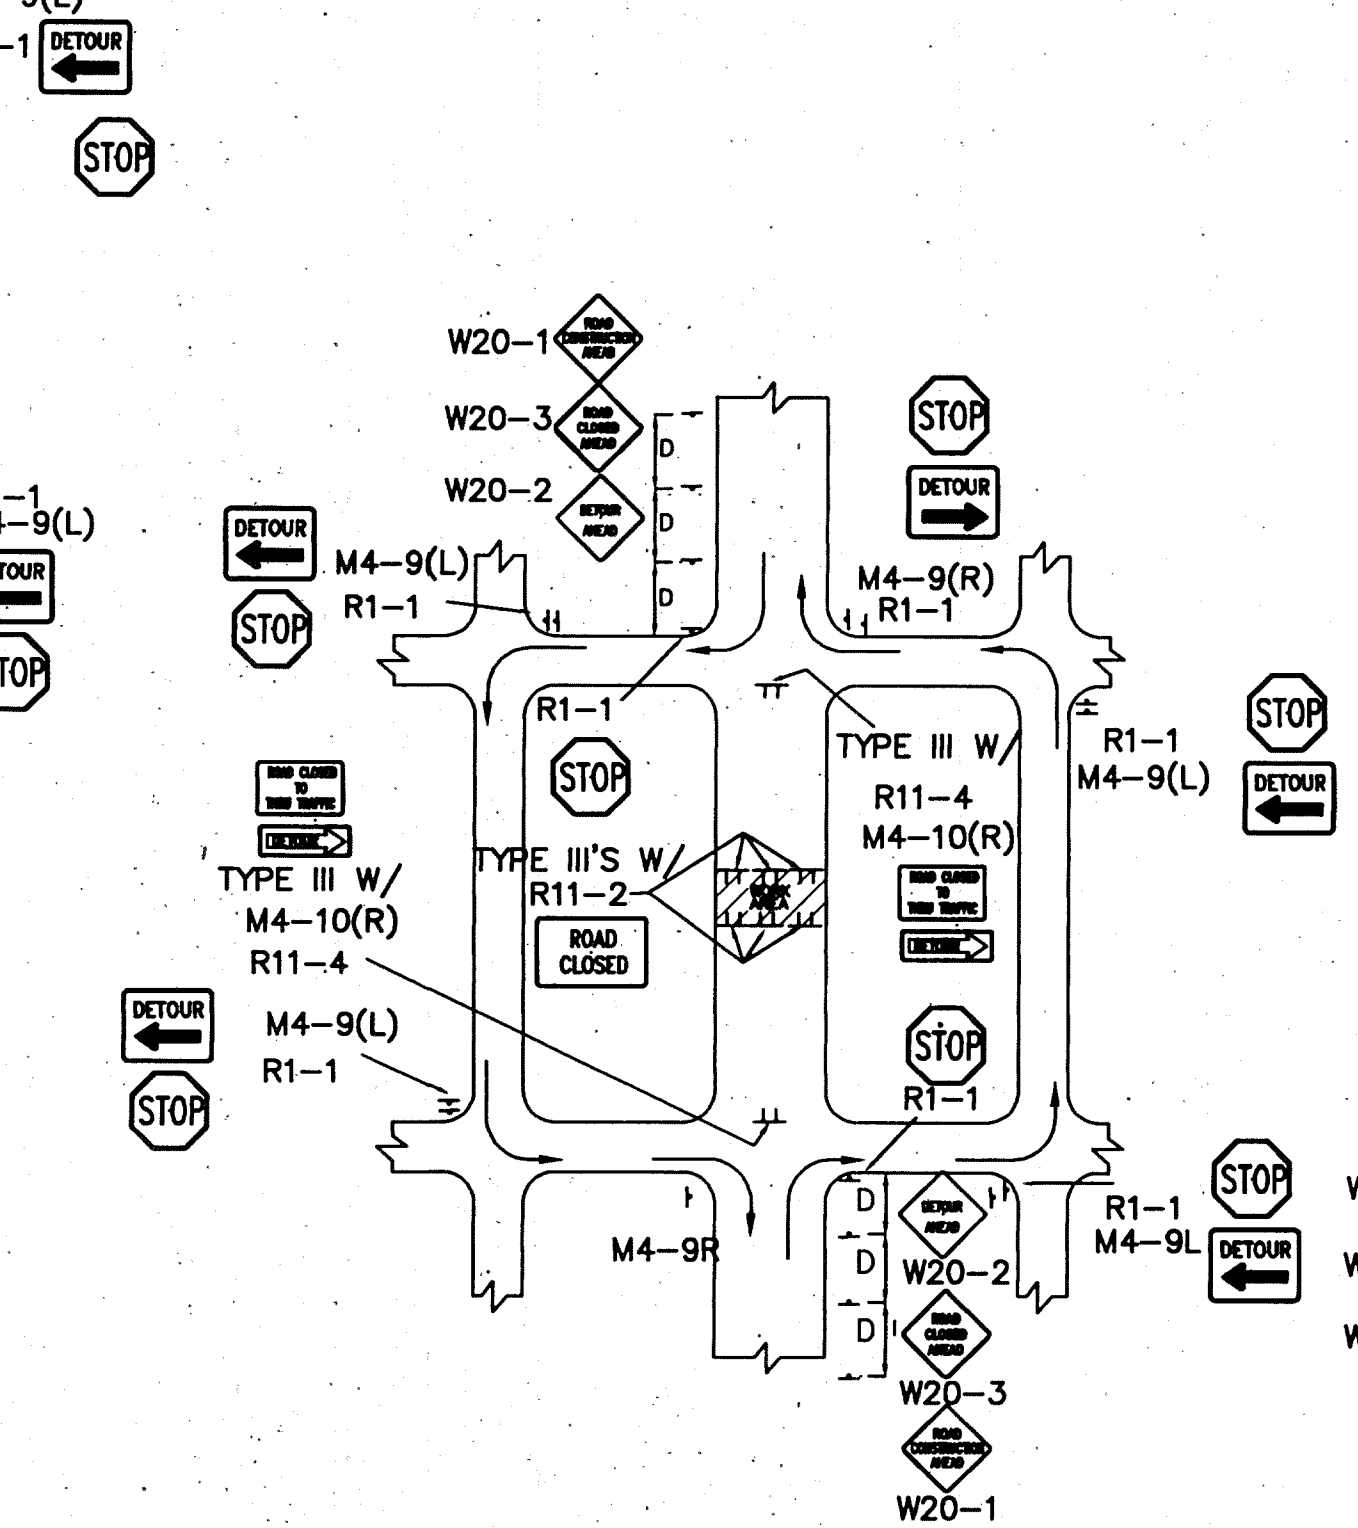

NOTE: (R1-1) BASED ON FIELD CONDITIONS.

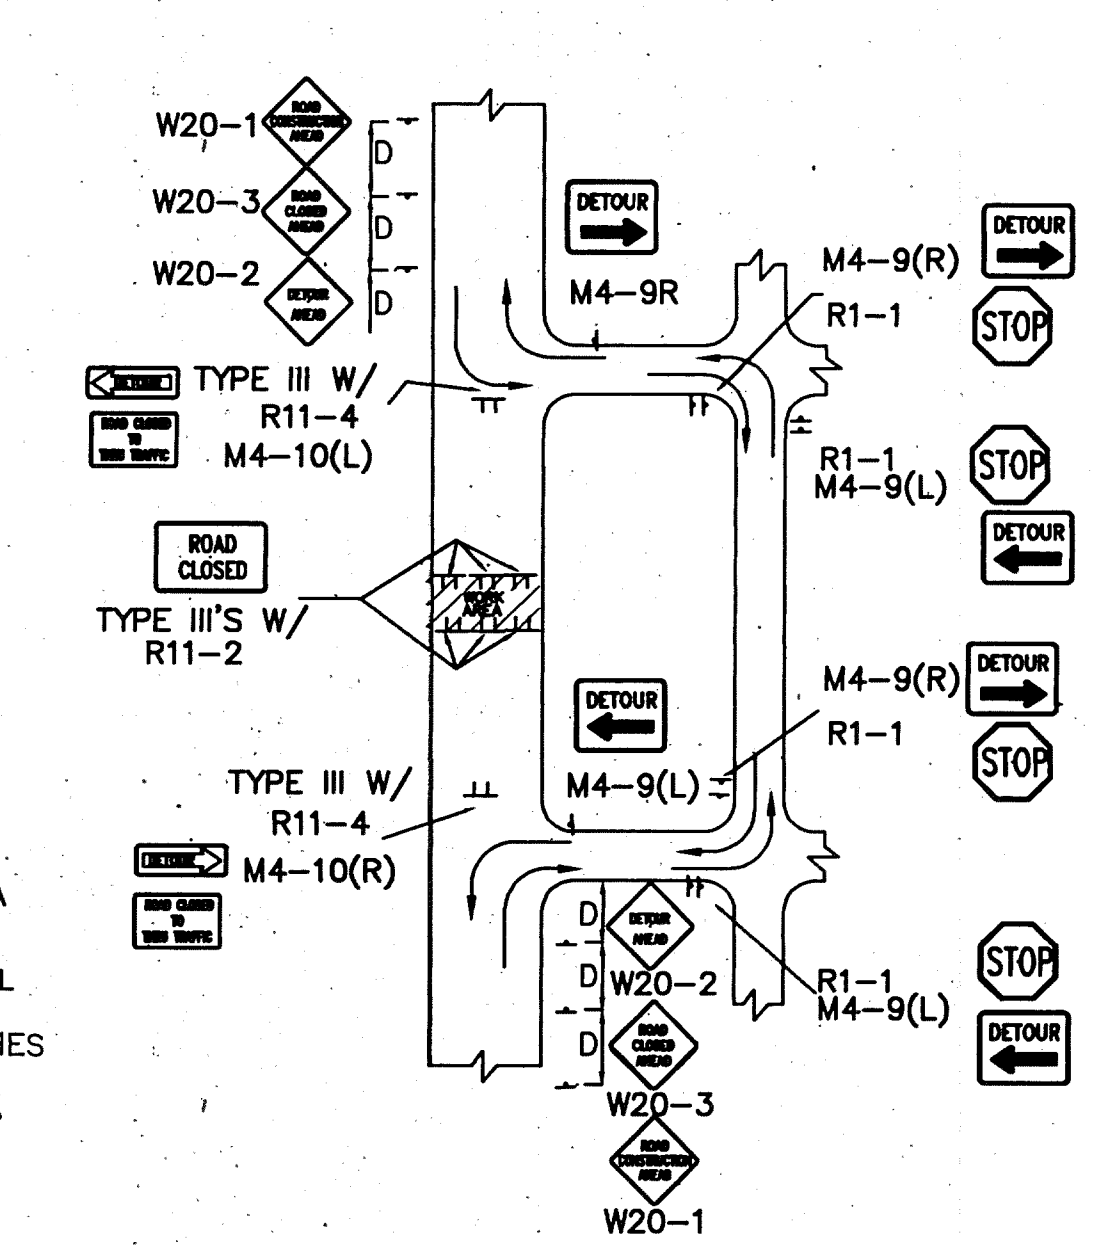

NOTE: (R1-1) BASED ON FIELD CONDITIONS.

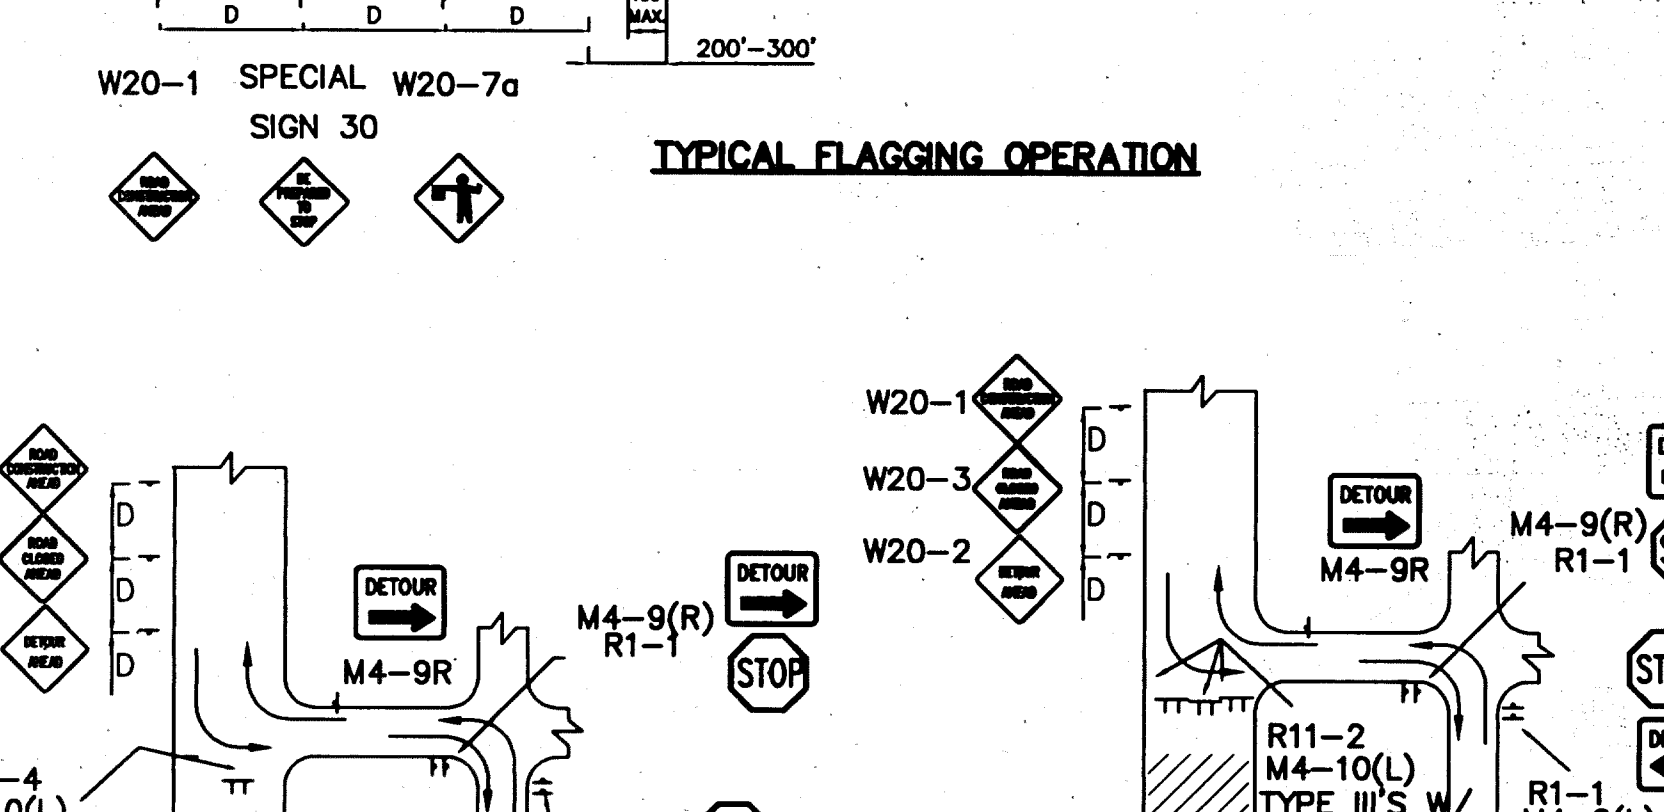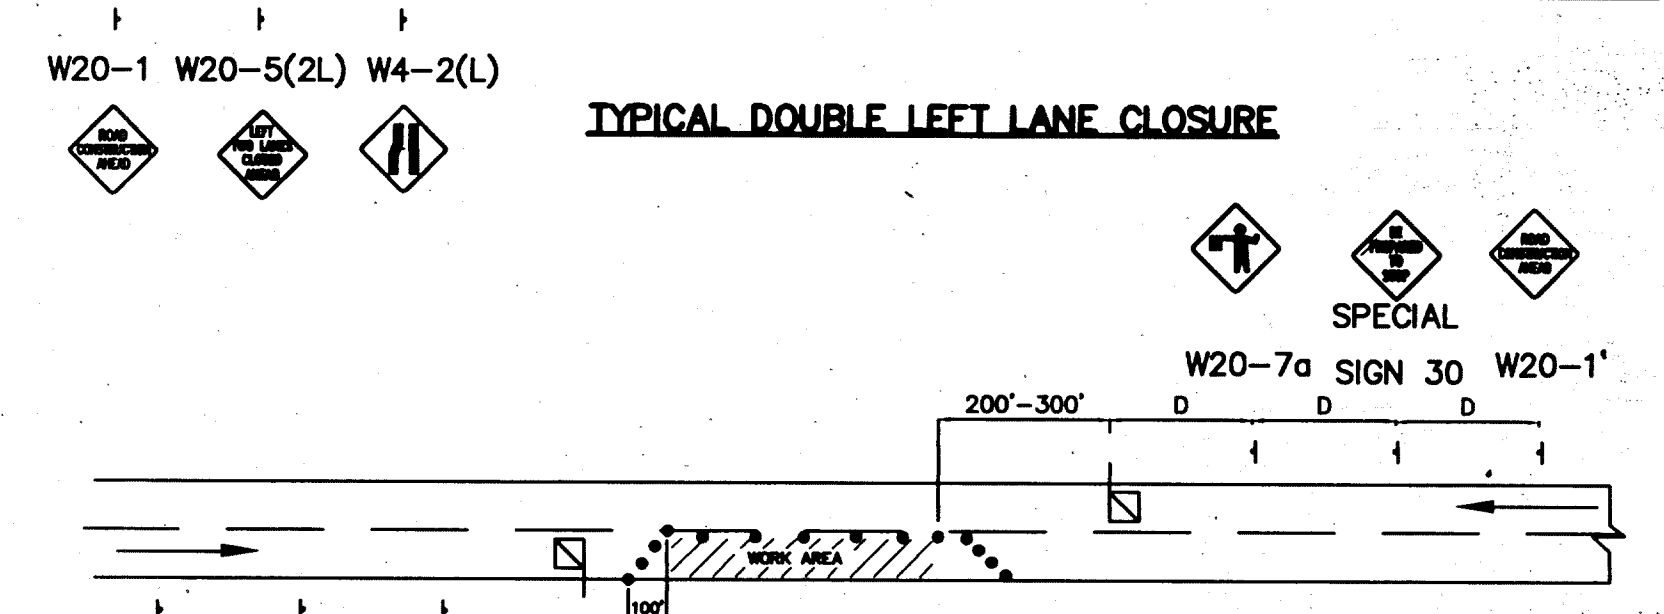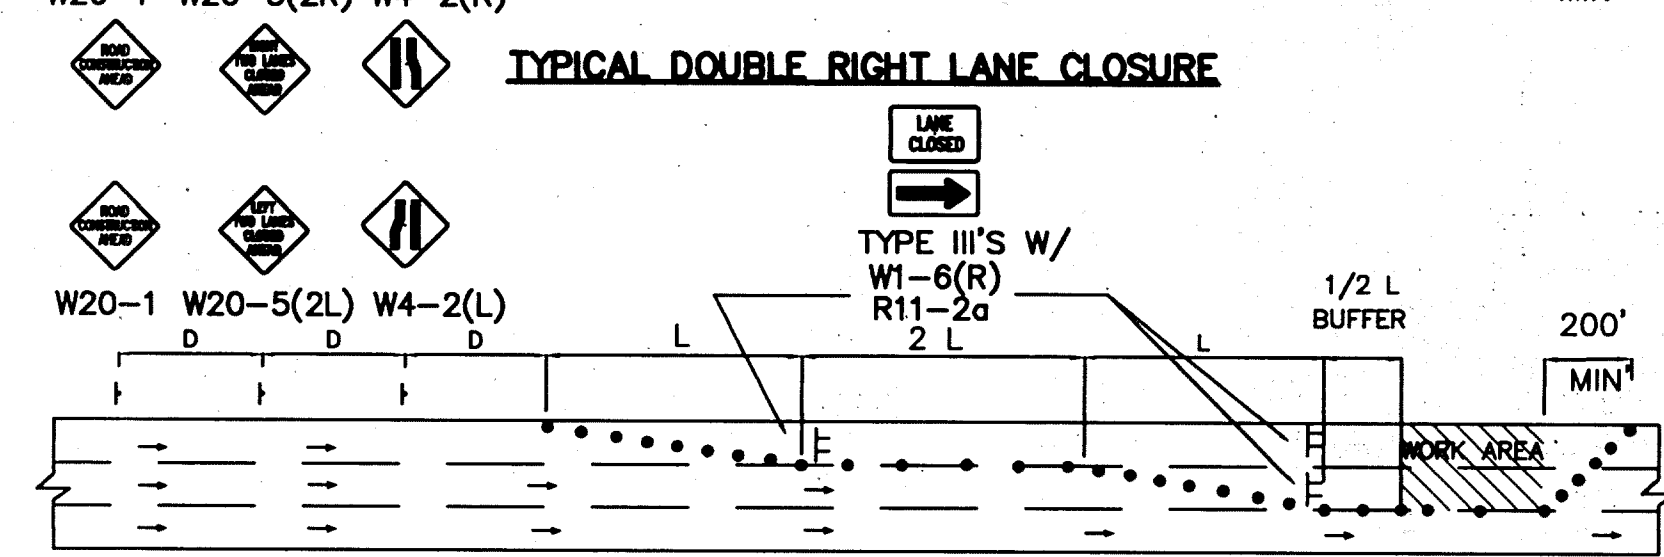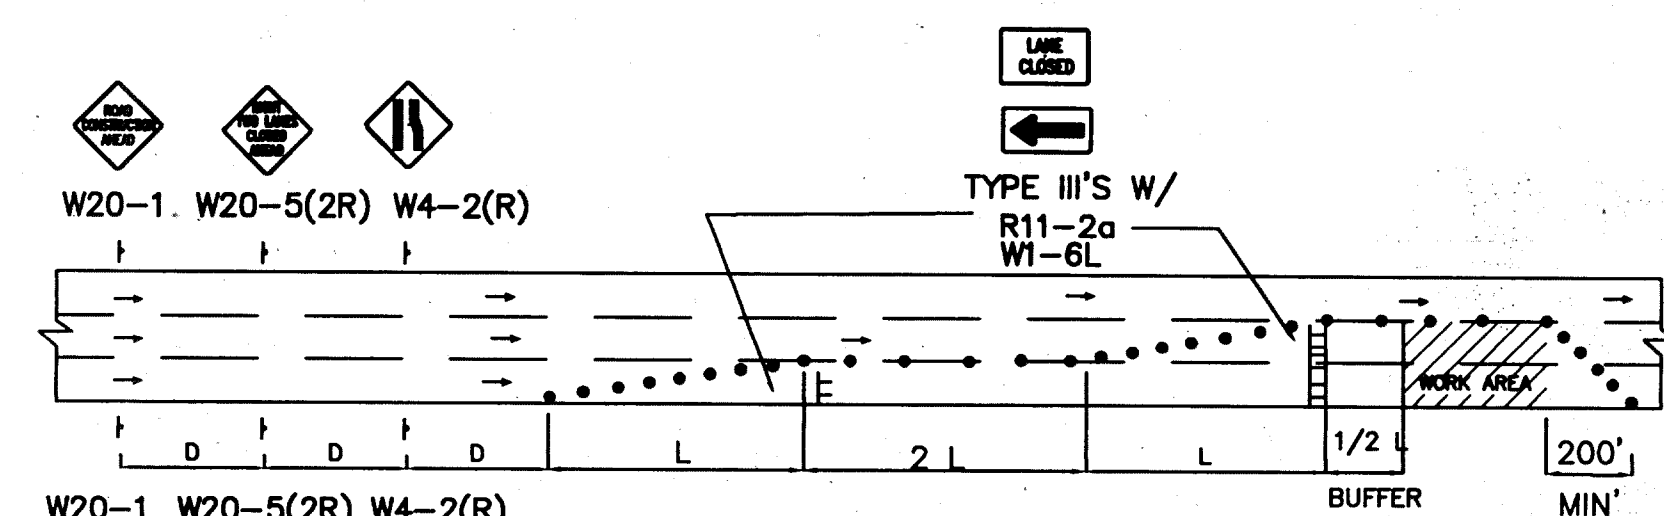

NOTE: (R1-1) BASED ON FIELD CONDITIONS.

- TRAFFIC SPLIT NOTES:**
1. THE OFFSET DISTANCE MUST BE CALCULATED IN ALL SHIFTING TAPERS. THE OFFSET DISTANCES SHALL INCLUDE LANE WIDTHS PLUS MEDIAN WIDTHS.
 2. 1/2 L IS MINIMUM DISTANCE FOR SHIFTING TAPERS.
 3. REVERSE CURVES MAY BE IMPLEMENTED. ALL CURVE DATA SHALL BE CALCULATED.
 4. MEDIAN REMOVAL SHALL BE REQUIRED IF 1/2 L OR REVERSE CURVE IS NOT SUFFICIENT. MEDIAN REMOVAL SHALL TAKE PLACE BEFORE SPLITS.
 5. REDUCED SPEED MAY BE CONSIDERED.
 6. * USE W1-3 FOR 30 MPH OR LESS, W1-4 FOR SPEED 35 MPH OR GREATER.

GENERAL NOTE:

ALL CONSTRUCTION WARNING SIGNS SHALL HAVE A BLACK LEGEND ON A ORANGE BACKGROUND.
ALL ADVANCE WARNING SIGNS SHALL BE A MINIMUM OF 36" THIRTY SIX INCHES BY 36" THIRTY SIX INCHES IN SIZE AND SHALL HAVE ONE WARNING LIGHT.

AS BUILT INFORMATION	
CONTRACTOR	DATE
DESIGNED BY	DATE
CHECKED BY	DATE
REVISIONS	DATE
NO.	DATE

BENCH MARKS	
NO.	DATE
NO.	DATE
SURVEY INFORMATION	
NO.	DATE
NO.	DATE
ENGINEER'S SEAL	
JDL	BY
REVISIONS	DATE
DESIGN	DATE
C.O.A. STANDARDS	DATE
CHECKED BY	DATE

CITY OF ALBUQUERQUE
PUBLIC WORKS DEPARTMENT
ENGINEERING DEVELOPMENT GROUP

TITLE: **TYPICAL TRAFFIC CONTROL & SIGNING EXAMPLES (REF. MUT.C.D.)**

DESIGN REVIEW COMMITTEE: CITY ENGINEER APPROVAL

LAST UPDATE: **COA Standard**


PROJECT NO. 5911.91

MAP J-13/ J-14


SHEET 3 OF 6

LEGEND




Area of Gate Location

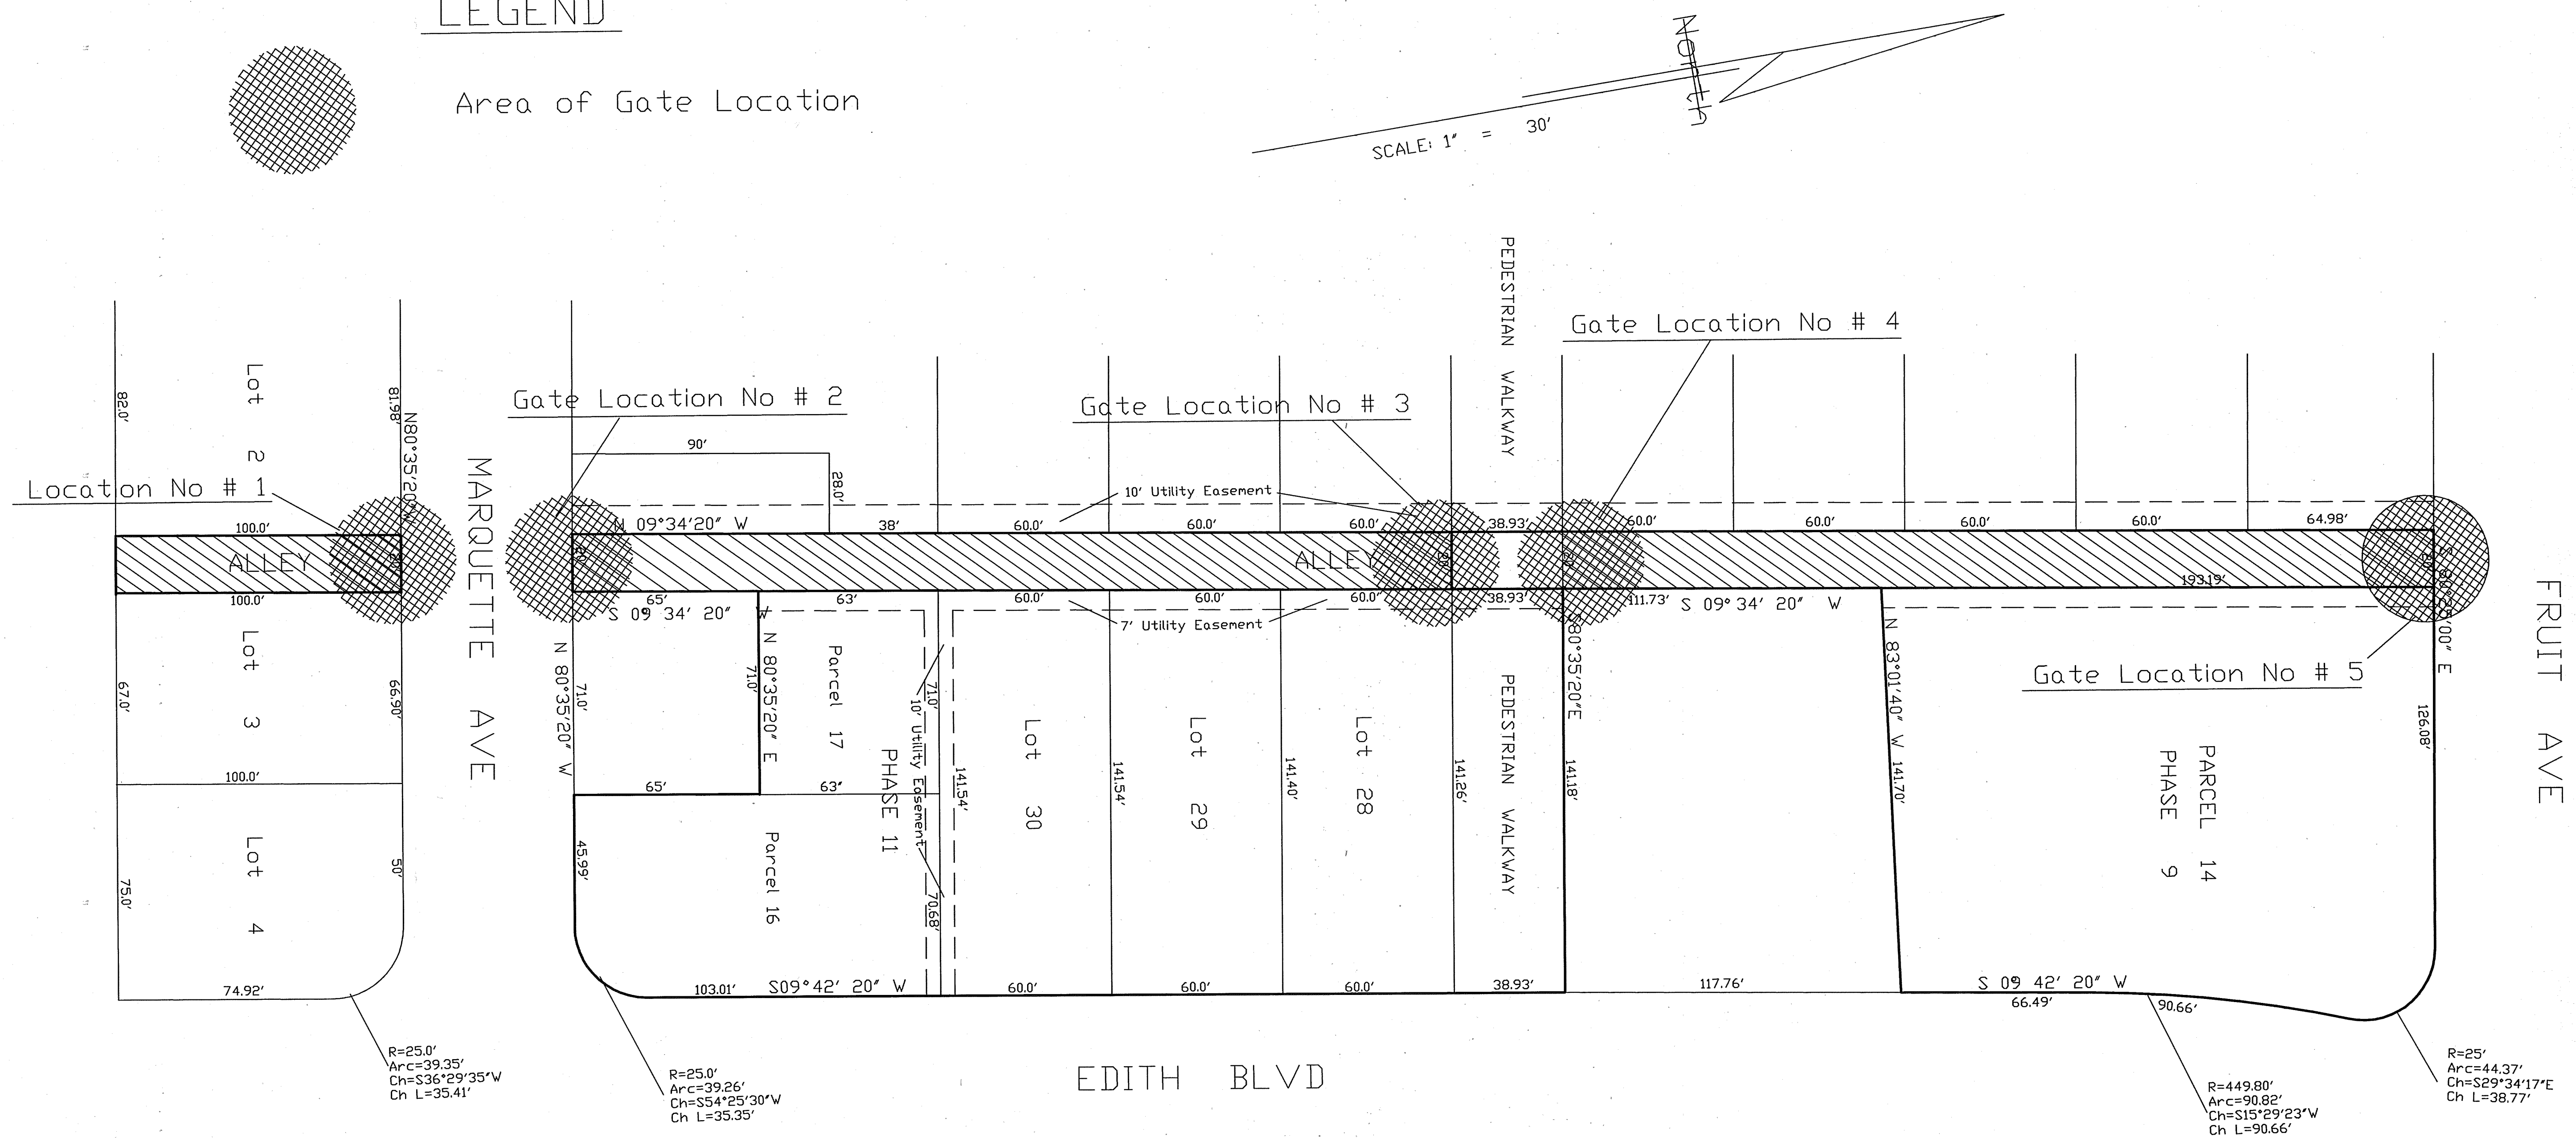

LOCATION OF ALLEY GATES

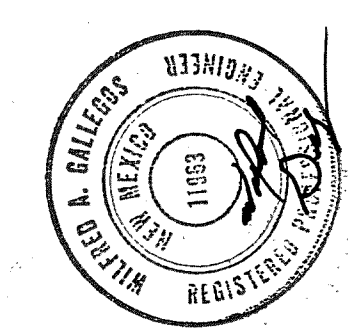ENGINEER'S SEAL		SURVEY INFORMATION		BENCH MARKS		AS BUILT INFORMATION	
		FIELD NOTES		Reference Plots C-9-66, and C-10-27 Plat of Martineztown Plan (Phase I) and Martineztown Plan (Phase II), Parcel 14, (Phase 10), Parcel 15, Lots 28, 29 and 30, (Phase 11, Parcel 16 & 17)		CONTRACTOR <i>Ross Pitay</i>	
		NO.		DATE		DATE	
		BY		V/N		BY <i>W. Gallegos</i>	
		REMARKS		NO. DATE		NO. DATE	
DESIGNED BY <i>Will Gallegos</i>		DATE <i>8/98</i>		NO. DATE		NO. DATE	
DRAWN BY <i>RMS / CAD</i>		DATE <i>8/98</i>		NO. DATE		NO. DATE	
CHECKED BY <i>Will Gallegos</i>		DATE <i>8/98</i>		NO. DATE		NO. DATE	

CITY OF ALBUQUERQUE PUBLIC WORKS DEPARTMENT TRANSPORTATION DEVELOPMENT			
TITLE: Location of Alley Gates Between Marquette Ave And Fruit / And West Of Edith Blvd			
DESIGN REVIEW COMMITTEE  SEP - 3 1998	CITY ENGINEER APPROVAL	MO./DAY/YR.	MO./DAY/YR.
City Project No. 5911.91	Zone Map No. J-13/J-14	Sheet 4	Of 6

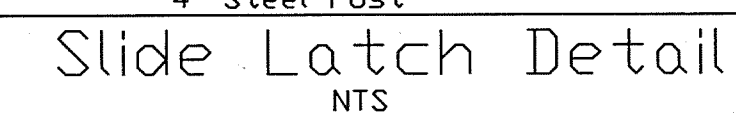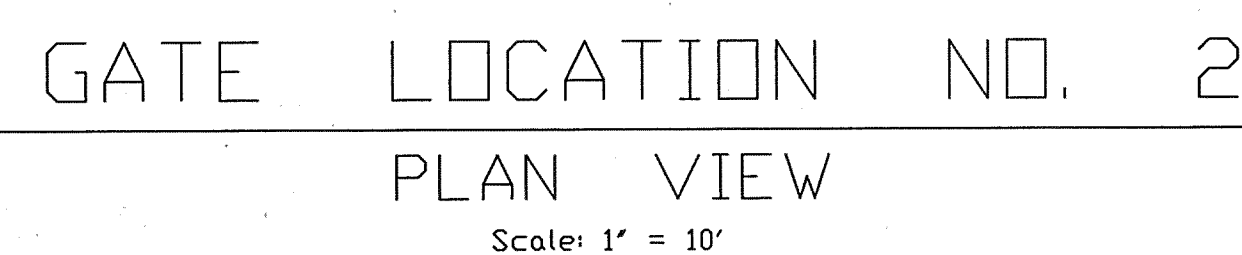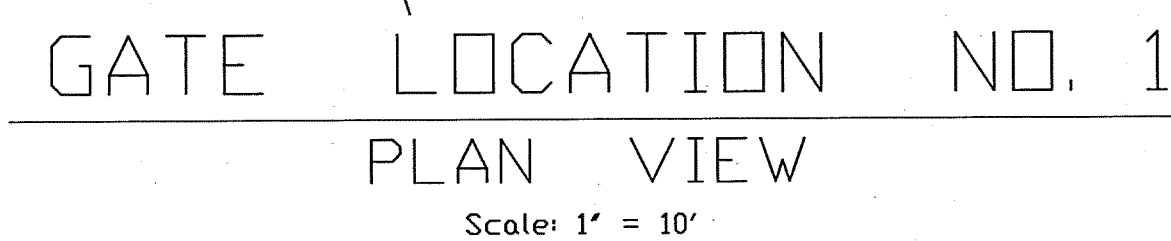

CITY OF ALBUQUERQUE
PUBLIC WORKS DEPARTMENT
TRANSPORTATION DEVELOPMENT

TITLE: Martinez Town Security Gates
 Between Marquette and Fruit St.

DESIGN REVIEW COMMITTEE

APPROVED

SEP - 3 1998

DESIGN REVIEW COMMITTEE


CITY ENGINEER APPROVAL

MO./DAY/YR.	MO./DAY/YR.


City Project No.
 5911 91

Zone Map No.
 J-13/J-14


Sheet 5 **Of** 6

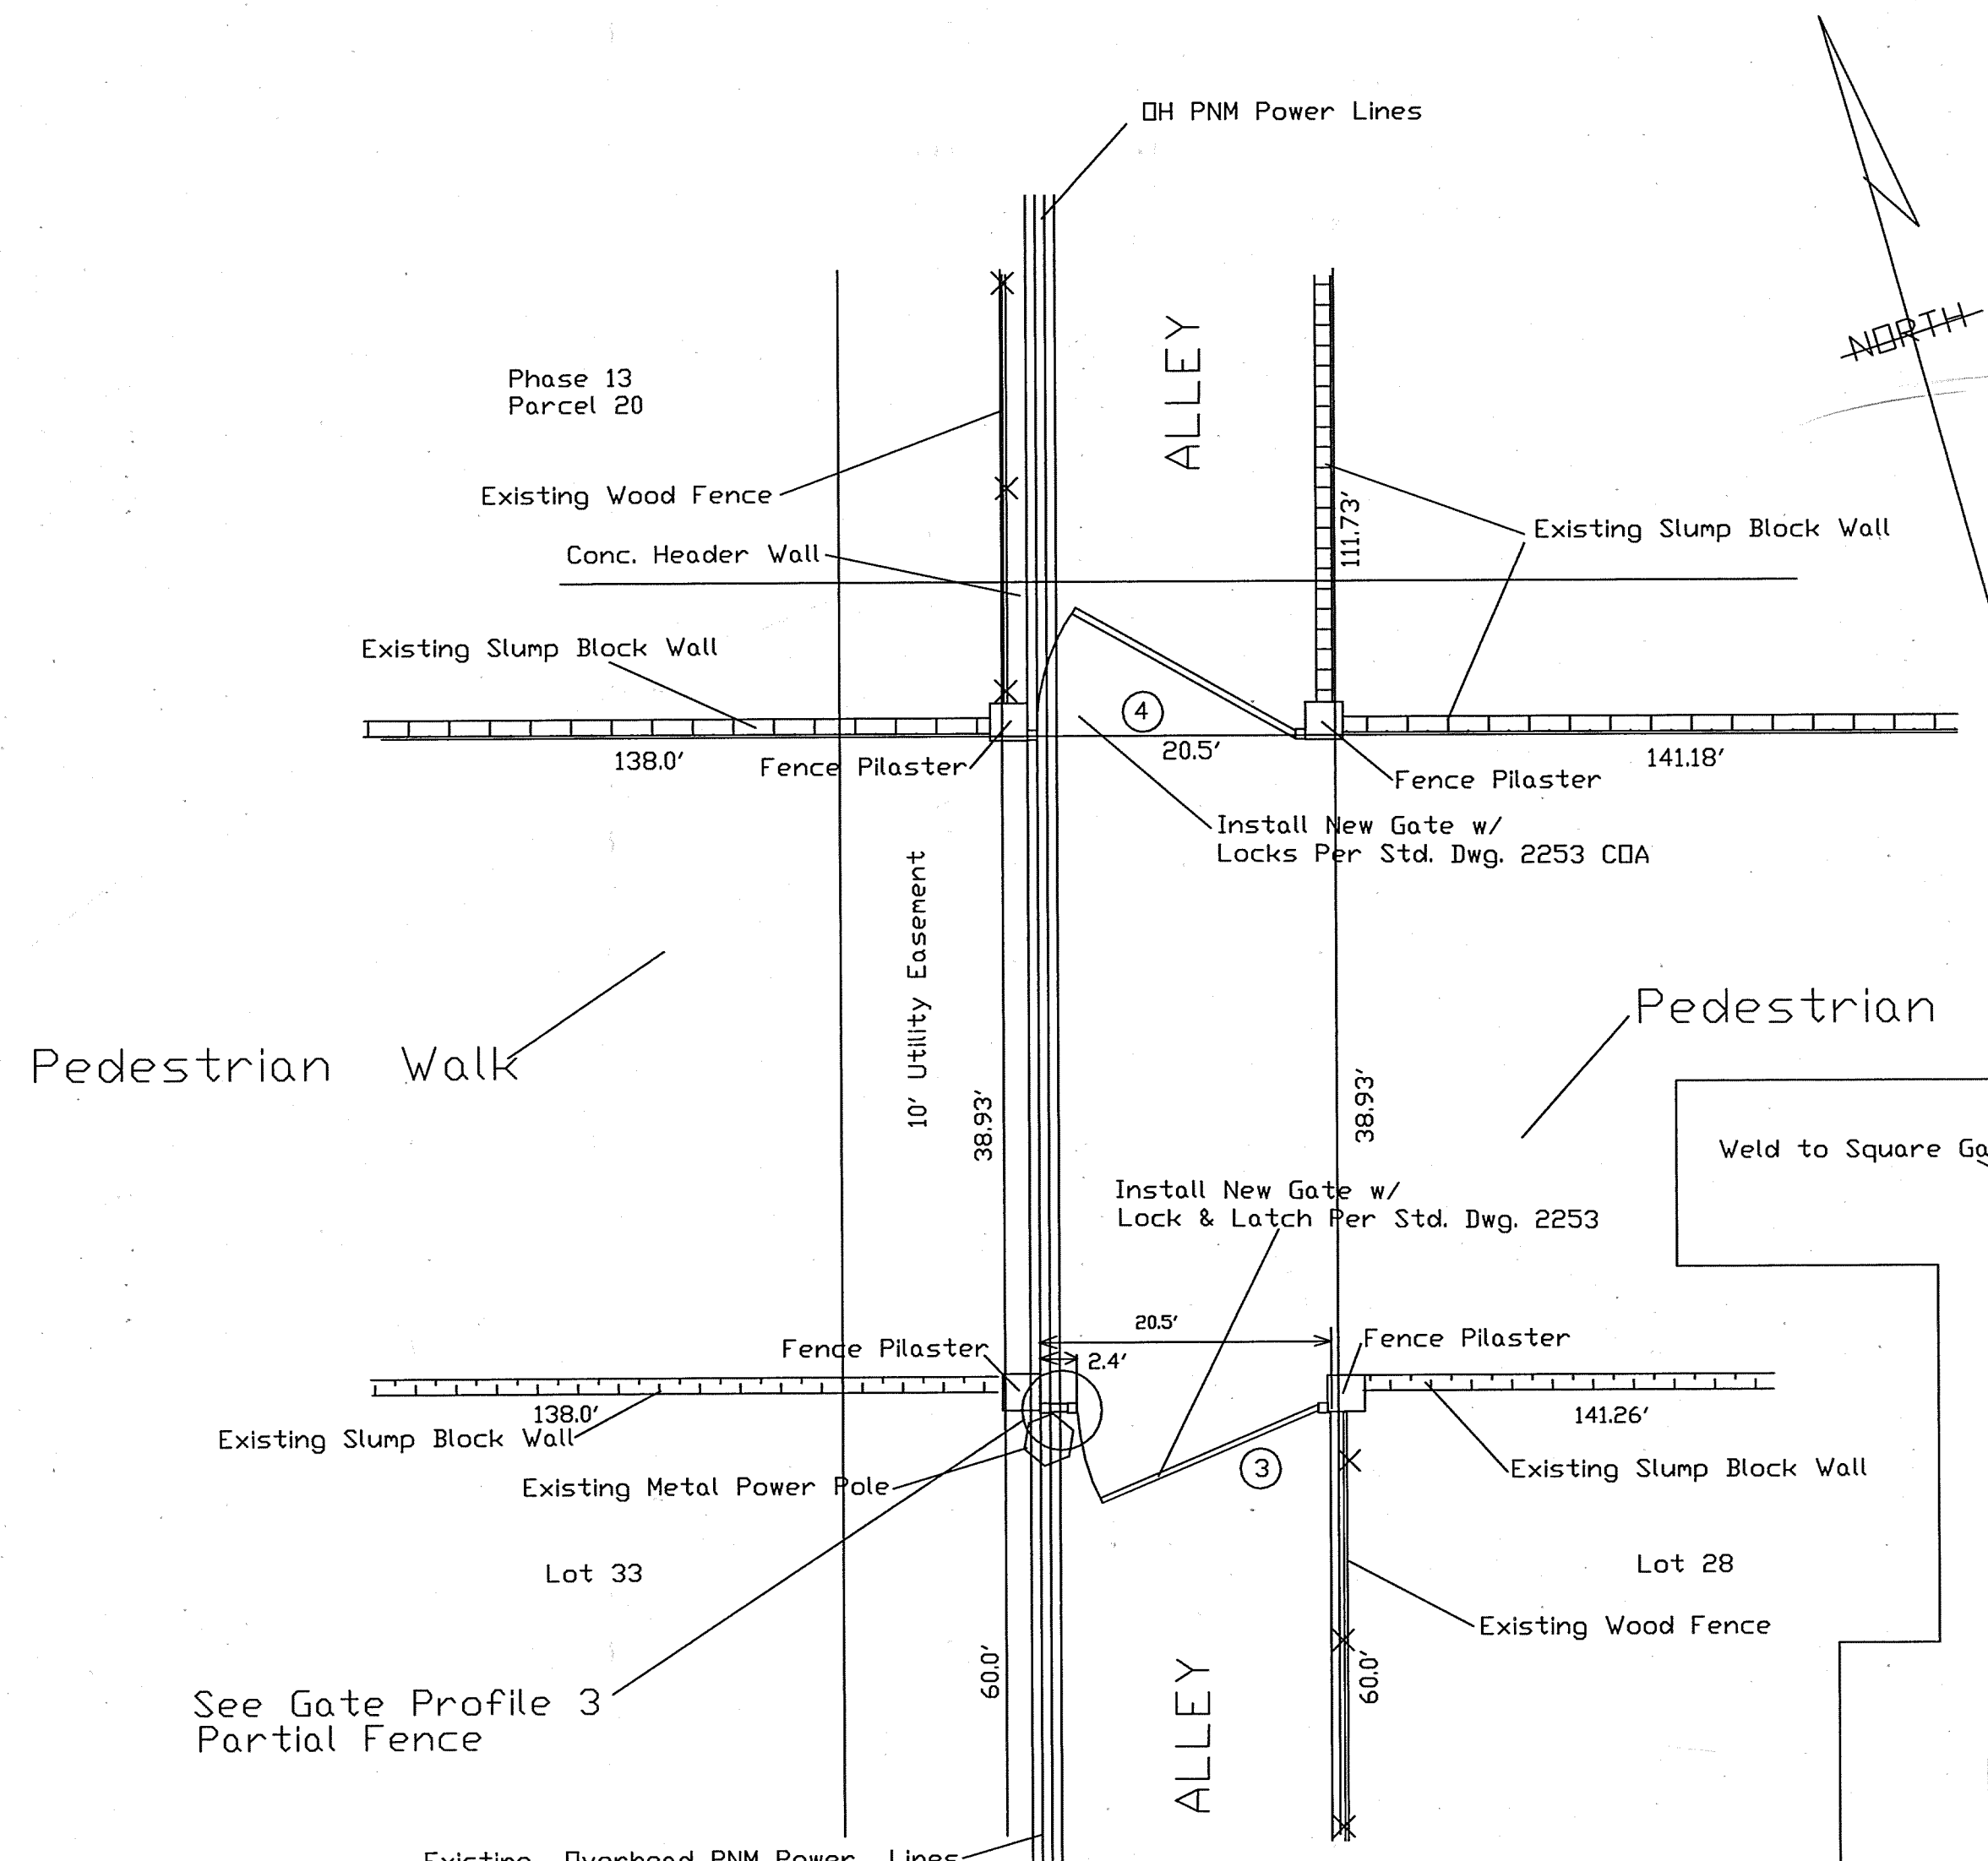


GATE LOCATIONS NO. 3 & 4
Plan View
Scale: 1" = 10'

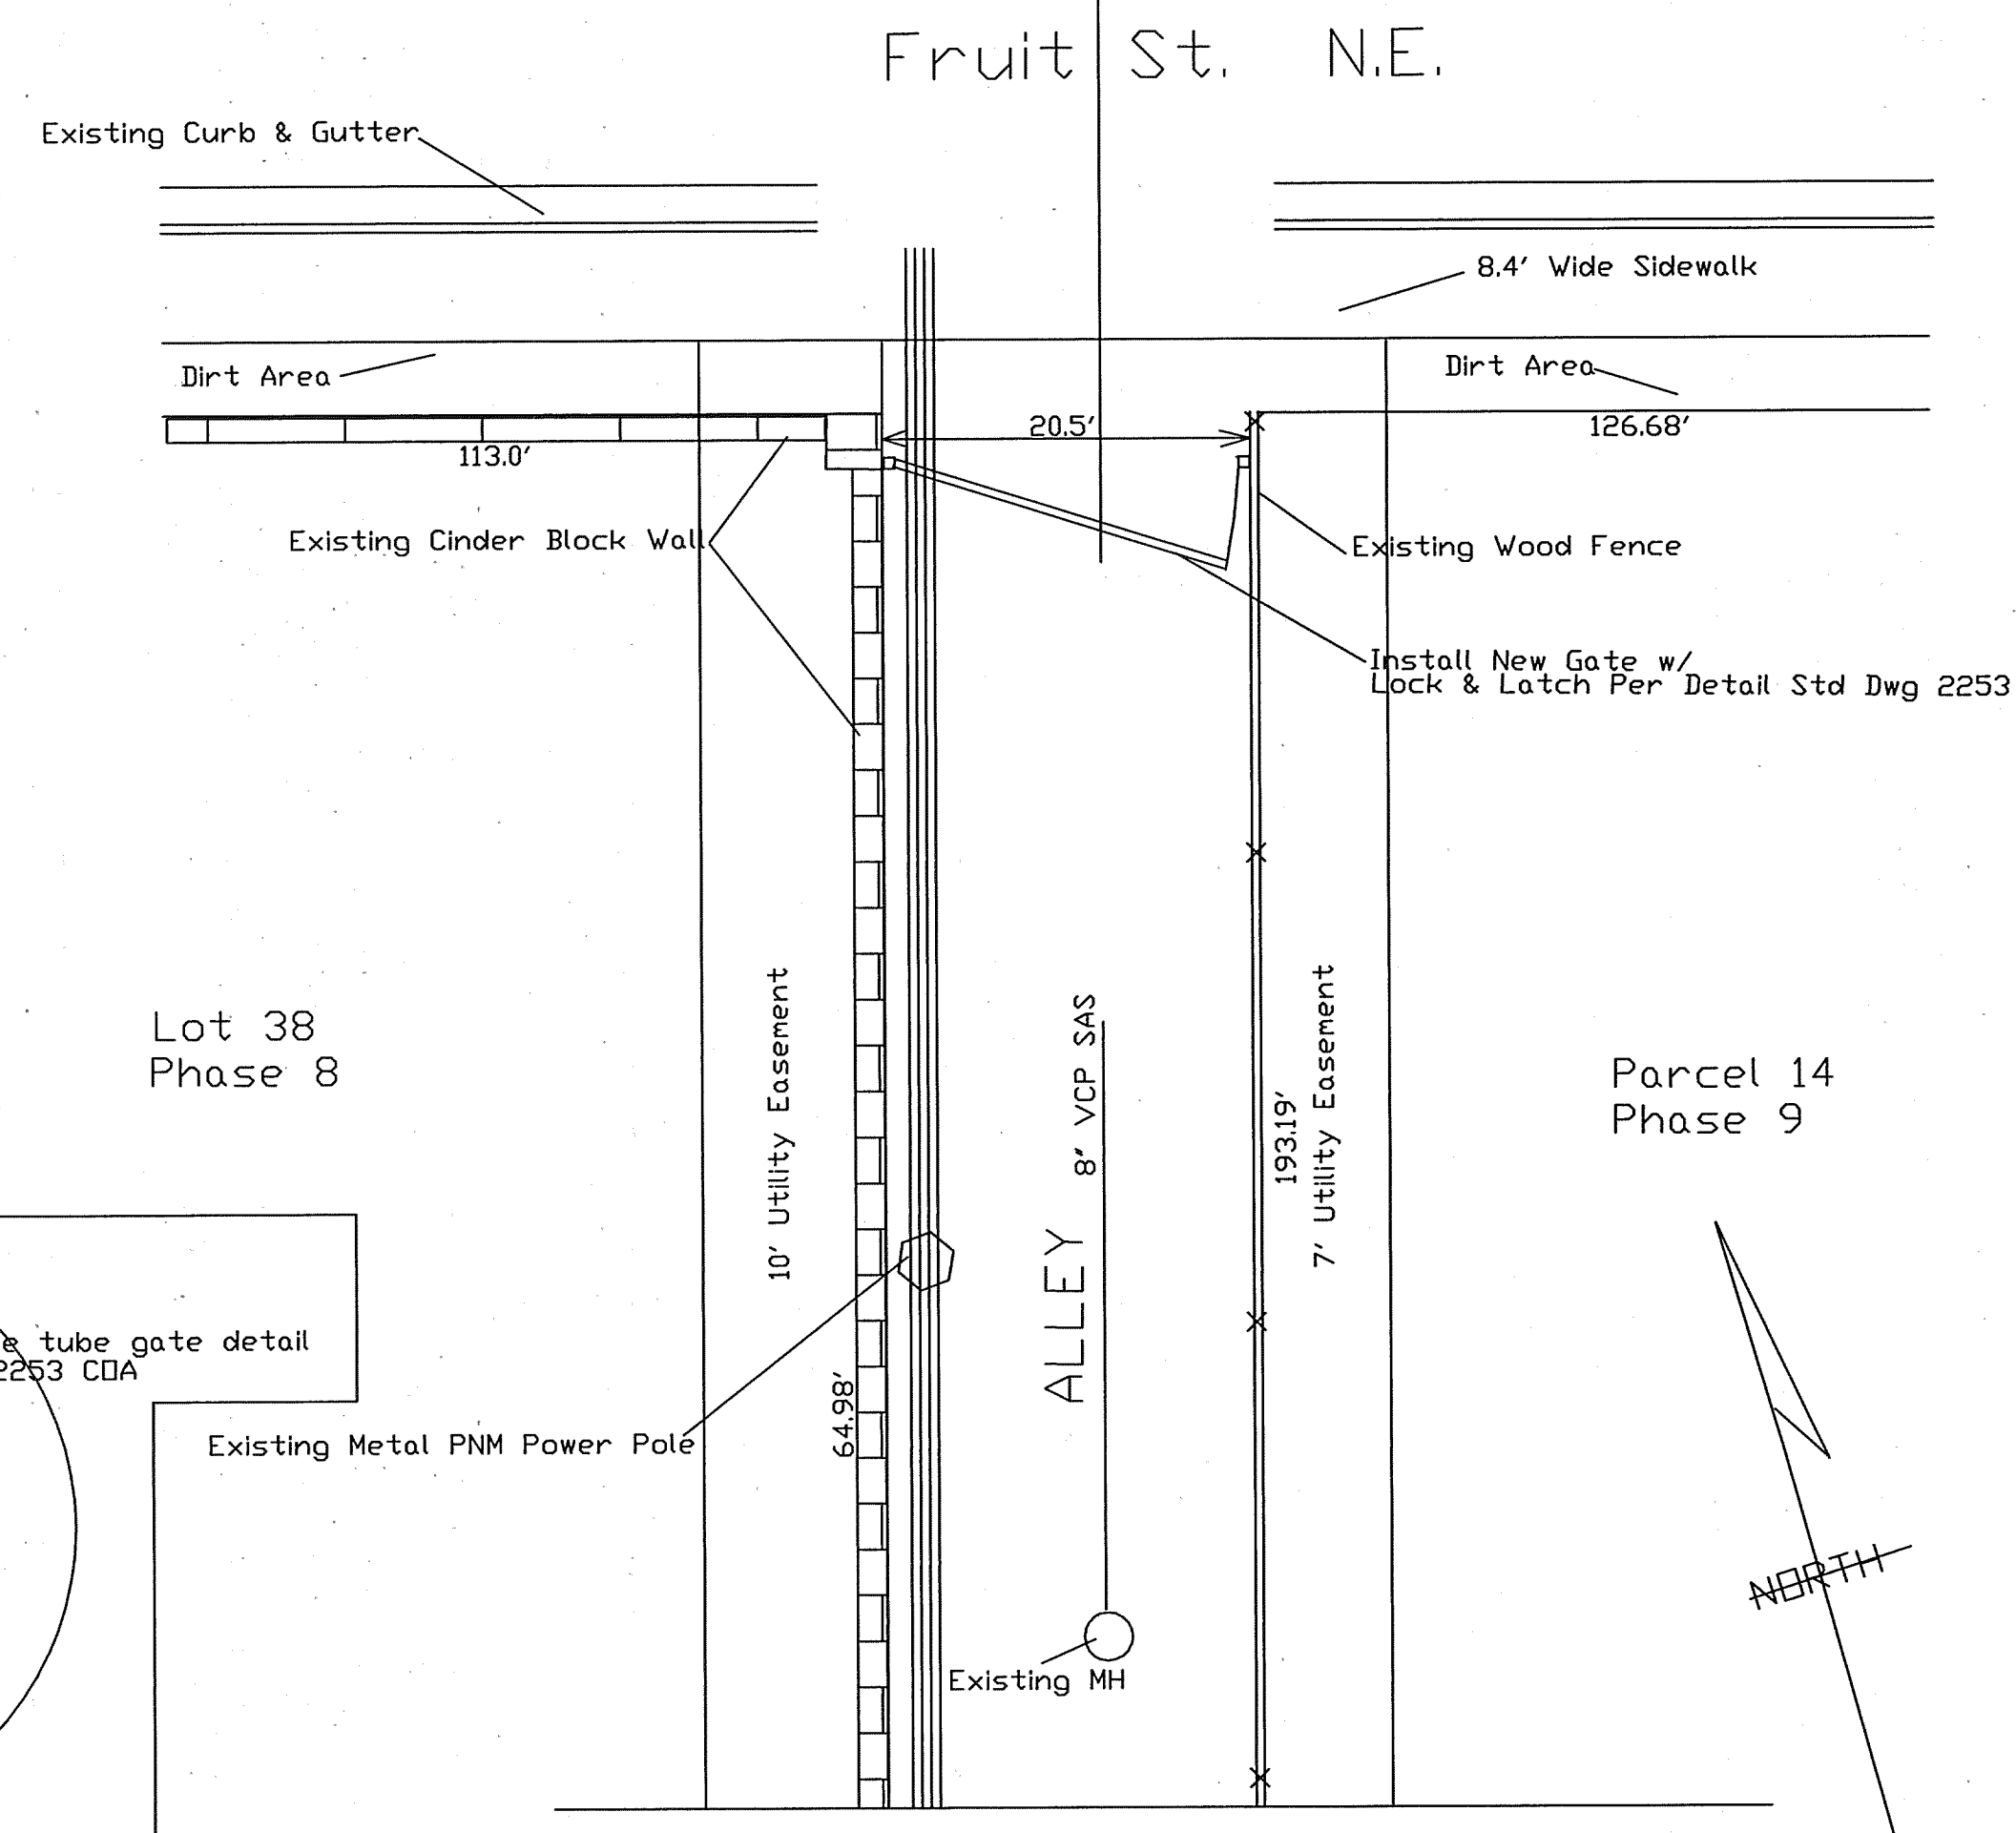


GATE LOCATION NO. 5
Plan View
Scale: 1" = 10'

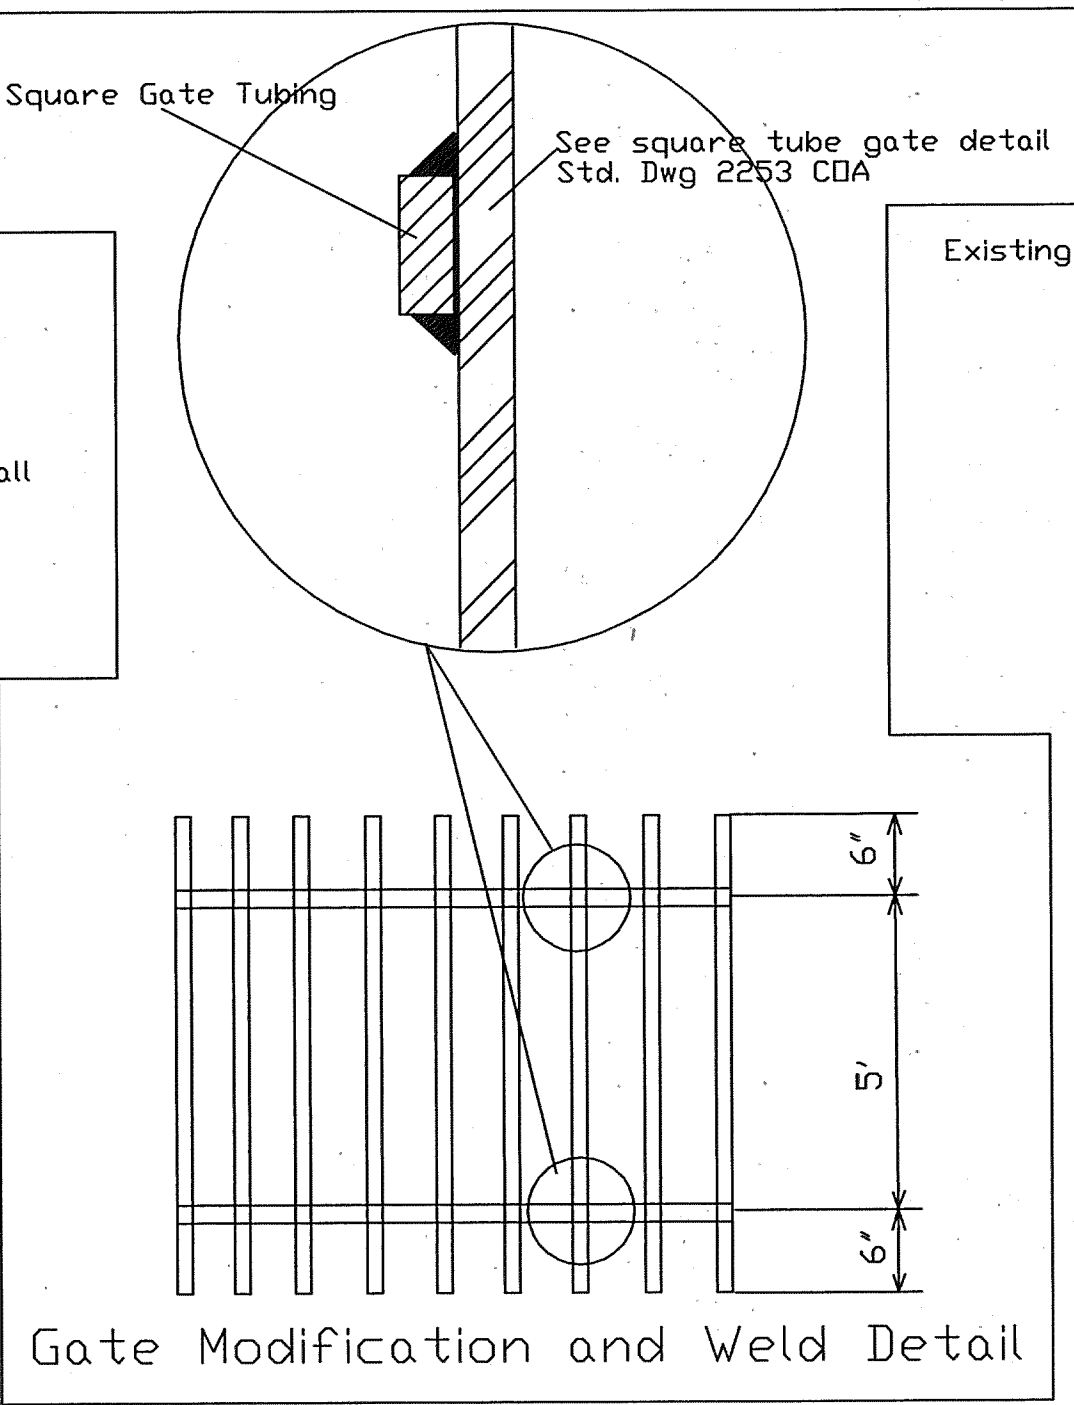


Gate Modification and Weld Detail

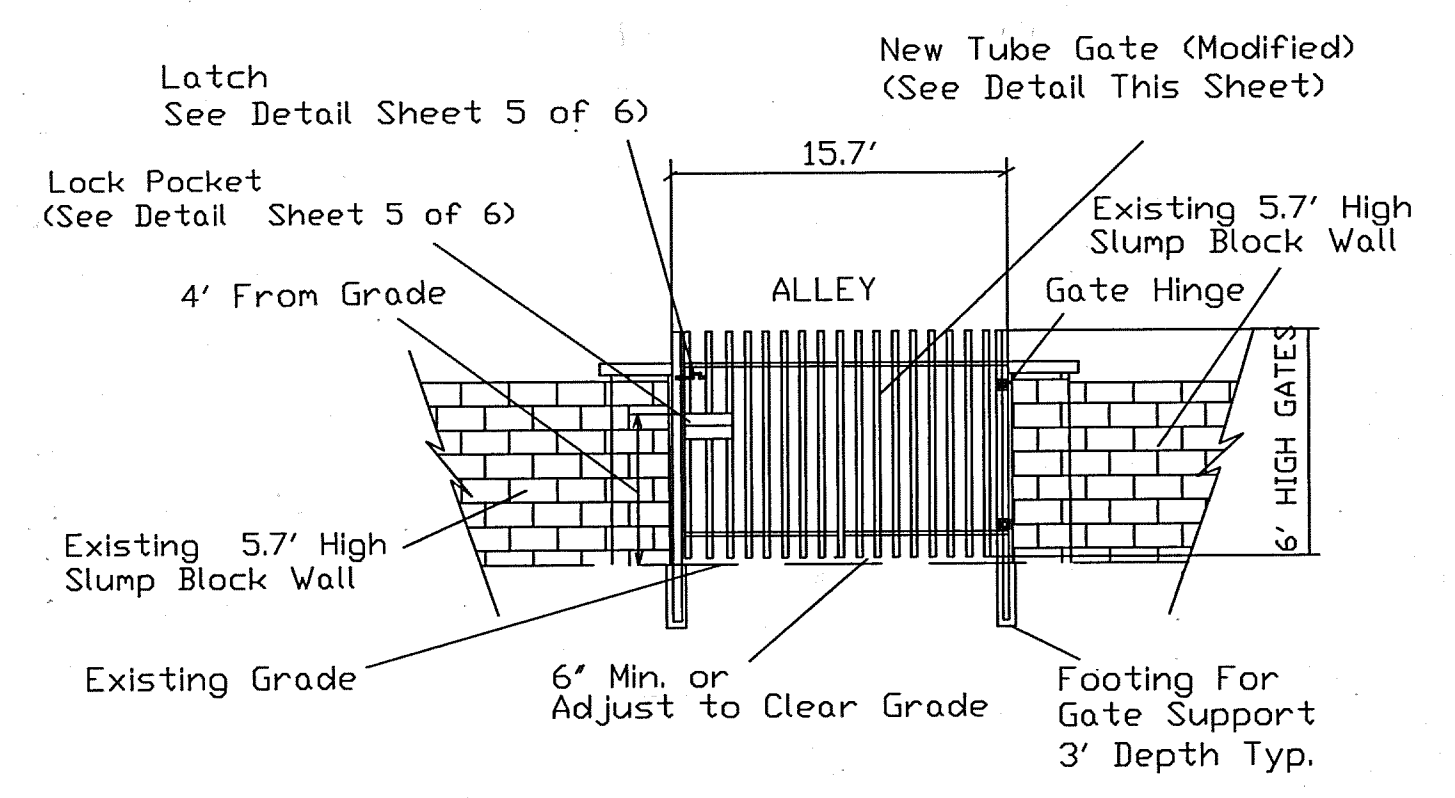

GATE PROFILE 4
NTS

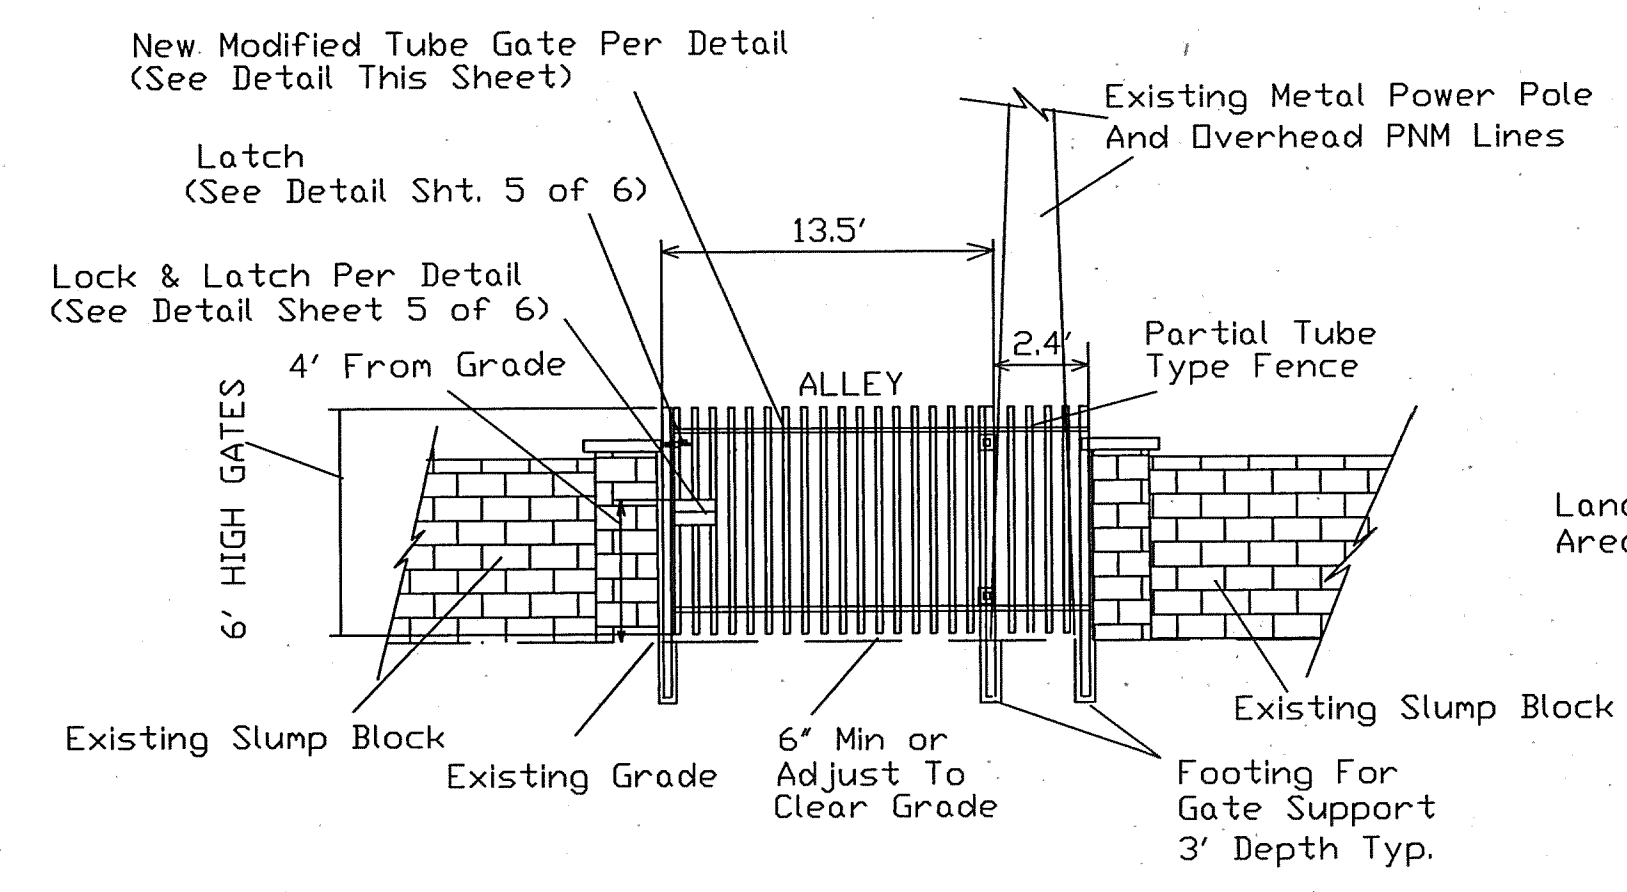

GATE PROFILE 3
NTS

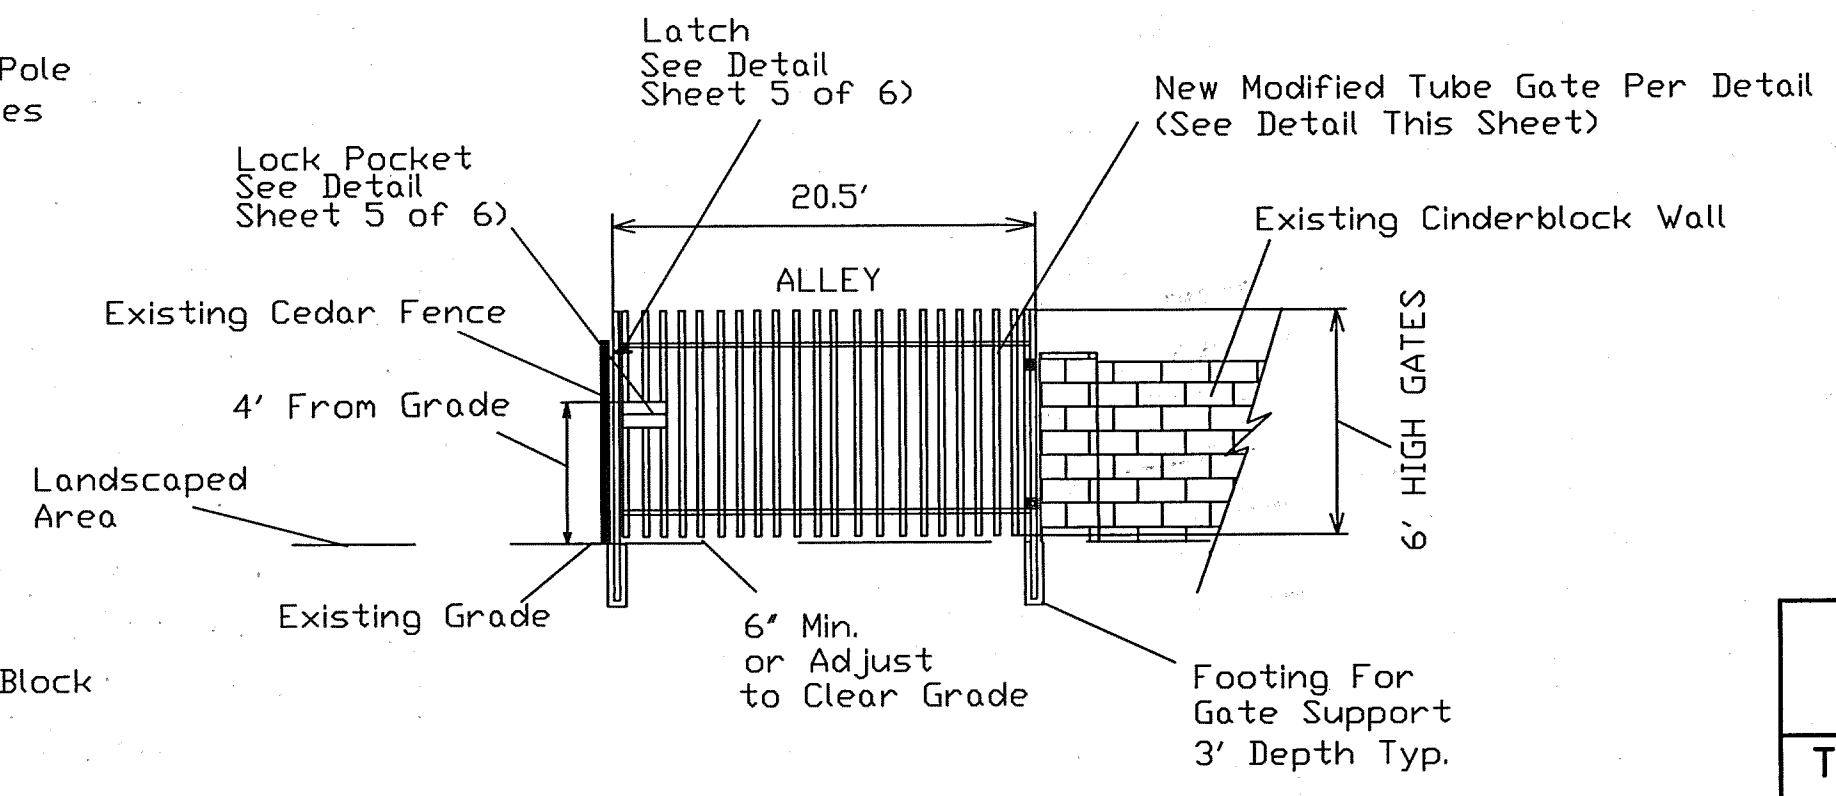

GATE PROFILE 5
NTS

CITY OF ALBUQUERQUE PUBLIC WORKS DEPARTMENT TRANSPORTATION DEVELOPMENT			
TITLE: Martinez Town Security Gates Between Marquette and Fruit St			
DESIGN REVIEW COMMITTEE APPROVED SEP - 3 1998	CITY ENGINEER APPROVAL	MO./DAY/YR.	MO./DAY/YR.
City Project No. 5911.91	Zone Map No. J-13/J-14	Sheet 6	Of 6

																																																																																																																																																																																																																																																																																																																																																																																																																																																																																																																																																																																																																																																																																																																																																																																																																																																																																																																																																																																																																																																																																																																																																																																																																																																																																																																																																																																																																					</
--	--	----