

SCANNED BY
MESA REPRO

RECORD DRAWING

CONSTRUCTION PLANS
FOR
UNIT 2 – THE CANYONS
AT HIGH DESERT
(TRACT 5A-1A-2 HIGH DESERT)
ALBUQUERQUE, NEW MEXICO

INDEX

SHEET NUMBER	DESCRIPTION
1	TITLE SHEET
2	PLAT
3A-B	GRADING PLAN
4	MASTER PAVING PLAN
5	PAVING PLAN AND PROFILE SHEETS JUNIPER CANYON TRAIL
6	CANYON BLUFF TRAIL
7	MASTER UTILITY PLAN
8	UTILITY PLAN AND PROFILE SHEETS JUNIPER CANYON TRAIL
9	CANYON BLUFF TRAIL
10	SIGNING AND CONSTRUCTION TRAFFIC CONTROL STANDARDS
11	TYPICAL TRAFFIC CONTROL AND SIGNING EXAMPLES (REF. M.U.T.C.D.)




SURVEYOR'S CERTIFICATION

I, Charles G. Cala, Jr., a duly qualified Registered Professional Land Surveyor under the laws of the State of New Mexico, do hereby certify that the "as-built" information shown on these drawings was obtained from field construction and "as-built" surveys performed by me or under my supervision, that the "as-built" information shown on these drawings was added by me or under my supervision, and that this "as-built" information is true and correct to the best of my knowledge and belief and that I am not responsible for any of the design concepts, calculations, engineering, or intent of the record drawings.

Charles G. Cala, Jr. 09-06-2000
Charles G. Cala, Jr., NMPS 41184 Date

APPROVAL OF AS BUILT DRAWINGS
CHIEF CONSTRUCTION ENGINEER
Chen Chang
DATE 11-2-00

J.M.A. # 2000.040.1
Bohannon & Huston
Courtyard One 7500 JEFFERSON NE Albuquerque NEW MEXICO 87109
ENGINEERS PLANNERS PHOTOGRAMMETRISTS SURVEYORS SOFTWARE DEVELOPERS

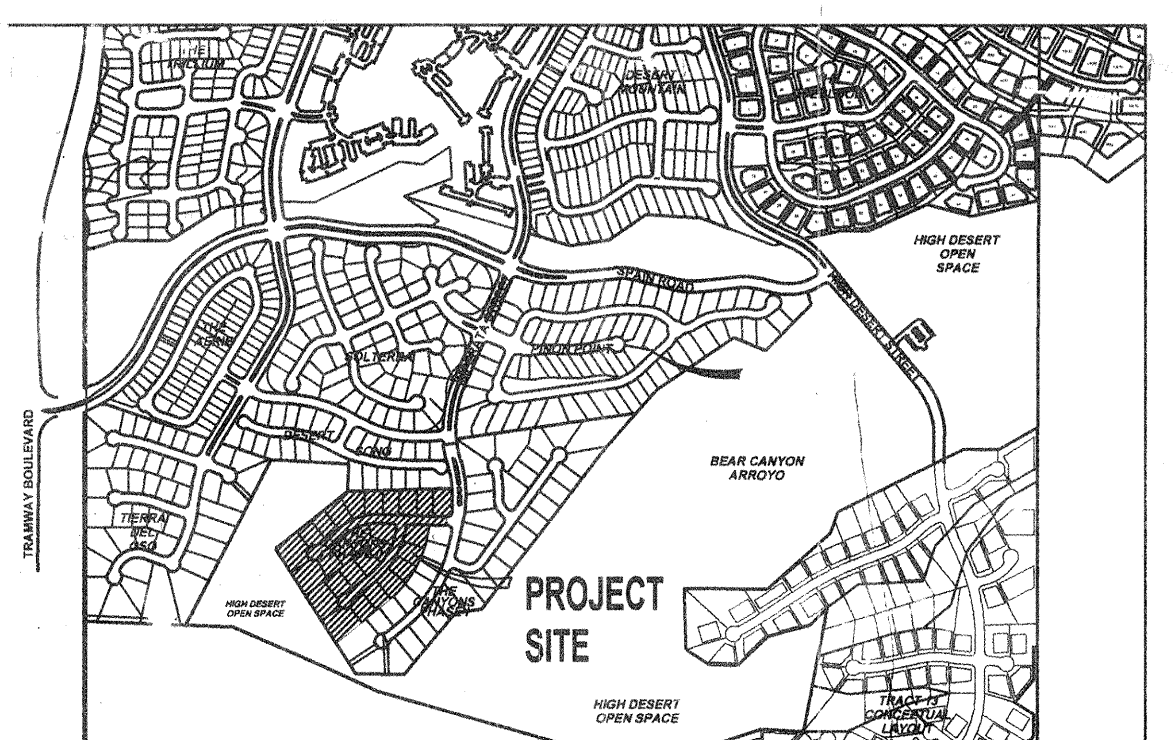

VICINITY MAP: NOT TO SCALE ZONE MAP NO. F-23

- NOTICE TO CONTRACTORS**
- AN EXCAVATION/CONSTRUCTION PERMIT WILL BE REQUIRED BEFORE BEGINNING ANY WORK WITHIN THE CITY RIGHT-OF-WAY.
 - ALL WORK DETAILED ON THESE PLANS TO BE PERFORMED UNDER CONTRACT SHALL, EXCEPT AS OTHERWISE STATED OR PROVIDED FOR HEREON, BE CONSTRUCTED IN ACCORDANCE WITH THE CITY OF ALBUQUERQUE STANDARD SPECIFICATIONS FOR PUBLIC WORKS CONSTRUCTION, 1986 EDITION, AS REVISED THROUGH UPDATE No. 6.
 - TWO WORKING DAYS PRIOR TO ANY EXCAVATION, THE CONTRACTOR MUST CONTACT NEW MEXICO ONE CALL SYSTEM (260-1990) FOR LOCATION OF EXISTING UTILITIES.
 - PRIOR TO CONSTRUCTION, THE CONTRACTOR SHALL EXCAVATE AND VERIFY THE HORIZONTAL AND VERTICAL LOCATIONS OF ALL OBSTRUCTIONS. SHOULD A CONFLICT EXIST, THE CONTRACTOR SHALL NOTIFY THE ENGINEER OR SURVEYOR IMMEDIATELY SO THAT THE CONFLICT CAN BE RESOLVED WITH A MINIMUM AMOUNT OF DELAY.
 - FIVE (5) WORKING DAYS PRIOR TO BEGINNING CONSTRUCTION, THE CONTRACTOR SHALL SUBMIT TO CONSTRUCTION COORDINATION DIVISION A DETAILED CONSTRUCTION SCHEDULE. TWO (2) WORKING DAYS PRIOR TO CONSTRUCTION, THE CONTRACTOR SHALL OBTAIN A BARRICADE PERMIT FROM THE CONST. COORDINATION DIVISION. CONTRACTOR SHALL NOTIFY CONSTRUCTION COORDINATION ENGINEER (768-2551) PRIOR TO OCCUPYING AN INTERSECTION. REFER TO SECTION 19 OF THE GENERAL CONDITIONS OF THE STANDARD SPECIFICATIONS.
 - ALL WORK EFFECTING ARTERIAL ROADWAYS REQUIRES TWENTY-FOUR HOUR CONSTRUCTION.
 - ALL STREET STRIPING ALTERED OR DESTROYED SHALL BE REPLACED W/ PLASTIC REFLECTORIZED PAVEMENT MARKING BY CONTRACTOR TO THE SAME LOCATION AS EXISTING, OR AS INDICATED BY THIS PLAN SET.
 - CONTRACTOR SHALL NOTIFY THE ENGINEER NOT LESS THAN SEVEN (7) DAYS PRIOR TO STARTING WORK IN ORDER THAT THE CITY SURVEYOR MAY TAKE NECESSARY MEASURES TO INSURE THE PRESERVATION OF SURVEY MONUMENTS. CONTRACTOR SHALL NOT DISTURB PERMANENT SURVEY MONUMENTS WITHOUT THE CONSENT OF THE CITY SURVEYOR AND SHALL NOTIFY THE CITY SURVEYOR AND BEAR THE EXPENSE OF REPLACING ANY THAT MAY BE DISTURBED WITHOUT PERMISSION. REPLACEMENT SHALL BE DONE ONLY BY THE CITY SURVEYOR. WHEN A CHANGE IS MADE IN THE FINISHED ELEVATIONS OF THE PAVEMENT OF ANY ROADWAY IN WHICH A PERMANENT SURVEY MONUMENT IS LOCATED, CONTRACTOR SHALL, AT HIS OWN EXPENSE, ADJUST THE MONUMENT COVER TO THE NEW GRADE UNLESS OTHERWISE SPECIFIED. REFER TO SECTION 4.4 OF THE GENERAL CONDITIONS OF THE STANDARD SPECIFICATIONS.
 - CONTRACTOR SHALL RECORD DATA ON ALL UTILITY LINES AND ACCESSORIES AS REQUIRED BY THE CITY OF ALBUQUERQUE FOR THE PREPARATION OF "AS CONSTRUCTED" DRAWING. CONTRACTOR SHALL NOT COVER UTILITY LINES AND ACCESSORIES UNTIL ALL DATA HAS BEEN RECORDED.
 - CONTRACTOR SHALL MAINTAIN A GRAFFITI-FREE WORK SITE. CONTRACTOR SHALL PROMPTLY REMOVE ANY GRAFFITI FROM ALL EQUIPMENT, WHETHER PERMANENT OR TEMPORARY.
 - CONTRACTOR SHALL COORDINATE WITH THE CITY OF ALBUQUERQUE WATER SYSTEMS DIVISION (857-8200) FIVE WORKING DAYS IN ADVANCE OF ANY WORK THAT MAY AFFECT EXISTING PUBLIC WATER OR SEWER UTILITIES. EXISTING VALVES TO BE OPERATED BY CITY PERSONNEL. ONLY CONTRACTOR SHALL CONTACT THE WATER SYSTEMS DIVISION (857-8200) DESIRING VALVES TURNED ON OR OFF.
- THE FOLLOWING NOTES ALSO APPLY WHEN CHECKED**
- ☒ ALL UTILITIES AND UTILITY SERVICE LINES SHALL BE INSTALLED PRIOR TO PAVING.
- ☒ BACKFILL COMPACTION SHALL BE ACCORDING TO SPECIFIED STREET USE.
- ☐ TACK COAT REQUIREMENTS SHALL BE DETERMINED BY THE CITY ENGINEER.
- ☒ SIDEWALKS AND WHEELCHAIR RAMPS WITHIN THE CURB RETURNS SHALL BE CONSTRUCTED WHEREVER A NEW CURB RETURN IS CONSTRUCTED.
- ☐ IF CURB IS DEPRESSED FOR A DRIVEPAD, THE DRIVEPAD SHALL BE CONSTRUCTED PRIOR TO ACCEPTANCE OF CURB AND GUTTER.
- ☒ ALL STORM DRAINAGE FACILITIES SHALL BE COMPLETED PRIOR TO FINAL ACCEPTANCE.
- ☒ THE REQUESTOR OR DEVELOPER SHALL BE RESPONSIBLE FOR REPAIR OR REPLACEMENT OF ALL CURB AND GUTTER OR SIDEWALK DAMAGED AFTER APPROVAL BY THE CITY ENGINEER OF WORK COMPLETED BY THE CONTRACTOR.

REV.	SHEETS	CITY ENGINEER	DATE	USER DEPARTMENT	DATE	USER DEPARTMENT	DATE
△	5A, 6A, 8, 9		08/00				
△	5, 6, 8, 9						
ENGINEERS STAMP & SIGNATURE		APPROVALS		ENGINEER		DATE	
		DRC Chairman		<i>Kevin Patton</i>		4/25/00	
		Transportation		<i>Chen Chang</i>		4/25/00	
		Water/Wastewater		<i>Chen Chang</i>		4/23/00	
		Hydrology		<i>Kevin Patton</i>		4-25-00	
		CIP		<i>Kevin Patton</i>		4/25/00	
DRB Case Number		City Project No.		City Engineer		Date	
98-168		594482		<i>Kevin Patton</i>		5/25/00	
Sheet		Of		1		11	


DRAINAGE CERTIFICATION

I, **KEVIN G. PATTON**, OF BOHANNAN HUSTON, N.M.P.E. # 13685, HEREBY CERTIFY THAT THE AS-BUILT DRAINAGE CONDITIONS OF THE SITE ARE IN SUBSTANTIAL COMPLIANCE WITH THE APPROVED GRADING AND DRAINAGE PLAN, TO THE BEST OF MY KNOWLEDGE AND BELIEF. AS-BUILT ELEVATIONS ARE SHOWN ON THE PLAN WHERE THE ORIGINAL DESIGN ELEVATION HAS BEEN CROSSED OUT AND THE AS-BUILT ELEVATION ADDED. AS-BUILT ELEVATIONS WERE VERIFIED BY ALDRICH LAND SURVEYING, INC., L.S. # 7719. THIS STATEMENT DOES NOT REPRESENT CERTIFICATION OF CONTRACTOR'S METHODS OR MATERIALS.

NAME: Kevin Patton
DATE: 7/8/99

KEVIN G. PATTON
NEW MEXICO
13685
REGISTERED PROFESSIONAL ENGINEER

SCANNED BY
MESA REPRO

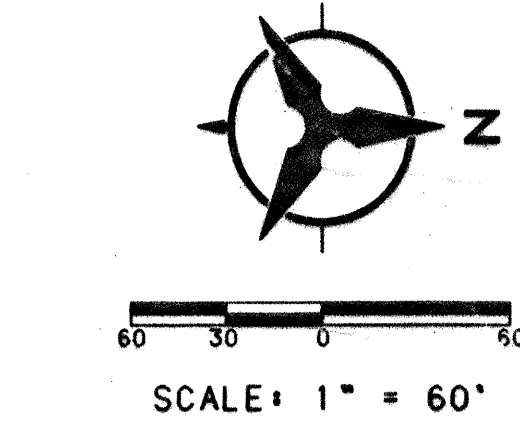

- LEGEND**
- PROJECT BOUNDARY
 - EXISTING CONTOUR
 - EXISTING SPOT ELEVATION
 - PROPOSED SPOT ELEVATION
 - DIRECTION OF FLOW
 - BASIN BOUNDARY
 - SUB-BASIN BOUNDARY
 - PROPOSED 2.5' FILLED CMU WALL
 - EXISTING GARDEN WALL
 - EXISTING STORM DRAIN LINE
 - EXISTING STORM DRAIN MANHOLE
 - EXISTING STORM DRAIN INLET
 - PROPOSED STORM DRAIN LINE
 - PROPOSED STORM DRAIN MANHOLE
 - PROPOSED STORM DRAIN INLET
 - TOE OF SLOPE
 - EROSION CONTROL BERM
 - SILT FENCE
 - AS-BUILT ELEVATION

APPROVED FOR ROUGH GRADING (± 1')

HYDROLOGY ENGINEER DATE

BOHANNAN-HUSTON INC.
ENGINEERS • PLANNERS • PHOTOGRAMMETRISTS • SURVEYORS • LANDSCAPE ARCHITECTS
ALBUQUERQUE LAS CRUCES SANTA FE

CITY OF ALBUQUERQUE
PUBLIC WORKS DEPARTMENT
ENGINEERING DEVELOPMENT GROUP

THE CANYONS AT HIGH DESERT
OVERALL GRADING AND DRAINAGE PLAN

DESIGN REVIEW BOARD NO. **98-168** APPROVAL DATE **6/22/98**

LAST DESIGN UPDATE

CITY PROJECT NO. **594482** ZONE MAP NO. **F-23** SHEET **3A** OF **11**

RECORD DRAWING

NOTE:
SHEET 1 OF 4 FOR GENERAL NOTES

ENGINEER'S SEAL SURVEY INFORMATION		BENCH MARKS		AS-BUILT INFORMATION	
NO.	DATE	STATION	MARK	CONTRACTOR	NO.
		GEODESIC SURVEY BENCH MARK, TOP			
		TABLET STAMPED "TUMBLE 1989" SET IN			
		GROUND, PROJECTING 0.2 FEET ABOVE			
		GROUND, LOCATED 489 FEET WEST OF			
		THE INTERSECTION OF SAN ANTONIO			
		DRIVE AND TENNYSON STREET, AND 35			
		FEET NORTH OF RIGHT-OF-WAY LINE			
		OF SAN ANTONIO DR. ELEV. = 6009.155			

REVISIONS	
NO.	DATE
1	5/98
2	5/98
3	5/98
FILENAME: C:\WINDOWS\TEMP\~NF000000.DLL




NO. 3
SEE OVERALL GRADING SHEET,
SHEET 1 OF 4 FOR GENERAL NOTES

594482	F-23	3B	11
--------	------	----	----

KEVIN G. PATTON
NEW MEXICO
13685
REGISTERED PROFESSIONAL ENGINEER

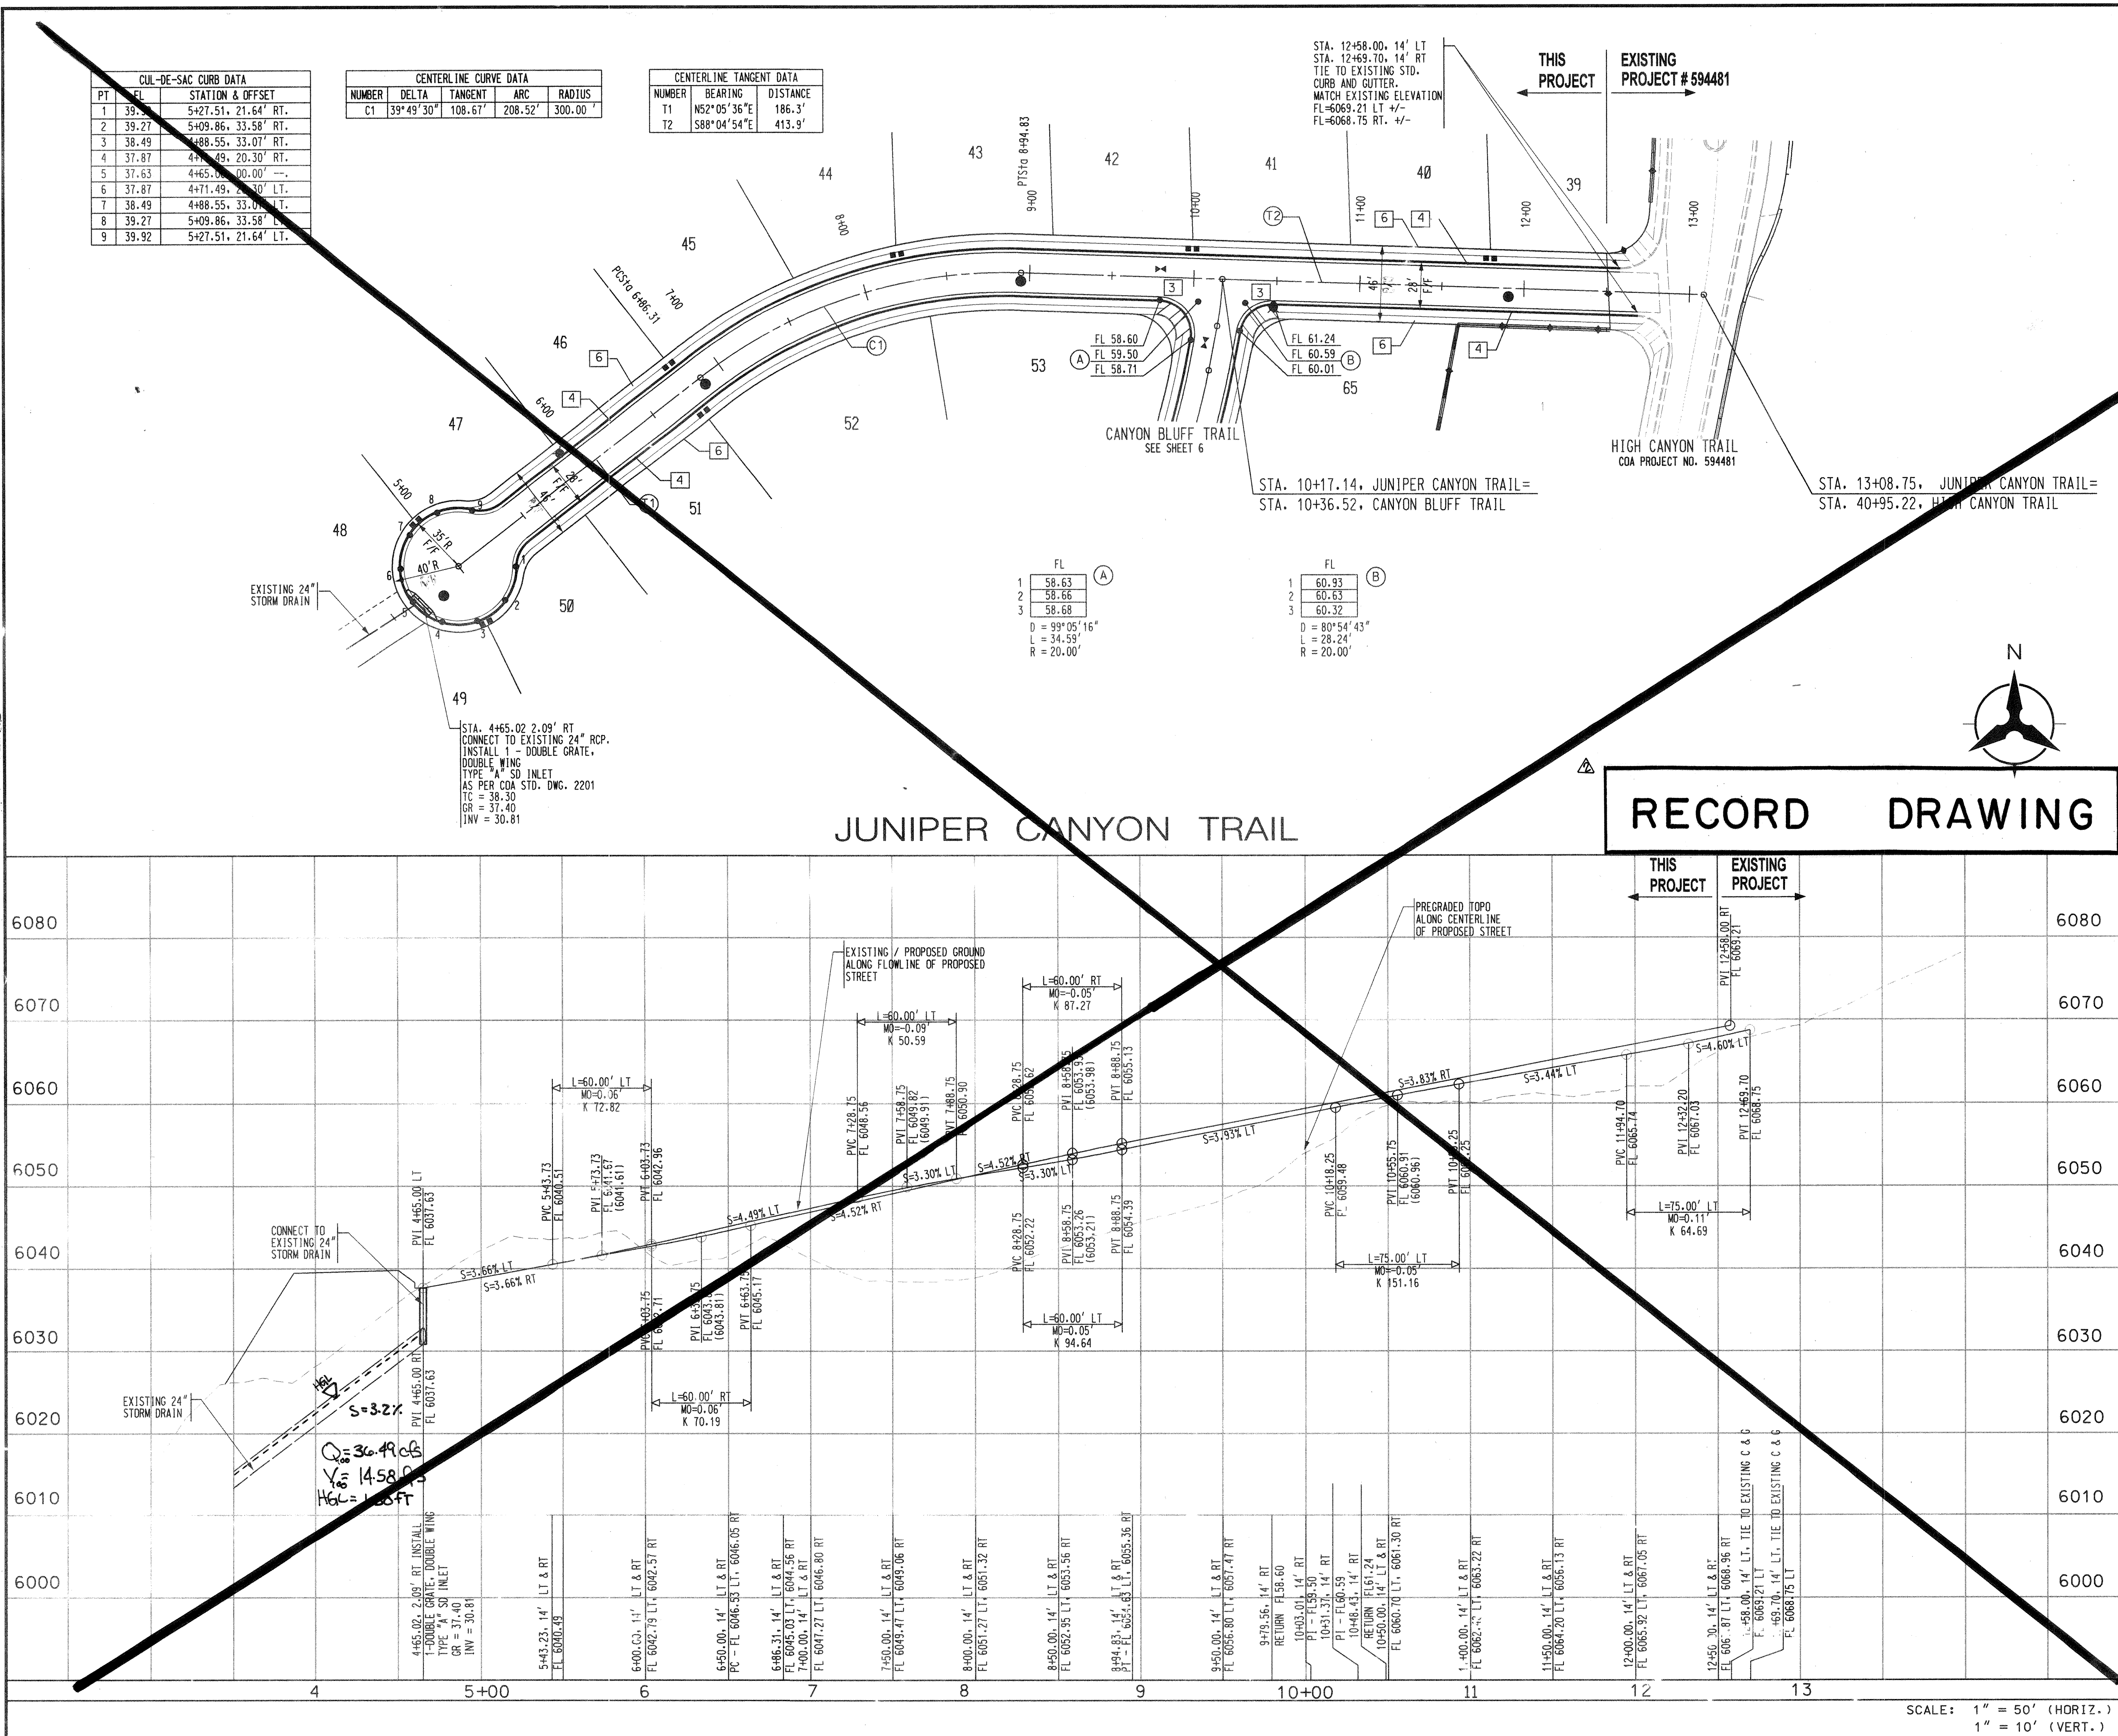
[illegible]

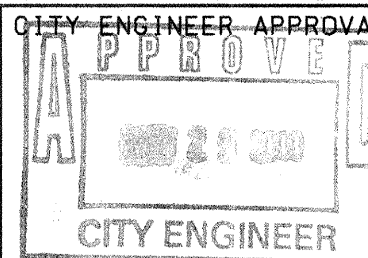KEYED GENERAL NOTES			
* [1]	INSTALL CONCRETE VALLEY GUTTER AS PER STD. DWG. 2420		
* [2]	INSTALL CONCRETE VALLEY GUTTER AS PER STD. DWG. 2421	ENGINEER'S SEAL	
[3]	INSTALL WHEELCHAIR RAMP AS PER DETAIL ON SHEET *		
[4]	STD. CURB & GUTTER AS PER STD. DWG. 2415	CGC. KG 6-20-00 7-2-00 THIS SHEET REPLACED BY SHEET 5A REMARKS BY REVISIONS DESIGN	
* [5]	MODIFIED MEDIAN CURB & GUTTER AS PER DETAIL ON SHEET 6		
[6]	FUTURE 4' SIDEWALK	DATE MON/YR DATE MON/YR DATE MON/YR	
* [7]	BUILD 4' SIDEWALK		
* = NOT APPLICABLE THIS SHEET		DESIGNED BY INITIALS DRAWN BY INITIALS CHECKED BY INITIALS	
Bohannon & Huston  Courtyard One 7500 JEFFERSON NE Albuquerque NEW MEXICO 87109 ENGINEERS PLANNERS PHOTOGRAMMETRISTS SURVEYORS SOFTWARE DEVELOPERS		RECORD DRAWING. 7-2-00 THIS SHEET REPLACED BY SHEET 5A DATE NO.	
CITY OF ALBUQUERQUE PUBLIC WORKS DEPARTMENT ENGINEERING DEVELOPMENT GROUP UNIT 2 - THE CANYONS AT HIGH DESERT PAVING PLAN & PROFILE JUNIPER CANYON TRAIL			
DESIGN REVIEW COMMITTEE 		CITY ENGINEER APPROVAL 	
CITY PROJECT NO.		LAST DESIGN UPDATE MO./DAY/YR. MO./DAY/YR.	
594482		SHEET OF	
F-23		5 11	

PT	FL	STATION & OFFSET
1	40.56	41 5+27.51, 21.64' RT.
2	39.85	10 5+09.86, 33.58' RT.
3	39.06	20 4+48.55, 33.07' RT.
4	38.44	37 4+71.49, 20.30' RT.
5	38.20	60 4+65.00, 00.00' ---
6	38.44	8 4+71.43, 20.30' LT.
7	39.06	10 4+48.55, 33.07' LT.
8	39.85	20 5+09.86, 33.58' LT.
9	40.56	50 5+27.51, 21.64' LT.

NUMBER	DELTA	TANGENT	ARC	RADIUS
C1	39°49'30"	108.67'	208.52'	300.00'

NUMBER	BEARING	DISTANCE
T1	N52°05'37"E	186.3'
T2	S88°04'54"E	413.9'

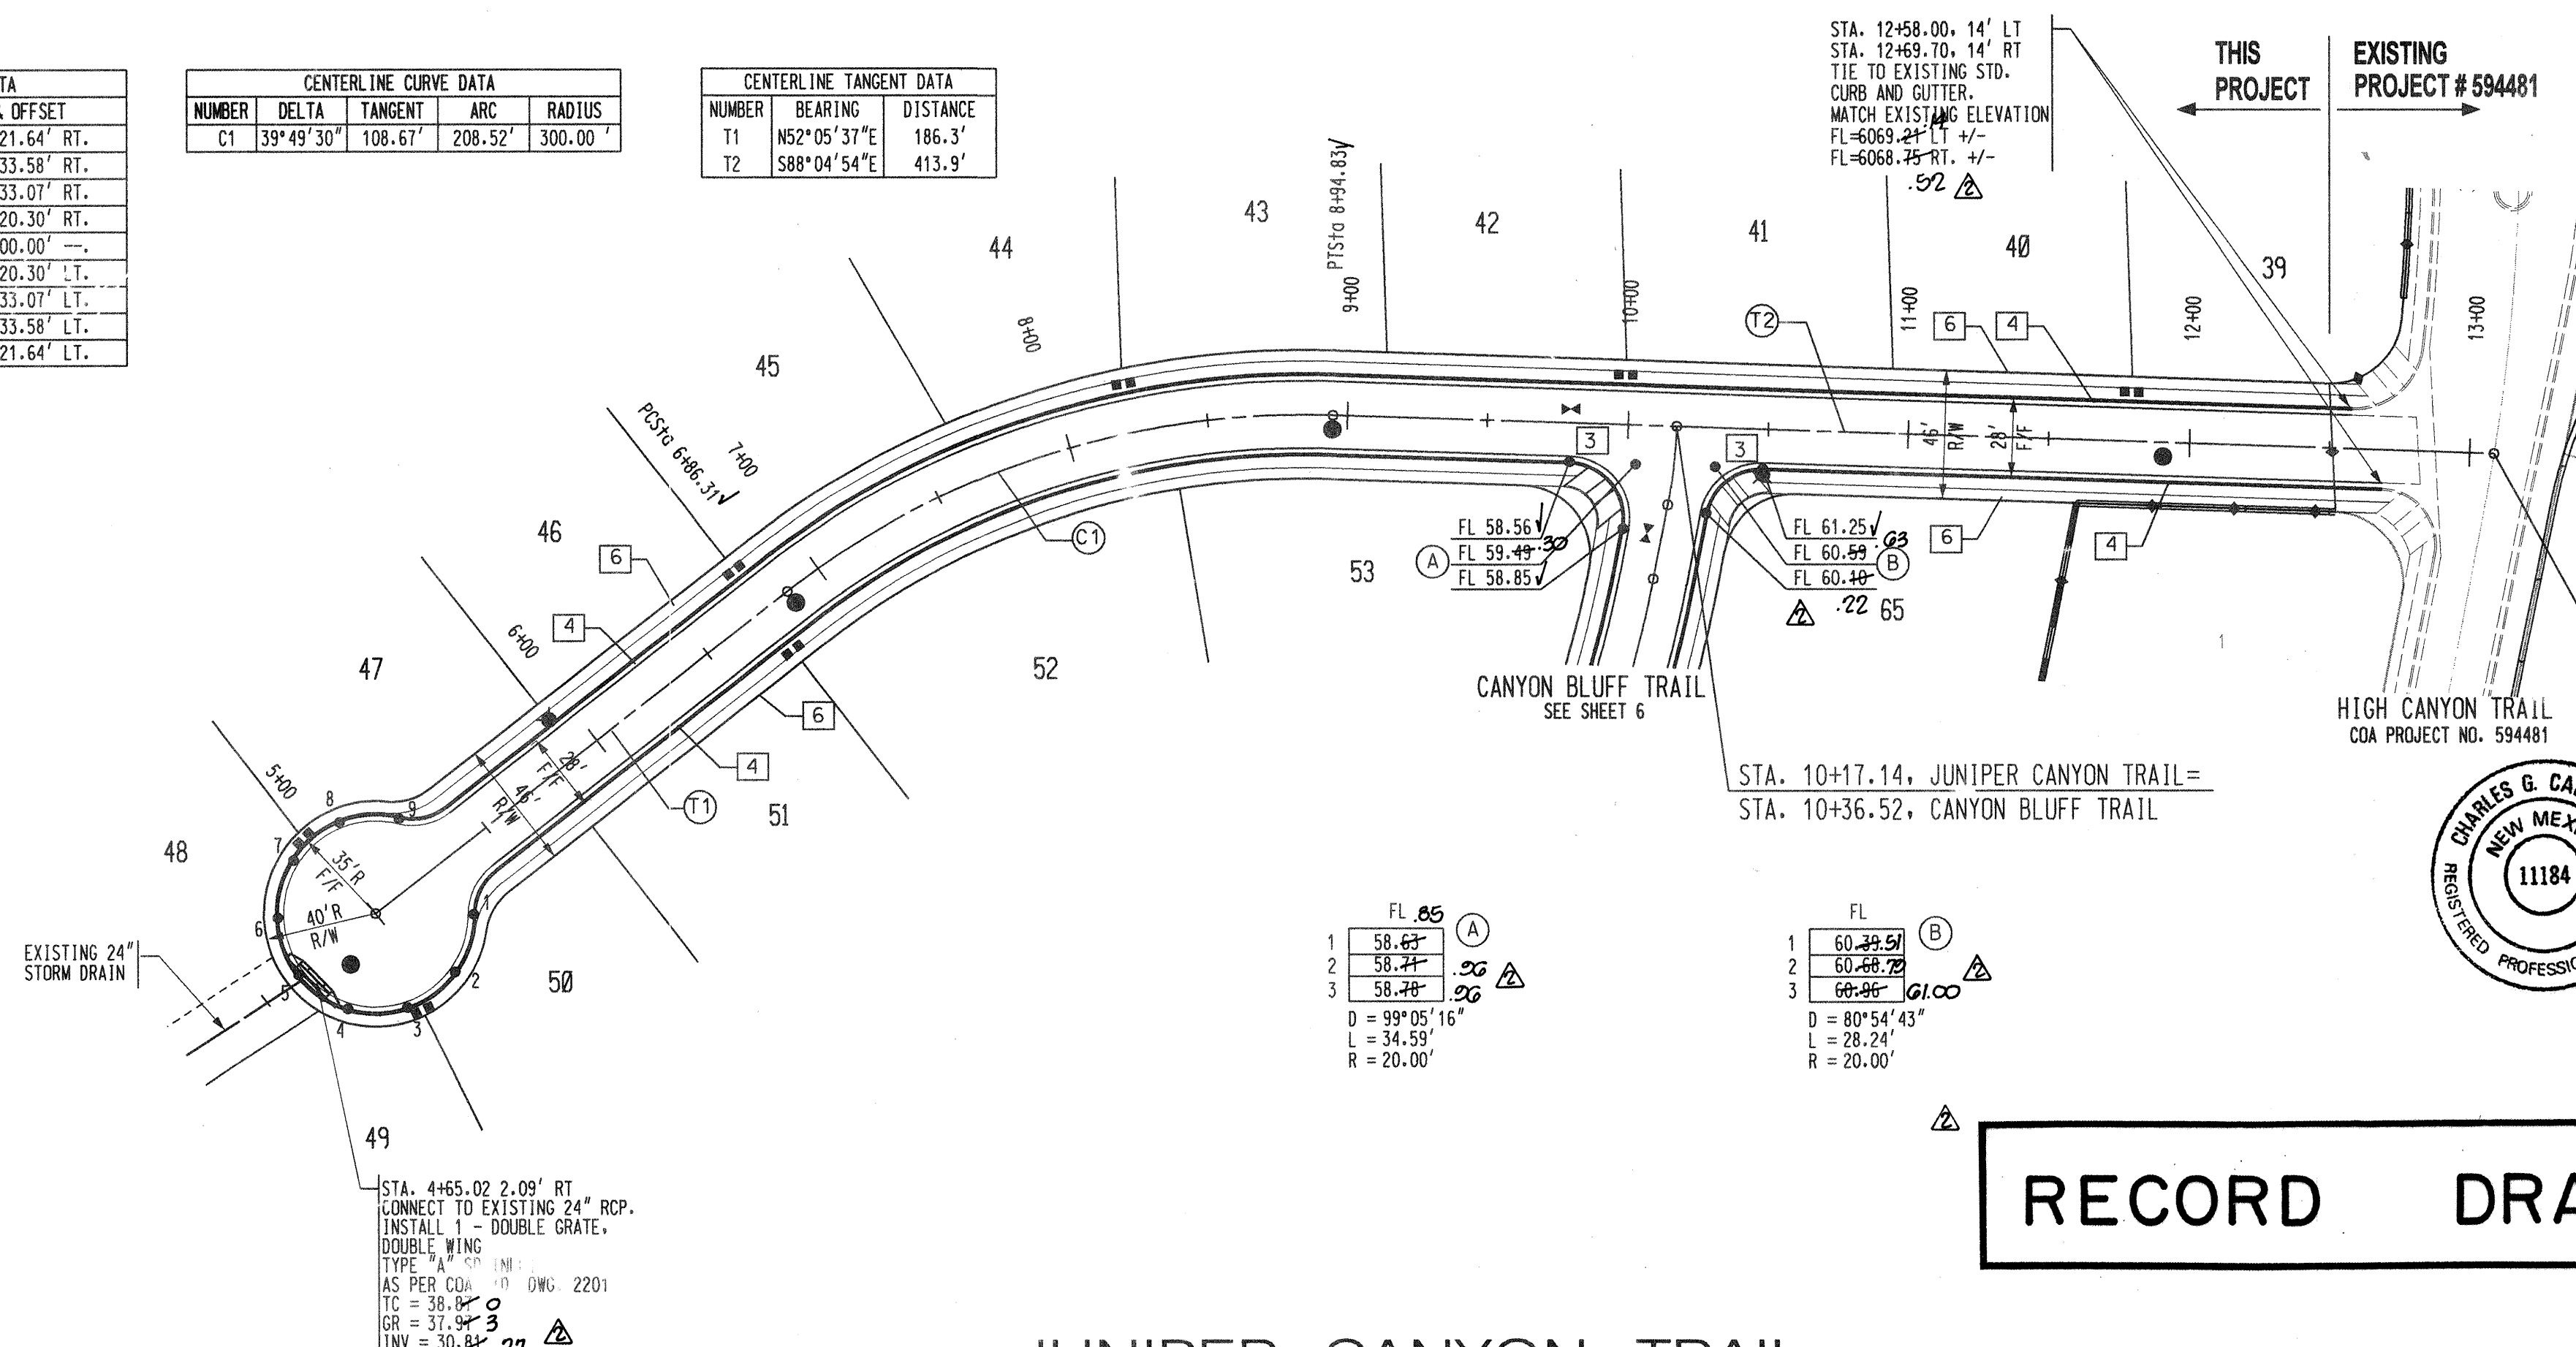

SURVEYOR'S CERTIFICATION


I, Charles G. Cala, Jr., a duly qualified Registered Professional Land Surveyor under the laws of the State of New Mexico, do hereby certify that the "as-built" information shown on these drawings was obtained from field construction and "as-built" surveys performed by me or under my supervision, that the "as-built" information shown on these drawings was added by me or under my supervision, and that this "as-built" information is true and correct to the best of my knowledge and belief and that I am not responsible for any of the design concepts, calculations, engineering, or intent of the record drawings.

Charles G. Cala, Jr. 07-06-2000
Charles G. Cala, Jr., NMPS 11184 Date

- NOTES**
- THE CONTRACTOR SHALL FIELD VERIFY ALL EXISTING UTILITY LOCATIONS AND NOTIFY THE ENGINEER IMMEDIATELY OF ANY DISCREPANCIES.
 - ALL CURB RETURN RADI SHALL BE 20' UNLESS OTHERWISE SPECIFIED.
 - ALL CURVE DATA AND DIMENSIONS REFER TO FACE OF CURB UNLESS OTHERWISE SPECIFIED.
 - GRADE ELEVATIONS, WHERE NOTED, ARE ALONG FLOWLINE OF CURB UNLESS OTHERWISE SPECIFIED.
 - CONTRACTOR IS TO INSTALL A 4" X 4" X 5' POST AND END AT THE END OF EACH SANITARY SEWER SERVICE.
 - CONTRACTOR IS RESPONSIBLE FOR REPAIR AND/OR REPLACEMENT OF ALL UTILITY CONDUITS AND EXISTING LINES.
 - ANY ADDITIONAL GRADING REQUIRED TO MATCH PROPOSED STREET GRADES SHALL BE INCIDENTAL TO PAVING ITEMS.
 - CONTRACTOR SHALL PROVIDE THE INSPECTORS, (CITY AND PRIVATE) WITH THE PROPOSED HYDROSTATIC TESTING PLAN. THE PLAN MUST BE APPROVED BEFORE TESTING OPERATIONS BEGIN.
 - CONTRACTOR SHALL PARK EQUIPMENT AND VEHICLES AS NOT TO INTERFERE WITH NORMAL ACTIVITIES OF RESIDENTS OR OTHER CONTRACTORS ON SITE.
 - ANY DAMAGE TO THE EXISTING FACILITIES (CURB & GUTTER), PAVEMENT, CONDUITS, LANDSCAPING, UTILITY LINES, ETC., DURING CONSTRUCTION SHALL BE REPLACED AT THE CONTRACTORS' EXPENSE.
 - REMOVAL OF THE EXISTING CURB AND GUTTER SHALL BE AS PER CDA STD. DWG. 2415 (SAWCUT ONLY).
 - WHEELCHAIR RAMPS SHALL BE CONSTRUCTED PRIOR TO ACCEPTANCE OF CURB & GUTTER.

RECORD DRAWING

JUNIPER CANYON TRAIL

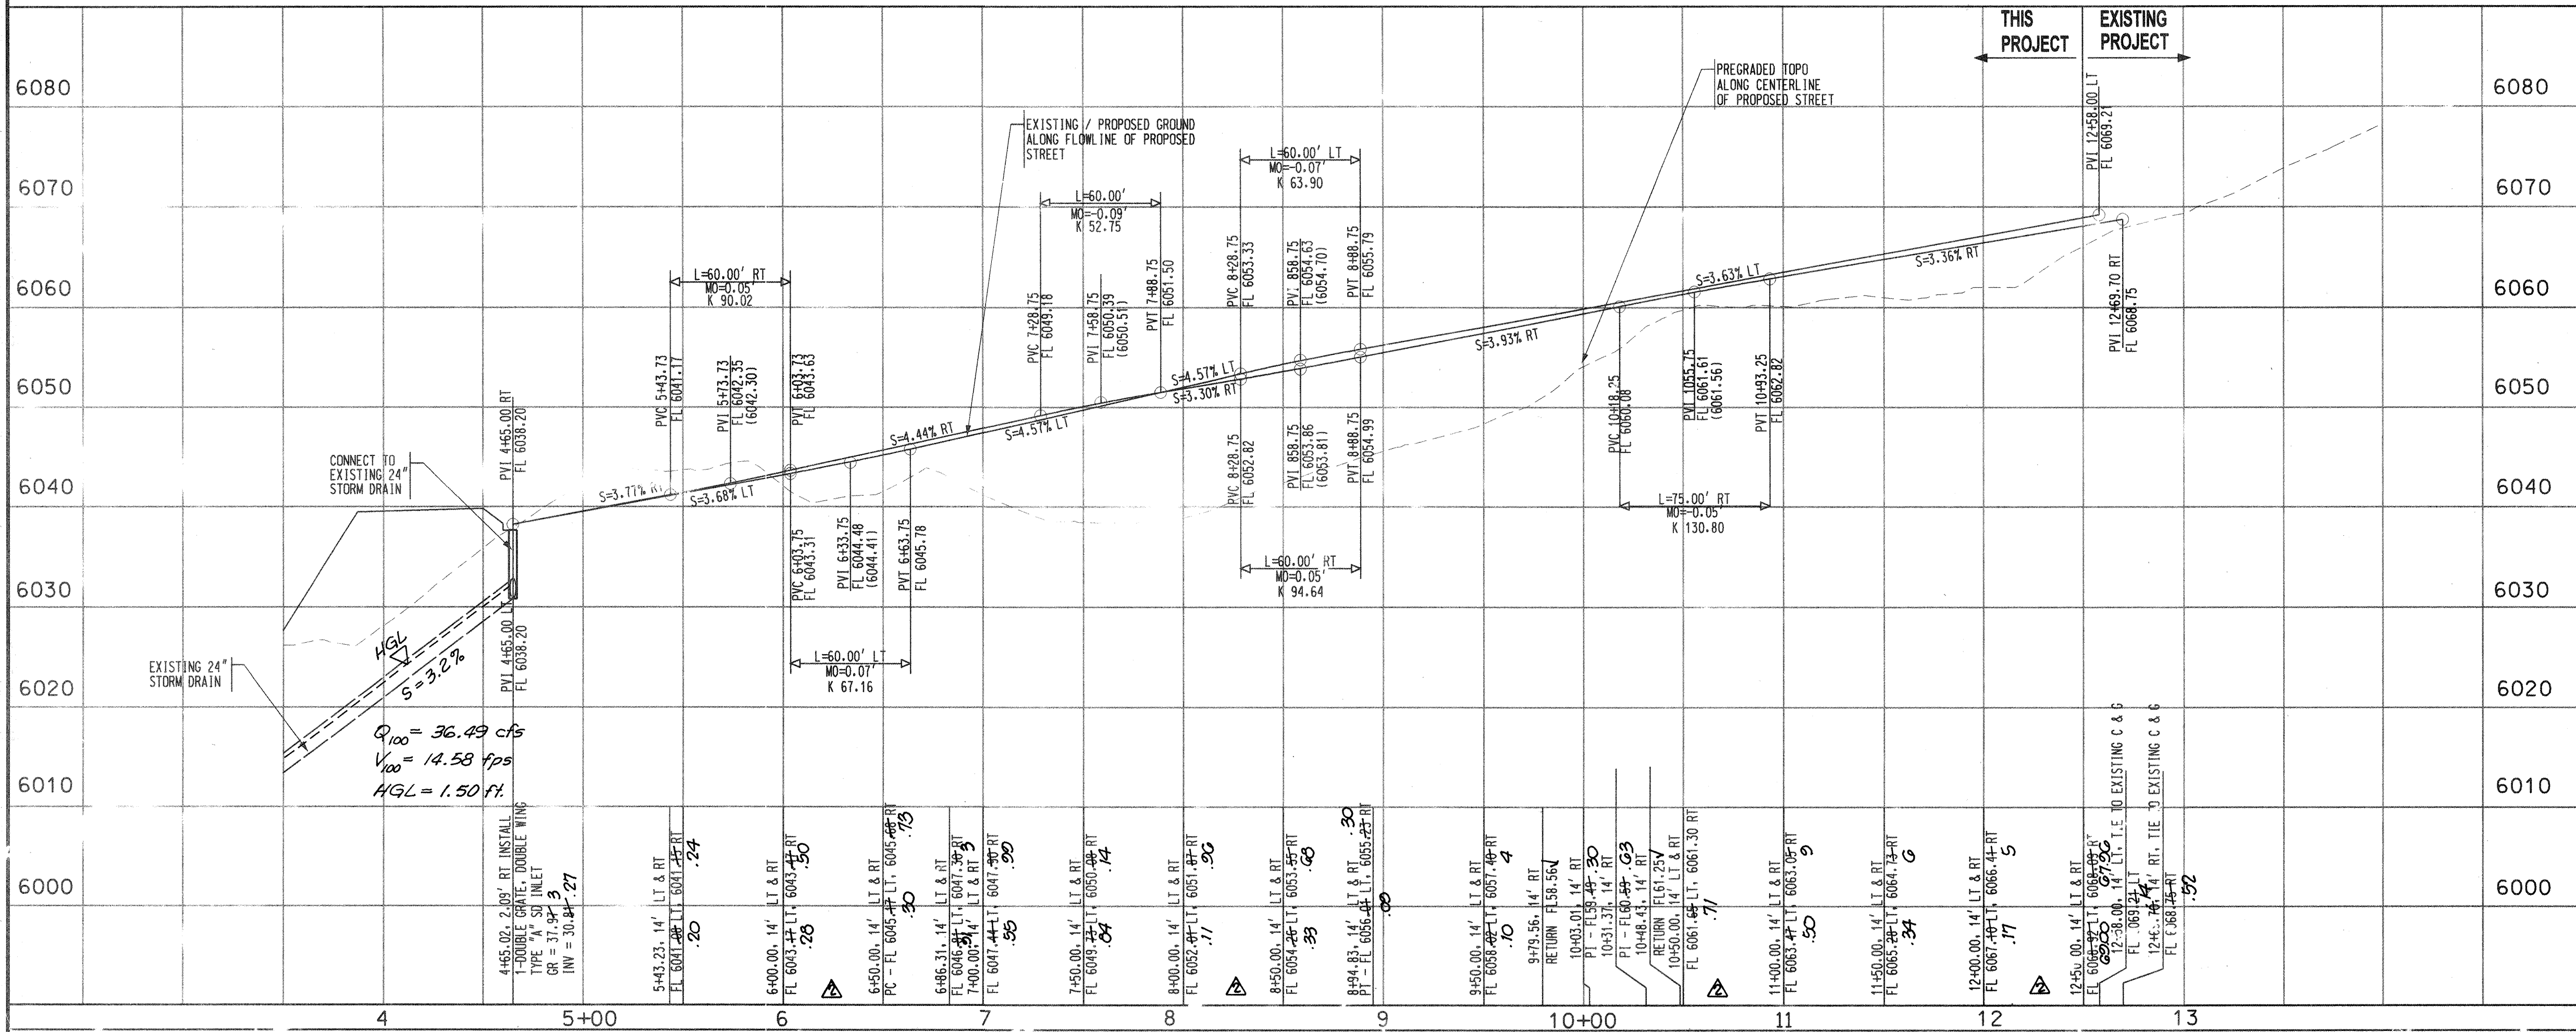

- KEYED GENERAL NOTES**
- INSTALL CONCRETE VALLEY GUTTER AS PER STD. DWG. 2420
 - INSTALL CONCRETE VALLEY GUTTER AS PER STD. DWG. 2421
 - INSTALL WHEELCHAIR RAMP AS PER DETAIL ON SHEET 4
 - STD. CURB & GUTTER AS PER STD. DWG. 2415
 - MODIFIED MEDIAN CURB & GUTTER AS PER DETAIL ON SHEET 6
 - FUTURE 4' SIDEWALK
 - BUILD 4' SIDEWALK
- * = NOT APPLICABLE THIS SHEET

Bohannon + Huston

Courtyard One 7500 JEFFERSON NE Albuquerque NEW MEXICO 87109

ENGINEERS PLANNERS PHOTOGRAMMETRISTS SURVEYORS SOFTWARE DEVELOPERS

CITY OF ALBUQUERQUE
PUBLIC WORKS DEPARTMENT
ENGINEERING DEVELOPMENT GROUP

UNIT 2 - THE CANYONS AT HIGH DESERT
PAVING PLAN & PROFILE
JUNIPER CANYON TRAIL

DESIGN REVIEW COMMITTEE	CITY ENGINEER APPROVAL	MO./DAY/YR.	MO./DAY/YR.

CITY PROJECT NO. 594482 ZONE MAP NO. F-23 SHEET 5A OF 11


SCANNED BY
MESA REPRO

CUL-DE-SAC DATA		
PT	FL	STATION & OFFSET
1	41.97	5+27.51, 21.64' RT.
2	41.20	5+09.86, 33.58' RT.
3	40.85	4+88.55, 33.07' RT.
4	39.52	4+71.49, 20.30' RT.
5	39.24	4+65.00, 00.00' CL.
6	39.52	4+71.49, 20.30' LT.
7	40.37	4+88.55, 33.07' LT.
8	41.20	5+09.86, 33.58' LT.
9	41.97	5+27.51, 21.64' LT.



CENTERLINE CURVE DATA			
NUMBER	DELTA	TANGENT	RADIUS
C1	39°38'49"	149.24'	286.48'
C2	09°05'16"	14.30'	28.55'

CENTERLINE TANGENT DATA		
NUMBER	BEARING	DISTANCE
T1	N50°47'00"E	194.41'
T2	N11°00'23"E	27.08'

RECORD DRAWING

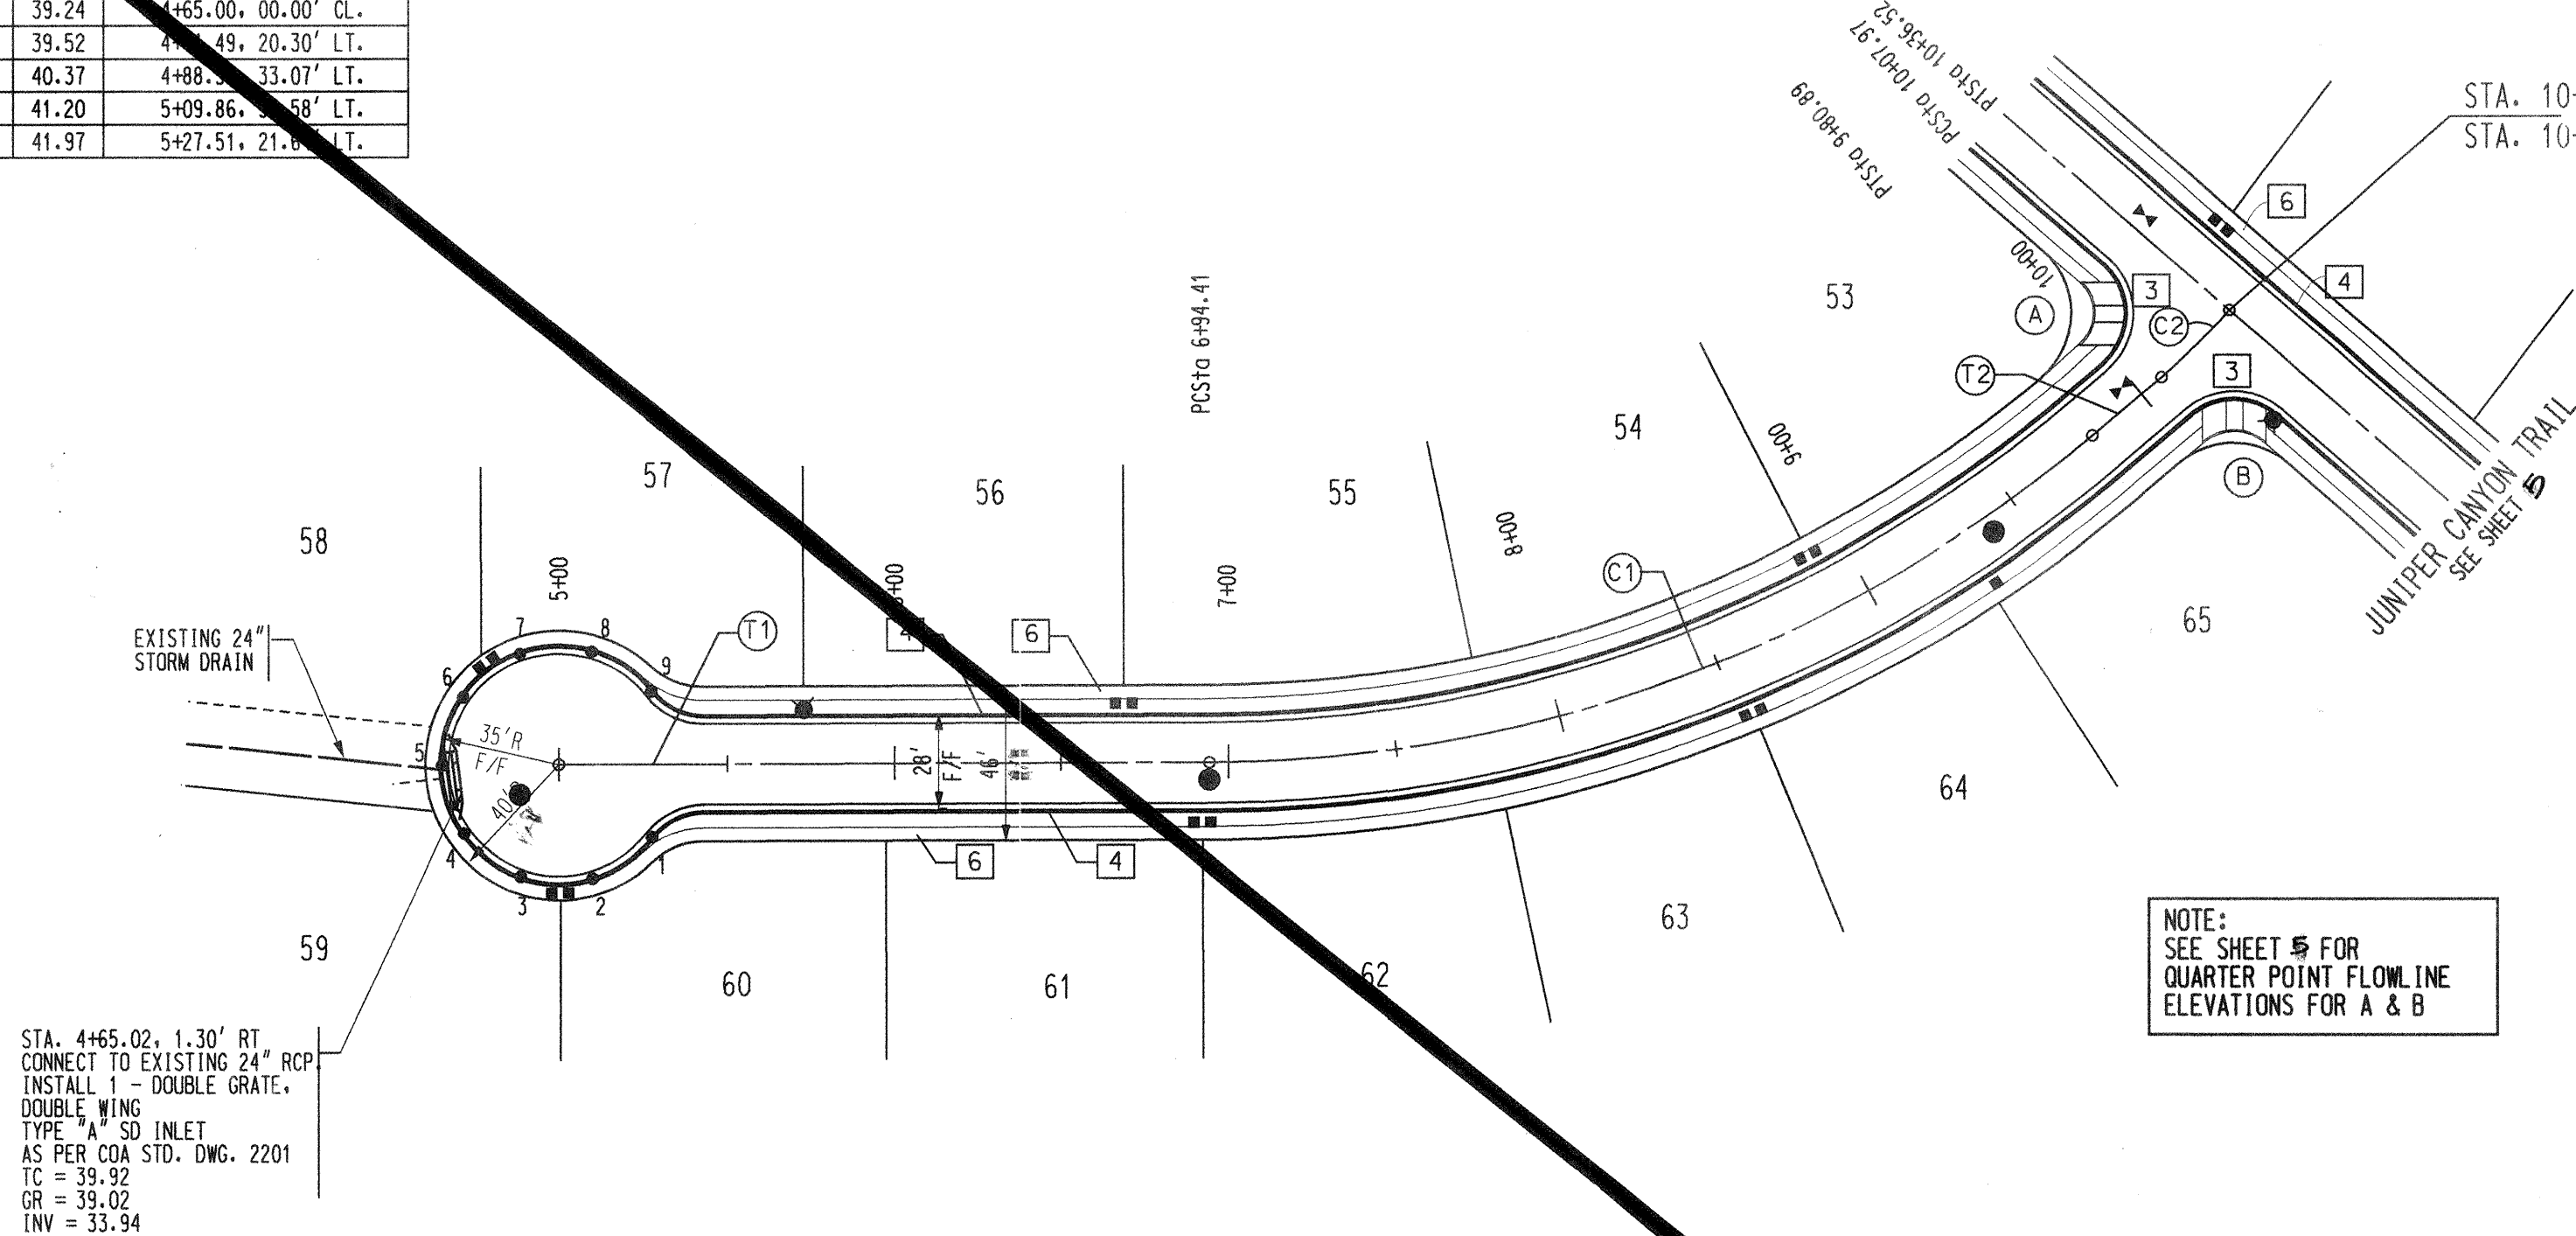

CANYON BLUFF TRAIL

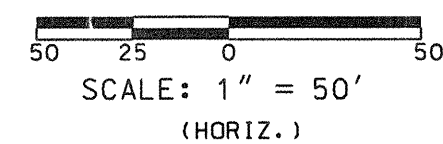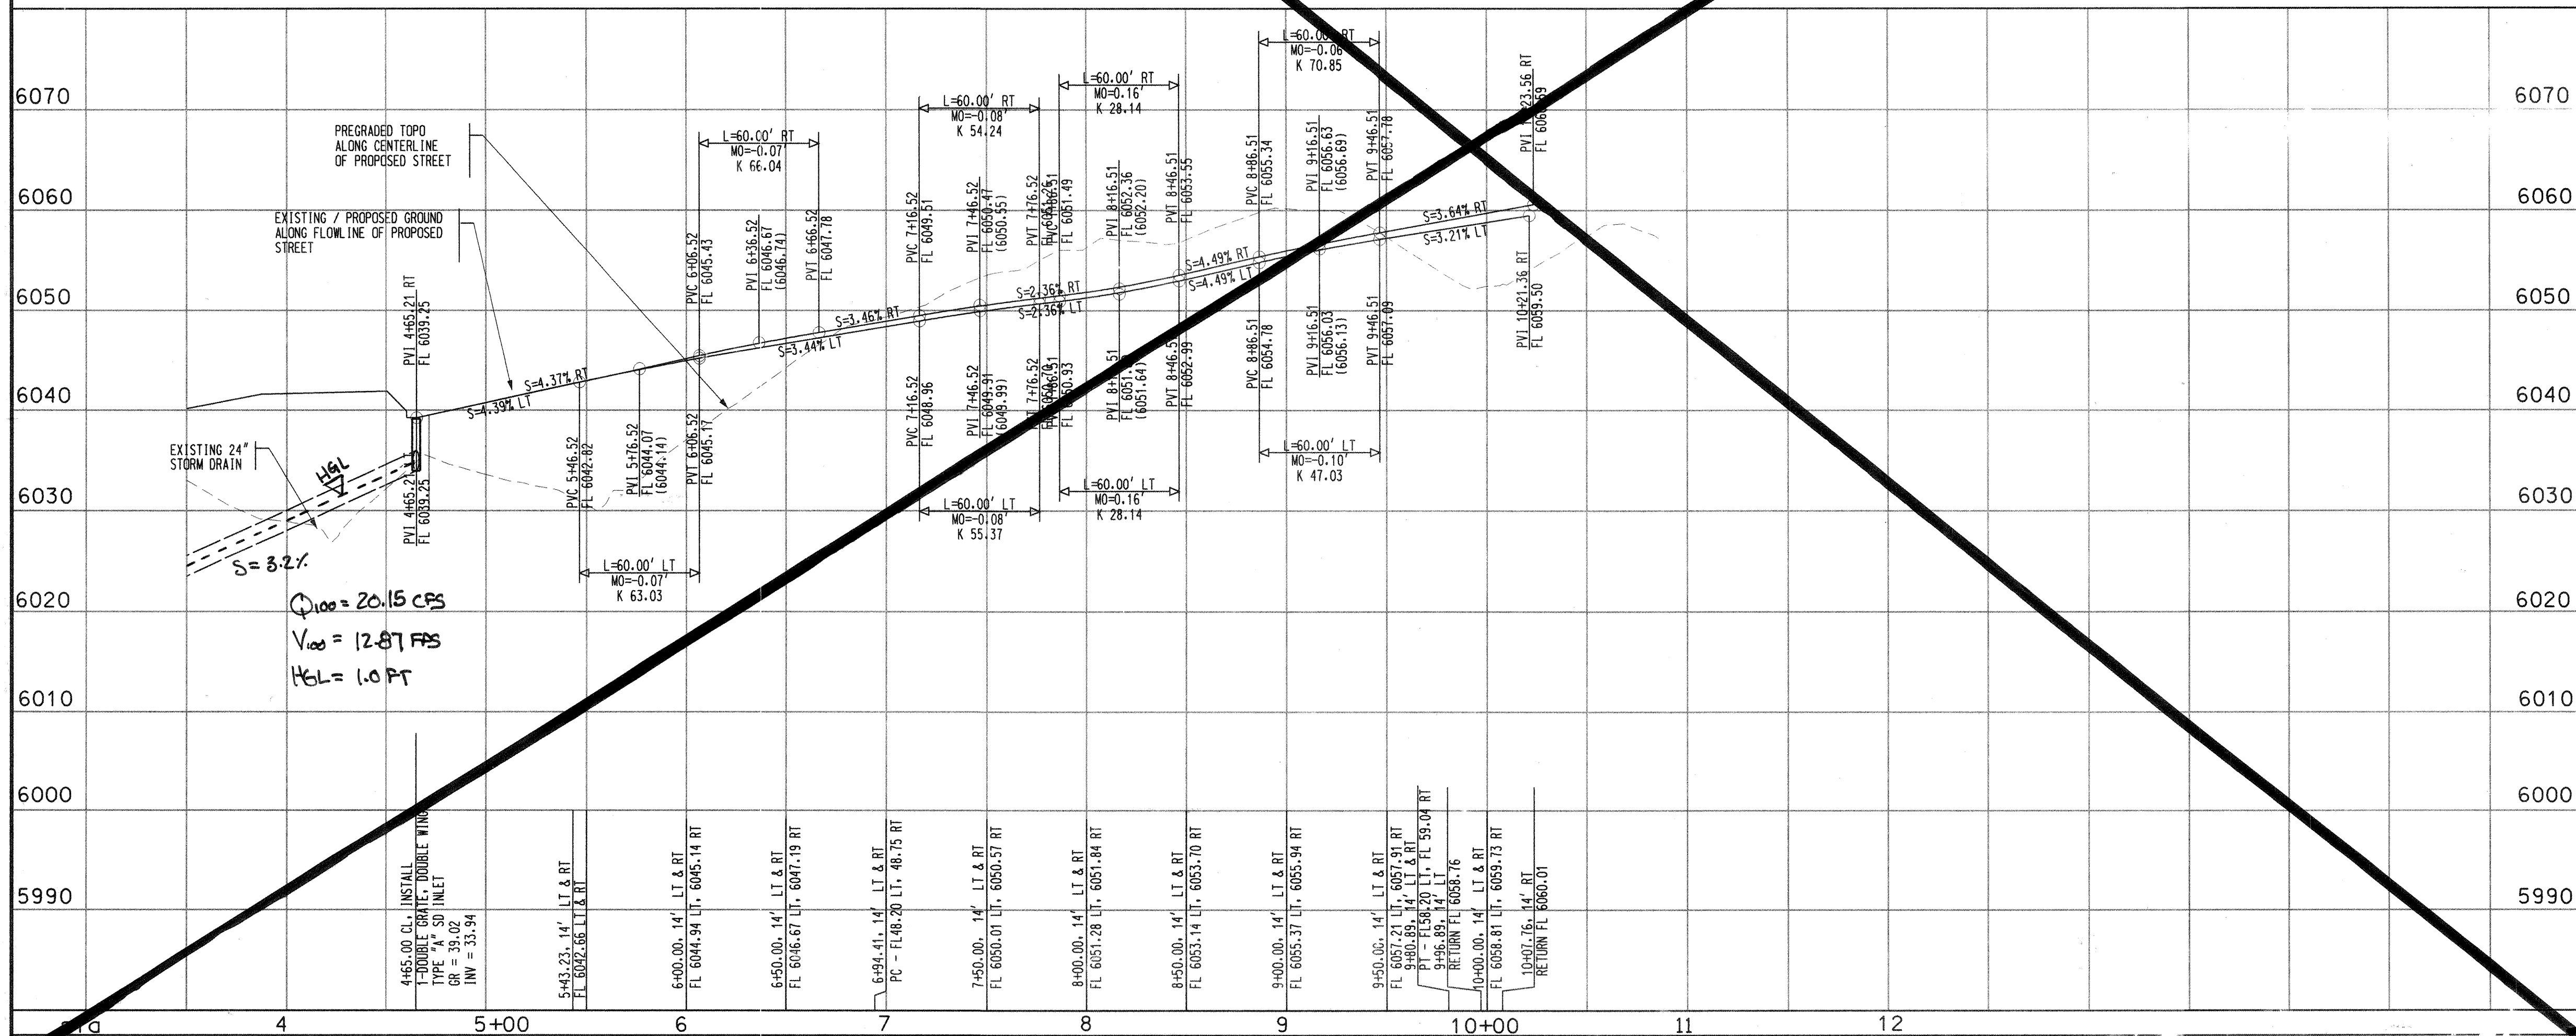

SCALE: 1" = 50' (HORIZ.)

NOTES

1. THE CONTRACTOR SHALL FIELD VERIFY ALL EXISTING UTILITY LOCATIONS AND NOTIFY THE ENGINEER IMMEDIATELY OF ANY DISCREPANCIES.
2. ALL CURB RETURN RADII SHALL BE 20' UNLESS OTHERWISE SPECIFIED.
3. ALL CURVE DATA AND DIMENSIONS REFER TO FACE OF CURB UNLESS OTHERWISE SPECIFIED.
4. GRADE ELEVATIONS, WHERE NOTED, ARE ALONG FLOWLINE OF CURB UNLESS OTHERWISE SPECIFIED.
5. CONTRACTOR IS TO INSTALL A 4" X 4" X 5' POST AND EMBARK AT THE END OF EACH SANITARY SEWER SERVICE.
6. CONTRACTOR IS RESPONSIBLE FOR REPAIR AND/OR REPLACEMENT OF ALL UTILITY CONDUITS AND EXISTING LINES.
7. ANY ADDITIONAL GRADING REQUIRED TO MATCH PROPOSED STREET GRADES SHALL BE INCIDENTAL TO PAVING ITEMS.
8. CONTRACTOR SHALL PROVIDE THE INSPECTORS, (CITY AND PRIVATE) WITH THE PROPOSED HYDROSTATIC TESTING PLAN. THE PLAN MUST BE APPROVED BEFORE TESTING OPERATIONS BEGIN.
9. CONTRACTOR SHALL PARK EQUIPMENT AND VEHICLES AS NOT TO INTERFERE WITH NORMAL ACTIVITIES OF RESIDENTS OR OTHER CONTRACTORS ON SITE.
10. ANY DAMAGE TO THE EXISTING FACILITIES (CURB & GUTTER), PAVEMENT, CONDUITS, LANDSCAPING, UTILITY LINES, ETC.) DURING CONSTRUCTION SHALL BE REPLACED AT THE CONTRACTORS' EXPENSE.
11. REMOVAL OF THE EXISTING CURB AND GUTTER SHALL BE AS PER CDA STD. DWG. 2415 (SAWCUT ONLY).
12. WHEELCHAIR RAMPS SHALL BE CONSTRUCTED PRIOR TO ACCEPTANCE OF CURB & GUTTER.

KEYED GENERAL NOTES

- * 1. INSTALL CONCRETE VALLEY GUTTER AS PER STD. DWG. 2420
- * 2. INSTALL CONCRETE VALLEY GUTTER AS PER STD. DWG. 2421
- * 3. INSTALL WHEELCHAIR RAMP AS PER DETAIL ON SHEET 4
- * 4. STD. CURB & GUTTER AS PER STD. DWG. 2415
- * 5. MODIFIED MEDIAN CURB & GUTTER AS PER DETAIL ON SHEET 6
- * 6. FUTURE 4' SIDEWALK
- * 7. BUILD 4' SIDEWALK
- * NOT APPLICABLE TO THIS SHEET

Bohannon & Huston

Courtyard One 7500 JEFFERSON NE Albuquerque NEW MEXICO 87109

ENGINEERS PLANNERS PHOTOGRAMMETRISTS SURVEYORS SOFTWARE DEVELOPERS

CITY OF ALBUQUERQUE
PUBLIC WORKS DEPARTMENT
ENGINEERING DEVELOPMENT GROUP

UNIT 2 - THE CANYONS AT HIGH DESERT
PAVING PLAN & PROFILE
CANYON BLUFF TRAIL

DESIGN REVIEW COMMITTEE	CITY ENGINEER APPROVAL	MO./DAY/YR.	MO./DAY/YR.
APR 2 2000	MAY 25 2000		
DESIGN REVIEW COMMITTEE	CITY ENGINEER		
LAST DESIGN UPDATE			

CITY PROJECT NO. 594482 ZONE MAP NO. F-23 SHEET 6 OF 11

BHI JOB NO. 00 352 A01

COPYRIGHT BOHANNAN HUSTON 2000


SCANNED BY
MESA REPRO

PT	FL	STATION & OFFSET
1	42.63	37 5427.51, 21.64' RT.
2	41.86	59 5409.86, 33.58' RT.
3	40.93	72 4488.55, 33.07' RT.
4	40.48	03 4471.49, 20.30' RT.
5	39.94	00 4465.00, 00.00' CL.
6	40.48	30 4471.49, 20.30' LT.
7	40.93	115 4488.55, 33.07' LT.
8	41.86	200 5409.86, 33.58' LT.
9	42.63	280 5427.51, 21.64' LT.


NUMBER	DELTA	TANGENT	ARC	RADIUS
C1	39°46'41"	149.77'	287.41'	414.00'
C2	09°05'16"	14.30'	28.55'	180.00'

NUMBER	BEARING	DISTANCE
T1	N50°47'00"E	193.89'
T2	N11°00'19"E	26.66'

RECORD DRAWING

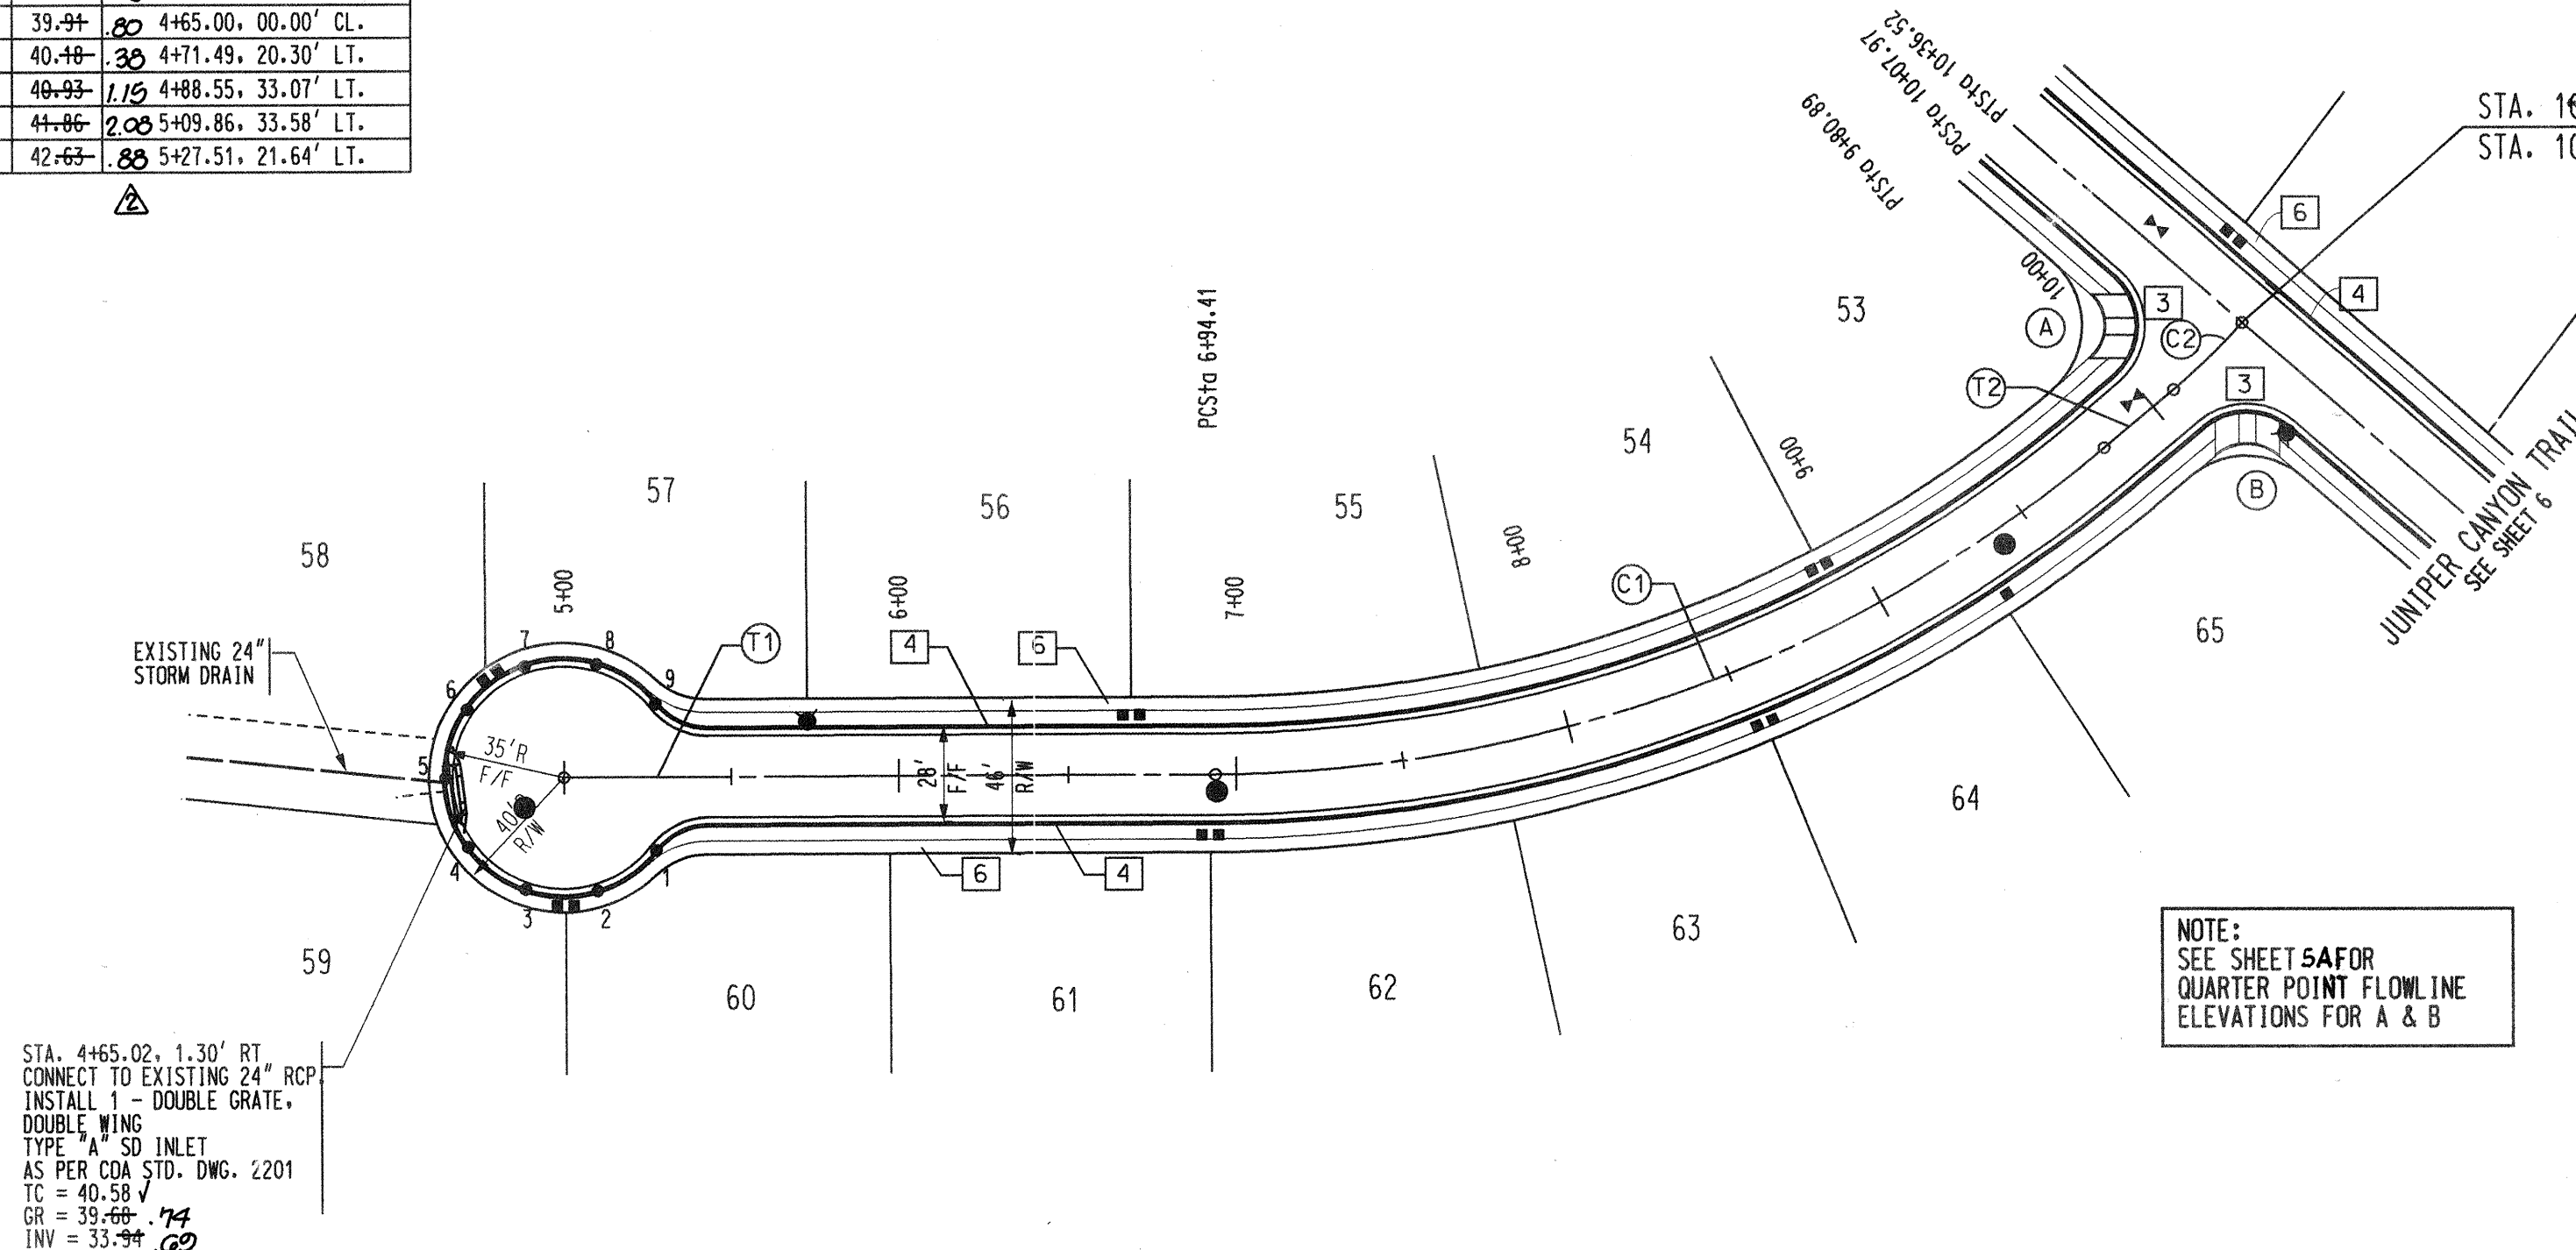


NOTE:
SEE SHEET 5A FOR
QUARTER POINT FLOWLINE
ELEVATIONS FOR A & B


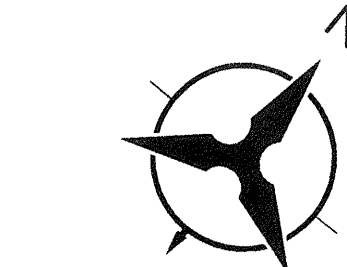


SCALE: 1" = 50'
(HORIZ.)

CANYON BLUFF TRAIL

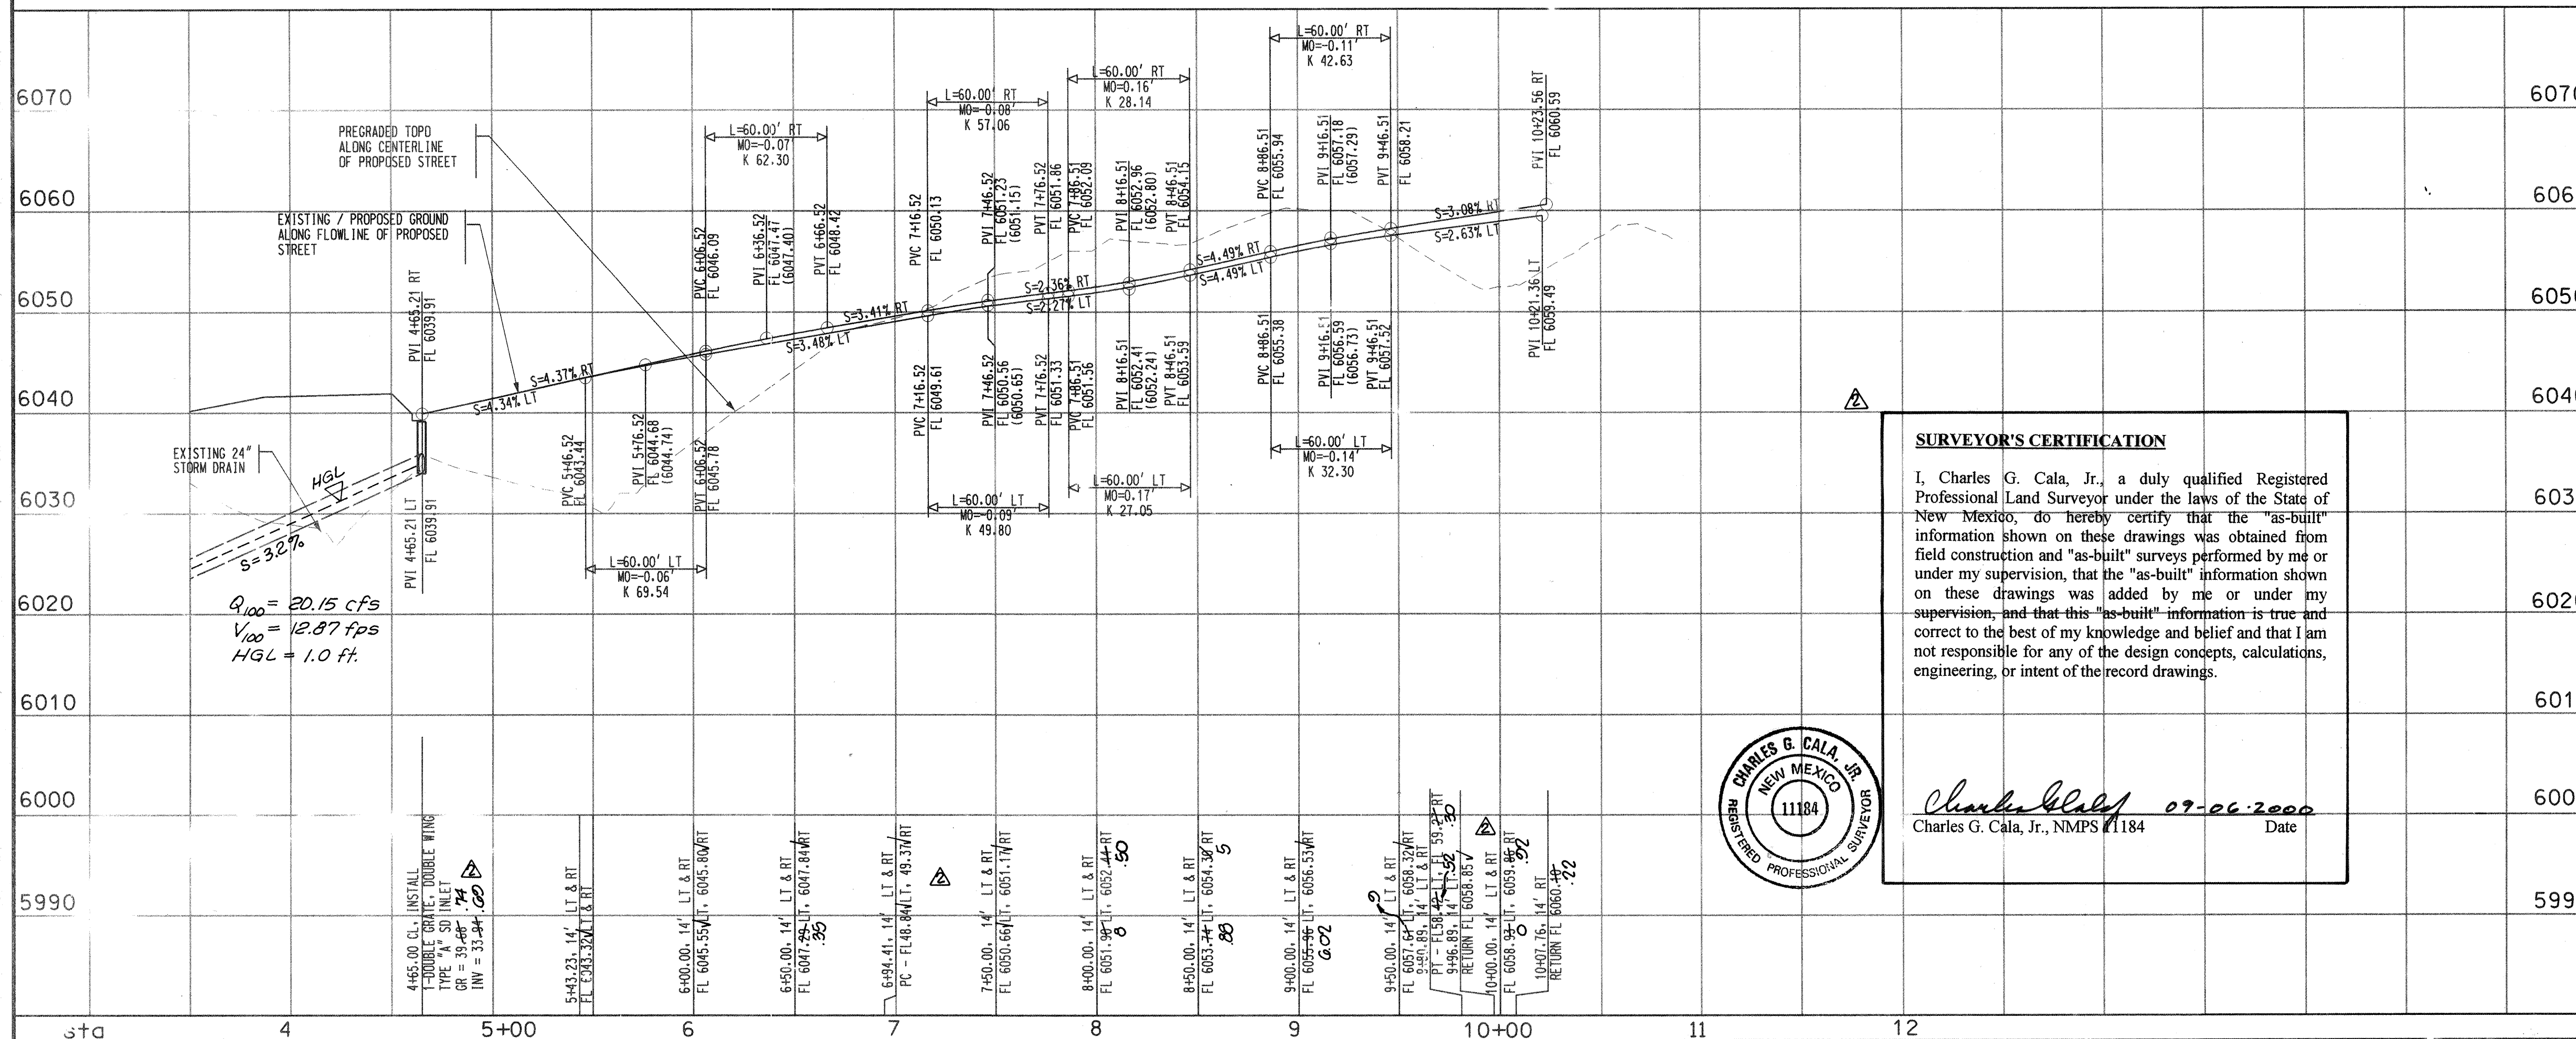

RECORD DRAWING

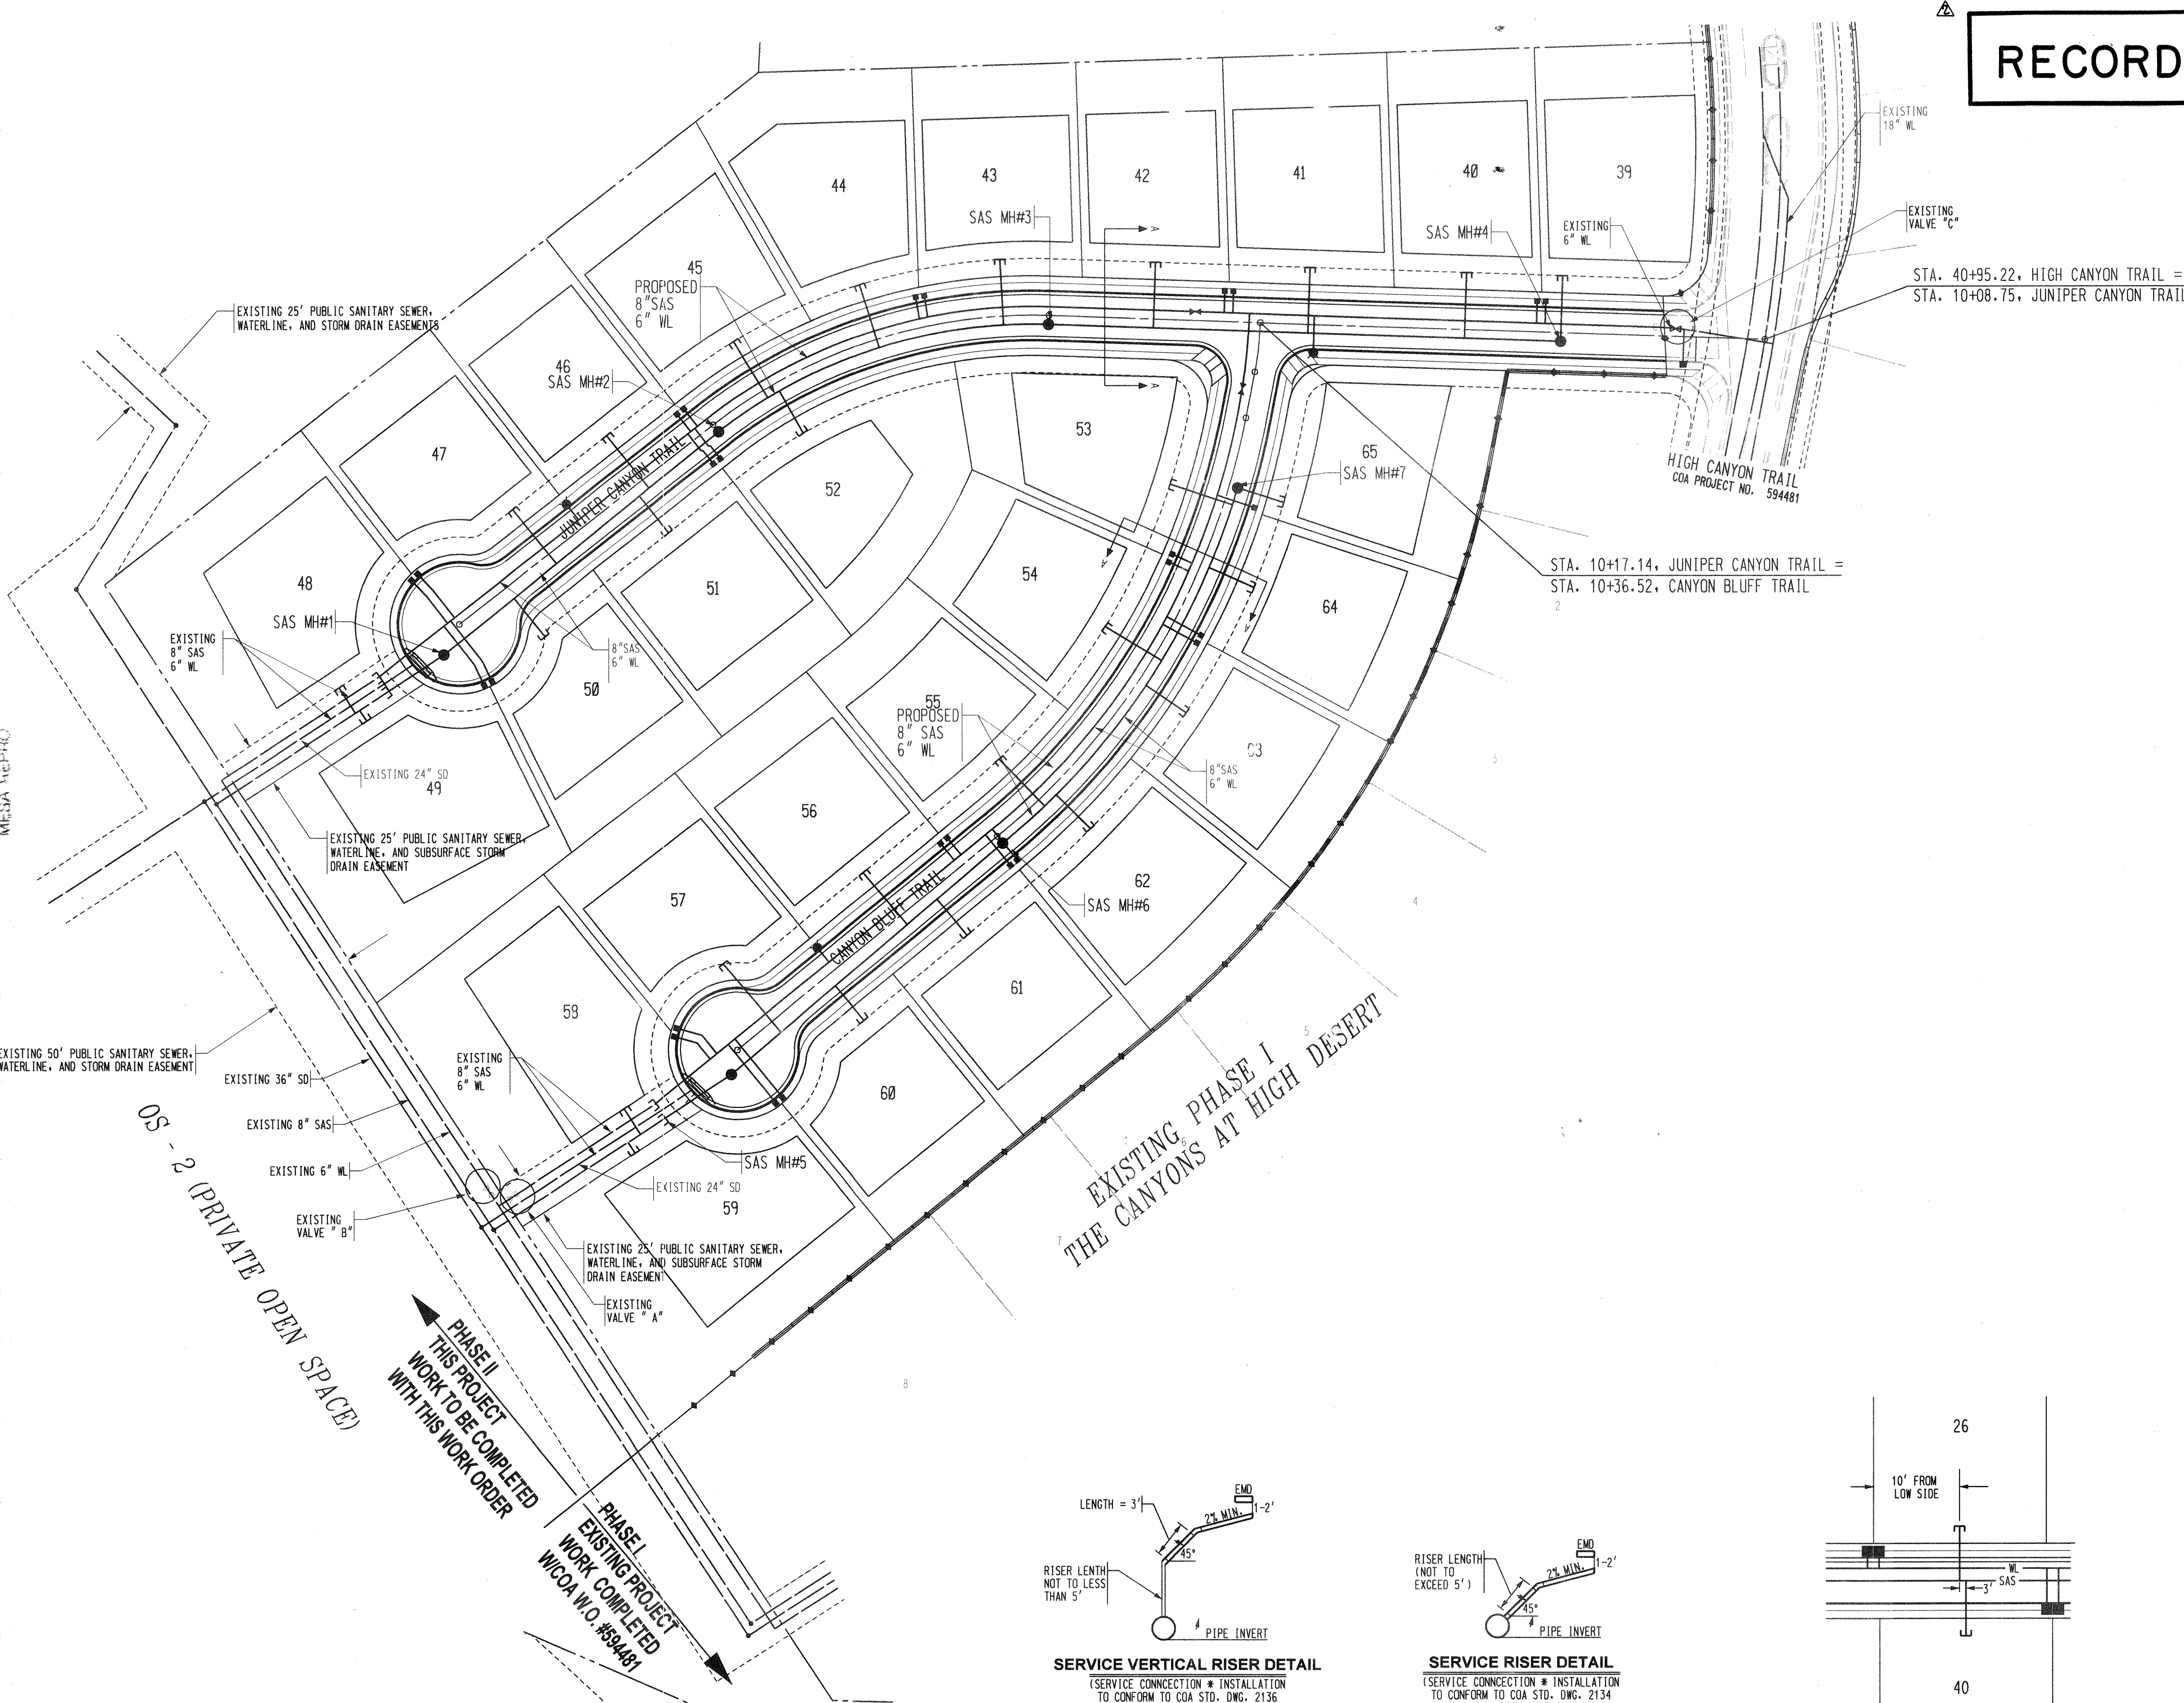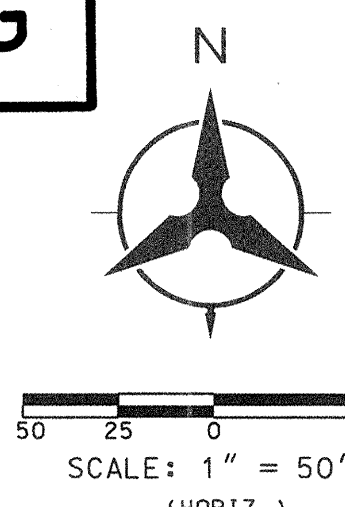


CONTRACTOR WILL BE RESPONSIBLE FOR THE TIMING AND COORDINATION OF THE WATER SHUT-OFF REQUIREMENTS IN CONJUNCTION WITH THE COMPLETION OF THE PROJECT.


AT LEAST FIVE (5) WORKING DAYS PRIOR TO CONSTRUCTION, THE CONTRACTOR SHALL CONTACT PHD/WATER SYSTEM DIV. (857-8200) TO INITIATE IMPLEMENTATION OF THIS WATER SHUT-OFF PLAN. CONTRACTOR SHALL NOT OPERATE CITY VALVES.

- WATER SHUT-OFF PLAN:
- | | CLUSE VALVE |
|---|-------------|
| 1. STUBOUT IN EASTMENT EAST END OF CANYON BLUFF TRAIL BETWEEN LOTS 58 AND 59 | "A" |
| 2. VALVE IN EASMENT EAST OF CANYON BLUFF TRAIL NORTH OF STUBOUT AT CANYON BLUFF TRAIL | "B" |
| 3. STUBOUT ON JUNIPER CANYON TRAIL EAST OF HIGH CANYON TRAIL | "C" |
- NOTE: VALVES A, B, & C ARE NOT SHOWN ON THE COA AUTOMATED WATER DISTRIBUTION SYSTEM SECTIONAL MAPS, AND FOR THIS REASON ARE LABELED AS SUCH FOR THIS PLAN ONLY. THE CONTRACTOR SHALL COORDINATE THE SHUT-OFF PLAN WITH THE OWNER.


- LEGEND
- | | |
|---------------------------------|-------|
| PROJECT PHASE BOUNDARY | —●—●— |
| PROPOSED CURB AND GUTTER | ===== |
| EXISTING CURB AND GUTTER | ===== |
| FUTURE CURB AND GUTTER | ----- |
| PROPOSED STORM DRAIN MANHOLE | ⊙ |
| EXISTING STORM DRAIN MANHOLE | ⊙ |
| PROPOSED SANITARY SEWER MANHOLE | ● |
| EXISTING SANITARY SEWER MANHOLE | ● |
| PROPOSED FIRE HYDRANT | ⊙ |
| PROPOSED GATE VALVE | ⊕ |
| EXISTING GATE VALVE | ⊕ |
| PROPOSED STREET LIGHT | ⊙ |
| 10' ASPHALT TRAIL | ===== |
| CROWN FLATTENING | ===== |

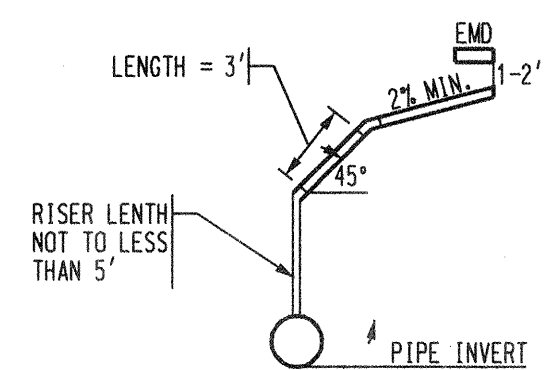

SERVICE VERTICAL RISER DETAIL
(SERVICE CONNECTION * INSTALLATION TO CONFORM TO COA STD. DWG. 2136 USE C1 SOIL PIPE ONLY)

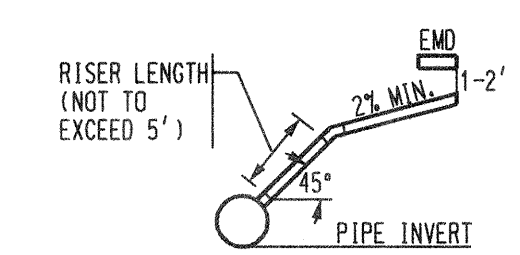

SERVICE RISER DETAIL
(SERVICE CONNECTION * INSTALLATION TO CONFORM TO COA STD. DWG. 2134 USE C1 SOIL PIPE ONLY)

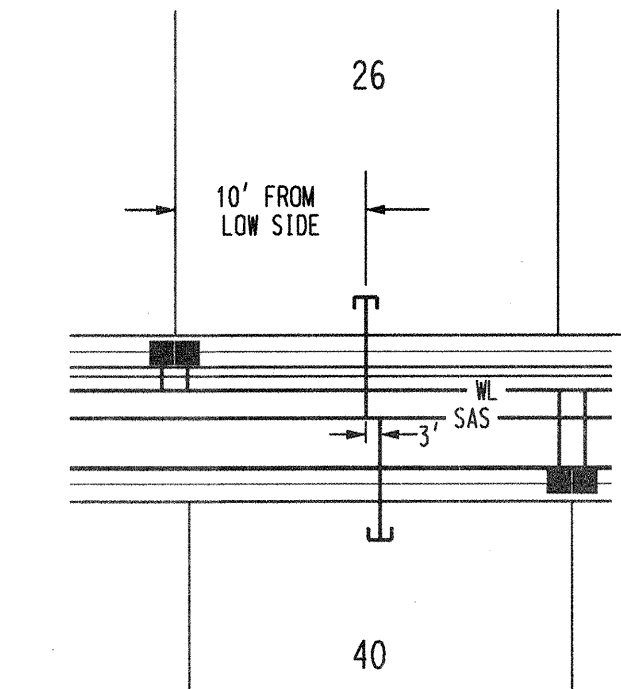

AS-BUILT INFORMATION		BENCH MARKS		SURVEY INFORMATION		SEAL		CGC ENGINEER'S SEAL		RECORD DRAWING	
CONTRACTOR	STATION	STATION	STATION	DATE	DATE	DATE	DATE	DATE	DATE	DATE	DATE
CONTRACTOR	STATION	STATION	STATION	DATE	DATE	DATE	DATE	DATE	DATE	DATE	DATE
INSPECTOR'S	TABLET STAMPED	TABLET STAMPED	TABLET STAMPED	DATE	DATE	DATE	DATE	DATE	DATE	DATE	DATE
FIELD LANCE BY	CONCRETE PROJECTING	CONCRETE PROJECTING	CONCRETE PROJECTING	DATE	DATE	DATE	DATE	DATE	DATE	DATE	DATE
DATE	GROUND. LOCATED	GROUND. LOCATED	GROUND. LOCATED	DATE	DATE	DATE	DATE	DATE	DATE	DATE	DATE
DATE	THE INTERSECTION	THE INTERSECTION	THE INTERSECTION	DATE	DATE	DATE	DATE	DATE	DATE	DATE	DATE
DATE	DRIVE AN "E" ON	DRIVE AN "E" ON	DRIVE AN "E" ON	DATE	DATE	DATE	DATE	DATE	DATE	DATE	DATE
DATE	FEET NORTH OF	FEET NORTH OF	FEET NORTH OF	DATE	DATE	DATE	DATE	DATE	DATE	DATE	DATE
DATE	OF SAN ANTONIO	OF SAN ANTONIO	OF SAN ANTONIO	DATE	DATE	DATE	DATE	DATE	DATE	DATE	DATE

4-25-00

NO.	DATE	REMARKS	DESIGNED BY	CHECKED BY
1	4/20/00	REVISIONS	YOP/KGP	KGP
2	4/20/00	DESIGN	BS	KGP

Bohannon & Huston

Courtyard One 7500 JEFFERSON NE ALBUQUERQUE NEW MEXICO 87109

ENGINEERS PLANNERS PHOTOGRAMMETRISTS SURVEYORS SOFTWARE DEVELOPERS

CITY OF ALBUQUERQUE

PUBLIC WORKS DEPARTMENT

ENGINEERING DEVELOPMENT GROUP

UNIT 2 - THE CANYONS AT HIGH DESERT

MASTER UTILITY PLAN

DESIGN REVIEW COMMITTEE

APPROVED

APR 25 2000

DESIGN REVIEW COMMITTEE

CITY ENGINEER APPROVAL

APPROVED

APR 25 2000

CITY ENGINEER

LAST DESIGN UPDATE

MO./DAY/YR.

MO./DAY/YR.

CITY PROJECT NO.

594482

ZONE MAP NO.

F-23


SHEET

7

OF

11

SCANNED BY
MESA REPRO

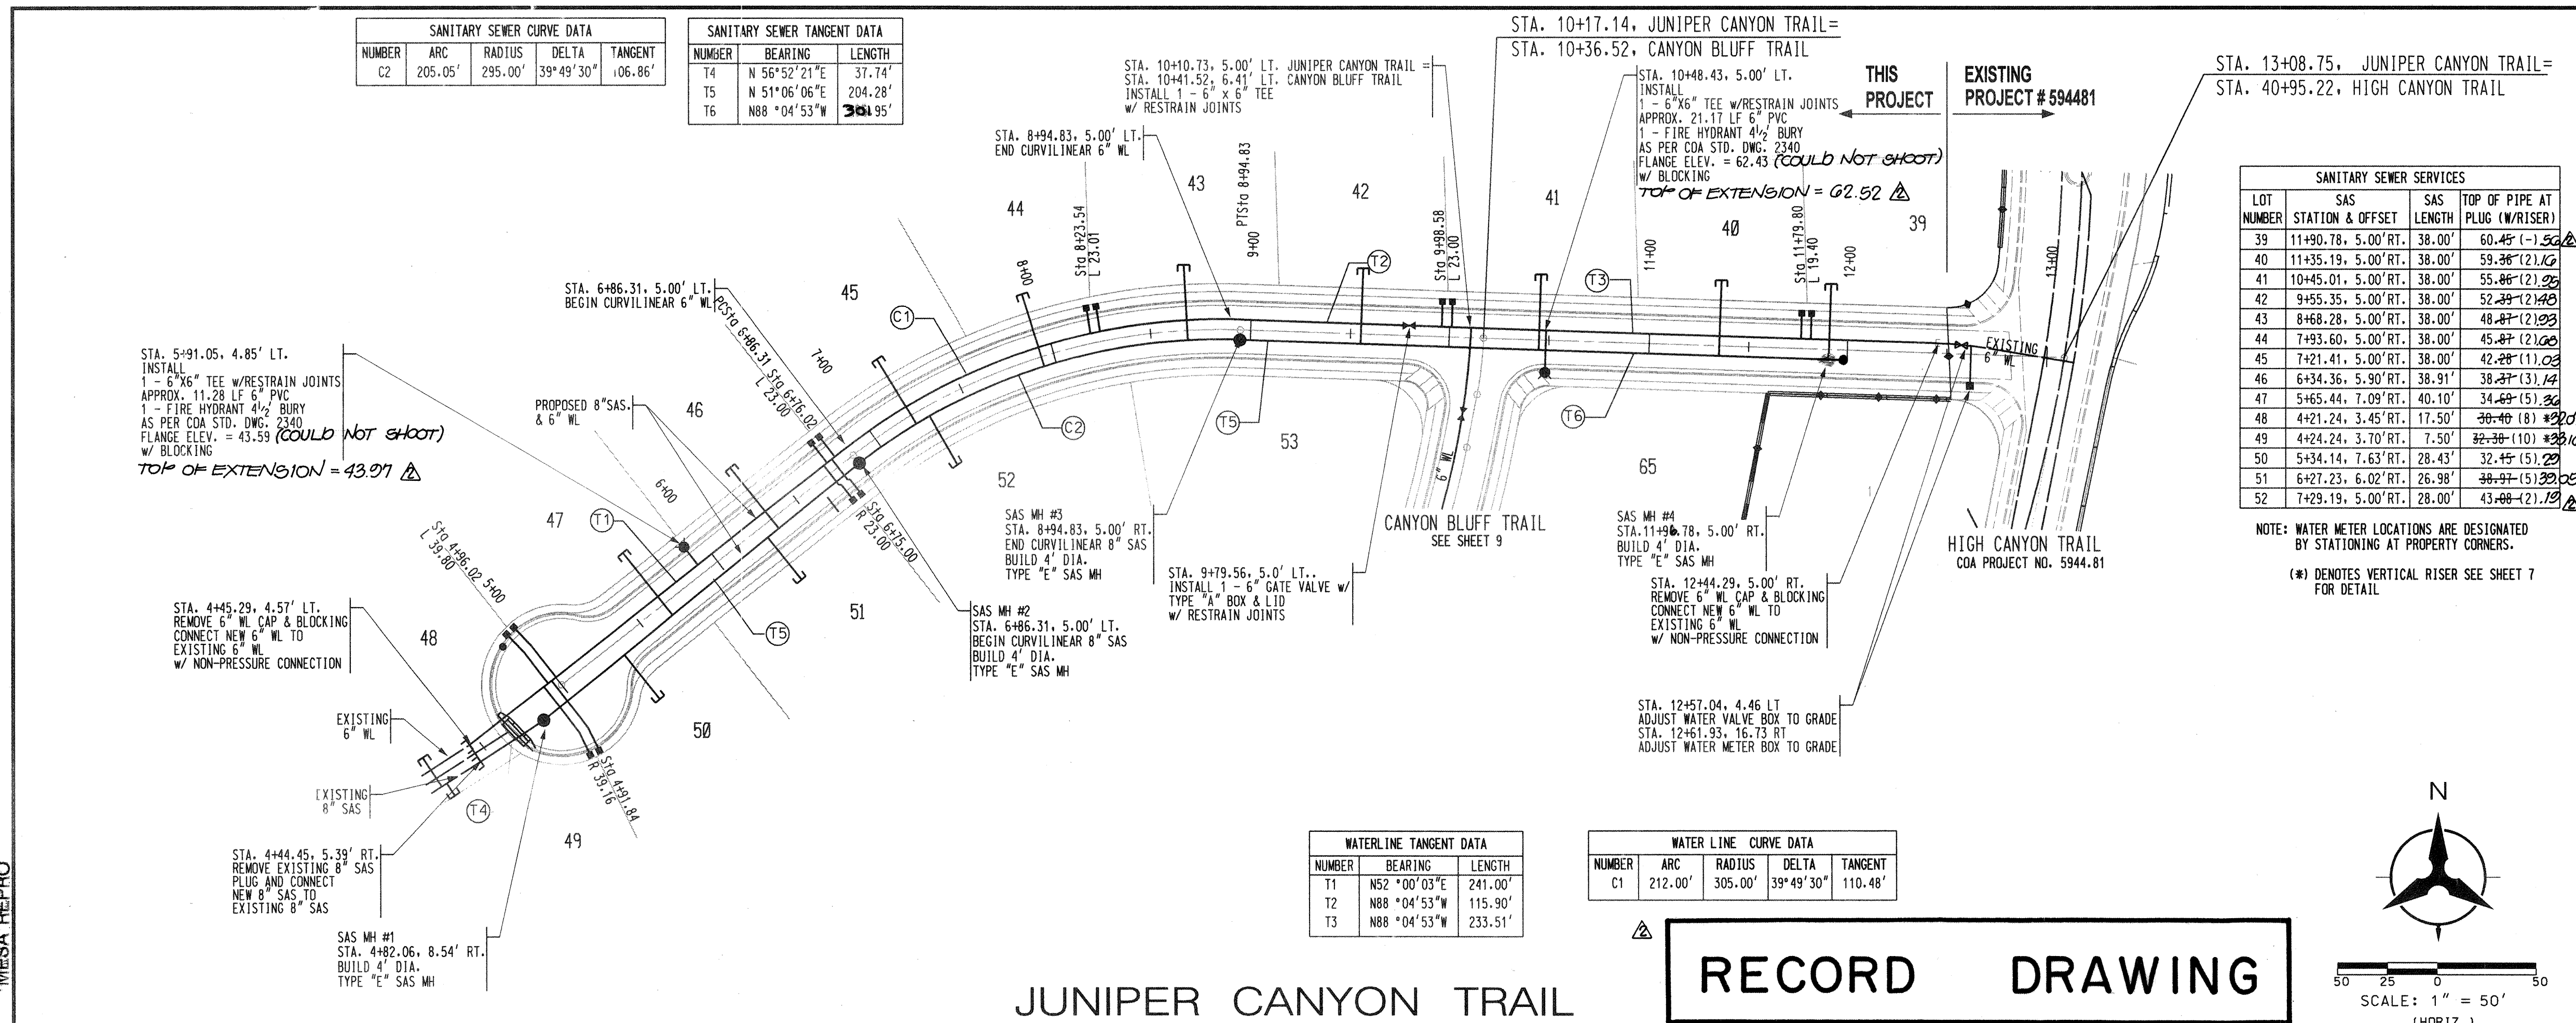

- NOTES
- THE CONTRACTOR SHALL FIELD VERIFY ALL EXISTING UTILITY LOCATIONS AND NOTIFY THE ENGINEER IMMEDIATELY OF ANY DISCREPANCIES.
 - ALL CURB RETURN RADIUS SHALL BE 20' UNLESS OTHERWISE SPECIFIED.
 - ALL CURVE DATA AND DIMENSIONS REFER TO FACE OF CURB UNLESS OTHERWISE SPECIFIED.
 - GRADE ELEVATIONS, WHERE NOTED, ARE ALONG FLOWLINE OF CURB UNLESS OTHERWISE SPECIFIED.
 - CONTRACTOR IS TO INSTALL A 4" X 4" X 5' POST AND EMD AT THE END OF EACH SANITARY SEWER SERVICE.
 - CONTRACTOR IS RESPONSIBLE FOR REPAIR AND/OR REPLACEMENT OF ALL UTILITY CONDUITS AND EXISTING LINES.
 - ANY ADDITIONAL GRADING REQUIRED TO MATCH PROPOSED STREET GRADES SHALL BE INCIDENTAL TO PAVING ITEMS.
 - CONTRACTOR SHALL PROVIDE THE INSPECTORS, (CITY AND PRIVATE) WITH THE PROPOSED HYDROSTATIC TESTING PLAN. THE PLAN MUST BE APPROVED BEFORE TESTING OPERATIONS BEGIN.
 - CONTRACTOR SHALL PARK EQUIPMENT AND VEHICLES AS NOT TO INTERFERE WITH NORMAL ACTIVITIES OF RESIDENTS OR OTHER CONTRACTORS ON SITE.
 - ANY DAMAGE TO THE EXISTING FACILITIES (CURB & GUTTER), PAVEMENT, CONDUITS, LANDSCAPING, UTILITY LINES, ETC.) DURING CONSTRUCTION SHALL BE REPLACED AT THE CONTRACTORS' EXPENSE.
 - REMOVAL OF THE EXISTING CURB AND GUTTER SHALL BE AS PER COA STD. DWG. 2415 (SAWCUT ONLY).
 - WHEELCHAIR RAMPS SHALL BE CONSTRUCTED PRIOR TO ACCEPTANCE OF CURB & GUTTER.

RESTRAINING JOINT TABLE

MECHANICAL JOINTS	LENGTH OF RESTRAINED JOINTS
GATE VALVE	55'
11.25" VERT. BEND	
UPPER	5'
LOWER	2'
6"X6" TEE	1'

- NOTE:
- ALL MECHANICAL JOINTS SHALL BE RESTRAINED AT THE FITTING.
 - THE CONTRACTOR SHALL PROVIDE A MINIMUM PIPE LENGTH OF 20 LF FROM ALL MECHANICAL JOINTS. ALL PIPE POINTS WITHIN 20 LF OF MJ SHALL BE RESTRAINED AT THE CONTRACTORS EXPENSE.
 - THE CONTRACTOR SHALL RESTRAIN ALL PIPE JOINTS IN THE SPECIFIED DISTANCE LISTED IN THE TABLE ABOVE. (SEE NOTE 2 ABOVE).
 - THE CONTRACTOR SHALL RESTRAIN ALL FIRE HYDRANT JOINTS FROM THE TEE ON THE MAIN TO THE FIRE HYDRANT FLANGE.
 - ALL CAPS SHALL UTILIZE PCC BLOCKING.

SURVEYOR'S CERTIFICATION

I, Charles G. Cala, Jr., a duly qualified Registered Professional Land Surveyor under the laws of the State of New Mexico, do hereby certify that the "as-built" information shown on these drawings was obtained from field construction and "as-built" surveys performed by me or under my supervision, that the "as-built" information shown on these drawings was added by me or under my supervision, and that this "as-built" information is true and correct to the best of my knowledge and belief and that I am not responsible for any of the design concepts, calculations, engineering, or intent of the record drawings.

Charles G. Cala, Jr.
Charles G. Cala, Jr., NMPS #1184

09-06-2000
Date

Bohannon & Huston

Courtyard One 7500 JEFFERSON NE Albuquerque NEW MEXICO 87109

ENGINEERS PLANNERS PHOTOGRAMMETRISTS SURVEYORS SOFTWARE DEVELOPERS

CITY OF ALBUQUERQUE
PUBLIC WORKS DEPARTMENT
ENGINEERING DEVELOPMENT GROUP

UNIT 2 - THE CANYONS AT HIGH DESERT
UTILITY PLAN & PROFILE
JUNIPER CANYON TRAIL

DESIGN REVIEW COMMITTEE APPROVAL

APPROVED

APR 25 2000

DESIGN REVIEW COMMITTEE

CITY ENGINEER

LAST DESIGN UPDATE

CITY PROJECT NO. 594482

ZONE MAP NO. F-23

SHEET 8

OF 11

BH JOB NO. 00 352 A01

COPYRIGHT BOHANNAN HUSTON 2000


RECORD DRAWING

WATERLINE CURVE DATA				
NUMBER	ARC	RADIUS	DELTA	TANGENT
C1	337.66'	409.00'	47°18'09"	179.12'

SANITARY SEWER CURVE DATA				
NUMBER	ARC	RADIUS	DELTA	TANGENT
C2	255.13'	419.00'	34°04'00"	128.37'

WATERLINE TANGENT DATA		
NUMBER	BEARING	LENGTH
T1	N51°01'14"E	251.59'
T2	N01°55'06"E	5.00'

NUMBER	BEARING	LENGTH
T3	N 56°52'21"W	45.74'
T4	N 49°43'27"E	206.14'

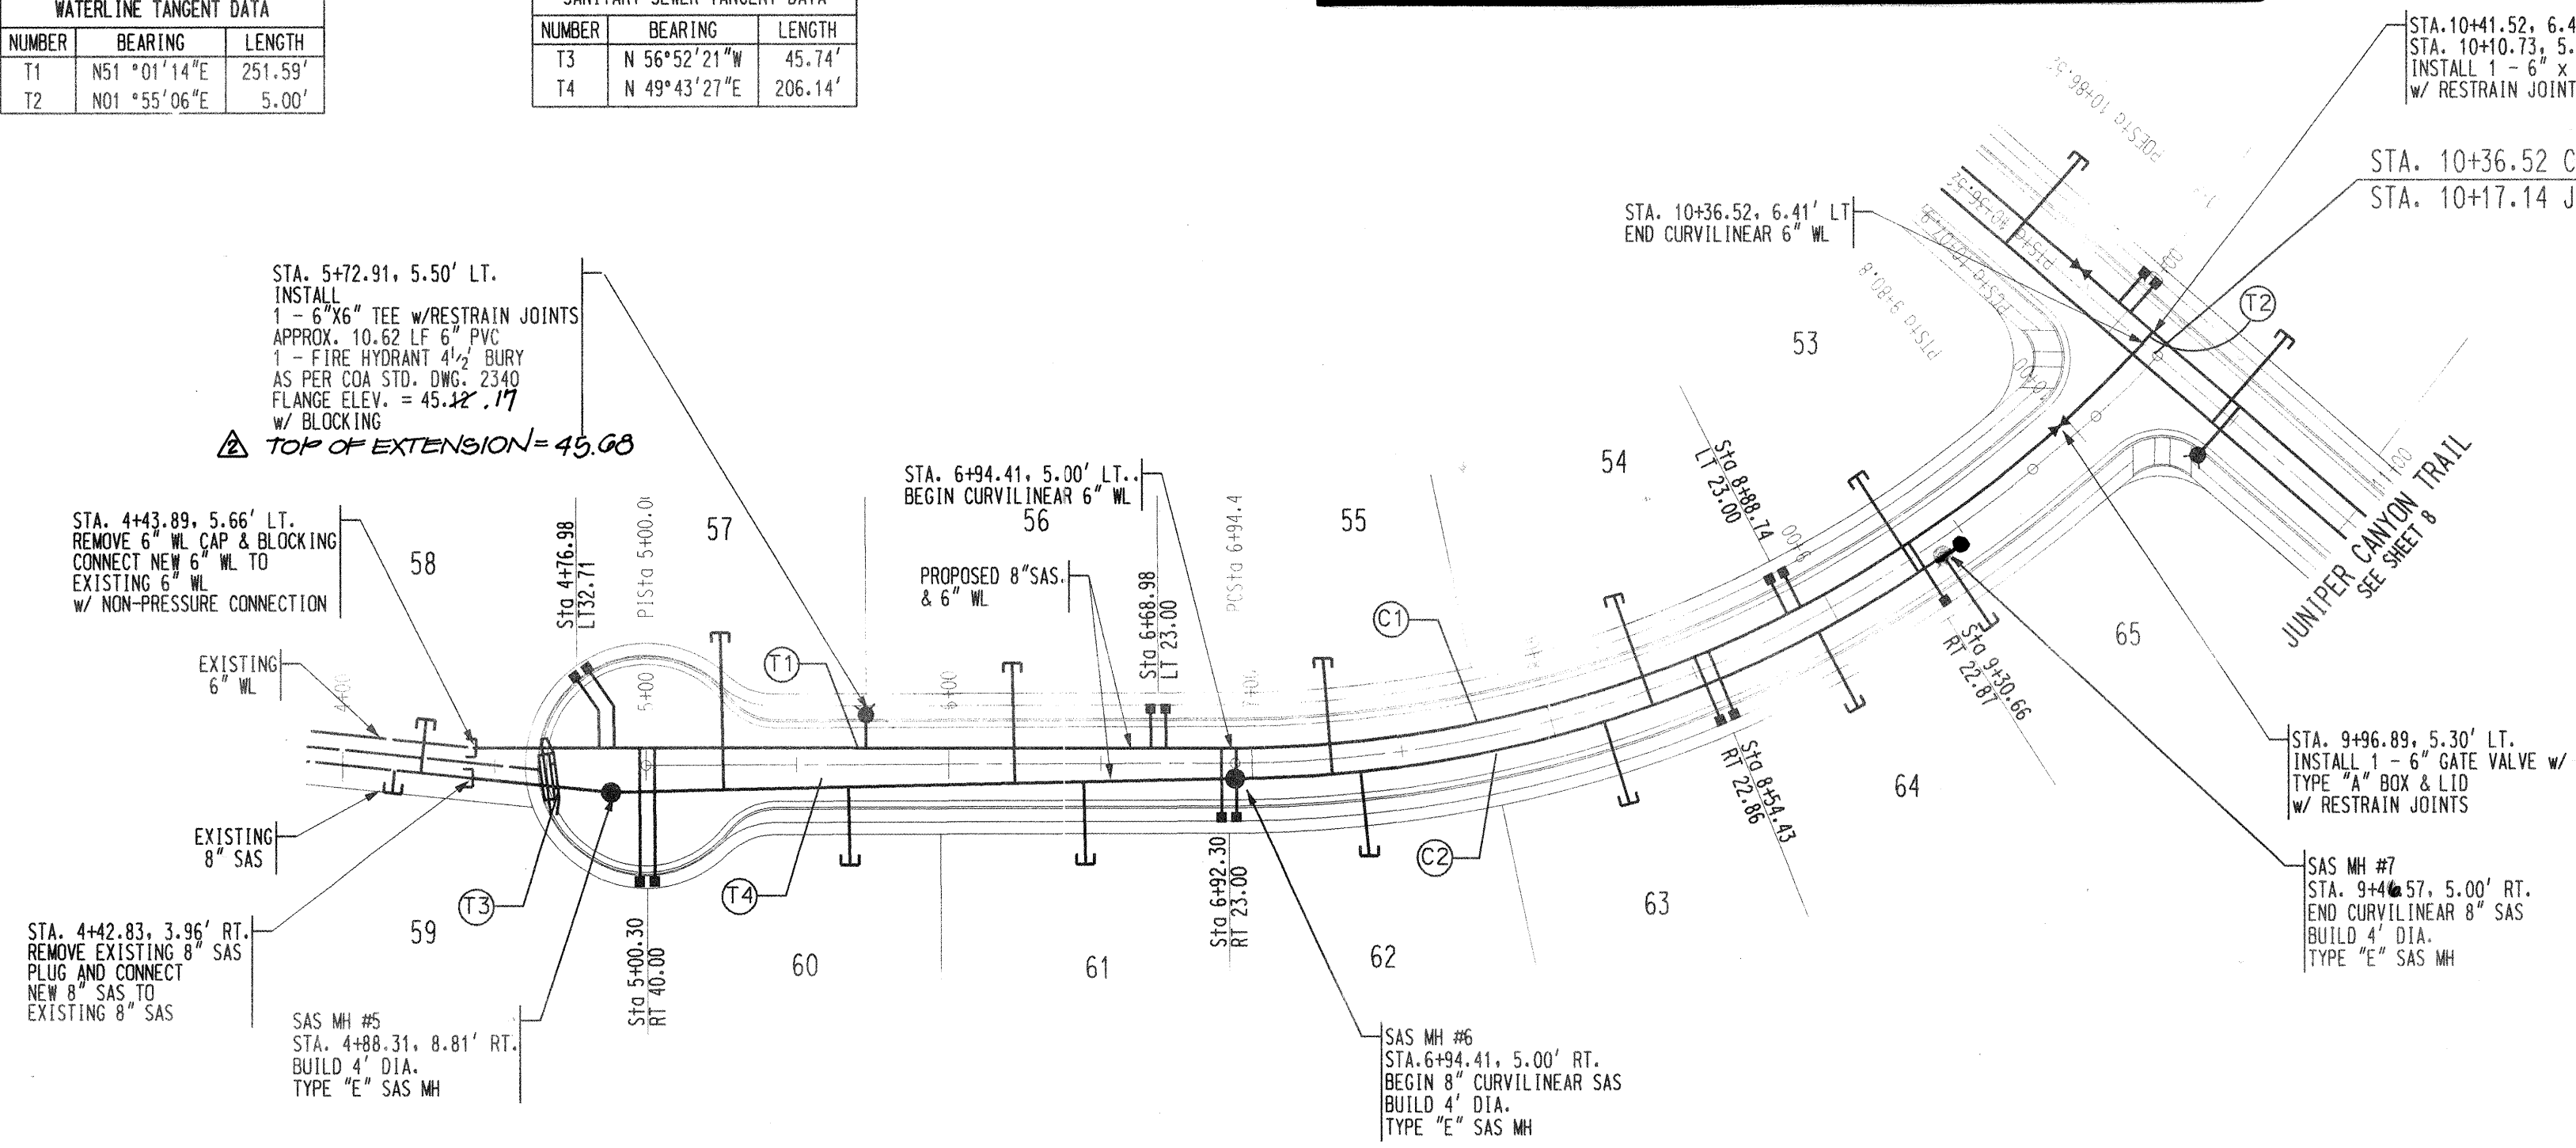

SANITARY SEWER SERVICES				
LOT NUMBER	SAS STATION & OFFSET	SAS LENGTH	TOP OF PIPE AT PLUG / W/ R/SER	
53	9+30.69, 5.00' RT.	38.00'	51.41' (-)	
54	8+33.22, 5.00' RT.	38.00'	48.42' (-)	
55	7+26.39, 5.00' RT.	38.00'	44.22' (-)	
56	6+21.66, 6.34' RT.	39.35'	40.70' (-)	
57	5+25.87, 8.12' RT.	51.47'	36.97' (-)	
58	4+25.74, 2.14' RT.	17.50'	37.33' (*)	
59	4+17.14, 1.22' RT.	7.50'	35.65' (8) *	
60	5+67.04, 7.35' RT.	25.65'	38.45' (-)	
61	6+44.34, 5.93' RT.	27.08'	41.43' (-)	
62	7+35.64, 5.00' RT.	28.00'	44.43' (-)	
63	8+16.64, 5.00' RT.	28.00'	47.45' (-)	
64	8+92.62, 5.00' RT.	28.00'	50.29' (-)	
65	9+40.57, 5.00' RT.	28.00'	52.08' (-)	


NOTE: WATER METER LOCATIONS ARE DESIGNATED BY STATIONING AT PROPERTY CORNERS.

(*) DENOTES VERTICAL RISER SEE SHEET 7
FOR DETAIL



50 25 0 50
SCALE: 1" = 50'
(HORIZ.)

CANYON BLUFF TRAIL

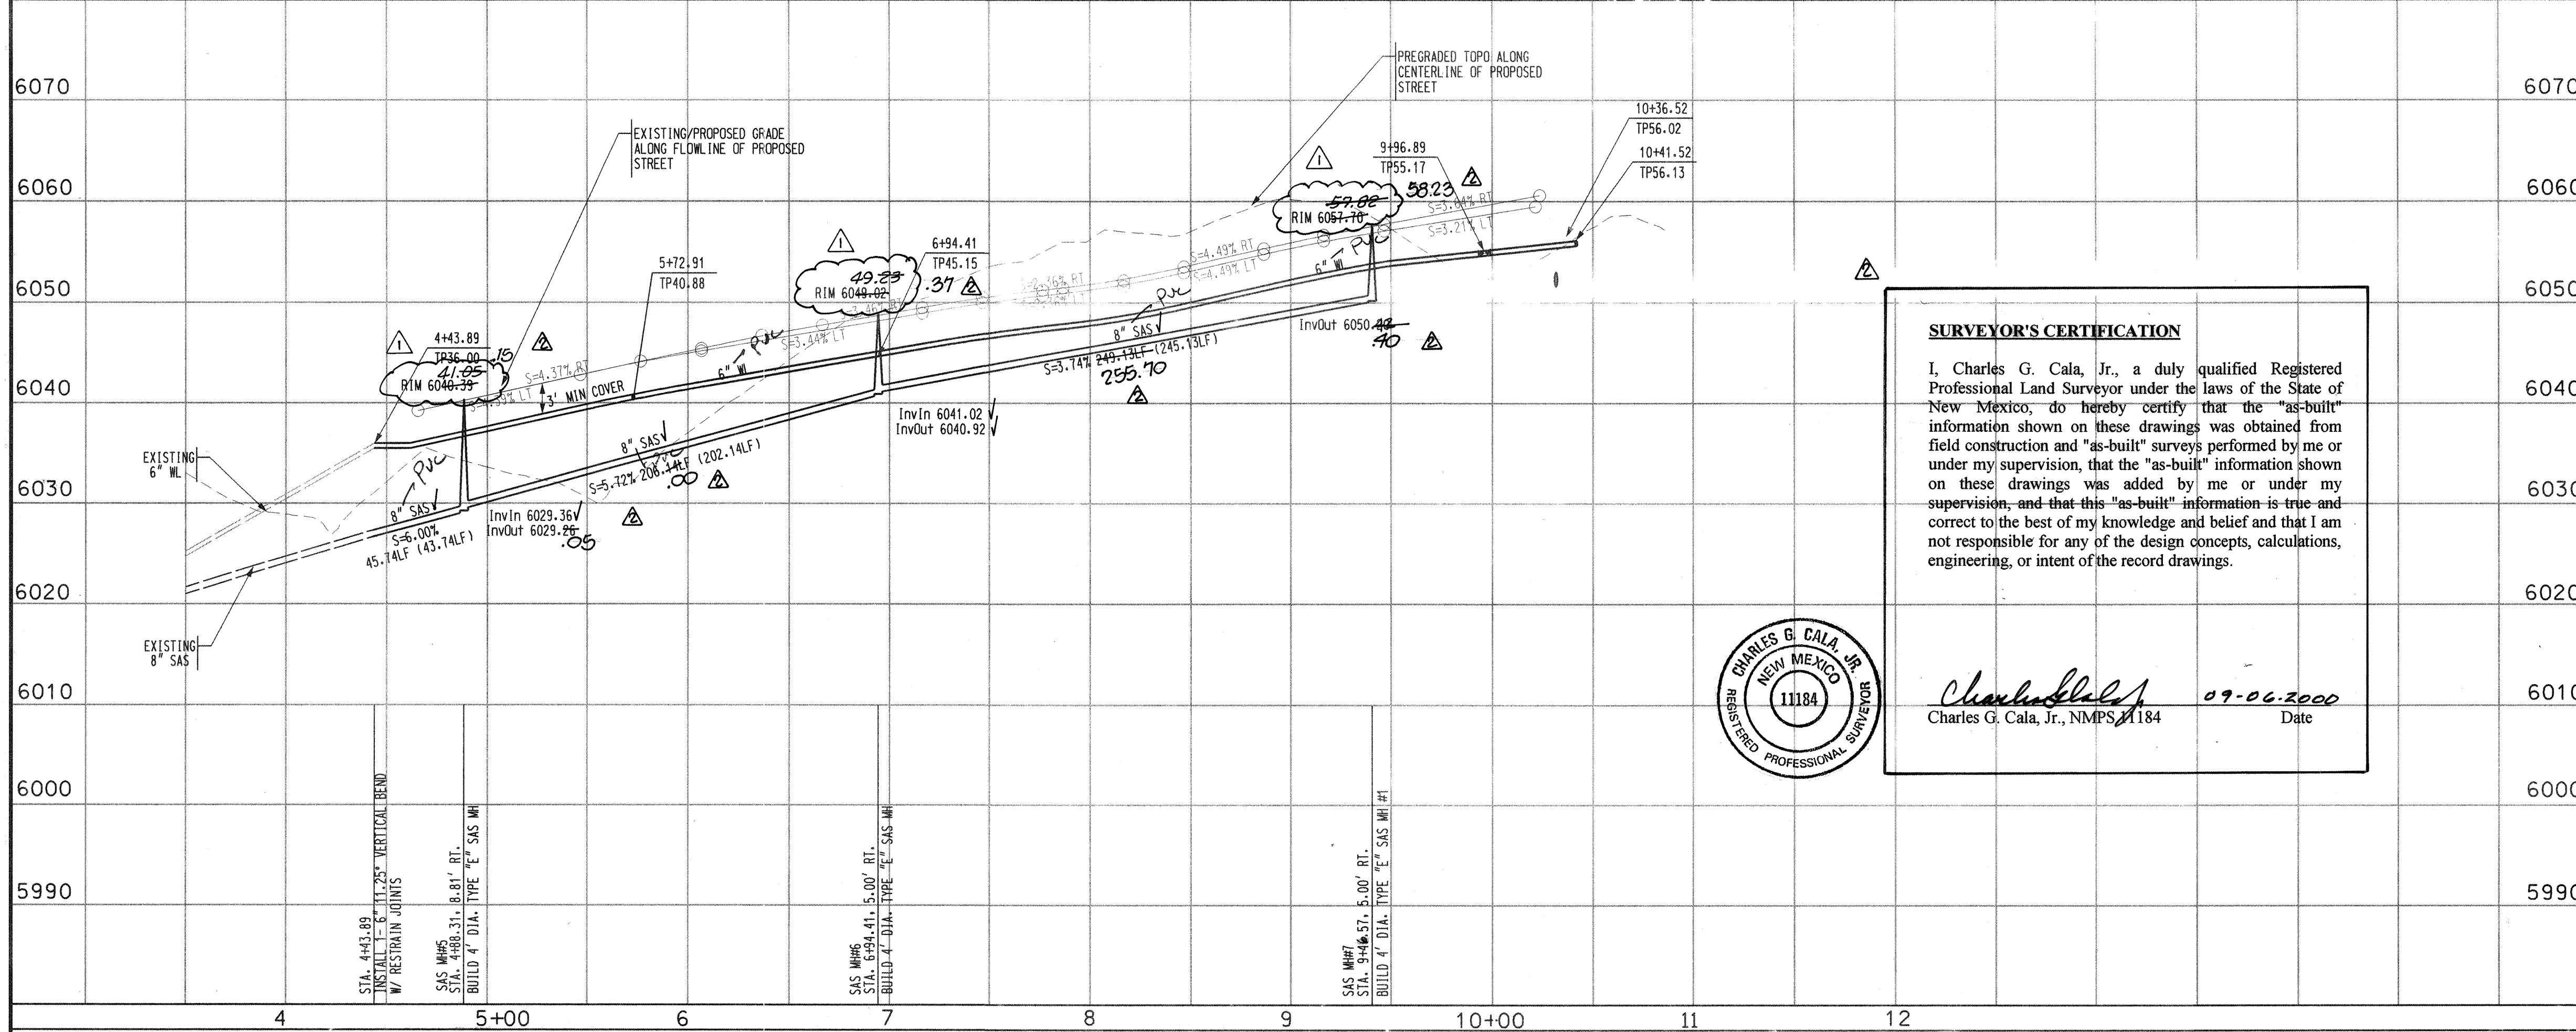

SURVEYOR'S CERTIFICATION

I, Charles G. Cala, Jr., a duly qualified Registered Professional Land Surveyor under the laws of the State of New Mexico, do hereby certify that the "as-built" information shown on these drawings was obtained from field construction and "as-built" surveys performed by me or under my supervision, that the "as-built" information shown on these drawings was added by me or under my supervision, and that this "as-built" information is true and correct to the best of my knowledge and belief and that I am not responsible for any of the design concepts, calculations, engineering, or intent of the record drawings.



	09-06-2000
Charles G. Cala, Jr., NMPS 1184	Date

Bohannon ▲ Huston

 Courtyard One 7500 JEFFERSON NE Albuquerque NEW MEXICO 87109

ENGINEERS PLANNERS PHOTOGRAMMETRISTS SURVEYORS SOFTWARE DEVELOPERS

 CITY OF ALBUQUERQUE
PUBLIC WORKS DEPARTMENT
ENGINEERING DEVELOPMENT GROUP

UNIT 2 – THE CANYONS AT HIGH DESERT

PAVING PLAN & PROFILE CANYON BLUFF TRAIL

DESIGN REVIEW COMMITTEE	CITY ENGINEER APPROVAL	MO./DAY/YR.	MO./DAY/YR.
APPROVED	APPROVED		






















DESIGN CITY ENGINEER LAST UP

CITY PROJECT NO.		ZONE MAP NO.	SHEET	OF
------------------	--	--------------	-------	----

594482	F-23	9	11
BH: CB NO 00 352 A01		COPYRIGHT ROHANIAN HUSTON 2000	

CONSTRUCTION TRAFFIC CONTROL GENERAL NOTES

1. CONTRACTOR MUST OBTAIN FROM CONSTRUCTION COORDINATION AN EXCAVATION/BARRICADING PERMIT BEFORE ENGAGING IN ANY CONSTRUCTION, MAINTENANCE OR REPAIR WORK IN ANY OF THE CITY OF ALBUQUERQUE'S RIGHTS-OF-WAY. EMERGENCY WORK THAT WOULD PRESERVE LIFE OR PROPERTY IS EXCLUDED WITH THE UNDERSTANDING, THAT A PERMIT SHALL BE OBTAINED WITHIN 24 TO 48 HOURS.

2. CONTRACTOR SHALL AT THE TIME OF PERMIT REQUEST, SUBMIT FOR APPROVAL BY CONSTRUCTION COORDINATION, A TRAFFIC CONTROL PLAN DETAILING ALL EXISTING TOPOGRAPHY SUCH AS LANE WIDTHS, DRIVEWAYS, AND BUSINESS/RESIDENTIAL ACCESSSES. THE TRAFFIC CONTROL PLAN SHALL INCLUDE ALL PHASES OF WORK AND SCHEDULES INVOLVED IN THE CONSTRUCTION PROJECT. ANY SEPARATE PHASES OF A CONSTRUCTION PROJECT SHALL BE GIVEN AN INDIVIDUAL PERMIT EACH. BLANKET PERMITS WILL NOT BE ISSUED.

3. THESE TYPICAL TRAFFIC CONTROL PLANS DO NOT REFLECT THE EXISTING TOPOGRAPHY SUCH AS DRIVEWAYS, LANE WIDTHS, AND BUSINESS/RESIDENTIAL ACCESSSES. EVERY LOCATION THAT REQUIRES CONSTRUCTION TRAFFIC CONTROL SHALL HAVE A DETAILED TRAFFIC CONTROL PLAN SHOWING ALL EXISTING TOPOGRAPHY.

4. CONSTRUCTION SHALL NOT BEGIN UNLESS A TRAFFIC CONTROL PLAN HAS BEEN APPROVED AND VERIFIED BY CONSTRUCTION COORDINATION.

5. CONSTRUCTION COORDINATION SHALL BE NOTIFIED 48 HOURS PRIOR TO ANY TRAFFIC CONTROL CHANGES NEEDED BY CONTRACTOR, THAT WERE NOT PREVIOUSLY APPROVED. THESE TRAFFIC CONTROL CHANGES SHALL BE REQUESTED IN WRITING ACCOMPANIED WITH A TRAFFIC CONTROL PLAN REFLECTING SUCH CHANGES.

6. ALL CONSTRUCTION TRAFFIC CONTROL DEVICES SHALL COMPLY TO THE MANUAL ON UNIFORM TRAFFIC CONTROL DEVICES (MUTCD), LATEST EDITION. IT IS THE RESPONSIBILITY OF THE CONTRACTOR TO INSTALL, SERVICE AND MAINTAIN ALL TRAFFIC CONTROL DEVICES. TRAFFIC CONTROL DEVICES SHALL NOT BE REMOVED OR ALTERED IN ANY WAY WITHOUT THE APPROVAL OF CONSTRUCTION COORDINATION, PER SECTION 6A-4 OF THE MUTCD, LATEST EDITION.

7. THE CONSTRUCTION TRAFFIC CONTROL INITIAL SET-UP SHALL BE BY AN AMERICAN TRAFFIC SAFETY SERVICES ASSOCIATION (ATSSA) CERTIFIED WORKSITE TRAFFIC SUPERVISOR. THE MAINTENANCE AND SERVICING SHALL ALSO BE DONE BY AN ATSSA CERTIFIED WORKSITE TRAFFIC SUPERVISOR OR EQUIVALENT.

8. CONTRACTOR IS RESPONSIBLE TO MAINTAIN AND SERVICE ALL TRAFFIC CONTROL DEVICES 24 HOURS A DAY, 7 DAYS A WEEK THROUGHOUT LENGTH OF PROJECT. CONTRACTOR IS RESPONSIBLE THAT ALL TRAFFIC CONTROL DEVICES COMPLY WITH THE MUTCD, LATEST EDITION.

9. ALL ADVANCE WARNING SIGNS SHALL BE DOUBLE INDICATED WHENEVER THERE ARE MULTI-LANE TRAFFIC IN ANY ONE GIVEN DIRECTION AND THERE IS SUFFICIENT MEDIAN SPACE.

10. ALL BARRICADES IN ALL TAPERS AND TANGENTS SHALL BE PLACED APART, A DISTANCE MEASURED IN FEET, EQUAL TO THAT OF THE POSTED SPEED LIMIT. NO EXCEPTIONS UNLESS APPROVED BY CONSTRUCTION COORDINATION PER MUTCD SECTION 6A-4.

11. ALL WORK IN ARTERIAL ROADWAYS SHALL BE ON A CONTINUOUS 24 HOUR PER DAY BASIS UNTIL COMPLETED.

12. CONTRACTOR IS RESPONSIBLE TO PROVIDE CONSTRUCTION COORDINATION, A WEEKLY LOG OF DAILY INSPECTIONS OF BARRICADE AND MAINTENANCE SCHEDULES ON PROJECTS THAT ARE OVER ONE WEEK DURATION.

13. EQUIPMENT OR MATERIALS SHALL NOT BE STORED WITHIN 15 FEET OF A TRAVELED TRAFFIC LANE DURING NON-WORKING HOURS WITHOUT THE APPROVAL OF CONSTRUCTION COORDINATION.

14. CONTRACTOR SHALL PROVIDE AND MAINTAIN A SAFE AND ADEQUATE MEANS OF CHANNELIZING PEDESTRIAN TRAFFIC AROUND AND THROUGH THE CONSTRUCTION AREA.

15. CONTRACTOR IS RESPONSIBLE FOR OBLITERATION OF ANY CONFLICTING STRIPING AND RESPONSIBLE FOR ALL TEMPORARY STRIPING.

16. CONTRACTOR SHALL MAINTAIN ACCESS TO ALL FACILITIES, BUSINESSES AND/OR RESIDENTS AT ALL TIMES.

17. CONTRACTOR SHALL PROVIDE ACCESS SIGNS FOR BUSINESSES LOCATED WITHIN THE CONSTRUCTION AREA UNDER THE SUPERVISION OF CONSTRUCTION COORDINATION. EACH ACCESS SIGN SHALL HAVE 5 INCH, WHITE OPAQUE LETTERING ON BLUE REFLECTORIZED BACKGROUND. ACCESS SIGNS SHALL BE CONSIDERED INCIDENTAL TO THE BID AND NOT PART OF THE CONTRACT UNLESS OTHERWISE STATED. NO MORE THAN 3 BUSINESSES SHALL BE LISTED ON A ACCESS SIGN. SHOPPING CENTERS AND MALLS SHALL BE LISTED AS SUCH.

18. ALL ADVANCE WARNING SIGNS SHALL MEET THE MINIMUM REFLECTIVE INTENSITY REQUIREMENTS SET FORTH BY THE CITY OF ALBUQUERQUE. CONSTRUCTION COORDINATION SHALL DETERMINE ALL REQUIREMENTS AND APPROVE OR DISAPPROVE ANY ADVANCE WARNING SIGN PER SECTION 6A-4 OF THE MUTCD, LATEST EDITION.

19. 48 HOURS PRIOR TO OCCUPYING OR CLOSING OF A RIGHT-OF-WAY, CONTRACTOR SHALL NOTIFY: POLICE, FIRE DEPARTMENT, SCHOOLS, HOSPITALS, TRANSIT AUTHORITY, BUSINESSES AND/OR RESIDENTS THAT WILL BE AFFECTED BY THE CONSTRUCTION.

20. ANY FIELD ADJUSTMENTS SHALL BE APPROVED BY CONSTRUCTION COORDINATION.

21. EXCAVATIONS SHALL BE PLATED, TEMPORARILY PATCHED OR RESURFACED PRIOR TO OPENING OF TRAFFIC. A MINIMUM OF 11 FEET SHALL BE PROVIDED FOR TRAFFIC IN ANY GIVEN DIRECTION. CONTRACTOR IS RESPONSIBLE FOR ANY WORK INVOLVED IN SATISFYING THESE REQUIREMENTS.

22. CONTRACTOR SHALL AT ALL TIMES COMPLY WITH THE FOLLOWING:
1. STANDARDS AND REQUIREMENTS SET FORTH IN THE MANUAL ON UNIFORM TRAFFIC CONTROL DEVICES, LATEST EDITION.
2. THE CITY OF ALBUQUERQUE TRAFFIC CODE, LATEST EDITION.
3. SECTION 19 OF THE CITY OF ALBUQUERQUE'S STANDARD SPECIFICATIONS FOR PUBLIC WORK CONSTRUCTION, AS WELL AS OTHER SECTIONS.



23. FAILURE TO COMPLY WITH ANY OF THE ABOVE MENTIONED, WILL BE ADEQUATE CAUSE TO CEASE ALL WORK ON ANY CONSTRUCTION PROJECT. WORK WILL NOT RESUME UNTIL ALL REQUIREMENTS ARE ADDRESSED AND APPROVED BY CONSTRUCTION COORDINATION.

24. ALL TRAFFIC CONTROL DEVICES SHALL BE KEPT IN NEW-CLEAN CONDITION, WASHING OF EQUIPMENT IS INCIDENTAL TO IT'S PLACEMENT AND MAINTENANCE.


25. TRAFFIC CONTROL STANDARDS APPLY ONLY WHERE THE CONSTRUCTION TRAFFIC CONTROL PLANS ARE NOT SPECIFIC.

26. ADVANCE WARNING SIGNS SHALL BE 36"x36" MIN. WITH SUPER ENGINEERING GRADE SHEETING OR BETTER. MOUNTING HEIGHT AT TOP OF SIGN SHALL BE THE SAME AS FOR A 48" SIGN AS INDICATED IN THE M.U.T.C.D.

27. CONTRACTOR SHALL MAINTAIN A GRAFFITI-FREE WORKSITE. ALL GRAFFITI SHALL BE PROMPTLY REMOVED FROM ALL EQUIPMENT, BOTH PERMANENT AND TEMPORARY.

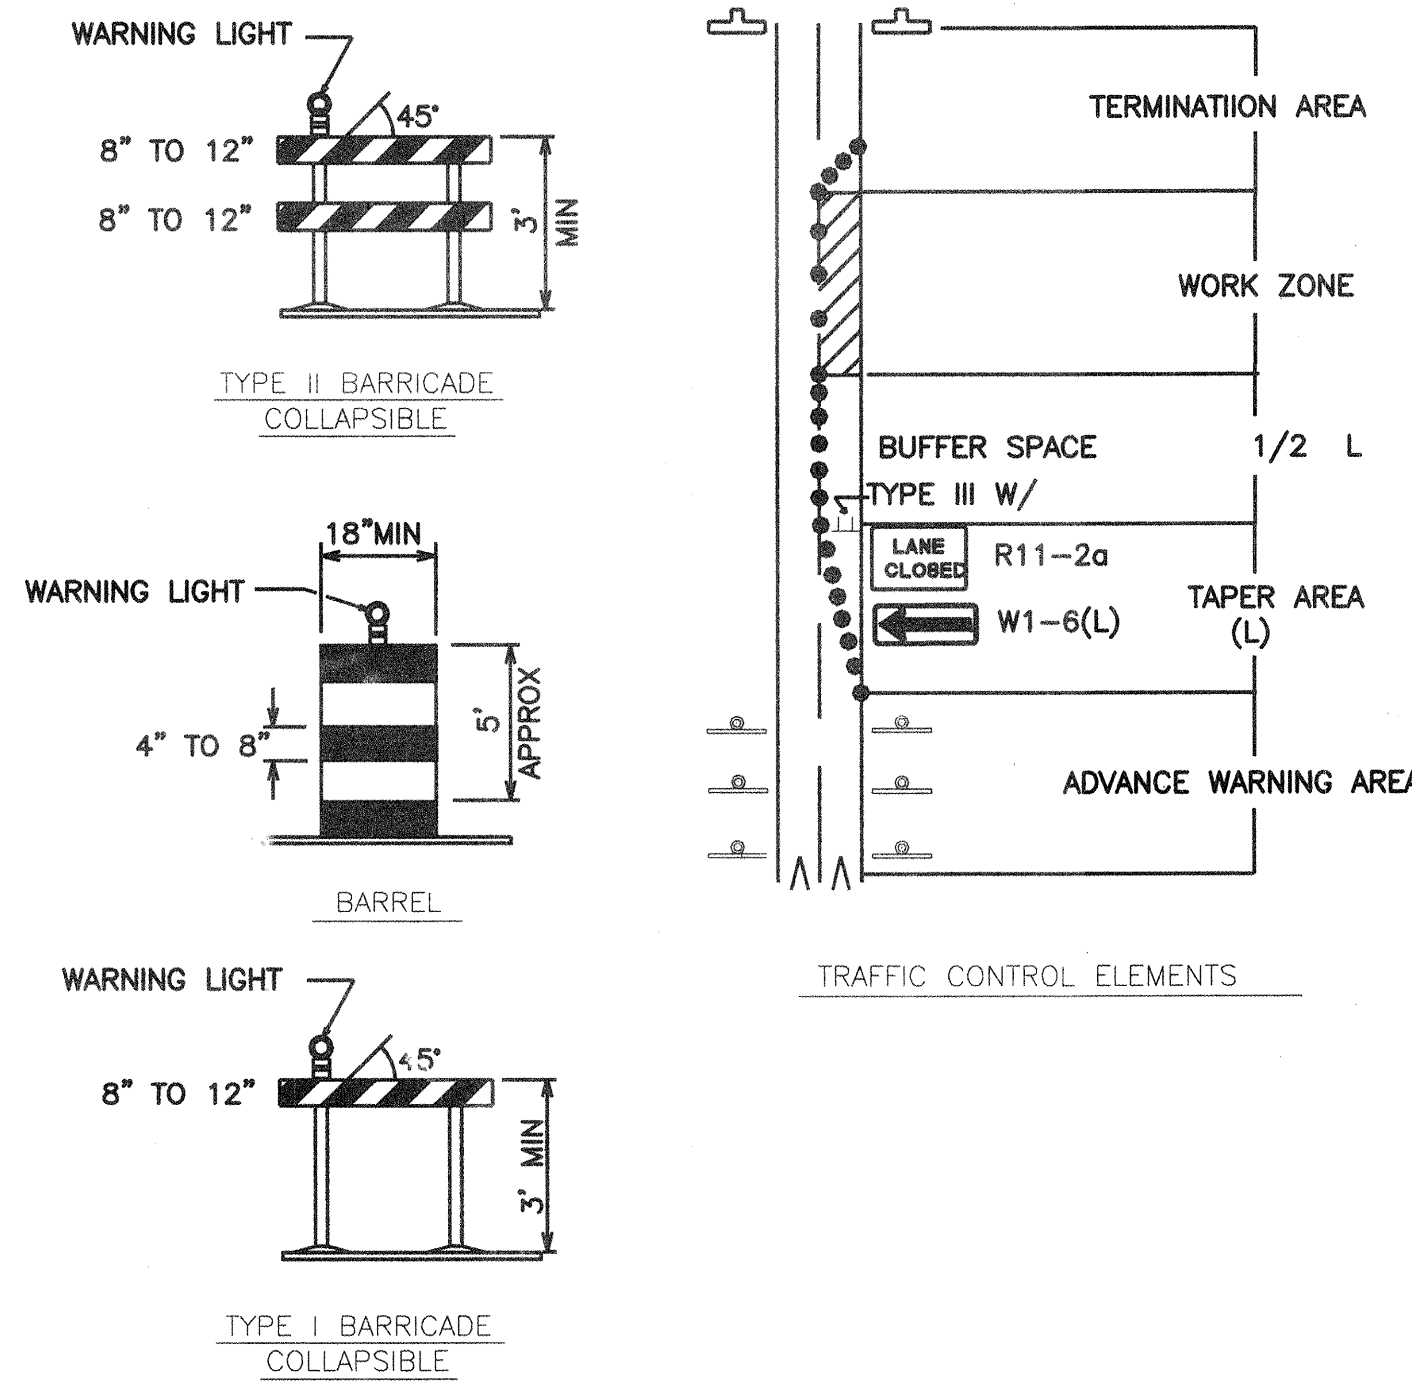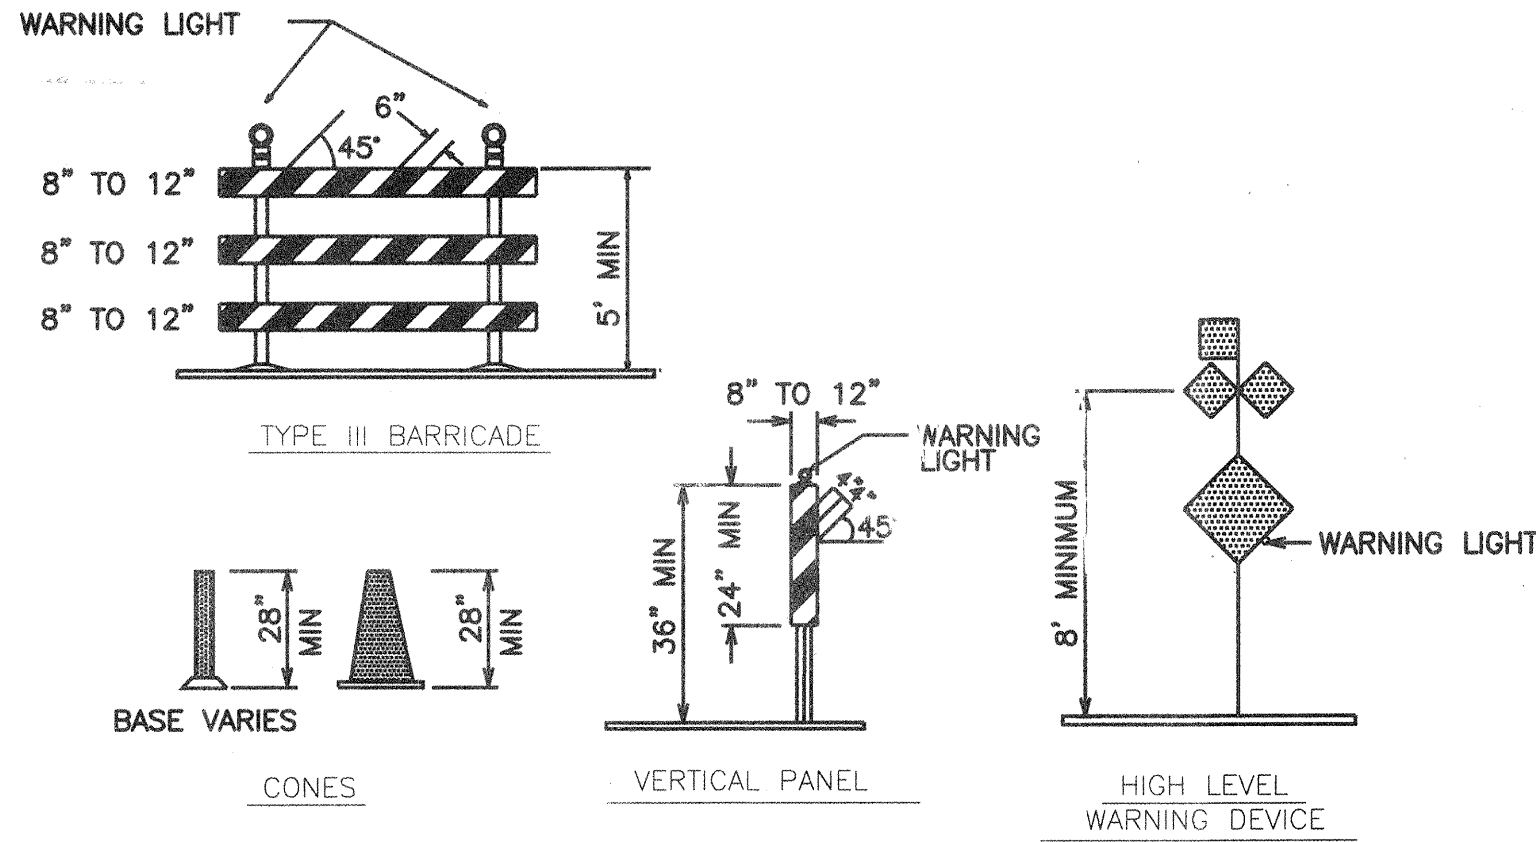

SIGN FACE DETAILS

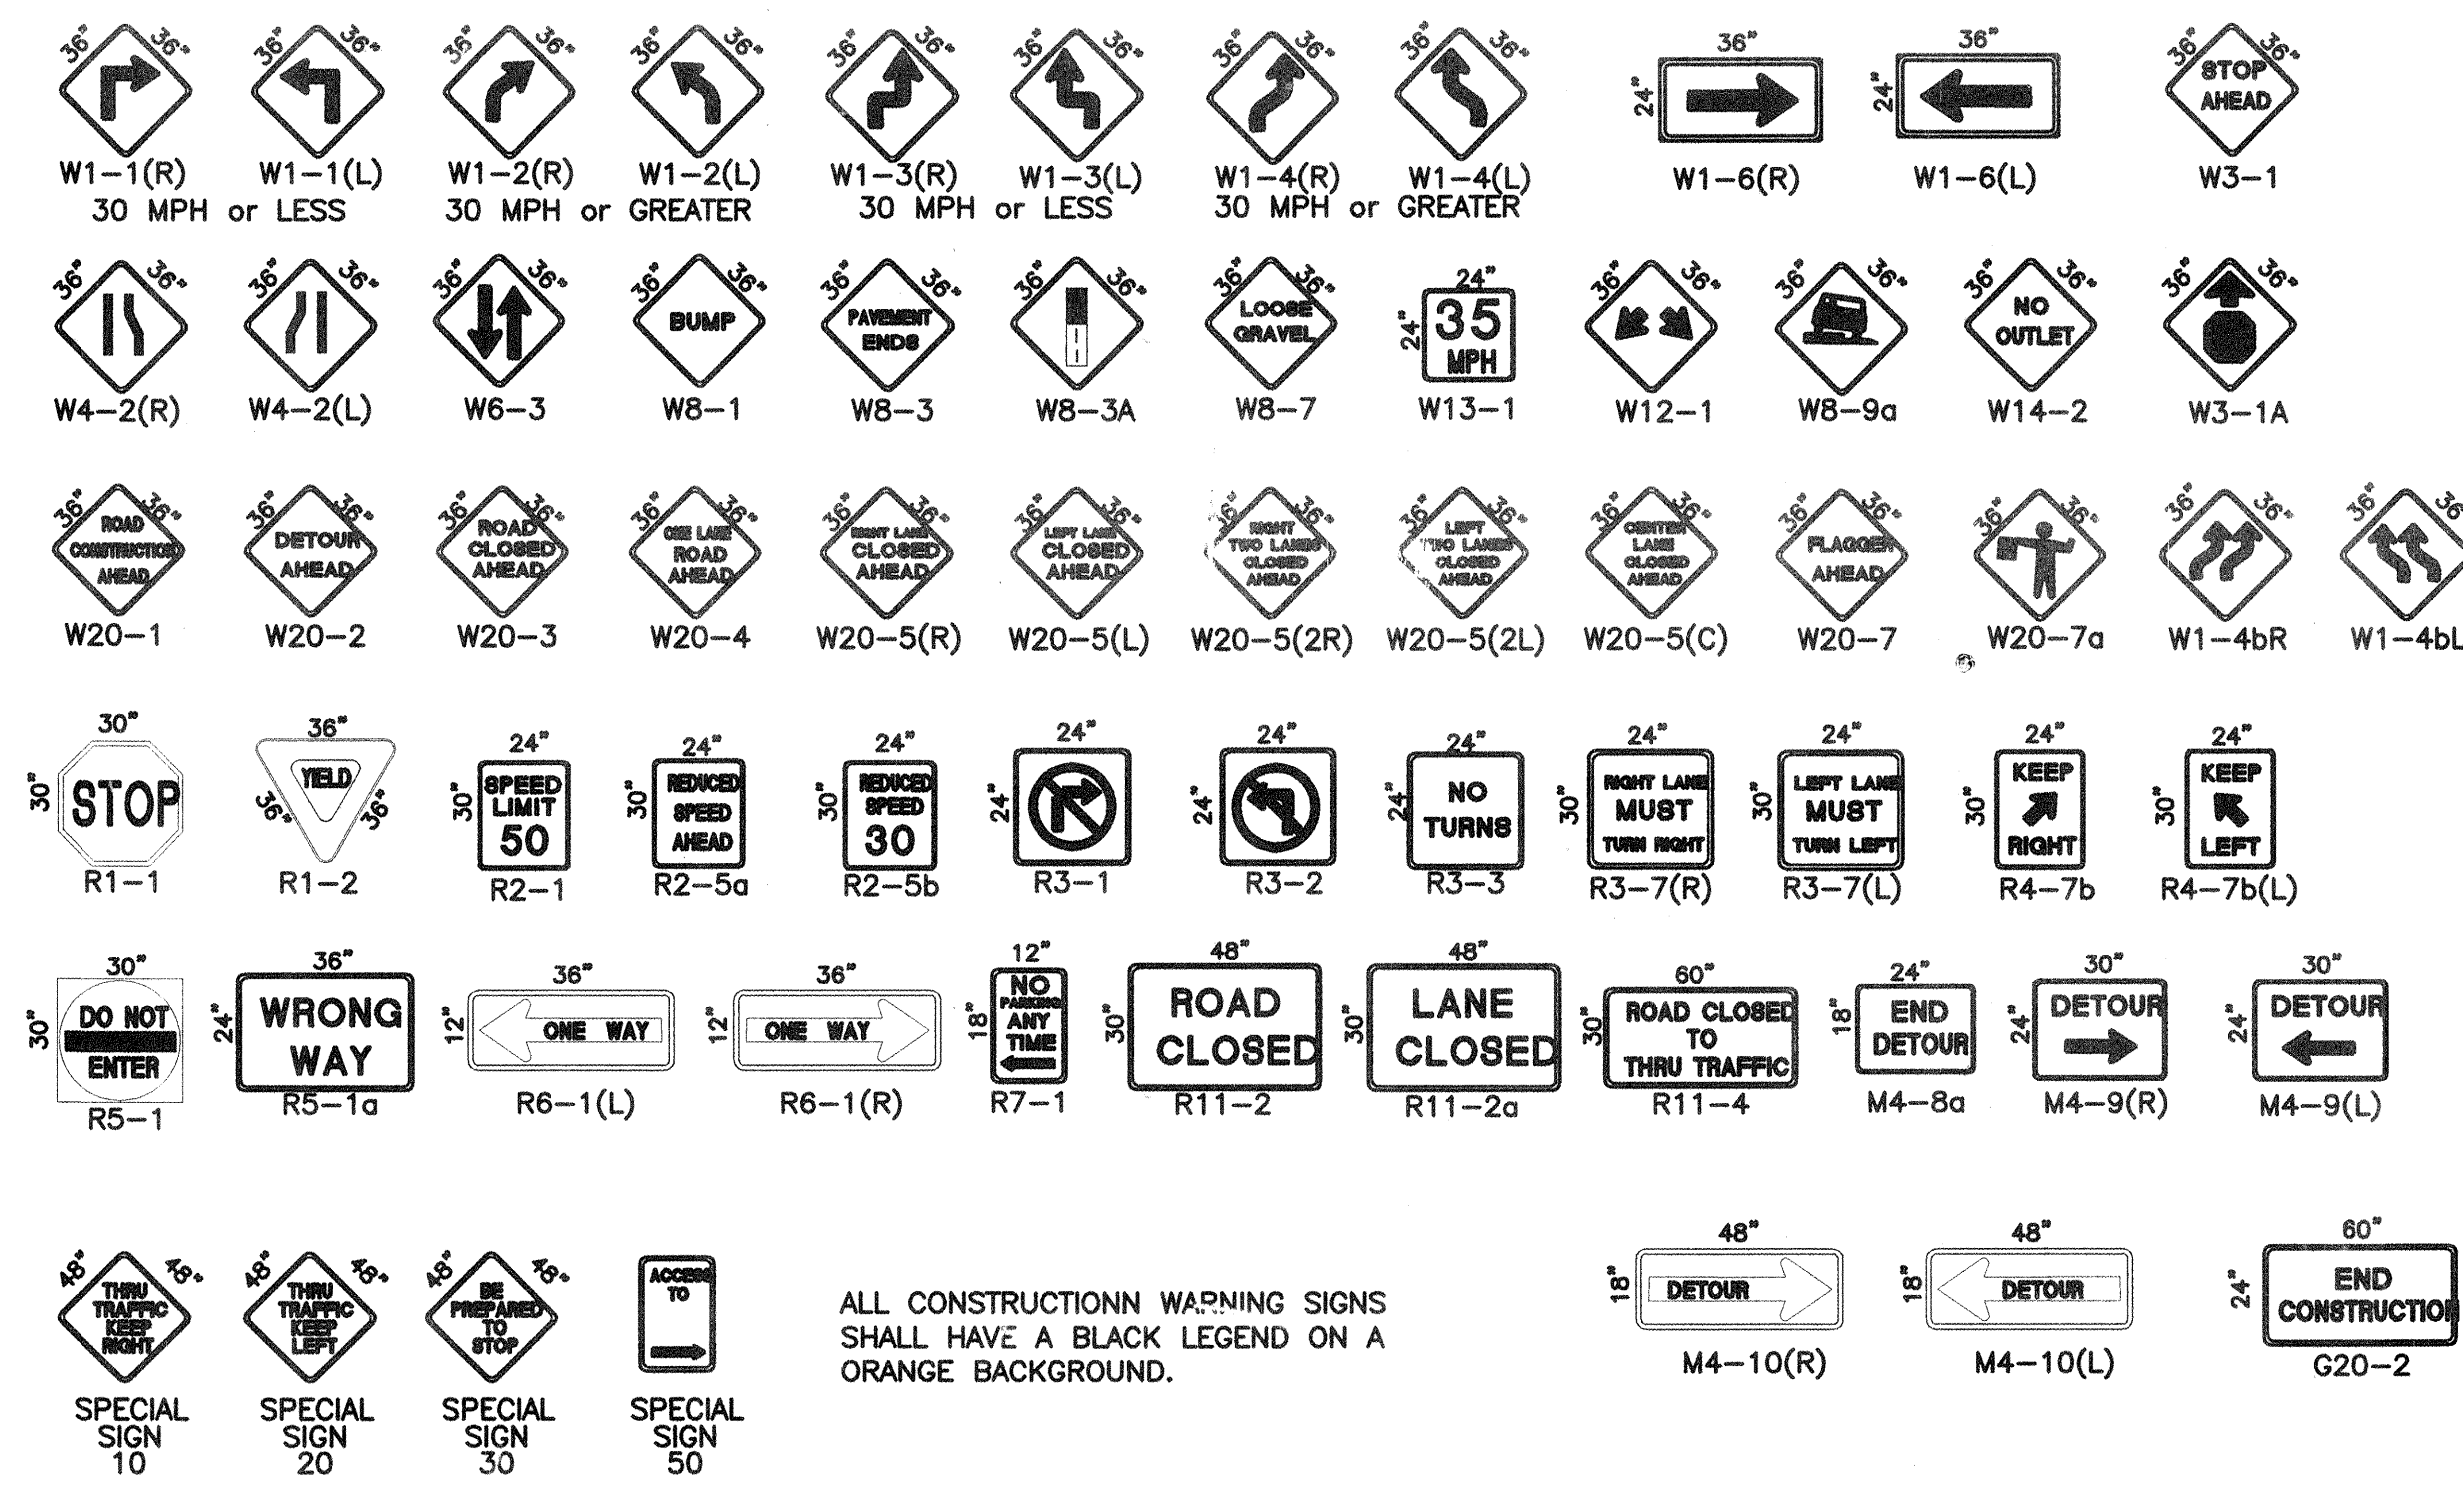

ALL CONSTRUCTION WARNING SIGNS SHALL HAVE A BLACK LEGEND ON A ORANGE BACKGROUND.

LEGEND

- WORK AREA
- BARRICADE - TYPE I, TYPE II, OR BARREL
- BARRICADE - TYPE III
- VERTICAL PANEL
- WARNING SIGN
- DISTANCE BETWEEN SIGNS - A DISTANCE MEASURED IN FEET EQUAL TO A VALUE OF TEN TIMES THE SPEED LIMIT OF THE STREET
- FLAGMAN POSITION
- SPACING BETWEEN BARRICADES - A DISTANCE MEASURED IN FEET EQUAL TO THE STREET LIMIT OF THE STREET
- TAPER LENGTH - SEE CHART BELOW

THE TANGENT LENGTH IS EQUAL TO THE TAPER LENGTH FOR A GIVEN STREET.

TAPER REQUIREMENT

SPEED LIMIT (MPH)	TAPER LENGTH(L) (FEET)			MINIMUM NUMBER OF DEVICES FOR TAPER	MAXIMUM DEVICE SPACING IN FEET	
	10' LANE	11' LANE	12' LANE		ALONG TAPER	AFTER TAPER
20	70	75	80	5	20	20
25	105	115	125	6	25	25
30	150	165	180	7	30	30
35	205	225	245	8	35	35
40	270	295	320	9	40	40
45	450	495	540	13	45	45
50	500	550	600	13	50	50
55	550	605	660	13	55	55

RECOMMENDED SIGN SPACING(D) FOR ADVANCE WARNING SIGN SERIES

SPEED LIMIT (MPH)	MILES PER HOUR	MINIMUM DISTANCE IN FEET BETWEEN SIGNS	
		FROM LAST SIGN TO TAPER	FROM TAPER TO LAST SIGN
0-20	10 X SPEED LIMIT	10 X SPEED LIMIT	10 X SPEED LIMIT
25-30	10 X SPEED LIMIT	10 X SPEED LIMIT	10 X SPEED LIMIT
30-35	10 X SPEED LIMIT	10 X SPEED LIMIT	10 X SPEED LIMIT
40-45	10 X SPEED LIMIT	10 X SPEED LIMIT	10 X SPEED LIMIT
50-60	10 X SPEED LIMIT	10 X SPEED LIMIT	10 X SPEED LIMIT

TAPER CRITERIA

TYPE OF TAPER	TAPER LENGTH
UPSTREAM TAPER:	
MERGING TAPER	L MINIMUM
SHIFTING TAPER	1/2 L MINIMUM
SHOULDER TAPER	1/2 L MINIMUM
TWO-WAY TRAFFIC TAPER	100 FEET MAXIMUM
DOWNSTREAM TAPERS	100 FEET PER LANE

TAPER LENGTH COMPUTATION

SPEED LIMIT	L = WS ² / 60
40 MPH OR LESS	
40 MPH OR GREATER	L = W x S

L = TAPER LENGTH
W = WIDTH OF OFFSET IN FEET
S = POSTED SPEED OR OFF-PEAK 85-PERCENTILE SPEED IN MPH

Bohannon & Huston


County One 7500 JEFFERSON NE Albuquerque NEW MEXICO 87109

ENGINEERS PLANNERS PHOTOGRAMMETRISTS SURVEYORS SOFTWARE DEVELOPERS


CITY OF ALBUQUERQUE
PUBLIC WORKS DEPARTMENT
ENGINEERING DEVELOPMENT GROUP

TITLE: UNIT 2 - THE CANYONS AT HIGH DESERT
SIGNING AND CONSTRUCTION
TRAFFIC CONTROL STANDARDS


DESIGN REVIEW COMMITTEE	CITY ENGINEER APPROVAL	MO./DAY/YR.	MO./DAY/YR.
COA STD.			
CITY PROJECT NO.	ZONE MAP NO.	SHEET	OF
594482	F-23	10	11

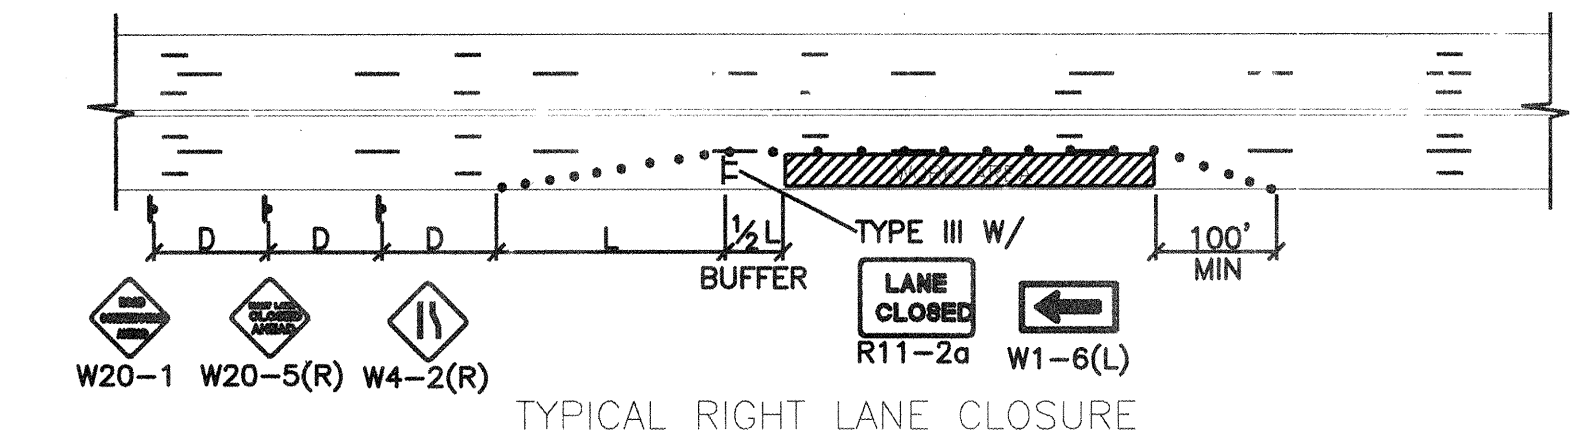


TYPICAL RIGHT LANE CLOSURE

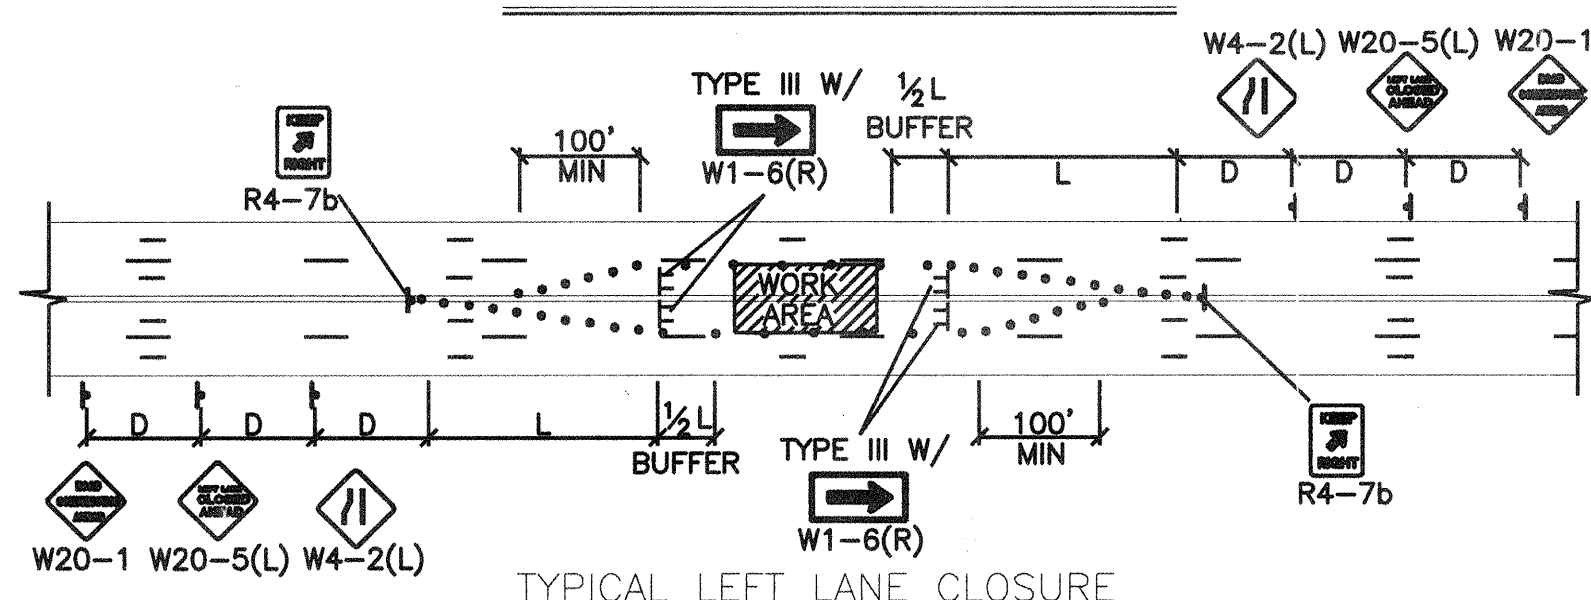


TYPICAL LEFT LANE CLOSURE

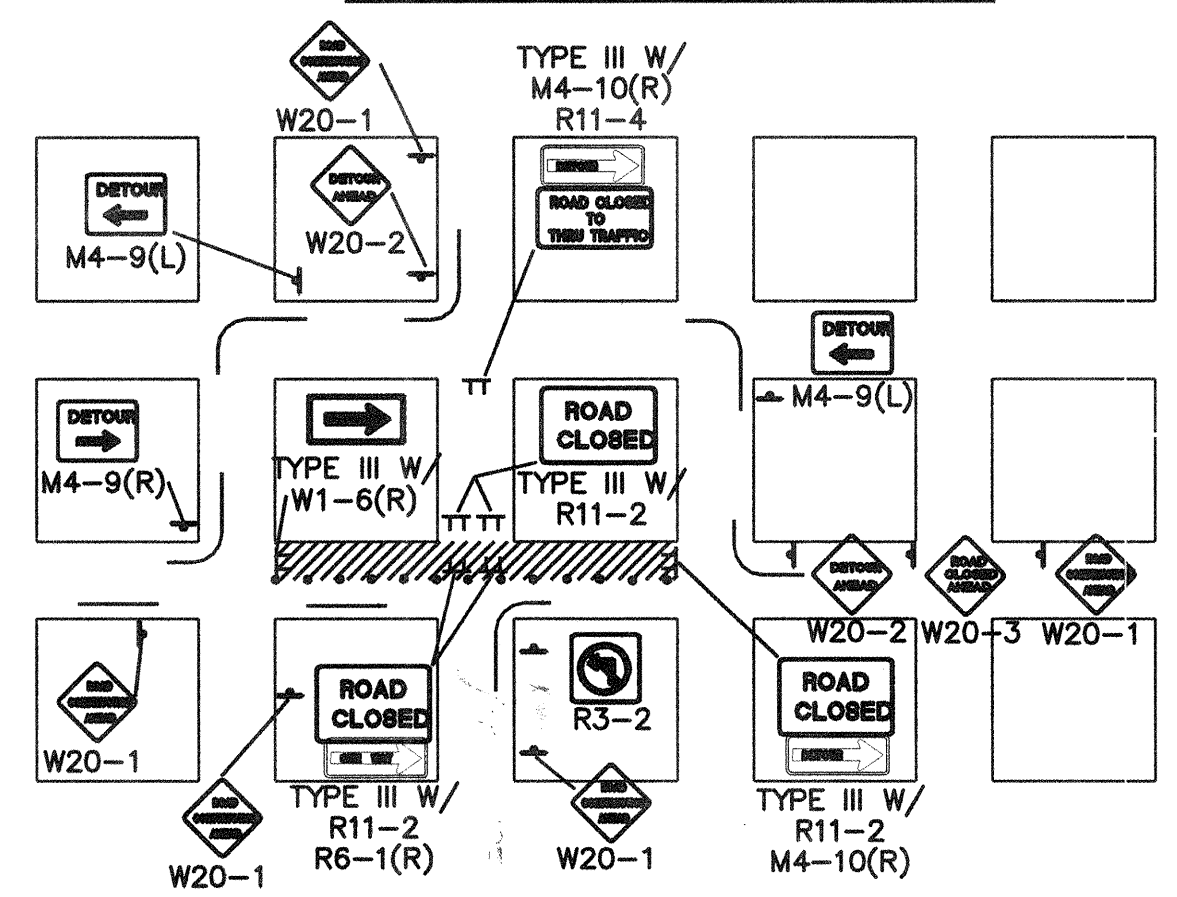

TYPICAL ONE DIRECTION DETOUR

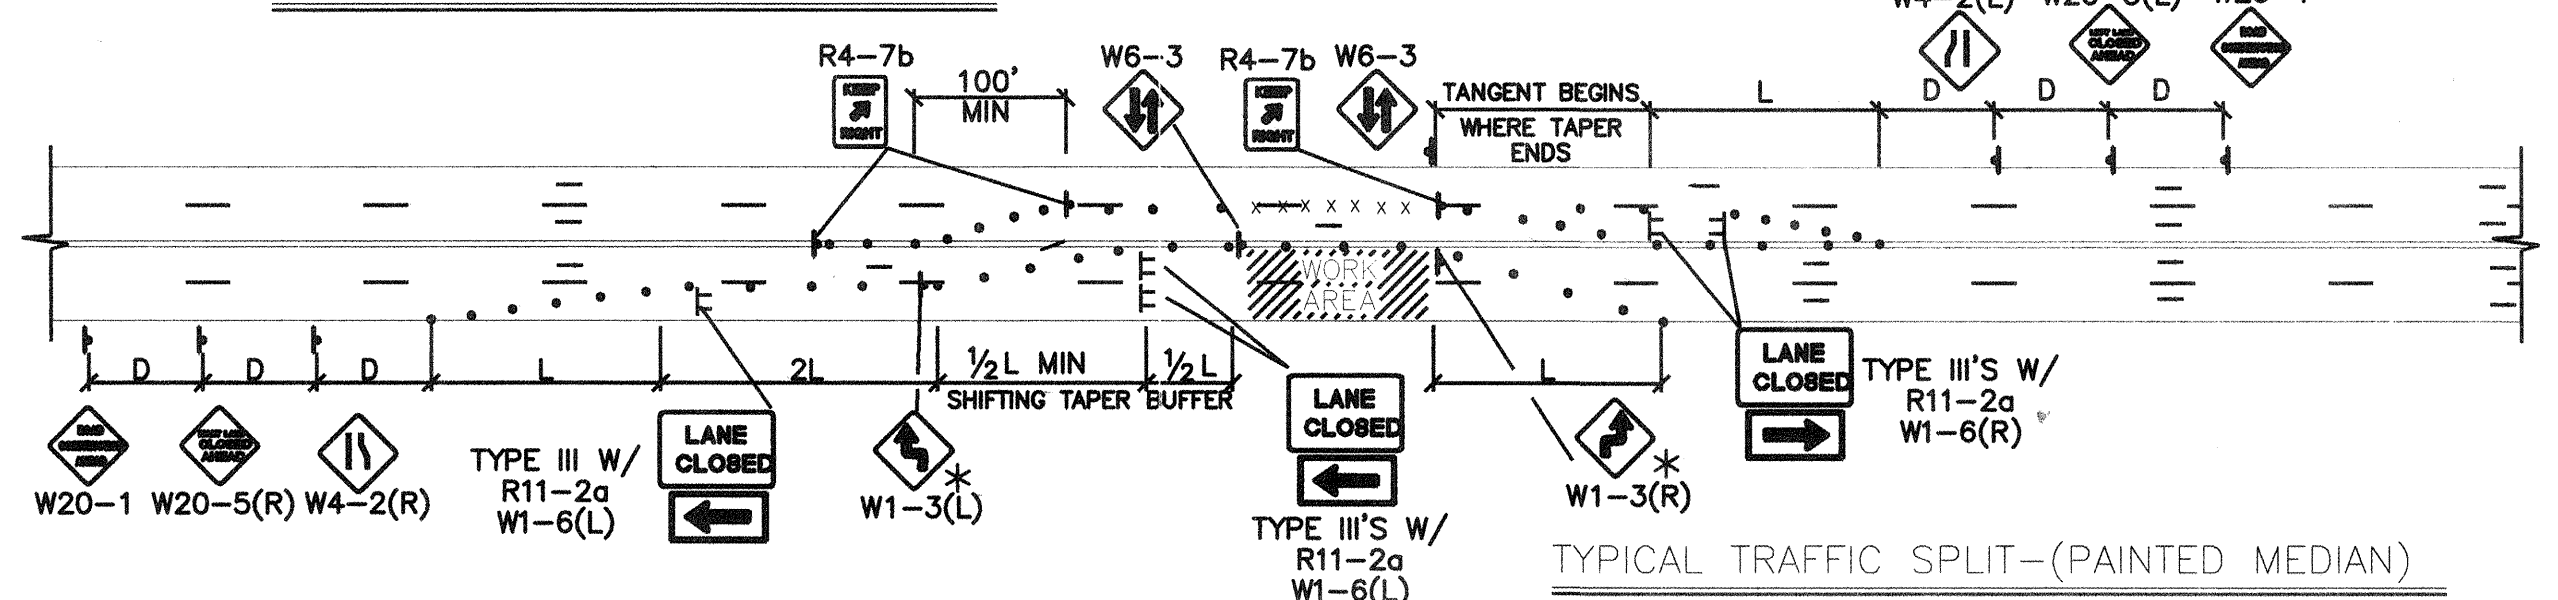


TYPICAL TRAFFIC SPLIT - (PAINTED MEDIAN)

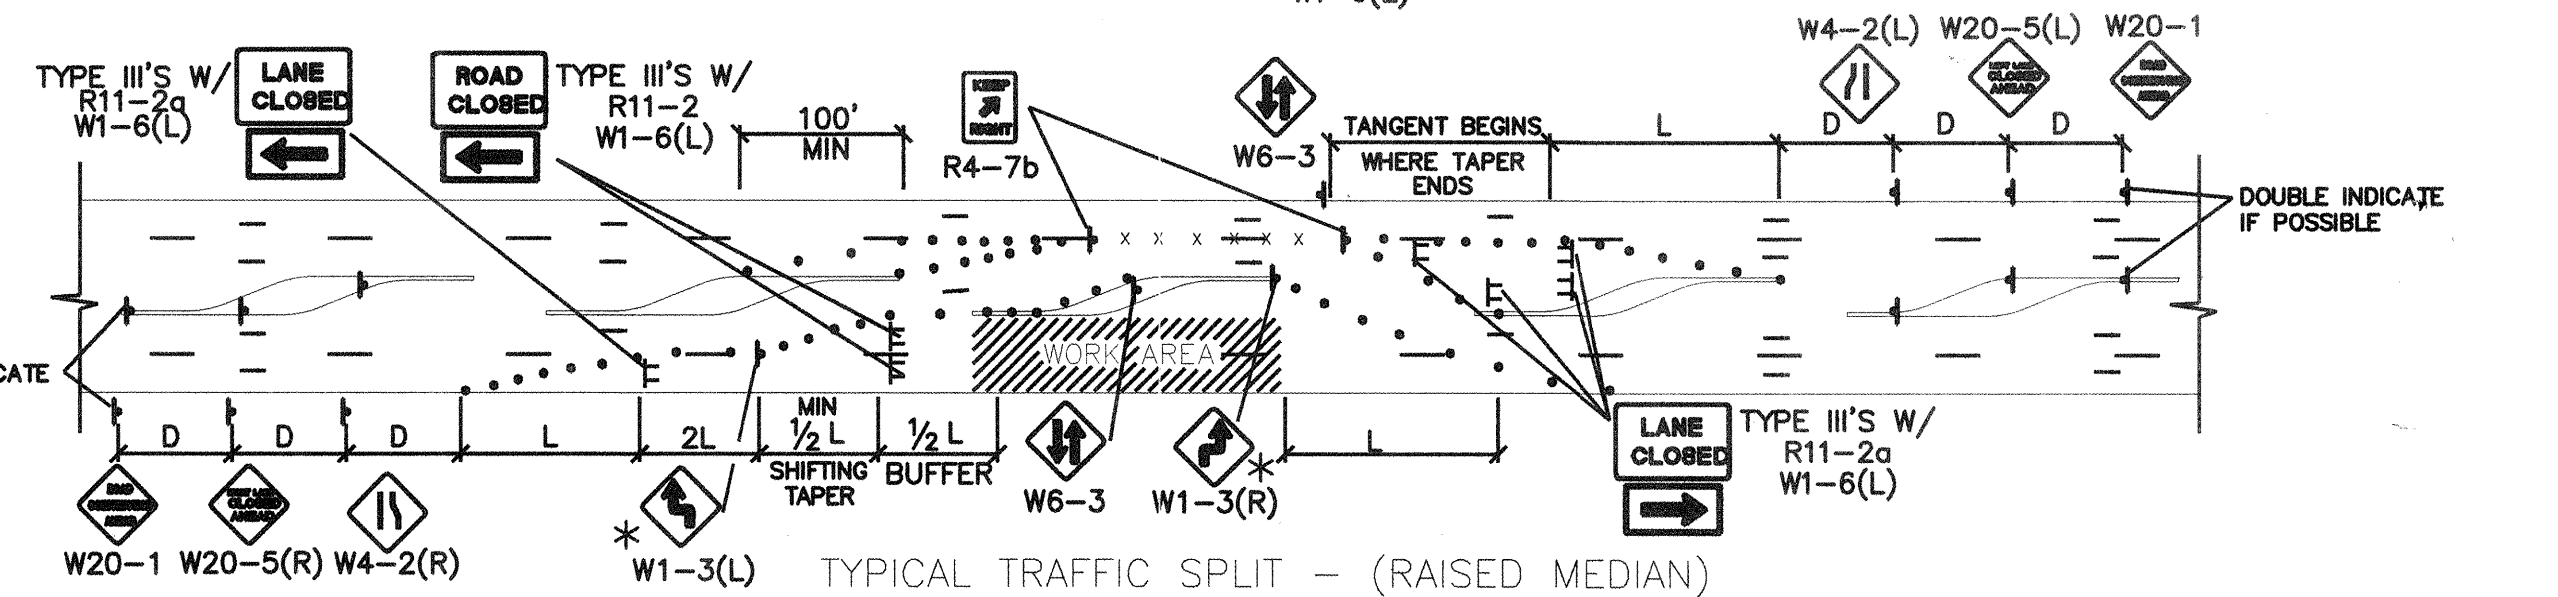

TYPICAL TRAFFIC SPLIT - (RAISED MEDIAN)


- TRAFFIC SPLIT NOTES:**
1. THE OFFSET DISTANCE MUST BE CALCULATED IN ALL SHIFTING TAPERS. THE OFFSET DISTANCES SHALL INCLUDE LANE WIDTHS PLUS MEDIAN WIDTHS.
 2. 1/2 L IS THE MINIMUM DISTANCE FOR SHIFTING TAPERS.
 3. REVERSE CURVES MAY BE IMPLEMENTED. ALL CURVE DATA SHALL BE CALCULATED.
 4. MEDIAN REMOVAL SHALL BE REQUIRED IF 1/2 L OR REVERSE CURVE IS NOT SUFFICIENT. MEDIAN REMOVAL SHALL TAKE PLACE BEFORE SPLITS.
 5. REDUCED SPEED MAY BE CONSIDERED.
 6. * USE W1-3 FOR 30 MPH OR LESS, W1-4 FOR SPEED 35 MPH OR GREATER.

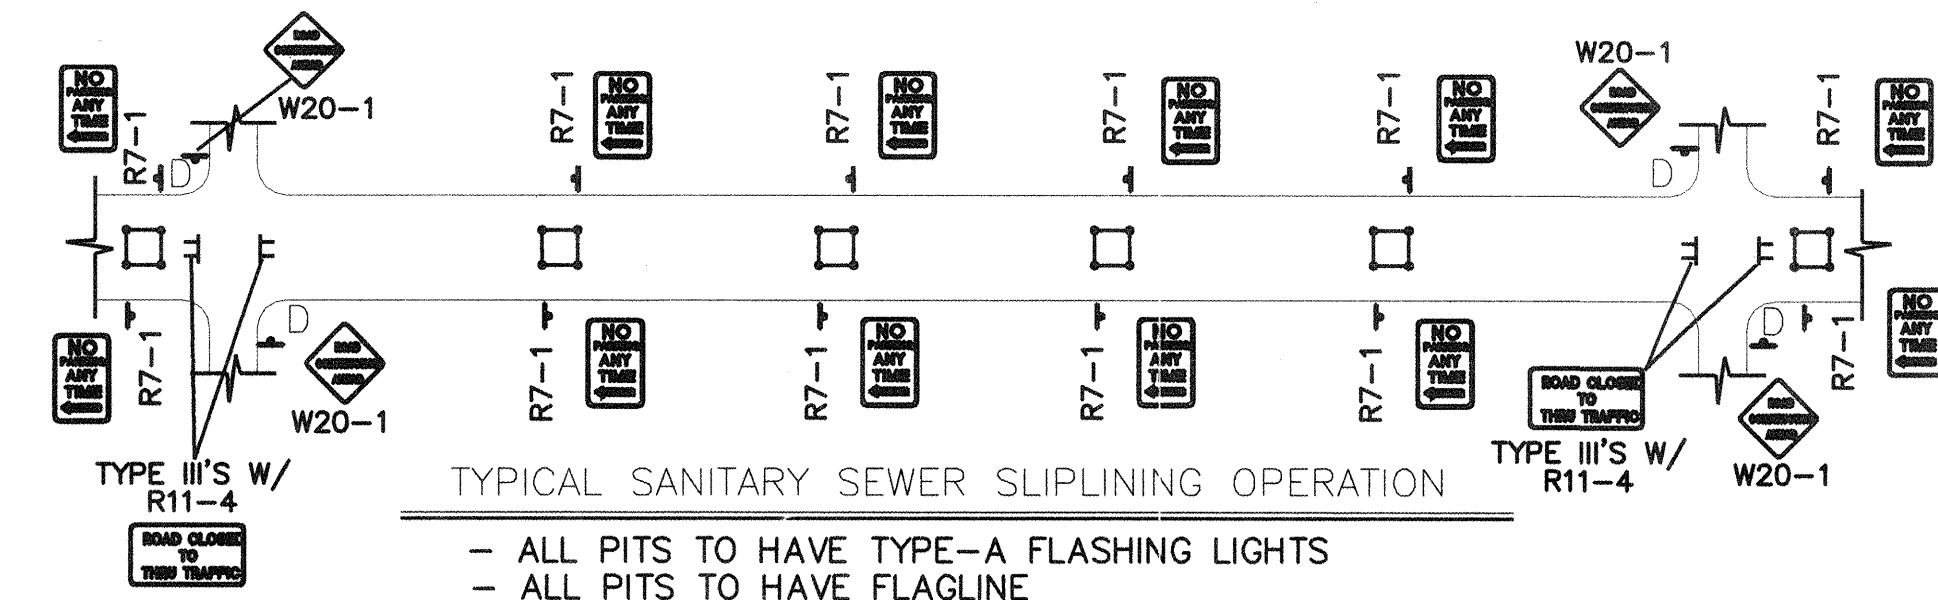

TYPICAL SANITARY SEWER SLIPLINING OPERATION


- ALL PITS TO HAVE TYPE-A FLASHING LIGHTS
- ALL PITS TO HAVE FLAGLINE

NOTE:
MAY REQUIRE LEFT LANE CLOSURE DEPENDING ON FIELD CONDITIONS.

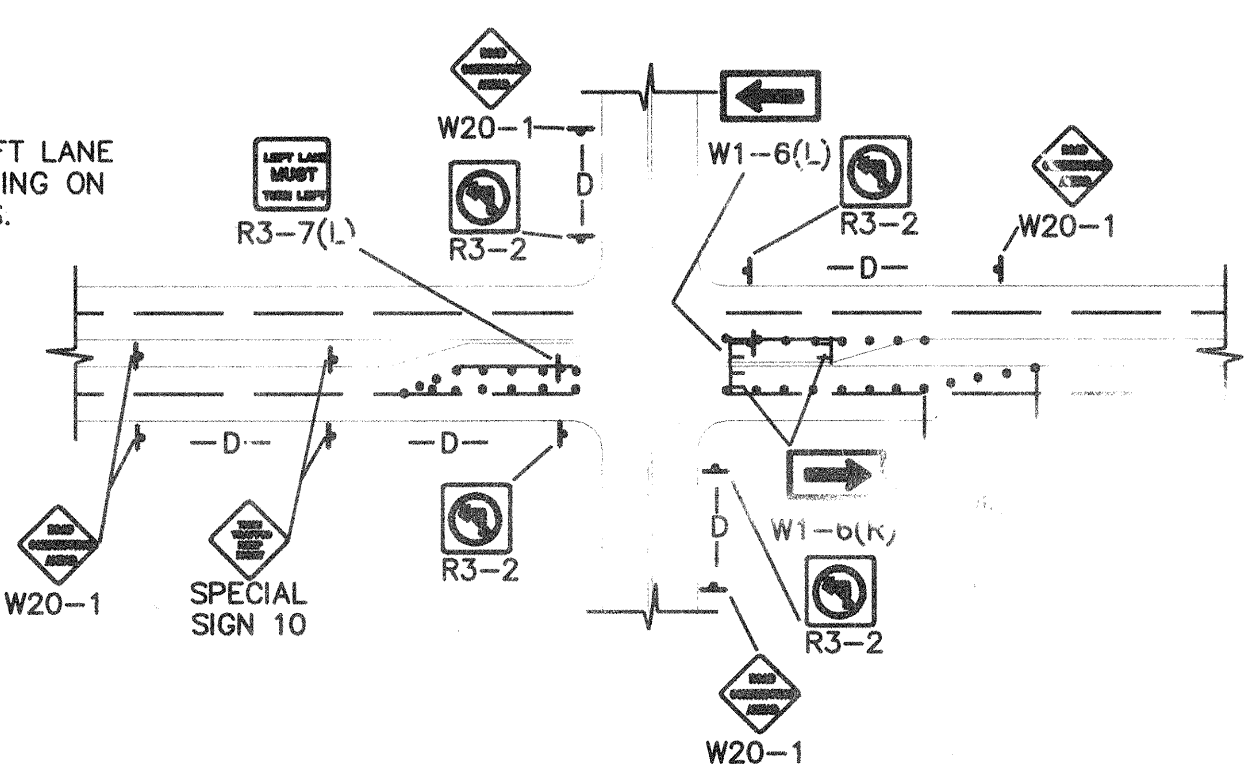


TYPICAL LANE CLOSURE AT INTERSECTION

NOTE: DEPENDING ON WORK ZONE LOCATION.

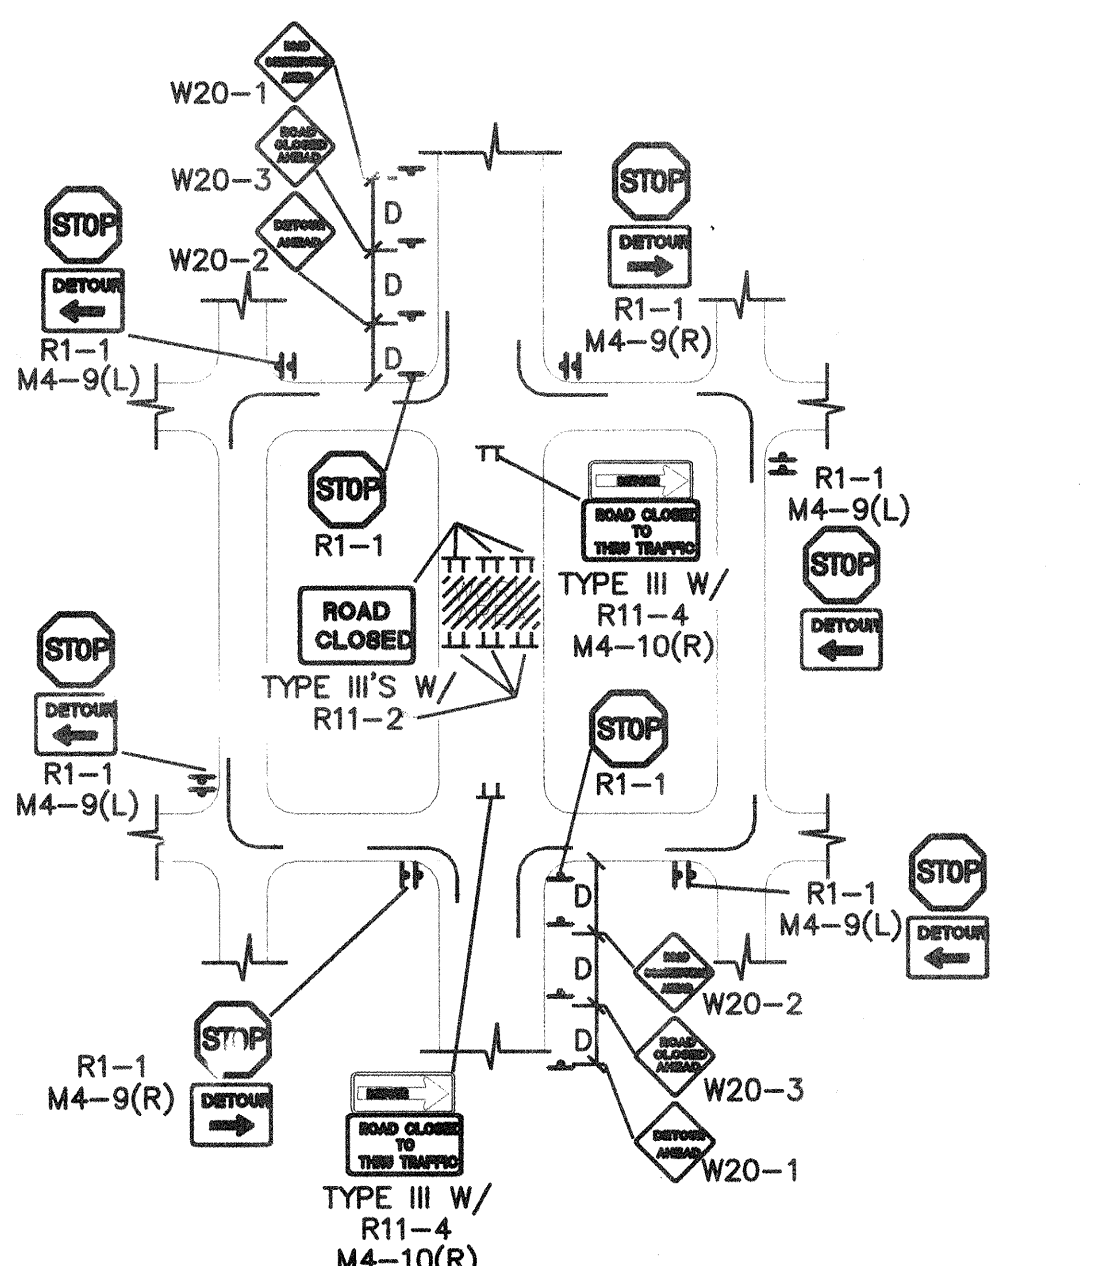


TYPICAL MID-BLOCK CLOSURE

NOTE: (R1-1) BASED ON FIELD CONDITIONS.

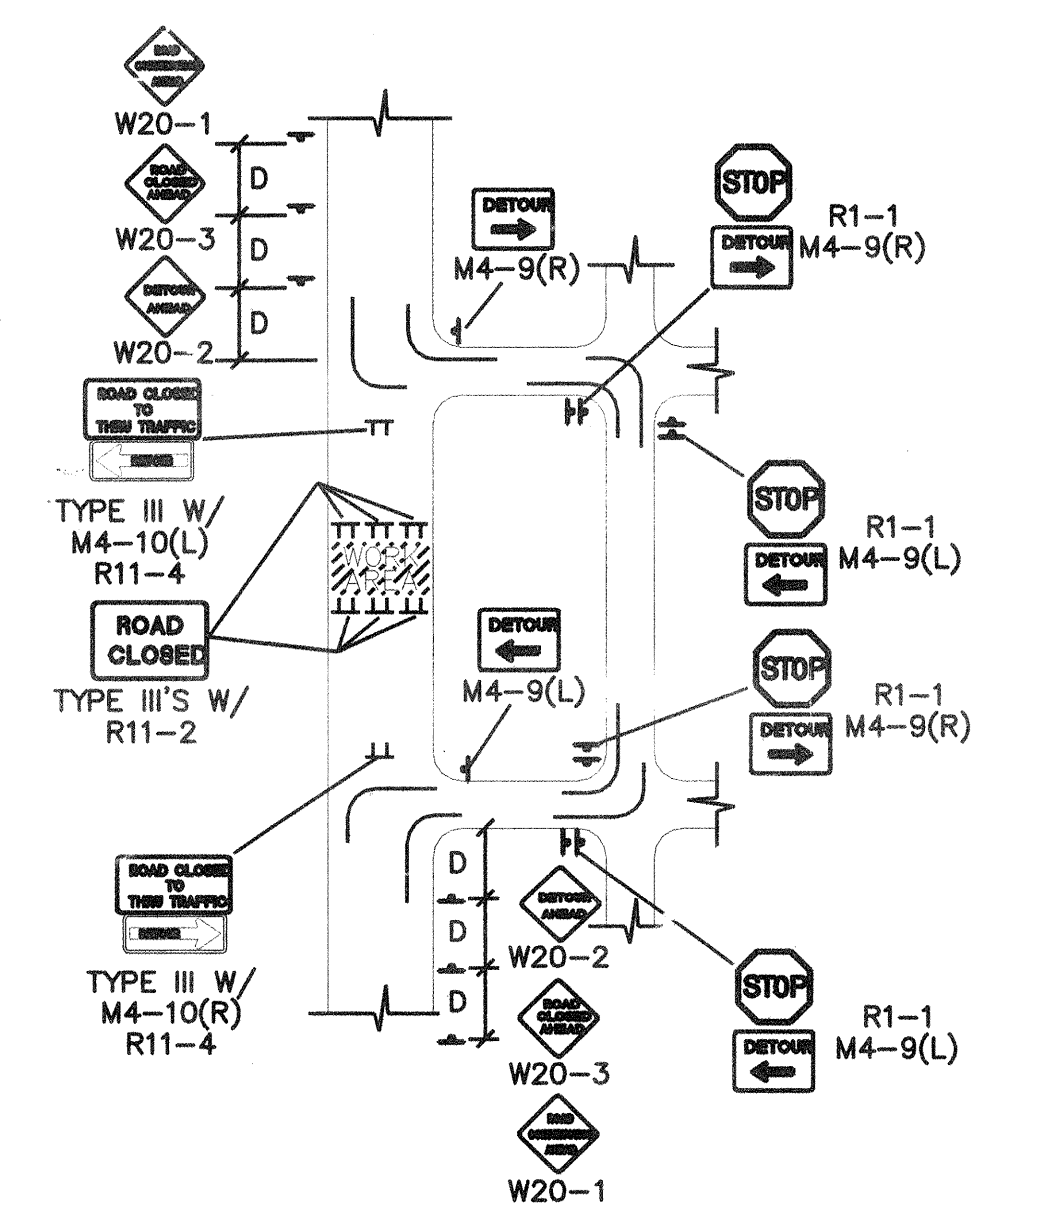


TYPICAL STREET CLOSURE


NOTE: (R1-1) BASED ON FIELD CONDITIONS.

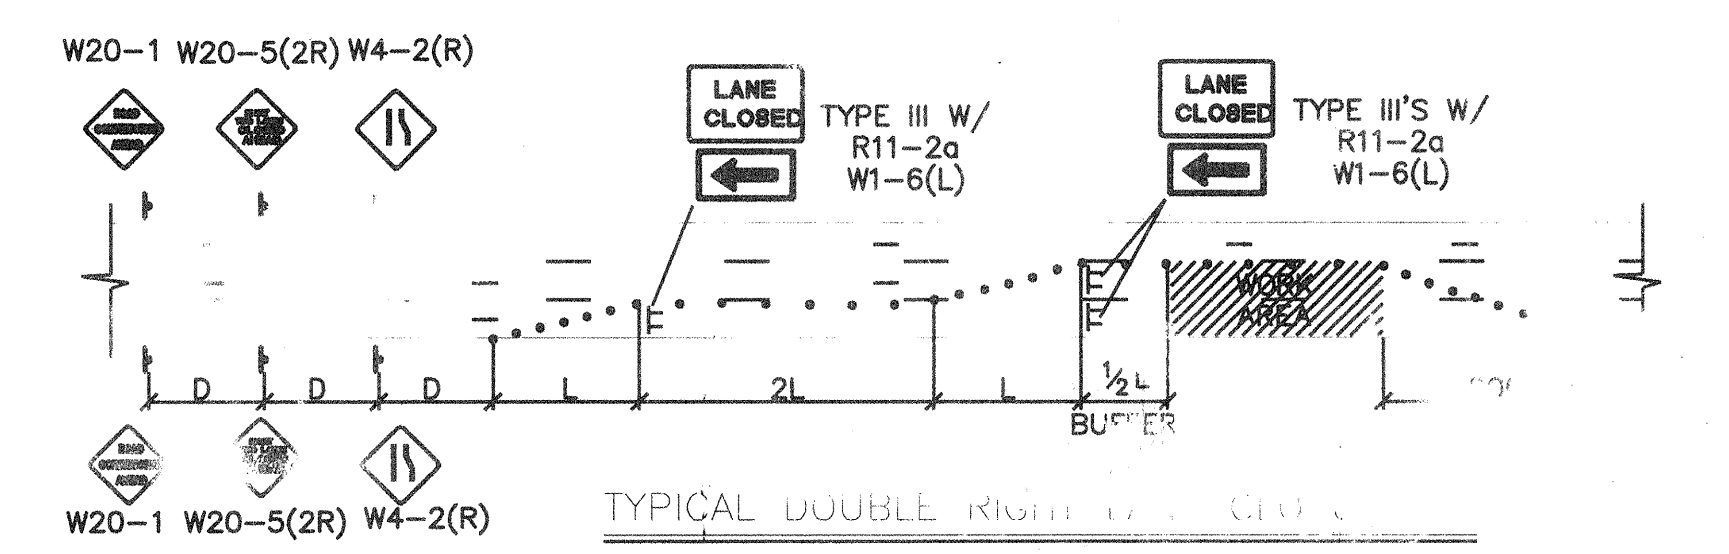


TYPICAL DOUBLE RIGHT LANE CLOSURE

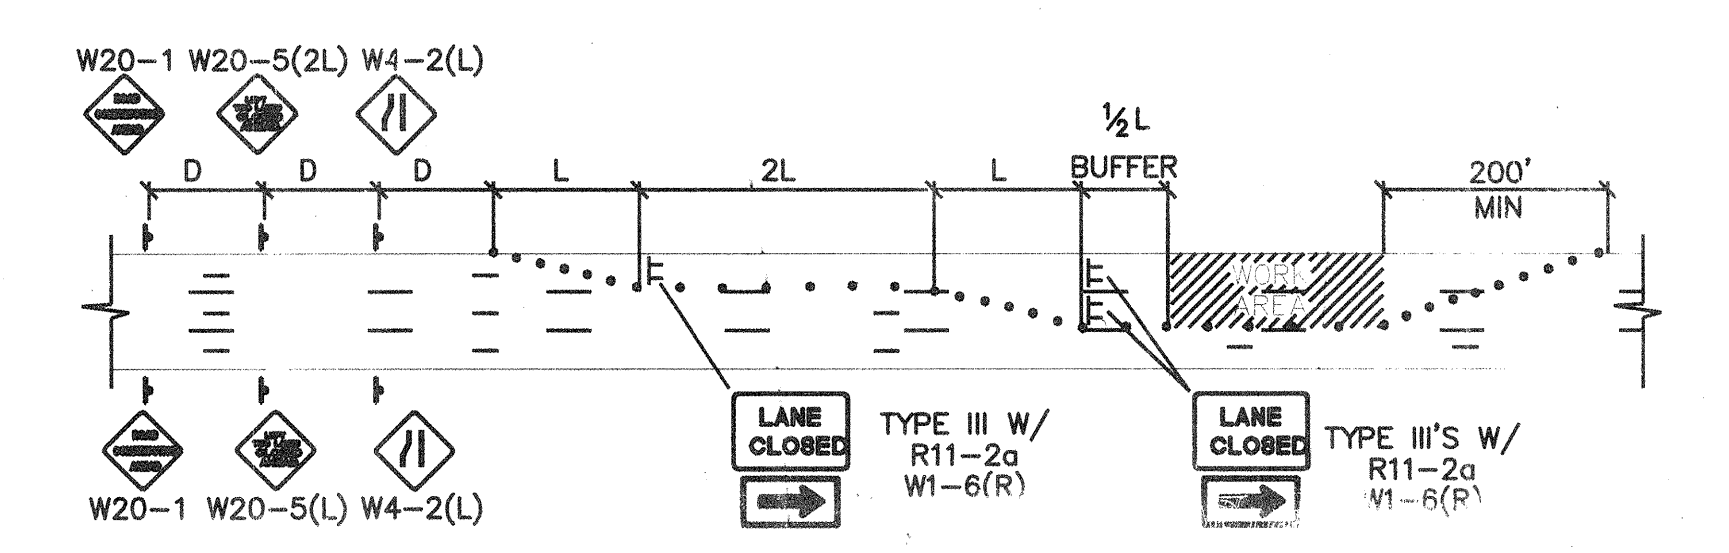

TYPICAL DOUBLE LEFT LANE CLOSURE

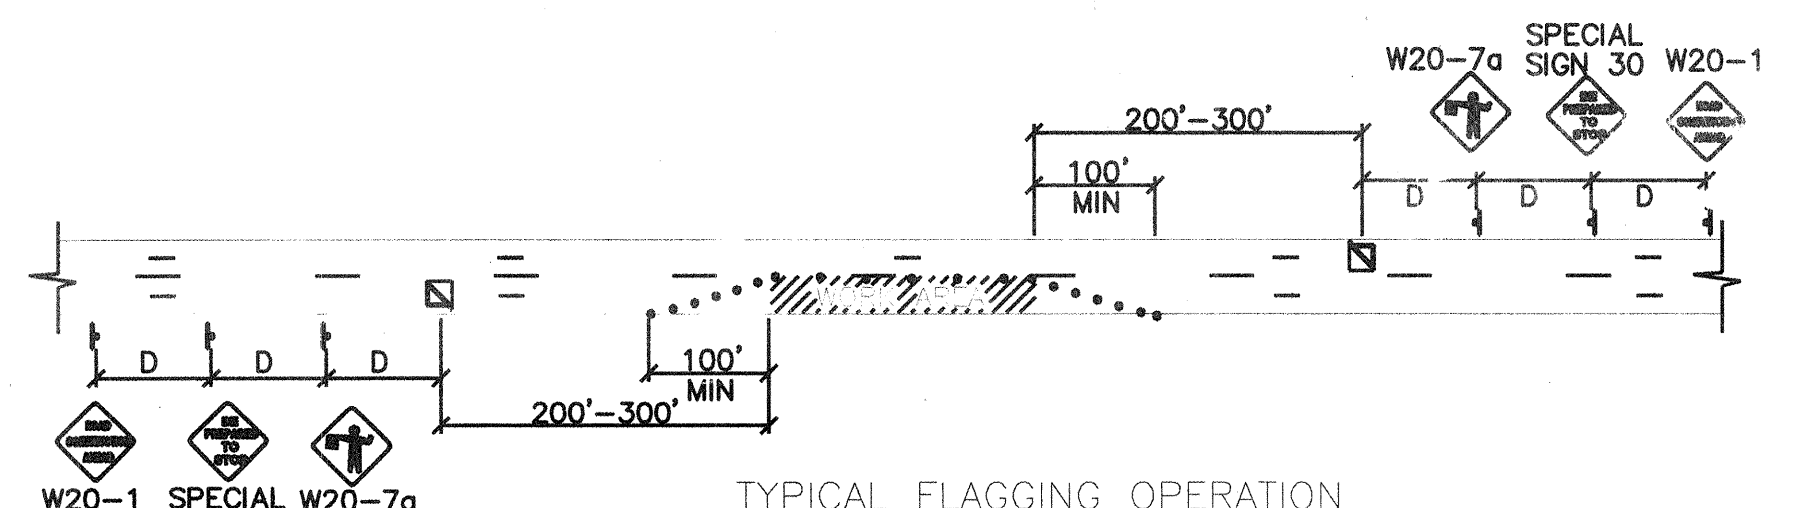

TYPICAL FLAGGING OPERATION

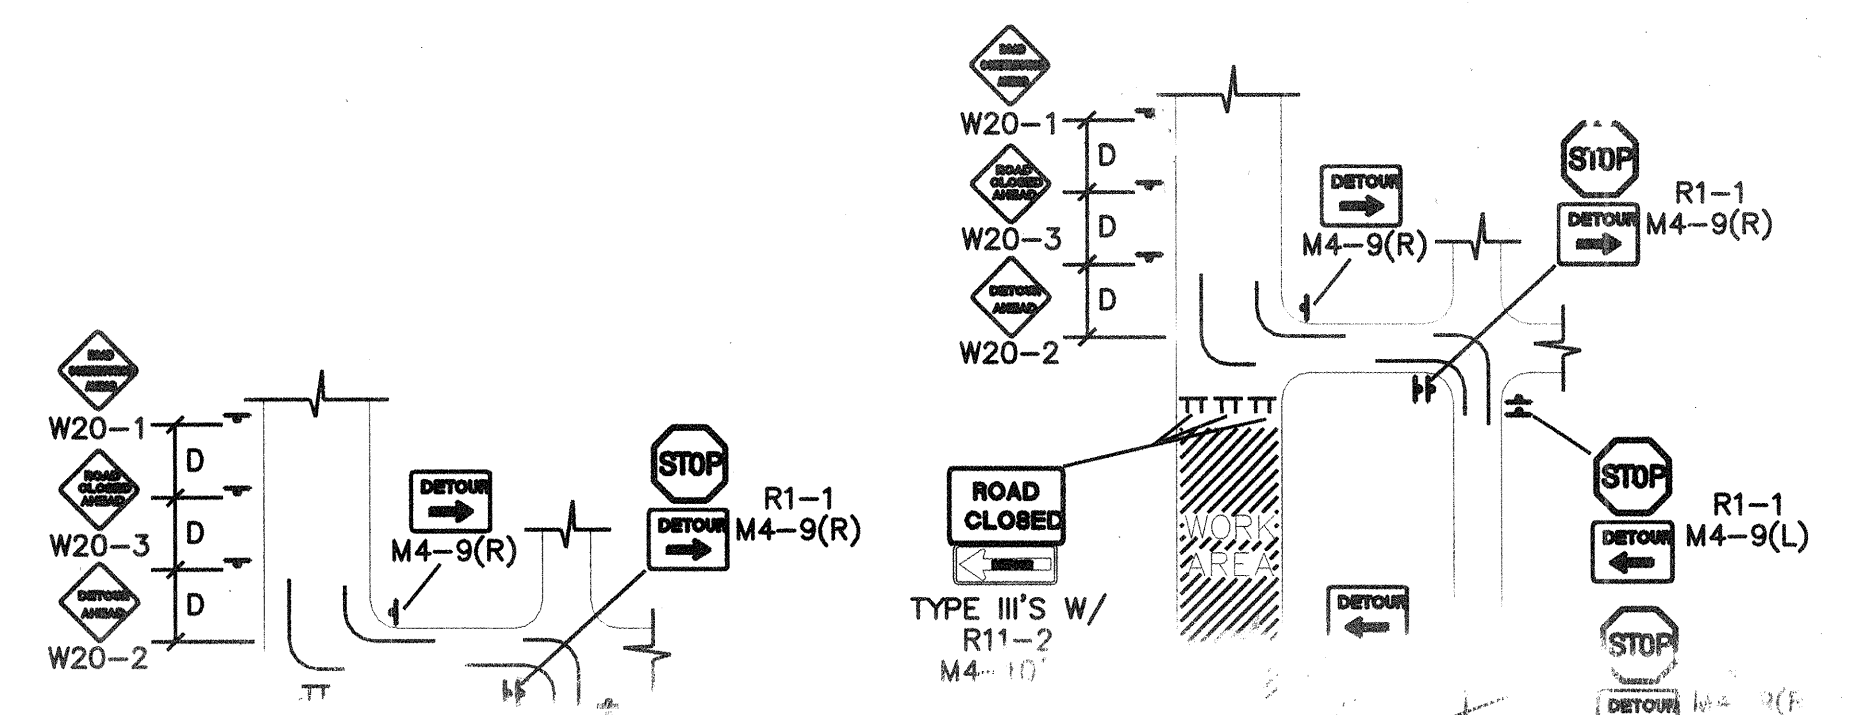

TYPICAL STREET CLOSURE

NOTE: (R1-1) BASED ON FIELD CONDITIONS.

Cohannan & Huston
Courtesy One 7500 JEFFERSON NE ALBUQUERQUE NEW MEXICO 87109
ENGINEERS PLANNERS PHOTOGRAMMETRISTS SURVEYORS SOFTWARE DEVELOPERS

CITY OF ALBUQUERQUE
PUBLIC WORKS DEPARTMENT
ENGINEERING DEVELOPMENT GROUP

TITLE: UNIT 2 - THE CANYONS AT HIGH DESERT
TYPICAL TRAFFIC CONTROL
& SIGNING EXAMPLES (REF M.U.T.C.D.)


DESIGN REVIEW COMMITTEE CITY ENGINEER APPROVAL MO./DAY/YR. MO./DAY/YR.
COA STD.

CITY PROJECT NO. 594482 ZONE MAP NO. F-23 SHEET 11 OF 11

ENGINEER'S SEAL										SUFF. INFORMATION										ARCH. MARKS										-BUILT INFORMATION																																							
										NO.										BY										DATE										CONT.																													
																																								WORK										DATE																			
																																								INSPEC										DATE																			
																																								ACCEP										DATE																			
																																								FIELD										DATE																			
																																								DRAWINGS										BY																			
																																								CORRECTED BY										DATE																			
																																								MICRO-FILM										INFORMATION																			
																																								RECORDED BY										DATE																			
																																								NO.																													

SCANNED BY
PLANNING

SP-00050909260278

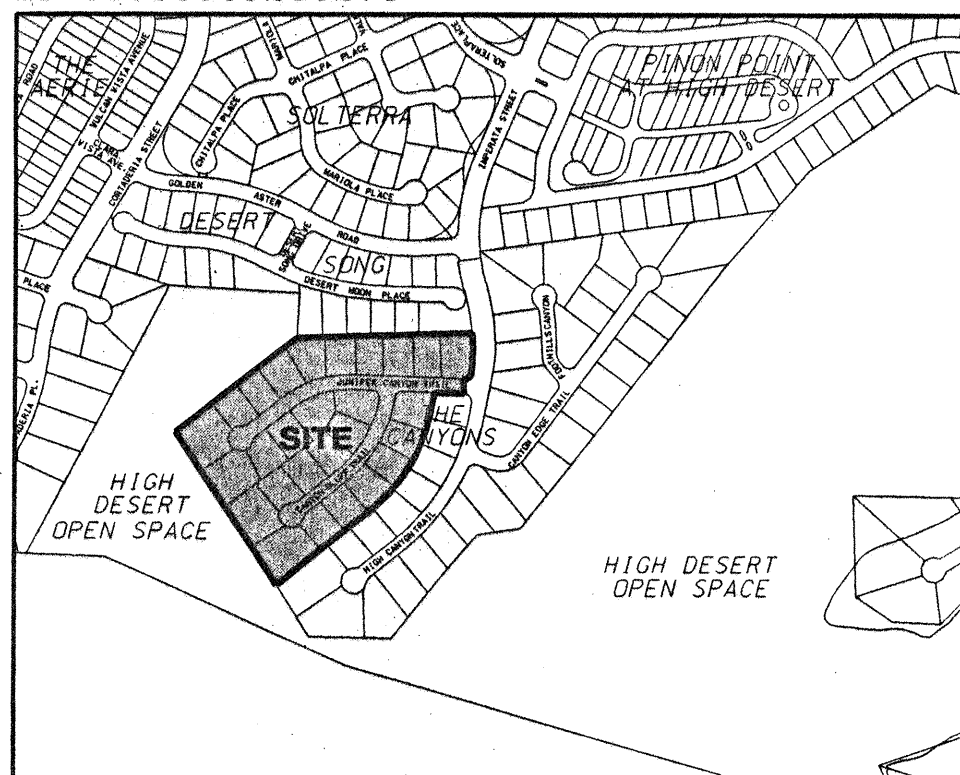

LOCATION MAP

ZONE ATLAS INDEX MAP No. F-23-Z
NOT TO SCALE

SUBDIVISION DATA

1. DRB No. 98-168, Project # 1000542, Application # 00440-00000-00680
2. Zone Atlas Index No. F-23-Z
3. Gross Subdivision Acreage: 9.6052 Acres.
4. Total Number of Lots/Tracts created: Twenty-seven (27) Lots and One (1) Tract.
5. This Plat shows existing easements.
6. Date of Survey: September, 1999
7. Total mileage of full width streets created: 0.2546 Mile.
8. Plat is located within the Elena Gallegos Grant, within Projected Section 35, T11N, R4E, N4PM.

DISCLOSURE STATEMENT

The purpose of this Plat is to subdivide Tract A of the PLAT OF THE CANYONS AT HIGH DESERT, Albuquerque, New Mexico as the same is shown and designated on the plat thereof, recorded in the office of the County Clerk of Bernalillo County, New Mexico on October 22, 1998 in Book 98C, Page 310 as Document No. 1998134990 into Twenty-seven (27) Lots and One (1) Tract and to grant easements.

PUBLIC UTILITY EASEMENTS

PUBLIC UTILITY EASEMENTS shown on this plat are for the common joint use of:

- A. PNM Electric Services for the installation, maintenance and service of underground electrical lines, transformers, and other equipment, fixtures, structures, and related facilities reasonably necessary to provide electrical service.
- B. PNM Gas services for installation, maintenance, and service of natural gas lines, valves and other equipment and facilities reasonably necessary to provide natural gas.
- C. U.S. West for the installation, maintenance, and service of all buried communication lines and other related equipment and facilities reasonably necessary to provide communication services, including but not limited to above ground pedestals and closures.
- D. Comcast Cable for the installation, maintenance, and service of such lines, cable, and other related equipment and facilities reasonably necessary to provide cable TV service.

Included is the right to build, rebuild, construct, reconstruct, locate, relocate, change, remove, modify, renew, operate, and maintain facilities for the purposes described above, together with free access to, from, and over said easements, including sufficient working area space for electric transformers, with the right and privilege to trim and remove trees, shrubs or bushes which interfere with the purposes set forth herein. No building, sign, pool, (above ground or subsurface), hot tub, concrete or wood pool decking, or other structure shall be erected or constructed on said easements, nor shall any well be drilled or operated thereon. Property owners shall be solely responsible for correcting any violations of National Electric Safety Code caused by construction of pools, decking, or any structures adjacent to or near easements shown on this plat.

DESCRIPTION

A certain tract of land situate within the Elena Gallegos Grant, within the northwest one-quarter (NW 1/4) of projected Section 35, Township 11 North, Range 4 East, New Mexico Principal Meridian, Bernalillo County, Albuquerque, New Mexico, said tract being and comprising all of Tract A of the PLAT OF THE CANYONS AT HIGH DESERT, Albuquerque, New Mexico, as the same is shown and designated on the plat thereof, recorded in the office of the County Clerk of Bernalillo County, New Mexico on October 22, 1998 in Book 98C, Page 310 as Document No. 1998134990 and being more particularly described by New Mexico State Plane Grid Bearings (Central Zone NAD 1927 Datum) and ground distances as follows:

BEGINNING at the northeast corner of said Tract A, a point on a curve on the westerly right-of-way line of High Canyon Trail (Private Street) whence the Albuquerque City Survey (ACS) Monument "1-024 (Reset) 1995" a 3-1/4 inch aluminum cap cemented in top of a 2-1/2 inch pipe (having New Mexico State Plane Coordinates Central Zone NAD27 of X=431,318.50 and Y=1,513,365.05 bears N28°38'23"E, a distance of 6421.85 feet and from said point of beginning running thence along the easterly boundary line of said Tract A and also along said right-of-way line, 123.58 feet along the arc of a curve to the right having a radius of 661.00 feet and a chord which bears S00°19'59"W, a distance of 123.40 feet to a point of compound curvature; thence, 37.62 feet along the arc of a curve to the right having a radius of 25.00 feet and a chord which bears S48°48'14"W, a distance of 34.17 feet to a point of non-tangency; thence, S02°34'50"E, a distance of 46.14 feet to a point, thence leaving said right-of-way line and running thence along the easterly boundary line of said Tract A, N88°04'54"W, a distance of 92.21 feet to a point; thence, S11°00'19"W, a distance of 55.02 feet to a point of curvature; thence, S86°10'00"W, a distance of 557.70 feet along the arc of a curve to the right having a radius of 557.00 feet and a chord which bears S30°53'40"W, a distance of 378.98 feet to a point of tangency; thence, S50°47'00"W, a distance of 370.05 feet to the most southerly corner of said Tract A, thence running along the southwesterly boundary line of said Tract A, N33°07'39"W, a distance of 585.37 feet to the most westerly corner of said Tract A, thence running along the northwesterly boundary line of said Tract A, N52°05'37"E, a distance of 480.00 feet to a point; thence, N88°13'46"E, a distance of 549.75 feet to the point and place of beginning.

Tract contains 9.6052 acres, more or less.

FREE CONSENT AND DEDICATION

The foregoing Plat of that certain tract of land situate within the Elena Gallegos Grant, within the northwest one-quarter (NW 1/4) of projected Section 35, Township 11 North, Range 4 East, New Mexico Principal Meridian, Bernalillo County, Albuquerque, New Mexico, being and comprising all of Tract A of the PLAT OF THE CANYONS AT HIGH DESERT, Albuquerque, New Mexico as the same is shown and designated on the plat thereof, recorded in the office of the County Clerk of Bernalillo County, New Mexico on October 22, 1998 in Book 98C, Page 310 as Document No. 1998134990, now comprising Lots 39 through 65 inclusive and Tract A of UNIT 2, THE CANYONS AT HIGH DESERT, is with the free consent and in accordance with the desires of the undersigned owner(s) and/or proprietor(s) thereof and said owner(s) and/or proprietor(s) do hereby grant: All access, Utility and Drainage Easements hereon including the right to construct, operate, inspect, and maintain facilities therein; and all Public Utility easements shown hereon for the common and joint use of Gas, Electric, Power and Communication Services for buried distribution lines, conduits, and pipes for underground utilities where shown or indicated, including the right of ingress and egress for construction and maintenance, and the right to trim interfering trees and shrubs. The City has the right to enter upon the Grant as Property at any time and perform whatever inspection, installation, maintenance, repair, modification or removal ("work") it deems appropriate without liability to the City. If the Work effects any improvements or encroachments made by the Grantee, the City will not be financially or otherwise responsible for rebuilding or repairing of improvements or encroachments. If in the opinion of the City, the Work to be performed by the City could endanger the structural integrity or otherwise damage the improvements or encroachments, the Grantee shall, at its own expense, take whatever protective measures are required to safeguard the improvements or encroachments. Said owner(s) and/or proprietor(s) do hereby consent to all of the foregoing and do hereby certify that this subdivision is their free act and deed.

HIGH DESERT INVESTMENT CORPORATION

BY: Douglas H. Collister
Douglas H. Collister, President

State of New Mexico)

County of Bernalillo)

This Instrument was acknowledged before me on 22 day of MAY, 2000 by Douglas H. Collister, President of High Desert Investment Corporation.My Commission Expires: 8/14/02 Randa Mills
Notary Public

NOTES

1. Bearings are New Mexico State Plane Grid Bearings (Central Zone) NAD 1927 Datum also being the same as Bearings shown on the plat of THE CANYONS AT HIGH DESERT, Albuquerque, New Mexico, recorded October 22, 1998 Book 98C, Page 310 as Document No. 1998134990.
2. Distances are ground distances.
3. All easements of record are shown or referenced.
4. Centerline (in lieu of R/W monumentation) to be installed at all centerline PC's, PT's, angle points and street intersections prior to acceptance of subdivision improvements and will consist of a standard four-inch (4") aluminum alloy cap stamped "City of Albuquerque", "Centerline Monumentation", "Survey Marker", "Do Not Disturb", PLS# 6544.
5. No more than 13 wood burning fireplaces are permitted in UNIT 2 OF THE CANYONS AT HIGH DESERT. There is no limit to the number of gas fired fireplaces in the plan area.
6. This subdivision lies within the City of Albuquerque. Water and sanitary sewer capabilities are based on the City of Albuquerque's facilities. Water and sanitary sewer infrastructure improvements must be approved by the City of Albuquerque.
7. Tract A (1.4941 acres) is granted as a public sanitary sewer, water, and subsurface storm drain easement, to be operated and maintained by the City of Albuquerque. Tract A is also granted as a permanent private access easement, reserved for, granted to, and to be maintained by the High Desert Residential Owners Association.
8. Building setbacks shall be in accordance with the approved High Desert Sector Development Plan (zoned SU-2 HD/RT High Desert).

SURVEYOR'S CERTIFICATION

I, A. Dwain Weaver, a registered Professional New Mexico Surveyor, certify that I am responsible for this survey and that this plat was prepared by me or under my supervision, shows all easements of record, and conforms to the Minimum Requirements of the Board of Registration for Professional Engineers and Professional Surveyors in February 1994 and meets the minimum requirements for monumentation and surveys contained in the Albuquerque Subdivision Ordinance, and is true and accurate to the best of my knowledge and belief.

A. Dwain Weaver
A. Dwain Weaver
New Mexico Professional Surveyor 6544

Date: May 18, 2000

PLAT OF
UNIT 2
THE CANYONS
AT HIGH DESERT
(A REPLAT OF TRACT A
THE CANYONS AT HIGH DESERT)
ALBUQUERQUE, NEW MEXICO
MAY, 2000

APPROVALS

PLANNING DIRECTOR	6/8/00
CITY ENGINEER	5-31-00
A. M. A. F. C.	5-31-00
TRAFFIC ENGINEER	5-31-00
CITY SURVEYOR	5-23-00
UTILITY DEVELOPMENT DEPARTMENT	5/31/00
PARKS & RECREATION	05-30-00
U.S. WEST COMMUNICATIONS	5-30-00
COMCAST CABLE	5-30-00
PNM ELECTRIC SERVICES	5-30-00
PNM GAS SERVICES	5/22/00
HIGH DESERT RESIDENTIAL OWNERS ASSOCIATION, INC.	

TAX CERTIFICATION

THIS IS TO CERTIFY THAT TAXES ARE CURRENT AND PAID ON
UPC # 1-023-061-178457-20502PROPERTY OWNER OF RECORD High Desert Investment Corp
Randa Mills 6/8/2000
BERNALILLO COUNTY TREASURER'S OFFICE DATE

PNM STAMP

In approving this plat, PNM Electric Services and Gas Services (PNM) did not conduct a Title Search of the properties shown hereon. Consequently, PNM does not waive nor release any easement or easement rights to which it may be entitled.

CRN# 594482

Bohannon & Huston



Courtyard One 7500 JEFFERSON NE Albuquerque NEW MEXICO 87109


ENGINEERS PLANNERS PHOTOGRAMMETRISTS SURVEYORS SOFTWARE DEVELOPERS

SHEET 1 OF 2

BHIMAN-00352\SURVEY\B02\GRAPHICS\FINAL PLAT
00352\FINAL PLAT.DGN

JOB NO. 00352A1 02

2507

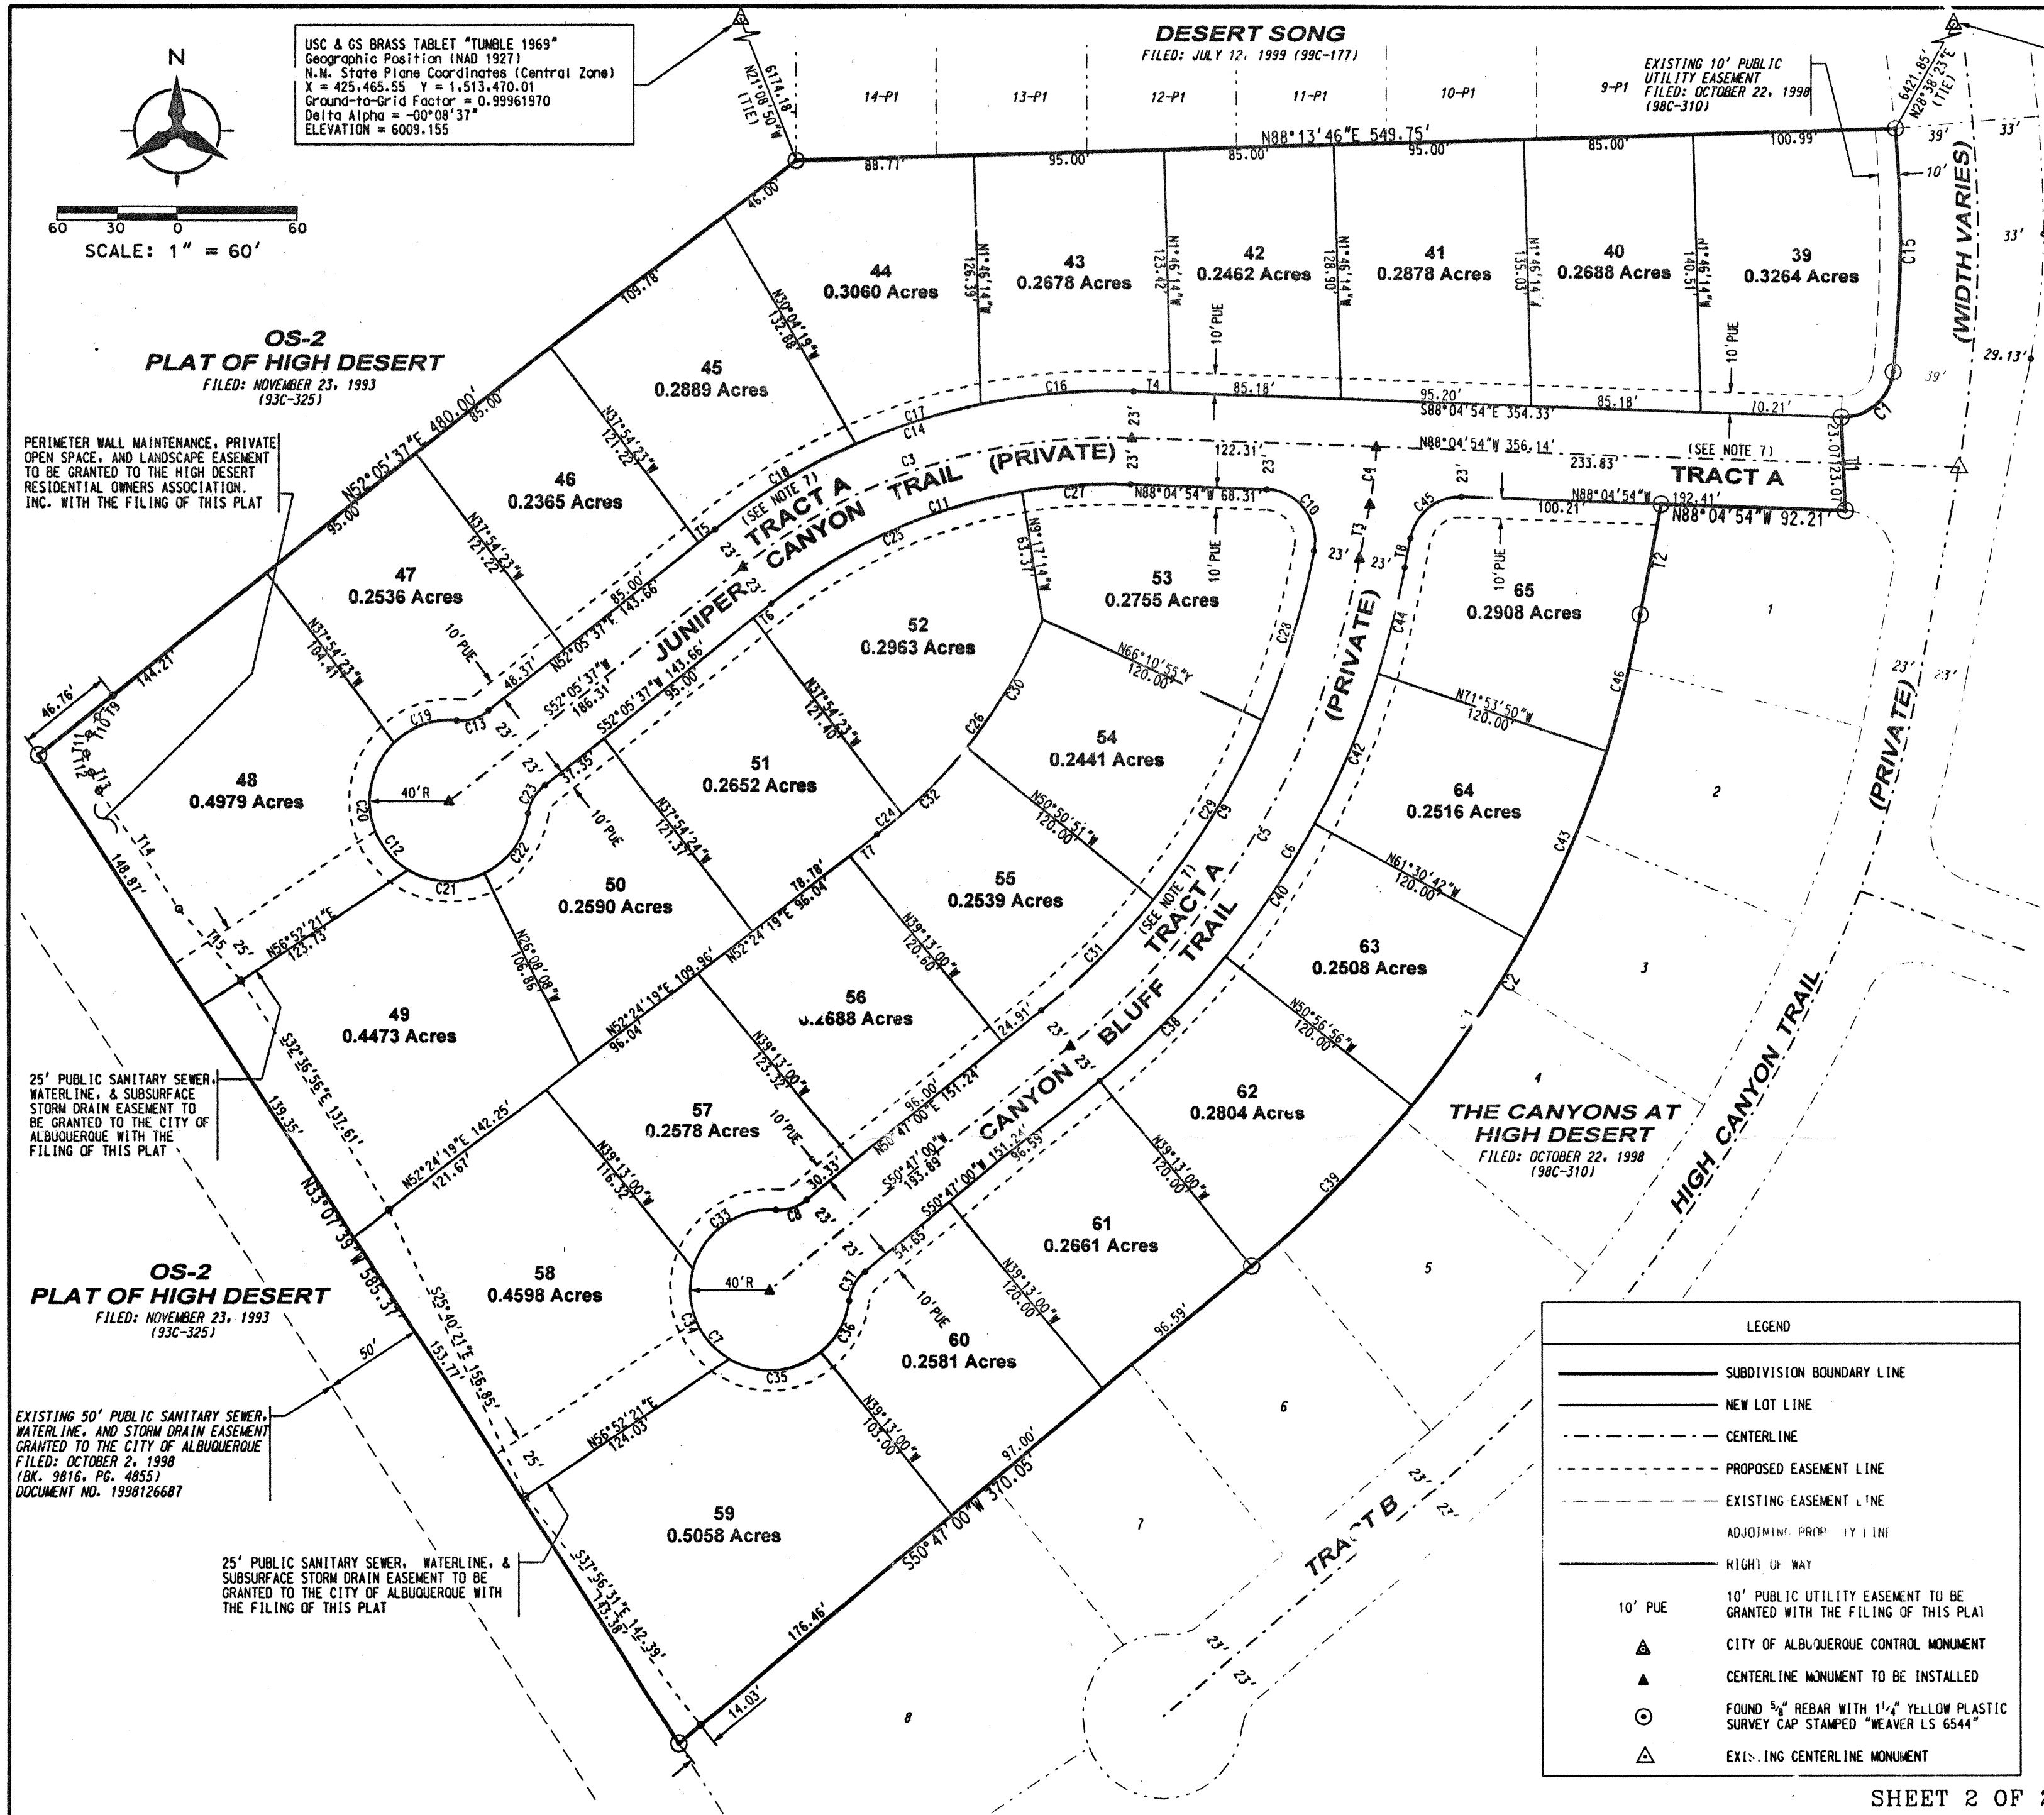

2000056897
Page: 2 of 2
86/98/2008 02:48P
Bk-2008C Pg-154

Judy D. Woodward Bern. Co. PLAT R 12.99

**PLAT OF
UNIT 2
THE CANYONS
AT HIGH DESERT**
(A REPLAT OF TRACT A
THE CANYONS AT HIGH DESERT)
ALBUQUERQUE, NEW MEXICO
MAY, 2000

ACS Aluminum Tablet stamped "1-024 reset 1995"
Geographic Position (NAD 1927)
N.M. State Plane Coordinates (Central Zone)
X = 431,318.50 Y = 1,513,365.05
Ground-to-Grid Factor = 0.9996059
Delta Alpha = -00°07'56"

CURVE DATA

STA.	DELTA	TANGENT	ARC	RADIUS	CHORD	CHORD BRG
C1	86°13'45"	23.41	37.62	25.00	34.48	S 48°48'14" W
C2	39°46'41"	201.51	386.70	557.00	378.38	S 30°53'40" W
C3	39°49'30"	108.67	208.52	300.00	204.35	S 2°00'11" W
C4	9°05'16"	14.31	28.55	180.00	28.52	S 6°27'11" W
C5	39°46'41"	149.78	27.42	414.00	281.69	S 10°53'40" W
C6	39°46'41"	158.10	30.39	437.00	297.33	S 0°53'39" W
C7	266°55'41"	186.35	40.00	58.06	N 8°13'00" W	
C8	47°27'51"	8.77	16.69	22.00	16.29	N 72°30'55" E
C9	39°38'45"	140.95	270.55	391.00	265.19	N 30°57'37" E
C10	99°13'08"	29.38	43.29	25.00	38.08	N 38°28'20" W
C11	39°49'30"	100.34	192.54	277.00	188.68	S 72°00'21" W
C12	266°55'41"	186.35	40.00	58.06	N 37°54'32" E	
C13	43°27'51"	8.77	16.69	22.00	16.29	N 73°49'32" E
C14	39°49'30"	117.00	224.51	323.00	220.02	N 72°00'21" E
C15	10°42'44"	61.97	123.58	661.00	123.40	S 0°19'11" W
C16	13°36'59"	38.56	76.76	323.00	76.58	S 85°06'37" W
C17	11°36'11"	37.85	65.48	323.00	65.37	S 72°29'33" W
C18	14°35'14"	41.36	82.27	323.00	82.04	S 59°23'23" W
C19	49°10'38"	18.30	34.33	10.00	33.29	S 70°58'08" W
C20	105°27'07"	52.56	73.62	40.00	63.66	S 6°20'45" E
C21	57°03'49"	21.75	39.84	40.00	38.21	S 87°36'13" E
C22	55°14'06"	20.93	38.56	40.00	37.09	S 36°14'49" E
C23	43°27'51"	8.77	16.69	22.00	16.29	S 30°21'41" W
C24	3°25'48"	8.11	16.22	271.00	16.22	S 50°41'26" W
C25	28°37'09"	76.66	138.36	277.00	136.93	N 66°24'11" E
C26	25°09'28"	60.47	118.99	271.00	118.04	S 36°23'47" W
C27	11°12'21"	27.17	54.17	277.00	54.09	N 86°18'50" E
C28	12°40'49"	43.44	86.53	391.00	86.36	S 17°28'39" W
C29	15°20'06"	52.64	104.65	391.00	104.34	S 31°29'06" W
C30	15°20'06"	36.48	72.53	271.00	72.32	N 31°29'06" E
C31	11°37'51"	39.82	79.37	391.00	79.23	S 44°58'05" W
C32	13°15'10"	31.48	62.68	271.00	62.54	N 45°46'44" E
C33	78°36'12"	32.74	54.88	40.00	50.67	S 54°56'45" W
C34	74°42'58"	30.54	52.16	40.00	48.54	S 21°42'50" E
C35	70°34'24"	28.31	49.27	40.00	46.21	N 85°38'29" E
C36	43°02'07"	15.77	30.04	40.00	29.34	N 28°50'13" E
C37	43°07'50"	8.77	16.69	22.00	16.29	S 29°03'05" W
C38	11°43'57"	44.90	89.48	437.00	89.33	N 44°55'02" E
C39	11°43'57"	57.23	114.06	557.00	113.86	S 44°55'02" W
C40	10°29'06"	40.10	79.97	437.00	79.86	N 33°48'31" E
C41	10°30'06"	51.19	102.09	557.00	101.95	S 33°48'00" W
C42	10°33'01"	40.35	80.47	437.00	80.35	N 23°17'27" E
C43	10°30'53"	51.25	102.22	557.00	102.08	S 23°17'31" W
C44	7°00'38"	26.77	53.47	437.00	53.44	N 14°30'38" E
C45	80°54'47"	21.31	35.31	25.00	32.44	S 51°27'43" W
C46	7°01'45"	31.21	68.33	557.00	68.29	S 14°31'12" W

TANGENT DATA

No.	BEARING	DISTANCE
T1	S 2°34'50" E	46.14
T2	S 11°00'19" W	55.02
T3	S 11°00'19" W	26.65
T4	N 88°04'54" W	18.57
T5	S 52°05'37" W	10.29
T6	N 52°05'37" E	11.31
T7	N 52°24'19" E	17.25
T8	S 11°00'19" W	14.51
T9	S 36°55'50" W	2.75
T10	S 27°37'36" W	9.58
T11	S 6°49'27" W	9.40
T12	S 15°08'05" W	9.65
T13	S 22°00'07" W	9.81
T14	S 34°32'22" W	71.13
T15	S 41°02'48" E	47.06

Bohannon & Huston

Courtyard One 7500 JEFFERSON NE Albuquerque NEW MEXICO 87109

ENGINEERS PLANNERS PHOTOGRAMMETRISTS SURVEYORS SOFTWARE DEVELOPERS

2507