


LEGEND


MATERIALS

CONCRETE
RIP-RAP

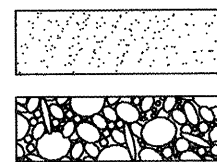


LINES

SUBDIVISION BOUNDARY
PROPERTY LINE (PLAN)
PROPERTY LINE (SECTION)
CENTERLINE
EASEMENT LINE
MATCH LINE
SECTION CUT LINE

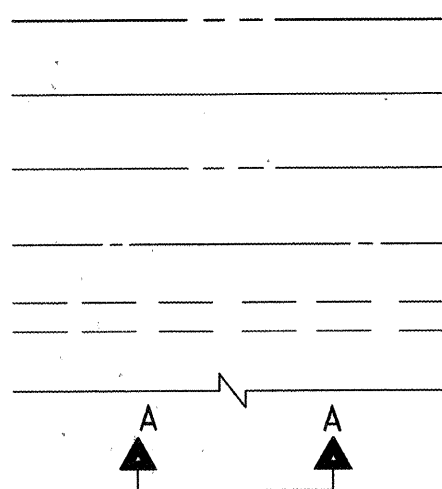


EARTHWORK

CONTOUR LINE
SPOT ELEVATION
PROJECT / PHASE BOUNDARY
FLOWLINE
DIRECTION OF FLOW

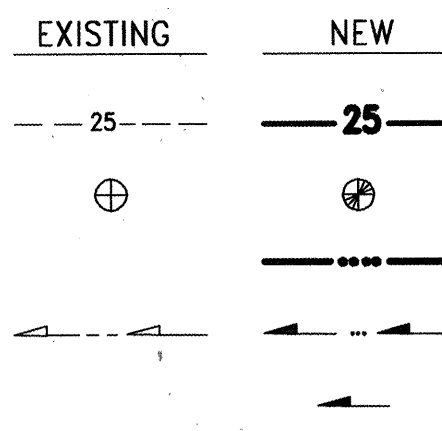


MISCELLANEOUS UTILITIES

GAS LINE
UNDERGROUND TELEPHONE
UNDERGROUND ELECTRICAL
STORM DRAIN
STORM DRAIN MANHOLE
STORM DRAIN INLET

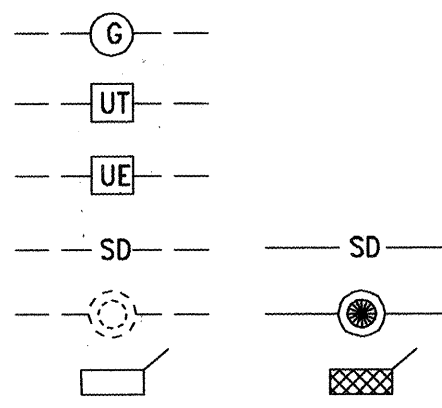


SANITARY SEWER

SANITARY SEWER LINE
SANITARY SEWER MANHOLE
SAS SERVICE CONNECTIONS
SAS CAP OR PLUG
ENCASEMENT

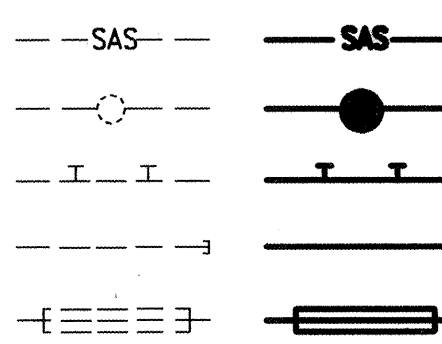


WATER

WATER LINE
WATER SERVICE CONNECTIONS
GATE VALVE
FIRE HYDRANT
BUTTERFLY VALVE
REDUCER
WATER PRESSURE ZONE BOUNDARY

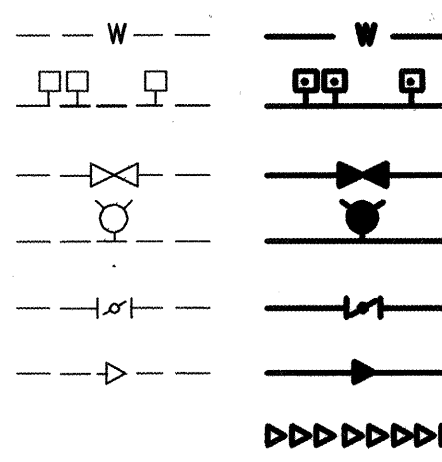


WATER FITTINGS

CAPS AND PLUGS
ELBOW
CROSS
TEE

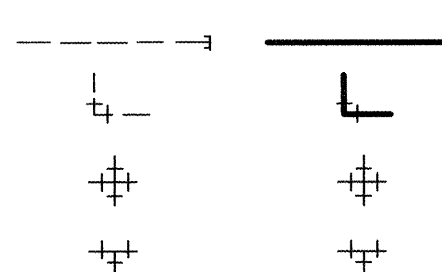

MISCELLANEOUS


CHAINLINK FENCE
FIELD FENCE
COMMON YARD WALL
RETAINING WALL
POWER OR TELEPHONE POLE

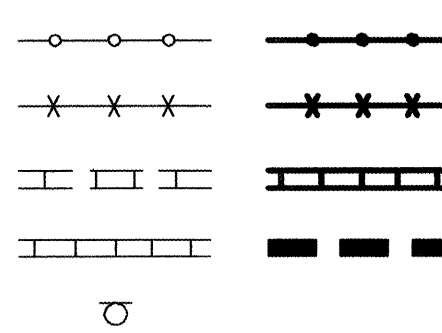


CONSTRUCTION PLANS for PATHWAY OFFICE PARK ALBUQUERQUE, NEW MEXICO FEBRUARY, 1999

INDEX OF DRAWINGS

SHEET	DESCRIPTION
1	COVER SHEET, VICINITY MAP, GENERAL NOTES, LEGEND AND INDEX OF DRAWINGS
2	SUBDIVISION PLAT
3	GRADING AND DRAINAGE PLAN
PAVING AND STORM DRAINAGE IMPROVEMENTS	
4	VASSAR DRIVE ENTRANCE MODIFICATION PLAN/VASSAR DRIVE AND PATHWAY AVE. STRIPING AND SIGNAGE PLAN
5	PAVING AND STORM DRAINAGE SITE PLAN
6	FUTURE PUBLIC STORM DRAIN - LINE "A" STA 178+99.11 TO STA 185+60.19
7	PUBLIC STORM DRAIN - LINE "A" STA 185+60.19 TO STA 193+00.07
8	PUBLIC STORM DRAIN - LINE "B" STA 4+75.00 TO STA 10+69.00
9	PATHWAY AVENUE NE STA 10+00 TO STA 20+25.00
10	VASSAR DRIVE NE STA 14+13.23 TO STA 20+65.04
11	TRACT A-4A TEMPORARY RETENTION POND, SECTIONS AND DETAILS
12	I-25 FRONTAGE ROAD DECELERATION LANES
13	PAVING AND STORM DRAINAGE SECTIONS AND DETAILS
WATER AND SANITARY SEWER LINE EXTENSIONS	
14	WATER AND SANITARY SEWER SITE PLAN, WATER VALVE SHUTOFF PLAN
15	VASSAR DRIVE NE STA 15+78.00 TO STA 20+31.00
16	I-25 FRONTAGE ROAD STA 186+64.87 TO STA 193+25.07
TRAFFIC CONTROL	
17	SIGNING AND CONSTRUCTION TRAFFIC CONTROL STANDARDS
18	TYPICAL TRAFFIC CONTROL AND SIGNING EXAMPLES (REF. M.U.T.C.D.)
19	I-25 FRONTAGE ROAD TRAFFIC CONTROL PLAN (NMSHTD)
LANDSCAPING IMPROVEMENTS	
LS-1	LANDSCAPE CONSTRUCTION & DIMENSION PLAN & NOTES
LS-2	IRRIGATION PLANS, SCHEDULES & NOTES
LS-3	LANDSCAPE PLANTING PLANS, SCHEDULES & NOTES

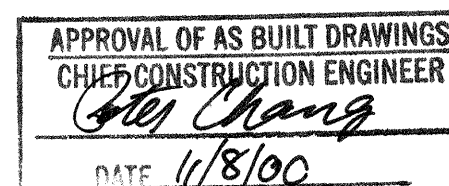

AS-BUILT
I certify that this plan shows as-built conditions based on actual field survey.
1/31/00
Celia S. Tomlinson, P.E.
NMPE No. 4895

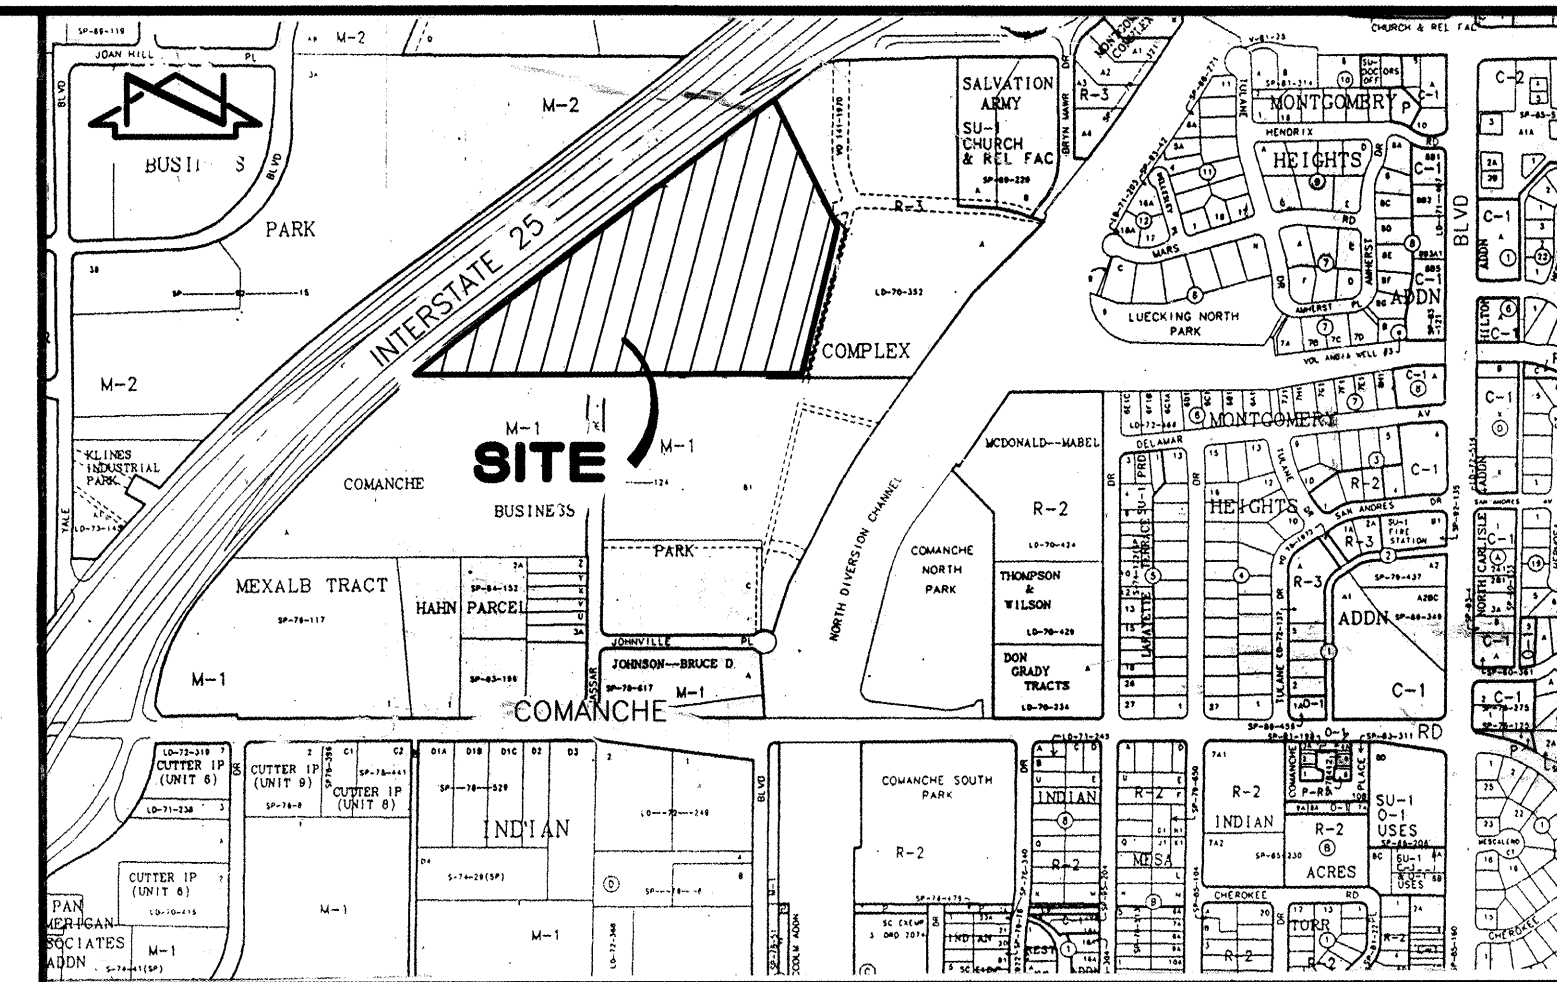


VICINITY MAP
SCALE: 1" = 750' (APPROX.)

G-16

GENERAL NOTES

- ALL WORK DETAILED ON THESE PLANS TO BE PERFORMED UNDER CONTRACT SHALL, EXCEPT AS OTHERWISE STATED OR PROVIDED FOR HEREON, BE CONSTRUCTED IN ACCORDANCE WITH THE CITY OF ALBUQUERQUE STANDARD SPECIFICATIONS-PUBLIC WORKS CONSTRUCTION-1986- UPDATE NO. 8, EXCEPT FOR PAVING WORK WITHIN N.M.S.H.T.D. R.O.W. WHICH SHALL BE CONSTRUCTED IN ACCORDANCE WITH THE NEW MEXICO STATE HIGHWAY AND TRANSPORTATION DEPARTMENT STANDARD SPECIFICATIONS FOR HIGHWAY AND BRIDGE CONSTRUCTION, 1994 EDITION. SHOULD A CONFLICT ARISE, THE MORE STRINGENT SPECIFICATION SHALL APPLY.
- TWO (2) WORKING DAYS PRIOR TO ANY EXCAVATION, CONTRACTOR MUST CONTACT NEW MEXICO ONE CALL SYSTEM, 260-1990, (ALBUQUERQUE AREA) 1-800-321-ALERT (2537) (STATEWIDE) FOR LOCATION OF EXISTING UTILITIES.
- IF ANY UTILITY LINES, PIPELINES, OR UNDERGROUND UTILITY LINES ARE SHOWN ON THESE DRAWINGS, THEY ARE SHOWN IN AN APPROXIMATE MANNER ONLY, AND SUCH LINES MAY EXIST WHERE NONE ARE SHOWN. IF ANY SUCH LINES ARE SHOWN, THE LOCATION IS BASED UPON INFORMATION PROVIDED BY THE OWNER OF SAID UTILITY, AND THE INFORMATION MAY BE INCOMPLETE, OR MAY BE OBSOLETE BY THE TIME CONSTRUCTION COMMENCES. THE ENGINEER HAS CONDUCTED ONLY PRELIMINARY INVESTIGATION OF THE LOCATION, DEPTH, SIZE, OR TYPE OF EXISTING UTILITY LINES, PIPELINES, OR UNDERGROUND UTILITY LINES. THIS INVESTIGATION IS NOT CONCLUSIVE, AND MAY NOT BE COMPLETE, THEREFORE, MAKES NO REPRESENTATION PERTAINING THERETO, AND ASSUMES NO RESPONSIBILITY OR LIABILITY THEREFOR. THE CONTRACTOR SHALL INFORM ITSELF OF THE LOCATION OF ANY UTILITY LINE, PIPELINE, OR UNDERGROUND UTILITY LINE IN OR NEAR THE AREA OF THE WORK IN ADVANCE OF AND DURING EXCAVATION WORK. THE CONTRACTOR IS FULLY RESPONSIBLE FOR ANY AND ALL DAMAGE CAUSED BY ITS FAILURE TO LOCATE, IDENTIFY AND PRESERVE ANY AND ALL EXISTING UTILITIES, PIPELINES, AND UNDERGROUND UTILITY LINES. IN PLANNING AND CONDUCTING EXCAVATION, THE CONTRACTOR SHALL COMPLY WITH STATE STATUTES, MUNICIPAL AND LOCAL ORDINANCES, RULES AND REGULATIONS, IF ANY, PERTAINING TO THE LOCATION OF THESE LINES AND FACILITIES.
- SHOULD A CONFLICT EXIST BETWEEN THESE PLANS AND ACTUAL FIELD CONDITIONS, THE CONTRACTOR SHALL PROMPTLY NOTIFY THE ENGINEER IN WRITING SO THAT THE CONFLICT CAN BE RESOLVED WITH A MINIMUM AMOUNT OF DELAY FOR ALL PARTIES.
- THE CONTRACTOR SHALL MAINTAIN ACCESS TO ADJACENT PROPERTIES DURING CONSTRUCTION.
- ALL WORK ON THIS PROJECT SHALL BE PERFORMED IN ACCORDANCE WITH APPLICABLE FEDERAL, STATE AND LOCAL LAWS, RULES AND REGULATIONS CONCERNING SAFETY AND HEALTH.
- ALL UTILITIES AND UTILITY SERVICE LINES SHALL BE INSTALLED PRIOR TO PAVING.
- BACKFILL COMPACTION SHALL BE ACCORDING TO SPECIFIED STREET USE.
- TACK COAT REQUIREMENTS SHALL BE DETERMINED DURING CONSTRUCTION BY THE PROJECT ENGINEER.
- SIDEWALKS AND WHEELCHAIR RAMPS WITHIN THE CURB RETURNS SHALL BE CONSTRUCTED WHEREVER A NEW CURB RETURN IS CONSTRUCTED.
- IF CURB IS DEEPENED FOR A DRIVEPAD OR A HANDICAP RAMP, THE DRIVEPAD OR RAMP SHALL BE CONSTRUCTED PRIOR TO ACCEPTANCE OF THE CURB AND GUTTER.
- ALL STORM DRAINAGE FACILITIES SHALL BE COMPLETED PRIOR TO FINAL ACCEPTANCE.
- CONTRACTOR SHALL COORDINATE WITH THE WATER SYSTEM DIVISION FOR THE EXECUTION OF THE VALVE SHUT OFF PLAN, NOT LESS THAN FIVE (5) WORKING DAYS IN ADVANCE OF ANY WORK THAT MAY AFFECT THE EXISTING PUBLIC WATER UTILITIES. ONLY WATER SYSTEM DIVISION PERSONNEL SHALL OPERATE EXISTING VALVES. REFER TO SECTION 18 OF THE SPECIFICATION. THE WATER SYSTEM DIVISION PHONE NUMBER IS 857-8200.
- CONTRACTOR SHALL NOTIFY THE CITY SURVEYOR NOT LESS THAN SEVEN (7) DAYS PRIOR TO STARTING WORK IN ORDER THAT THE CITY SURVEYOR MAY TAKE NECESSARY MEASURES TO INSURE THE PRESERVATION OF SURVEY MONUMENTS. CONTRACTOR SHALL NOT DISTURB PERMANENT SURVEY MONUMENTS WITHOUT THE CONSENT OF THE CITY SURVEYOR AND SHALL NOTIFY THE CITY SURVEYOR AND BEAR THE EXPENSE OF REPLACING ANY THAT MAY BE DISTURBED WITHOUT PERMISSION. REPLACEMENT SHALL BE DONE ONLY BY THE CITY SURVEYOR. WHEN A CHANGE IS MADE IN THE FINISHED ELEVATION OF THE PAVEMENT OF ANY ROADWAY IN WHICH A PERMANENT SURVEY MONUMENT IS LOCATED, CONTRACTOR SHALL, AT HIS OWN EXPENSE, ADJUST THE MONUMENT COVER TO THE NEW GRADE UNLESS OTHERWISE SPECIFIED. REFER TO SECTION 4.4 OF THE SPECIFICATIONS.
- FIVE (5) WORKING DAYS PRIOR TO BEGINNING CONSTRUCTION THE CONTRACTOR SHALL SUBMIT TO THE CONSTRUCTION CO-ORDINATION DIVISION A DETAILED CONSTRUCTION SCHEDULE. TWO (2) WORKING DAYS PRIOR TO CONSTRUCTION THE CONTRACTOR SHALL OBTAIN A BARRICADING PERMIT FROM THE CONSTRUCTION CO-ORDINATION DIVISION. CONTRACTOR SHALL NOTIFY BARRICADE ENGINEER (768-2551) PRIOR TO OCCUPYING AN INTERSECTION. CONTRACTOR MUST REFER TO SECTION 19 OF THE STANDARD SPECIFICATION FOR TRAFFIC CONTROL.
- ALL STREET STRIPING ALTERED OR DESTROYED SHALL BE REPLACED WITH PLASTIC REFLECTORIZED STRIPING BY CONTRACTOR TO EXISTING LOCATION OR AS INDICATED BY THIS PLAN SET.
- CAUTION: THESE DRAWINGS DO NOT INCLUDE NECESSARY COMPONENTS FOR CONSTRUCTION SAFETY WHICH SHALL REMAIN THE RESPONSIBILITY OF THE CONTRACTOR.
- ANY WORK OCCURRING WITHIN AN ARTERIAL ROADWAY REQUIRES TWENTY-FOUR HOUR CONSTRUCTION.
- CONTRACTOR SHALL MAINTAIN A GRAFFITI-FREE WORK SITE. CONTRACTOR SHALL PROMPTLY REMOVE ANY AND ALL GRAFFITI FROM EQUIPMENT, WHETHER PERMANENT OR TEMPORARY.
- NO WORK SHALL BE ALLOWED WITHIN NMSHTD R.O.W. UNTIL PERMITS ARE ISSUED BY THE NMSHTD.



980611

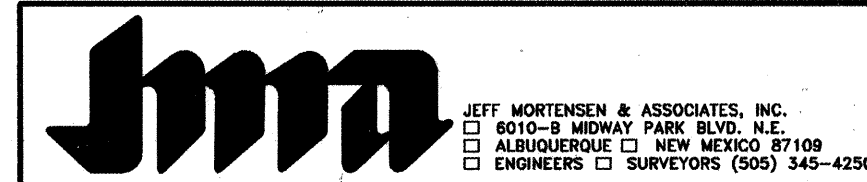

REV.	1, 2, 10, LS-1 LS-2, LS-3	DATE	12-16-99	USER	DEPARTMENT	DATE	USER	DEPARTMENT	DATE
ENGINEERS STAMP & SIGNATURE	APPROVALS		ENGINEER		DATE		*****		
	DRC Chairman		3-20-99		3-23-99		APPROVED FOR CONSTRUCTION		
	Transportation		3-23-99		3-23-99		3-23-99		
	Water/Wastewater		3-23-99		3-23-99		3-23-99		
	Hydrology		3-23-99		3-23-99		3-23-99		
	C.I.P.		3-23-99		3-23-99		3-23-99		
Const. Mngmt.		3-23-99		3-23-99		3-23-99		3-23-99	
Const. Coord.		3-23-99		3-23-99		3-23-99		3-23-99	
City Project No.		595281		SHEET		1		OF 19	

DRB 97-417

CPN 595281

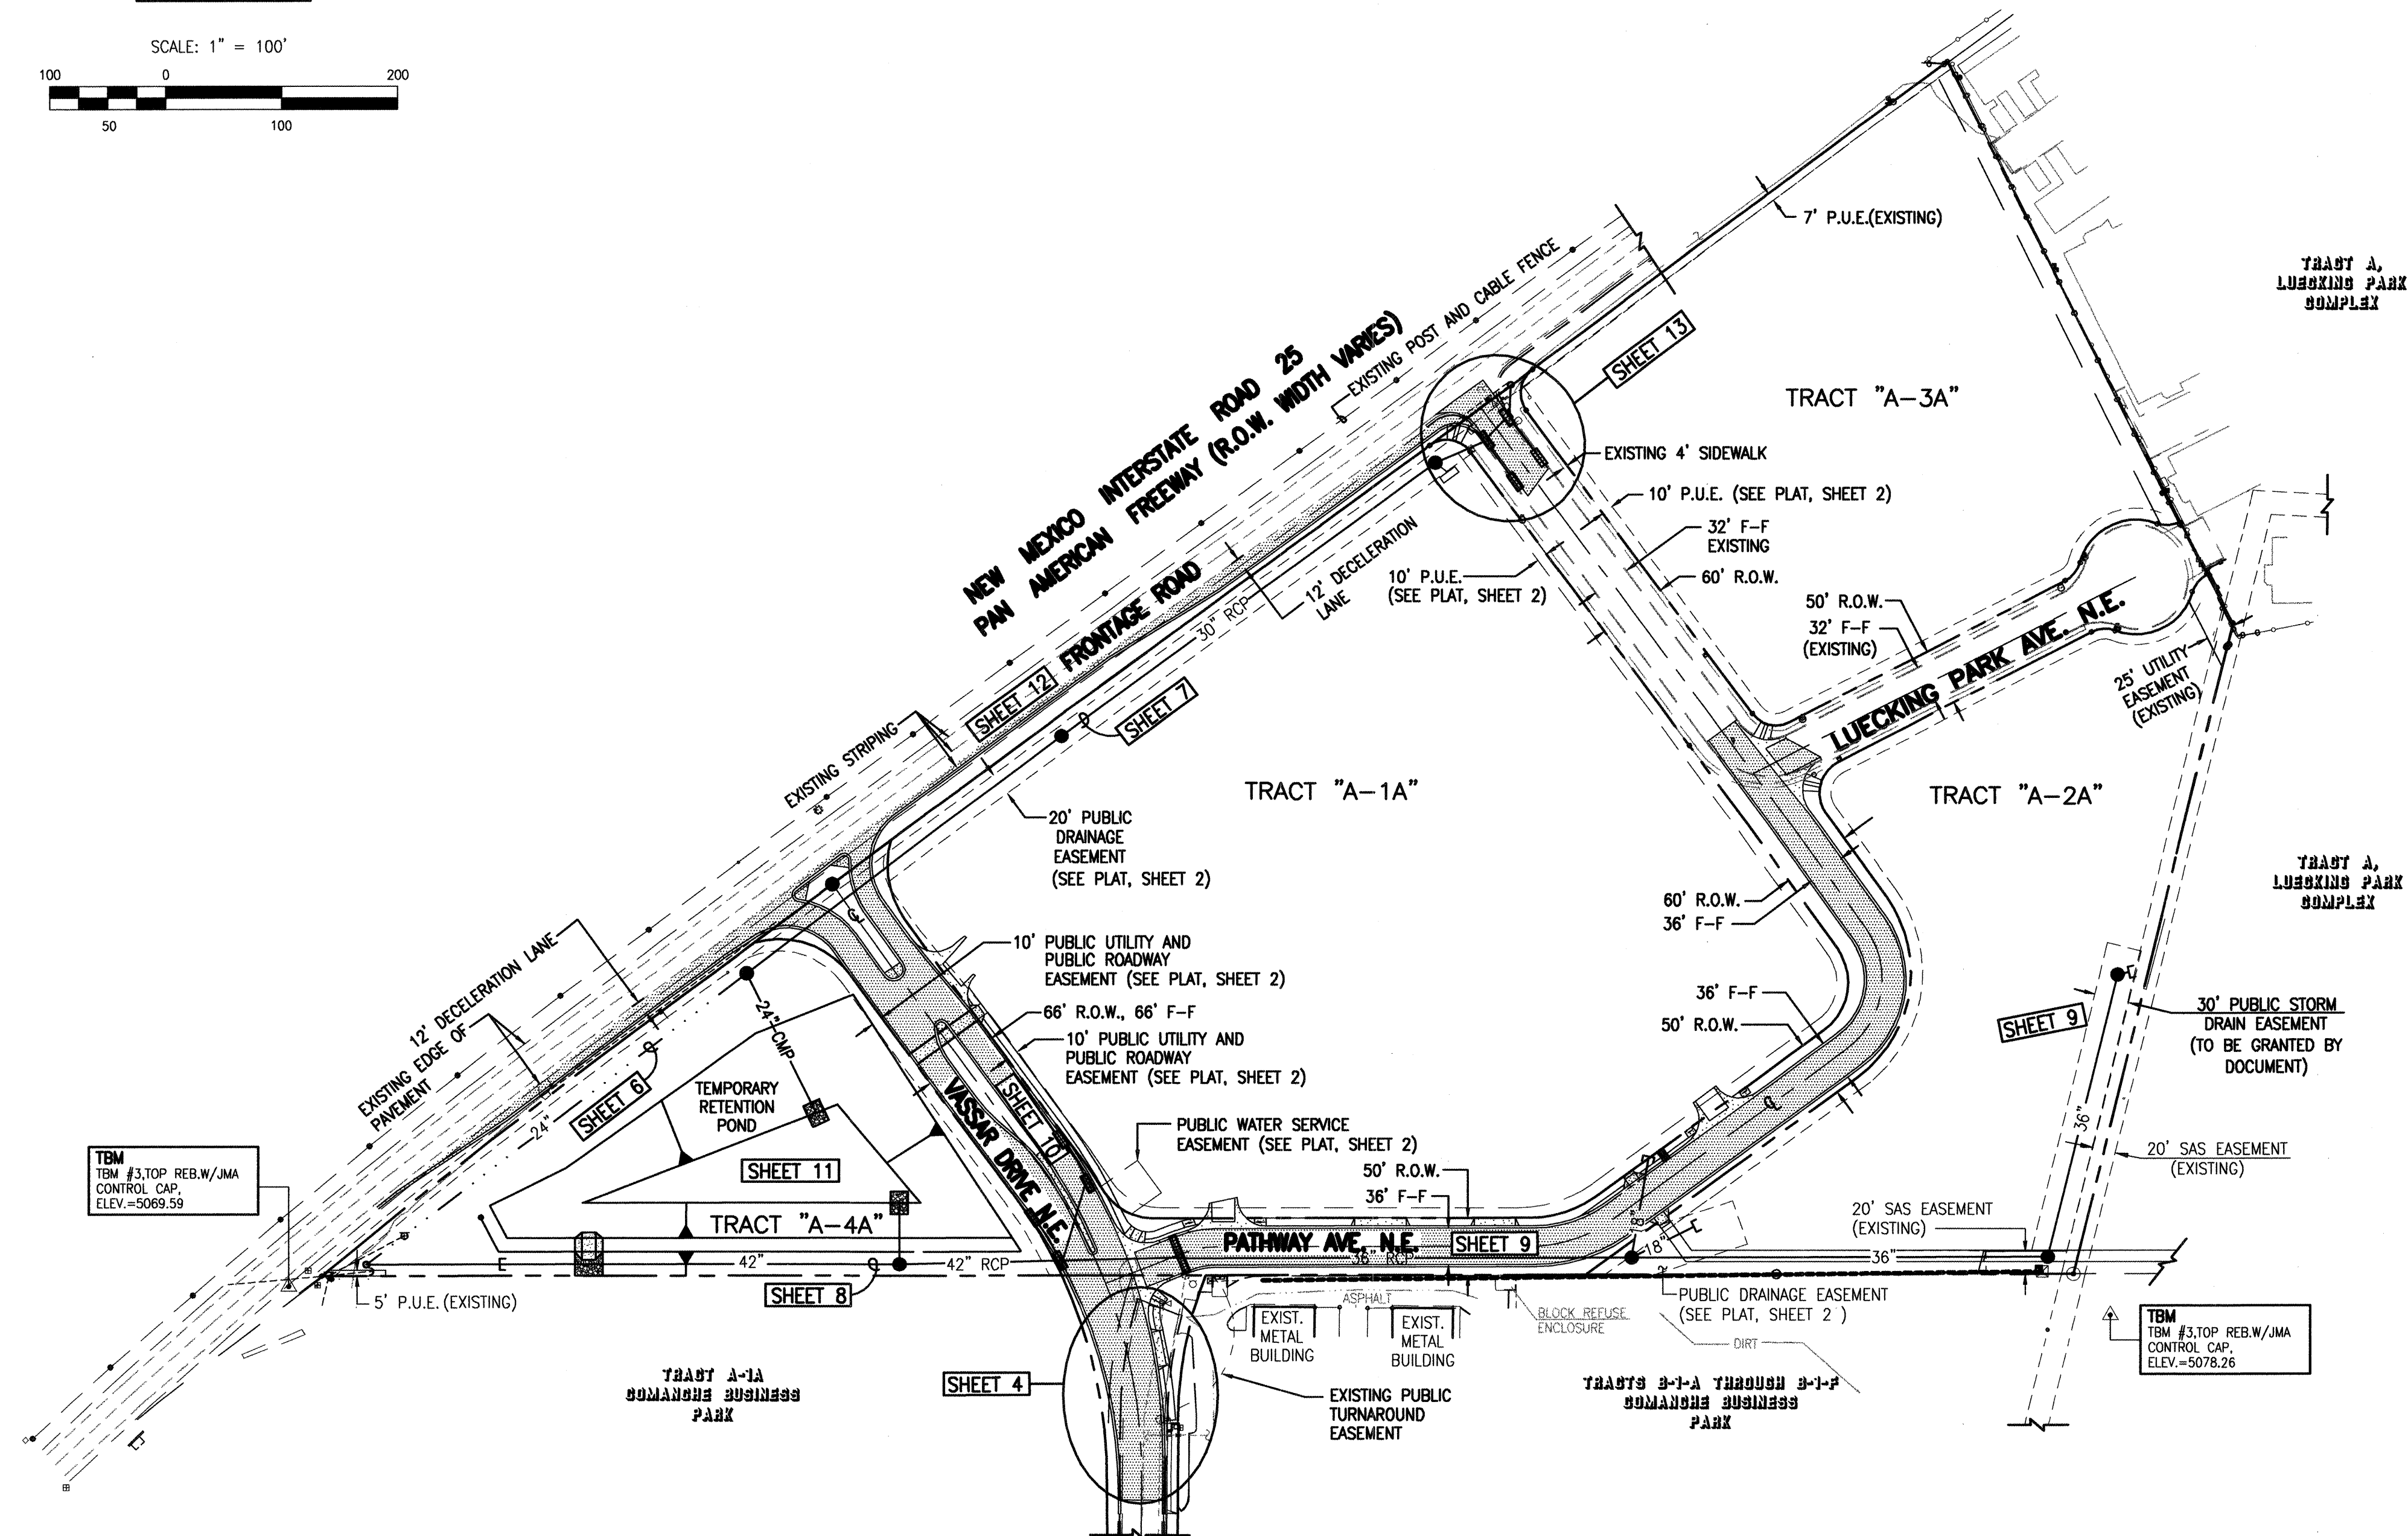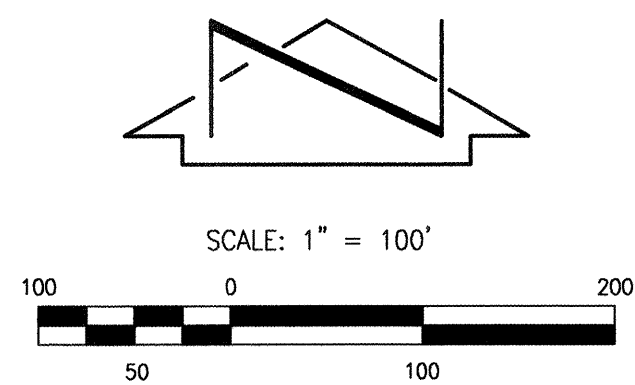

- NOTES:
1. REFER TO SHEET 13 FOR PAVING SECTIONS AND DETAILS.
 2. REFER TO SHEET 2 FOR SUBDIVISION PLAT


AS-BUILT



I certify that this plan shows as-built conditions based on actual field survey.
Celia S. Tomlinson 1/31/00
Celia S. Tomlinson, P.E.
NMPE No. 4895



JEFF MORTENSEN & ASSOCIATES, INC.
6010-B MIDWAY PARK BLVD. N.E.
ALBUQUERQUE, N.M. 87109
ENGINEERS & SURVEYORS (SOS) 345-4250

CITY OF ALBUQUERQUE PUBLIC WORKS DEPARTMENT ENGINEERING DEVELOPMENT GROUP	
TITLE: PATHWAY OFFICE PARK PAVING AND STORM DRAINAGE SITE PLAN	
Design-Review Committee APPROVED MAR 29 1999 DESIGN REVIEW COMMITTEE	City Engineer Approval APPROVED JUN 8 1999 CITY ENGINEER
City Project No. 595281	Zone Map No. G-16
Sheet 5	Of 19

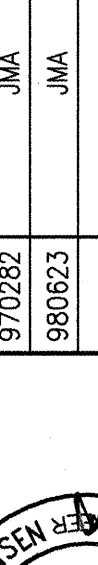
ENGINEER'S SEAL		SURVEY INFORMATION		BENCH MARKS		AS BUILT INFORMATION		
		BY	FIELD NOTES		ACS CONTROL MONUMENT "NDC 15-16", AN AMAFCA BRASS TABLET STAMPED "NDC 15-16", SET ON A CONCRETE POST PROJECTING 0.4 FEET ABOVE GROUND. ELEVATION = 5105.49 FEET (M.S.L.D.)	CONTRACTOR <i>Sundance</i>	AS BUILT INFORMATION	
			NO.	DATE				
			970282	5/97				
			980623	8/98				
	REMARKS		REVISIONS		REVISIONS		REVISIONS	
	DESIGN		DESIGN		DESIGN		DESIGN	
	Designed By	G.M.	Date	01-1999	RECORDED BY		DATE	
	Drawn By	J.Y.R.	Date	01-1999	NO.			
	Checked By	J.G.M.	Date	02-1999	CONTRACTOR		<i>con manual (mmt)</i>	
							MICRO-FILM INFORMATION	
							DATE	

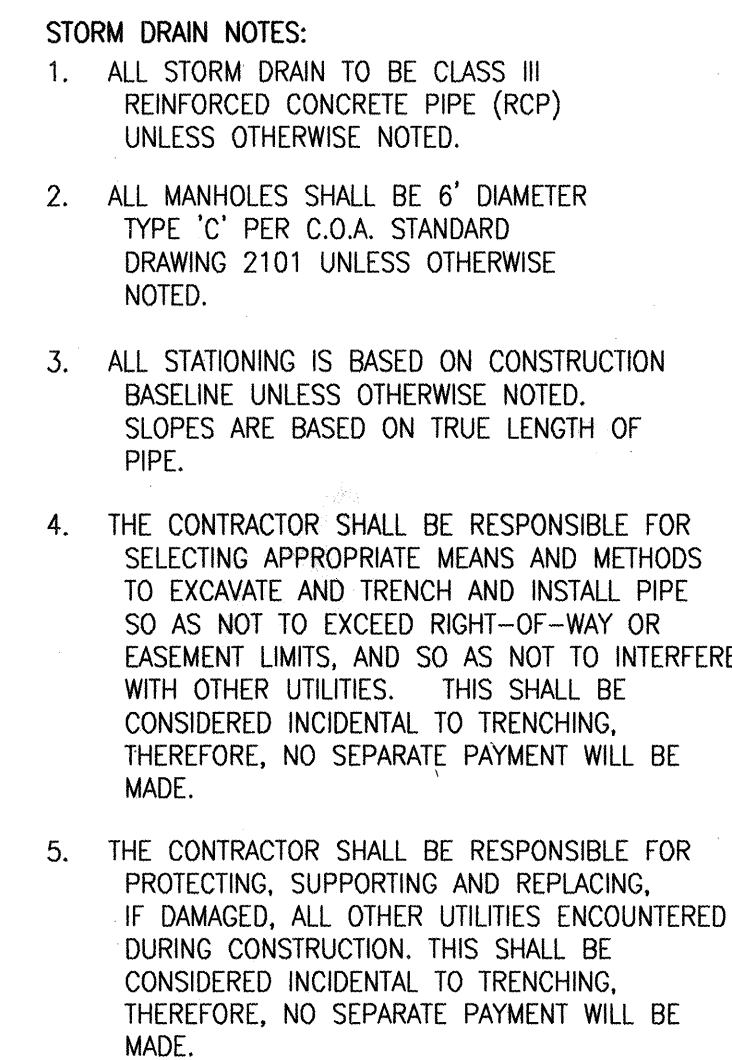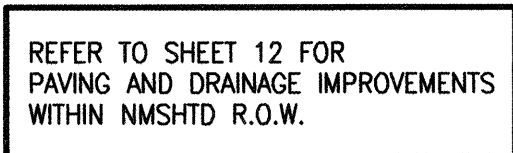

I certify that this plan shows as-built conditions based on actual field survey.

Celia S. Tomlinson 1/31/00

Celia S. Tomlinson, PE
NMPE No. 4895

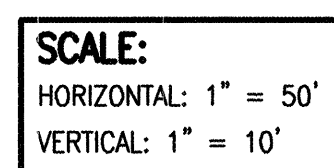


UE	
MENT	
T GROUP	
ARK	
ENTS PLAN AND PROFILE	
+60.19 TO STA 193+00.0	
Mo./Day/Yr.	Mo./Day/Yr.
Sheet	Of
7	19

CITY OF ALBUQUERQUE
PUBLIC WORKS DEPARTMENT
ENGINEERING DEVELOPMENT GROUP


TITLE: PATHWAY OFFICE PARK
PAVING AND STORM DRAINAGE IMPROVEMENTS PLAN AND PROFILE
PUBLIC STORM DRAIN - LINE "A" STA 185+60.19 TO STA 193+00.0

Design Review Committee		City Engineer Approval		Last Design Update	
APPROVE		APPROVE		Mo./Day/Yr.	Mo./Day/Yr.
MAR 29 1999		JUN 8 1999			
DESIGN REVIEW COMMITTEE		CITY ENGINEER			

980611	City Project No.	595281	Zone Map No.	G-16	Sheet	7	Of	19
--------	------------------	--------	--------------	------	-------	---	----	----

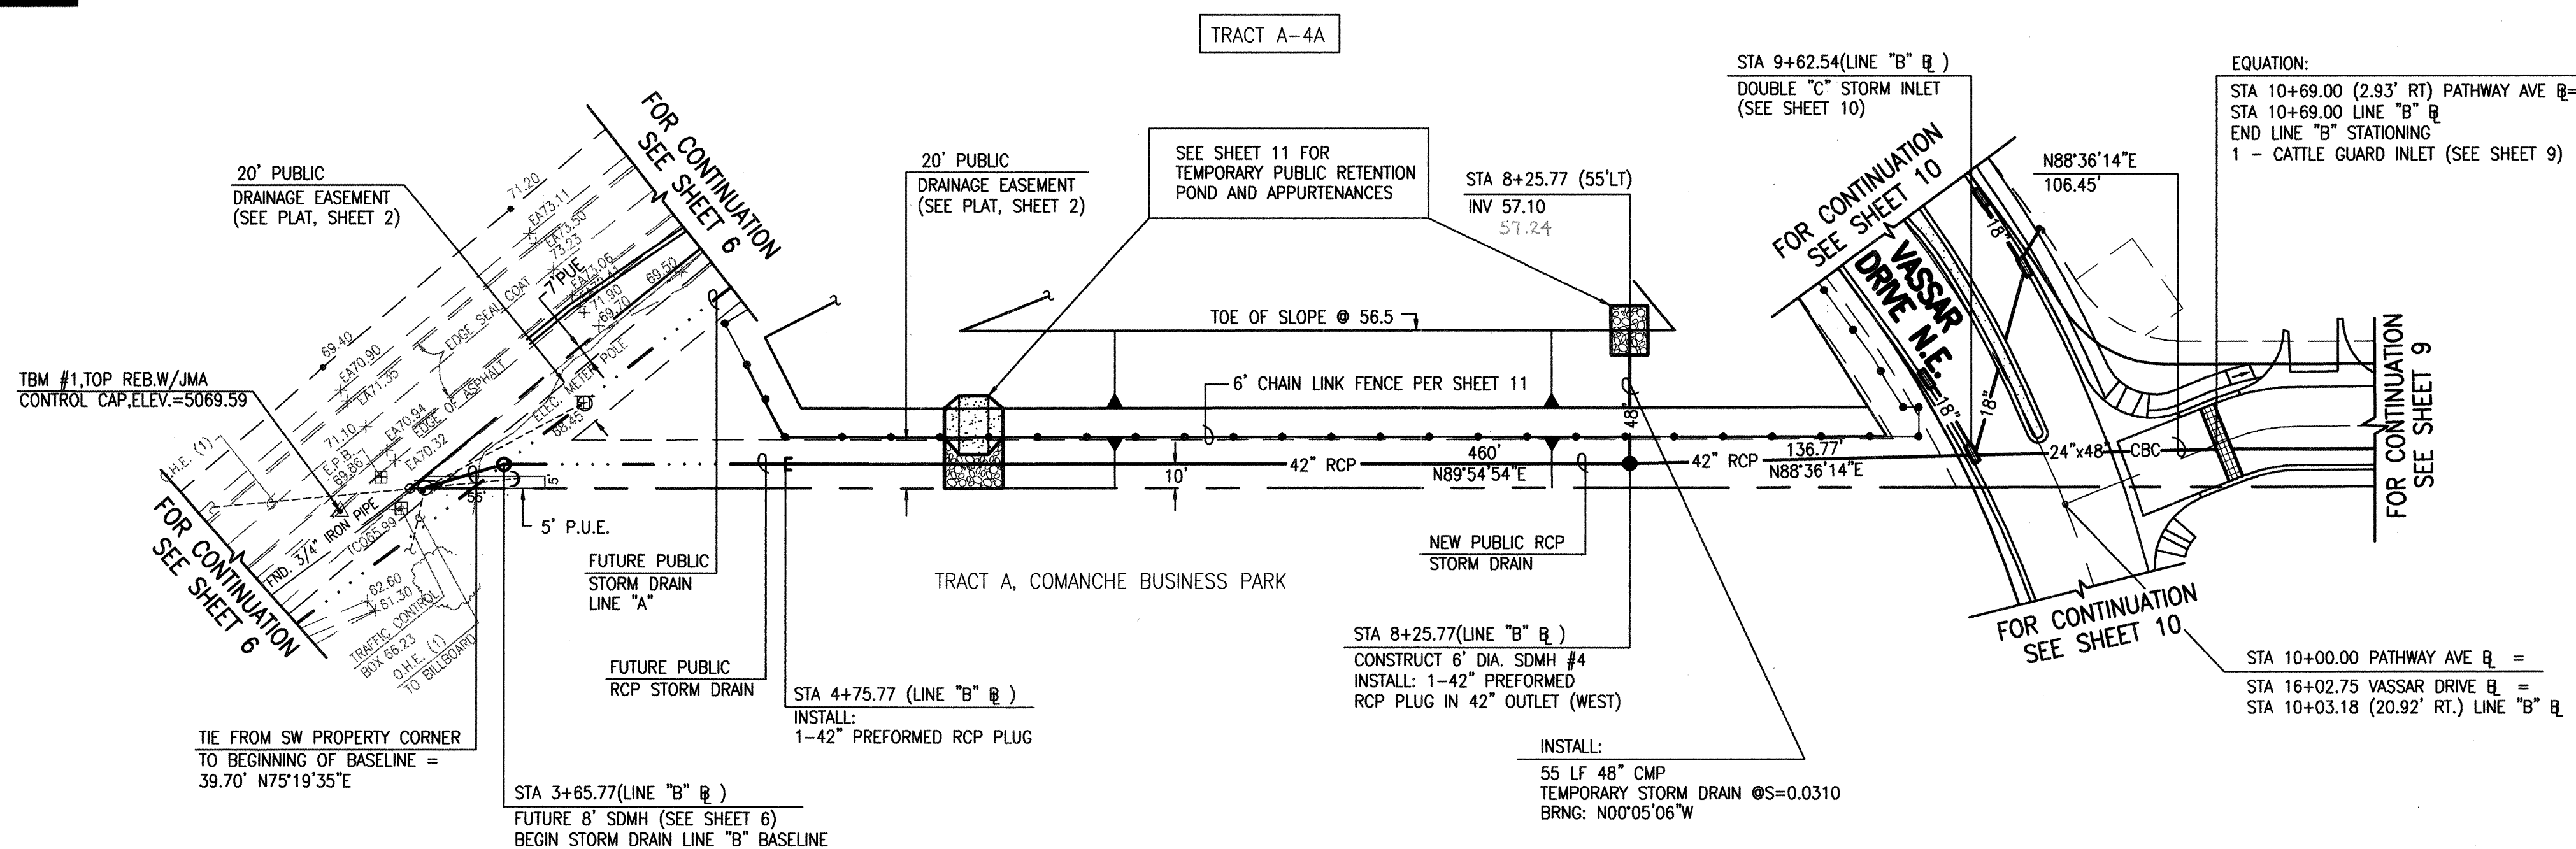

SCALE:
HORIZONTAL: 1" = 50'
VERTICAL: 1" = 10'

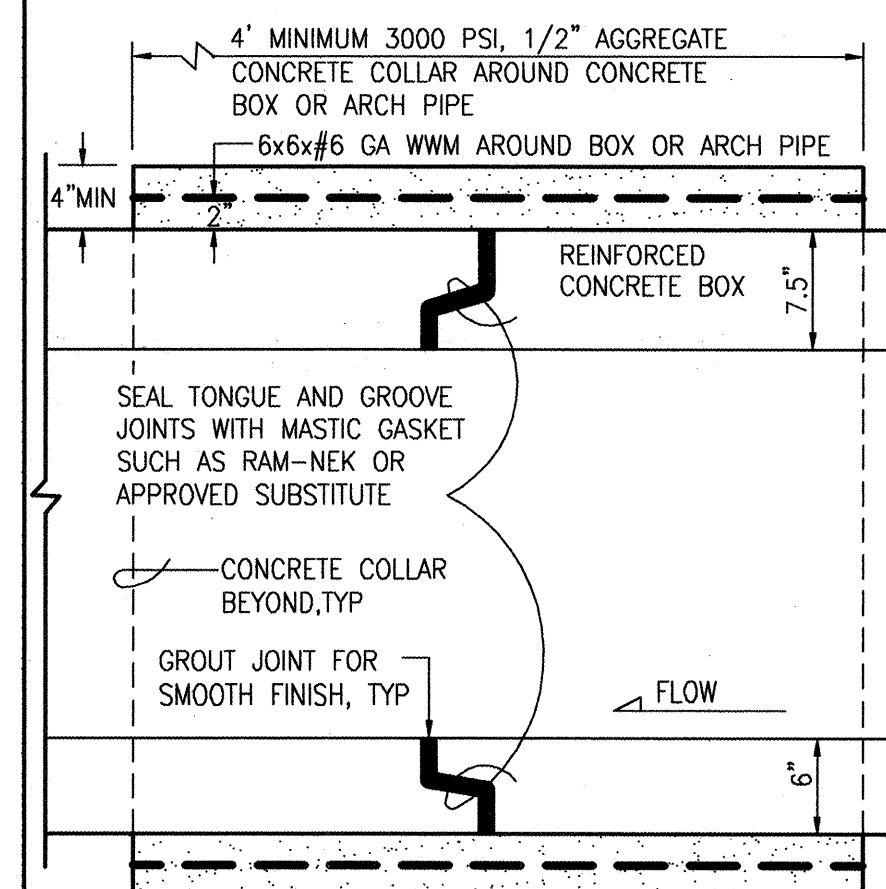


TYPICAL PRECAST CONCRETE BOX OR ARCH PIPE
JOINT SECTION

SCALE: 1"=1'-0"




CITY OF ALBUQUERQUE
PUBLIC WORKS DEPARTMENT
ENGINEERING DEVELOPMENT GROUP

TITLE: PATHWAY OFFICE PARK
PAVING AND STORM DRAINAGE IMPROVEMENTS PLAN AND PROFILE
PUBLIC STORM DRAIN - LINE "B" STA 4+75.00 TO 10+69.00

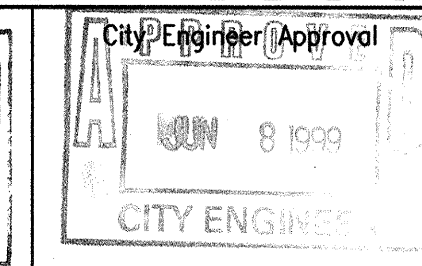

Last Design Update

[illegible]

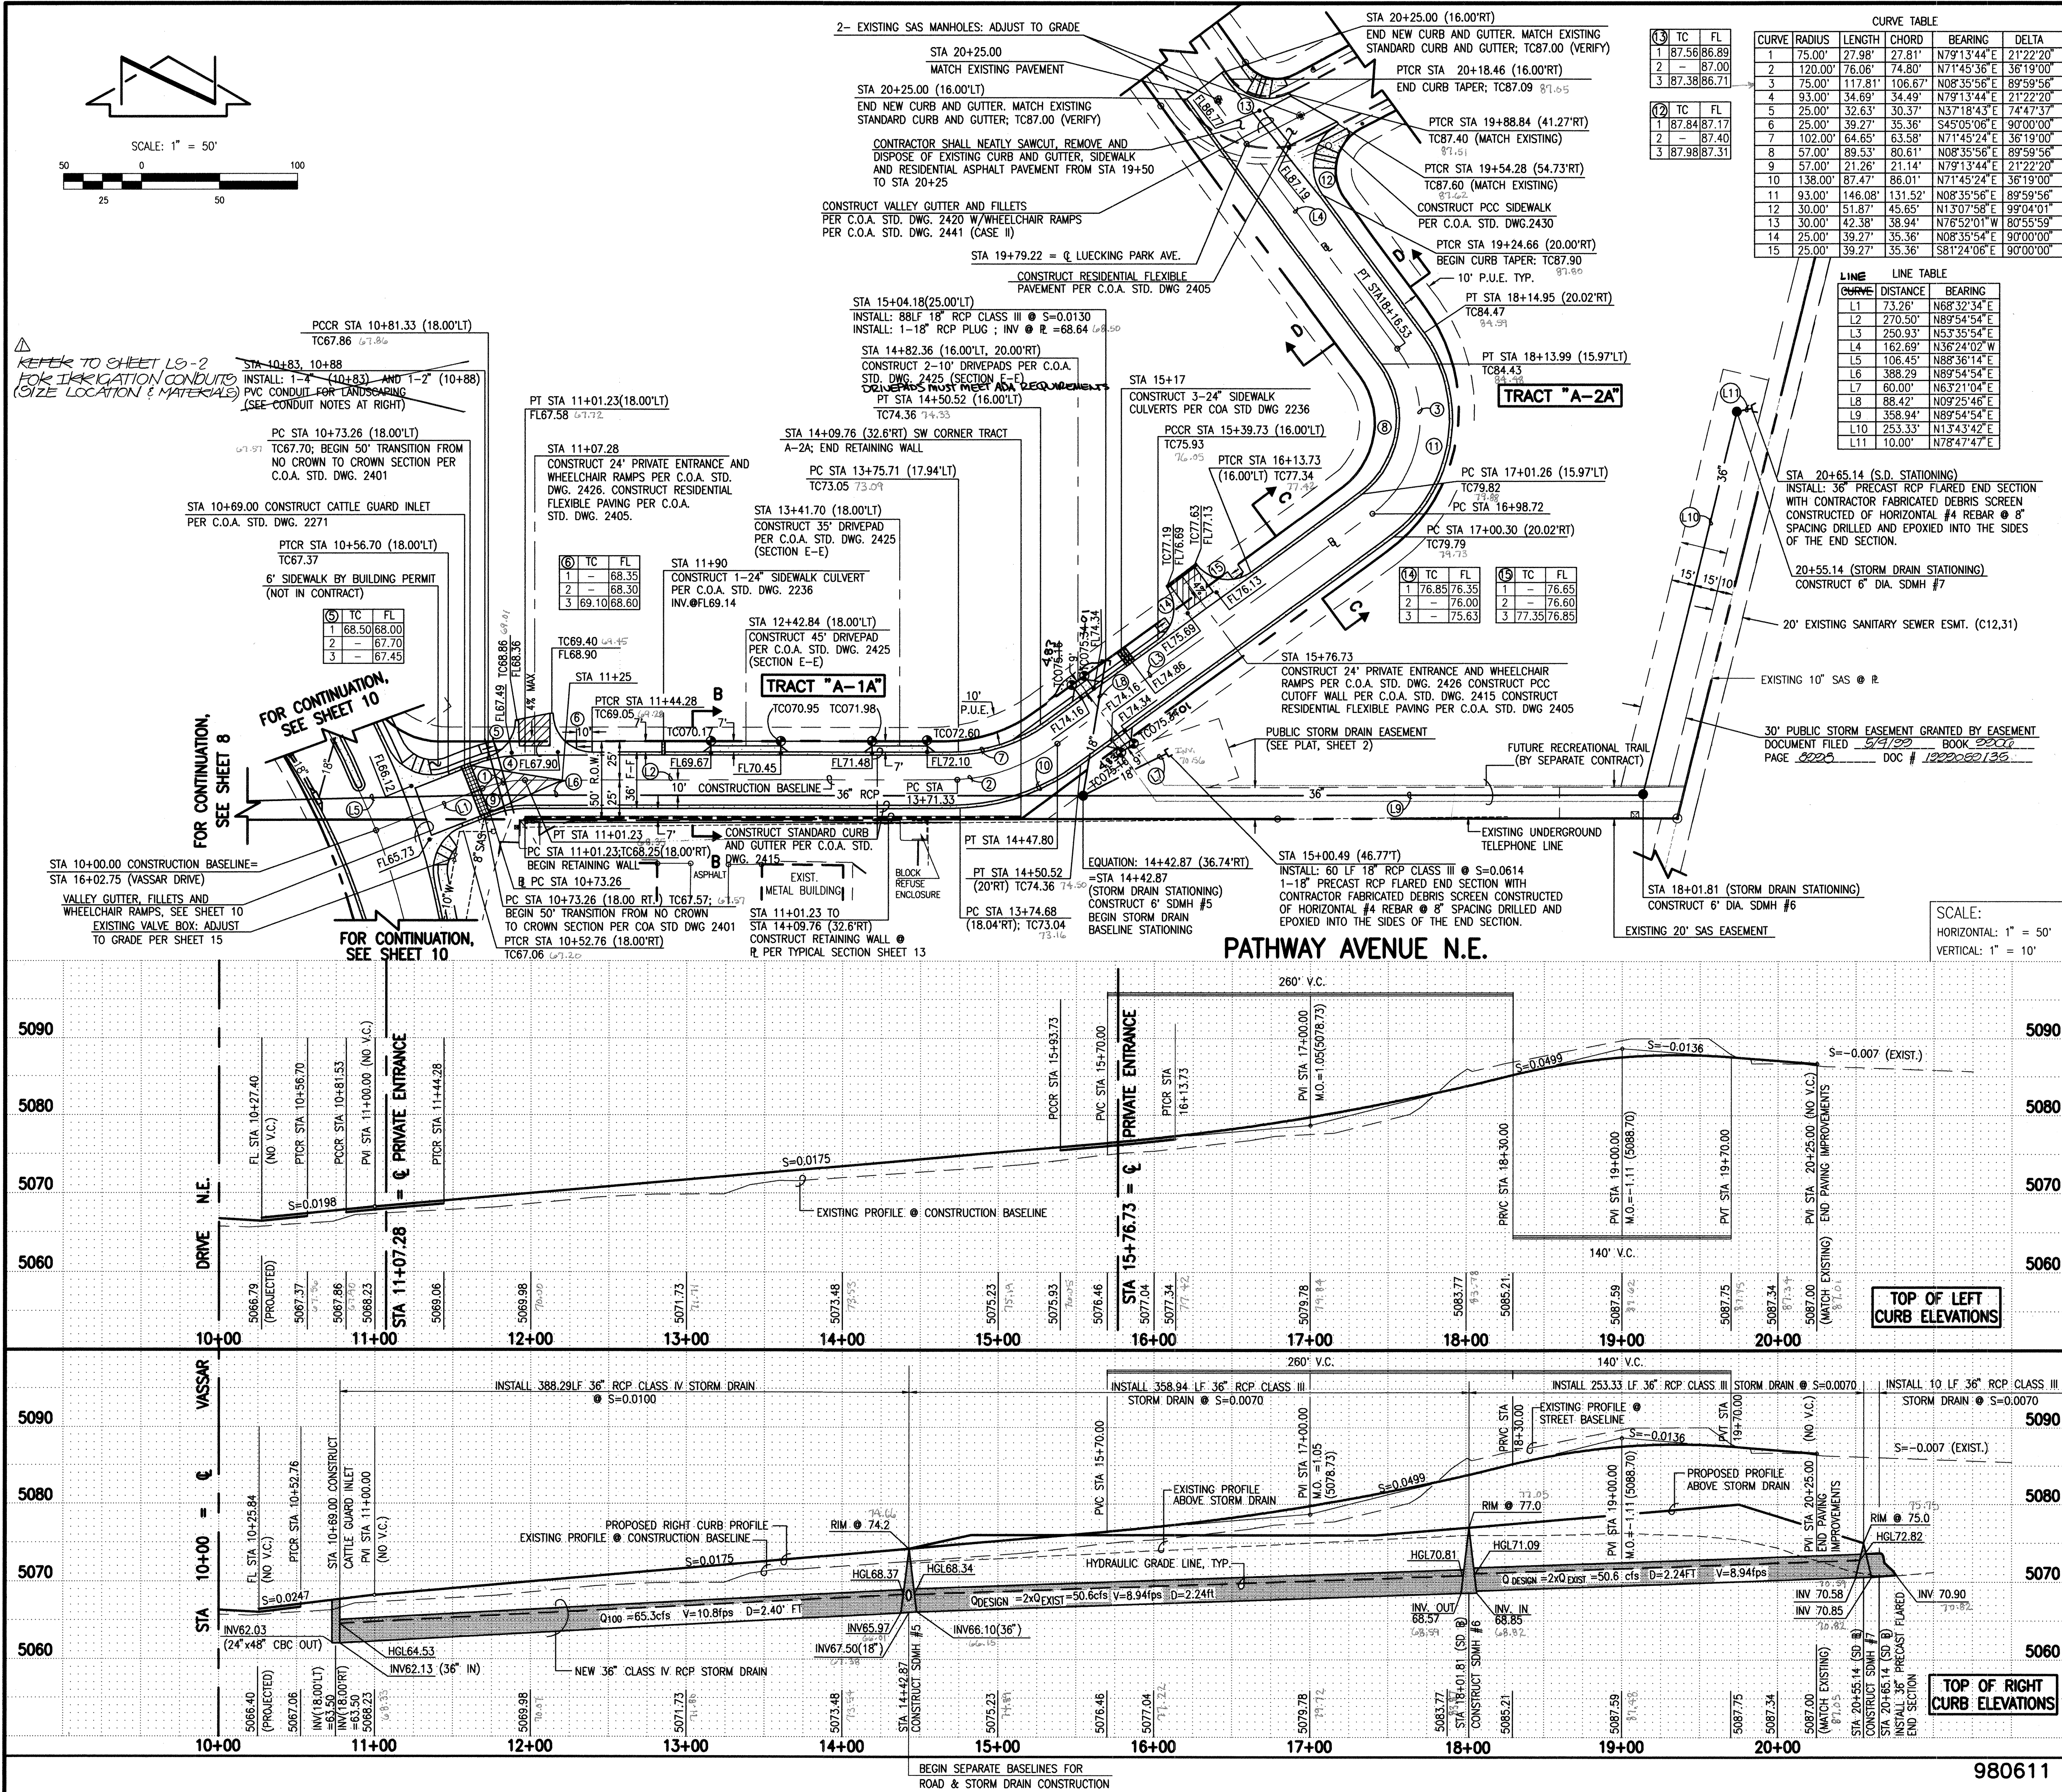

STREET PAVING IMPROVEMENTS:

- ALL SLOPES AS SHOWN ON PROFILES ARE BASED ON CONSTRUCTION BASELINE. STATIONING AS SHOWN AND DETAILED HEREON.
- WHERE REMOVAL OF EXISTING CURB AND GUTTER, SIDEWALK OR PAVEMENT IS REQUIRED, THE CONTRACTOR SHALL SAWCUT AND/OR REMOVE TO THE NEAREST JOINT. CURB AND GUTTER SHOWN AS EXISTING AND NOT TO BE REMOVED UNDER THIS CONTRACT WHICH IS DAMAGED OR DISPLACED BY THE CONTRACTOR SHALL BE REMOVED AND REPLACED BY THE CONTRACTOR AT THE CONTRACTOR'S EXPENSE.
- ALL DIMENSIONS OF CURB AND CURB RETURNS ARE SHOWN TO FACE-OF-CURB.
- ALL SIDEWALKS SHOWN HEREON SHALL BE CONSIDERED UNDER SEPARATE PERMIT (BUILDING PERMIT).
- ALL WHEELCHAIR RAMPS MUST BE CONSTRUCTED UNDER THIS WORK ORDER.
- ALL CURB AND GUTTER SHOWN HEREON SHALL BE STANDARD CURB AND GUTTER PER CITY OF ALBUQUERQUE STANDARD DRAWING 2415 UNLESS OTHERWISE NOTED.
- UPON COMPLETION OF CONSTRUCTION, THE CITY OF ALBUQUERQUE WILL PROVIDE AND INSTALL ALL STREET SIGNS.
- STRIPING BY CONTRACTOR WILL BE REQUIRED PRIOR TO FINAL ACCEPTANCE.
- REFER TO SHEET 13 FOR STREET SECTIONS

STORM DRAIN NOTES:

- ALL STORM DRAIN TO BE CLASS III REINFORCED CONCRETE PIPE (RCP) UNLESS OTHERWISE NOTED.
- ALL MANHOLES SHALL BE 6' DIAMETER TYPE 'C' PER C.O.A. STANDARD DRAWING 2101 UNLESS OTHERWISE NOTED.
- ALL STATIONING IS BASED ON CONSTRUCTION BASELINE UNLESS OTHERWISE NOTED. SLOPES ARE BASED ON TRUE LENGTH OF PIPE.
- THE CONTRACTOR SHALL BE RESPONSIBLE FOR SELECTING APPROPRIATE MEANS AND METHODS TO EXCAVATE AND TRENCH AND INSTALL PIPE SO AS NOT TO EXCEED RIGHT-OF-WAY OR EASEMENT LIMITS, AND SO AS NOT TO INTERFERE WITH OTHER UTILITIES. THIS SHALL BE CONSIDERED INCIDENTAL TO TRENCHING, THEREFORE, NO SEPARATE PAYMENT WILL BE MADE.
- THE CONTRACTOR SHALL BE RESPONSIBLE FOR PROTECTING, SUPPORTING AND REPLACING, IF DAMAGED, ALL OTHER UTILITIES ENCOUNTERED DURING CONSTRUCTION. THIS SHALL BE CONSIDERED INCIDENTAL TO TRENCHING, THEREFORE, NO SEPARATE PAYMENT WILL BE MADE.

REFER TO SHEET LS-2 FOR CONDUIT NOTES

CONDUIT NOTES:

- ALL CONDUIT SHALL BE CLASS 200 PVC SDR-21 SOLVENT WELD.
- ALL CONDUIT SHALL BE INSTALLED WITH 18" COVER (MIN.)
- ALL CONDUIT SHALL EXTEND 12" BEYOND CURB AND/OR SIDEWALK.
- CONTRACTOR SHALL COVER CONDUIT OPENINGS WITH DUCT TAPE. THIS SHALL BE CONSIDERED INCIDENTAL TO CONDUIT INSTALLATION.
- LANDSCAPING SHALL BE INSTALLED UNDER SEPARATE CONTRACT- NOT PART OF WORK ORDER.

AS-BUILT

I certify that this plan shows as-built conditions based on actual field survey.
Celia S. Tomlinson-PE
NMPE No. 4495




JEFF MORTENSEN & ASSOCIATES, INC.
6010-B MIDWAY PARK BLVD., N.E.
ALBUQUERQUE, NM 87109
ENGINEERS & SURVEYORS (505) 345-4250

CITY OF ALBUQUERQUE
PUBLIC WORKS DEPARTMENT
ENGINEERING DEVELOPMENT GROUP

TITLE: **PATHWAY OFFICE PARK
PAVING AND STORM DRAINAGE IMPROVEMENTS PLAN AND PROFILE
PATHWAY AVENUE N.E. STA 10+00.00 TO STA 20+25.00**

DESIGN REVIEW COMMITTEE	CITY ENGINEER APPROVAL	DATE	NO.	DATE	REMARKS
MAR 29 1999	JUN 8 1999				

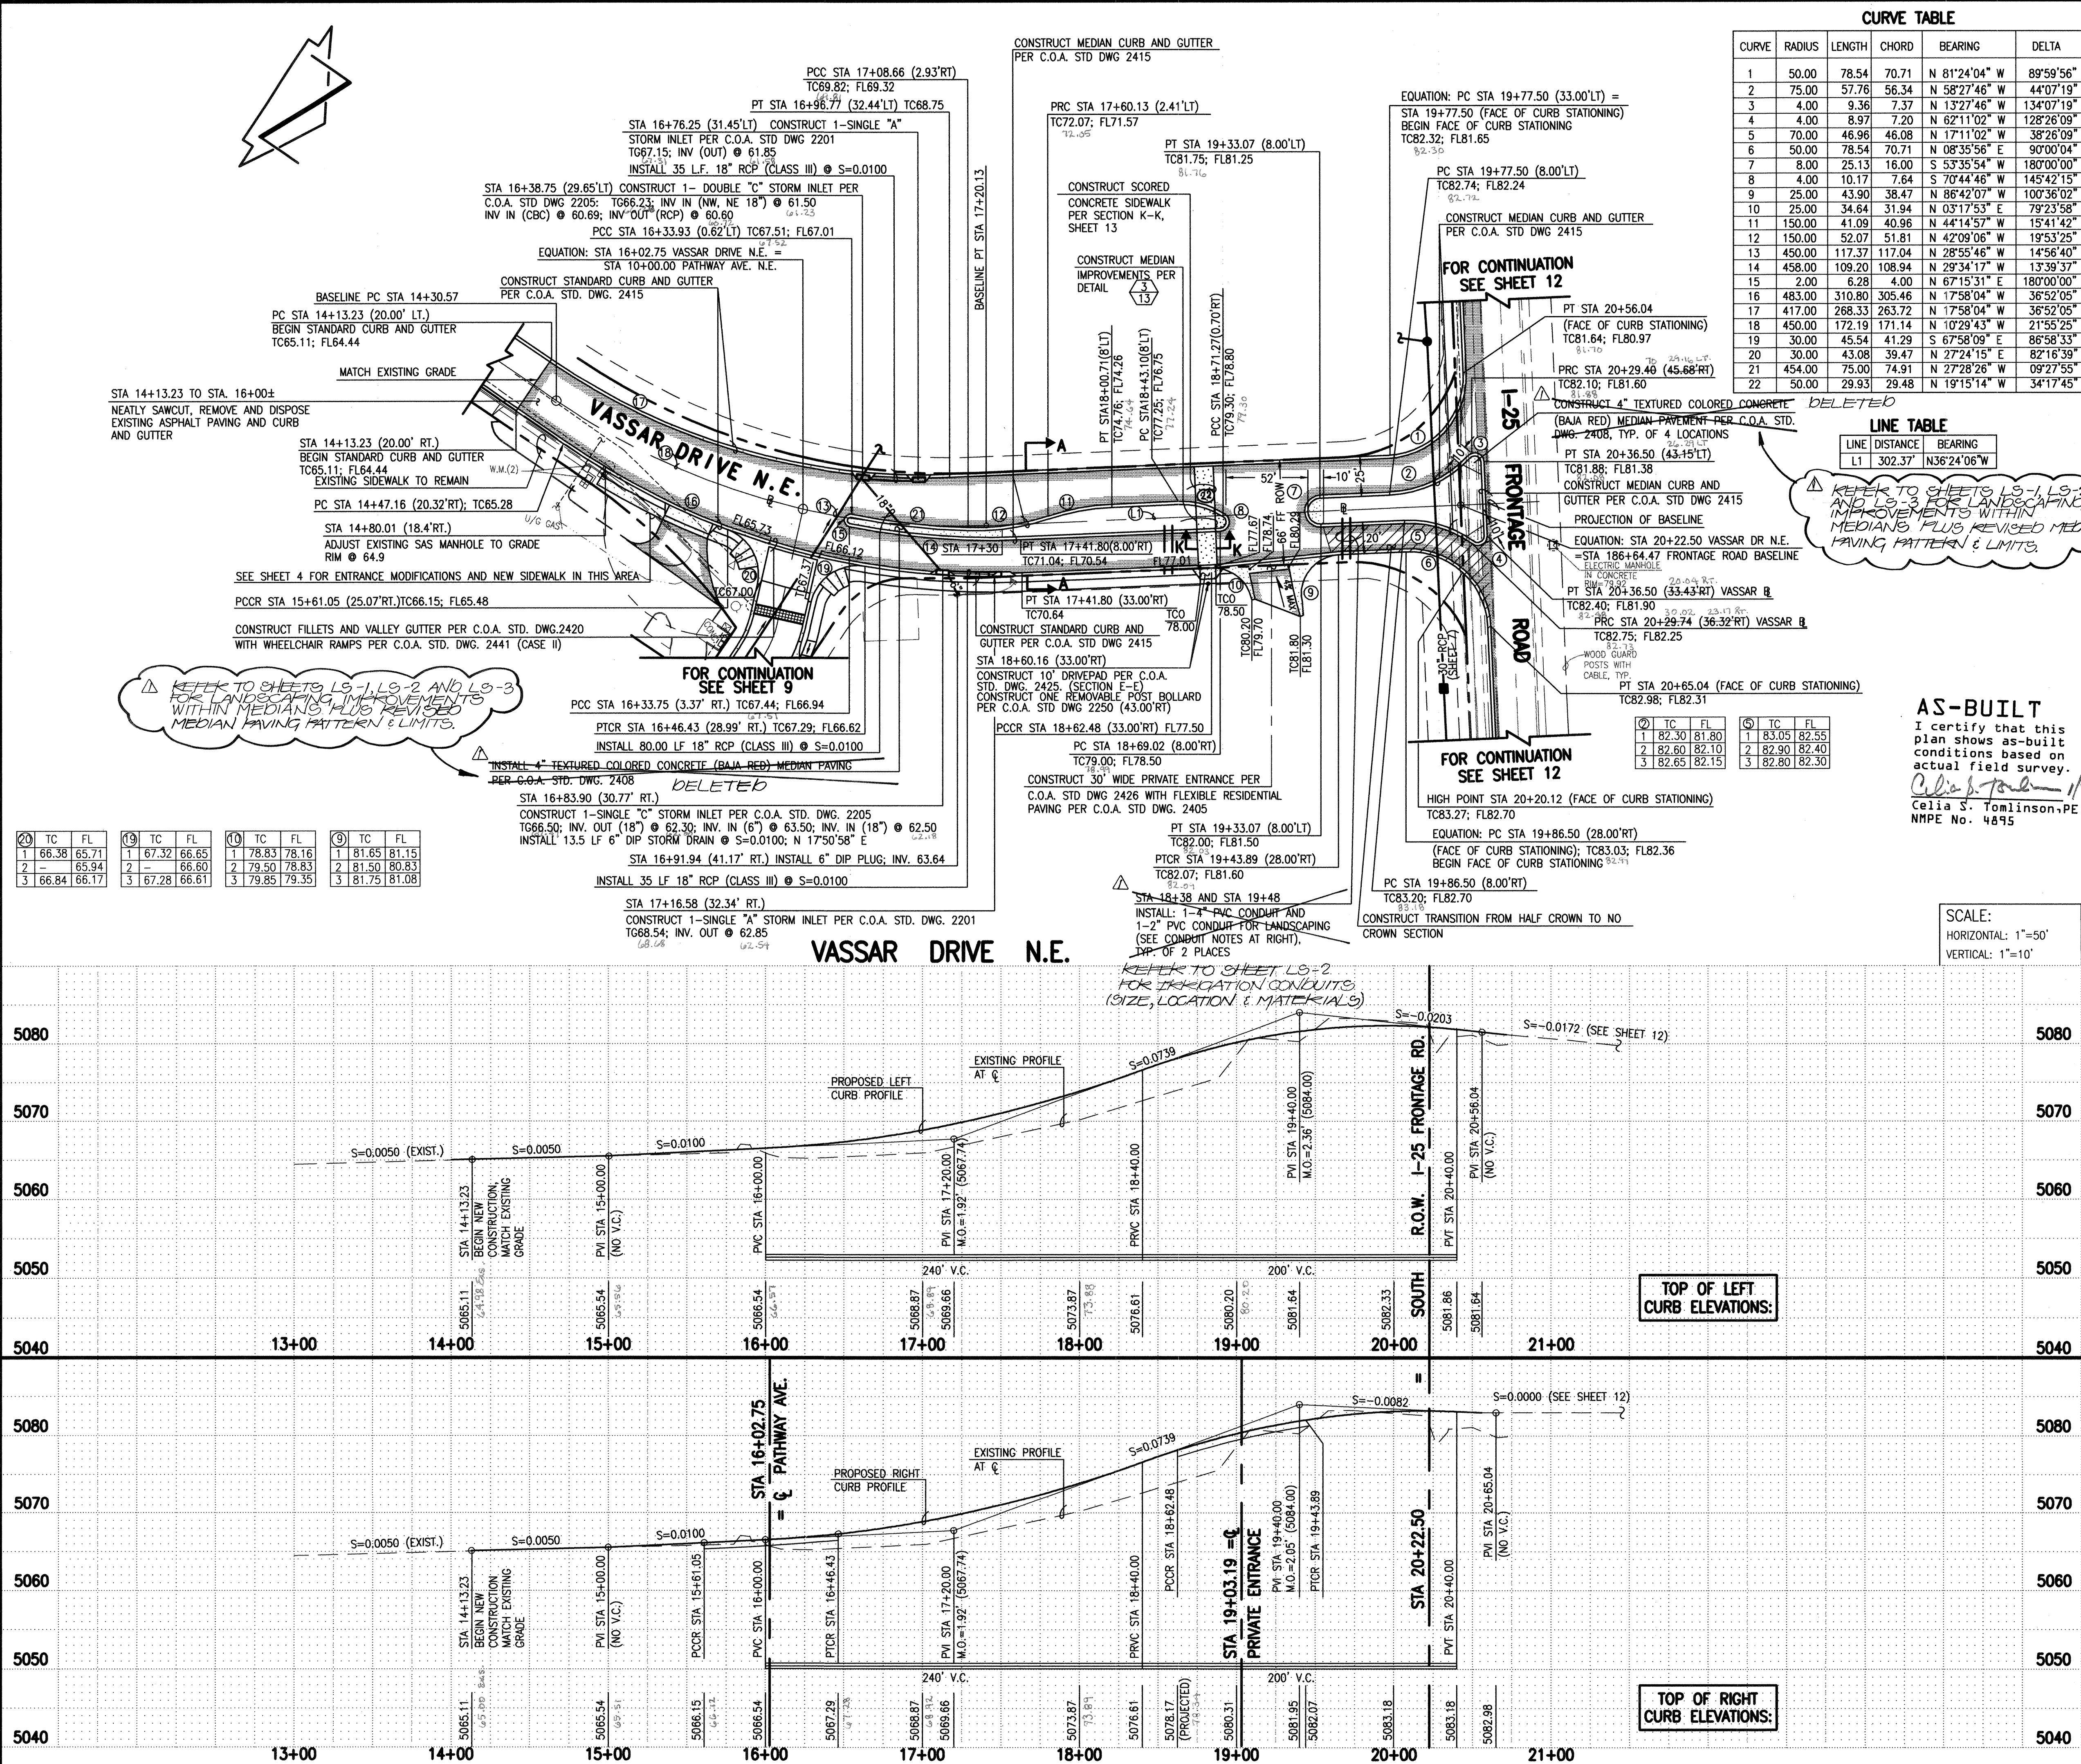

CURVE TABLE					
CURVE	RADIUS	LENGTH	CHORD	BEARING	DELTA
1	50.00	78.54	70.71	N 81°24'04" W	89°59'56"
2	75.00	57.76	56.34	N 58°27'46" W	44°07'19"
3	4.00	9.36	7.37	N 13°27'46" W	134°07'19"
4	4.00	8.97	7.20	N 62°11'02" W	128°26'09"
5	70.00	46.96	46.08	N 17°11'02" W	38°26'09"
6	50.00	78.54	70.71	N 08°35'56" E	90°00'04"
7	8.00	25.13	16.00	S 53°35'54" W	180°00'00"
8	4.00	10.17	7.64	S 70°44'46" W	145°42'15"
9	25.00	43.90	38.47	N 86°42'07" W	100°36'02"
10	25.00	34.64	31.94	N 03°17'53" E	79°23'58"
11	150.00	41.09	40.96	N 44°14'57" W	154°14'42"
12	150.00	52.07	51.81	N 42°09'06" W	19°53'25"
13	450.00	117.37	117.04	N 28°55'46" W	14°56'40"
14	458.00	109.20	108.94	N 29°34'17" W	13°39'37"
15	2.00	6.28	4.00	N 67°15'31" E	180°00'00"
16	483.00	310.80	305.46	N 17°58'04" W	36°52'05"
17	417.00	268.33	263.72	N 17°58'04" W	36°52'05"
18	450.00	172.19	171.14	N 10°29'43" W	21°55'25"
19	30.00	45.54	41.29	S 67°58'09" E	86°58'33"
20	30.00	43.08	39.47	N 27°24'15" E	82°16'39"
21	454.00	75.00	74.91	N 27°28'26" W	09°27'55"
22	50.00	29.93	29.48	N 19°15'14" W	34°17'45"

LINE TABLE		
LINE	DISTANCE	BEARING
L1	302.37	N36°24'06"W

AS-BUILT

I certify that this plan shows as-built conditions based on actual field survey.
Celia S. Tomlinson, PE
NMPE No. 4495

SCALE:
HORIZONTAL: 1"=50'
VERTICAL: 1"=10'

STREET PAVING IMPROVEMENTS:

- ALL SLOPES AS SHOWN ON PROFILES ARE BASED ON CONSTRUCTION BASELINE STATIONING AS SHOWN AND DEFINED HEREON.
- WHERE REMOVAL OF EXISTING CURB AND GUTTER, SIDEWALK OR PAVEMENT IS REQUIRED, THE CONTRACTOR SHALL SAWCUT AND/OR REMOVE TO THE NEAREST JOINT. CURB AND GUTTER SHOWN AS EXISTING AND NOT TO BE REMOVED UNDER THIS CONTRACT WHICH IS DAMAGED OR DISPLACED BY THE CONTRACTOR SHALL BE REMOVED AND REPLACED BY THE CONTRACTOR AT THE CONTRACTOR'S EXPENSE.
- ALL DIMENSIONS OF CURB AND CURB RETURNS ARE SHOWN TO FACE-OF-CURB.
- ALL SIDEWALKS SHOWN HEREON SHALL BE CONSIDERED UNDER SEPARATE PERMIT (BUILDING PERMIT).
- ALL WHEELCHAIR RAMPS MUST BE CONSTRUCTED UNDER THIS WORK ORDER.
- ALL CURB AND GUTTER SHOWN HEREON SHALL BE STANDARD CURB AND GUTTER PER CITY OF ALBUQUERQUE STANDARD DRAWING 2415 UNLESS OTHERWISE NOTED.
- UPON COMPLETION OF CONSTRUCTION, THE CITY OF ALBUQUERQUE WILL PROVIDE AND INSTALL ALL STREET SIGNS.
- STRIPING BY CONTRACTOR WILL BE REQUIRED PRIOR TO FINAL ACCEPTANCE.
- REFER TO SHEET 13 FOR STREET SECTIONS

STORM DRAIN NOTES:

- ALL STORM DRAIN TO BE CLASS III REINFORCED CONCRETE PIPE (RCP) UNLESS OTHERWISE NOTED.
- ALL MANHOLES SHALL BE 6' DIAMETER TYPE 'C' PER C.O.A. STANDARD DRAWING 2101 UNLESS OTHERWISE NOTED.
- ALL STATIONING IS BASED ON CONSTRUCTION BASELINE UNLESS OTHERWISE NOTED. SLOPES ARE BASED ON TRUE LENGTH OF PIPE.
- THE CONTRACTOR SHALL BE RESPONSIBLE FOR SELECTING APPROPRIATE MEANS AND METHODS TO EXCAVATE AND TRENCH AND INSTALL PIPE SO AS NOT TO EXCEED RIGHT-OF-WAY OR EASEMENT LIMITS, AND SO AS NOT TO INTERFERE WITH OTHER UTILITIES. THIS SHALL BE CONSIDERED INCIDENTAL TO TRENCHING, THEREFORE, NO SEPARATE PAYMENT WILL BE MADE.
- THE CONTRACTOR SHALL BE RESPONSIBLE FOR PROTECTING, SUPPORTING AND REPLACING, IF DAMAGED, ALL OTHER UTILITIES ENCOUNTERED DURING CONSTRUCTION. THIS SHALL BE CONSIDERED INCIDENTAL TO TRENCHING, THEREFORE, NO SEPARATE PAYMENT WILL BE MADE.

CONDUIT NOTES: REFER TO SHEET L9-2 FOR CONDUIT NOTES.

- ALL CONDUIT SHALL BE CLASS 200 PVC SDR 21 SOLVENT WELD.
- ALL CONDUIT SHALL BE INSTALLED WITH 18" COVER (MIN.).
- ALL CONDUIT SHALL EXTEND 12" BEYOND CURB AND/OR SIDEWALK.
- CONTRACTOR SHALL COVER CONDUIT OPENINGS WITH DUCT TAPE. THIS SHALL BE CONSIDERED INCIDENTAL TO CONDUIT INSTALLATION.
- LANDSCAPING SHALL BE INSTALLED UNDER SEPARATE CONTRACT- NOT PART OF WORK ORDER.

NOTES:


- REFER TO SHEET 13 FOR SECTIONS AND DETAILS
- REFER TO SHEET 4 FOR STRIPING PLAN
- REFER TO SHEET 4 FOR ENTRANCE MODIFICATION PLAN
- REFER TO SHEETS L9-1, L9-2 AND L9-3 FOR LANDSCAPING IMPROVEMENTS WITHIN MEDIAN



JEFF MORTESEN & ASSOCIATES, INC.
1010 N. MOUNTAIN PARK BLVD., N.W.
ALBUQUERQUE, N.M. 87109
ENGINEERS & SURVEYORS (505) 345-4250

CITY OF ALBUQUERQUE
PUBLIC WORKS DEPARTMENT
ENGINEERING DEVELOPMENT GROUP



TITLE: **PATHWAY OFFICE PARK
PAVING AND STORM DRAINAGE IMPROVEMENTS PLAN AND PROFILE
VASSAR DRIVE N.E. STA 14+13.23 TO STA 20+65.04**

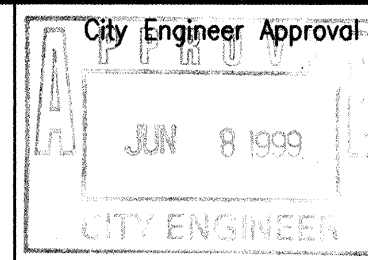


GRADING NOTES

1. THE CONTRACTOR SHALL ENSURE THAT NO SOIL ERODES FROM THE SITE INTO PUBLIC RIGHT-OF-WAY OR ONTO PRIVATE PROPERTY.
2. THE CONTRACTOR SHALL PROMPTLY CLEAN UP ANY MATERIAL EXCAVATED WITHIN THE PUBLIC RIGHT-OF-WAY SO THAT THE EXCAVATED MATERIAL IS NOT SUSCEPTIBLE TO BEING WASHED DOWN THE STREET.
3. A DISPOSAL SITE FOR ALL EXCESS EXCAVATION MATERIAL (CONTAMINATED OR OTHERWISE), ASPHALTIC PAVING, CONCRETE PAVING, ETC. SHALL BE OBTAINED BY THE CONTRACTOR IN COMPLIANCE WITH APPLICABLE REGULATIONS. ALL COSTS INCURRED IN OBTAINING A DISPOSAL SITE AND IN HAUL THERETO SHALL BE CONSIDERED INCIDENTAL TO CONSTRUCTION, THEREFORE, NO SEPARATE PAYMENT SHALL BE MADE.
4. A BORROW SITE FOR IMPORT MATERIAL SHALL BE OBTAINED BY THE CONTRACTOR IN COMPLIANCE WITH APPLICABLE REGULATIONS. ALL COSTS INCURRED IN OBTAINING A BORROW SITE AND IN HAUL THERETO SHALL BE CONSIDERED INCIDENTAL TO CONSTRUCTION, THEREFORE, NO SEPARATE PAYMENT SHALL BE MADE.
5. THE CONTRACTOR SHALL BE RESPONSIBLE FOR SAFELY OBTAINING THE REQUIRED COMPACTION. THE CONTRACTOR SHALL SELECT AND USE METHODS WHICH SHALL NOT BE INJURIOUS OR DAMAGING TO THE EXISTING FACILITIES AND STRUCTURES WHICH SURROUND THE WORK AREAS.
6. ALL FILL SHALL BE FREE FROM VEGETATION, DEBRIS, AND OTHER DELETERIOUS MATERIALS.
7. ALL FILL SHALL BE COMPACTED TO A MINIMUM OF 95% ASTM D-1557 UNLESS A GREATER COMPACTION REQUIREMENT IS OTHERWISE SPECIFIED. ALL EARTHWORK FOR BUILDING PADS SHALL BE PERFORMED IN ACCORDANCE WITH THE STRUCTURAL AND GEOTECHNICAL SPECIFICATIONS.
8. ALL EXISTING UTILITIES ENCOUNTERED WITHIN THE WORK LIMITS SHALL BE ADJUSTED TO GRADE AND SHALL BE CONSIDERED INCIDENTAL TO CONSTRUCTION.
9. REFER TO SHEET 3 FOR GRADING AND DRAINAGE PLAN (HYDROLOGY FILE G16/D114.)


LINE	DISTANCE	BEARING
①	233.89'	S74°02'03"W
②	236.18'	N68°32'13"E
③	112.20'	S39°58'13"E
④	291.87'	S89°54'54"W

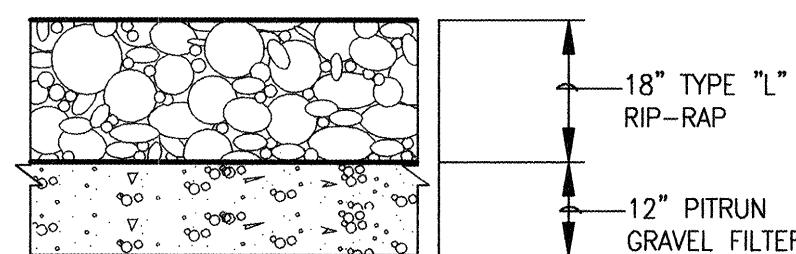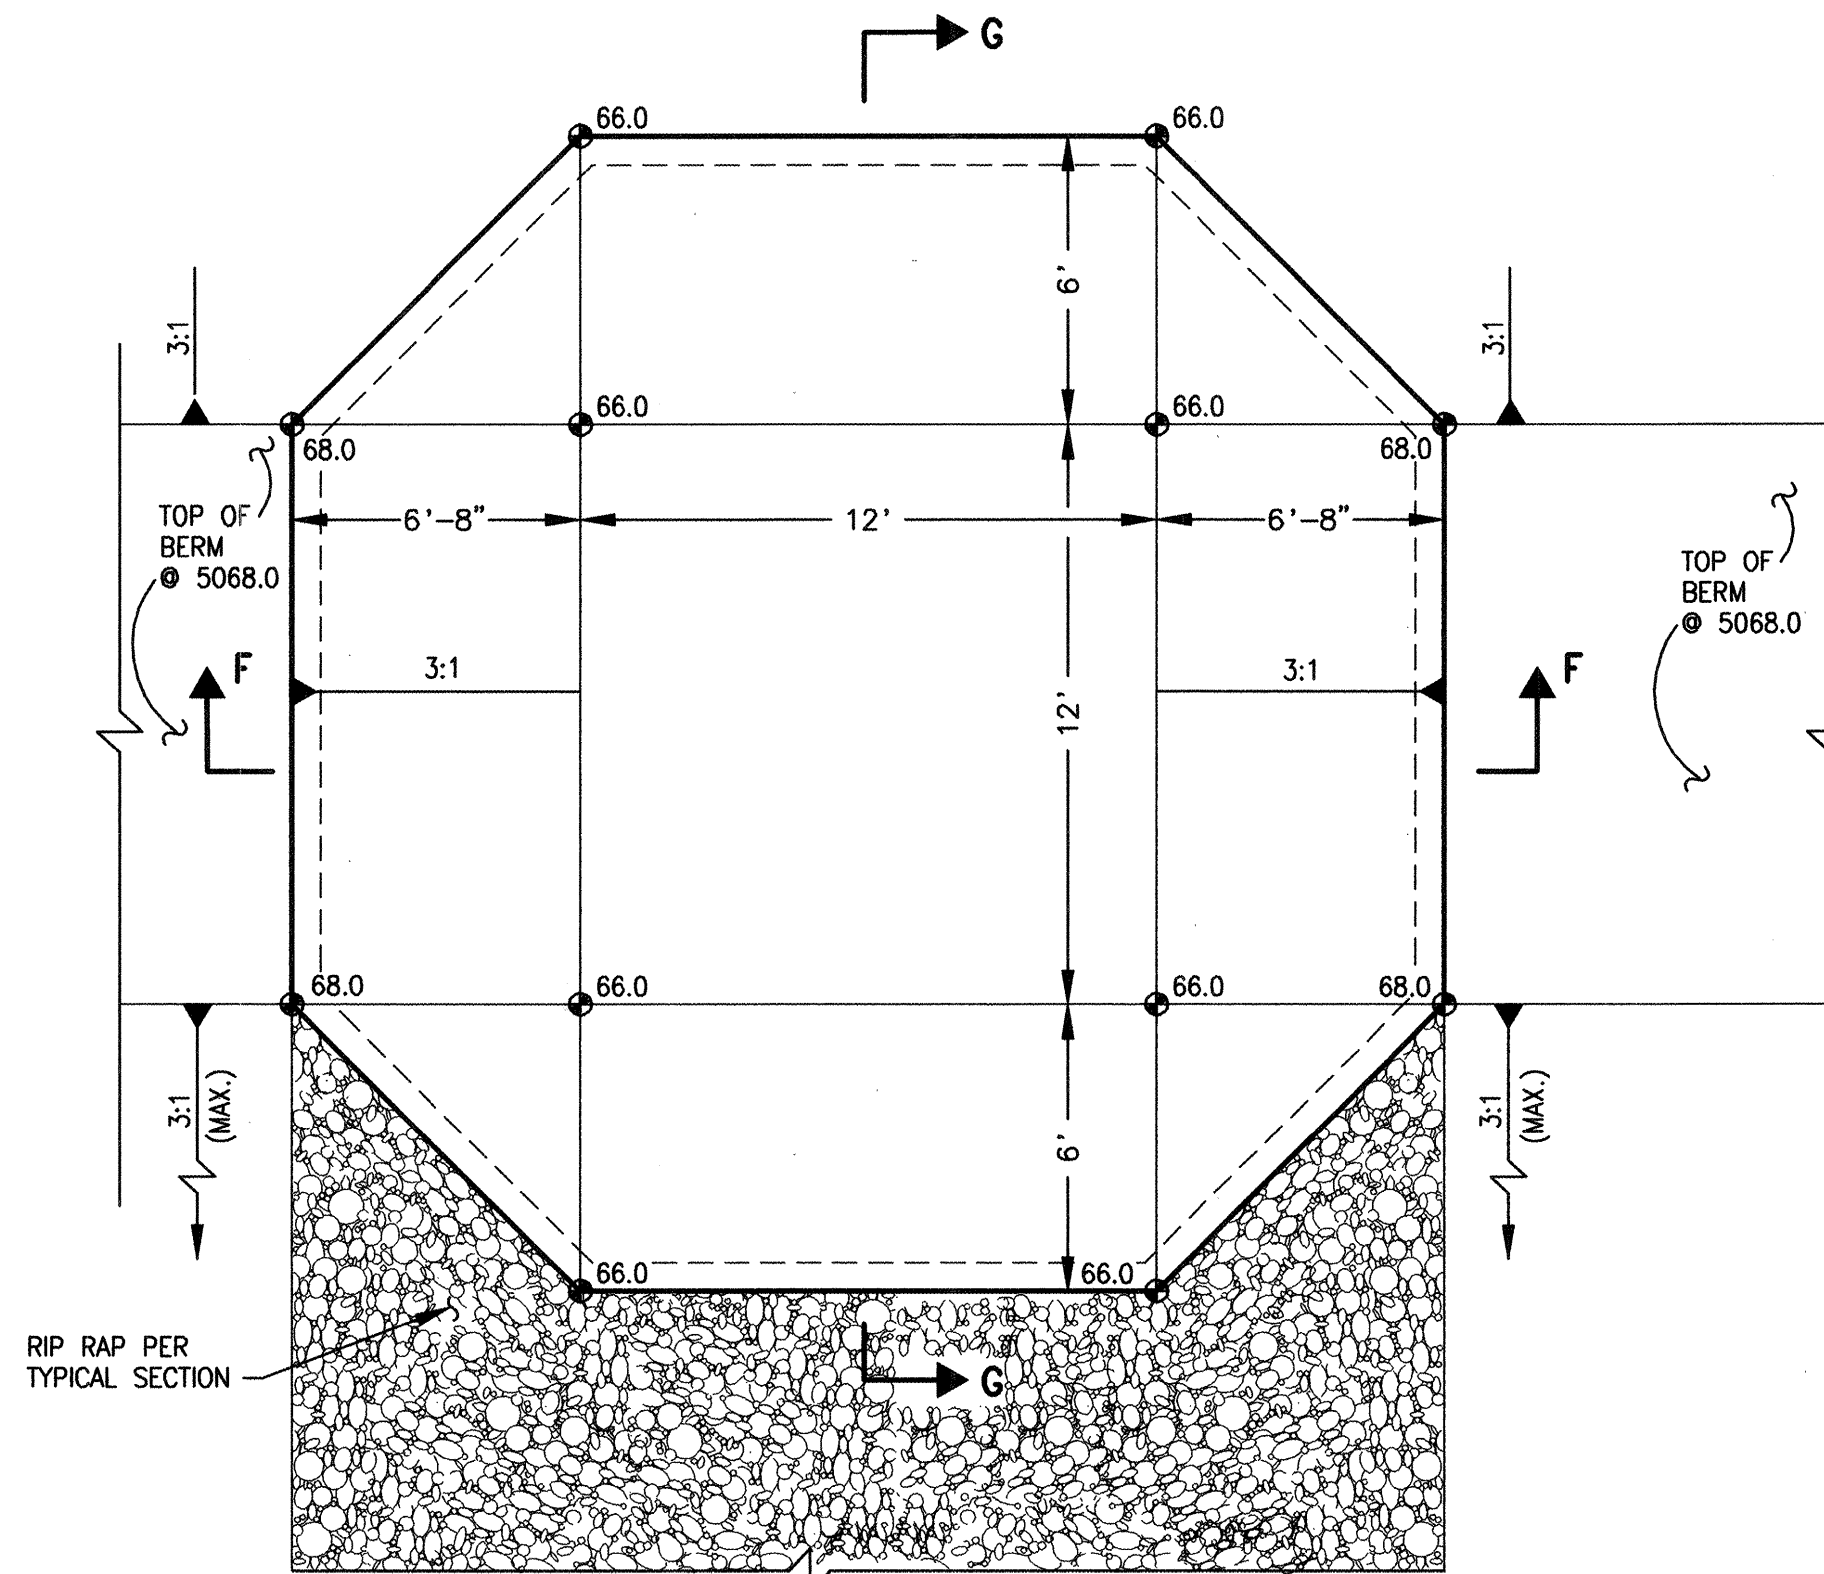


TYPICAL RIP-RAP SECTION
SCALE: 1" = 2' - 0"

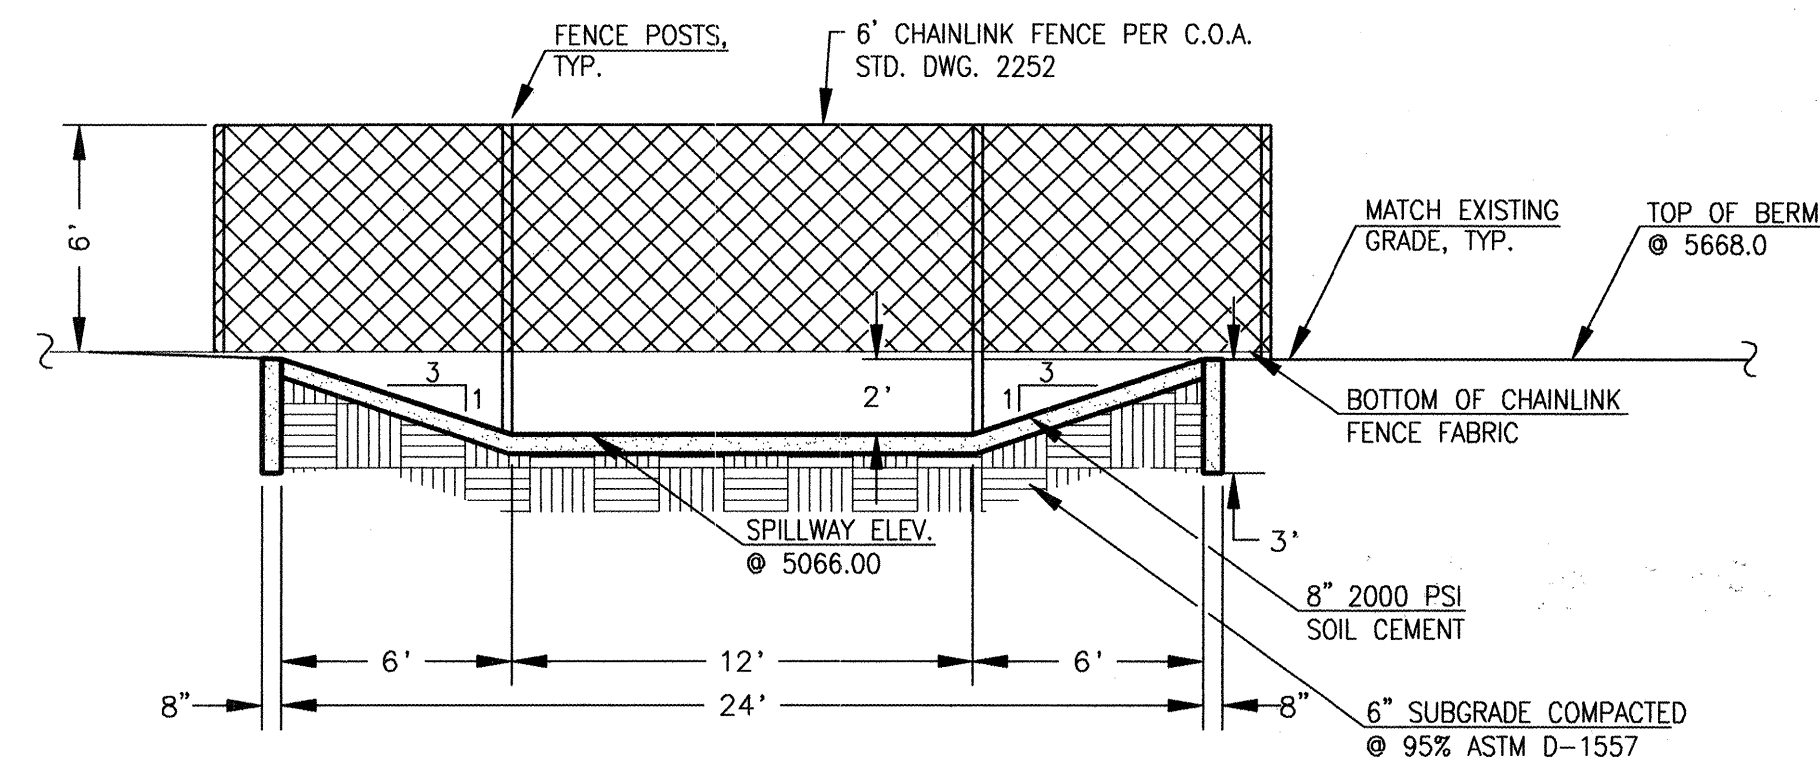

SECTION F-F
SCALE: 1" = 5'

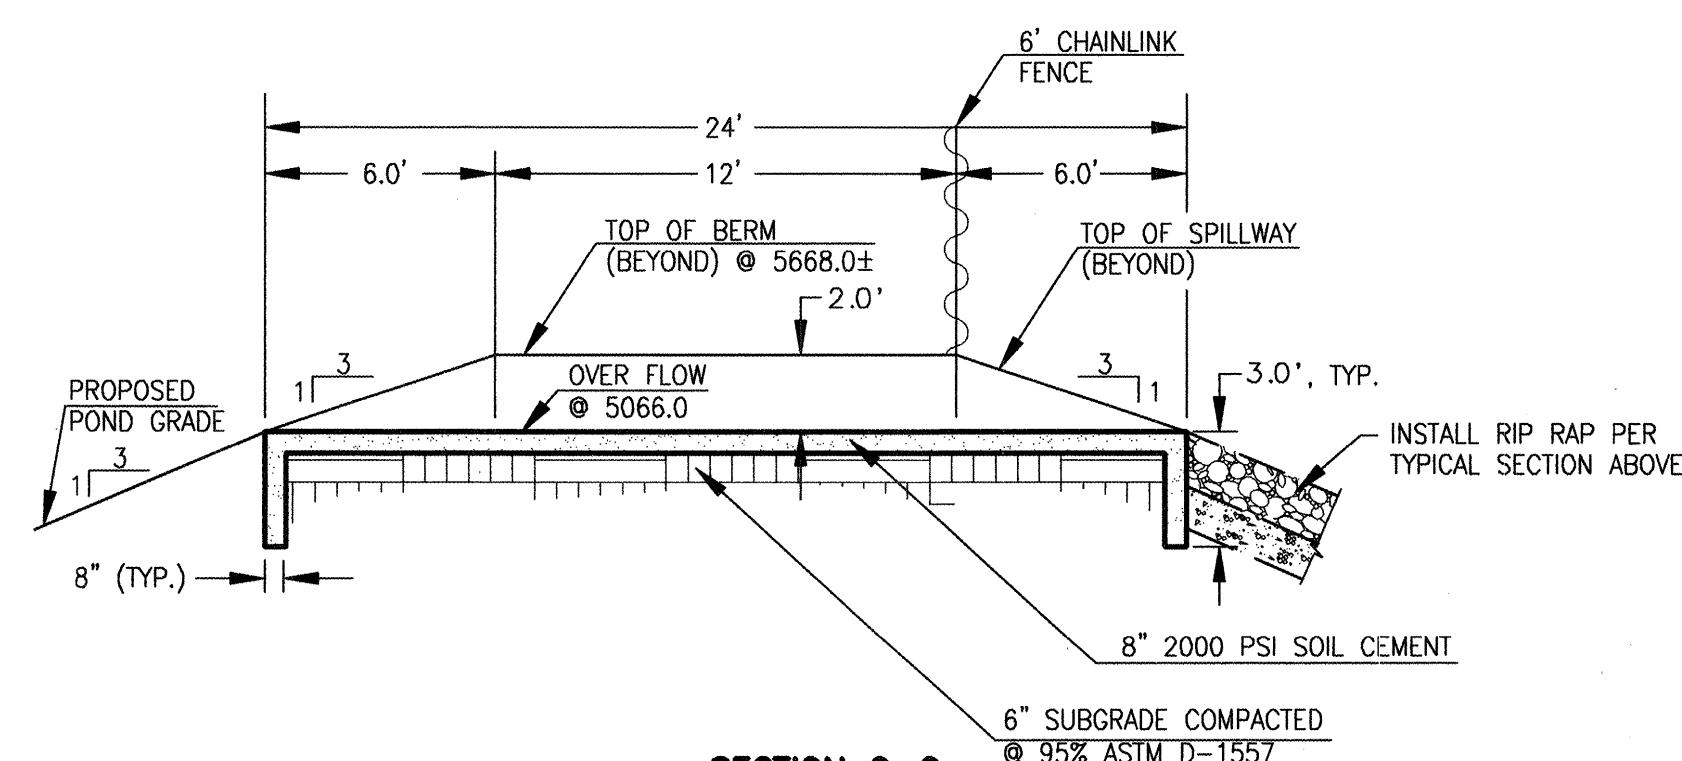

SECTION G-G
SCALE: 1" = 5'

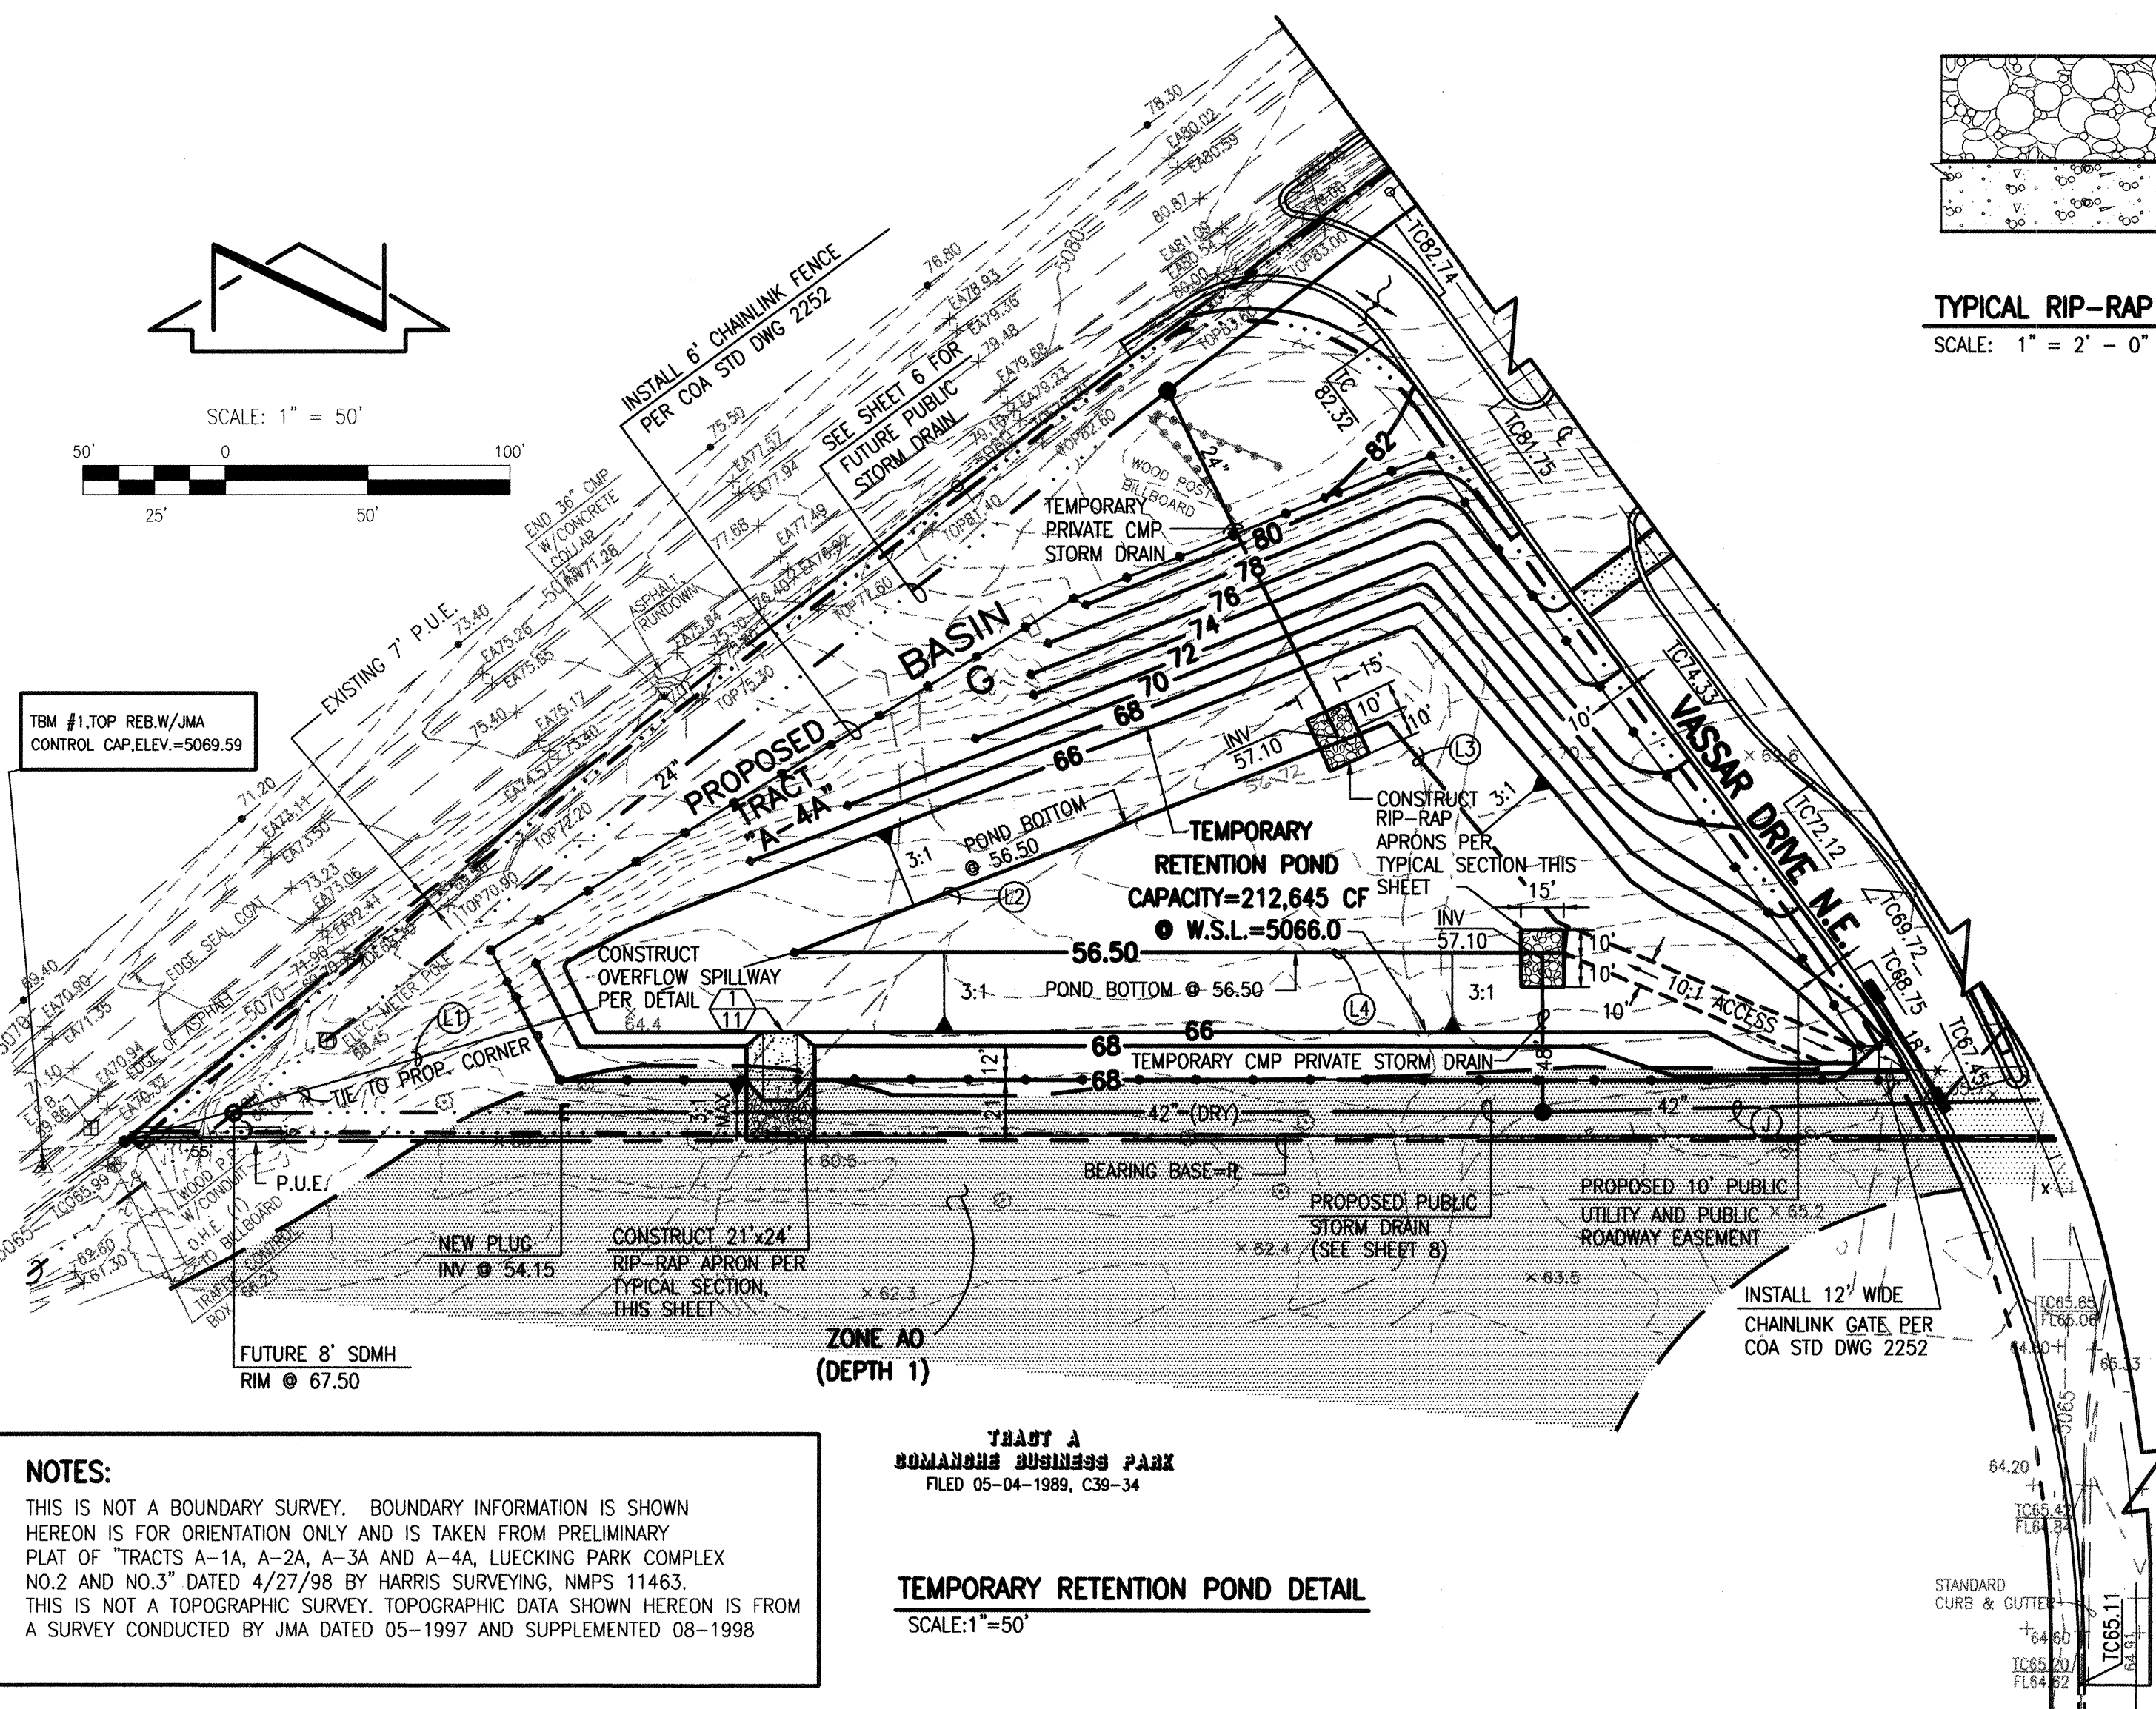

NOTES:
THIS IS NOT A BOUNDARY SURVEY. BOUNDARY INFORMATION IS SHOWN HEREON IS FOR ORIENTATION ONLY AND IS TAKEN FROM PRELIMINARY PLAT OF "TRACTS A-1A, A-2A, A-3A AND A-4A, LUECKING PARK COMPLEX NO.2 AND NO.3" DATED 4/27/98 BY HARRIS SURVEYING, NMPS 11463. THIS IS NOT A TOPOGRAPHIC SURVEY. TOPOGRAPHIC DATA SHOWN HEREON IS FROM A SURVEY CONDUCTED BY JMA DATED 05-1997 AND SUPPLEMENTED 08-1998

TRACT A
DOMINIQUE BUSINESS PARK
FILED 05-04-1999, C39-34

TEMPORARY RETENTION POND DETAIL
SCALE: 1" = 50'

AS-BUILT


I certify that this plan shows as-built conditions based on actual field survey.
Celia S. Tomlinson, PE
NMPE No. 4895





JET MORTENSEN & ASSOCIATES, INC.
6010-B MIDWAY PARK BLVD., N.E.
ALBUQUERQUE, N.M. 87109
(505) 345-4250


CITY OF ALBUQUERQUE PUBLIC WORKS DEPARTMENT ENGINEERING DEVELOPMENT GROUP			
TITLE: PATHWAY OFFICE PARK TRACT A-4A TEMPORARY RETENTION POND SECTIONS AND DETAILS			
Design/Review/Committee	City Engineer Approval	Ms./Rev./Tr.	Ms./Rev./Tr.
APPROVED MAR 29 1999 DESIGN REVIEW COMMITTEE	APPROVED JUN 8 1999 CITY ENGINEER	Ms./Rev./Tr.	Ms./Rev./Tr.
City Project No. 595281	Zone Map No. G-16	Sheet 11	Of 19

AS BUILT INFORMATION		BENCH MARKS		SURVEY INFORMATION		ENGINEER'S SEAL	
CONTRACTOR	DATE	MONUMENT	DATE	DATE	BY	NO.	REMARKS
AMATECH BRASS	5/97	TABLET STAMPED "NDC 15-16", SET ON A CONCRETE POST	5/97	JMA	BY	970282	DESIGN
PROJECTING 0.4 FEET ABOVE GROUND.	8/98	ELEVATION = 5105.49 FEET (M.S.L.D.)	8/98	JMA	BY	980623	REVISIONS
RECORDED BY	DATE	RECORDED BY	DATE	RECORDED BY	DATE	RECORDED BY	DATE
NO.	DATE	NO.	DATE	NO.	DATE	NO.	DATE

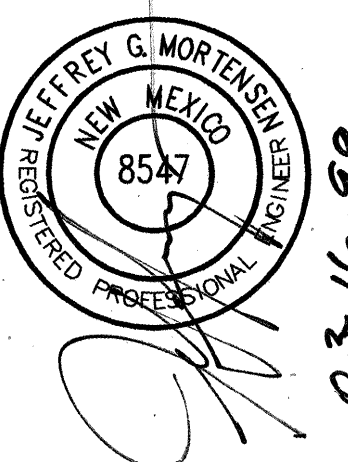


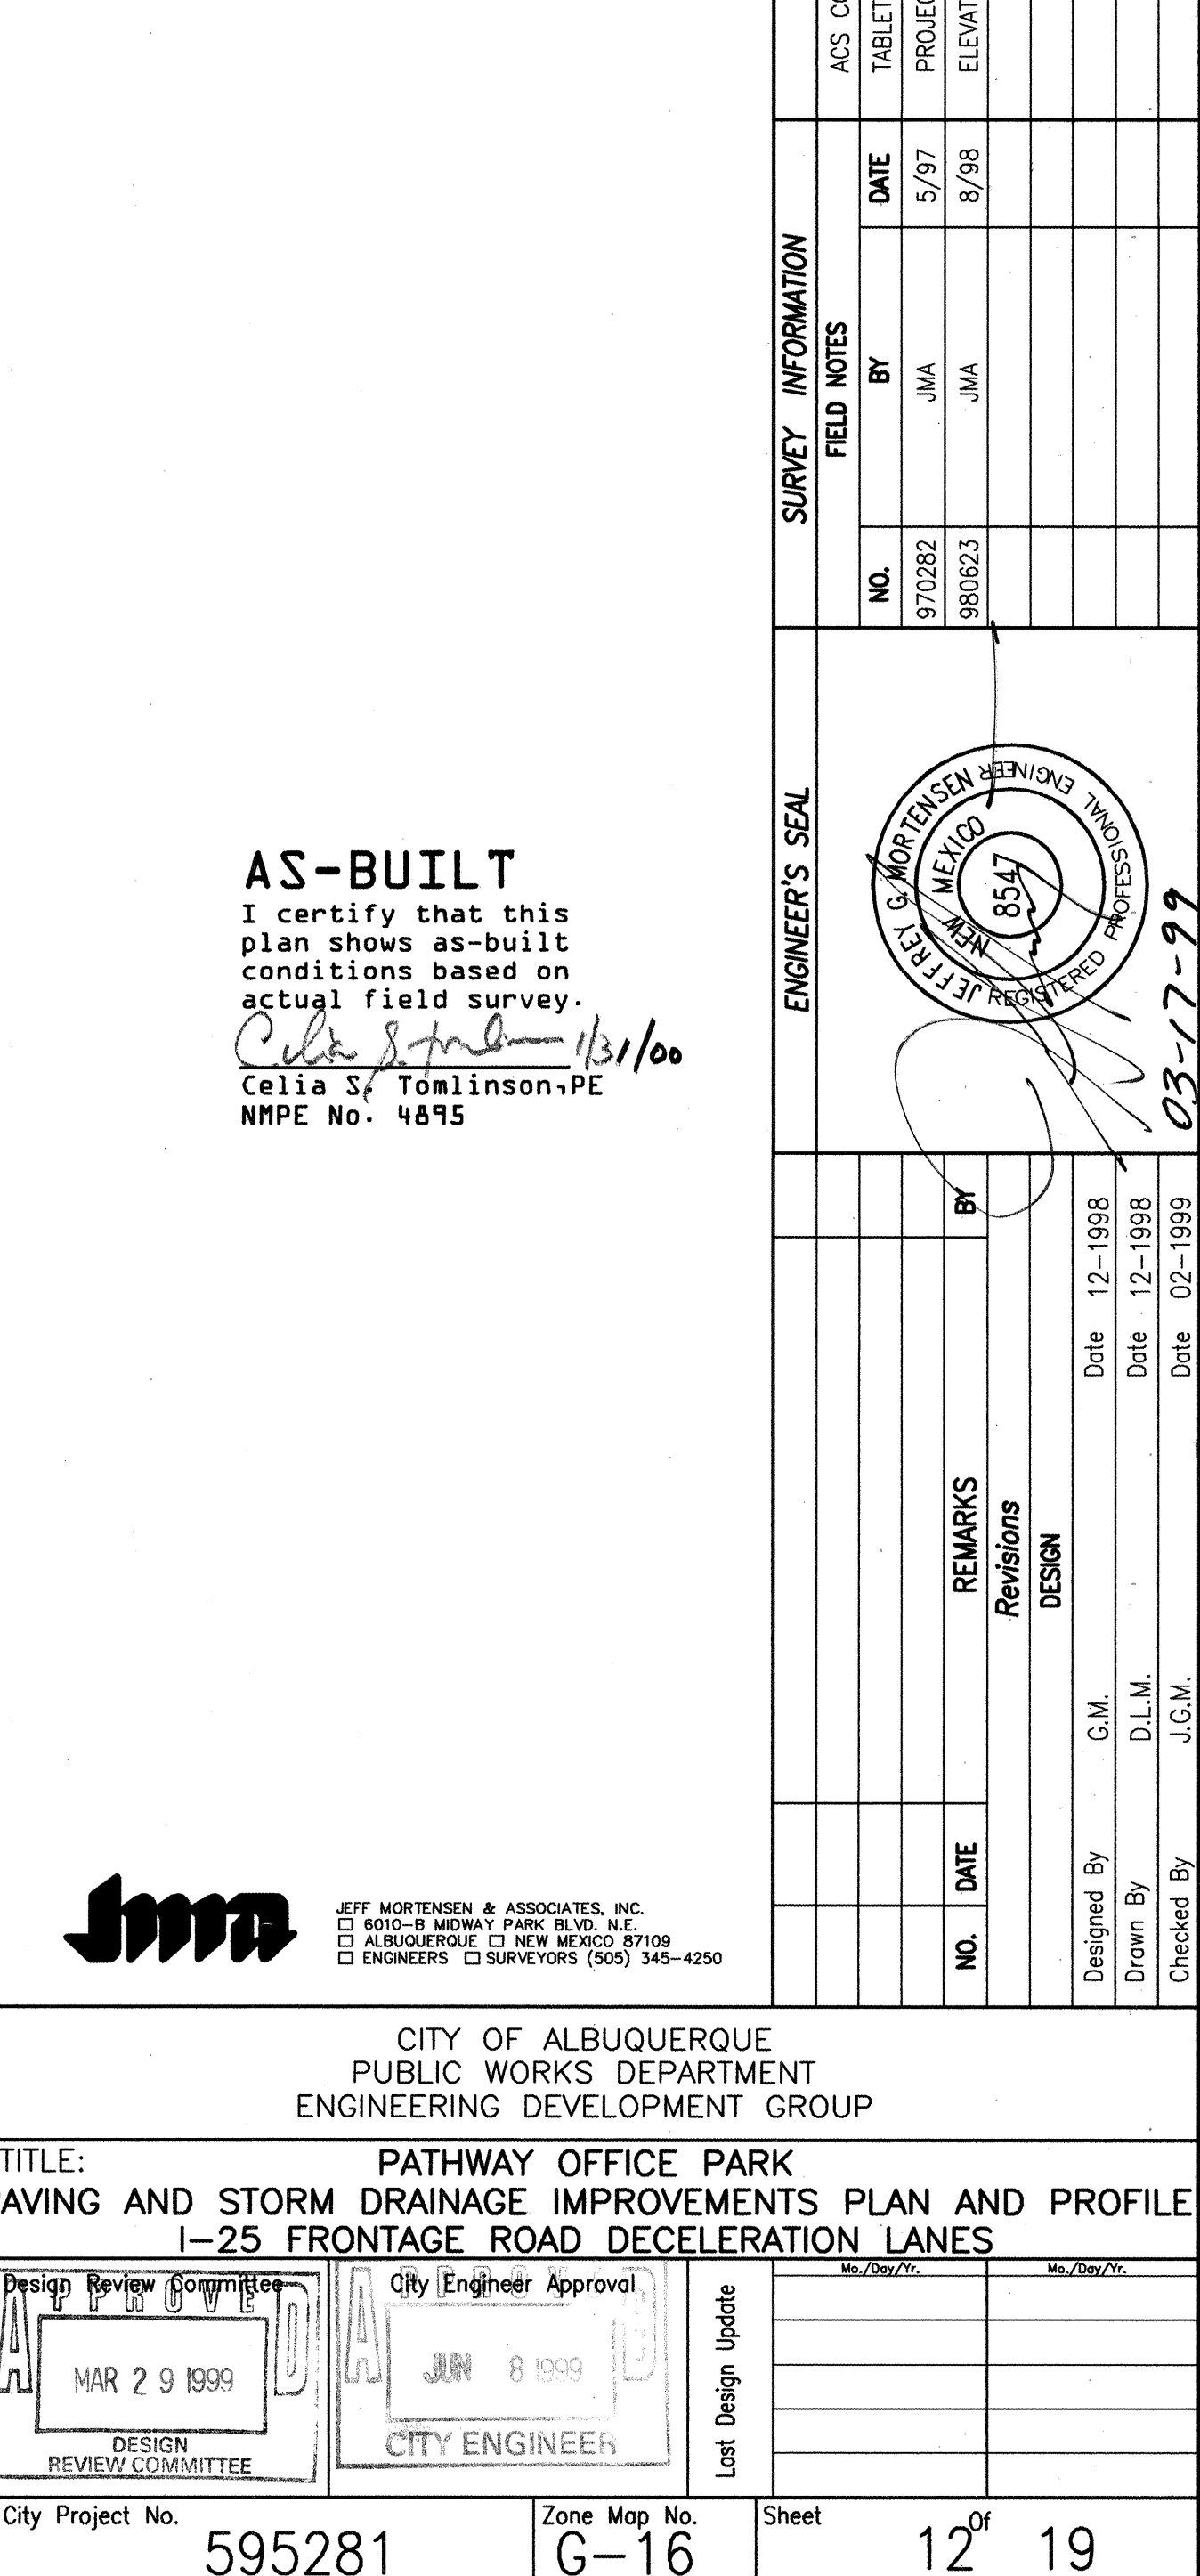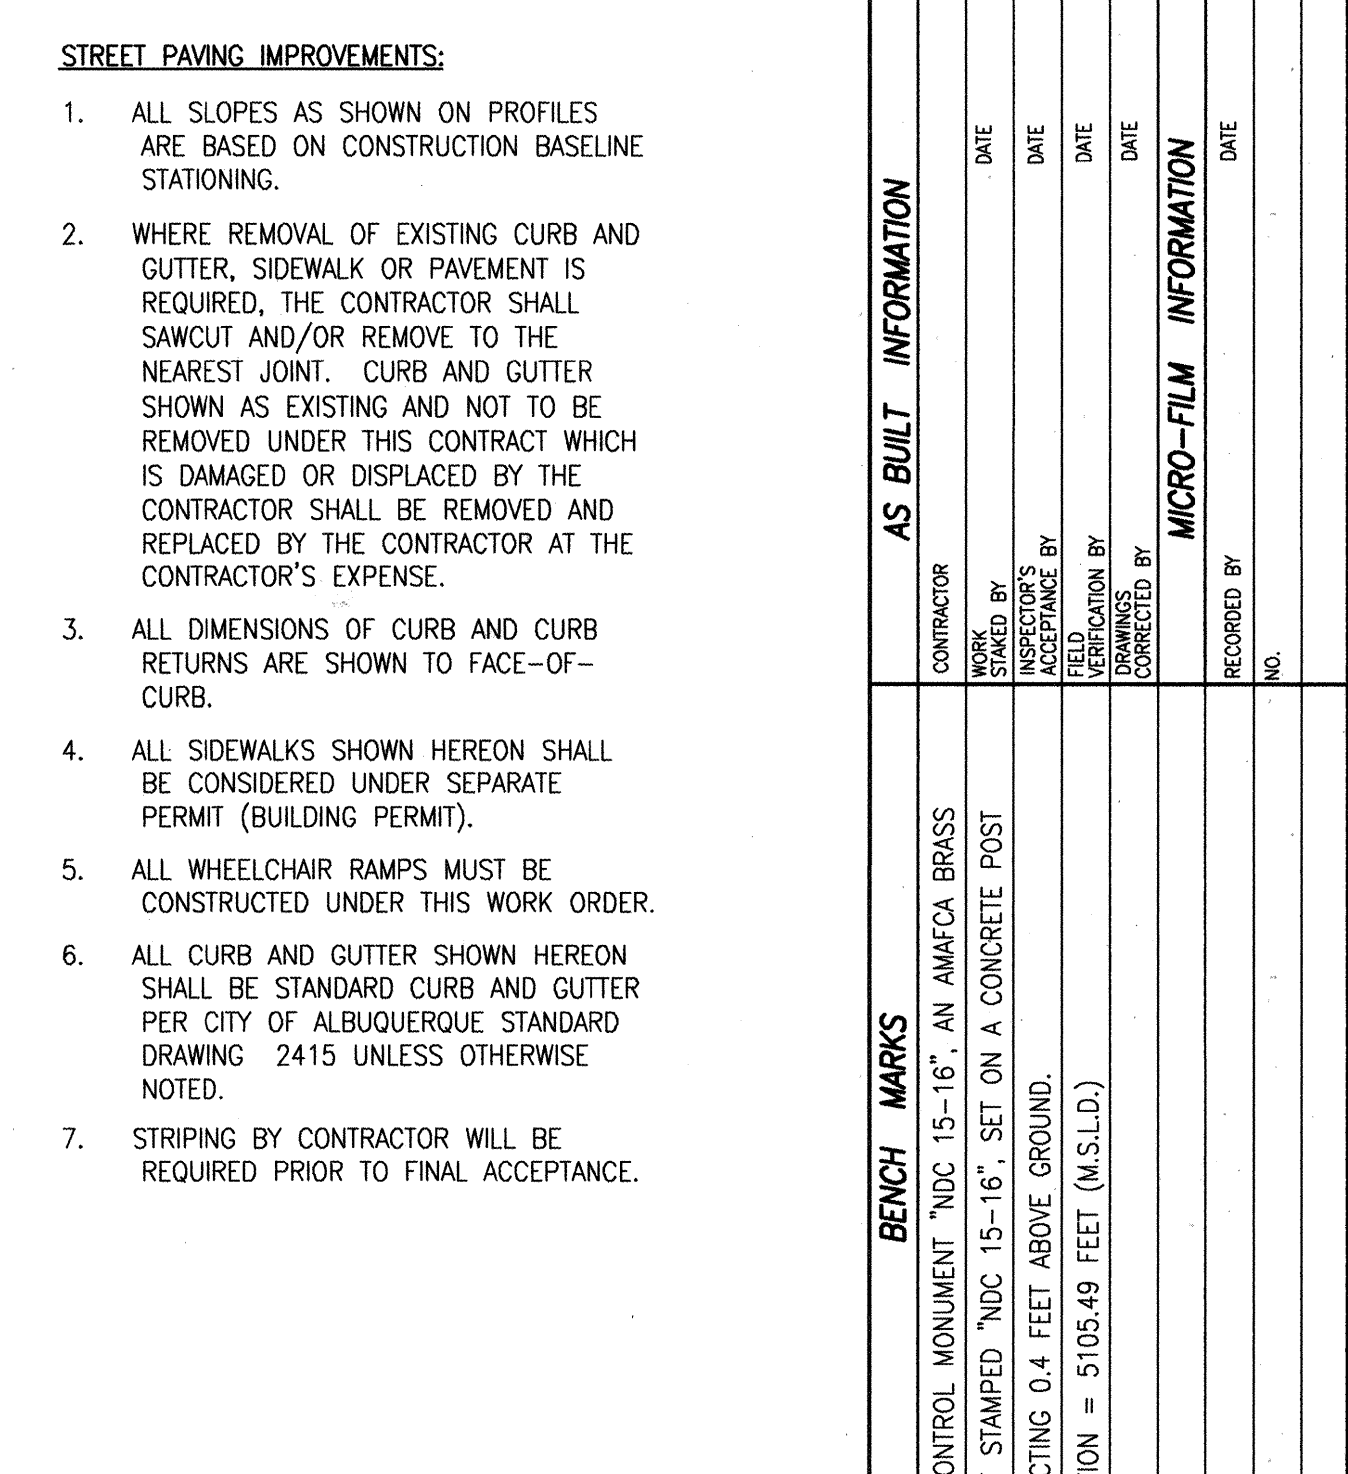


File Path: \\JMA\0014\980611
File Name: 980611.DWG
Plot Date: 03-01-1999
Plot Time: 08:06 am

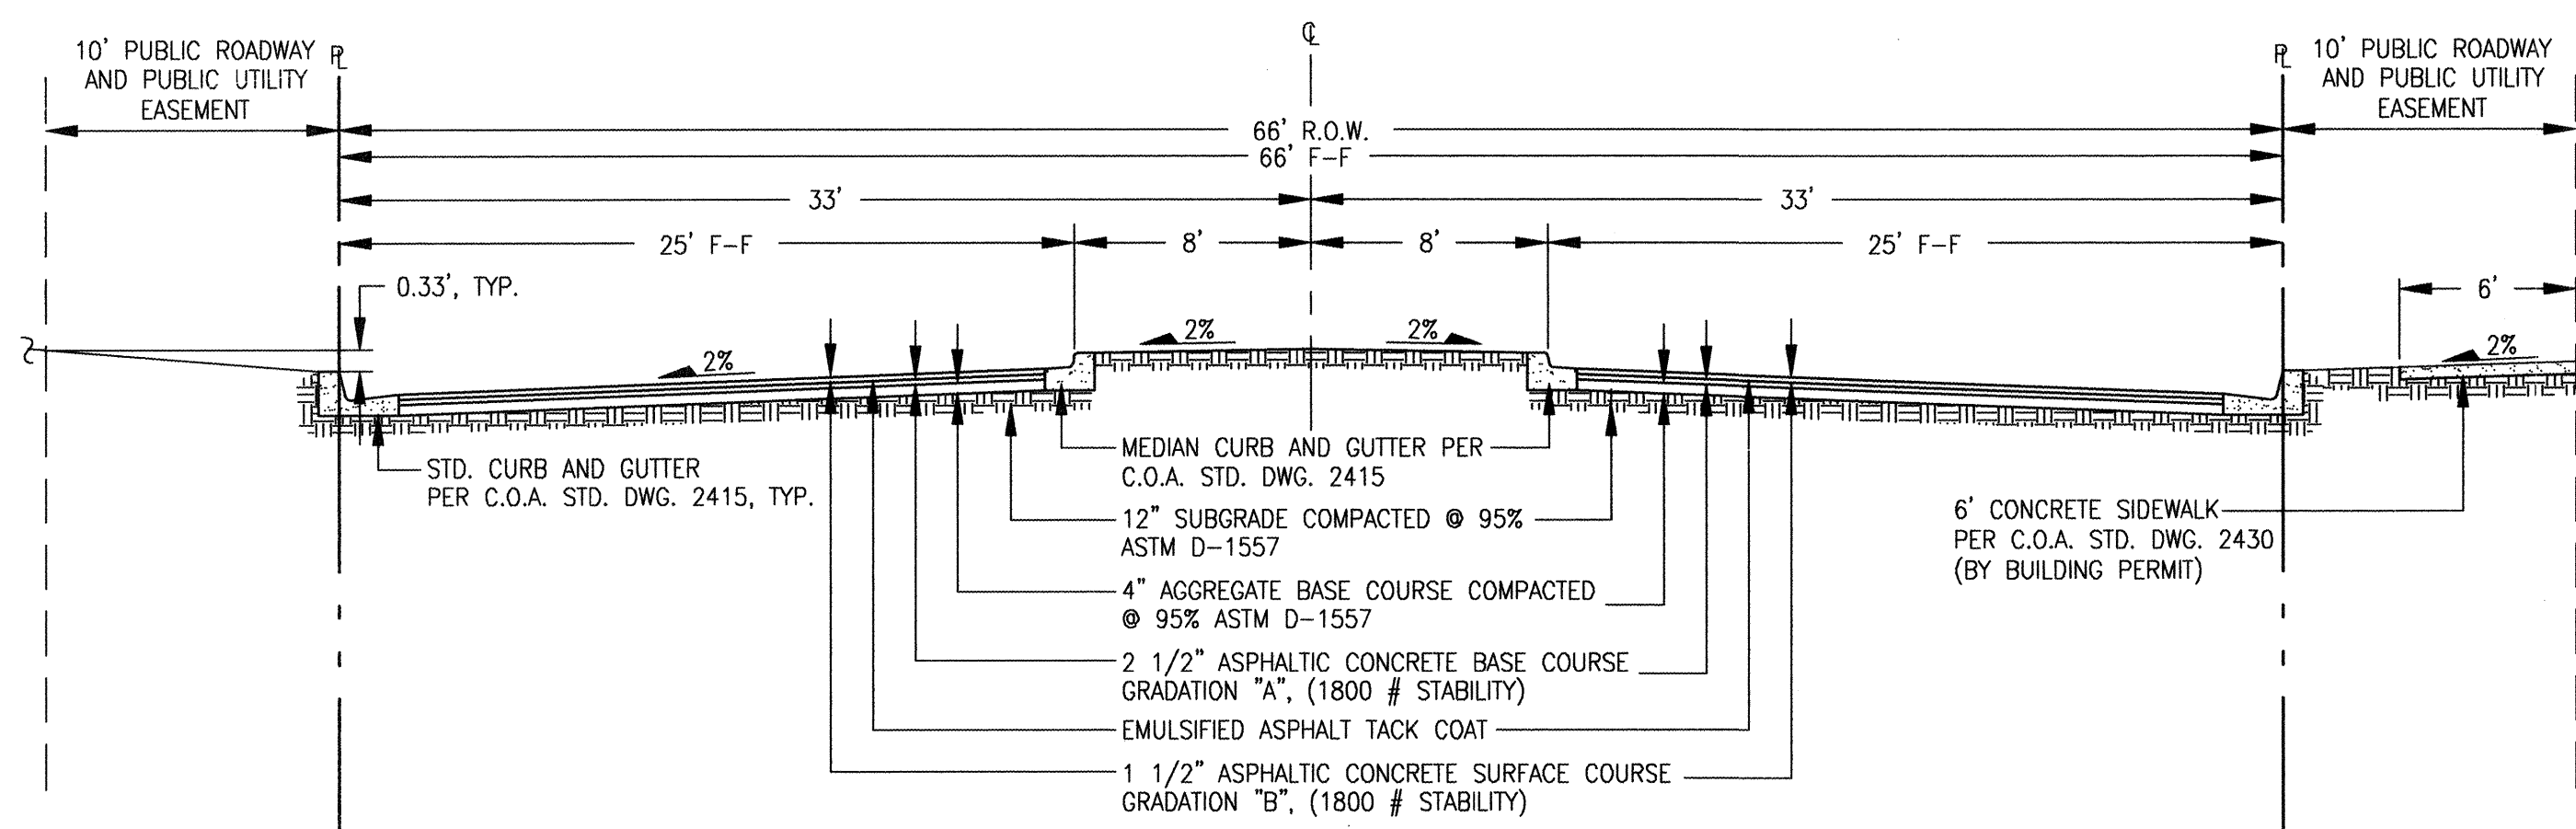


NOTE: THIS PAVEMENT SECTION MATCHES THAT OF VASSAR DRIVE
CONSTRUCTED BY C.O.A. PROJECT 5007.90
SECTION A-A (VASSAR DRIVE)
SCALE: 1" = 6'

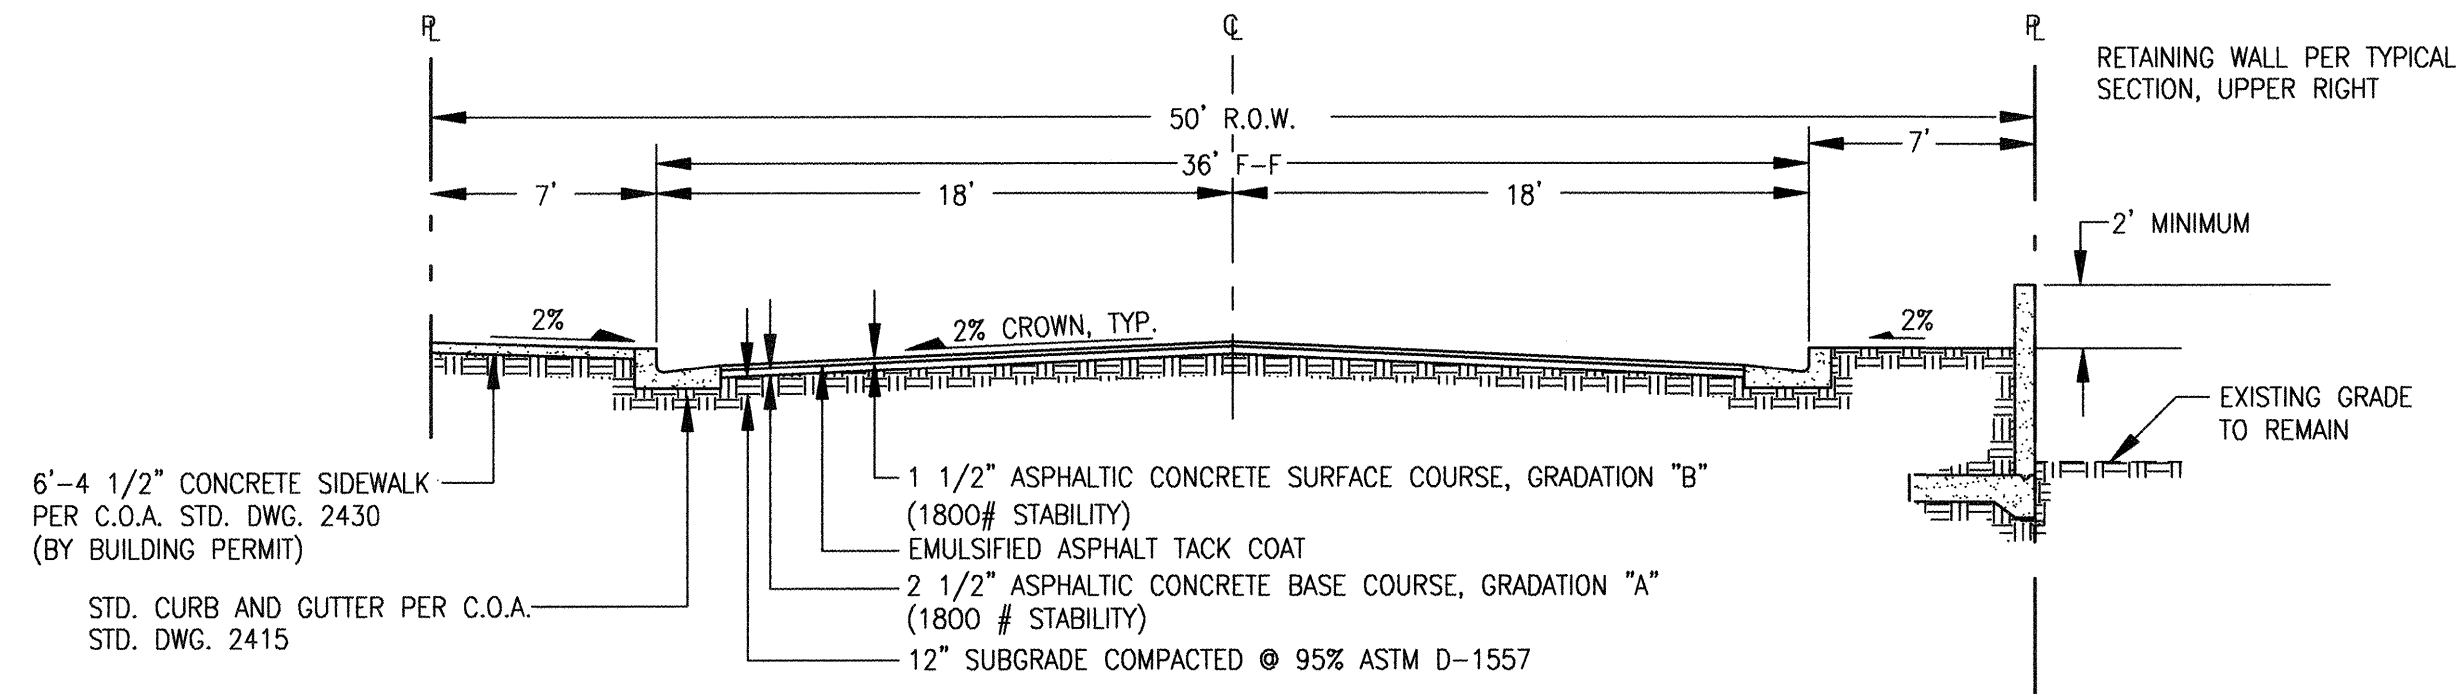


NOTE: THIS PAVEMENT SECTION MATCHES THAT OF LUECKING PARK AVE.
CONSTRUCTED BY C.O.A. S.A.D. 188
SECTION B-B (PATHWAY AVE.)
SCALE: 1" = 6'

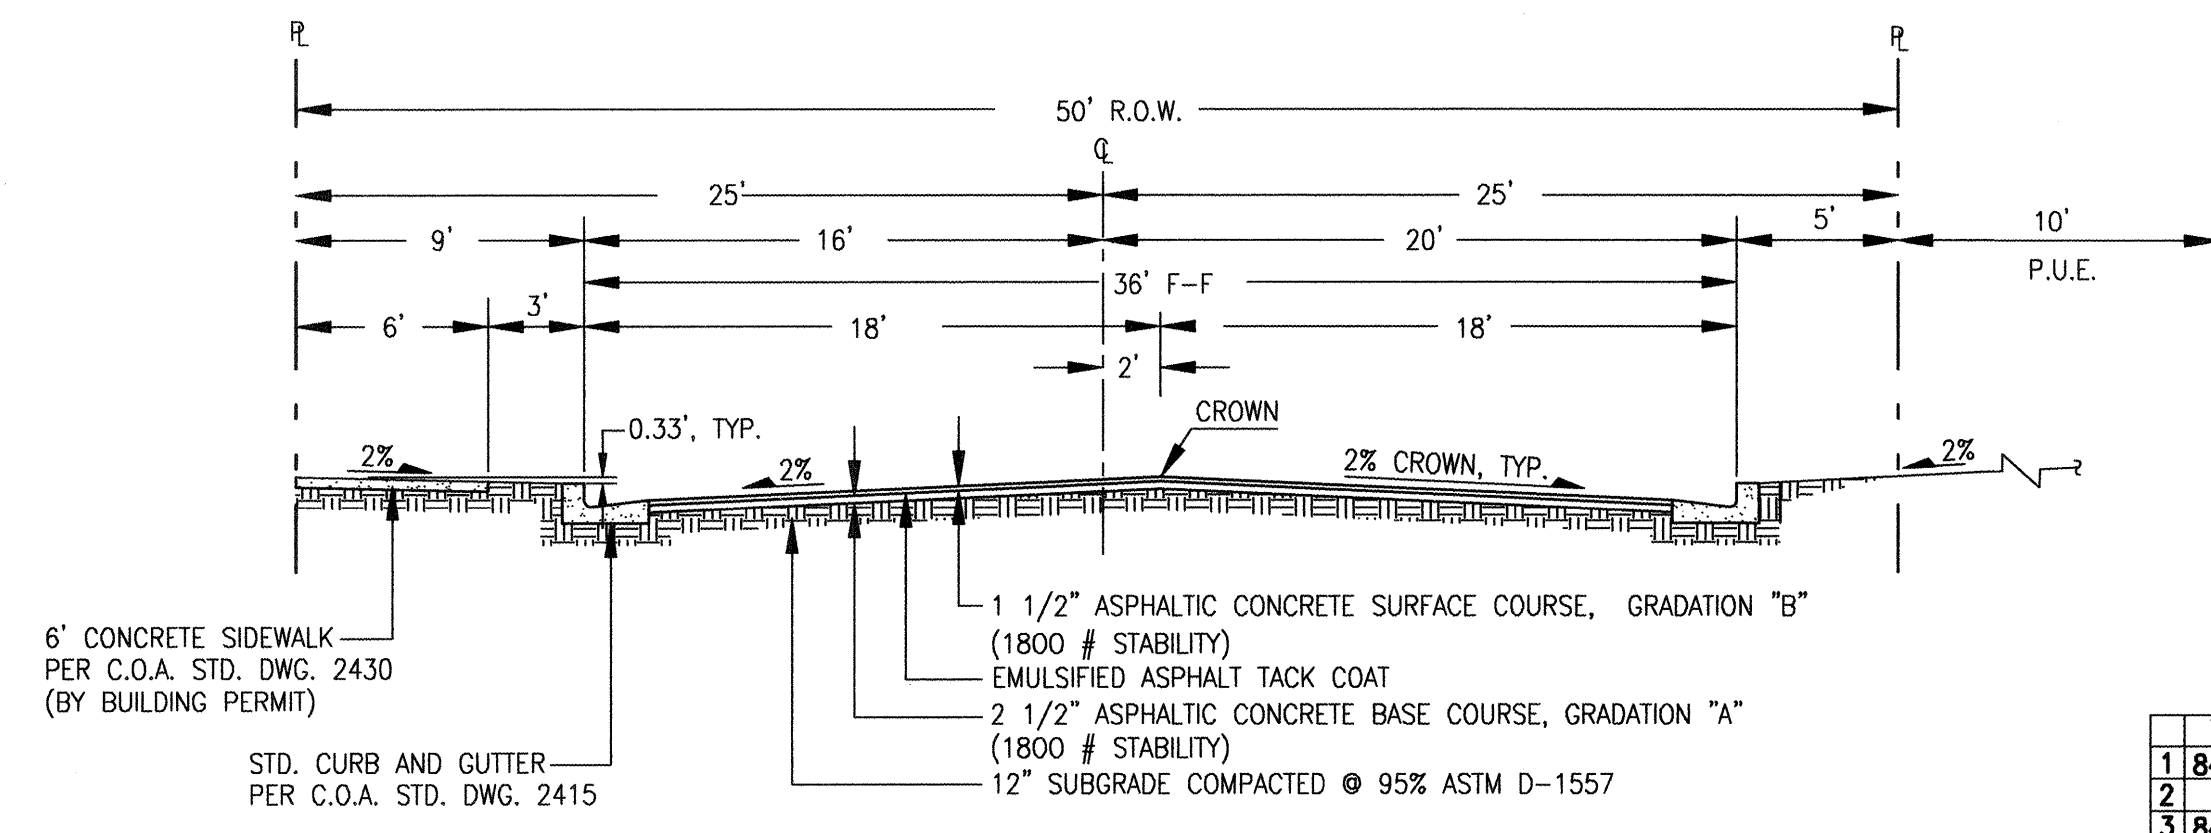


NOTE: THIS PAVEMENT SECTION MATCHES THAT OF LUECKING PARK AVE.
CONSTRUCTED BY C.O.A. S.A.D. 188
SECTION C-C (PATHWAY AVE.)
SCALE: 1" = 6'

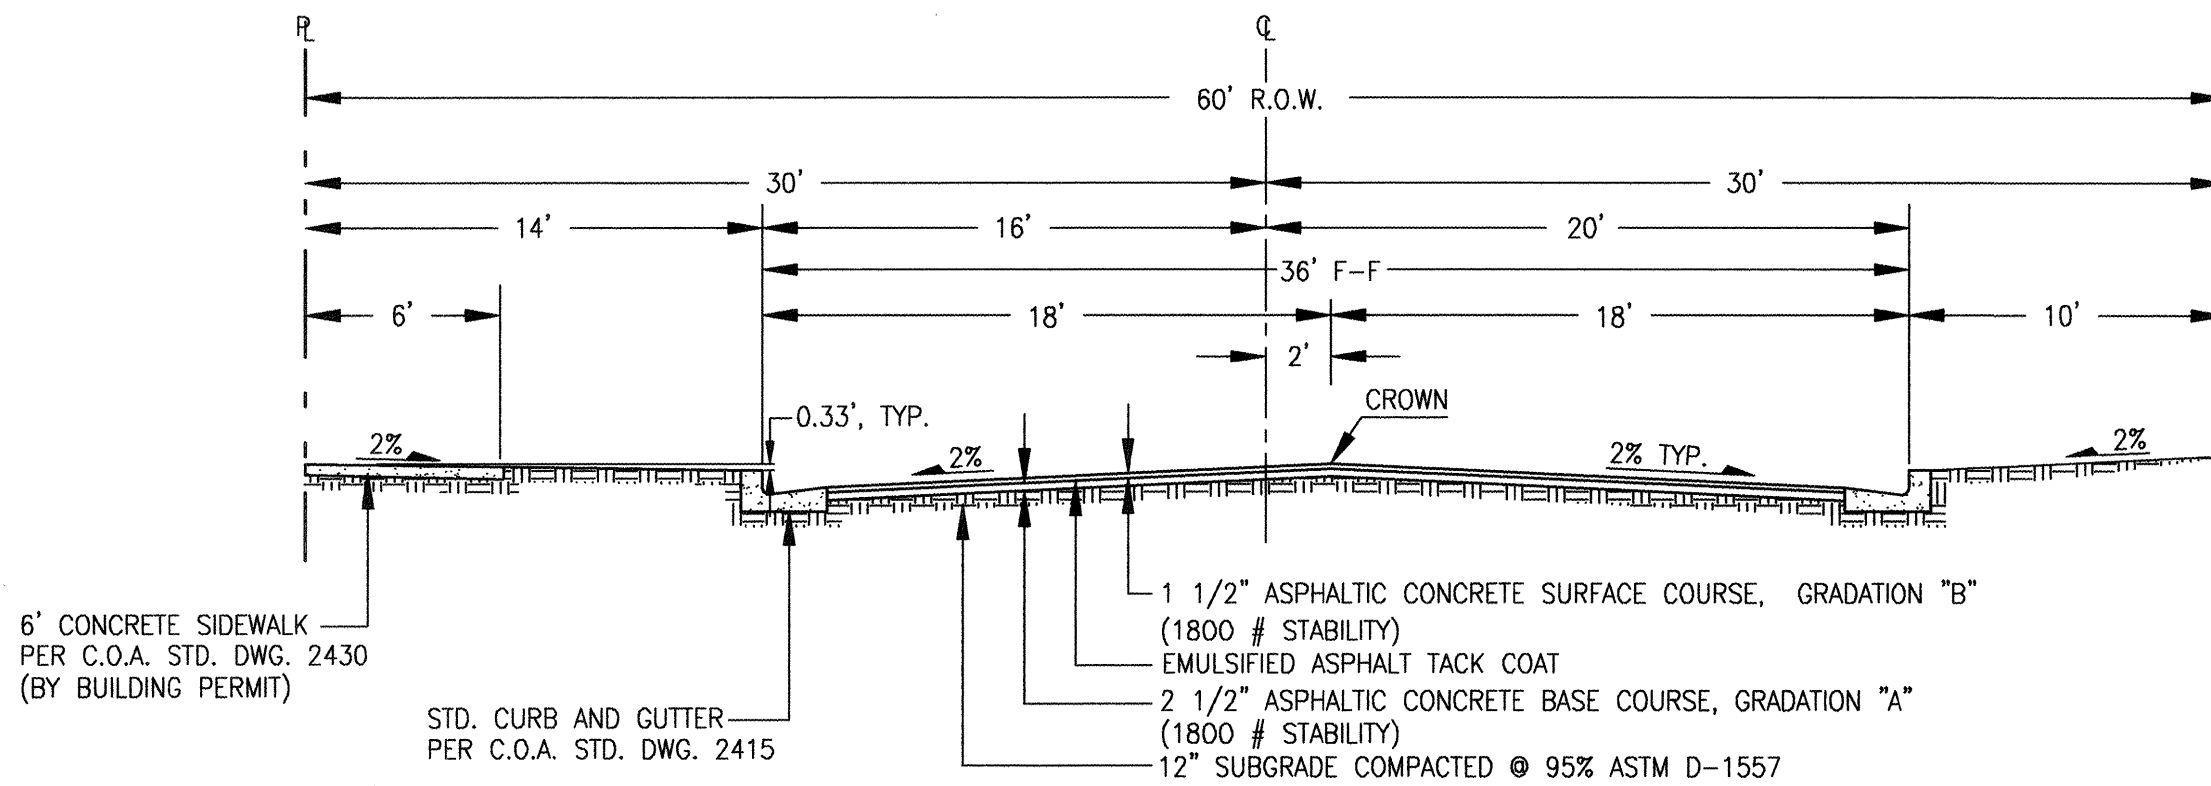


NOTE: THIS PAVEMENT SECTION MATCHES THAT OF LUECKING PARK AVE.
CONSTRUCTED BY C.O.A. S.A.D. 188
SECTION D-D (LUECKING PARK AVE.)
SCALE: 1" = 6'

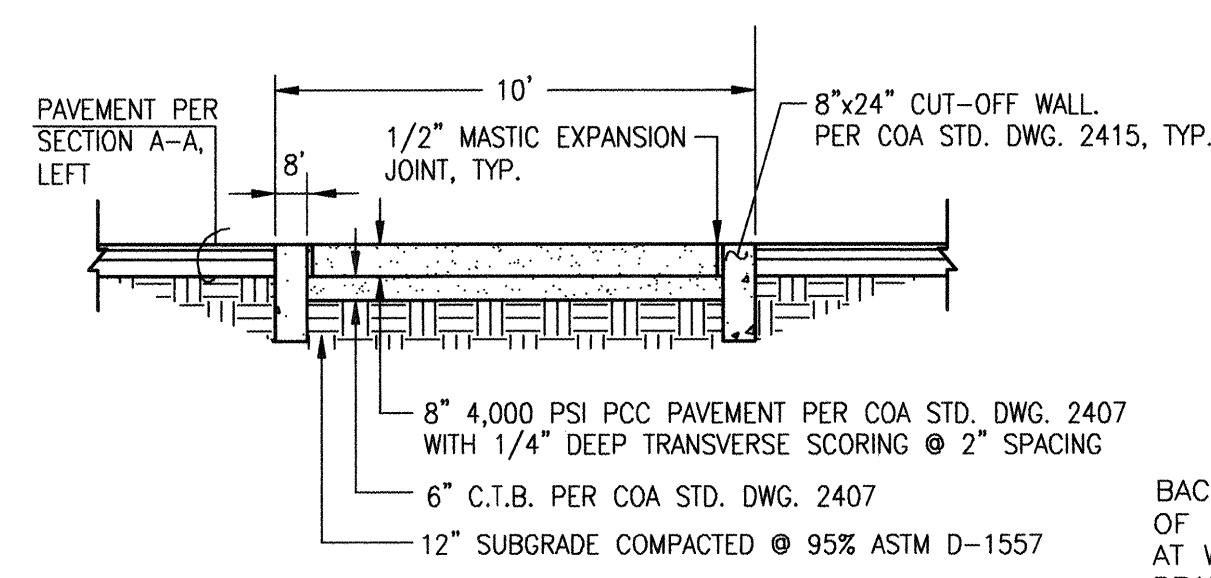

SECTION K-K
SCALE: 1" = 4'

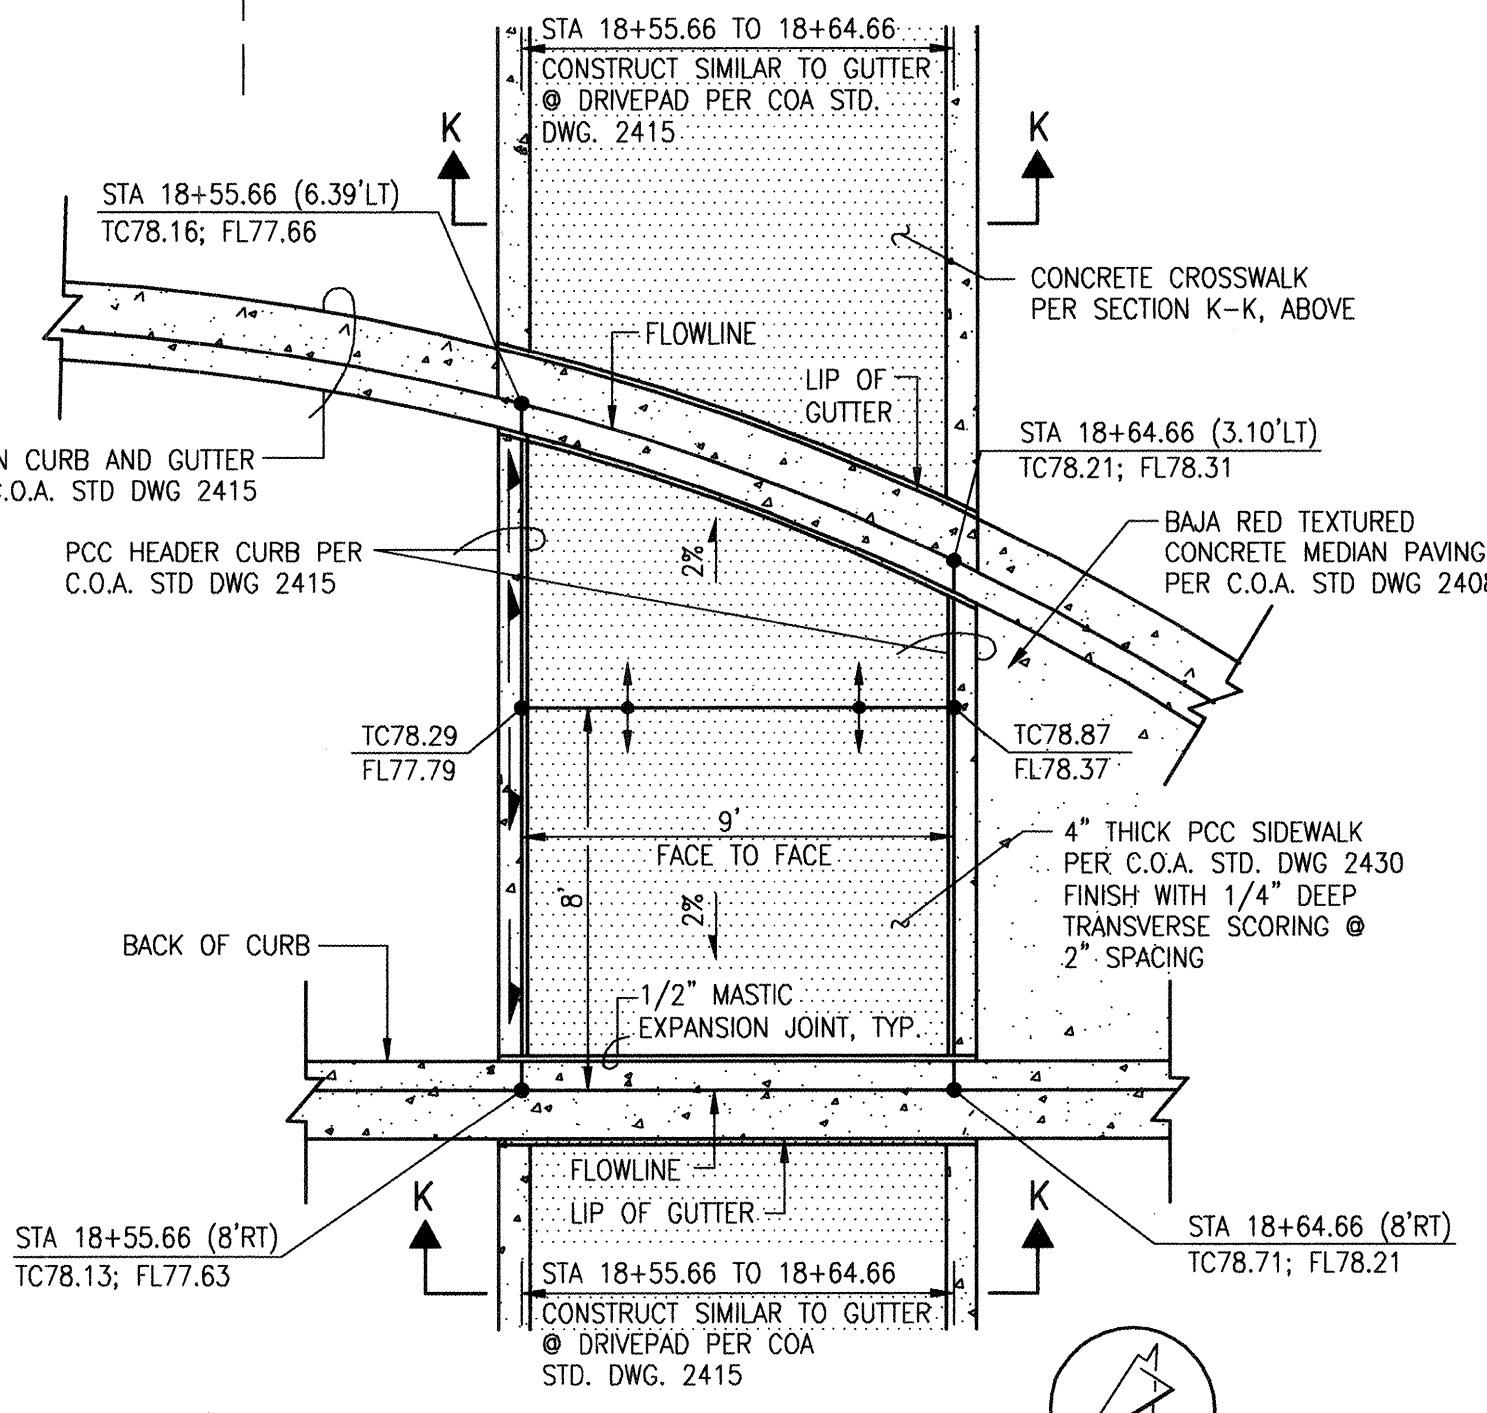


MEDIAN IMPROVEMENTS DETAIL
SCALE: 1" = 4'

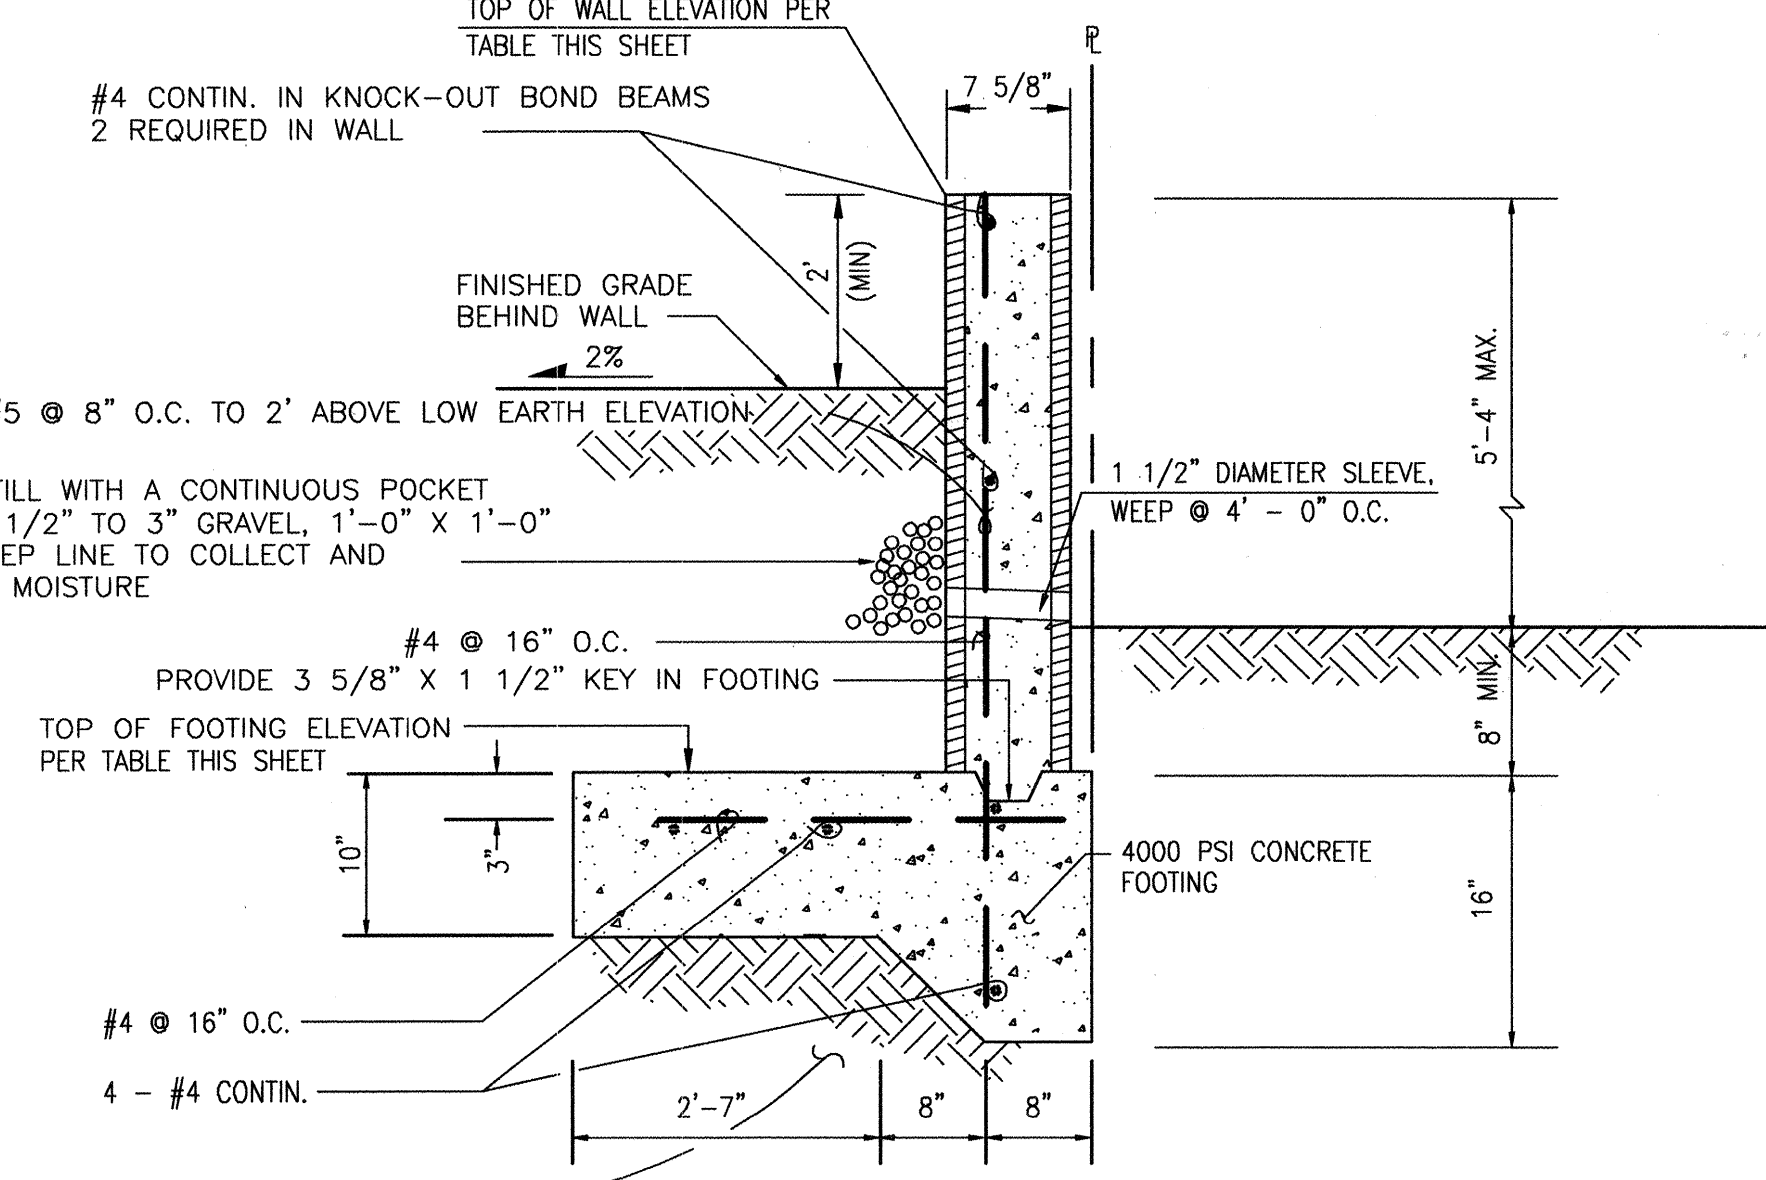


TYPICAL RETAINING WALL SECTION
SCALE: 1" = 1'

- RETAINING WALL NOTES:**
- 8"x8"x16" CMU of UBC STD. 24-4 OR 24-5.
 - USE KNOCK-OUT BOND BEAM BLOCK AT 4'-0" MAX C.C., VERTICALLY, AND 1 #4 CONTINUOUS.
 - FILL ALL BLOCK VOIDS WITH 3000 PSI CONCRETE.
 - REINFORCING TO BE INTERMEDIATE GRADE STEEL. $f_s=20,000$ psi
 - IN LIEU OF CONTINUOUS KNOCK-OUT BOND BEAMS, CONTRACTOR MAY INSTALL DUR-O-WALL REINFORCING EVERY SECOND COURSE.
 - SPLICE SHALL BE 40 BAR DIA. MINIMUM ALL BARS
 - CONCRETE FILL SHALL BE 21 DAYS OLD OR ACHIEVE ULTIMATE STRENGTH PRIOR TO BACKFILLING.
 - INSTALL MASONRY CONTROL JOINTS PER TYPICAL DETAIL AT UNIFORM SPACINGS OF 20' (MIN.) TO 24' (MAX.).
 - WALL CONSTRUCTION SHALL CONFIRM WITH SECTION 540 OF THE STANDARD SPECIFICATIONS


RETAINING WALL ELEVATION TABLE		
STATIONS	TOP OF FTG	TOP OF WALL
11+01.23 TO 11+45.00	5067.00	5071.67
11+45.00 TO 11+75.00	5067.00	5072.33
11+75.00 TO 12+50.00	5067.00	5073.00
12+50.00 TO 12+80.00	5067.67	5073.67
12+80.00 TO 13+25.00	5068.33	5074.33
13+25.00 TO 13+70.00	5069.00	5075.00
13+70.00 TO 14+00.00	5069.67	5075.67
14+00.00 TO 14+20.00	5070.33	5076.33

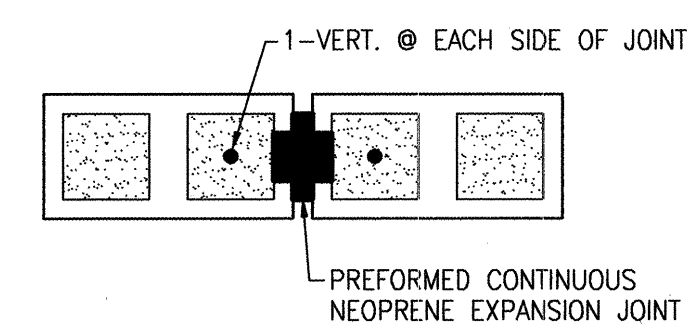

TYPICAL MASONRY CONTROL JOINT DETAIL
SCALE: 1" = 1'-0"

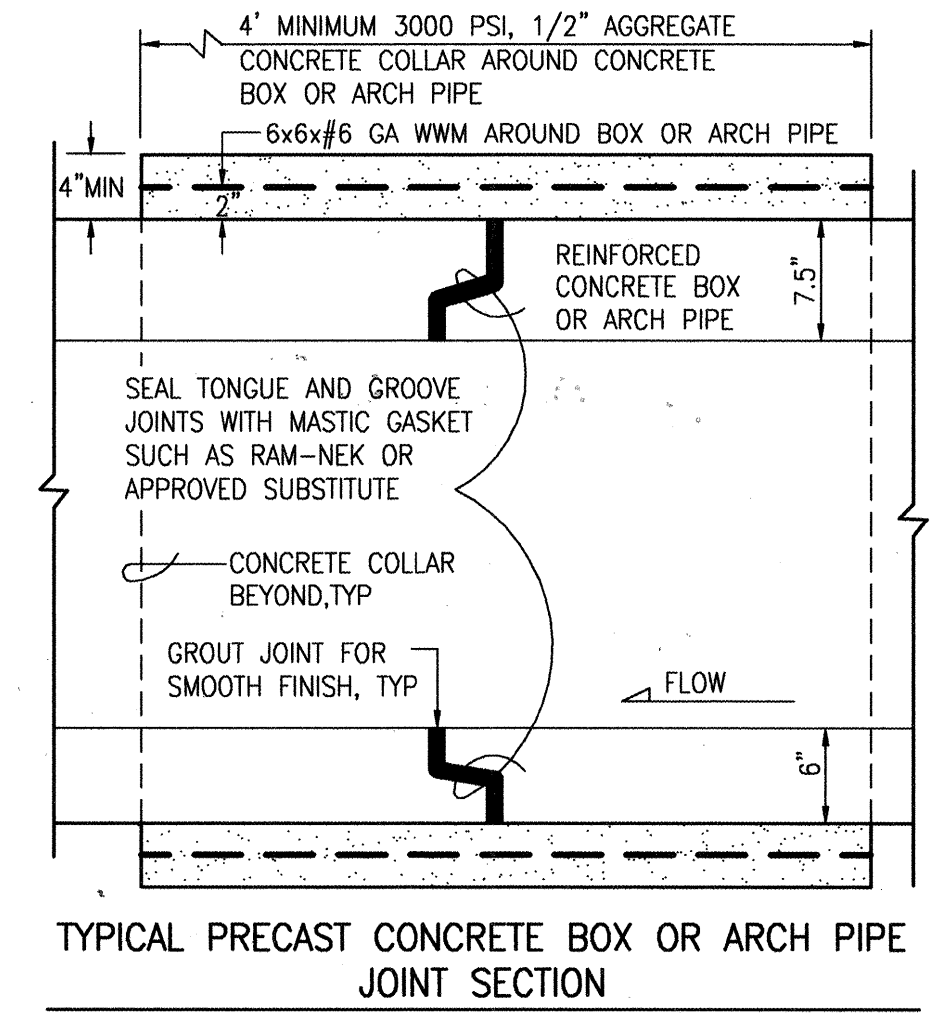

TYPICAL PRECAST CONCRETE BOX OR ARCH PIPE JOINT SECTION
SCALE: 1" = 1'-0"

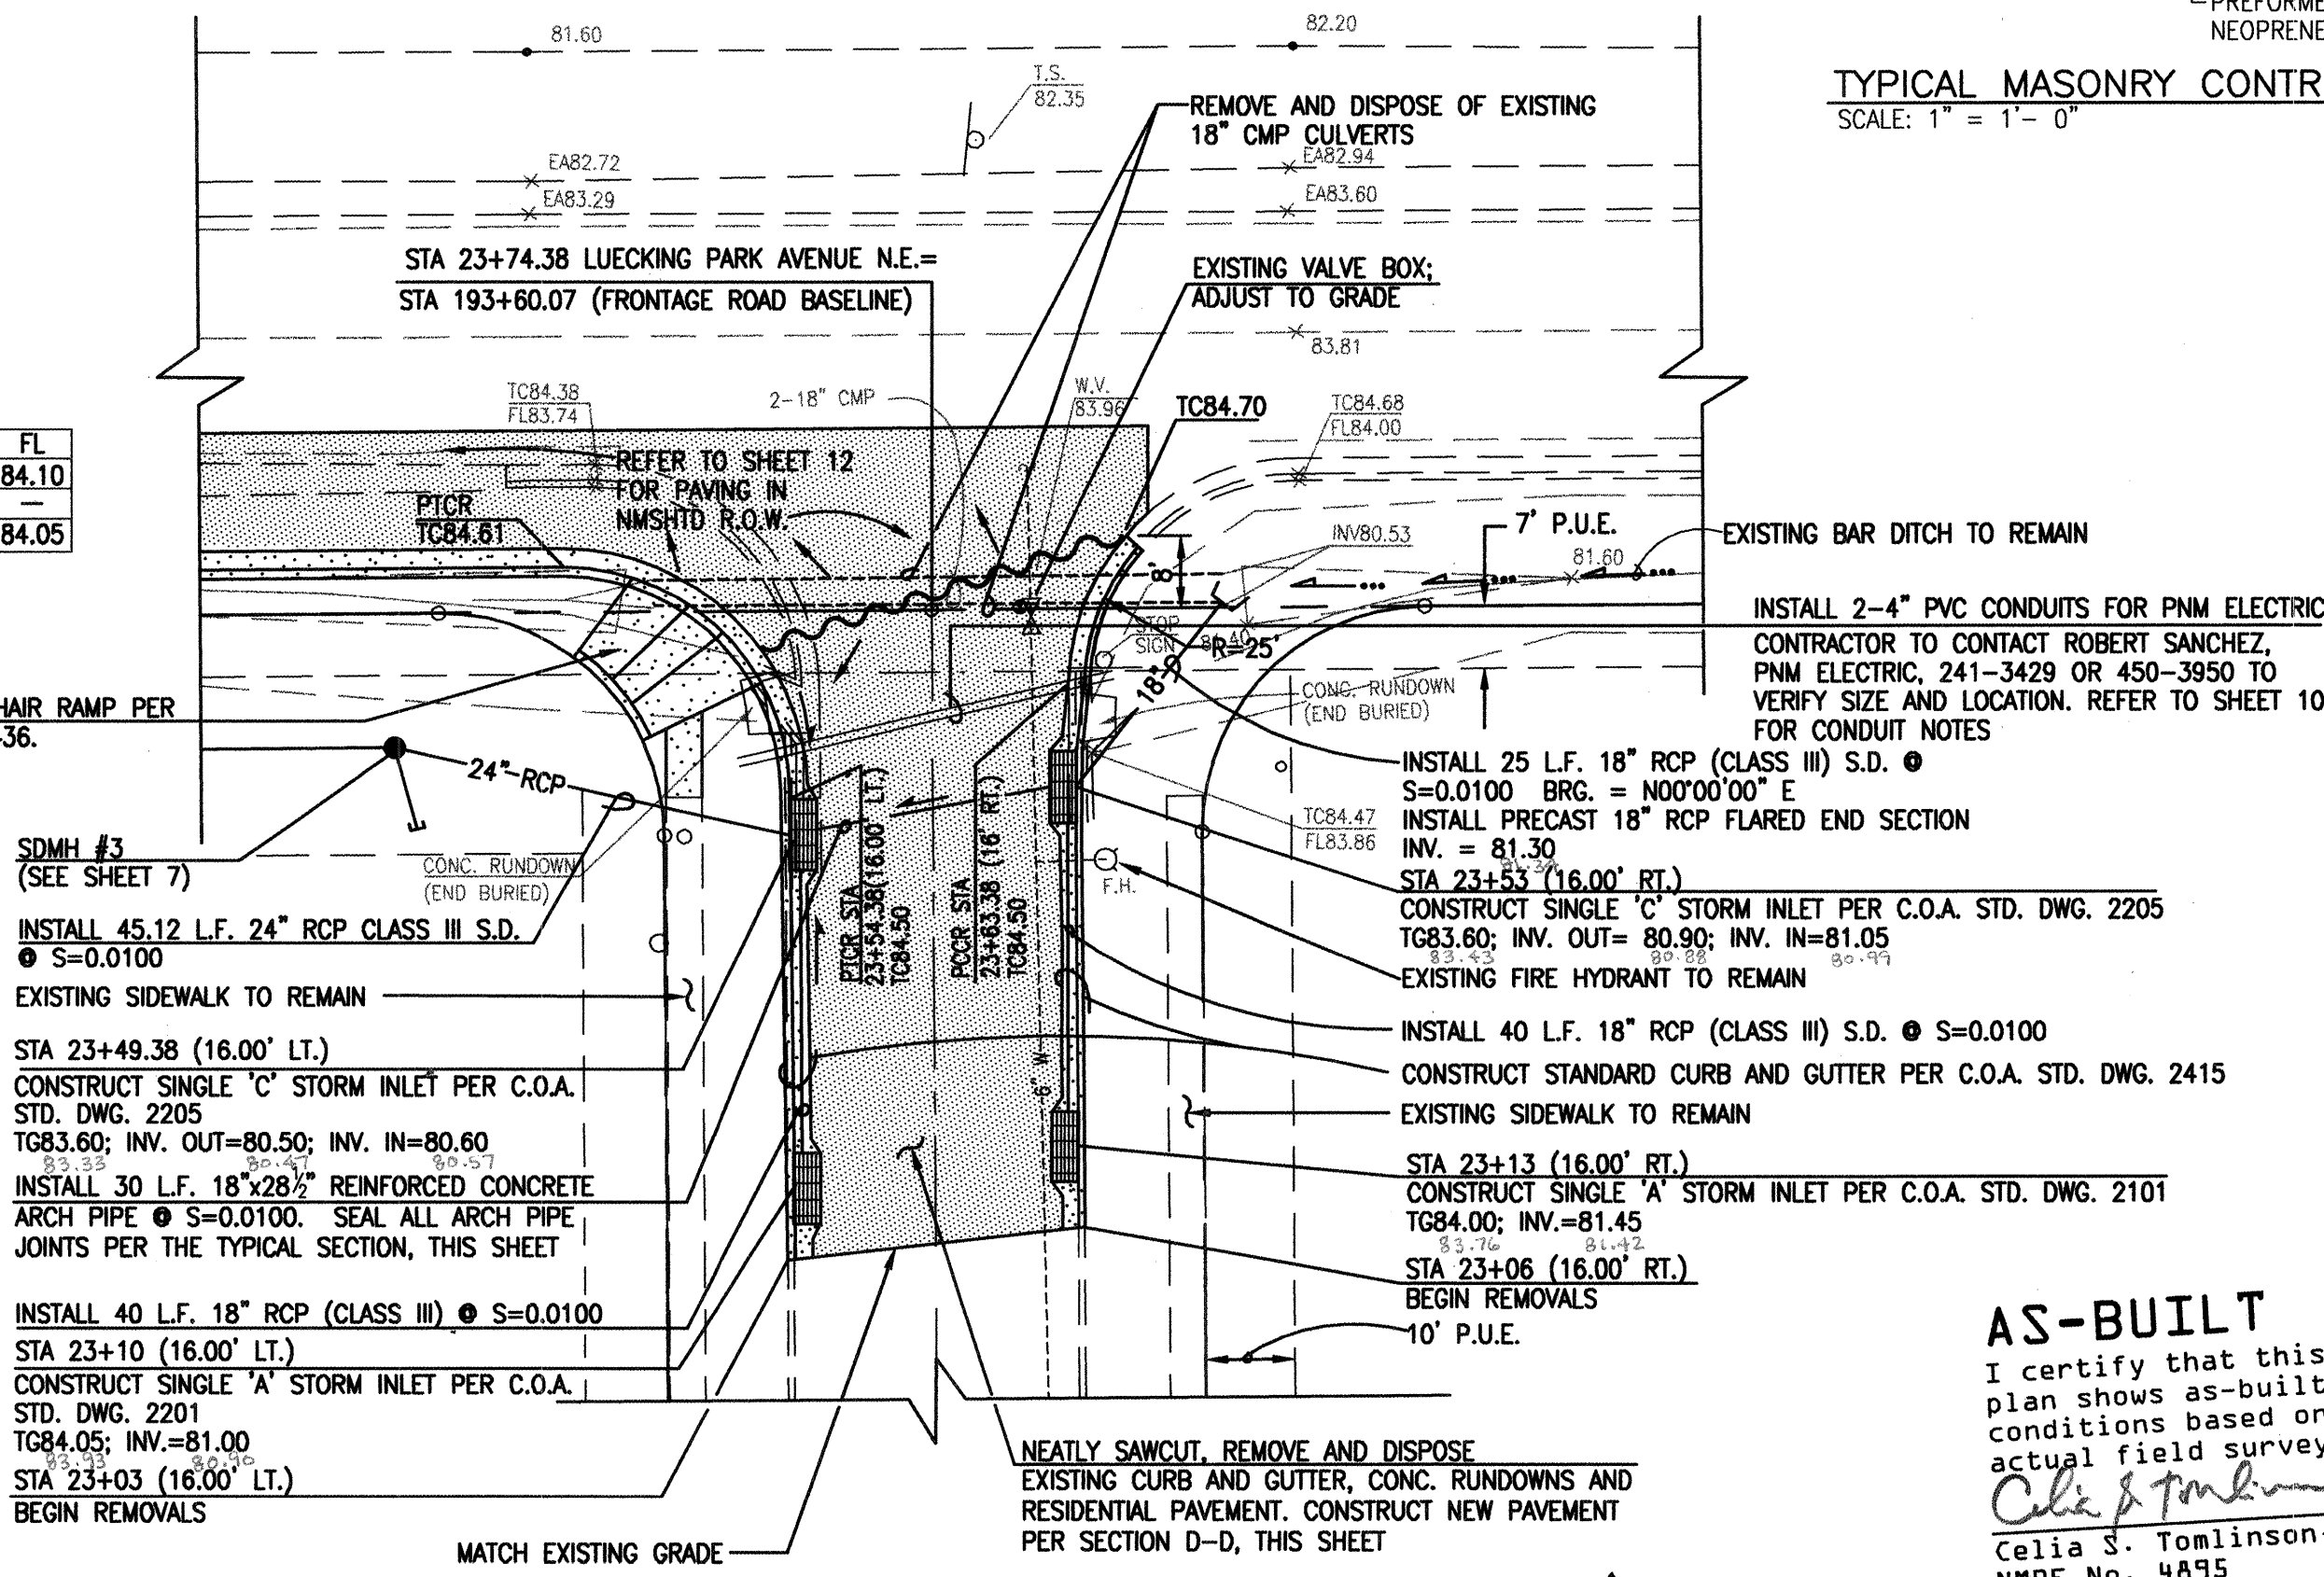

LUECKING PARK AVE. N.E. STORM DRAINAGE IMPROVEMENTS DETAIL
SCALE: 1" = 20'

AS-BUILT
I certify that this plan shows as-built conditions based on actual field survey.
Celia S. Tomlinson 1/31/00
Celia S. Tomlinson-PE
NMPE No. 4895


AS BUILT INFORMATION		BENCH MARKS		SURVEY INFORMATION		ENGINEER'S SEAL	
CONTRACTOR	DATE	AS CONTROL MONUMENT	DATE	FIELD NOTES	NO.		
INSPECTOR'S	DATE	TABLET STAMPED	DATE	BY	DATE		
ACCEPTANCE BY	DATE	PROJECTING	DATE	JMA	970282		
VERIFICATION BY	DATE	ELEVATION	DATE	JMA	980623		
COMPLETED BY	DATE	5105.49 FEET (M.S.L.D.)	DATE				
RECORDED BY	DATE		DATE				
NO.		NO.		REMARKS		DESIGN	
						Revisions	
						G.M.	
						D.L.M.	
						J.C.M.	
						Date	
						01-1999	
						01-1999	
						02-1999	

CITY OF ALBUQUERQUE
PUBLIC WORKS DEPARTMENT
ENGINEERING DEVELOPMENT GROUP

TITLE: **PATHWAY OFFICE PARK**
PAVING AND STORM DRAINAGE SECTIONS AND DETAILS

Design Review Committee:
City Engineer Approval:

City Project No. 595281
Zone Map No. G-16
Sheet 13 Of 19

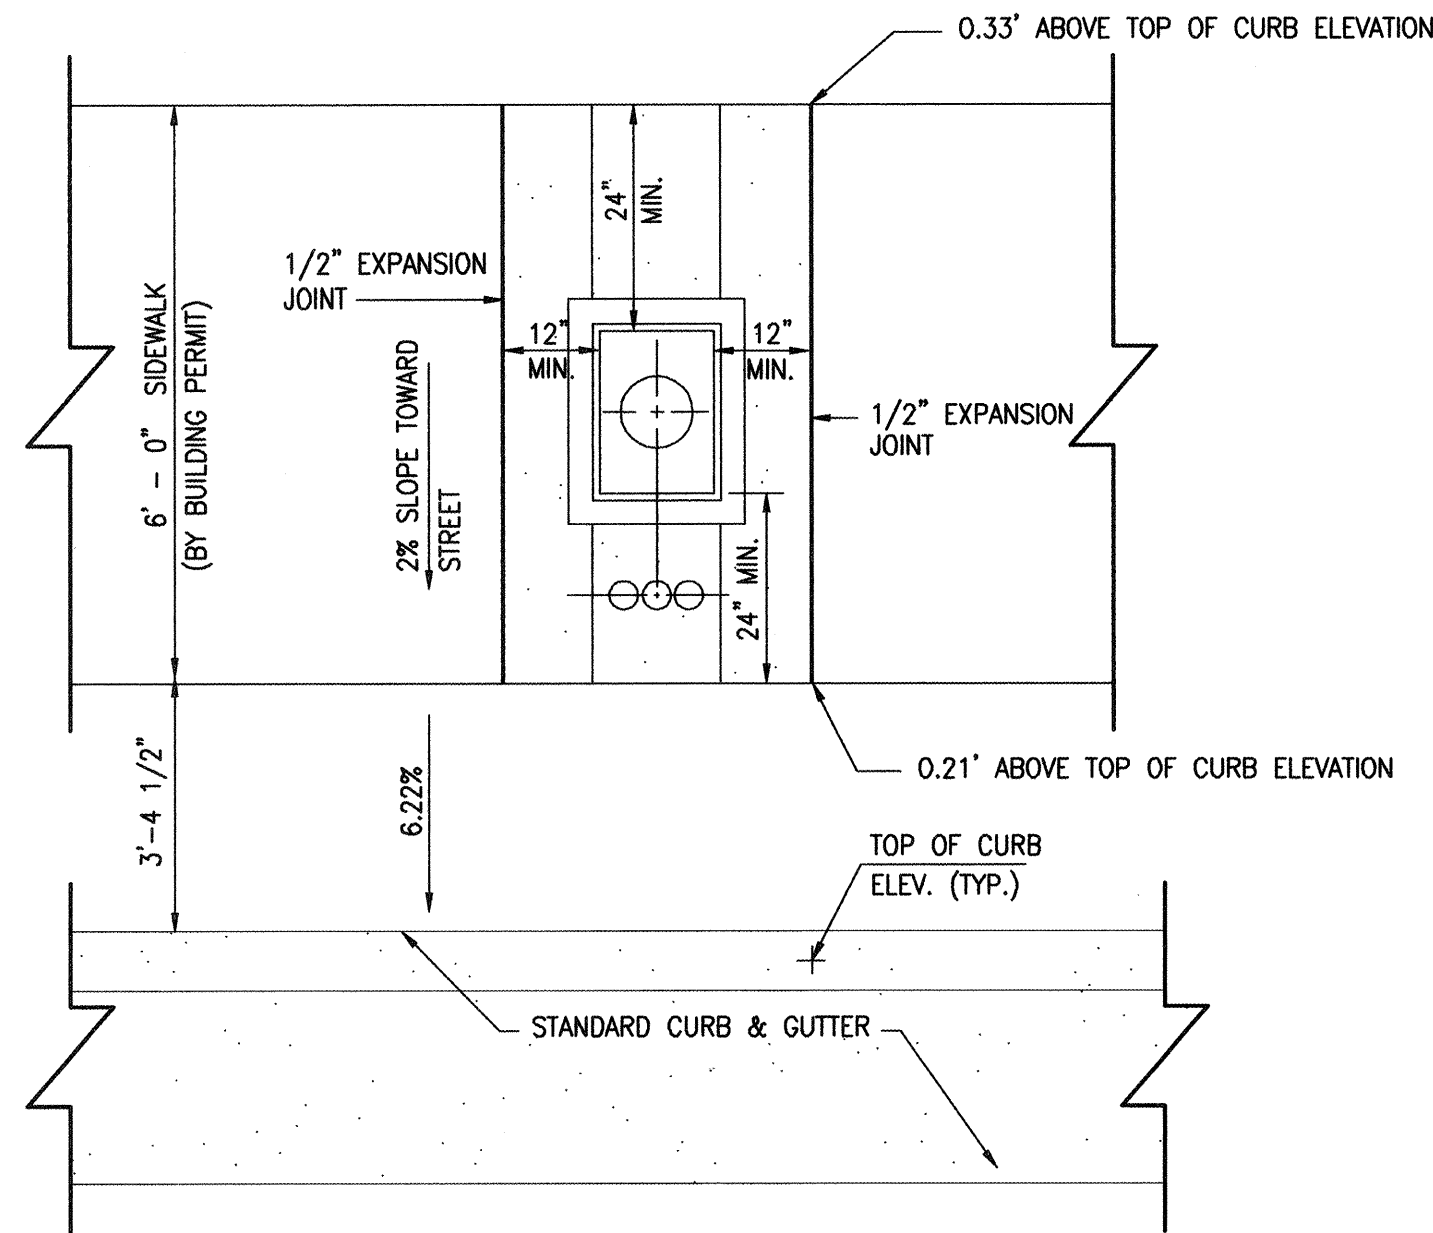


IRRIGATION METER BOX INSTALLATION

SCALE: 1" = 2' - 0"

NOTE: FOR CONSTRUCTION DETAILS REFER TO C.O.A. STD. DWGS. 2363 AND 2367



TBM #3 TOP REB.W/JMA CONTROL CAP. ELEV.=5069.59

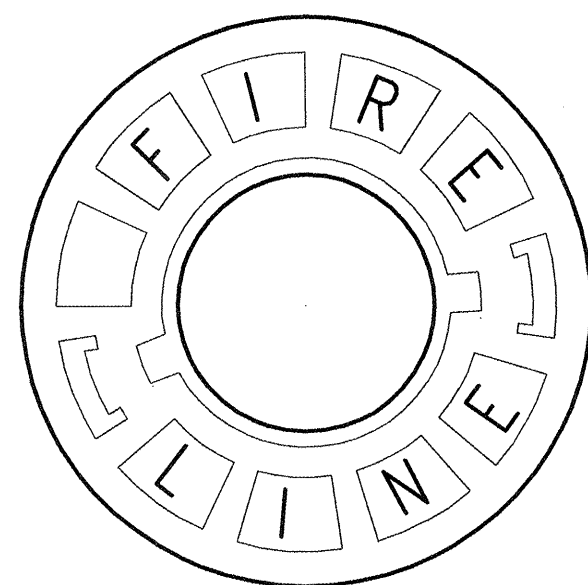

FIRELINE VALVE BOX LID
NO SCALE

NOTE:

ALL FIRE HYDRANTS SHALL BE SECURELY WRAPPED IN BLACK PLASTIC UNTIL SUCH TIME AS THE NEW WATERLINE IS PUT INTO SERVICE BY WATER SYSTEM DIVISION PERSONNEL.

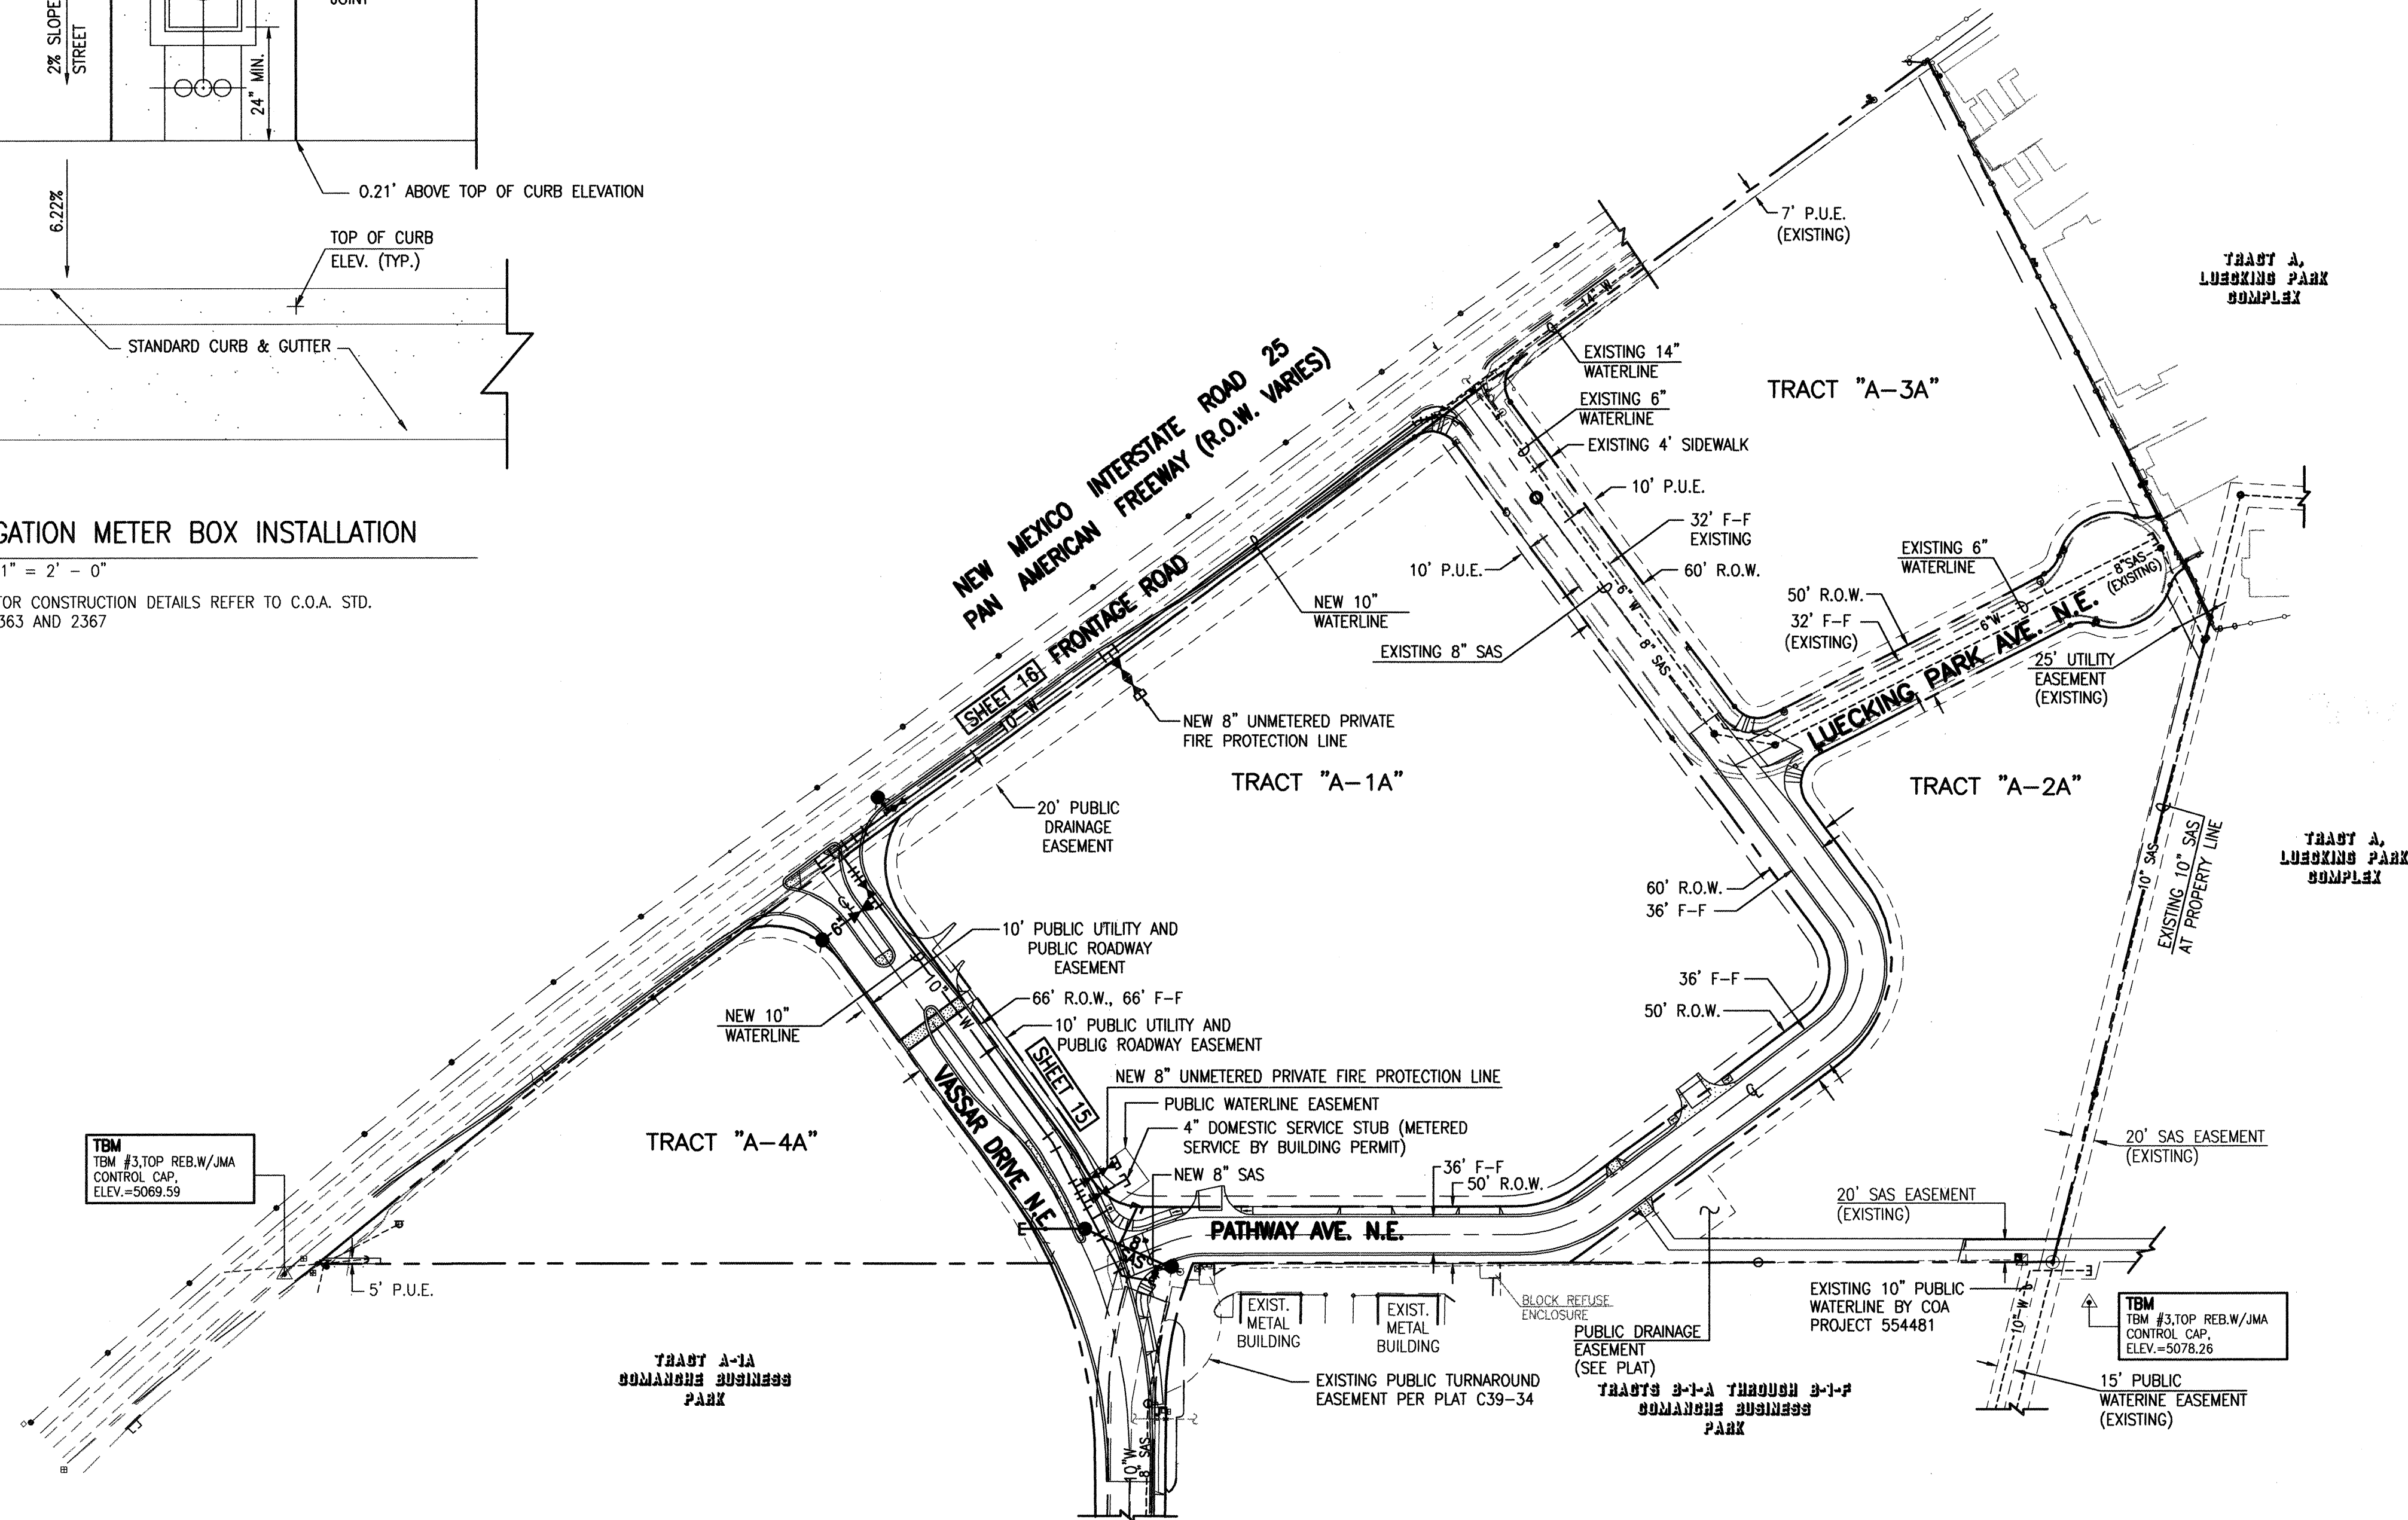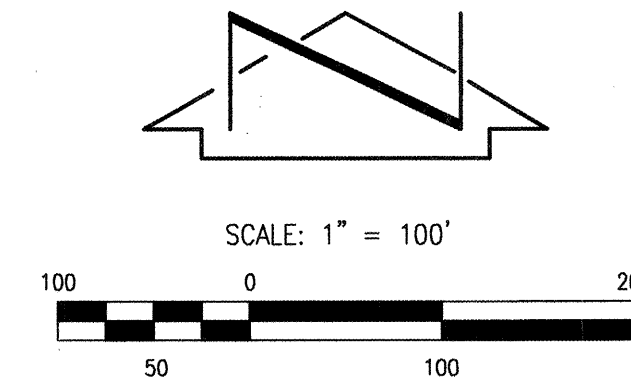

WATER SHUTOFF PLAN SCALE: 1"=600'

WATER VALVE SHUT-OFF PLAN

- AS A MINIMUM, THE FOLLOWING VALVES SHALL BE CLOSED TO FACILITATE THE PROPOSED CONNECTION:
a) FRONTAGE ROAD - VALVE 92
b) VASSAR DRIVE - VALVE ** (AS SHOWN ON WATER VALVE SHUT OFF PLAN)
- THE CONTRACTOR SHALL NOTIFY WATER SYSTEMS FIVE (5) WORKING DAYS IN ADVANCE OF ANY WORK THAT MAY AFFECT EXISTING WATERLINE. ALL SHUTOFFS SHALL BE PERFORMED BY THE WATER SYSTEM DIVISION PERSONNEL (857-8200).
- THE CONTRACTOR SHALL PROVIDE ALL RESTRAINTS AND THRUST BLOCKS NECESSARY TO EFFECT THE NECESSARY SHUTOFFS AND CONNECTIONS.
- EXISTING WATER VALVE AND WATERLINE INFORMATION OBTAINED FROM MAP G-16 OF THE CITY OF ALBUQUERQUE AUTOMATED WATER DISTRIBUTION SYSTEM SECTIONAL MAPS.
- AT THE TIME OF WATER SHUTOFF APPLICATION, THE CONTRACTOR SHALL REQUEST THAT THE WATER SYSTEM DIVISION NOTIFY ALL AFFECTED PROPERTY OWNERS AT LEAST 24 HOURS IN ADVANCE OF THE RESPECTIVE SHUTOFFS.

AS-BUILT

I certify that this plan shows as-built conditions based on actual field survey.


Celia S. Tomlinson 1/3/00
Celia S. Tomlinson, PE
NMPE No. 4895



JEFF MORTENSEN & ASSOCIATES, INC.
8010-B MIDWAY PARK BLVD. N.E.
ALBUQUERQUE, N.M. 87109
ENGINEERS & SURVEYORS (505) 345-4250

CITY OF ALBUQUERQUE PUBLIC WORKS DEPARTMENT ENGINEERING DEVELOPMENT GROUP	
TITLE: PATHWAY OFFICE PARK WATER AND SANITARY SEWER SITE PLAN WATER VALVE SHUTOFF PLAN	
Design-Review Committee APPROVED MAR 29 1999 DESIGN REVIEW COMMITTEE	City Engineer Approval JUN 8 1999 CITY ENGINEER
City Project No. 595281	Zone Map No. G-16
Sheet 14	Of 19

980611

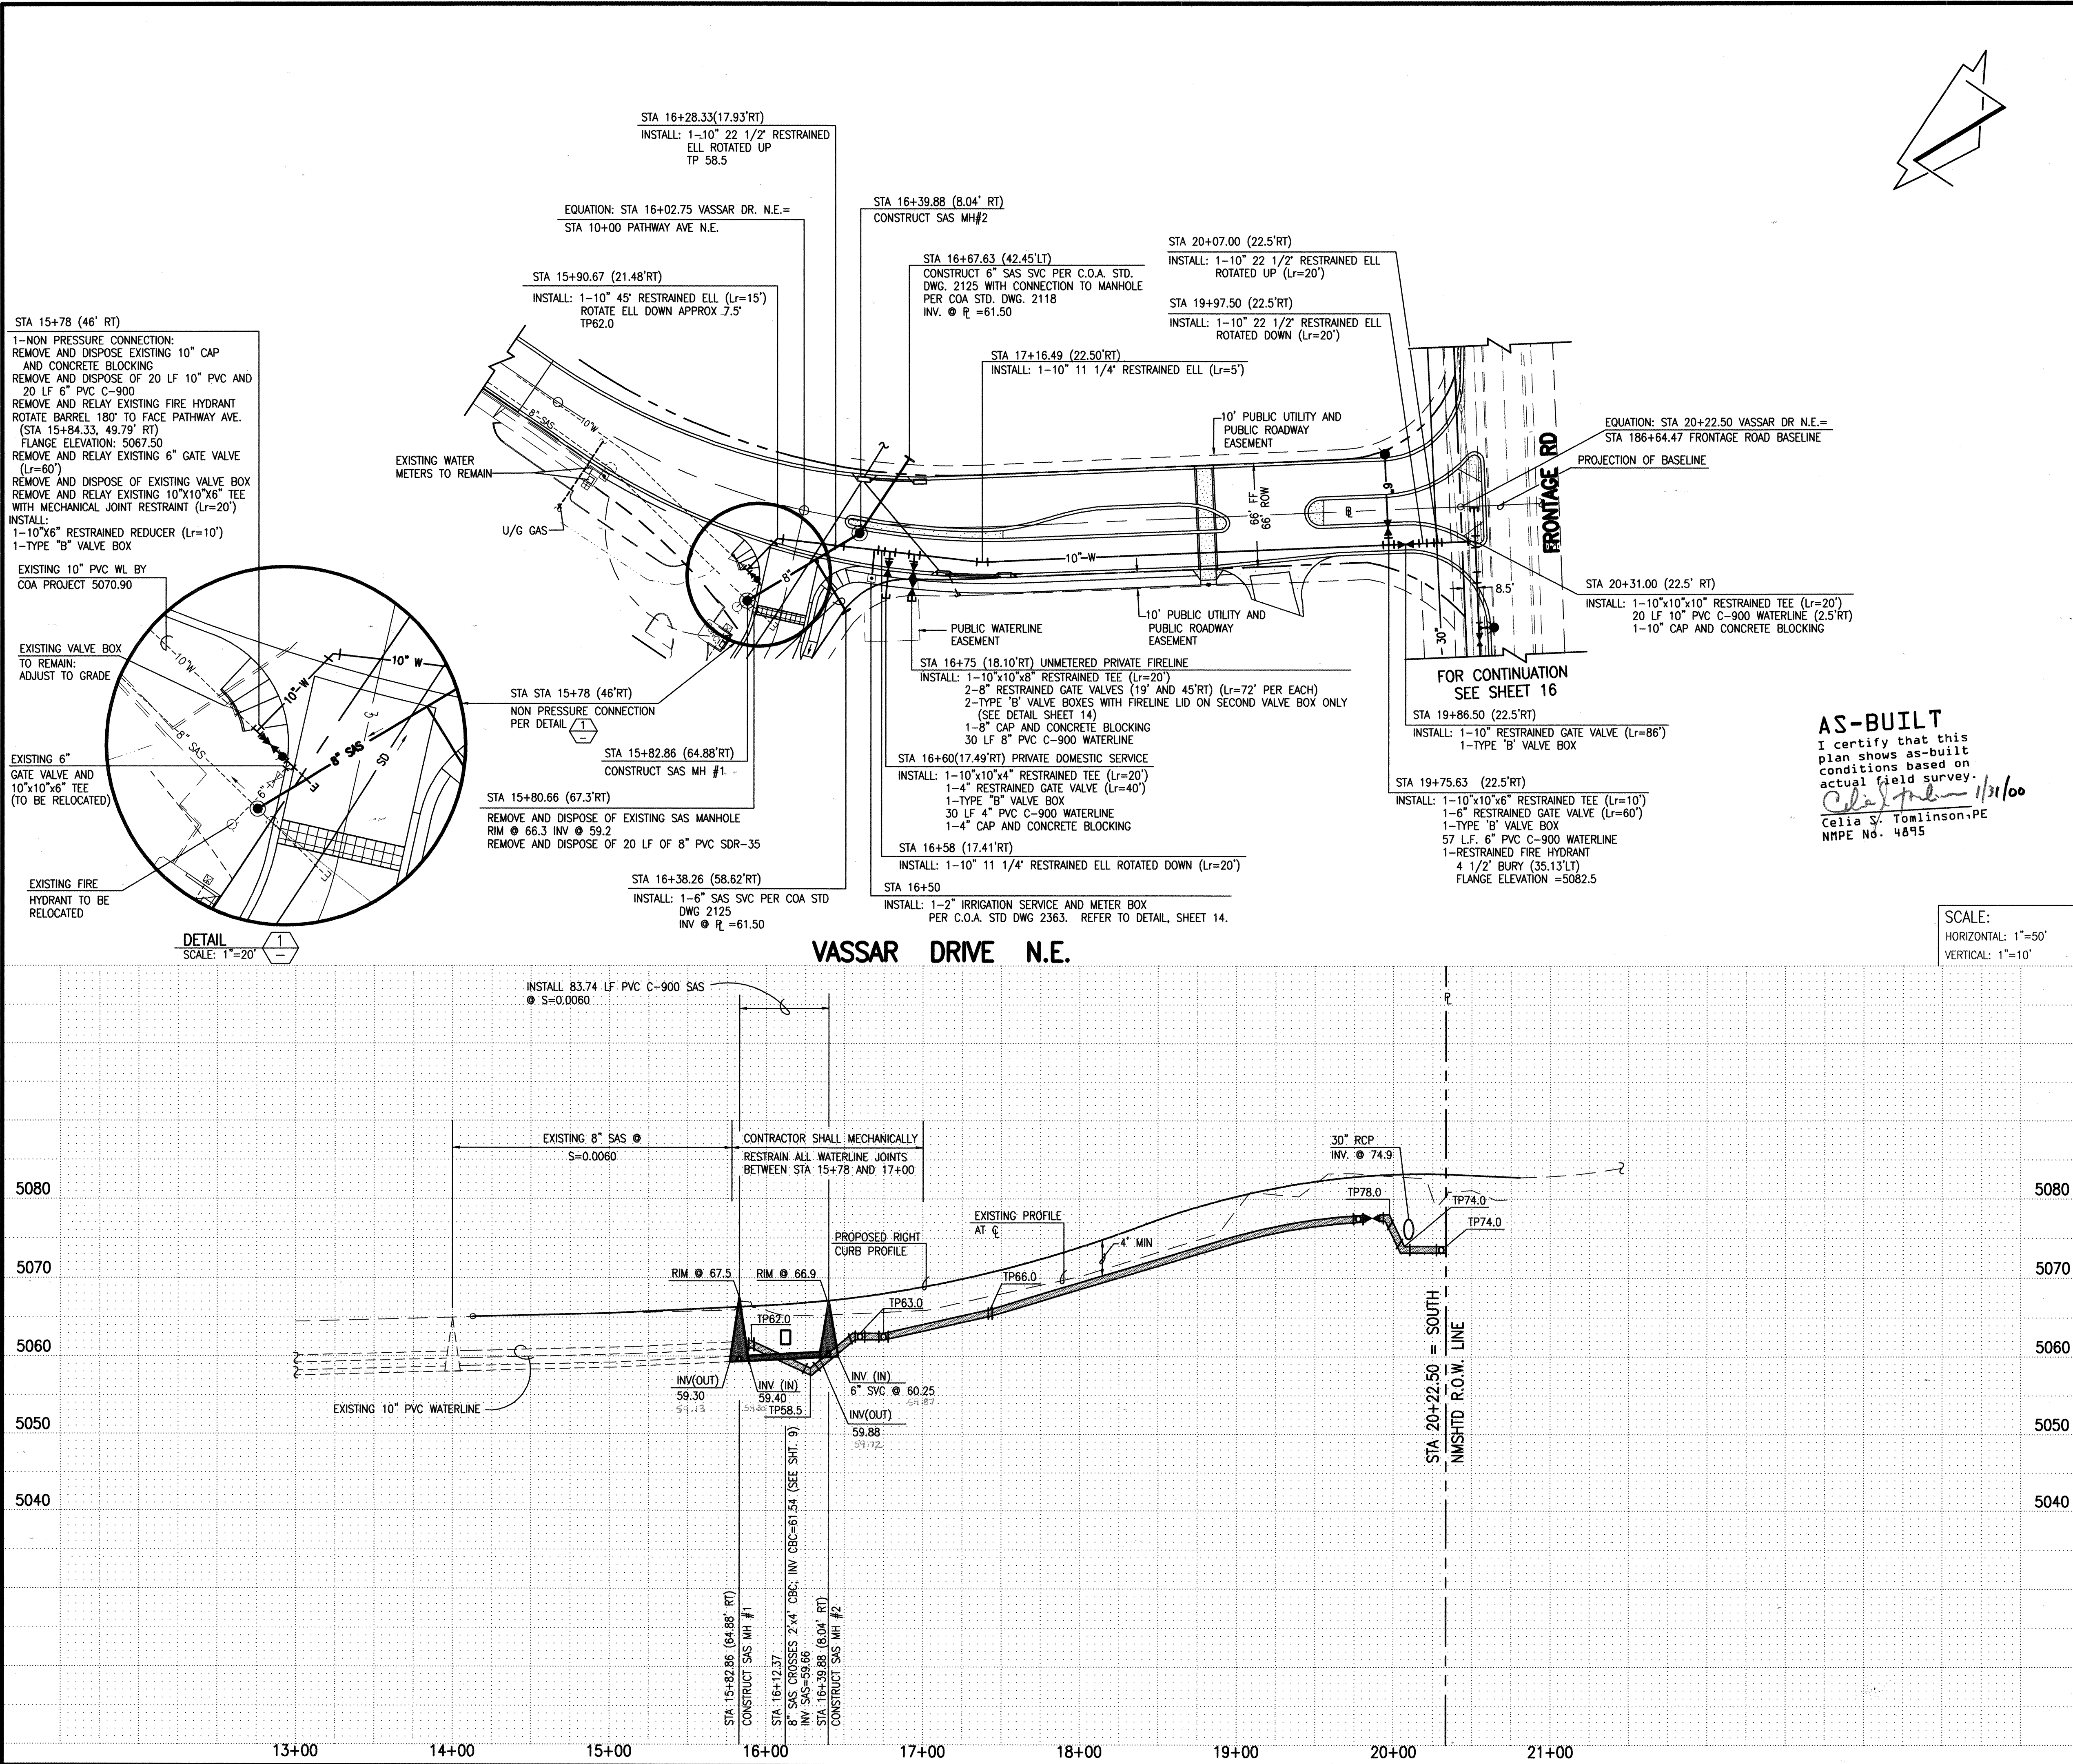

WATERLINE CONSTRUCTION NOTES:

- ALL STATIONING IS BASED ON STREET CONSTRUCTION BASELINE UNLESS INDICATED OTHERWISE.
- FOR ALL LINES 12" AND SMALLER, WATER MAIN SHALL BE PVC C-900 PIPE OR AS APPROVED BY THE CITY OF ALBUQUERQUE CITY ENGINEER. DUCTILE IRON IS AN ACCEPTABLE PIPE MATERIAL IN LIEU OF PVC.
- FOR ALL LINES 14" AND LARGER, WATER MAIN SHALL BE DUCTILE IRON OR AS APPROVED BY THE CITY OF ALBUQUERQUE CITY ENGINEER. CONCRETE CYLINDER IS AN ACCEPTABLE PIPE MATERIAL IN LIEU OF DUCTILE IRON.
- WATERLINE SHALL HAVE A MINIMUM COVER OF 4'0" (TO TOP OF CURB). EXTRA DEPTH TRENCHING, IF REQUIRED, SHALL BE CONSIDERED INCIDENTAL TO CONSTRUCTION. THEREFORE, NO SEPARATE PAYMENT WILL BE MADE.
- ELECTRONIC MARKER DISCS (EMD) SHALL BE INSTALLED IN ACCORDANCE WITH THE STANDARD SPECIFICATION.
- IN ACCORDANCE WITH SECTION 801 OF THE "STANDARD SPECIFICATIONS", METALIZED DETECTABLE WARNING TAPE SHALL BE INSTALLED 18" ABOVE ALL PVC PIPE INSTALLED ON THIS PROJECT.
- VALVE STEM AND FIRE HYDRANT EXTENSIONS SHALL BE PROVIDED IN ACCORDANCE WITH THE STANDARD SPECIFICATIONS. THE COST OF EACH EXTENSION SHALL BE CONSIDERED INCIDENTAL TO CONSTRUCTION THEREFORE NO SEPARATE PAYMENT WILL BE MADE.
- JOINT RESTRAINT SHALL BE CONSIDERED INCIDENTAL TO WATERLINE CONSTRUCTION THEREFORE NO SEPARATE PAYMENT WILL BE MADE.
- JOINT RESTRAINT SHALL BE PROVIDED ON ALL JOINTS OF FIRE HYDRANT LEGS FROM TEE TO FIRE HYDRANT INCLUDING THE TEE AND FIRE HYDRANT.
- FOR THE PURPOSES OF THIS PROJECT, ALL RESTRAINED JOINTS AND JOINT RESTRAINT SHALL BE MECHANICALLY RESTRAINED. JOINT RESTRAINT LENGTHS SPECIFIED HEREON ARE THE LENGTHS TO BE RESTRAINED EACH SIDE OF THE FITTING.
- ALL FIRE HYDRANTS SHALL BE SECURELY WRAPPED IN BLACK PLASTIC UNTIL SUCH TIME AS THE NEW WATERLINE IS PUT INTO SERVICE BY WATER SYSTEM DIVISION PERSONNEL.

SANITARY SEWER CONSTRUCTION NOTES:

- ALL STATIONING IS BASED ON STREET CONSTRUCTION BASELINE UNLESS INDICATED OTHERWISE.
- ALL SEWER PIPE SHALL BE PVC (SDR-35). UNLESS OTHERWISE INDICATED
- SLOPES SHOWN ON THE PROFILES ARE BASED ON TRUE DISTANCES.
- ALL MANHOLES SHALL BE FOUR-FOOT DIAMETER TYPE 'E' AS PER CITY OF ALBUQUERQUE STANDARD DRAWING 2102 UNLESS OTHERWISE NOTED. MANHOLE STEPS SHALL BE DELETED FROM THIS CONTRACT.
- SEWER SERVICE LATERALS SHALL BE PROVIDED WITH ELECTRONIC MARKER DISCS (EMD) AS PER CITY OF ALBUQUERQUE STANDARD DRAWING 2125. EMD SHALL BE PROVIDED IN ACCORDANCE WITH THE STANDARD SPECIFICATION.
- THE CONTRACTOR SHALL BE RESPONSIBLE FOR SELECTING APPROPRIATE MEANS AND METHODS TO EXCAVATE AND TRENCH AND INSTALL PIPE SO AS TO NOT EXCEED RIGHT-OF-WAY OR EASEMENT LIMITS, AND SO AS NOT TO INTERFERE WITH OTHER UTILITIES. THIS SHALL BE CONSIDERED INCIDENTAL TO TRENCHING, THEREFORE, NO SEPARATE PAYMENT WILL BE MADE.
- THE CONTRACTOR SHALL BE RESPONSIBLE FOR PROTECTING, SUPPORTING AND REPLACING, IF DAMAGED, ALL OTHER UTILITIES ENCOUNTERED DURING CONSTRUCTION. THIS SHALL BE CONSIDERED INCIDENTAL TO TRENCHING, THEREFORE, NO SEPARATE PAYMENT WILL BE MADE.
- WHERE WATER AND SANITARY SEWER LINES CROSS, THE SANITARY SEWER LINE SHALL BE INSTALLED AS PRESSURE PIPE BETWEEN MANHOLES IF 18 INCHES OF VERTICAL SEPARATION DOES NOT EXIST.

AS-BUILT

I certify that this plan shows as-built conditions based on actual field survey.

Celia S. Tomlinson, PE 1/31/00
NMPE No. 4895

SCALE:
HORIZONTAL: 1"=50'
VERTICAL: 1"=10'

BENCH MARKS		SURVEY INFORMATION		ENGINEER'S SEAL	
CONTRACTOR	DATE	NO.	BY	REMARKS	DATE
ACS CONTROL MONUMENT "NDC 15-16" AN AMATEC BRASS	5/97	970282	JMA		01-1999
TABLET STAMPED "NDC 15-16" SET ON A CONCRETE POST	5/97	980823	JMA		01-1999
PROJECTING 0.4 FEET ABOVE GROUND.					
ELEVATION = 5105.49 FEET (M.S.L.D.)					

DESIGNED BY: J.G.M. DATE: 01-1999
DRAWN BY: J.Y.R. DATE: 01-1999
CHECKED BY: J.G.M. DATE: 02-1999


CITY OF ALBUQUERQUE
PUBLIC WORKS DEPARTMENT
ENGINEERING DEVELOPMENT GROUP

TITLE:
PATHWAY OFFICE PARK
WATER AND SANITARY SEWER LINE EXTENSIONS PLAN AND PROFILE
VASSAR DRIVE N.E. STA 15+78.00 TO STA 20+31.00

DESIGN	REVIEW	COMMITTEE	CITY ENGINEER
APPROVED	APPROVED	APPROVED	APPROVED
MAR 29 1999	JUN 8 1999		

City Project No. 595281
Zone Map No. G-16
Sheet 15 of 19

File Path: E:\JMA\JMA04\980611\ Plot Date: 03-17-1999
File Name: 980613PG.DWG Plot Time: 08:08 am

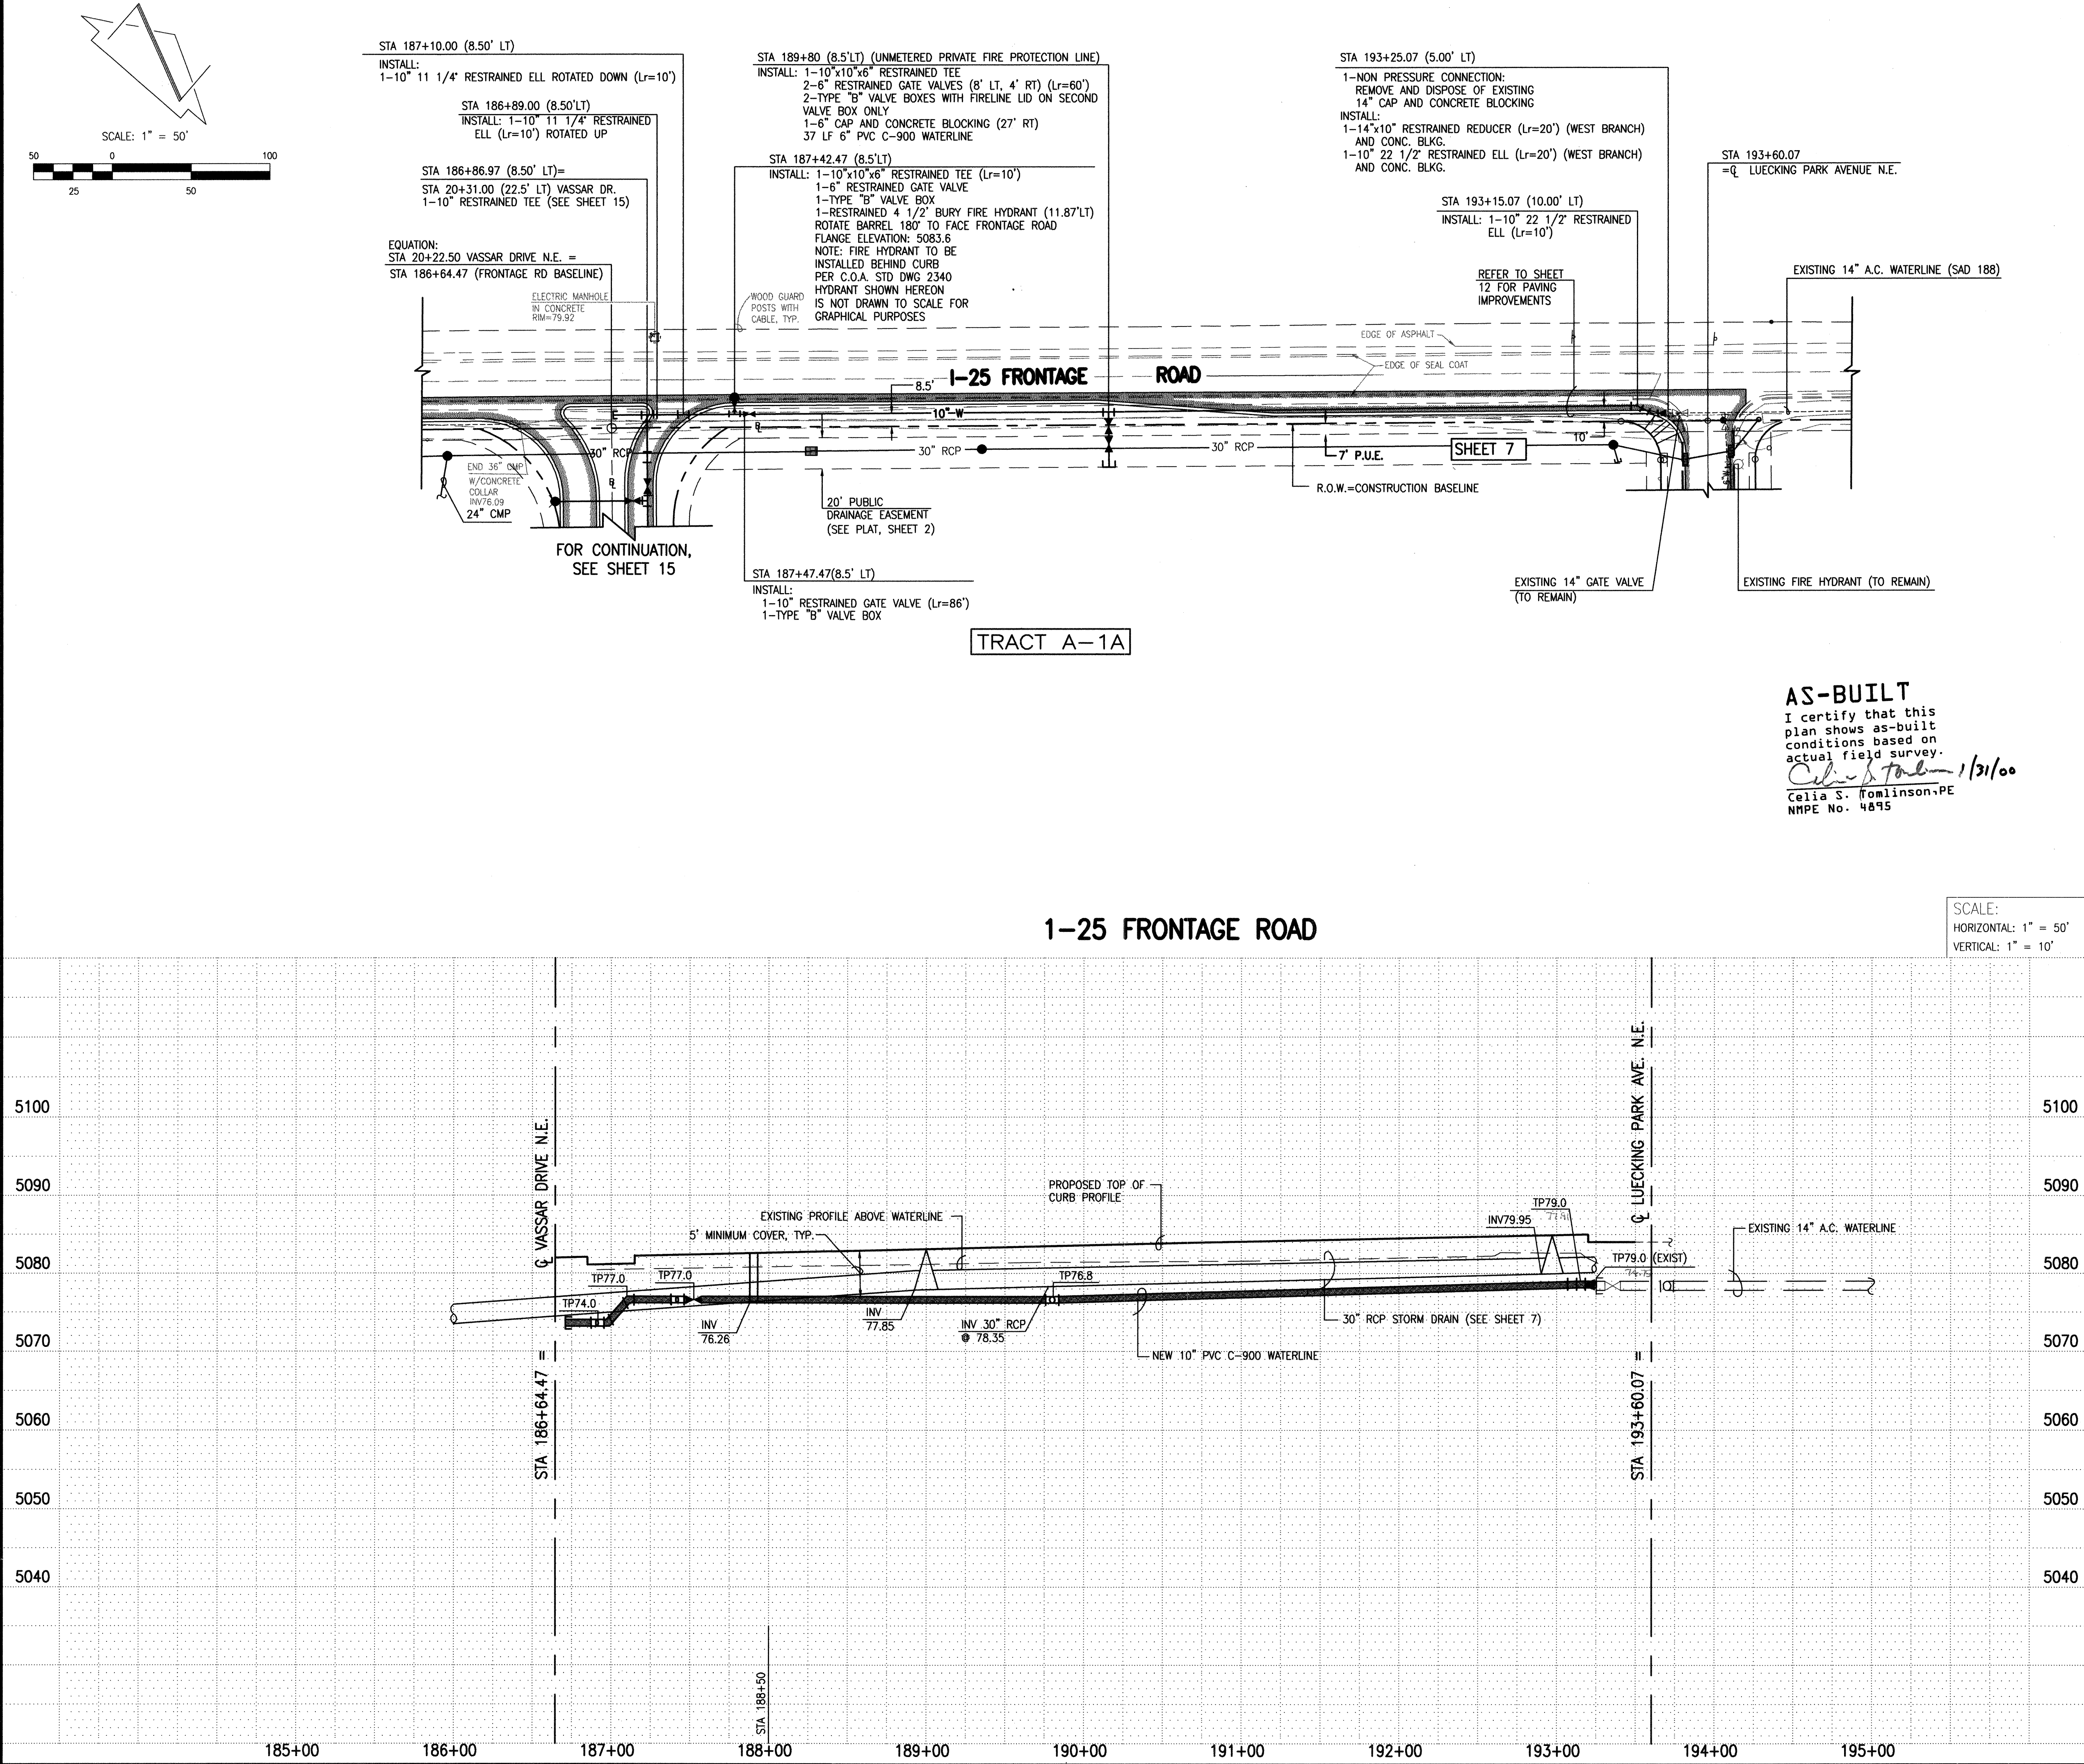

WATERLINE CONSTRUCTION NOTES:

- ALL STATIONING IS BASED ON STREET CONSTRUCTION BASELINE UNLESS INDICATED OTHERWISE.
- FOR ALL LINES 12" AND SMALLER, WATER MAIN SHALL BE PVC C-900 PIPE OR AS APPROVED BY THE CITY OF ALBUQUERQUE CITY ENGINEER. DUCTILE IRON IS AN ACCEPTABLE PIPE MATERIAL IN LIEU OF PVC.
- FOR ALL LINES 14" AND LARGER, WATER MAIN SHALL BE DUCTILE IRON OR AS APPROVED BY THE CITY OF ALBUQUERQUE CITY ENGINEER. CONCRETE CULINDER IS AN ACCEPTABLE PIPE MATERIAL IN LIEU OF DUCTILE IRON.
- WATERLINE SHALL HAVE A MINIMUM COVER OF 4'0" (TO TOP OF CURB). EXTRA DEPTH TRENCHING, IF REQUIRED, SHALL BE CONSIDERED INCIDENTAL TO CONSTRUCTION, THEREFORE, NO SEPARATE PAYMENT WILL BE MADE.
- ELECTRONIC MARKER DISCS (EMD) SHALL BE INSTALLED IN ACCORDANCE WITH THE STANDARD SPECIFICATION.
- IN ACCORDANCE WITH SECTION 801 OF THE "STANDARD SPECIFICATIONS", METALIZED DETECTABLE WARNING TAPE SHALL BE INSTALLED 18" ABOVE ALL PVC PIPE INSTALLED ON THIS PROJECT.
- VALVE STEM AND FIRE HYDRANT EXTENSIONS SHALL BE PROVIDED IN ACCORDANCE WITH THE STANDARD SPECIFICATIONS. THE COST OF EACH EXTENSION SHALL BE CONSIDERED INCIDENTAL TO CONSTRUCTION THEREFORE NO SEPARATE PAYMENT WILL BE MADE.
- JOINT RESTRAINT SHALL BE CONSIDERED INCIDENTAL TO WATERLINE CONSTRUCTION THEREFORE NO SEPARATE PAYMENT WILL BE MADE.
- JOINT RESTRAINT SHALL BE PROVIDED ON ALL JOINTS OF FIRE HYDRANT LEGS FROM TEE TO FIRE HYDRANT INCLUDING THE TEE AND FIRE HYDRANT.
- FOR THE PURPOSES OF THIS PROJECT, ALL RESTRAINED JOINTS AND JOINT RESTRAINT SHALL BE MECHANICALLY RESTRAINED. JOINT RESTRAINT LENGTHS SPECIFIED HEREON ARE THE LENGTHS TO BE RESTRAINED EACH SIDE OF THE FITTING.
- ALL FIRE HYDRANTS SHALL BE SECURELY WRAPPED IN BLACK PLASTIC UNTIL SUCH TIME AS THE NEW WATERLINE IS PUT INTO SERVICE BY WATER SYSTEM DIVISION PERSONNEL.

SANITARY SEWER CONSTRUCTION NOTES:

- ALL STATIONING IS BASED ON STREET CONSTRUCTION BASELINE UNLESS INDICATED OTHERWISE.
- ALL SEWER PIPE SHALL BE PVC (SDR-35). UNLESS OTHERWISE INDICATED
- SLOPES SHOWN ON THE PROFILES ARE BASED ON TRUE DISTANCES.
- ALL MANHOLES SHALL BE FOUR-FOOT DIAMETER TYPE 'E' AS PER CITY OF ALBUQUERQUE STANDARD DRAWING 2102 UNLESS OTHERWISE NOTED. MANHOLE STEPS SHALL BE DELETED FROM THIS CONTRACT.
- SEWER SERVICE LATERALS SHALL BE PROVIDED WITH ELECTRONIC MARKER DISCS (EMD) AS PER CITY OF ALBUQUERQUE STANDARD DRAWING 2125. EMD SHALL BE PROVIDED IN ACCORDANCE WITH THE STANDARD SPECIFICATION.
- THE CONTRACTOR SHALL BE RESPONSIBLE FOR SELECTING APPROPRIATE MEANS AND METHODS TO EXCAVATE AND TRENCH AND INSTALL PIPE SO AS TO NOT EXCEED RIGHT-OF-WAY OR EASEMENT LIMITS, AND SO AS NOT TO INTERFERE WITH OTHER UTILITIES. THIS SHALL BE CONSIDERED INCIDENTAL TO TRENCHING, THEREFORE, NO SEPARATE PAYMENT WILL BE MADE.
- THE CONTRACTOR SHALL BE RESPONSIBLE FOR PROTECTING, SUPPORTING AND REPLACING, IF DAMAGED, ALL OTHER UTILITIES ENCOUNTERED DURING CONSTRUCTION. THIS SHALL BE CONSIDERED INCIDENTAL TO TRENCHING, THEREFORE, NO SEPARATE PAYMENT WILL BE MADE.
- WHERE WATER AND SANITARY SEWER LINES CROSS, THE SANITARY SEWER LINE SHALL BE INSTALLED AS PRESSURE PIPE BETWEEN MANHOLES IF 18 INCHES OF VERTICAL SEPARATION DOES NOT EXIST.

AS-BUILT

I certify that this plan shows as-built conditions based on actual field survey.

Celia S. Tomlinson 1/31/00

Celia S. Tomlinson, P.E.
NMPE No. 4895

SCALE:
HORIZONTAL: 1" = 50'
VERTICAL: 1" = 10'

WATERLINE CONSTRUCTION NOTES:

- ALL STATIONING IS BASED ON STREET CONSTRUCTION BASELINE UNLESS INDICATED OTHERWISE.
- FOR ALL LINES 12" AND SMALLER, WATER MAIN SHALL BE PVC C-900 PIPE OR AS APPROVED BY THE CITY OF ALBUQUERQUE CITY ENGINEER. DUCTILE IRON IS AN ACCEPTABLE PIPE MATERIAL IN LIEU OF PVC.
- FOR ALL LINES 14" AND LARGER, WATER MAIN SHALL BE DUCTILE IRON OR AS APPROVED BY THE CITY OF ALBUQUERQUE CITY ENGINEER. CONCRETE CULINDER IS AN ACCEPTABLE PIPE MATERIAL IN LIEU OF DUCTILE IRON.
- WATERLINE SHALL HAVE A MINIMUM COVER OF 4'0" (TO TOP OF CURB). EXTRA DEPTH TRENCHING, IF REQUIRED, SHALL BE CONSIDERED INCIDENTAL TO CONSTRUCTION, THEREFORE, NO SEPARATE PAYMENT WILL BE MADE.
- ELECTRONIC MARKER DISCS (EMD) SHALL BE INSTALLED IN ACCORDANCE WITH THE STANDARD SPECIFICATION.
- IN ACCORDANCE WITH SECTION 801 OF THE "STANDARD SPECIFICATIONS", METALIZED DETECTABLE WARNING TAPE SHALL BE INSTALLED 18" ABOVE ALL PVC PIPE INSTALLED ON THIS PROJECT.
- VALVE STEM AND FIRE HYDRANT EXTENSIONS SHALL BE PROVIDED IN ACCORDANCE WITH THE STANDARD SPECIFICATIONS. THE COST OF EACH EXTENSION SHALL BE CONSIDERED INCIDENTAL TO CONSTRUCTION THEREFORE NO SEPARATE PAYMENT WILL BE MADE.
- JOINT RESTRAINT SHALL BE CONSIDERED INCIDENTAL TO WATERLINE CONSTRUCTION THEREFORE NO SEPARATE PAYMENT WILL BE MADE.
- JOINT RESTRAINT SHALL BE PROVIDED ON ALL JOINTS OF FIRE HYDRANT LEGS FROM TEE TO FIRE HYDRANT INCLUDING THE TEE AND FIRE HYDRANT.
- FOR THE PURPOSES OF THIS PROJECT, ALL RESTRAINED JOINTS AND JOINT RESTRAINT SHALL BE MECHANICALLY RESTRAINED. JOINT RESTRAINT LENGTHS SPECIFIED HEREON ARE THE LENGTHS TO BE RESTRAINED EACH SIDE OF THE FITTING.
- ALL FIRE HYDRANTS SHALL BE SECURELY WRAPPED IN BLACK PLASTIC UNTIL SUCH TIME AS THE NEW WATERLINE IS PUT INTO SERVICE BY WATER SYSTEM DIVISION PERSONNEL.

SANITARY SEWER CONSTRUCTION NOTES:

- ALL STATIONING IS BASED ON STREET CONSTRUCTION BASELINE UNLESS INDICATED OTHERWISE.
- ALL SEWER PIPE SHALL BE PVC (SDR-35). UNLESS OTHERWISE INDICATED
- SLOPES SHOWN ON THE PROFILES ARE BASED ON TRUE DISTANCES.
- ALL MANHOLES SHALL BE FOUR-FOOT DIAMETER TYPE 'E' AS PER CITY OF ALBUQUERQUE STANDARD DRAWING 2102 UNLESS OTHERWISE NOTED. MANHOLE STEPS SHALL BE DELETED FROM THIS CONTRACT.
- SEWER SERVICE LATERALS SHALL BE PROVIDED WITH ELECTRONIC MARKER DISCS (EMD) AS PER CITY OF ALBUQUERQUE STANDARD DRAWING 2125. EMD SHALL BE PROVIDED IN ACCORDANCE WITH THE STANDARD SPECIFICATION.
- THE CONTRACTOR SHALL BE RESPONSIBLE FOR SELECTING APPROPRIATE MEANS AND METHODS TO EXCAVATE AND TRENCH AND INSTALL PIPE SO AS TO NOT EXCEED RIGHT-OF-WAY OR EASEMENT LIMITS, AND SO AS NOT TO INTERFERE WITH OTHER UTILITIES. THIS SHALL BE CONSIDERED INCIDENTAL TO TRENCHING, THEREFORE, NO SEPARATE PAYMENT WILL BE MADE.
- THE CONTRACTOR SHALL BE RESPONSIBLE FOR PROTECTING, SUPPORTING AND REPLACING, IF DAMAGED, ALL OTHER UTILITIES ENCOUNTERED DURING CONSTRUCTION. THIS SHALL BE CONSIDERED INCIDENTAL TO TRENCHING, THEREFORE, NO SEPARATE PAYMENT WILL BE MADE.
- WHERE WATER AND SANITARY SEWER LINES CROSS, THE SANITARY SEWER LINE SHALL BE INSTALLED AS PRESSURE PIPE BETWEEN MANHOLES IF 18 INCHES OF VERTICAL SEPARATION DOES NOT EXIST.

ENGINEER'S SEAL

JEFF MORTENSEN & ASSOCIATES, INC.
6010-B MIDWAY PARK BLVD. N.E.
ALBUQUERQUE, NM 87109
ENGINEERS - SURVEYORS (505) 345-4250

03-17-99

CITY OF ALBUQUERQUE
PUBLIC WORKS DEPARTMENT
ENGINEERING DEVELOPMENT GROUP

TITLE:
WATER AND SANITARY SEWER LINE EXTENSIONS PLAN AND PROFILE
I-25 FRONTAGE ROAD STA 186+64.47 TO STA 193+25.07

APPROVED
MAR 29 1999
DESIGN REVIEW COMMITTEE

APPROVED
JUN 8 1999
CITY ENGINEER

REVISIONS

NO.	DATE	REVISIONS

DESIGNED BY G.M. **DATE** 01-1999
DRAWN BY D.L.M. **DATE** 01-1999
CHECKED BY J.G.M. **DATE** 02-1999

City Project No. 595281 Zone Map No. G-16 Sheet 16 of 19

CONSTRUCTION TRAFFIC CONTROL GENERAL NOTES

1. CONTRACTOR MUST OBTAIN FROM CONSTRUCTION COORDINATION AN EXCAVATION/BARRICADING PERMIT BEFORE ENGAGING IN ANY CONSTRUCTION, MAINTENANCE OR REPAIR WORK IN ANY OF THE CITY OF ALBUQUERQUE'S RIGHTS-OF-WAY. EMERGENCY WORK THAT WOULD PRESERVE LIFE OR PROPERTY IS EXCLUDED WITH THE UNDERSTANDING, THAT A PERMIT SHALL BE OBTAINED WITHIN 24 TO 48 HOURS.

2. CONTRACTOR SHALL AT THE TIME OF PERMIT REQUEST, SUBMIT FOR APPROVAL BY CONSTRUCTION COORDINATION, A TRAFFIC CONTROL PLAN DETAILING ALL EXISTING TOPOGRAPHY SUCH AS LANE WIDTHS, DRIVEWAYS, AND BUSINESS/RESIDENTIAL ACCESSES. THE TRAFFIC CONTROL PLAN SHALL INCLUDE ALL PHASES OF WORK AND SCHEDULES INVOLVED IN THE CONSTRUCTION PROJECT. ANY SEPARATE PHASES OF A CONSTRUCTION PROJECT SHALL BE GIVEN AN INDIVIDUAL PERMIT EACH. BLANKET PERMITS WILL NOT BE ISSUED.

3. THESE TYPICAL TRAFFIC CONTROL PLANS DO NOT REFLECT THE EXISTING TOPOGRAPHY SUCH AS DRIVEWAYS, LANE WIDTHS, AND BUSINESS/RESIDENTIAL ACCESSES. EVERY LOCATION THAT REQUIRES CONSTRUCTION TRAFFIC CONTROL SHALL HAVE A DETAILED TRAFFIC CONTROL PLAN SHOWING ALL EXISTING TOPOGRAPHY.

4. CONSTRUCTION SHALL NOT BEGIN UNLESS A TRAFFIC CONTROL PLAN HAS BEEN APPROVED AND VERIFIED BY CONSTRUCTION COORDINATION.

5. CONSTRUCTION COORDINATION SHALL BE NOTIFIED 48 HOURS PRIOR TO ANY TRAFFIC CONTROL CHANGES NEEDED BY CONTRACTOR, THAT WERE NOT PREVIOUSLY APPROVED. THESE TRAFFIC CONTROL CHANGES SHALL BE REQUESTED IN WRITING ACCOMPANIED WITH A TRAFFIC CONTROL PLAN REFLECTING SUCH CHANGES.

6. ALL CONSTRUCTION TRAFFIC CONTROL DEVICES SHALL COMPLY TO THE MANUAL ON UNIFORM TRAFFIC CONTROL DEVICES (MUTCD), LATEST EDITION. IT IS THE RESPONSIBILITY OF THE CONTRACTOR TO INSTALL, SERVICE AND MAINTAIN ALL TRAFFIC CONTROL DEVICES. TRAFFIC CONTROL DEVICES SHALL NOT BE REMOVED OR ALTERED IN ANY WAY WITHOUT THE APPROVAL OF CONSTRUCTION COORDINATION, PER SECTION 6A-4 OF THE MUTCD, LATEST EDITION.

7. THE CONSTRUCTION TRAFFIC CONTROL INITIAL SET-UP SHALL BE BY AN AMERICAN TRAFFIC SAFETY SERVICES ASSOCIATION (ATSSA) CERTIFIED WORKSITE TRAFFIC SUPERVISOR. THE MAINTENANCE AND SERVICING SHALL ALSO BE DONE BY AN ATSSA CERTIFIED WORKSITE TRAFFIC SUPERVISOR OR EQUIVALENT.

8. CONTRACTOR IS RESPONSIBLE TO MAINTAIN AND SERVICE ALL TRAFFIC CONTROL DEVICES 24 HOURS A DAY, 7 DAYS A WEEK THROUGHOUT LENGTH OF PROJECT. CONTRACTOR IS RESPONSIBLE THAT ALL TRAFFIC CONTROL DEVICES COMPLY WITH THE MUTCD, LATEST EDITION.

9. ALL ADVANCE WARNING SIGNS SHALL BE DOUBLE INDICATED WHENEVER THERE ARE MULTI-LANE TRAFFIC IN ANY ONE GIVEN DIRECTION AND THERE IS SUFFICIENT MEDIAN SPACE.

10. ALL BARRICADES IN ALL TAPERS AND TANGENTS SHALL BE PLACED APART, A DISTANCE MEASURED IN FEET, EQUAL TO THAT OF THE POSTED SPEED LIMIT. NO EXCEPTIONS UNLESS APPROVED BY CONSTRUCTION COORDINATION PER MUTCD SECTION 6A-4.

11. ALL WORK IN ARTERIAL ROADWAYS SHALL BE ON A CONTINUOUS 24-HOUR PER DAY BASIS UNTIL COMPLETED.

12. CONTRACTOR IS RESPONSIBLE TO PROVIDE CONSTRUCTION COORDINATION, A WEEKLY LOG OF DAILY INSPECTIONS OF BARRICADE AND MAINTENANCE SCHEDULES ON PROJECTS THAT ARE OVER ONE WEEK DURATION.

13. EQUIPMENT OR MATERIALS SHALL NOT BE STORED WITHIN 15 FEET OF A TRAVELLED TRAFFIC LANE DURING NON-WORKING HOURS WITHOUT THE APPROVAL OF CONSTRUCTION COORDINATION.

14. CONTRACTOR SHALL PROVIDE AND MAINTAIN A SAFE AND ADEQUATE MEANS OF CHANNELIZING PEDESTRIAN TRAFFIC AROUND AND THROUGH THE CONSTRUCTION AREA.

15. CONTRACTOR IS RESPONSIBLE FOR OBLITERATION OF ANY CONFLICTING STRIPING AND RESPONSIBLE FOR ALL TEMPORARY STRIPING.

16. CONTRACTOR SHALL MAINTAIN ACCESS TO ALL FACILITIES, BUSINESSES AND/OR RESIDENTS AT ALL TIMES.

17. CONTRACTOR SHALL PROVIDE ACCESS SIGNS FOR BUSINESSES LOCATED WITHIN THE CONSTRUCTION AREA UNDER THE SUPERVISION OF CONSTRUCTION COORDINATION. EACH ACCESS SIGN SHALL HAVE 5 INCH, WHITE OPAQUE LETTERING ON BLUE REFLECTORIZED BACKGROUND. ACCESS SIGNS SHALL BE CONSIDERED INCIDENTAL TO THE BID AND NOT PART OF THE CONTRACT UNLESS OTHERWISE STATED. NO MORE THAN 3 BUSINESSES SHALL BE LISTED ON A ACCESS SIGN. SHOPPING CENTERS AND MALLS SHALL BE LISTED AS SUCH.

18. ALL ADVANCE WARNING SIGNS SHALL MEET THE MINIMUM REFLECTIVE INTENSITY REQUIREMENTS SET FORTH BY THE CITY OF ALBUQUERQUE. CONSTRUCTION COORDINATION SHALL DETERMINE ALL REQUIREMENTS AND APPROVE OR DISAPPROVE ANY ADVANCE WARNING SIGN PER SECTION 6A-4 OF THE MUTCD, LATEST EDITION.

19. 48 HOURS PRIOR TO OCCUPYING OR CLOSING OF A RIGHT-OF-WAY, CONTRACTOR SHALL NOTIFY: POLICE, FIRE DEPARTMENT, SCHOOLS, HOSPITALS, TRANSIT AUTHORITY, BUSINESSES AND/OR RESIDENTS THAT WILL BE AFFECTED BY THE CONSTRUCTION.

20. ANY FIELD ADJUSTMENTS SHALL BE APPROVED BY CONSTRUCTION COORDINATION.

21. EXCAVATIONS SHALL BE PLATED, TEMPORARILY PATCHED OR RESURFACED PRIOR TO OPENING OF TRAFFIC. A MINIMUM OF 11 FEET SHALL BE PROVIDED FOR TRAFFIC IN ANY GIVEN DIRECTION. CONTRACTOR IS RESPONSIBLE FOR ANY WORK INVOLVED IN SATISFYING THESE REQUIREMENTS.

22. CONTRACTOR SHALL AT ALL TIMES COMPLY WITH THE FOLLOWING:
1. STANDARDS AND REQUIREMENTS SET FORTH IN THE MANUAL ON UNIFORM TRAFFIC CONTROL DEVICES, LATEST EDITION.
2. THE CITY OF ALBUQUERQUE TRAFFIC CODE, LATEST EDITION.
3. SECTION 19 OF THE CITY OF ALBUQUERQUE'S STANDARD SPECIFICATIONS FOR PUBLIC WORK CONSTRUCTION, AS WELL AS OTHER SECTIONS.


23. FAILURE TO COMPLY WITH ANY OF THE ABOVE MENTIONED, WILL BE ADEQUATE CAUSE TO CEASE ALL WORK ON ANY CONSTRUCTION PROJECT. WORK WILL NOT RESUME UNTIL ALL REQUIREMENTS ARE ADDRESSED AND APPROVED BY CONSTRUCTION COORDINATION.

24. ALL TRAFFIC CONTROL DEVICES SHALL BE KEPT IN NEW-CLEAN CONDITION. WASHING OF EQUIPMENT IS INCIDENTAL TO ITS PLACEMENT AND MAINTENANCE.


25. TRAFFIC CONTROL STANDARDS APPLY ONLY WHERE THE CONSTRUCTION TRAFFIC CONTROL PLANS ARE NOT SPECIFIC.

26. ADVANCE WARNING SIGNS SHALL BE 36"x36" MIN. WITH SUPER ENGINEERING GRADE SHEETING OR BETTER. MOUNTING HEIGHT AT TOP OF SIGN SHALL BE THE SAME AS FOR A 48" SIGN AS INDICATED IN THE MUTCD.

27. CONTRACTOR SHALL MAINTAIN A GRAFFITI-FREE WORKSITE. ALL GRAFFITI SHALL BE PROMPTLY REMOVED FROM ALL EQUIPMENT, BOTH PERMANENT AND TEMPORARY.

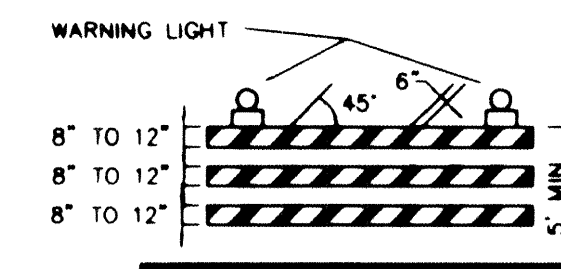

TYPE II BARRICADE

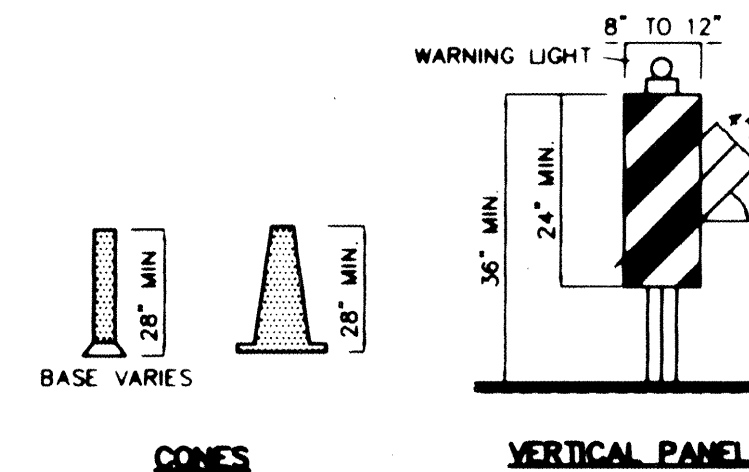

CONES

VERTICAL PANEL

HIGH LEVEL WARNING DEVICE

WORK AREA

BARRICADE - TYPE I, TYPE II, OR BARREL
BARRICADE - TYPE III
VERTICAL PANEL

WARNING SIGN
DISTANCE BETWEEN SIGNS - A DISTANCE MEASURED IN FEET EQUAL TO A VALUE OF TEN TIMES THE SPEED LIMIT OF THE STREET
FLAGMAN POSITION
SPACING BETWEEN BARRICADES - A DISTANCE MEASURED IN FEET EQUAL TO THE SPEED LIMIT OF THE STREET
TAPER LENGTH - SEE CHART BELOW
THE TANGENT LENGTH IS EQUAL TO THE TAPER LENGTH FOR A GIVEN STREET

TAPER REQUIREMENTS

SPEED LIMIT (MPH)	TAPER LENGTH (L) (FEET)			MINIMUM NUMBER OF DEVICES FOR TAPER	MAXIMUM DEVICE SPACING IN FEET	
	10' LANE	11' LANE	12' LANE		ALONG TAPER	AFTER TAPER
20	70	75	80	5	20	20
25	105	115	125	6	25	25
30	150	165	180	7	30	30
35	205	225	245	8	35	35
40	270	295	320	9	40	40
45	450	495	540	13	45	45
50	500	550	600	13	50	50
55	550	605	660	13	55	55

RECOMMENDED SIGN SPACING(D) FOR ADVANCE WARNING SIGN SERIES

SPEED LIMIT (MPH)	MINIMUM DISTANCE IN FEET BETWEEN SIGNS	FROM LAST SIGN TO TAPER
0-20	10 X SPEED LIMIT	10 X SPEED LIMIT
25-30	10 X SPEED LIMIT	10 X SPEED LIMIT
30-35	10 X SPEED LIMIT	10 X SPEED LIMIT
40-45	10 X SPEED LIMIT	10 X SPEED LIMIT
50-60	10 X SPEED LIMIT	10 X SPEED LIMIT


TAPER CRITERIA

TYPE OF TAPER	TAPER LENGTH
UPSTREAM TAPER	
MERGING TAPER	L MINIMUM
SHIFTING TAPER	1/2 L MINIMUM
SHOULDER TAPER	1/2 L MINIMUM
TWO-WAY TRAFFIC TAPER	100 FEET MAXIMUM
DOWNSTREAM TAPERS	100 FEET PER LANE

TAPER LENGTH COMPUTATION

SPEED LIMIT
40 MPH OR LESS
45 MPH OR GREATER
L = TAPER LENGTH
W = WIDTH OF OFFSET IN FEET
S = POSTED SPEED OR OFF-PEAK 85-PERCENTILE SPEED IN MPH

SIGN FACE DETAILS

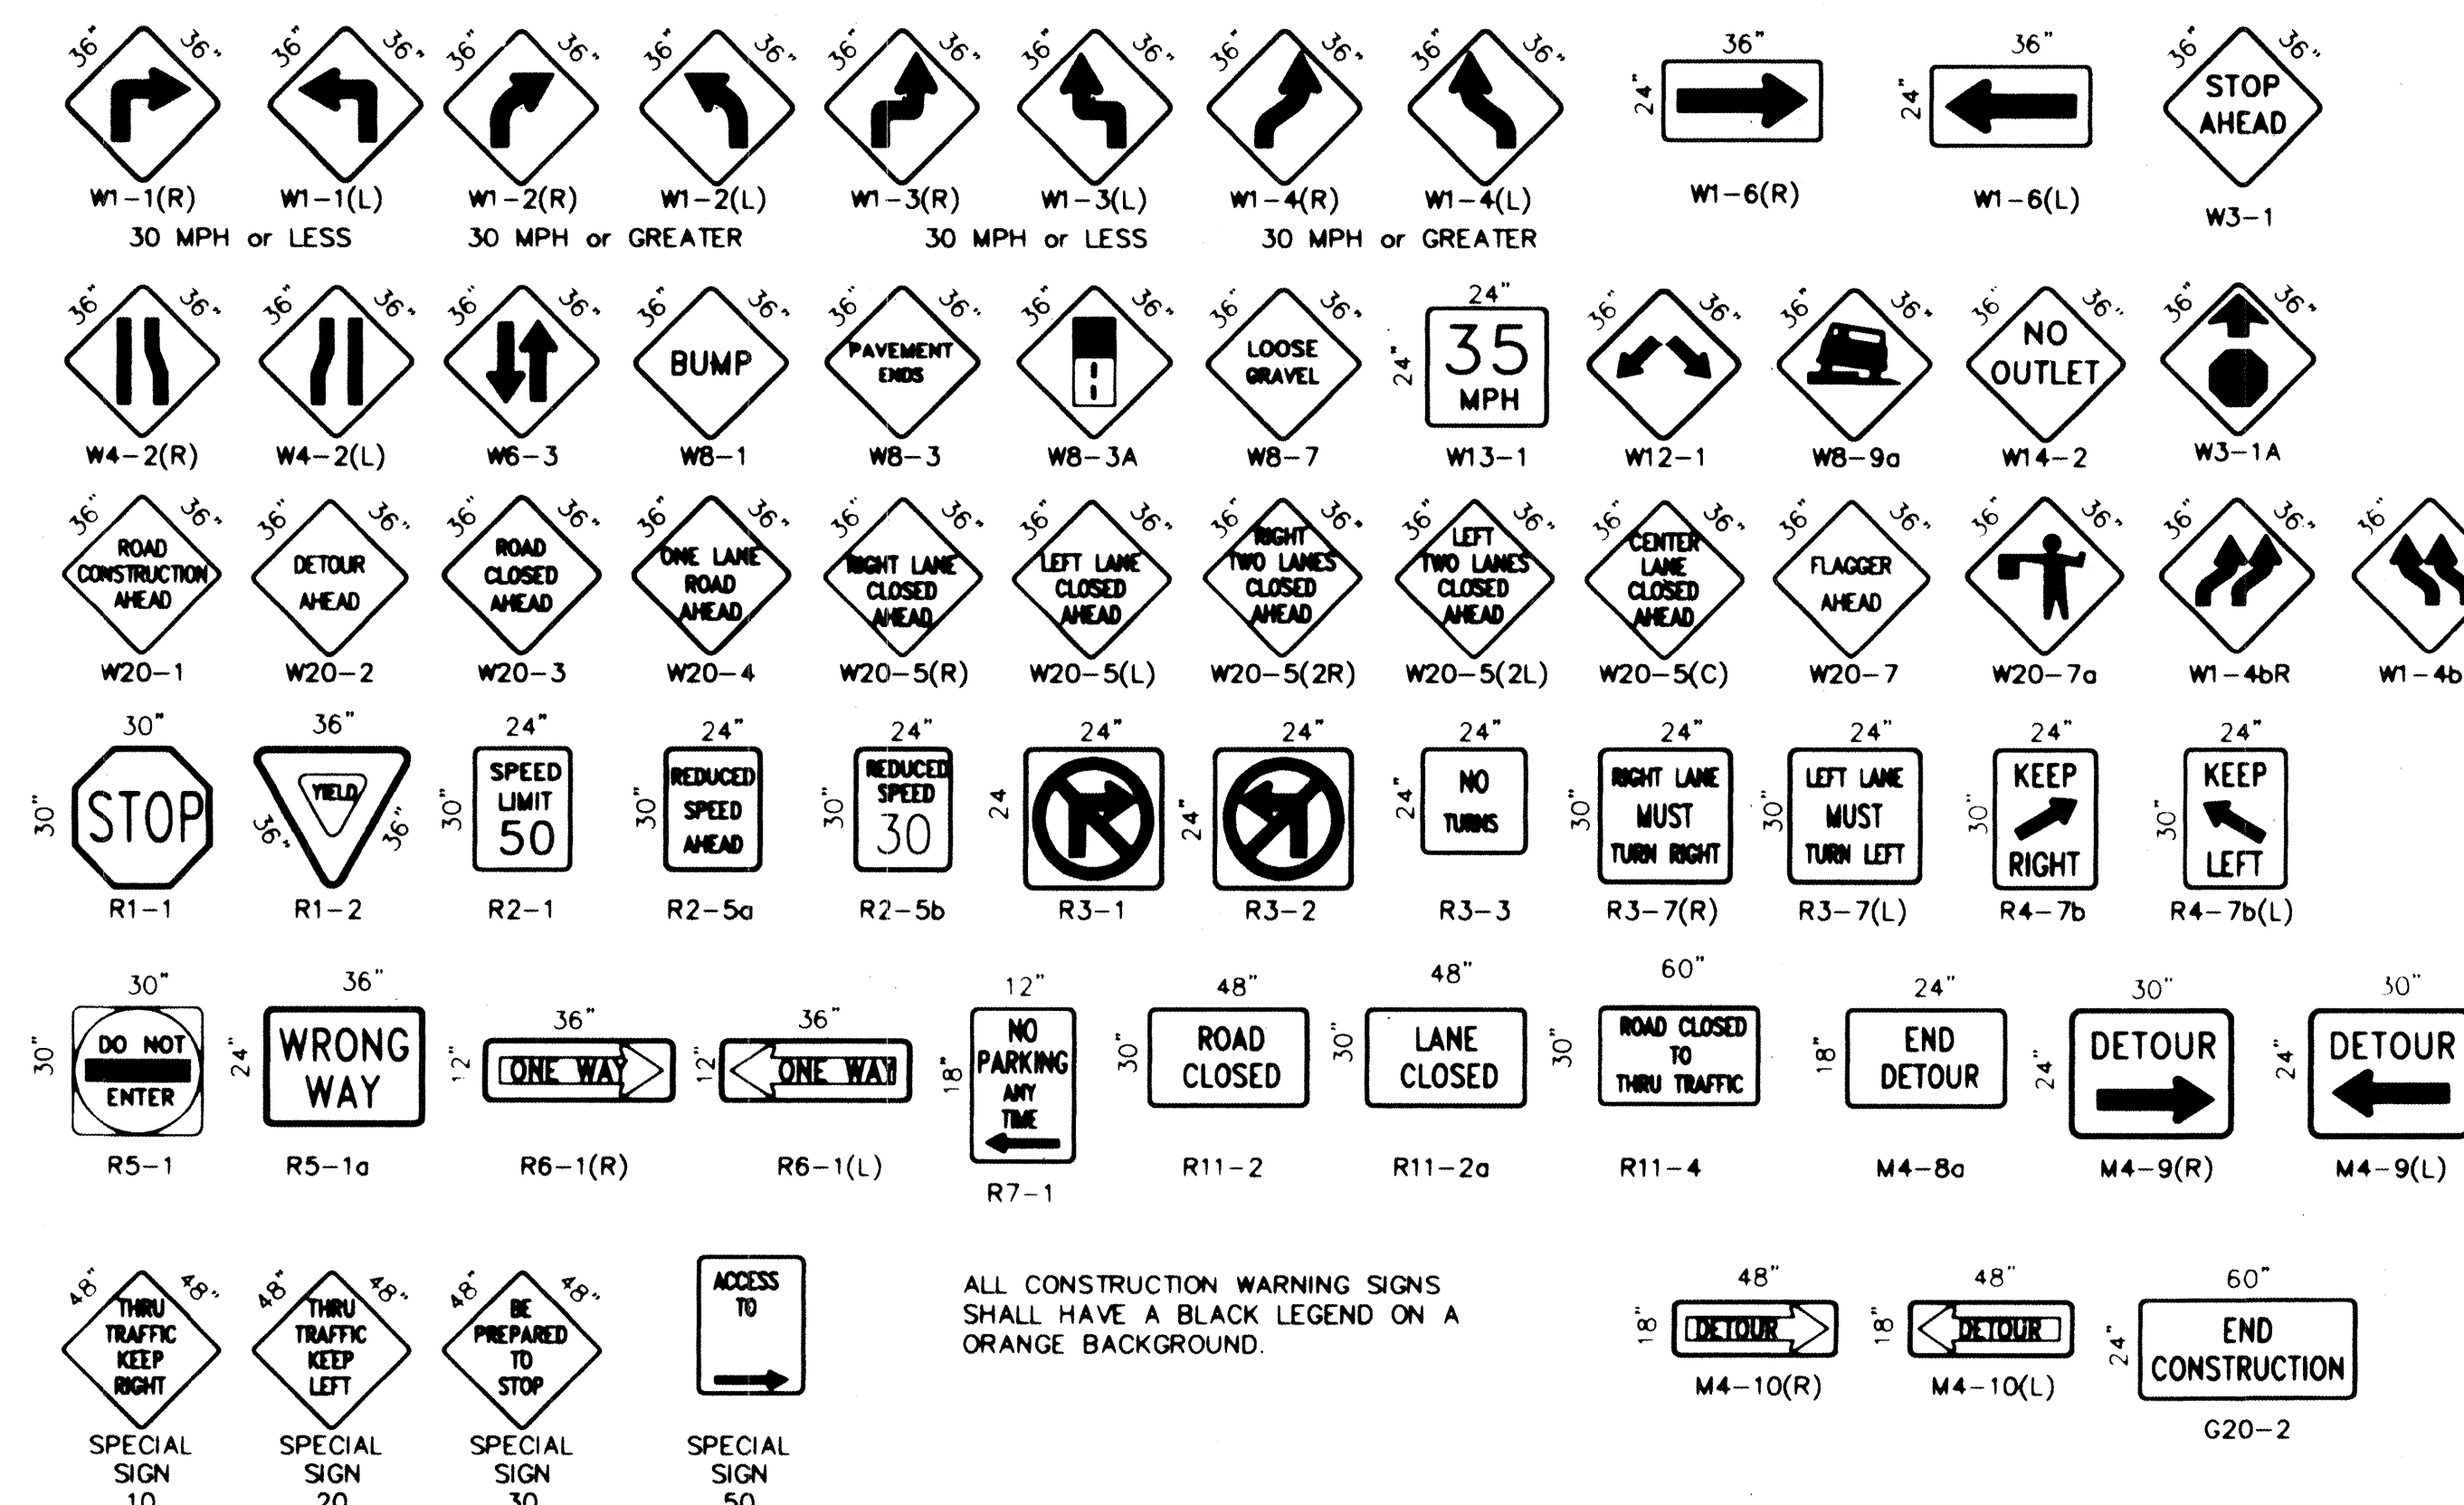

ALL CONSTRUCTION WARNING SIGNS SHALL HAVE A BLACK LEGEND ON A ORANGE BACKGROUND.

980611

TYPICAL RIGHT LANE CLOSURE

TYPICAL LEFT LANE CLOSURE

TYPICAL ONE DIRECTION DETOUR

TYPICAL TRAFFIC SPLIT-(PAINTED MEDIAN)

TYPICAL TRAFFIC SPLIT-(RAISED MEDIAN)

TYPICAL SANITARY SEWER SLIPLINING OPERATION

NOTE: MAY REQUIRE LEFT LANE CLOSURE DEPENDING ON FIELD CONDITIONS.

TYPICAL LANE CLOSURE AT INTERSECTION
NOTE: DEPENDING ON WORK ZONE LOCATION

TYPICAL MID-BLOCK CLOSURE
NOTE: (R1-1) BASED ON FIELD CONDITIONS.

TYPICAL STREET CLOSURE
NOTE: (R1-1) BASED ON FIELD CONDITIONS.

TYPICAL STREET CLOSURE
NOTE: (R1-1) BASED ON FIELD CONDITIONS.

TYPICAL DOUBLE RIGHT LANE CLOSURE

TYPICAL DOUBLE LEFT LANE CLOSURE

TYPICAL FLAGGING OPERATION

TRAFFIC SPLIT NOTES:

1. THE OFFSET DISTANCE MUST BE CALCULATED IN ALL SHIFTING TAPERS. THE OFFSET DISTANCES SHALL INCLUDE LANE WIDTHS PLUS MEDIAN WIDTHS.
2. 1/2 L IS MINIMUM DISTANCE FOR SHIFTING TAPERS.
3. REVERSE CURVES MAY BE IMPLEMENTED. ALL CURVE DATA SHALL BE CALCULATED.
4. MEDIAN REMOVAL SHALL BE REQUIRED IF 1/2 L OR REVERSE CURVE IS NOT SUFFICIENT. MEDIAN REMOVAL SHALL TAKE PLACE BEFORE SPLITS.
5. REDUCED SPEED MAY BE CONSIDERED.
6. * USE W1-3 FOR 30 MPH OR LESS, W1-4 FOR SPEED 35 MPH OR GREATER.

GENERAL NOTE:

ALL CONSTRUCTION WARNING SIGNS SHALL HAVE A BLACK LEGEND ON A ORANGE BACKGROUND.

ALL ADVANCE WARNING SIGNS SHALL BE A MINIMUM OF 36" THIRTY SIX INCHES BY 36" THIRTY SIX INCHES IN SIZE AND SHALL HAVE ONE WARNING LIGHT.

File Path: E:\JMA\2014\980613\DWG
Plot Date: 02-18-1999
File Name: 980613.TC.DWG
Plot Time: 07:59 am


LEGEND

- RIGHT OF WAY
- EASEMENT
- NEW PAVEMENT
- NEW CURB AND GUTTER
- EXISTING CURB AND GUTTER
- EXISTING EDGE OF PAVEMENT
- DIRECTION OF TRAFFIC
- TYPICAL CHANNELIZATION DEVICE (SEE DETAIL THIS SHEET)
- TRAFFIC CONTROL SIGN (AS LABELED)
- WORK ZONE

CALCULATIONS

$$\text{REQUIRED TAPER LENGTH} = \frac{WS^2}{60}$$
$$\text{POSTED SPEED} = S = 35 \text{ MPH}$$
$$\text{WIDTH} = W = 12 \text{ FT}$$
$$\text{TAPER} = 245 \text{ FT}$$

END
ROAD WORK
G20-2

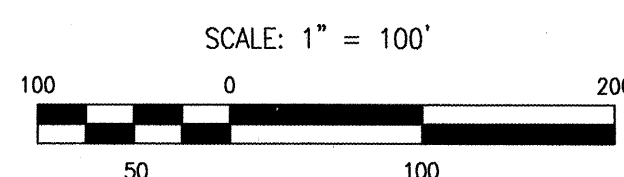

TRACT A
LUECKING PARK
SOMPLEX

TRACT "A-3A"

TRACT "A-2A"

TRACT A
LUECKING PARK
SOMPLEX

TRACT "A-1A"


TRACT "A-4A"
TEMPORARY
RETENTION
POND

PATHWAY AVE. N.E.

TRACTS "B-1-A" THROUGH "B-1-P"
KRYA RESERVE BUSINESS PARK

TRAFFIC CONTROL NOTES

- SIGNAGE, CHANNELIZING DEVICES AND TRAFFIC CONTROL IMPLEMENTATION SHALL CONFORM WITH PART VI OF THE M.U.T.C.D., LATEST EDITION.
- CONTRACTOR SHALL MAINTAIN ACCESS TO ADJACENT PROPERTIES DURING CONSTRUCTION.
- CONTRACTOR SHALL AT ALL TIMES COMPLY WITH THE STANDARDS AND REQUIREMENTS SET FORTH IN THE M.U.T.C.D. PART VI.
- CONTRACTOR IS RESPONSIBLE FOR OBTAINING ALL NECESSARY PERMITS PRIOR TO CONSTRUCTION.
- TRAFFIC CONTROL AS SHOWN HEREON IS INTENDED TO ACHIEVE A SINGLE LANE CLOSURE TO ALLOW FOR CONSTRUCTION WITHIN THE SHOULDER AND OUTSIDE 4' OF THE CLOSED LANE.
- IF LANE CLOSURES ON THE FRONTAGE ROAD ARE REQUIRED FROM 6:00 A.M. TO 9:00 A.M. OR FROM 3:00 P.M. TO 7:00 P.M., MONDAY THROUGH FRIDAY, THEN THE CONTRACTOR MUST WORK CONTINUOUSLY, 24 HOURS PER DAY UNTIL ALL LANES ARE OPENED TO TRAFFIC.

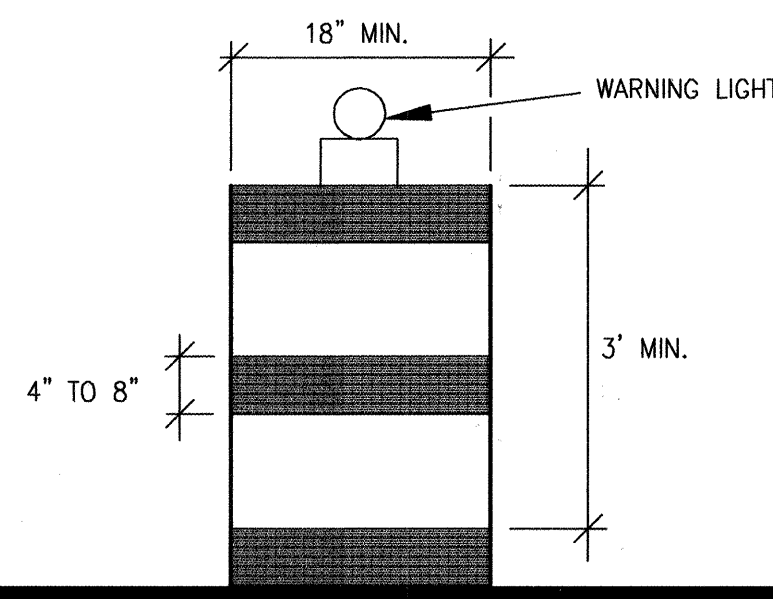


TYPICAL CHANNELIZATION DEVICE
(N.T.S.)

NOTES:

THIS IS NOT A BOUNDARY SURVEY. BOUNDARY INFORMATION IS SHOWN HEREON IS FOR ORIENTATION ONLY AND IS TAKEN FROM PRELIMINARY PLAT OF "TRACTS A-1A, A-2A, A-3A AND A-4A, LUECKING PARK COMPLEX NO.2 AND NO.3" DATED 4/27/98 BY HARRIS SURVEYING, NMPS 11463. THIS IS NOT A TOPOGRAPHIC SURVEY. TOPOGRAPHIC DATA SHOWN HEREON IS FROM A SURVEY CONDUCTED BY JMA DATED 05-1997 AND SUPPLEMENTED 08-1998

AS BUILT INFORMATION				BENCH MARKS				SURVEY INFORMATION				ENGINEER'S SEAL			
CONTRACTOR	DATE	WORK BY	DATE	INSPECTOR'S	DATE	ACCEPTANCE BY	DATE	NO.	DATE	BY	NO.	NO.	DATE	BY	NO.
								970282	5/97	JMA	970282				
								980623	8/98	JMA	980623				
MICRO-FILM INFORMATION				REVISIONS				DESIGN				DATE			
RECORDED BY	DATE	NO.		DESIGNED BY	DATE	DATE	DATE	DESIGNED BY	DATE	DATE	DATE	DESIGNED BY	DATE	DATE	DATE
				Drawn By	G.M.	01-1999	01-1999	Drawn By	G.M.	01-1999	01-1999	Drawn By	G.M.	01-1999	01-1999
				Checked By	J.C.M.	02-1999	02-1999	Checked By	J.C.M.	02-1999	02-1999	Checked By	J.C.M.	02-1999	02-1999

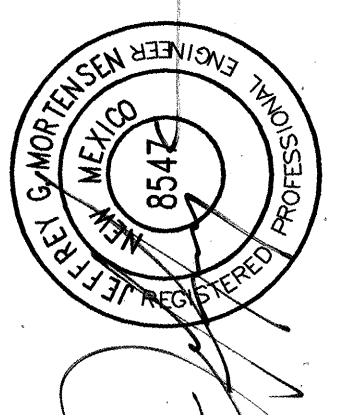

JMA

JEFF MORTENSON & ASSOCIATES, INC.
801-C MIDWAY PARK BLVD. N.E.
ALBUQUERQUE, N.M. 87109
ENGINEERS & SURVEYORS (505) 345-4250

CITY OF ALBUQUERQUE
PUBLIC WORKS DEPARTMENT
ENGINEERING DEVELOPMENT GROUP

TITLE: PATHWAY OFFICE PARK
I-25 FRONTAGE ROAD TRAFFIC CONTROL PLAN


Design Review Committee	City Engineer Approval	Mr./Date/By	Mr./Date/By
APPROVED MAR 29 1999 DESIGN REVIEW COMMITTEE	APPROVED JUN 8 1999 CITY ENGINEER		
City Project No.	Zone Map No.	Sheet	Of

980613

595281

G-16

19 Of 19

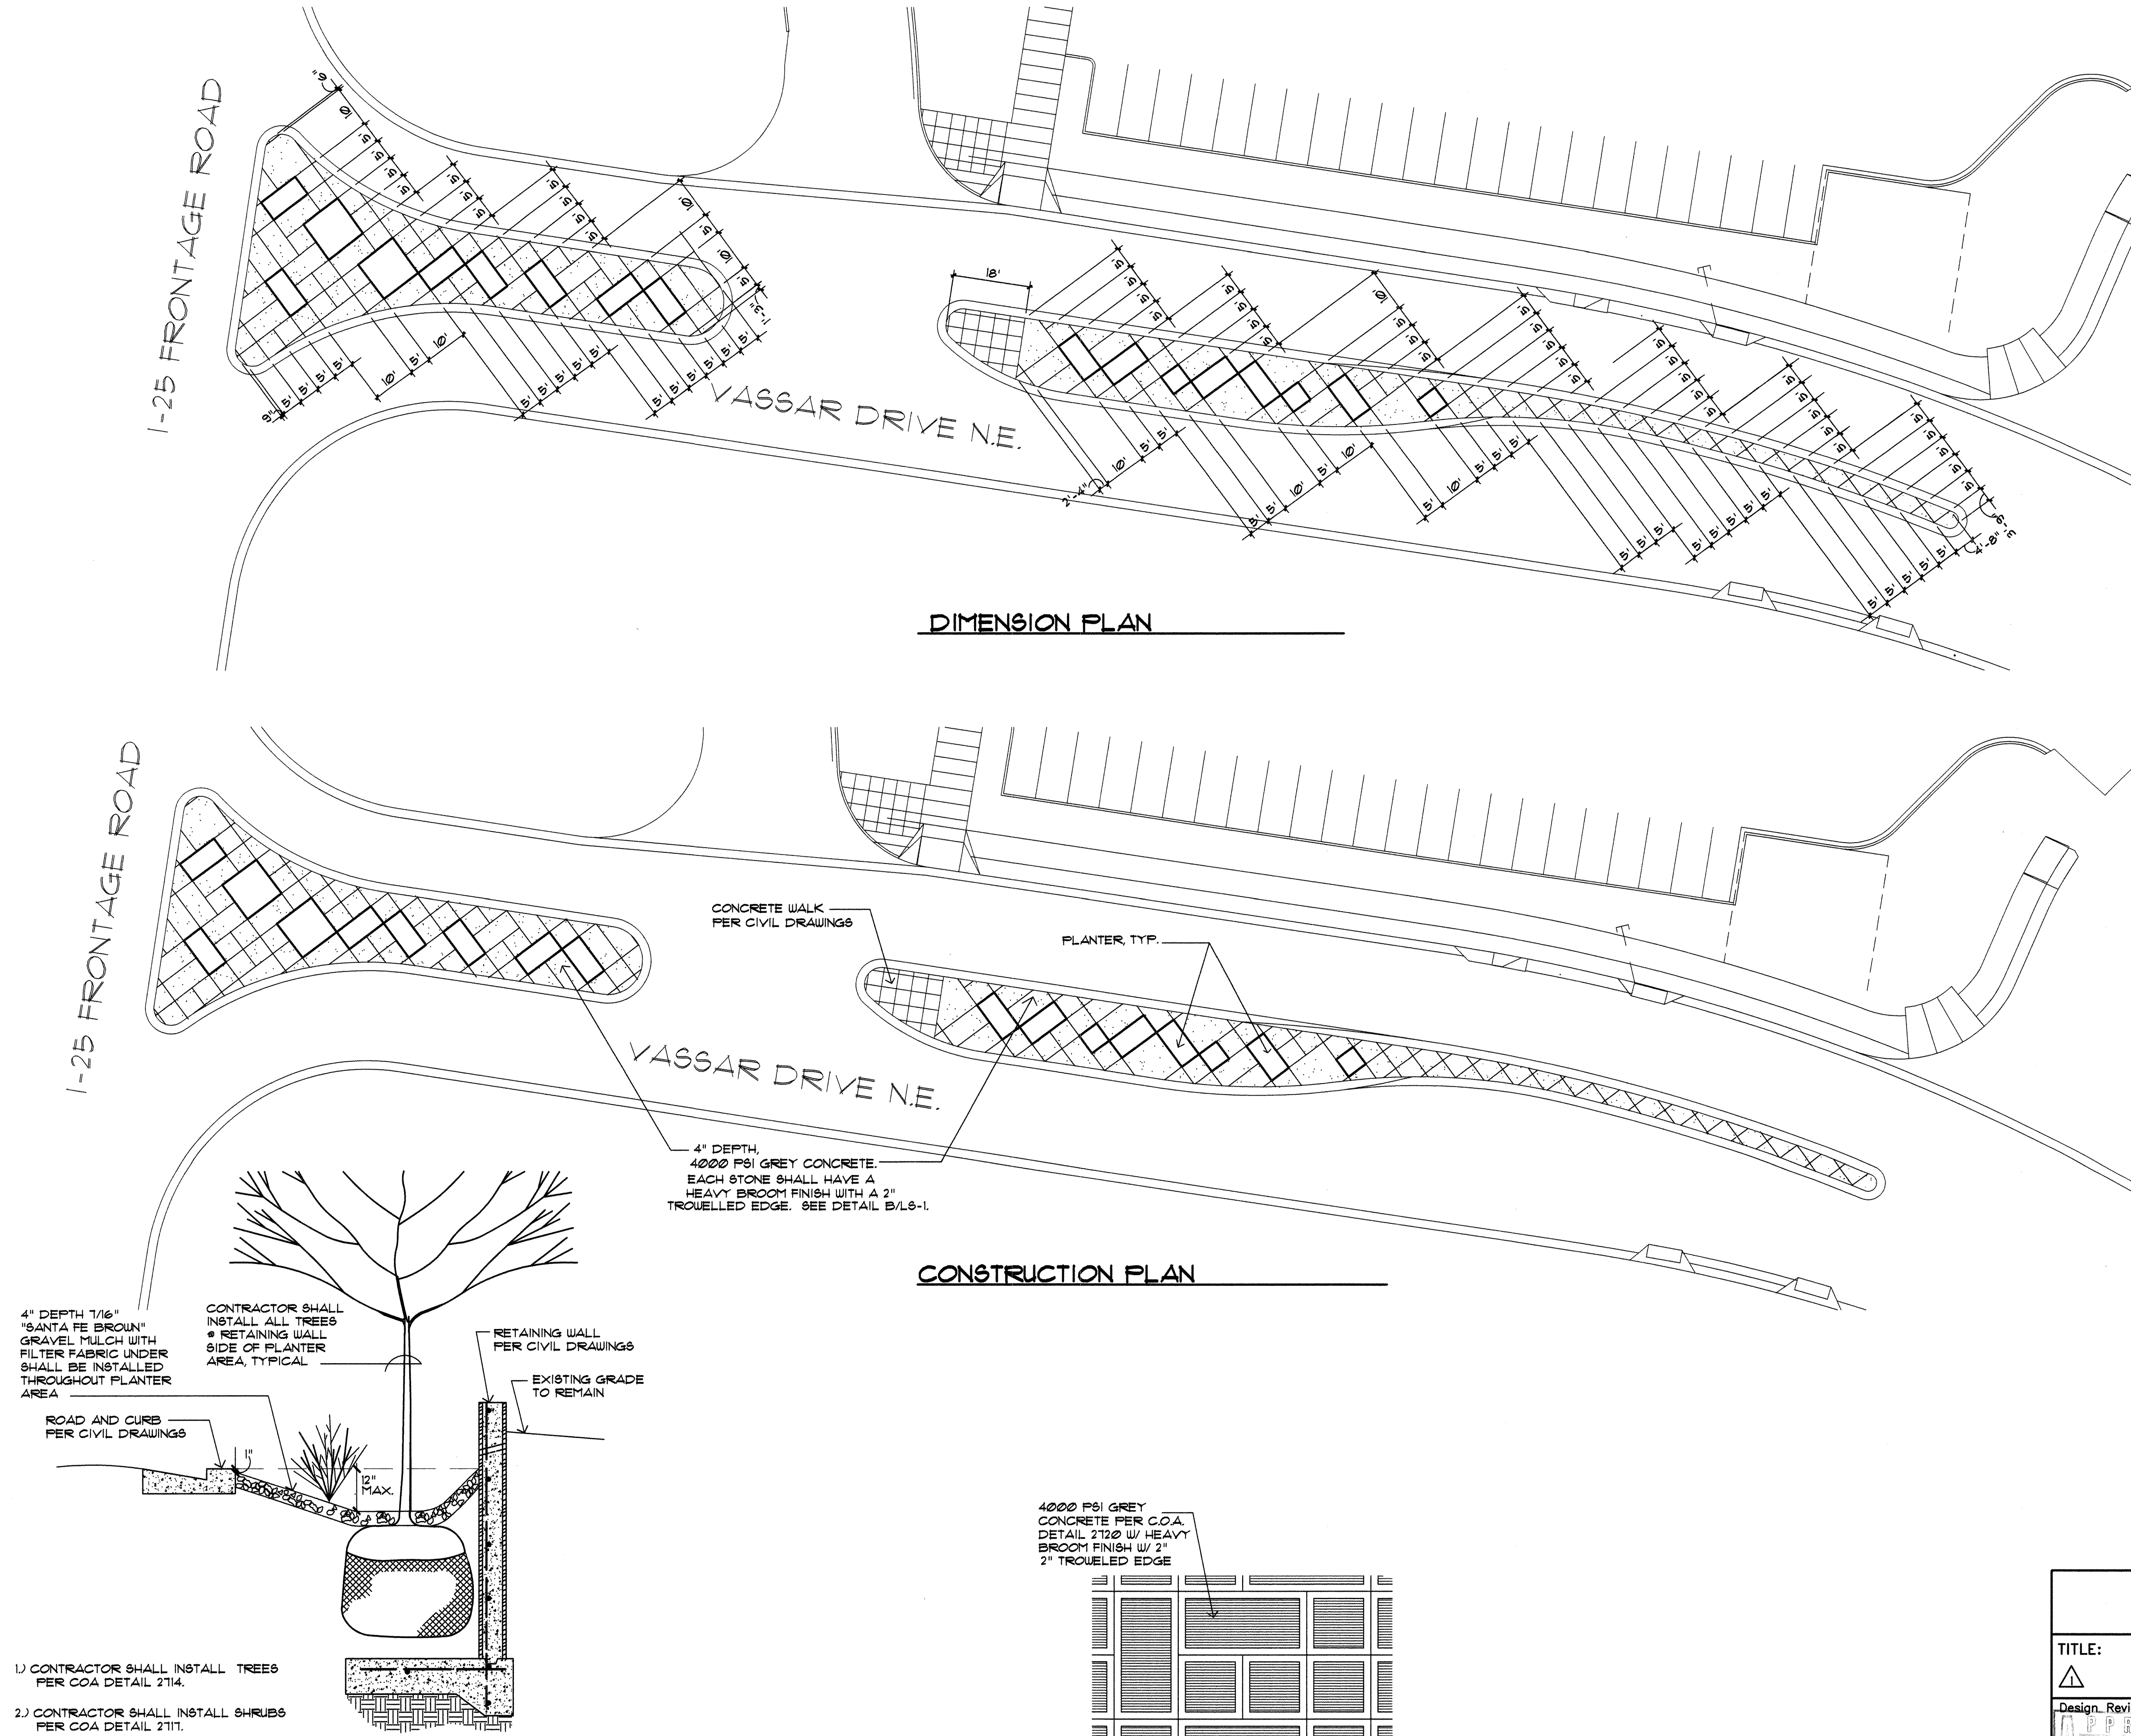

PATHWAY AVENUE PLANTER AREA

LS-1 MCD-0600 063093

PAVING FINISH DETAIL

LS-1 FFD 051793 N.T.S.

0 10 20 40 80

SCALE: 1" = 20'

MORROW & COMPANY, LTD.
LANDSCAPE ARCHITECTS
210 La Veta N.E.
Albuquerque, N.M. 87109
TEL: 505 265-2200 FAX: 505 265-9637

CITY OF ALBUQUERQUE PUBLIC WORKS DEPARTMENT ENGINEERING DEVELOPMENT GROUP			
TITLE: PATHWAY OFFICE PARK LANDSCAPE CONSTRUCTION PLAN & DIMENSION PLAN			
Design Review Committee		City Engineer Approval	
APPROVED	DEC 16 1999	APPROVED	DEC 16 1999
DESIGN REVIEW COMMITTEE		CITY ENGINEER	
CITY PROJECT NO. 595281		ZONE MAP NO. G-16	
SHEET 19		OF 19	

REVISIONS	
NO.	DATE
DESIGNED BY	EAC/BHM
DRAWN BY	EAC/VW
CHECKED BY	ECR/BHM
DATE	07-1999
DATE	07-1999

REVISIONS	
NO.	DATE
DESIGNED BY	EAC/BHM
DRAWN BY	EAC/VW
CHECKED BY	ECR/BHM
DATE	07-1999
DATE	07-1999


REVISIONS	
NO.	DATE
DESIGNED BY	EAC/BHM
DRAWN BY	EAC/VW
CHECKED BY	ECR/BHM
DATE	07-1999
DATE	07-1999

ENGINEER'S SEAL		SURVEY INFORMATION			BENCH MARKS		AS BUILT INFORMATION	
	FIELD NOTES							
	NO.		BY	DATE			CONTRACTOR	DATE
							WORK	DATE
							STAMPED BY	DATE
							INSPECTION BY	DATE
							FIELD VERIFICATION BY	DATE
							DRAWINGS CORRECTED BY	DATE
REVISIONS								
DESIGN								
DESIGNED BY				EAC/BHM	DATE		07-1999	
DRAWN BY				EAC/VW	DATE		07-1999	
CHECKED BY				ECR/BHM	DATE		07-1999	
MICRO-FILM INFORMATION								
RECORDED BY					DATE			
NO.								

NAME: D:\PATH\PH1\PHIPWD\PKWY-IRR.DWG DATE: AUG. 09, 1999 TIME: 9:15 AM PLOT: SHEET1A 1 of 1 EAC

PLANTING NOTES

1. IN CASE OF DISCREPANCY IN PLANT QUANTITIES SHOWN ON THE PLANT LIST AND SCHEDULE, SCHEDULE SHALL PREVAIL. THE QUANTITIES SHOWN ON THE PLAN SHALL GOVERN. CONTRACTOR SHALL VERIFY ALL QUANTITIES PRIOR TO BID AND INSTALLATION. NO ADDITIONAL PAYMENT WILL BE MADE FOR ANY DISCREPANCIES IN QUANTITIES BETWEEN THE PLANTING PLAN AND THE PLANT LIST.
2. A 4" DEPTH OF 7/16" SANTA FE BROWN CRUSHED GRAVEL MULCH WITH FILTER FABRIC UNDER SHRUBS, PLANTING BED THROUGHOUT PROJECT. FILTER FABRIC SHALL BE MIN. 4 OZ. WOVEN NEEDLE PUNCH POLYPROPYLENE (DEWITT OR EQUIVALENT). OVERLAP ENDS 3", TURN DOWN EDGES 6".
3. PLANTER AREAS AT MEDIANS ONLY, SHALL BE EXCAVATED AND PREPARED WITH ROADBED WATERPROOFING PER C.O.A. DETAIL # 2930.
4. THE CONTRACTOR SHALL PRUNE LOWER BRANCHES OF DECIDUOUS TREES TO 1 FEET ABOVE FINISH GRADE.
5. IF THERE IS A DISCREPANCY IN THE FIELD OR NURSERY PLANTS BETWEEN THE CONTAINER SIZE CALLED OUT UNDER "SPECIES" AND HEIGHT & SPREAD CALLED OUT UNDER "SIZE", THE SPECIFIED PLANT MUST MEET HEIGHT & SPREAD REQUIREMENTS SPECIFIED UNDER "SIZE", EVEN IF THE LARGER CONTAINER SIZE IS REQUIRED TO MEET THESE SPECIFICATIONS. AT NO ADDITIONAL COST TO THE OWNER.
6. AT MEDIANS: TREES SHALL BE PLANTED PER C.O.A. DETAIL #215 AND SHRUBS SHALL BE PLANTED PER C.O.A. DETAIL #218.
AT PATHWAY AVE: PLANTER AREA SHALL BE PER DETAIL B/L-1.

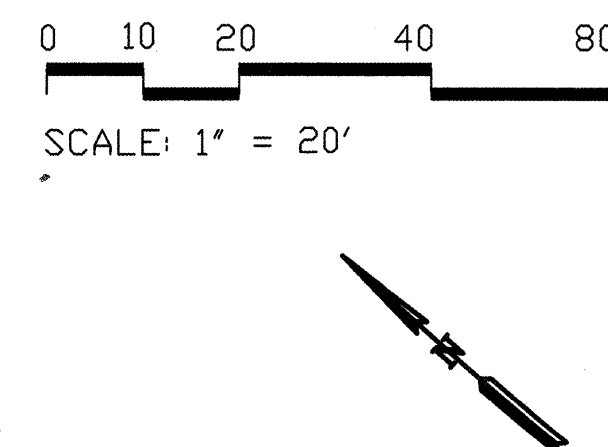

CITY OF ALBUQUERQUE PUBLIC WORKS DEPARTMENT ENGINEERING DEVELOPMENT GROUP			
TITLE: PATHWAY OFFICE PARK		LANDSCAPE PLANTING PLAN, SCHEDULE & NOTES	
Design Review Committee APPROVED DEC 16 1999 DESIGN REVIEW COMMITTEE		City Engineer Approval APPROVED DEC 16 1999 CITY ENGINEER	
		Mo/Day/yr. Mo/Day/yr.	Mo/Day/yr. Mo/Day/yr.
		Mo/Day/yr. Mo/Day/yr.	Mo/Day/yr. Mo/Day/yr.
CITY PROJECT NO. 595281		ZONE MAP NO. G-16	SHEET OF LS-3
		19	19