

RECORD
DRAWINGS
2/00

FUTURE IRVING BLVD.

CHANNEL

VENETIAN RANCH RD.

VENETIAN VILLAGE ROAD

RAINBOW BLVD.

PIPE

RANCH RD.

CHANNEL

FUTURE PARADISE BLVD.

PROJECT LOCATION

NORTH

VICINITY MAP
B9, B10

1. SECTION 22.2, HYDROLOGY OF THE DEVELOPMENT PROCESS
MANUAL, VOLUME 2, DESIGN CRITERIA FOR THE CITY OF
ALBUQUERQUE, NEW MEXICO, JANUARY 1993.
2. "PIEDRAS MARCADAS DRAINAGE MANAGEMENT PLAN",
MOLZEN-CORBIN & ASSOCIATES, MAY 1993
3. "LAS VENTANAS SUBDIVISION DRAINAGE MASTER PLAN", BOHANNAN
HUSTON INC., APRIL 1995, UPDATED OCTOBER 1995
4. "DESIGN ANALYSIS REPORT FOR VENTANA RANCH SUBDIVISION
DRAINAGE FACILITIES", BOHANNAN HUSTON INC., OCTOBER 1995

Frank H. Martinez 11/12/98
FRANK H. MARTINEZ DATE
EXECUTIVE DIRECTOR

RECOMMENDED:
John P. Kelly 11-9-98
JOHN KELLY P.E. DATE
CHIEF ENGINEER

ALBUQUERQUE METROPOLITAN ARROYO
FLOOD CONTROL AUTHORITY

INDEX	
SHEET NUMBER	DESCRIPTION
1	TITLE SHEET
2	PLAN & PROFILE STA. 7+56 TO STA. 18+00
3	PLAN & PROFILE STA. 18+00 TO STA. 20+53.71
4	TYPICAL CHANNEL SECTIONS
5	RUN DOWN DETAILS
6	PIPE PENETRATION DETAILS
7	SERIAL CB-33

INDEX	
SHEET NUMBER	DESCRIPTION
8	SERIAL CB-33
9	SERIAL CB-33-15
10	STRUCTURE LOCATION PLAN
11	CHANNEL CROSS SECTIONS
12	CHANNEL CROSS SECTIONS
13	CHANNEL CROSS SECTIONS


234, 11, 12 & 13
John Kelly 4/29/16


REV.	SHEETS	JOHN KELLY P.E. CHIEF ENGINEER	DATE
------	--------	---	------

APPROVAL OF AS BUILT DRAWING
CHIEF CONSTRUCTION ENGINEER
Peter Chang
DATE 4/13/00

 **Bohannon & Huston**
 Courtyard One 7500 IFFERSON NE Albuquerque NEW MEXICO 87113
 ENGINEERS PLANNERS PHOTOGRAMMETRISTS SURVEYORS SOFTWARE DEVELOPERS

[illegible]

SEE SH 10 FOR BLOW-UP
OF CROSSING

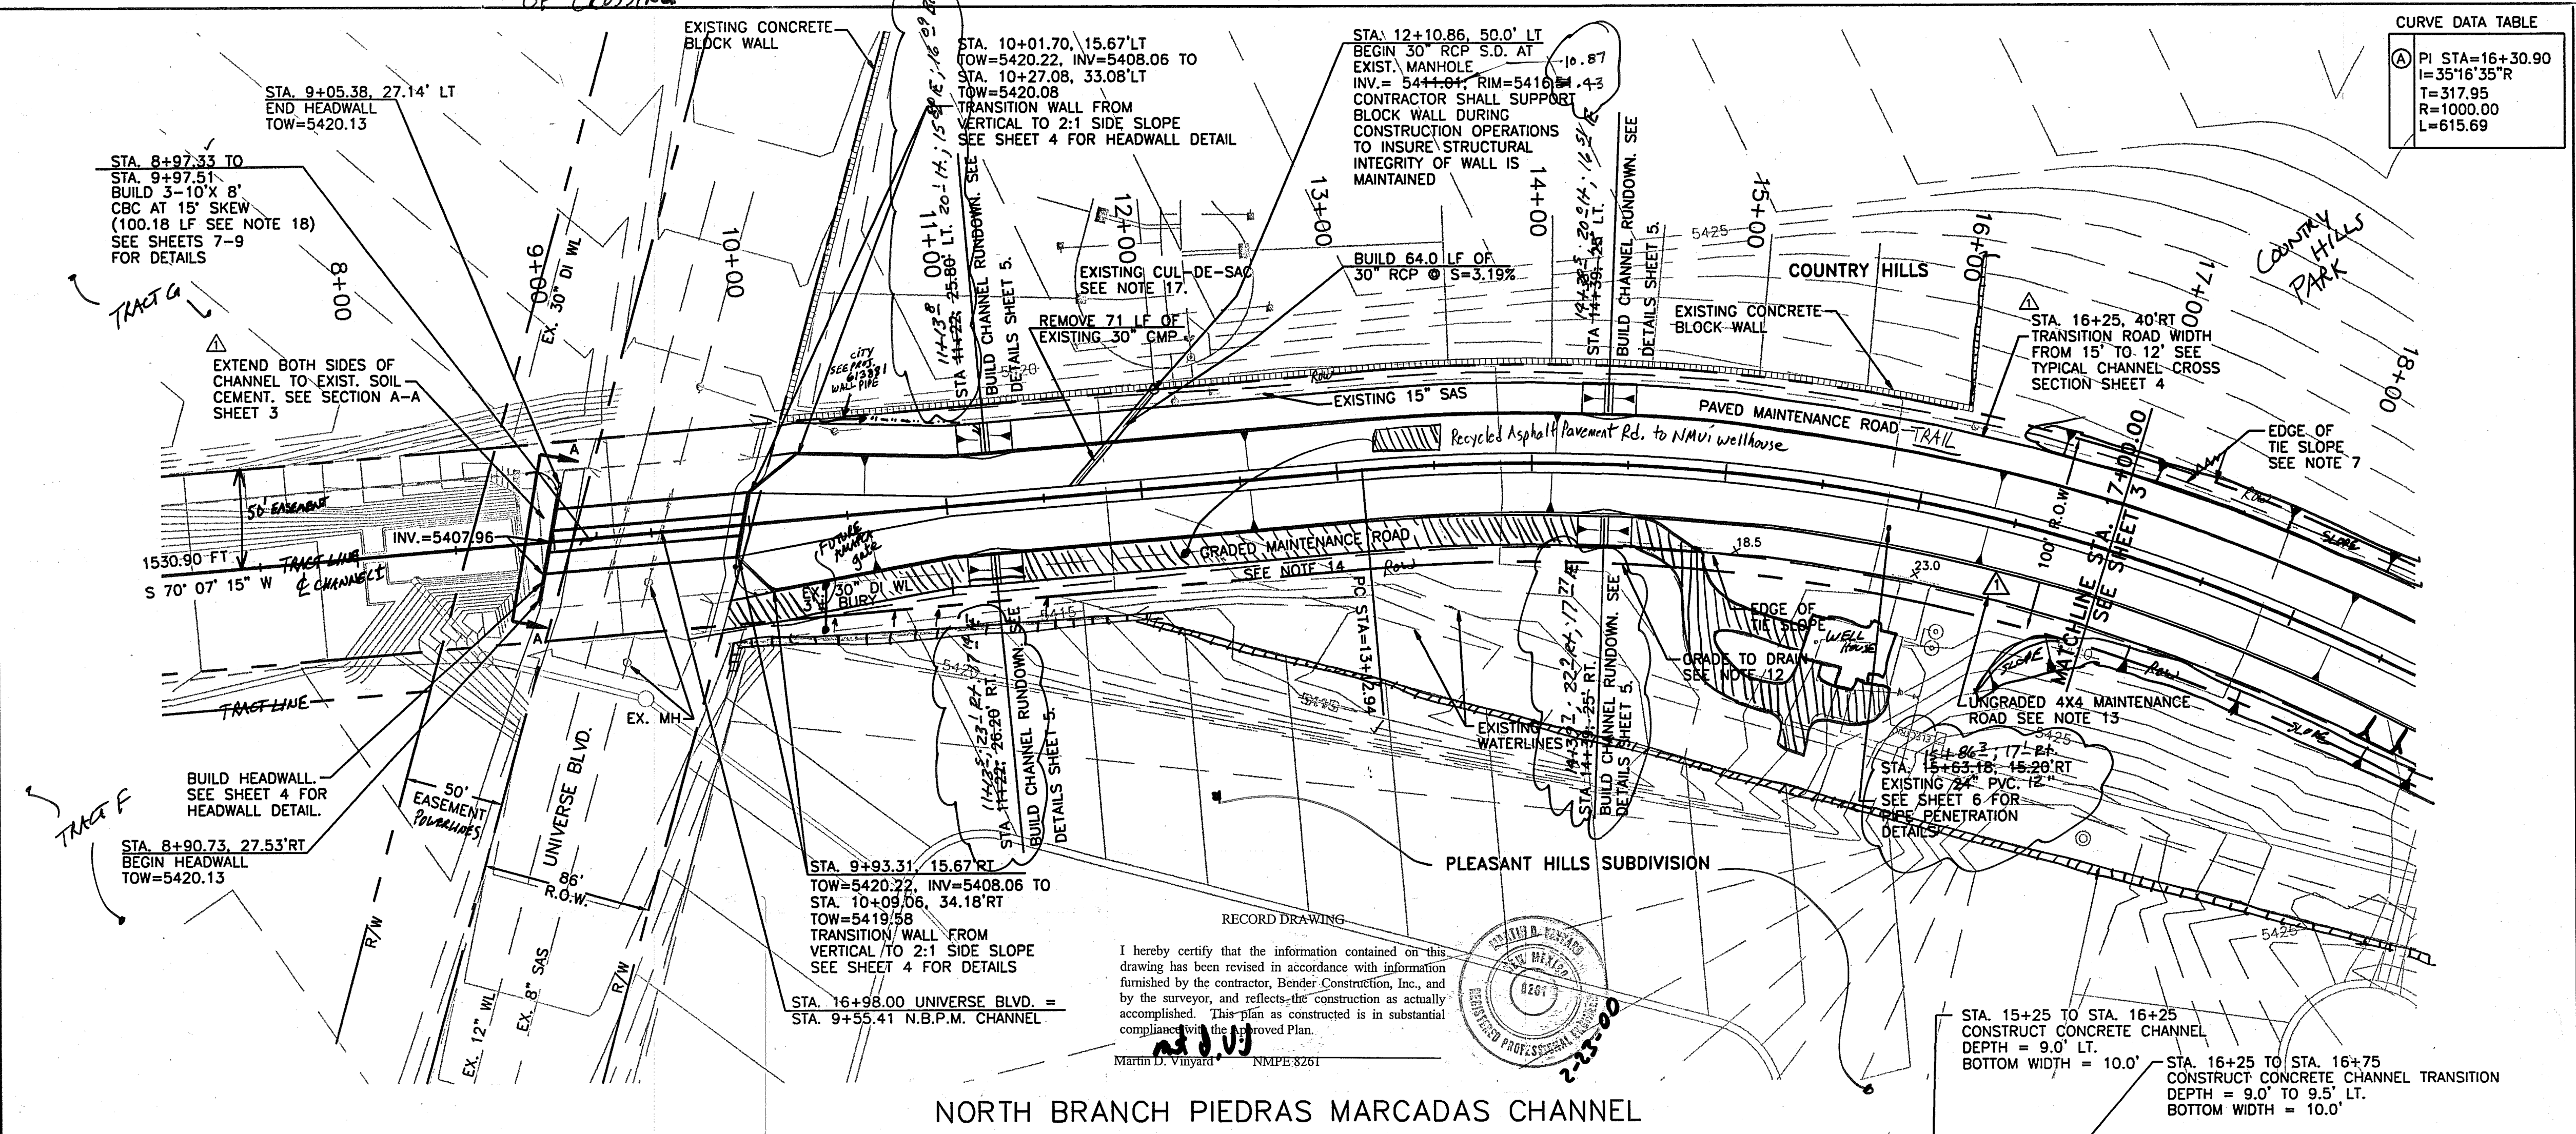


CURVE DATA TABLE

PI STA=16+30.90
I=35°16'35\"R
T=317.95
R=1000.00
L=615.69


- NOTES:
- THE CONTRACTOR SHALL FIELD VERIFY ALL EXISTING UTILITY LOCATIONS AND NOTIFY THE ENGINEER IMMEDIATELY OF ANY DISCREPANCIES.
 - SEE SHEET 4 FOR TYPICAL CHANNEL SECTIONS.
 - CENTERLINE DATA SHOWN IS FOR CENTERLINE OF R.O.W..
 - SEE SHEET 5 FOR TYPICAL CHANNEL RUNDOWN DETAILS.
 - TOP OF CHANNEL IS FROM CENTERLINE OF CHANNEL ELEVATION.
 - BEARINGS AND DISTANCES ARE FROM POINT OF TANGENCY TO POINT OF CURVATURE.
 - EXISTING CONTOURS SHOWN COMPILED FROM 1994 DATA AND FIELD CONDITIONS VARY. THE CHANNEL WAS EXCAVATED AND BASALT ROCK REMOVED DURING PHASE 2 OF THIS PROJECT. EXISTING GROUND IN EXCAVATED CHANNEL VARIES FROM BASALT ROCK TO EARTH.
 - STA. 8+97.33 TO STA. 9+97.51 (INCLUDING CONCRETE BOX CULVERT AND TRANSITION SECTIONS) SECTIONS SHALL BE CONSTRUCTED UNDER CITY OF ALBUQUERQUE STANDARD SPECIFICATIONS FOR PUBLIC WORKS CONSTRUCTION, 1986 (WITH CURRENT UPDATES). SEE SHEETS 4, 7-9.
 - END MAINTENANCE ROAD AT RIGHT OF WAY. DRIVE PAD AND UNIFORM BLVD. TO BE BUILT WITH FUTURE PROJECT.
 - STATIONING FOR PIPE PENETRATIONS IS ALONG TANGENT TO TOE OF CHANNEL SLOPE. SEE SHEET 6 FOR DETAIL.
 - TOW - TOP OF WALL.
 - CONTRACTOR SHALL GRADE AREA EAST OF THE NMUI WELL HOUSE TO DRAIN TO THE CHANNEL RUNDOWN.
 - FROM APPROX. STA. 16+00 TO STA. 20+54 (EOP) BUILD 12 FT. UNGRADED MAINTENANCE ROAD ON NORTH SIDE OF CHANNEL. THE SLOPE SHALL BE 2:1 IN ROCK AND 3:1 IN SOIL. ACCESS ROAD SHALL BE 4X4 ACCESSIBLE. SEE SHEET 12 AND 13 FOR CROSS SECTIONS.
 - FROM APPROX. STA. 9+90 TO STA. 16+00 BUILD 15 FT. GRADED MAINTENANCE ROAD.
 - BASALT ROCK WAS EXCAVATED ALONG ENTIRE LENGTH OF CHANNEL DURING PHASE II OF THIS PROJECT. CONTRACTOR SHALL REMOVE AND DISPOSE THIS BASALT ROCK.
 - ADDITIONAL ROCK EXCAVATION WILL BE PAID UNDER THE BID ITEM "ROCK EXCAVATION".
 - REMOVE AND REPLACE EXISTING ASPHALT PAVEMENT TRAIL FROM APPROXIMATELY STA. 10+00 TO STA. 12+25. THE NEW PAVED MAINTENANCE ROAD WILL TIE INTO THE EXISTING TRAIL AT THE CUL-DE-SAC AT STA. 12+25.
 - LENGTH OF CONCRETE BOX CULVERT(CBC) IS FROM FACE OF HEADWALL TO FACE OF HEADWALL.


* SEE SPECS FOR MEASUREMENT AND PAYMENT

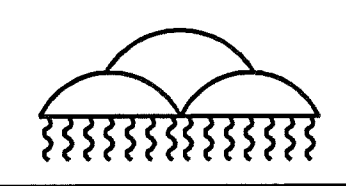




Bohannon & Huston
Courtney One 7500 JEFFERSON NE ALBUQUERQUE NEW MEXICO 87109
ENGINEERS PLANNERS PHOTOGRAMMETRISTS SURVEYORS SOFTWARE DEVELOPERS

ALBUQUERQUE METROPOLITAN	
ARROYO FLOOD CONTROL AUTHORITY	
NORTH BRANCH PIEDRAS MARCADAS CHANNEL	
PLAN & PROFILE STA. 7+56 TO STA 18+00	
DESIGN REVIEW COMMITTEE	CITY ENGINEER APPROVAL
MO./DAY/YR.	MO./DAY/YR.
LAST DESIGN UPDATE	
CITY PROJECT NO.	ZONE MAP NO.
5978.81	B9,R10
SHEET	OF
2	13

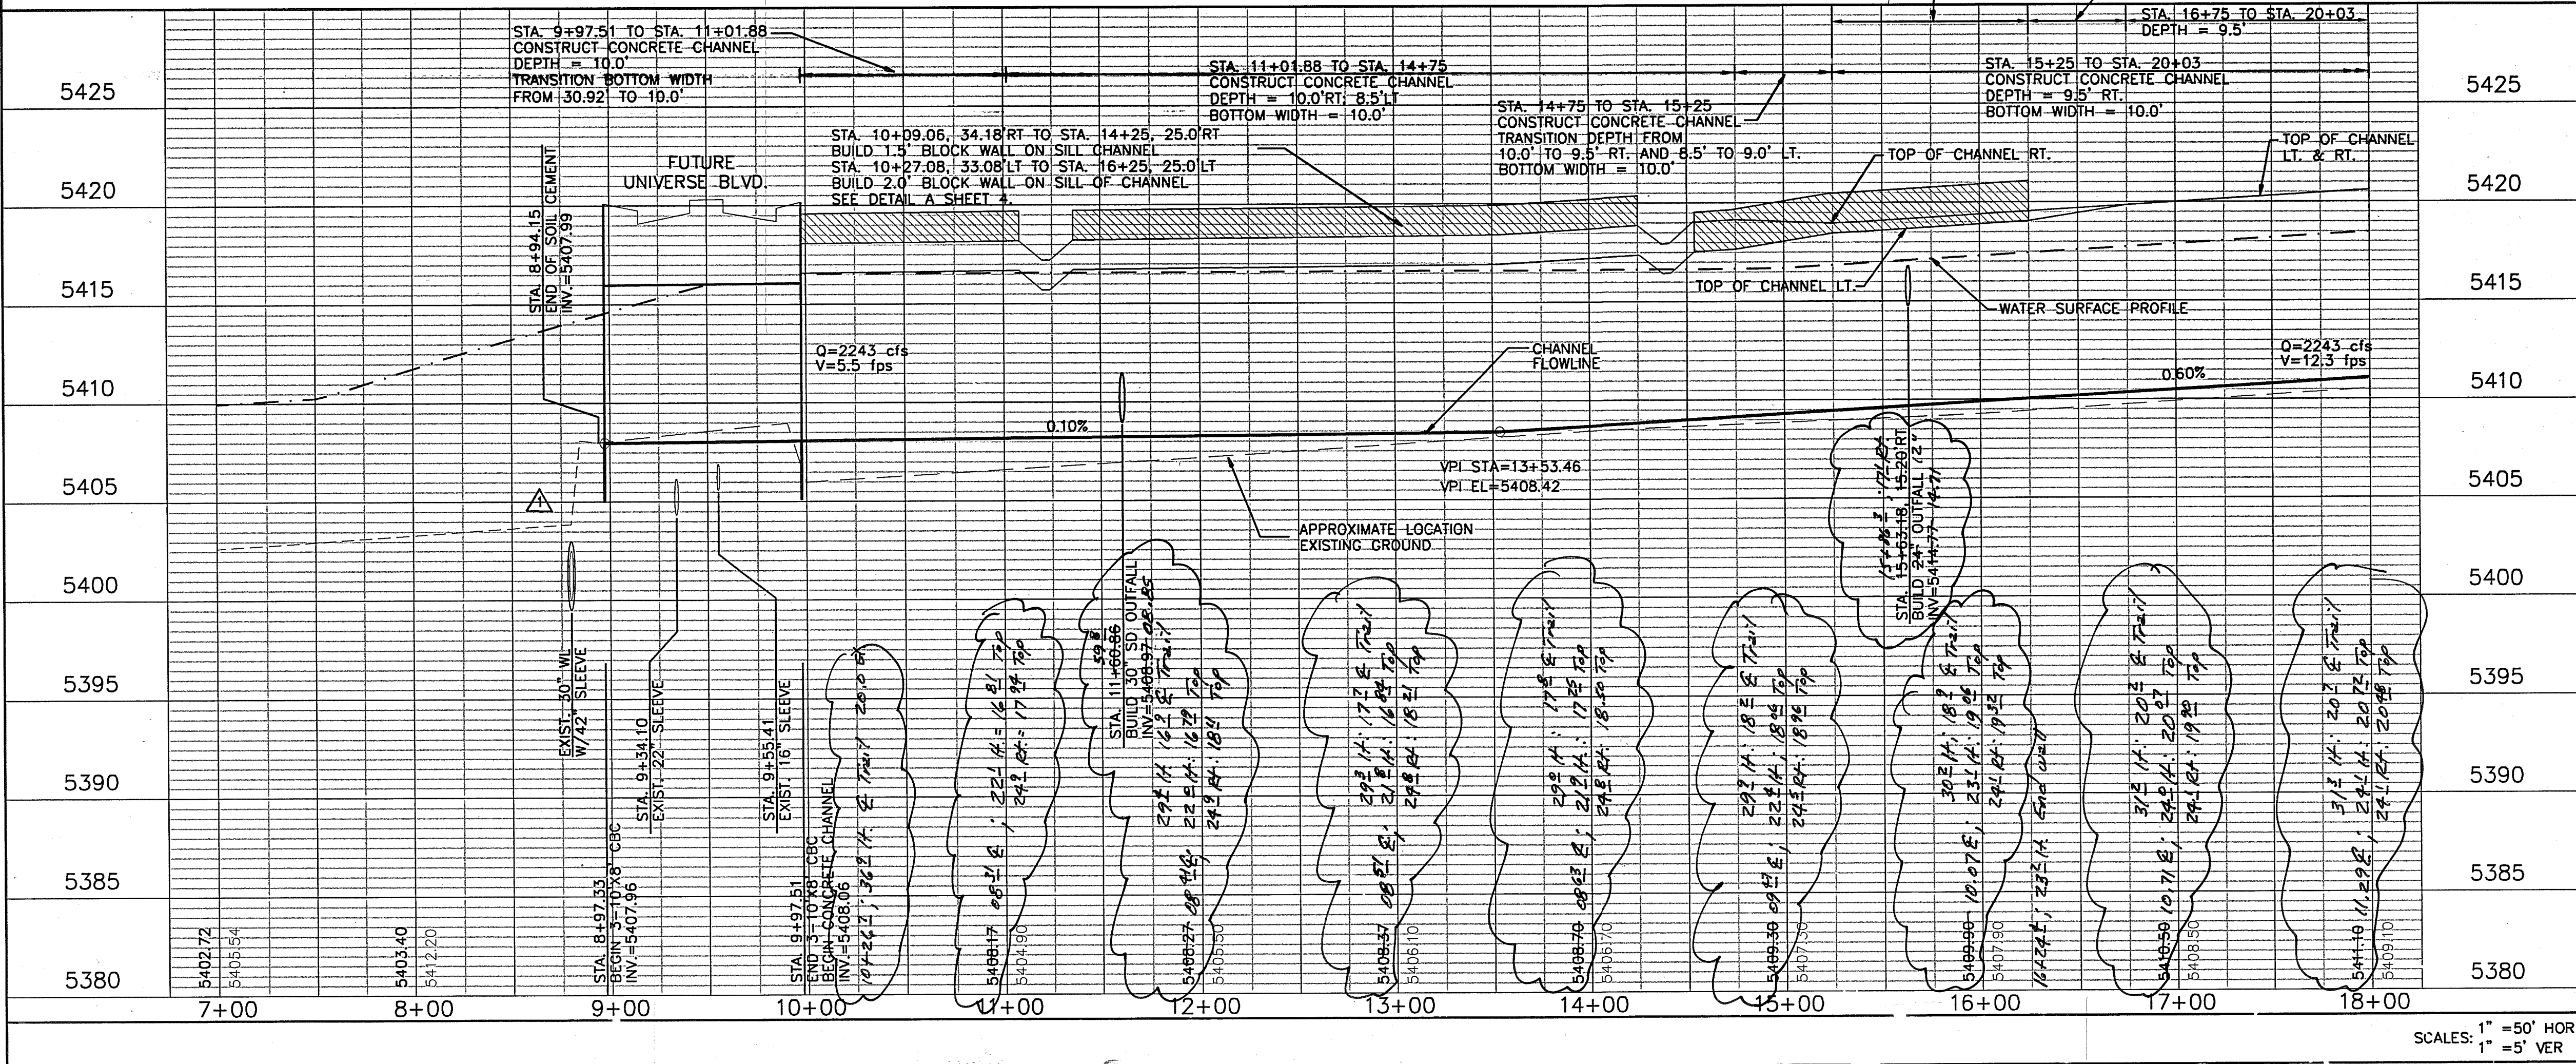


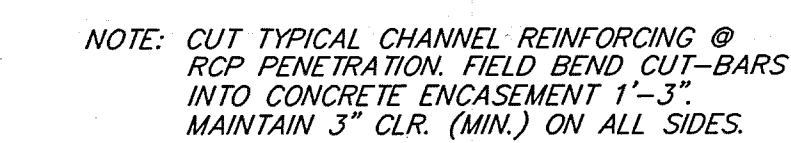


SCALE: 1/4" = 1'-0"

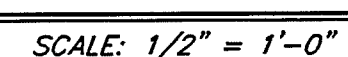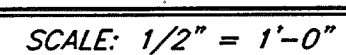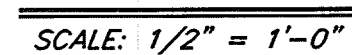

* MATCH EXISTING
** NMUI WILL PROVIDE A FLAP GATE TO BE INSTALLED

I hereby certify that the information contained on this drawing has been revised in accordance with information furnished by the contractor, Bender Construction, Inc., and by the surveyor, and reflects the construction as actually accomplished. This plan as constructed is in substantial compliance with the Approved Plan.





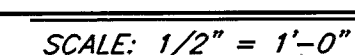
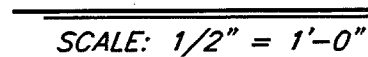


1. THE PIPE PENETRATION DETAILED HEREIN SHALL BE PAID FOR UNDER PIPE PENETRATION, (EACH) AND SHALL BE COMPENSATION FOR THE PENETRATION COMPLETE AND IN PLACE. INCLUDED IN THIS WORK (BUT NOT LIMITED TO) IS GRADING, SUBGRADE PREPARATION, REINFORCED CONCRETE, CONSTRUCTION JOINTS, CONCRETE PLACEMENT AND FINISHING. NOTE THE MEASUREMENT FOR CONCRETE CHANNEL LINING IS CONTINUOUS AND UNINTERRUPTED AT THE PENETRATION LOCATION.
2. THE TYPICAL TRANSVERSE AND LONGITUDINAL REINFORCEMENT SHALL BE CONTINUOUS THRU THE CONSTRUCTION JOINT LAPPED BAR SPLICES ADJACENT TO THE JOINT IS PERMITTED.

#8 BAR LAP = 4'-2"
#7 BAR LAP = 3'-2"
#5 BAR LAP = 2'-2"

BHI-MAIN: [95285.HYDRO.DESIGN.PHASE3\VRPPEN1.DWG]

DESIGNED BY: H.T. 10/60
DETAILED BY: J.A.K. 10/60

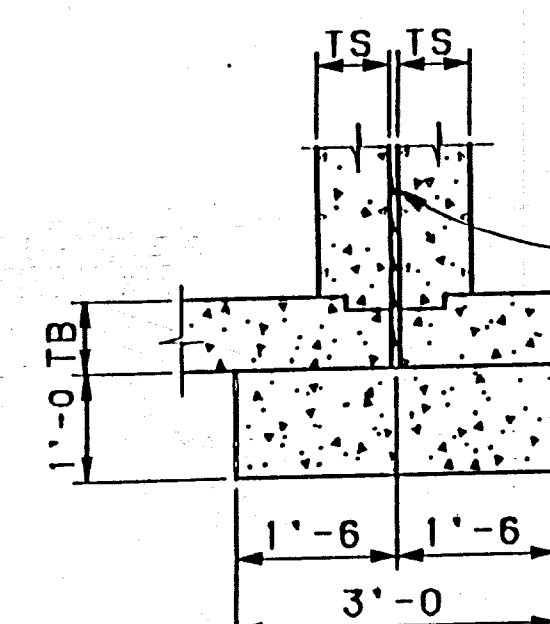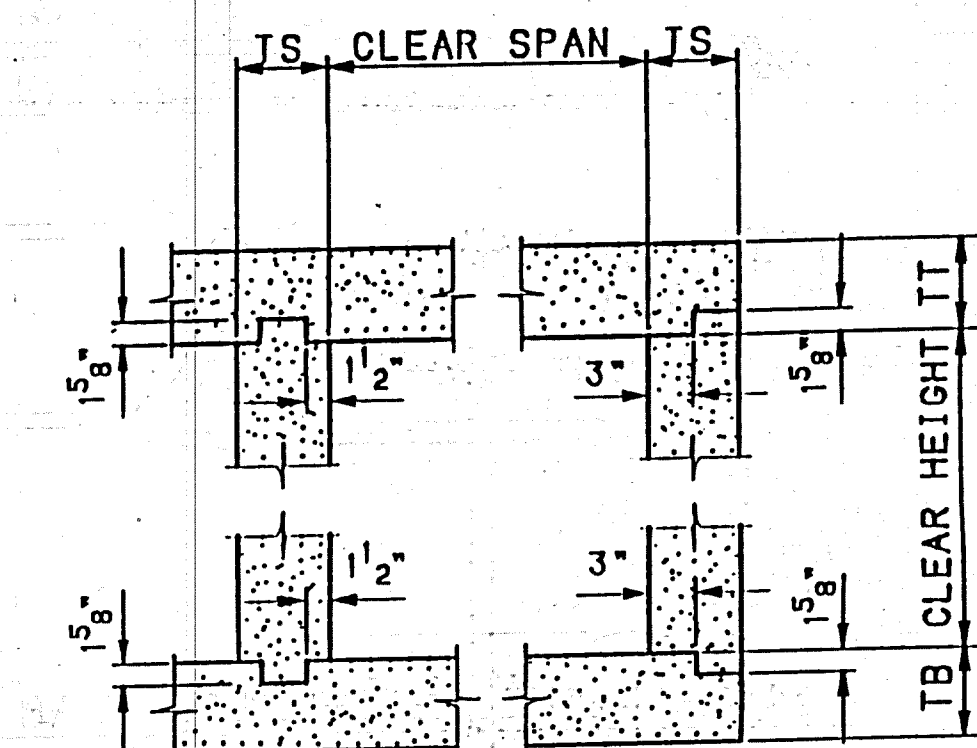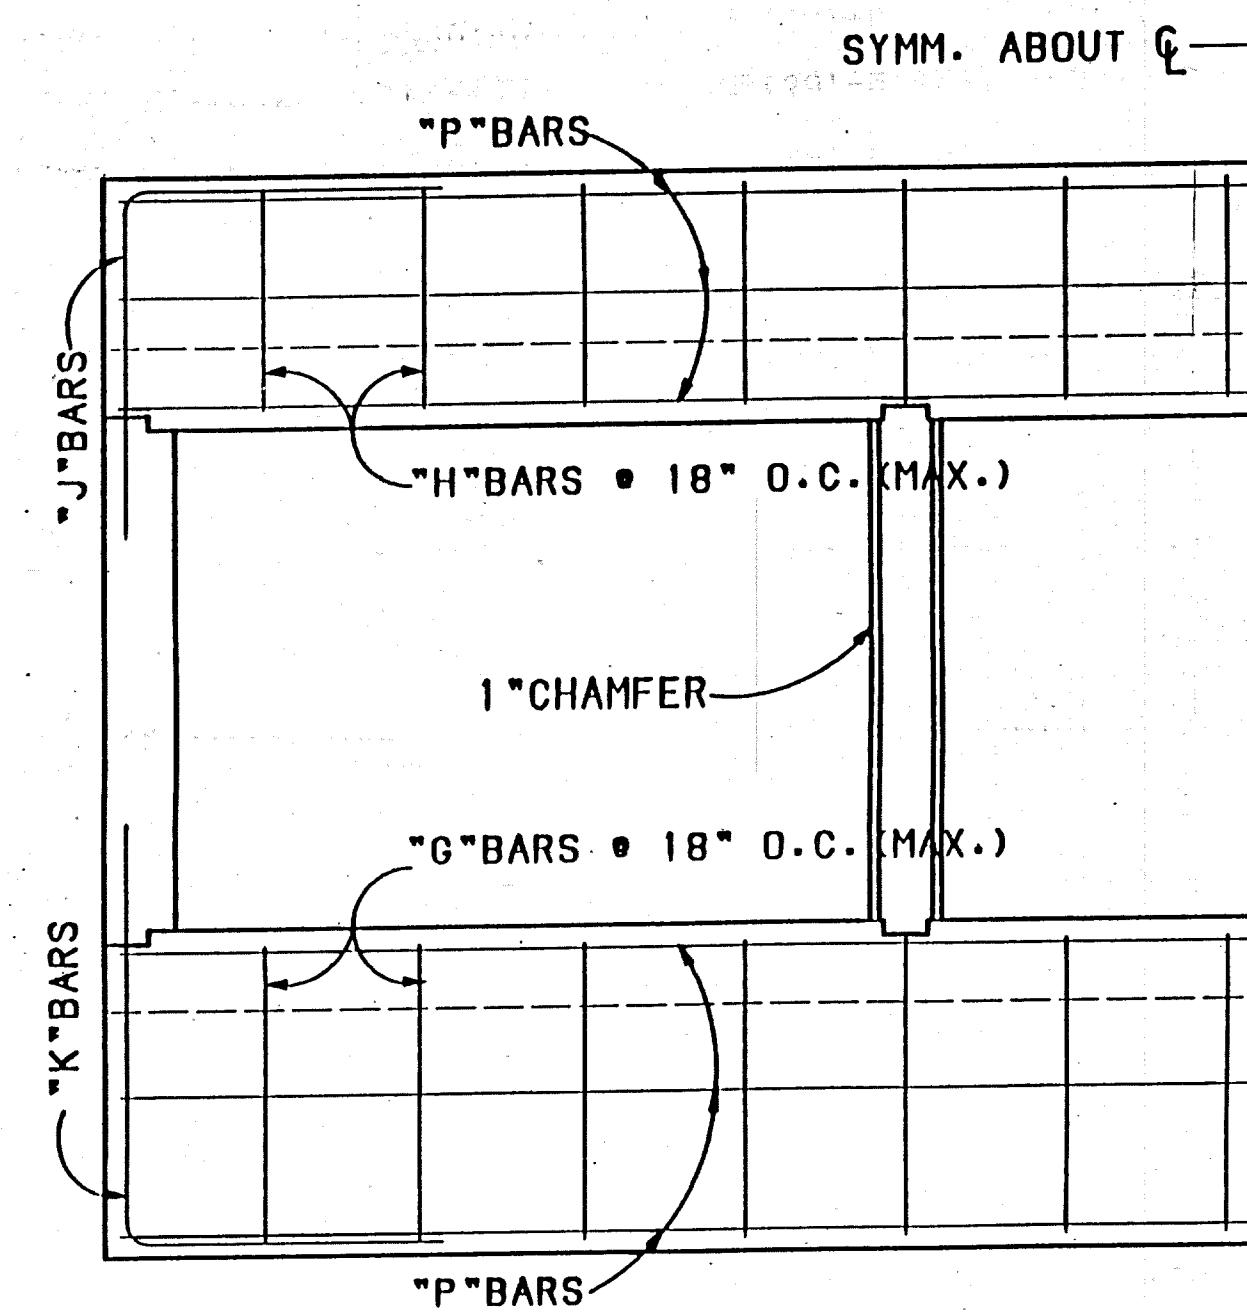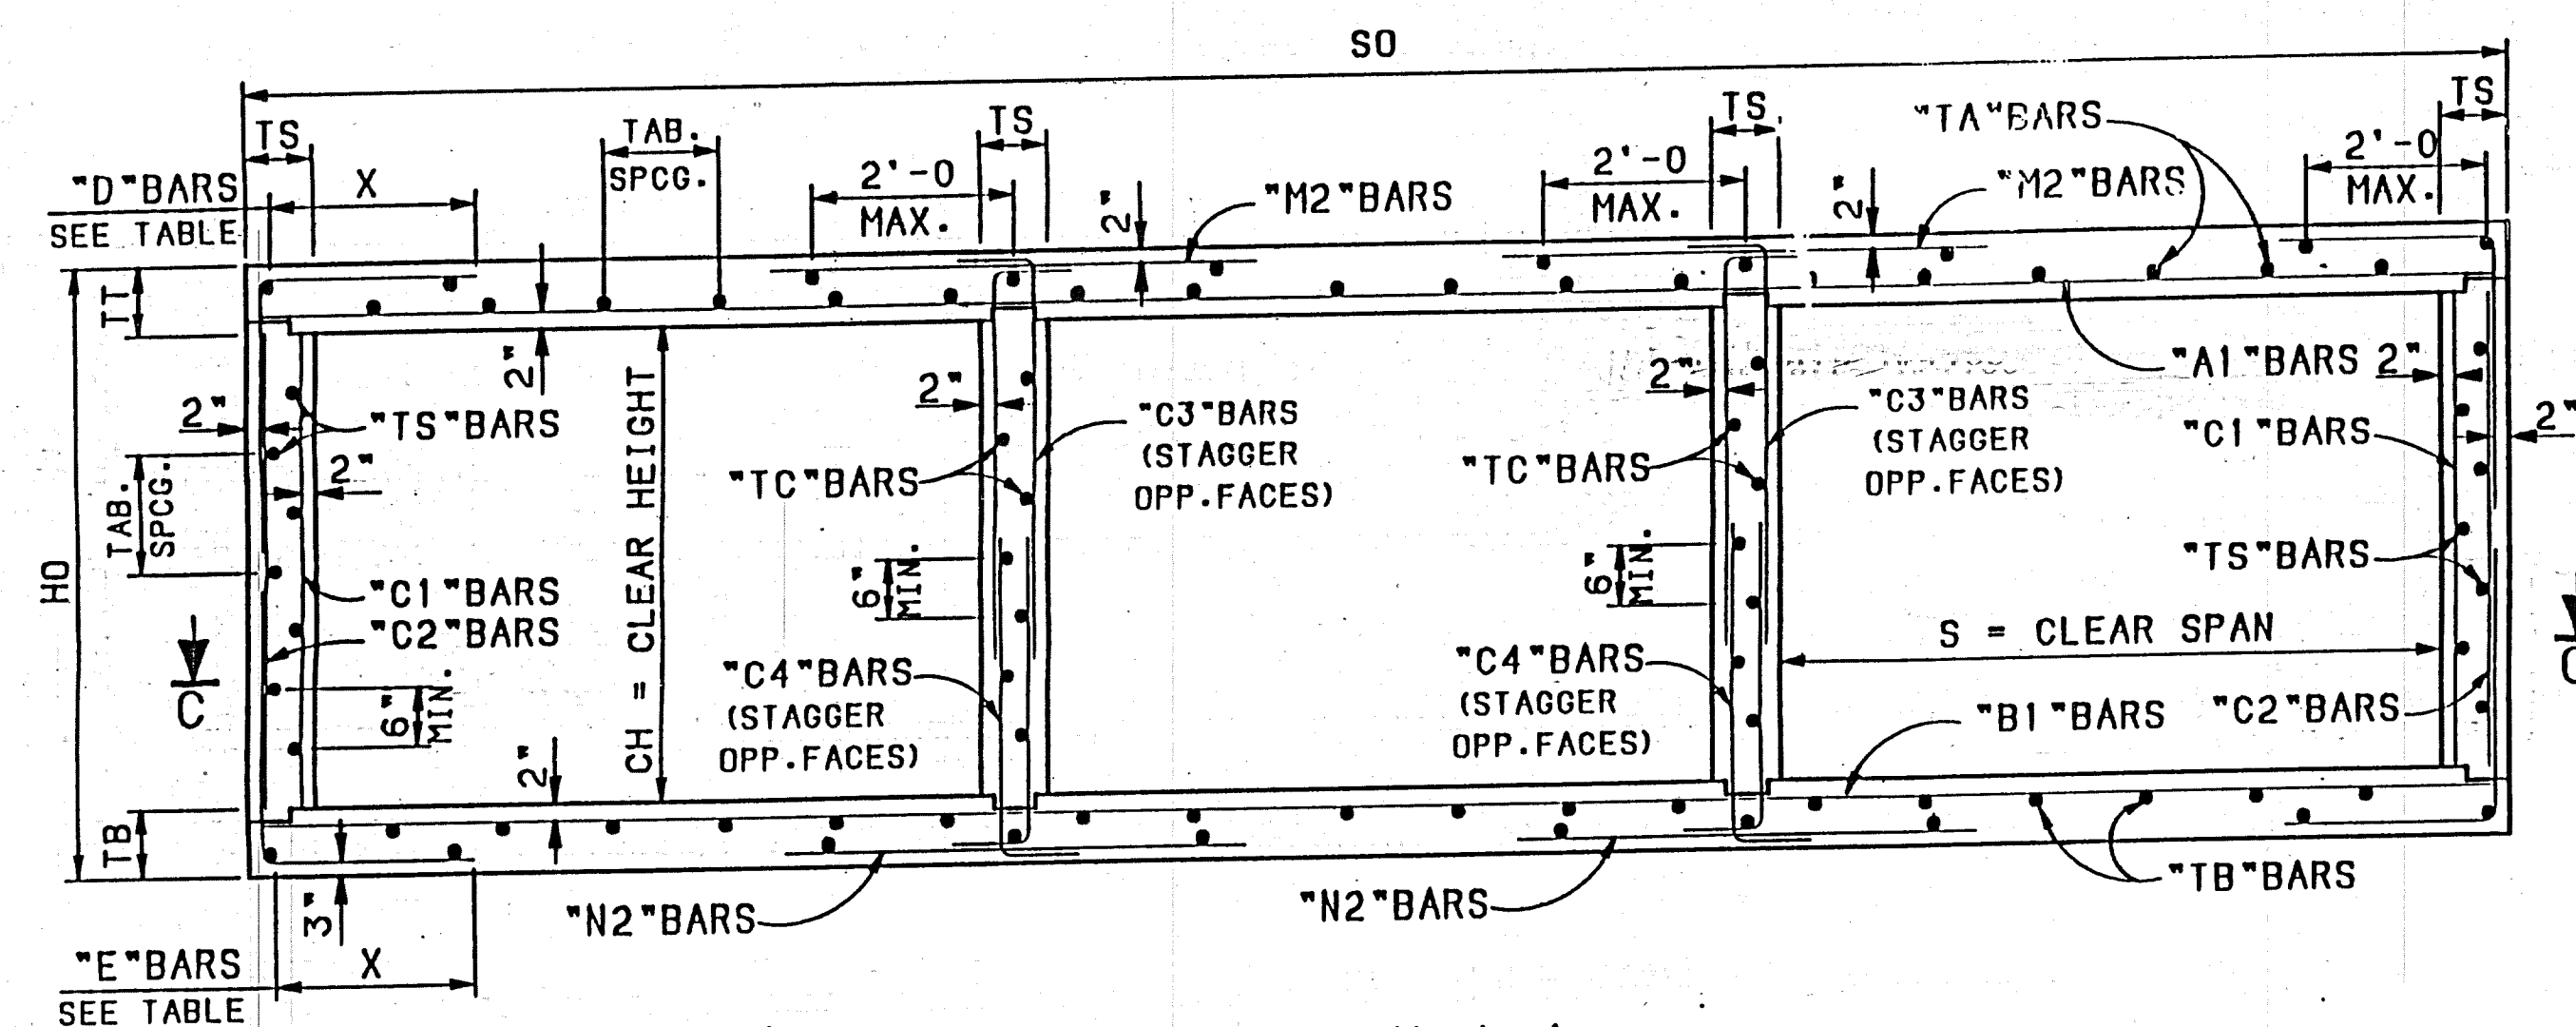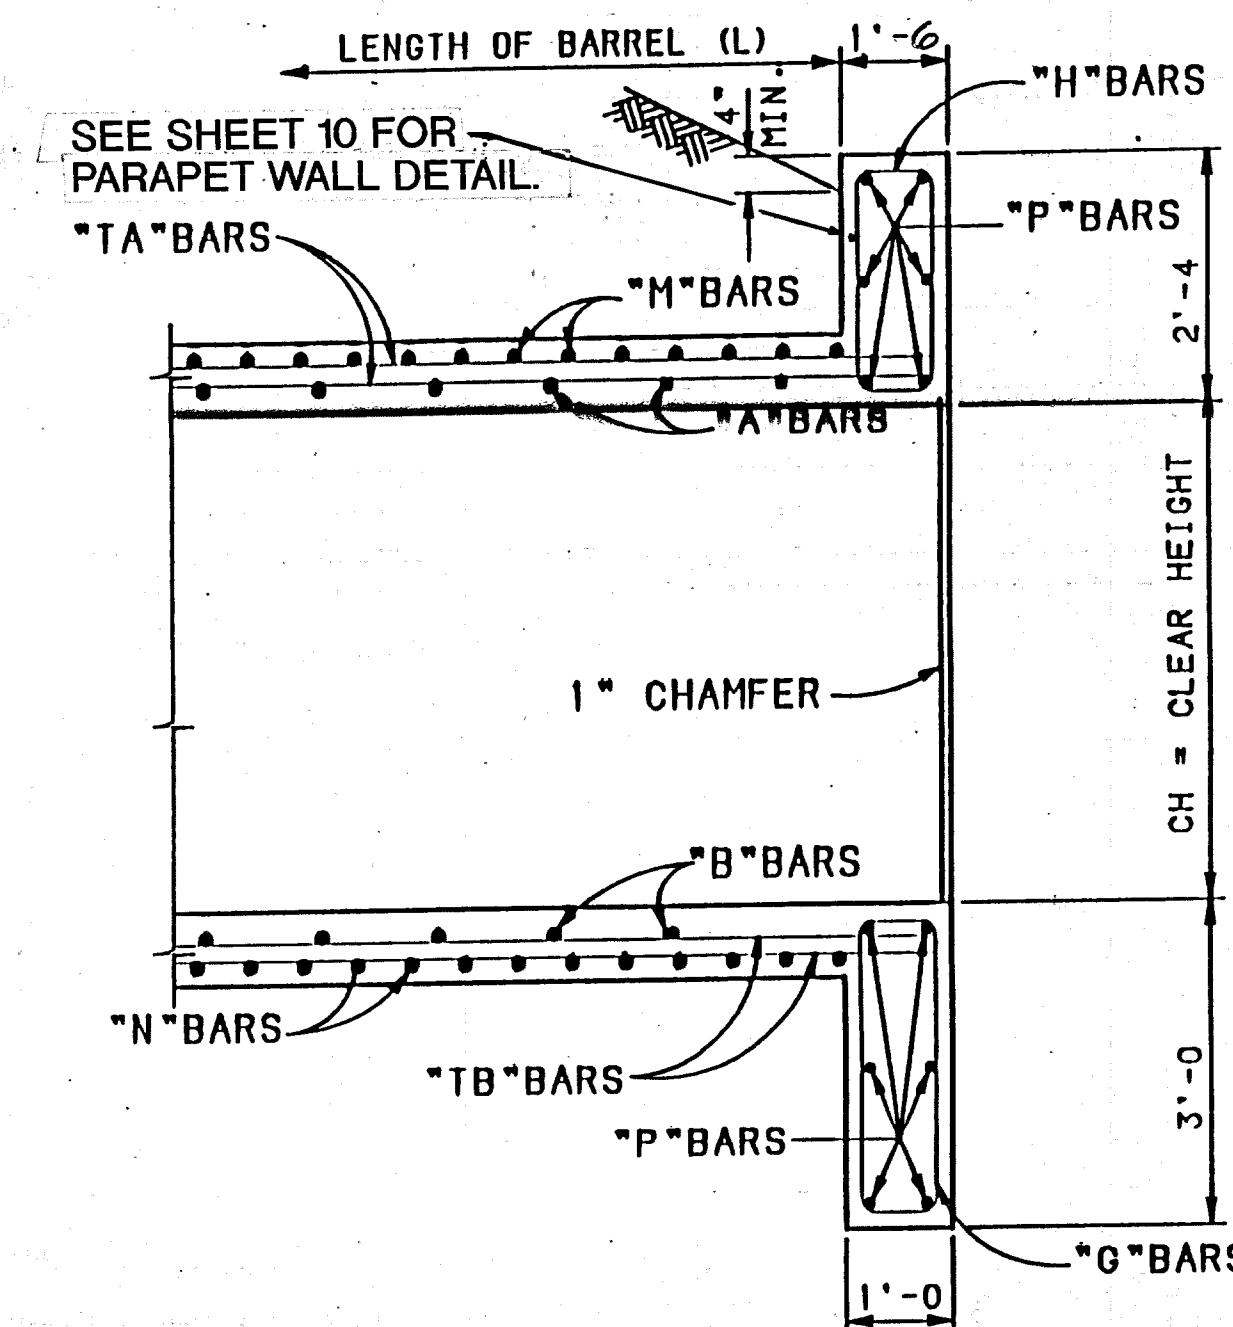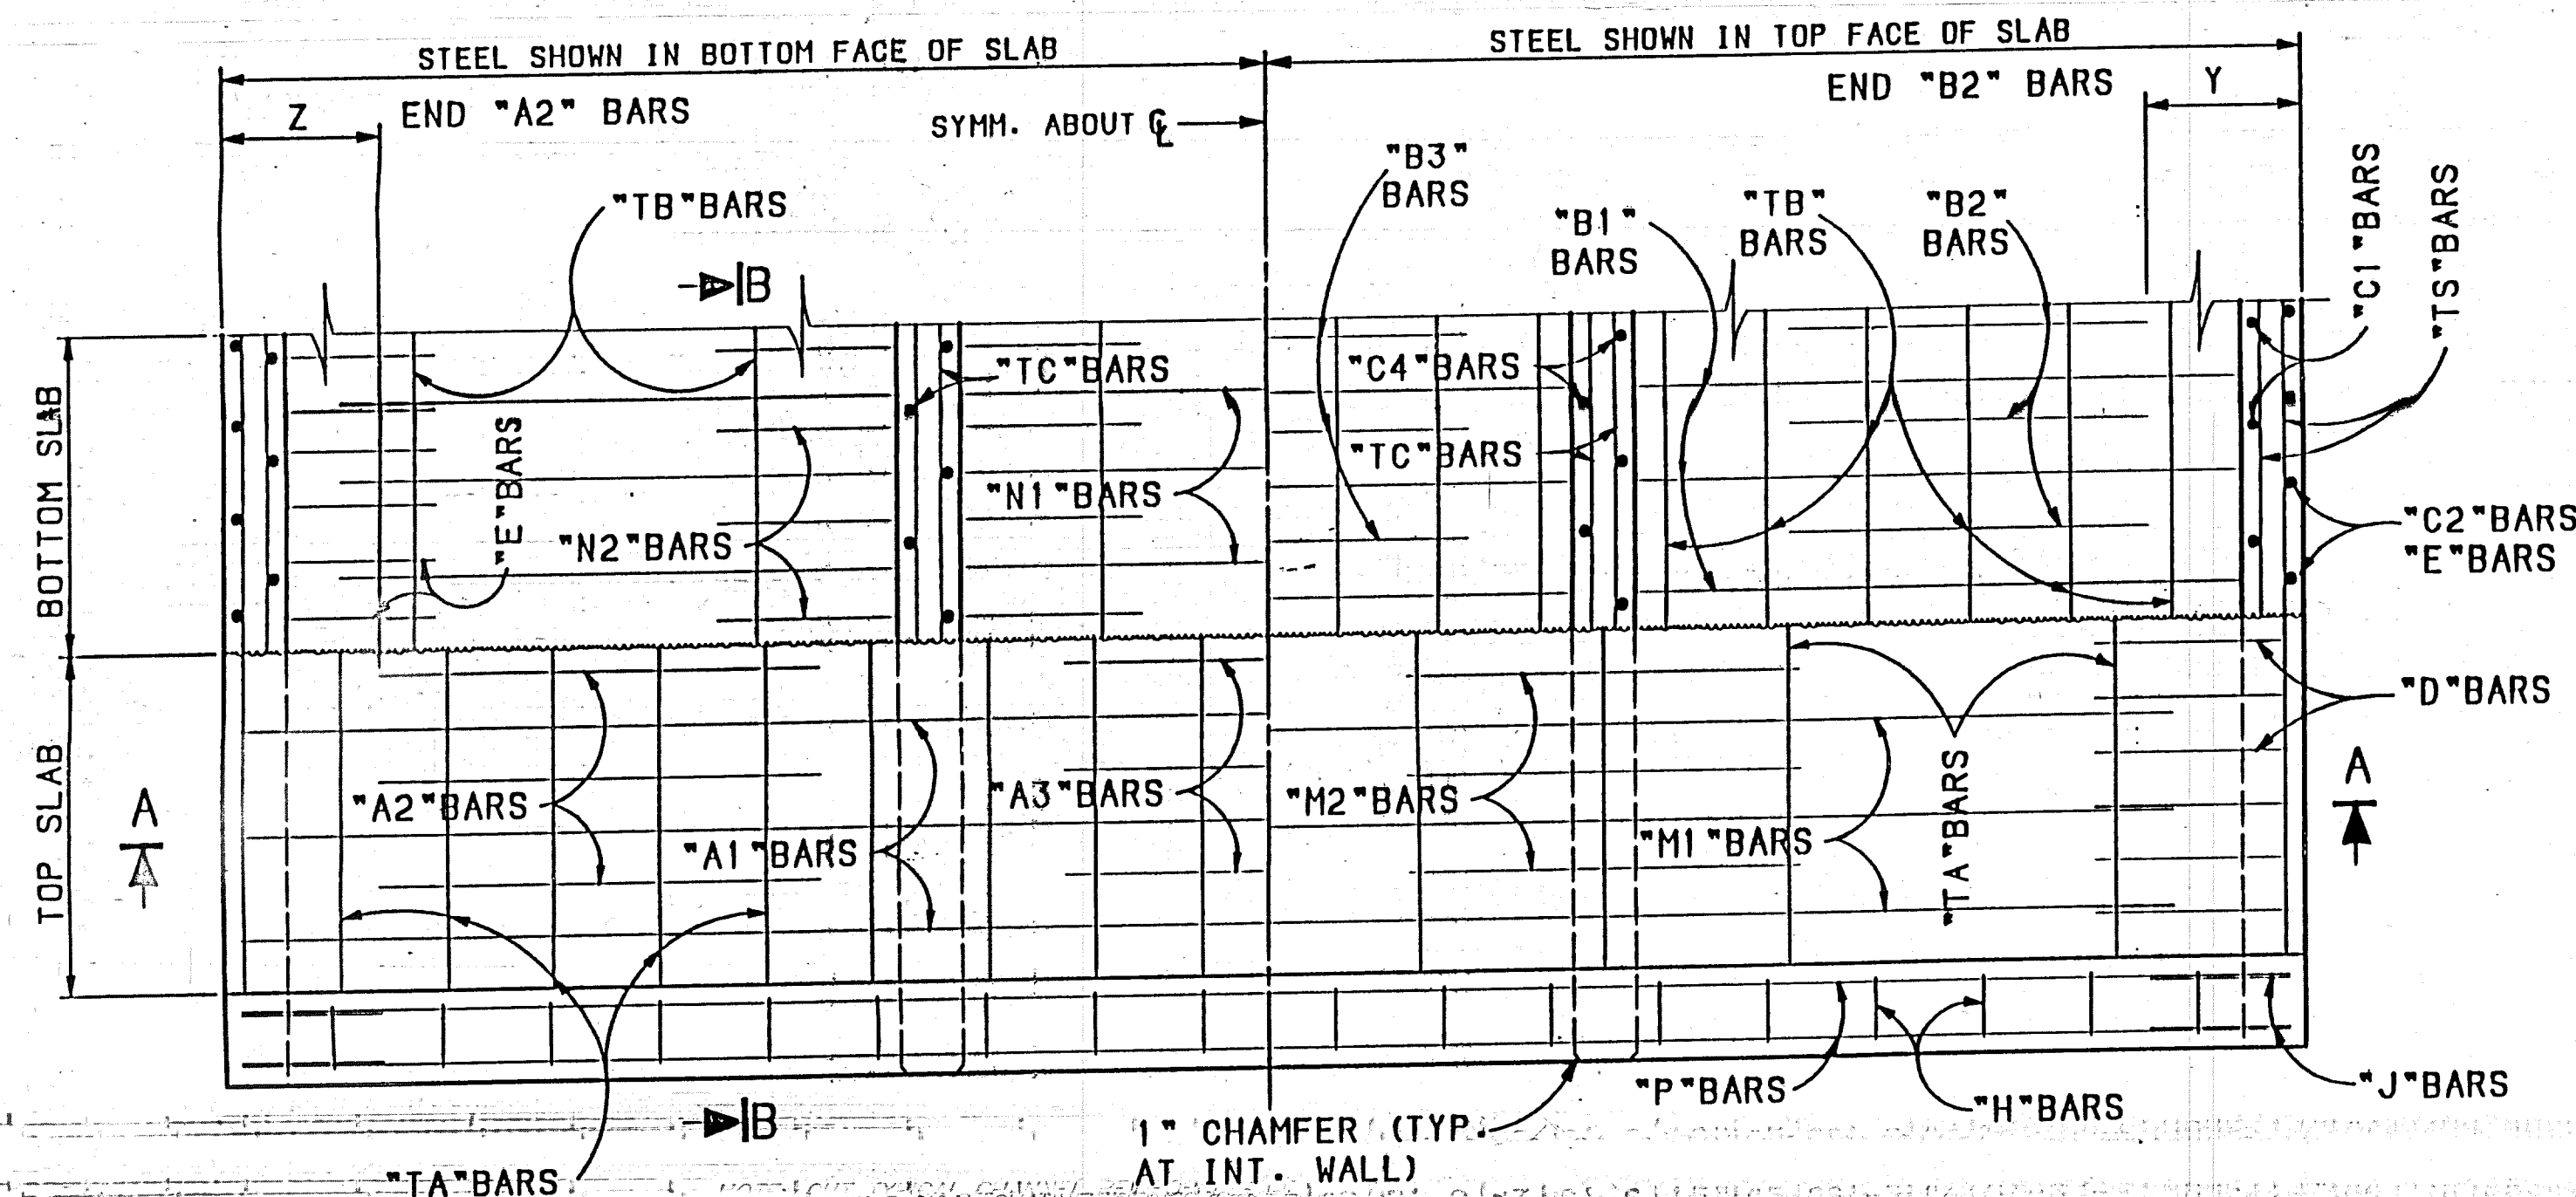

- 1/2" PREFORMED BITUMINOUS JOINT FILLER SHALL BE USED BETWEEN ADJACENT UNITS AND IT SHALL EXTEND BETWEEN BARRELS, PARAPETS, AND CUT-OFF WALLS.
- THE FOUNDATION BLOCK SHALL BE PLACED IN NEAT EXCAVATION AND EXTENDED FOR THE ENTIRE LENGTH OF BARREL UNDER JOINT BETWEEN UNITS. PLACE ONE LAYER OF TAR PAPER OVER THE ENTIRE TOP SURFACE OF THE FOUNDATION BLOCK. CONCRETE QUANTITY = 0.111 CU. YDS. PER LIN. FT. OF BLOCK.

SEE SHEET 10 FOR GENERAL NOTES.

GENERAL NOTES

1. ALL CONCRETE SHALL BE CLASS "A". CHAMFER ALL THE EXPOSED EDGES 3/4".
2. ALL REINFORCING STEEL TO BE DEFORMED BARS, CONFORMING TO AASHTO M-31, GRADE 60. ALL DIMENSIONS REFER TO THE CENTERLINE OF BAR.
3. WHEN NECESSARY, "T" BARS MAY BE SPLICED BY LAPPING AT LEAST 20 BAR DIAMETERS. PAY WEIGHT FOR REINFORCING STEEL DOES NOT INCLUDE SPLICES. THE COST OF THE SPLICE MATERIAL IS TO BE INCLUDED IN THE UNIT PRICE BID FOR REINFORCING STEEL.
4. VOLUME OF CONCRETE = (L) x (CONCRETE QUANTITY/LIN. FT.) PLUS CONCRETE AT ENDS.
5. WEIGHT OF REINFORCING STEEL = (L) x (WEIGHT OF REINF./LIN.FT.) PLUS WEIGHT AT ENDS.
6. PLACE "TA" BARS ON "A" BARS AND "TB" BARS UNDER "B" BARS, SPACED AS SHOWN IN THE TABLE. THE REMAINING "TA" BARS, AND "TB" BARS ARE TO BE PLACED ADJACENT TO THE "D", "E", "M", AND "N" BARS AS INDICATED IN "SECTION A-A", AT 2'-0" MAX.
7. PLACE "TS" BARS NEXT TO "C1" BARS, SPACED AS SHOWN IN THE TABLE. THE REMAINING "TS" BARS SHALL BE PLACED IN SIDEWALL NEXT TO "C2", "D", AND "E" BARS. WHEN "C1" BARS ARE NOT REQUIRED, PLACE ALL "TS" BARS NEXT TO "C2", "D", AND "E" BARS.
8. PLACE "A1", "A3", "B1", "B3", "M1", AND "N1" BARS SYMMETRICAL TO THE CENTERLINE OF THE BOX. PLACE "M2" AND "N2" BARS SYMMETRICAL TO THE CENTERLINE OF THE WALLS.
9. "COVER" IS HEIGHT OF FILL FROM TOP OF THE BOX TO THE FINISHED GRADE.

DESIGN DATA

DESIGN ACCORDING TO A.A.S.H.O. SPECIFICATIONS, 1957.
LIVE LOAD: H20-S16-44 & INTERSTATE ALTERNATE LOADING
WEIGHT OF FILL ON TOP OF BOX: 84#/CU.FT.
HORIZONTAL EARTH PRESSURE: 30#/CU.FT.², 2' SURCHARGE
DESIGN STRESSES: $f'_c = 3000$ psi, $f_s = 1200$ psi.
 $f_a = 20,000$ psi, $n = 10$.

6			
5			
4			
3			
2			
1	REVISED NOTE #2	6-8-94	P
NO.	DESCRIPTION	DATE	P

NEW MEXICO STATE
HIGHWAY AND TRANSPORTATION
DEPARTMENT

CONCRETE BOX CULVERT BARRELS
TRIPLE OPENING - NORMAL
ALL DESIGNS


GENERAL DATA

LAYOUT BY DRAWN BY CHECKED BY	APPROVAL <i>Monty Paul</i> 1/16/84 RECOMMENDED DATABASE ENGINEER DATE
	APPROVED <i>Joseph L. Chabrow</i> 2-27-84 DATABASE CHIEF DATE

SERIAL CB-33 SHEET 7 OF 13

~~CPN~~ CPN 597881... SHEET...

* NOTE: QUANTITIES "AT ONE END" INCLUDE PARAPET, CUT-OFF WALL, AND BARREL BEYOND LENGTH "L". WINGWALL QUANTITIES ARE NOT INCLUDED.	CLEAR SPAN	4'	6'	8'	10'	12'	14'
	SIZE	#5	#5	#6	#7	#8	#9

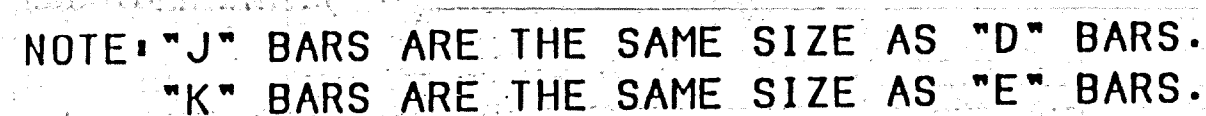


NUMBER OF BARS REQUIRED

NOTE: REFER TO SERIAL CB-33 SHEET 1 OF 5
FOR CONCRETE BOX CULVERT DETAILS,
DESIGN DATA, AND GENERAL NOTES.


RECORD DRAWING

I hereby certify that the information contained on this drawing has been revised in accordance with information furnished by the contractor, Bender Construction, Inc., and by the surveyor, and reflects the construction as actually accomplished. This plan as constructed is in substantial compliance with the Approved Plan.


Martin D. Vinyard NMPE 8261

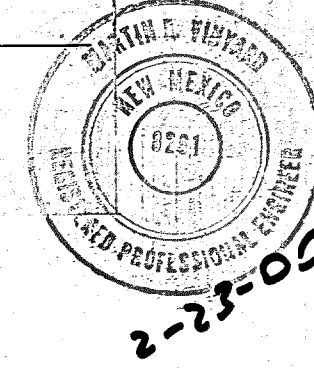




6			
5			
4			
3			
2			
1			
NO.	DESCRIPTION	DATE	BY
REVISONS (OR CHANGE NOTICES)			
NEW MEXICO STATE HIGHWAY AND TRANSPORTATION DEPARTMENT			
CONCRETE BOX CULVERT BARRELS' TRIPLE OPENING - NORMAL DESIGN No. 1 0' TO 5' COVER			
LAYOUT BY	APPROVAL	11/15/54	
DRAWN BY	RECOMMENDED	WILSON ENGINEER	DATE
CHECKED BY	APPROVED	<i>W. R. Baker</i>	1-2-58
		SEALING MACHINE UNIT	DATE
SERIAL CB-33		SHEET 8 OF 13	

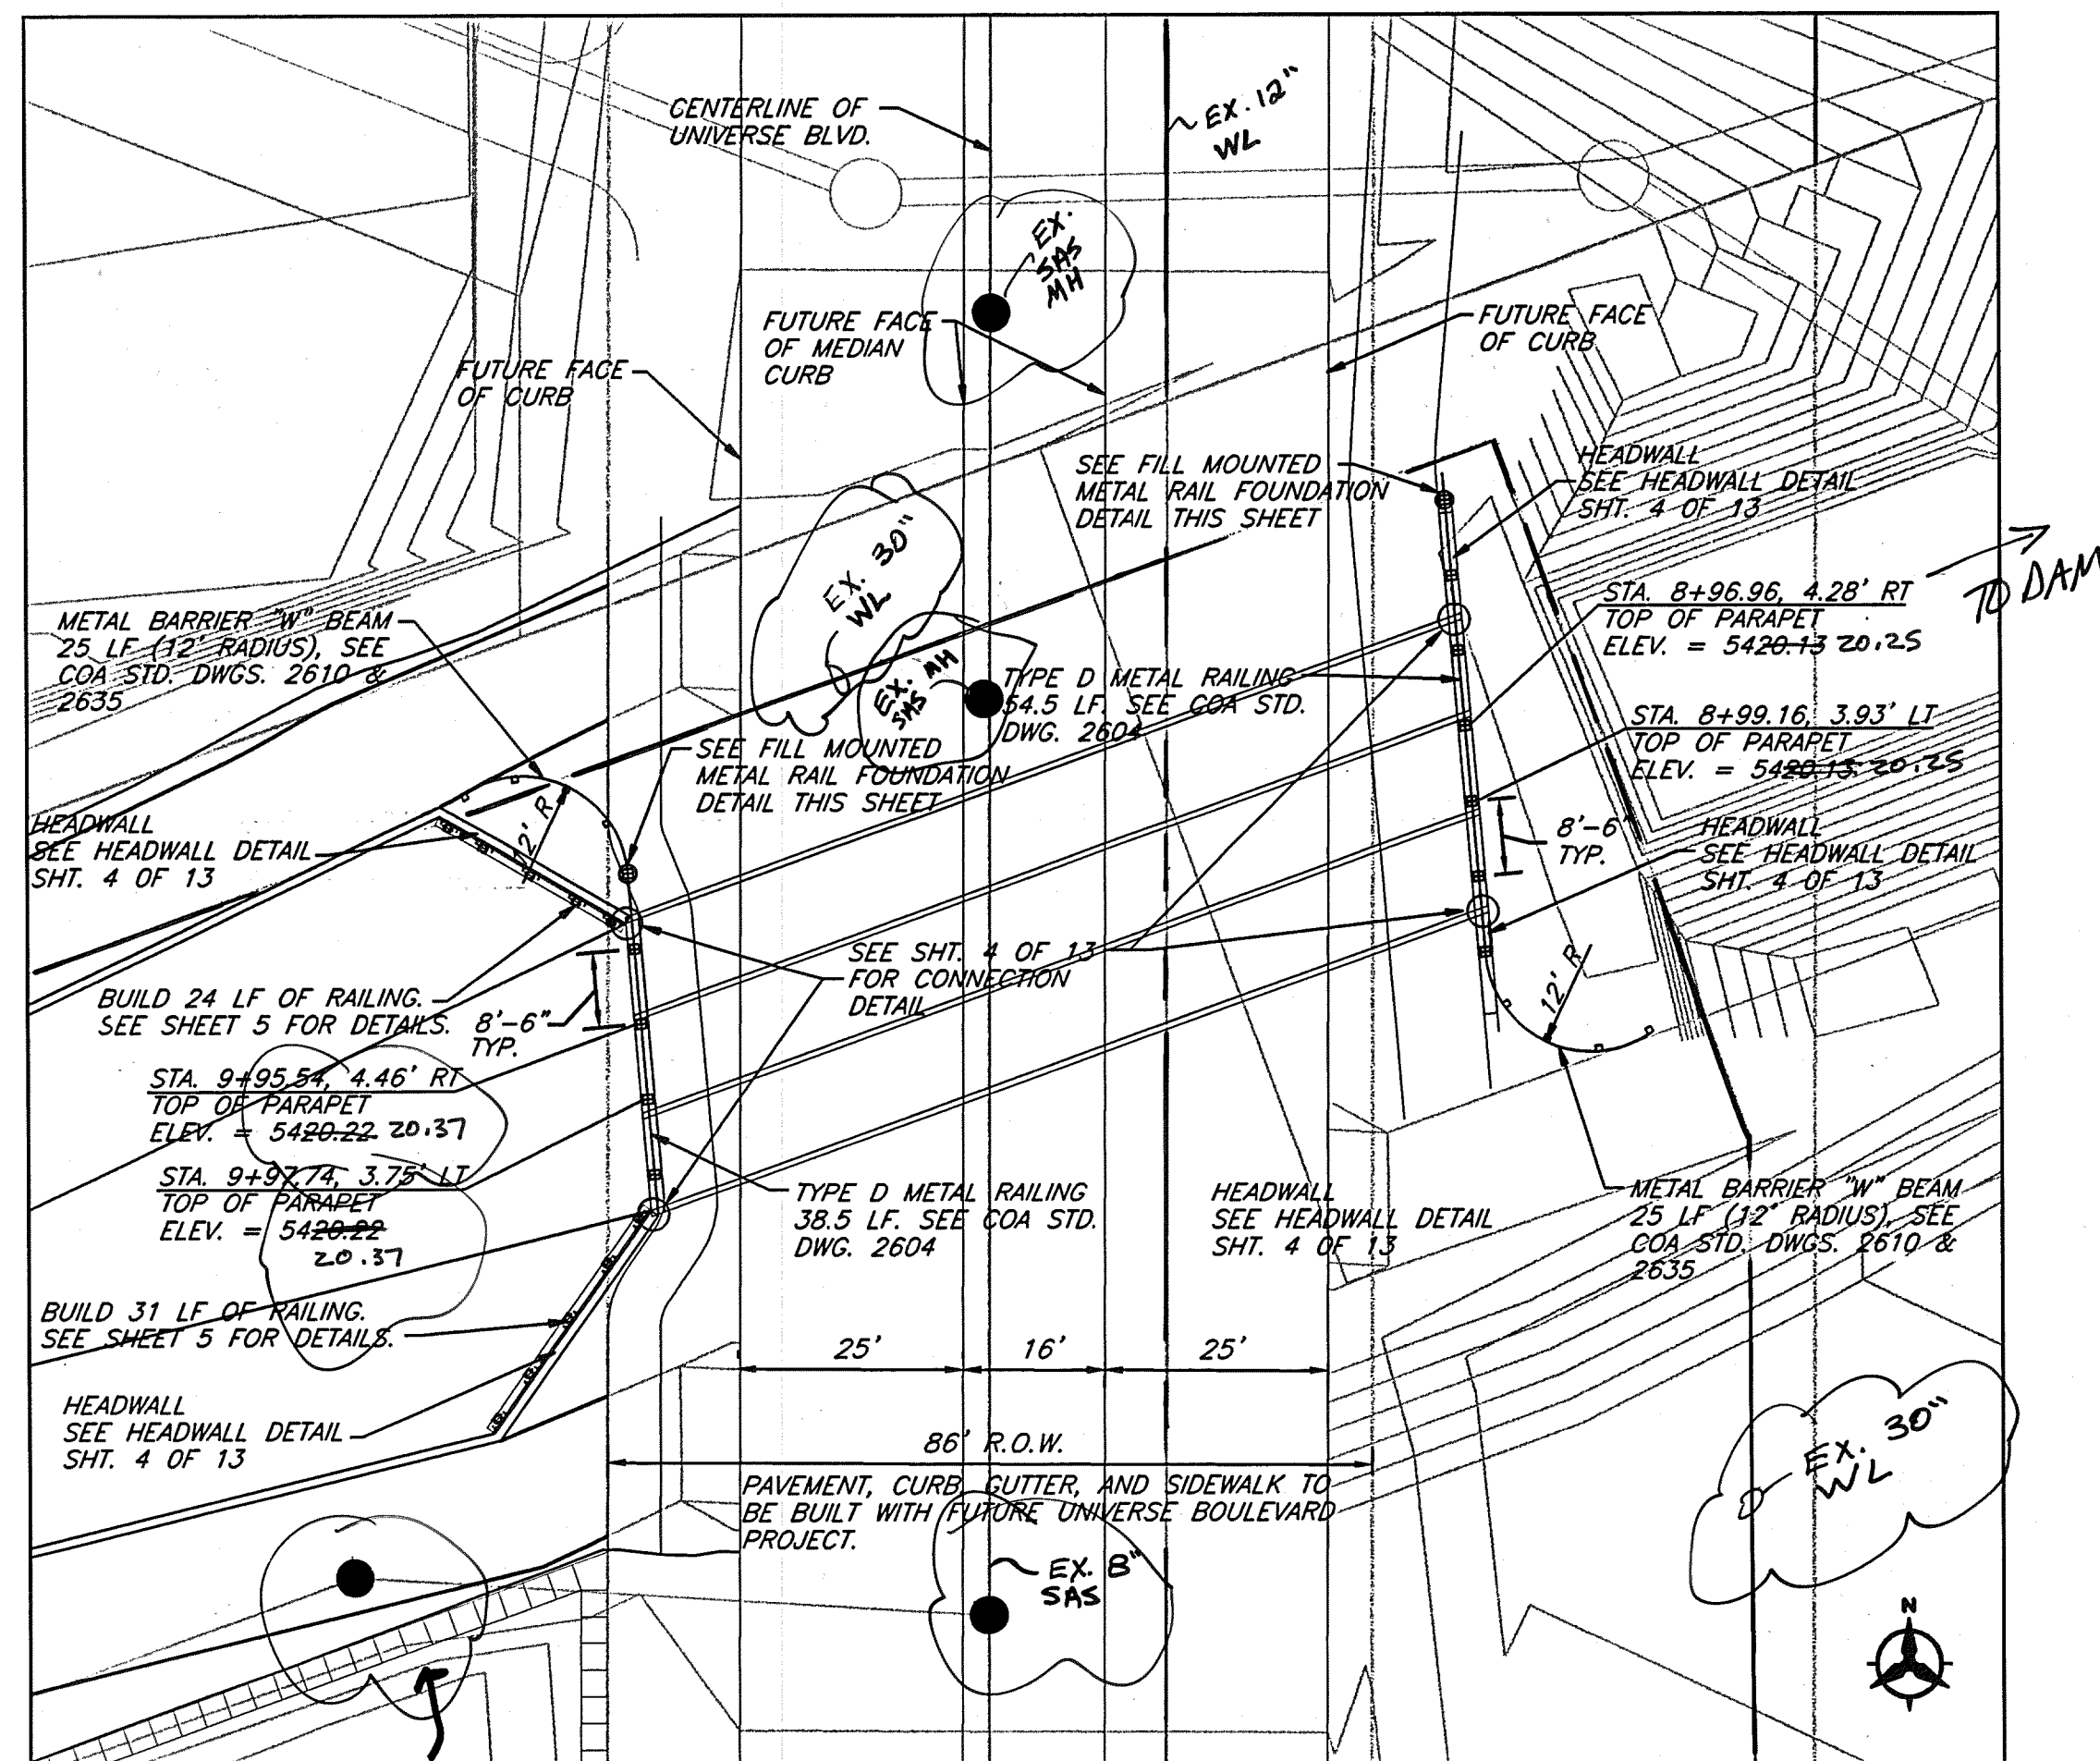


PLAN VIEW
NOT TO SCALE

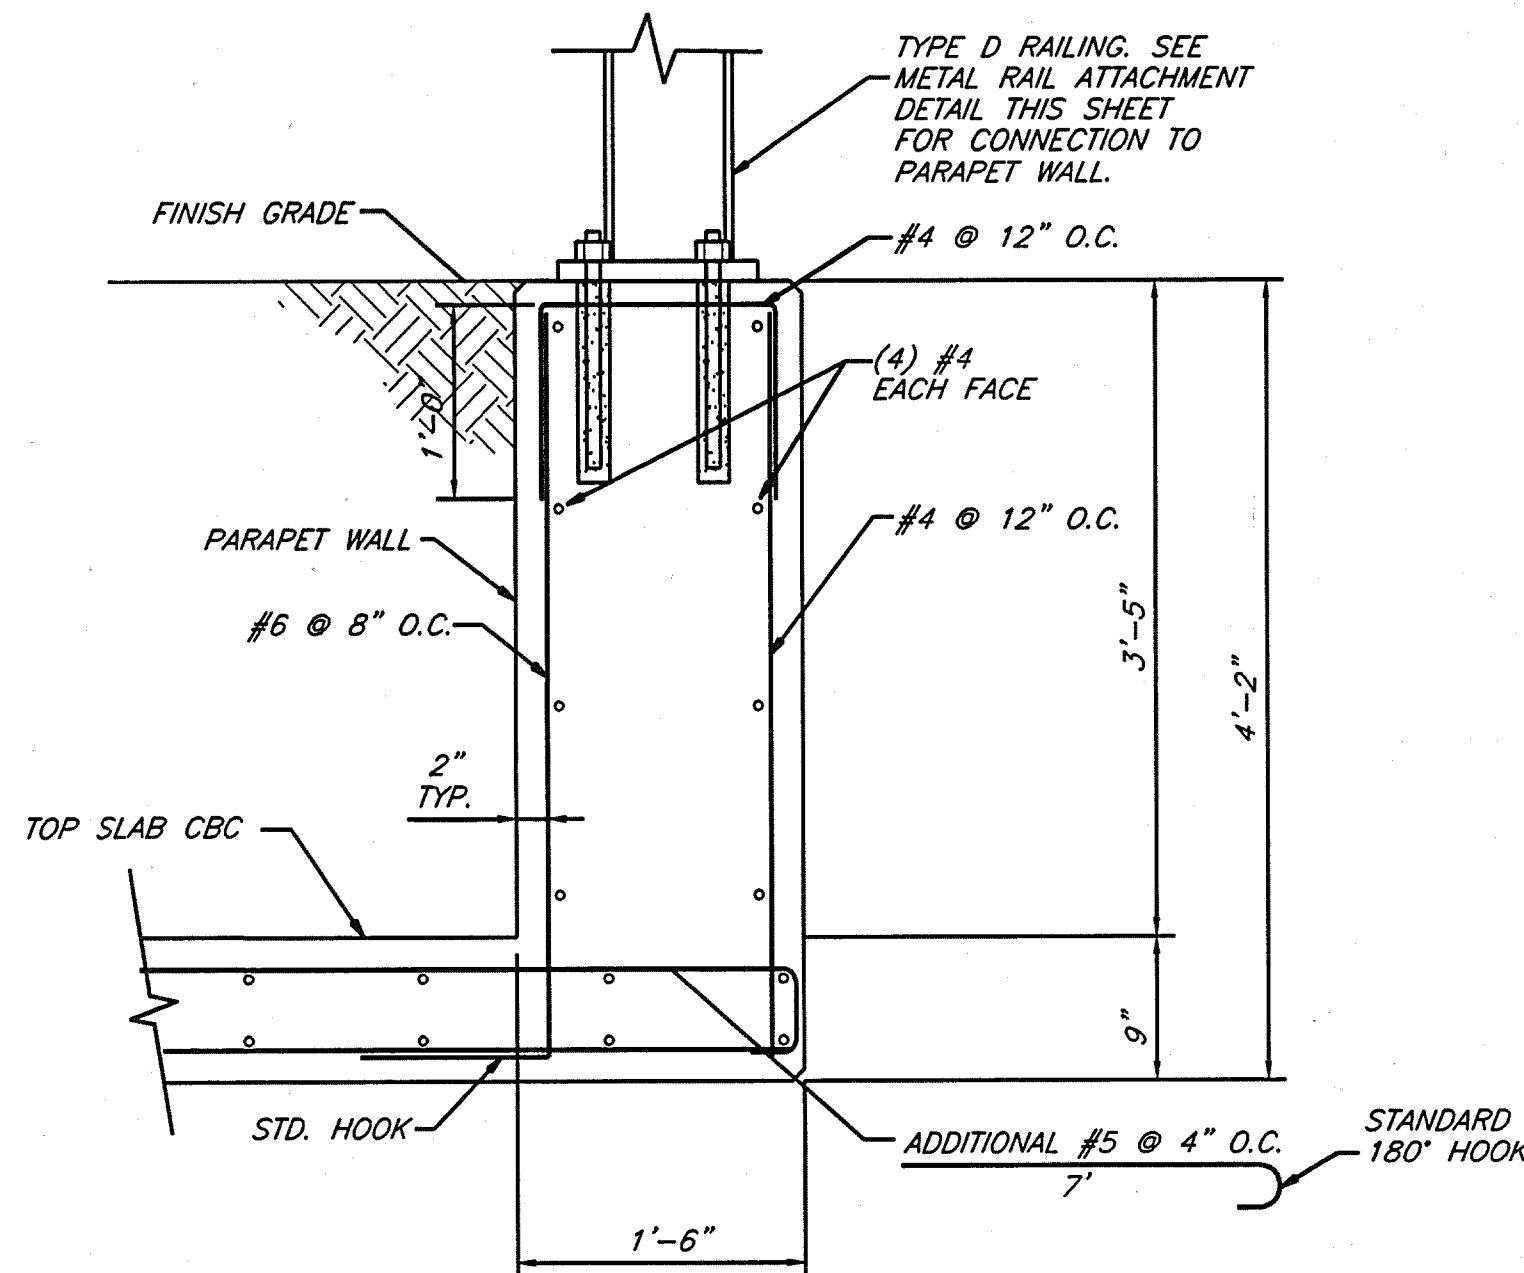

TYPICAL SECTION PARAPET WALL W/RAILING
NOT TO SCALE

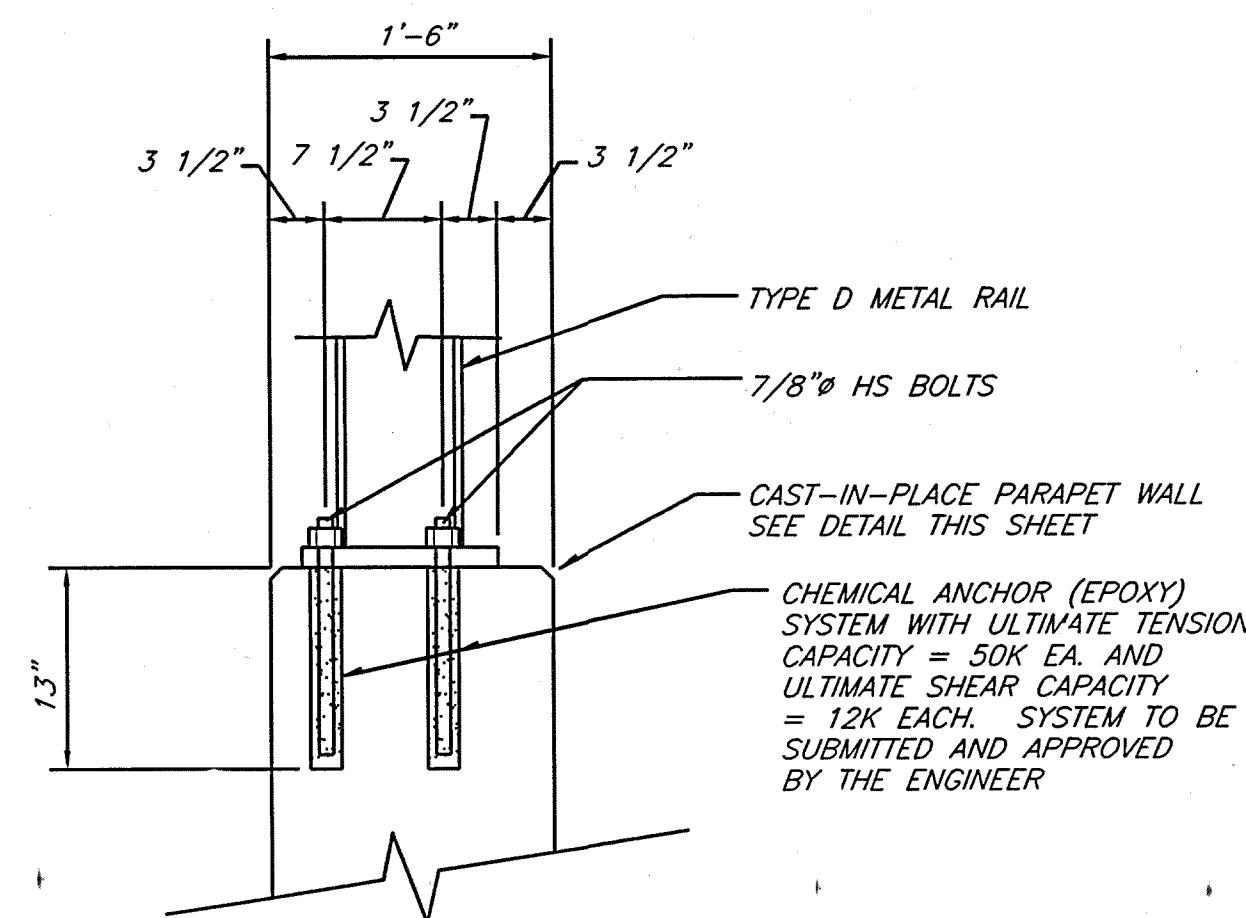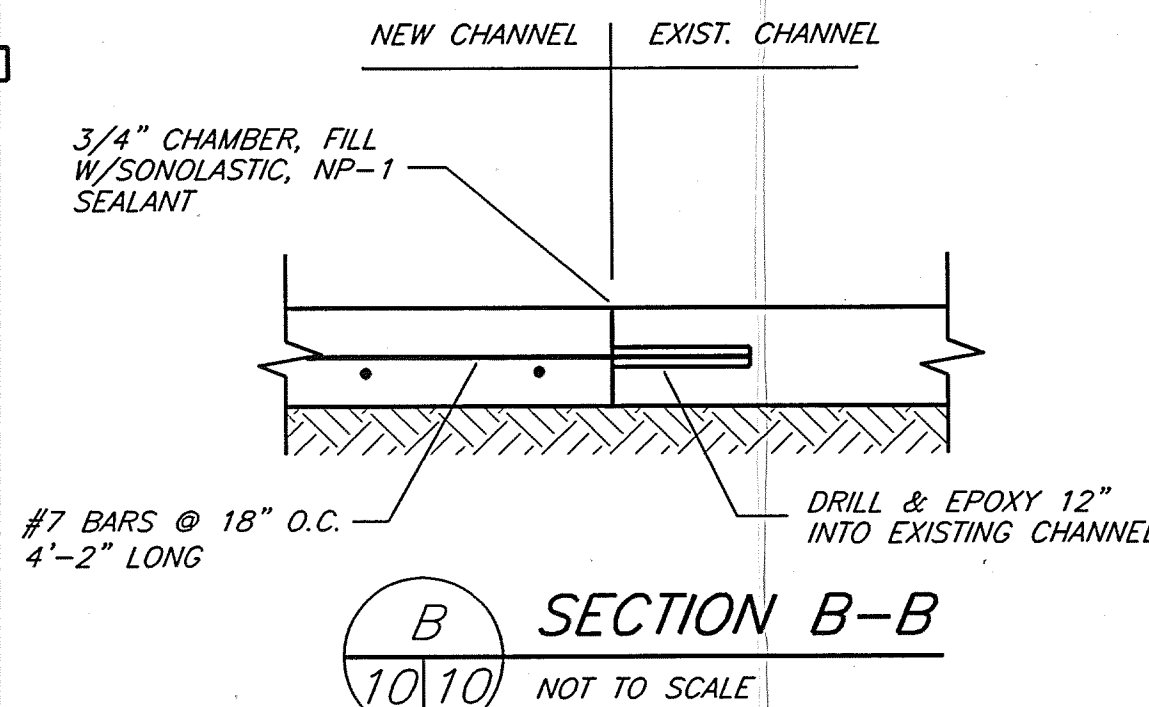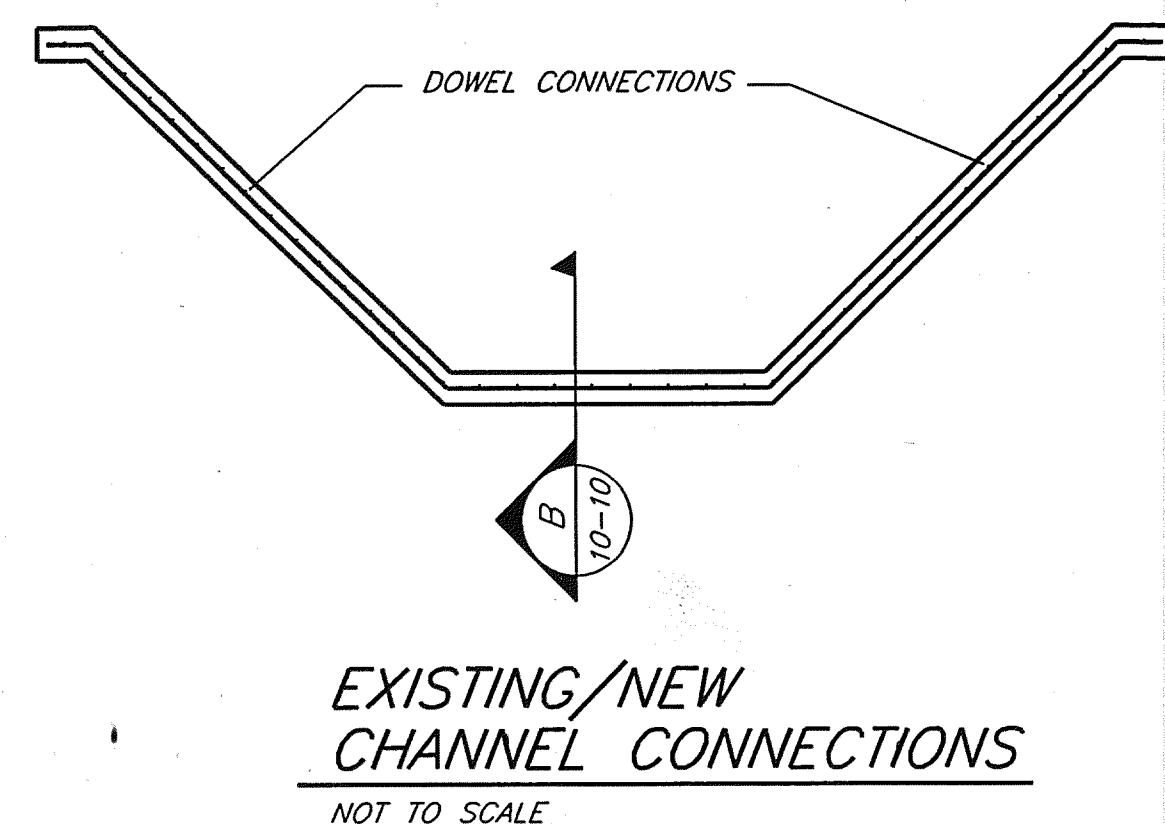

METAL RAIL ATTACHMENT
NOT TO SCALE

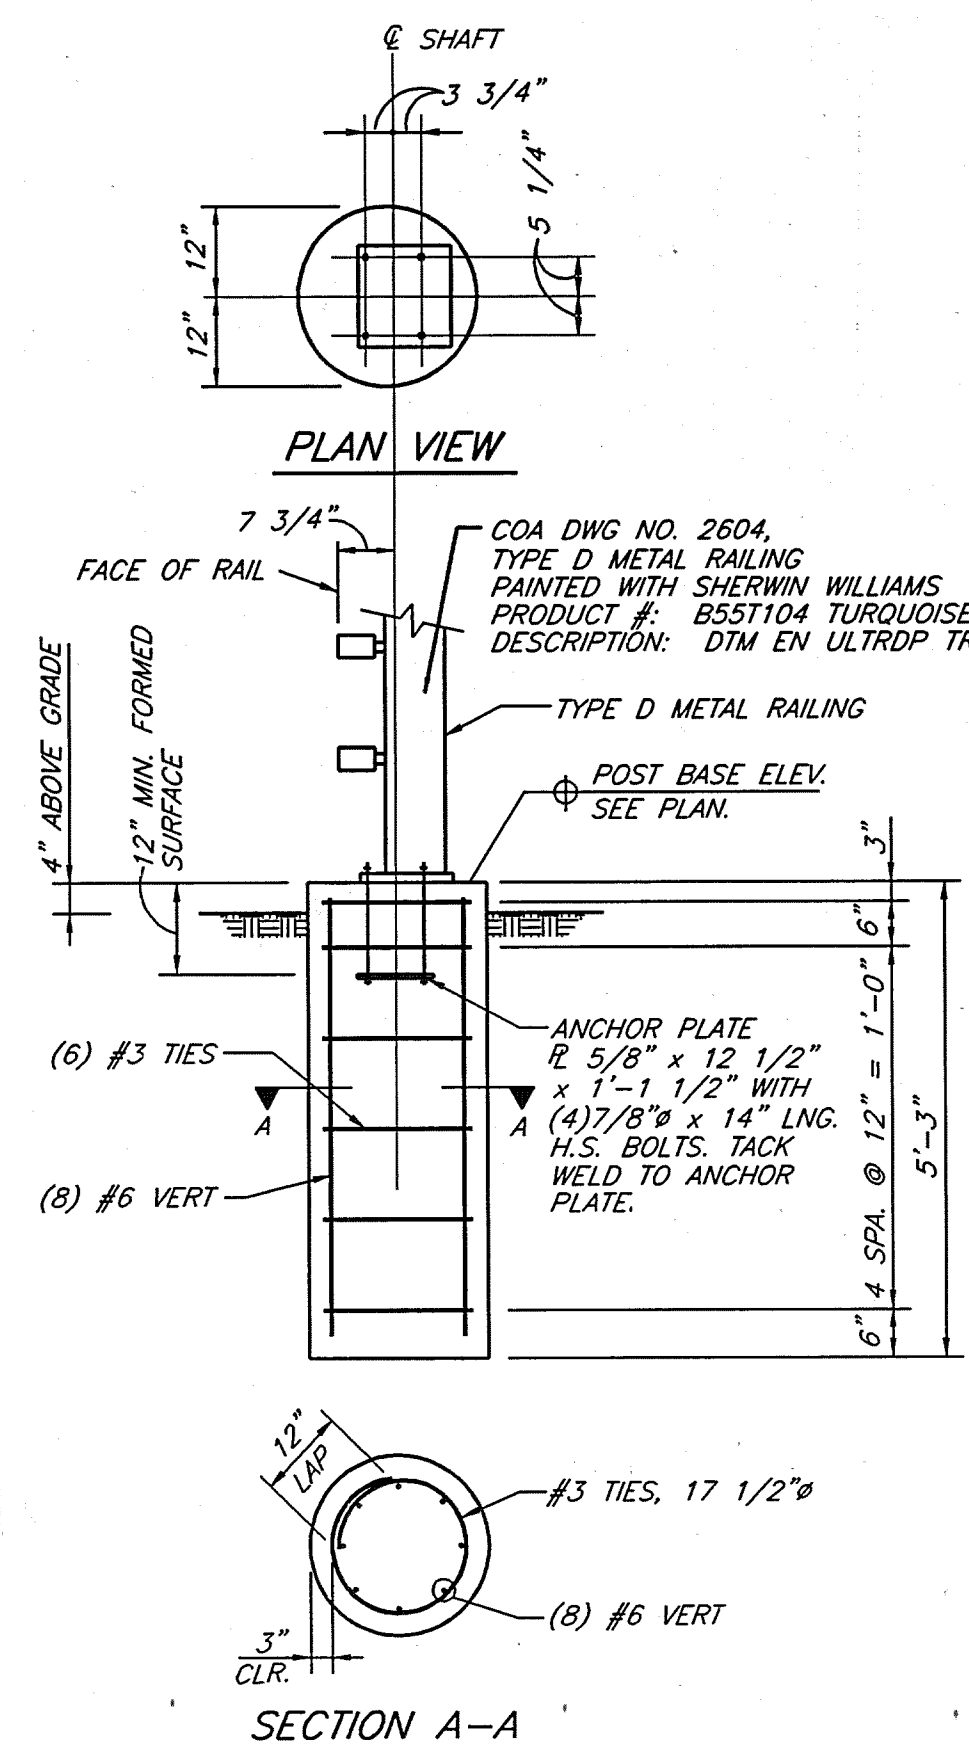


FILL MOUNTED METAL RAIL FOUNDATION
SCALE: 1/2" = 1'-0"


NOTES:

- WORKMANSHIP AND MATERIALS SHALL CONFORM TO THE CITY OF ALBUQUERQUE STANDARD SPECIFICATIONS FOR PUBLIC WORKS CONSTRUCTION, 1986.
- STRUCTURAL CAST-IN-PLACE CONCRETE SHALL BE IN ACCORDANCE WITH TABLE 101.C, CONCRETE FOR HYDRAULIC STRUCTURES.
- REINFORCING STEEL SHALL BE IN ACCORDANCE WITH SECTION 102-STEEL REINFORCEMENT AND SHALL BE GRADE 60. ALL LAP SPLICES SHALL BE CLASS B OR AS SHOWN ON THE PLANS.
- SUBGRADE PREPARATION
 - RETAINING WALLS: PRIOR TO PLACING WINGWALL FOOTINGS, EXPOSED SOIL SHALL BE SCARIFIED TO A DEPTH OF TWELVE INCHES, MOISTENED TO A NEAR OPTIMUM MOISTURE CONTENT (+2%), AND COMPACTED TO A MINIMUM OF 95% OF MAXIMUM DENSITY IN ACCORDANCE WITH ASTM D-1557.
 - CAST-IN-PLACE CONCRETE BOX CULVERTS: SUBGRADE DIRECTLY UNDER CONCRETE BOX CULVERTS SHALL BE EXCAVATED TWO FEET BELOW BOTTOM OF BOTTOM SLAB ELEVATION, MOISTENED TO OPTIMUM MOISTURE (+2%), AND PLACED IN 8-INCH LOOSE LIFTS AND COMPACTED TO 95% OF MAXIMUM DENSITY IN ACCORDANCE WITH ASTM D-1557, UNLESS BASALT ROCK IS ENCOUNTERED.
- BACKFILL
 - RETAINING WALLS: BACKFILL SHALL NOT BE PLACED UNTIL CONCRETE HAS ATTAINED 80% OF DESIGN STRENGTH. BACKFILL SHALL BE PLACED IN LIFTS NO GREATER THAN 8 INCHES. MOISTURE CONDITIONED TO OPTIMUM MOISTURE CONTENT (+2%), AND COMPACTED TO A MINIMUM OF 95% OF MAXIMUM DENSITY IN ACCORDANCE WITH ASTM D-1557. HEAVY EQUIPMENT SHALL REMAIN A DISTANCE EQUAL TO THE HEIGHT OF THE WALL AWAY FROM THE RETAINED EARTH SIDE OF THE WALL.
 - CAST-IN-PLACE CONCRETE BOX CULVERTS: AFTER CONSTRUCTION OF THE CAST-IN-PLACE BOX, BACKFILL ADJACENT TO CBC SHALL BE MOISTENED TO OPTIMUM MOISTURE (+2%), PLACED IN 8" LOOSE LIFTS AND COMPACTED TO A MINIMUM OF 95% OF MAXIMUM DENSITY IN ACCORDANCE WITH ASTM D-1557. A FIELD DENSITY TEST SHALL BE TAKEN ON ALTERNATE LIFTS, TO INSURE PROPER COMPACTION. FILL SHALL BE PLACED ON EACH SIDE OF THE CBC SUCH THAT EACH LIFT IS LEVEL AND WITHIN ONE FOOT OF THE FILL ELEVATION AT THE OPPOSITE SIDE OF THE CBC. HEAVY EQUIPMENT USED IN COMPACTION EFFORTS ABOVE THE CAST-IN-PLACE BOX SHALL NOT BE USED UNTIL 2 FEET OF COMPACTED SOIL LIES ABOVE THE BOX. IN NO CASE SHALL CONSTRUCTION EQUIPMENT GREATER THAN 32 TONS BE PLACED ON OR ABOVE THE STRUCTURE.
- WORK SHALL BE DONE BETWEEN THE MONTHS OF SEPTEMBER THRU JUNE 15.
- CONTRACTOR SHALL CLEAN ALL CONSTRUCTION DEBRIS FROM AREA.


RECORD DRAWING
I hereby certify that the information contained on this drawing has been revised in accordance with information furnished by the contractor, Bender Construction, Inc., and by the surveyor, and reflects the construction as actually accomplished. This plan as constructed is in substantial compliance with the Approved Plan.
Martin D. Vinjard NMPE 8261

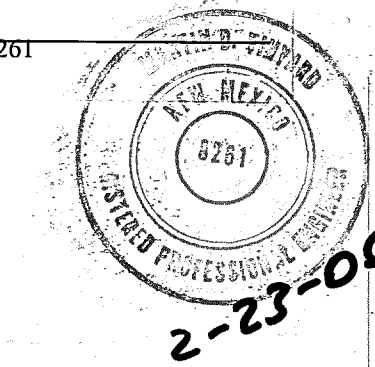

Bohannon & Huston			
Court yard One 7500 JEFFERSON NE Albuquerque NEW MEXICO 87109			
ENGINEERS PLANNERS PHOTOGRAMMETRISTS SURVEYORS SOFTWARE DEVELOPERS			
ALBUQUERQUE METROPOLITAN ARROYO FLOOD CONTROL AUTHORITY			
NORTH BRANCH PIEDRAS MARCADAS CHANNEL HEADWALL PENETRATION DETAILS			
DESIGN REVIEW COMMITTEE	CITY ENGINEER APPROVAL	MO./DAY/YR.	MO./DAY/YR.
APPROVE			
CITY PROJECT NO.	ZONE MAP NO.	SHEET	OF
5978.81	B9, B1C	10	13

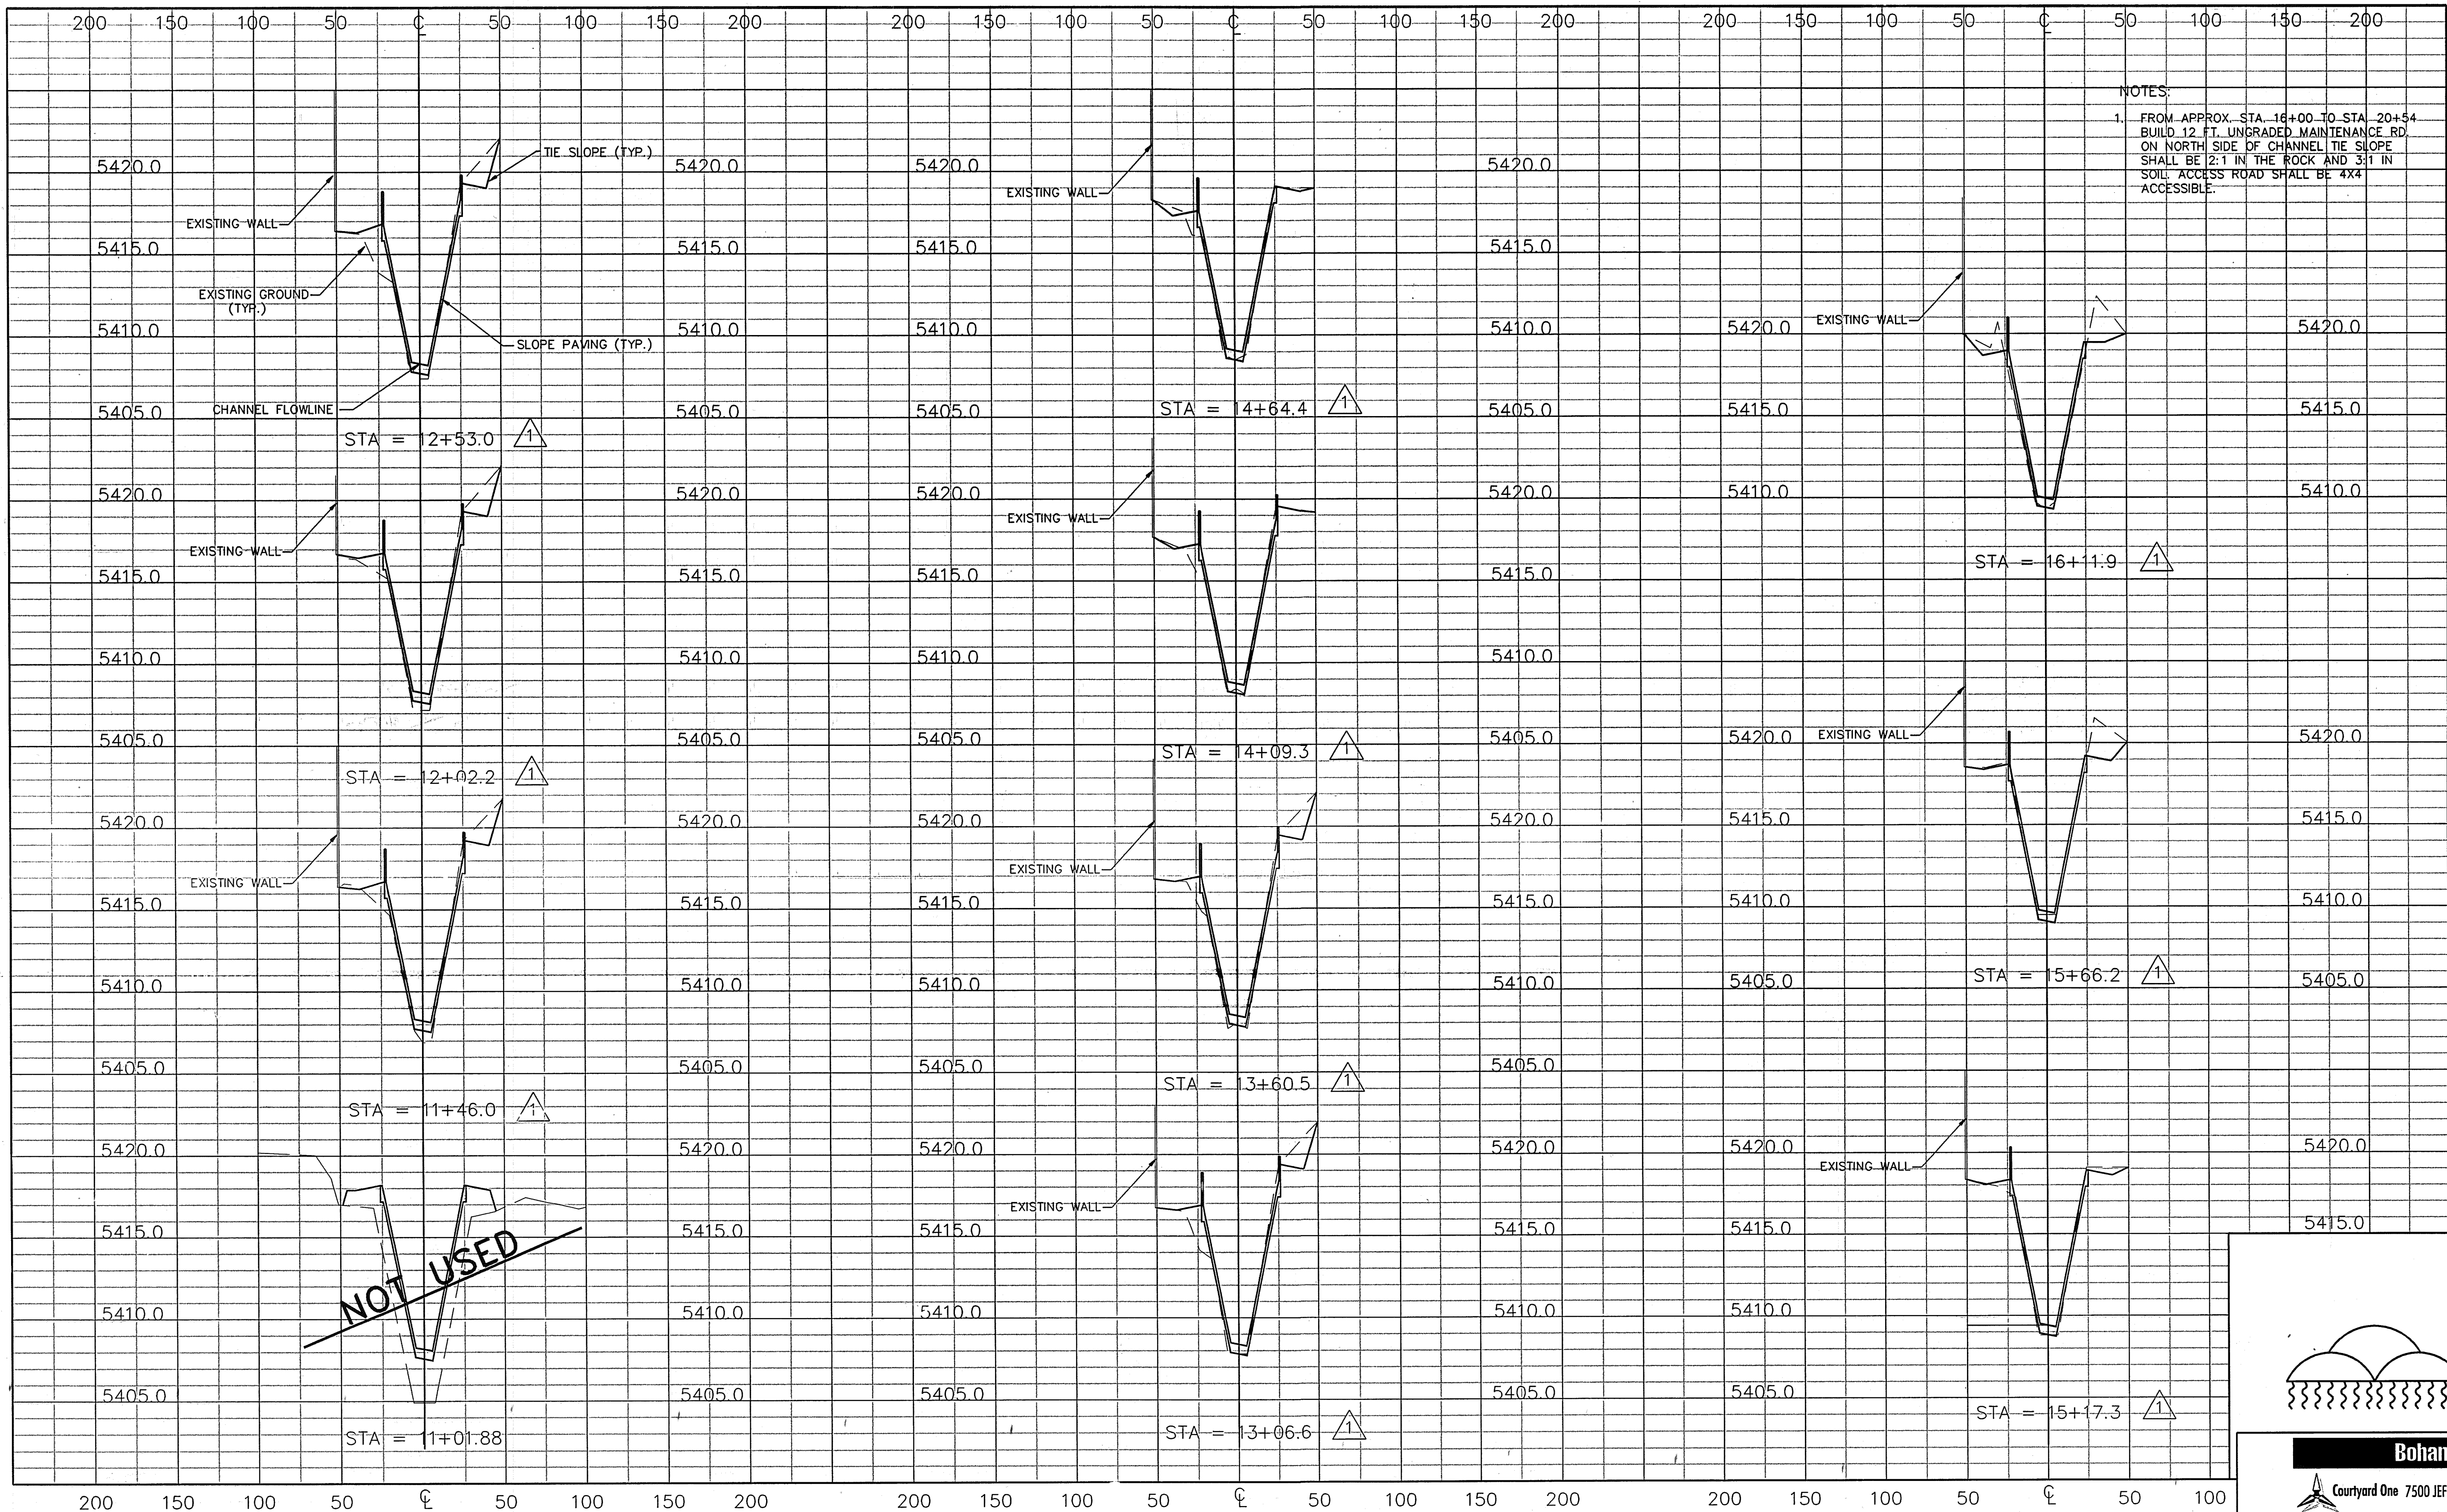

AS-BUILT INFORMATION		BENCH MARKS		SURVEY INFORMATION		ENGINEER'S SEAL	
CONTRACTOR	BOHANNAN & HUSTON	DATE	DATE	DATE	DATE	DATE	DATE
INSPECTOR	WILLIAM W. HUSTON	DATE	DATE	DATE	DATE	DATE	DATE
FIELD	WILLIAM W. HUSTON	DATE	DATE	DATE	DATE	DATE	DATE
NO. 1929	ELEVATION = 5419.522	DATE	DATE	DATE	DATE	DATE	DATE
STATION IS LOCATED 0.90 MILES NW FROM THE CORNER OF PARADISE BLVD. AND PARK LANE TO THE CROSSING OF A PLANS ELECT. CO-OP POWERLINE. THE STATION IS 225 FT. SOUTH OF THIS POINT BETWEEN THE POLES OF A Pylon.		DATE	DATE	DATE	DATE	DATE	DATE
STA. MK. IS SET IN TOP OF A CONC. POST FLUSH W/ GROUND.		DATE	DATE	DATE	DATE	DATE	DATE

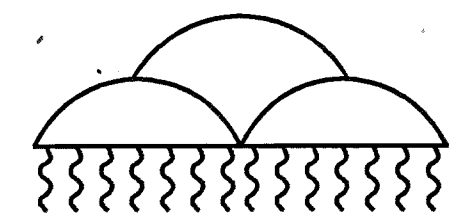

Bohannon & Huston



Courtyard One 7500 JEFFERSON NE ALBUQUERQUE NEW MEXICO 87109

ENGINEERS PLANNERS PHOTOGRAMMETRISTS SURVEYORS SOFTWARE DEVELOPERS

ALBUQUERQUE METROPOLITAN
ARROYO FLOOD CONTROL AUTHORITY

NORTH BRANCH PIEDRAS MARCADAS
CHANNEL CROSS SECTIONS

DESIGN REVIEW COMMITTEE	CITY ENGINEER APPROVAL	NO. / DAY / YR.	NO. / DAY / YR.

CITY PROJECT NO.	ZONE MAP NO.	SHEET	OF
5978.81	B9, B10	12	13

SCALE: 1"=50' Horizontal
1"=5' Vertical

