

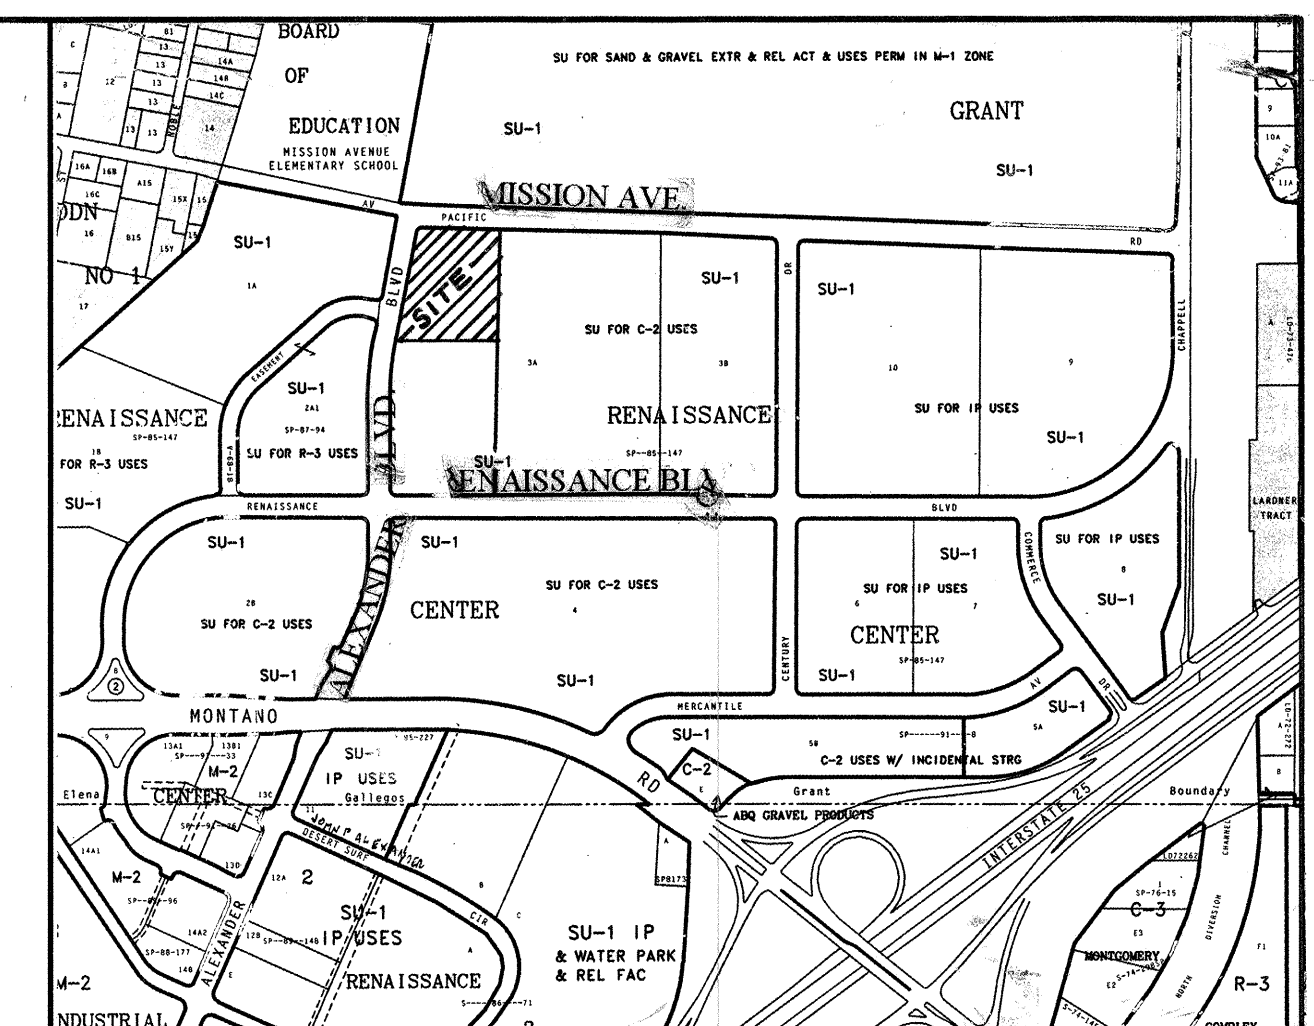


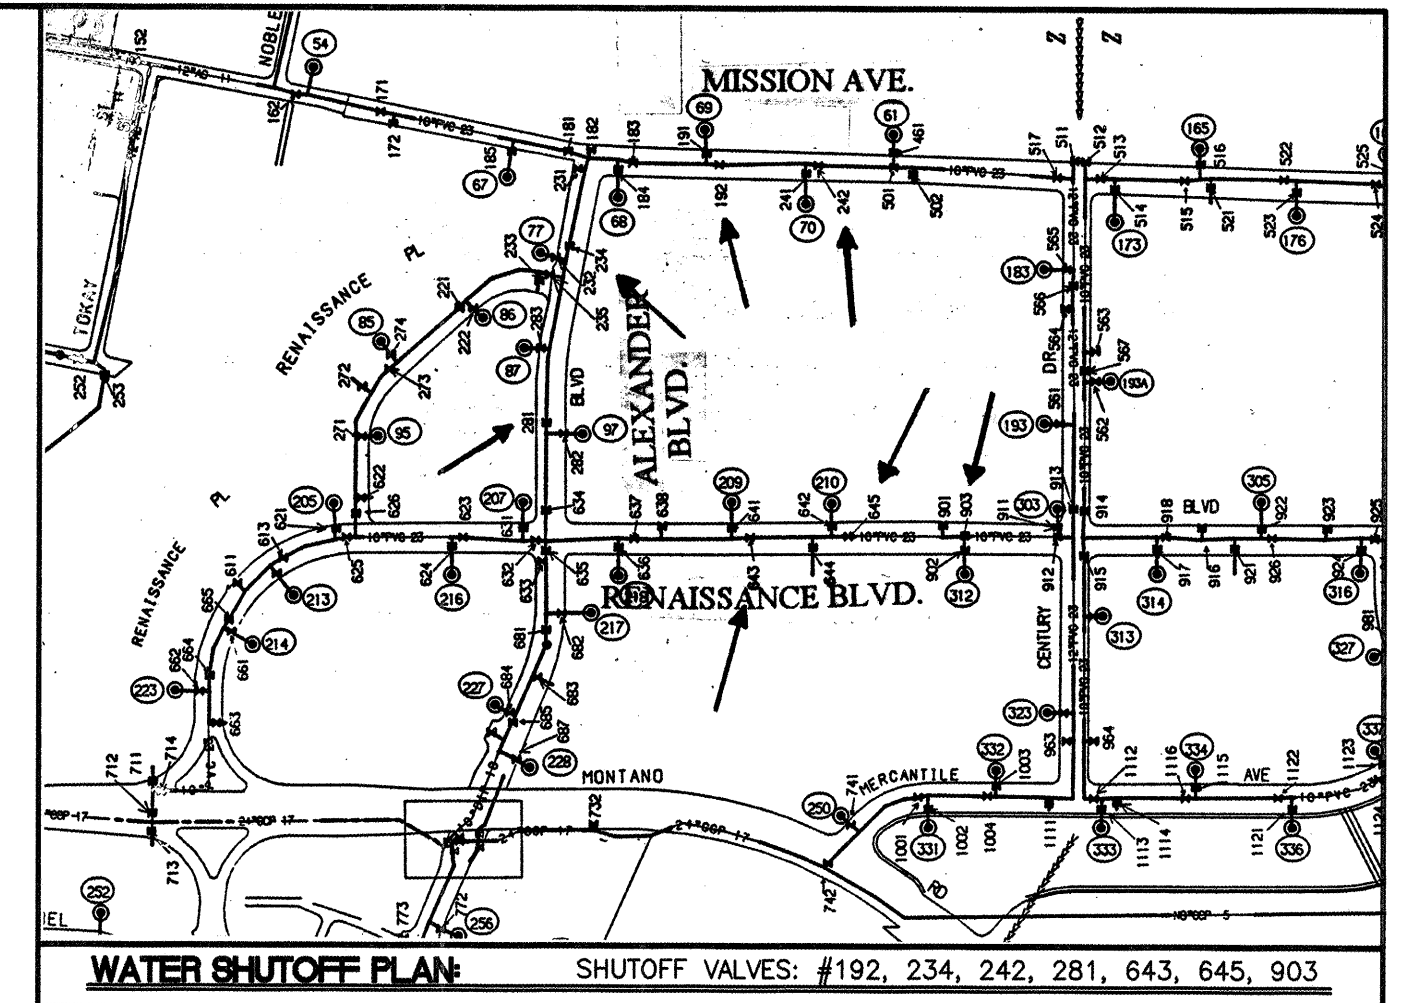

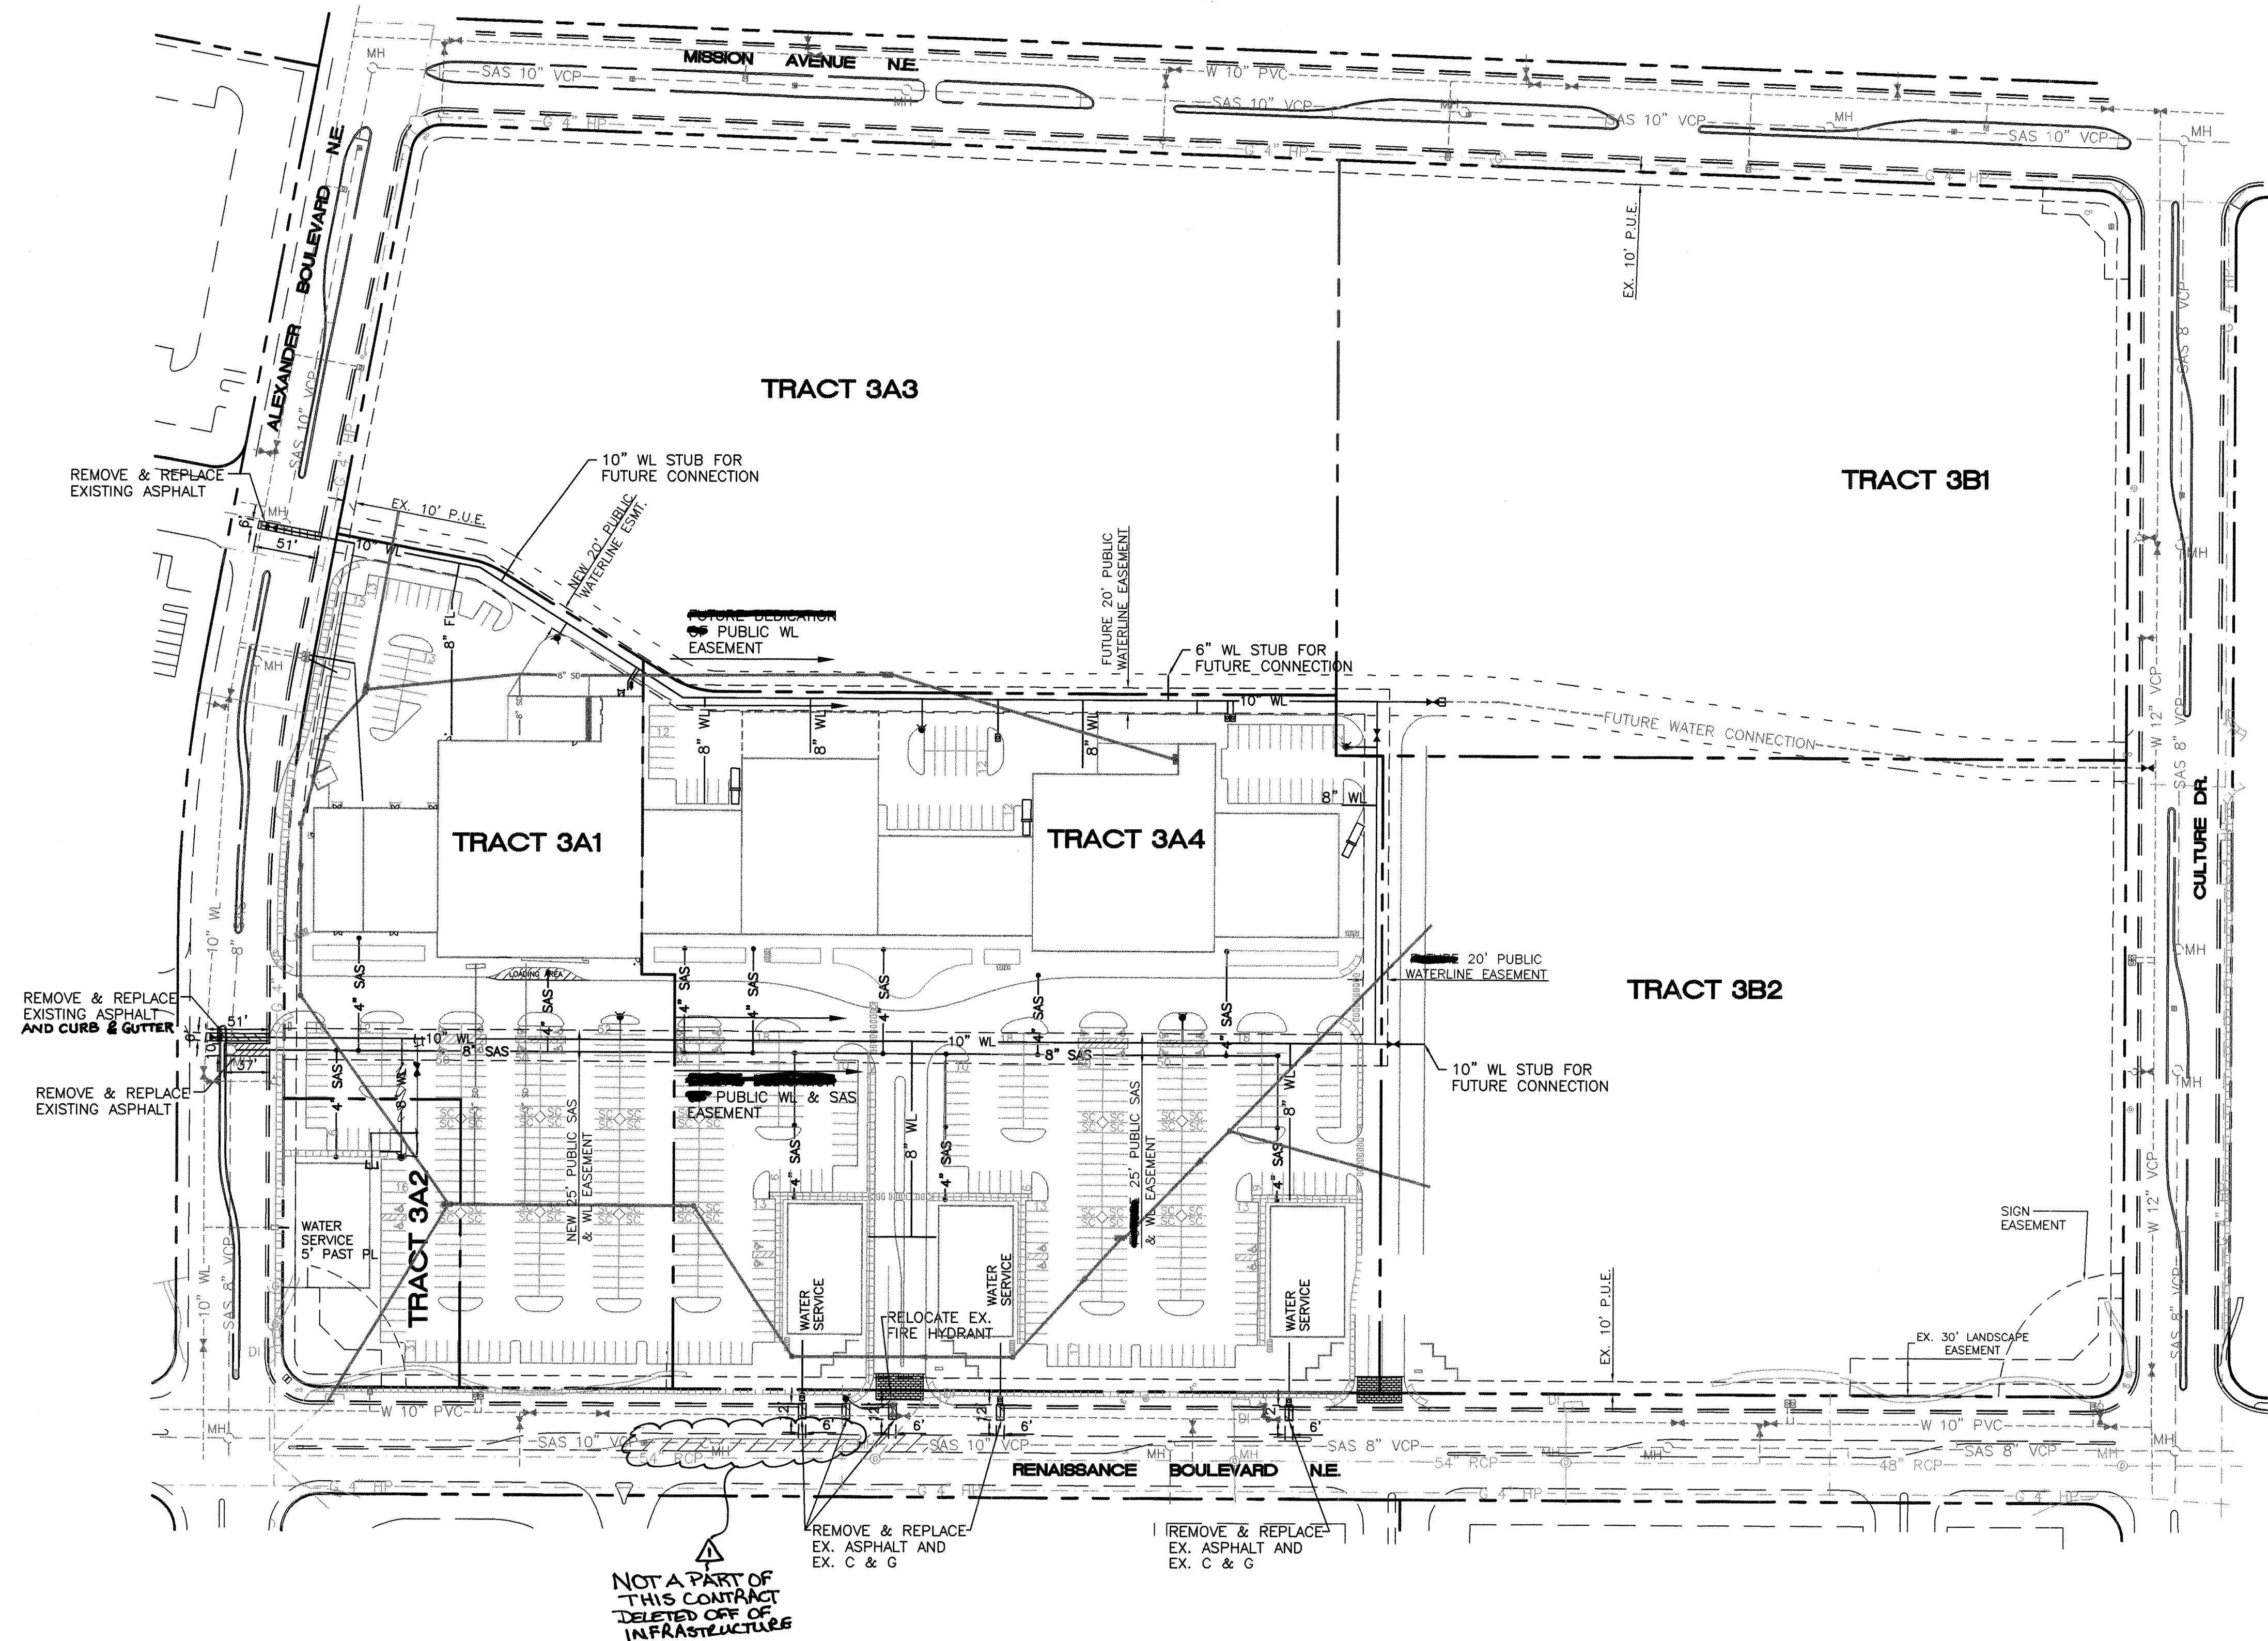

1. ONLY WATER SYSTEMS PERSONNEL ARE AUTHORIZED TO OPERATE VALVES.
2. NOTIFY CITY OF ALBUQUERQUE, WATER SYSTEMS DIVISION (PHONE 857-8200) FIVE (5) WORKING DAYS IN ADVANCE OF NEEDING EXECUTION OF THE WATER SHUT OFF PLAN
3. APPROXIMATE SHUT OFF TIME WILL BE 24 HOURS.
4. SHUTOFF THE VALVES INDICATED IN THE PLAN ABOVE.

LEGEND


- EXISTING SAS MANHOLE
- EXISTING METER
- EXISTING VALVE W/BOX
- EXISTING FIRE HYDRANT
- EXISTING REDUCER
- EX. 8" SAS
- EX. 16" WL
- EXISTING CURB & GUTTER
- BOUNDARY LINE
- EASEMENT
- PROPOSED SIDEWALK

RECORD DRAWING


DATE: 7-2-99
DRAFTED BY: RW
TIERRA WEST DEV.
THESE RECORD DRAWINGS HAVE BEEN PREPARED, IN PART, ON THE BASIS OF INFORMATION COMPILED AND FURNISHED BY OTHERS. THE ENGINEER WILL NOT BE RESPONSIBLE FOR ANY ERRORS OR OMISSIONS WHICH HAVE BEEN INCORPORATED INTO THE DOCUMENT AS A RESULT.

- GENERAL NOTES:
1. ALL WATER SERVICES SHALL BE 2" UNLESS OTHERWISE NOTED.
 2. ALL FIRE LINE STUBS TO THE BUILDINGS SHALL BE 8".
 3. ALL FIRE HYDRANTS ARE TO BE BUILT PER C.O.A.
 4. ALL EXISTING UTILITY CONNECTION LOCATIONS AND INVERTS MUST BE FIELD VERIFIED PRIOR TO CONSTRUCTION.


CAUTION:
SOME EXISTING UTILITIES MAY NOT BE SHOWN. IT SHALL BE THE SOLE RESPONSIBILITY OF THE CONTRACTOR TO CONDUCT ALL NECESSARY FIELD INVESTIGATIONS PRIOR TO ANY EXCAVATION TO DETERMINE THE ACTUAL LOCATION OF UTILITIES & OTHER IMPROVEMENTS.

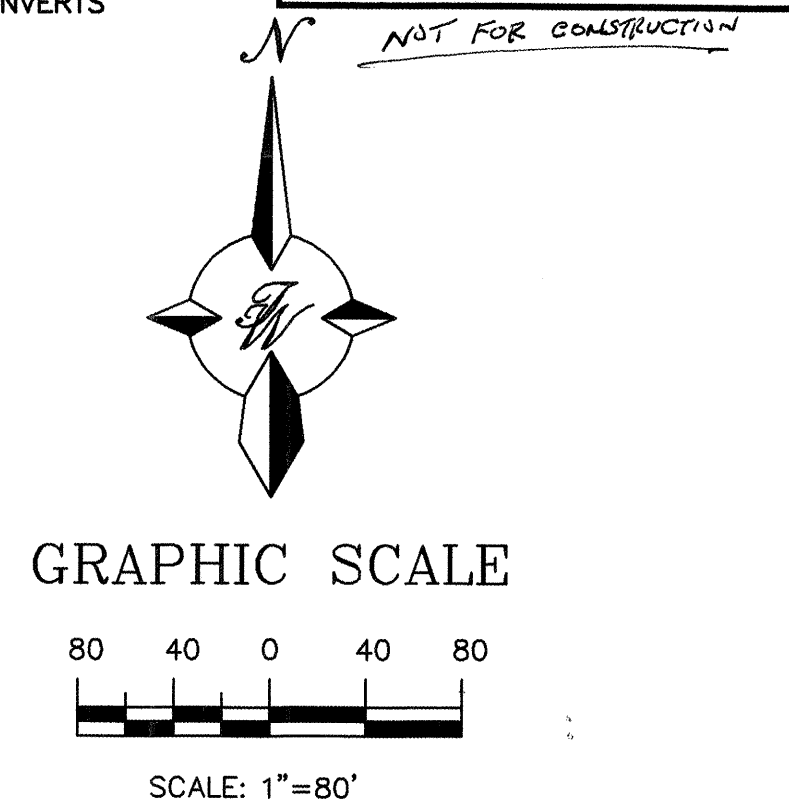


ENGINEER'S SEAL RONALD R. BOHANNAN P.E. #7868	TRACT 3 NORTH RENAISSANCE		DRAWN BY JDN
	OVERALL MASTER UTILITY PLAN		DATE 06-16-98
	TIERRA WEST, LLC 4421 McLEOD ROAD, N.E., SUITE D ALBUQUERQUE, NEW MEXICO 87109 (505)883-7592 CPN 598281		TRACT3MU.DWG
	SHEET # 3 11		JOB # 940021

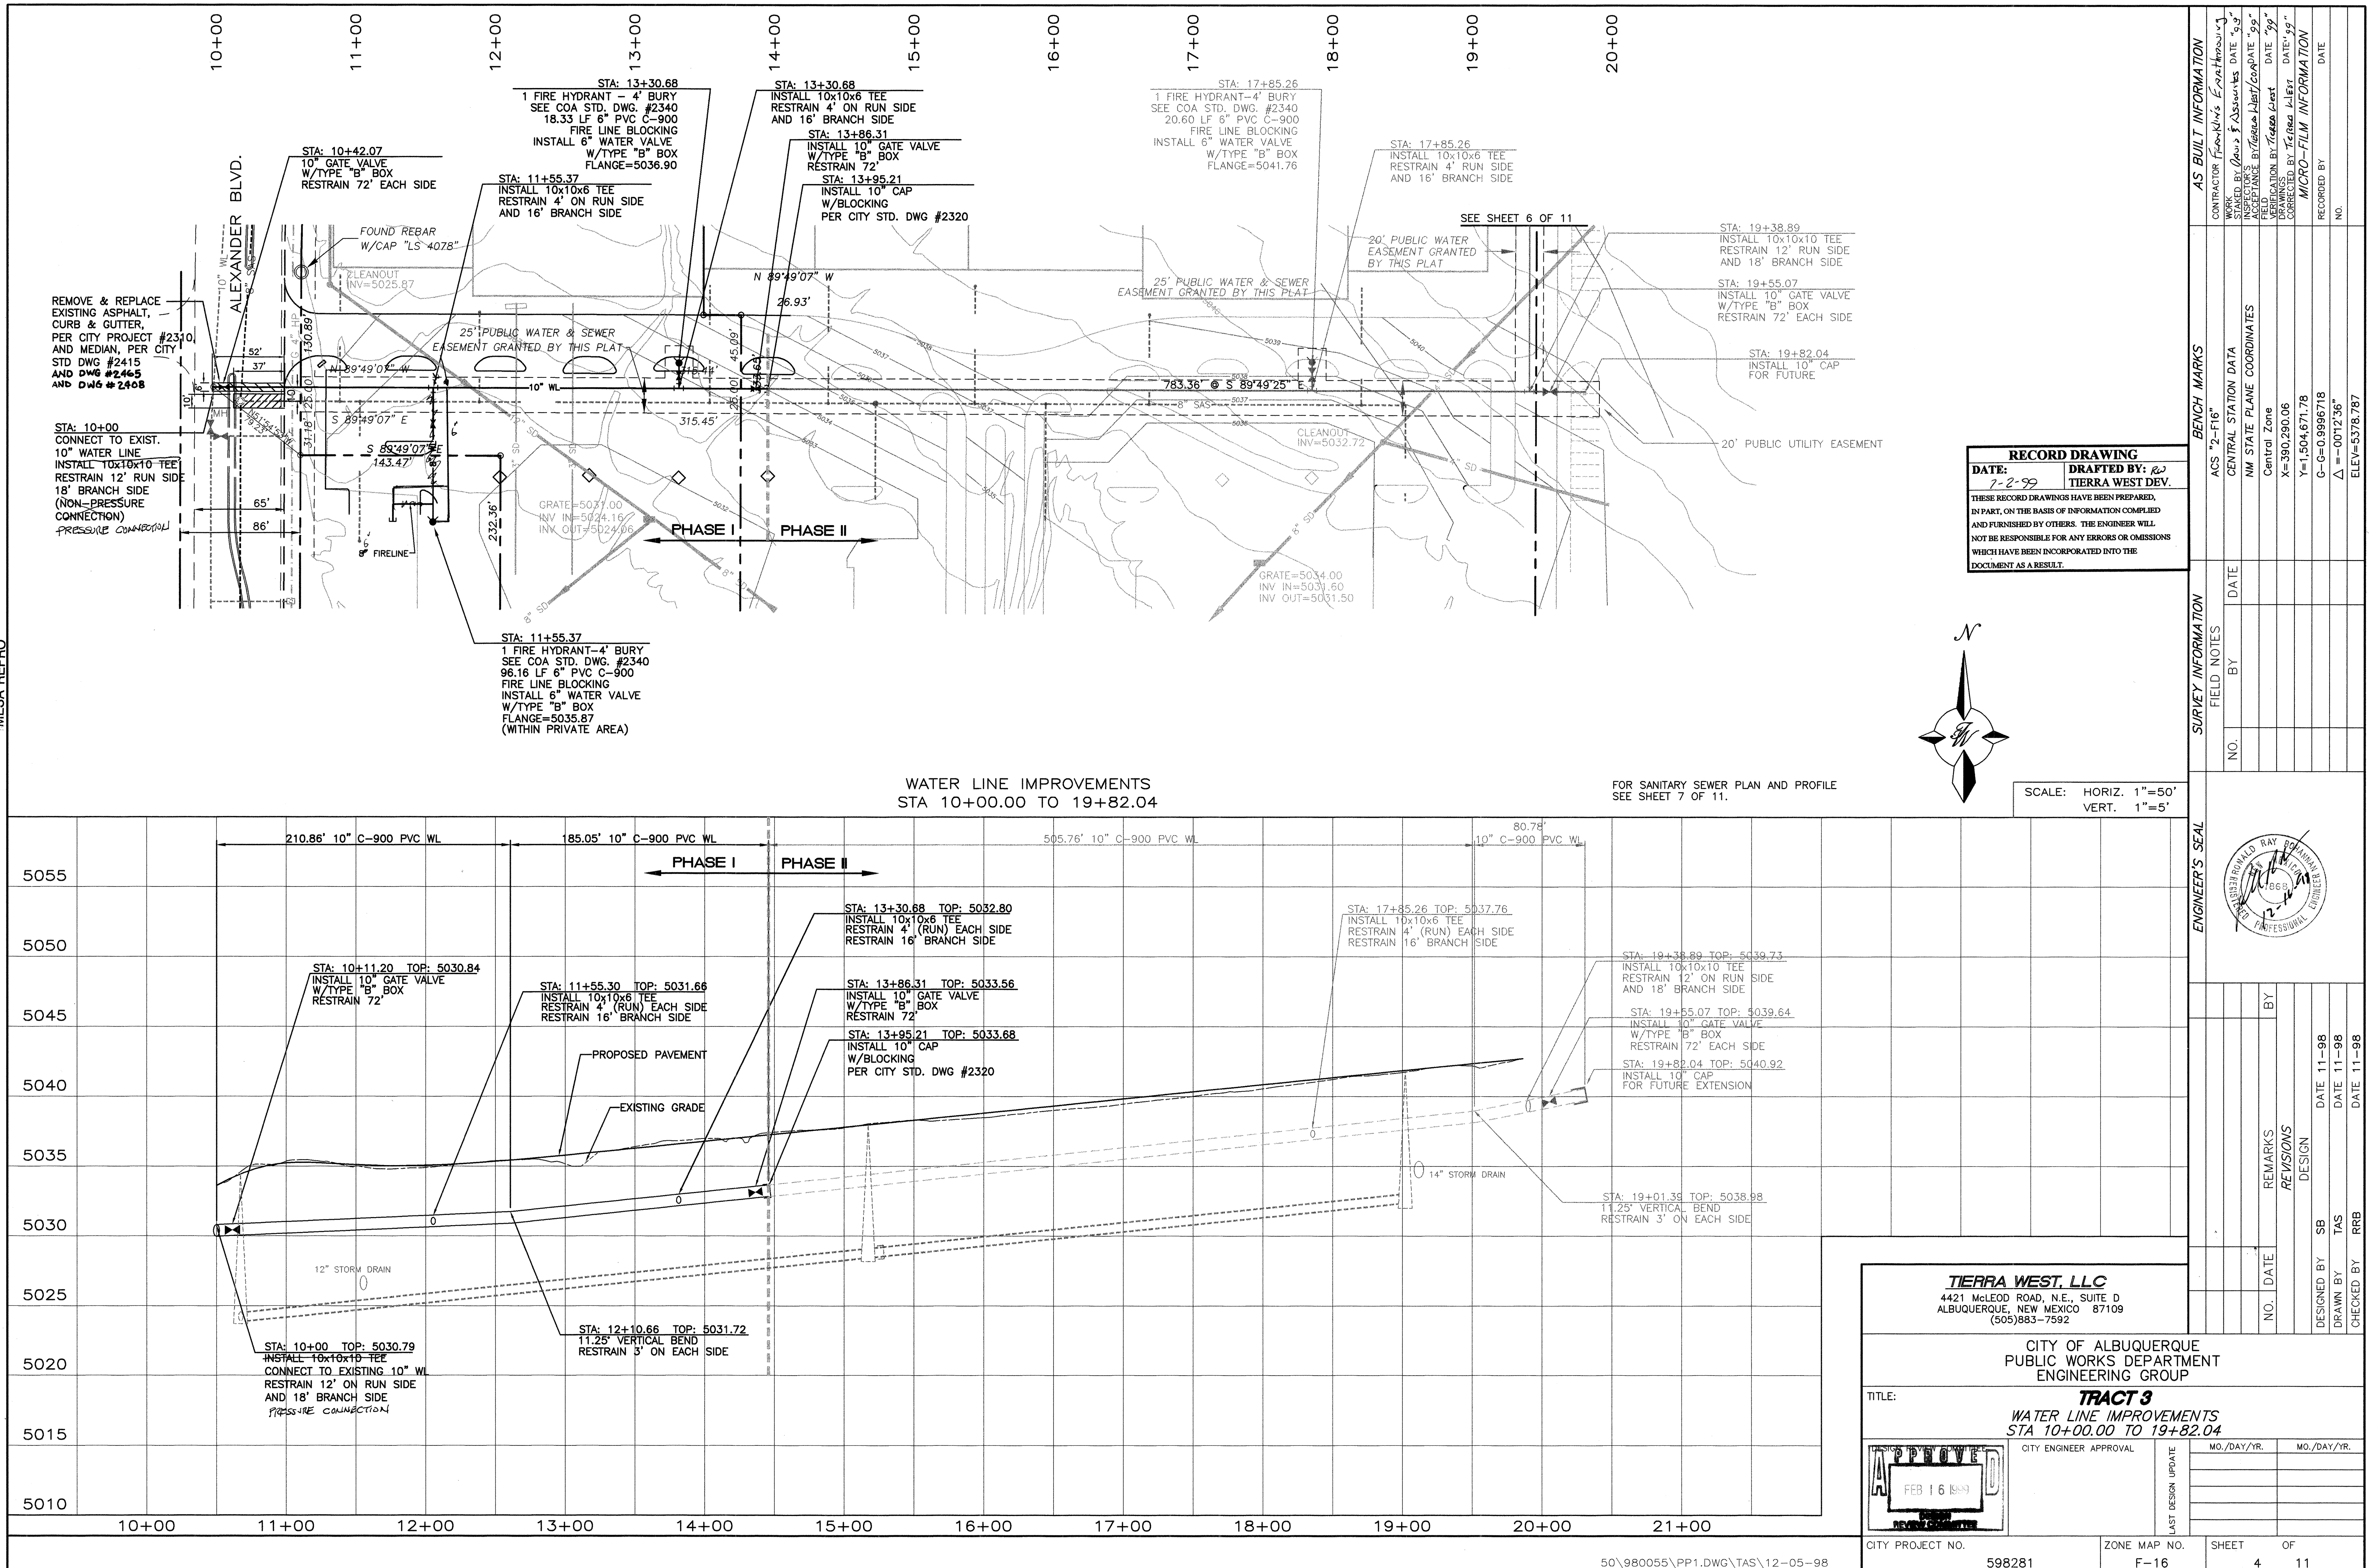

SCANNED BY
MESA REPRO

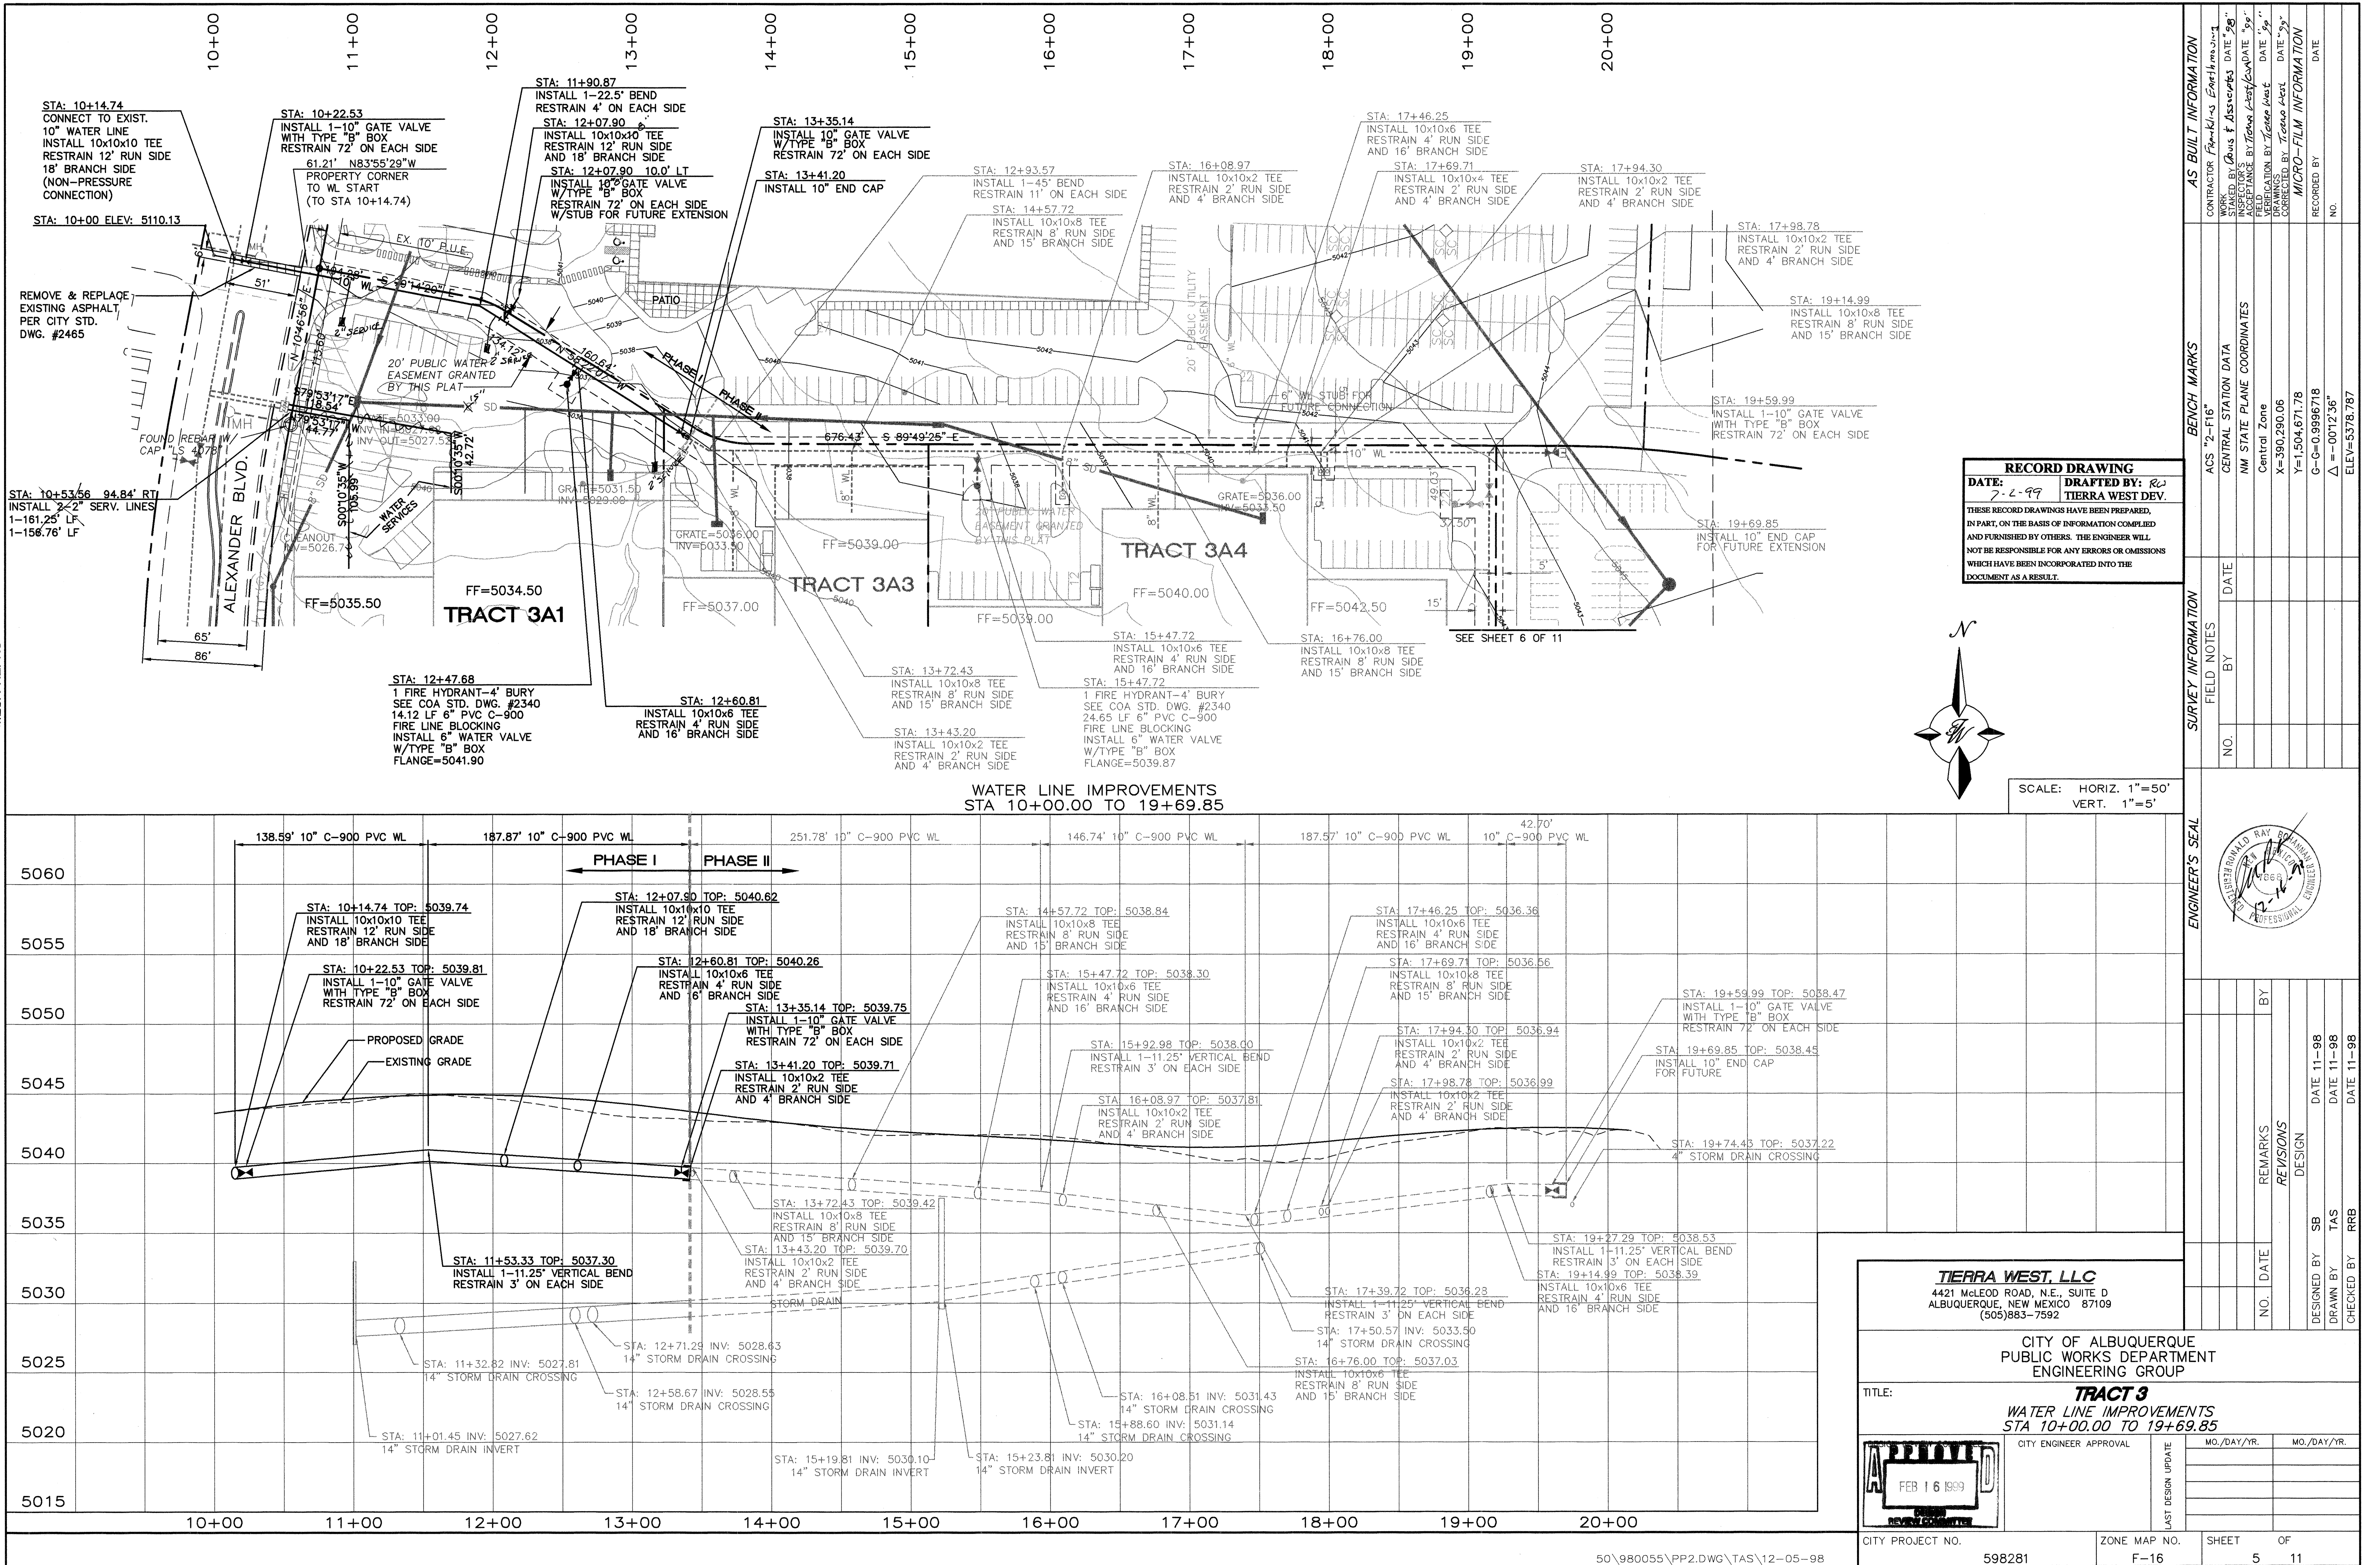


50\980055\PP2.DWG\TAS\12-05-98

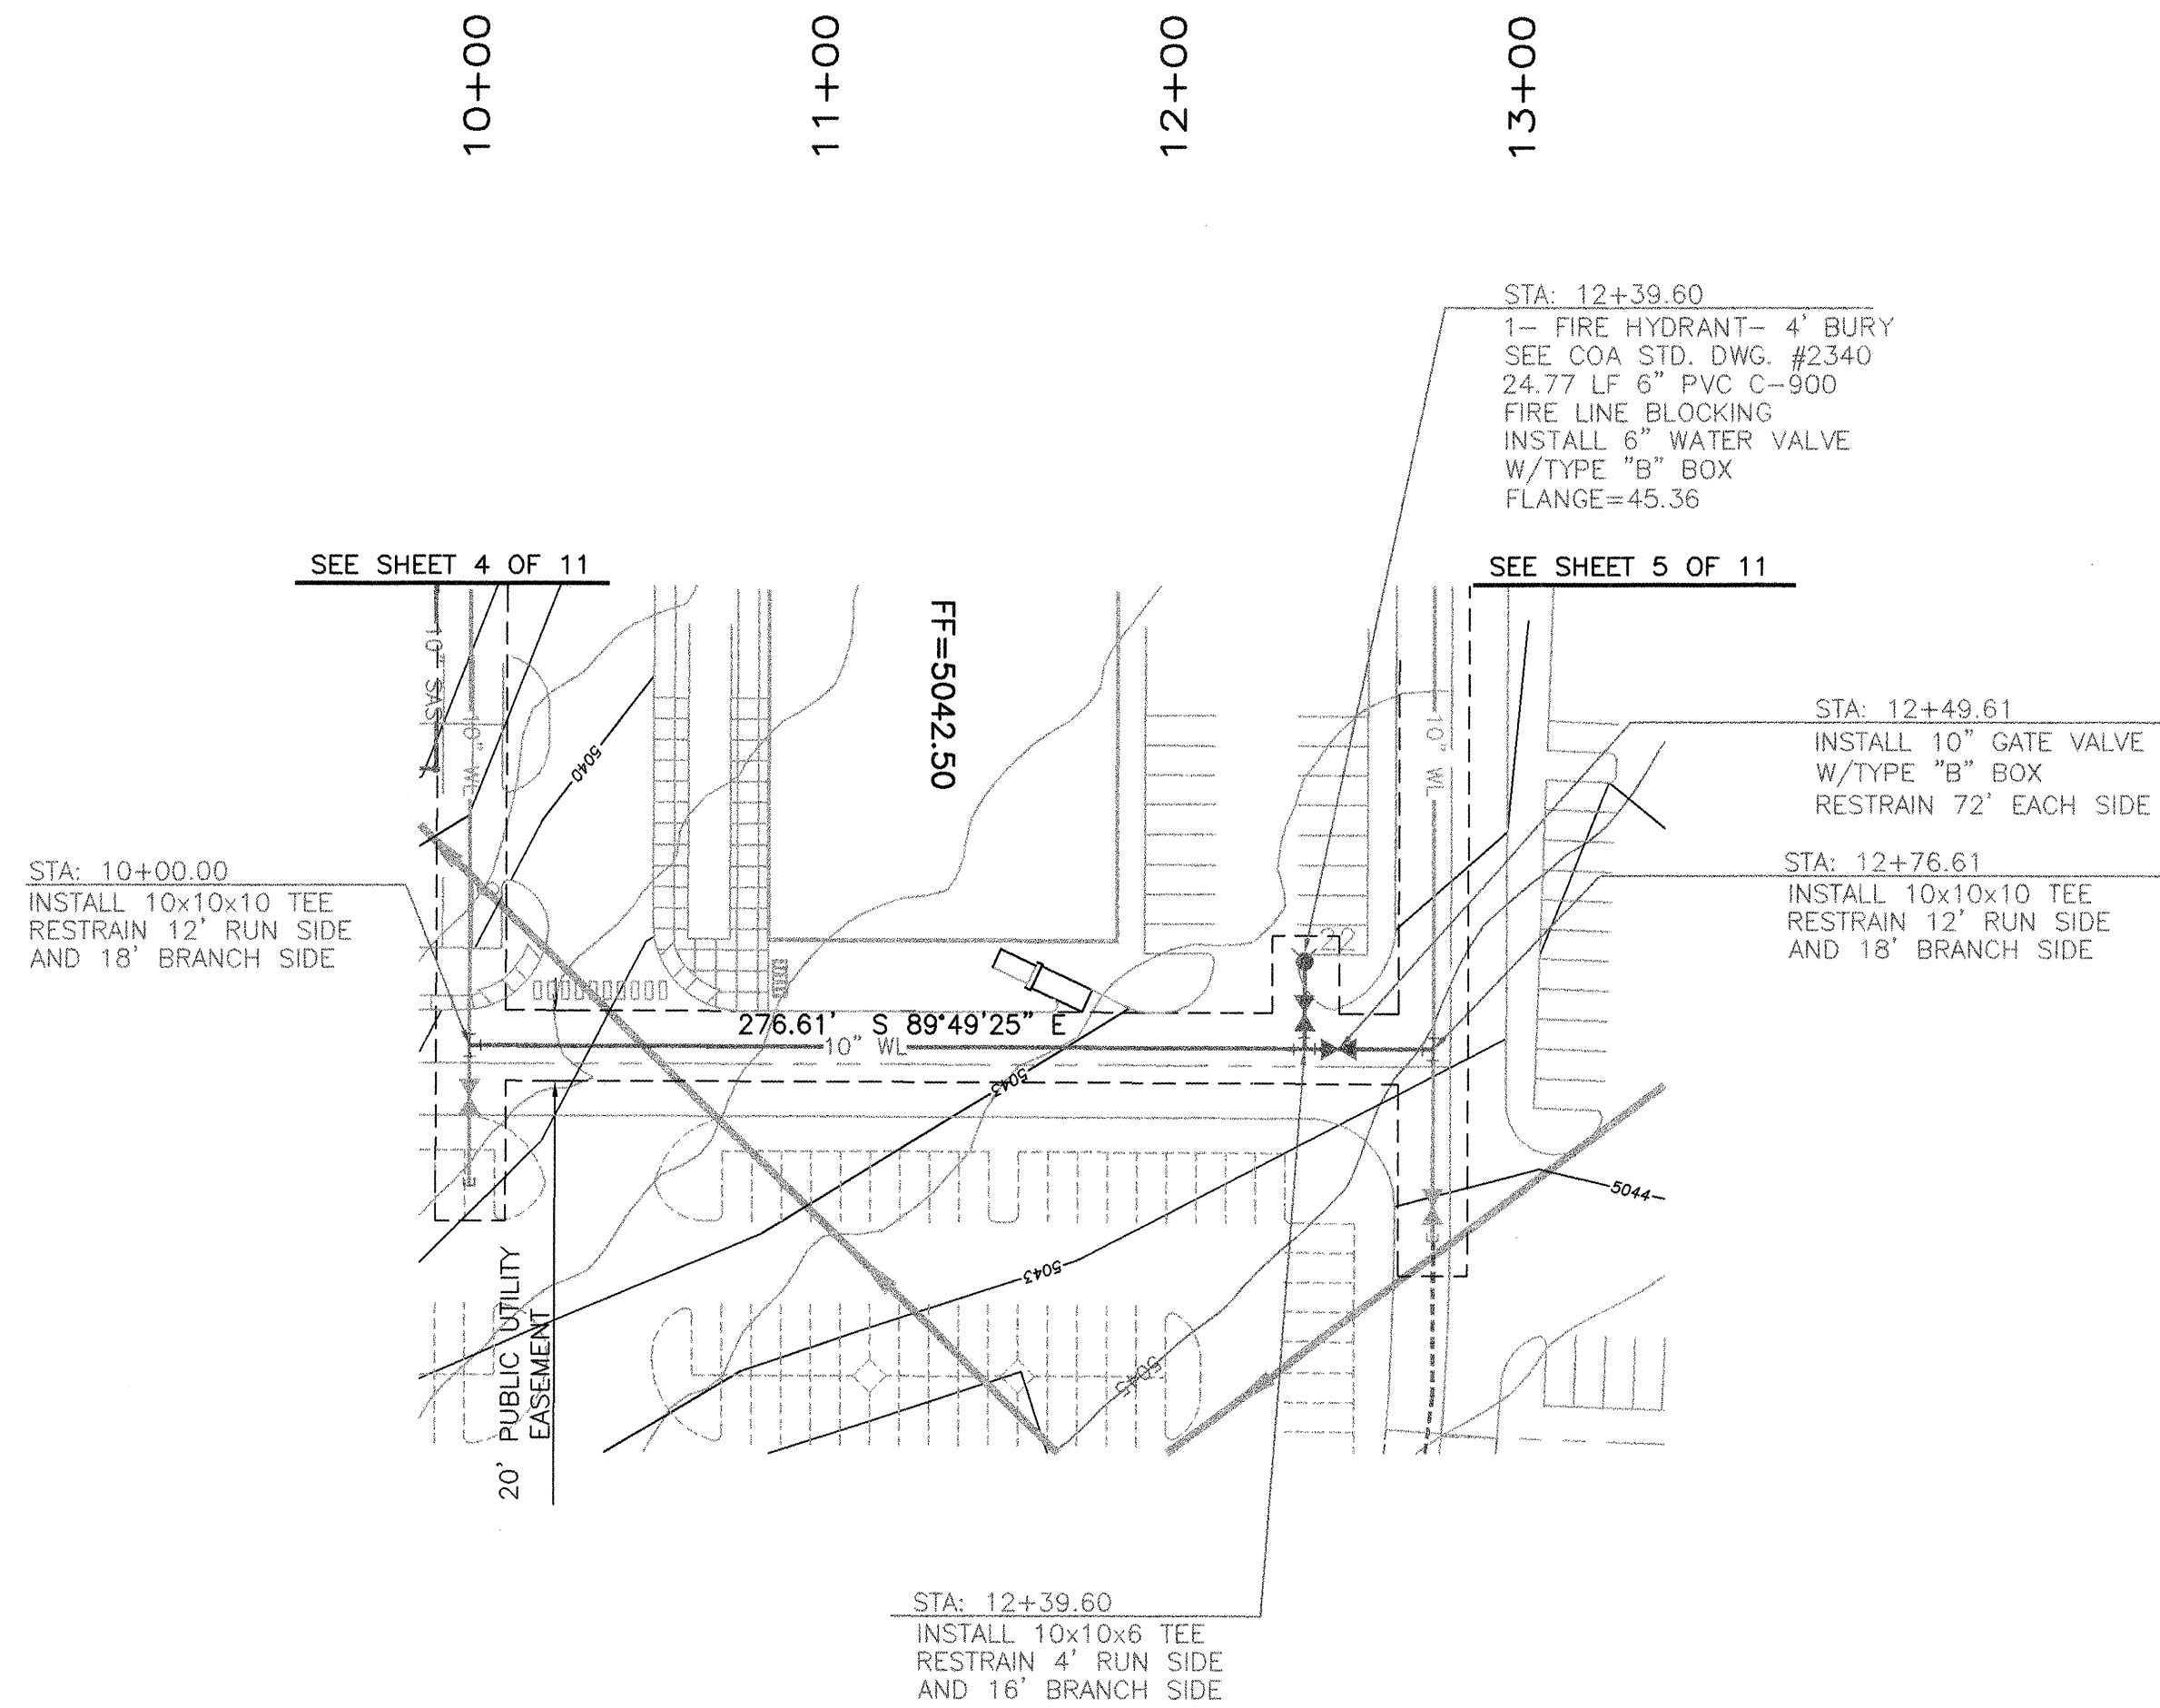


WATER LINE IMPROVEMENTS
STA 10+00.00 TO 12+76.61

NOTE:
THIS WILL BE BUILT IN PHASE II.

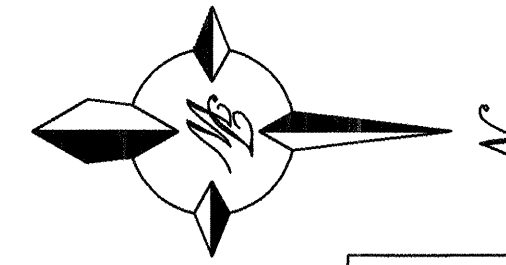


SCALE: HORIZ. 1"=50'
VERT. 1"=5'

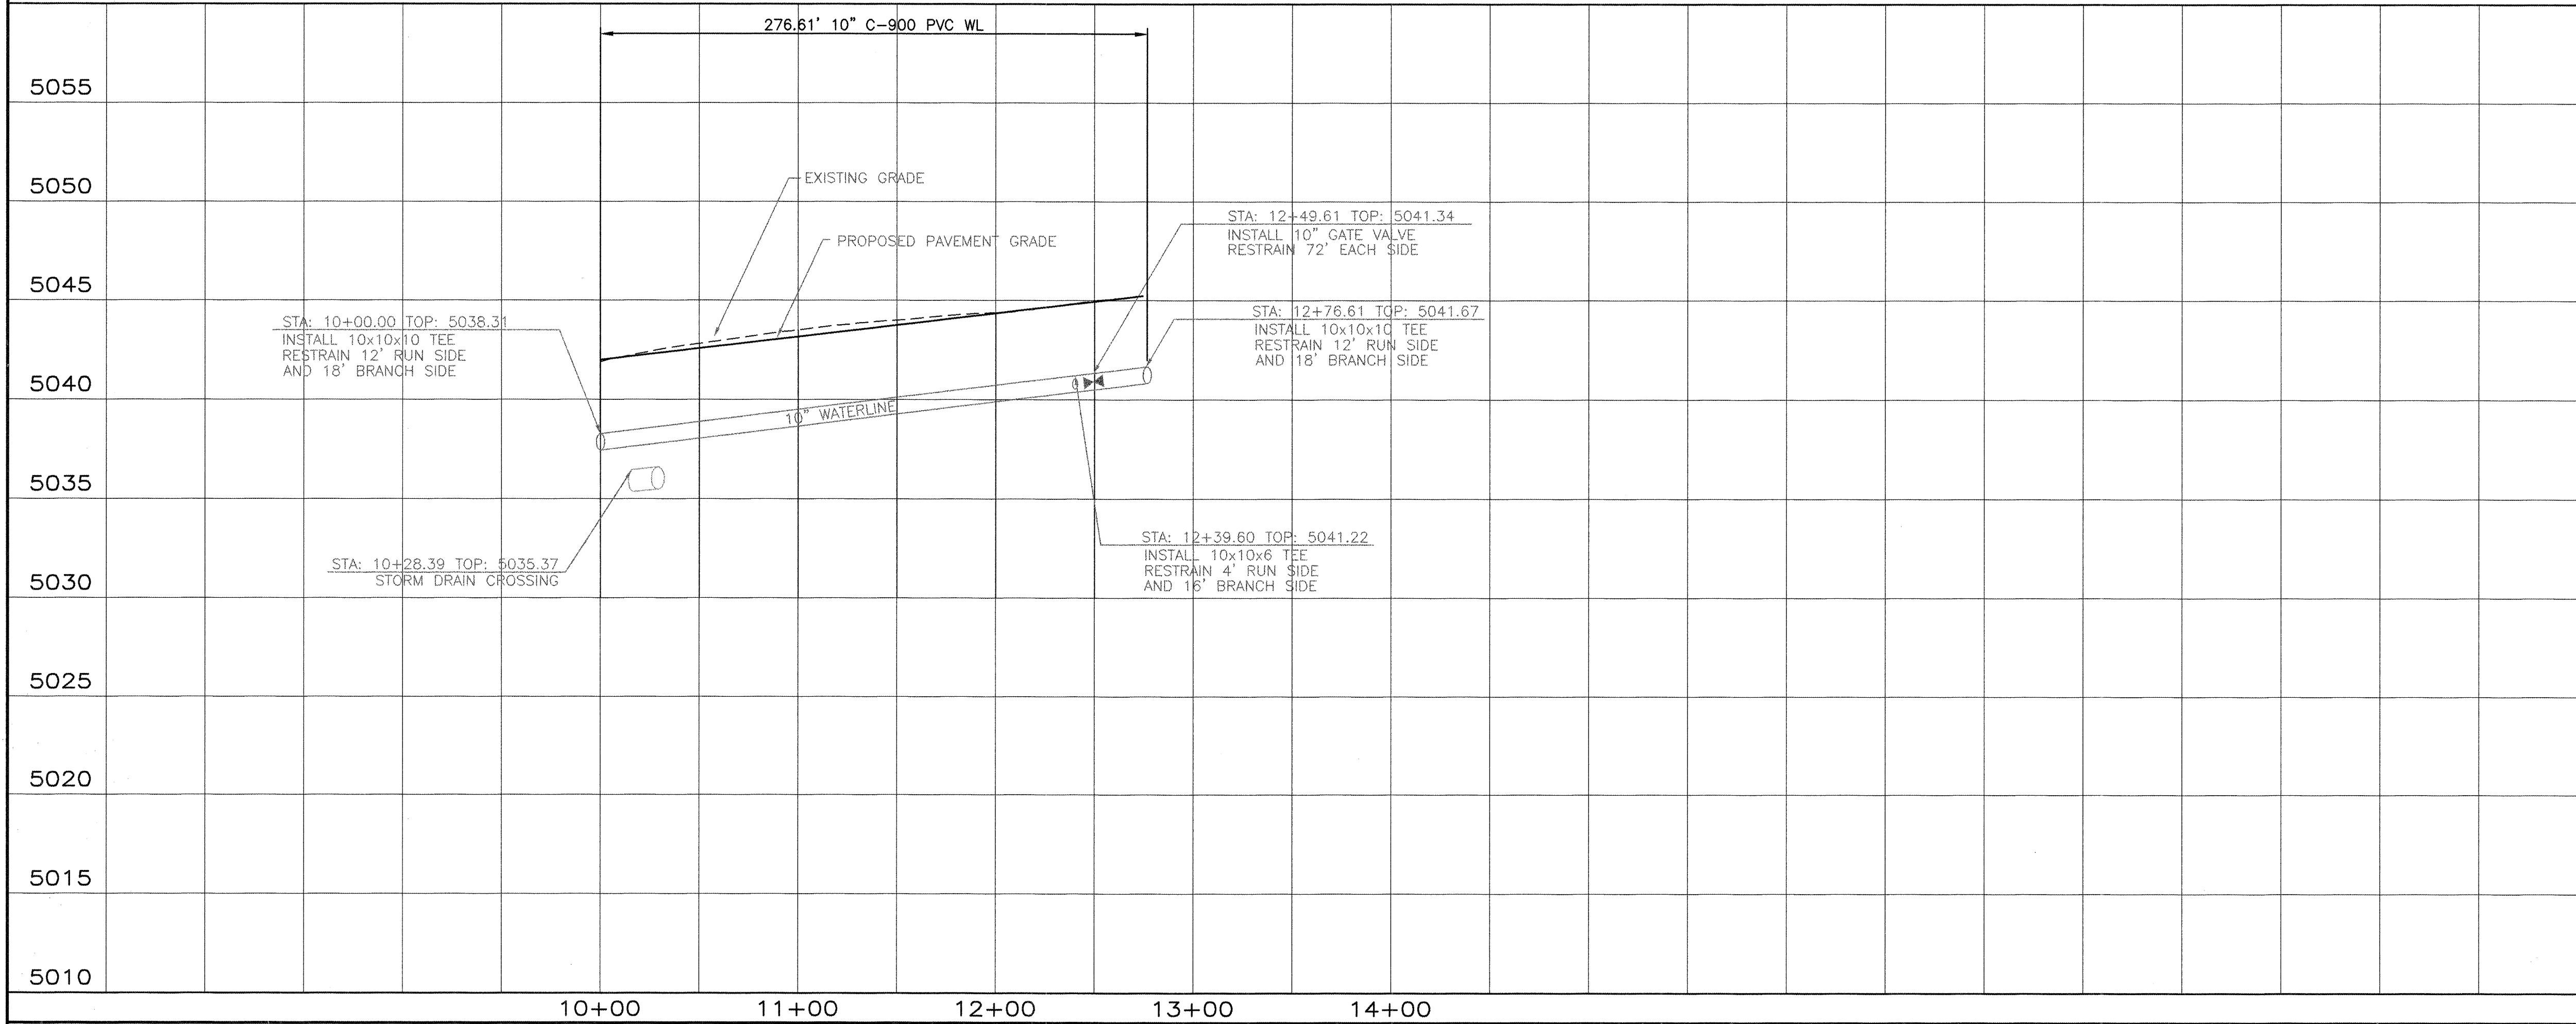

TIERRA WEST, LLC
4421 McLEOD ROAD, N.E., SUITE D
ALBUQUERQUE, NEW MEXICO 87109
(505)883-7592

CITY OF ALBUQUERQUE
PUBLIC WORKS DEPARTMENT
ENGINEERING GROUP

TITLE:
TRACT 3
WATER LINE IMPROVEMENTS
STA 10+00.00 TO STA 12+76.61

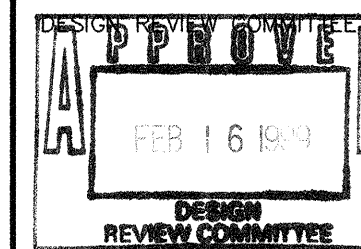

CITY ENGINEER APPROVAL

LAST DESIGN UPDATE

CITY PROJECT NO.


598281

ZONE MAP NO.

F-16

SHEET OF

6 11

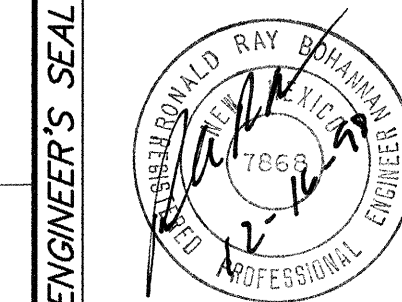

ENGINEER'S SEAL

SURVEY INFORMATION

FIELD NOTES

NO. BY DATE

BENCH MARKS

ACS "2-F16"

CENTRAL STATION DATA

NM STATE PLANE COORDINATES

Central Zone

X=390,290.06

Y=1,504,671.78

G-C=0.9996718

Δ=-0012'36"

ELEV=5378.787

AS BUILT INFORMATION

CONTRACTOR

STARTED BY

INSPECTOR'S

ACCEPTANCE BY

VERIFICATION BY

DRAWN BY

DATE

DATE

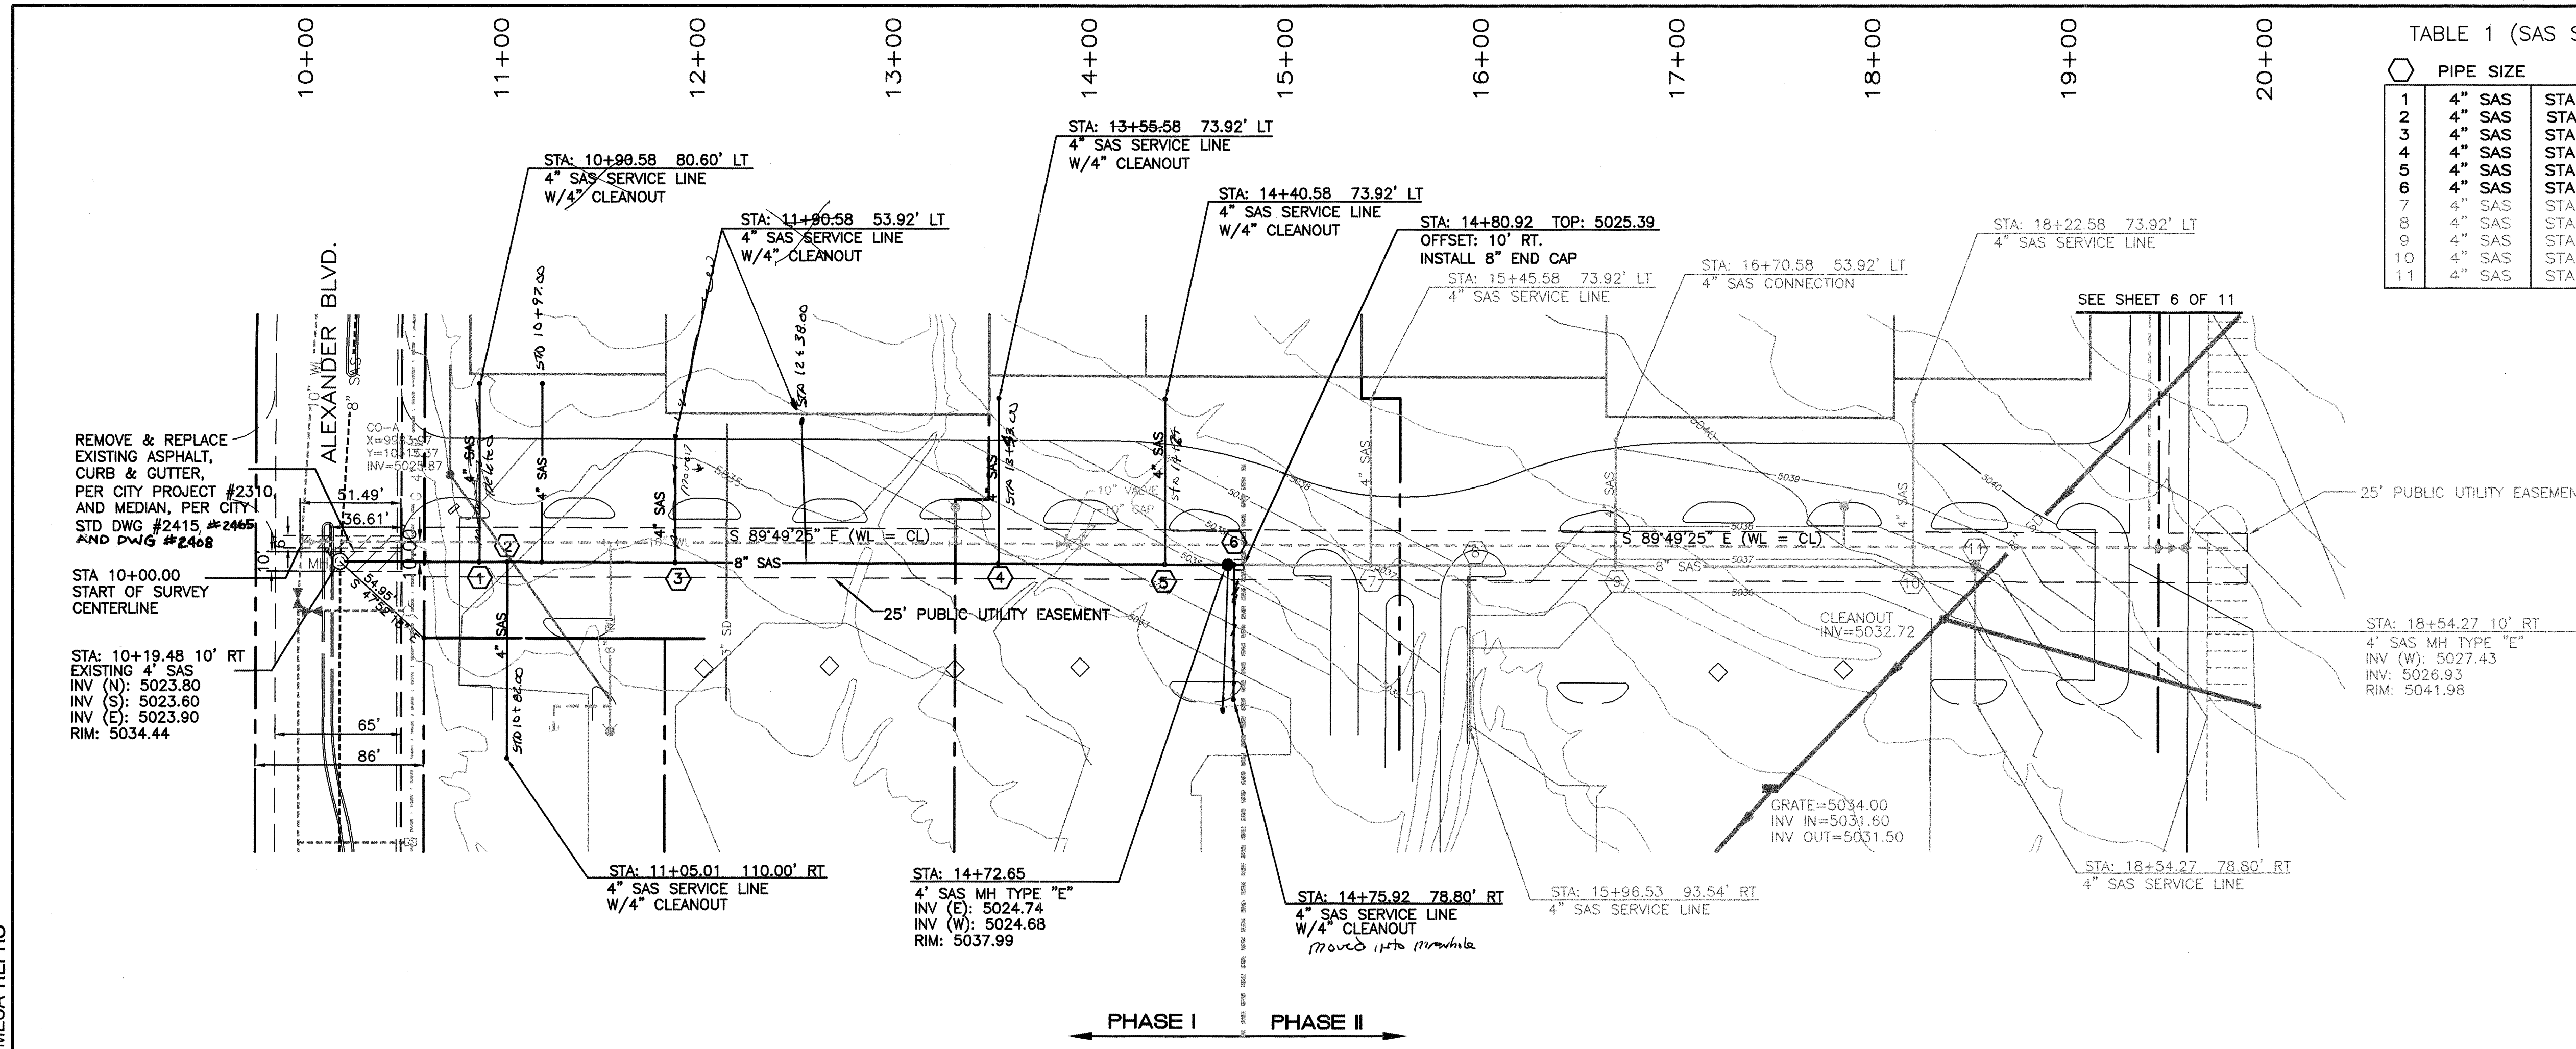


TABLE 1 (SAS SERVICES)


PIPE SIZE	STATION	LENGTH (2%)	INV	C.O. INV
1 4" SAS	STA 10+90.58	90.60' LT	5024.61	5025.97
2 4" SAS	STA 11+05.01	100.00' RT	5024.76	5026.26
3 4" SAS	STA 11+90.58	63.92' LT	5025.61	5026.57
4 4" SAS	STA 13+55.58	83.92' LT	5027.26	5028.52
5 4" SAS	STA 14+40.58	83.92' LT	5028.11	5029.37
6 4" SAS	STA 14+75.92	68.80' RT	5028.46	5028.50
7 4" SAS	STA 15+45.58	83.92' LT	5029.16	5030.42
8 4" SAS	STA 15+96.53	83.54' RT	5029.67	5030.92
9 4" SAS	STA 16+70.58	63.92' LT	5030.41	5031.37
10 4" SAS	STA 18+22.58	83.92' LT	5031.93	5033.19
11 4" SAS	STA 18+54.27	68.80' RT	5032.25	5033.28

RECORD DRAWING
 DATE: 7/6/99 DRAFTED BY: RJ
 TIERRA WEST DEV.
 THESE RECORD DRAWINGS HAVE BEEN PREPARED, IN PART, ON THE BASIS OF INFORMATION COMPILED AND FURNISHED BY OTHERS. THE ENGINEER WILL NOT BE RESPONSIBLE FOR ANY ERRORS OR OMISSIONS WHICH HAVE BEEN INCORPORATED INTO THE DOCUMENT AS A RESULT.

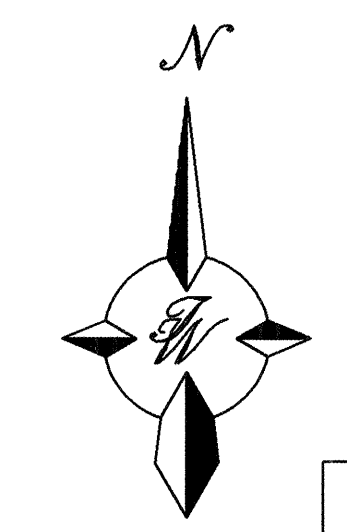

SANITARY SEWER IMPROVEMENTS
 STA 10+00.00 TO 18+54.27

FOR WATERLINE PLAN AND PROFILE
 SEE SHEET 4 OF 11.

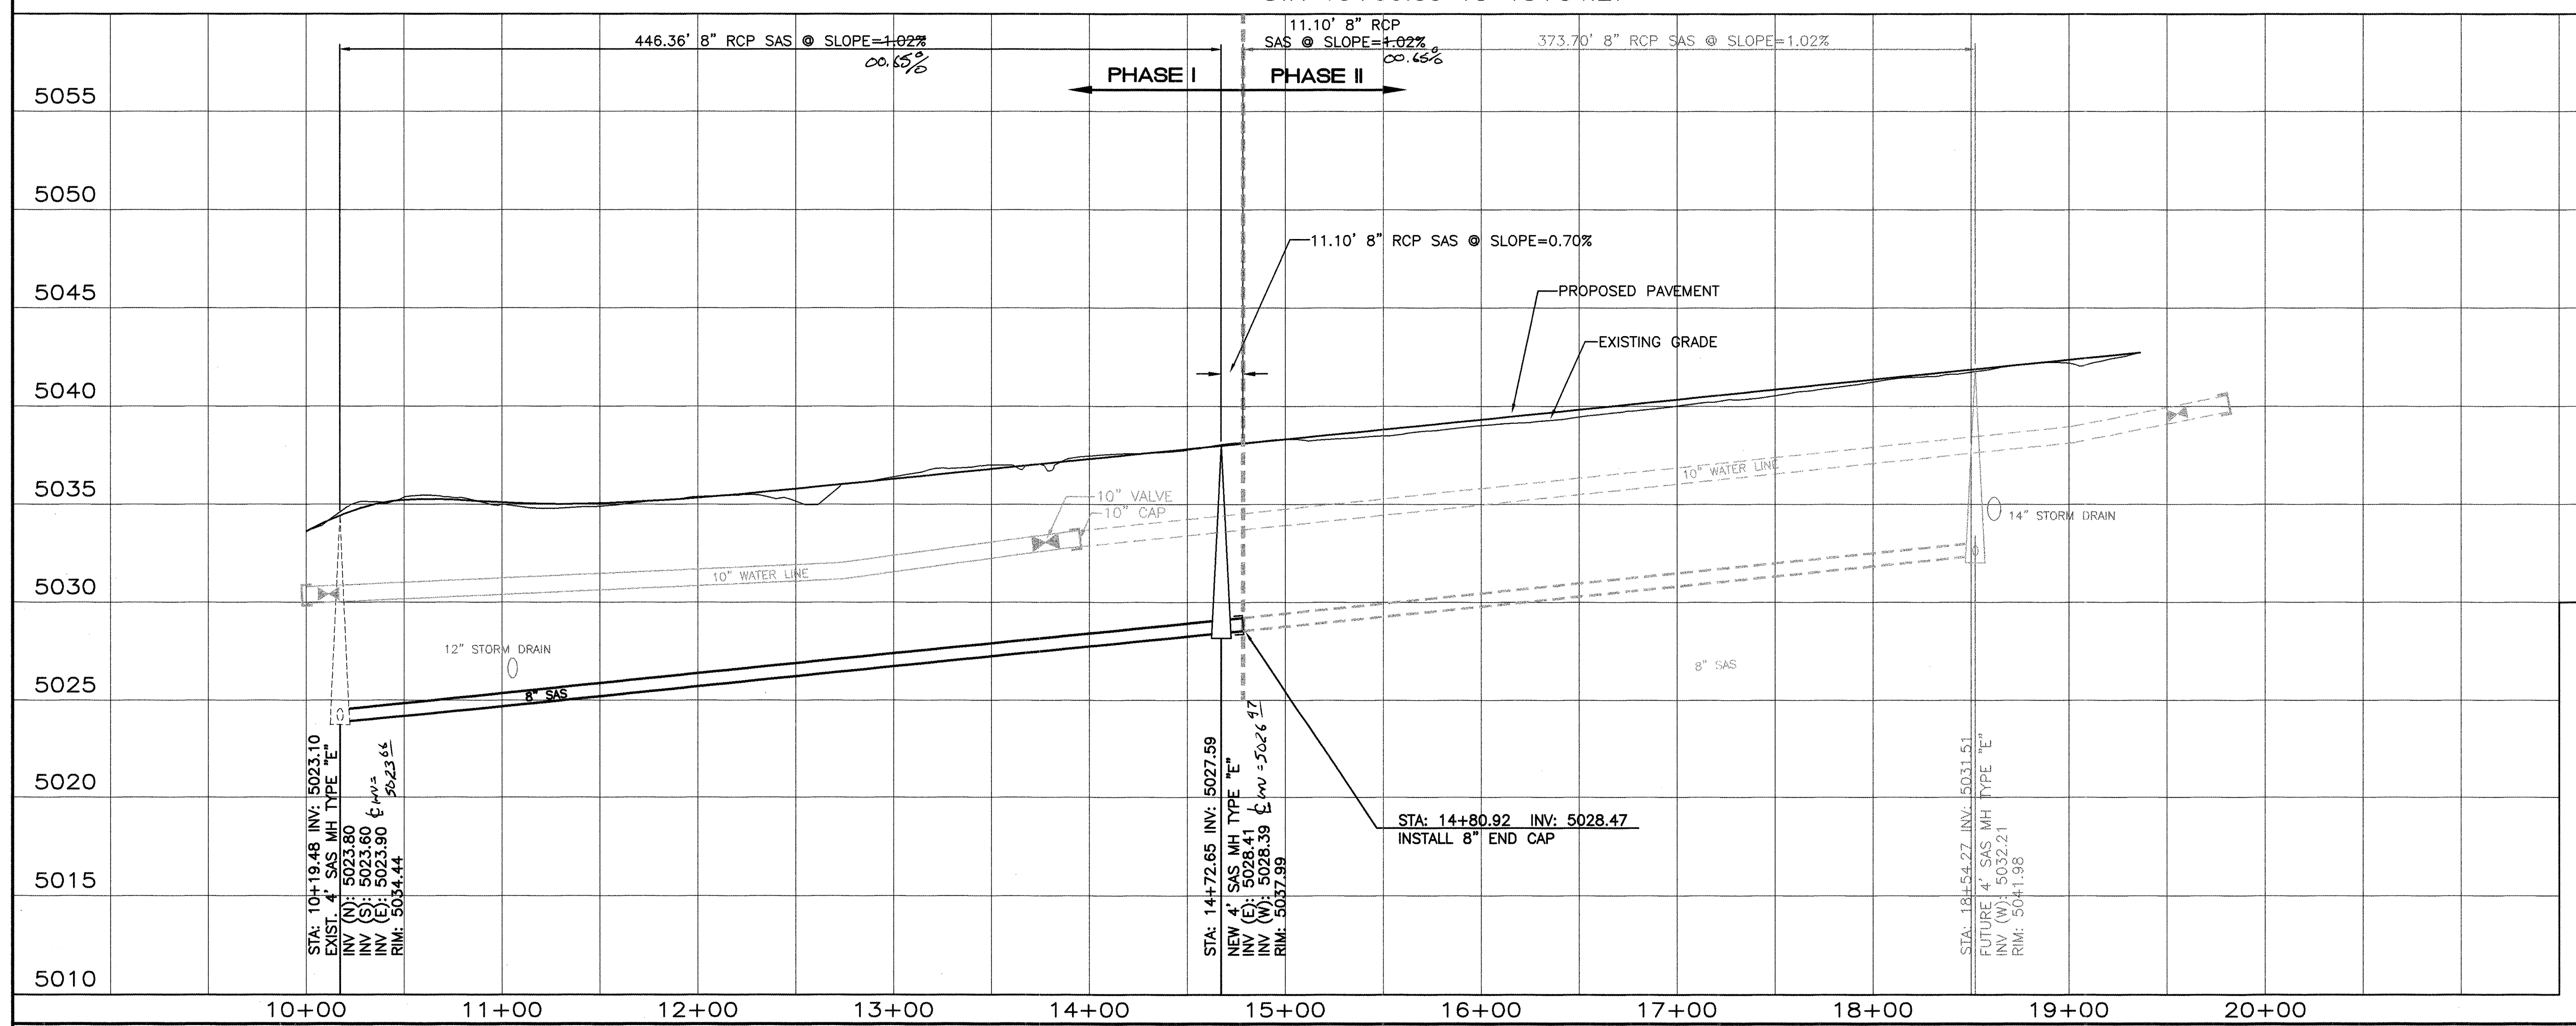

TIERRA WEST, LLC
 4421 McLEOD ROAD, N.E., SUITE D
 ALBUQUERQUE, NEW MEXICO 87109
 (505) 883-7592


CITY OF ALBUQUERQUE
 PUBLIC WORKS DEPARTMENT
 ENGINEERING GROUP

TRACT 3
 SANITARY SEWER IMPROVEMENTS
 STA 10+00.00 TO 18+54.27

DESIGN REVIEW COMMITTEE
 FEB 16 1999


CITY PROJECT NO. 598281 ZONE MAP NO. F-16 SHEET 7 OF 11

AS BUILT INFORMATION		BENCH MARKS		SURVEY INFORMATION		ENGINEER'S SEAL	
CONTRACTOR	FLORIAN'S ENGINEERING	ACS "2-F16"	DATE	NO.	BY	REMARKS	NO.
INSPECTED BY	DAVID E. ALBUQUERQUE	CENTRAL STATION DATA	DATE	NO.	BY	REMARKS	NO.
ACCEPTANCE DATE	7/6/99	NW STATE PLANE COORDINATES	DATE	NO.	BY	REMARKS	NO.
VERIFICATION DATE	7/6/99	Central Zone	DATE	NO.	BY	REMARKS	NO.
VERIFICATION BY	TERRA WEST	X=390,290.06	DATE	NO.	BY	REMARKS	NO.
DATE	7/6/99	Y=1,504,671.78	DATE	NO.	BY	REMARKS	NO.
DATE	7/6/99	G-G=0.996718	DATE	NO.	BY	REMARKS	NO.
DATE	7/6/99	Δ=-0012.36"	DATE	NO.	BY	REMARKS	NO.
DATE	7/6/99	ELEV=5378.78'	DATE	NO.	BY	REMARKS	NO.

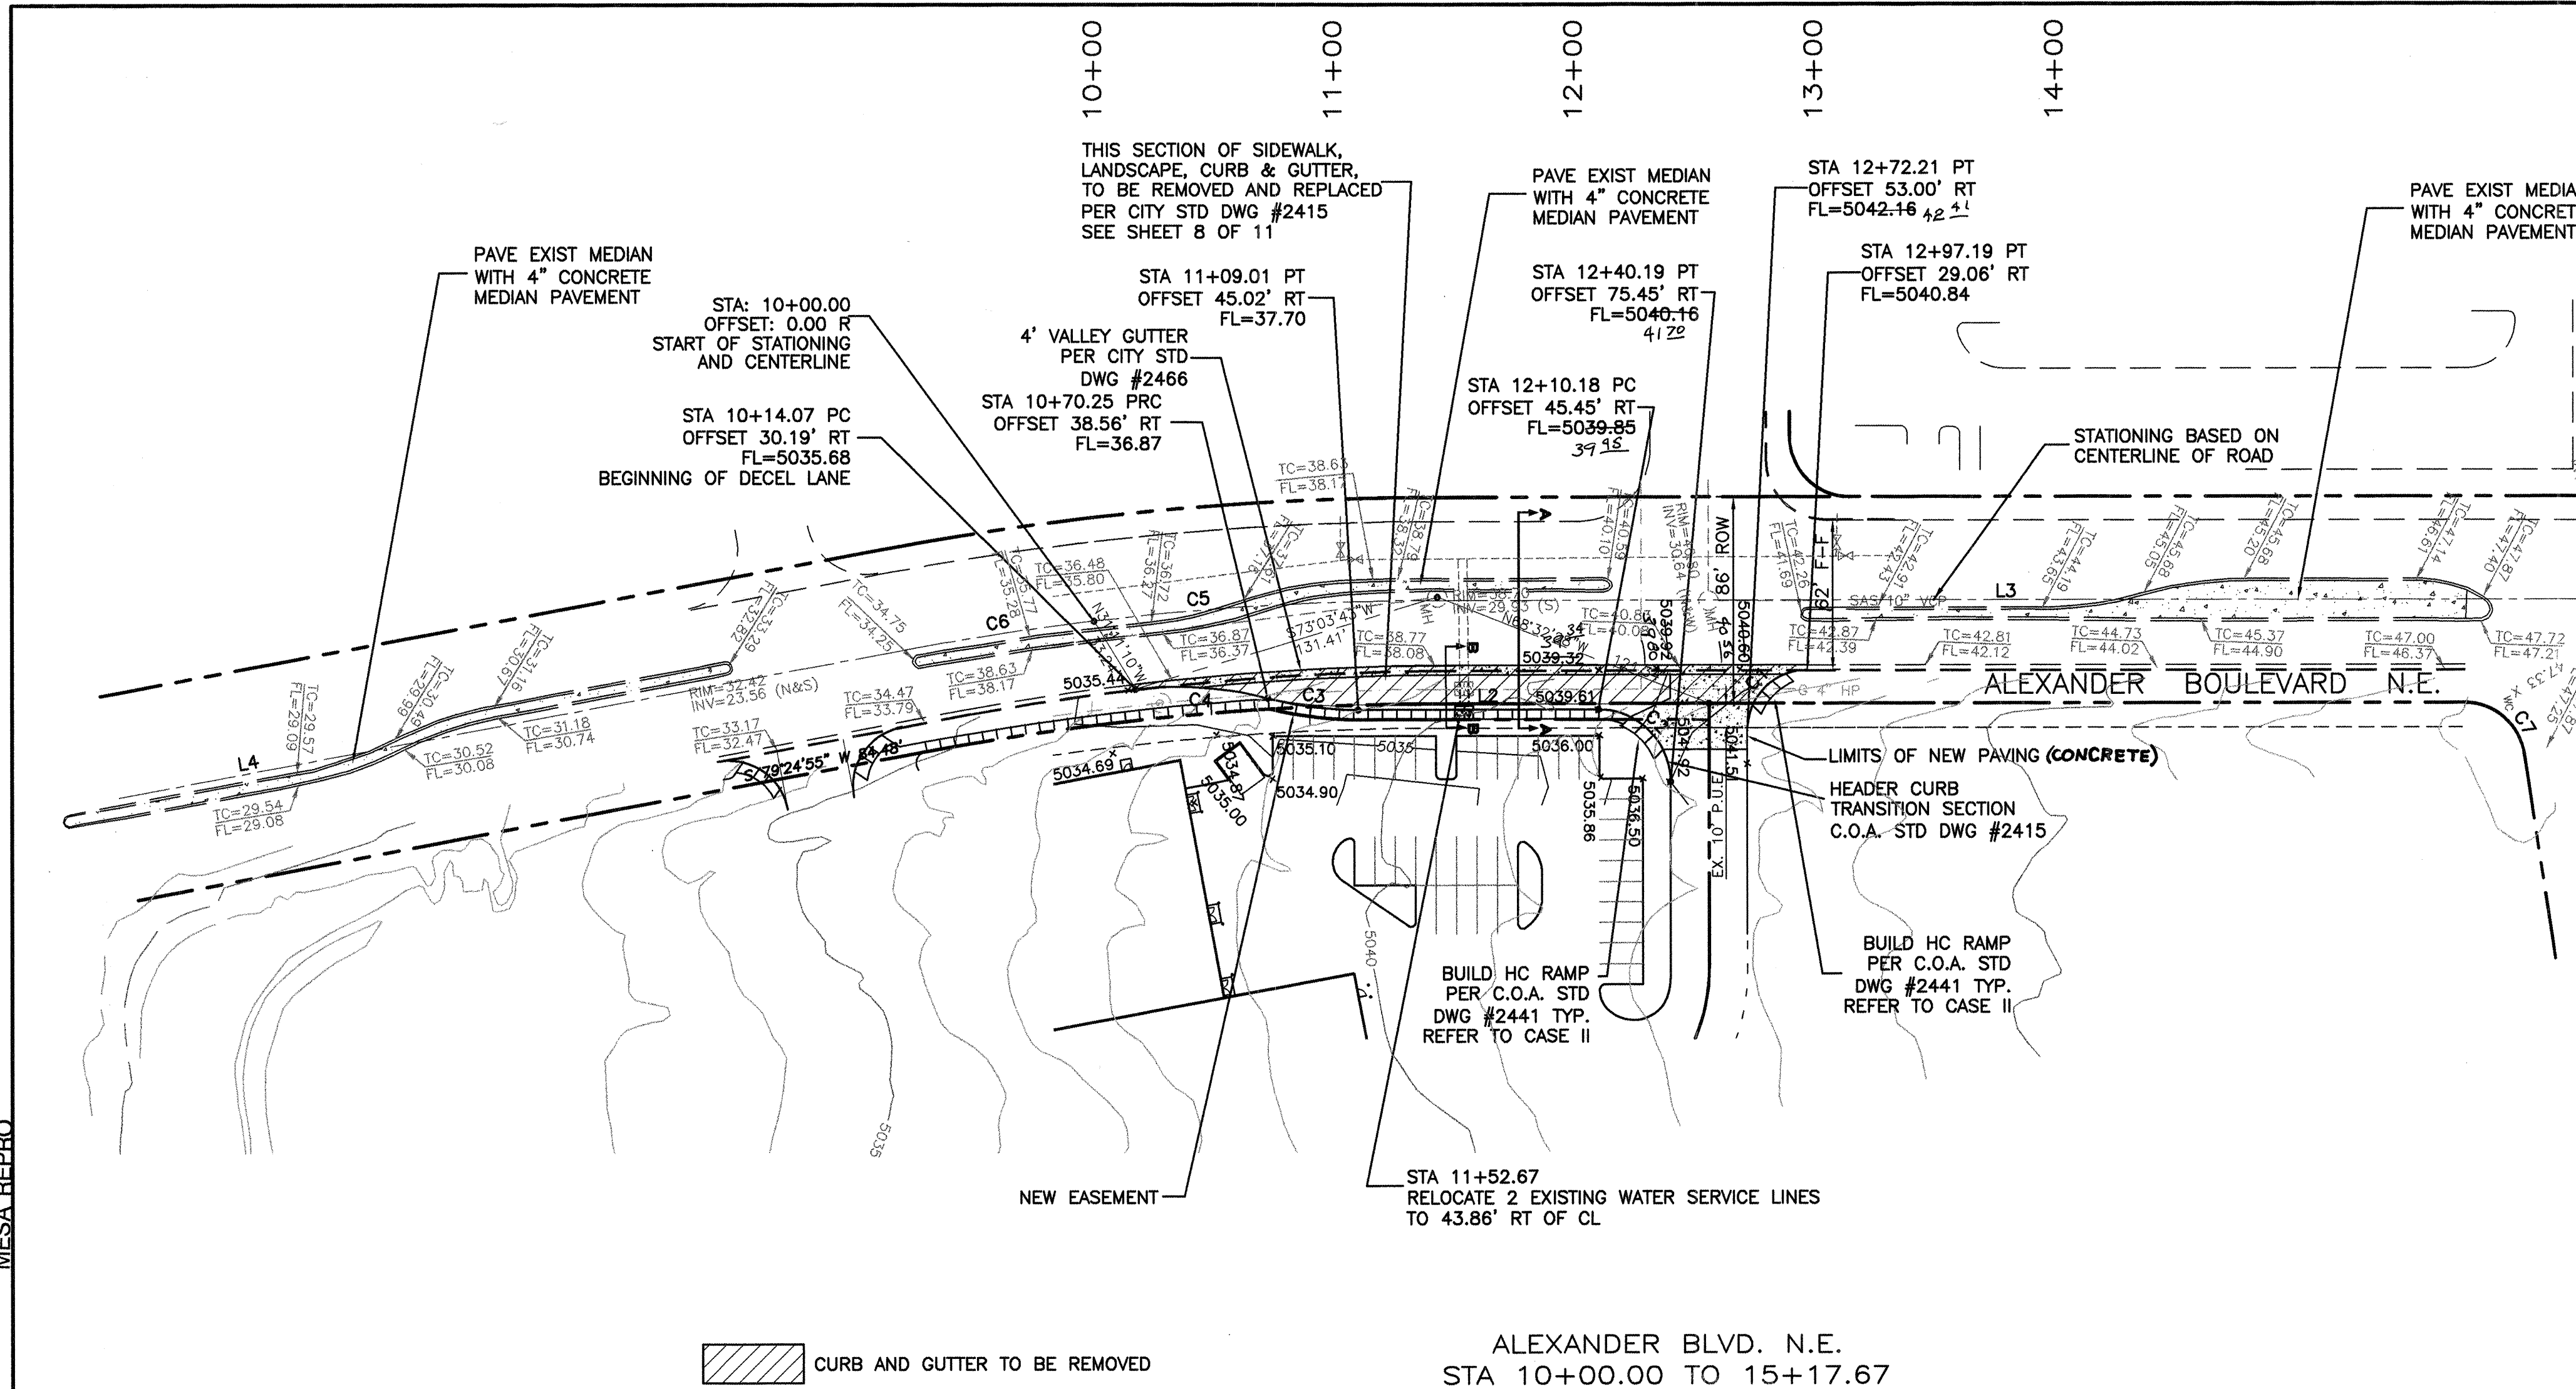


LINE TABLE		
LINE	LENGTH	BEARING
L2	99.91	S89°59'27"W
L3	474.54	N90°00'00"E
L4	333.08	N79°24'55"E

CURVE TABLE			
CURVE	LENGTH	RADIUS	TANGENT
C1	38.21	25.00	23.96
C2	47.13	30.00	30.00
C3	38.06	150.00	19.13
C4	55.51	150.00	28.08
C5	142.57	1200.12	71.37
C6	79.11	1200.00	39.57
C7	35.49	25.00	21.48

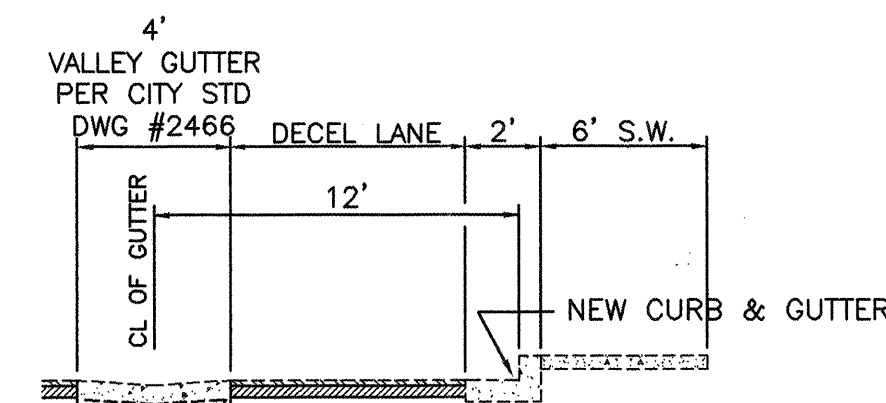

SECTION B-B - VALLEY GUTTER DETAIL
N.T.S.

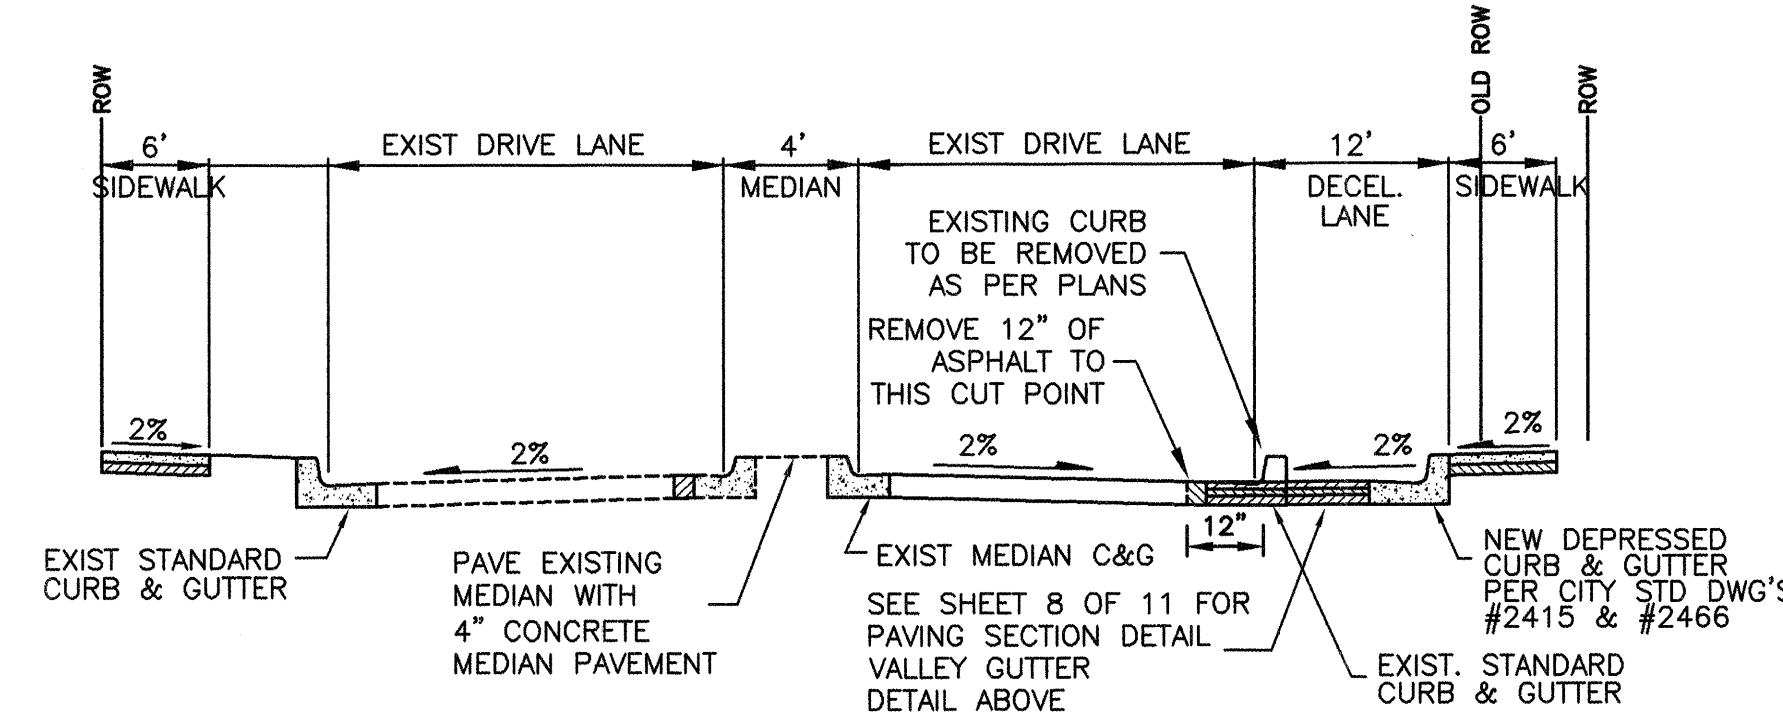


SECTION A-A
STREET/DECEL LANE CROSS SECTION
N.T.S.


RECORD DRAWING

DATE: 7-6-99 DRAFTED BY: RW
TIERRA WEST DEV.

THESE RECORD DRAWINGS HAVE BEEN PREPARED, IN PART, ON THE BASIS OF INFORMATION COMPLIED AND FURNISHED BY OTHERS. THE ENGINEER WILL NOT BE RESPONSIBLE FOR ANY ERRORS OR OMISSIONS WHICH HAVE BEEN INCORPORATED INTO THE DOCUMENT AS A RESULT.

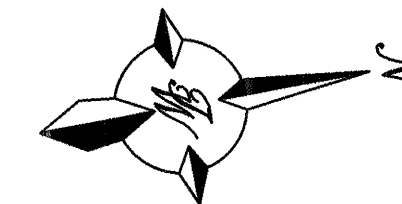

SCALE: HORIZ. 1"=50'
VERT. 1"=5'

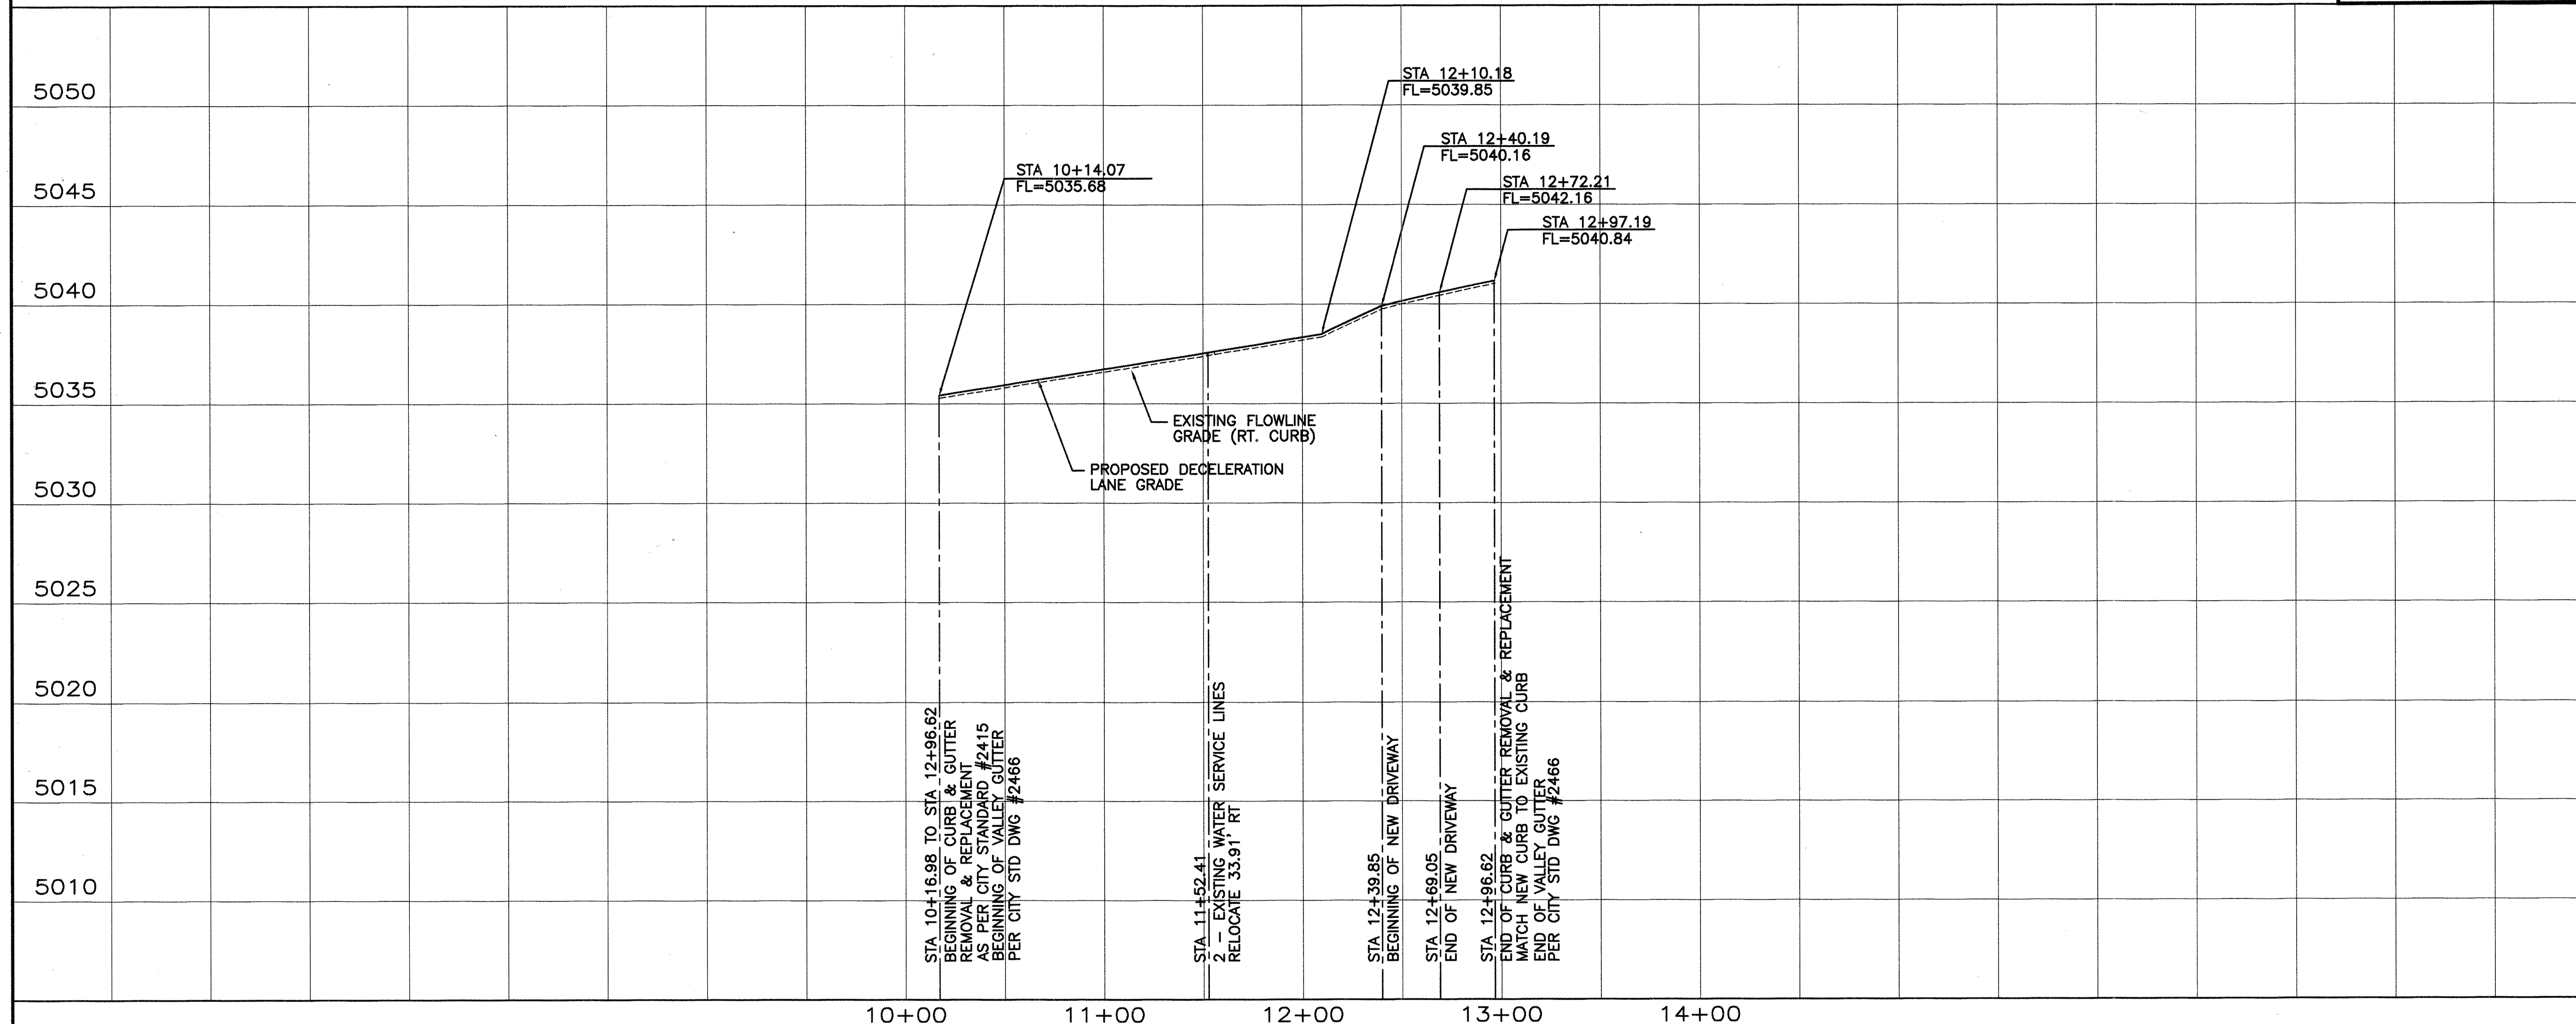

TIERRA WEST, LLC
4421 McLEOD ROAD, N.E., SUITE D
ALBUQUERQUE, NEW MEXICO 87109
(505)883-7592

CITY OF ALBUQUERQUE
PUBLIC WORKS DEPARTMENT
ENGINEERING GROUP

TRACT 3
DECELERATION LANE
ALEXANDER BLVD. STA 10+00.00 TO 16+76.26




CITY PROJECT NO. 598281 ZONE MAP NO. F-16 SHEET 9 OF 11

AS BUILT INFORMATION		BENCH MARKS		SURVEY INFORMATION		ENGINEER'S SEAL	
CONTRACTOR	Frederick Engineering	ACS "2-F16"	DATE	NO.	BY	NO.	DATE
INSPECTOR	David F. Asencio	CENTRAL STATION DATA	DATE	NO.	BY	NO.	DATE
FIELD ENGINEER	David F. Asencio	NM STATE PLANE COORDINATES	DATE	NO.	BY	NO.	DATE
FIELD ENGINEER	David F. Asencio	Central Zone	DATE	NO.	BY	NO.	DATE
FIELD ENGINEER	David F. Asencio	X=390,290.06	DATE	NO.	BY	NO.	DATE
FIELD ENGINEER	David F. Asencio	Y=1,504,671.78	DATE	NO.	BY	NO.	DATE
FIELD ENGINEER	David F. Asencio	G-G=0.9986718	DATE	NO.	BY	NO.	DATE
FIELD ENGINEER	David F. Asencio	Δ=-0012'36"	DATE	NO.	BY	NO.	DATE
FIELD ENGINEER	David F. Asencio	ELEV=5378.787	DATE	NO.	BY	NO.	DATE

SCANNED BY
MESA REPRO

20. ANY FIELD ADJUSTMENTS SHALL BE APPROVED BY CONSTRUCTION COORDINATION.

27. CONTRACTOR SHALL MAINTAIN A GRAFFITI-FREE WORKSITE. ALL GRAFFITI SHALL BE PROMPTLY REMOVED FROM ALL EQUIPMENT, BOTH PERMANENT AND TEMPORARY. 4

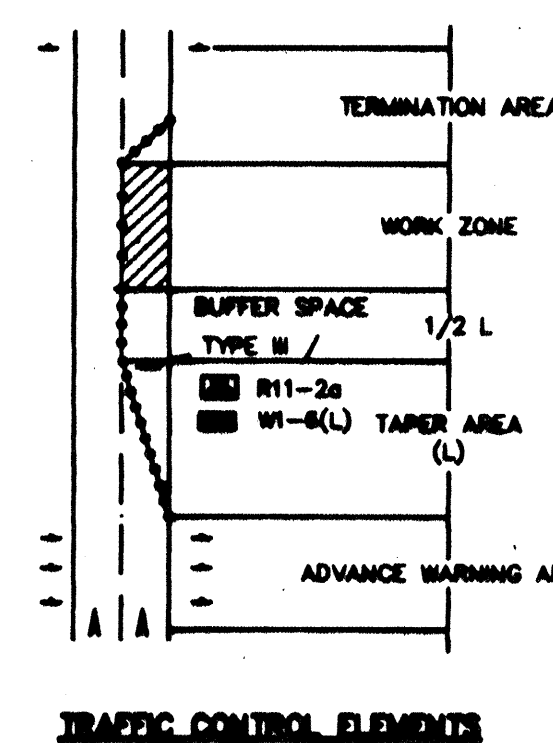

TAPER REQUIREMENTS

SPEED LIMIT (MPH)	TAPER LENGTH (L) (FEET)			MINIMUM NUMBER OF DEVICES FOR TAPER	MAXIMUM DEVICE SPACING IN FEET	
	10' LANE	11' LANE	12' LANE		ALONG TAPER	AFTER TAPER
20	70	75	80	5	20	20
25	105	115	125	6	25	25
30	150	165	180	7	30	30
35	205	225	245	8	35	35
40	270	295	320	9	40	40
45	450	495	540	13	45	45
50	500	550	600	13	50	50
55	550	605	660	13	55	55

SPEED MILES PER HOUR	MINIMUM DISTANCE IN FEET	
	BETWEEN SIGNS	FROM LAST SIGN TO TAPER
0-20	10 X SPEED LIMIT	10 X SPEED LIMIT
25-30	10 X SPEED LIMIT	10 X SPEED LIMIT
30-35	10 X SPEED LIMIT	10 X SPEED LIMIT
40-45	10 X SPEED LIMIT	10 X SPEED LIMIT
50-60	10 X SPEED LIMIT	10 X SPEED LIMIT

UPSTREAM TAPER:	
MERGING TAPER	L MINIMUM
SHIFTING TAPER	1/2 L MINIMUM
SHOULDER TAPER	1/2 L MINIMUM
TWO-WAY TRAFFIC TAPER	100 FEET MAXIMUM
DOWNSTREAM TAPERS	100 FEET PER LANE

SPEED LIMIT

40 MPH OR LESS $L = \frac{WS^2}{60}$

45 MPH OR GREATER $L = W \times S$

L = TAPER LENGTH
W = WIDTH OF OFFSET IN FEET
S = POSTED SPEED OR OFF-PEAK
85-PERCENTILE SPEED IN MPH

 W1-1(R) 30 MPH or LESS	 W1-1(L) 30 MPH or LESS	 W1-2(R) 30 MPH or GREATER	 W1-2(L) 30 MPH or GREATER	 W1-3(R) 30 MPH or LESS	 W1-3(L) 30 MPH or LESS	 W1-4(R) 30 MPH or GREATER	 W1-4(L) 30 MPH or GREATER	 W1-8(R) 36"	 W1-8(L) 36"	 W3-1 STOP AHEAD
 W4-2(R) 36"	 W4-2(L) 36"	 W6-3 36"	 W6-1 36"	 W6-3 36"	 W6-3A 36"	 W6-7 36"	 W13-1 36"	 W12-1 36"	 W6-9a 36"	 W4-2 36"
 W3-1A 36"	 W4-2 36"	 W6-3 36"	 W6-1 36"	 W6-3 36"	 W6-3A 36"	 W6-7 36"	 W13-1 36"	 W12-1 36"	 W6-9a 36"	 W4-2 36"
 W3-1A 36"	 W4-2 36"	 W6-3 36"	 W6-1 36"	 W6-3 36"	 W6-3A 36"	 W6-7 36"	 W13-1 36"	 W12-1 36"	 W6-9a 36"	 W4-2 36"
 W3-1A 36"	 W4-2 36"									

ALL CONSTRUCTION WARNING SIGNS SHALL HAVE A BLACK LEGEND ON A ORANGE BACKGROUND.

ENGINEER'S SEAL		SURVEY INFORMATION		BENCH MARKS		AS BUILT INFORMATION	
J.D.L.		FIELD NOTES					
		NO.	BY	DATE		DATE	
ADD NOTE NO. 27	9/25/93					CONTRACTOR	DATE
REVISED NOTE NO. 26	9/24/93					WORK	DATE
REVISED NOTE NO. 19	9/24/93					REVISIONS BY	DATE
REVISED NOTE NO. 11	9/24/93					DATE	DATE
NO. DATE	REMARKS					VERIFICATION BY	DATE
REVISIONS						CONNECTED BY	DATE
DESIGN						MICRO-FILM INFORMATION	
DESIGNED BY	DATE					RECORDED BY	DATE
DRAWN BY C.O.A. STANDARDS	DATE						
CHECKED BY	DATE						

CITY OF ALBUQUERQUE PUBLIC WORKS DEPARTMENT ENGINEERING DEVELOPMENT GROUP									
TITLE:		TRACT 3							
SIGNING AND CONSTRUCTION TRAFFIC CONTROL STANDARDS									
DESIGN REVIEW COMMITTEE		CITY ENGINEER APPROVAL		LAST UPDATE		MO./DAY/YR.		MO./DAY/YR.	
COA Standard									
PROJECT NO.		598281		MAP NO.		F-16		SHEET OF	
						11		11	