

EAGLE POINTE SUBDIVISION

ALBUQUERQUE, NEW MEXICO


IMPROVEMENTS FOR GRADING, PAVING, AND UTILITIES

INDEX OF DRAWINGS

SHEET NO.	DESCRIPTION
1.	TITLE SHEET
2.-3.	SUBDIVISION PLAT
4.	GRADING AND DRAINAGE PLAN
5.	GRADING DETAILS
PAVING PLAN AND PROFILES	
6.	COMPOSITE PAVING PLAN
7.	PAVING SECTIONS AND DETAILS
8.	RAVIN RIDGE DRIVE (STA 10+00 TO 10+57.62), EAGLE MESA ROAD (STA 10+00 TO STA 16+53.60), MOON EAGLE DRIVE (STA 16+53.60 TO 18+08.83) AND EAGLE POINT DRIVE (0+00 TO 1+43.74)
9.	RAVEN RIDGE DRIVE (STA 10+57.62-12+04.64), RED HAWK ROAD (STA 12+04.64-18+60.12) MOON EAGLE DRIVE (18+08.83-18+72.78)
10.	NE STUB STREET (STA 0+00.00-01+78.29) & SE STUB STREET (STA 0+00.00-1+70.13) NW STUB STREET (STA 0+00-01+81.82) & SW STUB STREET (STA 0+00.00-1+79.71)
11.	WILSHIRE AVENUE (STA 9+00 - STA 19+90.72)
12.	CORONA AVENUE (STA 8+50.00 - STA 19+90.40)
13.	LOUISIANA BOULEVARD (STA 55+90.40 TO STA 65+00.00 BK =20+32.85 AHD)
14.	LOUISIANA BOULEVARD (STA 20+32.85 TO STA 30+00.00)
15.	LOUISIANA BOULEVARD (STA 30+00.00 TO STA 41+00.00)
16.	LOUISIANA BOULEVARD (STA 41+00.00 TO STA 48+73.06)
UTILITY PLAN AND PROFILES	
17.	COMPOSITE UTILITY PLAN
18.	RAVIN RIDGE DR.(10+75.00-10+00), EAGLE MESA RD.(10+00.00-16+53.60) & MOON EAGLE DRIVE(STA 16+53.60-STA 18+08.83)
19.	RAVEN RIDGE DR.(STA 10+75.00-12+04.64), RED HAWK RD.(STA 12+04.64-18+60.12) MOON EAGLE DR.(STA 18+72.78-18+08.83)
20.	SE STUB STREET (STA 0+00-01+70.13) & SW STUB STREET (STA 0+00.00-1+79.71)
21.	CORONA AVENUE (STA 8+50.00 - STA 19+90.40)
TRAFFIC CONTROL	
22.	TYPICAL TRAFFIC CONTROL & SIGNING EXAMPLES
23.	SIGNING & CONSTRUCTION TRAFFIC CONTROL STANDARDS

FOR INFORMATION ONLY
Peter Chang 3/2/00

DRB 97-229

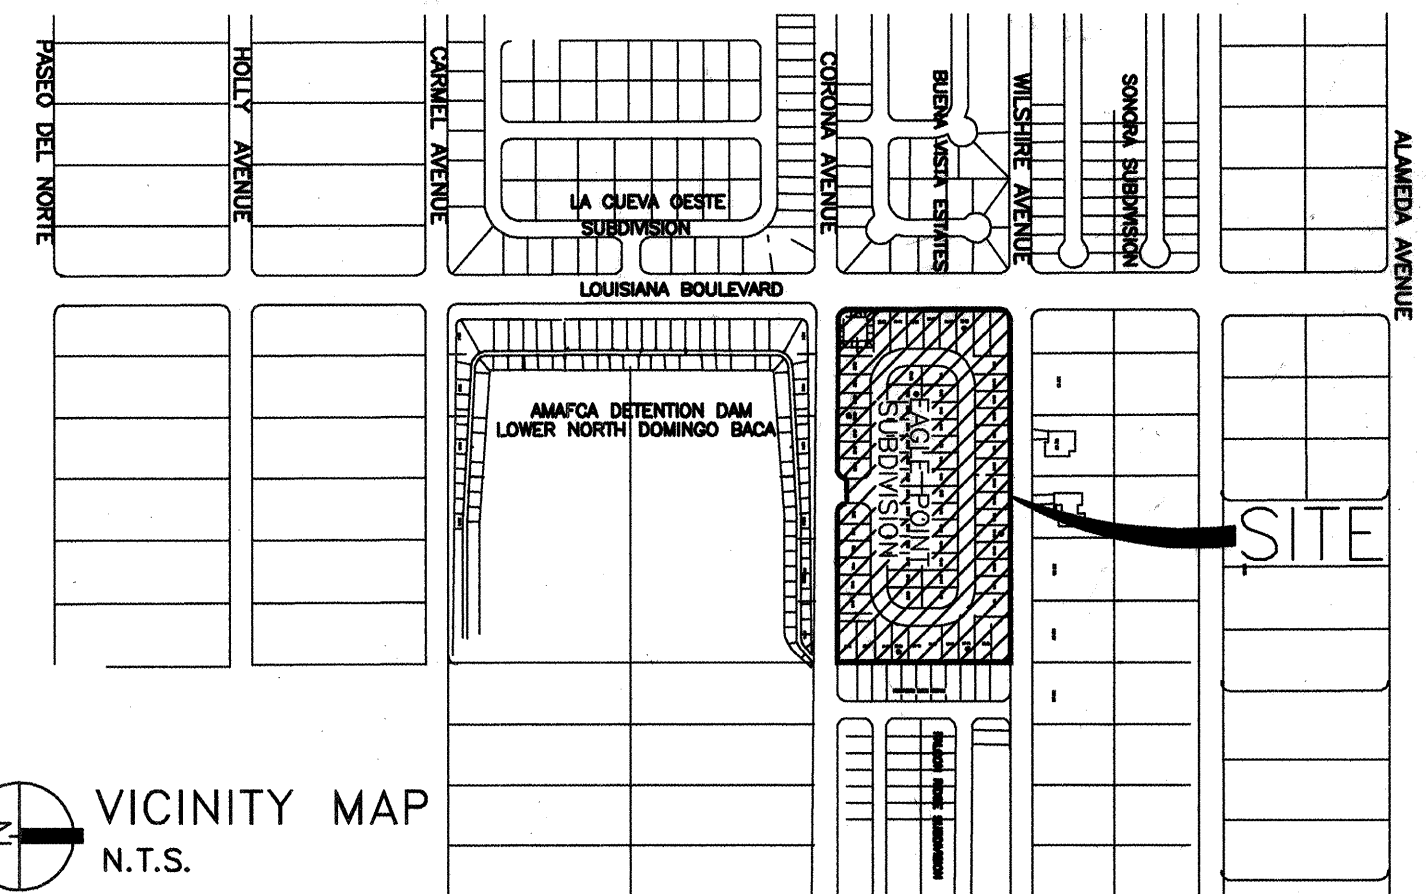

ZONE ATLAS PAGE NO. C-19

GENERAL NOTES


1. An EXCAVATION/CONSTRUCTION PERMIT will be required before beginning any work within the CITY RIGHT OF WAY.
2. All work detailed on these plans to be performed under contract shall, except as otherwise stated or provided for hereon, be constructed in accordance with the City of Albuquerque Standard Specifications for Public Works Construction 1986 Edition as REVISED through Update NO. 6.
3. Two (2) working days prior to any excavation, Contractor must contact Line Locating Service @ 260-1990 for location of existing utilities.
Warning - EXISTING UTILITY LINE LOCATIONS are shown in an approximate manner only, and such lines may exist where none are shown. The location of any such existing lines is based upon information provided by the utility company, the owner, or by others, and the information may be incomplete or may be obsolete by the time construction commences.
4. Prior to construction, the Contractor shall excavate & verify the horizontal and vertical locations of all obstructions. Should a conflict exist, the Contractor shall notify the Engineer immediately so that the conflict can be resolved with minimum delay.
5. TRAFFIC CONTROL: Five (5) working days prior to beginning construction the contractor shall submit to the Construction Coordination Division a detailed construction schedule. Two (2) working days prior to construction the contractor shall obtain a Barricading Permit from the Construction Coordination Division. Contractor shall notify Barricade Engineer (768-2521) prior to occupying an intersection. See Section 19 of the Specifications.
6. Any work affecting an arterial roadway requires twenty-four hour construction.
7. All street striping altered or destroyed shall be replaced with plastic reflectorized pavement markings by Contractor to the same location as was existing, or as otherwise indicated by the plans.
8. Contractor shall notify Engineer not less than seven (7) days prior to starting Work Order such that City Surveyor may take necessary measures to insure the preservation of survey monuments. Contractor shall not disturb permanent survey monuments without the consent of the City Surveyor and shall notify the City Surveyor and bear the expense of replacing any that may be disturbed without permission. Replacement shall be done only by the City Surveyor. When a change is made in the finished elevations of the pavement of any roadway in which a permanent Survey Monument is located, Contractor shall, at his own expense, adjust the monument cover to the new grade unless otherwise specified. Refer to Standard Specifications, Section 4.4 of the General Conditions.
9. Contractor shall record data on all utility lines and accessories as required by the City of Albuquerque for the preparation of "AS-CONSTRUCTED DRAWINGS". Contractor shall not cover utility lines and accessories until all data has been recorded.
10. Contractor shall maintain a "Graffiti-Free" work site. Contractor shall promptly remove any graffiti from all equipment, whether permanent or temporary.
11. Contractor shall coordinate with the City of Albuquerque Water Systems Division (857-8200) five (5) working days in advance of any work that may effect existing water and/or sanitary sewer utilities. Existing valves to be operated by City personnel only. Contractor to notify the Water Systems Division three (3) working days prior to needing valves turned on or off.

REV.	SHEETS	CITY ENGINEER	DATE	USER DEPARTMENT	DATE	USER DEPARTMENT	DATE
ENGINEERS STAMP & SIGNATURE		APPROVALS		ENGINEER	DATE	*****	
		DRC Chairman		<i>[Signature]</i>	8-24-00	APPROVED FOR CONSTRUCTION	
		Transportation		<i>[Signature]</i>	8-18-00		
		Water/Wastewater		<i>Bradley D. Brynham</i>	8-17-00		
		Hydrology		<i>[Signature]</i>	8-10-00		
		CIP		<i>[Signature]</i>	8-24-00		
Constr. Mngmt.		<i>[Signature]</i>	8-24-00	City Engineer		Date	
Const. Contr.		<i>[Signature]</i>	8-24-00	City PROJECT No.		6004.81	Sheet 1 Of 23


PLAT OF
EAGLE POINTE SUBDIVISION
CITY OF ALBUQUERQUE, BERNALILLO COUNTY
STATE OF NEW MEXICO
AUGUST, 2000

FILED: 9-10-31, BK. D1, FOLIO 20

FALCON RIDGE
SUBDIVISION
FILED: 7-31-97, BK. 97C, FOLIO 239

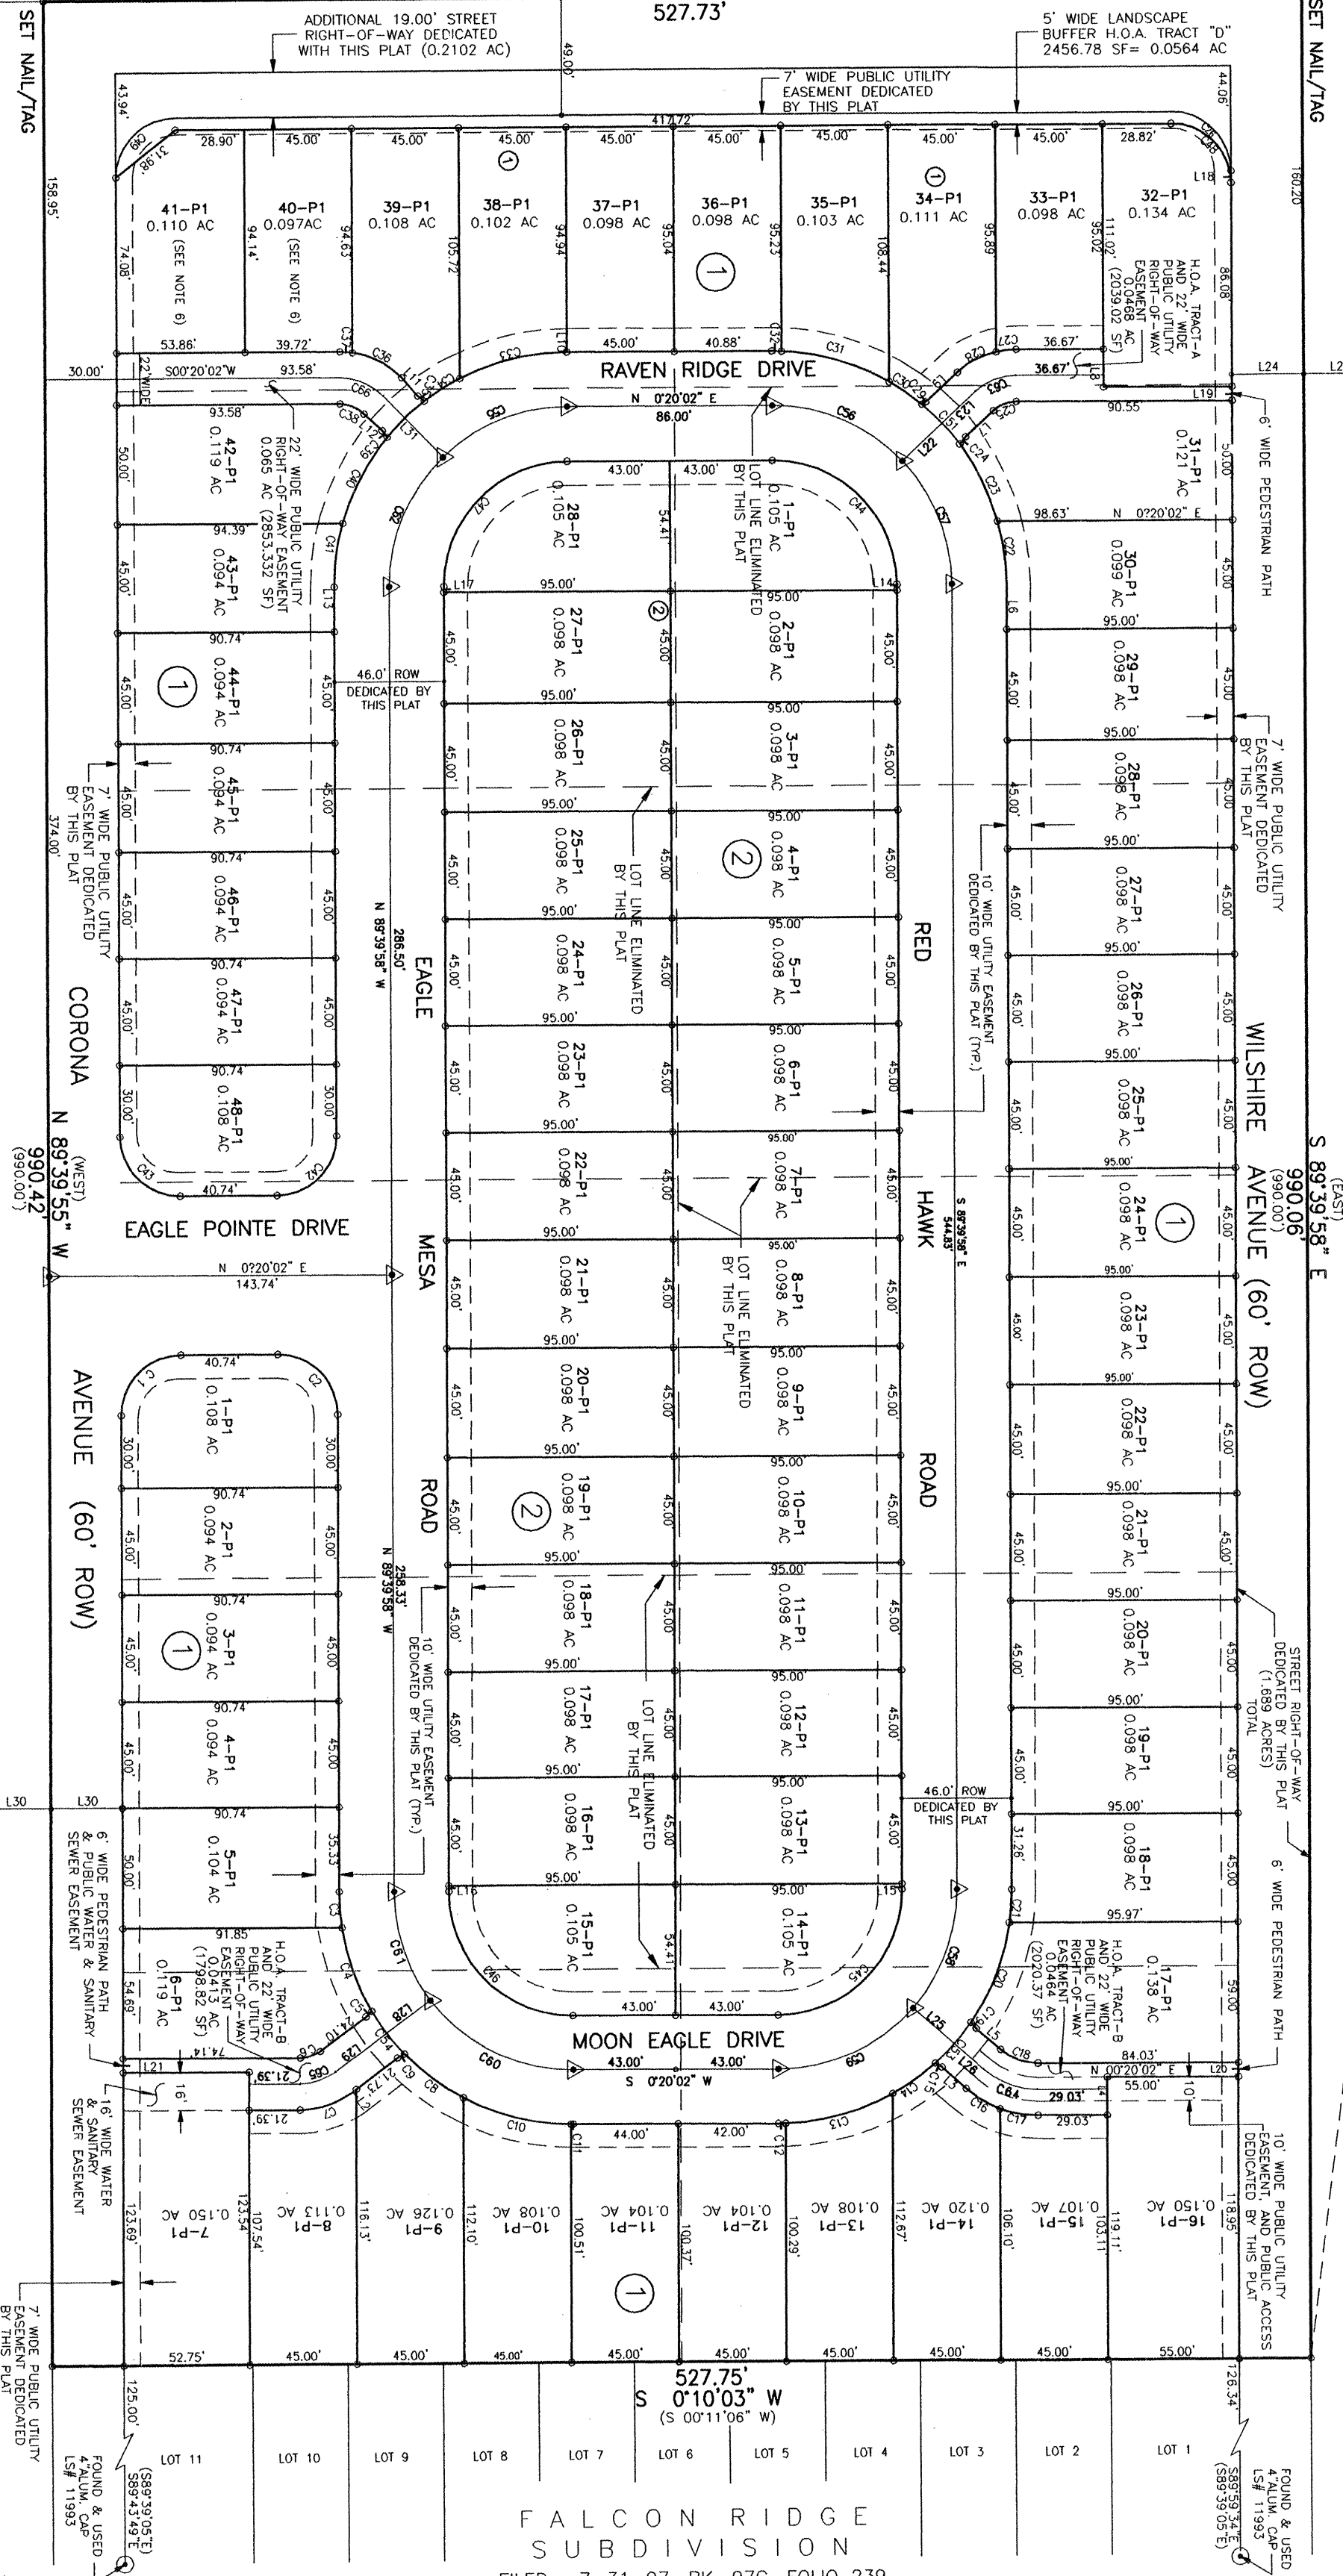

BUENA VISTA
ESTATES
(UNIT I)
FILED: 8-21-97, BK. 97C, FOLIO 257

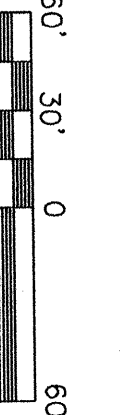

LINE	BEARING	DISTANCE	BEARING	DISTANCE	
1	N 89°29'55" E	24.1	1	N 89°29'55" E	24.1
2	N 89°29'55" E	24.1	2	N 89°29'55" E	24.1
3	N 89°29'55" E	24.1	3	N 89°29'55" E	24.1
32	N 89°29'55" E	24.1	32	N 89°29'55" E	24.1

NORTH ALBUQUERQUE ACRES
TRACT 2, UNIT 3
FILED: 9-10-31, BK. D1, FOLIO 20

LINE	BEARING	DISTANCE	BEARING	DISTANCE	
1	N 89°29'55" E	24.1	1	N 89°29'55" E	24.1
2	N 89°29'55" E	24.1	2	N 89°29'55" E	24.1
3	N 89°29'55" E	24.1	3	N 89°29'55" E	24.1
32	N 89°29'55" E	24.1	32	N 89°29'55" E	24.1



LEGEND

A = SPT CONCRETE MONUMENT
C = STAINLESS STEEL MONUMENT
D = CEMENT MONUMENT
E = IRON MONUMENT
F = BRASS MONUMENT
G = FOUND SURVEY MONUMENT - DESCRIPTION AS NOTED

EAGLE POINTE SUBDIVISION

CLINT SHERILL & ASSOC.
730 SAN MATEO S. E.
ALBUQUERQUE, NEW MEXICO 87108
(505) 266-7884 (505) 266-7880 FAX

DATE: AUGUST 2000
REVISION: SHEET 2 OF 2

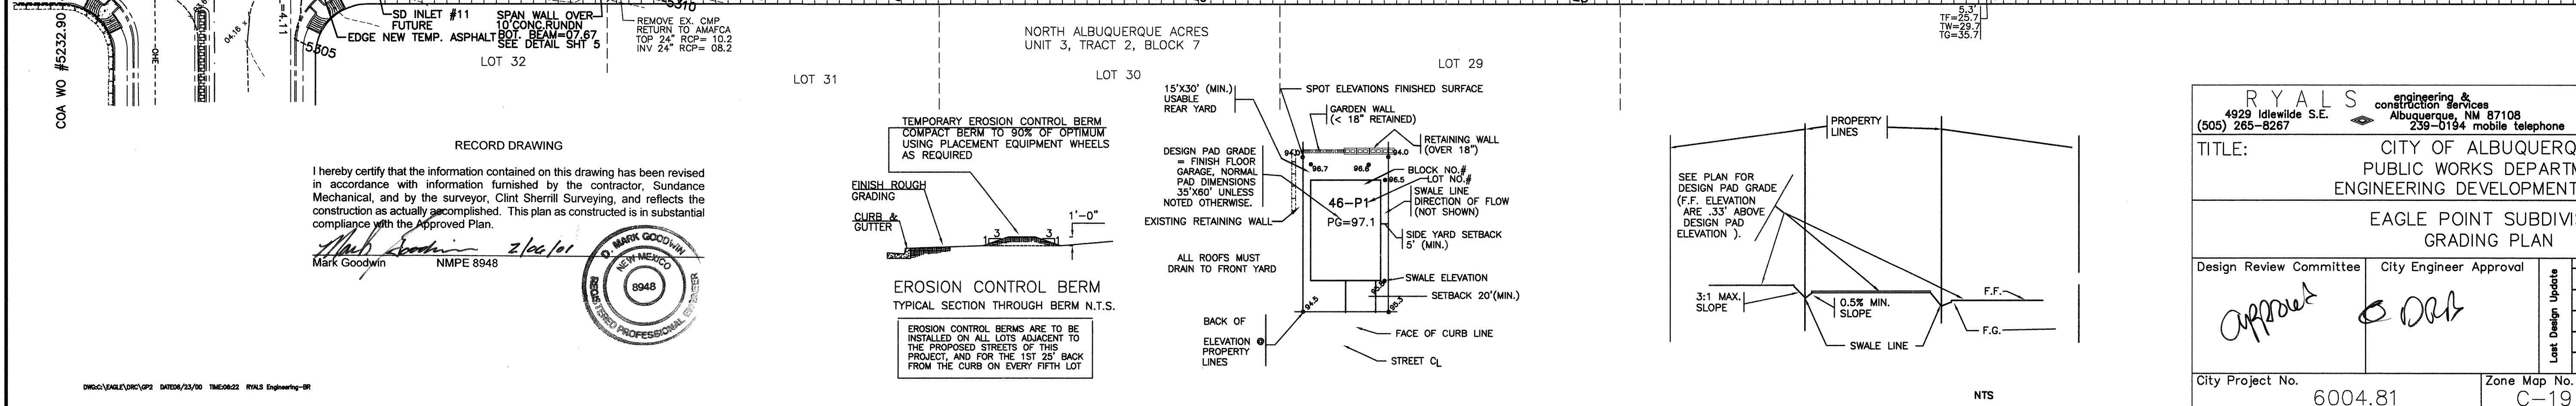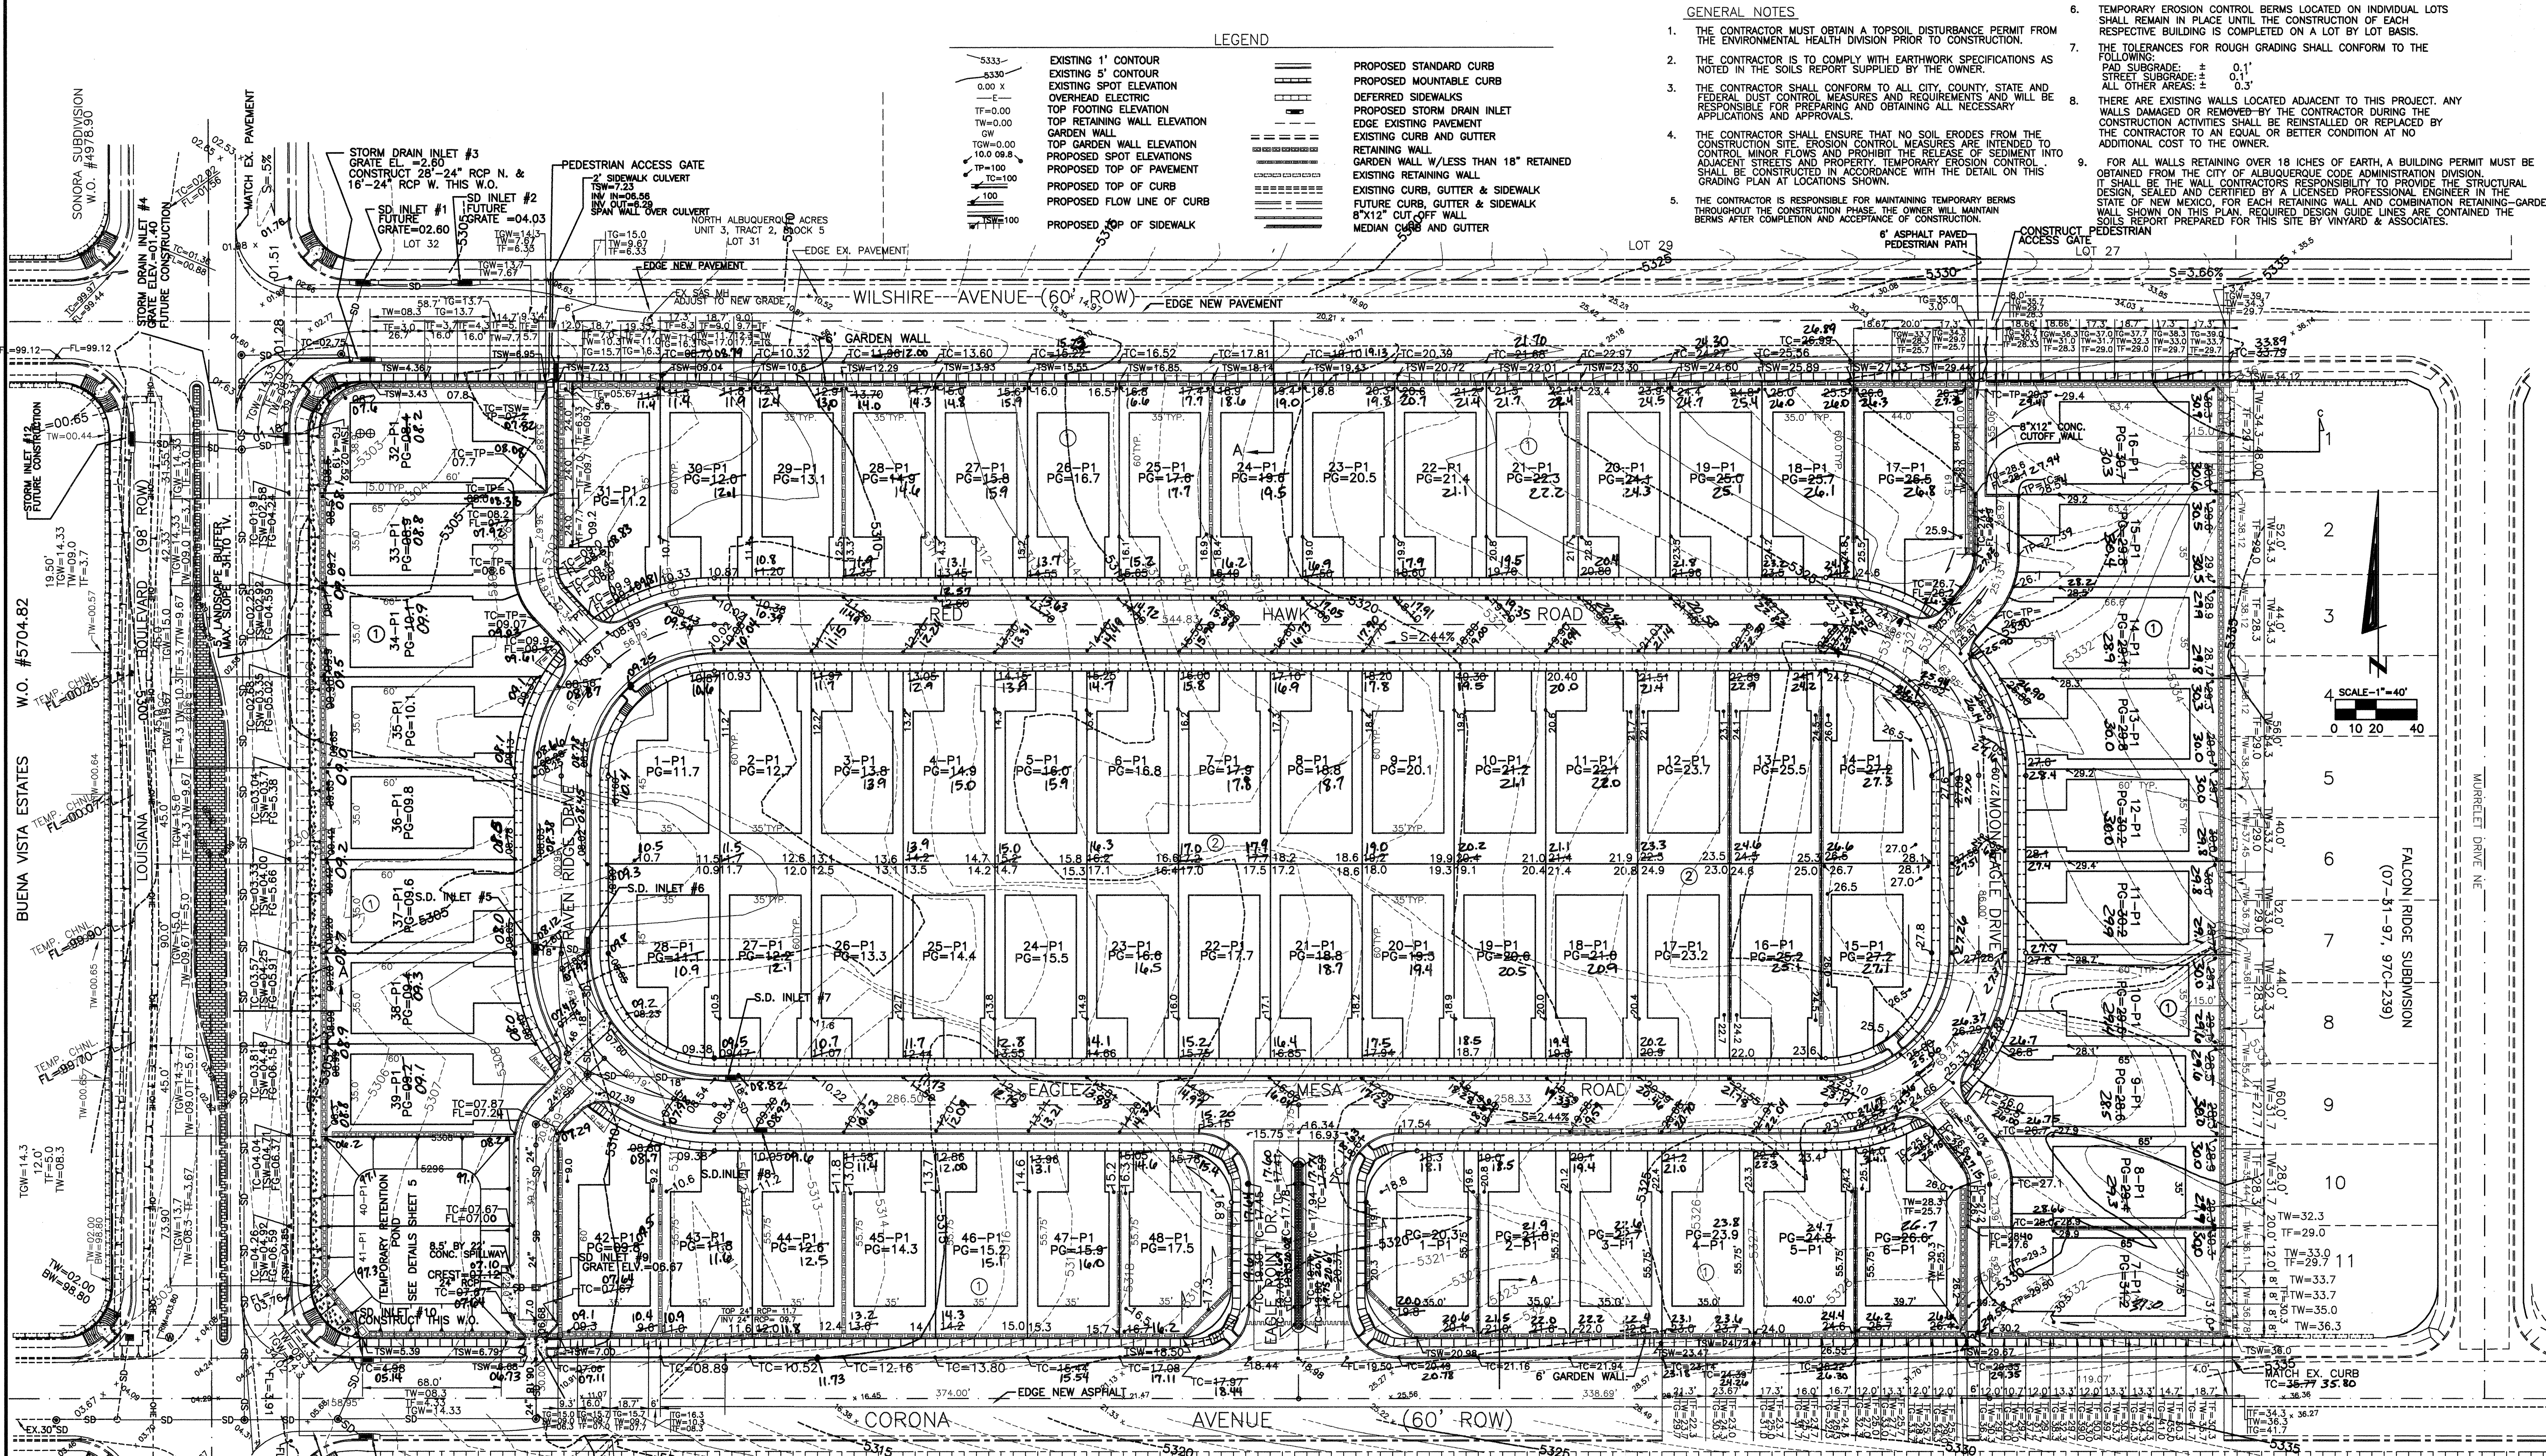

RECORD DRAWING

I hereby certify that the information contained on this drawing has been revised in accordance with information furnished by the contractor, Sundance Mechanical, and by the surveyor, Clint Sherrill Surveying, and reflects the construction as actually accomplished. This plan as constructed is in substantial compliance with the Approved Plan.

Mark Goodwin 2/06/01 NMPE 8948

EROSION CONTROL BERM
TYPICAL SECTION THROUGH BERM N.T.S.

EROSION CONTROL BERMS ARE TO BE INSTALLED ON ALL LOTS ADJACENT TO THE PROPOSED STREETS OF THIS PROJECT, AND FOR THE 1ST 25' BACK FROM THE CURB ON EVERY FIFTH LOT

TEMPORARY EROSION CONTROL BERM
COMPACT BERM TO 90% OF OPTIMUM USING PLACEMENT EQUIPMENT WHEELS AS REQUIRED

FINISH ROUGH GRADING

CURB & GUTTER

1'-0"

SEE PLAN FOR DESIGN PAD GRADE (F.F. ELEVATION ARE 3' ABOVE DESIGN PAD ELEVATION)

3:1 MAX. SLOPE

0.5% MIN. SLOPE

F.F.

F.G.

SWALE LINE

SWALE ELEVATION

SETBACK 20'(MIN.)

FACE OF CURB LINE

STREET CL

- GENERAL NOTES
- THE CONTRACTOR MUST OBTAIN A TOPSOIL DISTURBANCE PERMIT FROM THE ENVIRONMENTAL HEALTH DIVISION PRIOR TO CONSTRUCTION.
 - THE CONTRACTOR IS TO COMPLY WITH EARTHWORK SPECIFICATIONS AS NOTED IN THE SOILS REPORT SUPPLIED BY THE OWNER.
 - THE CONTRACTOR SHALL CONFORM TO ALL CITY, COUNTY, STATE AND FEDERAL DUST CONTROL MEASURES AND REQUIREMENTS AND WILL BE RESPONSIBLE FOR PREPARING AND OBTAINING ALL NECESSARY APPLICATIONS AND APPROVALS.
 - THE CONTRACTOR SHALL ENSURE THAT NO SOIL ERODES FROM THE CONSTRUCTION SITE. EROSION CONTROL MEASURES ARE INTENDED TO CONTROL MINOR FLOW AND PROHIBIT THE RELEASE OF SEDIMENT INTO ADJACENT STREETS AND PROPERTY. TEMPORARY EROSION CONTROL SHALL BE CONSTRUCTED IN ACCORDANCE WITH THE DETAIL ON THIS GRADING PLAN AT LOCATIONS SHOWN.
 - THE CONTRACTOR IS RESPONSIBLE FOR MAINTAINING TEMPORARY BERMS THROUGHOUT THE CONSTRUCTION PHASE. THE OWNER WILL MAINTAIN BERMS AFTER COMPLETION AND ACCEPTANCE OF CONSTRUCTION.
 - TEMPORARY EROSION CONTROL BERMS LOCATED ON INDIVIDUAL LOTS SHALL REMAIN IN PLACE UNTIL THE CONSTRUCTION OF EACH RESPECTIVE BUILDING IS COMPLETED ON A LOT BY LOT BASIS.
 - THE TOLERANCES FOR ROUGH GRADING SHALL CONFORM TO THE FOLLOWING:
PAD SUBGRADE: ± 0.1'
STREET SUBGRADE: ± 0.1'
ALL OTHER AREAS: ± 0.3'
 - THERE ARE EXISTING WALLS LOCATED ADJACENT TO THIS PROJECT. ANY WALLS DAMAGED OR REMOVED BY THE CONTRACTOR DURING THE CONSTRUCTION ACTIVITIES SHALL BE REINSTALLED OR REPLACED BY THE CONTRACTOR TO AN EQUAL OR BETTER CONDITION AT NO ADDITIONAL COST TO THE OWNER.
 - FOR ALL WALLS RETAINING OVER 18 INCHES OF EARTH, A BUILDING PERMIT MUST BE OBTAINED FROM THE CITY OF ALBUQUERQUE CODE ADMINISTRATION DIVISION. IT SHALL BE THE WALL CONTRACTOR'S RESPONSIBILITY TO PROVIDE THE ACTUAL DESIGN, SEALED AND CERTIFIED BY A LICENSED PROFESSIONAL ENGINEER IN THE STATE OF NEW MEXICO FOR THE RETAINING WALL AND COMBINATION RETAINING-GARDEN WALL SHOWN ON THIS PLAN. REQUIRED DESIGN GUIDE LINES ARE CONTAINED THE SOILS REPORT PREPARED FOR THIS SITE BY VINYARD & ASSOCIATES.

AS BUILT INFORMATION				BENCH MARKS				SURVEY INFORMATION				ENGINEER'S SEAL			
CONTRACTOR	SUNDANCE	DATE	8/00	CITY OF ALBUQUERQUE	SURVEY MONUMENT	NO.	FIELD NOTES	NO.	NO.	NO.	NO.	NO.	NO.	NO.	NO.
STAMPED BY	CLINT SHERRILL	DATE	8/00	ACS ALUMINUM CAP STAMPED "9-C18 1985"	LOCATED IN SW QUADRANT OF WILSHIRE	NO.	NO.	NO.	NO.	NO.	NO.	NO.	NO.	NO.	NO.
INSPECTOR'S	DATE	12/00	DATE	12/00	AVE. AND SAN PEDRO BLVD.	NO.	NO.	NO.	NO.	NO.	NO.	NO.	NO.	NO.	NO.
REVISION	DATE	12/00	DATE	12/00	ELEVATION = 5229.79, SLD 1929	NO.	NO.	NO.	NO.	NO.	NO.	NO.	NO.	NO.	NO.
VERIFICATION	DATE	12/00	DATE	12/00		NO.	NO.	NO.	NO.	NO.	NO.	NO.	NO.	NO.	NO.
CORRECTED BY	DATE	12/00	DATE	12/00		NO.	NO.	NO.	NO.	NO.	NO.	NO.	NO.	NO.	NO.
MICRO-FILM	DATE	12/00	DATE	12/00		NO.	NO.	NO.	NO.	NO.	NO.	NO.	NO.	NO.	NO.
RECORDED BY	DATE	12/00	DATE	12/00		NO.	NO.	NO.	NO.	NO.	NO.	NO.	NO.	NO.	NO.
NO.	DATE	12/00	DATE	12/00		NO.	NO.	NO.	NO.	NO.	NO.	NO.	NO.	NO.	NO.
CITY INSPECTOR	DATE	12/00	DATE	12/00		NO.	NO.	NO.	NO.	NO.	NO.	NO.	NO.	NO.	NO.



RYALS engineering & construction services
4929 Idlewild S.E. Albuquerque, NM 87108
(505) 265-8267 239-0184 mobile telephone

TITLE: CITY OF ALBUQUERQUE
PUBLIC WORKS DEPARTMENT
ENGINEERING DEVELOPMENT GROUP

EAGLE POINT SUBDIVISION
GRADING PLAN

Design Review Committee City Engineer Approval

City Project No. 6004.81 Zone Map No. C-19 Sheet 4 of 23

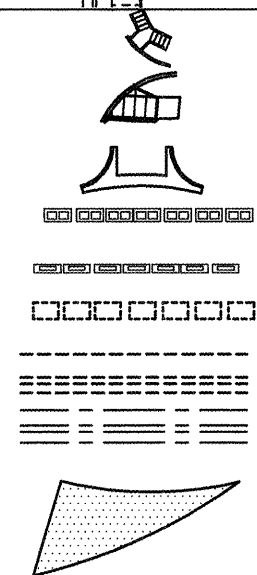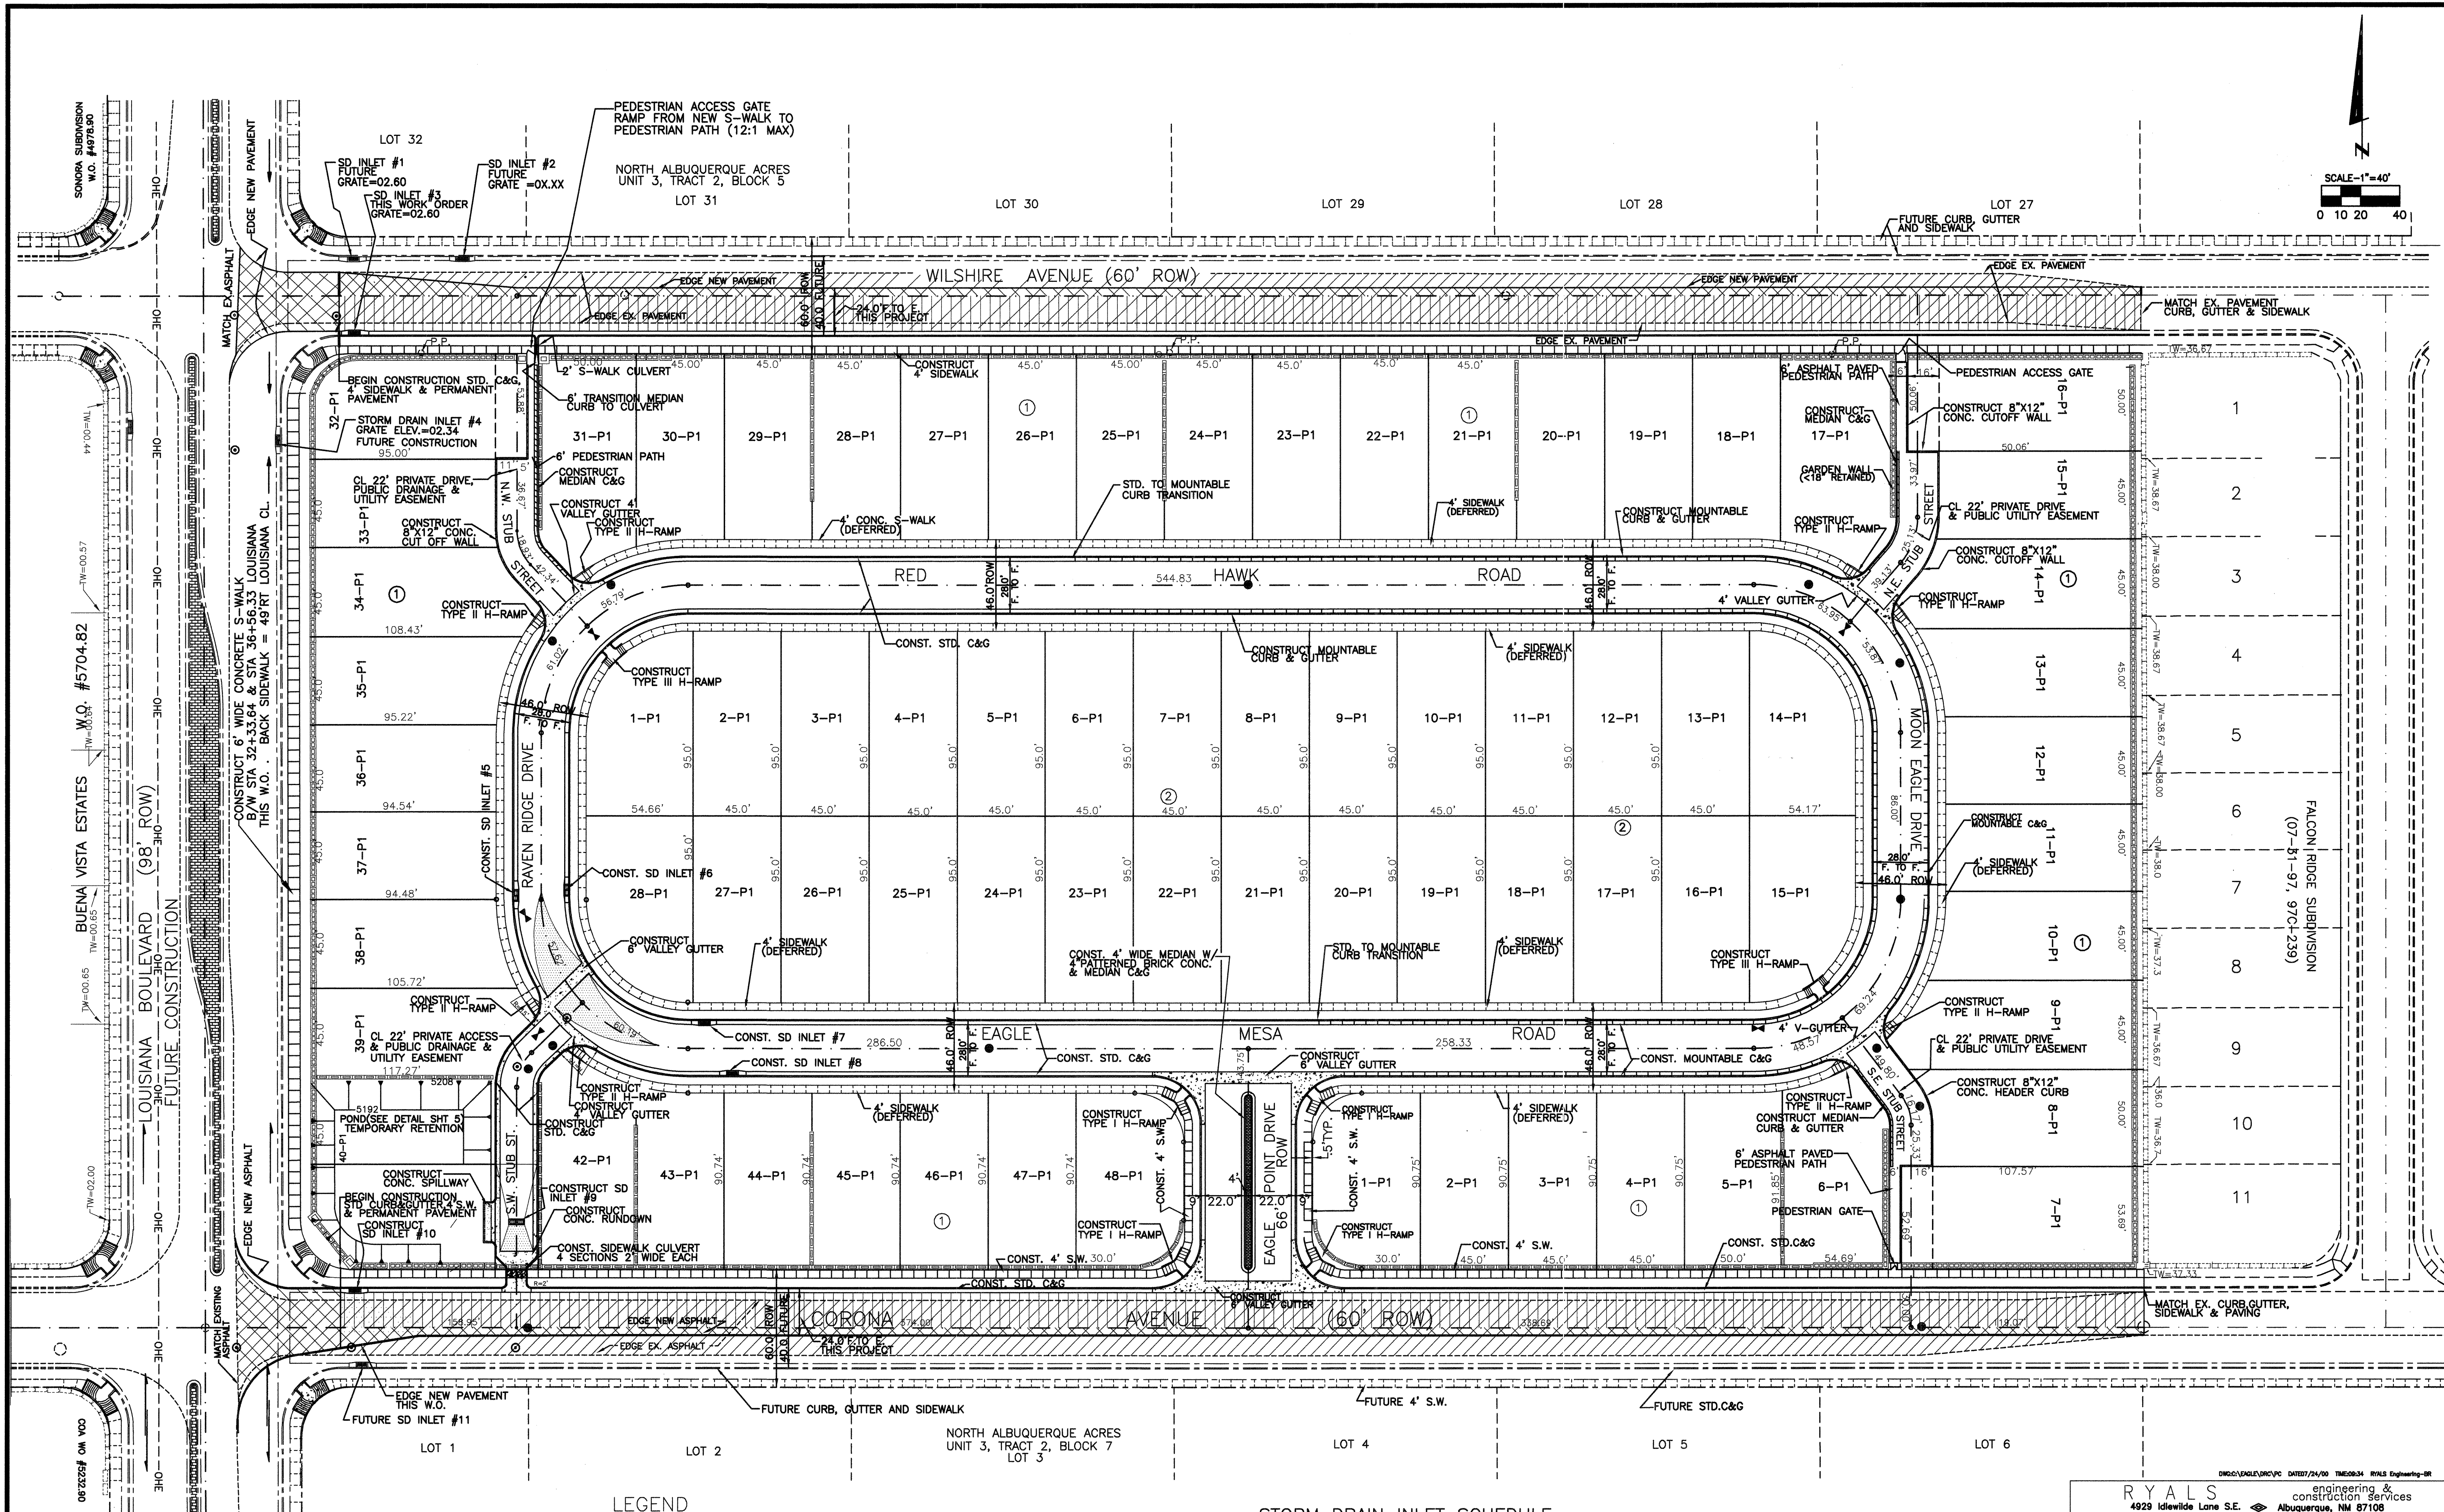

- LEGEND**
- HANDICAPPED RAMP-TYPE I
 - H.C. RAMP-TYPE II
 - VALLEY GUTTER
 - RETAINING WALL
 - GARDEN WALL (< 18" RETAINED)
 - EXISTING RETAINING WALL
 - EXISTING CURB, GUTTER & SIDEWALK
 - FUTURE CURB, GUTTER & SIDEWALK
 - 50' PAVEMENT TRANSITION
- PROPOSED STANDARD CURB
PROPOSED MOUNTABLE CURB
DEFERRED SIDEWALKS
PROPOSED STORM DRAIN INLET
8"x12" CUT OFF WALL
MEDIAN CURB AND GUTTER
SIDEWALK THIS WORK ORDER
STREET CENTER LINE
EXISTING EDGE OF ASPHALT
REMOVE & DISPOSE EX. ASPHALT
PAVE W/ TEMPORARY PAVEMENT SECTION
PAVE W/ PERMANENT PAVEMENT SECTION

STORM DRAIN INLET SCHEDULE

SD INLET #	TYPE	STREET	STATION	GRATE EL.	INV. EL.	LATERAL	STATUS
SD INLET #1	TYPE "C" DOUBLE GRATE	WILSHIRE	10+73.89 20'LT	5302.26	5297.16	24'-18"	FUTURE
SD INLET #2	TYPE "A" DOUBLE GRATE	WILSHIRE	11+23.89 20'LT	5304.09	5300.09	44'-18"	FUTURE
SD INLET #3	TYPE "A" DOUBLE GRATE	WILSHIRE	10+69.11 20'RT	5302.11	5297.16	8'-18"	THIS WO
SD INLET #4	TYPE "A" DOUBLE GRATE	LOUISIANA	36+56.53 39'RT	5300.67	5296.46	24'-18"	FUTURE
SD INLET #5	TYPE "A" DOUBLE GRATE	RAVEN R.	10+57.62 14'LT	5307.70	5303.70	24'-18"	THIS WO
SD INLET #6	TYPE "A" DOUBLE GRATE	RAVEN R.	10+57.62 14'RT	5307.70	5303.40	61'-18"	THIS WO
SD INLET #7	TYPE "A" DOUBLE GRATE	EAGLE M.	10+65.43 14'LT	5308.60	5304.71	68'-18"	THIS WO
SD INLET #8	TYPE "A" DOUBLE GRATE	EAGLE M.	10+78.69 14 RT	5309.20	5304.80	29'-18"	THIS WO
SD INLET #9	TYPE "D" DOUBLE GRATE	SW STUB	00+53.81 CL	5306.67	5295.75	32'-24"	THIS WO
SD INLET #10	TYPE "A" DOUBLE GRATE	CORONA	10+73.89 20'LT	5304.49	5299.49	29'-18"	THIS WO
SD INLET #11	TYPE "C" DOUBLE GRATE	CORONA	10+70.56 20'RT	5304.55	5300.00	8'-18"	FUTURE
SD INLET #12	TYPE "A" DOUBLE THROAT SINGLE GRATE	LOUISIANA	36+56.53 39'RT	5301.18	5296.48	56'-18"	FUTURE

* INLET FUTURE LATERAL FOR INLET THIS W.O.

RYALS engineering & construction services
4928 Idaville Lane S.E. Albuquerque, NM 87108
(505) 265-8267 239-0194 mobile telephone

CITY OF ALBUQUERQUE
PUBLIC WORKS DEPARTMENT
ENGINEERING DEVELOPMENT GROUP

TITLE: EAGLE POINT SUBDIVISION
PAVING COMPOSITE

Design Review Committee City Engineer Approval

AUG 24 2000

SEP 14 2000

CITY ENGINEER

City Project No. 600481 Zone Map No. C-19 Sheet 6 Of 23

AS BUILT INFORMATION

CONTRACTOR: SUNDANCE
STANDARD BY CLIENT: SHEET CELL # ASSOC. 7/60
FIELD ACCEPTANCE BY: DNG
DRAWING BY: RRB
CORRECTED BY: CLIENT SHEET CELL # ASSOC. 7/60
MICRO-FILM INFORMATION
RECORDED BY: NO.

BENCH MARKS

CITY OF ALBUQUERQUE SURVEY MONUMENT

DATE: 11-11-18
ELEV. = 5235.67

SURVEY INFORMATION

FIELD NOTES

NO. BY

ENGINEER'S SEAL


BY: DATE: 11/11/00

REMARKS: REVISIONS

DESIGNED BY: RRB DATE: 11/11/00

DRAWN BY: RRB

CITY INSPECTOR: W. M. C.

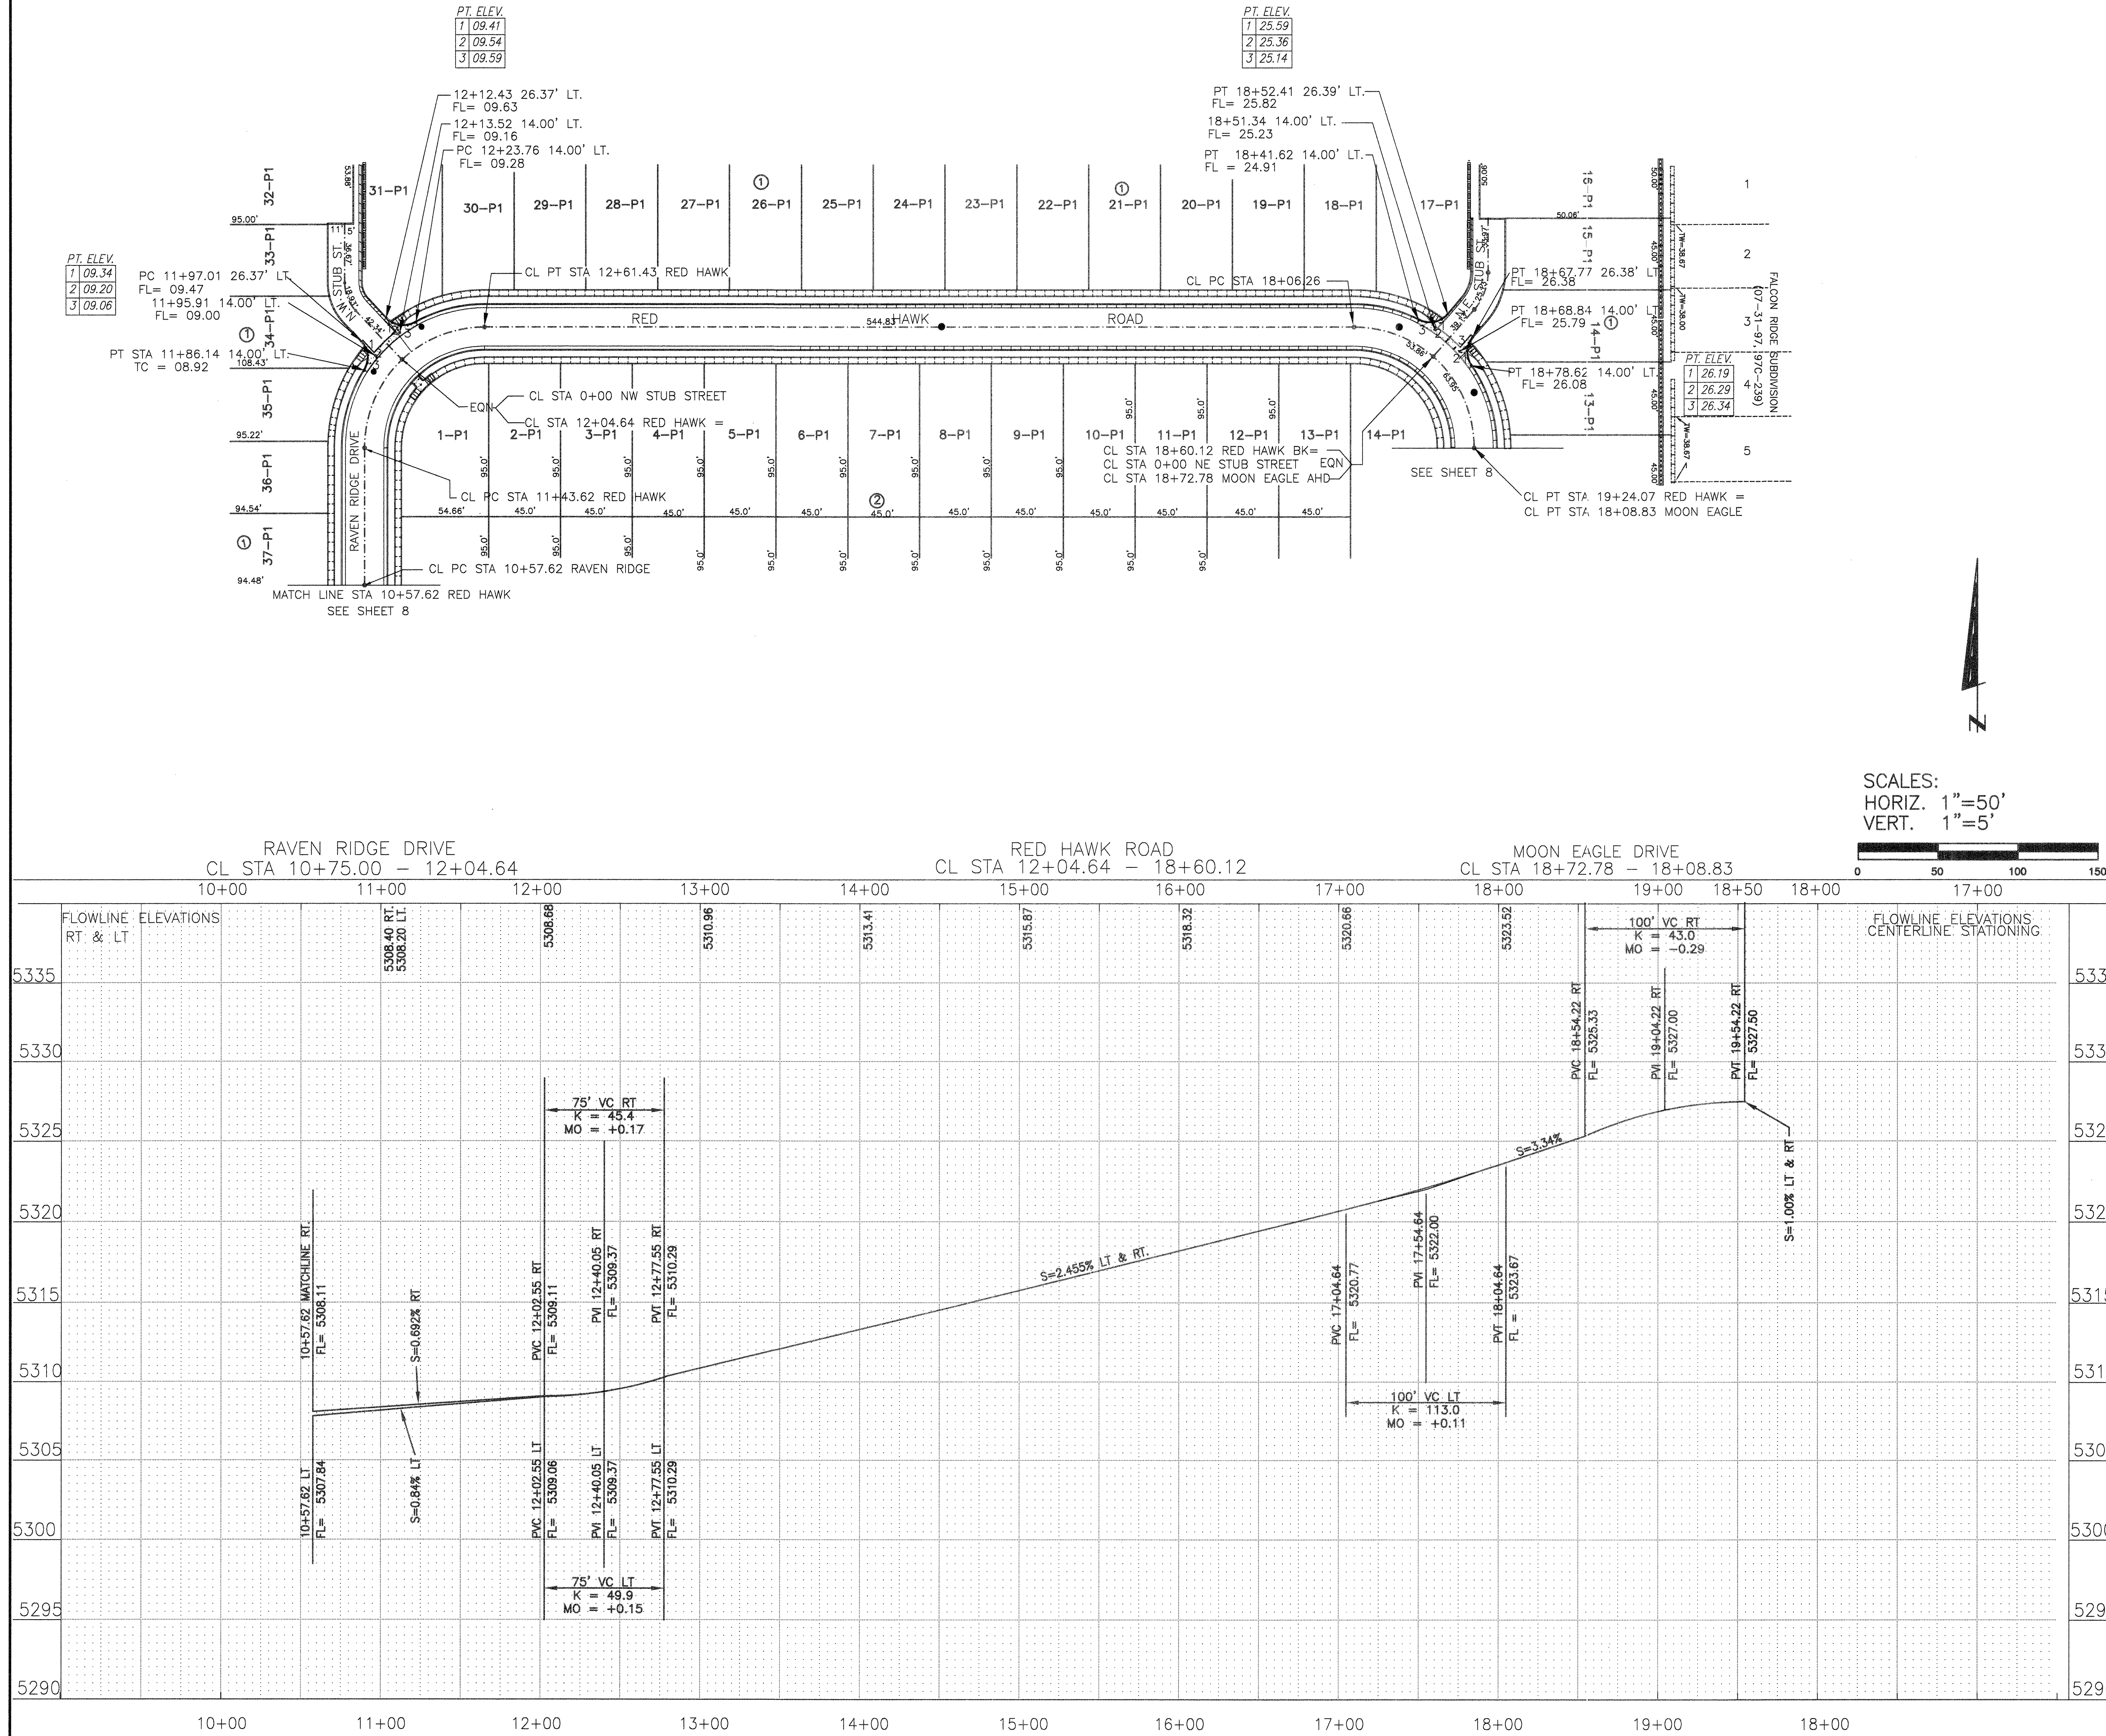

CURB CURVE DATA									
NO.	ARC	DELTA	C BRG	RADIUS	TANGENT				
A	46.86	44°00'59"	S 21°40'27" E	61.00'	24.66'				
B	48.96	45°59'01"	S 66°40'27" E	61.00'	25.88'				
C	48.88	39°32'20"	S 12°26'08" E	89.00'	23.48'				
D	18.77	75°31'21"	N 84°04'43" E	15.00'	11.62'				
E	18.77	75°31'21"	N 84°04'43" E	15.00'	11.62'				
F	48.94	31°30'20"	S 73°54'47" E	89.00'	25.11'				
G	18.77	75°31'21"	N 84°04'43" E	15.00'	11.62'				
H	39.27	89°00'00"	N 44°59'57" W	25.00'	25.00'				
I	35.15	72°37'51"	N 79°01'07" E	89.00'	17.81'				
J	18.77	75°31'21"	S 74°32'08" E	15.00'	11.62'				
K	18.77	75°31'21"	S 74°32'08" E	15.00'	11.62'				
L	59.67	18°24'51"	N 19°12'47" E	89.00'	31.01'				
M	95.82	30°00'00"	N 45°20'02" E	61.00'	61.00'				
N	39.27	89°00'00"	N 44°59'57" W	25.00'	25.00'				
O	39.27	89°59'57"	N 44°59'57" W	25.00'	25.00'				

CONSTRUCTION NOTES:

- CONC. VALLEY GUTTER PER C.O.A. DWG. 2420. (UNLESS OTHERWISE SHOWN.)
- CONSTRUCT WHEELCHAIR RAMP PER DETAIL SHEET 14 OF 22
- 50' TRANSITION PER C.O.A. DWG. 2401.
4' WIDE CONC. S.W. BY OTHERS
- CONSTRUCT STANDARD CURB & GUTTER PER C.O.A. DWG #2415.
- CONSTRUCT MOUNTABLE CURB & GUTTER PER C.O.A. DWG #2415.
- ADJUST EXISTING M.H. RIM TO MATCH PAVEMENT GRADE.
- TRANSITION MOUNTABLE TO STANDARD CURB PER DETAIL, SHT. 14 OF 22
- TRANSITION MOUNTABLE TO STANDARD CURB AT WHEELCHAIR RAMP PER C.O.A. DWG. #2418.
- END 4' WIDE CONC. S/W, BEGIN 6' WIDE PEDESTRIAN TRAIL
- CONSTRUCT MEDIAN CURB & GUTTER PER C.O.A. STD DWG #2415. INSTALL 4" MED. PVMT. PCC BRICK PATTERN
- INSTALL RESIDENTIAL PAVING PER DETAIL, SHT 14 OF 22.
- INSTALL MAJOR LOCAL PAVING PER DETAIL, SHT 14 OF 22.

LEGEND

HANDICAPPED RAMP

H.C. RAMP (NO SIDE STREET WALK)

VALLEY GUTTER

RETAINING WALL

GARDEN WALL (< 18" RETAINED)

EXISTING RETAINING WALL

EXISTING CURB, GUTTER & SIDEWALK

FUTURE CURB, GUTTER & SIDEWALK

50' PAVEMENT TRANSITION

PROPOSED STANDARD CURB

PROPOSED MOUNTABLE CURB

DEFERRED SIDEWALKS

PROPOSED STORM DRAIN INLET

8"x12" CUT OFF WALL

MEDIAN CURB AND GUTTER

SIDEWALK THIS WORK ORDER

STREET CENTER LINE

EXISTING EDGE OF ASPHALT

REMOVE & DISPOSE EX. ASPHALT

PAVE W/ TEMPORARY PAVEMENT SECTION

PAVE W/ PERMANENT PAVEMENT SECTION

SAS MANHOLE

STORM DRAIN MANHOLE

REV 8-15-00 DWG
DWG: EAGLE/ARC/RED DATED: 5/22/00 TIME: 08:22 RYALS Engineering-BR

RYALS
5301 Central, N.E.
(505) 265-8267
engineering & construction services
Albuquerque, NM 87108
239-0194 mobile telephone

CITY OF ALBUQUERQUE
PUBLIC WORKS DEPARTMENT
ENGINEERING DEVELOPMENT GROUP

TITLE:
EAGLE POINT SUBDIVISION
STA 10+75.00-12+04.64 RAVIN RIDGE-STA 12+04.64-18+60.12 REDHAWK
STA 18+72.78-18+08.83 MOON EAGLE

Design Review Committee
AUG 24 2000

APPROVE
SEP 14 2000
CITY ENGINEER

REVISIONS

NO.	DATE	REMARKS
1		
2		
3		
AS BUILT INFORMATION

CONTRACTOR: SUNDANCE

DATE: 11/00

INSPECTED BY: CLINT SHERILL & ASSOCIATES

DATE: 12/00

FIELD NOTES BY: DMG

DATE: 12/00

APPROVED BY: CLINT SHERILL & ASSOCIATES

DATE: 12/00

CORRECTED BY: CLINT SHERILL & ASSOCIATES

DATE: 12/00

SURVEY INFORMATION

FIELD NOTES

NO.

DATE

BY

ENGINEER'S SEAL

NO.

DATE

BY

REMARKS


DESIGNED BY: RRB, HFB, CC

DRAWN BY: [Signature]

CITY PROJECT NO. 600481

ZONE MAP NO. C-19

SHEET 9 OF 23

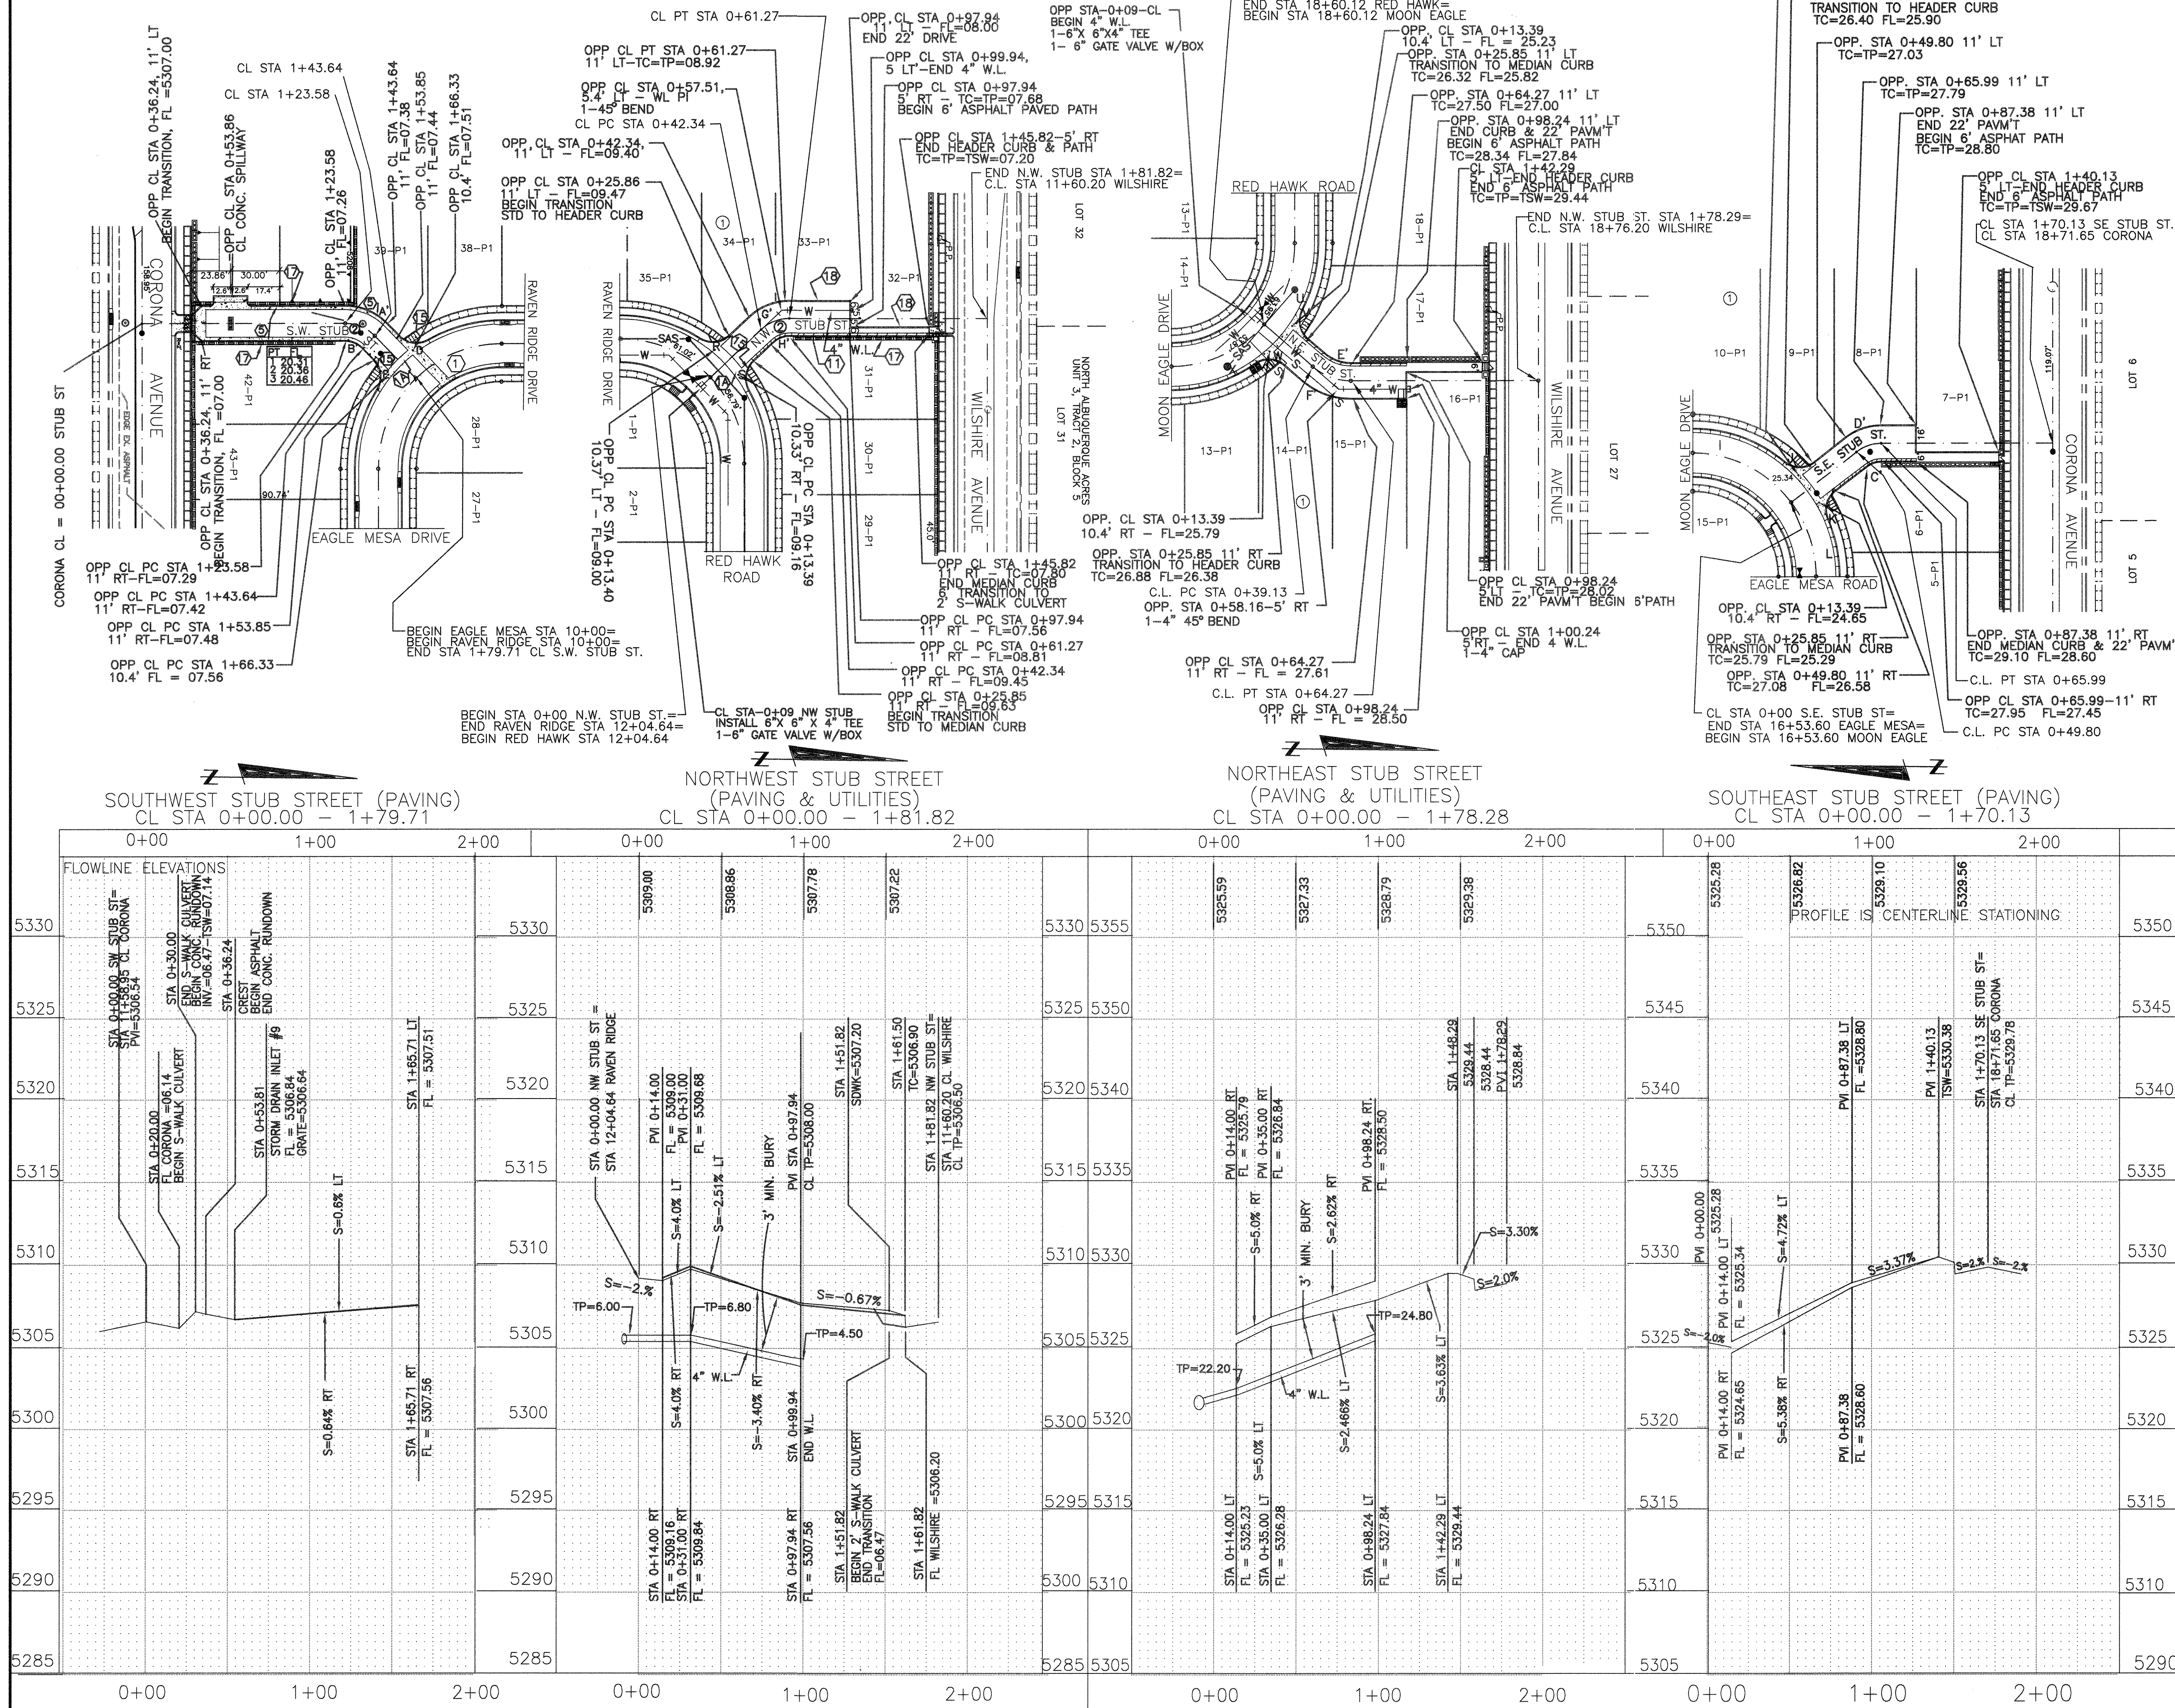

CURB CURVE DATA										BENCH MARKS										
NO.	ARC	DELTA	C BRG	RADIUS	TANGENT	DATE	NO.	DELTA	C BRG	RADIUS	TANGENT	DATE	NO.	DELTA	C BRG	RADIUS	TANGENT	DATE	NO.	
A	28.89	45°09'01"	N 23°18'32"E	36.00'	15.28'	1985	B	11.24	45°09'01"	N 23°18'32"E	14.00'	5.94'	1985	C	23.32	37°06'30"	S 18°13'13"E	14.00'	4.70'	1985
D	17.24	41°08'46"	S 20°54'25"E	24.00'	9.01'	1985	E	33.03	41°08'46"	S 20°54'25"E	46.00'	17.27'	1985	F	27.26	43°23'03"	N 21°20'30"W	27.26'	14.32'	1985
G	10.60	43°23'03"	N 21°20'30"W	25.00'	25.00'	1985	H	46.86	44°00'59"	S 21°40'27"E	61.00'	24.66'	1985	I	48.96	45°09'01"	S 21°40'27"E	61.00'	25.88'	1985
J	45.88	29°32'20"	S 14°26'08"E	89.00'	23.46'	1985	K	19.77	75°31'21"	S 08°33'23"W	15.00'	11.62'	1985	L	48.94	31°30'20"	S 73°54'47"E	89.00'	25.11'	1985
M	39.27	90°00'00"	S 44°38'58"E	25.00'	25.00'	1985	N	39.27	90°00'00"	S 44°38'58"E	25.00'	25.00'	1985	O	35.15	22°37'51"	N 79°01'07"E	89.00'	17.81'	1985
P	19.77	75°31'21"	S 74°32'08"E	15.00'	11.62'	1985	Q	19.77	75°31'21"	S 74°32'08"E	15.00'	11.62'	1985	R	59.67	38°24'51"	N 19°32'27"E	89.00'	31.01'	1985
S	95.82	90°00'00"	N 45°20'02"E	61.00'	61.00'	1985	T	39.27	90°00'00"	N 45°20'02"E	25.00'	25.00'	1985	U	39.27	89°59'57"	N 44°49'57"W	25.00'	25.00'	1985

SCALES:

HORIZ. 1"=50'

VERT. 1"=5'

CONSTRUCTION NOTES:

- 6' WIDE CONC. VALLEY GUTTER PER C.O.A. DWG. 2420 (UNLESS OTHERWISE SHOWN).
- 4' WIDE CONC. VALLEY GUTTER PER C.O.A. DWG. 2420 (UNLESS OTHERWISE SHOWN).
- CONSTRUCT 4' WIDE CONC. SIDEWALK THIS WORK ORDER.
- 50' TRANSITION PER C.O.A. DWG. 2401.
- 4' WIDE CONC. S.W. DEFERRED CONSTRUCT STANDARD CURB & GUTTER PER C.O.A. DWG #2415.
- CONSTRUCT MOUNTABLE CURB & GUTTER PER C.O.A. DWG #2415.
- ADJUST EXISTING M.H. RIM TO MATCH PAVEMENT GRADE.
- TRANSITION MOUNTABLE TO STANDARD CURB PER DETAIL, SHT. 8 OF 22
- TRANSITION MOUNTABLE TO STANDARD CURB AT WHEELCHAIR RAMP PER C.O.A. DWG. #2418.
- CONSTRUCT MEDIAN PAVING - PATTERNED BRICK CONCRETE.
- CONSTRUCT MEDIAN CURB & GUTTER PER C.O.A. STD DWG #2415. INSTALL DETAIL, SHT. 8 OF 22.
- INSTALL MAJOR LOCAL PAVING PER DETAIL, SHT. 8 OF 22.
- CONSTRUCT TYPE I HANDICAPPED RAMP SEE DETAIL SHEET 8 OF 22
- CONSTRUCT TYPE II HANDICAPPED RAMP SEE DETAIL SHEET 8 OF 22
- CONSTRUCT TYPE III HANDICAPPED RAMP SEE DETAIL SHEET 8 OF 22
- GARDEN WALL < 18" RETAINED BY OTHERS. TO BE CONSTRUCTED PRIOR TO CURB.
- CONSTRUCT CONCRETE HEADER CURB PER DETAIL SHEET 8 OF 22.
- RETAINING WALL > 18" RETAINED BY OTHERS TO BE CONSTRUCTED PRIOR TO CURB.
- CONSTRUCT TYPE III HANDICAPPED RAMP SEE DETAIL SHEET 8 OF 22.
- CONSTRUCT TYPE III HANDICAPPED RAMP SEE DETAIL SHEET 8 OF 22.

LEGEND

Handicapped Ramp

H.C. RAMP (NO SIDE STREET WALK)

VALLEY GUTTER

RETAINING WALL

GARDEN WALL (< 18" RETAINED)

EXISTING RETAINING WALL

EXISTING CURB, GUTTER & SIDEWALK

FUTURE CURB, GUTTER & SIDEWALK

50' PAVEMENT TRANSITION

PROPOSED STANDARD CURB

PROPOSED MOUNTABLE CURB

DEFERRED SIDEWALK

PROPOSED STORM DRAIN INLET

6"x12" CUT OFF WALL

MEDIAN CURB AND GUTTER

SIDEWALK THIS WORK ORDER

STREET CENTER LINE

EXISTING EDGE OF ASPHALT

REMOVE & DISPOSE EX. ASPHALT

PAVE W/ TEMPORARY PAVEMENT SECTION

PAVE W/ PERMANENT PAVEMENT SECTION

DWG:G/EAGLE/DRO/STUBB-P DATE:03/07/00 TIME:16:39 RYALS Engineering-BR

engineering & construction services

Albuquerque, NM 87108

239-0194 mobile telephone

RYALS

5301 Central, N.E.

(505) 265-8267

CITY OF ALBUQUERQUE

PUBLIC WORKS DEPARTMENT

ENGINEERING DEVELOPMENT GROUP

EAGLE POINT SUBDIVISION

TITLE:

PAVING PLAN AND PROFILE

SW STUB ST STA 0+00-1+79.71 NW STUB ST STA 0+00-1+81.82

SE STUB ST STA 0+00-1+70.13 NE STUB ST STA 0+00-1+78.29

Design Review Committee

APPROVED

AUG 24 2000

SEP 14 2000

CITY ENGINEER

Last Design Update


No./Day/Yr.

No./Day/Yr.

City Project No. 600481

Zone Map No. C-19

Sheet 10 Of 23

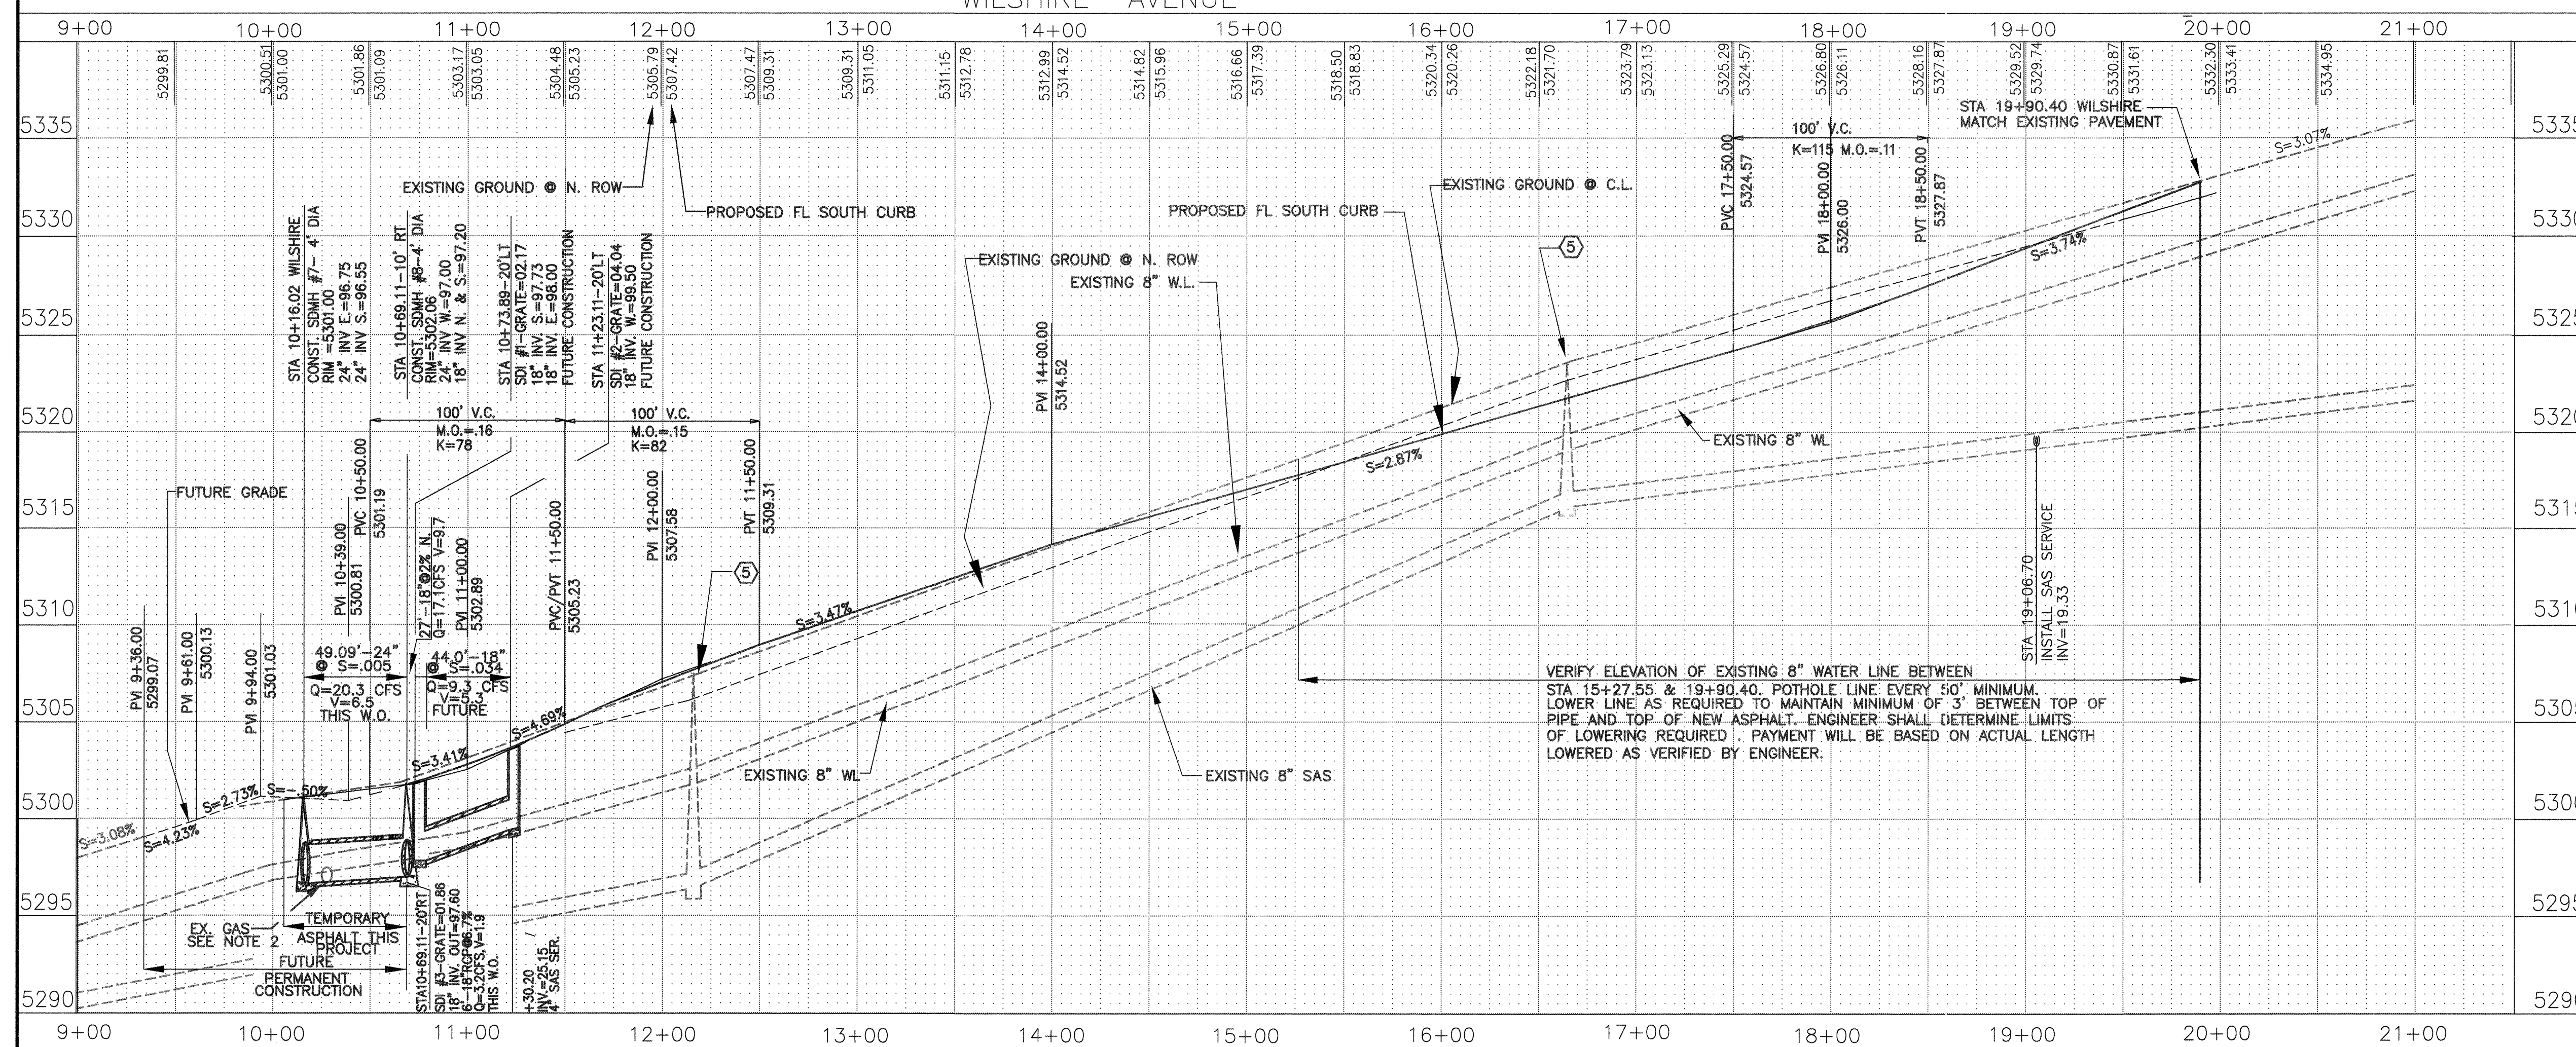

- ① CONSTRUCT 6' WIDE PCC. VALLEY GUTTER WITH 1" INVERT PER STD. DWG. #2420.
- ② CONSTRUCT TYPE I WHEELCHAIR RAMP PER DETAIL ON SHEET 7 OF 23
- ③ 50' TRANSITION, 2% CROWN TO NO CROWN PER STD. DWG. #2401.
- ④ CONSTRUCT STANDARD CURB AND GUTTER PER C.O.A. DWG #2415.
- ⑤ ADJUST EXISTING M.H. RING AND COVER TO MATCH NEW FAYAT GRADE PER STD. DWG #2460.
- ⑥ INSTALL MAJOR LOCAL PAVEMENT. SECTION PER DETAIL, SHT 7 OF 23.
- ⑦ FUTURE STORM DRAIN MH. SEE SHEET 21 OF 23.
- ⑧ CONSTRUCT 4' PCC SIDEWALK TO AVOID EXISTING POWER POLE PER STD DETAIL #2431.
- ⑨ CONSTRUCT 4' WIDE PCC SIDEWALK THIS WORK ORDER PER STD. DWG #2430.

HANDICAPPED RAMP

H.C. RAMP (NO SIDE STREET WALK)

VALLEY GUTTER

RETAINING WALL

GARDEN WALL (< 18" RETAINED)

EXISTING RETAINING WALL

EXISTING CURB, GUTTER & SIDEWALK

FUTURE CURB, GUTTER & SIDEWALK

50' PAVEMENT TRANSITION

PROPOSED STANDARD CURB

PROPOSED MOUNTABLE CURB

DEFERRED SIDEWALKS

PROPOSED STORM DRAIN INLET

8'X12" CUT OFF WALL

MEDIAN CURB AND GUTTER

SIDEWALK THIS WORK ORDER

STREET CENTER LINE

EXISTING EDGE OF ASPHALT

REMOVE & DISPOSE EX. ASPHALT

PAVE W/ TEMPORARY PAVEMENT SECTION

PAVE W/ PERMANENT PAVEMENT SECTION


SAS MANHOLE

STORM DRAIN MANHOLE

[illegible]

City Project No.	Zone Map No.	Sheet	Of
600481	C-19	11	23

[illegible]

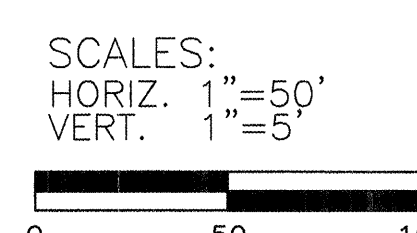

KEYED CONSTRUCTION NOTES:

- (1) CONSTRUCT 6' WIDE PCC. VALLEY GUTTER WITH 1" INVERT PER STD. DWG. #2420.
- (2) CONSTRUCT TYPE I WHEELCHAIR RAMP PER DETAIL ON SHEET 7 OF 23
- (3) 50' TRANSITION, 2% CROWN TO NO CROWN PER STD. DWG. #2401.
- (4) CONSTRUCT STANDARD CURB AND GUTTER PER C.O.A. DWG #2415.
- (5) ADJUST EXISTING M.H. RING AND COVER TO MATCH NEW PAV'T GRADE PER STD. DWG #2460.
- (6) INSTALL MAJOR LOCAL PAVEMENT. SECTION PER DETAIL, SHT 7 OF 23.
- (7) FUTURE STORM DRAIN MH. SEE SHEET 21 OF 23.
- (8) CONSTRUCT STORM DRAIN MH THIS WORK ORDER. SEE SHEET 21 OF 23.
- (8) CONSTRUCT 4' WIDE PCC SIDEWALK THIS WORK ORDER PER STD. DWG #2430.

 

 H.C. RAMP (NO SIDE STREET WALK)



 VALLEY GUTTER


 RETAINING WALL


 GARDEN WALL (< 18" RETAINED)



 EXISTING RETAINING WALL


 EXISTING CURB, GUTTER & SIDEWALK

 

 FUTURE CURB, GUTTER & SIDEWALK



 50' PAVEMENT TRANSITION

 

 PROPOSED STANDARD CURB


 PROPOSED MOUNTABLE CURB


 DEFERRED SIDEWALKS

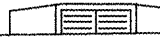

 PROPOSED STORM DRAIN INLET

 

 8"x12" CUT OFF WALL

 

 MEDIAN CURB AND GUTTER



 SIDEWALK THIS WORK ORDER

 
 STREET CENTER LINE


 EXISTING EDGE OF ASPHALT

 
 REMOVE & DISPOSE EX. ASPHALT

 
 PAVE W/ TEMPORARY PAVEMENT SECTION

 
 PAVE W/ PERMANENT PAVEMENT SECTION


 SAS MANHOLE


 STORM DRAIN MANHOLE

Design Review Committee

AUG 24 2000

DESIGN REVIEW COMMITTEE

CITY ENGINEER Approval

APPROVE


SEP 14 2000

CITY ENGINEER


Last Design Update

Mo./Day/Yr.	Mo./Day/Yr.

City Project No.	600481	Zone Map No.	C-19	Sheet	Of	12	23
------------------	--------	--------------	------	-------	----	----	----

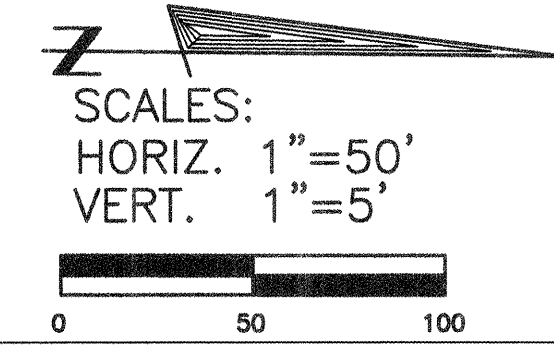

SCALES:
HORIZ. 1"=50'
VERT. 1"=5'

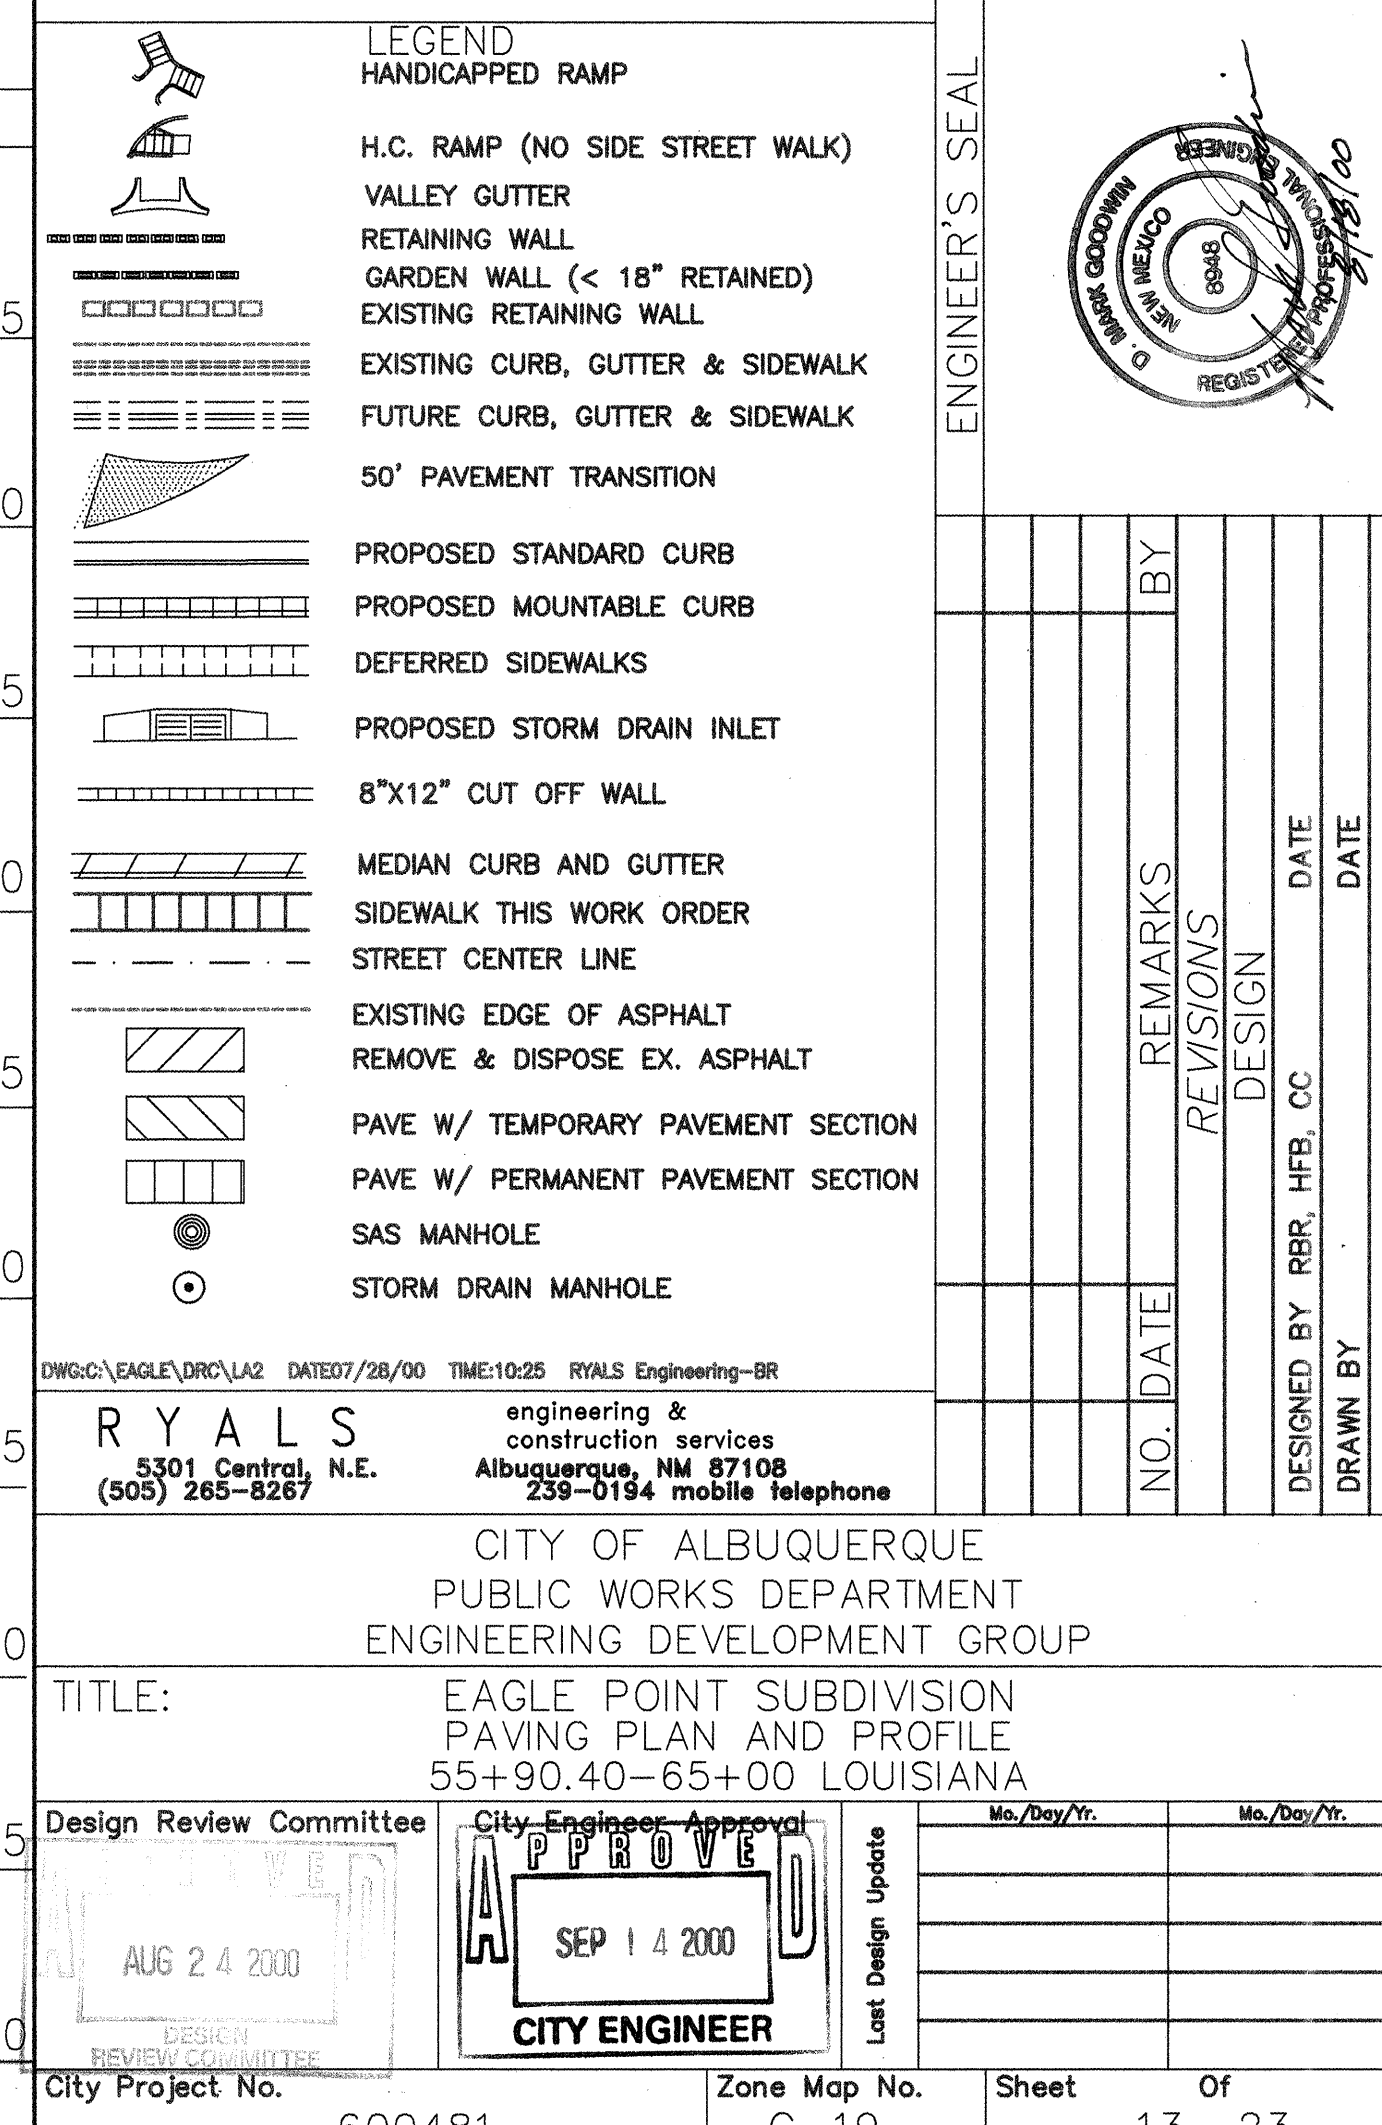

CONSTRUCTION NOTES:

- 1 CONSTRUCT 6" WIDE CONC. VALLEY GUTTER PER C.O.A. STD. DWG. #2420 (LESS OTHERWISE SHOWN.)
- 2 CONSTRUCT TYPE I HANDICAPPED RAMP PER DETAIL SHEET OF
- 3 CONSTRUCT STANDARD CURB & GUTTER PER C.O.A. DWG. #2415.
- 4 CONSTRUCT 6" WIDE CONCRETE SIDEWALK PER DETAILS ON STD. DWG. #2430.
- 5 OVERHEAD POWER AND TELEPHONE LINES TO BE RELOCATED BY OTHERS. CONTRACTOR SHALL COORDINATE AND SCHEDULE, THROUGH THE PROJECT ENGINEER, ALL WORK TO BE PERFORMED UNDER THIS CONTRACT THAT MAY BE IMPACTED BY THE RELOCATION. EXISTING STREET LIGHT TO BE RELOCATED BY OTHERS.
- 6 ADJUST EXISTING MANHOLE RING AND COVER TO MATCH PAVEMENT GRADE.
- 7 ADJUST EXISTING VALVE BOX RING AND COVER TO MATCH PAVEMENT GRADE PER DWG. 2460.
- 8 CONSTRUCT MEDIAN CURB & GUTTER PER C.O.A. STD DWG. #2415. PAVE MEDIAN W/ 4" THK. PCC TEXTURED CONCRETE RUNNING BOND PATTERN. PER DETAILS STD. DWG. #2408.
- 9 CONSTRUCT COMBINATION OF GARDEN/RETAINING WALL ADJACENT TO EXISTING BLOCK WALL. PRIOR TO CONSTRUCTION VERIFY WITH ENGINEER TOP OF FOOTING, TOP OF RETAINING AND TOP OF GARDEN WALL ELEVATIONS. WHERE TF=ORC+TF EX-WALK+8", TRW=TOP S-WALK AND TRW=TOP S-WALK +4 FT. THE WALL SHOULD BE CONSTRUCTED W/OUT DAMAGE TO OR SURCHARGING THE EXISTING WALL.
- 10 CONSTRUCT ARTERIAL PAVEMENT SECTION PER DETAIL, SHT 14 OF 22.
- 11 REMOVE & DIPOSE EX ASPHALT DRAINAGE SWALE, SLOPE & S&S INLET PRIOR TO PLACING TILL FOR ROAD SUBGRADE.
- 12 CONTACT GAS COMPANY FOR THEIR FIELD VERIFICATION OF EXACT VERTICAL & HORIZ. LOCATION AND DETERMINE IF LOCATION IS IN CONFLICT
- 13 POTHOLE EX. 16" W/L. TO VERIFY EXACT LOCATION OF FLEET, SCHED. TOP & BOTTOM & ENGINEER 48 HRS. IN ADVANCE. ENGINEER SHALL REVIEW DATA & PROVIDE DESIGN CHANGE INFORMATION, AS REQUIRED.

LEGEND

HANDICAPPED RAMP

H.C. RAMP (NO SIDE STREET WALK)
VALLEY GUTTER
RETAINING WALL
GARDEN WALL (< 18" RETAINED)
EXISTING RETAINING WALL
EXISTING CURB, GUTTER & SIDEWALK
FUTURE CURB, GUTTER & SIDEWALK
50' PAVEMENT TRANSITION
PROPOSED STANDARD CURB
PROPOSED MOUNTABLE CURB
DEFERRED SIDEWALKS
PROPOSED STORM DRAIN INLET
8"x12" CUT OFF WALL
MEDIAN CURB AND GUTTER
SIDEWALK THIS WORK ORDER
STREET CENTER LINE
EXISTING EDGE OF ASPHALT
REMOVE & DISPOSE EX. ASPHALT
PAVE W/ TEMPORARY PAVEMENT SECTION
PAVE W/ PERMANENT PAVEMENT SECTION
SAS MANHOLE
STORM DRAIN MANHOLE

G:\EAGLE\DRG\LA2 DATE07/28/00 TIME:10:25 RYALS Engineering-BR

RYALS
5301 Central, N.E.
(505) 265-8267

engineering &
construction services
Albuquerque, NM 87108
239-0194 mobile telephone

CITY OF ALBUQUERQUE
PUBLIC WORKS DEPARTMENT
ENGINEERING DEVELOPMENT


TITLE:	EAGLE POINT SUBDIV PAVING PLAN AND PR 55+90.40-65+00 LOU
--------	--

Design Review Committee



AUG 24 2000 DESIGN REVIEW COMMITTEE	SEP 14 2000 CITY ENGINEER	Last Design
---	------------------------------	-------------

City Project No. 600481 Zone Map No. C-19

[illegible]

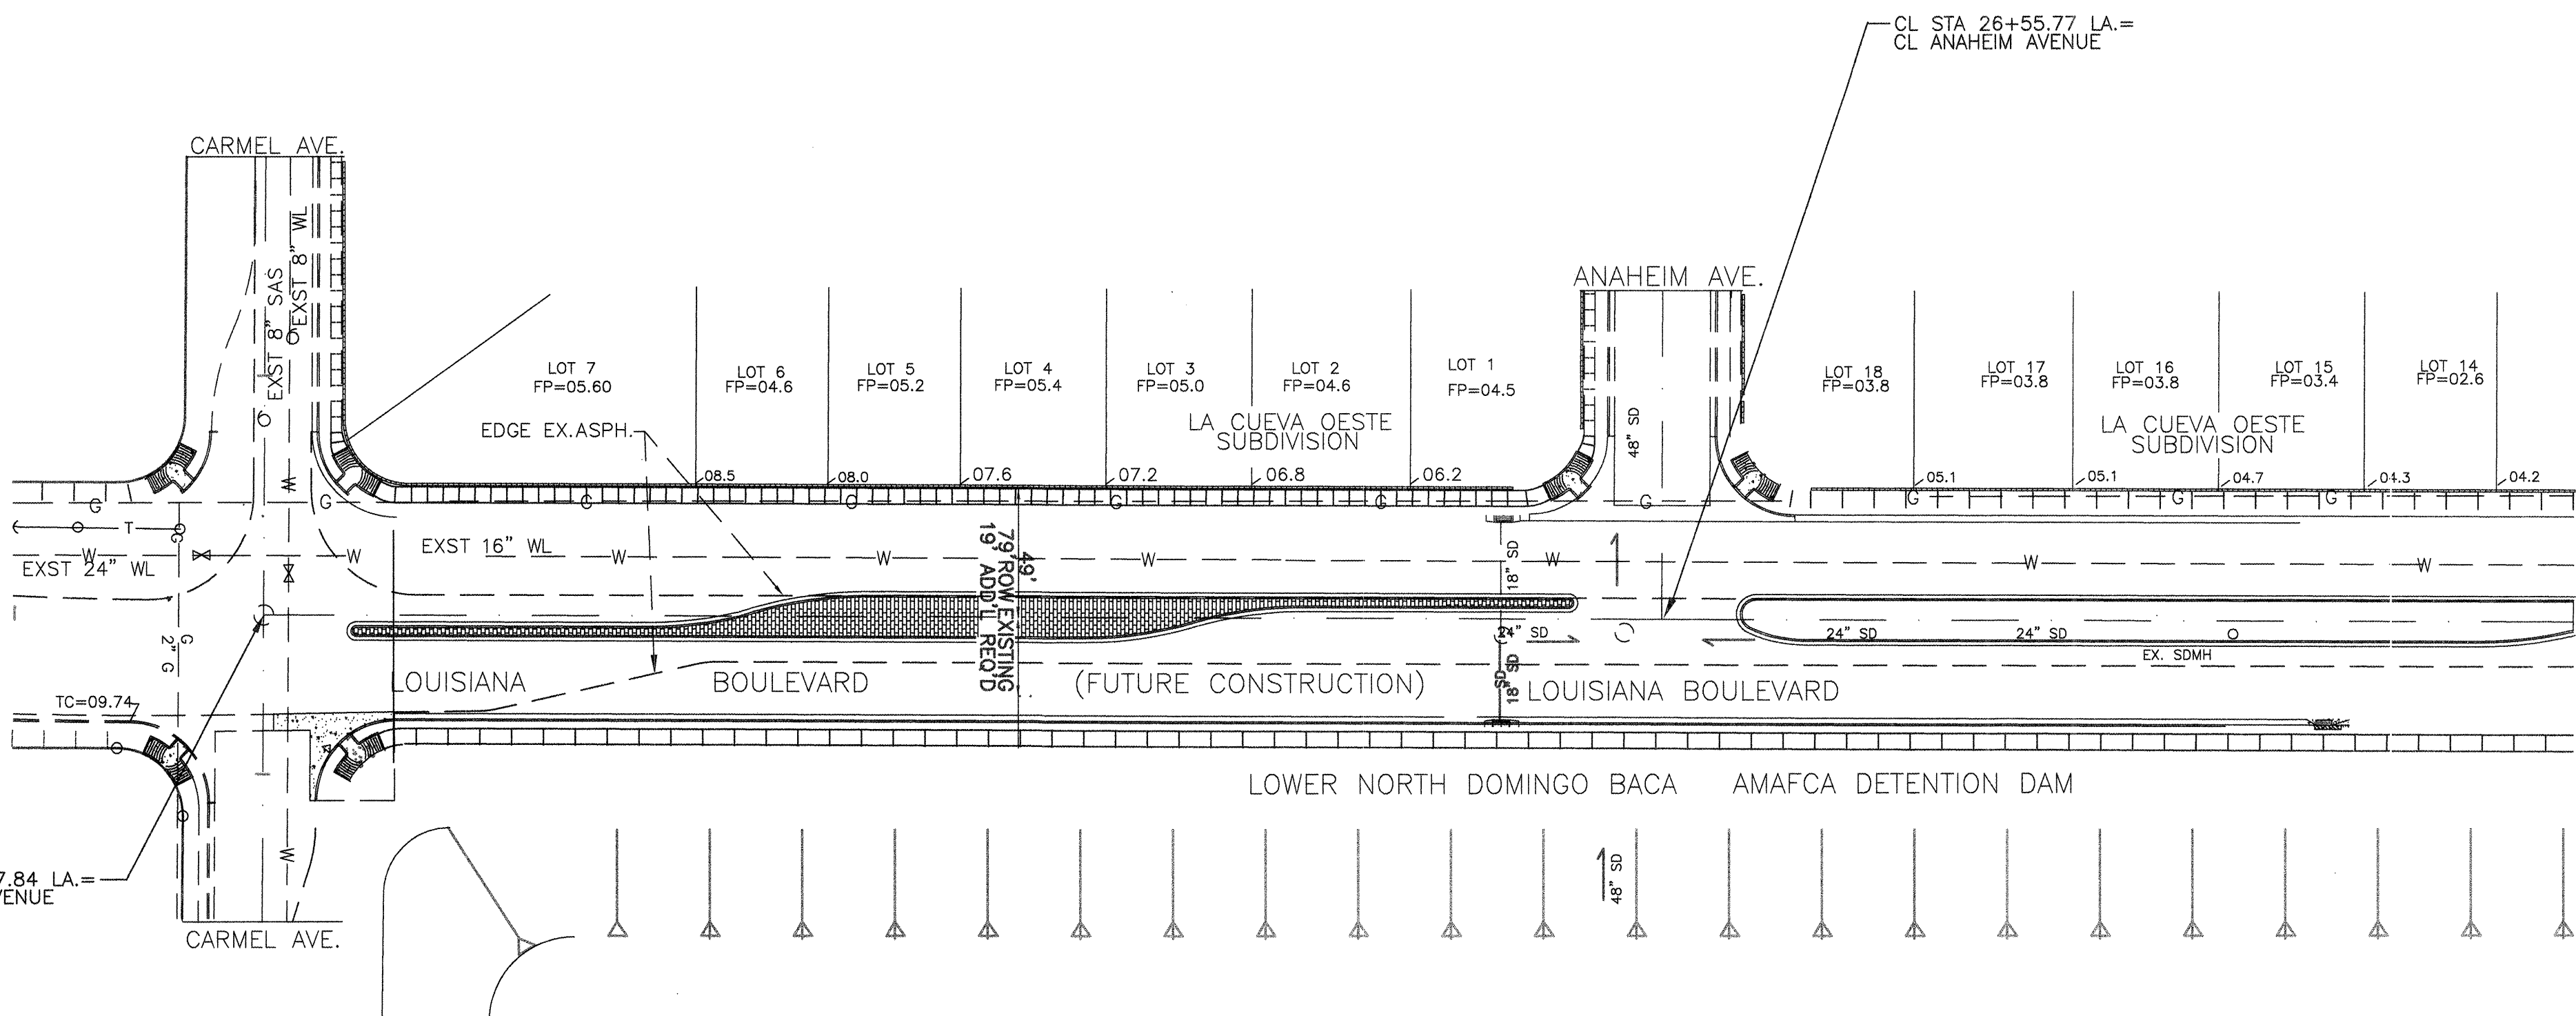

FOR INFORMATION ONLY

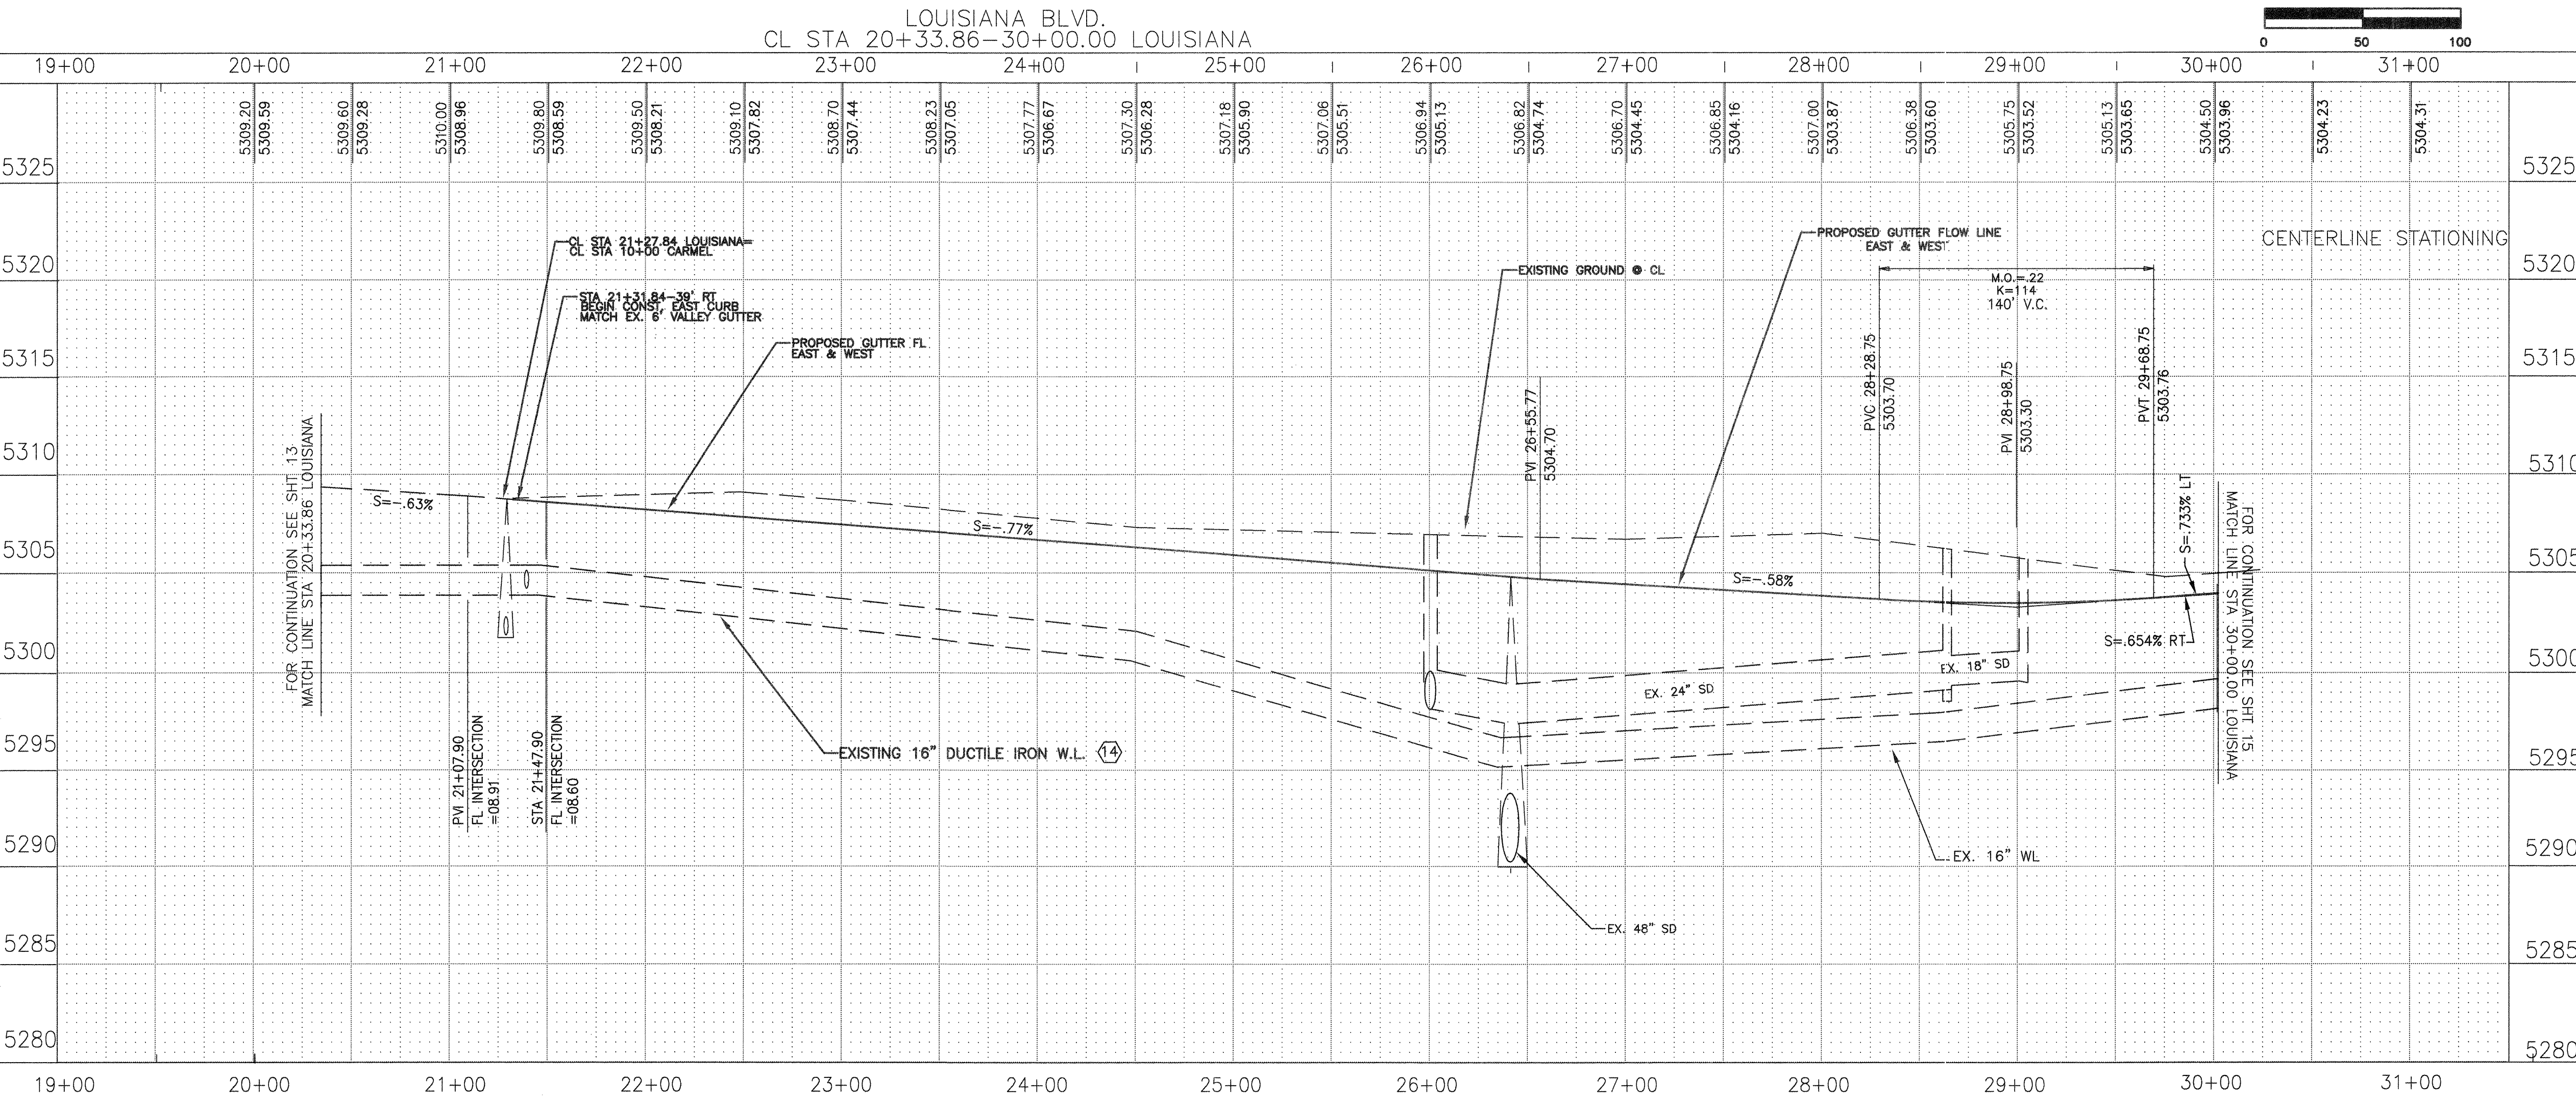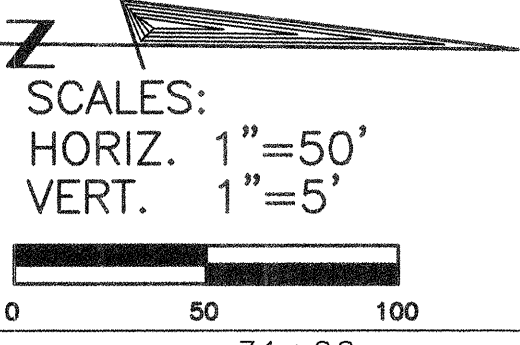

GENERAL NOTES:
THE WORK DETAILED ON THIS SHEET IS DEFERRED EXCEPT FOR THE FOLLOWING:
PAVING:
1. CONSTRUCT 6' SIDEWALK B/W STA 32+08 AND 36+40 LOUISIANA. RAMPS ARE DEFERRED.
2. CONSTRUCT TEMPORARY PAVEMENT AT CORONA AND WILSHIRE INTERSECTIONS AS REQUIRED TO REPLACE THAT REMOVED FOR UTILITY CONST.
STORM DRAIN:
PAVED ACCESS IN BOTH DIRECTIONS MUST REMAIN OPEN AT ALL TIMES FOR LOUISIANA.

- CONSTRUCTION NOTES:**
- ① CONSTRUCT 6' WIDE CONC. VALLEY GUTTER PER C.O.A. STD. DWG #2420 (LESS OTHERWISE SHOWN.)
 - ② CONSTRUCT TYPE I HANDICAPPED RAMP PER DETAIL SHEET OF
 - ③ CONSTRUCT STANDARD CURB & GUTTER PER PER C.O.A. DWG #2415.
 - ④ CONSTRUCT 6' WIDE CONCRETE SIDEWALK PER DETAILS ON STD. DWG. #2430.
 - ⑤ OVERHEAD POWER AND TELEPHONE LINES TO BE RELOCATED BY OTHERS. CONTRACTOR SHALL COORDINATE AND SCHEDULE, THROUGH THE PROJECT ENGINEER, ALL WORK TO BE PERFORMED UNDER THIS CONTRACT THAT MAY BE IMPACTED BY THE RELOCATION.
 - ⑥ EXISTING STREET LIGHT TO BE RELOCATED BY OTHERS.
 - ⑦ ADJUST EXISTING MANHOLE RING AND COVER TO MATCH PAVEMENT GRADE.
 - ⑧ ADJUST EXISTING VALVE BOX RING AND COVER TO MATCH PAVEMENT GRADE PER DWG. 2460.
 - ⑨ CONSTRUCT MEDIAN CURB & GUTTER PER C.O.A. STD DWG #2415. PAVE MEDIAN W/ 4" THICK PCC TEXTURED CONCRETE RUNNING BOND PATTERN. PER DETAILS STD. DWG. #2408.
 - ⑩ CONSTRUCT COMBINATION GARDEN/RETAINING WALL ADJACENT TO EXISTING BLOCK WALL. PRIOR TO CONSTRUCTION VERIFY WITH ENGINEER TOP OF FOOTING, TOP OF RETAINING AND TOP OF GARDEN WALL ELEVATIONS. WHERE TR=OR< TF EX.WALL+8'. TRW= TOP S-WALK AND TGW=TOP S-WALK +4 FT. THE WALL SHOULD BE CONSTRUCTED W/OUT DAMAGE TO OR SURCHARGING THE EXISTING WALL.
 - ⑪ CONSTRUCT ARTERIAL PAVEMENT SECTION PER DETAIL SHT 14 OF 22.
 - ⑫ REMOVE & DIPOSE EX. ASPHALT DRAINAGE SWALE, 24" RCP & SD INLET PRIOR TO PLACING FILL FOR ROAD SUBGRADE.
 - ⑬ CONTACT GAS COMPANY FOR THEIR FIELD VERIFICATION OF EXACT VERTICAL & HORIZ. LOCATION AND DETERMINE IF LOCATION IS IN CONFLICT.
 - ⑭ POTHOLE EX. 16" W.L. TO VERIFY EXACT LOCATION & ELEV. SCHEDULE W/ SURVEYOR & ENGINEER 48 HRS. IN ADVANCE. ENGINEER SHALL REVIEW DATA & PROVIDE DESIGN CHANGE INFORMATION AS REQ'D.

- LEGEND**
- H.C. RAMP (NO SIDE STREET WALK)
 - VALLEY GUTTER
 - RETAINING WALL
 - GARDEN WALL (< 18" RETAINED)
 - EXISTING RETAINING WALL
 - EXISTING CURB, GUTTER & SIDEWALK
 - FUTURE CURB, GUTTER & SIDEWALK
 - 50' PAVEMENT TRANSITION
 - PROPOSED STANDARD CURB
 - PROPOSED MOUNTABLE CURB
 - DEFERRED SIDEWALKS
 - PROPOSED STORM DRAIN INLET
 - 8"x12" CUT OFF WALL
 - MEDIAN CURB AND GUTTER
 - SIDEWALK THIS WORK ORDER
 - STREET CENTER LINE
 - EXISTING EDGE OF ASPHALT
 - REMOVE & DISPOSE EX. ASPHALT
 - PAVE W/ TEMPORARY PAVEMENT SECTION
 - PAVE W/ PERMANENT PAVEMENT SECTION
 - SAS MANHOLE
 - STORM DRAIN MANHOLE

DRWG: EAGLE/DRG/LAS DATED: 07/28/00 TIME: 10:55 RYALS Engineering-BR
RYALS engineering & construction services
5301 Central N.E. Albuquerque, NM 87108
(505) 265-8287 259-0184 mobile telephone


CITY OF ALBUQUERQUE
PUBLIC WORKS DEPARTMENT
ENGINEERING DEVELOPMENT GROUP

TITLE: EAGLE POINT SUBDIVISION
PAVING PLAN AND PROFILE
STA 20+33.86 TO 30+00.00 LOUISIANA


Design Review Committee	City Engineer Approval	Mo./Day/Yr.	Mo./Day/Yr.
AUG 24 2000	SEP 14 2000		
DESIGN REVIEW COMMITTEE	CITY ENGINEER		

City Project No. 600481 Zone Map No. C-19 Sheet 14 Of 23

AS BUILT INFORMATION		BENCH MARKS		SURVEY INFORMATION		ENGINEER'S SEAL	
CONTRACTOR	DATE	ACS ALUMINUM CAP STAMPED	DATE	NO.	BY		REVISIONS
WORK	DATE	LOCATED ON	DATE				
INSPECTED BY	DATE	AVE. AND SAN PEDRO BLVD.					
ACCEPTANCE BY	DATE	ELEV. = 5229.79, SLD 1929					
CORRECTED BY		CORRECTED BY		MICRO-FILM INFORMATION		DESIGNED BY	DATE
RECORDED BY		NO.		NO.		DRAWN BY	DATE
						CHECKED BY	DATE

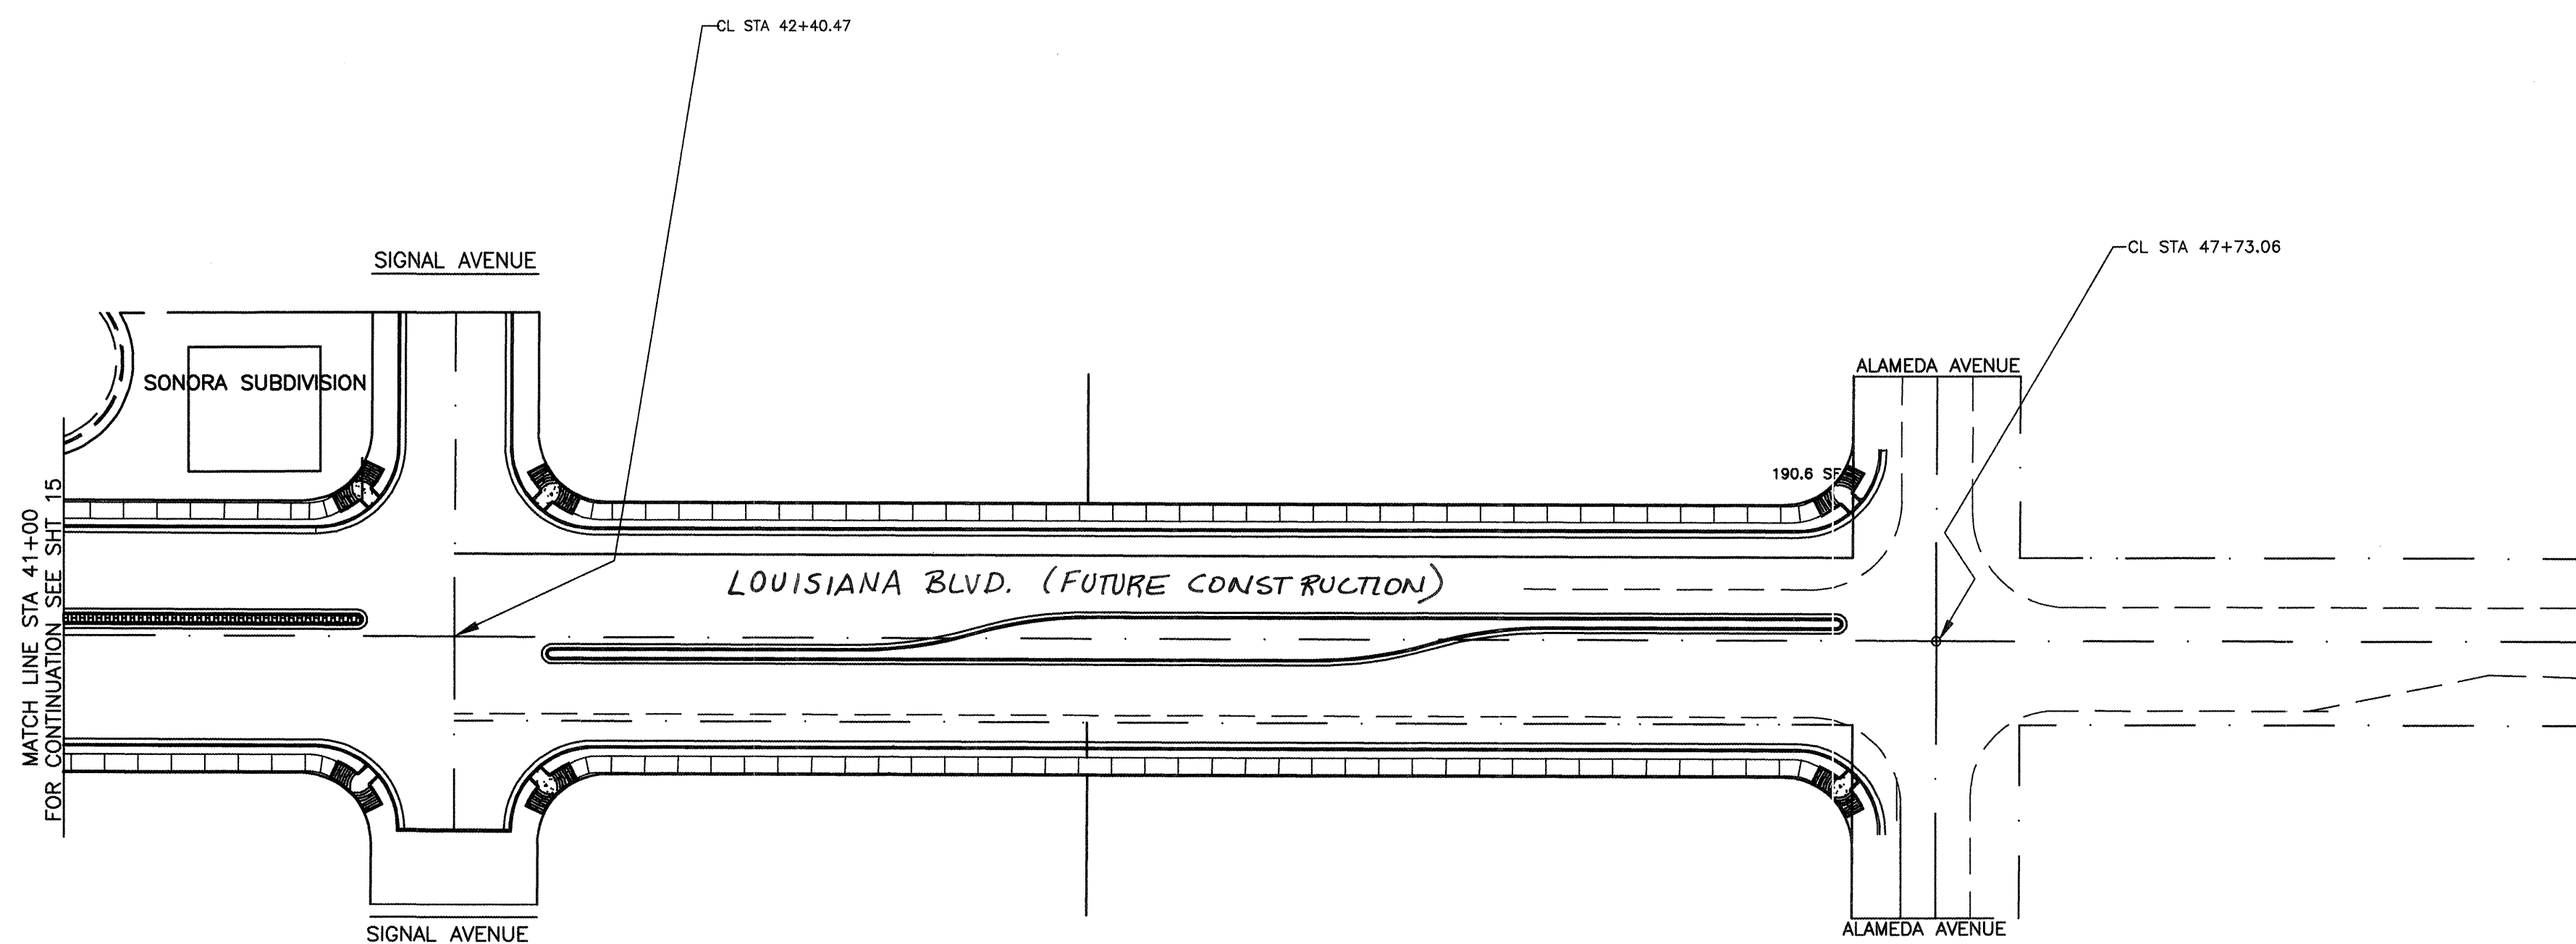

FOR INFORMATION ONLY

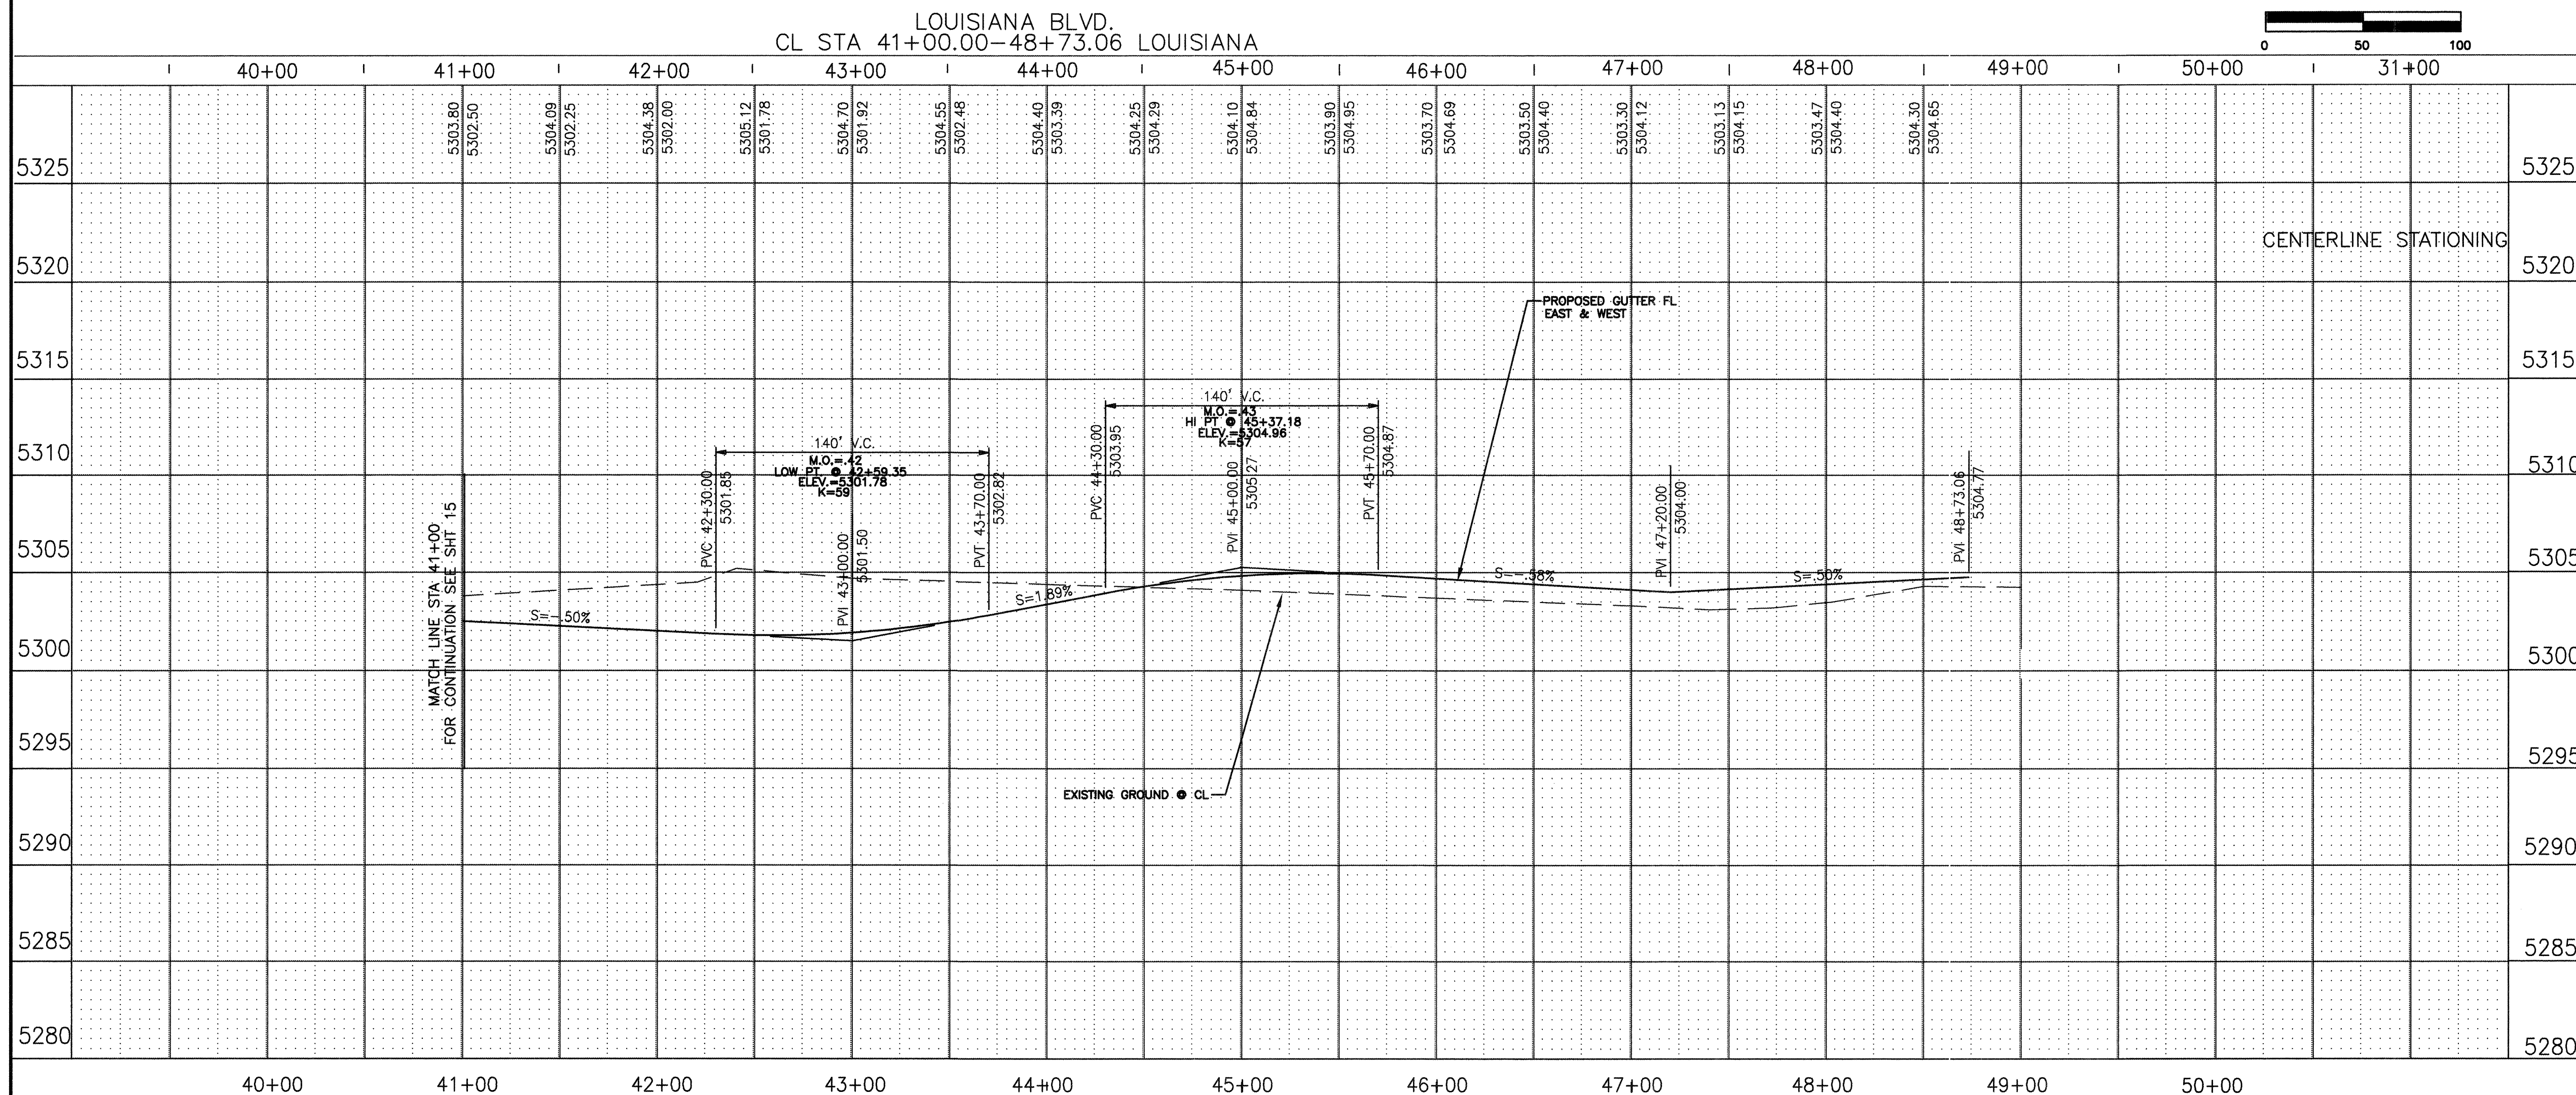

GENERAL NOTES:

THE WORK DETAILED ON THIS SHEET IS DEFERRED EXCEPT FOR THE FOLLOWING:

PAVING:

1. CONSTRUCT 6' SIDEWALK B/W STA 32+08 AND 36+40 LOUISIANA. RAMPS ARE DEFERRED.

2. CONSTRUCT TEMPORARY PAVEMENT AT CORONA AND WILSHIRE INTERSECTIONS AS REQUIRED TO REPLACE THAT REMOVED FOR UTILITY CONST.

STORM DRAIN:

PAVED ACCESS IN BOTH DIRECTIONS MUST REMAIN OPEN AT ALL TIMES FOR LOUISIANA.

CONSTRUCTION NOTES:

① CONSTRUCT 6' WIDE CONC. VALLEY GUTTER PER C.O.A. STD. DWG #2420 (LESS OTHERWISE SHOWN.)

② CONSTRUCT TYPE I HANDICAPPED RAMP PER DETAIL SHEET OF

③ CONSTRUCT STANDARD CURB & GUTTER PER PER C.O.A. DWG #2415.

④ CONSTRUCT 6' WIDE CONCRETE SIDEWALK PER DETAILS ON STD. DWG. #2430.

⑤ OVERHEAD POWER AND TELEPHONE LINES TO BE RELOCATED BY OTHERS. CONTRACTOR SHALL COORDINATE AND SCHEDULE, THROUGH THE PROJECT ENGINEER, ALL WORK TO BE PERFORMED UNDER THIS CONTRACT THAT MAY BE IMPACTED BY THE RELOCATION. EXISTING STREET LIGHT TO BE RELOCATED BY OTHERS.

⑥ ADJUST EXISTING MANHOLE RING AND COVER TO MATCH PAVEMENT GRADE.

⑦ ADJUST EXISTING VALVE BOX RING AND COVER TO MATCH PAVEMENT GRADE PER DWG. 2460.

⑧ CONSTRUCT MEDIAN CURB & GUTTER PER C.O.A. STD DWG #2415. PAVE MEDIAN W/ 4" THK. PCC TEXTURED CONCRETE RUNNING BOND PATTERN. PER DETAILS STD. DWG. #2408.

⑨ CONSTRUCT COMBINATION GARDEN/RETAINING WALL ADJACENT TO EXISTING BLOCK WALL. PRIOR TO CONSTRUCTION VERIFY WITH ENGINEER TOP OF FOOTING, TOP OF RETAINING AND TOP OF GARDEN WALL ELEVATIONS. WHERE TF=OR< TF EX.WALL+8", TRW= TOP S-WALK AND TOW=TOP S-WALK +4 FT. THE WALL SHOULD BE CONSTRUCTED W/OUT DAMAGE TO OR SURCHARGING THE EXISTING WALL.

⑩ CONSTRUCT ARTERIAL PAVEMENT SECTION PER DETAIL, SHT 14 OF 22.

⑪ REMOVE & DISPOSE EX. ASPHALT DRAINAGE SWALE 24" RCP & SO INLET PRIOR TO PLACING FILL FOR ROAD SUBGRADE.

⑫ CONTACT GAS COMPANY FOR THEIR FIELD VERIFICATION OF EXACT VERTICAL & HORIZ. LOCATION AND DETERMINE IF LOCATION IS IN CONFLICT.

⑬ POTHOLE EX. 16" W/L. TO VERIFY EXACT LOCATION & ELEV. SCHEDULE W/ SURVEYOR & ENGINEER 48 HRS. IN ADVANCE. ENGINEER SHALL REVIEW DATA & PROVIDE DESIGN CHANGE INFORMATION AS REQ'D.

LEGEND

HANDICAPPED RAMP

H.C. RAMP (NO SIDE STREET WALK)

VALLEY GUTTER

RETAINING WALL

GARDEN WALL (< 18" RETAINED)

EXISTING RETAINING WALL

EXISTING CURB, GUTTER & SIDEWALK

FUTURE CURB, GUTTER & SIDEWALK

50' PAVEMENT TRANSITION

PROPOSED STANDARD CURB

PROPOSED MOUNTABLE CURB

DEFERRED SIDEWALKS

PROPOSED STORM DRAIN INLET

8"x12" CUT OFF WALL

MEDIAN CURB AND GUTTER

SIDEWALK THIS WORK ORDER

STREET CENTER LINE

EXISTING EDGE OF ASPHALT

REMOVE & DISPOSE EX. ASPHALT

PAVE W/ TEMPORARY PAVEMENT SECTION

PAVE W/ PERMANENT PAVEMENT SECTION

SAS MANHOLE

STORM DRAIN MANHOLE

ENGINEER'S SEAL

NO. DATE REMARKS REVISIONS DESIGN DATE DATE

DESIGNED BY RBR, HFB, CC DATE

DRAWN BY DATE

CHECKED BY DATE

AS BUILT INFORMATION

CONTRACTOR SUNDANCE

DATE 1/00

WORK ORDER BY CLINT SHEPPELL + PAVE

INSPECTOR'S ACCEPTANCE BY DOTG

DATE 12/00

VERIFICATION BY CLINT SHEPPELL + PAVE

DATE 12/00

COMMENTS BY CLINT SHEPPELL + PAVE

DATE 12/00

MICRO-FILM INFORMATION

RECORDED BY

DATE

NO.

BENCH MARKS

ACS ALUMINUM CAP STAMPED "9-C18 1985"

LOCATED ON SOUTHEAST QUARRANT OF WILSHIRE AVE. AND SAN PEDRO BLVD.

ELEV. = 5229.79, SLD 1929

SURVEY INFORMATION

FIELD NOTES

NO. BY

DATE

DATE

NO. DATE

REMARKS

REVISIONS

DESIGN

DATE

DATE

DATE

DWG:C:\EAGLE\LABASE DATED:07/27/00 TIME:03:23 RYALS Engineering-BR

RYALS engineering & construction services

5301 Central, N.E. Albuquerque, NM 87108

(505) 265-8267 238-0194 mobile telephone

CITY OF ALBUQUERQUE

PUBLIC WORKS DEPARTMENT

ENGINEERING DEVELOPMENT GROUP

TITLE: EAGLE POINT SUBDIVISION PAVING PLAN AND PROFILE STA 41+00.00 TO 48+73.06 LOUISIANA

Design Review Committee

City Engineer Approval


SEP 1 4 2000

CITY ENGINEER



City Project No. 600481

Zone Map No. C-19

Sheet 16 Of 23

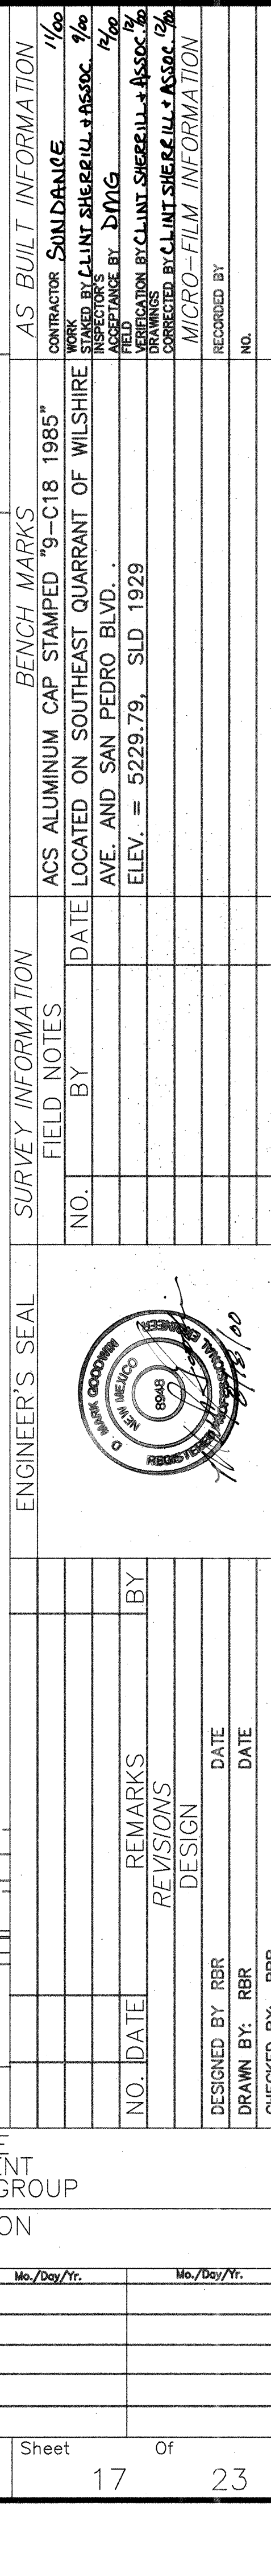

Mo./Day/Yr.	Mo./Day/Yr.
Sheet	Of
17	23

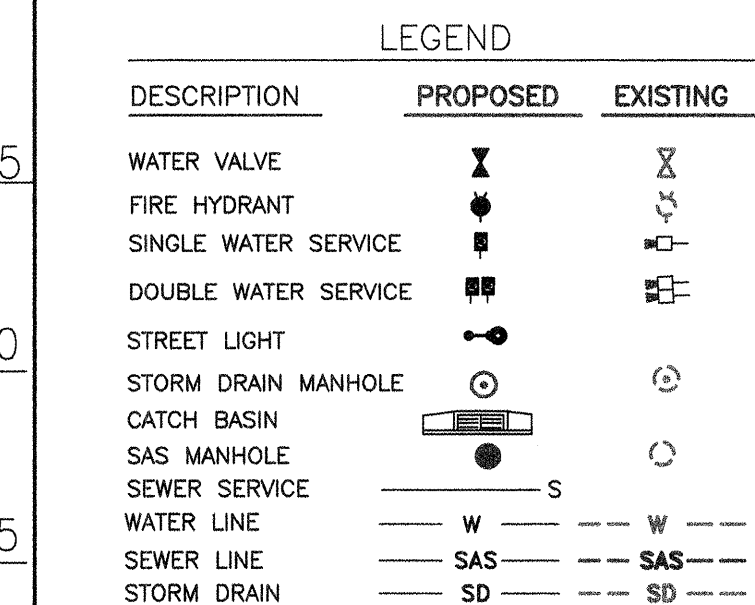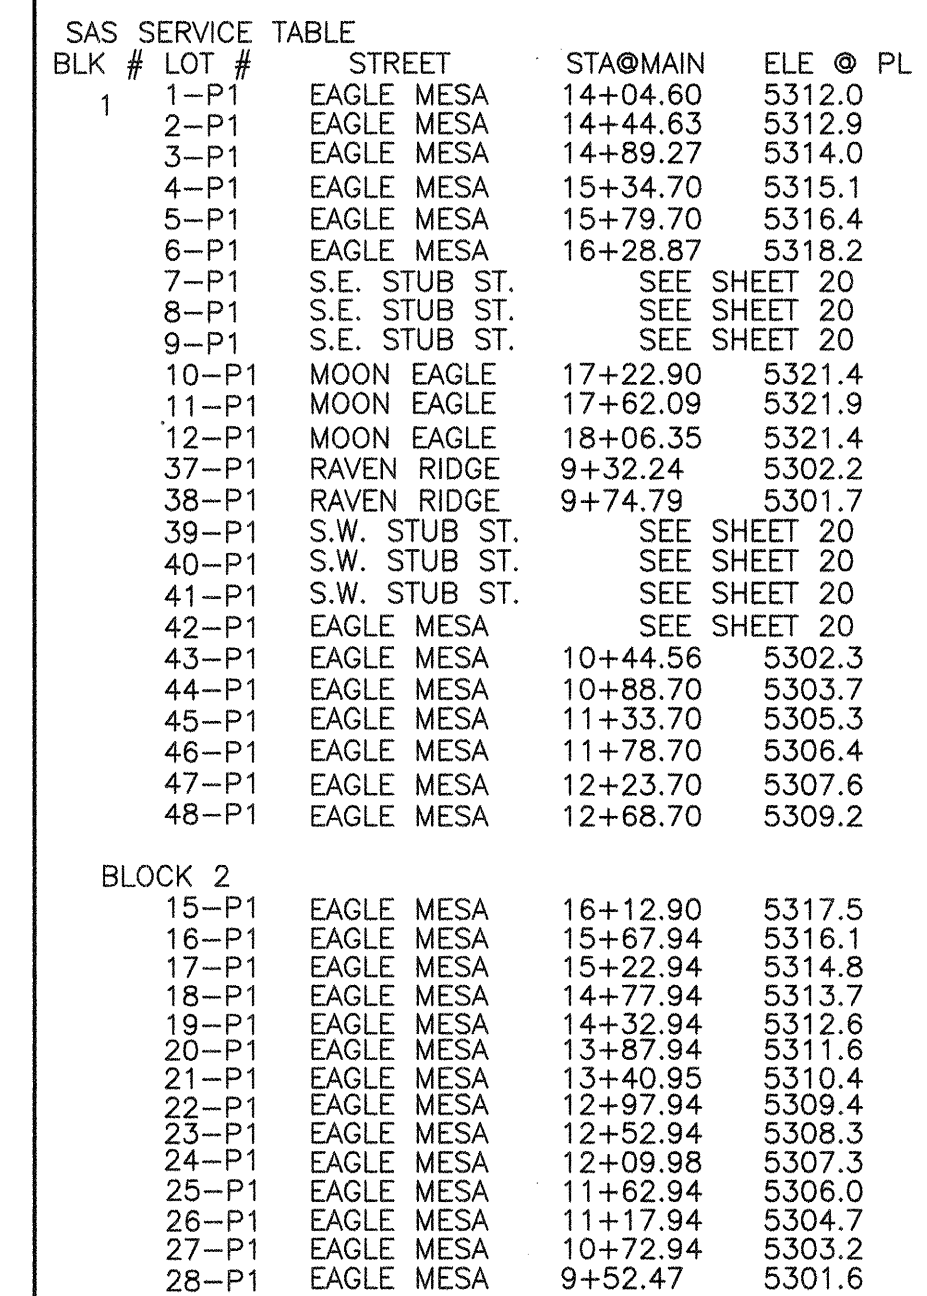

DWG:C:\EAGLE\EPJ DATED:02/22/00 TIME:13:28 RYALS Engineering-BR
 RYALS engineering & construction
 4929 Idlewild S.E. Albuquerque, NM 87112
 (505) 265-8267 239-0194 fax

CITY OF ALBUQUERQUE
PUBLIC WORKS DEPARTMENT
ENGINEERING DEVELOPMENT GROUP
EAGLE POINT SUBDIVISION

TITLE:	UTILITY PLAN AND PROFILE
STA 10+75.00-10+00	RAVEN RIDGE STA 10+00-16+53.60 E. MESA
	STA 16+53.60-18+08.83 MOON EAGLE

	Mo./Day/Yr.	Mo./Day/Yr.
Last Design Update		

Design Review Committee	City Engineer Approval
AUG 24 2000 DESIGN REVIEW COMMITTEE	APPROVED SEP 14 2000 CITY ENGINEER

City Project No.	600481	Zone Map No.	C-19	Sheet	18	Of	23
------------------	--------	--------------	------	-------	----	----	----

AS BUILT INFORMATION	
CONTRACTOR SUNDANCE	DATE 1/10
WORK INSPECTED BY CLINT SHREVELL + ASSOCIATES	DATE 1/10
ACCEPTANCE BY JMMG	DATE 1/10
VERIFICATION BY CLINT SHREVELL + ASSOCIATES	DATE 1/10
DRAWINGS	DATE 1/10
MICRO-FILM INFORMATION	
RECORDED BY	DATE
RECORDED BY	DATE

BENCH MARKS

CITY OF ALBUQUERQUE SURVEY MONUMENT

CS ALUMINUM CAP STAMPED "9-C18 1985"

LOCATED ON SOUTHEAST QUARRANT OF WILSHIRE



VE. AND SAN PEDRO BLVD. .



LEV. = 5225.79, SLD 1929

SURVEY INFORMATION					
	FIELD NOTES				
NO.	BY	DATE	A	L	E

NO.	DATE	REMARKS	BY
<i>REVISIONS</i>			
<i>DESIGN</i>			
DESIGNED BY RBR, HFB, CC			DATE
DRAWN BY			DATE
CHECKED BY			DATE
APPROVED BY			DATE

[illegible]

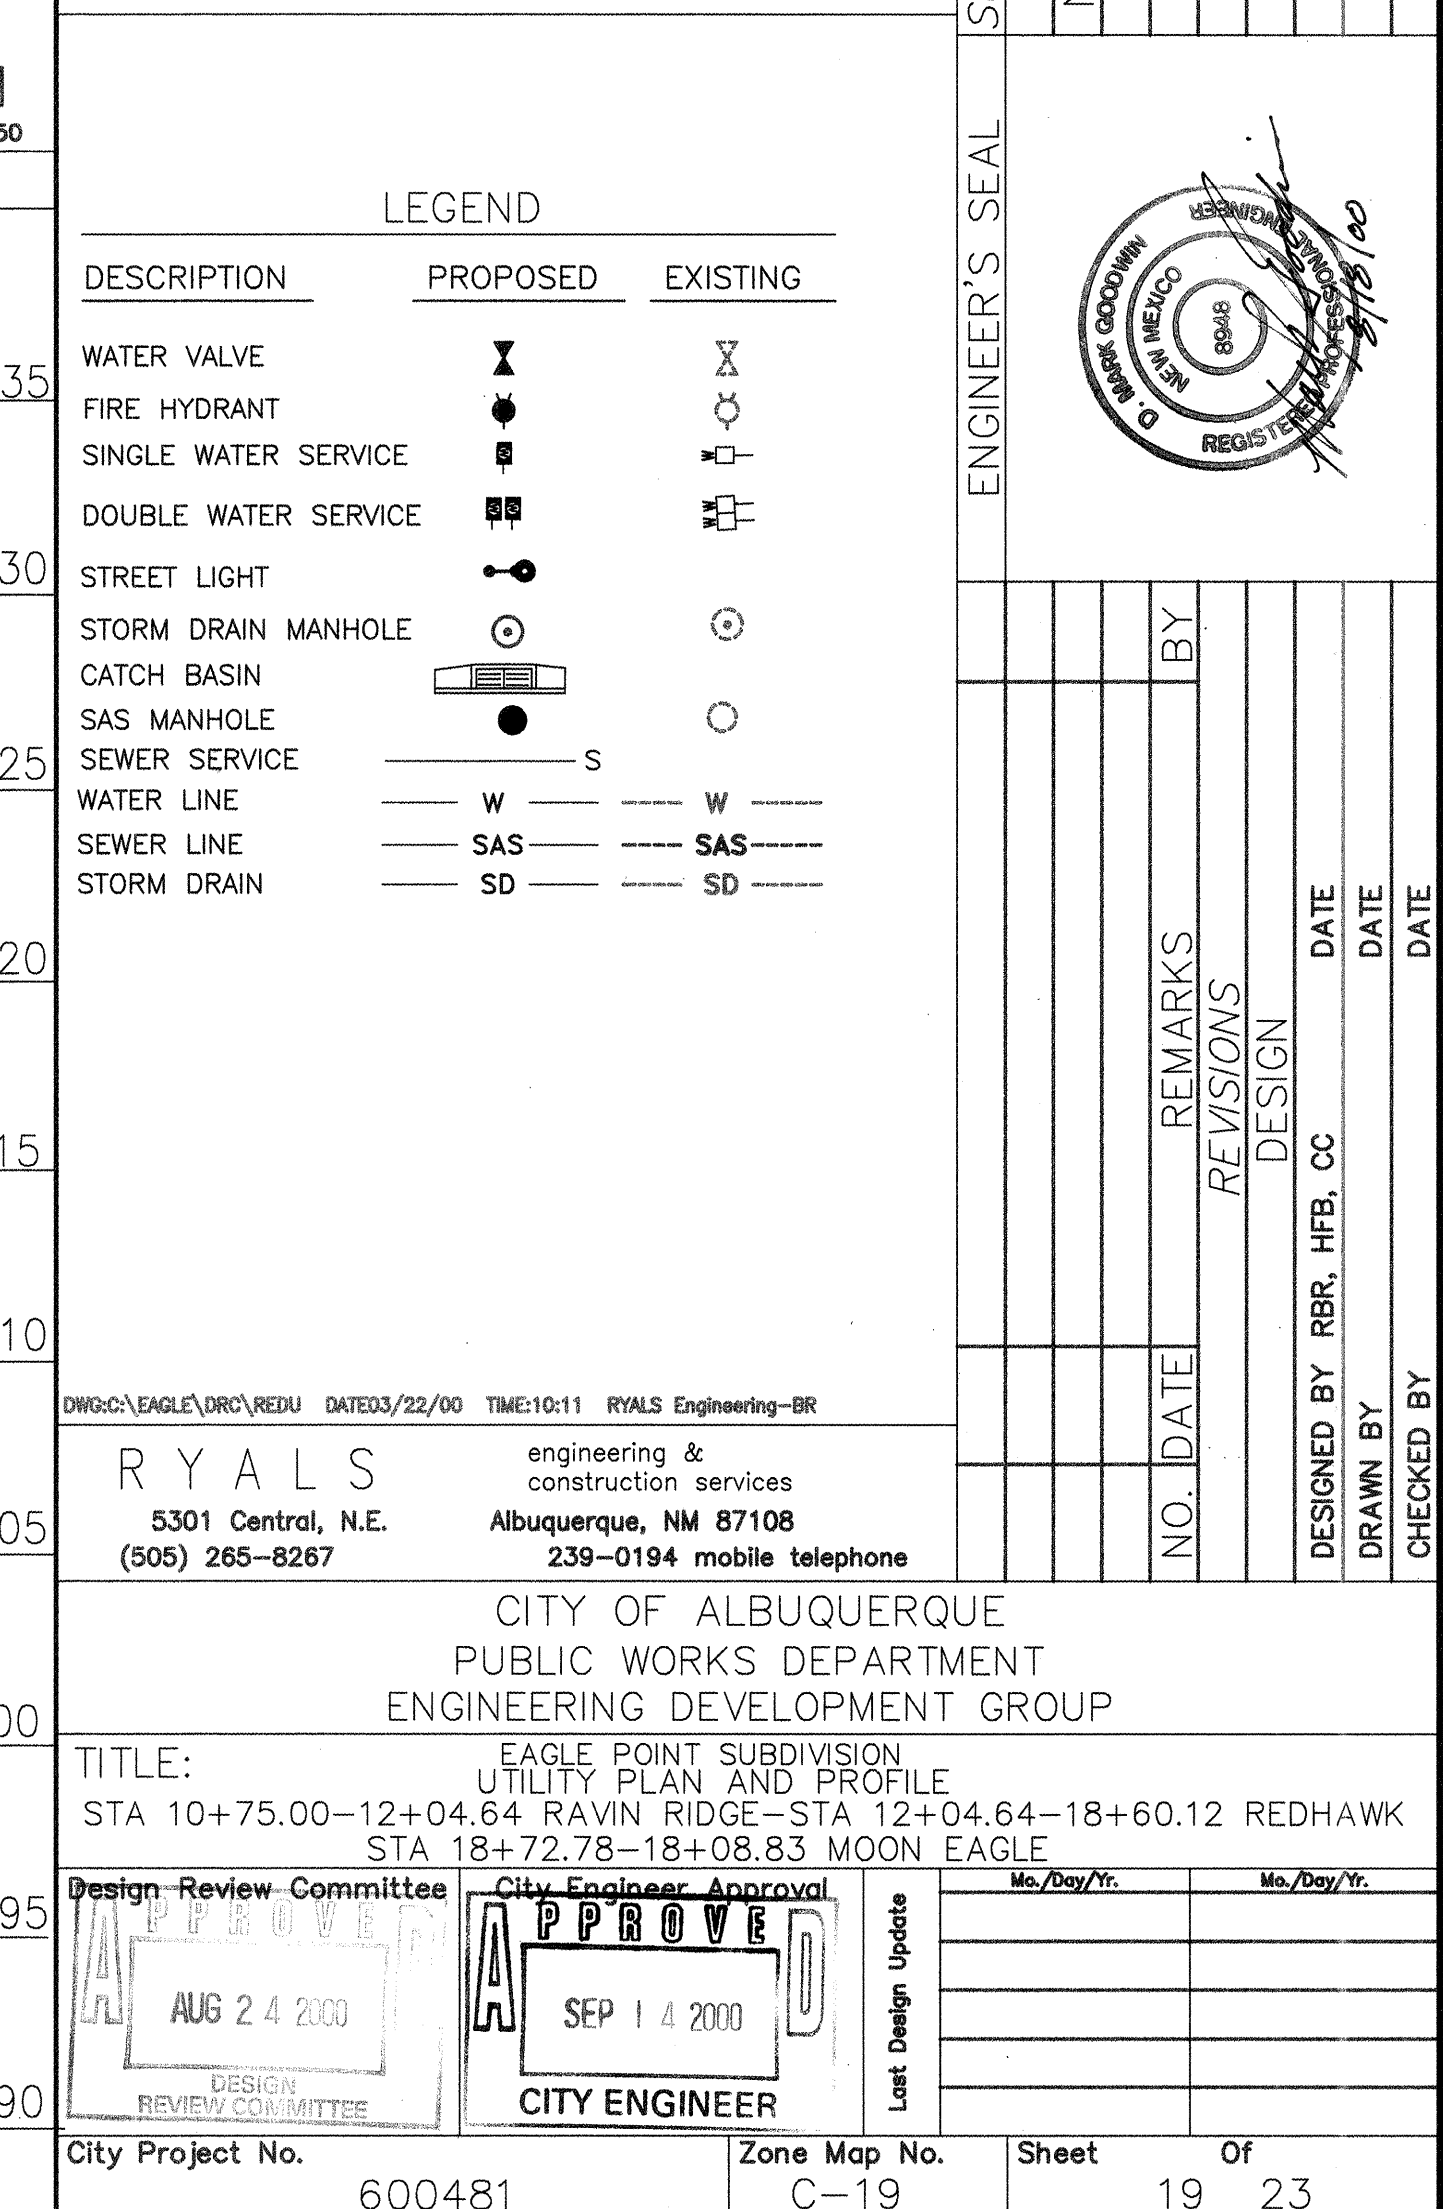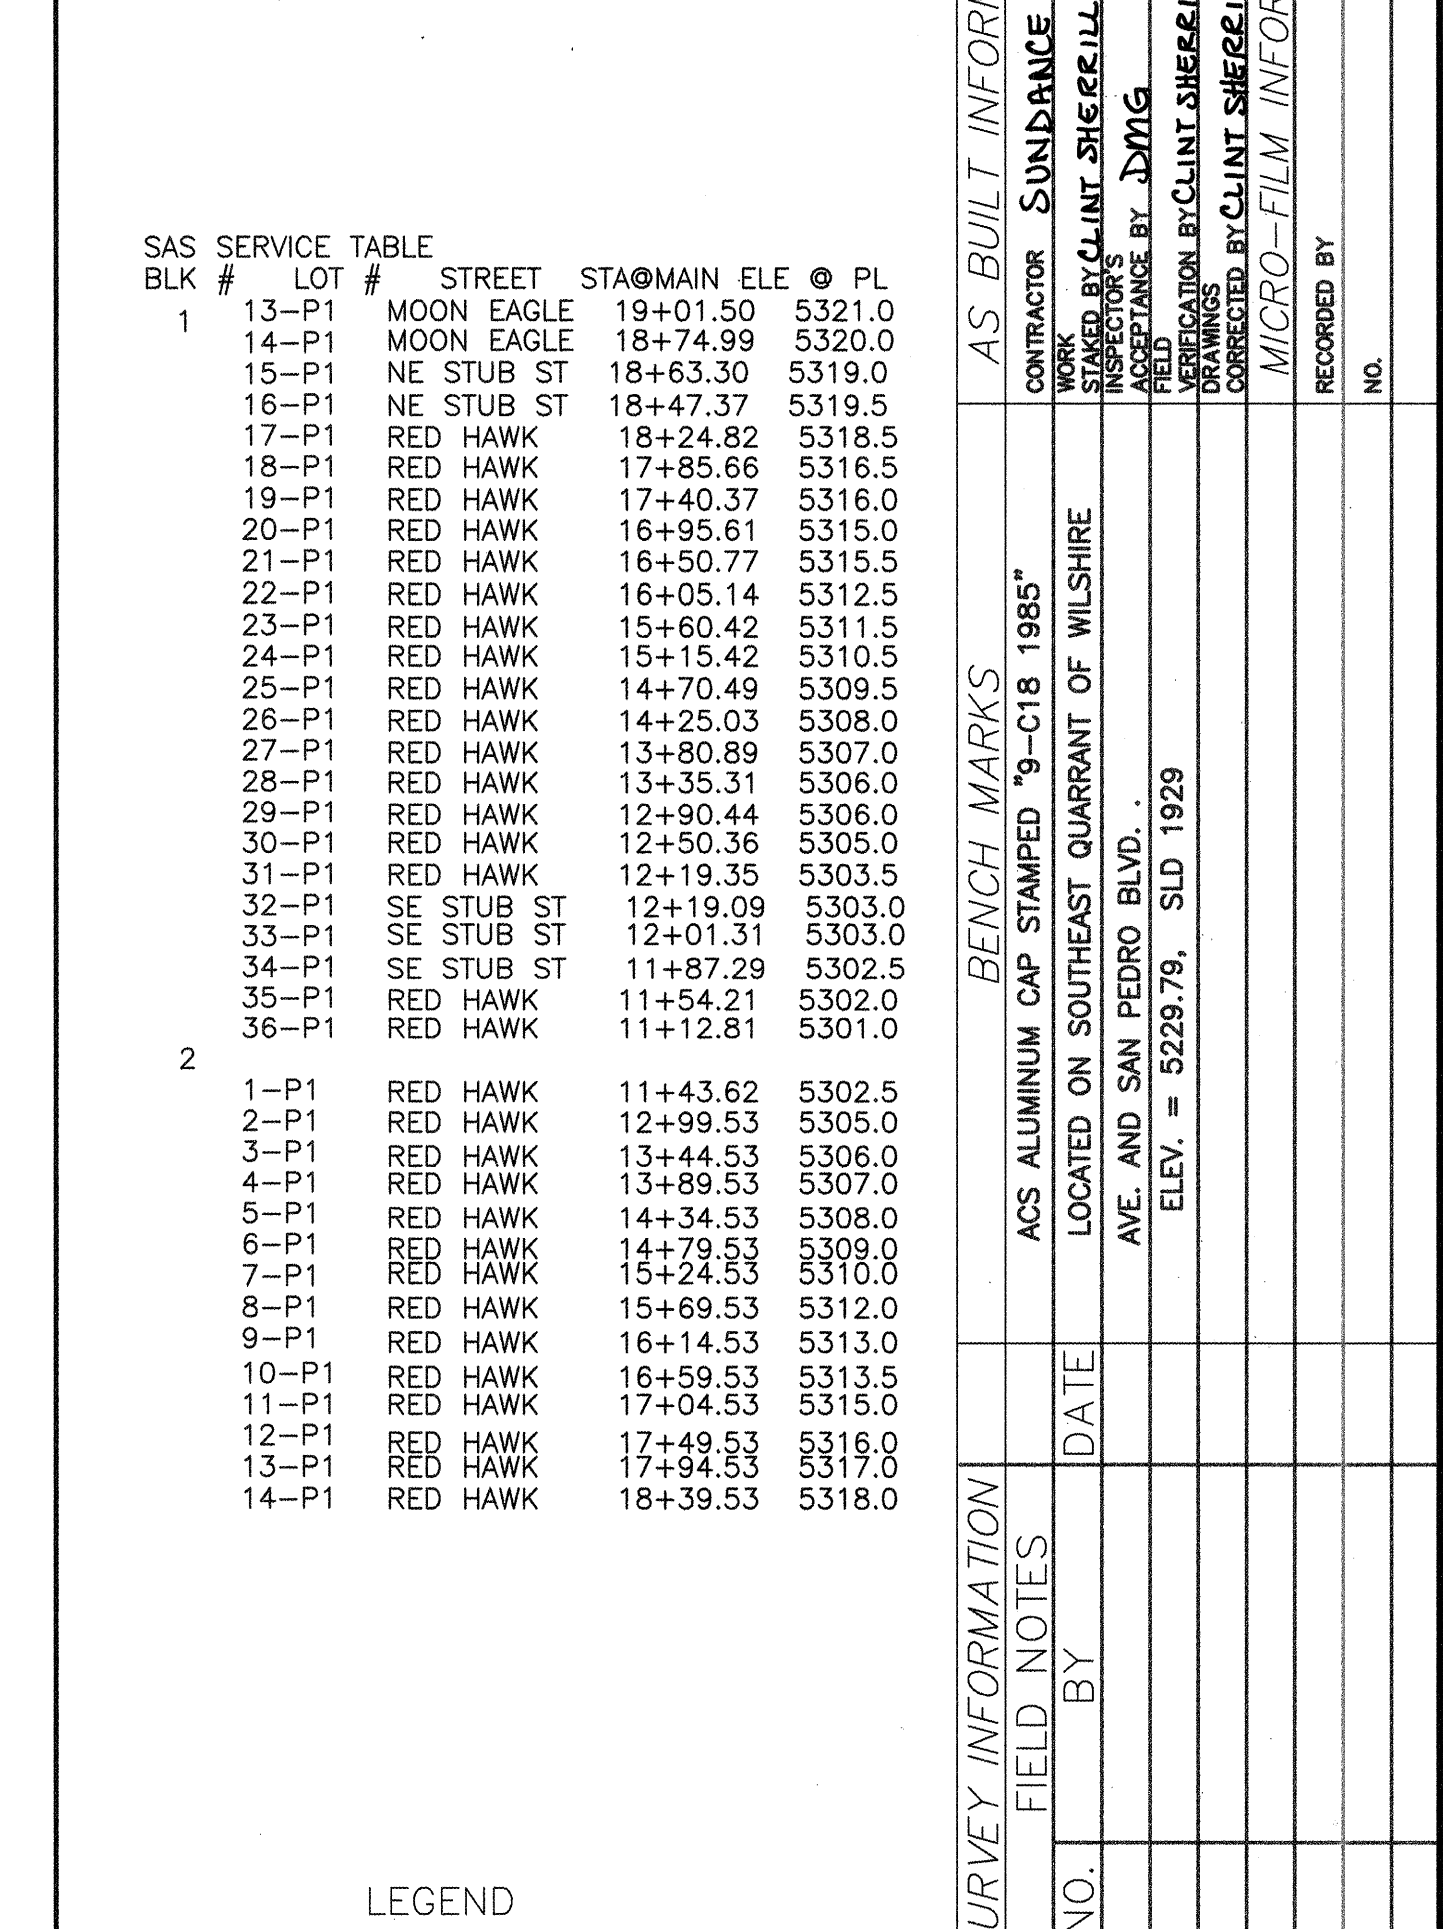

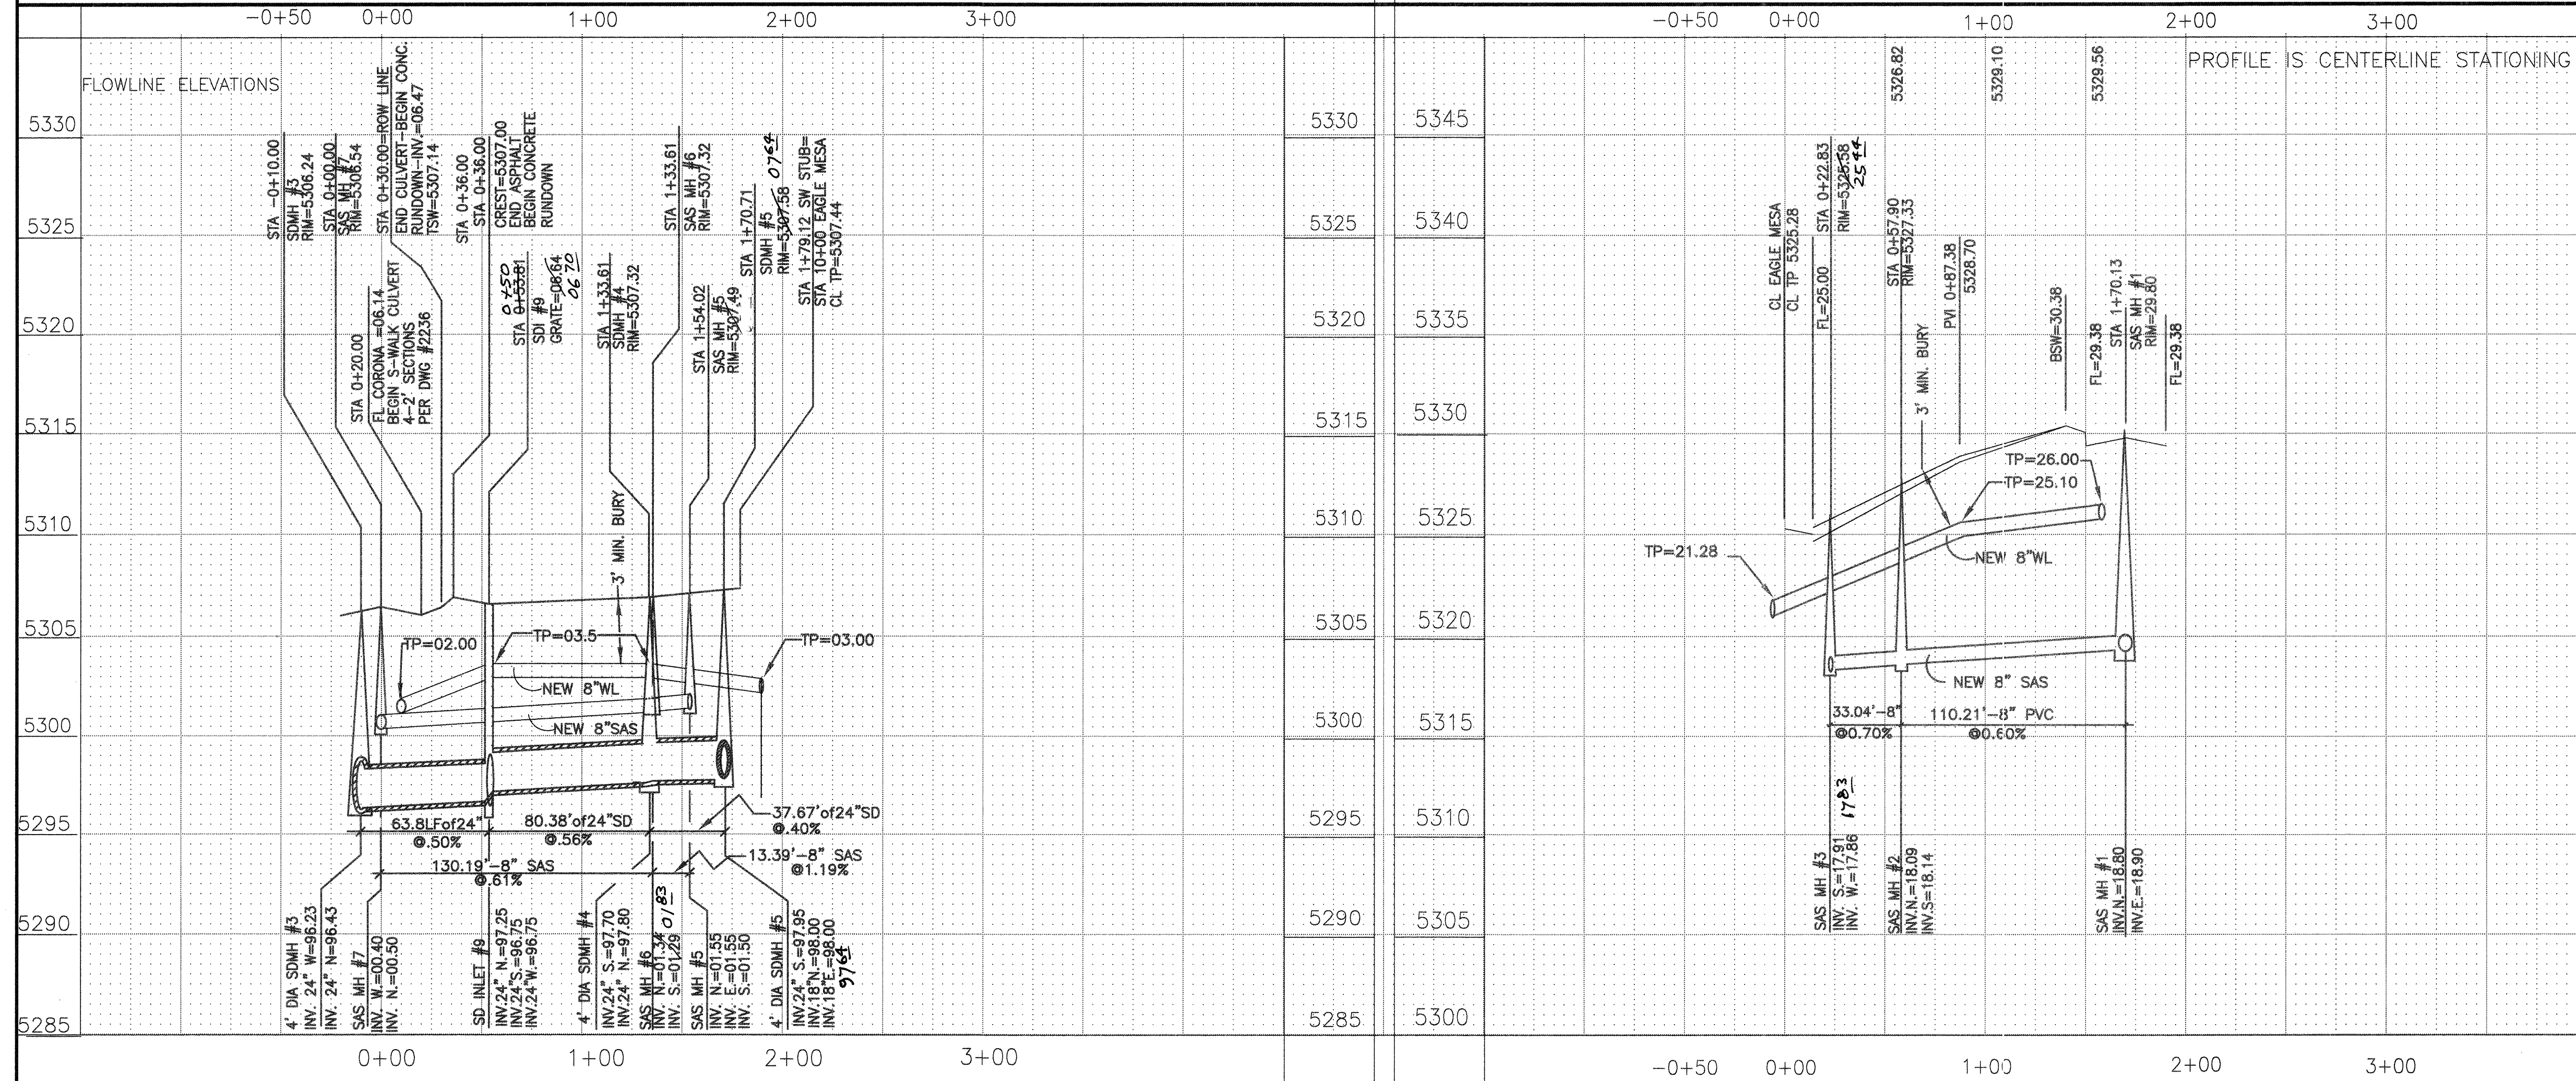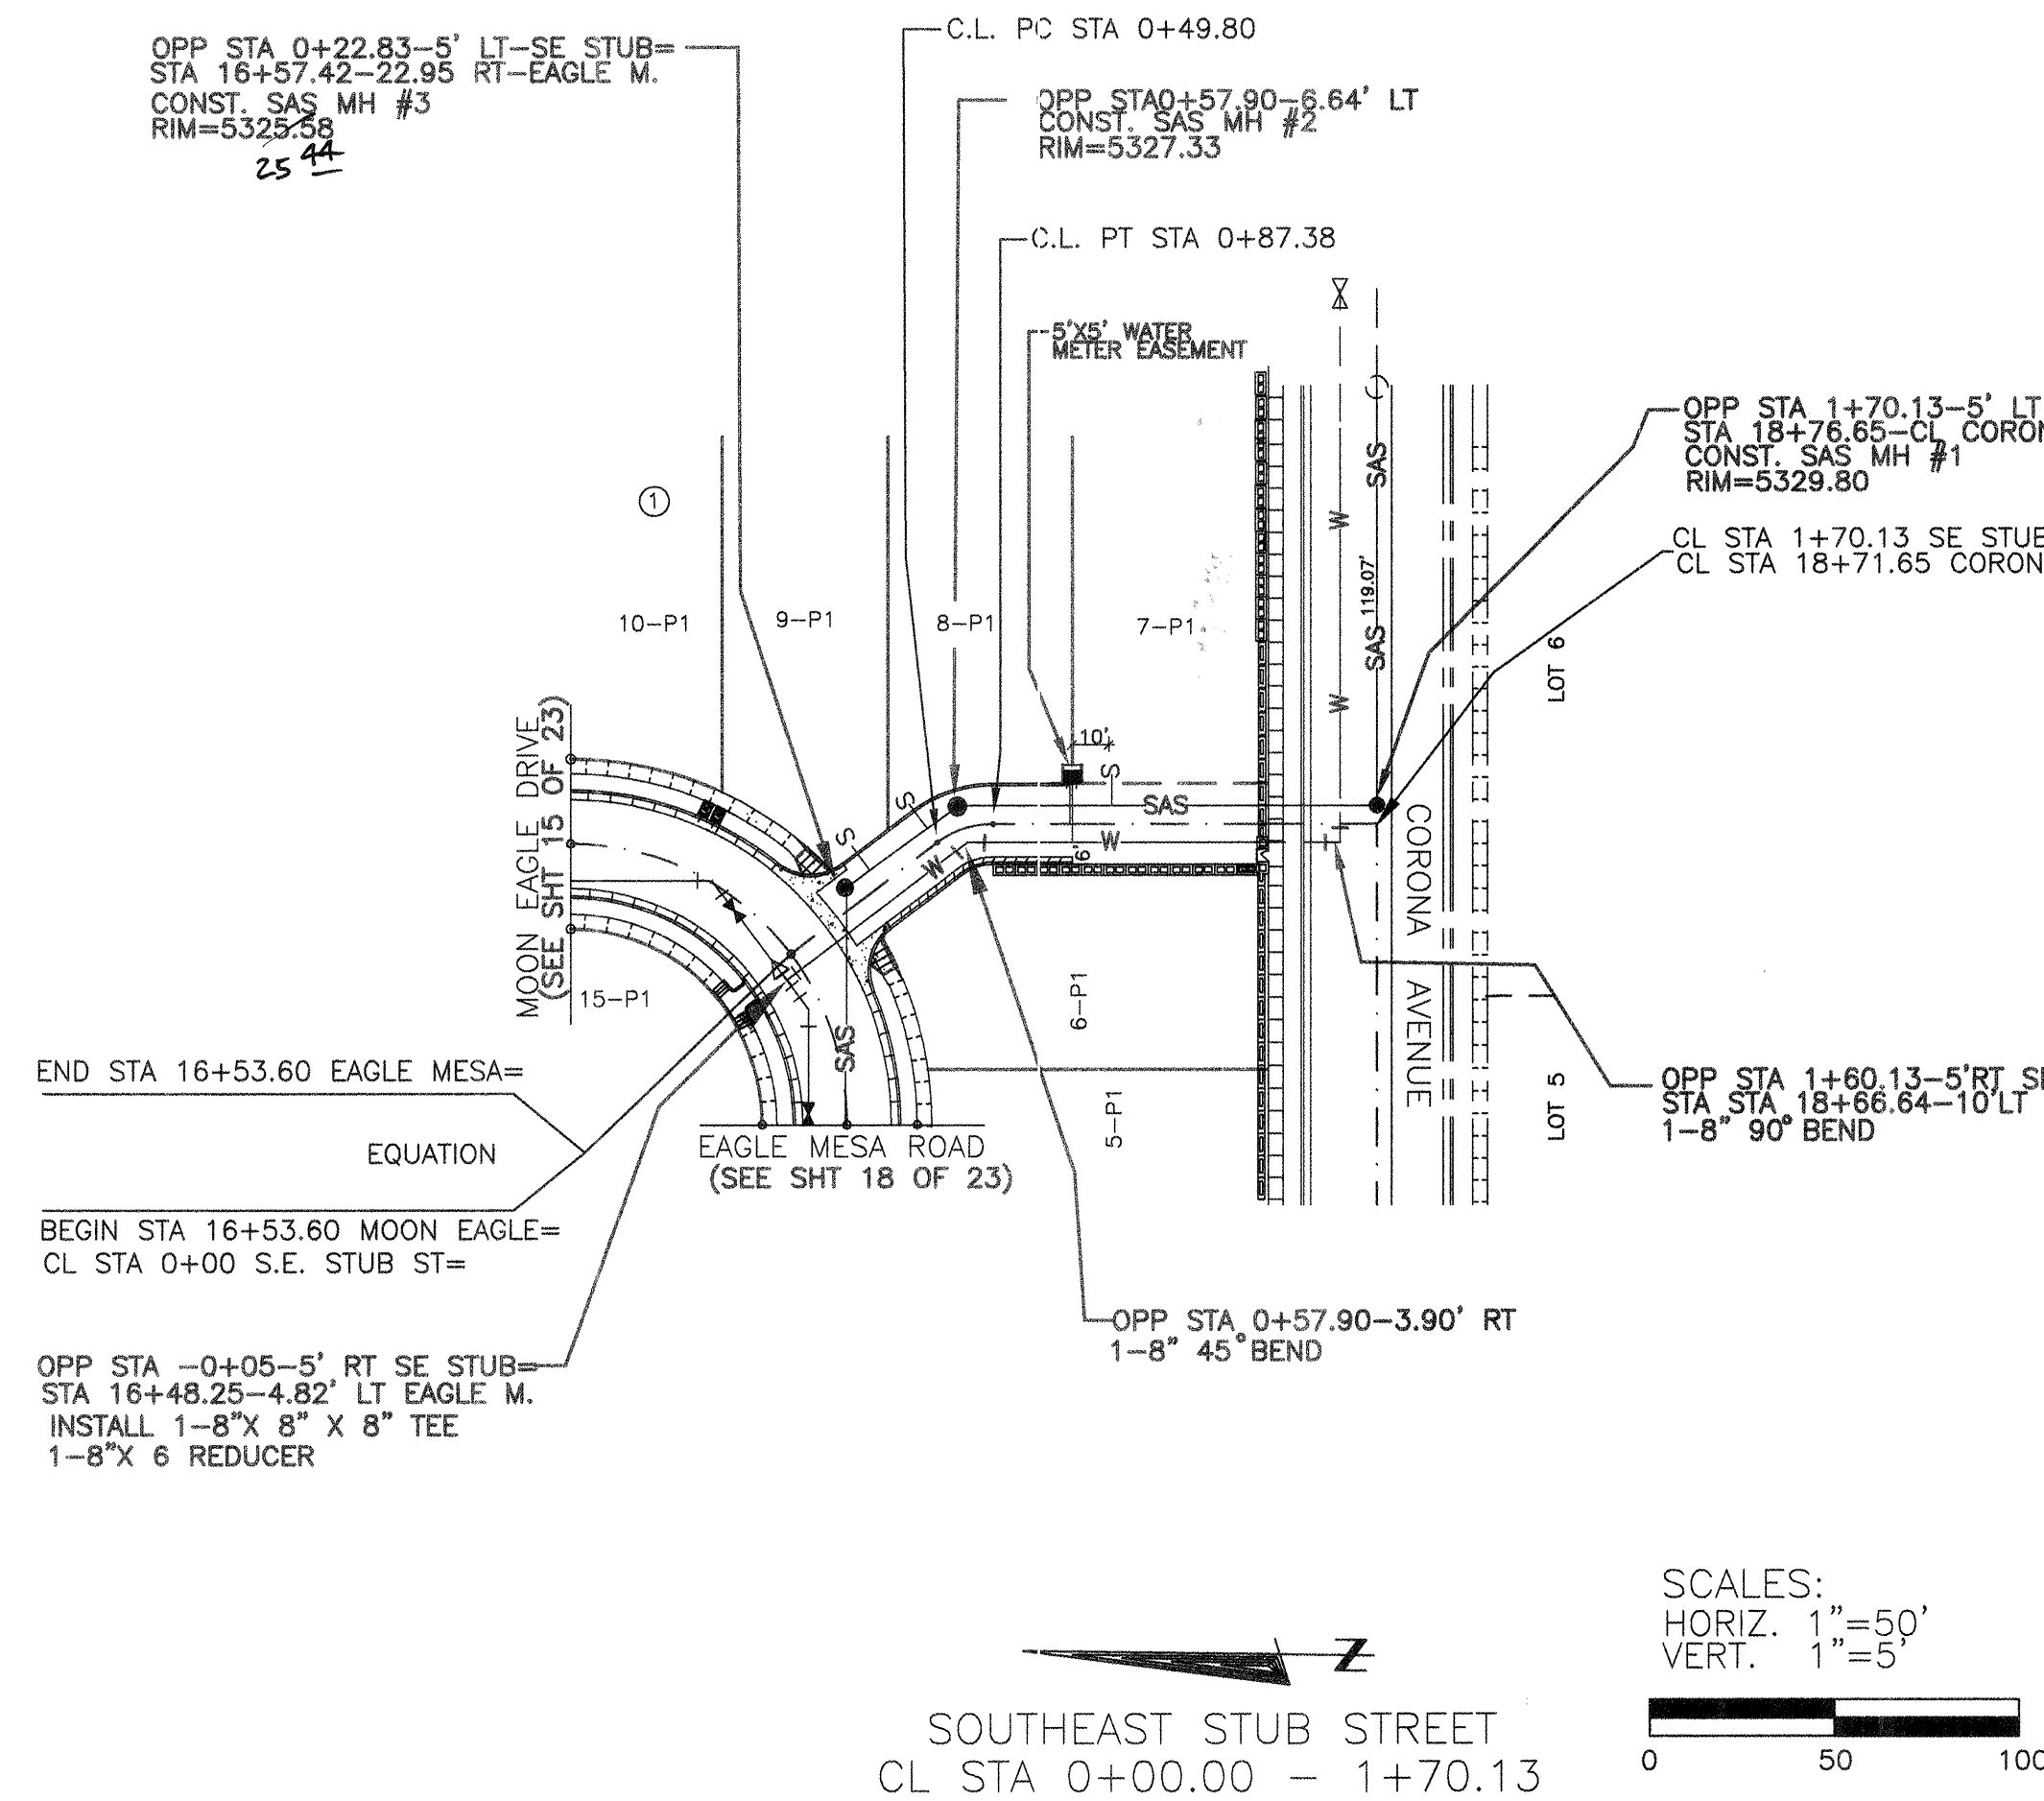

SAS BLK	SERVICE #	TABLE LOT #	STREET	STA@MAIN	ELE @ PL
1	7-P1	SE	STUB ST	1+19.51	5325.0
	8-P1	SE	STUB ST	0+50.01	5321.5
	9-P1	SE	STUB ST	0+30.64	5320.4
	39-P1	SW	STUB ST	1+33.86	5301.0
	42-P1	SW	STUB ST	1+20.87	5301.0

AS BUILT INFORMATION	
CONTRACTOR	DATE 11/6
WORK	DATE 11/6
INSPECTOR'S	DATE 12/6
ACCEPTANCE BY	DATE 12/6
REGISTRATION BY	DATE 12/6
REMARKS	DATE 12/6
MICRO-FILM INFORMATION	
RECORDED BY	DATE
10.	

BENCH MARKS

CITY OF ALBUQUERQUE SURVEY MONUMENT

ACS CAP "7-K9"

ELEV. = 5137.36

[illegible]

Professional Engineer's Seal for the State of Mexico, No. 9048, signed by Ing. Roberto Aguilar.

[illegible]

QU TMENT NT GROUP VISION OFILE 1+79.71 +70.13		
	Mo./Day/Yr.	Mo./Day/Yr.
o.	Sheet	Of
	20	23

LEGEND		
DESCRIPTION	PROPOSED	EXISTING
WATER VALVE		
FIRE HYDRANT		
SINGLE WATER SERVICE		
DOUBLE WATER SERVICE		
STREET LIGHT		
STORM DRAIN MANHOLE		
CATCH BASIN		
SAS MANHOLE		
SEWER SERVICE	_____ S	
WATER LINE	_____ W	_____ W
SEWER LINE	_____ SAS	_____ SAS
STORM DRAIN	_____ SD	_____ SD

DWG:C:\EAGLE\DRG\STUBS-U DATED:4/11/00 TIME:11:14 RYALS Engineering-BR

RYALS engineering &
3301 Central, N.E. construction services
(505) 265-8267 Albuquerque, NM 87108
239-0194 mobile telephone

	CITY OF ALBUQUERQUE			
	PUBLIC WORKS DEPARTMENT			
	ENGINEERING DEVELOPMENT GROUP			
	EAGLE POINT SUBDIVISION			
TITLE:	UTILITY PLAN AND PROFILE			
	SW STUB	ST STA	0+00-1+79.71	
	SE STUB	ST STA	0+00-1+70.13	

Design Review Committee

APPROVE

AUG 24 2000

DESIGN REVIEW COMMITTEE


CITY ENGINEER APPROVAL

APPROVE

SEP 14 2000

CITY ENGINEER

City Project No.	Zone Map No.	Sheet	Of
600481	C-19	20	23

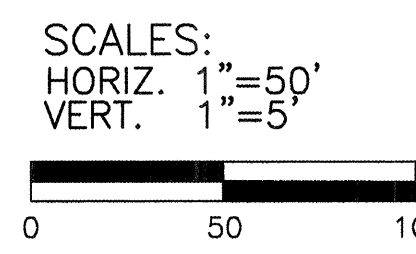

SCALES:
HORIZ. 1"=50'
VERT. 1"=5'



0 50 100

- DWG-C:\EAGLE\DRG\CORU DATE08/02/00 TIME:11:03 RYALS Engineering-BR
- | | |
|--|--|
| RYALS
5301 Central, N.E.
(505) 265-8267 | engineering &
construction services
Albuquerque, NM 87108
239-0194 mobile telephone |
|--|--|

	CITY OF ALBUQUERQUE PUBLIC WORKS DEPARTMENT ENGINEERING DEVELOPMENT
TITLE:	EAGLE POINT SUBDIVISION UTILITY PLAN AND PROPOSED STA 9+00.00-20+00.00 CROSS

Design Review Committee AUG 24 2000 DESIGN REVIEW COMMITTEE	City Engineer Approval APPROVE SEP 14 2000 CITY ENGINEER	Last Design Update
City Project No. 600481	Zone Map No. C-10	

								ENGINEER'S SEAL		SURVEY INFORMATION		BENCH MARKS		AS BUILT INFORMATION	
										FIELD NOTES					
										NO.		BY		DATE	
														CONTRACTOR SURVEYANCE	
														DATE 1/90	
														WORK	
														DATE 07/90	
														INSPECTOR'S	
														DATE 07/90	
														FIELD CHANGE BY	
														DATE 07/90	
														VERIFICATION BY	
														DATE 07/90	
														CORRECTED BY	
														DATE 07/90	
														MICRO-FILM INFORMATION	
														RECORDED BY	
														DATE	
														NO.	

ENGINEER'S SEAL



										ENGINEER'S SEAL		SURVEY INFORMATION		BENCH MARKS		AS BUILT INFORMATION	
												FIELD NOTES					
												NO.		BY		DATE	
																CONTRACTOR SURVEYANCE	
																DATE 1/90	
																WORK	
																DATE 07/90	
																INSPECTOR'S	
																DATE 07/90	
																FIELD CHANGE BY	

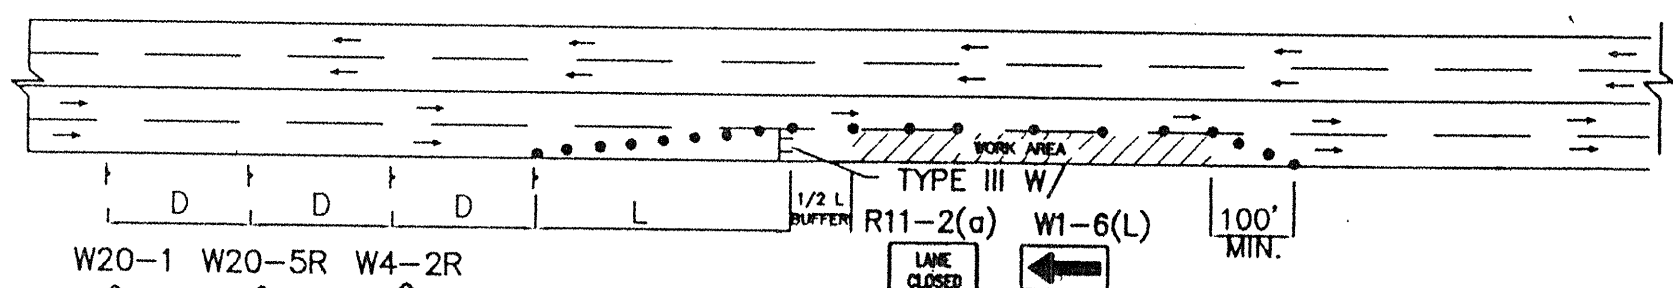


TYPICAL RIGHT LANE CLOSURE

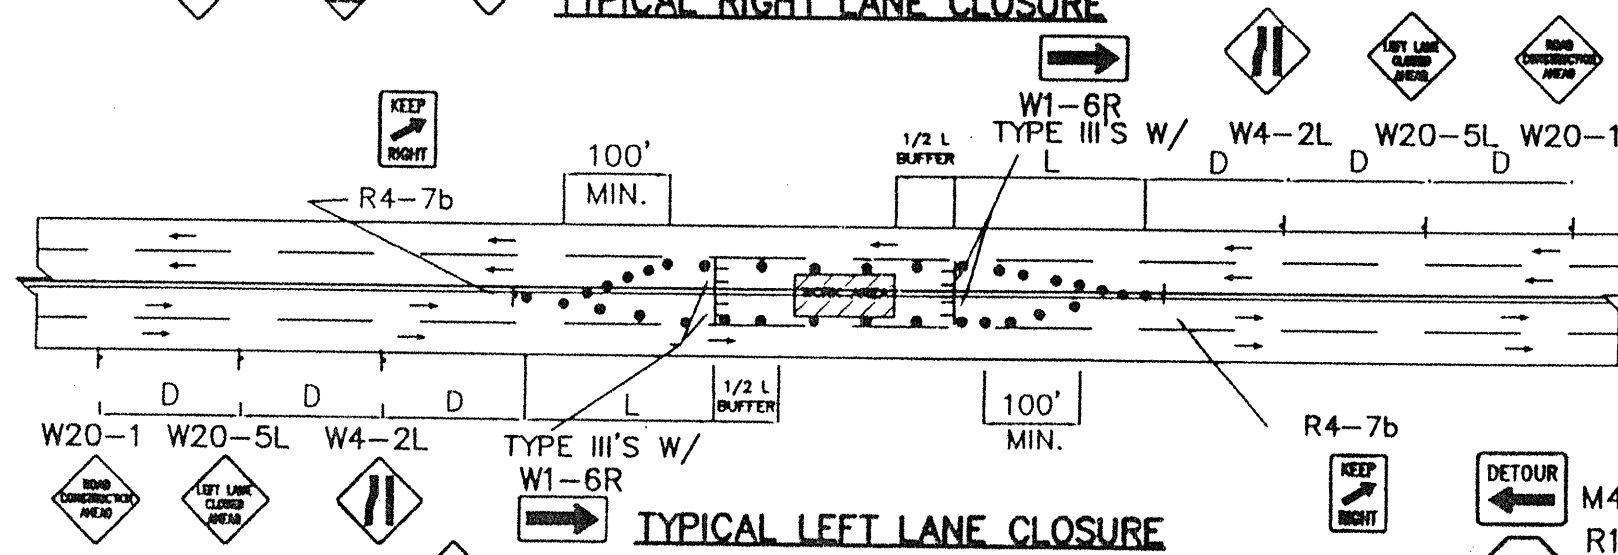


TYPICAL LEFT LANE CLOSURE

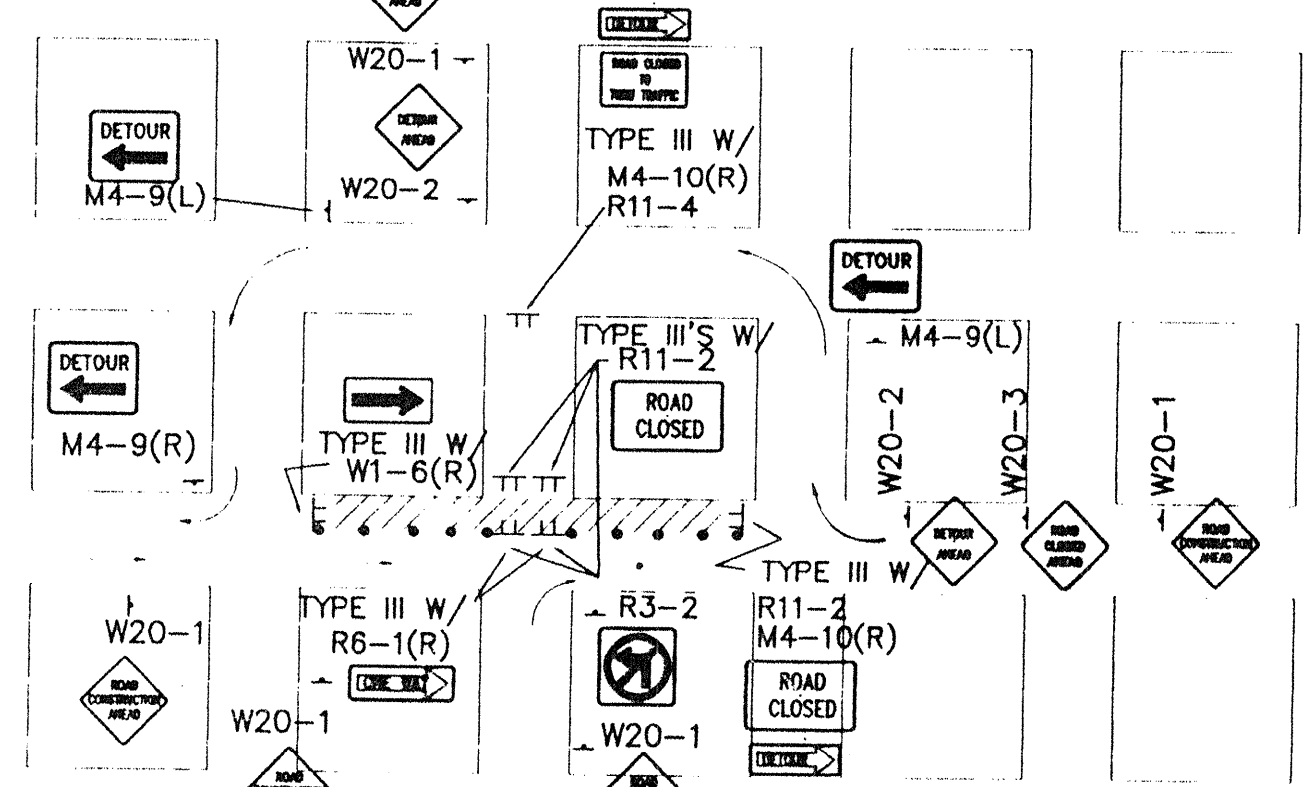

TYPICAL ONE DIRECTION DETOUR

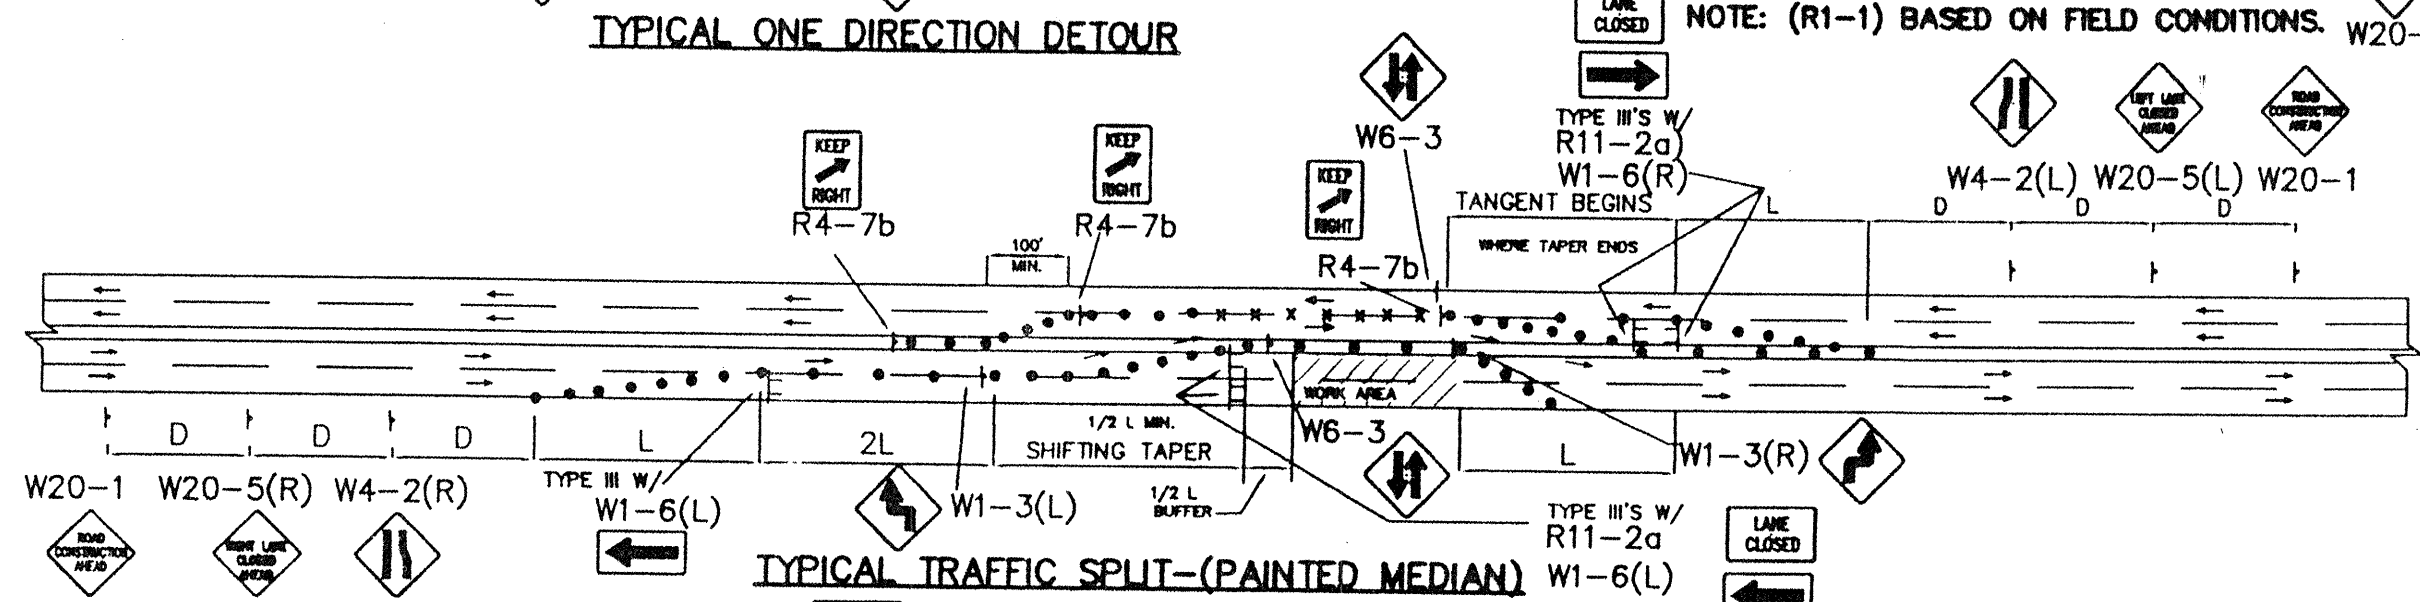

TYPICAL TRAFFIC SPLIT-(PAINTED MEDIAN)

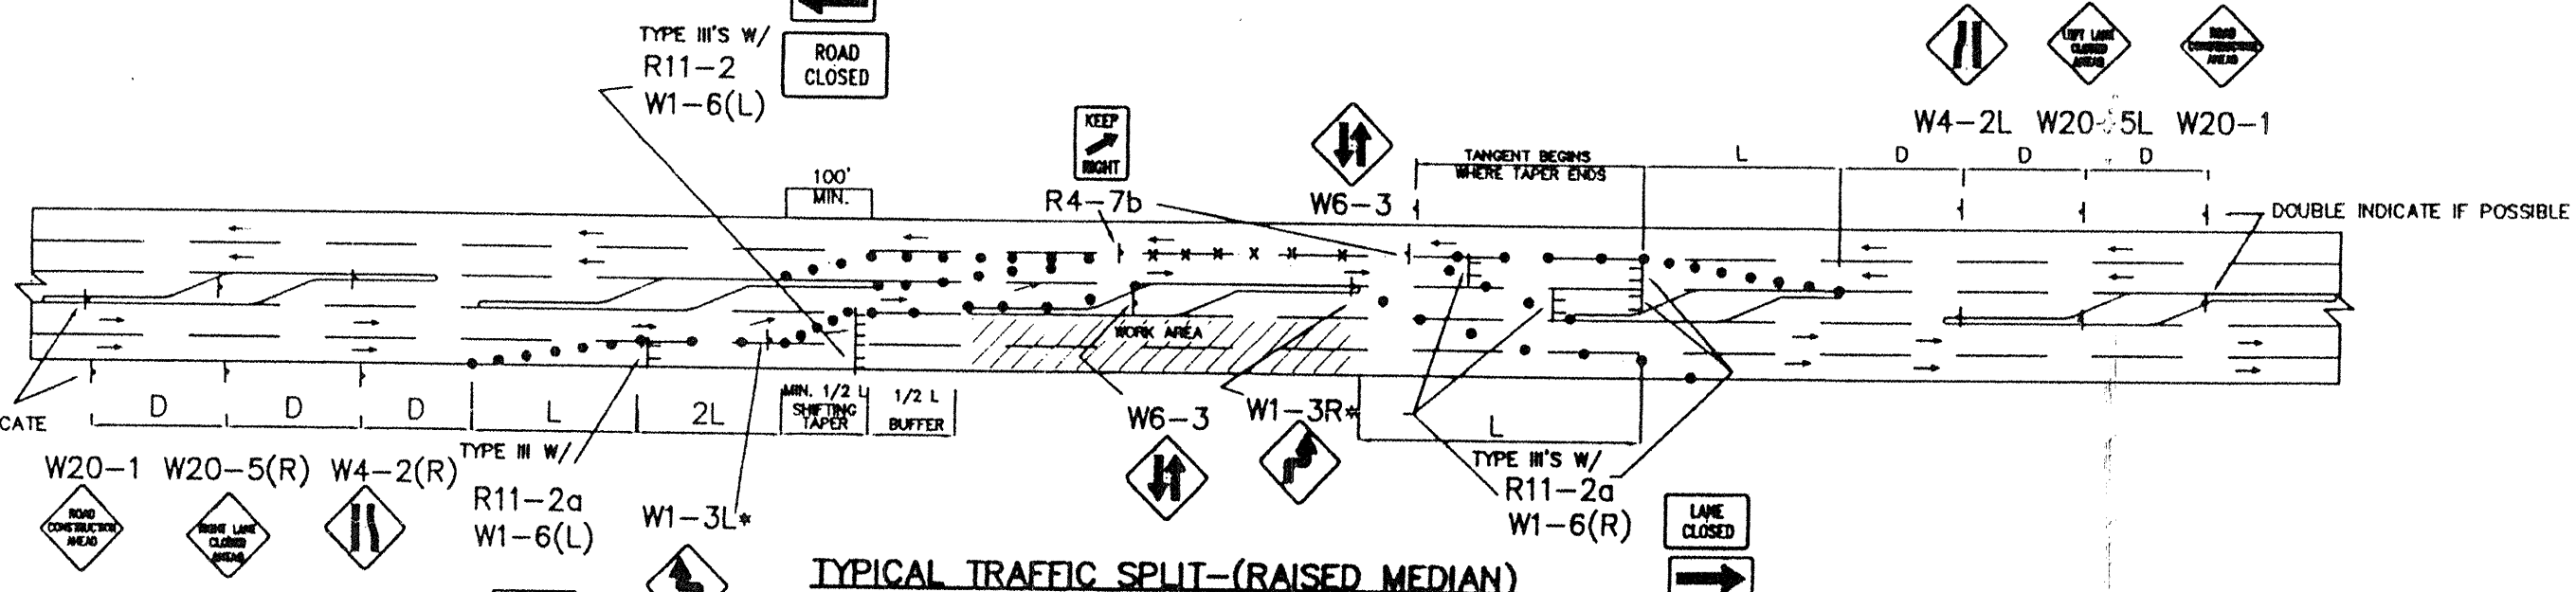


TYPICAL TRAFFIC SPLIT-(RAISED MEDIAN)

- TRAFFIC SPLIT NOTES:
1. THE OFFSET DISTANCE MUST BE CALCULATED IN ALL SHIFTING TAPERS. THE OFFSET DISTANCES SHALL INCLUDE LANE WIDTHS PLUS MEDIAN WIDTHS.
 2. 1/2 L IS MINIMUM DISTANCE FOR SHIFTING TAPERS.
 3. REVERSE CURVES MAY BE IMPLEMENTED. ALL CURVE DATA SHALL BE CALCULATED.
 4. MEDIAN REMOVAL SHALL BE REQUIRED IF 1/2 L OR REVERSE CURVE IS NOT SUFFICIENT. MEDIAN REMOVAL SHALL TAKE PLACE BEFORE SPLITS.
 5. REDUCED SPEED MAY BE CONSIDERED.
 6. * USE W1-3 FOR 30 MPH OR LESS, W1-4 FOR SPEED 35 MPH OR GREATER.

GENERAL NOTE:


ALL CONSTRUCTION WARNING SIGNS SHALL HAVE A BLACK LEGEND ON A ORANGE BACKGROUND.
ALL ADVANCE WARNING SIGNS SHALL BE A MINIMUM OF 36" THIRTY SIX INCHES BY 36" THIRTY SIX INCHES IN SIZE AND SHALL HAVE ONE WARNING LIGHT.

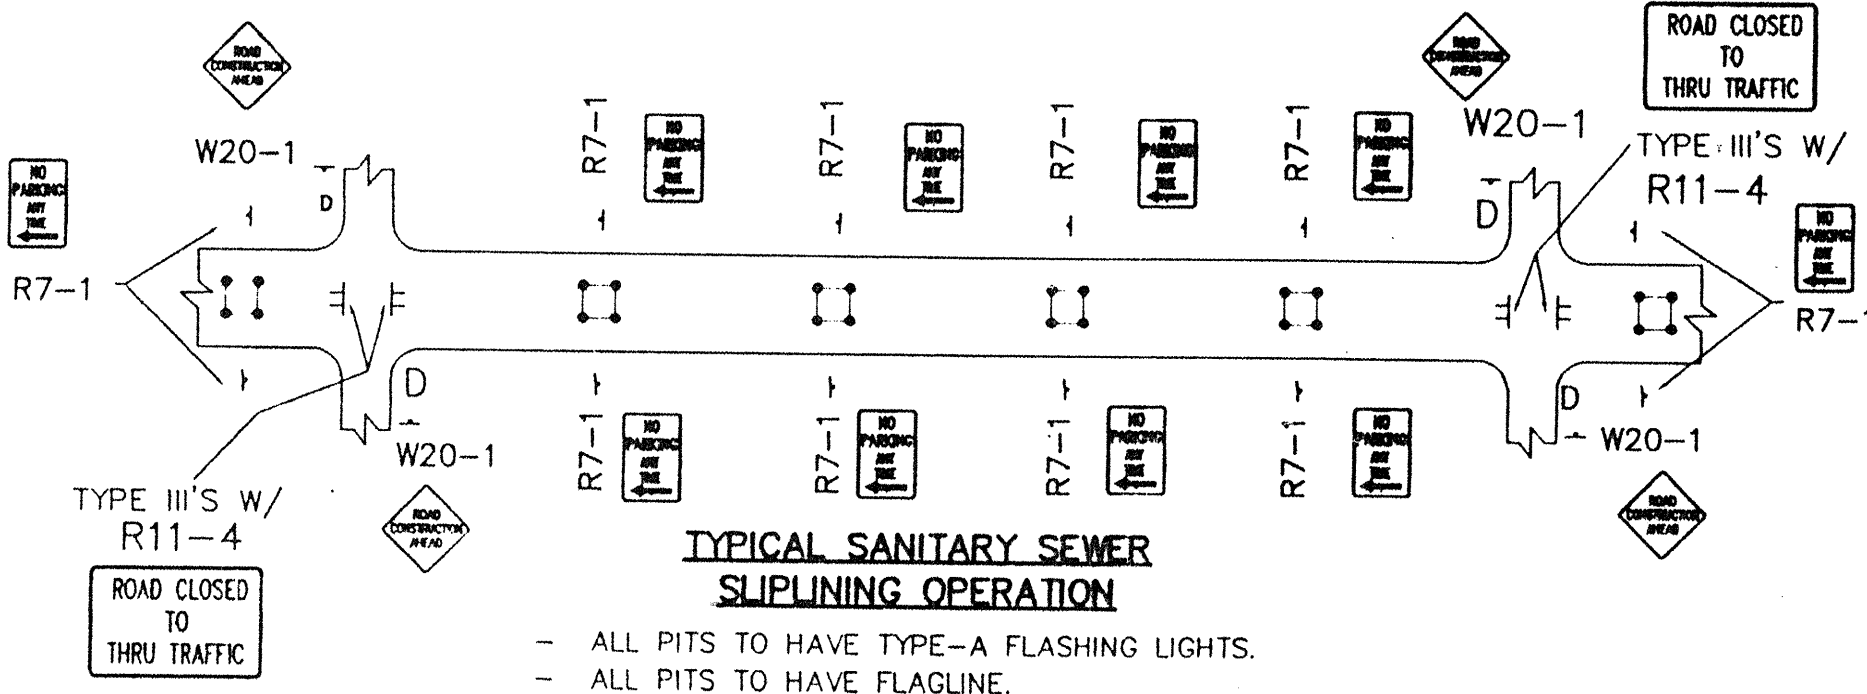

TYPICAL SANITARY SEWER SNUFFLING OPERATION


- ALL PITS TO HAVE TYPE-A FLASHING LIGHTS.
- ALL PITS TO HAVE FLAGLINE.

NOTE: MAY REQUIRE LEFT LANE CLOSURE DEPENDING ON FIELD CONDITIONS.

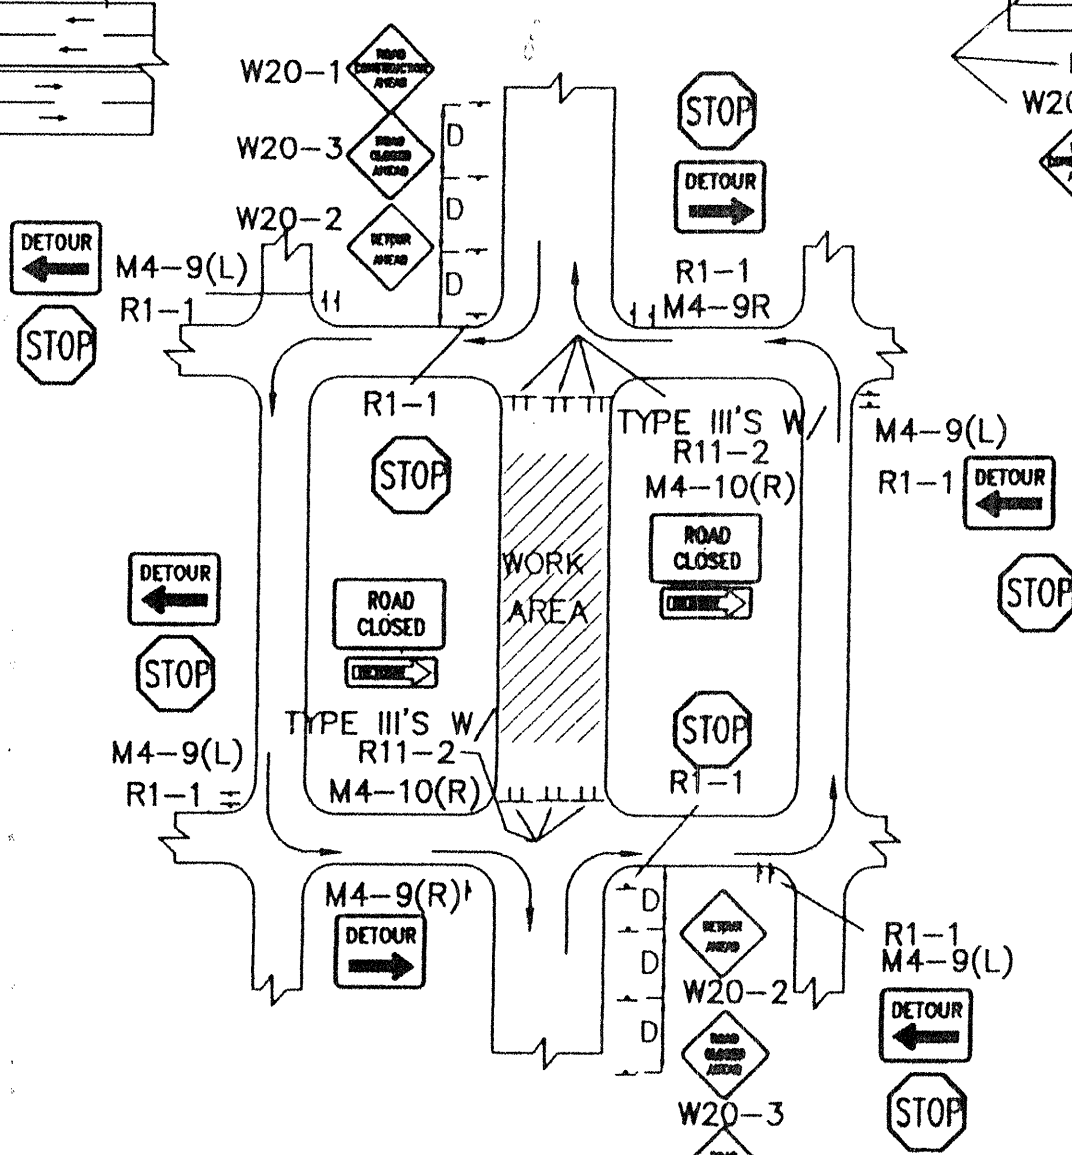


TYPICAL STREET CLOSURE

NOTE: (R1-1) BASED ON FIELD CONDITIONS.

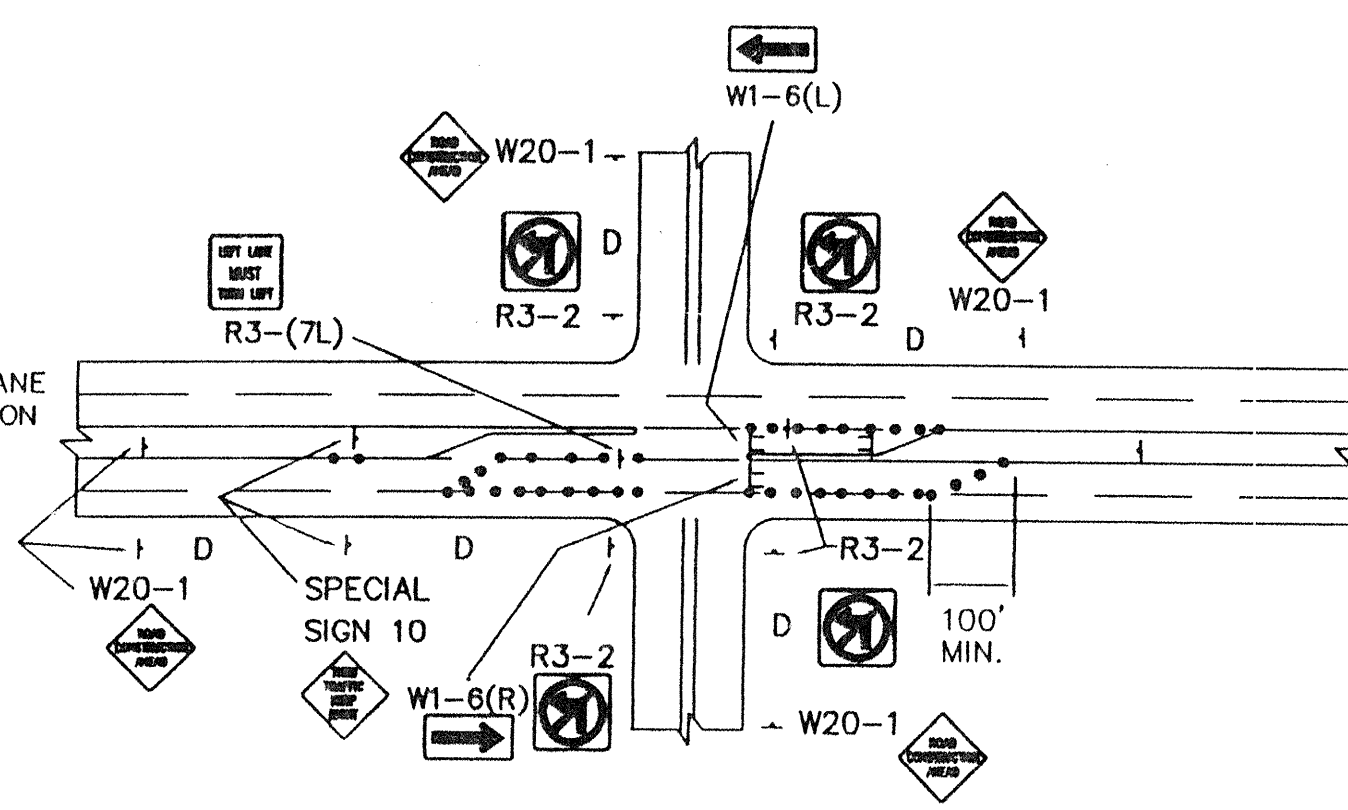


TYPICAL LANE CLOSURE AT INTERSECTION

NOTE: DEPENDING ON WORK ZONE LOCATION

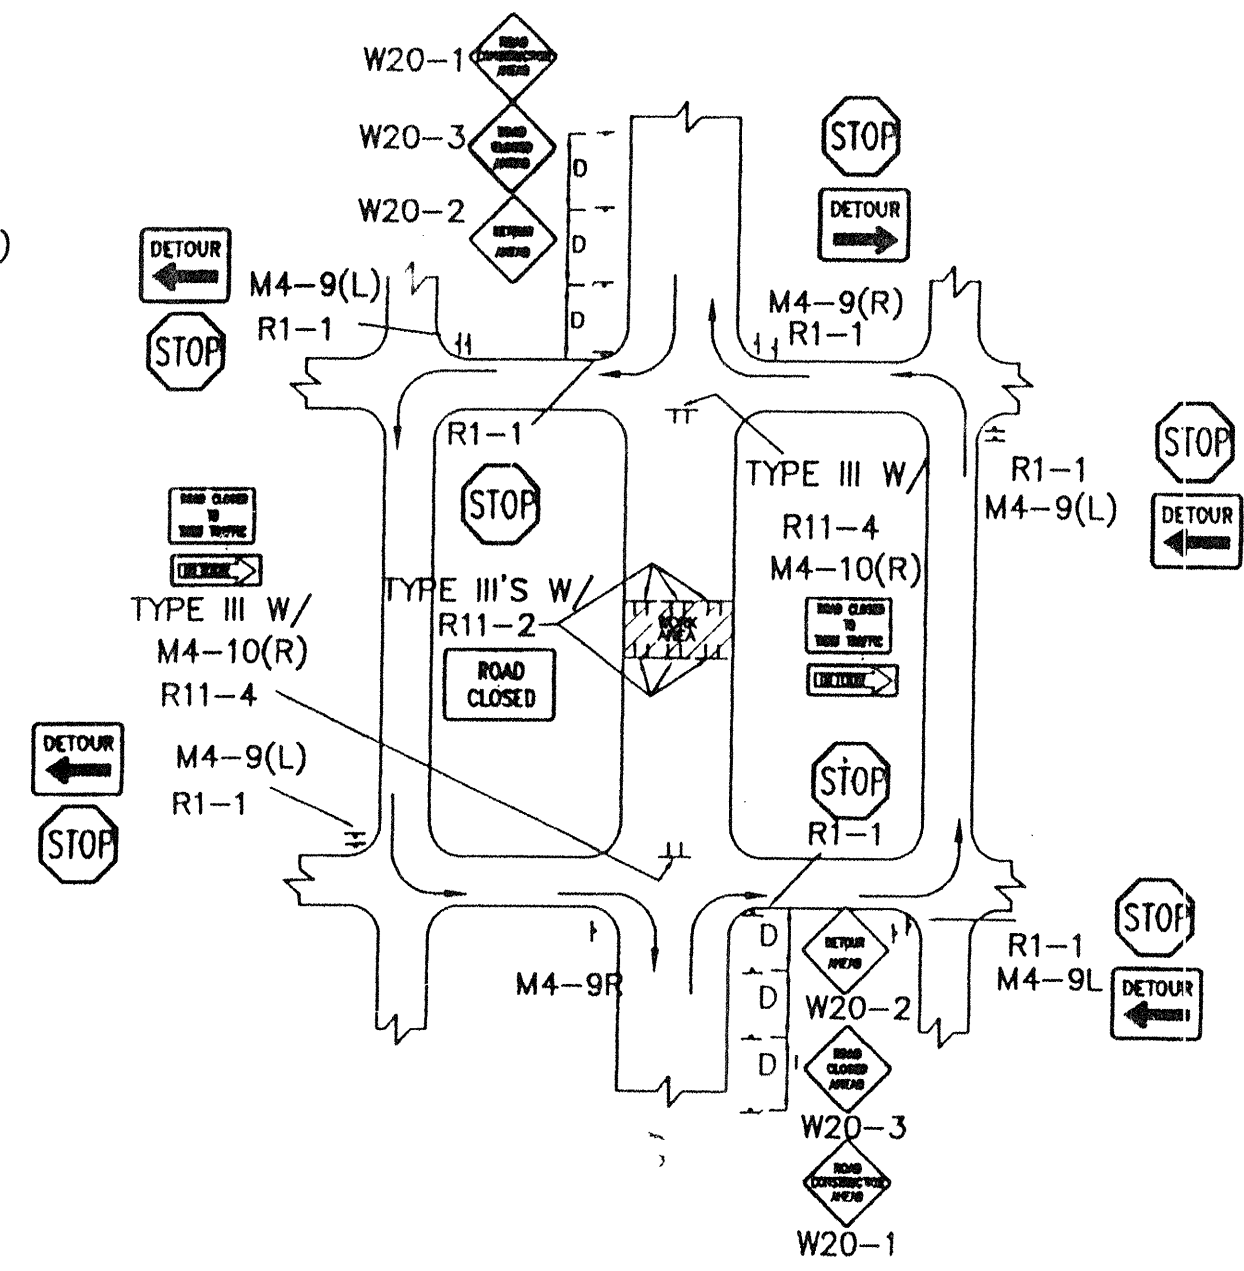


TYPICAL MID-BLOCK CLOSURE

NOTE: (R1-1) BASED ON FIELD CONDITIONS.

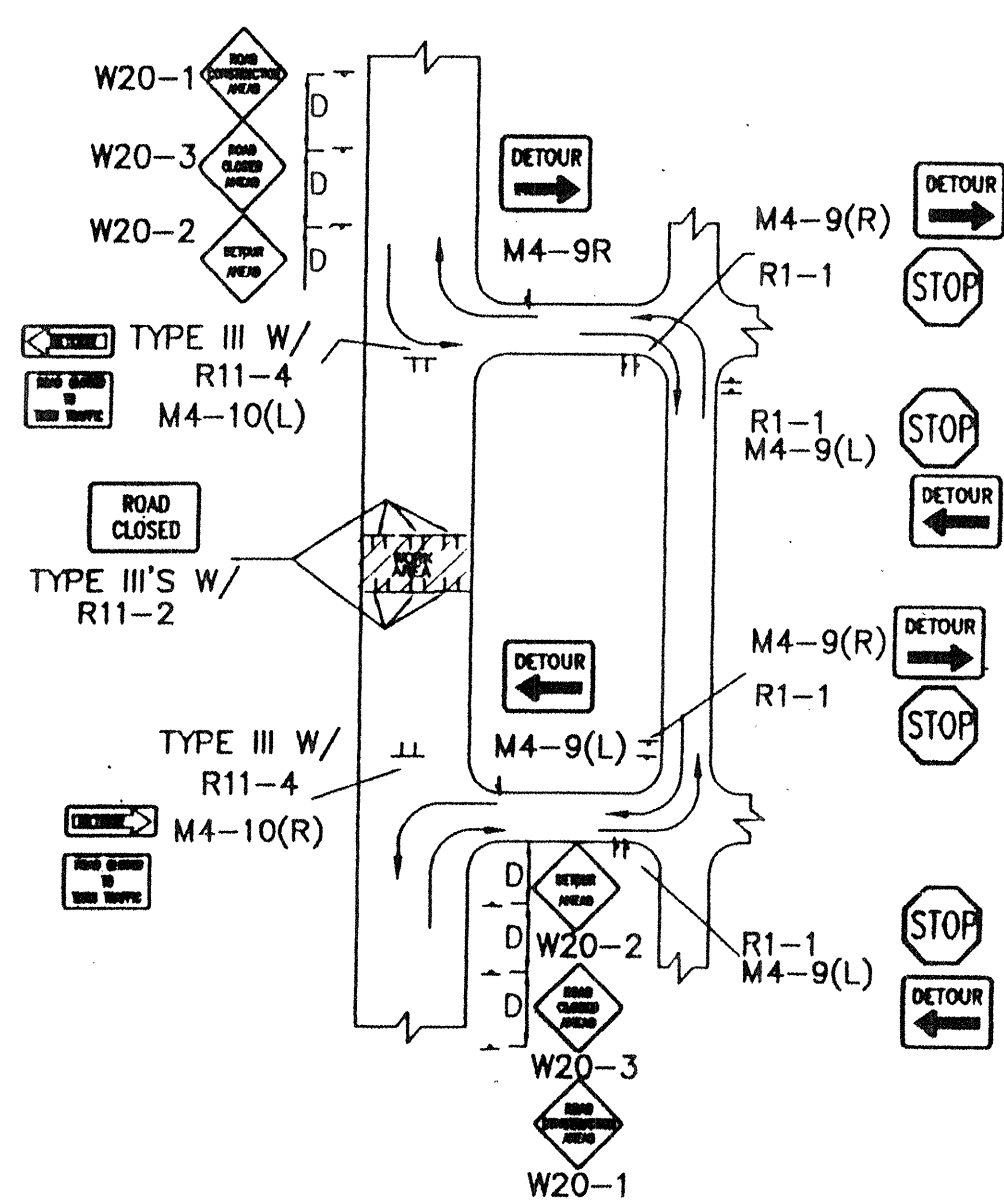


TYPICAL STREET CLOSURE


NOTE: (R1-1) BASED ON FIELD CONDITIONS.

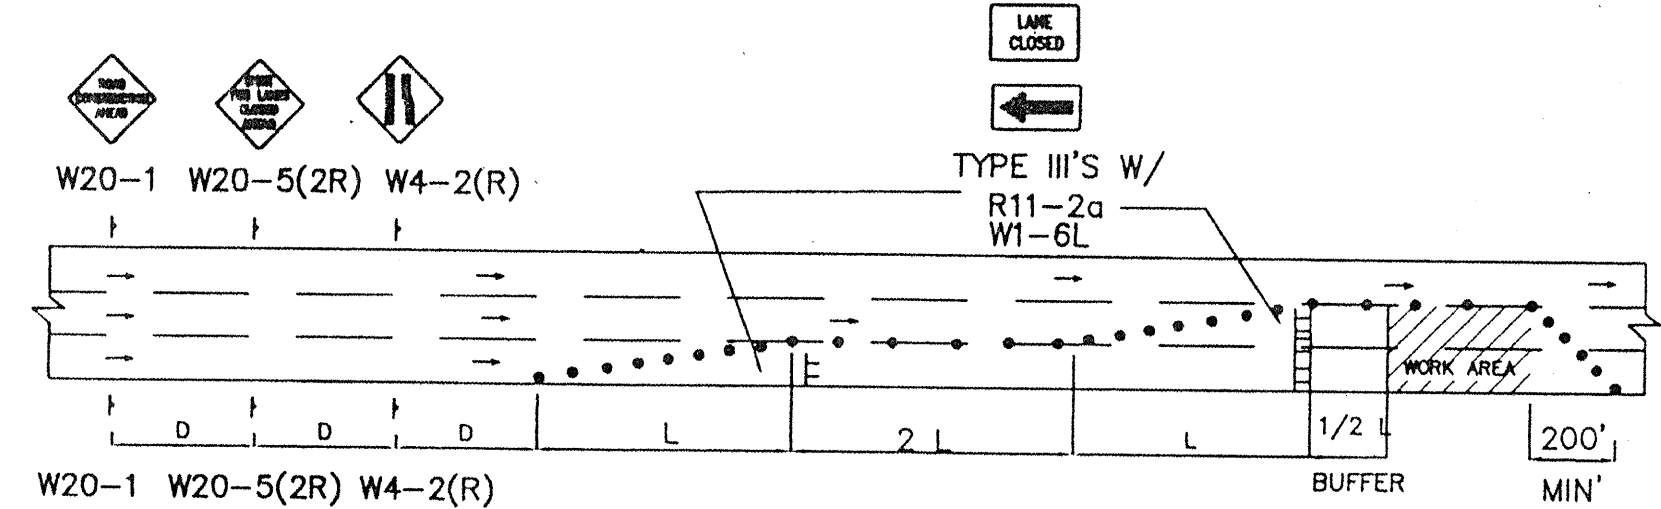


TYPICAL DOUBLE RIGHT LANE CLOSURE

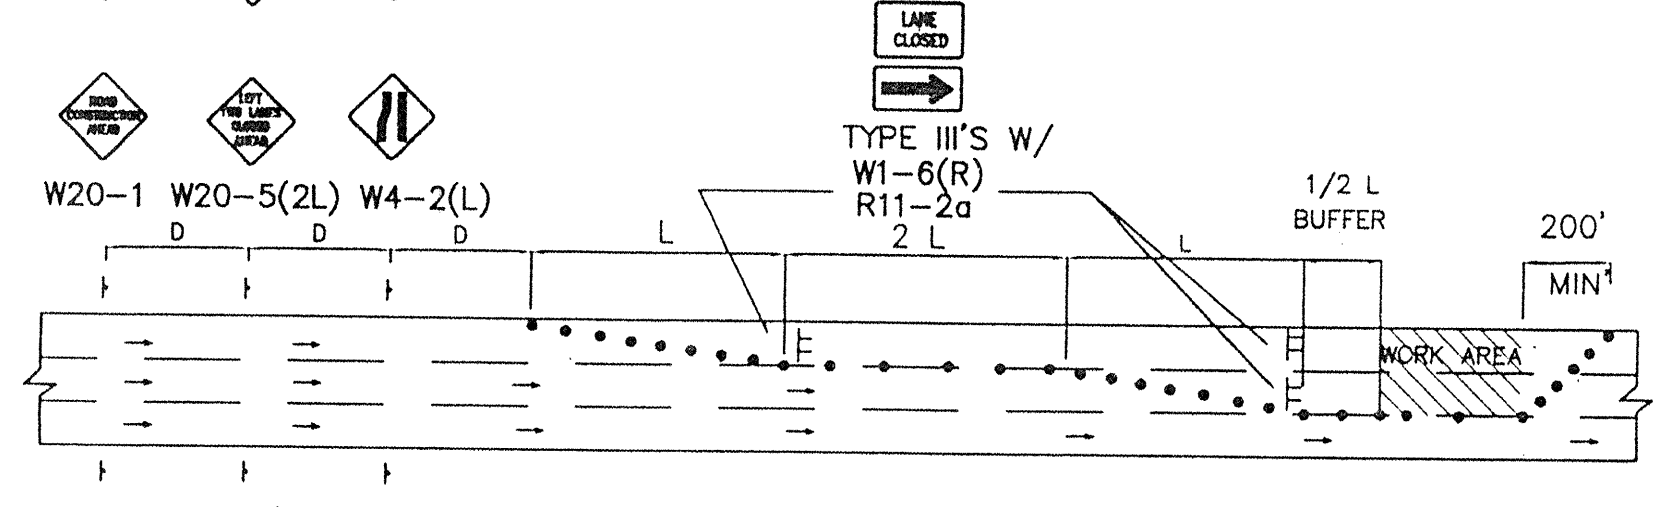

TYPICAL DOUBLE LEFT LANE CLOSURE

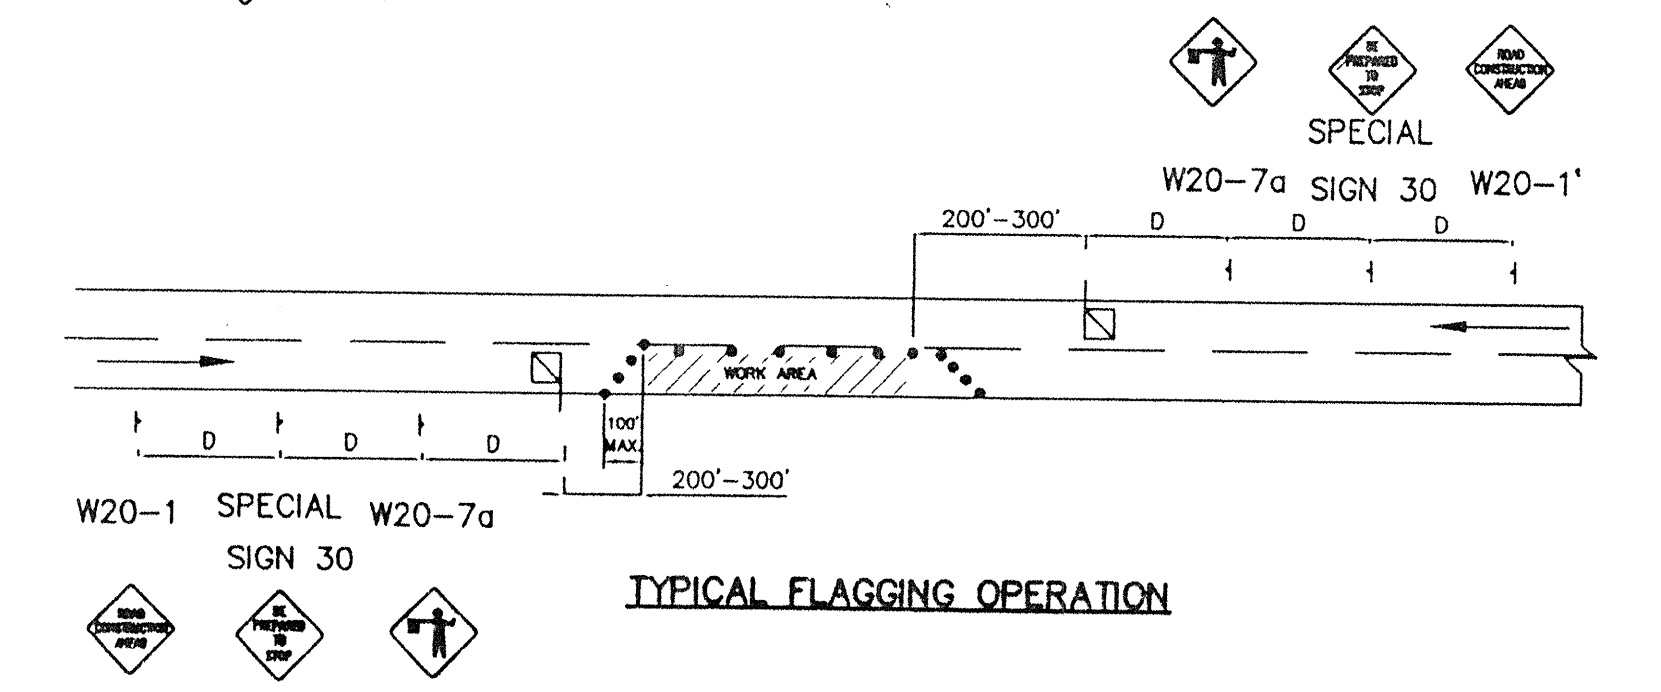


TYPICAL FLAGGING OPERATION

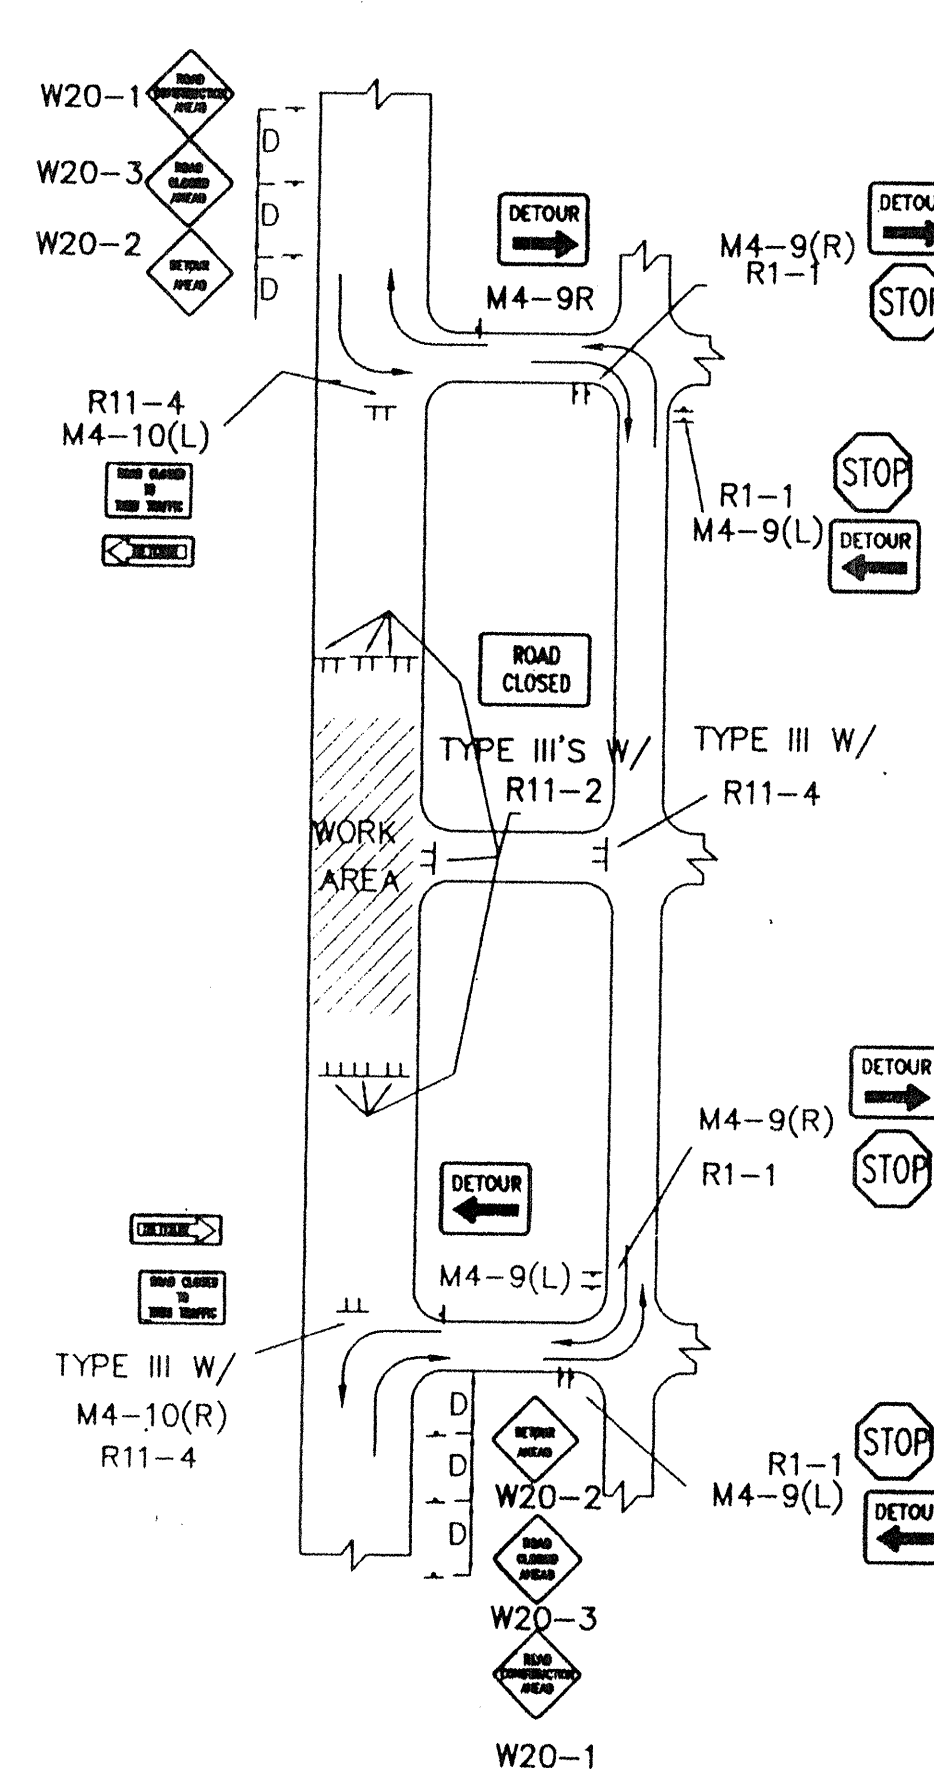

TYPICAL STREET CLOSURE

NOTE: (R1-1) BASED ON FIELD CONDITIONS.

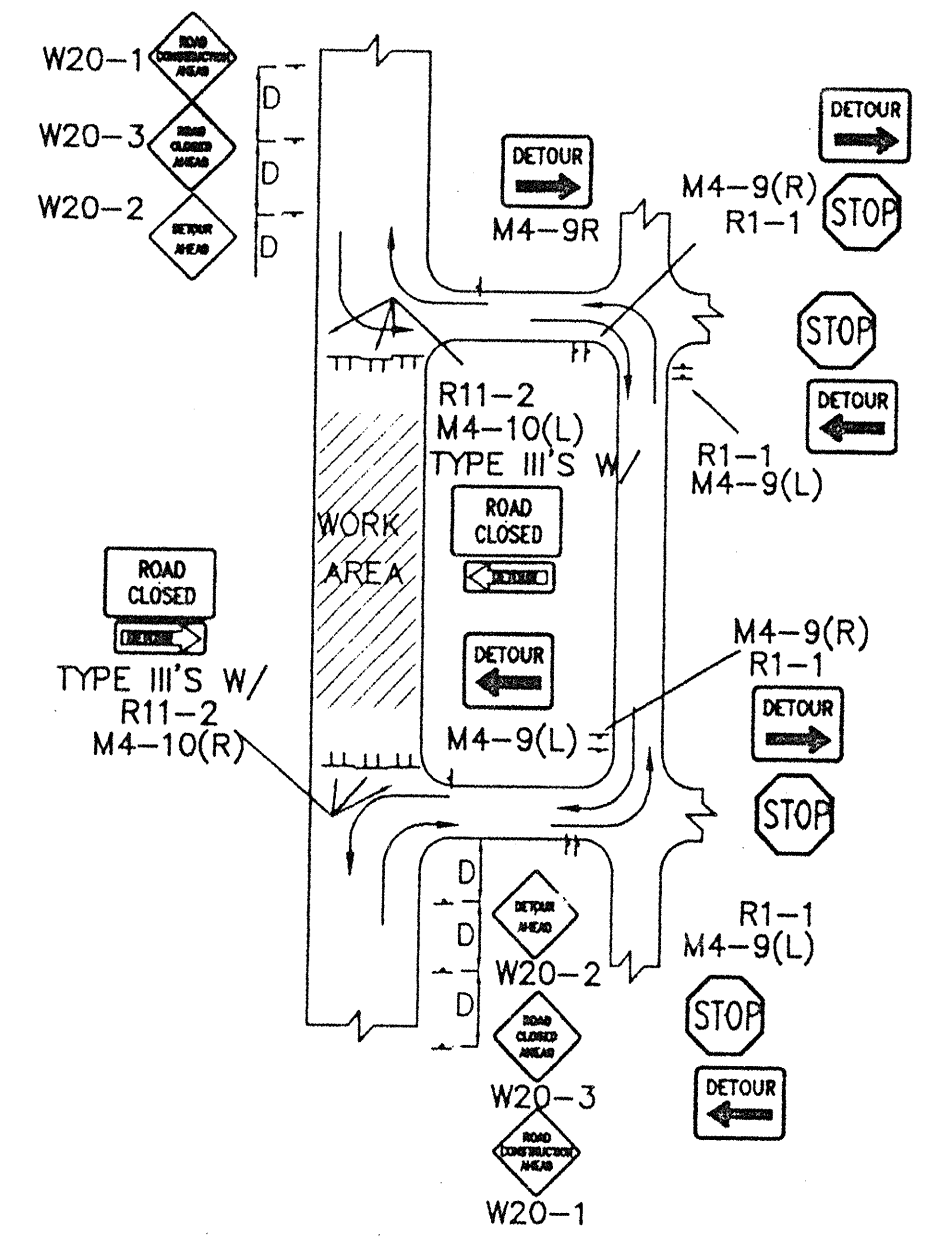

TYPICAL STREET CLOSURE

NOTE: (R1-1) BASED ON FIELD CONDITIONS.

AS-BUILT INFORMATION		CONTRACTOR: STANDARD		DATE: 9/24/97	
INSPECTOR: DMG		STANDARD BY: DMG		DATE: 9/24/97	
REVISIONS		NO.		DATE	
DESIGNED BY: C.O.A.		STANDARDS		DATE: 9/24/97	
DRAWN BY: DMG		CHECKED BY: DMG		DATE: 9/24/97	
REMARKS		NO.		DATE	
DESIGN		NO.		DATE	
CITY OF ALBUQUERQUE PUBLIC WORKS DEPARTMENT ENGINEERING DEVELOPMENT GROUP		TYPICAL TRAFFIC CONTROL & SIGNING EXAMPLES (REF. MUT.C.D.)		C.O.A. Standard	
DESIGN REVIEW COMMITTEE		CITY ENGINEER APPROVAL		MO./DAY/YR.	
PROJECT NO. 600481		MAP NO. C-19		SHEET 22 OF 23	

