

WESTERN BREEZE SUBDIVISION
PHASE II
WESTERN BREEZE COURT
BRAY COURT
WATER, SANITARY SEWER & STREET
INFRASTRUCTURE

INDEX


I	TITLE SHEET
2	PLAT
3	GRADING AND DRAINAGE PLAN, WESTERN BREEZE COURT NW
4	GRADING AND DRAINAGE PLAN, BRAY COURT NW
5	STREET PLAN AND PROFILE, WESTERN BREEZE COURT NW
6	WATER & SANITARY SEWER PLAN & PROFILE, WESTERN BREEZE CT NW
7	STREET PLAN AND PROFILE, BRAY COURT NW
8	WATER & SANITARY SEWER PLAN & PROFILE, BRAY COURT NW
9	DETAILS
10	TRAFFIC CONTROL STANDARDS
11	TRAFFIC CONTROL SIGNS AND EXAMPLES

APPROVAL OF AS BUILT DRAWINGS
CHIEF CONSTRUCTION ENGINEER
Edo Chang
DATE 11-2-00

MARVIN R. KORTUM, P.E.
Civil Engineering
NM PE 6519

1605 Speakman Drive, S.E.
Albuquerque, New Mexico 87123
(505) 299-0774



DRB 97-163

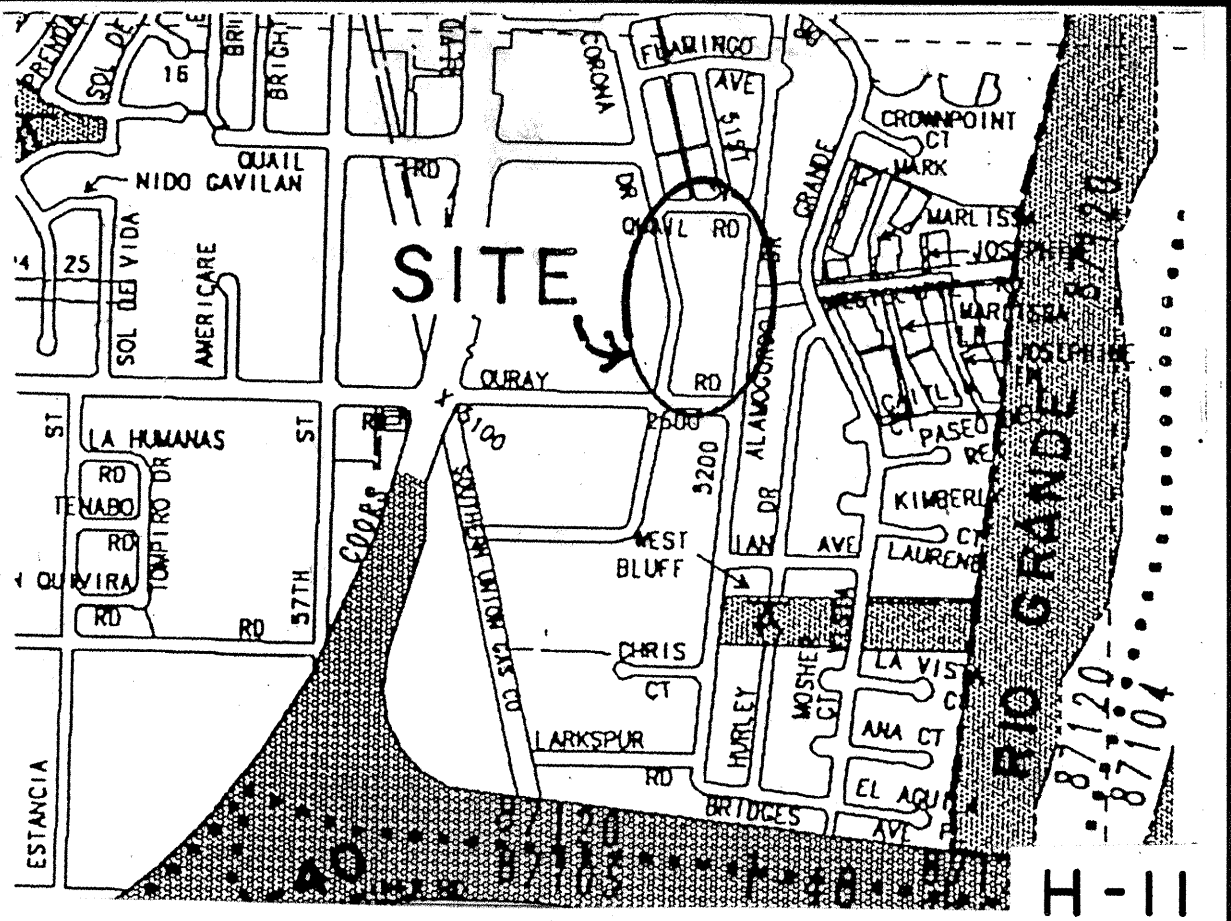

NOTICE TO CONTRACTORS

- ALL WORK DETAILED ON THESE PLANS TO BE PERFORMED UNDER CONTRACT SHALL, EXCEPT AS OTHERWISE STATED OR PROVIDED FOR HEREON, BE CONSTRUCTED IN ACCORDANCE WITH THE CITY OF ALBUQUERQUE STANDARD SPECIFICATIONS FOR PUBLIC WORKS CONSTRUCTION, 1986 EDITION, AS AMENDED THROUGH AMENDMENT 6.
 - TWO (2) WORKING DAYS PRIOR TO ANY EXCAVATION, THE CONTRACTOR MUST CONTACT NEW MEXICO ONE-CALL SYSTEMS, 260-1990, FOR LOCATION OF EXISTING UTILITIES.
 - PRIOR TO CONSTRUCTION, THE CONTRACTOR SHALL EXCAVATE AND VERIFY THE HORIZONTAL AND VERTICAL LOCATIONS OF ALL OBSTRUCTIONS. SHOULD A CONFLICT EXIST, THE CONTRACTOR SHALL NOTIFY THE ENGINEER OR SURVEYOR SO THAT THE CONFLICT CAN BE RESOLVED WITH A MINIMUM AMOUNT OF DELAY.
 - CONTRACTOR SHALL NOTIFY THE ENGINEER NOT LESS THAN SEVEN (7) DAYS PRIOR TO STARTING WORK IN ORDER THAT THE ENGINEER MAY TAKE NECESSARY MEASURES TO INSURE THE PRESERVATION OF SURVEY MONUMENTS. CONTRACTOR SHALL NOT DISTURB PERMANENT SURVEY MONUMENTS WITHOUT THE CONSENT OF THE ENGINEER AND SHALL NOTIFY THE ENGINEER AND BEAR THE EXPENSE OF REPLACING ANY THAT MAY BE DISTURBED WITHOUT PERMISSION. REPLACEMENT SHALL BE DONE ONLY BY THE CITY SURVEY SECTION. WHEN A CHANGE IS MADE IN THE FINISHED ELEVATION OF THE PAVEMENT OF ANY ROADWAY IN WHICH A PERMANENT SURVEY MONUMENT IS LOCATED, CONTRACTOR SHALL, AT HIS OWN EXPENSE, ADJUST THE MONUMENT COVER TO THE NEW GRADE UNLESS OTHERWISE SPECIFIED. REFER TO SECTION 4.4 OF GENERAL CONDITIONS OF STANDARD SPECIFICATIONS.
 - FIVE (5) WORKING DAYS PRIOR TO CONSTRUCTION, CONTRACTOR SHALL SUBMIT TO THE CONSTRUCTION COORDINATING DIVISION, A DETAILED CONSTRUCTION SCHEDULE. TWO (2) DAYS PRIOR TO CONSTRUCTION THE CONTRACTOR SHALL OBTAIN A BARRICADING PERMIT FROM THE CONSTRUCTION COORDINATING DIVISION. CONTRACTOR SHALL NOTIFY THE BARRICADING ENGINEER (768-2551) PRIOR TO OCCUPYING AN INTERSECTION. SEE SECTION 19 OF THE SPECIFICATION.
 - ALL STREET STRIPING ALTERED OR DESTROYED SHALL BE REPLACED WITH PLASTIC REFLECTORIZED PAVEMENT MARKINGS BY THE CONTRACTOR TO LOCATION AS EXISTED OR INDICATED BY THIS PLAN SET.
- ☒ ALL UTILITIES AND UTILITY SERVICE LINES SHALL BE INSTALLED PRIOR TO PAVING.
 - ☒ BACKFILL COMPACTION SHALL BE ACCORDING TO SPECIFIED STREET USE.
 - ☒ TACK COAT REQUIREMENTS SHALL BE DETERMINED BY THE CITY ENGINEER
 - ☒ SIDEWALKS AND WHEELCHAIR RAMPS WITHIN THE CURB RETURNS SHALL BE CONSTRUCTED WHEREVER A NEW CURB RETURN IS CONSTRUCTED.
 - ☒ IF CURB IS DEPRESSIONED FOR A DRIVEPAD OR A HANDICAP RAMP, THE DRIVEPAD OR RAMP SHALL BE CONSTRUCTED PRIOR TO ACCEPTANCE OF THE CURB AND GUTTER.
 - ☒ ALL STORM DRAINAGE FACILITIES SHALL BE COMPLETED PRIOR TO FINAL ACCEPTANCE.

REV.	SHEETS	CITY ENGINEER	DATE	USER DEPARTMENT	DATE	USER DEPARTMENT	DATE
ENGINEERS STAMP, SIGNATURE		APPROVALS		ENGINEER	DATE	APPROVED FOR CONSTRUCTION	
		DRC Chairman		<i>Bill G. Gohlsch</i>	2-24-99	<i>Edo Chang</i> 11/2/99 City Engineer Date	
		Transportation		<i>Edo Chang</i>	1-11-99		
		Water/Wastewater		<i>R.W. Korte</i>	11-18-98		
		Hydrology		<i>Edo Chang</i>	11/16/98		
		Parks					
		Constr. Mngmnt.		<i>Edo Chang</i>	6-25-90		
		CONST. COORD.					
		City Project No.		601581		Sheet 1 of 11	

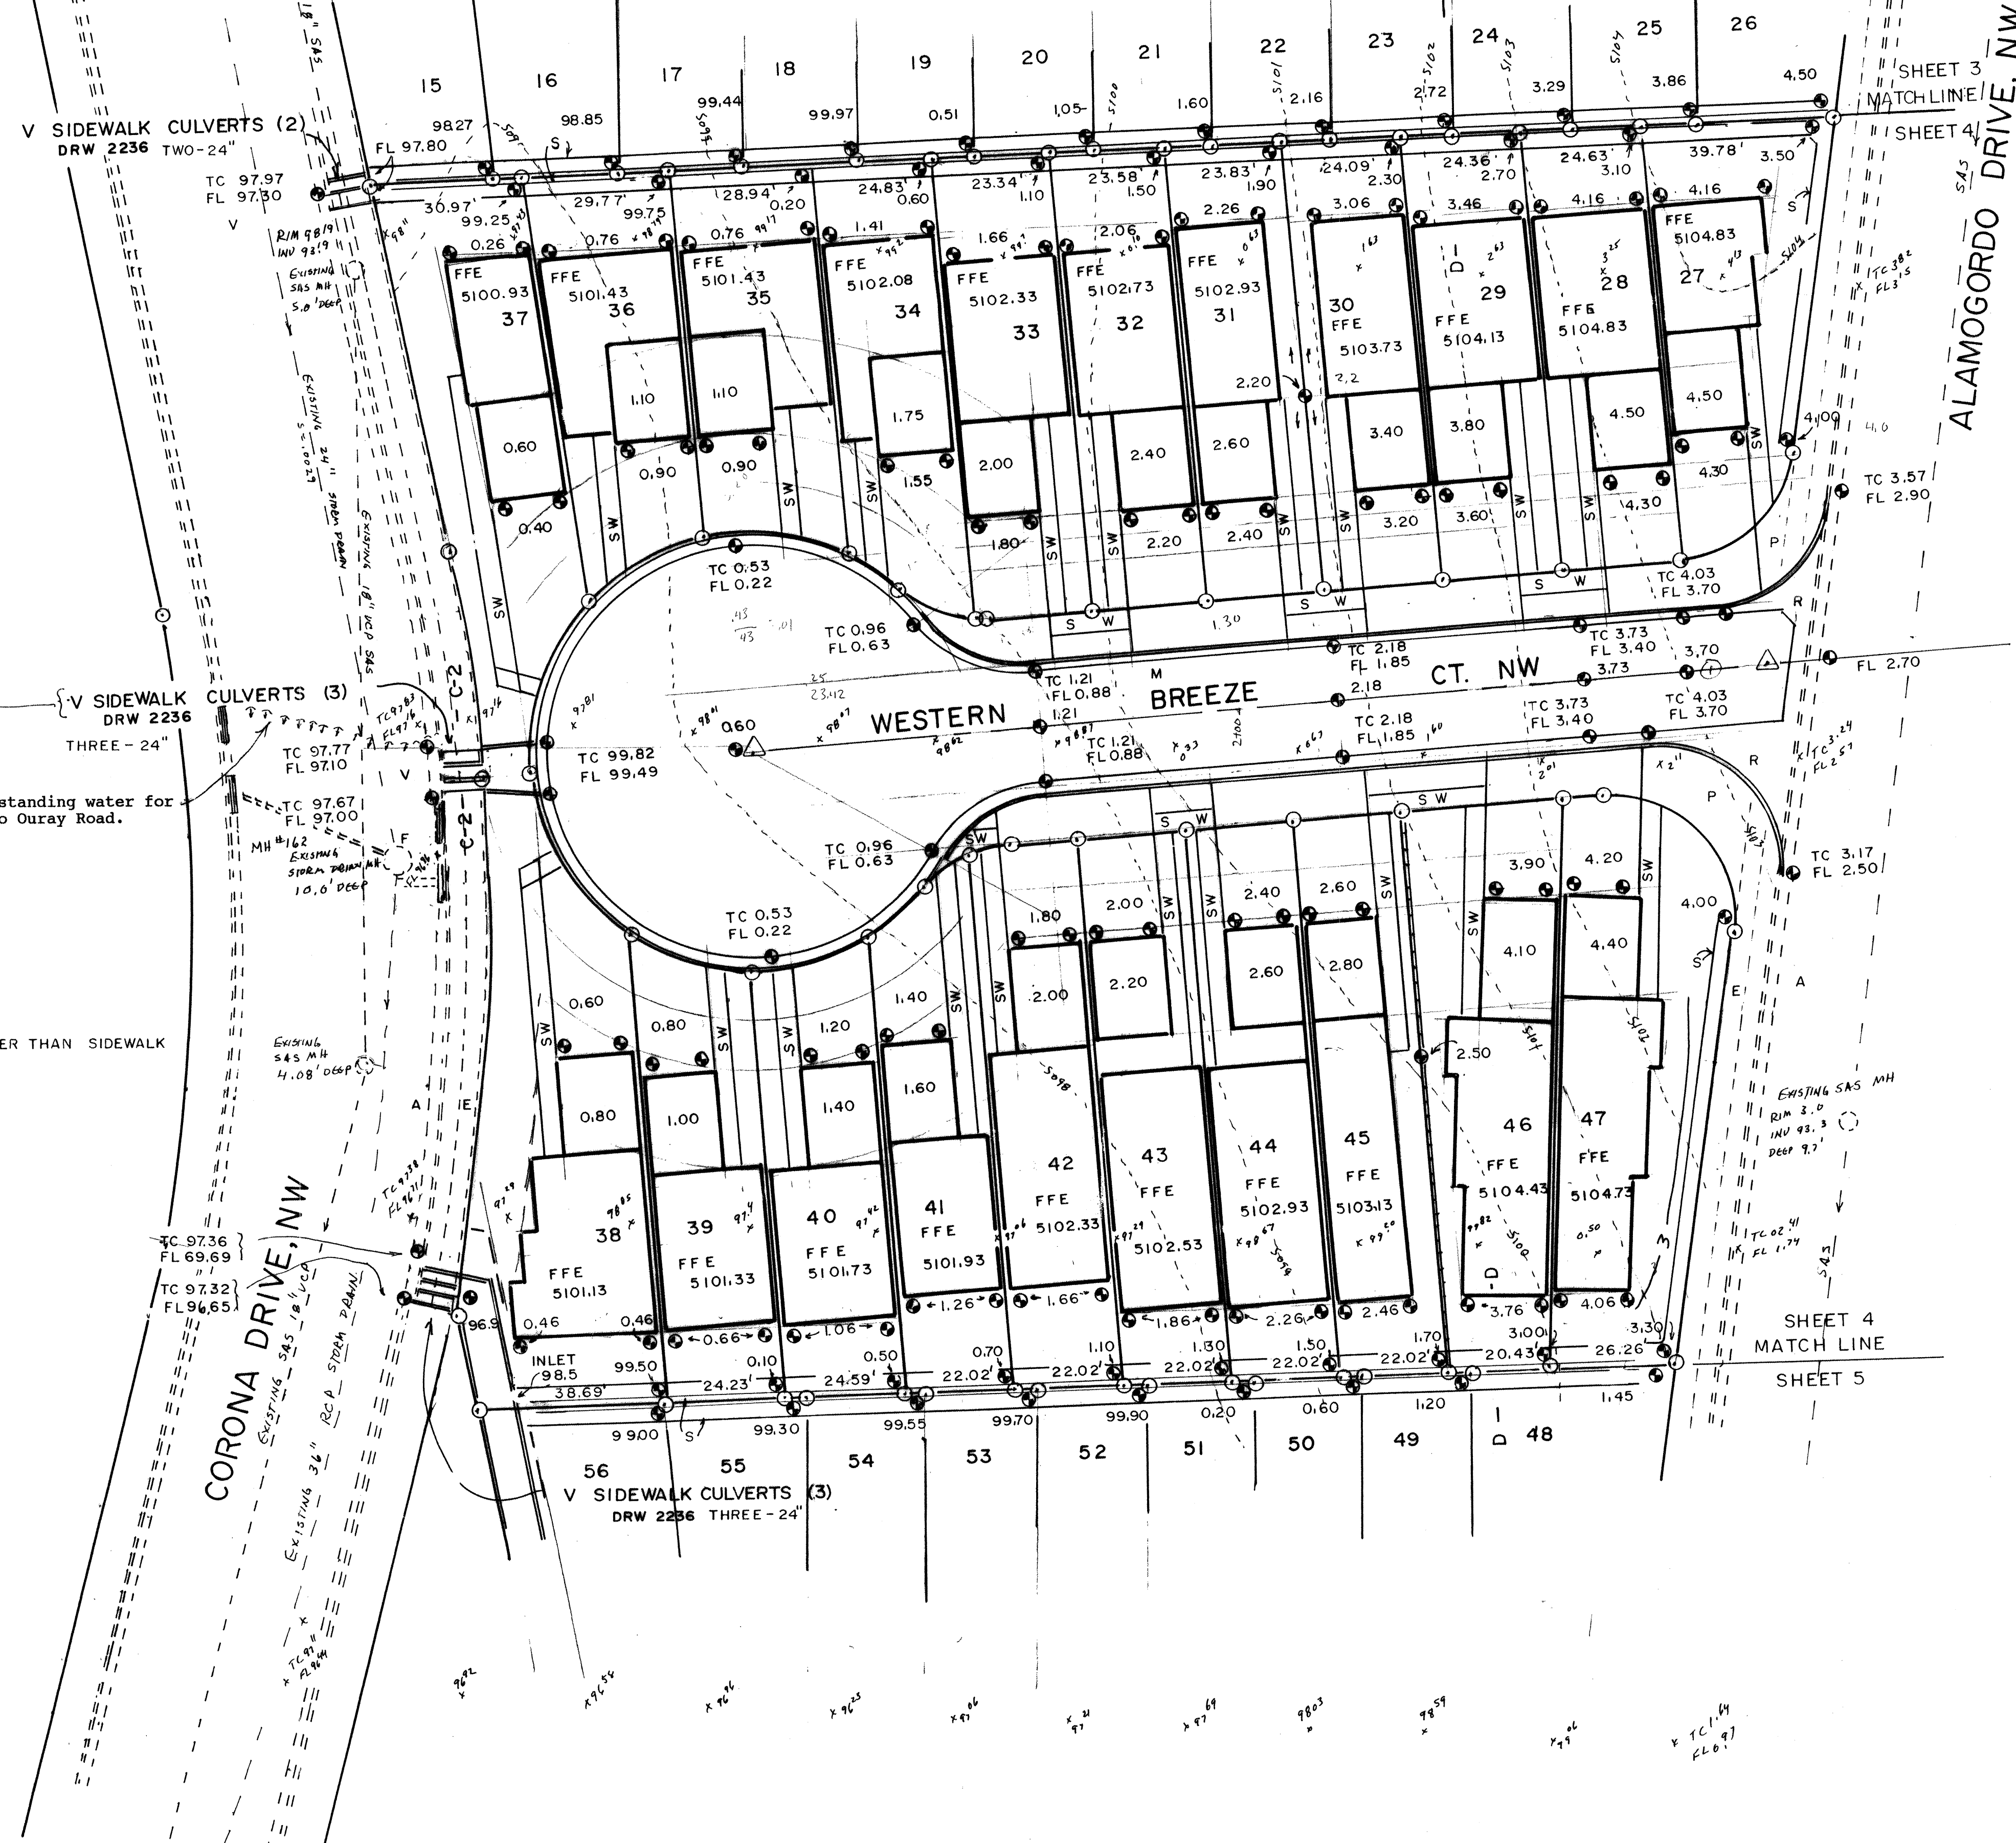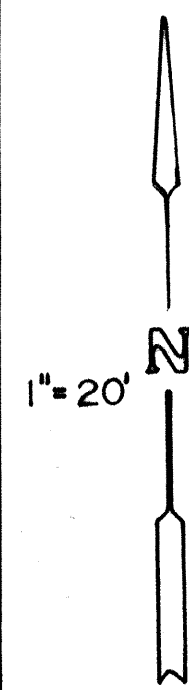

LEGEND		
	Existing	Proposed
Spot Elevation	$\times$ 42	$\bullet$ 43.27
Top of Curb	TL	TC
Flow Line Invert	FL	FL
Finished Floor Elevation	FFE	FFE
Contour Line	--- 41 ---	--- 44 ---
Property Line	---	---
Lot Number	3	3
Structure	---	---
Curb and Gutter	---	---
Drainage basin boundary	$\diamond$	$\blacklozenge$
Roof drain		$\blacktriangledown$
Retaining wall		$\blacksquare$


PHASE I
PHASE II

SEE WORK ORDER FOR STREET PLAN & PROFILE, DRAINAGE

SEE WO 585482 FOR FINAL GRADE ON STREET
SEE WO 585482 FOR INLET AND STORM DRAIN RATHER THAN SIDEWALK
CULVERTS AND CHANNEL

Approximate level of standing water for
overflow to occur onto Ouray Road.

ADD SW CULVERT SIZE, PHASE LINE	MRK	JAN 21, 1998
ADD SIDEWALK CULVERT NOTE	MRK	DEC 24, 1997
ADD SIDEWALK CULVERTS	MRK	DEC 4, 1997
Preliminary	Marvin R Kortum	October 15, 1997
APPROVALS, REVISIONS	BY	DATE

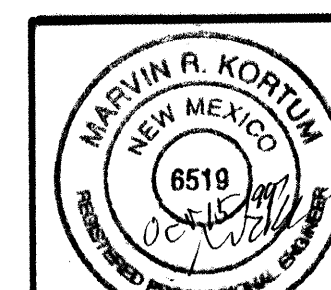

MARVIN R. KORTUM, P.E.
Civil Engineering
NM PE 6519
1605 Speakman Drive, S.E.
Albuquerque, New Mexico 87123
(505) 299-0774

WESTERN BREEZE SUBDIVISION
LOTS 37-47 - VIA SHANE-
GRADING AND DRAINAGE PLAN


WORK ORDER NO.

601581 H-II 3 11

HII/D23 H-II 4 6

1"=20'


LEGEND	Existing	Proposed
Spot Elevation	X 42	43.27
Top of Curb	TC	TC
Flow Line Invert	FL	FL
Finished Floor Elevation	FFE	FFE
Contour Line	--- 44 ---	---
Property Line	---	---
Lot Number	3	3
Structure	---	---
Curb and Gutter	---	---
Drainage basin boundary	◇ ◇	◆ ◆
Roof drain	---	---
Retaining wall	---	---

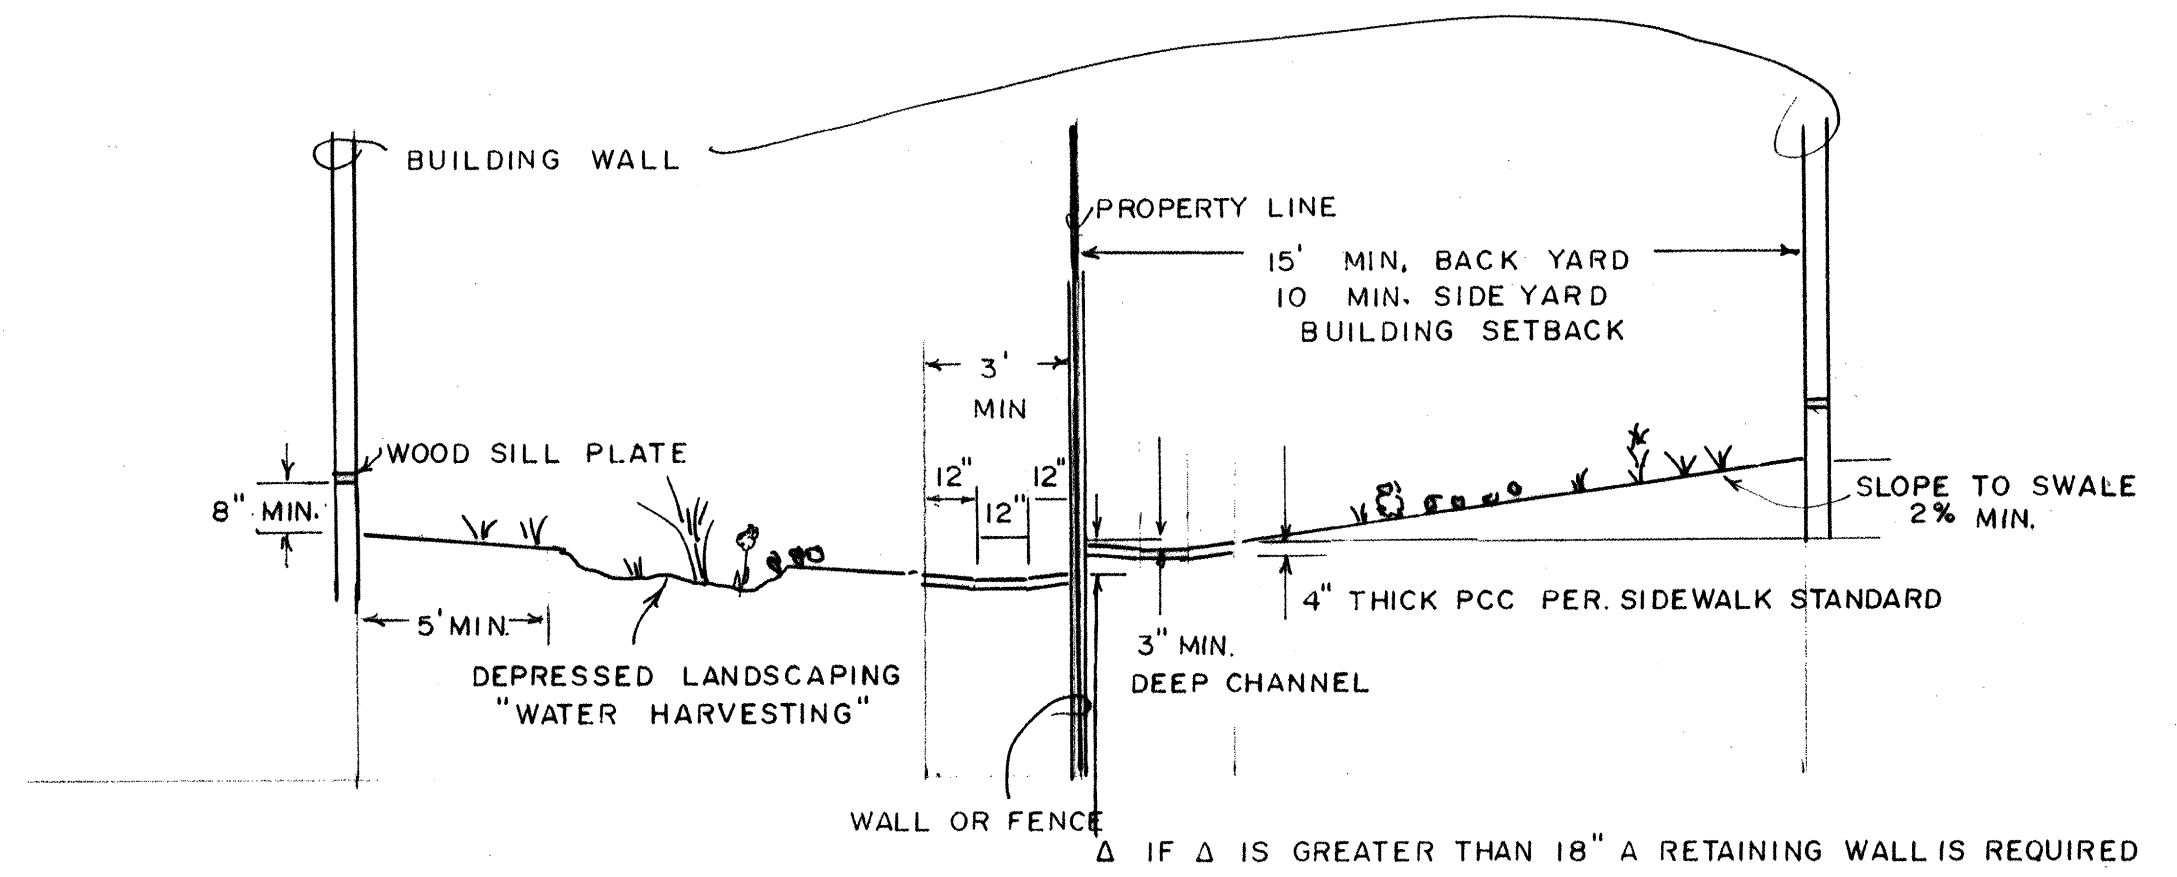

A paved drainage swale will be constructed within the rear and side yards to permit runoff of local precipitation and minor flows. Longitudinal slope of the swale may vary from a minimum slope of .005 feet/feet (.5%) to a maximum slope of 20%. The surface of the swale may be patterned, colored or otherwise treated to blend in with landscaping. The swale capacity must remain sufficient to carry the required flow. Runoff will not include roof runoff because all roof runoff is to be directed to the street.

SECTION D-D

SEE WORK ORDER FOR STREET PLAN & PROFILE,

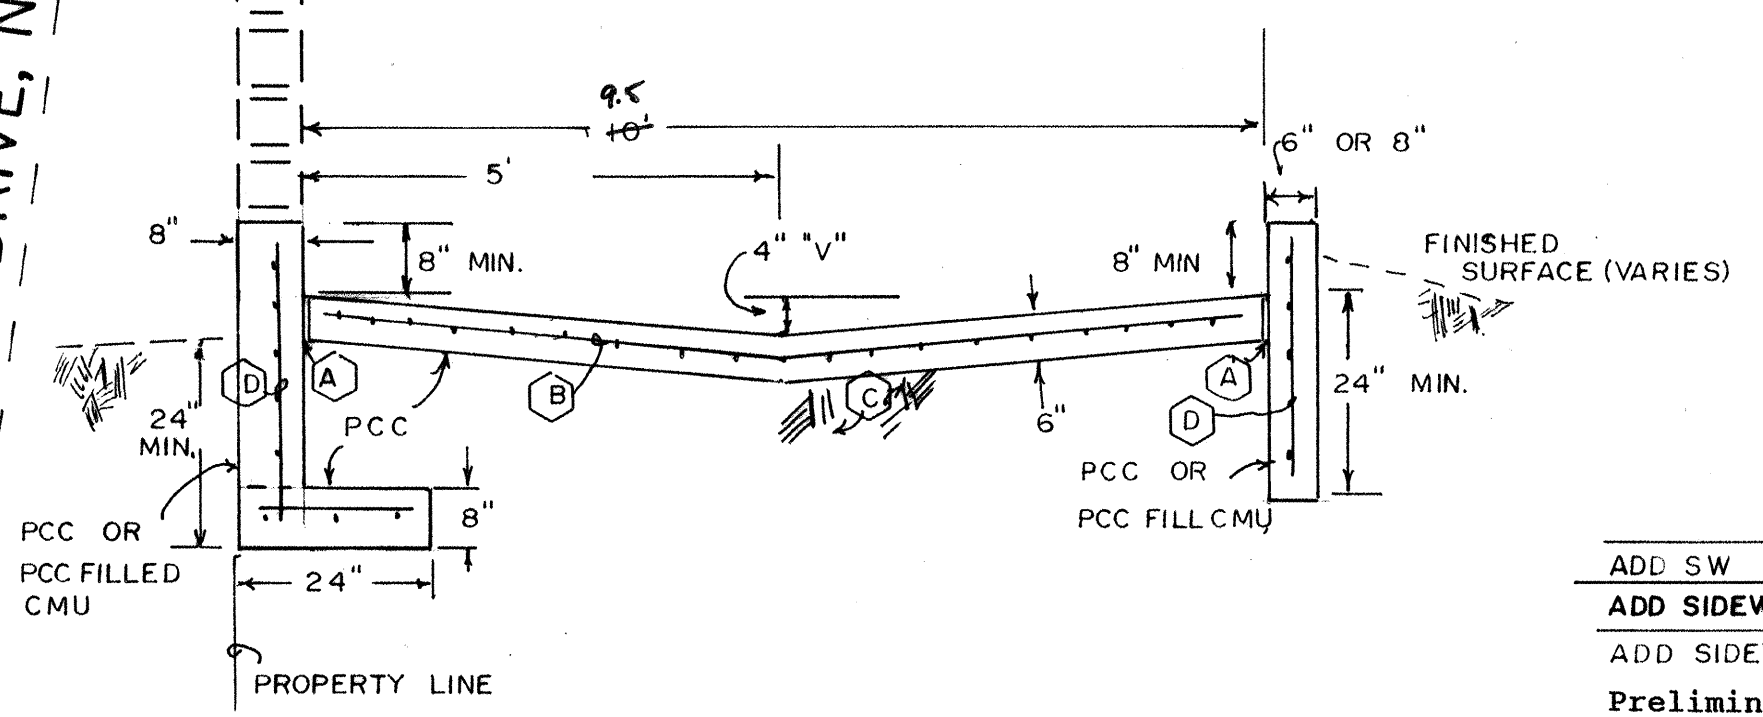

Channel shall be constructed according to City of Albuquerque Standard Specification and standard drawing 2260, Typical Lining for Drainage Easements, and 2265, Channel Expansion Joint with Sleeper. Specific notes are as follows:

- A. Expansion joint, see drawing 2260.
- B. No. 4 Rebars at 6" on center longitudinally and 12" on center transverse.
- C. 6" Compacted soil, 95% per ASTM D 1557.
- D. No. 4 Rebars at 8" on center horizontally and 16" on center vertical.
- E. A block garden wall or other fence may be placed on top of the channel wall to a height of 6 feet. The block wall may be place with 8" or 6" concrete masonry blocks. A reinforced (two no. 4 rebars with portland cement fill) pilaster will be required at a 12 feet spacing for the garden wall.
- F. Channel expansion joints with sleeper, drawing 2265, shall be placed at 20 feet spacing in the channel. Expansion joints shall be placed in the side walls at the same locations.

SECTION E-E CHANNEL DETAIL

ADD SW CULVERT SIZES, PHASE LINE	MRK	JAN 21, 1998
ADD SIDEWALK CULVERT NOTES	MRK	DEC 24, 1997
ADD SIDEWALK CULVERTS	MRK	DEC 4, 1997
Preliminary	Marvin R Kortum	October 15, 1997
APPROVALS, REVISIONS	BY	DATE



MARVIN R. KORTUM, P.E.
Civil Engineering
NM PE 6519
1605 Speakman Drive, S.E.
Albuquerque, New Mexico 87123
(505) 299-0774

WESTERN BREEZE SUBDIVISION
LOTS 48-62 - VIA PATRICIA -
GRADING AND DRAINAGE PLAN

WORK ORDER NO.	H-II	4	II
601581			
HII/D23	H-II	5	6

SCANNED BY
MESA REPRO

SEE SHEET 5 FOR NOTES & LEGEND

REFER TO THE FOLLOWING STANDARD DRAWINGS

```
SEWER
2102 MANHOLE TYPE "E"
2110 MANHOLE FRAME AND COVER
2118 SERVICE LINE CONNECTION
      AT MANHOLES
2125 SERVICE LINE DETAILS
2136 RISER DETAILS FLEXIBLE
      PIPE MAIN
2145 SEWER LINE DEAD-END
      MARKER
```

WATER

2301 WATER CONNECTION DETAILS

2315 PIPE TRENCH TERMINOLOGY

2320 CONCRETE BLOCKING DESIGN

2326 VALVE BOX TYPE "B"

2328 RING AND COVER FOR
VALVE BOX

2333 WATER VALVE ANCHORAGE

2360 METER BOX LOCATION

2361 TYPICAL METER BOX INSTALLATIONS


2362 METERED SERVICE LINE INSTALLATION

2366 DOUBLE METER BOX FOR 3/4" AND
1" METERS

2368 METER BOX COVER AND LID

2369 HEAVYWEIGHT METER BOX COVER
AND LID

2465 CITYWIDE PAVEMENT CUTS
FOR ALL UTILITIES

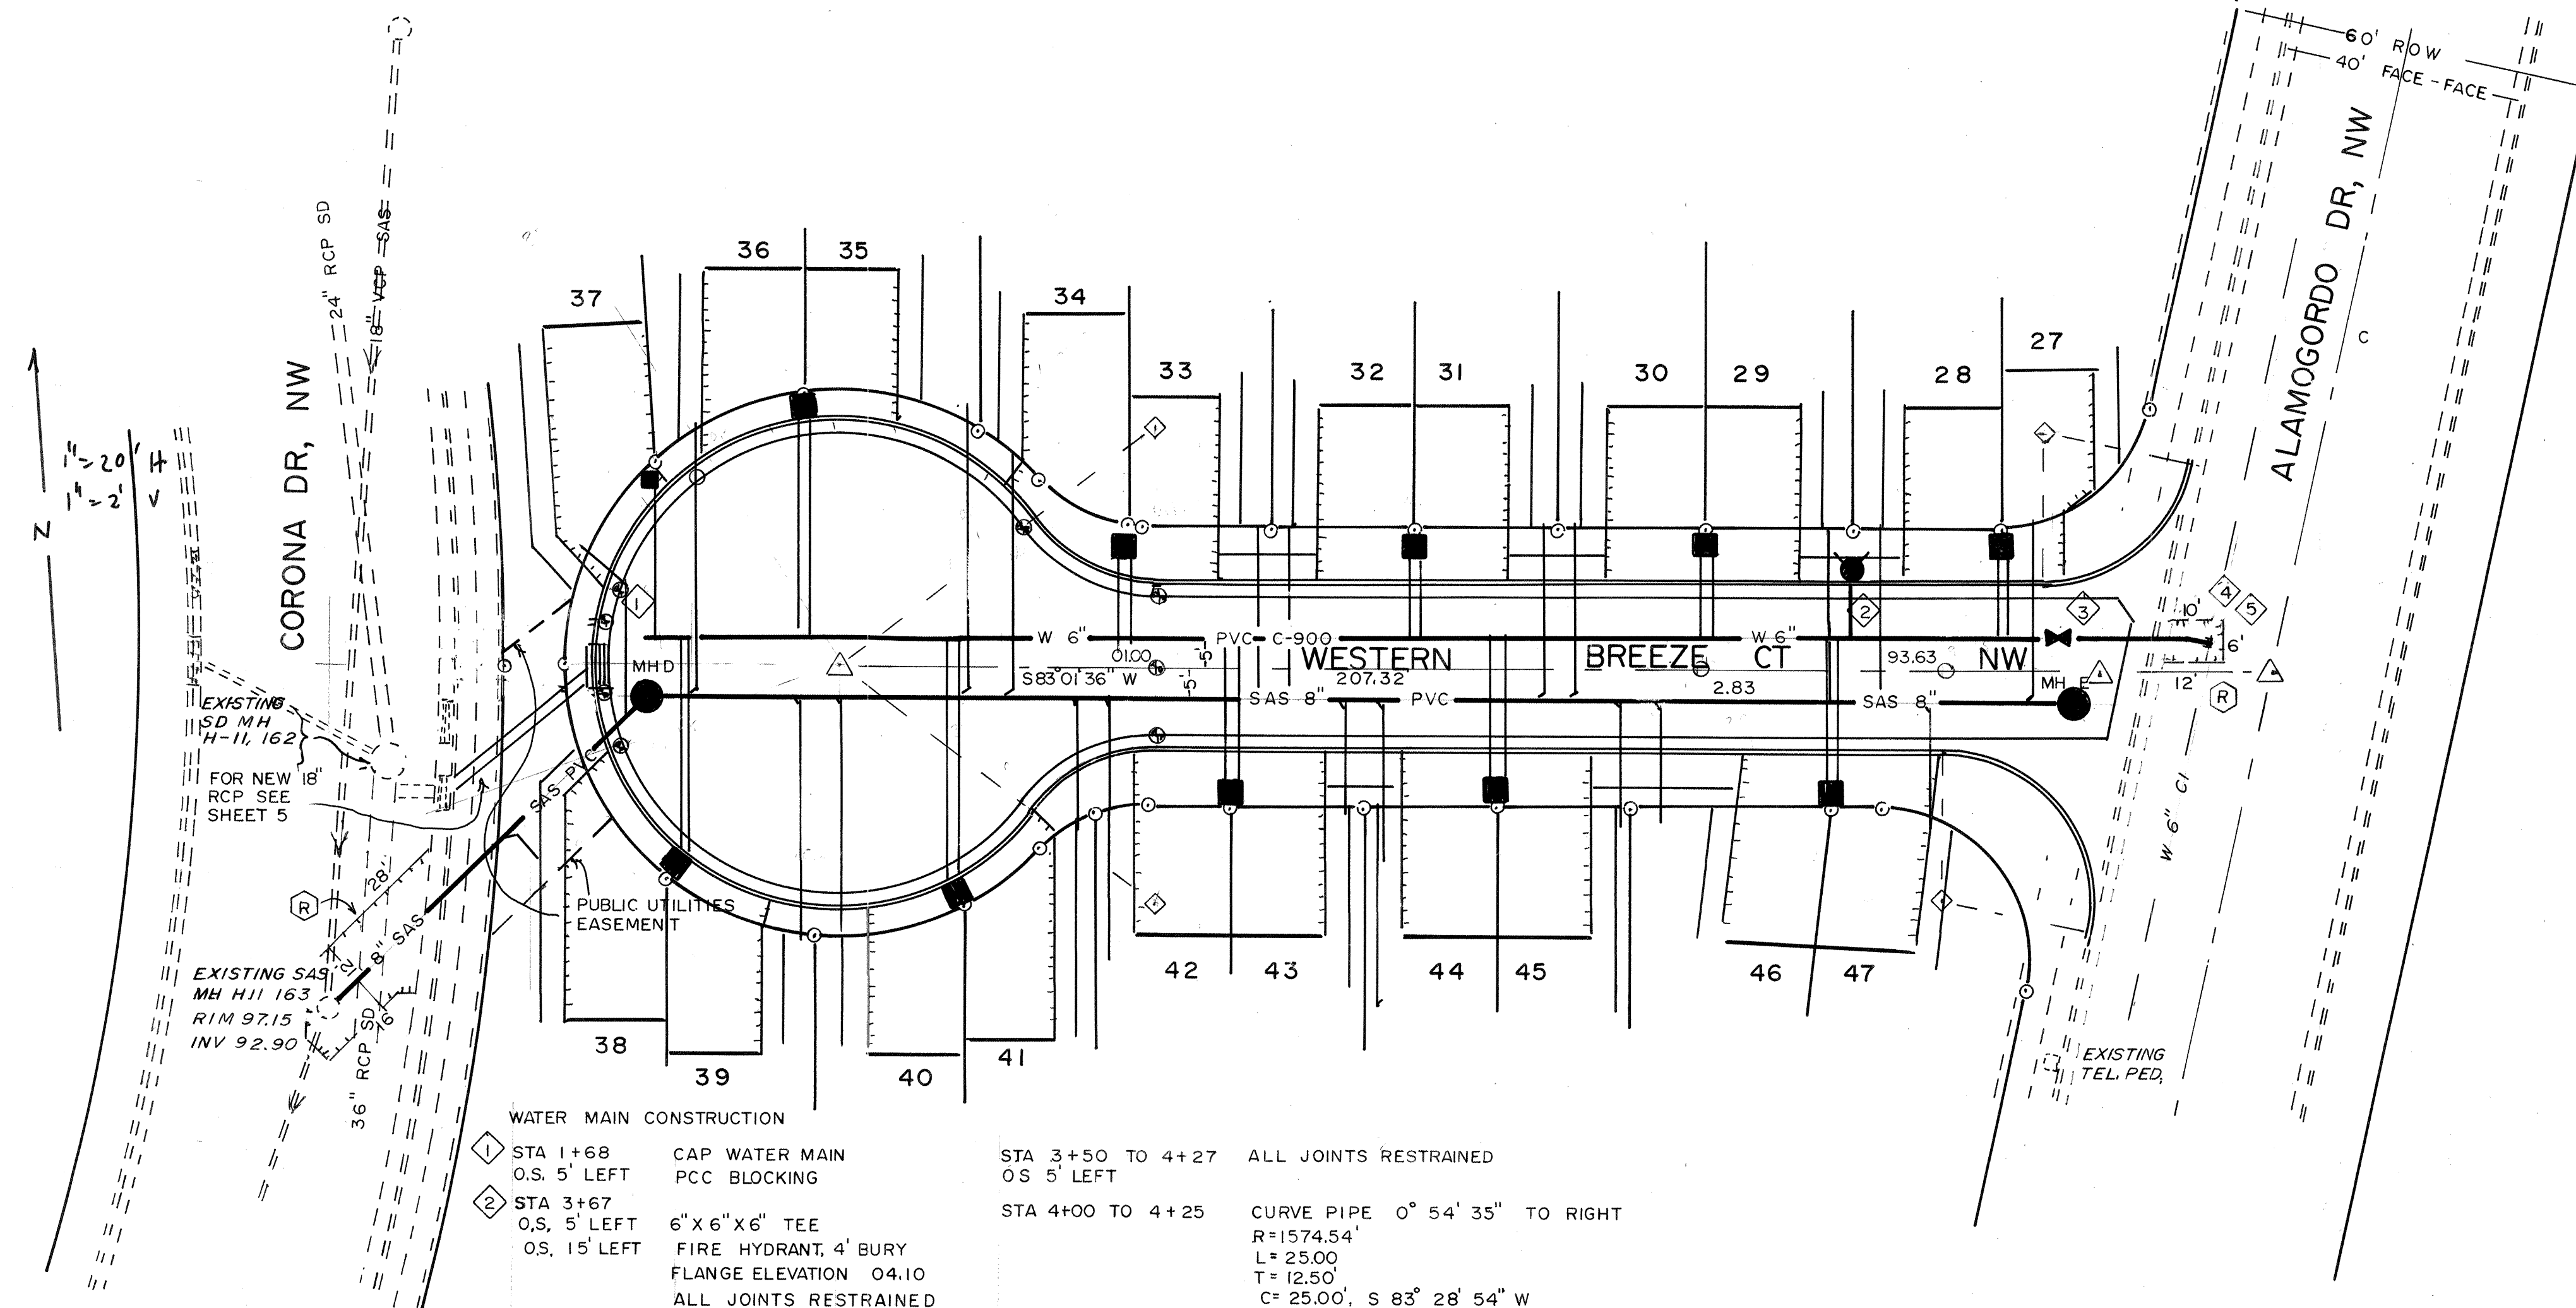

WATER MAIN CONSTRUCTION

1	STA 1+68 O.S. 5' LEFT	CAP WATER MAIN PCC BLOCKING
2	STA 3+67 O.S. 5' LEFT O.S. 15' LEFT	6" X 6" X 6" TEE FIRE HYDRANT, 4'

STA 3+50 TO 4+27 ALL JOINTS RESTRAINED
OS 5' LEFT


STA 4+00 TO 4+25 CURVE PIPE 0° 54' 35" TO RIGHT
R=1574.54'
L= 25.00
T= 12.50'
C= 25.00', S 83° 28' 54" W

3 STA 3+98
O.S. 5' LEFT

4 STA 4+25
O.S. 5' LEFT

5 STA 4 + 27
O.S. 4.6' LEB

NON-PRESSURE CONNECTION
PCC BLOCKING

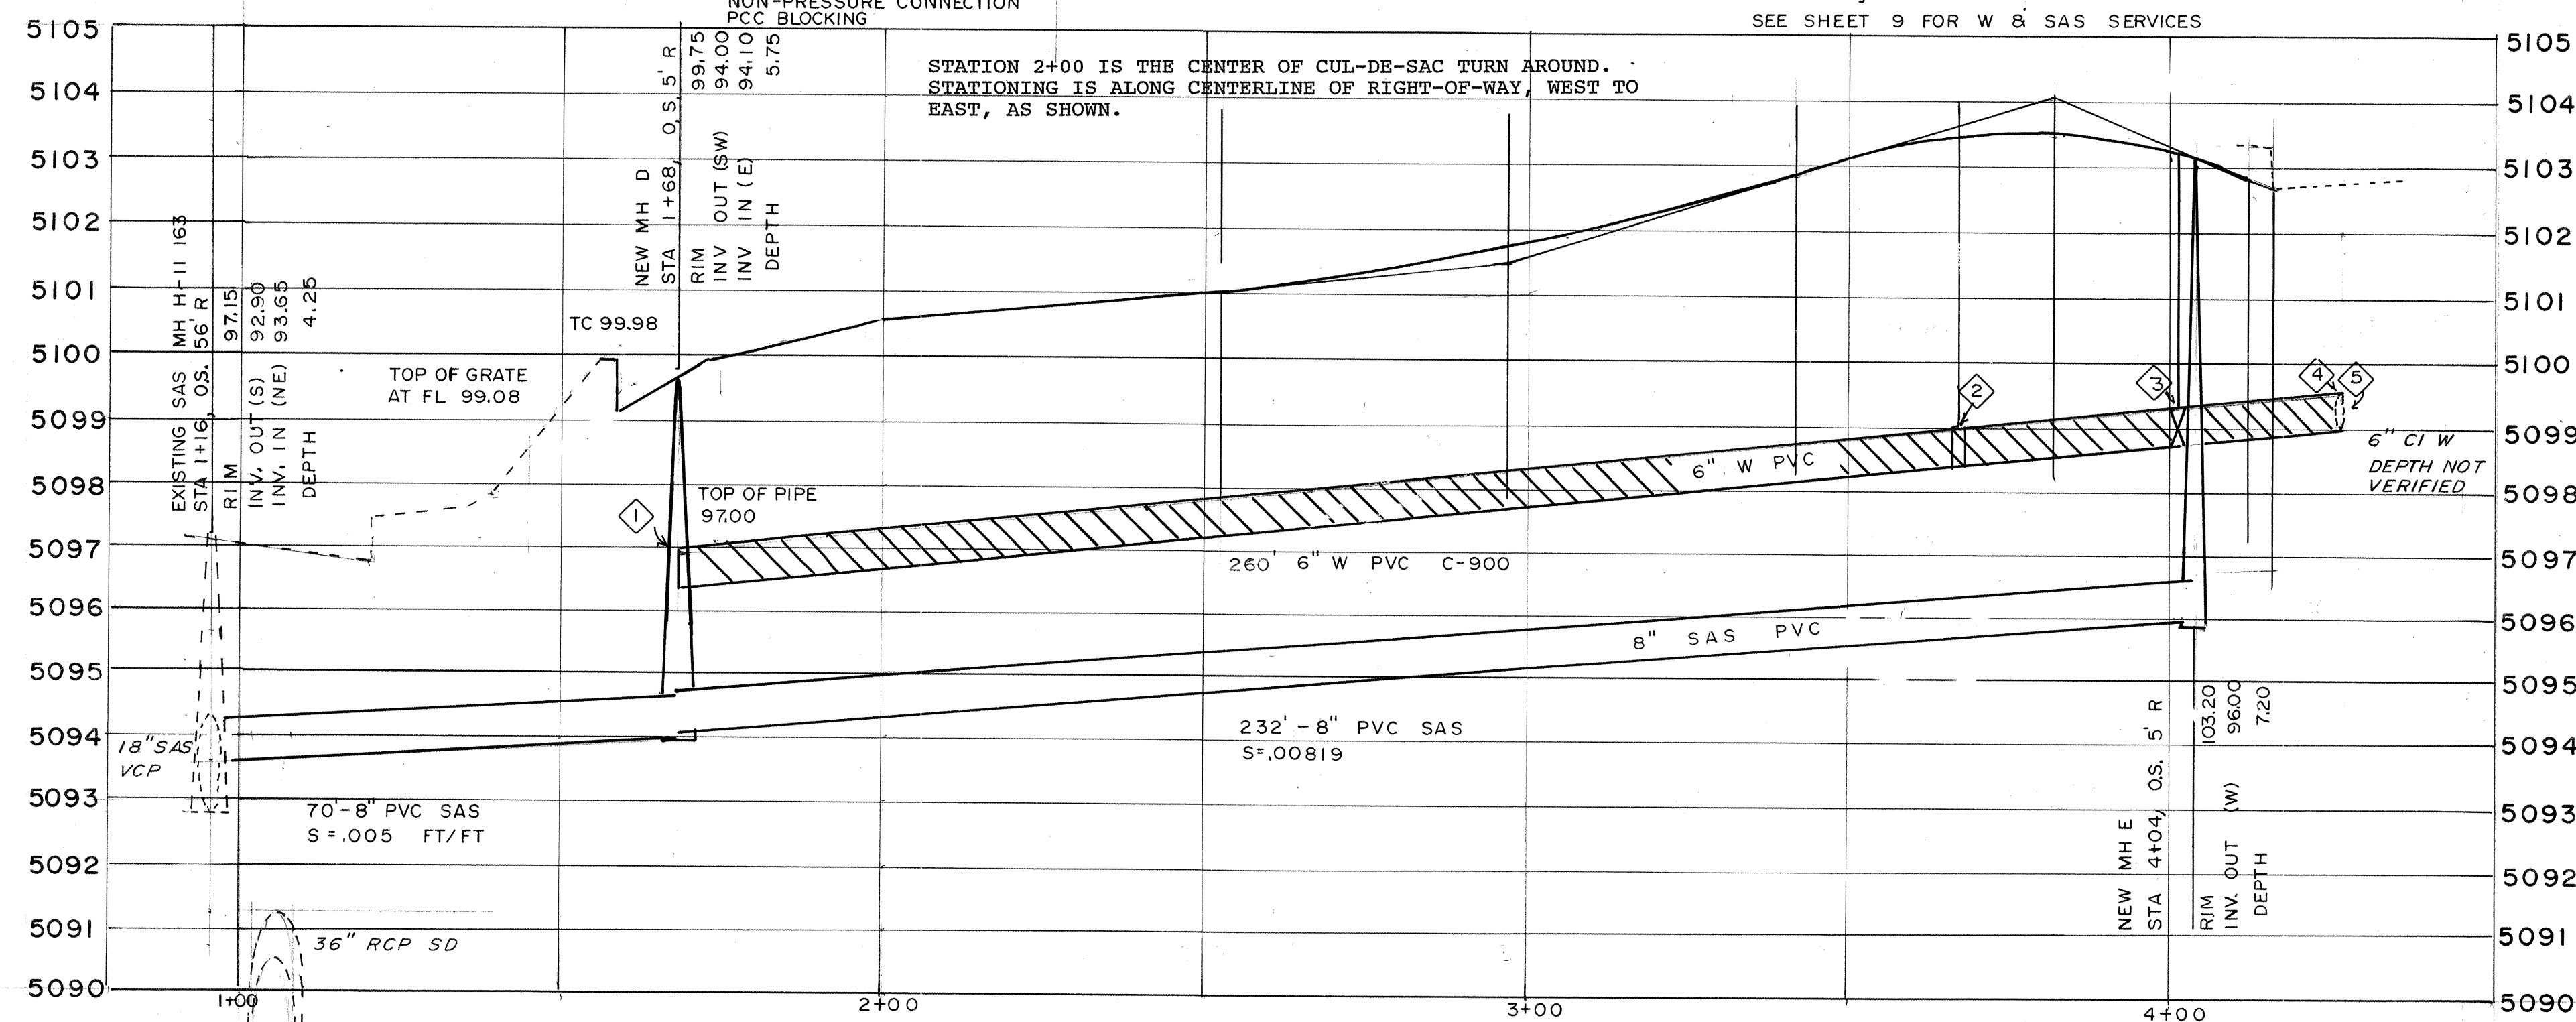

SEE SHEET 9 FOR W & SAS SERVICES

STATION 2+00 IS THE CENTER OF CUL-DE-SAC TURN AROUND. STATIONING IS ALONG CENTERLINE OF RIGHT-OF-WAY, WEST TO EAST, AS SHOWN.

MARVIN R. KORTUM, P.E.
Civil Engineering
NM PE 6519

1605 Speakman Drive, S.E.
Albuquerque, New Mexico 87123
(505) 299-0774

CITY OF ALBUQUERQUE
PUBLIC WORKS DEPARTMENT
ENGINEERING DEVELOPMENT GROUP

TITLE: WESTERN BREEZE SUBDIVISION
WESTERN BREEZE COURT NW
WATER, SANITARY SEWER PLAN & PROFILE

Design Review Committee

APPROVED

FEB 24 1989

DESIGN
REVIEW COMMITTEE

CITY ENGINEER APPROVAL






A P P R O V E D

NOV 12 2003

CITY ENGINEER

Last Design Update	Mo. / Day / Yr.	Mo. / Day / Yr.

City Project No.	Zone Map No.	Sheet	Of
601581	H - 11	6	11

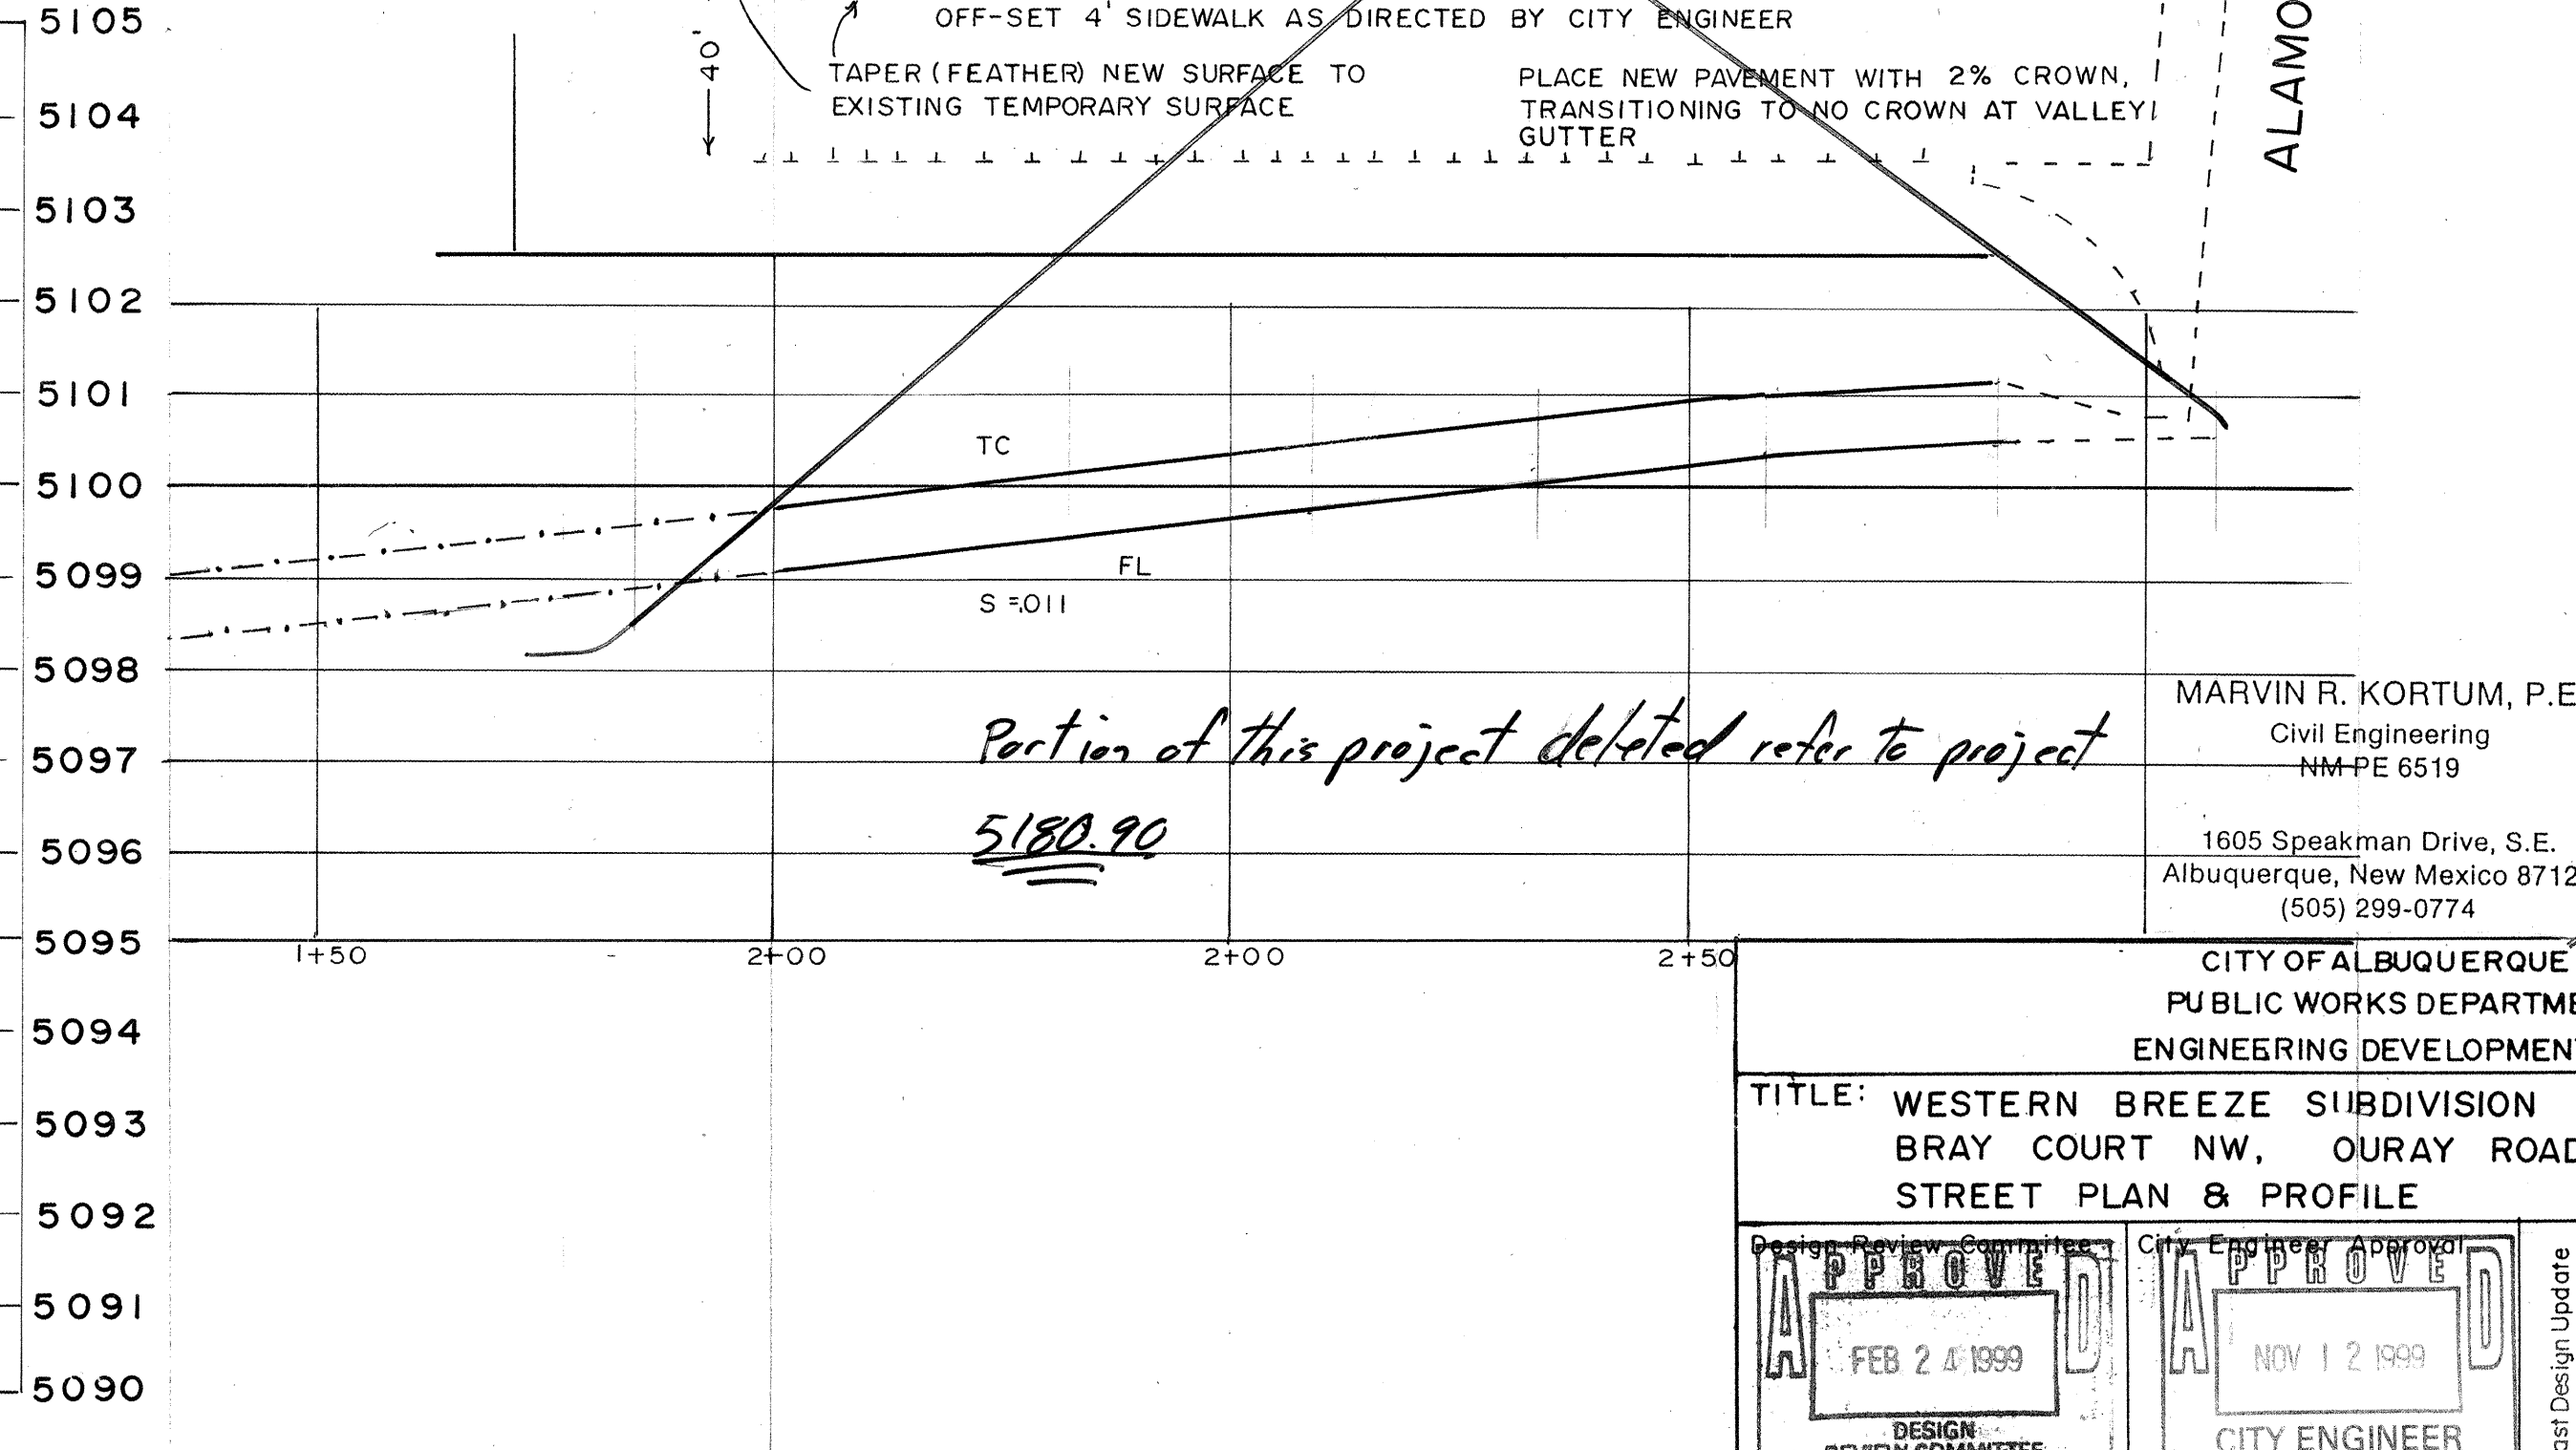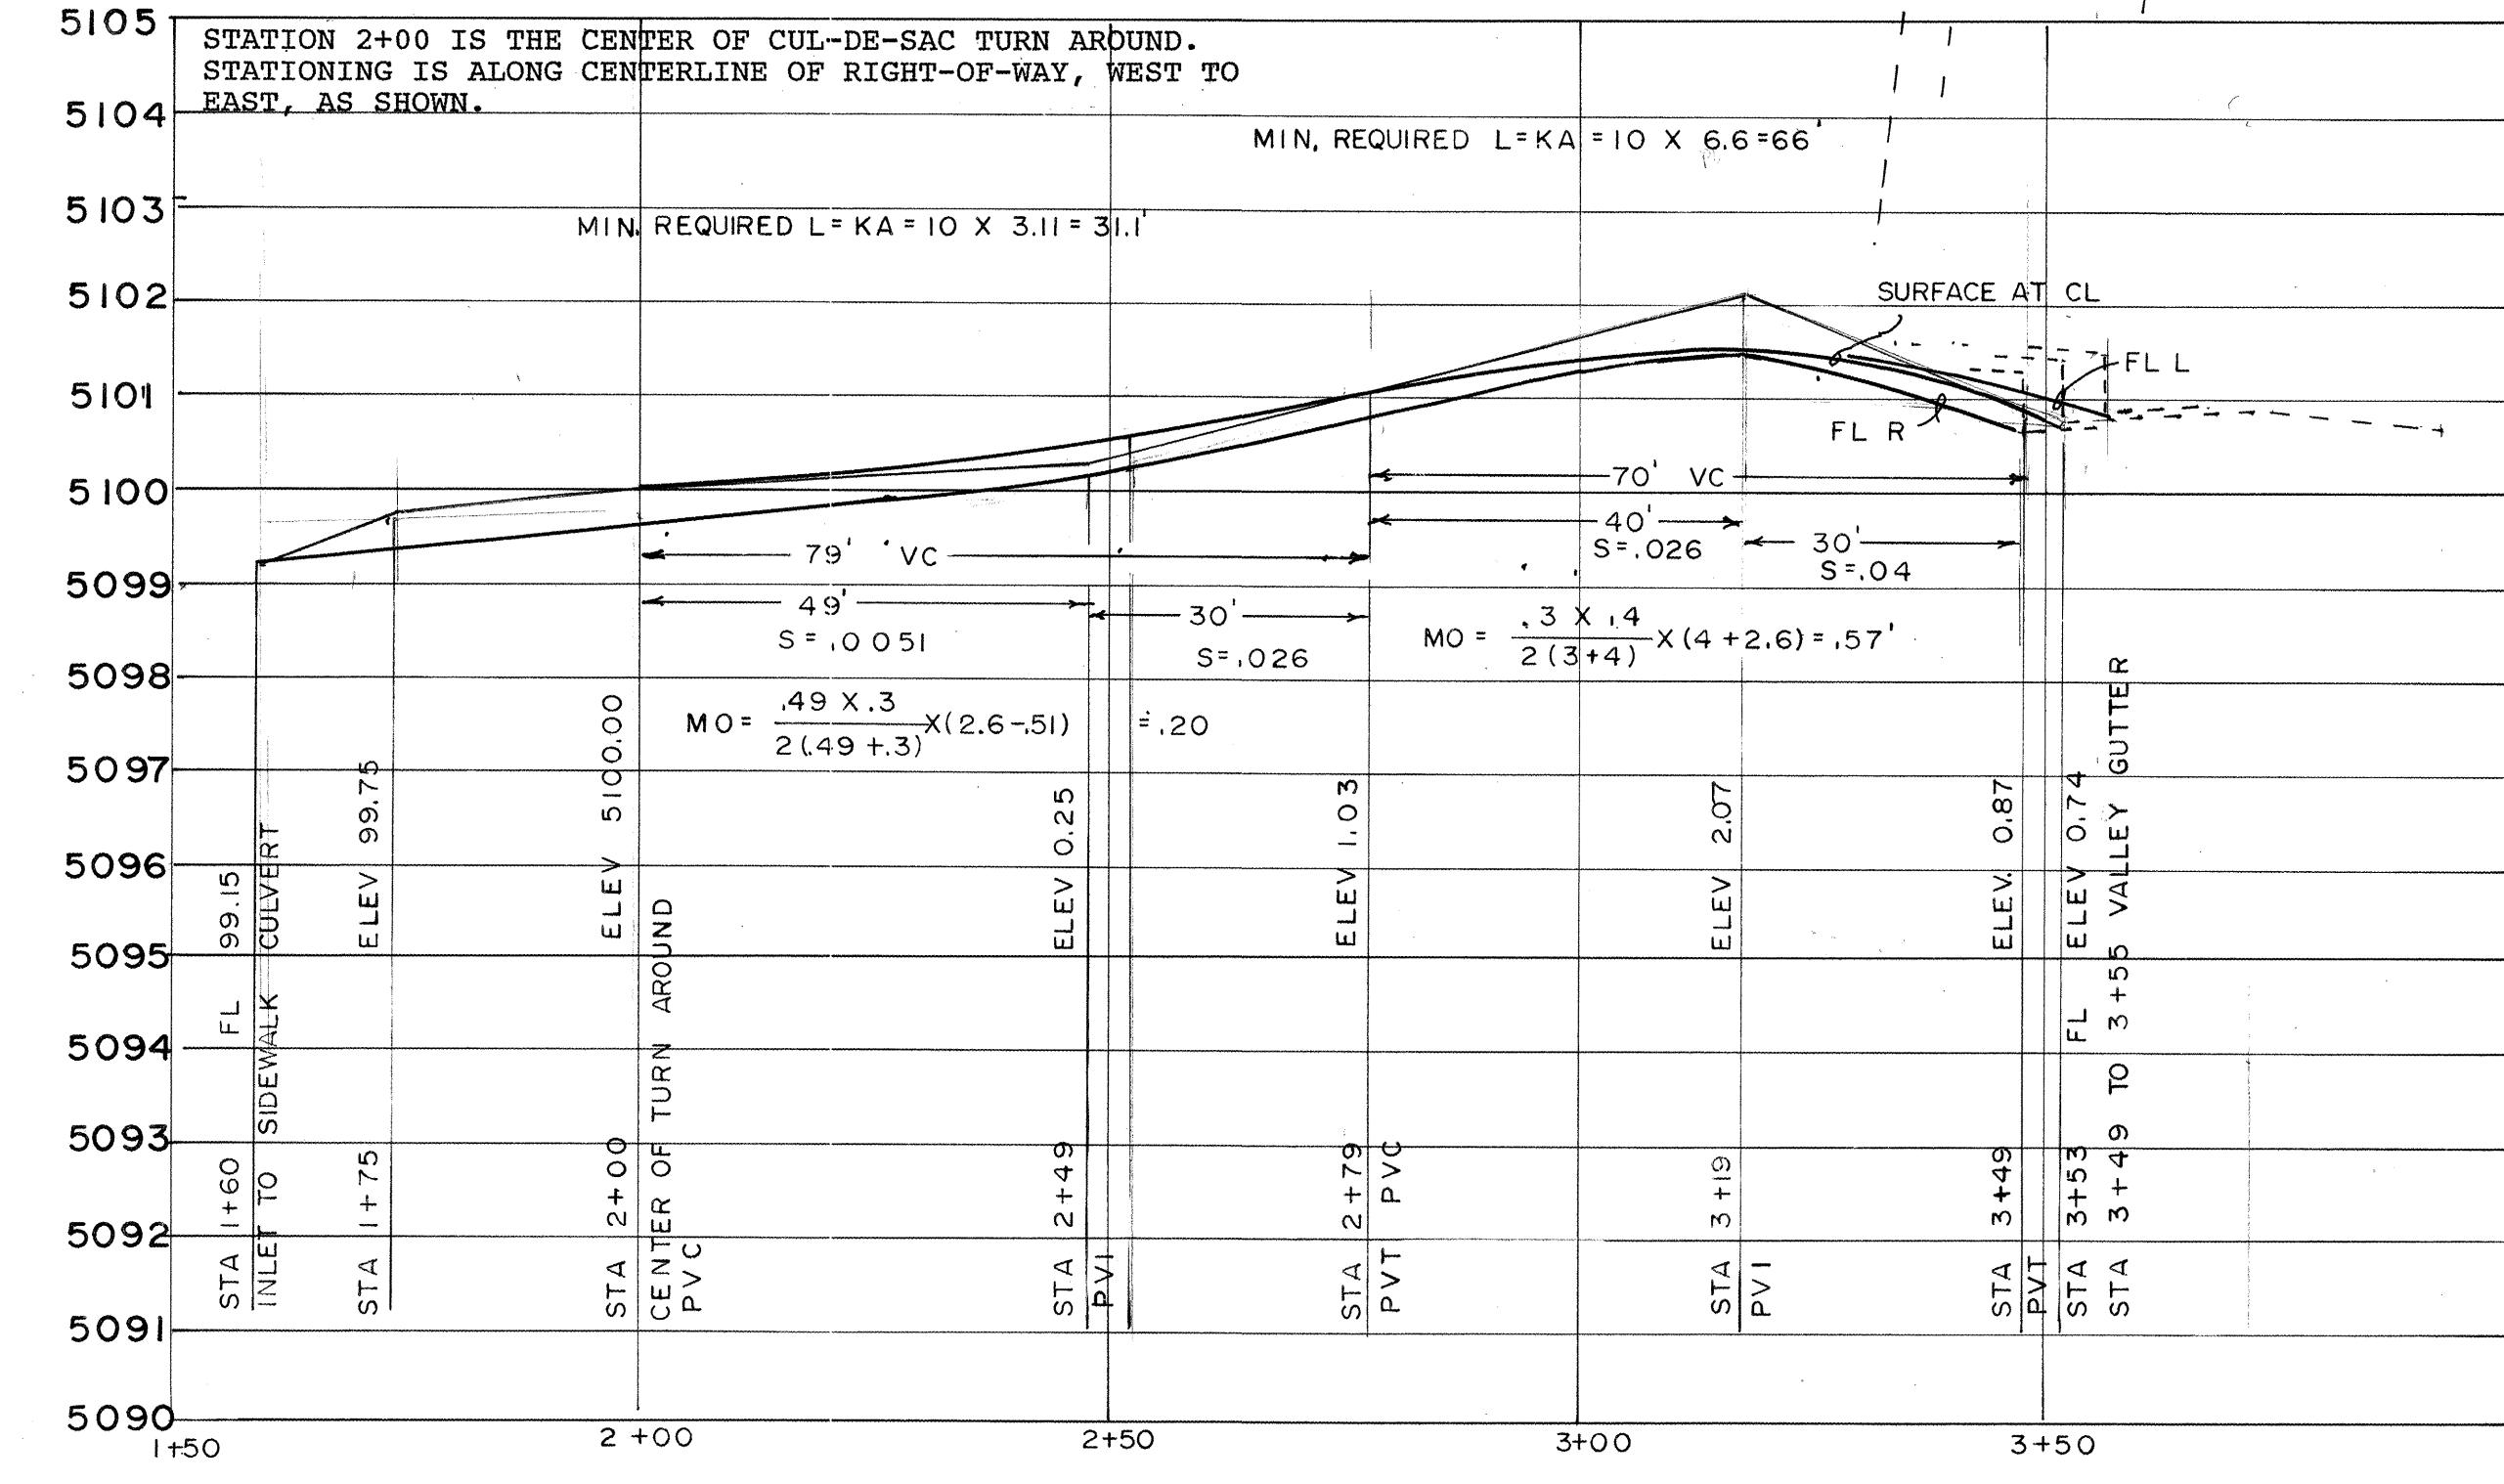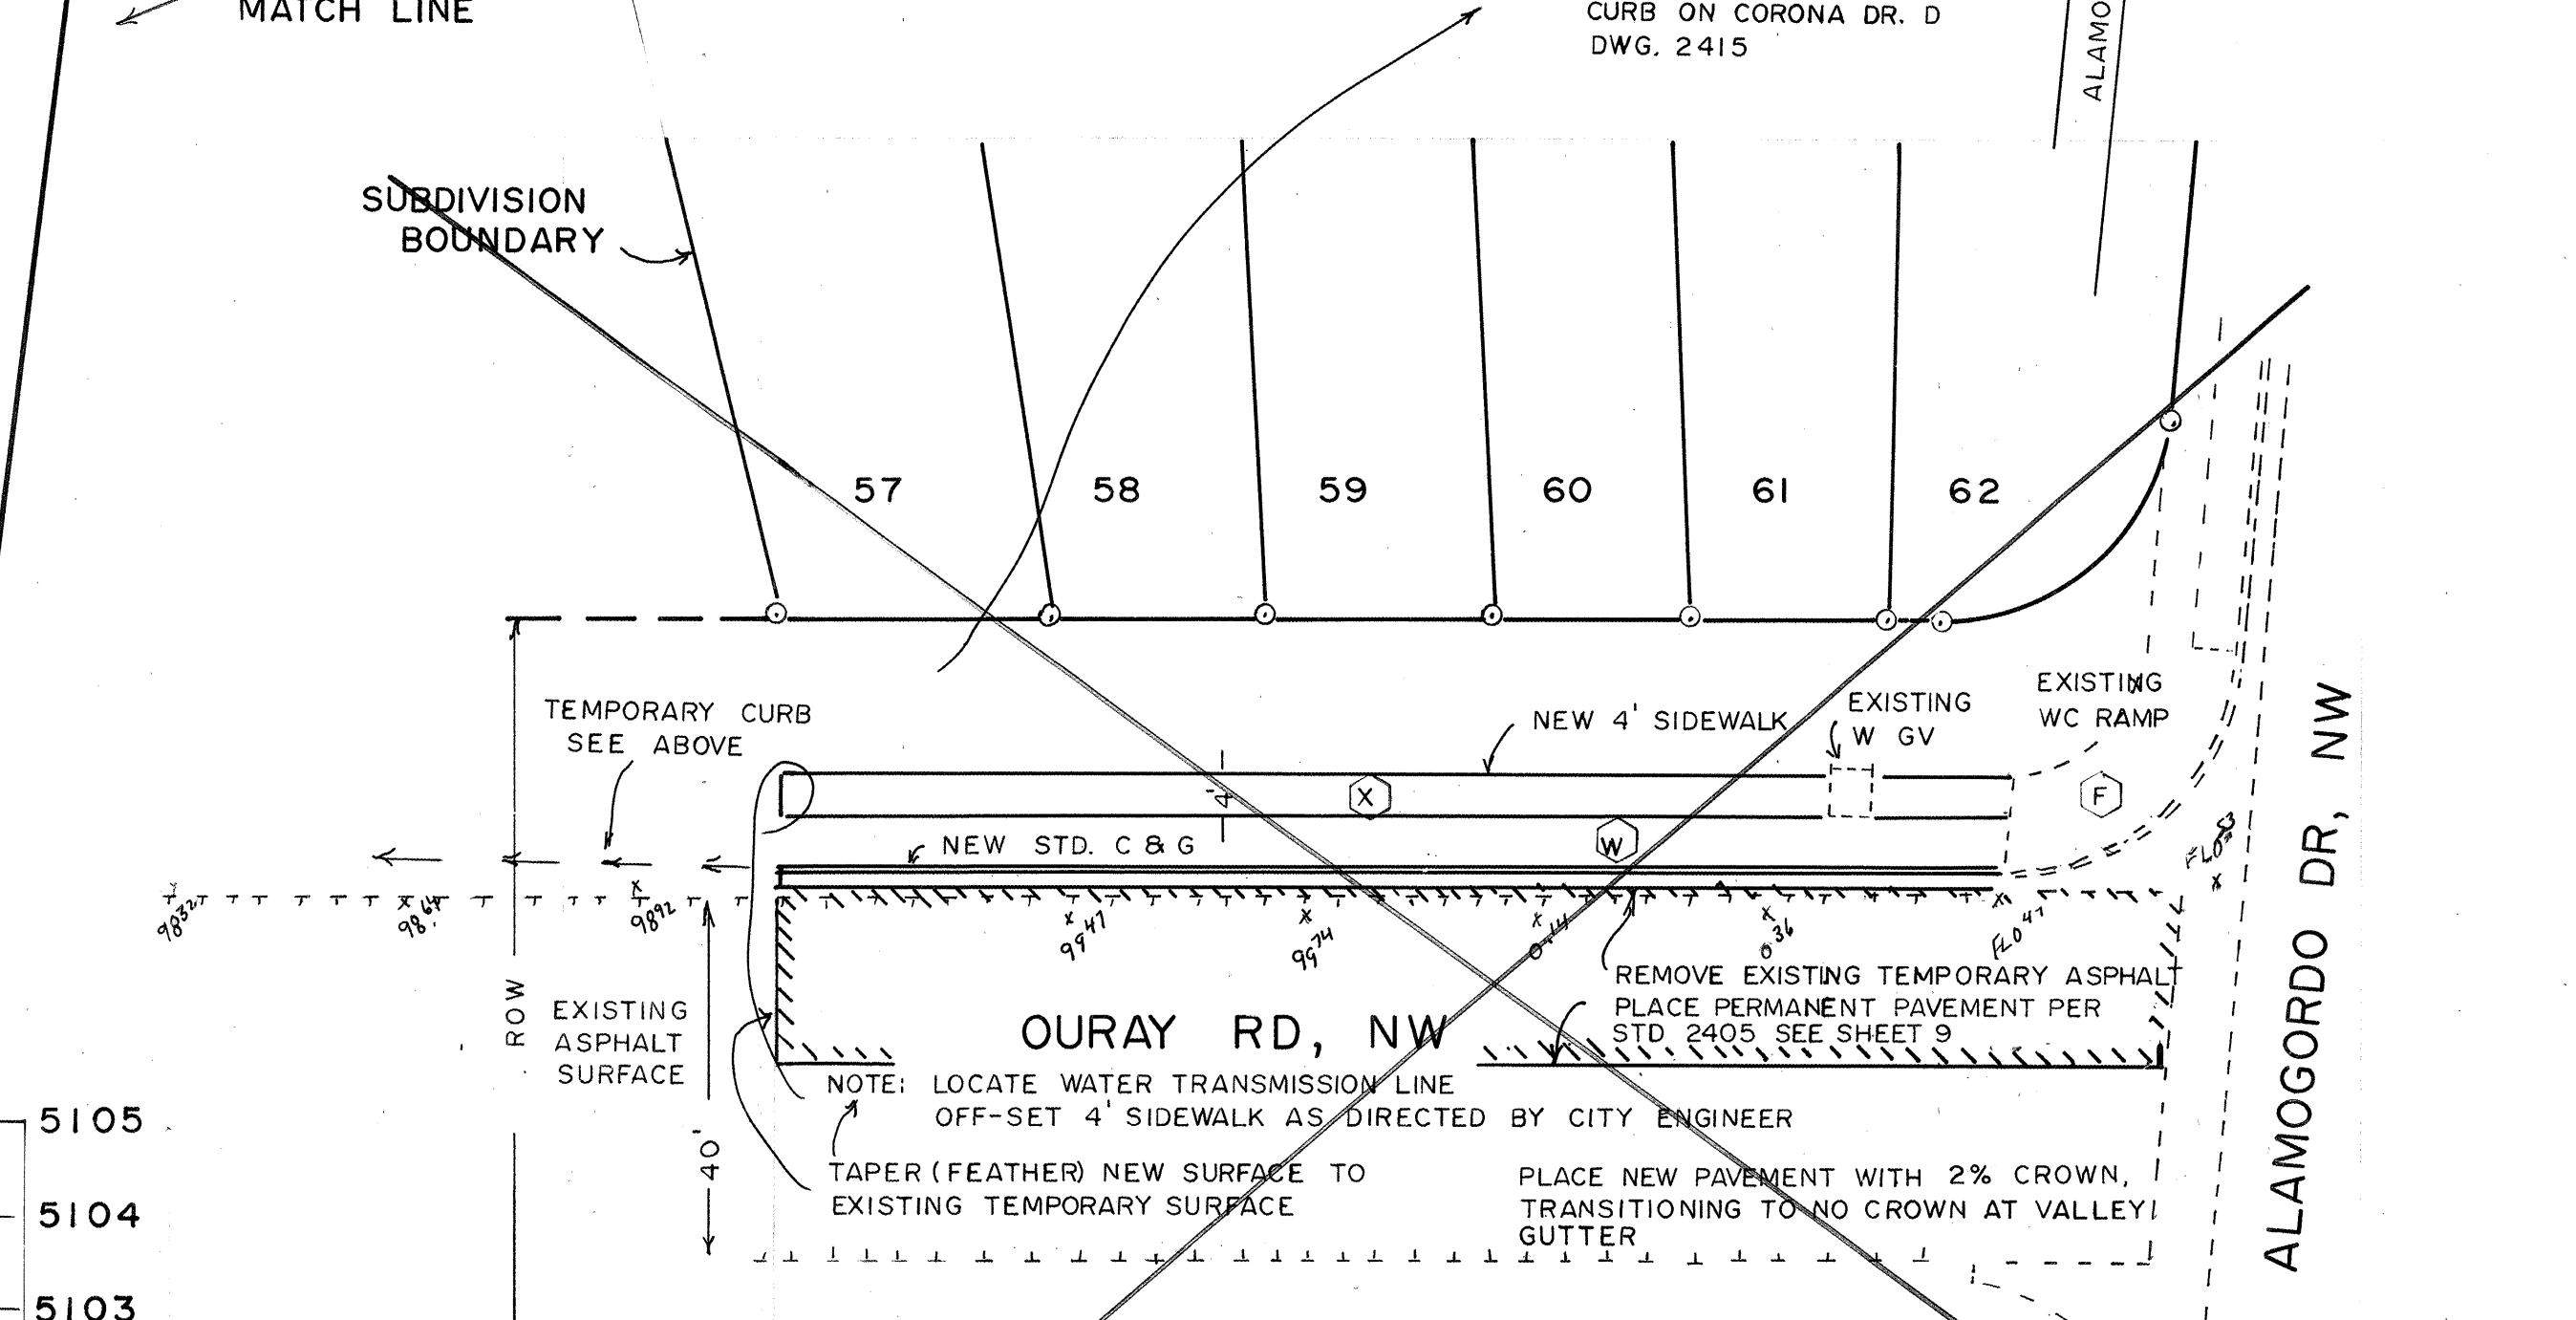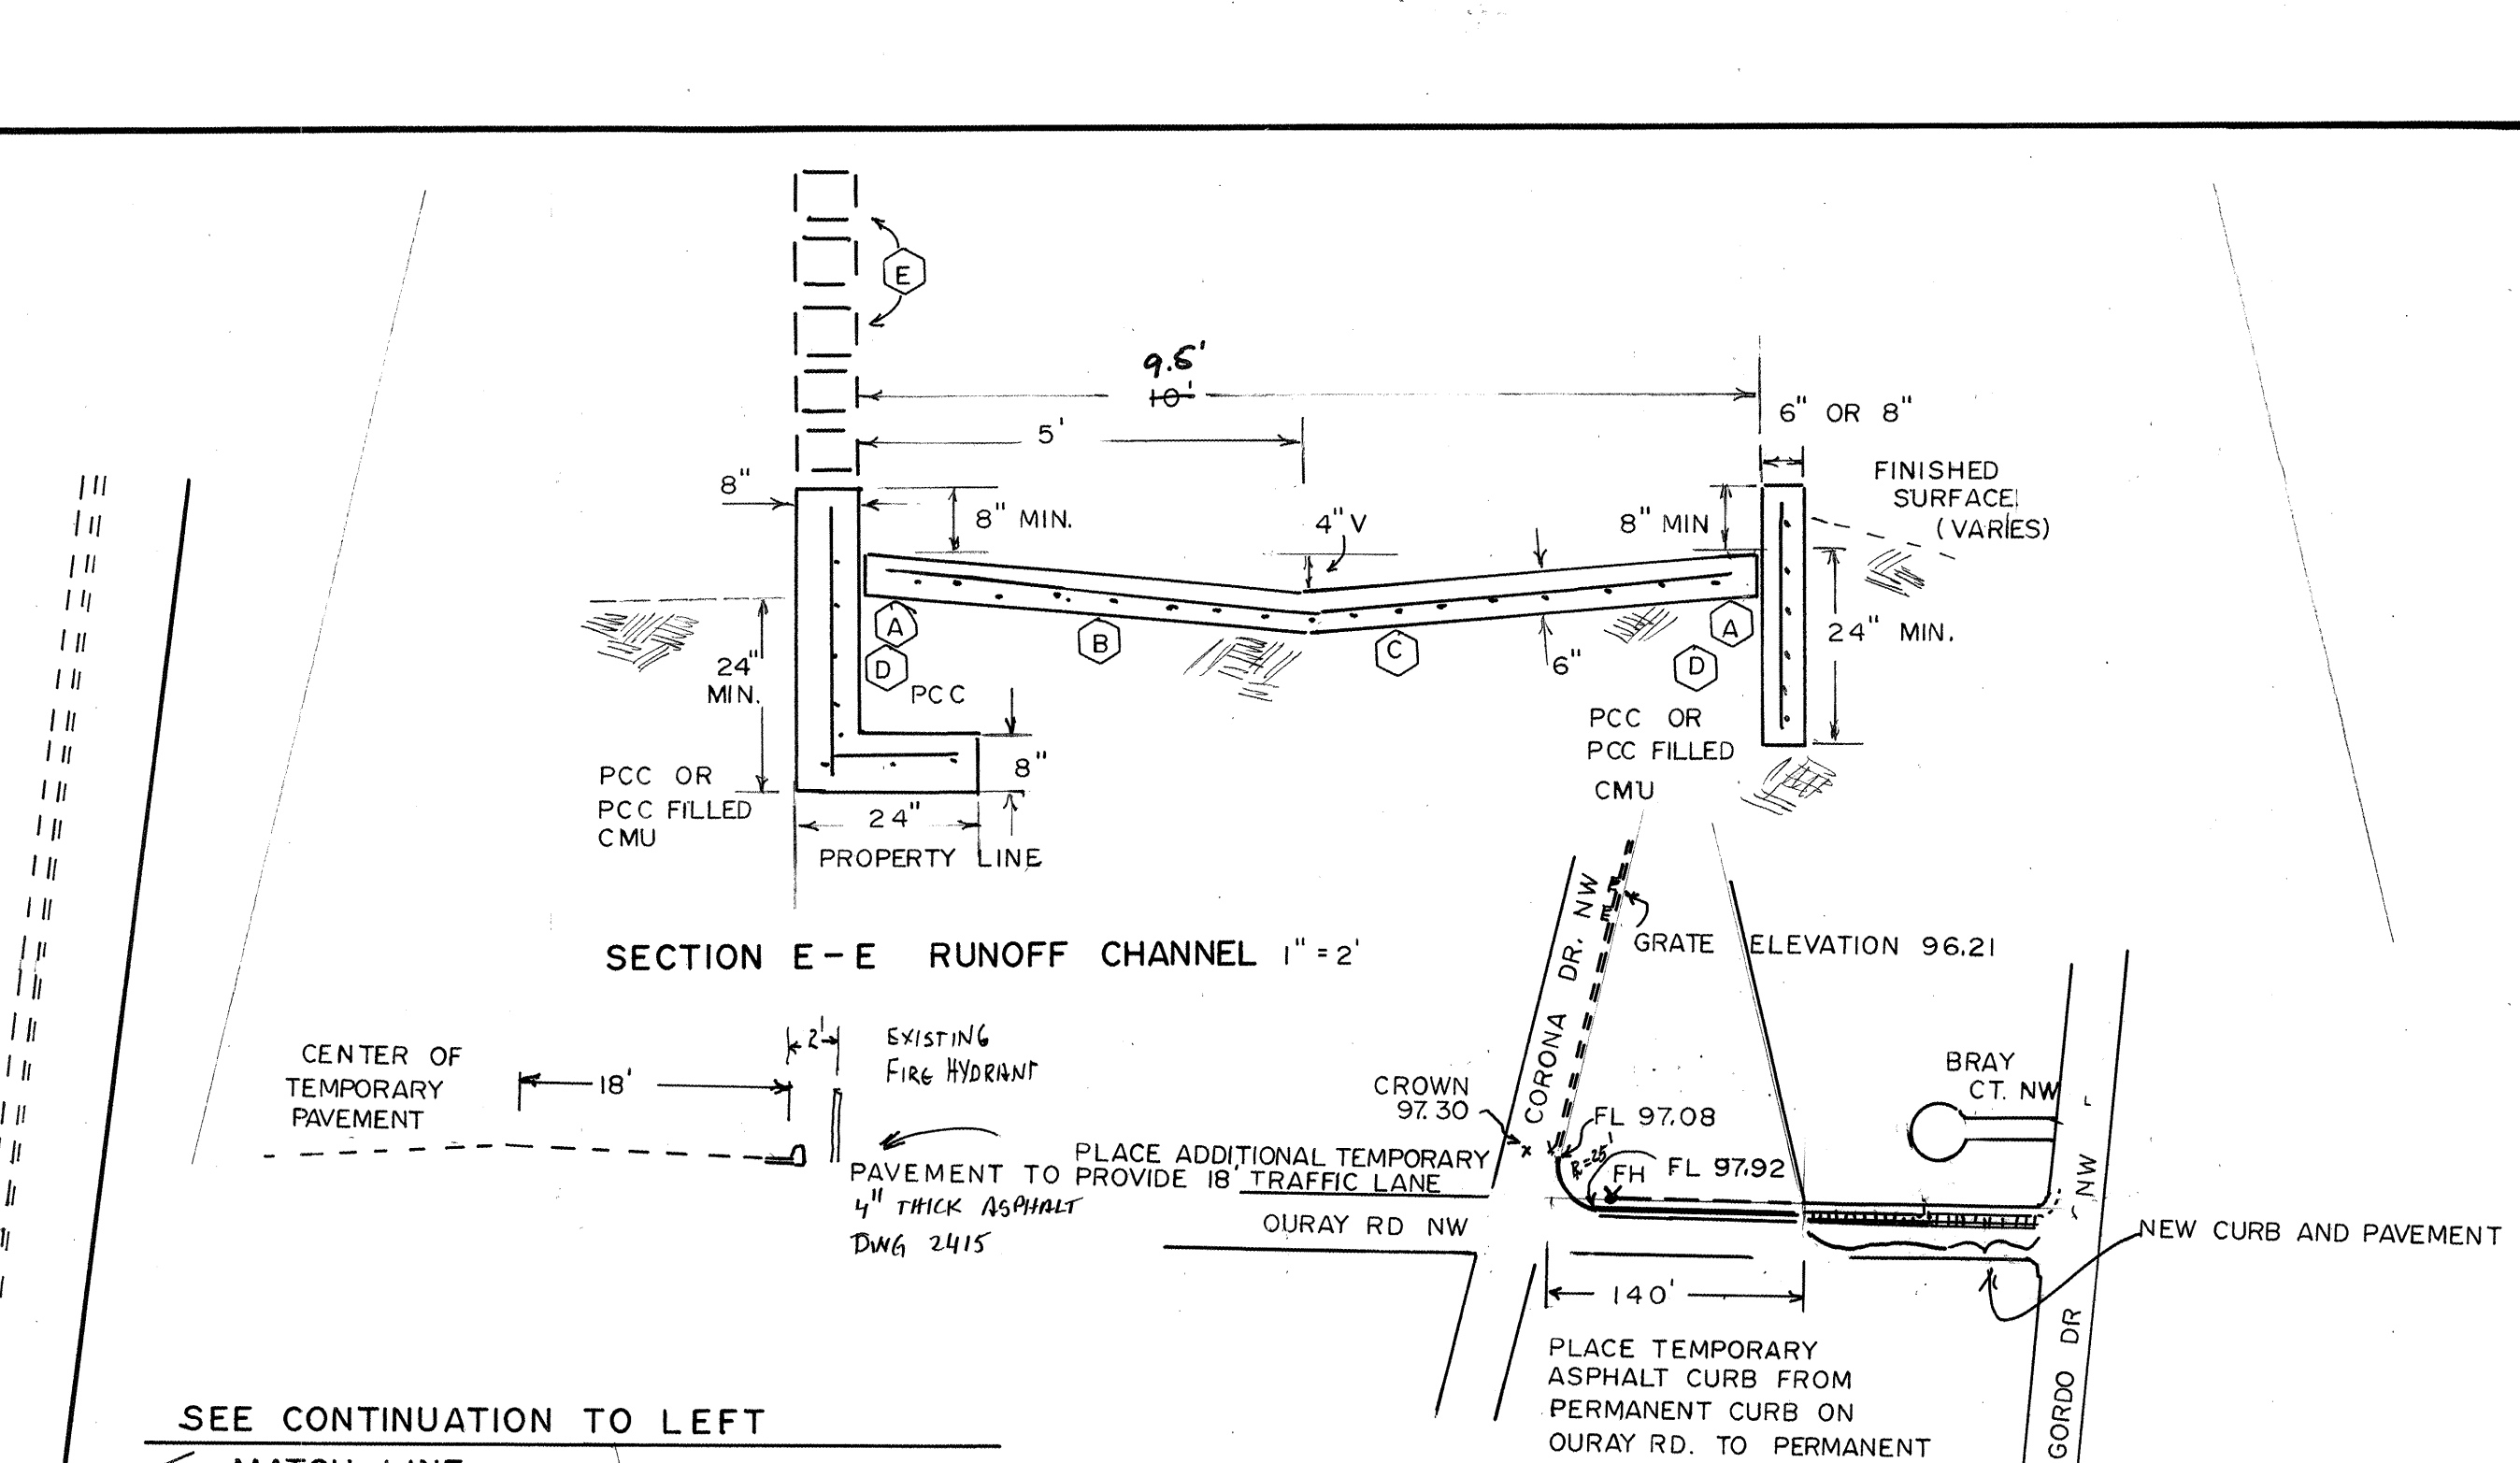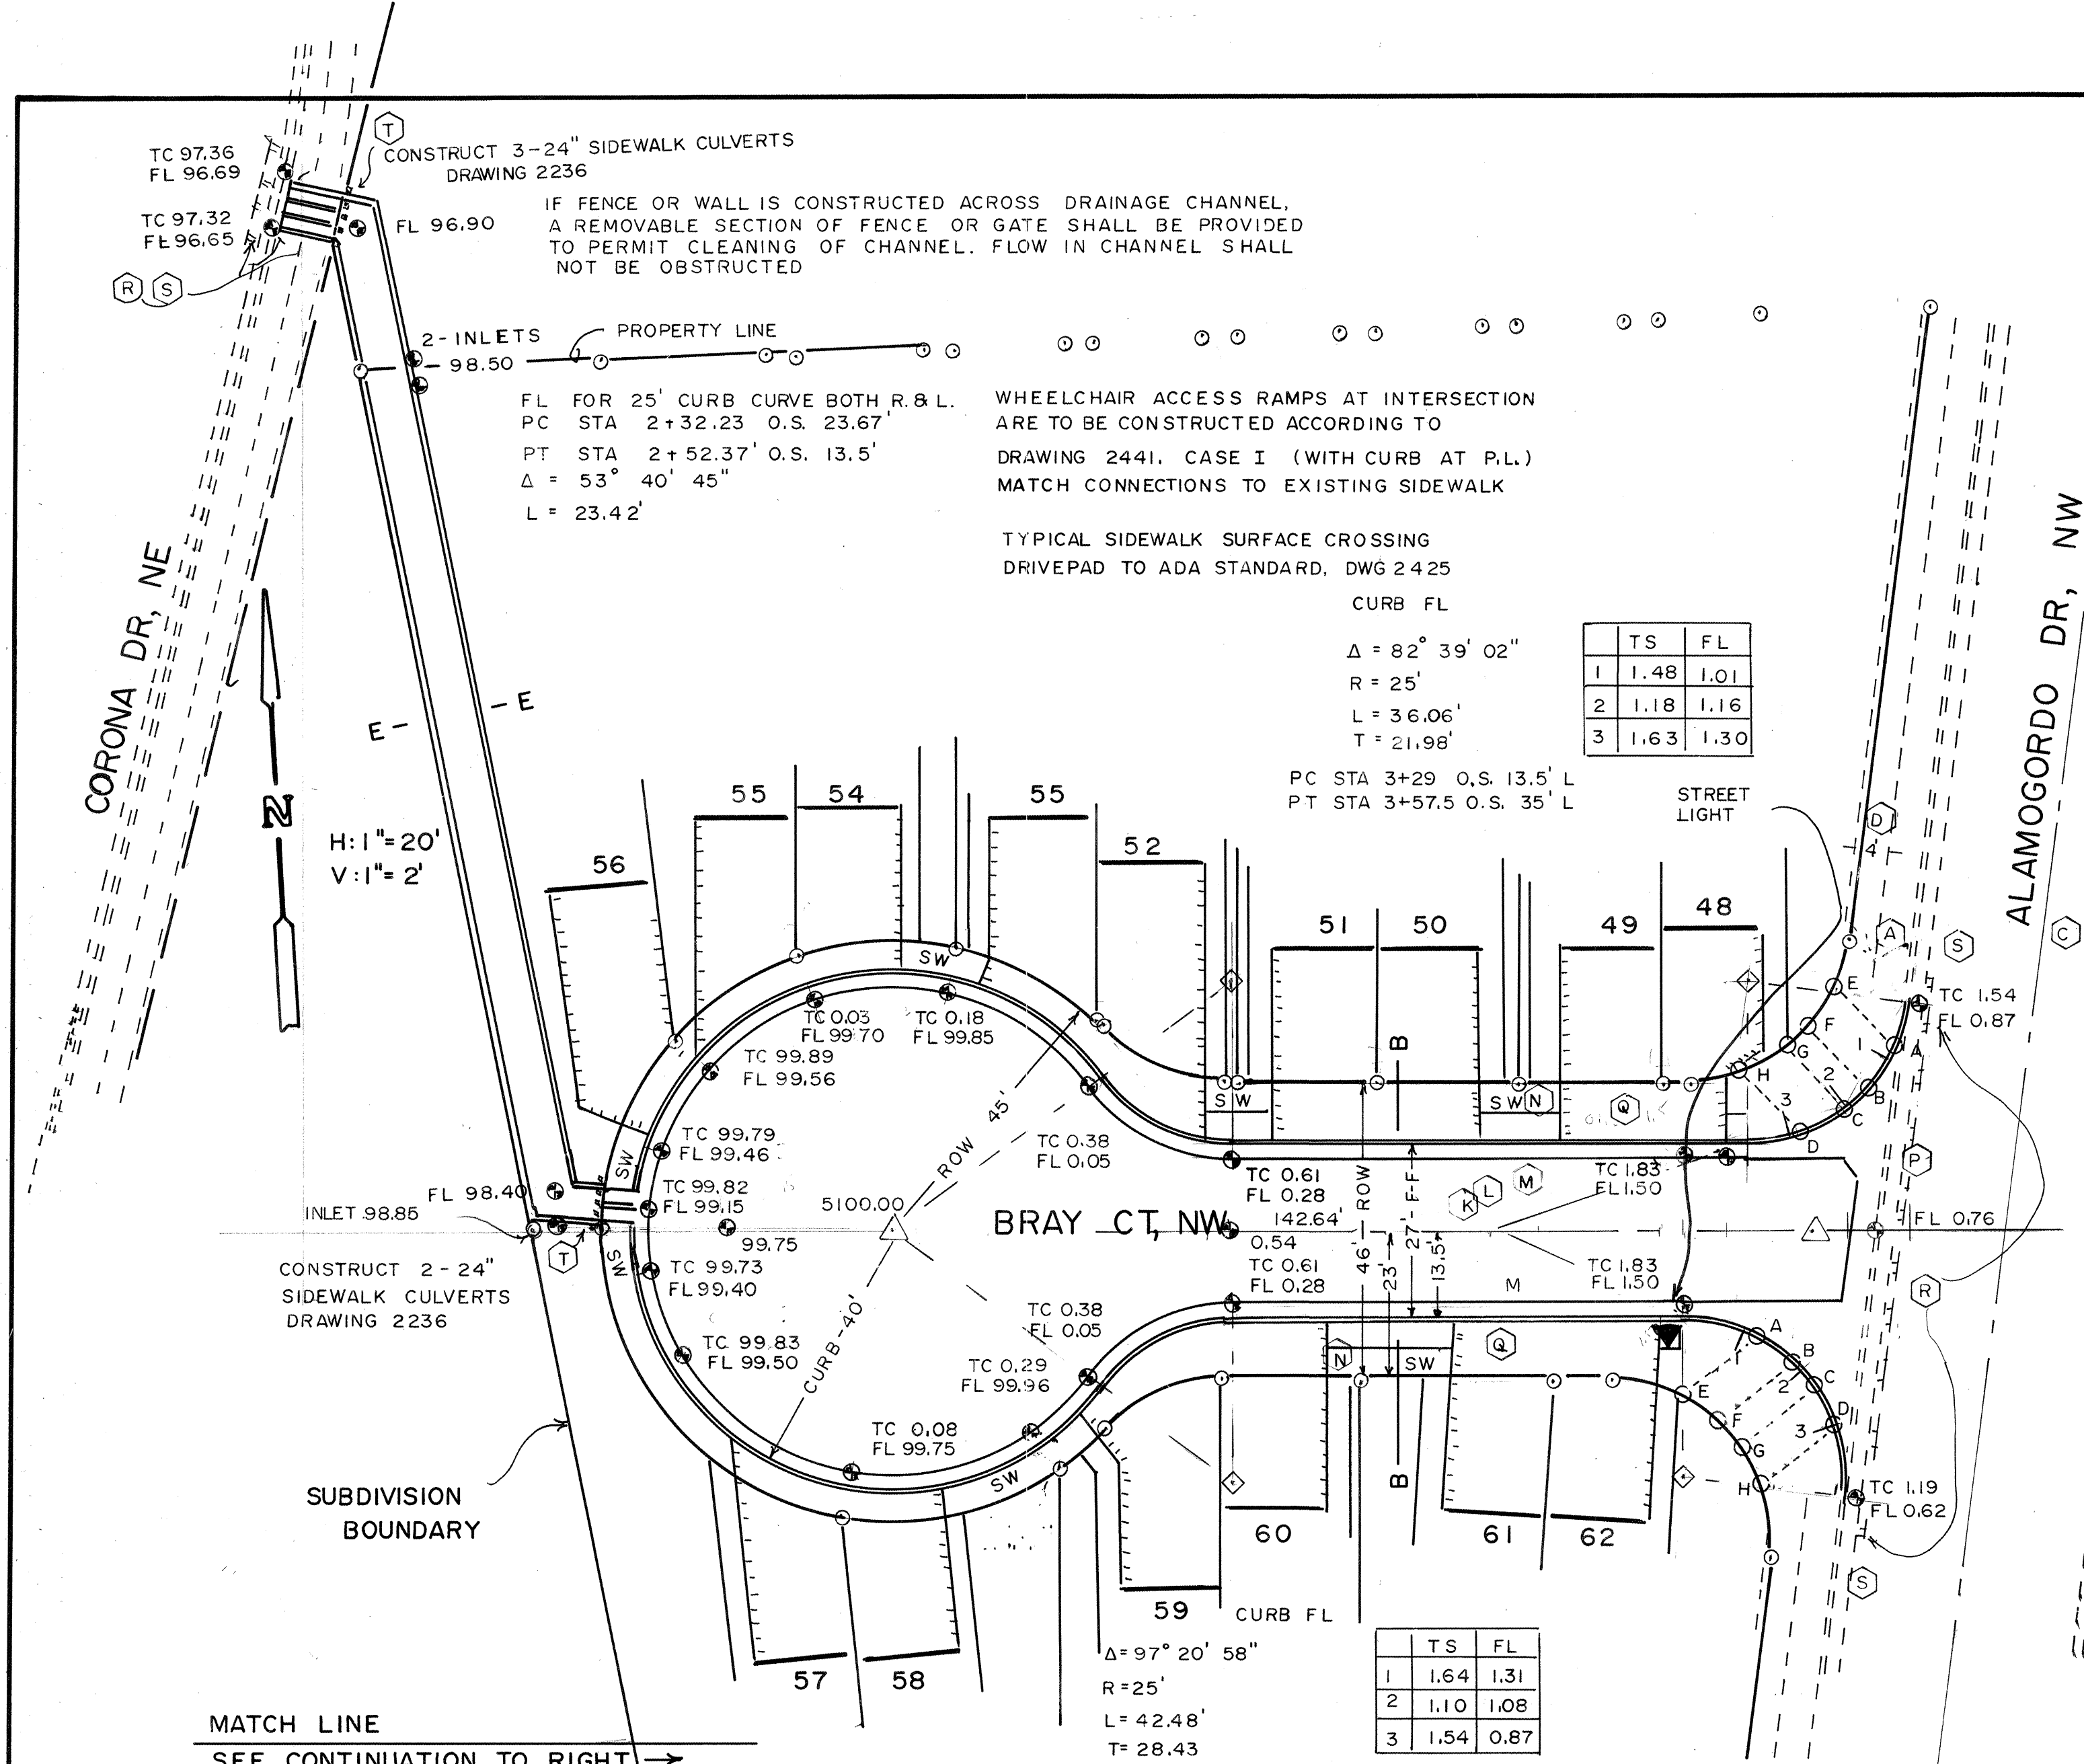

AS BUILT INFORMATION		BENCH MARKS		SURVEY INFORMATION		ENGINEER'S SEAL		REVISIONS		DESIGN	
CONTRACTOR	DATE	CONTRACTOR	DATE	NO.	BY	NO.	DATE	NO.	DATE	NO.	DATE
CONTRACTOR	DATE	CONTRACTOR	DATE								
INSPECTOR	DATE	INSPECTOR	DATE								
FIELD	DATE	FIELD	DATE								
VERIFICATION BY	DATE	VERIFICATION BY	DATE								
CORRECTED BY	DATE	CORRECTED BY	DATE								
RECORDED BY	DATE	RECORDED BY	DATE								

BENCHMARK: A.C.S. 17-H11, LOCATED ON TOP OF CURB IN THE SOUTHWEST QUADRANT OF THE INTERSECTION OF ALAMOGORDO DRIVE AND CORONA DRIVE NW. ELEVATION IS 5104.700 FEET (S.D. 1929)

ENGINEER'S SEAL

MARVIN R. KORTUM, P.E.
Civil Engineering
NM-PE 6519

1605 Speakman Drive, S.E.
Albuquerque, New Mexico 87123
(505) 299-0774

CITY OF ALBUQUERQUE
PUBLIC WORKS DEPARTMENT
ENGINEERING DEVELOPMENT GROUP

TITLE: WESTERN BREEZE SUBDIVISION
BRAY COURT NW, OURAY ROAD NW
STREET PLAN & PROFILE



APPROVED
FEB 24 1999
DESIGN REVIEW COMMITTEE

APPROVED
NOV 12 1999
CITY ENGINEER

City Project No. 601581

Zone Map No. H-11

Sheet 7 Of 11

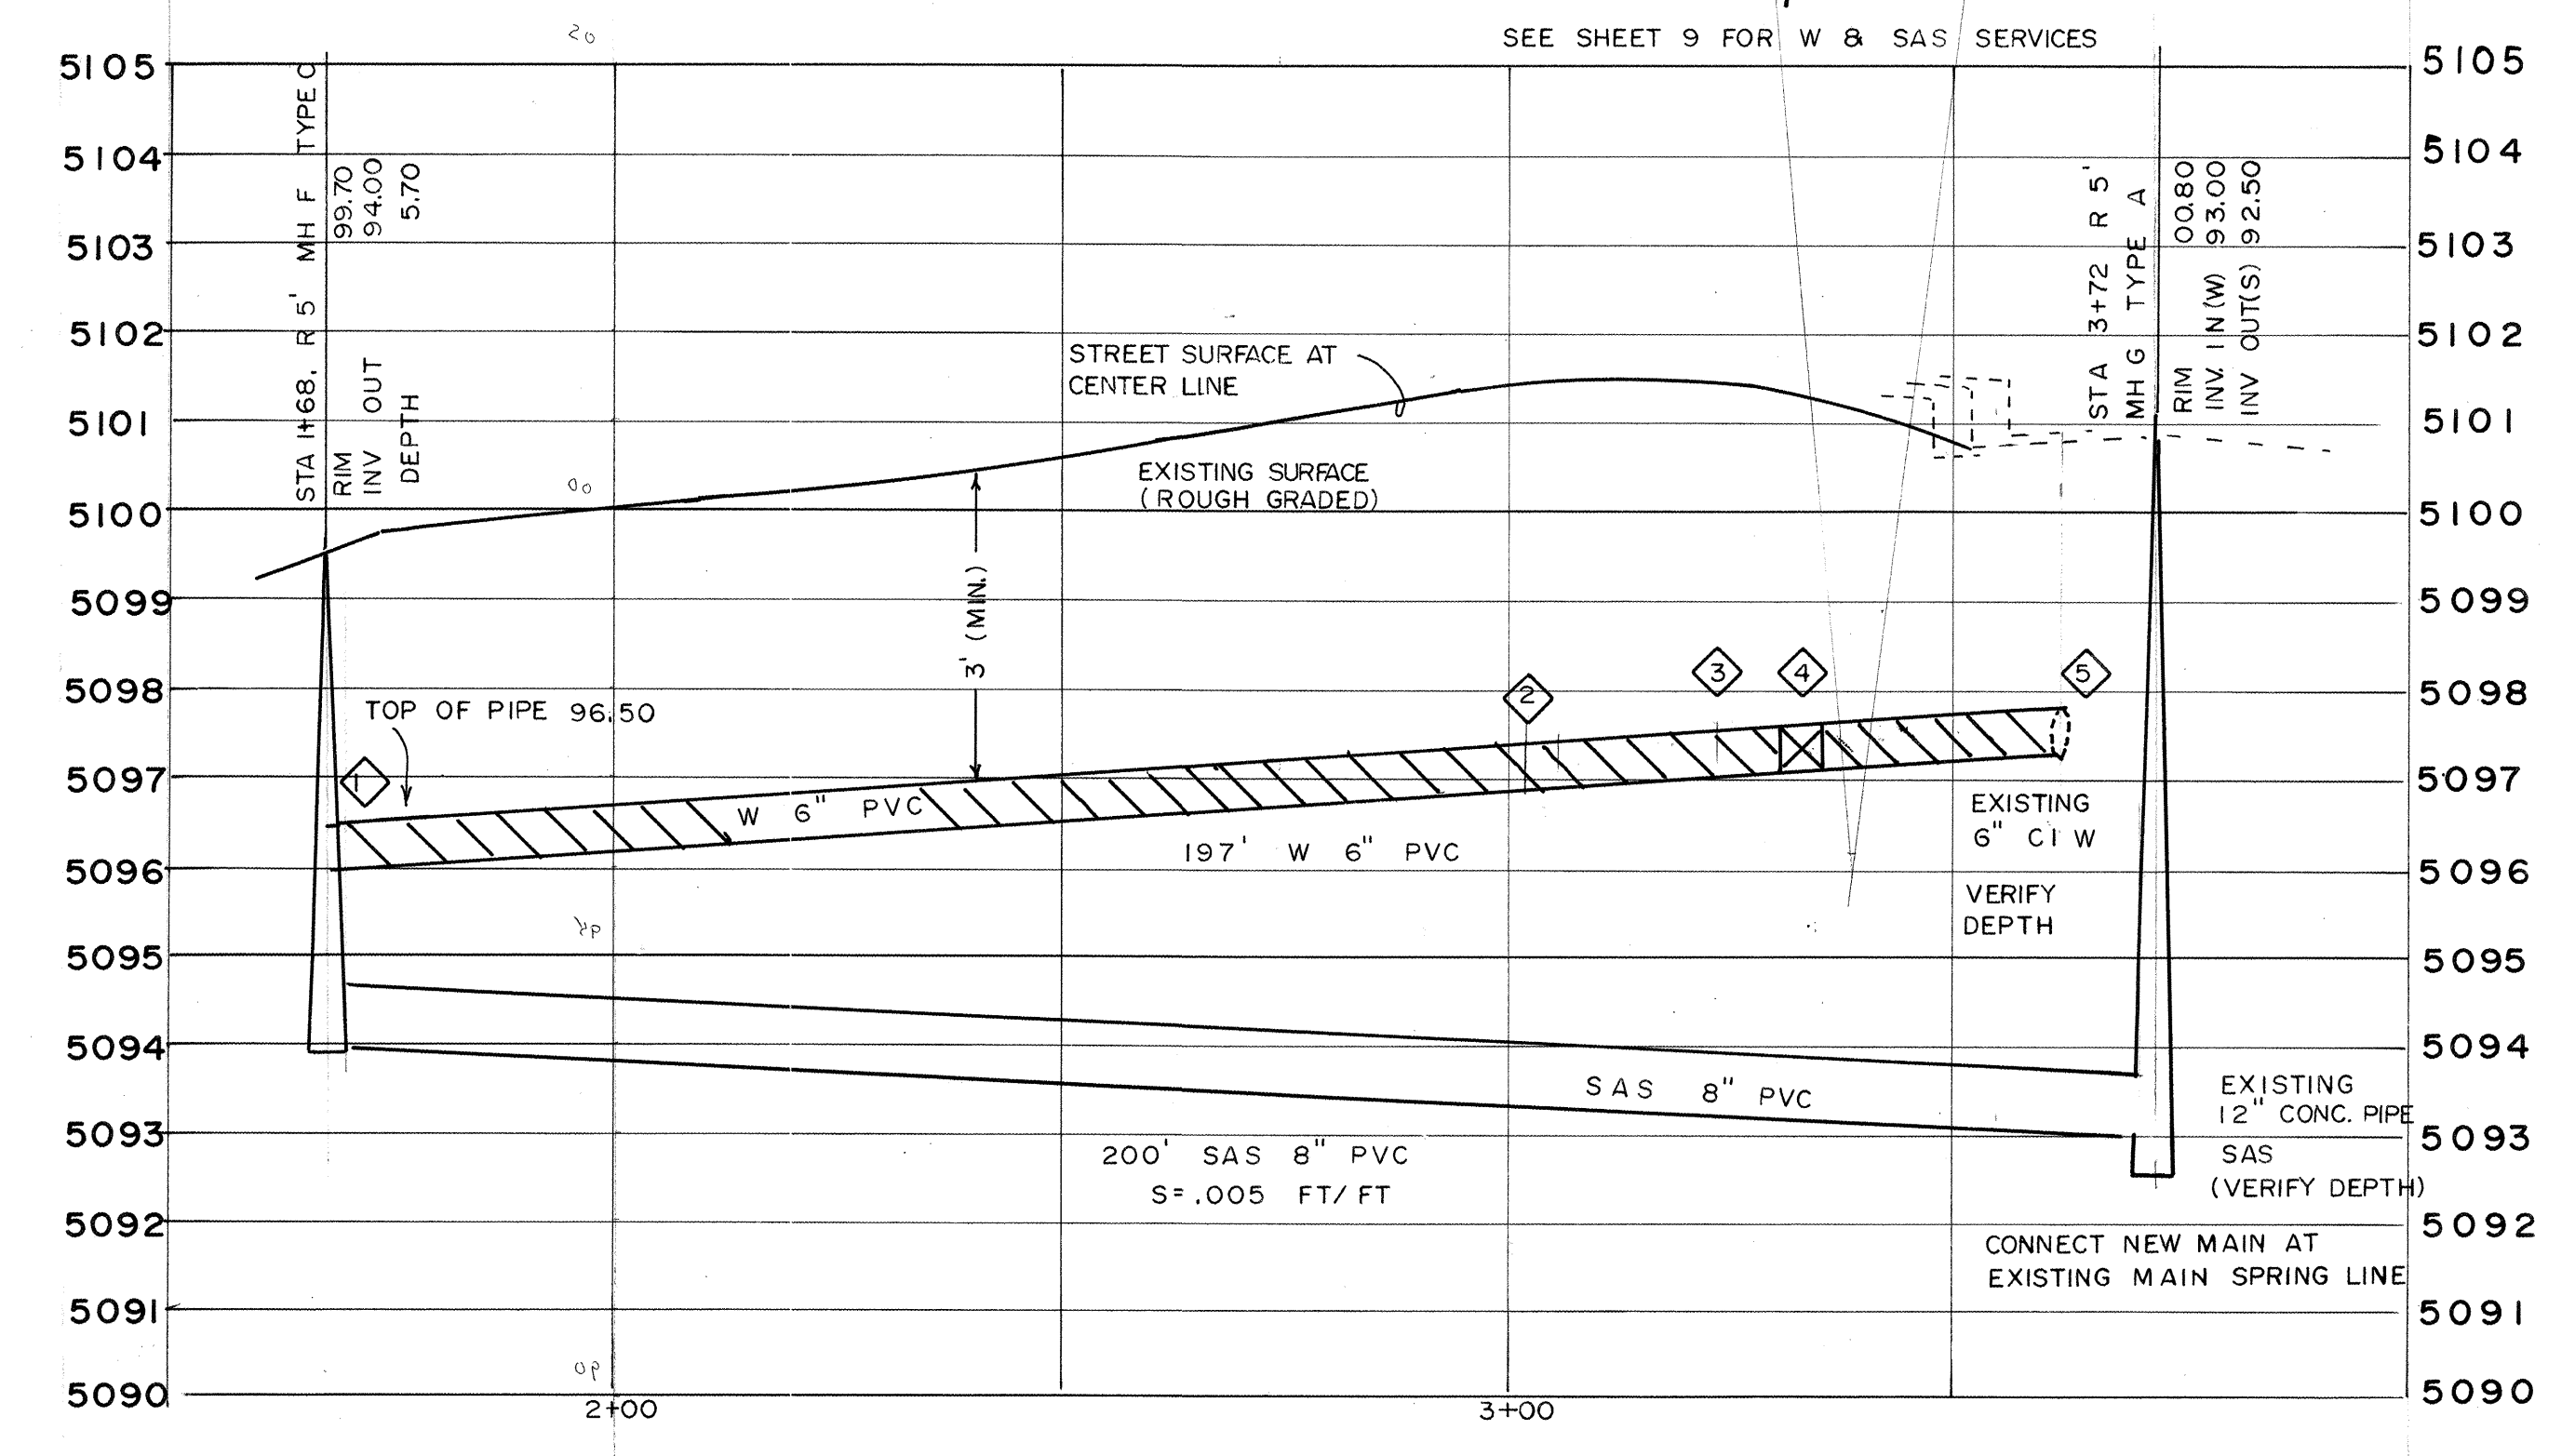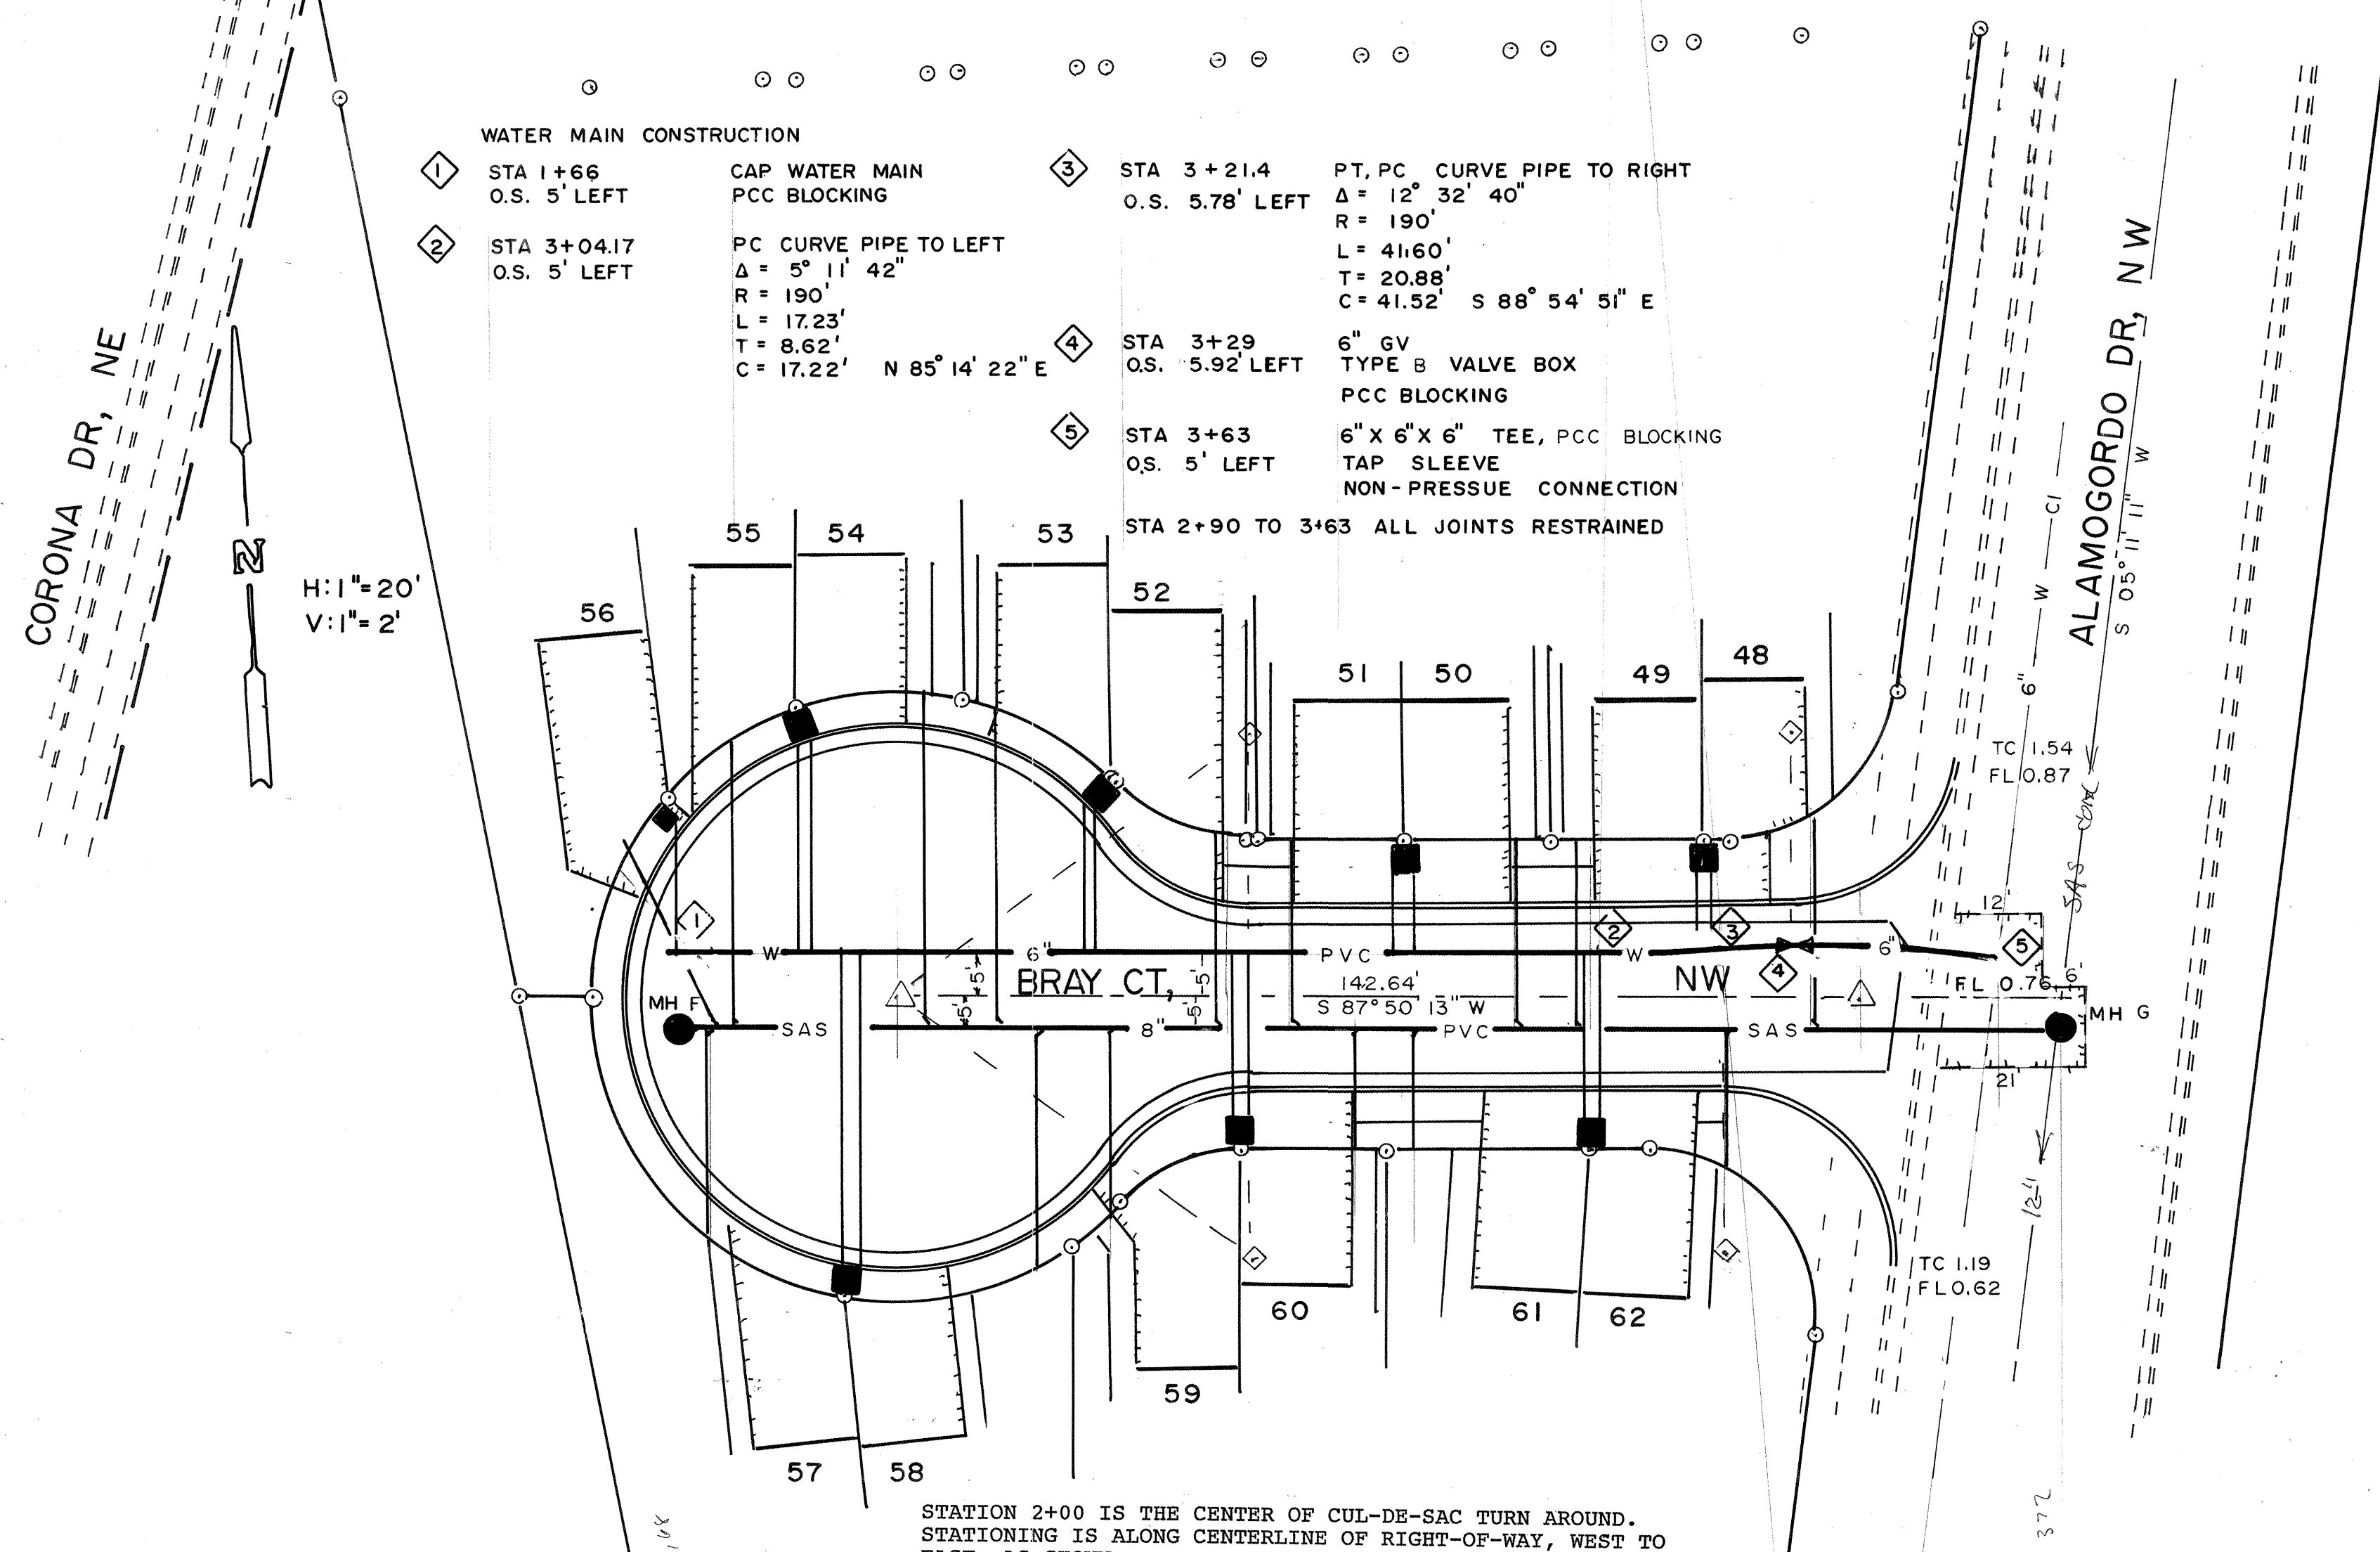

STATION 2+00 IS THE CENTER OF CUL-DE-SAC TURN AROUND.
STATIONING IS ALONG CENTERLINE OF RIGHT-OF-WAY, WEST TO EAST, AS SHOWN.

SEE SHEET 9 FOR W & SAS SERVICES

MARVIN R. KORTUM, P.E.
Civil Engineering
NM PE 6519

1605 Speakman Drive, S.E.
Albuquerque, New Mexico 87123
(505) 299-0774

CITY OF ALBUQUERQUE PUBLIC WORKS DEPARTMENT ENGINEERING DEVELOPMENT GROUP	
TITLE: WESTERN BREEZE SUBDIVISION, PHASE II BRAY COURT NW WATER, SANITARY SEWER PLAN & PROFILE	
Design Review Committee APPROVED FEB 24 1999 REVIEW COMMITTEE	City Engineer Approval APPROVED NOV 12 1999 CITY ENGINEER
City Project No. 601581	Zone Map No. H-11
Sheet 8	Of 11


ENGINEER'S SEAL		SURVEY INFORMATION		BENCH MARKS		AS BUILT INFORMATION		
 NOV 4 1998 mrl		FIELD NOTES		BENCHMARK: A. C. S. 17-HILL, LOCATED ON TOP OF CURB IN THE SOUTHWEST QUADRANT OF THE INTERSECTION OF ALAMOGORDO DRIVE AND QUAIL ROAD, NW. ELEVATION IS 5104.760 FEET (SLD 1929)	CONTRACTOR			
		NO.	BY		DATE	WORK DONE BY	DATE	
						INSPECTED BY		
						ACCEPTANCE BY		
						DATE		
		NO.	DATE		REMARKS	BY	VERIFICATION BY	DATE
		REVISIONS						DRAWINGS
DESIGN						DATE	NO.	
DESIGNED BY	MARVIN R. KORTUM	DATE	OCT 12 1998	RECORDED BY		MICRO-FILM INFORMATION		
DRAWN BY	"	DATE	"	NO.		DATE		
CHECKED BY	"	DATE	"	NO.		DATE		

OCTOBER 6, 1998
WESTERN BREEZE, WESTERN BREEZE COURT
SANITARY SEWER SERVICES

WESTERN BREEZE, BRAY COURT
SANITARY SEWER SERVICES

LOT #	TAP ON MAIN STATION	OFFSET (FEET)	DIRECTION	END AT RIGHT-OF-WAY STATION	OFFSET (FEET)	DIRECTION	INVERT AT MH	SLOPE OF MAIN	DISTANCE TO SVC TAP	TOP OF MAIN AT SVC	LENGTH OF SERVICE (FEET)	TOP OF CURB	SERVICE LINE INVERT AT RIGHT-OF-WAY MAXIMUM (HIGHEST)	MINIMUM (LOWEST)
38	1+44	28	RIGHT (SOUTH)	1+50	30.0	RIGHT (SOUTH)	93.65	0.0050	40	94.65	6.0	99.98	95.98	94.77
37	1+65	8	RIGHT (SOUTH)	1+58	19.0	LEFT (NORTH)	93.65	0.0050	67	94.78	30.0	99.98	95.98	95.38
36	1+75	5	RIGHT (SOUTH)	1+75	43.0	LEFT (NORTH)	94.10	0.00819	5	94.94	43.0	100.21	96.21	95.80
35	2+21	5	RIGHT (SOUTH)	2+21	46.0	LEFT (NORTH)	94.10	0.00819	21	95.07	46.0	100.67	96.67	95.99
34	2+29	5	RIGHT (SOUTH)	2+29	40.0	LEFT (NORTH)	94.10	0.00819	29	95.14	40.0	100.80	96.80	95.94
33	2+69	5	RIGHT (SOUTH)	2+69	23.5	LEFT (NORTH)	94.10	0.00819	69	95.47	28.5	101.35	97.35	96.04
32	2+74	5	RIGHT (SOUTH)	2+74	23.5	LEFT (NORTH)	94.10	0.00819	74	95.51	28.5	101.43	97.43	96.08
31	3+16	5	RIGHT (SOUTH)	3+16	23.5	LEFT (NORTH)	94.10	0.00819	116	95.85	28.5	102.41	98.41	96.42
30	3+21	5	RIGHT (SOUTH)	3+21	23.5	LEFT (NORTH)	94.10	0.00819	121	95.89	28.5	102.81	98.81	96.46
29	3+63	5	RIGHT (SOUTH)	3+63	23.5	LEFT (NORTH)	94.10	0.00819	163	96.23	28.5	103.80	99.80	96.80
28	3+71	5	RIGHT (SOUTH)	3+71	23.5	LEFT (NORTH)	94.10	0.00819	171	96.30	28.5	103.80	99.80	96.87
27	3+97	5	RIGHT (SOUTH)	3+97	23.5	LEFT (NORTH)	94.10	0.00819	197	96.51	28.5	103.50	99.50	97.08
39	1+93	5	RIGHT (SOUTH)	1+93	45.0	RIGHT (SOUTH)	94.10	0.00819	23	95.09	40.0	100.40	96.40	95.89
40	2+00	5	RIGHT (SOUTH)	2+00	45.0	RIGHT (SOUTH)	94.10	0.00819	25	95.10	40.0	100.46	96.46	95.90
41	2+39	5	RIGHT (SOUTH)	2+39	26.0	RIGHT (SOUTH)	94.10	0.00819	39	95.22	21.0	100.95	96.95	95.64
42	2+44	5	RIGHT (SOUTH)	2+44	24.0	RIGHT (SOUTH)	94.10	0.00819	44	95.26	19.0	101.00	97.00	95.64
43	2+83	5	RIGHT (SOUTH)	2+83	14.0	RIGHT (SOUTH)	94.10	0.00819	83	95.58	18.5	101.57	97.57	95.95
44	2+88	5	RIGHT (SOUTH)	2+88	18.5	RIGHT (SOUTH)	94.10	0.00819	88	95.62	18.5	101.67	97.67	95.99
45	3+29	5	RIGHT (SOUTH)	3+29	18.5	RIGHT (SOUTH)	94.10	0.00819	129	95.96	18.5	102.58	98.58	96.33
46	3+34	5	RIGHT (SOUTH)	3+34	18.5	RIGHT (SOUTH)	94.10	0.00819	134	96.00	18.5	102.73	98.73	96.37
47	3+80	5	RIGHT (SOUTH)	3+80	18.5	RIGHT (SOUTH)	94.10	0.00819	180	96.37	18.5	103.85	99.85	96.74
TOTAL											577.0			

LOT #	TAP ON MAIN STATION	OFFSET (FEET)	DIRECTION	END AT RIGHT-OF-WAY STATION	OFFSET (FEET)	DIRECTION	INVERT AT MH	SLOPE OF MAIN	DISTANCE TO SVC TAP	TOP OF MAIN AT SVC	LENGTH OF SERVICE (FEET)	TOP OF CURB	SERVICE LINE INVERT AT RIGHT-OF-WAY MAXIMUM (HIGHEST)	MINIMUM (LOWEST)
56	1+73	5	RIGHT (SOUTH)	1+60	25.0	LEFT (NORTH)	94.00	0.0050	3	94.815	30.0	99.79	95.79	95.41
55	1+76	5	RIGHT (SOUTH)	1+76	38.0	LEFT (NORTH)	94.00	0.0050	6	94.83	43.0	99.89	95.89	95.69
54	2+04	5	RIGHT (SOUTH)	2+04	45.0	LEFT (NORTH)	94.00	0.0050	34	94.97	50.0	100.15	96.15	95.97
53	2+15	5	RIGHT (SOUTH)	2+15	42.0	LEFT (NORTH)	94.00	0.0050	45	95.02	47.0	100.21	96.21	95.96
52	2+47	5	RIGHT (SOUTH)	2+47	24.0	LEFT (NORTH)	94.00	0.0050	77	95.18	29.0	100.55	96.55	95.76
51	2+58	5	RIGHT (SOUTH)	2+58	23.5	LEFT (NORTH)	94.00	0.0050	88	95.24	28.5	100.65	96.65	95.81
50	2+91	5	RIGHT (SOUTH)	2+91	23.5	LEFT (NORTH)	94.00	0.0050	121	95.40	28.5	101.31	97.31	95.98
49	3+01	5	RIGHT (SOUTH)	3+01	23.5	LEFT (NORTH)	94.00	0.0050	131	95.46	28.5	101.45	97.45	96.02
48	3+35	5	RIGHT (SOUTH)	3+35	23.5	LEFT (NORTH)	94.00	0.0050	165	95.63	28.5	101.72	97.72	96.19
57	1+72	5	RIGHT (SOUTH)	1+72	35.0	RIGHT (SOUTH)	94.00	0.0050	2	94.81	30.0	99.90	95.90	95.41
58	2+20	5	RIGHT (SOUTH)	2+20	41.0	RIGHT (SOUTH)	94.00	0.0050	51	95.05	36.0	100.27	96.27	95.77
59	3+30	5	RIGHT (SOUTH)	3+30	33.0	RIGHT (SOUTH)	94.00	0.0050	61	95.11	28.0	100.38	96.38	95.67
60	2+66	5	RIGHT (SOUTH)	2+66	18.5	RIGHT (SOUTH)	94.00	0.0050	97	95.28	18.5	100.89	96.89	95.66
61	2+96	5	RIGHT (SOUTH)	2+96	18.5	RIGHT (SOUTH)	94.00	0.0050	107	95.34	18.5	101.03	97.03	95.70
62	3+42	5	RIGHT (SOUTH)	3+42	18.5	RIGHT (SOUTH)	94.00	0.0050	153	95.56	18.5	101.83	97.83	95.94
TOTAL											462.5			

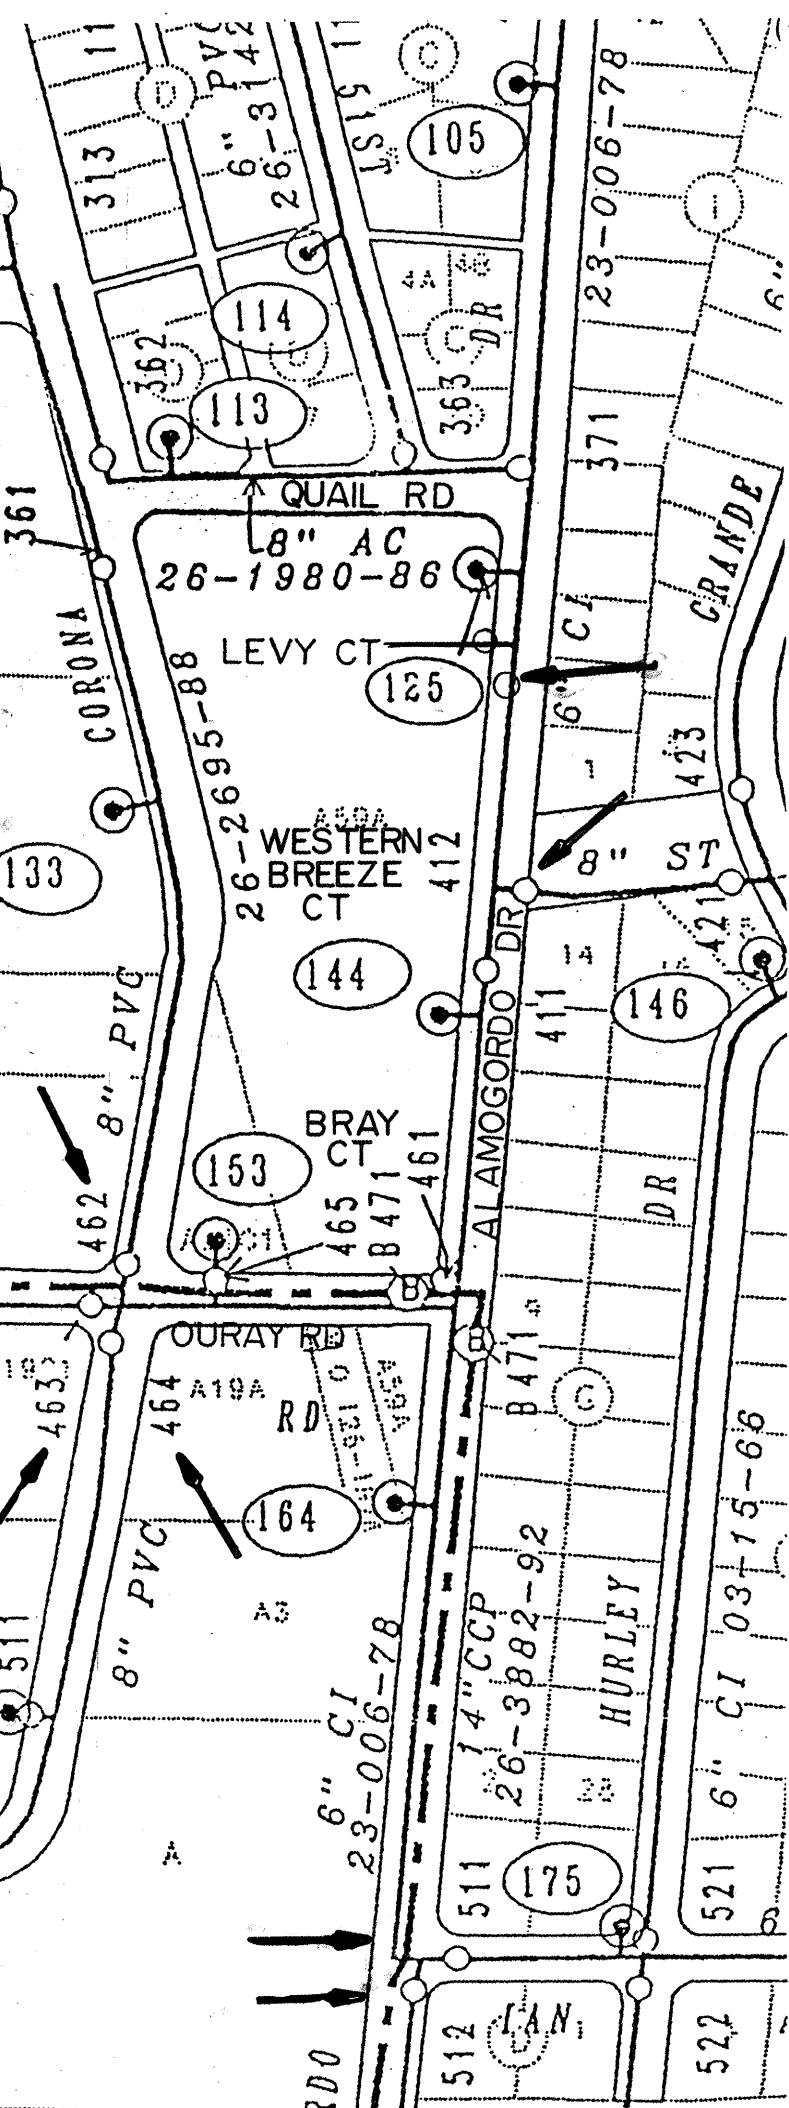

1-1/2" ASPHALT CONCRETE TYPICAL FINISH
COURSE PLACED AFTER ALL MANHOLES, VALVES,
COVERS/RINGS ARE SET TO GRADE. 1500 LBS.
STABILITY, TYPE B GRADATION.

FINISHED SURFACE OF SUBGRADE SHALL BE
MOISTURE CONTROLLED AT COMPACTION
MOISTURE RANGE, OR PRIME COAT APPLIED AS
REQUIRED BY THE ENGINEER UNTIL NEXT/FINAL
SURFACING COMPLETED. SUBGRADE
PREPARATION SHALL BE PERFORMED AFTER ALL
SUBSURFACE R/W UTILITIES CONSTRUCTION IS
COMPLETED.

90% MINIMUM COMPACTION


TACK COAT AS REQUIRED BY THE ENGINEER
BETWEEN ALL ASPHALT/AGGREGATE MATERIAL
LIFTS.

1-1/2" ASPHALT CONCRETE, 1500 LBS.
STABILITY, TYPE B GRADATION.

12" SUBGRADE SOIL, R-VALUE = 50, PLACED
IN TWO 6" LIFTS. 95% MINIMUM COMPACTION
AT OPTIMUM MOISTURE CONTENT, +/- 2%, ASTM
D1557, OR OPTIMUM MOISTURE TO +4%, ASTM
D698, FOR SOIL WITH 35% OR MORE MATERIAL
PASSING THE NO. 200 SIEVE.

REFER TO STANDARD DRAWING 2405.

FLEXIBLE PAVEMENT SECTION

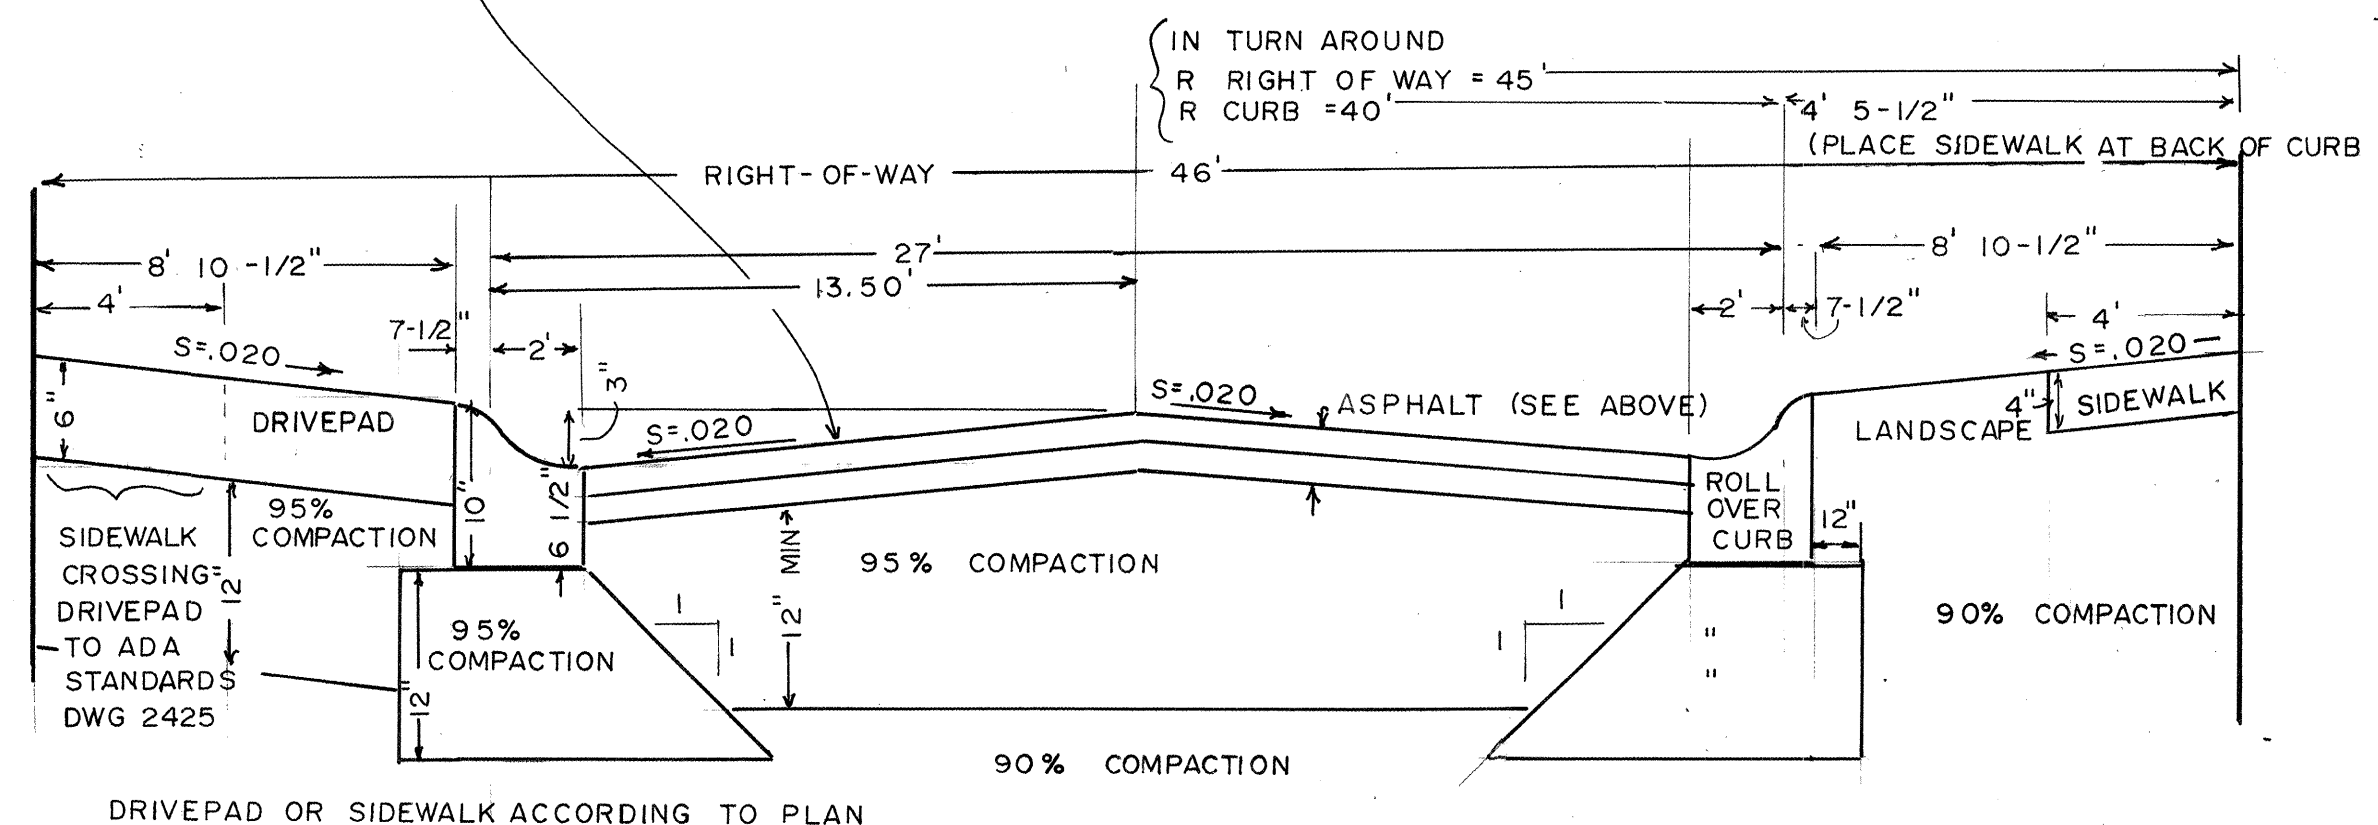

SECTION B-B RIGHT-OF-WAY

REFER TO CITY OF ALBUQUERQUE STANDARD SPECIFICATIONS DRAWING
2405 FOR PROFILE AND ADDITIONAL DETAILS ON THE STREET
CONSTRUCTION. CONTRACTOR IS RESPONSIBLE FOR VERIFYING THAT
THE REQUIRED R VALUE FOR THE STREET EARTH MATERIALS IS
OBTAINED USING IMPORTED FILL OR LOCAL MATERIAL. THE
CONTRACTOR IS RESPONSIBLE FOR IMPORTING ADDITIONAL MATERIALS
TO OBTAIN THE REQUIRED R VALUE IF THE ON-SITE SOIL IS NOT
SATISFACTORY.

WATER MAIN SHUT-OFF REQUIREMENTS

THE CONTRACTOR SHALL BE RESPONSIBLE FOR TIMING AND
COORDINATION OF THE WATER MAIN SHUT-OFF REQUIREMENTS TO
CONSTRUCT THIS PROJECT.

AT LEAST FIVE (5) WORKING DAYS PRIOR TO CONSTRUCTION,
CONTRACTOR SHALL CONTACT THE FWD/WATER SYSTEMS DIVISION
(857-8200) TO START THIS SHUT-OFF PLAN.

THE VALVES LISTED BELOW AND SHOWN ON THE ADJACENT SKETCH
MUST BE CLOSED PRIOR TO A NON-PRESSURE CONNECTION:

NEW VALVES AT LEVY COURT AND ALAMOGORDO DRIVE NW
H-11 511 H-11 512 H-11 412 H-11-462
H-11 463 H-11 464

OCTOBER 6, 1998
WESTERN BREEZE SUBDIVISION, WESTERN BREEZE COURT
WATER SERVICES

LOT #	STATION	OFFSET TO SERVICE BOX DIRECTION	LENGTH OF SERVICE (FEET)	TYPE OF BOX
37	1+70	LEFT (NORTH)	33	28 SINGLE
35 & 36	1+94	LEFT (NORTH)	43	38 DOUBLE
33 & 34	2+48	LEFT (NORTH)	21	16 DOUBLE
31 & 32	2+95	LEFT (NORTH)	21	16 DOUBLE
29 & 30	3+43	LEFT (NORTH)	21	16 DOUBLE
27 & 28	3+93	LEFT (NORTH)	21	16 DOUBLE
38 & 39	1+74	RIGHT (SOUTH)	33	38 DOUBLE
40 & 41	2+18	RIGHT (SOUTH)	39	44 DOUBLE
42 & 43	2+65	RIGHT (SOUTH)	21	26 DOUBLE
44 & 45	3+09	RIGHT (SOUTH)	21	26 DOUBLE
46 & 47	3+64	RIGHT (SOUTH)	21	26 DOUBLE
TOTAL				262

WESTERN BREEZE SUBDIVISION, BRAY COURT
WATER SERVICES

LOT #	STATION	OFFSET TO SERVICE BOX DIRECTION	LENGTH OF SERVICE (FEET)	TYPE OF BOX
56	1+66	LEFT (NORTH)	25	20 SINGLE
54 & 55	1+87	LEFT (NORTH)	49	44 DOUBLE
52 & 53	2+48	LEFT (NORTH)	32	27 DOUBLE
50 & 51	2+95	LEFT (NORTH)	21	16 DOUBLE
48 & 49	3+43	LEFT (NORTH)	21	16 DOUBLE
57 & 58	1+93	RIGHT (SOUTH)	37	42 DOUBLE
59 & 60	2+51	RIGHT (SOUTH)	21	26 DOUBLE
61 & 62	3+02	RIGHT (SOUTH)	21	26 DOUBLE
TOTAL				217

MARVIN R. KORTUM, P.E.
Civil Engineering
NM PE 6519

1605 Speakman Drive, S.E.
Albuquerque, New Mexico 87123
(505) 299-0774

CITY OF ALBUQUERQUE
PUBLIC WORKS DEPARTMENT
ENGINEERING DEVELOPMENT GROUP

TITLE: WESTERN BREEZE SUBDIVISION, PHASE II
WESTERN BREEZE COURT, BRAY COURT NW
DETAILS

DESIGNED BY	DRAWN BY	CHECKED BY	DATE
MARVIN R. KORTUM	MARVIN R. KORTUM	MARVIN R. KORTUM	FEB 3, 1998

REVISIONS	NO.	DATE


APPROVED	APPROVED
FEB 24 1998	NOV 12 1999
CITY ENGINEER	CITY ENGINEER

City Project No. 601581
Zone Map No. H-11
Sheet 9 Of 11


CONSTRUCTION TRAFFIC CONTROL GENERAL NOTES

- CONTRACTOR MUST OBTAIN FROM CONSTRUCTION COORDINATION AN EXCAVATION/BARRICADING PERMIT BEFORE ENGAGING IN ANY CONSTRUCTION, MAINTENANCE OR REPAIR WORK IN ANY OF THE CITY OF ALBUQUERQUE'S RIGHTS-OF-WAY. EMERGENCY WORK THAT WOULD PRESERVE LIFE OR PROPERTY IS EXCLUDED WITH THE UNDERSTANDING, THAT A PERMIT SHALL BE OBTAINED WITHIN 24 TO 48 HOURS.
- CONTRACTOR SHALL AT THE TIME OF PERMIT REQUEST, SUBMIT FOR APPROVAL BY CONSTRUCTION COORDINATION, A TRAFFIC CONTROL PLAN DETAILING ALL EXISTING TOPOGRAPHY SUCH AS LANE WIDTHS, DRIVEWAYS, AND BUSINESS/RESIDENTIAL ACCESSES. THE TRAFFIC CONTROL PLAN SHALL INCLUDE ALL PHASES OF WORK AND SCHEDULES INVOLVED IN THE CONSTRUCTION PROJECT. ANY SEPARATE PHASES OF A CONSTRUCTION PROJECT SHALL BE GIVEN AN INDIVIDUAL PERMIT EACH. BLANKET PERMITS WILL NOT BE ISSUED.
- THESE TYPICAL TRAFFIC CONTROL PLANS DO NOT REFLECT THE EXISTING TOPOGRAPHY SUCH AS DRIVEWAYS, LANE WIDTHS, AND BUSINESS/RESIDENTIAL ACCESSES. EVERY LOCATION THAT REQUIRES CONSTRUCTION TRAFFIC CONTROL SHALL HAVE A DETAILED TRAFFIC CONTROL PLAN SHOWING ALL EXISTING TOPOGRAPHY.
- CONSTRUCTION SHALL NOT BEGIN UNLESS A TRAFFIC CONTROL PLAN HAS BEEN APPROVED AND VERIFIED BY CONSTRUCTION COORDINATION.
- CONSTRUCTION COORDINATION SHALL BE NOTIFIED 48 HOURS PRIOR TO ANY TRAFFIC CONTROL CHANGES NEEDED BY CONTRACTOR, THAT WERE NOT PREVIOUSLY APPROVED. THESE TRAFFIC CONTROL CHANGES SHALL BE REQUESTED IN WRITING ACCOMPANIED WITH A TRAFFIC CONTROL PLAN REFLECTING SUCH CHANGES.
- ALL CONSTRUCTION TRAFFIC CONTROL DEVICES SHALL COMPLY TO THE MANUAL ON UNIFORM TRAFFIC CONTROL DEVICES (MUTCD), LATEST EDITION. IT IS THE RESPONSIBILITY OF THE CONTRACTOR TO INSTALL, SERVICE AND MAINTAIN ALL TRAFFIC CONTROL DEVICES. TRAFFIC CONTROL DEVICES SHALL NOT BE REMOVED OR ALTERED IN ANY WAY WITHOUT THE APPROVAL OF CONSTRUCTION COORDINATION, PER SECTION 6A-4 OF THE MUTCD, LATEST EDITION.
- THE CONSTRUCTION TRAFFIC CONTROL INITIAL SET-UP SHALL BE BY AN AMERICAN TRAFFIC SAFETY SERVICES ASSOCIATION (ATSSA) CERTIFIED WORKSITE TRAFFIC SUPERVISOR. THE MAINTENANCE AND SERVICING SHALL ALSO BE DONE BY AN ATSSA CERTIFIED WORKSITE TRAFFIC SUPERVISOR OR EQUIVALENT.
- CONTRACTOR IS RESPONSIBLE TO MAINTAIN AND SERVICE ALL TRAFFIC CONTROL DEVICES 24 HOURS A DAY, 7 DAYS A WEEK THROUGHOUT LENGTH OF PROJECT. CONTRACTOR IS RESPONSIBLE THAT ALL TRAFFIC CONTROL DEVICES COMPLY WITH THE MUTCD, LATEST EDITION.
- ALL ADVANCE WARNING SIGNS SHALL BE DOUBLE INDICATED WHENEVER THERE ARE MULTI-LANE TRAFFIC IN ANY ONE GIVEN DIRECTION AND THERE IS SUFFICIENT MEDIAN SPACE.
- ALL BARRICADES IN ALL TAPERS AND TANGENTS SHALL BE PLACED APART, A DISTANCE MEASURED IN FEET, EQUAL TO THAT OF THE POSTED SPEED LIMIT. NO EXCEPTIONS UNLESS APPROVED BY CONSTRUCTION COORDINATION PER MUTCD SECTION 6A-4.
- ALL WORK IN ARTERIAL ROADWAYS SHALL BE ON A CONTINUOUS 24 HOUR PER DAY BASIS UNTIL COMPLETED.
- CONTRACTOR IS RESPONSIBLE TO PROVIDE CONSTRUCTION COORDINATION, A WEEKLY LOG OF DAILY INSPECTIONS OF BARRICADE AND MAINTENANCE SCHEDULES ON PROJECTS THAT ARE OVER ONE WEEK DURATION.
- EQUIPMENT OR MATERIALS SHALL NOT BE STORED WITHIN 15 FEET OF A TRAVELLED TRAFFIC LANE DURING NON-WORKING HOURS WITHOUT THE APPROVAL OF CONSTRUCTION COORDINATION.
- CONTRACTOR SHALL PROVIDE AND MAINTAIN A SAFE AND ADEQUATE MEANS OF CHANNELIZING PEDESTRIAN TRAFFIC AROUND AND THROUGH THE CONSTRUCTION AREA.
- CONTRACTOR IS RESPONSIBLE FOR OBLITERATION OF ANY CONFLICTING STRIPING AND RESPONSIBLE FOR ALL TEMPORARY STRIPING.
- CONTRACTOR SHALL MAINTAIN ACCESS TO ALL FACILITIES, BUSINESSES AND/OR RESIDENTS AT ALL TIMES.
- CONTRACTOR SHALL PROVIDE ACCESS SIGNS FOR BUSINESSES LOCATED WITHIN THE CONSTRUCTION AREA UNDER THE SUPERVISION OF CONSTRUCTION COORDINATION. EACH ACCESS SIGN SHALL HAVE 5 INCH, WHITE OPAQUE LETTERING ON BLUE REFLECTORIZED BACKGROUND. ACCESS SIGNS SHALL BE CONSIDERED INCIDENTAL TO THE BID AND NOT PART OF THE CONTRACT UNLESS OTHERWISE STATED. NO MORE THAN 3 BUSINESSES SHALL BE LISTED ON A ACCESS SIGN. SHOPPING CENTERS AND MALLS SHALL BE LISTED AS SUCH.
- ALL ADVANCE WARNING SIGNS SHALL MEET THE MINIMUM REFLECTIVE INTENSITY REQUIREMENTS SET FORTH BY THE CITY OF ALBUQUERQUE. CONSTRUCTION COORDINATION SHALL DETERMINE ALL REQUIREMENTS AND APPROVE OR DISAPPROVE ANY ADVANCE WARNING SIGN PER SECTION 6A-4 OF THE MUTCD, LATEST EDITION.
- 48 HOURS PRIOR TO OCCUPYING OR CLOSING OF A RIGHT-OF-WAY, CONTRACTOR SHALL NOTIFY: POLICE, FIRE DEPARTMENT, SCHOOLS, HOSPITALS, TRANSIT AUTHORITY, BUSINESSES AND/OR RESIDENTS THAT WILL BE AFFECTED BY THE CONSTRUCTION.
- ANY FIELD ADJUSTMENTS SHALL BE APPROVED BY CONSTRUCTION COORDINATION.


- EXCAVATIONS SHALL BE PLATED, TEMPORARILY PATCHED OR RESURFACED PRIOR TO OPENING OF TRAFFIC. A MINIMUM OF 11 FEET SHALL BE PROVIDED FOR TRAFFIC IN ANY GIVEN DIRECTION. CONTRACTOR IS RESPONSIBLE FOR ANY WORK INVOLVED IN SATISFYING THESE REQUIREMENTS.
- CONTRACTOR SHALL AT ALL TIMES COMPLY WITH THE FOLLOWING:
 - STANDARDS AND REQUIREMENTS SET FORTH IN THE MANUAL ON UNIFORM TRAFFIC CONTROL DEVICES, LATEST EDITION.
 - THE CITY OF ALBUQUERQUE TRAFFIC CODE, LATEST EDITION.
 - SECTION 19 OF THE CITY OF ALBUQUERQUE'S STANDARD SPECIFICATIONS FOR PUBLIC WORK CONSTRUCTION, AS WELL AS OTHER SECTIONS.
- FAILURE TO COMPLY WITH ANY OF THE ABOVE MENTIONED, WILL BE ADEQUATE CAUSE TO CEASE ALL WORK ON ANY CONSTRUCTION PROJECT. WORK WILL NOT RESUME UNTIL ALL REQUIREMENTS ARE ADDRESSED AND APPROVED BY CONSTRUCTION COORDINATION.
- ALL TRAFFIC CONTROL DEVICES SHALL BE KEPT IN NEW-CLEAN CONDITION. WASHING OF EQUIPMENT IS INCIDENTAL TO ITS PLACEMENT AND MAINTENANCE.
- TRAFFIC CONTROL STANDARDS APPLY ONLY WHERE THE CONSTRUCTION TRAFFIC CONTROL PLANS ARE NOT SPECIFIC.
- ADVANCE WARNING SIGNS SHALL BE 36"x36" MIN. WITH SUPER ENGINEERING GRADE SHEETING OR BETTER. MOUNTING HEIGHT AT TOP OF SIGN SHALL BE THE SAME AS FOR A 48" SIGN AS INDICATED IN THE M.U.T.C.D.
- CONTRACTOR SHALL MAINTAIN A GRAFFITI-FREE WORKSITE. ALL GRAFFITI SHALL BE PROMPTLY REMOVED FROM ALL EQUIPMENT, BOTH PERMANENT AND TEMPORARY.

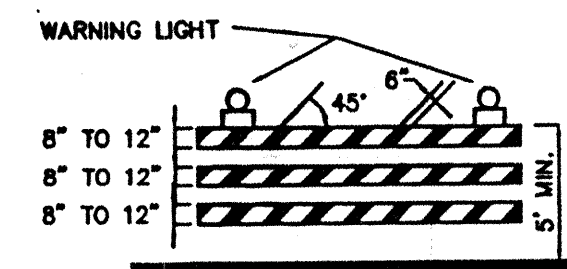


TYPE II BARRICADE

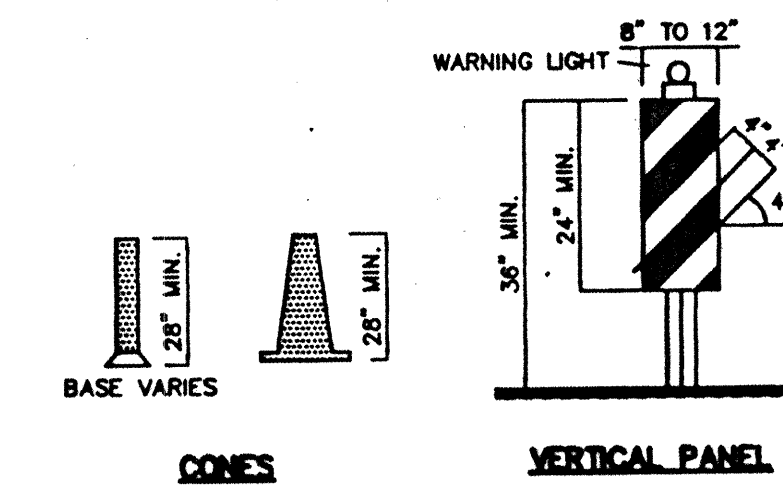


VERTICAL PANEL

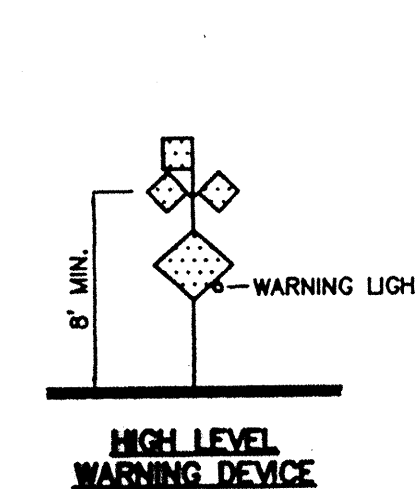


HIGH LEVEL WARNING DEVICE

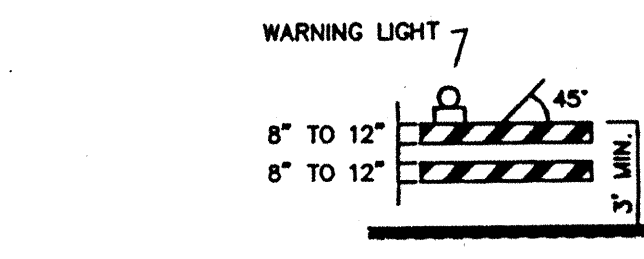


TYPE II BARRICADE

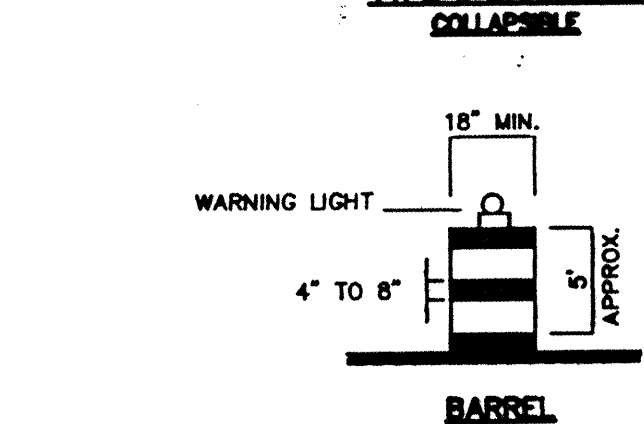

BARREL

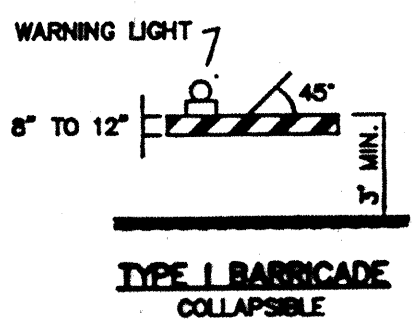

TYPE I BARRICADE

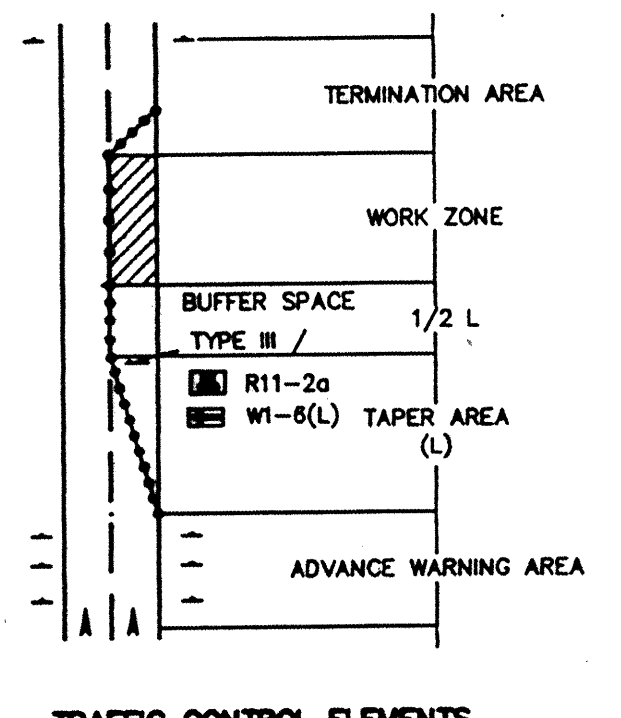

TRAFFIC CONTROL ELEMENTS

LEGEND

- WORK AREA
- BARRICADE - TYPE I, TYPE II, OR BARREL
- BARRICADE - TYPE III
- VERTICAL PANEL
- WARNING SIGN
- DISTANCE BETWEEN SIGNS - A DISTANCE MEASURED IN FEET EQUAL TO A VALUE OF TEN TIMES THE SPEED LIMIT OF THE STREET
- FLAGMAN POSITION
- SPACING BETWEEN BARRICADES- A DISTANCE MEASURED IN FEET EQUAL TO THE SPEED LIMIT OF THE STREET
- TAPER LENGTH - SEE CHART BELOW
- THE TANGENT LENGTH IS EQUAL TO THE TAPER LENGTH FOR A GIVEN STREET.

TAPER REQUIREMENTS

SPEED LIMIT (MPH)	TAPER LENGTH (L) (FEET)			MINIMUM NUMBER OF DEVICES FOR TAPER	MAXIMUM DEVICE SPACING IN FEET	
	10' LANE	11' LANE	12' LANE		ALONG TAPER	AFTER TAPER
20	70	75	80	5	20	20
25	105	115	125	6	25	25
30	150	165	180	7	30	30
35	205	225	245	8	35	35
40	270	295	320	9	40	40
45	450	495	540	13	45	45
50	500	550	600	13	50	50
55	550	605	660	13	55	55

RECOMMENDED SIGN SPACING(D) FOR ADVANCE WARNING SIGN SERIES

SPEED LIMIT (MPH)	MINIMUM DISTANCE BETWEEN SIGNS	DISTANCE FROM LAST SIGN TO TAPER
0-20	10 X SPEED LIMIT	10 X SPEED LIMIT
25-30	10 X SPEED LIMIT	10 X SPEED LIMIT
30-35	10 X SPEED LIMIT	10 X SPEED LIMIT
40-45	10 X SPEED LIMIT	10 X SPEED LIMIT
50-60	10 X SPEED LIMIT	10 X SPEED LIMIT

TAPER CRITERIA


TYPE OF TAPER	TAPER LENGTH
UPSTREAM TAPER:	
MERGING TAPER	L MINIMUM
SHIFTING TAPER	1/2 L MINIMUM
SHOULDER TAPER	1/2 L MINIMUM
TWO-WAY TRAFFIC TAPER	100 FEET MAXIMUM
DOWNSTREAM TAPERS	100 FEET PER LANE

TAPER LENGTH COMPUTATION

SPEED LIMIT	L = WS ² / 60
40 MPH OR LESS	L = WS ² / 60
45 MPH OR GREATER	L = W X S


L = TAPER LENGTH
W = WIDTH OF OFFSET IN FEET
S = POSTED SPEED OR OFF-PEAK 85-PERCENTILE SPEED IN MPH

SIGN FACE DETAILS

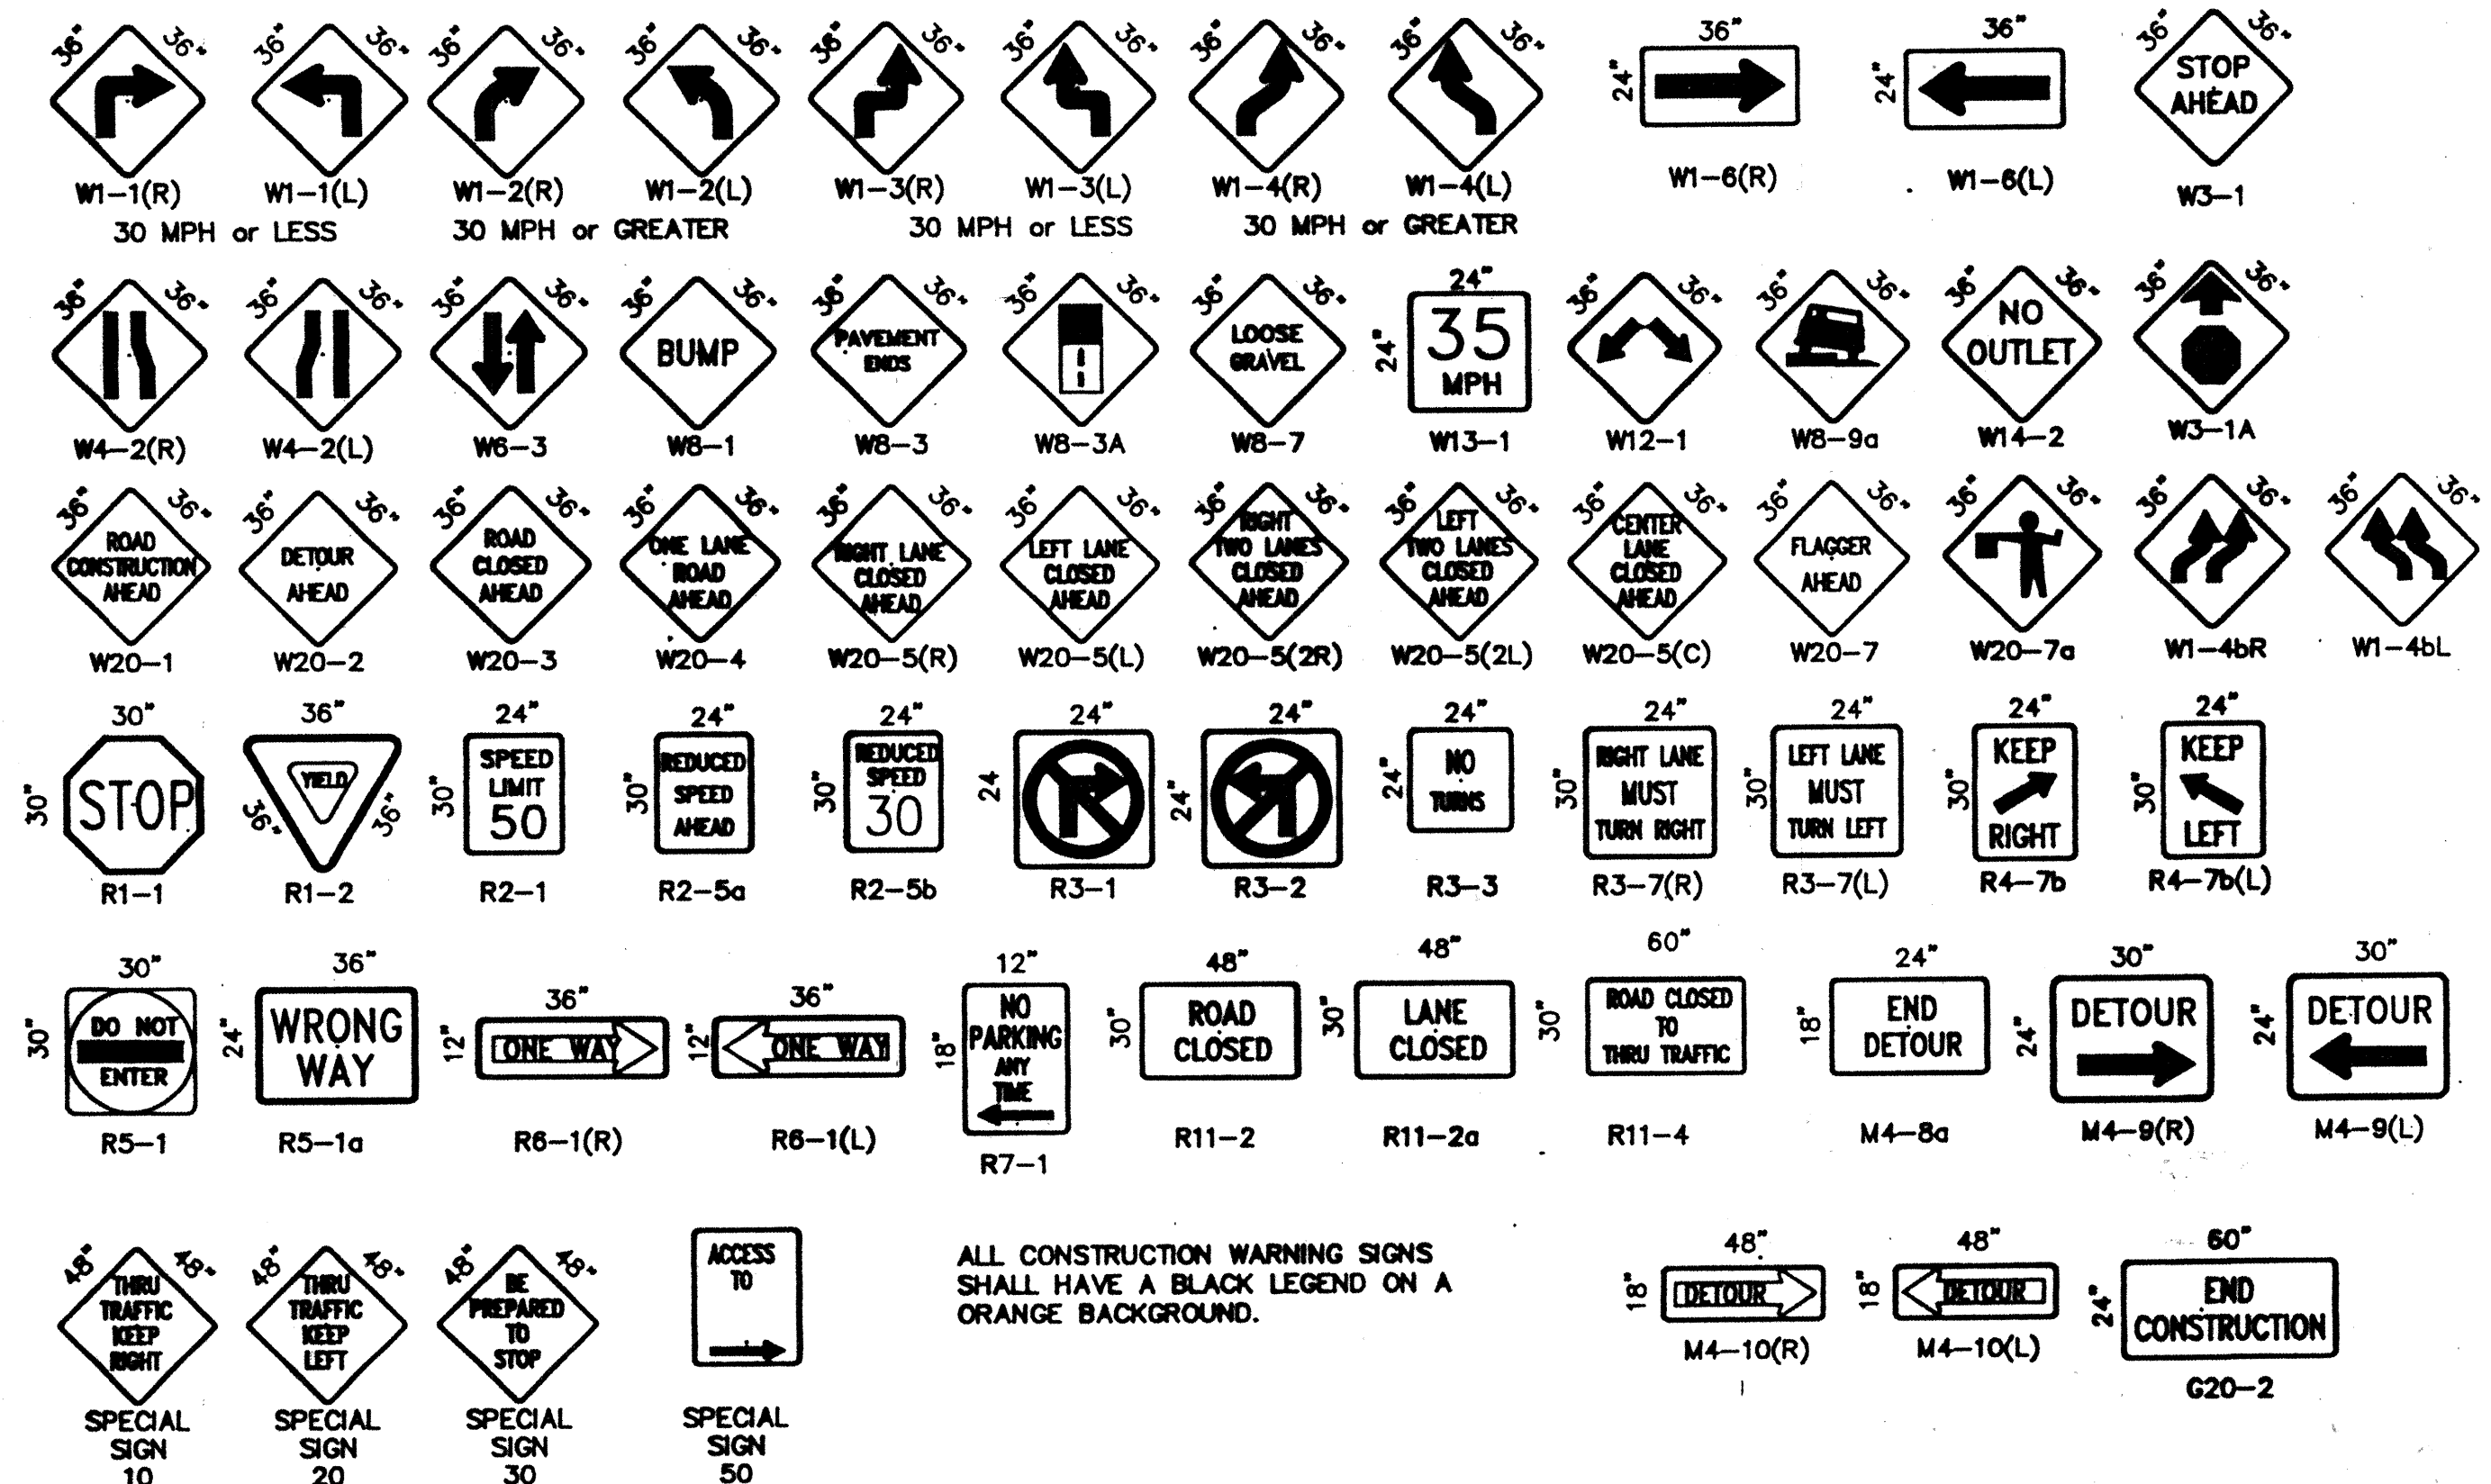

ALL CONSTRUCTION WARNING SIGNS SHALL HAVE A BLACK LEGEND ON A ORANGE BACKGROUND.

AS BUILT INFORMATION		BENCH MARKS		SURVEY INFORMATION		ENGINEER'S SEAL	
CONTRACTOR	DATE	CONTRACTOR	DATE	NO.	BY	DATE	DATE
DESIGNED BY	DATE	DESIGNED BY	DATE	NO.	BY	DATE	DATE
FIELD ACCEPTANCE BY	DATE	FIELD ACCEPTANCE BY	DATE	NO.	BY	DATE	DATE
RECORDED BY	DATE	RECORDED BY	DATE	NO.	BY	DATE	DATE
MICRO-FILM INFORMATION		MICRO-FILM INFORMATION		MICRO-FILM INFORMATION		MICRO-FILM INFORMATION	
NO.	DATE	NO.	DATE	NO.	DATE	NO.	DATE


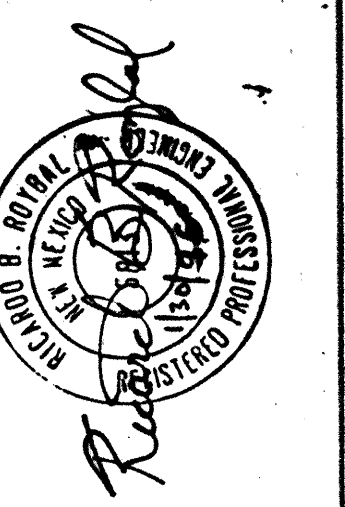


CITY OF ALBUQUERQUE PUBLIC WORKS DEPARTMENT ENGINEERING DEVELOPMENT GROUP	
TITLE: SIGNING AND CONSTRUCTION TRAFFIC CONTROL STANDARDS	
DESIGN REVIEW COMMITTEE	CITY ENGINEER APPROVAL
LAST UPDATE	NO. DAY/YR.
PROJECT NO. 601581	
MAP NO. H-11	SHEET 10 OF 11



ALL CONSTRUCTION WARNING SIGNS SHALL HAVE A BLACK LEGEND ON A ORANGE BACKGROUND.

ALL ADVANCE WARNING SIGNS SHALL BE A MINIMUM OF 36" THIRTY SIX INCHES BY 36" THIRTY SIX INCHES IN SIZE AND SHALL HAVE ONE WARNING LIGHT.

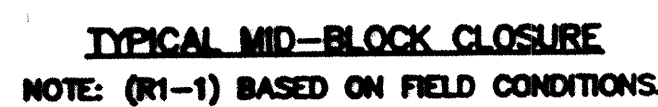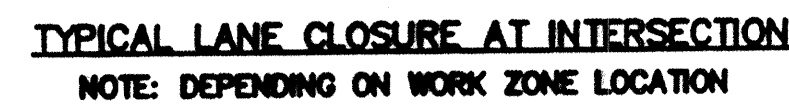

CITY OF ALBUQUERQUE PUBLIC WORKS DEPARTMENT ENGINEERING DEVELOPMENT GROUP			
TITLE: TYPICAL TRAFFIC CONTROL & SIGNING EXAMPLES (REF. M.U.T.C.D.)			
DESIGN REVIEW COMMITTEE	CITY ENGINEER APPROVAL	DATE 11/1/01	MO./DAY/YR.
COA Standard			
PROJECT NO. 601581	MAP NO. H-11	SHEET 11	OF 11