

CONSTRUCTION PLANS
FOR
TUSCANY RIDGE UNIT 2
ALBUQUERQUE, NEW MEXICO

INDEX

SHEET NUMBER	DESCRIPTION
1	COVER SHEET
2	PLAT
3	OVERALL GRADING PLAN
4	OVERALL PAVING PLAN
	PAVING PLAN AND PROFILE SHEETS
5	McMAHON BLVD. STA. 31+50 TO 38+50
6	TUSCANY DRIVE STA. 8+75 TO 11+16.97
7	TERRA FORTE ROAD, MONTE De NEVE DRIVE & STUB ST.
8	ALBERO ROSSO DRIVE
9	SOLE GRANDE ROAD
10	OVERALL UTILITY PLAN
	UTILITY AND SD PLAN AND PROFILE SHEETS
11	TUSCANY DRIVE STA. 8+75 TO 12+00 (UTILITY & SD)
12	TERRA FORTE ROAD, MONTE De NEVE DRIVE & STUB ST. (UTILITY ONLY)
13	ALBERO ROSSO DRIVE (UTILITY ONLY)
14	SOLE GRANDE ROAD (UTILITY & SD)
15	DETAIL SHEET
15A & 15B	GENERAL TRAFFIC CONTROL


APPROVAL OF AS BUILT DRAWINGS
CHIEF CONSTRUCTION ENGINEER
Peter Chang
DATE 12-9-99
COA INSP. RAY BACA



"RECORD DRAWINGS"
I CERTIFY THAT THE INFORMATION CONTAINED ON THESE DRAWINGS HAS BEEN REVISED IN ACCORDANCE WITH THE INFORMATION FURNISHED BY THE CONTRACTOR CCM CONSTRUCTION/BOHANNON-HUSTON, INC. PROVIDED THE CONSTRUCTION STAKING FOR THE PROJECT AND THIS SURVEY INFORMATION REFLECTS THE CONSTRUCTION AS ACTUALLY ACCOMPLISHED WHILE A CONSTRUCTION OBSERVER FROM SMITH ENGINEERING WAS PRESENT. THESE PLAN DRAWINGS, AS CONSTRUCTED, ARE IN SUBSTANTIAL COMPLIANCE WITH THE APPROVED PLAN DRAWINGS.
[Signature] 11/01/99
PATRICK J. CONLEY, PE 10141 DATE


RECORD DRAWING
DATE: 8-6-99


Bohannon & Huston
Courtyard One 7500 JEFFERSON NE ALBUQUERQUE NEW MEXICO 87109
ENGINEERS PLANNERS PHOTOGRAMMETRISTS SURVEYORS SOFTWARE DEVELOPERS

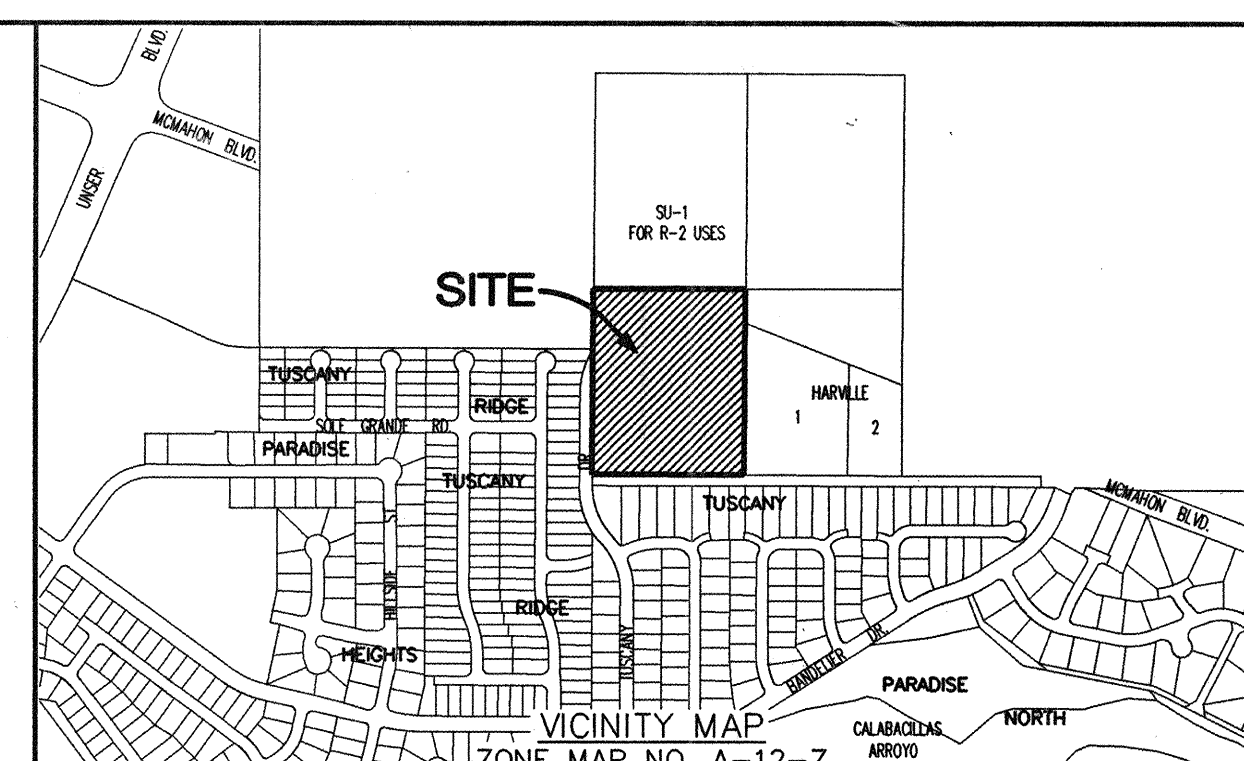

- NOTICE TO CONTRACTORS
- ALL WORK DETAILED ON THESE PLANS TO BE PERFORMED UNDER CONTRACT SHALL, EXCEPT AS OTHERWISE STATED OR PROVIDED FOR HEREON, BE CONSTRUCTED IN ACCORDANCE WITH THE CITY OF ALBUQUERQUE STANDARD SPECIFICATIONS FOR PUBLIC WORKS CONSTRUCTION, 1986 EDITION AND SHALL INCLUDE UPDATE No.6
 - TWO WORKING DAYS PRIOR TO ANY EXCAVATION, THE CONTRACTOR MUST CONTACT NEW MEXICO ONE CALL SYSTEM (260-1990) FOR LOCATION OF EXISTING UTILITIES.
 - PRIOR TO CONSTRUCTION, THE CONTRACTOR SHALL EXCAVATE AND VERIFY THE HORIZONTAL AND VERTICAL LOCATIONS OF ALL OBSTRUCTIONS. SHOULD A CONFLICT EXIST, THE CONTRACTOR SHALL NOTIFY THE ENGINEER OR SURVEYOR IMMEDIATELY SO THAT THE CONFLICT CAN BE RESOLVED WITH A MINIMUM AMOUNT OF DELAY.
 - FIVE (5) WORKING DAYS PRIOR TO BEGINNING CONSTRUCTION, THE CONTRACTOR SHALL SUBMIT TO CONSTRUCTION COORDINATION DIVISION A DETAILED CONSTRUCTION SCHEDULE. TWO (2) WORKING DAYS PRIOR TO CONSTRUCTION, THE CONTRACTOR SHALL OBTAIN A BARRICADING PERMIT FROM THE CONST. COORDINATION DIVISION. CONTRACTOR SHALL NOTIFY BARRICADE ENGINEER (768-2551) PRIOR TO OCCUPYING AN INTERSECTION. REFER TO SECTION 19 OF THE GENERAL CONDITIONS OF THE STANDARD SPECIFICATIONS.
 - ALL STREET STRIPING ALTERED OR DESTROYED SHALL BE REPLACED W/ PLASTIC REFLECTORIZED PAVEMENT MARKING BY CONTRACTOR TO LOCATION AS EXISTING OR AS INDICATED BY THIS PLAN SET.
 - CONTRACTOR SHALL NOTIFY THE ENGINEER NOT LESS THAN SEVEN (7) DAYS PRIOR TO STARTING WORK IN ORDER THAT THE CITY SURVEYOR MAY TAKE NECESSARY MEASURES TO INSURE THE PRESERVATION OF SURVEY MONUMENTS. CONTRACTOR SHALL NOT DISTURB PERMANENT SURVEY MONUMENTS WITHOUT THE CONSENT OF THE CITY SURVEYOR AND SHALL NOTIFY THE CITY SURVEYOR AND BEAR THE EXPENSE OF REPLACING ANY THAT MAY BE DISTURBED WITHOUT PERMISSION. REPLACEMENT SHALL BE DONE ONLY BY THE CITY SURVEYOR. WHEN A CHANGE IS MADE IN THE FINISHED ELEVATIONS OF THE PAVEMENT OF ANY ROADWAY IN WHICH A PERMANENT SURVEY MONUMENT IS LOCATED, CONTRACTOR SHALL, AT HIS OWN EXPENSE, ADJUST THE MONUMENT COVER TO THE NEW GRADE UNLESS OTHERWISE SPECIFIED. REFER TO SECTION 4.4 OF THE GENERAL CONDITIONS OF THE STANDARD SPECIFICATIONS.
 - ANY WORK WITHIN AN ARTERIAL ROADWAY REQUIRES TWENTY-FOUR HOUR CONSTRUCTION.
 - ALL UTILITY WORK SHALL BE CONSTRUCTED IN ACCORDANCE WITH NEW MEXICO UTILITIES, INC. SPECIFICATIONS FOR WATER AND WASTEWATER FACILITIES (MOST RECENT REVISIONS).
 - THE CONTRACTOR SHALL NOTIFY NEW MEXICO UTILITIES (898-2661) THREE WORKING DAYS PRIOR TO BEGINNING THE CONSTRUCTION OF THE UTILITIES.
 - CONTRACTOR SHALL MAINTAIN A GRAFFITI - FREE WORK SITE. CONTRACTOR SHALL PROMPTLY REMOVE ANY GRAFFITI FROM ALL EQUIPMENT, WHETHER PERMANENT OR TEMPORARY.
- THE FOLLOWING NOTES ALSO APPLY WHEN CHECKED
- ☒ ALL UTILITIES AND UTILITY SERVICE LINES SHALL BE INSTALLED PRIOR TO PAVING.
 - ☒ BACKFILL COMPACTION SHALL BE ACCORDING TO SPECIFIED STREET USE.
 - ☐ TACK COAT REQUIREMENTS SHALL BE DETERMINED BY THE CITY ENGINEER.
 - ☒ SIDEWALKS AND WHEELCHAIR RAMPS WITHIN THE CURB RETURNS SHALL BE CONSTRUCTED WHEREVER A NEW CURB RETURN IS CONSTRUCTED.
 - ☒ IF CURB IS DEPRESSED FOR A DRIVEPAD, THE DRIVEPAD SHALL BE CONSTRUCTED PRIOR TO ACCEPTANCE OF CURB AND GUTTER.
 - ☒ ALL STORM DRAINAGE FACILITIES SHALL BE COMPLETED PRIOR TO FINAL ACCEPTANCE.
 - ☒ THE REQUESTOR OR DEVELOPER SHALL BE RESPONSIBLE FOR REPAIR OR REPLACEMENT OF ALL CURB AND GUTTER OR SIDEWALK DAMAGED AFTER APPROVAL BY THE CITY ENGINEER OF WORK COMPLETED BY THE CONTRACTOR.







																																																																																																																																																																																																																																																																																																																																																																																																																																																																																																																																																																																																																																																																																																																																																																																																																																																																																																																																																																																																																																																																																																																																																																																																																																																																																																																																																																																																																					</
--	--	----

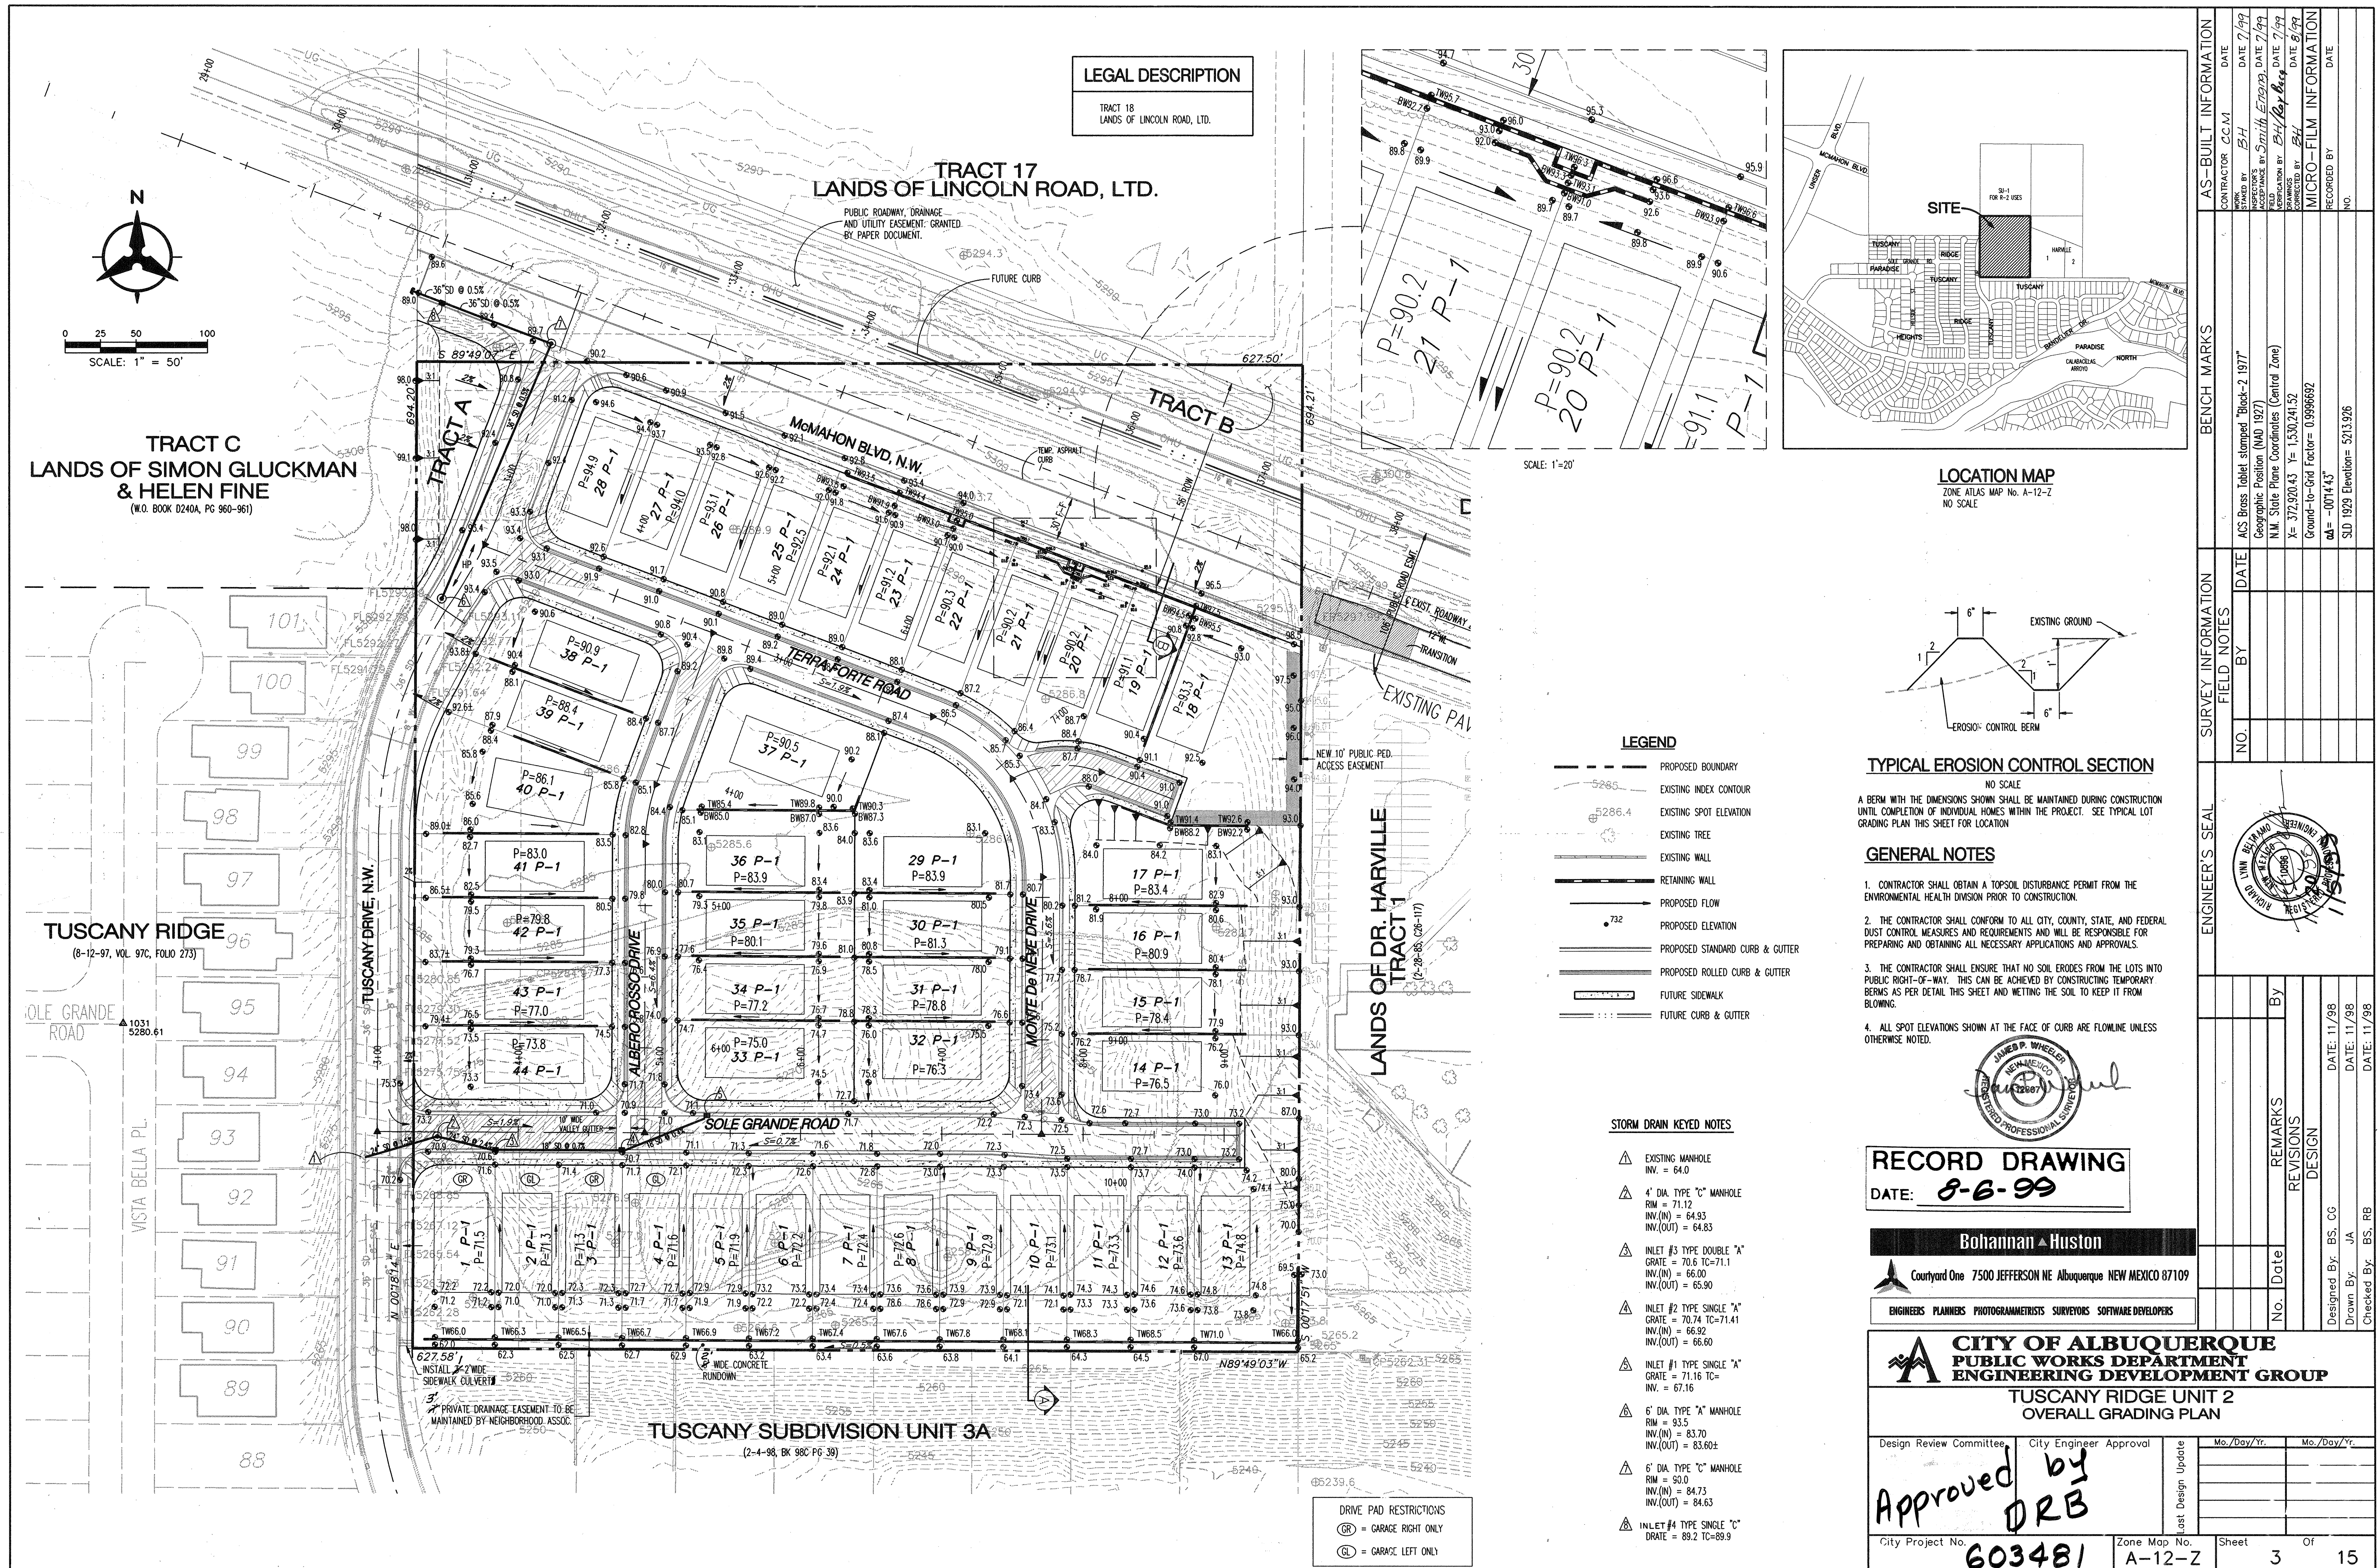

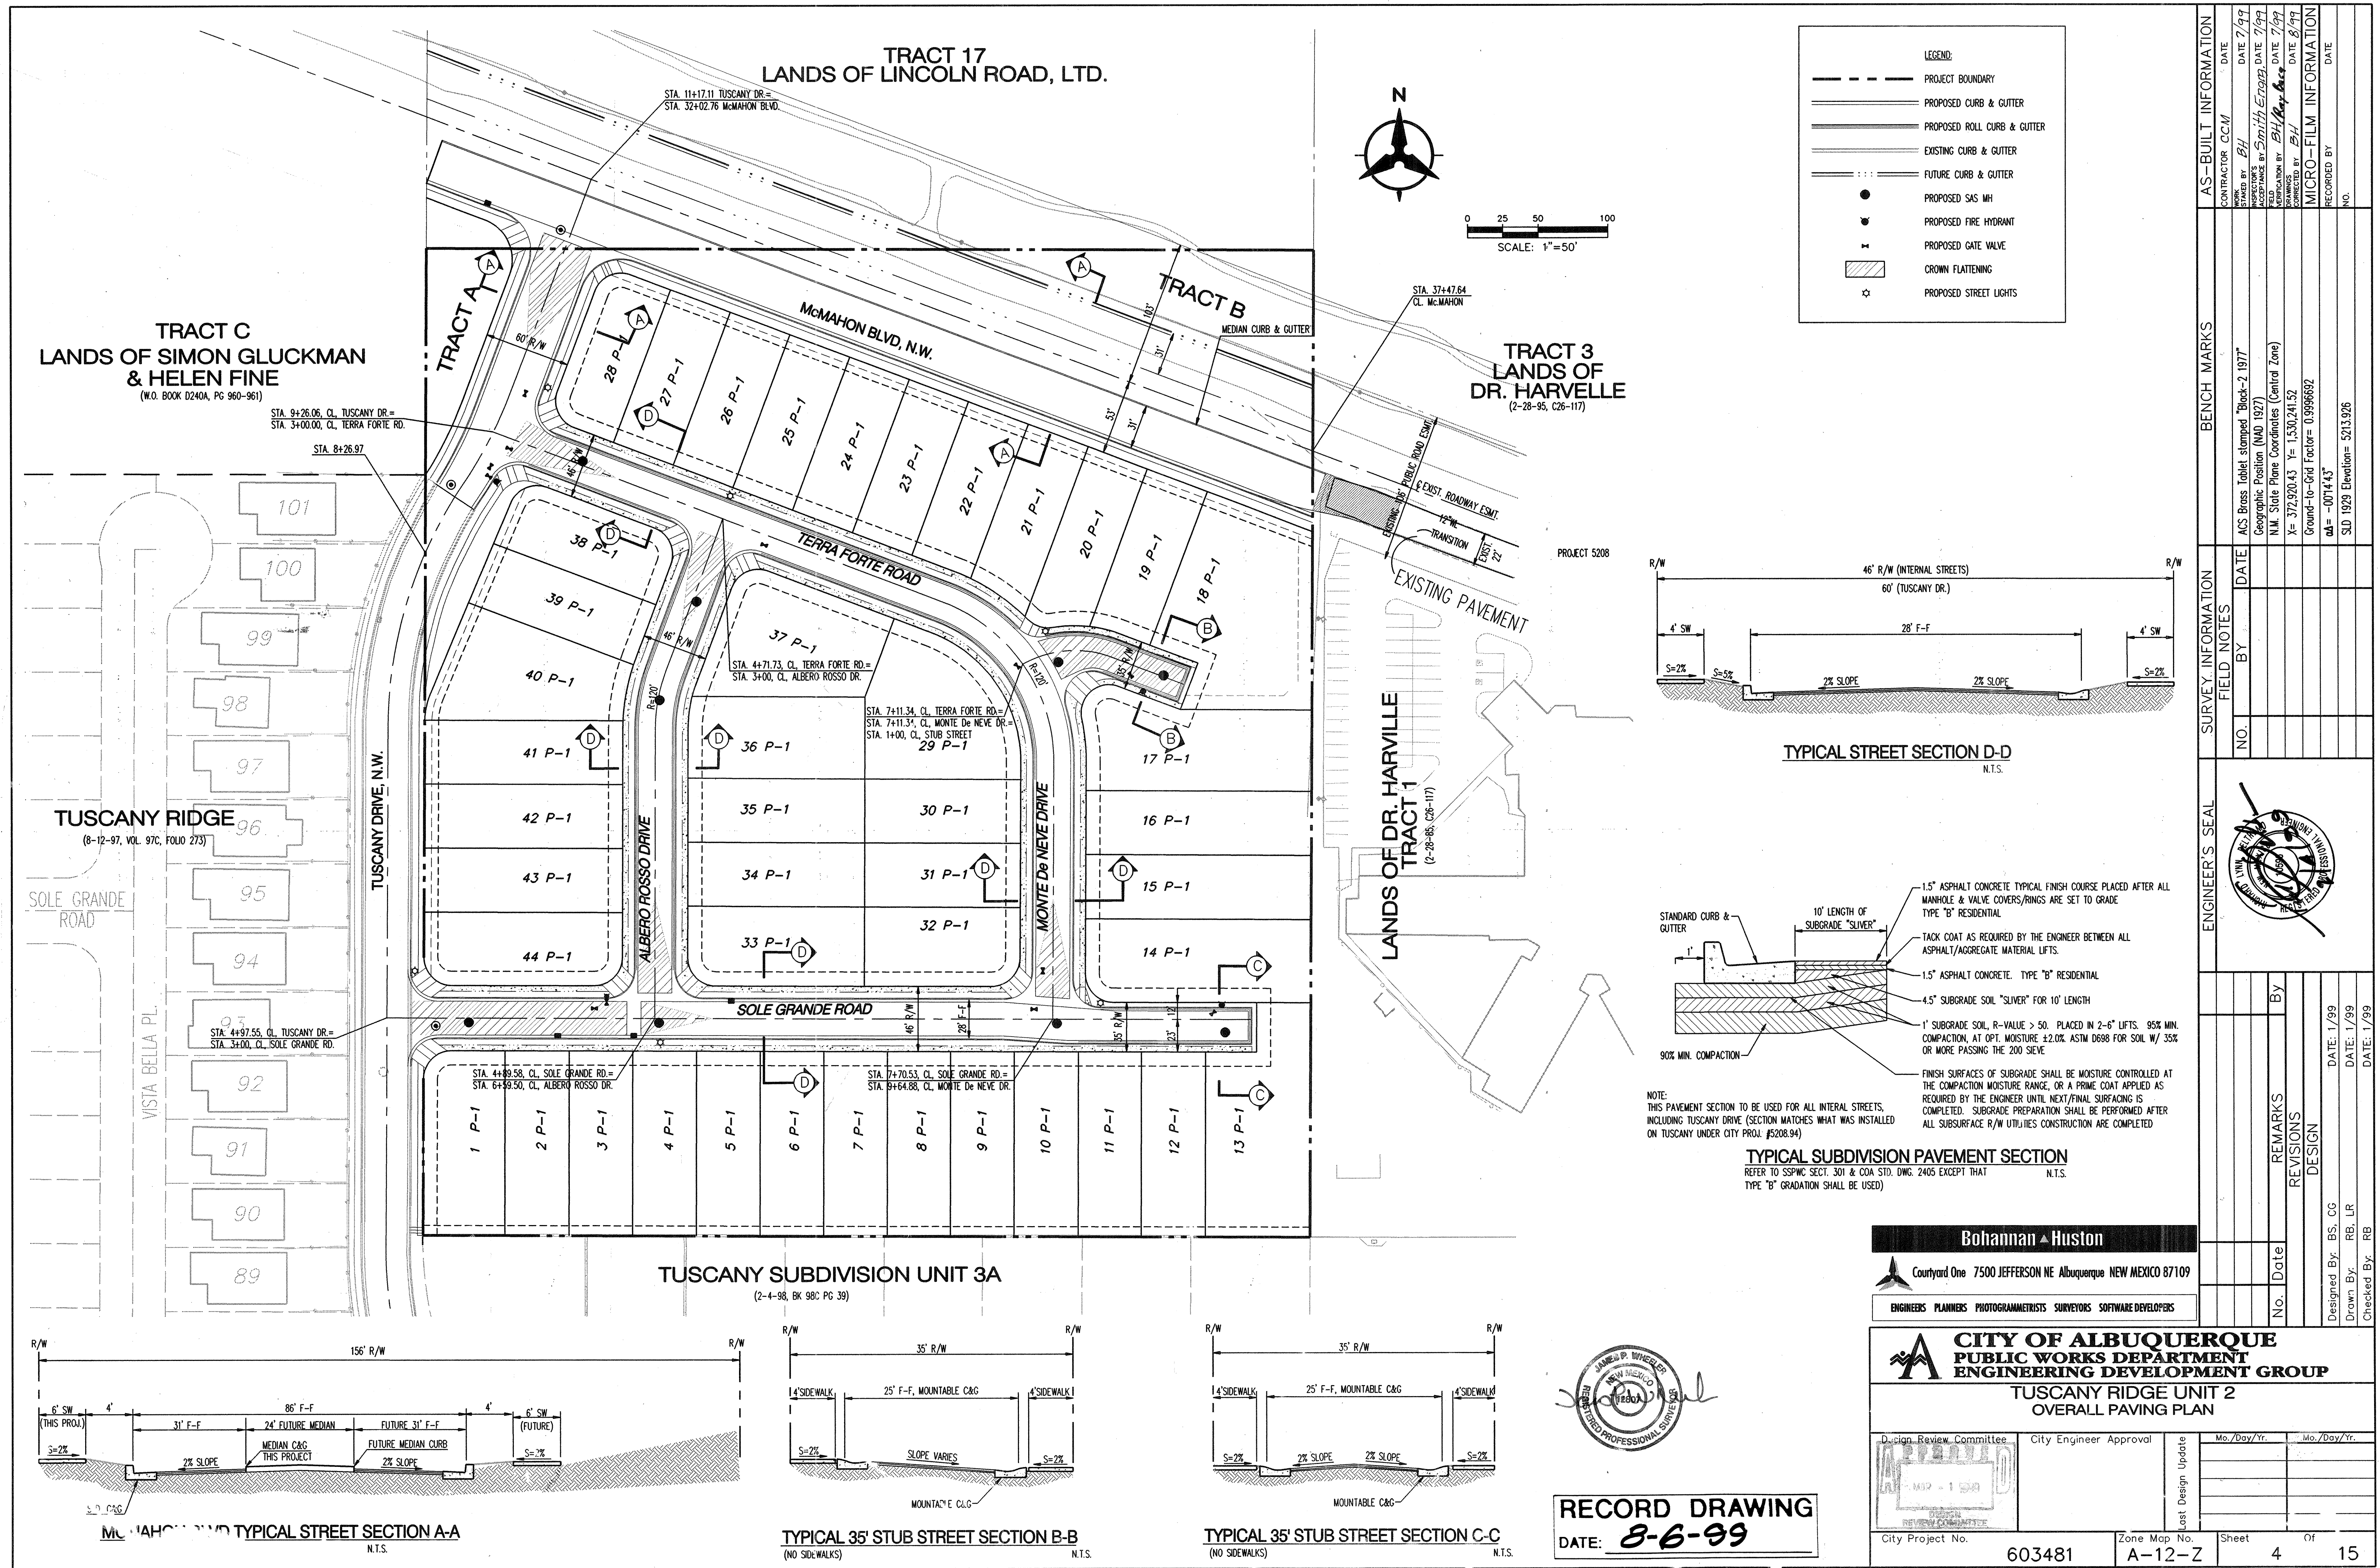

LEGEND:

- PROJECT BOUNDARY
- PROPOSED CURB & GUTTER
- PROPOSED ROLL CURB & GUTTER
- EXISTING CURB & GUTTER
- FUTURE CURB & GUTTER
- PROPOSED SAS MH
- PROPOSED FIRE HYDRANT
- PROPOSED GATE VALVE
- CROWN FLATTENING
- PROPOSED STREET LIGHTS

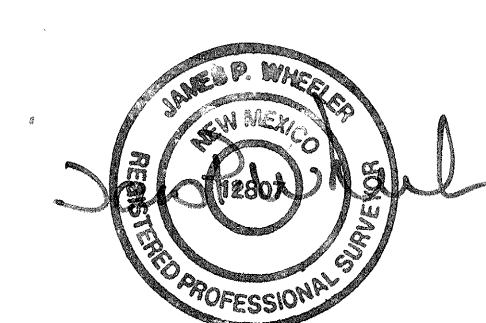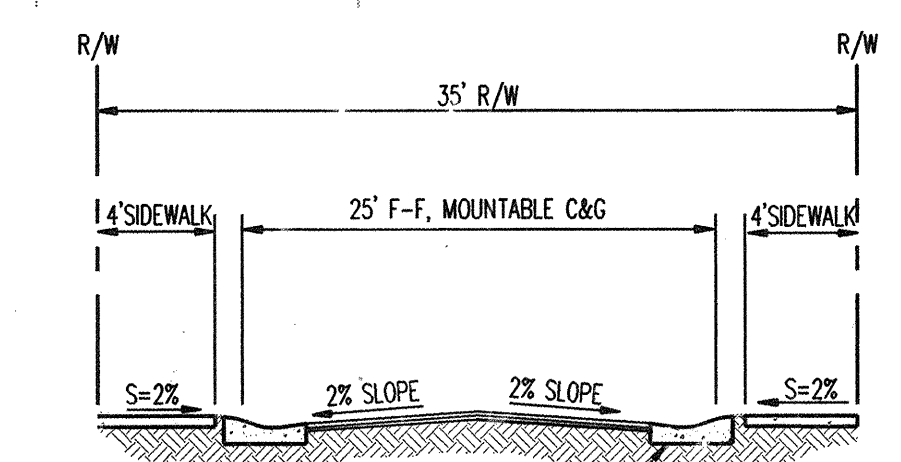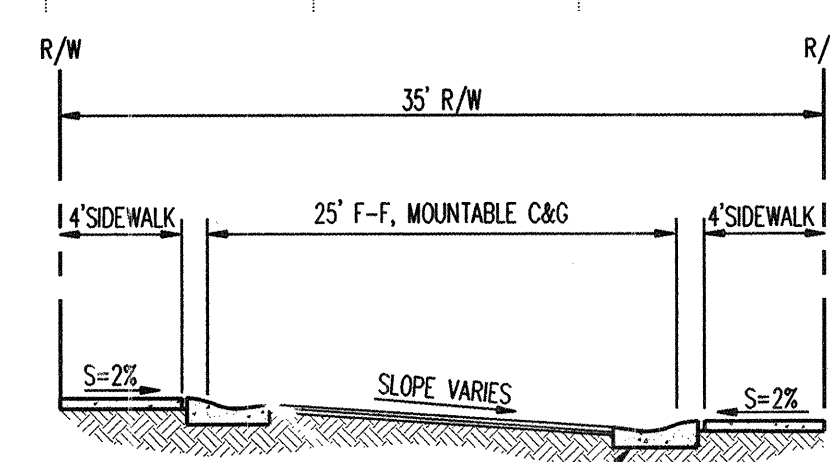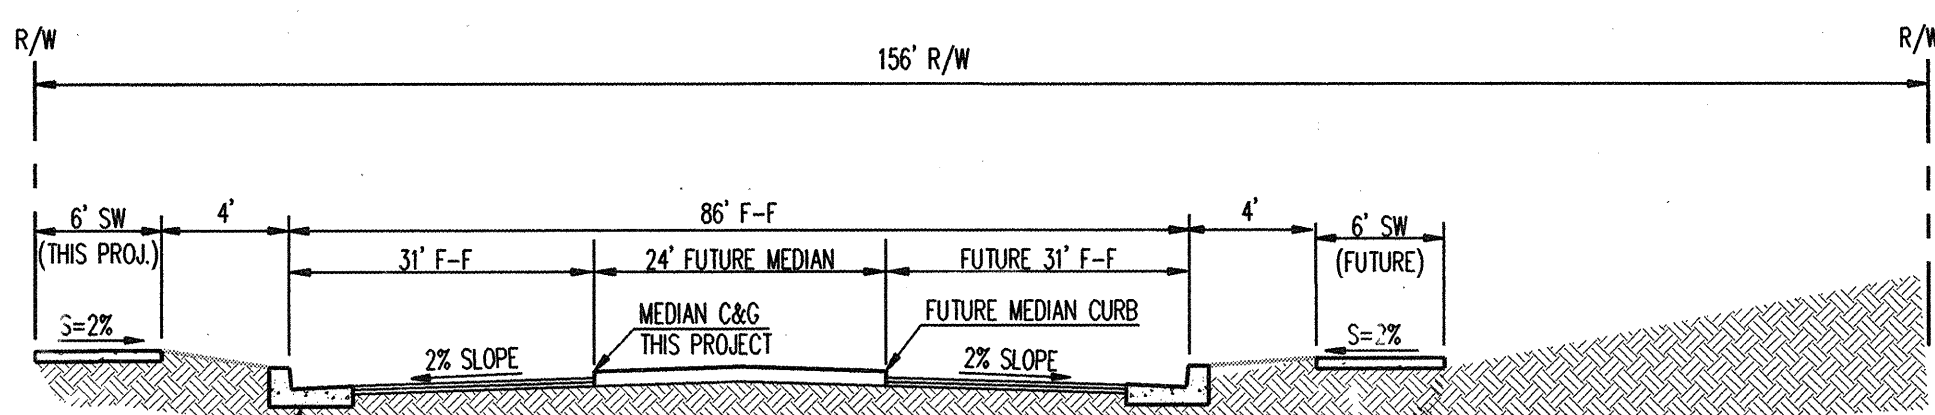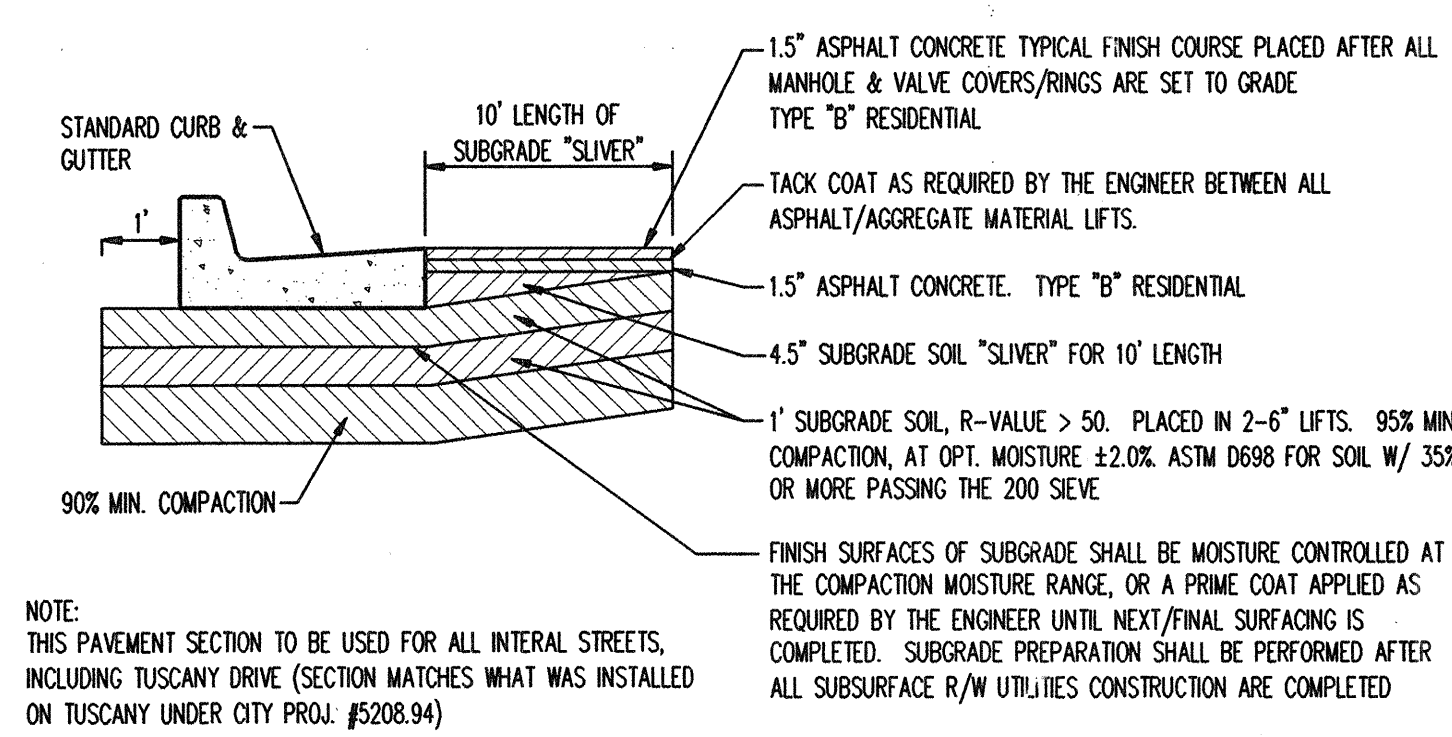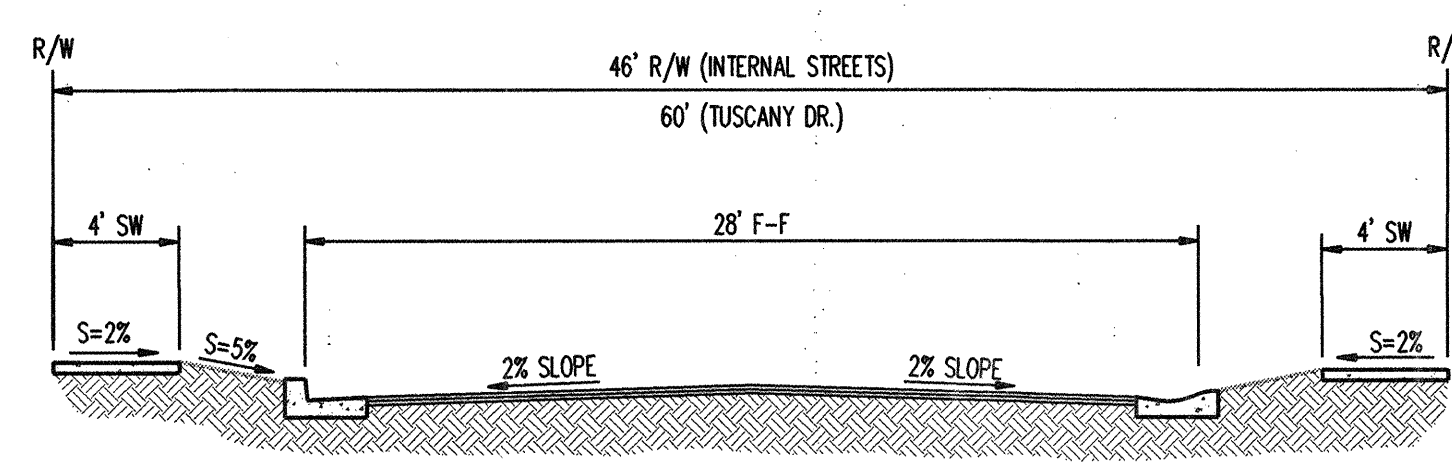

RECORD DRAWING
DATE: **8-6-99**

Bohannon & Huston
Courtyard One 7500 JEFFERSON NE ALBUQUERQUE NEW MEXICO 87109
ENGINEERS PLANNERS PHOTOGRAMMETRISTS SURVEYORS SOFTWARE DEVELOPERS

CITY OF ALBUQUERQUE
PUBLIC WORKS DEPARTMENT
ENGINEERING DEVELOPMENT GROUP



TUSCANY RIDGE UNIT 2
OVERALL PAVING PLAN


Design Review Committee	City Engineer Approval	Mo./Day/Yr.	Mo./Day/Yr.

City Project No. **603481** Zone Map No. **A-12-Z** Sheet **4** Of **15**

Designed By: BS, CG
Drawn By: RB, LR
Checked By: RB

Date: 1/99
Date: 1/99
Date: 1/99

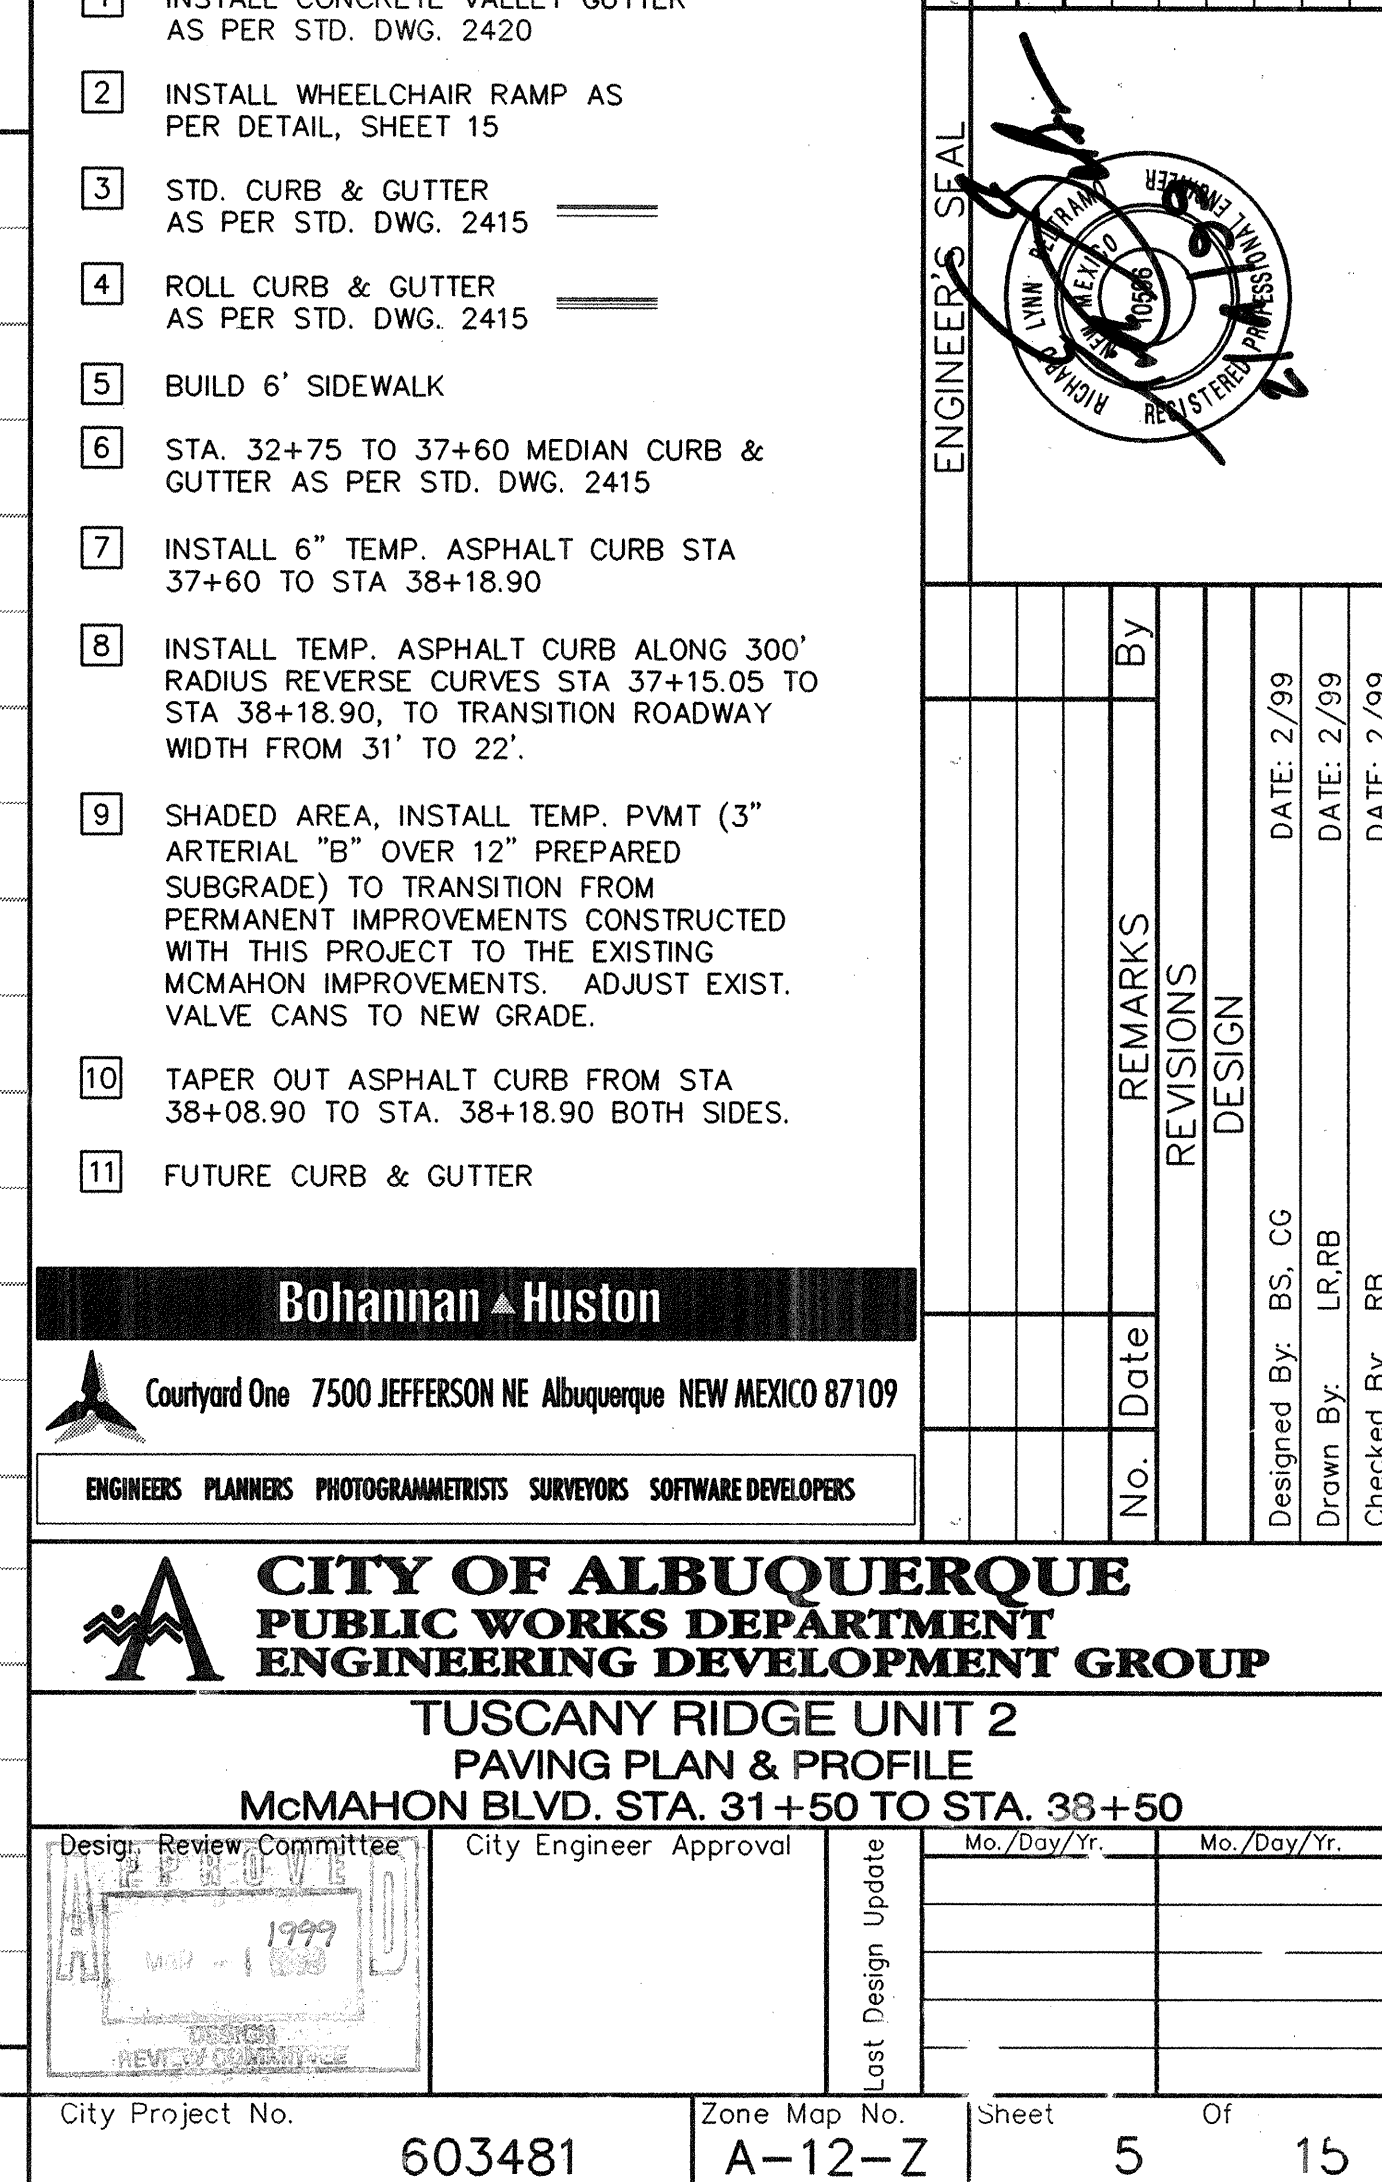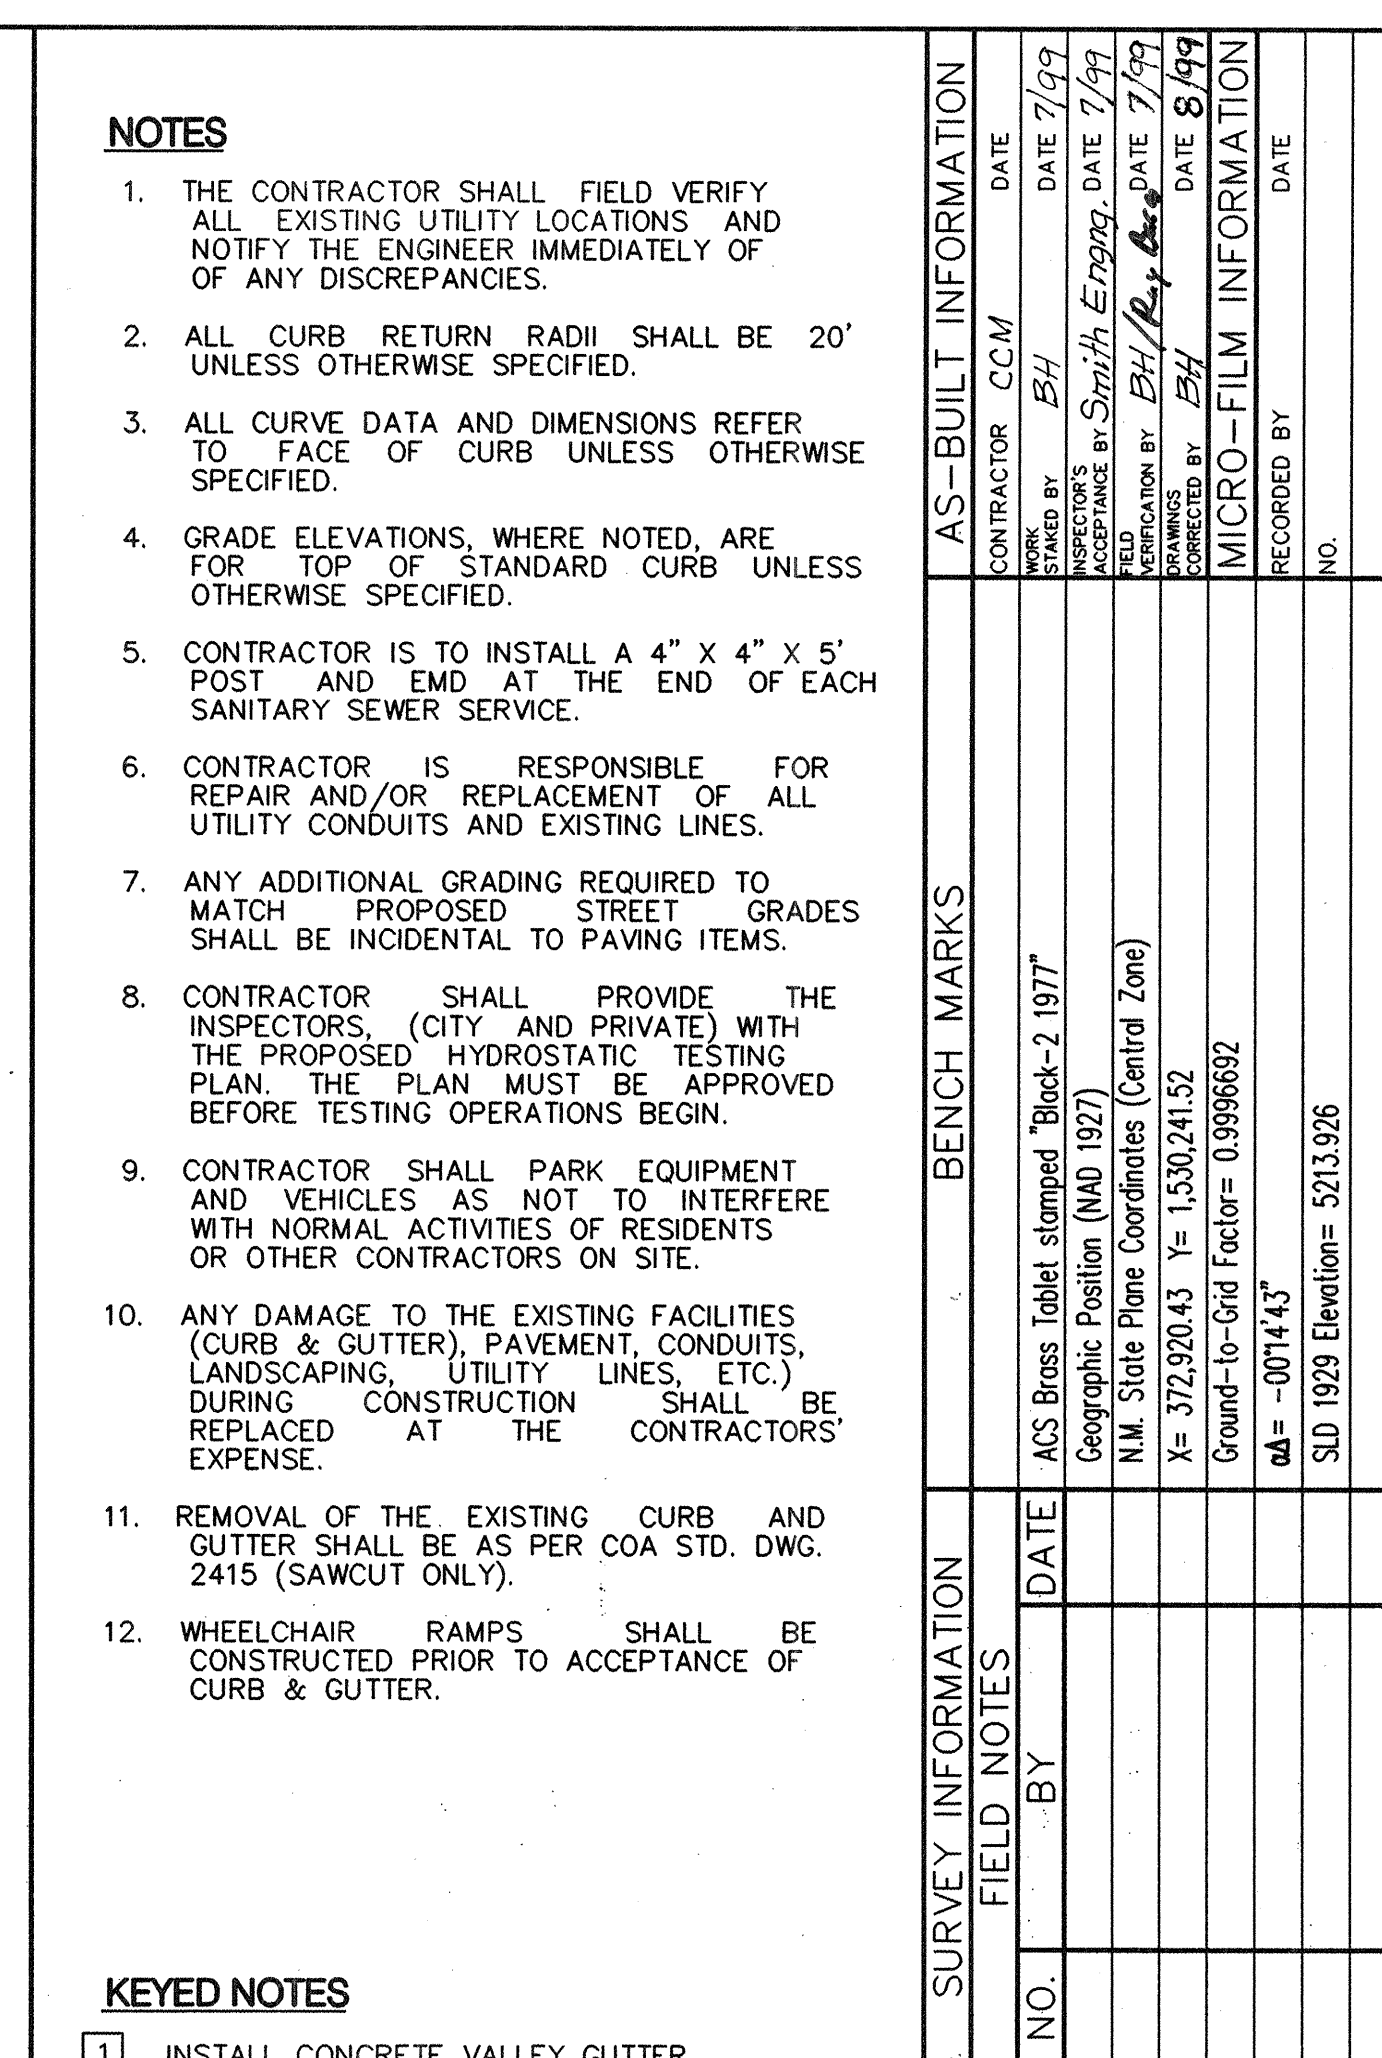

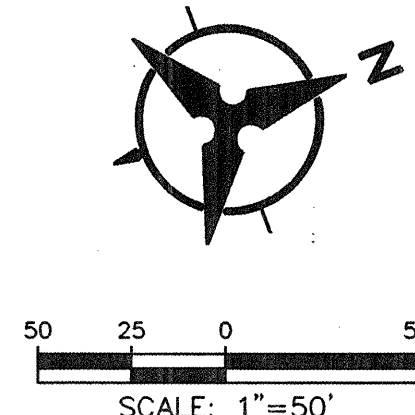[illegible]

RECORD DRAWING
DATE: 8-6-99

1. THE CONTRACTOR SHALL FIELD VERIFY ALL EXISTING UTILITY LOCATIONS AND NOTIFY THE ENGINEER IMMEDIATELY OF ANY DISCREPANCIES.
2. ALL CURB RETURN RADII SHALL BE 20' UNLESS OTHERWISE SPECIFIED.
3. ALL CURVE DATA AND DIMENSIONS REFER TO THE FACE OF CURB UNLESS OTHERWISE SPECIFIED.
4. GRADE ELEVATIONS, WHEN NOTED, ARE FOR TOP OF STANDARD CURB UNLESS OTHERWISE SPECIFIED.
5. CONTRACTOR IS TO INSTALL A 4" X 4" X 5' POST AND END AT THE END OF EACH SANITARY SEWER SERVICE.
6. CONTRACTOR IS RESPONSIBLE FOR REPAIR AND/OR REPLACEMENT OF ALL UTILITY CONDUITS AND EXISTING LINES.
7. ANY ADDITIONAL GRADING REQUIRED TO MATCH PROPOSED STREET GRADES SHALL BE INCIDENTAL TO PAVING ITEMS.
8. CONTRACTOR SHALL PROVIDE THE INSPECTORS, (CITY AND PRIVATE) WITH THE PROPOSED HYDROSTATIC TESTING PLAN. THE PLAN MUST BE APPROVED BEFORE TESTING OPERATIONS BEGIN.
9. CONTRACTOR SHALL PARK EQUIPMENT AND VEHICLES AS NOT TO INTERFERE WITH NORMAL ACTIVITIES OF RESIDENTS OR OTHER CONTRACTORS ON SITE.
10. ANY DAMAGE TO THE EXISTING FACILITIES (CURB & GUTTER), PAVEMENT, CONDUITS, LANDSCAPING, UTILITIES LINES, ETC.) DURING CONSTRUCTION SHALL BE REPLACED AT THE CONTRACTORS' EXPENSE.
11. REMOVAL OF THE EXISTING CURB AND GUTTER SHALL BE AS PER COA STD. DWG. 2415 (SAWCUT ONLY).
12. WHEELCHAIR RAMPS SHALL BE CONSTRUCTED PRIOR TO ACCEPTANCE OF CURB & GUTTER.

- 1 INSTALL CONCRETE VALLEY GUTTER
AS PER STD. DWG. 2420
- 2 INSTALL WHEELCHAIR RAMP AS
PER DETAIL, SHEET 15
- 3 STD. CURB & GUTTER =====
AS PER STD. DWG. 2415
- 4 ROLL CURB & GUTTER =====
AS PER STD. DWG. 2415
- 5 FUTURE 4' SIDEWALK
- 6 BUILD 4' SIDEWALK
- 7 6" ASPHALT CURB AS PER STD. DWG. 2415
- 8 EXISTING CURB & GUTTER TO BE REMOVED
STA. 4+64.19 TO STA. 5+31.06, TUSCANY DR.
- 9 REMOVE EXIST. CUTOFF WALL FULL STREET
WIDTH.

 Courtyard One 7500 JEFFERSON NE Albuquerque NEW MEXICO 87109

ENGINEERS PLANNERS PHOTOGRAMMETRISTS SURVEYORS SOFTWARE DEVELOPERS





CITY OF ALBUQUERQUE
PUBLIC WORKS DEPARTMENT
ENGINEERING DEVELOPMENT GROUP



TUSCANY RIDGE UNIT 2
PAVING PLAN & PROFILE
TUSCANY DRIVE STA. 2+35 TO STA. 11+10.07

TUSCANY DRIVE STA. 8+75 TO STA. 11+16.97		Mo./Day/Yr.	Mo./Day/Yr.
Design Review Committee	City Engineer Approval		
 DESIGN REVIEW COMMITTEE		Most Design Update	

City Project No.	603481	Zone Map No.	A-12-Z	Sheet	6	Of	15
------------------	--------	--------------	--------	-------	---	----	----

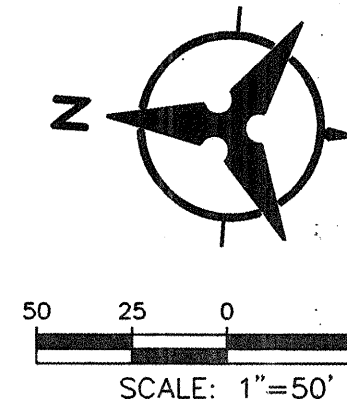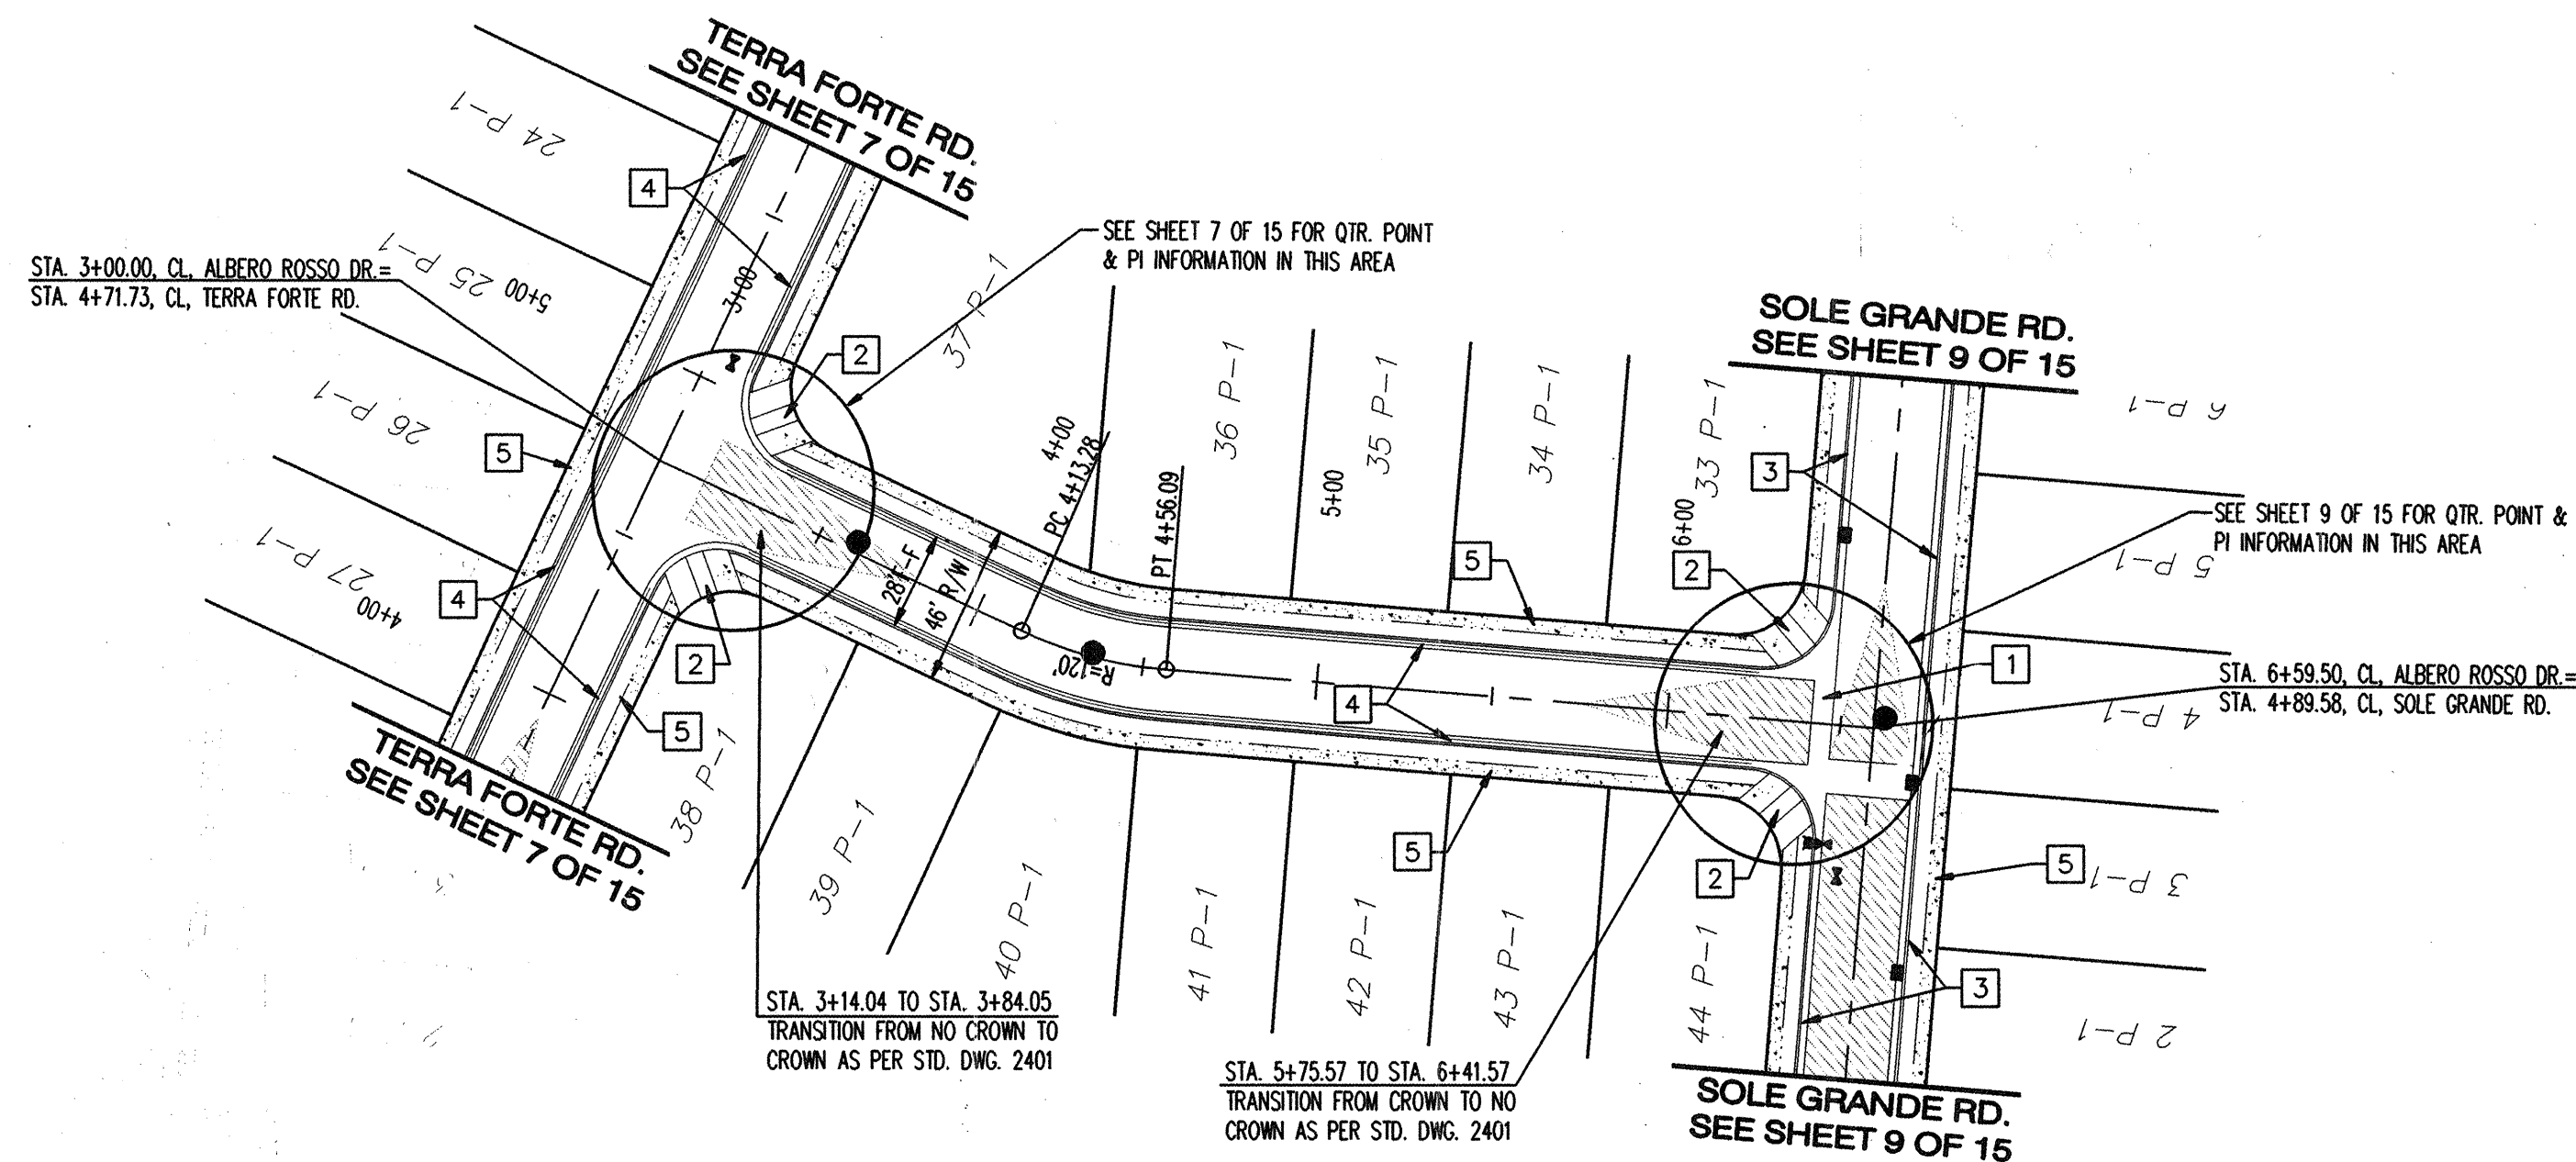

ALBERO ROSSO DRIVE

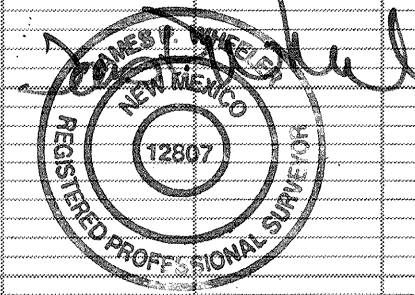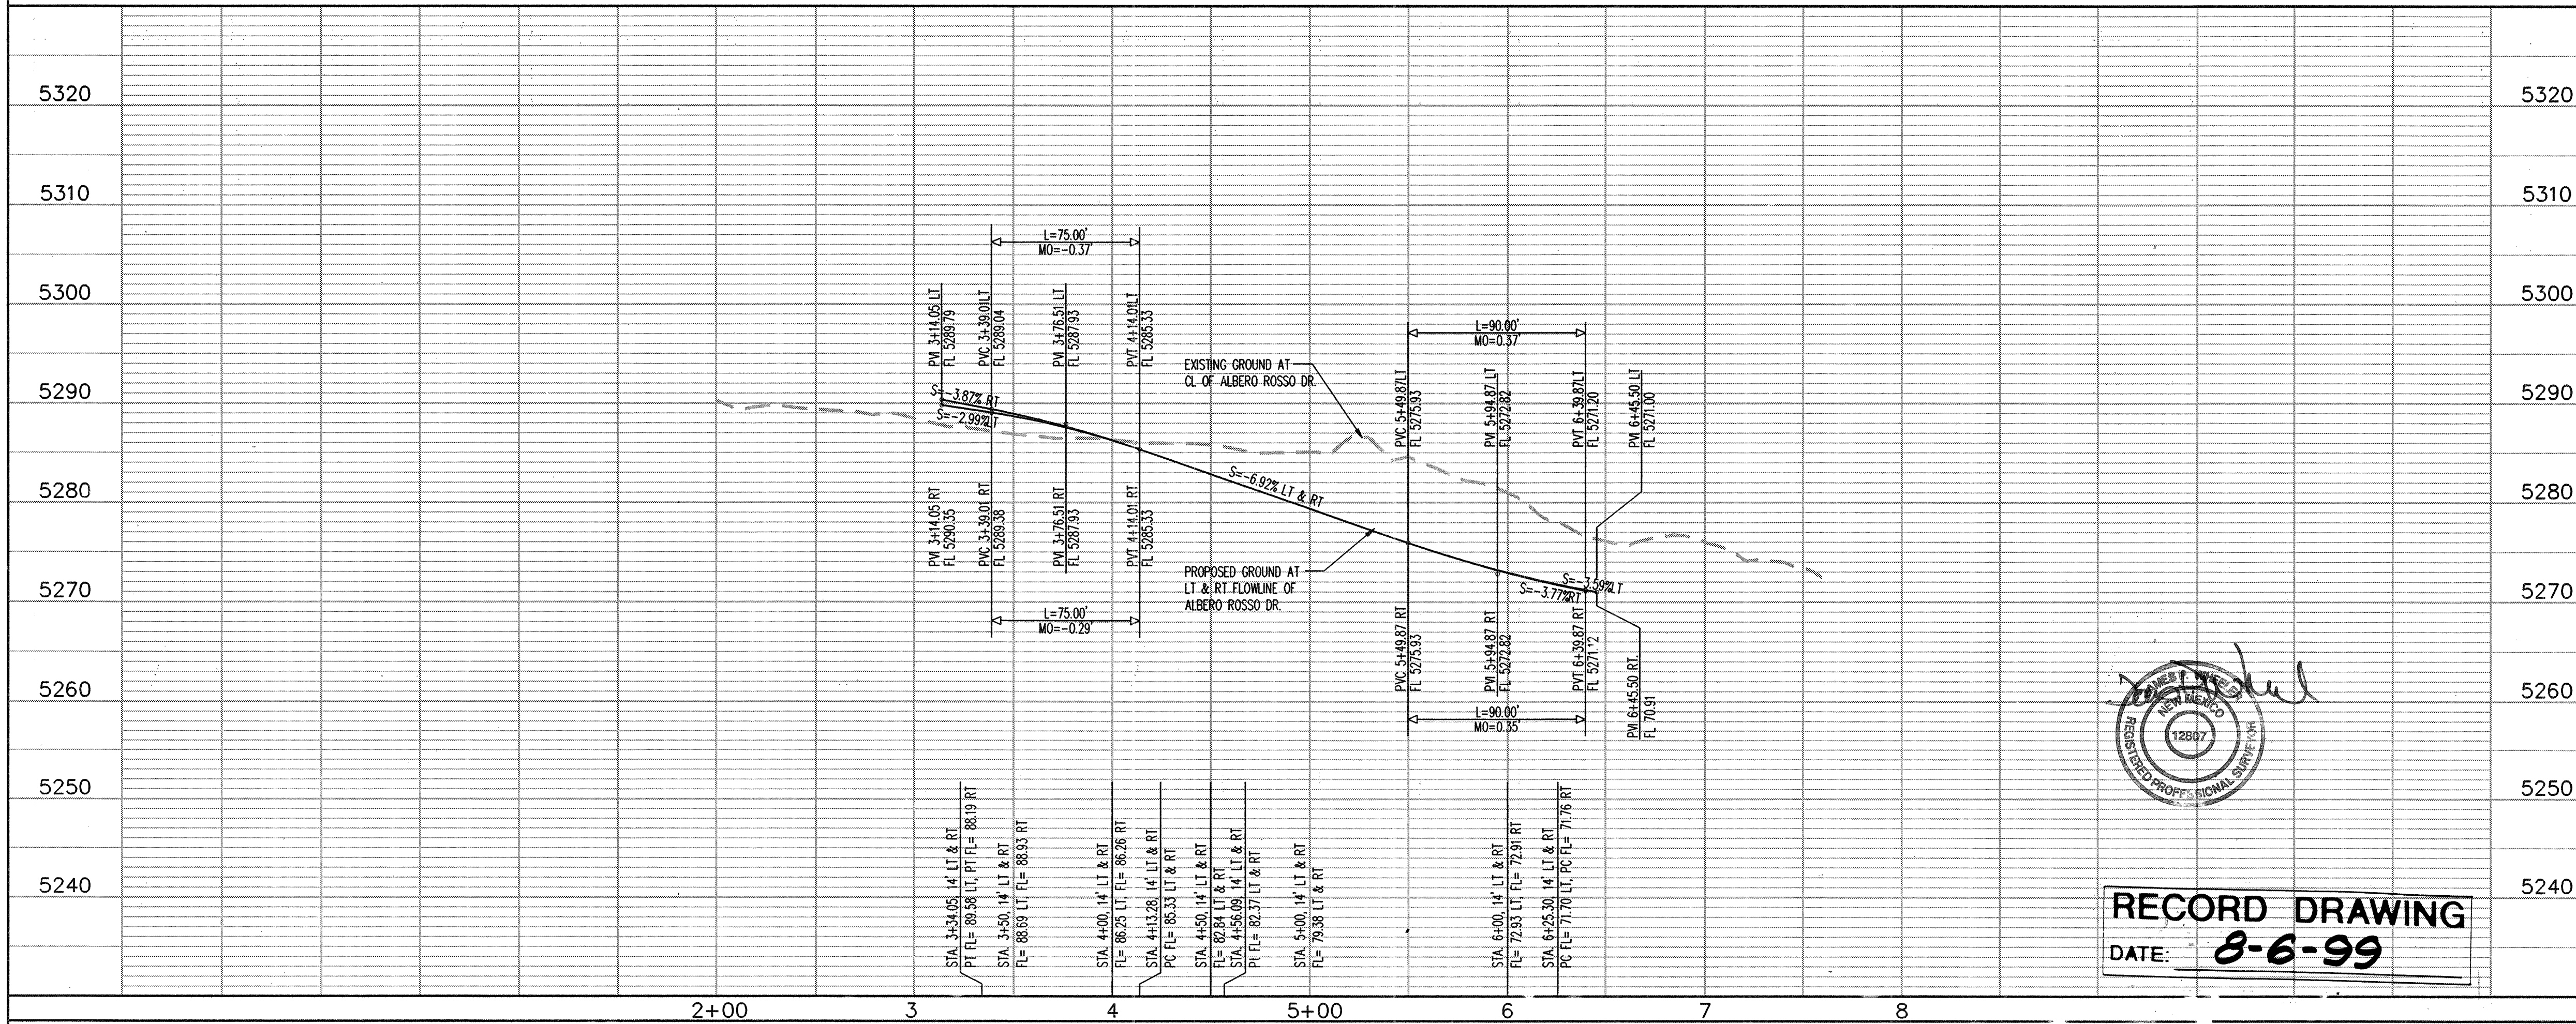

RECORD DRAWING
DATE: 8-6-99

NOTES

1. THE CONTRACTOR SHALL FIELD VERIFY ALL EXISTING UTILITY LOCATIONS AND NOTIFY THE ENGINEER IMMEDIATELY OF ANY DISCREPANCIES.
2. ALL CURB RETURN RADII SHALL BE 20' UNLESS OTHERWISE SPECIFIED.
3. ALL CURVE DATA AND DIMENSIONS REFER TO FACE OF CURB UNLESS OTHERWISE SPECIFIED.
4. GRADE ELEVATIONS, WHERE NOTED, ARE FOR TOP OF STANDARD CURB UNLESS OTHERWISE SPECIFIED.
5. CONTRACTOR IS TO INSTALL A 4" X 4" X 5' POST AND END AT THE END OF EACH SANITARY SEWER SERVICE.
6. CONTRACTOR IS RESPONSIBLE FOR REPAIR AND/OR REPLACEMENT OF ALL UTILITY CONDUITS AND EXISTING LINES.
7. ANY ADDITIONAL GRADING REQUIRED TO MATCH PROPOSED STREET GRADES SHALL BE INCIDENTAL TO PAVING ITEMS.
8. CONTRACTOR SHALL PROVIDE THE INSPECTORS, (CITY AND PRIVATE) WITH THE PROPOSED HYDROSTATIC TESTING PLAN. THE PLAN MUST BE APPROVED BEFORE TESTING OPERATIONS BEGIN.
9. CONTRACTOR SHALL PARK EQUIPMENT AND VEHICLES AS NOT TO INTERFERE WITH NORMAL ACTIVITIES OF RESIDENTS OR OTHER CONTRACTORS ON SITE.
10. ANY DAMAGE TO THE EXISTING FACILITIES (CURB & GUTTER), PAVEMENT, CONDUITS, LANDSCAPING, UTILITY LINES, ETC.) DURING CONSTRUCTION SHALL BE REPLACED AT THE CONTRACTORS' EXPENSE.
11. REMOVAL OF THE EXISTING CURB AND GUTTER SHALL BE AS PER COA STD. DWG. 2415 (SAWCUT ONLY).
12. WHEELCHAIR RAMPS SHALL BE CONSTRUCTED PRIOR TO ACCEPTANCE OF CURB & GUTTER.

KEYED NOTES

1. INSTALL CONCRETE VALLEY GUTTER AS PER STD. DWG. 2420
2. INSTALL WHEELCHAIR RAMP AS PER DETAIL, SHEET 15
3. STD. CURB & GUTTER AS PER STD. DWG. 2415
4. ROLL CURB & GUTTER AS PER STD. DWG. 2415
5. FUTURE 4' SIDEWALK

Bohannon & Huston
Court yard One 7500 JEFFERSON NE Albuquerque NEW MEXICO 87109
ENGINEERS PLANNERS PHOTOGRAMMETRISTS SURVEYORS SOFTWARE DEVELOPERS

CITY OF ALBUQUERQUE
PUBLIC WORKS DEPARTMENT
ENGINEERING DEVELOPMENT GROUP

TUSCANY RIDGE UNIT 2
PAVING PLAN & PROFILE
ALBERO ROSSO DRIVE

Design Review Committee	City Engineer Approval	Mo./Day/Yr.	Mo./Day/Yr.



City Project No. 603481
Zone Map No. A-12-Z
Sheet 8 Of 15

TC	FL	TC
1 34.40 73.73 74.10	1 34.40 73.73 74.10	1 34.40 73.73 74.10
2 34.47 74.75 75.38	2 34.47 74.75 75.38	2 34.47 74.75 75.38
3 34.45 74.78 75.38	3 34.45 74.78 75.38	3 34.45 74.78 75.38
A=89.59' 25	A=89.59' 25	A=89.59' 25
R=20.00	R=20.00	R=20.00
L=31.41	L=31.41	L=31.41



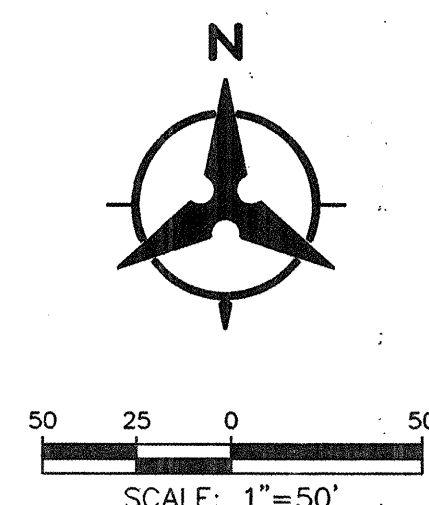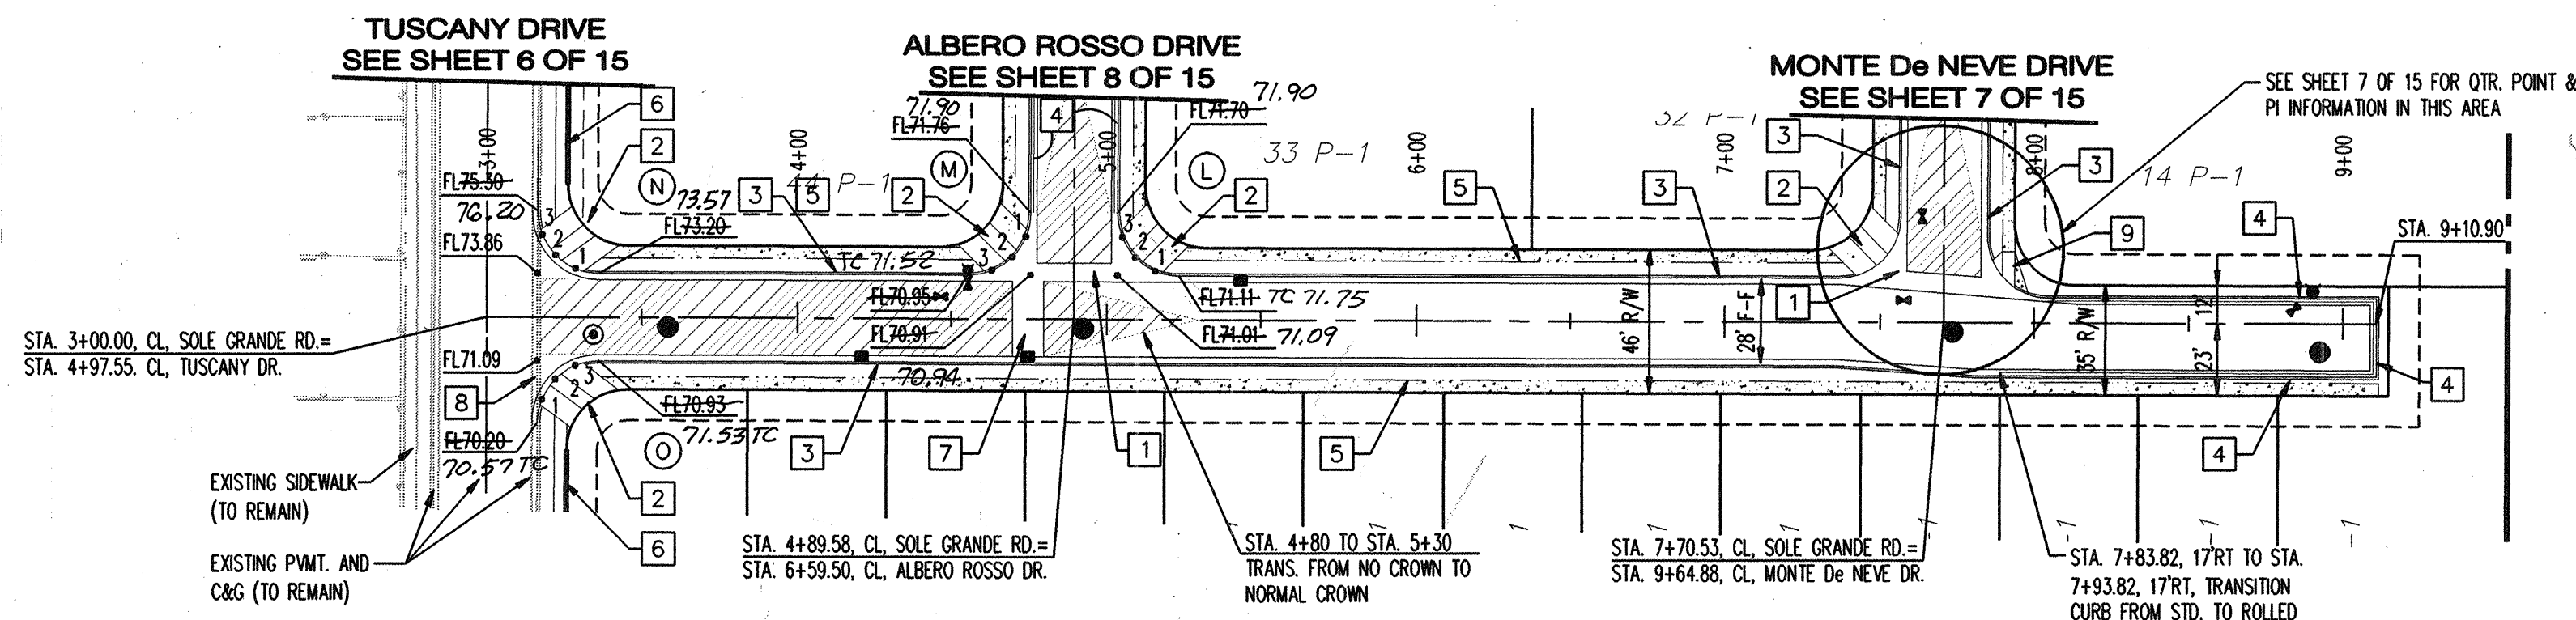

SOLE GRANDE ROAD

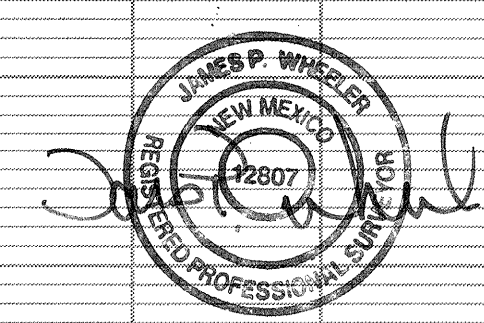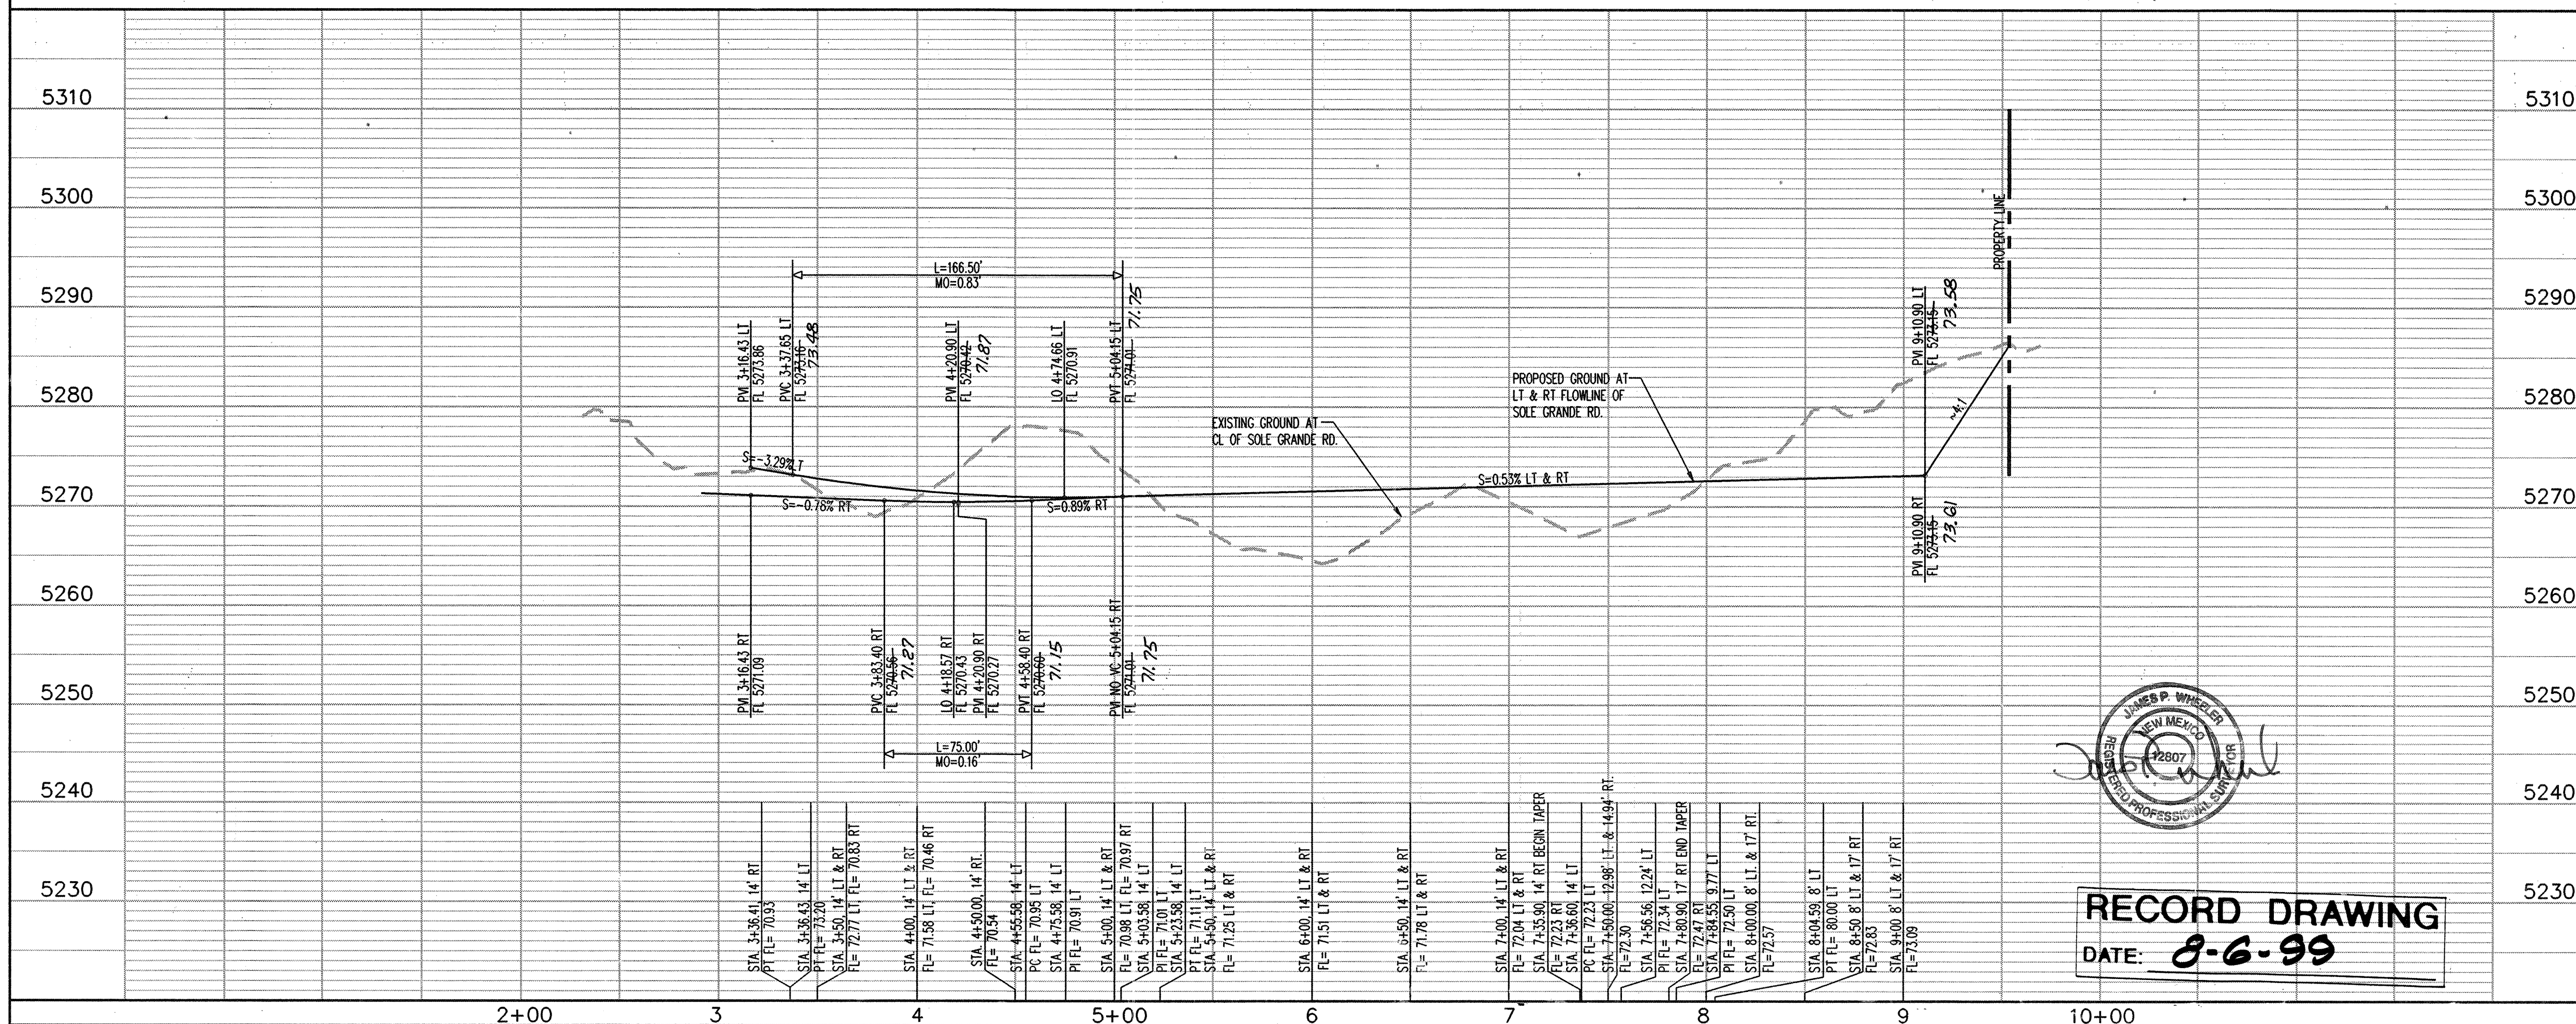

RECORD DRAWING
DATE: 8-6-99

NOTES

- THE CONTRACTOR SHALL FIELD VERIFY ALL EXISTING UTILITY LOCATIONS AND NOTIFY THE ENGINEER IMMEDIATELY OF ANY DISCREPANCIES.
- ALL CURB RETURN RADII SHALL BE 20' UNLESS OTHERWISE SPECIFIED.
- ALL CURVE DATA AND DIMENSIONS REFER TO FACE OF CURB UNLESS OTHERWISE SPECIFIED.
- GRADE ELEVATIONS, WHERE NOTED, ARE FOR TOP OF STANDARD CURB UNLESS OTHERWISE SPECIFIED.
- CONTRACTOR IS TO INSTALL A 4" X 4" X 5' POST AND EMD AT THE END OF EACH SANITARY SEWER SERVICE.
- CONTRACTOR IS RESPONSIBLE FOR REPAIR AND/OR REPLACEMENT OF ALL UTILITY CONDUITS AND EXISTING LINES.
- ANY ADDITIONAL GRADING REQUIRED TO MATCH PROPOSED STREET GRADES SHALL BE INCIDENTAL TO PAVING ITEMS.
- CONTRACTOR SHALL PROVIDE THE INSPECTORS (CITY AND PRIVATE) WITH THE PROPOSED HYDROSTATIC TESTING PLAN. THE PLAN MUST BE APPROVED BEFORE TESTING OPERATIONS BEGIN.
- CONTRACTOR SHALL PARK EQUIPMENT AND VEHICLES AS NOT TO INTERFERE WITH NORMAL ACTIVITIES OF RESIDENTS OR OTHER CONTRACTORS ON SITE.
- ANY DAMAGE TO THE EXISTING FACILITIES (CURB & GUTTER), PAVEMENT, CONDUITS, LANDSCAPING, UTILITY LINES, ETC.) DURING CONSTRUCTION SHALL BE REPLACED AT THE CONTRACTORS' EXPENSE.
- REMOVAL OF THE EXISTING CURB AND GUTTER SHALL BE AS PER COA STD. DWG. 2415 (SAWCUT ONLY).
- WHEELCHAIR RAMPS SHALL BE CONSTRUCTED PRIOR TO ACCEPTANCE OF CURB & GUTTER.

KEYED NOTES

- INSTALL CONCRETE VALLEY GUTTER AS PER STD. DWG. 2420
- INSTALL WHEELCHAIR RAMP AS PER DETAIL, SHEET 15
- STD. CURB & GUTTER AS PER STD. DWG. 2415
- ROLL CURB & GUTTER AS PER STD. DWG. 2415
- FUTURE 4' SIDEWALK
- BUILD 4' SIDEWALK
- STA. 4+74.66, INSTALL 10' WIDE BY 3/4" DEEP VALLEY GUTTER PER STD. DWG. 2422: FL 14'LT = 70.91 FL 14'RT = 70.74
- EXISTING CURB & GUTTER TO BE REMOVED SEE SHEET 6 OF 15
- INSTALL SINGLE DIRECTION HC RAMP. PROVIDE 5' X 5' LANDING AT BOTTOM (MAX SLOPE=2%). RAMP MAX = 12:1.


Bohannon & Huston
Courtney One 7500 JEFFERSON NE ALBUQUERQUE NEW MEXICO 87109
ENGINEERS PLANNERS PHOTOGRAMMETRISTS SURVEYORS SOFTWARE DEVELOPERS

CITY OF ALBUQUERQUE
PUBLIC WORKS DEPARTMENT
ENGINEERING DEVELOPMENT GROUP

TUSCANY RIDGE UNIT 2
PAVING PLAN & PROFILE
SOLE GRANDE ROAD

Design Review Committee	City Engineer Approval	Mo./Day/Yr.	Mo./Day/Yr.

City Project No. 603481 Zone Map No. A-12-Z Sheet 9 Of 15

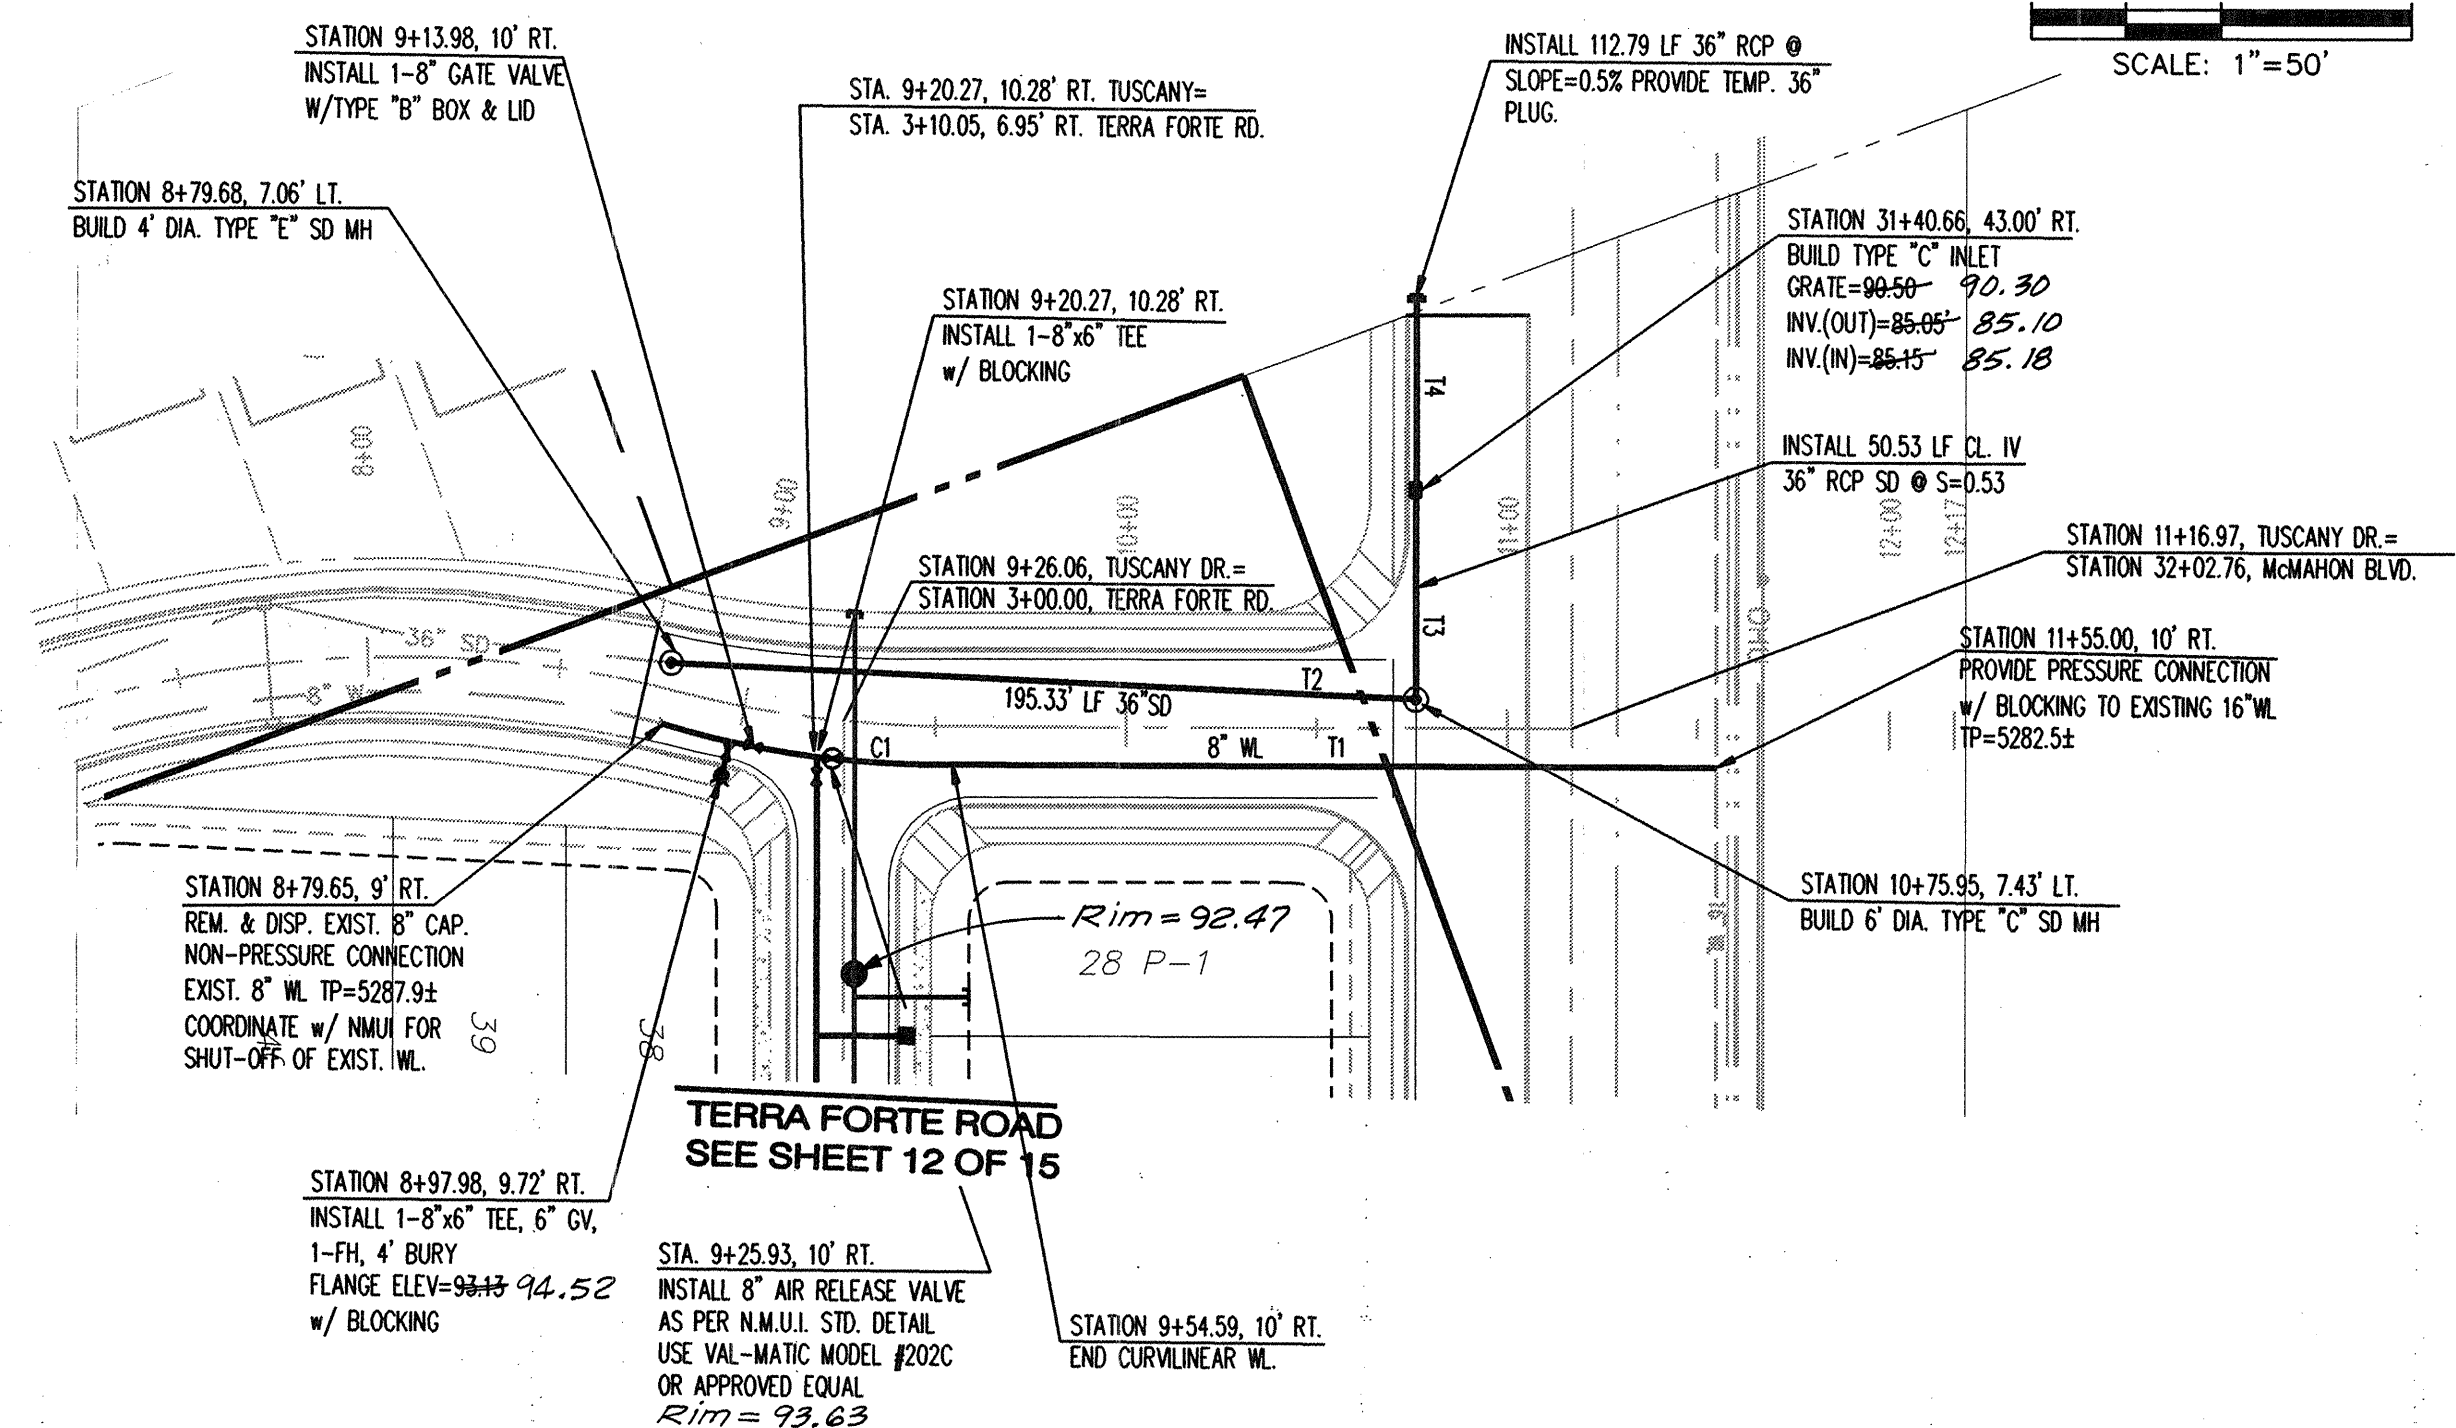

8" WATER CURVE DATA TABLE					
NUMBER	PI STATION	RADIUS	ARC	TANGENT	DELTA
C1	9+17.18	258.82'	77.25'	38.91'	17°06'03"

EXISTING GROUND @ CL OF TUSCANY DRIVE

HIGH POINT
9+25.93
TP=5292.68

STA 9+29.61
TP=5287.72

PROPOSED GROUND @ LT & RT FLOWLINE OF ROAD

31'

55'

STA 11+55.00
TP=5282.5

EXIST 8' ML

EXIST 36' SD

STA 8+73.46
TP=5289.10

4' MIN COVER

HGL


195.33' LF 36' SD S=50%
(189.33' LF)

8' ML

Q=37.5 cfs
V=5.3 fps

STATION 8+73.68 7.05' LT
BUILD 4 DIA. TYPE 'C' SD MH
RM=94.69 90' LBS
WV (M)=83.70
WV (OVT)=83.60±

STATION 10+73.95 7.45' LT
BUILD 6 DIA. TYPE 'C' SD MH
RM=94.69 90' LBS
WV (M)=84.73 84.59
WV (OVT)=84.68 84.59

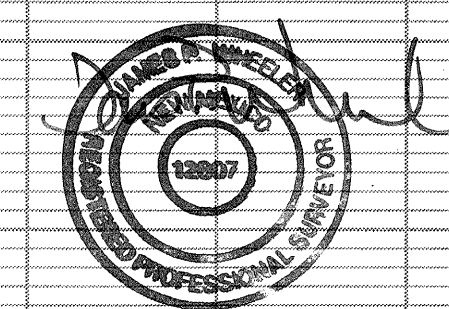

RECORD DRAWING	
DATE:	8-6-99

- | SURVEY INFORMATION | | | BENCH MARKS | AS-BUILT INFORMATION | | |
|--------------------|----|------|---|---------------------------|-------------------|-----------|
| NO. | BY | DATE | | CONTRACTOR | CM | DATE |
| | | | ACS Brass Tablet stamped "Block-2 197" | INSPECTOR'S
STAMPED BY | BH | DATE 7/99 |
| | | | Geographic Position (NAD 1927) | FIELD
MEASURED BY | Smith Engineering | DATE 7/99 |
| | | | N.M. State Plane Coordinates (Central Zone) | REPLICATION BY | BH | DATE 7/99 |
| | | | X= 372,920.43 Y= 1,530,241.52 | REVISIONS
CORRECTED BY | BH | DATE 8/99 |
| | | | Ground-to-Grid Factor= 0.9996992 | MICRO-FILM INFORMATION | | |
| | | | ad = -00714.43" | RECORDED BY | | DATE |
| | | | S/LD 1929 Elevation= 5213.976 | NO. | | |

	No.	Date	REMARKS	By
DESIGN REVISIONS				
DESIGN				
	Designed By:	BS, CG	DATE: 1 / 99	
	Drawn By:	RB, LR	DATE: 1 / 99	
	CHECKED BY:	BB	DATE: 1 / 00	

Bohannon ▲ Huston

 Courtyard One 7500 JEFFERSON NE Albuquerque NEW MEXICO 87109

ENGINEERS PLANNERS PHOTOGRAMMETRISTS SURVEYORS SOFTWARE DEVELOPERS

CITY OF ALBUQUERQUE
PUBLIC WORKS DEPARTMENT
ENGINEERING DEVELOPMENT GROUP
 TUSCANY RIDGE UNIT 2
 UTILITY & STORM DRAIN PLAN & PROFILE
 TUSCANY DRIVE STA. 2+00 TO STA. 12+00




[illegible]

City Project No.	603481	Zone Map No.	A-12-Z	Sheet	11	Of	15
------------------	--------	--------------	--------	-------	----	----	----



NUMBER	BEARING	DISTANCE
11	S 20°37'20" W	74.14'
12	S 00°10'57" W	226.89'

NUMBER	BEARING	DISTANCE
13	S 20°37'20" W	129.81'
14	S 00°10'57" W	218.69'

LOT NUMBER	WL STATION & OFFSET	WL TYPE	SAS STATION & OFFSET	SAS LENGTH	TOP OF PIPE AT PLUG (W/RISE)
33	5+80.65, 7.00' RT.	DOUBLE	6+03.09, 3.00' LT.	30.00'	5268.74
34	4+90.65, 7.00' RT.	DOUBLE	5+13.19, 3.00' LT.	30.00'	5271.44
35	4+90.65, 7.00' RT.	DOUBLE	4+68.19, 3.00' LT.	30.00'	5274.16
36	4+23.83, 7.43' RT.	SINGLE	3+69.05, 3.00' LT.	28.10'	5276.84
37	3+73.05, 7.00' RT.	DOUBLE	3+66.05, 3.00' LT.	37.90'	5283.94
38	4+50.61, 7.17' RT.	SINGLE	4+35.37, 1.11' LT.	34.10'	5278.78
39	4+95.24, 7.00' RT.	DOUBLE	4+72.74, 3.00' LT.	36.00'	5276.69
40	5+85.24, 7.00' RT.	DOUBLE	5+17.74, 3.00' LT.	36.00'	5273.99
41			5+62.74, 3.00' LT.	36.00'	5271.29
42			6+07.74, 3.00' LT.	36.00'	5268.59

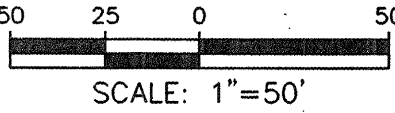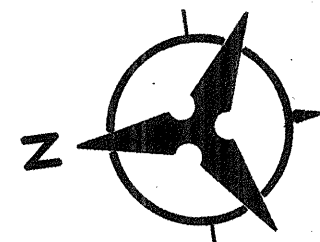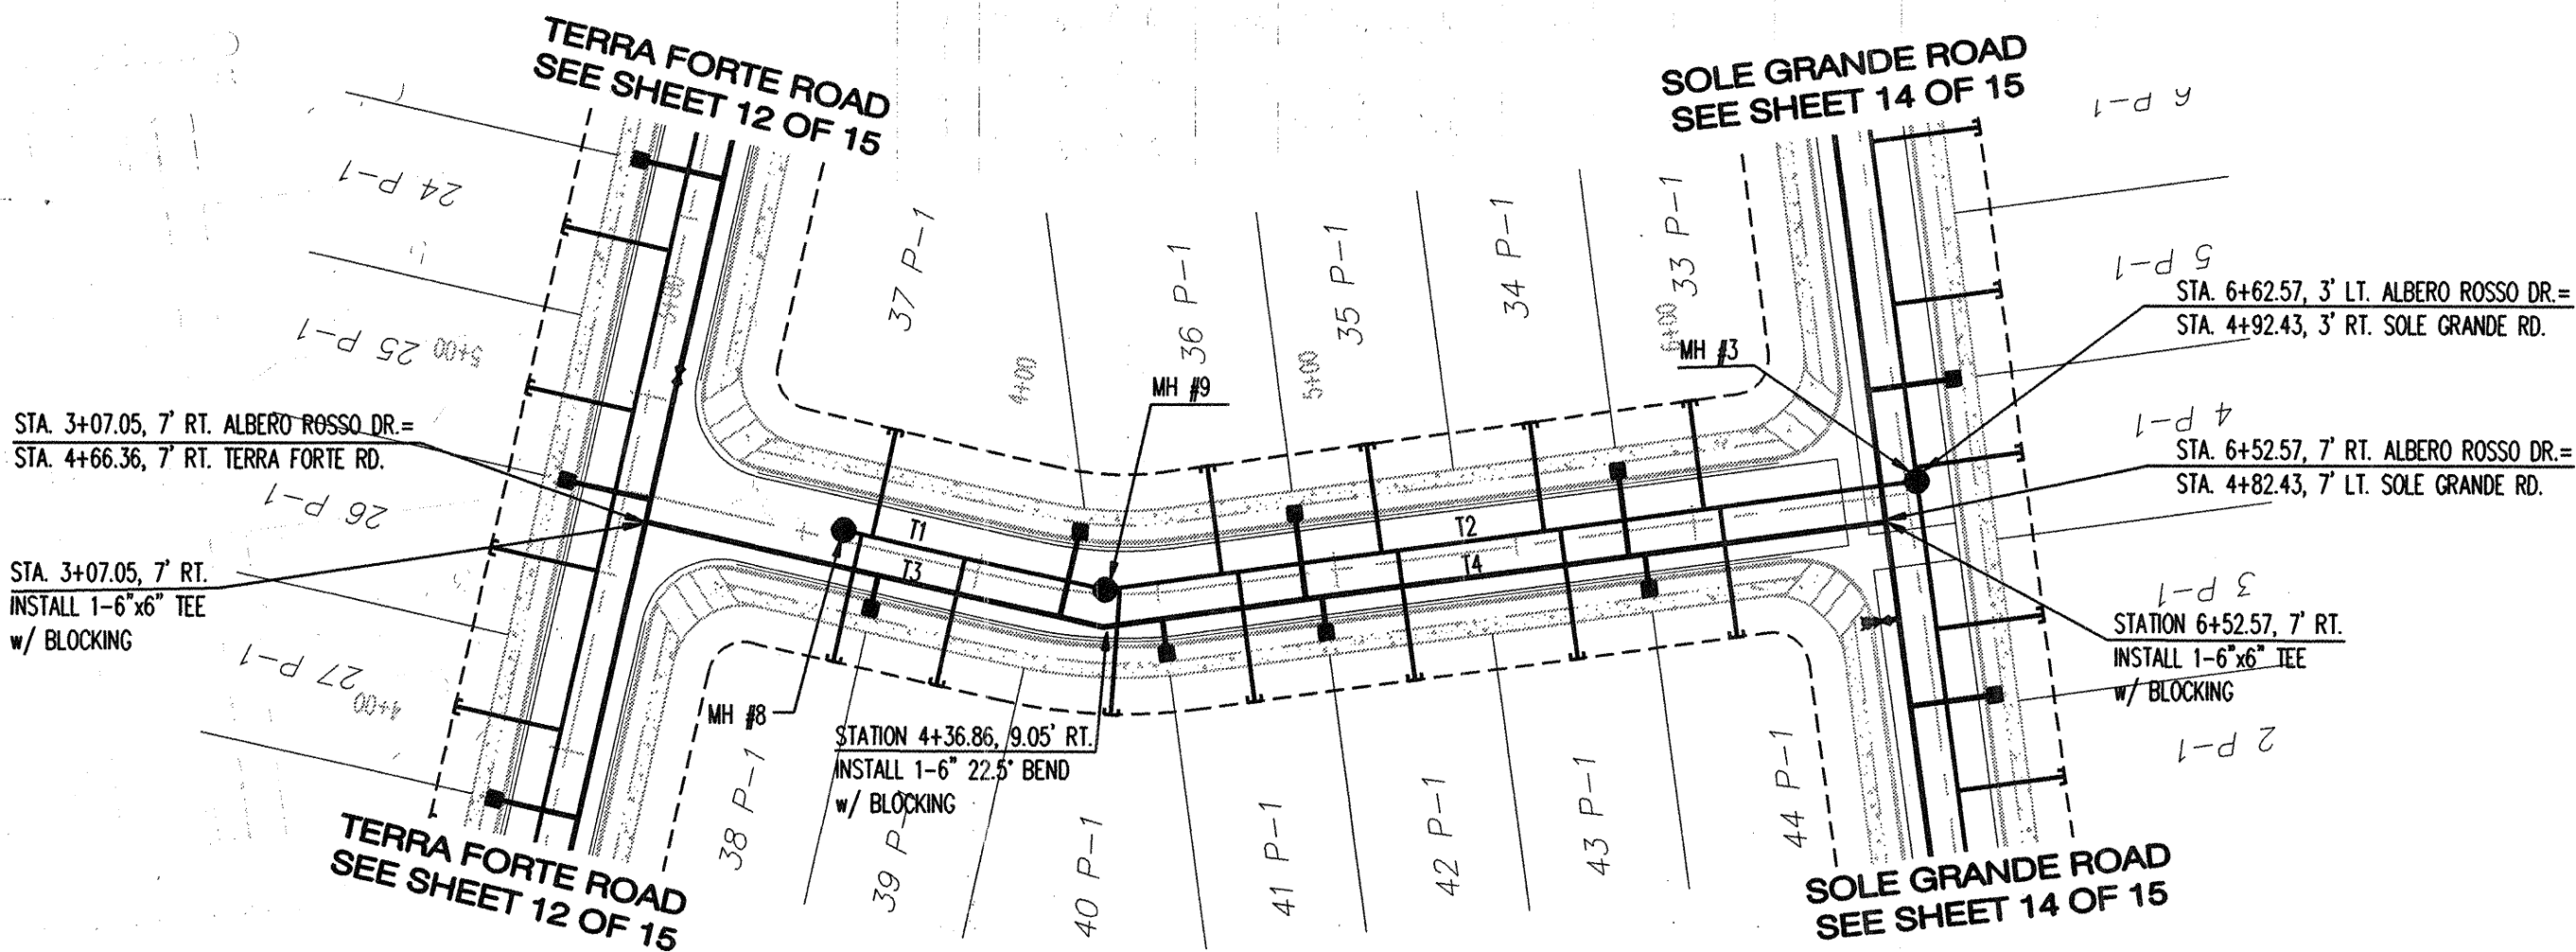

ALBERO ROSSO DRIVE

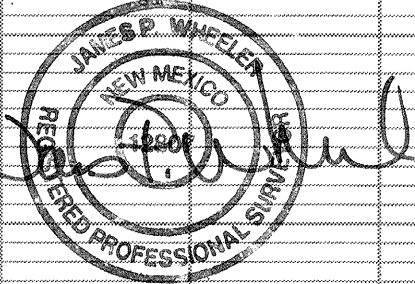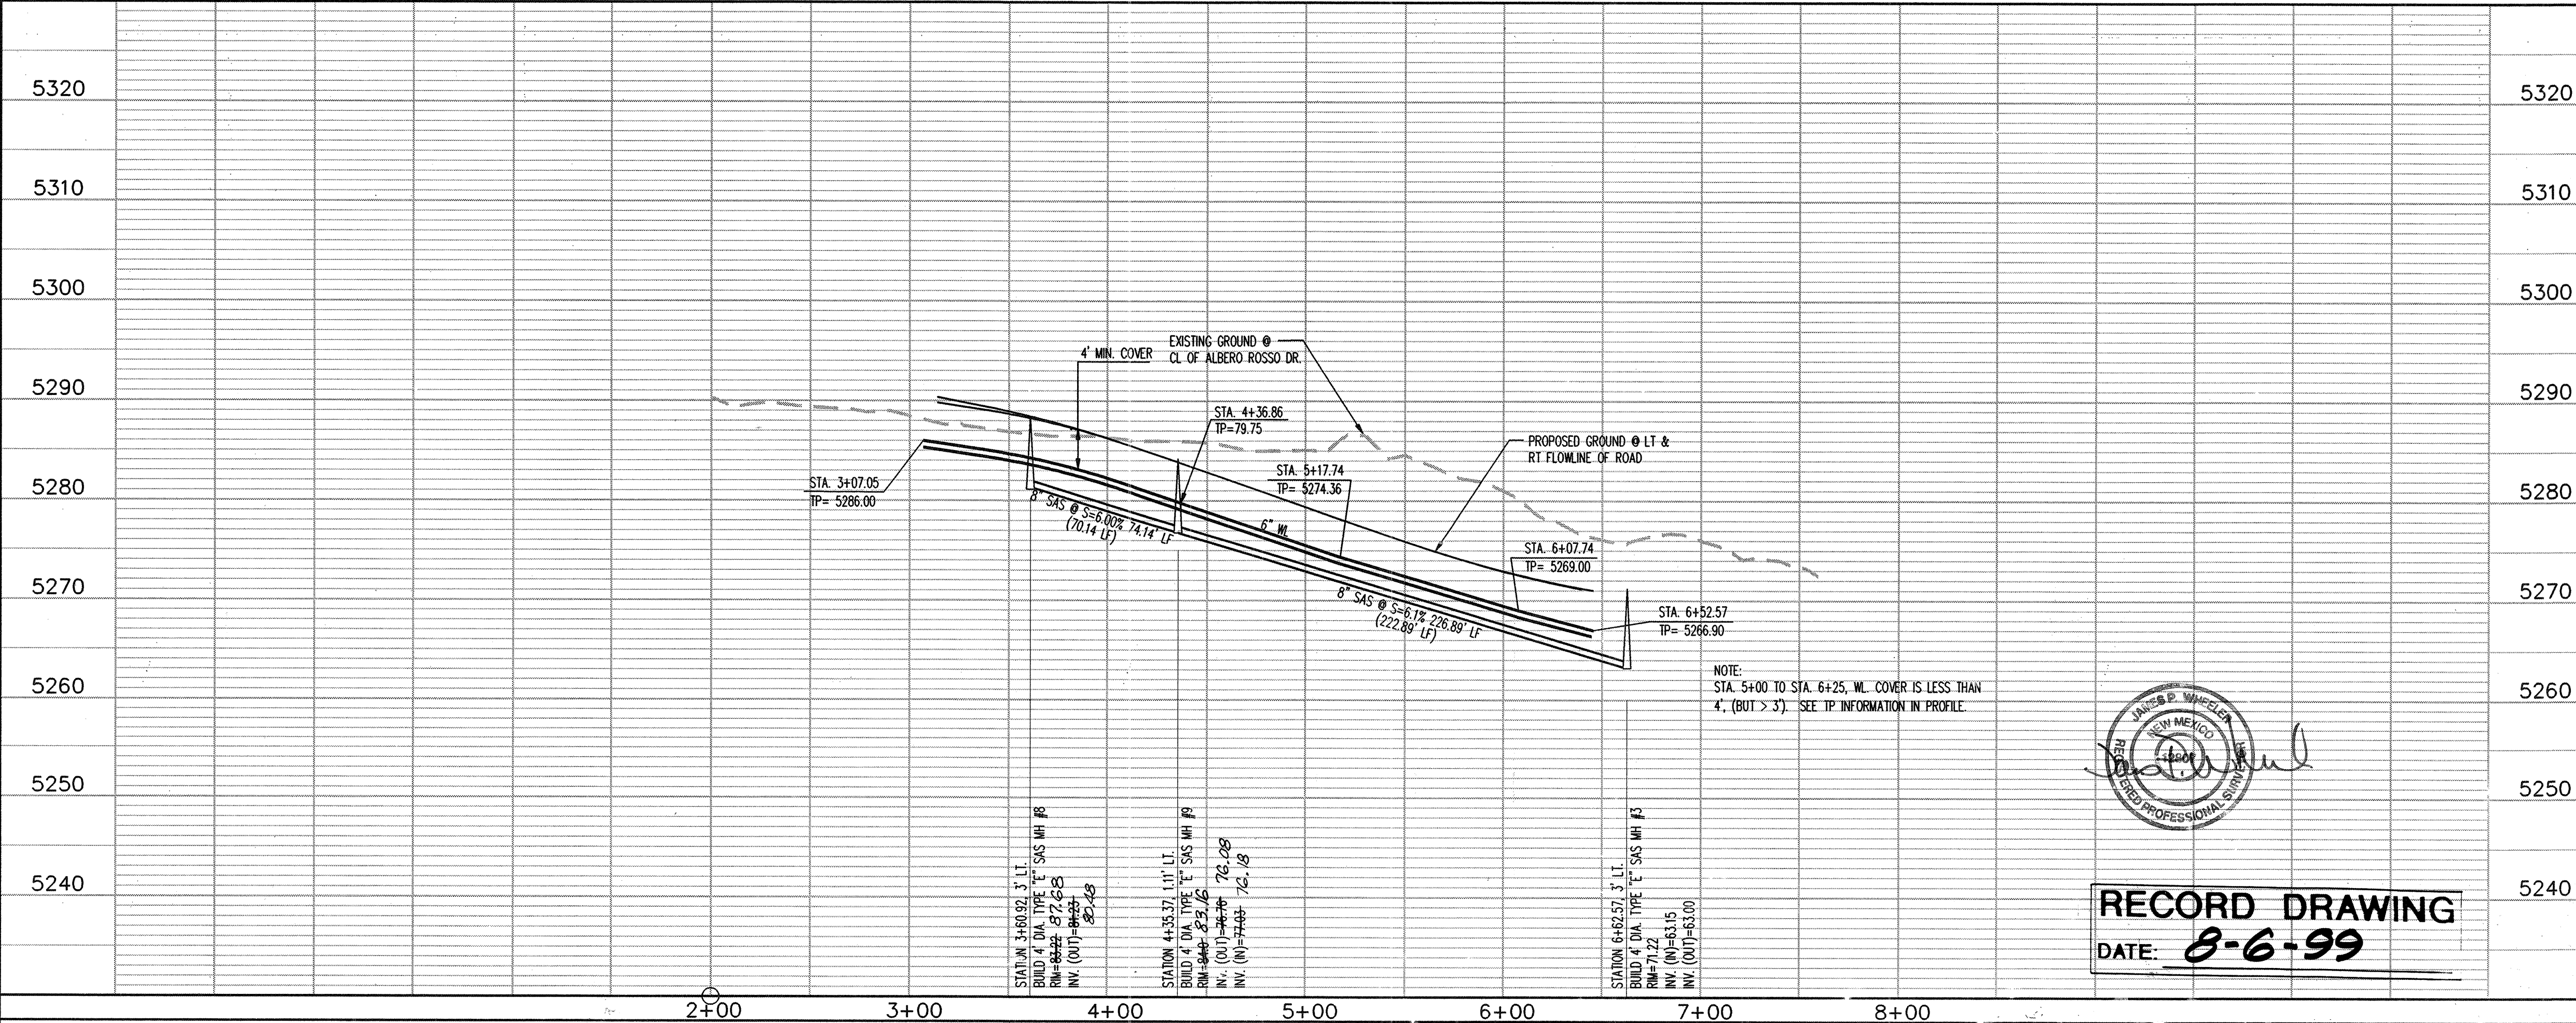

RECORD DRAWING
DATE: 8-6-99

- NOTES**
- THE CONTRACTOR SHALL FIELD VERIFY ALL EXISTING UTILITY LOCATIONS AND NOTIFY THE ENGINEER IMMEDIATELY OF ANY DISCREPANCIES.
 - ALL CURB RETURN RADII SHALL BE 20' UNLESS OTHERWISE SPECIFIED.
 - ALL CURVE DATA AND DIMENSIONS REFER TO FACE OF CURB UNLESS OTHERWISE SPECIFIED.
 - GRADE ELEVATIONS, WHERE NOTED, ARE FOR TOP OF STANDARD CURB UNLESS OTHERWISE SPECIFIED.
 - CONTRACTOR IS TO INSTALL A 4" X 4" X 5' POST AND EMD AT THE END OF EACH SANITARY SEWER SERVICE.
 - CONTRACTOR IS RESPONSIBLE FOR REPAIR AND/OR REPLACEMENT OF ALL UTILITY CONDUITS AND EXISTING LINES.
 - ANY ADDITIONAL GRADING REQUIRED TO MATCH PROPOSED STREET GRADES SHALL BE INCIDENTAL TO PAVING ITEMS.
 - CONTRACTOR SHALL PROVIDE THE INSPECTORS, (CITY AND PRIVATE) WITH THE PROPOSED HYDROSTATIC TESTING PLAN. THE PLAN MUST BE APPROVED BEFORE TESTING OPERATIONS BEGIN.
 - CONTRACTOR SHALL PARK EQUIPMENT AND VEHICLES AS NOT TO INTERFERE WITH NORMAL ACTIVITIES OF RESIDENTS OR OTHER CONTRACTORS ON SITE.
 - ANY DAMAGE TO THE EXISTING FACILITIES (CURB & GUTTER), PAVEMENT, CONDUITS, LANDSCAPING, UTILITY LINES, ETC., DURING CONSTRUCTION SHALL BE REPLACED AT THE CONTRACTORS' EXPENSE.
 - REMOVAL OF THE EXISTING CURB AND GUTTER SHALL BE AS PER COA STD. DWG. 2415 (SAWCUT ONLY).
 - WHEELCHAIR RAMPS SHALL BE CONSTRUCTED PRIOR TO ACCEPTANCE OF CURB & GUTTER.

Bohannon & Huston


Courtyard One 7500 JEFFERSON NE Albuquerque NEW MEXICO 87109

ENGINEERS PLANNERS PHOTOGRAMMETRISTS SURVEYORS SOFTWARE DEVELOPERS

CITY OF ALBUQUERQUE
PUBLIC WORKS DEPARTMENT
ENGINEERING DEVELOPMENT GROUP

TUSCANY RIDGE UNIT 2
UTILITY PLAN & PROFILE
ALBERO ROSSO DRIVE STA. 3+00 TO STA. 6+59.57

Design Review Committee	City Engineer Approval	Mo./Day/Yr.	Mo./Day/Yr.
City Project No. 603481	Zone Map No. A-12-Z	Sheet 13	15

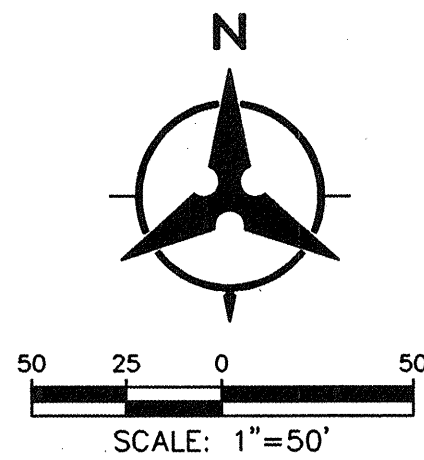




WATER & SANITARY SEWER SERVICES					
LOT NUMBER	STATION & OFFSET	WL TYPE	SAS STATION & OFFSET	SAS LENGTH	TOP OF PIPE AT PLUG (W/RISE)
1	3+83.82, 7.00' LT.	DOUBLE	3+64.06, 3.00' RT.	30.00'	5264.00 (-)
2			4+06.32, 3.00' RT.	30.00'	5264.50 (-)
3	4+31.20, 7.00' LT.	SINGLE	4+51.32, 3.00' RT.	30.00'	5264.00 (-)
4	5+18.82, 7.00' LT.	DOUBLE	4+96.32, 3.00' RT.	30.00'	5265.45 (-)
5			5+41.32, 3.00' RT.	30.00'	5265.72 (-)
6	6+08.82, 7.00' LT.	DOUBLE	5+86.32, 3.00' RT.	30.00'	5265.99 (-)
7			6+31.32, 3.00' RT.	30.00'	5266.26 (-)
8	6+98.82, 7.00' LT.	DOUBLE	6+76.32, 3.00' RT.	30.00'	5266.53 (-)
9			7+21.32, 3.00' RT.	30.00'	5266.80 (-)
10	7+90.04, 7.00' LT.	DOUBLE	7+66.32, 3.00' RT.	30.00'	5267.07 (-)
11			8+13.26, 5.03' RT.	28.00'	5266.98 (-)
12	8+80.08, 7.00' LT.	DOUBLE	8+58.15, 7.33' RT.	25.70'	5267.38 (-)
13			8+86.59, 8.96' RT.	24.08'	5267.42 (-)

8" SAS TANGENT TABLE		
NUMBER	BEARING	DISTANCE
T1	S 60°18'09" W	70.18'
T2	S 89°49'03" E	415.11'
T3	S 86°53'03" E	119.19'


6" WATER TANGENT TABLE		
NUMBER	BEARING	DISTANCE
T4	N 89°49'03" W	464.81'
T5	S 86°53'03" E	107.05'

24" SD TANGENT TABLE		
NUMBER	BEARING	DISTANCE
T7	N 74°01'27" E	44.94'
T8	S 85°08'25" E	84.43'

18" SD TANGENT TABLE		
NUMBER	BEARING	DISTANCE
T9	S 89°49'18" E	49.84'
T10	N 71°09'45" E	70.64'

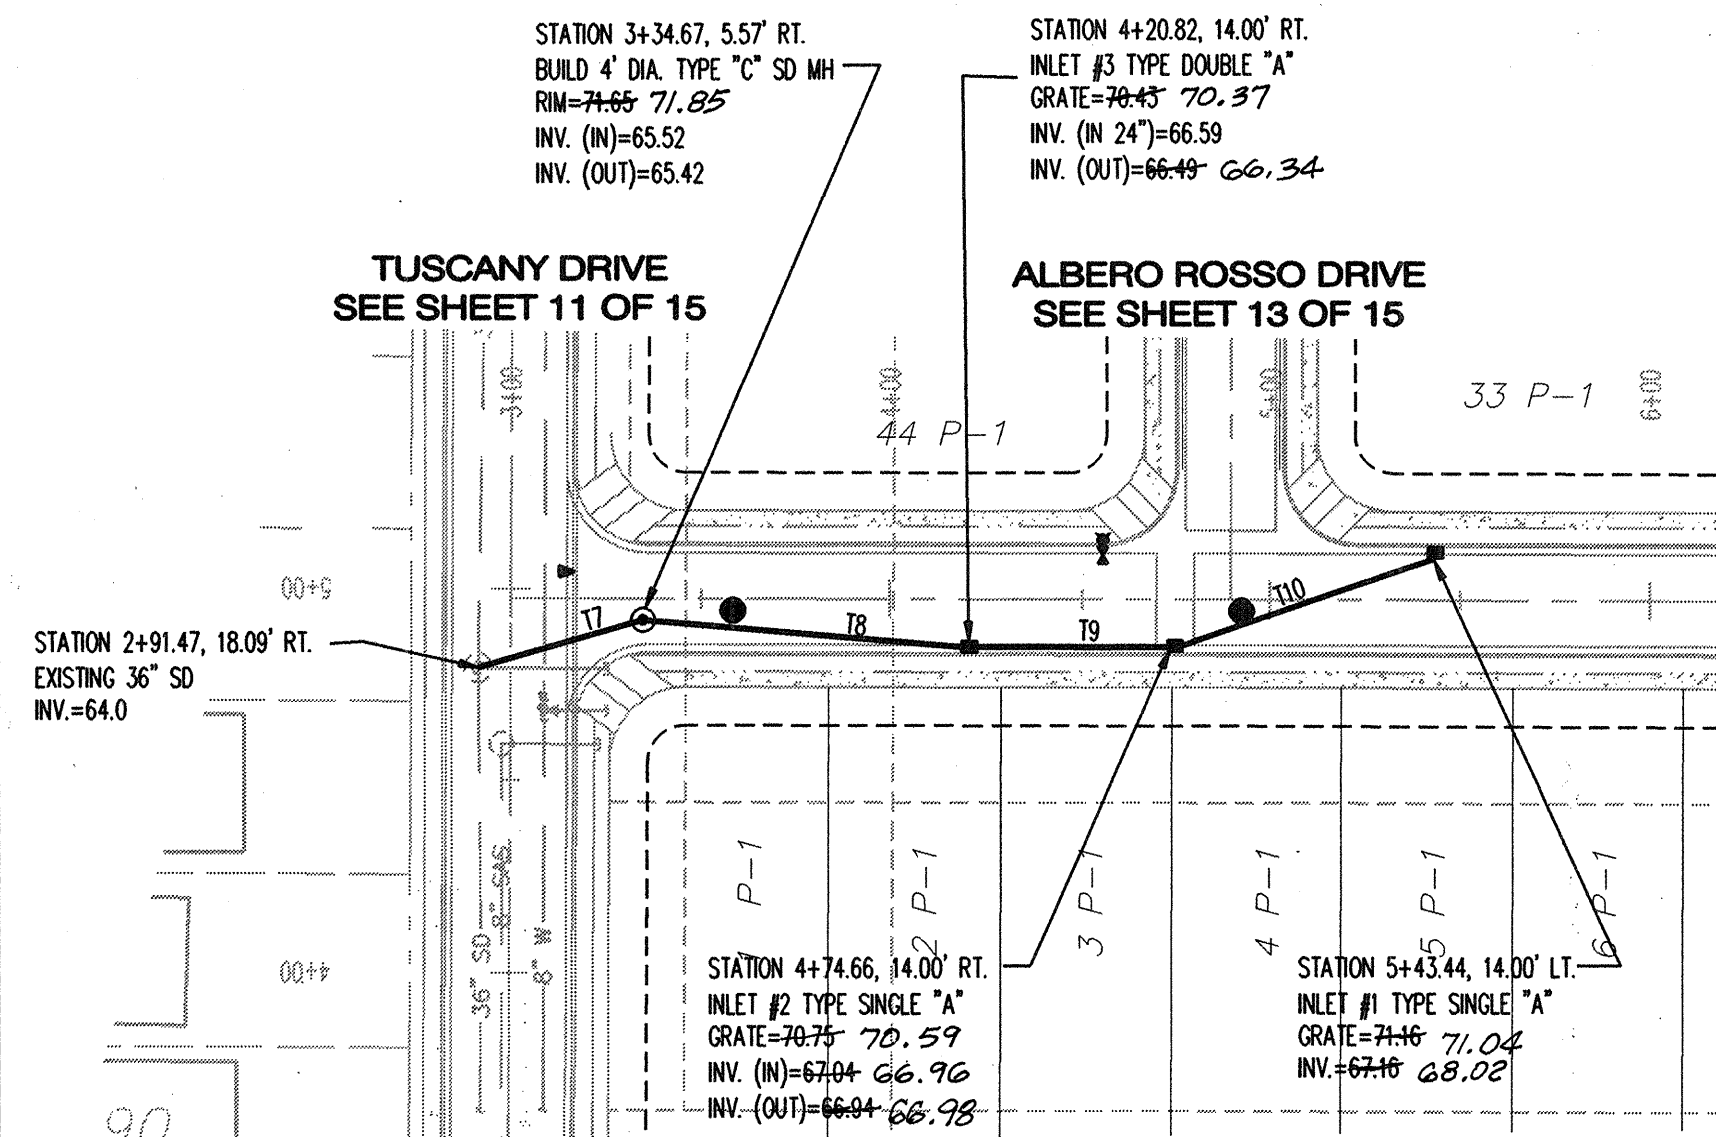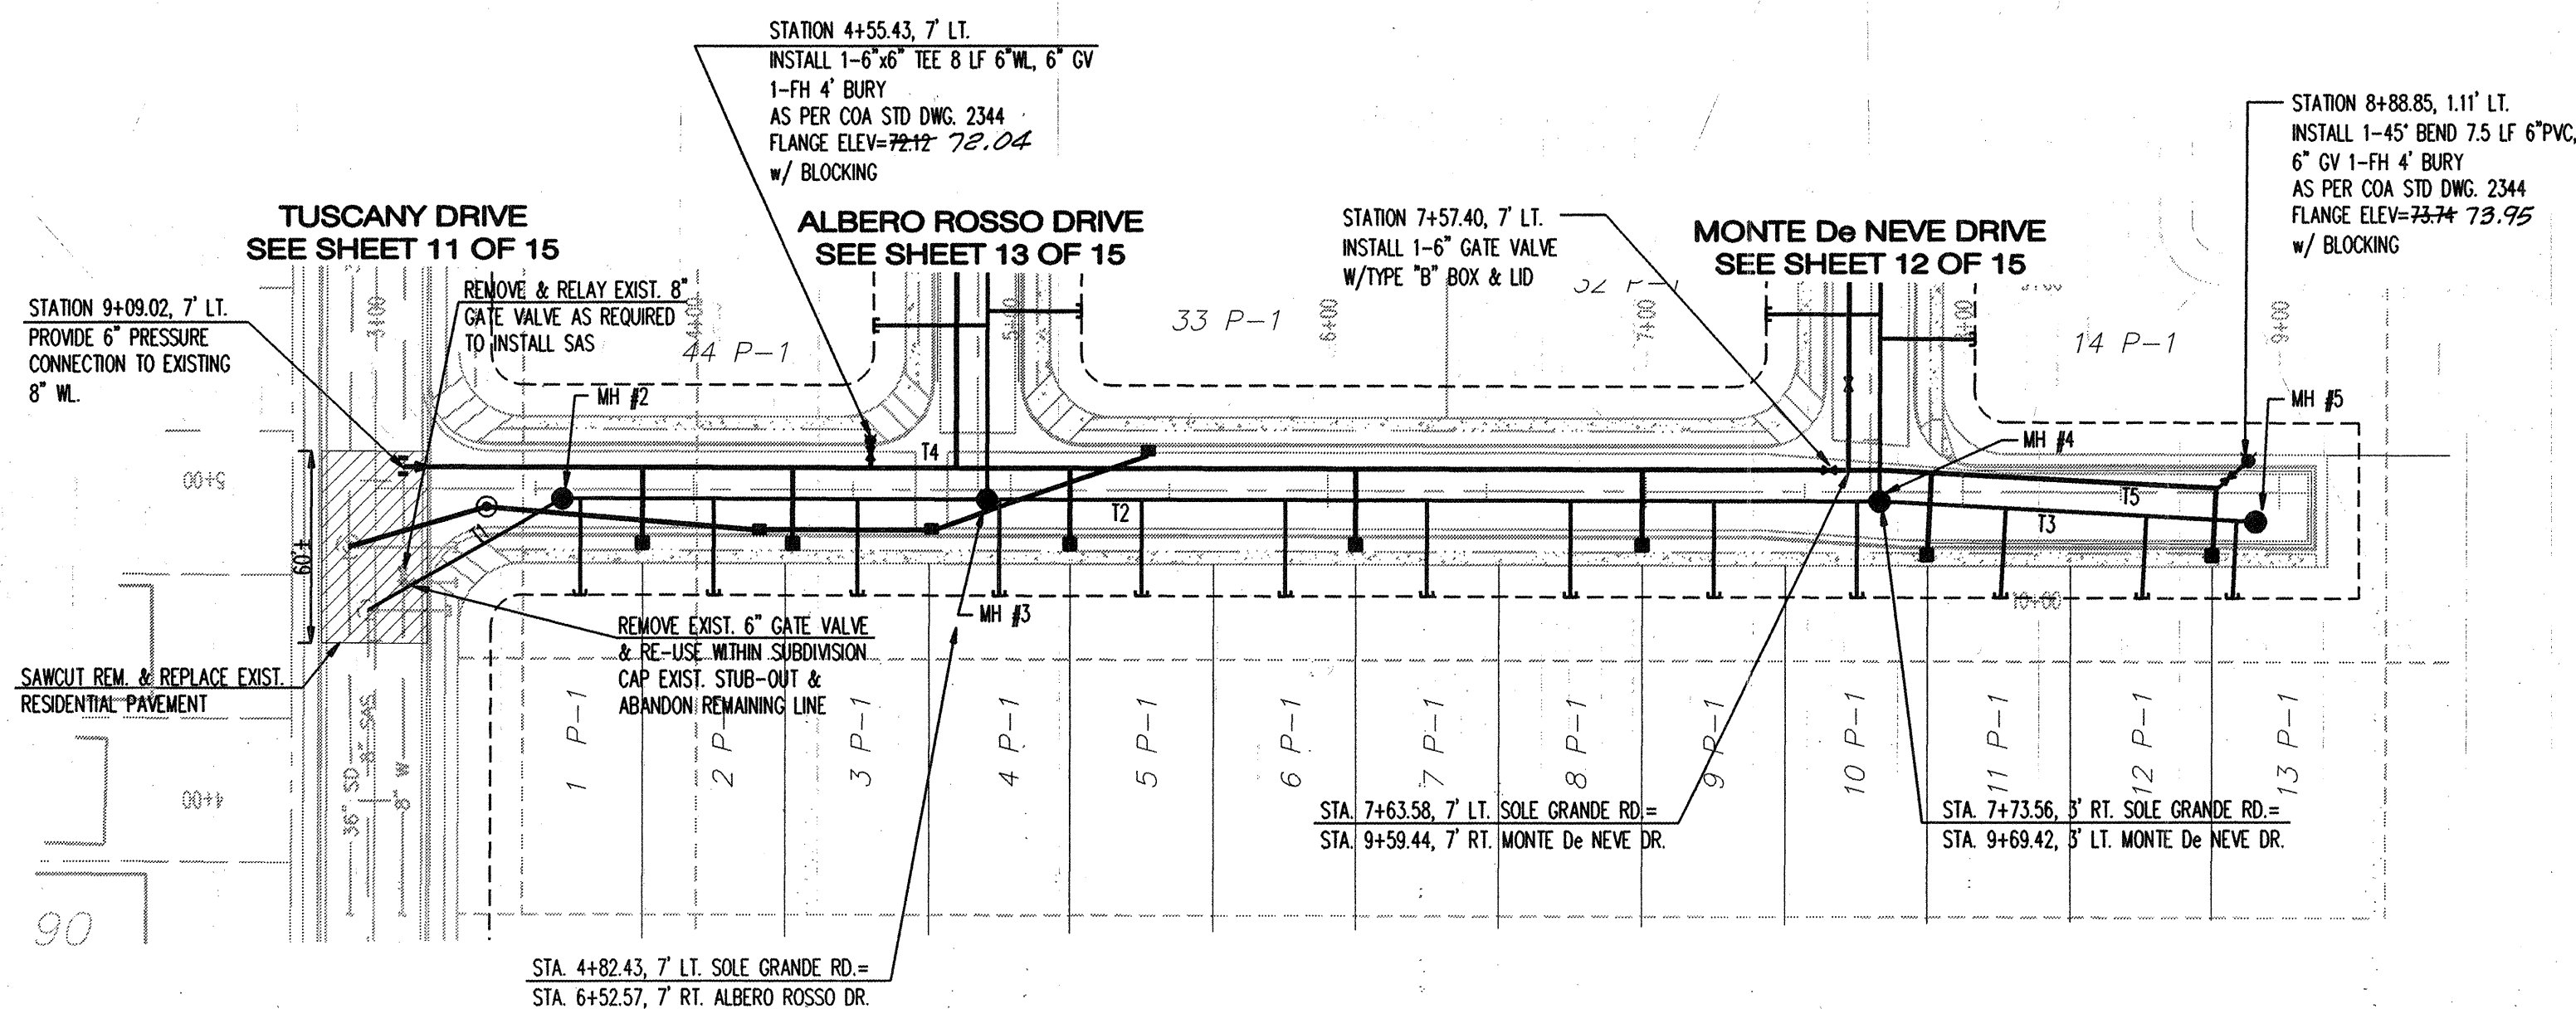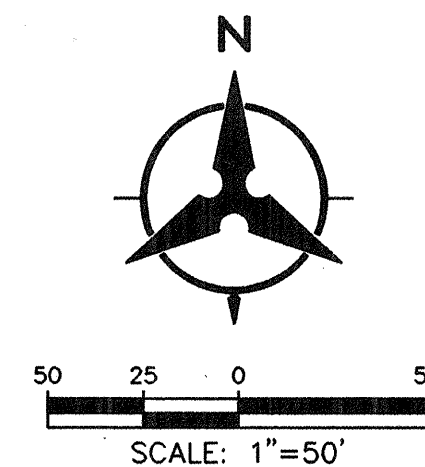

SOLE GRANDE ROAD

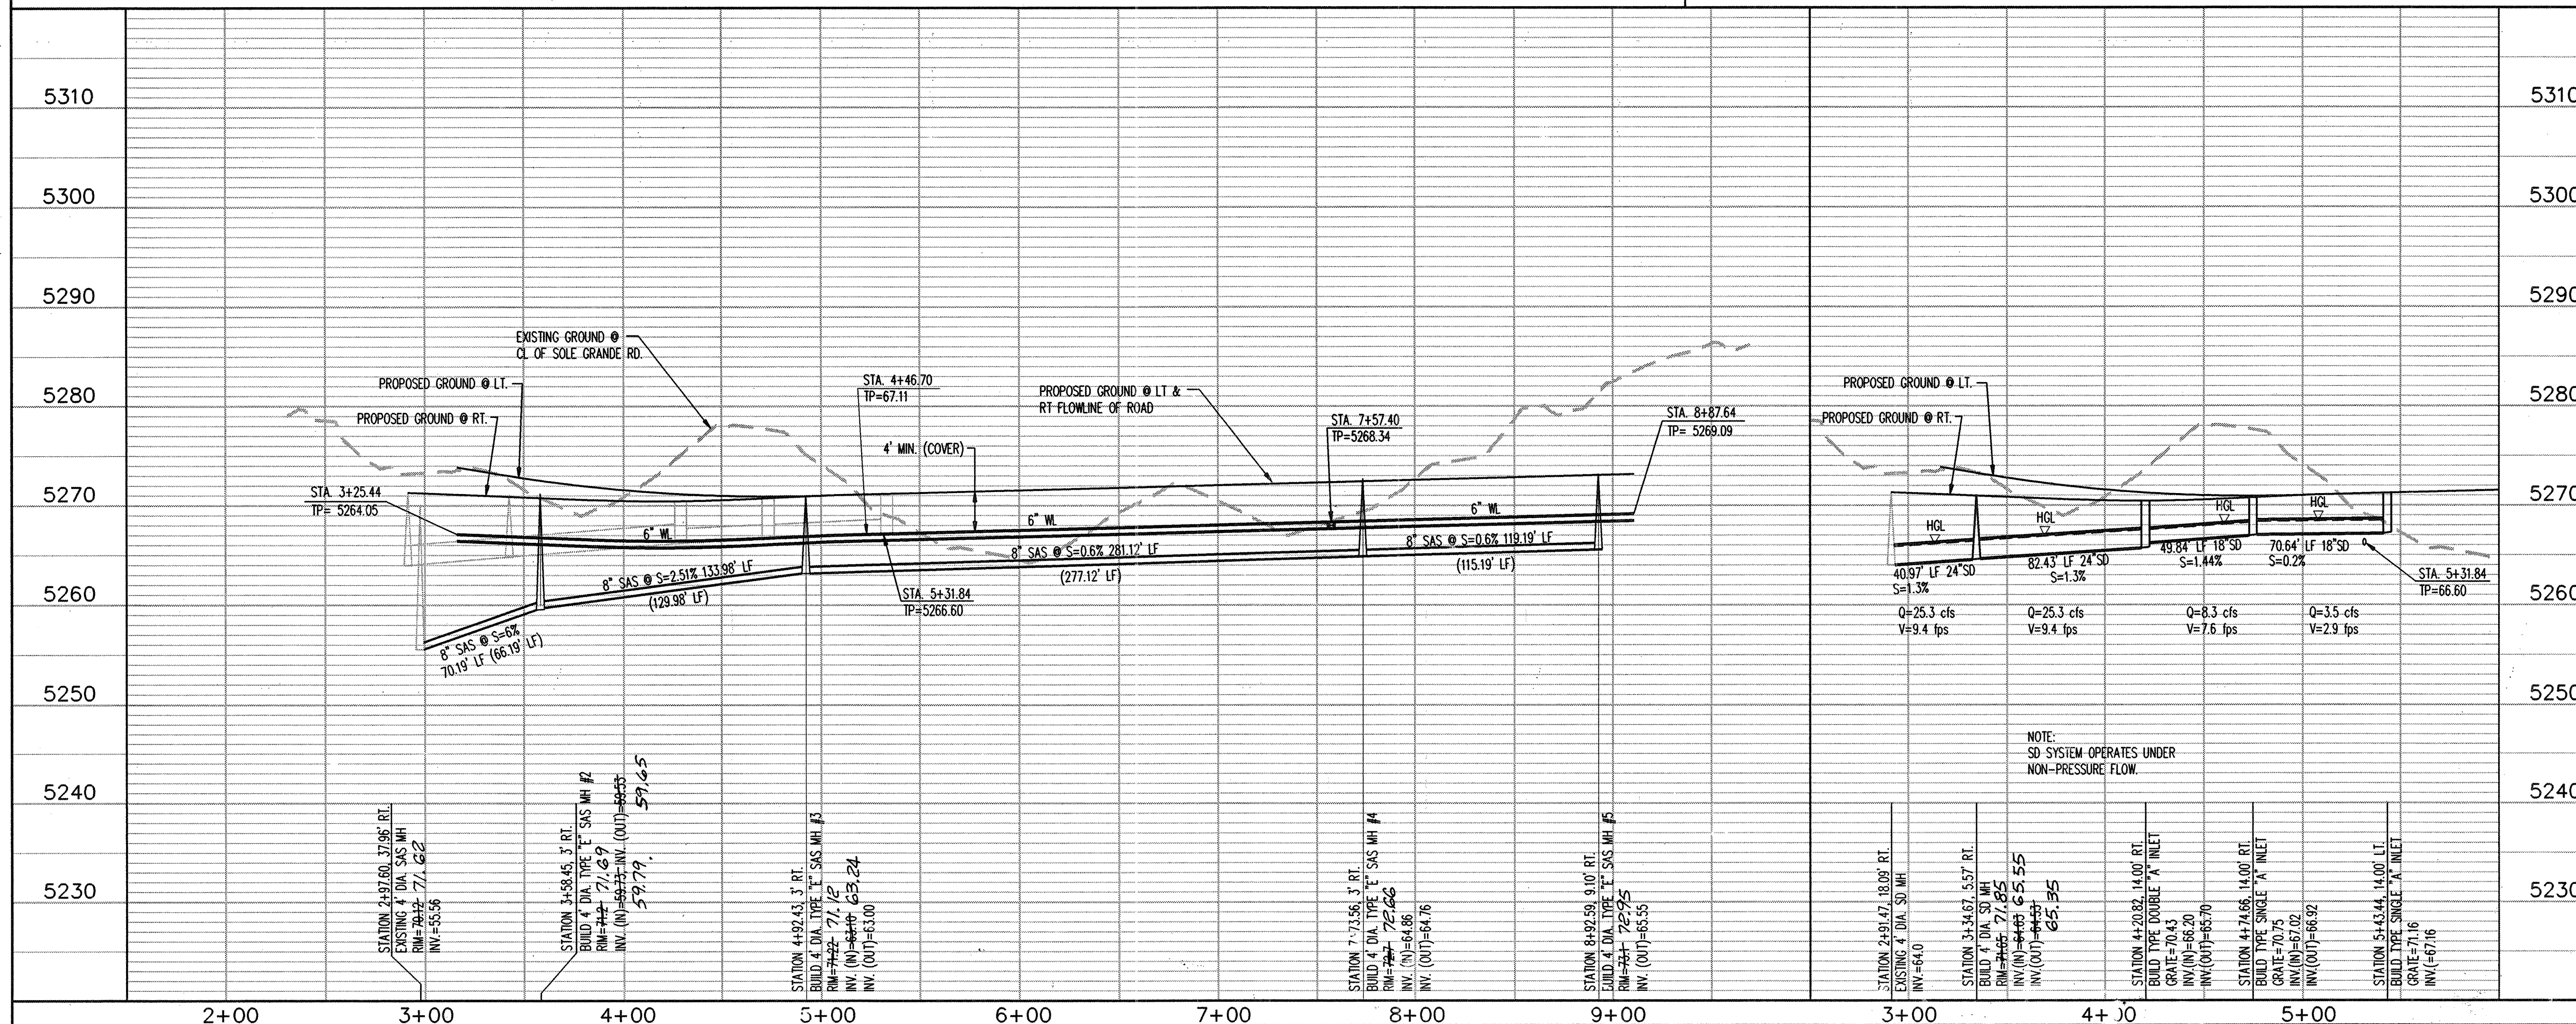

NOTES

- THE CONTRACTOR SHALL FIELD VERIFY ALL EXISTING UTILITY LOCATIONS AND NOTIFY THE ENGINEER IMMEDIATELY OF ANY DISCREPANCIES.
- ALL CURB RETURN RADII SHALL BE 20' UNLESS OTHERWISE SPECIFIED.
- ALL CURVE DATA AND DIMENSIONS REFER TO FACE OF CURB UNLESS OTHERWISE SPECIFIED.
- GRADE ELEVATIONS, WHERE NOTED, ARE FOR TOP OF STANDARD CURB UNLESS OTHERWISE SPECIFIED.
- CONTRACTOR IS TO INSTALL A 4" X 4" X 5' POST AND EMD AT THE END OF EACH SANITARY SEWER SERVICE.
- CONTRACTOR IS RESPONSIBLE FOR REPAIR AND/OR REPLACEMENT OF ALL UTILITY CONDUITS AND EXISTING LINES.
- ANY ADDITIONAL GRADING REQUIRED TO MATCH PROPOSED STREET GRADES SHALL BE INCIDENTAL TO PAVING ITEMS.
- CONTRACTOR SHALL PROVIDE THE INSPECTORS (CITY AND PRIVATE) WITH THE PROPOSED HYDROSTATIC TESTING PLAN. THE PLAN MUST BE APPROVED BEFORE TESTING OPERATIONS BEGIN.
- CONTRACTOR SHALL PARK EQUIPMENT AND VEHICLES AS NOT TO INTERFERE WITH NORMAL ACTIVITIES OF RESIDENTS OR OTHER CONTRACTORS ON SITE.
- ANY DAMAGE TO THE EXISTING FACILITIES (CURB & GUTTER), PAVEMENT, CONDUITS, LANDSCAPING, UTILITY LINES, ETC.) DURING CONSTRUCTION SHALL BE REPLACED AT THE CONTRACTORS' EXPENSE.
- REMOVAL OF THE EXISTING CURB AND GUTTER SHALL BE AS PER COA STD. DWG. 2415 (SAWCUT ONLY).
- WHEELCHAIR RAMPS SHALL BE CONSTRUCTED PRIOR TO ACCEPTANCE OF CURB & GUTTER.




RECORD DRAWING
DATE: **8-6-99**

Bohannon & Huston
Courtney One 7500 JEFFERSON NE ALBUQUERQUE NEW MEXICO 87109
ENGINEERS PLANNERS PHOTOGRAMMETRISTS SURVEYORS SOFTWARE DEVELOPERS


CITY OF ALBUQUERQUE
PUBLIC WORKS DEPARTMENT
ENGINEERING DEVELOPMENT GROUP
TUSCANY RIDGE UNIT 2
UTILITY & STORM DRAIN PLAN & PROFILE
SOLE GRANDE ROAD STA. 3+00 TO STA. 9+50

Design Review Committee City Engineer Approval
Mo./Day/Yr. Mo./Day/Yr.
1999


City Project No. **603481** Zone Map No. **A-12-Z** Sheet **14** Of **15**

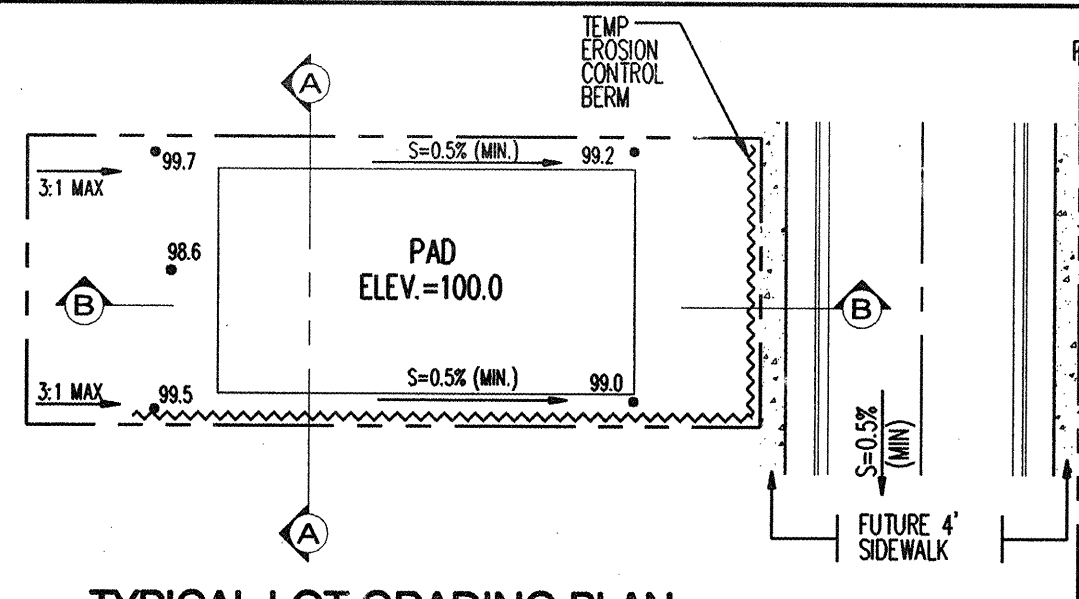

TYPICAL LOT GRADING PLAN
(SEE GRADING PLAN FOR SPOT ELEVATIONS)

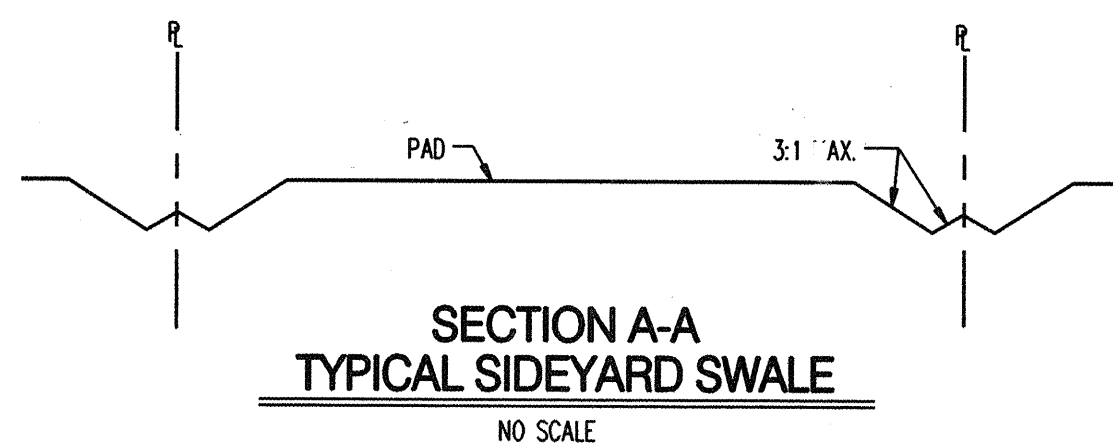


SECTION A-A
TYPICAL SIDEYARD SWALE
NO SCALE

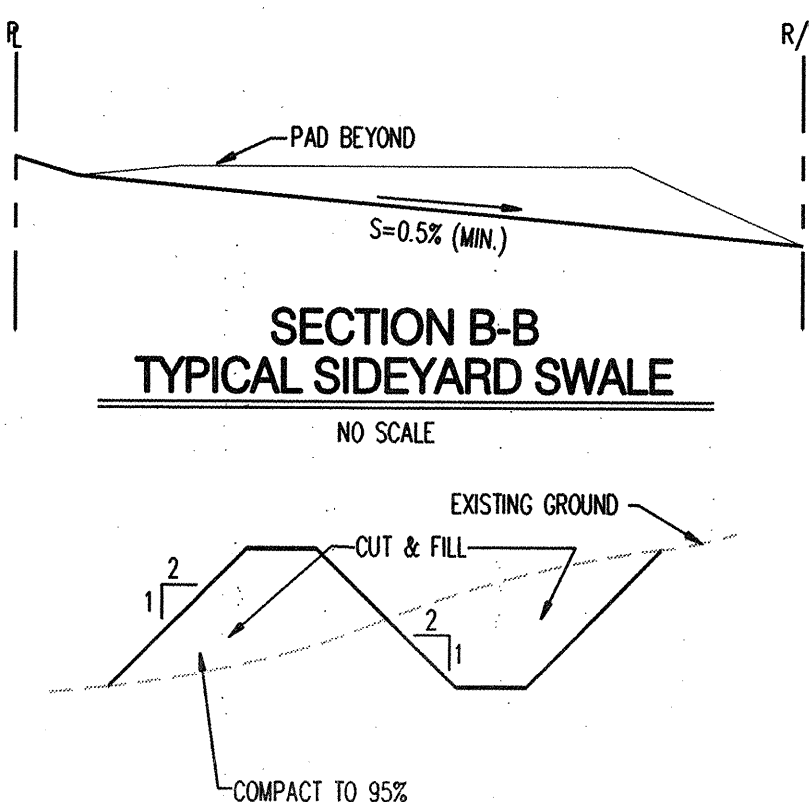

SECTION B-B
TYPICAL SIDEYARD SWALE
NO SCALE


TEMPORARY EROSION CONTROL BERM

BERM SHALL BE CONSTRUCTED IN LOCATION SHOWN ON TYPICAL LOT GRADING PLAN ALONG SOUTH EDGE OF SUBDIVISION

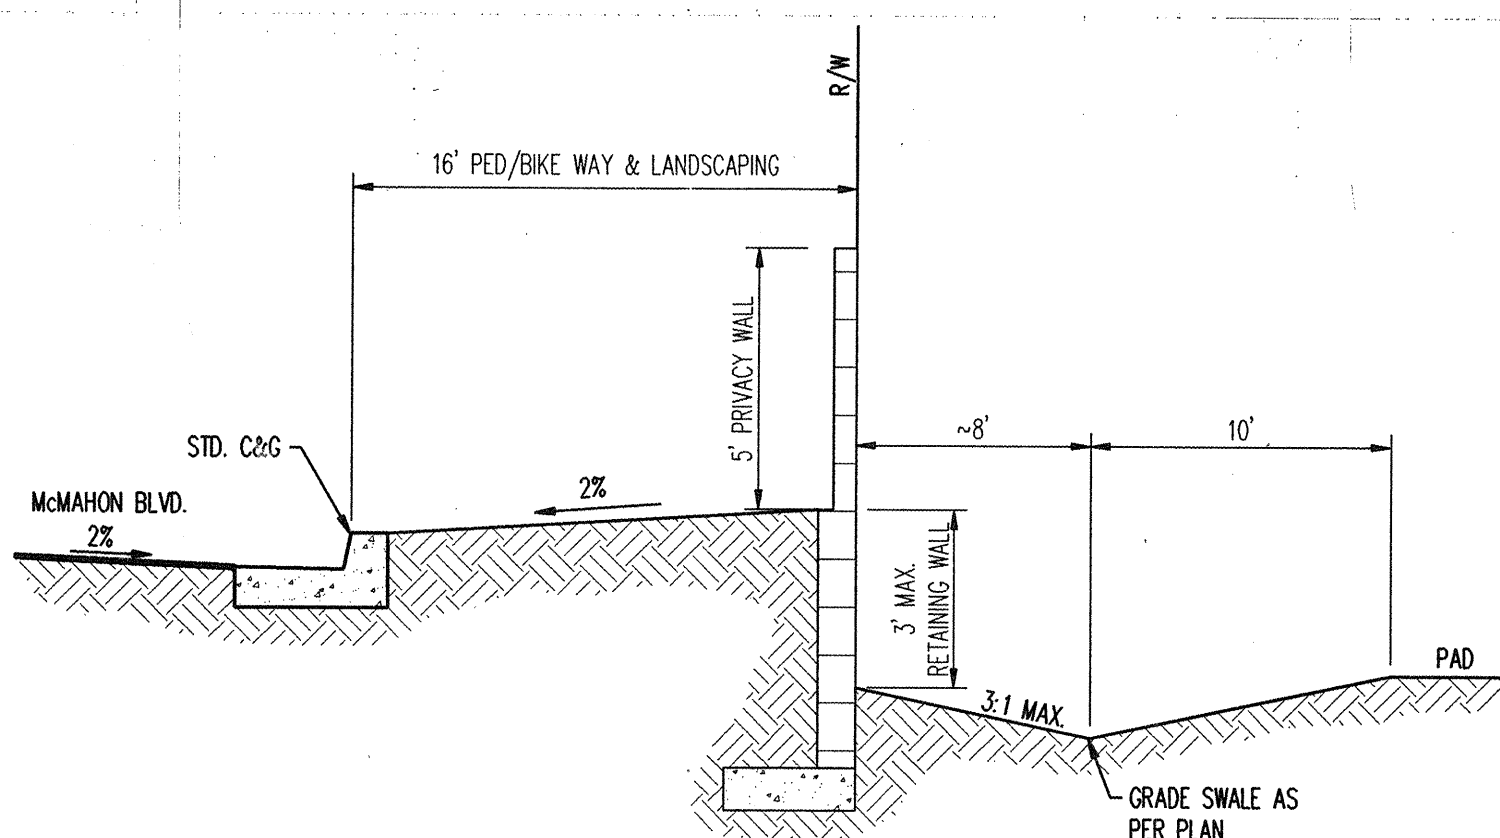


TYPICAL SECTION B

ALTERNATE #1

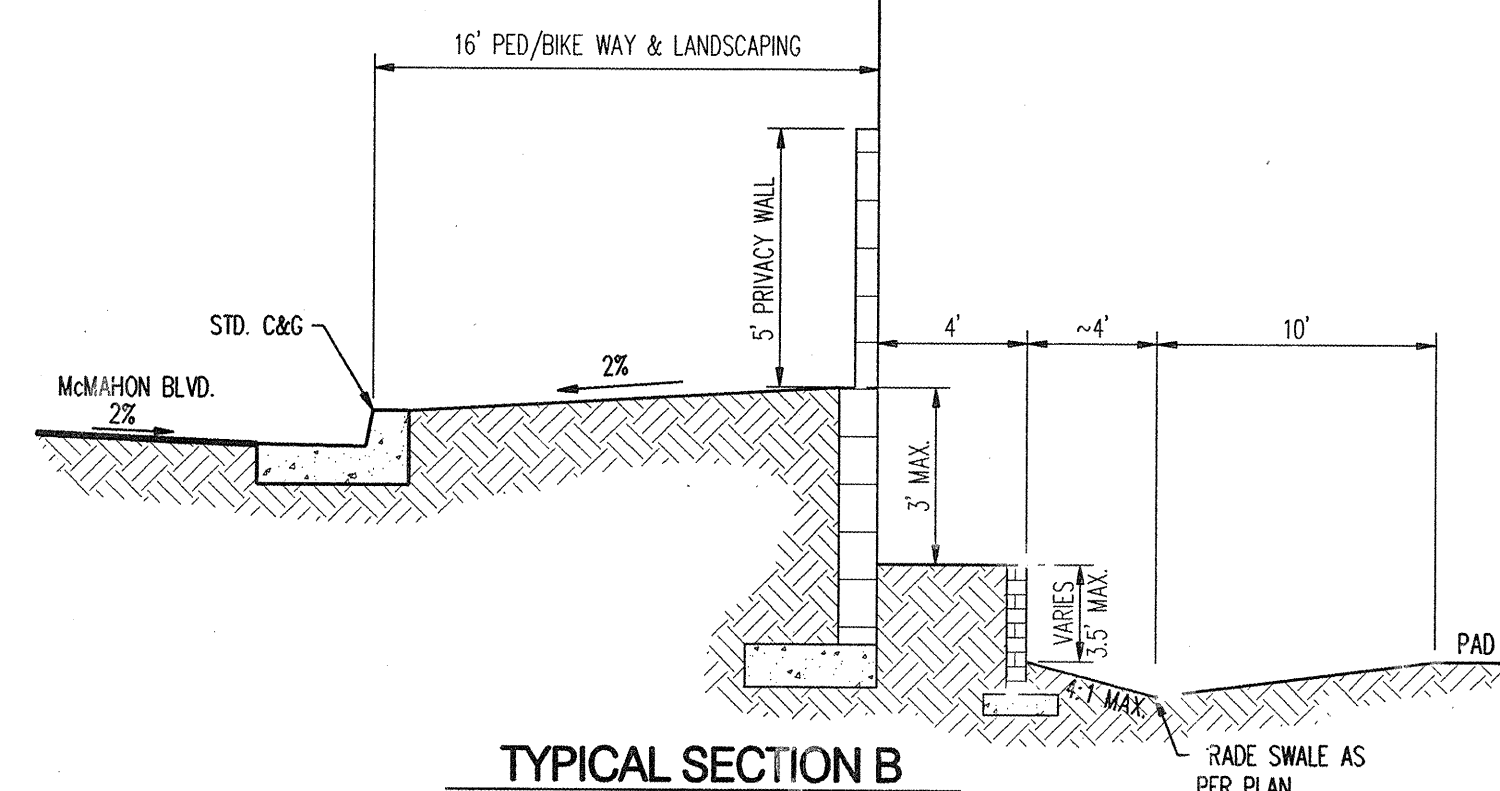


TYPICAL SECTION B

ALTERNATE #2

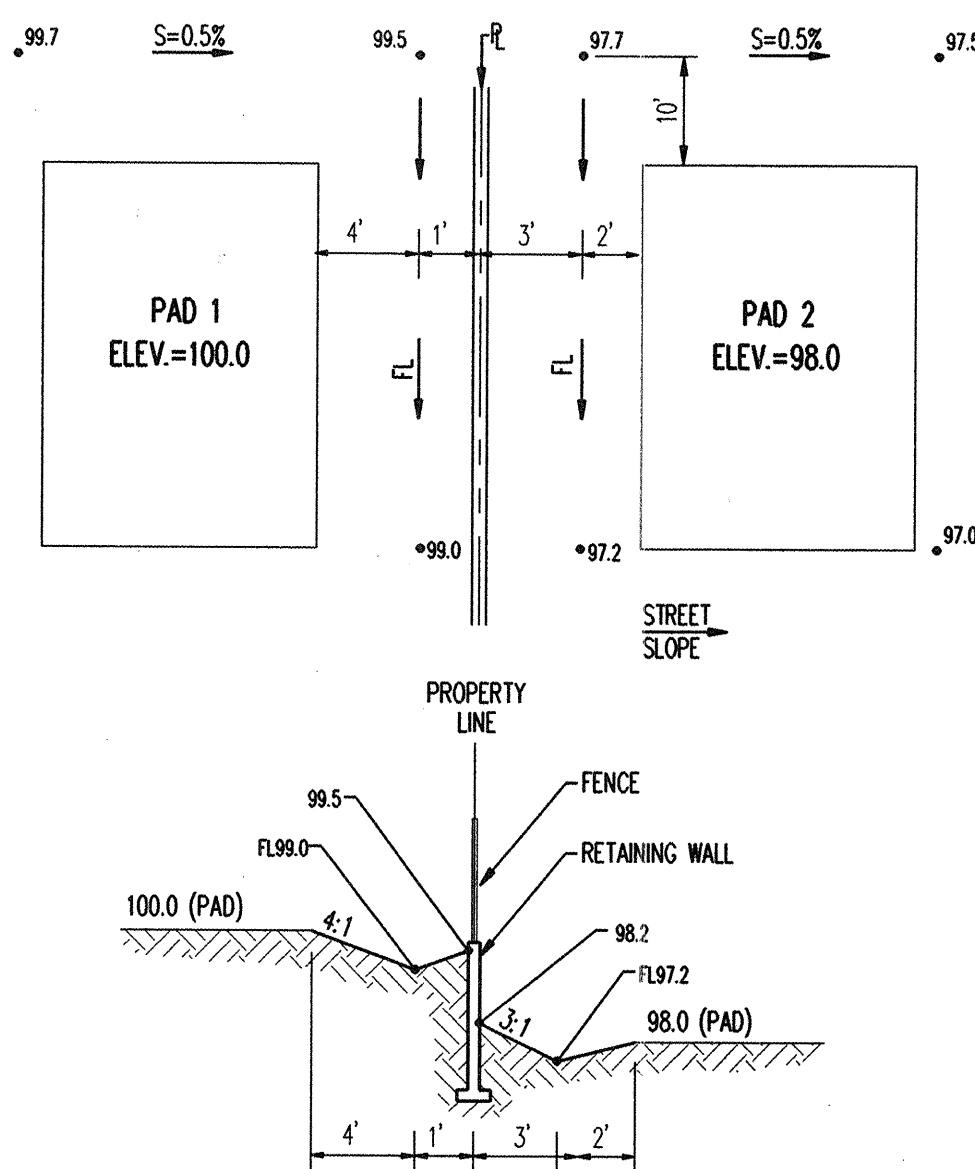


SIDE LOT GRADING

(TYPICAL FOR 5' SIDE YARDS W/ RETAINING WALLS)

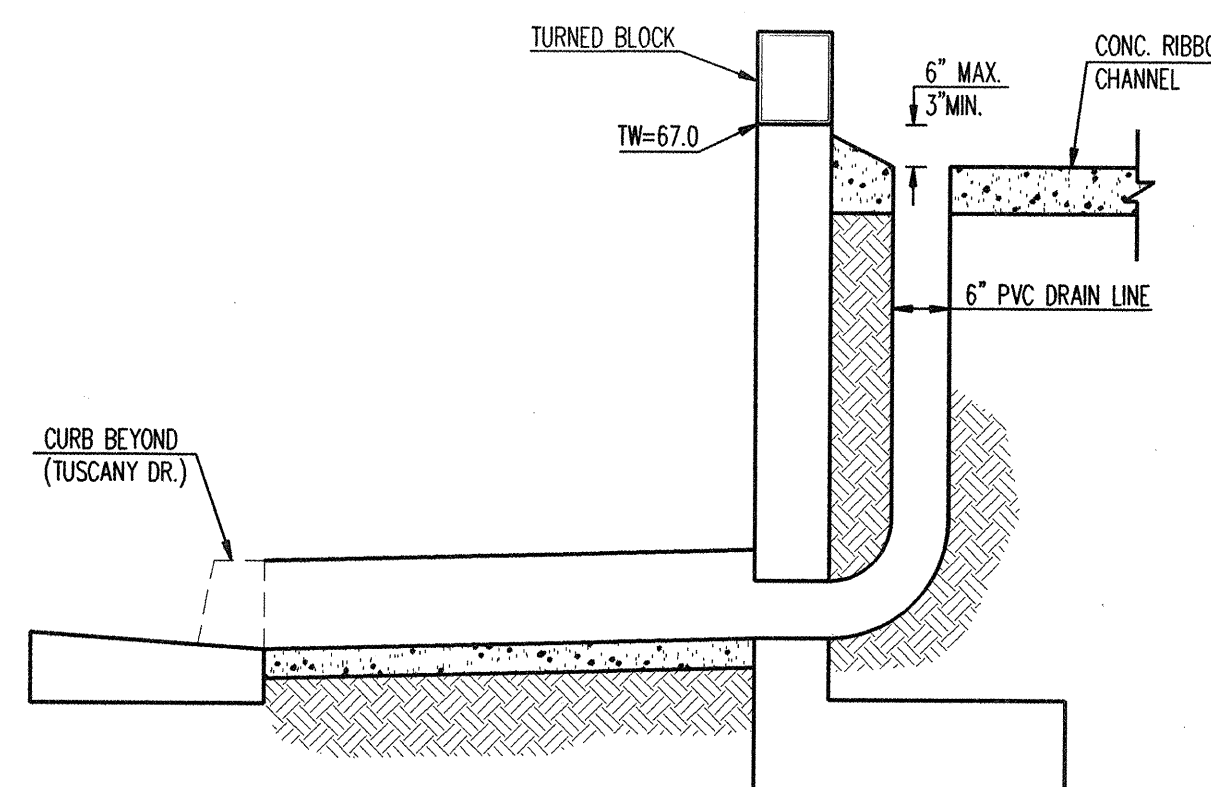


SECTION AT SIDEWALK
CORNER OF LOT 1
(THRU SIDEYARD)

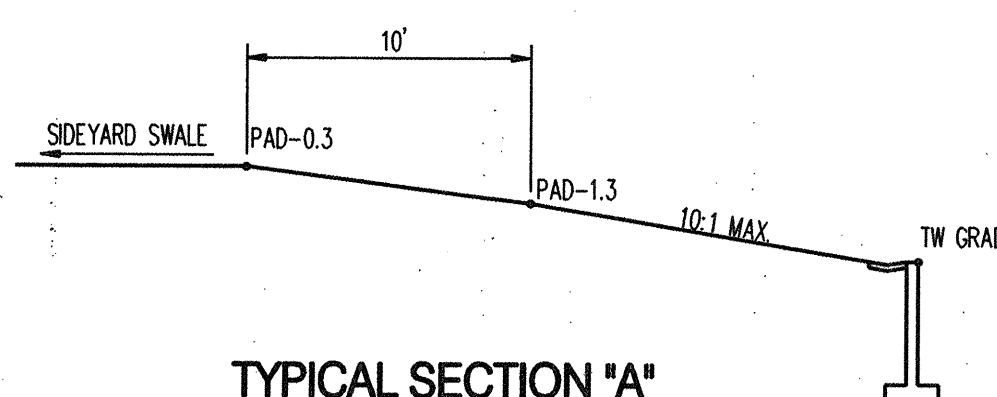


TYPICAL SECTION 'A'

(THRU SIDEYARD)

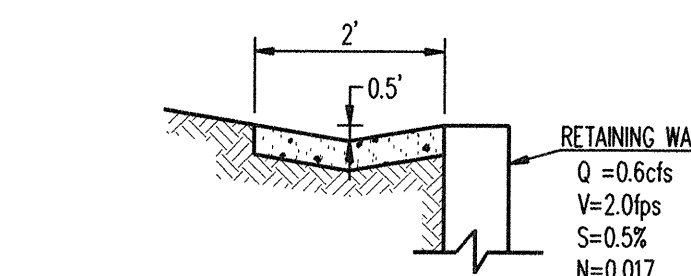


NOTE:
PROVIDE EXP. JTS & CONTROL JTS
AS REQUIRED FOR SIDEWALK

CONC. RIBBON CHANNEL DETAIL
(THRU SIDEYARD)

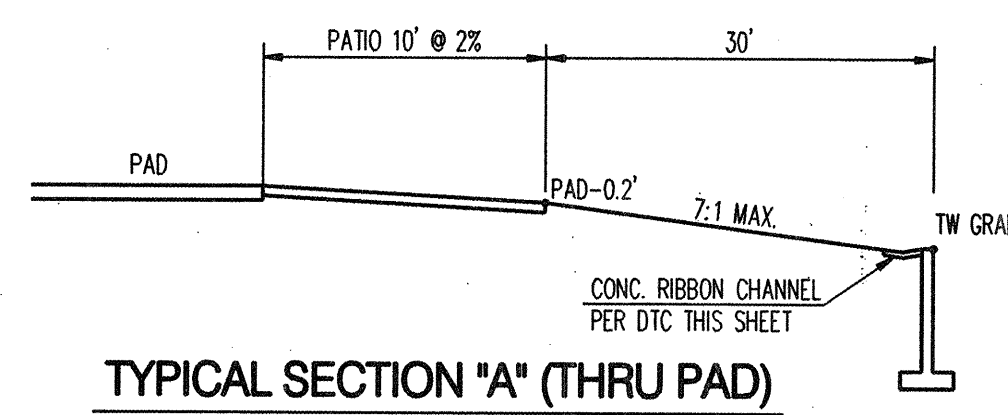


TYPICAL SECTION 'A' (THRU PAD)


(THRU SIDEYARD)

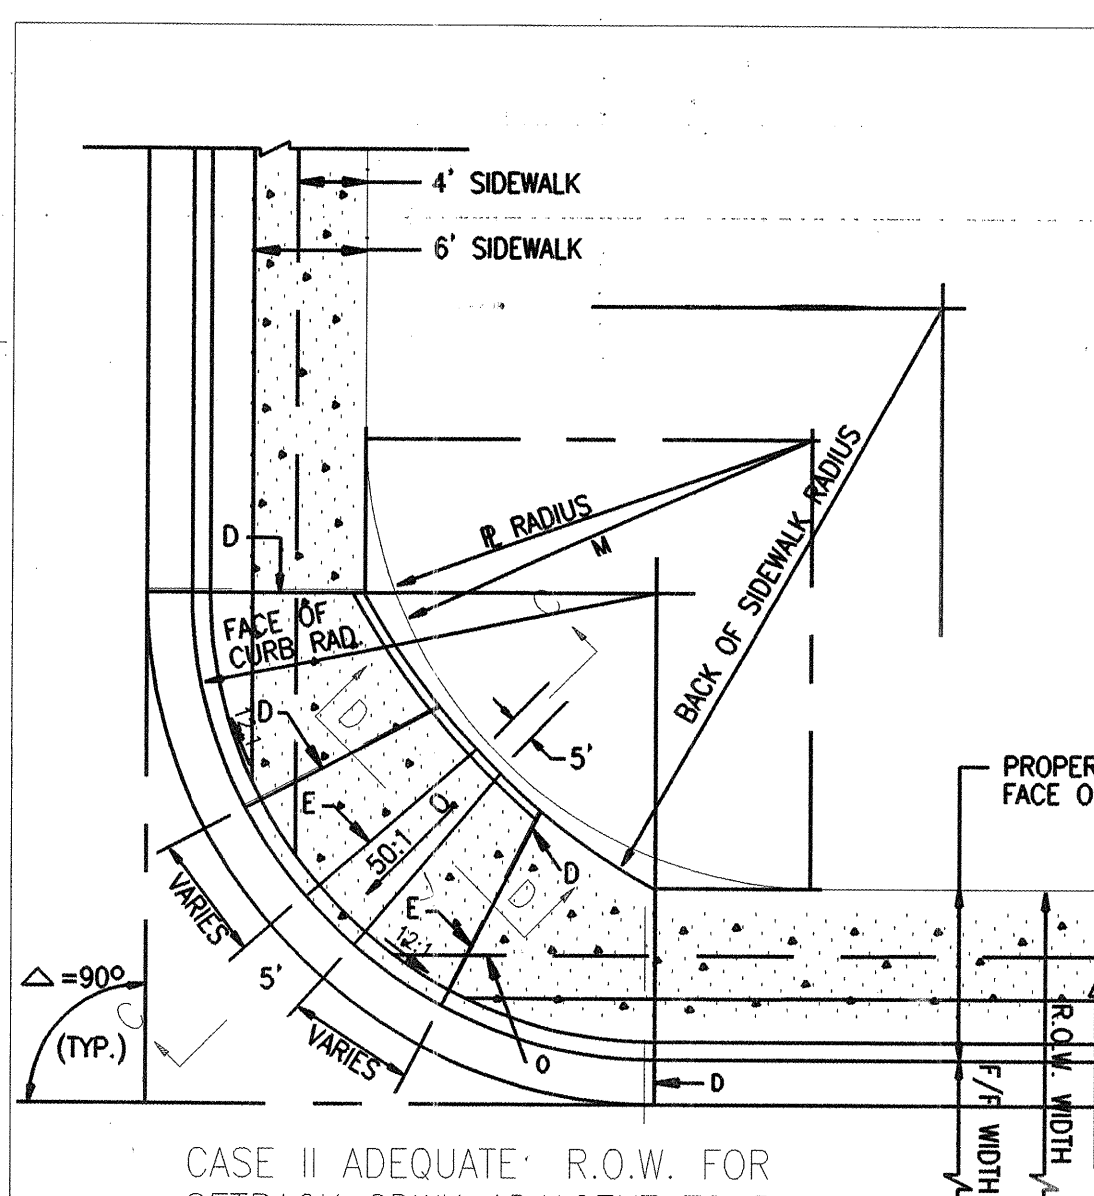


CASE II ADEQUATE R.O.W. FOR
SETBACK SDWK ADJACENT TO R

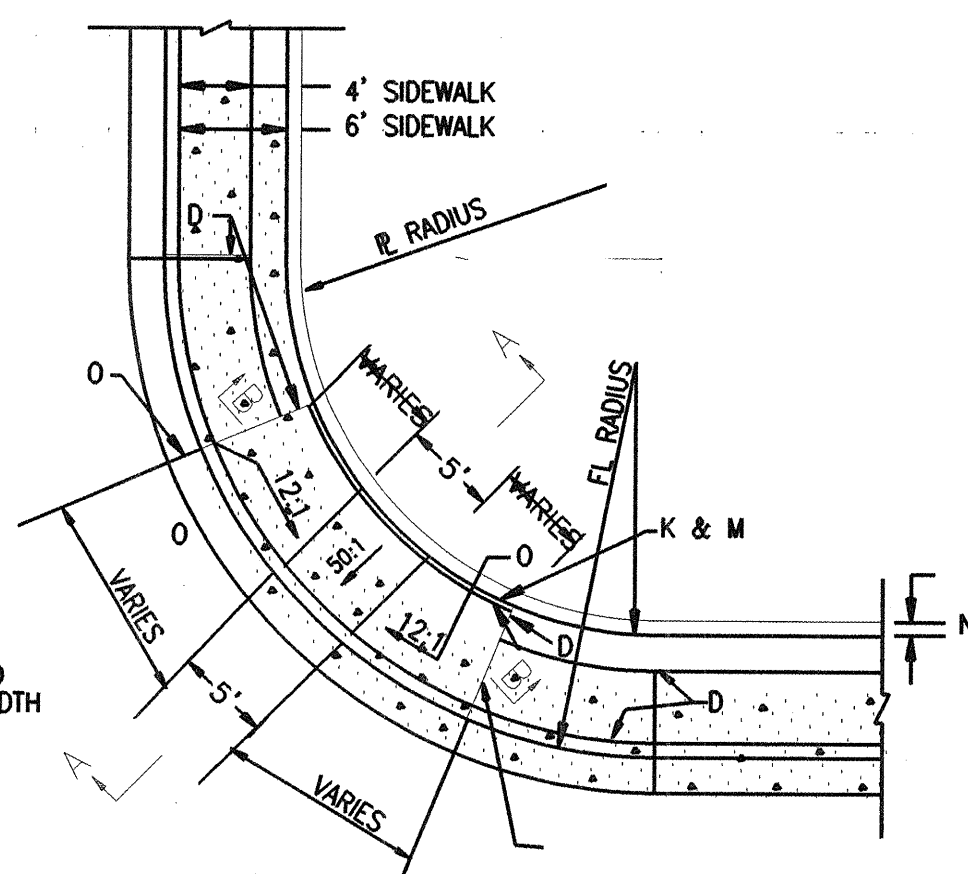


CASE I MINIMAL R.O.W. FOR
SIDEWALK AT BACK OF CURB

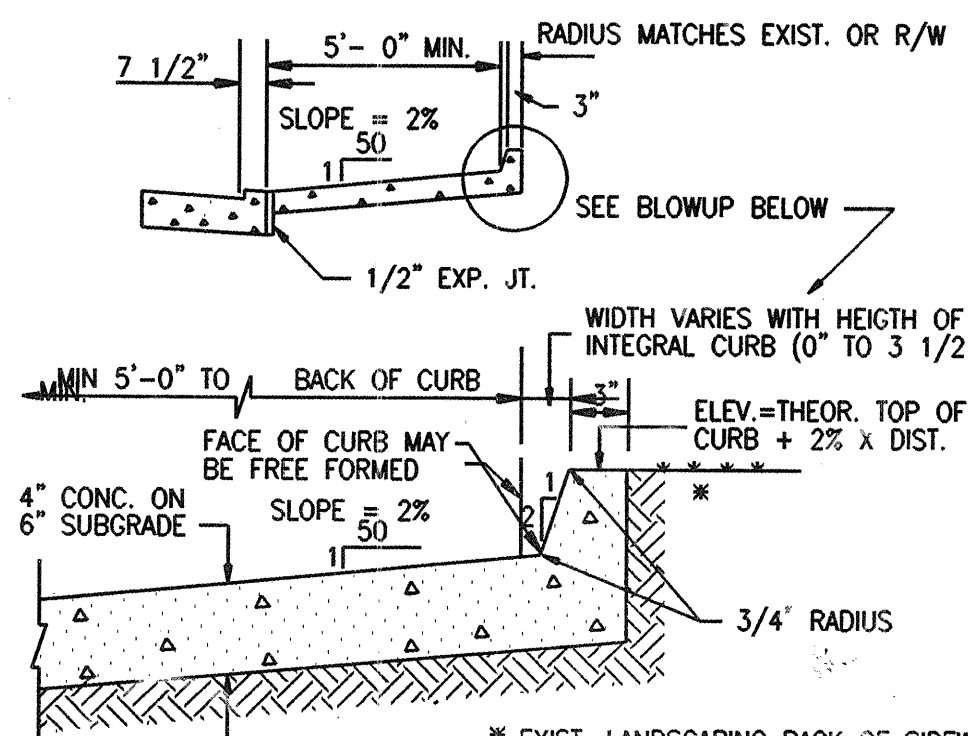


ALTERNATE SECTION
A-A

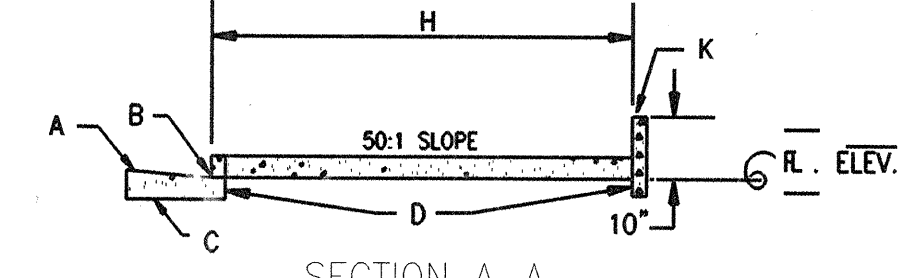

SECTION A-A

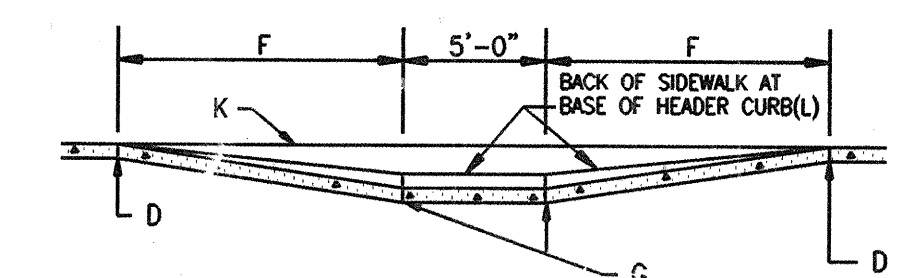

SECTION B-B

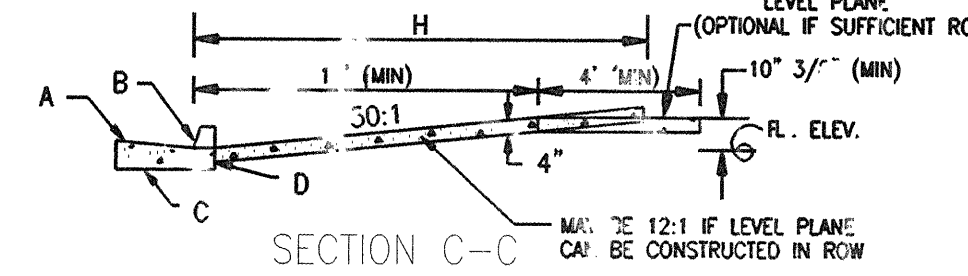

SECTION C-C


GENERAL NOTES:

1. CURB ACCESS RAMPS ARE NORMALLY TO BE LOCATED AT THE CENTER OF THE RETURN OR AS DIRECTED BY THE CITY TRAFFIC ENGINEER.
2. SURFACE TEXTURE OF CURB ACCESS RAMPS SHALL BE OBTAINED BY HEAVY BROOMING (TEXTURE DEPTH .035\"/>
3. GUTTER FLOW-LINE PROFILE SHALL BE MAINTAINED THROUGH THE AREA OF THE RAMP. DRAINAGE CATCH BASIN STRUCTURES SHALL NOT BE PLACED IN LINE WITH RAMPS.
4. WIDTH OF SIDEWALK AND RAMP MUST BE MAINTAINED AT A MINIMUM OF 5'-0\"/>



CONSTRUCTION NOTES:

- A. SLOPE OF GUTTER DEPENDENT ON REQUIREMENTS FOR VALLEY GUTTER.
- B. 1/4\"/>
- C. CURB & GUTTER (SEE STD. DWG 2415 - GUTTER AT THE CURB ACCESS RAMP).
- D. 1/2\"/>
- E. PARALLEL LINES - TOP AND BOTTOM OF RAMP.
- F. 12:1 SLOPE AT FACE OF CURB. (SEE STD. DWG 2418)
- G. CONTRACTION (DUMMY) JOINT.
- H. VARIES WITH AVAILABLE R.O.W.
- I. VARIABLE.
- J. HEADER CURB, SEE DWG. 2415.
- K. BACK OF SIDEWALK.
- L. BACK OF SIDEWALK.
- M. BACK OF SIDEWALK RADIUS TO BE ESTABLISHED SO AS TO MAINTAIN A 5'-0\"/>
- N. 4 1/2\"/>
- O. 12:1 SLOPE MAXIMUM ON RAMP.
- P. ANY PRIVATE LANDSCAPING AND/OR IRRIGATION SHALL BE RESTORED TO ORIGINAL CONDITION. SHOULD ANY PRIVATE IMPROVEMENT NEED TO BE REMOVED, OWNER MUST BE NOTIFIED.

IR RAD	CURB RAD	CURB WIDTH	BACK SW RAD
90'	25'	4'	25'
30'	30'	25'	4'
30'	25'	4'	30'
90'	30'	30'	4'

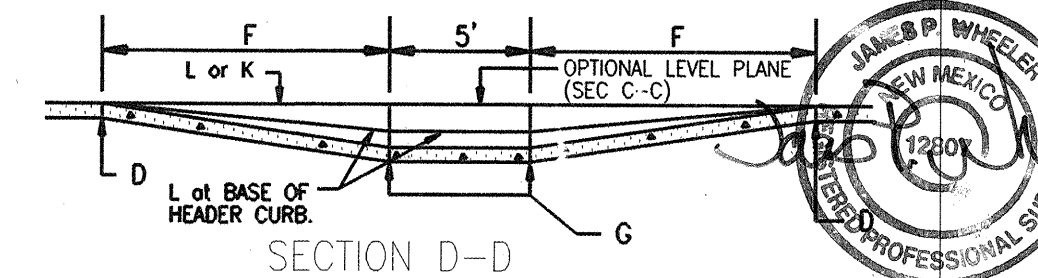

SECTION D-D

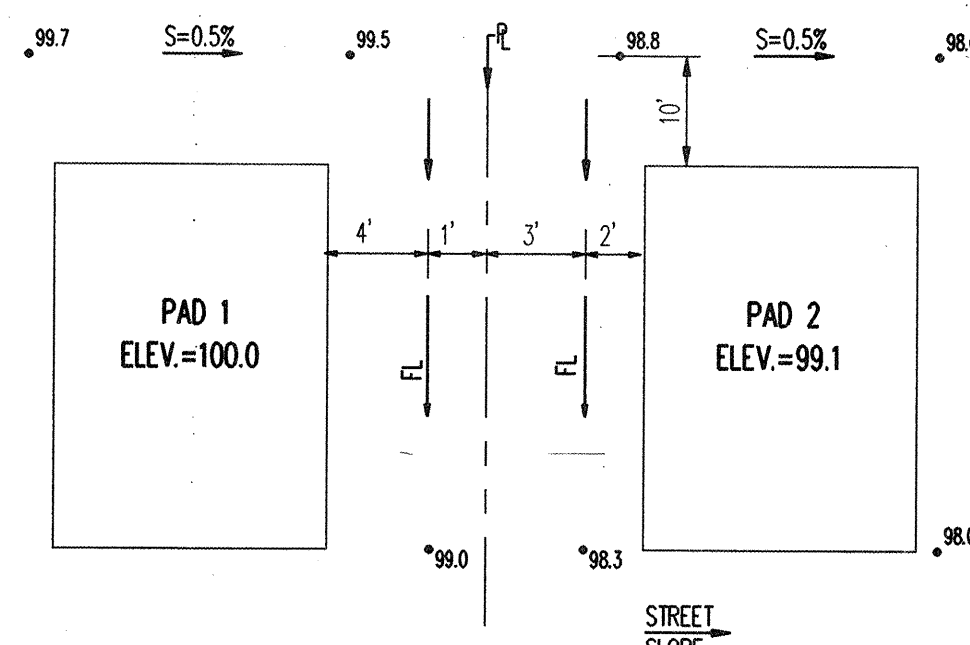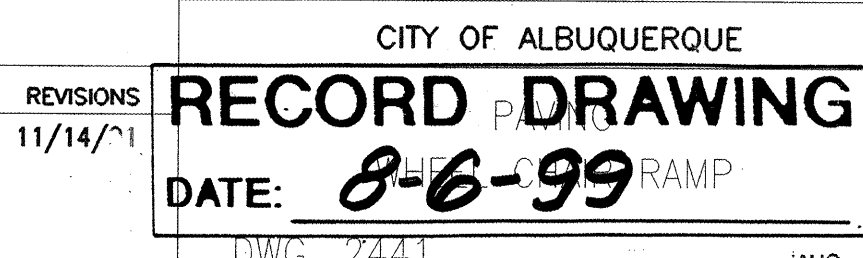

SIDE LOT GRADING

(TYPICAL FOR 5' SIDE YARDS W/O RETAINING WALLS)




Bohannon & Huston

Courtyard One 7500 JEFFERSON NE ALBUQUERQUE NEW MEXICO 87109


ENGINEERS PLANNERS PHOTOGRAMMETRISTS SURVEYORS SOFTWARE DEVELOPERS

CITY OF ALBUQUERQUE
PUBLIC WORKS DEPARTMENT
ENGINEERING DEVELOPMENT GROUP
TUSCANY RIDGE UNIT 2
MISCELLANEOUS DETAILS

Design-Review-Committee	City Engineer Approval	Mo./Day/Yr.	Mo./Day/Yr.
1999			
City Project No.	Zone Map No.	Sheet	Of
603481	A-12-Z	15	15

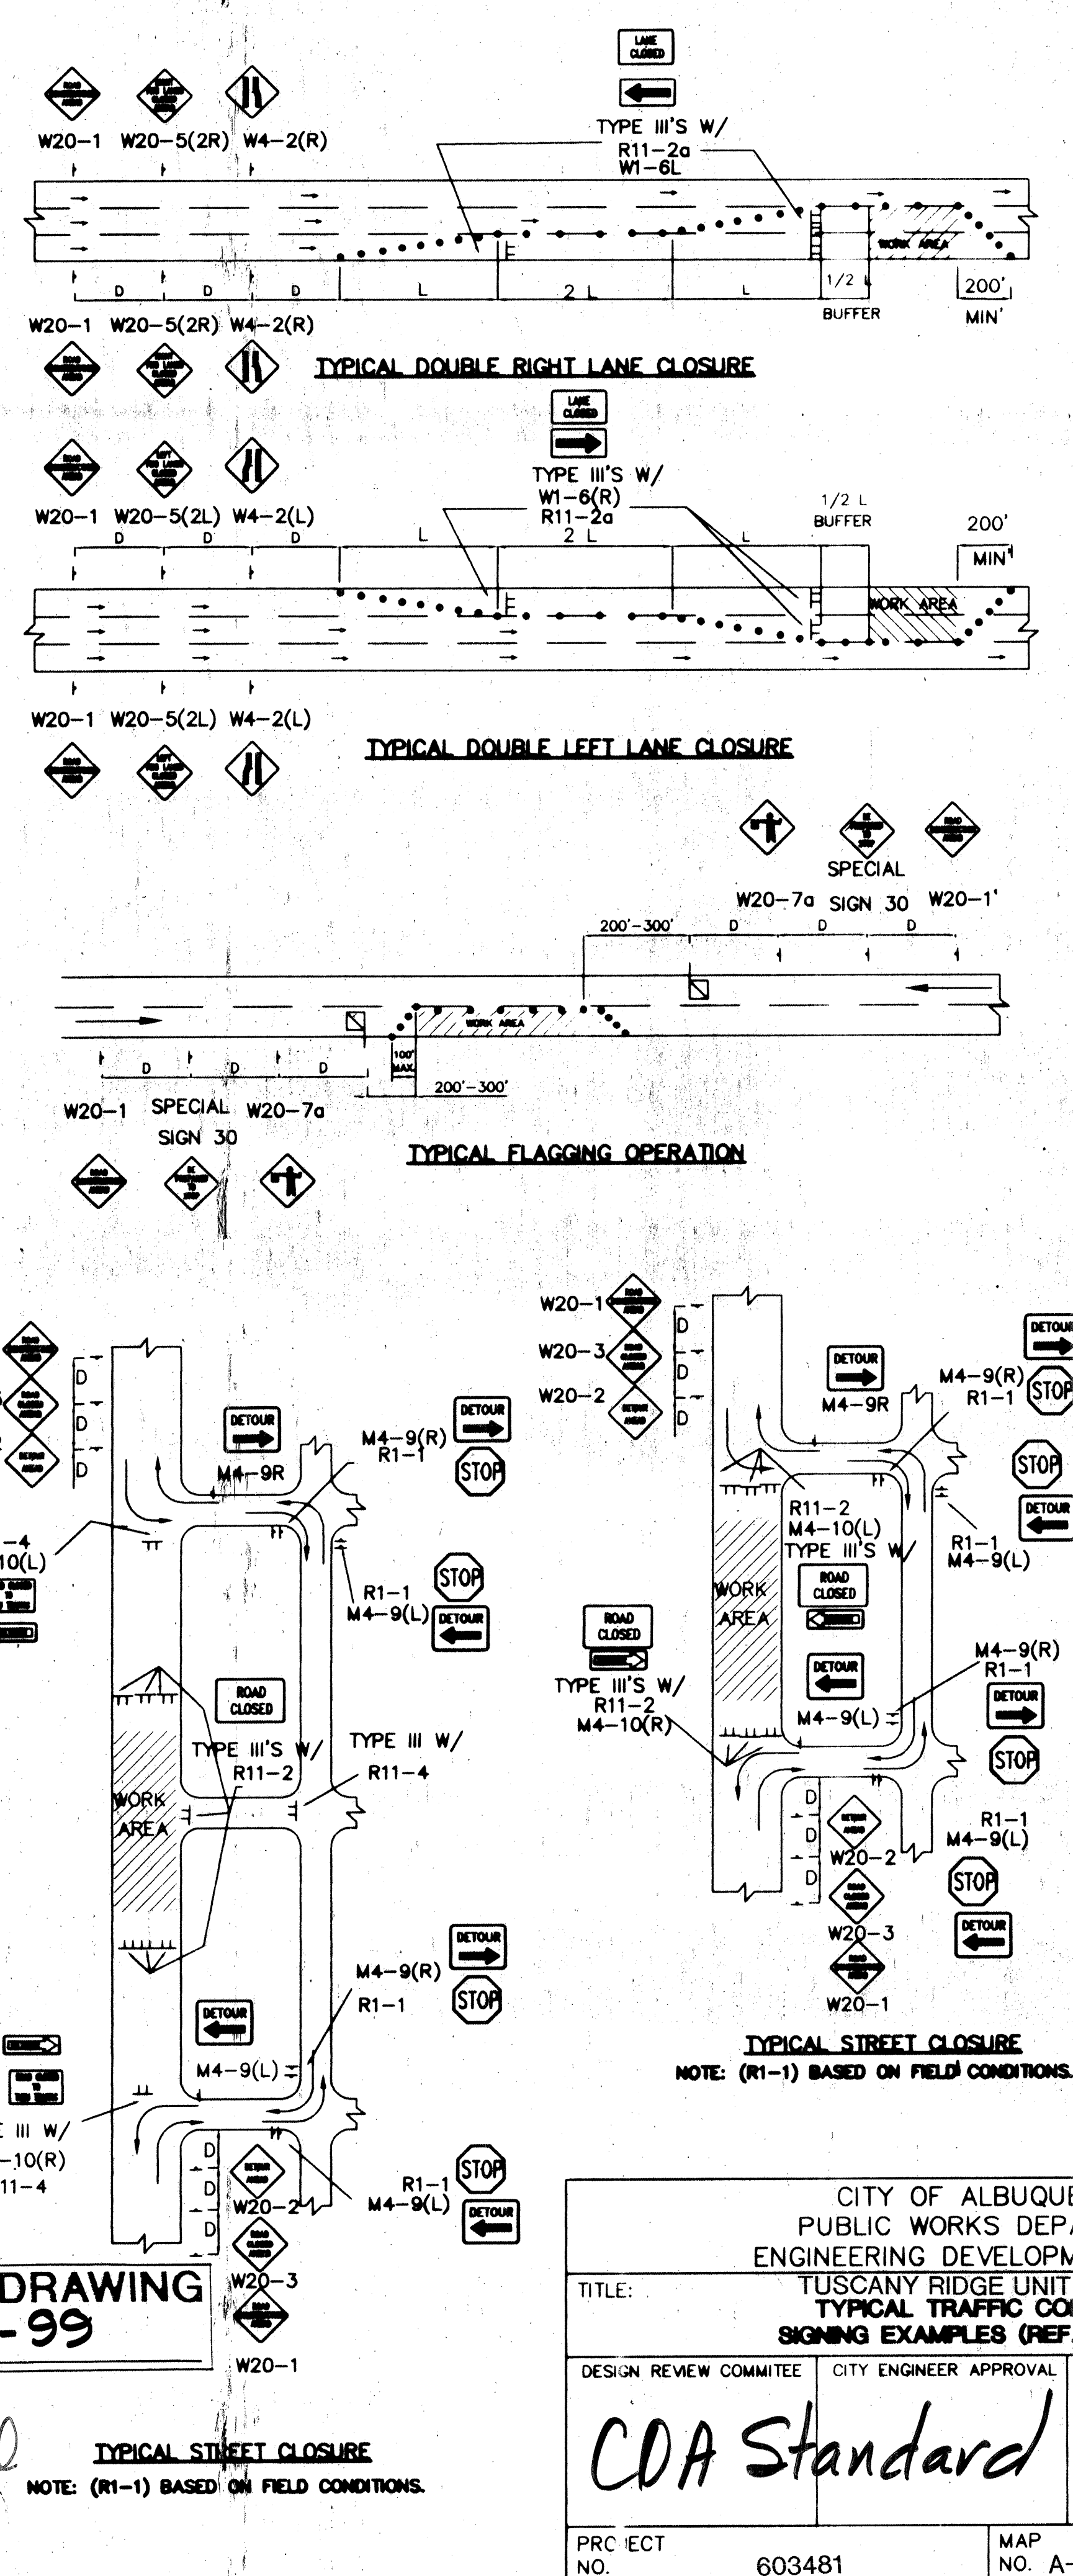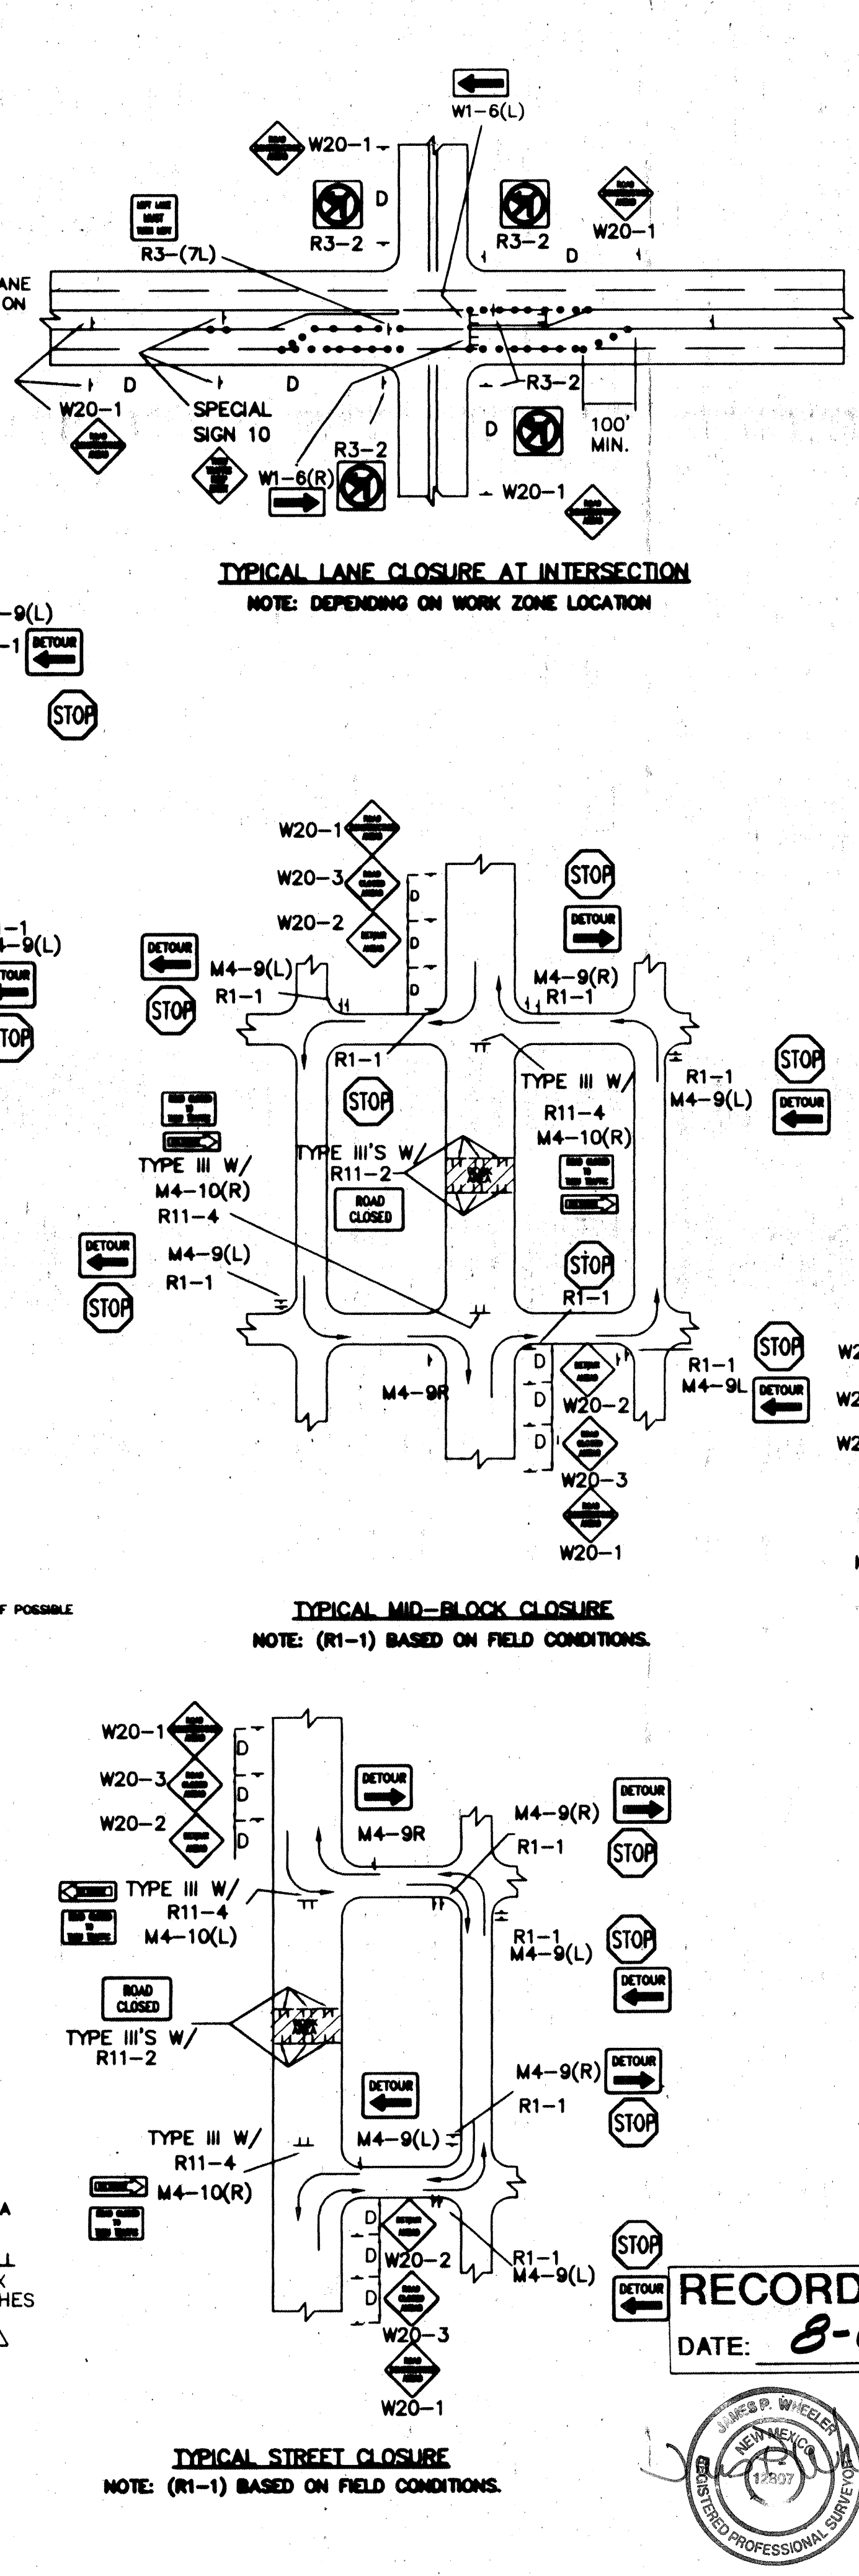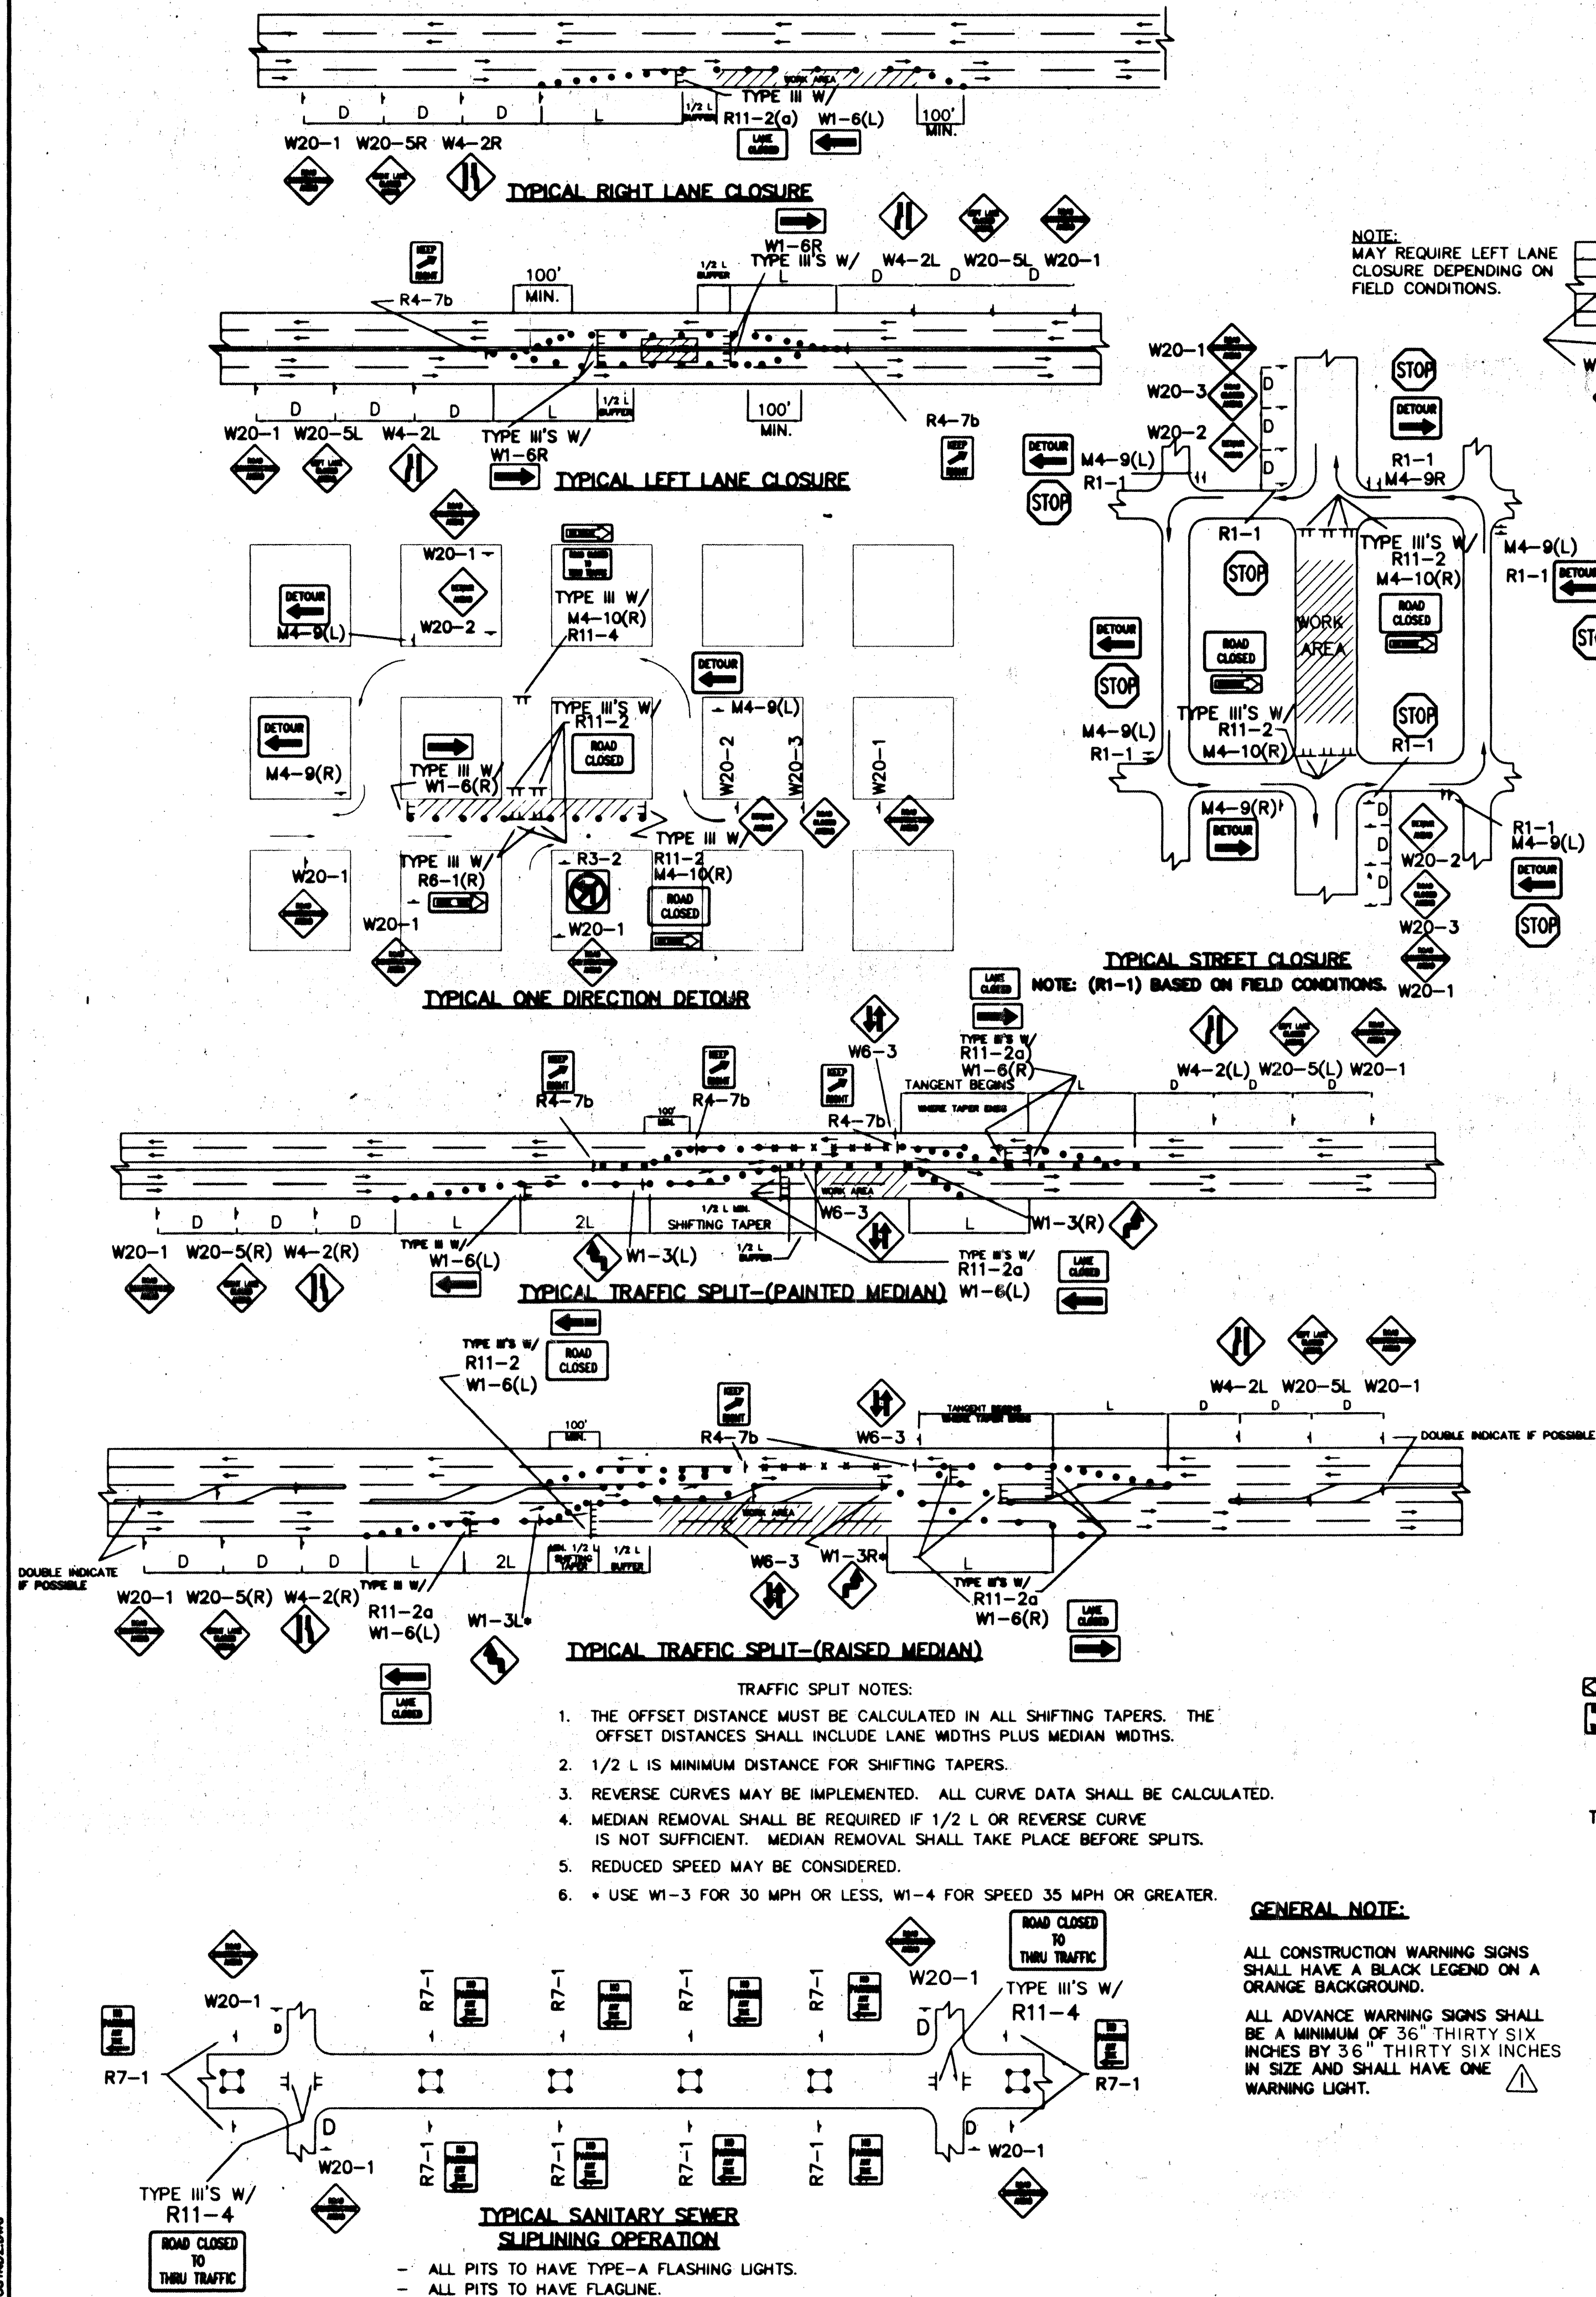

RECORD DRAWING
DATE: 8-6-99

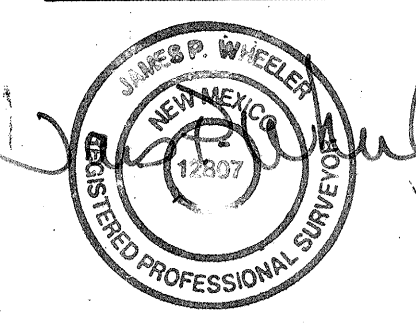

CITY OF ALBUQUERQUE
PUBLIC WORKS DEPARTMENT
ENGINEERING DEVELOPMENT GROUP

TITLE: TUSCANY RIDGE UNIT 2
SIGNING EXAMPLES (REF. M.U.T.C.D.)

DESIGN REVIEW COMMITTEE CITY ENGINEER APPROVAL

LAST UPDATE

PRC ECT NO. 603481 MAP NO. A-12-Z SHEET 15A OF 15

AS BUILT INFORMATION		BENCH MARKS		SURVEY INFORMATION		ENGINEER'S SEAL	
CONTRACTOR	DATE	NO.	DATE	NO.	DATE	NO.	DATE
WORK BY	DATE	NO.	DATE	NO.	DATE	NO.	DATE
INSPECTED BY	DATE	NO.	DATE	NO.	DATE	NO.	DATE
APPROVED BY	DATE	NO.	DATE	NO.	DATE	NO.	DATE
CHECKED BY	DATE	NO.	DATE	NO.	DATE	NO.	DATE
RECORDED BY	DATE	NO.	DATE	NO.	DATE	NO.	DATE

CONSTRUCTION TRAFFIC CONTROL GENERAL NOTES

1. CONTRACTOR MUST OBTAIN FROM CONSTRUCTION COORDINATION AN EXCAVATION/BARRICADING PERMIT BEFORE ENGAGING IN ANY CONSTRUCTION, MAINTENANCE OR REPAIR WORK IN ANY OF THE CITY OF ALBUQUERQUE'S RIGHTS-OF-WAY. EMERGENCY WORK THAT WOULD PRESERVE LIFE OR PROPERTY IS EXCLUDED WITH THE UNDERSTANDING, THAT A PERMIT SHALL BE OBTAINED WITHIN 24 TO 48 HOURS.

2. CONTRACTOR SHALL AT THE TIME OF PERMIT REQUEST, SUBMIT FOR APPROVAL BY CONSTRUCTION COORDINATION, A TRAFFIC CONTROL PLAN DETAILING ALL EXISTING TOPOGRAPHY SUCH AS LANE WIDTHS, DRIVEWAYS, AND BUSINESS/RESIDENTIAL ACCESSES. THE TRAFFIC CONTROL PLAN SHALL INCLUDE ALL PHASES OF WORK AND SCHEDULES INVOLVED IN THE CONSTRUCTION PROJECT. ANY SEPARATE PHASES OF A CONSTRUCTION PROJECT SHALL BE GIVEN AN INDIVIDUAL PERMIT EACH. BLANKET PERMITS WILL NOT BE ISSUED.

3. THESE TYPICAL TRAFFIC CONTROL PLANS DO NOT REFLECT THE EXISTING TOPOGRAPHY, SUCH AS DRIVEWAYS, LANE WIDTHS, AND BUSINESS/RESIDENTIAL ACCESSES. EVERY LOCATION THAT REQUIRES CONSTRUCTION TRAFFIC CONTROL SHALL HAVE A DETAILED TRAFFIC CONTROL PLAN SHOWING ALL EXISTING TOPOGRAPHY.

4. CONSTRUCTION SHALL NOT BEGIN UNLESS A TRAFFIC CONTROL PLAN HAS BEEN APPROVED AND VERIFIED BY CONSTRUCTION COORDINATION.

5. CONSTRUCTION COORDINATION SHALL BE NOTIFIED 48 HOURS PRIOR TO ANY TRAFFIC CONTROL CHANGES NEEDED BY CONTRACTOR, THAT WERE NOT PREVIOUSLY APPROVED. THESE TRAFFIC CONTROL CHANGES SHALL BE REQUESTED IN WRITING ACCOMPANIED WITH A TRAFFIC CONTROL PLAN REFLECTING SUCH CHANGES.

6. ALL CONSTRUCTION TRAFFIC CONTROL DEVICES SHALL COMPLY TO THE MANUAL ON UNIFORM TRAFFIC CONTROL DEVICES (MUTCD), LATEST EDITION. IT IS THE RESPONSIBILITY OF THE CONTRACTOR TO INSTALL, SERVICE AND MAINTAIN ALL TRAFFIC CONTROL DEVICES. TRAFFIC CONTROL DEVICES SHALL NOT BE REMOVED OR ALTERED IN ANY WAY WITHOUT THE APPROVAL OF CONSTRUCTION COORDINATION, PER SECTION 6A-4 OF THE MUTCD, LATEST EDITION.

7. THE CONSTRUCTION TRAFFIC CONTROL INITIAL SET-UP SHALL BE BY AN AMERICAN TRAFFIC SAFETY SERVICES ASSOCIATION (ATSSA) CERTIFIED WORKSITE TRAFFIC SUPERVISOR. THE MAINTENANCE AND SERVICING SHALL ALSO BE DONE BY AN ATSSA CERTIFIED WORKSITE TRAFFIC SUPERVISOR OR EQUIVALENT.

8. CONTRACTOR IS RESPONSIBLE TO MAINTAIN AND SERVICE ALL TRAFFIC CONTROL DEVICES 24 HOURS A DAY, 7 DAYS A WEEK THROUGHOUT LENGTH OF PROJECT. CONTRACTOR IS RESPONSIBLE THAT ALL TRAFFIC CONTROL DEVICES COMPLY WITH THE MUTCD, LATEST EDITION.

9. ALL ADVANCE WARNING SIGNS SHALL BE DOUBLE INDICATED WHENEVER THERE ARE MULTI-LANE TRAFFIC IN ANY ONE GIVEN DIRECTION AND THERE IS SUFFICIENT MEDIAN SPACE.

10. ALL BARRICADES IN ALL TAPERS AND TANGENTS SHALL BE PLACED APART, A DISTANCE MEASURED IN FEET, EQUAL TO THAT OF THE POSTED SPEED LIMIT. NO EXCEPTIONS UNLESS APPROVED BY CONSTRUCTION COORDINATION PER MUTCD SECTION 6A-4.

11. ALL WORK IN ARTERIAL ROADWAYS SHALL BE ON A CONTINUOUS 24HOUR PER DAY BASIS UNTIL COMPLETED.

12. CONTRACTOR IS RESPONSIBLE TO PROVIDE CONSTRUCTION COORDINATION, A WEEKLY LOG OF DAILY INSPECTIONS OF BARRICADE AND MAINTENANCE SCHEDULES ON PROJECTS THAT ARE OVER ONE WEEK DURATION.

13. EQUIPMENT OR MATERIALS SHALL NOT BE STORED WITHIN 15 FEET OF A TRAVELLED TRAFFIC LANE DURING NON-WORKING HOURS WITHOUT THE APPROVAL OF CONSTRUCTION COORDINATION.

14. CONTRACTOR SHALL PROVIDE AND MAINTAIN A SAFE AND ADEQUATE MEANS OF CHANNELIZING PEDESTRIAN TRAFFIC AROUND AND THROUGH THE CONSTRUCTION AREA.

15. CONTRACTOR IS RESPONSIBLE FOR OBLITERATION OF ANY CONFLICTING STRIPING AND RESPONSIBLE FOR ALL TEMPORARY STRIPING.

16. CONTRACTOR SHALL MAINTAIN ACCESS TO ALL FACILITIES, BUSINESSES AND/OR RESIDENTS AT ALL TIMES.

17. CONTRACTOR SHALL PROVIDE ACCESS SIGNS FOR BUSINESSES LOCATED WITHIN THE CONSTRUCTION AREA UNDER THE SUPERVISION OF CONSTRUCTION COORDINATION. EACH ACCESS SIGN SHALL HAVE 5 INCH, WHITE OPAQUE LETTERING ON BLUE REFLECTORIZED BACKGROUND. ACCESS SIGNS SHALL BE CONSIDERED INCIDENTAL TO THE BID AND NOT PART OF THE CONTRACT UNLESS OTHERWISE STATED. NO MORE THAN 3 BUSINESSES SHALL BE LISTED ON A ACCESS SIGN. SHOPPING CENTERS AND MALLS SHALL BE LISTED AS SUCH.

18. ALL ADVANCE WARNING SIGNS SHALL MEET THE MINIMUM REFLECTIVE INTENSITY REQUIREMENTS SET FORTH BY THE CITY OF ALBUQUERQUE. CONSTRUCTION COORDINATION SHALL DETERMINE ALL REQUIREMENTS AND APPROVE OR DISAPPROVE ANY ADVANCE WARNING SIGN PER SECTION 6A-4 OF THE MUTCD, LATEST EDITION.

19. 48 HOURS PRIOR TO OCCUPANCY OR CLOSING OF A RIGHT-OF-WAY, CONTRACTOR SHALL NOTIFY: POLICE, FIRE DEPARTMENT, SCHOOLS, HOSPITALS, TRANSIT AUTHORITY, BUSINESSES AND/OR RESIDENTS THAT WILL BE AFFECTED BY THE CONSTRUCTION.

20. ANY FIELD ADJUSTMENTS SHALL BE APPROVED BY CONSTRUCTION COORDINATION.

21. EXCAVATIONS SHALL BE PLATED, TEMPORARILY PATCHED OR RESURFACED PRIOR TO OPENING OF TRAFFIC. A MINIMUM OF 11 FEET SHALL BE PROVIDED FOR TRAFFIC IN ANY GIVEN DIRECTION. CONTRACTOR IS RESPONSIBLE FOR ANY WORK INVOLVED IN SATISFYING THESE REQUIREMENTS.

22. CONTRACTOR SHALL AT ALL TIMES COMPLY WITH THE FOLLOWING:
1. STANDARDS AND REQUIREMENTS SET FORTH IN THE MANUAL ON UNIFORM TRAFFIC CONTROL DEVICES, LATEST EDITION.
2. THE CITY OF ALBUQUERQUE TRAFFIC CODE, LATEST EDITION.
3. SECTION 19 OF THE CITY OF ALBUQUERQUE'S STANDARD SPECIFICATIONS FOR PUBLIC WORK CONSTRUCTION, AS WELL AS OTHER SECTIONS.


23. FAILURE TO COMPLY WITH ANY OF THE ABOVE MENTIONED, WILL BE ADEQUATE CAUSE TO CEASE ALL WORK ON ANY CONSTRUCTION PROJECT. WORK WILL NOT RESUME UNTIL ALL REQUIREMENTS ARE ADDRESSED AND APPROVED BY CONSTRUCTION COORDINATION.

24. ALL TRAFFIC CONTROL DEVICES SHALL BE KEPT IN NEW-CLEAN CONDITION. WASHING OF EQUIPMENT IS INCIDENTAL TO ITS PLACEMENT AND MAINTENANCE.


25. TRAFFIC CONTROL STANDARDS APPLY ONLY WHERE THE CONSTRUCTION TRAFFIC CONTROL PLANS ARE NOT SPECIFIC.

26. ADVANCE WARNING SIGNS SHALL BE 36"x36" MIN. WITH SUPER ENGINEERING GRADE SHEETING OR BETTER. MOUNTING HEIGHT AT TOP OF SIGN SHALL BE THE SAME AS FOR A 48" SIGN AS INDICATED IN THE M.U.T.C.D.


27. CONTRACTOR SHALL MAINTAIN A GRAFFITI-FREE WORKSITE. ALL GRAFFITI SHALL BE PROMPTLY REMOVED FROM ALL EQUIPMENT, BOTH PERMANENT AND TEMPORARY.

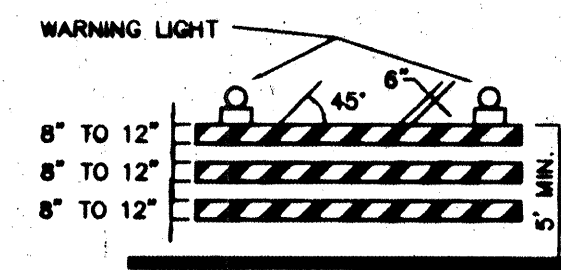


TYPE II BARRICADE

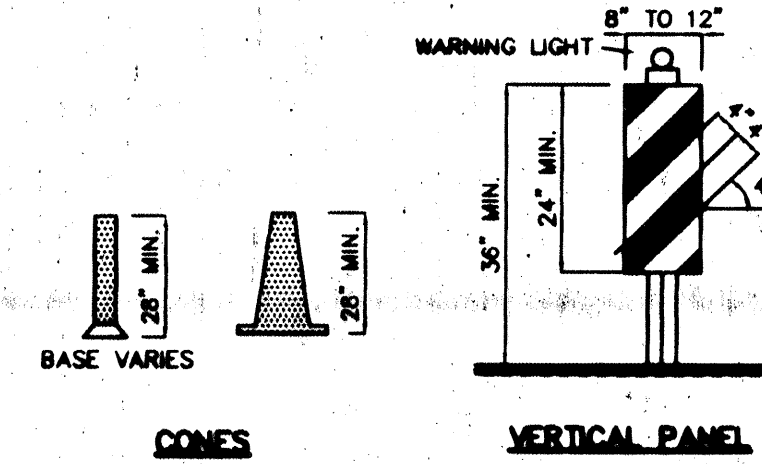


TYPE I BARRICADE

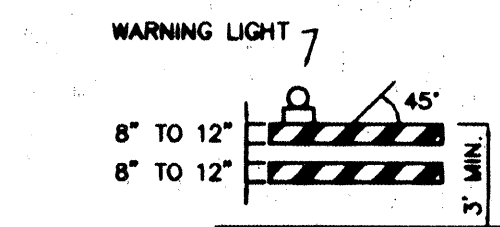

TYPE I BARRICADE

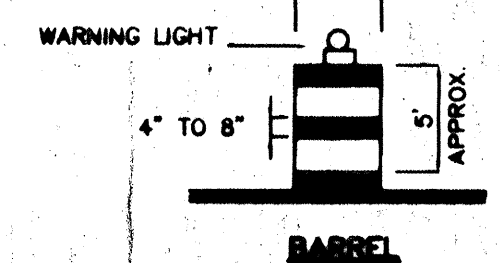

TYPE I BARRICADE

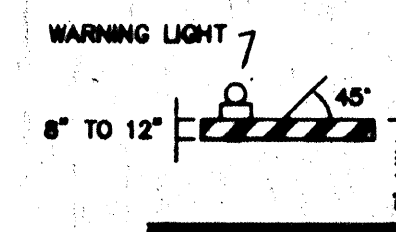

TYPE I BARRICADE



TYPE I BARRICADE

LEGEND

- WORK AREA
- BARRICADE - TYPE I, TYPE II, OR BARREL
- BARRICADE - TYPE III
- VERTICAL PANEL
- WARNING SIGN
- DISTANCE BETWEEN SIGNS - A DISTANCE MEASURED IN FEET EQUAL TO A VALUE OF TEN TIMES THE SPEED LIMIT OF THE STREET
- FLAGMAN POSITION
- SPACING BETWEEN BARRICADES - A DISTANCE MEASURED IN FEET EQUAL TO THE SPEED LIMIT OF THE STREET
- TAPER LENGTH - SEE CHART BELOW
- THE TANGENT LENGTH IS EQUAL TO THE TAPER LENGTH FOR A GIVEN STREET.

TAPER REQUIREMENTS

SPEED LIMIT (MPH)	TAPER LENGTH (L) (FEET)			MINIMUM NUMBER OF DEVICES FOR TAPER	MAXIMUM DEVICE SPACING IN FEET	
	10' LANE	11' LANE	12' LANE		ALONG TAPER	AFTER TAPER
20	70	75	80	5	20	20
25	105	115	125	6	25	25
30	150	165	180	7	30	30
35	205	225	245	8	35	35
40	270	295	320	9	40	40
45	450	495	540	13	45	45
50	500	550	600	13	50	50
55	550	605	660	13	55	55

RECOMMENDED SIGN SPACING(D) FOR ADVANCE WARNING SIGN SERIES

SPEED LIMIT (MPH)	MINIMUM DISTANCE BETWEEN SIGNS	MINIMUM DISTANCE FROM LAST SIGN TO TAPER
0-20	10 X SPEED LIMIT	10 X SPEED LIMIT
25-30	10 X SPEED LIMIT	10 X SPEED LIMIT
30-35	10 X SPEED LIMIT	10 X SPEED LIMIT
40-45	10 X SPEED LIMIT	10 X SPEED LIMIT
50-60	10 X SPEED LIMIT	10 X SPEED LIMIT


TAPER CRITERIA

TYPE OF TAPER	TAPER LENGTH
UPSTREAM TAPER:	
MERGING TAPER:	L MINIMUM
SHIFTING TAPER:	1/2 L MINIMUM
SHOULDER TAPER:	1/2 L MINIMUM
TWO-WAY TRAFFIC TAPER:	100 FEET MAXIMUM
DOWNSTREAM TAPERS:	100 FEET PER LANE

TAPER LENGTH COMPUTATION

SPEED LIMIT	L =
40 MPH OR LESS	$L = \frac{W^2}{60}$
45 MPH OR GREATER	$L = W \times S$
	L = TAPER LENGTH
	W = WIDTH OF OFFSET IN FEET
	S = POSTED SPEED OR OFF-PEAK 85-PERCENTILE SPEED IN MPH

SIGN FACE DETAILS

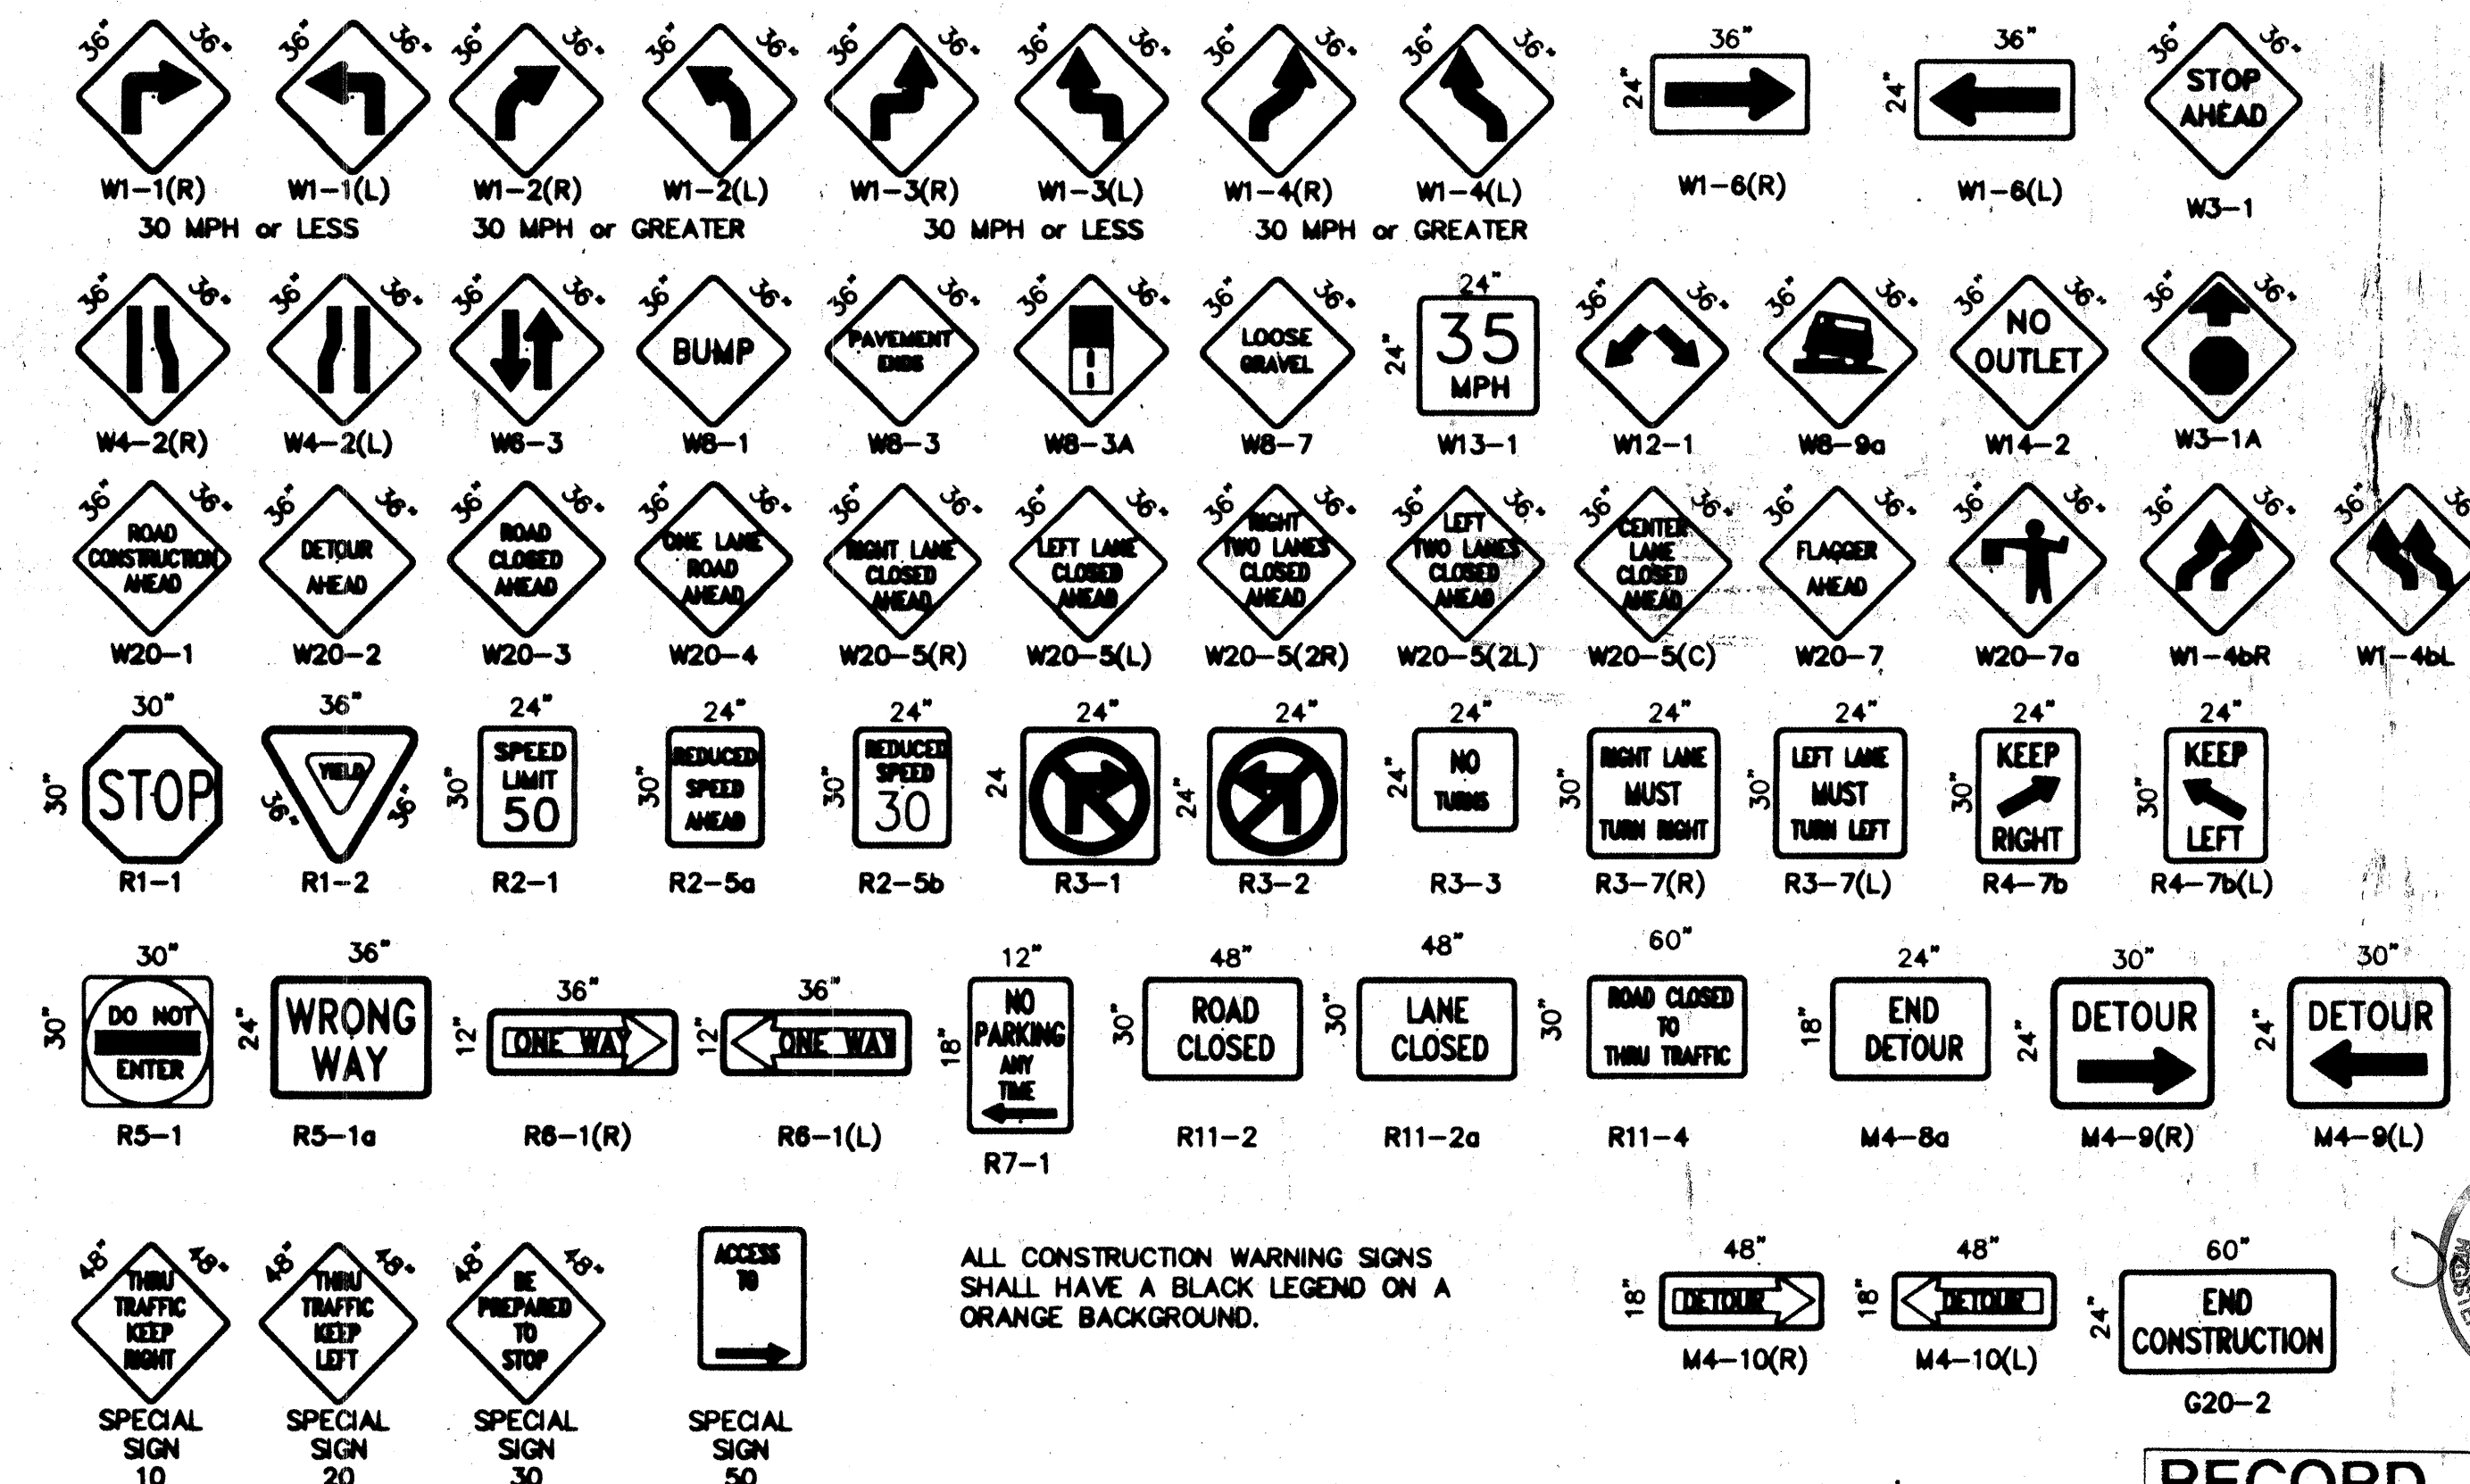

RECORD DRAWING
DATE: 8-6-99

CITY OF ALBUQUERQUE PUBLIC WORKS DEPARTMENT ENGINEERING DEVELOPMENT GROUP			
TITLE: TUSCANY RIDGE UNIT 2			
SIGNING AND CONSTRUCTION TRAFFIC CONTROL STANDARDS			
DESIGN REVIEW COMMITTEE	CITY ENGINEER APPROVAL	NO. 2047/99	NO. 2047/99
CDA Standard		LAST UPDATE	
PROJECT NO.	603481	MAP NO.	A-12-Z
SHEET 15B		OF 15	