


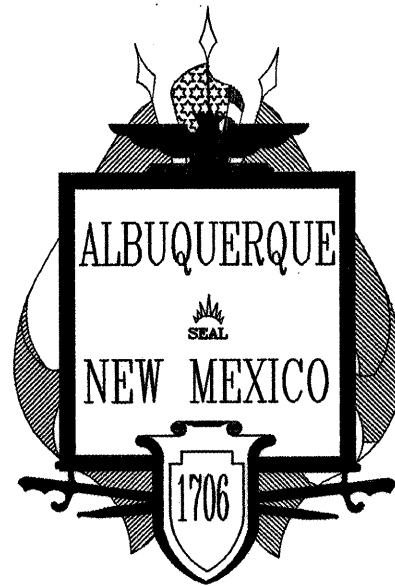

CITY OF ALBUQUERQUE, NEW MEXICO

SOUTH ARROYO DE DOMINGO BACA

CHANNEL IMPROVEMENTS

(I-25 EAST TO STA. 18+75)


JULY 2003

INDEX TO DRAWINGS

SHEET No.	DESCRIPTION	SHEET No.	DESCRIPTION
1	COVER SHEET	6	NMSH&TD C.B.C. DETAILS
2	GRADING PLAN	7	FENCE AND INLET GRATE DETAILS
3	PLAN & PROFILE STA. 10+00 TO STA. 18+75	8	CHANNEL CROSS-SECTIONS
4	TYPICAL CHANNEL & C.B.C. DETAILS	9	SIGNING AND CONSTRUCTION TRAFFIC CONTROL STANDARDS
5	TRANSITION SECTION DETAILS	10	TYPICAL TRAFFIC CONTROL & SIGNING EXAMPLES (REF. M.U.T.C.D.)

RECORD DRAWINGS

I, Charles M. Easterling, of the firm Easterling & Associates, Inc., a Registered Professional Engineer in the State of New Mexico, do hereby certify, to the best of my knowledge and belief, that the infrastructure installed as part of this project has been inspected by me or by a qualified person under my direct supervision and has been constructed in general accordance with the plans and specifications approved by the City Engineer, except as noted herein, and that the original design intent of the approved plans has been met. Survey information provided by William W. Plotner Jr., NMPS number 14271.

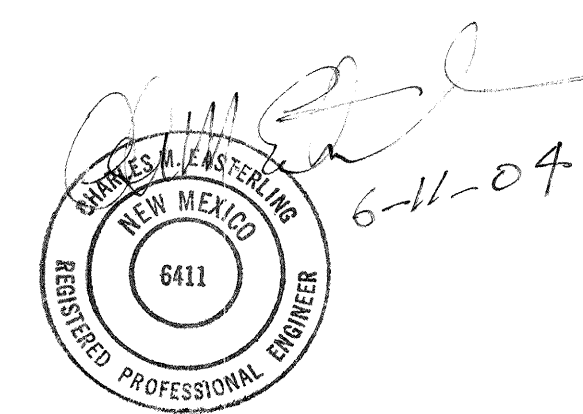

NOTE


THE ENGINEER HAS UNDERTAKEN LIMITED FIELD VERIFICATION OF THE LOCATION, DEPTH, SIZE, OR TYPE OF EXISTING UNDERGROUND UTILITY LINES. MAKES NO REPRESENTATION PERTAINING THERETO AND ASSUMES NO RESPONSIBILITY OR LIABILITY THEREFOR. THE CONTRACTOR SHALL INFORM ITSELF OF THE LOCATION OF ANY UTILITY LINE IN OR NEAR THE AREA OF THE WORK IN ADVANCE OF AND DURING EXCAVATION WORK. THE CONTRACTOR IS FULLY RESPONSIBLE FOR ANY AND ALL DAMAGE CAUSED BY ITS FAILURE TO LOCATE, IDENTIFY, AND PRESERVE ANY AND ALL EXISTING UTILITIES. THE CONTRACTOR SHALL COMPLY WITH STATE STATUTES, MUNICIPAL AND LOCAL ORDINANCES, RULES AND REGULATIONS PERTAINING TO THE LOCATION OF THESE LINES AND FACILITIES IN PLANNING AND CONDUCTING EXCAVATION, WHETHER BY CALLING OR NOTIFYING THE UTILITIES, COMPLYING WITH "BLUE STAKES" PROCEDURES, OR OTHERWISE.

NOTE

THESE DRAWINGS DO NOT INCLUDE NECESSARY COMPONENTS FOR CONSTRUCTION SAFETY WHICH SHALL REMAIN THE RESPONSIBILITY OF THE CONTRACTOR.

NOTE

THIS DOCUMENT, AND THE IDEAS AND DESIGNS INCORPORATED HEREIN, ARE INTENDED FOR USE ON THIS PROJECT AND ARE NOT TO BE USED, IN WHOLE OR IN PART, FOR ANY OTHER PROJECT WITHOUT THE WRITTEN AUTHORIZATION OF EASTERLING & ASSOCIATES, INC. IN THE EVENT OF UNAUTHORIZED USE, THE USER ASSUMES ALL RESPONSIBILITY AND LIABILITY WITH RESULTS.

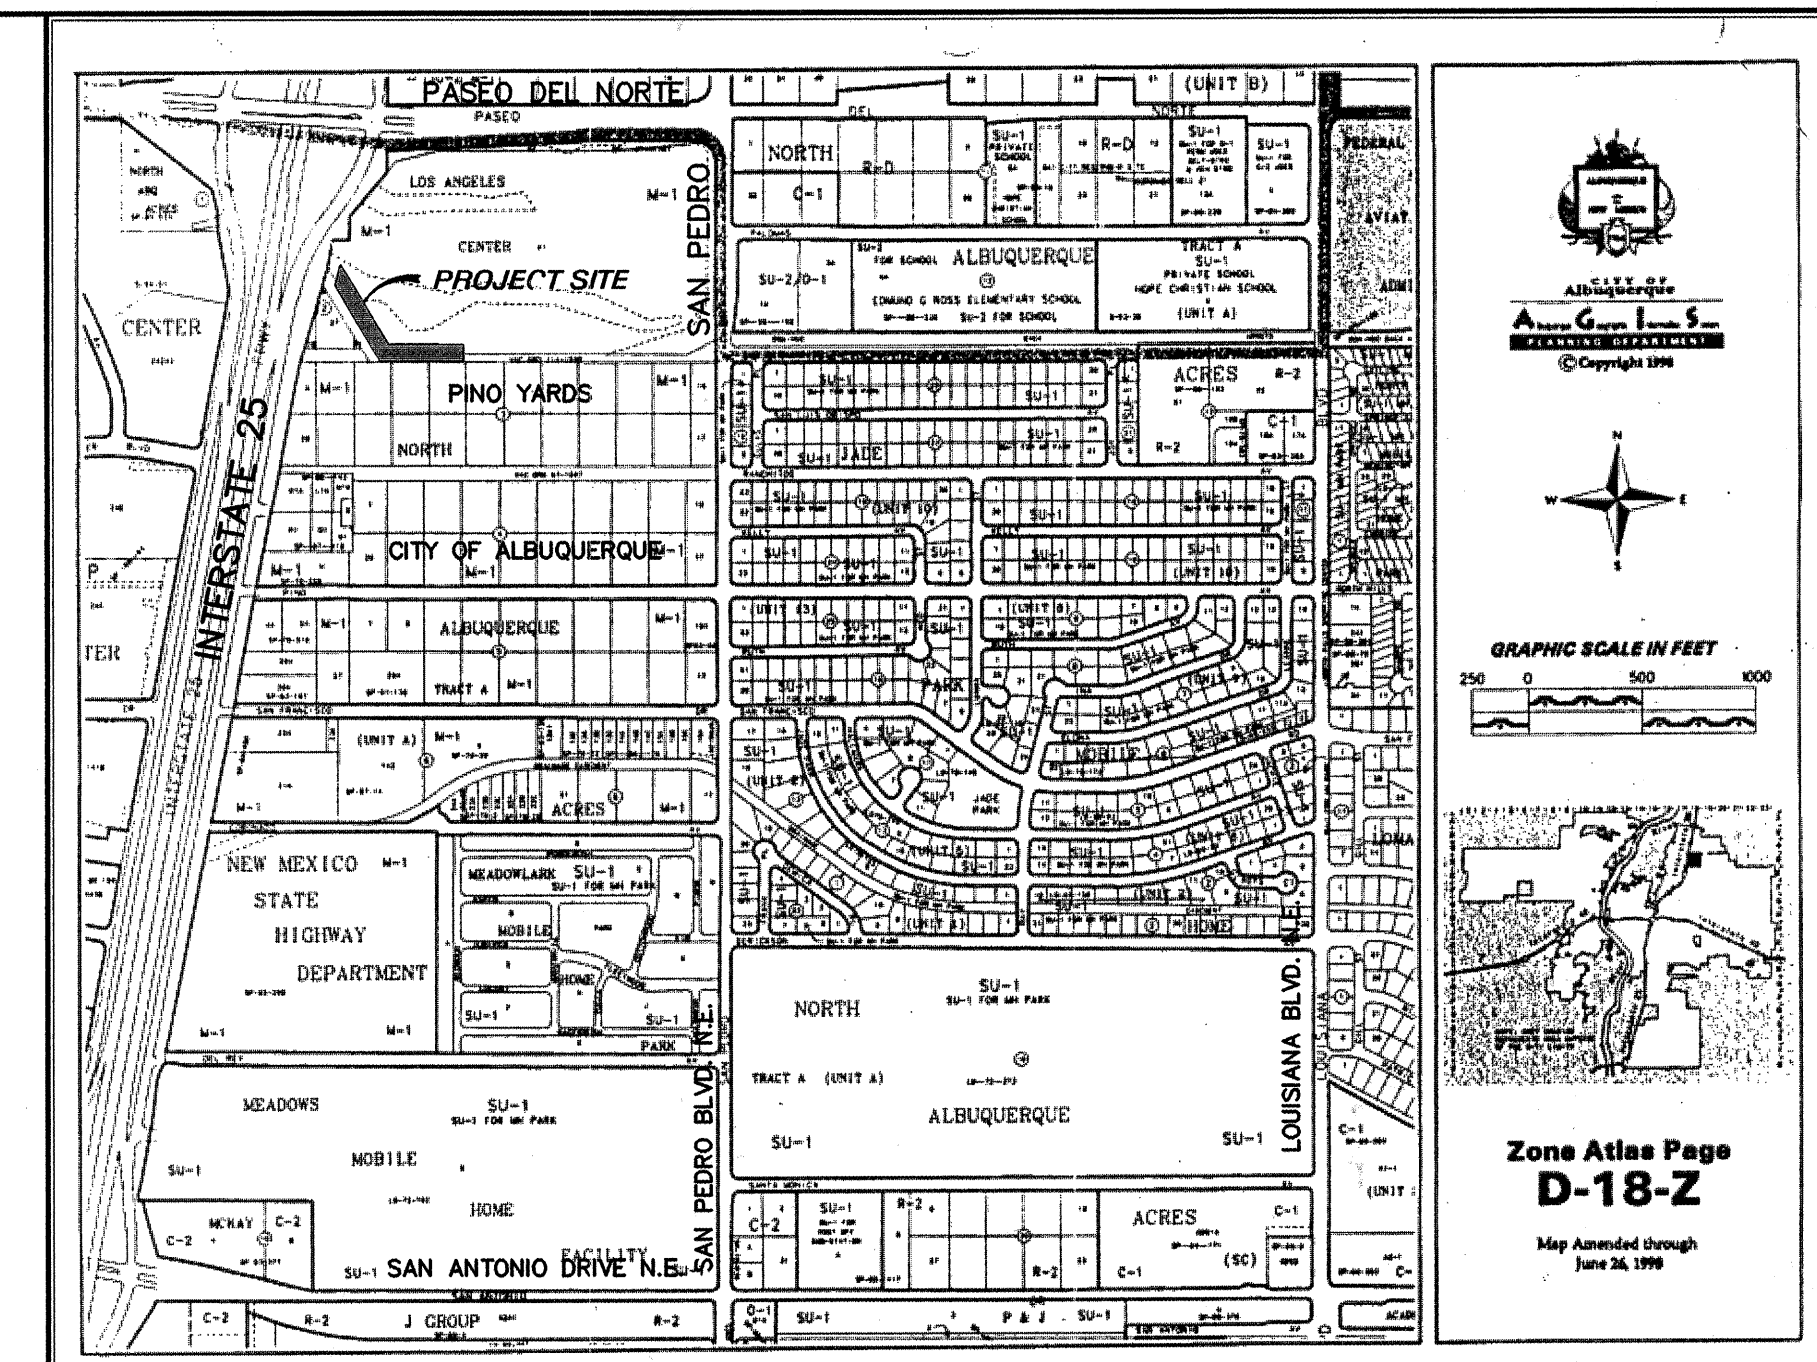

VICINITY MAP

GENERAL NOTES

- ALL WORK DETAILED ON THESE PLANS TO BE PERFORMED UNDER THIS CONTRACT SHALL, EXCEPT AS OTHERWISE STATED OR PROVIDED HEREIN, BE CONSTRUCTED IN ACCORDANCE WITH THE CITY OF ALBUQUERQUE STANDARD SPECIFICATIONS FOR PUBLIC WORKS CONSTRUCTION, 1986 EDITION AS AMENDED THROUGH UPDATE NO. 6.
- ALL EXCAVATION, TRENCHING, AND SHORING ACTIVITIES MUST BE CARRIED OUT IN CONFORMANCE WITH OSHA 29CFR 1926.650, SUB-PART P.
- CONTRACTOR SHALL NOTIFY THE PROJECT ENGINEER NOT LESS THAN SEVEN (7) DAYS PRIOR TO STARTING WORK IN ORDER THAT THE ENGINEER MAY TAKE NECESSARY MEASURES TO INSURE THE PRESERVATION OF SURVEY MONUMENTS. CONTRACTOR SHALL NOT DISTURB PERMANENT SURVEY MONUMENTS WITHOUT THE CONSENT OF THE ENGINEER, AND SHALL BEAR THE EXPENSE OF REPLACING ANY THAT MAY BE DISTURBED WITHOUT PERMISSION. REPLACEMENT SHALL BE DONE ONLY BY THE CITY SURVEY SECTION. WHEN A CHANGE IS MADE IN ANY ROADWAY IN WHICH A PERMANENT SURVEY MONUMENT IS LOCATED, CONTRACTOR SHALL, AT HIS OWN EXPENSE, ADJUST THE MONUMENT COVER TO THE NEW GRADE UNLESS OTHERWISE SPECIFIED. REFER TO SECTION 4.4 OF GENERAL CONDITIONS OF THE CITY OF ALBUQUERQUE STANDARD SPECIFICATIONS FOR PUBLIC WORKS CONSTRUCTION.
- FIVE (5) WORKING DAYS PRIOR TO BEGINNING CONSTRUCTION, THE CONTRACTOR SHALL SUBMIT TO THE CONSTRUCTION COORDINATION DIVISION A DETAILED CONSTRUCTION SCHEDULE. TWO (2) WORKING DAYS PRIOR TO CONSTRUCTION, THE CONTRACTOR SHALL OBTAIN A BARRICADING PERMIT FROM THE CONSTRUCTION COORDINATION DIVISION. CONTRACTOR SHALL NOTIFY BARRICADING ENGINEER (768-2551) PRIOR TO OCCUPYING AN INTERSECTION. SEE SECTION 19 OF THE SPECIFICATIONS.
- TWO (2) WORKING DAYS PRIOR TO ANY EXCAVATION, CONTRACTOR MUST CONTACT NEW MEXICO ONE CALL SYSTEM, INC. (260-1990) FOR LOCATION OF EXISTING UTILITIES.
- PRIOR TO CONSTRUCTION, THE CONTRACTOR SHALL EXCAVATE AND VERIFY THE HORIZONTAL AND VERTICAL LOCATIONS OF ALL OBSTRUCTIONS AND EXISTING PAVEMENT. SHOULD A CONFLICT EXIST, THE CONTRACTOR SHALL NOTIFY THE ENGINEER OR SURVEYOR SO THAT THE CONFLICT CAN BE RESOLVED WITH A MINIMUM OF DELAY.
- THE CONTRACTOR SHALL CONTACT WATER SYSTEMS DIVISION (857-8200) SEVEN (7) WORKING DAYS PRIOR TO NEEDING SHUT-OFF OR TURN-ON OF VALVES. ONLY CITY WATER SYSTEMS PERSONNEL ARE AUTHORIZED TO OPERATE VALVES.
- RESTRAINED JOINTS ARE REQUIRED AT ALL WATER LINE BENDS, TEES, CAPS AND GATE VALVES. RESTRAINED JOINTS SHALL BE CONSIDERED INCIDENTAL TO OTHER ITEMS AND NO SEPARATE MEASUREMENT OR PAYMENT SHALL BE MADE.
- THE PUBLIC WATER LINE MUST BE A MINIMUM OF 18" ABOVE THE SEWER LINE AT ALL CROSSINGS.
- THE CONTRACTOR SHALL FURNISH EMD'S ON ALL WATER AND SEWER SERVICE STUBS, CAPS AND PLUGS.
- ALL UTILITIES AND UTILITY SERVICE LINES SHALL BE INSTALLED PRIOR TO PAVING.
- BACKFILL COMPACTION SHALL BE ACCORDING TO SPECIFIED STREET USE.
- TACK COAT REQUIREMENTS SHALL BE DETERMINED BY THE PROJECT ENGINEER.
- SIDEWALKS AND WHEELCHAIR RAMPS WITHIN THE CURB RETURNS SHALL BE CONSTRUCTED WHEREVER A NEW CURB RETURN IS CONSTRUCTED.
- IF CURB IS DEPRESSIONED FOR A DRIVEPAD OR A HANDICAP RAMP, THE DRIVEPAD OR RAMP SHALL BE CONSTRUCTED PRIOR TO ACCEPTANCE OF THE CURB AND GUTTER.
- ALL STREET STRIPING ALTERED OR DESTROYED SHALL BE REPLACED BY CONTRACTOR WITH PLASTIC REFLECTORIZED PAVEMENT MARKINGS IN EXISTING STRIPING LOCATIONS UNLESS OTHERWISE INDICATED BY THIS PLAN SET.
- ANY WORK AFFECTING AN ARTERIAL ROADWAY REQUIRES 24 HOUR CONSTRUCTION.
- THE CONTRACTOR SHALL BE RESPONSIBLE FOR REPAIR, OR REMOVAL AND REPLACEMENT, OF ANY PAVEMENT, PAVEMENT MARKINGS, CURB AND GUTTER, DRIVEPADS, SIDEWALK, WHEELCHAIR RAMP OR ANY OTHER EXISTING IMPROVEMENTS DAMAGED BY THE CONTRACTOR'S OPERATIONS.
- THE CONTRACTOR SHALL GRADE ALL AREAS DISTURBED BY THE CONSTRUCTION ACTIVITIES AND NOT SHOWN ON THESE PLANS TO RECEIVE OTHER SURFACE IMPROVEMENTS AS DIRECTED BY THE PROJECT ENGINEER, AND SHALL MULCH AND SEED ALL SUCH AREAS IN ACCORDANCE WITH SECTION 1012, "NATIVE GRASS SEEDING" OF THE STANDARD SPECIFICATIONS.

SITE LOCATION:

LAT. 35° 10' 15" N
LONG. 106° 34' 55" W

FOR INFORMATION ONLY

CITY OF ALBUQUERQUE
Principal Engineer, Utility Development
Greg Olson
P.O. Box 1293
Albuquerque, New Mexico 87103
Ph: (505) 768-2719
Fax: (505) 768-3629

MCI Worldcom
Operations Manager
Andy Darnell
3700 Singer Blvd. NE, Suite A
Albuquerque, New Mexico 87109
Ph: (505) 346-4478
Fax: (505) 346-4481

PNM - Electric
Engineering Representative
Robt Garcia
420 E 4th Blvd. NE
Albuquerque, New Mexico 87107
Ph: (505) 241-7745
Fax: (505) 241-7753

Tiz - Warner Telecom
Plan Manager
John Harrison
3801 Singer Blvd. NE, Suite 1000
Albuquerque, New Mexico 87109
Ph: (505) 938-7339
Fax: (505) 938-7380

PNM - GAS Co. of NM
Planning Engineer
Elisabeth Gabel
4625 Edith Blvd. NE MS-6566
Albuquerque, New Mexico 87107
Ph: (505) 241-7745
Fax: (505) 241-7753

Espire Communications
Engineering Representative
John Mares
505 Marquette Ave. NW, Suite 1605
Albuquerque, New Mexico 87102
Ph: (505) 998-2274
Fax: (505) 998-9161

WEST/US WEST
Capacity Provisioning Specialist
David Muller
201 Third Street NW, Suite 700
Albuquerque, New Mexico 87102
Ph: (505) 245-6706
Fax: (505) 245-6831

McLeod USA
Supervisor of Outside Techs.
Rick Mueller
505 Marquette Ave. NW, Suite 1605
Albuquerque, New Mexico 87102
Ph: (505) 244-3161
Fax: (505) 244-0094


AT&T
Resource Supervisor
David Crowl
111 Third St., NW
Albuquerque, New Mexico 87103
Ph: (505) 842-2911
Fax: (505) 842-2890

CityNet Telecommunications
Consultant
Joshua Nelson
505 Marquette Ave. NW, Suite 119-A
Albuquerque, New Mexico 87102
Ph: (505) 991-2120
Fax: (505) 217-0070

COMCAST
Planning and Design Supervisor
Rita Erickson
4611 Montbel Pl. NE
Albuquerque, NM 87107
Ph: (505) 761-6235
Fax: (505) 761-0599

Genuity
Supervisor - OSP Maintenance
Tom Turley
50 Centre on the Lake
Lake Saint Louis, MO 63367
Ph: (636) 561-0339
Fax: (636) 561-0355

REV.	SHEETS	CITY ENGINEER	DATE	USER DEPARTMENT	DATE	USER DEPARTMENT	DATE
ENGINEER'S STAMP & SIGNATURE	APPROVALS	ENGINEER	DATE	*****			
	DRC CHAIR	<i>Charles M. Easterling</i>	6-27-03	APPROVED FOR CONSTRUCTION			
	TRANSPORTATION	<i>Michael J. Pyle</i>	6-11-03				
	WATER/WASTEWATER	<i>William J. Pyle</i>	6-9-03				
	HYDROLOGY	<i>John C. Pyle</i>	6-9-03				
	PARKS						
CONSTR. MGMT.							
CONSTR. COORD.							
Easterling & Associates, Inc.		CITY PROJECT NO.		SHEET		OF	
CONSULTING ENGINEERS 2800 American Rd. SE, Suite 100 (505) 268-9001 FAX (505) 268-9001 E-Mail: eol_engr@comp.com		6050.92		1		10	

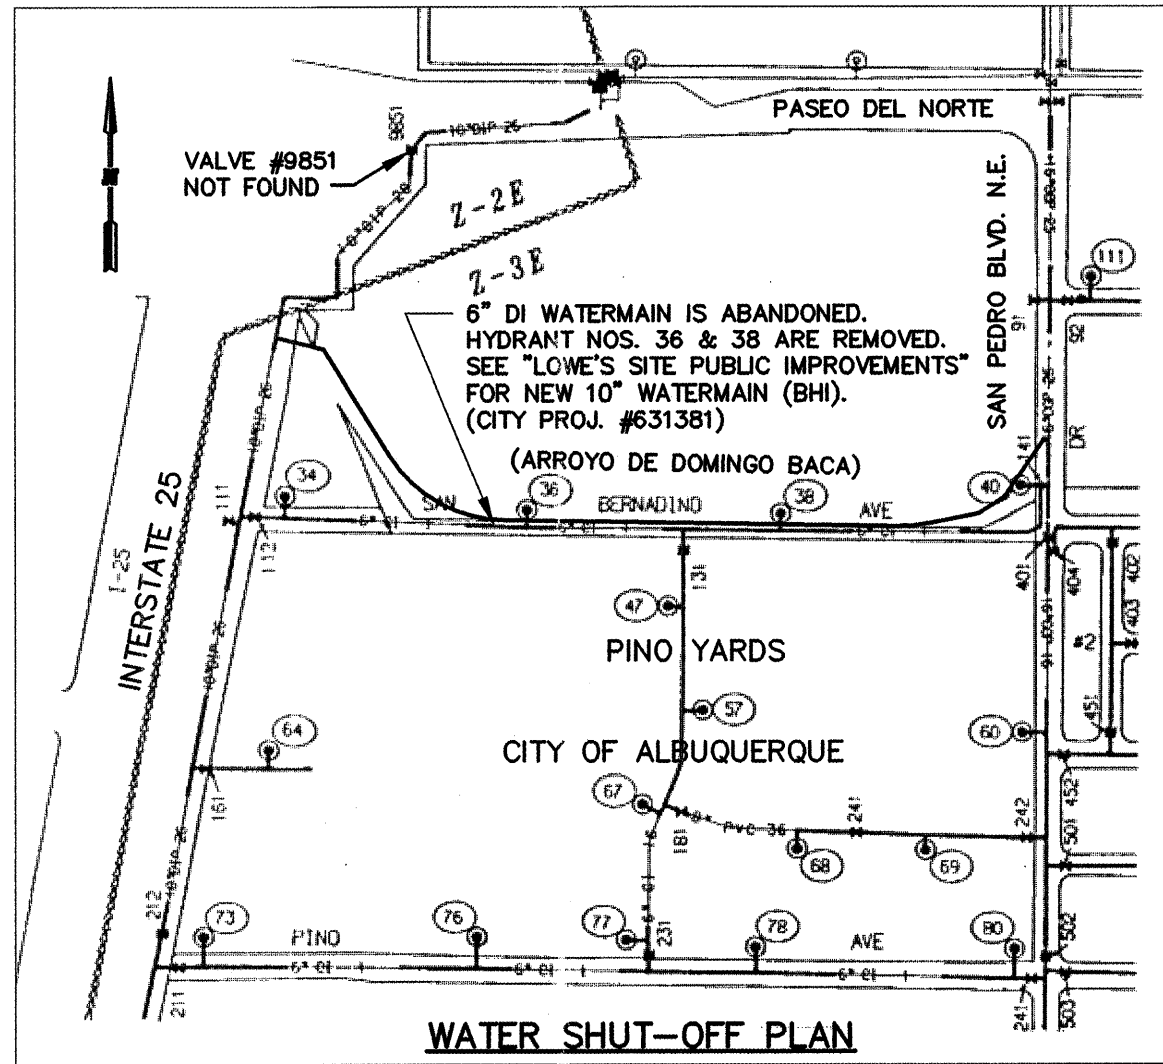

NOTES

1. EXISTING GROUND ELEVATION = 5191.43 ABOVE EXISTING 10" PVC WATERLINE @ INSTALLED G.V..
2. EXISTING TOP OF 10" PVC WATERLINE ELEVATION = 5182.93 @ INSTALLED G.V..
3. TOP SOUTH CORNER OF EXISTING CBC PARAPET WALL ELEVATION = 5189.40.

[illegible]



FOR INFORMATION ONLY

RECORD
DRAWING
6-11-04

Easterling & Associates, Inc.
CONSULTING ENGINEERS
2600 American Rd. SE, Suite 100
Rio Rancho, New Mexico 87124
(505) 898-8021 FAX (505) 898-8501
E-Mail: creasterling@wilsonco.com

CITY OF ALBUQUERQUE
PUBLIC WORKS DEPARTMENT
ENGINEERING DEVELOPMENT GROUP
SOUTH ARROYO DE DOMINGO BAC.
(1-25 EAST TO STA. 18+75)
GRADING PLAN

DESIGN REVIEW COMMITTEE APPROVED JUN 2 8 2003 DESIGN REVIEW COMMITTEE		CITY ENGINEER APPROVAL APPROVED JUN 2 4 2003 CITY ENGINEER		LAST DESIGN UPDATE <table><thead><tr><th>Mo./DAY/YR.</th><th>Mo./DAY/YR.</th></tr></thead><tbody><tr><td></td><td></td></tr><tr><td></td><td></td></tr><tr><td></td><td></td></tr><tr><td></td><td></td></tr></tbody></table>		Mo./DAY/YR.	Mo./DAY/YR.								
Mo./DAY/YR.	Mo./DAY/YR.														
CITY PROJECT No.		ZONE MAP NO.		SHEET OF											
6050.92		D-18		2 10											

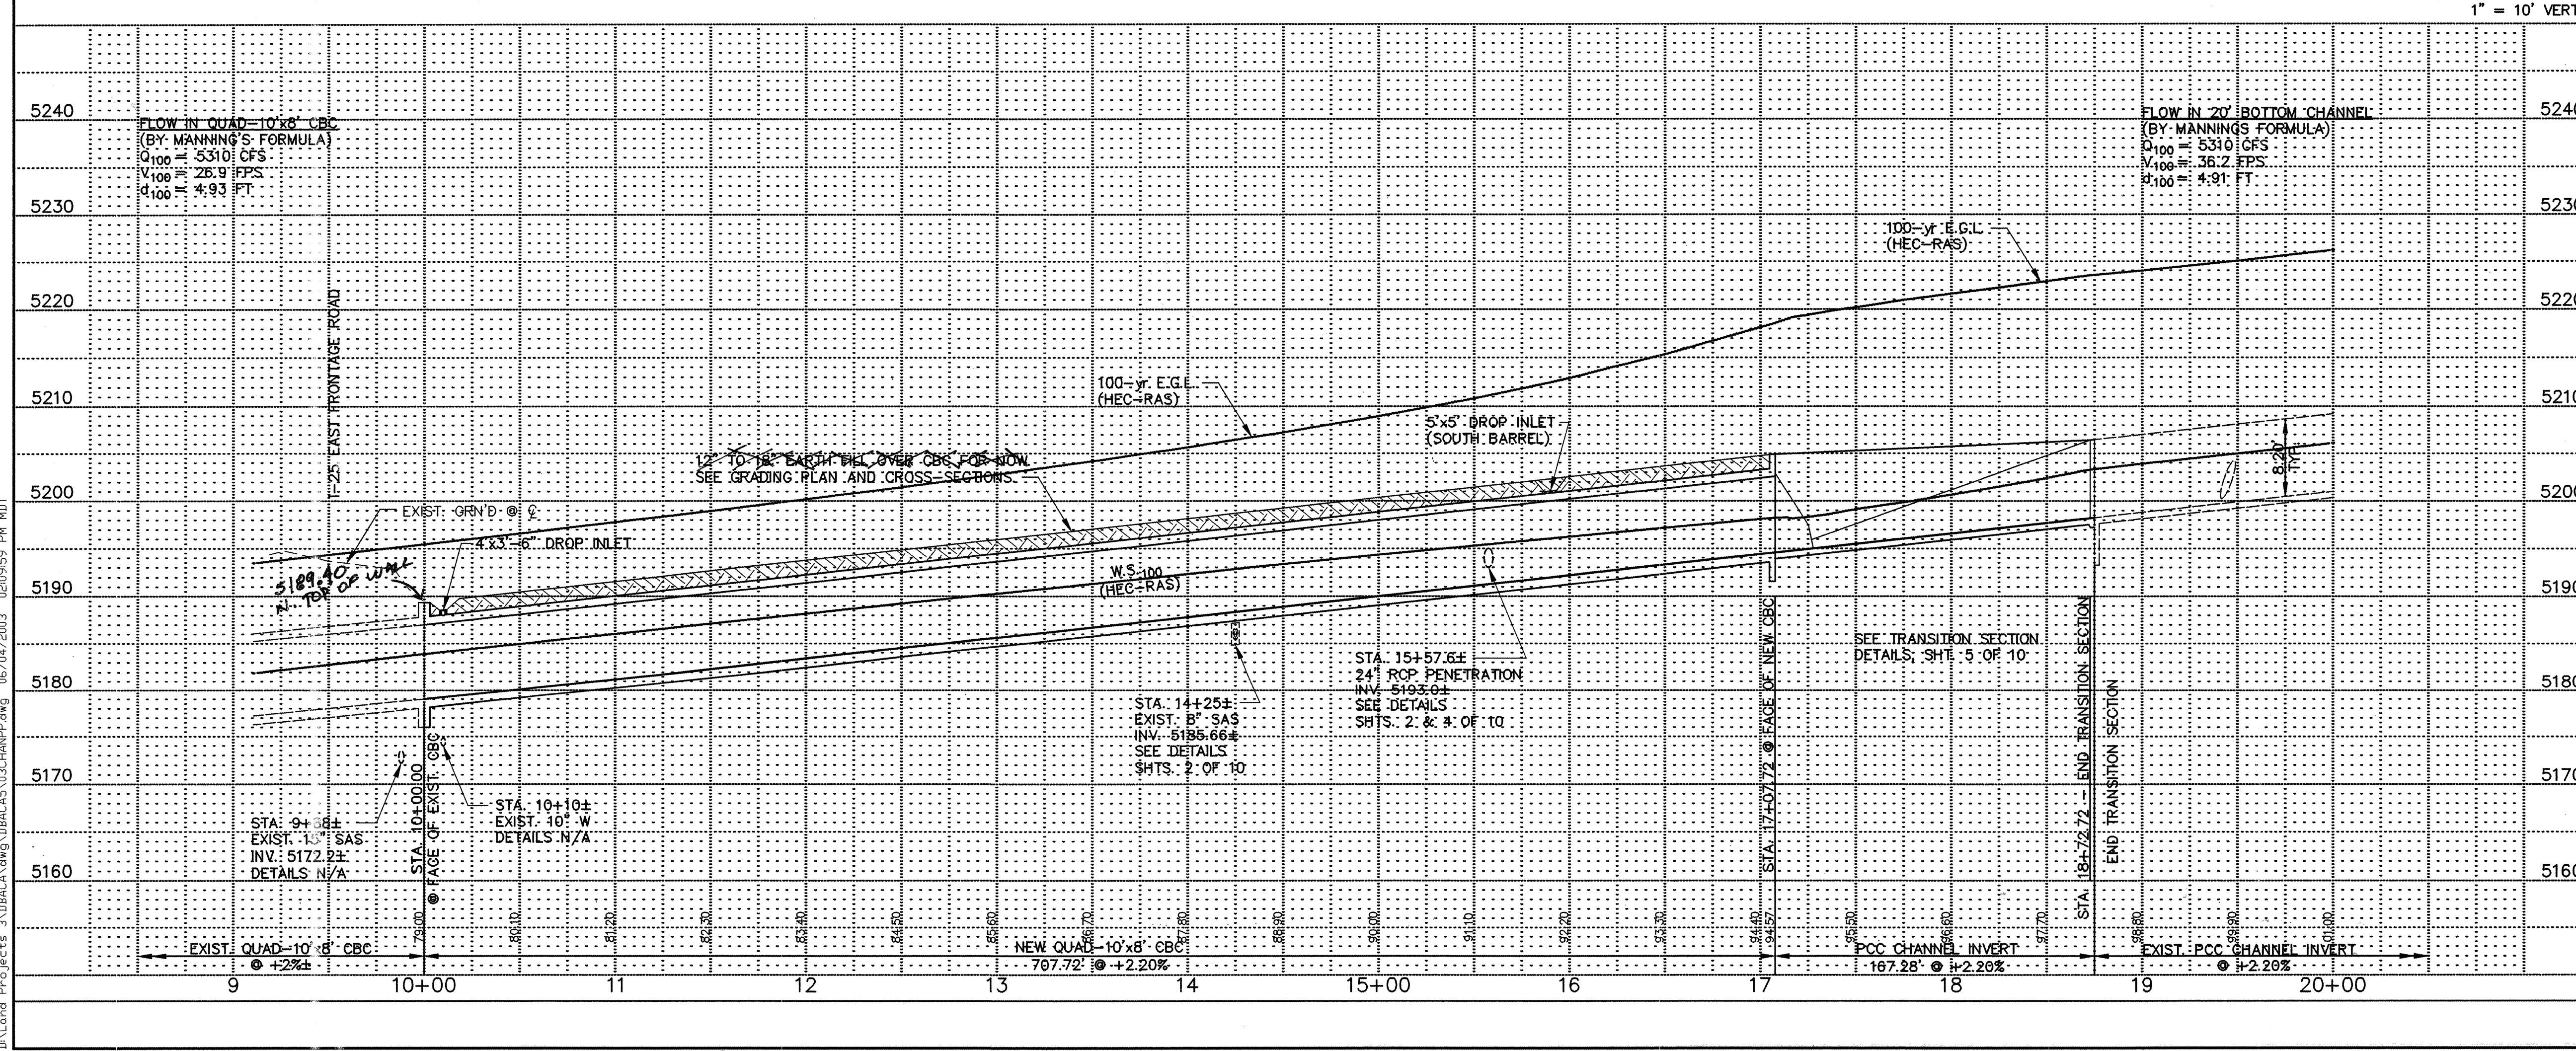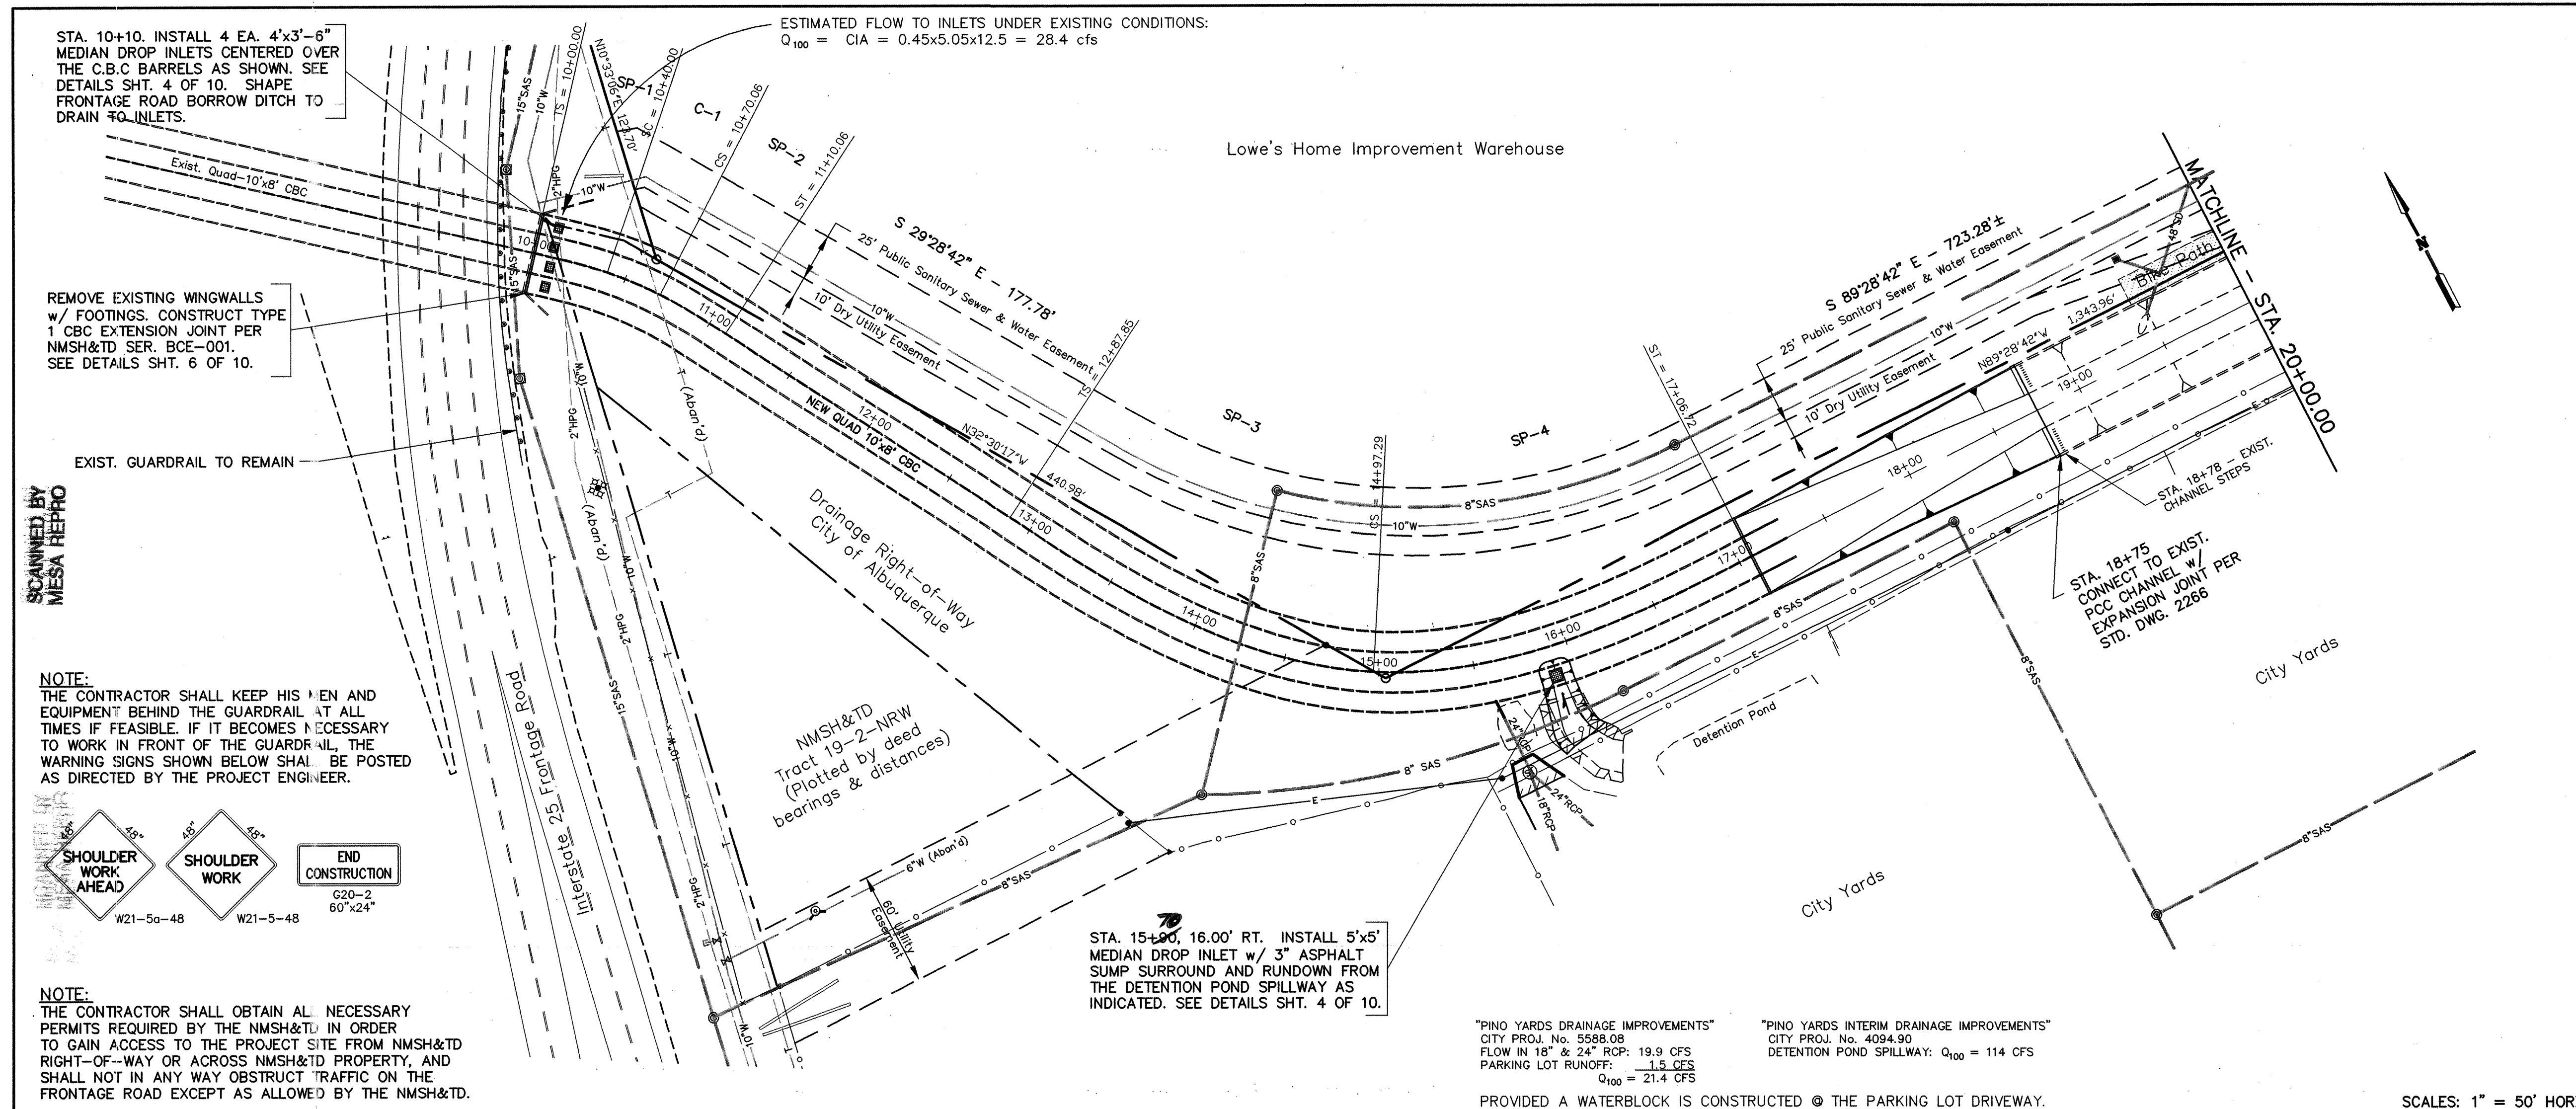

SP-1 (Clothoid)

TS	North: 1518709.19	East: 400654.73
SPI	North: 1518691.88	East: 400626.04
SC	North: 1518682.25	East: 400635.28
K	19.99	P: 0.33
A	89.44	Tau: 0.10
Xs	39.96	Ys: 1.33
Long Tan	26.68	Course: S 49-33-00 E
Short Tan	13.35	Course: S 43-49-14 E
Length	40.00	Radius: 200.00 Theta: 5-43-46

C-1

Begin	North: 1518659.08	East: 400654.39
Radial Point	North: 1518543.77	East: 400490.97
End	North: 1518682.25	East: 400635.28
PI	North: 1518671.39	East: 400645.70
Tangent	15.06	Chord: 30.04 Course: N 39-30-51 W
Arc Length	30.06	Radius: 200.00 Delta: 8-36-45

SP-2 (Clothoid)

TS	North: 1518624.95	East: 400675.21
SPI	North: 1518648.18	East: 400662.08
SC	North: 1518659.08	East: 400654.39
K	19.99	P: 0.33
A	89.44	Tau: 0.10
Xs	39.96	Ys: 1.33
Long Tan	26.68	Course: N 29-28-42 W
Short Tan	13.35	Course: N 35-12-28 W
Length	40.00	Radius: 200.00 Theta: 5-43-46

SP-3 (Clothoid)

TS	North: 1518470.18	East: 400762.70
SPI	North: 1518346.84	East: 400832.42
SC	North: 1518310.43	East: 400894.17
K	103.77	P: 9.05
A	204.67	Tau: 0.52
Xs	203.77	Ys: 35.84
Long Tan	141.69	Course: S 29-28-42 E
Short Tan	71.69	Course: S 59-28-42 E
Length	209.44	Radius: 200.00 Theta: 30-00-00

SP-4 (Clothoid)

TS	North: 1518272.74	East: 401097.61
SPI	North: 1518274.03	East: 400955.93
SC	North: 1518310.43	East: 400894.17
K	103.77	P: 9.05
A	204.67	Tau: 0.52
Xs	203.77	Ys: 35.84
Long Tan	141.69	Course: N 89-28-42 W
Short Tan	71.69	Course: N 59-28-42 W
Length	209.44	Radius: 200.00 Theta: 30-00-00

AS BUILT INFORMATION

CONTRACTOR	MOORE & CONWART
INSPECTOR	BOHANNAN-HUSTON, INC.
DATE	3-21-04
ACCEPTANCE BY	WILSON/CO
DATE	5-28-04
VERIFICATION BY	WILSON/CO
DATE	3-21-04
CORRECTED BY	EASTERLING
DATE	6-11-04
RECORDED BY	
DATE	

BENCH MARKS

ACS ALUM. CAP	9-CIB 1985
X	402,255.61
Y	1,521,435.09
ELEV.	5229.79 (SLD 1929)

SURVEY INFORMATION

NO.	DATE	BY
BOHANNAN-HUSTON, INC.		
TOPOGRAPHIC MAP OF		
PLAZA DEL PASEO - 7/98		
ADD'L POINTS AS REQUIRED		
BY SURV-TEK - 12/98		

ENGINEER'S SEAL

FOR INFORMATION ONLY

RECORD DRAWING 6-11-04

Easterling & Associates, Inc.
CONSULTING ENGINEERS
2600 American Rd. SE, Suite 100
Rio Rancho, New Mexico 87124
(505) 898-8021 FAX (505) 898-8501
E-Mail: edl_engr@wcp.com


CITY OF ALBUQUERQUE
PUBLIC WORKS DEPARTMENT
ENGINEERING DEVELOPMENT GROUP
SOUTH ARROYO DE DOMINGO BACA
(1-25 EAST TO STA. 18+75)
PLAN & PROFILE - STA. 10+00 TO STA. 20+00

DESIGN/REVIEW COMMITTEE
CITY ENGINEER APPROVAL
Mo./DAY/YR.
Mo./DAY/YR.

LAST DESIGN UPDATE
DESIGN REVIEW COMMITTEE
CITY ENGINEER
JUN 24 2003
JUN 24 2003


CITY PROJECT No. 6050.92
ZONE MAP NO. D-18
SHEET 3 OF 10

SCANNED BY
MESA REPHO

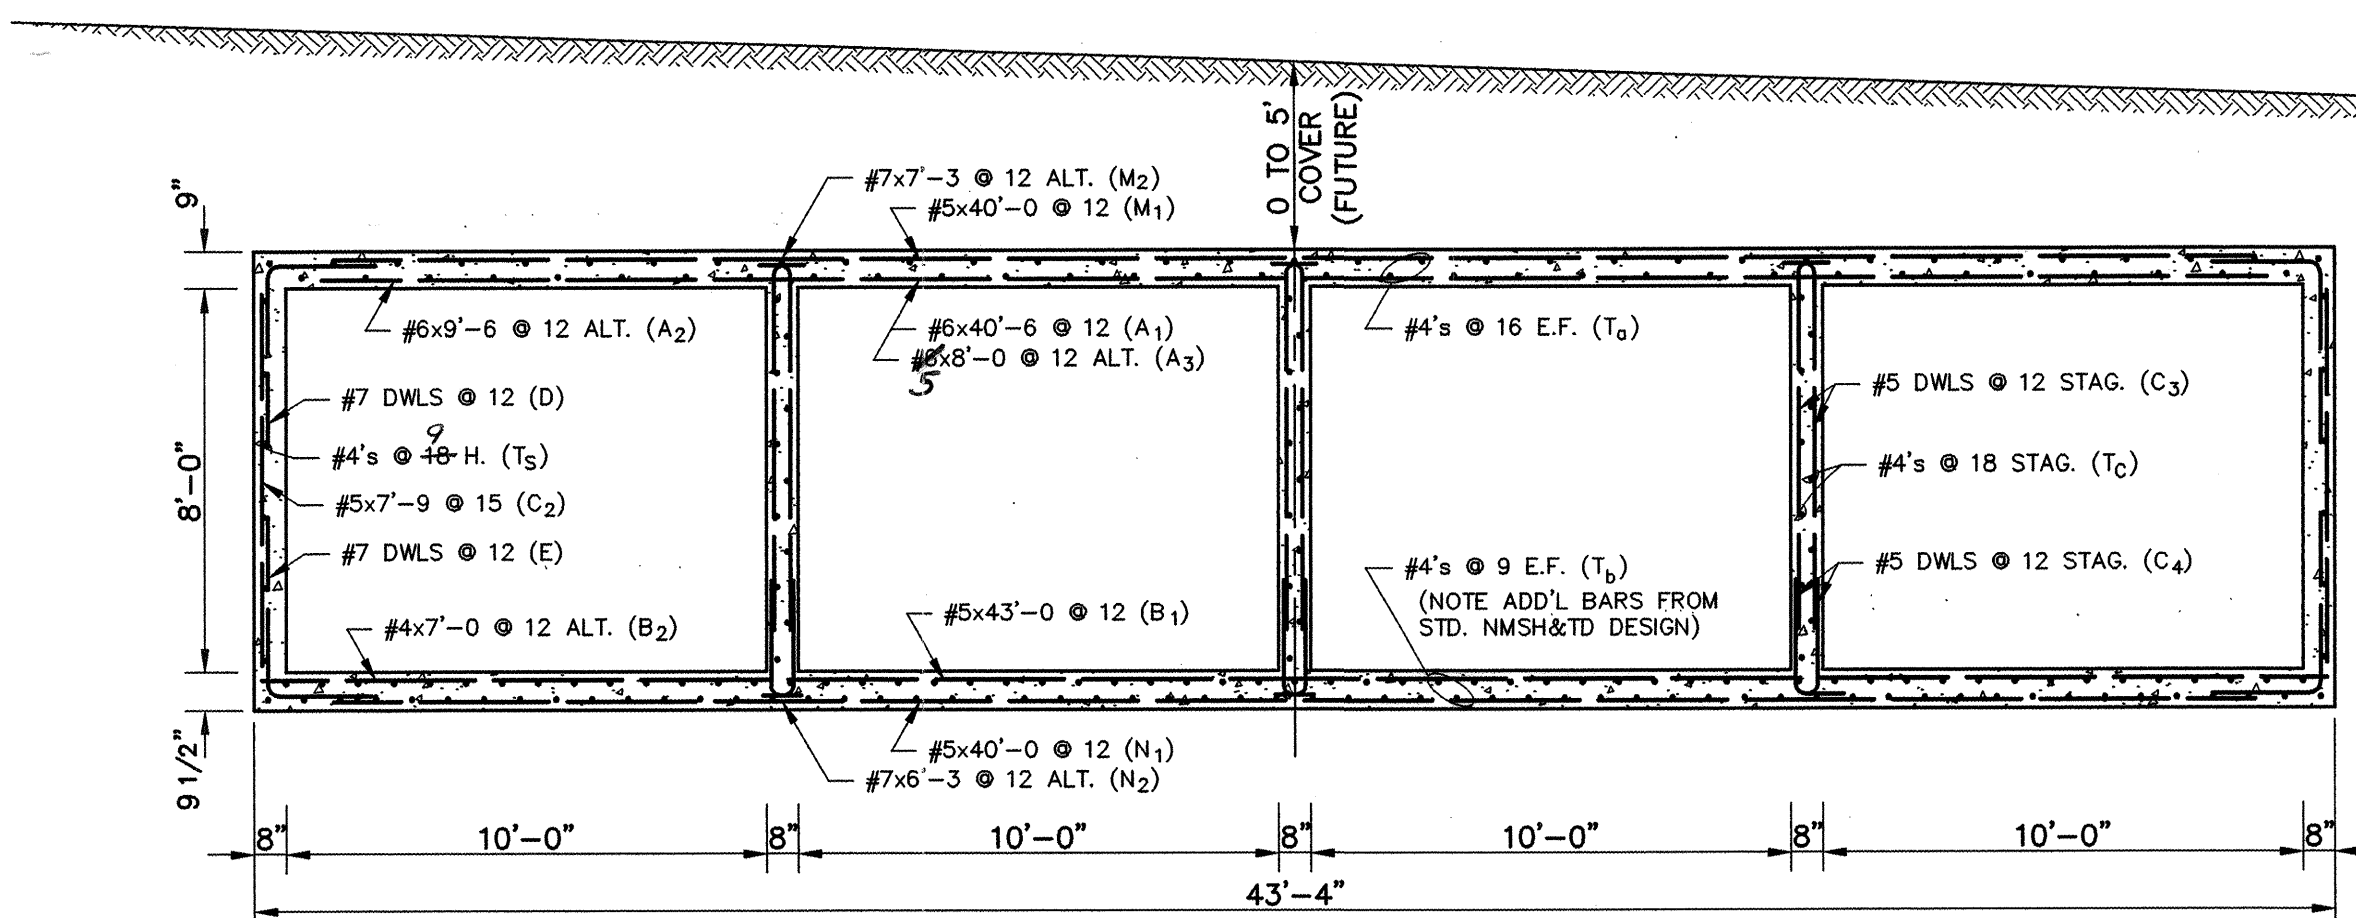


TYPICAL SECTION THRU QUAD-10'x8' CBC

- NOTES:
- THE CONCRETE BOX CULVERT SHALL BE CONSTRUCTED IN ACCORDANCE WITH NMHS&TD SERIAL CB-34, SHEETS 1 & 2 OF 5 (DESIGN NO. 1) EXCEPT AS OTHERWISE INDICATED HEREIN.
 - CAREFULLY MAINTAIN SPACING OF TRANSVERSE BARS @ THE C.B.C. CENTERLINE AND PLACE BARS RADIALLY AROUND CURVES, SUCH THAT THE REINFORCING STEEL WILL BE MAINTAINED WITHIN $\pm 10\%$ OF THE NOMINAL DESIGN.
 - ADD SINGLE CURTAIN #4 BARS @ 9" O.C. IN OUTSIDE WALLS (HORIZONTAL) PER AM AFCA REQUEST

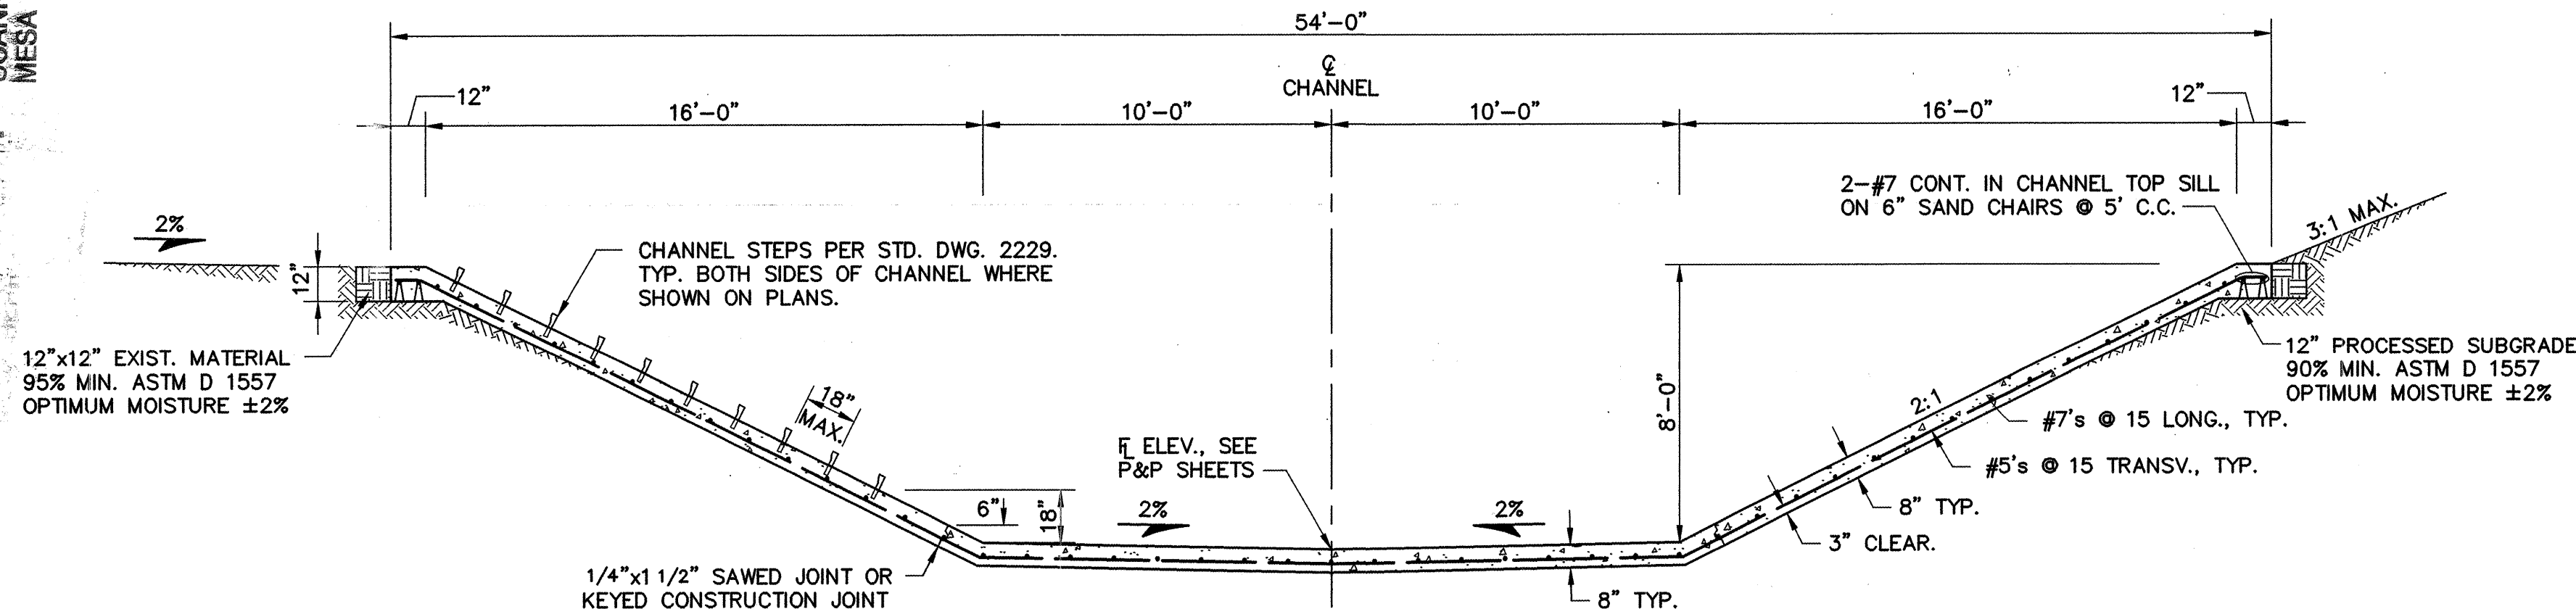


TYPICAL SECTION @ 20' BOTTOM CHANNEL


NOTE:
SEE STD. DWG'S 2265 & 2268 FOR GENERAL NOTES AND DIMENSIONS.
BOTTOM FILLER (KB) = 2" WIDE x 6" DEEP.
TOP FILLER (KT) = 3" WIDE x 3 3/4" DEEP.
SEALANT BLOCK-OUT = 3" WIDE x 2 1/2" DEEP.
SEALANT ORDER SIZE = 3 3/4" WIDE x 2 1/2" DEEP.

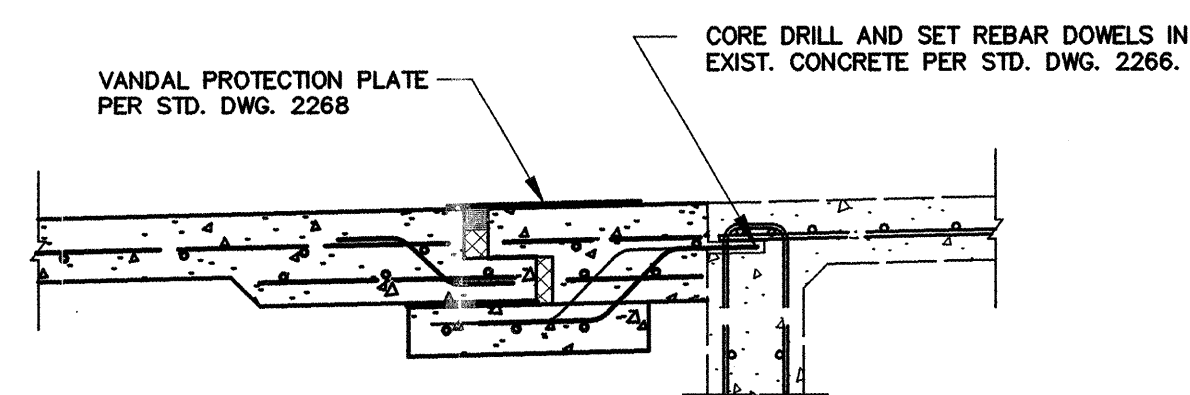

EXPANSION JOINT @ STA. 18+72.72
AND CONNECTION TO THE EXIST. CHANNEL

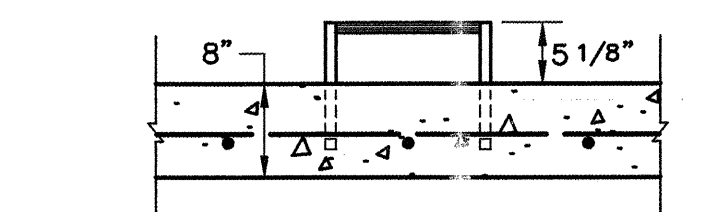


SECTION @ SIDESLOPE LADDER

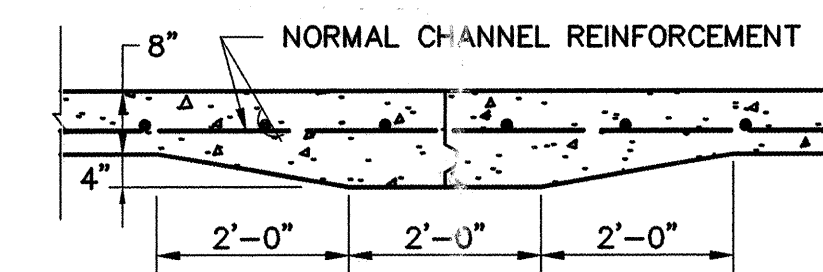


CONSTRUCTION JOINT DETAIL

- NOTES:
- FURNISH AND INSTALL GRATES AND SEAT ANGLES PER NMHS&TD SER. BMDI-001.
 - PRIME AND PAINT EXPOSED STEEL PER CoA STD. REQUIREMENTS.
- (SEE SHEET 7 OF 10 FOR GRATE DETAILS.)

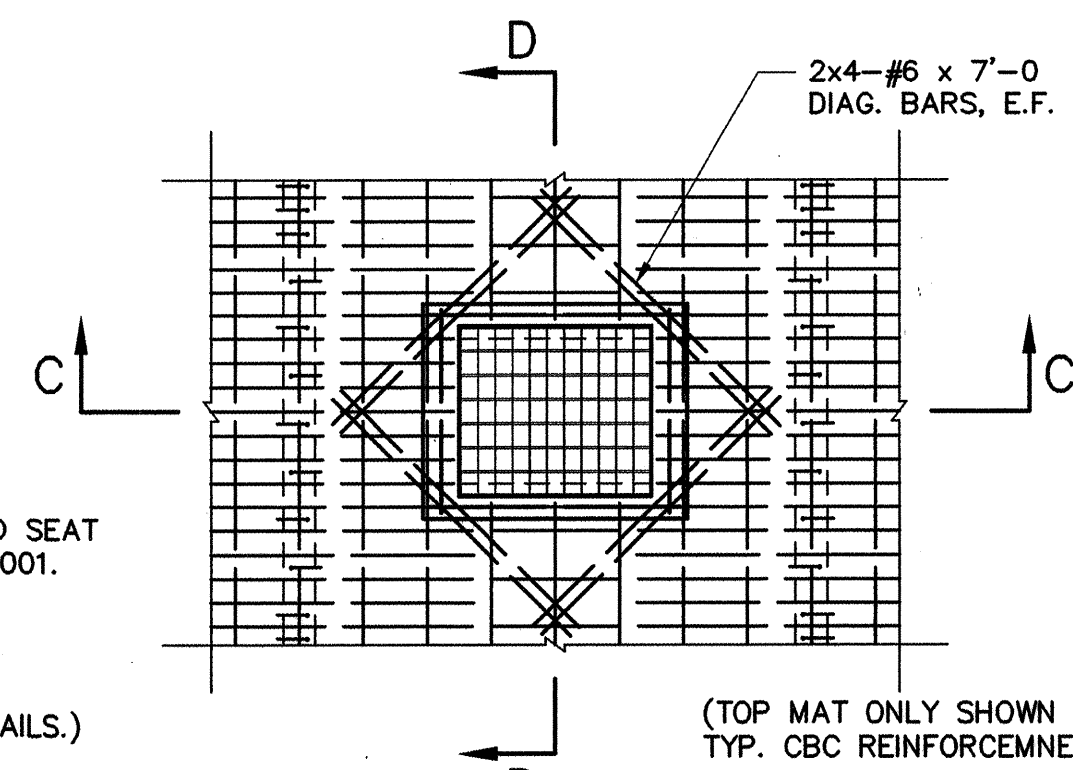


TYP. PLAN SECTION @ 4'x3'-6" MEDIAN DROP INLET
IN C.B.C. ROOF SLAB @ STA. 10+10 (4 THUS)

2x4-#5 x 4'-0 ADD'L
PIPE PENETRATION.
CUT PIPE FLUSH WITH
INSIDE WALL FACE.

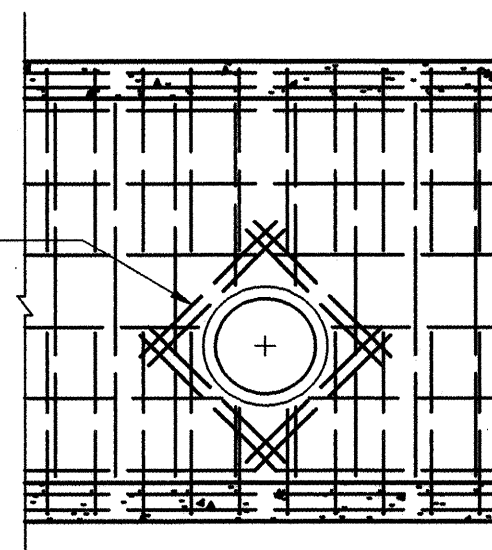


CBC WALL ELEVATION
@ 24" RCP PIPE PENETRATION
(SEE SHT. 2 OF 10) 1/4" = 1'-0"


2x4-#5 x 4'-0
DIAG. BARS, E.F.

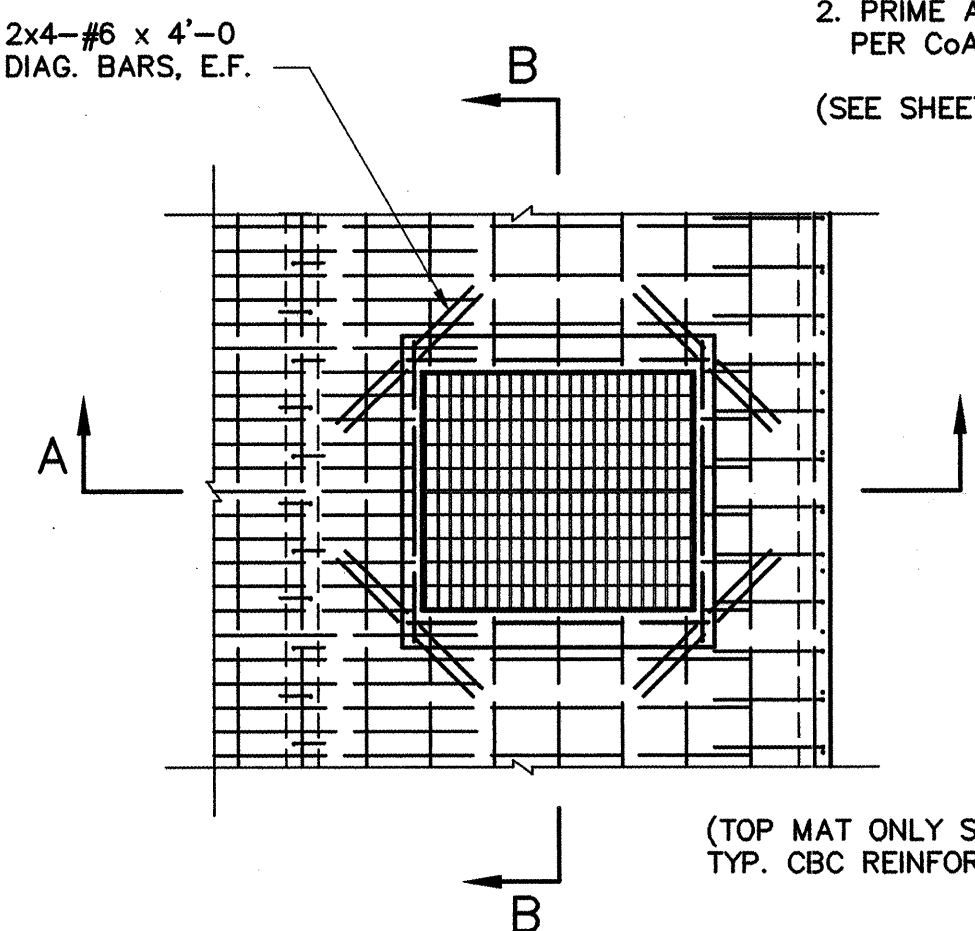


PLAN SECTION @ 5'x5' MEDIAN DROP INLET
IN C.B.C. ROOF SLAB @ STA. 15+90.16' RT.
1/4" = 1'-0"

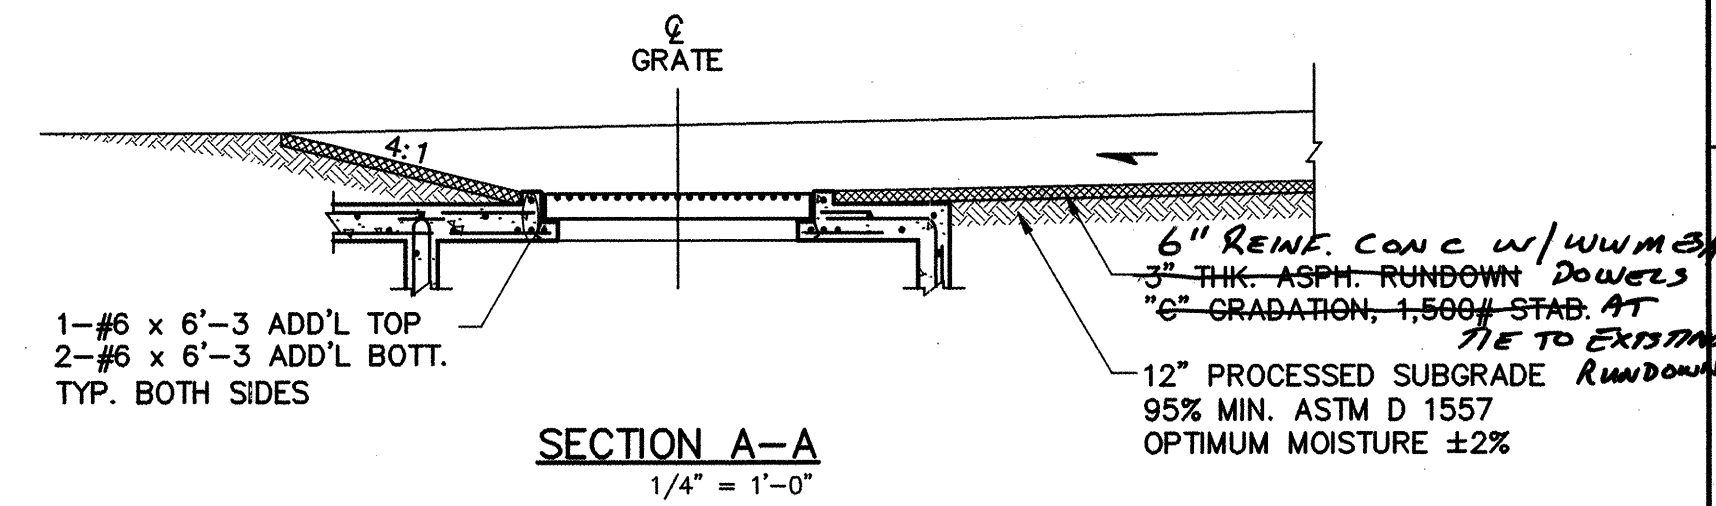

SECTION A-A
1/4" = 1'-0"

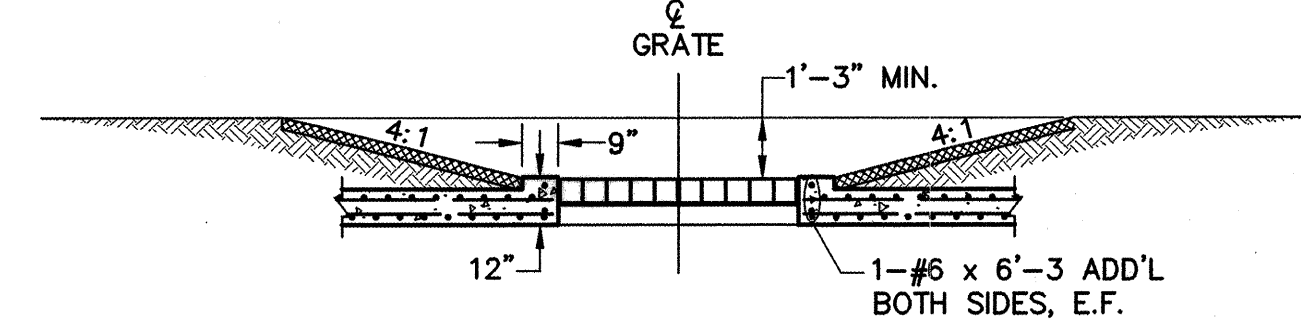

SECTION B-B
1/4" = 1'-0"

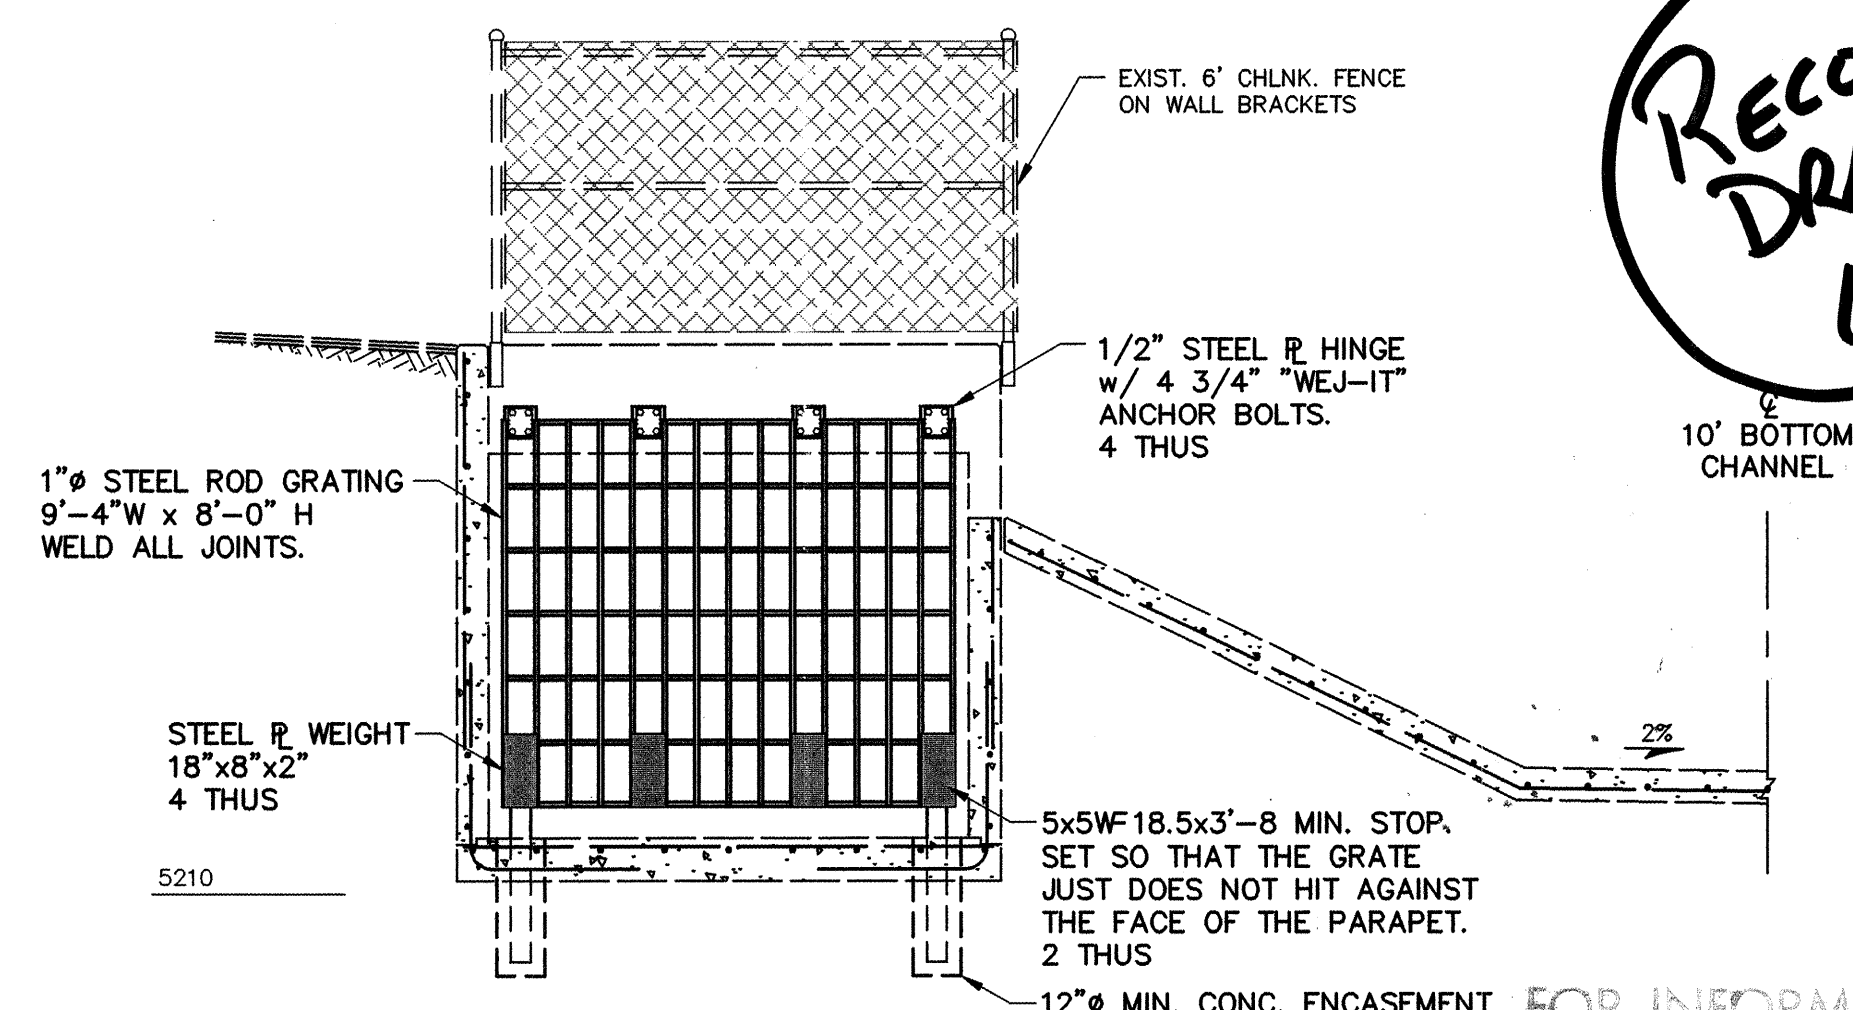

SAFETY GRATING
@ EXIST. 10x8 C.B.C. OUTLET
(CHANNEL @ STA. 25+04±)

NOTE:
ALL EXPOSED STEEL SHALL BE THOROUGHLY CLEANED AND
DEBURRED, AND PAINTED WITH ONE SHOPCOAT OF RED OXIDE
PRIMER AND TWO FINISH COATS ALUMINUM PAINT (AASHTO M 69).

- NOTES:
- PORTLAND CEMENT CONCRETE SHALL MEET THE REQUIREMENTS OF SECTION 101 FOR USE IN DRAINAGE STRUCTURES. (4000#, 6-BAG MIX W/ CLASS F FLYASH.)
 - REINFORCING STEEL SHALL MEET THE REQUIREMENTS OF ASTM A 615, GRADE 40 OR 60.
 - REINFORCING DETAILS NOT SHOWN SHALL CONFORM TO C.R.S.I. RECOMMENDED PRACTICE.
 - #5 BARS AND SMALLER SHALL BE DETAILED FOR 30 BAR DIAMETERS MINIMUM LAPS. 20 BAR DIAMETERS WILL BE THE MINIMUM ACCEPTABLE LAP @ SPLICES IN THE FIELD.
 - EXPOSED CONCRETE SURFACES SHALL BE GIVEN A CLASS I SURFACE FINISH.

- NOTES:
- FURNISH AND INSTALL GRATES AND SEAT ANGLES PER NMHS&TD SER. BMDI-006.
 - PRIME AND PAINT EXPOSED STEEL PER CoA STD. REQUIREMENTS.
- (SEE SHEET 7 OF 10 FOR GRATE DETAILS.)


RECORD
DRAWING
6-11-04

FOR INFORMATION ONLY
Easterling & Associates, Inc.
CONSULTING ENGINEERS
2600 American Rd. SE, Suite 100
Rio Rancho, New Mexico 87124
(505) 898-8021 FAX (505) 898-8501
E-Mail: eoi_engr@swcp.com


DESIGN REVIEW COMMITTEE		CITY ENGINEER APPROVAL		LAST DESIGN UPDATE	
DESIGN	REVIEW	DATE	BY	Mo./DAY/YR.	Mo./DAY/YR.
APPROVED	APPROVED	JUN 24 2003			
CITY PROJECT NO. 6050.92		ZONE MAP NO. D-18		SHEET 4 OF 10	

SCANNED BY
MUSA REPIO

D:\Land Projects\3\DBACADwg\DBACAS\TRANS.dwg 06/04/2003 02:12:06 PM MDT

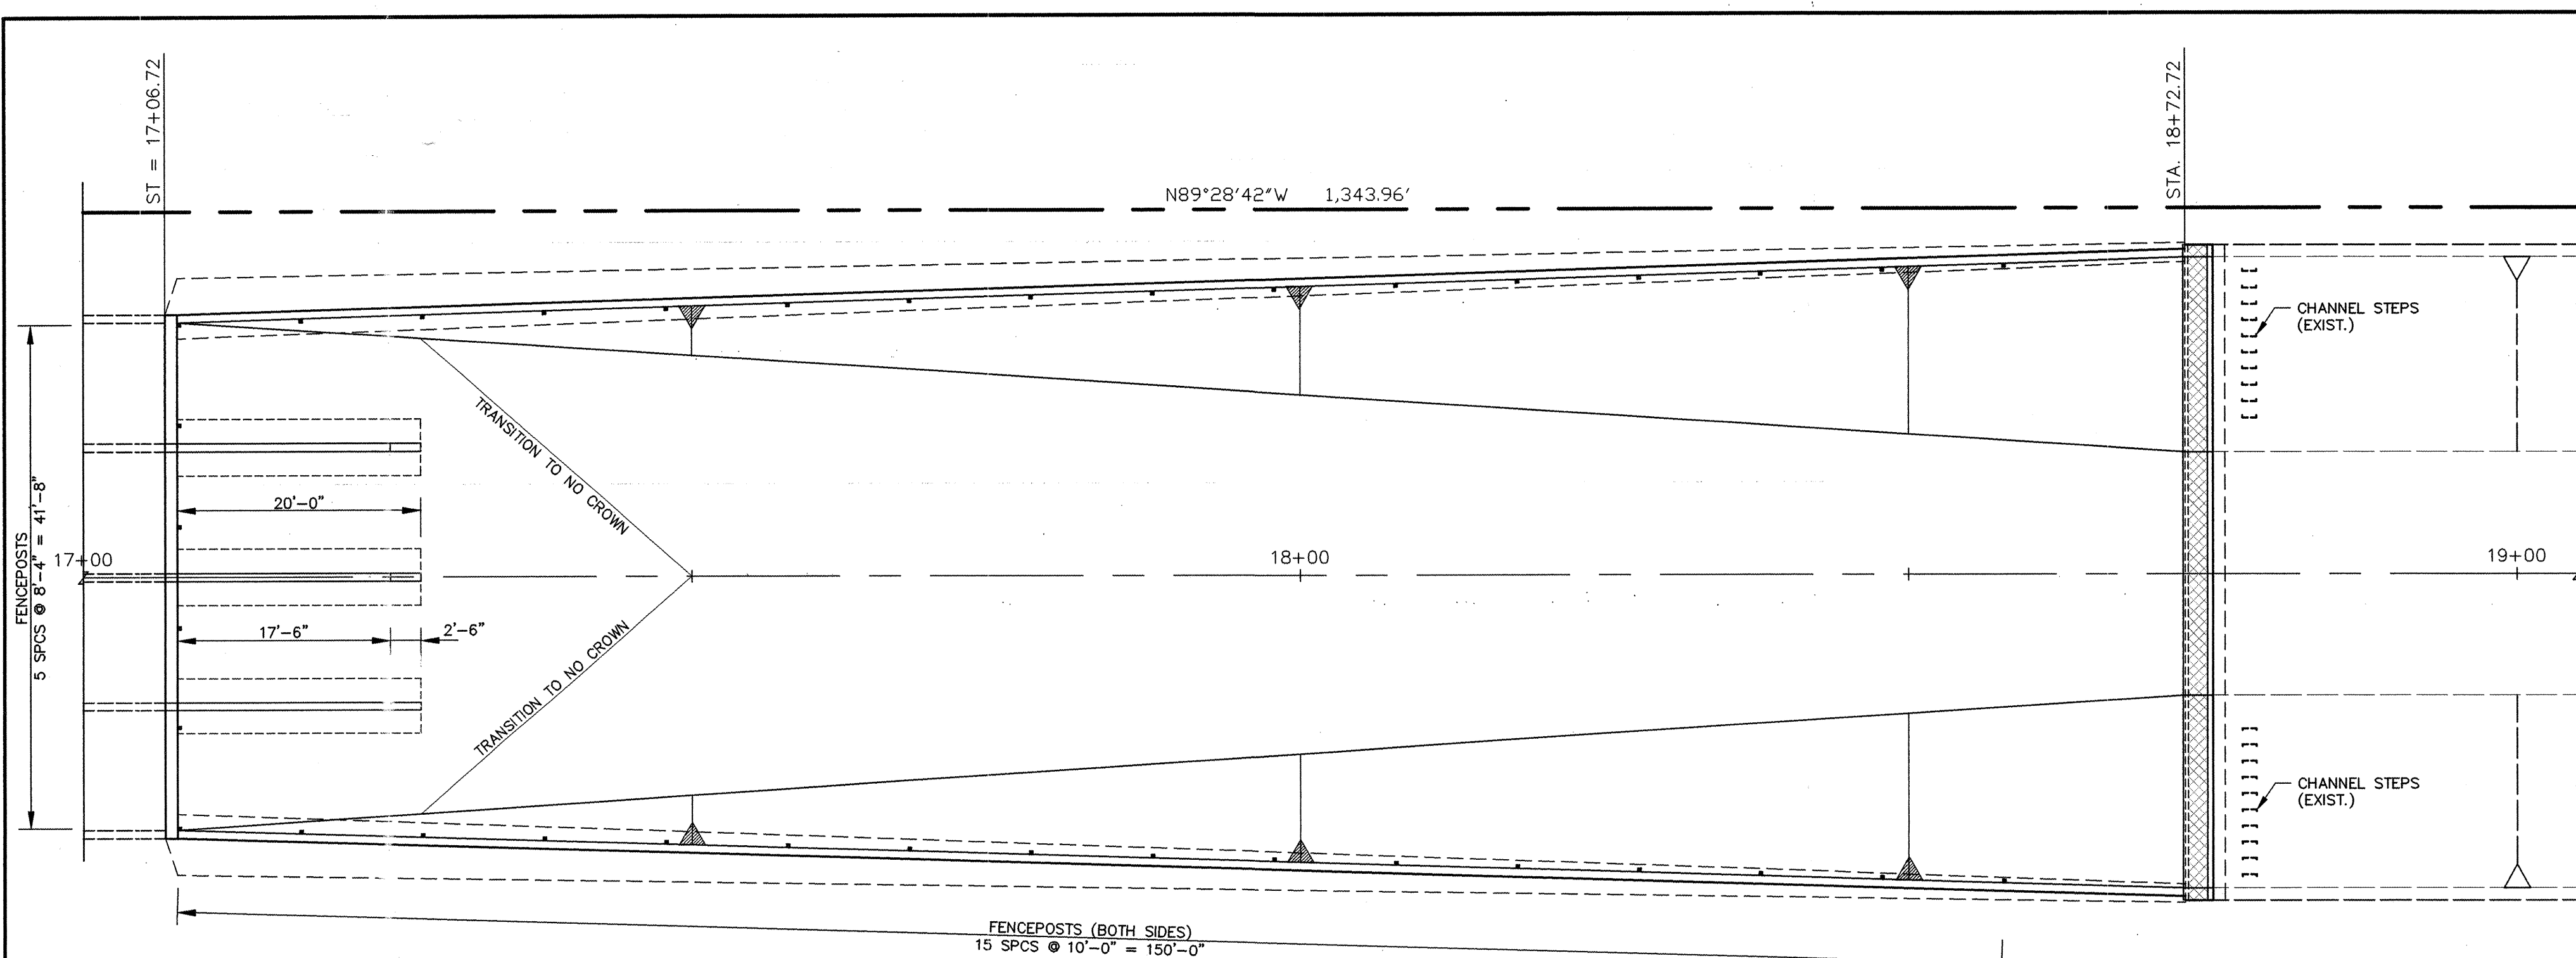


PLAN LAYOUT @ TRANSITION SECTION
1" = 10'-0"

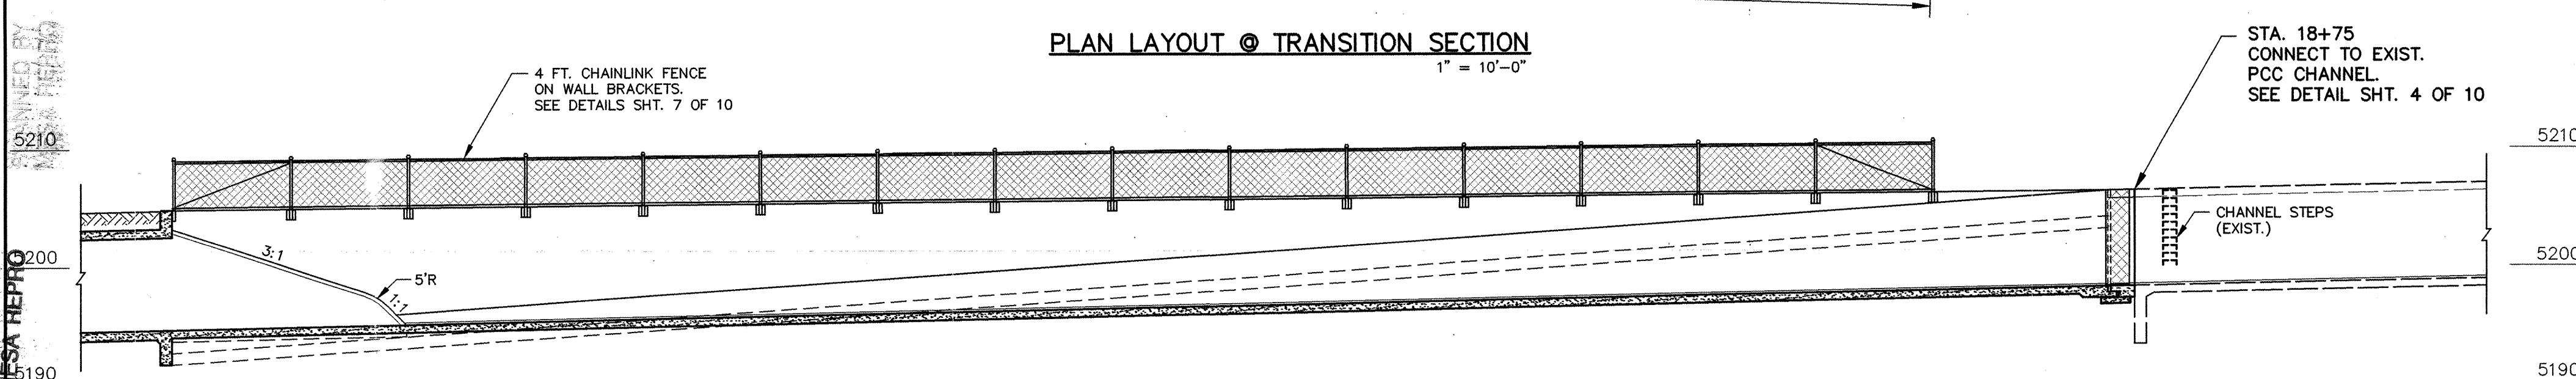


LONGITUDINAL SECTION THROUGH TRANSITION
1" = 10'-0"


NOTE:
EXTEND OR DOWEL HORIZONTAL RETAINING WALL
AND NOSE BARS 18" MIN. INTO C.B.C. WALLS.
EXTEND OR DOWEL LONGITUDINAL CHANNEL SLAB
BARS 24" MIN. INTO C.B.C. FLOORSLAB.

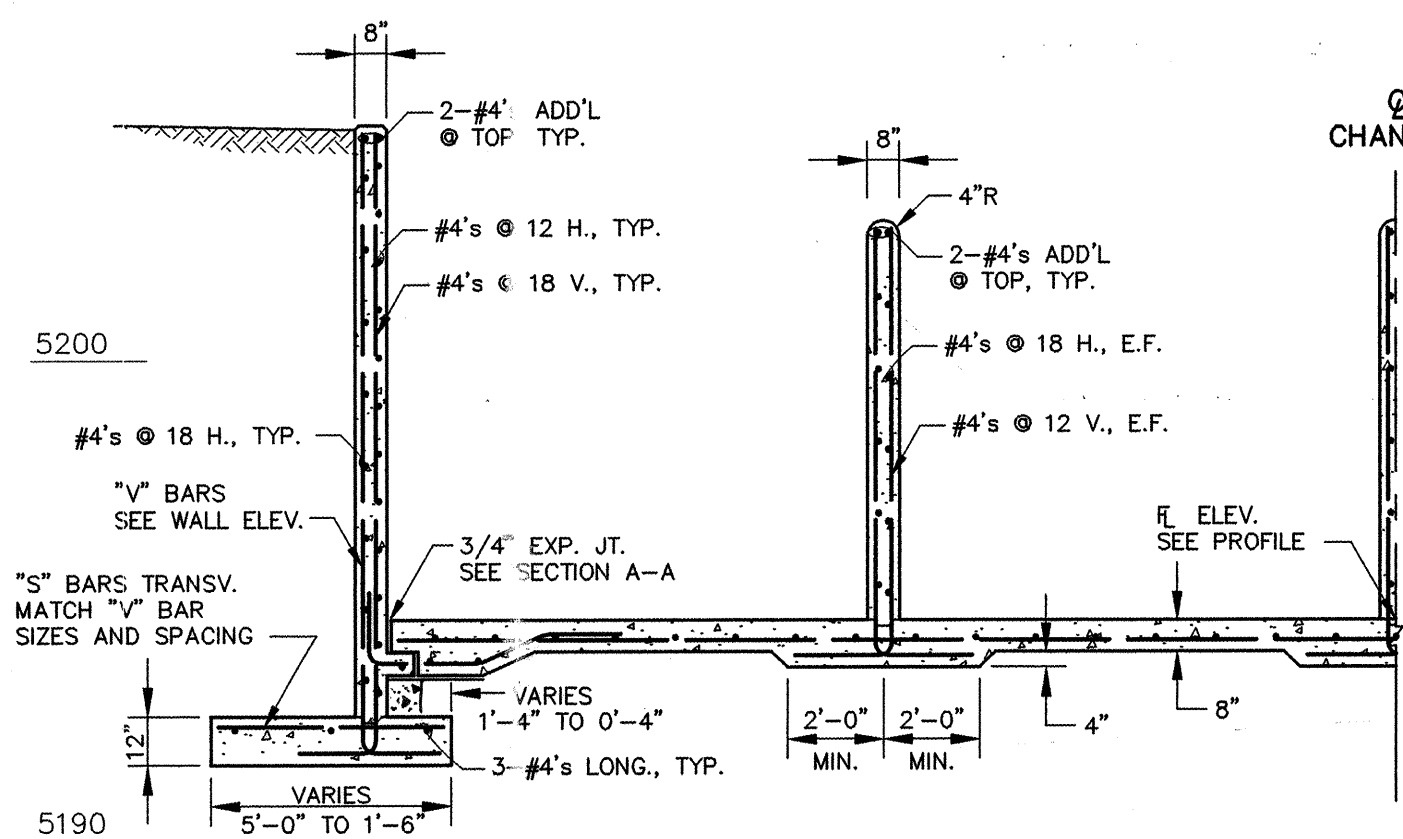


HALF-SECTION @ STA. 17+08.00
1/4" = 1'-0"

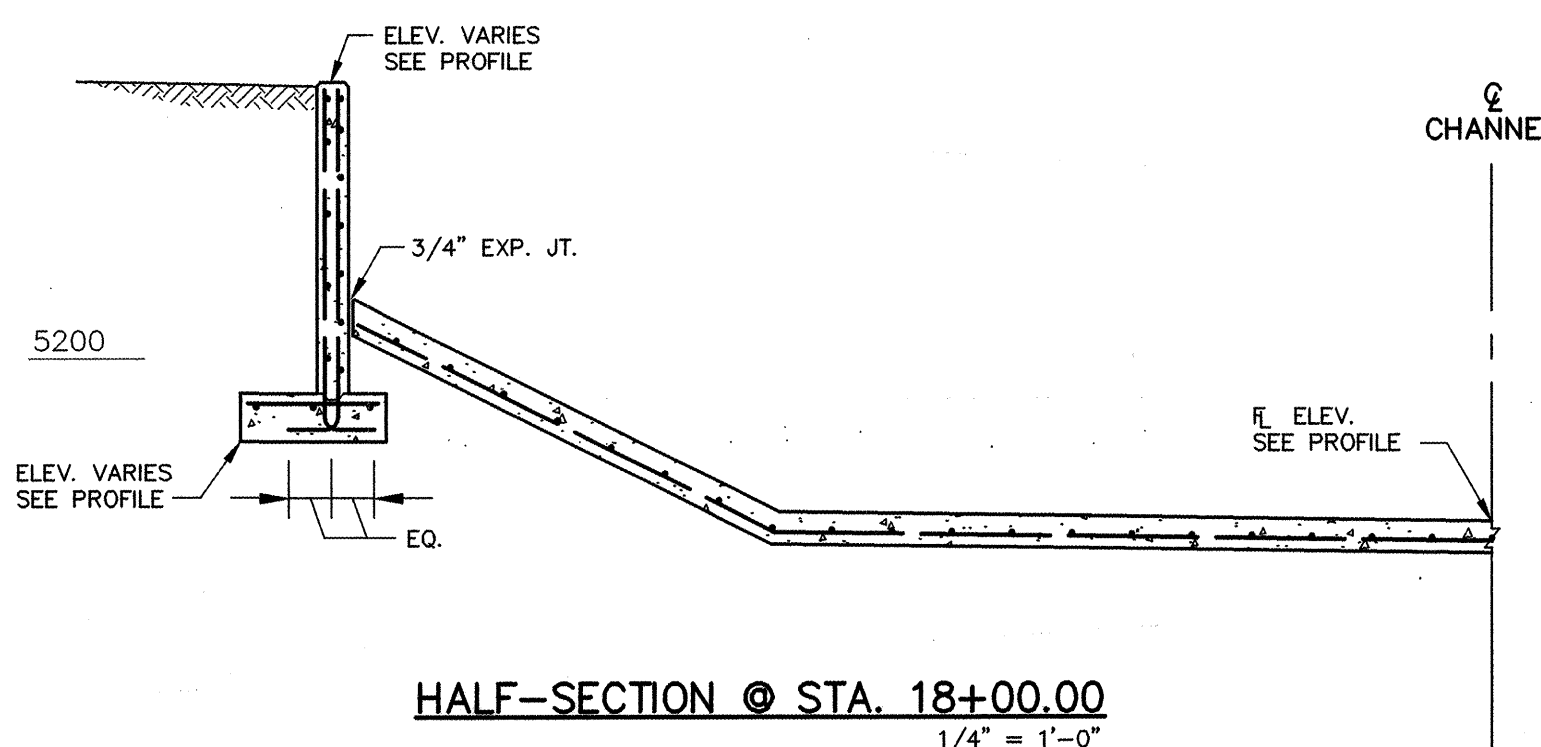


HALF-SECTION @ STA. 18+00.00
1/4" = 1'-0"

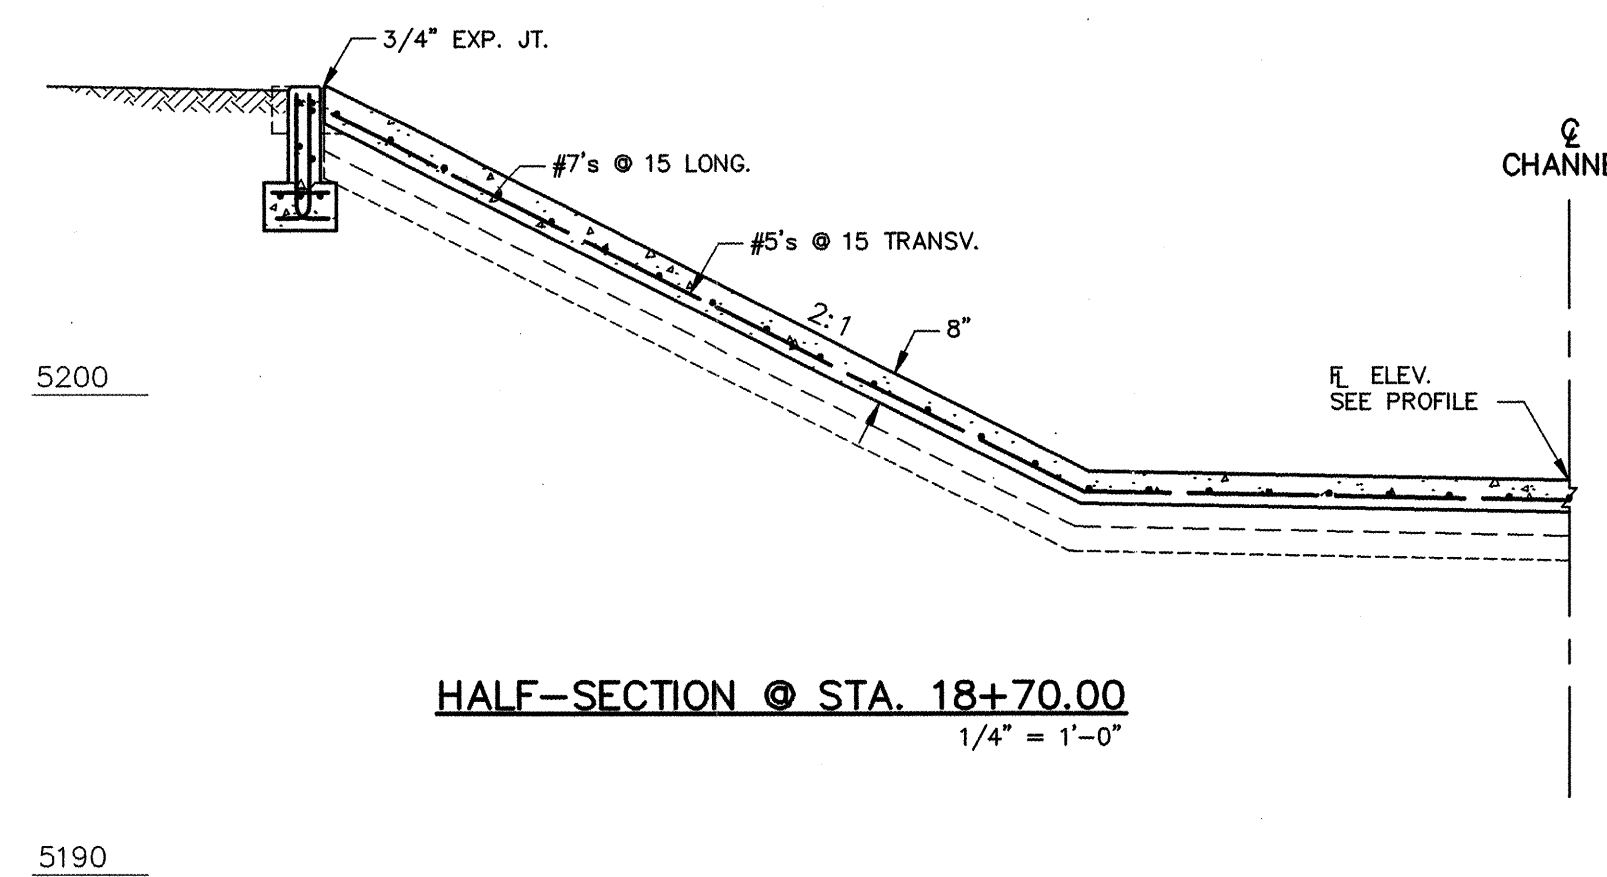


HALF-SECTION @ STA. 18+70.00
1/4" = 1'-0"

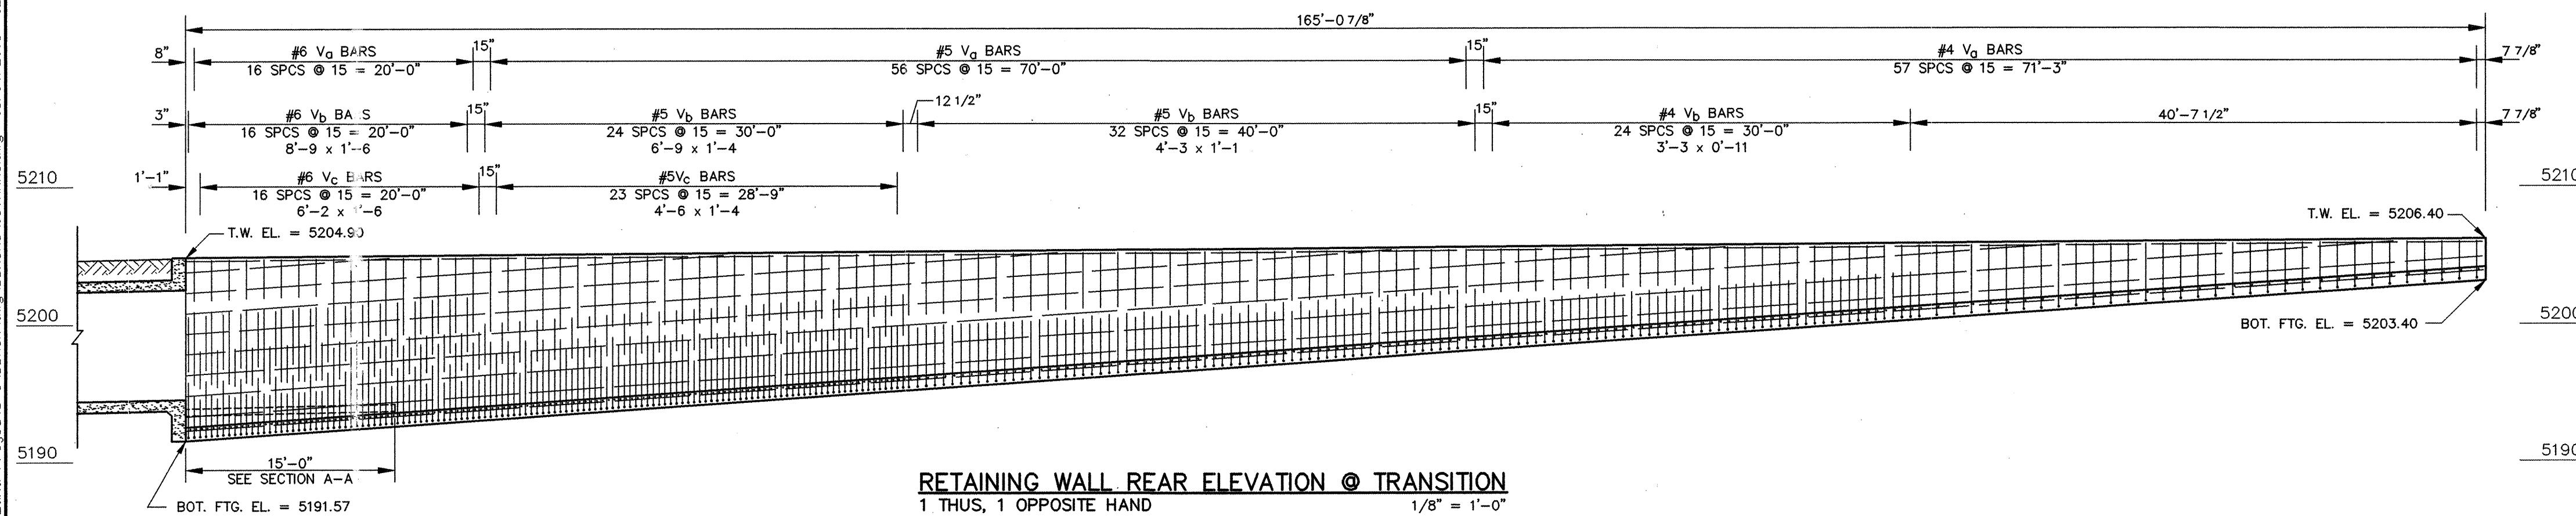

RETAINING WALL REAR ELEVATION @ TRANSITION
1 THUS, 1 OPPOSITE HAND
1/8" = 1'-0"

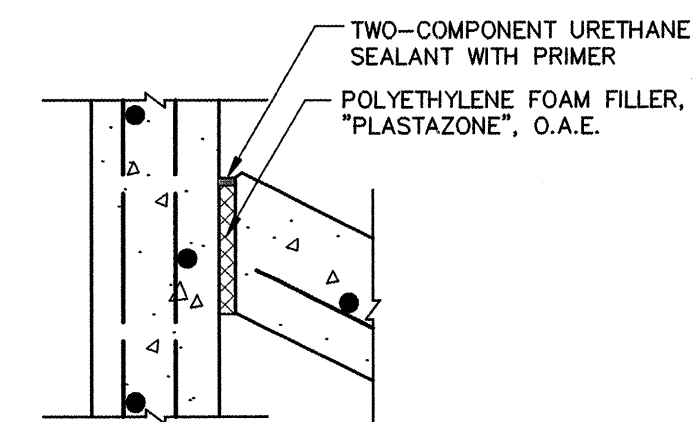


TYP. 3/4" EXPANSION JOINT @ RET. WALLS
(STD. DWG. 2260 SIM.)
1" = 1'-0"

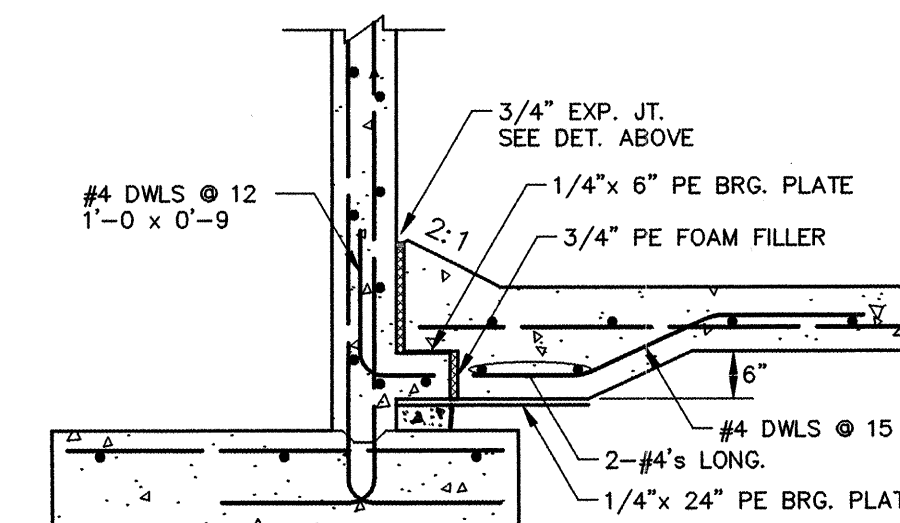

3/4" EXPANSION JOINT @ SECTION A-A
(STD. DWG. 2266 SIM.)
1/2" = 1'-0"

FOR INFORMATION ONLY

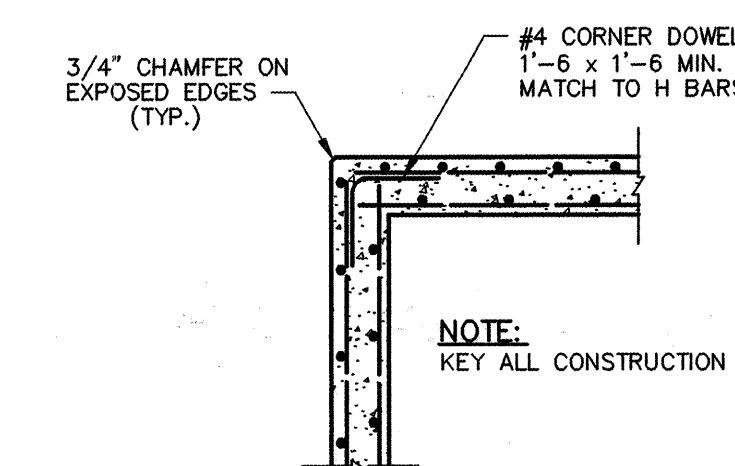

TYPICAL CORNER DETAIL
NO SCALE






Revised
Drawing
6-11-04

Easterling & Associates, Inc.
CONSULTING ENGINEERS
2800 American Rd. SE, Suite 100
Rio Rancho, New Mexico 87124
(505) 898-8021 FAX (505) 898-8501
E-Mail: ead_engr@swcp.com

CITY OF ALBUQUERQUE
PUBLIC WORKS DEPARTMENT
ENGINEERING DEVELOPMENT GROUP
**SOUTH ARROYO DE DOMINGO BACA
(I-25 EAST TO STA. 18+75)
TRANSITION SECTION DETAILS**

DESIGN REVIEW COMMITTEE	CITY ENGINEER APPROVAL	Mo./DAY/YR.	Mo./DAY/YR.
DESIGN REVIEW COMMITTEE	CITY ENGINEER APPROVAL		
CITY PROJECT No.	ZONE MAP No.	SHEET	OF
6050.92	D-18	5	10

AS BUILT INFORMATION		BENCH MARKS		SURVEY INFORMATION		ENGINEER'S SEAL	
CONTRACTOR	MOORE & COWART	ACS ALUM. CAP	9-C18 1985	FIELD NOTES	NO.	ENGINEER'S SEAL	NO.
WORKED BY	CARSTENSON	X=	402,255.61	DATE	DATE	ENGINEER'S SEAL	DATE
INSPECTED BY	WILSON	Y=	1,521,435.09	BOHANNAN-HUSTON, INC.	BOHANNAN-HUSTON, INC.	ENGINEER'S SEAL	BOHANNAN-HUSTON, INC.
APPROVED BY	WILSON	ELEV.	5229.79	TOPOGRAPHIC MAP OF	TOPOGRAPHIC MAP OF	ENGINEER'S SEAL	TOPOGRAPHIC MAP OF
VERIFIED BY	WILSON	ACS BC 17-D18	ACS BC 17-D18	PLAZA DEL PASO - 7/98	PLAZA DEL PASO - 7/98	ENGINEER'S SEAL	PLAZA DEL PASO - 7/98
DATE	6-11-04	X=	402,438.55	ADD'L. POINTS AS REQUIRED	ADD'L. POINTS AS REQUIRED	ENGINEER'S SEAL	ADD'L. POINTS AS REQUIRED
DATE	6-11-04	Y=	1,518,290.84	BY SURV-TEK - 12/98	BY SURV-TEK - 12/98	ENGINEER'S SEAL	BY SURV-TEK - 12/98
DATE	6-11-04	ELEV.	5235.58			ENGINEER'S SEAL	

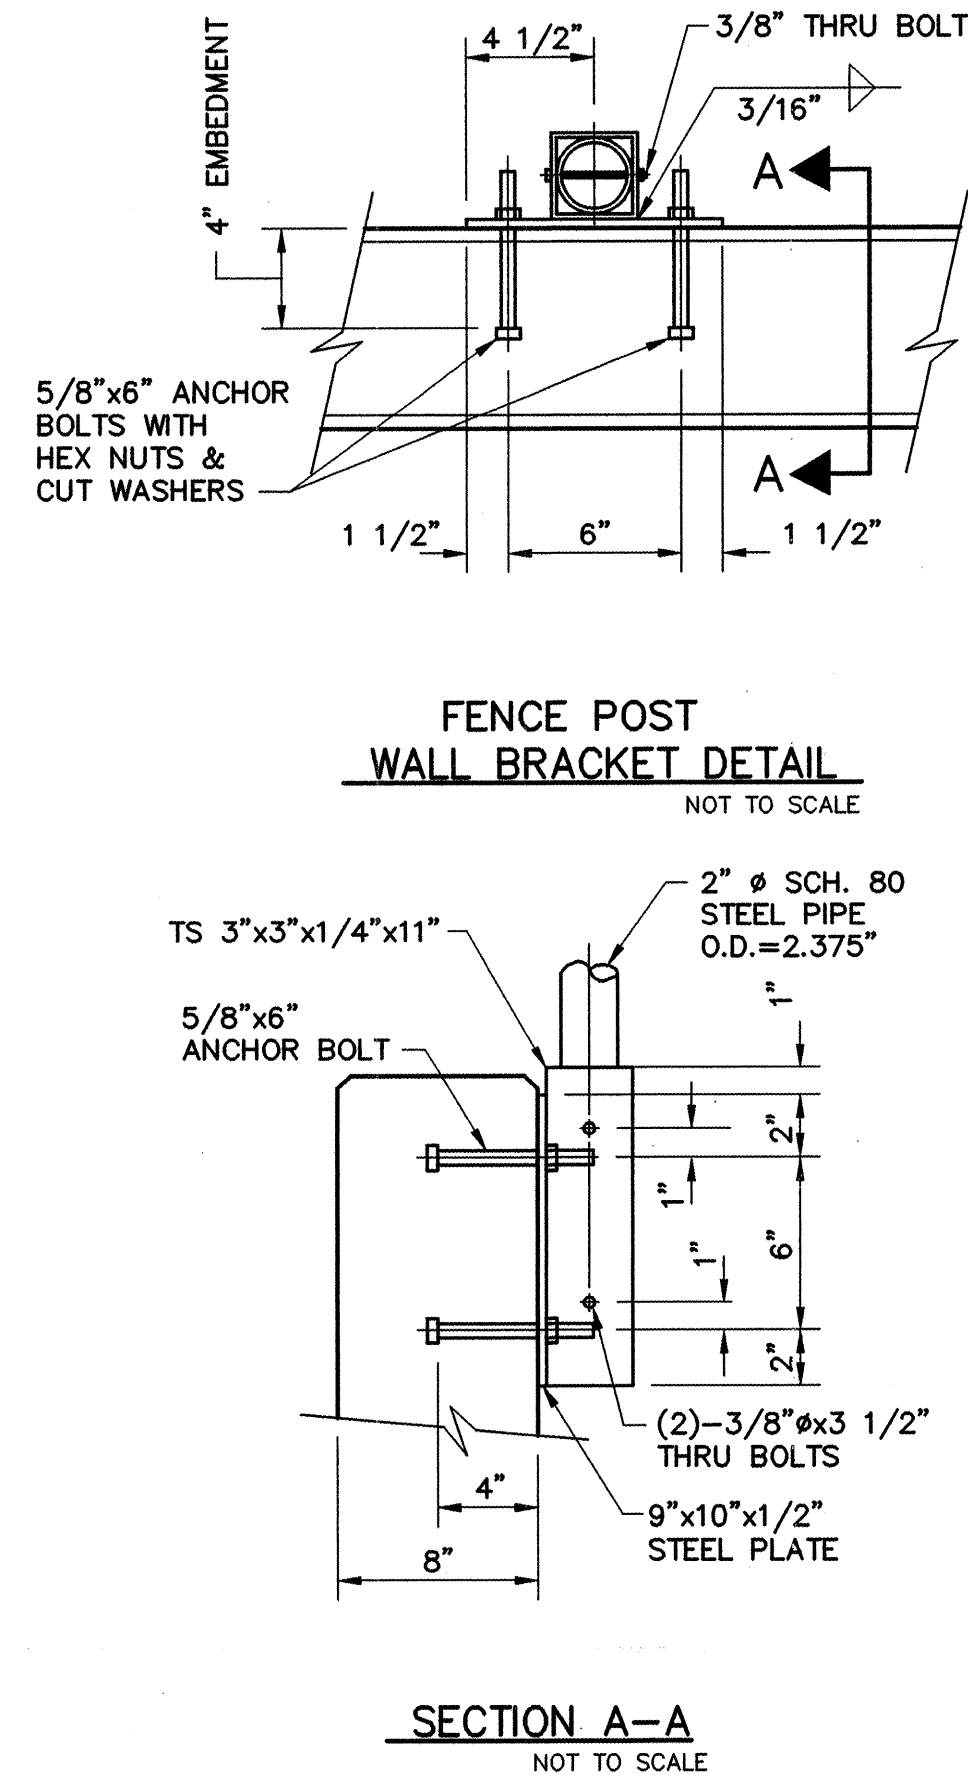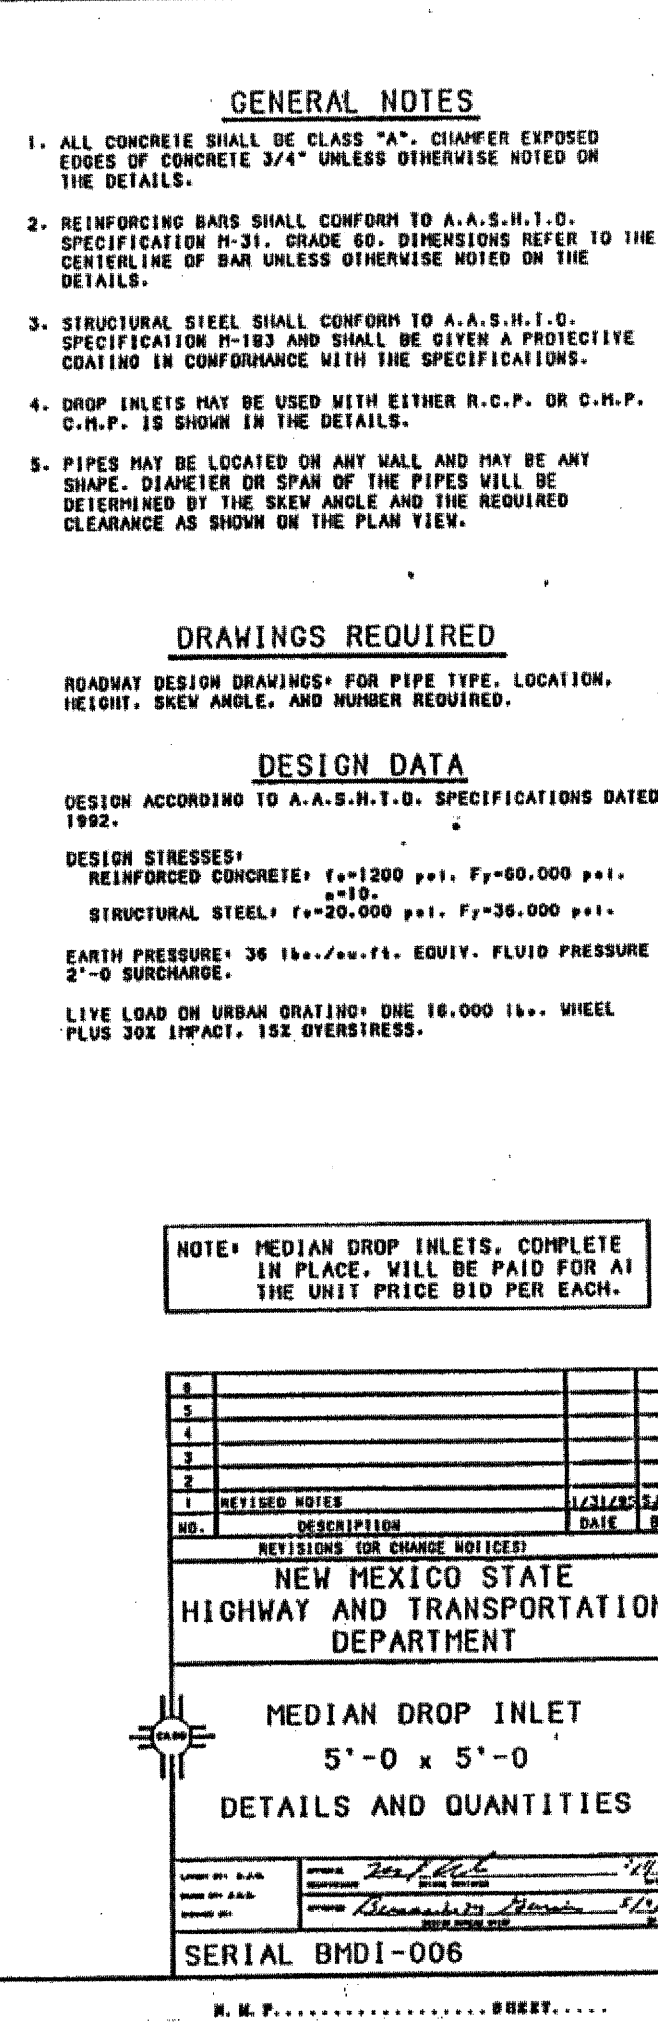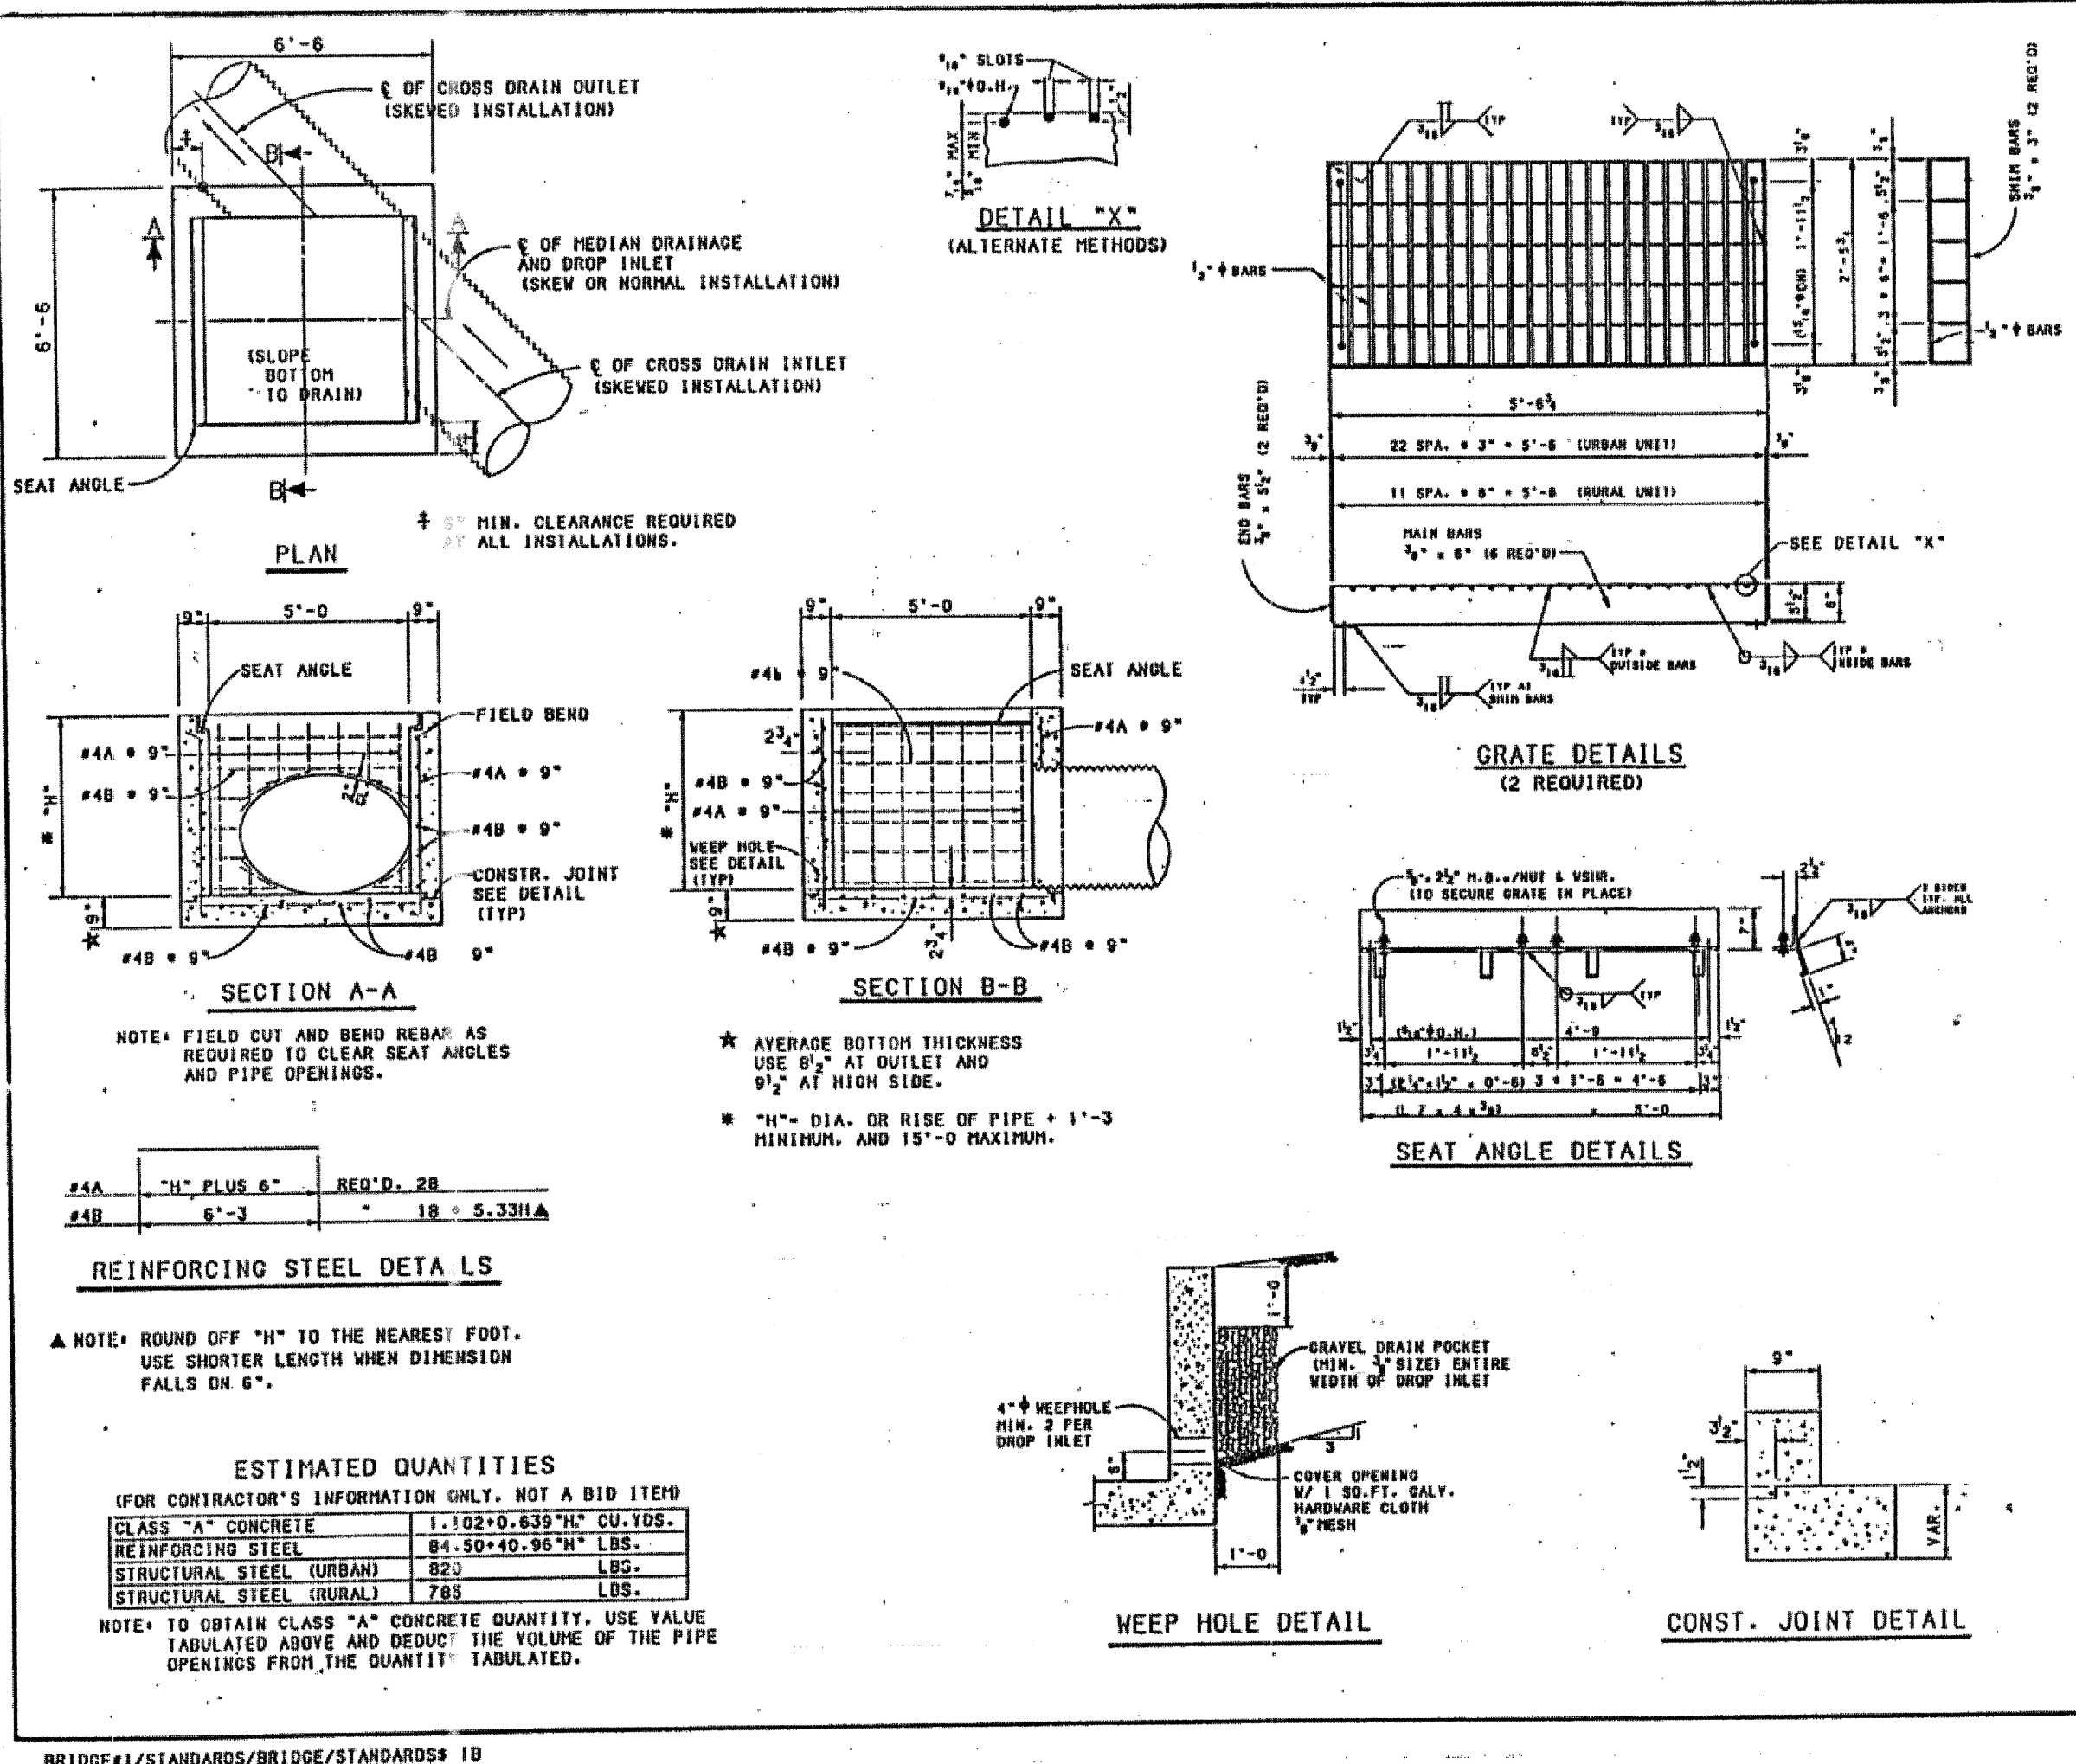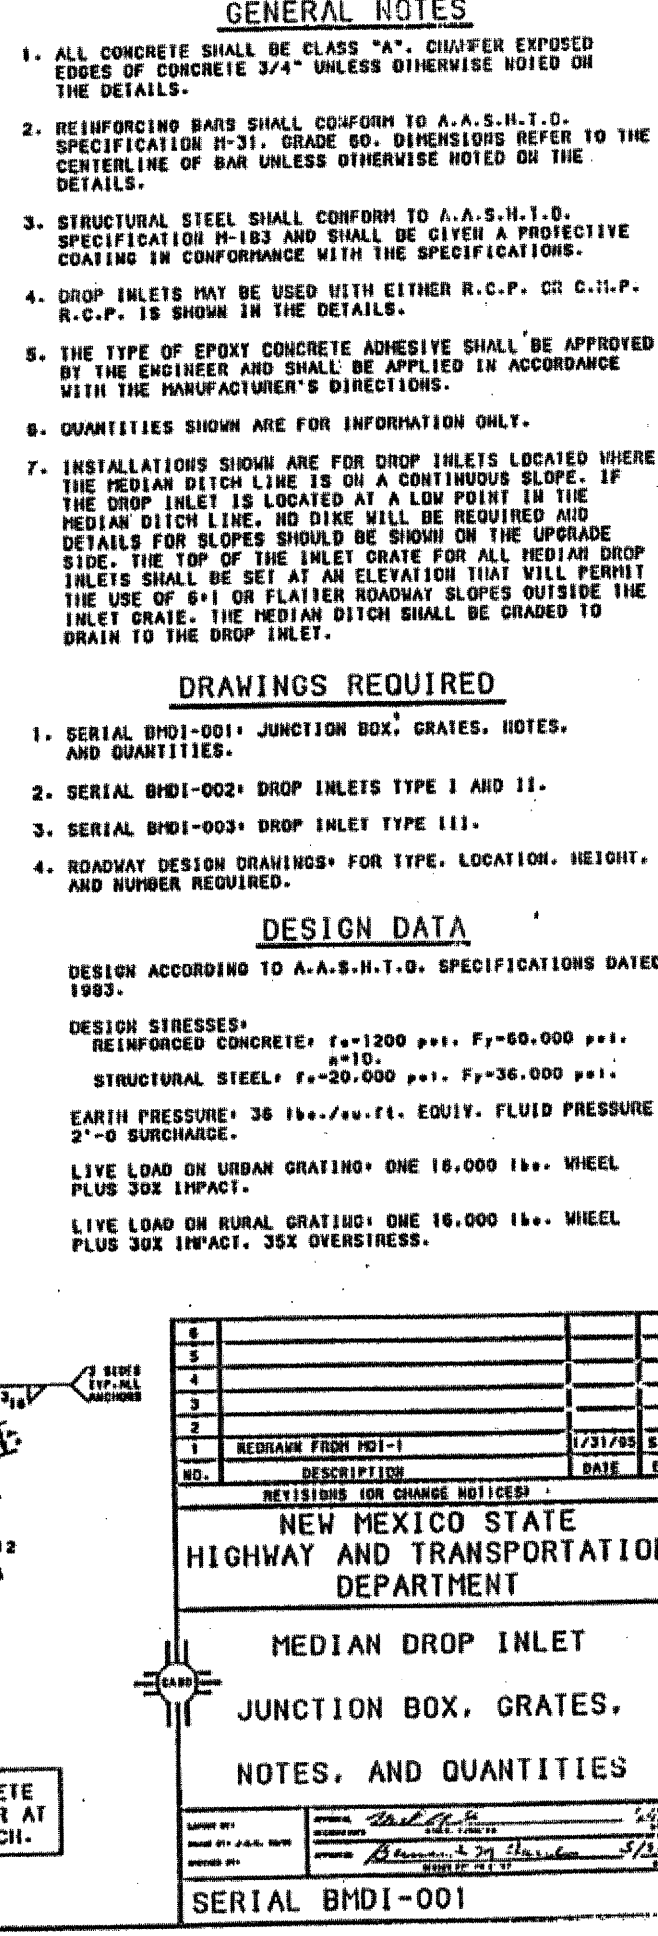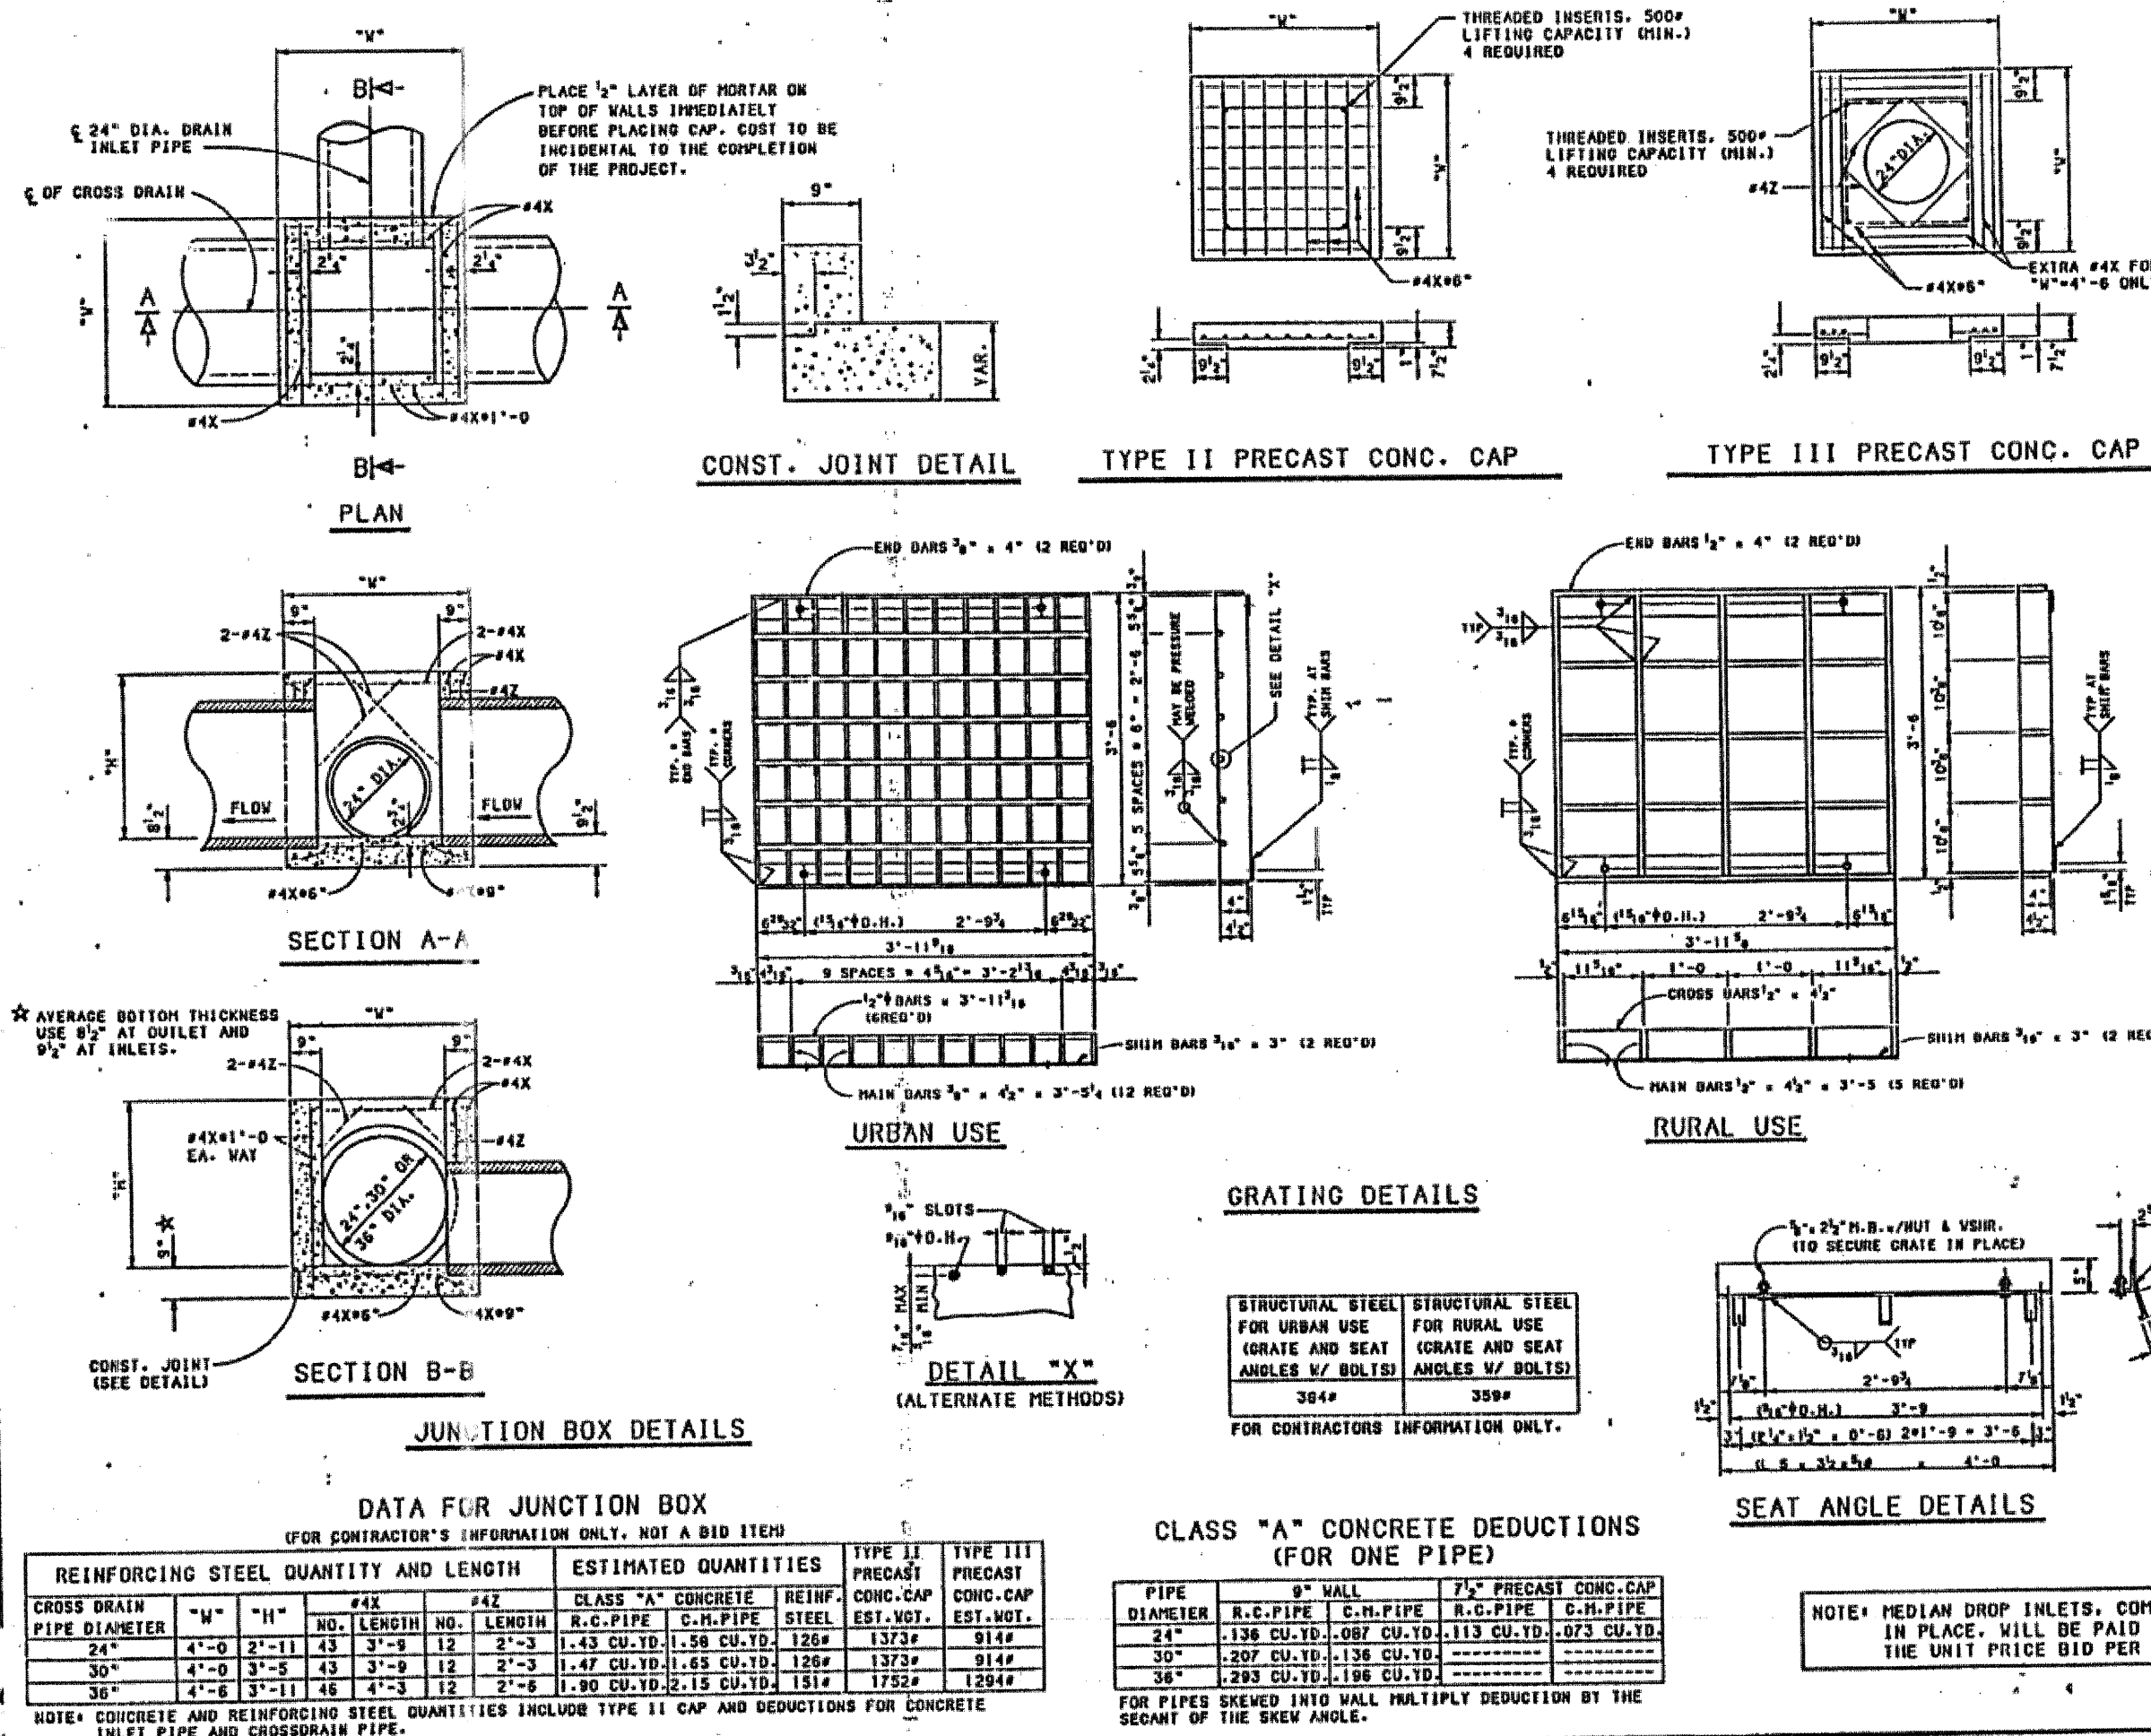

FOR INFORMATION ONLY

RECORD
DRAWING
6-11-04

Easterling & Associates, Inc.
 CONSULTING ENGINEERS
 2600 American Rd. SE, Suite 100
 Rio Rancho, New Mexico 87124
 (505) 898-8021 FAX (505) 898-8501
 E-Mail: eei_engr@comp.com

CITY OF ALBUQUERQUE PUBLIC WORKS DEPARTMENT ENGINEERING DEVELOPMENT GROUP			
SOUTH ARROYO DE DOMINGO BACA (1-25 EAST TO STA. 18+75) FENCE AND INLET GRATE DETAILS			
DESIGN REVIEW COMMITTEE	CITY ENGINEER APPROVAL	Mo./DAY/YR.	Mo./DAY/YR.
JUN 24 2003	JUN 24 2003		
DESIGN REVIEW COMMITTEE	CITY ENGINEER		
CITY PROJECT No.	ZONE MAP NO.	SHEET	OF
6050.92	D-18	7	10

AS BUILT INFORMATION			
CONTRACTOR	MOORE & CONNETT	DATE	5-18-04
WORKED BY	CHAPMAN	DATE	5-18-04
INSPECTED BY	WILSON	DATE	5-18-04
APPROVED BY	WILSON	DATE	5-18-04
VERIFIED BY	WILSON	DATE	5-18-04
DATE	6-11-04		
MICRO-FILM INFORMATION			
RECORDED BY		DATE	
NO.			

ENGINEER'S SEAL			
NO.	DATE	REVISIONS	BY
		DESIGN	
		HC-A	
		HC-A	
		CME	
		DATE 6-04-03	
		DATE 6-04-03	
		DATE 6-04-03	



SCANNED BY
MESA REPRO

D:\land Projects\3\BACA.dwg, DBACA\08CHSECT.dwg 06/04/2003 02:14:40 PM MDT

NOTES:
FOR ESTIMATING PURPOSES, THE EXISTING "PLACED RIP-RAP" (CONCRETE RUBBLE) FROM APPROXIMATELY STA. 10+00 TO STA. 18+75 WAS ASSUMED TO BE 3 FT. THICK ON THE NORTH BANK, 5 FT. THICK ON THE BOTTOM, AND 4 FT. THICK ON THE SOUTH BANK, AS PER THE NOMINAL THICKNESSES SPECIFIED BY FIELD ORDER TO THE CONTRACTOR FOR CITY PROJECT NO. 6050.91

FOR THIS CONTRACT, REMOVE THE EXISTING CONCRETE RUBBLE FROM THE NORTH BANK AND PLACE IT ALONG THE SOUTH BANK, OUT OF THE WAY OF THE NEW CONSTRUCTION, WITH WATER AND EQUIPMENT COMPACTION. WHERE THE NEW C.B.C. LIES OVER CONCRETE RUBBLE, OVER-EXCAVATE TO 2' DEPTH MIN. AND PLACE THE EXCAVATED RUBBLE ALONG THE SOUTH BANK. REPLACE THE OVER-EXCAVATION WITH WITH REASONABLY CLEAN MATERIAL. PREPARE THE SUBGRADE FOR THE C.B.C. AND CHANNEL CONSTRUCTION AS REQUIRED BY SECTION 501 OF THE STANDARD SPECIFICATIONS.

R = EST. RELOCATE CONCRETE RUBBLE - SQ. FT.
C = EST. REQ'D EARTH CUT - SQ. FT.
F = EST. REQ'D EARTH FILL - SQ. FT.

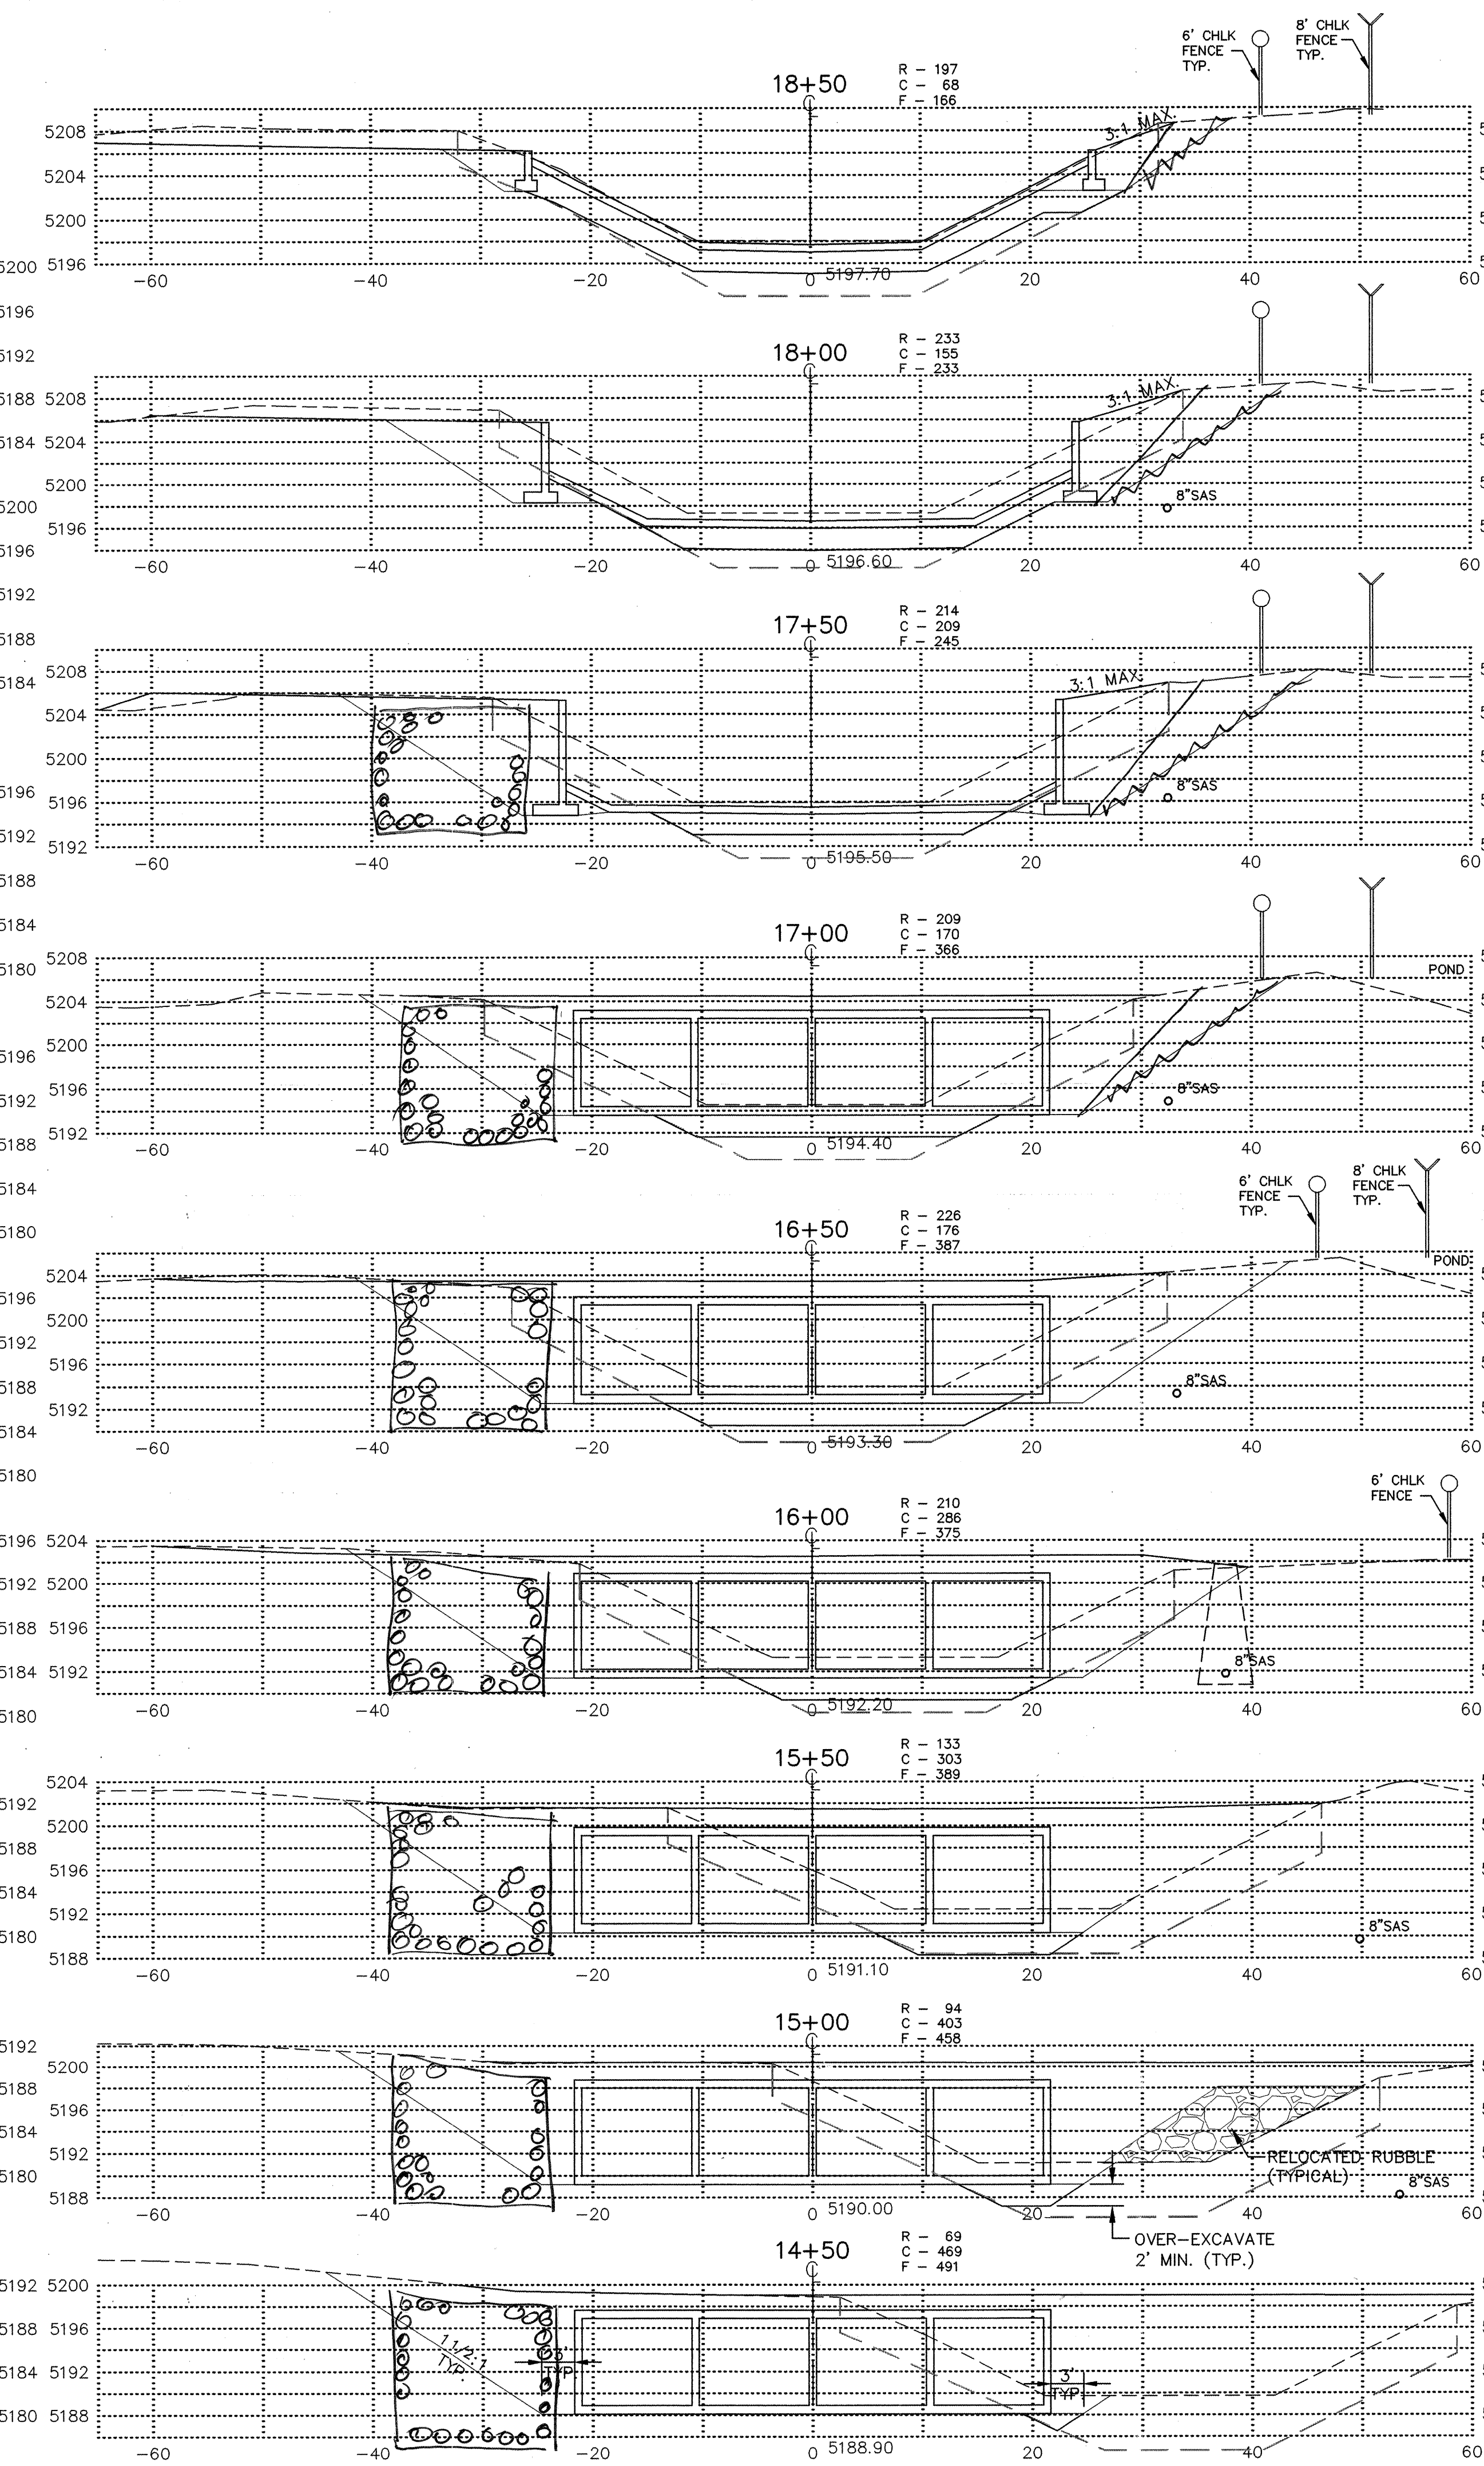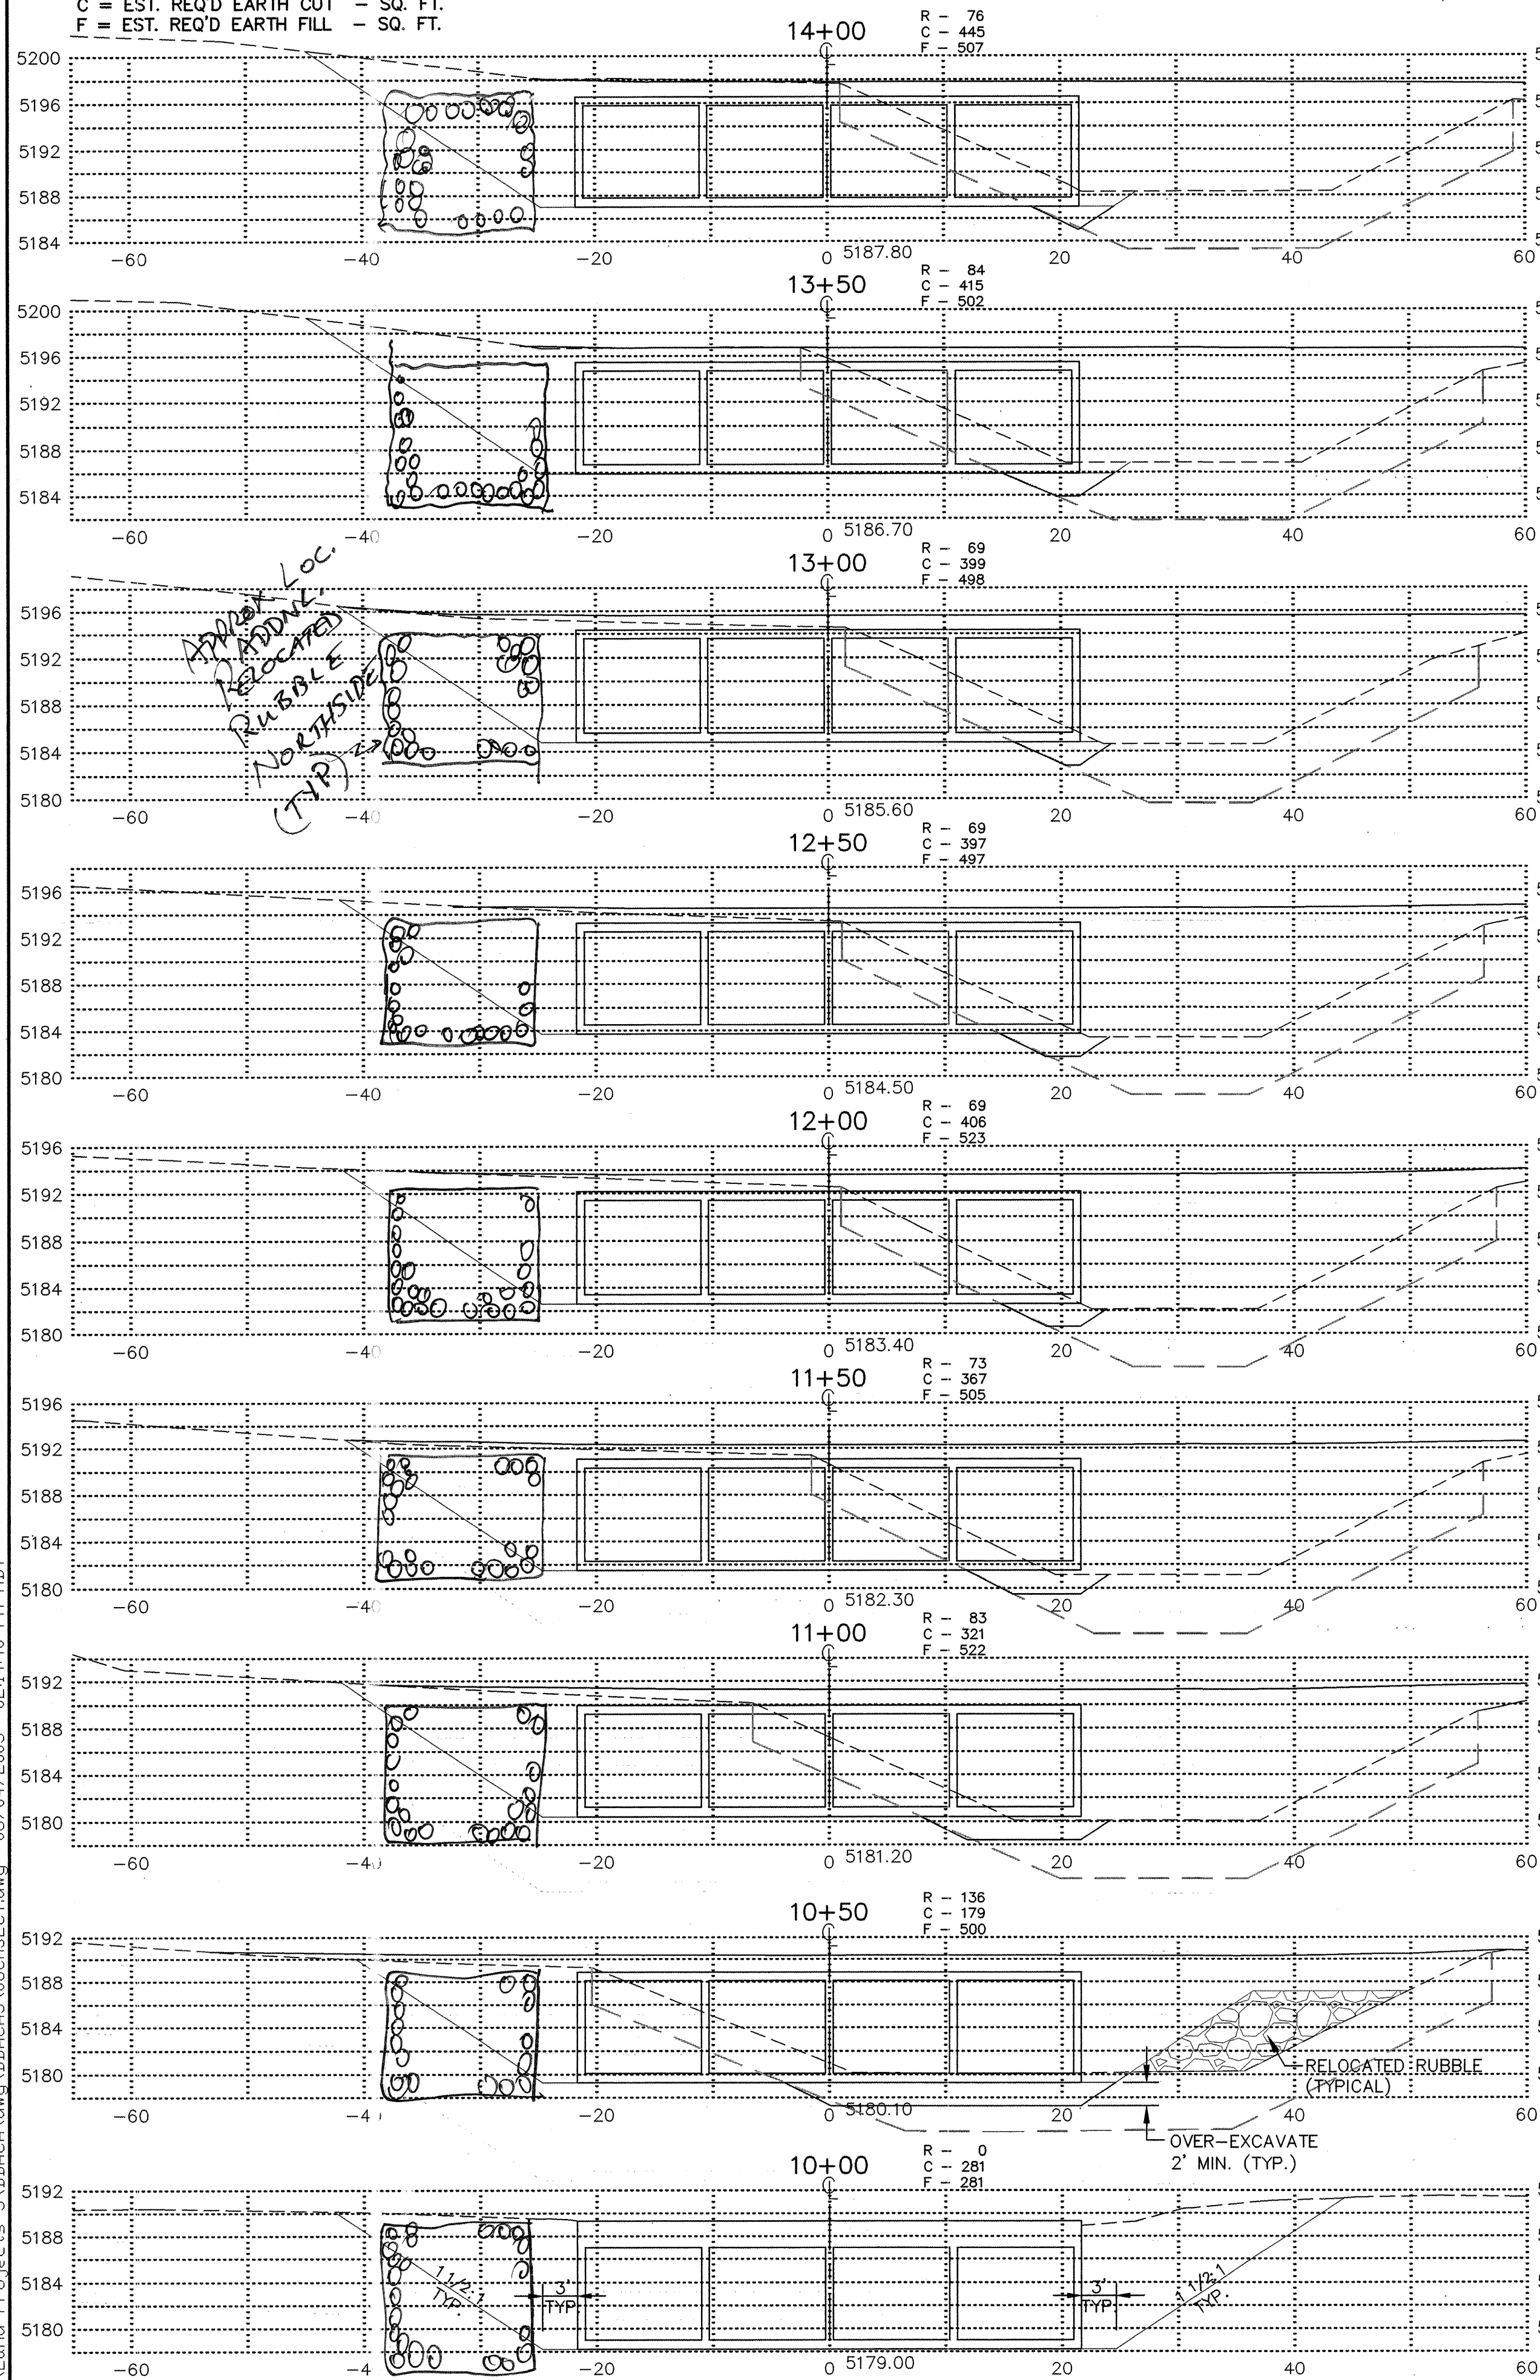

FOR INFORMATION ONLY



Easterling & Associates, Inc.
CONSULTING ENGINEERS
2600 American Rd. SE, Suite 100
Rio Rancho, New Mexico 87124
(505) 898-8021 FAX (505) 898-8501
E-Mail: eal_engr@swcp.com

CITY OF ALBUQUERQUE
PUBLIC WORKS DEPARTMENT
ENGINEERING DEVELOPMENT GROUP
SOUTH ARROYO DE DOMINGO BACA
(I-25 EAST TO STA. 18+75)
CROSS-SECTIONS

DESIGN REVIEW COMMITTEE APPROVED JUN 24 2003 DESIGN REVIEW COMMITTEE	CITY ENGINEER APPROVAL JUN 24 2003 CITY ENGINEER	LAST DESIGN UPDATE	Mo./DAY/YR.	Mo./DAY/YR.
CITY PROJECT No. 6050.92		ZONE MAP NO. D-18	SHEET 8	OF 10

ENGINEER'S SEAL		SURVEY INFORMATION		BENCH MARKS		AS BUILT INFORMATION								
NO.	DATE	BY	FIELD NOTES	ACS ALUM. CAP "9-C18 1985"	X= 402,255.61 Y= 1,521,435.09 (NAD 1927)	ELEV. 5229.79 (SLD 1929)	CONTRACTOR: <i>Alvarez & Co. Inc.</i>							
								BOHANNAN-HUSTON, INC.	DATE 5-31-04	WORKED BY: <i>Christopher</i>	INSPECTED BY: <i>Christopher</i>			
												TOPOGRAPHIC MAP OF PLAZA DEL PASEO - 7/98	VERIFICATION BY: <i>Christopher</i>	DATE 5-31-04
ADD'L POINTS AS REQUIRED	BY SURV-TEK - 12/98	RECORDED BY	DATE											



ALL CONSTRUCTION WARNING SIGNS SHALL HAVE A BLACK LEGEND ON A ORANGE BACKGROUND.

ALL ADVANCE WARNING SIGNS SHALL BE A MINIMUM OF FORTY EIGHT (48) INCHES BY FORTY EIGHT (48) INCHES IN SIZE AND SHALL HAVE ONE WARNING LIGHT.



FOR INFORMATION ONLY

CITY OF ALBUQUERQUE
PUBLIC WORKS DEPARTMENT
ENGINEERING DEVELOPMENT GROUP

TYPICAL TRAFFIC CONTROL & SIGNING EXAMPLES (REF. M.U.T.C.D.)

COASTD

CITY PROJECT No. 6050.92

ONE MAP NO.
D-18

OF
10 10

[illegible]