

SCANNED BY
MESA REPRO

F:\DATA\DWG\98\005\6118\UNIT3\6118TLE.DWG Thu Sep 09 10:36:14 1999 PLOTTED BY ACH


CONSTRUCTION PLANS

FOR

VISTA SANDIA SUBDIVISION

UNIT III

ALBUQUERQUE, NEW MEXICO

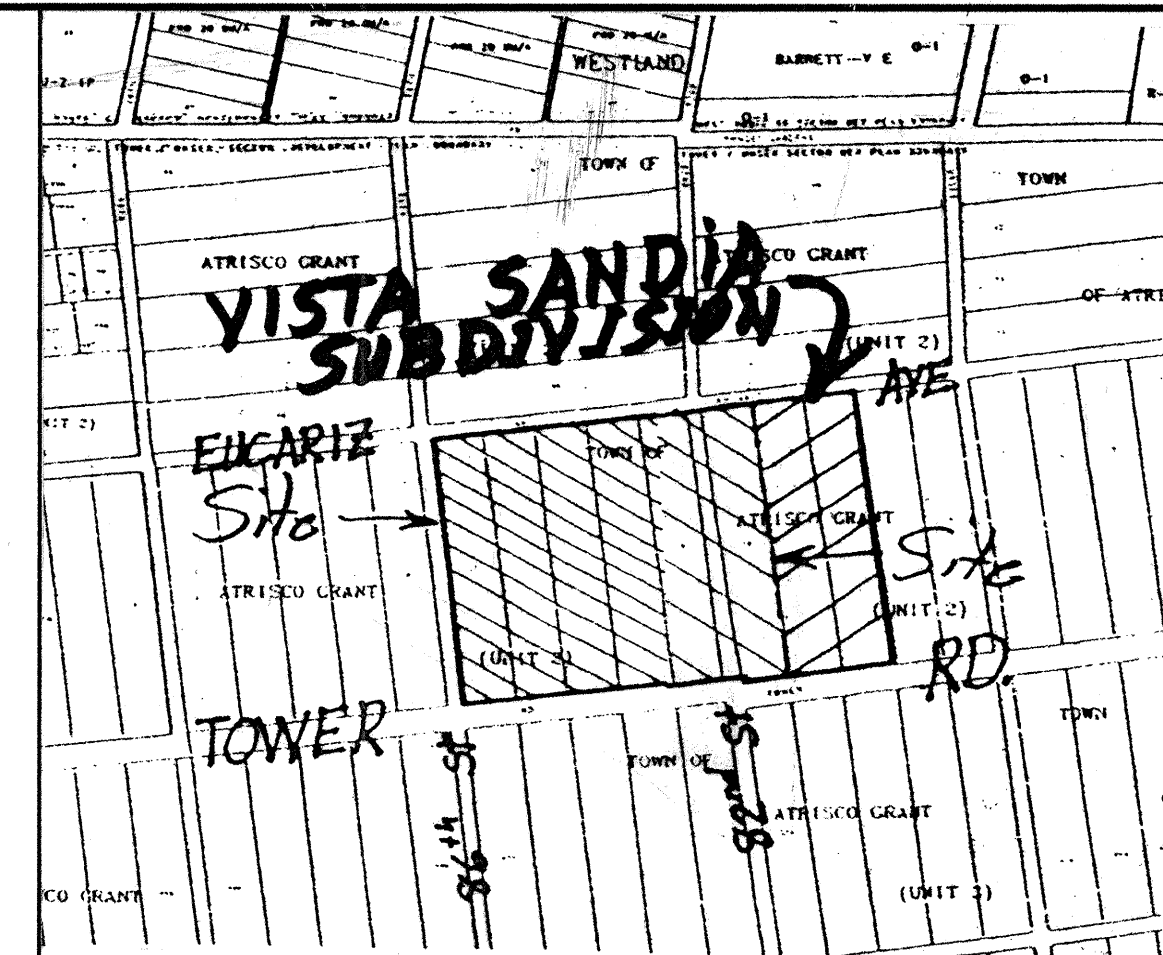

VICINITY MAP L-9, L-10
SCALE: NONE

GENERAL NOTES

NOTICE TO CONTRACTORS

- CITY OF ALBUQUERQUE SPECIFICATIONS FOR PUBLIC WORKS CONSTRUCTION, 1986 EDITION AS AMENDED THROUGH UPDATE 6, WILL BE REFERRED TO HEREIN AS THE "STANDARD SPECIFICATIONS".
- TWO WORKING DAYS PRIOR TO ANY EXCAVATION, CONTRACTOR MUST CONTACT NEW MEXICO ONE CALL SYSTEM (260-1990) AND DETERMINE LOCATION OF EXISTING UTILITIES.
- PRIOR TO ANY CONSTRUCTION, THE CONTRACTOR SHALL EXCAVATE AND VERIFY THE HORIZONTAL AND VERTICAL LOCATIONS OF ALL OBSTRUCTIONS. SHOULD A CONFLICT EXIST, THE CONTRACTOR SHALL NOTIFY THE ENGINEER OR THE SURVEYOR SO THAT THE CONFLICT CAN BE RESOLVED WITHOUT DELAY.
- ALL EXISTING SIGNS, MARKERS, DELINEATORS, ETC., WITHIN THE CONSTRUCTION LIMITS SHALL BE REMOVED, STORED AND RE-SET BY THE CONTRACTOR.
- FIVE (5) WORKING DAYS PRIOR TO BEGINNING CONSTRUCTION THE CONTRACTOR SHALL SUBMIT TO THE CONSTRUCTION CO-ORDINATION DIVISION A DETAILED CONSTRUCTION SCHEDULE. TWO (2) WORKING DAYS PRIOR TO CONSTRUCTION THE CONTRACTOR SHALL OBTAIN A BARRICADING PERMIT FROM THE CONSTRUCTION CO-ORDINATION DIVISION. CONTRACTOR SHALL NOTIFY BARRICADE ENGINEER (768-2551) PRIOR TO OCCUPYING AN INTERSECTION. SEE SECTION 19 OF THE SPECIFICATIONS.
- ALL STREET STRIPING ALTERED OR DESTROYED SHALL BE REPLACED WITH PLASTIC REFLECTORIZED PAVEMENT MARKINGS BY CONTRACTOR IN EXISTING OR NEW LOCATION AS INDICATED BY THIS SET.
- THE CONTRACTOR SHALL NOTIFY THE ENGINEER NOT LESS THAN SEVEN (7) DAYS PRIOR TO STARTING WORK IN ORDER THAT THE ENGINEER MAY TAKE NECESSARY MEASURES TO INSURE THE PRESERVATION OF SURVEY MONUMENTS. CONTRACTOR SHALL NOT DISTURB PERMANENT SURVEY MONUMENTS WITHOUT THE CONSENT OF THE ENGINEER AND SHALL NOTIFY THE ENGINEER AND BEAR THE EXPENSE OF REPLACING ANY THAT MAY BE DISTURBED WITHOUT PERMISSION. REPLACEMENT SHALL BE DONE ONLY BY THE CITY SURVEYOR. WHEN A CHANGE IS MADE IN THE FINISHED ELEVATIONS OF THE PAVEMENT OF ANY ROADWAY IN WHICH A PERMANENT SURVEY MONUMENT IS LOCATED, CONTRACTOR SHALL, AT HIS OWN EXPENSE, ADJUST THE MONUMENT COVER TO THE NEW GRADE UNLESS OTHERWISE SPECIFIED. REFER TO SECTION 4.4 OF THE GENERAL CONDITIONS OF THE STANDARD SPECIFICATIONS.
- ANY WORK OCCURRING WITHIN AN ARTERIAL ROADWAY REQUIRES 24 HOURS CONSTRUCTION.

THE FOLLOWING NOTES ALSO APPLY WHEN CHECKED

- ☒ ALL UTILITIES AND UTILITY SERVICE LINES SHALL BE INSTALLED PRIOR TO PAVING.
- ☒ BACKFILL COMPACTION SHALL BE ACCORDING TO SPECIFIED STREET USE.
- ☐ TACK COAT REQUIREMENTS SHALL BE DETERMINED BY THE CITY ENGINEER.
- ☒ SIDEWALK AND WHEELCHAIR RAMPS WITHIN THE CURB RETURNS SHALL BE CONSTRUCTED WHEREVER A NEW CURB RETURN IS CONSTRUCTED.
- ☐ IF CURB IS DEPRESSIONED FOR A DRIVEPAD, THE DRIVEPAD SHALL BE CONSTRUCTED PRIOR TO ACCEPTANCE OF CURB AND GUTTER.
- ☒ ALL STORM DRAINAGE FACILITIES SHALL BE COMPLETED PRIOR TO FINAL ACCEPTANCE.

INDEX TO DRAWINGS

SHEET NO.	SHEET
1	TITLE SHEET
2-4	PLAT
5-6	GRADING AND DRAINAGE PLAN
7	MASTER PAVING PLAN
8-11	PAVING IMPROVEMENTS
12	MASTER UTILITY PLAN
13-16	UTILITY IMPROVEMENTS
17	STORM IMPROVEMENTS
18-19	TRAFFIC CONTROL

APPROVAL OF RECORD DRAWINGS
CHIEF CONSTRUCTION ENGINEER
John Chang
DATE 4/3/02

RECORD DRAWING

I hereby certify that the information contained on this drawing has been revised in accordance with information furnished by the contractor, Hydro-Sytems, Inc., and by the surveyor, Daggett Surveying, and reflects the construction as actually accomplished. This plan as constructed is in substantial compliance with the Approved Plan.
James D. Hughes 3-20-02
James D. Hughes NMPE 11674

CAUTION:
NOTE THAT ALL EXISTING UTILITIES MAY NOT BE SHOWN. ALL EXISTING SERVICE CONNECTIONS ARE NOT SHOWN. ANY EXISTING UTILITIES THAT ARE SHOWN ARE APPROXIMATE LOCATION ONLY. IT SHALL BE THE SOLE RESPONSIBILITY OF THE CONTRACTOR TO CONTACT ALL THE UTILITY OWNERS AND TO CONDUCT ALL NECESSARY FIELD INVESTIGATIONS PRIOR TO ANY EXCAVATIONS TO DETERMINE THE ACTUAL LOCATION OF UTILITIES AND OTHER IMPROVEMENTS.

dmg D. MARK GOODWIN & ASSOCIATES, P.A.
CONSULTING ENGINEERS
P. O. BOX 90606
ALBUQUERQUE, NEW MEXICO 87199
(505) 828-2200, FAX (505) 797-9539

REV.	SHEETS	CITY ENGINEER	DATE	USER DEPARTMENT	DATE	USER DEPARTMENT	DATE
ENGINEERS STAMP & SIGNATURE	APPROVALS	ENGINEER	DATE	*****			
	DRC CHAIRMAN	<i>John Chang</i>	12-12-99	APPROVED FOR CONSTRUCTION			
	TRANSPORTATION	<i>John Chang</i>	12-12-99				
	WATER/WASTEWATER	<i>John Chang</i>	12-12-99				
	HYDROLOGY	<i>John Chang</i>	12-12-99				
	CIP	<i>John Chang</i>	12-12-99				
	CONSTR. MGMT.	<i>John Chang</i>	12-12-99				
	CONSTR. COORD.	<i>John Chang</i>	12-12-99				
CITY PROJECT NO.		6071.83		SHEET		OF 19	

DRB-98-245

RECORD DRAWING

I hereby certify that the information contained on this drawing has been reviewed in accordance with the information furnished by the contractor. Hydro Systems, Inc., and the State of New Mexico Surveying and Mapping Commission are not responsible for the accuracy of the information contained on this drawing. The information contained on this drawing is for informational purposes only and is not to be used for any other purpose.

James D. Ferguson, Jr. DATE 11/6/74



SUBDIVISION DATA:

CASE NO. DRB-98-245, SV-98-62

GROSS SUBDIVISION ACREAGE 11.5346

ZONE ATLAS INDEX NO. 1-9, L-10

NO. OF EXISTING TRACTS 0

NO. OF EXISTING LOTS 0

NO. OF EXISTING EASEMENTS 89

NO. OF TRACTS CREATED 1

MILES OF FULL WIDTH STREETS CREATED 0.43 MILES

AREA DEDICATED TO CITY OF ALBUQUERQUE 0 ACRES

DATE OF SURVEY AUGUST, 1999

S.P. LOG NO.

FREE CONSENT AND DEDICATION:

THE SUBDIVISION SHOWN HEREON IS WITH THE FREE CONSENT AND IN ACCORDANCE WITH THE DESIRES OF THE UNDERSIGNED OWNERS(S) AND/OR PROPRIETOR(S) THEREOF AND SAID OWNERS(S) AND/OR PROPRIETOR(S) DO HEREBY GRANT WITH WARRANTY COVENANTS ALL ACCESS, SANITARY SEWER, WATER, STORM SEWER, GAS, ELECTRIC, AND ALL OTHER UTILITIES, AND ALL PUBLIC UTILITY EASEMENTS SHOWN HEREON FOR THE COMMON AND JOINT USE OF GAS, ELECTRICAL POWER, AND COMMUNICATION SERVICES FOR BURIED AND/OR OVERHEAD DISTRIBUTION LINES, AND INCLUDING THE RIGHT OF INGRESS AND EGRESS FOR CONSTRUCTION AND (SEE NOTE MAINTENANCE, AND THE RIGHT TO REMAINING TREES AND SHRUBS OF THE FOREGOING AND DO HEREBY CERTIFY THAT THIS SUBDIVISION IS THEIR FREE ACT AND DEED.

D.R. HORTON, INC.

BY: MARK FERGUSON

STATE OF NEW MEXICO }
COUNTY OF BERNALILLO }

THIS INSTRUMENT WAS ACKNOWLEDGED BEFORE ME ON _____, 1998
BY MARK FERGUSON, OFFICER, ON BEHALF OF SAID CORPORATION.

BY: NOTARY PUBLIC

MY COMMISSION EXPIRES: _____

US WEST COMMUNICATION QUITCLAIM

KNOWN ALL MEN BY THESE PRESENTS THAT US WEST COMMUNICATIONS, INC., a Colorado Corporation, hereinafter called "Company", for and in consideration of One Dollar (\$1.00) and other good and valuable consideration, have made receipt of the sum of One Hundred and Fifty Thousand Dollars (\$150,000.00) and have caused to be executed by the undersigned, its duly authorized officer, a certain right-of-way grant, recorded in the Office of Bernalillo Clerk on: Recorded in Book 112, Page 290 on May 17, 1930, AND a Modification of this Easement in Book Misc. 298, Page 635, filed for record February 13, 1973, AND Assignment of this Easement in Book Misc. 575, Page 928, filed for record December 19, 1977, unto the present owner or owners, as their representative interest may appear therein, in the following described property, to wit:

A tract of land situated in the Town of Atrisco Grant, Projected Sections 27 & 28, Township 10 North, Range 2 East, N10W, City of Albuquerque, Bernalillo County, New Mexico.

It is the intent of this Quitclaim Deed to vacate any portion of the above stated documents which may be located in Tracts 12, 13, 14, 15, 16, & 17, Unit 2, Town of Atrisco Grant as recorded in Volume D, Folio 118, and recorded December 5, 1944,

and hereby expressly excepting and reserving to the Company, any and all interest otherwise acquired in said property, except as above stated.

IN WITNESS WHEREOF, The Company has caused these presents to be executed by its duly authorized officer _____

US WEST COMMUNICATIONS

BY
MANAGER - NETWORK & TECHNOLOGY SERVICES

ACKNOWLEDGMENT

STATE OF NEW MEXICO }
COUNTY OF BERNALILLO }

This instrument was acknowledged before me on _____

NOTARY PUBLIC

MY COMMISSION EXPIRES _____

VISTA SANDIA SUBDIVISION UNIT THREE

WITHIN THE
"TOWN OF ATRISCO GRANT"
PROJECTED SECTION 27 & 28, T.10N., R.2E., N.M.P.M.
CITY OF ALBUQUERQUE
BERNALILLO COUNTY, NEW MEXICO
AUGUST, 1999

APPROVALS:

Subdivision Case No. _____

Traffic Engineer _____

Date _____

Design & Development, CIP _____

Date _____

City Surveyor _____

Date _____

Utility Development Division _____

Date _____

Property Management _____

Date _____

Albuquerque Metropolitan Arroyo Flood Control Authority _____

Date _____

City Engineer _____

Date _____

PNM Electric Services _____

Date _____

PNM Gas Services _____

Date _____

U S West Communications _____

Date _____

Jones Intercable _____

Date _____

APPROVAL & CONDITIONAL EXCEPTION as specified by the Albuquerque Subdivision Ordinance, Article XI of Chapter 7 of the Revised Ordinances of Albuquerque, N.M.

City Planner, Albuquerque/Bernalillo County Planning Division _____

Date _____


SURVEYORS CERTIFICATE:

1. KEVIN C. DAGGETT, NEW MEXICO PROFESSIONAL SURVEYOR NO. 11000, DO HEREBY CERTIFY THAT THE PLAT SHOWN HEREON WAS PREPARED UNDER MY SUPERVISION, AND THAT THE SAME IS TRUE AND CORRECT TO THE BEST OF MY KNOWLEDGE AND BELIEF. I FURTHER CERTIFY THAT THE SURVEY UPON WHICH THIS PLAT IS BASED, MEETS THE MINIMUM REQUIREMENTS FOR MONUMENTATION AND BOUNDARY SURVEYS OF THE ALBUQUERQUE SUBDIVISION ORDINANCE AND THE MINIMUM STANDARDS AS SET FORTH FOR LAND SURVEYS IN THE STATE OF NEW MEXICO.

Kevin C. Daggett
KEVIN C. DAGGETT, N.M.P.L.S. 11000
DATE 8-2-99

Scale: 1" = N/A

Designed By: KCD
Drawn By: KCD/JMM
Checked By: KCD
File No: 98-2E
Date: 8-2-99

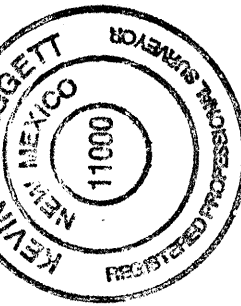

DAGGETT
ENGINEERING &
SURVEYING

2112 Case Dr. Corral, N.W.
Albuquerque, New Mexico 87104
(505) 836-2837 (Office)
(505) 836-2838 (Home)
(505) 836-2839 (Fax)

© COPYRIGHT

Sheet 1 of 3

NOTES:

1. THE PURPOSE OF THIS PLAT IS TO SUBDIVIDE 11.5346 ACRES INTO 89 SINGLE FAMILY LOTS, 1 TRACT, GRANT PRIVATE ACCESS EASEMENTS; AND GRANT PUBLIC WATER, SANITARY SEWER, STORM DRAIN AND UTILITY EASEMENTS AS SHOWN HEREON.
2. ALL BEARINGS SHOWN HEREON ARE GRID BEARINGS BASED ON NEW MEXICO STATE PLANE COORDINATE SYSTEM, CENTRAL ZONE, MEAN DELTA ALPHA (DEGREES 16 MINUTES 27 SECONDS). ALL DISTANCES ARE GROUND DISTANCES.
3. BEARINGS AND DISTANCES SHOWN IN PARENTHESIS ARE RECORD.
4. BENCHMARK FOR THIS PLAT IS ACS CONTROL POINT 7-K9, 1989, LOCATED IN THE MEDIAN AT THE INTERSECTION OF 90TH STREET AND CENTRAL AVENUE, ELEVATION 5137.36
5. UNLESS OTHERWISE NOTED, ALL CORNERS ARE EVIDENCED BY A 5/8 REBAR WITH ALUMINUM CAP STAMPED, "P.S. 11000".
6. CENTERLINE (IN LIEU OF R/W) MONUMENTATION WILL BE INSTALLED AT ALL POINTS OF CURVATURE, POINTS OF TANGENCY, AND POINTS OF STREET INTERSECTIONS PRIOR TO THE ACCEPTANCE OF SUBDIVISION STREET IMPROVEMENTS AND WILL CONSIST OF A FOUR INCH DIAMETER ALUMINUM ALLOY CAP SET FLUSH WITH THE TOP OF ASPHALT STAMPED "CITY OF ALBUQUERQUE CENTERLINE MONUMENTATION SURVEY MARKER, DO NOT DISTURB, P.S. 11000". THE SMALL, SOLID-FILLED TRIANGLE SYMBOLS DEPICTED HEREON DENOTE CENTERLINE MONUMENTS TO BE SET.
7. PUBLIC UTILITY EASEMENTS (P.U.E.) SHOWN ON THIS PLAT ARE GRANTED FOR THE COMMON AND JOINT USE OF:
- A. PNM ELECTRICAL SERVICES FOR INSTALLATION, MAINTAINANCE AND SERVICE OF OVERHEAD AND UNDERGROUND ELECTRICAL LINES, TRANSFORMERS, POLES AND ANY OTHER EQUIPMENT, FIXTURES, STRUCTURES AND RELATED FACILITIES REASONABLY NECESSARY TO PROVIDE ELECTRICAL SERVICE.
- B. PNM GAS SERVICES FOR THE INSTALLATION, MAINTAINANCE, AND SERVICE OF NATURAL GAS LINES, VALVES AND OTHER EQUIPMENT AND FACILITIES REASONABLY NECESSARY TO PROVIDE NATURAL GAS SERVICE.
- C. U.S. WEST FOR THE INSTALLATION, MAINTAINANCE AND SERVICE OF ALL BURIED COMMUNICATION LINES AND RELATED EQUIPMENT AND FACILITIES REASONABLY NECESSARY TO PROVIDE COMMUNICATION SERVICES, INCLUDING BUT NOT LIMITED TO ABOVE GROUND PEDESTALS AND CLOSURES.
- D. JONES INTERCABLE FOR THE INSTALLATION, MAINTAINANCE AND SERVICE OF SUCH UNDER GROUND LINES, CABLE AND OTHER RELATED EQUIPMENT AND FACILITIES REASONABLY NECESSARY TO PROVIDE CABLE TV SERVICE.
- E. CITY OF ALBUQUERQUE WATER AND SEWER DEPARTMENT FOR THE INSTALLATION, MAINTAINANCE AND SERVICE OF SUCH UNDERGROUND WATER AND SANITARY SEWER LINES ACROSS THE EASEMENT AND OTHER RELATED EQUIPMENT OR FACILITIES REASONABLY NECESSARY TO PROVIDE SERVICE.
- INCLUDED IS THE RIGHT TO BUILD, REBUILD, CONSTRUCT, RECONSTRUCT, LOCATE, RELOCATE, CHANGE, REMOVE, MODIFY, RENEW, OPERATE, AND MAINTAIN FACILITIES FOR THE PURPOSES DESCRIBED ABOVE, TOGETHER WITH THE FREE ACCESS TO, FROM, AND OVER SAID EASEMENTS, INCLUDING SUFFICIENT WORKING AREA SPACE FOR ELECTRIC TRANSFORMERS, WITH THE RIGHT AND PRIVILEGE TO TRIM AND REMOVE TREES, SHRUBS OR BUSHES WHICH INTERFERE WITH THE PURPOSES SET FORTH HEREIN, NO BUILDING, SIGN, POOL (ABOVE GROUND OR SUBSURFACE), HOT TUB, CONCRETE OR WOOD POOL DECKING, OR OTHER STRUCTURE SHALL BE ERRECTED OR CONSTRUCTED ON SAID EASEMENTS, NOR SHALL ANY WELL BE DRILLED OR OPERATED THEREON. PROPERTY OWNERS SHALL BE SOLELY RESPONSIBLE FOR CORRECTING ANY VIOLATIONS OF NATIONAL ELECTRIC SAFETY CODE CAUSED BY THE CONSTRUCTION OF POOLS, DECKING, OR ANY STRUCTURES ADJACENT TO, OR NEAR EASEMENTS SHOWN ON THIS PLAT
8. SPECIFICALLY THE PARKING DENSITY CATEGORY OF INTERMITTENT PARKING IS MET FOR EACH LOT BY PROVIDING: THREE PARKING SPACES FOR UP TO TWO BEDROOMS, OR FOUR PARKING SPACES FOR THREE TO FOUR BEDROOMS, OR FIVE PARKING SPACES FOR FIVE OR MORE BEDROOMS.
9. BUILDING SETBACKS FOR ALL LOTS ARE COMPLIANT WITH RD-9 ZONING REQUIREMENTS.
10. TRACT "A" IS DEDICATED IN FEE SIMPLE TO THE VISTA SANDIA HOMEOWNERS ASSOCIATION AS A COMMON AREA FOR PRIVATE STREET BY THIS PLAT. A PRIVATE ACCESS AND PRIVATE DRAINAGE EASEMENT IS GRANTED TO EACH LOT OWNER ACROSS THIS TRACT BY THIS PLAT. A PUBLIC WATER, SANITARY SEWER AND STORM DRAIN EASEMENT IS GRANTED WITHIN TRACT "A" TO THE CITY OF ALBUQUERQUE BY THIS PLAT. MAINTAINANCE AND OPERATION OF THE PRIVATE STREETS SHALL BE THE RESPONSIBILITY OF THE VISTA SANDIA HOA. WATER, SANITARY SEWER AND STORM DRAIN SYSTEMS SHALL BE MAINTAINED AND OPERATED BY THE CITY OF ALBUQUERQUE. A P.U.E. IS ALSO GRANTED ACROSS THIS TRACT TO U.S. WEST COMMUNICATIONS, JONES INTERCABLE, PNM GAS SERVICES, AND PNM ELECTRIC.
11. A 10' PRIVATE DRAINAGE EASEMENT IS CENTERED ON ALL COMMON SIDE LOT LINES.
12. RD-9 OPEN SPACE REQUIREMENTS:

*PERMITTED BUILDING AREA (Sq. Ft.)	MINIMUM LOT AREA (Sq. Ft.)
>2211	>4611
>2042	>4442
>1903	>4303
>1810	>4210
>1690	>4090
>1553	>3953

*INCLUDES BUILDING AND DRIVE PAD.

LEGAL DESCRIPTION:

A TRACT OF LAND SITUATE WITHIN THE TOWN OF ATRISCO GRANT, PROJECTED SECTION 27 & 28, TOWNSHIP 10 NORTH, RANGE 2 EAST, NEW MEXICO PRINCIPAL MERIDIAN, CITY OF ALBUQUERQUE, BERNALILLO COUNTY, NEW MEXICO BEING ALL OF TRACTS 10 THRU 17, TOWN OF ATRISCO GRANT, UNIT 2 AS THE SAME IS SHOWN AND DESIGNATED ON SAID PLAT FILED FOR RECORD IN THE OFFICE OF THE COUNTY CLERK OF BERNALILLO COUNTY, NEW MEXICO ON DECEMBER 5, 1944 IN VOLUME D, FOLIO 118, TOGETHER WITH VACATED 82ND STREET S.W. (SV-98-62) AND BEING MORE PARTICULARLY DESCRIBED AS FOLLOWS:

BEGINNING AT THE SOUTHWEST CORNER OF THE TRACT HEREIN DESCRIBED, SAID POINT BEING THE INTERSECTION OF THE NORTHERLY RIGHT-OF-WAY LINE OF TOWER ROAD S.W. AND THE EASTERLY RIGHT-OF-WAY LINE 86TH STREET S.W., FROM WHENCE THE ALBUQUERQUE CONTROL SURVEY MONUMENT "8-L9" BEARS N 89°27'29" E, 205.89 FEET;

THENCE CONTINUING FROM SAID POINT OF BEGINNING, LEAVING SAID NORTHERLY RIGHT-OF-WAY LINE ALONG SAID EASTERLY RIGHT-OF-WAY LINE N 05°54'0" W, 1067.08 FEET TO THE NORTHWEST CORNER, SAID POINT BEING THE INTERSECTION OF SAID EASTERLY RIGHT-OF-WAY LINE AND THE SOUTHERLY RIGHT-OF-WAY LINE OF EUCARIZ AVENUE S.W.;

THENCE LEAVING SAID EASTERLY RIGHT-OF-WAY LINE ALONG SAID SOUTHERLY RIGHT-OF-WAY LINE N 84°01'41" E, 1691.47 FEET TO THE NORTHEAST CORNER, SAID POINT BEING THE NORTHWEST CORNER OF TRACT 9, TOWN OF ATRISCO GRANT, UNIT 2 AS THE SAME IS SHOWN AND DESIGNATED ON SAID PLAT FILED FOR RECORD IN THE OFFICE OF THE COUNTY CLERK OF BERNALILLO COUNTY, NEW MEXICO ON DECEMBER 5, 1944 IN VOLUME D, FOLIO 118;

THENCE LEAVING SAID SOUTHERLY RIGHT-OF-WAY LINE S 05°57'28" E, 1067.03 FEET ALONG THE WESTERLY LINE OF SAID TRACT 9 TO THE SOUTHEAST CORNER, SAID POINT LYING ON THE NORTHERLY RIGHT-OF-WAY LINE OF TOWER ROAD, S.W. AND BEING THE SOUTHWEST CORNER OF SAID TRACT 9;

THENCE CONTINUING ALONG SAID NORTHERLY RIGHT-OF-WAY LINE S 84°01'35" W, 1692.33 FEET TO THE POINT AND PLACE OF BEGINNING, CONTAINING 41.4452 ACRES MORE OR LESS.

CURVE TABLE

CURVE	ARC	DELTA	RADIUS	CH. LENGTH	CH. BEARING
C1	47.12	89°59'54"	30.00	42.43	N39°01'38"E
C2	47.12	90°00'06"	30.00	42.43	S50°58'22"E
C3	39.27	90°00'00"	25.00	35.36	S39°01'41"W
C4	39.27	90°00'00"	25.00	35.36	N50°58'19"W
C5	31.42	90°00'00"	20.00	28.28	N39°01'41"E
C6	31.42	90°00'00"	20.00	28.28	S50°58'19"E
C7	31.42	90°00'00"	20.00	28.28	S50°58'19"E
C8	31.42	90°00'00"	20.00	28.28	N39°01'41"E
C9	26.17	15°18'05"	98.00	26.09	S88°19'16"E
C10	7.95	22°46'47"	20.00	7.90	S87°56'23"W
C11	8.56	24°31'08"	20.00	8.49	S64°17'25"W
C12	29.50	42°15'44"	40.00	28.84	N73°09'43"E
C13	24.93	35°42'37"	40.00	24.53	S67°51'06"E
C14	23.63	33°50'52"	40.00	23.29	S33°04'22"E
C15	29.44	42°10'26"	40.00	28.78	S04°56'17"W
C16	12.31	35°15'52"	20.00	12.12	N08°23'35"E
C17	26.17	15°18'05"	98.00	26.09	S13°37'22"E
C18	74.66	82°15'49"	52.00	68.41	S47°06'14"E
C19	7.02	07°44'11"	52.00	7.02	N87°53'46"E
C20	58.90	45°00'00"	75.00	57.40	S73°28'19"E
C21	58.90	45°00'00"	75.00	57.40	S28°28'19"E
C22	31.42	90°00'00"	20.00	28.28	S50°58'19"E
C23	31.42	90°00'00"	20.00	28.28	S39°01'41"W
C24	39.27	90°00'00"	25.00	35.36	N50°58'19"W
C25	39.24	89°56'21"	25.00	35.34	S39°03'30"W
C26	39.30	90°03'39"	25.00	35.37	S50°56'30"E
C27	39.27	90°00'00"	25.00	35.36	N39°01'41"E
C28	31.42	90°00'00"	20.00	28.28	S39°01'41"W
C29	31.42	90°00'00"	20.00	28.28	S50°58'19"E
C30	26.17	15°18'05"	98.00	26.09	S01°40'44"W
C31	16.51	47°17'55"	20.00	16.05	N14°19'11"W
C32	68.92	98°43'31"	40.00	60.71	S11°23'37"W
C33	31.20	44°41'34"	40.00	30.42	S83°06'09"W
C34	74.66	82°15'49"	52.00	68.41	S35°09'36"W
C35	58.90	45°00'00"	75.00	57.40	S16°31'41"W
C36	58.90	45°00'00"	75.00	57.40	S61°31'41"W
C37	7.38	10°34'35"	40.00	7.37	N69°15'47"W
C38	16.51	47°17'55"	20.00	16.05	S87°37'27"E
C39	17.84	10°25'44"	98.00	17.81	S73°56'28"W
C40	8.33	04°52'21"	98.00	8.33	S81°35'31"W
C41	38.05	87°12'31"	25.00	34.48	S40°25'25"W
C42	29.12	02°43'50"	611.00	29.12	S04°32'45"E
C43	31.42	90°00'00"	20.00	28.28	N50°58'19"W
C44	31.42	90°00'00"	20.00	28.28	S39°01'41"W
C45	39.27	90°00'00"	25.00	35.36	N39°01'41"E
C46	39.27	90°00'00"	25.00	35.36	N50°58'19"W
C47	39.27	90°00'00"	25.00	35.36	S39°01'41"W
C48	39.27	90°00'00"	25.00	35.36	S50°58'19"E
C49	5.68	03°19'13"	98.00	5.68	S85°41'18"W
C50	20.49	11°58'52"	98.00	20.46	N86°39'40"W
C51	16.51	47°17'55"	20.00	16.05	N75°40'49"E
C52	4.50	06°26'24"	40.00	4.49	S55°15'03"W
C53	32.53	46°35'34"	40.00	31.64	S81°46'02"W
C54	25.06	35°54'00"	40.00	24.65	N56°59'11"W
C55	27.73	39°42'59"	40.00	27.18	N19°10'41"W
C56	17.69	25°20'42"	40.00	17.55	N13°21'09"E
C57	16.51	47°17'55"	20.00	16.05	S02°22'33"W
C58	7.76	04°32'23"	98.00	7.76	N19°00'13"W
C59	18.41	10°45'42"	98.00	18.38	N11°21'10"W
C60	58.90	45°00'00"	75.00	57.40	N28°28'19"W
C61	74.66	82°15'49"	52.00	68.41	N47°06'14"W
C62	7.02	07°44'11"	52.00	7.02	S87°53'46"W
C63	58.90	45°00'00"	75.00	57.40	N73°28'19"W
C64	31.42	90°00'00"	20.00	28.28	N50°58'19"W
C65	31.42	90°00'00"	20.00	28.28	S39°01'41"W
C66	31.42	90°00'00"	20.00	28.28	N39°01'41"E
C67	31.42	90°00'00"	20.00	28.28	N50°58'19"W
C68	31.42	90°00'00"	20.00	28.28	S50°58'19"E
C69	31.42	90°00'00"	20.00	28.28	S39°01'41"W
C70	31.42	90°00'00"	20.00	28.28	N39°01'41"E
C71	31.42	90°00'00"	20.00	28.28	N50°58'19"W
C72	31.42	90°00'00"	20.00	28.28	S50°58'19"E
C73	31.42	90°00'00"	20.00	28.28	S39°01'41"W
C74	74.66	82°15'49"	52.00	68.41	N35°09'36"E
C75	7.02	07°44'11"	52.00	7.02	N80°09'36"E
C76	58.90	45°00'00"	75.00	57.40	N16°31'41"E
C77	58.90	45°00'00"	75.00	57.40	N61°31'41"E
C78	26.17	15°18'05"	98.00	26.09	N01°40'44"E
C79	16.51	47°17'55"	20.00	16.05	S14°19'11"E
C80	107.51	153°59'39"	40.00	77.95	N39°01'41"E
C81	16.51	47°17'55"	20.00	16.05	N87°37'27"W
C82	26.17	15°18'05"	98.00	26.09	N76°22'38"E
C83	22.22	50°55'57"	25.00	21.50	S70°30'26"E
C84	17.07	39°07'48"	25.00	16.74	S25°28'34"E
C85	31.42	90°00'00"	20.00	28.28	N39°01'41"E
C86	31.42	90°00'00"	20.00	28.28	N50°58'19"W
C87	7.02	07°44'11"	52.00	7.02	S80°09'36"W
C88	31.42	90°00'00"	20.00	28.28	N39°01'41"E
C89	31.42	90°00'00"	20.00	28.28	N50°58'19"W
C90	4.20	12°02'03"	20.00	4.19	N15°15'23"W

PLAT OF
VISTA SANDIA SUBDIVISION
UNIT THREE

WITHIN THE
"TOWN OF ATRISCO GRANT"
PROJECTED SECTION 27 & 28, T.10N., R.2E., N.M.P.M.
CITY OF ALBUQUERQUE
BERNALILLO COUNTY, NEW MEXICO
AUGUST, 1999

LINE TABLE

LINE	LENGTH	BEARING
L1	15.12	N84°01'35"E
L2	15.00	N84°01'35"E
L3	20.00	N84°01'41"E
L4	20.12	N84°01'41"E
L5	25.00	N84°01'41"E
L6	25.00	N84°01'41"E
L7	6.26	N84°01'41"E
L8	10.00	N05°58'19"W
L9	14.00	S39°01'41"W
L10	25.00	N84°01'41"E
L11	25.00	N84°01'41"E
L12	25.00	N05°58'19"W
L13	25.03	S05°54'40"E
L14	24.97	N05°54'40"W
L15	25.00	N05°58'19"W
L16	25.00	N84°01'41"E
L17	25.00	N84°01'41"E
L18	14.00	S50°58'19"E
L19	17.63	N03°10'50"W
L20	25.00	N84°01'41"E
L21	20.00	N84°01'41"E
L22	20.00	N84°01'41"E
L23	6.32	N84°01'41"E
L24	14.00	N39°01'41"E
L25	25.00	N84°01'41"E
L26	25.00	N84°01'41"E
L27	25.00	N84°01'41"E
L28	25.00	N84°01'41"E
L29	25.00	N84°01'41"E
L30	25.00	N84°01'41"E
L31	25.00	N84°01'41"E
L32	25.00	N84°01'41"E
L33	14.00	S50°58'19"E
L34	2.00	N05°58'19"W
L35	21.70	N05°58'19"W
L36	25.00	N84°01'41"E
L37	25.00	N84°01'41"E
L38	25.00	N84°01'41"E

RECORD DRAWING

I hereby certify that the information contained on this drawing has been revised in accordance with information furnished by the contractor, Hydro-Systems, Inc., and by the surveyor, Daggett Surveying, and reflects the construction as actually accomplished. This plan as constructed is in substantial compliance with the Approved Plan.

James D. Hughes NMPE 11674



SCALE: 1" = N/A		
Designed By: KCD	Drawn By: KCD	Checked By: KCD
File No.	Date: 08-02-99	


DAGGETT
ENGINEERING &
SURVEYING
2125 Corte De Chamisa, N.W.
Albuquerque, N.M. 87120
505) 228-1821 (Mobile)
505) 341-4642 (Fax)

© COPYRIGHT
Sheet 3 of 3

607183 Map L9,L10 Sheet 4 of 19

NOTES


- CONTRACTOR MUST OBTAIN A TOPSOIL DISTURBANCE PERMIT FROM THE ENVIRONMENTAL HEALTH DIVISION PRIOR TO CONSTRUCTION.
- CITY OF ALBUQUERQUE STANDARD SPECIFICATIONS FOR PUBLIC WORKS CONSTRUCTION, LATEST EDITION SHALL GOVERN ALL WORK.
- THE CONTRACTOR SHALL CONFORM TO ALL CITY, COUNTY, STATE AND FEDERAL DUST CONTROL MEASURES AND REQUIREMENTS AND WILL BE RESPONSIBLE FOR PREPARING AND OBTAINING ALL NECESSARY APPLICATIONS AND APPROVALS.
- THE CONTRACTOR SHALL ENSURE THAT NO SOIL ERODES FROM THE LOTS INTO PUBLIC RIGHT-OF-WAY. THIS CAN BE ACHIEVED BY CONSTRUCTING TEMPORARY BERMS AS PER DTL. THIS SHIT, AND WETTING THE SOIL TO KEEP IT FROM BLOWING.
- THE EARTHWORK CONTRACTOR SHALL STOCKPILE ENOUGH MATERIAL ADJACENT TO RETAINING WALL LOCATIONS TO BE UTILIZED FOR WALL BACKFILL.
- ALL STREET ELEVATIONS SHOWN ARE FINISHED FLOWLINE ELEVATIONS.
- TOPOGRAPHY IS BASED ON SURVEY BY DAGGETT ENGINEERING, AND SURVEYING, MAY 1998.

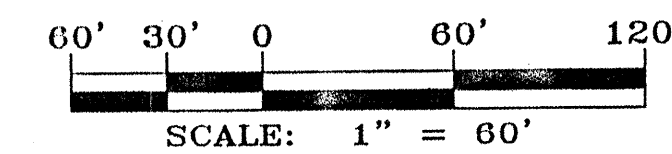

THIS PROJECT FUTURE DEVELOPMENT

SEE SHEET 4 FOR GRADING THIS PROJECT ONLY.

ANNEXATION BEING PROCESSED

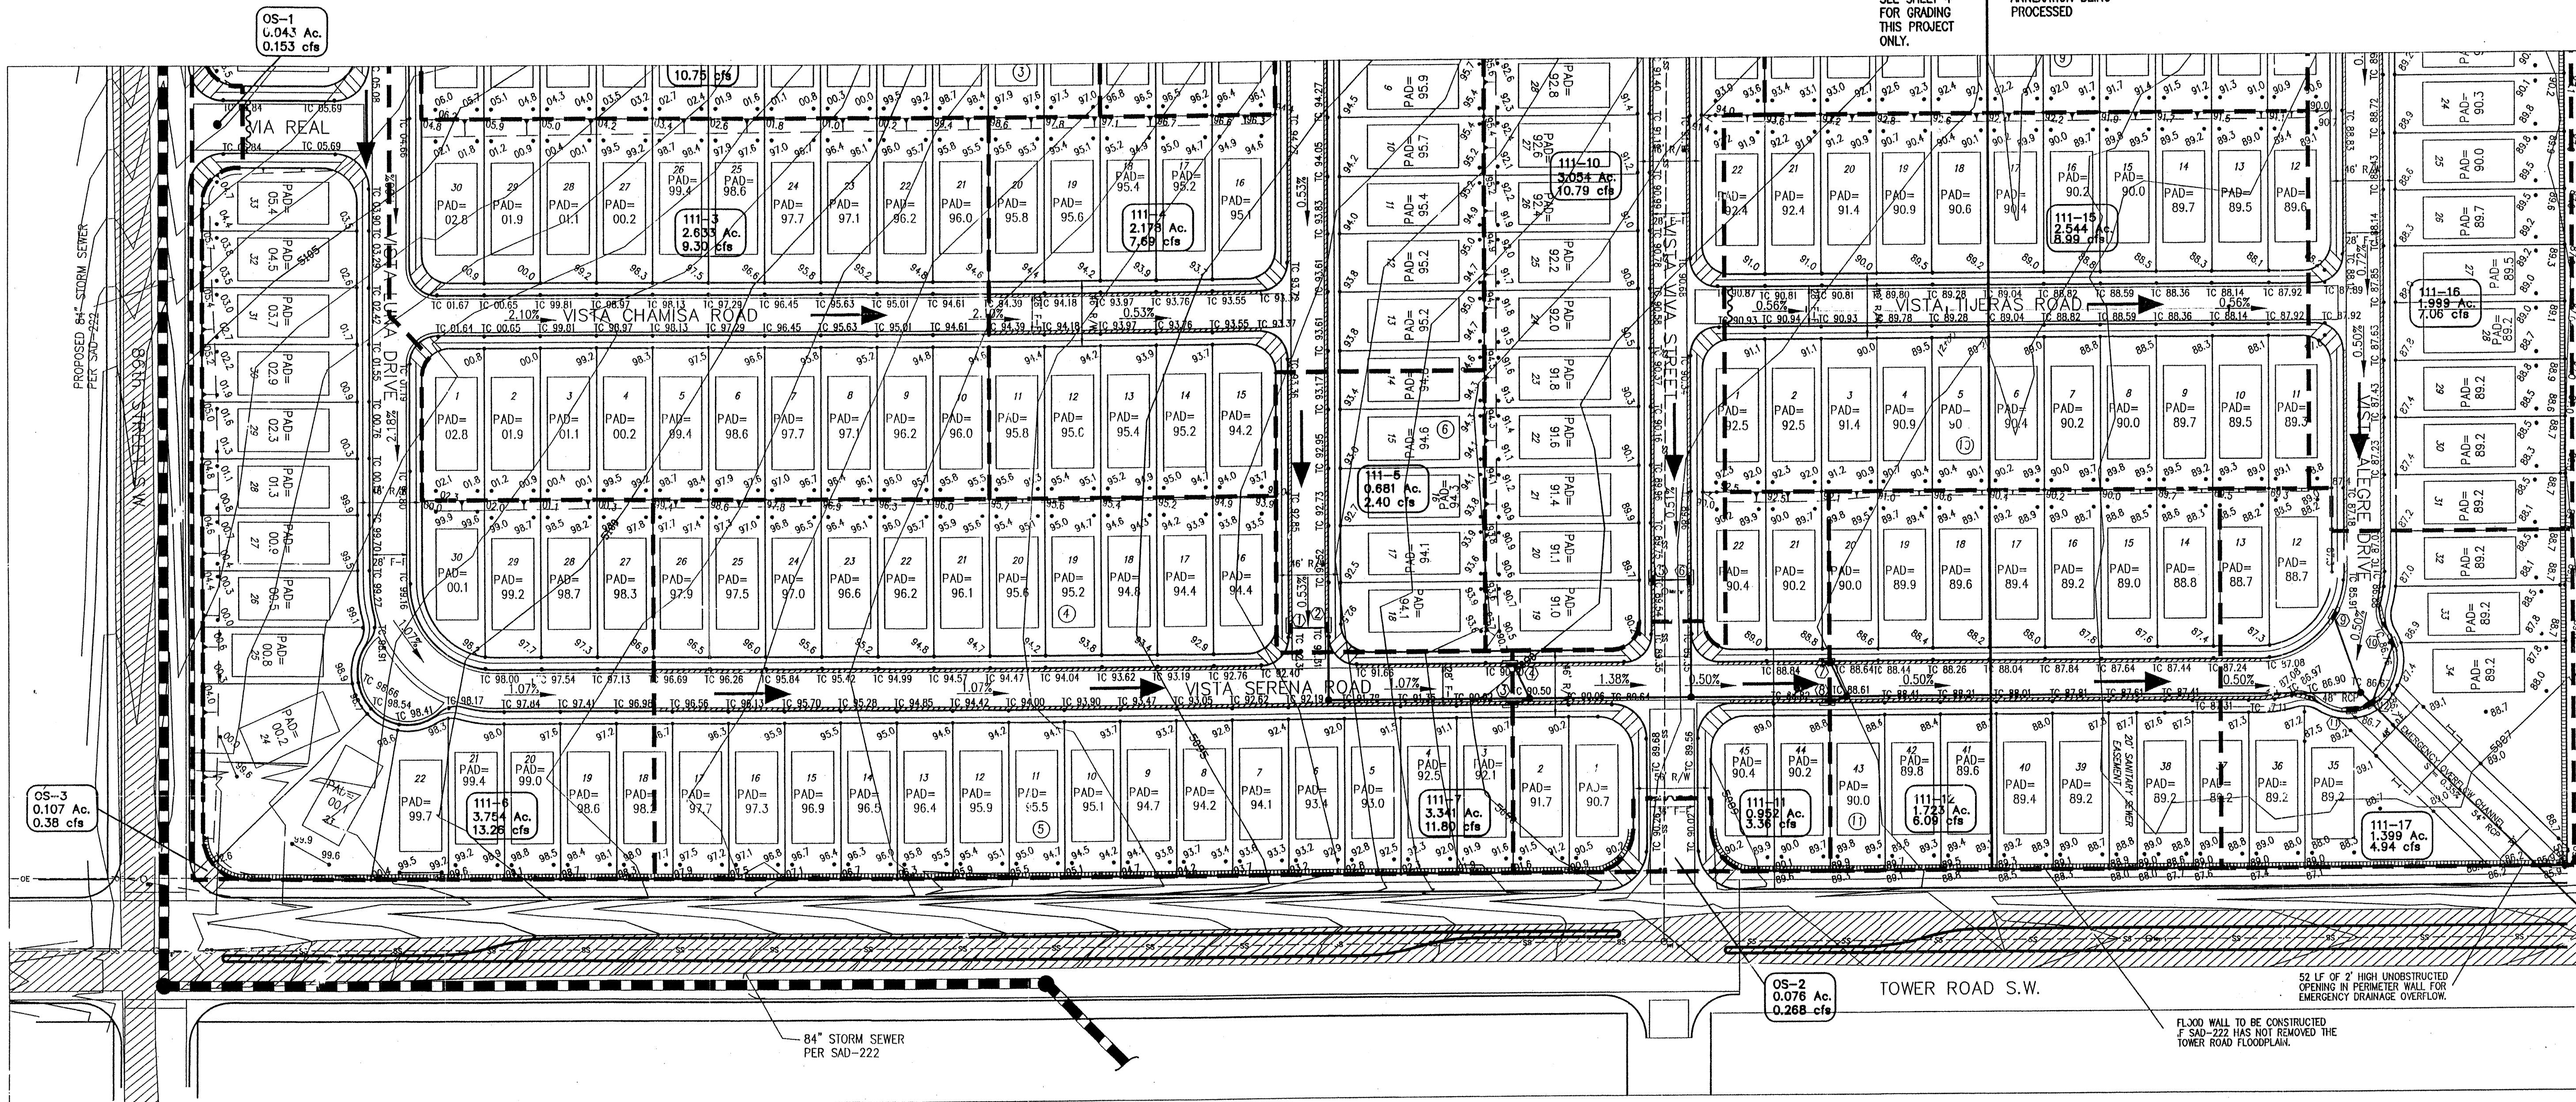

LEGEND

TOP OF CURB ELEVATION	EXISTING CONTOUR
PROPOSED SPOT ELEVATION	EXISTING TOP OF CURB
FINISHED PAD ELEVATION	EXISTING FLOWLINE
PROPOSED STANDARD CURB & GUTTER	EXISTING SPOT ELEVATION
PROPOSED MOUNTABLE CURB & GUTTER	EXISTING CURB AND GUTTER
PROPOSED DRAINAGE BASIN	EXISTING SANITARY SEWER MANHOLE
EXISTING OVERHEAD ELECTRIC	EXISTING WATER VALVE
EXISTING SANITARY SEWER	EXISTING POWER POLE
EXISTING WATERLINE	EXISTING TELEPHONE PEDESTAL
SD BY SAD-222	EXISTING FIRE HYDRANT
WATER BLOCK	EXISTING STORM SEWER MANHOLE
EXISTING PAVEMENT	EXISTING DROP INLET
	SLOPE INDICATOR
	TOE OF SLOPE
	EX MOUNTABLE CURB & GUTTER
	EX STANDARD 8" CURB & GUTTER
	STREET SLOPE ARROW
	DRAINAGE BASIN BOUNDARY

RECORD DRAWING

I hereby certify that the information contained on this drawing has been revised in accordance with information furnished by the contractor, Hydro-Systems, Inc., and by the surveyor, Daggett Engineering, and reflects the construction as actually accomplished. This plan as constructed is in substantial compliance with the Approved Plan.

James D. Hughes NMPE 11674

APPROVED FOR ROUGH GRADING ± 1 FT.

CITY HYDROLOGY DATE

DAGGETT ENGINEERING & SURVEYING

2125 CORTE DE CHAMISA NW
ALBUQUERQUE, NM 87120
(505) 636-2657

CITY OF ALBUQUERQUE
PUBLIC WORKS DEPARTMENT
ENGINEERING DEVELOPMENT GROUP

TITLE: VISTA SANDIA SUBDIVISION
GRADING PLAN

Design Review Committee City Engineer Approval

Approved @ DRB

City Project No. 6071.83

Zone Map No. L9-L10


Sheet 6 of 19

FOR INFORMATION ONLY

SURVEY INFORMATION

NO.	DATE	BY

ENGINEER'S SEAL

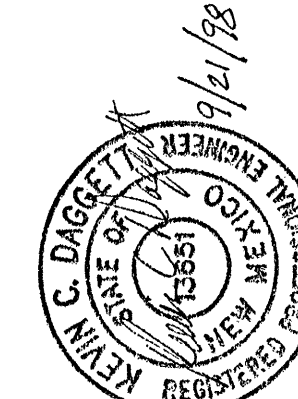

REVISIONS

No.	Date	By	Remarks

Designed By

Drawn By

Checked By

Date 9-98

Date 9-98

BENCH MARKS

STATION	DATE	BY

AS BUILT INFORMATION


CONTRACTOR	DATE
Hydro-Systems	2/91
WORK	DATE
DESIGN	2/91
FIELD	DATE
DESIGN	2/91
REVISIONS	DATE
DESIGN	2/91
REVISIONS	DATE
DESIGN	2/91

MICRO-FILM INFORMATION

NO.	DATE



SCANNED BY
MESA REPRO

F:\DATA\DWG\98\005\8118VIST\UNIT3\8118PAV.DWG Thu Sep 30 13:07:23 1999 PLOTTED BY KJS

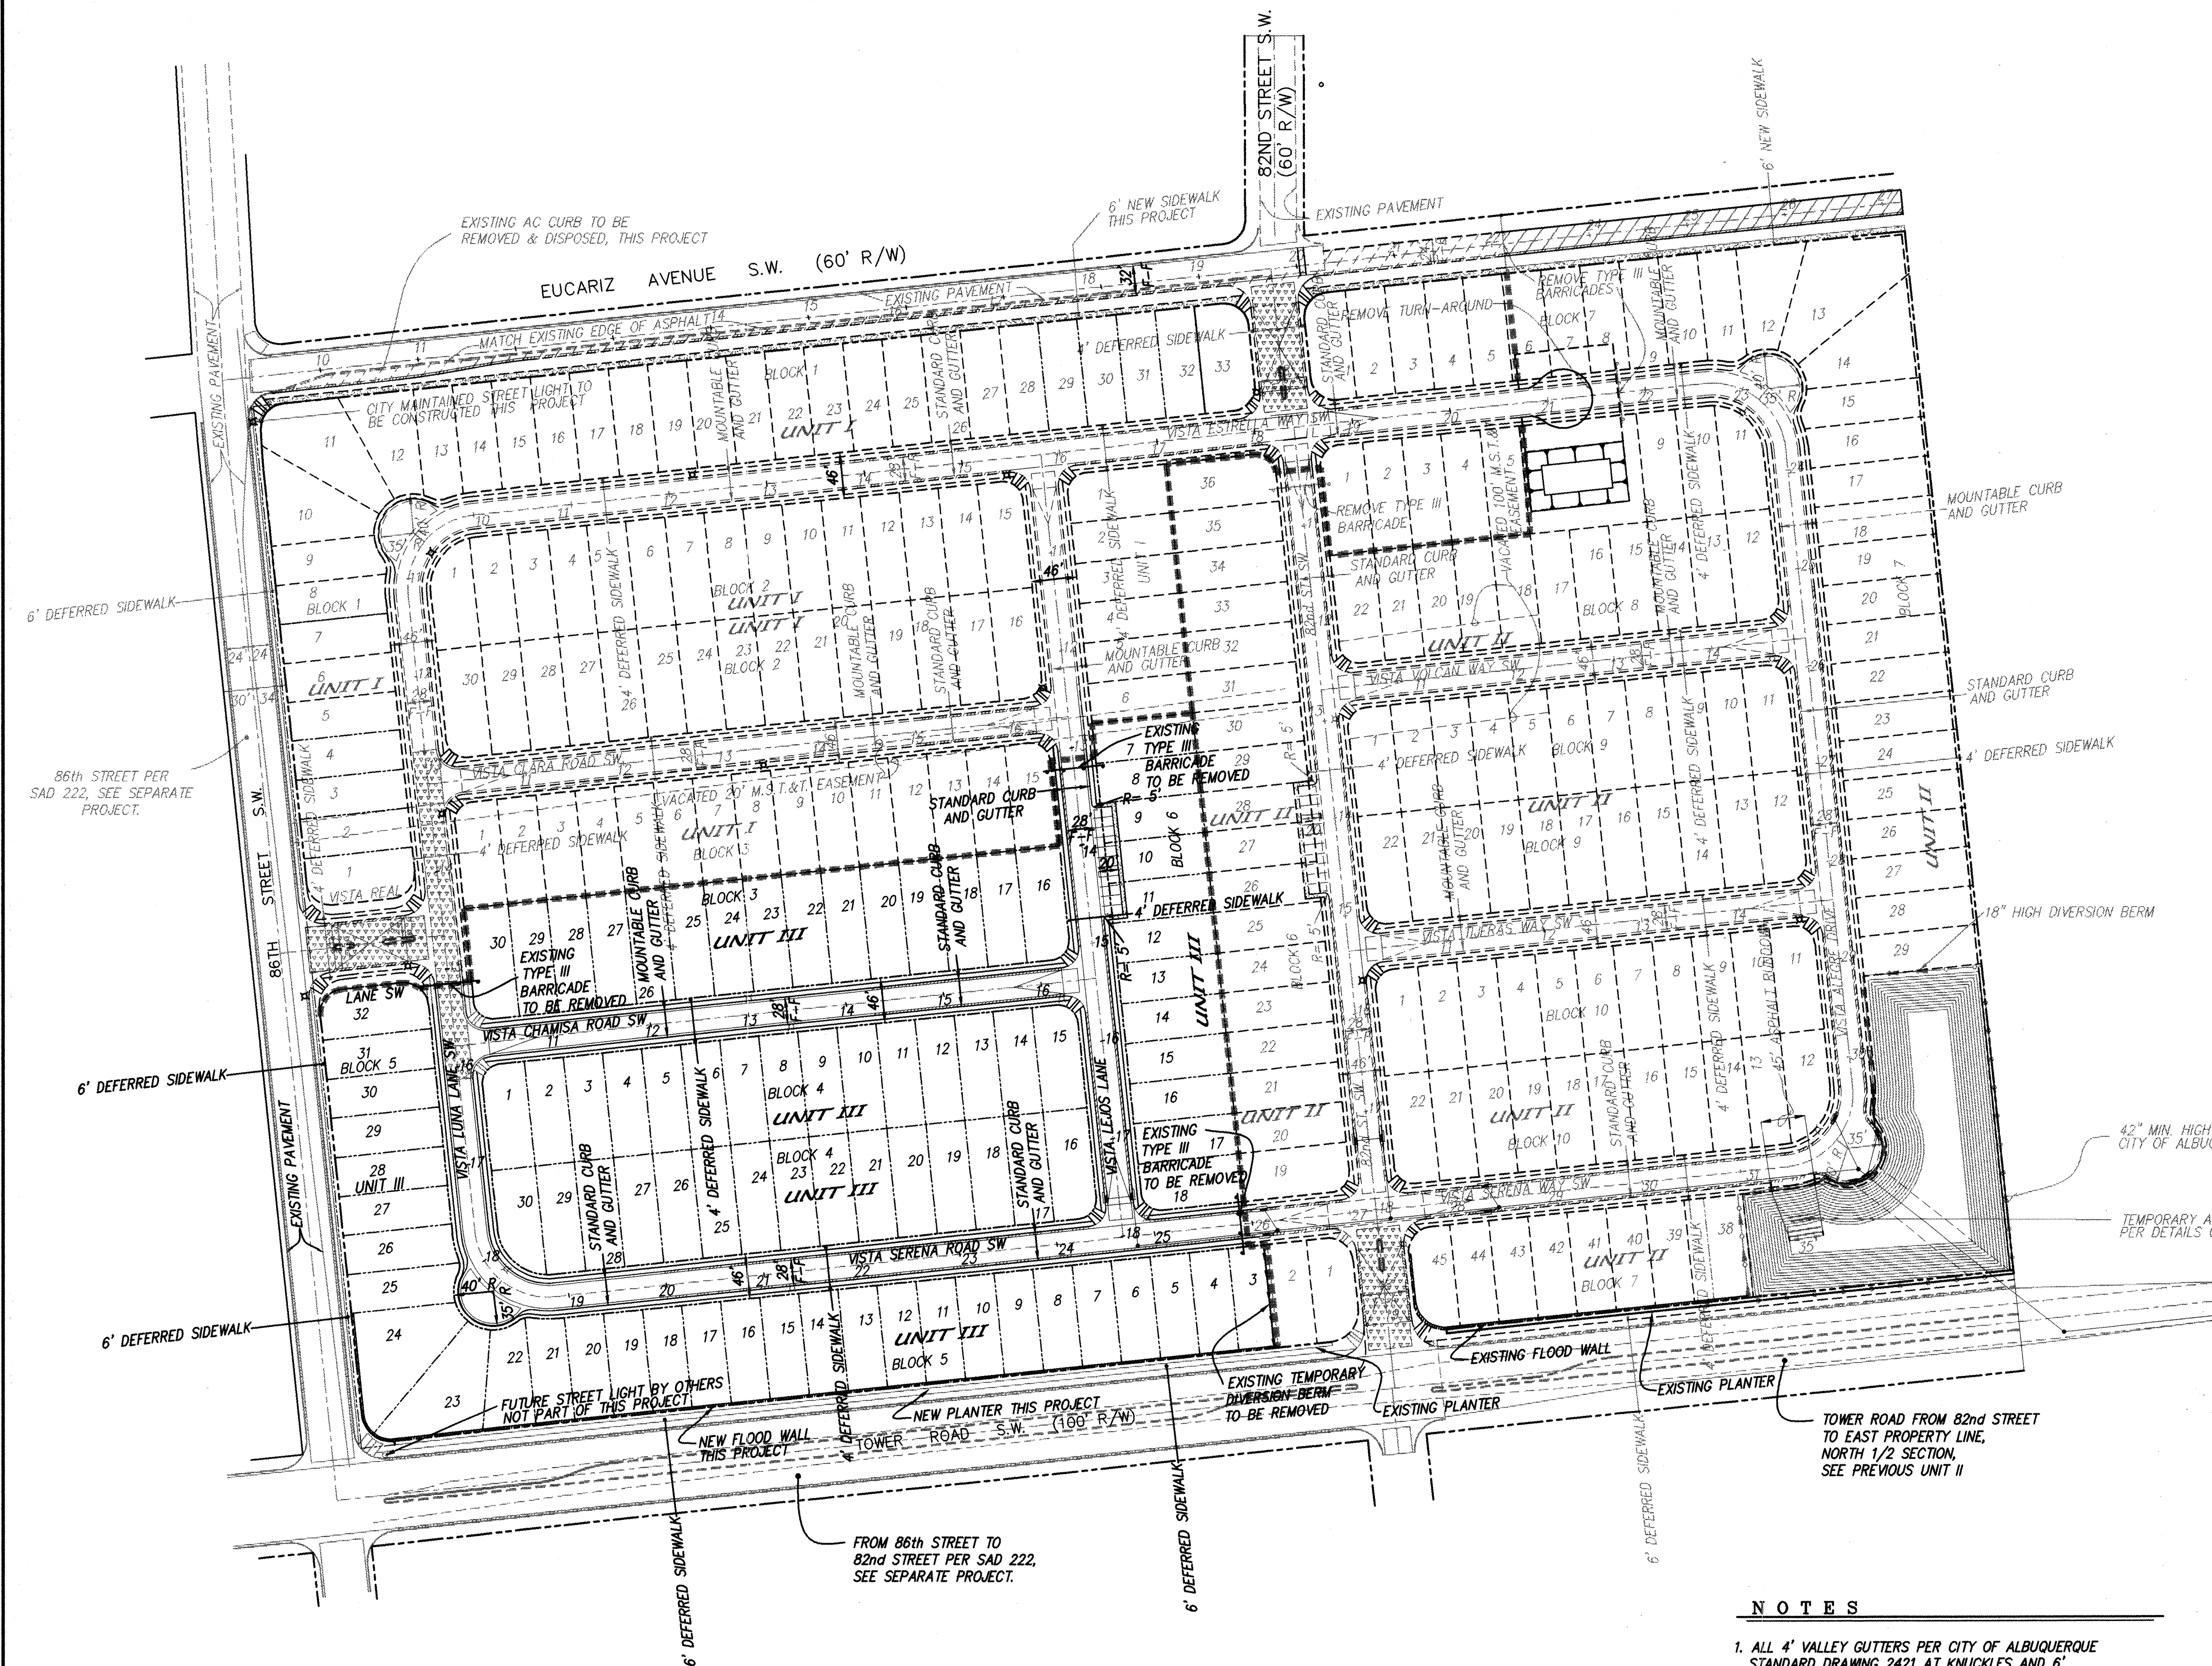

N.T.S.

TYPICAL FLOODWALL DETAIL

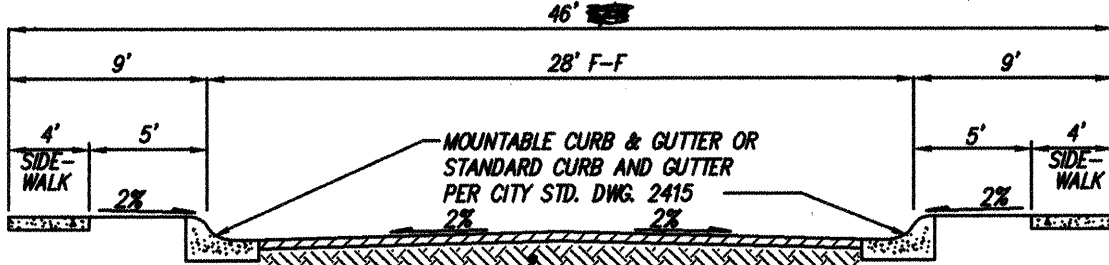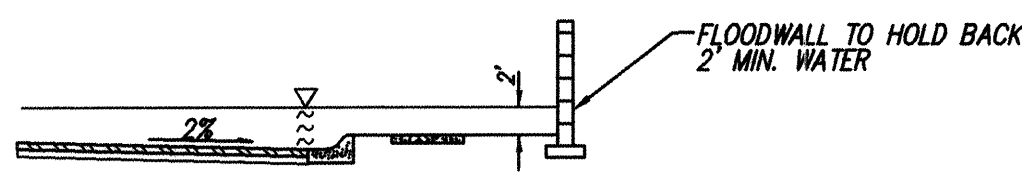


N.T.S.

TYPICAL STREET SECTION

LEGEND

- 5" ENTRANCE PAVEMENT
- NEW 6" SIDEWALK CONSTRUCTED THIS PROJECT
- 50' CROWN TRANSITION PER COA STD. DWG. 2401 THIS PROJECT
- ROLL CURB & GUTTER
- STANDARD 8" CURB & GUTTER
- RED BRICK TEXTURED CONCRETE PER DWG #2411, THIS PROJECT.
- EUCARIZ & RESIDENTIAL PAVING THIS PROJECT
- MEDIAN CURB & GUTTER
- TRACT/LOT BOUNDARY
- RIGHT OF WAY
- PROPERTY LINE
- HANDICAP RAMPS PER COA DWG #2418 THIS PROJECT CASE II
- TYPE III BARRICADES THIS PROJECT
- STREET LIGHT

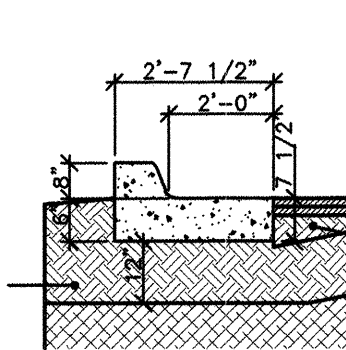

12" SUBGRADE SOIL R-VALUE > 50 RESIDENTIAL. 62 ENTRANCE, PLACED IN 2-6" COMPACTED LIFT. 90% MIN. COMPACTION AT OPT. MOISTURE. ± 2.0% ASTM D1557, OR OPT. MOISTURE TO ± 4% ASTM D698 FOR SOIL W/35% OR MORE MATERIAL PASSING THE NO. 200 SIEVE. TO EXTEND FULL WIDTH OF ROADWAY TO 1.0' BACK OF NEW CURB PER SECTION 301.4.1.

1-1/2" ASPHALT CONC. TYPICAL FINISH COURSE PLACED AFTER ALL MANHOLE VALVES COVERS/RINGS ARE SET TO GRADE. 1500 LBS. STABILITY TYPE B GRADATION. 1-1/2" ASPHALT CONCRETE 1500 LBS. STABILITY, TYPE B GRADATION. 5" SUBBASE TO BE ADDED AFTER COMPLETION OF CURB AND TAPERED TO 0" IN 10: FROM EDGE OF GUTTER. SUBGRADE PREP SHALL NOT EXTEND BELOW THE BOTTOM OF THE GUTTER PER SECTION 301.4.1. 90% MIN. COMPACTION. NOTE: IF R-VALUE IS LESS THAN 50 CONTRACTOR WILL REPLACE 12" OF SUBGRADE WITH MATERIAL WITH AN R-VALUE OF 50 OR GREATER. IN RESIDENTIAL STREET, R-VALUE OF 62 IS REQUIRED FOR 5" ENTRANCE PAVING.

RESIDENTIAL PAVEMENT SECTION

N.T.S. (PER CITY STD. DWG. 2405)


RECORD DRAWING

I hereby certify that the information contained on this drawing has been revised in accordance with information furnished by the contractor, Hydro-Systems, Inc., and by the surveyor, Daggett Surveying, and reflects the construction as actually accomplished. This plan as constructed is in substantial compliance with the Approved Plan.

James D. Hughes NMPE 11674

NOTES

- ALL 4" VALLEY GUTTERS PER CITY OF ALBUQUERQUE STANDARD DRAWING 2421 AT KNUCKLES AND 6" VALLEY GUTTERS PER CITY OF ALBUQUERQUE STANDARD DRAWING 2420 AT ALL INTERSECTIONS.
- ALL 4" INTERIOR SIDEWALKS ARE DEFERRED.
- ALL HANDICAP RAMPS TO BE CASE II PER CITY OF ALBUQUERQUE STANDARD DRAWING 2441. WHERE GRADES DO NOT PERMIT A MAXIMUM SLOPE OF 12:1 TO BE MAINTAINED WITHIN THE 7' LENGTH AS SPECIFIED, THEN THE 7' LENGTH AS SHOWN IN DRAWING 2441 SHALL MUST BE INCREASED TO MAINTAIN A SLOPE < 12:1.
- TRANSITION FROM ROLL CURB TO STANDARD CURB SHALL BE PER CITY OF ALBUQUERQUE DRAWING 2418, UNLESS OTHERWISE SPECIFIED.
- TRANSITION SECTION FROM FULL CROWN TO NO CROWN TO BE A MINIMUM OF 50', PER CITY OF ALBUQUERQUE STANDARD DRAWING 2401.
- ALL INTERIOR SUBDIVISION STREETS ARE PRIVATE.

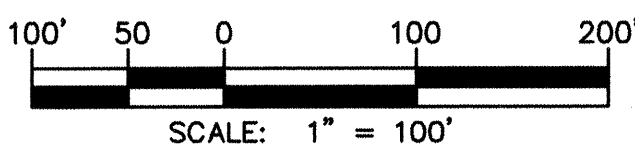

8118VIST/UNIT 3/8118PAV/09-01-99

AS BUILT INFORMATION		CONTRACTOR		DATE	
WORK		Hydro Systems		2/01	
INSPECTOR		JES		DATE	
ACCEPTANCE		R. B. C.		DATE	
DRAWINGS		DES		DATE	
CORRECTIONS		DMG		DATE	
MICRO-FILM INFORMATION		RECORDED BY		DATE	
NO.		NO.		NO.	
BENCH MARKS		CITY OF ALBUQUERQUE ACS MONUMENT "B-18"		DATE	
SURVEY INFORMATION		FIELD NOTES		DATE	
NO.		BY		DATE	
ENGINEER'S SEAL		DATE		DATE	
DATE		DATE		DATE	
REMARKS		REVISIONS		DESIGN	
NO.		DATE		BY	
DESIGNED BY		JDH		10-98	
DRAWN BY		KJS		10-98	
CHECKED BY		DMG		10-98	

MARK GOODWIN & ASSOCIATES, P.A.
CONSULTING ENGINEERS
P.O. BOX 90606
ALBUQUERQUE, NEW MEXICO 87199
(505) 828-2200, FAX (505) 797-9539

CITY OF ALBUQUERQUE
PUBLIC WORKS DEPARTMENT
ENGINEERING DEVELOPMENT GROUP

TITLE: VISTA SANDIA SUBDIVISION UNIT III MASTER PAVING PLAN

DESIGN REVIEW COMMITTEE
3/19/01 KB
DEC 12 1999

CITY ENGINEER APPROVAL
APPROVE
APR 9 2001

CITY ENGINEER
APPROVE

CITY PROJECT NO. 607183 ZONE MAP NO. L-9, L-10 SHEET 7 OF 19



NOTES

- ALL 4' VALLEY GUTTERS PER CITY OF ALBUQUERQUE STANDARD DRAWING 2421 AT KNUCKLES AND 6' VALLEY GUTTERS PER CITY OF ALBUQUERQUE STANDARD DRAWING 2420 AT ALL INTERSECTIONS.
- ALL 4' INTERIOR SIDEWALKS ARE DEFERRED.
- ALL HANDICAP RAMPS TO BE CASE II PER CITY OF ALBUQUERQUE STANDARD DRAWING 2441. WHERE GRADES DO NOT PERMIT A MAXIMUM SLOPE OF 12:1 TO BE MAINTAINED WITHIN THE 7' LENGTH AS SPECIFIED, THEN THE 7' LENGTH AS SHOWN IN DRAWING 2441 SHALL BE INCREASED TO MAINTAIN A SLOPE < 12:1.
- TRANSITION FROM MOUNTABLE CURB TO STANDARD CURB SHALL BE PER CITY OF ALBUQUERQUE DRAWING 2401.
- TRANSITION SECTION FROM FULL CROWN TO NO CROWN TO BE A MINIMUM OF 50', PER CITY OF ALBUQUERQUE STANDARD DRAWING 2401.
- ALL INTERIOR SUBDIVISION STREETS ARE PRIVATE.

CURVE DATA - DESCRIBES CENTERLINE

① $\Delta = 90^{\circ}00'00''$ $R = 75.00'$ $L = 117.81'$ $T = 75.00'$	② $\Delta = 90^{\circ}00'00''$ $R = 75.00'$ $L = 117.81'$ $T = 75.00'$
---	---

CURVE DATA - DESCRIBES FACE OF NEW CURB

① $\Delta = 14^{\circ}50'56''$ $R = 89.00'$ $L = 23.07'$ $T = 11.60'$	② $\Delta = 54^{\circ}22'07''$ $R = 20.00'$ $L = 18.98'$ $T = 10.27'$	③ $\Delta = 169^{\circ}02'21''$ $R = 35.00'$ $L = 103.26'$ $T = N/A$
④ $\Delta = 54^{\circ}22'07''$ $R = 20.00'$ $L = 18.98'$ $T = 10.27'$	⑤ $\Delta = 14^{\circ}50'56''$ $R = 89.00'$ $L = 23.07'$ $T = 11.60'$	⑥ $\Delta = 90^{\circ}00'00''$ $R = 20.00'$ $L = 31.42'$ $T = 20.00'$
⑦ $\Delta = 90^{\circ}00'00''$ $R = 20.00'$ $L = 31.42'$ $T = 20.00'$	⑧ $\Delta = 90^{\circ}00'00''$ $R = 25.00'$ $L = 39.27'$ $T = 25.00'$	⑨ $\Delta = 90^{\circ}00'00''$ $R = 25.00'$ $L = 39.27'$ $T = 25.00'$
⑩ $\Delta = 90^{\circ}00'00''$ $R = 20.00'$ $L = 31.42'$ $T = 20.00'$	⑪ $\Delta = 90^{\circ}00'00''$ $R = 20.00'$ $L = 31.42'$ $T = 20.00'$	⑫ $\Delta = 14^{\circ}50'56''$ $R = 89.00'$ $L = 23.07'$ $T = 11.60'$
⑬ $\Delta = 54^{\circ}22'07''$ $R = 20.00'$ $L = 18.98'$ $T = 10.27'$	⑭ $\Delta = 169^{\circ}02'21''$ $R = 35.00'$ $L = 103.26'$ $T = N/A$	⑮ $\Delta = 54^{\circ}22'07''$ $R = 20.00'$ $L = 18.98'$ $T = 10.27'$
⑯ $\Delta = 14^{\circ}50'56''$ $R = 89.00'$ $L = 23.07'$ $T = 11.60'$	⑰ $\Delta = 90^{\circ}00'00''$ $R = 61.00'$ $L = 95.82'$ $T = 61.00'$	⑱ $\Delta = 90^{\circ}00'00''$ $R = 61.00'$ $L = 95.82'$ $T = 61.00'$

VISTA LUNA LANE SW AND VISTA SERENA SW

STA. 10+00.00 TO STA. 21+00.00
SCALE: HORZ. 1" = 50'
VERT. 1" = 10'

REVISIONS

NO.	DATE	REMARKS	BY
1	12/98	DESIGN	JDH
2	12/98	DESIGN	KIS
3	12/98	DESIGN	DMG

ENGINEER'S SEAL

James D. Hughes
REGISTERED PROFESSIONAL ENGINEER
NEW MEXICO
114776
9-99

CITY OF ALBUQUERQUE PUBLIC WORKS DEPARTMENT ENGINEERING DEVELOPMENT GROUP

TITLE: **VISTA SANDIA SUBDIVISION UNIT III PAVING IMPROVEMENTS**

DESIGN REVIEW COMMITTEE
DEC 12 1999

CITY ENGINEER APPROVAL
APR 9 1999


CITY PROJECT NO. 607183

ZONE MAP NO. L-9,L-10

SHEET 8 OF 19

I hereby certify that the information contained on this drawing has been reviewed in accordance with information furnished by the contractor Hydro-Systems, Inc., and by the surveyor Daguerre Surveying, and reflects the construction as actually accomplished. This plan as constructed is in substantial compliance with the Approved Plan.

James D. Hughes JNPE 11874

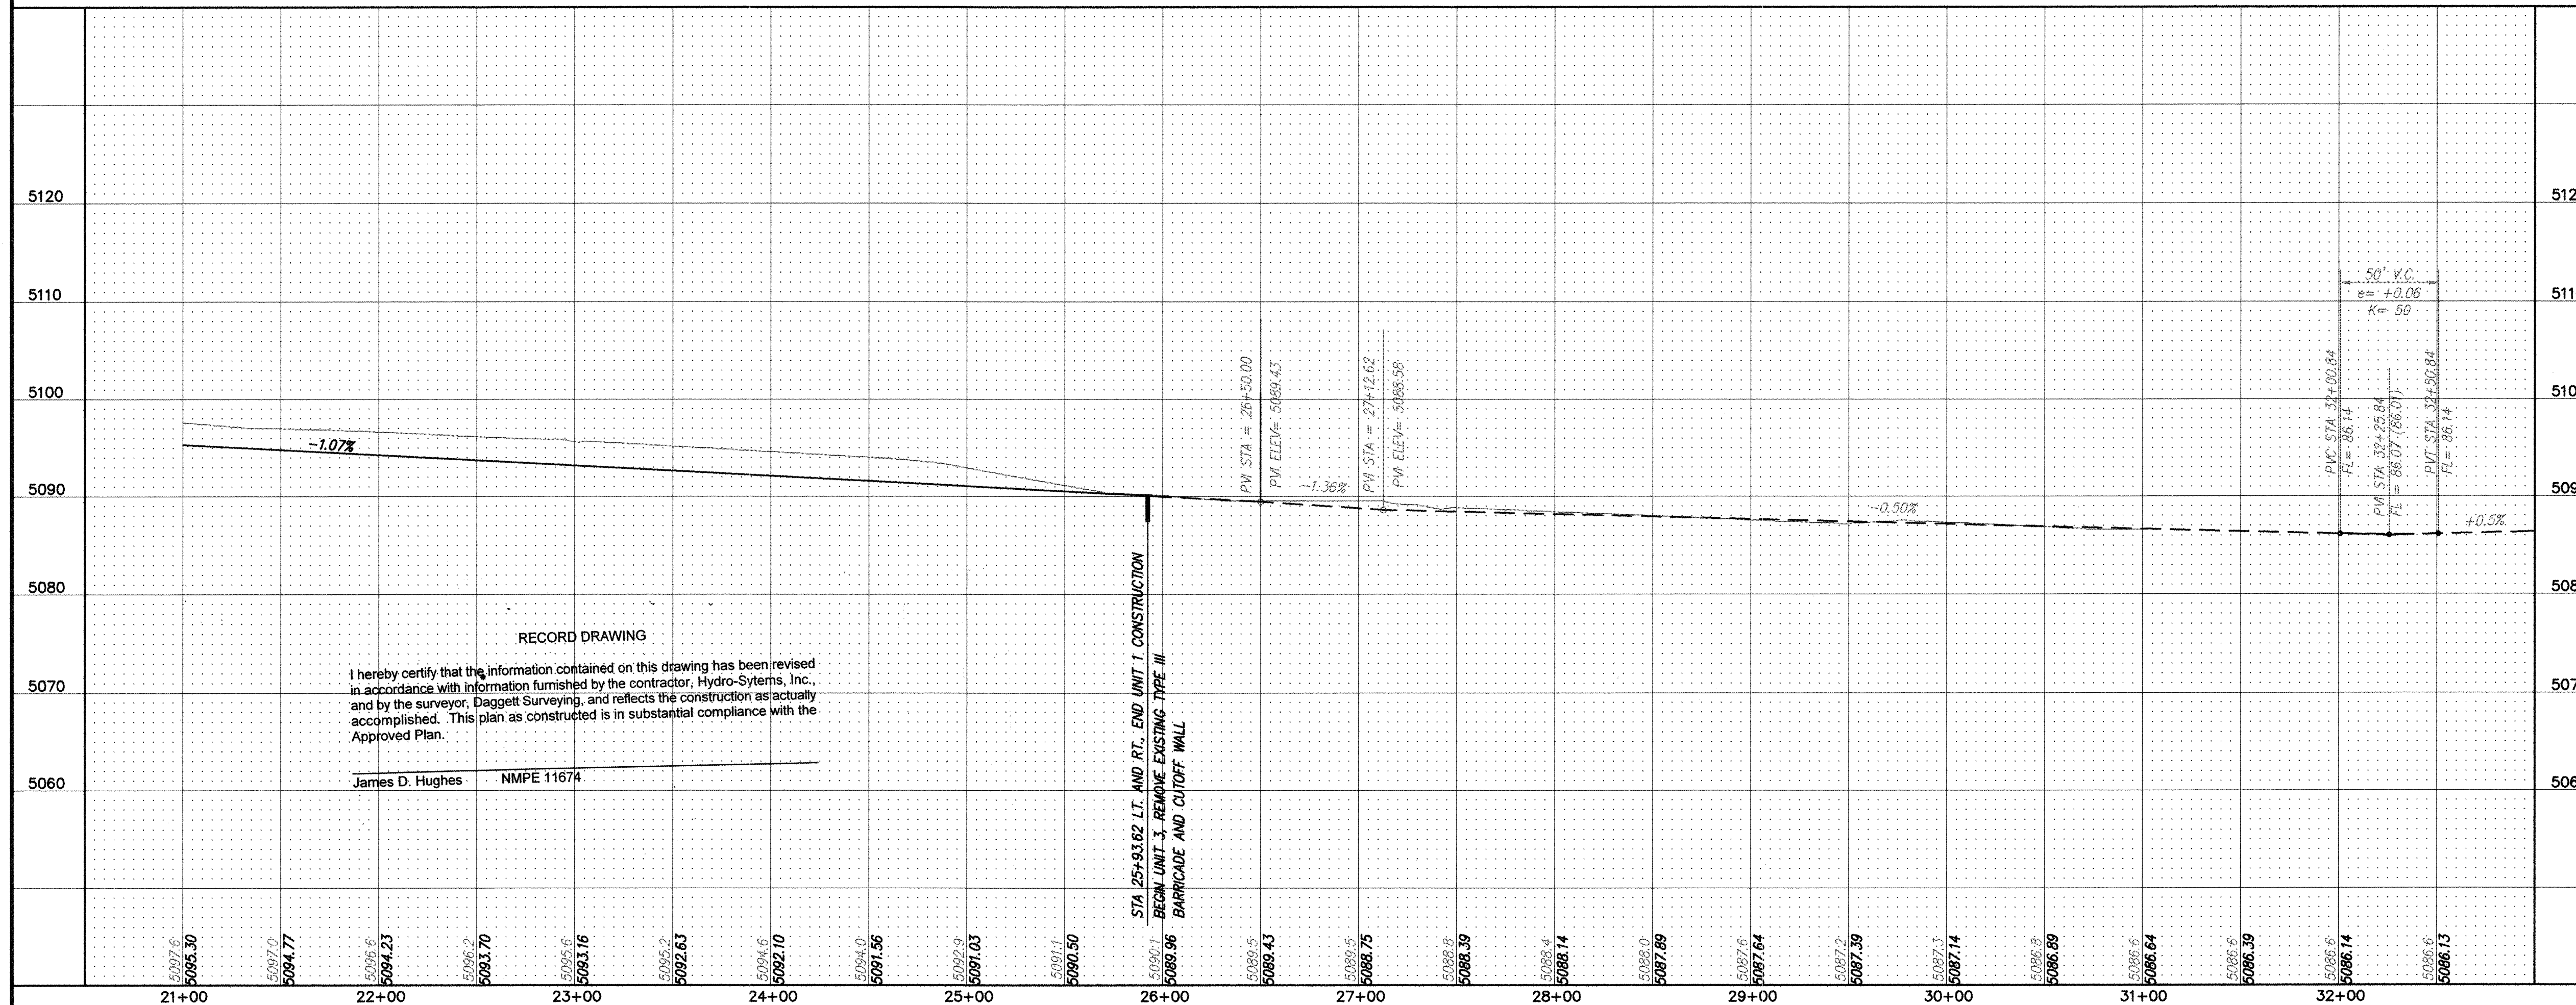

James D. Hughes	NMPE 11674
-----------------	------------

VISTA SERENA WAY SW
STA. 21+00.00 TO STA. 31+00.00
SCALE: HORZ. 1" = 50'
VERT. 1" = 10'

NO.	FIELD NOTES	DATE	CITY OF ALBUQUERQUE ACS MONUMENT "8-19"
	BY		NEW MEXICO STATE PLANE COORDINATES (CENTRAL ZONE) MAD 1927
			$X = 356,637.67, Y = 1,478,811.91, \Delta \text{ELTA ALPHA} + -076.37"$
			$G - G = 0.99967955, \text{ELEVATION} = 5101.34'$

A circular professional engineer seal for James D. Hines, No. 9674, State of Michigan. The seal is stamped in black ink. The outer ring contains the text "JAMES D. HINES" at the top and "REGISTERED PROFESSIONAL ENGINEER" at the bottom. The inner ring contains the text "MICHIGAN" at the top and "M.E.N.C.O." at the bottom. The center of the seal contains the number "9674". The seal is signed with a cursive signature across it.


[illegible]



	MARK GOODWIN & ASSOCIATES, P.A. CONSULTING ENGINEERS			DAT	DESIGNED BY DRAWN BY
		P.O. BOX 90606 ALBUQUERQUE, NEW MEXICO 87199 (505) 828-2200, FAX (505) 797-9539			

	CITY OF ALBUQUERQUE PUBLIC WORKS DEPARTMENT ENGINEERING DEVELOPMENT GROUP
	TITLE: <i>PROJECT TITLE</i> <i>UNIT III</i> <i>PLAN AND PROFILE PLAN</i>

DESIGN REVIEW COMMITTEE		CITY ENGINEER APPROVAL		MO./DAY/YR.		MO./DAY/YR.	
APPROVED DEC 12 1999		APPROVED APR 9 2001					
DESIGN REVIEW COMMITTEE		CITY ENGINEER		LAST DESIGN UPDATE			

CITY PROJECT NO.	607183	ZONE MAP NO.	4-9.4-10	SHEET	OF	9	1
------------------	--------	--------------	----------	-------	----	---	---

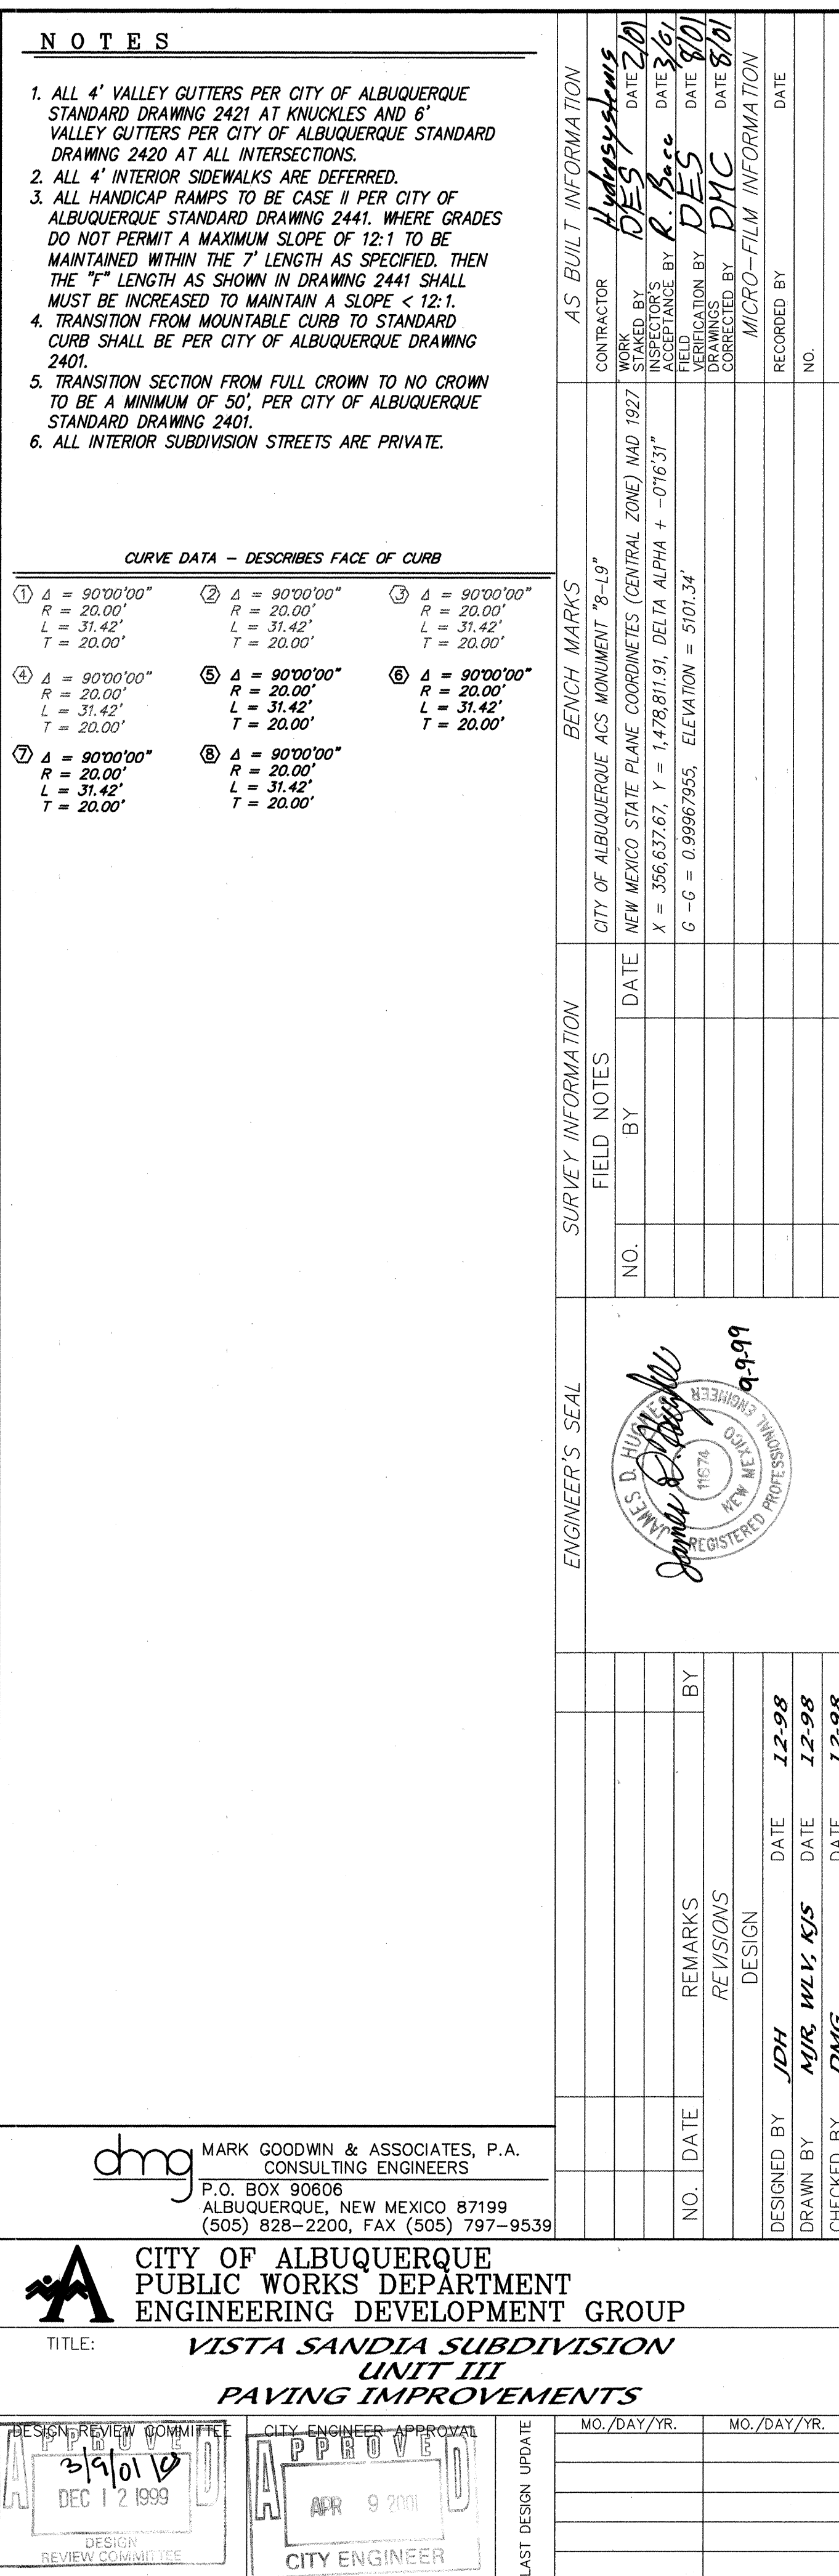

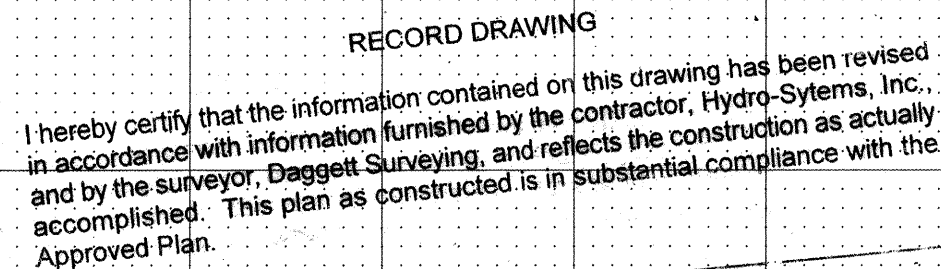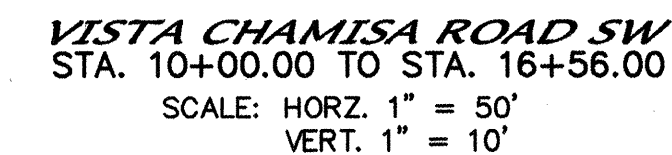

8118VIST/UNIT 3/8118PP2/09-01-99/ACH

1. ALL 4' VALLEY GUTTERS PER CITY OF ALBUQUERQUE STANDARD DRAWING 2421 AT KNUCKLES AND 8' VALLEY GUTTERS PER CITY OF ALBUQUERQUE STANDARD DRAWING 2420 AT ALL INTERSECTIONS.
2. ALL 4' INTERIOR SIDEWALKS ARE DEFERRED.
3. ALL HANDICAP RAMPS TO BE CASE II PER CITY OF ALBUQUERQUE STANDARD DRAWING 2441. WHERE GRADES DO NOT PERMIT A MAXIMUM SLOPE OF 12:1 TO BE MAINTAINED WITHIN THE 7' LENGTH AS SPECIFIED. THEN THE 7' LENGTH AS SHOWN IN DRAWING 2441 SHALL MUST BE INCREASED TO MAINTAIN A SLOPE < 12:1.
4. TRANSITION FROM MOUNTABLE CURB TO STANDARD CURB SHALL BE PER CITY OF ALBUQUERQUE DRAWING 2401.
5. TRANSITION SECTION FROM FULL CROWN TO NO CROWN TO BE A MINIMUM OF 50' PER CITY OF ALBUQUERQUE STANDARD DRAWING 2401.
6. ALL INTERIOR SUBDIVISION STREETS ARE PRIVATE.

① $\Delta = 90^{\circ}00'00''$
 $R = 20.00'$
 $L = 31.42'$
 $T = 20.00'$


② $\Delta = 90^{\circ}00'00''$
 $R = 20.00'$
 $L = 31.42'$
 $T = 20.00'$

③ $\Delta = 90^{\circ}00'00''$
 $R = 20.00'$
 $L = 31.42'$
 $T = 20.00'$

④ $\Delta = 90^{\circ}00'00''$
 $R = 20.00'$
 $L = 31.42'$
 $T = 20.00'$

[illegible]

SCANNED BY
MESA REPRO

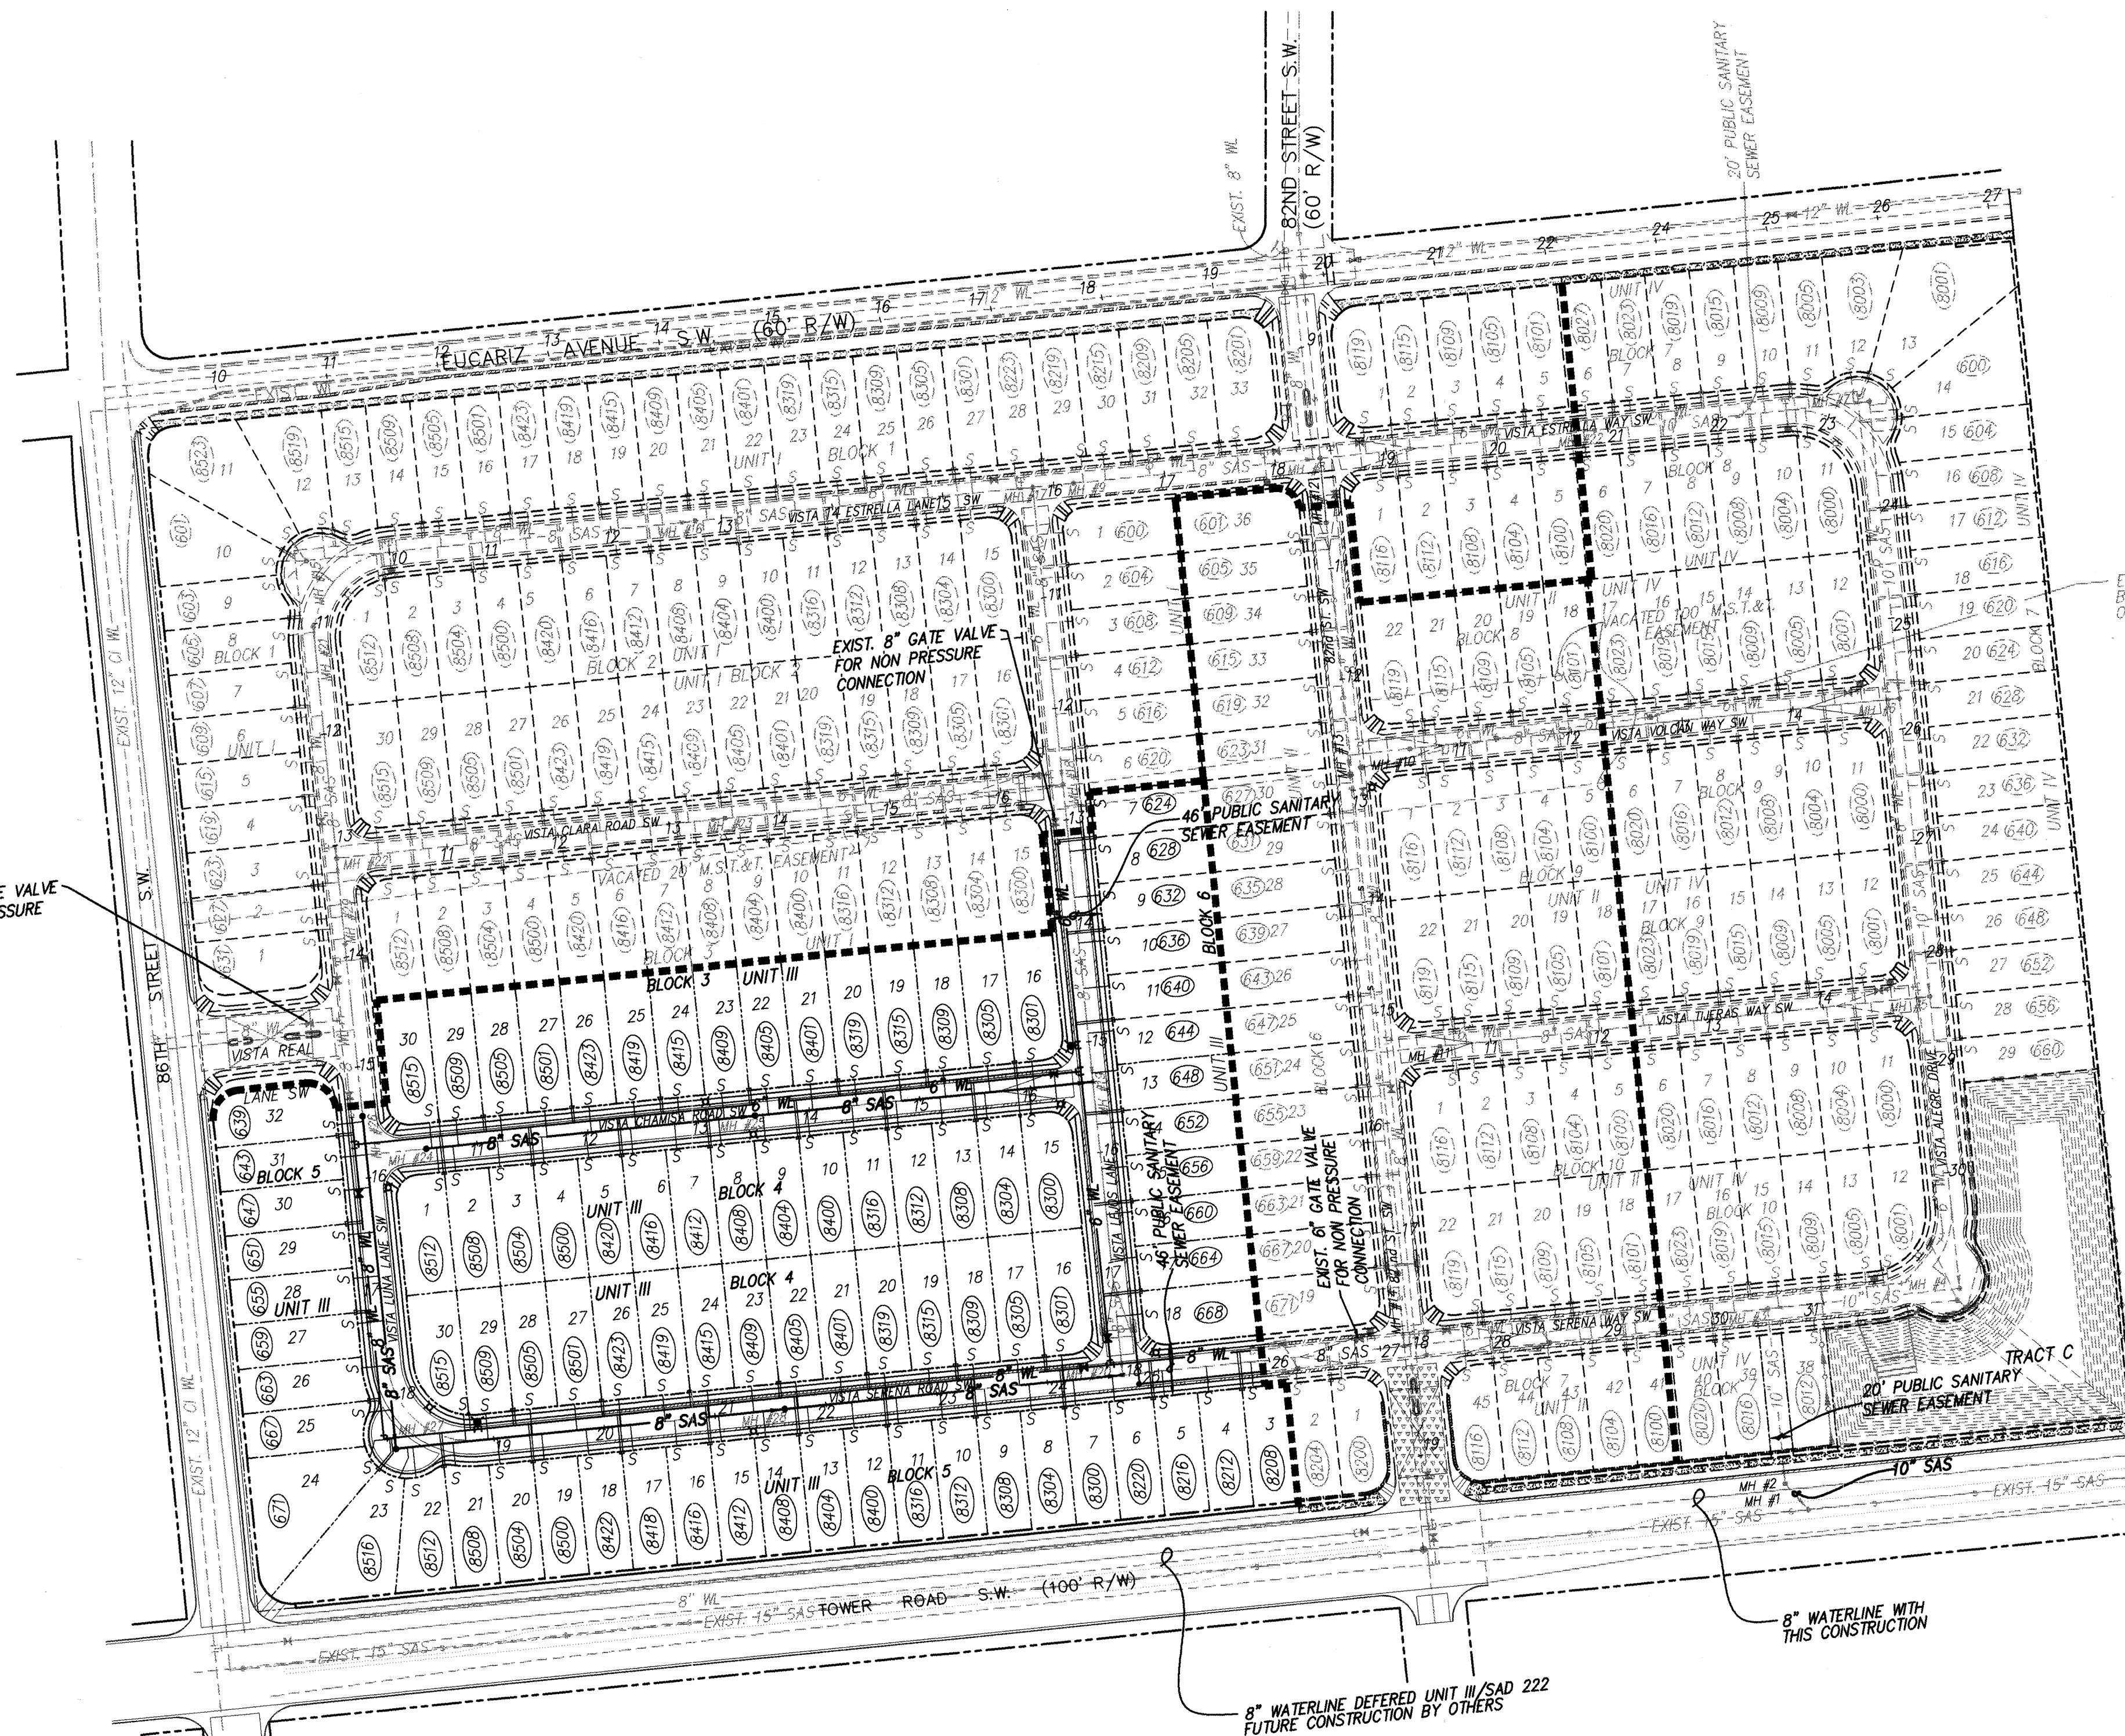

NOTES

1. ALL STATIONING IS CENTERLINE STATIONING.
2. ALL FIRE HYDRANTS ARE 4' BURY UNLESS OTHERWISE SPECIFIED.

WATER SHUT-OFF NOTES

1. CONTRACTOR WILL CONTACT WATER SYSTEMS AT 857-8200, FIVE (5) DAYS PRIOR TO NECESSARY SHUT-OFF.
2. VALVES SHALL ONLY BE OPERATED BY CITY WATER EMPLOYEES.
3. THE THREE UNIT 3 CONNECTIONS AT VISTA SERENA RD, VISTA LUNA LANE, AND VISTA LEADS LANE ARE TO STUBS WITH VALVES CONSTRUCTED WITH PREVIOUS UNITS OF THIS SAME PROJECT. UNIT 3 CONNECTIONS WILL ALL BE NON-PRESSURE WITH LOTS 1 AND 2 IN BLOCK 5 BEING THE ONLY SERVICES AFFECTED BY THE SHUTDOWN.


LEGEND

- NEW CONCRETE SIDEWALK
- NEW RETAINING WALL
- MOUNTABLE CURB & GUTTER
- STANDARD 8" CURB & GUTTER
- PROPOSED SANITARY SEWER
- PROPOSED STORM DRAIN LINE
- SAS - PROPOSED SANITARY SEWER
- WL - PROPOSED WATERLINE
- NEW FIRE HYDRANT
- DOUBLE WATER SERVICE
- SINGLE WATER SERVICE
- GATE VALVE
- TEE
- BEND
- SANITARY SEWER SERVICE
- PROPOSED STORM DRAIN MH
- PROPOSED SAS MH
- EXISTING SANITARY SEWER MANHOLE
- EXISTING WATER VALVE
- EXISTING OVERHEAD TELEPHONE LINE
- EXISTING SANITARY SEWER
- ADDRESSING
- UNIT BOUNDARY
- STREET LIGHT
- EXISTING WATERLINE

RECORD DRAWING

I hereby certify that the information contained on this drawing has been revised in accordance with information furnished by the contractor, Hydro-Siem, Inc., and by the surveyor, Daggett Surveying, and reflects the construction as actually accomplished. This plan is constructed in substantial compliance with the Approved Plan.

James D. Hughes NMPF 11674

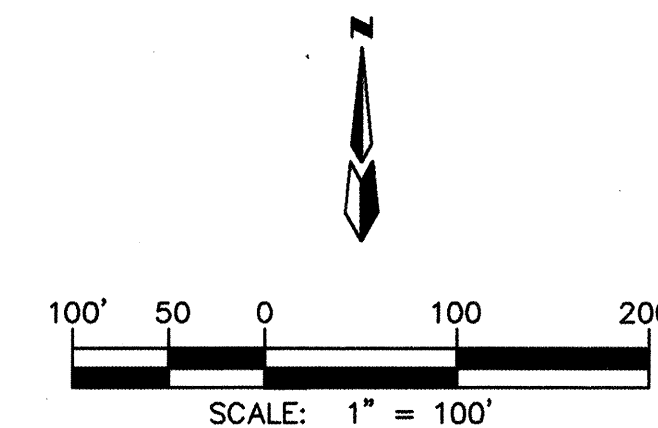

dmg MARK GOODWIN & ASSOCIATES, P.A.
CONSULTING ENGINEERS
P.O. BOX 90606
ALBUQUERQUE, NEW MEXICO 87199
(505) 828-2200, FAX (505) 797-9539

CITY OF ALBUQUERQUE
PUBLIC WORKS DEPARTMENT
ENGINEERING DEVELOPMENT GROUP
TITLE: **VISTA SANDIA SUBDIVISION**
UNIT III
MASTER UTILITY PLAN

DESIGN REVIEW COMMITTEE APPROVED DEC 12 1999	CITY ENGINEER APPROVAL APPROVED DEC 9 2000	LAST DESIGN UPDATE	MO./DAY/YR.	MO./DAY/YR.
DESIGN REVIEW COMMITTEE	CITY ENGINEER			

CITY PROJECT NO. **607183** ZONE MAP NO. **L-9, L-10** SHEET **12** OF **19**


AS BUILT INFORMATION			
CONTRACTOR	Hydro-Siem	DATE	2/01
WORK STARTED BY	DES	DATE	2/01
ACCEPTANCE BY		DATE	
FIELD LOCATION BY	DES	DATE	9/01
DRAWINGS	DMG	DATE	8/01
CORRECTED BY		DATE	
MICRO-FILM INFORMATION		DATE	
RECORDED BY		DATE	
NO.			

BENCH MARKS			
CITY OF ALBUQUERQUE ACS MONUMENT "B-19"			
NEW MEXICO STATE PLANE COORDINATES (CENTRAL ZONE) NAD 1927			
X = 356,637.67, Y = 1,478,871.91, DELTA ALPHA + -016.3"			
G - C = 0.99967955, ELEVATION = 5101.34'			

SURVEY INFORMATION			
FIELD NOTES	BY	DATE	
NO.			

ENGINEER'S SEAL
James D. Hughes
REGISTERED PROFESSIONAL ENGINEER
NEW MEXICO
11674
9-9-99

DATE	DATE	DATE	BY
NO.	DATE	REMARKS	BY
		DESIGN	
		REVISIONS	
DESIGNED BY	JDH	10-98	
DRAWN BY	KJS	10-98	
CHECKED BY	DMG	##	

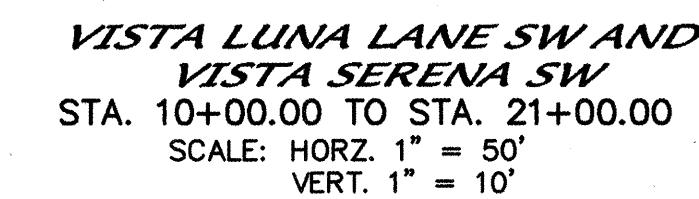

SANITARY SEWER SERVICES					
BLOCK	LOT	STATION AT PL	INV. ELEV. AT PL	LENGTH AT PL	
1	1	13+62.81	00.1	23.00'	
1	2	13+72.81	00.3	23.00'	
1	3	13+42.81	00.7	23.00'	
1	4	12+62.81	01.1	23.00'	
1	5	12+22.81	01.5	23.00'	
1	6	11+82.81	01.9	23.00'	
1	7	11+42.81	02.2	23.00'	
1	8	11+10.14	02.3	22.49'	
1	9	10+80.76	02.3	33.71'	
1	10	10+68.37	02.3	25.28'	
1	11	10+55.50	02.3	23.25'	
1	12	10+38.75	02.1	27.67'	
1	13	10+28.79	01.2	20.15'	
2	1	10+17.47	01.0	24.40'	
4	24	20+64.62	90.3	23.00'	
4	25	20+54.62	90.7	23.00'	
4	26	20+14.62	91.1	23.00'	
4	27	19+74.62	91.6	23.00'	
4	28	19+34.62	92.0	23.00'	
4	29	18+91.49	92.4	23.00'	
4	30	18+69.15	92.8	24.40'	
5	16	13+62.81	90.6	23.00'	
5	17	20+42.88	91.0	23.00'	
5	18	19+62.88	91.5	23.00'	
5	19	19+22.88	91.9	23.00'	
5	20	18+82.88	92.3	23.00'	
5	21	18+68.88	92.7	20.08'	
5	22	18+47.01	93.0	27.82'	
5	23	18+38.78	93.1	27.00'±	
5	24	18+19.74	93.2	27.00'±	
5	25	17+98.45	93.5	23.00'	
5	26	17+68.81	93.8	23.00'	
5	27	17+28.81	94.2	23.00'	
5	28	16+88.81	94.6	23.00'	
5	29	16+48.81	95.4	23.00'	
5	30	16+08.81	96.0	23.00'	
5	31	15+88.81	96.6	23.00'	
5	32	15+48.81	97.5	23.00'	

RESTRAINED JOINT LENGTH FOR BENDS, VALVES, DEAD ENDS (FT.)					
PIPE SIZE	90°	45°	22.5°	11.25°	VALVE
6"	17'	7'	-	-	46'

LENGTH OF RESTRAINED PIPE ON EACH SIDE OF THE BEND. RESTRAIN BRANCH AT FITTING ONLY MINIMUM ATTACHED PIPE LENGTH, RUN SIDE OF TEE: 10.00 FEET.


RESTRAINED JOINT LENGTH FOR TEES (FT.)		
PIPE SIZE	RUN	BRANCH
8"x8"x8"	13'	3'
8"x8"x6"	7'	5'

CITY OF ALBUQUERQUE
PUBLIC WORKS DEPARTMENT
ENGINEERING DEVELOPMENT GROUP

MARK GOODWIN & ASSOCIATES, P.A.
CONSULTING ENGINEERS
P.O. BOX 90606
ALBUQUERQUE, NEW MEXICO 87199
(505) 828-2200, FAX (505) 797-9539

DESIGN REVIEW COMMITTEE		CITY ENGINEER APPROVAL		LAST DESIGN UPDATE		MO./DAY/YR.		MO./DAY/YR.	
 3/9/01 KS DEC 12 1999 DESIGN REVIEW COMMITTEE		 APPROVED CITY ENGINEER		 LAST DESIGN UPDATE		MO./DAY/YR. _____		MO./DAY/YR. _____	

CITY PROJECT NO.		ZONE MAP NO.		SHEET		OF	
607183		L-9,L-10		13		9	

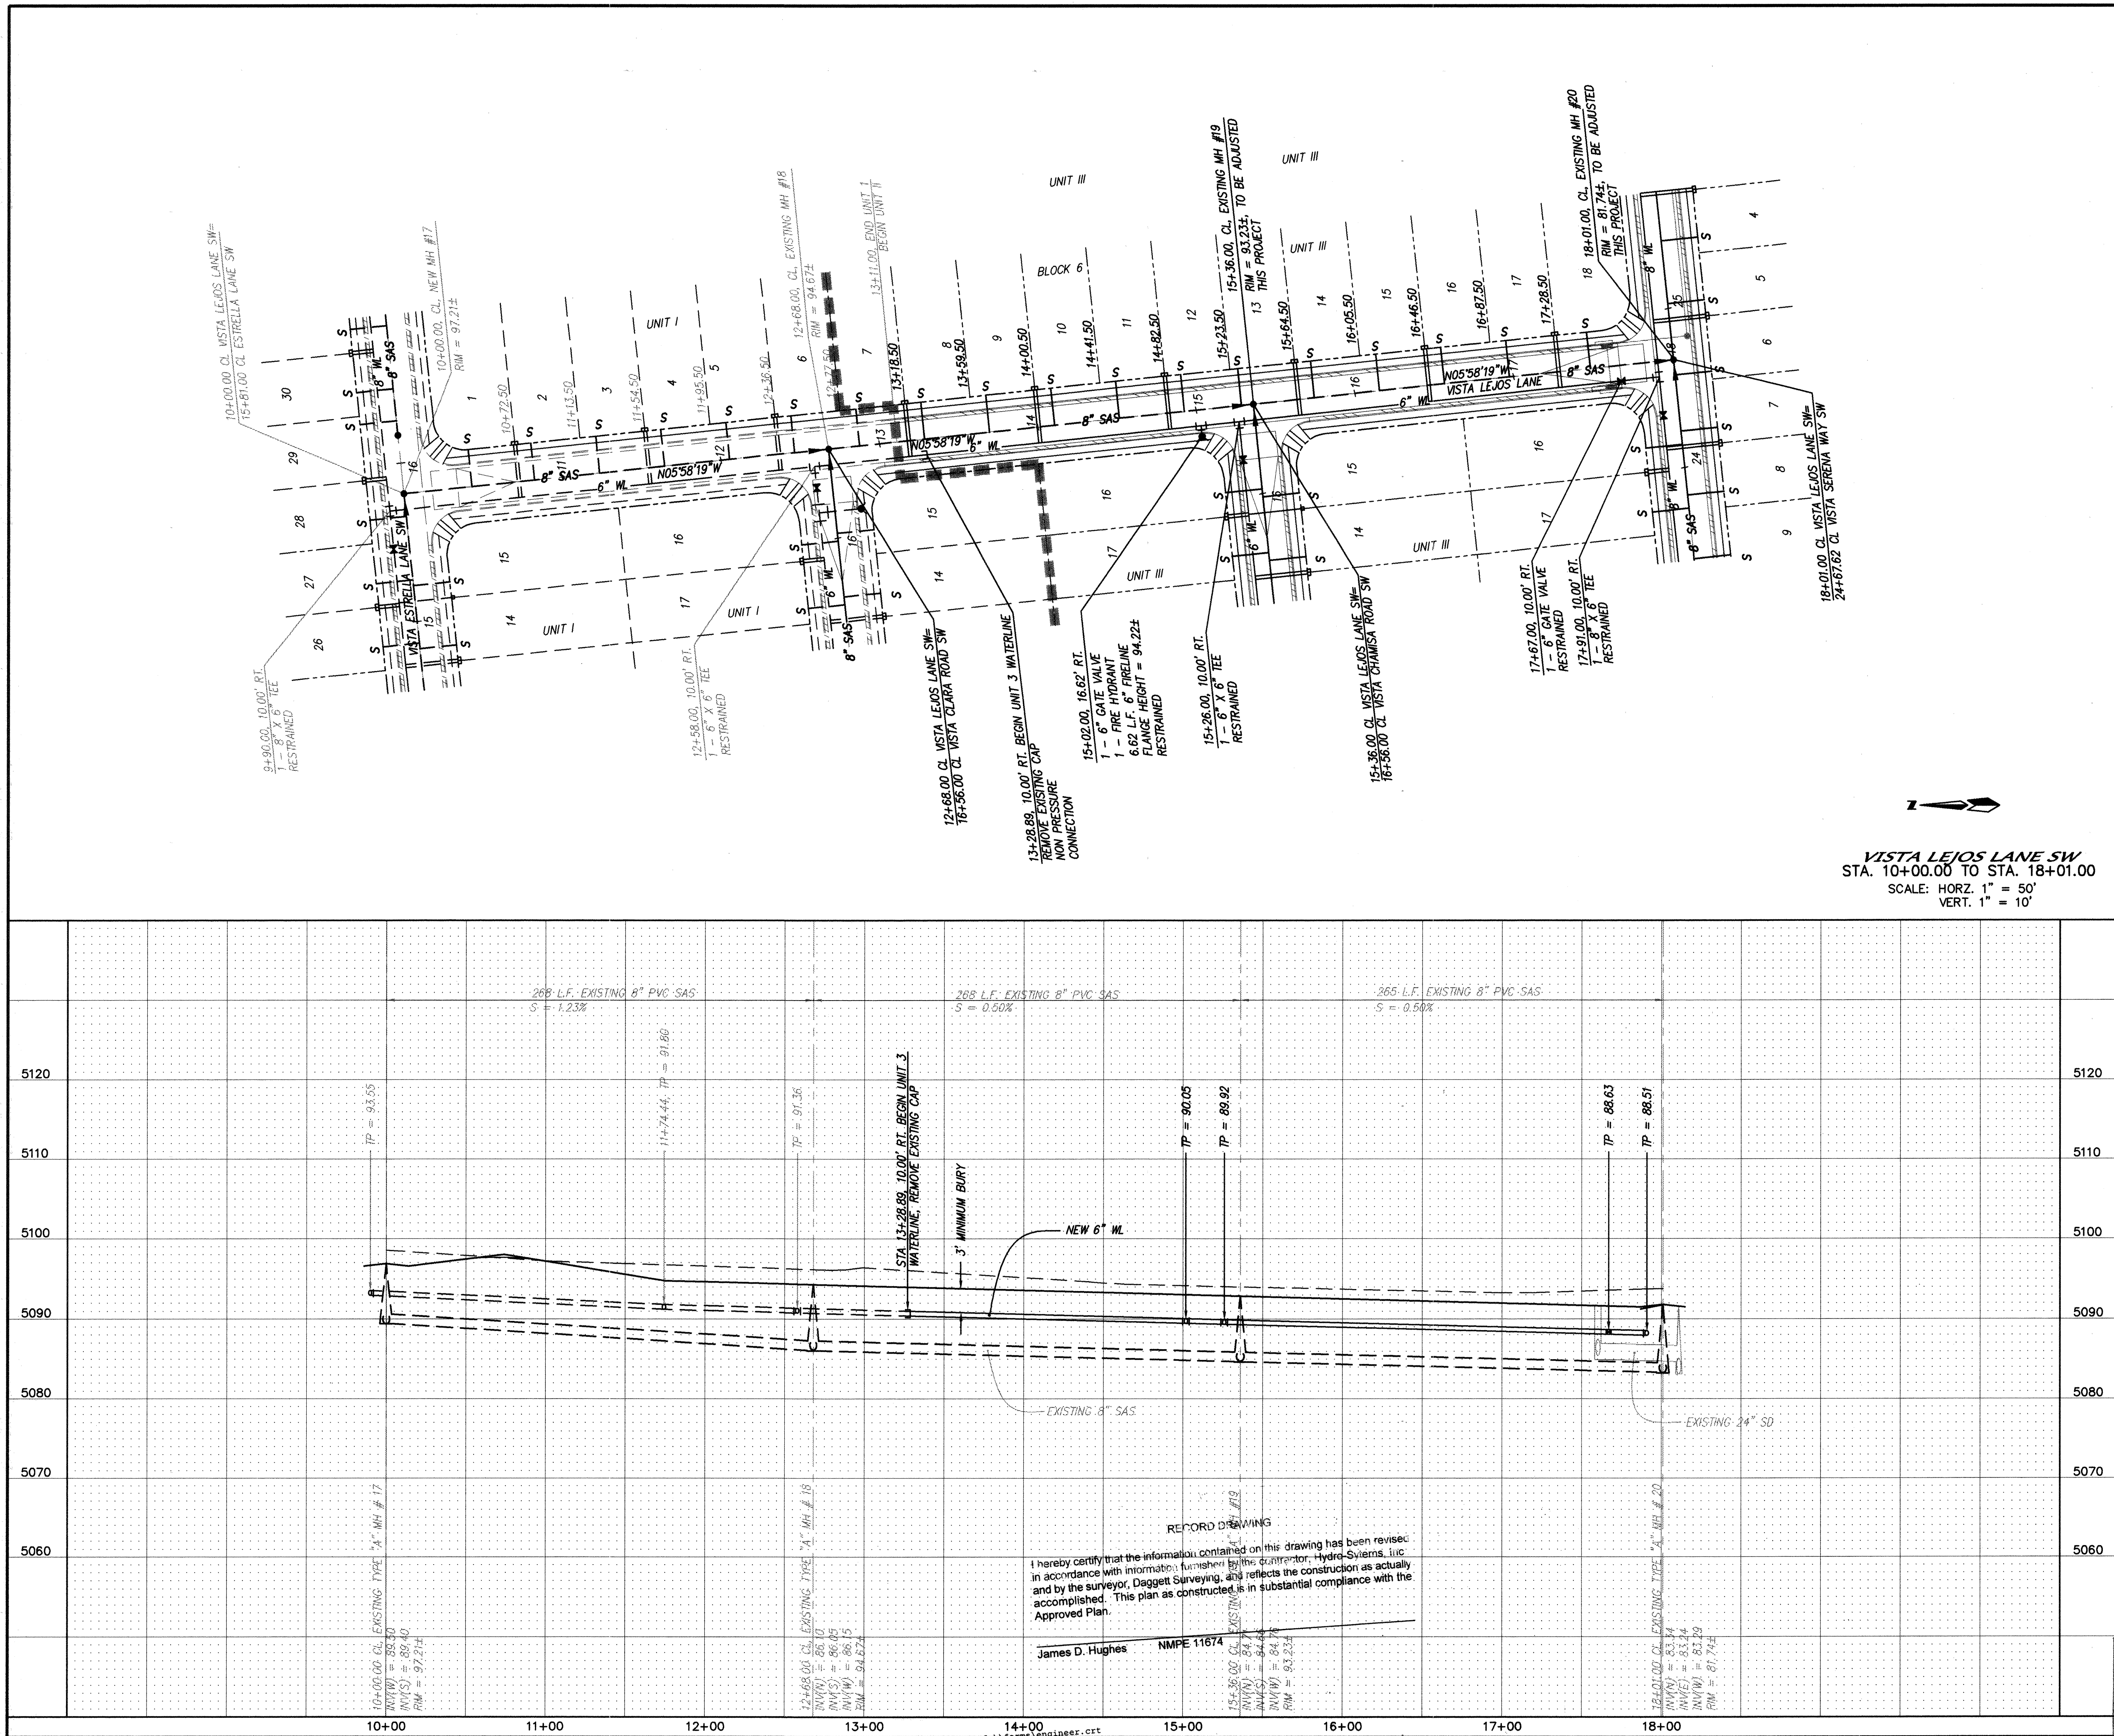

NOTES

1. ALL STATIONING IS CENTERLINE STATIONING.

LEGEND

DOUBLE WATER SERVICE

SANITARY SEWER SERVICE

MANHOLE

FLOW

WATER GATE VALVE

TEE (WATER CONNECTION)

FIRE HYDRANT

SANITARY SEWER SERVICES

BLOCK	LOT	STATION AT PL	INV. ELEV. AT PL	LENGTH AT PL
6	1	10+43.00	92.3	23' LT.
6	2	10+82.50	91.8	23' LT.
6	3	11+23.50	90.9	23' LT.
6	4	11+64.50	90.1	23' LT.
6	5	12+05.50	89.8	23' LT.
6	6	12+46.50	89.6	23' LT.
6	7	12+87.50	89.4	23' LT.
6	8	13+28.50	89.2	23' LT.
6	9	13+69.50	89.0	23' LT.
6	10	14+10.50	88.8	23' LT.
6	11	14+51.50	88.6	23' LT.
6	12	14+92.50	88.4	23' LT.
6	13	15+28.50	88.2	23' LT.
6	14	15+74.50	88.0	23' LT.
6	15	16+15.50	87.8	23' LT.
6	16	16+56.50	87.6	23' LT.
6	17	16+97.50	87.4	23' LT.
6	18	17+48.50	87.2	23' LT.

RESTRAINED JOINT LENGTH FOR BENDS, VALVES, DEAD ENDS (FT.)

PIPE SIZE	90°	45°	22.5°	11.25°	VALVE
6"	17'	7'	-	-	46'
8"	22'	9'	4'	2'	60'

LENGTH OF RESTRAINED PIPE ON EACH SIDE OF THE BEND. RESTRAIN BRANCH AT FITTING ONLY MINIMUM ATTACHED PIPE LENGTH, RUN SIDE OF TEE: 10.00 FEET.

RESTRAINED JOINT LENGTH FOR TEES (FT.)

PIPE SIZE	RUN	BRANCH
8"x8"x8"	13'	3'
8"x8"x6"	7'	5'
6"x6"x6"	10'	2'

MARK GOODWIN & ASSOCIATES, P.A.
CONSULTING ENGINEERS
P.O. BOX 90606
ALBUQUERQUE, NEW MEXICO 87199
(505) 828-2200, FAX (505) 797-9539

CITY OF ALBUQUERQUE
PUBLIC WORKS DEPARTMENT
ENGINEERING DEVELOPMENT GROUP
TITLE: VISTA SANDIA SUBDIVISION
UNIT III
UTILITY IMPROVEMENTS

DESIGN REVIEW COMMITTEE
APPROVE
3/19/01
DEC 12 1999

CITY ENGINEER APPROVAL
APPROVE
APR 9 2001

LAST DESIGN UPDATE

NO./DAY/YR.	MO./DAY/YR.

CITY PROJECT NO. 607183

ZONE MAP NO. L-9,L-10

SHEET 15 OF 19

AS BUILT INFORMATION

CONTRACTOR	DATE
Hydra Systems	2/01

BENCH MARKS

CITY OF ALBUQUERQUE ACS MONUMENT "B-19"	DATE
NEW MEXICO STATE PLANE COORDINATES (CENTRAL ZONE) NAD 1927 X = 395,637.67, Y = 1,478,811.91, DELTA ALPHA = -076.37" G-G = 0.99997955, ELEVATION = 5101.34'	

SURVEY INFORMATION

NO.	DATE	BY

ENGINEER'S SEAL

James D. Hughes
REGISTERED PROFESSIONAL ENGINEER
NEW MEXICO
1974

DESIGNED BY JDH


DRAWN BY M/R

CHECKED BY DMG

DATE 12-98

DATE 12-98

DATE 12-98

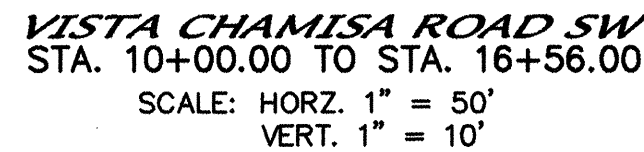

1. ALL STATIONING IS CENTERLINE STATIONING

	DOUBLE WATER SERVICE
	SANITARY SEWER SERVICE
	MANHOLE
	FLOW
	WATER GATE VALVE
	TEE (WATER CONNECTION)
	FIRE HYDRANT

SANITARY SEWER SERVICES				
BLOCK	LOT	STATION AT PL	INV. ELEV. AT PL	LENGTH AT PL
4	1	10+63.00	95.3	23'RT.
4	2	10+78.00	94.9	23'RT.
4	3	11+18.00	94.1	23'RT.
4	4	11+58.00	93.3	23'RT.
4	5	11+98.00	92.5	23'RT.
4	6	13+38.00	91.7	23'RT.
4	7	12+78.00	90.8	23'RT.
4	8	13+18.00	90.0	23'RT.
4	9	13+58.00	89.5	23'RT.
4	10	13+98.00	89.4	23'RT.
4	11	14+38.00	89.0	23'RT.
4	12	14+78.00	88.7	23'RT.
4	13	15+18.00	88.5	23'RT.
4	14	15+58.00	88.3	23'RT.
4	15	15+98.00	88.1	23'RT.
3	16	16+03.00	88.1	23'LT.
3	17	15+63.00	88.3	23'LT.
3	18	15+23.00	88.5	23'LT.
3	19	14+83.00	88.7	23'LT.
3	20	14+43.00	89.0	23'LT.
3	21	14+03.00	89.3	23'LT.
3	22	13+63.00	89.6	23'LT.
3	23	13+23.00	90.0	23'LT.
3	24	12+83.00	90.8	23'LT.
3	25	12+43.00	91.7	23'LT.
3	26	12+03.00	92.5	23'LT.
3	27	11+63.00	93.3	23'LT.
3	28	11+23.00	94.1	23'LT.
3	29	10+83.00	94.9	23'LT.
3	30	10+59.00	95.3	23'LT.

RESTRAINED JOINT LENGTH FOR BENDS, VALVES, DEAD ENDS (FT.)					
PIPE SIZE	90°	45°	22.5°	11.25°	VALVE
6"	17'	7'	—	—	46'
8"	22'	9'	4'	2'	60'
LENGTH OF RESTRAINED PIPE ON EACH SIDE OF THE BEND. RESTRAIN BRANCH AT FITTING ONLY MINIMUM ATTACHED PIPE LENGTH, RUN SIDE OF TEE: 10.00 FEET.					

RESTRAINED JOINT LENGTH FOR TEES (FT.)		
PIPE SIZE	RUN	BRANCH
8"x8"x8"	13'	3'
8"x8"x6"	7'	5'
6"x6"x6"	10'	2'

dmg MARK GOODWIN & ASSOCIATES, P.A.
CONSULTING ENGINEERS
P.O. BOX 90606
ALBUQUERQUE, NEW MEXICO 87199
(505) 828-2200, FAX (505) 797-9539

A CITY OF ALBUQUERQUE
PUBLIC WORKS DEPARTMENT
ENGINEERING DEVELOPMENT GROUP

TITLE: ***VISTA SANDIA SUBDIVISION
UNIT III
UTILITY IMPROVEMENTS***

DESIGN REVIEW COMMITTEE

APPROVED

29/10/1999

DEC 12 1999

DESIGN REVIEW COMMITTEE

CITY ENGINEER APPROVAL

APPROVED

APR 9 2000

CITY ENGINEER

LAST DESIGN UPDATE



CITY PROJECT NO. 607183	ZONE MAP NO. L-9, L-1
--------------------------------	------------------------------

[illegible]

RECORD DRAWING

I hereby certify that the information contained on this drawing has been revised in accordance with information furnished by the contractor, Hyde-Sytems, Inc., and by the surveyor, Daggett Surveying, and reflects the construction as actually accomplished. This plan as constructed is in substantial compliance with the Approved Plan.

James D. Hughes NMPE 11674

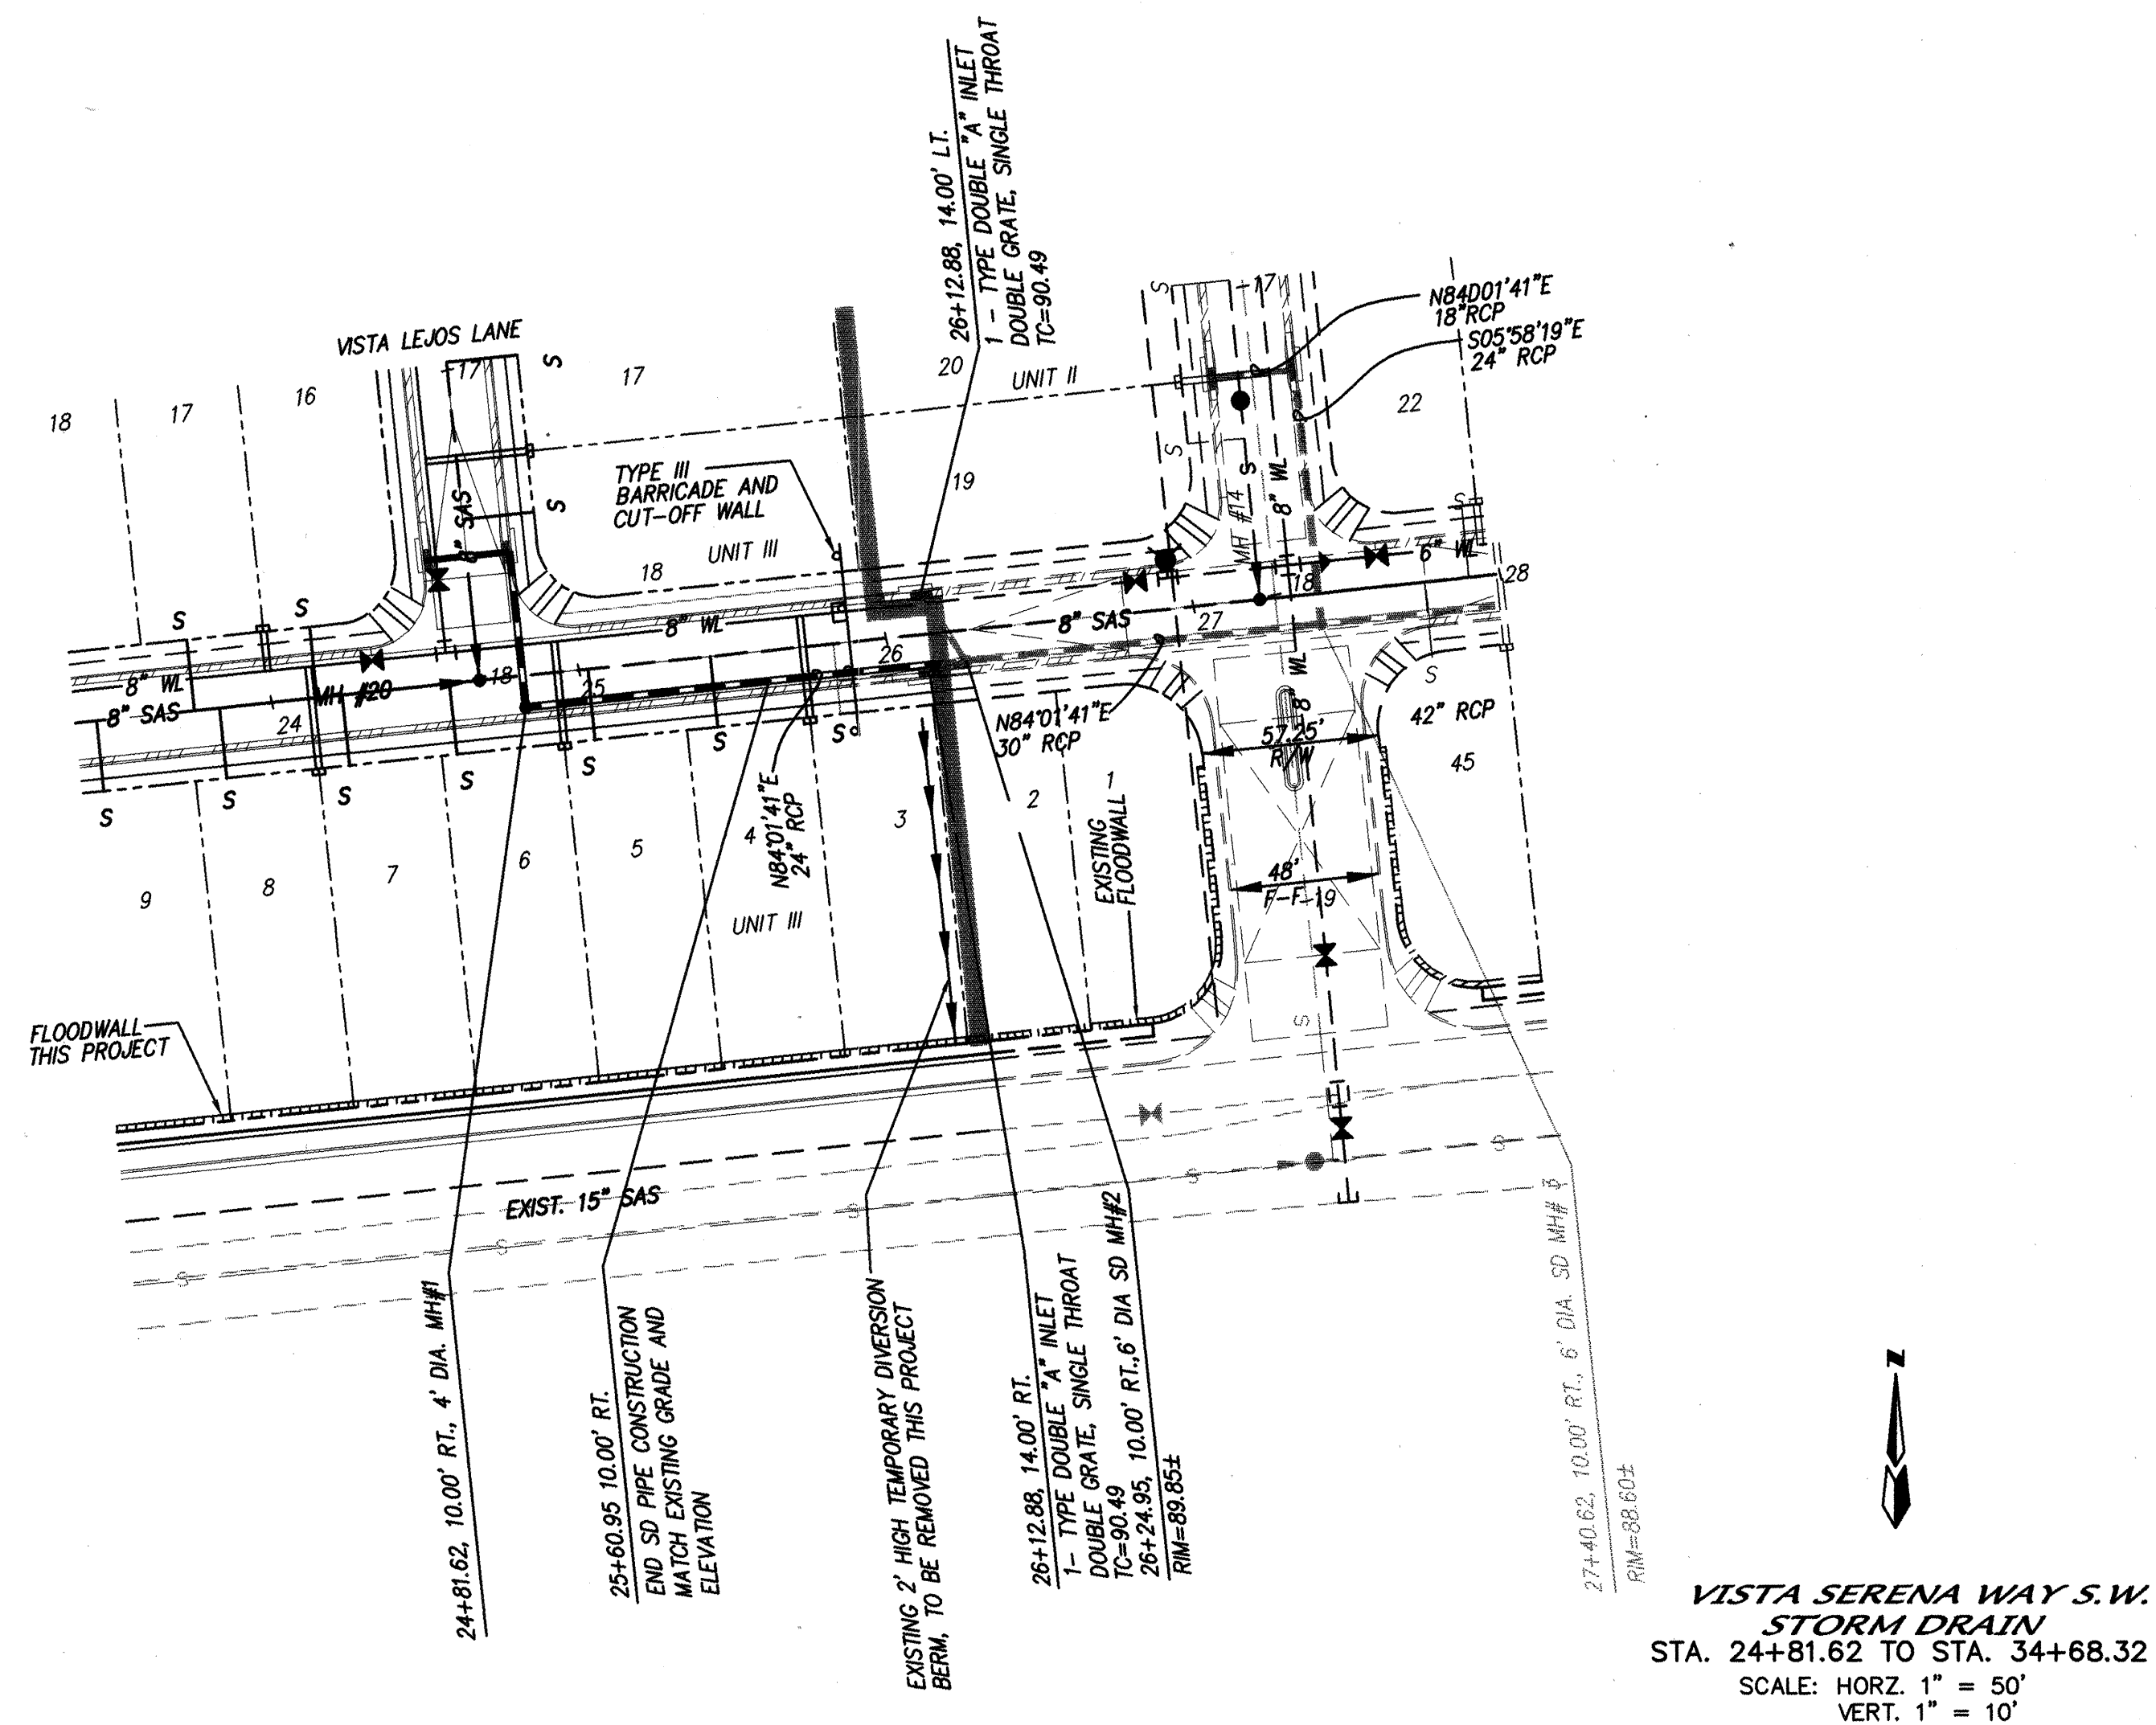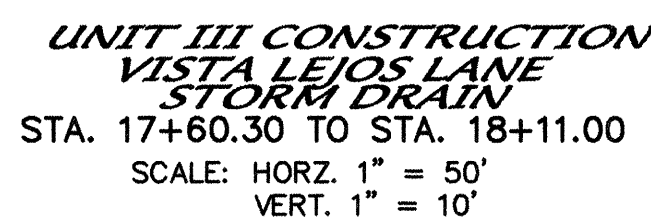

NOTES

[illegible]

dmg MARK GOODWIN & ASSOCIATES, P.A.
CONSULTING ENGINEERS
P.O. BOX 90606
ALBUQUERQUE, NEW MEXICO 87199
(505) 828-2200, FAX (505) 797-9539

**CITY OF ALBUQUERQUE
PUBLIC WORKS DEPARTMENT
ENGINEERING DEVELOPMENT GROUP**

**TITLE: *VISTA SANDIA SUBDIVISION
UNIT III
STORM DRAIN IMPROVEMENTS***

DESIGN REVIEW COMMITTEE		CITY ENGINEER APPROVAL		LAST DESIGN UPDATE	MO./DAY/YR.	MO./DAY/YR.


8118VIST/UNIT 3/8118SD/09-01-99/ACH

CITY PROJECT NO.	607183	ZONE MAP NO.	L-9, L-10	SHEET	OF	17	19
------------------	--------	--------------	-----------	-------	----	----	----


CONSTRUCTION TRAFFIC CONTROL GENERAL NOTES

- CONTRACTOR MUST OBTAIN FROM CONSTRUCTION COORDINATION AN EXCAVATION/BARRICADING PERMIT BEFORE ENGAGING IN ANY CONSTRUCTION, MAINTENANCE OR REPAIR WORK IN ANY OF THE CITY OF ALBUQUERQUE'S RIGHTS-OF-WAY. EMERGENCY WORK THAT WOULD PRESERVE LIFE OR PROPERTY IS EXCLUDED WITH THE UNDERSTANDING, THAT A PERMIT SHALL BE OBTAINED WITHIN 24 TO 48 HOURS.
- CONTRACTOR SHALL AT THE TIME OF PERMIT REQUEST, SUBMIT FOR APPROVAL BY CONSTRUCTION COORDINATION, A TRAFFIC CONTROL PLAN DETAILING ALL EXISTING TOPOGRAPHY SUCH AS LANE WIDTHS, DRIVEWAYS, AND BUSINESS/RESIDENTIAL ACCESSES. THE TRAFFIC CONTROL PLAN SHALL INCLUDE ALL PHASES OF WORK AND SCHEDULES INVOLVED IN THE CONSTRUCTION PROJECT. ANY SEPARATE PHASES OF A CONSTRUCTION PROJECT SHALL BE GIVEN AN INDIVIDUAL PERMIT EACH. BLANKET PERMITS WILL NOT BE ISSUED.
- THESE TYPICAL TRAFFIC CONTROL PLANS DO NOT REFLECT THE EXISTING TOPOGRAPHY SUCH AS DRIVEWAYS, LANE WIDTHS, AND BUSINESS/RESIDENTIAL ACCESSES. EVERY LOCATION THAT REQUIRES CONSTRUCTION TRAFFIC CONTROL SHALL HAVE A DETAILED TRAFFIC CONTROL PLAN SHOWING ALL EXISTING TOPOGRAPHY.
- CONSTRUCTION SHALL NOT BEGIN UNLESS A TRAFFIC CONTROL PLAN HAS BEEN APPROVED AND VERIFIED BY CONSTRUCTION COORDINATION.
- CONSTRUCTION COORDINATION SHALL BE NOTIFIED 48 HOURS PRIOR TO ANY TRAFFIC CONTROL CHANGES NEEDED BY CONTRACTOR, THAT WERE NOT PREVIOUSLY APPROVED. THESE TRAFFIC CONTROL CHANGES SHALL BE REQUESTED IN WRITING ACCOMPANIED WITH A TRAFFIC CONTROL PLAN REFLECTING SUCH CHANGES.
- ALL CONSTRUCTION TRAFFIC CONTROL DEVICES SHALL COMPLY TO THE MANUAL ON UNIFORM TRAFFIC CONTROL DEVICES (MUTCD), LATEST EDITION. IT IS THE RESPONSIBILITY OF THE CONTRACTOR TO INSTALL, SERVICE AND MAINTAIN ALL TRAFFIC CONTROL DEVICES. TRAFFIC CONTROL DEVICES SHALL NOT BE REMOVED OR ALTERED IN ANY WAY WITHOUT THE APPROVAL OF CONSTRUCTION COORDINATION, PER SECTION 6A-4 OF THE MUTCD, LATEST EDITION.
- THE CONSTRUCTION TRAFFIC CONTROL INITIAL SET-UP SHALL BE BY AN AMERICAN TRAFFIC SAFETY SERVICES ASSOCIATION (ATSSA) CERTIFIED WORKSITE TRAFFIC SUPERVISOR. THE MAINTENANCE AND SERVICING SHALL ALSO BE DONE BY AN ATSSA CERTIFIED WORKSITE TRAFFIC SUPERVISOR OR EQUIVALENT.
- CONTRACTOR IS RESPONSIBLE TO MAINTAIN AND SERVICE ALL TRAFFIC CONTROL DEVICES 24 HOURS A DAY, 7 DAYS A WEEK THROUGHOUT LENGTH OF PROJECT. CONTRACTOR IS RESPONSIBLE THAT ALL TRAFFIC CONTROL DEVICES COMPLY WITH THE MUTCD, LATEST EDITION.
- ALL ADVANCE WARNING SIGNS SHALL BE DOUBLE INDICATED WHENEVER THERE ARE MULTI-LANE TRAFFIC IN ANY ONE GIVEN DIRECTION AND THERE IS SUFFICIENT MEDIAN SPACE.
- ALL BARRICADES IN ALL TAPERS AND TANGENTS SHALL BE PLACED APART, A DISTANCE MEASURED IN FEET, EQUAL TO THAT OF THE POSTED SPEED LIMIT. NO EXCEPTIONS UNLESS APPROVED BY CONSTRUCTION COORDINATION PER MUTCD SECTION 6A-4.
- ALL WORK IN ARTERIAL ROADWAYS SHALL BE ON A CONTINUOUS 24-HOUR PER DAY BASIS UNTIL COMPLETED.
- CONTRACTOR IS RESPONSIBLE TO PROVIDE CONSTRUCTION COORDINATION, A WEEKLY LOG OF DAILY INSPECTIONS OF BARRICADE AND MAINTENANCE SCHEDULES ON PROJECTS THAT ARE OVER ONE WEEK DURATION.
- EQUIPMENT OR MATERIALS SHALL NOT BE STORED WITHIN 15 FEET OF A TRAVELLED TRAFFIC LANE DURING NON-WORKING HOURS WITHOUT THE APPROVAL OF CONSTRUCTION COORDINATION.
- CONTRACTOR SHALL PROVIDE AND MAINTAIN A SAFE AND ADEQUATE MEANS OF CHANNELIZING PEDESTRIAN TRAFFIC AROUND AND THROUGH THE CONSTRUCTION AREA.
- CONTRACTOR IS RESPONSIBLE FOR OBLITERATION OF ANY CONFLICTING STRIPING AND RESPONSIBLE FOR ALL TEMPORARY STRIPING.
- CONTRACTOR SHALL MAINTAIN ACCESS TO ALL FACILITIES, BUSINESSES AND/OR RESIDENTS AT ALL TIMES.
- CONTRACTOR SHALL PROVIDE ACCESS SIGNS FOR BUSINESSES LOCATED WITHIN THE CONSTRUCTION AREA UNDER THE SUPERVISION OF CONSTRUCTION COORDINATION. EACH ACCESS SIGN SHALL HAVE 5 INCH, WHITE OPAQUE LETTERING ON BLUE RECTANGULAR BACKGROUND. ACCESS SIGNS SHALL BE CONSIDERED INCIDENTAL TO THE BID AND NOT PART OF THE CONTRACT UNLESS OTHERWISE STATED. NO MORE THAN 3 BUSINESSES SHALL BE LISTED ON A ACCESS SIGN. SHOPPING CENTERS AND MALLS SHALL BE LISTED AS SUCH.
- ALL ADVANCE WARNING SIGNS SHALL MEET THE MINIMUM REFLECTIVE INTENSITY REQUIREMENTS SET FORTH BY THE CITY OF ALBUQUERQUE. CONSTRUCTION COORDINATION SHALL DETERMINE ALL REQUIREMENTS AND APPROVE OR DISAPPROVE ANY ADVANCE WARNING SIGN PER SECTION 6A-4 OF THE MUTCD, LATEST EDITION.
- 48 HOURS PRIOR TO OCCUPYING OR CLOSING OF A RIGHT-OF-WAY, CONTRACTOR SHALL NOTIFY: POLICE, FIRE DEPARTMENT, SCHOOLS, HOSPITALS, TRANSIT AUTHORITY, BUSINESSES AND/OR RESIDENTS THAT WILL BE AFFECTED BY THE CONSTRUCTION.
- ANY FIELD ADJUSTMENTS SHALL BE APPROVED BY CONSTRUCTION COORDINATION.

- EXCAVATIONS SHALL BE PLATED, TEMPORARILY PATCHED OR RESURFACED PRIOR TO OPENING OF TRAFFIC. A MINIMUM OF 11 FEET SHALL BE PROVIDED FOR TRAFFIC IN ANY GIVEN DIRECTION. CONTRACTOR IS RESPONSIBLE FOR ANY WORK INVOLVED IN SATISFYING THESE REQUIREMENTS.
- CONTRACTOR SHALL AT ALL TIMES COMPLY WITH THE FOLLOWING:
 - STANDARDS AND REQUIREMENTS SET FORTH IN THE MANUAL ON UNIFORM TRAFFIC CONTROL DEVICES, LATEST EDITION.
 - THE CITY OF ALBUQUERQUE TRAFFIC CODE, LATEST EDITION.
 - SECTION 19 OF THE CITY OF ALBUQUERQUE'S STANDARD SPECIFICATIONS FOR PUBLIC WORK CONSTRUCTION, AS WELL AS OTHER SECTIONS.
- FAILURE TO COMPLY WITH ANY OF THE ABOVE MENTIONED, WILL BE ADEQUATE CAUSE TO CEASE ALL WORK ON ANY CONSTRUCTION PROJECT. WORK WILL NOT RESUME UNTIL ALL REQUIREMENTS ARE ADDRESSED AND APPROVED BY CONSTRUCTION COORDINATION.
- ALL TRAFFIC CONTROL DEVICES SHALL BE KEPT IN NEW-CLEAN CONDITION. WASHING OF EQUIPMENT IS INCIDENTAL TO ITS PLACEMENT AND MAINTENANCE.
- TRAFFIC CONTROL STANDARDS APPLY ONLY WHERE THE CONSTRUCTION TRAFFIC CONTROL PLANS ARE NOT SPECIFIC.
- ADVANCE WARNING SIGNS SHALL BE 36"x36" MIN. WITH SUPER ENGINEERING GRADE SHEETING OR BETTER. MOUNTING HEIGHT AT TOP OF SIGN SHALL BE THE SAME AS FOR A 48" SIGN AS INDICATED IN THE M.U.T.C.D.
- CONTRACTOR SHALL MAINTAIN A GRAFFITI-FREE WORKSITE. ALL GRAFFITI SHALL BE PROMPTLY REMOVED FROM ALL EQUIPMENT, BOTH PERMANENT AND TEMPORARY.

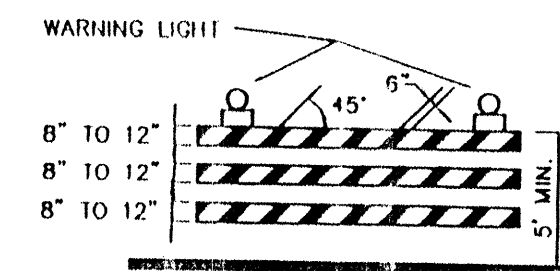


TYPE III BARRICADE

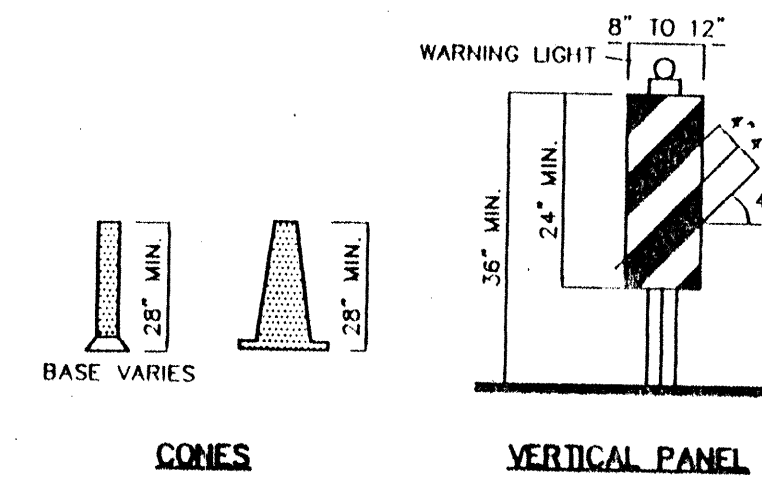


CONES

VERTICAL PANEL


HIGH LEVEL WARNING DEVICE

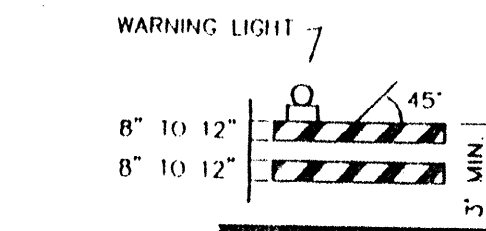


TYPE II BARRICADE COLLAPSIBLE

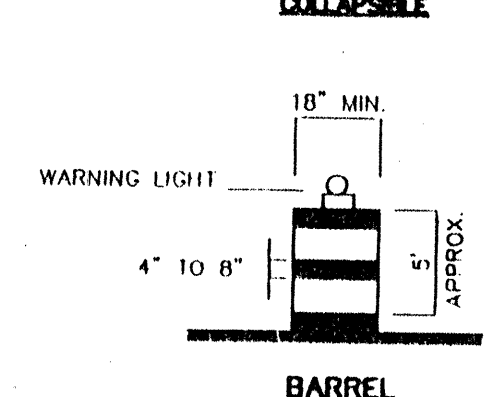

BARREL

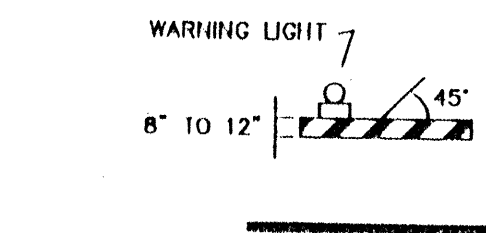

TYPE I BARRICADE COLLAPSIBLE

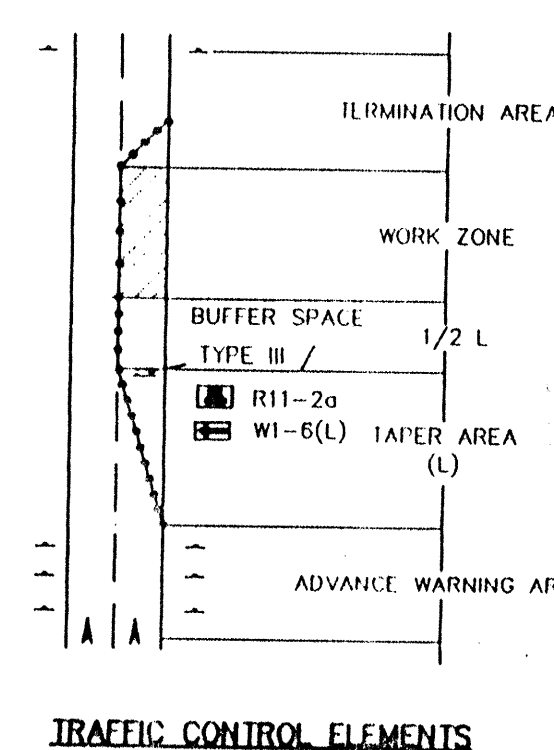

TRAFFIC CONTROL ELEMENTS

LEGEND

- WORK AREA
- BARRICADE - TYPE I, TYPE II, OR BARREL
- BARRICADE - TYPE III
- VERTICAL PANEL
- WARNING SIGN
- DISTANCE BETWEEN SIGNS - A DISTANCE MEASURED IN FEET EQUAL TO A VALUE OF TEN TIMES THE SPEED LIMIT OF THE STREET
- FLAGMAN POSITION
- SPACING BETWEEN BARRICADES - A DISTANCE MEASURED IN FEET EQUAL TO THE SPEED LIMIT OF THE STREET
- TAPER LENGTH - SEE CHART BELOW
- THE TANGENT LENGTH IS EQUAL TO THE TAPER LENGTH FOR A GIVEN STREET.

TAPER REQUIREMENTS

SPEED LIMIT (MPH)	TAPER LENGTH (L) (FEET)			MINIMUM NUMBER OF DEVICES FOR TAPER	MAXIMUM DEVICE SPACING IN FEET	
	10' LANE	11' LANE	12' LANE		ALONG TAPER	AFTER TAPER
20	70	75	80	5	20	20
25	105	115	125	6	25	25
30	150	165	180	7	30	30
35	205	225	245	8	35	35
40	270	295	320	9	40	40
45	450	495	540	13	45	45
50	500	550	600	13	50	50
55	550	605	660	13	55	55

RECOMMENDED SIGN SPACING(D) FOR ADVANCE WARNING SIGN SERIES

SPEED LIMIT (MPH)	MINIMUM DISTANCE BETWEEN SIGNS	MINIMUM DISTANCE FROM LAST SIGN TO TAPER
0-20	10 X SPEED LIMIT	10 X SPEED LIMIT
25-30	10 X SPEED LIMIT	10 X SPEED LIMIT
30-35	10 X SPEED LIMIT	10 X SPEED LIMIT
40-45	10 X SPEED LIMIT	10 X SPEED LIMIT
50-60	10 X SPEED LIMIT	10 X SPEED LIMIT

TAPER CRITERIA


TYPE OF TAPER	TAPER LENGTH
UPSTREAM TAPER:	
MERGING TAPER	L MINIMUM
SHIFTING TAPER	1/2 L MINIMUM
SHOULDER TAPER	1/2 L MINIMUM
TWO-WAY TRAFFIC TAPER	100 FEET MAXIMUM
DOWNSTREAM TAPERS	100 FEET PER LANE

TAPER LENGTH COMPUTATION

SPEED LIMIT	L
40 MPH OR LESS	$L = \frac{WS^2}{60}$
45 MPH OR GREATER	$L = W \times S$

L = TAPER LENGTH
W = WIDTH OF OFFSET IN FEET
S = POSTED SPEED OR OFF-PEAK 85-PERCENTILE SPEED IN MPH

SIGN FACE DETAILS

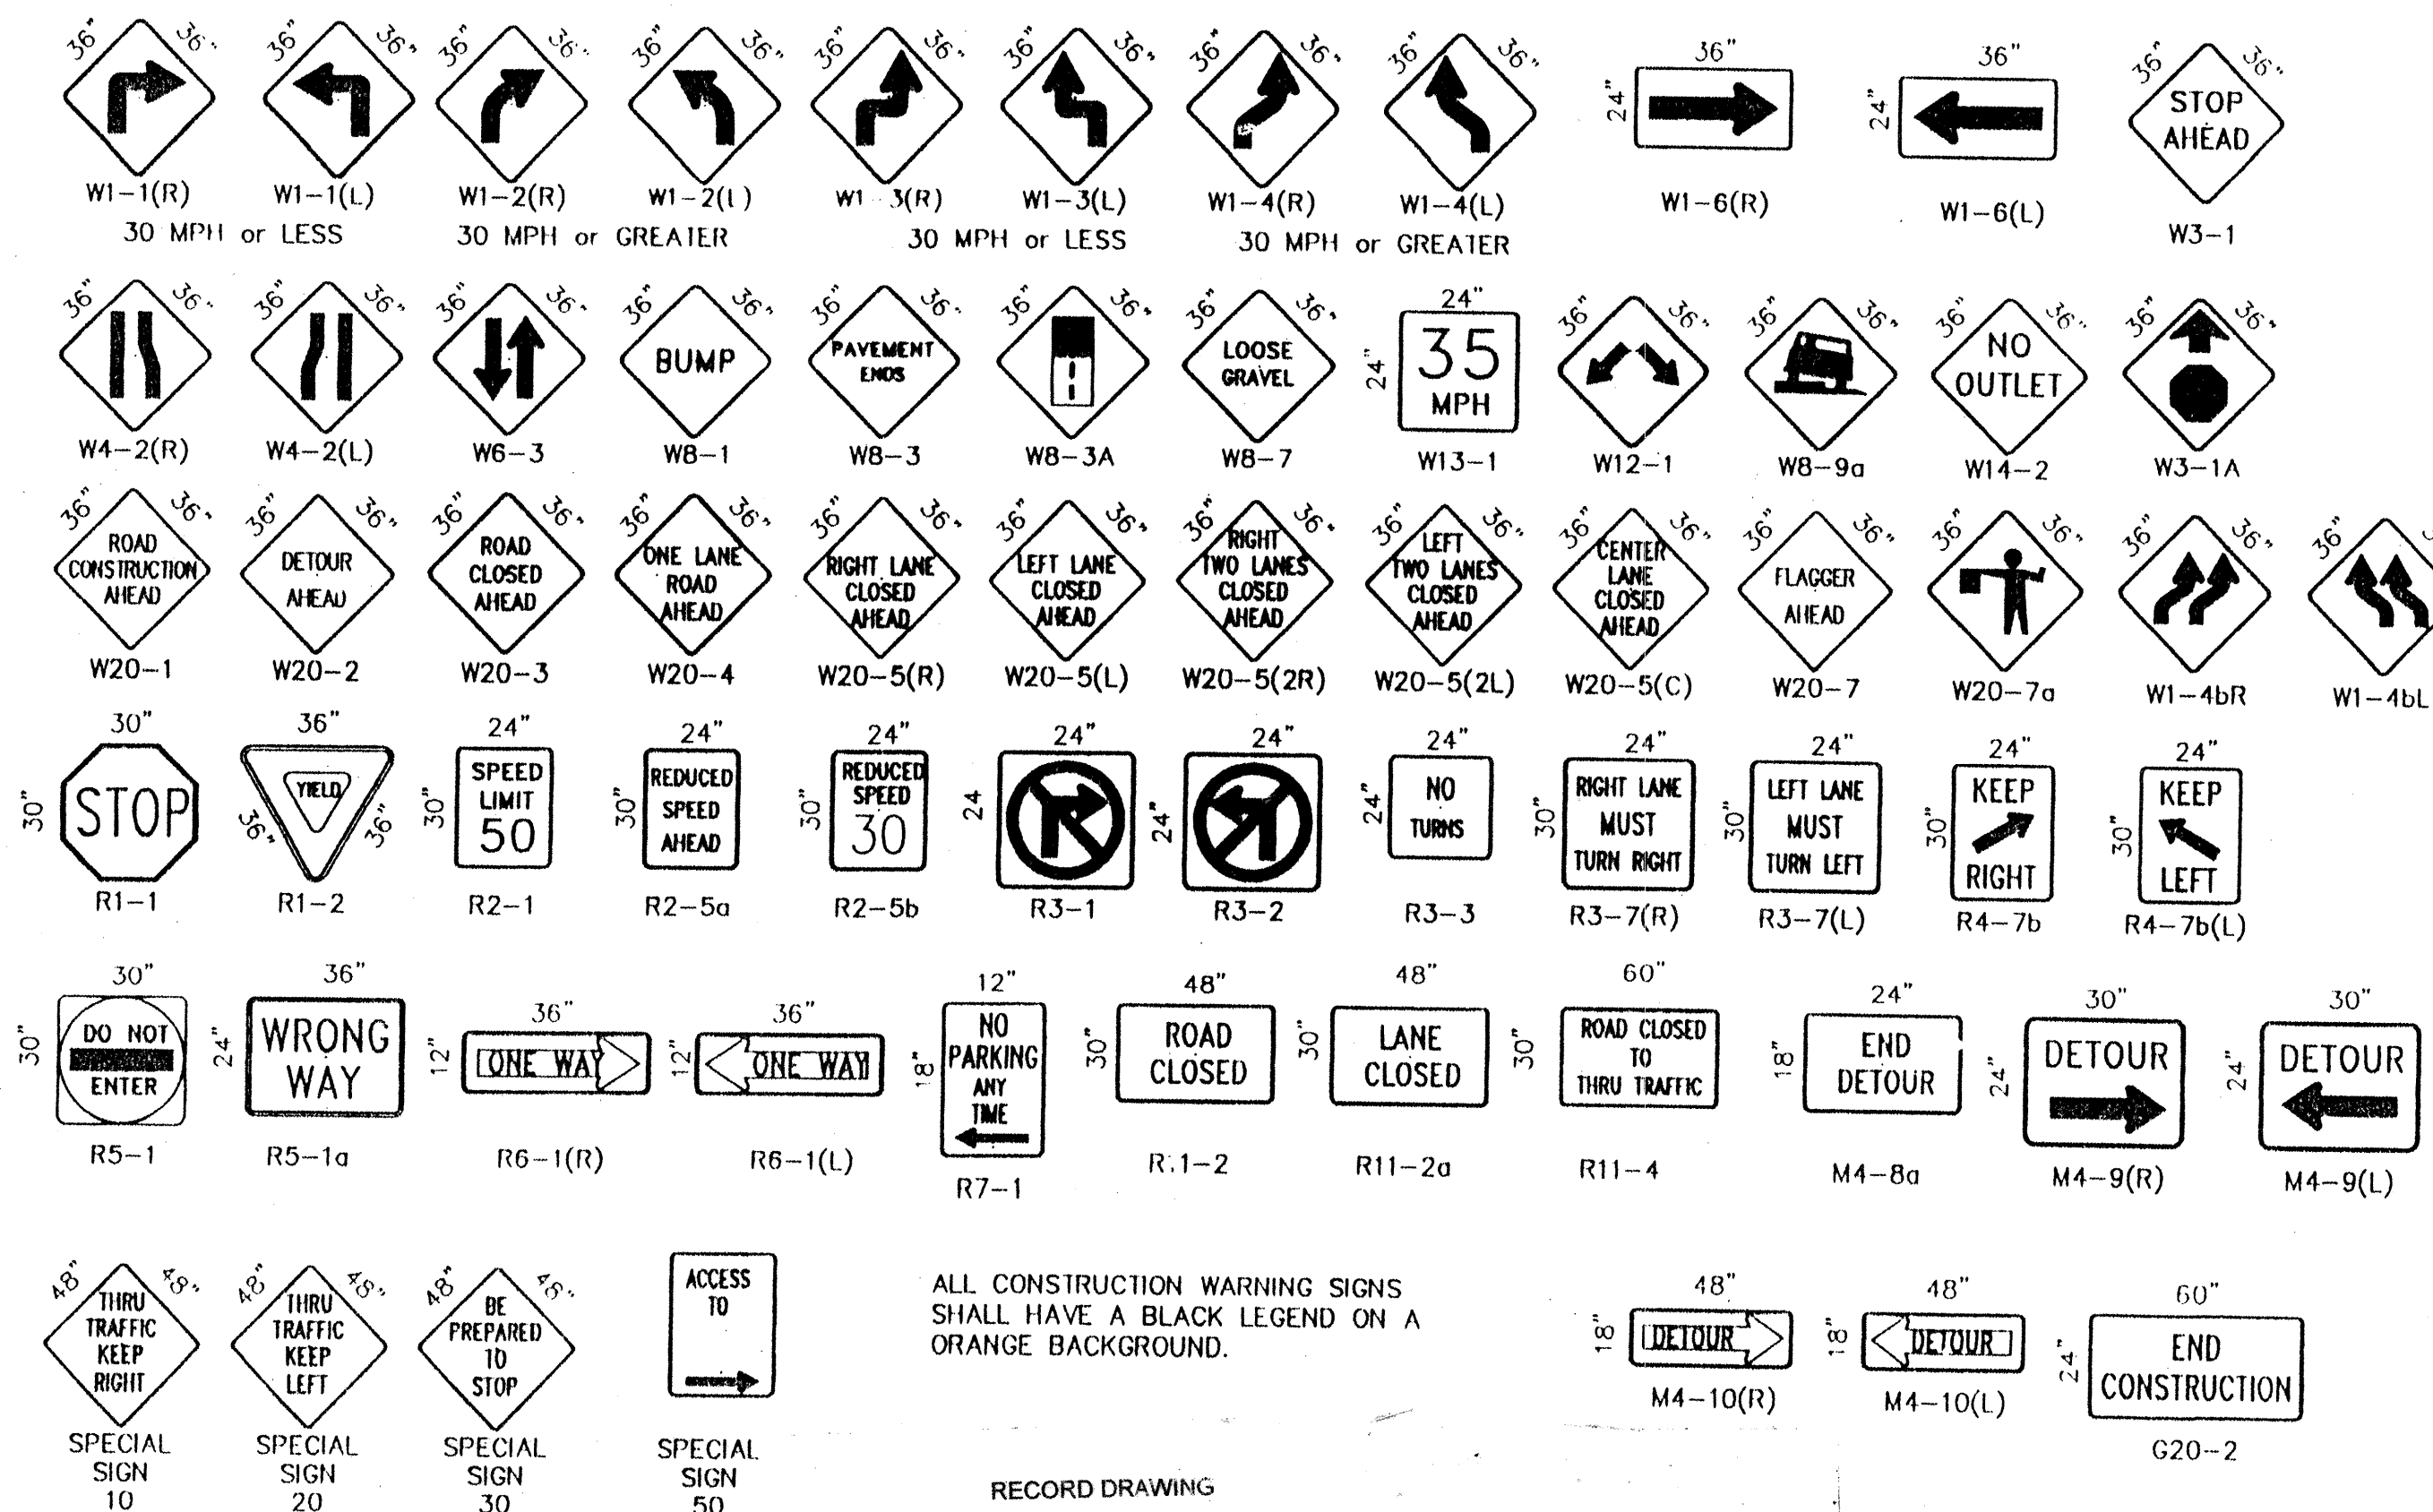

RECORD DRAWING

I hereby certify that the information contained on this drawing has been reviewed in accordance with information furnished by the contractor, and is true and correct, and by the surveyor, and reflects the construction as actually accomplished. This plan as constructed is in substantial compliance with the approved plan.



James D. Hughes NMPE 11674

AS BUILT INFORMATION				BENCH MARKS				SURVEY INFORMATION				ENGINEER'S SEAL				
CONTRACTOR	DATE	BY	NO.	CONTRACTOR	DATE	BY	NO.	DATE	BY	NO.	DATE	BY	NO.	DATE	BY	NO.
Hydrographers	8/25/97	DES	10	Hydrographers	8/25/97	DES	10	8/25/97	DES	10	8/25/97	DES	10	8/25/97	DES	10
INSPECTOR	DATE	BY	NO.	INSPECTOR	DATE	BY	NO.	INSPECTOR	DATE	BY	NO.	INSPECTOR	DATE	BY	NO.	INSPECTOR
DES	8/25/97	DES	10	DES	8/25/97	DES	10	DES	8/25/97	DES	10	DES	8/25/97	DES	10	DES
CHECKED BY	DATE	BY	NO.	CHECKED BY	DATE	BY	NO.	CHECKED BY	DATE	BY	NO.	CHECKED BY	DATE	BY	NO.	CHECKED BY
DMG	8/25/97	DMG	10	DMG	8/25/97	DMG	10	DMG	8/25/97	DMG	10	DMG	8/25/97	DMG	10	DMG
MICRO-FILM INFORMATION	DATE	BY	NO.	MICRO-FILM INFORMATION	DATE	BY	NO.	MICRO-FILM INFORMATION	DATE	BY	NO.	MICRO-FILM INFORMATION	DATE	BY	NO.	MICRO-FILM INFORMATION
RECORDED BY	DATE	BY	NO.	RECORDED BY	DATE	BY	NO.	RECORDED BY	DATE	BY	NO.	RECORDED BY	DATE	BY	NO.	RECORDED BY


CITY OF ALBUQUERQUE PUBLIC WORKS DEPARTMENT ENGINEERING DEVELOPMENT GROUP			
TITLE: VISTA SANDIA SUBDIVISION Unit 1 SIGNING AND CONSTRUCTION TRAFFIC CONTROL STANDARDS			
DESIGN REVIEW COMMITTEE	CITY ENGINEER APPROVAL	LAST UPDATE	NO. DATE/HR
COA Standard			
PROJECT NO. 6071.83	MAP NO. L9, L10	SHEET 18 OF 19	




- ALL PITS TO HAVE TYPE-A FLASHING LIGHTS.
- ALL PITS TO HAVE FLAGLINE.

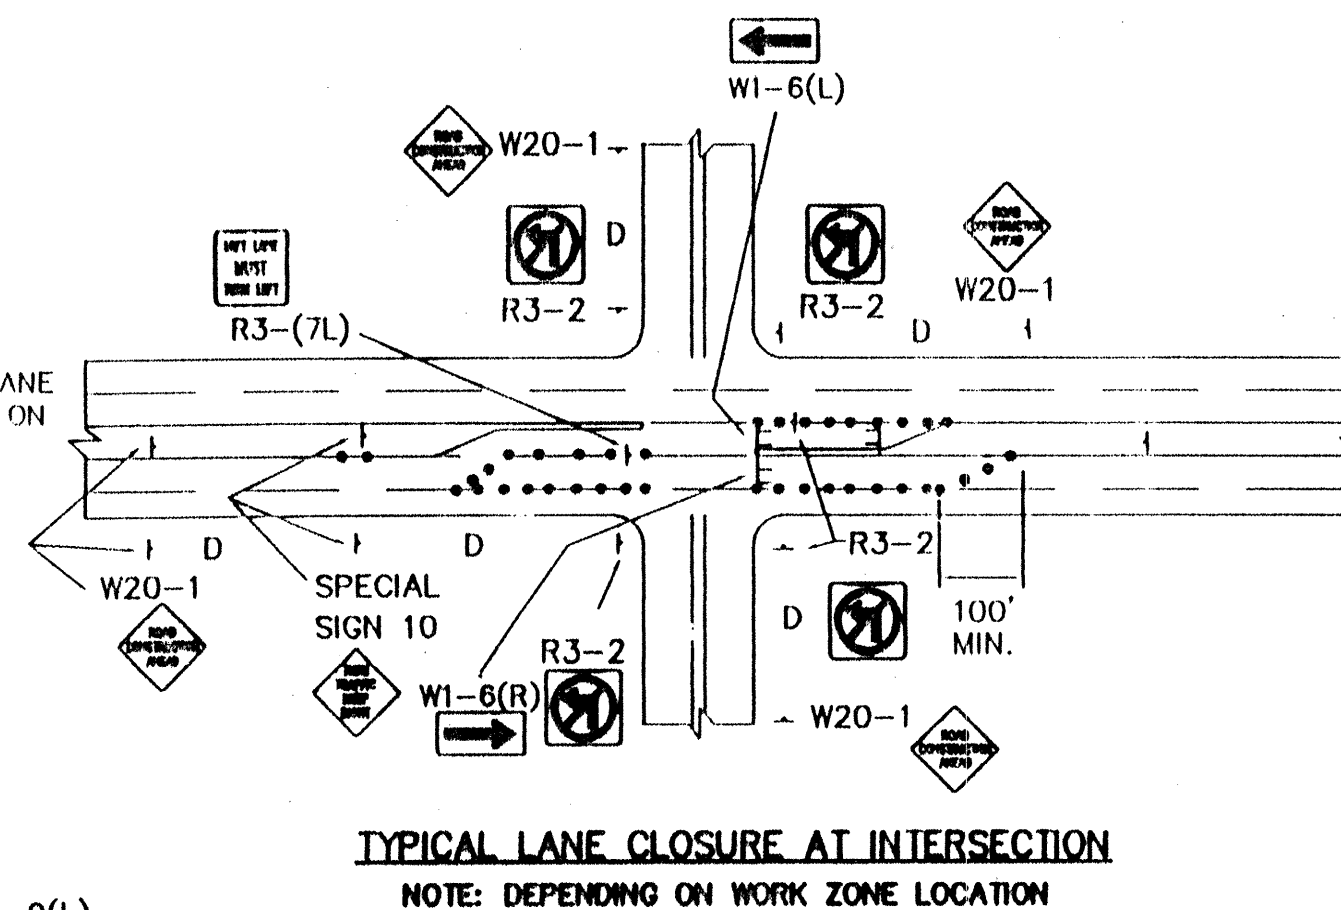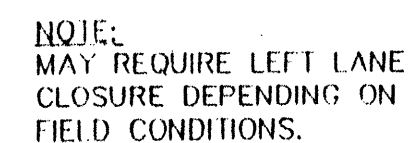

TYPICAL LANE CLOSURE AT INTERSECTION
NOTE: DEPENDING ON WORK ZONE LOCATION

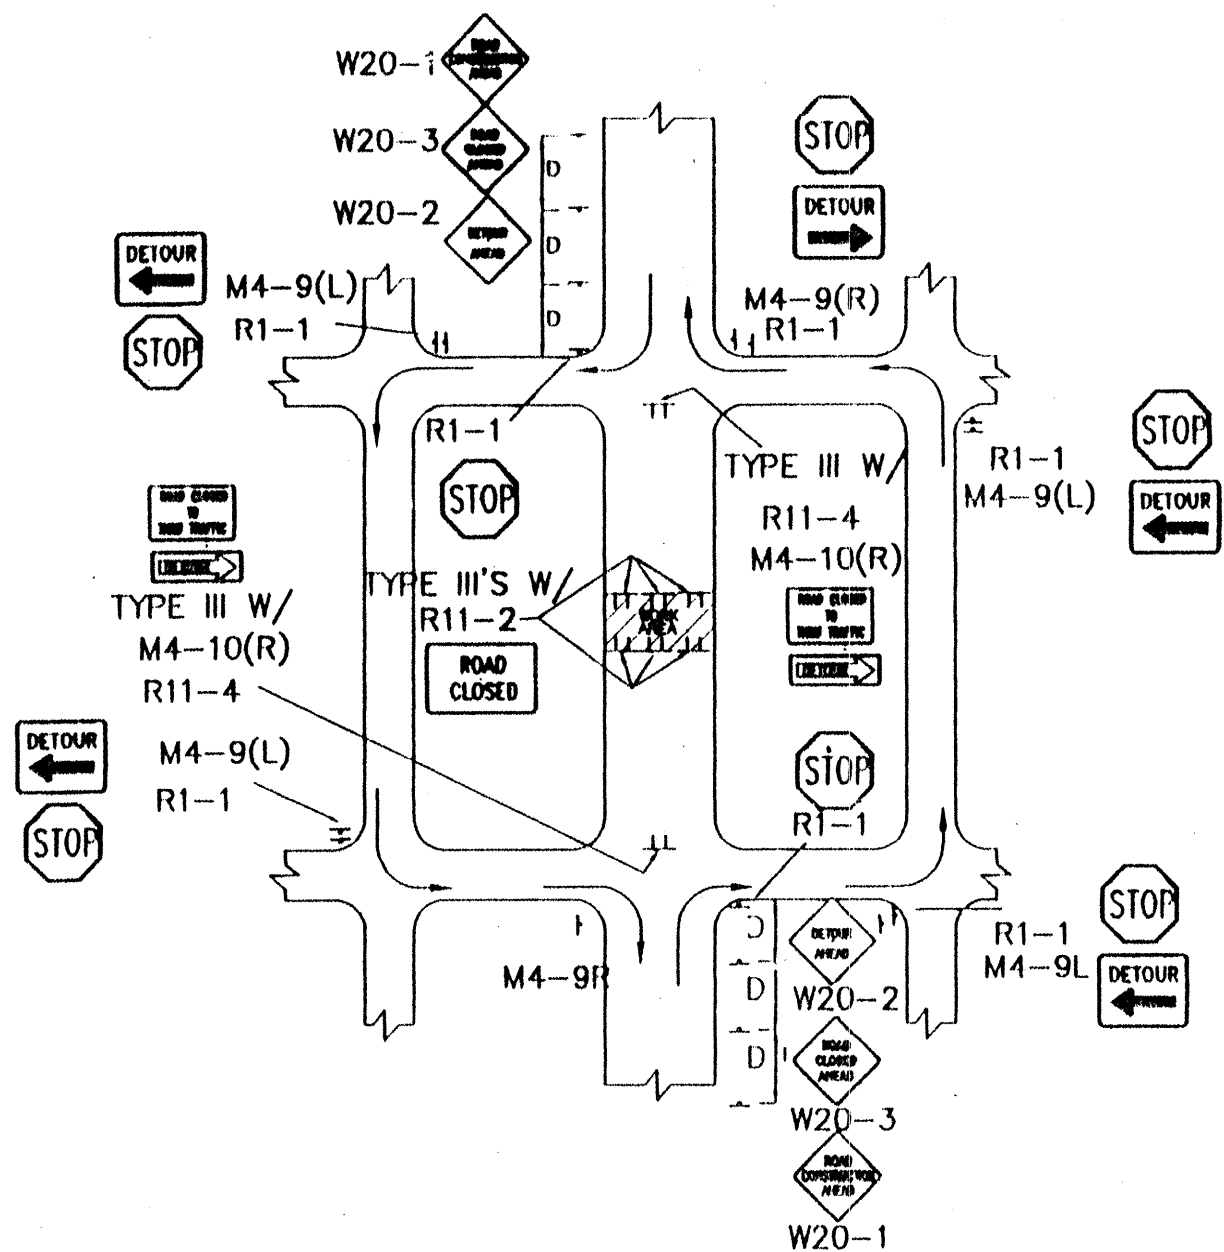


TYPICAL MID-BLOCK CLOSURE
NOTE: (R1-1) BASED ON FIELD CONDITIONS

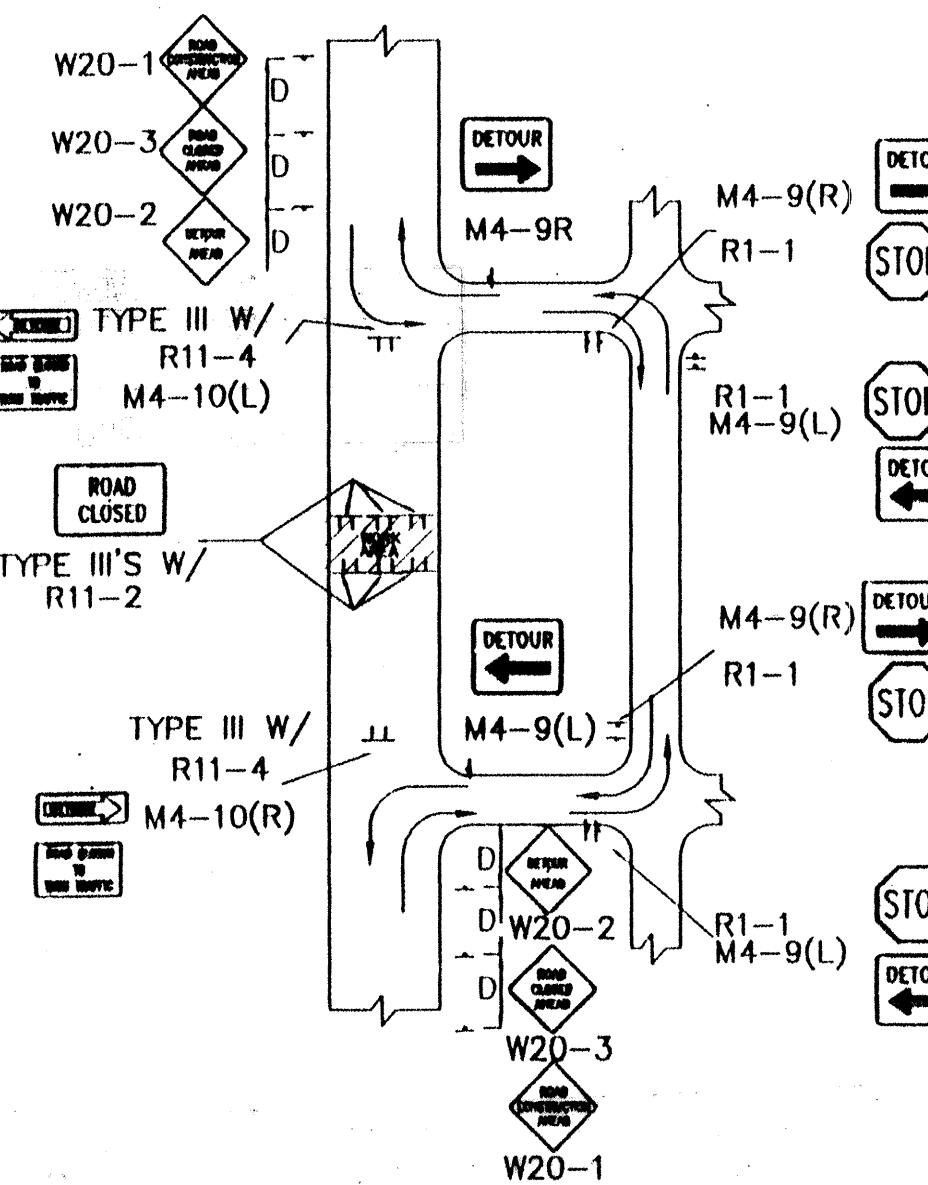


RECORD DRAWING
TYPICAL STREET CLOSURE


I hereby certify that the information furnished by the contractor, Hydro-Systems, Inc., and by the surveyor, Daggett Surveying, reflects the construction as actually accomplished. This plan as constructed is in substantial compliance with the Approved Plan.

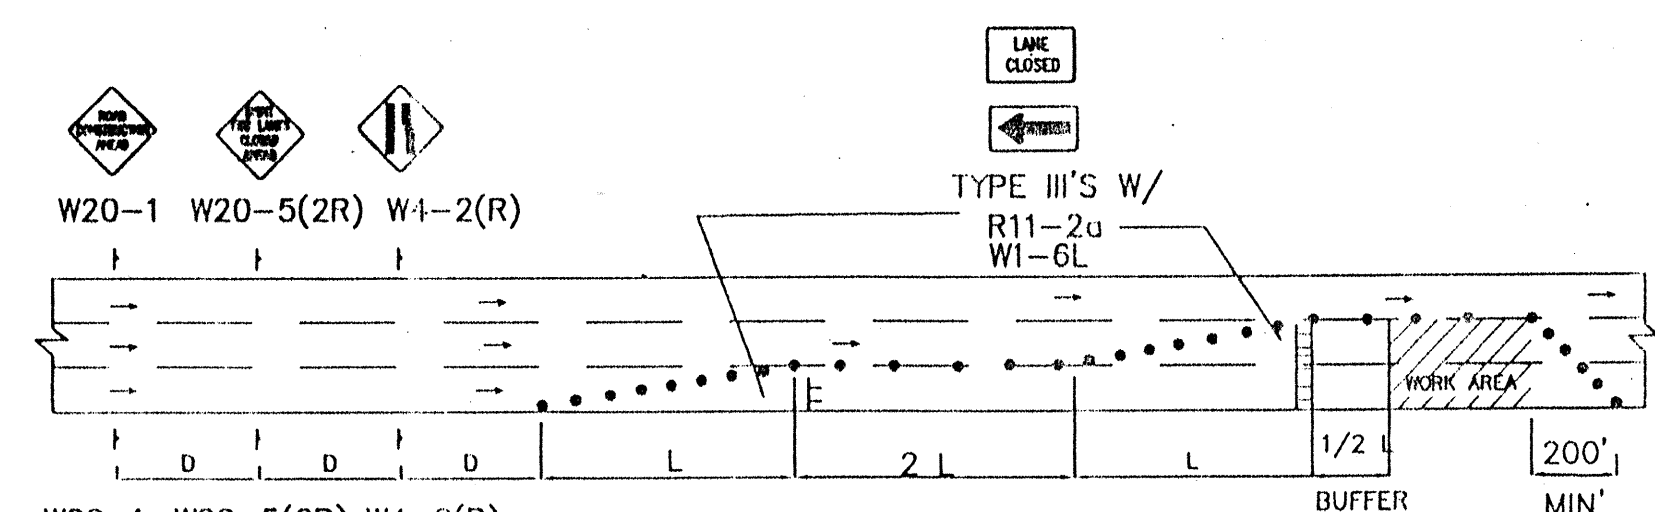


TYPICAL DOUBLE RIGHT LANE CLOSURE

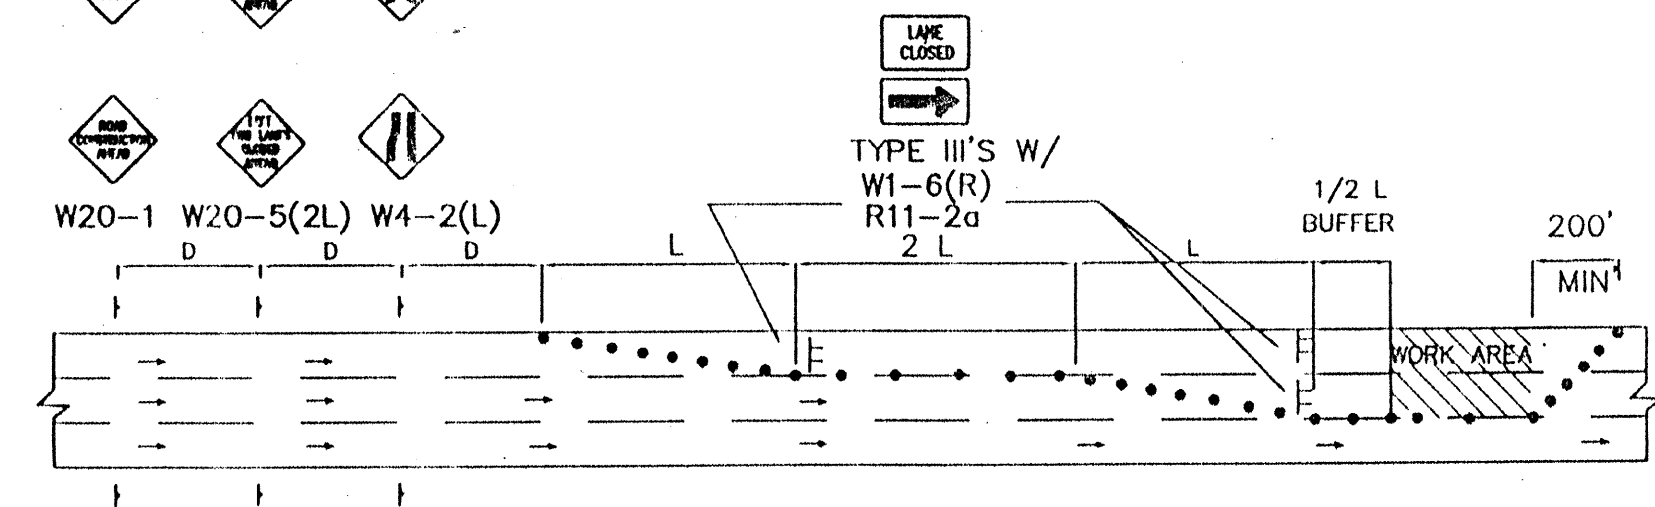

TYPICAL DOUBLE LEFT LANE CLOSURE

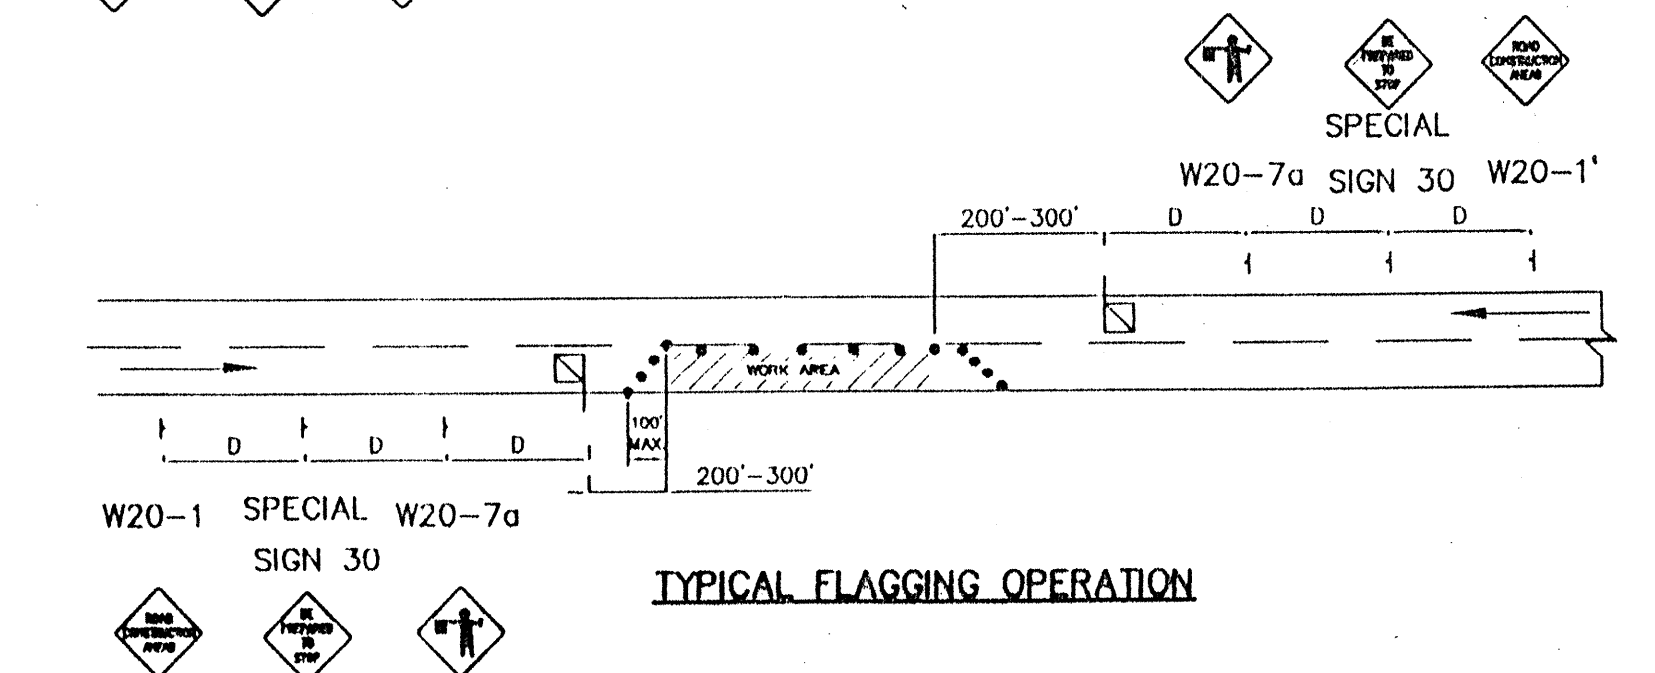

TYPICAL FLAGGING OPERATION

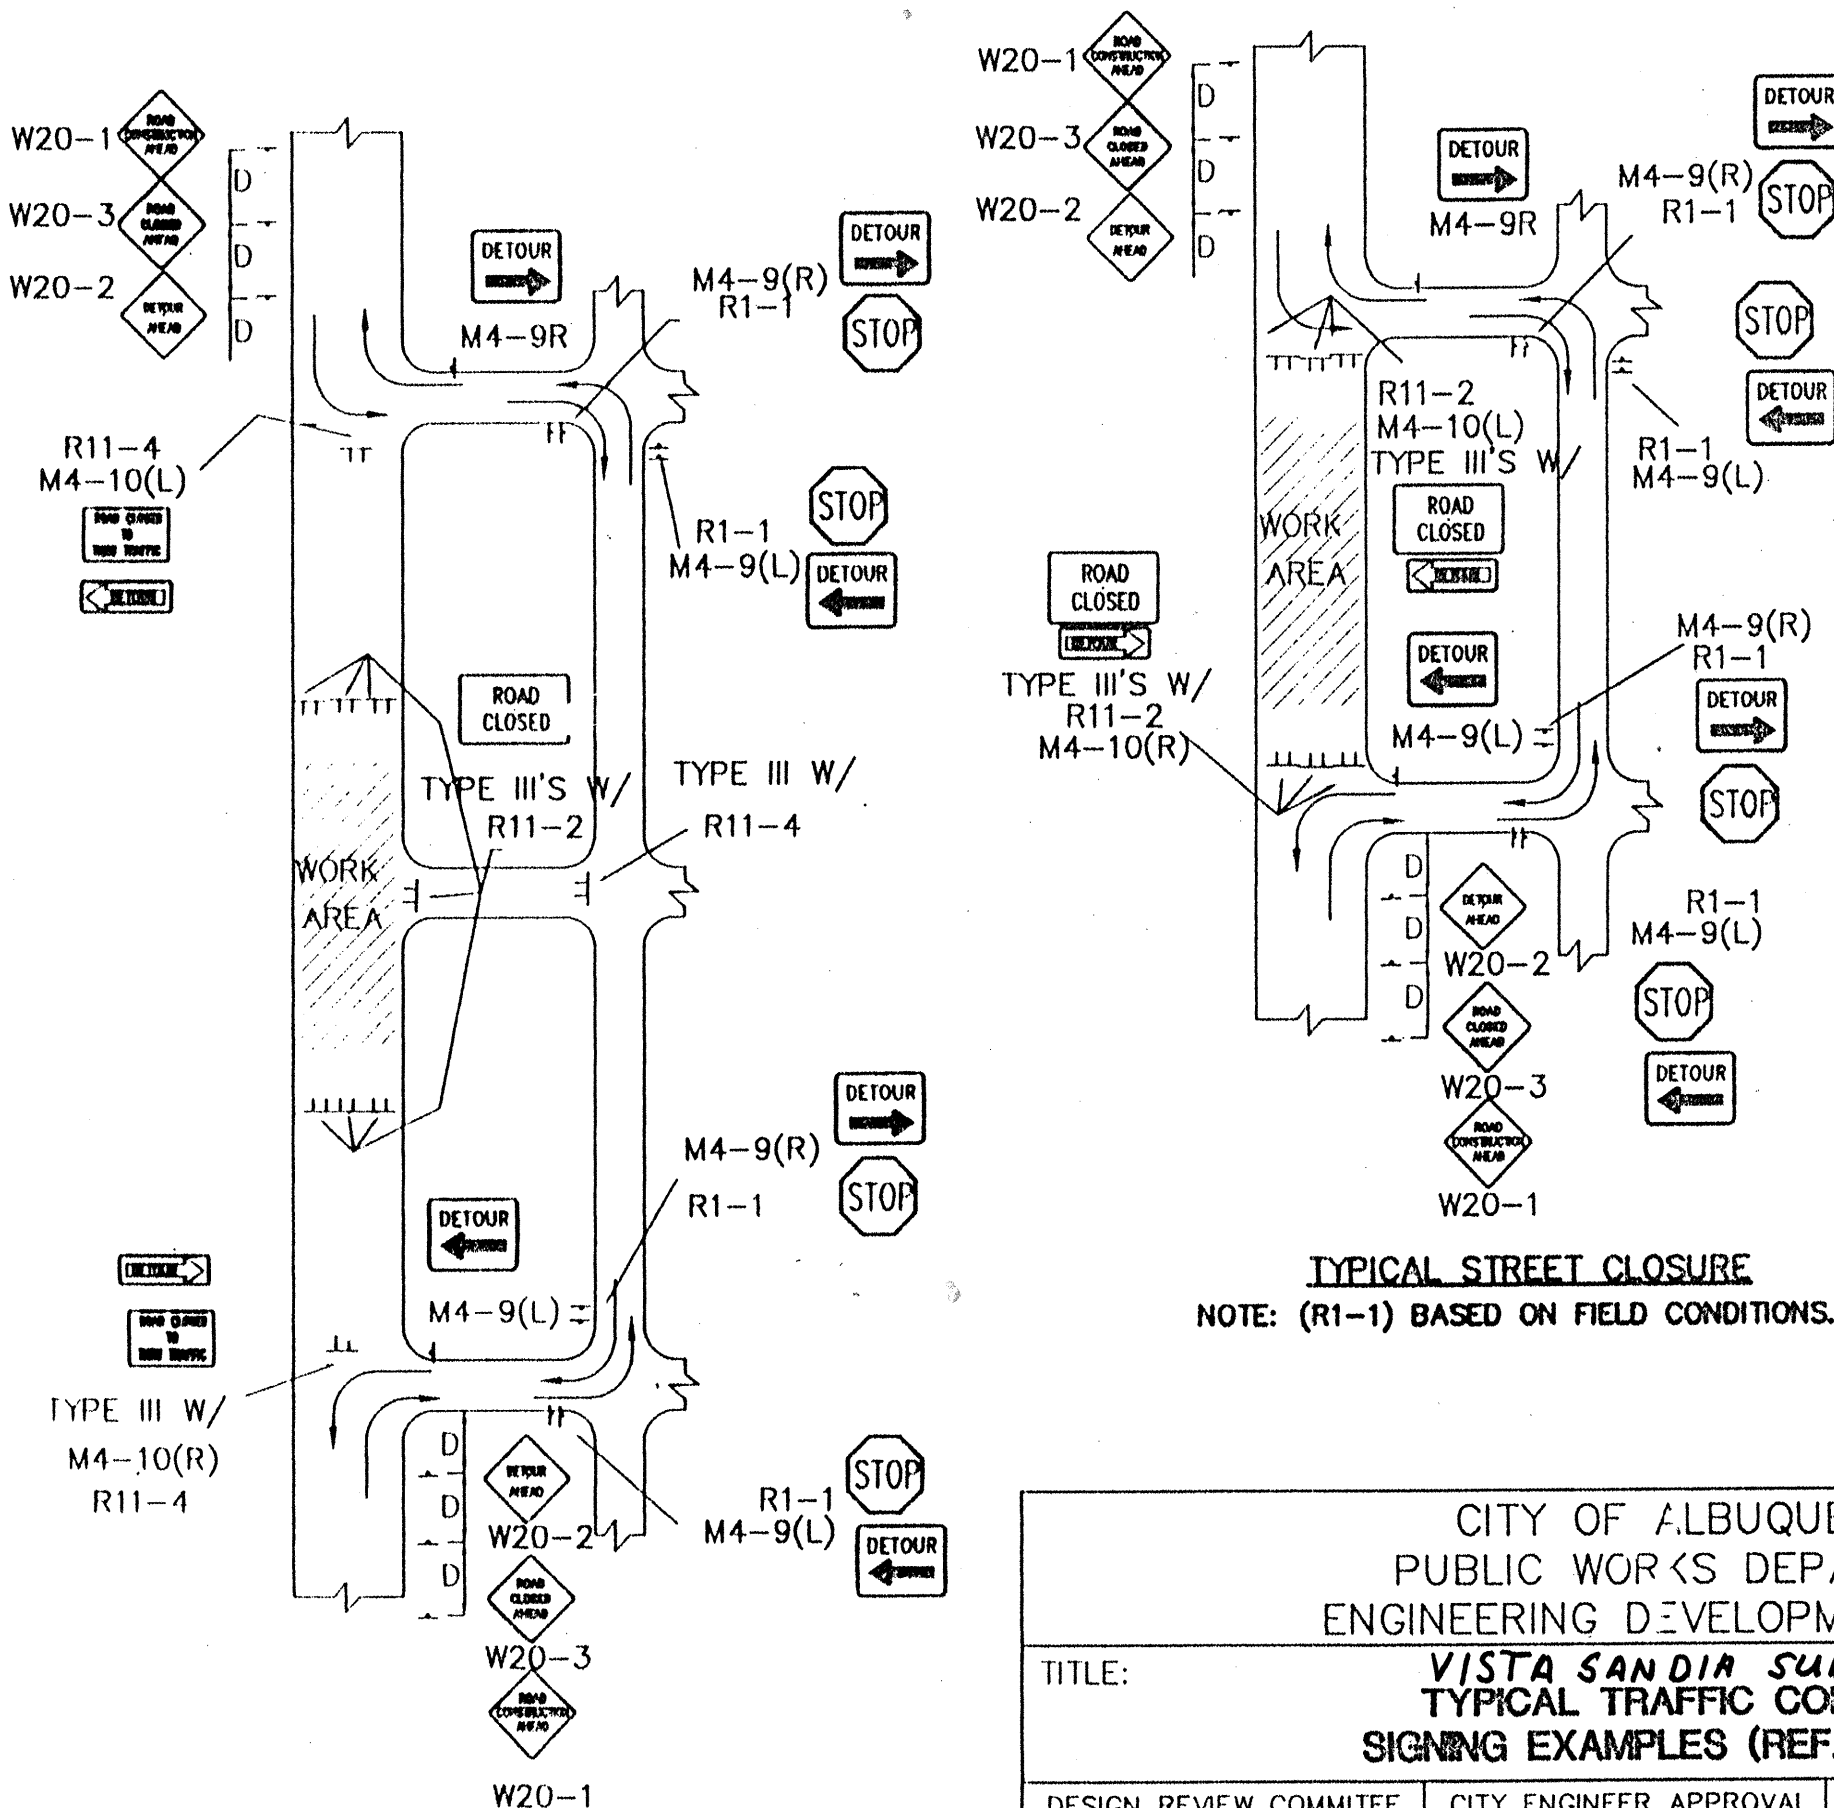

TYPICAL STREET CLOSURE
NOTE: (R1-1) BASED ON FIELD CONDITIONS.

TYPICAL STREET CLOSURE

NOTE: (R1-1) BASED ON FIELD CONDITIONS.

[illegible]