

CONSTRUCTION PLANS
FOR
COTTONWOOD HILLS SUBDIVISION
ALBUQUERQUE, NEW MEXICO

INDEX

SHEET NUMBER	DESCRIPTION
1	TITLE SHEET
2	FINAL-PLAT
3	COTTONWOOD HILLS GRADING AND DRAINAGE PLAN (FOR INFORMATION ONLY)
4	COTTONWOOD HILLS GRADING AND DRAINAGE PLAN (FOR INFORMATION ONLY)
5	OFFSITE GRADING & DETAILS (FOR INFORMATION ONLY)
6	OVERALL PAVING PLAN
7	PAVING PLAN AND PROFILE SHEETS
8	CHANDLER DRIVE ENTRANCE & CHAPPARRO DRIVE
9	CHANDLER DRIVE
10	RIDINGCIRCLE ROAD
11	CANADA PLACE
12	CROSSCUT DRIVE
13	PACKAWAY ROAD
13	OVERALL UTILITY PLAN
14	UTILITY PLAN AND PROFILE SHEETS
15	CHANDLER DRIVE ENTRANCE & CHAPPARRO DRIVE
16	CHANDLER DRIVE
17	RIDINGCIRCLE ROAD
18	CANADA PLACE
19	CROSSCUT DRIVE
20	PACKAWAY ROAD
21	UTILITY EASEMENT
22	STORM DRAIN EASEMENT AND DETAILS
23 & 24	STORM DRAIN OUTLET DETAILS
23 & 24	TRAFFIC CONTROL STANDARDS

SURVEYOR'S CERTIFICATION

"I, Timothy Aldrich, a duly qualified Registered Professional Land Surveyor under the laws of the State of New Mexico, do hereby certify that the 'as-built' information shown on these drawings was obtained from field construction and 'as-built' surveys performed by me or under my supervision, that the 'as-built' information shown on these drawings was added by me or under my supervision, and that this 'as-built' information is true and correct to the best of my knowledge and belief." Aldrich Land Surveying is not responsible for any of the design concepts, calculations, engineering, or contents of the record drawings.

Timothy Aldrich, PLS No. 7719
Date 11-16-99

APPROVAL OF AS BUILT DRAWINGS
CHIEF CONSTRUCTION ENGINEER
Cesar Alarcon
DATE 1-24-00


COA INSPECTOR: MARCIAL MARTINEZ

DRB# 98-138

Bohannon & Huston

Courtyard One 7500 JEFFERSON NE Albuquerque, NM 87109

ENGINEERS PLAINERS PHOTOGRAMMETRISTS SURVEYORS SOFTWARE DEVELOPERS

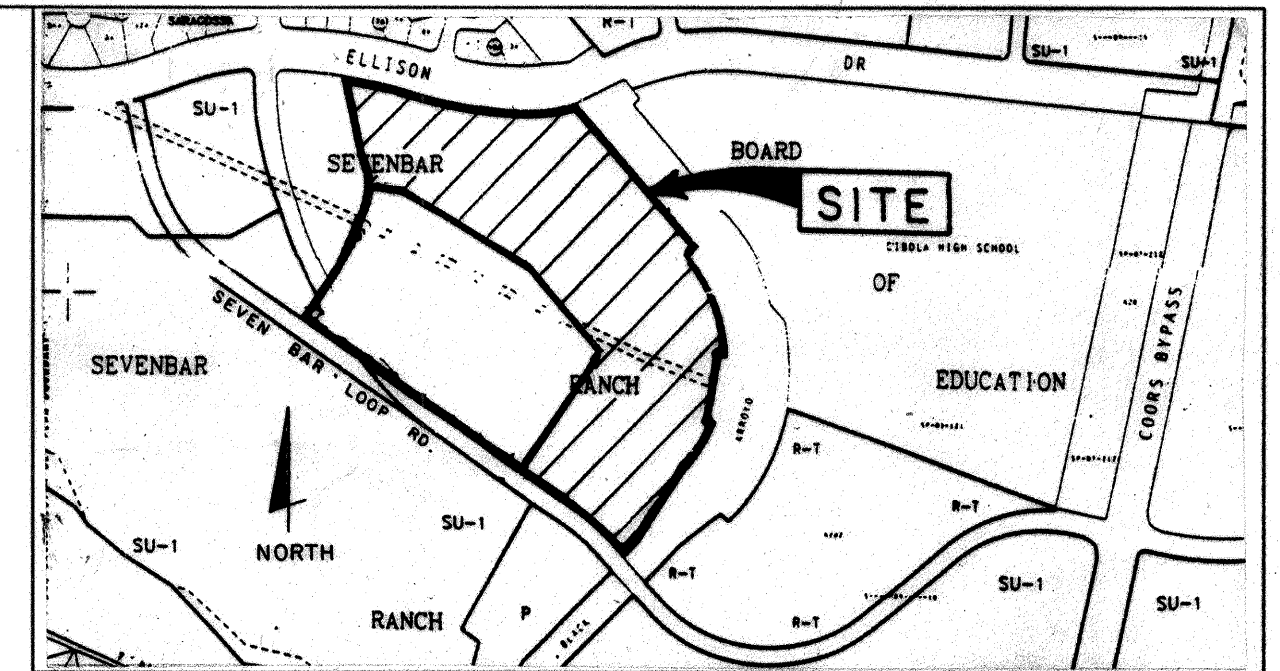

VICINITY MAP
NOT TO SCALE
A-13/B-13

NOTICE TO CONTRACTORS

- ALL WORK DETAILED ON THESE PLANS TO BE PERFORMED UNDER CONTRACT SHALL, EXCEPT AS OTHERWISE STATED OR PROVIDED HEREON, BE CONSTRUCTED IN ACCORDANCE WITH THE CITY OF ALBUQUERQUE STANDARD SPECIFICATIONS FOR PUBLIC WORKS CONSTRUCTION, 1986 EDITION AND SHALL INCLUDE UPDATE No.6.
- TWO WORKING DAYS PRIOR TO ANY EXCAVATION, THE CONTRACTOR MUST CONTACT NEW MEXICO ONE CALL SYSTEM (260-1990) FOR LOCATION OF EXISTING UTILITIES.
- PRIOR TO CONSTRUCTION, THE CONTRACTOR SHALL EXCAVATE AND VERIFY THE HORIZONTAL AND VERTICAL LOCATIONS OF ALL OBSTRUCTIONS. SHOULD A CONFLICT EXIST, THE CONTRACTOR SHALL NOTIFY THE ENGINEER OR SURVEYOR IMMEDIATELY SO THAT THE CONFLICT CAN BE RESOLVED WITH A MINIMUM AMOUNT OF DELAY.
- FIVE (5) WORKING DAYS PRIOR TO BEGINNING CONSTRUCTION, THE CONTRACTOR SHALL SUBMIT TO CONSTRUCTION COORDINATION DIVISION A DETAILED CONSTRUCTION SCHEDULE. TWO (2) WORKING DAYS PRIOR TO CONSTRUCTION, THE CONTRACTOR SHALL OBTAIN A BARRICADING PERMIT FROM THE CONSTRUCTION COORDINATION DIVISION. CONTRACTOR SHALL NOTIFY BARRICADE ENGINEER (768-2551) PRIOR TO OCCUPYING AN INTERSECTION. REFER TO SECTION 19 OF THE GENERAL CONDITIONS OF THE STANDARD SPECIFICATIONS.
- ALL STREET STRIPING ALTERED OR DESTROYED SHALL BE REPLACED W/ PLASTIC REFLECTORIZED PAVEMENT MARKING BY CONTRACTOR TO LOCATION AS EXISTING OR AS INDICATED BY THIS PLAN SET.
- CONTRACTOR SHALL NOTIFY THE ENGINEER NOT LESS THAN SEVEN (7) DAYS PRIOR TO STARTING WORK IN ORDER THAT THE CITY SURVEYOR MAY TAKE NECESSARY MEASURES TO INSURE THE PRESERVATION OF SURVEY MONUMENTS. CONTRACTOR SHALL NOT DISTURB PERMANENT SURVEY MONUMENTS WITHOUT THE CONSENT OF THE CITY SURVEYOR AND SHALL NOTIFY THE CITY SURVEYOR AND BEAR THE EXPENSE OF REPLACING ANY THAT MAY BE DISTURBED WITHOUT PERMISSION. REPLACEMENT SHALL BE DONE ONLY BY THE CITY SURVEYOR. WHEN A CHANGE IS MADE IN THE FINISHED ELEVATIONS OF THE PAVEMENT OF ANY ROADWAY IN WHICH A PERMANENT SURVEY MONUMENT IS LOCATED, CONTRACTOR SHALL AT HIS OWN EXPENSE ADJUST THE MONUMENT COVER TO THE NEW GRADE UNLESS OTHERWISE SPECIFIED. REFER TO SECTION 4.4 OF THE GENERAL CONDITIONS OF THE STANDARD SPECIFICATIONS. ANY PERMANENT SURVEY MONUMENT LOCATED WITHIN 50' PROJECT LIMITS NOT SHOWN ON THE PLANS THAT IS DESTROYED DURING CONSTRUCTION WILL BE REPLACED AT DESIGNER'S EXPENSE.
- ANY WORK WITHIN AN ARTERIAL ROADWAY REQUIRES TWENTY-FOUR HOUR CONSTRUCTION.
- ALL UTILITY WORK SHALL BE CONSTRUCTED IN ACCORDANCE WITH NEW MEXICO UTILITIES INC. SPECIFICATIONS FOR WATER AND WASTEWATER FACILITIES (MOST RECENT REVISIONS).
- THE CONTRACTOR SHALL NOTIFY NEW MEXICO UTILITIES (898-2661) THREE WORKING DAYS PRIOR TO BEGINNING THE CONSTRUCTION OF THE UTILITIES.
- CONTRACTOR SHALL MAINTAIN A GRAFFITI-FREE WORK SITE. CONTRACTOR SHALL PROMPTLY REMOVE ANY GRAFFITI FROM ALL EQUIPMENT, WHETHER PERMANENT OR TEMPORARY.

THE FOLLOWING NOTES ALSO APPLY WHEN CHECKED


- ☒ ALL UTILITIES AND UTILITY SERVICE LINES SHALL BE INSTALLED PRIOR TO PAVING.
- ☒ BACKFILL COMPACTION SHALL BE ACCORDING TO SPECIFIED STREET USE.
- ☐ TACK COAT REQUIREMENTS SHALL BE DETERMINED BY THE CITY ENGINEER.
- ☒ SIDEWALKS AND WHEELCHAIR RAMPS WITHIN THE CURB RETURNS SHALL BE CONSTRUCTED WHEREVER A NEW CURB RETURN IS CONSTRUCTED.
- ☐ IF CURB IS DERESSED FOR A DRIVEPAD, THE DRIVEPAD SHALL BE CONSTRUCTED PRIOR TO ACCEPTANCE OF CURB AND GUTTER.
- ☒ ALL STORM DRAINAGE FACILITIES SHALL BE COMPLETED PRIOR TO FINAL ACCEPTANCE.
- ☒ THE REQUESTOR OR DEVELOPER SHALL BE RESPONSIBLE FOR REPAIR OR REPLACEMENT OF ALL CURB AND GUTTER OR SIDEWALK DAMAGED AFTER APPROVAL BY THE CITY ENGINEER OF WORK COMPLETED BY THE CONTRACTOR.

																																																																																																																																																																																																																																																																																																																																																																																																																																																																																																																																																																																																																																																																																																																																																																																																																																																																																																																																																																																																																																																																																																																																																																																																																																																																																																																																																																																																																															</
--	--	----

(A REPEAT OF TRACT A-2A-1 SEVEN -
ALBUQUERQUE, NEW MEXICO
APRIL, 1989

(A)	(B)
1	1
2	2
3	3
100	100

ACS Brass Tablet stamped "3-B13"
Geographic Position (NAD 1927)
N.M. State Plane Coordinates (Central)
X = 375,789.23 Y = 1,529,391.51
Ground-to-Grid Factor = 0.9996703
 $\Delta\alpha = -00^{\circ}14'23''$
SLD 1929 Elevation = 5159.50

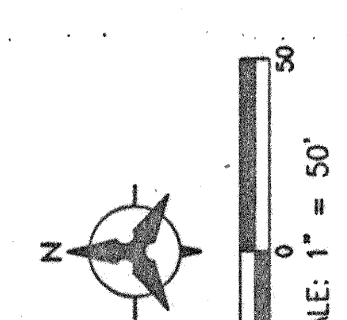

EXISTING 7' MOUNTAIN
WELL UNDERGROUND
TELEPHONE EASEMENT
FILED: APRIL 21, 1965
HISC 8/W 143 PG 126

EXISTING 7' MOUNTAIN
BELL UNDERGROUND
TELEPHONE EASEMENT
FILED: APRIL 21, 1965
MISC. R/W 143, PG. 329

EXISTING 30' SOUTHERN UNION
GAS COMPANY EASEMENT
FILED: JANUARY 14, 1946
MISC. 270, PG. 547
FEBRUARY 28, 1961
MISC. D385, PG. 409
EASEMENT BY PLAT
FILED: JUNE 8, 1981
C18-96
VACATED BY VACATION
ACTION V-98-71

EXISTING 30' SOUTHERN UNION
GAS COMPANY EASEMENT
FILED: JANUARY 14, 1946
MISC. 220, PG. 547
FEBRUARY 28, 1961
MISC. D585, PG. 409
EASEMENT BY PLAT
FILED: JUNE 8, 1981
C18-06

ATLANTA FLOOD DIVISION NO. 2 (BLACK ARROYO)
(FROM WIDTH VALUES)


 **Bohannon Huston**
 Courtyard One 7500 JEFFERSON NE Albuquerque NEW MEXICO 87109
 JOB NO. 99-413A-03

SHEET 3 OF 7

P:\99413\SURVEY\GRAPHICS\99413A03\DWG\99413A03PLAT03.DWG 04/01/1999

PLAT OF
COTTONWOOD HILLS
SUBDIVISION
SEVEN - BAR RANCH
OF TRACT A - 2A - 1 SEVEN - BAR RANCH)
ALBUQUERQUE, NEW MEXICO

SEVEN-BAR RANCH
(A REPLAT OF TRACT A-2A-1 SEVEN-BAR RANCH)
ALBUQUERQUE, NEW MEXICO
APRIL, 1999

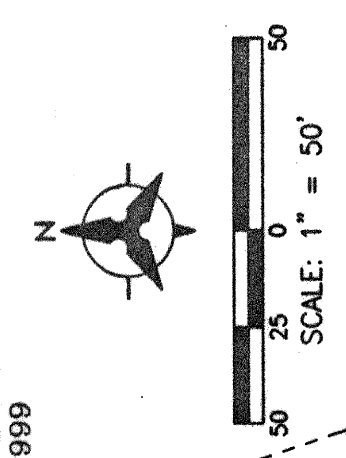

A.M.A.F.C.A. FLOOD DIVERSION NO. 2 (BLACK ARROYO)
(ROW WIDTH VARIES)

ACS Brass Tablet stamped "3-B13"
 Geographic Position (NAD 1927)
 N.M. State Plane Coordinates (Central Zone)
 X = 375,789.23 Y = 1,529,391.51
 Ground-to-Grid Factor = 0.9996709
 $\Delta\alpha = -00^{\circ}14'23''$
 SLD 1929 Elevation = 5159.50

Bohannon Huston
 Courtyard One 7500 JEFFERSON NE Albuquerque NEW MEXICO 87109
 JOB NO. 99-413A-03

SHEET 4 OF 7

P:\9941J\SURVEY\GRAPHICS\99413A03\DWG\99413A03PLA104.DWG 04/01/1999

TRACT A-2A-2
TRACTS A-2A-1 & A-2A-2
SEVEN BAR RANCH
FILED: SEPTEMBER 24, 1998
(98C-286)

CPN 609281
SHEET 2B OF 24

PLAT OF
COTTONWOOD HILLS
SUBDIVISION
SEVEN - BAR RANCH

(A REPLAT OF TRACT A-2A-1 SEVEN-BAR RANCH)
ALBUQUERQUE, NEW MEXICO
APRIL, 1999

TANGENT	BEARING	DISTANCE
11	N44°33'00"W	29.15
12	N44°33'00"W	52.05
13	S14°13'40"E	11.18
14	S14°22'23"W	23.00
15	S67°48'33"W	11.80
16	S03°16'20"W	24.00
17	S87°13'49"W	1.91
18	S87°13'49"W	27.96
19	S87°13'49"W	33.48
20	S87°13'49"W	15.32
21	S87°13'49"W	0.71
22	S87°13'49"W	135.58
23	S87°13'49"W	101.83

CURVE	RADIUS	LENGTH	TANGENT	CHORD	CHORD BEARING	DELTA
C181	97.00	15.40	7.71	15.38	S37°10'51"E	09°05'38"
C182	97.00	51.04	26.13	50.46	S73°33'33"E	01°48'52"
C183	254.00	153.44	76.84	153.38	S62°13'27"E	20°39'50"
C184	254.00	53.50	26.85	53.40	S50°09'32"E	12°04'47"
C185	254.00	10.63	5.31	10.63	S42°59'35"E	02°23'04"
C186	1558.75	69.40	34.71	69.39	S89°30'29"E	07°33'04"
C187	1558.75	49.36	24.68	49.36	S87°19'31"E	01°48'52"
C188	1558.75	49.36	24.68	49.36	S85°38'48"E	01°48'52"
C189	1558.75	49.36	24.68	49.36	S83°50'02"E	01°48'52"
C190	1558.75	49.36	24.68	49.36	S81°52'56"E	01°48'52"
C191	1558.75	49.36	24.68	49.36	S79°44'03"E	01°48'52"
C192	1558.75	49.36	24.68	49.36	S77°14'47"E	01°48'52"
C193	1558.75	49.36	24.68	49.36	S74°28'42"E	01°48'52"
C194	1558.75	49.36	24.68	49.36	S71°46'40"E	01°48'52"
C195	1558.75	49.36	24.68	49.36	S68°49'35"E	01°48'52"
C196	1558.75	49.36	24.68	49.36	S65°38'48"E	01°48'52"
C197	1558.75	49.36	24.68	49.36	S62°13'27"E	01°48'52"
C198	1558.75	49.36	24.68	49.36	S58°49'35"E	01°48'52"
C199	1558.75	49.36	24.68	49.36	S55°17'54"W	04°00'36"

CURVE	RADIUS	LENGTH	TANGENT	CHORD	CHORD BEARING	DELTA
C1	884.00	193.30	97.54	193.91	N51°03'04"W	23°35'36"
C2	300.00	47.06	23.58	47.01	N81°37'55"E	08°59'17"
C3	300.00	81.49	40.78	81.45	N76°04'16"E	08°59'17"
C4	300.00	46.90	23.52	46.90	N70°42'41"W	08°59'17"
C5	300.00	12.51	6.25	12.51	N72°40'19"E	00°34'18"
C6	300.00	46.85	23.47	46.80	N61°43'17"W	08°58'52"
C7	300.00	46.78	23.42	46.73	N59°43'53"W	08°58'52"
C8	300.00	46.73	23.37	46.68	N57°43'27"W	08°58'52"
C9	300.00	46.68	23.32	46.63	N55°43'01"W	08°58'52"
C10	300.00	46.63	23.27	46.58	N53°42'35"W	08°58'52"
C11	300.00	46.58	23.22	46.53	N51°42'09"W	08°58'52"
C12	300.00	46.53	23.17	46.48	N49°41'43"W	08°58'52"
C13	300.00	46.48	23.12	46.43	N47°41'17"W	08°58'52"
C14	300.00	46.43	23.07	46.38	N45°40'51"W	08°58'52"
C15	300.00	46.38	23.02	46.33	N43°40'25"W	08°58'52"
C16	300.00	46.33	22.97	46.28	N41°39'59"W	08°58'52"
C17	300.00	46.28	22.92	46.23	N39°39'33"W	08°58'52"
C18	300.00	46.23	22.87	46.18	N37°39'07"W	08°58'52"
C19	300.00	46.18	22.82	46.13	N35°38'41"W	08°58'52"
C20	300.00	46.13	22.77	46.08	N33°38'15"W	08°58'52"
C21	300.00	46.08	22.72	46.03	N31°37'49"W	08°58'52"
C22	300.00	46.03	22.67	45.98	N29°37'23"W	08°58'52"
C23	300.00	46.03	22.67	45.98	N27°36'57"W	08°58'52"
C24	300.00	46.03	22.67	45.98	N25°36'31"W	08°58'52"
C25	300.00	46.03	22.67	45.98	N23°36'05"W	08°58'52"
C26	300.00	46.03	22.67	45.98	N21°35'39"W	08°58'52"
C27	300.00	46.03	22.67	45.98	N19°35'13"W	08°58'52"
C28	300.00	46.03	22.67	45.98	N17°34'47"W	08°58'52"
C29	300.00	46.03	22.67	45.98	N15°34'21"W	08°58'52"
C30	300.00	46.03	22.67	45.98	N13°33'55"W	08°58'52"
C31	300.00	46.03	22.67	45.98	N11°33'29"W	08°58'52"
C32	300.00	46.03	22.67	45.98	N9°33'03"W	08°58'52"
C33	300.00	46.03	22.67	45.98	N7°32'37"W	08°58'52"
C34	300.00	46.03	22.67	45.98	N5°32'11"W	08°58'52"
C35	300.00	46.03	22.67	45.98	N3°31'45"W	08°58'52"
C36	300.00	46.03	22.67	45.98	N1°31'19"W	08°58'52"
C37	300.00	46.03	22.67	45.98	N0°30'53"W	08°58'52"
C38	300.00	46.03	22.67	45.98	N0°30'27"W	08°58'52"
C39	300.00	46.03	22.67	45.98	N0°29'51"W	08°58'52"
C40	300.00	46.03	22.67	45.98	N0°29'25"W	08°58'52"
C41	300.00	46.03	22.67	45.98	N0°28'59"W	08°58'52"
C42	300.00	46.03	22.67	45.98	N0°28'33"W	08°58'52"
C43	300.00	46.03	22.67	45.98	N0°28'07"W	08°58'52"
C44	300.00	46.03	22.67	45.98	N0°27'41"W	08°58'52"
C45	300.00	46.03	22.67	45.98	N0°27'15"W	08°58'52"
C46	300.00	46.03	22.67	45.98	N0°26'49"W	08°58'52"
C47	300.00	46.03	22.67	45.98	N0°26'23"W	08°58'52"
C48	300.00	46.03	22.67	45.98	N0°25'57"W	08°58'52"
C83	300.00	46.03	22.67	45.98	N0°11'47"W	08°58'52"
C84	300.00	46.03	22.67	45.98	N0°11'21"W	08°58'52"
C85	300.00	46.03	22.67	45.98	N0°10'55"W	08°58'52"
C86	300.00	46.03	22.67	45.98	N0°10'29"W	08°58'52"
C87	300.00	46.03	22.67	45.98	N0°10'03"W	08°58'52"
C88	300.00	46.03	22.67	45.98	N0°09'37"W	08°58'52"
C89	300.00	46.03	22.67	45.98	N0°09'11"W	08°58'52"
C90	300.00	46.03	22.67	45.98	N0°08'45"W	08°58'52"

JOB NO. 99-413A-03

Bohannan Huslon




Conrad One 7500 JEFFERSON NE Albuquerque NEW MEXICO 87109

BUSINESS PLANNERS PHOTOGRAPHERS SURVEYORS SOFTWARE PROGRAMERS

P:\98413\SURVEY\GRAPHICS\98413A03.DWG 6/4/1999 10:40:27 AM



SHEET 7 OF 7

CPN 609281
SHEET 20 OF 24

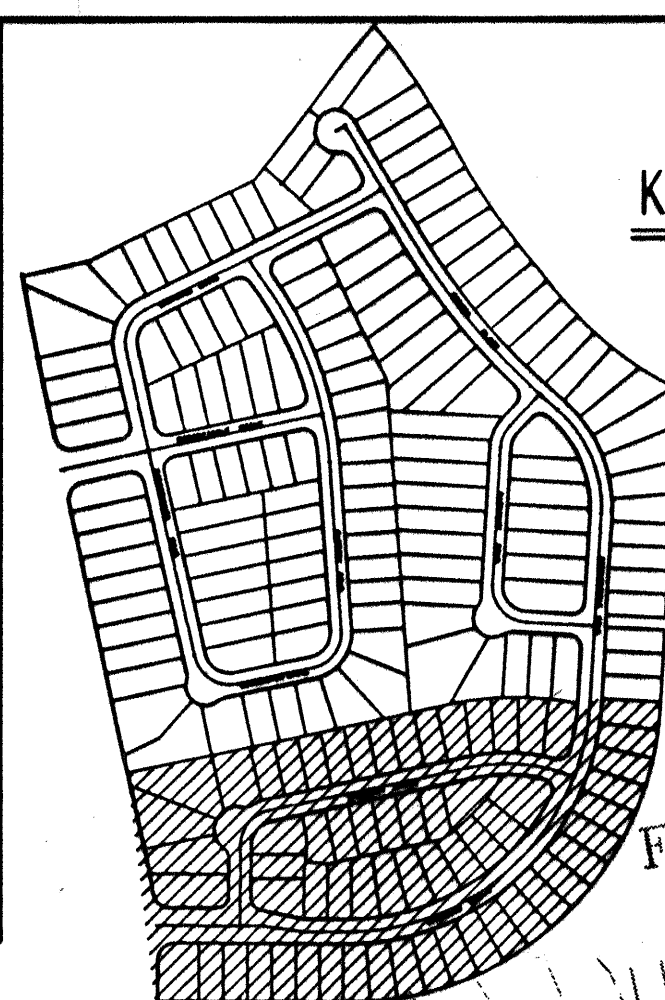


1. JAMES R. TOPMILLER OF BOHANNAN
HUSTON, N.M.P.E. # 9354 HEREBY CERTIFY THAT THE
AS-BUILT DRAINAGE CONDITIONS OF THE SITE ARE IN
SUBSTANTIAL COMPLIANCE WITH THE APPROVED GRADING AND
DRAINAGE PLAN. TO THE BEST OF MY KNOWLEDGE AND BELIEF
AS-BUILT ELEVATIONS ARE SHOWN ON THE PLAN WHERE THE
ORIGINAL DESIGN ELEVATION HAS BEEN CROSSED OUT AND
THE AS-BUILT ELEVATION ADDED. AS-BUILT ELEVATIONS WERE
VERIFIED BY WALKER SURVEYING L.S.
0401 THIS STATEMENT DOES NOT REPRESENT
CERTIFICATION OF CONTRACTOR'S METHODS OR MATERIALS.

NOTE:
AS-BUILT PAD & YARD
ELEVATIONS VERIFIED BY
WALKER SURVEYING.
AS-BUILT WALL ELEVATION
VERIFIED BY ALDRICH
SURVEYING.

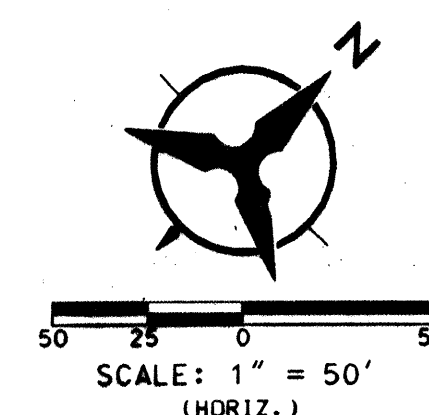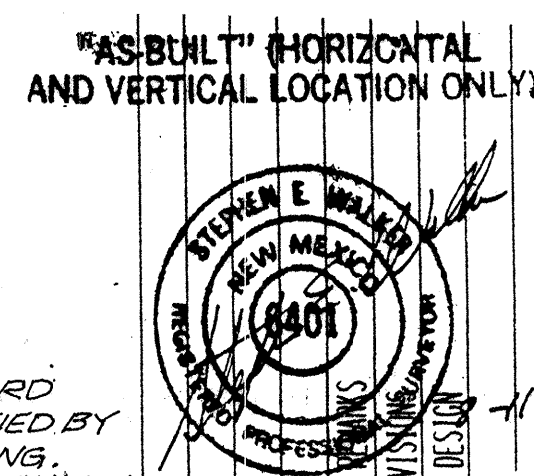

VICINITY MAP
NOT TO SCALE
ZONE MAP NO. A-12B-13

FUTURE MIRADOR SANDIAS SUBDIVISION
(PHASE II)

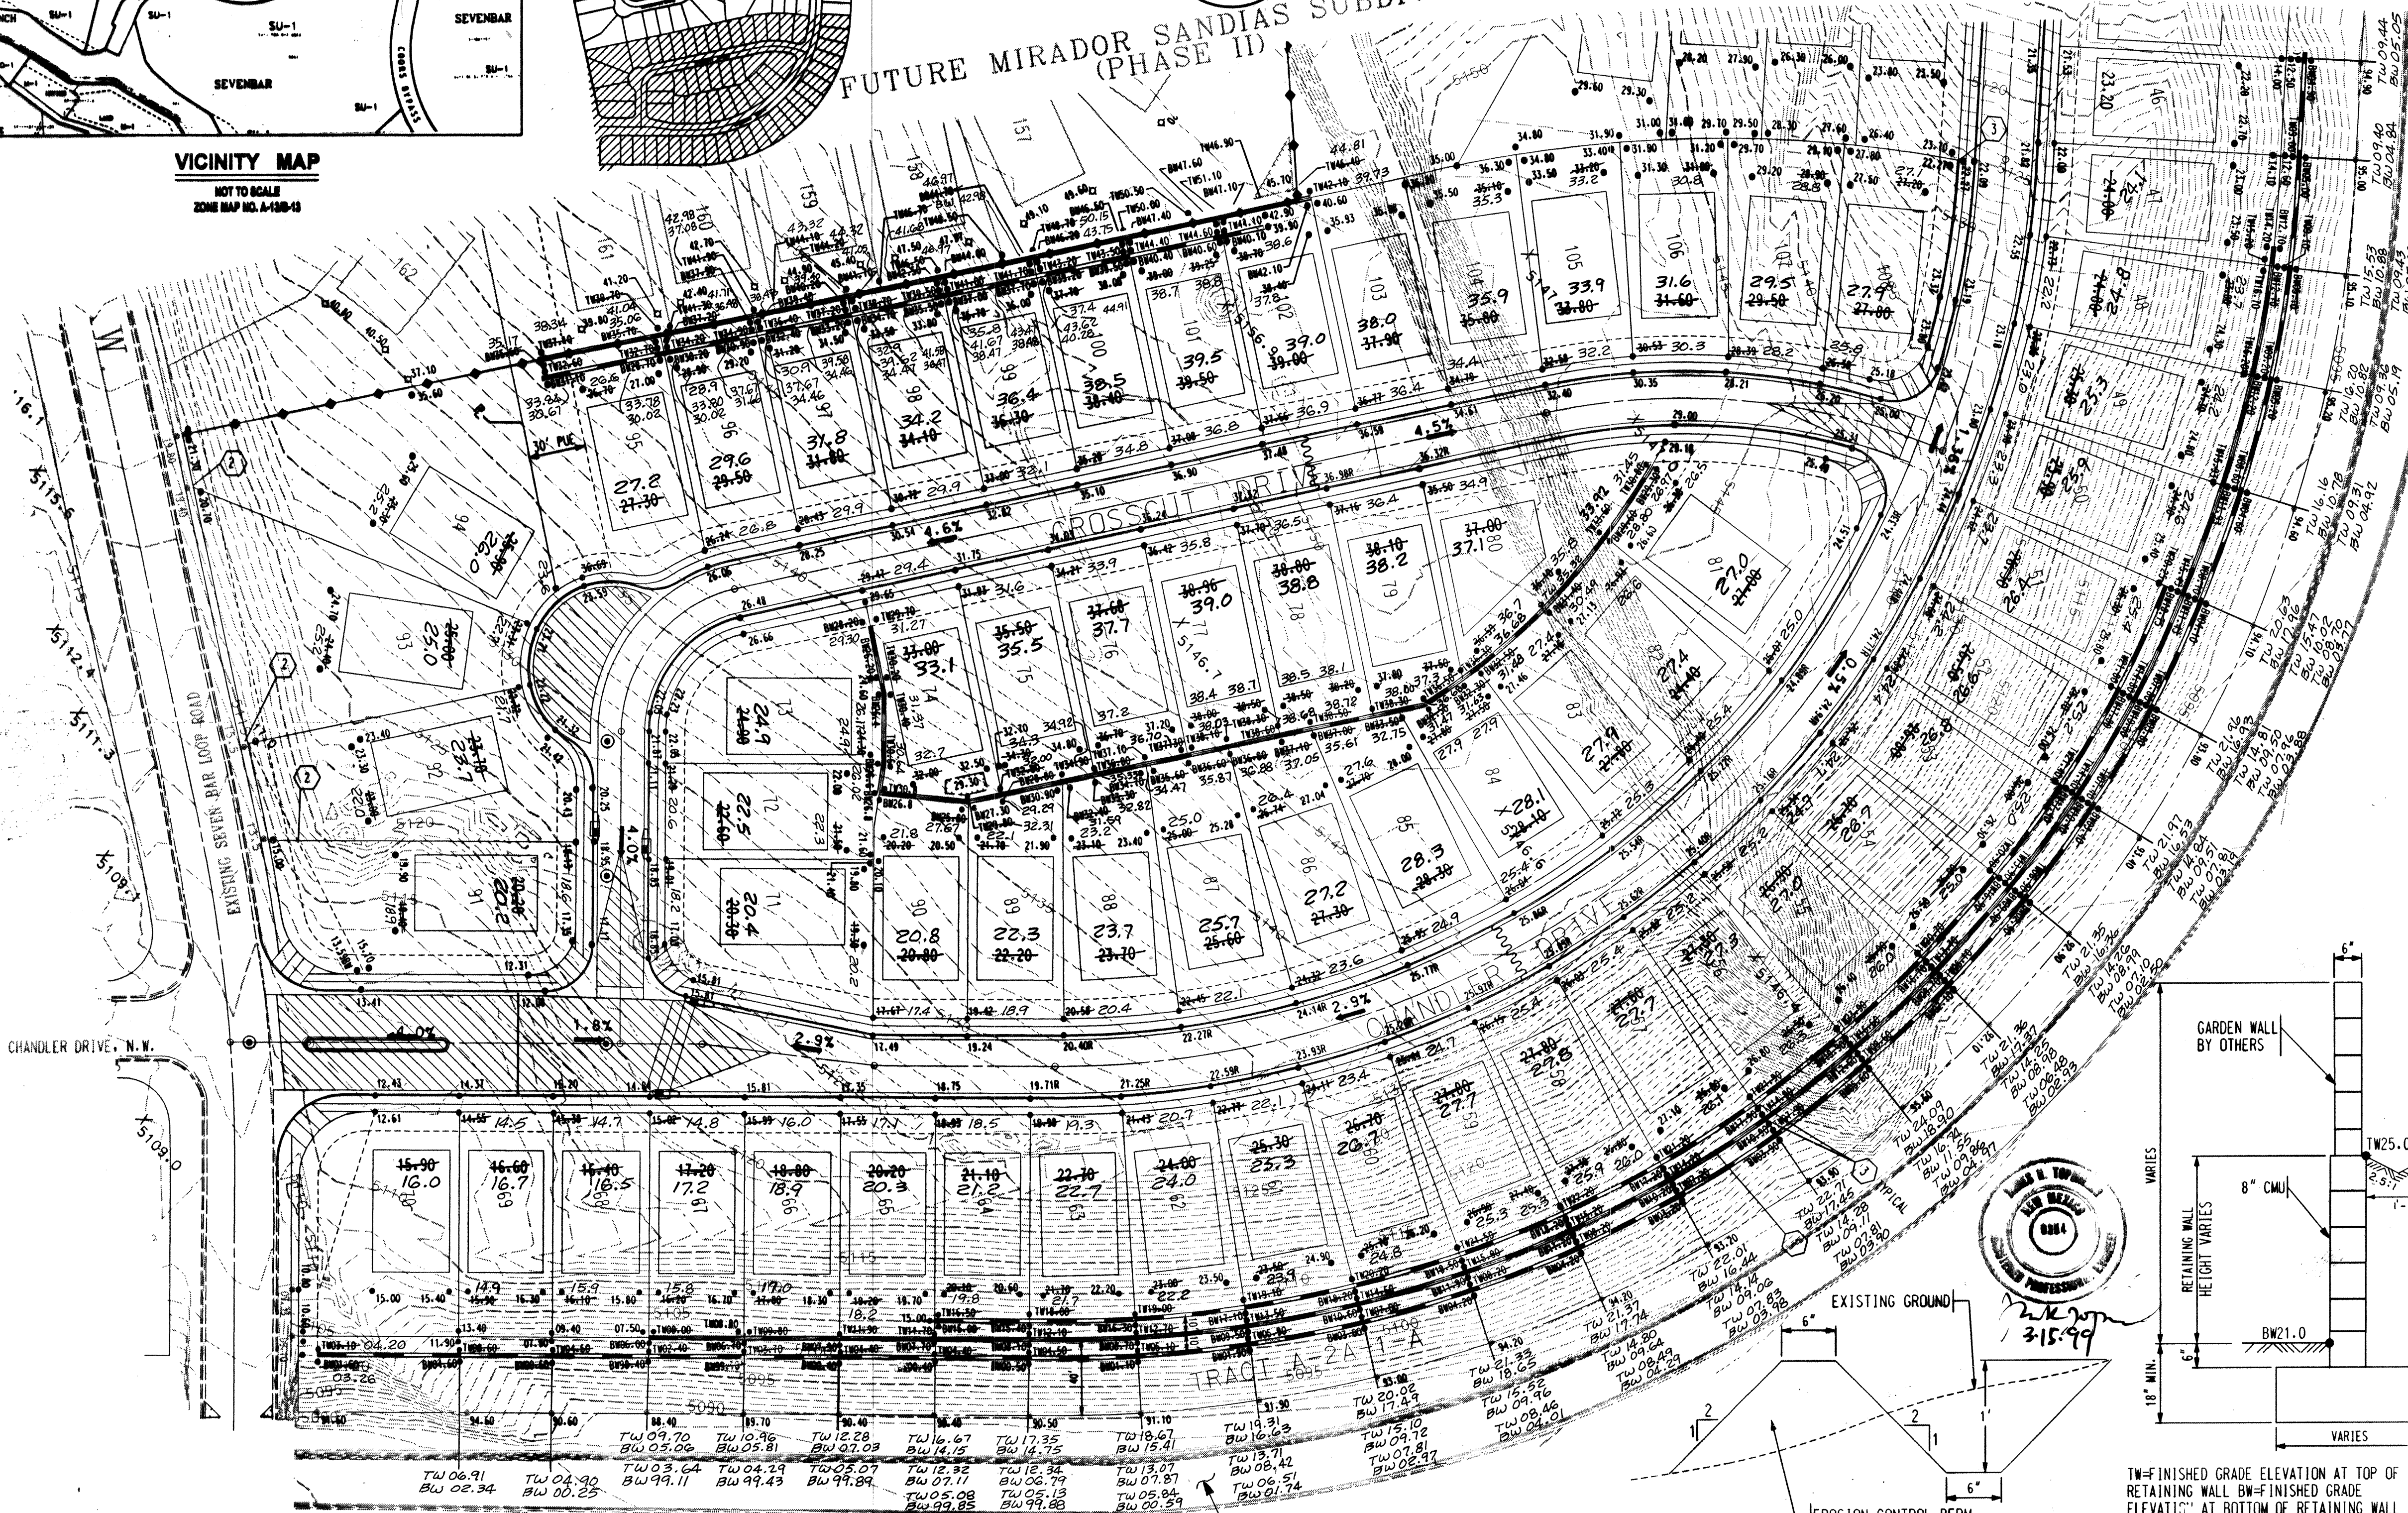

1. CONTRACTOR MUST OBTAIN A TOPSOIL DISTURBANCE PERMIT FROM THE ENVIRONMENTAL HEALTH DIVISION PRIOR TO CONSTRUCTION.
2. THE CONTRACTOR IS TO REFER TO EARTHWORK SPECIFICATION AS NOTED IN THE SOILS REPORT.
3. THE CONTRACTOR SHALL CONFORM TO ALL CITY, COUNTY, STATE AND FEDERAL DUST CONTROL MEASURES AND REQUIREMENTS AND WILL BE RESPONSIBLE FOR PREPARING AND OBTAINING ALL NECESSARY APPLICATIONS AND APPROVALS.
4. THE CONTRACTOR SHALL ENSURE THAT NO SOIL ERODES FROM THE LOTS INTO PUBLIC RIGHT-OF-WAY. THIS SHALL BE ACCOMPLISHED BY CONSTRUCTING TEMPORARY BERMS AS PER THE DETAIL ON THIS SHEET AND WETTING THE SOIL TO KEEP IT FROM BLOWING AS PER THE EROSION CONTROL DETAIL ON THIS SHEET.
5. ALL STREET SPOT ELEVATIONS ARE TO TOP OF CURB UNLESS OTHERWISE NOTED. VALLEY CULVERT ELEVATIONS ARE SHOWN AT FLOWLINE ELEVATION.

SPOT ELEVATIONS CONTAINING AN
"R" DENOTES TOP OF MOUNTABLE
ROLL TYPE CURB, i.e. xx.x0R

LEGAL DESCRIPTION

- ①
CONCRETE MASSONARY UNIT FENCE REQUIRED
ALONG REAR PROPERTY LINE FOR LOTS 18 THROUGH 70
AND ALONG SEVEN BAR LOOP ROAD. STANDARD C.I.W.U. IS
6" X 8" X 16" GROUT REINFORCED CELLS ONLY.
- ②
FENCING CONTRACTOR IS TO PROVIDE ONE
TURNED OUT BLOCK IN LOWEST CORNER OF
LOT JUST ABOVE BACKYARD DRAINAGE TO PROVIDE
BACKYARD DRAINAGE TO SEVEN BAR LOOP
ROAD RIGHT OF WAY FOR LOTS 91 THROUGH 94.
- ③
FENCING CONTRACTOR IS TO PROVIDE ONE
TURNED OUT BLOCK IN LOWEST CORNER
OF LOT JUST ABOVE BACKYARD DRAINAGE TO PROVIDE
BACKYARD DRAINAGE TO THE ADJACENT STREET ROW
FOR LOTS 18 THROUGH 70, AND LOT 101.

PROPOSED SPOT ELEVATION ● 5235.25
TOP OF HILL CURB ELEVATION ● 5235.25
EXISTING SPOT ELEVATION ● 5235.25
FUTURE SPOT ELEVATION ◇ 5235.25
PROPOSED RETAINING WALL
EXISTING CONTOUR
DIRECTION OF FLOW
EXISTING STORM DRAIN LINE
EXISTING STORM DRAIN MANHOLE
PROPOSED STORM DRAIN INLET
PROPOSED STORM DRAIN LINE
PROPOSED STORM DRAIN MANHOLE
PROPOSED WATER BLOCK
PROPOSED BACKYARD POND
EXISTING SAS MANHOLE
PHASING BOUNDARY
AS-BUILT ELEVATION
FOR 0.00 BACKYARDS

 Courtyard One 7500 JEFFERSON NE Albuquerque NEW MEXICO 87106

ENGINEERS PLANNERS PHOTOGRAMMETRISTS SURVEYORS SOFTWARE DEVELOPERS

 CITY OF ALBUQUERQUE
PUBLIC WORKS DEPARTMENT
ENGINEERING DEVELOPMENT GROUP

COTTONWOOD HILLS

GRADING AND DRAINAGE PLAN

DEVELOPMENT REVIEW BOARD

DRB APPROVAL DATE: 11/11/2011

~~Approved~~
~~@ DRB~~
~~609281~~


ZONE MAP NO.
A-13/B-13

SHEET 3 OF 24

COPYRIGHT © JOHANN H. HUSTON, 1999

P:\BHI-MAIN\PROJECTS\99413\CDP\GENERAL\99413GPO

BHI 100 NO 99413A01

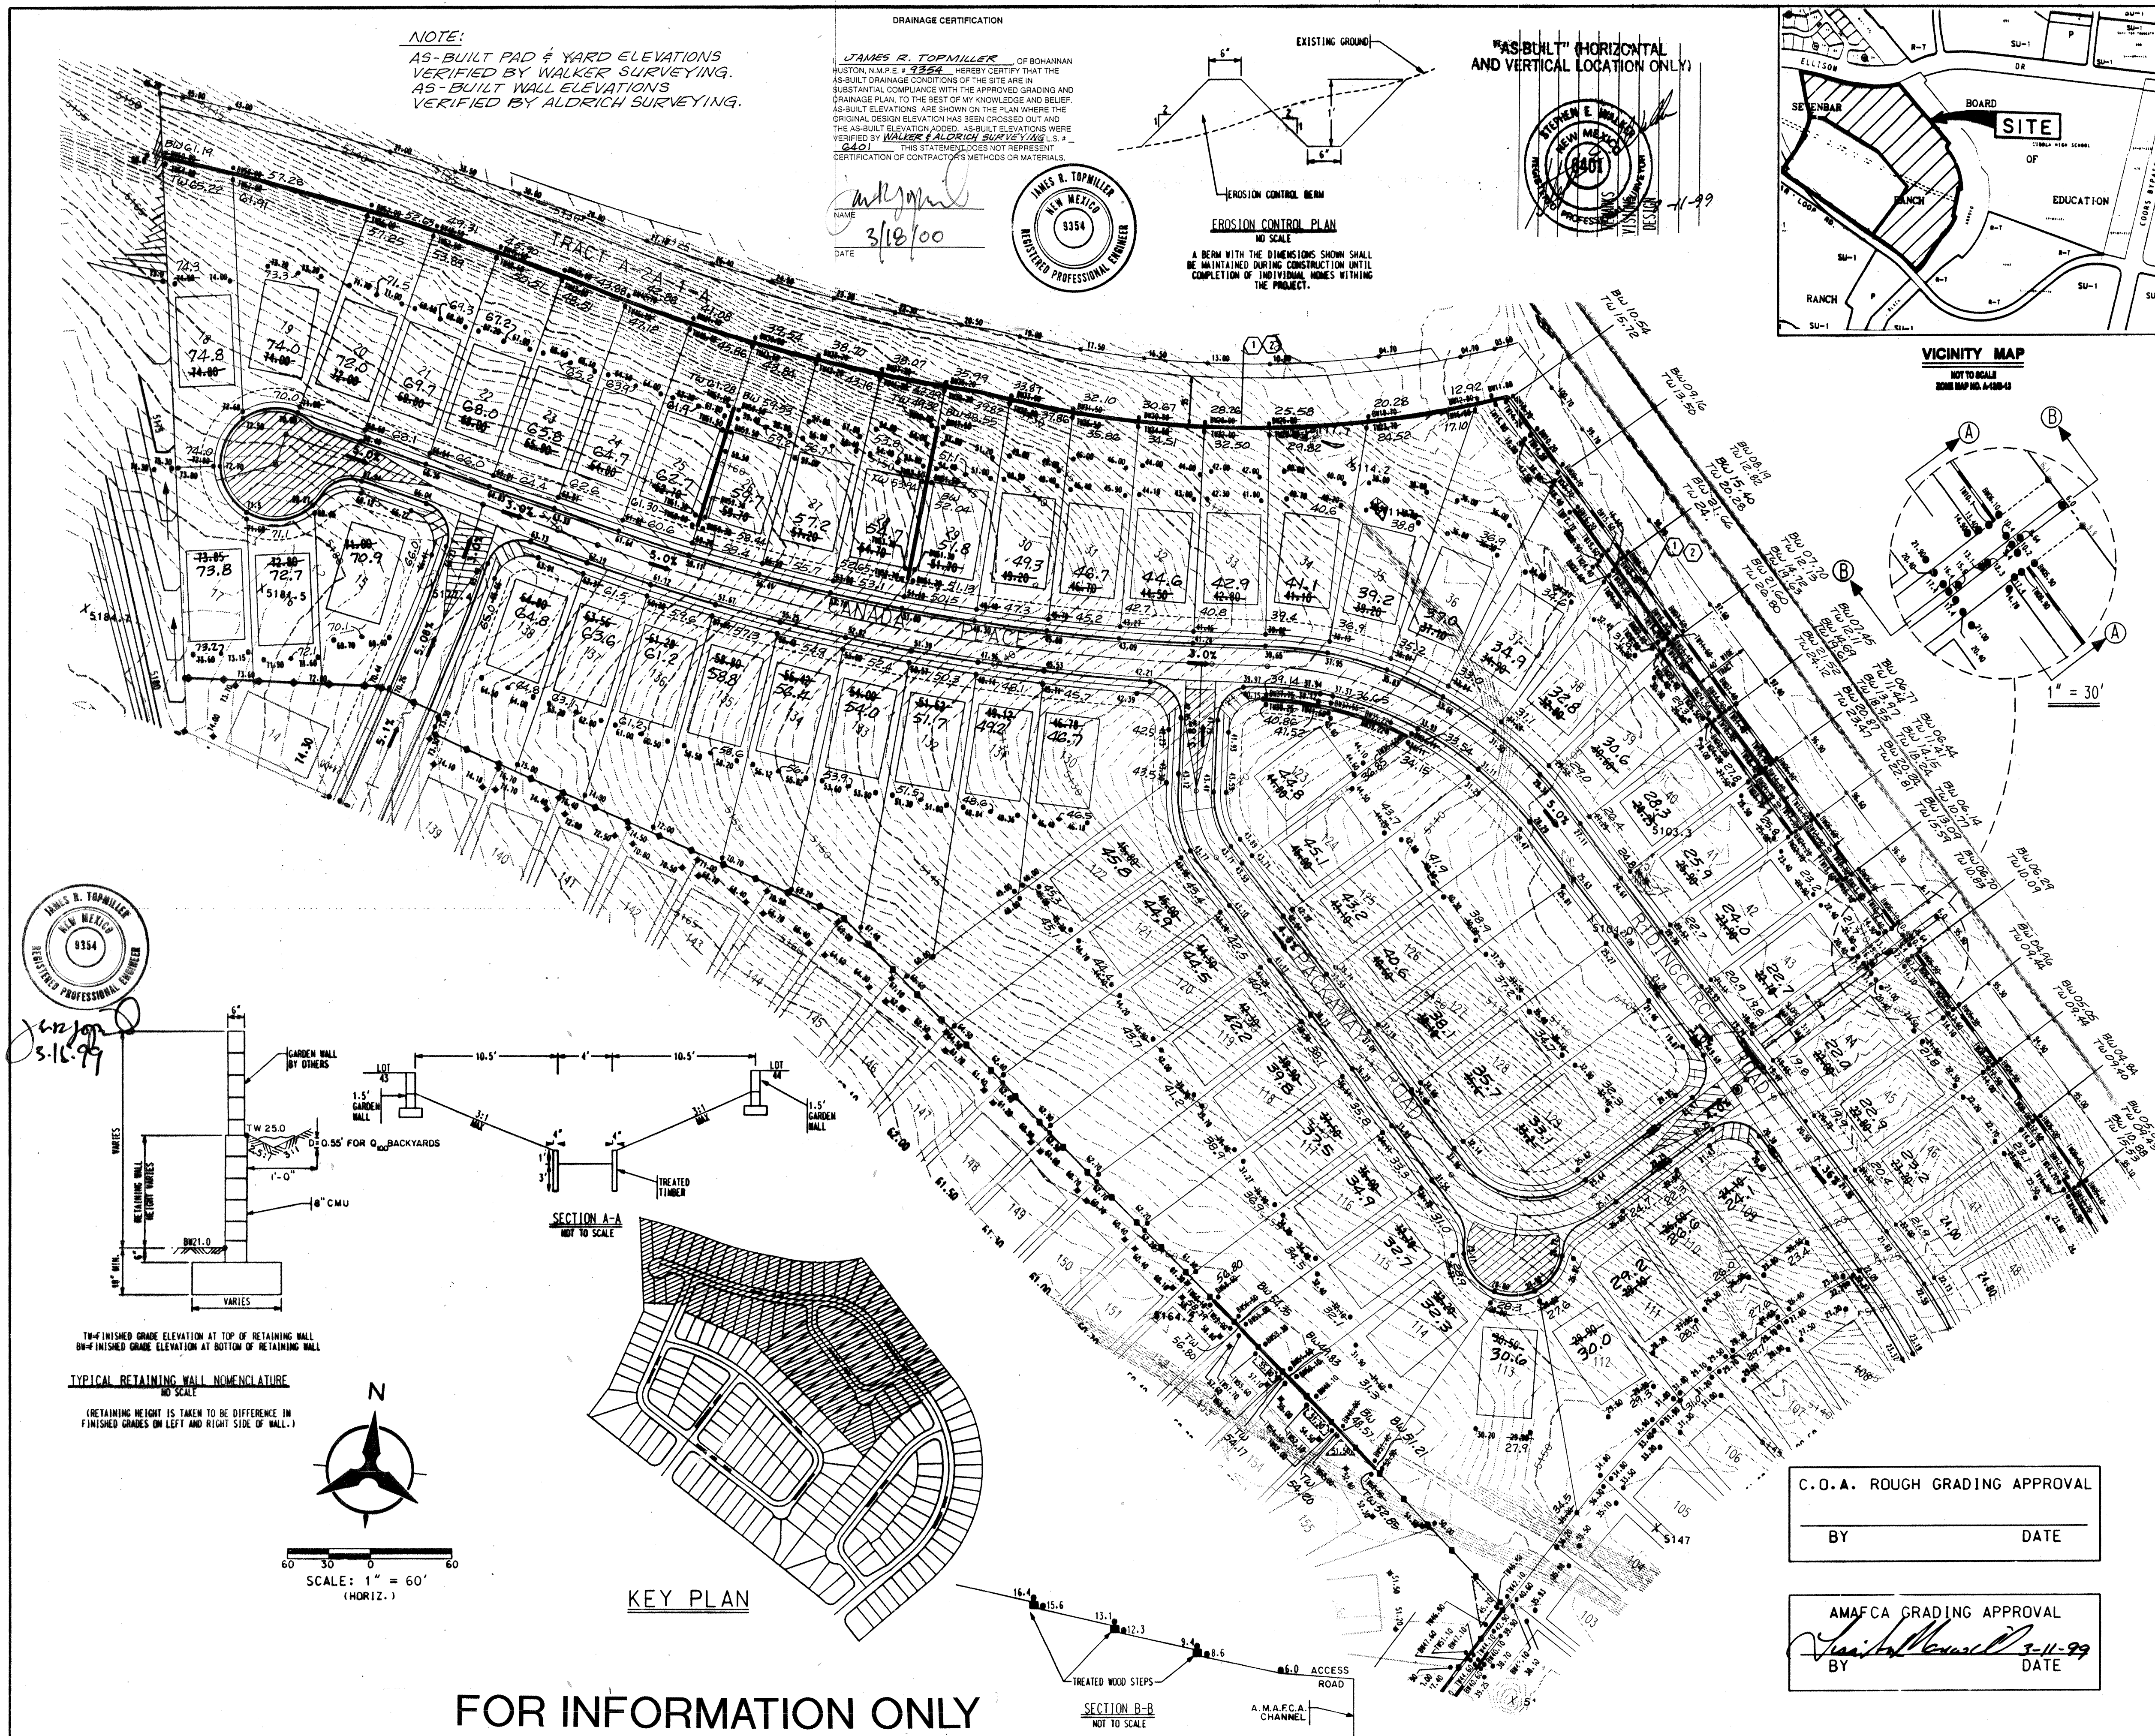

GENERAL NOTES

1. CONTRACTOR MUST OBTAIN A TOPSOIL DISTURBANCE PERMIT FROM THE ENVIRONMENTAL HEALTH DIVISION PRIOR TO CONSTRUCTION.
2. THE CONTRACTOR IS TO REFER TO EARTHWORK SPECIFICATION AS NOTED IN THE SOILS REPORT.
3. THE CONTRACTOR SHALL CONFORM TO ALL CITY, COUNTY, STATE AND FEDERAL DUST CONTROL MEASURES AND REQUIREMENTS AND WILL BE RESPONSIBLE FOR PREPARING AND OBTAINING ALL NECESSARY APPLICATIONS AND APPROVALS.
4. THE CONTRACTOR SHALL ENSURE THAT NO SOIL ERODES FROM THE LOTS INTO PUBLIC RIGHT-OF-WAY. THIS CAN BE ACHIEVED BY CONSTRUCTING TEMPORARY BERMS AS PER THE DETAIL ON THIS SHEET AND WETTING THE SOIL TO KEEP IT FROM BLOWING AS PER THE EROSION CONTROL DETAIL ON THIS SHEET.
5. ALL STREET SPOT ELEVATIONS ARE TO TOP OF CURB UNLESS OTHERWISE NOTED. VALLEY GUTTER ELEVATIONS ARE SHOWN AT FLOWLINE ELEVATION.

KEYED NOTES:

1. CONCRETE MASSONARY UNIT FENCE REQUIRED ALONG THE REAR PROPERTY LINE FOR LOTS 18 THROUGH 70 STANDARD C.M.U. = 6" X 8" X 16" GRADE REINFORCED CELLS ONLY.
2. FENCING CONTRACTOR IS TO PROVIDE ONE TURNED OUT BLOCK IN LOWEST CORNER OF LOT JUST ABOVE GROUND SURFACE TO PROVIDE BACKYARD DRAINAGE TO THE ADJACENT TRACT FOR LOTS 18 THROUGH 70.

LEGEND

PROPOSED SPOT ELEVATION • 5235.25
EXISTING SPOT ELEVATION • 5235.25
FUTURE SPOT ELEVATION • 5235.25
PROPOSED RETAINING WALL ————
EXISTING CONTOUR ————
DIRECTION OF FLOW ————
EXISTING STORM DRAIN LINE ————
EXISTING STORM DRAIN MANHOLE •
PROPOSED STORM DRAIN INLET ————
PROPOSED STORM DRAIN LINE ————
PROPOSED STORM DRAIN MANHOLE •
PROPOSED WATER BLOCK ————
PROPOSED BACKYARD POND ————
EXISTING SAS MANHOLE •
PHASING BOUNDARY ————
AS-BUILT ELEVATION • 22.88 • 23.89

Bohannon - Huston

Courtyard One 7500 JEFFERSON NE Albuquerque NEW MEXICO 87109

ENGINEERS PLANNERS PHOTOGRAMMETRISTS SURVEYORS SOFTWARE DEVELOPERS

CITY OF ALBUQUERQUE
PUBLIC WORKS DEPARTMENT
ENGINEERING DEVELOPMENT GROUP

COTTONWOOD HILLS
GRADING AND DRAINAGE PLAN



DEVELOPMENT REVIEW BOARD DRB APPROVAL DATE

Approved @ DRB


609281 A-13/B-13

4 OF 24



COPYRIGHT BOHANNAN HUSTON, 1999

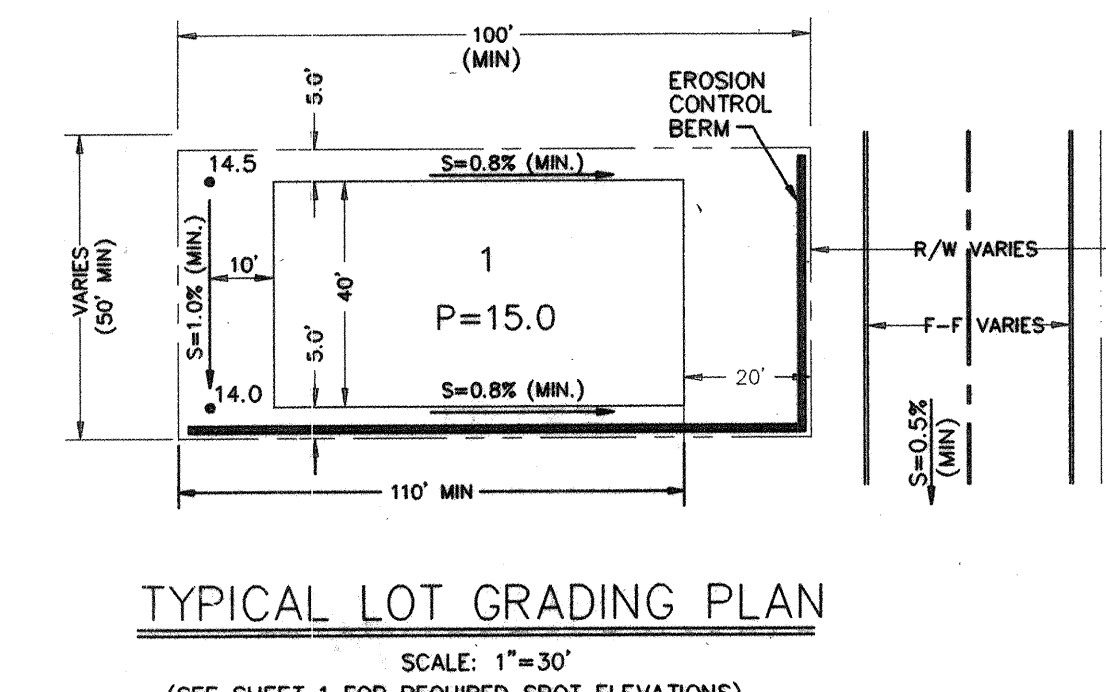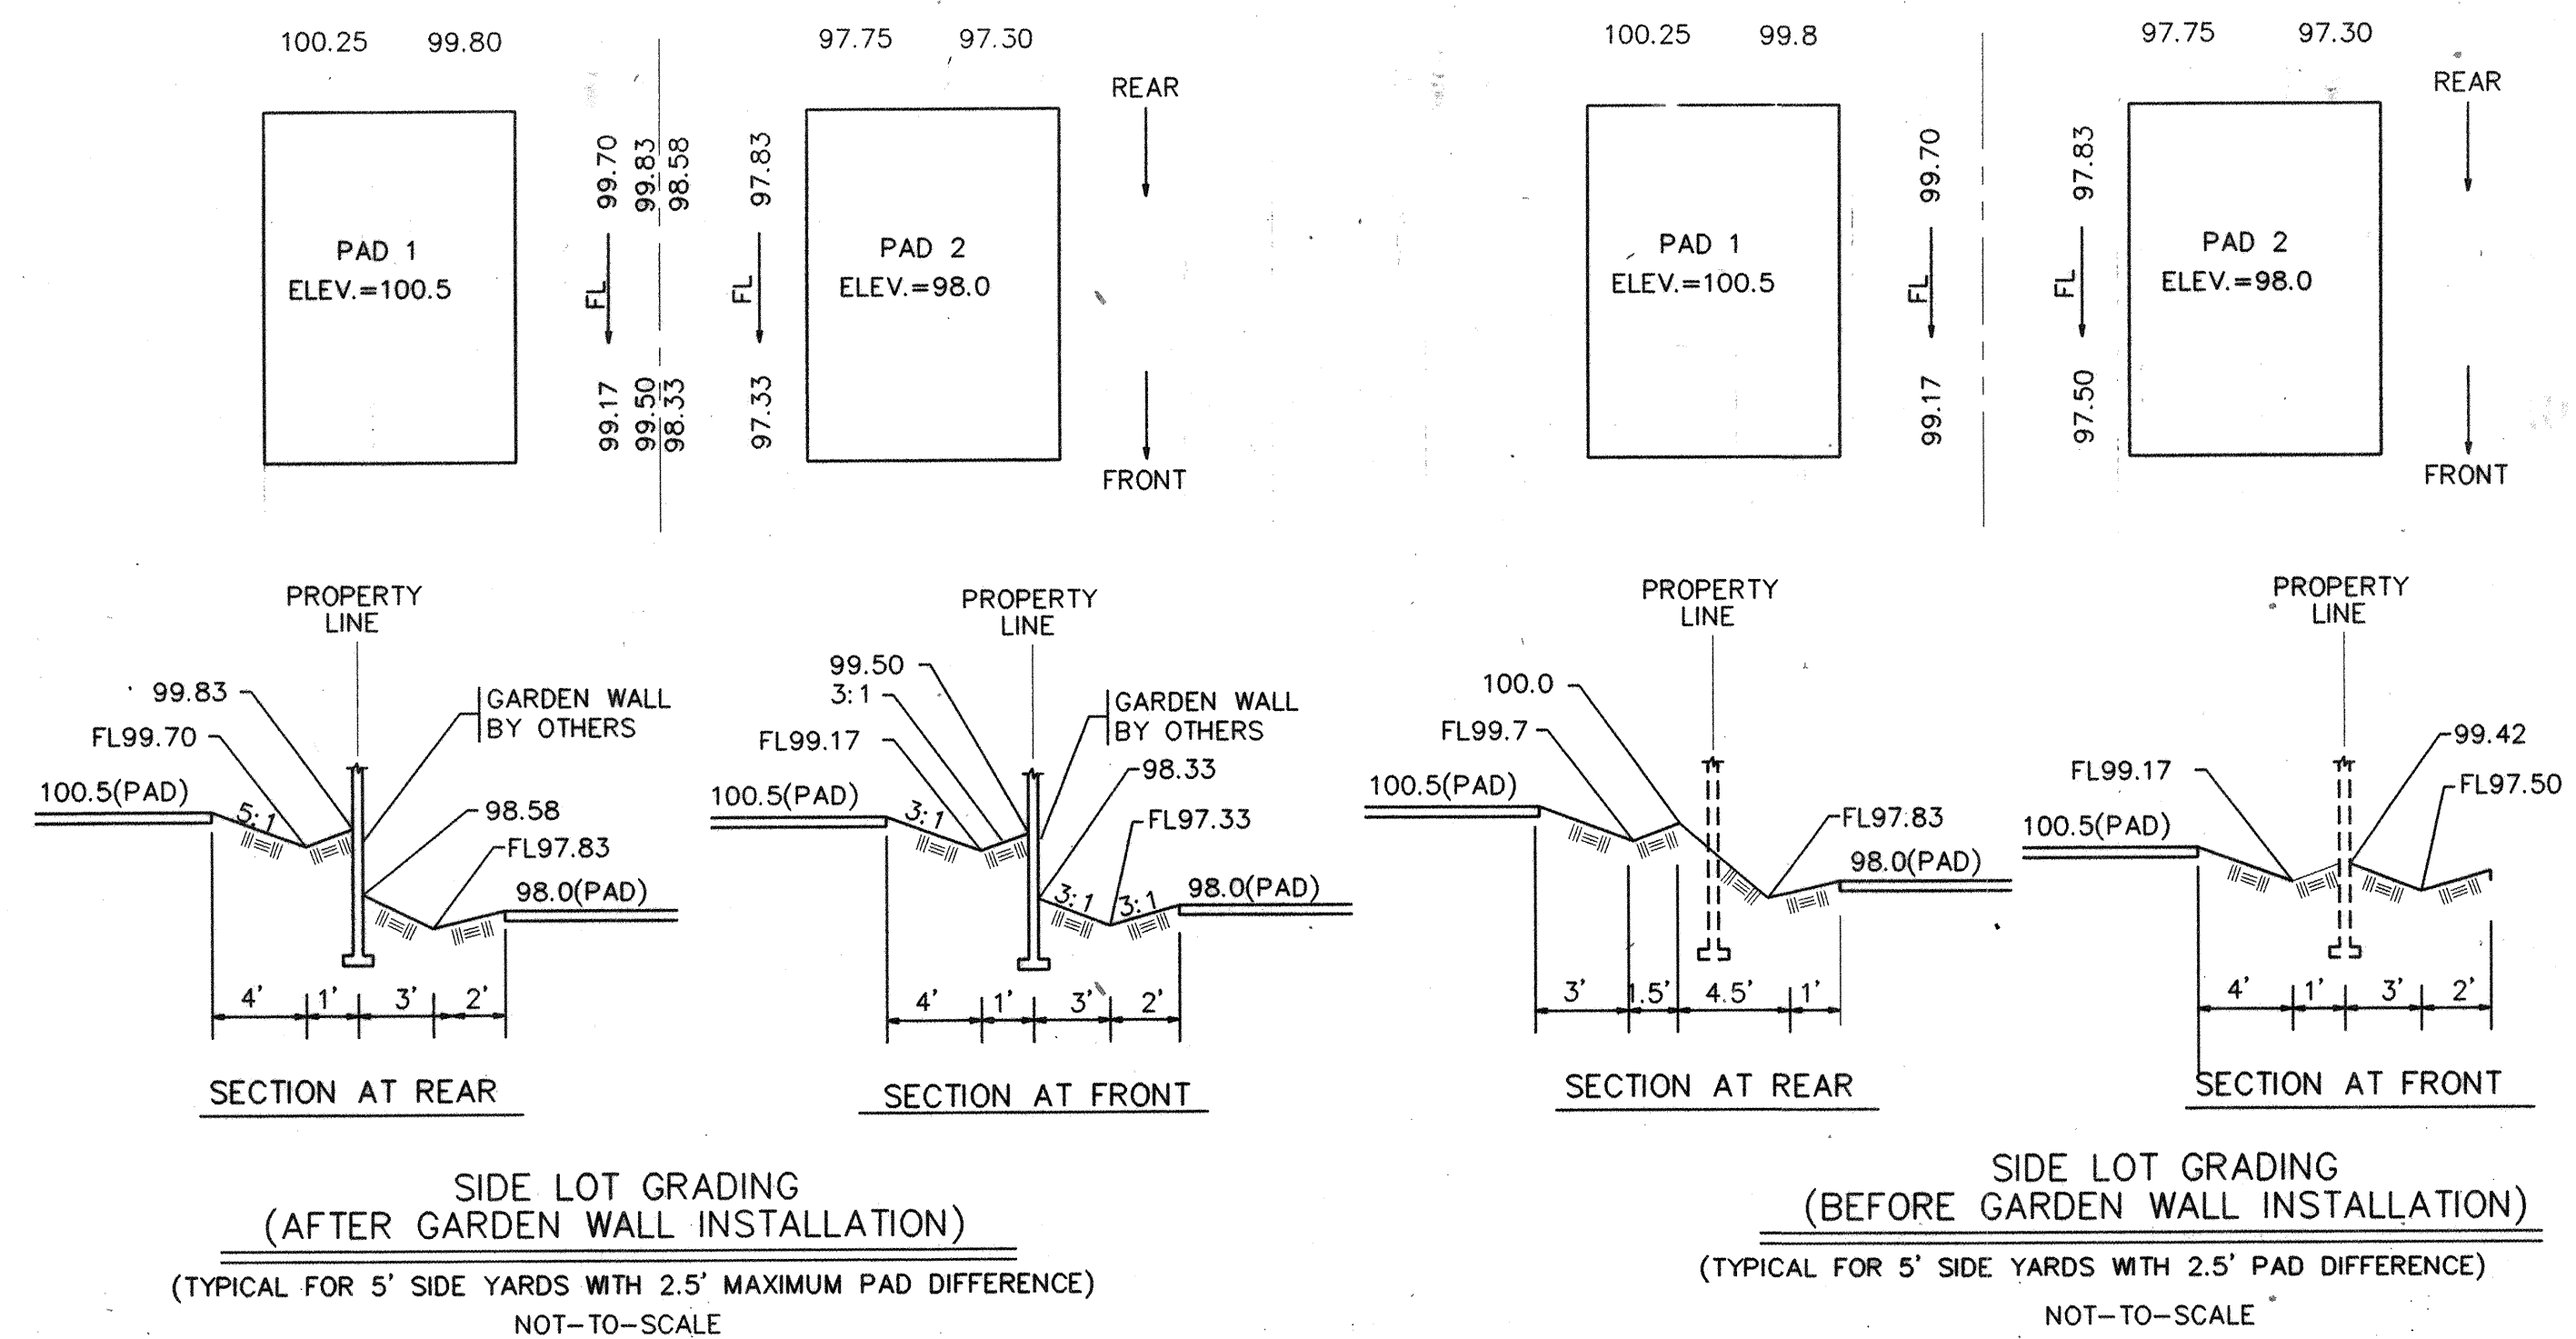

- GENERAL NOTES**
- THE CONTRACTOR MUST OBTAIN A TOPSOIL DISTRIBUTION PERMIT FROM THE ENVIRONMENTAL HEALTH DIVISION PRIOR TO CONSTRUCTION.
 - THE CONTRACTOR IS TO REFER TO EARTHWORK SPECIFICATIONS AS NOTED IN SOILS REPORT PREPARED BY VINEYARD AND ASSOCIATES DATED JUNE 14, 1995.
 - THE CONTRACTOR SHALL CONFORM TO ALL CITY, COUNTY, STATE AND FEDERAL DUST CONTROL MEASURES AND REQUIREMENTS AND WILL BE RESPONSIBLE FOR PREPARING AND OBTAINING ALL NECESSARY APPLICATIONS AND APPROVALS.
 - THE CONTRACTOR SHALL ENSURE THAT NO SOIL ERODES FROM THE LOTS INTO PUBLIC RIGHT-OF-WAY. THIS CAN BE ACHIEVED BY CONSTRUCTING TEMPORARY BERMS AS PER DETAIL THIS SHEET, AND WETTING THE SOIL TO KEEP IT FROM BLOWING.


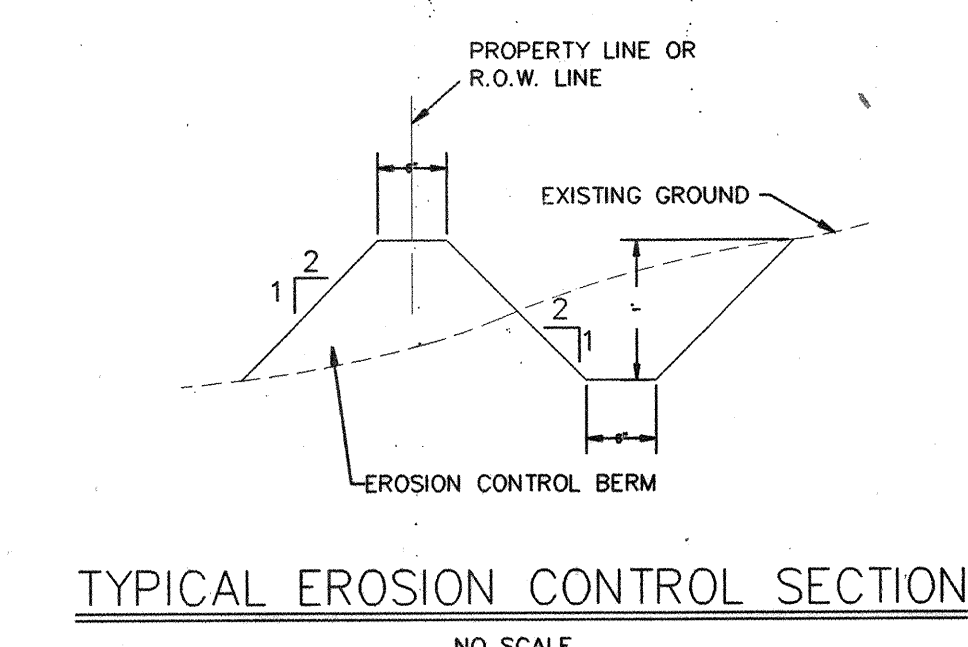


A BERM WITH THE DIMENSIONS SHOWN SHALL BE MAINTAINED DURING CONSTRUCTION UNTIL COMPLETION OF INDIVIDUAL HOMES WITHIN THE PROJECT. SEE TYPICAL LOT GRADING PLAN THIS SHEET FOR LOCATION.

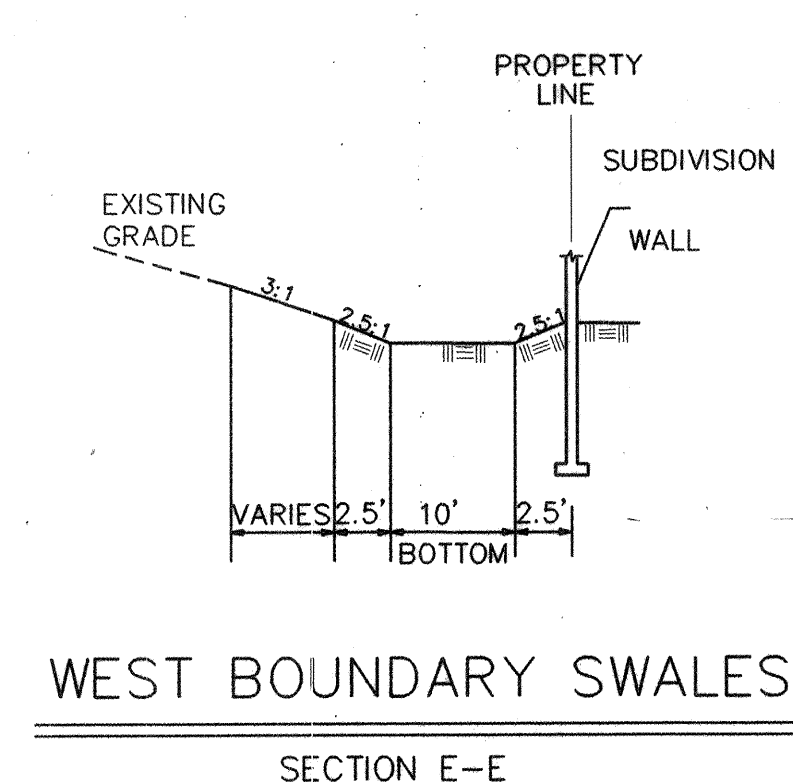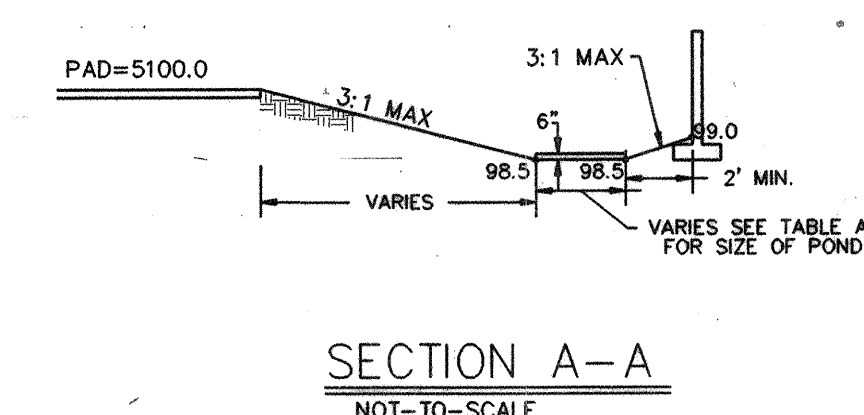

APPROVED FOR OFFSITE GRADING PER THIS PLAN

SIGNED _____ DATE _____

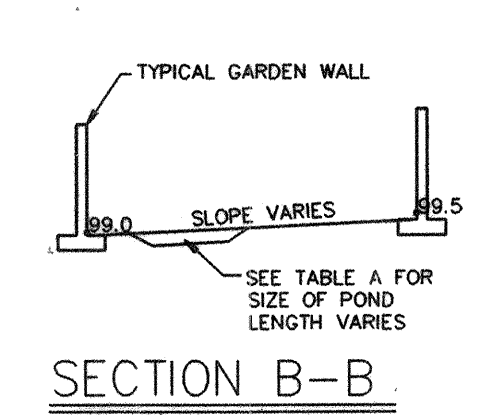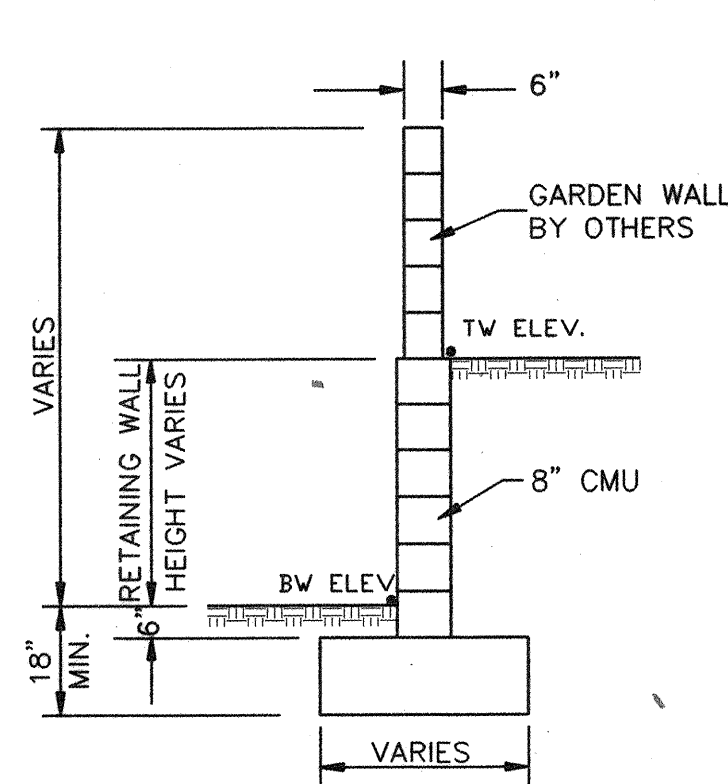

LOT # UNIT B-9	BACKYARD AREA (SQ. FT.)	REQUIRED V(100) (CU. FT.)	POND DIMENSION (FT.) (AVG. WIDTHS)				POND VOLUME (CU. FT.)	C	I	Q(100) cfs
			L	W1	W2	D				
74	1755	126	21	5.8	9.4	0.8	128	0.52	4.7	0.10
153	1558.8	113	22	6.1	6.7	0.8	113	0.52	4.7	0.09
154	1710	123	26	7.6	4.2	0.8	123	0.52	4.7	0.10
155	3660	258	23	14.1	13.9	0.8	258	0.52	4.7	0.21
156	7610.9	531	35	19.8	23.7	0.7	531	0.52	4.7	0.43
174	1585.3	115	23	7.3	7.5	0.7	117	0.52	4.7	0.09
175	1585.3	115	21	7.6	8.2	0.7	115	0.52	4.7	0.09

AS-BUILT INFORMATION		BENCH MARKS		SURVEY INFORMATION		ENGINEER'S SEAL	
CONTRACTOR	DATE	NO.	DATE	NO.	DATE	NO.	DATE
WALKER	99						
INSPECTOR	DATE	NO.	DATE	NO.	DATE	NO.	DATE
WALKER	99						
APPROVED BY	DATE	NO.	DATE	NO.	DATE	NO.	DATE
WALKER	99						
RECORDED BY	DATE	NO.	DATE	NO.	DATE	NO.	DATE

Bohannon & Huston
 Courtyard One 7500 JEFFERSON NE Albuquerque NEW MEXICO 87109
 ENGINEERS PLANNERS PHOTOGRAMMETRISTS SURVEYORS SOFTWARE DEVELOPERS

CITY OF ALBUQUERQUE
PUBLIC WORKS DEPARTMENT
ENGINEERING DEVELOPMENT GROUP
SEVEN BAR, CORTONWOOD HILLS
OFFSITE GRADING AND DETAILS


Design Review Committee: MAY 1999 MAY - 3 1999
 City Engineer Approval: [Signature]
 City Project No. 6092.81
 Zone Map No. 13
 Sheet 5 of 24

	FL	
1	15.13	①
2	15.48	
3	15.83	

$D = 78^{\circ}40'19''$
 $L = 34.33'$
 $R = 25.00'$



MEDIAN CURB DATA					
PT	FL	STATION & OFFSET	PT	FL	STATION & OFFSET
1	11.02	1441.82, 2.00' LT.	8	10.87	1441.82, 4.00' RT.
2	11.47	1453.17, 2.00' LT.	9	11.32	1453.17, 4.00' RT.
3	11.92	1464.51, 2.00' LT.	10	11.77	1464.51, 4.00' RT.
4	12.48	1475.86, 2.00' LT.	11	12.33	1475.86, 4.00' RT.
5	13.09	1487.21, 2.00' LT.	12	12.94	1487.21, 4.00' RT.
6	13.62	1498.56, 2.00' LT.	13	13.47	1498.56, 4.00' RT.
7	14.07	2409.90, 2.00' LT.	14	13.92	2409.90, 4.00' RT.

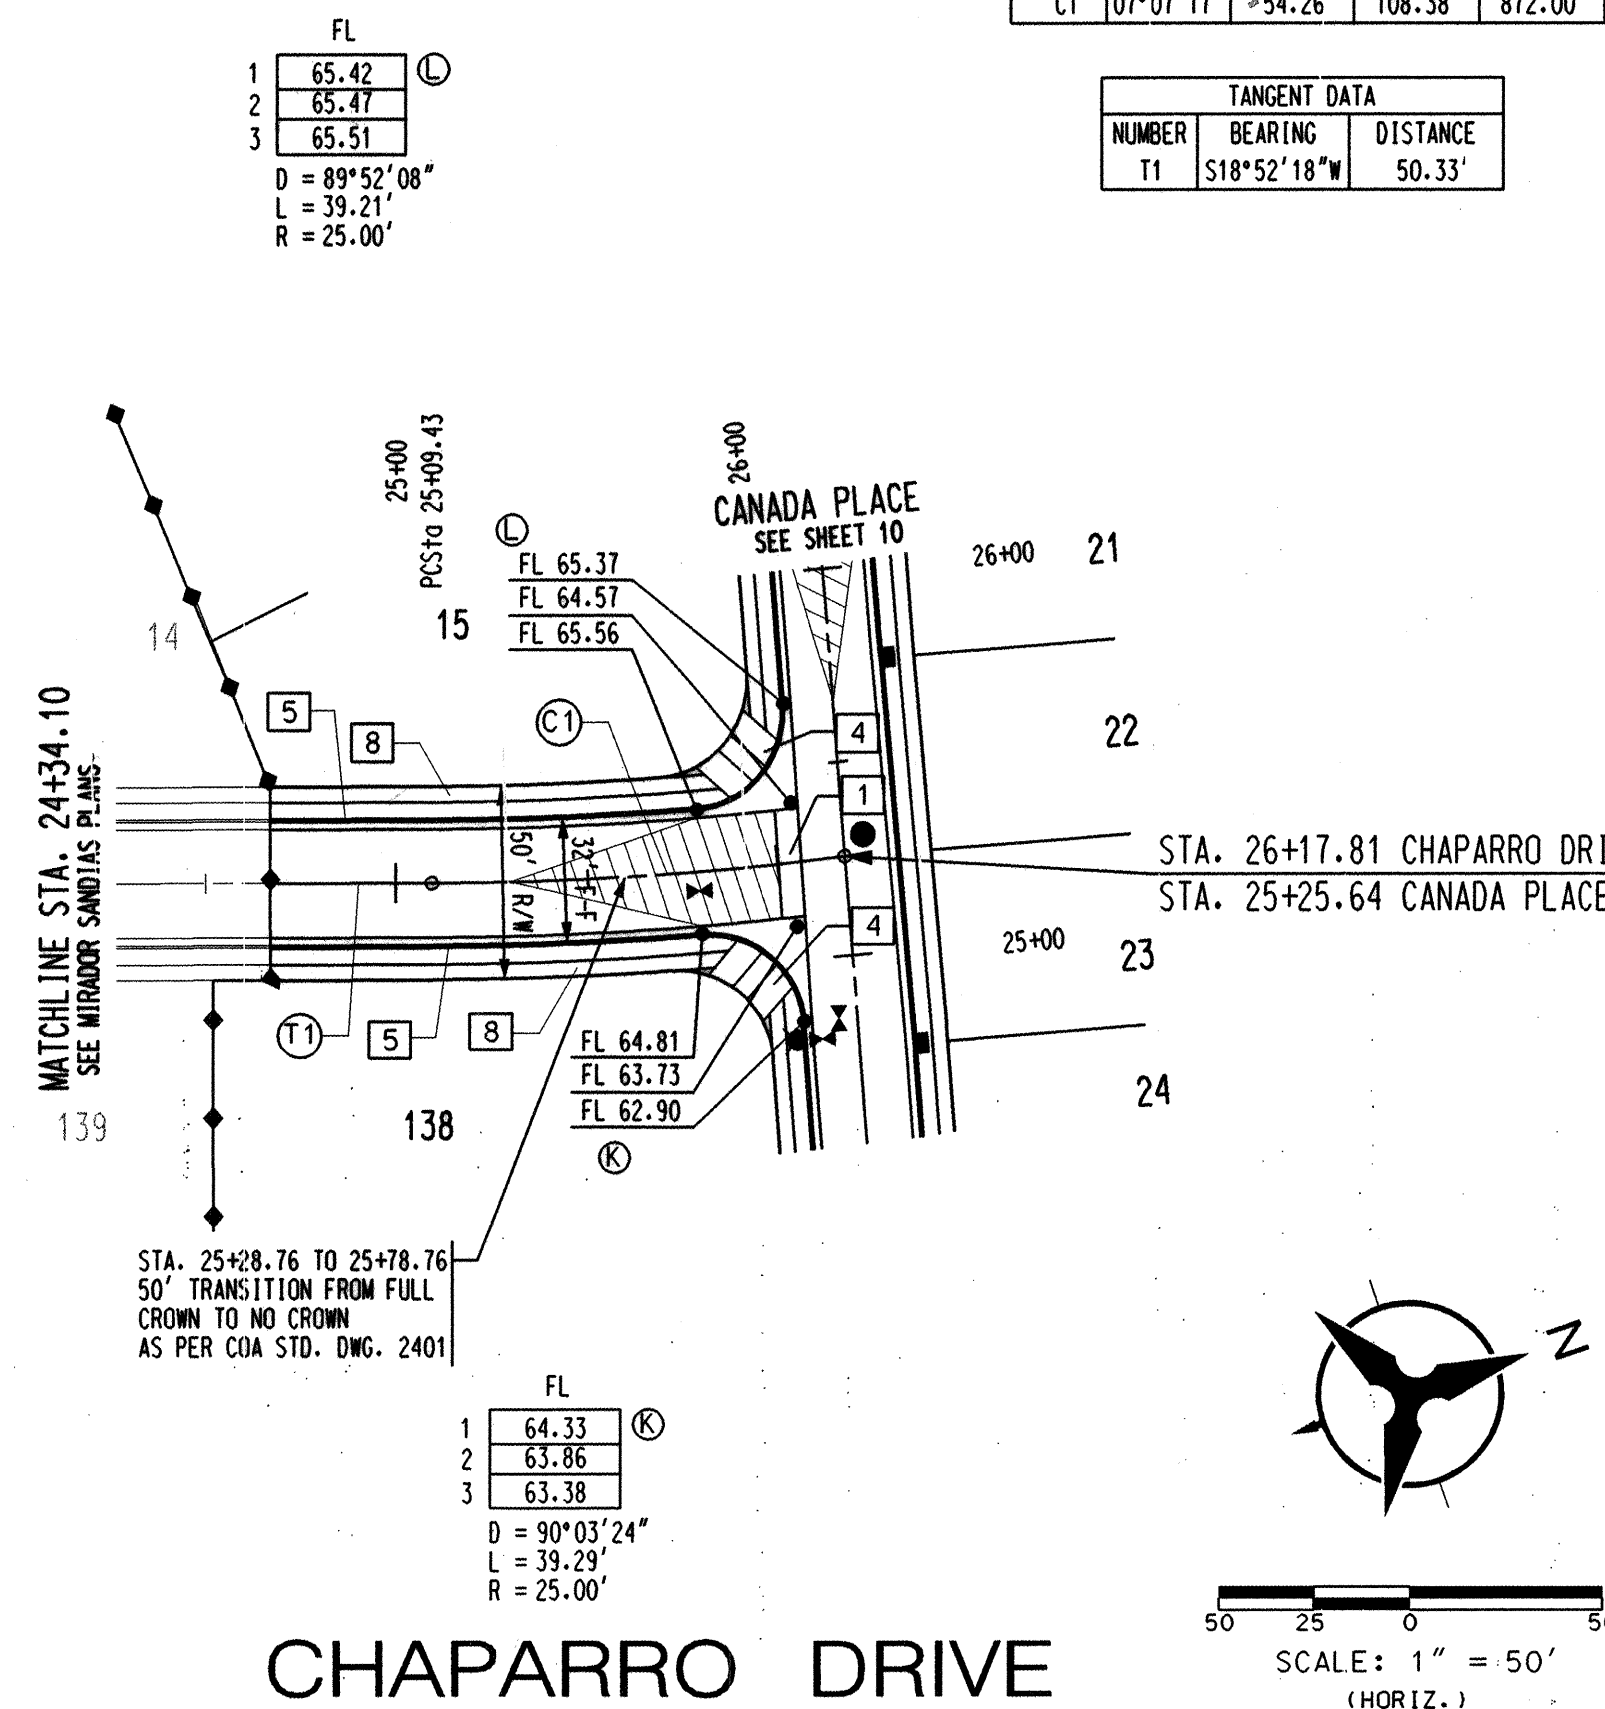

1. THE CONTRACTOR SHALL FIELD VERIFY ALL EXISTING UTILITY LOCATIONS AND NOTIFY THE ENGINEER IMMEDIATELY OF ANY DISCREPANCIES.
2. ALL CURB RETURN RADII SHALL BE 25' UNLESS OTHERWISE SPECIFIED.
3. ALL CURVE DATA AND DIMENSIONS REFER TO FACE OF CURB UNLESS OTHERWISE SPECIFIED.
4. GRADE ELEVATIONS, WHERE NOTED, ARE ALONG FLOWLINE OF STANDARD CURB UNLESS OTHERWISE SPECIFIED.
5. CONTRACTOR IS TO INSTALL A 4" X 4" X 5' POST AND END AT THE END OF EACH SANITARY SEWER SERVICE.
6. CONTRACTOR IS RESPONSIBLE FOR REPAIR AND/OR REPLACEMENT OF ALL UTILITY CONDUITS AND EXISTING LINES.
7. ANY ADDITIONAL GRADING REQUIRED TO MATCH PROPOSED STREET GRADES SHALL BE INCIDENTAL TO PAVING ITEMS.
8. CONTRACTOR SHALL PROVIDE THE INSPECTORS (CITY AND PRIVATE) WITH THE PROPOSED HYDROSTATIC TESTING PLAN. THE PLAN MUST BE APPROVED BEFORE TESTING OPERATIONS BEGIN.
9. CONTRACTOR SHALL PARK EQUIPMENT AND VEHICLES AS NOT TO INTERFERE WITH NORMAL ACTIVITIES OF RESIDENTS OR OTHER CONTRACTORS ON SITE.
10. ANY DAMAGE TO THE EXISTING FACILITIES (CURB & GUTTER), PAVEMENT, CONDUITS, LANDSCAPING, UTILITY LINES, ETC.) DURING CONSTRUCTION SHALL BE REPLACED AT THE CONTRACTORS' EXPENSE.
11. REMOVAL OF THE EXISTING CURB AND GUTTER SHALL BE AS PER COA STD. DWG. 2415 (SAWCUT ONLY).
12. WHEELCHAIR RAMPS SHALL BE CONSTRUCTED PRIOR TO ACCEPTANCE OF CURB & GUTTER.
13. STATIONING AND OFFSETS GIVEN FOR DROP INLETS ARE GIVEN AT CENTER OF GRATE AT FLOWLINE.

* NOT APPLICABLE THIS SHEET

KEYED GENERAL NOTES

- 1 INSTALL CONCRETE VALLEY GUTTER
AS PER STD. DWG. 2420
- * 2 INSTALL CONCRETE VALLEY GUTTER
AS PER STD. DWG. 2421
- * 3 INSTALL WHEELCHAIR RAMP AS
PER STD. DWG. 2441, CASE I
WITH ALTERNATE SECTION AA
- 4 INSTALL WHEELCHAIR RAMP AS
PER DETAIL, SEE SHEET 6
- 5 STD. CURB & GUTTER
AS PER STD. DWG. 2415
- * 6 ROLL CURB & GUTTER
AS PER STD. DWG. 2415
- 7 MEDIAN CURB & GUTTER
AS PER STD. DWG. 2415
- 8 FUTURE 4' SIDEWALK
- 9 BUILD 4' SIDEWALK



Bohannon ▴ Huston

 Courtyard One 7500 JEFFERSON NE Albuquerque NEW MEXICO 87109
 ENGINEERS PLANNERS PHOTOGRAMMETRISTS SURVEYORS SOFTWARE DEVELOPERS

 CITY OF ALBUQUERQUE
PUBLIC WORKS DEPARTMENT
ENGINEERING DEVELOPMENT GROUP

COTTONWOOD HILLS
PAVING PLAN & PROFILE
CHANDLER DRIVE ENTRANCE & CHAPARRO DRIVE

DESIGN REVIEW COMMITTEE	CITY ENGINEER APPROVAL	3	MO./DAY/YR.	MO./DAY/YR.
-------------------------	------------------------	---	-------------	-------------


APPROVED
MAY 1999
DESIGN REVIEW COMMITTEE

CITY PROJECT NO.	ZONE MAP NO.	SHEET	OF
6092.81	A-13/B-13	7	2

COPYRIGHT BOHANNAN HUSTO 1998
DATE: FEBRUARY, 1999

CURVE DATA				
NUMBER	DELTA	TANGENT	ARC	RADIUS
C2	18°01'31"	79.31'	157.30'	500.00'
C3	51°02'31"	132.25'	246.77'	277.00'
C4	00°17'09"	03.83'	07.66'	1535.75'
C5	16°51'25"	227.56'	451.83'	1535.75'

TANGENT DATA		
NUMBER	BEARING	DISTANCE
T5	N41°43'40"W	160.44'
T6	N41°43'40"W	236.84'
T7	S87°13'49"W	41.01'

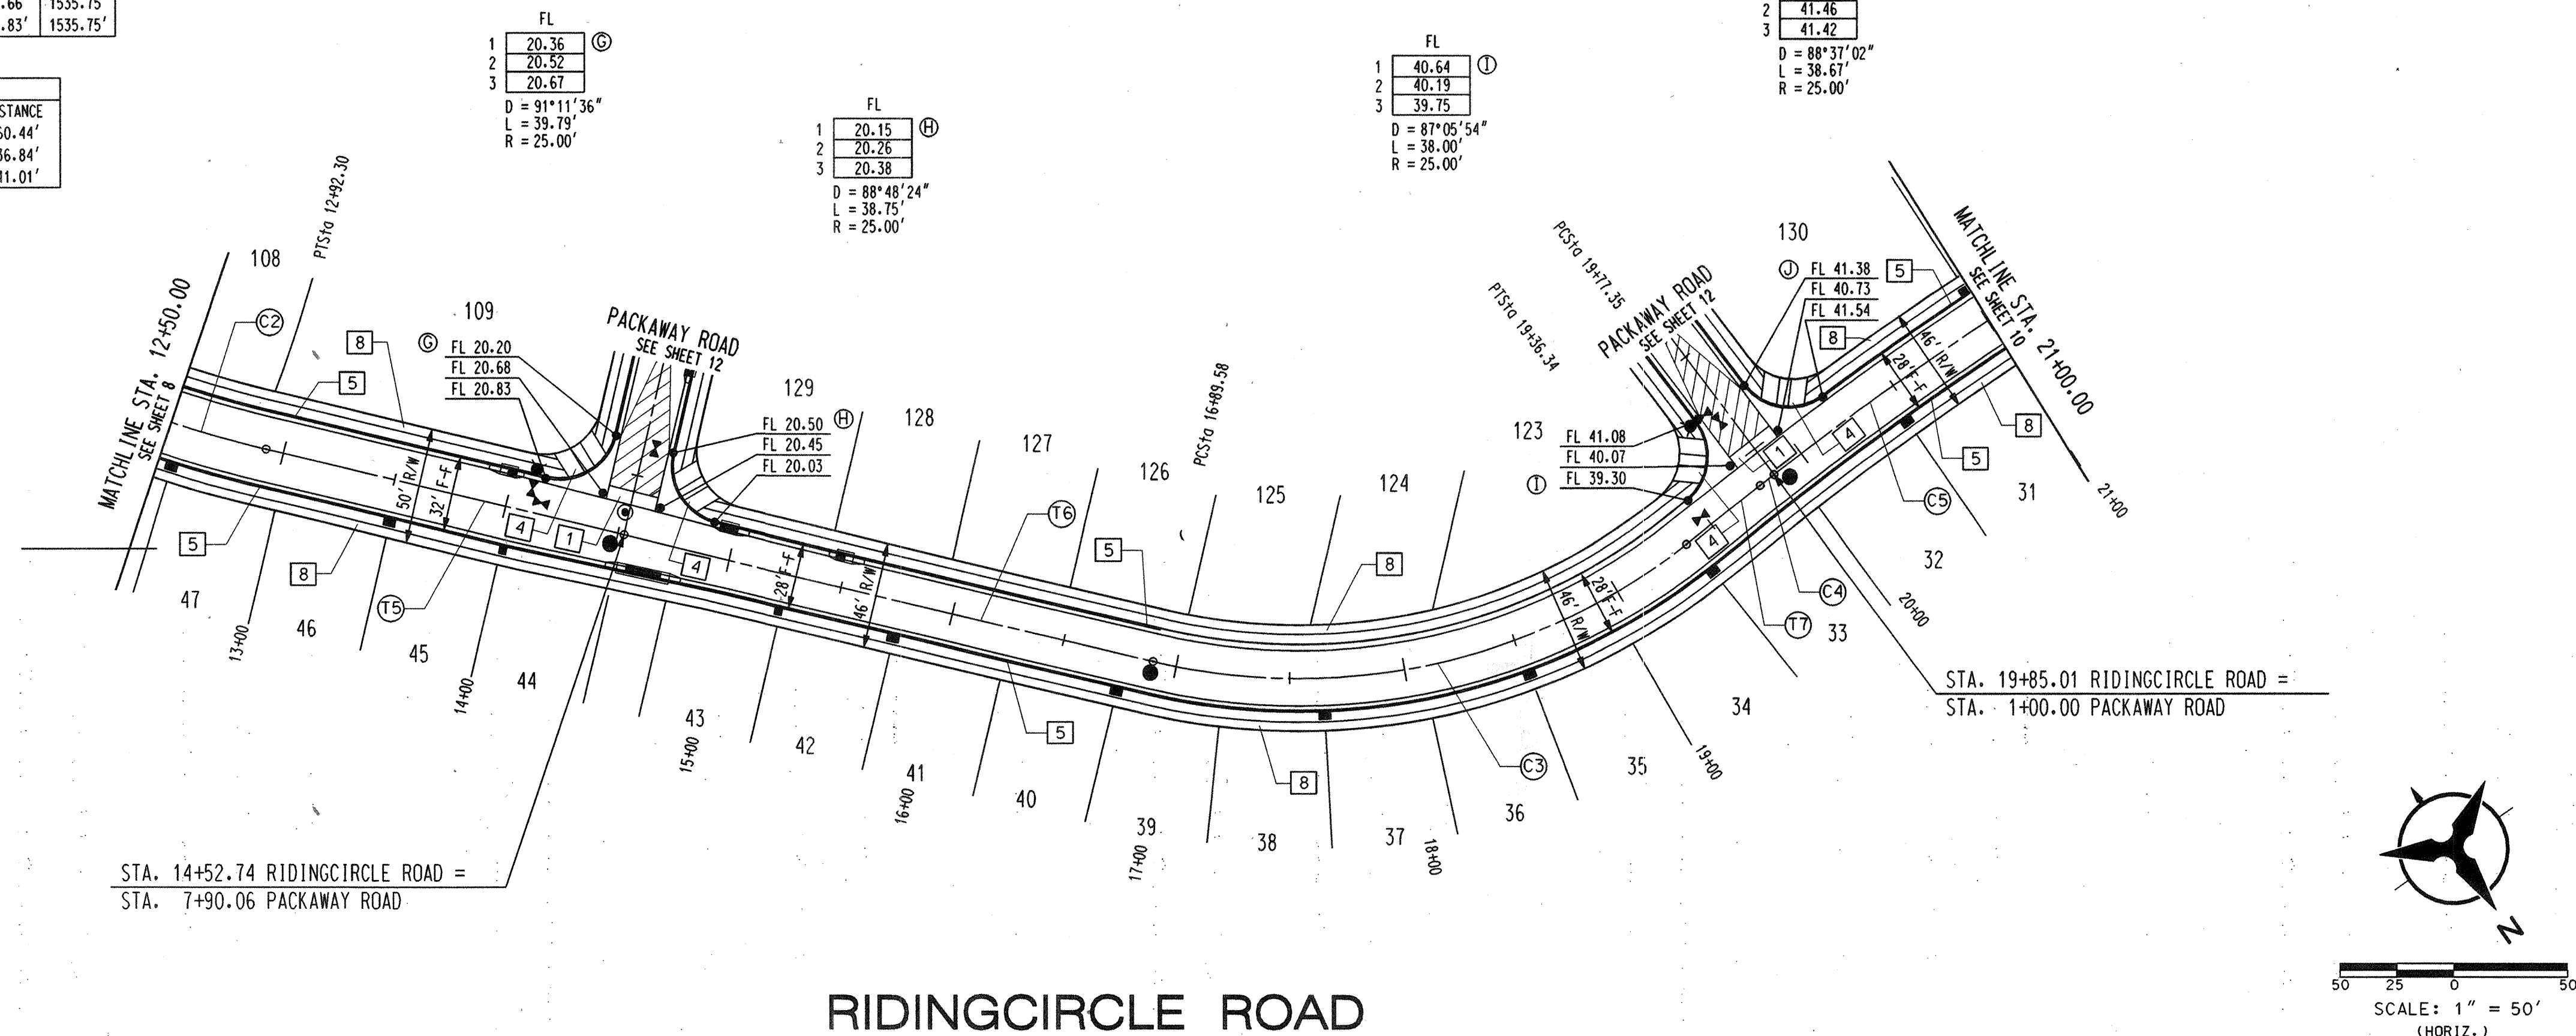

- NOTES
1. THE CONTRACTOR SHALL FIELD VERIFY ALL EXISTING UTILITY LOCATIONS AND NOTIFY THE ENGINEER IMMEDIATELY OF ANY DISCREPANCIES.
 2. ALL CURB RETURN RADI SHALL BE 25' UNLESS OTHERWISE SPECIFIED.
 3. ALL CURVE DATA AND DIMENSIONS REFER TO FACE OF CURB UNLESS OTHERWISE SPECIFIED.
 4. GRADE ELEVATIONS, WHERE NOTED, ARE ALONG FLOWLINE OF STANDARD CURB UNLESS OTHERWISE SPECIFIED.
 5. CONTRACTOR IS TO INSTALL A 4" X 4" X 5' POST AND END AT THE END OF EACH SANITARY SEWER SERVICE.
 6. CONTRACTOR IS RESPONSIBLE FOR REPAIR AND/OR REPLACEMENT OF ALL UTILITY CONDUITS AND EXISTING LINES.
 7. ANY ADDITIONAL GRADING REQUIRED TO MATCH PROPOSED STREET GRADES SHALL BE INCIDENTAL TO PAVING ITEMS.
 8. CONTRACTOR SHALL PROVIDE THE INSPECTORS (CITY AND PRIVATE) WITH THE PROPOSED HYDROSTATIC TESTING PLAN. THE PLAN MUST BE APPROVED BEFORE TESTING OPERATIONS BEGIN.
 9. CONTRACTOR SHALL PARK EQUIPMENT AND VEHICLES AS NOT TO INTERFERE WITH NORMAL ACTIVITIES OF RESIDENTS OR OTHER CONTRACTORS ON SITE.
 10. ANY DAMAGE TO THE EXISTING FACILITIES (CURB & GUTTER), PAVEMENT, CONDUITS, LANDSCAPING, UTILITY LINES, ETC.) DURING CONSTRUCTION SHALL BE REPLACED AT THE CONTRACTORS EXPENSE.
 11. REMOVAL OF THE EXISTING CURB AND GUTTER SHALL BE AS PER COA STD. DWG. 2415 (SAWCUT ONLY).
 12. WHEELCHAIR RAMPS SHALL BE CONSTRUCTED PRIOR TO ACCEPTANCE OF CURB & GUTTER.
 13. STATIONING AND OFFSETS GIVEN FOR DROP INLETS ARE GIVEN AT CENTER OF GRATE AT FLOWLINE

* NOT APPLICABLE THIS SHEET

KEYED GENERAL NOTES


1. INSTALL CONCRETE VALLEY GUTTER AS PER STD. DWG. 2420
2. INSTALL CONCRETE VALLEY GUTTER AS PER STD. DWG. 2421
3. INSTALL WHEELCHAIR RAMP AS PER STD. DWG. 2441, CASE 1 WITH ALTERNATE SECTION AA
4. INSTALL WHEELCHAIR RAMP AS PER DETAIL, SEE SHEET 6
5. STD. CURB & GUTTER AS PER STD. DWG. 2415
6. ROLL CURB & GUTTER AS PER STD. DWG. 2415
7. MEDIAN CURB & GUTTER AS PER STD. DWG. 2415
8. FUTURE 4' SIDEWALK
9. BUILD 4' SIDEWALK

Bohannon & Huston
 Courtyard One 7500 JEFFERSON NE ALBUQUERQUE NEW MEXICO 87109
 ENGINEERS PLANNERS PHOTOGRAMMETRISTS SURVEYORS SOFTWARE DEVELOPERS

CITY OF ALBUQUERQUE
 PUBLIC WORKS DEPARTMENT
 ENGINEERING DEVELOPMENT GROUP
COTTONWOOD HILLS
 PAVING PLAN & PROFILE
 RIDINGCIRCLE ROAD

DESIGN REVIEW COMMITTEE CITY ENGINEER APPROVAL
 LAST DESIGN UPDATE
 MAY 1999
 DESIGN REVIEW COMMITTEE

CITY PROJECT NO. 6092.81 ZONE MAP NO. A-13/B-13 SHEET 9 OF 24

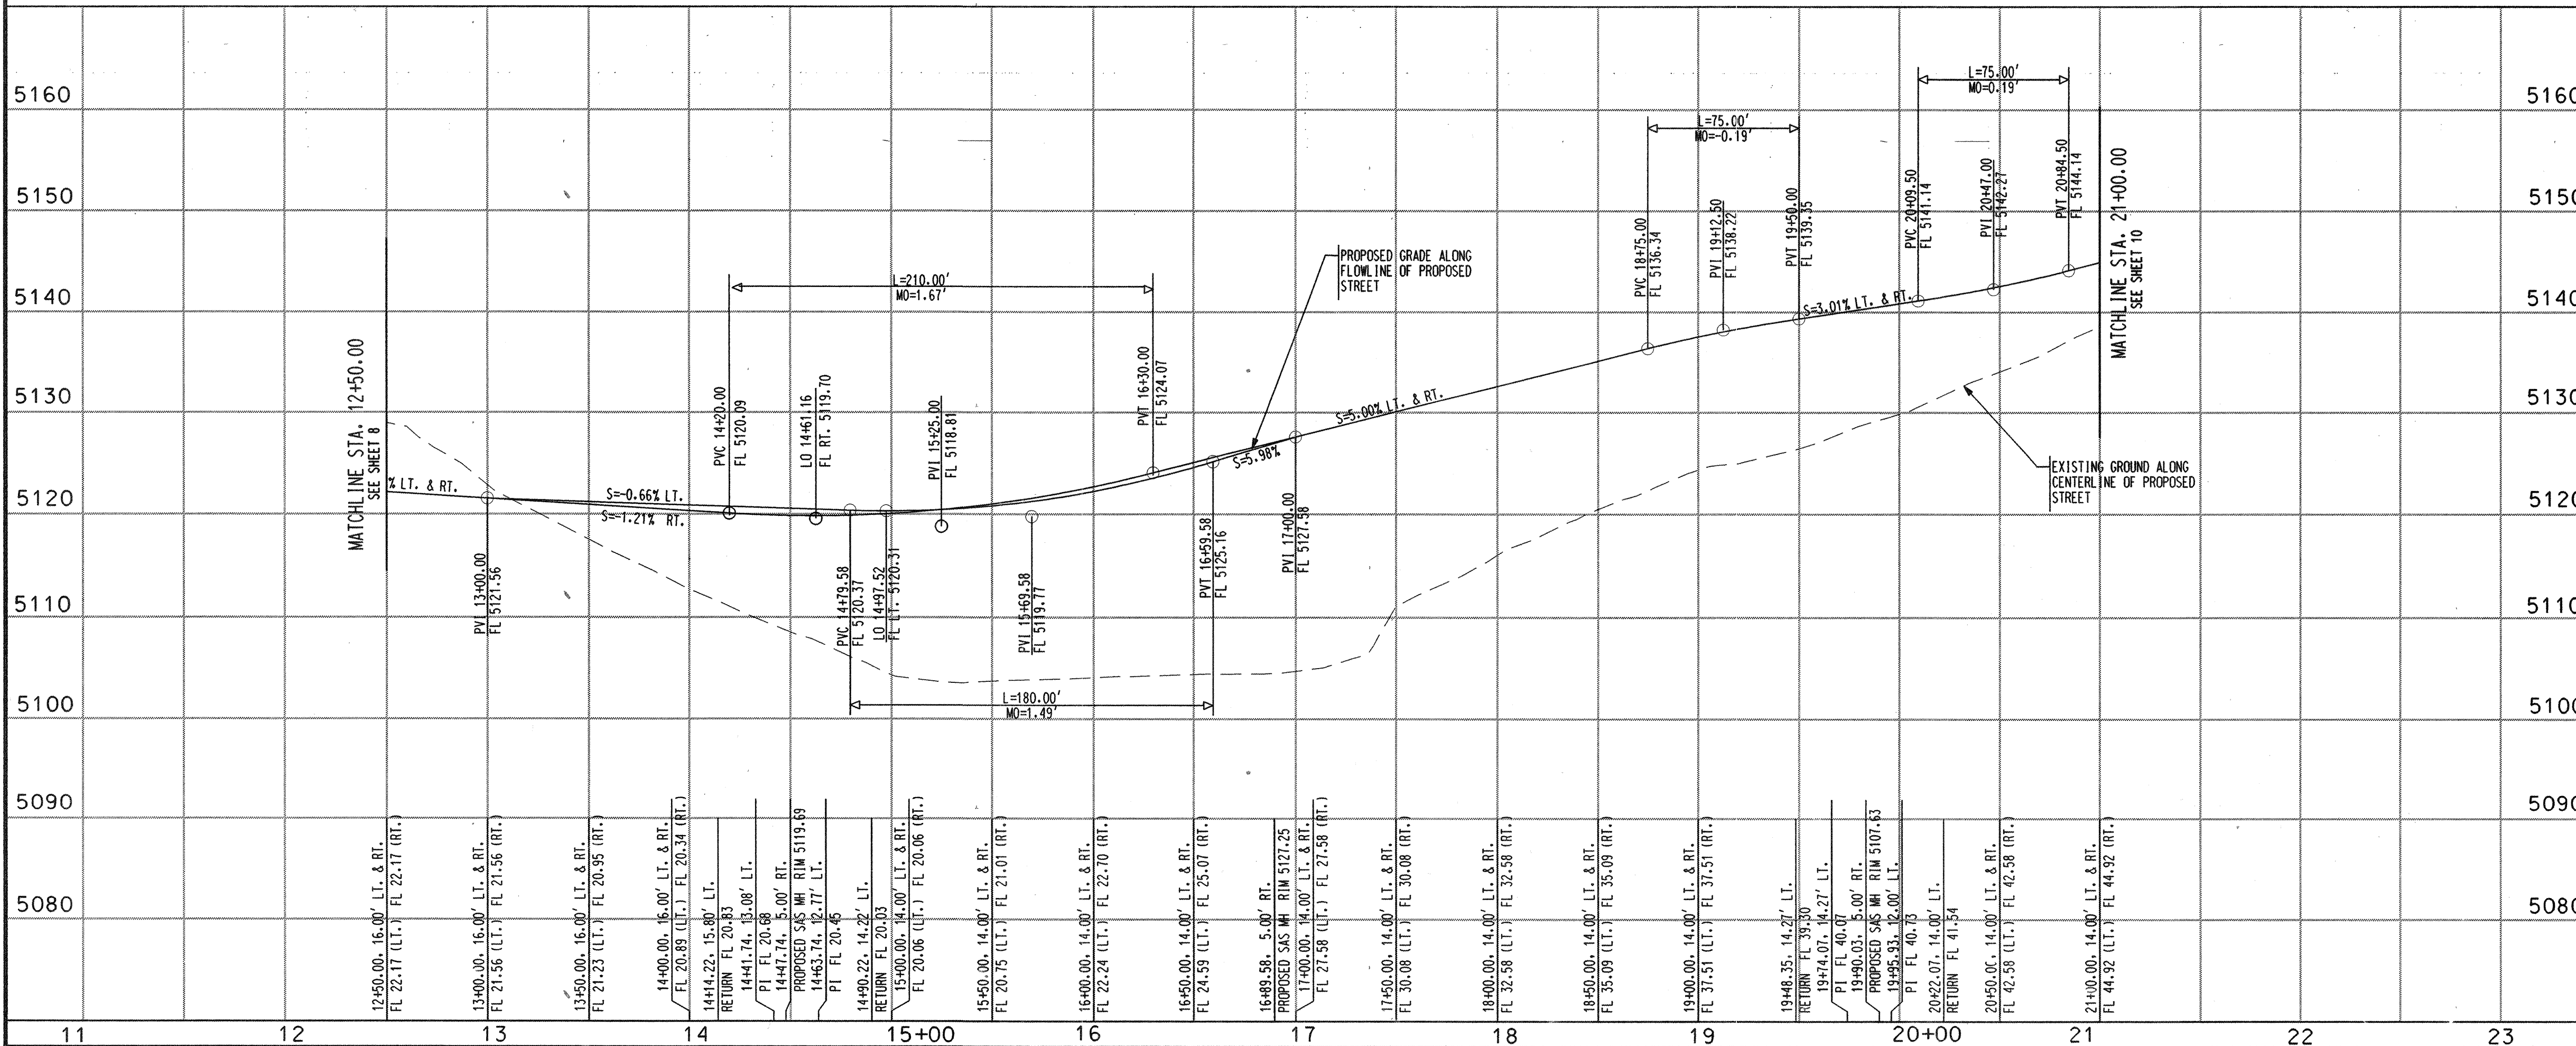

CURVE DATA				
NUMBER	DELTA	TANGENT	ARC	RADIUS
C5	16°51'25"	227.56'	451.83'	1535.75'

TANGENT DATA		
NUMBER	BEARING	DISTANCE
T8	N75°37'37"W	88.79'
T9	N75°37'37"W	153.01'
T10	N14°22'23"E	23.00'



FL	
1	64.33
2	63.86
3	63.38

D = 90°03'24"
L = 39.29'
R = 25.00'


FL	
1	65.42
2	65.47
3	65.51

D = 89°52'08"
L = 39.21'
R = 25.00'

CUL-DE-SAC CURB DATA		
PT	FL	STATION & OFFSET
1	68.43	26+39.73, 32.23' LT.
2	68.98	26+50.68, 52.46' LT.
3	69.96	26+70.22, 62.08' LT.
4	71.09	26+92.90, 60.38' LT.
5	71.99	27+10.85, 47.45' LT.
6	72.40	27+19.15, 26.44' LT.
7	72.20	27+15.05, 05.26' LT.
8	71.20	26+95.07, 14.02' RT.
9	69.69	26+64.84, 14.54' RT.

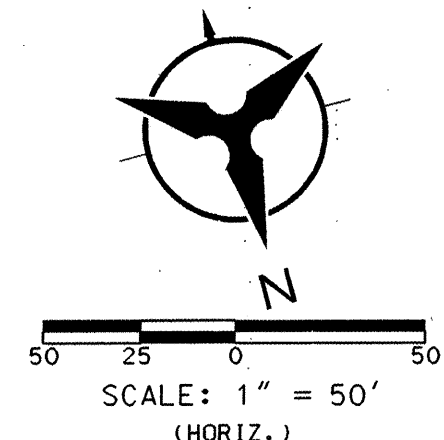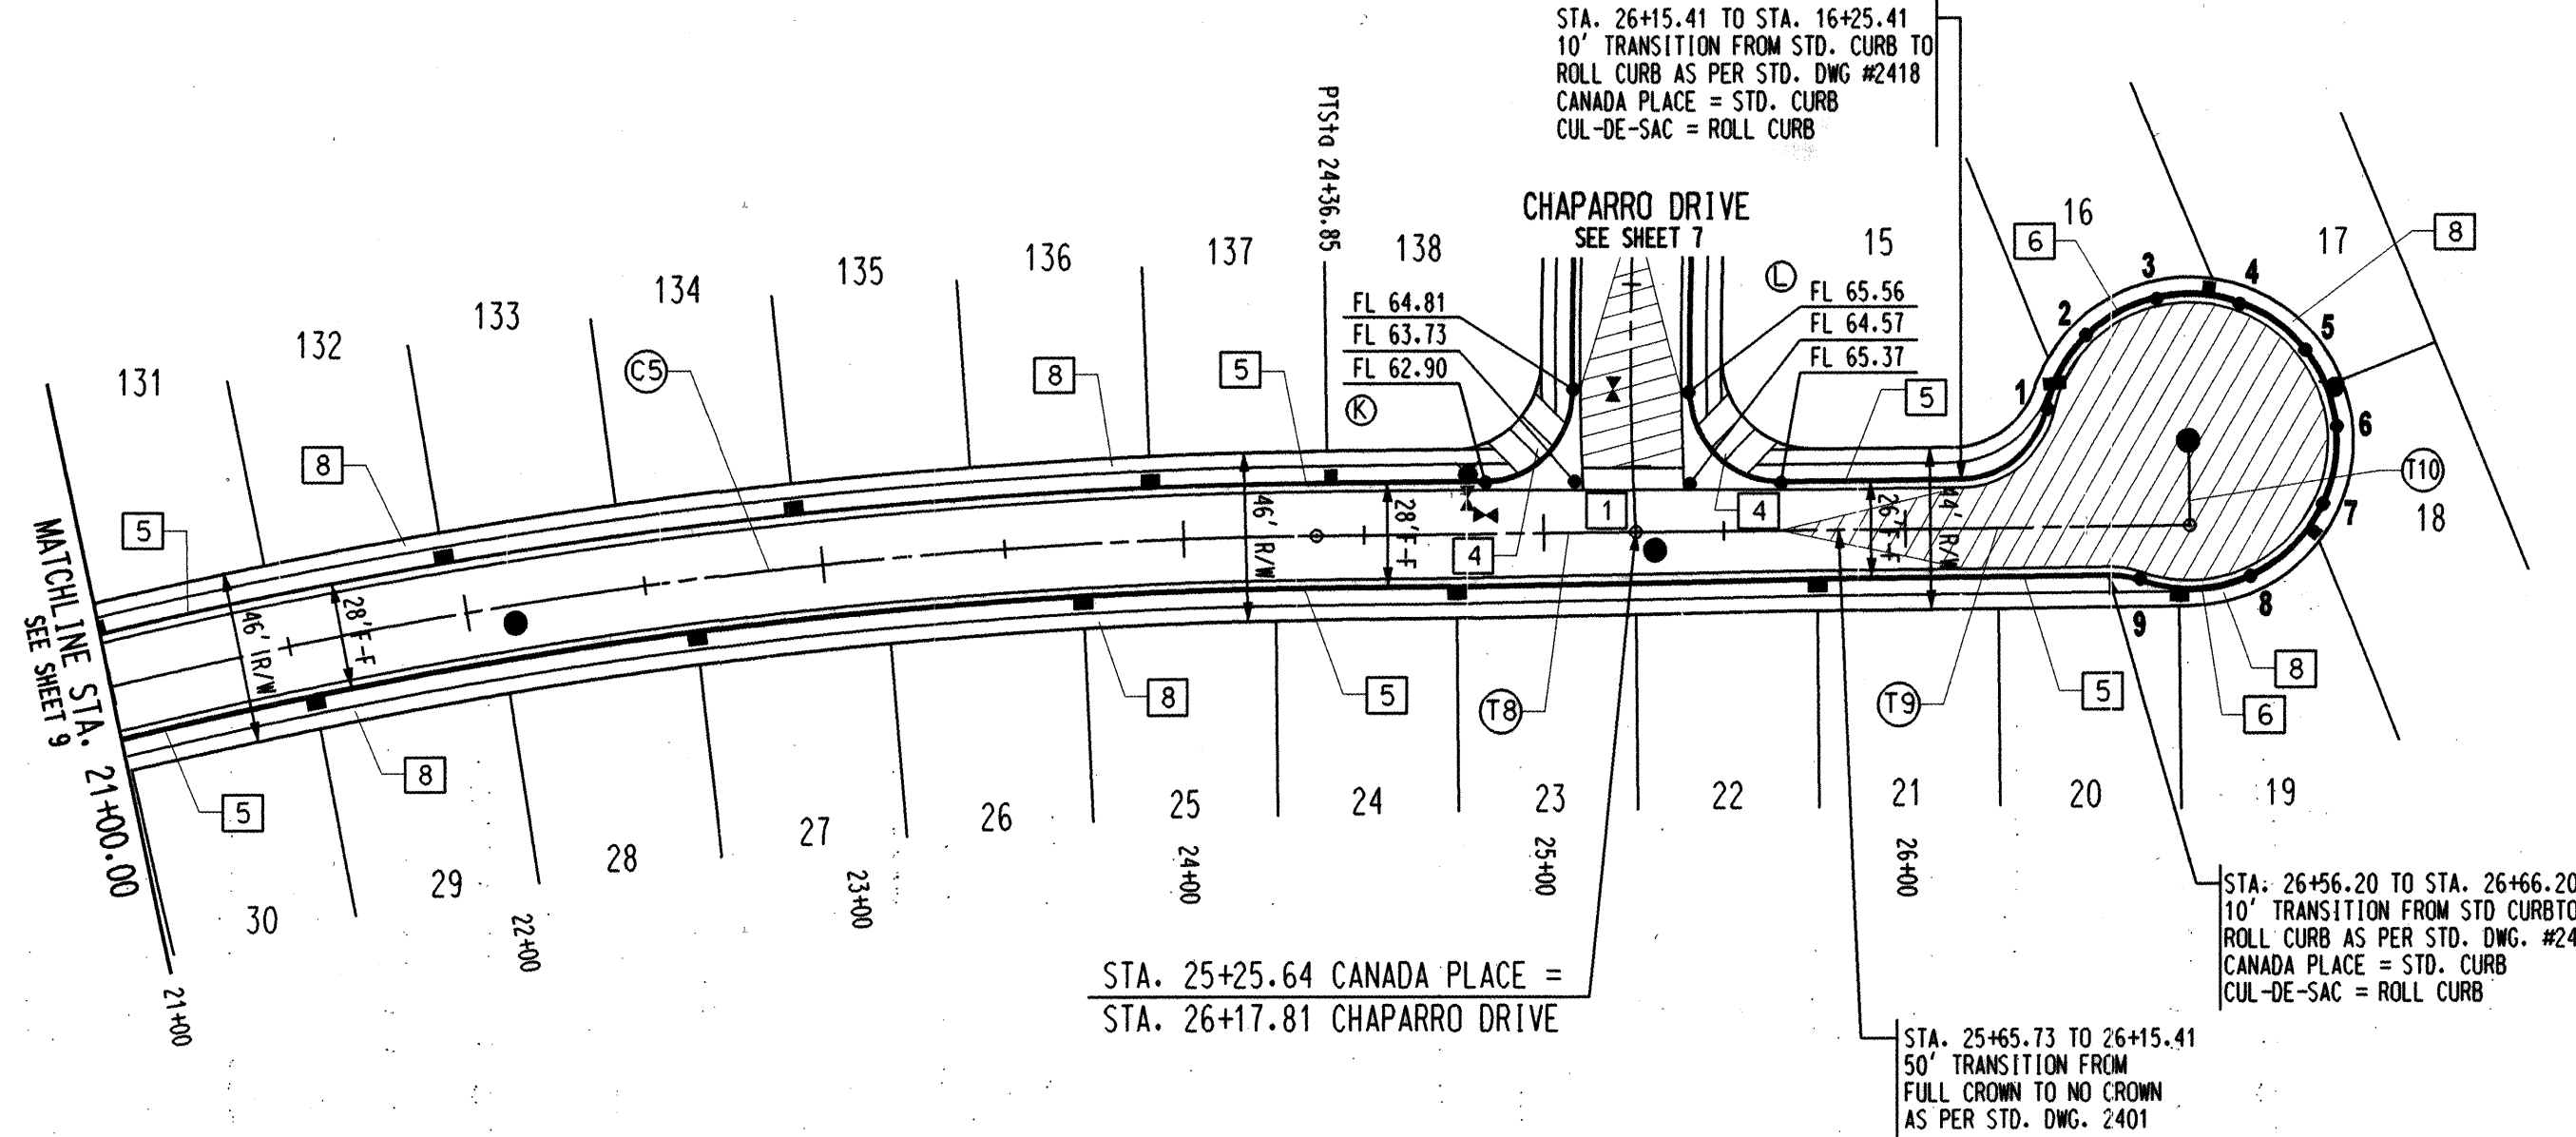

CANADA PLACE

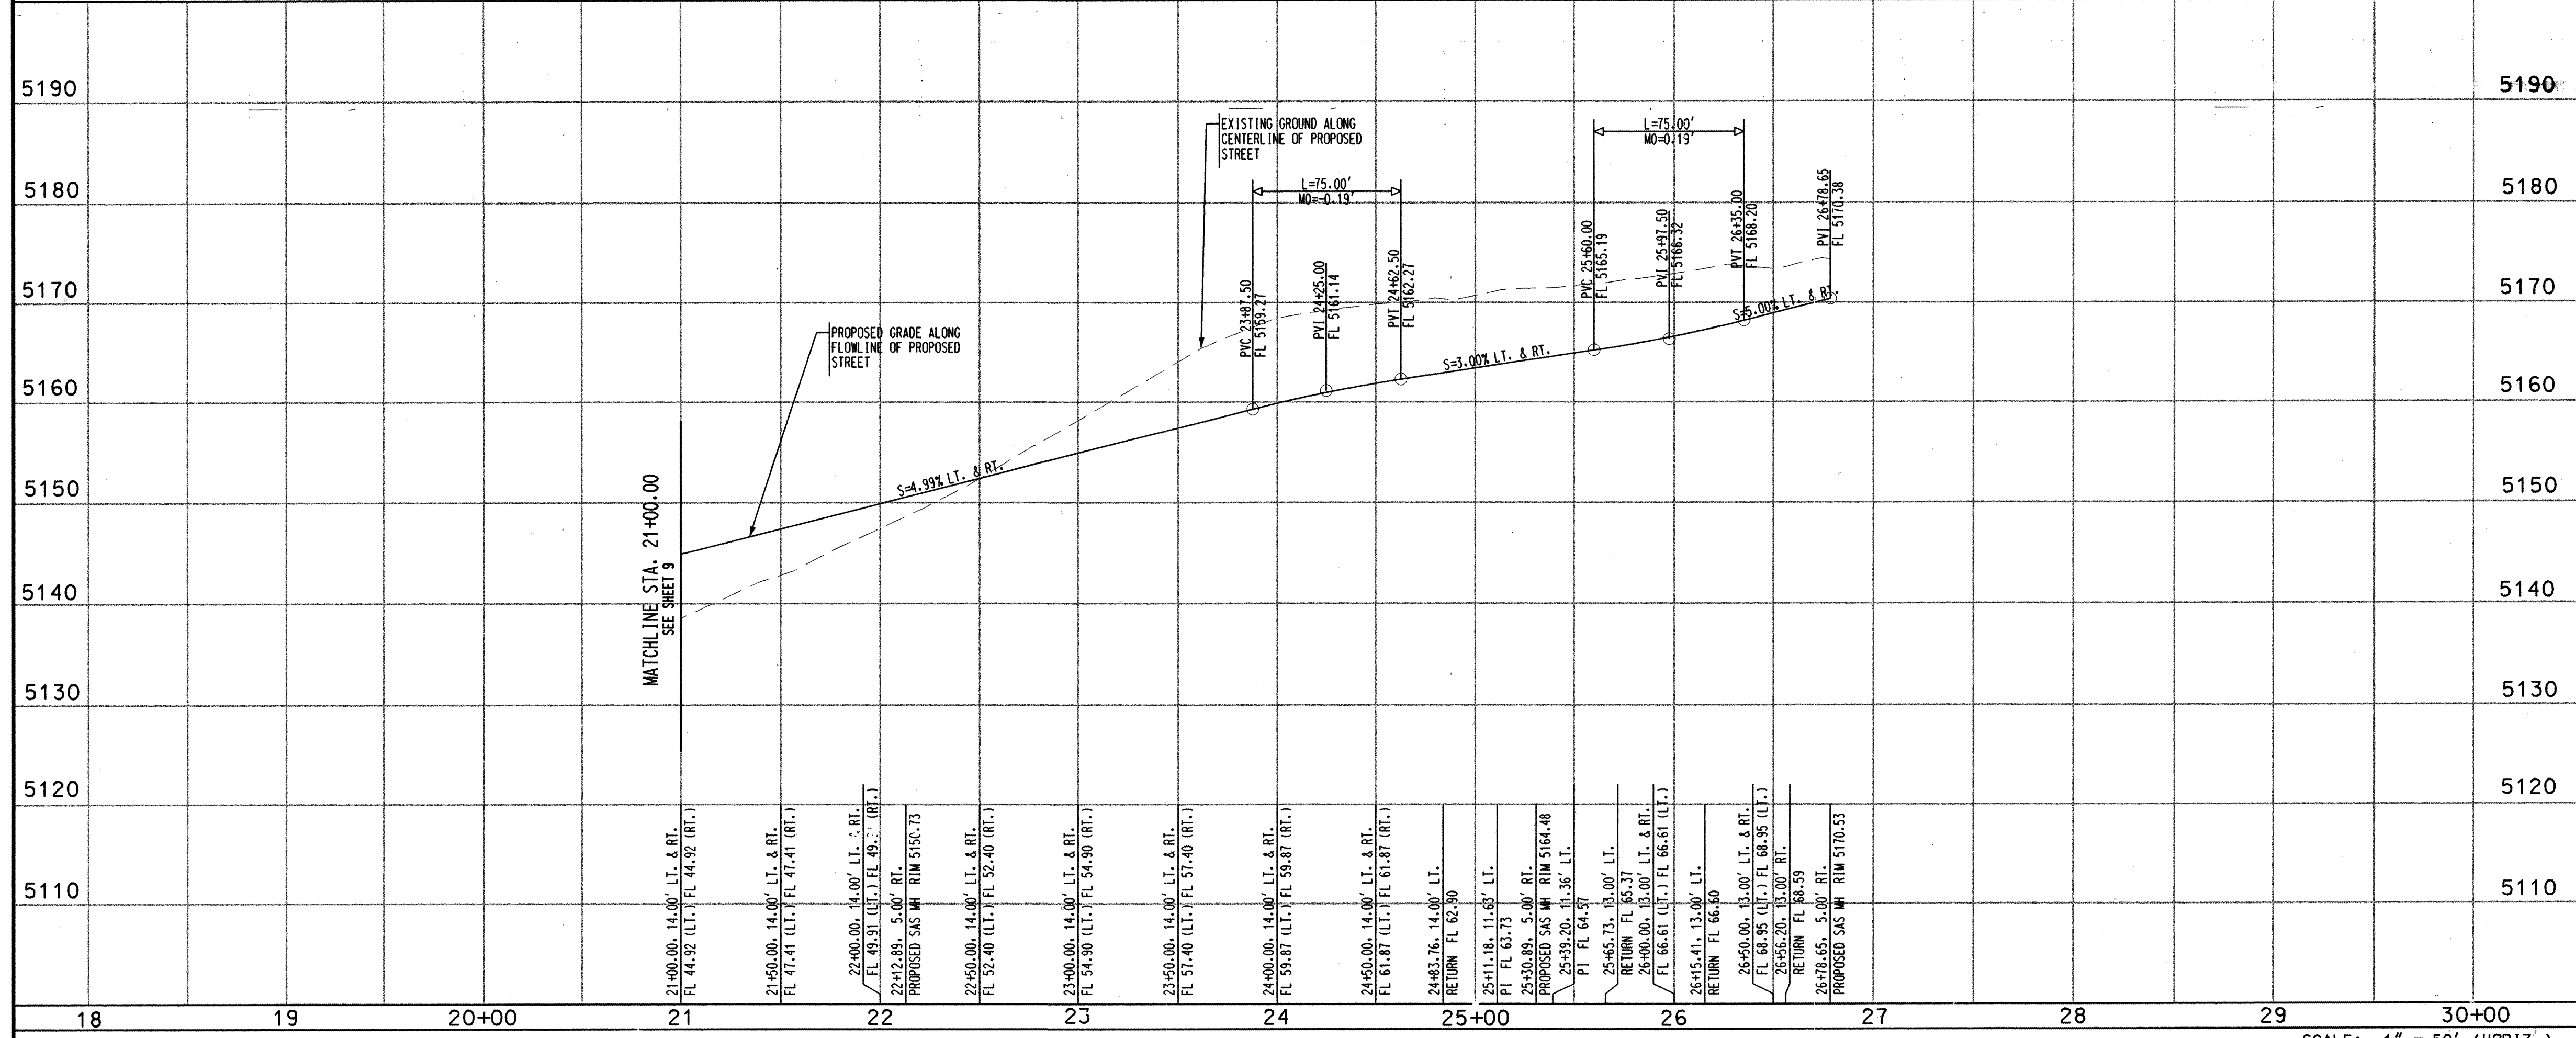

- NOTES
- THE CONTRACTOR SHALL FIELD VERIFY ALL EXISTING UTILITY LOCATIONS AND NOTIFY THE ENGINEER IMMEDIATELY OF ANY DISCREPANCIES.
 - ALL CURB RETURN RADII SHALL BE 25' UNLESS OTHERWISE SPECIFIED.
 - ALL CURVE DATA AND DIMENSIONS REFER TO FACE OF CURB UNLESS OTHERWISE SPECIFIED.
 - GRADE ELEVATIONS, WHERE NOTED, ARE ALONG FLOWLINE OF STANDARD CURB UNLESS OTHERWISE SPECIFIED.
 - CONTRACTOR IS TO INSTALL A 4" X 4" X 5' POST AND END AT THE END OF EACH SANITARY SEWER SERVICE.
 - CONTRACTOR IS RESPONSIBLE FOR REPAIR AND/OR REPLACEMENT OF ALL UTILITY CONDUITS AND EXISTING LINES.
 - ANY ADDITIONAL GRADING REQUIRED TO MATCH PROPOSED STREET GRADES SHALL BE INCIDENTAL TO PAVING ITEMS.
 - CONTRACTOR SHALL PROVIDE THE INSPECTORS (CITY AND PRIVATE) WITH THE PROPOSED HYDROSTATIC TESTING PLAN. THE PLAN MUST BE APPROVED BEFORE TESTING OPERATIONS BEGIN.
 - CONTRACTOR SHALL PARK EQUIPMENT AND VEHICLES AS NOT TO INTERFERE WITH NORMAL ACTIVITIES OF RESIDENTS OR OTHER CONTRACTORS ON SITE.
 - ANY DAMAGE TO THE EXISTING FACILITIES (CURB & GUTTER), PAVEMENT, CONDUITS, LANDSCAPING, UTILITY LINES, ETC.) DURING CONSTRUCTION SHALL BE REPLACED AT THE CONTRACTORS' EXPENSE.
 - REMOVAL OF THE EXISTING CURB AND GUTTER SHALL BE AS PER COA STD. DWG. 2415 (SAWCUT ONLY).
 - WHEELCHAIR RAMPS SHALL BE CONSTRUCTED PRIOR TO ACCEPTANCE OF CURB & GUTTER.
 - STATIONING AND OFFSETS GIVEN FOR DROP INLETS ARE GIVEN AT CENTER OF GRATE AT FLOWLINE

* NOT APPLICABLE THIS SHEET

KEYED GENERAL NOTES

- INSTALL CONCRETE VALLEY GUTTER AS PER STD. DWG. 2420
- INSTALL CONCRETE VALLEY GUTTER AS PER STD. DWG. 2421
- INSTALL WHEELCHAIR RAMP AS PER STD. DWG. 2421, CASE 1 WITH ALTERNATE SECTION AA
- INSTALL WHEELCHAIR RAMP AS PER DETAIL, SEE SHEET 6
- STD. CURB & GUTTER AS PER STD. DWG. 2415
- ROLL CURB & GUTTER AS PER STD. DWG. 2415
- MEDIAN CURB & GUTTER AS PER STD. DWG. 2415
- FUTURE 4' SIDEWALK
- BUILD 4' SIDEWALK

Bohannon & Huston
Courtney One 7500 JEFFERSON NE Albuquerque NEW MEXICO 87109
ENGINEERS PLANNERS PHOTOGRAMMETRISTS SURVEYORS SOFTWARE DEVELOPERS

CITY OF ALBUQUERQUE
PUBLIC WORKS DEPARTMENT
ENGINEERING DEVELOPMENT GROUP
COTTONWOOD HILLS
PAVING PLAN & PROFILE
CANADA PLACE




CITY PROJECT NO. 6092.81
SHEET 1C OF 24
ZONE MAP NO. A-13/B-13
DATE: FEBRUARY, 1999

AS-BUILT INFORMATION
CONTRACTOR: **ALB, INC.**
INSPECTOR: **ALB, INC.**
DATE: **11/99**
FIELD VERIFICATION BY: **ALB, INC.**
DATE: **11/99**
CORRECTED BY: **ALB, INC.**
DATE: **11/99**
MICRO-FILM INFORMATION
RECORDED BY: **ALB, INC.**
NO. **11/99**

ENGINEER'S SEAL
JAMES R. TOPMILLER
REGISTERED PROFESSIONAL ENGINEER
NEW MEXICO
9354
DATE: 02/99
DESIGNED BY: CMG/JCA
DRAWN BY: PEG/JAO/GGG
CHECKED BY: JCA

KNUCKLE CURB DATA							
PT	FL	STATION & OFFSET		PT	FL	STATION & OFFSET	
1	21.32	2+59.95, 26.56' LT.		1A	21.19	2+59.95, 14.00' LT.	
2	22.22	2+78.70, 49.62' LT.		2A	21.59	2+78.70, 14.00' LT.	
3	23.21	2+95.78, 54.68' LT.		3A	22.48	2+95.78, 14.00' LT.	
4	23.59	3+05.40, 51.46' LT.		4A	22.92	3+05.40, 14.00' LT.	
5	23.93	3+26.95, 24.57' LT.		5A	23.95	3+26.95, 14.00' LT.	

STA. 2+28.27, 14.00' LT.
BEGIN 10' TRANSITION FROM STD.
CURB TO ROLL CURB (LT. ONLY)

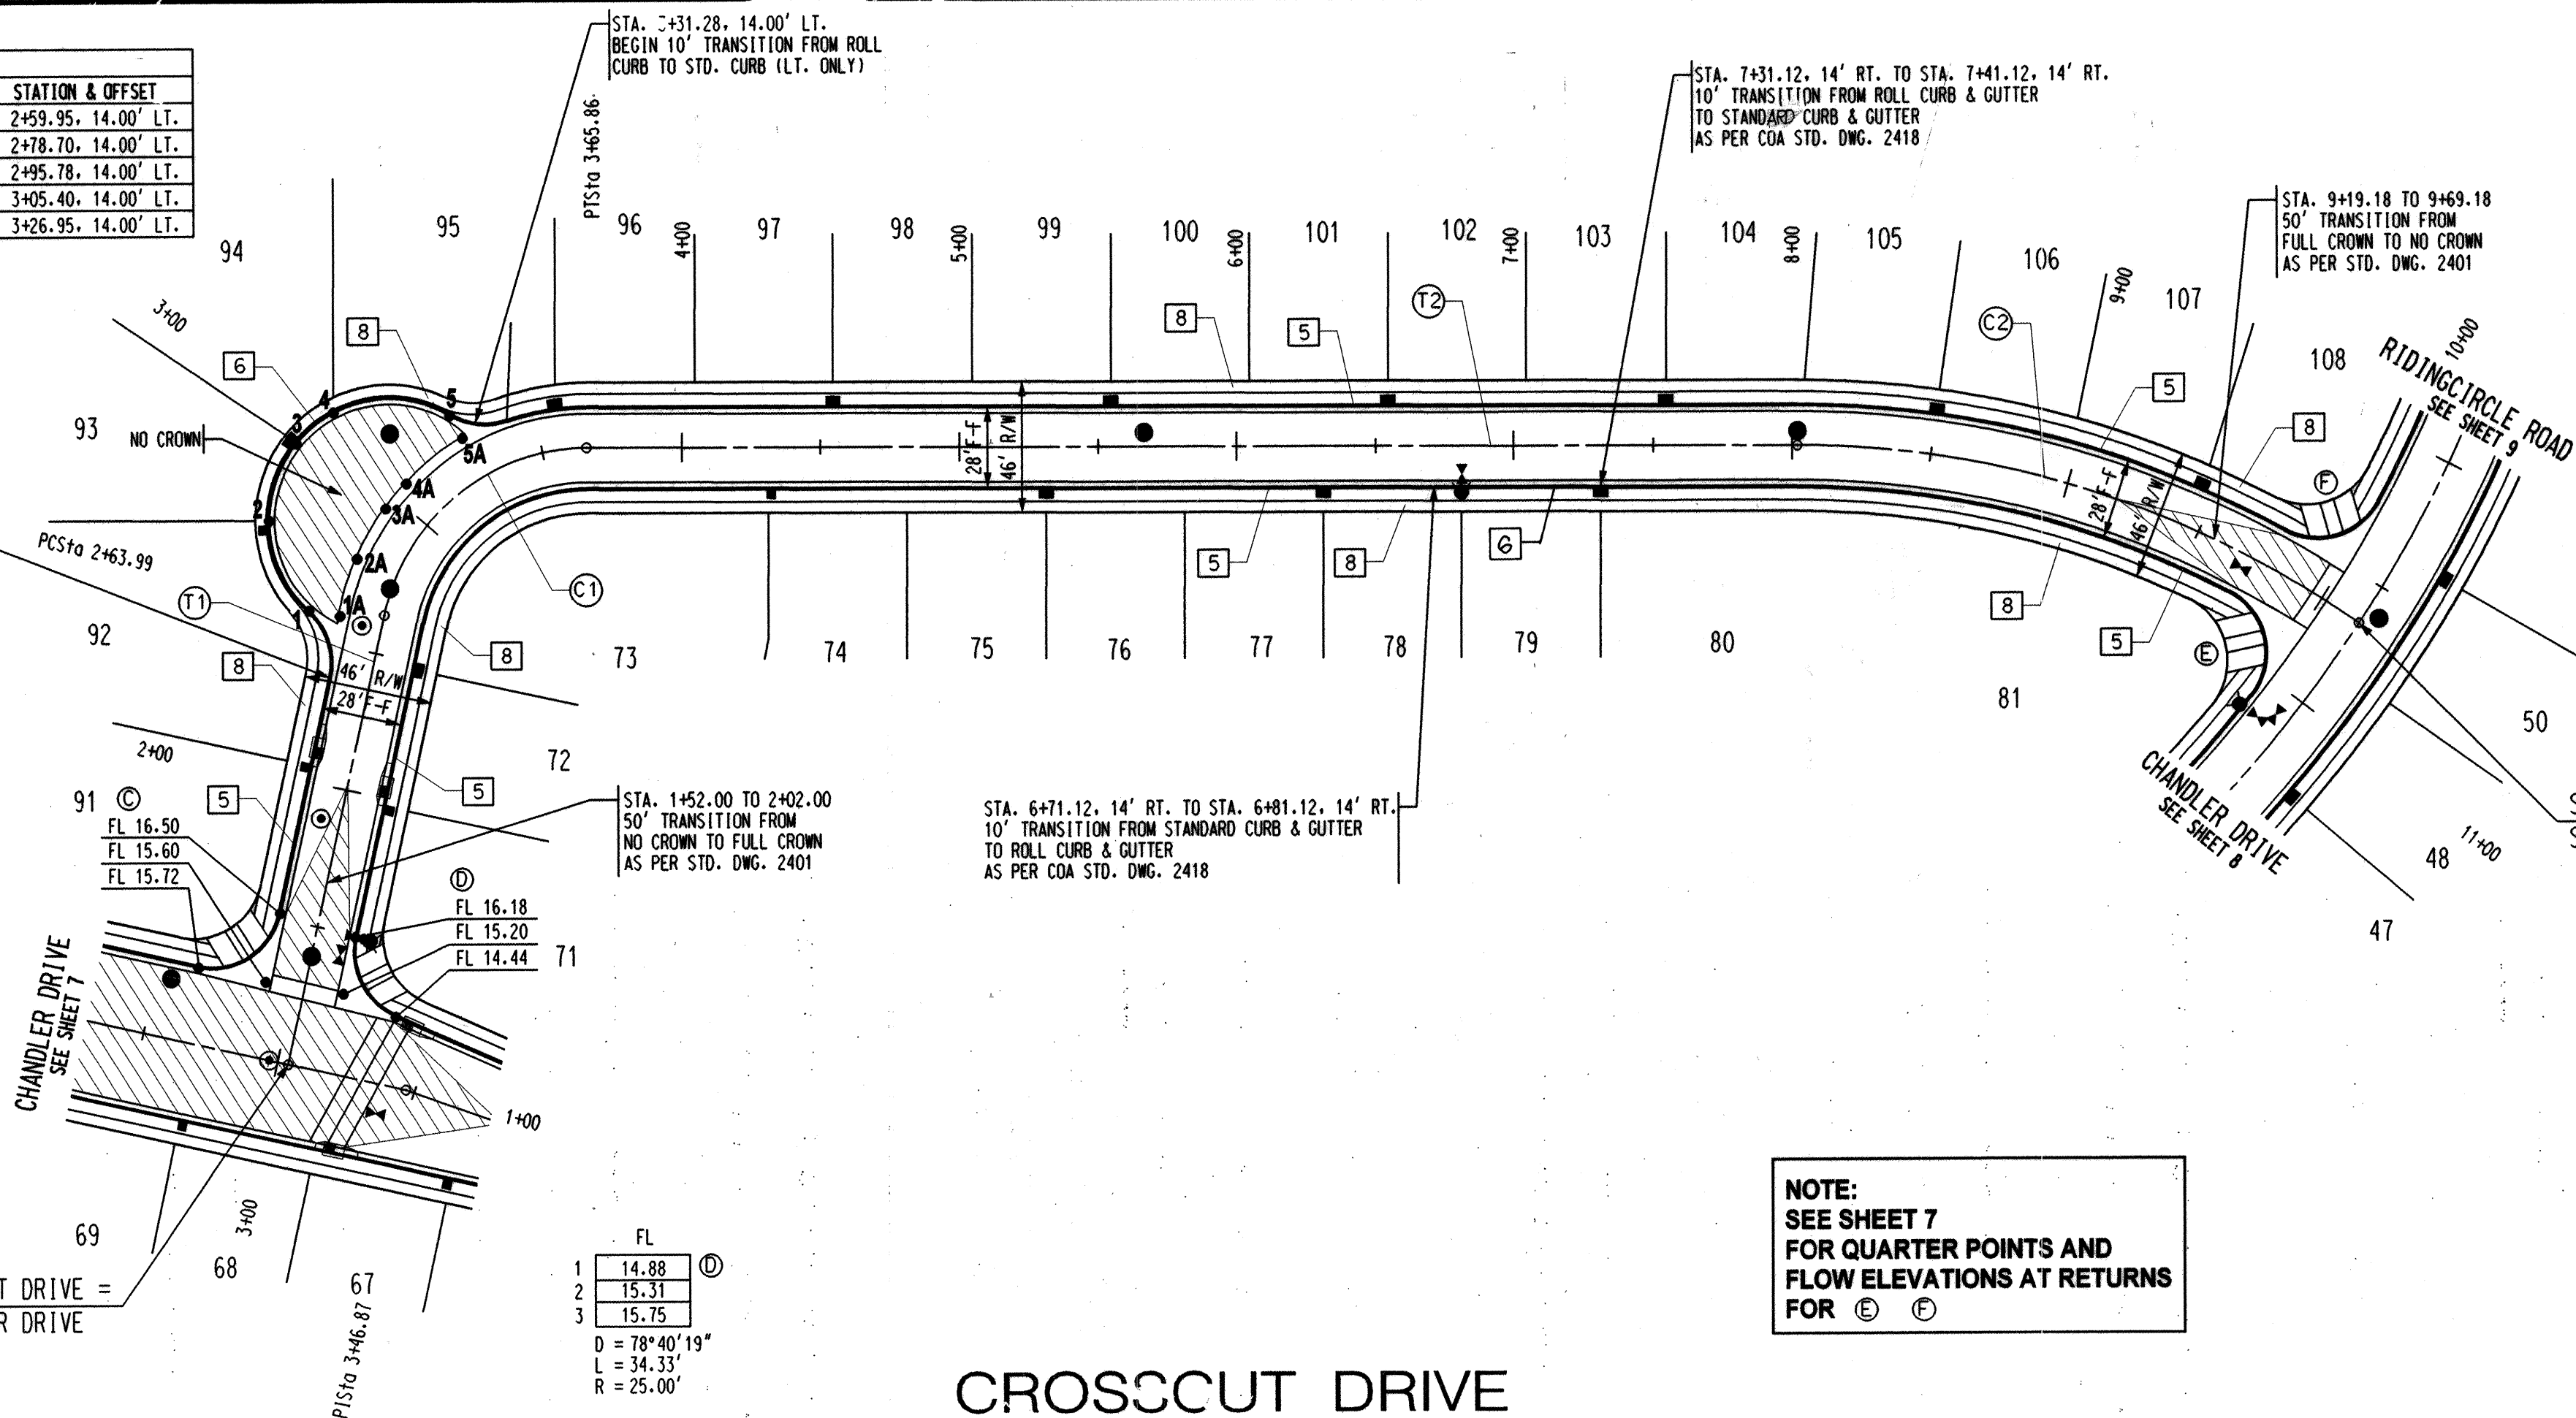


FL
1 16.31
2 16.11
3 15.92
D = 90°00'00"
L = 39.27'
R = 25.00'


STA. 1+00.00 CROSSCUT DRIVE =
STA. 3+03.87 CHANDLER DRIVE

FL
1 14.88
2 15.31
3 15.75
D = 78°40'19"
L = 34.33'
R = 25.00'

NOTE:
SEE SHEET 7
FOR QUARTER POINTS AND
FLOW ELEVATIONS AT RETURNS
FOR ① ②

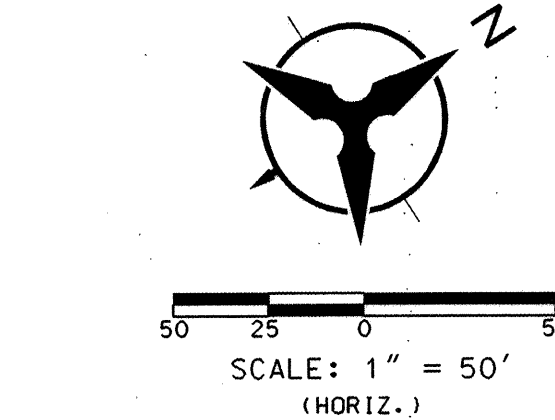

CROSSCUT DRIVE

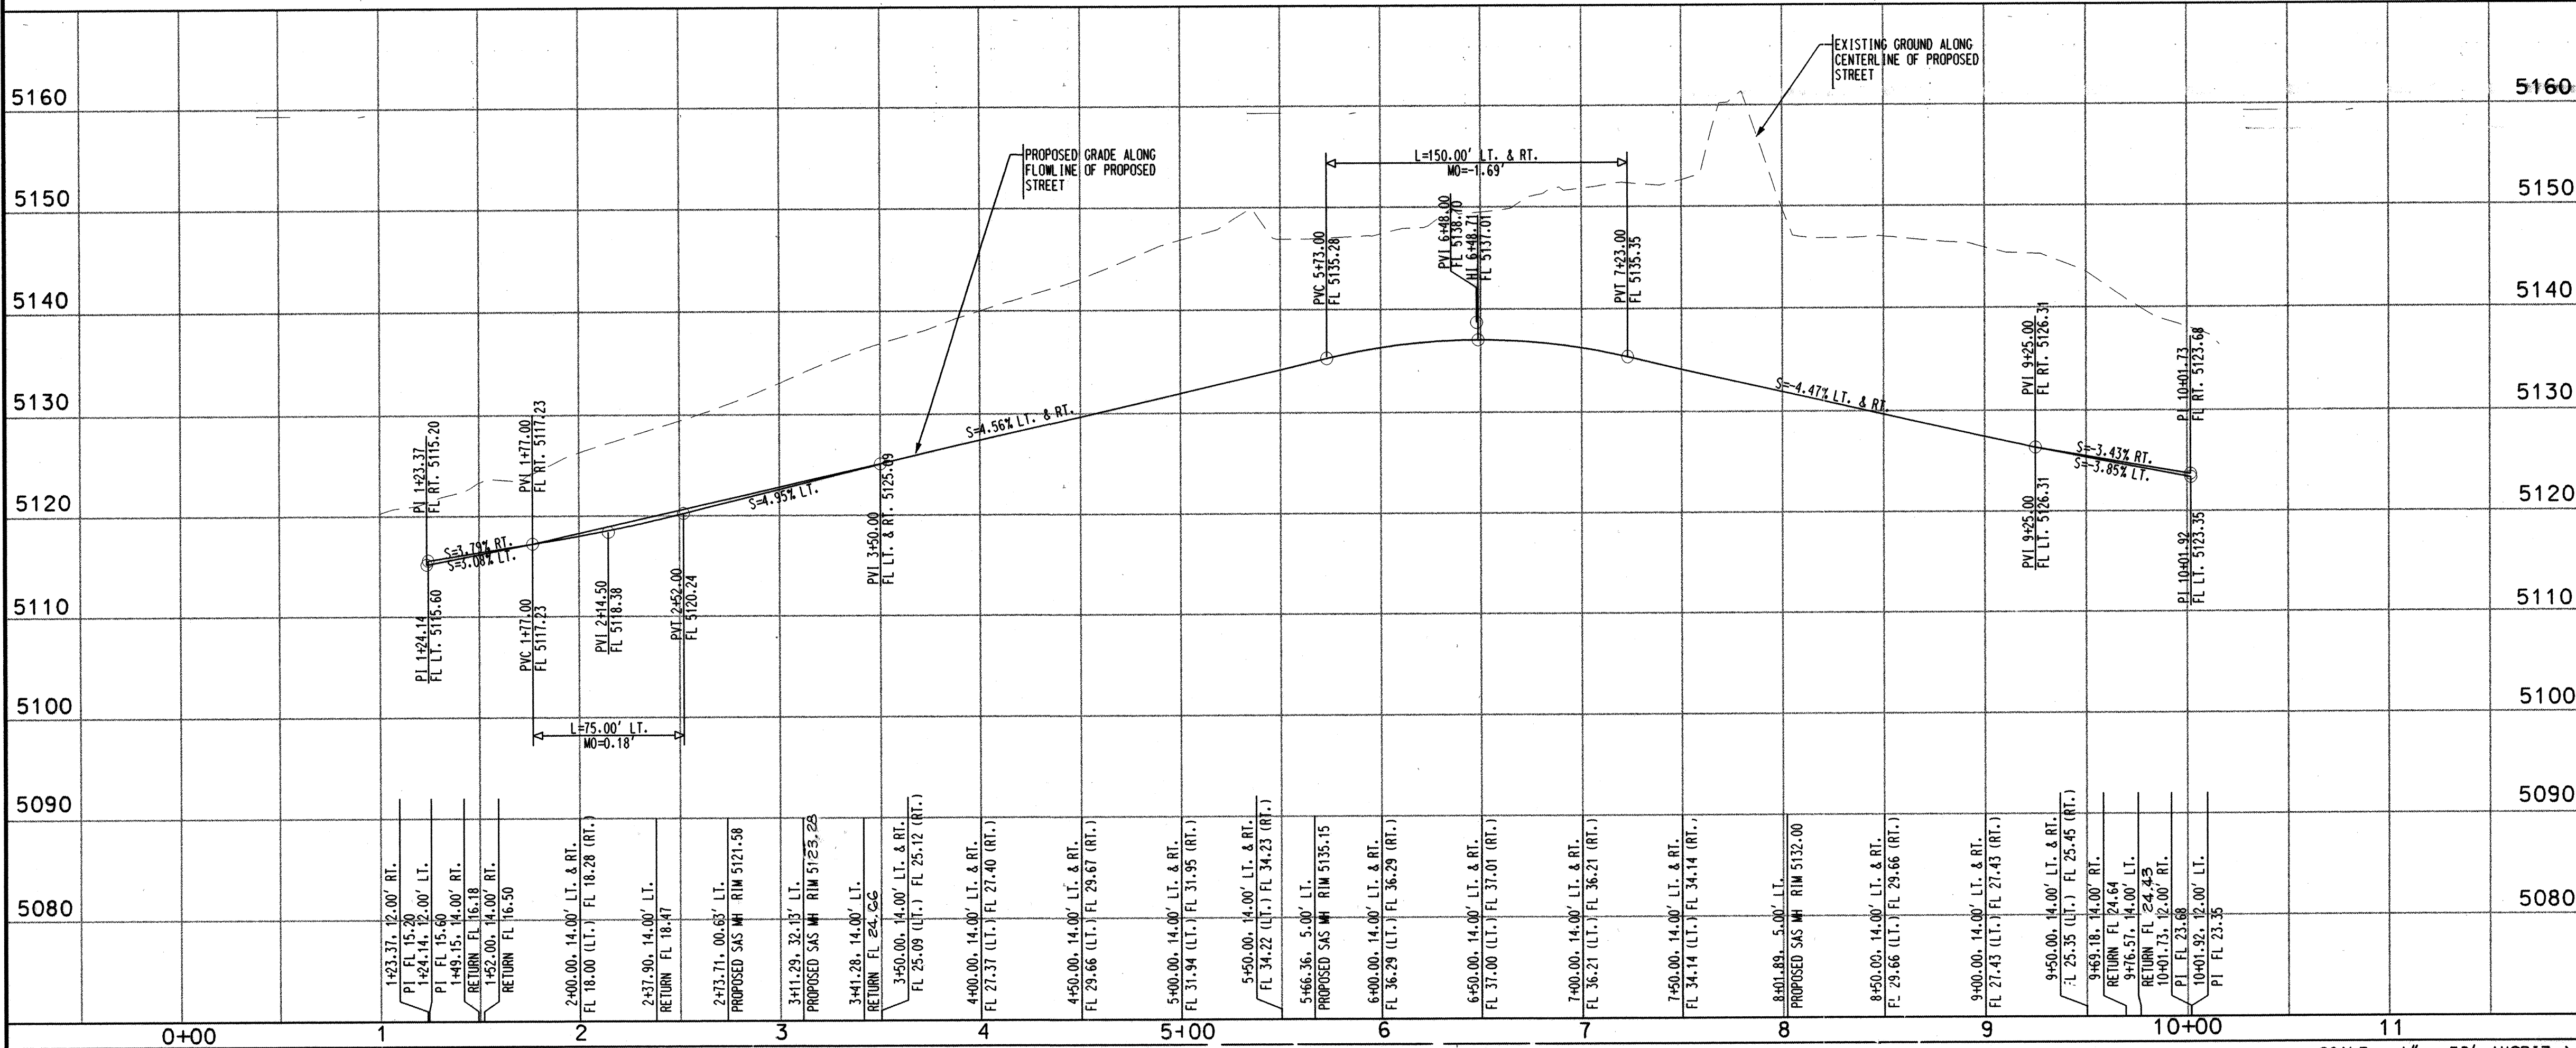

SCALE: 1" = 50' (HORIZ.)
1" = 10' (VERT.)

CURVE DATA			
NUMBER	DELTA	TANGENT	RADIUS
C1	77°49'31"	60.54'	101.87'
C2	35°02'47"	110.51'	214.09'

TANGENT DATA		
NUMBER	BEARING	DISTANCE
T1	N44°43'40"W	163.99'
T2	N33°05'51"E	436.03'

NOTES

- THE CONTRACTOR SHALL FIELD VERIFY ALL EXISTING UTILITY LOCATIONS AND NOTIFY THE ENGINEER IMMEDIATELY OF ANY DISCREPANCIES.
- ALL CURB RETURN RADII SHALL BE 25' UNLESS OTHERWISE SPECIFIED.
- ALL CURVE DATA AND DIMENSIONS REFER TO FACE OF CURB UNLESS OTHERWISE SPECIFIED.
- GRADE ELEVATIONS, WHERE NOTED, ARE ALONG FLOWLINE OF STANDARD CURB UNLESS OTHERWISE SPECIFIED.
- CONTRACTOR IS TO INSTALL A 4" X 4" X 5' POST AND END AT THE END OF EACH SANITARY SEWER SERVICE.
- CONTRACTOR IS RESPONSIBLE FOR REPAIR AND/OR REPLACEMENT OF ALL UTILITY CONDUITS AND EXISTING LINES.
- ANY ADDITIONAL GRADING REQUIRED TO MATCH PROPOSED GRADES SHALL BE INCIDENTAL TO PAVING ITEMS.
- CONTRACTOR SHALL PROVIDE THE INSPECTORS, (CITY AND PRIVATE) WITH THE PROPOSED HYDROSTATIC TESTING PLAN. THE PLAN MUST BE APPROVED BEFORE TESTING OPERATIONS BEGIN.
- CONTRACTOR SHALL PARK EQUIPMENT AND VEHICLES AS NOT TO INTERFERE WITH NORMAL ACTIVITIES OF RESIDENTS OR OTHER CONTRACTORS ON SITE.
- ANY DAMAGE TO THE EXISTING FACILITIES (CURB & GUTTER), PAVEMENT, CONDUITS, LANDSCAPING, UTILITY LINES, ETC.) DURING CONSTRUCTION SHALL BE REPLACED AT THE CONTRACTORS' EXPENSE.
- REMOVAL OF THE EXISTING CURB AND GUTTER SHALL BE AS PER COA STD. DWG. 2415 (SAWCUT ONLY).
- WHEELCHAIR RAMPS SHALL BE CONSTRUCTED PRIOR TO ACCEPTANCE OF CURB & GUTTER.
- STATIONING AND OFFSETS GIVEN FOR DROP INLETS ARE GIVEN AT CENTER OF GRATE AT FLOWLINE

* NOT APPLICABLE THIS SHEET

KEYED GENERAL NOTES

- INSTALL CONCRETE VALLEY GUTTER AS PER STD. DWG. 2420
- INSTALL CONCRETE VALLEY GUTTER AS PER STD. DWG. 2421
- INSTALL WHEELCHAIR RAMP AS PER STD. DWG. 2441, CASE 1 WITH ALTERNATE SECTION AA
- INSTALL WHEELCHAIR RAMP AS PER DETAIL, SEE SHEET 6
- STD. CURB & GUTTER AS PER STD. DWG. 2415
- ROLL CURB & GUTTER AS PER STD. DWG. 2415
- MEDIAN CURB & GUTTER AS PER STD. DWG. 2415
- FUTURE 4' SIDEWALK
- BUILD 4' SIDEWALK

Bohannon & Huston
 Courtyard One 7500 JEFFERSON NE ALBUQUERQUE NEW MEXICO 87109
 ENGINEERS PLANNERS PHOTOGRAMMETRISTS SURVEYORS SOFTWARE DEVELOPERS

CITY OF ALBUQUERQUE
 PUBLIC WORKS DEPARTMENT
 ENGINEERING DEVELOPMENT GROUP



COTTONWOOD HILLS
 PAVING PLAN & PROFILE
 CROSSCUT DRIVE

DESIGN REVIEW COMMITTEE CITY ENGINEER APPROVAL
 MO./DAY/YR. MO./DAY/YR.

LAST DESIGN UPDATE


CITY PROJECT NO. 6092.81 ZONE MAP NO. A-13/B-13 SHEET 11 OF 24

DESIGNED BY CMG/JCA DATE 02/99
 DRAWN BY PEG/JAO/GGG DATE 02/99
 CHECKED BY JCA DATE 02/99

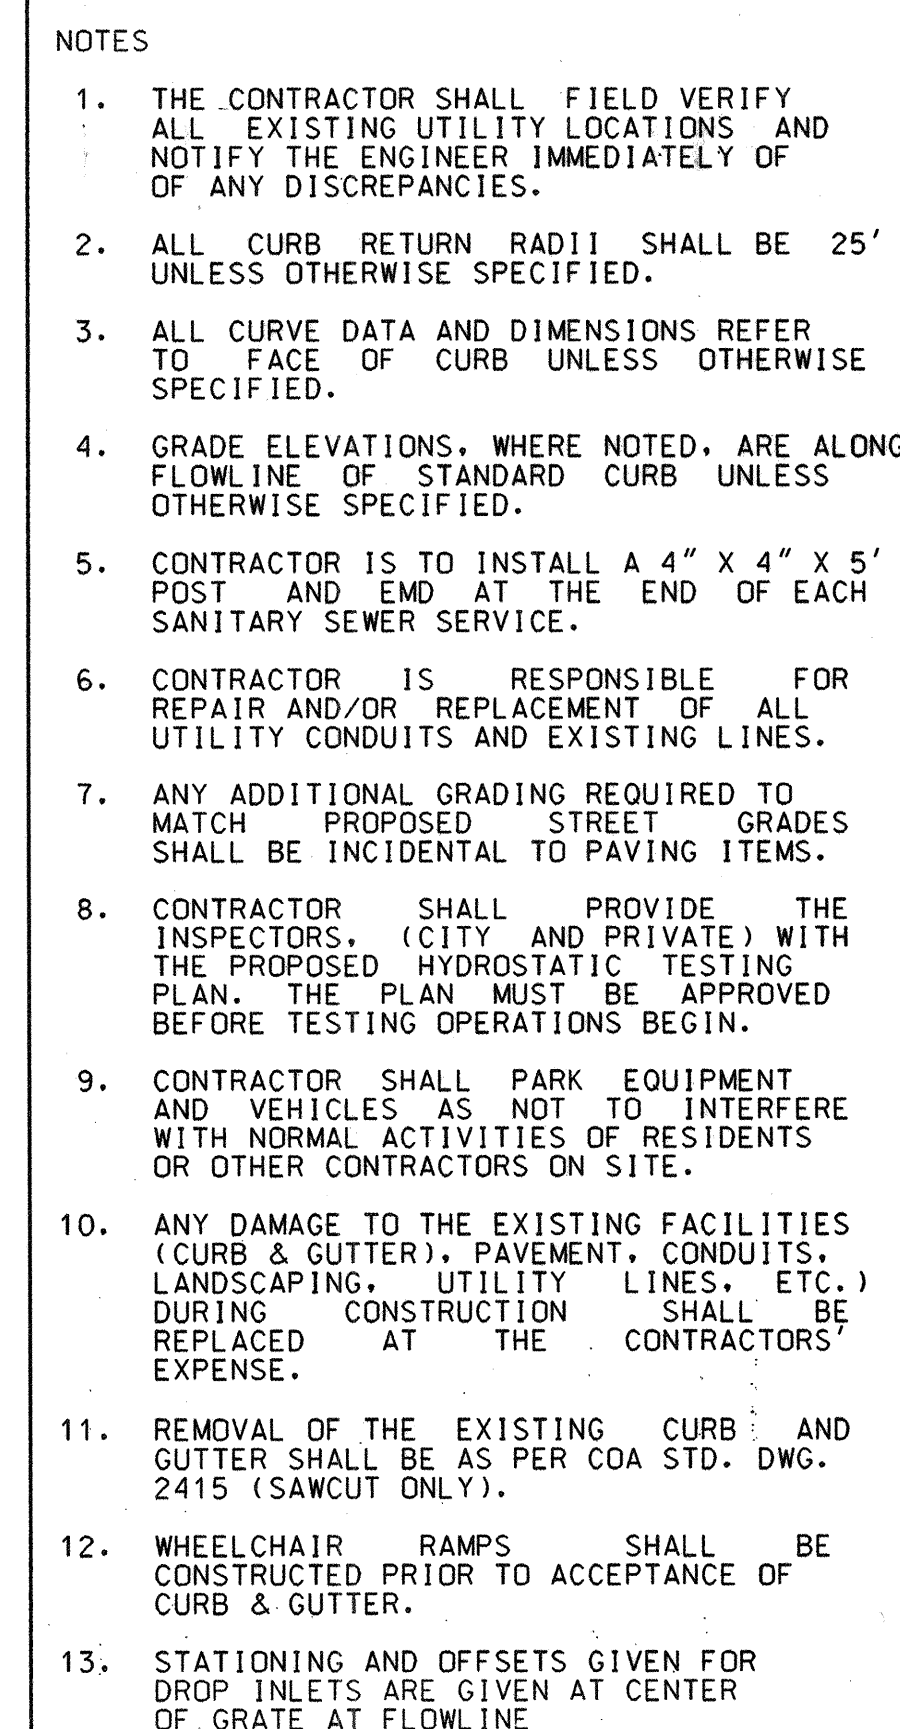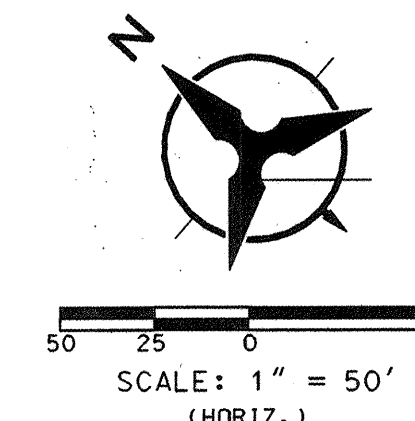

KEYED GENERAL NOTES

- 1 INSTALL CONCRETE VALLEY GUTTER
AS PER STD. DWG. 2420
- 2 INSTALL CONCRETE VALLEY GUTTER
AS PER STD. DWG. 2421
- * 3 INSTALL WHEELCHAIR RAMP AS
PER STD. DWG. 2444, CASE 1
WITH ALTERNATE SECTION AA
- 4 INSTALL WHEELCHAIR RAMP AS
PER DETAIL. SEE SHEET 6
- 5 STD. CURB & GUTTER
AS PER STD. DWG. 2415
- * 6 ROLL CURB & GUTTER
AS PER STD. DWG. 2415
- * 7 MEDIAN CURB & GUTTER
AS PER STD. DWG. 2415
- 8 FUTURE 4' SIDEWALK
- * 9 BUILD 4' SIDEWALK

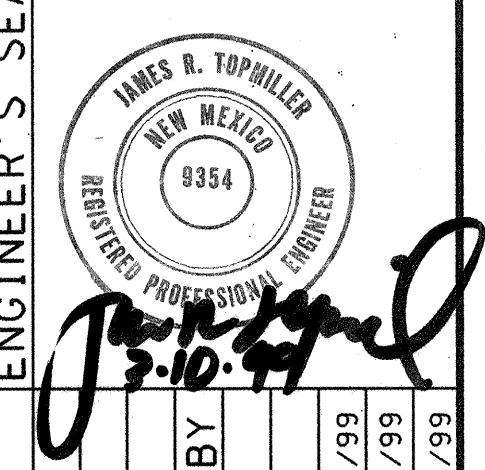


Bohannon ▴ Huston

 Courtyard One 7500 JEFFERSON NE Albuquerque NEW MEXICO 87109

ENGINEERS PLANNERS PHOTOGRAMMETRISTS SURVEYORS SOFTWARE DEVELOPERS

 CITY OF ALBUQUERQUE
PUBLIC WORKS DEPARTMENT
ENGINEERING DEVELOPMENT GROUP

COTTONWOOD HILLS
PAVING PLAN & PROFILE
PACKAWAY ROAD

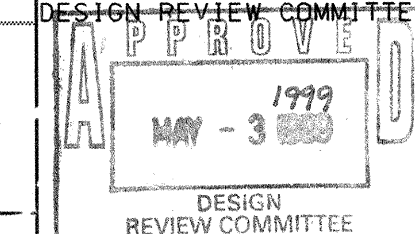

CITY PROJECT NO.	ZONE MAP NO.	SHEET	OF
6092.81	A-13/B-13	12	24


NUMBER	BEARING	LENGTH
T4	S41°29'44"W	162.82'
T5	S52°53'34"W	279.02'

NOTE: WATER METER LOCATIONS ARE DESIGNATED
BY STATIONING AT PROPERTY CORNERS.

WATERLINE CURVE DATA				
NUMBER	ARC	RADIUS	DELTA	TANGENT
C1	103.77'	877.00'	06°31'59"	51.95'



- | ENGINEER'S SEAL | | SURVEY INFORMATION | | BENCH MARKS | | AS-BUILT INFORMATION | |
|-----------------|--|--------------------|--|--|--|-----------------------------------|--|
| F.I.E.D. NOTES | | DATE | | CONTRACTOR | | WORKED BY | |
| | | | | ACS ALUMINUM TABLET STAMPED "4-813" (IND 1927) | | CONTRACTOR <i>SUNDADE</i> | |
| | | | | NM STATE PLANE COORDINATES (CENTRAL ZONE) | | WORKED BY <i>ALS, INC</i> | |
| | | | | X=375,489.27 Y=4525,104-55 GROUND-TO-GRID FACTOR= | | INSPECTOR'S | |
| | | | | 0.9996705 DELTA ALPHA = -001'14"25" ELEVATION 5169.51' | | DATE <i>11-29</i> | |
| | | | | | | FIELD LOCATION BY <i>ALS, INC</i> | |
| | | | | | | DRAWINGS | |
| | | | | | | DATE <i>11-29</i> | |
| | | | | USGS BRASS STAMPED "BLACK 2 1987" (MS 1927) | | CORRECTED BY <i>ALS, INC</i> | |
| | | | | NM STATE PLANE COORDINATES (CENTRAL ZONE) | | MICRO-FILM INFORMATION | |
| | | | | X=375,920.43 Y=4530,241.52 GROUND-TO-GRID FACTOR= | | RECORDED BY | |
| | | | | 0.999669164 DELTA ALPHA=001'14.43" ELEVATION 5213.93 | | DATE | |
| | | | | | | NO. | |

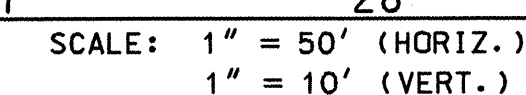

BHI JOB NO. 99413A02

COPYRIGHT BOHANNAN HUSTON 1998
DATE: FEBRUARY, 1999

COPYRIGHT BOHANNAN HUSTON 1998
DATE: FEBRUARY, 1999

SANITARY SEWER SERVICES			
LOT NUMBER	SAS STATION & OFFSET	SAS LENGTH	TOP OF PIPE AT PLUG (W/RISE)
108	SEE SHEET 15		
109	SEE SHEET 19		
123	SEE SHEET 19		
124	SEE SHEET 19		
125	SEE SHEET 19		
126	SEE SHEET 19		
127	SEE SHEET 19		
128	SEE SHEET 19		
129	SEE SHEET 19		

WATERLINE TANGENT DATA		
NUMBER	BEARING	LENGTH
T1	N41°43'40"W	165.43'
T2	N41°43'40"W	231.84'
T3	N87°19'26"E	46.79'


SANITARY SEWER TANGENT DATA		
NUMBER	BEARING	LENGTH
T4	S41°43'40"W	155.44'
T5	S41°43'40"E	241.94'
T6	N87°17'09"E	53.70'

WATERLINE CURVE DATA				
NUMBER	ARC	RADIUS	DELTA	TANGENT
C1	160.60'	495.00'	11°34'29"	81.01'
C2	242.31'	272.00'	21°03'52"	129.86'
C3	458.30'	1540.75'	03°43'07"	230.86'


SANITARY SEWER CURVE DATA				
NUMBER	ARC	RADIUS	DELTA	TANGENT
C4	153.75'	505.00'	11°20'45"	77.47'
C5	251.22'	282.00'	20°19'04"	134.63'
C6	222.13'	1530.75'	03°44'35"	111.26'

SANITARY SEWER SERVICES			
LOT NUMBER	SAS STATION & OFFSET	SAS LENGTH	TOP OF PIPE AT PLUG (W/RISE)
31	20+75.25, 5.00' RT.	28.00'	38.77(N/A)
32	20+21.14, 5.00' RT.	28.00'	36.31(N/A)
33	19+67.08, 5.03' RT.	28.00'	34.24(N/A)
34	19+16.12, 5.00' RT.	28.00'	32.50(1.00)
35	18+73.86, 5.00' RT.	28.00'	30.49(1.00)
36	18+29.13, 5.00' RT.	28.00'	28.36(1.00)
37	17+85.78, 5.00' RT.	28.00'	26.29(1.00)
38	17+44.09, 5.00' RT.	28.00'	24.31(1.00)
39	17+01.82, 5.00' RT.	28.00'	21.62(N/A)
40	16+52.04, 5.00' RT.	28.00'	19.43(N/A)
41	16+02.04, 5.00' RT.	28.00'	17.95(N/A)
42	15+52.04, 5.00' RT.	28.00'	16.48(N/A)
43	15+02.04, 5.00' RT.	28.00'	15.00(N/A)
44	14+27.04, 5.00' RT.	29.61'	13.24(N/A)
45	13+77.04, 5.00' RT.	30.00'	14.16(1.00)
46	13+27.04, 5.00' RT.	30.00'	14.48(2.00)
47	12+77.19, 5.00' RT.	30.00'	15.47(4.00)
48	12+31.97, 5.00' RT.	30.00'	15.82(5.00)
130	20+71.75, 5.00' RT.	38.00'	38.84(N/A)

NOTE: WATER METER LOCATIONS ARE DESIGNATED BY STATIONING AT PROPERTY CORNERS.

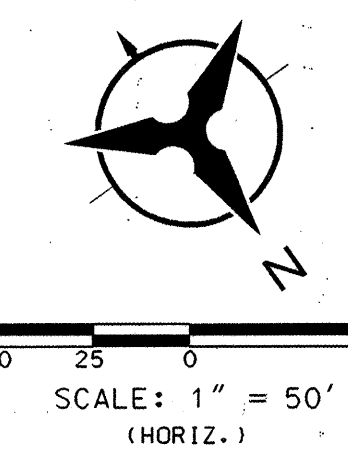

- NOTES
- THE CONTRACTOR SHALL FIELD VERIFY ALL EXISTING UTILITY LOCATIONS AND NOTIFY THE ENGINEER IMMEDIATELY OF ANY DISCREPANCIES.
 - ALL CURB RETURN RADIUS SHALL BE 25' UNLESS OTHERWISE SPECIFIED.
 - ALL CURVE DATA AND DIMENSIONS REFER TO FACE OF CURB UNLESS OTHERWISE SPECIFIED.
 - GRADE ELEVATIONS, WHERE NOTED, ARE ALONG FLOWLINE OF STANDARD CURB UNLESS OTHERWISE SPECIFIED.
 - CONTRACTOR IS TO INSTALL A 4" X 4" X 5' POST AND END AT THE END OF EACH SANITARY SEWER SERVICE.
 - CONTRACTOR IS RESPONSIBLE FOR REPAIR AND/OR REPLACEMENT OF ALL UTILITY CONDUITS AND EXISTING LINES.
 - ANY ADDITIONAL GRADING REQUIRED TO MATCH PROPOSED STREET GRADES SHALL BE INCIDENTAL TO PAVING ITEMS.
 - CONTRACTOR SHALL PROVIDE THE INSPECTORS (CITY AND PRIVATE) WITH THE PROPOSED HYDROSTATIC TESTING PLAN. THE PLAN MUST BE APPROVED BEFORE TESTING OPERATIONS BEGIN.
 - CONTRACTOR SHALL PARK EQUIPMENT AND VEHICLES AS NOT TO INTERFERE WITH NORMAL ACTIVITIES OF RESIDENTS OR OTHER CONTRACTORS ON SITE.
 - ANY DAMAGE TO THE EXISTING FACILITIES (CURB & GUTTER), PAVEMENT, CONDUITS, LANDSCAPING, UTILITY LINES, ETC.) DURING CONSTRUCTION SHALL BE REPLACED AT THE CONTRACTORS' EXPENSE.
 - REMOVAL OF THE EXISTING CURB AND GUTTER SHALL BE AS PER COA STD. DWG. 2415 (SAWCUT ONLY).
 - WHEELCHAIR RAMPS SHALL BE CONSTRUCTED PRIOR TO ACCEPTANCE OF CURB & GUTTER.
 - STATIONING AND OFFSETS GIVEN FOR DROP INLETS ARE GIVEN AT CENTER OF GRATE AT FLOWLINE.

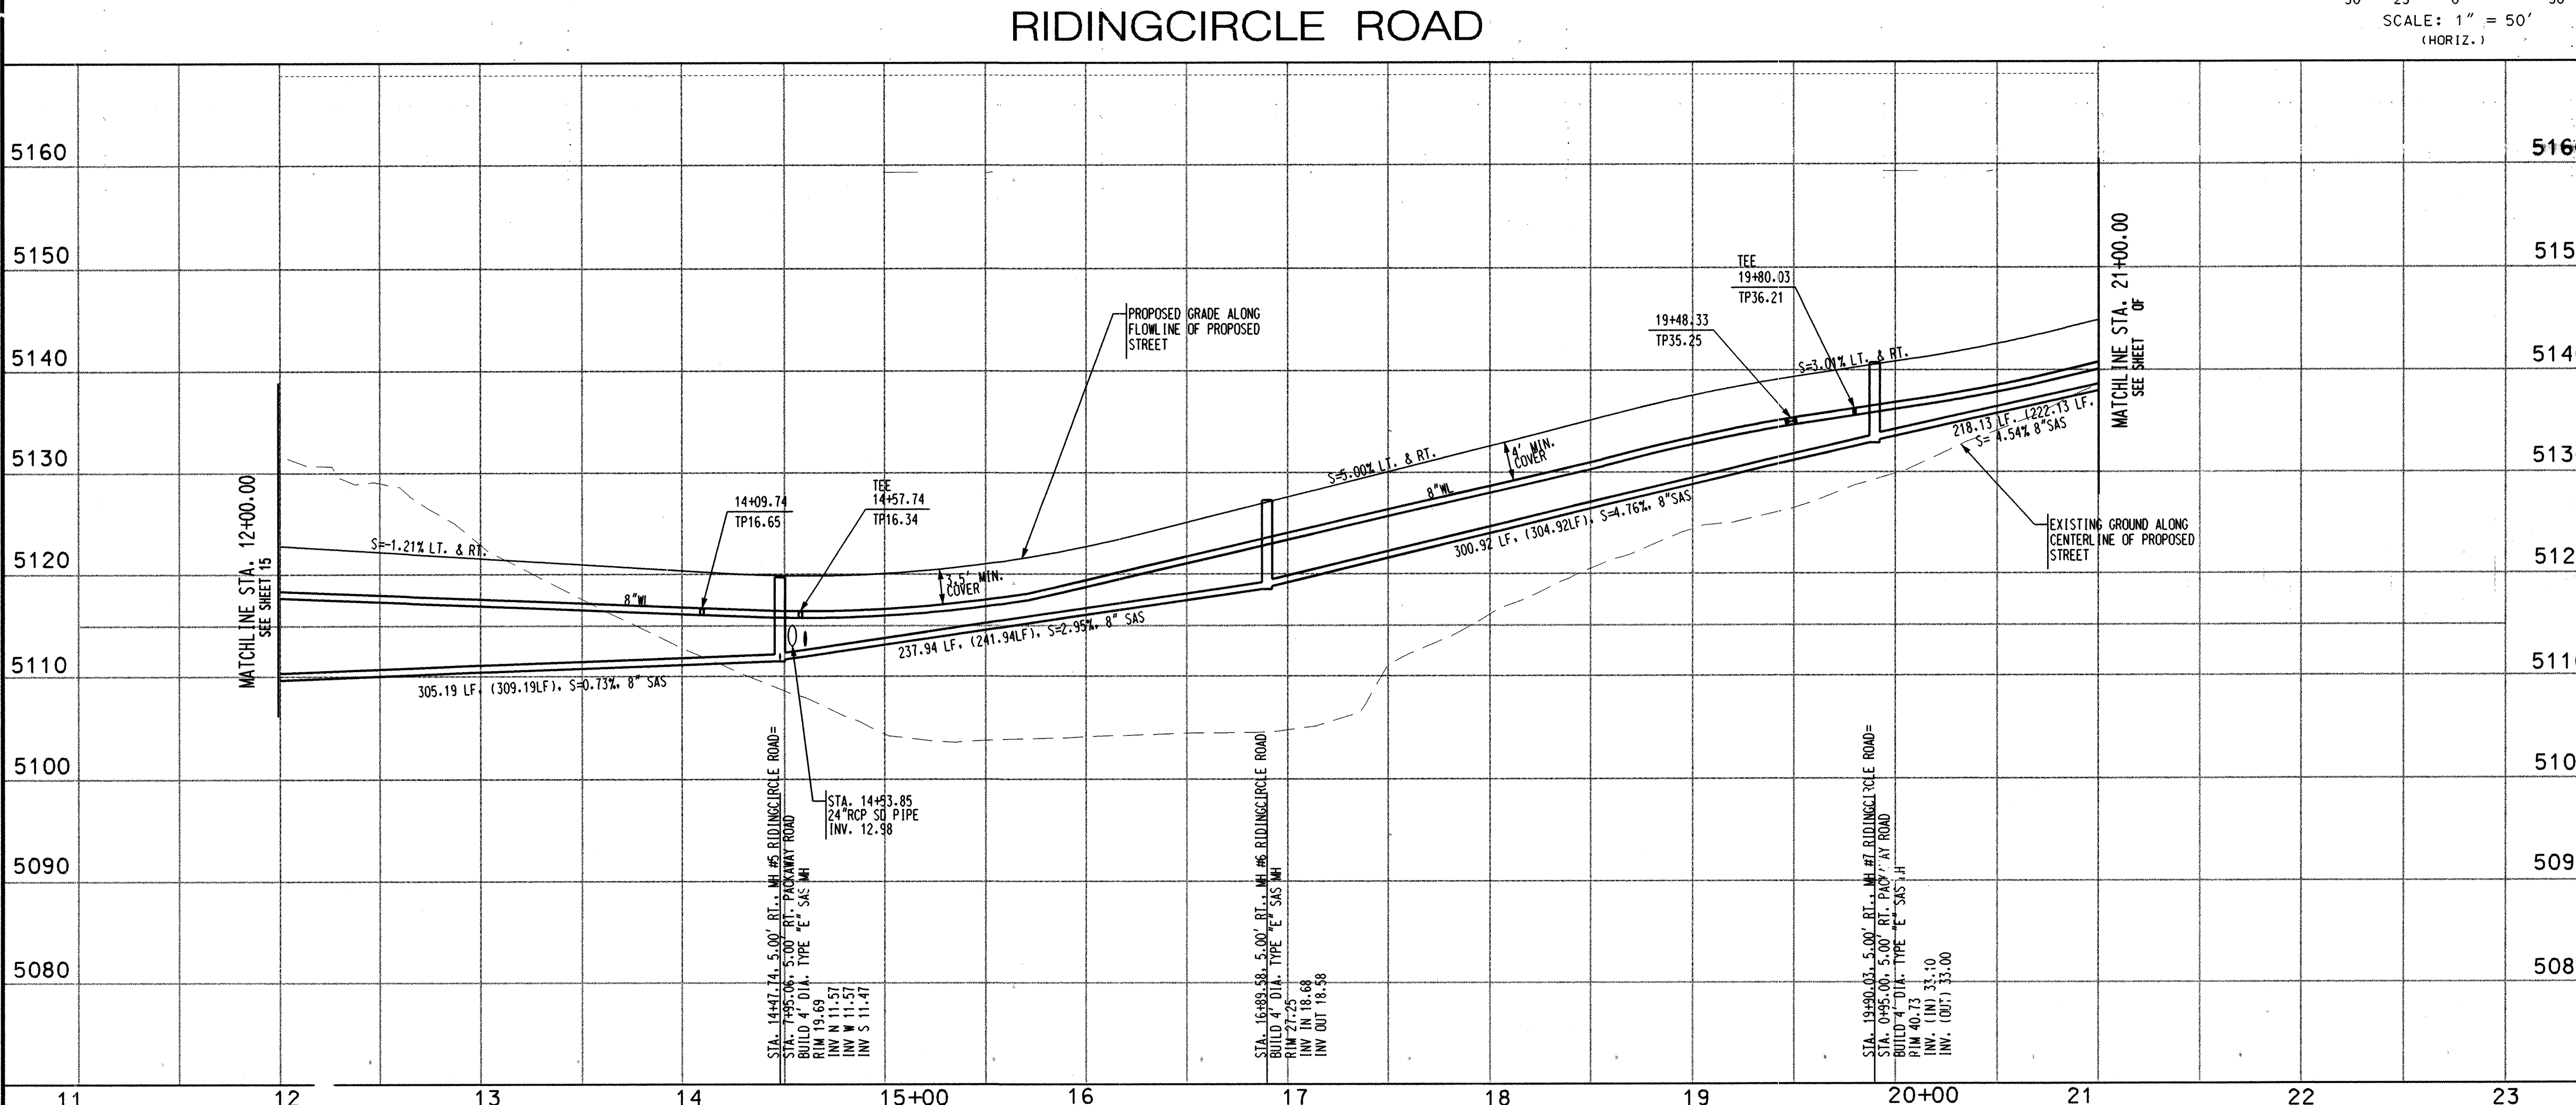

SCALE: 1" = 50' (HORIZ.)
1" = 10' (VERT.)

P:\01_BHMAN\99413\CDP\PNP\UNIT 1\99413UPNP03.DGN

James R. Topmiller
NEW MEXICO
REGISTERED PROFESSIONAL ENGINEER
3.10.99

ENGINEER'S SEAL SURVEY INFORMATION

NO. DATE BY

REMARKS
REVISIONS
DESIGN

DESIGNED BY CAG/JCA
DRAWN BY PEG/JAO/GGG
CHECKED BY JCA

DATE 02/99
DATE 02/99
DATE 02/99

Bohannon & Huston

Courtyard One 7500 JEFFERSON NE Albuquerque NEW MEXICO 87109

ENGINEERS PLANNERS PHOTOGRAMMETRISTS SURVEYORS SOFTWARE DEVELOPERS

CITY OF ALBUQUERQUE
PUBLIC WORKS DEPARTMENT
ENGINEERING DEVELOPMENT GROUP

COTTONWOOD HILLS
UTILITY PLAN & PROFILE
RIDINGCIRCLE ROAD

DESIGN REVIEW COMMITTEE CITY ENGINEER APPROVAL

APPROVED 1999

DESIGN REVIEW COMMITTEE

CITY PROJECT NO. 6092.81

ZONE MAP NO. A-13/B-13

SHEET 16 OF 24

COPYRIGHT BOHANNAN HUSTON 1998
DATE: FEBRUARY, 1999

BH1 JOB NO. 99413A02

SANITARY SEWER SERVICES			
LOT NUMBER	SAS STATION & OFFSET	SAS LENGTH	TOP OF PIPE AT PLUG (W/RISE)
15	26+13.59, 3.31' RT.	35.31'	61.69(N/A)
16	26+68.28, 16.35' LT.	57.74'	63.35(N/A)
17	26+78.65, MANHOLE	55.00'	64.34(N/A)
18	26+78.65, MANHOLE	55.00'	65.44(N/A)
19	26+78.65, MANHOLE	55.00'	65.44(N/A)
20	26+38.84, 2.78' LT.	36.68'	63.70(N/A)
21	26+00.50, 5.00' RT.	27.29'	61.30(N/A)
22	25+50.50, 5.00' RT.	27.00'	58.90(N/A)
23	25+00.50, 5.00' RT.	28.00'	56.97(N/A)
24	24+50.50, 5.00' RT.	28.00'	55.65(1.00)
25	24+00.38, 5.00' RT.	28.00'	53.65(1.00)
26	23+45.91, 5.00' RT.	28.00'	50.79(N/A)
27	22+91.76, 5.00' RT.	28.00'	48.62(N/A)
28	22+37.62, 5.00' RT.	28.00'	46.46(N/A)
29	21+83.48, 5.00' RT.	28.00'	43.68(N/A)
30	21+29.36, 5.00' RT.	28.00'	41.22(N/A)
31	21+23.14, 5.00' RT.	38.00'	42.14(N/A)
32	21+71.77, 5.00' RT.	38.00'	43.35(N/A)
33	22+20.72, 5.00' RT.	38.00'	46.18(N/A)
34	22+69.35, 5.00' RT.	38.00'	48.13(N/A)
35	23+17.99, 5.00' RT.	38.00'	50.07(N/A)
36	23+66.62, 5.00' RT.	38.00'	52.70(1.00)
37	24+15.69, 5.00' RT.	38.00'	54.66(1.00)
38	24+64.95, 5.00' RT.	38.00'	55.95(N/A)


NOTE: WATER METER LOCATIONS ARE DESIGNATED BY STATIONING AT PROPERTY CORNERS.

WATERLINE TANGENT DATA		
NUMBER	BEARING	LENGTH
T1	N75°37'37"W	83.57'
T2	N75°37'37"W	71.25'



SANITARY SEWER TANGENT DATA		
NUMBER	BEARING	LENGTH
T4	S75°37'37"E	94.11'

WATERLINE CURVE DATA				
NUMBER	ARC	RADIUS	DELTA	TANGENT
C1	458.30'	1540.75'	03°43'07"	230.86'

SANITARY SEWER CURVE DATA				
NUMBER	ARC	RADIUS	DELTA	TANGENT
C2	222.13'	1530.75'	3°44'35"	111.26'
C3	223.23'	1530.75'	3°44'35"	111.81'
C4	151.81'	300.00'	28°59'38"	77.57'

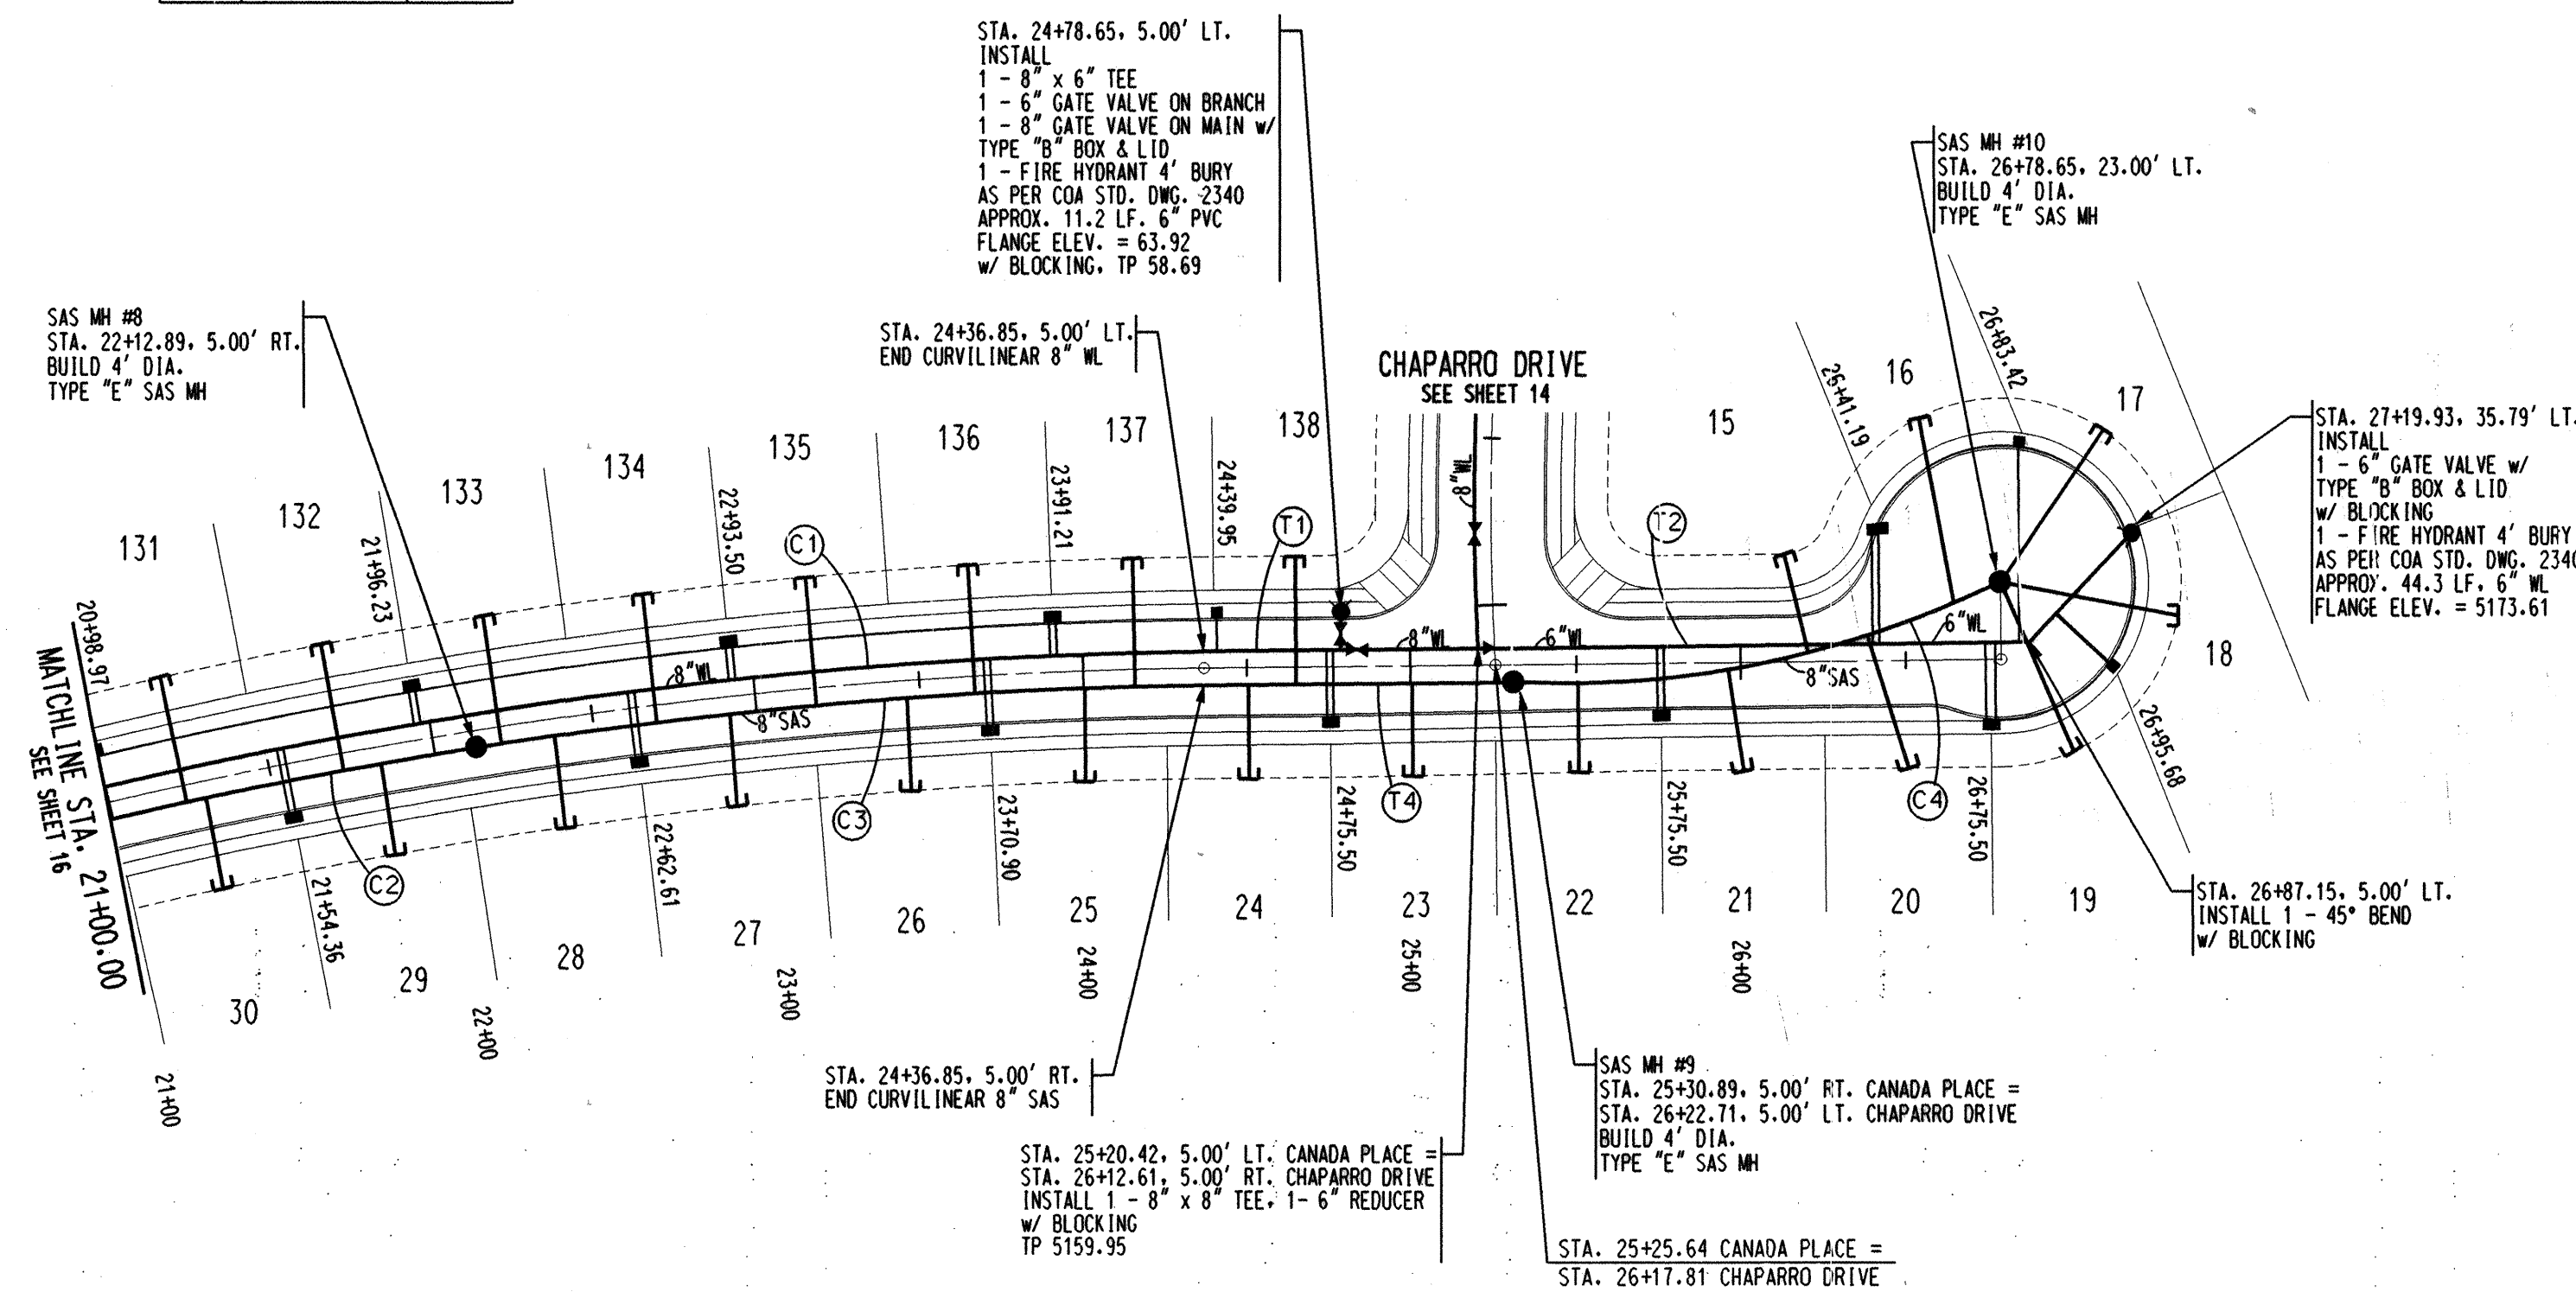

CANADA PLACE

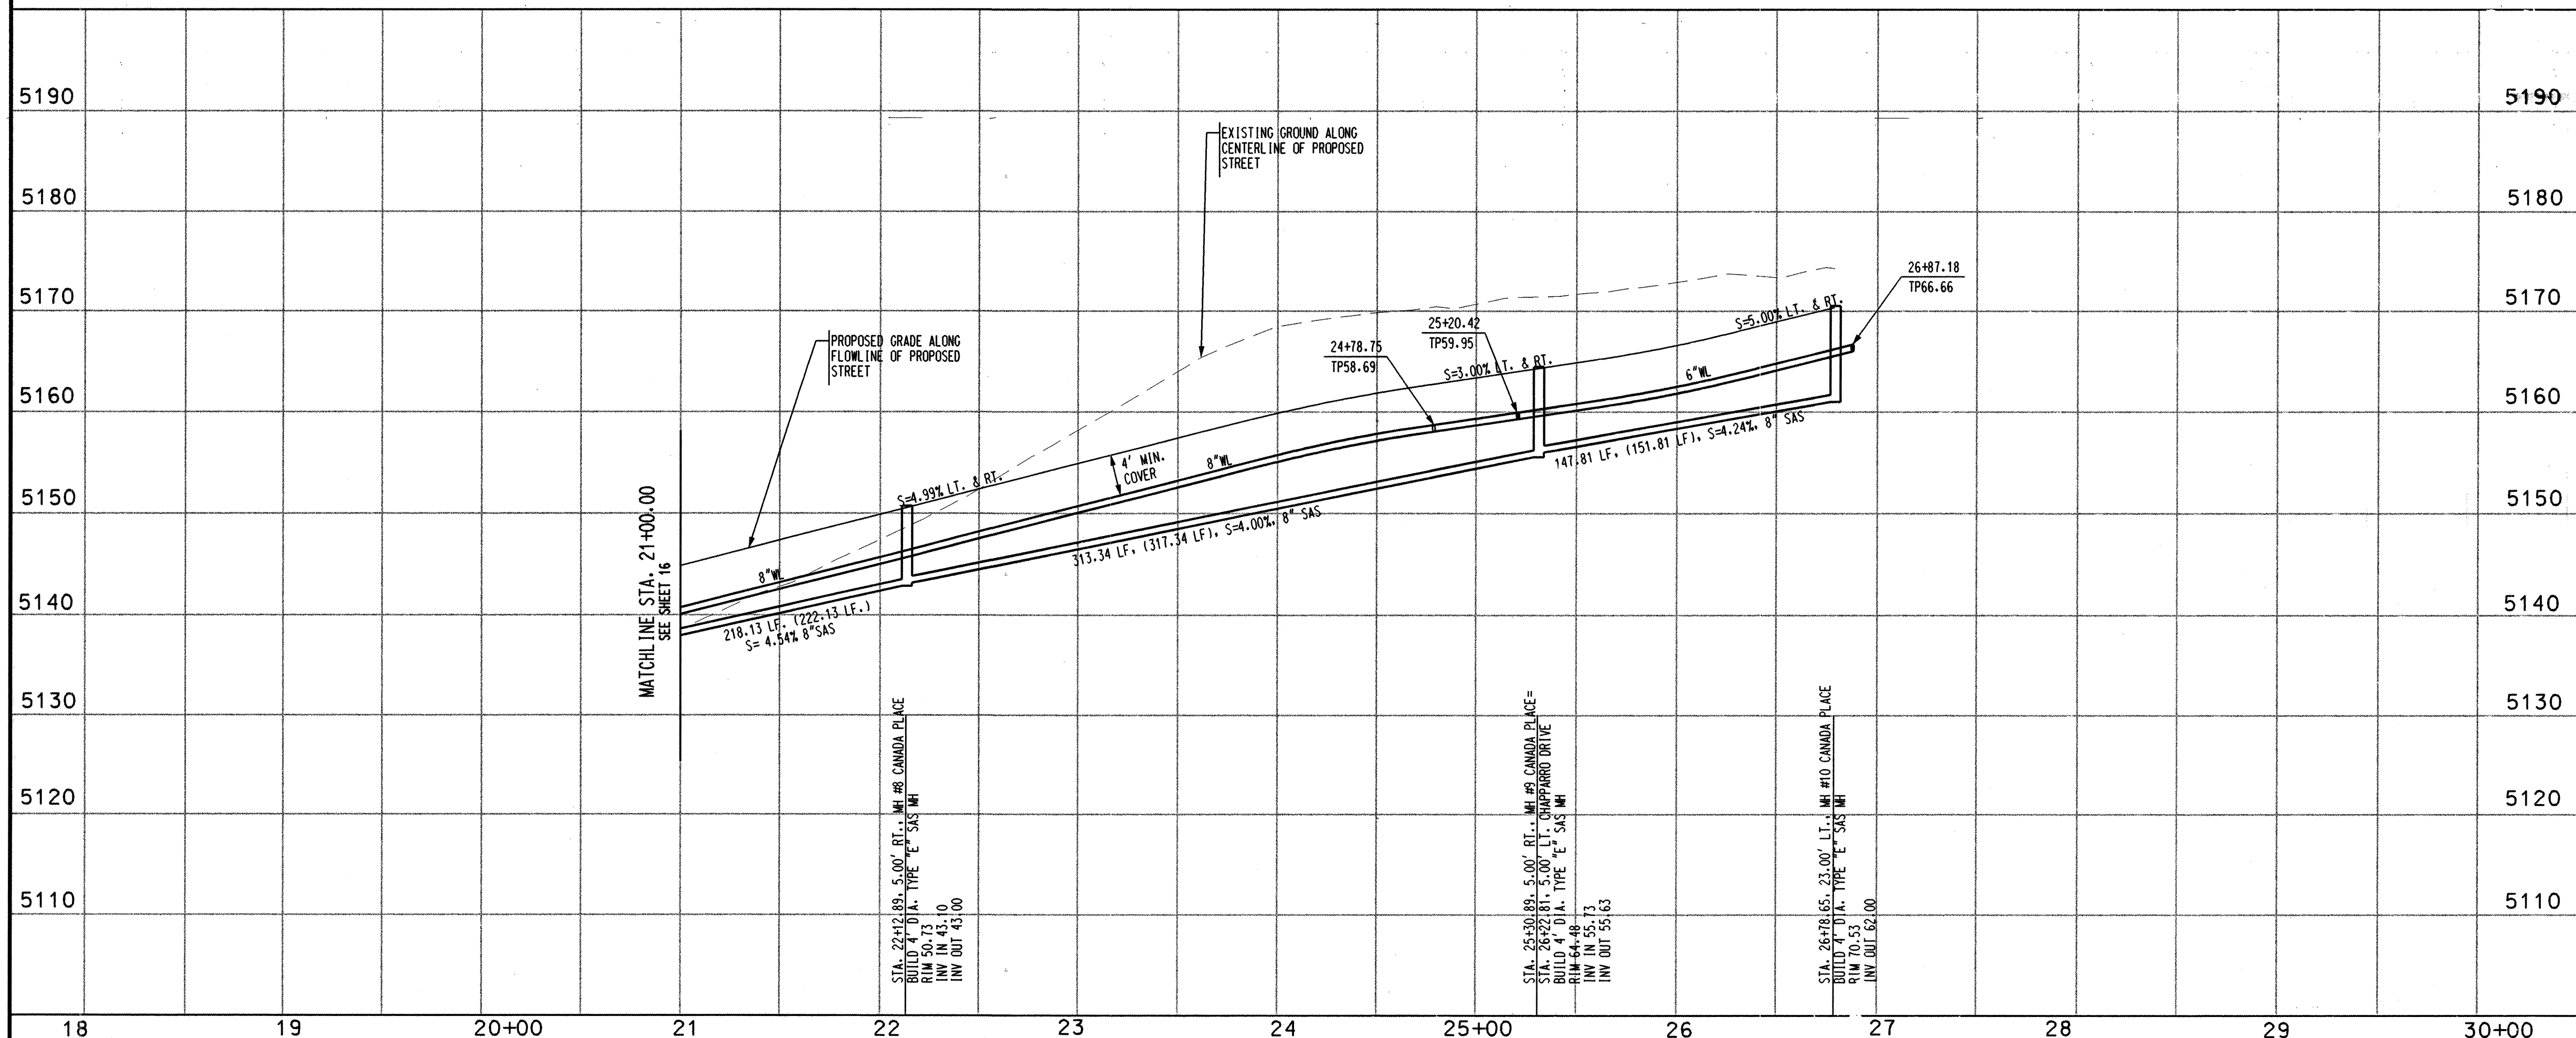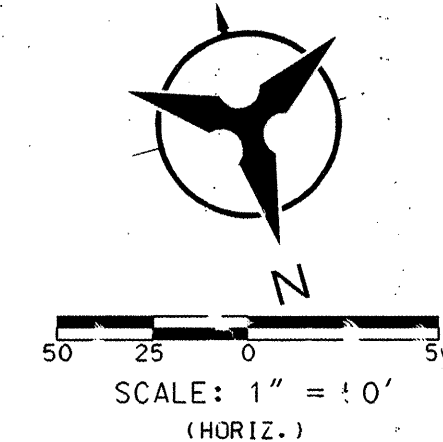

NOTES

- THE CONTRACTOR SHALL FIELD VERIFY ALL EXISTING UTILITY LOCATIONS AND NOTIFY THE ENGINEER IMMEDIATELY OF ANY DISCREPANCIES.
- ALL CURB RETURN RADI SHALL BE 25' UNLESS OTHERWISE SPECIFIED.
- ALL CURVE DATA AND DIMENSIONS REFER TO FACE OF CURB UNLESS OTHERWISE SPECIFIED.
- GRADE ELEVATIONS, WHERE NOTED, ARE ALONG FLOWLINE OF STANDARD CURB UNLESS OTHERWISE SPECIFIED.
- CONTRACTOR IS TO INSTALL A 4" X 4" X 5' POST AND END AT THE END OF EACH SANITARY SEWER SERVICE.
- CONTRACTOR IS RESPONSIBLE FOR REPAIR AND/OR REPLACEMENT OF ALL UTILITY CONDUITS AND EXISTING LINES.
- ANY ADDITIONAL GRADING REQUIRED TO MATCH PROPOSED STREET GRADES SHALL BE INCIDENTAL TO PAVING ITEMS.
- CONTRACTOR SHALL PROVIDE THE INSPECTORS, (CITY AND PRIVATE) WITH THE PROPOSED HYDROSTATIC TESTING PLAN. THE PLAN MUST BE APPROVED BEFORE TESTING OPERATIONS BEGIN.
- CONTRACTOR SHALL PARK EQUIPMENT AND VEHICLES AS NOT TO INTERFERE WITH NORMAL ACTIVITIES OF RESIDENTS OR OTHER CONTRACTORS ON SITE.
- ANY DAMAGE TO THE EXISTING FACILITIES (CURB & GUTTER), PAVEMENT, CONDUITS, LANDSCAPING, UTILITY LINES, ETC.) DURING CONSTRUCTION SHALL BE REPLACED AT THE CONTRACTORS' EXPENSE.
- REMOVAL OF THE EXISTING CURB AND GUTTER SHALL BE AS PER COA STD. DWG. 2415 (SAWCUT ONLY).
- WHEELCHAIR RAMPS SHALL BE CONSTRUCTED PRIOR TO ACCEPTANCE OF CURB & GUTTER.
- STATIONING AND OFFSETS GIVEN FOR DROP INLETS ARE GIVEN AT CENTER OF GRATE AT FLOWLINE

ENGINEER'S SEAL

BOHANNAN & HUSTON

COURTYARD ONE 7500 JEFFERSON NE ALBUQUERQUE NEW MEXICO 87109

ENGINEERS PLANNERS PHOTOGRAMMETRISTS SURVEYORS SOFTWARE DEVELOPERS

CITY OF ALBUQUERQUE
PUBLIC WORKS DEPARTMENT
ENGINEERING DEVELOPMENT GROUP

COTTONWOOD HILLS
UTILITY PLAN & PROFILE
CANADA PLACE

DESIGN REVIEW COMMITTEE CITY ENGINEER APPROVAL

APPROVED

1999

MM - 3


DESIGN REVIEW COMMITTEE

CITY PROJECT NO. 6092.81

ZONE MAP NO. A-13/B-13

SHEET 17 OF 24

DATE: FEBRUARY, 1999

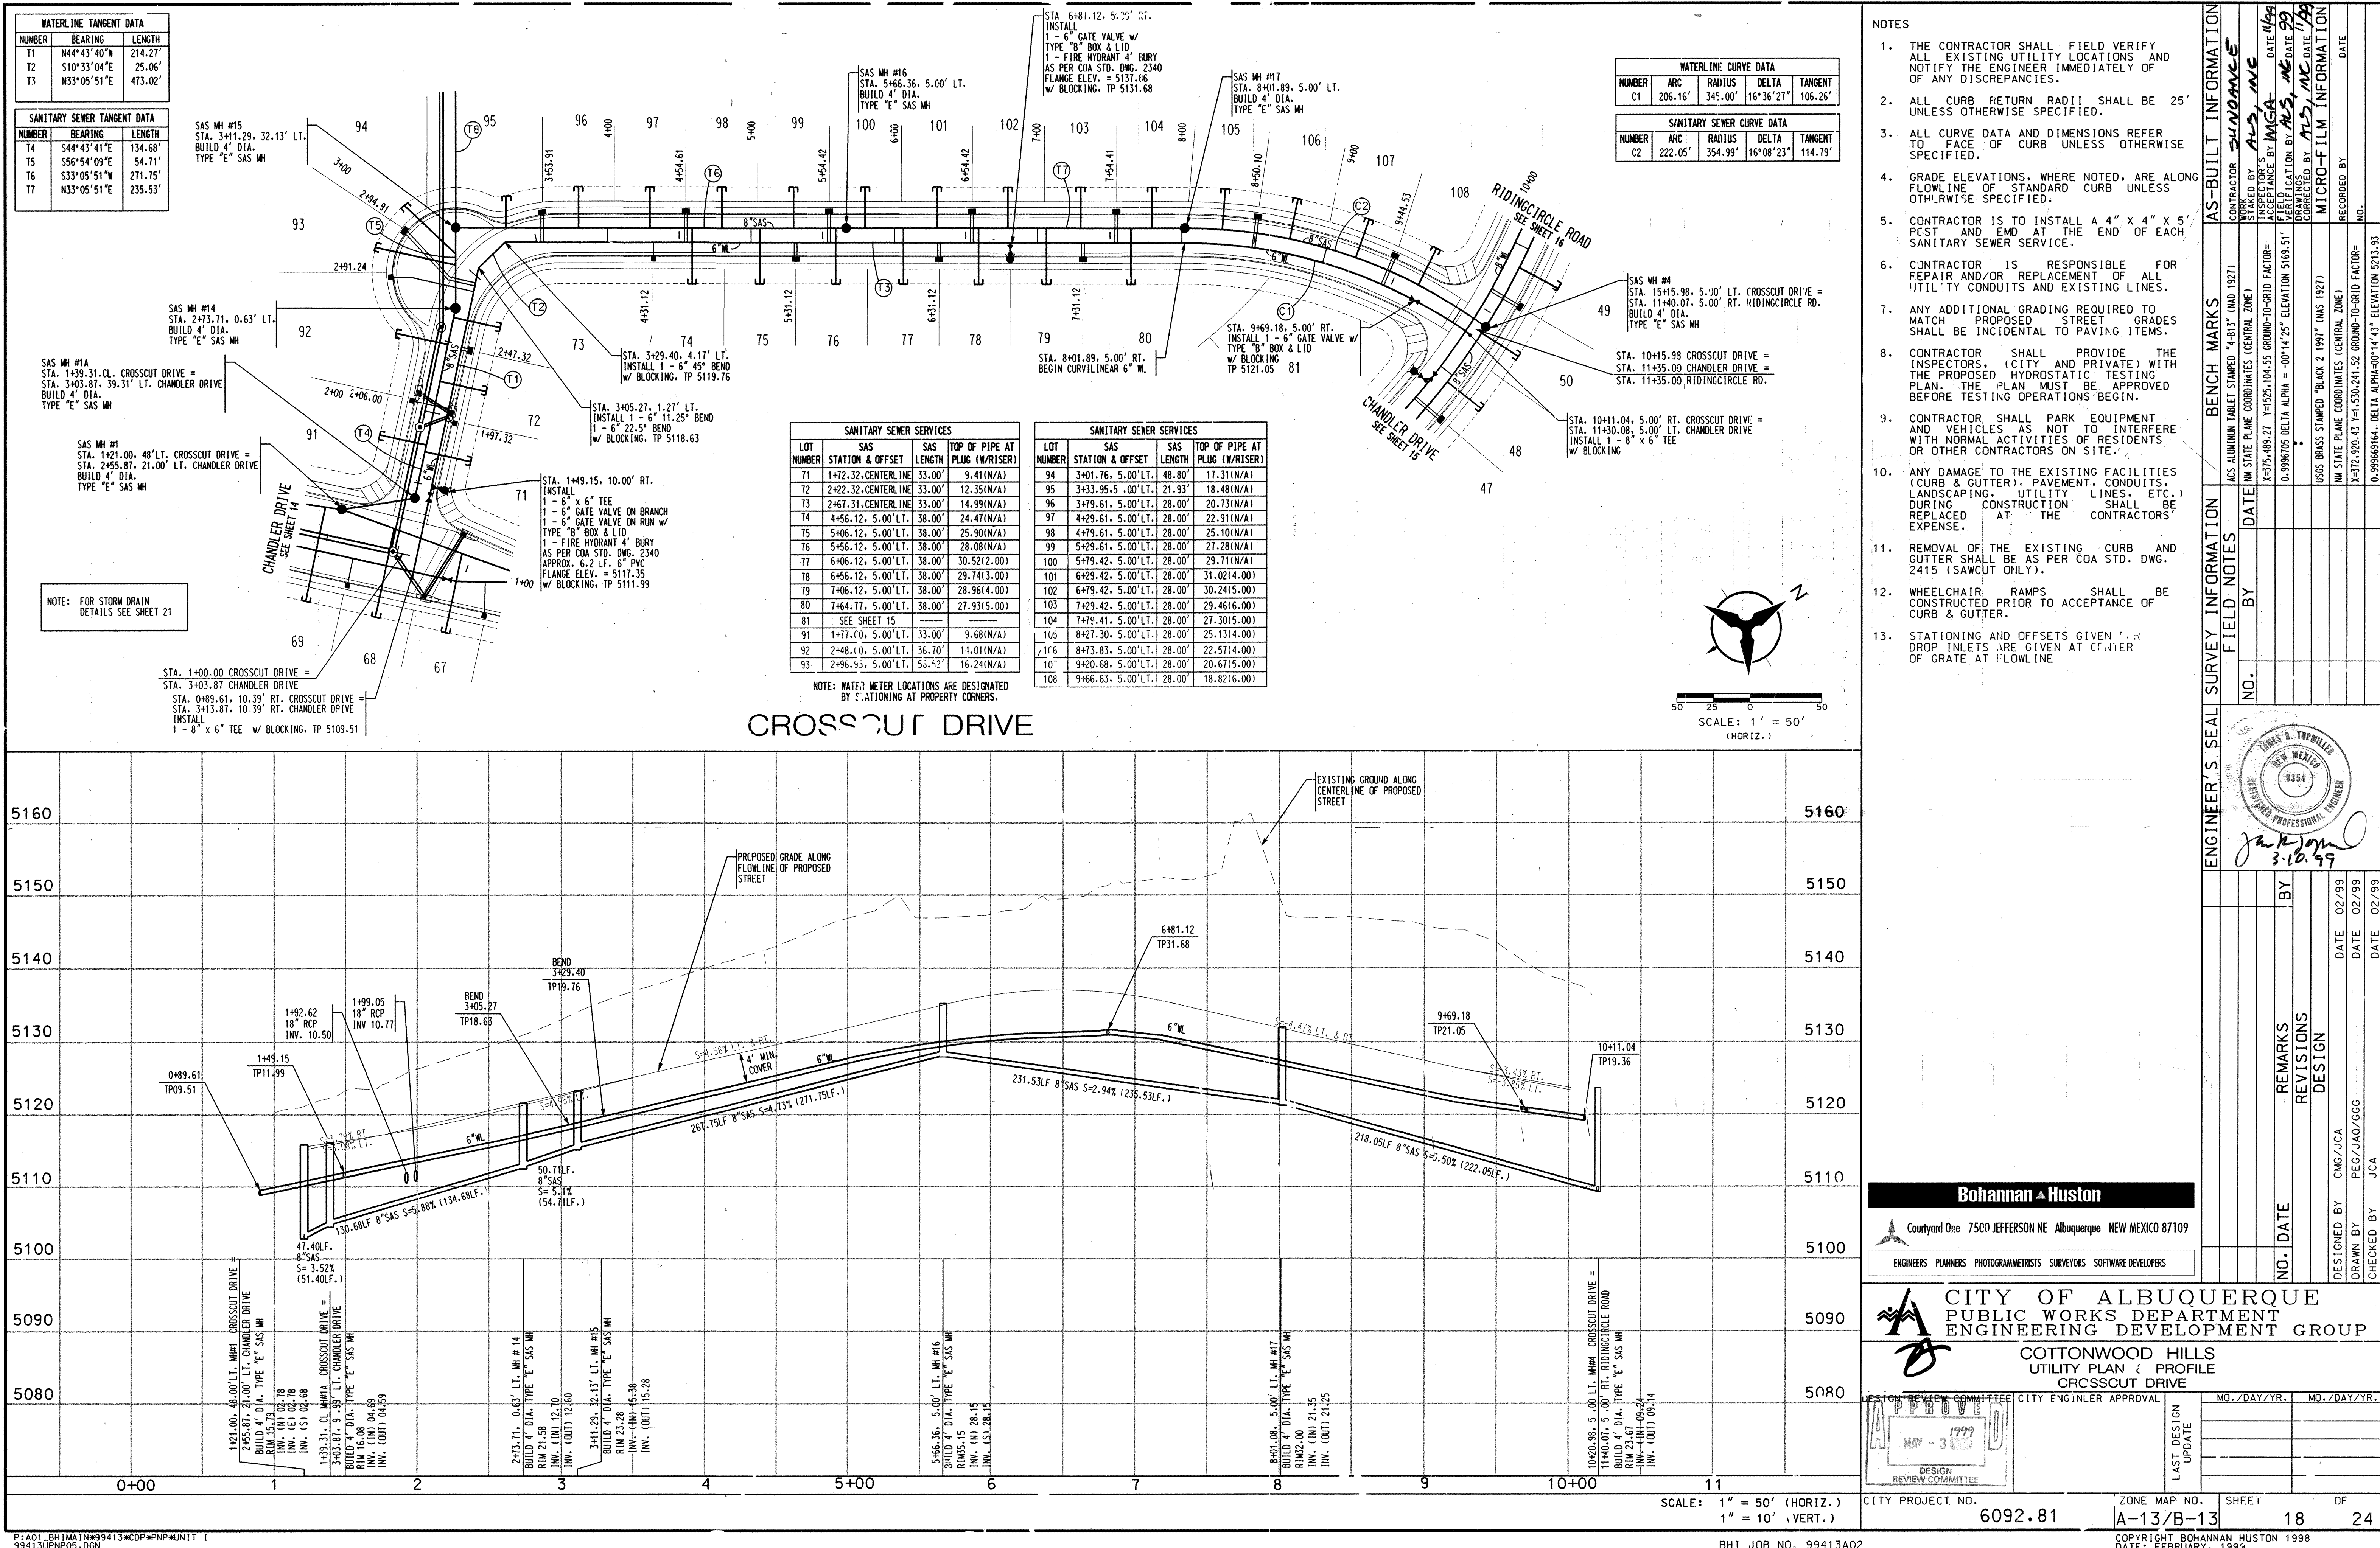

NOTES

- THE CONTRACTOR SHALL FIELD VERIFY ALL EXISTING UTILITY LOCATIONS AND NOTIFY THE ENGINEER IMMEDIATELY OF ANY DISCREPANCIES.
- ALL CURB RETURN RADII SHALL BE 25' UNLESS OTHERWISE SPECIFIED.
- ALL CURVE DATA AND DIMENSIONS REFER TO FACE OF CURB UNLESS OTHERWISE SPECIFIED.
- GRADE ELEVATIONS, WHERE NOTED, ARE ALONG FLOWLINE OF STANDARD CURB UNLESS OTHERWISE SPECIFIED.
- CONTRACTOR IS TO INSTALL A 4" X 4" X 5' POST AND END AT THE END OF EACH SANITARY SEWER SERVICE.
- CONTRACTOR IS RESPONSIBLE FOR REPAIR AND/OR REPLACEMENT OF ALL UTILITY CONDUITS AND EXISTING LINES.
- ANY ADDITIONAL GRADING REQUIRED TO MATCH PROPOSED STREET GRADES SHALL BE INCIDENTAL TO PAVING ITEMS.
- CONTRACTOR SHALL PROVIDE THE INSPECTORS (CITY AND PRIVATE) WITH THE PROPOSED HYDROSTATIC TESTING PLAN. THE PLAN MUST BE APPROVED BEFORE TESTING OPERATIONS BEGIN.
- CONTRACTOR SHALL PARK EQUIPMENT AND VEHICLES AS NOT TO INTERFERE WITH NORMAL ACTIVITIES OF RESIDENTS OR OTHER CONTRACTORS ON SITE.
- ANY DAMAGE TO THE EXISTING FACILITIES (CURB & GUTTER), PAVEMENT, CONDUITS, LANDSCAPING, UTILITY LINES, ETC.) DURING CONSTRUCTION SHALL BE REPLACED AT THE CONTRACTORS' EXPENSE.
- REMOVAL OF THE EXISTING CURB AND GUTTER SHALL BE AS PER COA STD. DWG. 2415 (SAWCUT ONLY).
- WHEELCHAIR RAMPS SHALL BE CONSTRUCTED PRIOR TO ACCEPTANCE OF CURB & GUTTER.
- STATIONING AND OFFSETS GIVEN FOR DROP INLETS ARE GIVEN AT CENTER OF GRATE AT FLOWLINE

ENGINEER'S SEAL

BOHANNAN & HUSTON
 Courtyard One 7500 JEFFERSON NE Albuquerque NEW MEXICO 87109
 ENGINEERS PLANNERS PHOTOGRAMMETRISTS SURVEYORS SOFTWARE DEVELOPERS

CITY OF ALBUQUERQUE
 PUBLIC WORKS DEPARTMENT
 ENGINEERING DEVELOPMENT GROUP

COTTONWOOD HILLS
 UTILITY PLAN & PROFILE
 CROSSCUT DRIVE

APPROVED
 MAY - 3 1999
 DESIGN REVIEW COMMITTEE

REVISIONS

NO.	DATE	REMARKS
1	02/99	DESIGN

DESIGNED BY CMG/JCA **DATE** 02/99
DRAWN BY PEG/JAO/GGG **DATE** 02/99
CHECKED BY JCA **DATE** 02/99

CITY PROJECT NO. 6092.81 **ZONE MAP NO.** A-13/B-13 **SHEET** 18 **OF** 24

DATE FEBRUARY, 1999




WATERLINE TANGENT DATA		
NUMBER	BEARING	LENGTH
T1	N02°29'03"W	88.74'
T2	S22°06'21"E	41.40'
T3	N41°43'40"W	363.09'
T4	S48°16'20"W	205.00'

SANITARY SEWER TANGENT DATA		
NUMBER	BEARING	LENGTH
T5	S22°06'22"E	50.47'
T6	S41°43'40"E	371.85'
T7	N48°16'20"E	225.00'

SANITARY SEWER SERVICES			
LOT NUMBER	SAS STATION & OFFSET	SAS LENGTH	TOP OF PIPE AT PLUG (N/RISER)
109	7+35.06, 5.00' RT.	27.00'	16.74(N/A)
110	6+85.06, 5.00' RT.	27.00'	18.82(N/A)
111	6+36.15, 6.39' RT.	27.00'	20.85(N/A)
112	6+03.01, 23.81' RT.	39.57'	22.48(N/A)
113	5+91.15, 38.14' RT.	41.27'	22.93(N/A)
114	5+86.98, 32.33' RT.	40.98'	25.46(N/A)
115	5+50.22, 7.35' RT.	27.00'	26.02(N/A)
116	5+01.80, 5.00' RT.	27.00'	27.51(N/A)
117	4+51.80, 5.00' RT.	27.00'	29.04(N/A)
118	4+01.80, 5.00' RT.	27.00'	30.57(N/A)
119	3+51.80, 5.00' RT.	27.00'	33.45(2.00)
120	3+01.80, 5.00' RT.	27.00'	35.66(3.00)
121	2+51.80, 5.00' RT.	27.00'	36.51(2.00)
122	2+11.80, 1.08' RT.	30.96'	37.38(N/A)
123	2+20.84, 1.07' RT.	27.00'	37.17(N/A)
124	2+81.96, 5.00' RT.	37.00'	35.99(2.00)
125	3+33.78, 5.00' RT.	37.00'	34.40(2.00)
126	3+85.78, 5.00' RT.	37.00'	32.13(1.00)
127	4+38.53, 5.00' RT.	37.00'	31.88(3.00)
128	4+91.28, 5.00' RT.	37.00'	29.59(2.00)
129	5+43.22, 5.86' RT.	38.64'	26.70(N/A)
130	SEE SHEET 16	-----	-----

NOTE: WATER METER LOCATIONS ARE DESIGNATED BY STATIONING AT PROPERTY CORNERS.

- NOTES
- THE CONTRACTOR SHALL FIELD VERIFY ALL EXISTING UTILITY LOCATIONS AND NOTIFY THE ENGINEER IMMEDIATELY OF ANY DISCREPANCIES.
 - ALL CURB RETURN RADII SHALL BE 25' UNLESS OTHERWISE SPECIFIED.
 - ALL CURVE DATA AND DIMENSIONS REFER TO FACE OF CURB UNLESS OTHERWISE SPECIFIED.
 - GRADE ELEVATIONS, WHERE NOTED, ARE ALONG FLOWLINE OF STANDARD CURB UNLESS OTHERWISE SPECIFIED.
 - CONTRACTOR IS TO INSTALL A 4" X 4" X 5' POST AND EMD AT THE END OF EACH SANITARY SEWER SERVICE.
 - CONTRACTOR IS RESPONSIBLE FOR REPAIR AND/OR REPLACEMENT OF ALL UTILITY CONDUITS AND EXISTING LINES.
 - ANY ADDITIONAL GRADING REQUIRED TO MATCH PROPOSED STREET GRADES SHALL BE INCIDENTAL TO PAVING ITEMS.
 - CONTRACTOR SHALL PROVIDE THE INSPECTORS, (CITY AND PRIVATE) WITH THE PROPOSED HYDROSTATIC TESTING PLAN. THE PLAN MUST BE APPROVED BEFORE TESTING OPERATIONS BEGIN.
 - CONTRACTOR SHALL PARK EQUIPMENT AND VEHICLES AS NOT TO INTERFERE WITH NORMAL ACTIVITIES OF RESIDENTS OR OTHER CONTRACTORS ON SITE.
 - ANY DAMAGE TO THE EXISTING FACILITIES (CURB & GUTTER), PAVEMENT, CONDUITS, LANDSCAPING, UTILITY LINES, ETC.) DURING CONSTRUCTION SHALL BE REPAIRED AT THE CONTRACTORS' EXPENSE.
 - REMOVAL OF THE EXISTING CURB AND GUTTER SHALL BE AS PER COA STD. DWG. 2415 (SAWCUT ONLY).
 - WHEELCHAIR RAMPS SHALL BE CONSTRUCTED PRIOR TO ACCEPTANCE OF CURB & GUTTER.
 - STATIONING AND OFFSETS GIVEN FOR DROP INLETS ARE GIVEN AT CENTER OF GRATE AT FLOWLINE

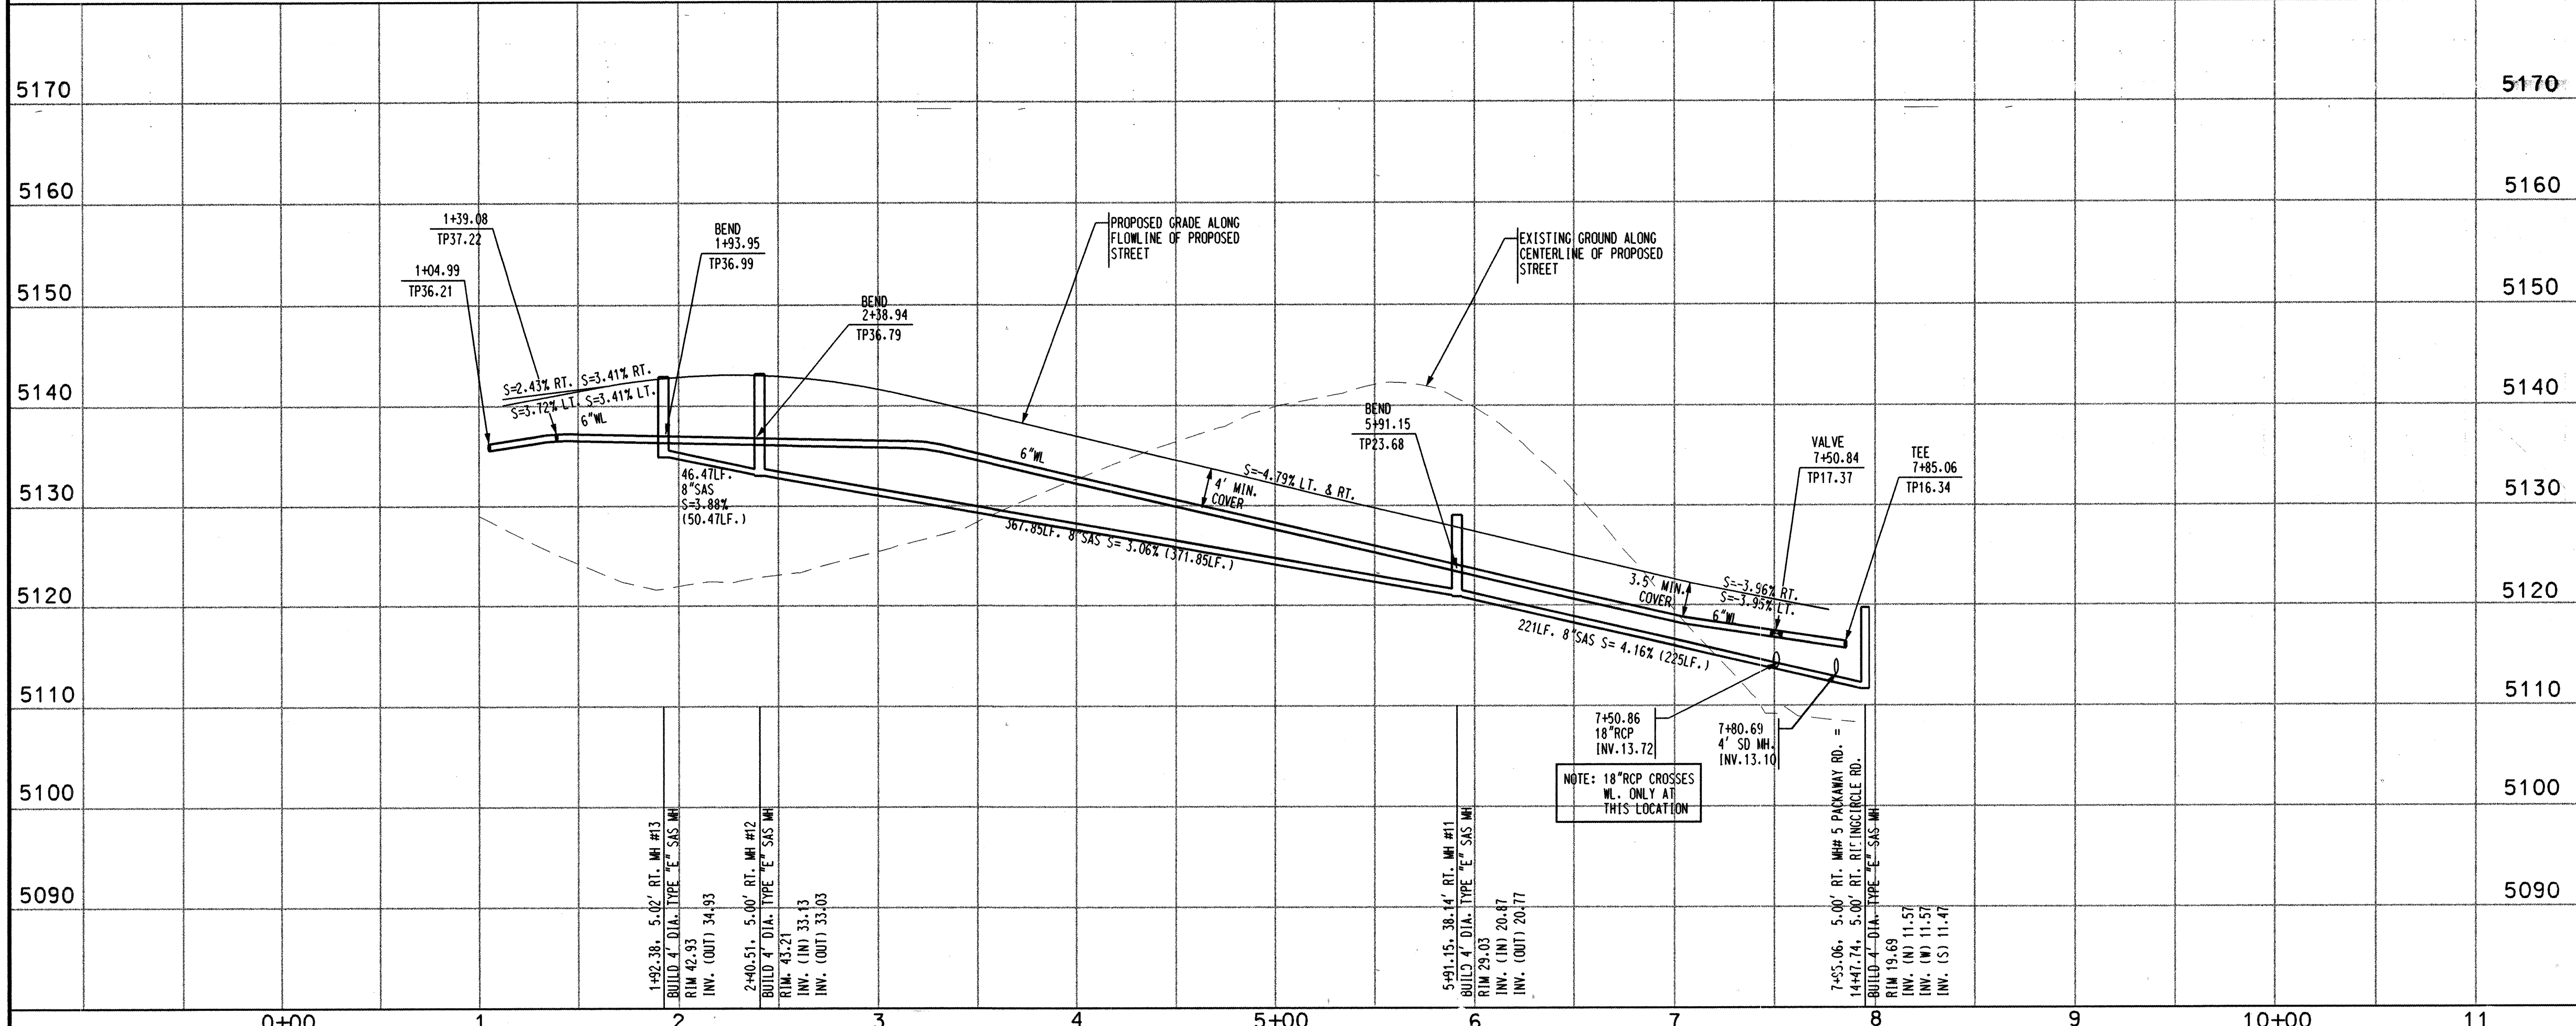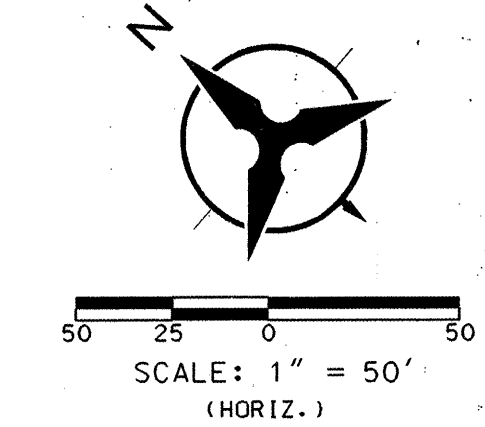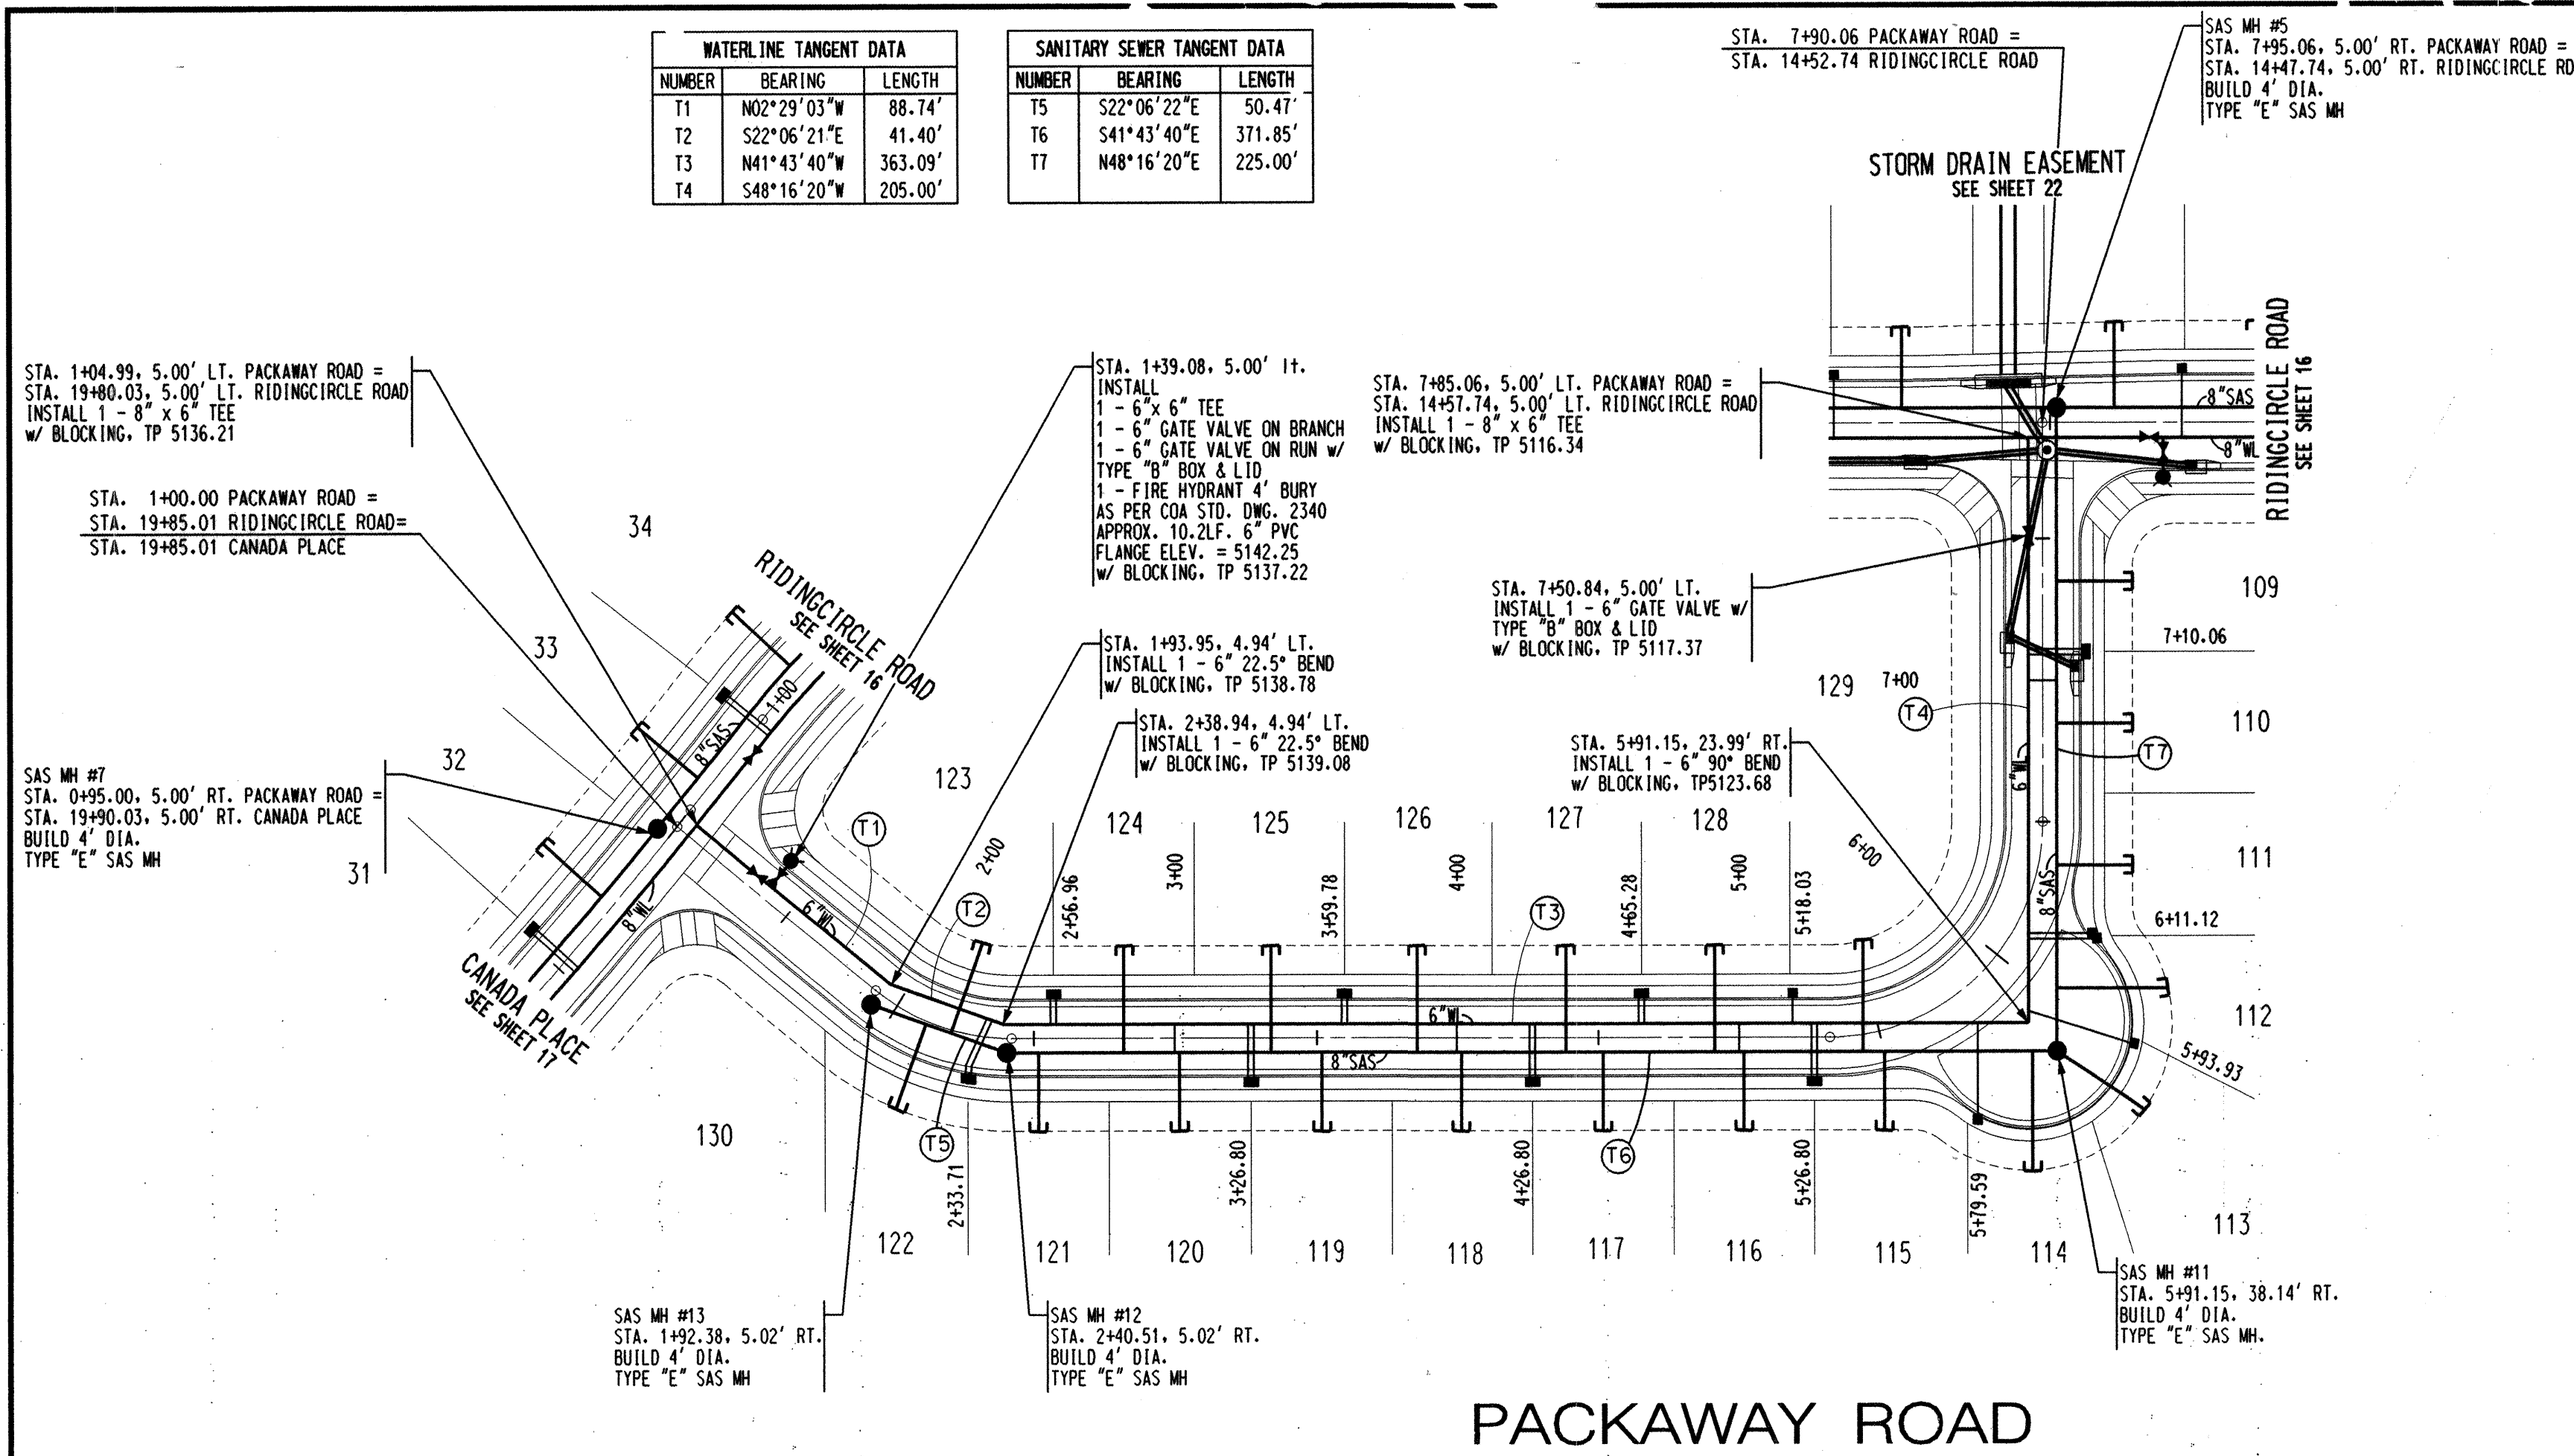

SCALE: 1" = 50' (HORIZ.)
1" = 10' (VERT.)

Bohannon & Huston
Courtyard One 7500 JEFFERSON NE Albuquerque NEW MEXICO 87109
ENGINEERS PLANNERS PHOTOGRAMMETRISTS SURVEYORS SOFTWARE DEVELOPERS

CITY OF ALBUQUERQUE
PUBLIC WORKS DEPARTMENT
ENGINEERING DEVELOPMENT GROUP

COTTONWOOD HILLS
UTILITY PLAN & PROFILE
PACKAWAY ROAD

DESIGN REVIEW COMMITTEE CITY ENGINEER APPROVAL


APPROVED
MAY - 3 1999
DESIGN REVIEW COMMITTEE

LAST DESIGN UPDATE


CITY PROJECT NO. 6092.81
SHEET 19 OF 24
ZONE MAP NO. A-13/B-13

MO./DAY/YR. MO./DAY/YR.

DESIGNED BY CMG/JCA DATE 02/99
DRAWN BY PEG/JAO/GGG DATE 02/99
CHECKED BY JCA DATE 02/99

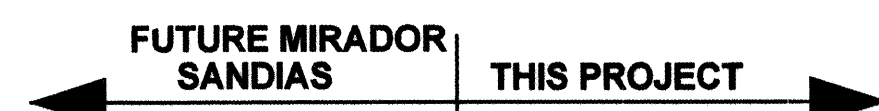

STORM DRAIN TANGENT DATA		
NUMBER	BEARING	LENGTH
T1	S56°54'09"E	206.01'
T2	S44°43'40"E	66.62'
T3	N65°55'16"E	24.56'
T4	S12°30'46"W	23.40'
T5	S44°43'40"E	84.16'
T6	S24°05'47"E	48.85'
T7	N87°47'12"E	36.26'
T8	N45°16'19"E	183.70'

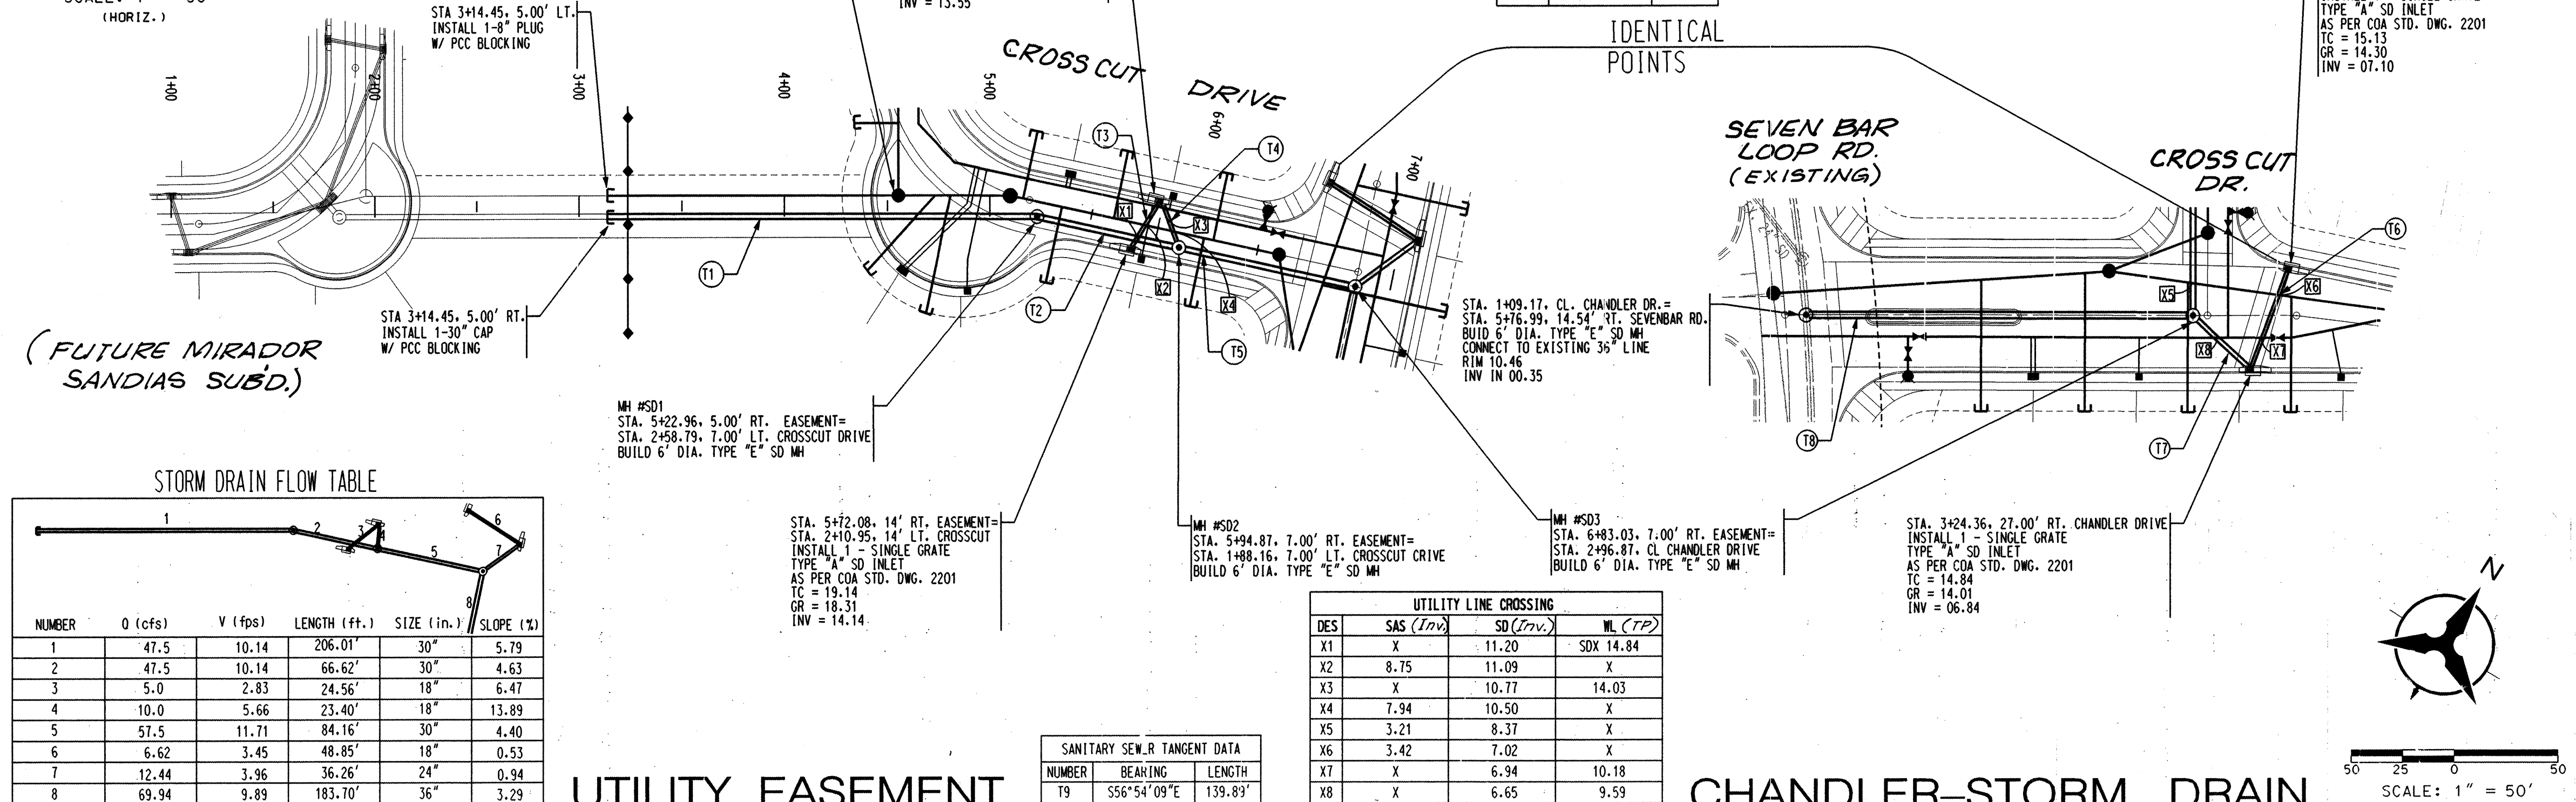


STORM DRAIN FLOW TABLE

NUMBER	Q (cfs)	V (fps)	LENGTH (ft.)	SIZE (in.)	SLOPE (%)
1	47.5	10.14	206.01'	30"	5.79
2	47.5	10.14	66.62'	30"	4.63
3	5.0	2.83	24.56'	18"	6.47
4	10.0	5.66	23.40'	18"	13.89
5	57.5	11.71	84.16'	30"	4.40
6	6.62	3.45	48.85'	18"	0.53
7	12.44	3.96	36.26'	24"	0.94
8	69.94	9.89	183.70'	36"	3.29


SANITARY SEW_R TANGENT DATA		
NUMBER	BEARING	LENGTH
T9	S56°54'09"E	139.89'

UTILITY LINE CROSSING			
DES	SAS	SD (Inv.)	WL (TP)
X1	X	11.20	SDX 14.84
X2	8.75	11.09	X
X3	X	10.77	14.03
X4	7.94	10.50	X
X5	3.21	8.37	X
X6	3.42	7.02	X
X7	X	6.94	10.18
X8	X	6.65	9.59

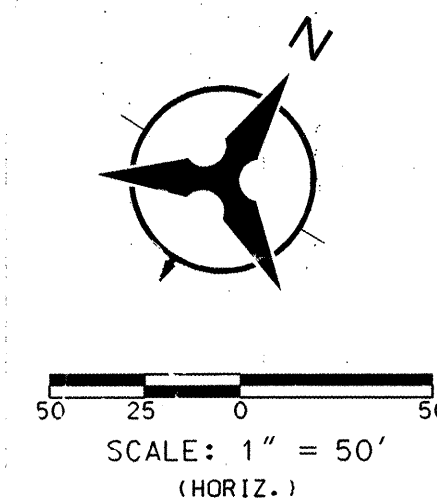

1. THE CONTRACTOR SHALL FIELD VERIFY ALL EXISTING UTILITY LOCATIONS AND NOTIFY THE ENGINEER IMMEDIATELY OF ANY DISCREPANCIES.
2. ALL CURB RETURN RADII SHALL BE 25' UNLESS OTHERWISE SPECIFIED.
3. ALL CURVE DATA AND DIMENSIONS REFER TO FILE OF CURB UNLESS OTHERWISE SPECIFIED.
4. GRADE ELEVATIONS, WHERE NOTED, ARE ALONG FLOWLINE OF STANDARD CURB UNLESS OTHERWISE SPECIFIED.
5. CONTRACTOR IS TO INSTALL A 4" X 4" X 5' POST AND END AT THE END OF EACH SANITARY SEWER SERVICE.
6. CONTRACTOR IS RESPONSIBLE FOR REPAIR AND/OR REPLACEMENT OF ALL UTILITY CONDUITS AND EXISTING LINES.
7. ANY ADDITIONAL GRADING REQUIRED TO MATCH PROPOSED STREET GRADES SHALL BE INCIDENTAL TO PAVING ITEMS.
8. CONTRACTOR SHALL PROVIDE THE INSPECTORS (CITY AND PRIVATE) WITH THE PROPOSED HYDROSTATIC TESTING PLAN. THE PLAN MUST BE APPROVED BEFORE TESTING OPERATIONS BEGIN.
9. CONTRACTOR SHALL PARK EQUIPMENT AND VEHICLES AS NOT TO INTERFERE WITH NORMAL ACTIVITIES OF RESIDENTS OR OTHER CONTRACTORS ON SITE.
10. ANY DAMAGE TO THE EXISTING FACILITIES (CURB & GUTTER, PAVEMENT, CONDUITS, LANDSCAPING, UTILITY LINES, ETC.) DURING CONSTRUCTION SHALL BE REPLACED AT THE CONTRACTORS' EXPENSE.
11. REMOVAL OF THE EXISTING CURB AND GUTTER SHALL BE AS PER COA STD. DWG. 2415 (SAWCUT ONLY).
12. WHEELCHAIR RAMPS SHALL BE CONSTRUCTED PRIOR TO ACCEPTANCE OF CURB & GUTTER.
13. STATIONING AND OFFSETS GIVEN FOR DROP INLETS ARE GIVEN AT CENTER OF GRATE AT FLOWLINE.

ENGINEER'S SEAL		SURVEY INFORMATION		BENCH MARKS		AS-BUILT INFORMATION	
NO.	BY	DATE	FIELD NOTES	ACS ALUMINUM TABLE STAMPED "4-813" (MAD 1927)	WORK STAMPED BY	CONTRACTOR	AS-BUILT INFORMATION
				Y=575,489.27 X=1525,104.55 GROUND-TO-GRID FACTOR=0.9996705 DELTA ALPHA = "00"14.25' ELEVATION 5169.51'	BY MGA	DATE 1/17/99	CONTRACTOR SURVIVANCE
					FIELD LOCATION BY	DATE 9/9/99	
					ORAN LUTS	DATE 1/17/99	
					CORRECTED BY	DATE 1/17/99	
					MICRO-FILM INFORMATION		
					RECORDED BY	DATE	
					NO.		
					WM STATE PLANE COORDINATES (CENTRAL ZONE)		
					X=372,920.43 Y=1,530,241.52 GROUND-TO-GRID FACTOR=0.999668164 DELTA ALPHA="00"14.41' ELEVATION 5213.53		

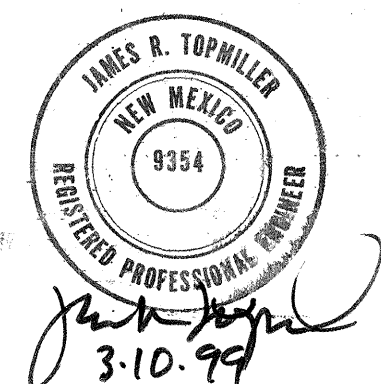[illegible]

Bohannon ▲ Huston

 Courtyard One 7500 JEFFERSON NE Albuquerque NEW MEXICO 87109

ENGINEERS PLANNERS PHOTOGRAMMETRISTS SURVEYORS SOFTWARE DEVELOPERS

 CITY OF ALBUQUERQUE
PUBLIC WORKS DEPARTMENT
ENGINEERING DEVELOPMENT GROUP

 COTTONWOOD HILLS
UTILITY PLAN & PROFILE
UTILITY EASEMENT & CHANDLER-STORM DRAIN

DESIGN REVIEW COMMITTEE	CITY ENGINEER APPROVAL	MO./DAY/YR.	MO./DAY/YR.
-------------------------	------------------------	-------------	-------------

APPROVED
MAY - 3 1999
DESIGN
REVIEW COMMITTEE

		MO./DAY/YR.	MO./DAY/YR.
--	--	-------------	-------------

GN		
----	--	--

ESM		
ATE		

T D PDA		
------------	--	--

AST		
U		

1		
---	--	--

MAP NO.	SHEET	OF
---------	-------	----

3/B-13	20	24
--------	----	----

RIGHT BOHANNAN HUSTON 1998

FEBRUARY, 1999

05 06001 06002 06003 06682

P:A01_BHIMAIN*99413*CDP*PNP*
99413EASMNT01.DGN

BHI JOB NO. 99413A02

CITY PROJECT NO.	3092.8
------------------	--------


ZONE MAP NO.	SHEET	OF
A-13/B-13	20	24

COPYRIGHT BOHANNAN HUSTON 1998


DATE: FEBRUARY, 1999

[illegible]

NUMBER	BEARING	LENGTH
T1	S16°25'37"E	23.24'
T2	N60°04'25"E	62.04'
T3	S35°33'57"E	50.17'
T4	S41°40'18"E	44.97'
T5	S46°28'54"E	42.78'
T6	N15°52'44"E	21.29'
T7	N48°16'20"E	168.59'

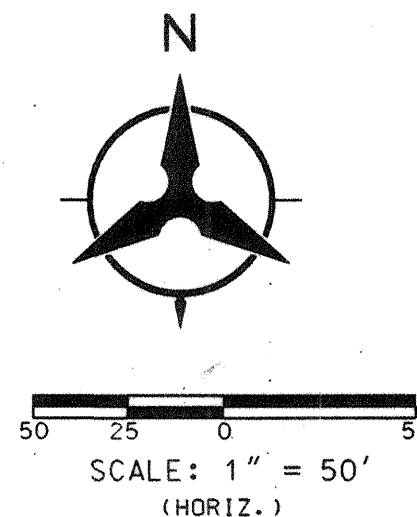

STORM DRAIN EASEMENT

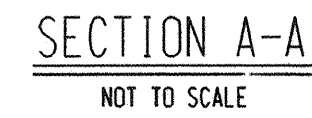

MODIFIED DOUBLE GRATE TYPE "A" INLET DETAIL

CONSTRUCT VAULT WALL AS DIMENSIONED ON THE
DETAILS PER THIS SHEET. DIMENSIONS AND
REINFORCEMENT NOT SHOWN ON THIS SHEET
SHALL BE TAKEN FROM THE C.O.A. STD.
DWG 2201 AND 2202.

- A. FRAME AND GRATE
- B. CENTER SUPPORT ASSEMBLY
- C. CUT HORIZONTAL AND VERTICAL BAR
MAX. AT PIPE OPENING. (SEE SECTION
B-B AND C-C ON COA STD DWG 2202).
- D. NO. 4 BARS AT 6" O. C. EACH WAY
- E. USE STANDARD STEP, SEE COA STD. DWG 2229
- F. CONC. FILL. SEE NOT C. DWG 2201
- G. INVERT PER DESIGN
- H. INSTALL STEPS ON DOWNSTREAM FACE
- I. STATIONING AND OFFSETS GIVEN FOR
DROP INLETS ARE GIVEN AT CENTER OF GRATE
ASSEMBLY AT FLOW LINE

A circular professional engineer seal for James R. Topmiller, New Mexico, No. 9354. The seal is stamped in black ink. Below the seal, the name "James R. Topmiller" is handwritten in cursive, followed by the date "3.10.99".

Bohannon ▲ Huston

 Courtyard One 7500 JEFFERSON NE Albuquerque NEW MEXICO 87109







ENGINEERS PLANNERS PHOTOGRAMMETRISTS SURVEYORS SOFTWARE DEVELOPERS

 CITY OF ALBUQUERQUE
PUBLIC WORKS DEPARTMENT
ENGINEERING DEVELOPMENT GROUP

COTTONWOOD HILLS UTILITY PLAN & PROFILE STORM DRAIN EASEMENT & DETAILS		
DESIGN REVIEW COMMENTS (BY ENGINEER APPROVAL)	NO / DAY / YR	NO / DAY / YR

DESIGN REVIEW COMMITTEE	CITY ENGINEER APPROVAL	MU. / DAT / TR.	MU. / DAT / TR.
		LAST DESIGN UPDATE	

CITY PROJECT NO.		ZONE MAP NO.	SHEET
6092.81		A-13/3-13	21 24
COPYRIGHT BOHANNAN HUSTON 1998			
DATE: FEBRUARY 1999			

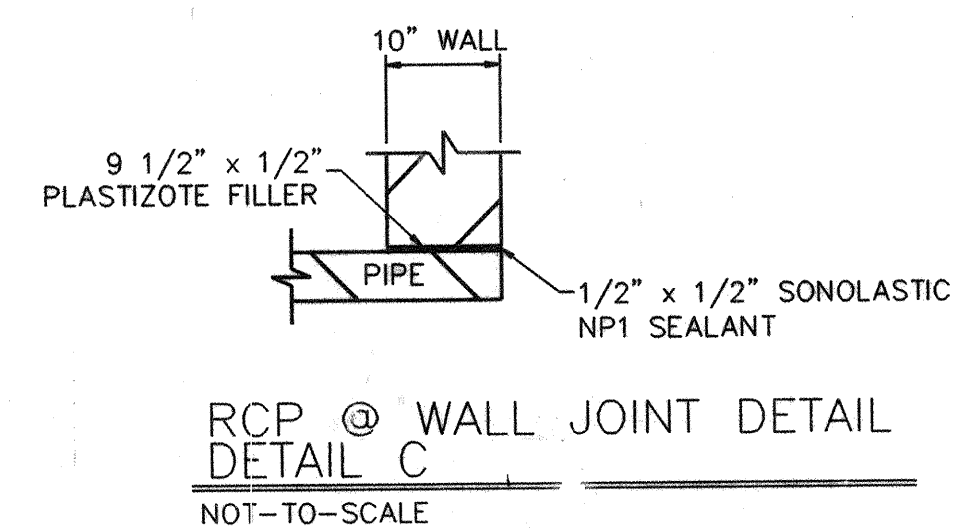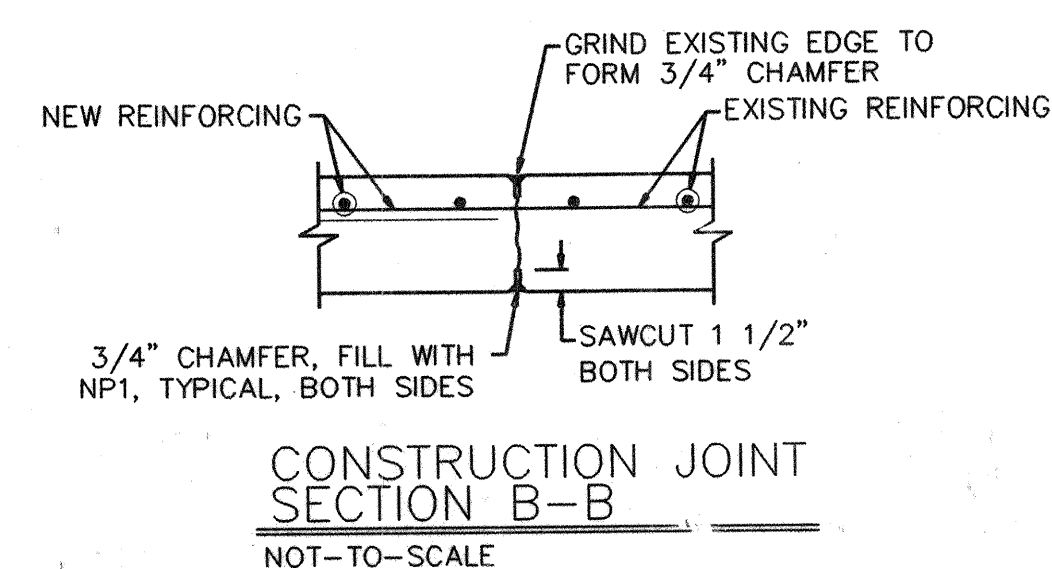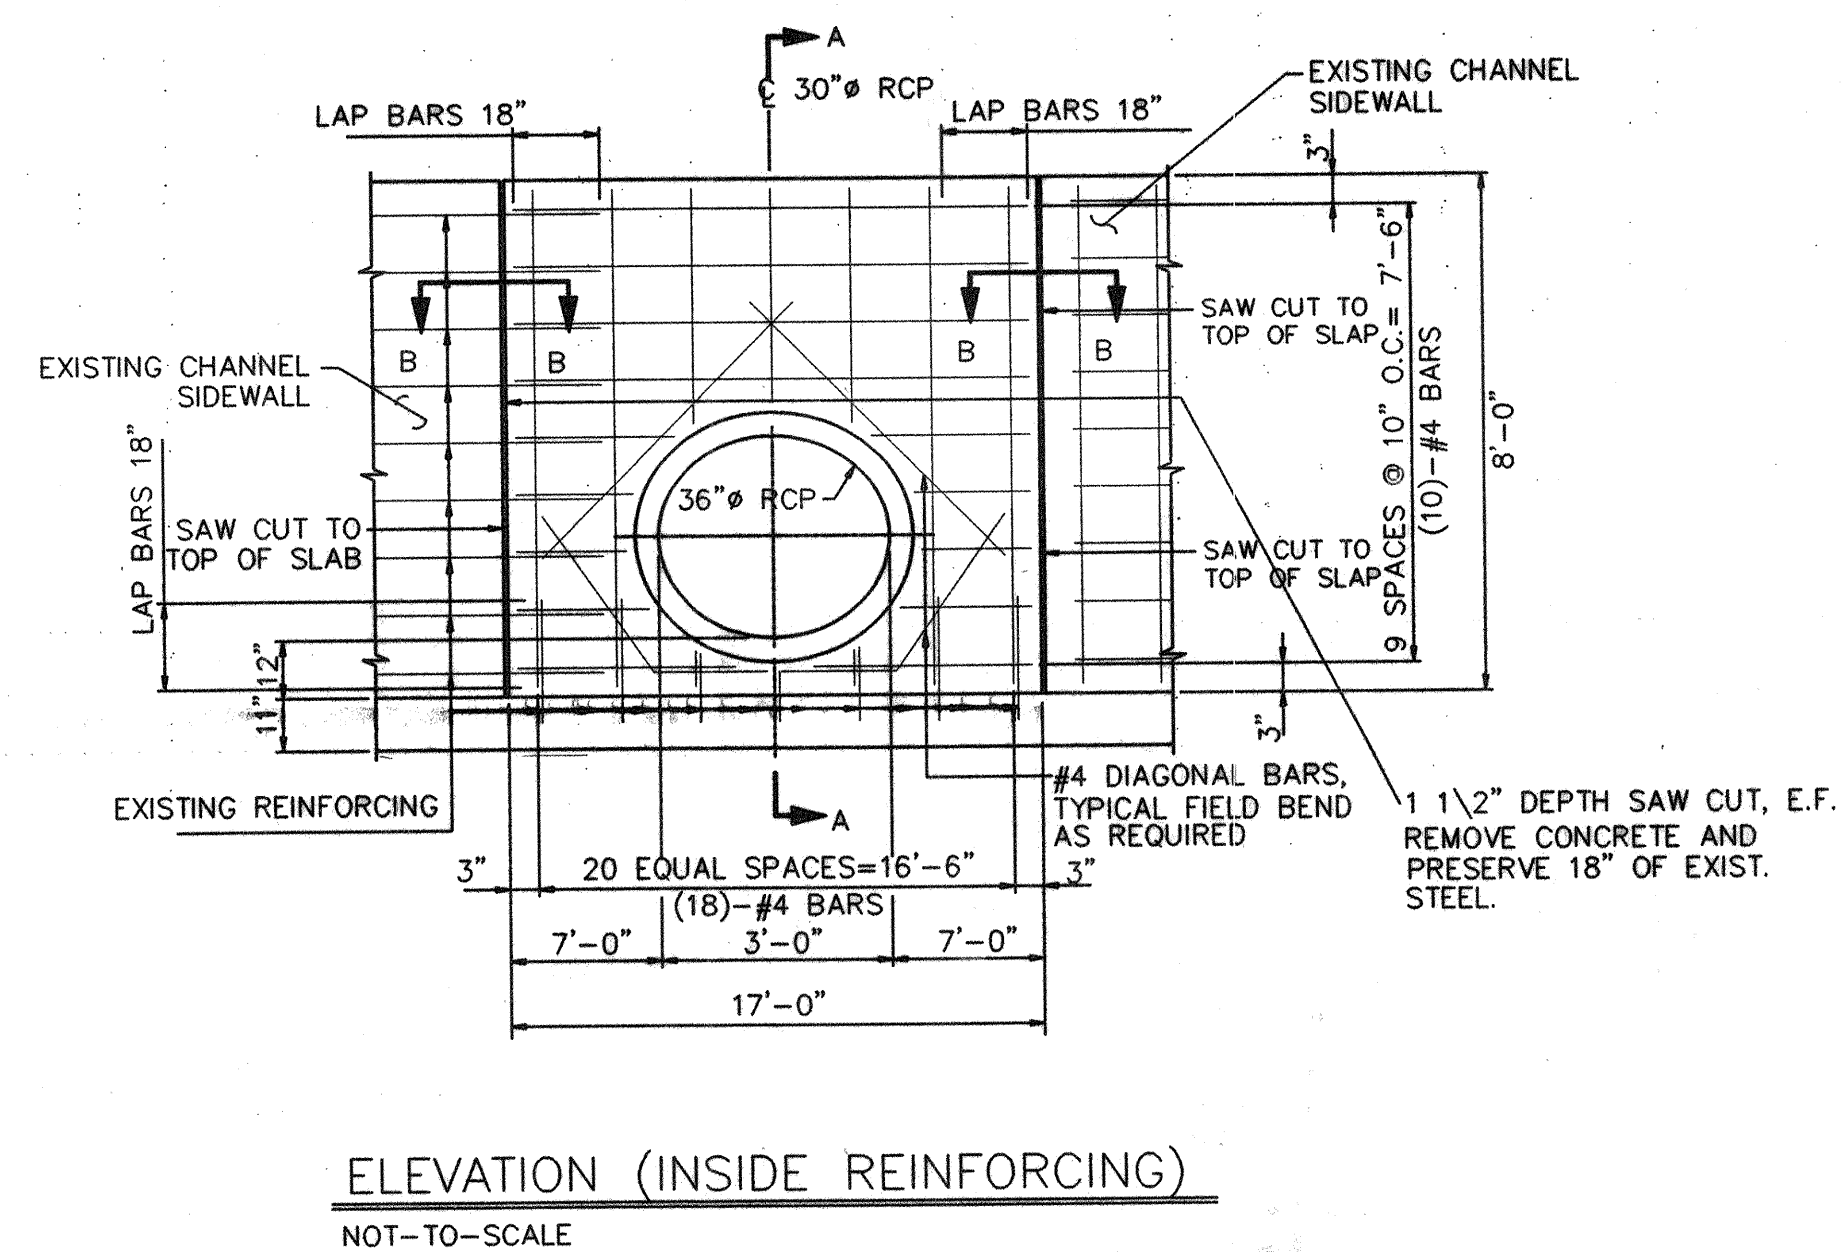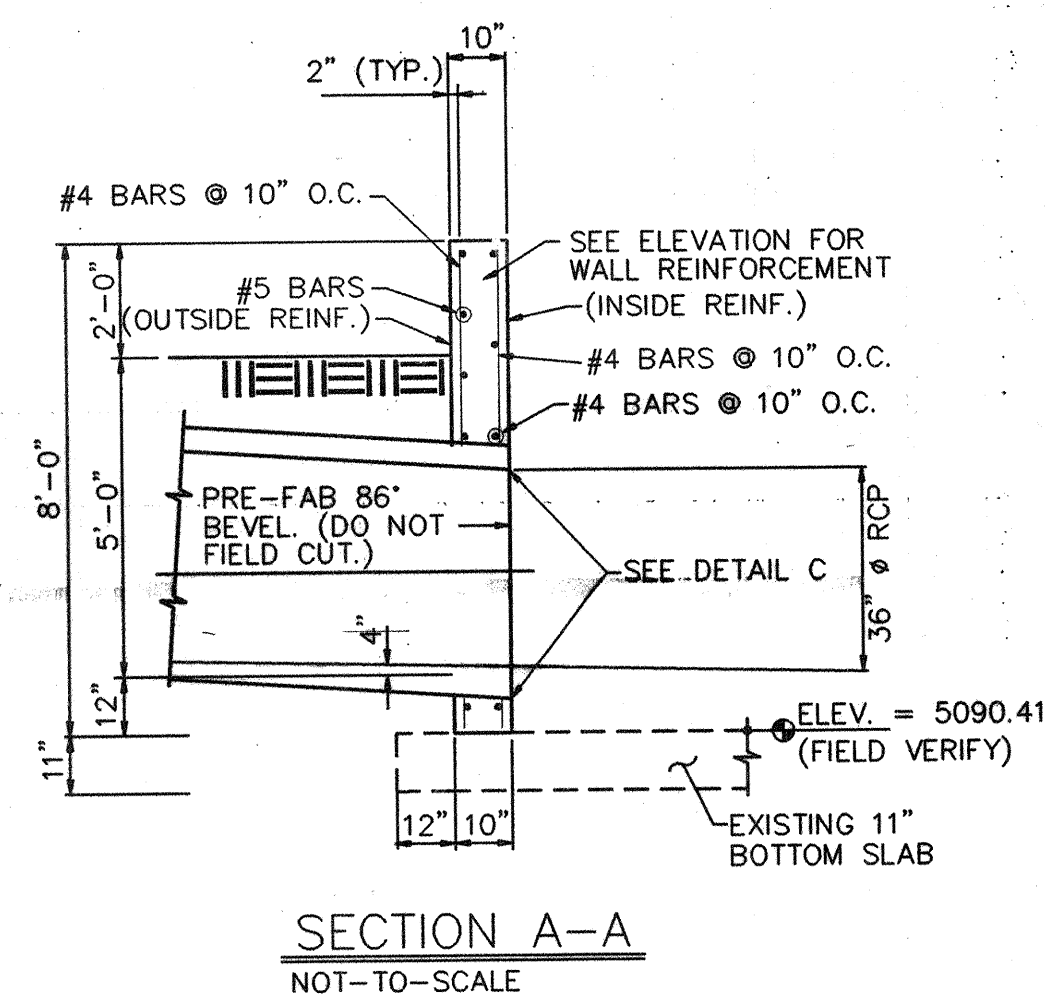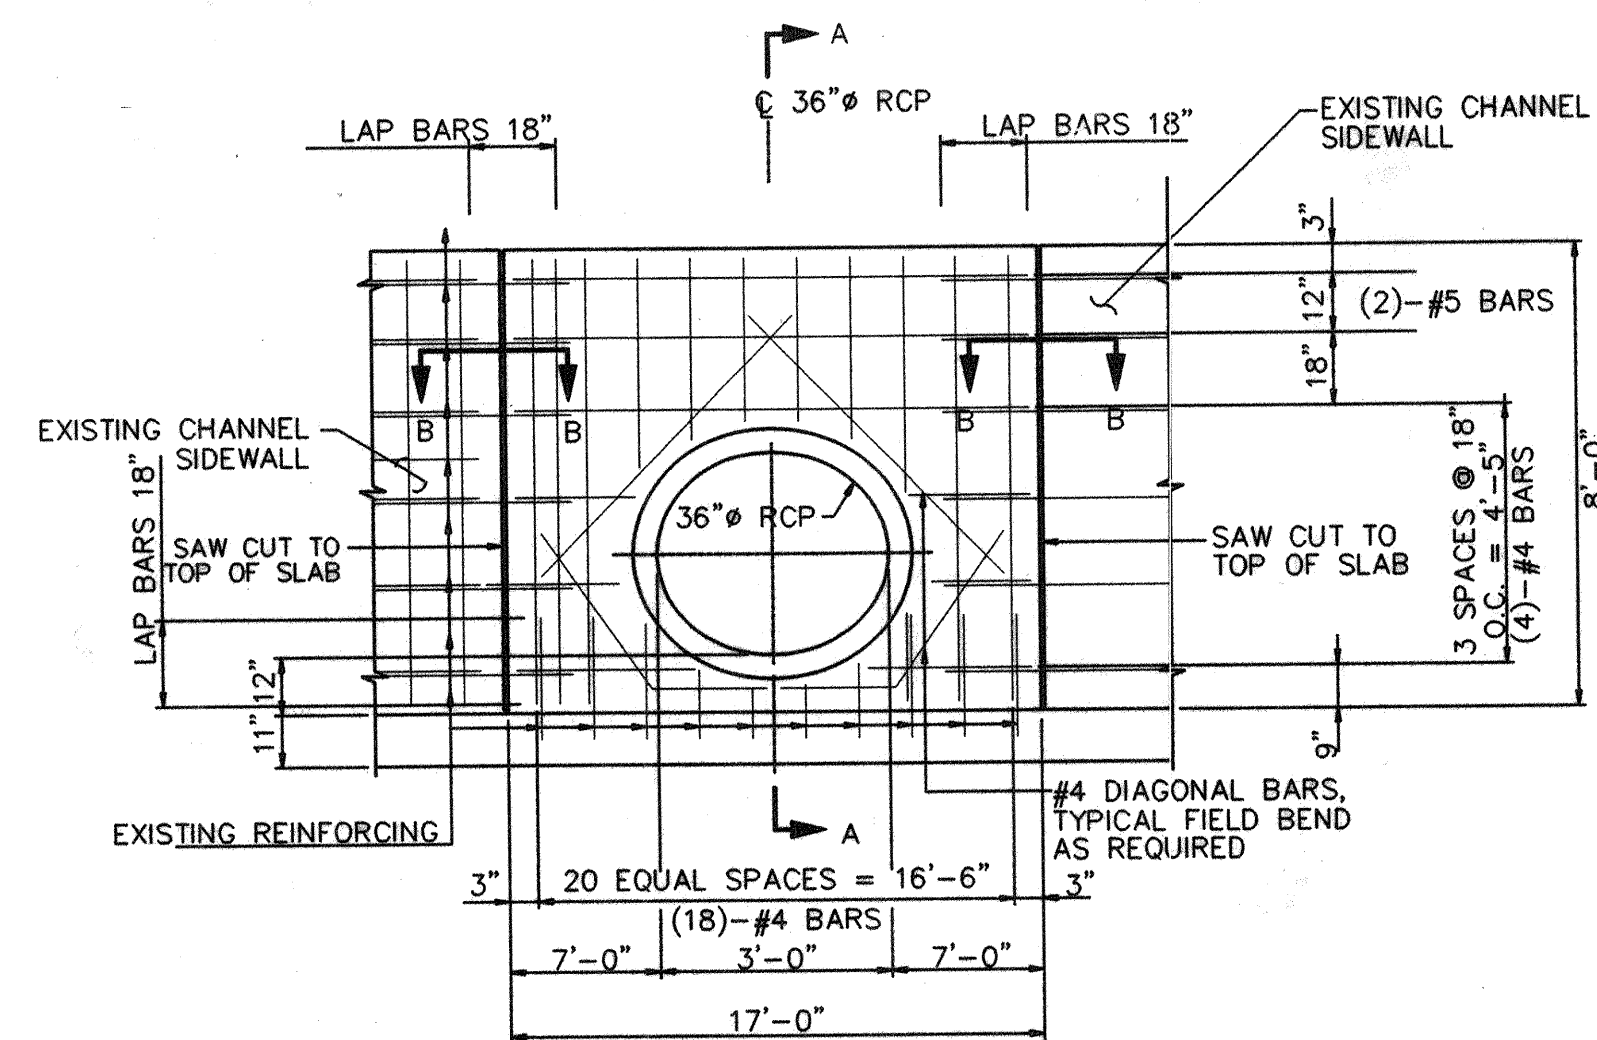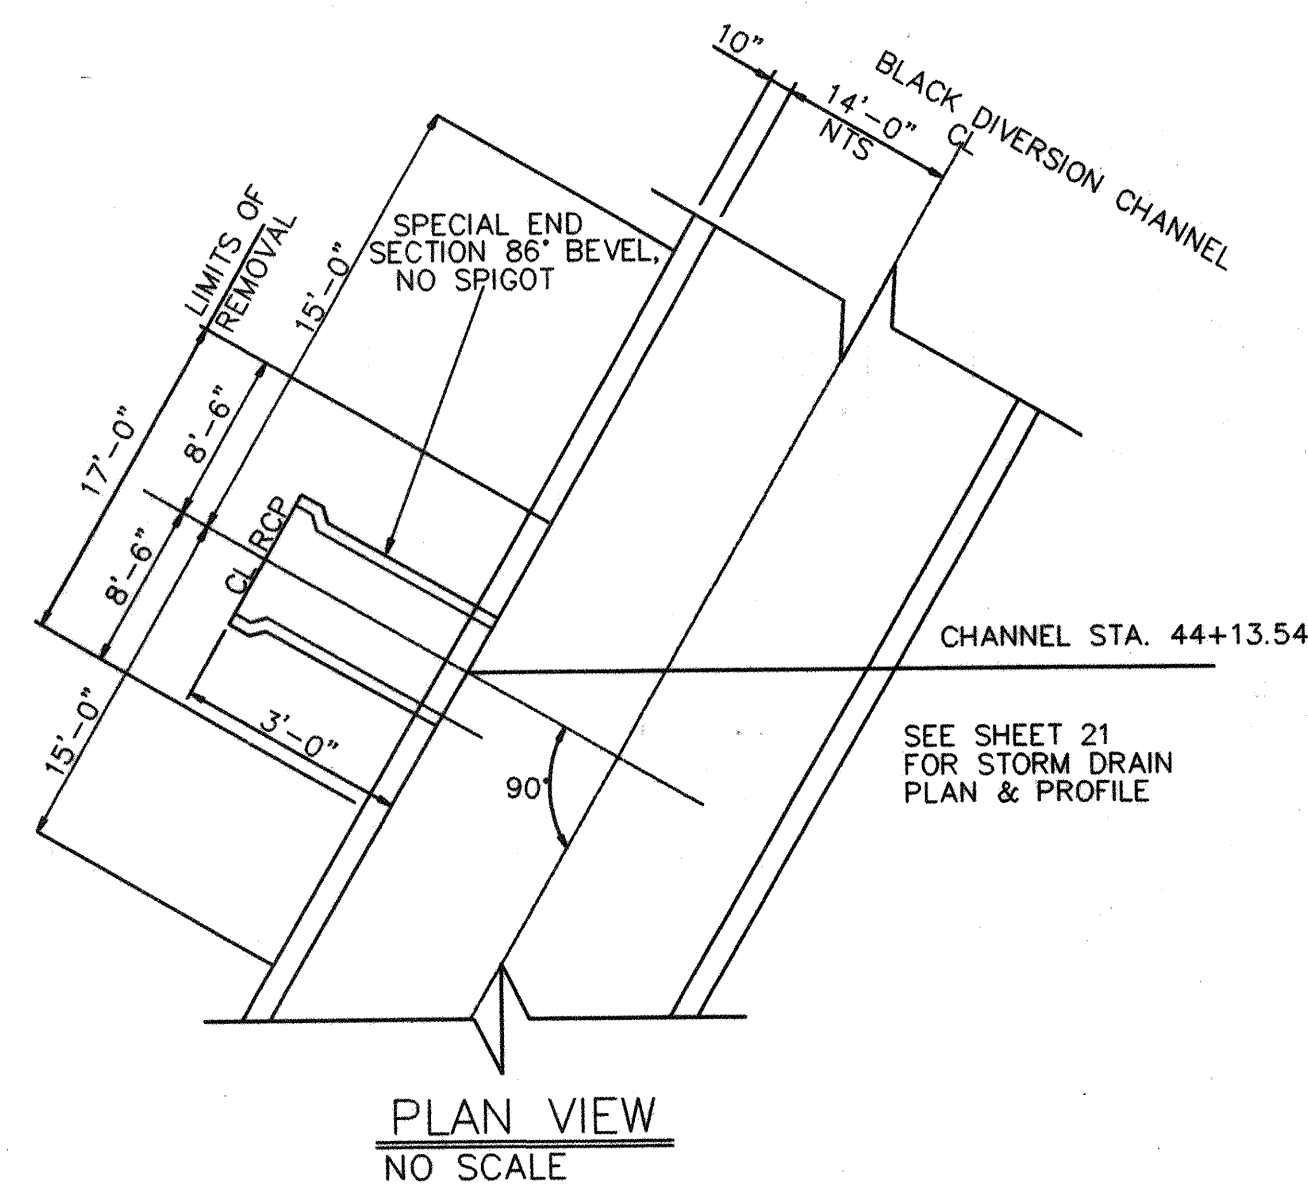

NOTES:

1. MATERIALS:
CONCRETE FOR HYDRAULIC STRUCTURES
REF. SPEC. TABLE 101-C
1c = 4000 PSI
REINFORCING: ASTM A516. GRADE 60.
2. WORK SHALL BE DONE BETWEEN THE MONTHS
OF SEPTEMBER THRU JUNE 15.
3. CONTRACTOR SHALL CONTACT:
MR. JOHN KELLY
AMAFCA
(505) 884-2215
PRIOR TO CONCRETE PLACEMENT FOR
INSPECTION OF FORMS AND STEEL.
4. DISTURBED SUBGRADE SHALL BE RECOMPACTED
TO 100% MOD. PROCTOR DENSITY AS
DETERMINED BY ASTM D1557.
5. CONTRACTOR SHALL CLEAN ALL CONSTRUCTION
DEBRIS FROM AREA.
6. SEE GRADING PLAN FOR FINISHED GRADE.
7. SEE SHEET 21 FOR ALIGNMENT OF 36" RCP.
8. CONTRACTOR SHALL VERIFY INVERT ELEVATION
SHOWN IN SECTION A-A.

CONSTRUCTION NOTES:

1. EXCAVATE BACK SIDE OF WALL TO LIMITS SHOWN IN PLAN.
2. SAW CUT EXISTING CHANNEL WALL IN LOCATION SHOWN 1 1/2" DEEP ON BOTH SIDE AND TOP.
3. REMOVE CONCRETE OF EXISTING WALL FROM TOP OF SLAB TO TOP OF WALL AND FROM SAW CUT EDGES. SEE PLAN FOR LIMITS OF REMOVAL.
4. BREAK OUT EXISTING CONCRETE ADJACENT TO SAW CUT AND BOTTOM SLAB USING A 30# CHIPPING HAMMER TO AVOID DAMAGE TO REMAINING CONCRETE.
5. PRESERVE 18" OF EXISTING HORIZONTAL WALL REINFORCING AND VERTICAL DOWELS IN BOTTOM SLAB.
6. TIE STEEL AND INSTALL JOINTS AS SHOWN IN DETAILS.
7. MATCH FORM LINERS, COLOR AND FINISH OF EXISTING CONCRETE.
8. BACKFILL OUTSIDE OF CHANNEL TO ORIGINAL GRADE AFTER CONCRETE HAS GAINED 80% OF DESIGN STRENGTH.
9. RCP END SECTION SHALL HAVE PRE-FABRICATED 86° BEVEL. DO NOT FIELD CUT.

AMAFCA APPROVAL

[Signature] 3-11-99

BY DATE

Bohannon ▲ Huston

 Courtyard One 7500 JEFFERSON NE Albuquerque NEW MEXICO 87109

ENGINEERS PLANNERS PHOTOGRAMMETRISTS SURVEYORS SOFTWARE DEVELOPERS



CITY OF ALBUQUERQUE
PUBLIC WORKS DEPARTMENT
ENGINEERING DEVELOPMENT GROUP

COTTONWOOD HILLS
STORM DRAIN OUTLET DETAILS

Design Review Committee		City Engineer Approval		Last Design Update		Mo./Day/Yr.		Mo./Day/Yr.	
APPROVED 1999 MAY - 3 1999 DESIGN REVIEW COMMITTEE									
City Project No.		Zone Map No.		Sheet					
609281603501		A13313		20				24	

CONSTRUCTION TRAFFIC CONTROL GENERAL NOTES

- CONTRACTOR MUST OBTAIN FROM CONSTRUCTION COORDINATION AN EXCAVATION/BARRICADING PERMIT BEFORE ENGAGING IN ANY CONSTRUCTION, MAINTENANCE OR REPAIR WORK IN ANY OF THE CITY OF ALBUQUERQUE'S RIGHTS-OF-WAY. EMERGENCY WORK THAT WOULD PRESERVE LIFE OR PROPERTY IS EXCLUDED WITH THE UNDERSTANDING, THAT A PERMIT SHALL BE OBTAINED WITHIN 24 TO 48 HOURS.
- CONTRACTOR SHALL AT THE TIME OF PERMIT REQUEST, SUBMIT FOR APPROVAL BY CONSTRUCTION COORDINATION, A TRAFFIC CONTROL PLAN DETAILING ALL EXISTING TOPOGRAPHY SUCH AS LANE WIDTHS, DRIVEWAYS, AND BUSINESS/RESIDENTIAL ACCESSES. THE TRAFFIC CONTROL PLAN SHALL INCLUDE ALL PHASES OF WORK AND SCHEDULES INVOLVED IN THE CONSTRUCTION PROJECT. ANY SEPARATE PHASES OF A CONSTRUCTION PROJECT SHALL BE GIVEN AN INDIVIDUAL PERMIT EACH. BLANKET PERMITS WILL NOT BE ISSUED.
- THESE TYPICAL TRAFFIC CONTROL PLANS DO NOT REFLECT THE EXISTING TOPOGRAPHY SUCH AS DRIVEWAYS, LANE WIDTHS, AND BUSINESS/RESIDENTIAL ACCESSES. EVERY LOCATION THAT REQUIRES CONSTRUCTION TRAFFIC CONTROL SHALL HAVE A DETAILED TRAFFIC CONTROL PLAN SHOWING ALL EXISTING TOPOGRAPHY.
- CONSTRUCTION SHALL NOT BEGIN UNLESS A TRAFFIC CONTROL PLAN HAS BEEN APPROVED AND VERIFIED BY CONSTRUCTION COORDINATION.
- CONSTRUCTION COORDINATION SHALL BE NOTIFIED 48 HOURS PRIOR TO ANY TRAFFIC CONTROL CHANGES NEEDED BY CONTRACTOR, THAT WERE NOT PREVIOUSLY APPROVED. THESE TRAFFIC CONTROL CHANGES SHALL BE REQUESTED IN WRITING ACCOMPANIED WITH A TRAFFIC CONTROL PLAN REFLECTING SUCH CHANGES.
- ALL CONSTRUCTION TRAFFIC CONTROL DEVICES SHALL COMPLY TO THE MANUAL ON UNIFORM TRAFFIC CONTROL DEVICES (MUTCD), LATEST EDITION. IT IS THE RESPONSIBILITY OF THE CONTRACTOR TO INSTALL, SERVICE AND MAINTAIN ALL TRAFFIC CONTROL DEVICES. TRAFFIC CONTROL DEVICES SHALL NOT BE REMOVED OR ALTERED IN ANY WAY WITHOUT THE APPROVAL OF CONSTRUCTION COORDINATION, PER SECTION 6A-4 OF THE MUTCD, LATEST EDITION.
- THE CONSTRUCTION TRAFFIC CONTROL INITIAL SET-UP SHALL BE BY AN AMERICAN TRAFFIC SAFETY SERVICES ASSOCIATION (ATSSA) CERTIFIED WORKSITE TRAFFIC SUPERVISOR. THE MAINTENANCE AND SERVICING SHALL ALSO BE DONE BY AN ATSSA CERTIFIED WORKSITE TRAFFIC SUPERVISOR OR EQUIVALENT.
- CONTRACTOR IS RESPONSIBLE TO MAINTAIN AND SERVICE ALL TRAFFIC CONTROL DEVICES 24 HOURS A DAY, 7 DAYS A WEEK THROUGHOUT LENGTH OF PROJECT. CONTRACTOR IS RESPONSIBLE THAT ALL TRAFFIC CONTROL DEVICES COMPLY WITH THE MUTCD, LATEST EDITION.
- ALL ADVANCE WARNING SIGNS SHALL BE DOUBLE INDICATED WHENEVER THERE ARE MULTI-LANE TRAFFIC IN ANY ONE GIVEN DIRECTION AND THERE IS SUFFICIENT MEDIAN SPACE.
- ALL BARRICADES IN ALL TAPERS AND TANGENTS SHALL BE PLACED APART, A DISTANCE MEASURED IN FEET, EQUAL TO THAT OF THE POSTED SPEED LIMIT. NO EXCEPTIONS UNLESS APPROVED BY CONSTRUCTION COORDINATION PER MUTCD SECTION 6A-4.
- ALL WORK IN ARTERIAL ROADWAYS SHALL BE ON A CONTINUOUS 24 HOUR PER DAY BASIS UNTIL COMPLETED.
- CONTRACTOR IS RESPONSIBLE TO PROVIDE CONSTRUCTION COORDINATION, A WEEKLY LOG OF DAILY INSPECTIONS OF BARRICADE AND MAINTENANCE SCHEDULES ON PROJECTS THAT ARE OVER ONE WEEK DURATION.
- EQUIPMENT OR MATERIALS SHALL NOT BE STORED WITHIN 15 FEET OF A TRAVELLED TRAFFIC LANE DURING NON-WORKING HOURS WITHOUT THE APPROVAL OF CONSTRUCTION COORDINATION.
- CONTRACTOR SHALL PROVIDE AND MAINTAIN A SAFE AND ADEQUATE MEANS OF CHANNELIZING PEDESTRIAN TRAFFIC AROUND AND THROUGH THE CONSTRUCTION AREA.
- CONTRACTOR IS RESPONSIBLE FOR OBLITERATION OF ANY CONFLICTING STRIPING AND RESPONSIBLE FOR ALL TEMPORARY STRIPING.
- CONTRACTOR SHALL MAINTAIN ACCESS TO ALL FACILITIES, BUSINESSES AND/OR RESIDENTS AT ALL TIMES.
- CONTRACTOR SHALL PROVIDE ACCESS SIGNS FOR BUSINESSES LOCATED WITHIN THE CONSTRUCTION AREA UNDER THE SUPERVISION OF CONSTRUCTION COORDINATION. EACH ACCESS SIGN SHALL HAVE 5 INCH, WHITE OPAQUE LETTERING ON BLUE REFLECTORIZED BACKGROUND. ACCESS SIGNS SHALL BE CONSIDERED INCIDENTAL TO THE BID AND NOT PART OF THE CONTRACT UNLESS OTHERWISE STATED. NO MORE THAN 3 BUSINESSES SHALL BE LISTED ON A ACCESS SIGN. SHOPPING CENTERS AND MALLS SHALL BE LISTED AS SUCH.
- ALL ADVANCE WARNING SIGNS SHALL MEET THE MINIMUM REFLECTIVE INTENSITY REQUIREMENTS SET FORTH BY THE CITY OF ALBUQUERQUE. CONSTRUCTION COORDINATION SHALL DETERMINE ALL REQUIREMENTS AND APPROVE OR DISAPPROVE ANY ADVANCE WARNING SIGN PER SECTION 6A-4 OF THE MUTCD, LATEST EDITION.
- 48 HOURS PRIOR TO OCCUPYING OR CLOSING OF A RIGHT-OF-WAY, CONTRACTOR SHALL NOTIFY: POLICE, FIRE DEPARTMENT, SCHOOLS, HOSPITALS, TRANSIT AUTHORITY, BUSINESSES AND/OR RESIDENTS THAT WILL BE AFFECTED BY THE CONSTRUCTION.
- ANY FIELD ADJUSTMENTS SHALL BE APPROVED BY CONSTRUCTION COORDINATION.

21. EXCAVATIONS SHALL BE PLATED, TEMPORARILY PATCHED OR RESURFACED PRIOR TO OPENING OF TRAFFIC. A MINIMUM OF 11 FEET SHALL BE PROVIDED FOR TRAFFIC IN ANY GIVEN DIRECTION. CONTRACTOR IS RESPONSIBLE FOR ANY WORK INVOLVED IN SATISFYING THESE REQUIREMENTS.

22. CONTRACTOR SHALL AT ALL TIMES COMPLY WITH THE FOLLOWING:
 1. STANDARDS AND REQUIREMENTS SET FORTH IN THE MANUAL ON UNIFORM TRAFFIC CONTROL DEVICES, LATEST EDITION.
 2. THE CITY OF ALBUQUERQUE TRAFFIC CODE, LATEST EDITION.
 3. SECTION 19 OF THE CITY OF ALBUQUERQUE'S STANDARD SPECIFICATIONS FOR PUBLIC WORK CONSTRUCTION, AS WELL AS OTHER SECTIONS.


23. FAILURE TO COMPLY WITH ANY OF THE ABOVE MENTIONED, WILL BE ADEQUATE CAUSE TO CEASE ALL WORK ON ANY CONSTRUCTION PROJECT. WORK WILL NOT RESUME UNTIL ALL REQUIREMENTS ARE ADDRESSED AND APPROVED BY CONSTRUCTION COORDINATION.

24. ALL TRAFFIC CONTROL DEVICES SHALL BE KEPT IN NEW-CLEAN CONDITION. WASHING OF EQUIPMENT IS INCIDENTAL TO ITS PLACEMENT AND MAINTENANCE.


25. TRAFFIC CONTROL STANDARDS APPLY ONLY WHERE THE CONSTRUCTION TRAFFIC CONTROL PLANS ARE NOT SPECIFIC.

26. ADVANCE WARNING SIGNS SHALL BE 36"x36" MIN. WITH SUPER ENGINEERING GRADE SHEETING OR BETTER. MOUNTING HEIGHT AT TOP OF SIGN SHALL BE THE SAME AS FOR A 48" SIGN AS INDICATED IN THE M.U.T.C.D.


27. CONTRACTOR SHALL MAINTAIN A GRAFFITI-FREE WORKSITE. ALL GRAFFITI SHALL BE PROMPTLY REMOVED FROM ALL EQUIPMENT, BOTH PERMANENT AND TEMPORARY.

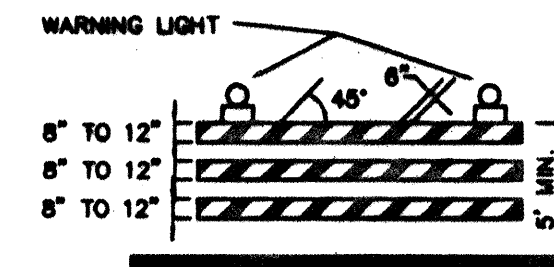


TYPE II BARRICADE

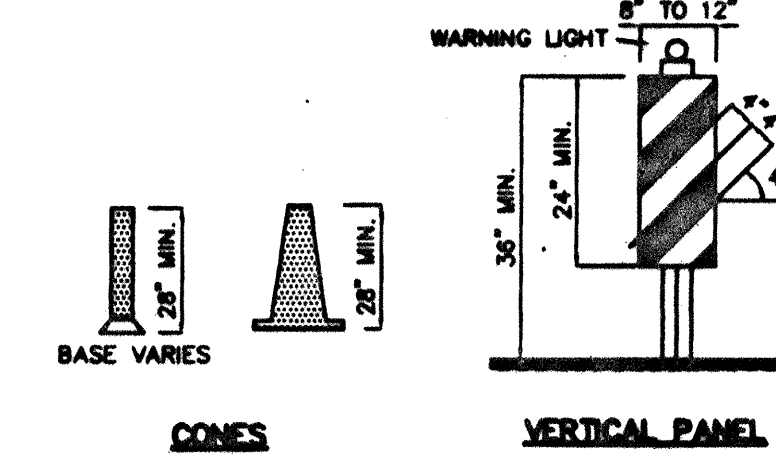


TYPE III BARRICADE

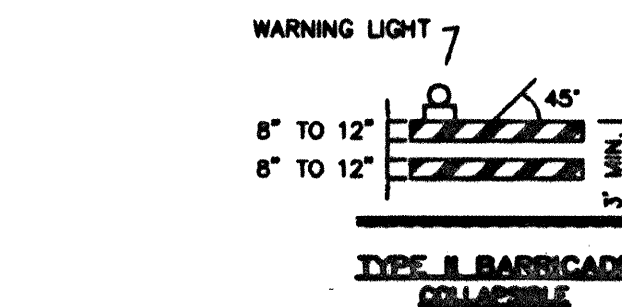


TYPE I BARRICADE

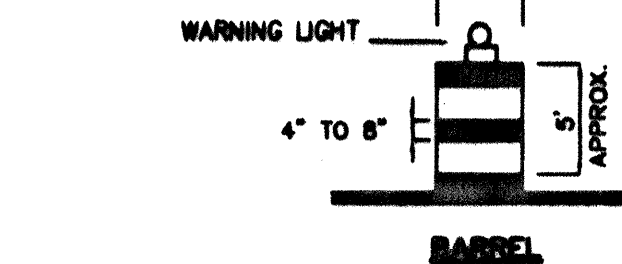

TYPE I BARRICADE

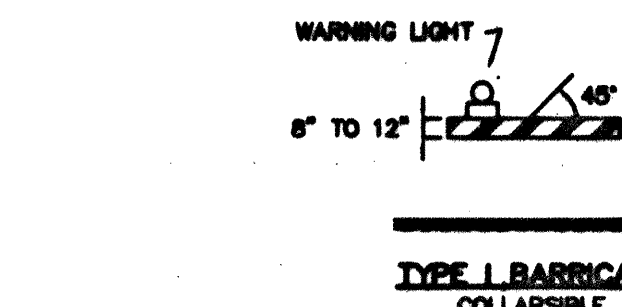

TYPE I BARRICADE

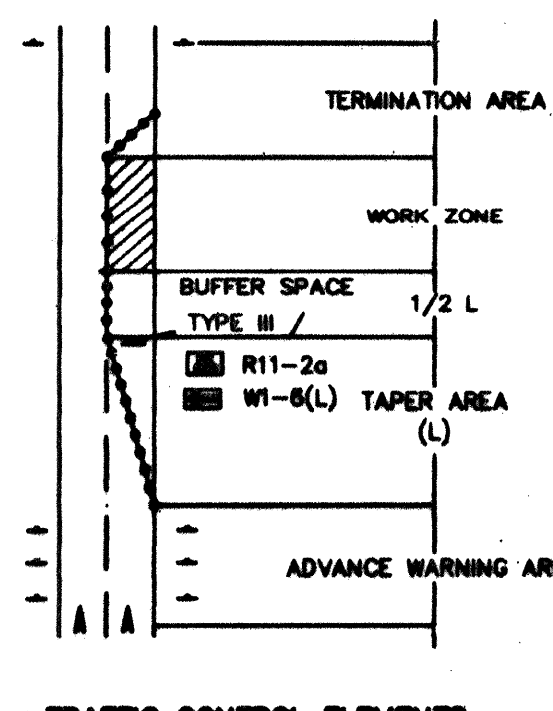

TRAFFIC CONTROL ELEMENTS

LEGEND

- WORK AREA
- BARRICADE - TYPE I, TYPE II, OR BARREL
- BARRICADE - TYPE III
- VERTICAL PANEL
- WARNING SIGN
- DISTANCE BETWEEN SIGNS - A DISTANCE MEASURED IN FEET EQUAL TO A VALUE OF TEN TIMES THE SPEED LIMIT OF THE STREET
- FLAGMAN POSITION
- SPACING BETWEEN BARRICADES - A DISTANCE MEASURED IN FEET EQUAL TO THE SPEED LIMIT OF THE STREET
- TAPER LENGTH - SEE CHART BELOW
- THE TANGENT LENGTH IS EQUAL TO THE TAPER LENGTH FOR A GIVEN STREET.

TAPER REQUIREMENTS

SPEED LIMIT (MPH)	TAPER LENGTH (L) (FEET)			MINIMUM NUMBER OF DEVICES FOR TAPER	MAXIMUM DEVICE SPACING IN FEET	
	10' LANE	11' LANE	12' LANE		ALONG TAPER	AFTER TAPER
20	70	75	80	5	20	20
25	105	115	125	6	25	25
30	150	165	180	7	30	30
35	205	225	245	8	35	35
40	270	295	320	9	40	40
45	450	495	540	13	45	45
50	500	550	600	13	50	50
55	550	605	660	13	55	55

RECOMMENDED SIGN SPACING(D) FOR ADVANCE WARNING SIGN SERIES

SPEED LIMIT (MPH)	MINIMUM DISTANCE IN FEET BETWEEN SIGNS	FROM LAST SIGN TO TAPER
0-20	10 X SPEED LIMIT	10 X SPEED LIMIT
25-30	10 X SPEED LIMIT	10 X SPEED LIMIT
30-35	10 X SPEED LIMIT	10 X SPEED LIMIT
40-45	10 X SPEED LIMIT	10 X SPEED LIMIT
50-60	10 X SPEED LIMIT	10 X SPEED LIMIT

TAPER CRITERIA


TYPE OF TAPER	TAPER LENGTH
UPSTREAM TAPER:	
MERGING TAPER	L MINIMUM
SHIFTING TAPER	1/2 L MINIMUM
SHOULDER TAPER	1/2 L MINIMUM
TWO-WAY TRAFFIC TAPER	100 FEET MAXIMUM
DOWNSTREAM TAPERS	100 FEET PER LANE

TAPER LENGTH COMPUTATION

SPEED LIMIT	L = WS ² / 60
40 MPH OR LESS	
45 MPH OR GREATER	L = W x S


L = TAPER LENGTH
 W = WIDTH OF OFFSET IN FEET
 S = POSTED SPEED OR OFF-PEAK 85-PERCENTILE SPEED IN MPH

SIGN FACE DETAILS

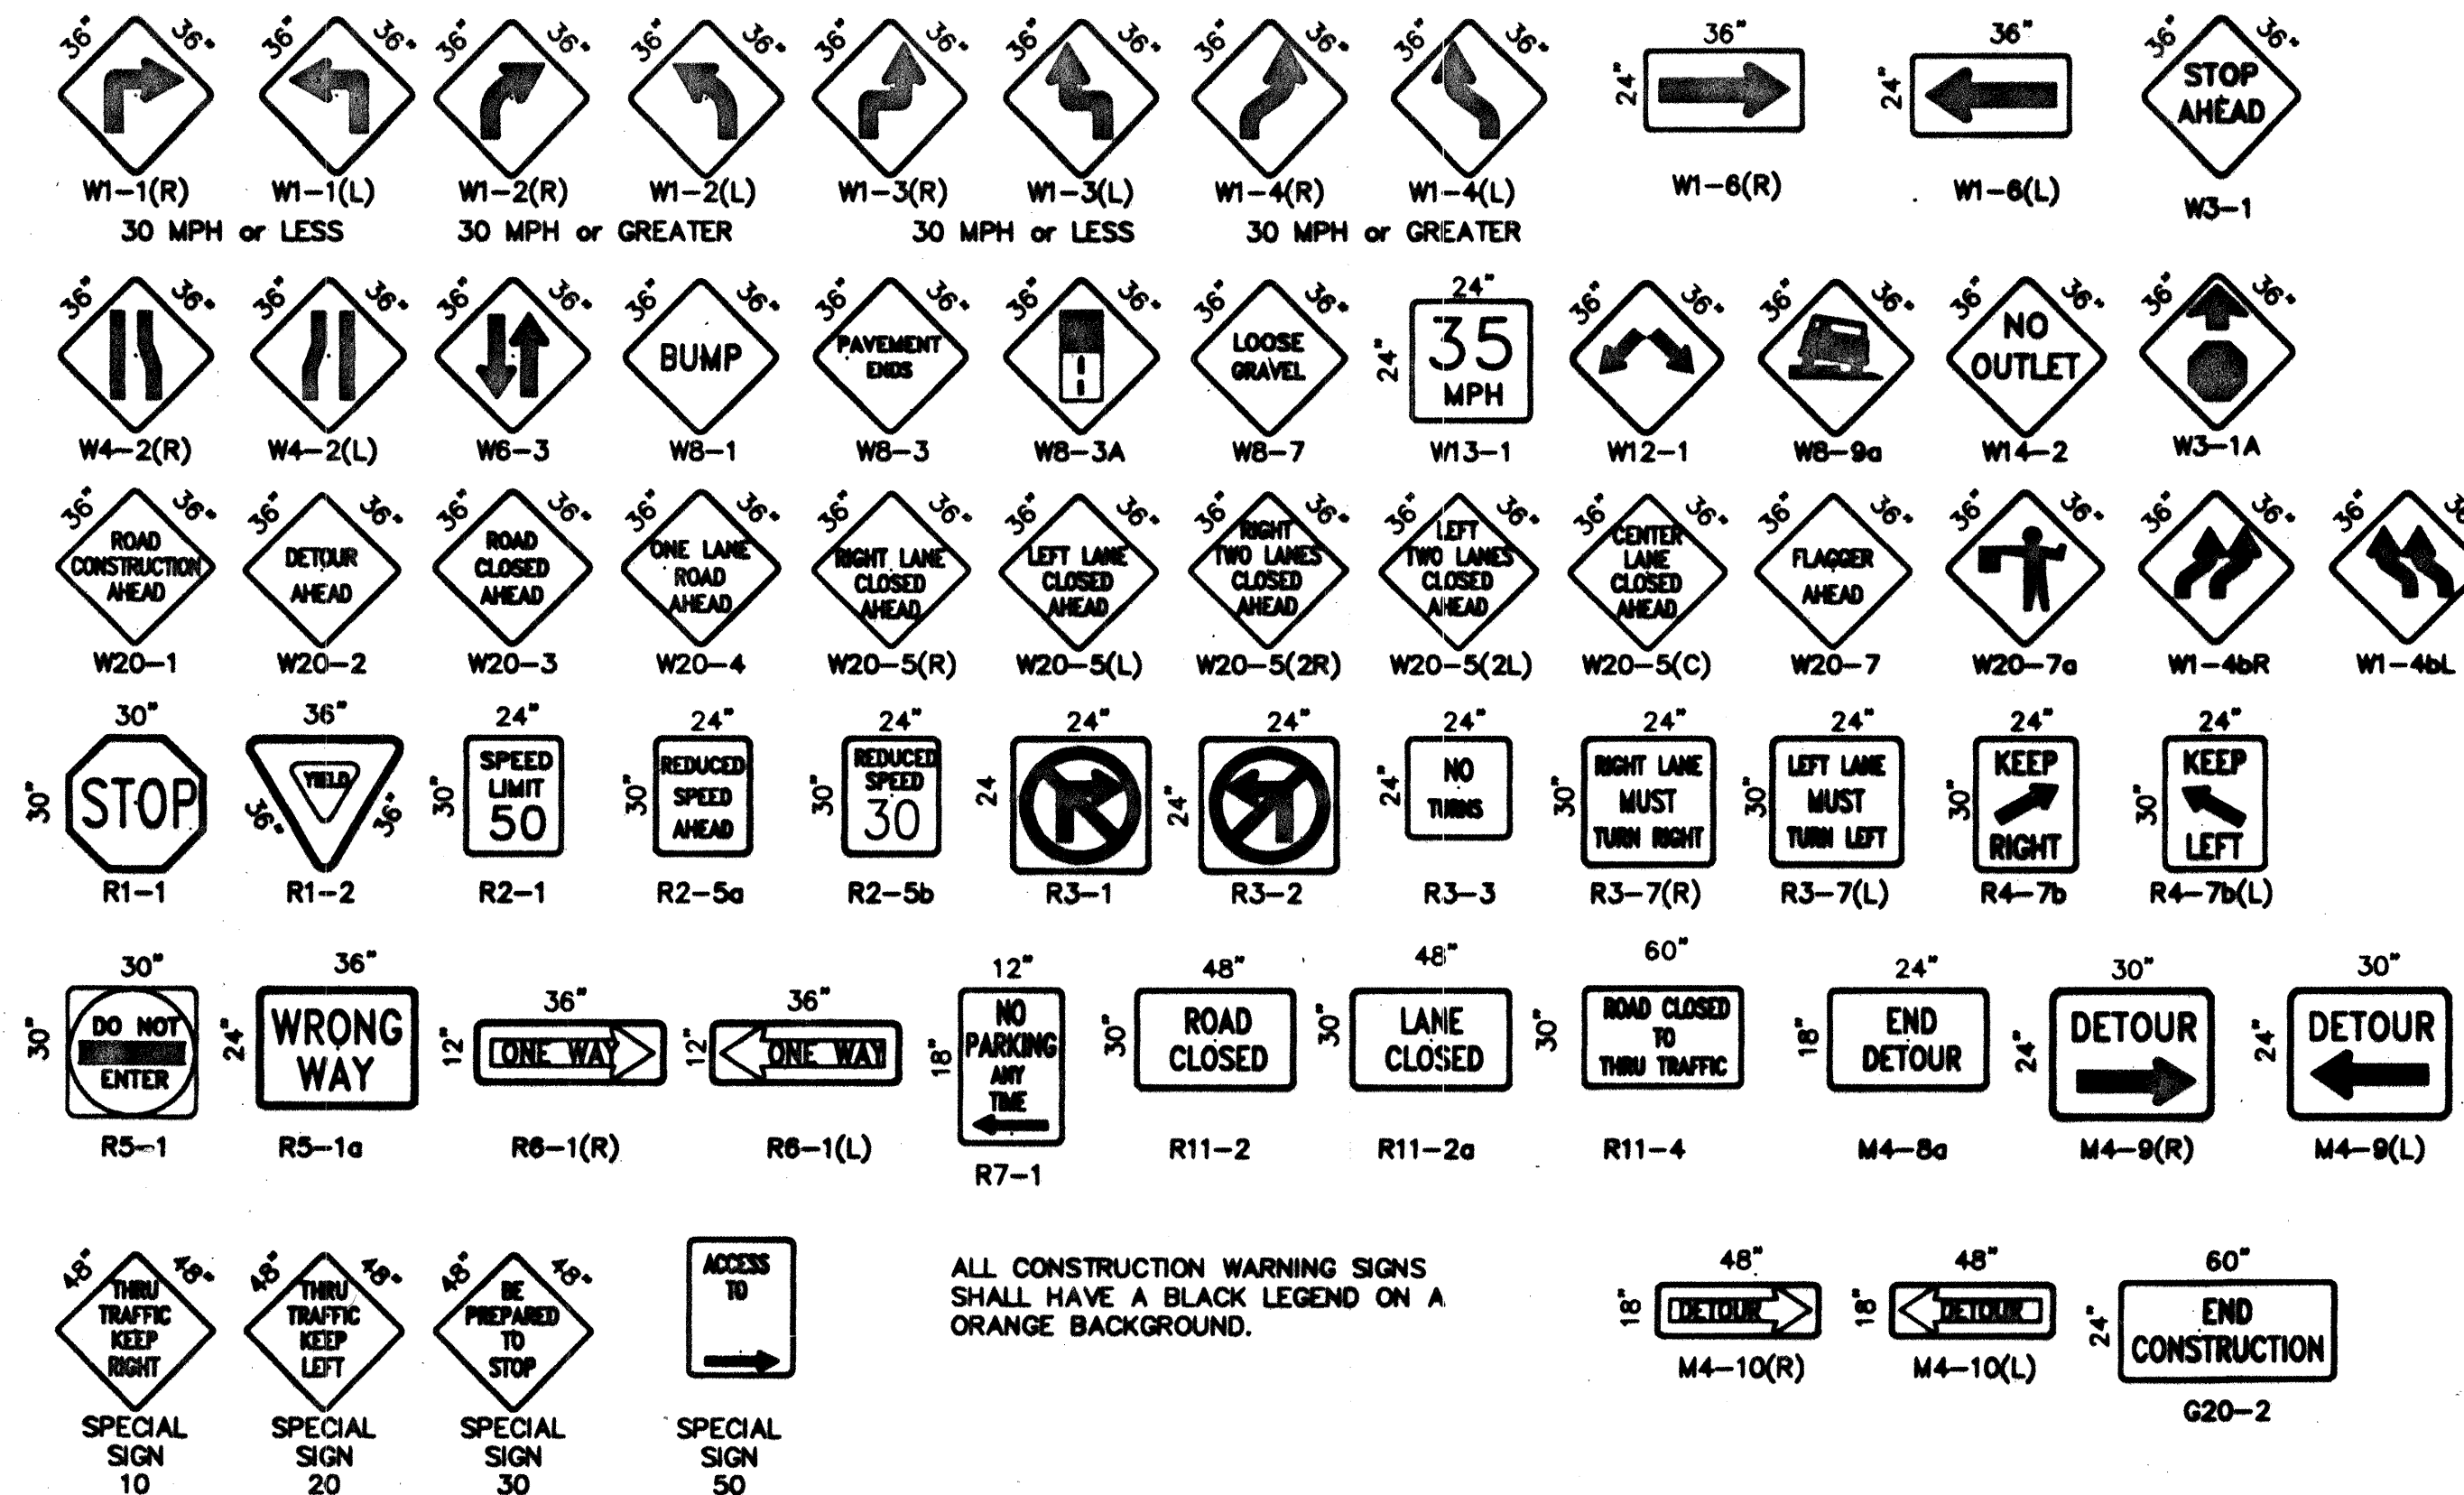

ALL CONSTRUCTION WARNING SIGNS SHALL HAVE A BLACK LEGEND ON AN ORANGE BACKGROUND.

CITY OF ALBUQUERQUE PUBLIC WORKS DEPARTMENT ENGINEERING DEVELOPMENT GROUP			
TITLE: SIGNING AND CONSTRUCTION TRAFFIC CONTROL STANDARDS			
DESIGN REVIEW COMMITTEE	CITY ENGINEER APPROVAL	NO. DATE	NO. DATE
CDA Standard		LAST UPDATE	
PROJECT NO. 609281	MAP NO.	SHEET 23 OF 24	

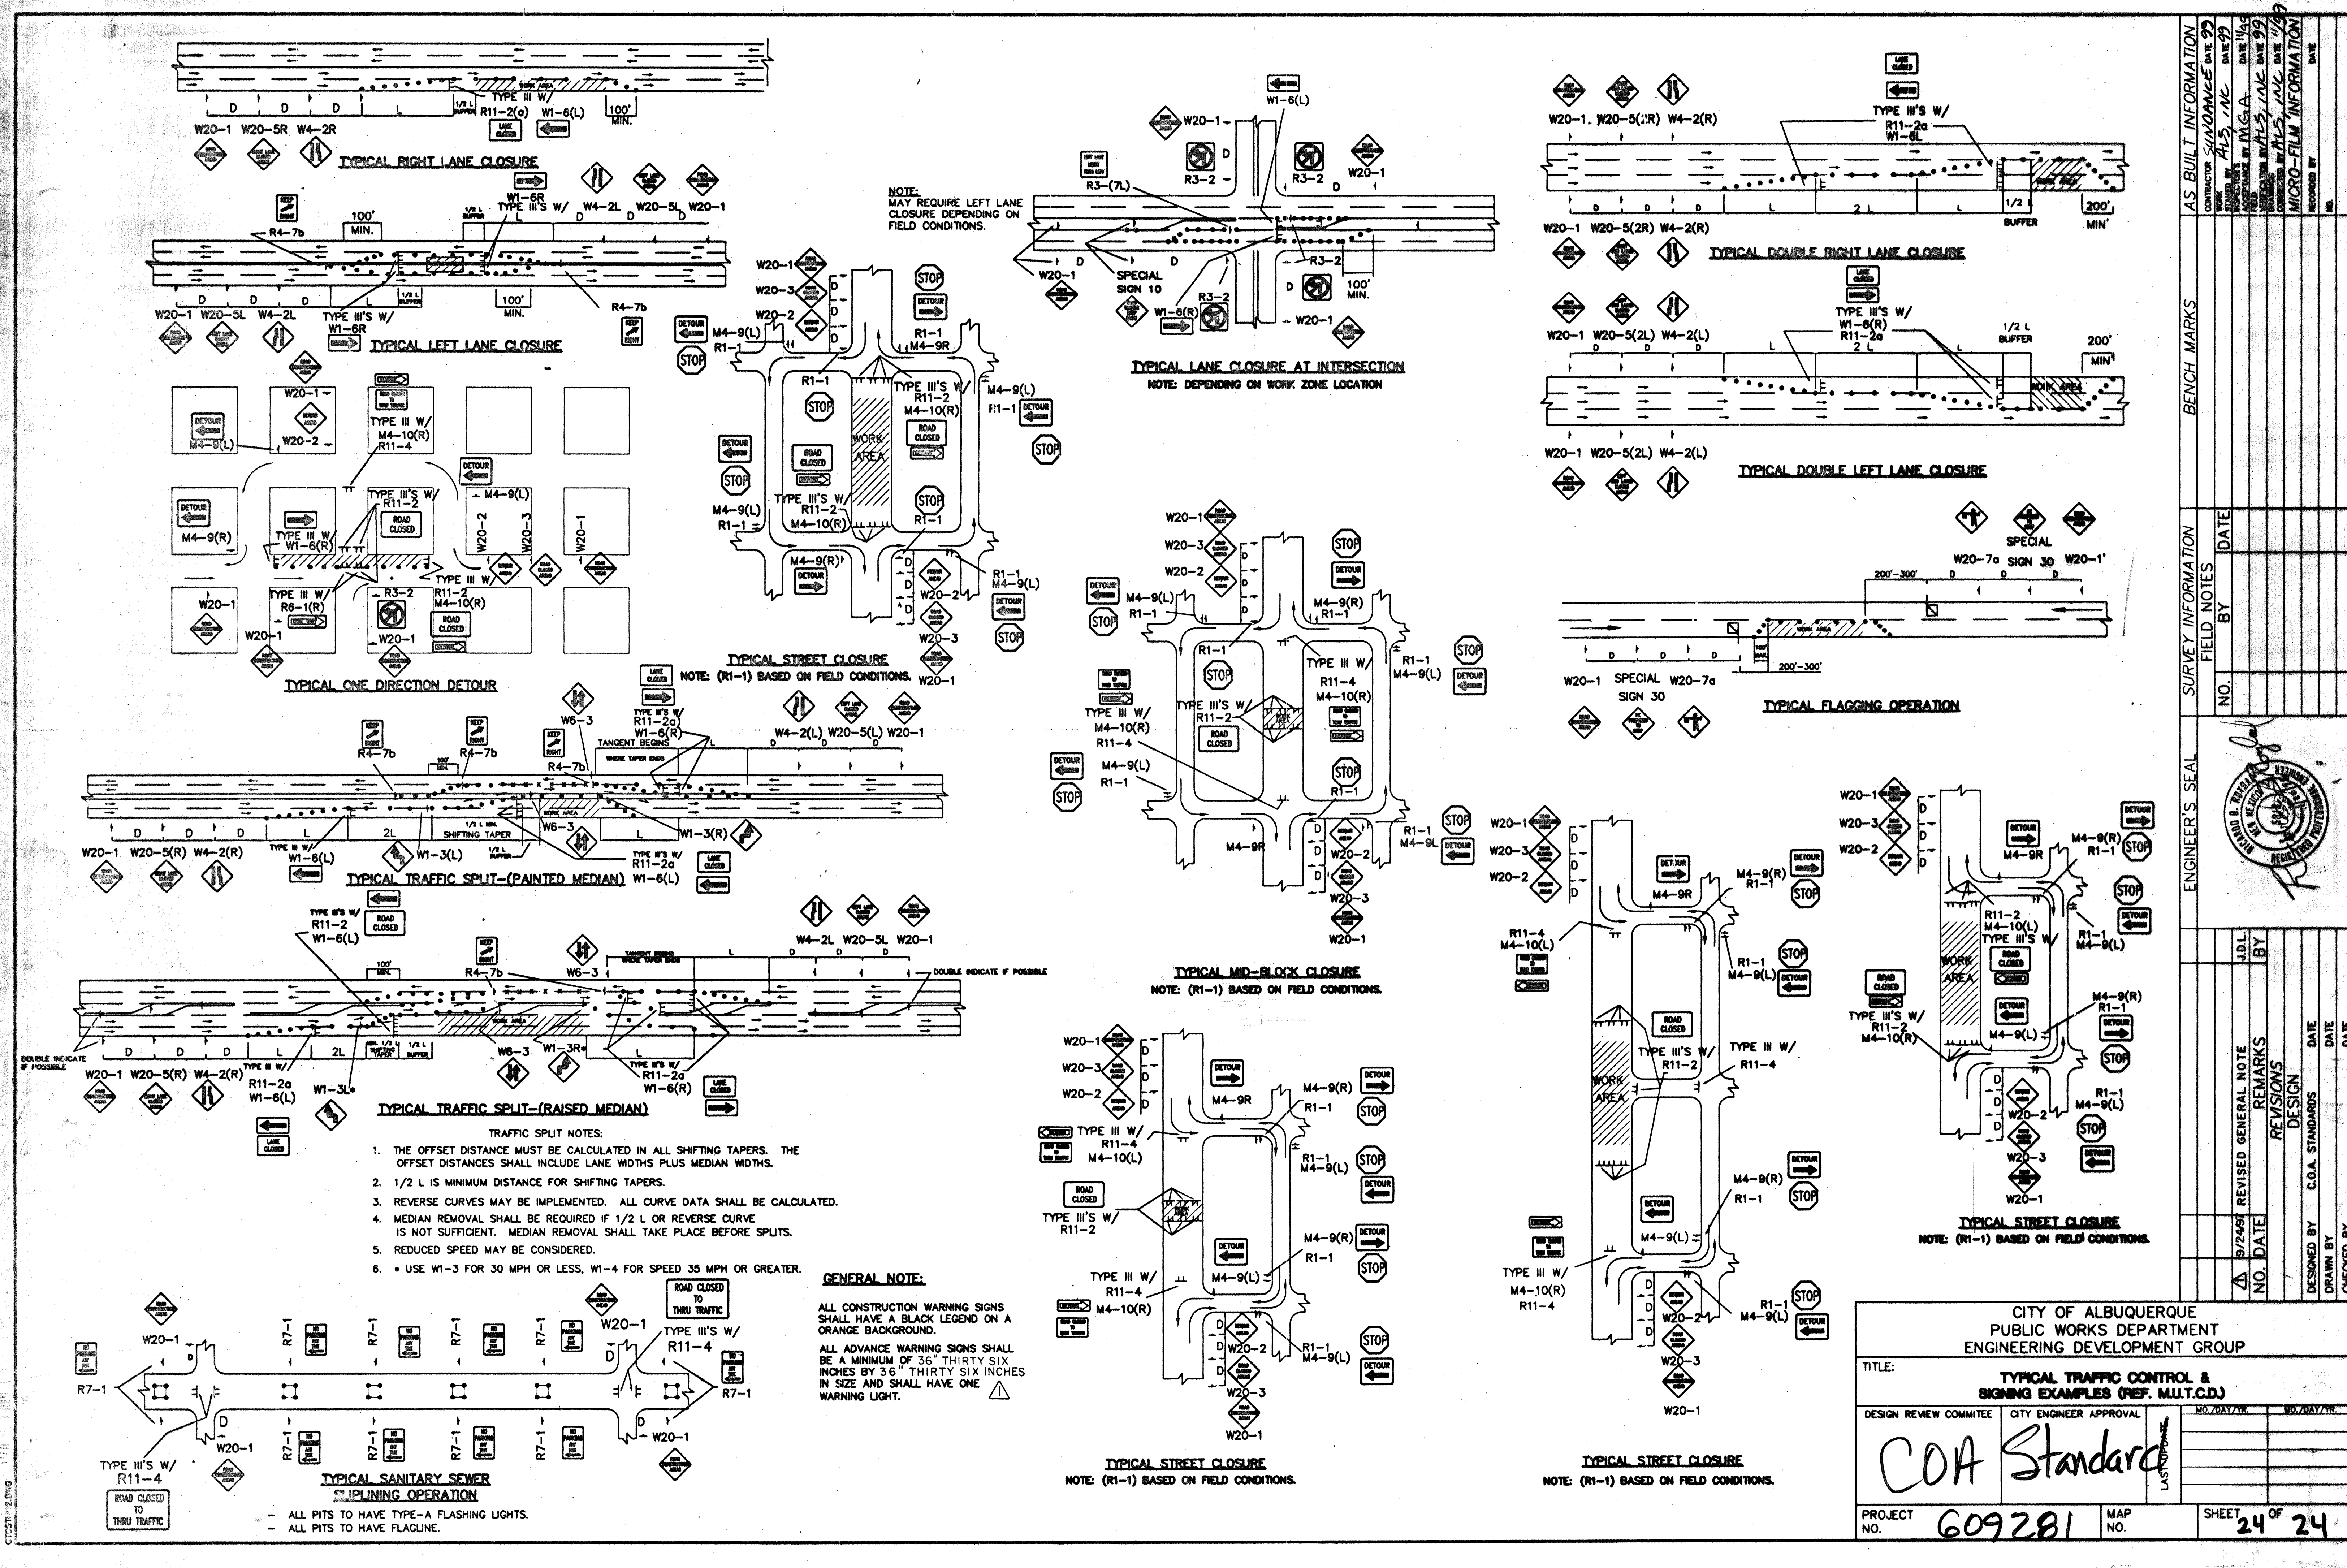

- TRAFFIC SPLIT NOTES:**
1. THE OFFSET DISTANCE MUST BE CALCULATED IN ALL SHIFTING TAPERS. THE OFFSET DISTANCES SHALL INCLUDE LANE WIDTHS PLUS MEDIAN WIDTHS.
 2. 1/2 L IS MINIMUM DISTANCE FOR SHIFTING TAPERS.
 3. REVERSE CURVES MAY BE IMPLEMENTED. ALL CURVE DATA SHALL BE CALCULATED.
 4. MEDIAN REMOVAL SHALL BE REQUIRED IF 1/2 L OR REVERSE CURVE IS NOT SUFFICIENT. MEDIAN REMOVAL SHALL TAKE PLACE BEFORE SPLITS.
 5. REDUCED SPEED MAY BE CONSIDERED.
 6. * USE W1-3 FOR 30 MPH OR LESS, W1-4 FOR SPEED 35 MPH OR GREATER.

GENERAL NOTE:

ALL CONSTRUCTION WARNING SIGNS SHALL HAVE A BLACK LEGEND ON A ORANGE BACKGROUND.

ALL ADVANCE WARNING SIGNS SHALL BE A MINIMUM OF 36" THIRTY SIX INCHES BY 36" THIRTY SIX INCHES IN SIZE AND SHALL HAVE ONE WARNING LIGHT.

CITY OF ALBUQUERQUE PUBLIC WORKS DEPARTMENT ENGINEERING DEVELOPMENT GROUP			
TITLE: TYPICAL TRAFFIC CONTROL & SIGNING EXAMPLES (REF. M.U.T.C.D.)			
DESIGN REVIEW COMMITTEE	CITY ENGINEER APPROVAL	NO. / DAY / YR.	NO. / DAY / YR.
PROJECT NO. 609281		MAP NO.	SHEET 24 OF 24