


CONSTRUCTION PLANS
FOR
LAS SENDAS DEL NORTE
SUBDIVISION
ALBUQUERQUE, NEW MEXICO

INDEX

SHEET NUMBER	DESCRIPTION
1	TITLE SHEET
2	FINAL-PLAT
3	GRADING PLAN UNIT II
4	UNIT II OVERALL PAVING PLAN
5	PAVING PLAN AND PROFILE SHEETS
6	VIA CHAMISA
7	VIA TOMAS
8	UNIT II OVERALL UTILITY PLAN
9	UTILITY PLAN AND PROFILE SHEETS
10	VIA CHAMISA
11	VIA DEL CERRO & STORM DRAIN
12	STORM DRAIN DETAIL SHEET
13 & 14	TRAFFIC CONTROL STANDARDS

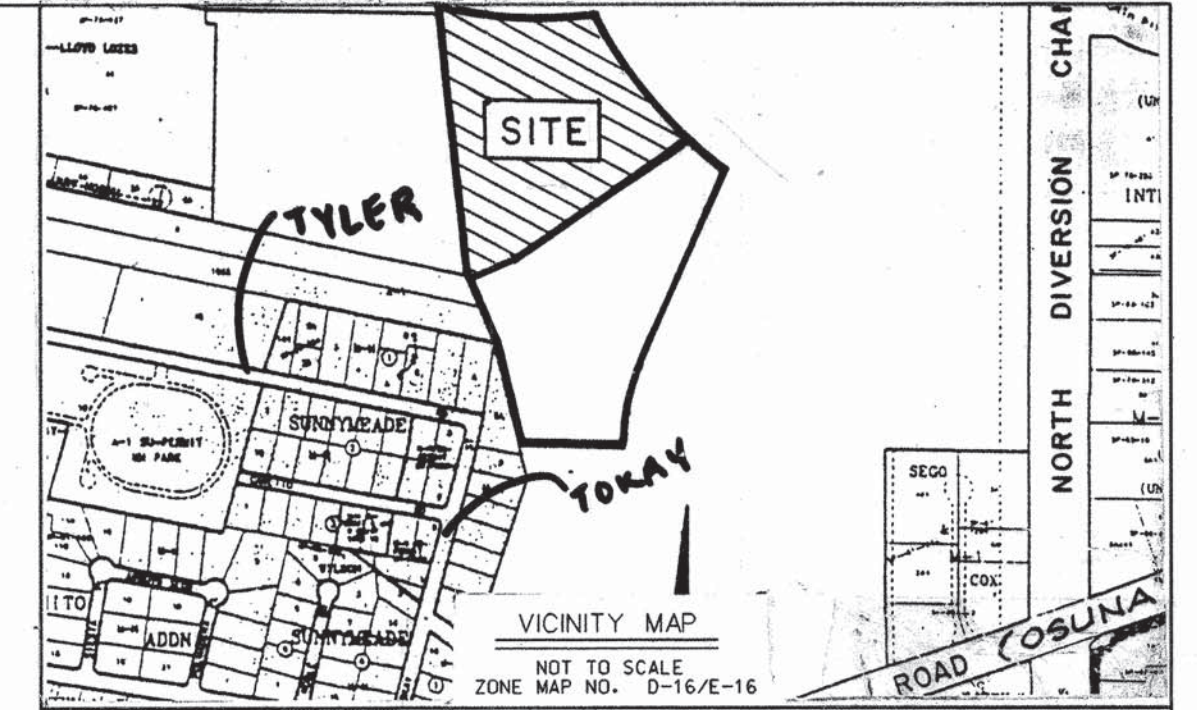

- NOTICE TO CONTRACTORS**
- ALL WORK DETAILED ON THESE PLANS TO BE PERFORMED UNDER CONTRACT SHALL, EXCEPT AS OTHERWISE STATED OR PROVIDED HEREON, BE CONSTRUCTED IN ACCORDANCE WITH THE CITY OF ALBUQUERQUE STANDARD SPECIFICATIONS FOR PUBLIC WORKS CONSTRUCTION, 1986 EDITION AND SHALL INCLUDE UPDATE NO. 6.
 - TWO WORKING DAYS PRIOR TO ANY EXCAVATION, THE CONTRACTOR MUST CONTACT NEW MEXICO ONE CALL SYSTEM (260-1990) FOR LOCATION OF EXISTING UTILITIES.
 - PRIOR TO CONSTRUCTION, THE CONTRACTOR SHALL EXCAVATE AND VERIFY THE HORIZONTAL AND VERTICAL LOCATIONS OF ALL OBSTRUCTIONS. SHOULD A CONFLICT EXIST, THE CONTRACTOR SHALL NOTIFY THE ENGINEER OR SURVEYOR IMMEDIATELY SO THAT THE CONFLICT CAN BE RESOLVED WITH A MINIMUM AMOUNT OF DELAY.
 - FIVE (5) WORKING DAYS PRIOR TO BEGINNING CONSTRUCTION, THE CONTRACTOR SHALL SUBMIT TO CONSTRUCTION COORDINATION DIVISION A DETAILED CONSTRUCTION SCHEDULE, TWO (2) WORKING DAYS PRIOR TO CONSTRUCTION, THE CONTRACTOR SHALL OBTAIN A BARRICADING PERMIT FROM THE CONST. COORDINATION DIVISION. CONTRACTOR SHALL NOTIFY BARRICADE ENGINEER (768-2551) PRIOR TO OCCUPYING AN INTERSECTION. REFER TO SECTION 19 OF THE GENERAL CONDITIONS OF THE STANDARD SPECIFICATIONS.
 - ALL STREET STRIPING ALTERED OR DESTROYED SHALL BE REPLACED W/ PLASTIC REFLECTORIZED PAVEMENT MARKING BY CONTRACTOR TO LOCATION AS EXISTING OR AS INDICATED BY THIS PLAN SET.
 - CONTRACTOR SHALL NOTIFY THE ENGINEER NOT LESS THAN SEVEN (7) DAYS PRIOR TO STARTING WORK IN ORDER THAT THE CITY SURVEYOR MAY TAKE NECESSARY MEASURES TO INSURE THE PRESERVATION OF SURVEY MONUMENTS. CONTRACTOR SHALL NOT DISTURB PERMANENT SURVEY MONUMENTS WITHOUT THE CONSENT OF THE CITY SURVEYOR AND SHALL NOTIFY THE CITY SURVEYOR AND BEAR THE EXPENSE OF REPLACING ANY THAT MAY BE DISTURBED WITHOUT PERMISSION. REPLACEMENT SHALL BE DONE ONLY BY THE CITY SURVEYOR. WHEN A CHANGE IS MADE IN THE FINISHED ELEVATIONS OF THE PAVEMENT OF ANY ROADWAY IN WHICH A PERMANENT SURVEY MONUMENT IS LOCATED, CONTRACTOR SHALL, AT HIS OWN EXPENSE, ADJUST THE MONUMENT COVER TO THE NEW GRADE, UNLESS OTHERWISE SPECIFIED. REFER TO SECTION 4.4 OF THE GENERAL CONDITIONS OF THE STANDARD SPECIFICATIONS.
 - ANY WORK WITHIN AN ARTERIAL ROADWAY REQUIRES TWENTY-FOUR HOUR CONSTRUCTION.
 - CONTRACTOR SHALL MAINTAIN A GRAFFITI-FREE WORK SITE. CONTRACTOR SHALL PROMPTLY REMOVE ANY GRAFFITI FROM ALL EQUIPMENT, WHETHER PERMANENT OR TEMPORARY.

THE FOLLOWING NOTES ALSO APPLY WHEN CHECKED

- ☒ ALL UTILITIES AND UTILITY SERVICE LINES SHALL BE INSTALLED PRIOR TO PAVING.
- ☒ BACKFILL COMPACTION SHALL BE ACCORDING TO SPECIFIED STREET USE.
- ☐ TACK COAT REQUIREMENTS SHALL BE DETERMINED BY THE CITY ENGINEER.
- ☒ SIDEWALKS AND WHEELCHAIR RAMPS WITHIN THE CURB RETURNS SHALL BE CONSTRUCTED WHEREVER A NEW CURB RETURN IS CONSTRUCTED.
- ☐ IF CURB IS DEPRESSED FOR A DRIVEPAD, THE DRIVEPAD SHALL BE CONSTRUCTED PRIOR TO ACCEPTANCE OF CURB AND GUTTER.
- ☒ ALL STORM DRAINAGE FACILITIES SHALL BE COMPLETED PRIOR TO FINAL ACCEPTANCE.
- ☒ THE REQUESTOR OR DEVELOPER SHALL BE RESPONSIBLE FOR REPAIR OR REPLACEMENT OF ALL CURB AND GUTTER OR SIDEWALK DAMAGED AFTER APPROVAL BY THE CITY ENGINEER OF WORK COMPLETED BY THE CONTRACTOR.

SURVEYOR'S CERTIFICATION

"I, Timothy Aldrich, a duly qualified Registered Professional Land Surveyor under the laws of the State of New Mexico, do hereby certify that the 'as-built' information shown on these drawings was obtained from field construction and 'as-built' surveys performed by me or under my supervision, that the 'as-built' information shown on these drawings was added by me or under my supervision, and that this 'as-built' information is true and correct to the best of my knowledge and belief." Aldrich Land Surveying is not responsible for any of the design concepts, calculations, engineering, or intent of the record drawings.

Timothy Aldrich, P.S. No. 7719

Date

DRB# 98-314

Bohannon & Huston

Consulting One 7500 JEFFERSON NE Albuquerque NEW MEXICO 87109

ENGINEERS PLANNERS PHOTOGRAMMETRISTS SURVEYORS LANDSCAPE ARCHITECTS


BP JOB NO. 97-35A04

APRIL 1999

REV.	SHEETS	CITY ENGINEER	DATE	USER DEPARTMENT	DATE	USER DEPARTMENT	DATE
ENGINEERS STAMP & SIGNATURE	APPROVAL	ENGINEER	DATE	*****	APPROVED FOR CONSTRUCTION		
DRC Chairman	6-17-99						
Transportation	5-25-99						
Water/Wastewater	5-4-99						
Hydrology	5-22-99						
Const. Coord.	5-4-99						
Const. Mgmt.							
City Project No.	609381						
Sheet	1						
Of	14						

26 6093.81 0101

SCANNED BY
MES.15799

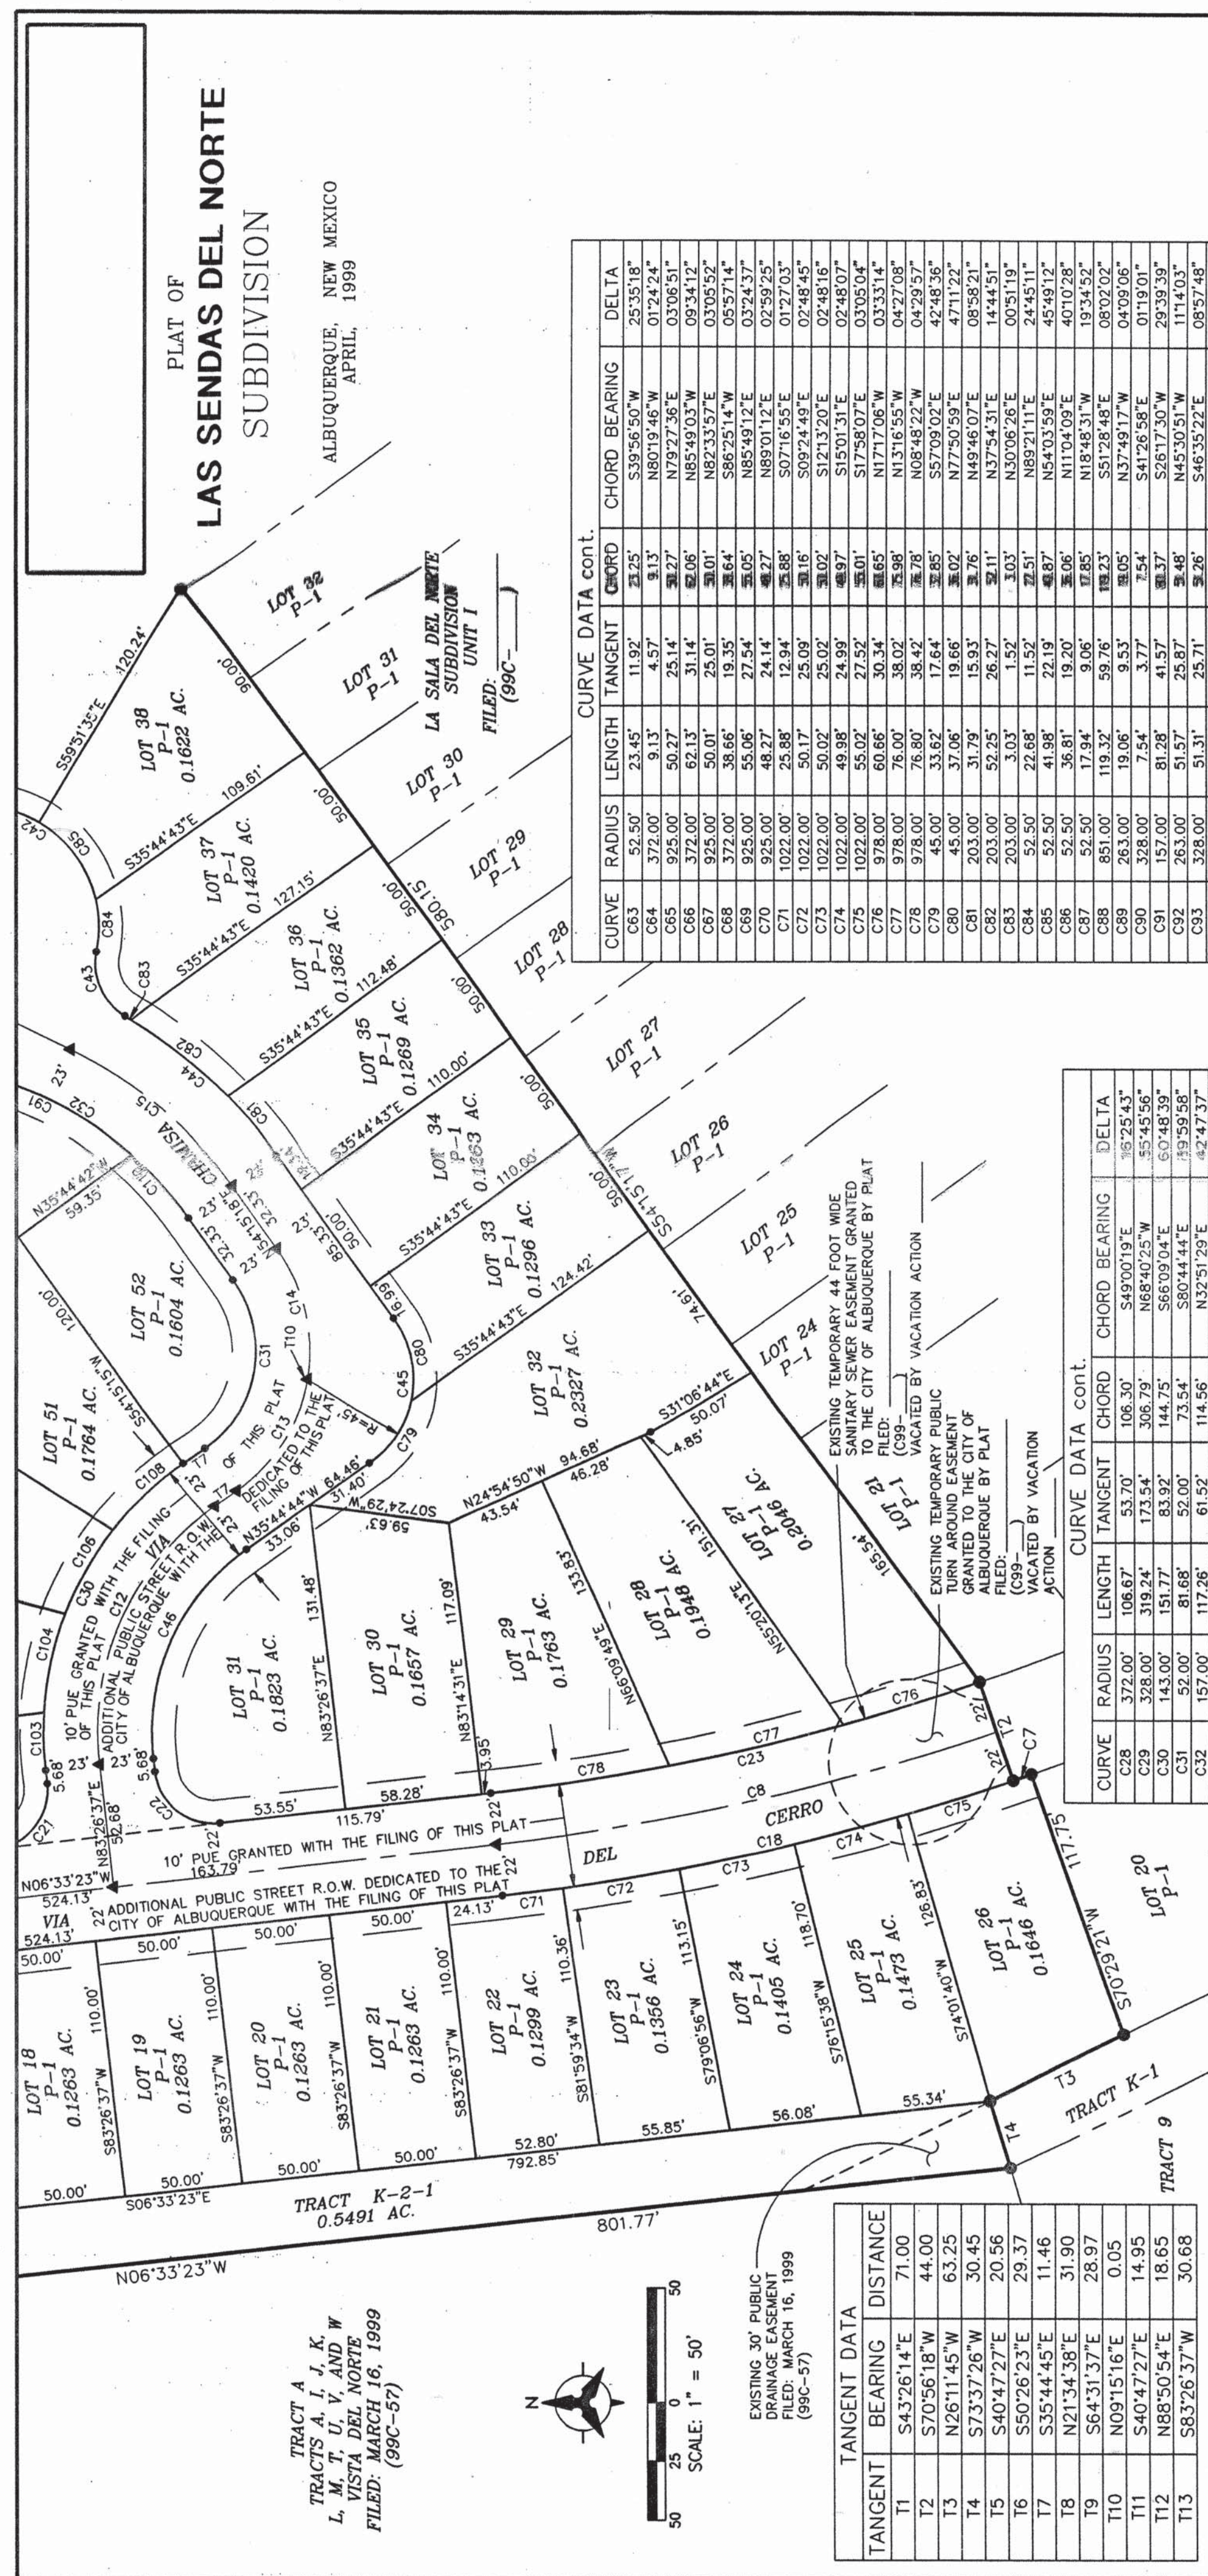


TANGENT	TANGENT DATA	
	BEARING	DISTANCE
T1	S43°26'14"E	71.00
T2	S70°56'18"W	44.00
T3	N26°11'45"W	63.25
T4	S73°37'26"W	30.45
T5	S40°47'27"E	20.56
T6	S50°26'23"E	29.37
T7	S35°44'45"E	11.46
T8	N21°34'38"E	31.90
T9	S64°33'37"E	28.97
T10	N09°15'16"E	0.05
T11	S40°47'27"E	14.95
T12	N88°50'54"E	18.65
T13	S83°26'37"W	30.68


CURVE	RADIUS	LENGTH	TANGENT	CURVE DATA	CHORD BEARING	DELTA
C1	925.00'	306.71'	154.78'	305.31'	N81°00'58"E	18°59'53"
C2	25.00'	37.84'	23.81'	34.33'	S85°43'39"	86°43'39"
C3	851.00'	263.22'	132.67'	262.17'	S89°30'58"E	17°43'18"
C4	25.00'	37.84'	23.81'	34.33'	S89°30'58"E	86°43'39"
C5	25.00'	37.84'	23.81'	34.33'	N89°30'58"E	86°43'39"
C6	851.00'	120.30'	60.25'	120.20'	S51°26'50"E	08°05'58"
C7	1022.00'	8.01'	4.00'	8.01'	S19°17'11"E	07°26'57"
C8	1000.00'	218.26'	109.58'	217.83'	N1°48'33.3"W	12'30.91"
C9	850.00'	184.96'	92.48'	184.96'	S87°24'33"W	12'30.91"
C10	25.00'	148.96'	92.48'	148.96'	N87°24'33"W	21°30.91"
C11	180.00'	30.31'	15.19'	30.38'	S45°36'55"E	09°38'56"
C12	120.00'	127.36'	70.42'	121.47'	S66°09'04"E	6°04'38"
C13	75.00'	58.90'	31.07'	57.40'	S58°14'44"E	4°45'59"
C14	75.00'	58.90'	31.07'	57.40'	N58°14'44"E	4°45'59"
C15	180.00'	44.26'	22.24'	44.14'	N43°30'41"E	14°05'13"
C16	180.00'	22.00'	11.01'	21.99'	N43°30'41"E	07°00'09"
C17	180.00'	22.00'	11.01'	21.99'	N17°48'33"W	12'30.91"
C18	1092.00'	223.05'	111.97'	222.62'	S51°33'22"E	9°00'00"
C19	16.00'	25.13'	16.00'	22.63'	S51°33'22"E	9°00'00"
C20	25.00'	39.27'	25.00'	35.98'	S51°33'22"E	9°00'00"
C21	25.00'	39.27'	25.00'	35.98'	S38°26'37"E	9°00'00"
C22	25.00'	39.27'	25.00'	35.98'	S38°26'37"E	12°30.91"
C23	378.00'	213.45'	107.15'	213.03'	S87°05'33"E	16°55'49"
C24	372.00'	109.92'	55.36'	109.52'	S87°05'33"E	16°55'49"
C25	25.00'	154.92'	92.48'	154.92'	S68°23'27"E	168°50'54"
C26	25.00'	154.92'	92.48'	154.92'	S68°23'27"E	168°50'54"
C27	30.00'	31.95'	18.57'	28.82'	S20°36'33"E	2°31'57"

CURVE	CURVE DATA				CHORD BEARING	DELTA
	RADIUS	LENGTH	TANGENT	CHORD		
C28	372.00	106.87	173.70	106.30	S49007.97E	55455.36
C29	328.00	319.24	53.52	306.73	N68402.17E	55455.36
C30	143.00	51.67	83.92	144.75	S66709.04E	619.59.58
C31	132.00	181.68	85.00	73.54	S80044.04E	619.59.58
C32	157.00	61.56	61.56	114.56	S1257.29E	42473.37
C33	215.90	42.33	21.23	42.26	N17065.18E	1115.16
C34	215.90	42.33	21.23	42.26	N17065.18E	1115.16
C35	202.00	11.37	5.69	11.37	N42242.11E	63133.27
C36	25.00	40.42	26.18	36.16	S87066.51E	9328.47
C37	25.00	37.51	23.30	34.03	N03234.32E	55583.72
C38	851.00	0.97	0.49	0.97	S3926.34E	4003.96
C39	851.00	0.97	0.49	0.97	S4725.52E	4003.96
C40	25.00	37.51	23.30	34.03	S9306.34E	55583.72
C41	25.00	37.51	23.30	34.03	S9306.34E	55583.72
C42	52.00	119.42	113.44	95.23	S36335.54E	2019.43
C43	25.00	31.44	18.18	29.41	S6542.16W	7202.59
C44	203.00	87.07	44.27	86.40	N41580.02E	2434.31
C45	45.00	70.69	45.00	63.64	N8044.44W	5959.58
C46	97.00	102.95	56.92	98.19	N6509.04W	5959.58
C47	372.00	106.87	173.70	106.30	N42381.21E	55455.36
C48	372.00	23.97	11.99	23.96	N42381.21E	55455.36
C49	851.00	41.95	20.78	41.54	S50205.22E	0247.50
C50	372.00	73.90	37.07	71.78	S50104.22E	11722.55
C51	851.00	50.03	25.07	50.02	S37007.24E	0322.06
C52	372.00	8.60	4.40	8.60	N6832.31W	9121.93
C53	25.00	16.70	9.31	16.70	S2333.31E	9416.59
C54	52.00	119.42	113.44	95.23	S36335.54E	2019.43
C55	851.00	127.25	63.74	127.13	S2602.20E	9834.02
C56	92.00	27.31	13.97	27.01	N162817.7W	3948.25
C57	925.00	2.90	1.45	2.90	N7136.25E	9101.47
C58	25.00	35.97	21.90	32.95	S6715.18E	9226.40
C59	52.00	119.42	113.44	95.23	S36335.54E	2019.43
C60	92.00	27.31	13.97	27.01	N162817.7W	3948.25
C61	92.00	52.38	26.60	50.23	S819316.5W	9709.35
C62	925.00	50.13	25.07	50.13	N76210.1E	03506.19


CURVE DATA cont.					CHORD BEARING		DELTA
CURVE	RADIUS	LENGTH	TANGENT	CHORD	BEARING		
C61	372.00'	9.13'	4.57'	9.13'	S 88°19'46"W	2°18'24"	
C62	372.00'	9.13'	4.57'	9.13'	S 88°19'46"W	2°18'24"	
C63	372.00'	9.13'	4.57'	9.13'	S 88°19'46"W	2°18'24"	
C64	372.00'	9.13'	4.57'	9.13'	S 88°19'46"W	2°18'24"	
C65	925.00'	60.23'	25.14'	31.14'	N 79°27'36"E	0°306.91"	
C66	372.00'	9.13'	4.57'	9.13'	S 88°19'46"W	0°306.91"	
C67	925.00'	50.01'	25.01'	25.01'	N 82°33'57"E	0°305.92"	
C68	372.00'	38.66'	19.35'	19.35'	S 86°25'14"W	0°579.54"	
C69	925.00'	55.06'	27.54'	27.54'	N 85°49'12"E	0°324.37"	
C70	925.00'	48.81'	24.41'	24.41'	S 87°16'15"E	0°324.37"	
C71	925.00'	48.81'	24.41'	24.41'	S 87°16'15"E	0°324.37"	
C72	1022.00'	50.17'	25.09'	25.09'	S 89°24'49"E	0°248.45"	
C73	1022.00'	50.02'	25.02'	25.02'	S 121°31'20"E	0°248.45"	
C74	1022.00'	49.98'	24.99'	24.99'	S 150°31'31"E	0°248.07"	
C75	1022.00'	55.02'	27.52'	27.52'	N 71°58'07"E	0°305.04"	
C76	978.00'	60.66'	30.34'	30.34'	N 71°57'06"W	0°333.14"	
C77	978.00'	76.00'	38.02'	38.02'	N 13°16'55"E	0°427.08"	
C78	978.00'	76.00'	38.02'	38.02'	N 13°16'55"E	0°427.08"	
C79	45.00'	33.62'	17.66'	17.66'	S 92°09'02"E	0°424.95"	
C80	45.00'	37.06'	19.64'	19.64'	S 97°00'59"E	0°424.95"	
C81	203.00'	31.79'	15.93'	15.93'	N 74°50'59"E	0°88.21"	
C82	203.00'	52.25'	26.27'	26.27'	N 49°46'31"E	1°44.51"	
C83	203.00'	3.03'	1.52'	3.03'	N 37°45'31"E	0°93.19"	
C84	52.50'	22.88'	11.59'	22.81'	N 89°21'11"E	0°93.19"	
C85	52.50'	22.88'	11.59'	22.81'	N 89°21'11"E	0°93.19"	
C86	52.50'	36.81'	19.20'	19.20'	N 11°04'09"E	0°401.28"	
C87	52.50'	17.94'	9.06'	17.85'	N 18°48'31"W	1°34.52"	
C88	851.00'	119.32'	59.76'	120.23'	S 51°28'48"E	0°802.02"	
C89	263.00'	19.06'	9.53'	19.06'	N 37°49'17"W	0°409.06"	
C90	398.00'	7.54'	3.77'	7.54'	S 41°26'58"E	0°190.91"	
C91	157.00'	81.88'	41.57'	81.37'	S 26°17'30"W	2°93.39"	
C92	157.00'	81.88'	41.57'	81.37'	S 26°17'30"W	2°93.39"	
C93	320.00'	31.79'	15.93'	31.79'	N 74°50'59"E	0°88.21"	
C94	263.00'	47.98'	24.05'	47.91'	N 56°51'28"W	1°027.10"	
C95	328.00'	63.96'	32.08'	63.86'	S 66°39'28"E	1°10.23"	
C96	263.00'	52.58'	26.38'	52.50'	N 67°18'42"E	1°127.19"	
C97	328.00'	58.87'	29.51'	58.79'	S 67°23'08"E	1°01.58"	
C98	263.00'	41.35'	20.72'	41.31'	S 72°39'59"W	0°903.34"	
C99	328.00'	63.98'	35.13'	63.88'	S 78°38'45"E	1°21.29"	
C100	328.00'	63.98'	35.13'	63.88'	S 78°38'45"E	1°21.29"	
C101	328.00'	67.98'	33.91'	67.88'	N 69°20'45"E	1°146.17"	
C102	263.00'	24.41'	12.21'	24.40'	S 86°06'09"E	0°519.04"	
C103	143.00'	24.48'	12.27'	24.45'	S 88°02'35"W	0°948.32"	
C104	143.00'	43.41'	21.87'	43.24'	N 78°03'06"W	1°723.31"	
C105	263.00'	89.86'	45.37'	89.42'	S 81°27'02"E	1°934.34"	
C106	143.00'	42.12'	21.22'	41.97'	N 60°55'00"W	1°852.44"	
C107	143.00'	41.36'	21.03'	41.31'	N 64°16'42"E	1°852.44"	
C108	143.00'	41.36'	21.03'	41.31'	N 64°16'42"E	1°854.55"	
C109	263.00'	86.29'	43.54'	85.90'	S 45°08'12"E	1°847.55"	
C110	157.00'	35.99'	18.07'	35.91'	S 47°41'19"W	1°307.58"	

CPN 609381 - Sh 2A of 14

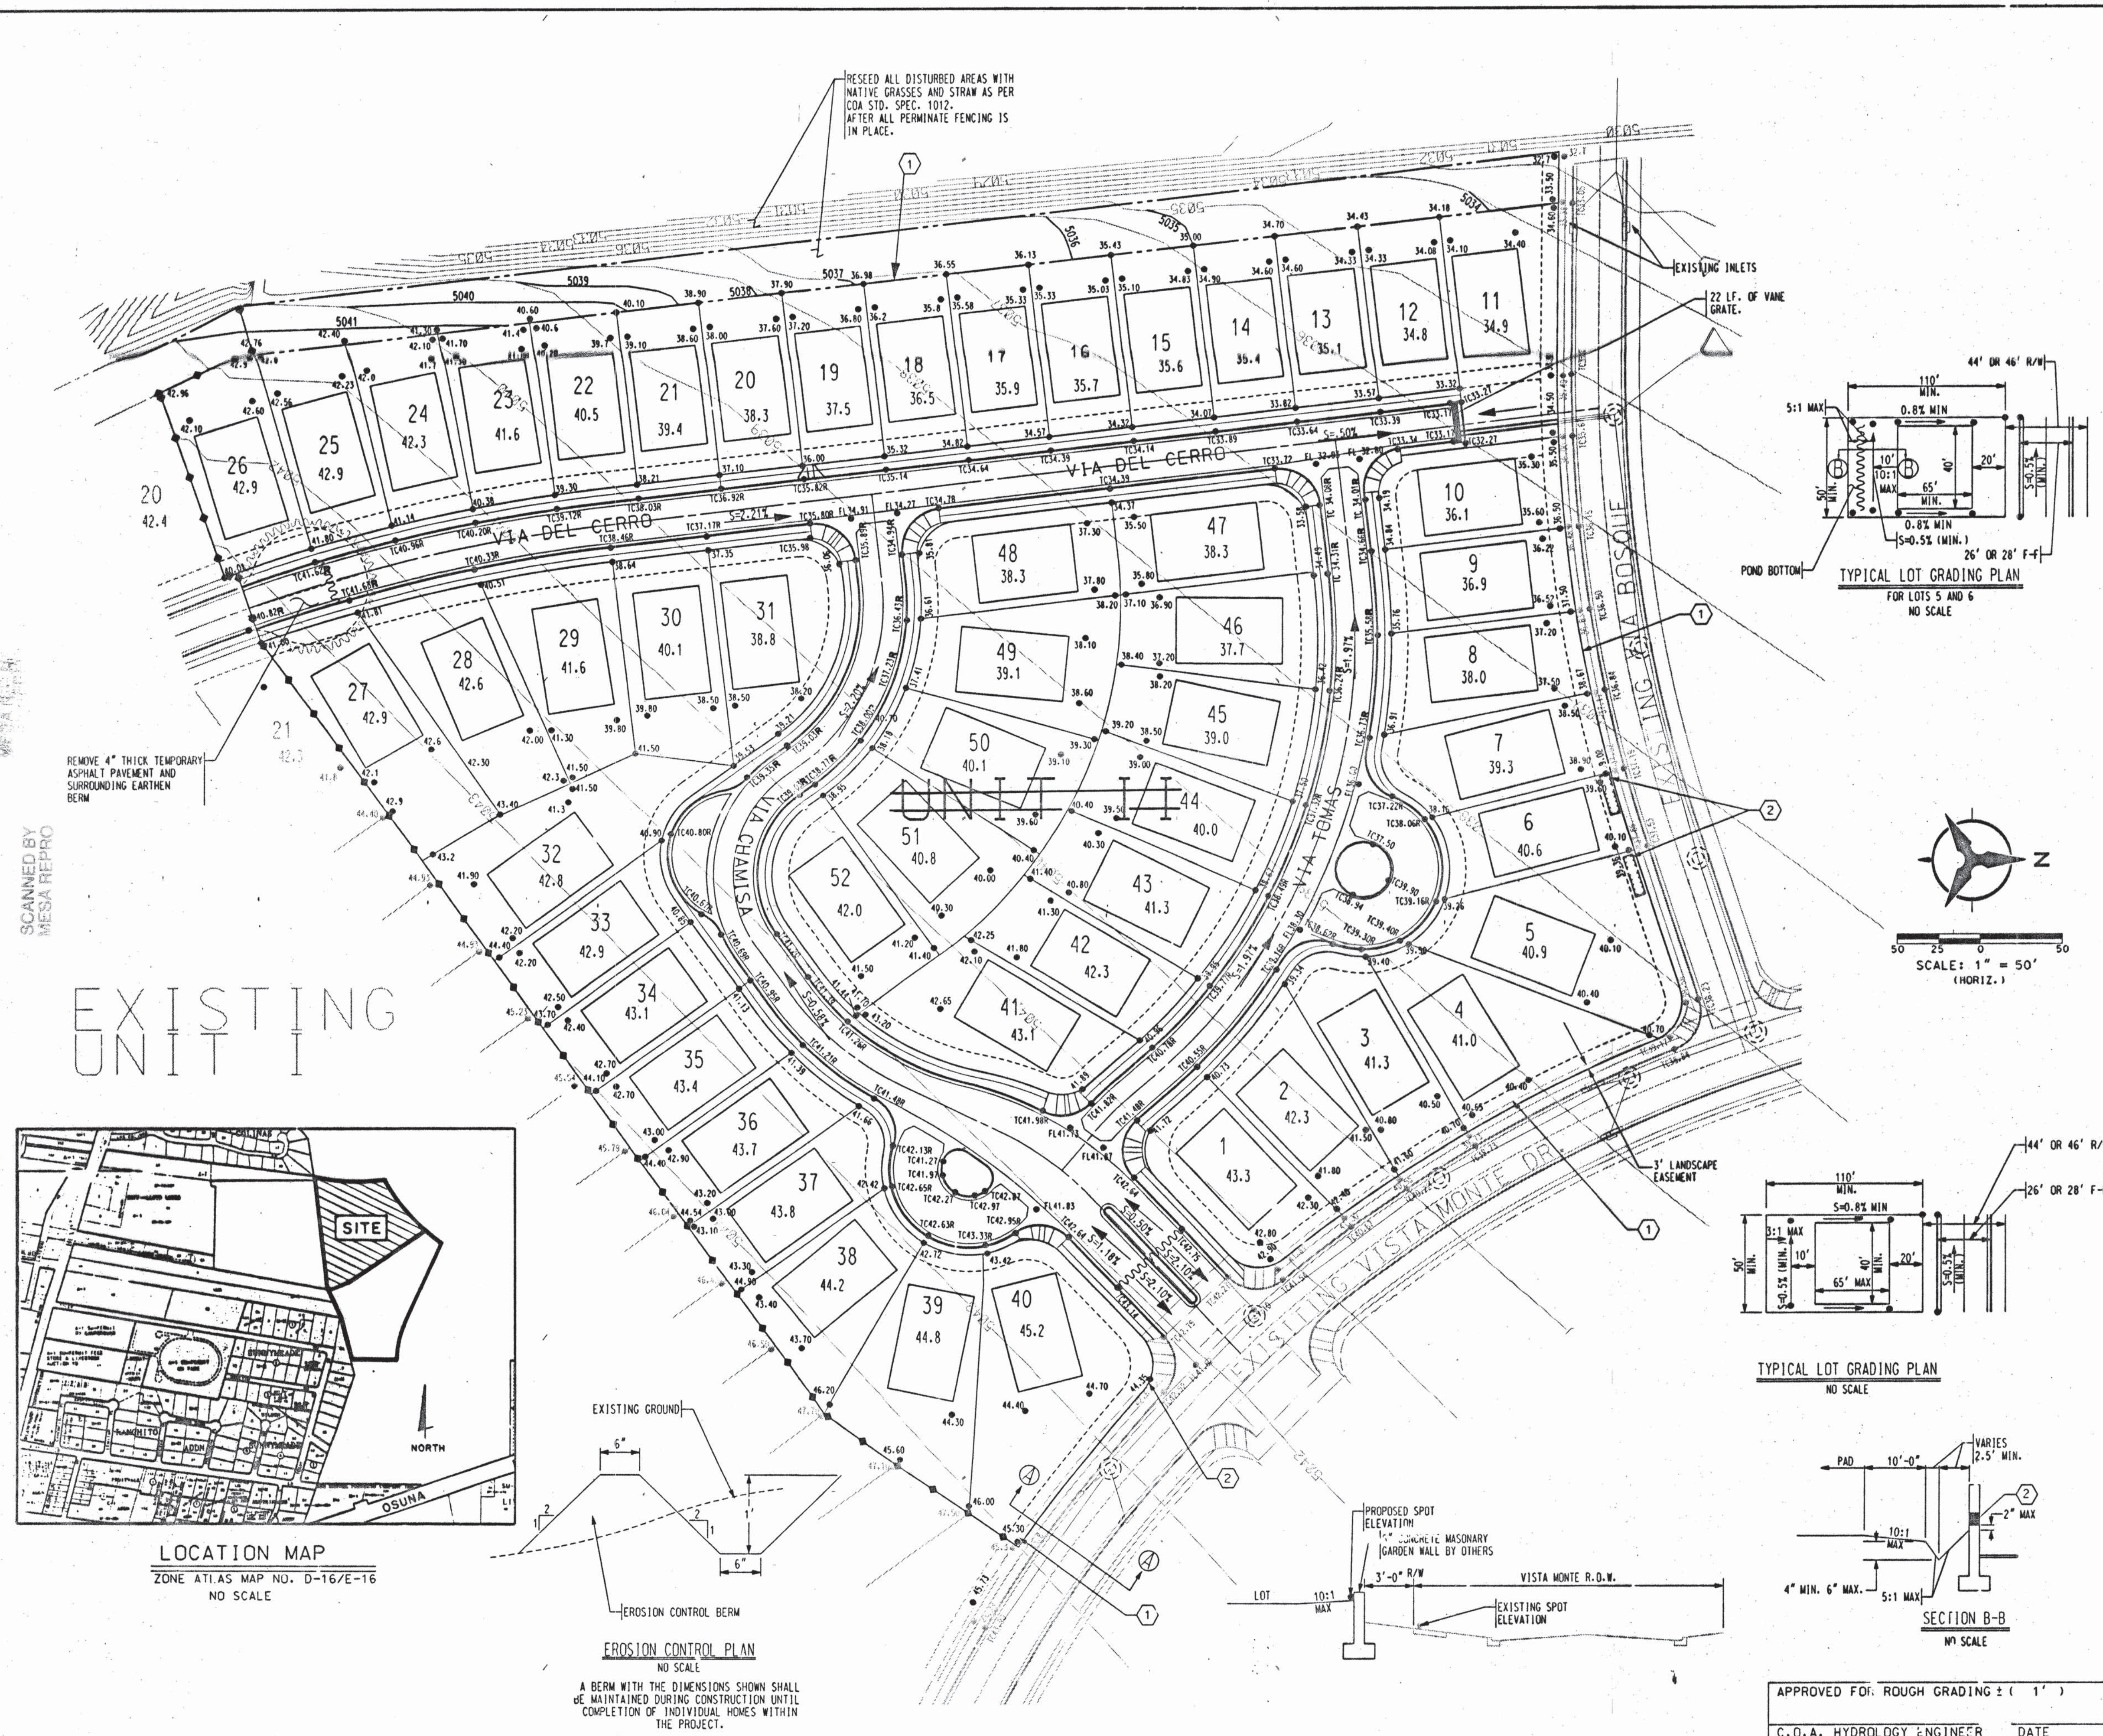


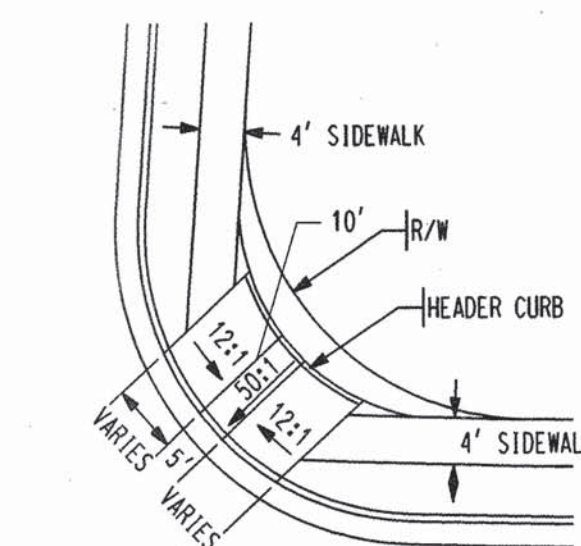


WHEEL CHAIR RAMP DETAIL
SEE MODIFIED STD. DWG. 2441 CASE II
NOT TO SCALE

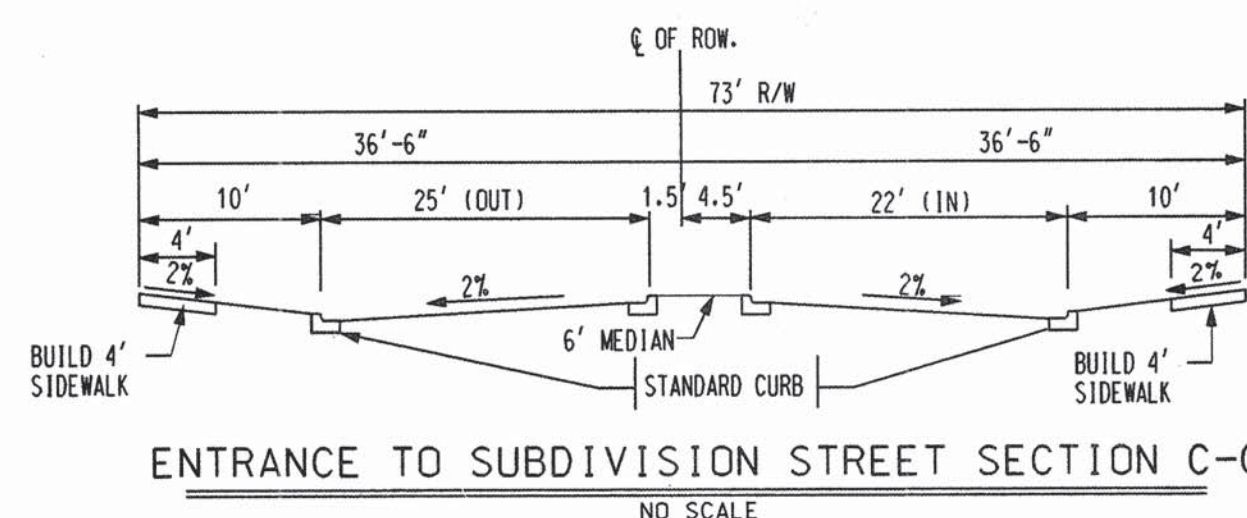

ENTRANCE TO SUBDIVISION STREET SECTION C-C

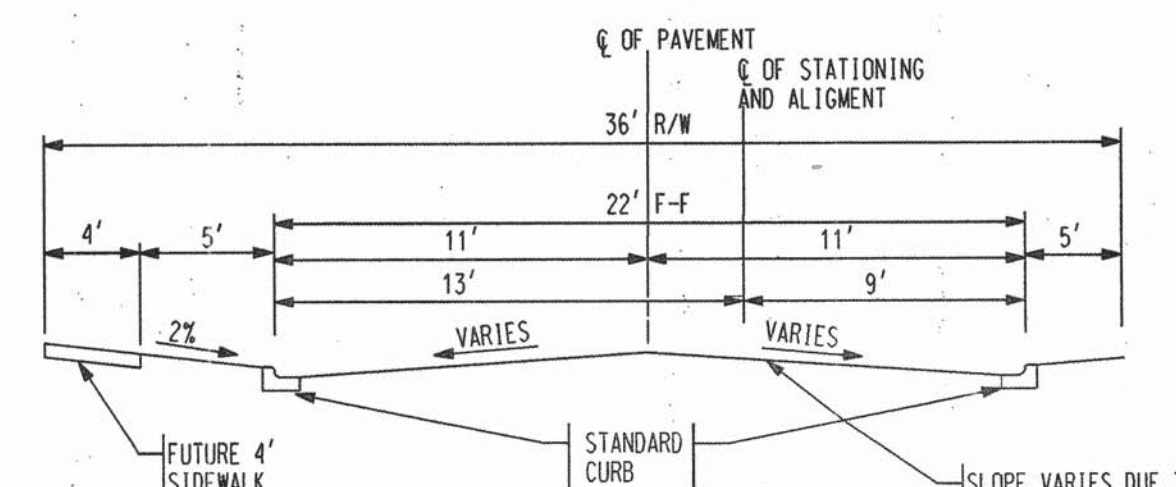

STREET SECTION B-B
A PORTION OF VIA DEL CERRO ONLY
NO SCALE

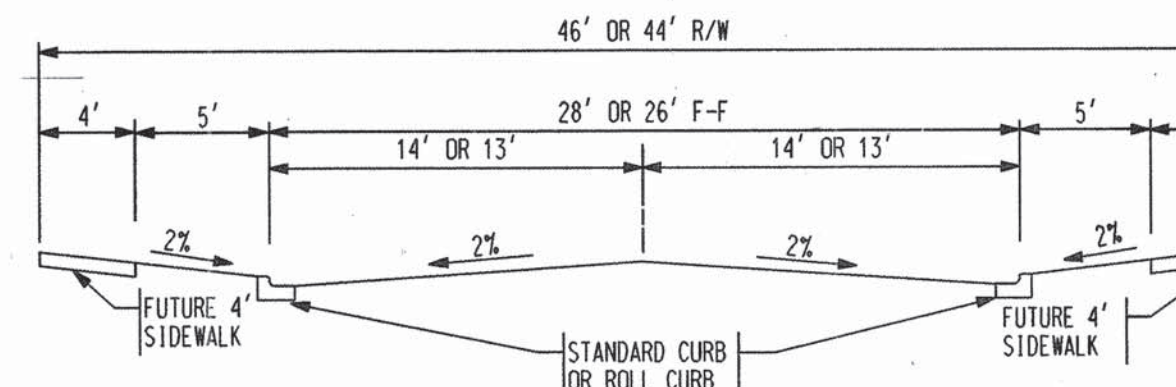


TYPICAL STREET SECTION A-A

ALL SUBDIVISION STREETS UNLESS OTHERWISE NOTED

NO SCALE

NOTE: SOIL NOT HAVING THE MINIMUM R-VALUE OF 50, SHALL BE REMOVED TO A DEPTH OF 2 FEET AND REPLACED, BY THE CONTRACTOR, WITH SUITABLE MATERIAL OR A PAVEMENT SECTION SHALL BE DESIGNED BY THE CONSULTANT ACCOMMODATING THE EXISTING R-VALUE PER CITY OF ALBUQUERQUE STANDARD SPECIFICATIONS.

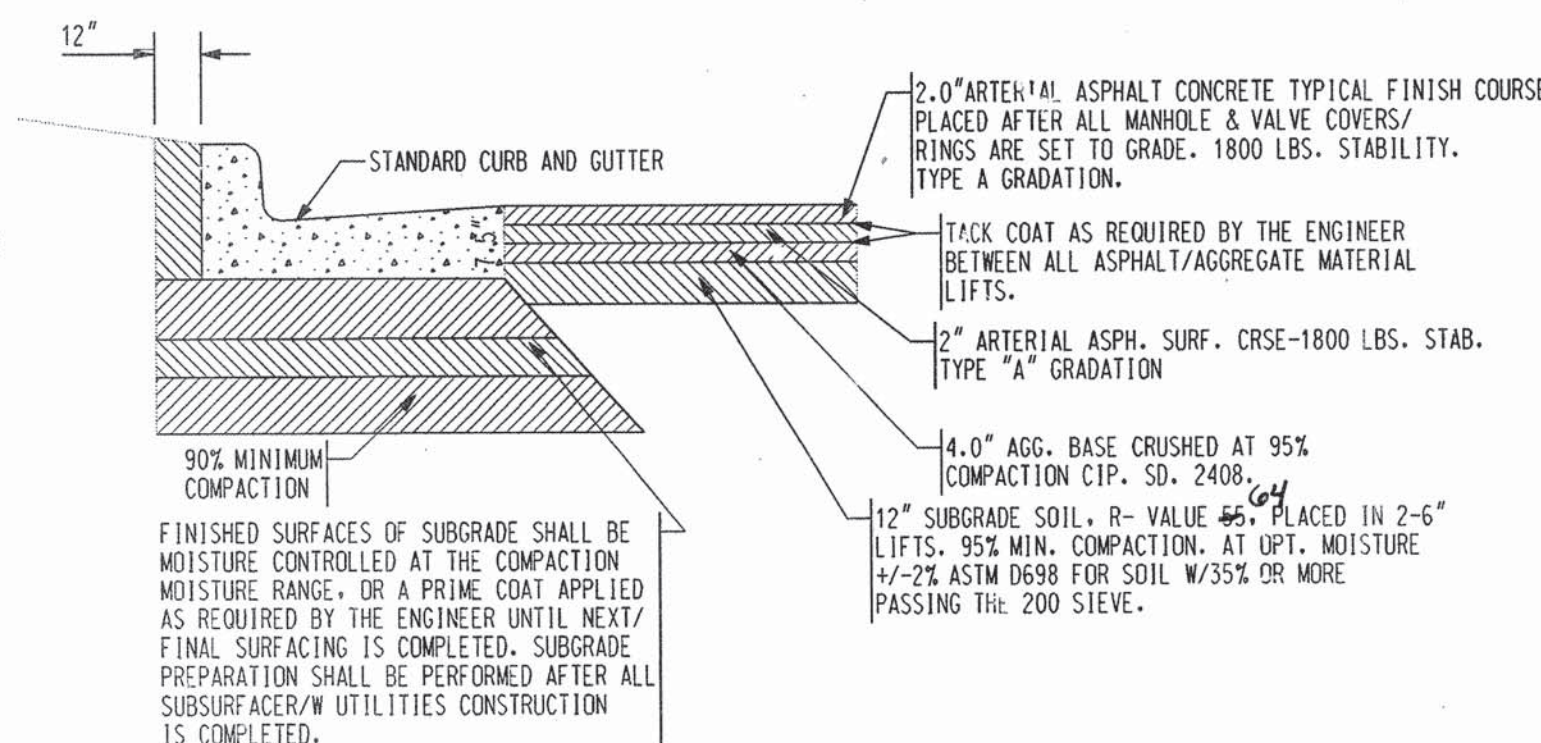

ENTRANCE TO SUBDIVISION PAVEMENT SECTION

IDENTICAL TO 6035.81 C.O.A. PROJECT #
NO SCALE

LEGEND

PROPOSED CURB AND GUTTER	
EXISTING CURB AND GUTTER	
EXISTING SANITARY SEWER MANHOLE	
PROPOSED SANITARY SEWER MANHOLE	
PROPOSED FIRE HYDRANT	
PROPOSED GATE VALVE	
EXISTING GATE VALVE	
PROPOSED STREET LIGHT	
PROPOSED WATER BLOCK	
EXISTING STREET LIGHT	

[illegible]

Bohannon ▲ Huston

 Courtyard One 7500 JEFFERSON NE Albuquerque NEW MEXICO 87109

ENGINEERS PLANNERS PHOTOGRAMMETRISTS SURVEYORS SOFTWARE DEVELOPERS



CITY OF ALBUQUERQUE
PUBLIC WORKS DEPARTMENT
ENGINEERING DEVELOPMENT GROUP

LAS SENDAS DEL NORTE



OVERALL PAVING PLAN

DESIGN REVIEW COMMITTEE	CITY ENGINEER APPROVAL	MO./DAY/YR.	MO./DAY/YR.
JUN 1999 <i>S/S/ewb</i> C.E.S.	APPROVED  CITY ENGINEER	LAST SIGN UPDATE	

CITY PROJECT NO.	6093.81	ZONE MAP NO.	D 16/E-16	SHEET	4	OF	14
------------------	---------	--------------	-----------	-------	---	----	----

1	2	3	4	5	6	7	8	9	10	11	12	13	14	15
2	6	0	9	3	.	8	1			0	4	0	1	

COPYRIGHT BOHANNAN...
DATE: DECEMBER 1964

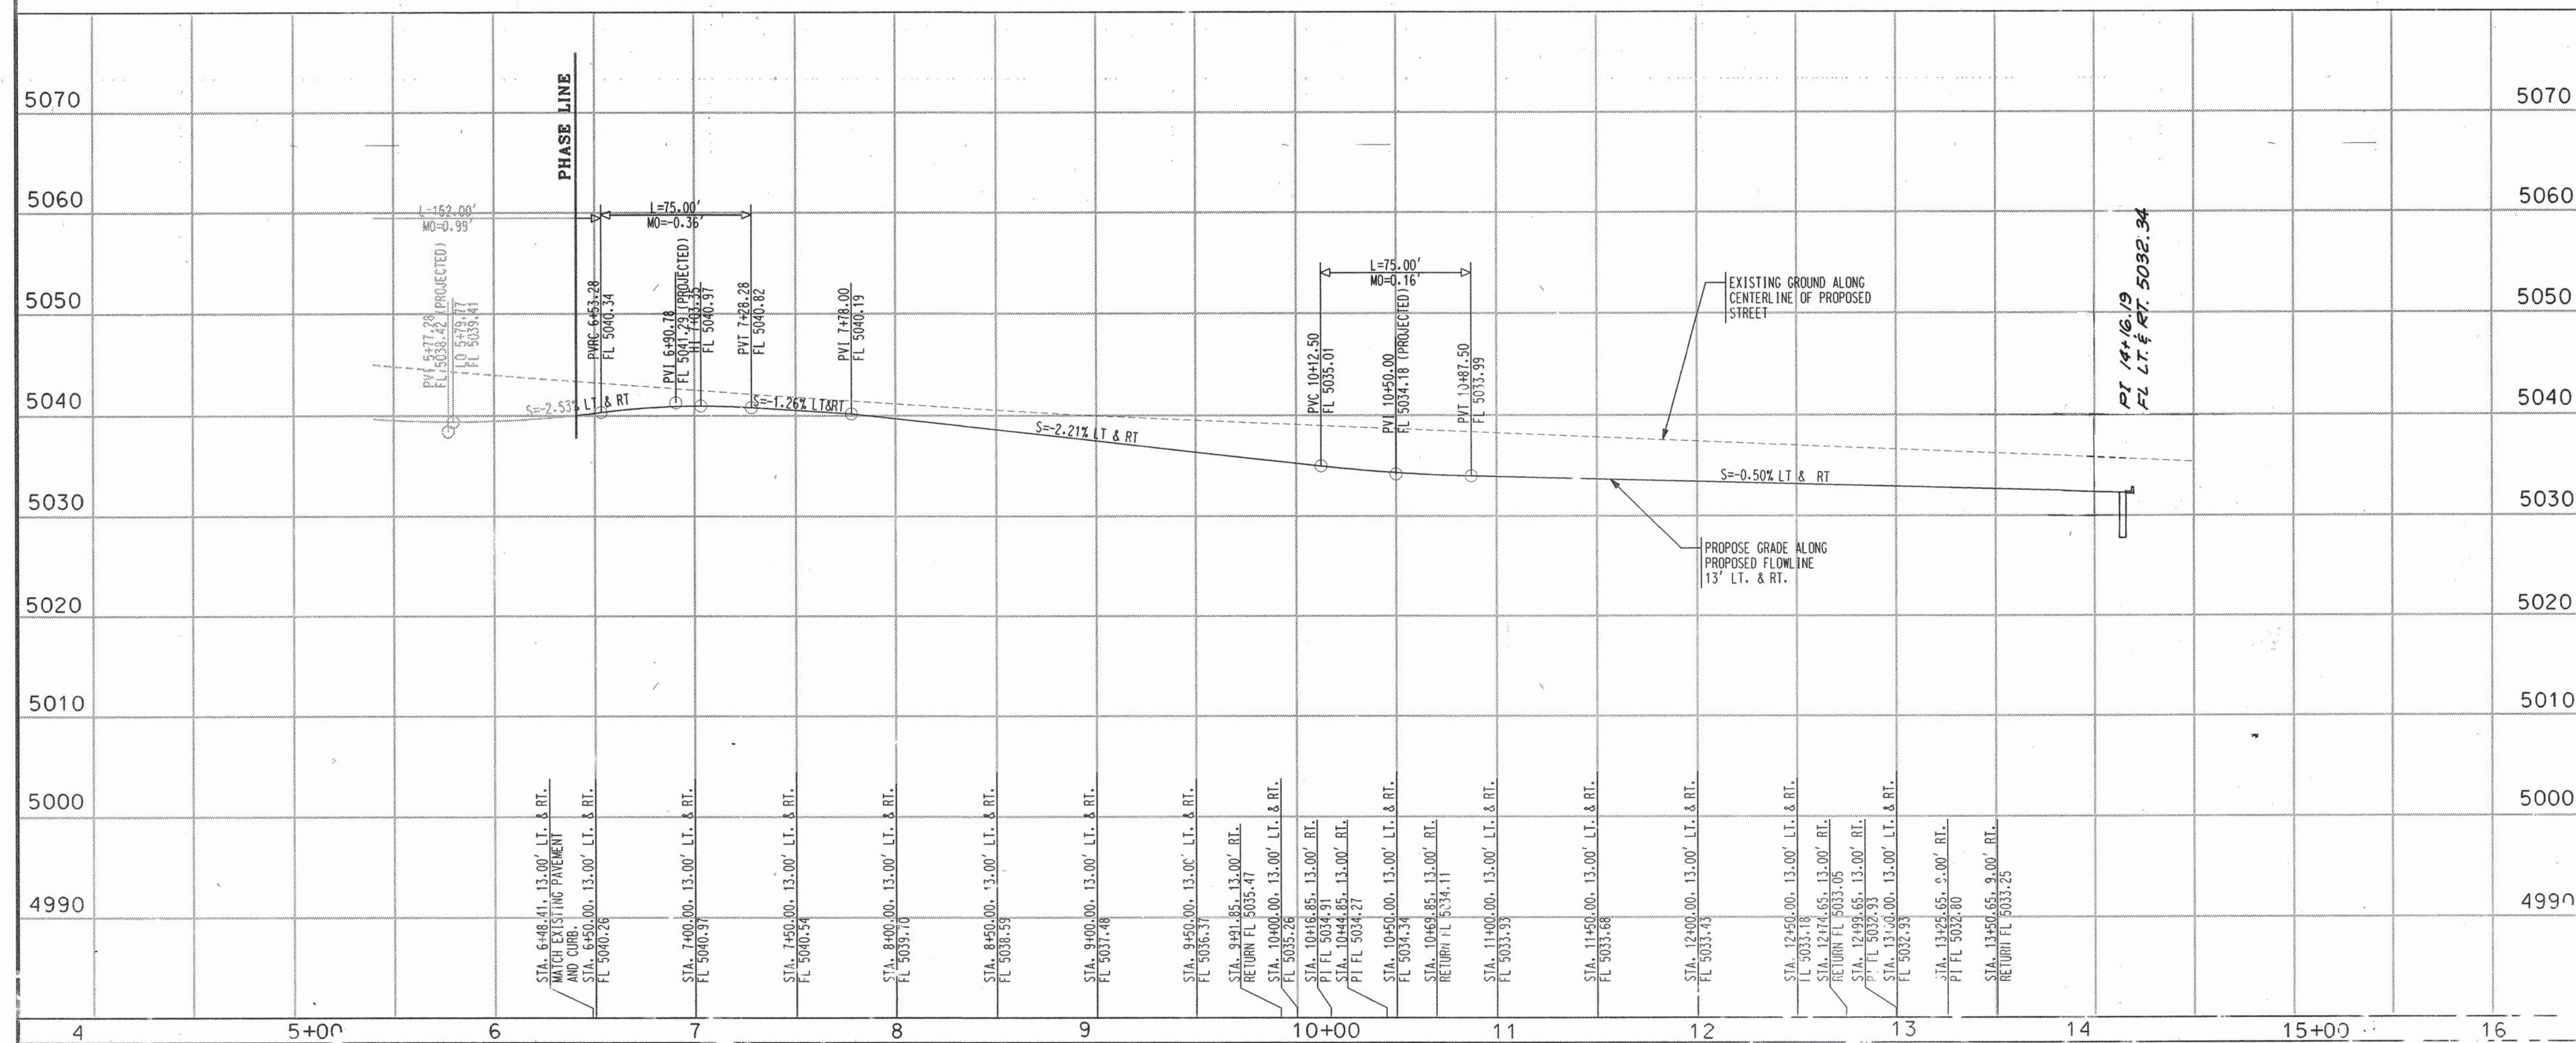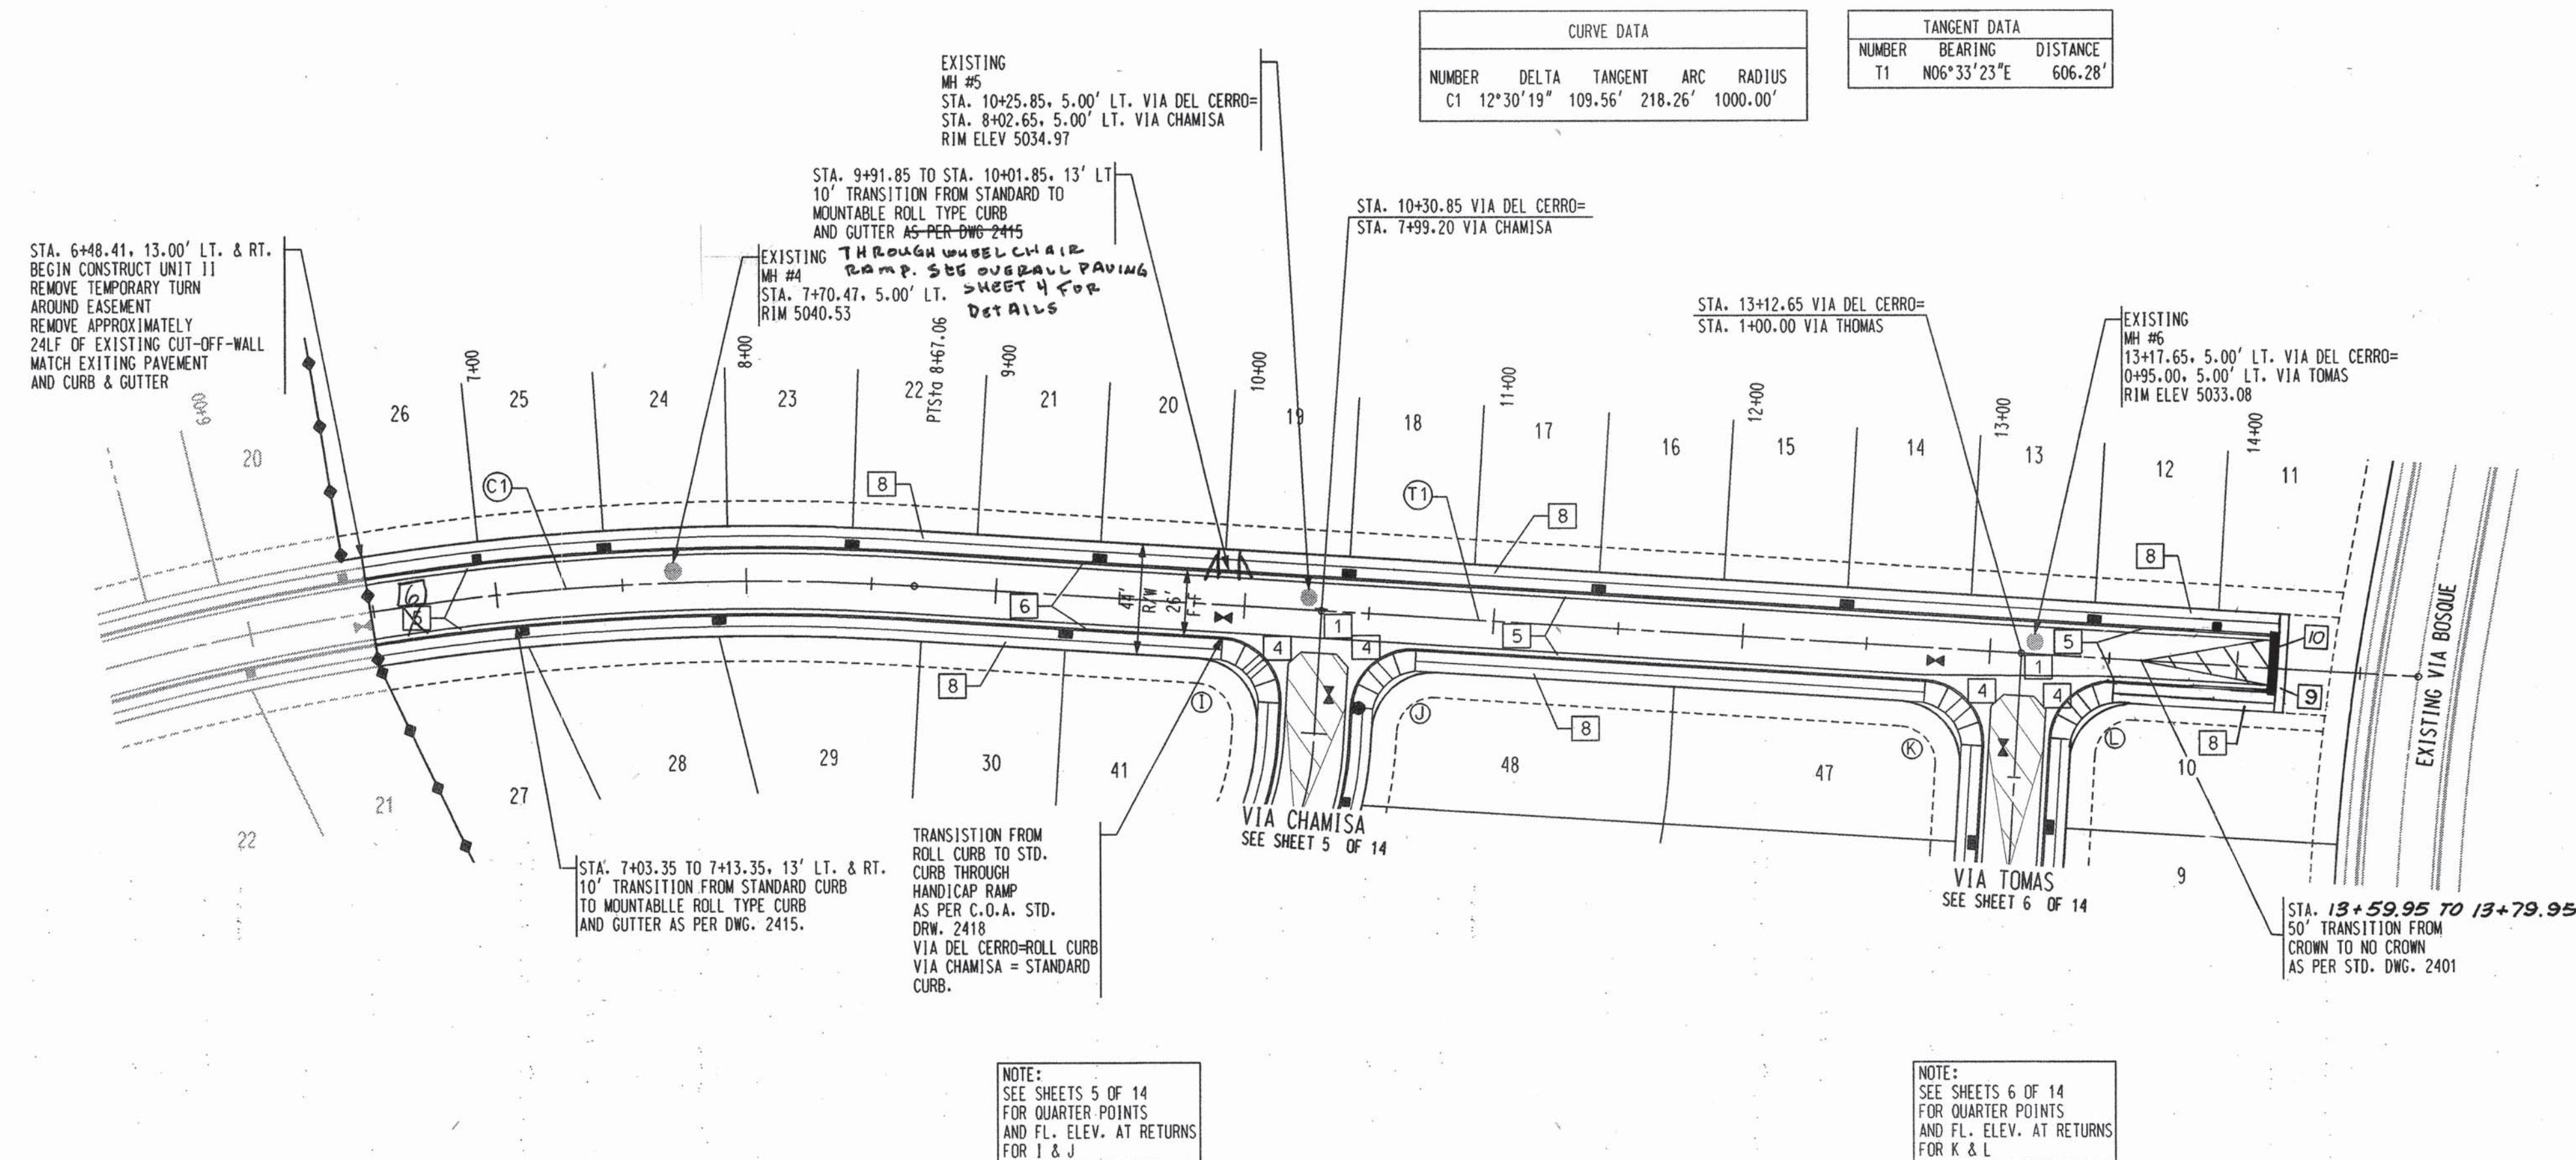

1. THE CONTRACTOR SHALL FIELD VERIFY ALL EXISTING UTILITY LOCATIONS AND NOTIFY THE ENGINEER IMMEDIATELY OF ANY DISCREPANCIES.
2. ALL CURB RETURN RADII SHALL BE 25' UNLESS OTHERWISE SPECIFIED.
3. ALL CURVE DATA AND DIMENSIONS REFER TO FACE OF CURB UNLESS OTHERWISE SPECIFIED.
4. GRADE ELEVATIONS, WHERE NOTED, ARE ALONG FLOWLINE OF STANDARD CURB UNLESS OTHERWISE SPECIFIED.
5. CONTRACTOR IS TO INSTALL A 4" X 4" X 5' POST AND END AT THE END OF EACH SANITARY SEWER SERVICE.
6. CONTRACTOR IS RESPONSIBLE FOR REPAIR AND/OR REPLACEMENT OF ALL UTILITY CONDUITS AND EXISTING LINES.
7. ANY ADDITIONAL GRADING REQUIRED TO MATCH PROPOSED STREET GRADES SHALL BE INCIDENTAL TO PAVING ITEMS.
8. CONTRACTOR SHALL PROVIDE THE INSPECTORS, (CITY AND PRIVATE) WITH THE PROPOSED HYDROSTATIC TESTING PLAN. THE PLAN MUST BE APPROVED BEFORE TESTING OPERATIONS BEGIN.
9. CONTRACTOR SHALL PARK EQUIPMENT AND VEHICLES AS NOT TO INTERFERE WITH NORMAL ACTIVITIES OF RESIDENTS OR OTHER CONTRACTORS ON SITE.
10. ANY DAMAGE TO THE EXISTING FACILITIES (CURB & GUTTER), PAVEMENT, CONDUITS, LANDSCAPING, UTILITY LINES, ETC.) DURING CONSTRUCTION SHALL BE REPLACED AT THE CONTRACTORS' EXPENSE.
11. REMOVAL OF THE EXISTING CURB AND GUTTER SHALL BE AS PER COA STD. DWG. 2415 (SAWCUT ONLY).
12. WHEELCHAIR RAMPS SHALL BE CONSTRUCTED PRIOR TO ACCEPTANCE OF CURB & GUTTER.
13. STATIONING AND OFFSETS GIVEN FOR DROP INLETS ARE GIVEN AT CENTER OF GRATE AT FLOWLINE

* NOT APPLICABLE THIS SHEET

KEYED GENERAL NOTES

1. INSTALL CONCRETE VALLEY GUTTER AS PER STD. DWG. 2420
- * 2. INSTALL CONCRETE VALLEY GUTTER AS PER STD. DWG. 2421
- * 3. INSTALL WHEELCHAIR RAMP AS PER STD. DWG. 2441, CASE I WITH ALTERNATE SECTION AA
4. INSTALL WHEELCHAIR RAMP AS PER STD. DWG. 2441, CASE II
5. STD. CURB & GUTTER AS PER STD. DWG. 2415
6. ROLL CURB & GUTTER AS PER STD. DWG. 2415
- * 7. MEDIAN CURB & GUTTER AS PER STD. DWG. 2415
8. FUTURE 4' SIDEWALK
- * 9. BUILD 4' SIDEWALK
10. DEPRESS CURB AND GUTTER AS PER STD. DWG. 2415.

Bohannon ▴ Huston

 Courtyard One 7500 JEFFERSON NE Albuquerque NEW MEXICO 87109

ENGINEERS PLANNERS PHOTOGRAMMETRISTS SURVEYORS SOFTWARE DEVELOPERS

CITY OF ALBUQUERQUE
PUBLIC WORKS DEPARTMENT
ENGINEERING DEVELOPMENT GROUP

LAS SENDAS DEL NORTE
PAVING PLAN & PROFILE
VIA DEL CERRO

DESIGN REVIEW COMMITTEE		CITY ENGINEER APPROVAL		MO./DAY/YR.		MO./DAY/YR.	
 APPROVED JUN 17 1999 8/28/00		 APPROVED JUN - 10 2000		LUT DESIGN UPDATE			
DESIGN REVIEW COMMITTEE		CITY		ZONE MAP NO.		SHEET	
CITY PROJECT NO. 609381				D-16/E-16		OF 14	


1 2 3 4 5 6 7 8 9 10 11 12 13 14 15
26 6093.81 0701

P:A01_BHIMAIN\97455\CDP\FNP\UNIT 2
97455F7NP05.DGN

Doc. No. 97455/01

1	2	3	4	5	6	7	8	9	10	11	12	13	14	15
26		6	0	9	3	.	8	1		0	7	0	1	

EXISTING
UNIT

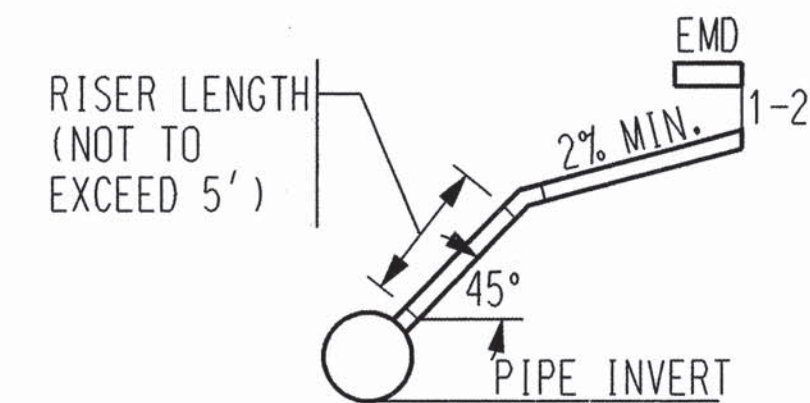


1	2	3	4	5	6	7	8	9	10	11	12	13	14
26		60	93	.	81					08	0		

9

COPYRIGHT BOHANNAN-HUSTON, INC. 1998
DATE: DECEMBER, 1998


SCANNED BY
MESA REPRO

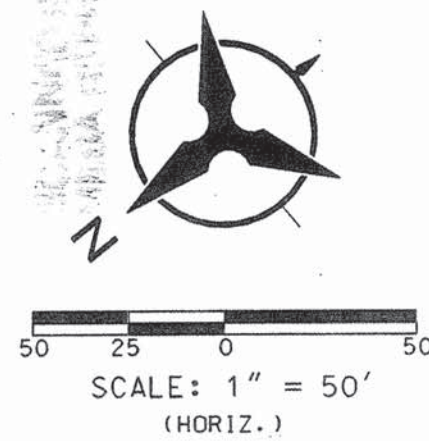


SCALE: 1" = 50'
(HORIZ.)

WATERLINE TANGENT DATA		
NUMBER	BEARING	LENGTH
T1	N26°12'31"E	144.57'
T2	S47°24'07"W	41.58'
T3	N59°32'37"E	78.09'
T4	N86°42'23"E	32.39'
T5	S41°42'23"E	83.27'
T6	S51°33'23"E	35.07'
T7	S14°03'23"E	36.77'
T8	N83°26'37"E	79.55'

SAS TANGENT DATA		
NUMBER	BEARING	LENGTH
T8	S27°15'02"W	132.45'
T9	S53°44'08"W	138.46'
T10	N42°42'03"W	132.45'
T11	N65°36'41"W	51.68'
T12	S83°26'37"W	75.56'

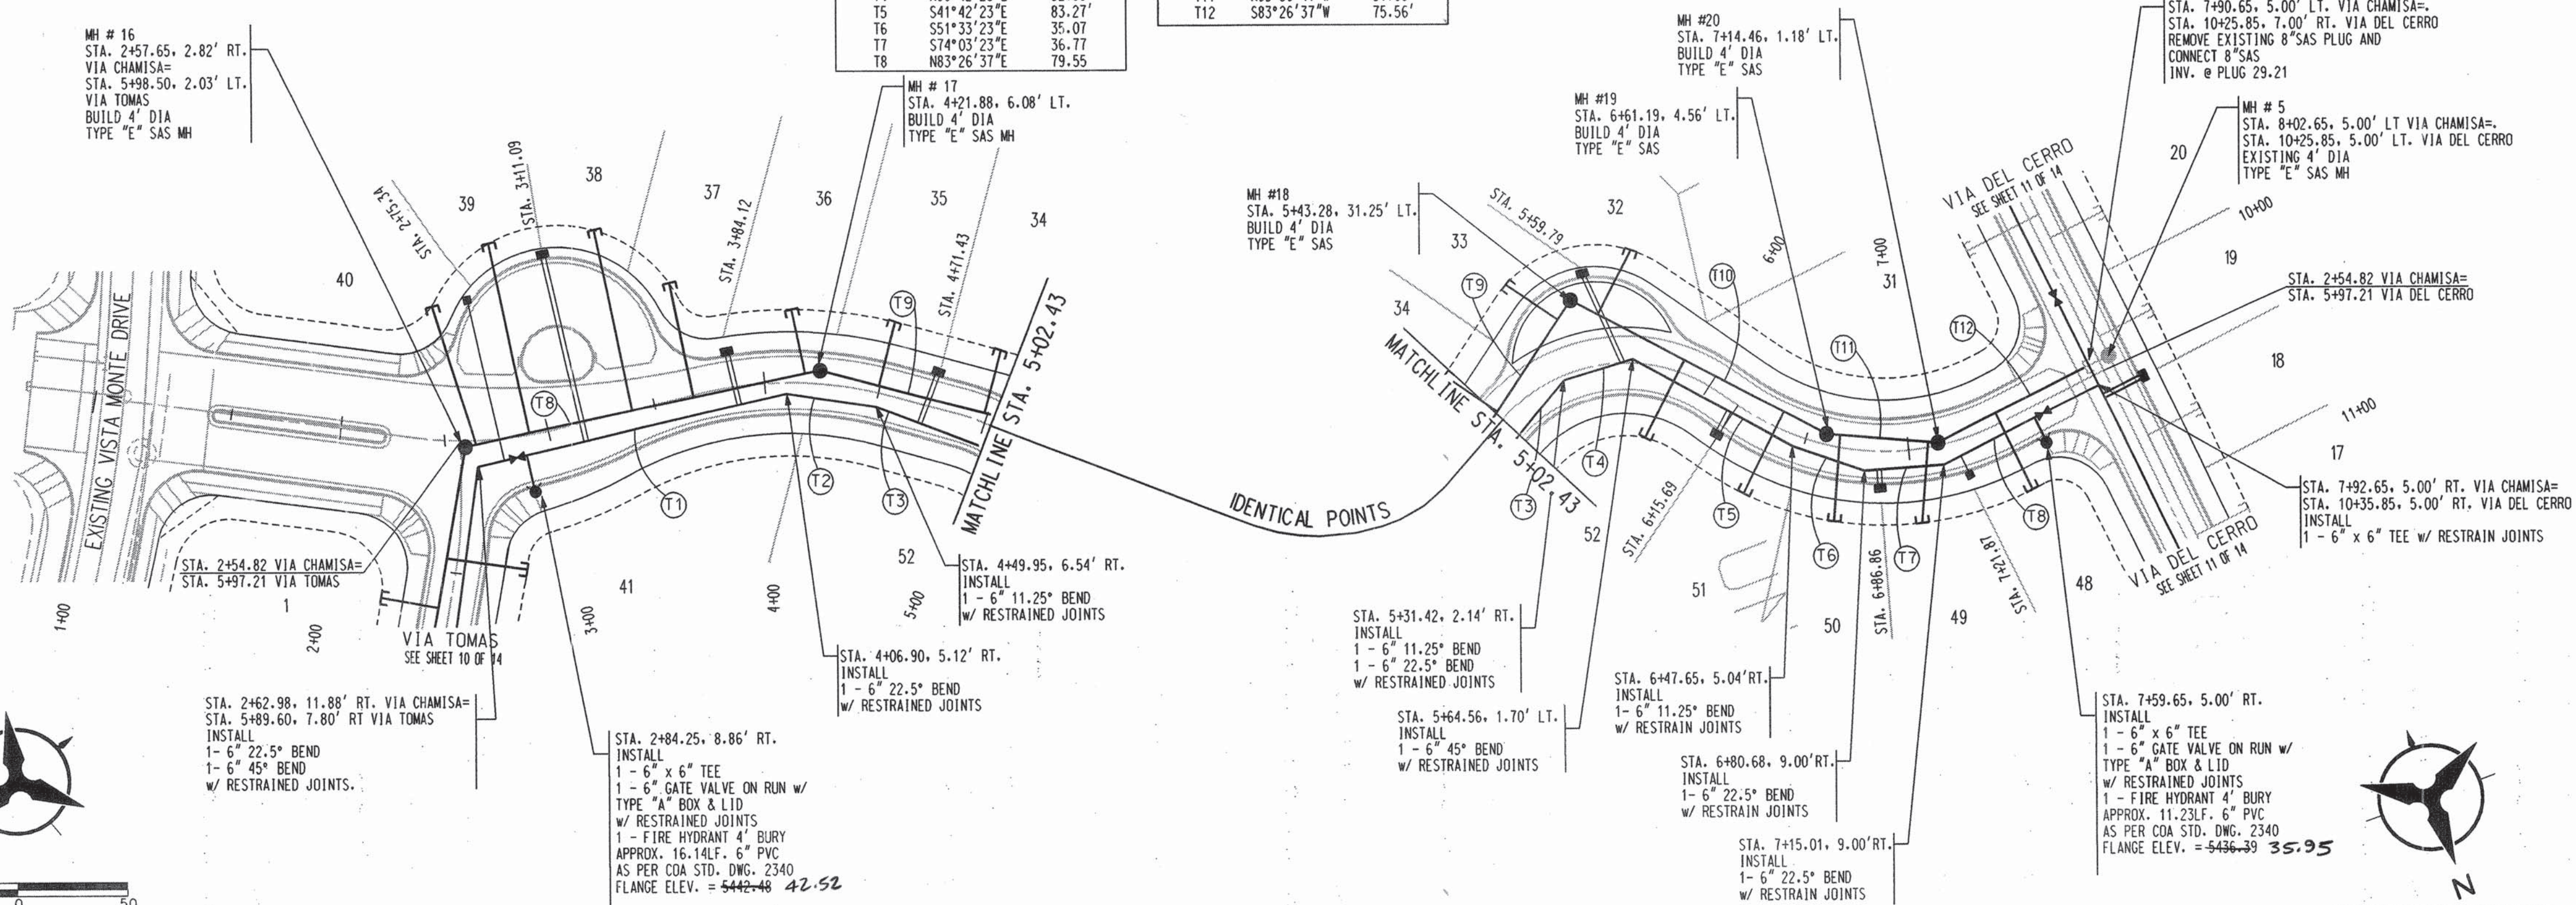

VIA CHAMISA

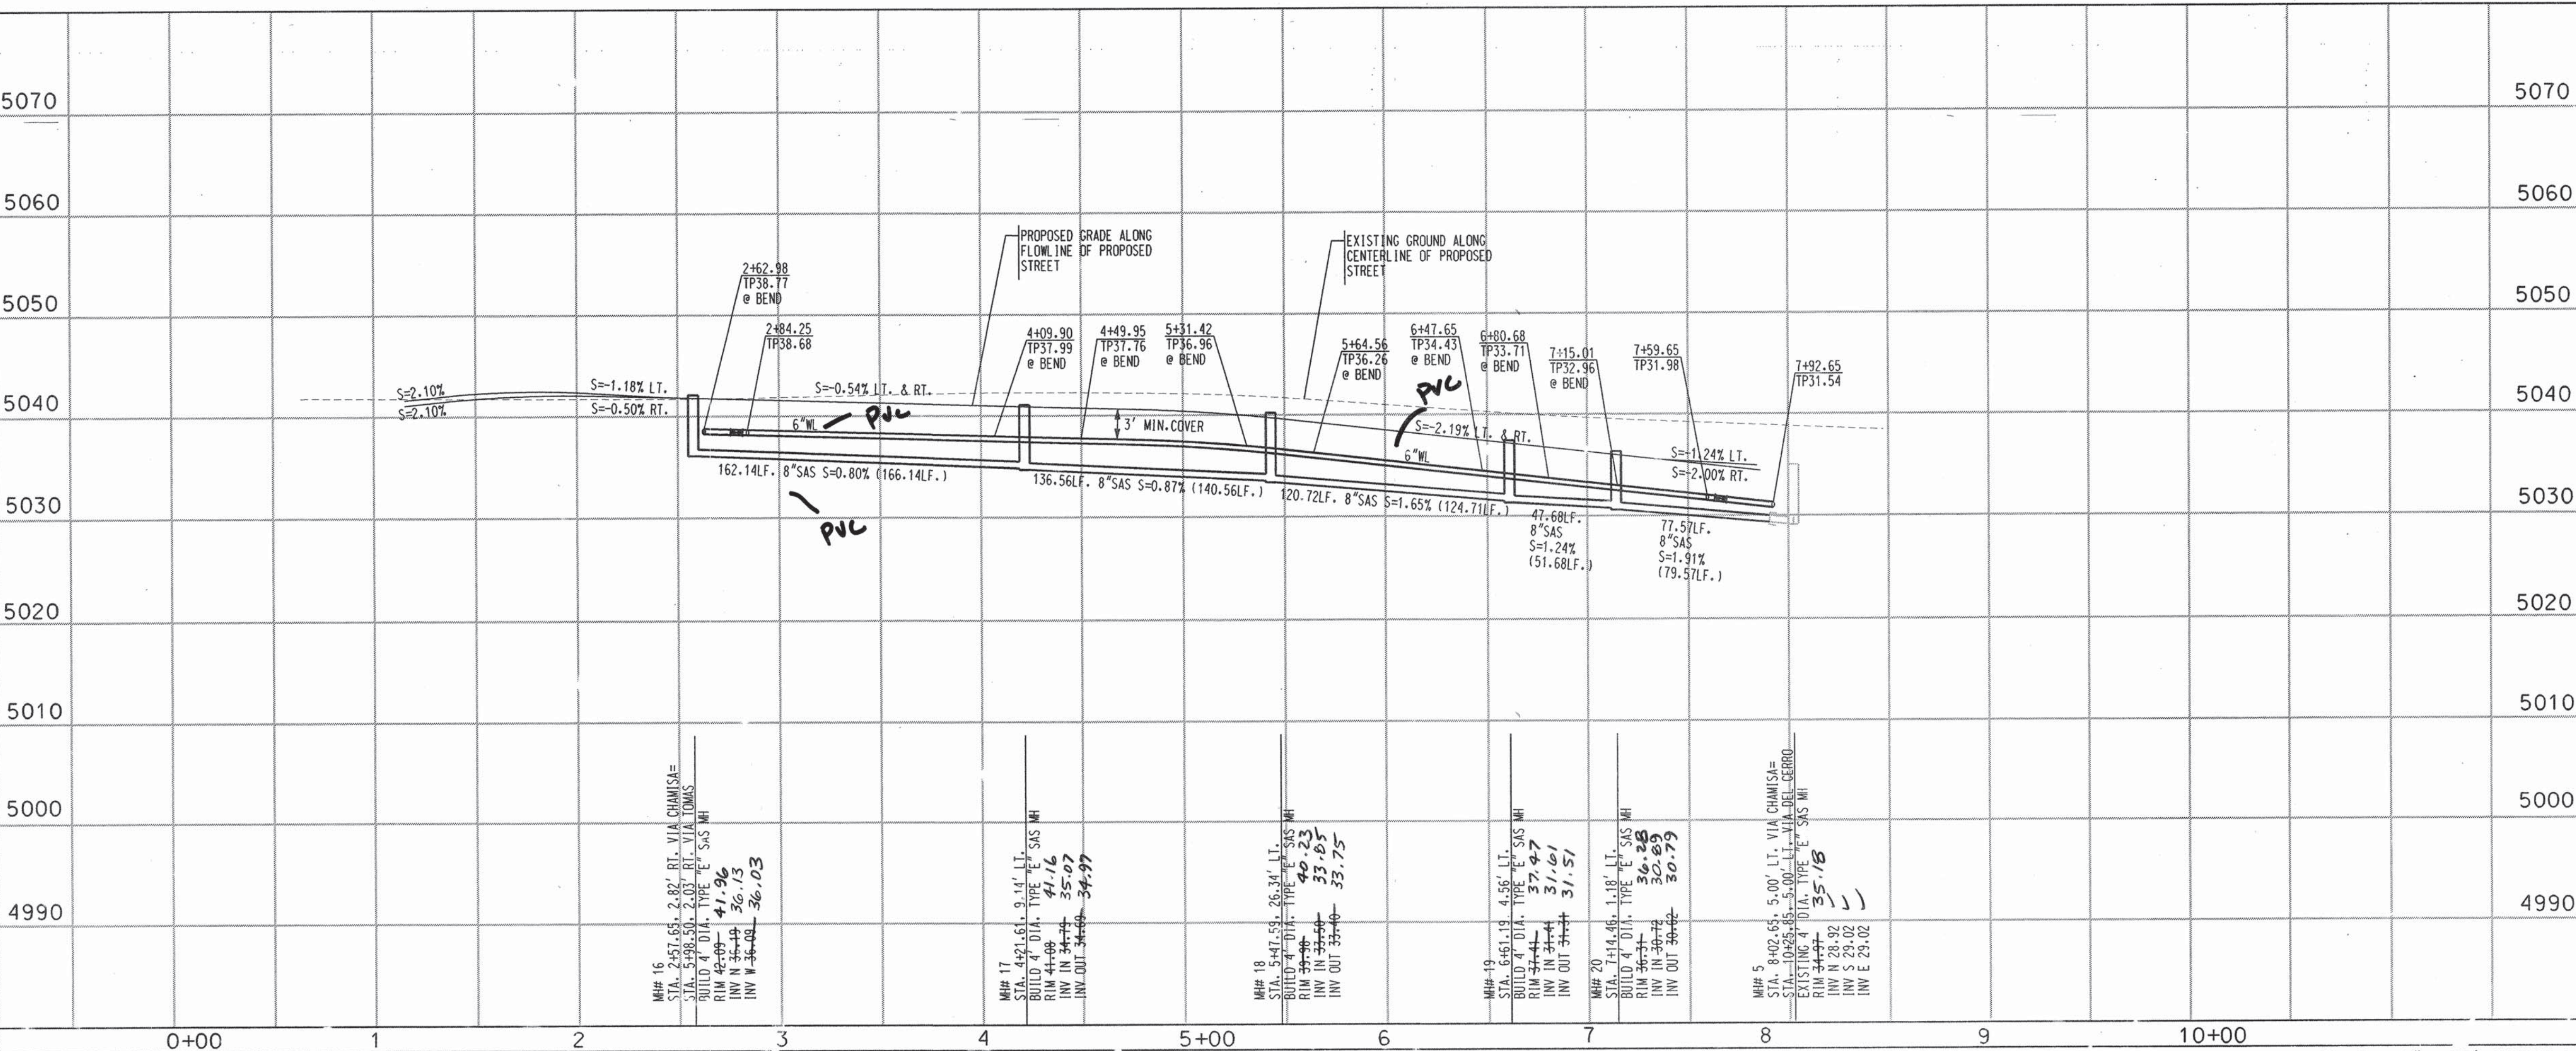

PA01 BHMAIN 97455\CDP\PNP\UNIT 2
97455UPNP07.DGN

NOTES

1. THE CONTRACTOR SHALL FIELD VERIFY ALL EXISTING UTILITY LOCATIONS AND NOTIFY THE ENGINEER IMMEDIATELY OF ANY DISCREPANCIES.
2. ALL CURB RETURN RADII SHALL BE 25' UNLESS OTHERWISE SPECIFIED.
3. ALL CURVE DATA AND DIMENSIONS REFER TO FACE OF CURB UNLESS OTHERWISE SPECIFIED.
4. GRADE ELEVATIONS, WHERE NOTED, ARE ALONG FLOWLINE OF STANDARD CURB UNLESS OTHERWISE SPECIFIED.
5. CONTRACTOR IS TO INSTALL A 4" X 4" X 5' POST AND END AT THE END OF EACH SANITARY SEWER SERVICE.
6. CONTRACTOR IS RESPONSIBLE FOR REPAIR AND/OR REPLACEMENT OF ALL UTILITY CONDUITS AND EXISTING LINES.
7. ANY ADDITIONAL GRADING REQUIRED TO MATCH PROPOSED STREET GRADES SHALL BE INCIDENTAL TO PAVING ITEMS.
8. CONTRACTOR SHALL PROVIDE THE INSPECTORS, (CITY AND PRIVATE) WITH THE PROPOSED HYDROSTATIC TESTING PLAN. THE PLAN MUST BE APPROVED BEFORE TESTING OPERATIONS BEGIN.
9. CONTRACTOR SHALL PARK EQUIPMENT AND VEHICLES AS NOT TO INTERFERE WITH NORMAL ACTIVITIES OF RESIDENTS OR OTHER CONTRACTORS ON SITE.
10. ANY DAMAGE TO THE EXISTING FACILITIES (CURB & GUTTER), PAVING, CONDUITS, LANDSCAPING, UTILITY LINES, ETC.) DURING CONSTRUCTION SHALL BE REPLACED AT THE CONTRACTORS' EXPENSE.
11. REMOVAL OF THE EXISTING CURB AND GUTTER SHALL BE AS PER COA STD. DWG. 2415 (SAWCUT ONLY).
12. WHEELCHAIR RAMPS SHALL BE CONSTRUCTED PRIOR TO ACCEPTANCE OF CURB & GUTTER.
13. STATIONING AND OFFSETS GIVEN FOR DROP INLETS ARE GIVEN AT CENTER OF GATE AT FLOWLINE

SANITARY SEWER SERVICES			
LOT NUMBER	SAS STATION & OFFSET	SAS LENGTH	TOP OF PIPE AT LENGTH PLUG (W/RISE)
31	SEE SHEET 12 OF 15		
32	5+51.48, 22.56' LT.	33.11'	35.74(N/A)
33	5+37.45, 24.47' LT.	28.51'	36.86(N/A)
34	4+98.43, 4.17' LT.	29.49'	36.23(N/A)
35	4+49.07, 3.14' LT.	29.08'	35.78(N/A)
36	4+15.23, 4.24' LT.	29.52'	37.05(N/A)
37	3+63.76, 1.11' RT.	52.00'	37.87(N/A)
38	3+34.98, 0.22' RT.	83.76'	38.68(N/A)
39	2+86.85, 0.80' RT.	87.77'	39.10(N/A)
40	2+62.53, 1.87' RT.	65.39'	38.83(N/A)
41	SEE SHEET 10 OF 14		
48	7+46.03, 5.00' LT.	38.00'	32.21(N/A)
49	7+11.51, 2.39' LT.	36.21'	32.78(N/A)
50	6+67.72, 5.39' LT.	38.54'	33.35(N/A)
51	6+38.19, 7.78' LT.	40.81'	34.09(N/A)
52	5+86.94, 5.83' LT.	39.52'	34.90(N/A)

NOTE: WATER METER LOCATIONS ARE DESIGNATED BY STATIONING AT PROPERTY CORNERS.

Bohannon & Huston

Courtyard One 7500 JEFFERSON NE Albuquerque NEW MEXICO 87109

ENGINEERS PLANNERS PHOTOGRAMMETRISTS SURVEYORS SOFTWARE DEVELOPERS

CITY OF ALBUQUERQUE
PUBLIC WORKS DEPARTMENT
ENGINEERING DEVELOPMENT GROUP

LAS SENDAS DEL NORTE
UTILITY PLAN & PROFILE
VIA CHAMISA


DESIGN REVIEW COMMITTEE	CITY ENGINEER APPROVAL	MO./DAY/YR.	MO./DAY/YR.
LAST DESIGN UPDATE			

CITY PROJECT NO.	ZONE MAP NO.	SHEET	OF
6093.81	D-16/E-16	3	14

BHI JOB NO. 9.455304

DATE: APRIL 1998

26 6093.81 0901

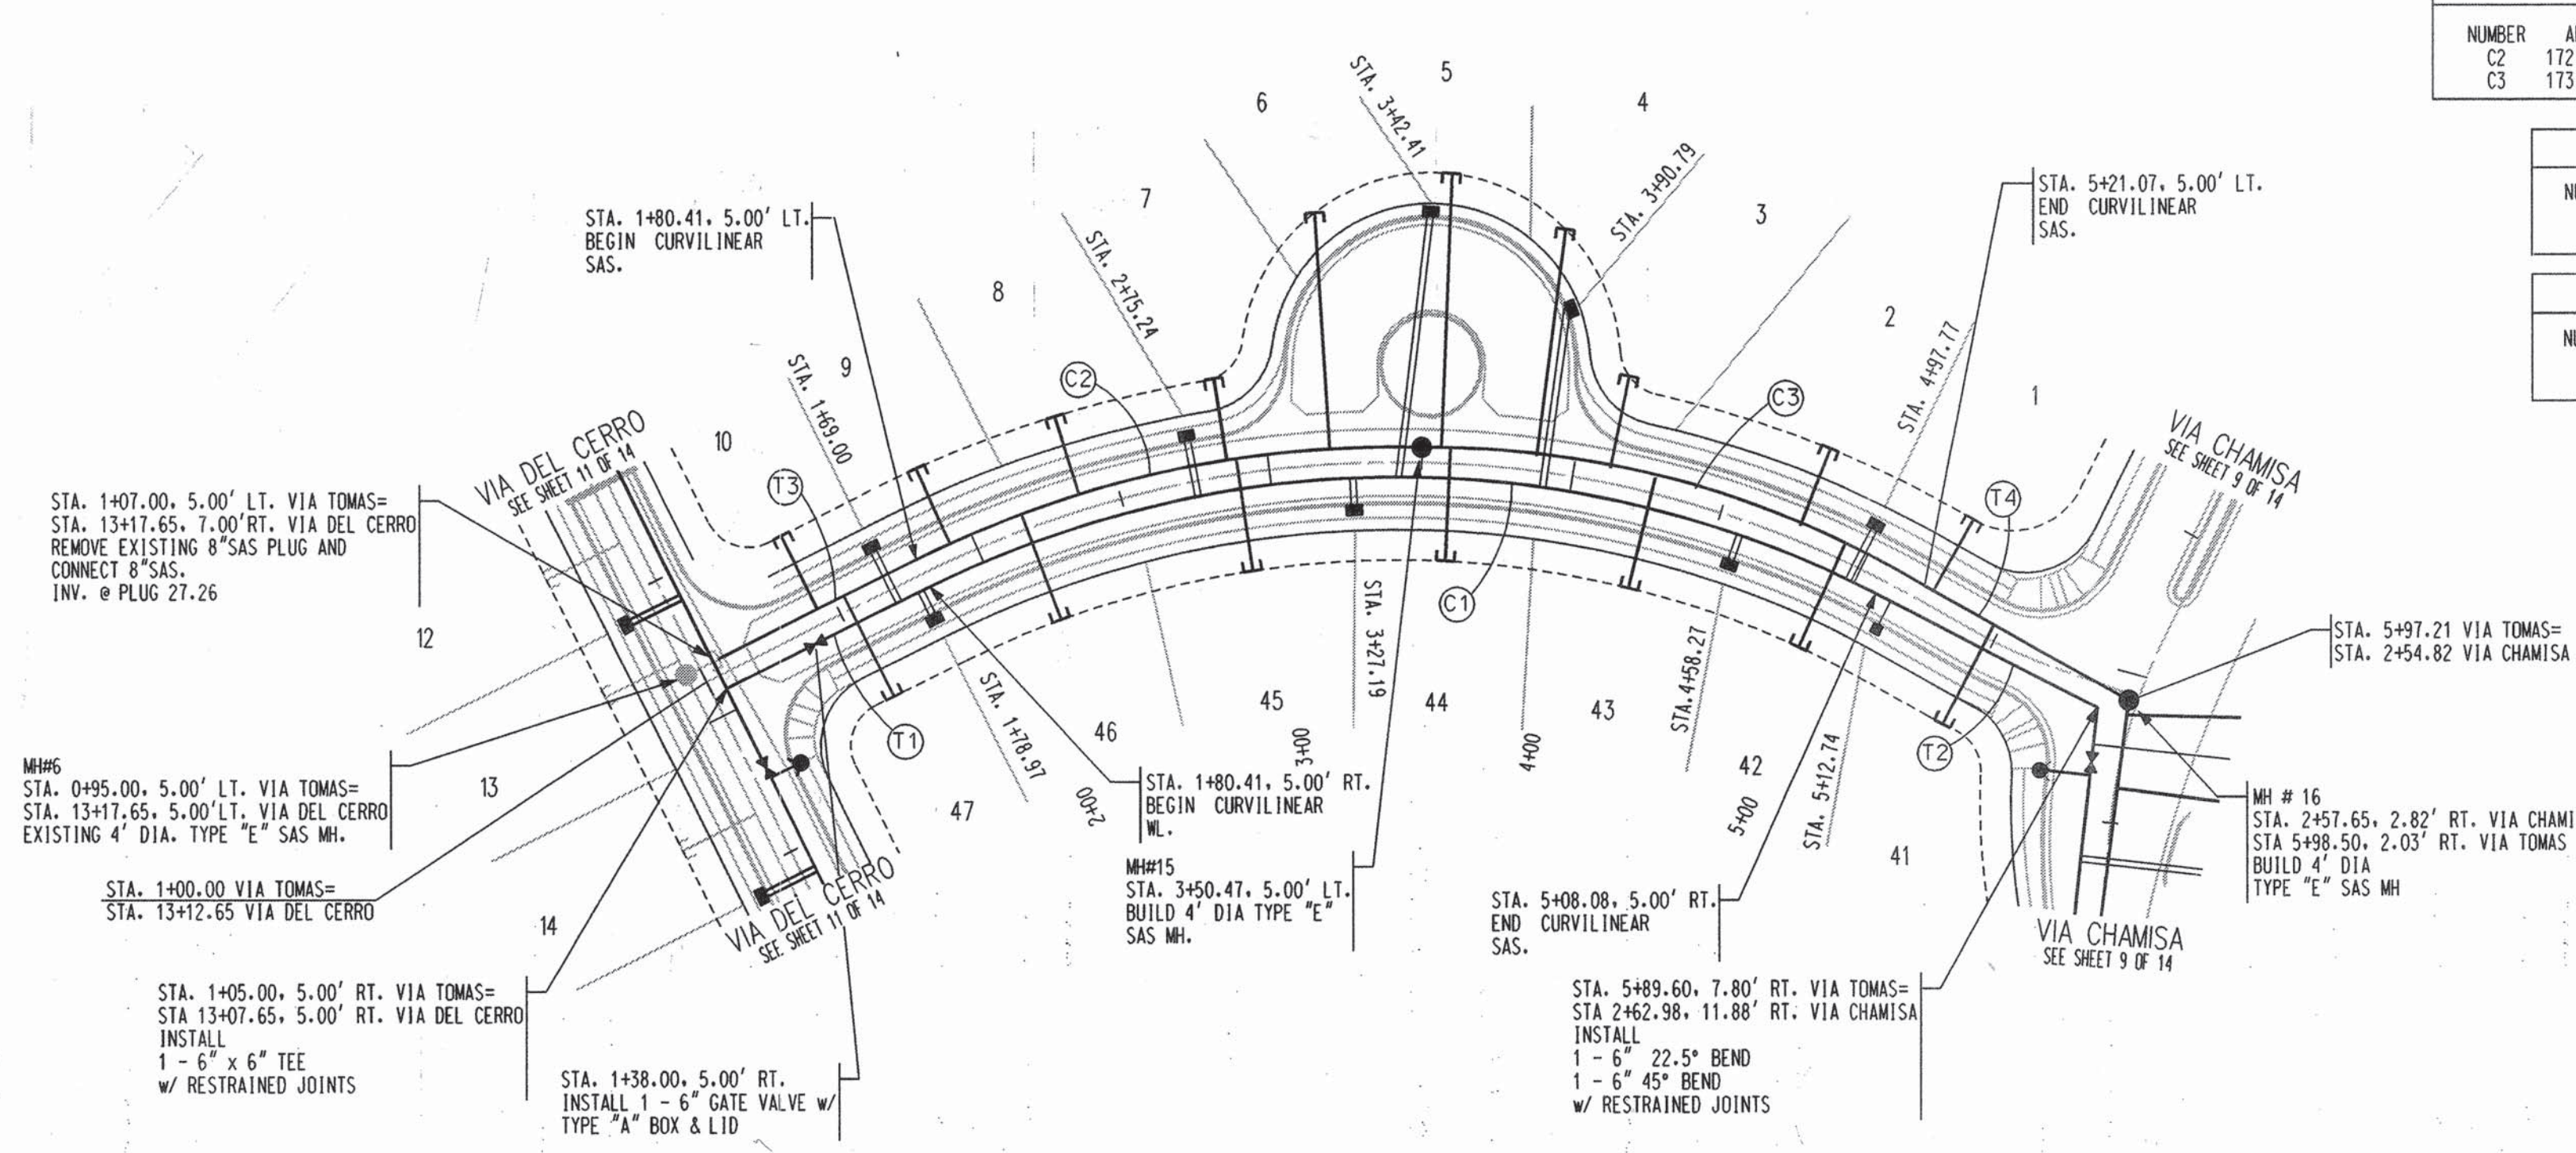

WATERLINE CURVE DATA				
NUMBER	ARC	RADIUS	DELTA	TANGENT
C1	322.99'	345.00'	16°36'27"	174.42'


SAS CURVE DATA				
NUMBER	ARC	RADIUS	DELTA	TANGENT
C2	172.04'	351.90'	16°16'54"	87.77'
C3	173.91'	320.67'	17°52'02"	89.15'

WATERLINE TANGENT DATA		
NUMBER	BEARING	LENGTH
T1	N63°26'37"E	75.41'
T2	N42°54'58"W	82.29'


SAS TANGENT DATA		
NUMBER	BEARING	LENGTH
T3	S83°26'37"W	73.41'
T4	N40°47'27"W	71.27'

SANITARY SEWER SERVICES			
LOT NUMBER	SAS STATION & OFFSET	SAS LENGTH	TOP OF PIPE AT PLUG (W/RISER)
1	5+24.60, 5.00' LT.	27.00'	36.72(N/A)
2	4+76.02, 5.00' LT.	27.00'	35.85(N/A)
3	4+11.80, 5.00' LT.	30.78'	34.70(N/A)
4	3+87.58, 5.00' LT.	74.22'	35.11(N/A)
5	3+56.36, 5.00' LT.	89.22'	34.82(N/A)
6	3+20.17, 5.00' LT.	77.09'	33.83(N/A)
7	2+86.72, 5.00' LT.	27.00'	32.25(N/A)
8	2+37.04, 5.00' LT.	27.00'	31.40(N/A)
9	1+92.51, 5.00' LT.	27.00'	30.63(N/A)
10	1+43.77, 5.00' LT.	27.00'	29.80(N/A)
41	5+47.68, 5.00' LT.	37.12'	34.48(2.00)
42	4+91.90, 5.00' LT.	37.00'	33.84(2.00)
43	4+26.66, 5.00' LT.	37.00'	32.89(2.00)
44	3+59.37, 5.00' LT.	37.00'	31.35(1.00)
45	2+89.76, 5.00' LT.	37.00'	32.50(N/A)
46	2+17.48, 5.00' LT.	37.00'	31.26(N/A)
47	1+53.74, 5.00' LT.	33.41'	30.17(N/A)

- NOTES
- THE CONTRACTOR SHALL FIELD VERIFY ALL EXISTING UTILITY LOCATIONS AND NOTIFY THE ENGINEER IMMEDIATELY OF ANY DISCREPANCIES.
 - ALL CURB RETURN RADII SHALL BE 25' UNLESS OTHERWISE SPECIFIED.
 - ALL CURVE DATA AND DIMENSIONS REFER TO FACE OF CURB UNLESS OTHERWISE SPECIFIED.
 - GRADE ELEVATIONS, WHERE NOTED, ARE ALONG FLOWLINE OF STANDARD CURB UNLESS OTHERWISE SPECIFIED.
 - CONTRACTOR IS TO INSTALL A 4" X 4" X 5' POST AND EMD AT THE END OF EACH SANITARY SEWER SERVICE.
 - CONTRACTOR IS RESPONSIBLE FOR REPAIR AND/OR REPLACEMENT OF ALL UTILITY CONDUITS AND EXISTING LINES.
 - ANY ADDITIONAL GRADING REQUIRED TO MATCH PROPOSED STREET GRADES SHALL BE INCIDENTAL TO PAVING ITEMS.
 - CONTRACTOR SHALL PROVIDE THE INSPECTORS, (CITY AND PRIVATE) WITH THE PROPOSED HYDROSTATIC TESTING PLAN. THE PLAN MUST BE APPROVED BEFORE TESTING OPERATIONS BEGIN.
 - CONTRACTOR SHALL PARK EQUIPMENT AND VEHICLES AS NOT TO INTERFERE WITH NORMAL ACTIVITIES OF RESIDENTS OR OTHER CONTRACTORS ON SITE.
 - ANY DAMAGE TO THE EXISTING FACILITIES (CURB & GUTTER), PAVEMENT, CONDUITS, LANDSCAPING, UTILITY LINES, ETC.) DURING CONSTRUCTION SHALL BE REPLACED AT THE CONTRACTORS' EXPENSE.
 - REMOVAL OF THE EXISTING CURB AND GUTTER SHALL BE AS PER COA STD. DWG. 2415 (SAWCUT ONLY).
 - WHEELCHAIR RAMP SHALL BE CONSTRUCTED PRIOR TO ACCEPTANCE OF CURB & GUTTER.
 - STATIONING AND OFFSETS GIVEN FOR DROP INLETS ARE GIVEN AT CENTER OF GRATE AT FLOWLINE

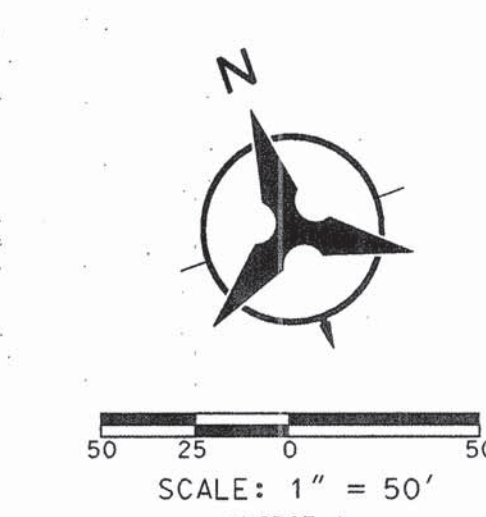

VIA TOMAS

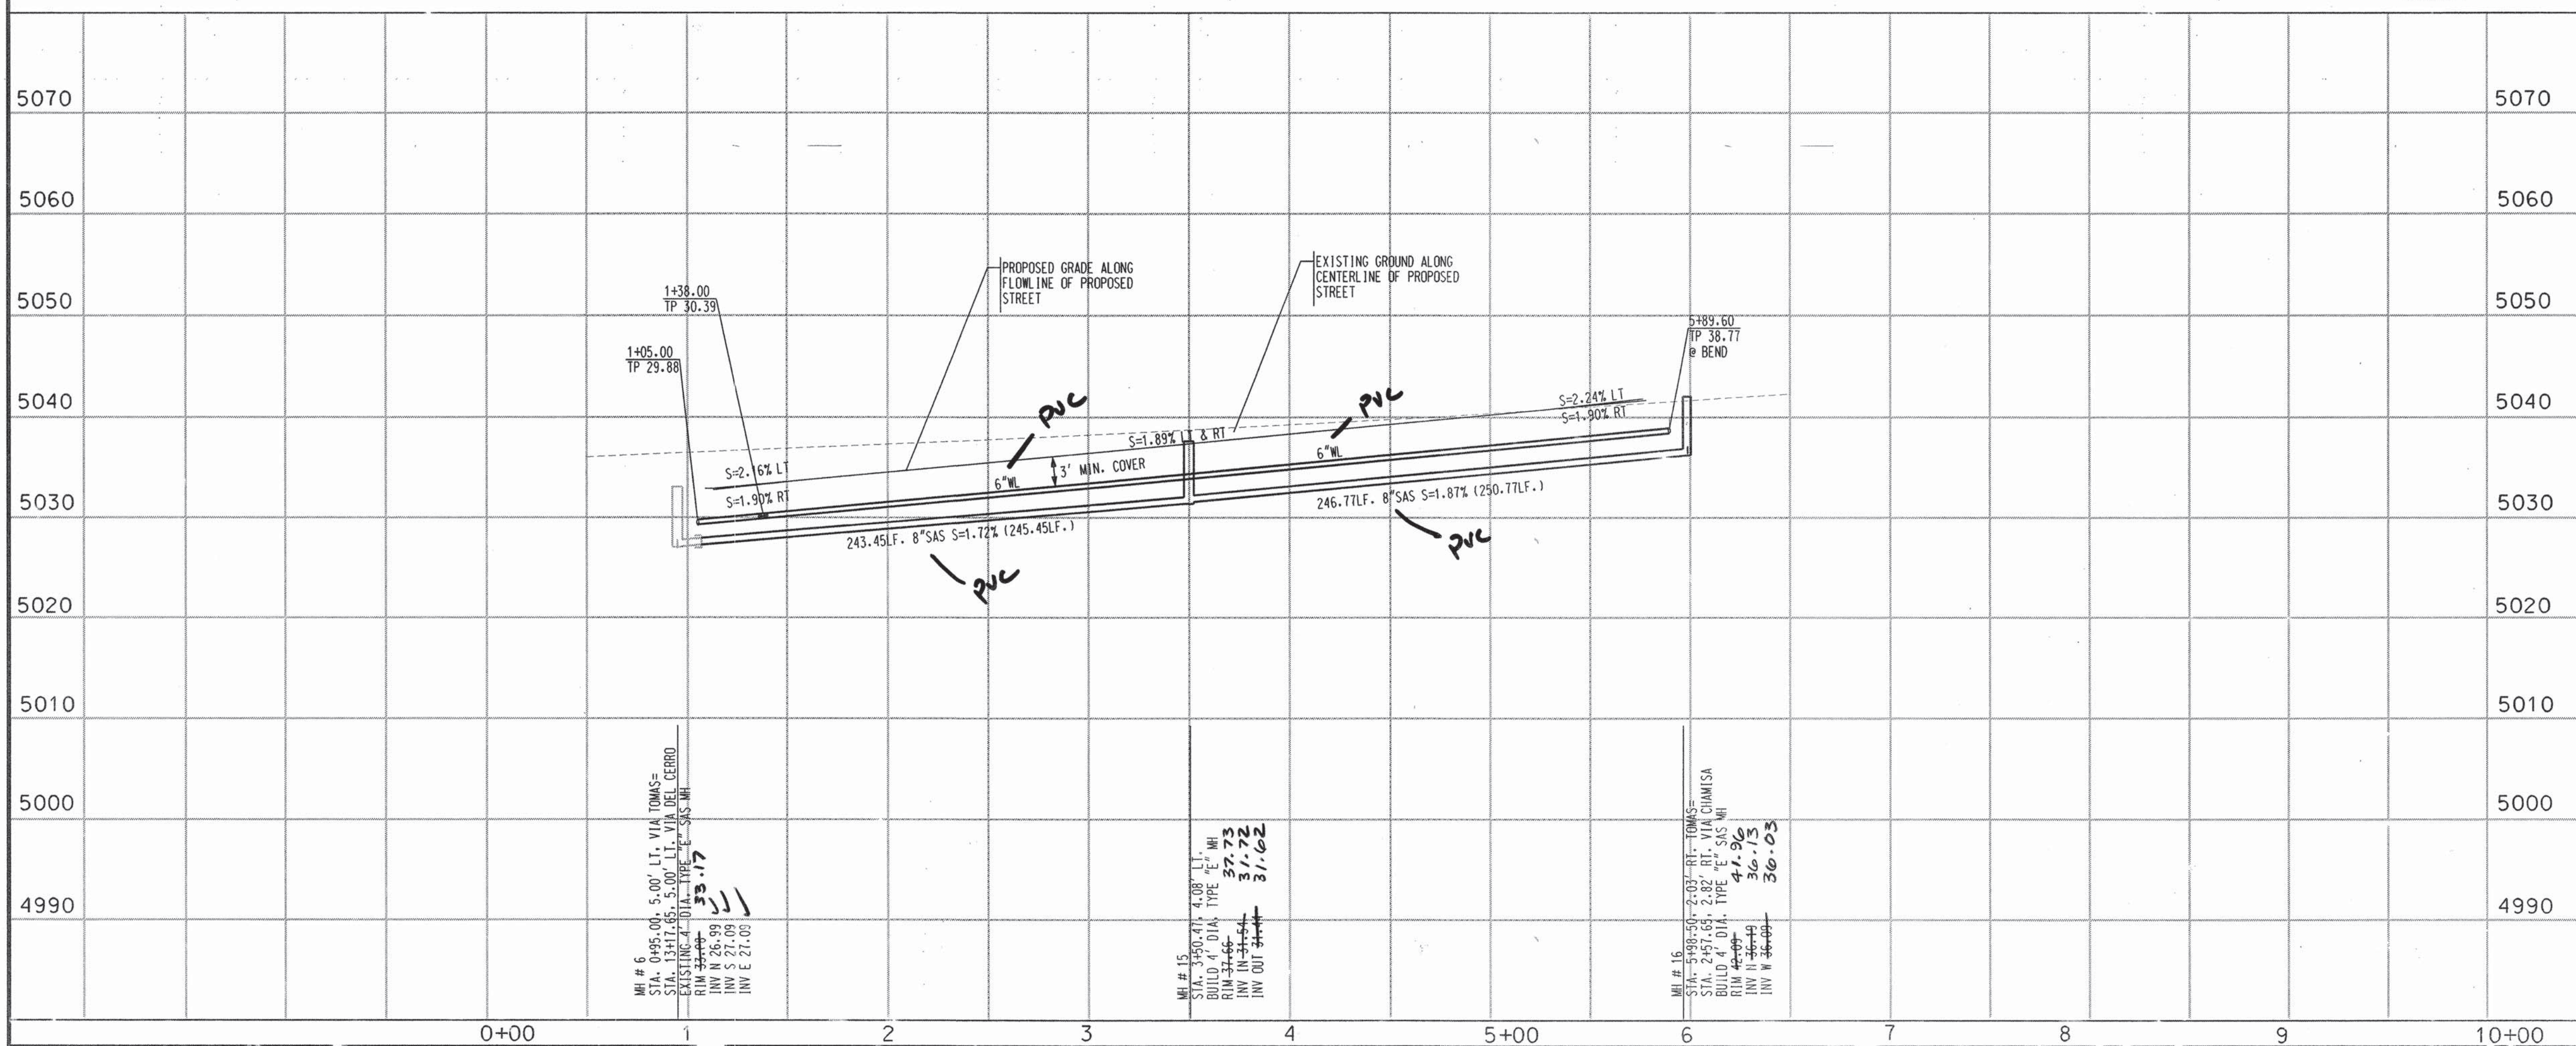

Bohannon & Huston
Courtney One 7500 JEFFERSON NE Albuquerque NEW MEXICO 87109
ENGINEERS PLANNERS PHOTOGRAMMETRISTS SURVEYORS SOFTWARE DEVELOPERS

CITY OF ALBUQUERQUE
PUBLIC WORKS DEPARTMENT
ENGINEERING DEVELOPMENT GROUP
LAS SENDAS DEL NORTE
UTILITY PLAN & PROFILE
VIA TOMAS

DESIGN REVIEW COMMITTEE CITY ENGINEER APPROVAL
APPROVED
CITY ENGINEER


MO./DAY/YR. MO./DAY/YR.
LAST DESIGN UPDATE

CITY PROJECT NO. 6093.81 ZONE MAP NO. D-1/E-10 SHEET 10 OF 14
DATE: APRIL, 1999


ENGINEER'S SEAL SURVEY INFORMATION		BENCH MARKS		AS-BUILT INFORMATION	
NO.	DATE	NO.	DATE	NO.	DATE
1		1		1	
2		2		2	
3		3		3	
100		100		100	

WATERLINE CURVE DATA				
NUMBER	ARC	RADIUS	DELTA	TANGENT
C1	180.96'	995.00'	5°45'30"	90.73'

WATERLINE TANGENT DATA		
NUMBER	BEARING	LENGTH
T1	N06°33'23"W	168.78'
T2	N06°33'23"W	271.80'
T3	N06°33'23"W	81.40'
T4	N51°33'23"W	28.28'
T5	N06°33'23"W	40.54'

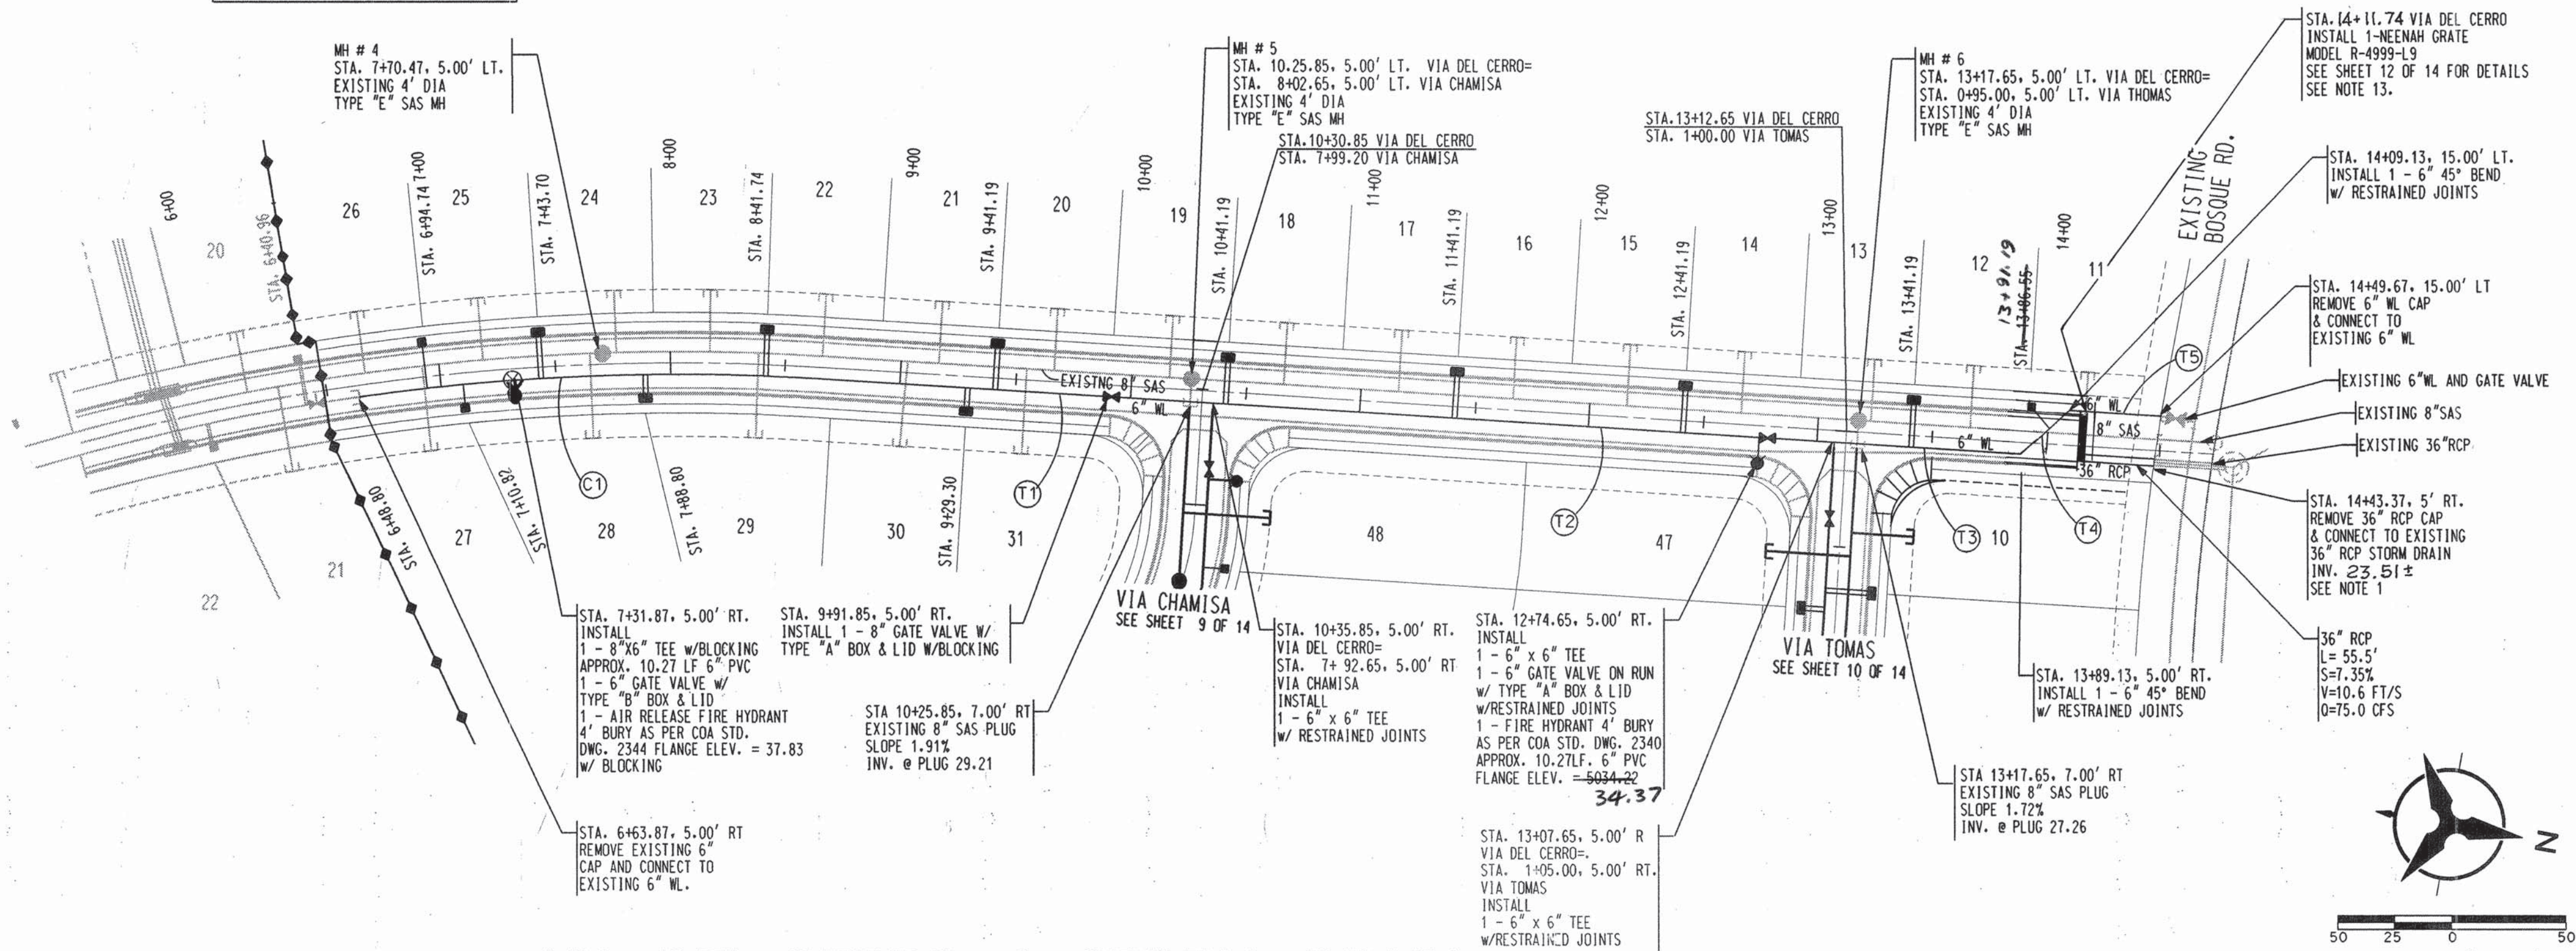

VIA DEL CERRO & STORM DRAIN

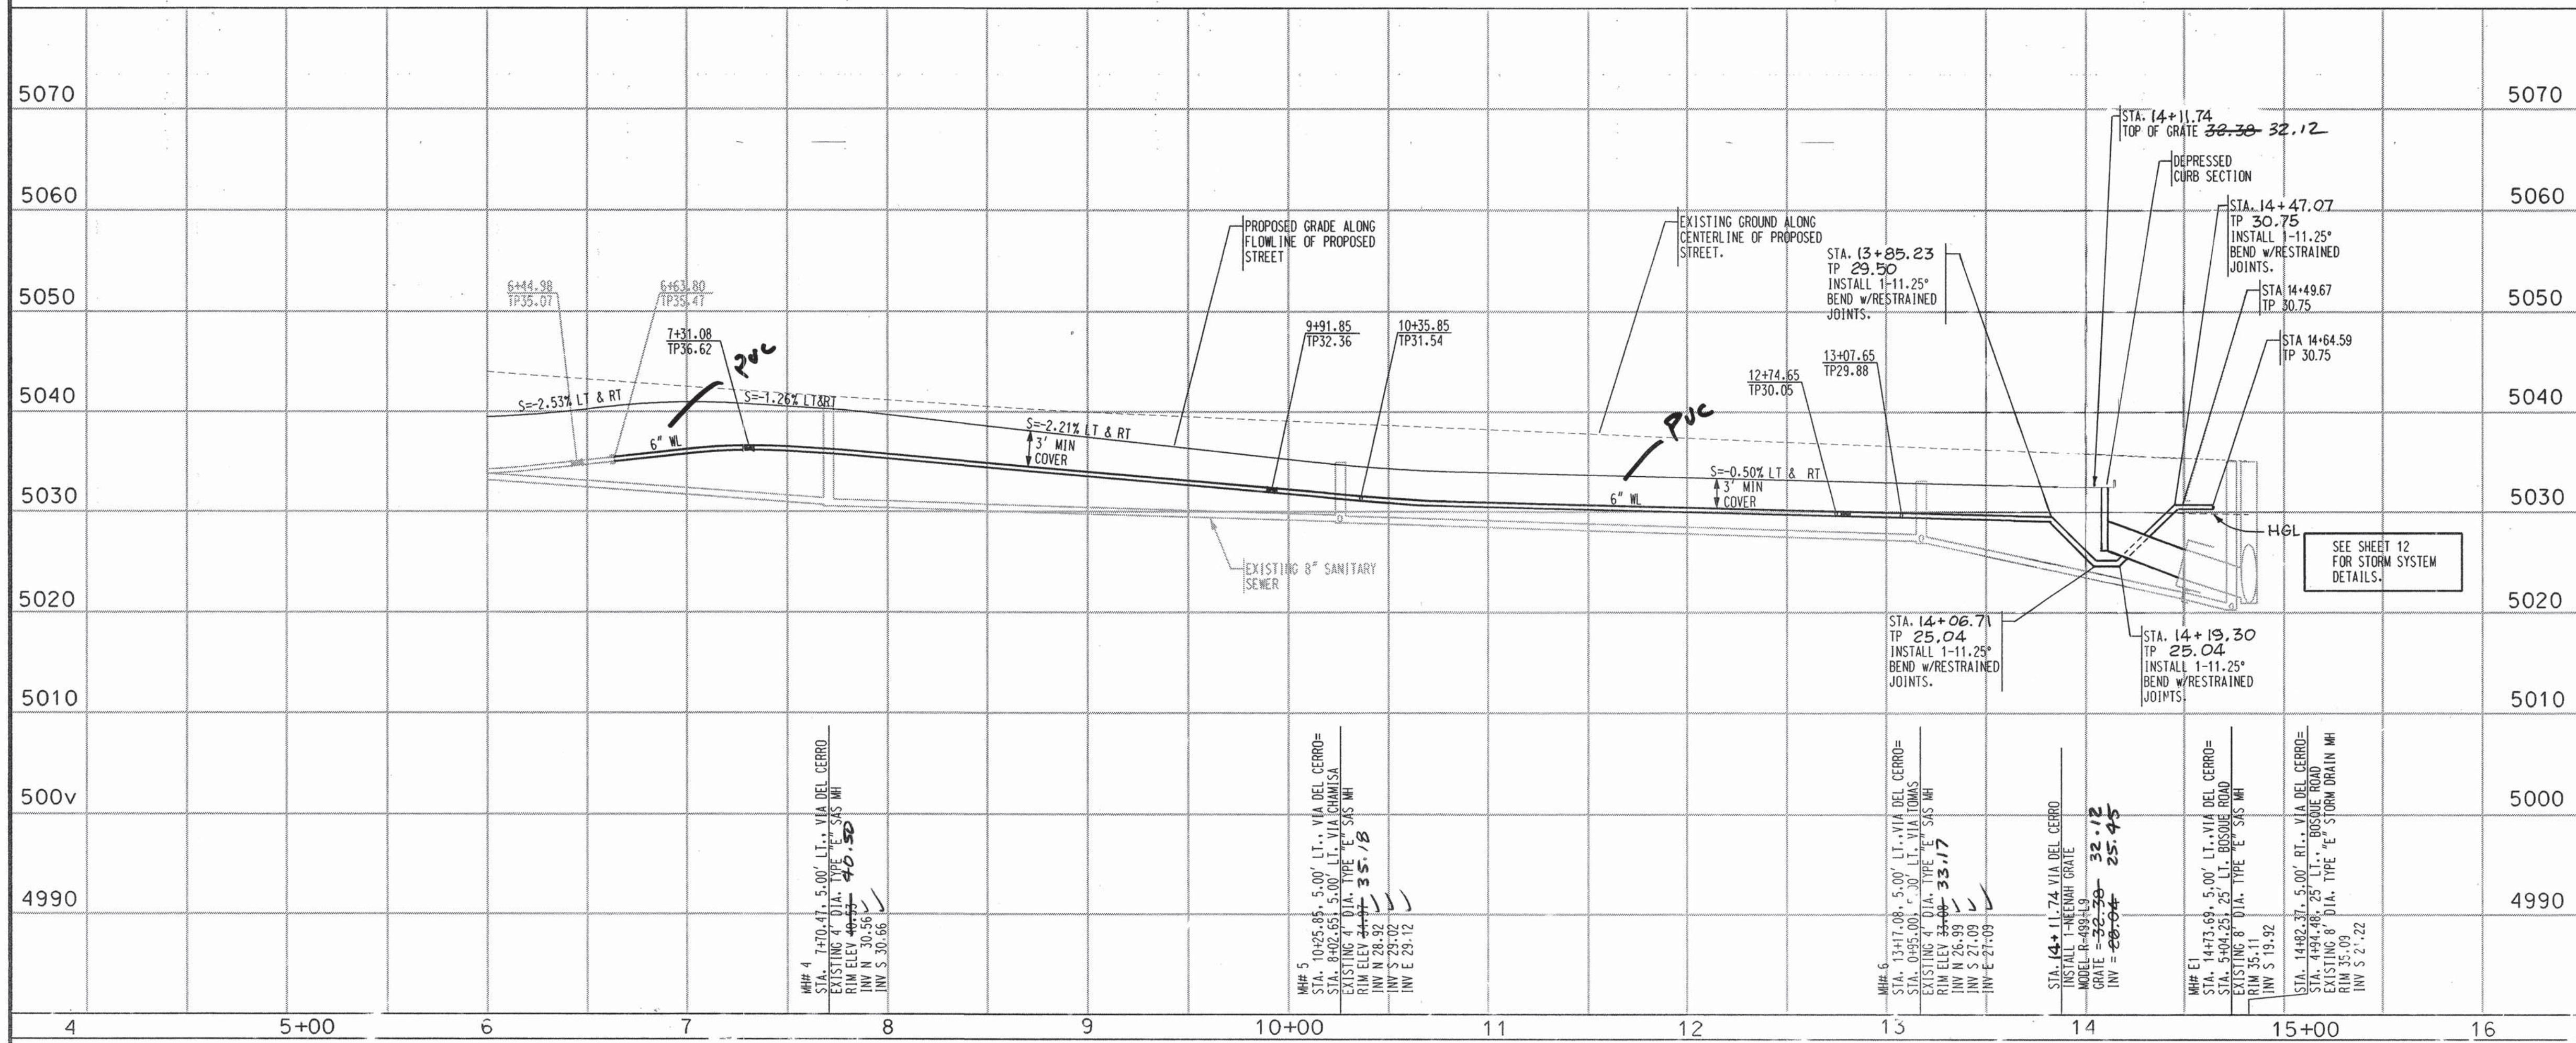

NOTES

1. THE CONTRACTOR SHALL FIELD VERIFY ALL EXISTING UTILITY LOCATIONS AND NOTIFY THE ENGINEER IMMEDIATELY OF ANY DISCREPANCIES.
2. ALL CURB RETURN RADIUS SHALL BE 25' UNLESS OTHERWISE SPECIFIED.
3. ALL CURVE DATA AND DIMENSIONS REFER TO FACE OF CURB UNLESS OTHERWISE SPECIFIED.
4. GRADE ELEVATIONS, WHERE NOTED, ARE ALONG FLOWLINE OF STANDARD CURB UNLESS OTHERWISE SPECIFIED.
5. CONTRACTOR IS TO INSTALL A 4" X 4" X 5' POST AND END AT THE END OF EACH SANITARY SEWER SERVICE.
6. CONTRACTOR IS RESPONSIBLE FOR REPAIR AND/OR REPLACEMENT OF ALL UTILITY CONDUITS AND EXISTING LINES.
7. ANY ADDITIONAL GRADING REQUIRED TO MATCH PROPOSED STREET GRADES SHALL BE INCIDENTAL TO PAVING ITEMS.
8. CONTRACTOR SHALL PROVIDE THE INSPECTORS, (CITY AND PRIVATE) WITH THE PROPOSED HYDROSTATIC TESTING PLAN. THE PLAN MUST BE APPROVED BEFORE TESTING OPERATIONS BEGIN.
9. CONTRACTOR SHALL PARK EQUIPMENT AND VEHICLES AS NOT TO INTERFERE WITH NORMAL ACTIVITIES OF RESIDENTS OR OTHER CONTRACTORS ON SITE.
10. ANY DAMAGE TO THE EXISTING FACILITIES (CURB & GUTTER) PAVEMENT, CONDUITS, LANDSCAPING, UTILITY LINES, ETC.) DURING CONSTRUCTION SHALL BE REPLACED AT THE CONTRACTORS' EXPENSE.
11. REMOVAL OF THE EXISTING CURB AND GUTTER SHALL BE AS PER COA STD. DWG. 2415 (SAWCUT ONLY).
12. WHEELCHAIR RAMPS SHALL BE CONSTRUCTED PRIOR TO ACCEPTANCE OF CURB & GUTTER.
13. STATIONING AND OFFSETS GIVEN FOR DRAIN INLETS ARE GIVEN AT CENTER OF GRATE AT FLOWLINE

EXISTING SANITARY SEWER SERVICES				
LOT NUMBER	SAS	LENGTH	TOP OF PIPE AT	PLUG (W/RISE)
11	14+16.19, 5.00' LT.	27.00'	25.76(2')	
12	13+66.19, 5.00' LT.	27.00'	26.70(-)	
13	13+22.97, 5.00' LT.	27.00'	28.71(-)	
14	12+66.19, 5.00' LT.	27.00'	29.27(-)	
15	12+16.19, 5.00' LT.	27.00'	29.59(-)	
16	11+66.19, 5.00' LT.	27.00'	29.91(-)	
17	11+16.19, 5.00' LT.	27.00'	30.23(-)	
18	10+66.19, 5.00' LT.	27.00'	30.55(-)	
19	10+16.19, 5.00' LT.	27.00'	30.87(-)	
20	9+16.19, 5.00' LT.	27.00'	30.23(-)	
21	9+16.19, 5.00' LT.	27.00'	30.78(-)	
22	8+65.96, 5.00' LT.	27.00'	32.03(1')	
23	8+17.18, 5.00' LT.	27.00'	33.26(2')	
24	7+76.48, 5.00' LT.	27.00'	33.71(2')	
25	7+19.40, 5.00' LT.	27.00'	33.88(1')	
26	6+67.68, 5.00' LT.	27.00'	33.96(-)	
27	6+92.56, 5.00' LT.	37.00'	34.48(1')	
28	7+65.07, 5.00' LT.	37.00'	34.09(2')	
29	8+30.26, 5.00' LT.	37.00'	33.23(2')	
30	9+02.83, 5.00' LT.	37.00'	31.13(-)	
31	9+54.30, 5.00' LT.	37.00'	30.56(-)	

NOTE: WATER METER LOCATIONS ARE DESIGNATED BY STATIONING AT PROPERTY CORNERS.

Bohannon & Huston

Courtyard One 7500 JEFFERSON NE ALBUQUERQUE NEW MEXICO 87109

ENGINEERS PLANNERS PHOTOGRAMMETRISTS SURVEYORS SOFTWARE DEVELOPERS

CITY OF ALBUQUERQUE
PUBLIC WORKS DEPARTMENT
ENGINEERING DEVELOPMENT GROUP

LAS SENDAS DEL NORTE

UTILITY PLAN & PROFILE

VIA DEL CERRO & STORM DRAIN

DESIGN REVIEW COMMITTEE CITY ENGINEER APPROVAL

MO./DAY/YR. MO./DAY/YR.

APPROVED

CITY ENGINEER

LAST DESIGN UPDATE

CITY PROJECT NO. 6093.81

ZONE MAP NO. D-16/E-16


SHEET 11 OF 14

COPYRIGHT BOHANNON & HUSTON 1998

DATE: APRIL 1998


26 6093.81 1101

SCANNED BY
MESA REPRO

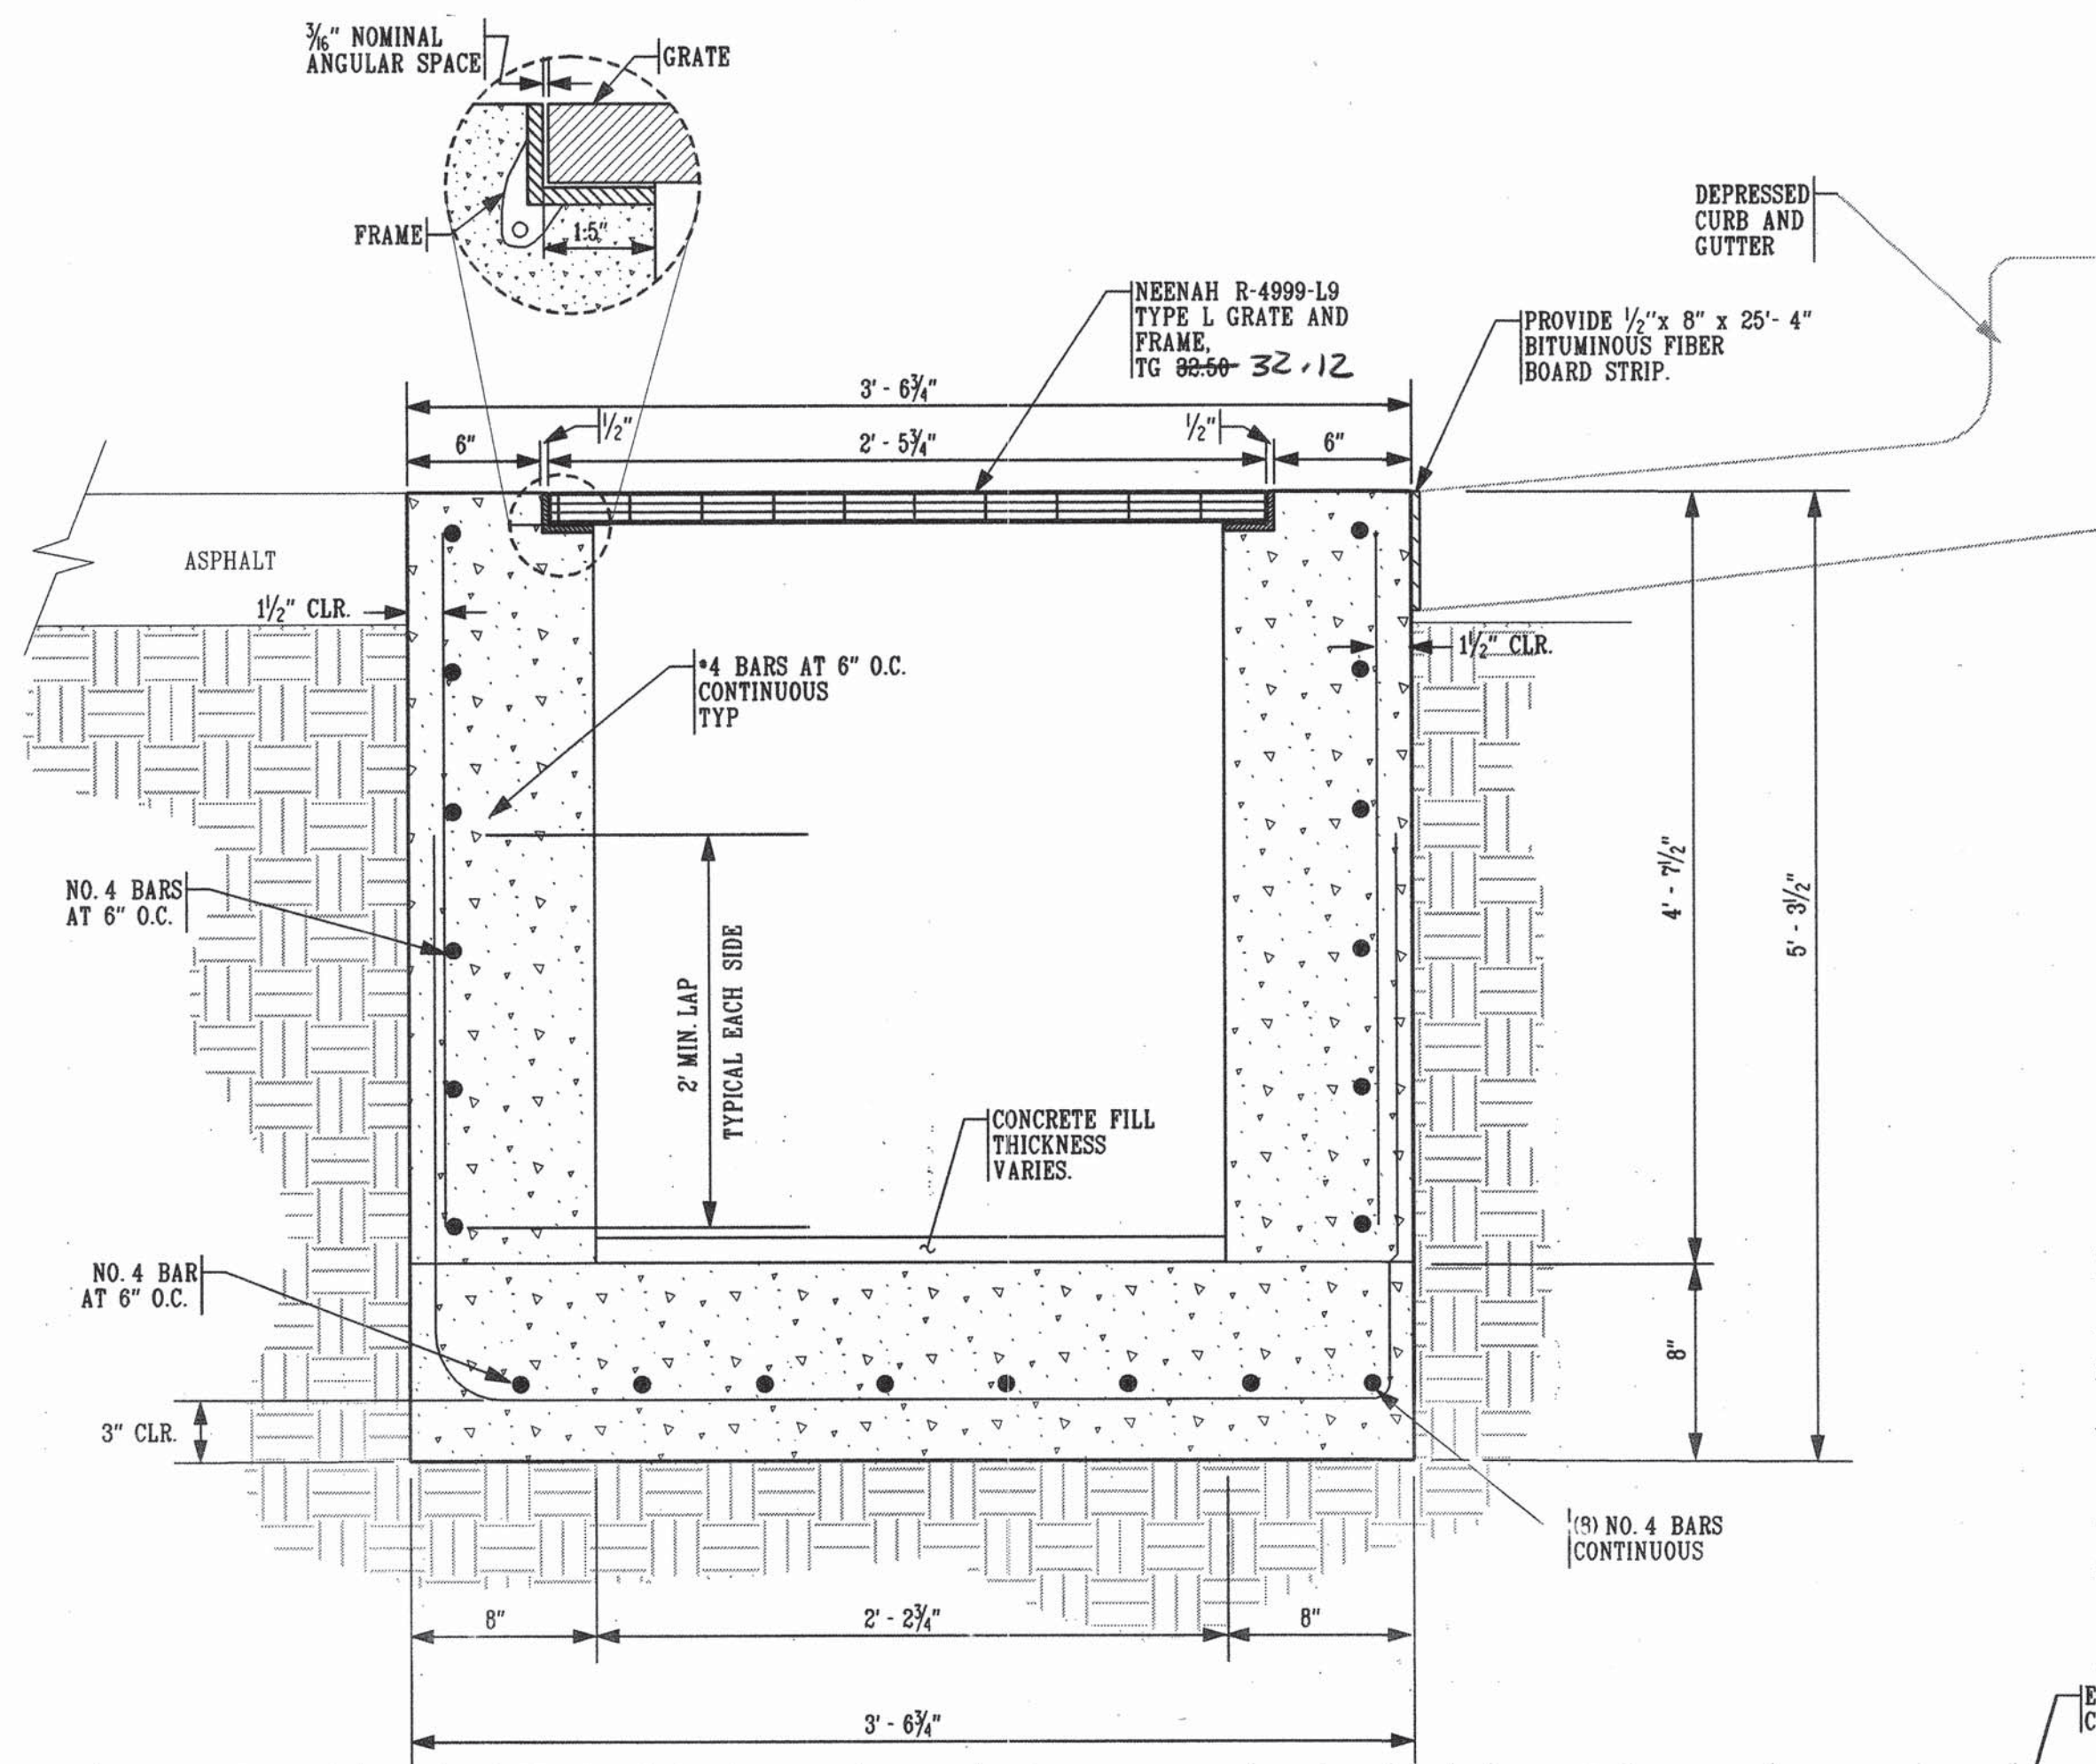


GRATE CROSS SECTION C-C
NOT TO SCALE


PROVIDE 1/2" x 8" x 25' 4"
BITUMINOUS FIBER
BOARD STRIP.

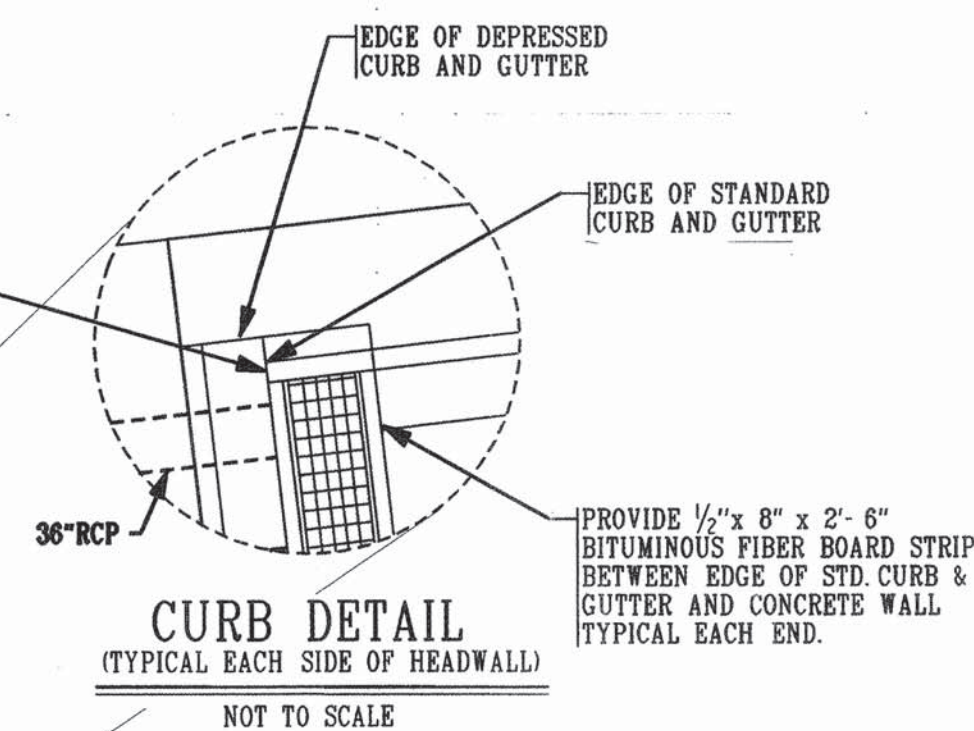


CURB DETAIL
(TYPICAL EACH SIDE OF HEADWALL)
NOT TO SCALE

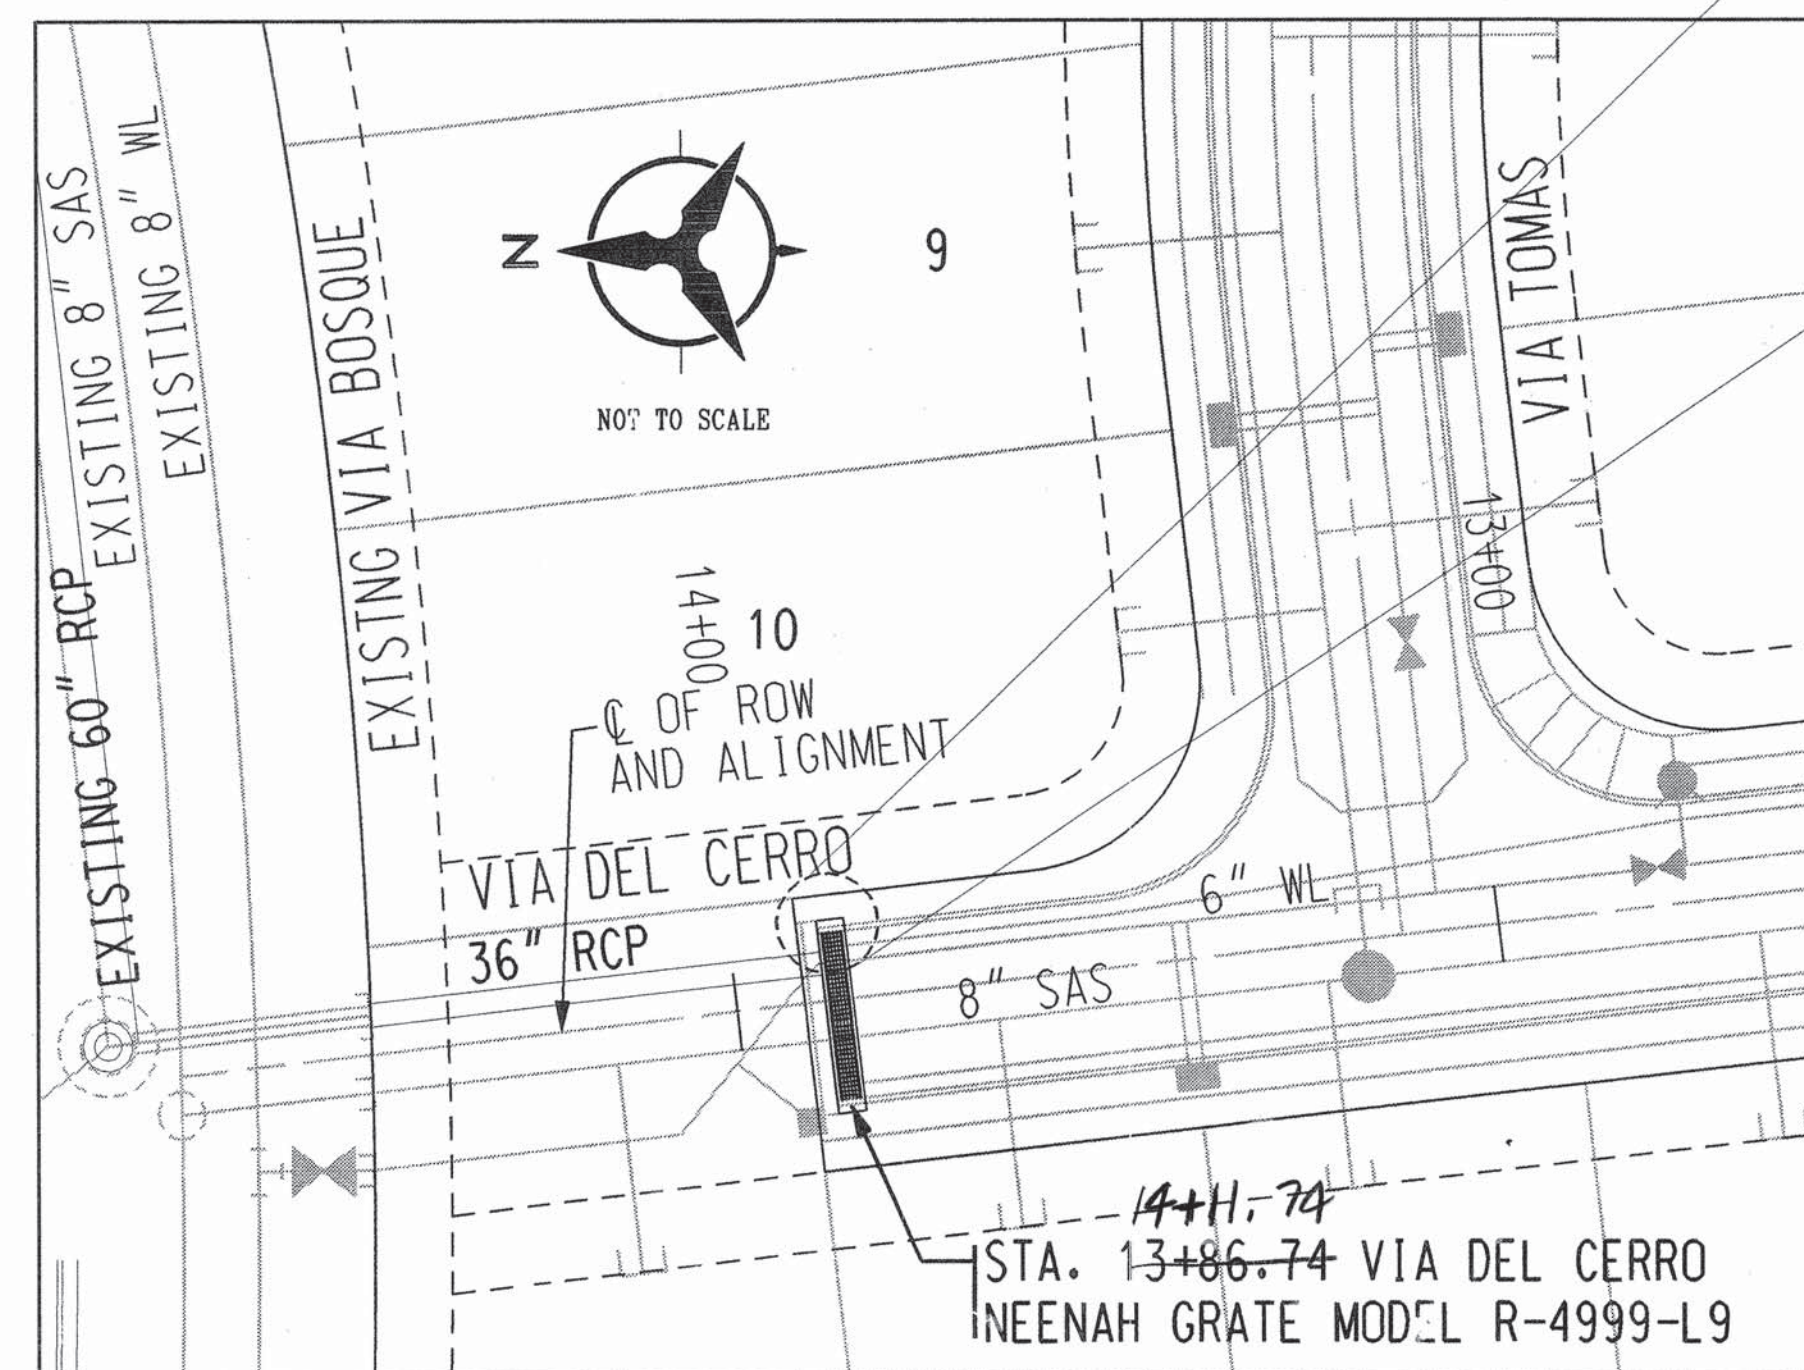


GENERAL LOCATION OF INLET

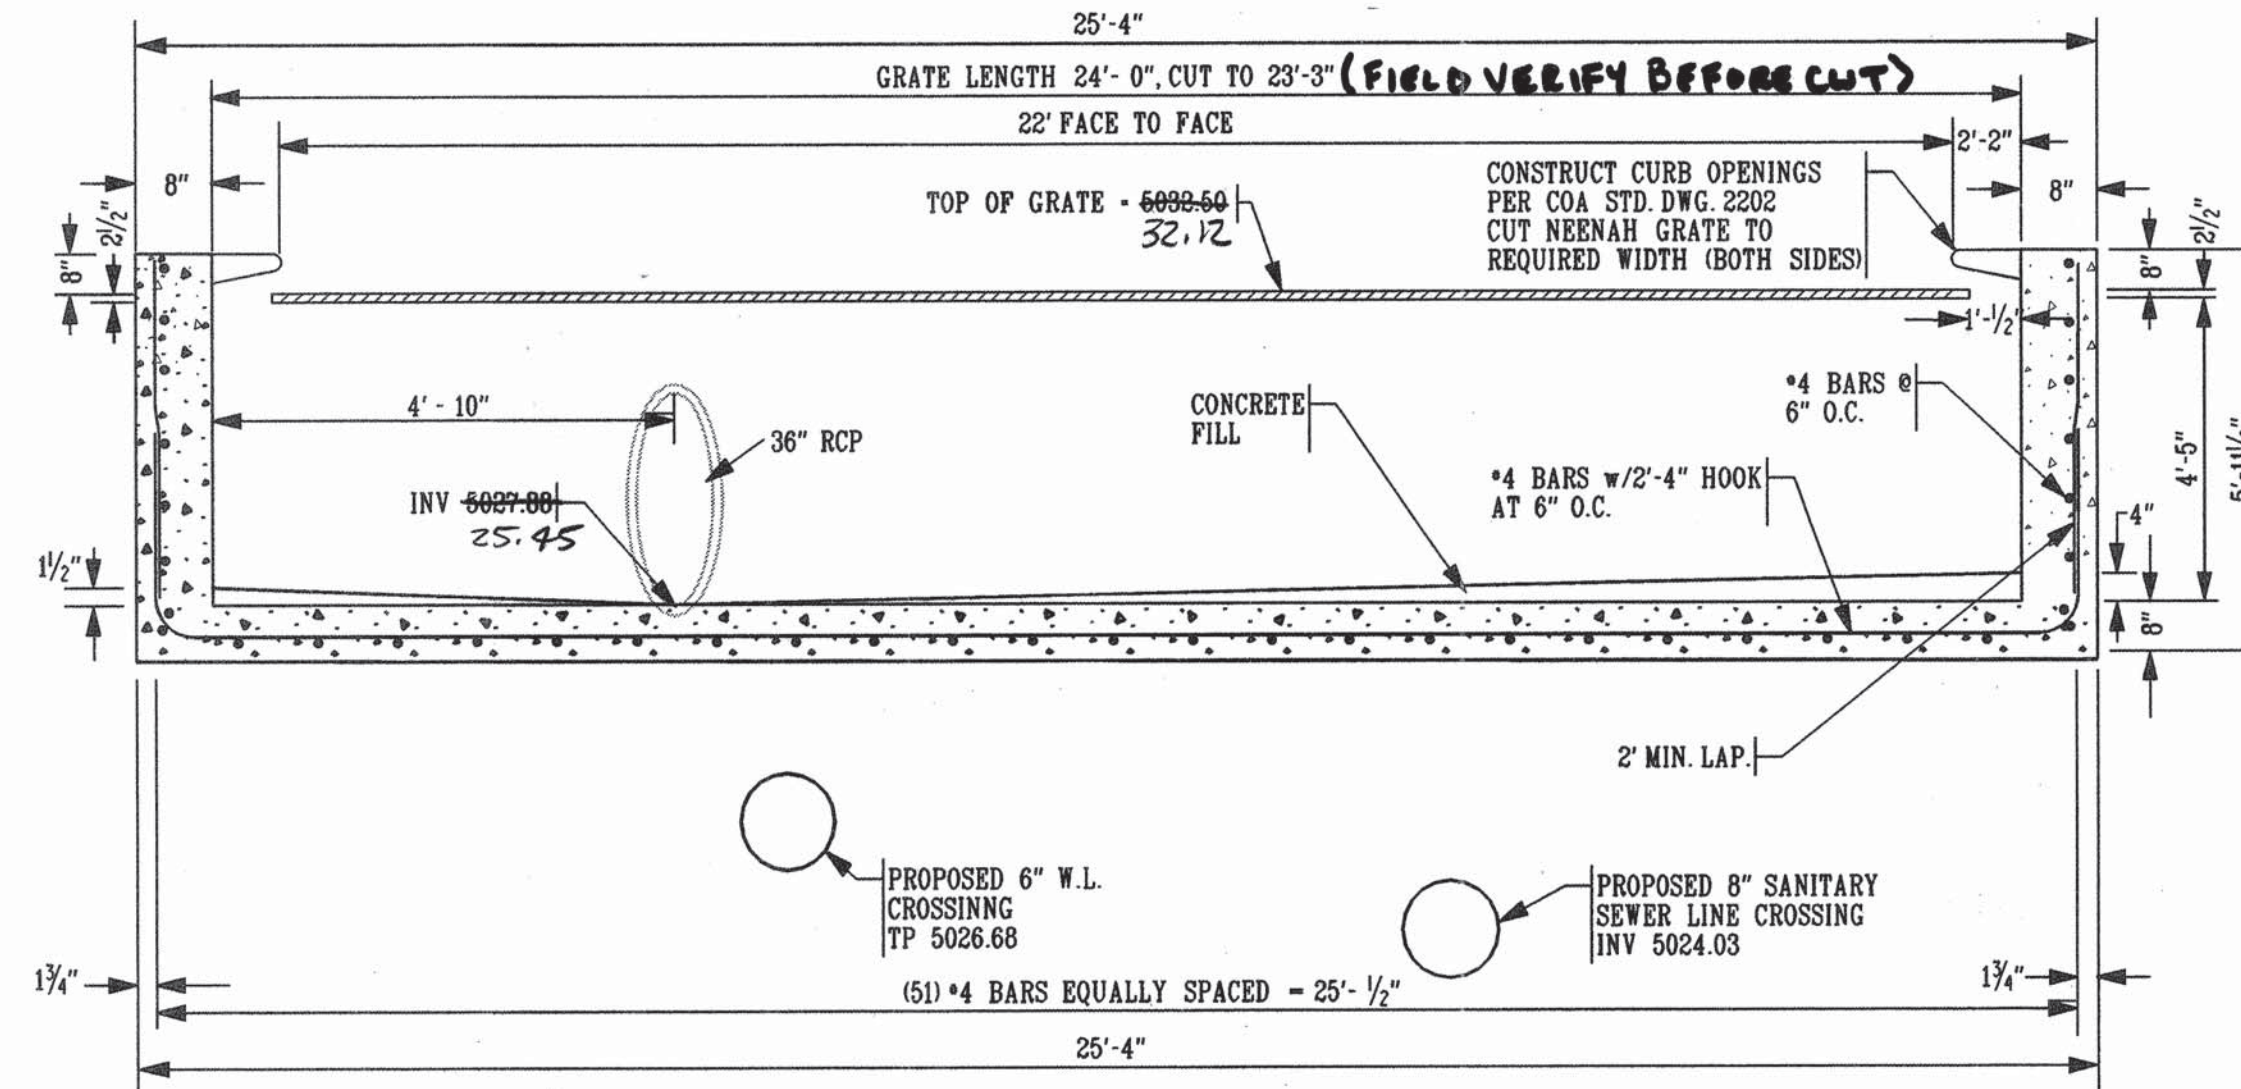


NEENAH R-4999-L9 INLET CROSS SECTION A-A
NOT TO SCALE

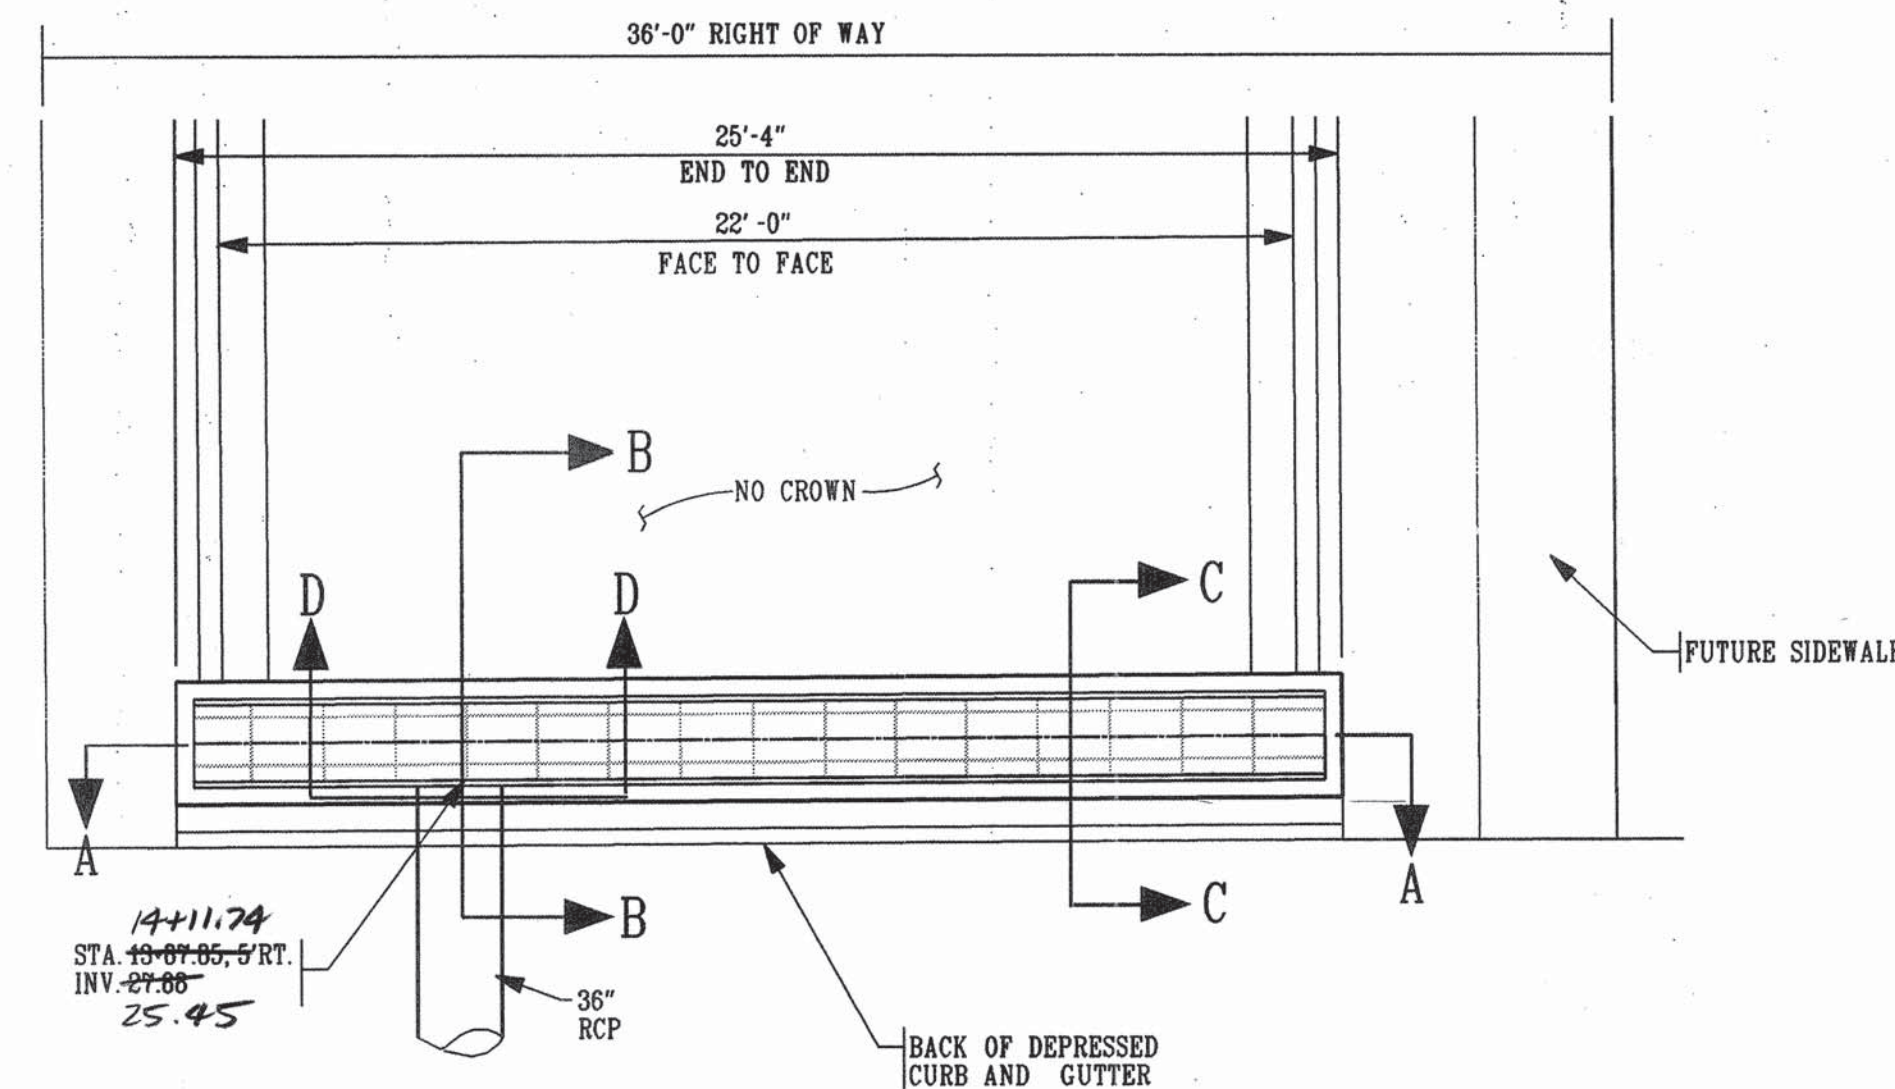

INLET PLAN VIEW
NEENAH R-4999-L9
CATALOG "R", 11TH EDITION
NOT TO SCALE

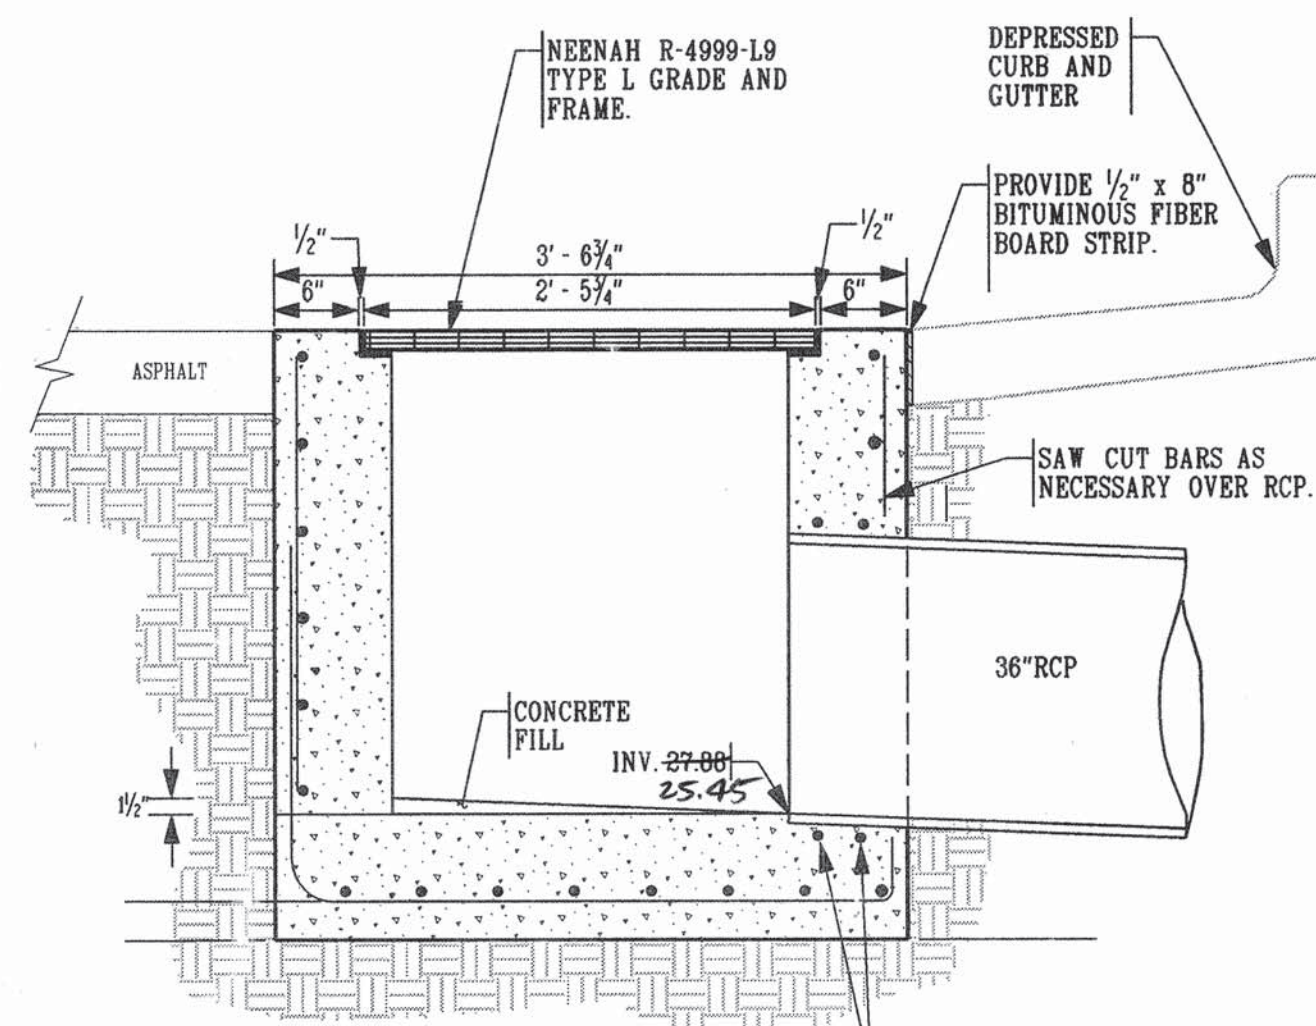

SECTION B-B
NOT TO SCALE

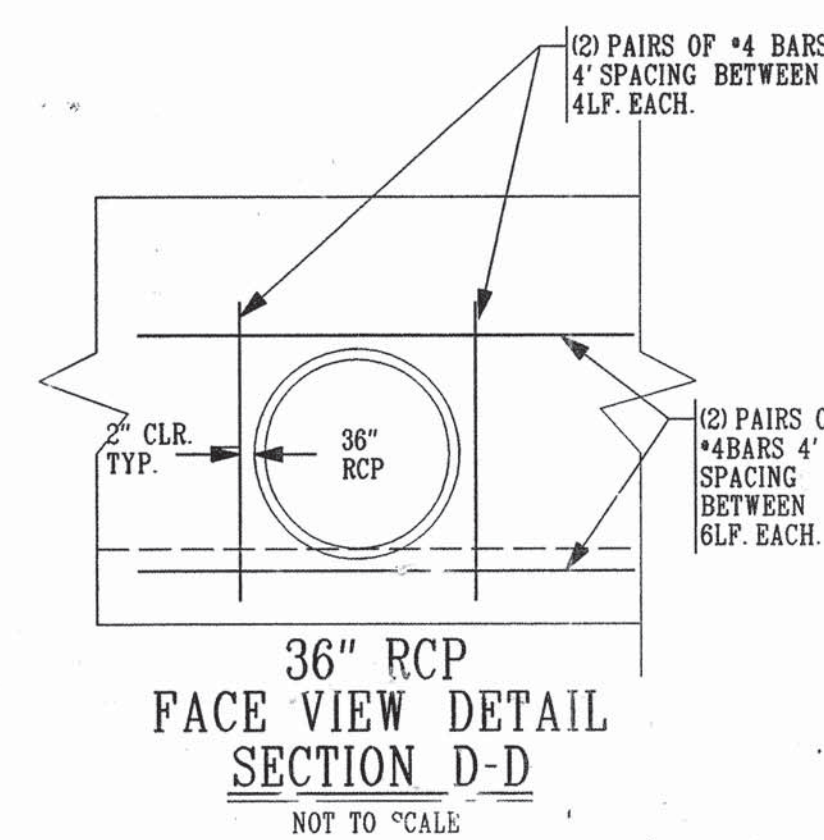

36" RCP
FACE VIEW DETAIL
SECTION D-D
NOT TO SCALE

Bohannon & Huston
Courtney One 7500 JEFFERSON NE Albuquerque NEW MEXICO 87109
ENGINEERS PLANNERS PHOTOGRAMMETRISTS SURVEYORS SOFTWARE DEVELOPERS

CITY OF ALBUQUERQUE
PUBLIC WORKS DEPARTMENT
ENGINEERING DEVELOPMENT GROUP

LAS SENDAS DEL NORTE
STORM DRAIN DETAIL SHEET

DESIGN REVIEW COMMITTEE	CITY ENGINEER APPROVAL	MO./DAY/YR.	MO./DAY/YR.
JUN 17 1999	APPROVED		
CITY PROJECT NO. 609381	ZONE MAP NO. D-16/E-15	SHEET 12	OF 14

CONSTRUCTION TRAFFIC CONTROL GENERAL NOTES

1. CONTRACTOR MUST OBTAIN FROM CONSTRUCTION COORDINATION AN EXCAVATION/BARRICADING PERMIT BEFORE ENGAGING IN ANY CONSTRUCTION, MAINTENANCE OR REPAIR WORK IN ANY OF THE CITY OF ALBUQUERQUE'S RIGHTS-OF-WAY. EMERGENCY WORK THAT WOULD PRESERVE LIFE OR PROPERTY IS EXCLUDED WITH THE UNDERSTANDING, THAT A PERMIT SHALL BE OBTAINED WITHIN 24 TO 48 HOURS.

2. CONTRACTOR SHALL AT THE TIME OF PERMIT REQUEST, SUBMIT FOR APPROVAL BY CONSTRUCTION COORDINATION, A TRAFFIC CONTROL PLAN DETAILING ALL EXISTING TOPOGRAPHY SUCH AS LANE WIDTHS, DRIVEWAYS, AND BUSINESS/RESIDENTIAL ACCESSES. THE TRAFFIC CONTROL PLAN SHALL INCLUDE ALL PHASES OF WORK AND SCHEDULES INVOLVED IN THE CONSTRUCTION PROJECT. ANY SEPARATE PHASES OF A CONSTRUCTION PROJECT SHALL BE GIVEN AN INDIVIDUAL PERMIT EACH. BLANKET PERMITS WILL NOT BE ISSUED.

3. THESE TYPICAL TRAFFIC CONTROL PLANS DO NOT REFLECT THE EXISTING TOPOGRAPHY SUCH AS DRIVEWAYS, LANE WIDTHS, AND BUSINESS/RESIDENTIAL ACCESSES. EVERY LOCATION THAT REQUIRES CONSTRUCTION TRAFFIC CONTROL SHALL HAVE A DETAILED TRAFFIC CONTROL PLAN SHOWING ALL EXISTING TOPOGRAPHY.

4. CONSTRUCTION SHALL NOT BEGIN UNLESS A TRAFFIC CONTROL PLAN HAS BEEN APPROVED AND VERIFIED BY CONSTRUCTION COORDINATION.

5. CONSTRUCTION COORDINATION SHALL BE NOTIFIED 48 HOURS PRIOR TO ANY TRAFFIC CONTROL CHANGES NEEDED BY CONTRACTOR, THAT WERE NOT PREVIOUSLY APPROVED. THESE TRAFFIC CONTROL CHANGES SHALL BE REQUESTED IN WRITING ACCOMPANIED WITH A TRAFFIC CONTROL PLAN REFLECTING SUCH CHANGES.

6. ALL CONSTRUCTION TRAFFIC CONTROL DEVICES SHALL COMPLY TO THE MANUAL ON UNIFORM TRAFFIC CONTROL DEVICES (MUTCD), LATEST EDITION. IT IS THE RESPONSIBILITY OF THE CONTRACTOR TO INSTALL, SERVICE AND MAINTAIN ALL TRAFFIC CONTROL DEVICES. TRAFFIC CONTROL DEVICES SHALL NOT BE REMOVED OR ALTERED IN ANY WAY WITHOUT THE APPROVAL OF CONSTRUCTION COORDINATION, PER SECTION 6A-4 OF THE MUTCD, LATEST EDITION.

7. THE CONSTRUCTION TRAFFIC CONTROL INITIAL SET-UP SHALL BE BY AN AMERICAN TRAFFIC SAFETY SERVICES ASSOCIATION (ATSSA) CERTIFIED WORKSITE TRAFFIC SUPERVISOR. THE MAINTENANCE AND SERVICING SHALL ALSO BE DONE BY AN ATSSA CERTIFIED WORKSITE TRAFFIC SUPERVISOR OR EQUIVALENT.

8. CONTRACTOR IS RESPONSIBLE TO MAINTAIN AND SERVICE ALL TRAFFIC CONTROL DEVICES 24 HOURS A DAY, 7 DAYS A WEEK THROUGHOUT LENGTH OF PROJECT. CONTRACTOR IS RESPONSIBLE THAT ALL TRAFFIC CONTROL DEVICES COMPLY WITH THE MUTCD, LATEST EDITION.

9. ALL ADVANCE WARNING SIGNS SHALL BE DOUBLE INDICATED WHENEVER THERE ARE MULTI-LANE TRAFFIC IN ANY ONE GIVEN DIRECTION AND THERE IS SUFFICIENT MEDIAN SPACE.

10. ALL BARRICADES IN ALL TAPERS AND TANGENTS SHALL BE PLACED APART, A DISTANCE MEASURED IN FEET, EQUAL TO THAT OF THE POSTED SPEED LIMIT. NO EXCEPTIONS UNLESS APPROVED BY CONSTRUCTION COORDINATION PER MUTCD SECTION 6A-4.

11. ALL WORK IN ARTERIAL ROADWAYS SHALL BE ON A CONTINUOUS 24-HOUR PER DAY BASIS UNTIL COMPLETED.

12. CONTRACTOR IS RESPONSIBLE TO PROVIDE CONSTRUCTION COORDINATION, A WEEKLY LOG OF DAILY INSPECTIONS OF BARRICADE AND MAINTENANCE SCHEDULES ON PROJECTS THAT ARE OVER ONE WEEK DURATION.

13. EQUIPMENT OR MATERIALS SHALL NOT BE STORED WITHIN 15 FEET OF A TRAVELLED TRAFFIC LANE DURING NON-WORKING HOURS WITHOUT THE APPROVAL OF CONSTRUCTION COORDINATION.

14. CONTRACTOR SHALL PROVIDE AND MAINTAIN A SAFE AND ADEQUATE MEANS OF CHANNELIZING PEDESTRIAN TRAFFIC AROUND AND THROUGH THE CONSTRUCTION AREA.

15. CONTRACTOR IS RESPONSIBLE FOR OBLITERATION OF ANY CONFLICTING STRIPING AND RESPONSIBLE FOR ALL TEMPORARY STRIPING.

16. CONTRACTOR SHALL MAINTAIN ACCESS TO ALL FACILITIES, BUSINESSES AND/OR RESIDENTS AT ALL TIMES.

17. CONTRACTOR SHALL PROVIDE ACCESS SIGNS FOR BUSINESSES LOCATED WITHIN THE CONSTRUCTION AREA UNDER THE SUPERVISION OF CONSTRUCTION COORDINATION. EACH ACCESS SIGN SHALL HAVE 5 INCH, WHITE OPAQUE LETTERING ON BLUE REFLECTORIZED BACKGROUND. ACCESS SIGNS SHALL BE CONSIDERED INCIDENTAL TO THE BID AND NOT PART OF THE CONTRACT UNLESS OTHERWISE STATED. NO MORE THAN 3 BUSINESSES SHALL BE LISTED ON A ACCESS SIGN. SHOPPING CENTERS AND MALLS SHALL BE LISTED AS SUCH.

18. ALL ADVANCE WARNING SIGNS SHALL MEET THE MINIMUM REFLECTIVE INTENSITY REQUIREMENTS SET FORTH BY THE CITY OF ALBUQUERQUE. CONSTRUCTION COORDINATION SHALL DETERMINE ALL REQUIREMENTS AND APPROVE OR DISAPPROVE ANY ADVANCE WARNING SIGN PER SECTION 6A-4 OF THE MUTCD, LATEST EDITION.

19. 48 HOURS PRIOR TO OCCUPYING OR CLOSING OF A RIGHT-OF-WAY, CONTRACTOR SHALL NOTIFY: POLICE, FIRE DEPARTMENT, SCHOOLS, HOSPITALS, TRANSIT AUTHORITY, BUSINESSES AND/OR RESIDENTS THAT WILL BE AFFECTED BY THE CONSTRUCTION.

20. ANY FIELD ADJUSTMENTS SHALL BE APPROVED BY CONSTRUCTION COORDINATION.

21. EXCAVATIONS SHALL BE PLATED, TEMPORARILY PATCHED OR RESURFACED PRIOR TO OPENING OF TRAFFIC. A MINIMUM OF 11 FEET SHALL BE PROVIDED FOR TRAFFIC IN ANY GIVEN DIRECTION. CONTRACTOR IS RESPONSIBLE FOR ANY WORK INVOLVED IN SATISFYING THESE REQUIREMENTS.

22. CONTRACTOR SHALL AT ALL TIMES COMPLY WITH THE FOLLOWING:

1. STANDARDS AND REQUIREMENTS SET FORTH IN THE MANUAL ON UNIFORM TRAFFIC CONTROL DEVICES, LATEST EDITION.
2. THE CITY OF ALBUQUERQUE TRAFFIC CODE, LATEST EDITION.
3. SECTION 19 OF THE CITY OF ALBUQUERQUE'S STANDARD SPECIFICATIONS FOR PUBLIC WORK CONSTRUCTION, AS WELL AS OTHER SECTIONS.


23. FAILURE TO COMPLY WITH ANY OF THE ABOVE MENTIONED, WILL BE ADEQUATE CAUSE TO CEASE ALL WORK ON ANY CONSTRUCTION PROJECT. WORK WILL NOT RESUME UNTIL ALL REQUIREMENTS ARE ADDRESSED AND APPROVED BY CONSTRUCTION COORDINATION.

24. ALL TRAFFIC CONTROL DEVICES SHALL BE KEPT IN NEW-CLEAN CONDITION. WASHING OF EQUIPMENT IS INCIDENTAL TO ITS PLACEMENT AND MAINTENANCE.


25. TRAFFIC CONTROL STANDARDS APPLY ONLY WHERE THE CONSTRUCTION TRAFFIC CONTROL PLANS ARE NOT SPECIFIC.

26. ADVANCE WARNING SIGNS SHALL BE 36"x36" MIN. WITH SUPER ENGINEERING GRADE SHEETING OR BETTER. MOUNTING HEIGHT AT TOP OF SIGN SHALL BE THE SAME AS FOR A 48" SIGN AS INDICATED IN THE M.U.T.C.D.


27. CONTRACTOR SHALL MAINTAIN A GRAFFITI-FREE WORKSITE. ALL GRAFFITI SHALL BE PROMPTLY REMOVED FROM ALL EQUIPMENT, BOTH PERMANENT AND TEMPORARY.

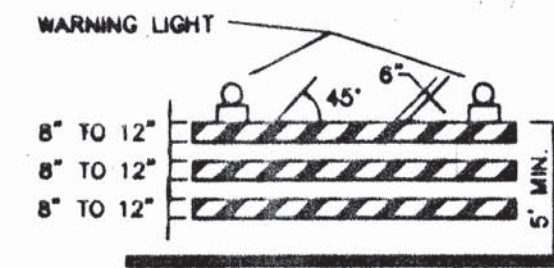


TYPE III BARRICADE

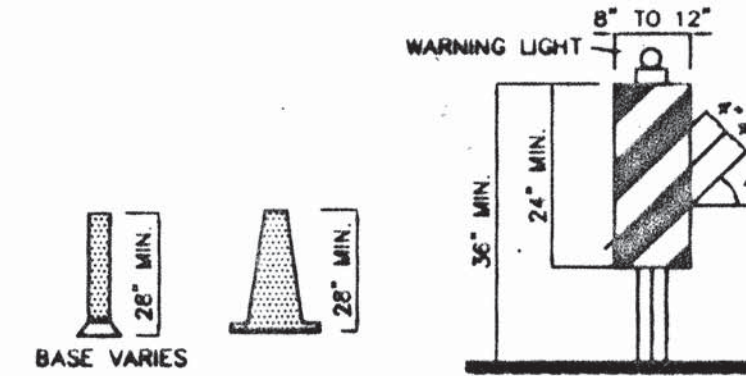


VERTICAL PANEL

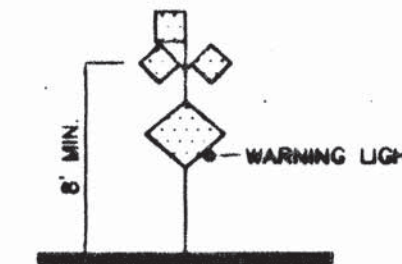


HIGH LEVEL WARNING DEVICE

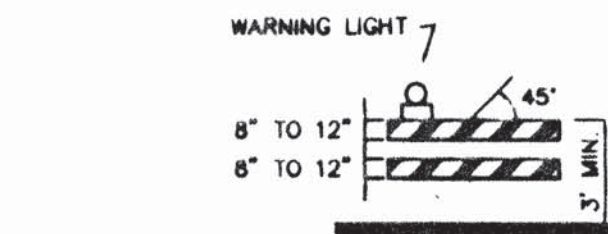


TYPE II BARRICADE

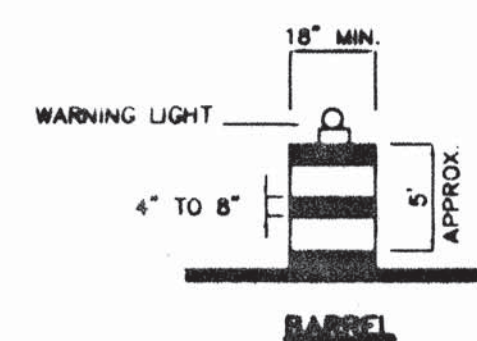

BARREL

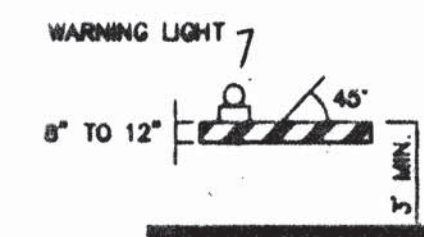

TYPE I BARRICADE

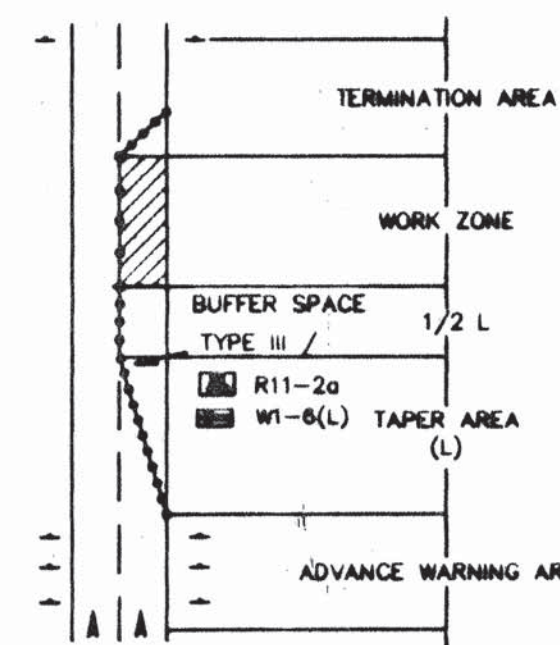

TRAFFIC CONTROL ELEMENTS

LEGEND

- WORK AREA
- BARRICADE - TYPE I, TYPE II, OR BARREL
- BARRICADE - TYPE III
- VERTICAL PANEL
- WARNING SIGN
- DISTANCE BETWEEN SIGNS - A DISTANCE MEASURED IN FEET EQUAL TO A VALUE OF TEN TIMES THE SPEED LIMIT OF THE STREET
- FLAGMAN POSITION
- SPACING BETWEEN BARRICADES - A DISTANCE MEASURED IN FEET EQUAL TO THE SPEED LIMIT OF THE STREET
- TAPER LENGTH - SEE CHART BELOW
- THE TANGENT LENGTH IS EQUAL TO THE TAPER LENGTH FOR A GIVEN STREET.

TAPER REQUIREMENTS

SPEED LIMIT (MPH)	TAPER LENGTH (L) (FEET)			MINIMUM NUMBER OF DEVICES FOR TAPER	MAXIMUM DEVICE SPACING IN FEET	
	10' LANE	11' LANE	12' LANE		ALONG TAPER	AFTER TAPER
20	70	75	80	5	20	20
25	105	115	125	6	25	25
30	150	165	180	7	30	30
35	205	225	245	8	35	35
40	270	295	320	9	40	40
45	450	495	540	13	45	45
50	500	550	600	13	50	50
55	550	605	660	13	55	55

RECOMMENDED SIGN SPACING(D) FOR ADVANCE WARNING SIGN SERIES

SPEED (MIL'S PER HOUR)	MINIMUM DISTANCE IN FEET	
	BETWEEN SIGNS	FROM LAST SIGN TO TAPER
0-20	10 X SPEED LIMIT	10 X SPEED LIMIT
25-30	10 X SPEED LIMIT	10 X SPEED LIMIT
30-35	10 X SPEED LIMIT	10 X SPEED LIMIT
40-45	10 X SPEED LIMIT	10 X SPEED LIMIT
50-60	10 X SPEED LIMIT	10 X SPEED LIMIT

TAPER CRITERIA


TYPE OF TAPER	TAPER LENGTH
UPSTREAM TAPER:	
MERGING TAPER	L MINIMUM
SHIFTING TAPER	1/2 L MINIMUM
SHOULDER TAPER	1/2 L MINIMUM
TWO-WAY TRAFFIC TAPER	100 FEET MAXIMUM
DOWNSTREAM TAPERS	100 FEET PER LANE

TAPER LENGTH COMPUTATION


SPEED LIMIT	L
40 MPH OR LESS	$L = \frac{W^2}{60}$
45 MPH OR GREATER	$L = W \times S$

L = TAPER LENGTH
W = WIDTH OF OFFSET IN FEET
S = POSTED SPEED OR OFF-PEAK 85-PERCENTILE SPEED IN MPH

SIGN FACE DETAILS

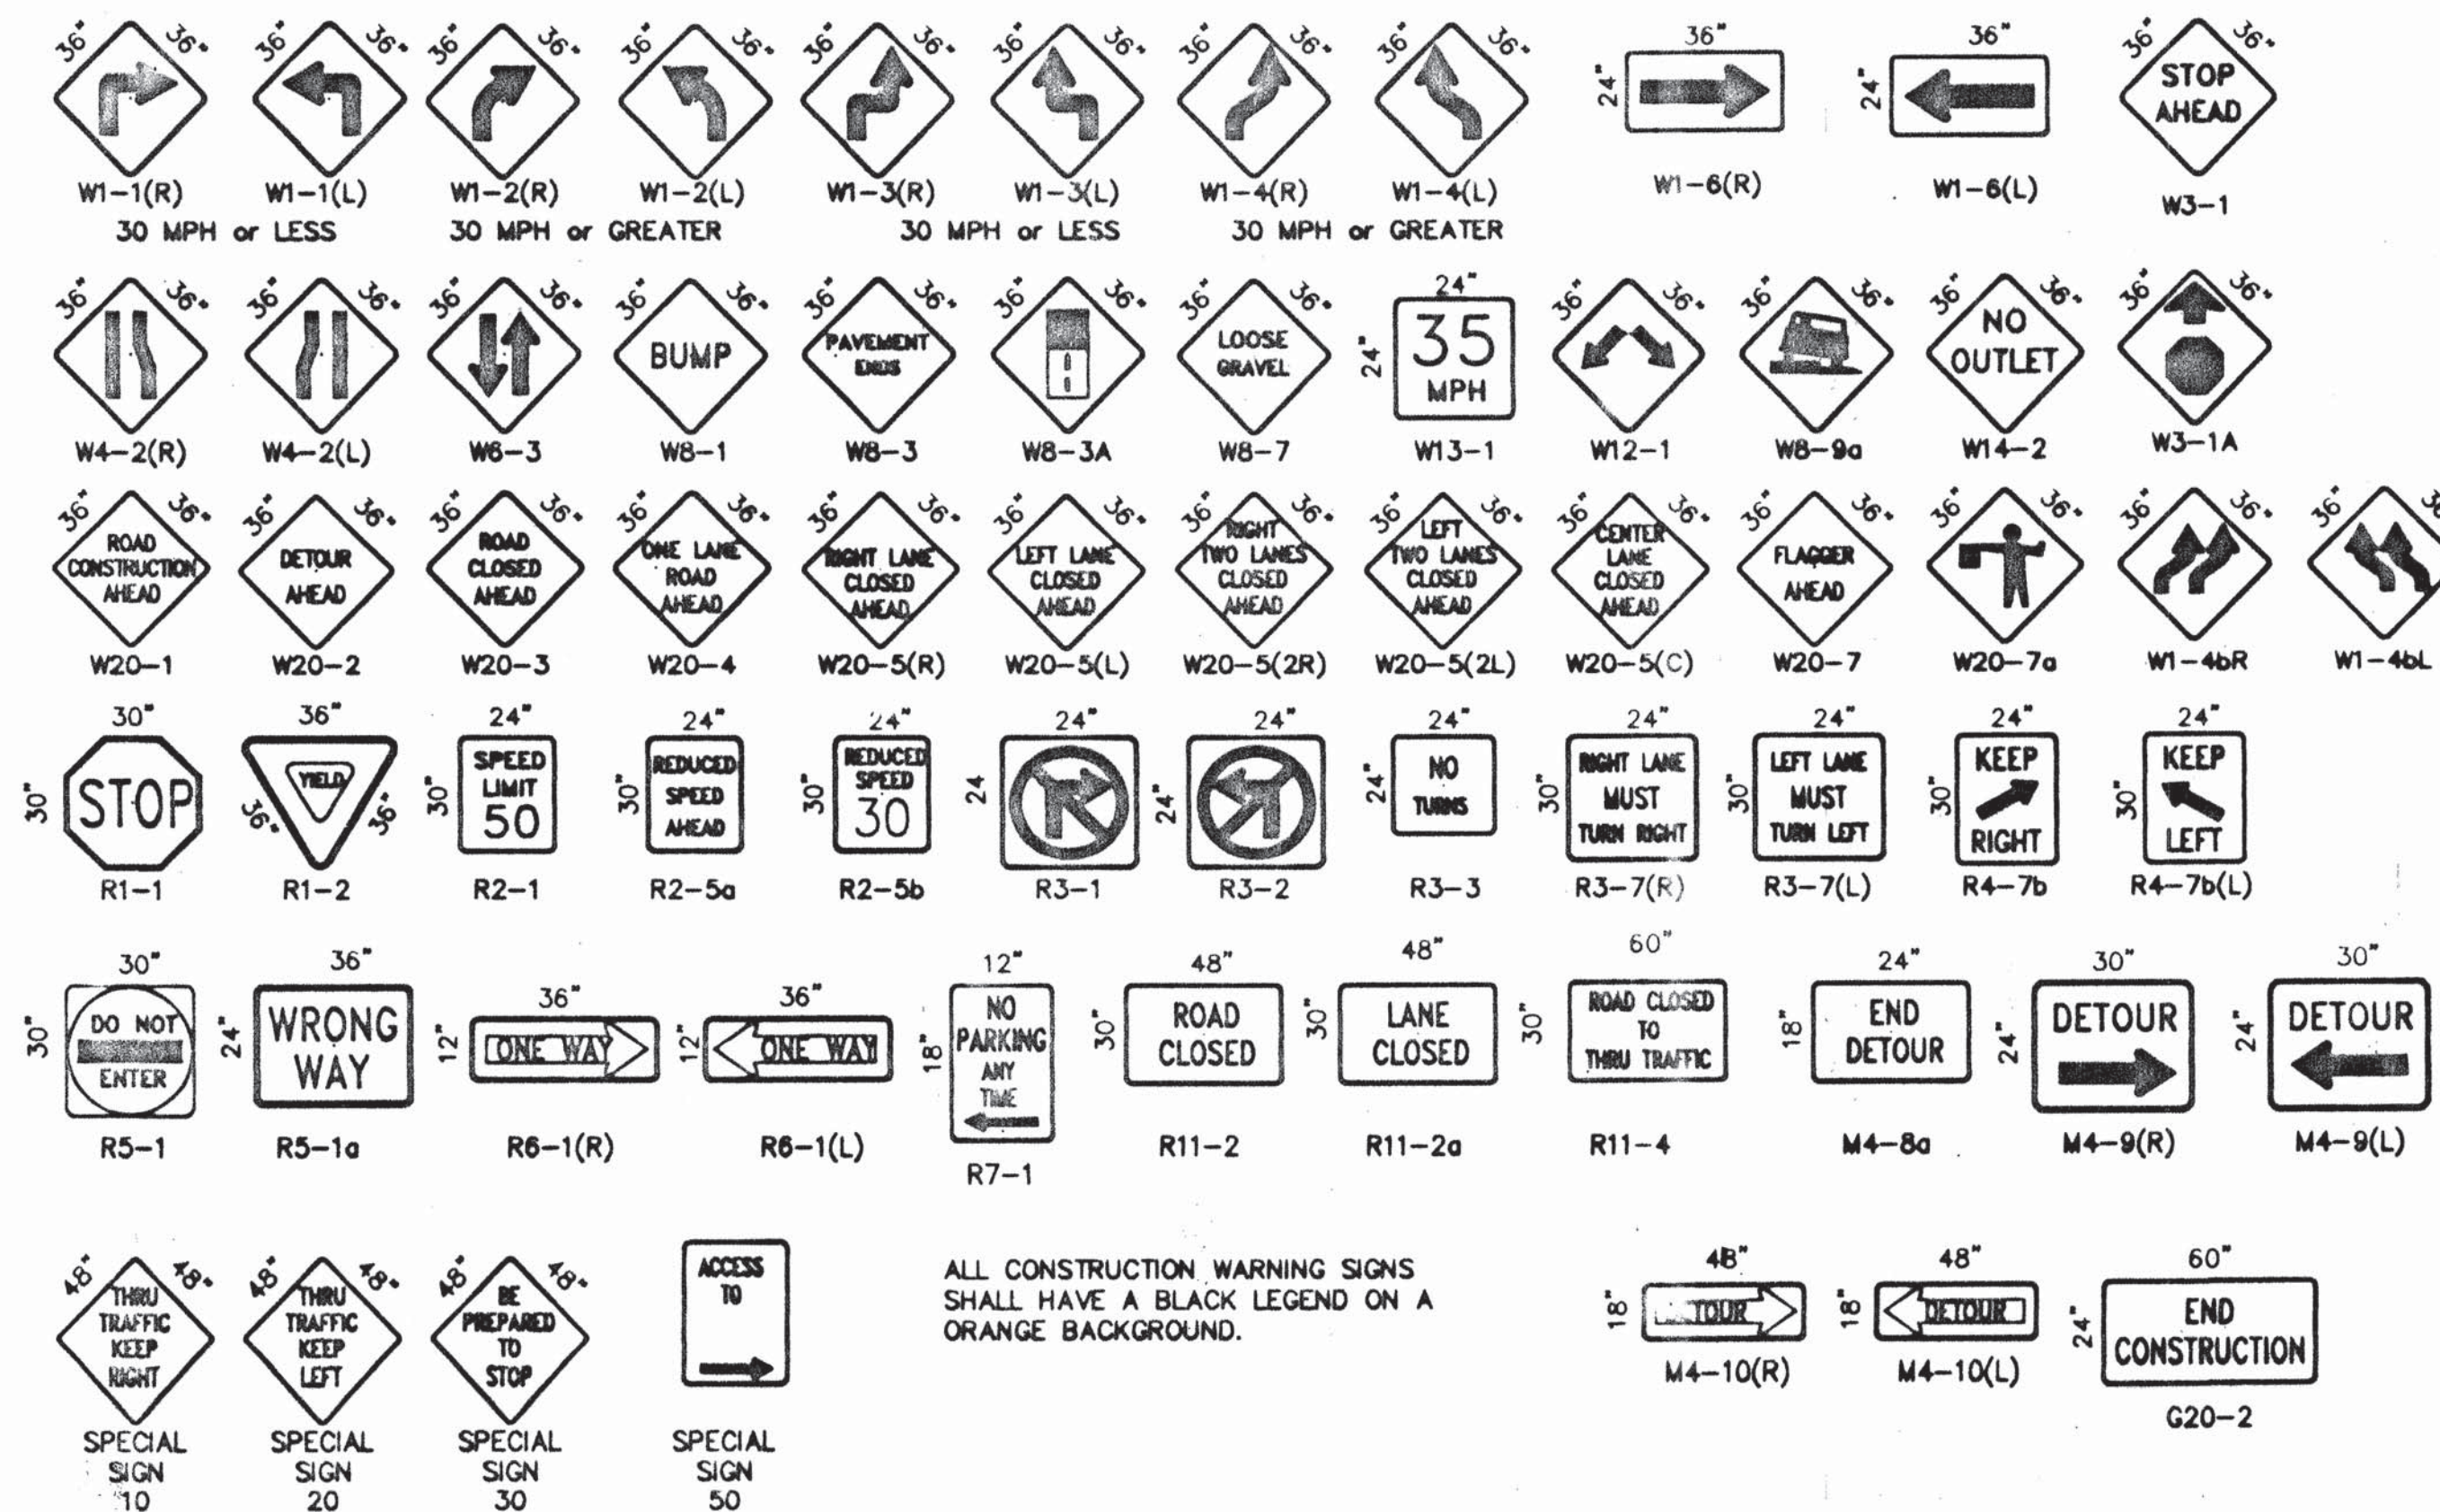

ALL CONSTRUCTION WARNING SIGNS SHALL HAVE A BLACK LEGEND ON A ORANGE BACKGROUND.






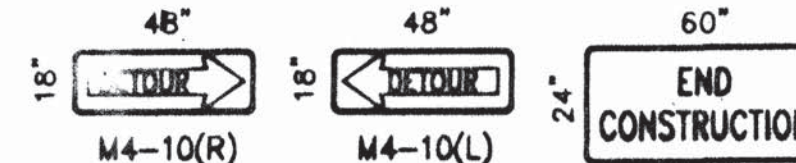


G20-2













CITY OF ALBUQUERQUE PUBLIC WORKS DEPARTMENT ENGINEERING DEVELOPMENT GROUP	
TITLE LAS SENDAS DEL NORTE SIGNING AND CONSTRUCTION TRAFFIC CONTROL STANDARDS	
DESIGN REVIEW COMMITTEE	CITY ENGINEER APPROVAL
LAST UPDATE	
PROJECT NO. 6093.81	MAP NO. DW16
SHEET 13 OF 14	

1 2 3 4 5 6 7 8 9 10 11 12 13 14 15
26-6093.81 1301

SCANNED BY
MESA REPRO

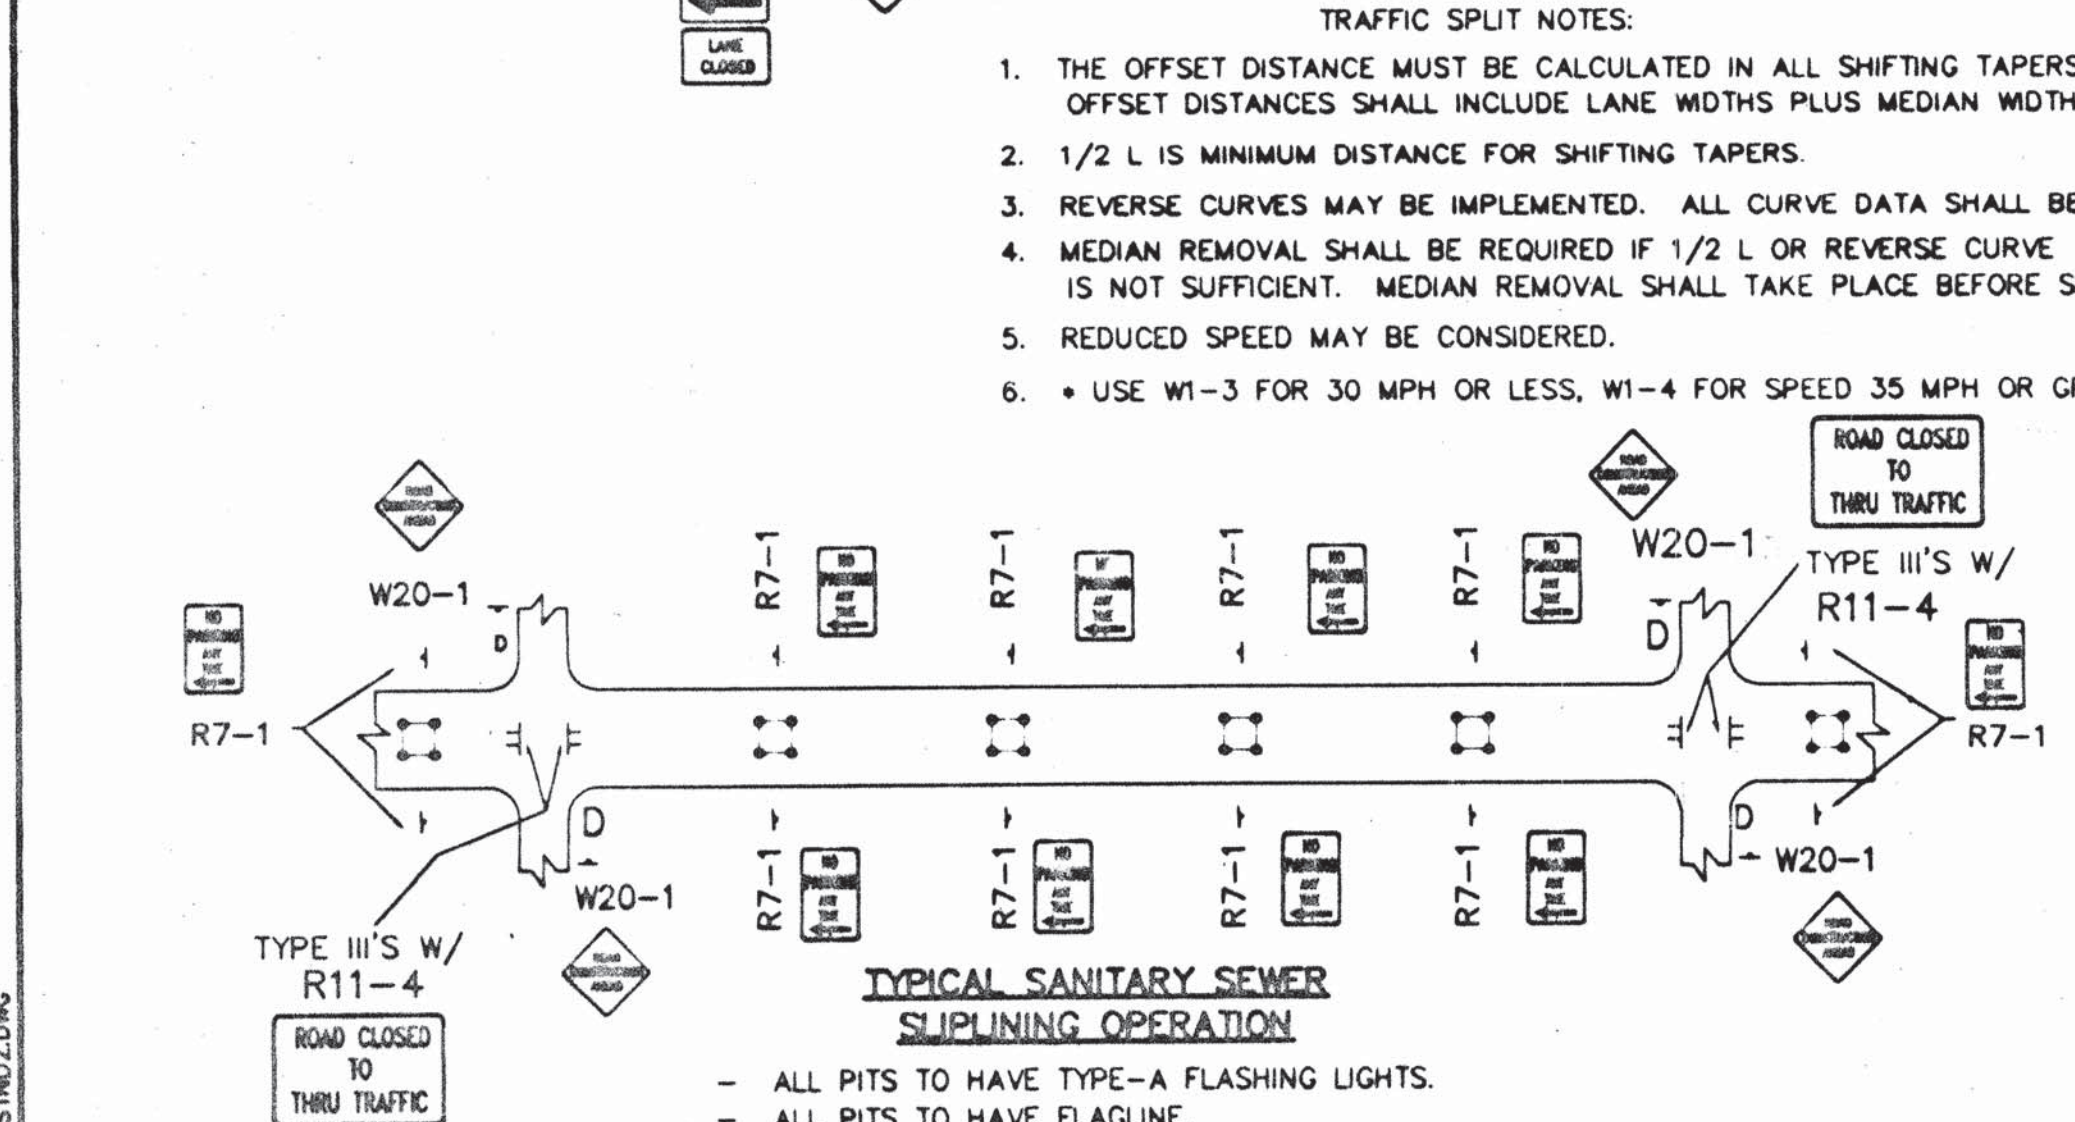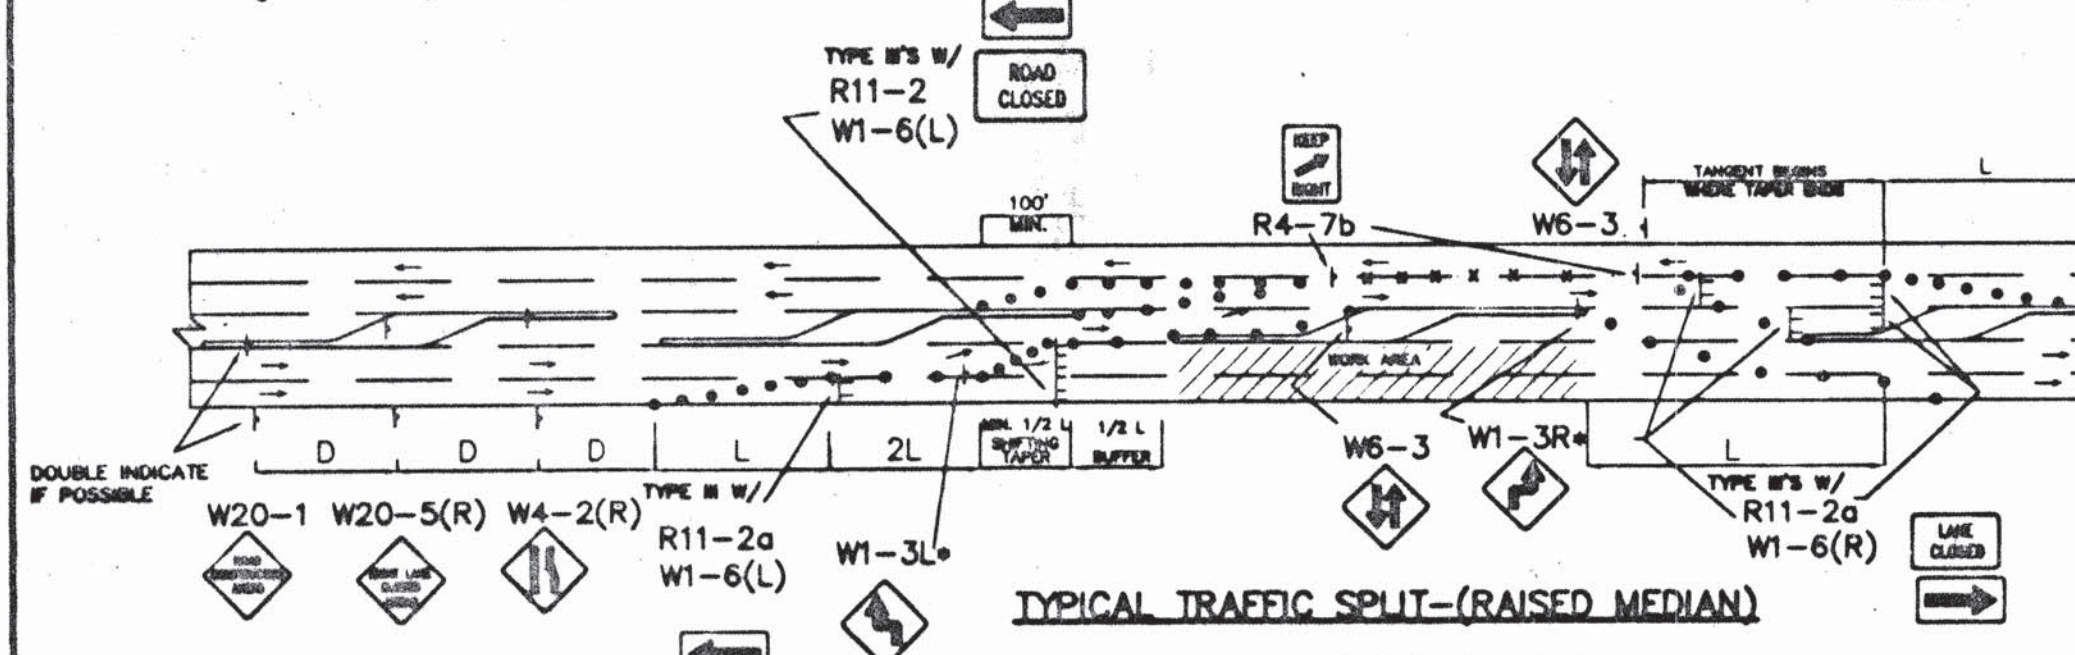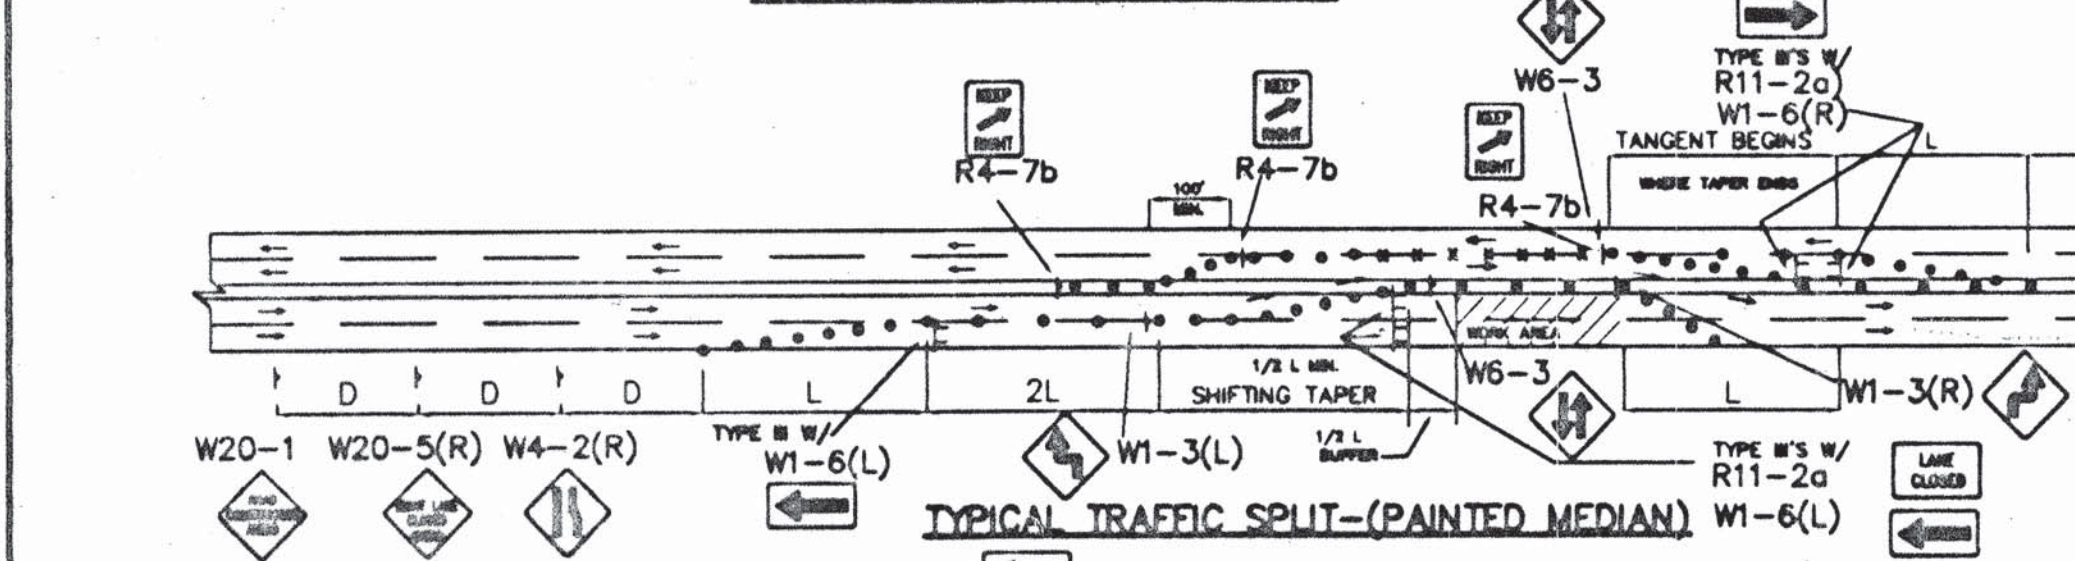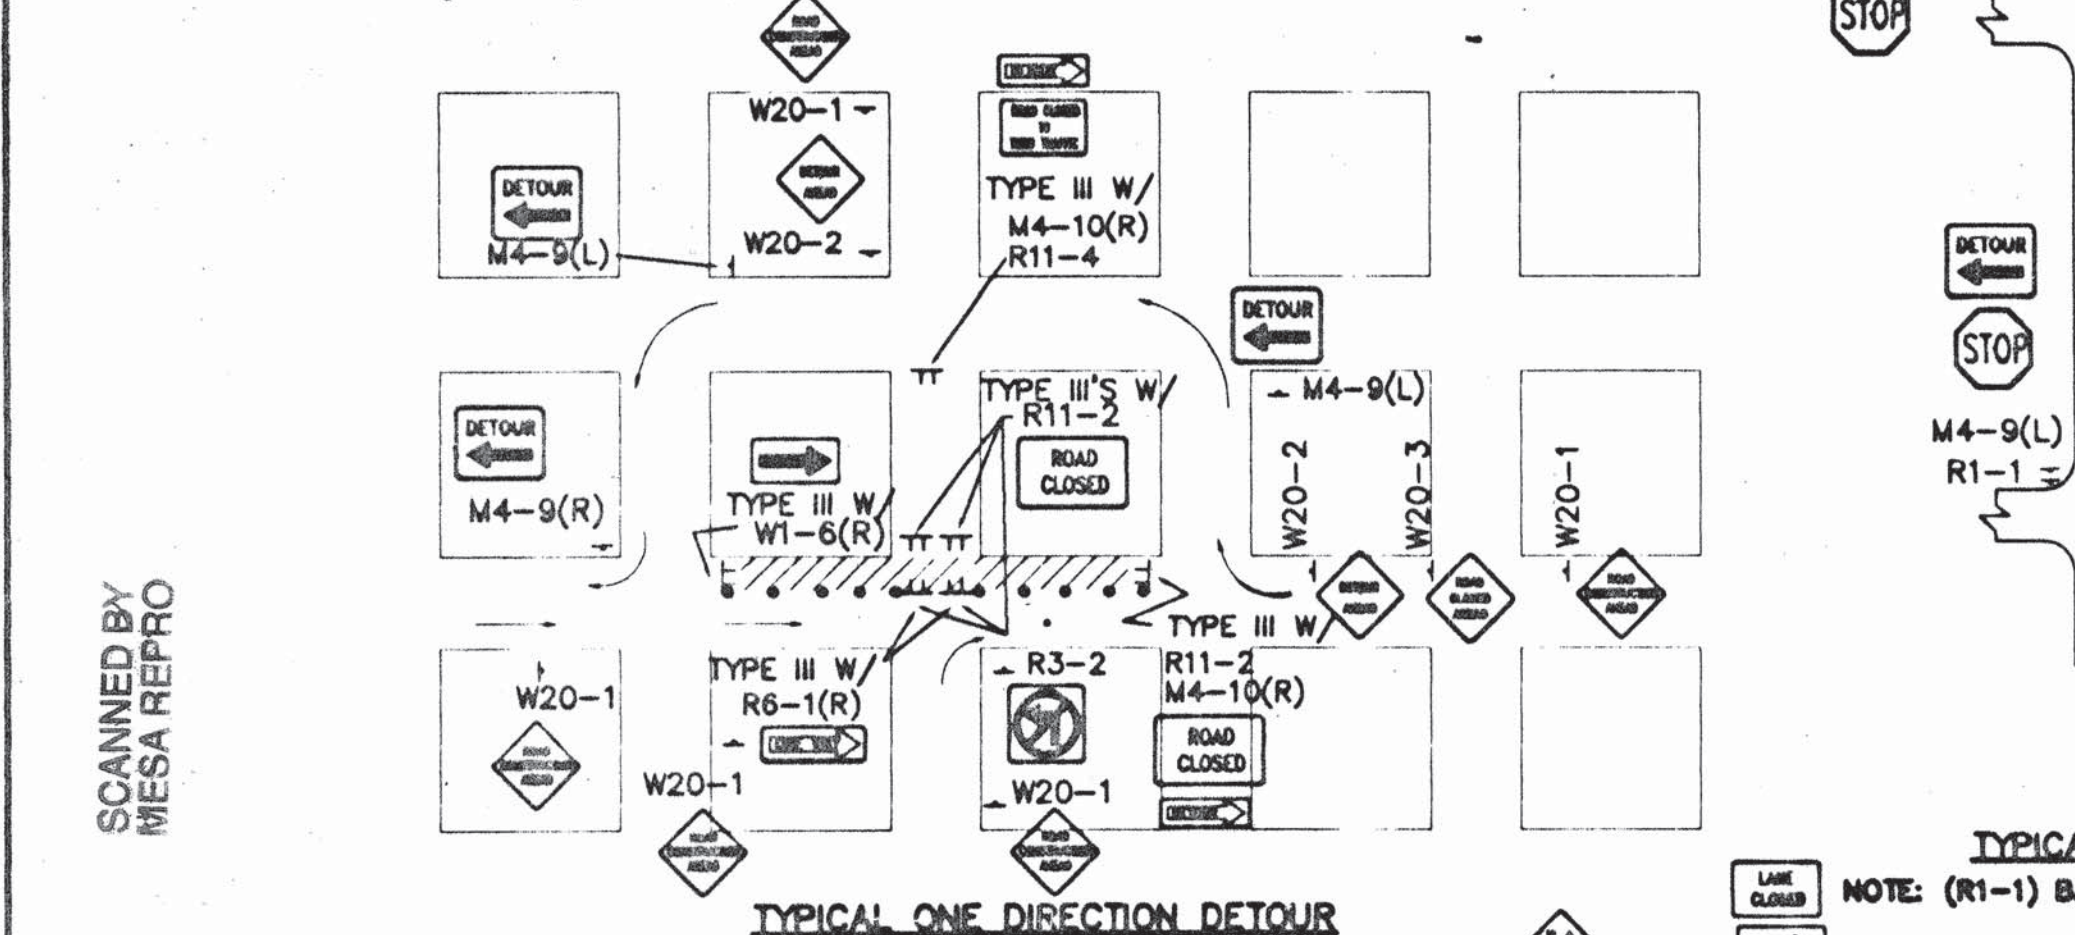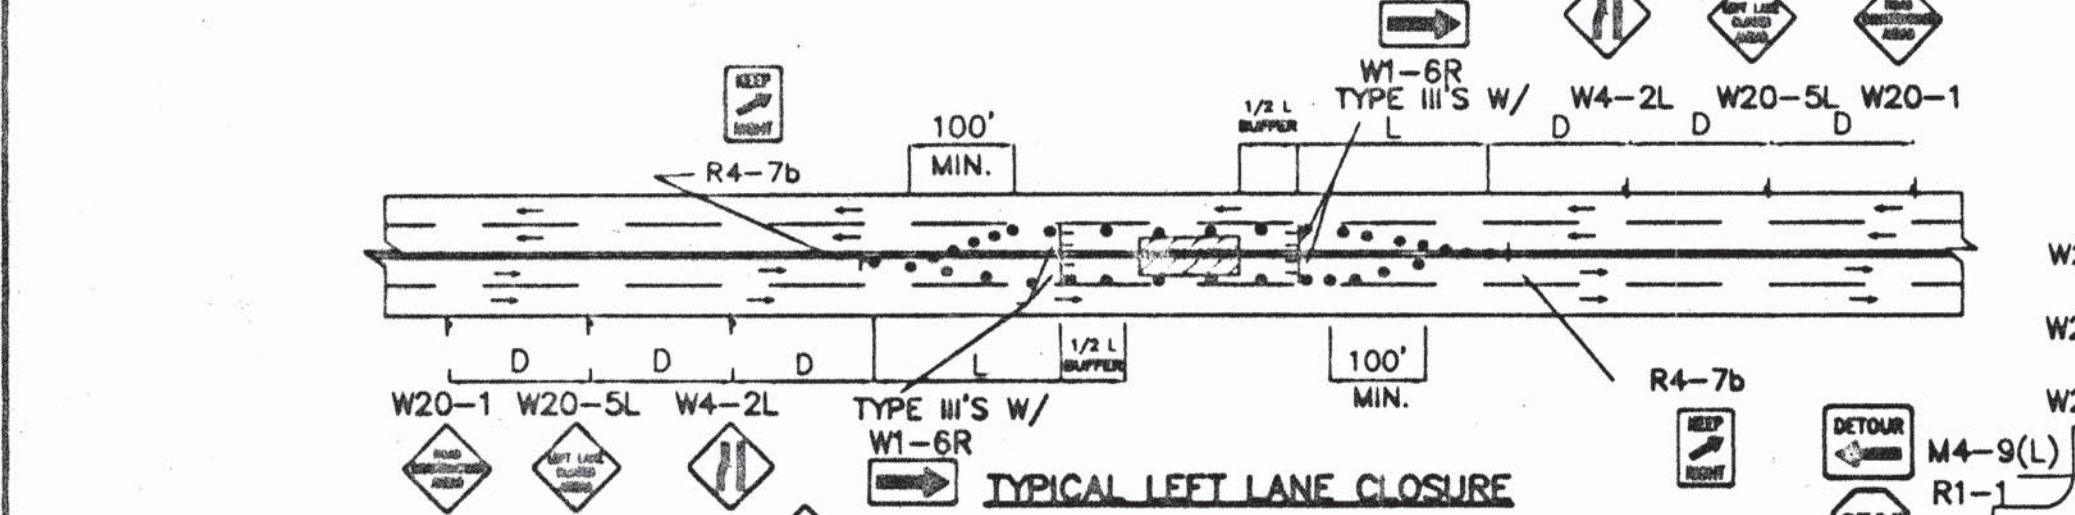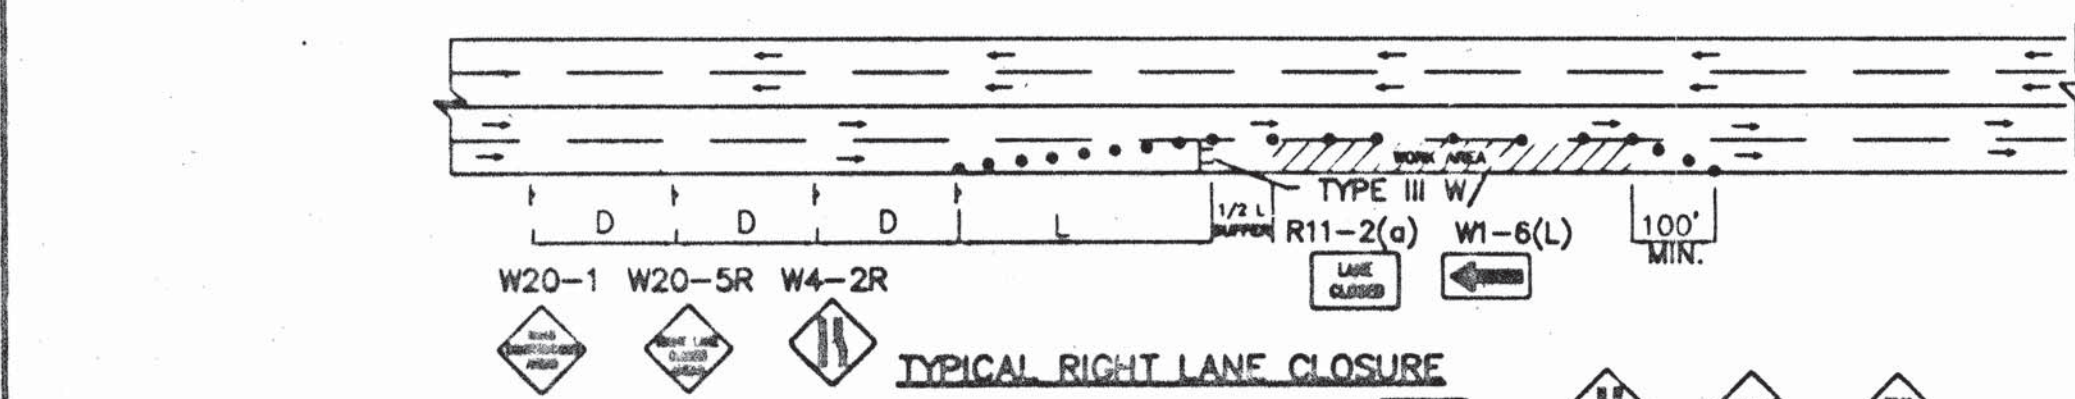

NOTE:
MAY REQUIRE LEFT LANE
CLOSURE DEPENDING ON
FIELD CONDITIONS.

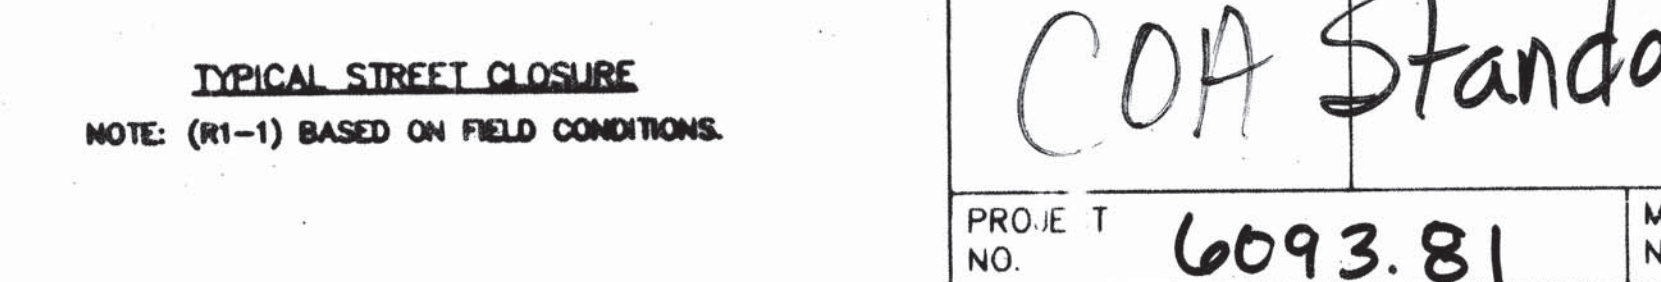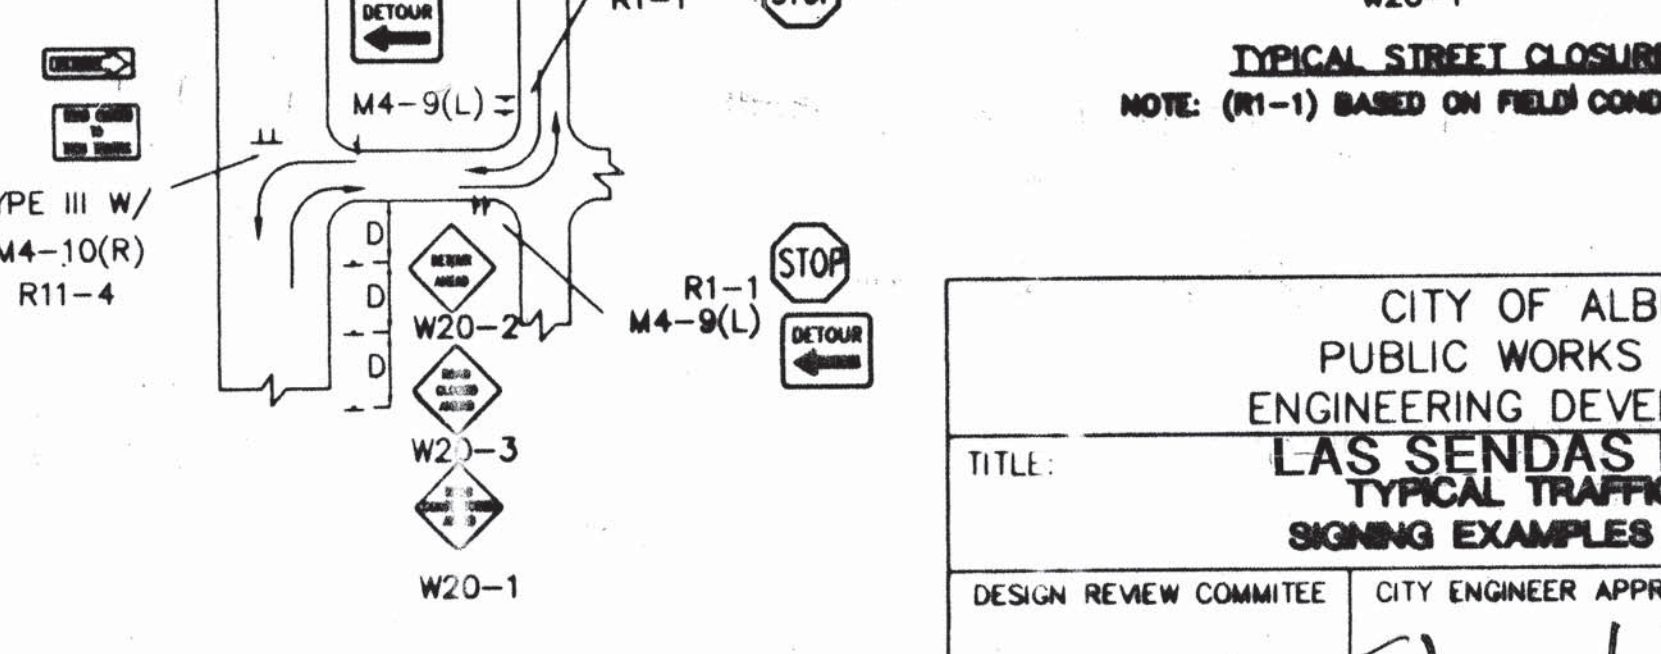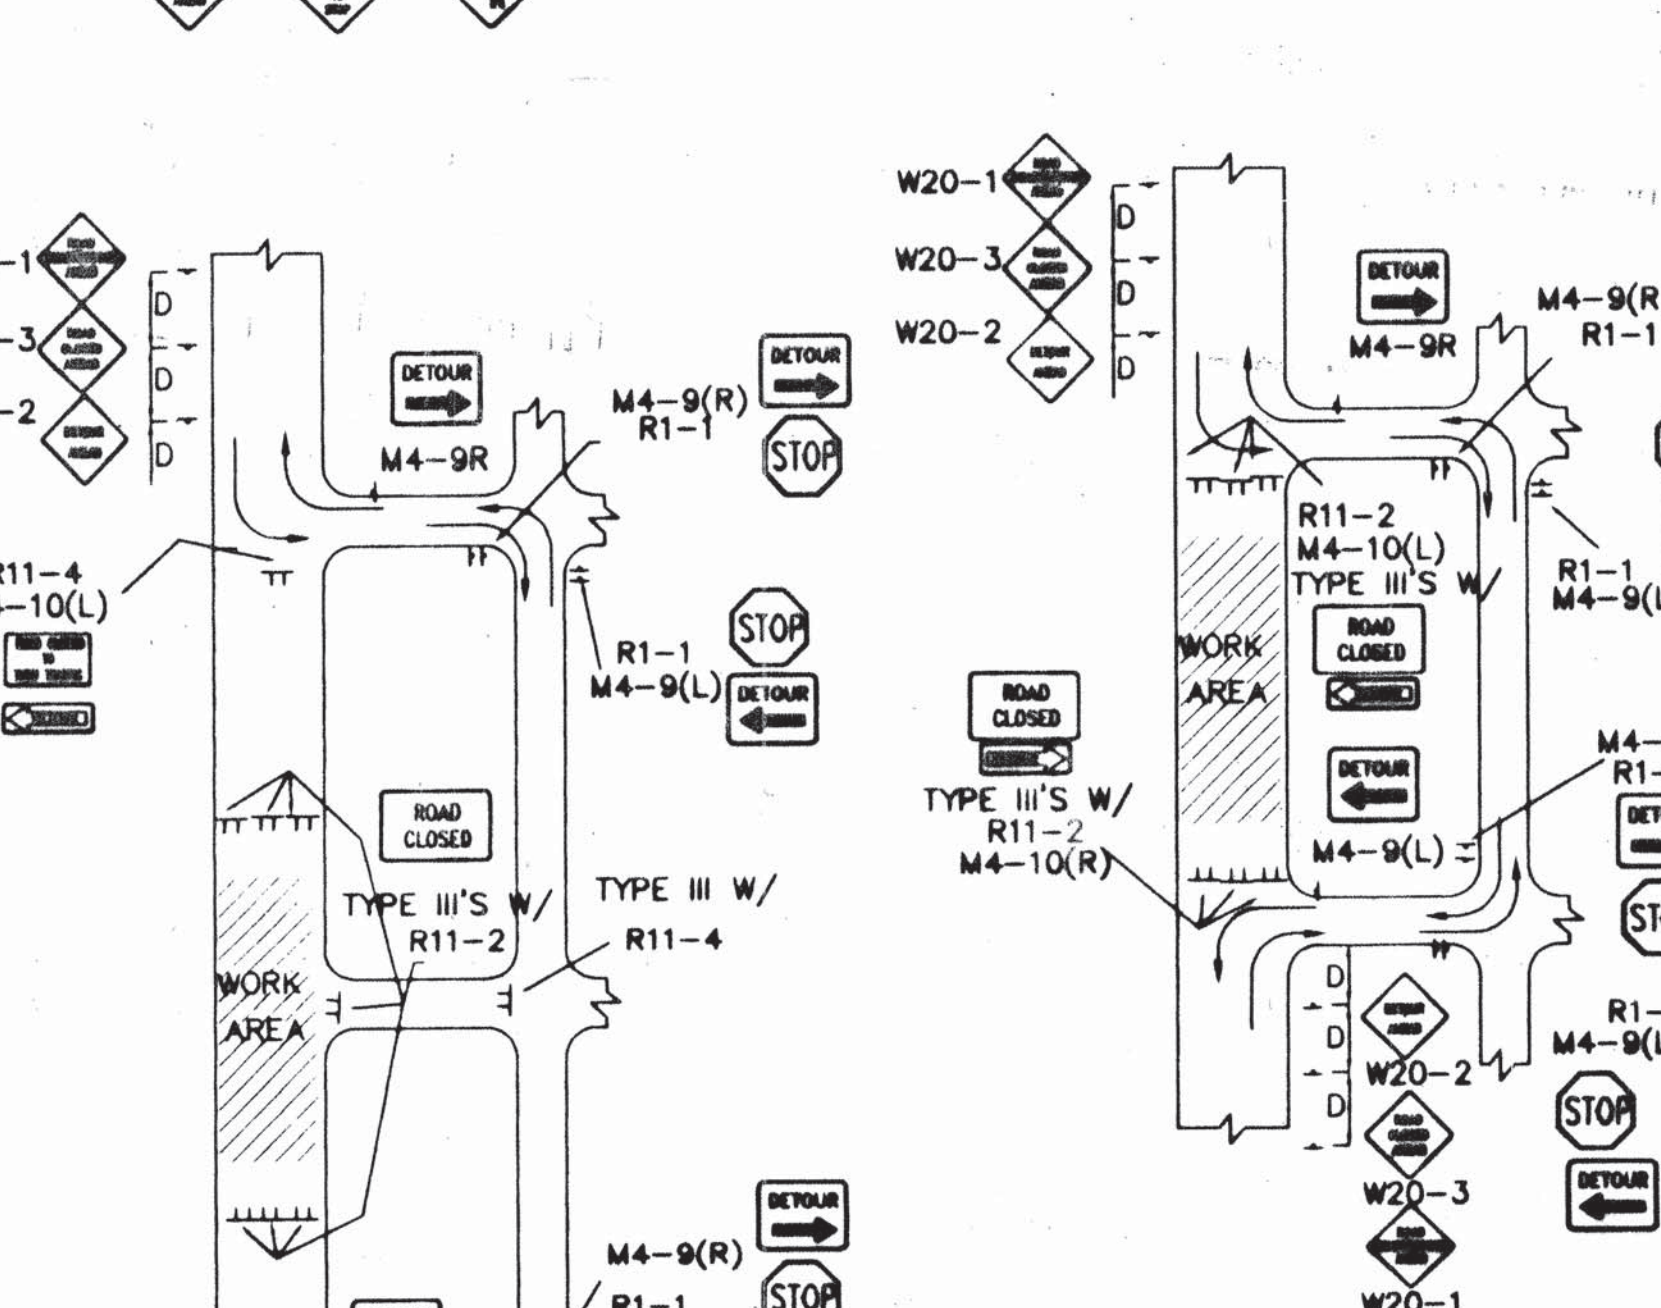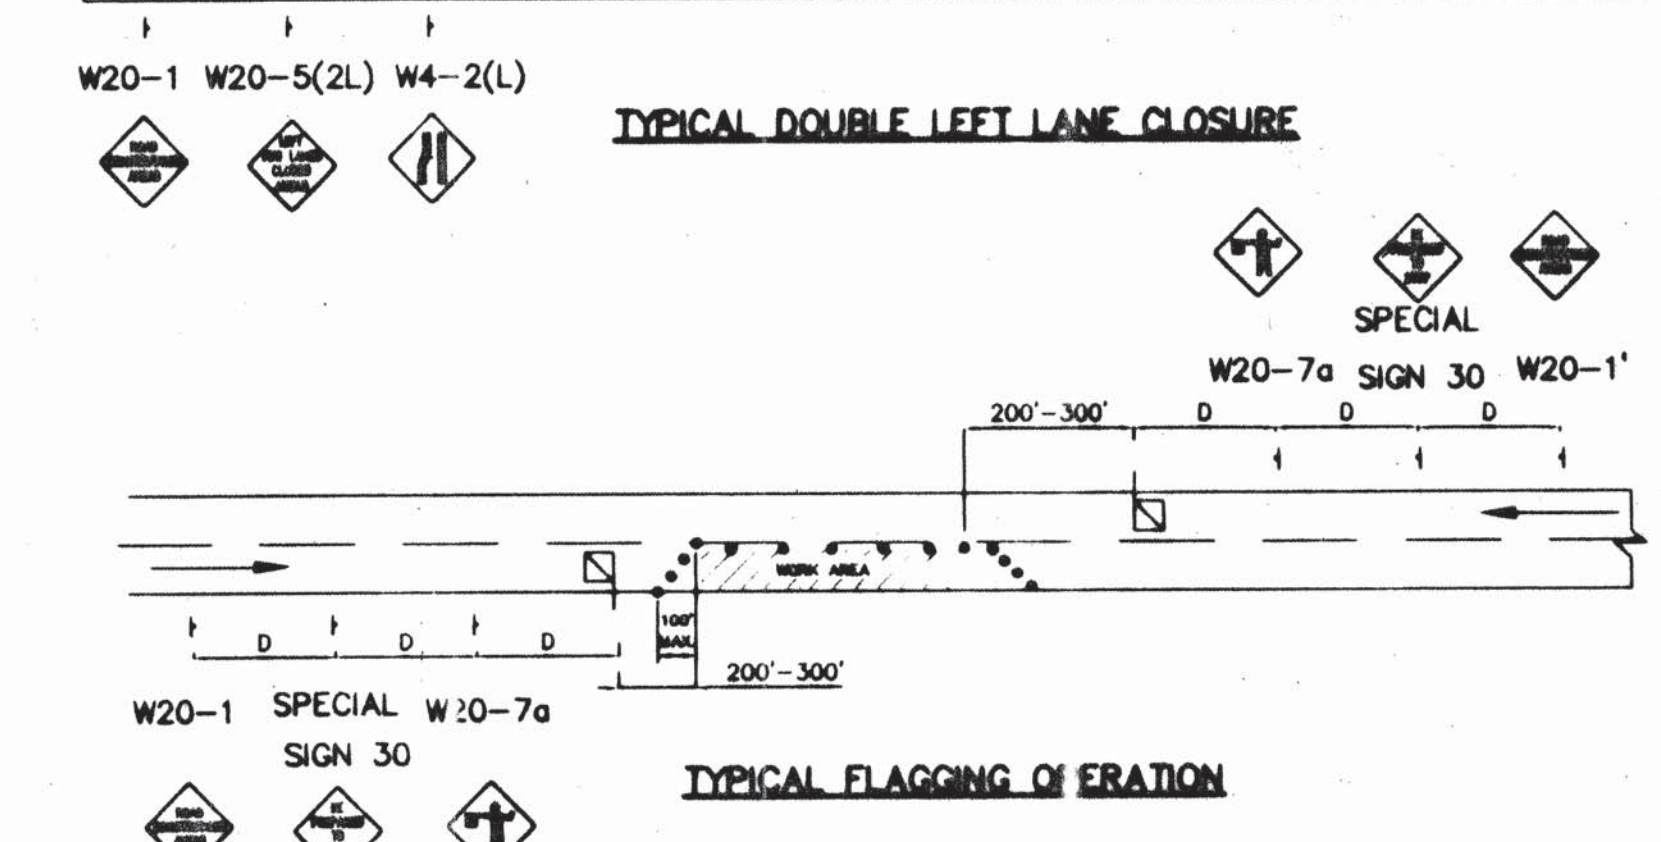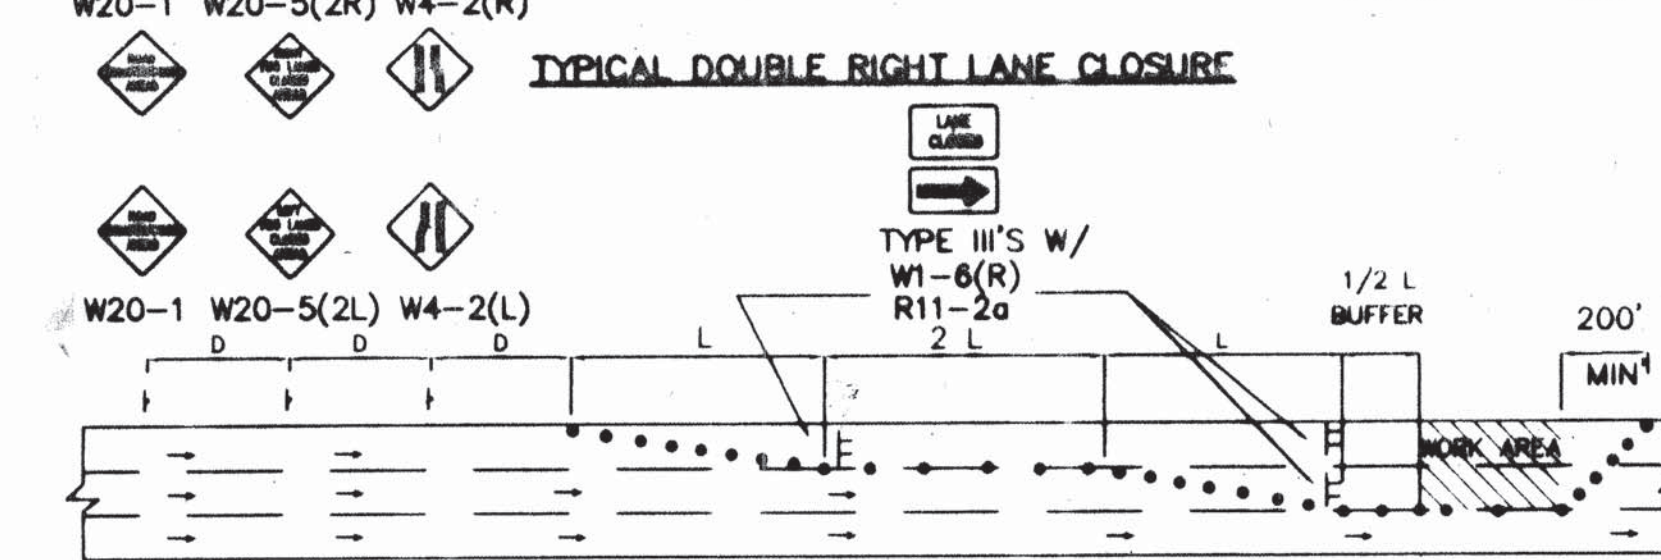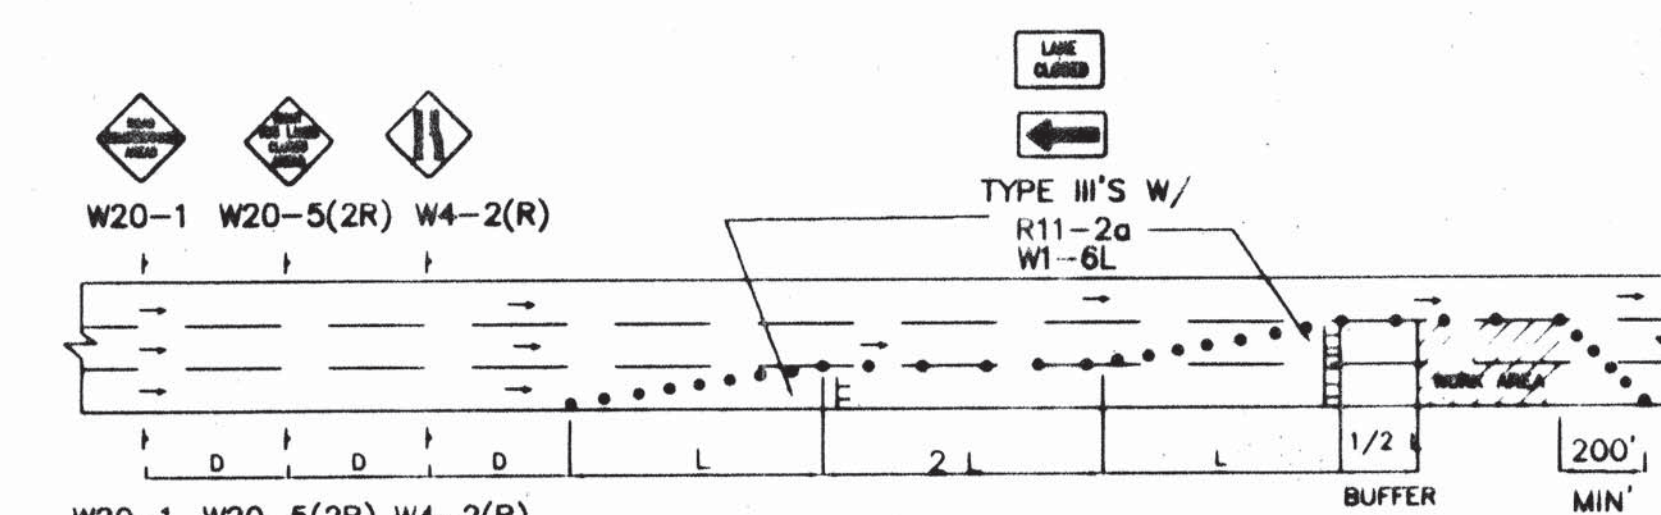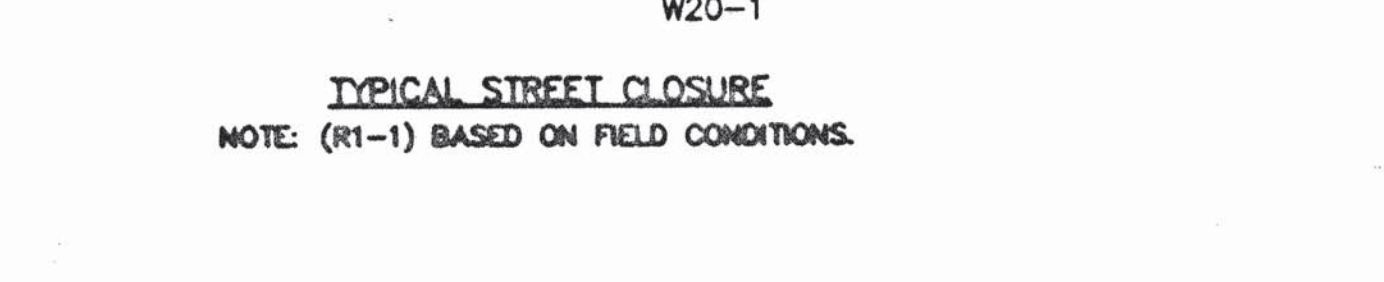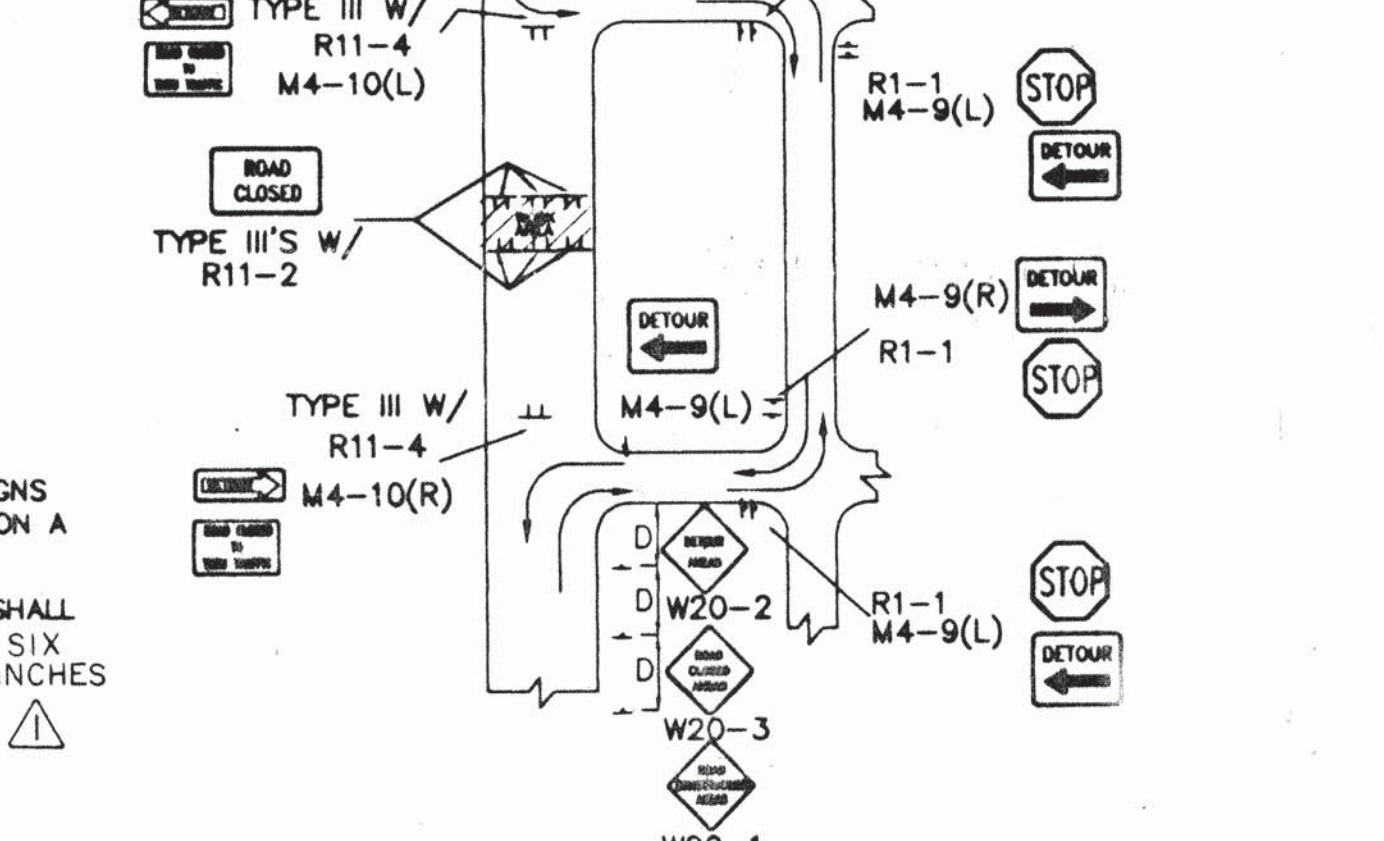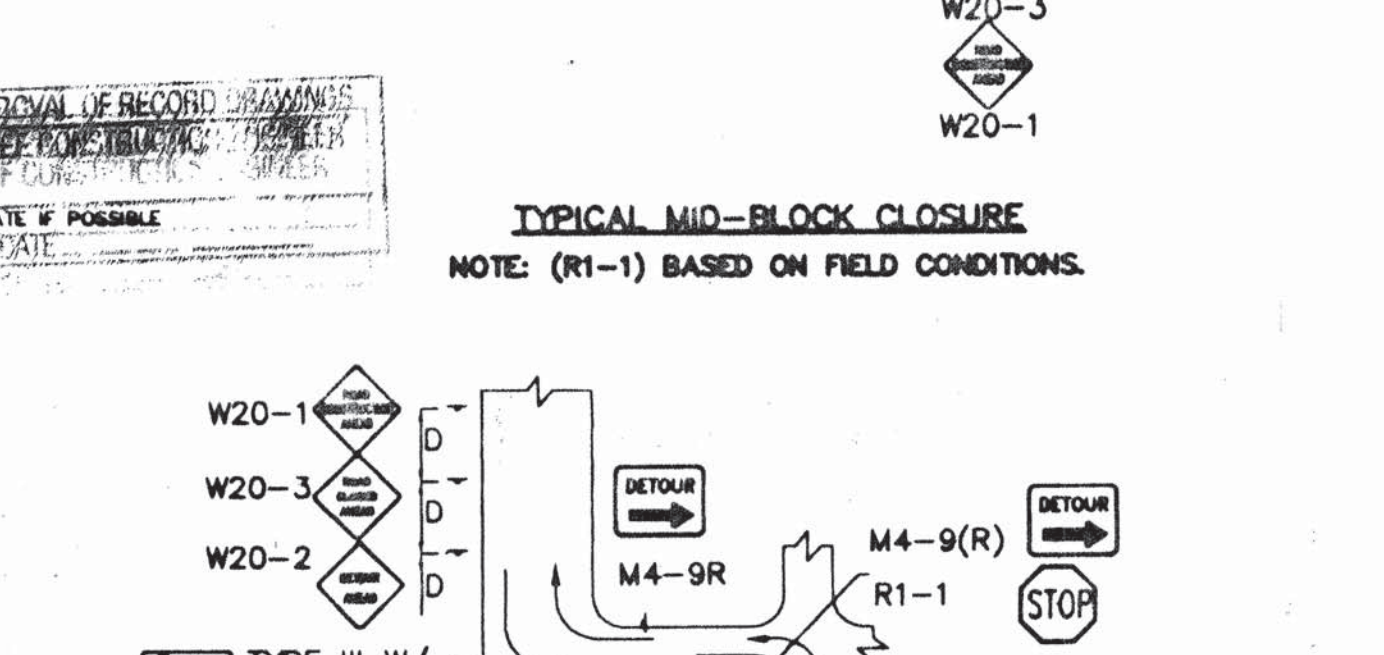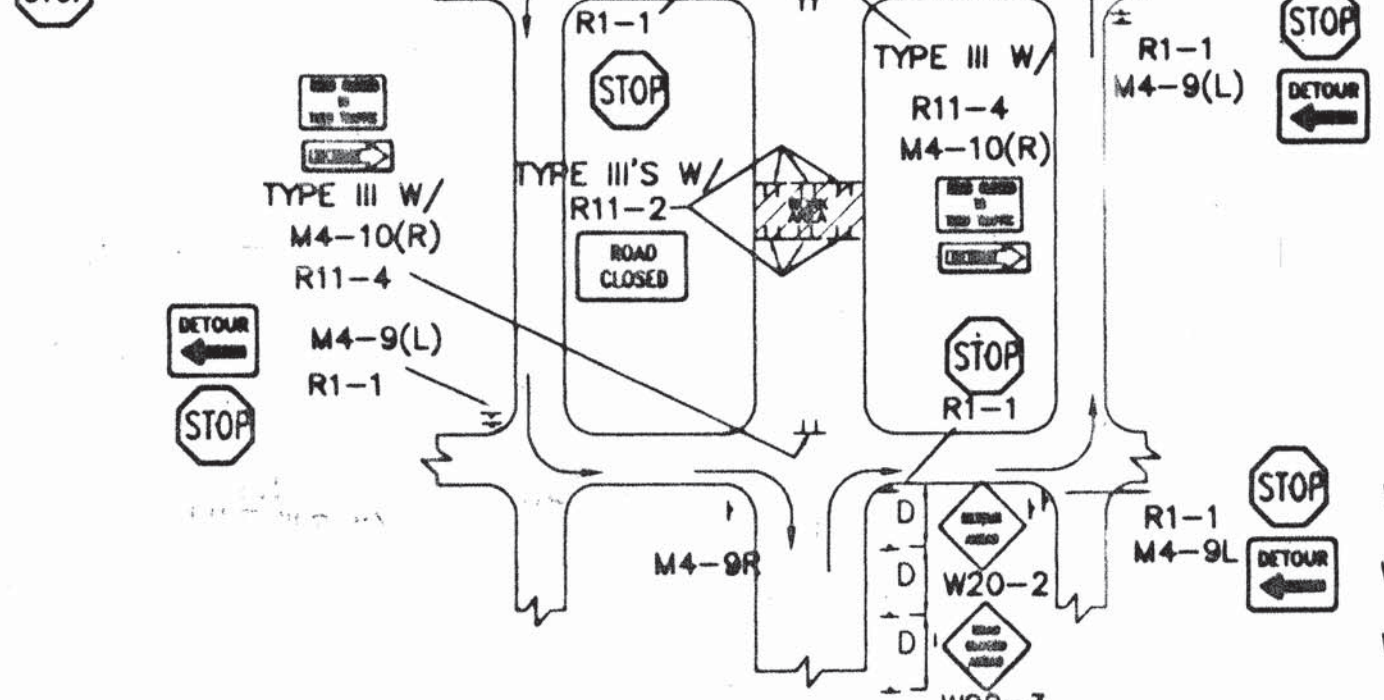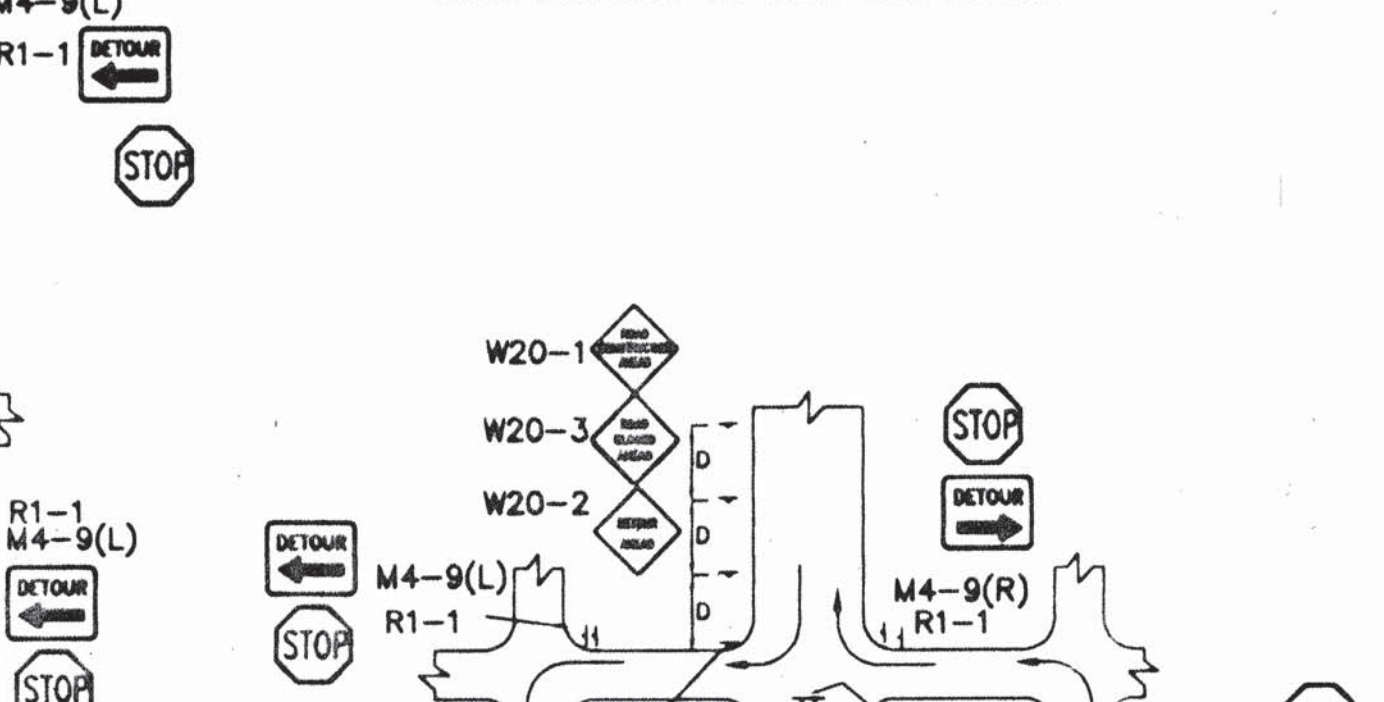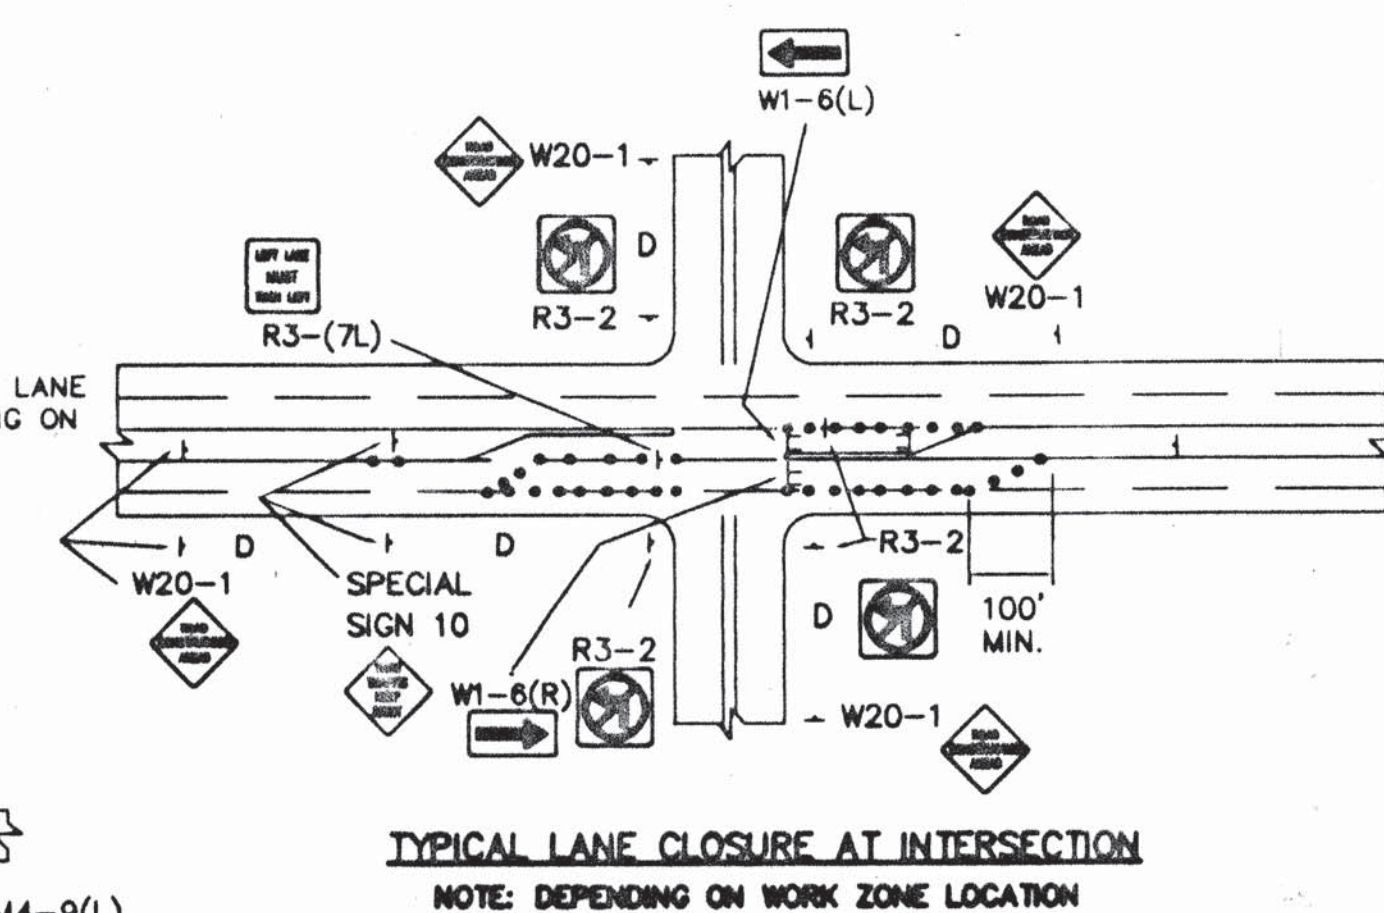

GENERAL NOTE:
ALL CONSTRUCTION WARNING SIGNS
SHALL HAVE A BLACK LEGEND ON A
ORANGE BACKGROUND.
ALL ADVANCE WARNING SIGNS SHALL
BE A MINIMUM OF 36" THIRTY SIX
INCHES BY 36" THIRTY SIX INCHES
IN SIZE AND SHALL HAVE ONE
WARNING LIGHT.

- TRAFFIC SPLIT NOTES:
1. THE OFFSET DISTANCE MUST BE CALCULATED IN ALL SHIFTING TAPERS. THE OFFSET DISTANCES SHALL INCLUDE LANE WIDTHS PLUS MEDIAN WIDTHS.
 2. 1/2 L IS MINIMUM DISTANCE FOR SHIFTING TAPERS.
 3. REVERSE CURVES MAY BE IMPLEMENTED. ALL CURVE DATA SHALL BE CALCULATED.
 4. MEDIAN REMOVAL SHALL BE REQUIRED IF 1/2 L OR REVERSE CURVE IS NOT SUFFICIENT. MEDIAN REMOVAL SHALL TAKE PLACE BEFORE SPLITS.
 5. REDUCED SPEED MAY BE CONSIDERED.
 6. * USE W1-3 FOR 30 MPH OR LESS, W1-4 FOR SPEED 35 MPH OR GREATER.

CITY OF ALBUQUERQUE PUBLIC WORKS DEPARTMENT ENGINEERING DEVELOPMENT GROUP			
TITLE: LAS SENDAS DEL NORTE TYPICAL TRAFFIC CONTROL & SIGNING EXAMPLES (REF. M.U.T.C.D.)			
DESIGN REVIEW COMMITTEE	CITY ENGINEER APPROVAL	MO/DA/YR	MO/DA/YR
COA Standard		LAST UPDATE	
PROJECT NO. 6093.81	MAP NO. DWG-1	SHEET 14 OF 14	

1 2 3 4 5 6 7 8 9 10 11 12 13 14 15
26 6093.81 1401