


CONSTRUCTION PLANS
FOR
LOS JARDINES SUBDIVISION
ALBUQUERQUE, NEW MEXICO

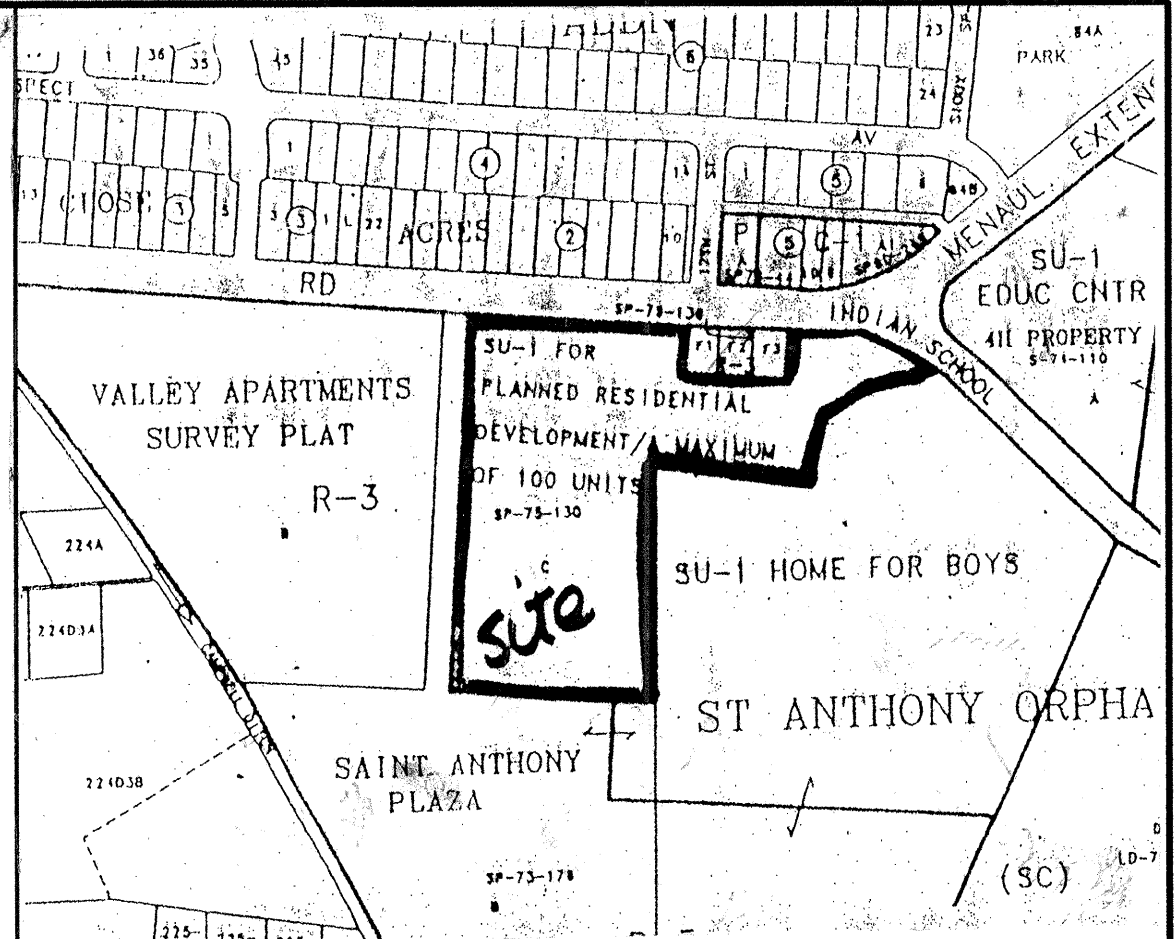

VICINITY MAP
ZONE ATLAS H-13
SCALE: NONE

GENERAL NOTES

NOTICE TO CONTRACTORS

1. CITY OF ALBUQUERQUE SPECIFICATIONS FOR PUBLIC WORKS CONSTRUCTION, 1986 EDITION AS AMENDED THROUGH UPDATE 6, WILL BE REFERRED TO HEREIN AS THE "STANDARD SPECIFICATIONS".
2. TWO WORKING DAYS PRIOR TO ANY EXCAVATION, CONTRACTOR MUST CONTACT NEW MEXICO ONE CALL SYSTEM (260-1990) AND DETERMINE LOCATION OF EXISTING UTILITIES.
3. PRIOR TO ANY CONSTRUCTION, THE CONTRACTOR SHALL EXCAVATE AND VERIFY THE HORIZONTAL AND VERTICAL LOCATIONS OF ALL OBSTRUCTIONS. SHOULD A CONFLICT EXIST, THE CONTRACTOR SHALL NOTIFY THE ENGINEER OR THE SURVEYOR SO THAT THE CONFLICT CAN BE RESOLVED WITHOUT DELAY.
4. ALL EXISTING SIGNS, MARKERS, DELINEATORS, ETC., WITHIN THE CONSTRUCTION LIMITS SHALL BE REMOVED, STORED AND RE-SET BY THE CONTRACTOR.
5. FIVE (5) WORKING DAYS PRIOR TO BEGINNING CONSTRUCTION THE CONTRACTOR SHALL SUBMIT TO THE CONSTRUCTION CO-ORDINATION DIVISION A DETAILED CONSTRUCTION SCHEDULE. TWO (2) WORKING DAYS PRIOR TO CONSTRUCTION THE CONTRACTOR SHALL OBTAIN A BARRICADING PERMIT FROM THE CONSTRUCTION CO-ORDINATION DIVISION. CONTRACTOR SHALL NOTIFY BARRICADE ENGINEER (768-2551) PRIOR TO OCCUPYING AN INTERSECTION. SEE SECTION 19 OF THE SPECIFICATIONS.
6. ALL STREET STRIPING ALTERED OR DESTROYED SHALL BE REPLACED WITH PLASTIC REFLECTORIZED PAVEMENT MARKINGS BY CONTRACTOR IN EXISTING OR NEW LOCATION AS INDICATED BY THIS SET.
7. THE CONTRACTOR SHALL NOTIFY THE ENGINEER NOT LESS THAN SEVEN (7) DAYS PRIOR TO STARTING WORK IN ORDER THAT THE ENGINEER MAY TAKE NECESSARY MEASURES TO INSURE THE PRESERVATION OF SURVEY MONUMENTS. CONTRACTOR SHALL NOT DISTURB PERMANENT SURVEY MONUMENTS WITHOUT THE CONSENT OF THE ENGINEER AND SHALL NOTIFY THE ENGINEER AND BEAR THE EXPENSE OF REPLACING ANY THAT MAY BE DISTURBED WITHOUT PERMISSION. REPLACEMENT SHALL BE DONE ONLY BY THE CITY SURVEYOR. WHEN A CHANGE IS MADE IN THE FINISHED ELEVATIONS OF THE PAVEMENT OF ANY ROADWAY IN WHICH A PERMANENT SURVEY MONUMENT IS LOCATED, CONTRACTOR SHALL, AT HIS OWN EXPENSE, ADJUST THE MONUMENT COVER TO THE NEW GRADE UNLESS OTHERWISE SPECIFIED. REFER TO SECTION 4.4 OF THE GENERAL CONDITIONS OF THE STANDARD SPECIFICATIONS.
8. ANY WORK OCCURRING WITHIN AN ARTERIAL ROADWAY REQUIRES 24 HOURS CONSTRUCTION.

THE FOLLOWING NOTES ALSO APPLY WHEN CHECKED

- ☒ ALL UTILITIES AND UTILITY SERVICE LINES SHALL BE INSTALLED PRIOR TO PAVING.
- ☒ BACKFILL COMPACTION SHALL BE ACCORDING TO SPECIFIED STREET USE.
- ☐ TACK COAT REQUIREMENTS SHALL BE DETERMINED BY THE CITY ENGINEER.
- ☒ SIDEWALK AND WHEELCHAIR RAMPS WITHIN THE CURB RETURNS SHALL BE CONSTRUCTED WHEREVER A NEW CURB RETURN IS CONSTRUCTED.
- ☐ IF CURB IS DEPRESSED FOR A DRIVEPAD, THE DRIVEPAD SHALL BE CONSTRUCTED PRIOR TO ACCEPTANCE OF CURB AND GUTTER.
- ☒ ALL STORM DRAINAGE FACILITIES SHALL BE COMPLETED PRIOR TO FINAL ACCEPTANCE.

CAUTION:
NOTE THAT ALL EXISTING UTILITIES MAY NOT BE SHOWN. ALL EXISTING SERVICE CONNECTIONS ARE NOT SHOWN. ANY EXISTING UTILITIES THAT ARE SHOWN ARE APPROXIMATE LOCATION ONLY. IT SHALL BE THE SOLE RESPONSIBILITY OF THE CONTRACTOR TO CONTACT ALL THE UTILITY OWNERS AND TO CONDUCT ALL NECESSARY FIELD INVESTIGATIONS PRIOR TO ANY EXCAVATIONS TO DETERMINE THE ACTUAL LOCATION OF UTILITIES AND OTHER IMPROVEMENTS.

dmg
D. MARK GOODWIN & ASSOCIATES, P.A.
CONSULTING ENGINEERS
P. O. BOX 90606
ALBUQUERQUE, NEW MEXICO 87199
(505) 825-2200, FAX (505) 787-9539

INDEX TO DRAWINGS

SHEET NO.	SHEET
1	TITLE SHEET
2-6	PLAT
7-9	GRADING AND DRAINAGE PLAN
10	MASTER PAVING PLAN
11-13	PAVING IMPROVEMENTS
14	MASTER UTILITY PLAN
15-18	UTILITY IMPROVEMENTS
19-20	TRAFFIC CONTROL

RECORD DRAWING



I hereby certify that the information contained on this drawing has been revised in accordance with information furnished by the contractor, Condore Construction, and by the surveyor, Albuquerque Surveying, and reflects the construction as actually accomplished. This plan as constructed is in substantial compliance with the Approved Plan.

Mark Goodwin 11/6/99
Mark Goodwin NMPE 8948




DRB NO. 98-404

REV.	SHEETS	CITY ENGINEER	DATE	USER DEPARTMENT	DATE	USER DEPARTMENT	DATE
ENGINEERS STAMP & SIGNATURE		APPROVALS	ENGINEER	DATE	APPROVED FOR CONSTRUCTION		
		DRC CHAIRMAN	<i>Bill H. Hulse</i>	5/14/99	<i>John J. O'Brien</i> 5-26-99 CITY ENGINEER DATE		
		TRANSPORTATION	<i>R.W. Kane</i>	5-13-99			
		WATER/WASTEWATER	<i>R.W. Kane</i>	5-14-99			
		HYDROLOGY	<i>Mark Goodwin</i>	5-13-99			
		CIP					
		CONSTR. MGMT.	<i>John J. O'Brien</i>	5-14-99			
		CONSTRUCTION COORD.					
		CITY PROJECT NO.					
				610081	SHEET OF 1 20		

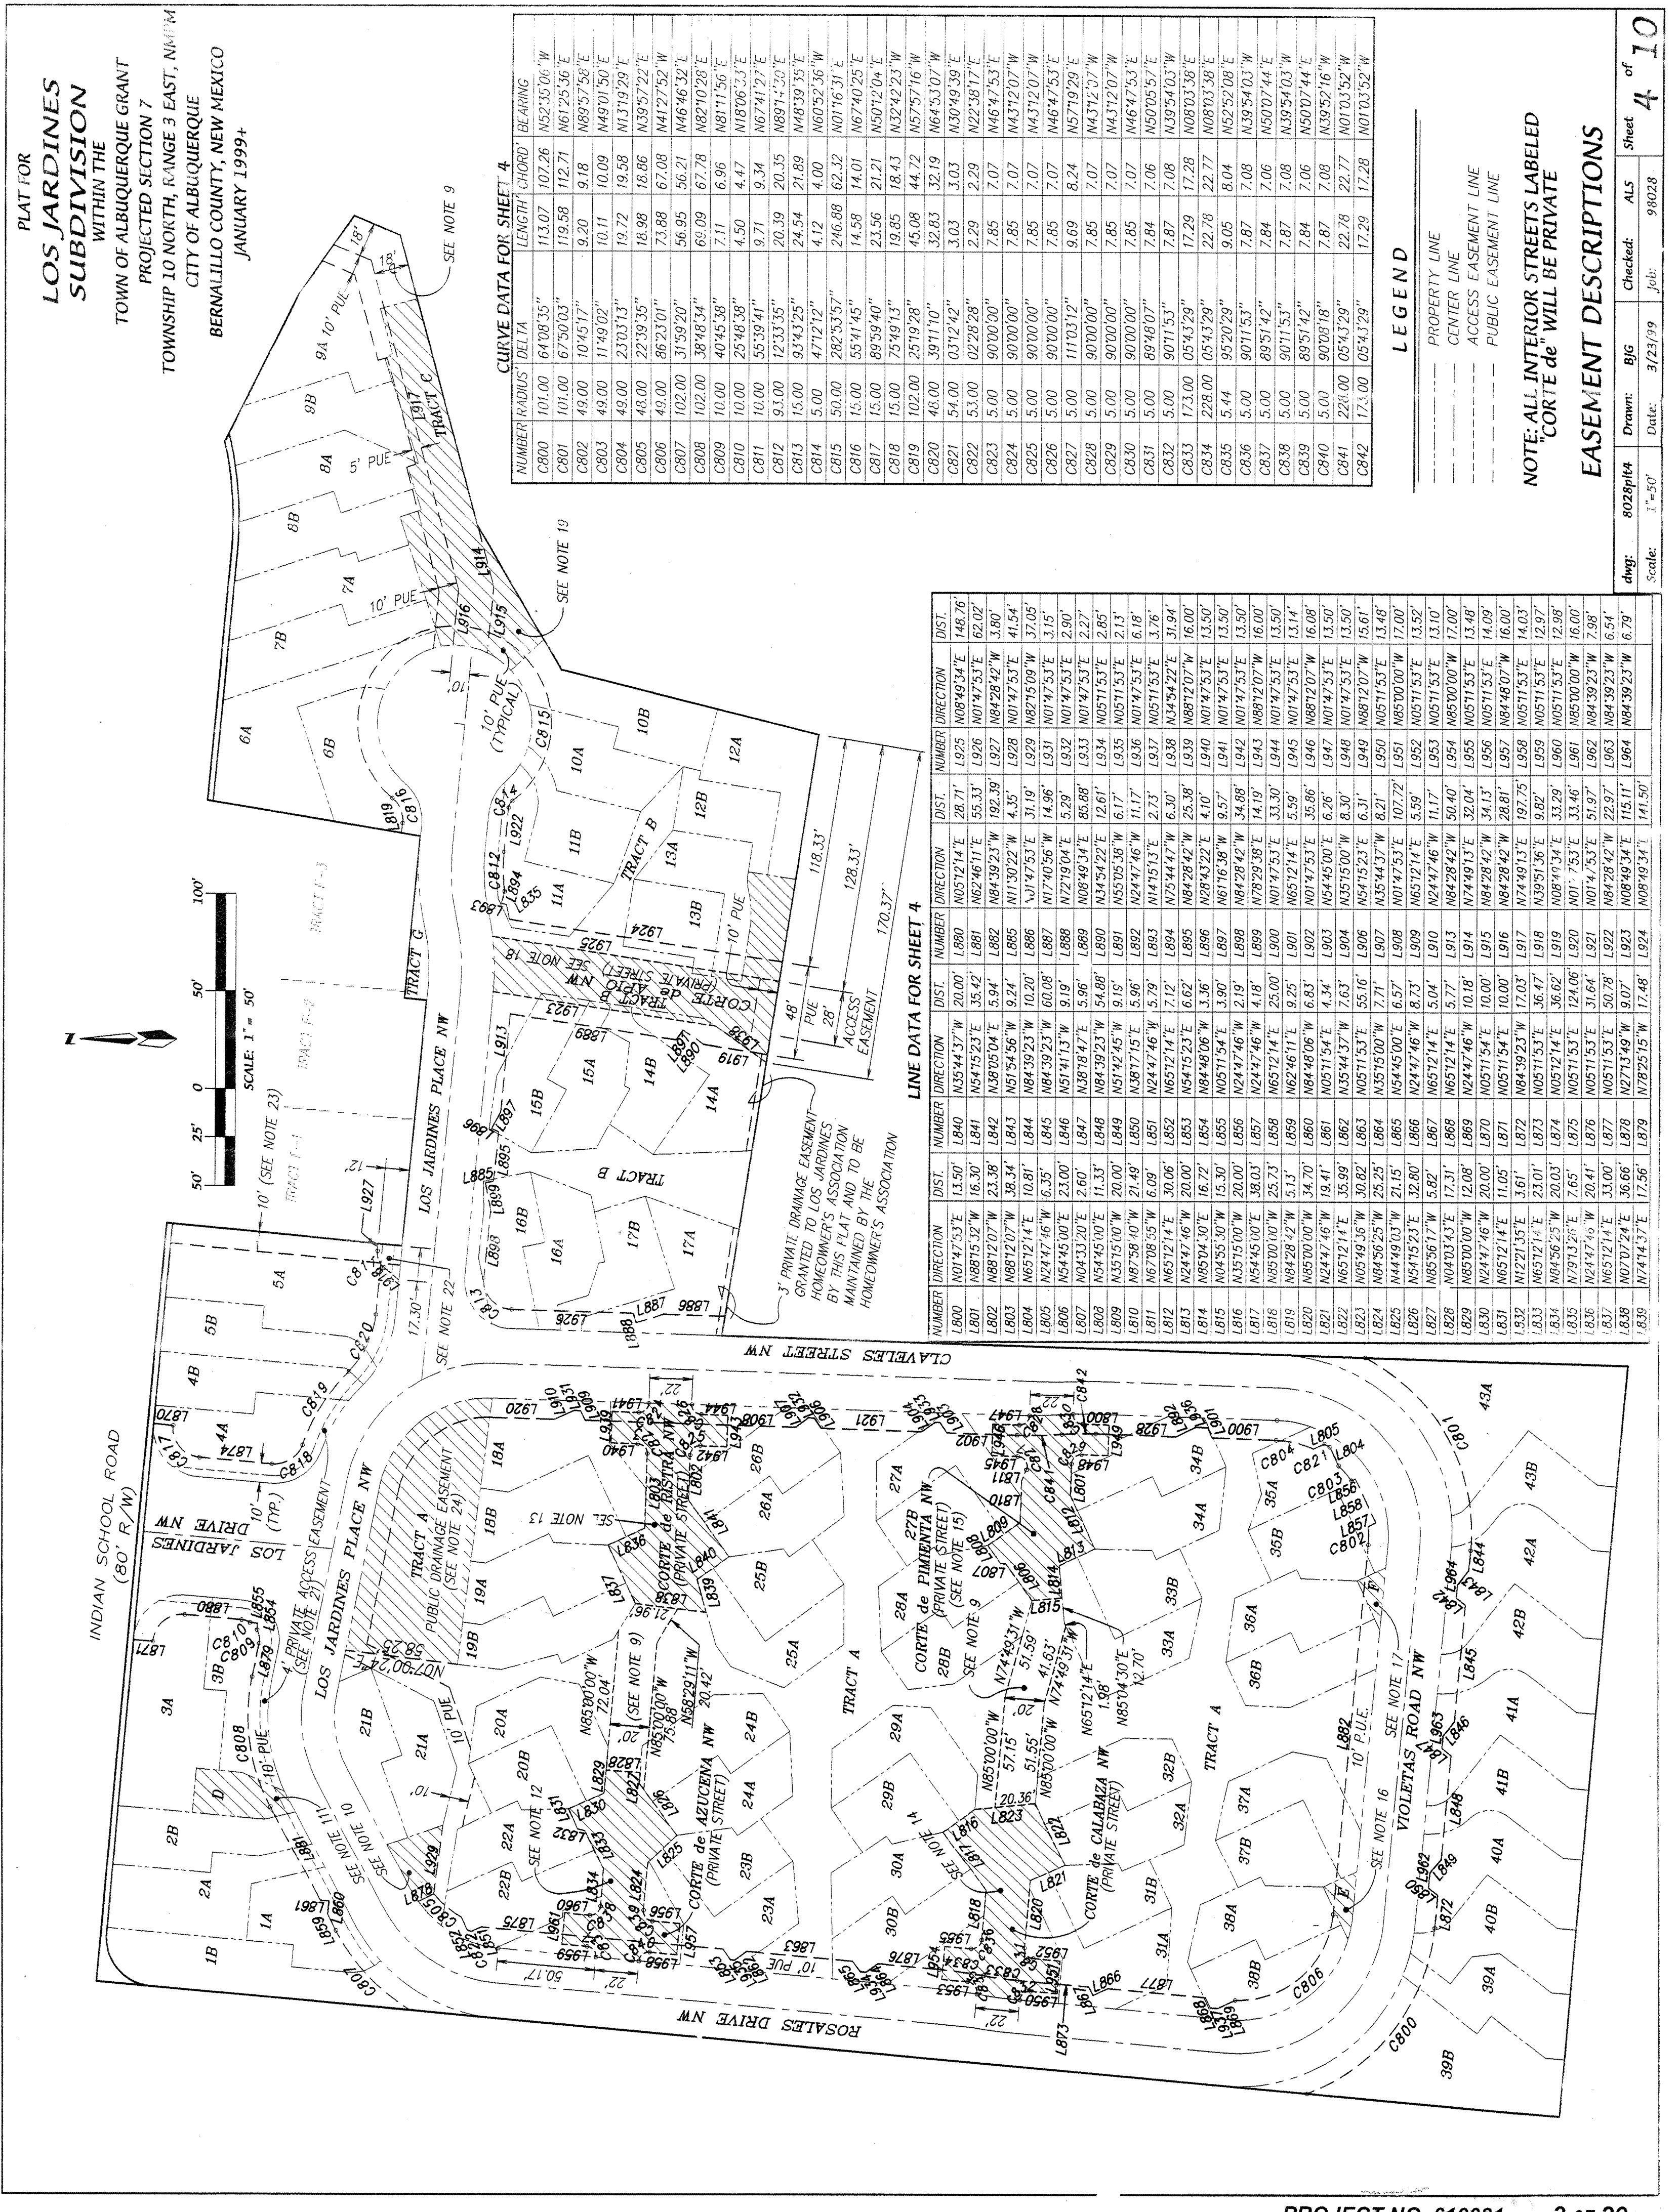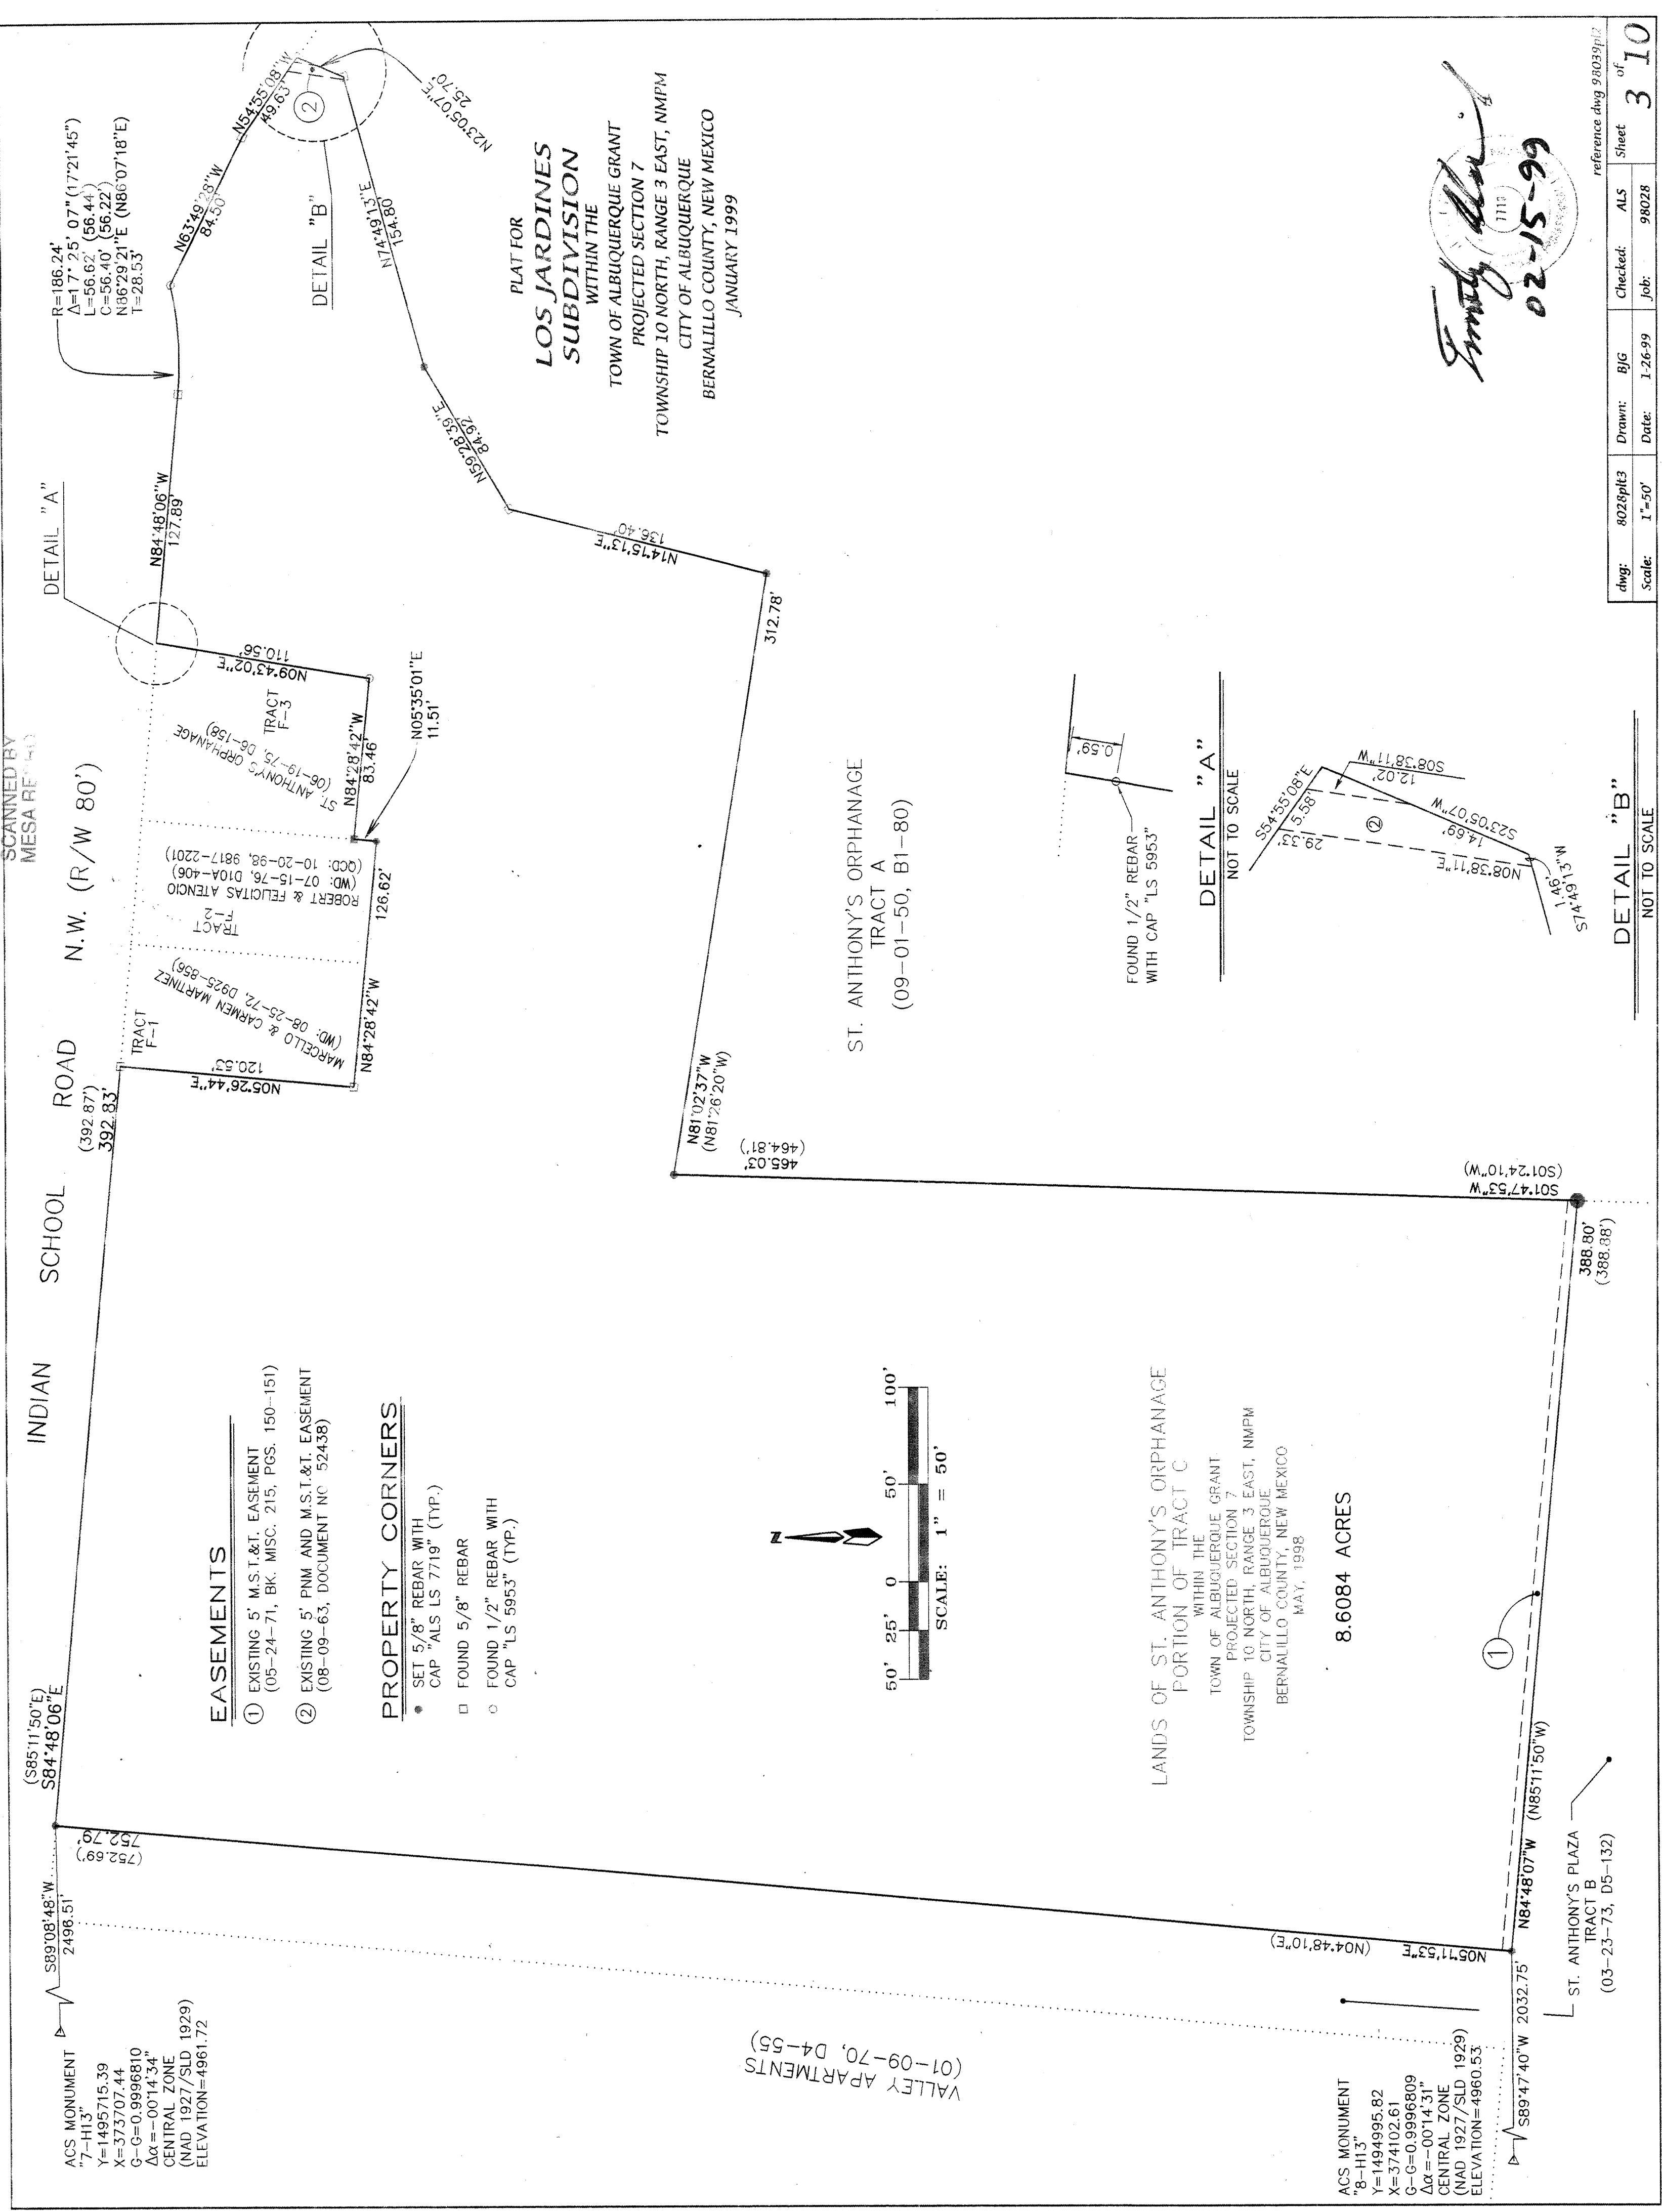


LINE DATA FOR SHEET 5		
NUMBER	DIRECTION	DISTANCE
L1	N81°11.08'W	5.97'
L2	N71°48.52'E	11.50'
L3	N71°48.52'E	11.50'
L4	N71°48.52'E	8.63'
L5	N41°09.37'W	4.86'
L6	N71°48.52'E	5.00'
L7	N81°11.08'W	8.00'
L8	N71°48.52'E	5.00'
L9	N80°59.16'W	0.44'
L10	N80°59.16'W	15.00'
L11	N41°15.13'E	9.34'
L12	N81°10.26'W	4.69'
L13	N61°16.38'W	8.17'
L14	N80°59.16'W	8.00'
L15	N80°59.16'W	

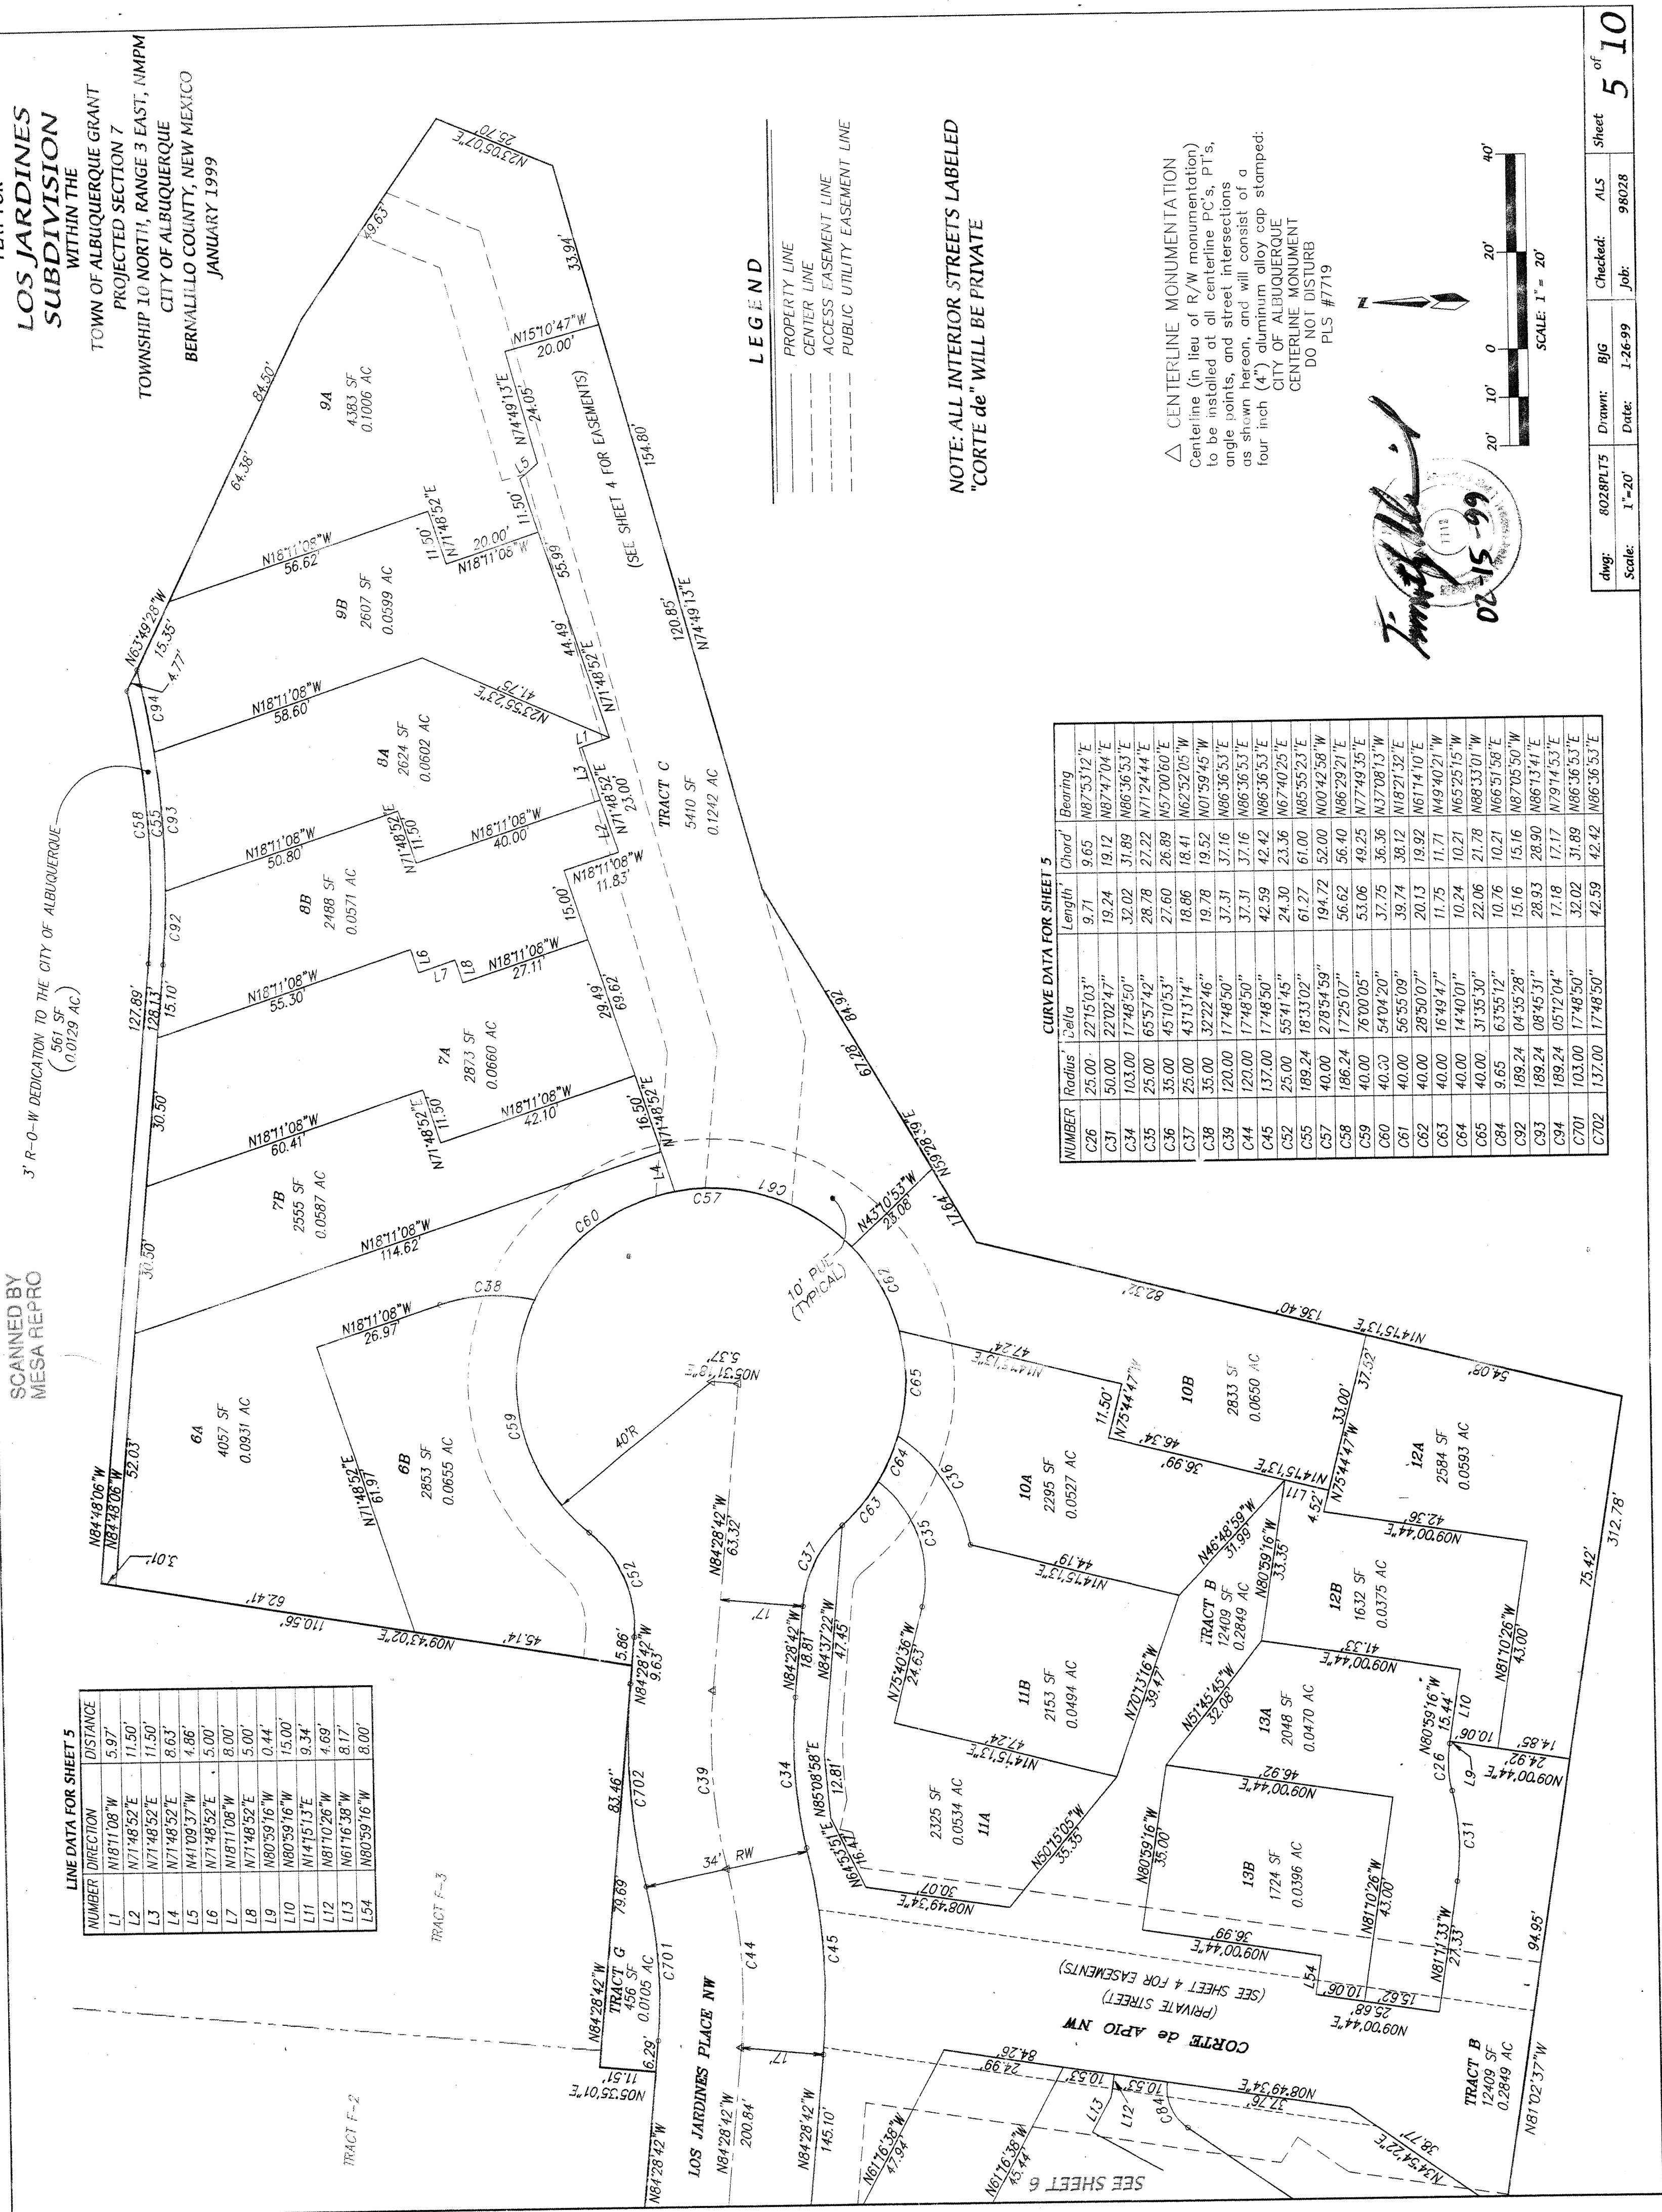

NOTE: ALL INTERIOR STREETS LABELED
"CORTE de" WILL BE PRIVATE

Δ CENTERLINE MONUMENTATION
 centerline (in lieu of R/W monumentation)
 can be installed at all centerline P.C.'s, P.T.'s,
 angle points, and street intersections
 as shown here, and will consist of a
 four inch (4") aluminum alloy cap stamped:
 CITY OF ALBUQUERQUE
 CENTERLINE MONUMENT
 DO NOT DISTURB
 PLS #7719

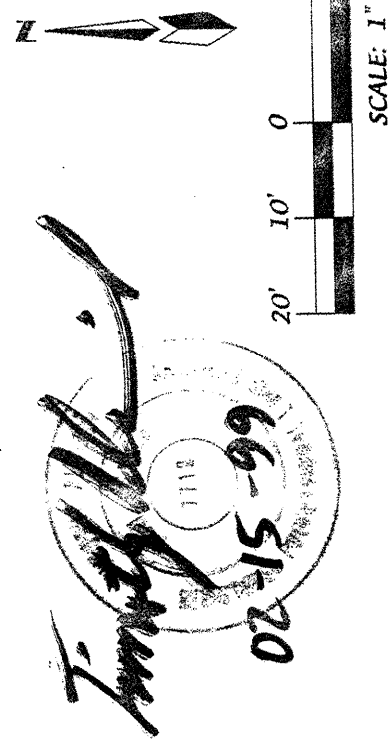

CURVE DATA FOR SHEET 5				Chord		Bearing
NUMBER	Radius	Delta	Length	Chord		
C26	25.00	2720.513"	9.71	9.65	N67°53.12"E	
C31	50.00	2702.947"	19.74	19.12	N67°40.74"E	
C33	103.00	1740.952"	32.02	31.69	N66°36.53"E	
C35	65.57	1740.952"	28.78	27.22	N71°24.44"E	
C36	35.00	457.053"	27.60	26.69	N67°00.60"E	
C37	25.00	432.114"	18.86	18.41	N62°52.85"W	
C38	35.00	332.2246"	19.78	19.52	N61°59.45"W	
C39	120.00	1748.500"	37.31	37.16	N66°36.53"E	
C44	120.00	1748.500"	37.31	37.16	N66°36.53"E	
C45	137.00	1748.500"	42.59	42.36	N67°40.75"E	
C46	25.00	55.9145"	24.30	23.62	N67°40.75"E	
C48	189.24	1811.029"	61.27	62.00	N65°55.23"E	
C57	40.00	728.9459"	194.72	52.00	N64°02.58"W	
C58	166.24	1725.077"	56.62	56.40	N68°29.21"E	
C59	40.00	767.005"	53.06	49.25	N77°49.35"W	
C60	40.30	5494.200"	37.75	36.36	N83°08.13"W	
C61	40.00	565.509"	39.74	38.12	N81°21.32"E	
C62	40.00	285.007"	20.13	19.92	N67°14.10"E	
C63	40.00	1649.474"	11.75	11.71	N49°40.21"W	
C64	40.00	1440.001"	10.24	10.21	N65°25.15"E	
C65	40.00	3135.300"	22.06	21.78	N68°33.01"W	
C68	9.55	635.9512"	10.76	10.21	N68°33.01"W	
C82	189.24	1811.029"	56.62	56.40	N68°29.21"E	
C83	189.24	1811.029"	28.83	28.80	N65°13.41"E	
C94	189.24	1811.029"	17.18	17.17	N79°14.53"E	
C701	137.00	1748.500"	32.02	31.69	N66°36.53"E	
C702	137.00	1748.500"	42.59	42.42	N67°40.75"E	

dwg:	8028PLT5	Drawn:	BJG	Checked:	ALS	Sheet	5 of 10
Scale:	1"=20'	Date:	1-26-99	Job:	98028		

INDIAN SCHOOL ROAD
(80' R-O-W)


LINE DATA FOR SHEET 6

[illegible]

CURVE DATA FOR SHEET 6

NUMBER	RAJES	Delta	Length	Chord
C24	25.00	55.69.13"	33.08	30.72
C25	25.00	55.69.13"	33.08	30.72
C26	22.17	16.30	52.07.46"	15.01
C27	25.00	55.69.13"	33.08	30.72
C28	25.00	55.69.13"	33.08	30.72
C29	25.00	55.69.13"	33.08	30.72
C30	25.00	55.69.13"	33.08	30.72
C31	25.00	55.69.13"	33.08	30.72
C32	25.00	55.69.13"	33.08	30.72
C33	103.03	17.48.50"	32.02	31.89
C34	25.00	55.69.13"	33.08	30.72
C35	25.00	55.69.13"	33.08	30.72
C36	35.00	32.22.46"	18.78	19.52
C37	35.00	32.22.46"	18.78	19.52
C38	35.00	32.22.46"	18.78	19.52
C39	120.00	17.48.50"	37.31	37.16
C40	120.00	17.48.50"	37.31	37.16
C41	120.00	17.48.50"	37.31	37.16
C42	120.00	17.48.50"	37.31	37.16
C43	120.00	17.48.50"	37.31	37.16
C44	120.00	17.48.50"	37.31	37.16
C45	137.00	17.48.50"	42.59	42.42
C46	137.00	17.48.50"	42.59	42.42
C47	137.00	17.48.50"	42.59	42.42
C48	137.00	17.48.50"	42.59	42.42
C49	92.00	25.19.28"	106.05	96.64
C50	92.00	25.19.28"	106.05	96.64
C51	75.00	55.69.15"	24.30	23.36
C52	25.00	55.69.15"	39.27	36.35
C53	25.00	55.69.15"	39.27	36.35
C54	25.00	55.69.15"	39.27	36.35
C55	25.00	55.69.15"	39.27	36.35
C56	92.00	25.19.28"	106.05	96.64
C57	92.00	25.19.28"	106.05	96.64
C95				

PLAT FOR
**LOS JARDINES
SUBDIVISION**
WITHIN THE
TOWN OF ALBUQUERQUE GRANT
PROJECTED SECTION 7
TOWNSHIP 10 NORTH, RANGE 3 EAST, N. 1
CITY OF ALBUQUERQUE
BERNALILLO COUNTY, NEW MEXICO
JANUARY 1999

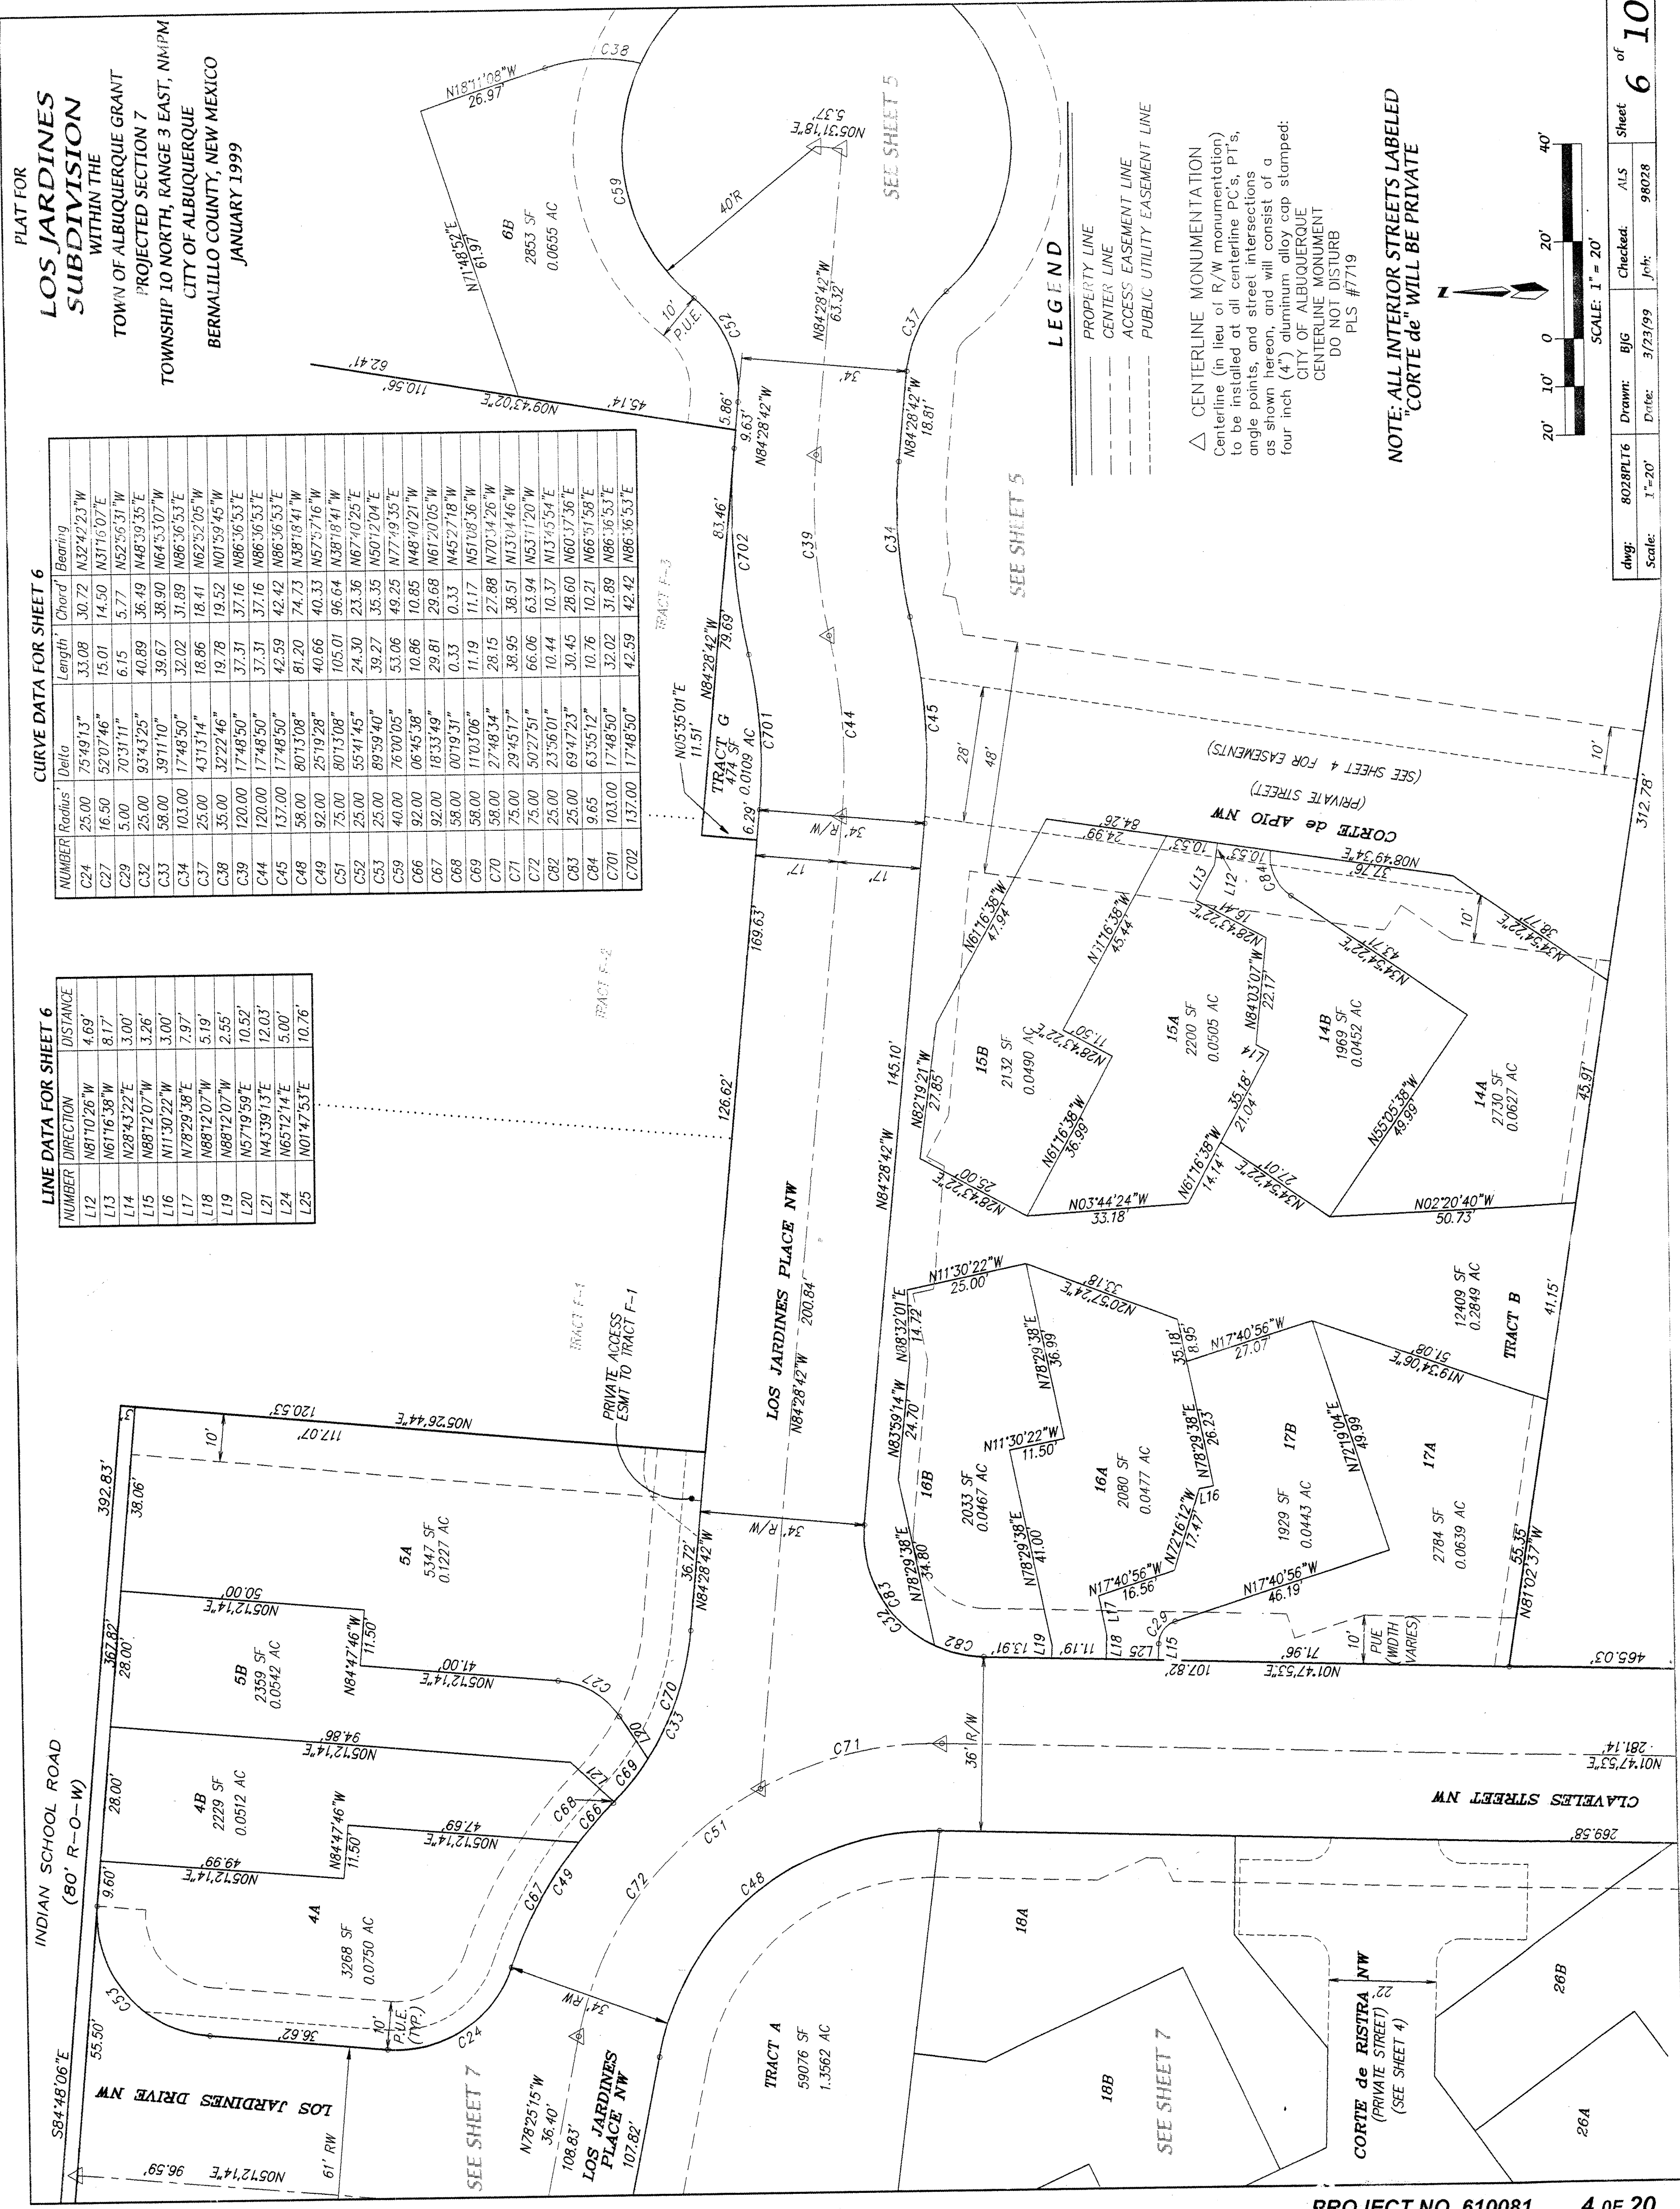

NOTE: ALL INTERIOR STREETS LABELED
"CORTE de" WILL BE PRIVATE

dwg:	8028PLT'6	Drawn:	BJG	Checked:	ALS	Sheet 6 of 10
Scale:	1"=20'	Date:	3/23/99	Job:	98028	

SCANNED BY
MESA REPRO


PLAT FOR
LOS JARDINES
SUBDIVISION

WITHIN THE
 TOWN OF ALBUQUERQUE GRANT
 PROJECTED SECTION 7
 TOWNSHIP 10 NORTH, RANGE 3 EAST, N104PM
 CITY OF ALBUQUERQUE
 BERNALILLO COUNTY, NEW MEXICO
 JANUARY 1999

LEGEND

—————	PROPERTY LINE
—————	CENTER LINE
—————	ACCESS EASEMENT LINE
—————	PUBLIC UTILITY EASEMENT LINE

NOTE: ALL INTERIOR STREETS LABELED "CORTE de" WILL BE PRIVATE

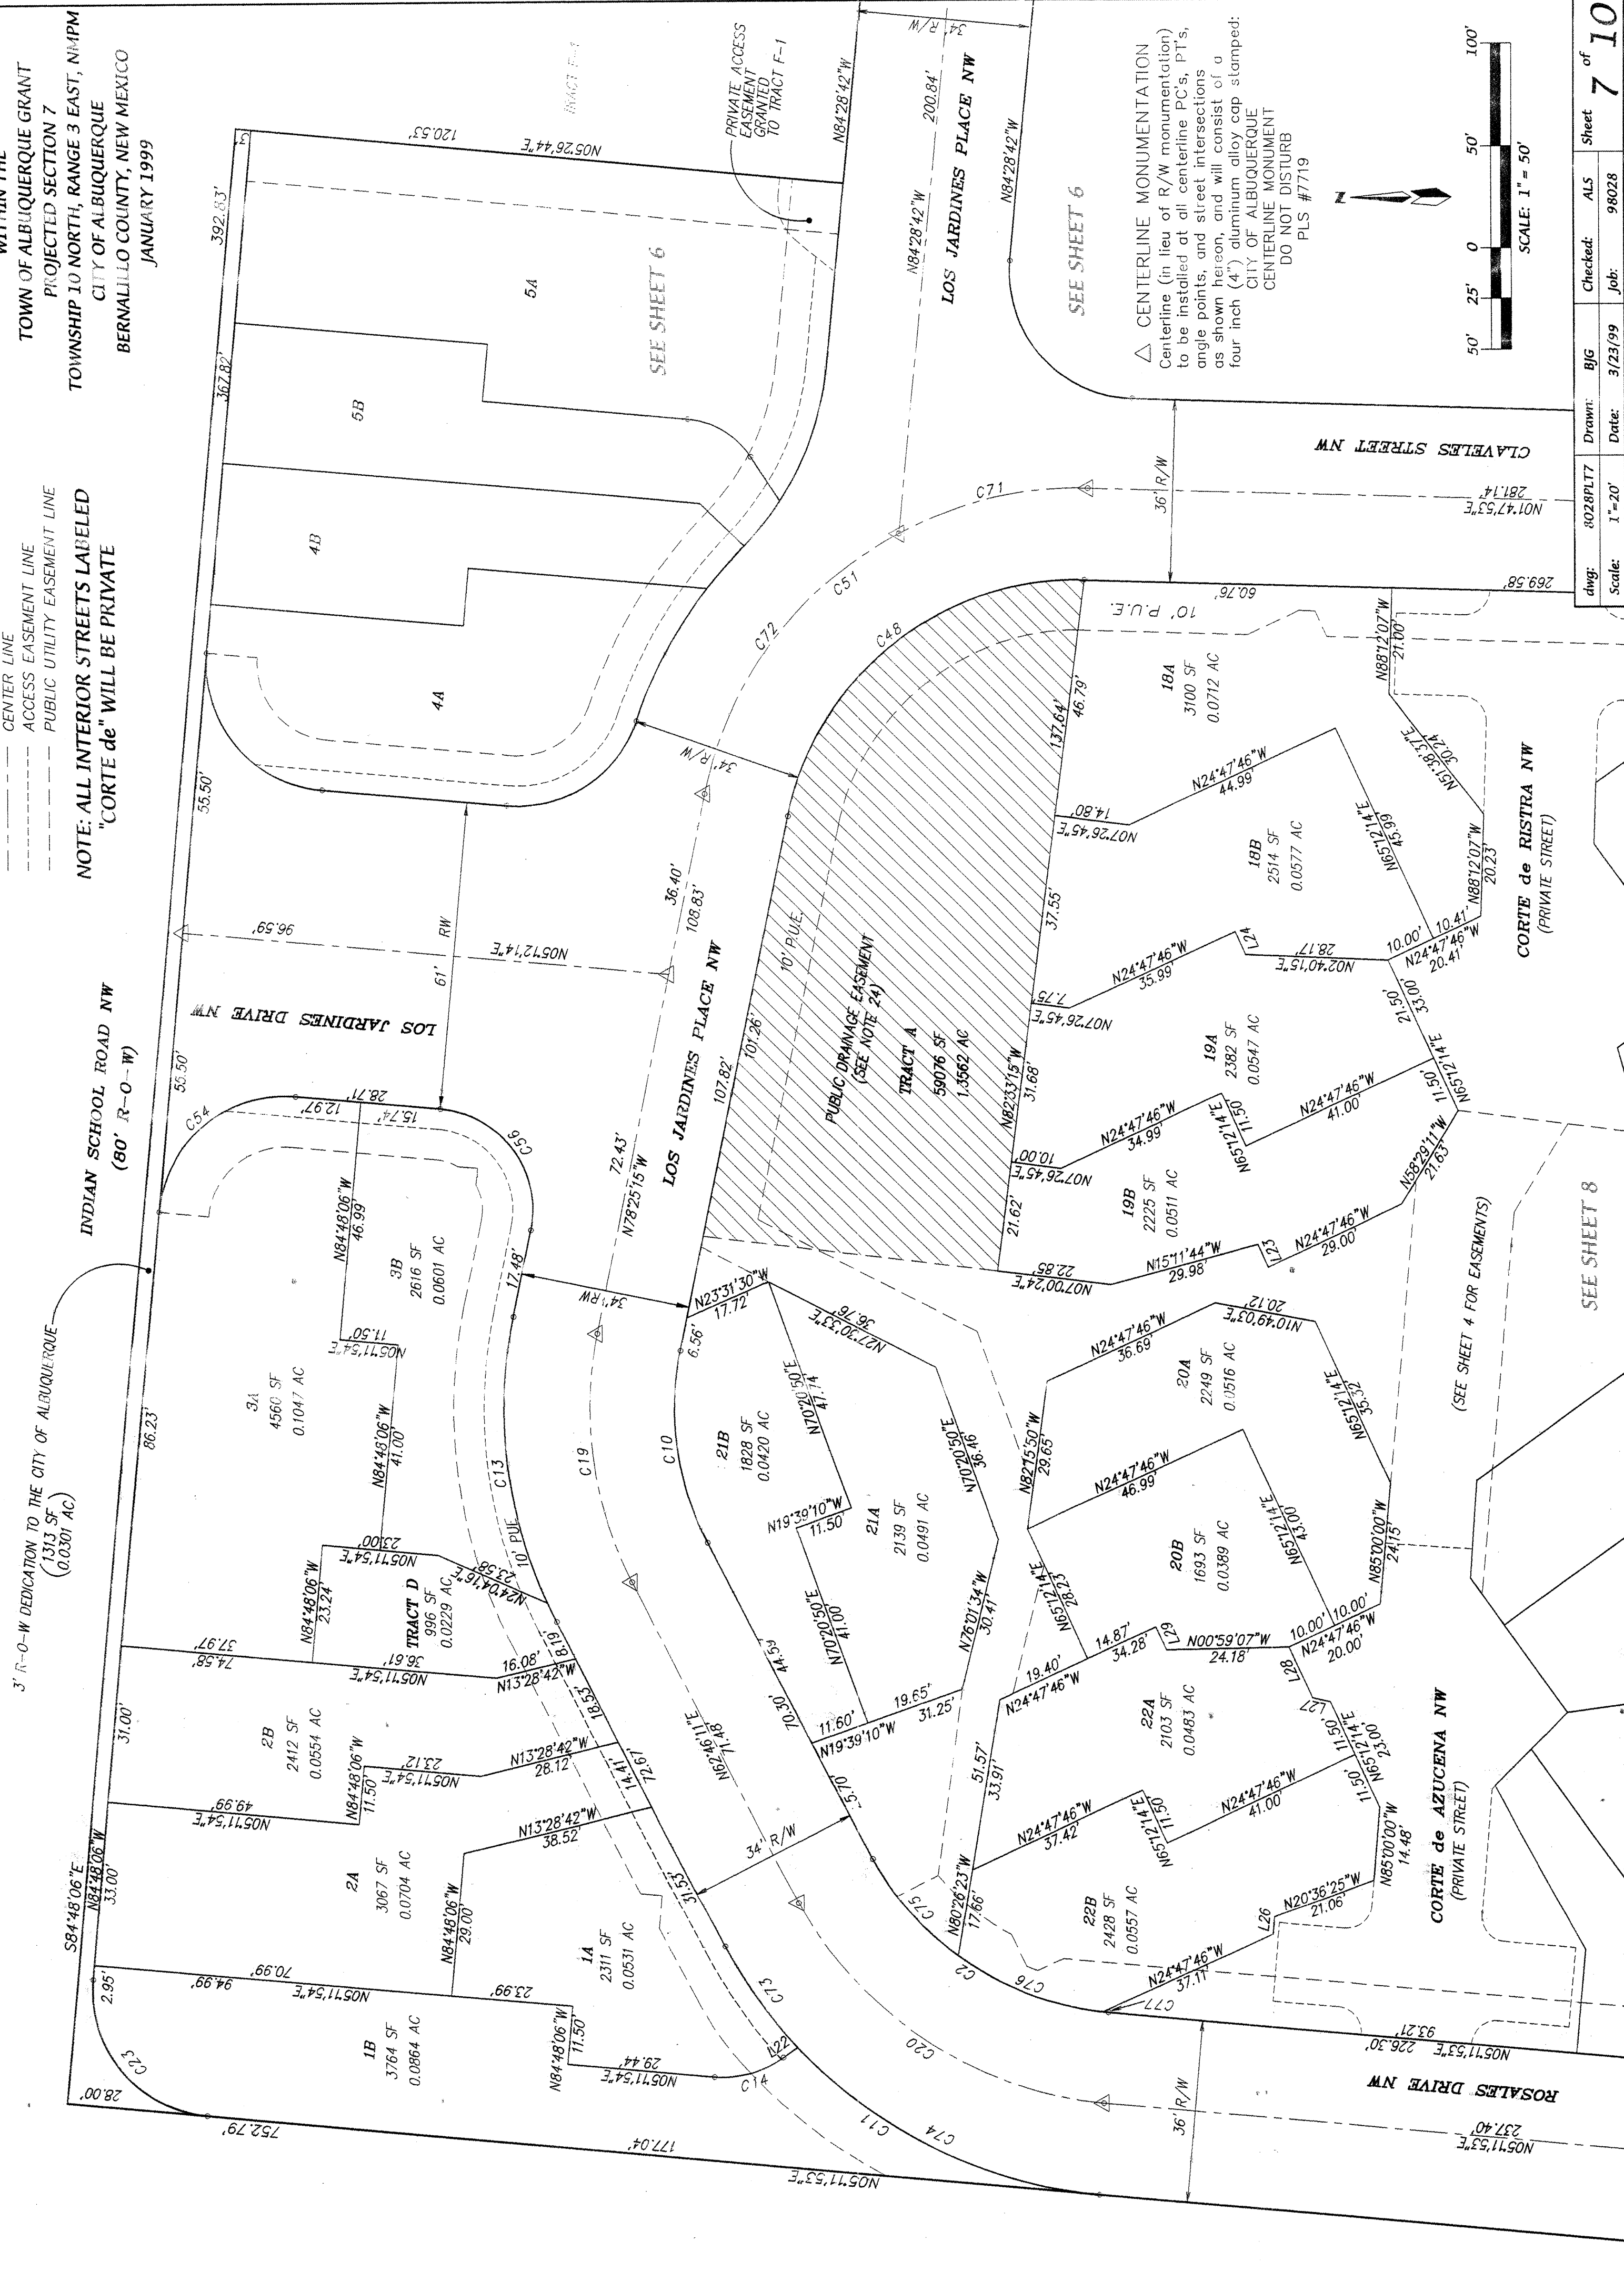

dwg:	3028PLT7	Drawn:	BjG	Checked:	ALS	Sheet of 7 10
Scale:	1"=20'	Date:	3/23/99	Job:	98028	

PLAT FOR
**LOS JARDINES
SUBDIVISION**
WITHIN THE
TOWN OF ALBUQUERQUE GRANT
PROJECTED SECTION 7
TOWNSHIP 10 NORTH, RANGE 3 EAST, NMPH
CITY OF ALBUQUERQUE
BERNALILLO COUNTY, NEW MEXICO
JANUARY 1999

LEGEND

————	PROPERTY LINE
————	CENTER LINE
-----	ACCESS EASEMENT LINE
-----	PUBLIC UTILITY EASEMENT LINE

NOTE: ALL INTERIOR STREETS LABELED "CORTEO de" WILL BE PRIVATE



dwg:	8028PLT8	Drawn: BJG	Checked: ALS	Sheet 8 of 10
Scale:	1"=20'	Date: 3/23/99	Job: 98028	

CURVE DATA FOR SHEET 7

Number	Radius	Delta	Length	Chord	Bearing
C2	58.00	57°34'18"	58.28	55.86	N33°59'02"E
C10	58.00	38°48'34"	39.29	38.54	N82°10'28"E
C11	92.00	57°34'18"	92.44	88.60	N33°59'02"E
C13	92.00	38°48'34"	62.32	61.13	N82°10'28"E
C14	20.00	41°36'25"	14.52	14.21	N55°36'19"W
C19	75.00	38°48'34"	50.80	49.84	N82°10'28"E
C20	75.00	57°34'18"	75.36	72.23	N33°59'02"E
C23	25.00	90°00'01"	39.27	35.36	N50°11'54"E
C48	58.00	80°13'08"	81.20	74.73	N36°18'41"W
C51	75.00	80°13'08"	105.01	96.64	N36°18'41"W
C54	25.00	90°00'20"	39.27	35.36	N50°11'54"E
C56	20.00	96°22'32"	33.64	29.81	N53°23'30"E
C71	75.00	29°45'17"	38.95	38.51	N37°04'46"W
C72	75.00	50°27'51"	66.06	63.94	N57°11'20"W
C73	92.00	15°25'07"	24.76	24.68	N65°03'38"E
C74	92.00	42°09'11"	67.69	66.17	N26°16'29"E
C75	58.00	25°36'43"	25.83	25.71	N49°51'50"E
C76	58.11	30°55'30"	31.37	30.99	N21°40'51"E
C77	56.36	07°00'01"	0.99	0.99	N05°11'53"E

LINE DATA FOR SHEET 7

NUMBER	DIRECTION	DISTANCE
L22	N65°24'31"W	3.47
L23	N65°12'14"E	5.00'
L24	N65°12'14"E	5.00'
L26	N65°00'00"W	3.48
L27	N72°21'35"E	3.61
L28	N65°12'14"E	11.05'
L29	N65°12'14"E	5.00'

CURVE DATA FOR SHEET 8

NUMBER	Radius	Delta	Length	Chord	Bearing
C16	200.00	04°03'08"	14.15	14.14	N07°13'27"E
C17	200.00	04°03'08"	14.15	14.14	N07°13'27"E
C18	75.00	89°51'16"	117.62	105.93	N39°43'45"W
C21	183.00	05°43'29"	18.28	18.28	N08°03'38"E
C22	218.00	05°43'29"	21.78	21.77	N08°03'38"E
C40	200.00	04°03'08"	14.15	14.14	N00°13'11"W
C41	200.00	04°03'08"	14.15	14.14	N00°13'11"W
C42	183.00	05°43'29"	18.28	18.28	N01°03'52"W
C43	218.00	05°43'29"	21.78	21.77	N01°03'52"W
C78	59.00	77°42'22"	80.02	74.02	N33°39'18"W

LINE DATA FOR SHEET 8


NUMBER	DIRECTION	DISTANCE
L30	N64°15'21"E	5.00'
L31	N64°46'00"E	5.00'
L32	N04°33'20"E	2.60'
L33	N64°45'00"E	5.00'
L34	N64°45'00"E	17.33'
L35	N68°12'07"W	6.47'
L35	N65°12'14"E	5.00'

PRELIMINARY
PLAT FOR
**LOS JARDINES
SUBDIVISION**
WITHIN THE
TOWN OF ALBUQUERQUE GRANT
PROJECTED SECTION 7
TOWNSHIP 10 NORTH, RANGE 3 EAST, NMPM
CITY OF ALBUQUERQUE
BERNALILLO COUNTY, NEW MEXICO
JANUARY 1999

CURVE DATA & LINE DATA

dwg:	8028PL10	Drawn:	BIG	Checked:	ALS	Sheet:	10
Scale:	1"=50'	Date:	1-26-99	Job:	98028	of	10

Timothy L. ...
02-15-99

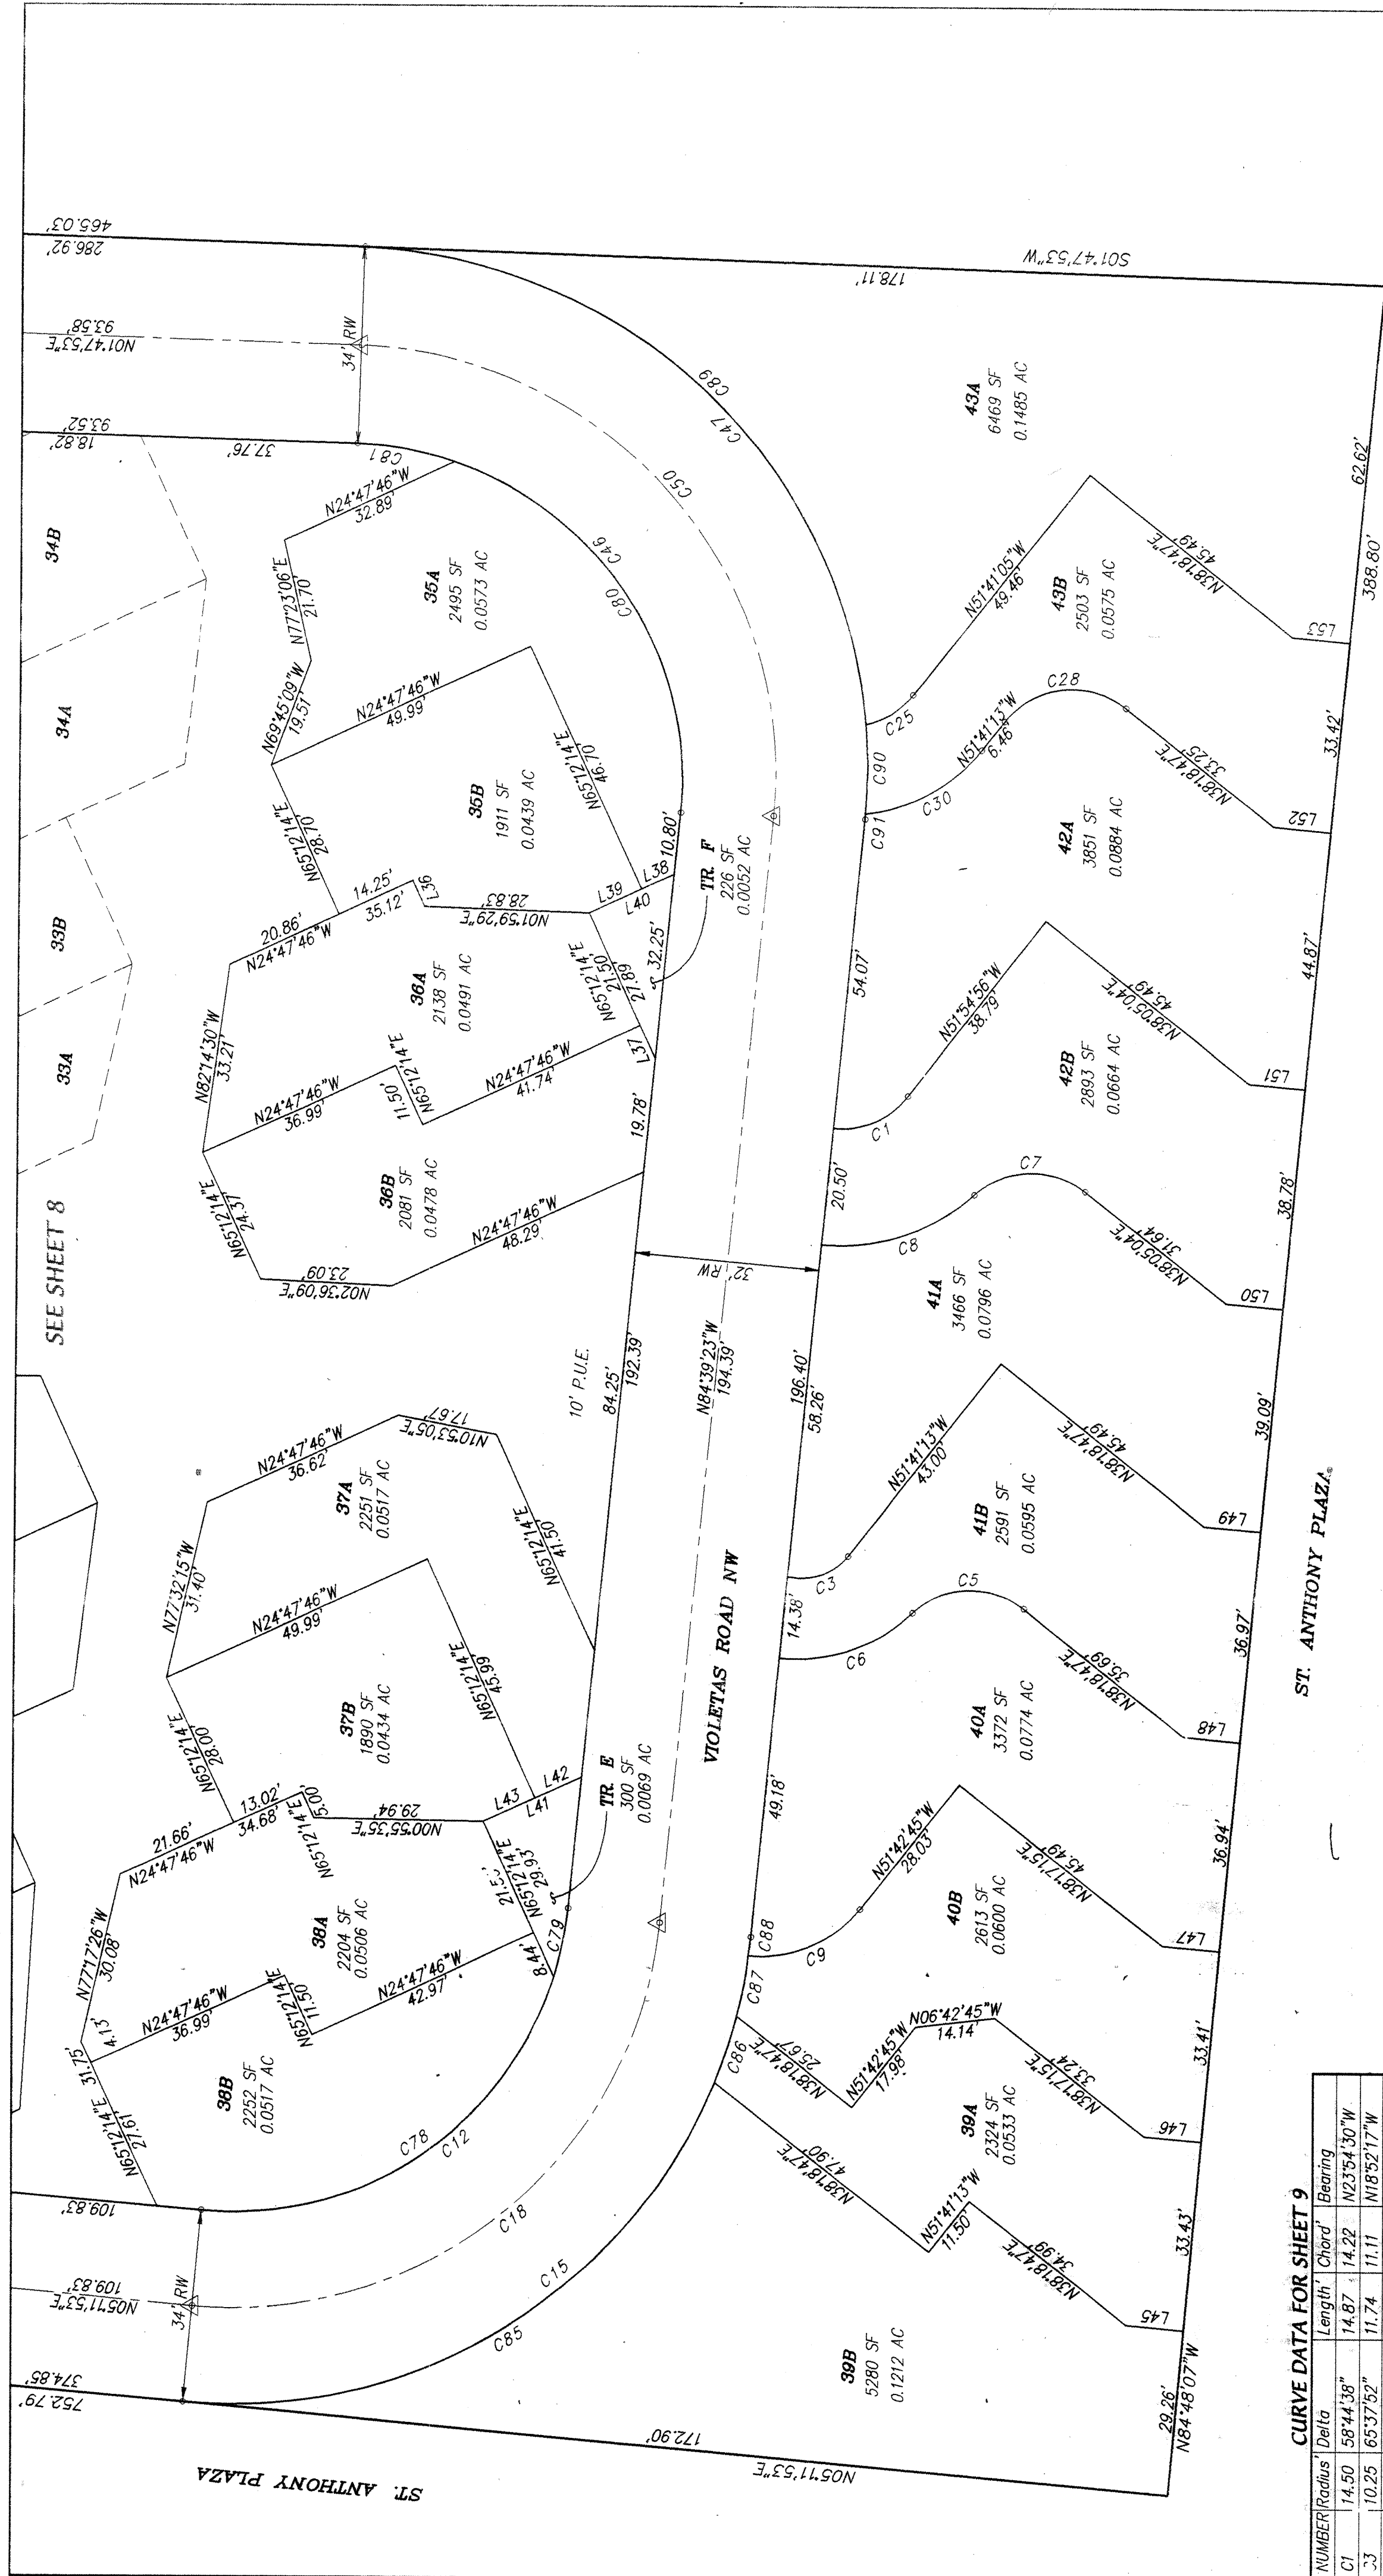

CURVE DATA FOR SHEET 9

NUMBER	Radius	Delta	Length	Chord	Bearing
C1	14.50	58°44'38"	14.87	14.22	N23°54'30"W
C3	10.25	65°57'52"	11.74	11.11	N18°52'17"W
C5	15.00	81°21'60"	21.30	19.56	N02°22'13"W
C6	30.00	48°27'19"	25.37	24.62	N16°49'14"W
C7	15.00	80°11'39"	20.99	19.32	N02°00'46"W
C8	35.00	47°30'11"	29.02	28.19	N16°21'30"W
C9	22.00	57°19'24"	21.97	21.06	N23°09'23"W
C12	59.00	85°57'16"	92.53	83.53	N33°43'45"W
C15	91.00	88°57'16"	142.71	128.53	N39°43'45"W
C18	75.00	88°57'16"	117.62	105.93	N39°43'45"W
C25	15.00	39°14'44"	9.93	9.74	N32°03'51"W
C28	15.00	90°00'00"	23.56	21.21	N06°41'13"W
C30	59.00	45°38'40"	66.33	65.98	N46°34'15"E
C36	59.00	93°32'44"	148.57	132.61	N46°34'15"E
C50	75.00	93°32'44"	122.45	109.30	N46°34'15"E
C79	59.00	77°42'22"	80.02	74.02	N33°39'18"W
C81	59.00	12°08'54"	12.51	12.49	N76°34'56"W
C82	59.00	76°32'26"	78.82	73.09	N57°04'24"E
C84	59.00	17°00'16"	17.51	17.45	N10°18'02"E
C85	91.00	72°00'42"	116.49	108.70	N12°29'24"W
C86	91.00	07°43'58"	12.27	12.26	N72°00'35"W
C87	91.00	08°42'20"	10.65	10.64	N79°15'31"W
C88	91.00	02°04'42"	3.30	3.30	N63°57'02"W
C89	91.00	05°04'20"	131.94	120.68	N42°20'03"E
C90	91.00	08°52'47"	15.69	15.67	N69°48'36"E
C91	91.00	00°35'38"	0.94	0.94	N84°57'12"W


LINE DATA FOR SHEET 9

NUMBER	DIRECTION	DISTANCE
L36	N65°12'14"E	5.00'
L37	N65°12'14"E	6.39'
L38	N24°47'46"W	6.19'
L39	N24°47'46"W	10.00'
L40	N24°47'46"W	16.19'
L41	N24°47'46"W	18.86'
L42	N24°47'46"W	8.86'
L43	N24°47'46"W	10.00'
L45	N05°11'53"E	10.00'
L46	N05°11'53"E	10.00'
L47	N05°11'53"E	10.00'
L48	N05°11'53"E	10.00'
L49	N05°11'53"E	10.00'
L50	N05°11'53"E	10.00'
L51	N05°11'53"E	9.84'
L52	N05°11'53"E	10.00'
L53	N05°11'53"E	10.00'

△ CENTERLINE MONUMENTATION
Centerline (in lieu of R/W monumentation)
to be located at all centerline P.C.s, P.T.s,
single points, and all intersections
as shown hereon, and will consist of a
four inch (4") aluminum alloy cap stamped:
CITY OF ALBUQUERQUE
CENTERLINE MONUMENT
DO NOT DISTURB
PLS #7719

PLAT FOR
**LOS JARDINES
SUBDIVISION**
WITHIN THE
TOWN OF ALBUQUERQUE GRANT
PROJECTED SECTION 7
TOWNSHIP 10 NORTH, RANGE 3 EAST, NMPM
CITY OF ALBUQUERQUE
BERNALILLO COUNTY, NEW MEXICO
JANUARY 1999

Timothy L. ...
02-15-99

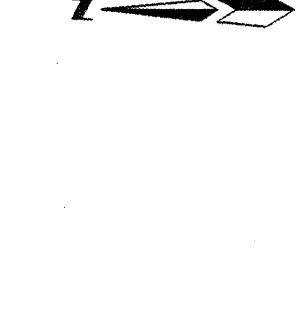

dwg:	8028PL19	Drawn:	BIG	Checked:	ALS	Sheet:	9
Scale:	1"=20'	Date:	1-26-99	Job:	98028	of	10

CONTRACTOR MUST OBTAIN A TOPSOIL DISTURBANCE PERMIT FROM THE ENVIRONMENTAL HEALTH DIVISION PRIOR TO CONSTRUCTION.

2. CITY OF ALBUQUERQUE STANDARD SPECIFICATIONS FOR
PUBLIC WORKS CONSTRUCTION, LATEST EDITION SHALL
1. GOVERN ALL WORK.

3. THE CONTRACTOR SHALL CONFORM TO ALL CITY, COUNTY, STATE AND FEDERAL DUST CONTROL MEASURES AND REQUIREMENTS AND WILL BE RESPONSIBLE FOR PREPARING AND OBTAINING ALL NECESSARY APPLICATIONS AND APPROVALS.

4. THE CONTRACTOR SHALL ENSURE THAT NO SOIL ERODES FROM THE LOTS INTO PUBLIC RIGHT-OF-WAY. THIS CAN BE ACHIEVED BY CONSTRUCTING TEMPORARY BERMS AS PER DTL. THIS SHT. AND WETTING THE SOIL TO KEEP IT FROM BLOWING.


5. THE EARTHWORK CONTACTOR SHALL STOCKPILE ENOUGH MATERIAL ADJACENT TO RETAINING WALL LOCATIONS TO BE UTILIZED FOR WALL BACKFILL.

6. A PERIMETER WALL WILL BE BUILT ALONG THE EXTERIOR PROPERTY LINES ON THE NORTH, WEST, EAST AND SOUTH SIDES.


7. ALL STORM DRAIN AND LATERALS ARE BUILT WITH REINFORCED CONCRETE PIPE.

8. ALL INLETS ON THIS PLAN ARE TYPE "A" INLETS
EXCEPT WHERE NOTED OTHERWISE.

	PRIVATE DRIVE (CRUSHER FINES)
	PRIVATE COURTYARDS
	PEDESTRIAN PATHWAY (CRUSHER FINES)
	PATTERNED CONCRETE CROSSING
	PORTAL AREA
	STRAW BALE/TUBULAR STEEL WALL/FLOODWALL
	FLOODWALL
	SETBACK LINE
	PROPERTY LINE
	EASEMENT LINE
	CENTERLINE
	LOT LINES
	INDIVIDUAL AND PRIVATE LIGHTING
	COURTYARD BENCH
	NEW SPOT ELEVATION
	WATER BLOCK
	FLOW DIRECTION
	SIDE SLOPES
	SITE BASIN

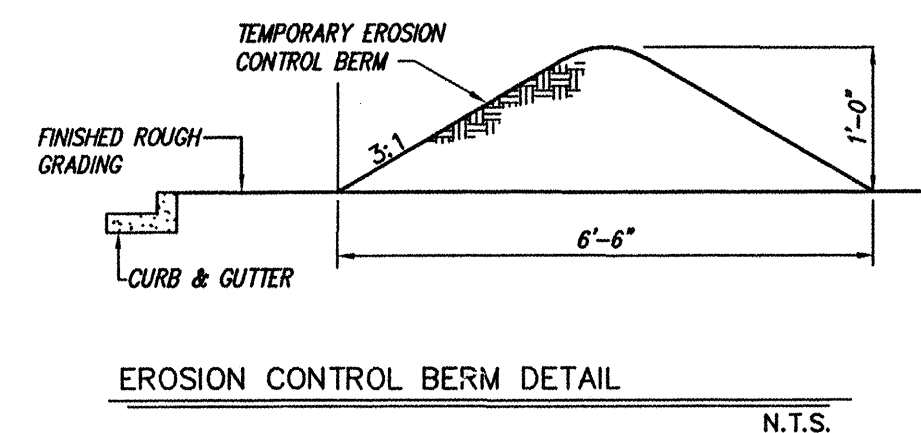

1. CONTRACTOR IS RESPONSIBLE FOR KEEPING ALL SEDIMENT OUT OF EXISTING RIGHT-OF-WAY.
2. CONTRACTOR IS RESPONSIBLE FOR CLEANING UP ANY SEDIMENT THAT GETS INTO EXISTING RIGHT-OF-WAY.
3. EROSION CONTROL BERMS ARE REQUIRED AROUND THE ENTIRE SITE.
4. ALL EROSION CONTROL BERMS MUST BE IN PLACE AND ENGINEER CERTIFIED PRIOR TO BUILDING PERMIT RELEASE.

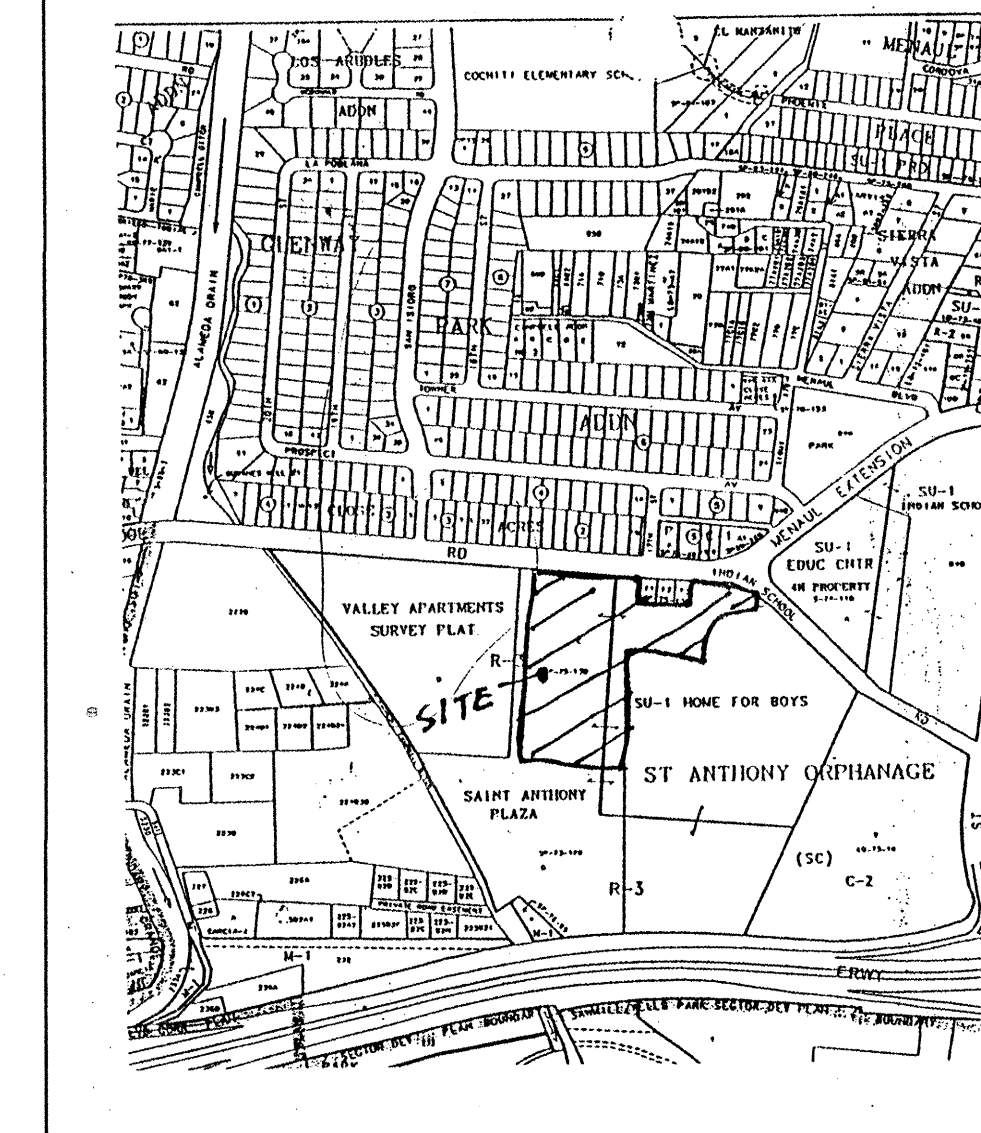

MAP NO. H-13

1. "AS BUILT SURVEYS MAY SHOW ACTUAL GRADE VARIATIONS OF $\pm 0.2'$; BASED UPON DESIGN GRADES; HOWEVER LOTS MUST DRAIN AS DESIGNED.

2. PORTALS ARE 0.50' BELOW FINISH PAD ELEVATION.


3. ALL PATIOS AND PORTALS AREAS SHOULD BE GRADED TO DRAIN AWAY FROM HOUSE AT A MINIMUM 0.6% SLOPE OR .08 INCHES/FOOT.

4. ALL SIDEYARD WALLS CONSTRUCTED MUST ALLOW RUNOFF TO PASS FREELY BETWEEN ADJACENT PROPERTIES AT ALL TIMES.


5. ALL SPILLWAYS WILL BE ARMORED WITH +4.0" DIAMETER ROCK.

STORM DRAIN MANHOLE, ELEVATION = 4962
(INDIAN SCHOOL ROAD)


LANDS OF ST. ANTHONY'S ORPHANAGE
TRACT C

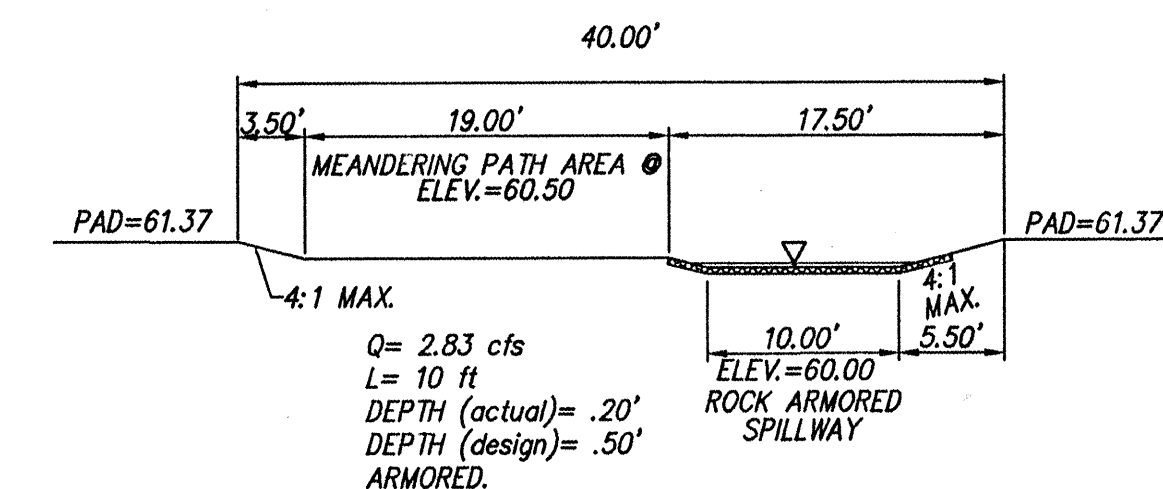


NOT TO SCALE

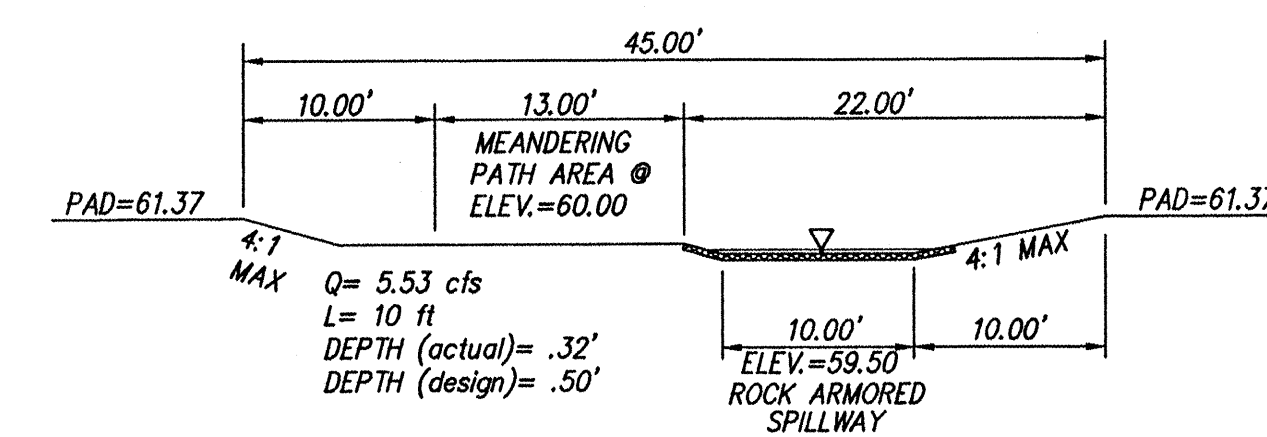

NOT TO SCALE

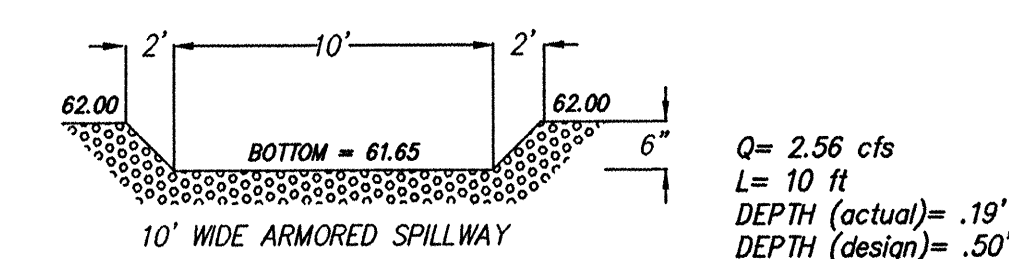


NOT TO SCALE

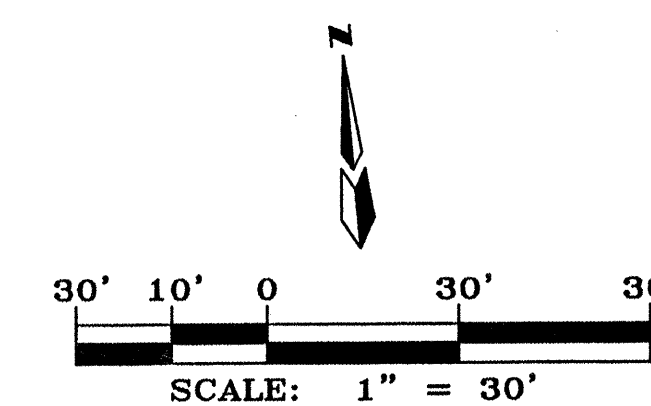



	MARK GOODWIN & ASSOCIATES, P.A. CONSULTING ENGINEERS								NO.	DAT.	DESIGNED BY DRAWN BY CHECKED BY
	P.O. BOX 90806 ALBUQUERQUE, NEW MEXICO 87199 (505) 828-2200, FAX (505) 797-9539										
 CITY OF ALBUQUERQUE PUBLIC WORKS DEPARTMENT ENGINEERING DEVELOPMENT GROUP											
TITLE: LOS JARDINES GRADING & DRAINAGE PLAN											
DESIGN REVIEW COMMITTEE		CITY ENGINEER APPROVAL		LAST DESIGN UPDATE	MO./DAY/YR.		MO./DAY/YR.				
											
CITY PROJECT NO. 610081				ZONE "A" NO. H - 13		SHEET		OF 20			





1. PORTALS ARE 0.50' BELOW FINISH PAD ELEVATION.
2. ALL PATIOS AND PORTALS AREAS SHOULD BE GRADED TO DRAIN AWAY FROM HOUSE AT A MINIMUM 0.6% SLOPE OR .08 INCHES/FOOT.
3. ALL SIDEYARD WALLS CONSTRUCTED MUST ALLOW RUNOFF TO PASS FREELY BETWEEN ADJACENT PROPERTIES AT ALL TIMES.
4. ALL SPILLWAYS WILL BE ARMORED WITH +4.0" DIAMETER ROCK.

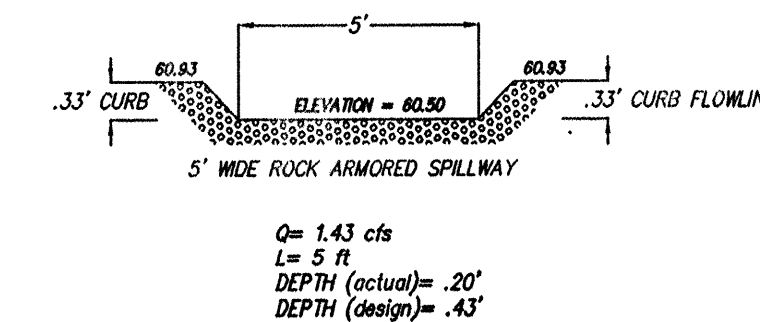



SECTION G-G: SUB-BASIN 7 SPILLWAY
NOT TO SCALE

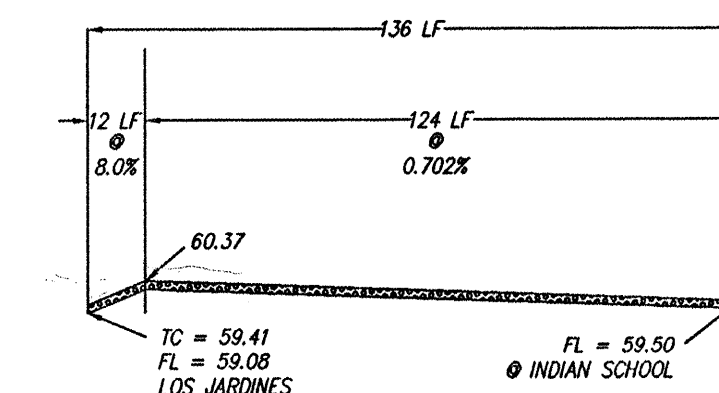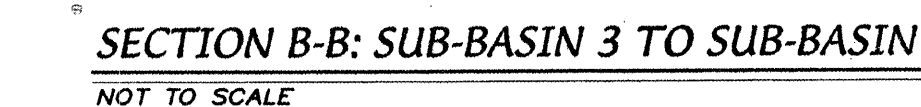


CONCRETE EMERGENCY SPILLWAY
CHANNEL PROFILE

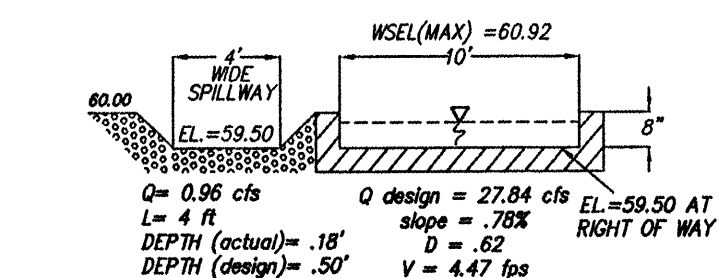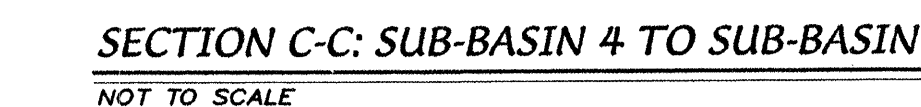

**SECTION F-F: CONCRETE EMERGENCY
SPILLWAY & SUB-BASIN 8 SPILLWAY**

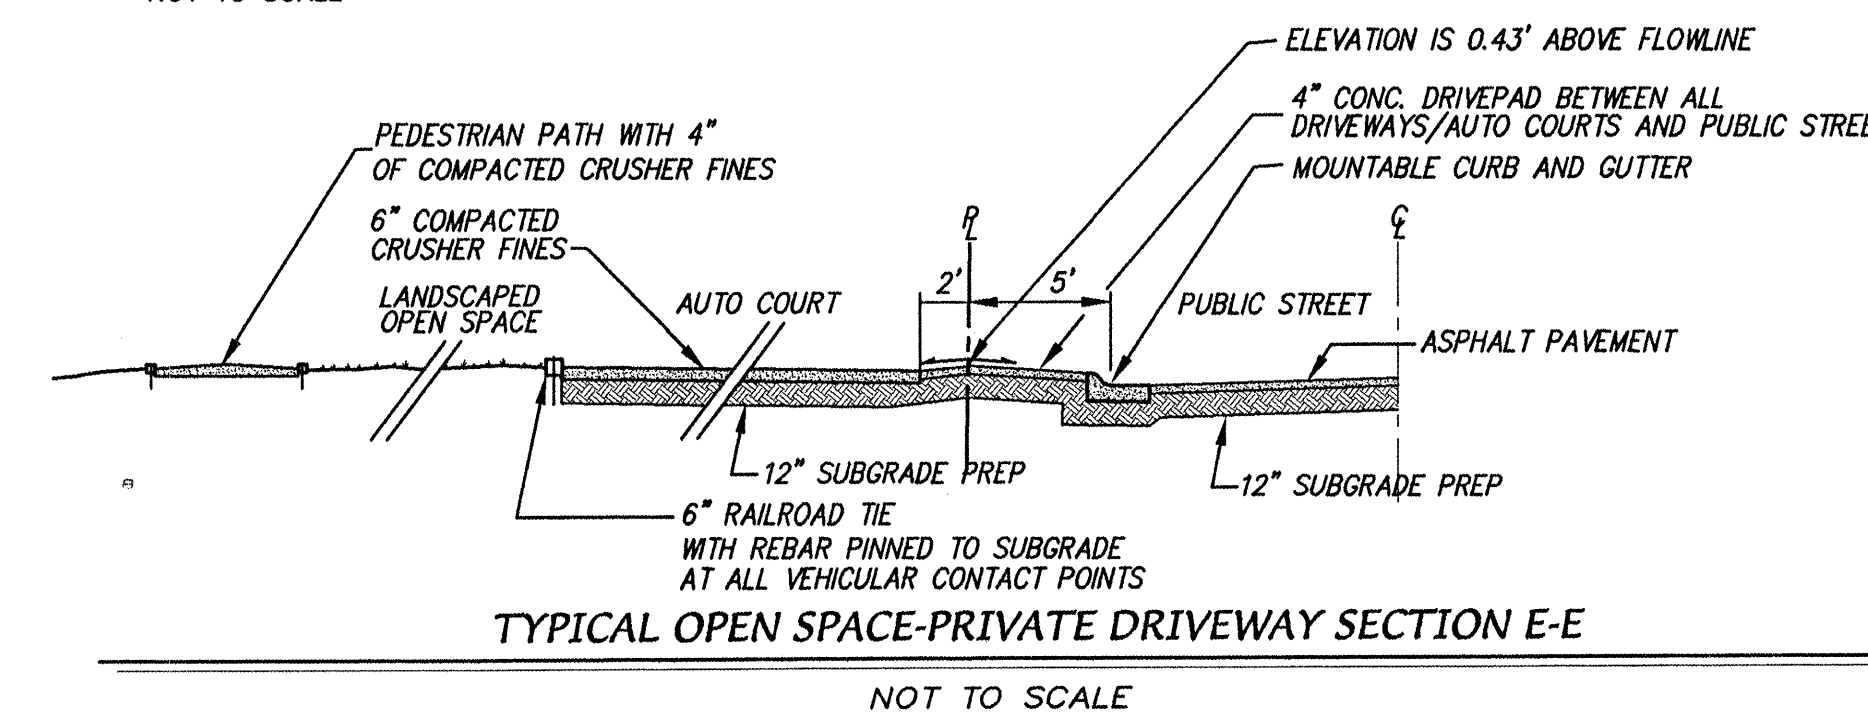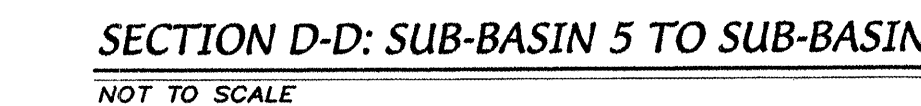

NOT TO SCALE

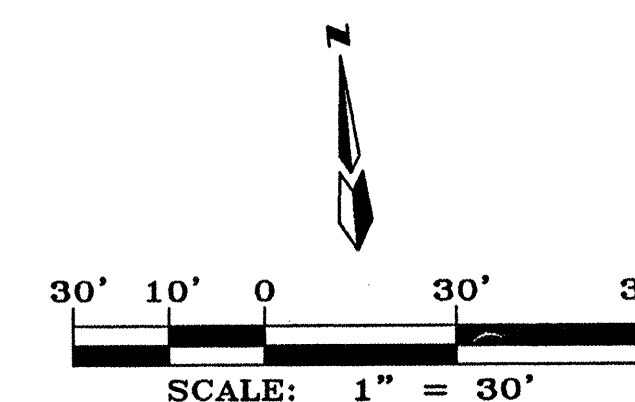

8028/8086GD2/11 - 23 - 98/MJ


LAST DESIGN UPDATE		MO./DAY/YR.		MO./DAY/YR.	
NO. - 13		SHEET 8		OF 20	

DESIGN GROUP




PAGE PLAN

ENGINEER'S SEAL		SURVEY INFORMATION		BENCH MARKS	AS BUILT INFORMATION
<i>6-11-98</i>		FIELD NOTES		ACS MONUMENT "10 - H13", ELEVATION = 4960.18	CONTRACTOR <i>Franklin's</i>
		NO.	BY	DATE	WORK STARTED BY <i>ASS</i> DATE <i>9/9</i>
					DRAWINGS ACCEPTANCE BY <i>MGA</i> DATE <i>11/9</i>
					FIELD LOCATION BY <i>ASS</i> DATE <i>11/9</i>
					DRAWINGS CORRECTED BY <i>MGA</i> DATE <i>11/9</i>
					MICRO-FILM INFORMATION RECORDED BY _____ DATE _____ NO. _____

DESIGNED BY <i>DLH</i>	DATE <i>11-11-98</i>
DRAWN BY <i>NJR</i>	DATE <i>11-11-98</i>

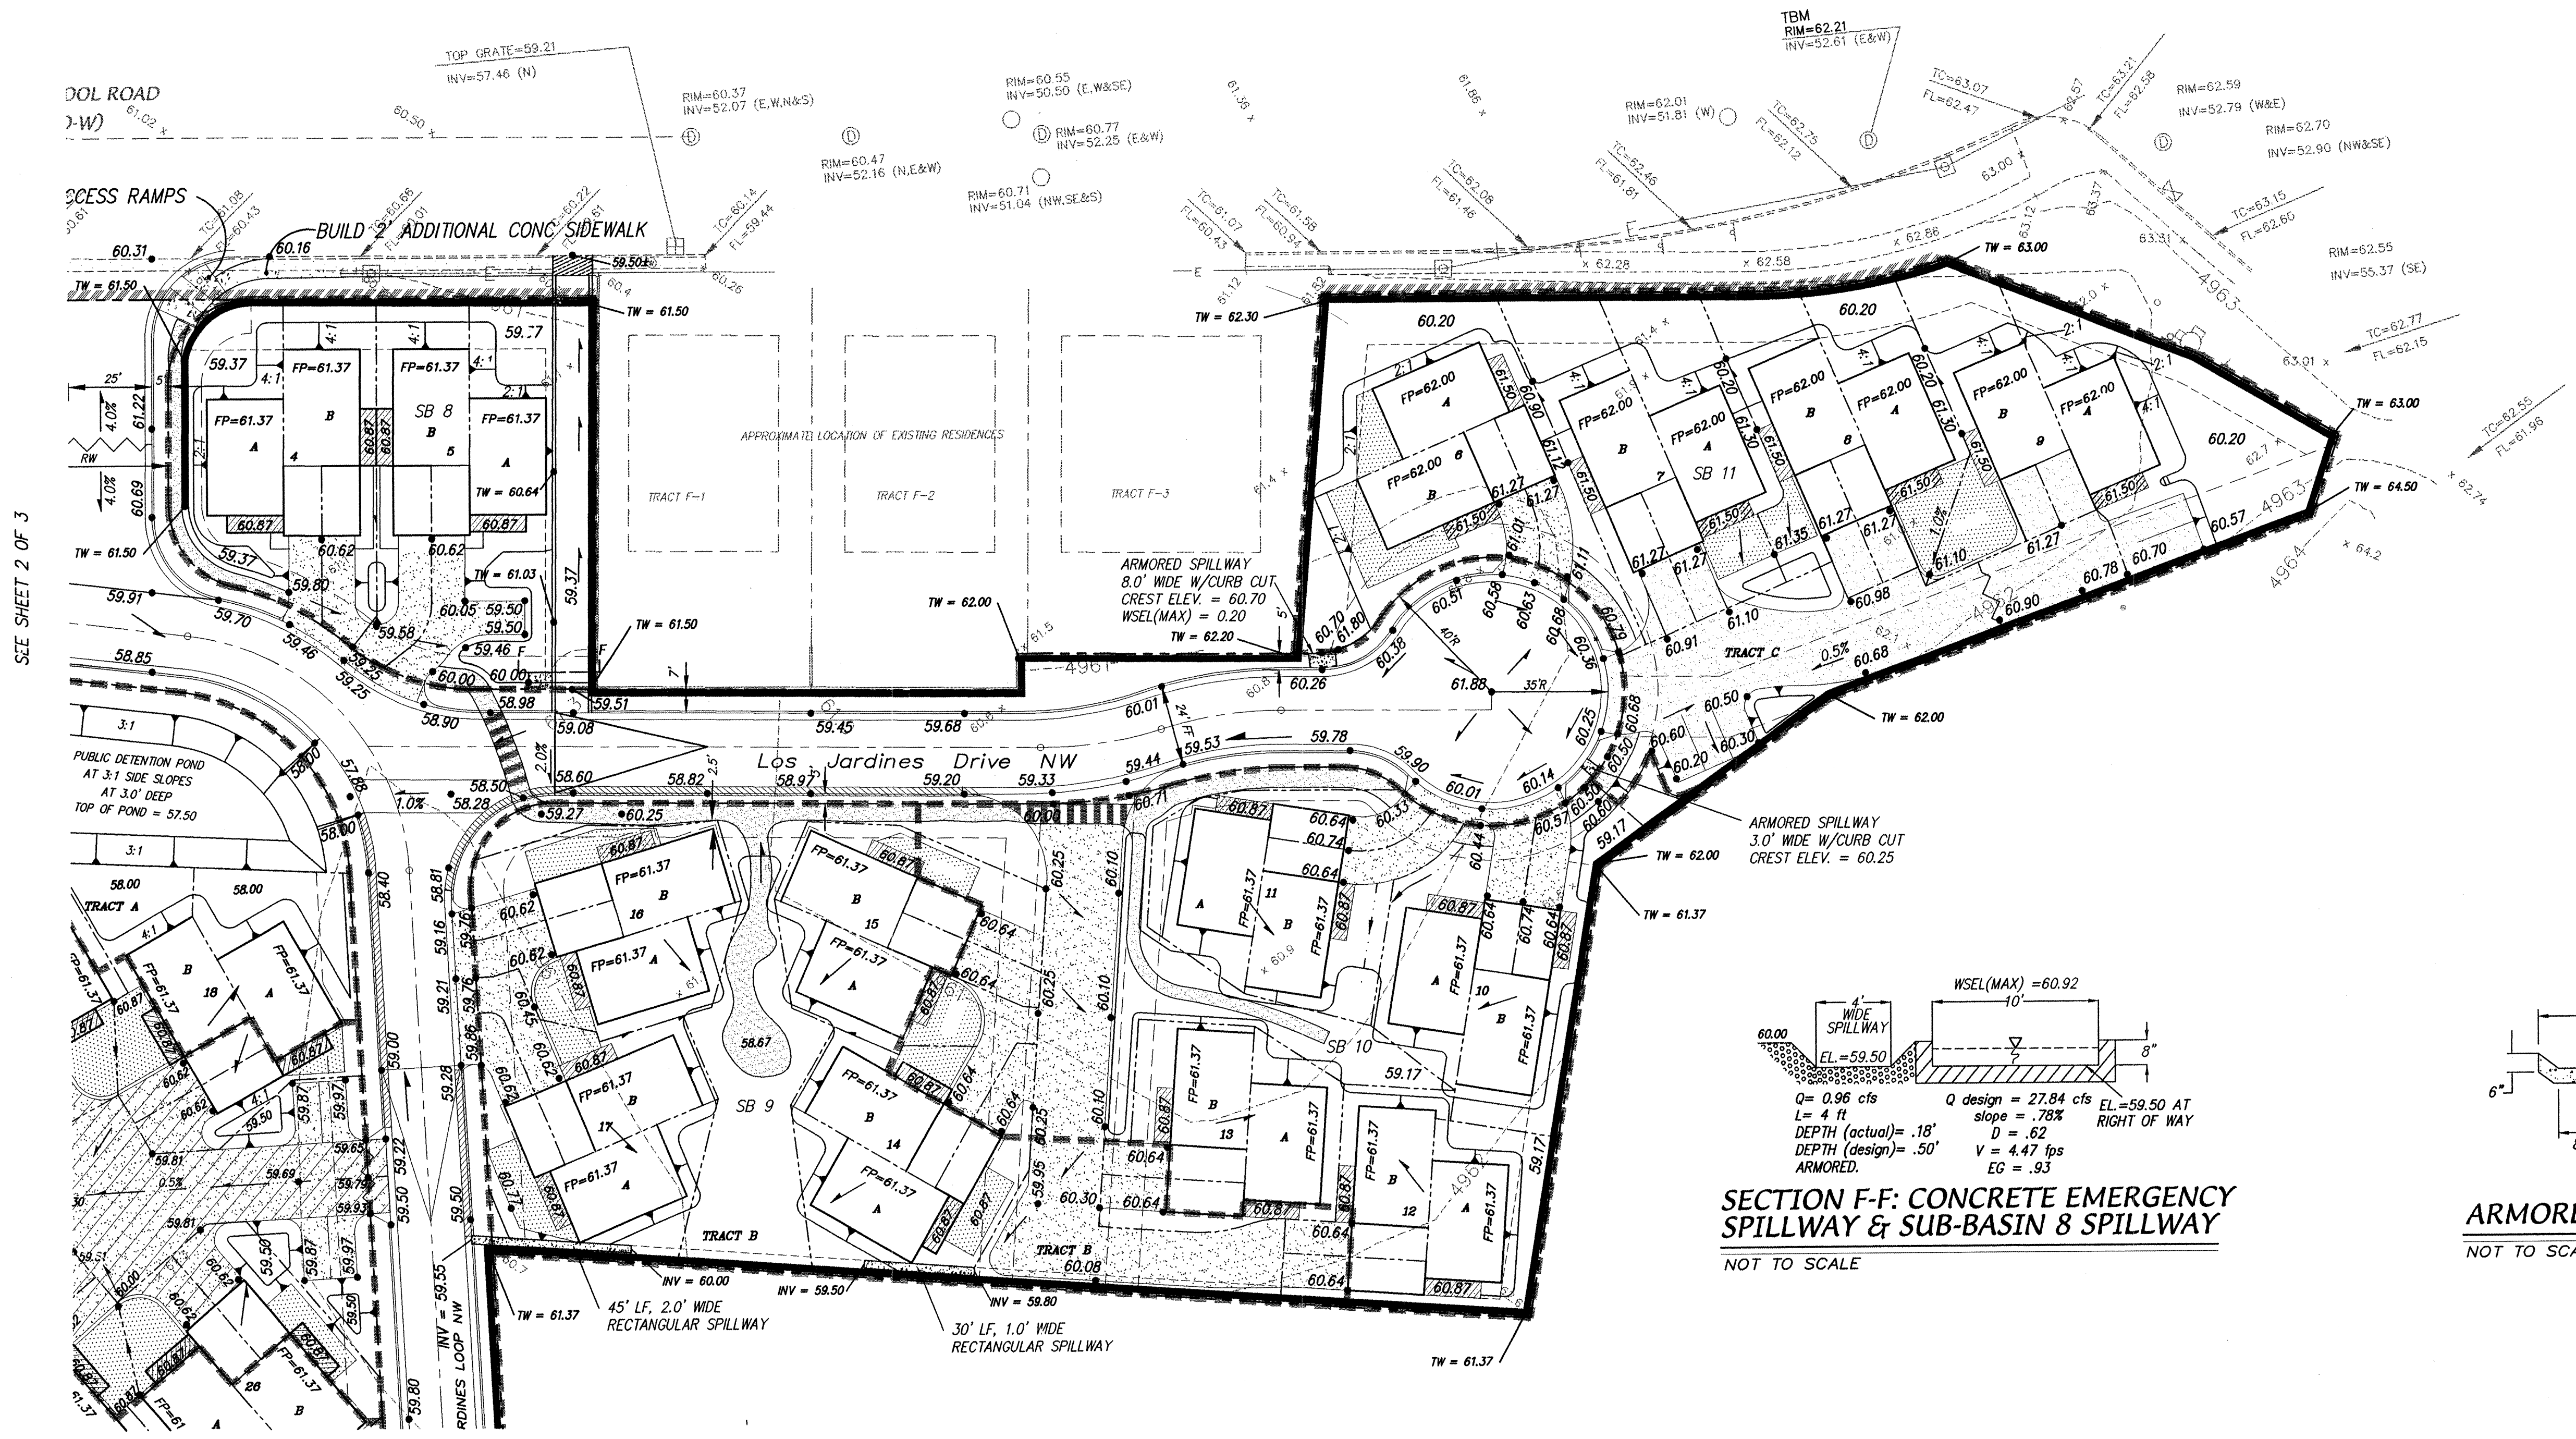


- NOTES**
1. PORTALS ARE 0.50' BELOW FINISH PAD ELEVATION.
 2. ALL PATIOS AND PORTALS AREAS SHOULD BE GRADED TO DRAIN AWAY FROM HOUSE AT A MINIMUM 0.6% SLOPE OR .08 INCHES/FOOT.
 3. ALL SIDEYARD WALLS CONSTRUCTED MUST ALLOW RUNOFF TO PASS FREELY BETWEEN ADJACENT PROPERTIES AT ALL TIMES.
 4. ALL SPILLWAYS WILL BE ARMORED WITH +4.0" DIAMETER ROCK.

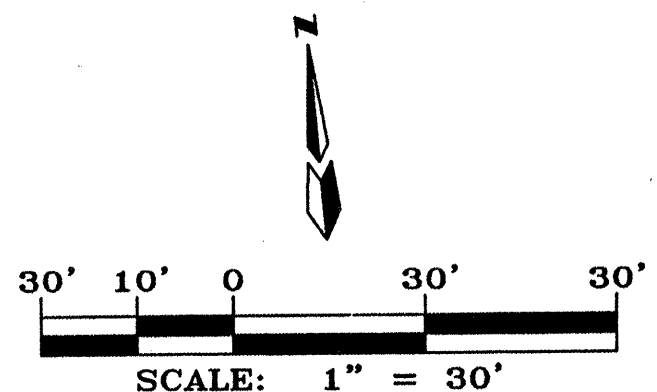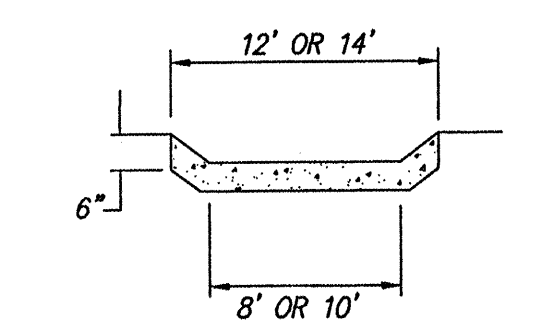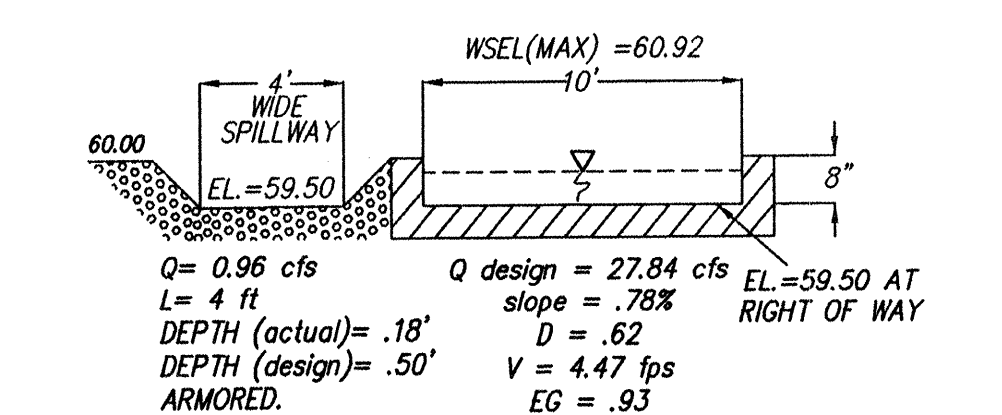

dmg MARK GOODWIN & ASSOCIATES, P.A. CONSULTING ENGINEERS P.O. BOX 90606 ALBUQUERQUE, NEW MEXICO 87199 (505) 828-2200, FAX (505) 797-9539	
CITY OF ALBUQUERQUE PUBLIC WORKS DEPARTMENT ENGINEERING DEVELOPMENT GROUP	
TITLE: LOS JARDINES GRADING & DRAINAGE PLAN	
DESIGN REVIEW COMMITTEE	CITY ENGINEER APPROVAL
DESIGNED BY DLH	DATE 11-98
DRAWN BY MJR	DATE 11-98
CHECKED BY DMG	DATE 11-98
CITY PROJECT NO. 610081	ZONE MAP NO. H-13
SHEET 9 OF 20	



AS BUILT INFORMATION		BENCH MARKS		SURVEY INFORMATION		ENGINEER'S SEAL	
CONTRACTOR	DATE	ACS MONUMENT	ELEVATION	FIELD NOTES	BY	NO.	DATE
Franklin	ASB	10	4960.18				
STAKED BY	DATE						
ACCEPTANCE BY	DATE						
FIELD DRAWING BY	DATE						
REVISIONS	DATE						
CORRECTED BY	DATE						
MICRO-FILM INFORMATION	DATE						
RECORDED BY	DATE						
NO.							



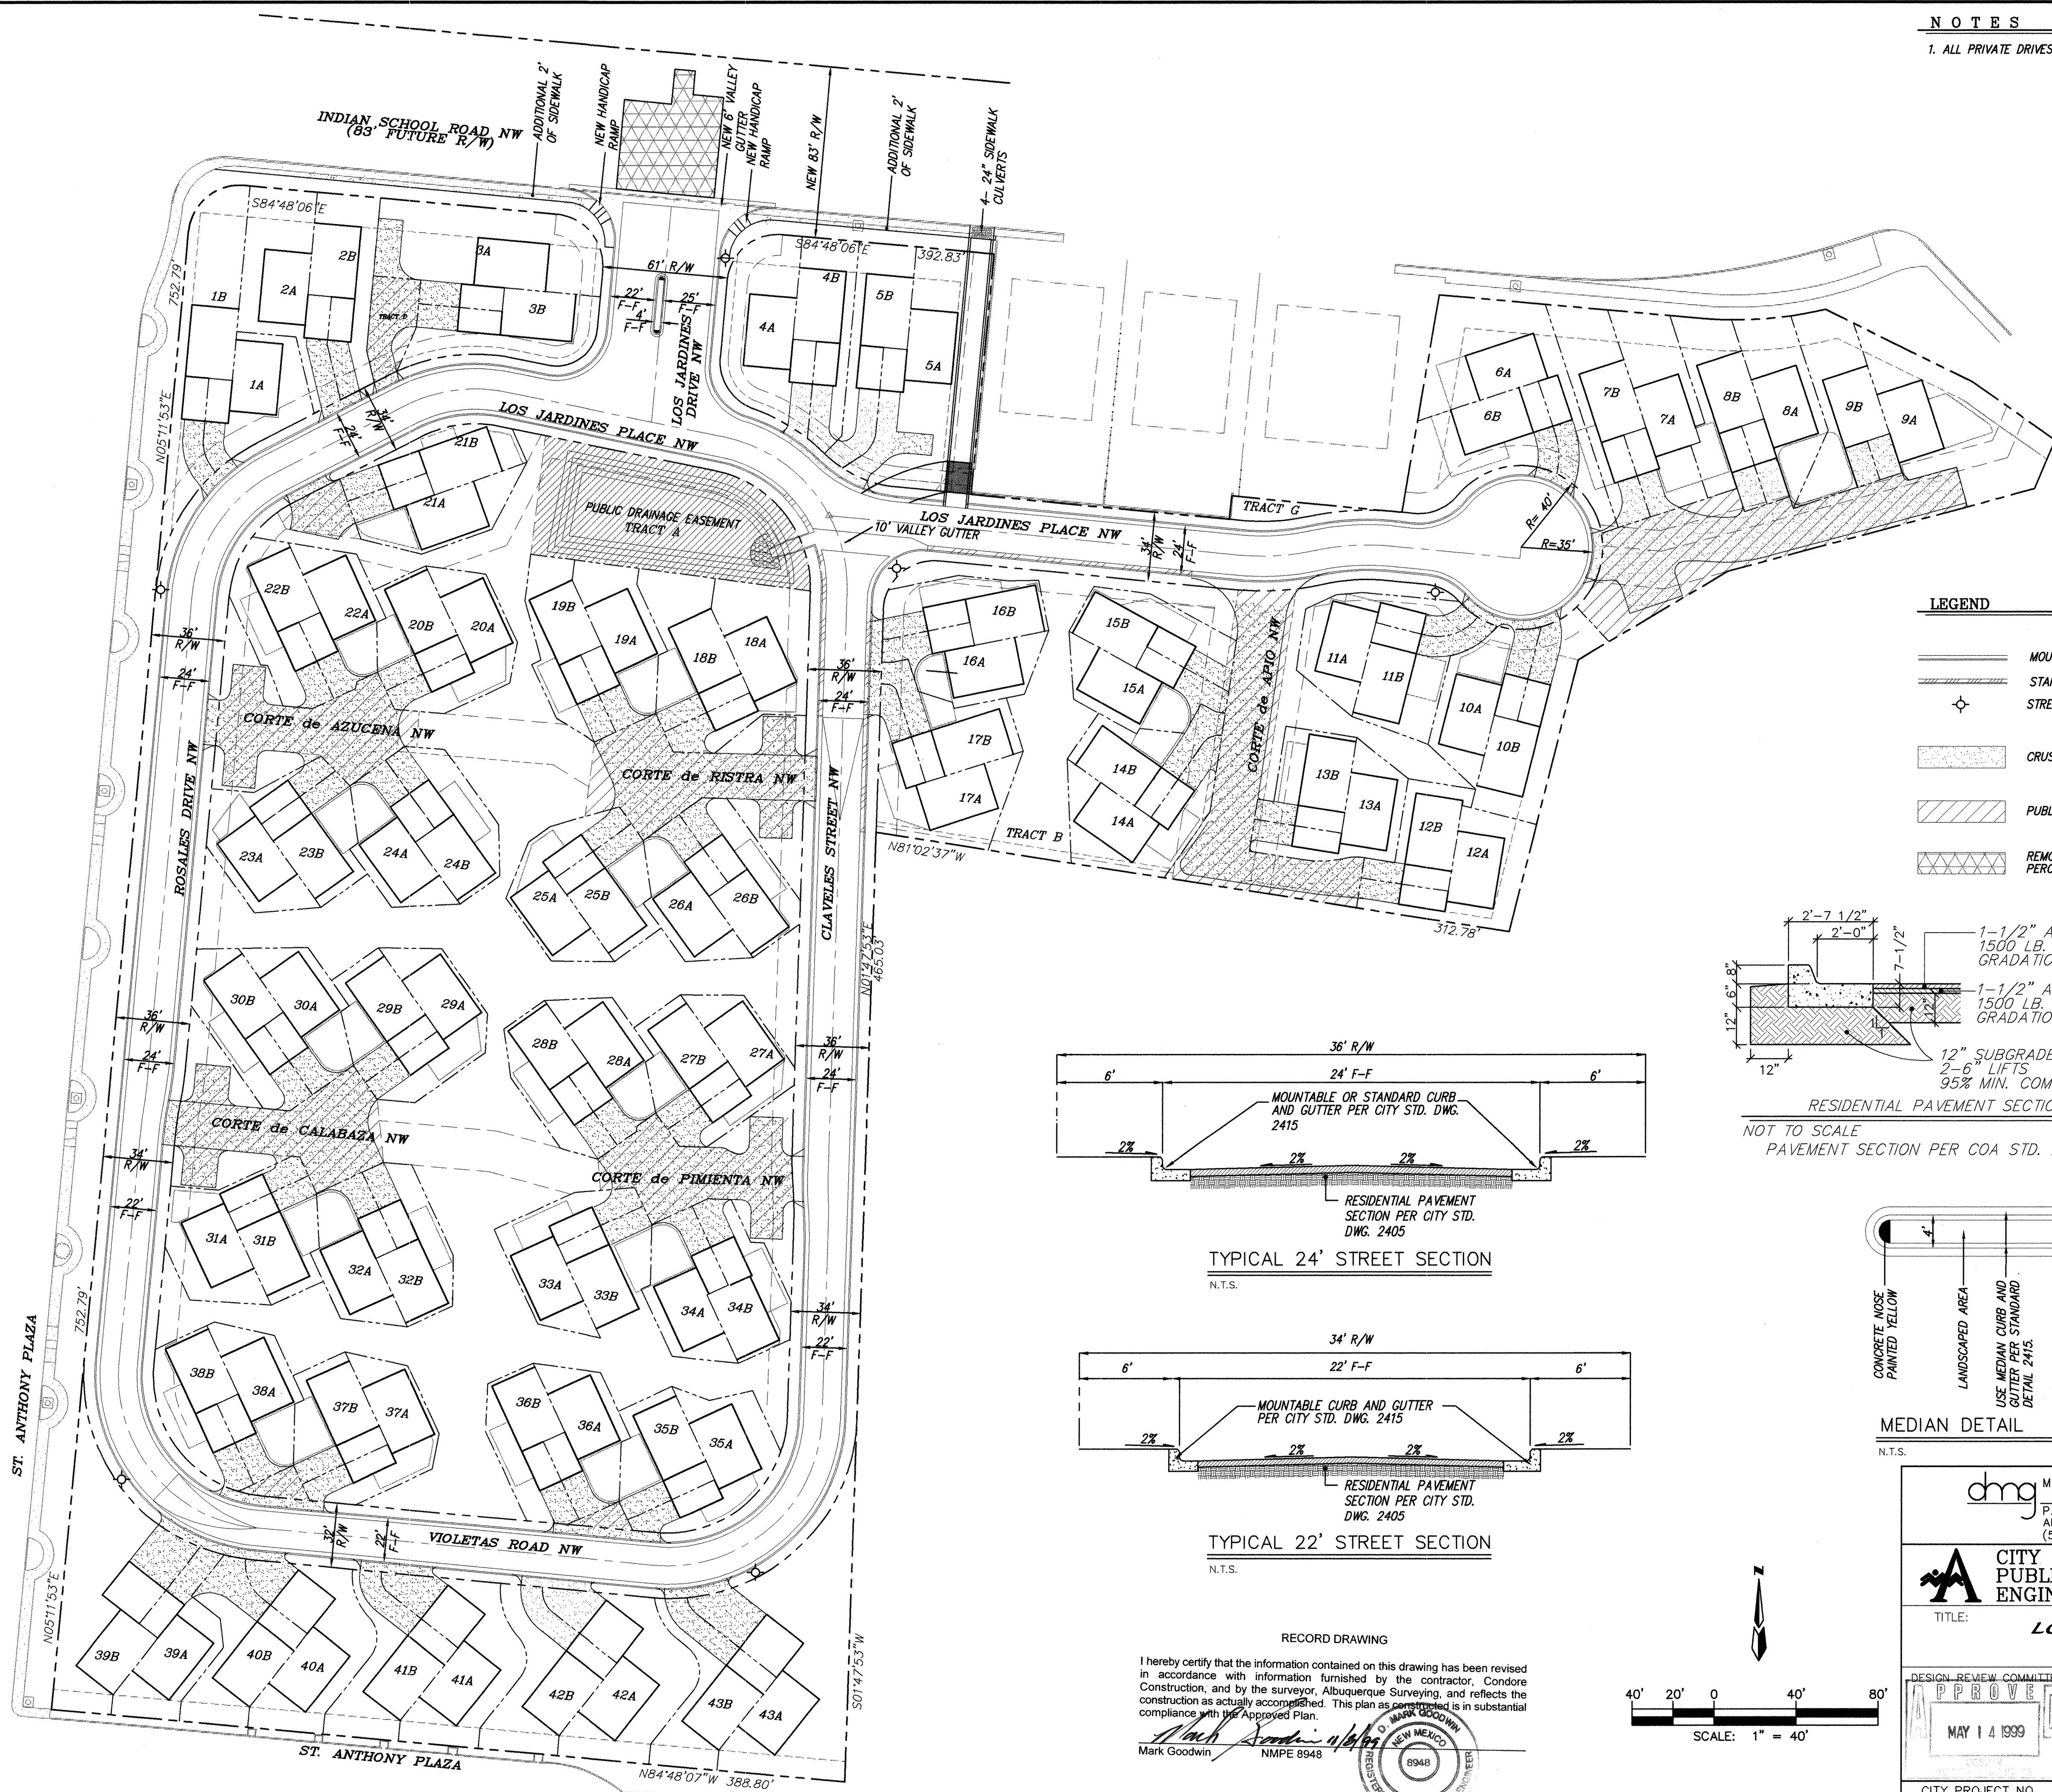


NOTES
1. ALL PRIVATE DRIVES WILL BE OF CRUSHER FINES.

- LEGEND
- MOUNTABLE CURB & GUTTER
 - STANDARD 8" CURB & GUTTER
 - STREET LIGHT
 - CRUSHER FINES
 - PUBLIC UTILITY EASEMENT
 - REMOVE AND REPLACE PAVEMENT PER COA STD. DWG. 2465.

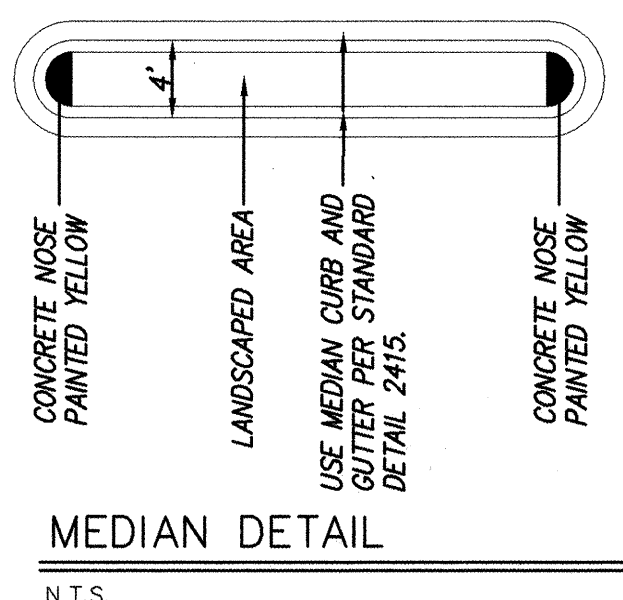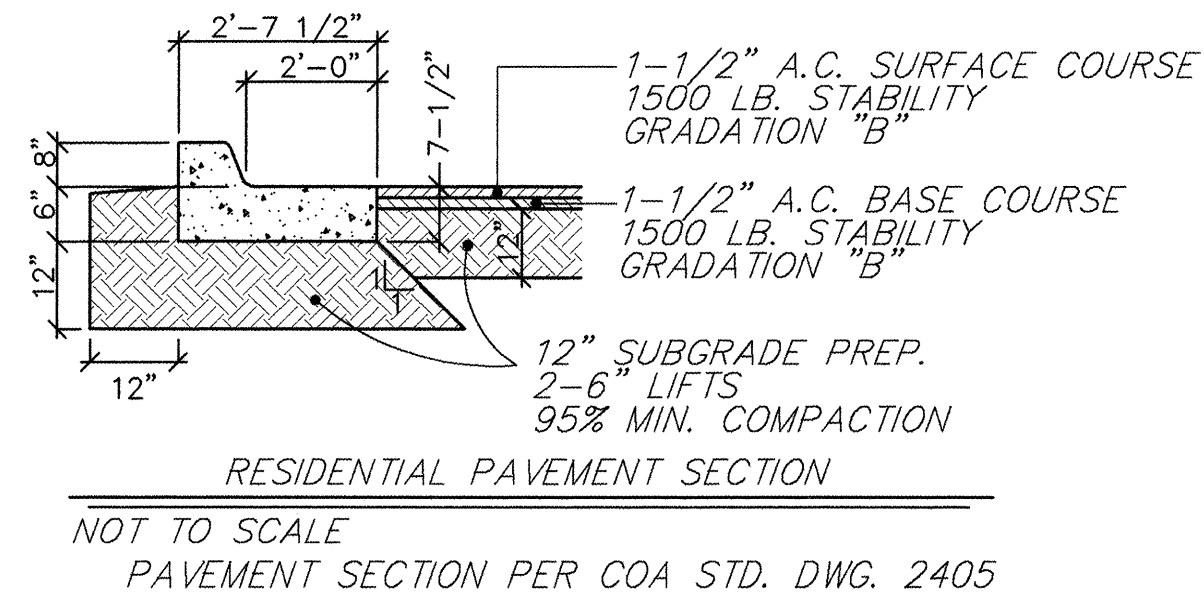

RECORD DRAWING
I hereby certify that the information contained on this drawing has been revised in accordance with information furnished by the contractor, Condore Construction, and by the surveyor, Albuquerque Surveying, and reflects the construction as actually accomplished. This plan as constructed is in substantial compliance with the Approved Plan.
Mark Goodwin NMPE 8948

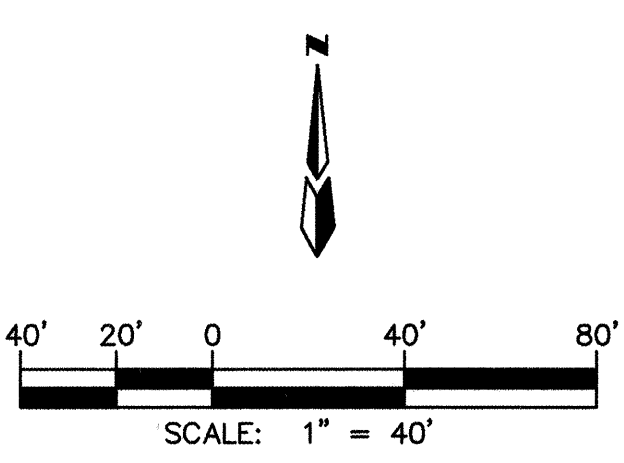

dmg MARK GOODWIN & ASSOCIATES, P.A. CONSULTING ENGINEERS
P.O. BOX 90606
ALBUQUERQUE, NEW MEXICO 87199
(505) 828-2200, FAX (505) 797-9539

CITY OF ALBUQUERQUE
PUBLIC WORKS DEPARTMENT
ENGINEERING DEVELOPMENT GROUP

TITLE: **LOS JARDINES SUBDIVISION MASTER PAVING PLAN**


DESIGN REVIEW COMMITTEE APPROVE MAY 14 1999

CITY PROJECT NO. **610081** ZONE MAP NO. **H-13** SHEET **10** OF **20**

NO.	DATE	REMARKS
1	3/99	DESIGN
2	3/99	REVISED
3	3/99	REVISED

DESIGNED BY **DLH** DATE **3/99**
DRAWN BY **KJS** DATE **3/99**
CHECKED BY **DMG** DATE **3/99**


CONTRACTOR **Condore**
STATION IS A STANDARD ACS BRASS TABLET STAMPED
7-HI3 SET FLUSH WITH ASPHALT PAVEMENT.
FROM THE INTERCHANGE AT I-40 AND RIO GRANDE BLVD
GO NORTH ON RIO GRANDE 0.4 MILES TO THE STATION ON THE LEFT.
CONTRACTOR **Condore**
WORK **AS BUILT**
DATE **3/99**
STATION **11+00**
DATE **3/99**
FIELD **AS BUILT**
DATE **3/99**
DRAWINGS **AS BUILT**
DATE **3/99**
CORRECTED BY **AS BUILT**
DATE **3/99**
MICRO-FILM INFORMATION
RECORDED BY **AS BUILT**
DATE **3/99**
NO.

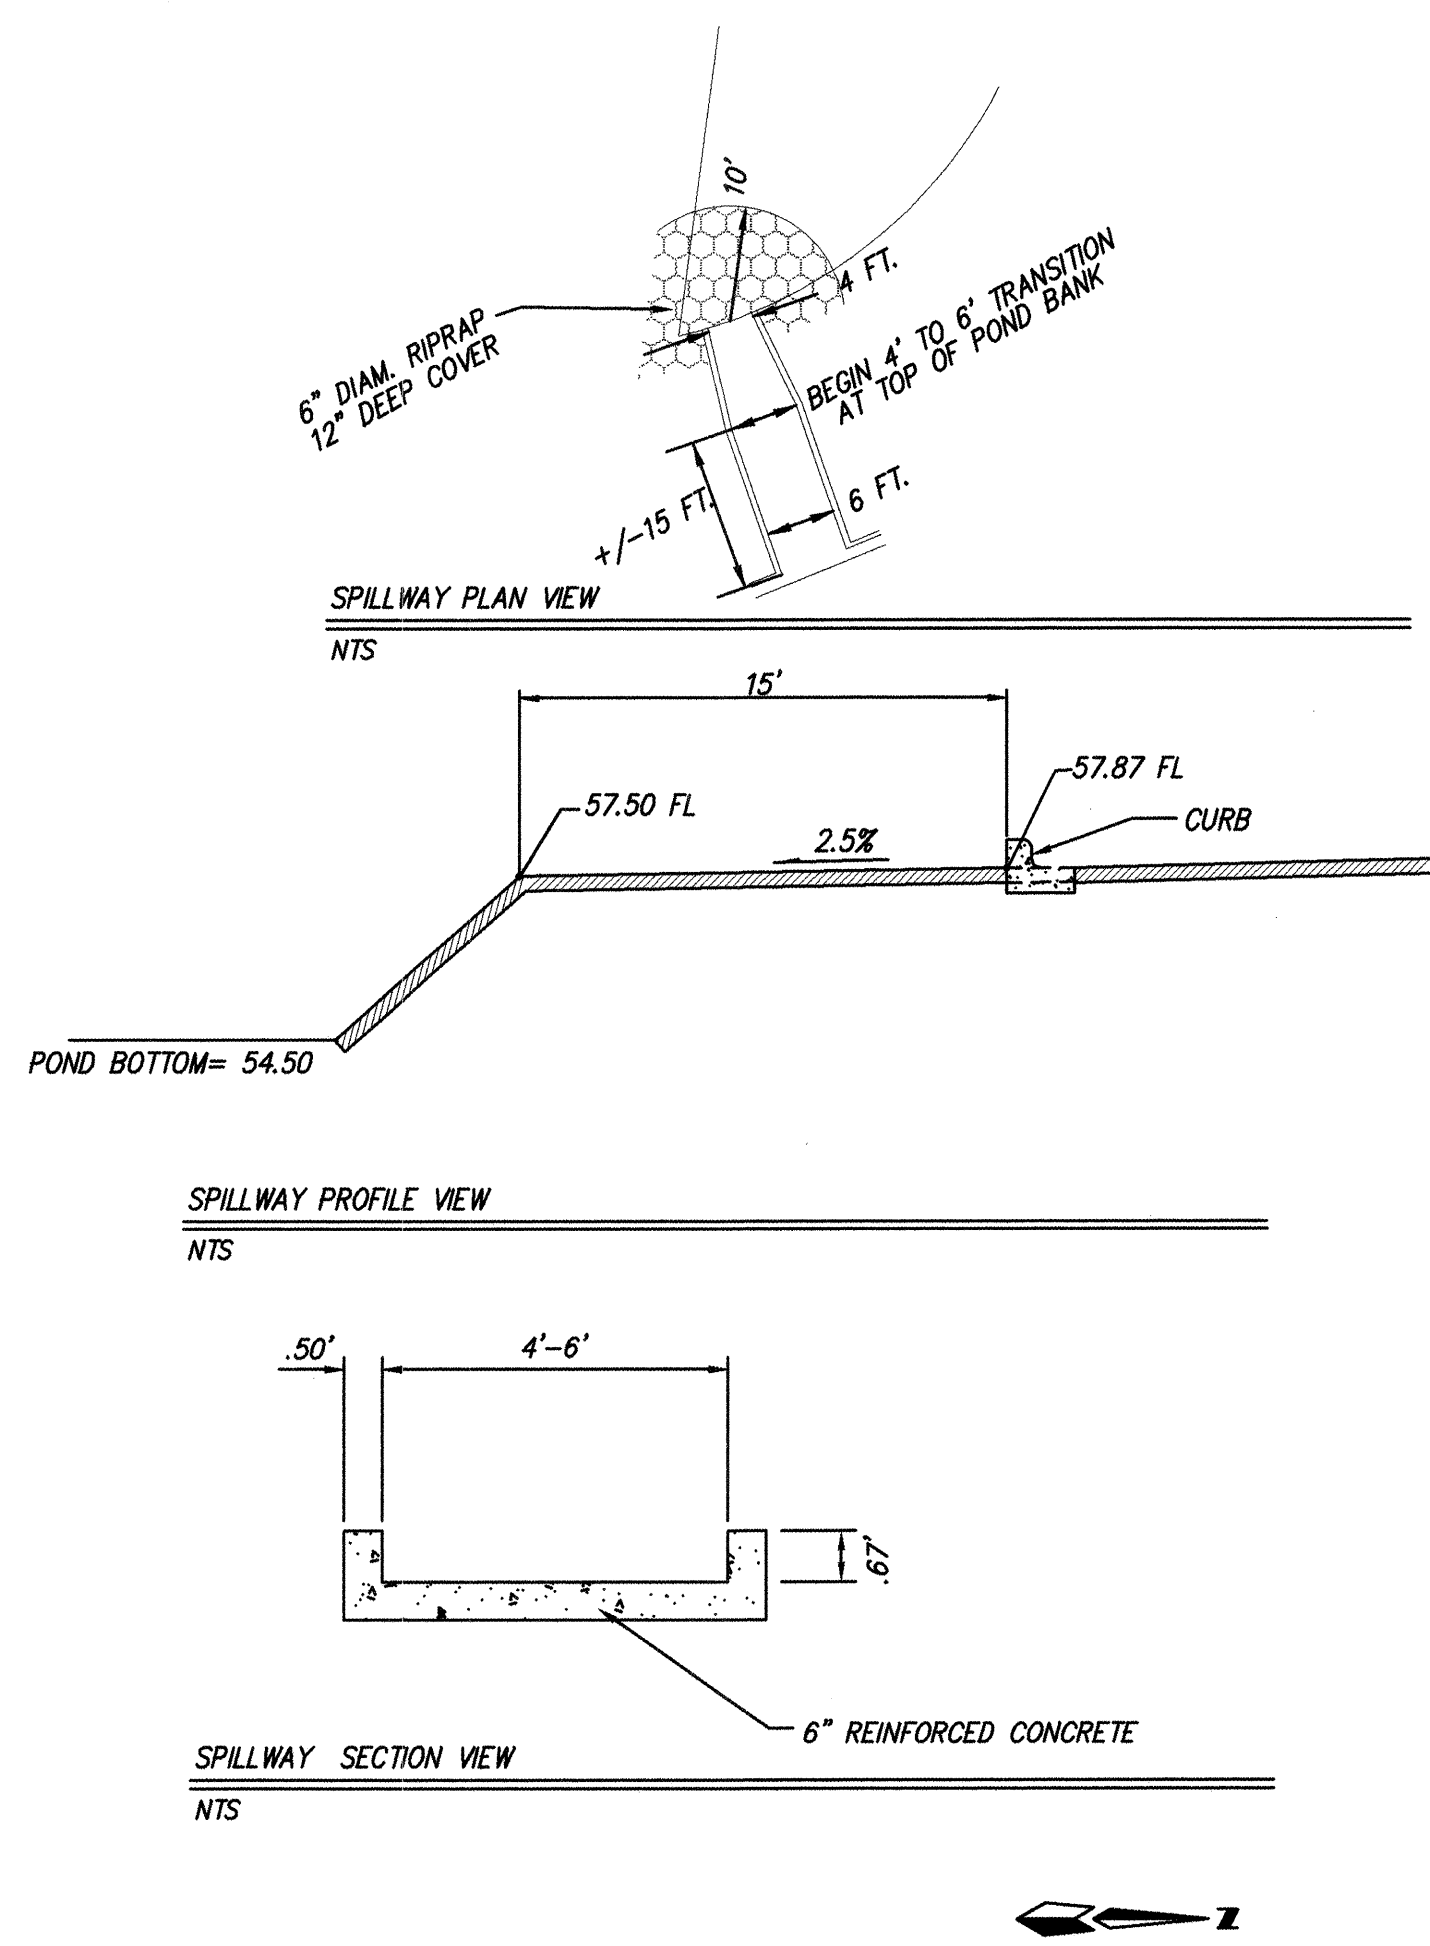

N O T E S		
CURVE DATA - DESCRIBES CENTERLINE		
①	$\Delta = 89^{\circ}51'16''$ $R = 75.00'$ $L = 117.62'$ $T = 74.81'$	② $\Delta = 93^{\circ}32'45''$ $R = 75.00'$ $L = 122.45'$ $T = 79.79'$
④	$\Delta = 04^{\circ}03'08''$ $R = 200.00'$ $L = 14.15'$ $T = 7.08'$	③ $\Delta = 04^{\circ}03'08''$ $R = 200.00'$ $L = 14.15'$ $T = 7.08'$
⑤	$\Delta = 80^{\circ}13'08''$ $R = 75.00'$ $L = 105.01'$ $T = 63.18'$	

CURVE DATA - DESCRIBES FACE OF NEW CURB					
①	$\Delta = 89^{\circ}51'20"$ $R = 96.00'$ $L = 134.38'$ $T = 15.87'$	②	$\Delta = 93^{\circ}32'45"$ $R = 86.00'$ $L = 140.41'$ $T = 9.14'$	③	$\Delta = 93^{\circ}43'25"$ $R = 25.00'$ $L = 40.89'$ $T = 26.68'$
④	$\Delta = 39^{\circ}07'17"$ $R = 63.00'$ $L = 43.02'$ $T = 22.38'$	⑤	$\Delta = 27^{\circ}46'14"$ $R = 87.00'$ $L = 42.17'$ $T = 21.51'$	⑥	$\Delta = 78^{\circ}19'53"$ $R = 25.00'$ $L = 34.18'$ $T = 20.36'$
⑦	$\Delta = 89^{\circ}51'20"$ $R = 64.00'$ $L = 100.37'$ $T = 63.94'$	⑧	$\Delta = 93^{\circ}32'44"$ $R = 63.00'$ $L = 104.49'$ $T = 68.09'$	⑨	$\Delta = 05^{\circ}43'29"$ $R = 189.00'$ $L = 18.88'$ $T = 9.45'$
⑩	$\Delta = 05^{\circ}43'29"$ $R = 212.00'$ $L = 21.18'$ $T = 10.60'$	⑪	$\Delta = 80^{\circ}13'08"$ $R = 25.00'$ $L = 88.21'$ $T = 53.07'$		

I hereby certify that the information contained on this drawing has been revised in accordance with information furnished by the contractor, Condore Construction, and by the surveyor, Albuquerque Surveying, and reflects the construction as actually accomplished. This plan as constructed is in substantial compliance with the Approved Plan.

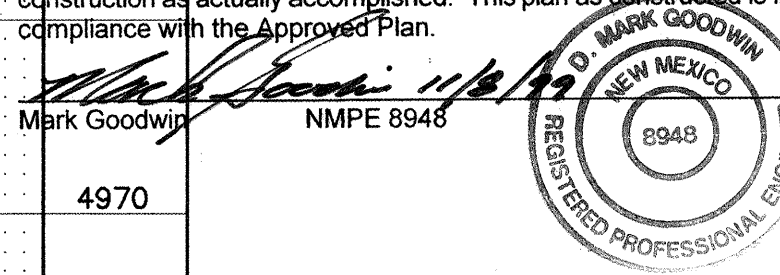

dmg MARK GOODWIN & ASSOCIATES, P.A.
CONSULTING ENGINEERS
P.O. BOX 90606
ALBUQUERQUE, NEW MEXICO 87199
(505) 828-2200, FAX (505) 797-9531



CITY OF ALBUQUERQUE
PUBLIC WORKS DEPARTMENT
ENGINEERING DEVELOPMENT GROUP

TITLE:

LOS JARDINES SUBDIVISION
PAVING IMPROVEMENTS
CLAVELES STREET NW

DESIGN REVIEW COMMITTEE
APPROVED
MAY 14 1999
DESIGN
REVIEW COMMITTEE

CITY PROJECT NO.

CITY ENGINEER APPROVAL


ZONE MAP NO.

SHEET OF

SURVEY INFORMATION			BENCH MARKS		AS BUILT INFORMATION		
NO.	FIELD NOTES		STATION IS A STANDARD ACS BRASS TABLET STAMPED "7-HI3" SET FLUSH WITH ASPHALT PAVEMENT. FROM THE INTERCHANGE AT I-40 AND RIO GRANDE BLVD GO NORTH ON RIO GRANDE 0.4 MILES TO THE STATION ON THE LEFT.	CONTRACTOR <i>Concore</i>	INSPECTOR'S ACCEPTANCE BY VERIFICATION BY DRAWINGS CORRECTED BY	DATE <i>1/19/19</i>	DATE <i>1/19/19</i>
	BY	DATE					
			X= 373707.44 Y= 1495715.39 ELEV= 4961.60				

[illegible]

VISION MENTS T NW	
MO./DAY/YR.	MO./DAY/YR.
NO. 13	SHEET OF 12 20

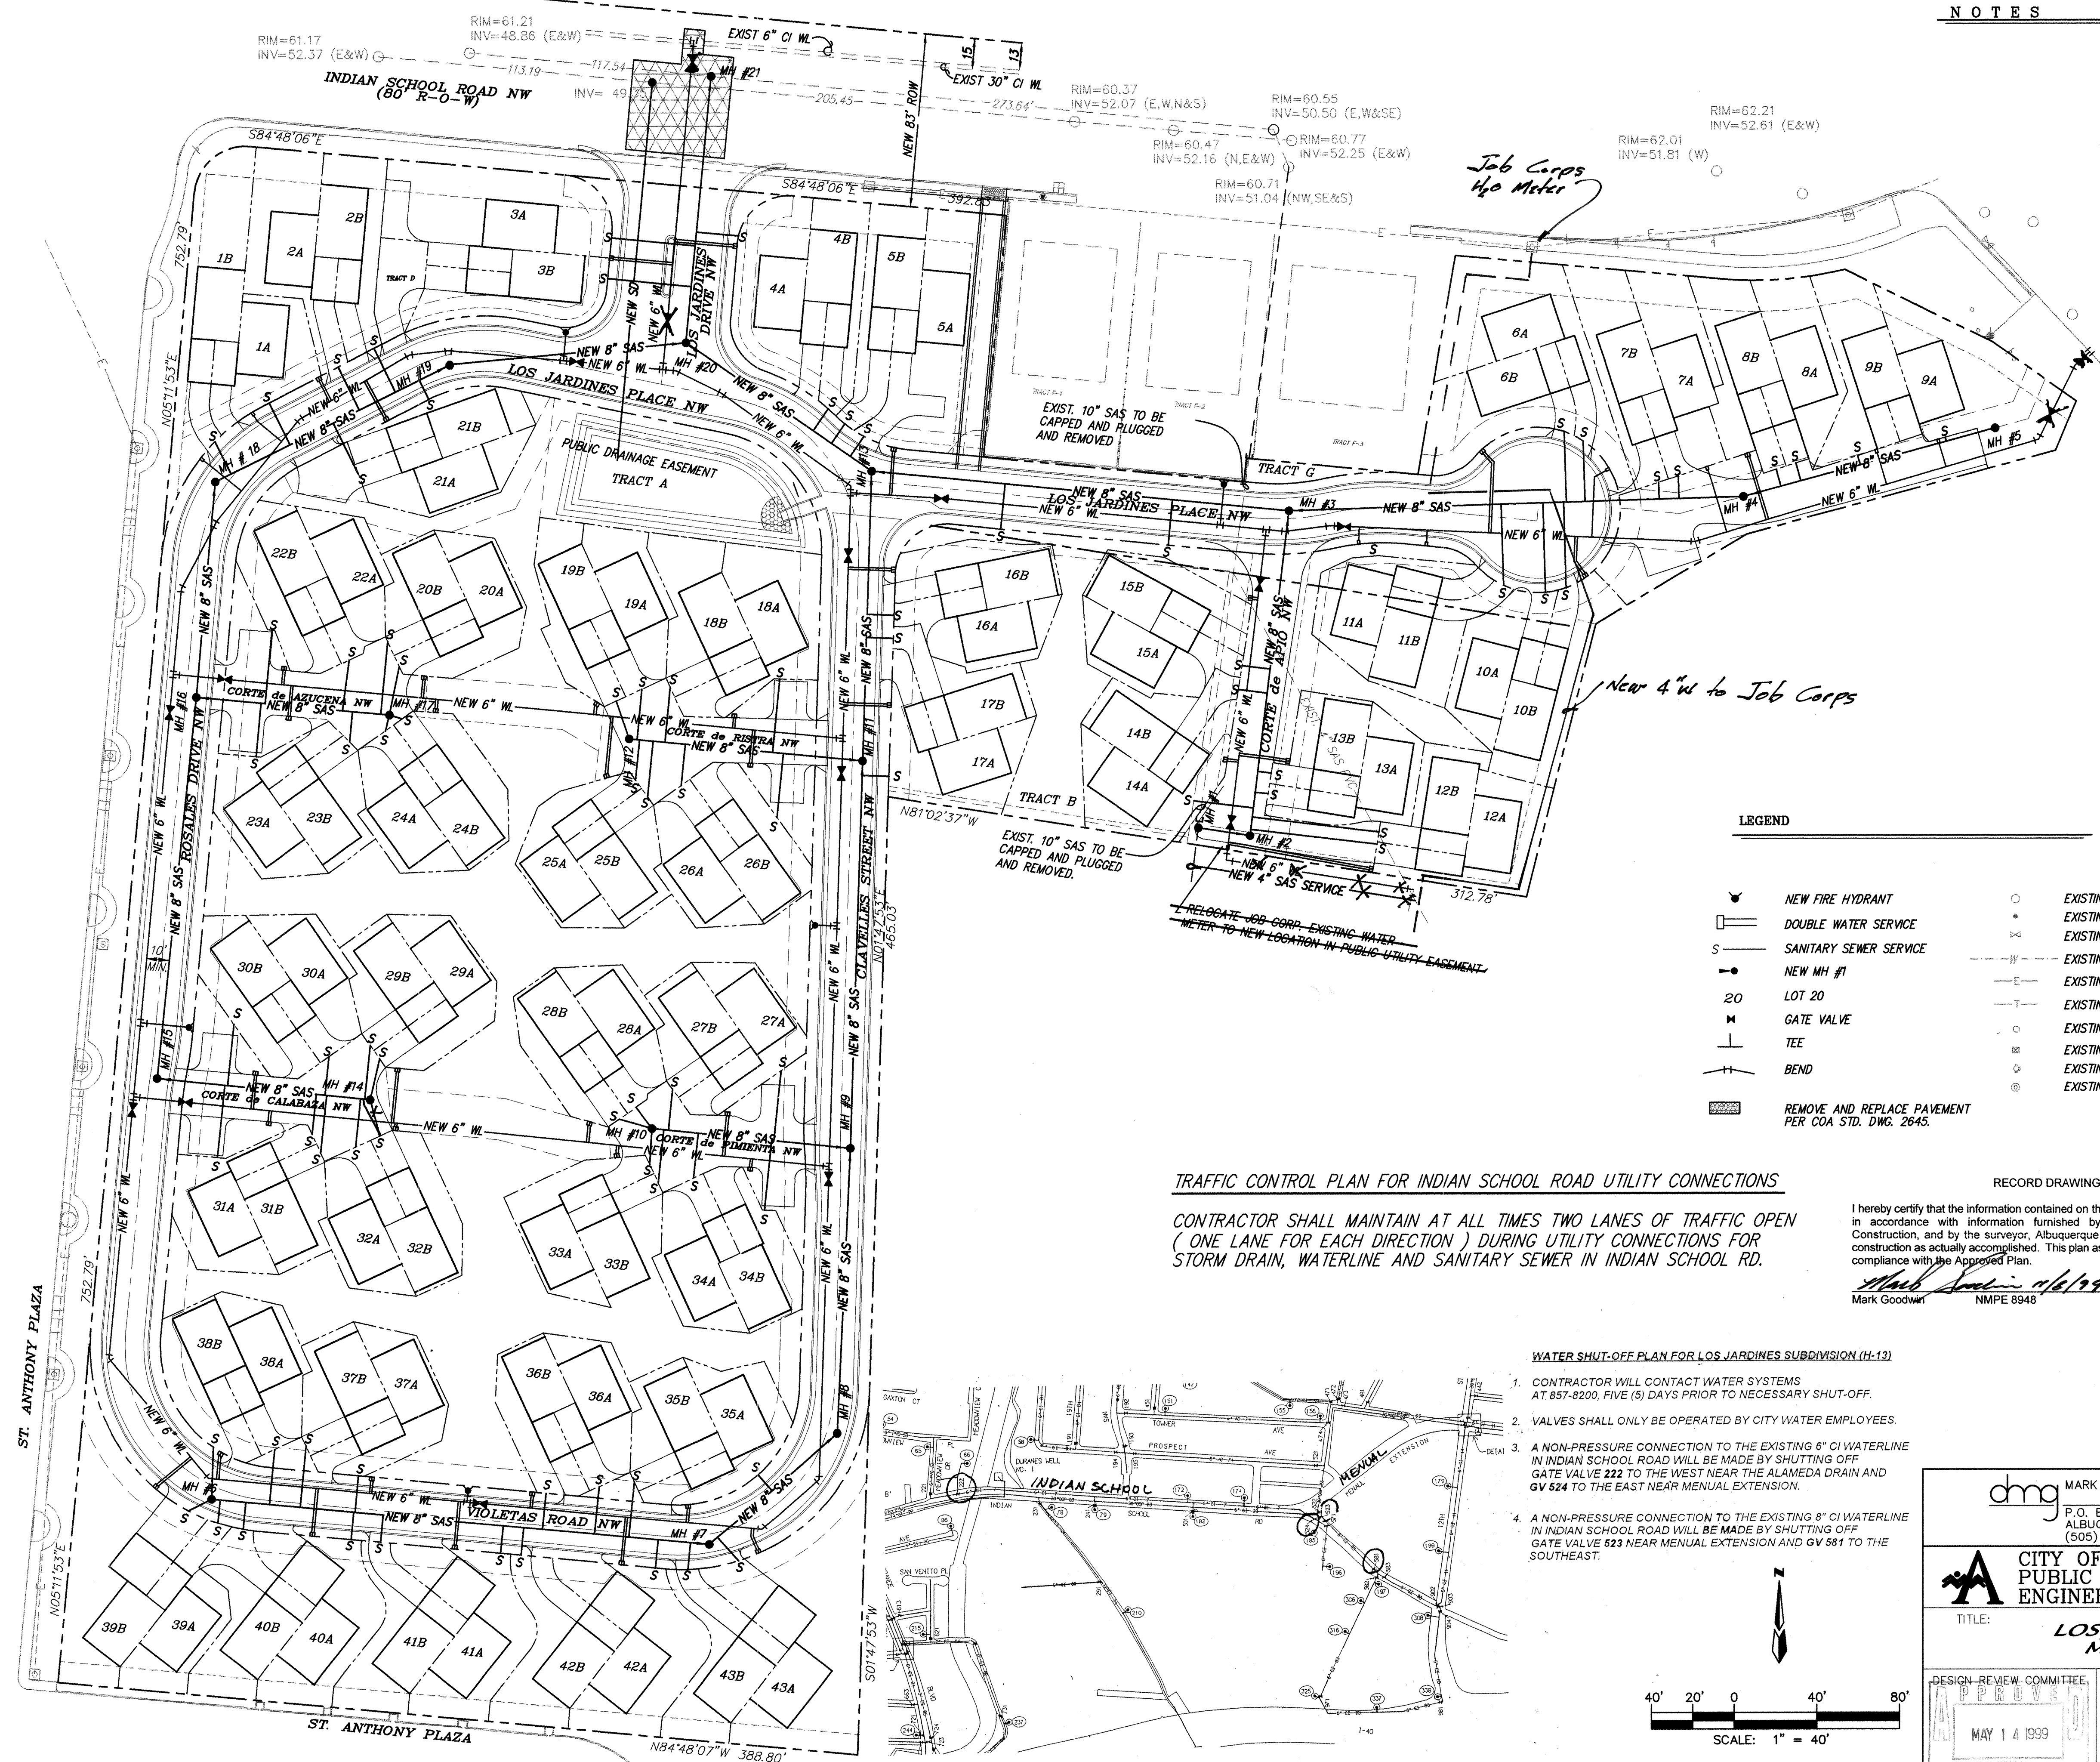

NOTES

LEGEND

- NEW FIRE HYDRANT
- DOUBLE WATER SERVICE
- SANITARY SEWER SERVICE
- NEW MH #1
- LOT 20
- GATE VALVE
- TEE
- BEND
- REMOVE AND REPLACE PAVEMENT PER COA STD. DWG. 2645.
- EXISTING SANITARY SEWER MANHOLE
- EXISTING CABLE T.V. PEDESTAL
- EXISTING WATER VALVE
- EXISTING WATER LINE
- EXISTING OVERHEAD ELECTRIC LINE
- EXISTING OVERHEAD TELEPHONE LINE
- EXISTING POWER POLE
- EXISTING TELEPHONE PEDESTAL
- EXISTING FIRE HYDRANT
- EXISTING STORM DRAIN MANHOLE

TRAFFIC CONTROL PLAN FOR INDIAN SCHOOL ROAD UTILITY CONNECTIONS

CONTRACTOR SHALL MAINTAIN AT ALL TIMES TWO LANES OF TRAFFIC OPEN (ONE LANE FOR EACH DIRECTION) DURING UTILITY CONNECTIONS FOR STORM DRAIN, WATERLINE AND SANITARY SEWER IN INDIAN SCHOOL RD.


WATER SHUT-OFF PLAN FOR LOS JARDINES SUBDIVISION (H-13)

- CONTRACTOR WILL CONTACT WATER SYSTEMS AT 857-8200, FIVE (5) DAYS PRIOR TO NECESSARY SHUT-OFF.
- VALVES SHALL ONLY BE OPERATED BY CITY WATER EMPLOYEES.
- A NON-PRESSURE CONNECTION TO THE EXISTING 6" CI WATERLINE IN INDIAN SCHOOL ROAD WILL BE MADE BY SHUTTING OFF GATE VALVE 222 TO THE WEST NEAR THE ALAMEDA DRAIN AND GV 524 TO THE EAST NEAR MANUAL EXTENSION.
- A NON-PRESSURE CONNECTION TO THE EXISTING 8" CI WATERLINE IN INDIAN SCHOOL ROAD WILL BE MADE BY SHUTTING OFF GATE VALVE 623 NEAR MANUAL EXTENSION AND GV 581 TO THE SOUTHEAST.

RECORD DRAWING

I hereby certify that the information contained on this drawing has been revised in accordance with information furnished by the contractor, Condore Construction, and by the surveyor, Albuquerque Surveying, and reflects the construction as actually accomplished. This plan as constructed is in substantial compliance with the Approved Plan.

Mark Goodman NMPE 8948

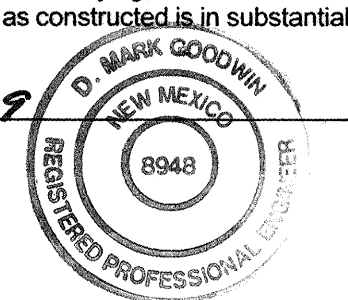

dmg MARK GOODMAN & ASSOCIATES, P.A. CONSULTING ENGINEERS
P.O. BOX 90606
ALBUQUERQUE, NEW MEXICO 87199
(505) 828-2200, FAX (505) 797-9539


CITY OF ALBUQUERQUE
PUBLIC WORKS DEPARTMENT
ENGINEERING DEVELOPMENT GROUP
TITLE: LOS JARDINES SUBDIVISION MASTER UTILITY PLAN

DESIGN REVIEW COMMITTEE	CITY ENGINEER APPROVAL	NO./DAY/YR.	MO./DAY/YR.
APPROVE			
DESIGN REVIEW COMMITTEE			
CITY PROJECT NO.	ZONE MAP NO.	SHEET	OF
610081	H-13	14	20


AS BUILT INFORMATION			
CONTRACTOR	CONDORE	DATE	7/1/99
WORK	7-HI-3 SET FUSH WITH ASPHALT PAVEMENT.	DATE	7/1/99
STATIONED BY	FROM THE INTERCHANGE AT I-40 AND RIO GRANDE BLVD	DATE	7/1/99
ACCEPTANCE BY	GO NORTH ON RIO GRANDE 0.4 MILES TO THE STATION ON THE LEFT.	DATE	7/1/99
FIELD CHECK BY		DATE	7/1/99
DRAWINGS		DATE	7/1/99
CORRECTED BY		DATE	7/1/99
MICRO-FILM INFORMATION			
RECORDED BY		DATE	
NO.			

BENCH MARKS			
STATION IS A STANDARD ACS BRASS TABLET STAMPED			
7-HI-3 SET FUSH WITH ASPHALT PAVEMENT.			
FROM THE INTERCHANGE AT I-40 AND RIO GRANDE BLVD			
GO NORTH ON RIO GRANDE 0.4 MILES TO THE STATION ON THE LEFT.			
X= 373702.44	Y= 1495715.39	ELEV= 4961.60	

SURVEY INFORMATION			
FIELD NOTES			
NO.	BY	DATE	

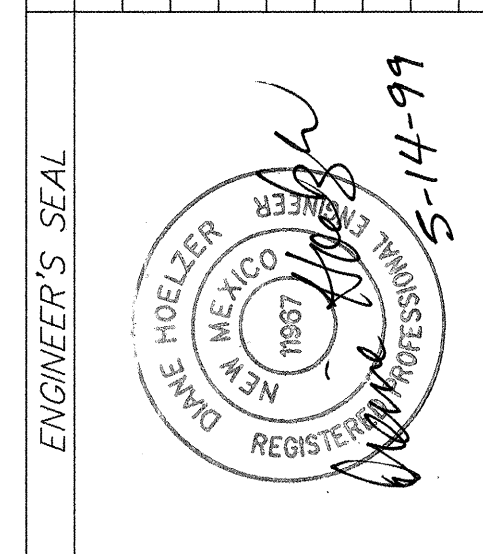

ENGINEER'S SEAL			
DATE	BY	REVISIONS	DATE
5-14-99			
NO.	DATE	REVISIONS	DATE
DESIGNED BY	DATE	3/99	
DRAWN BY	DATE	3/99	
CHECKED BY	DATE	3/99	

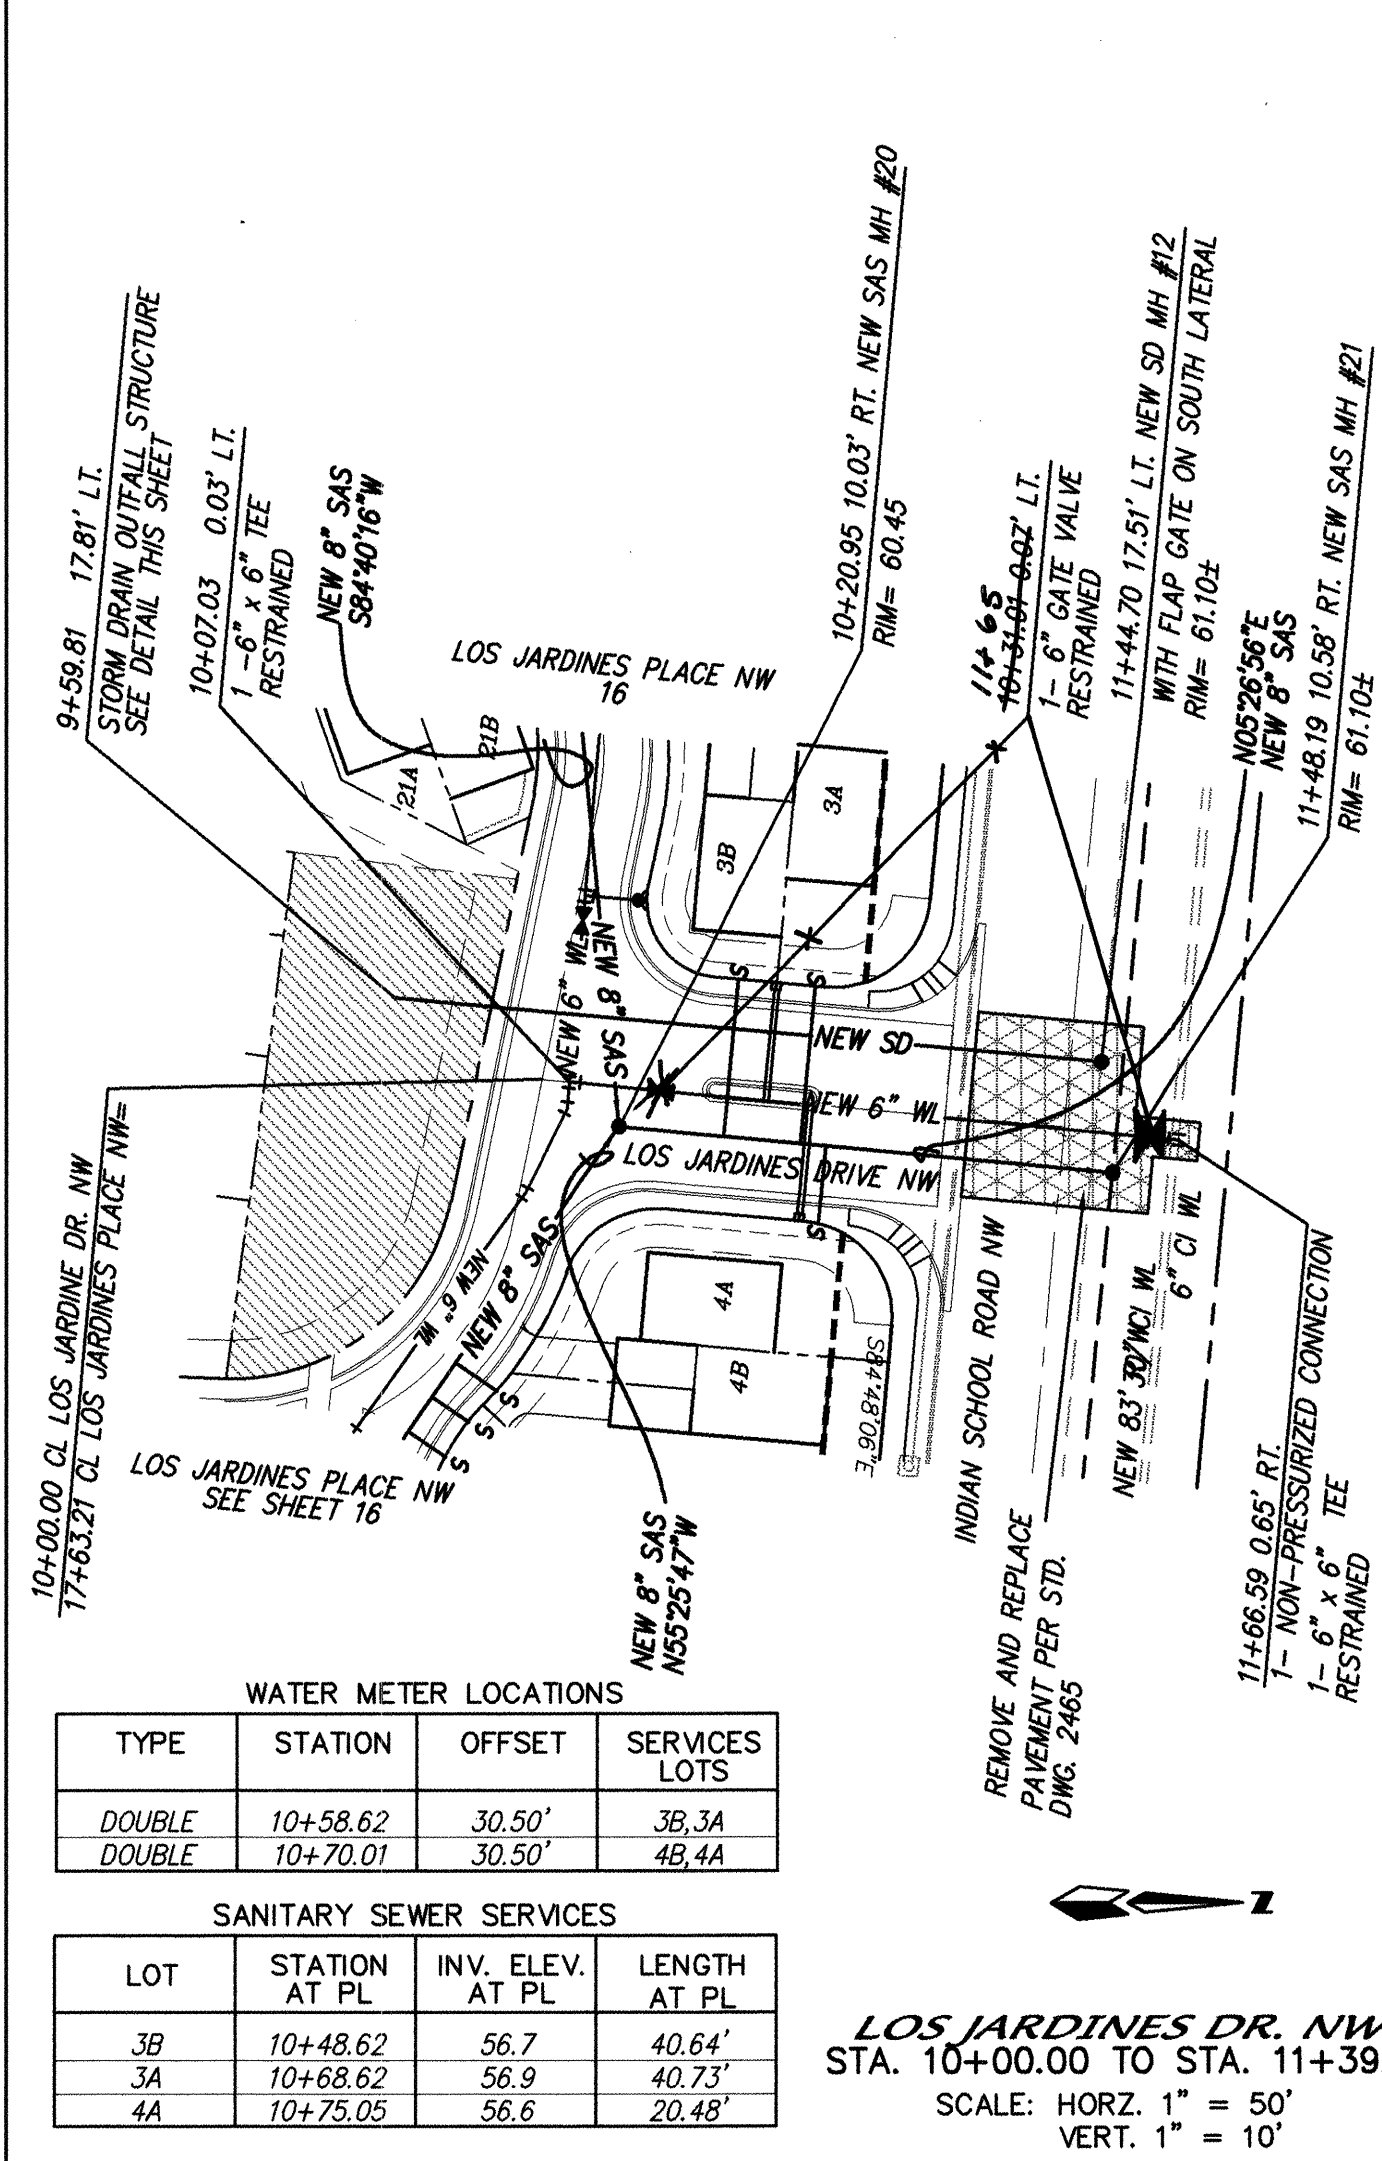


TYPE	STATION	OFFSET	SERVICES LOTS
<i>SINGLE</i>	<i>15+62.40</i>	<i>17.08'</i>	<i>1A</i>
<i>SINGLE</i>	<i>15+35.12</i>	<i>17.50'</i>	<i>1B</i>
<i>DOUBLE</i>	<i>15+97.24</i>	<i>17.00'</i>	<i>2A,2B</i>
<i>DOUBLE</i>	<i>16+17.32</i>	<i>17.00'</i>	<i>21A,21B</i>
<i>DOUBLE</i>	<i>10+30.76</i>	<i>16.37'</i>	<i>38A,38B</i>
<i>DOUBLE</i>	<i>10+47.16</i>	<i>16.58'</i>	<i>39A,39B</i>

RESTRAINED JOINT LENGTH FOR BENDS, VALVES, DEAD ENDS (FT.)					
PIPE SIZE	90°	45°	22.5°	11.25°	VAL
6"	17'	7'	3	2	46
LENGTH OF RESTRAINED PIPE ON EACH SIDE OF THE BEND. RESTRAIN BRANCH AT FITTING ONLY MINIMUM ATTACHED PIPE LENGTH, RUN SIDE OF TEE: 10.00 FEET.					

RESTRAINED JOINT LENGTH FOR TEES (FT.)		
PIPE SIZE	RUN	BRANCH
6"x6"x6"	10'	2'

I hereby certify that the information contained on this drawing has been revised in accordance with information furnished by the contractor, Condor Construction, and by the surveyor, Albuquerque Surveying, and reflects the construction as actually accomplished. This plan as constructed is in substantial compliance with the Approved Plan.

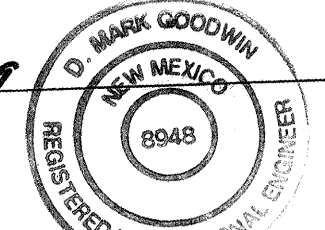

dmg MARK GOODWIN & ASSOCIATES, P.A.
CONSULTING ENGINEERS
P.O. BOX 90606
ALBUQUERQUE, NEW MEXICO 87199
(505) 828-2200, FAX (505) 797-9539

CITY OF ALBUQUERQUE
PUBLIC WORKS DEPARTMENT
ENGINEERING DEVELOPMENT GROUP

TITLE: *LOS JARDINES SUBDIVISION*
UTILITY IMPROVEMENTS
ROSALES ROAD AND LOS JARDINES DR NW

DESIGN REVIEW COMMITTEE

MAY 14 1999

DESIGN
REVIEW COMMITTEE

CITY ENGINEER APPROVAL

CITY PROJECT NO

ZONE MAP NO.	
--------------	--


SHEET	OF
-------	----

8028JARD /UPVIOLET/04/18/99/KJS

610081

H-13

15 20

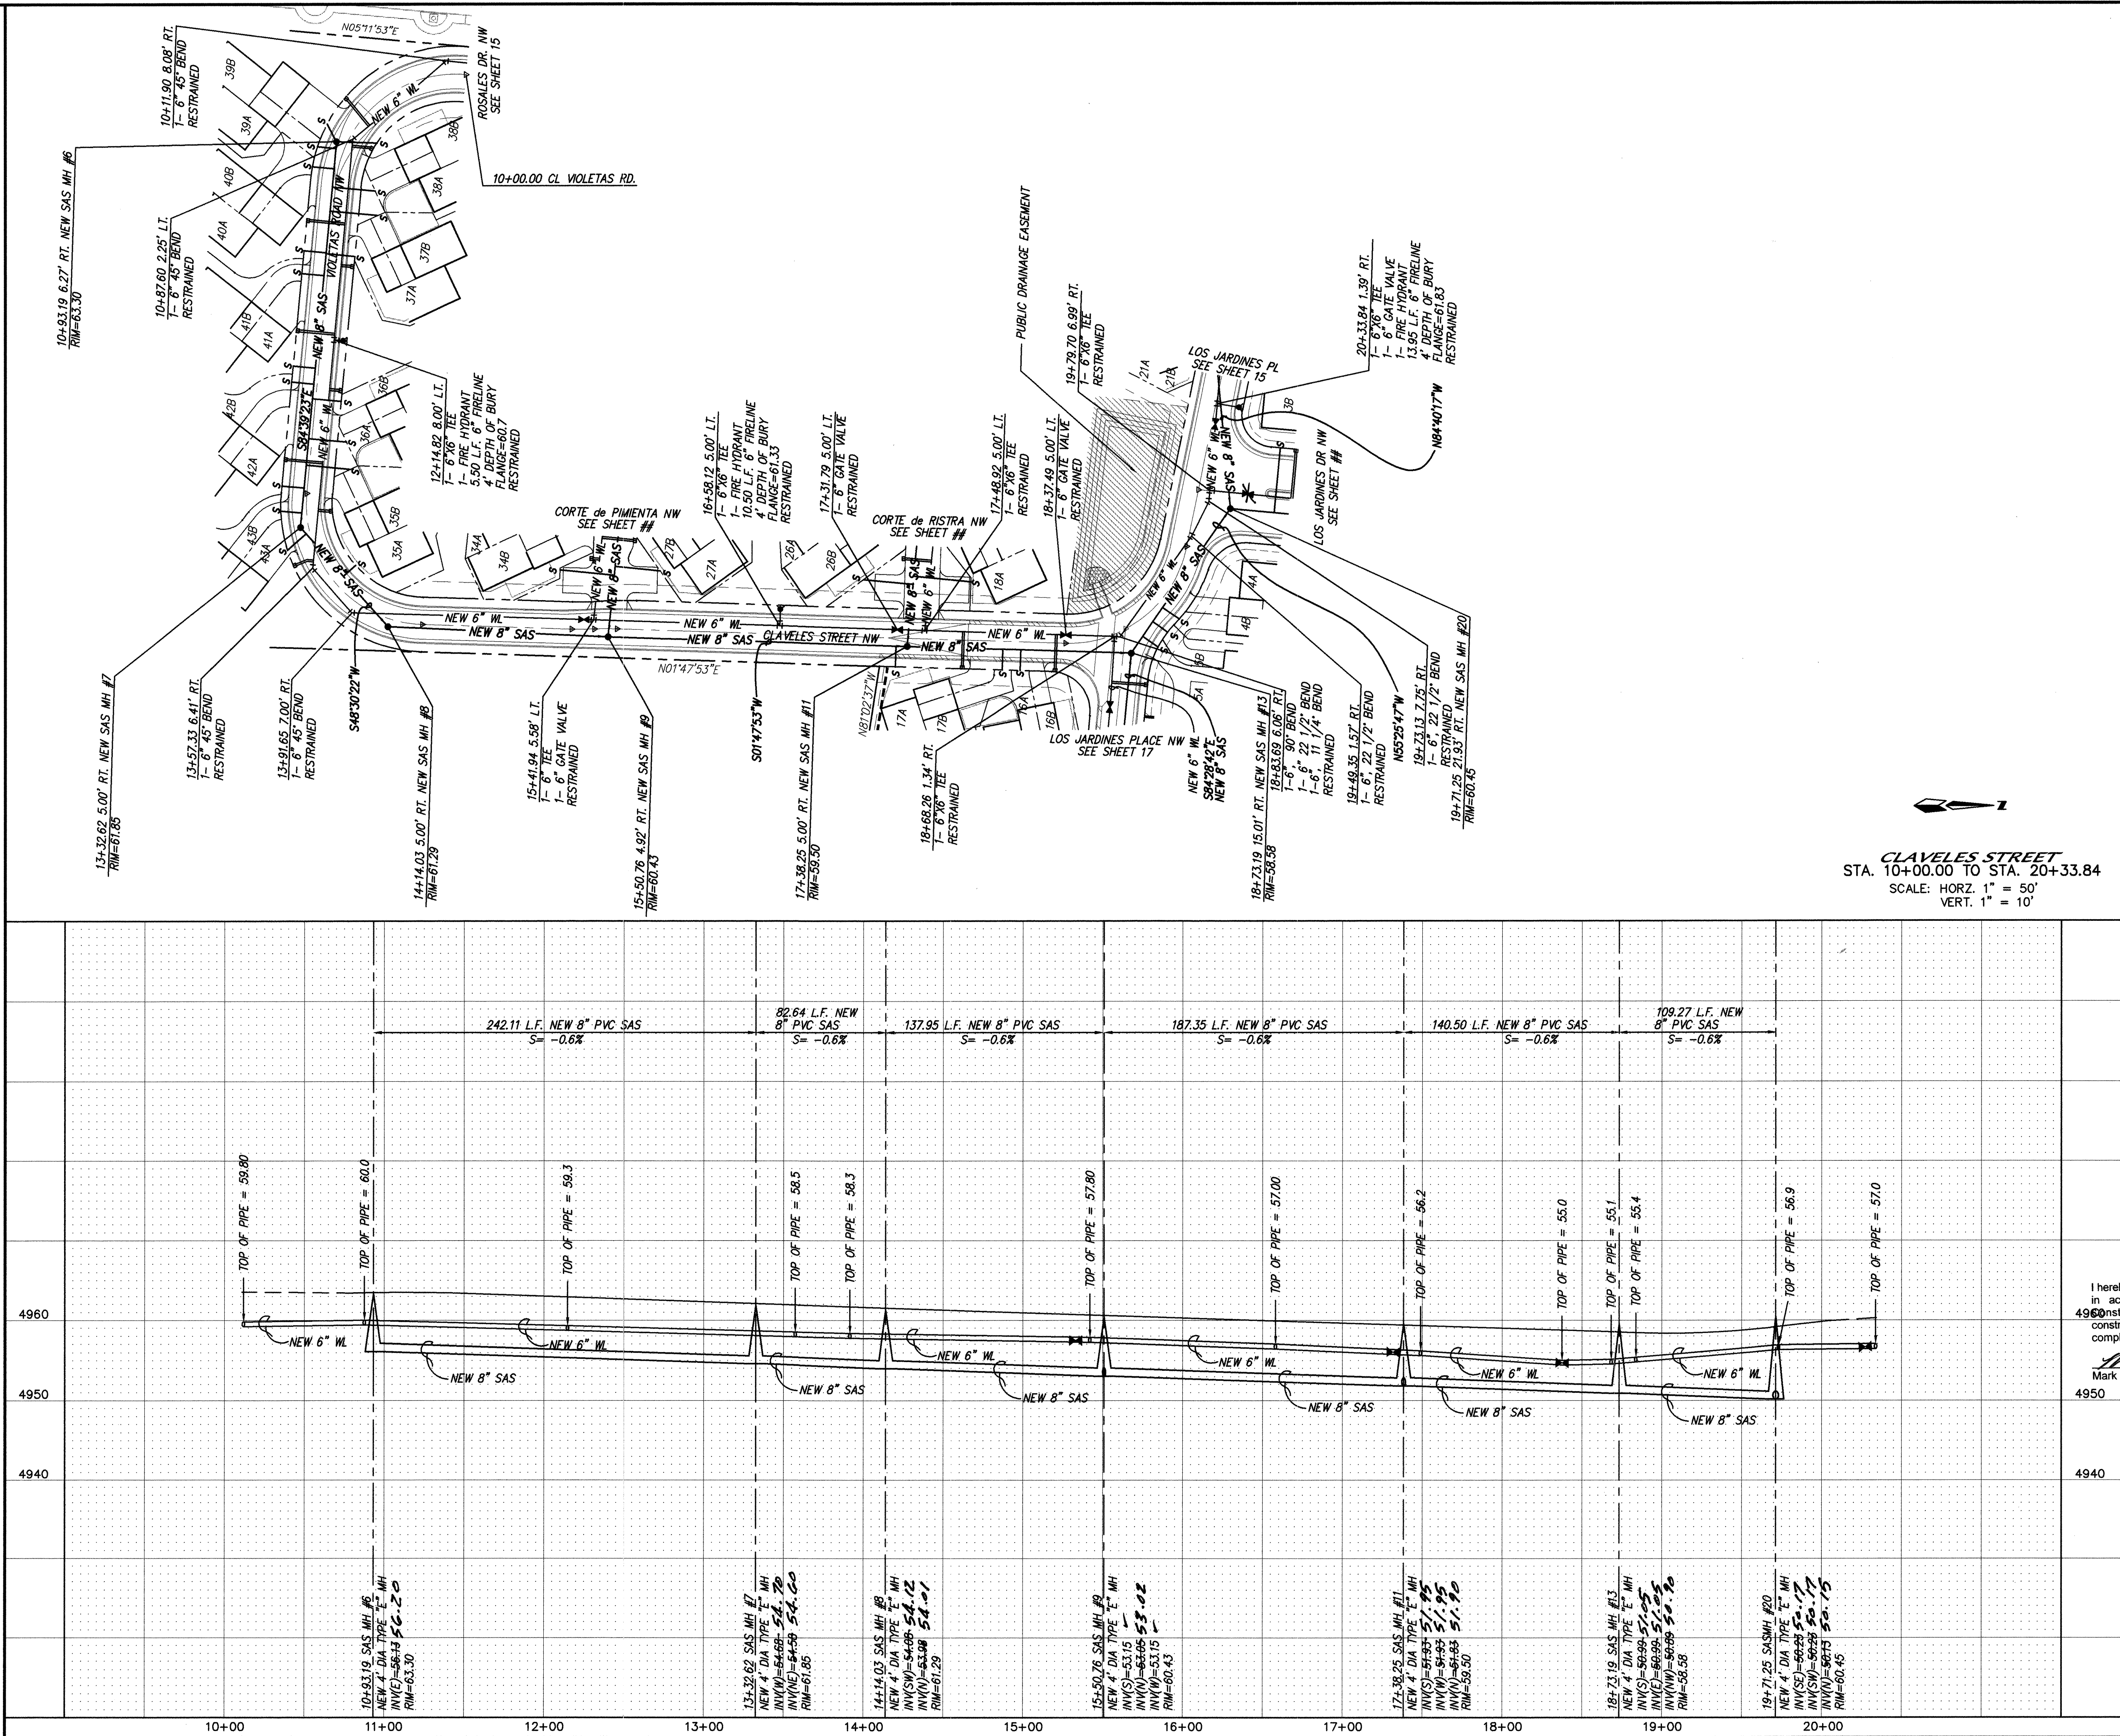

NOTES

SANITARY SEWER SERVICES

LOT	STATION AT PL	INV. ELEV. AT PL	LENGTH
4B	19+03.73	58.3	16.49'
5B	18+94.80	53.3	11.41'
5A	18+86.45	53.4	11.67'
16A	18+09.52	53.9	13.00'
17B	17+98.31	54.0	13.00'
17A	17+31.27	54.4	13.00'
35A	13+22.36	56.8	10.23'
35B	12+94.59	57.3	27.68'
36A	12+77.81	57.5	23.72'
36B	12+52.50	57.6	18.00'
37A	11+61.42	58.3	18.00'
37B	11+34.73	58.4	30.10'
38A	11+19.74	58.5	27.03'
38B	10+86.86	58.4	25.41'
39B	10+86.78	58.4	12.51'
39A	10+99.54	58.5	11.60'
40B	11+09.95	58.5	13.62'
40A	11+60.80	58.3	14.00'
41B	11+75.14	58.2	14.00'
41A	12+33.44	57.6	14.00'
42B	12+43.44	57.7	14.00'
42A	13+08.87	57.2	14.00'
43B	13+22.38	57.1	13.26'
43A	13+42.96	57.0	15.50'

WATER METER LOCATIONS

METER TYPE	STATION	OFFSET	SERVICES LOTS
DOUBLE	10+70.46	16.58' RT.	39A, 39B
DOUBLE	10+86.86	16.37' LT.	38A, 38B
DOUBLE	11+41.99	16.00' RT.	40A, 40B
DOUBLE	11+67.99	16.00' LT.	37A, 37B
DOUBLE	12+11.19	16.00' RT.	41A, 41B
DOUBLE	12+45.95	16.00' LT.	36A, 36B
DOUBLE	12+92.36	16.00' RT.	42A, 42B
DOUBLE	13+24.31	16.17' LT.	35A, 35B
DOUBLE	13+51.61	16.50' RT.	43A, 43B
DOUBLE	17+73.29	18.00' RT.	17A, 17B
DOUBLE	18+31.44	18.10' RT.	16A, 16B

RESTRAINED JOINT LENGTH FOR BENDS, VALVES, DEAD ENDS (FT.)

PIPE SIZE	90°	45°	22.5°	11.25°	VALVE
6"	17'	7'	9'	2'	46'

RESTRAINED JOINT LENGTH FOR TEES (FT.)

PIPE SIZE	RUN	BRANCH
6"x6"x6"	10'	2'

RECORD DRAWING

I hereby certify that the information contained on this drawing has been revised in accordance with information furnished by the contractor, Condore 4960, and by the surveyor, Albuquerque Surveying, and reflects the construction as actually accomplished. This plan as constructed is in substantial compliance with the Approved Plan.

Mark Goodwin
NMP# 8948

11/8/99

MARK GOODWIN & ASSOCIATES, P.A.
CONSULTING ENGINEERS
P.O. BOX 90606
ALBUQUERQUE, NEW MEXICO 87199
(505) 828-2200, FAX (505) 797-9539

CITY OF ALBUQUERQUE
PUBLIC WORKS DEPARTMENT
ENGINEERING DEVELOPMENT GROUP
LOS JARDINES SUBDIVISION
UTILITY IMPROVEMENTS
CLAVELES STREET NW

TITLE:

DESIGN REVIEW COMMITTEE
MAY 14 1999
DESIGN REVIEW COMMITTEE

CITY ENGINEER APPROVAL

MO./DAY/YR.

LAST DESIGN UPDATE


CITY PROJECT NO. 610081

ZONE MAP NO. H-13

SHEET 16 OF 20

NOTES


1. STATIONING FOR JARDINES PLACE NW IS ALONG THE CENTERLINE OF LOS JARDINES PLACE

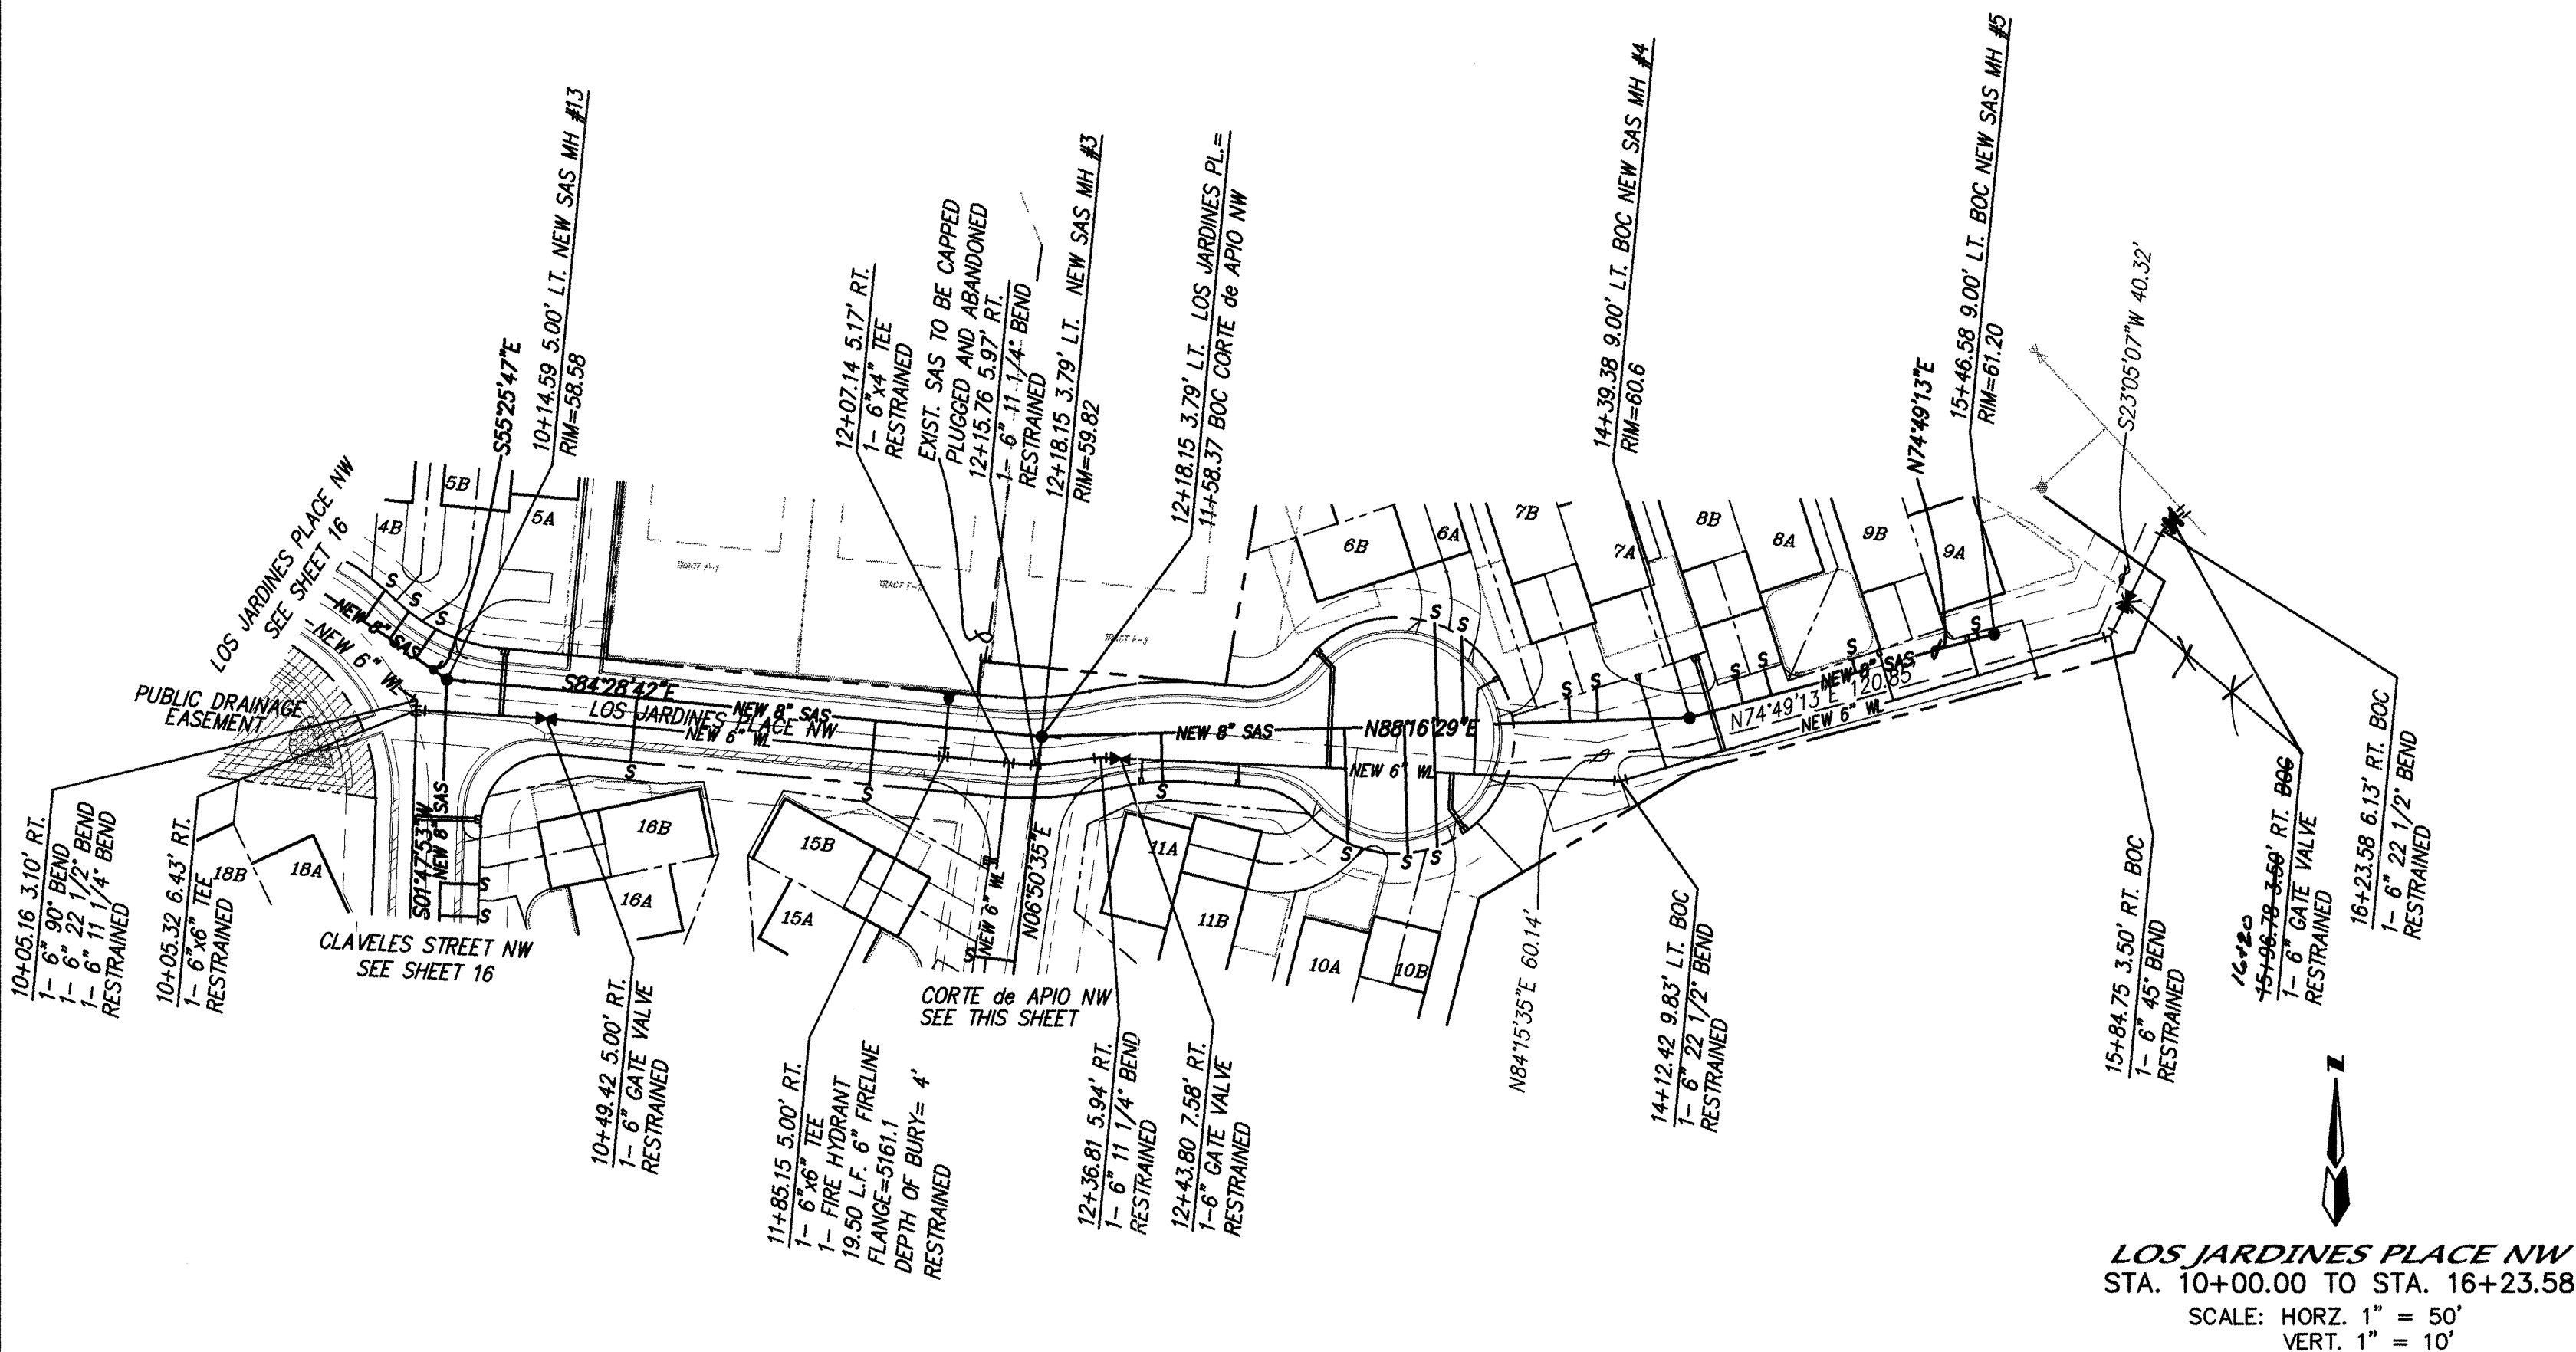

LOS JARDINES PLACE NW
STA. 10+00.00 TO STA. 16+23.58
SCALE: HORZ. 1" = 50'
VERT. 1" = 10'

NOTES

1. STATIONING FOR CORTE de APIO IS BASED OFF THE SANITARY SEWER LINE.

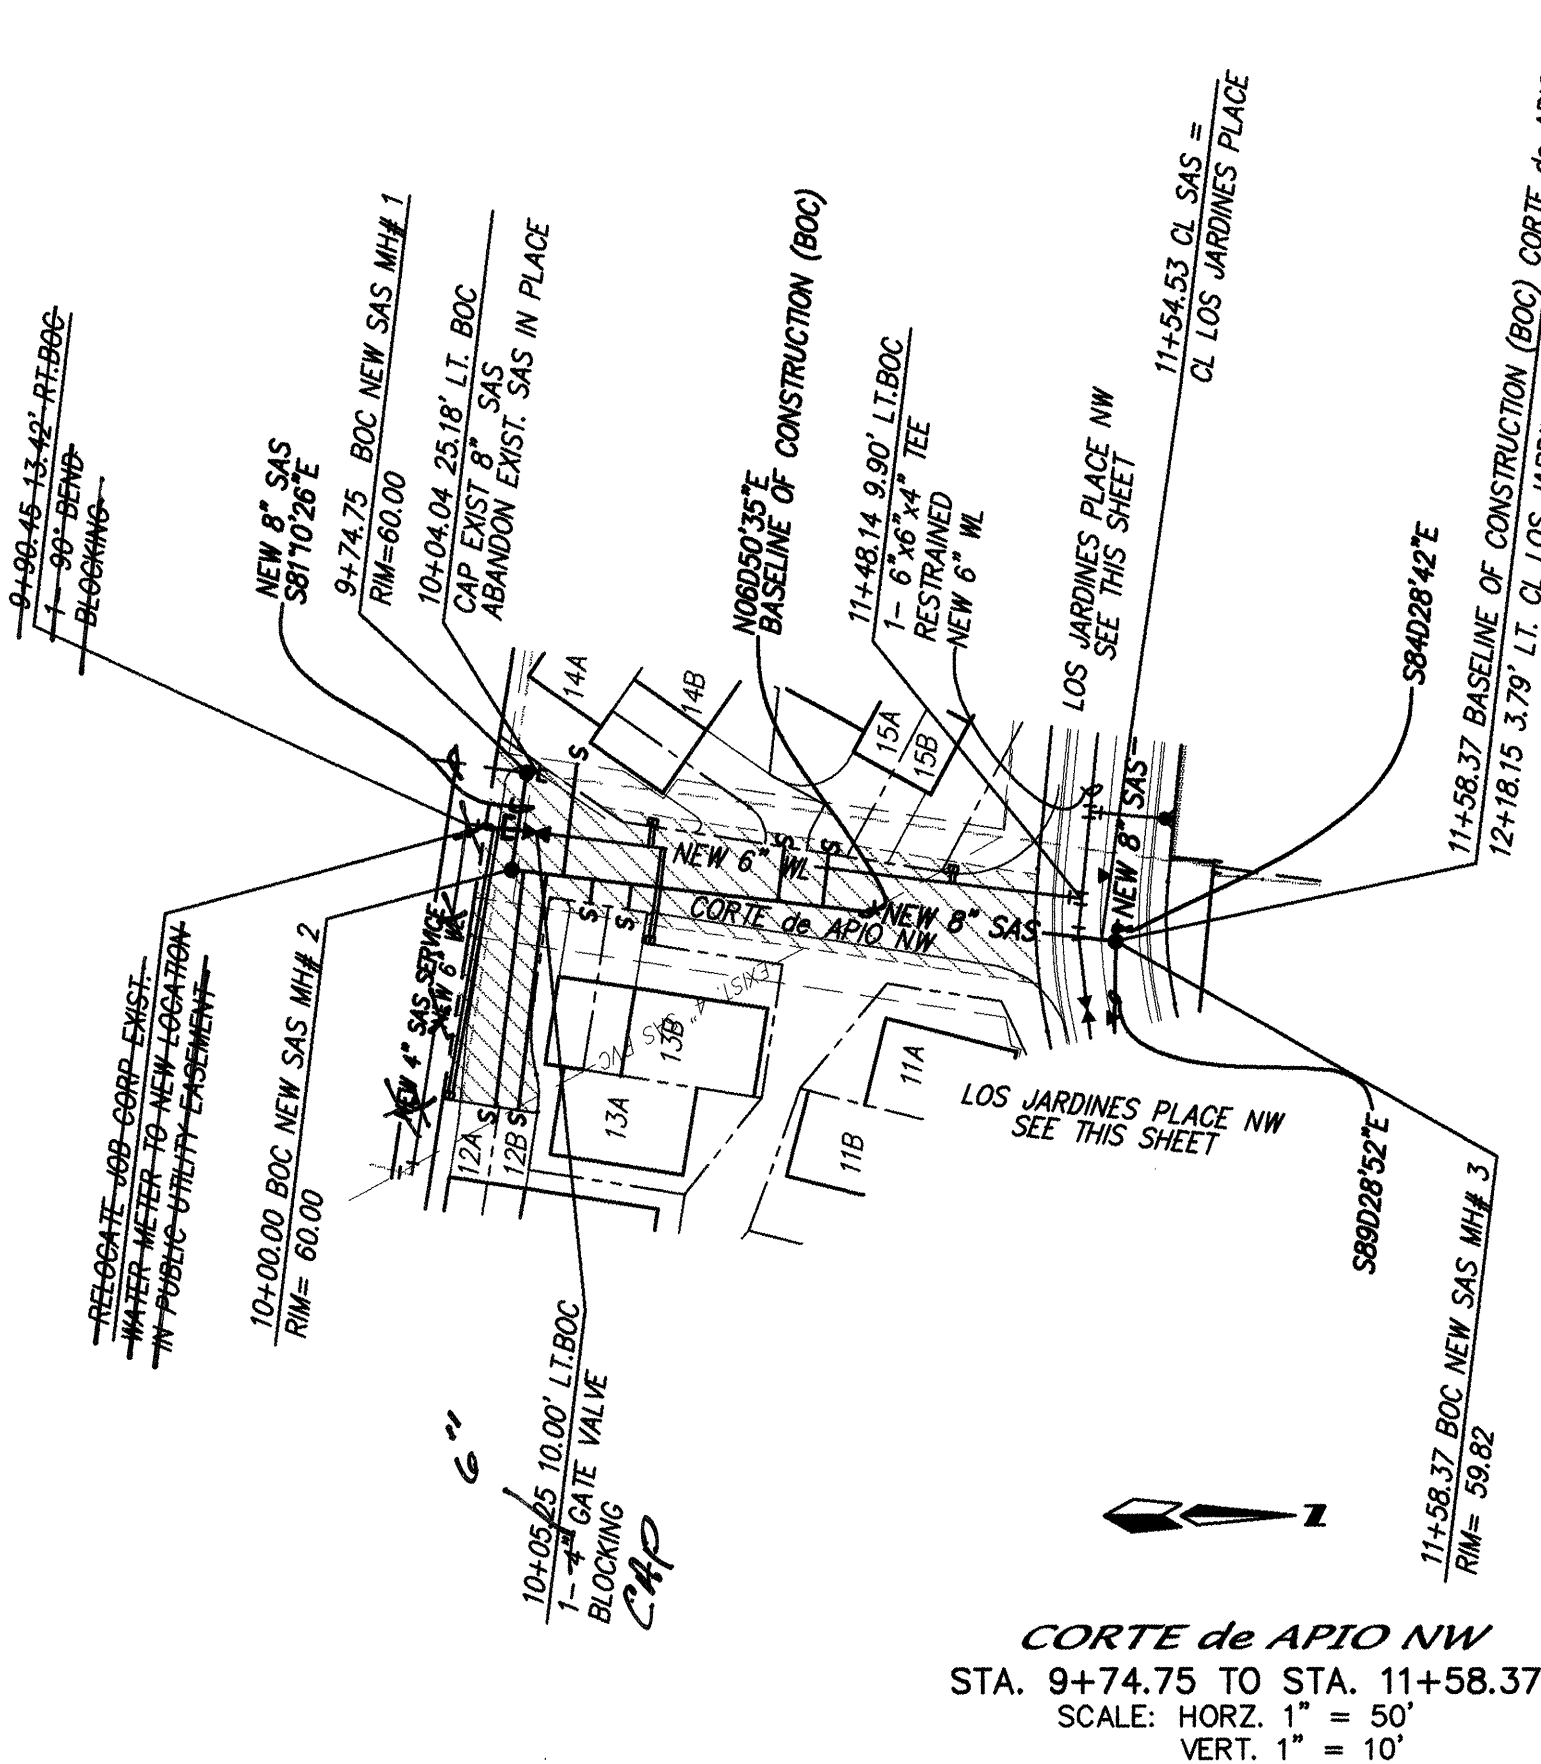

CORTE de APIO NW
STA. 9+74.75 TO STA. 11+58.37
SCALE: HORZ. 1" = 50'
VERT. 1" = 10'

NOTES

SANITARY SEWER SERVICES			
LOT	STATION AT PL	INV. ELEV. AT PL	LENGTH AT PL
6A	13+57.37	55.2	29.41'
6B	13+47.81	55.2	34.14'
7A	14+09.90	55.5	10.98'
7B	14+00.13	55.4	8.15'
8A	14+70.52	55.8	9.05'
8B	14+60.53	55.7	8.53'
9A	15+43.48	56.2	2.00'
9B	15+00.28	55.9	4.63'
10A	13+46.30	55.1	43.30'
10B	13+55.98	55.2	41.37'
11A	12+58.74	54.7	16.76'
11B	13+25.67	55.0	39.21'
15B	11+60.92	54.2	22.00'
16B	10+79.51	53.8	22.00'
12A	10+03.15	55.0	61.62'
12B	10+09.14	55.2	61.83'
13A	10+21.25	55.4	6.29'
13B	10+31.24	55.4	6.64'
14A	10+13.52	55.2	29.07'
14B	10+69.73	55.4	14.08'
15A	10+81.47	55.4	13.67'

WATER METER LOCATIONS			
TYPE	STATION	OFFSET	SERVICES LOTS
DOUBLE	10+33.50	17.00'	5A, 5B
DOUBLE	13+08.63	31.66'	6A, 6B
SINGLE	13+71.35	28.58'	7B
SINGLE	14+24.03	25.66'	7A
DOUBLE	9+48.94	28.77'	8A, 8B
SINGLE	15+09.58	14.12'	9B
SINGLE	15+39.84	11.00'	9A
SINGLE	12+50.42	17.00'	11A
SINGLE	12+86.58	17.00'	11B
DOUBLE	9+90.94	61.16'	12A, 12B
DOUBLE	10+37.93	14.91'	13A, 13B
DOUBLE	10+35.14	17.11'	14A, 14B
DOUBLE	11+14.25	14.40'	15A, 15B

RESTRAINED JOINT LENGTH FOR BENDS, VALVES, DEAD ENDS (FT.)				
PIPE SIZE	90°	45°	22.5°	11.25° VALVE
6"	17'	7'	3'	46'
4"	12'	5'	2'	32'

LENGTH OF RESTRAINED PIPE ON EACH SIDE OF THE BEND. RESTRAIN BRANCH AT FITTING ONLY MINIMUM ATTACHED PIPE LENGTH, RUN SIDE OF TEE: 10.00 FEET.

RESTRAINED JOINT LENGTH FOR TEES (FT.)		
PIPE SIZE	RUN	BRANCH
6"x6"x6"	10'	2'
6"x6"x4"	4'	7'

RECORD DRAWING

I hereby certify that the information contained on this drawing has been revised in accordance with information furnished by the contractor, Condor Construction, and by the surveyor, Albuquerque Surveying, and reflects the construction as actually accomplished. This plan as constructed is in substantial compliance with the Approved Plan.

Mark Goodwin
NMPE 8948




MARK GOODWIN & ASSOCIATES, P.A.
CONSULTING ENGINEERS
P.O. BOX 90606
ALBUQUERQUE, NEW MEXICO 87199
(505) 828-2200, FAX (505) 797-9539

CITY OF ALBUQUERQUE
PUBLIC WORKS DEPARTMENT
ENGINEERING DEVELOPMENT GROUP

TITLE: **LOS JARDINES SUBDIVISION UTILITY IMPROVEMENTS**
LOS JARDINES PLACE AND CORTE de APIO NW

DESIGN REVIEW COMMITTEE: MAY 14 1999
CITY ENGINEER APPROVAL: [Signature]
LAST DESIGN UPDATE: [Blank]
CITY PROJECT NO. **610081** ZONE MAP NO. **H-13** SHEET **17** OF **20**

SCANNED BY
MESA PL

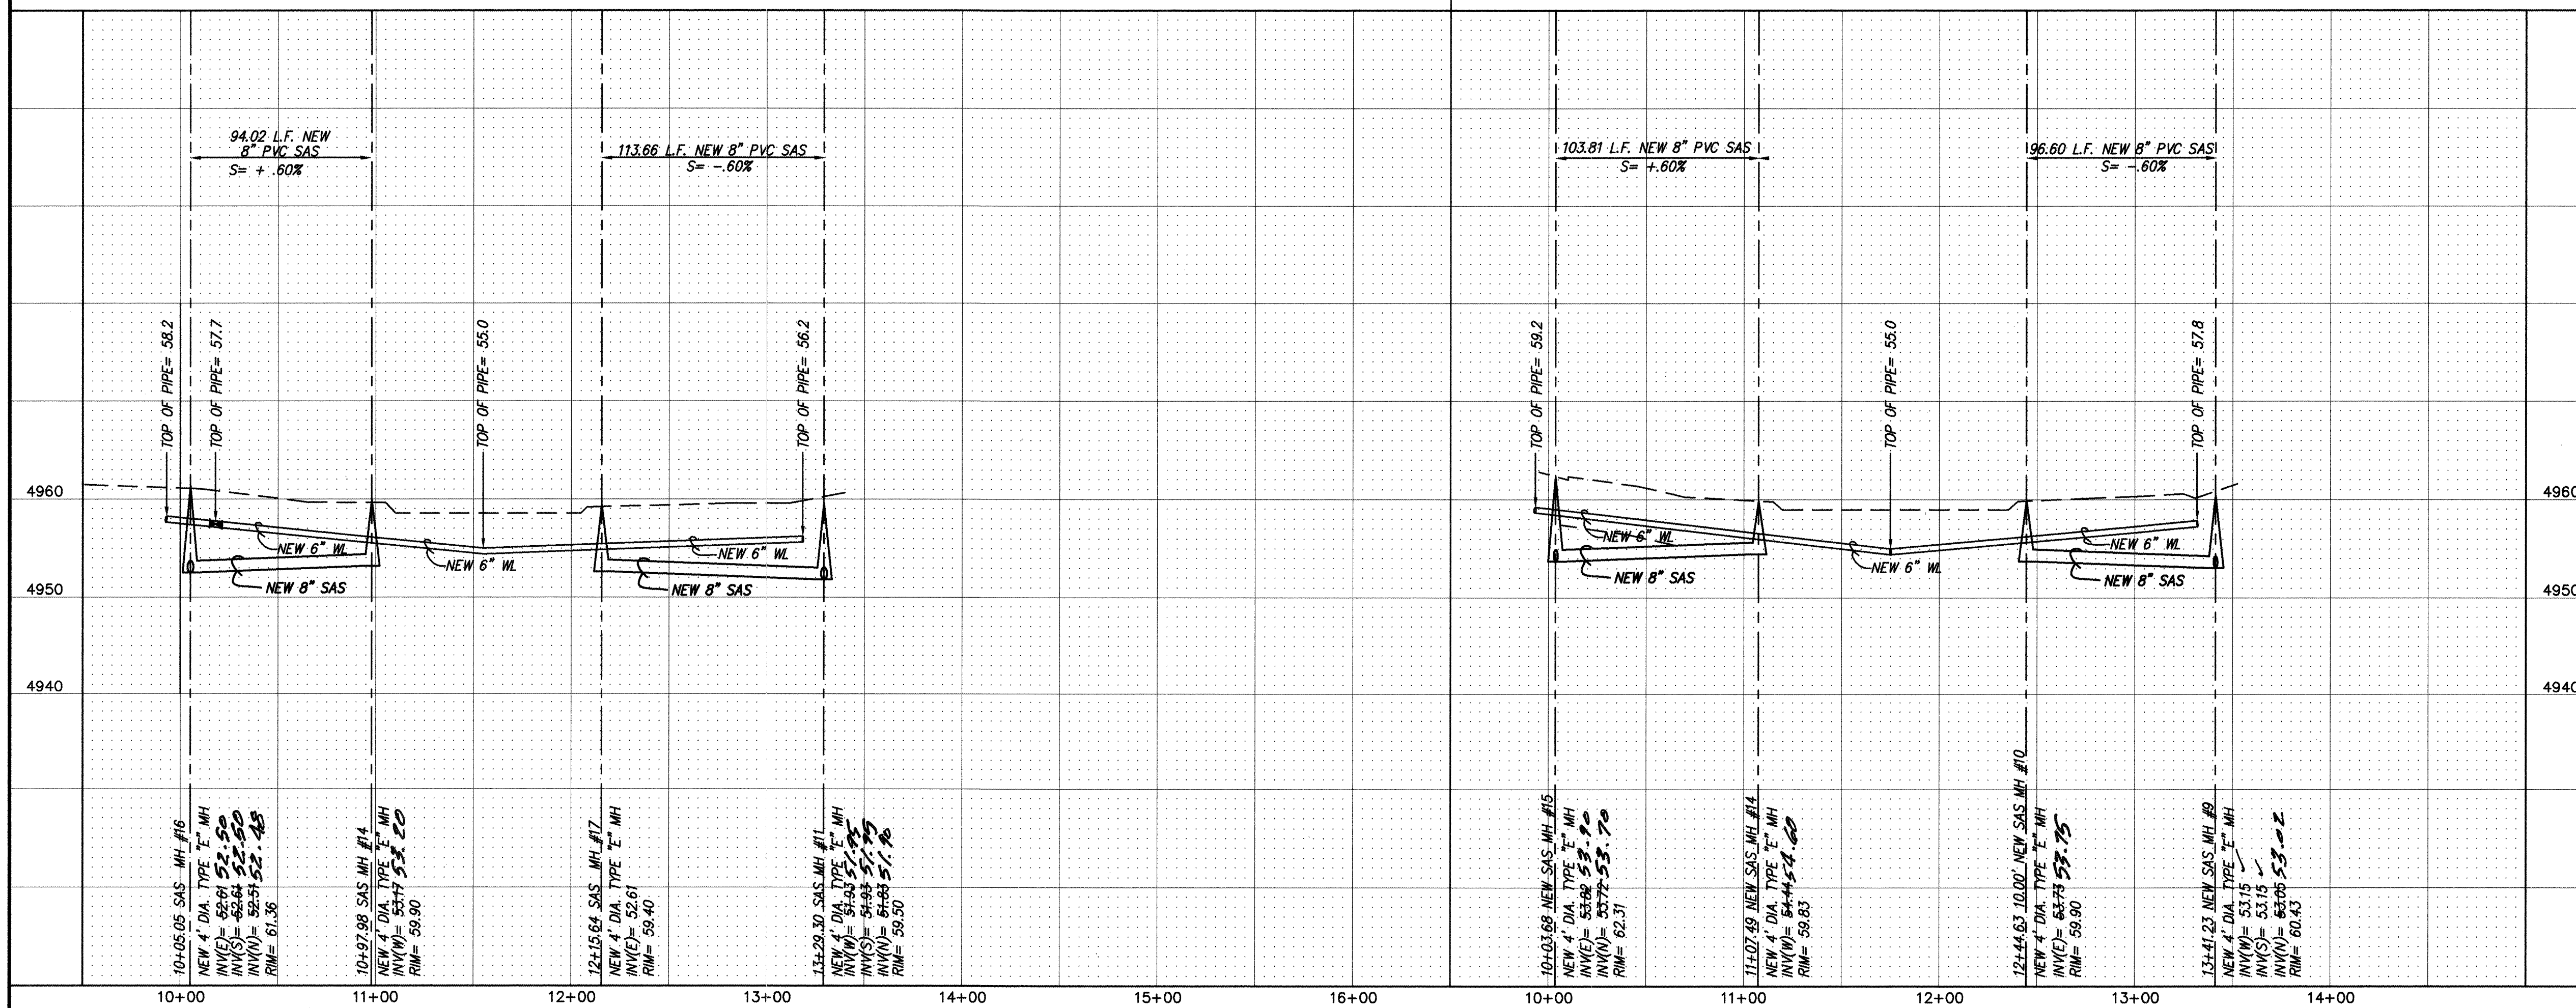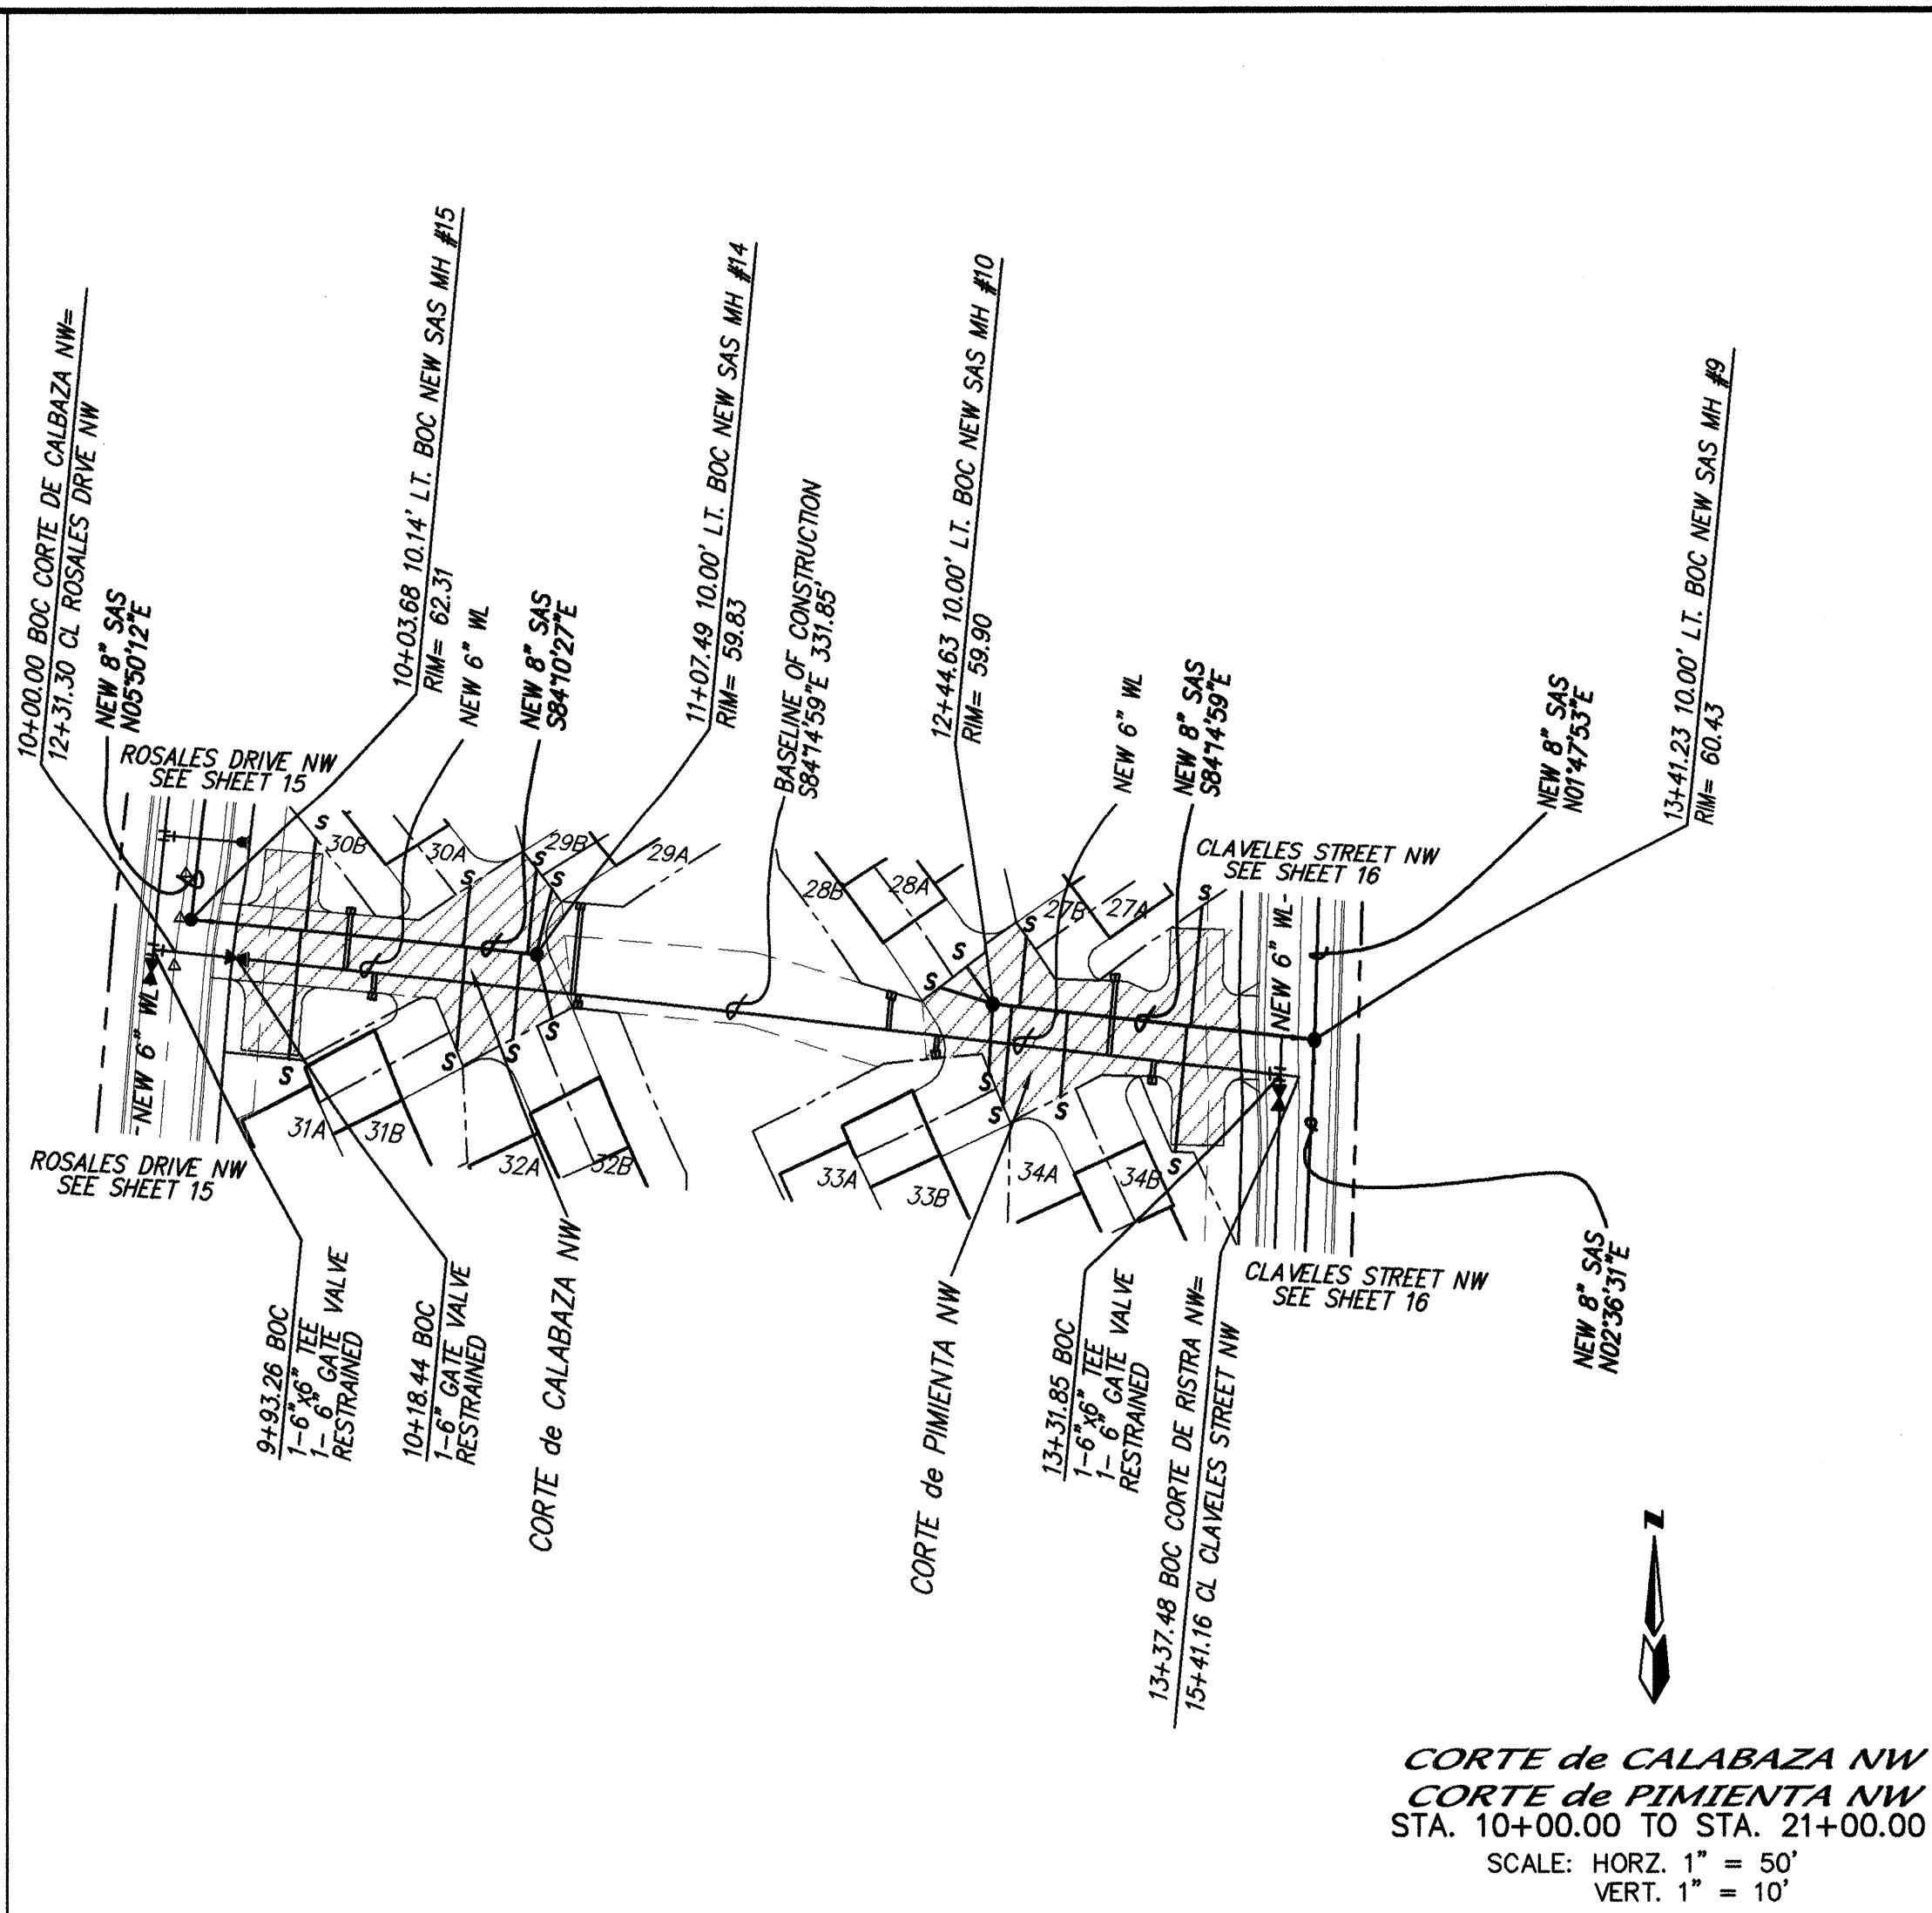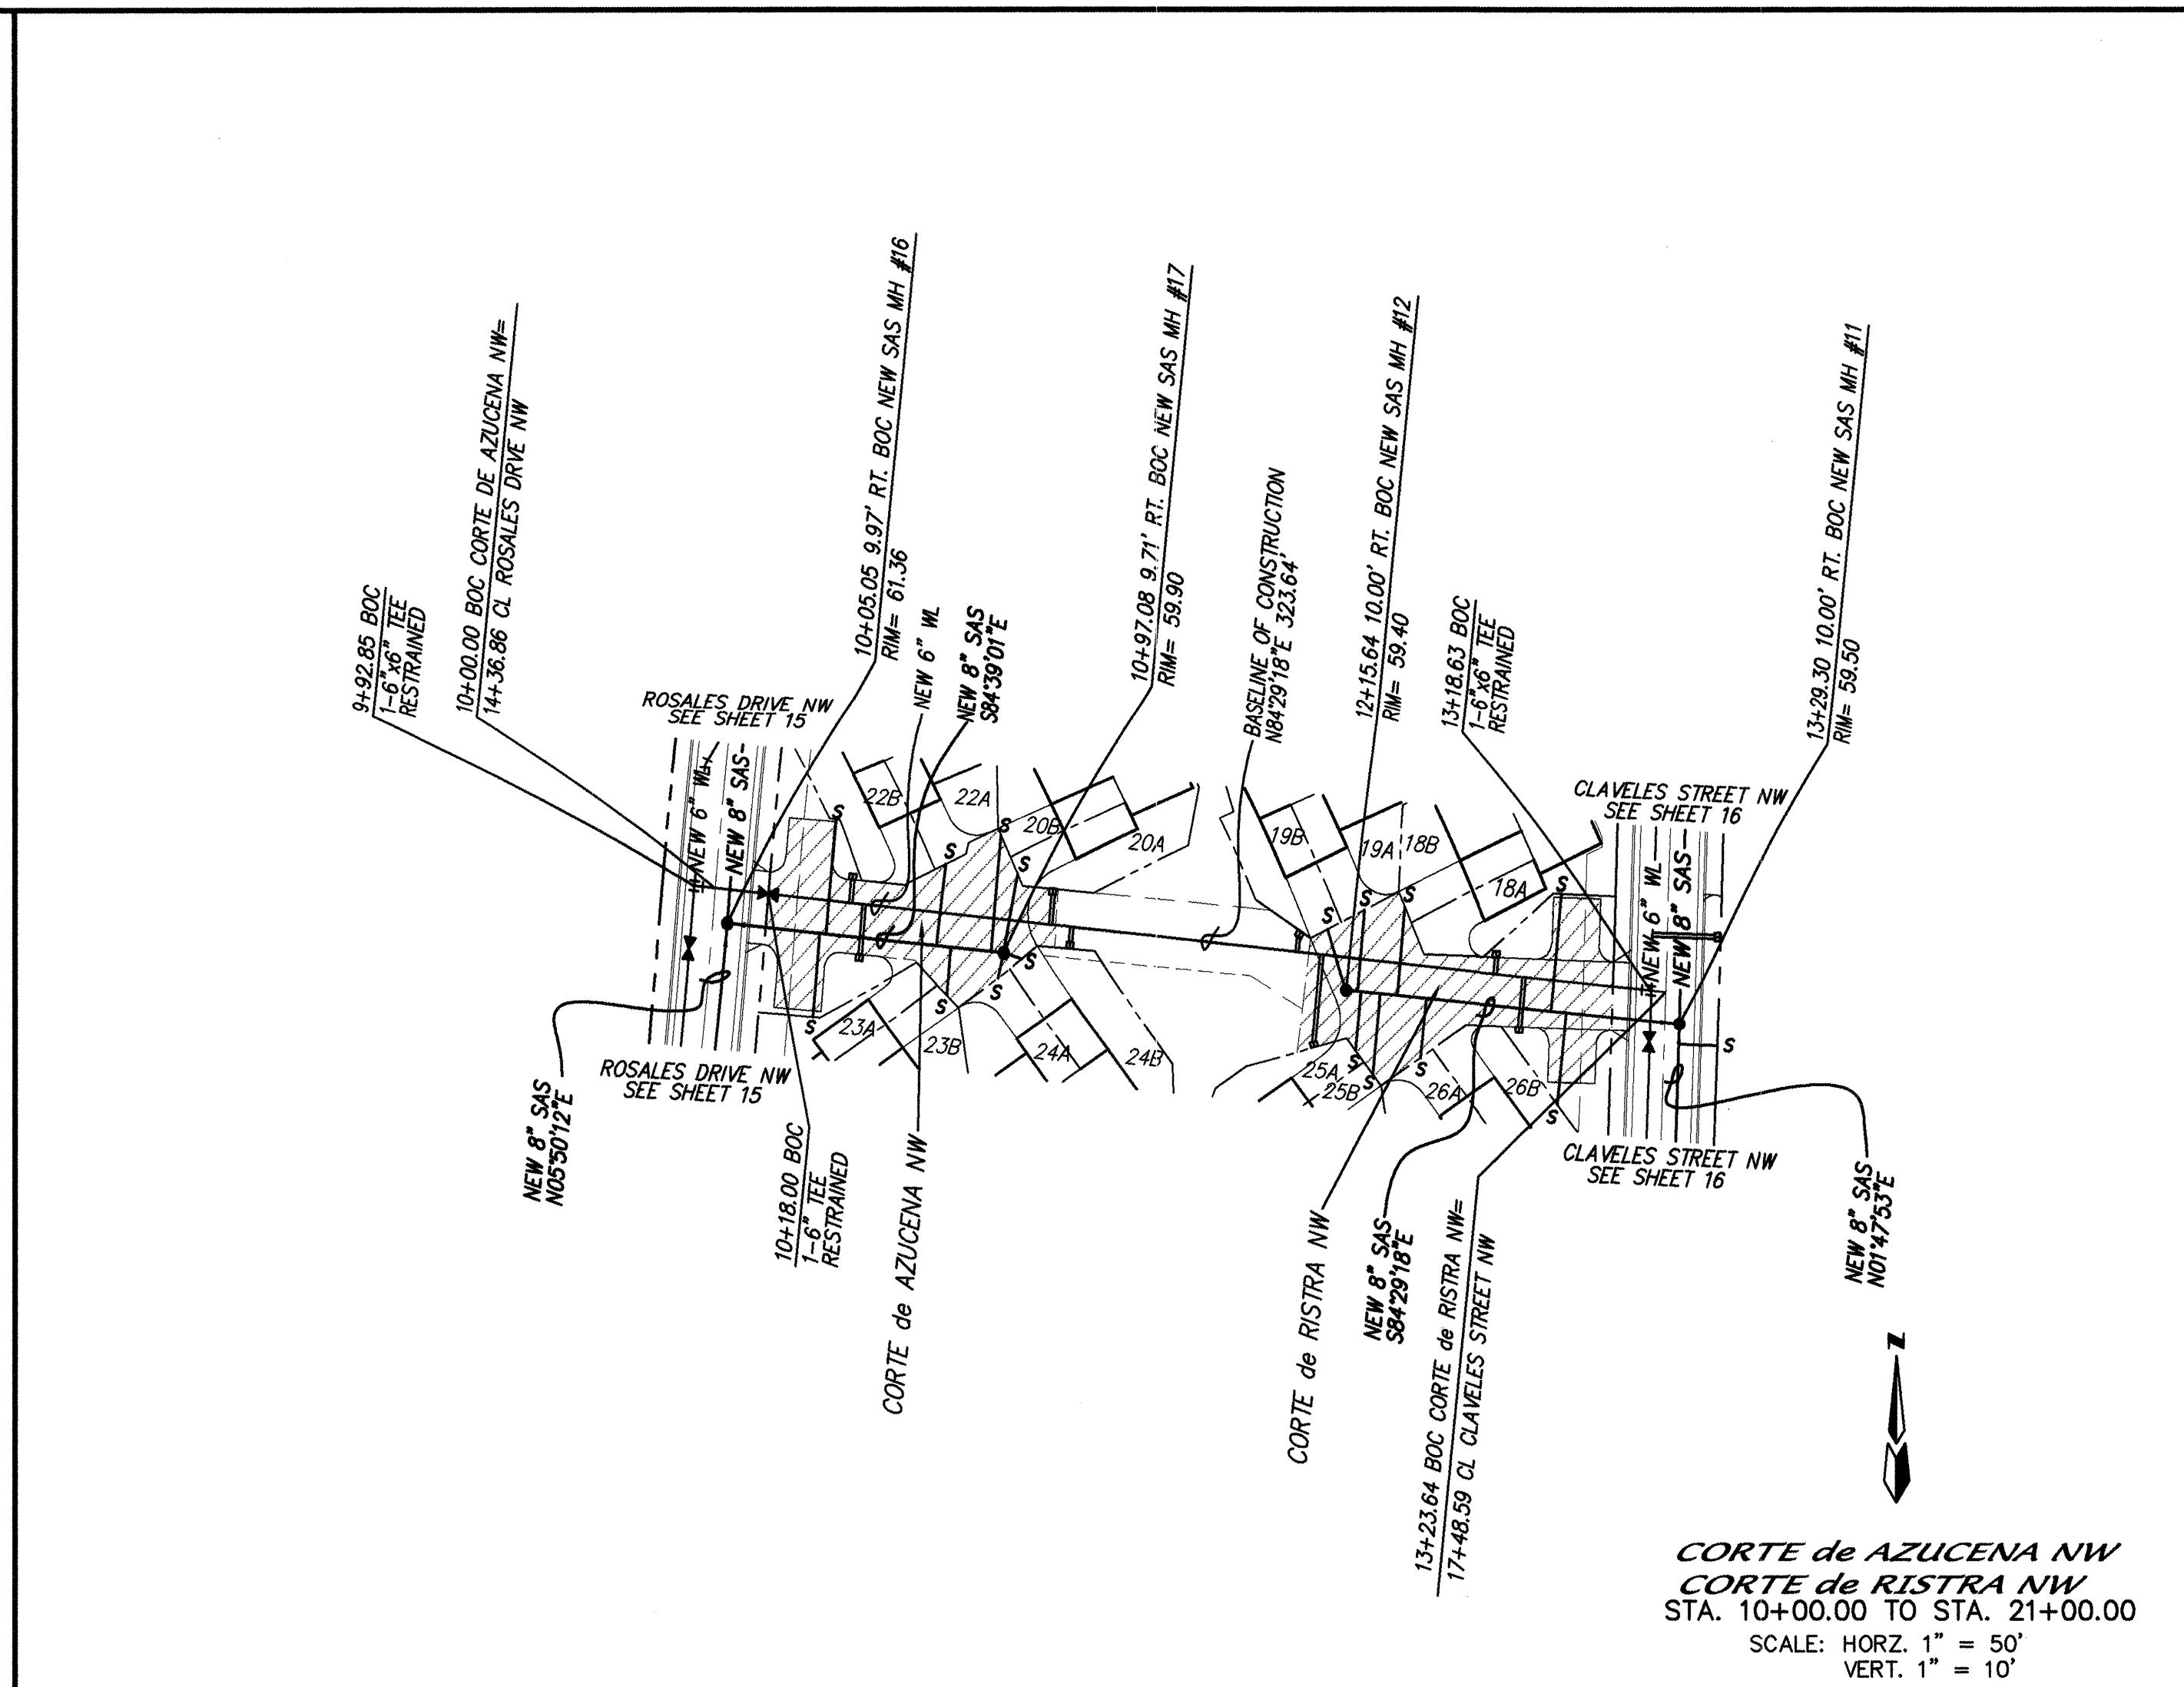

NOTES

SANITARY SEWER SERVICES			
LOT	STATION AT PL	INV. ELEV. AT PL	LENGTH AT PL
23A	10+36.69	55.3	26.21'
22B	10+38.55	55.3	35.86'
22A	10+77.03	54.6	24.82'
23B	10+81.10	54.6	14.77'
20B	10+94.73	54.6	35.54'
24A	10+97.85	54.6	7.90'
20A	11+01.55	54.6	24.00'
24B	11+05.37	54.4	6.41'
19B	12+07.72	54.0	19.39'
19A	12+19.54	54.2	24.61'
18B	12+33.12	54.3	26.76'
26A	12+43.03	54.3	20.01'
18A	12+85.55	54.6	35.89'
26B	12+90.67	54.5	31.11'
31A	10+36.70	56.5	35.32'
30B	10+38.14	56.5	29.90'
30A	10+85.54	55.1	18.96'
31B	10+86.29	55.1	28.08'
32A	11+02.77	54.9	23.52'
29B	11+04.85	54.8	26.40'
29A	11+01.09	54.9	20.53'
32B	11+13.96	54.7	18.11'
28B	12+28.42	53.9	16.47'
28A	12+35.97	53.9	12.83'
33A	12+44.09	54.8	17.61'
27B	12+52.65	55.8	19.99'
34A	12+6715	55.0	22.13'
34B	13+02.91	55.3	34.11'
27A	13+04.05	55.3	34.21'

WATER METER LOCATIONS			
TYPE	STATION	OFFSET	SERVICES LOTS
DOUBLE	10+46.11	8.89'	22A, 22B
DOUBLE	10+60.67	16.74'	23A, 23B
DOUBLE	11+13.97	10.80'	20A, 20B
DOUBLE	11+21.25	6.35'	24A, 24B
DOUBLE	11+98.80	6.03'	19A, 19B
DOUBLE	12+06.92	29.95'	25A, 25B
DOUBLE	12+65.31	6.87'	18A, 18B
DOUBLE	12+75.49	18.19'	26A, 26B
DOUBLE	10+50.99	18.29'	30A, 30B
DOUBLE	10+59.57	7.26'	31A, 31B
DOUBLE	11+19.25	26.67'	29A, 29B
DOUBLE	11+21.20	3.59'	32A, 32B
DOUBLE	12+14.43	10.14'	28A, 28B
DOUBLE	12+29.24	5.85'	33A, 33B
DOUBLE	12+80.27	21.69'	27A, 27B
DOUBLE	12+94.11	6.00'	34A, 34B

RESTRAINED JOINT LENGTH FOR BENDS, VALVES, DEAD ENDS (FT.)

PIPE SIZE	90°	45°	22.5°	11.25°	VALVE
6"	17'	7'	-	-	46'

LENGTH OF RESTRAINED PIPE ON EACH SIDE OF THE BEND. RESTRAIN BRANCH AT FITTING ONLY MINIMUM ATTACHED PIPE LENGTH, RUN SIDE OF TEE: 10.00 FEET.

RESTRAINED JOINT LENGTH FOR TEES (FT.)

PIPE SIZE	RUN	BRANCH
6"x6"x6"	10'	2'

RECORD DRAWING

I hereby certify that the information contained on this drawing has been revised in accordance with information furnished by the contractor, Condore Construction, and by the surveyor, Albuquerque Surveying, and reflects the construction as actually accomplished. This plan as constructed is in substantial compliance with the Approved Plan.

Mark Goodwin 11/12/99
Mark Goodwin NMPE 8948

dmg

MARK GOODWIN & ASSOCIATES, P.A.
CONSULTING ENGINEERS
P.O. BOX 90606
ALBUQUERQUE, NEW MEXICO 87199
(505) 828-2200, FAX (505) 797-9539

CITY OF ALBUQUERQUE
PUBLIC WORKS DEPARTMENT
ENGINEERING DEVELOPMENT GROUP

TITLE: **LOS JARDINES SUBDIVISION
UTILITY IMPROVEMENTS
ROSALES DRIVE NW TO CLAVELES STREET NW**

APPROVED
MAY 12, 1999
DESIGN REVIEW COMMITTEE

CITY ENGINEER APPROVAL

LAST DESIGN UPDATE

MO./DAY/YR.

MO./DAY/YR.

CITY PROJECT NO.

610081

ZONE MAP NO.




H-13

SHEET

OF

18

20

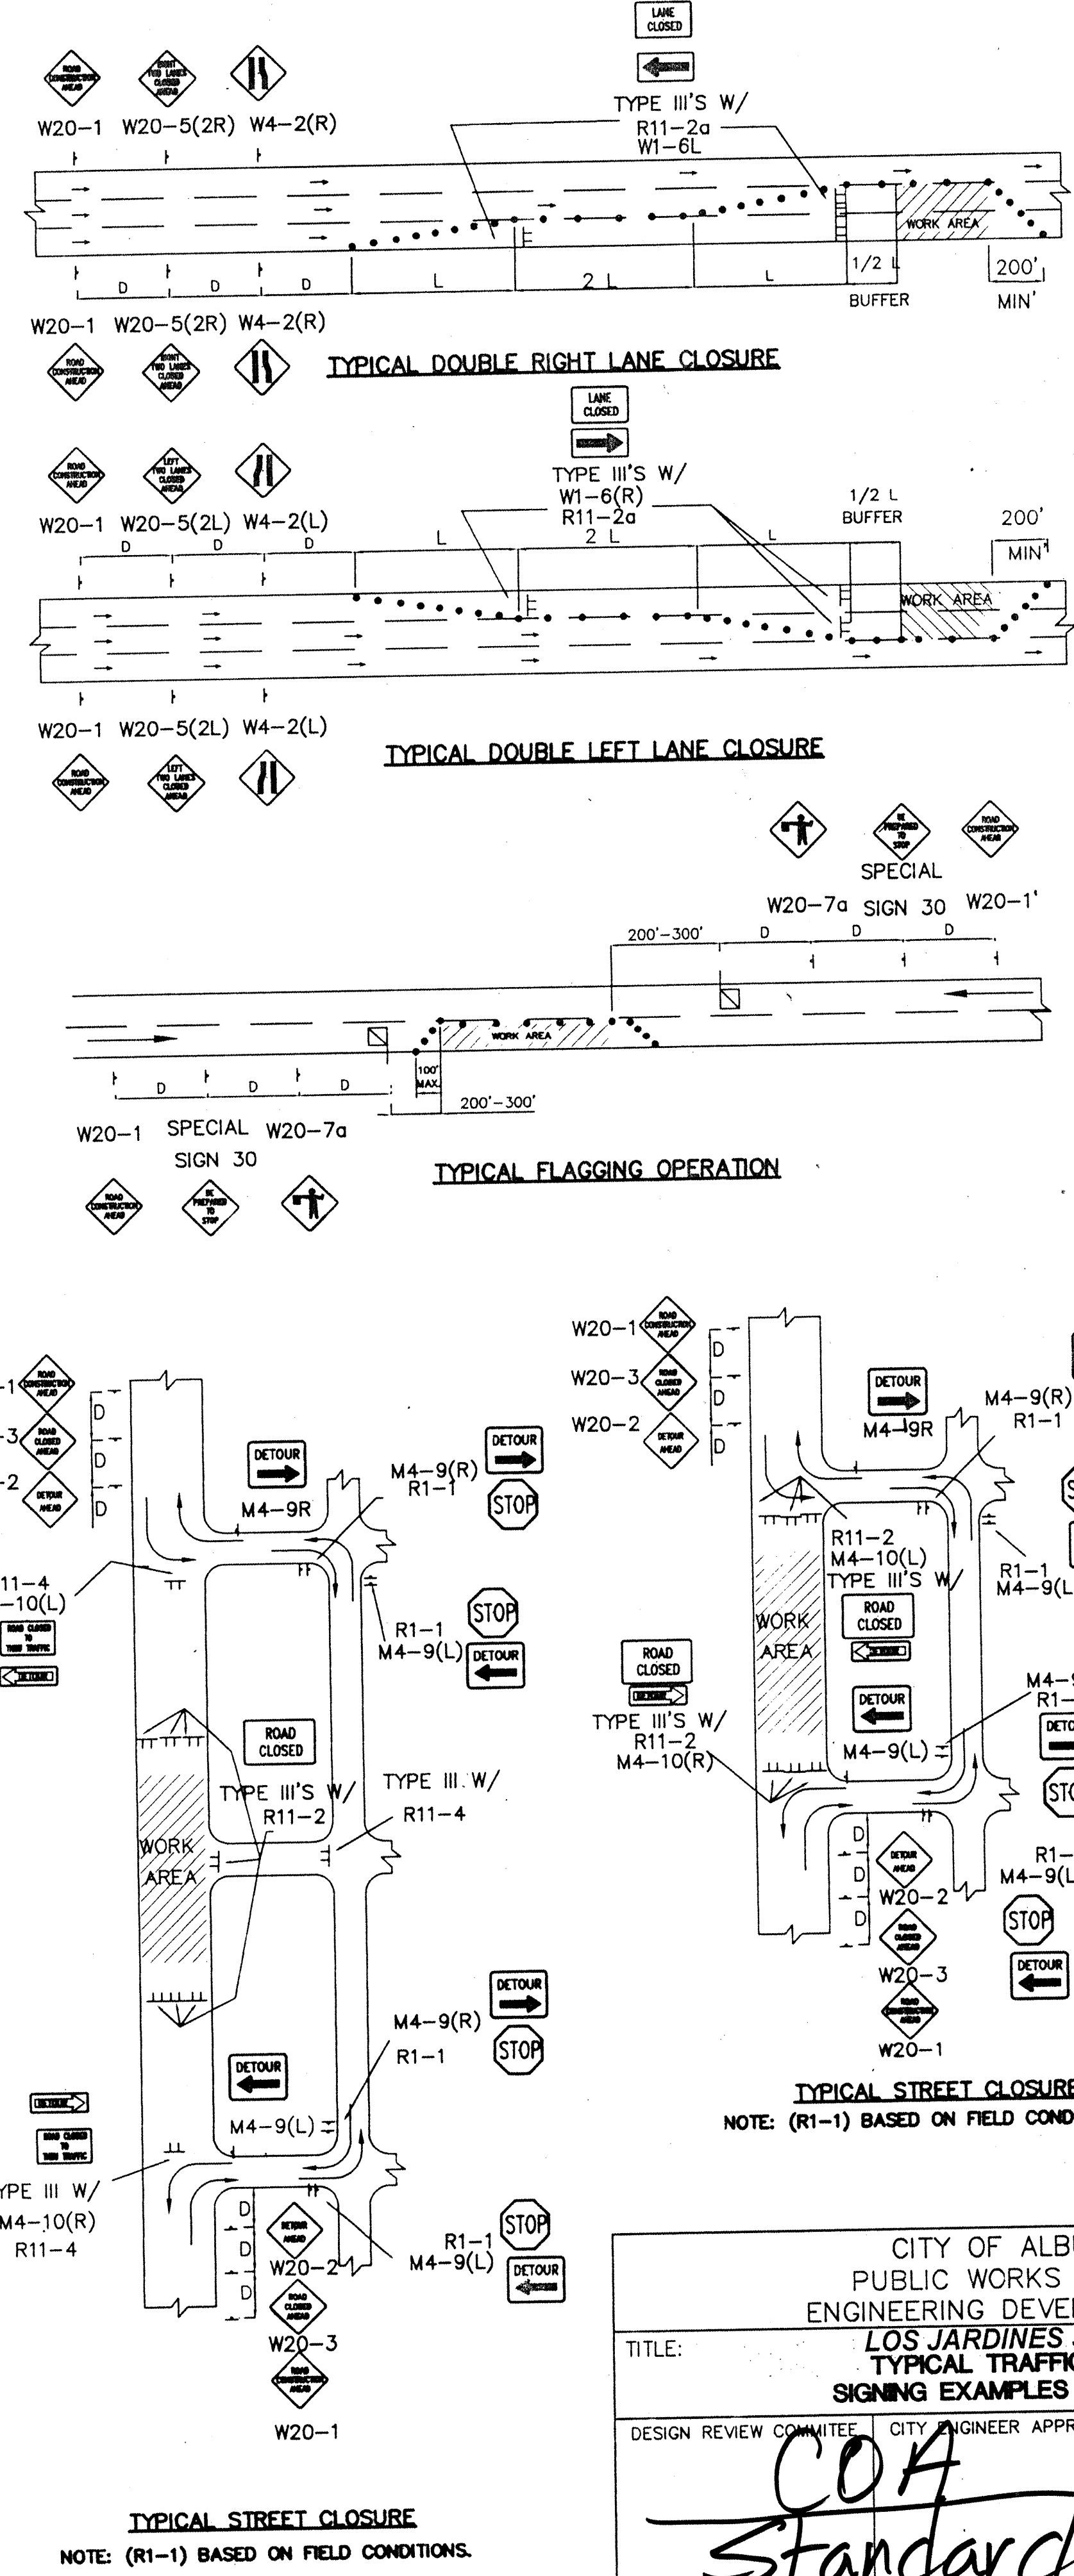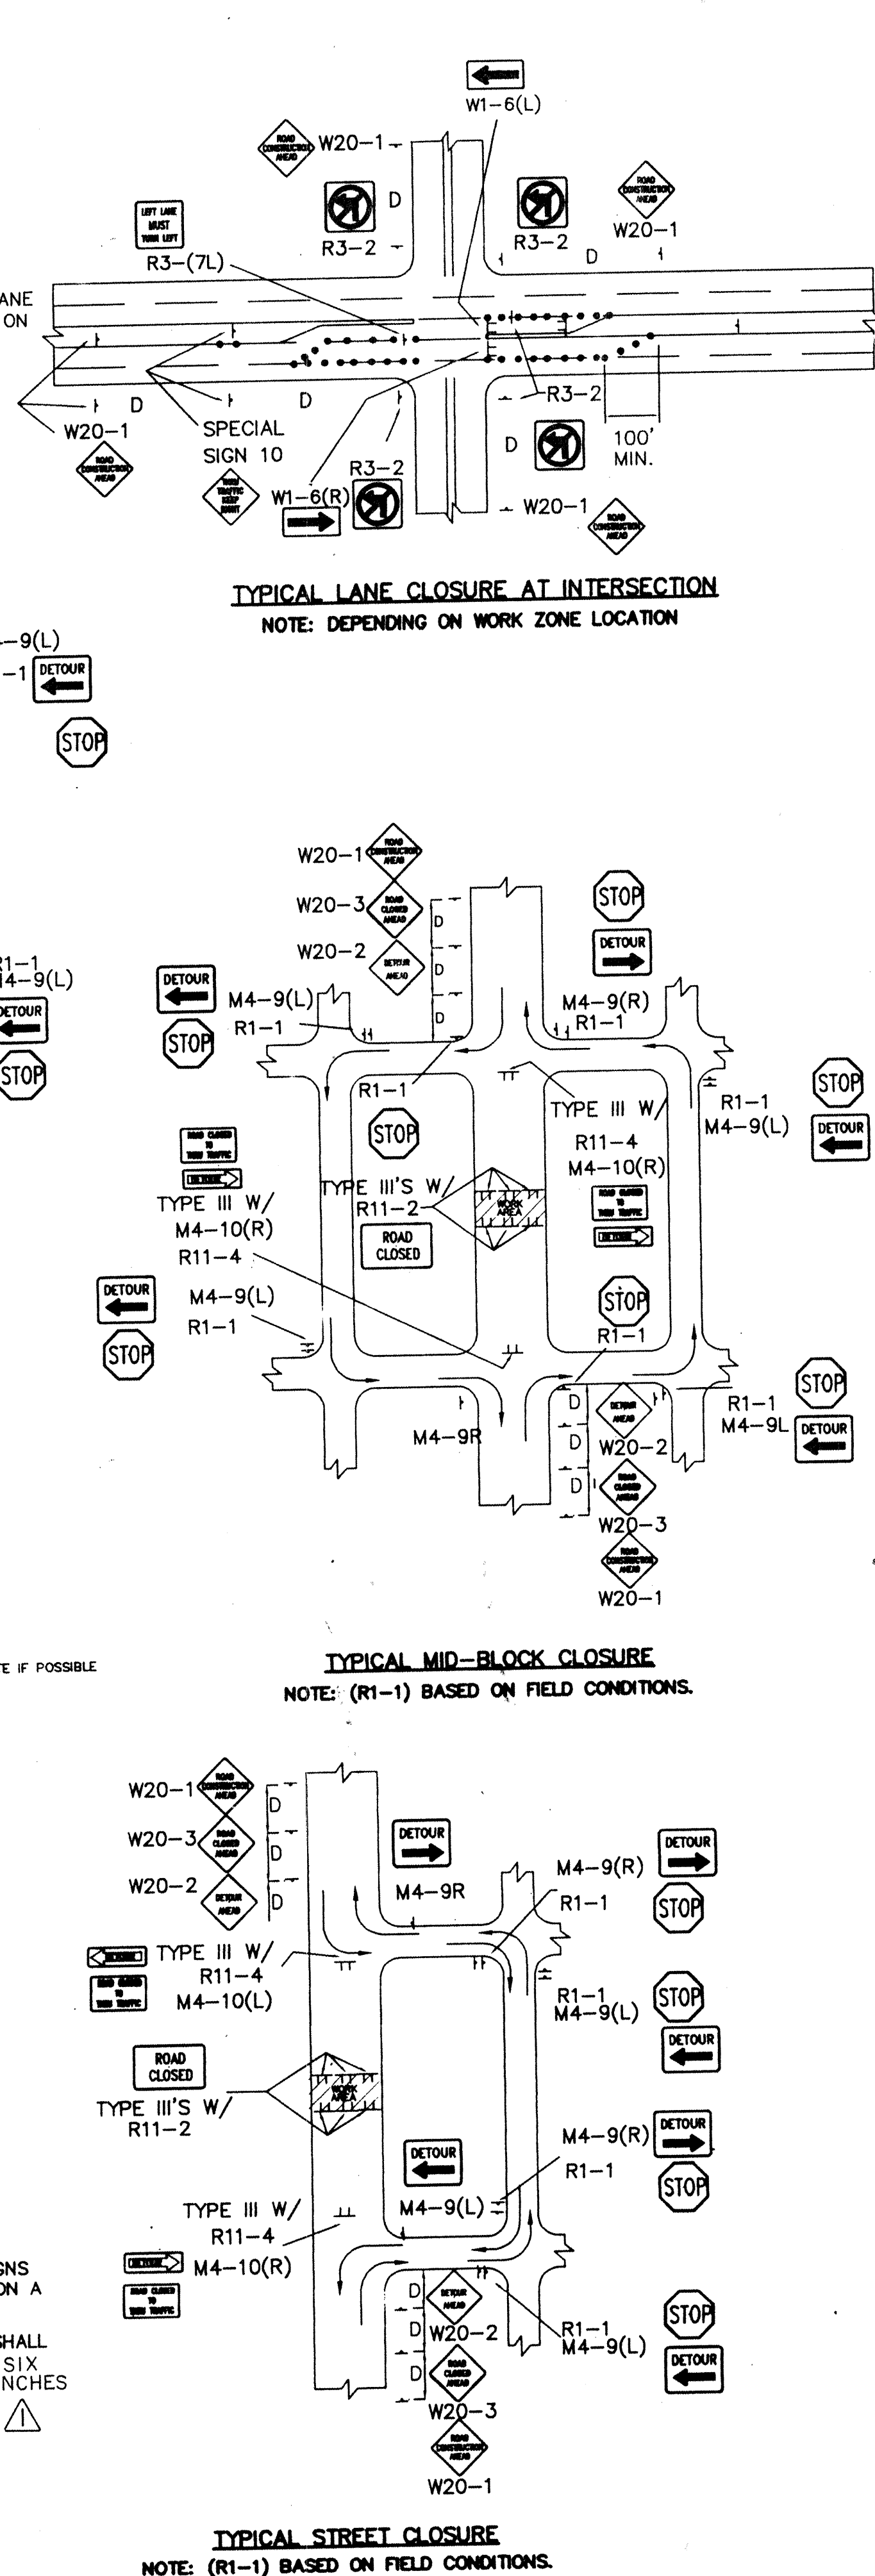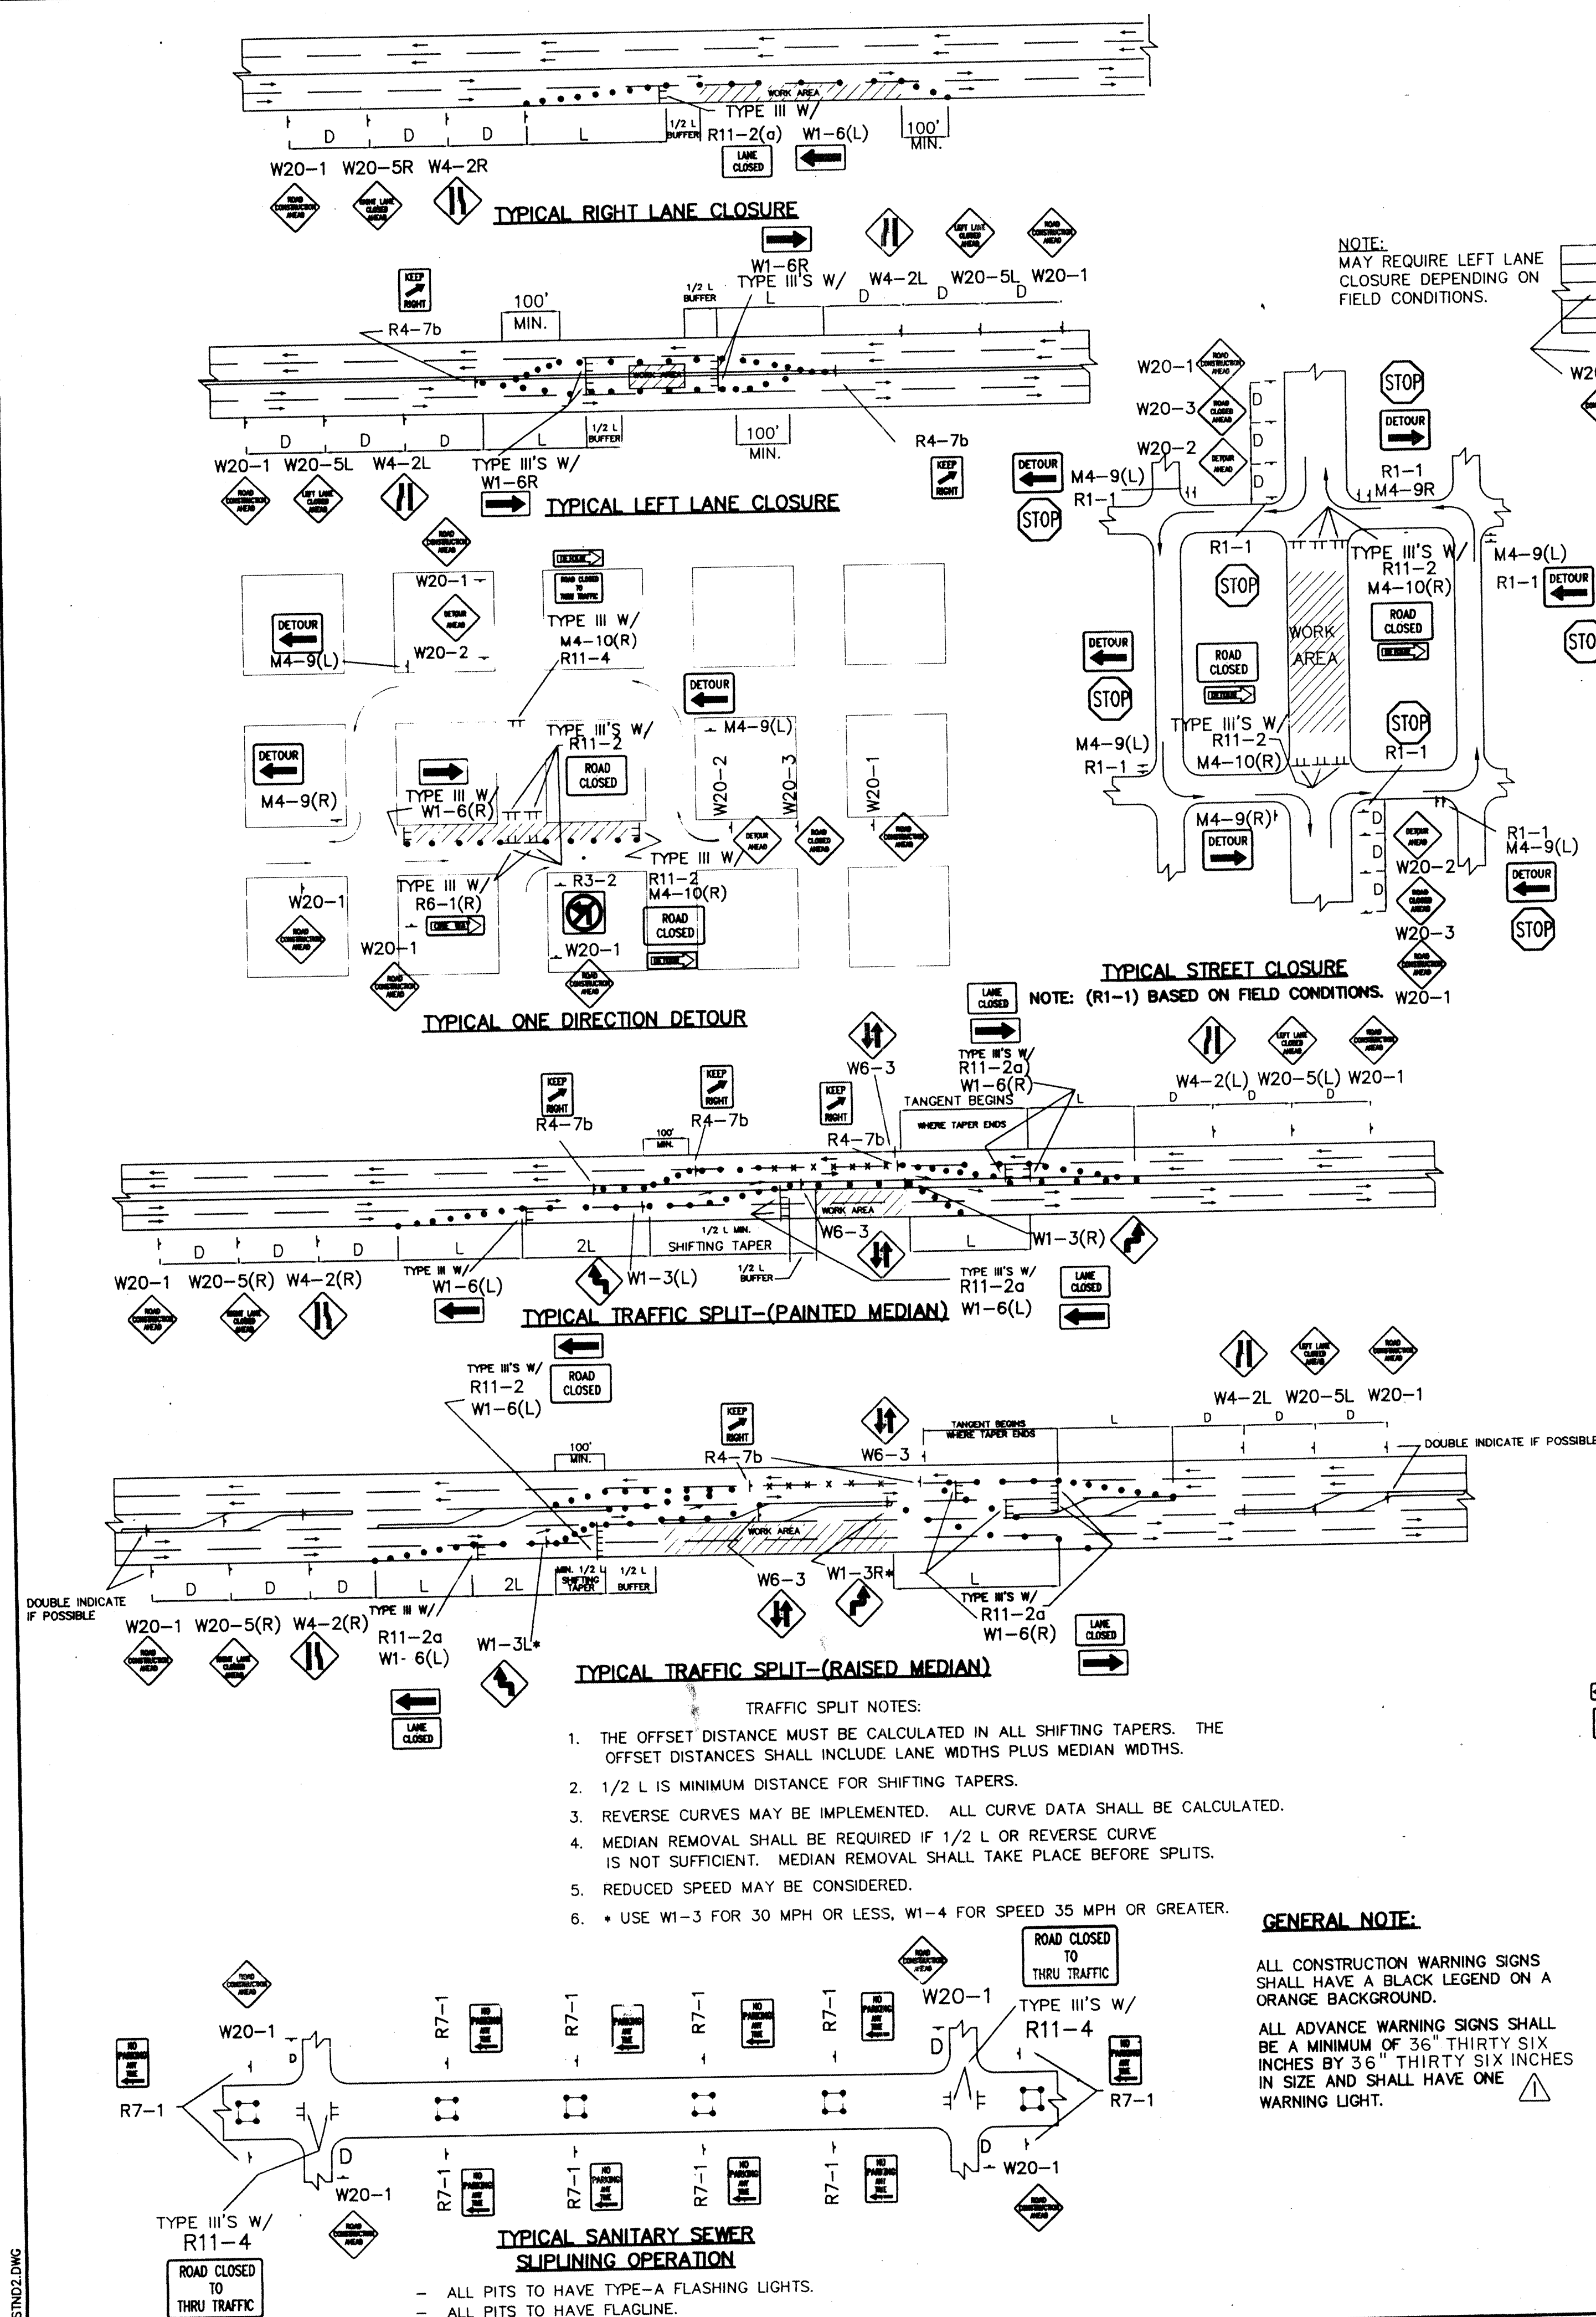

CITY OF ALBUQUERQUE
PUBLIC WORKS DEPARTMENT
ENGINEERING DEVELOPMENT GROUP

**LOS JARDINES SUBDIVISION
TYPICAL TRAFFIC CONTROL &
SIGNING EXAMPLES (REF. MUT.C.D.)**

DESIGN REVIEW COMMITTEE CITY ENGINEER APPROVAL

PROJECT NO. 610081 MAP NO. H-13 SHEET 20 OF 20

AS BUILT INFORMATION		BENCH MARKS		SURVEY INFORMATION		ENGINEER'S SEAL		REVISIONS		DESIGN	
CONTRACTOR	DATE	STATION	DATE	NO.	DATE	SEAL	DATE	NO.	DATE	NO.	DATE
INSPECTED BY	DATE	STATION	DATE	NO.	DATE	SEAL	DATE	NO.	DATE	NO.	DATE
FIELD NOTES	DATE	STATION	DATE	NO.	DATE	SEAL	DATE	NO.	DATE	NO.	DATE
RECORDED BY	DATE	STATION	DATE	NO.	DATE	SEAL	DATE	NO.	DATE	NO.	DATE
NO.	DATE	STATION	DATE	NO.	DATE	SEAL	DATE	NO.	DATE	NO.	DATE