


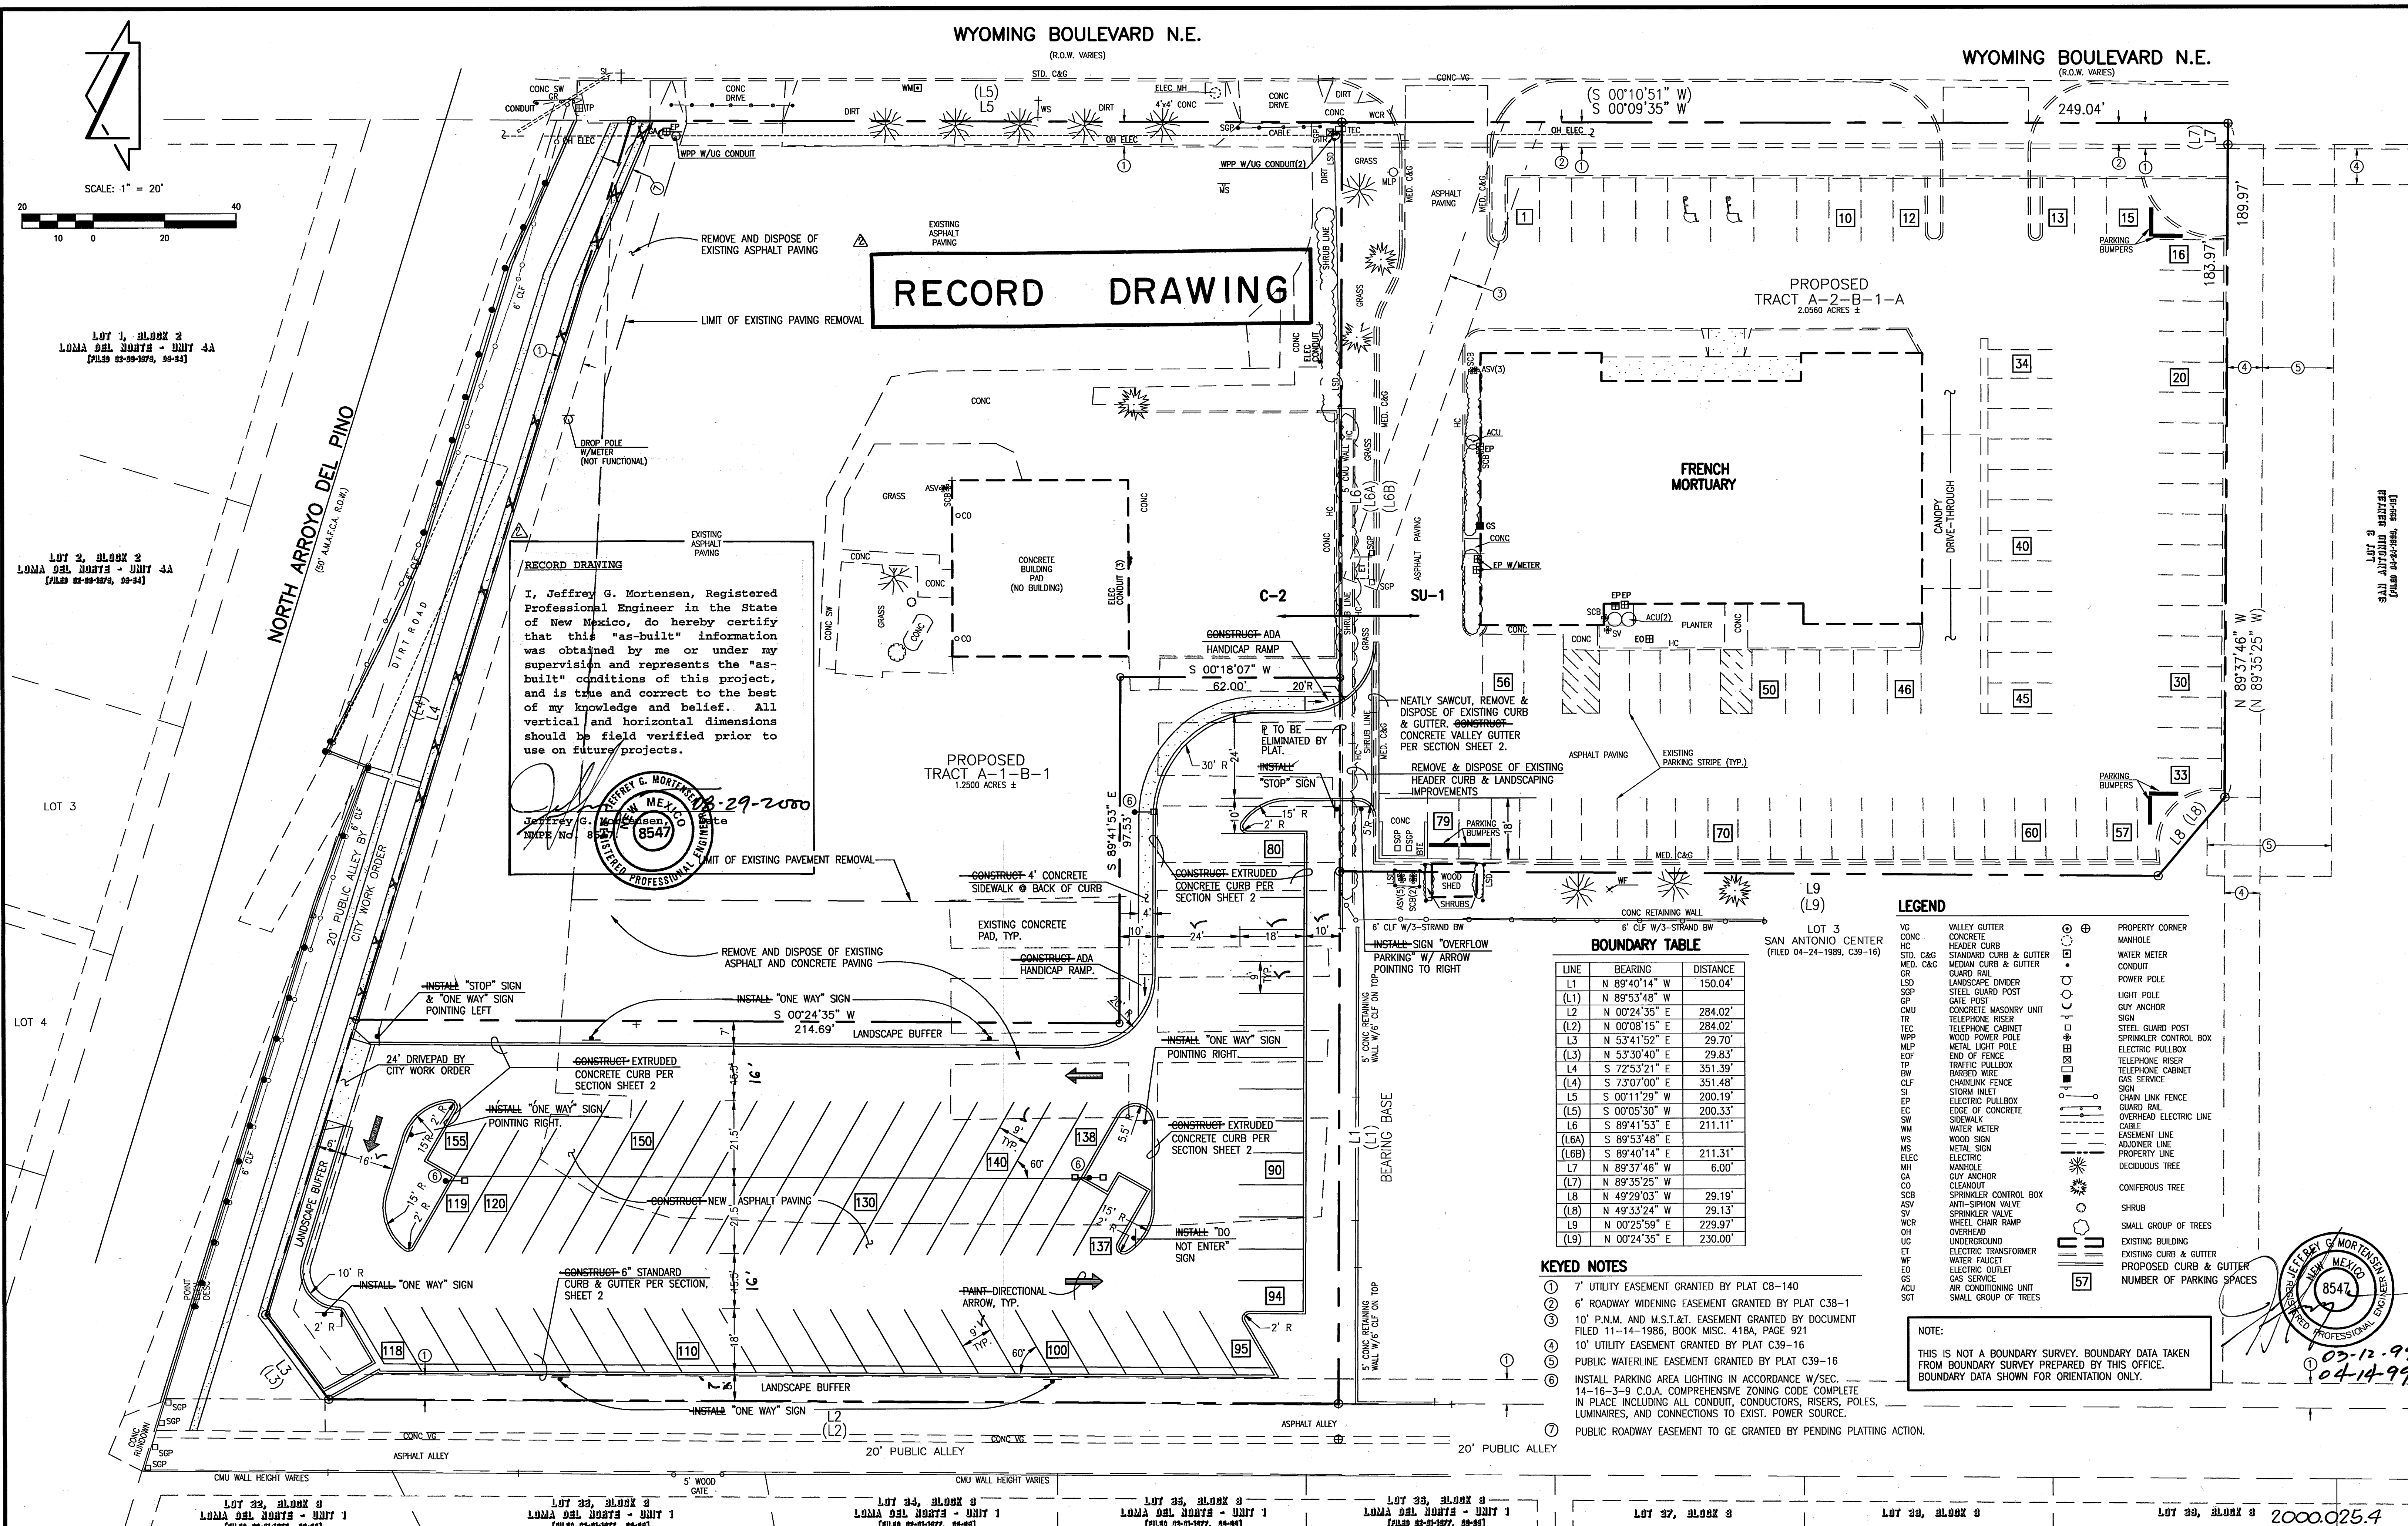

RECORD DRAWING

RECORD DRAWING

I, Jeffrey G. Mortensen, Registered Professional Engineer in the State of New Mexico, do hereby certify that this "as-built" information was obtained by me or under my supervision and represents the "as-built" conditions of this project, and is true and correct to the best of my knowledge and belief. All vertical and horizontal dimensions should be field verified prior to use on future projects.

Jeffrey G. Mortensen
New Mexico
Professional Engineer
No. 8547
12-29-2000

BOUNDARY TABLE		
LINE	BEARING	DISTANCE
L1	N 89°40'14" W	150.04'
(L1)	N 89°53'48" W	
L2	N 00°24'35" E	284.02'
(L2)	N 00°08'15" E	284.02'
L3	N 53°41'52" E	29.70'
(L3)	N 53°30'40" E	29.83'
L4	S 72°53'21" E	351.39'
(L4)	S 73°07'00" E	351.48'
L5	S 00°11'29" W	200.19'
(L5)	S 00°05'30" W	200.33'
L6	S 89°41'53" E	211.11'
(L6A)	S 89°53'48" E	
(L6B)	S 89°40'14" E	211.31'
L7	N 89°37'46" W	6.00'
(L7)	N 89°35'25" W	
L8	N 49°29'03" W	29.19'
(L8)	N 49°33'24" W	29.13'
L9	N 00°25'59" E	229.97'
(L9)	N 00°24'35" E	230.00'


- KEYED NOTES
- 7' UTILITY EASEMENT GRANTED BY PLAT C8-140
 - 6' ROADWAY WIDENING EASEMENT GRANTED BY PLAT C38-1
 - 10' P.N.M. AND M.S.T.&T. EASEMENT GRANTED BY DOCUMENT FILED 11-14-1986, BOOK MISC. 418A, PAGE 921
 - 10' UTILITY EASEMENT GRANTED BY PLAT C39-16
 - PUBLIC WATERLINE EASEMENT GRANTED BY PLAT C39-16
 - INSTALL PARKING AREA LIGHTING IN ACCORDANCE W/SEC. 14-16-3-9 C.O.A. COMPREHENSIVE ZONING CODE COMPLETE IN PLACE INCLUDING ALL CONDUIT, CONDUCTORS, RISERS, POLES, LUMINAIRES, AND CONNECTIONS TO EXIST. POWER SOURCE.
 - PUBLIC ROADWAY EASEMENT TO BE GRANTED BY PENDING PLATTING ACTION.

NOTE:

THIS IS NOT A BOUNDARY SURVEY. BOUNDARY DATA TAKEN FROM BOUNDARY SURVEY PREPARED BY THIS OFFICE. BOUNDARY DATA SHOWN FOR ORIENTATION ONLY.

03-12-99
04-14-99

Plot Date: 04-12-1999
File Name: 9402552.DWG
Plot Time: 09:52 am

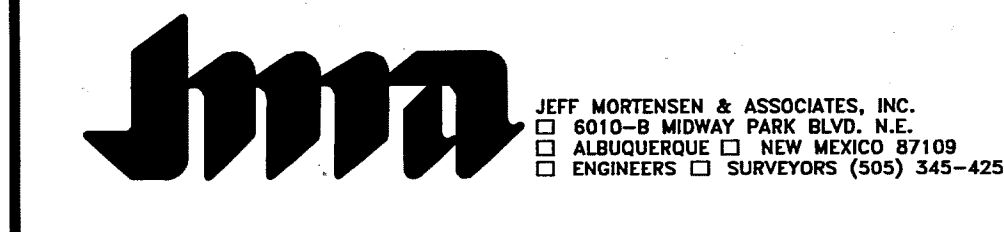

SITE PLAN

FRENCH MORTUARY-WYOMING OVERFLOW PARKING

DESIGNED BY				NO.				DATE				BY				LIMITS OF PAVING REMOVAL				AS-BUILT & CERTIFY				JOB NO.			
C.S.				04/99				C.J.S.				M.B.S.												940258			
D.L.M./J.M.C.																								03-1999			
J.G.M.																								3 OF 9			

CPN 611981

CPN 611981

RECORD DRAWING


STREET PAVING IMPROVEMENTS:

- ALL SLOPES AS SHOWN ON PROFILES ARE BASED ON ALLEY CENTERLINE STATIONING EXCEPT CUL-DE-SACS WHERE STATIONING IS ALONG FACE-OF-CURB.
- WHERE REMOVAL OF EXISTING CURB AND GUTTER, SIDEWALK OR PAVEMENT IS REQUIRED, THE CONTRACTOR SHALL SAWCUT AND/OR REMOVE TO THE NEAREST JOINT. CURB AND GUTTER SHOWN AS EXISTING AND NOT TO BE REMOVED UNDER THIS CONTRACT WHICH IS DAMAGED OR REPLACED BY THE CONTRACTOR SHALL BE REMOVED AND REPLACED BY THE CONTRACTOR AT THE CONTRACTOR'S EXPENSE.
- ALL DIMENSIONS OF PAVING AND RETURNS ARE SHOWN TO EDGE OF PAVING.

AS BUILT INFORMATION		BENCH MARKS		SURVEY INFORMATION	
CONTRACTOR	Camco Concrete	NO.	940252	DATE	01/99
WORK STARTED BY	J.M.A.	BY	JMA	DATE	01/99
WORK STOPPED BY	J.M.A.	NO.	940252	DATE	01/99
APPROVED BY	J.M.A.	NO.	940252	DATE	01/99
RECORDED BY	J.M.A.	NO.	940252	DATE	01/99
DATE	08/00	NO.	940252	DATE	01/99
DATE	08/00	NO.	940252	DATE	01/99
DATE	08/00	NO.	940252	DATE	01/99
DATE	08/00	NO.	940252	DATE	01/99

RECORD DRAWING

I, Jeffrey G. Mortensen, Registered Professional Engineer in the State of New Mexico, do hereby certify that this "as-built" information was obtained by me or under my supervision and represents the "as-built" conditions of this project, and is true and correct to the best of my knowledge and belief. All vertical and horizontal dimensions should be field verified prior to use on future projects.

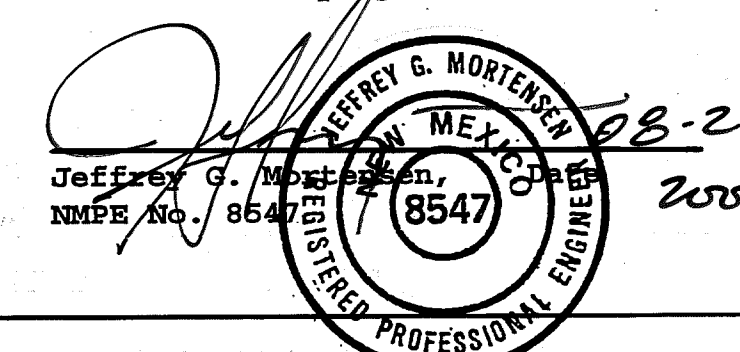

KEYED NOTES:

- 7' UTILITY EASEMENT GRANTED BY PLAT C8-140.
- PUBLIC ROADWAY EASEMENT TO BE GRANTED BY PENDING PLATTING ACTION.

LEGEND

VS CONCRETE	VALLEY GUTTER	PROPERTY CORNER
HC STD. C&G	CONCRETE	MANHOLE
MD. C&G	HEADER CURB	WATER METER
SR	STANDARD CURB & GUTTER	CONDUIT
LSD	LANDSCAPE DIVIDER	POWER POLE
SGP	STEEL GUARD POST	LIGHT POLE
CMU	GATE POST	GUY ANCHOR
TR	CONCRETE MASONRY UNIT	SIGN
WPP	TELEPHONE RISER	GUARD POST
MLP	TELEPHONE CABINET	ELECTRIC PULLBOX
OT	WOOD POWER POLE	SPRINKLER CONTROL BOX
TP	METAL LIGHT POLE	ELECTRIC PULLBOX
BF	END OF FENCE	TELEPHONE RISER
CLF	TRAFFIC PULLBOX	TELEPHONE CABINET
EP	BARBED WIRE	GAS SERVICE
FC	CHAINLINK FENCE	SIGN
WM	STORM INLET	CHAIN LINK FENCE
WS	ELECTRIC PULLBOX	GUARD RAIL
ELEC	EDGE OF CONCRETE	OVERHEAD ELECTRIC LINE
MS	WATER METER	CABLE
WM	WOOD SIGN	EASEMENT LINE
MS	METAL SIGN	ADJOINER LINE
ELEC	ELECTRIC	PROPERTY LINE
MA	MANHOLE	DECIDUOUS TREE
MA	GUY ANCHOR	CONIFEROUS TREE
CO	CLEANOUT	SHRUB
SCB	SPRINKLER CONTROL BOX	SMALL GROUP OF TREES
SV	ANTI-SIPHON VALVE	EXISTING BUILDING
SV	SPRINKLER VALVE	EXISTING CURB & GUTTER
WCR	WHEEL CHAIR RAMP	PROPOSED CURB & GUTTER
OH	OVERHEAD	
UG	UNDERGROUND	
WF	ELECTRIC TRANSFORMER	
CO	WATER FAUCET	
ACU	ELECTRIC OUTLET	
SGT	GAS SERVICE	
	AIR CONDITIONING UNIT	
	SMALL GROUP OF TREES	




JEFF MORTENSEN & ASSOCIATES, INC.
6010-B MIDWAY PARK BLVD. N.E.
ALBUQUERQUE, N.M. 87109
ENGINEERS & SURVEYORS (505) 345-4250

CITY OF ALBUQUERQUE
PUBLIC WORKS DEPARTMENT
ENGINEERING DEVELOPMENT GROUP

TITLE: TRACT A-1-B, LOMA DEL NORTE
PAVING IMPROVEMENTS PLAN & PROFILE


NO.	DATE	REVISIONS	DESIGN
1	04/19/99		
2	05/25/00		
3			
4			
5			
6			
7			
8			
9			
10			

City Project No.	611981	Zone Map No.	D-19	Sheet	5	Of	9
------------------	--------	--------------	------	-------	---	----	---

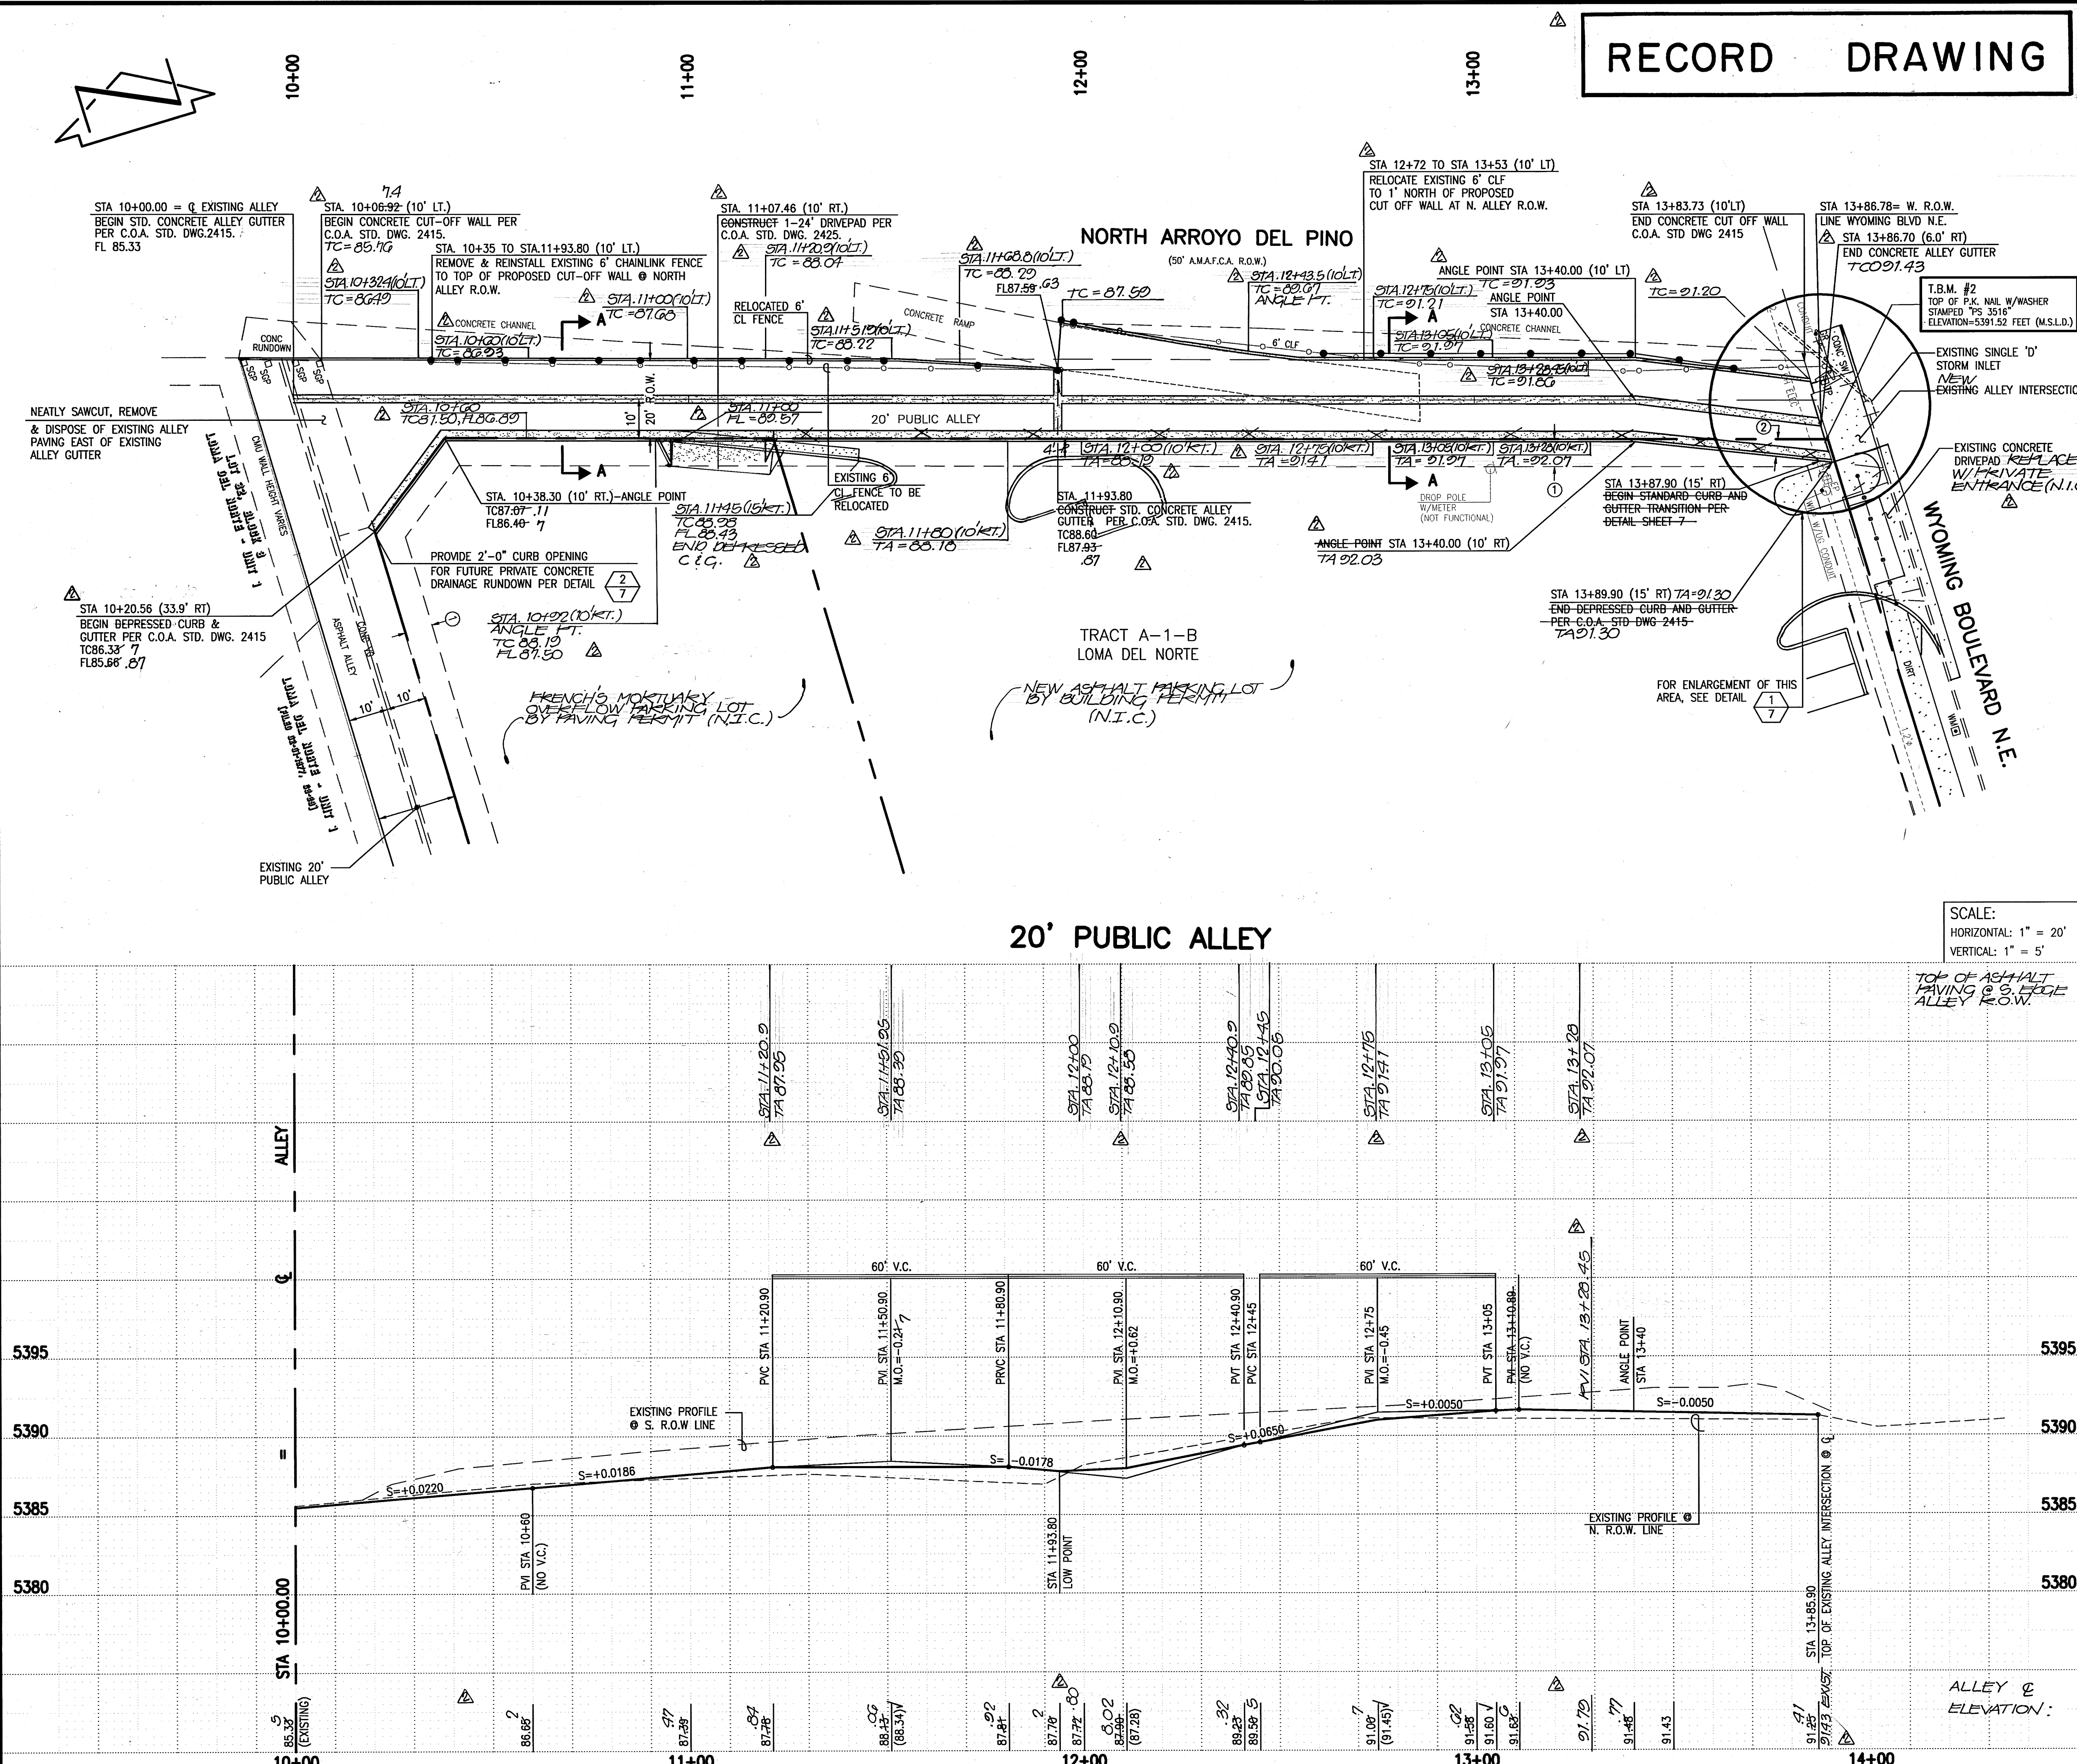


File Path: D:\MORTENSEN\940252\ Plot Date: 04-12-1999
File Name: 940252P1.DWG Plot Time: 10:13 am


File Path: E:\JMW\2000\940258\DWG
File Name: 940258.DWG
Plot Date: 04-12-1999
Plot Time: 09:48 am

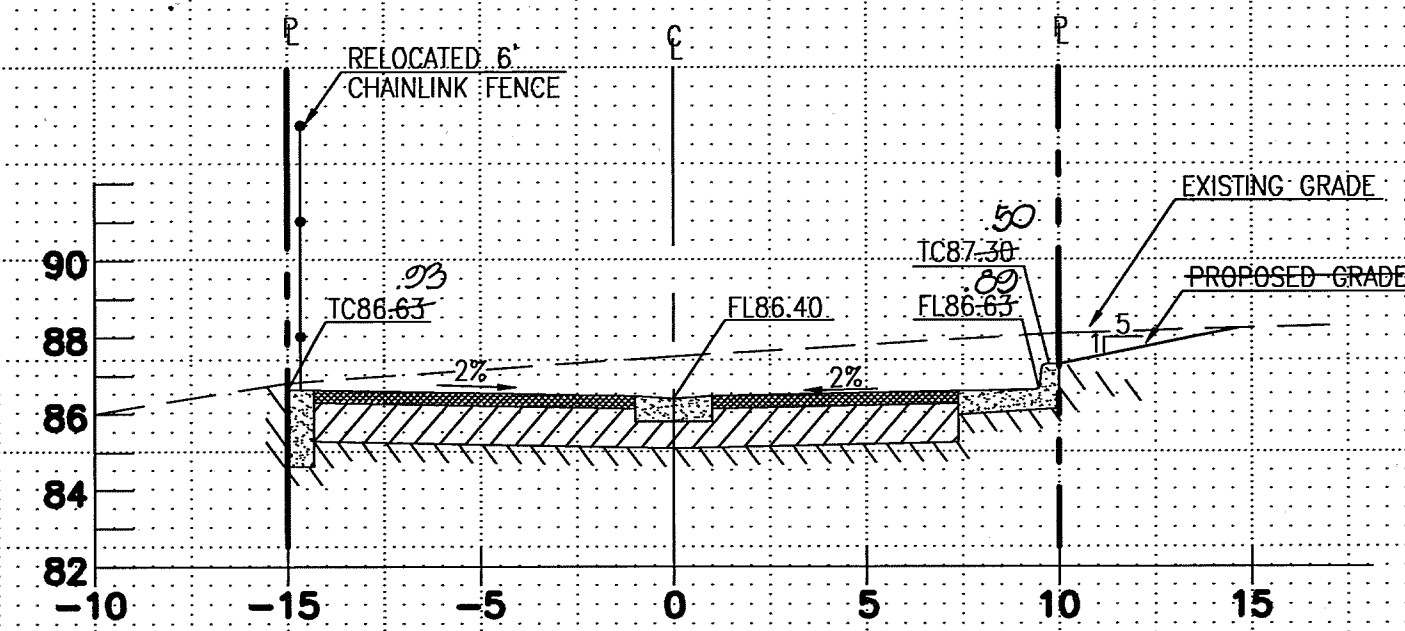


Sta. 10+50

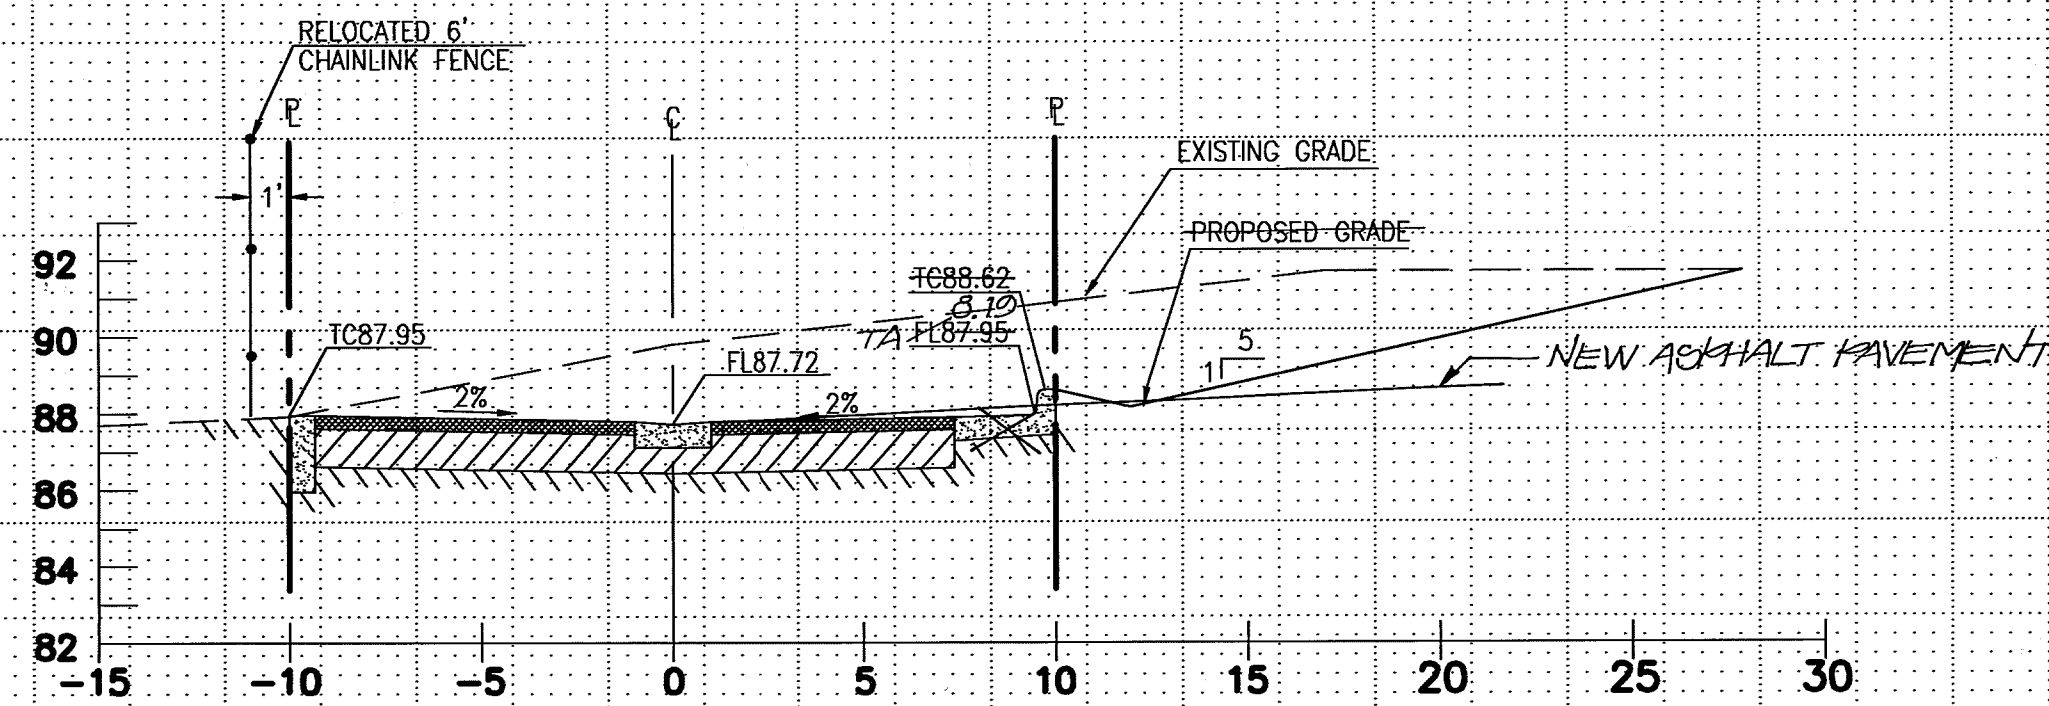


Sta. 12+00

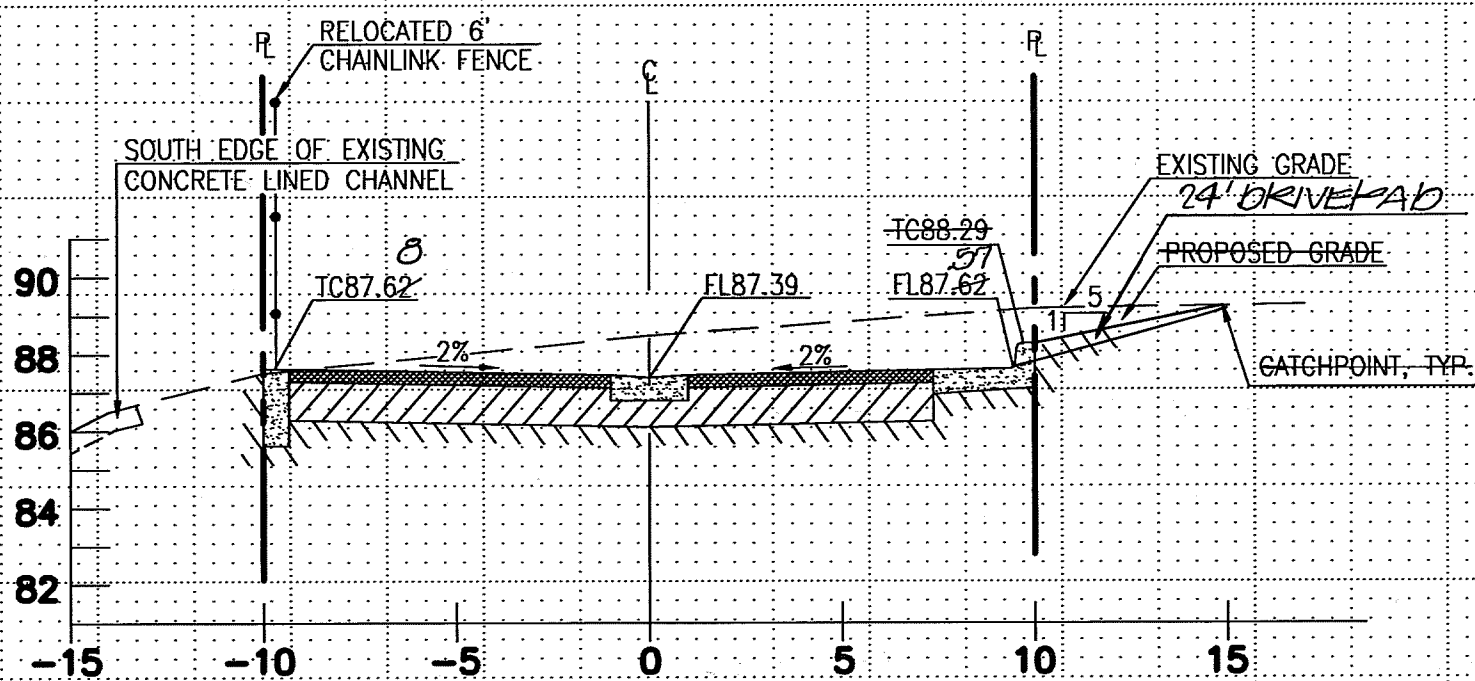


Sta. 11+00

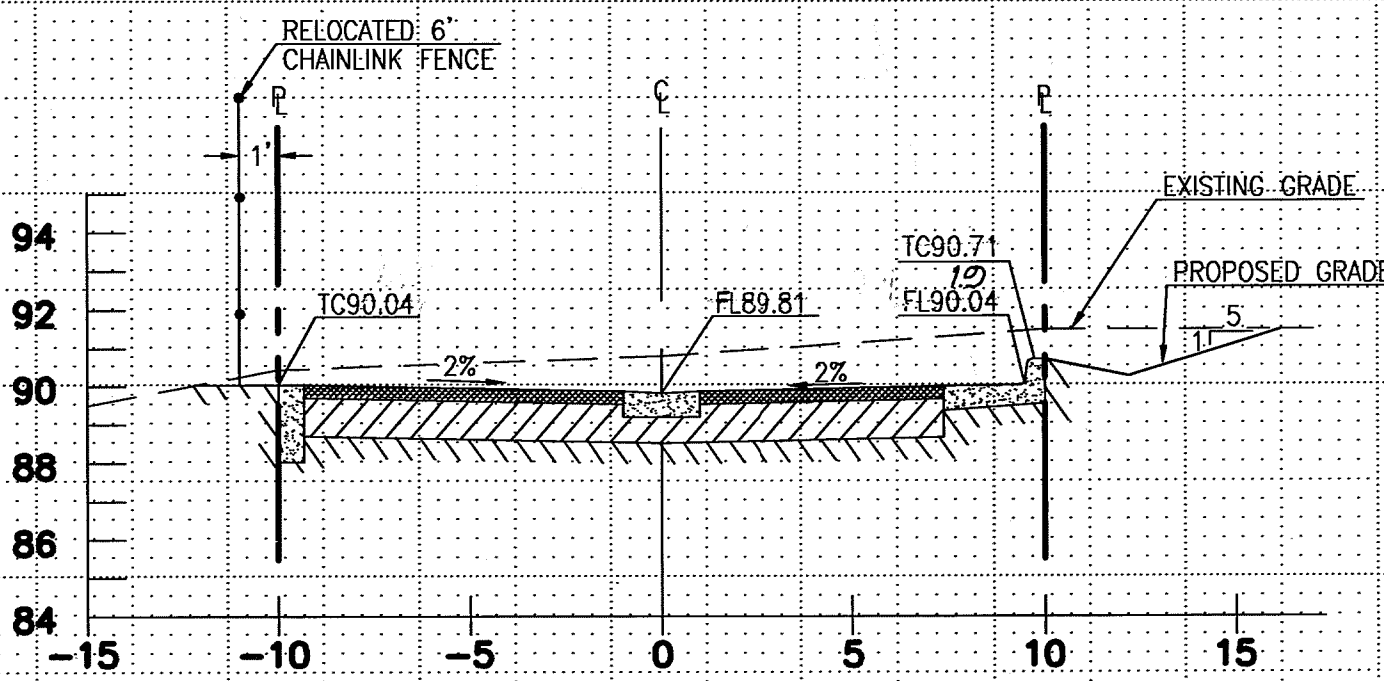


Sta. 12+50

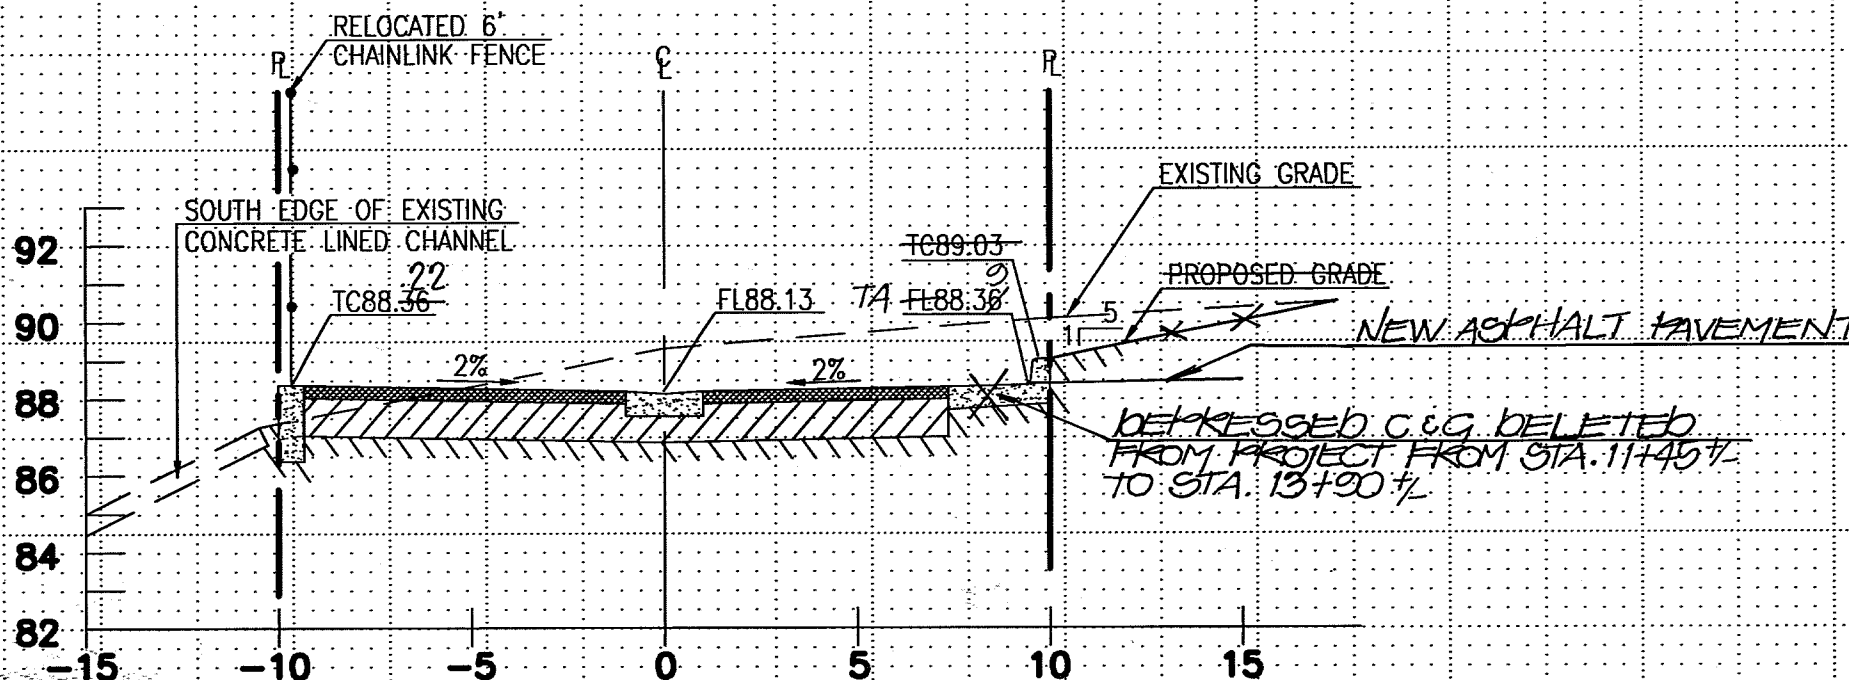


Sta. 11+50

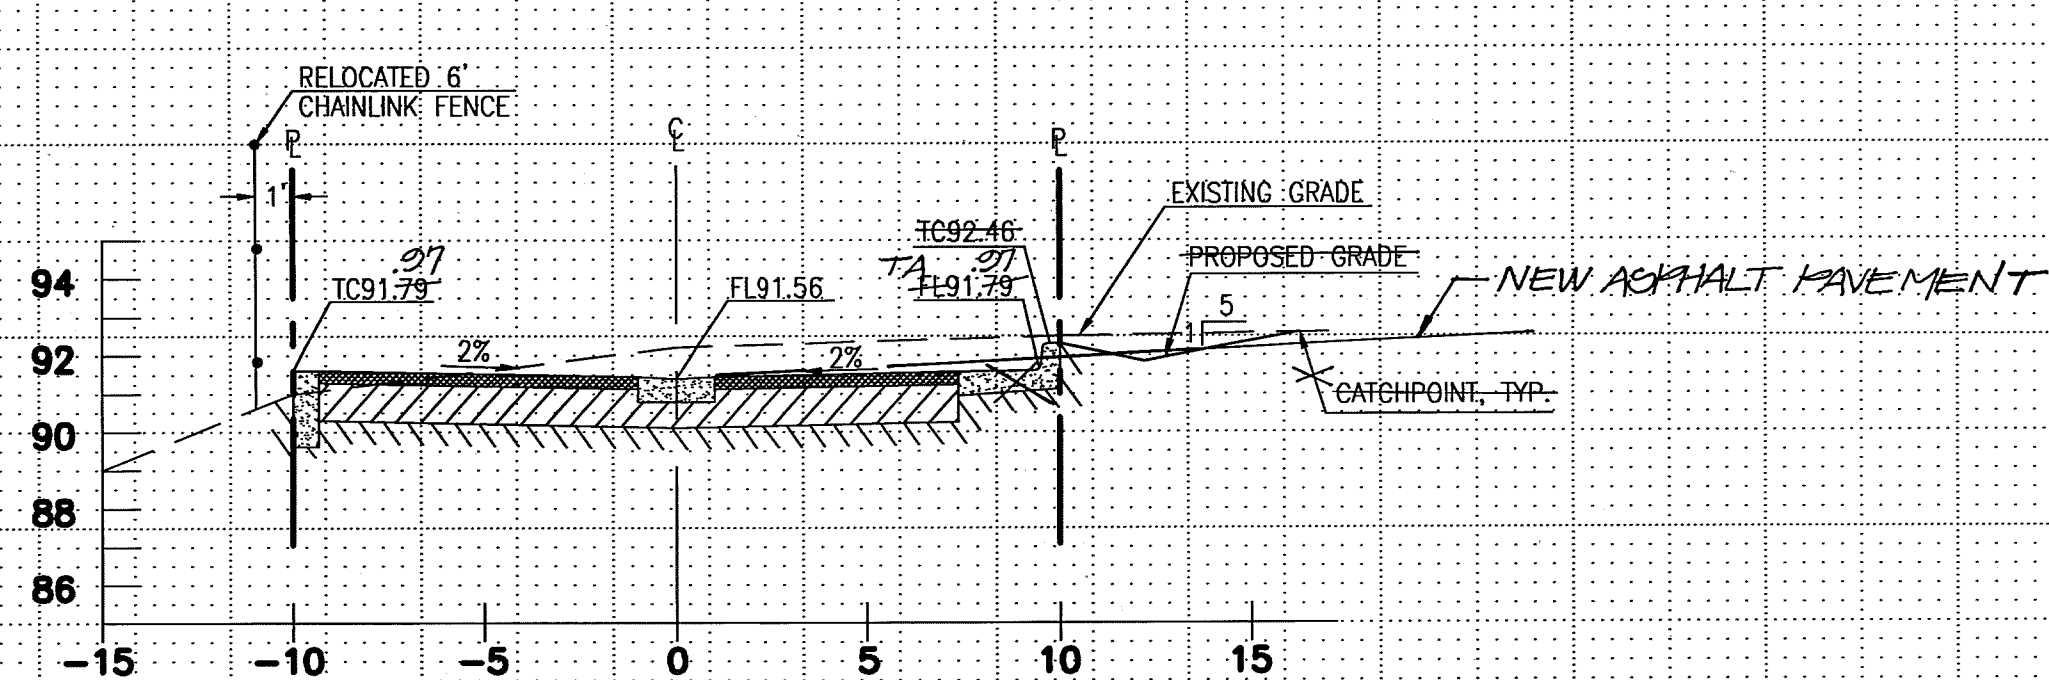

Sta. 13+00

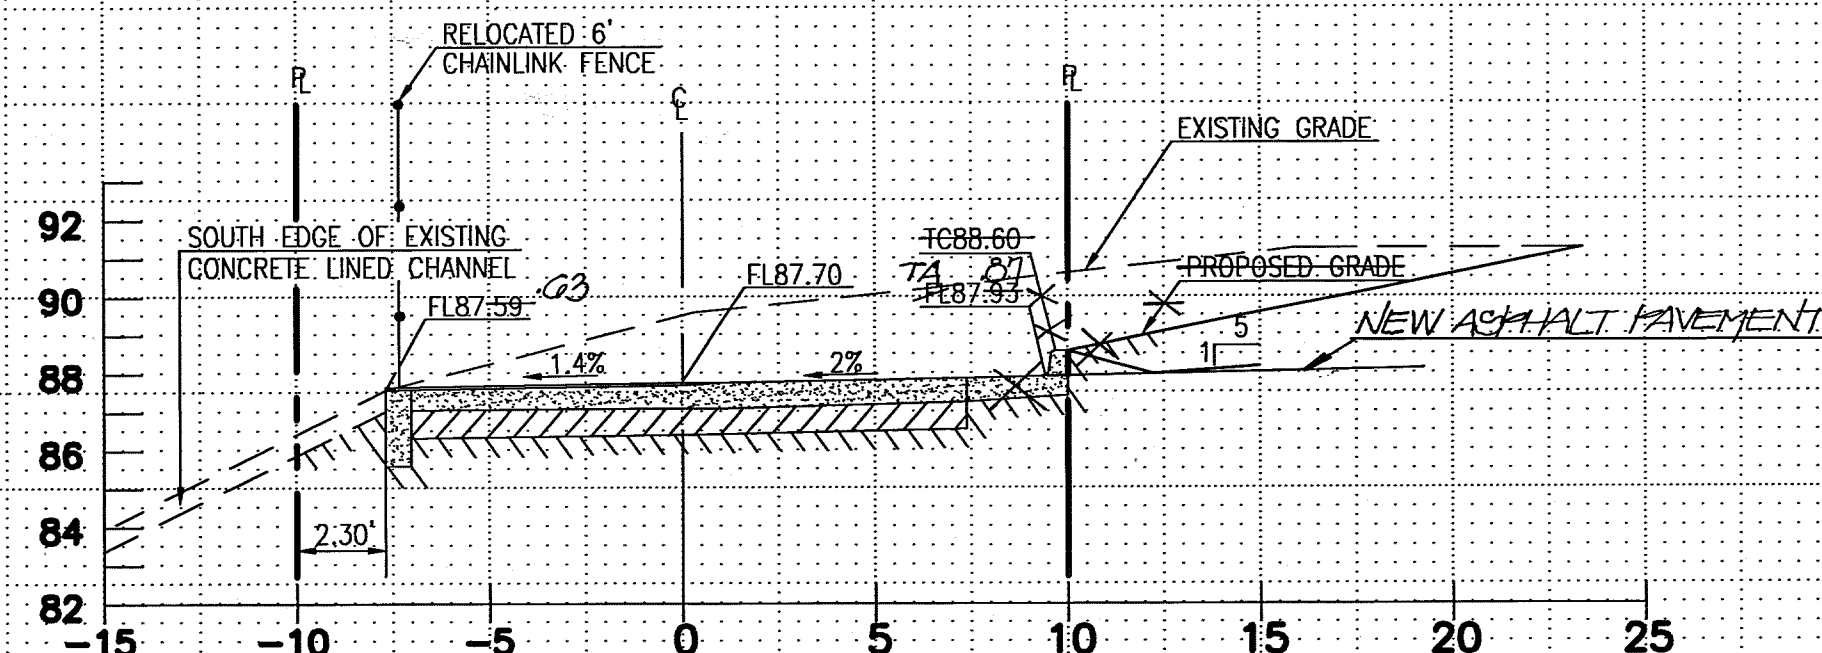

Sta. 11+93.80

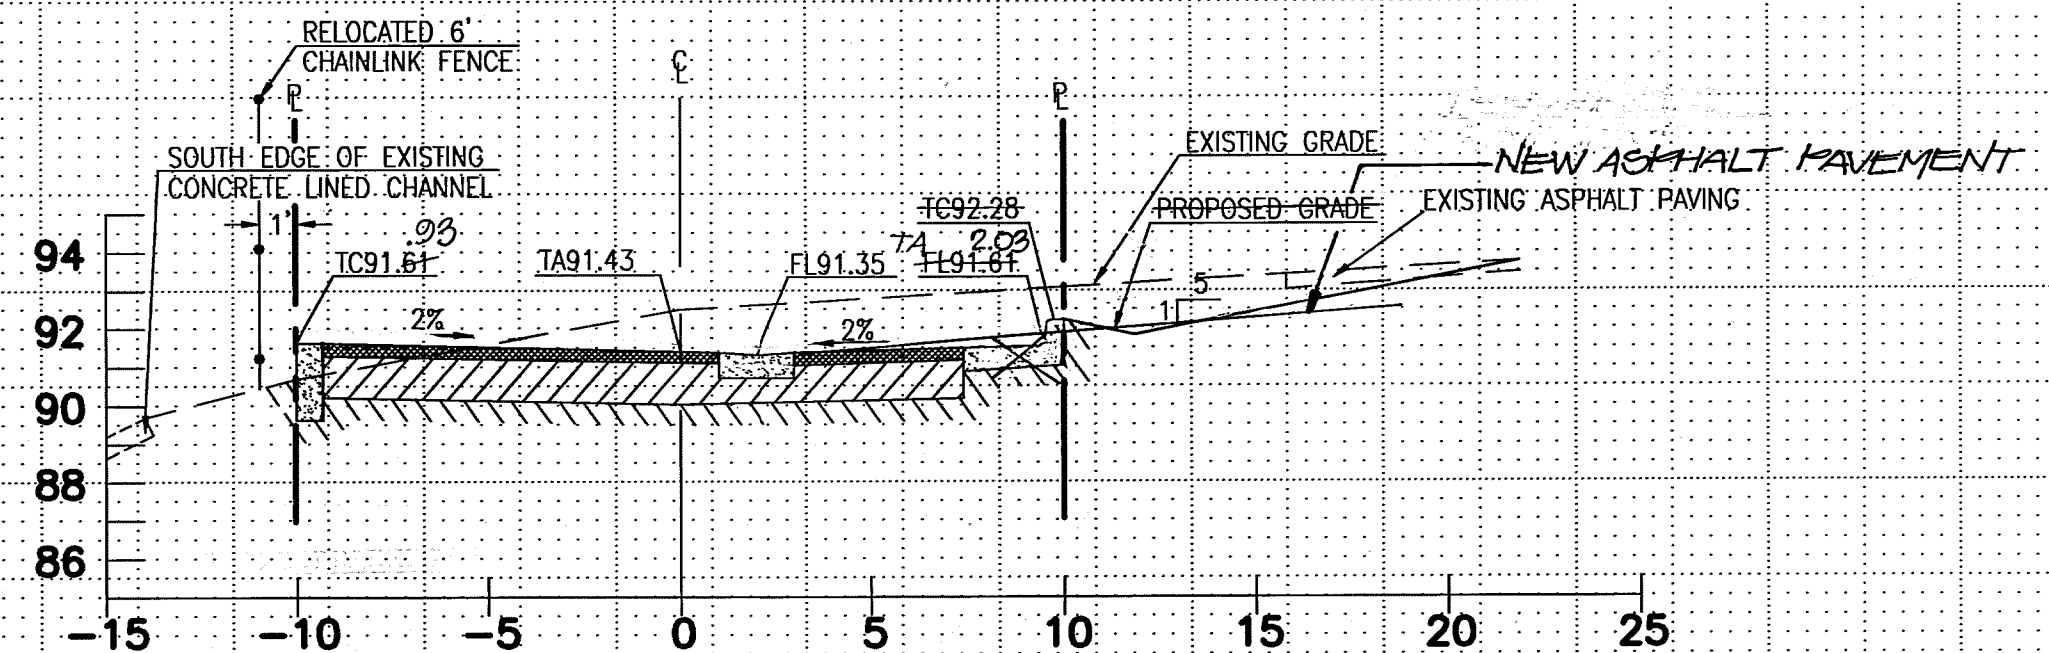


Sta. 13+50

RECORD DRAWING

RECORD DRAWING

I, Jeffrey G. Mortensen, Registered Professional Engineer in the State of New Mexico, do hereby certify that this "as-built" information was obtained by me or under my supervision and represents the "as-built" conditions of this project, and is true and correct to the best of my knowledge and belief. All vertical and horizontal dimensions should be field verified prior to use on future projects.

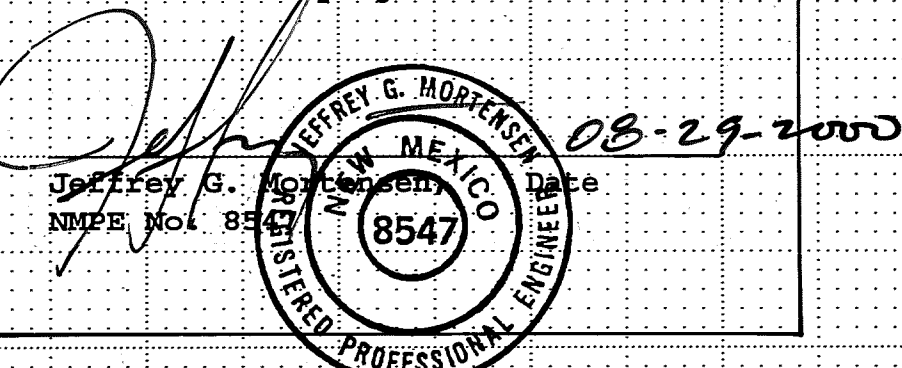


HORIZONTAL SCALE: 1" = 5'
VERTICAL SCALE: 1" = 5'



JEFF MORTENSEN & ASSOCIATES, INC.
6010-B MIDWAY PARK BLVD., N.E.
ALBUQUERQUE, N.M. 87109
ENGINEERS & SURVEYORS (505) 345-4250

CITY OF ALBUQUERQUE PUBLIC WORKS DEPARTMENT ENGINEERING DEVELOPMENT GROUP	
TITLE: TRACT A-1-B, LOMA DEL NORTE 20' PUBLIC ALLEY CROSS-SECTIONS, STA 10+50 TO 13+50	
Design Review Committee	City Engineer Approval
DATE: 4/19/99	DATE: MAY 25 2000
CITY PROJECT NO. 611981	ZONE MAP NO. D-19
SHEET 6	OF 9



RECORD DRAWING

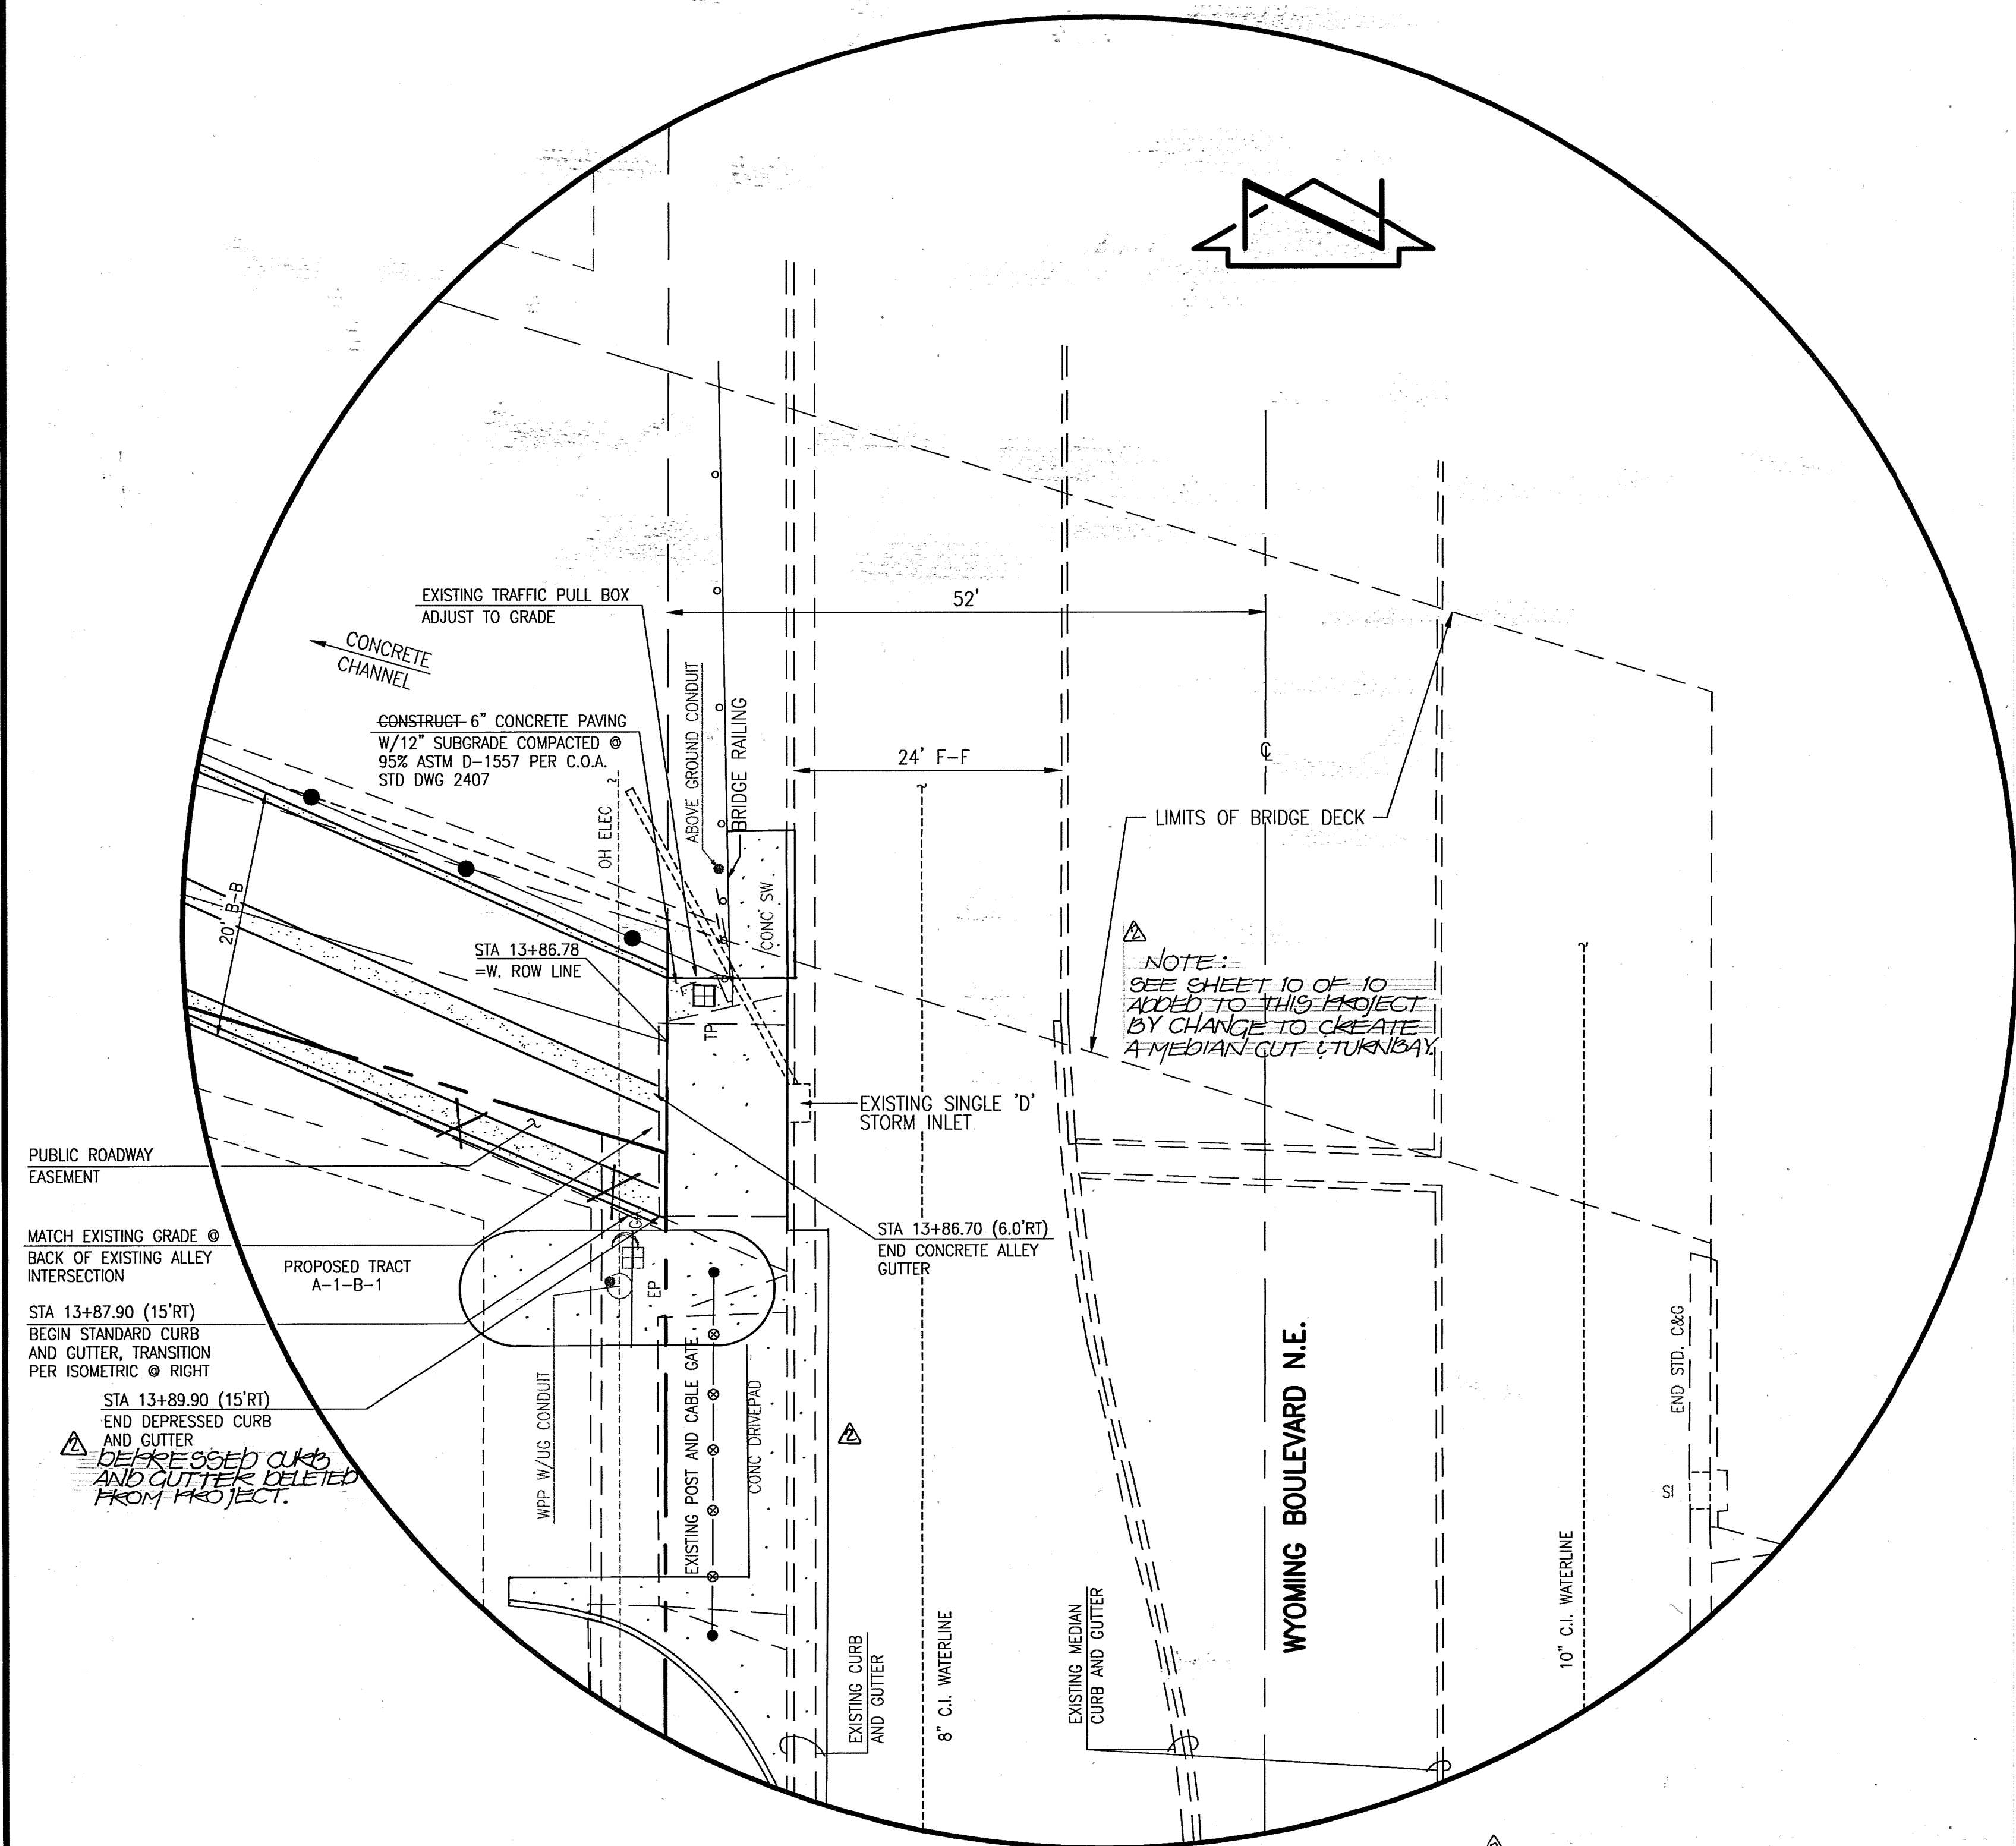


INTERSECTION ALLEY DETAIL
SCALE: 1"=10'

RECORD DRAWING


I, Jeffrey G. Mortensen, Registered Professional Engineer in the State of New Mexico, do hereby certify that this "as-built" information was obtained by me or under my supervision and represents the "as-built" conditions of this project, and is true and correct to the best of my knowledge and belief. All vertical and horizontal dimensions should be field verified prior to use on future projects.

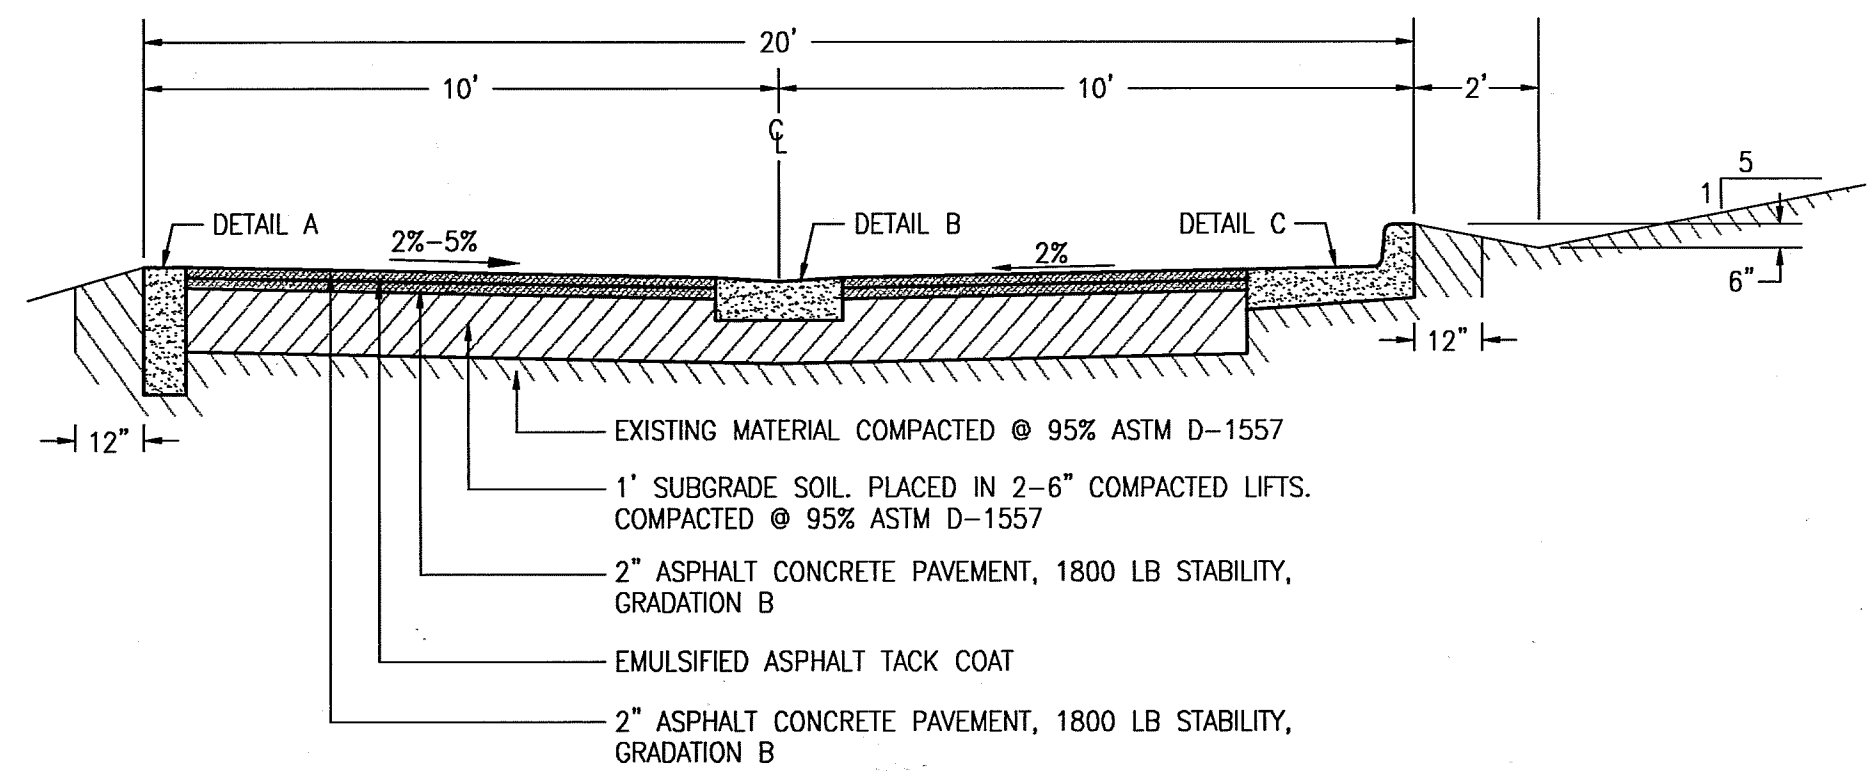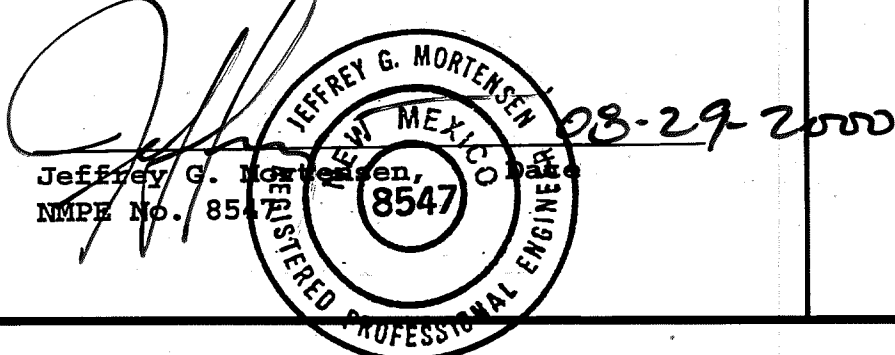


SECTION A-A TYPICAL ALLEY SECTION
SCALE: 1"=30'

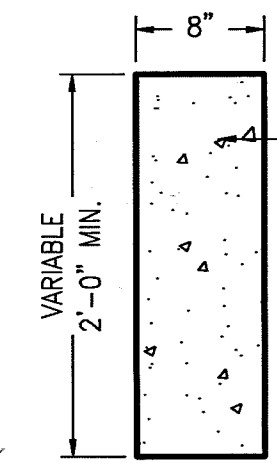


DETAIL A
CUT-OFF WALL

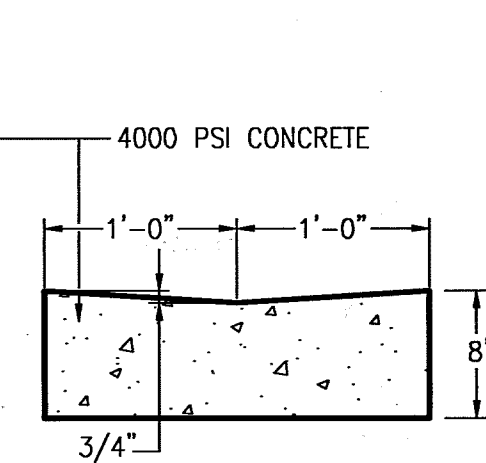


DETAIL B
ALLEY GUTTER

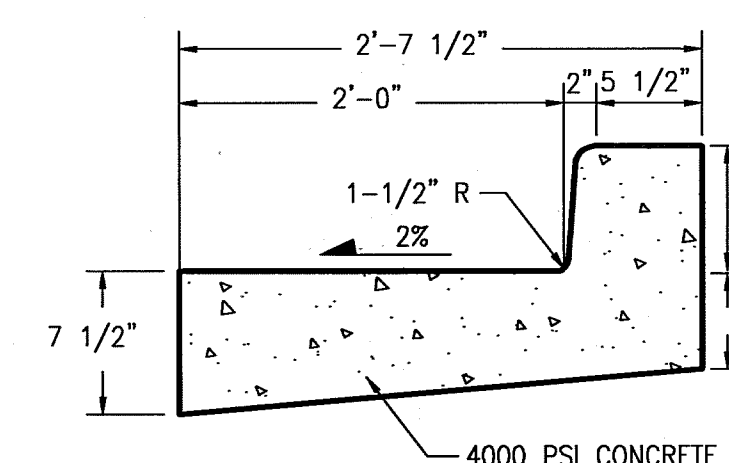

DETAIL C
DEPRESSED GUTTER

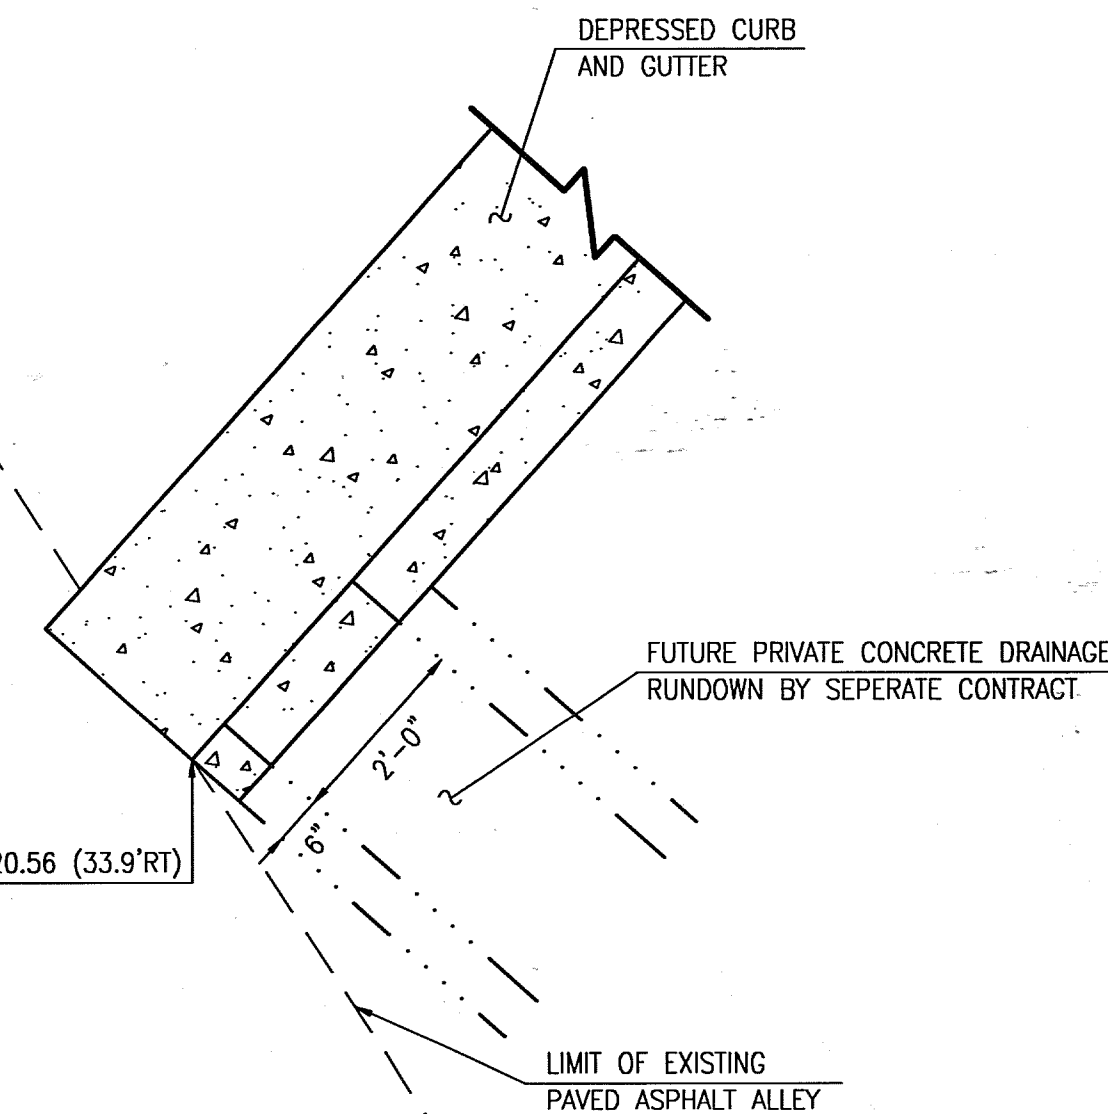

CURB OPENING DETAIL
SCALE: 1"=2'

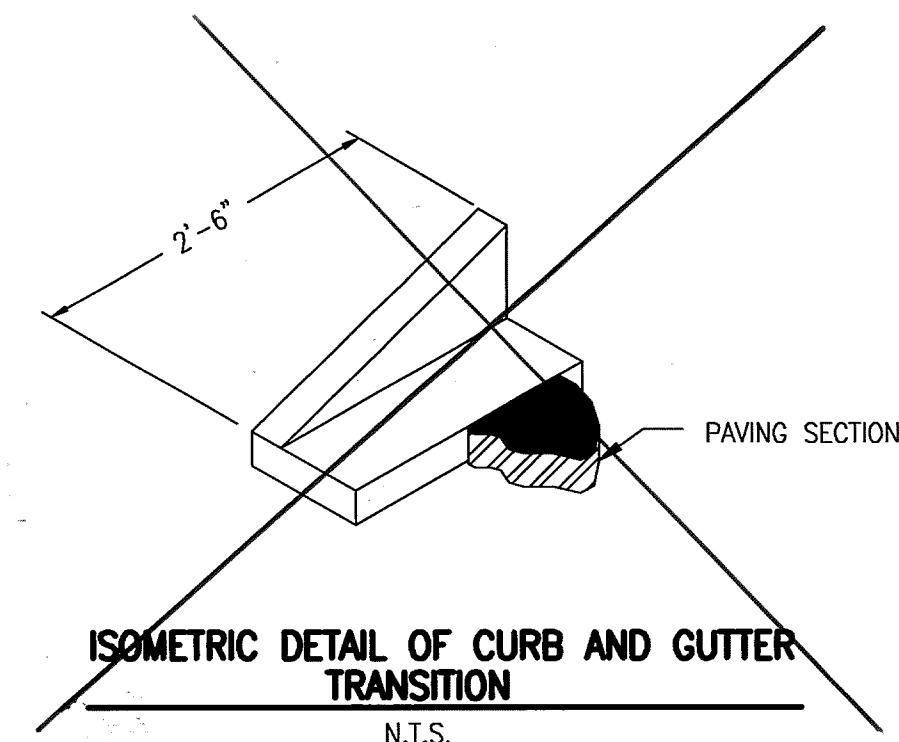

ISOMETRIC DETAIL OF CURB AND GUTTER TRANSITION
N.T.S.




JEFF MORTENSEN & ASSOCIATES, INC.
8010-B MIDWAY PARK BLVD. N.E.
ALBUQUERQUE, N.M. 87109
ENGINEERS SURVEYORS (505) 345-4250

CITY OF ALBUQUERQUE PUBLIC WORKS DEPARTMENT ENGINEERING DEVELOPMENT GROUP	
TITLE: TRACT A-1-B, LOMA DEL NORTE 20' ALLEY PAVING SECTIONS AND DETAILS	
Design Review Committee 4/19/99	CITY ENGINEER MAY 25 2000
City Project No. 611981	Zone Map No. D-19
Sheet 7	Of 9


AS BUILT INFORMATION		BENCH MARKS		SURVEY INFORMATION		ENGINEER'S SEAL	
CONTRACTOR	Carco Concrete	ACCS 1 3/4" ALUMINUM DISK STAMPED "ACS BM 12-E19"	DATE 04/00	NO.	940252	ENGINEER'S SEAL	JEFF MORTENSEN
WORK ORDER	177A	EXPLODED TO THE TOP OF THE CONCRETE CURB, AT THE	DATE 04/00	BY	JMA	DATE	04-14-11
FIELD NOTES	MD5	W.A.W. CURB RETURN IN THE NORTHWEST QUADRANT OF	DATE 05/00				
REVISIONS	177A	THE INTERSECTION OF WYOMING BLVD. AND SAN ANTONIO	DATE 08/00				
CORRECTED BY	177A	DRIVE N.E.					
RECORDED BY		ELEVATION = 5414.28 FEET (M.S.L.D.)					
NO.							

RECORD DRAWING

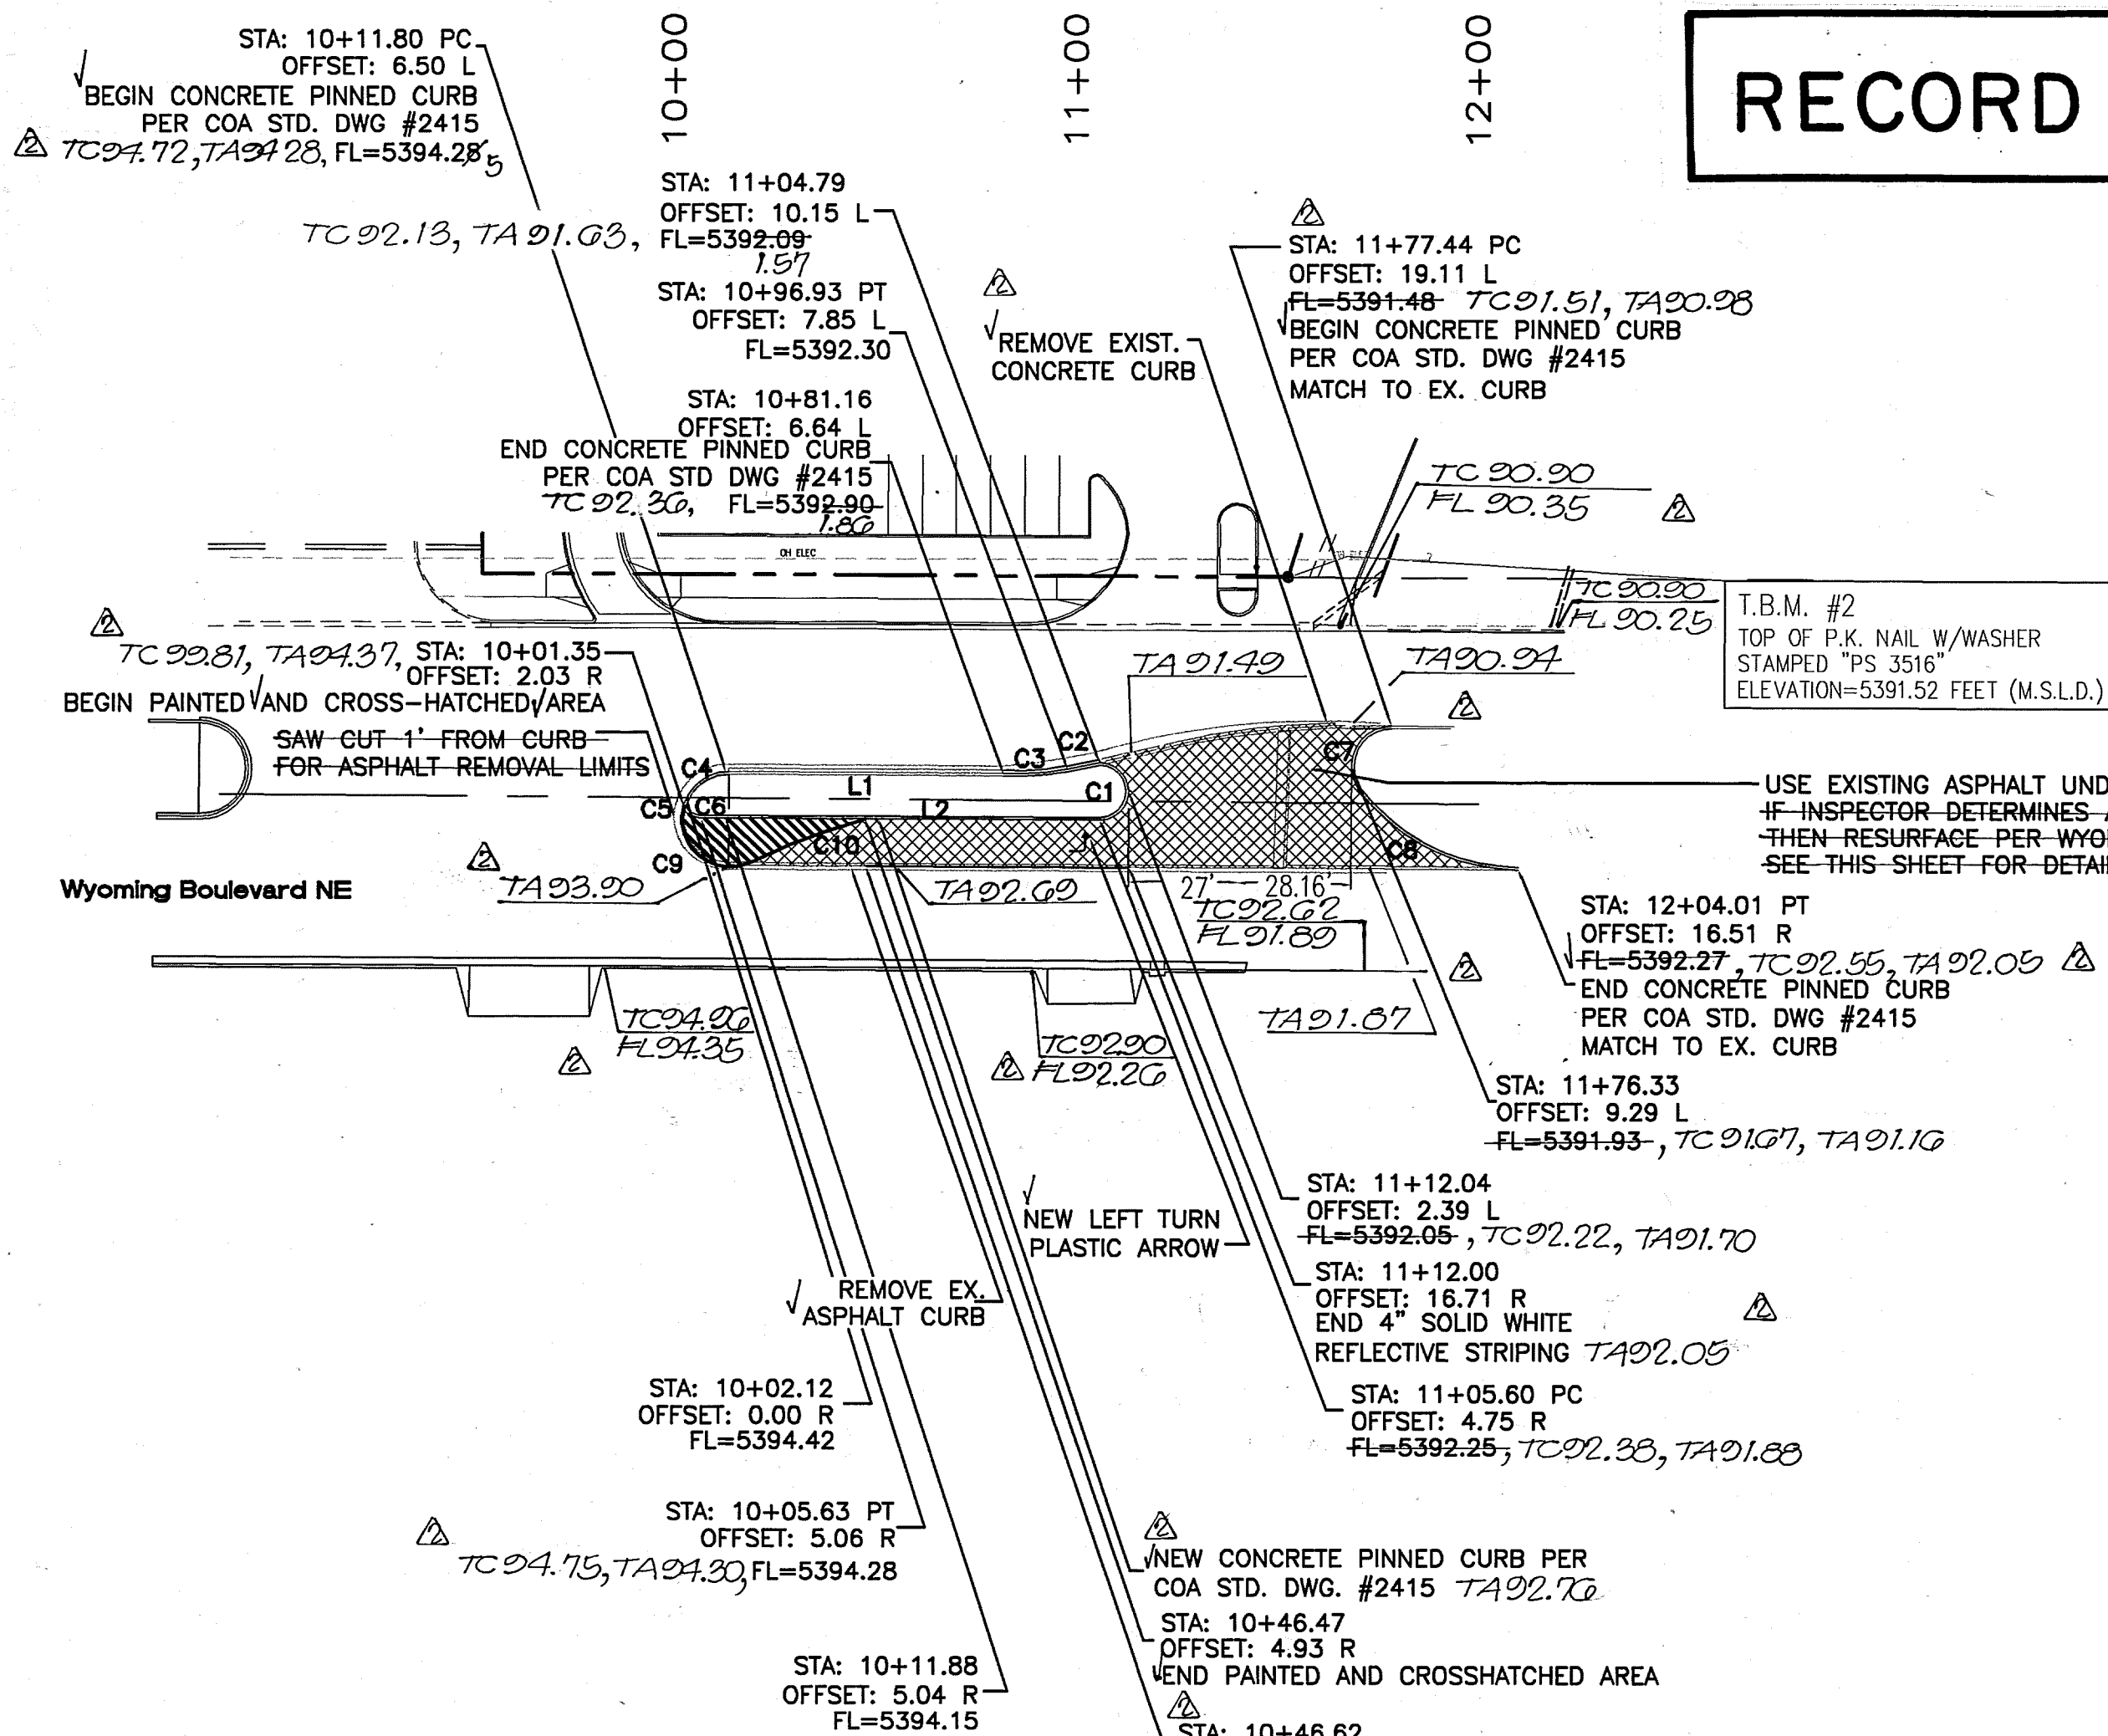


**--PAINT NOSE OF MEDIAN YELLOW TO 10' BACK
 **--PAVING SECTION FOR WYOMING MATCH TO EXISTING PAVING, SEE THIS SHEET FOR DETAIL
 **--ALL STATIONING BASED ON CENTERLINE OF WYOMING

WYOMING BOULEVARD
 STA 10+00 TO 11+91.15

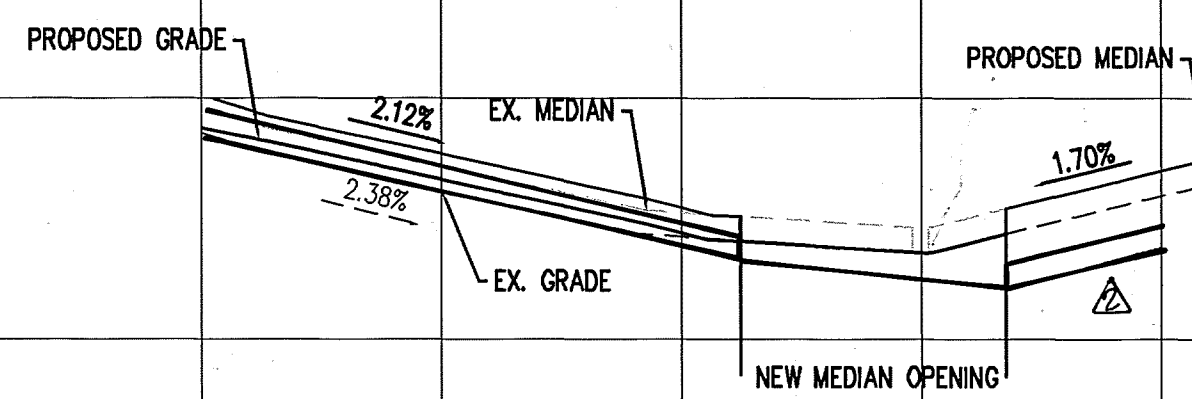


RECORD DRAWING


I, Jeffrey G. Mortensen, Registered Professional Engineer in the State of New Mexico, do hereby certify that this "as-built" information was obtained by me or under my supervision and represents the "as-built" conditions of this project, and is true and correct to the best of my knowledge and belief. All vertical and horizontal dimensions should be field verified prior to use on future projects.

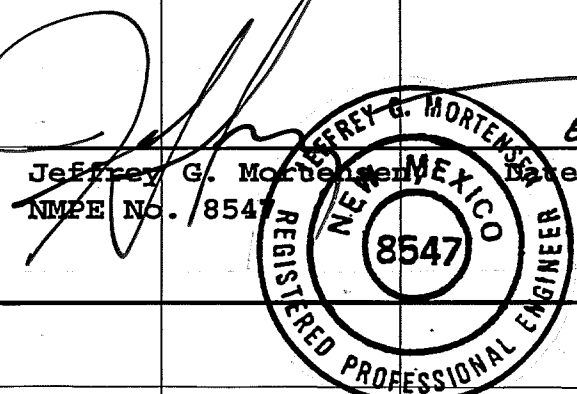


APPROVED - TRANSPORTATION 4-12-00
 APPROVED - DRC CHAIR 4-18-00

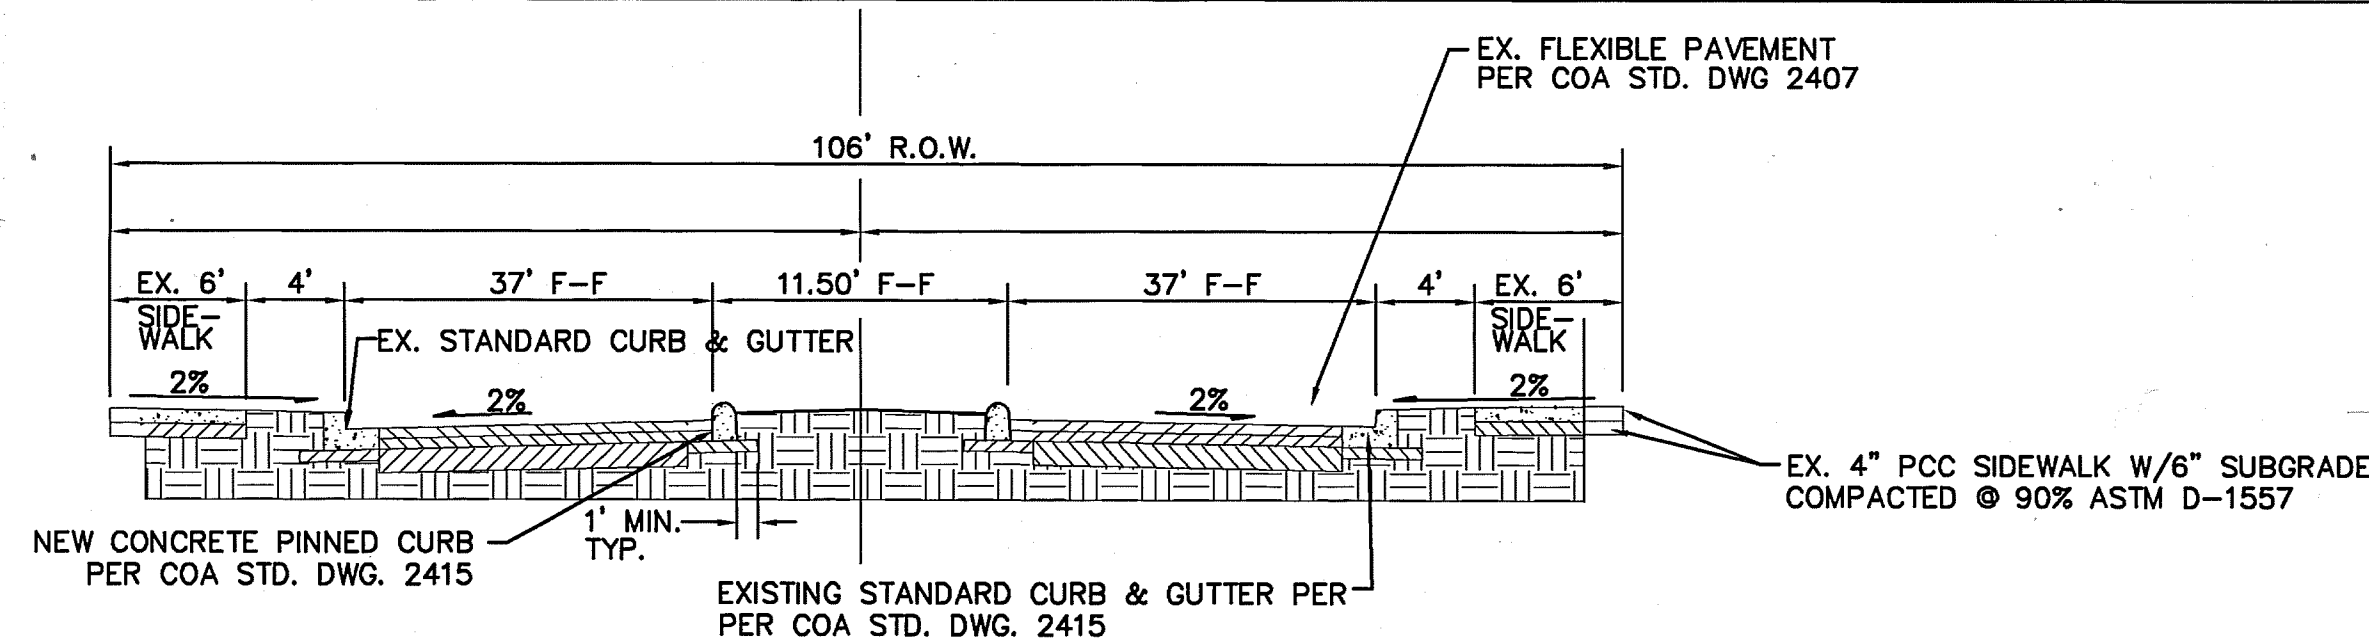

WYOMING PAVING CROSS SECTION
 N.T.S.

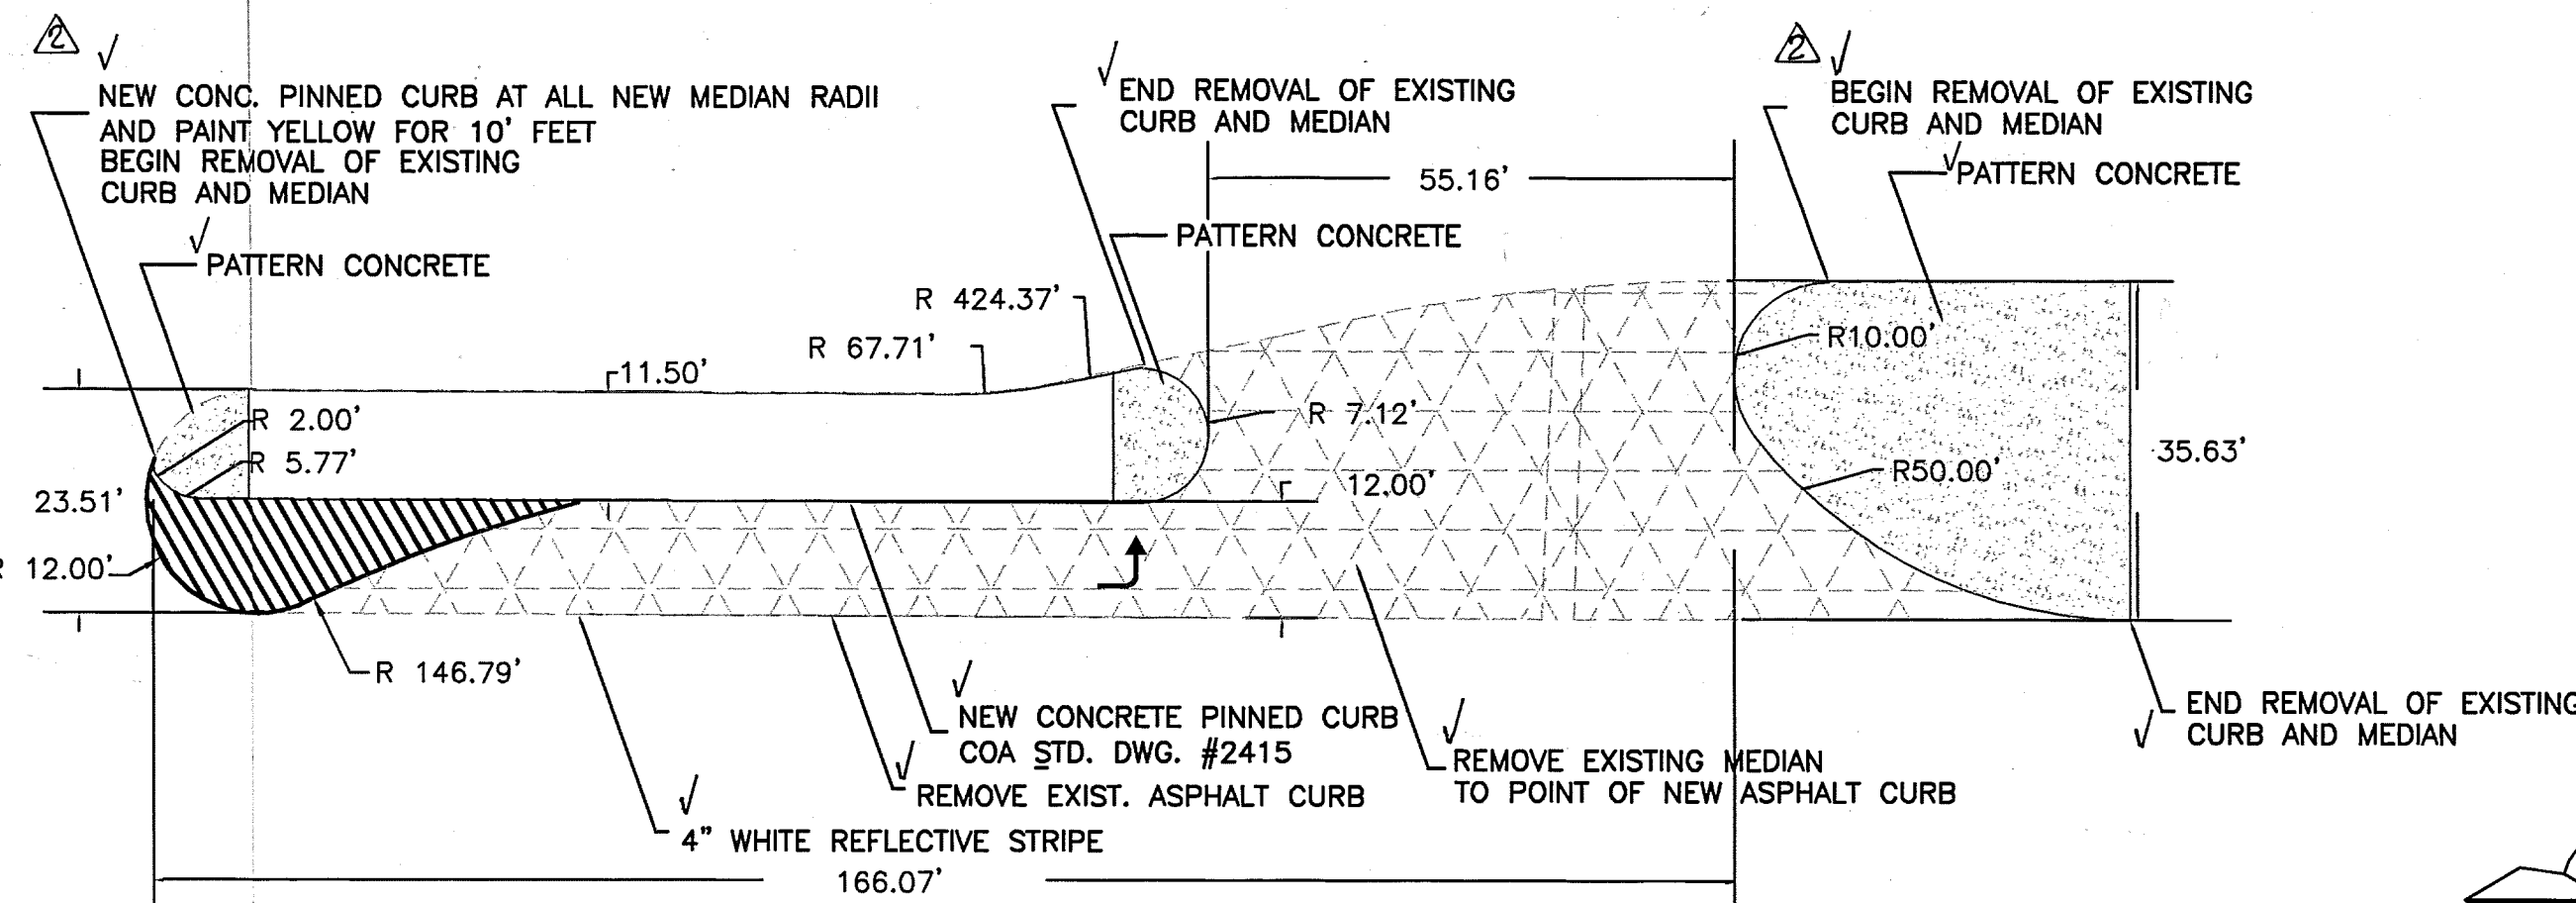


WYOMING PAVING MEDIAN DESIGN PLAN
 N.T.S.

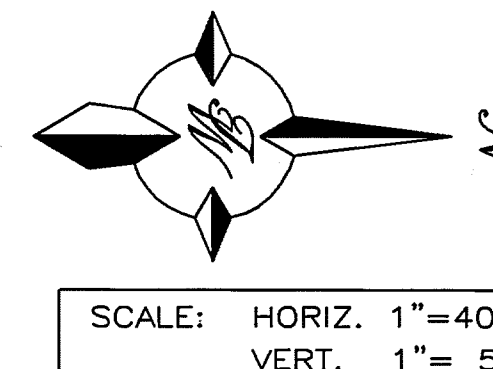

TACK COAT AS REQUIRED BY THE ENGINEER BETWEEN ALL ASPHALT/AGGREGATE MATERIAL LIFTS.
 TWO 3" ASPHALT CONCRETE, 1800 LBS. STABILITY, TYPE B GRADATION.

FINISH SURFACE OF SUBGRADE SHALL BE MOISTURE CONTROLLED AT COMPACTION MOISTURE RANGE, OR PRIME COAT APPLIED AS REQUIRED BY THE ENGINEER UNTIL NEXT/FINAL SURFACE IS COMPLETED. SUBGRADE PREPARATION SHALL BE PERFORMED AFTER ALL SUBSURFACE R/W UTILITIES CONSTRUCTION IS COMPLETED.
 1' SUBGRADE SOIL, R-VALUE > 50. PLACED IN 2-6" COMPACTED LIFTS. 95% MIN. COMPACTION, AT OPT. MOISTURE ± 2.0% ASTM D1557, OR OPT. MOISTURE, TO +4% ASTM D698 FOR SOIL W/35% OR MORE MATERIAL PASSING THE NO. 200 SIEVE. SOIL NOT HAVING THE MIN. R-VALUE OF 50 SHALL BE REMOVED TO A DEPTH OF 2 FEET AND REPLACED BY THE CONTRACTOR WITH SUITABLE MATERIAL OR A PAVEMENT SHALL BE DESIGNED BY TIERRA WEST, LLC ACCOMMODATING THE EXISTING R-VALUE PER C.O.A. STANDARD SPECIFICATIONS. REQUIRED

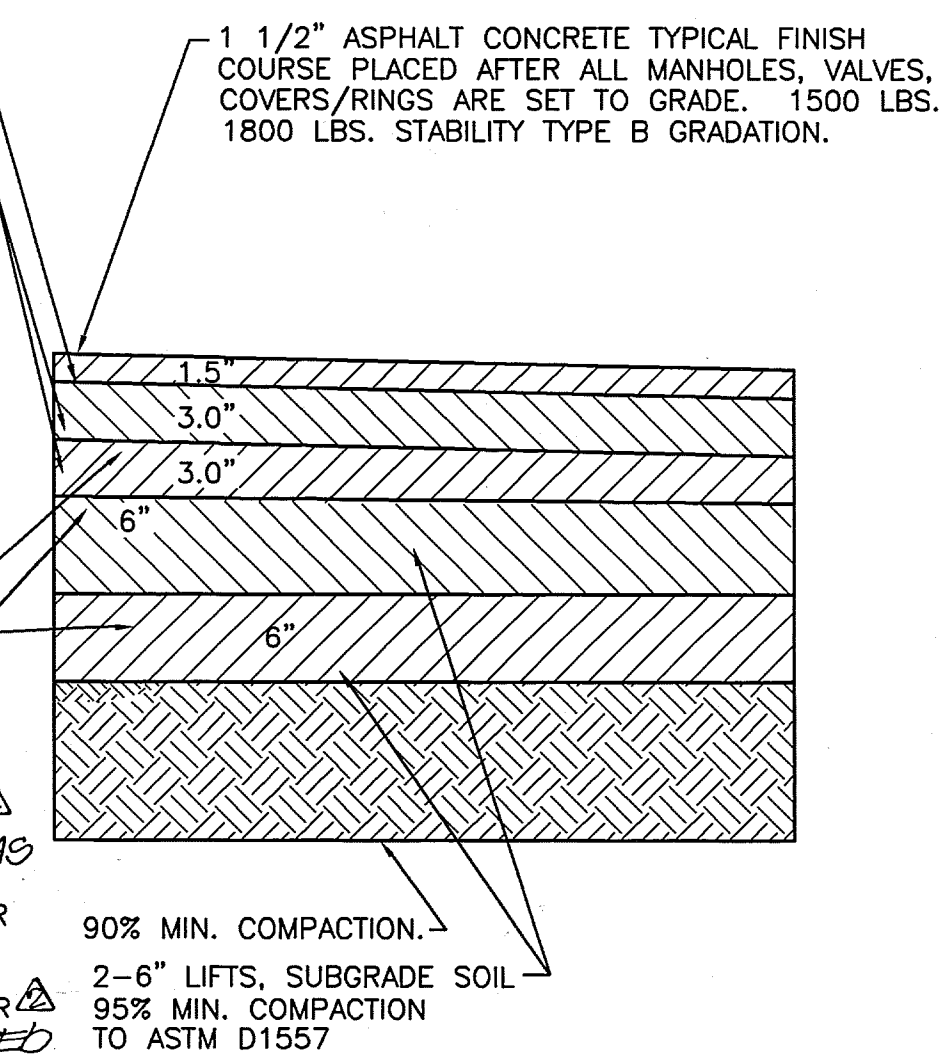



WYOMING PAVING SECTION
 N.T.S.

LINE TABLE		
LINE	LENGTH	BEARING
L1	68.34	S0°04'12"W
L2	99.23	S0°00'21"W

CURVE TABLE					
CURVE	LENGTH	RADIUS	CHORD BEARING	CHORD	
C1	22.34	7.12	N89°40'25"W	14.24	
C2	8.30	424.37	S11°6'13"E	8.30	
C3	15.99	67.71	S03°57'26"E	15.96	
C4	14.37	11.08	S35°44'01"E	13.39	
C5	2.40	2.00	N74°12'28"E	2.26	
C6	3.91	5.77	N20°23'11"E	3.83	
C7	22.26	10.00	S63°28'05"E	17.94	
C8	45.77	50.00	N26°31'55"E	44.19	
C9	28.02	12	S38°49'39"W	22.08	
C10	29.94	146.79	N20°52'01"W	29.85	

TIERRA WEST, LLC
 8509 JEFFERSON NE
 ALBUQUERQUE, NEW MEXICO 87113
 (505)858-3100

CITY OF ALBUQUERQUE
 PUBLIC WORKS DEPARTMENT
 ENGINEERING GROUP
 TITLE: CHRYSLER SERVICE CENTER
 WYOMING BLVD. PAVING IMPROVEMENTS
 STA: 10+00.00 TO 11+76.35

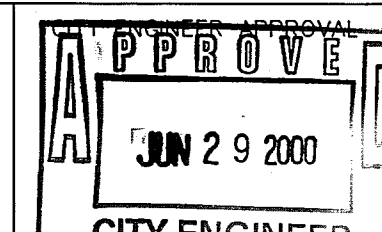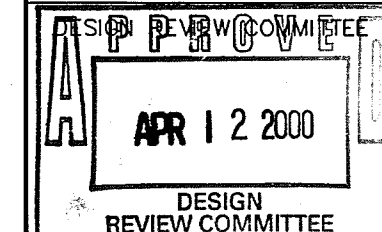


CITY PROJECT NO. 611981
 ZONE MAP NO. D-19-Z
 SHEET 7A & 9

AS BUILT INFORMATION				BENCH MARKS				SURVEY INFORMATION				ENGINEER'S SEAL			
CONTRACTOR	Camco Concrete	WORK	DATE	ACS BM, 12-ET9	EXPLOD TO THE TOP OF THE CONCRETE CURB, AT THE	DATE	BY	NO.	DATE	BY	NO.	DATE	BY	NO.	DATE
INSPECTOR	M.A.	ACCEPTANCE BY	DATE	W.A.W. CURB RETURN IN THE NORTHWEST QUADRANT OF	THE INTERSECTION OF WYOMING BLVD. AND SAN ANTONIO	DATE	BY	NO.	DATE	BY	NO.	DATE	BY	NO.	DATE
VERIFICATION BY	M.A.	VERIFICATION BY	DATE	DRIVE N.E.	ELEV.=9404.28'	DATE	BY	NO.	DATE	BY	NO.	DATE	BY	NO.	DATE
DRAWINGS	M.A.	DRAWINGS	DATE			DATE	BY	NO.	DATE	BY	NO.	DATE	BY	NO.	DATE
CORRECTIONS	M.A.	CORRECTIONS	DATE			DATE	BY	NO.	DATE	BY	NO.	DATE	BY	NO.	DATE
MICROFILM INFORMATION		MICROFILM INFORMATION	DATE			DATE	BY	NO.	DATE	BY	NO.	DATE	BY	NO.	DATE

CONSTRUCTION TRAFFIC CONTROL GENERAL NOTES

- CONTRACTOR MUST OBTAIN FROM CONSTRUCTION COORDINATION AN EXCAVATION/BARRICADING PERMIT BEFORE ENGAGING IN ANY CONSTRUCTION, MAINTENANCE OR REPAIR WORK IN ANY OF THE CITY OF ALBUQUERQUE'S RIGHTS-OF-WAY. EMERGENCY WORK THAT WOULD PRESERVE LIFE OR PROPERTY IS EXCLUDED WITH THE UNDERSTANDING, THAT A PERMIT SHALL BE OBTAINED WITHIN 24 TO 48 HOURS.
- CONTRACTOR SHALL AT THE TIME OF PERMIT REQUEST, SUBMIT FOR APPROVAL BY CONSTRUCTION COORDINATION, A TRAFFIC CONTROL PLAN DETAILING ALL EXISTING TOPOGRAPHY SUCH AS LANE WIDTHS, DRIVEWAYS, AND BUSINESS/RESIDENTIAL ACCESSES. THE TRAFFIC CONTROL PLAN SHALL INCLUDE ALL PHASES OF WORK AND SCHEDULES INVOLVED IN THE CONSTRUCTION PROJECT. ANY SEPARATE PHASES OF A CONSTRUCTION PROJECT SHALL BE GIVEN AN INDIVIDUAL PERMIT EACH. BLANKET PERMITS WILL NOT BE ISSUED.
- THESE TYPICAL TRAFFIC CONTROL PLANS DO NOT REFLECT THE EXISTING TOPOGRAPHY SUCH AS DRIVEWAYS, LANE WIDTHS, AND BUSINESS/RESIDENTIAL ACCESSES. EVERY LOCATION THAT REQUIRES CONSTRUCTION TRAFFIC CONTROL SHALL HAVE A DETAILED TRAFFIC CONTROL PLAN SHOWING ALL EXISTING TOPOGRAPHY.
- CONSTRUCTION SHALL NOT BEGIN UNLESS A TRAFFIC CONTROL PLAN HAS BEEN APPROVED AND VERIFIED BY CONSTRUCTION COORDINATION.
- CONSTRUCTION COORDINATION SHALL BE NOTIFIED 48 HOURS PRIOR TO ANY TRAFFIC CONTROL CHANGES NEEDED BY CONTRACTOR, THAT WERE NOT PREVIOUSLY APPROVED. THESE TRAFFIC CONTROL CHANGES SHALL BE REQUESTED IN WRITING ACCOMPANIED WITH A TRAFFIC CONTROL PLAN REFLECTING SUCH CHANGES.
- ALL CONSTRUCTION TRAFFIC CONTROL DEVICES SHALL COMPLY TO THE MANUAL ON UNIFORM TRAFFIC CONTROL DEVICES (MUTCD), LATEST EDITION. IT IS THE RESPONSIBILITY OF THE CONTRACTOR TO INSTALL, SERVICE AND MAINTAIN ALL TRAFFIC CONTROL DEVICES. TRAFFIC CONTROL DEVICES SHALL NOT BE REMOVED OR ALTERED IN ANY WAY WITHOUT THE APPROVAL OF CONSTRUCTION COORDINATION, PER SECTION 6A-4 OF THE MUTCD, LATEST EDITION.
- THE CONSTRUCTION TRAFFIC CONTROL INITIAL SET-UP SHALL BE BY AN AMERICAN TRAFFIC SAFETY SERVICES ASSOCIATION (ATSSA) CERTIFIED WORKSITE TRAFFIC SUPERVISOR. THE MAINTENANCE AND SERVICING SHALL ALSO BE DONE BY AN ATSSA CERTIFIED WORKSITE TRAFFIC SUPERVISOR OR EQUIVALENT.
- CONTRACTOR IS RESPONSIBLE TO MAINTAIN AND SERVICE ALL TRAFFIC CONTROL DEVICES 24 HOURS A DAY, 7 DAYS A WEEK THROUGHOUT LENGTH OF PROJECT. CONTRACTOR IS RESPONSIBLE THAT ALL TRAFFIC CONTROL DEVICES COMPLY WITH THE MUTCD, LATEST EDITION.
- ALL ADVANCE WARNING SIGNS SHALL BE DOUBLE INDICATED WHENEVER THERE ARE MULTI-LANE TRAFFIC IN ANY ONE GIVEN DIRECTION AND THERE IS SUFFICIENT MEDIAN SPACE.
- ALL BARRICADES IN ALL TAPERS AND TANGENTS SHALL BE PLACED APART, A DISTANCE MEASURED IN FEET, EQUAL TO THAT OF THE POSTED SPEED LIMIT. NO EXCEPTIONS UNLESS APPROVED BY CONSTRUCTION COORDINATION PER MUTCD SECTION 6A-4.
- ALL WORK IN ARTERIAL ROADWAYS SHALL BE ON A CONTINUOUS 24 HOUR PER DAY BASIS UNTIL COMPLETED.
- CONTRACTOR IS RESPONSIBLE TO PROVIDE CONSTRUCTION COORDINATION, A WEEKLY LOG OF DAILY INSPECTIONS OF BARRICADE AND MAINTENANCE SCHEDULES ON PROJECTS THAT ARE OVER ONE WEEK DURATION.
- EQUIPMENT OR MATERIALS SHALL NOT BE STORED WITHIN 15 FEET OF A TRAVELLED TRAFFIC LANE DURING NON-WORKING HOURS WITHOUT THE APPROVAL OF CONSTRUCTION COORDINATION.
- CONTRACTOR SHALL PROVIDE AND MAINTAIN A SAFE AND ADEQUATE MEANS OF CHANNELIZING PEDESTRIAN TRAFFIC AROUND AND THROUGH THE CONSTRUCTION AREA.
- CONTRACTOR IS RESPONSIBLE FOR OBLITERATION OF ANY CONFLICTING STRIPING AND RESPONSIBLE FOR ALL TEMPORARY STRIPING.
- CONTRACTOR SHALL MAINTAIN ACCESS TO ALL FACILITIES, BUSINESSES AND/OR RESIDENTS AT ALL TIMES.
- CONTRACTOR SHALL PROVIDE ACCESS SIGNS FOR BUSINESSES LOCATED WITHIN THE CONSTRUCTION AREA UNDER THE SUPERVISION OF CONSTRUCTION COORDINATION. EACH ACCESS SIGN SHALL HAVE 5 INCH, WHITE OPAQUE LETTERING ON BLUE REFLECTORIZED BACKGROUND. ACCESS SIGNS SHALL BE CONSIDERED INCIDENTAL TO THE BID AND NOT PART OF THE CONTRACT UNLESS OTHERWISE STATED. NO MORE THAN 3 BUSINESSES SHALL BE LISTED ON A ACCESS SIGN. SHOPPING CENTERS AND MALLS SHALL BE LISTED AS SUCH.
- ALL ADVANCE WARNING SIGNS SHALL MEET THE MINIMUM REFLECTIVE INTENSITY REQUIREMENTS SET FORTH BY THE CITY OF ALBUQUERQUE. CONSTRUCTION COORDINATION SHALL DETERMINE ALL REQUIREMENTS AND APPROVE OR DISAPPROVE ANY ADVANCE WARNING SIGN PER SECTION 6A-4 OF THE MUTCD, LATEST EDITION.
- 48 HOURS PRIOR TO OCCUPYING OR CLOSING OF A RIGHT-OF-WAY, CONTRACTOR SHALL NOTIFY: POLICE, FIRE DEPARTMENT, SCHOOLS, HOSPITALS, TRANSIT AUTHORITY, BUSINESSES AND/OR RESIDENTS THAT WILL BE AFFECTED BY THE CONSTRUCTION.
- ANY FIELD ADJUSTMENTS SHALL BE APPROVED BY CONSTRUCTION COORDINATION.

- EXCAVATIONS SHALL BE PLATED, TEMPORARILY PATCHED OR RESURFACED PRIOR TO OPENING OF TRAFFIC. A MINIMUM OF 11 FEET SHALL BE PROVIDED FOR TRAFFIC IN ANY GIVEN DIRECTION. CONTRACTOR IS RESPONSIBLE FOR ANY WORK INVOLVED IN SATISFYING THESE REQUIREMENTS.
- CONTRACTOR SHALL AT ALL TIMES COMPLY WITH THE FOLLOWING:
 - STANDARDS AND REQUIREMENTS SET FORTH IN THE MANUAL ON UNIFORM TRAFFIC CONTROL DEVICES, LATEST EDITION.
 - THE CITY OF ALBUQUERQUE TRAFFIC CODE, LATEST EDITION.
 - SECTION 19 OF THE CITY OF ALBUQUERQUE'S STANDARD SPECIFICATIONS FOR PUBLIC WORK CONSTRUCTION, AS WELL AS OTHER SECTIONS.
- FAILURE TO COMPLY WITH ANY OF THE ABOVE MENTIONED, WILL BE ADEQUATE CAUSE TO CEASE ALL WORK ON ANY CONSTRUCTION PROJECT. WORK WILL NOT RESUME UNTIL ALL REQUIREMENTS ARE ADDRESSED AND APPROVED BY CONSTRUCTION COORDINATION.
- ALL TRAFFIC CONTROL DEVICES SHALL BE KEPT IN NEW-CLEAN CONDITION. WASHING OF EQUIPMENT IS INCIDENTAL TO ITS PLACEMENT AND MAINTENANCE.
- TRAFFIC CONTROL STANDARDS APPLY ONLY WHERE THE CONSTRUCTION TRAFFIC CONTROL PLANS ARE NOT SPECIFIC.
- ADVANCE WARNING SIGNS SHALL BE 36"x36" MIN. WITH SUPER ENGINEERING GRADE SHEETING OR BETTER. MOUNTING HEIGHT AT TOP OF SIGN SHALL BE THE SAME AS FOR A 48" SIGN AS INDICATED IN THE M.U.T.C.D.
- CONTRACTOR SHALL MAINTAIN A GRAFFITI-FREE WORKSITE. ALL GRAFFITI SHALL BE PROMPTLY REMOVED FROM ALL EQUIPMENT, BOTH PERMANENT AND TEMPORARY.

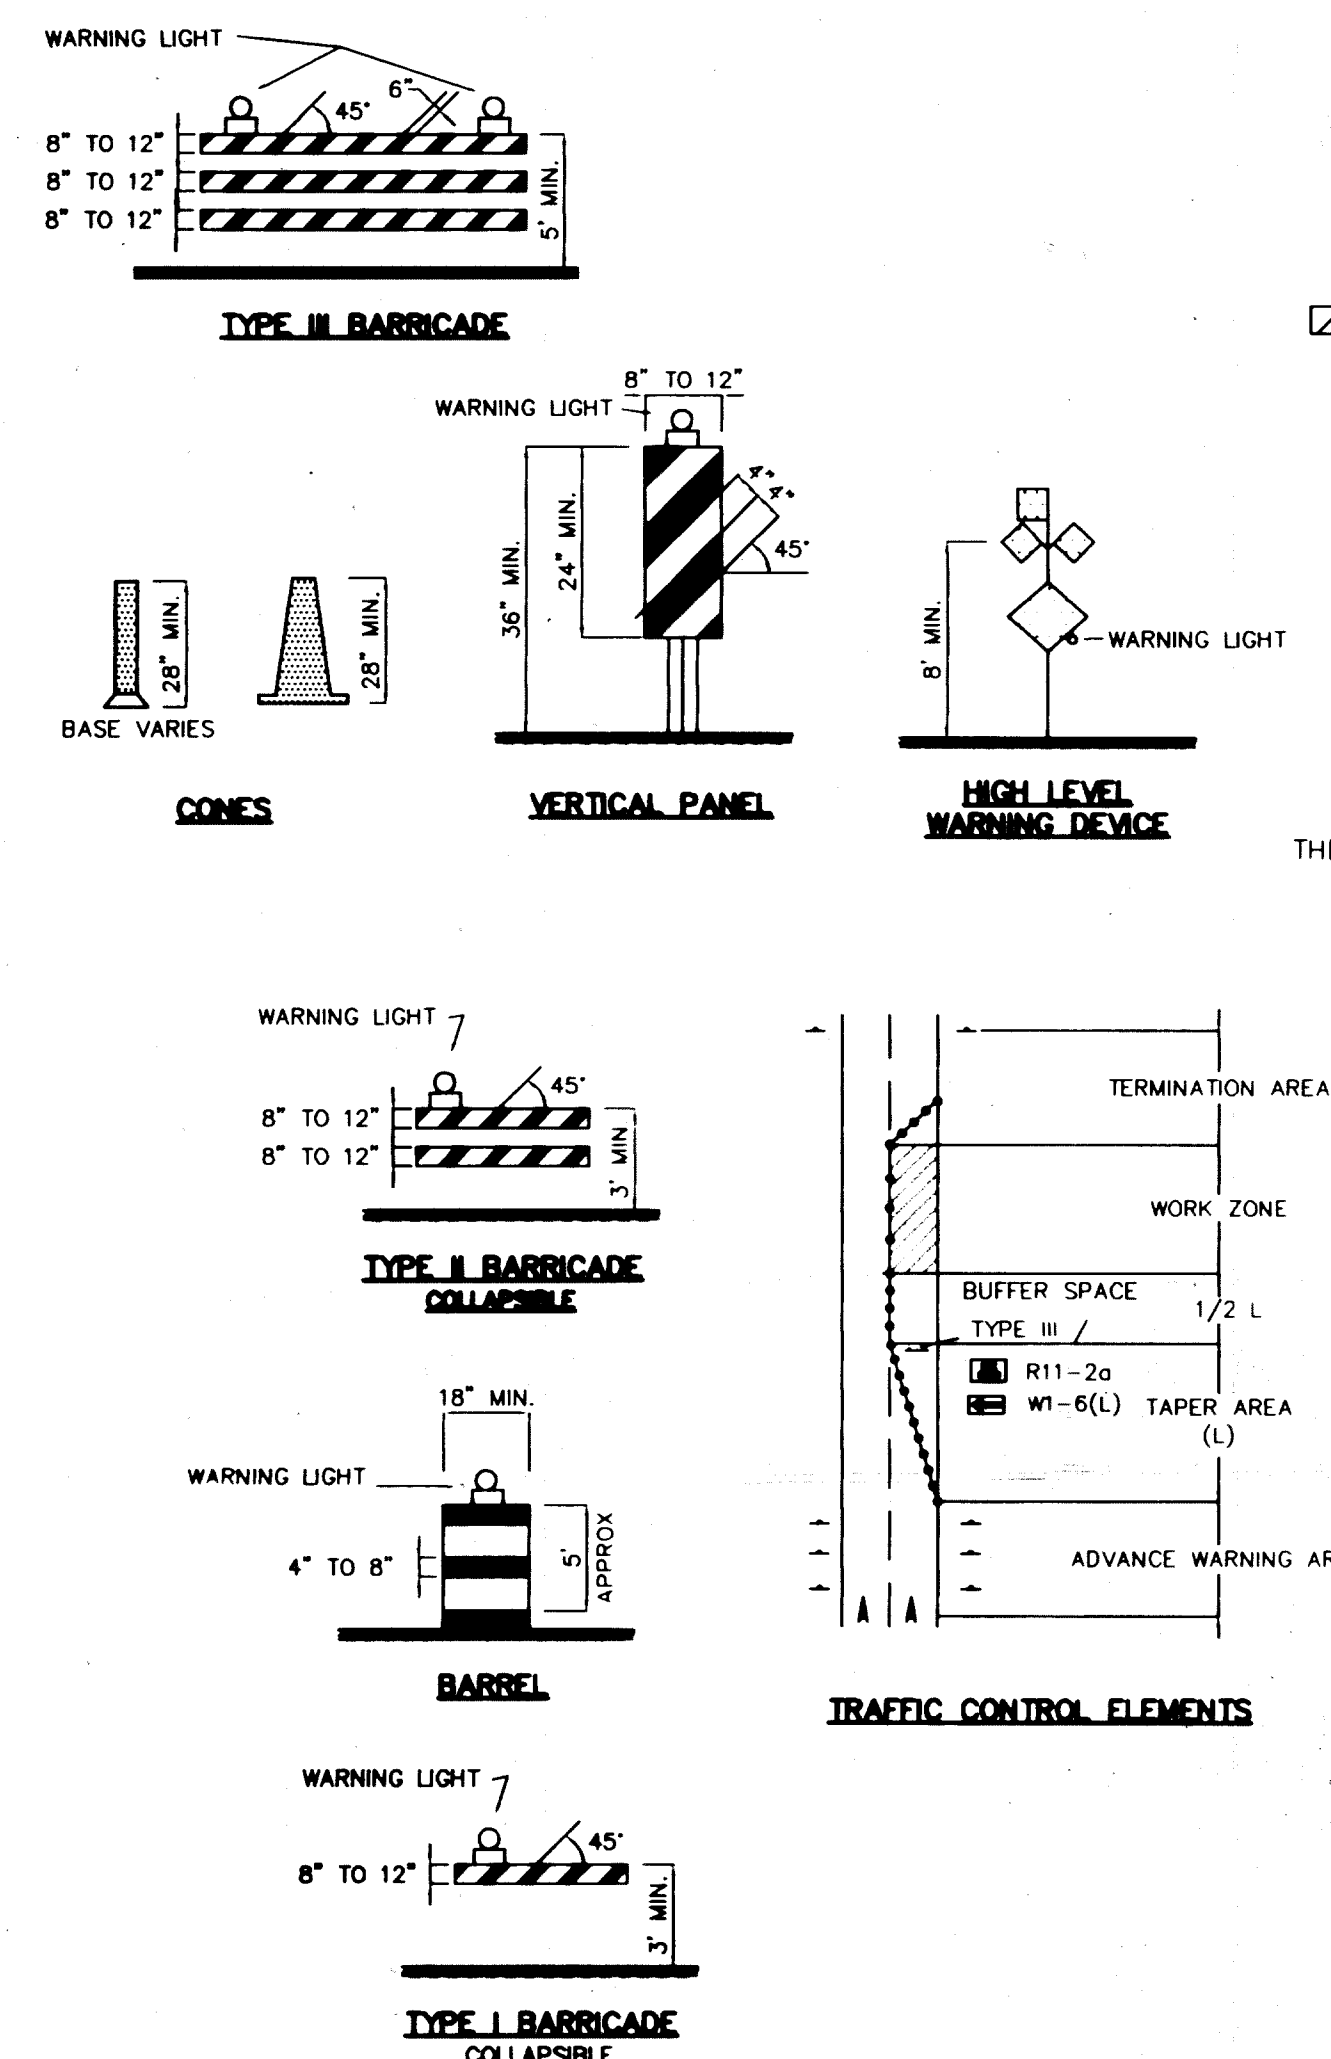

LEGEND

- WORK AREA
 - BARRICADE - TYPE I, TYPE II, OR BARREL
 - BARRICADE - TYPE III
 - VERTICAL PANEL
 - WARNING SIGN
 - DISTANCE BETWEEN SIGNS - A DISTANCE MEASURED IN FEET EQUAL TO A VALUE OF TEN TIMES THE SPEED LIMIT OF THE STREET
 - FLAGMAN POSITION
 - SPACING BETWEEN BARRICADES - A DISTANCE MEASURED IN FEET EQUAL TO THE SPEED LIMIT OF THE STREET
 - TAPER LENGTH - SEE CHART BELOW
- THE TANGENT LENGTH IS EQUAL TO THE TAPER LENGTH FOR A GIVEN STREET.

TAPER REQUIREMENTS

SPEED LIMIT (MPH)	TAPER LENGTH (L) (FEET)			MINIMUM NUMBER OF DEVICES FOR TAPER	MAXIMUM DEVICE SPACING IN FEET	
	10' LANE	11' LANE	12' LANE		ALONG TAPER	AFTER TAPER
20	70	75	80	5	20	20
25	105	115	125	6	25	25
30	150	165	180	7	30	30
35	205	225	245	8	35	35
40	270	295	320	9	40	40
45	450	495	540	13	45	45
50	500	550	600	13	50	50
55	550	605	660	13	55	55

RECOMMENDED SIGN SPACING(D) FOR ADVANCE WARNING SIGN SERIES

SPEED MILES PER HOUR	MINIMUM DISTANCE IN FEET	
	BETWEEN SIGNS	FROM LAST SIGN TO TAPER
0-20	10 X SPEED LIMIT	10 X SPEED LIMIT
25-30	10 X SPEED LIMIT	10 X SPEED LIMIT
30-35	10 X SPEED LIMIT	10 X SPEED LIMIT
40-45	10 X SPEED LIMIT	10 X SPEED LIMIT
50-60	10 X SPEED LIMIT	10 X SPEED LIMIT


TAPER CRITERIA

TYPE OF TAPER	TAPER LENGTH
UPSTREAM TAPER:	
MERGING TAPER	L MINIMUM
SHIFTING TAPER	1/2 L MINIMUM
SHOULDER TAPER	1/2 L MINIMUM
TWO-WAY TRAFFIC TAPER	100 FEET MAXIMUM
DOWNSTREAM TAPERS	100 FEET PER LANE

TAPER LENGTH COMPUTATION

SPEED LIMIT	
40 MPH OR LESS	$L = \frac{WS^2}{60}$
45 MPH OR GREATER	$L = W \times S$
L = TAPER LENGTH	
W = WIDTH OF OFFSET IN FEET	
S = POSTED SPEED OR OFF-PEAK 85-PERCENTILE SPEED IN MPH	

SIGN FACE DETAILS

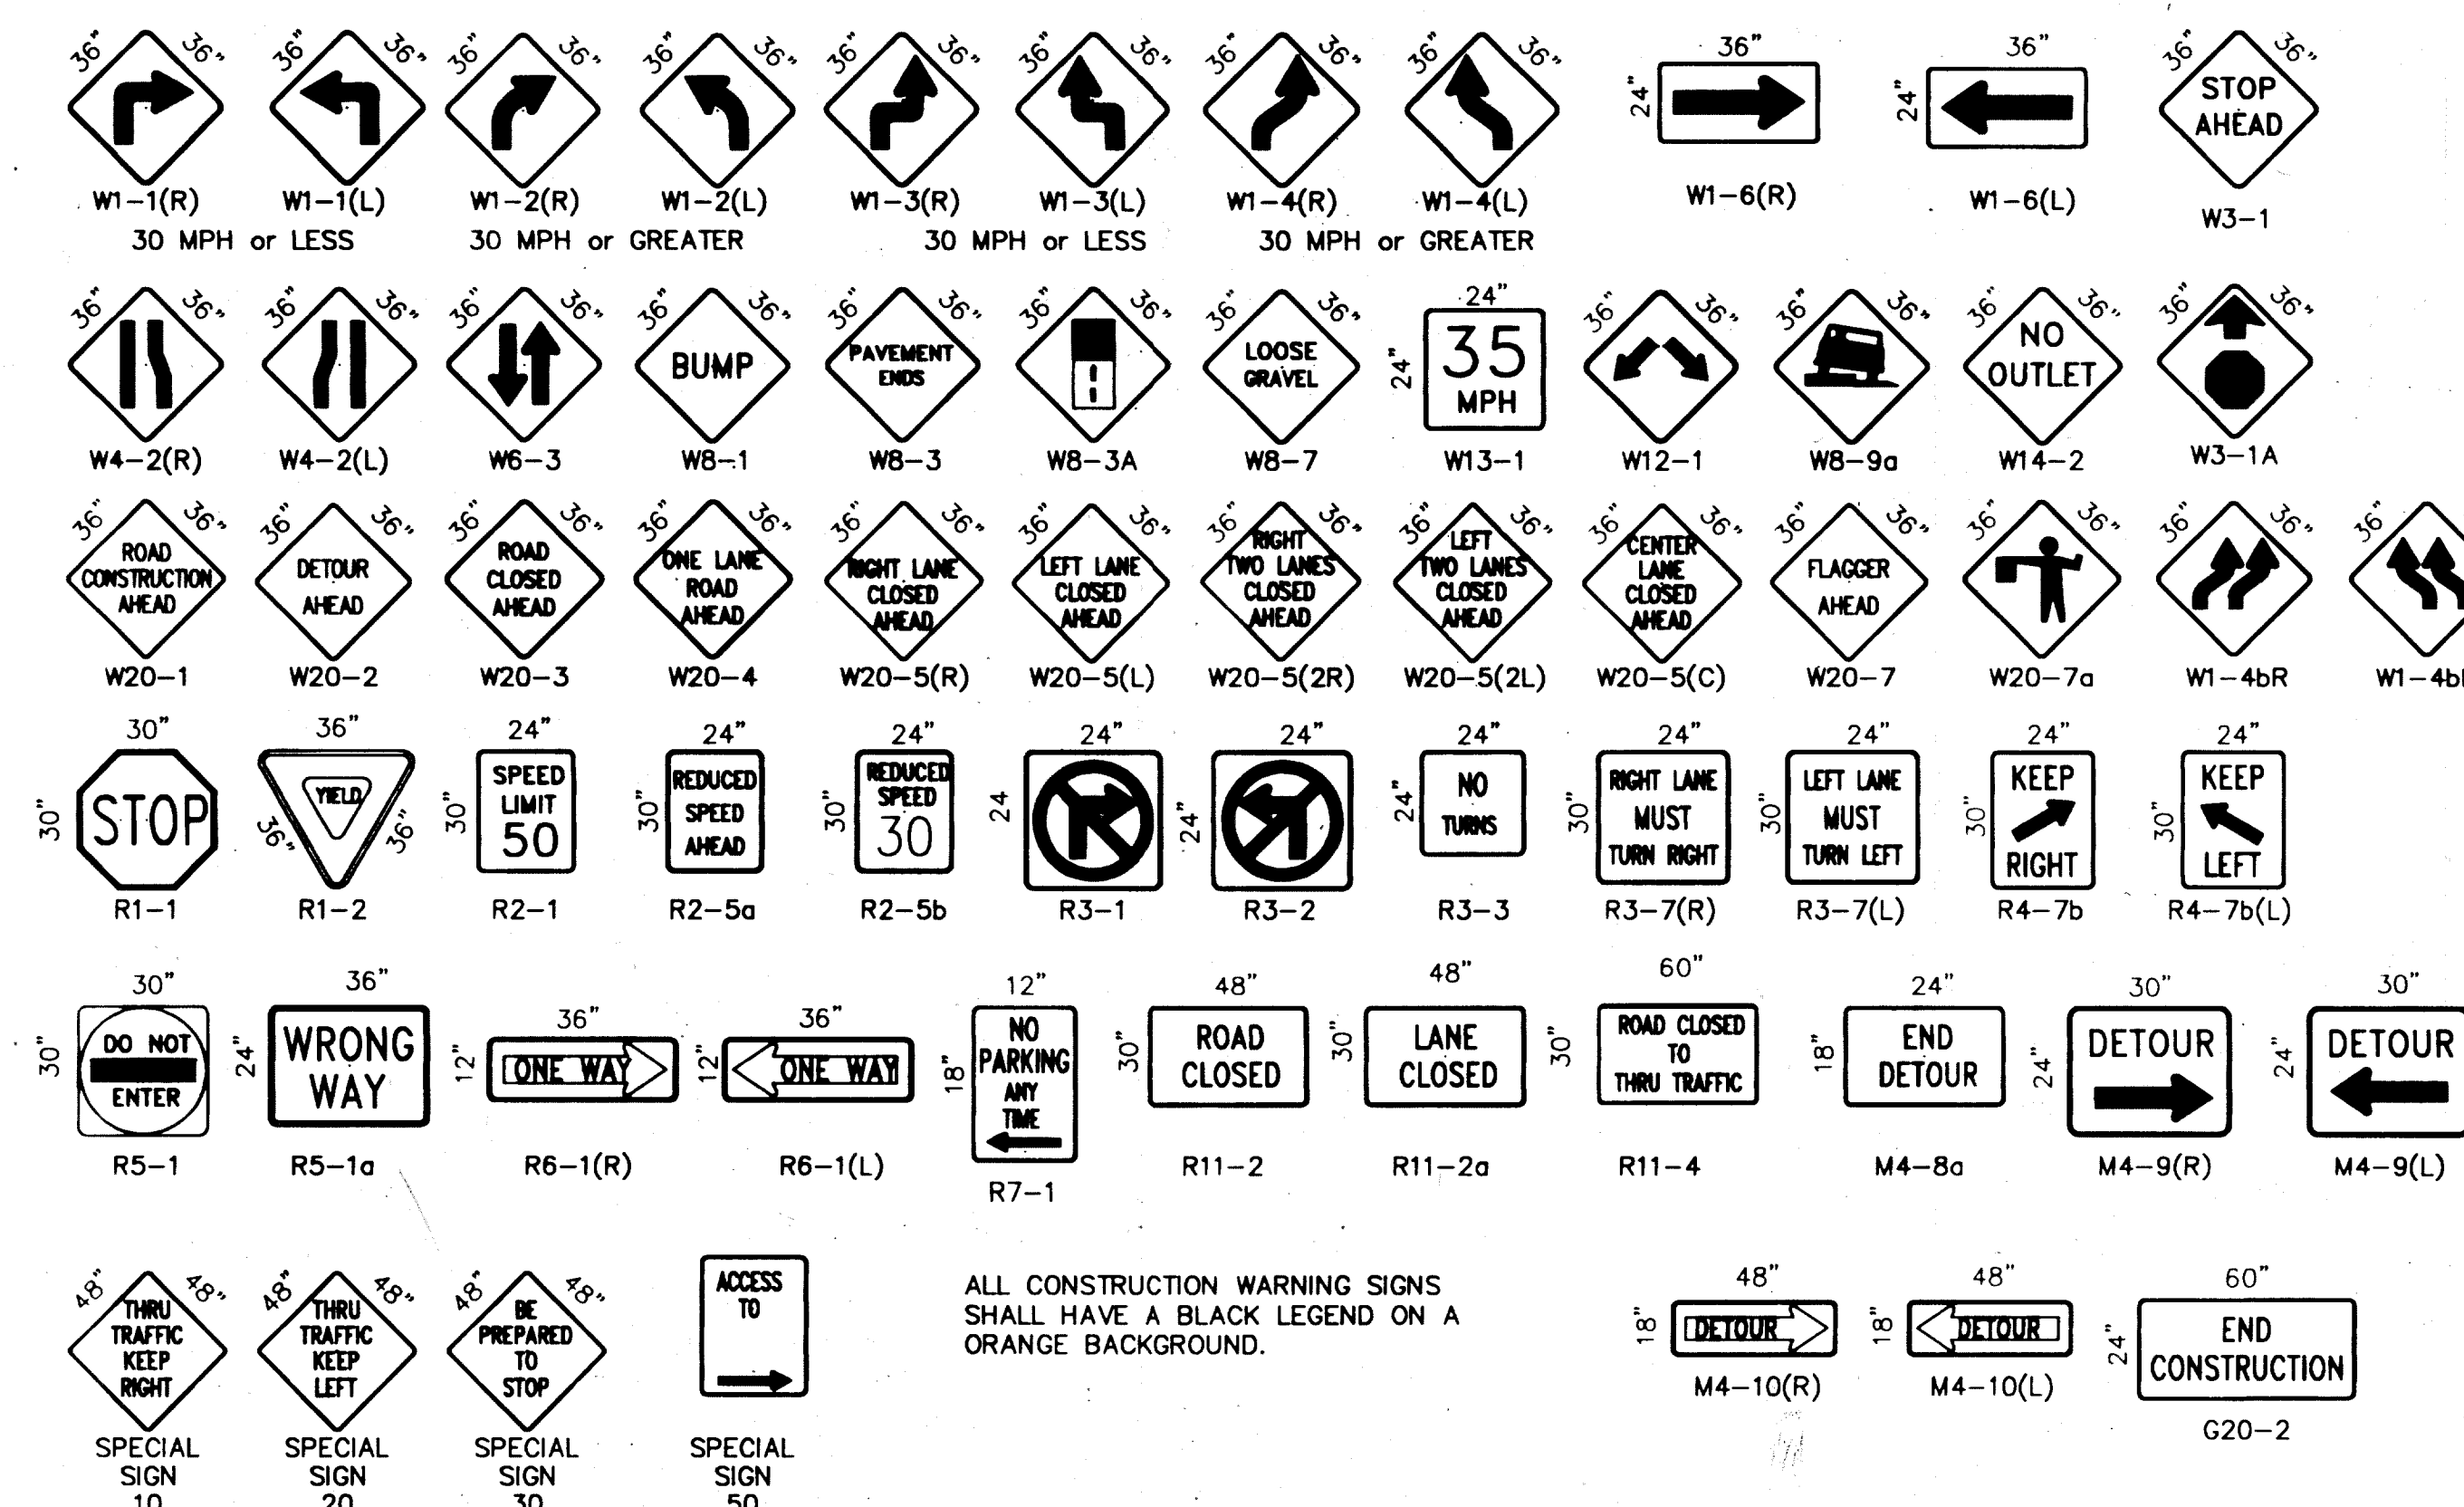

RECORD DRAWING

CITY OF ALBUQUERQUE
PUBLIC WORKS DEPARTMENT
ENGINEERING DEVELOPMENT GROUP

TITLE: TRACT A-1-B, LOMA DEL NORTE
SIGNING AND CONSTRUCTION TRAFFIC CONTROL STANDARDS

DESIGN REVIEW COMMITTEE: CITY ENGINEER APPROVAL

PROJECT NO. 611981 MAP NO. D19 SHEET 8 OF 10

LAST UPDATE: MO/DAY/YR

DESIGNED BY: DATE

DRAWN BY: C.O.A. STANDARDS DATE

CHECKED BY: DATE

