


CONSTRUCTION PLANS
FOR
TIMARRON WEST UNIT 2
ALBUQUERQUE, NEW MEXICO

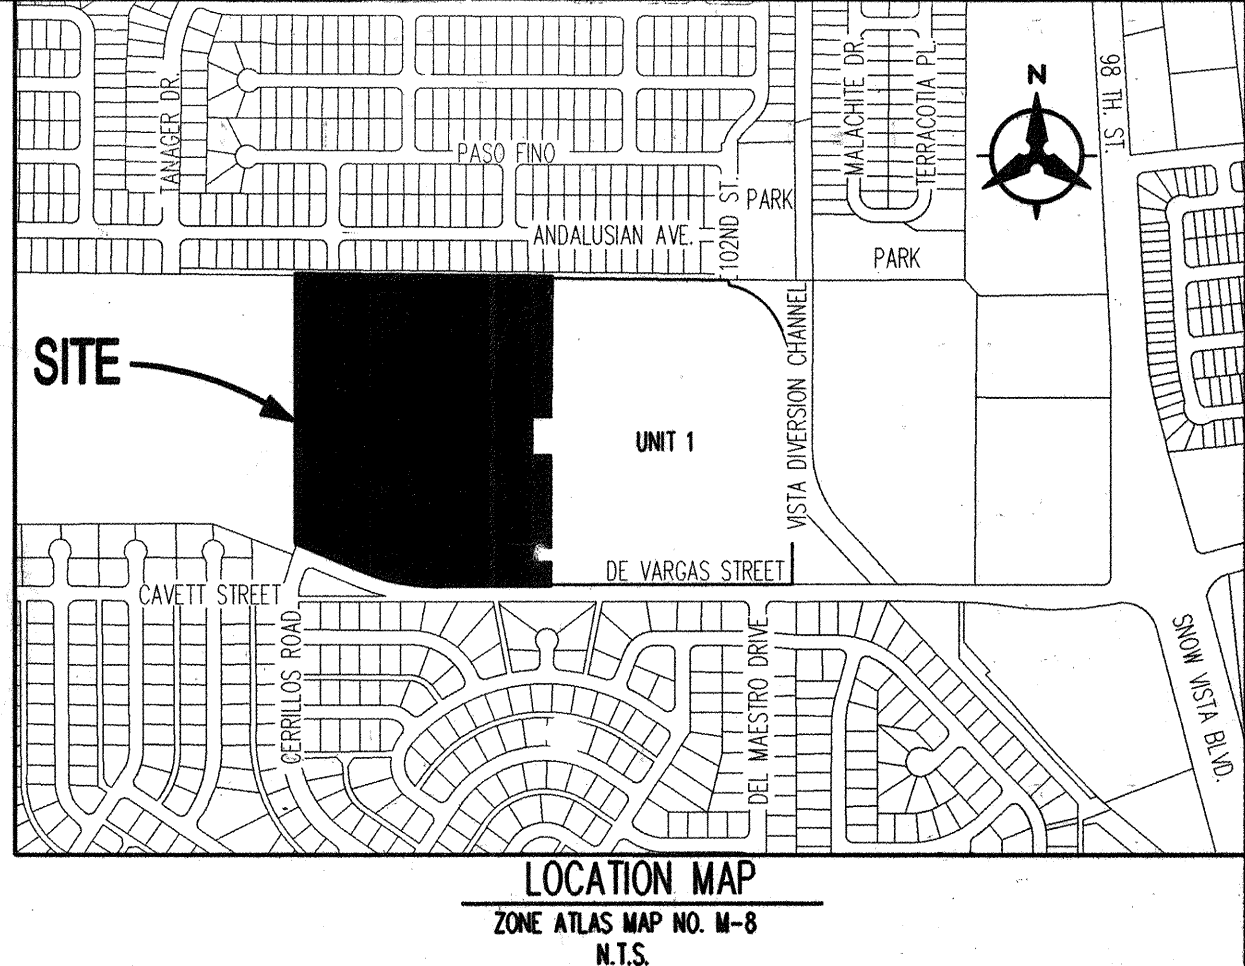

SHEET NUMBER	DESCRIPTION
1	COVER SHEET
2 & 3	PLATS
4	GRADING AND EROSION CONTROL PLAN
5	GRADING DETAILS
6	OVERALL PAVING PLAN
7	CRANE DRIVE / TEAL STUB PAVING PLAN & PROFILE
8	TEAL ROAD PAVING PLAN & PROFILE
9	RED ROBIN ROAD PAVING PLAN & PROFILE
10	CHUCKAR DRIVE / TEAL STUB PAVING PLAN & PROFILE
11	FINCH DRIVE PAVING PLAN & PROFILE
12	DEVARGAS ROAD PAVING PLAN & PROFILE
13	OVERALL UTILITY PLAN
14	CRANE DRIVE / TEAL STUB UTILITY PLAN & PROFILE
15	TEAL ROAD UTILITY PLAN & PROFILE
16	RED ROBIN ROAD UTILITY PLAN & PROFILE
17	CHUCKER DRIVE/ TEAL STUB UTILITY PLAN & PROFILE
18	FINCH DRIVE UTILITY PLAN & PROFILE
19	DEVARGAS ROAD UTILITY PLAN & PROFILE
20	STORM DRAIN PLAN & PROFILE
21	DETAILS
22 & 23	SIGNING AND TRAFFIC CONTROL STANDARDS
24	DE VARGAS STRIPING PLAN

- NOTES TO CONTRACTORS**
1. ALL WORK DETAILED ON THESE PLANS TO BE PERFORMED UNDER CONTRACT SHALL, EXCEPT AS OTHERWISE STATED OR PROVIDED FOR HEREON, BE CONSTRUCTED IN ACCORDANCE WITH THE CITY OF ALBUQUERQUE STANDARD SPECIFICATIONS FOR PUBLIC WORKS CONSTRUCTION, 1986 EDITION AND SHALL INCLUDE UPDATE No. 6
 2. TWO WORKING DAYS PRIOR TO ANY EXCAVATION, THE CONTRACTOR MUST CONTACT NEW MEXICO ONE CALL SYSTEM (260-1990) FOR LOCATION OF EXISTING UTILITIES.
 3. EXISTING WATERLINE LOCATION TAKEN FROM AVAILABLE RECORDS. CONTRACTOR SHALL FIELD VERIFY EXACT LOCATION OF EXISTING UTILITIES. SHOULD A CONFLICT EXIST, THE CONTRACTOR SHALL NOTIFY THE ENGINEER IMMEDIATELY IN ORDER TO RESOLVE IT WITH A MINIMUM AMOUNT OF DELAY.
 4. FIVE (5) WORKING DAYS PRIOR TO BEGINNING CONSTRUCTION, THE CONTRACTOR SHALL SUBMIT TO CONSTRUCTION COORDINATION DIVISION A DETAILED CONSTRUCTION SCHEDULE. TWO (2) WORKING DAYS PRIOR TO CONSTRUCTION, THE CONTRACTOR SHALL OBTAIN A BARRICADING PERMIT FROM THE CONST. COORDINATION DIVISION. CONTRACTOR SHALL NOTIFY BARRICADE ENGINEER (768-2551) PRIOR TO OCCUPYING AN INTERSECTION, REFER TO SECTION 19 OF THE GENERAL CONDITIONS OF THE STANDARD SPECIFICATIONS.
 5. ALL STREET STRIPING ALTERED OR DESTROYED SHALL BE REPLACED W/ PLASTIC REFLECTORIZED PAVEMENT MARKING BY CONTRACTOR TO LOCATION AS EXISTING OR AS INDICATED BY THIS PLAN SET.
 6. CONTRACTOR SHALL NOTIFY THE ENGINEER NOT LESS THAN SEVEN (7) DAYS PRIOR TO STARTING WORK IN ORDER THAT THE CITY SURVEYOR MAY TAKE NECESSARY MEASURES TO INSURE THE PRESERVATION OF SURVEY MONUMENTS. CONTRACTOR SHALL NOT DISTURB PERMANENT SURVEY MONUMENTS WITHOUT THE CONSENT OF THE CITY SURVEYOR AND SHALL NOTIFY THE CITY SURVEYOR AND BEAR THE EXPENSE OF REPLACING ANY THAT MAY BE DISTURBED WITHOUT PERMISSION. REPLACEMENT SHALL BE DONE ONLY BY THE CITY SURVEYOR. WHEN A CHANGE IS MADE IN THE FINISHED ELEVATIONS OF THE PAVEMENT OF ANY ROADWAY IN WHICH A PERMANENT SURVEY MONUMENT IS LOCATED, CONTRACTOR SHALL AT HIS OWN EXPENSE, ADJUST THE MONUMENT COVER TO THE NEW GRADE UNLESS OTHERWISE SPECIFIED. REFER TO SECTION 4.4 OF THE GENERAL CONDITIONS OF THE STANDARD SPECIFICATIONS.
 7. ANY WORK WITHIN AN ARTERIAL ROADWAY REQUIRES TWENTY-FOUR HOUR CONSTRUCTION.
 8. CONTRACTOR SHALL MAINTAIN A GRAFFITI-FREE WORK SITE. CONTRACTOR SHALL PROMPTLY REMOVE ANY AND ALL GRAFFITI FROM ALL EQUIPMENT, WHETHER PERMANENT OR TEMPORARY.

- THE FOLLOWING NOTES ALSO APPLY WHEN CHECKED**
- ☒ ALL UTILITIES AND UTILITY SERVICE LINES SHALL BE INSTALLED PRIOR TO PAVING.
 - ☐ BACKFILL COMPACTION SHALL BE ACCORDING TO SPECIFIED STREET USE.
 - ☐ TACK COAT REQUIREMENTS SHALL BE DETERMINED BY THE CITY ENGINEER.
 - ☒ SIDEWALKS AND WHEELCHAIR RAMPS WITHIN THE CURB RETURNS SHALL BE CONSTRUCTED WHEREVER A NEW CURB RETURN IS CONSTRUCTED.
 - ☒ IF CURB IS DEPRESSED FOR A DRIVEPAD, THE DRIVEPAD SHALL BE CONSTRUCTED PRIOR TO ACCEPTANCE OF CURB AND GUTTER.
 - ☒ ALL STORM DRAINAGE FACILITIES SHALL BE COMPLETED PRIOR TO FINAL ACCEPTANCE.
 - ☒ THE REQUESTER OR DEVELOPER SHALL BE RESPONSIBLE FOR REPAIR OR REPLACEMENT OF ALL CURB AND GUTTER OR SIDEWALK DAMAGED AFTER APPROVAL BY THE CITY ENGINEER OF WORK COMPLETED BY THE CONTRACTOR.

APPROVAL OF AS-BUILT DRAWINGS
CHIEF CONSTRUCTION ENGINEER
John Chang
DATE 1-27-00
COA INSPECTOR: HERMAN RAY BACA

SCANNED BY
MESA REPRO

I, PHILIP W. TURNER, N.M.P.S. 10204, DO HEREBY CERTIFY THAT THE CONSTRUCTED IMPROVEMENTS AS SHOWN ON THE PLANS HEREIN ARE BUILT IN SUBSTANTIAL COMPLIANCE WITH THE CONSTRUCTION PLANS APPROVED BY THE CITY OF ALBUQUERQUE.

THE AS-BUILT SURVEY WAS COMPLETED ON October 28, 1999.

Philip W. Turner
PHILIP W. TURNER
DATE 12-16-99

"RECORD DRAWINGS"

I CERTIFY THAT THE INFORMATION CONTAINED ON THESE DRAWINGS HAS BEEN REVISED IN ACCORDANCE WITH THE INFORMATION FURNISHED BY THE CONTRACTOR CCM CONSTRUCTION INC. COMMUNITY SCIENCES INC. PROVIDED THE CONSTRUCTION STAKING FOR THE PROJECT AND THIS SURVEY INFORMATION REFLECTS THE CONSTRUCTION AS ACTUALLY ACCOMPLISHED WHILE A CONSTRUCTION OBSERVER FROM SMITH ENGINEERING WAS PRESENT. THESE PLAN DRAWINGS, AS CONSTRUCTED, ARE IN SUBSTANTIAL COMPLIANCE WITH THE APPROVED PLAN DRAWINGS.

Patrick J. Conley
PATRICK J. CONLEY, PE 10141
DATE 01/07/00



AS-BUILT

DRB# 98-136




Bohannon & Huston

Courtyard One 7500 JEFFERSON NE Albuquerque NEW MEXICO 87109

ENGINEERS PLANNERS PHOTOGRAMMETRISTS SURVEYORS SOFTWARE DEVELOPERS

																																																																																																																																																																																																																																																																																																																																																																																																																																																																																																																																																																																																																																																																																																																																																																																																																																																																																																																																																																																																																																																																																																																																																																																																																																																																																																																																																																																																																					</
--	--	----

SCANNED BY
MESA REPRO

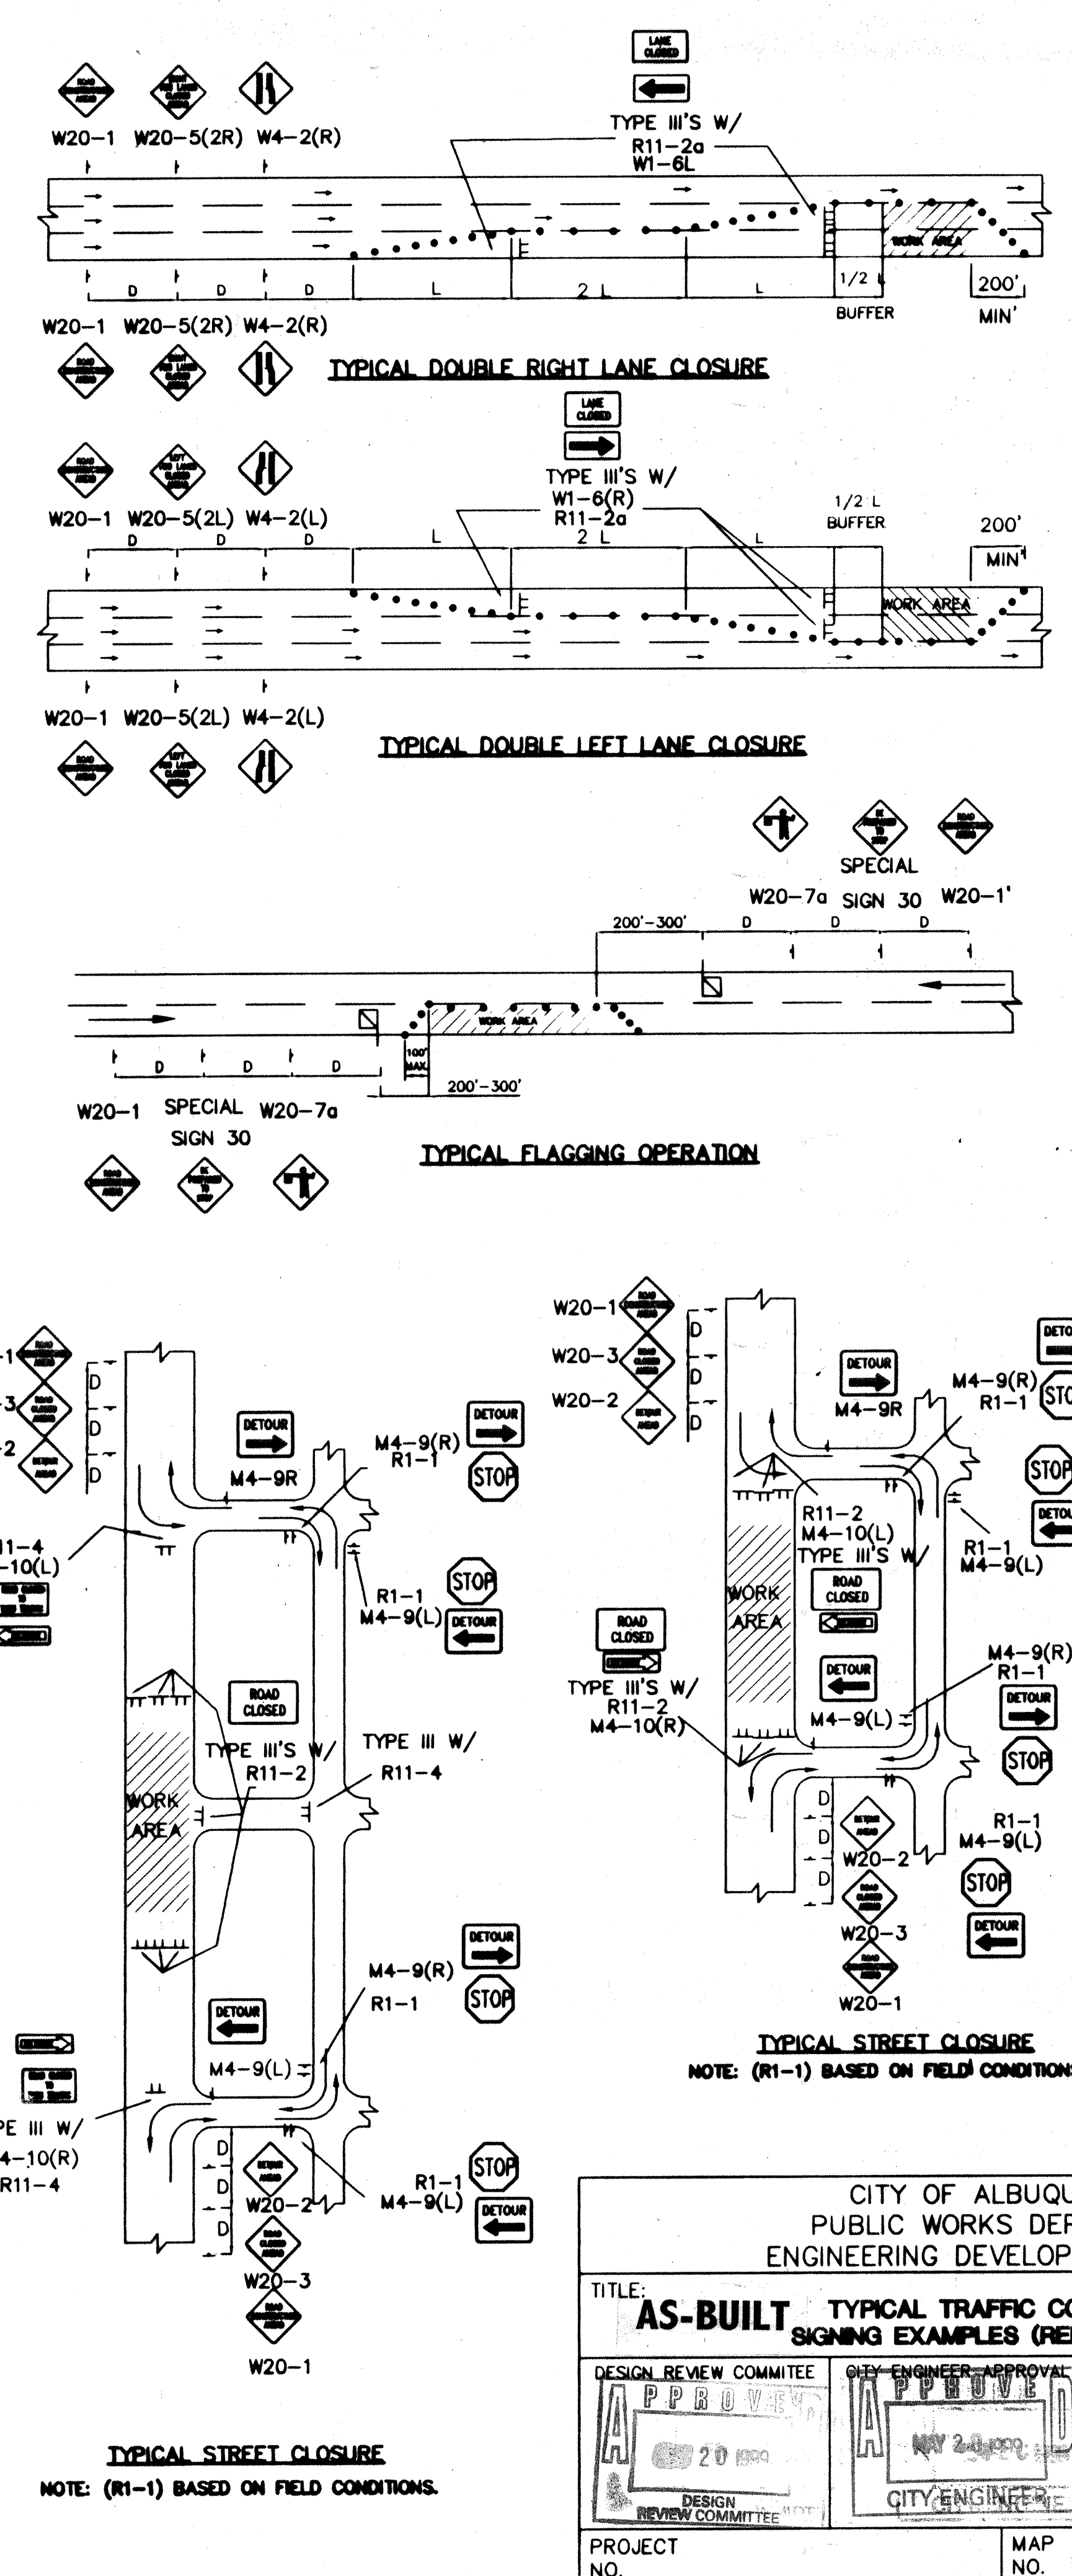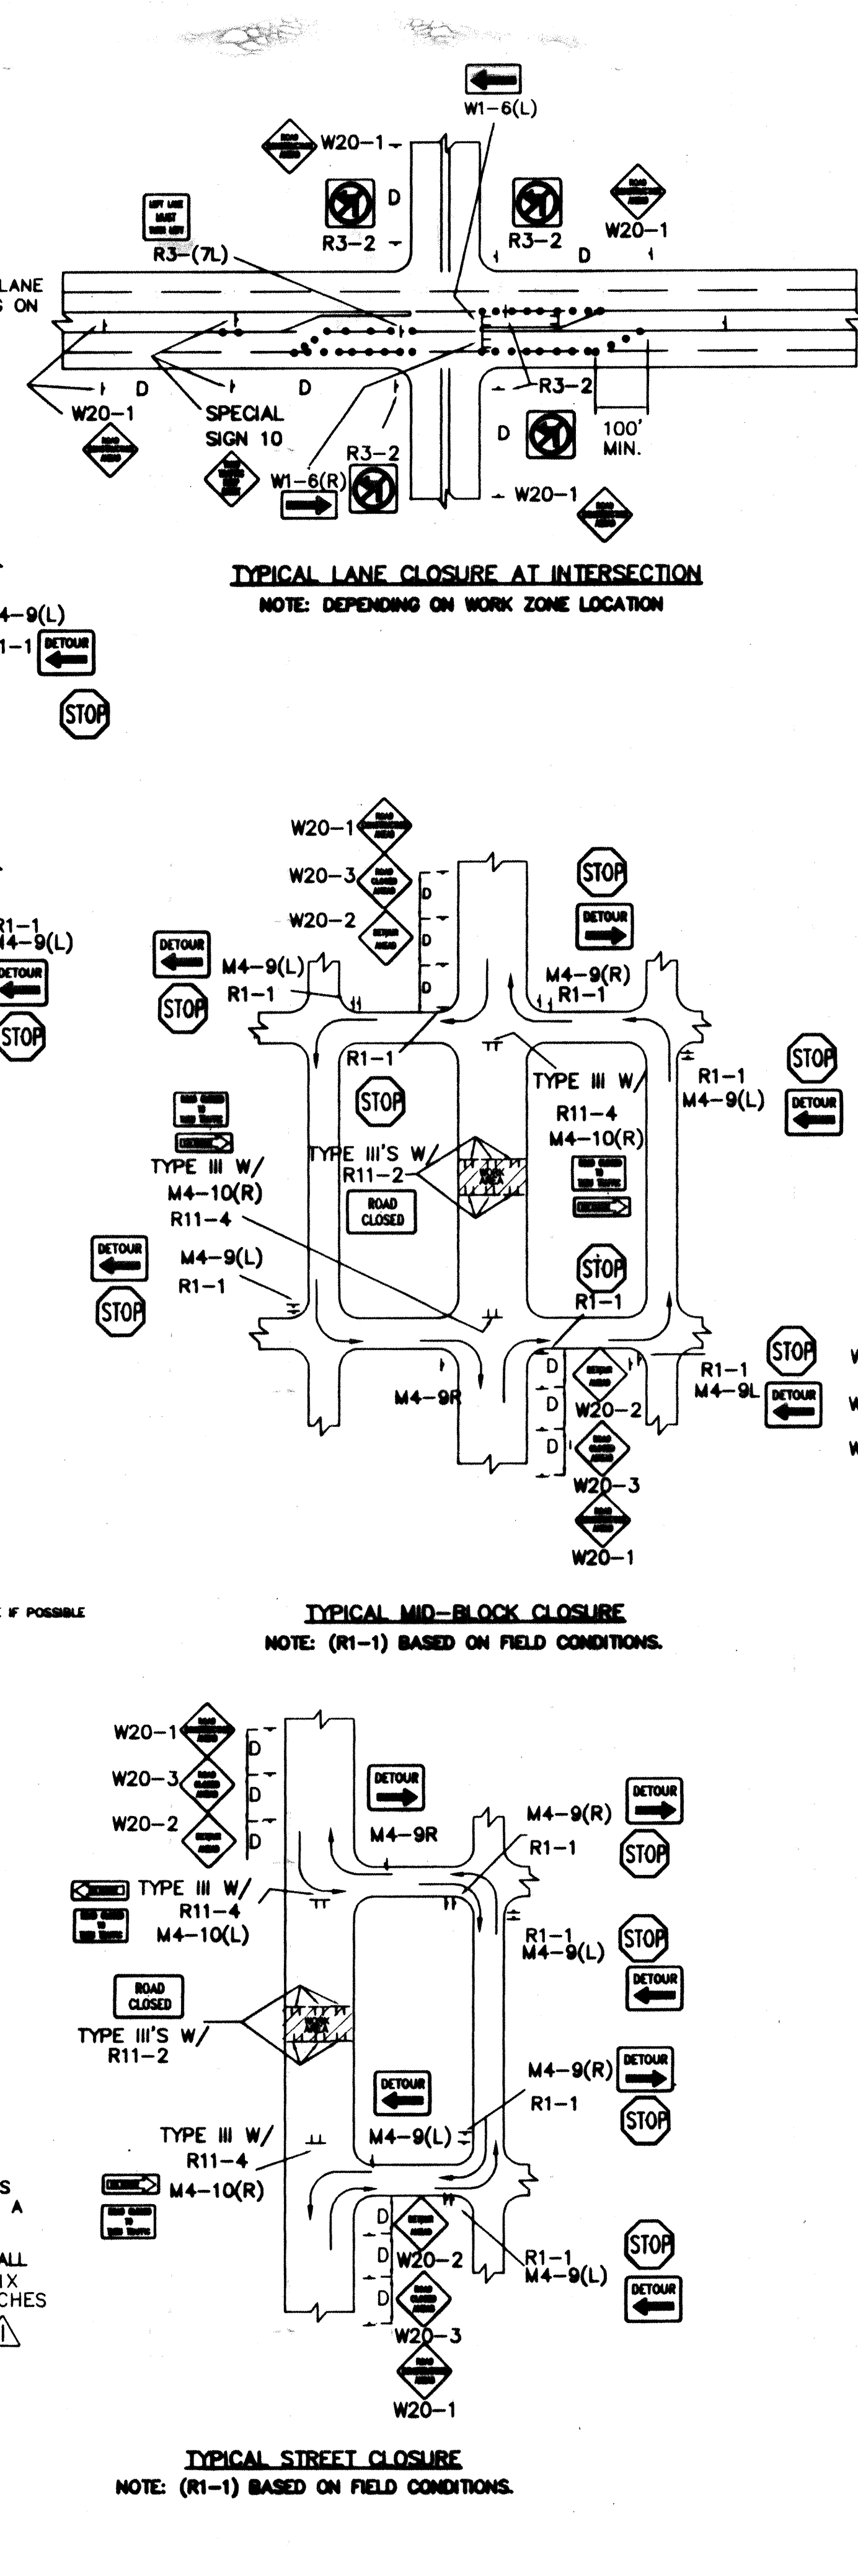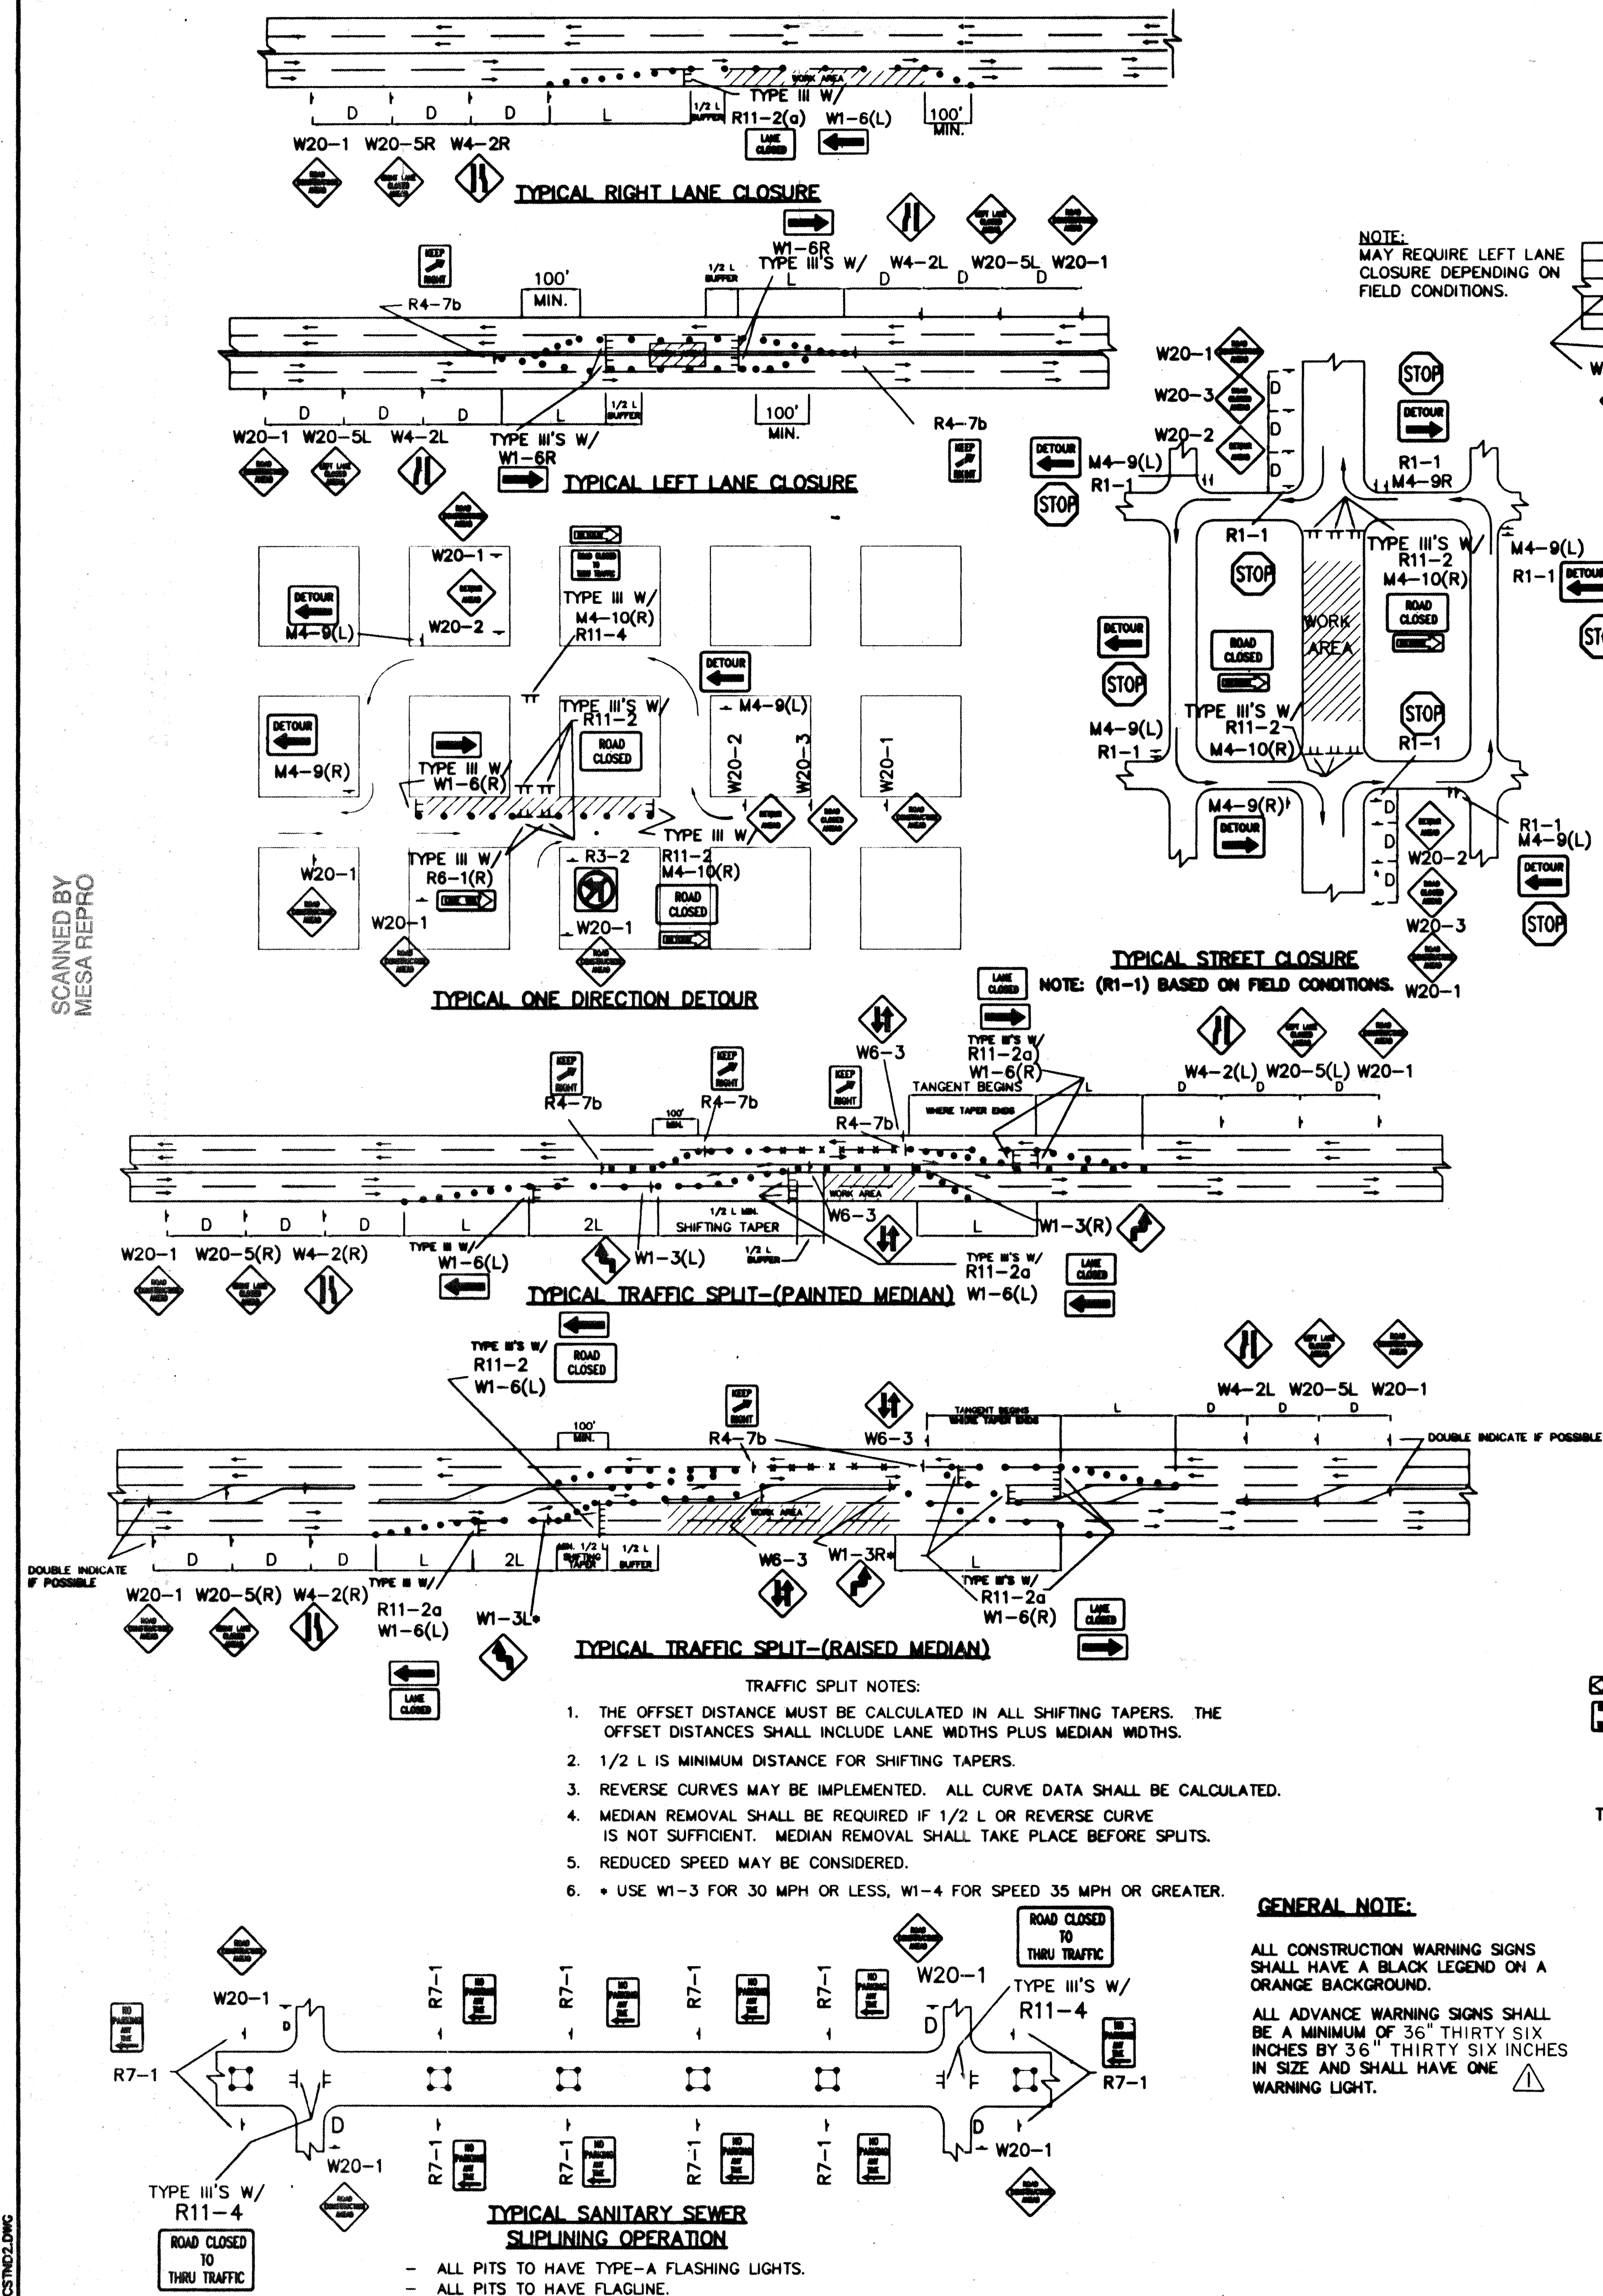

AS-BUILT INFORMATION		BENCH MARKS		SURVEY INFORMATION		ENGINEER'S SEAL	
CONTRACTOR	DATE	NO.	DATE	NO.	DATE	NO.	DATE
CSM	05/01						
DESIGNED BY	DATE	DESIGNED BY	DATE	DESIGNED BY	DATE	DESIGNED BY	DATE
REVIEWED BY	DATE	REVIEWED BY	DATE	REVIEWED BY	DATE	REVIEWED BY	DATE
APPROVED BY	DATE	APPROVED BY	DATE	APPROVED BY	DATE	APPROVED BY	DATE
RECORDED BY	DATE	RECORDED BY	DATE	RECORDED BY	DATE	RECORDED BY	DATE
MICRO-FILM INFORMATION		NO.		NO.		NO.	

REVISIONS		REMARKS	
NO.	DATE	NO.	DATE
1	9/24/97	1	9/24/97

DESIGNED BY: C.O.A. STANDARDS
DRAWN BY: J.D.L.
CHECKED BY: J.D.L.


CITY OF ALBUQUERQUE
PUBLIC WORKS DEPARTMENT
ENGINEERING DEVELOPMENT GROUP

TITLE: **AS-BUILT TYPICAL TRAFFIC CONTROL & SIGNING EXAMPLES (REF. M.U.T.C.D.)**

DESIGN REVIEW COMMITTEE: APPROVED
CITY ENGINEER: APPROVED

PROJECT NO. MAP NO. M-8 SHEET 22 OF 24


SCANNED BY
MESA REPRO

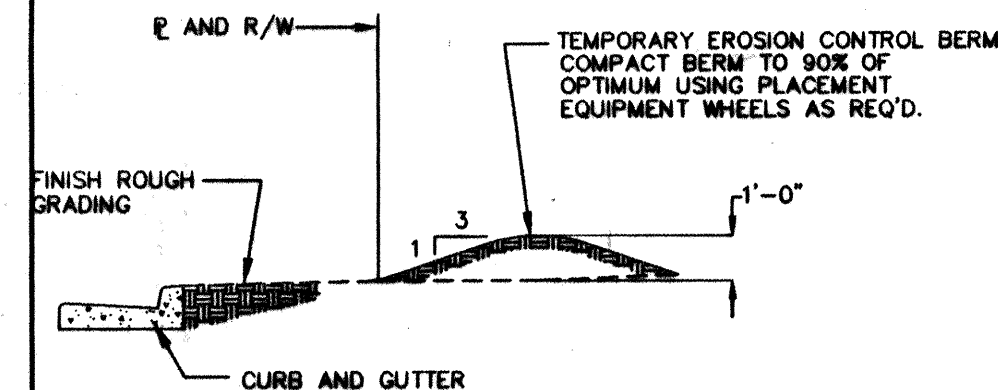


EROSION CONTROL BERM
TYPICAL SECTION THROUGH BERM
NOT TO SCALE

EROSION CONTROL NOTES:

1. CONTRACTOR SHALL OBTAIN A TOP SOIL DISTURBANCE PERMIT FROM THE ENVIRONMENTAL HEALTH DIVISION PRIOR TO GRADING.
2. PROTECTION OF ADJACENT RIGHT-OF-WAY AND PRIVATE PROPERTY FROM SEDIMENT WILL BE RESPONSIBLE FOR THE EROSION CONTROL BERM SHOWN HERE ON.
3. DISTURBED AREAS WILL BE RESEEDD PER C.O.A. DPM SECTION 102, AS INDICATED.
4. THE CONTRACTOR SHALL CONFORM TO ALL CITY, COUNTY, STATE AND FEDERAL DUST CONTROL MEASURES AND REQUIREMENTS AND WILL BE RESPONSIBLE FOR PREPARING AND OBTAINING ALL NECESSARY APPLICATIONS AND APPROVALS.

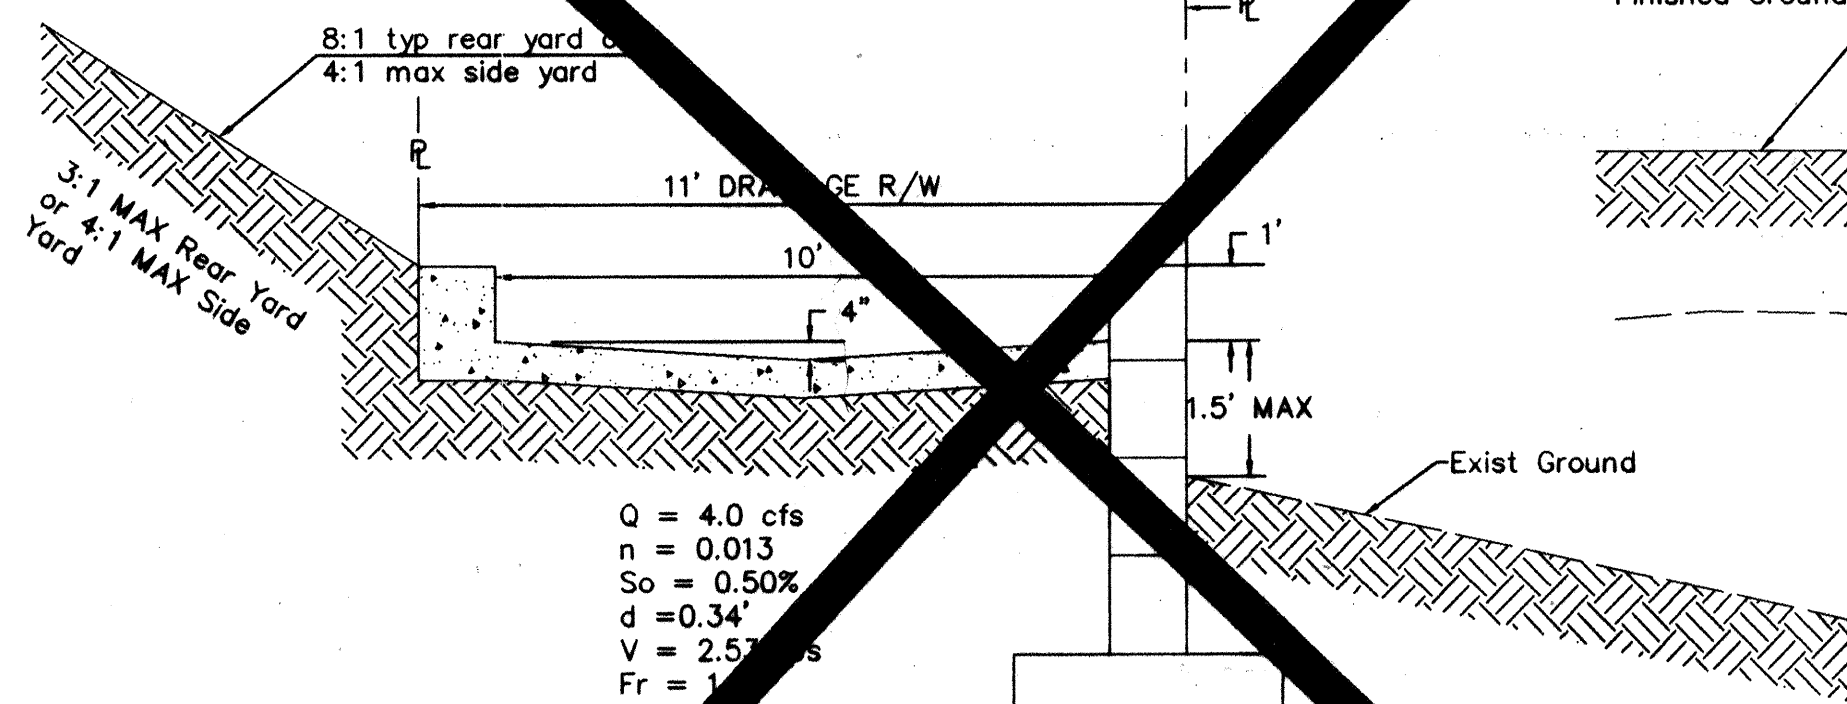


TYPICAL SECTION E - E
DRAINAGE R/W
N.T.S.

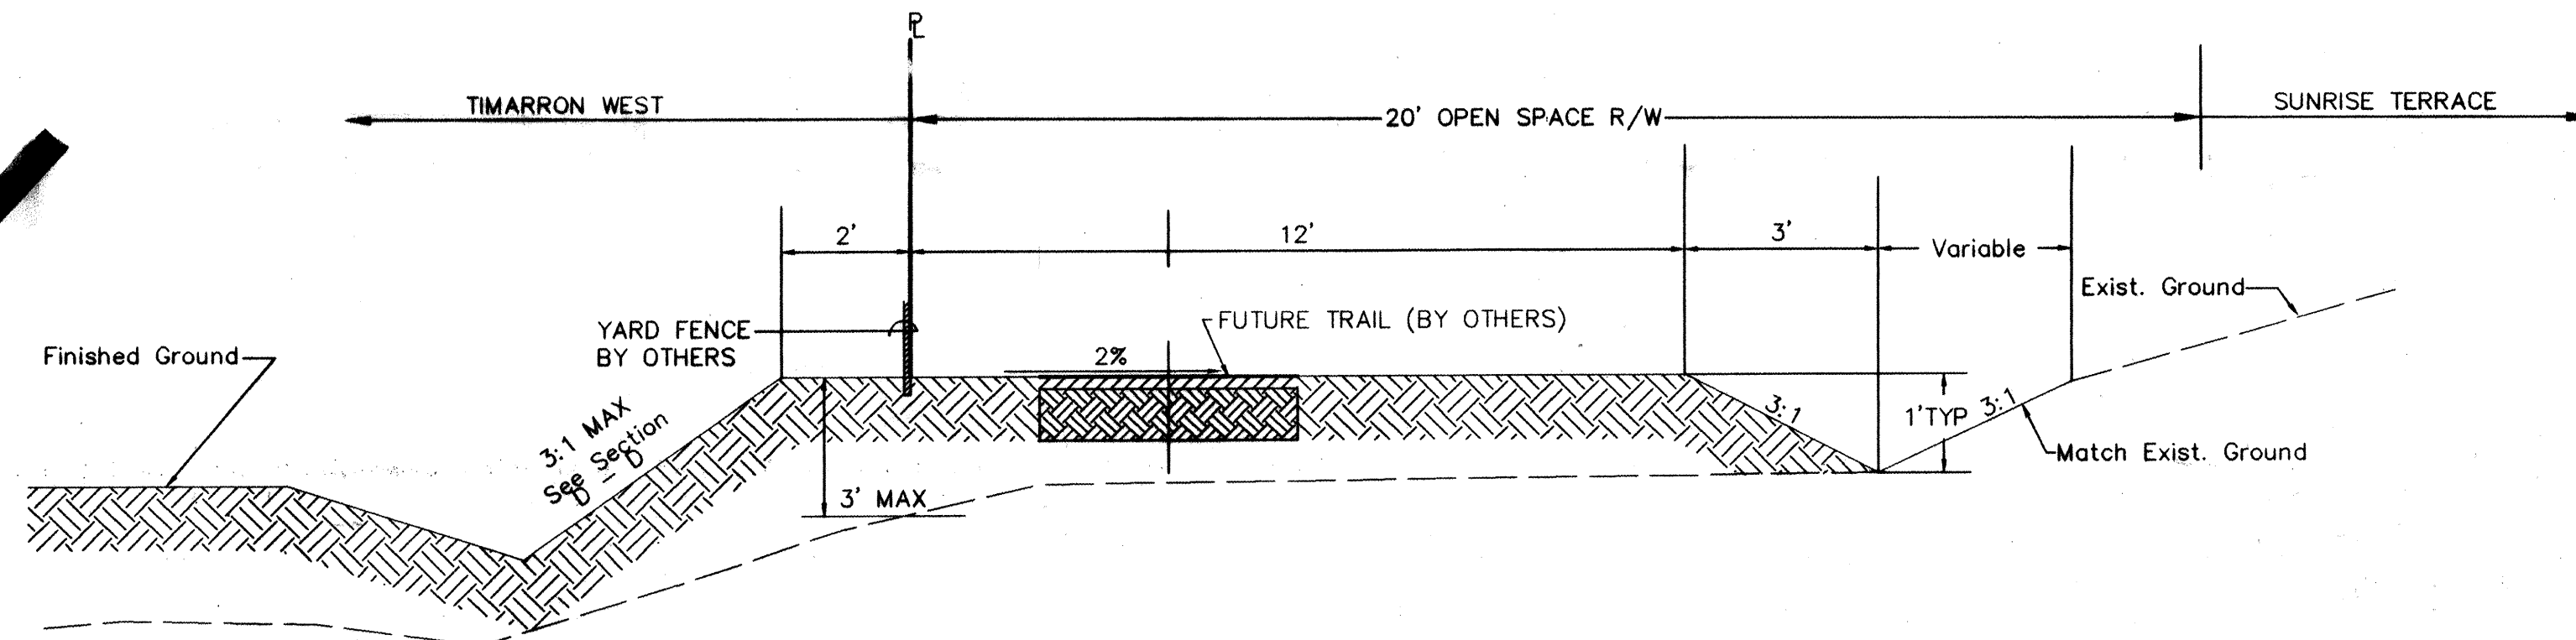

TYPICAL SECTION F - F
NORTH PROPERTY LINE
DRAINAGE DIVERSION SWALE

N.T.S.

NOTE: DRAINAGE FROM THE 20' OPEN SPACE R/W SHALL BE CONFINED TO THE SWALE AND PERMITTED TO ENTER TIMARRON WEST UNIT 1 AT THE WESTERN HOA TRACT AND AT 102nd STREET.

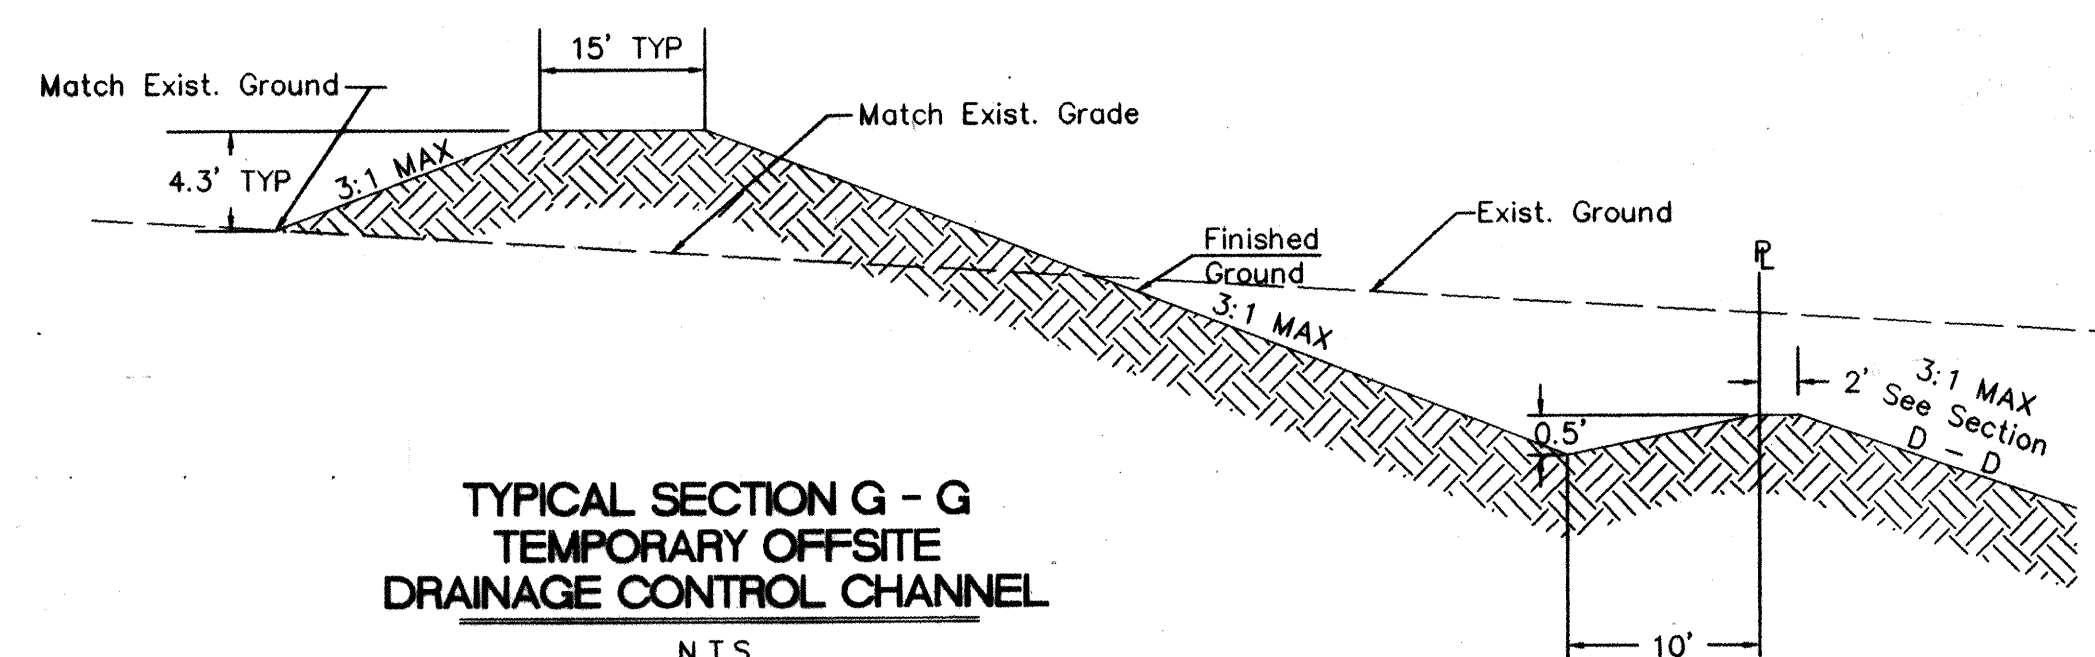

TYPICAL SECTION G - G
TEMPORARY OFFSITE
DRAINAGE CONTROL CHANNEL

N.T.S.


Q = 50 cfs
n = 0.030
So = 0.50%
d = 1.23'
V = 2.53 fps
FREEBOARD = $1 + 0.025 V_d^{1/3}$
FREEBOARD = 1.07'
REQUIRED DEPTH = 2.3'

NOTE: THIS SECTION CAN BE USED AT THE WEST BOUNDARY OF ALL PHASES OF CONSTRUCTION.

EARTHWORK QUANTITIES

	<u>CUT</u>	<u>FILL</u>
Onsite (Unadjusted)*	87,900 cy	62,700 cy
Offsite (Unadjusted)	8,900 cy	3,500 cy
Foundation Subexcavation	27,500 cy	27,500 cy
Shrinkage from *** Mass earth moving	N/A	25,100 cy
Shrinkage from **** subexcavation	N/A	5,500 cy
Total	124,300 cy	124,300 cy

- * UNADJUSTED CUT/FILL QUANTITIES ARE NET OF ESTIMATED YARD UNDERCUTTING FOR SPOILS PLACEMENT
- ** OFFSITE FILL QUANTITIES IS FOR DRAINAGE DIVERSION EMANKMENT WHICH ALSO SERVES AS A STOCKPILE FOR FUTURE DEVELOPMENT.
- *** BASED ON 35% SHRINKAGE FACTOR
- **** BASED ON 20% SHRINKAGE FACTOR

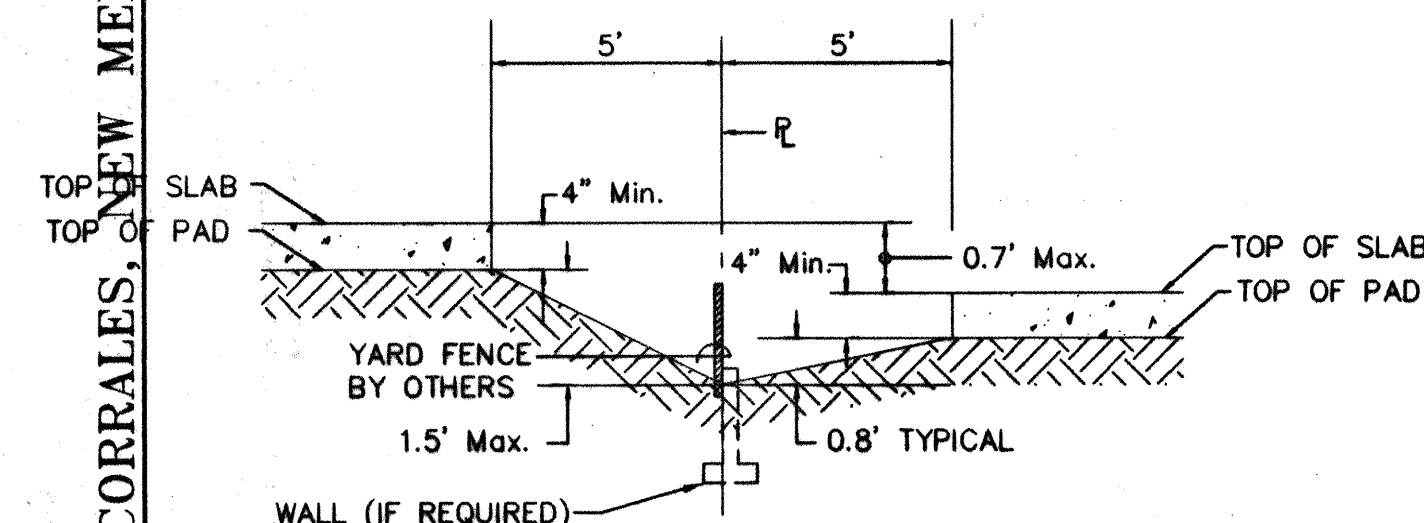


**TYPICAL SECTION A - A
(AT FRONT OF PAD)**

N.T.S.


NOTE: 1) FENCES ARE ALLOWED ON THE PROPERTY LINE.

2) IF THE GRADE DIFFERENTIAL BETWEEN PADS IS BETWEEN 0.7' AND 2.2', A NON-STRUCTURAL GARDEN WALL MAY BE CONSTRUCTED TO RETAIN THE AMOUNT IN EXCESS OF 0.7'. A STRUCTURAL RETAINING WALL SHALL BE CONSTRUCTED ON ALL LOT LINES IN WHICH THE GRADE DIFFERENTIAL BETWEEN PADS EXCEEDS 2.2'.

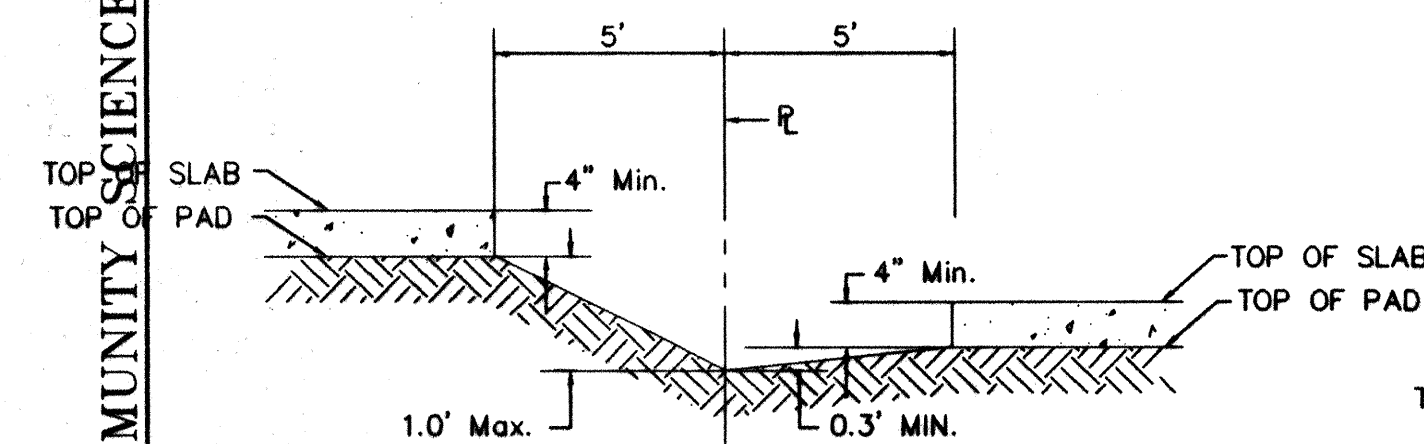

TYPICAL SECTION B - B
(AT REAR OF PAD)

N.T.S

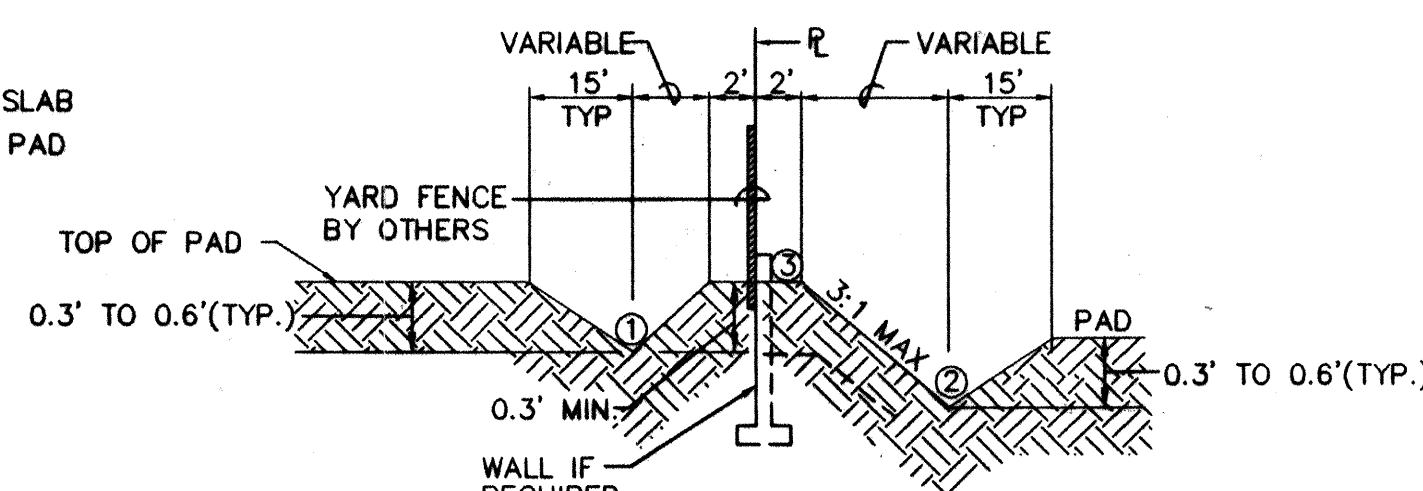


NOTE: 1) Drainage from Point # 1 must be directed to the street, and prevented from continuing across the property line to Point # 2.

2) If the grade differential between Point #2 and Point #3 exceeds the maximum grade differential which can be taken up by a 3:1 slope and leave a 2' shelf at the property line as shown, a non-structural garden wall may be constructed to retain a maximum of 1.5'. A structural retaining wall shall be constructed at all locations where retainage exceeds 1.5'.


**TYPICAL SECTION D - D
(AT REAR PROPERTY LINE)**

N.T.S

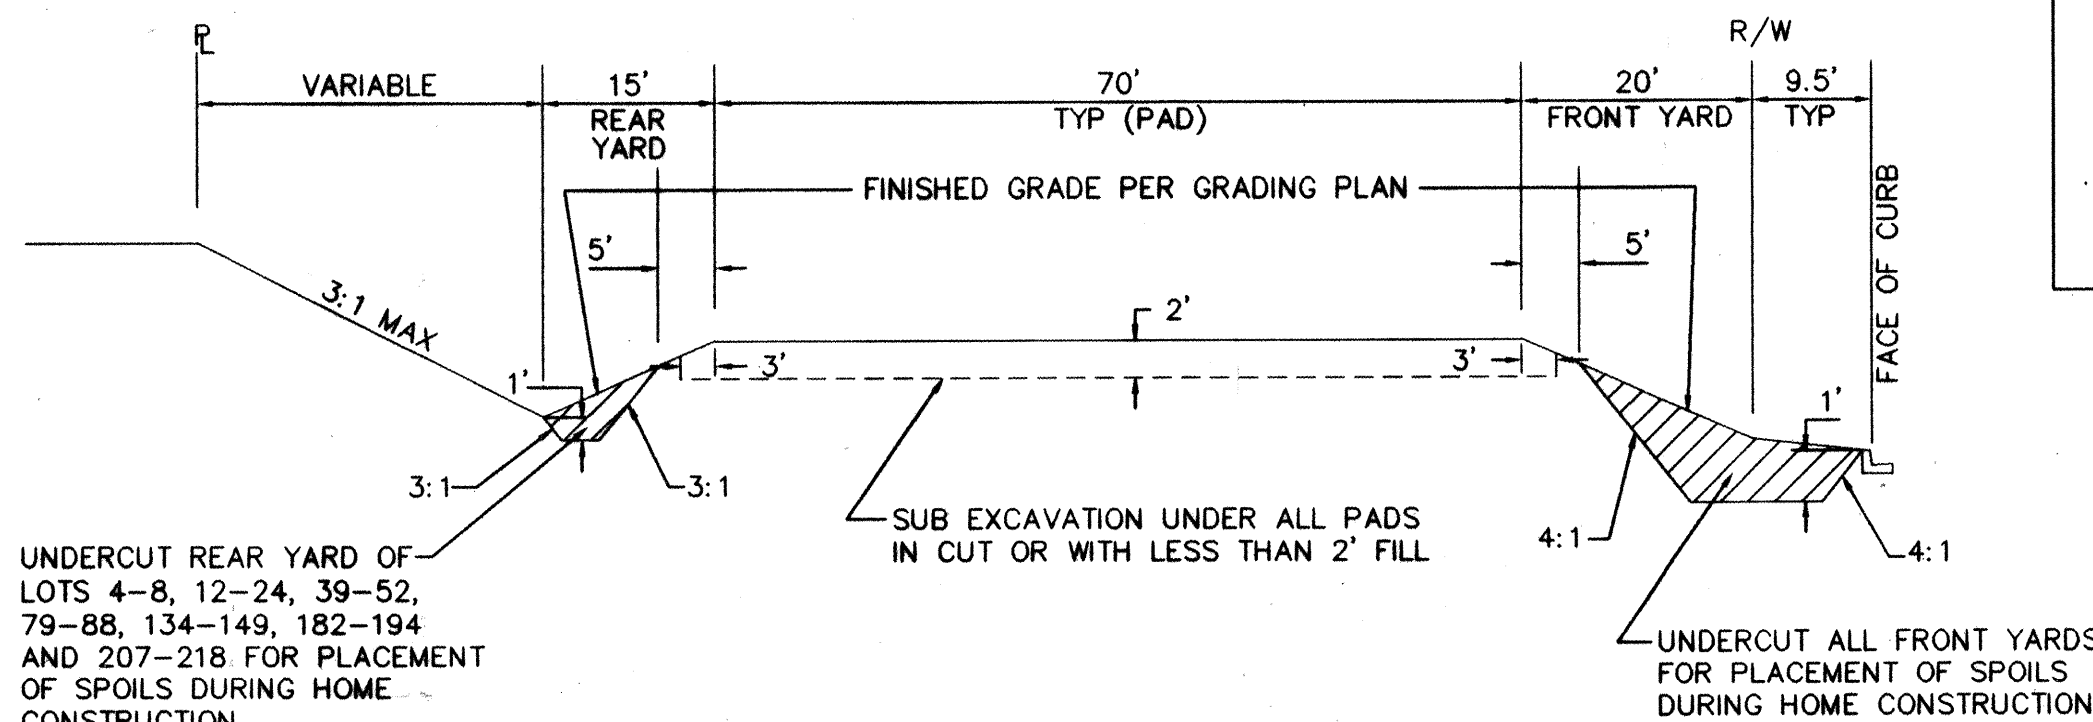

SUBEXCAVATION AND YARD UNDERCUTTING DETAIL

N.T.S.

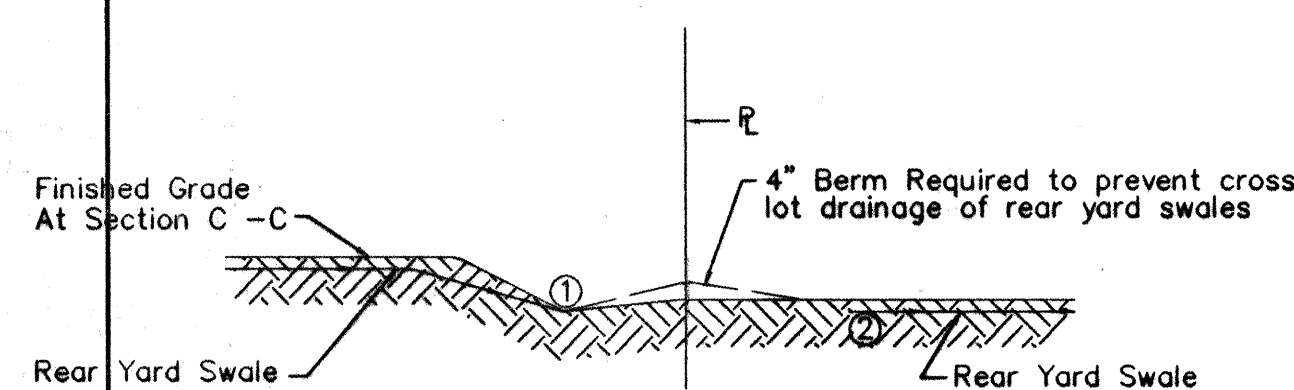

**TYPICAL SECTION C - C
(AT REAR YARD SWALE)**

N.T.S.

SURVEY INFORMATION						ENGINEER'S SEAL		BENCH MARKS		AS BUILT INFORMATION	
NO.		BY		DATE				BENCHMARK:		CONTRACTOR	
1		COMMUNITY SCIENCES		1/98				STATION IS ACS MONUMENT "6-M"		C&M	
								THE ESE QUADRANT OF DE VARGAS RD. AND DEL MASTRO DR., SW.		INSPECTOR'S DATE 10/99	
								EPOXIED TO TOP OF CONCRETE CURB. DESCRIPTION: ACS 1 3/4"		FIELD MAKE BY C&M DATE 11	
								ALUMINUM DISK, STAMPED "ACS BM, 6-M"		VERIFICATION BY C&M DATE 11	
								ELEVATION = 5174.047		CORRECTED BY C&M DATE 11	
DESIGN						REVISIONS		MICRO-FILM INFORMATION		RECORDED BY	
										DATE	
										DATE	
DESIGNED BY KMW/SOM						DATE 4/98				NO.	
DRAWN BY DLW						DATE 4/98				No. Transcribed per Base	
CHECKED BY						DATE					

AS-BUILT

LEGAL DESCRIPTION
TRACT 1, LANDS OF GREVEY/LIBERMAN

DATE: 1/98
SCALE:
HORIZ: 1"=50'

*community
sciences
corporation*

JOB NO.: 300-06-036 LAND PLANNING ENGINEERING SURVEYING
P.O.Box 1328 Corrales, N.M. 87048 (505)897-0000

CITY OF ALBUQUERQUE
PUBLIC WORKS DEPARTMENT
ENGINEERING DEVELOPMENT GROUP

TITLE: TIMARRON WEST UNITS 1 & 2
GRADING & EROSION CONTROL PLAN DETAILS

D.R.B. NO.
96-136

APPROVED FOR ROUGH GRADING (± 1 FT.)

CITY HYDROLOGY
PROJECT NO.MAP
NO. 1-8/M-8

SHEET 5 OF 24

11/98	REVISED: 9/2/98	DIW
-------	-----------------	-----





CITY OF ALBUQUERQUE

PUBLIC WORKS DEPARTMENT

ENGINEERING DEVELOPMENT GROUP


TIMARRON WEST UNIT 2

OVERALL PAVING


Design Review Committee	City Engineer Approval	Last Design Update	Mo./Day/Yr.	Mo./Day/Yr.
APPROVED  DESIGN REVIEW COMMITTEE	APPROVED  CITY ENGINEER	APPROVED  CITY ENGINEER	APPROVED  CITY ENGINEER	APPROVED  CITY ENGINEER
City Project No.	612781	Zone Map No.	M-8	Sheet
				6
				24

ENGINEER'S SEAL		SURVEY INFORMATION		BENCH MARKS		AS-BUILT INFORMATION	
		FIELD NOTES					
		NO.	BY	DATE			
					STATION IS ACS MONUMENT "6-48" LOCATED AT THE QUADRANT OF DE VARGAS ROAD AND DEL MAGRO DRIVE. S.W. EXPOSED TO TOP OF CONCRETE CURB DESCRIPTION: ACS 1 3/4" ALUMINUM DISK, STAMPED "ACS B.M. 6-48" ELEVATION=5174.017		CONTRACTOR <u>CSM</u> DATE <u>6/19/99</u>
							WORK SHOWN BY <u>CSM</u> DATE <u>6/19/99</u>
							ACCEPTANCE BY <u>CSM</u> DATE <u>6/19/99</u>
							FIELD PREPARATION BY <u>CSM</u> DATE <u>6/19/99</u>
							REVISIONS BY <u>CSM</u> DATE <u>6/19/99</u>
							CORRECTED BY <u>CSM</u> DATE <u>6/19/99</u>
							MICRO-FILM INFORMATION
							RECORDED BY <u>CSM</u> DATE <u>6/19/99</u>
							NO.
							<u>C. J. Martinez</u>


CENTERLINE CURVE DATA TABLE					CENTERLINE TANGENT DATA		
No.	PI STA.	DELTA	TANGENT	ARC	RADIUS	No.	BEARING
C1	16+61.36	67°41'19"	80.47'	141.77'	120.00'	T1	N 89°52'38" W
C2	10+87.85	36°31'01"	39.59'	76.49'	120.00'	T2	N 14°25'12" W

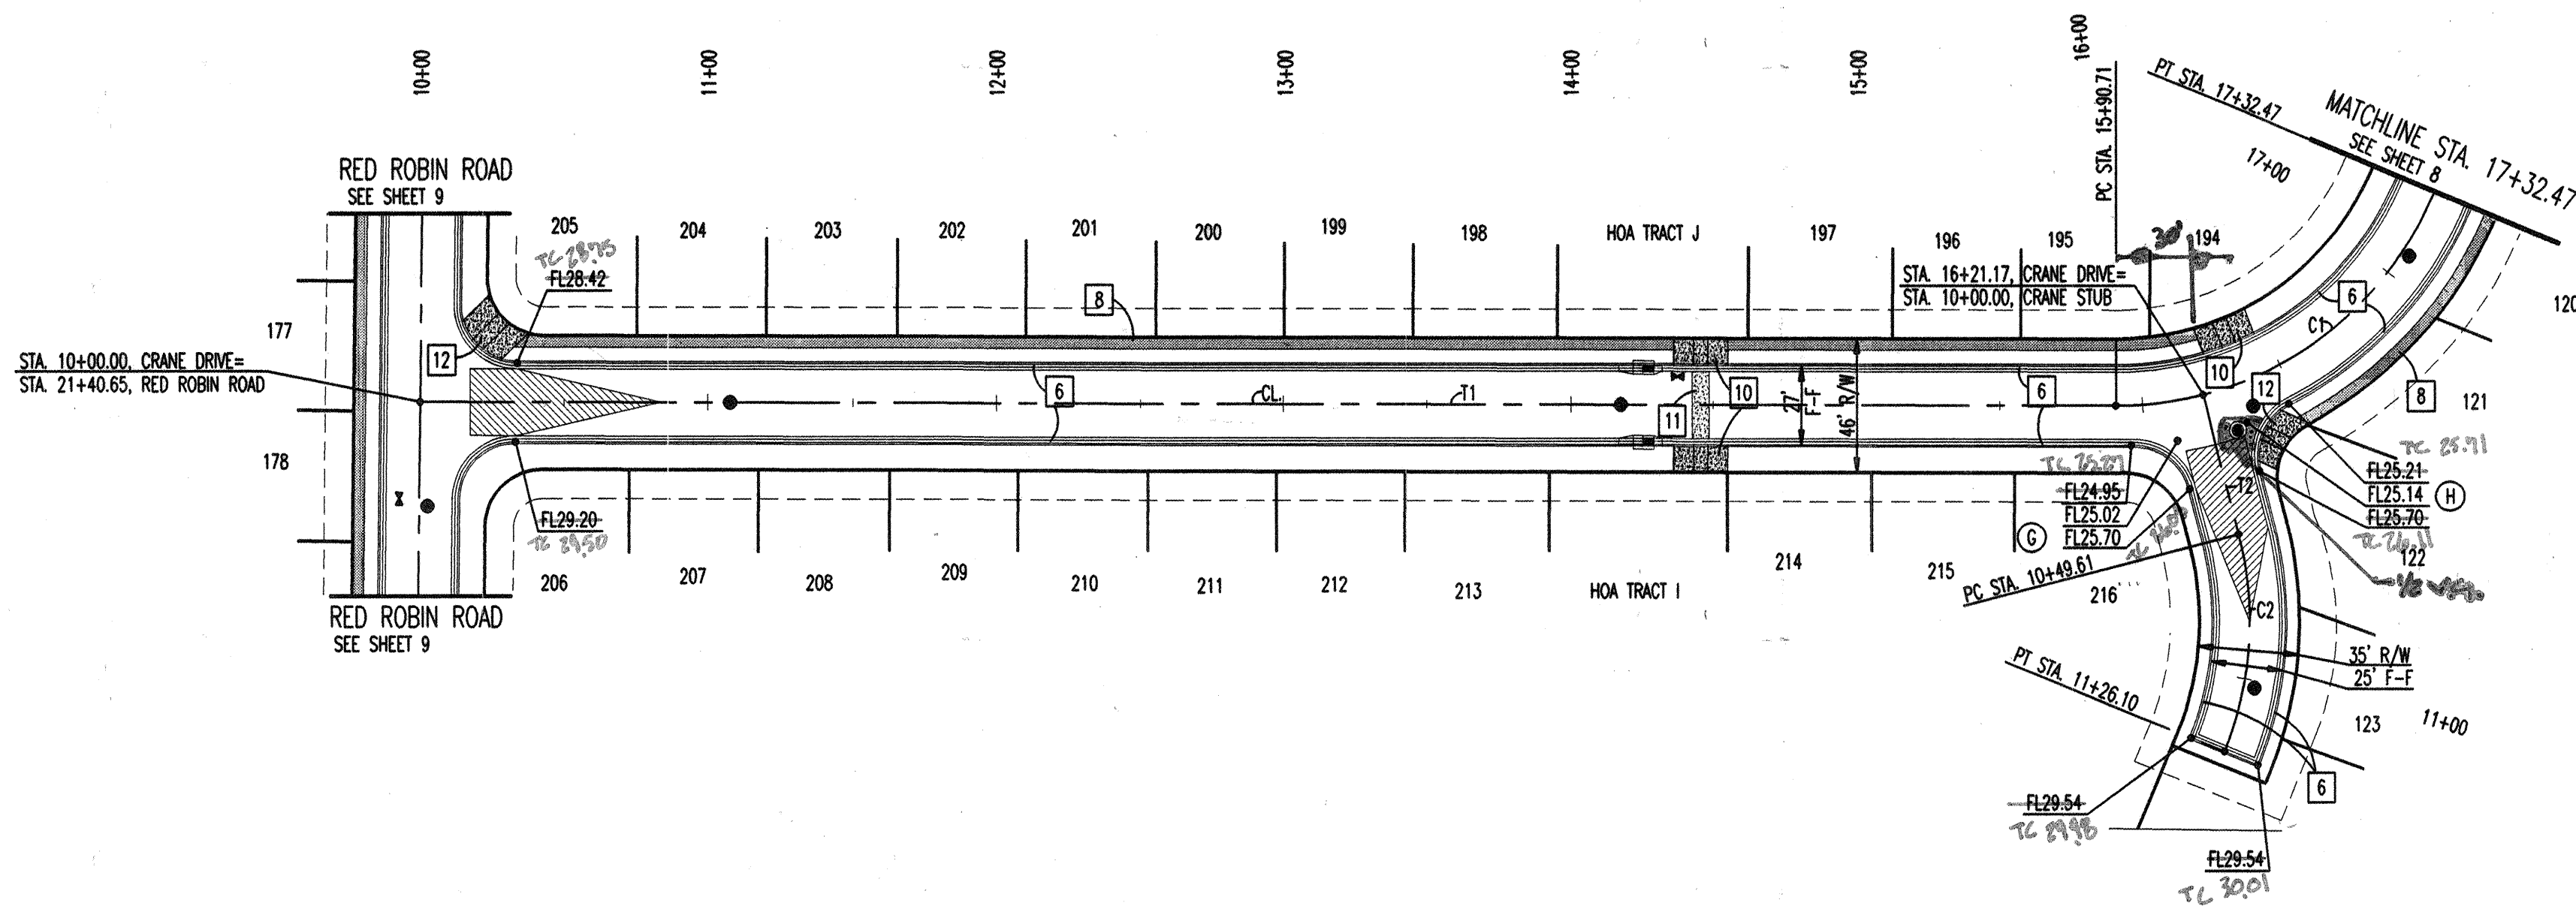

PC		PT	
1	24.95	1	25.70
2	25.14	2	25.58
3	25.33	3	25.46
4	25.51	4	25.33
5	25.70	5	25.21

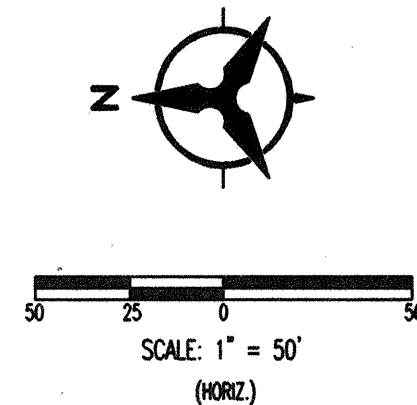

CRANE DRIVE / CRANE STUB

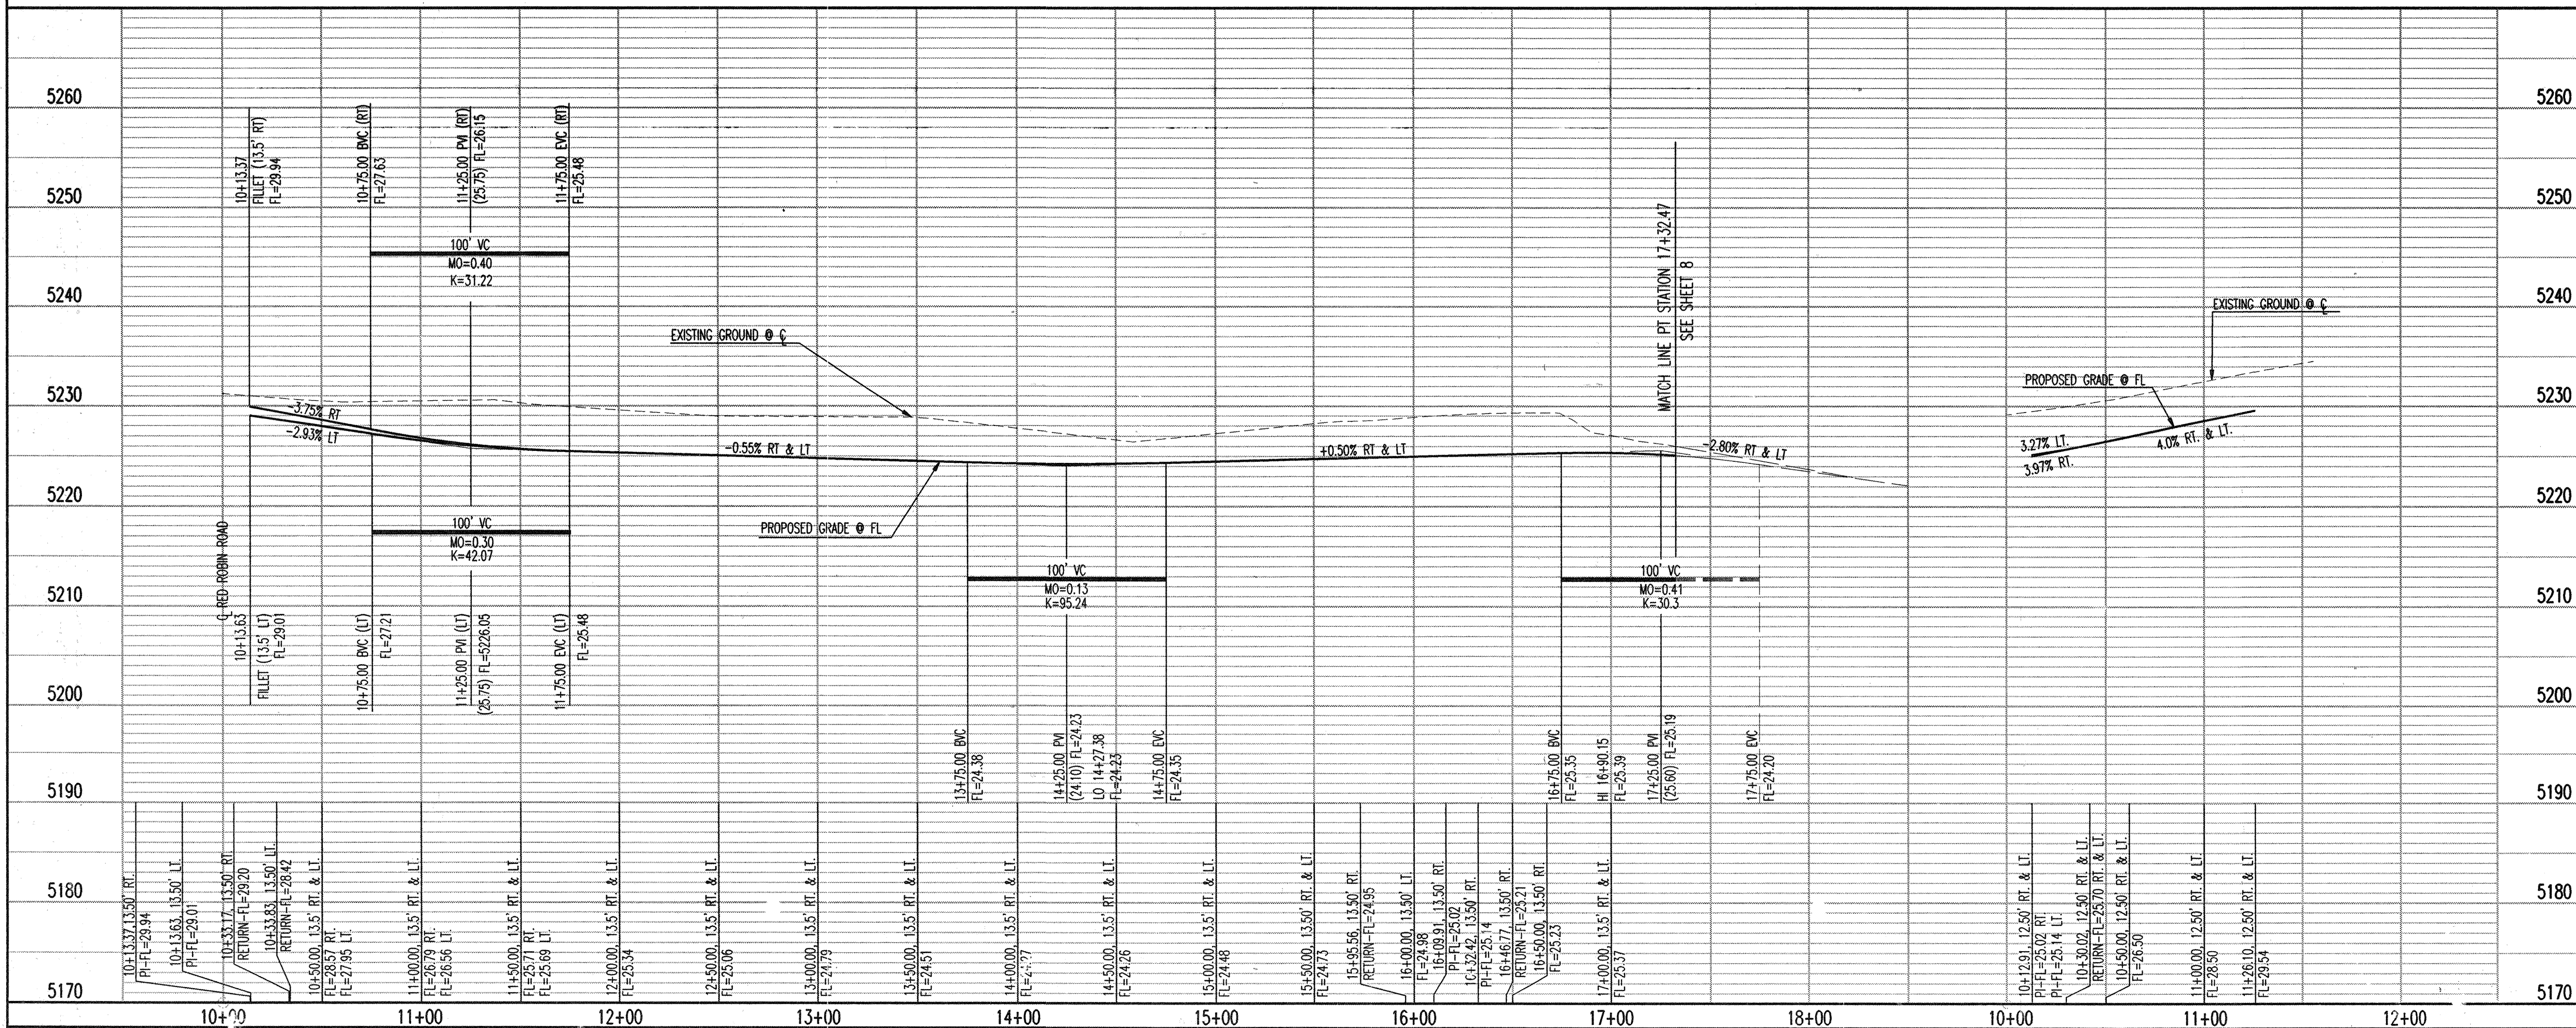

NOTES:

1. THE CONTRACTOR SHALL FIELD VERIFY ALL EXISTING PAVING AND UTILITY LOCATIONS AND NOTIFY THE ENGINEER IMMEDIATELY OF ANY DISCREPANCIES. NOTIFICATION WILL BE IN SUCH A MANNER AS TO ALLOW THE ENGINEER TIME TO MAKE REVISIONS PRIOR TO CONSTRUCTION. FAILURE TO DO SO MAY RESULT IN CONTRACTOR RESPONSIBILITY FOR RESOLUTION OF DISCREPANCIES.
2. ALL CURB RETURN RADII SHALL BE 25' UNLESS OTHERWISE SPECIFIED.
3. ALL CURVE DATA AND DIMENSIONS REFER TO FACE OF CURB UNLESS OTHERWISE SPECIFIED.
4. GRADE ELEVATIONS, WHERE NOTED, ARE FL OF CURB UNLESS OTHERWISE SPECIFIED.
5. CONTRACTOR IS TO INSTALL A 4" X 4" X 5' POST AND END AT THE END OF EACH SANITARY SEWER SERVICE.
6. CONTRACTOR IS RESPONSIBLE FOR REPAIR AND/OR REPLACEMENT OF ALL UTILITY CONDUITS AND EXISTING LINES.
7. ANY ADDITIONAL GRADING REQUIRED TO MATCH PROPOSED STREET GRADES SHALL BE INCIDENTAL TO PAVING ITEMS.
8. CONTRACTOR SHALL PROVIDE THE INSPECTORS, (CITY AND PRIVATE) WITH THE PROPOSED HYDROSTATIC TESTING PLAN. THE PLAN MUST BE APPROVED BEFORE TESTING OPERATIONS BEGIN.
9. CONTRACTOR SHALL PARK EQUIPMENT AND VEHICLES AS NOT TO INTERFERE WITH NORMAL ACTIVITIES OF RESIDENTS OR OTHER CONTRACTORS ON SITE.
10. ANY DAMAGE TO THE EXISTING FACILITIES (CURB & GUTTER), PAVEMENT, CONDUITS, LANDSCAPING, UTILITY LINES, ETC.) DURING CONSTRUCTION SHALL BE REPLACED AT THE CONTRACTORS' EXPENSE.
11. REMOVAL OF THE EXISTING CURB AND GUTTER SHALL BE AS PER COA STD. DWG. 2415 (SAW-CUT ONLY).
12. WHEELCHAIR RAMPS SHALL BE CONSTRUCTED PRIOR TO ACCEPTANCE OF CURB & GUTTER.
13. CONSTRUCTION TRAFFIC CONTROL COST INCIDENTAL TO PAVING ITEMS.
14. MANHOLE RIM & CATCH BASIN ELEVATIONS ARE APPROX. THE CONTRACTOR WILL VERIFY AND CONSTRUCT TO MATCH FINAL PAVEMENT GRADES.
15. FIRE HYDRANT FLANGE ELEVATIONS SHOWN ARE APPROX. THE CONTRACTOR WILL VERIFY AND CONSTRUCT TO FINAL CURB ELEVATIONS PER COA DETAIL 2340.

KEY NOTES

1. INSTALL CONCRETE VALLEY GUTTER AS PER STD. DWG. 2420
2. INSTALL CONCRETE VALLEY GUTTER AS PER STD. DWG. 2421
3. INSTALL WHEELCHAIR RAMP AS PER DETAIL SHEET 21, CASE I
4. INSTALL WHEELCHAIR RAMP AS PER DETAIL SHEET 21, CASE II WITH ALTERNATE SECTION AA
5. EXISTING STD. CURB & GUTTER AS PER STD. DWG. 2415
6. BUILD ROLL CURB & GUTTER AS PER STD. DWG. 2415
7. BUILD 4' SIDEWALK
8. DEFERRED 4' SIDEWALK
9. BUILD STD. CURB & GUTTER AS PER STD. DWG. 2415
10. INSTALL WHEELCHAIR RAMP. SEE CASE III DETAIL ON SHEET 21.
11. 6"x6"x6" WIDE RED BRICK PATTERNED CONCRETE CROSSWALK. MUST MEET ADA STANDARDS: GROOVES NOT TO EXCEED 1/4" DEEP AND 1/8" WIDE.
12. INSTALL WHEELCHAIR RAMP. SEE CASE V DETAIL ON SHEET 21.

Bohannon & Huston

County One 7500 JEFFERSON NE ALBUQUERQUE NEW MEXICO 87109
ENGINEERS PLANNERS PHOTOGRAMMETRISTS SURVEYORS SOFTWARE DEVELOPERS

CITY OF ALBUQUERQUE
PUBLIC WORKS DEPARTMENT
ENGINEERING DEVELOPMENT GROUP

AS-BUILT


Design Review Committee		City Engineer Approval		Mo./Day/Yr.	
APPROVED	APPROVED	APPROVED	APPROVED		
DESIGN REVIEW COMMITTEE	CITY ENGINEER				

City Project No. 612781	Zone Map No. M-8	Sheet 7	Of 24
-------------------------	------------------	---------	-------

SCANNED BY
MESA REPRO


①	FL	18.90
1	19.24	
2	19.59	
3	19.93	
PT	20.27	
D=89°55'26"		
L=34.53'		
R=20.00'		

①	PC	17.90
1	18.05	
2	18.20	
3	18.35	
PT	18.50	
D=89°58'53"		
L=31.42'		
R=20.00'		

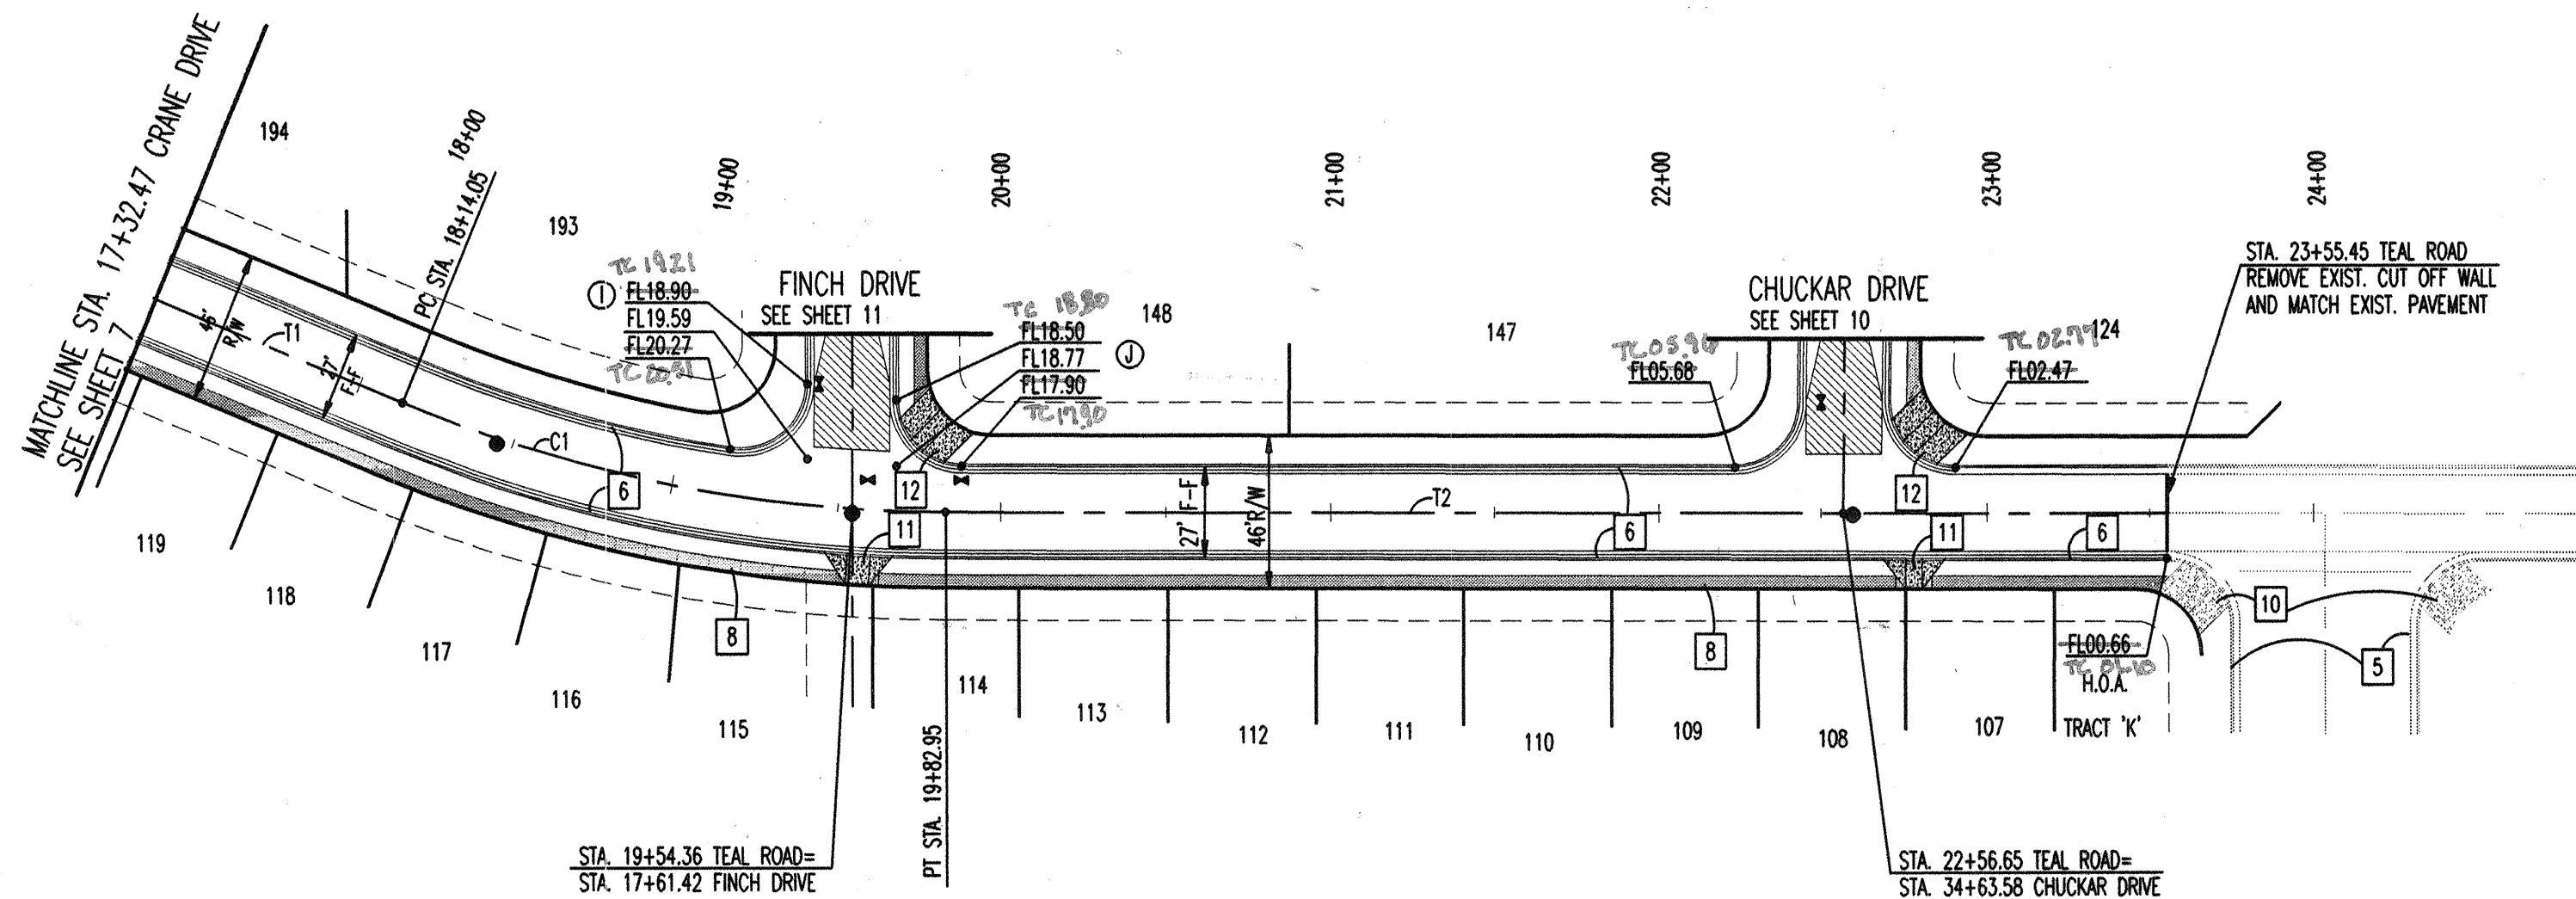


CENTERLINE CURVE DATA TABLE					CENTERLINE TANGENT DATA	
No.	PI STA.	DELTA	TANGENT	ARC RADIUS	No.	BEARING
C1	18+98.50	22°18'54"	85.53'	168.90'	T1	S 22°26'03" W
				433.78'	T2	S 00°07'24" W

DISTANCE	
81.58'	
372.48'	

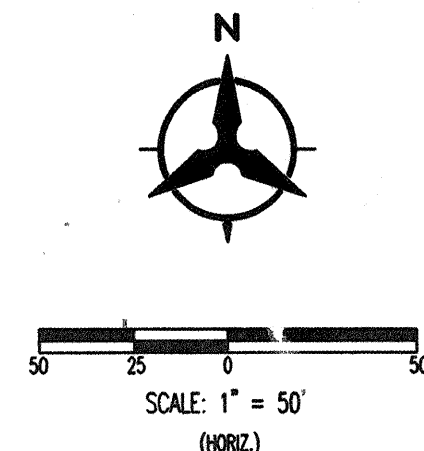

TEAL ROAD

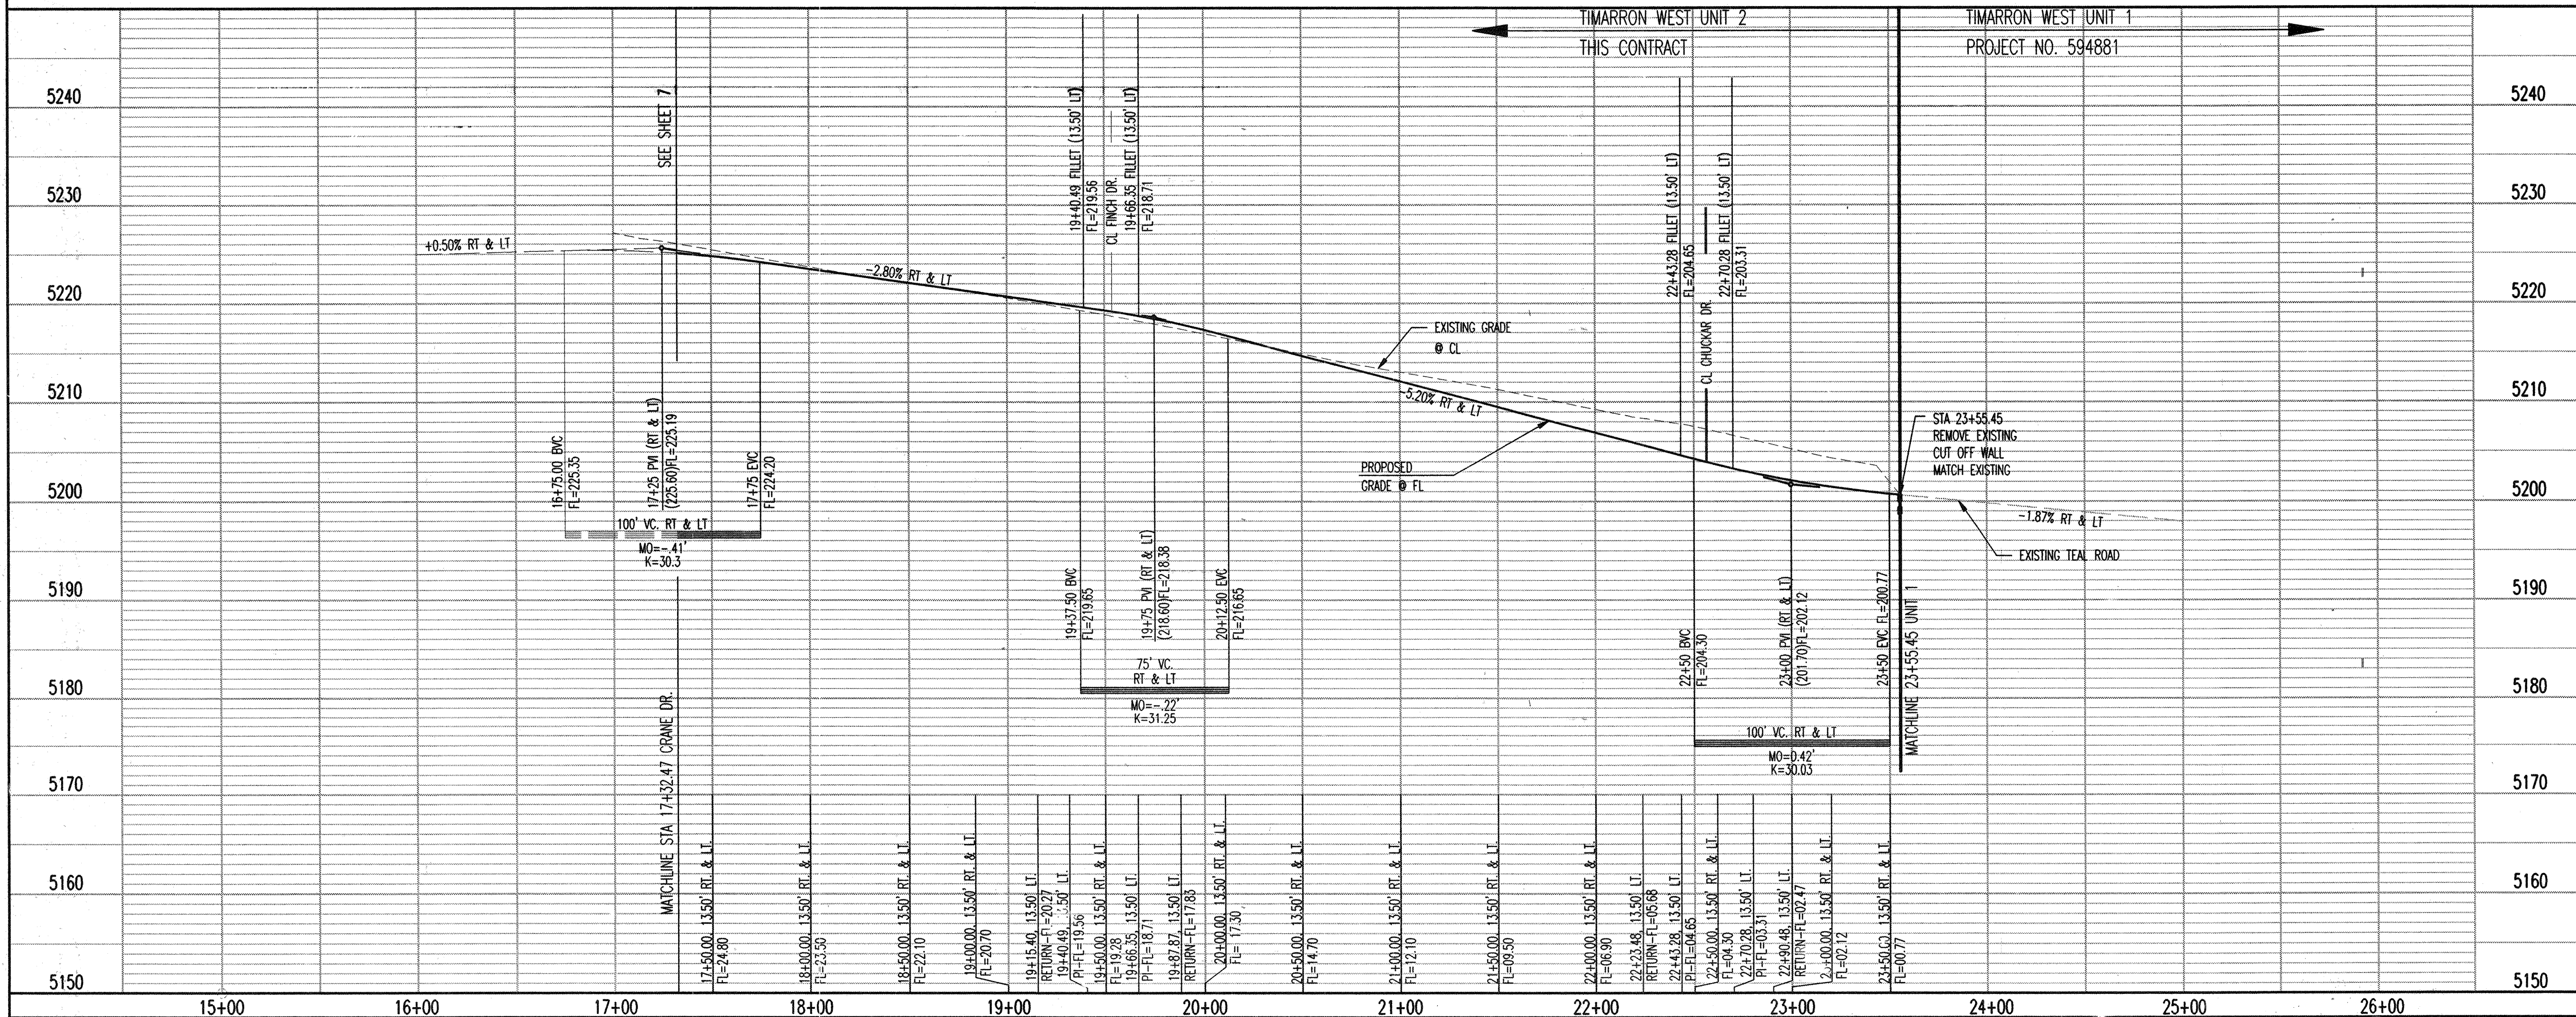

NOTES:

1. THE CONTRACTOR SHALL FIELD VERIFY ALL EXISTING PAVING AND UTILITY LOCATIONS AND NOTIFY THE ENGINEER IMMEDIATELY OF ANY DISCREPANCIES. NOTIFICATION WILL BE IN SUCH A MANNER AS TO ALLOW THE ENGINEER TIME TO MAKE REVISIONS PRIOR TO CONSTRUCTION. FAILURE TO DO SO MAY RESULT IN CONTRACTOR RESPONSIBILITY FOR RESOLUTION OF DISCREPANCIES.
2. ALL CURB RETURN RADI SHALL BE 25' UNLESS OTHERWISE SPECIFIED.
3. ALL CURVE DATA AND DIMENSIONS REFER TO FACE OF CURB UNLESS OTHERWISE SPECIFIED.
4. GRADE ELEVATIONS, WHERE NOTED, ARE FL OF CURB UNLESS OTHERWISE SPECIFIED.
5. CONTRACTOR IS TO INSTALL A 4" X 4" X 5' POST AND END AT THE END OF EACH SANITARY SEWER SERVICE.
6. CONTRACTOR IS RESPONSIBLE FOR REPAIR AND/OR REPLACEMENT OF ALL UTILITY CONDUITS AND EXISTING LINES.
7. ANY ADDITIONAL GRADING REQUIRED TO MATCH PROPOSED STREET GRADES SHALL BE INCIDENTAL TO PAVING ITEMS.
8. CONTRACTOR SHALL PROVIDE THE INSPECTORS, (CITY AND PRIVATE) WITH THE PROPOSED HYDROSTATIC TESTING PLAN. THE PLAN MUST BE APPROVED BEFORE TESTING OPERATIONS BEGIN.
9. CONTRACTOR SHALL PARK EQUIPMENT AND VEHICLES AS NOT TO INTERFERE WITH NORMAL ACTIVITIES OF RESIDENTS OR OTHER CONTRACTORS ON SITE.
10. ANY DAMAGE TO THE EXISTING FACILITIES (CURB & GUTTER), PAVEMENT, CONDUITS, LANDSCAPING, UTILITY LINES, ETC.) DURING CONSTRUCTION SHALL BE REPLACED AT THE CONTRACTORS' EXPENSE.
11. REMOVAL OF THE EXISTING CURB AND GUTTER SHALL BE AS PER COA STD. DWG. 2415 (SAWCUT ONLY).
12. WHEELCHAIR RAMPS SHALL BE CONSTRUCTED PRIOR TO ACCEPTANCE OF CURB & GUTTER.
13. CONSTRUCTION TRAFFIC CONTROL COST INCIDENTAL TO PAVING ITEMS.
14. MANHOLE RIM & CATCH BASIN ELEVATIONS ARE APPROX. THE CONTRACTOR WILL VERIFY AND CONSTRUCT TO MATCH FINAL PAVEMENT GRADES.
15. FIRE HYDRANT FLANGE ELEVATIONS SHOWN ARE APPROX. THE CONTRACTOR WILL VERIFY AND CONSTRUCT TO FINAL CURB ELEVATIONS PER COA DETAIL 2340.

KEYED NOTES

1. INSTALL CONCRETE VALLEY GUTTER AS PER STD. DWG. 2420
2. INSTALL CONCRETE VALLEY GUTTER AS PER STD. DWG. 2421
3. INSTALL WHEELCHAIR RAMP AS PER DETAIL SHEET 21, CASE I
4. INSTALL WHEELCHAIR RAMP AS PER DETAIL SHEET 21, CASE II WITH ALTERNATE SECTION AA
5. EXISTING STD. CURB & GUTTER AS PER STD. DWG. 2415
6. BUILD ROLL CURB & GUTTER AS PER STD. DWG. 2415
7. BUILD 4' SIDEWALK
8. DEFERRED 4' SIDEWALK
9. BUILD STD. CURB & GUTTER AS PER STD. DWG. 2415
10. EXISTING WHEELCHAIR RAMP
11. INSTALL WHEELCHAIR RAMP AS PER DETAIL SHEET 21, CASE IV.
12. INSTALL WHEELCHAIR RAMP AS PER DETAIL SHEET 21, CASE V.

Bohannon & Huston



Countywide One 7500 JEFFERSON NE ALBUQUERQUE NEW MEXICO 87109

ENGINEERS PLANNERS PHOTOGRAMMETRISTS SURVEYORS SOFTWARE DEVELOPERS

CITY OF ALBUQUERQUE
PUBLIC WORKS DEPARTMENT
ENGINEERING DEVELOPMENT GROUP

AS-BUILT

TEAL ROAD N.W.
PAVING PLAN & PROFILE
TIMARRON WEST UNIT 2

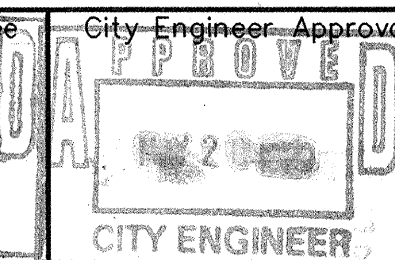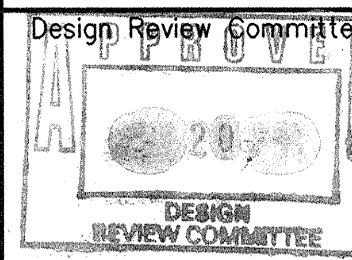


Mo./Day/Yr.		Mo./Day/Yr.	

City Project No.	Zone Map No.	Sheet	Of
612781	M-8	8	24

CENTERLINE TANGENT DATA		
No.	BEARING	DISTANCE
T1	S 89°22'37" E	661.40'



SCANNED BY
MESA REPRO

A		FL	B		FL	C		FL	D		FL
PC	1	30.62	PC	1	28.42	PC	1	20.75	PC	1	18.88
1	2	30.27	1	2	28.39	1	2	20.40	1	2	18.77
2	3	29.91	2	3	28.37	2	3	20.04	2	3	18.66
3	4	29.55	3	4	28.34	3	4	19.69	3	4	18.54
4	5	29.20	4	5	28.31	4	5	19.33	4	5	18.43
PT			PT			PT			PT		
D=89°26'18"			D=90°33'42"			D=89°26'18"			D=90°33'42"		
L=31.22'			L=31.61'			L=31.22'			L=31.61'		
R=20.00'			R=20.00'			R=20.00'			R=20.00'		

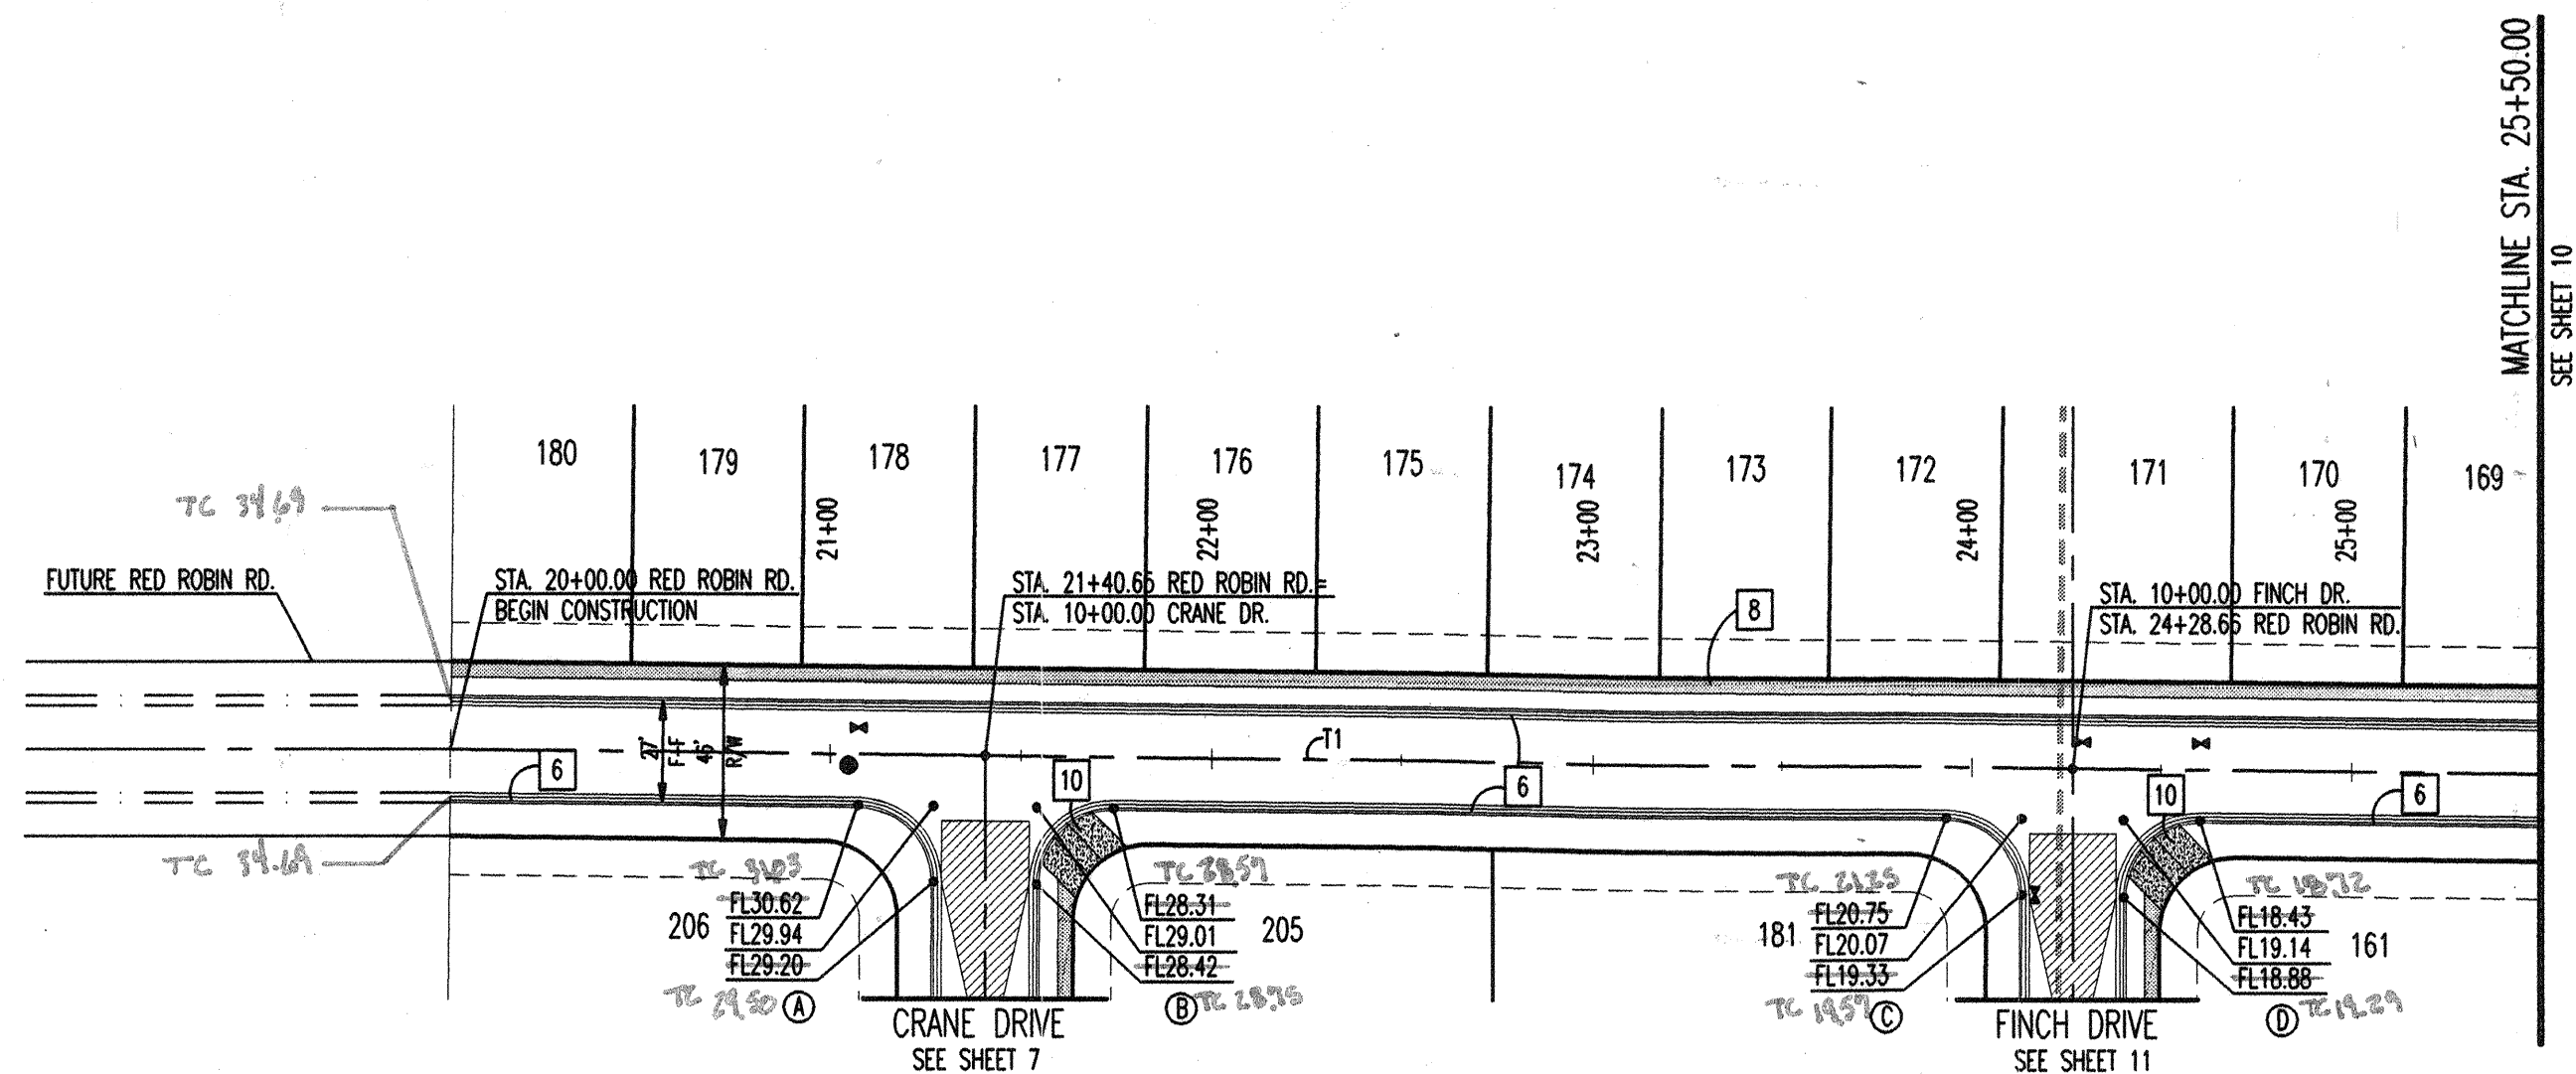

MATCHLINE STA. 25+50.00
SEE SHEET 10

RED ROBIN ROAD

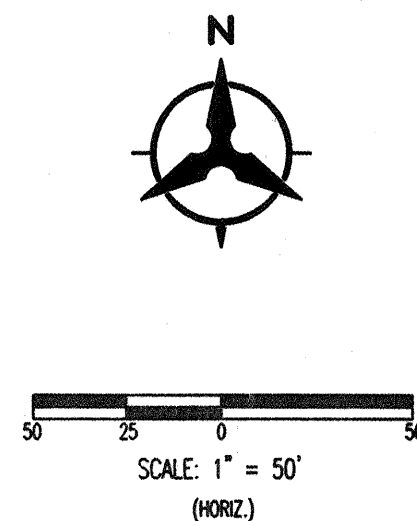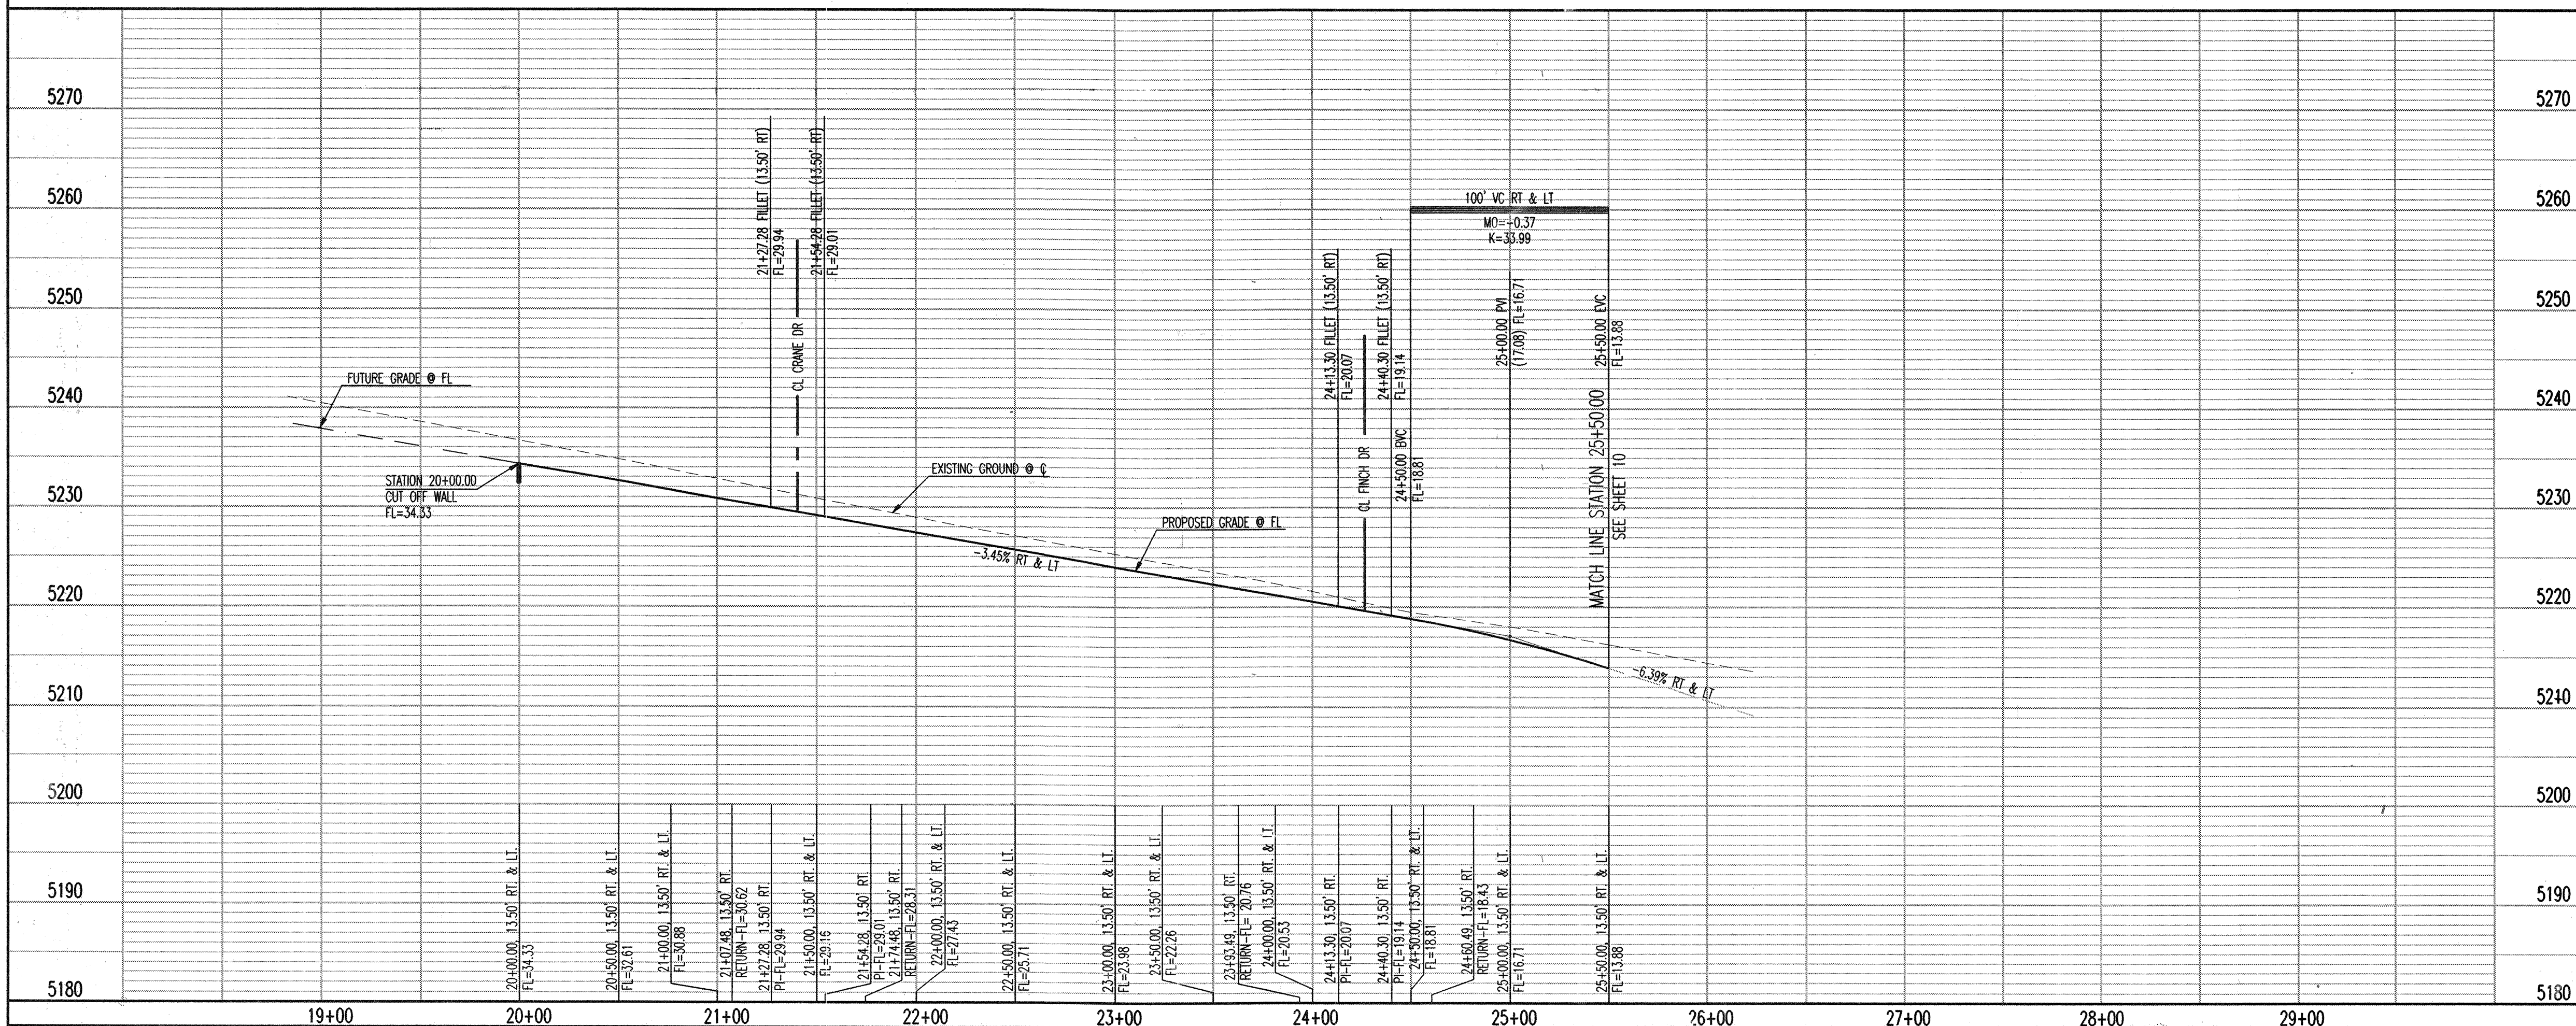

NOTES:

1. THE CONTRACTOR SHALL FIELD VERIFY ALL EXISTING PAVING AND UTILITY LOCATIONS AND NOTIFY THE ENGINEER IMMEDIATELY OF ANY DISCREPANCIES. NOTIFICATION WILL BE IN SUCH A MANNER AS TO ALLOW THE ENGINEER TIME TO MAKE REVISIONS PRIOR TO CONSTRUCTION. FAILURE TO DO SO MAY RESULT IN CONTRACTOR RESPONSIBILITY FOR RESOLUTION OF DISCREPANCIES.
2. ALL CURB RETURN RADI SHALL BE 25' UNLESS OTHERWISE SPECIFIED.
3. ALL CURVE DATA AND DIMENSIONS REFER TO FACE OF CURB UNLESS OTHERWISE SPECIFIED.
4. GRADE ELEVATIONS, WHERE NOTED, ARE FL OF CURB UNLESS OTHERWISE SPECIFIED.
5. CONTRACTOR IS TO INSTALL A 4" X 4" X 5' POST AND END AT THE END OF EACH SANITARY SEWER SERVICE.
6. CONTRACTOR IS RESPONSIBLE FOR REPAIR AND/OR REPLACEMENT OF ALL UTILITY CONDUITS AND EXISTING LINES.
7. ANY ADDITIONAL GRADING REQUIRED TO MATCH PROPOSED STREET GRADES SHALL BE INCIDENTAL TO PAVING ITEMS.
8. CONTRACTOR SHALL PROVIDE THE INSPECTORS, (CITY AND PRIVATE) WITH THE PROPOSED HYDROSTATIC TESTING PLAN. THE PLAN MUST BE APPROVED BEFORE TESTING OPERATIONS BEGIN.
9. CONTRACTOR SHALL PARK EQUIPMENT AND VEHICLES AS NOT TO INTERFERE WITH NORMAL ACTIVITIES OF RESIDENTS OR OTHER CONTRACTORS ON SITE.
10. ANY DAMAGE TO THE EXISTING FACILITIES (CURB & GUTTER), PAVEMENT, CONDUITS, LANDSCAPING, UTILITY LINES, ETC.) DURING CONSTRUCTION SHALL BE REPLACED AT THE CONTRACTORS' EXPENSE.
11. REMOVAL OF THE EXISTING CURB AND GUTTER SHALL BE AS PER COA STD. DWG. 2415 (SAWCUT ONLY).
12. WHEELCHAIR RAMPS SHALL BE CONSTRUCTED PRIOR TO ACCEPTANCE OF CURB & GUTTER.
13. CONSTRUCTION TRAFFIC CONTROL COST INCIDENTAL TO PAVING ITEMS.
14. MANHOLE RIM & CATCH BASIN ELEVATIONS ARE APPROX. THE CONTRACTOR WILL VERIFY AND CONSTRUCT TO MATCH FINAL PAVEMENT GRADES.
15. FIRE HYDRANT FLANGE ELEVATIONS SHOWN ARE APPROX. THE CONTRACTOR WILL VERIFY AND CONSTRUCT TO FINAL CURB ELEVATIONS PER COA. DETAIL 2340.

KEYED NOTES

- 1 INSTALL CONCRETE VALLEY GUTTER AS PER STD. DWG. 2420
- 2 INSTALL CONCRETE VALLEY GUTTER AS PER STD. DWG. 2421
- 3 INSTALL WHEELCHAIR RAMP AS PER DETAIL SHEET 21, CASE I
- 4 INSTALL WHEELCHAIR RAMP AS PER DETAIL SHEET 21, CASE II WITH ALTERNATE SECTION AA
- 5 EXISTING STD. CURB & GUTTER AS PER STD. DWG. 2415
- 6 BUILD ROLL CURB & GUTTER AS PER STD. DWG. 2415
- 7 BUILD 4' SIDEWALK
- 8 DEFERRED 4' SIDEWALK
- 9 BUILD STD. CURB & GUTTER AS PER STD. DWG. 2415
- 10 INSTALL WHEELCHAIR RAMP AS PER DETAIL SHEET 21, CASE V



Bohannon + Huston

Courtyard One 7500 JEFFERSON NE ALBUQUERQUE NEW MEXICO 87109

ENGINEERS PLANNERS PHOTOGRAMMETRISTS SURVEYORS SOFTWARE DEVELOPERS

CITY OF ALBUQUERQUE
PUBLIC WORKS DEPARTMENT
ENGINEERING DEVELOPMENT GROUP

AS-BUILT RED ROBIN ROAD
PAVING PLAN & PROFILE
TIMARRON WEST UNIT 2

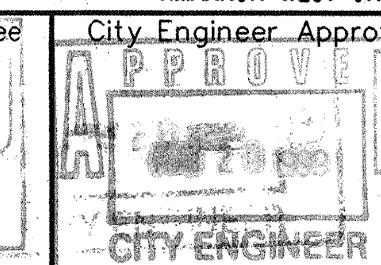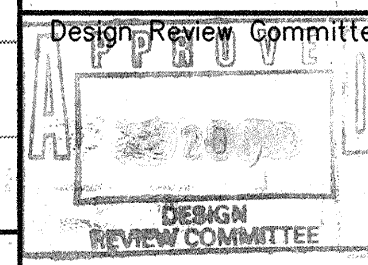

City Project No.
612781

Zone Map No.
M-8

Sheet
9



Of
24

CENTERLINE TANGENT DATA TABLE

No.	BEARING	DISTANCE
T1	S 00°37'23" W	684.37'
T2	S 89°22'37" E	78.56'


CENTERLINE CURVE DATA TABLE

No.	PI STA.	DELTA	TANGENT	ARC	RADIUS
C1	27+20.30	90°00'00"	75.00'	117.81'	75.00'
C2	10+41.41	43°03'11"	47.82'	91.09'	121.22'

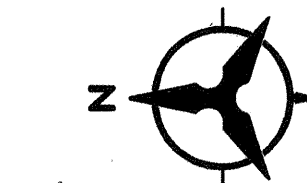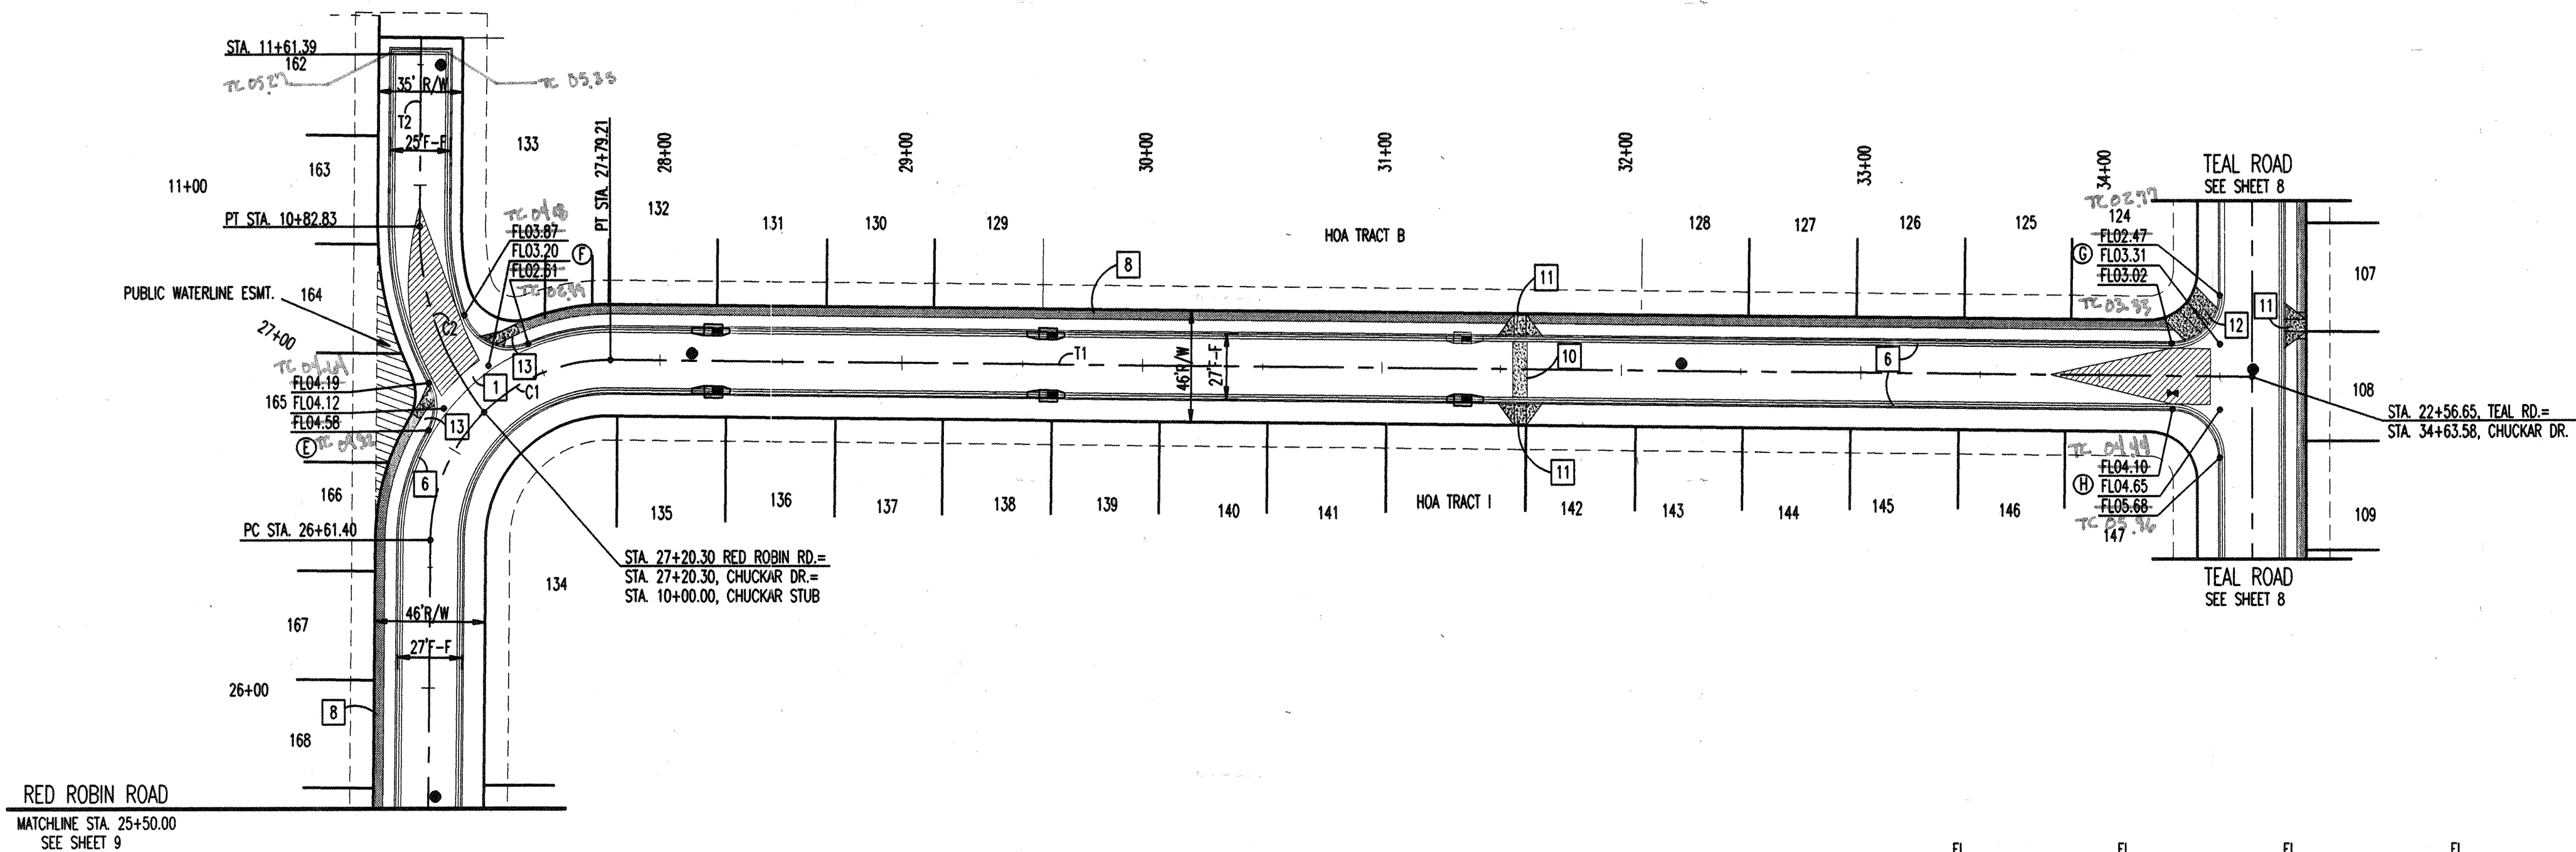

SCALE: 1" = 50'
(HORIZ.)

CHUKAR DRIVE / CHUKAR STUB

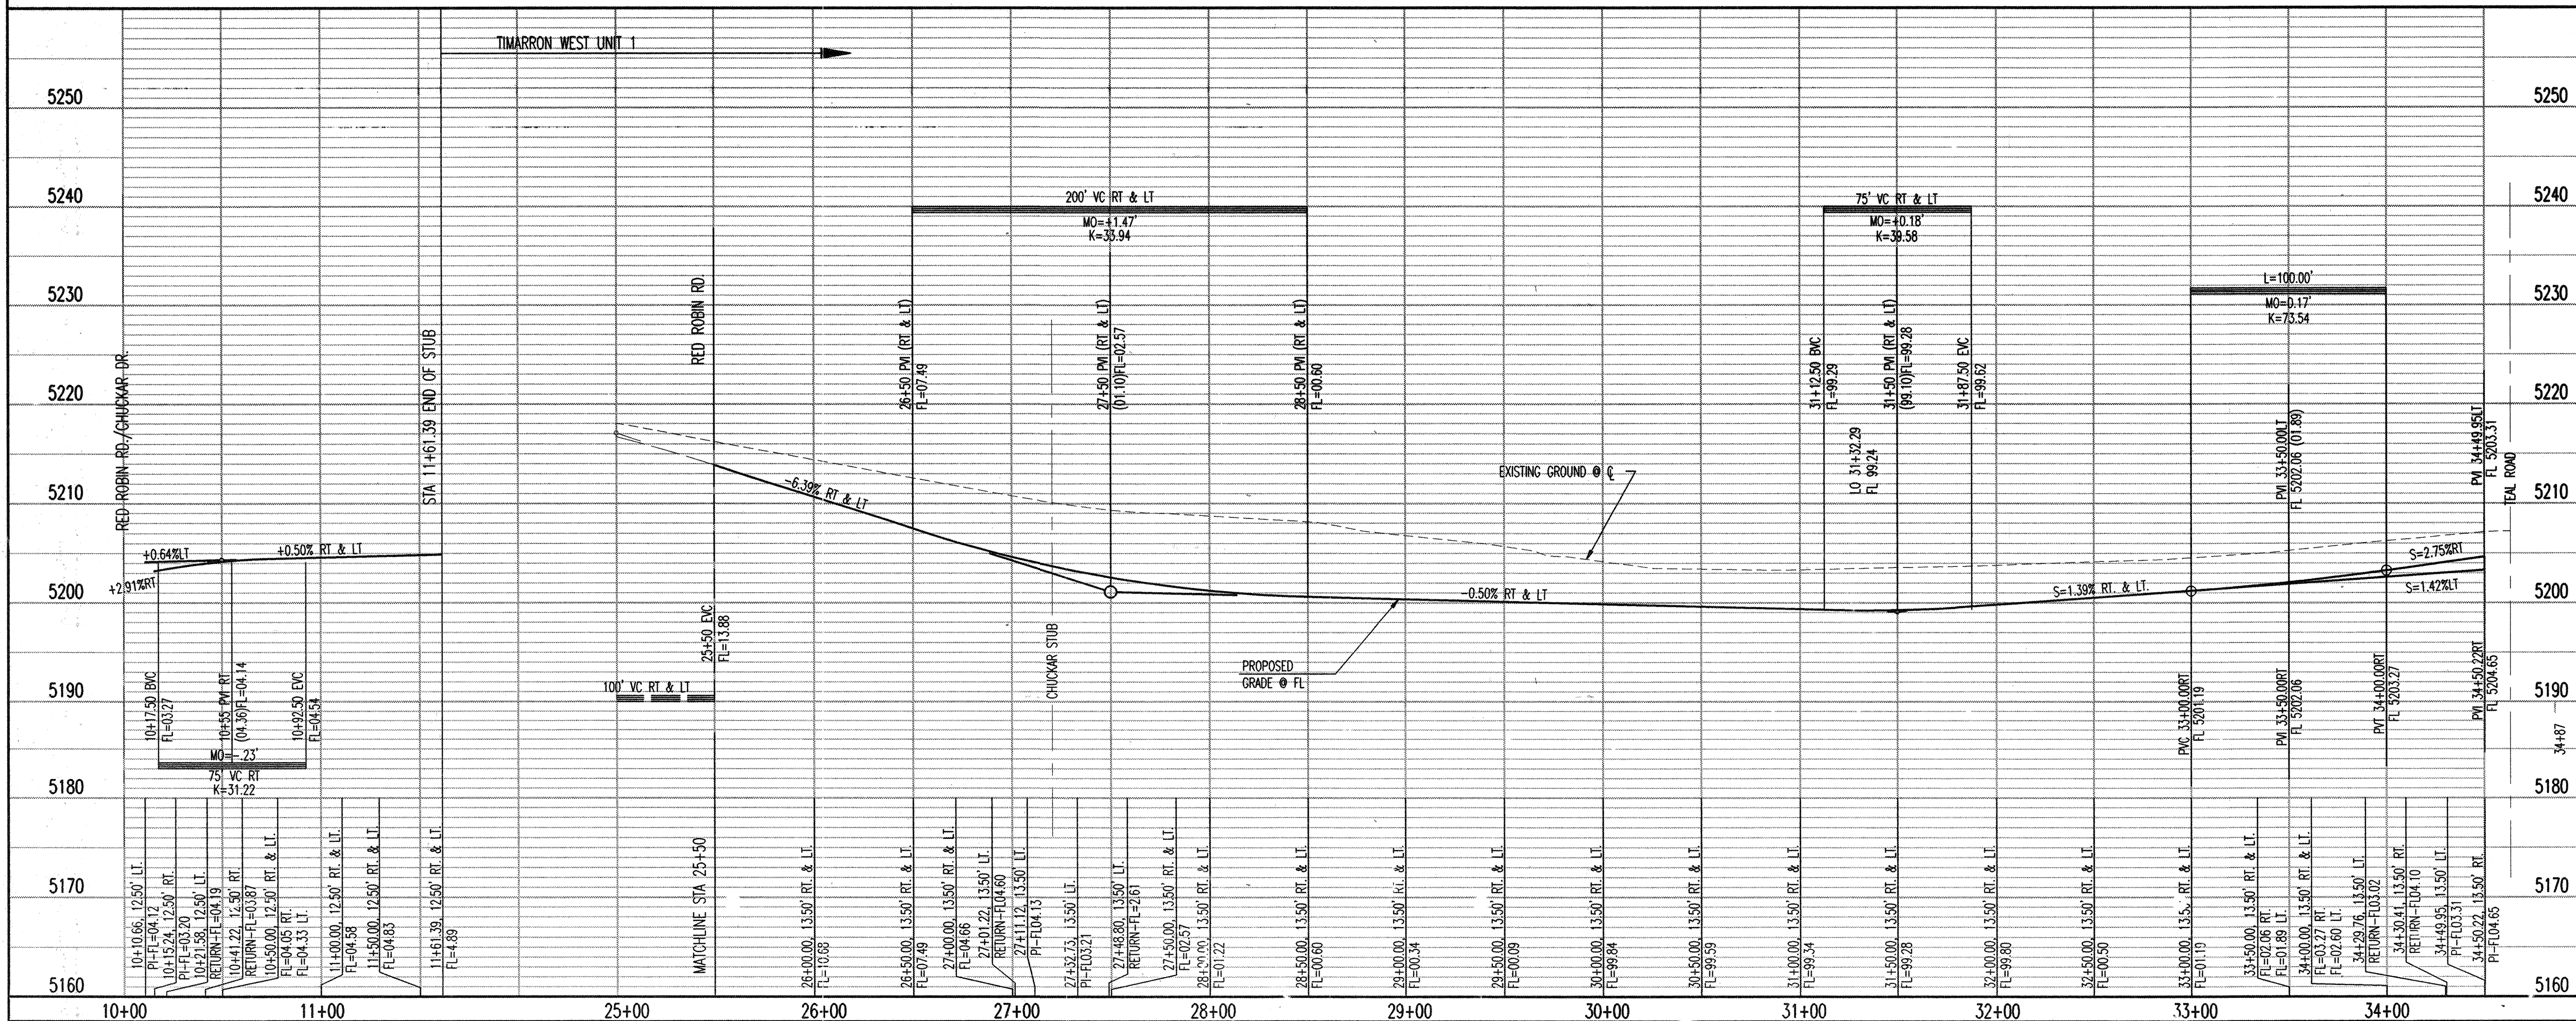

NOTES:

- THE CONTRACTOR SHALL FIELD VERIFY ALL EXISTING PAVING AND UTILITY LOCATIONS AND NOTIFY THE ENGINEER IMMEDIATELY OF ANY DISCREPANCIES. NOTIFICATION WILL BE IN SUCH A MANNER AS TO ALLOW THE ENGINEER TIME TO MAKE REVISIONS PRIOR TO CONSTRUCTION. FAILURE TO DO SO MAY RESULT IN CONTRACTOR RESPONSIBILITY FOR RESOLUTION OF DISCREPANCIES.
- ALL CURB RETURN RADII SHALL BE 25' UNLESS OTHERWISE SPECIFIED.
- ALL CURVE DATA AND DIMENSIONS REFER TO FACE OF CURB UNLESS OTHERWISE SPECIFIED.
- GRADE ELEVATIONS, WHERE NOTED, ARE FL OF CURB UNLESS OTHERWISE SPECIFIED.
- CONTRACTOR IS TO INSTALL A 4" X 4" X 5' POST AND END AT THE END OF EACH SANITARY SEWER SERVICE.
- CONTRACTOR IS RESPONSIBLE FOR REPAIR AND/OR REPLACEMENT OF ALL UTILITY CONDUITS AND EXISTING LINES.
- ANY ADDITIONAL GRADING REQUIRED TO MATCH PROPOSED STREET GRADES SHALL BE INCIDENTAL TO PAVING ITEMS.
- CONTRACTOR SHALL PROVIDE THE INSPECTORS, (CITY AND PRIVATE) WITH THE PROPOSED HYDROSTATIC TESTING PLAN. THE PLAN MUST BE APPROVED BEFORE TESTING OPERATIONS BEGIN.
- CONTRACTOR SHALL PARK EQUIPMENT AND VEHICLES AS NOT TO INTERFERE WITH NORMAL ACTIVITIES OF RESIDENTS OR OTHER CONTRACTORS ON SITE.
- ANY DAMAGE TO THE EXISTING FACILITIES (CURB & GUTTER), PAVEMENT, CONDUITS, LANDSCAPING, UTILITY LINES, ETC.) DURING CONSTRUCTION SHALL BE REPLACED AT THE CONTRACTORS' EXPENSE.
- REMOVAL OF THE EXISTING CURB AND GUTTER SHALL BE AS PER COA STD. DWG. 2415 (SAW-CUT ONLY).
- WHEELCHAIR RAMPS SHALL BE CONSTRUCTED PRIOR TO ACCEPTANCE OF CURB & GUTTER.
- CONSTRUCTION TRAFFIC CONTROL COST INCIDENTAL TO PAVING ITEMS.
- MANHOLE RIM & CATCH BASIN ELEVATIONS ARE APPROX. THE CONTRACTOR WILL VERIFY AND CONSTRUCT TO MATCH FINAL PAVEMENT GRADES.
- FIRE HYDRANT FLANGE ELEVATIONS SHOWN ARE APPROX. THE CONTRACTOR WILL VERIFY AND CONSTRUCT TO FINAL CURB ELEVATIONS PER COA DETAIL 2340.

KEY NOTES

- INSTALL CONCRETE VALLEY GUTTER AS PER STD. DWG. 2420
- INSTALL CONCRETE VALLEY GUTTER AS PER STD. DWG. 2421
- INSTALL WHEELCHAIR RAMP AS PER DETAIL SHEET 21, CASE I
- INSTALL WHEELCHAIR RAMP AS PER DETAIL SHEET 21, CASE II WITH ALTERNATE SECTION AA
- EXISTING STD. CURB & GUTTER AS PER STD. DWG. 2415
- BUILD ROLL CURB & GUTTER AS PER STD. DWG. 2415
- BUILD 4' SIDEWALK
- DEFERRED 4' SIDEWALK
- BUILD STD. CURB & GUTTER AS PER STD. DWG. 2415
- 6" x 6" x 6" WIDE RED BRICK PATTERNED CONCRETE
- INSTALL WHEELCHAIR RAMP CASE III, SEE DETAIL SHEET 21
- INSTALL WHEELCHAIR RAMP CASE V, SEE DETAIL SHEET 21
- INSTALL WHEELCHAIR RAMP CASE VI, SEE DETAIL SHEET 21

Bohannon & Huston





Courtyard One 7500 JEFFERSON NE ALBUQUERQUE NEW MEXICO 87109


ENGINEERS PLANNERS PHOTOGRAMMETRISTS SURVEYORS SOFTWARE DEVELOPERS

CITY OF ALBUQUERQUE
PUBLIC WORKS DEPARTMENT
ENGINEERING DEVELOPMENT GROUP


AS-BUILT

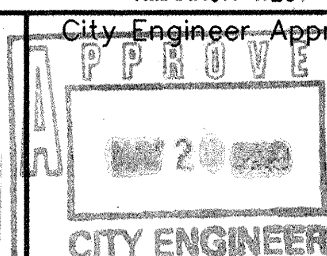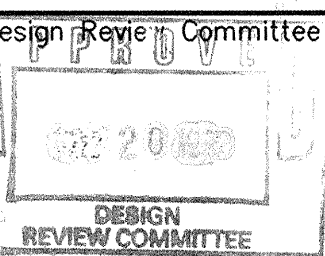CHUKAR DRIVE / RED ROBIN ROAD
PAVING PLAN & PROFILE
TIMARRON WEST UNIT 2City Project No.
612781Zone Map No.
M-8Sheet
10Of
24

SCANNED BY
MESA REPRO

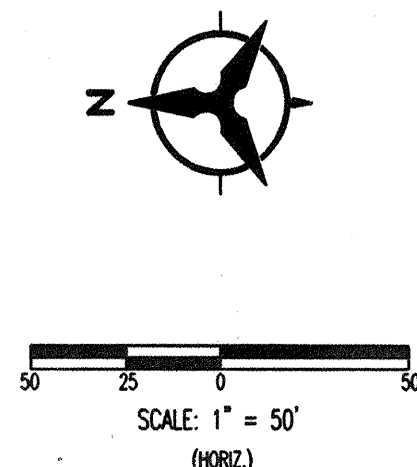

FINCH DRIVE

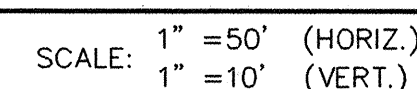

15. FIRE HYDRANT FLANGE ELEVATIONS SHOWN ARE APPROX. THE CONTRACTOR WILL VERIFY AND CONSTRUCT TO FINAL CURB ELEVATIONS PER COA DETAIL 2340.

City Project No.	Zone Map No.	Sheet	Of
612781	M-8	11	24

[illegible]

CENTERLINE TANGENT DATA TABLE		
No.	BEARING	DISTANCE
T1	S 67°57'22" E	262.05
T2	S 89°56'12" E	362.49

CENTERLINE CURVE DATA TABLE					
No.	PI STA.	DELTA	TANGENT	ARC	RADIUS
C1	43+75.00	21°58'42"	120.38	237.79	619.90'

LEGEND

- PROPOSED ARTERIAL SECTION
- REMOVE TYPE III BARRICADE

NOTES:

- THE CONTRACTOR SHALL FIELD VERIFY ALL EXISTING PAVING AND UTILITY LOCATIONS AND NOTIFY THE ENGINEER IMMEDIATELY OF ANY DISCREPANCIES. NOTIFICATION WILL BE IN SUCH A MANNER AS TO ALLOW THE ENGINEER TIME TO MAKE REVISIONS PRIOR TO CONSTRUCTION. FAILURE TO DO SO MAY RESULT IN CONTRACTOR RESPONSIBILITY FOR RESOLUTION OF DISCREPANCIES.
- ALL CURB RETURN RADII SHALL BE 25' UNLESS OTHERWISE SPECIFIED.
- ALL CURVE DATA AND DIMENSIONS REFER TO FACE OF CURB UNLESS OTHERWISE SPECIFIED.
- GRADE ELEVATIONS, WHERE NOTED, ARE FL OF CURB UNLESS OTHERWISE SPECIFIED.
- CONTRACTOR IS TO INSTALL A 4" X 4" X 5' POST AND END AT THE END OF EACH SANITARY SEWER SERVICE.
- CONTRACTOR IS RESPONSIBLE FOR REPAIR AND/OR REPLACEMENT OF ALL UTILITY CONDUITS AND EXISTING LINES.
- ANY ADDITIONAL GRADING REQUIRED TO MATCH PROPOSED STREET GRADES SHALL BE INCIDENTAL TO PAVING ITEMS.
- CONTRACTOR SHALL PROVIDE THE INSPECTORS, (CITY AND PRIVATE) WITH THE PROPOSED HYDROSTATIC TESTING PLAN. THE PLAN MUST BE APPROVED BEFORE TESTING OPERATIONS BEGIN.
- CONTRACTOR SHALL PARK EQUIPMENT AND VEHICLES AS NOT TO INTERFERE WITH NORMAL ACTIVITIES OF RESIDENTS OR OTHER CONTRACTORS ON SITE.
- ANY DAMAGE TO THE EXISTING FACILITIES (CURB & GUTTER), PAVEMENT, CONDUITS, LANDSCAPING, UTILITY LINES, ETC.) DURING CONSTRUCTION SHALL BE REPLACED AT THE CONTRACTORS' EXPENSE.
- REMOVAL OF THE EXISTING CURB AND GUTTER SHALL BE AS PER COA STD. DWG. 2415 (SANDCUT ONLY).
- WHEELCHAIR RAMPS SHALL BE CONSTRUCTED PRIOR TO ACCEPTANCE OF CURB & GUTTER.
- CONSTRUCTION TRAFFIC CONTROL COST INCIDENTAL TO PAVING ITEMS.
- MANHOLE RIM & CATCH BASIN ELEVATIONS ARE APPROX. THE CONTRACTOR WILL VERIFY AND CONSTRUCT TO MATCH FINAL PAVEMENT GRADES.
- FIRE HYDRANT FLANGE ELEVATIONS SHOWN ARE APPROX. THE CONTRACTOR WILL VERIFY AND CONSTRUCT TO FINAL CURB ELEVATIONS PER COA DETAIL 2340.

KEYED NOTES

- INSTALL CONCRETE VALLEY GUTTER AS PER STD. DWG. 2420
- INSTALL CONCRETE VALLEY GUTTER AS PER STD. DWG. 2421
- INSTALL WHEELCHAIR RAMP AS PER DETAIL SHEET 21, CASE I
- INSTALL WHEELCHAIR RAMP AS PER DETAIL SHEET 21, CASE II WITH ALTERNATE SECTION AA
- EXISTING STD. CURB & GUTTER AS PER STD. DWG. 2415
- BUILD ROLL CURB & GUTTER AS PER STD. DWG. 2415
- BUILD 8' MEANDERING AC PATHWAY
- DEFERRED 4' SIDEWALK
- BUILD STD. CURB & GUTTER AS PER STD. DWG. 2415
- 6" x 6" x 6" WIDE RED BRICK PATTERNED CONCRETE CROSSWALK, AS PER STD DWG 2412
- REMOVE AND DISPOSE OF EXISTING CURB AND GUTTER STA. 39+89.30 TO STA. 48+56.38


Bohannon & Huston

Courtyard One 7500 JEFFERSON NE Albuquerque NEW MEXICO 87109
ENGINEERS PLANNERS PHOTOGRAMMETRISTS SURVEYORS SOFTWARE DEVELOPERS

CITY OF ALBUQUERQUE
PUBLIC WORKS DEPARTMENT
ENGINEERING DEVELOPMENT GROUP

AS-BUILT

DE VARGAS ROAD
PAVING PLAN & PROFILE
TIMARRON WEST UNIT 2

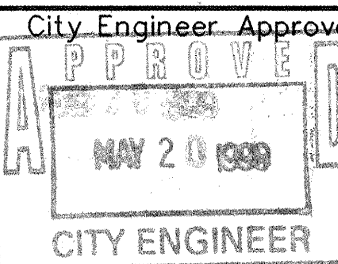


City Project No.
612781

Zone Map No.
M-8

Sheet
12 Of
24

SCANNED BY
MESA REPRO

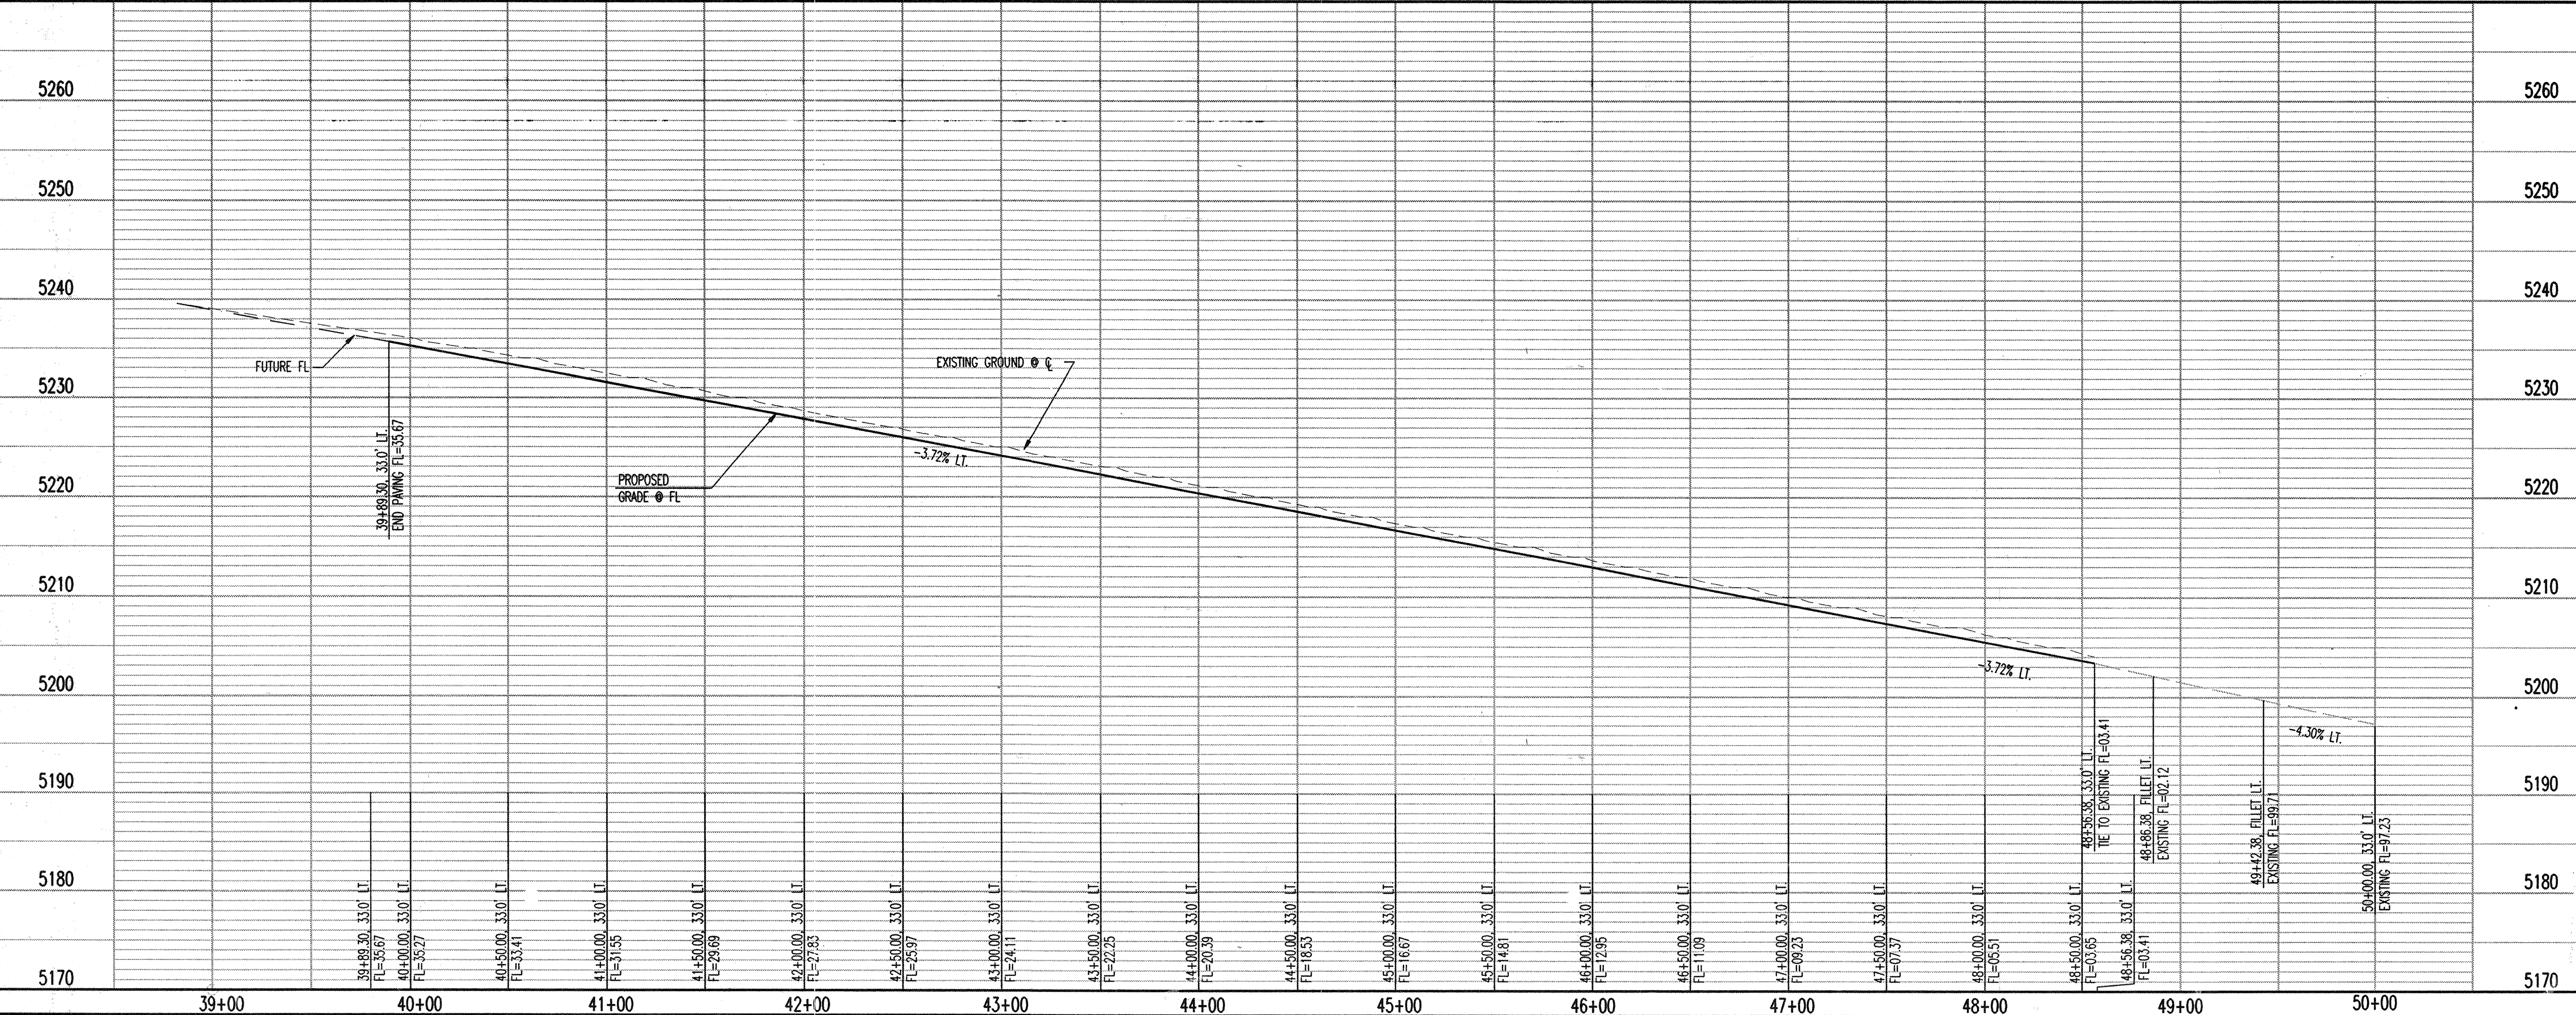

DE VARGAS ROAD

SCALE: 1" = 50' (HORIZ.)
1" = 10' (VERT.)

BHI JOB NO. 99795


Copyright Bohannon & Huston 1999
Date: 5/15/99

P:\mimain\99395.CDP.DESIGN.PNP\PPNP-DE-VARGAS.DWG

SCANNED BY
MESA REPRO


TRACT 2, LANDS OF
GREVEY/LIBERMAN

SEE DETAIL 'A'
THIS SHEET

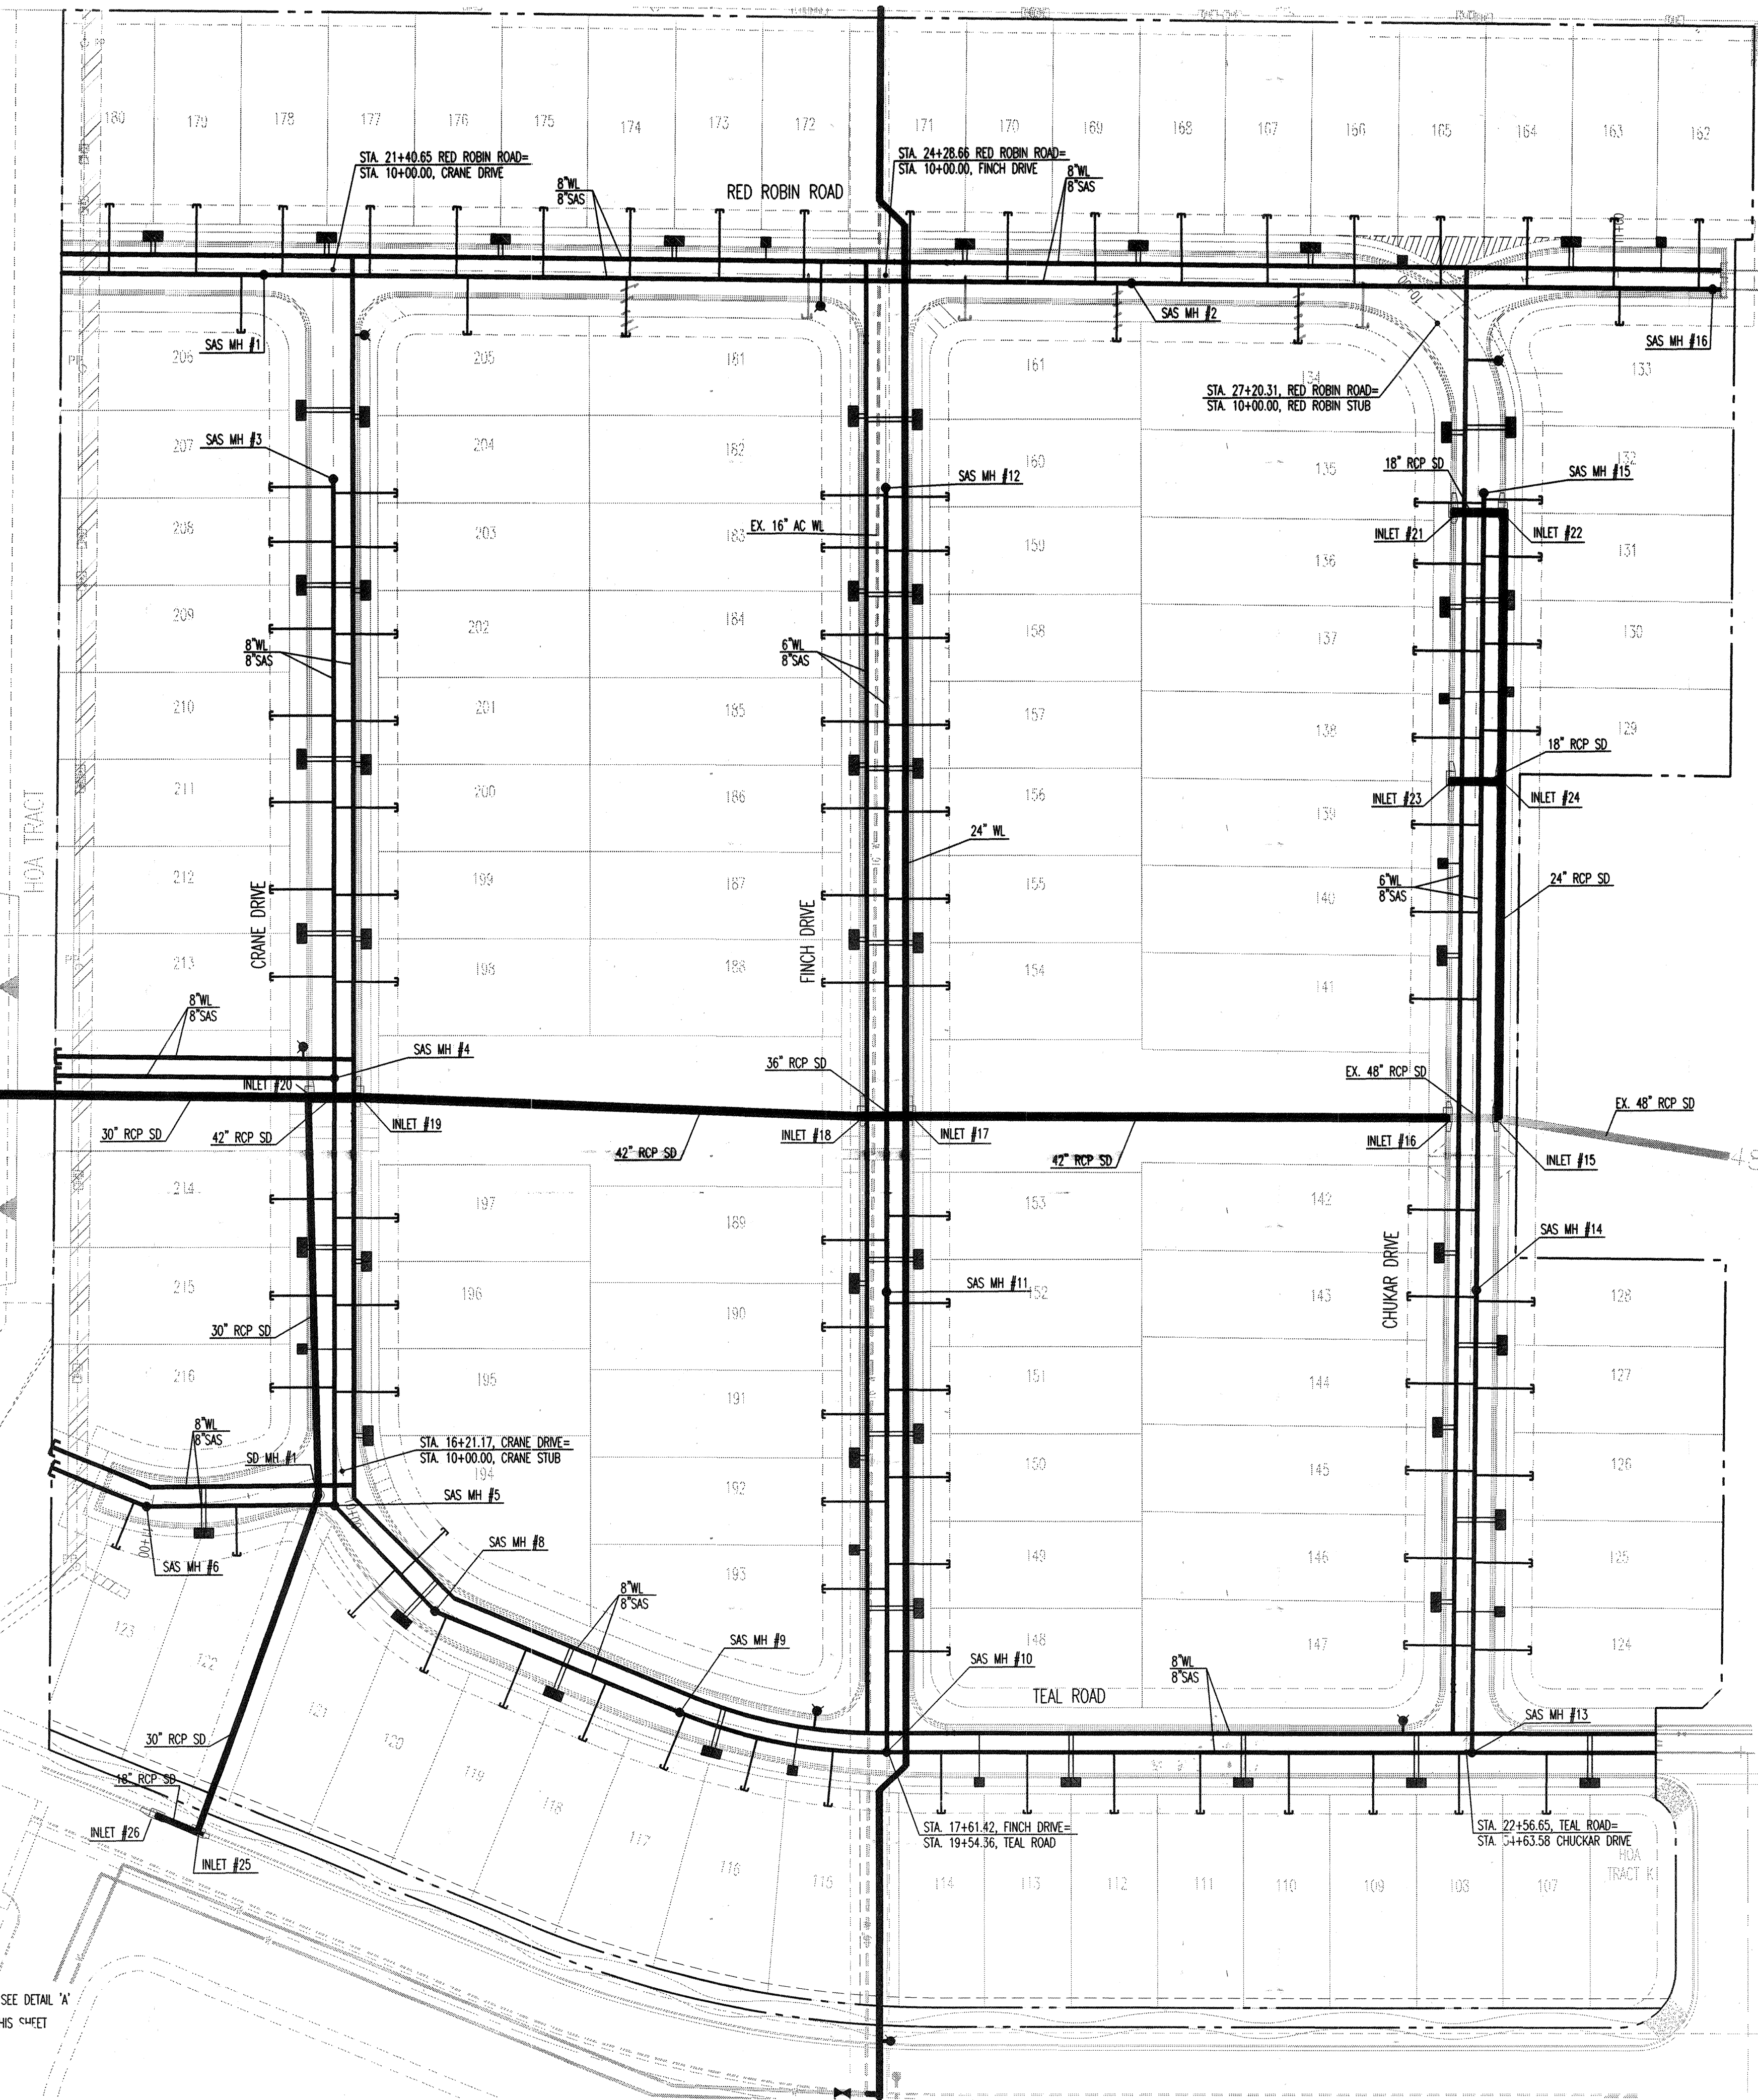

WARNING - EXISTING UTILITY LINE LOCATIONS ARE SHOWN IN AN APPROXIMATE MANNER ONLY, AND SUCH LINES MAY EXIST WHERE NONE ARE SHOWN. THE LOCATION OF ANY SUCH EXISTING LINES IS BASED UPON INFORMATION PROVIDED BY THE UTILITY COMPANY, THE OWNER, OR BY OTHERS, AND THE INFORMATION MAY BE INCOMPLETE OR MAY BE OBSOLETE BY THE TIME CONSTRUCTION COMMENCES.

THE ENGINEER HAS UNDERTAKEN LIMITED FIELD VERIFICATION OF THE LOCATION, DEPTH, SIZE, OR TYPE OF EXISTING UNDERGROUND UTILITY LINES. MAKES NO REPRESENTATION PERTAINING THERETO AND ASSUMES NO RESPONSIBILITY OR LIABILITY THEREFORE. THE CONTRACTOR SHALL INFORM ITSELF OF THE LOCATION OF ANY UTILITY LINE IN OR NEAR THE AREA OF THE WORK IN ADVANCE OF AND DURING EXCAVATION WORK. THE CONTRACTOR IS FULLY RESPONSIBLE FOR ANY AND ALL DAMAGE CAUSED BY ITS FAILURE TO LOCATE, IDENTIFY, AND PRESERVE ANY AND ALL EXISTING UTILITIES. THE CONTRACTOR SHALL COMPLY WITH STATE, MUNICIPAL AND LOCAL ORDINANCES, RULES AND REGULATIONS PERTAINING TO THE LOCATION OF THESE LINES AND FACILITIES IN PLANNING AND CONDUCTING EXCAVATION, WHETHER BY CALLING OR NOTIFYING THE UTILITIES, COMPLYING WITH (BLUE STAKES) PROCEDURES, OR OTHERWISE.

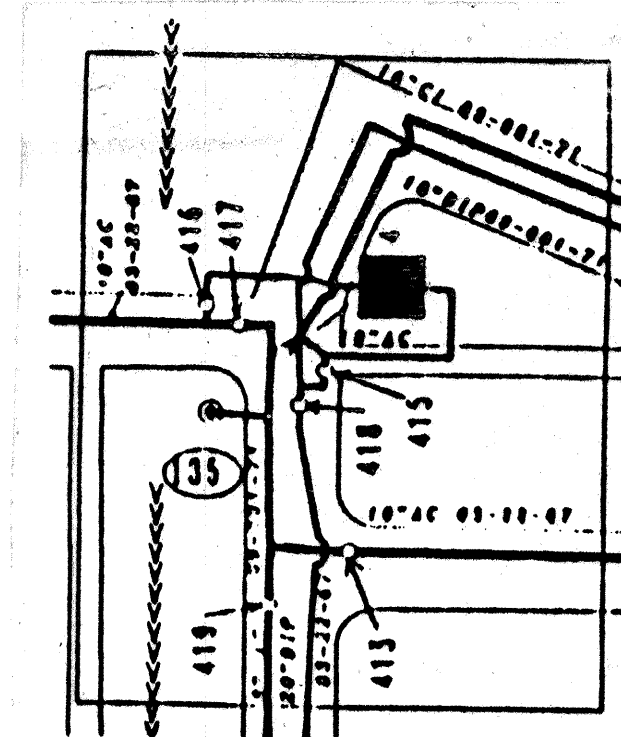


Detail A

PAVEMENT LEGEND	
	PROPOSED STORM SEWER CATCH BASIN
	EXISTING STORM SEWER CATCH BASIN
	PROPOSED GATE VALVE
	PROPOSED SANITARY SEWER
	EXISTING SAS MANHOLE
	PROPOSED FIRE HYDRANT
	EXISTING WATER LINE
	PROPOSED WATER LINE
	PROPOSED SANITARY SEWER LINE

RESTRAINING JOINT TABLE		
MECHANICAL JOINTS	LENGTH OF RESTRAINED JOINTS FROM EACH SIDE OF MJ LISTED (6")	(24")
11.25" H BEND	2'	3'
22.50" H BEND	4'	5'
45" H BEND	8'	11'
90" H BEND	20'	26'
GATE VALVE	55'	72'
BITTERLY VALVE	---	---
REDUCER (8"x6")	30'	40'
CAP	55'	72'
TEE	---	87'


- NOTE:
1. ALL MECHANICAL JOINTS SHALL BE RESTRAINED AT THE FITTING.
 2. THE CONTRACTOR SHALL PROVIDE A MINIMUM PIPE LENGTH OF 20 LF FROM ALL MECHANICAL JOINTS. ALL PIPE JOINTS WITHIN 20 LF OF A MJ SHALL BE RESTRAINED AT THE CONTRACTOR'S EXPENSE.
 3. THE CONTRACTOR SHALL RESTRAIN ALL PIPE JOINTS IN THE SPECIFIED DISTANCE LISTED IN THE TABLE ABOVE. (SEE NOTE 2 ABOVE)
 4. THE CONTRACTOR SHALL RESTRAIN ALL FIRE HYDRANTS JOINTS FROM THE TEE ON THE MAIN TO THE FIRE HYDRANT FLANGE.
 5. ALL CAPS SHALL UTILIZE PCC BLOCKING (INCIDENTAL TO TO WATERLINE CONSTRUCTION)

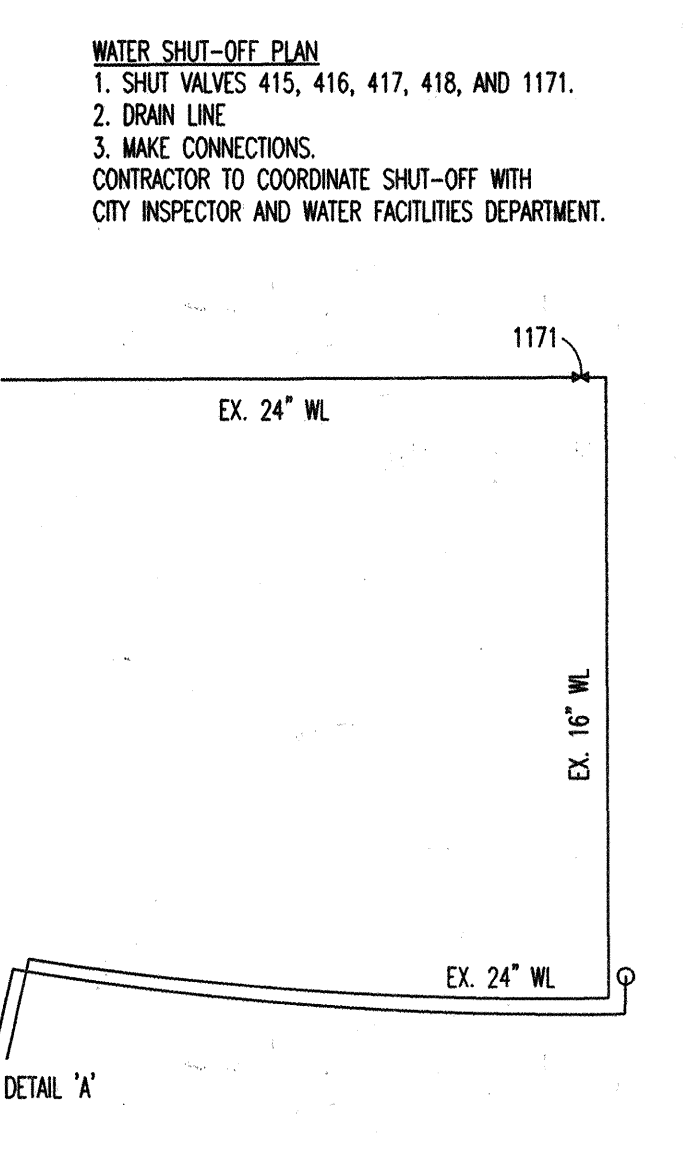

Bohannon & Huston
Courtney One 7500 JEFFERSON NE ALBUQUERQUE NEW MEXICO 87109
ENGINEERS PLANNERS PHOTOGRAMMETRISTS SURVEYORS SOFTWARE DEVELOPERS

CITY OF ALBUQUERQUE
PUBLIC WORKS DEPARTMENT
ENGINEERING DEVELOPMENT GROUP
AS-BUILT TIMARRON WEST UNIT 2
OVERALL UTILITY PLAN
Design Review Committee City Engineer Approval
APPROVED APPROVED
DESIGN REVIEW COMMITTEE CITY ENGINEER
City Project No. 612781 Zone Map No. M-8 Sheet 15 Of 24
Mo./Day/Yr. Mo./Day/Yr.
Last Design Update
Designed By: EES DATE: 3/99
Drawn By: JAJ DATE: 3/99
Checked By: RLB DATE: 3/99

SCANNED BY
MESA REPRO

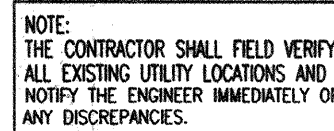

ALL SANITARY SEWER AND WATER LINES
SHALL BE PVC UNLESS OTHERWISE NOTED

1. THE CONTRACTOR SHALL FIELD VERIFY ALL EXISTING PAVING AND UTILITY LOCATIONS AND NOTIFY THE ENGINEER IMMEDIATELY OF ANY DISCREPANCIES. NOTIFICATION WILL BE IN SUCH A MANNER AS TO ALLOW THE ENGINEER TIME TO MAKE REVISIONS PRIOR TO CONSTRUCTION. FAILURE TO DO SO MAY RESULT IN CONTRACTOR RESPONSIBILITY FOR RESOLUTION OF DISCREPANCIES.
2. ALL CURB RETURN RADIUS SHALL BE 25' UNLESS OTHERWISE SPECIFIED.
3. ALL CURVE DATA AND DIMENSIONS REFER TO FACE OF CURB UNLESS OTHERWISE SPECIFIED.
4. GRADE ELEVATIONS, WHERE NOTED, ARE F.L. OF CURB UNLESS OTHERWISE SPECIFIED.
5. CONTRACTOR IS TO INSTALL A 4" X 4" X 5' POST AND END AT THE END OF EACH SANITARY SEWER SERVICE.
6. CONTRACTOR IS RESPONSIBLE FOR REPAIR AND/OR REPLACEMENT OF ALL UTILITY CONDUITS AND EXISTING LINES.
7. ANY ADDITIONAL GRADING REQUIRED TO MATCH PROPOSED STREET GRADES SHALL BE INCIDENTAL TO PAVING ITEMS.
8. CONTRACTOR SHALL PROVIDE THE INSPECTORS, (CITY AND PRIVATE) WITH THE PROPOSED HYDROSTATIC TESTING PLAN. THE PLAN MUST BE APPROVED BEFORE TESTING OPERATIONS BEGIN.
9. CONTRACTOR SHALL PARK EQUIPMENT AND VEHICLES AS NOT TO INTERFERE WITH NORMAL ACTIVITIES OF RESIDENTS OR OTHER CONTRACTORS ON SITE.
10. ANY DAMAGE TO THE EXISTING FACILITIES (CURB & GUTTER), PAVEMENT, CONDUITS, LANDSCAPING, UTILITY LINES, ETC.) DURING CONSTRUCTION SHALL BE REPLACED AT THE CONTRACTORS' EXPENSE.
11. REMOVAL OF THE EXISTING CURB AND GUTTER SHALL BE AS PER COA STD. DWG. 2415 (SAWCUT ONLY).
12. WHEELCHAIR RAMPS SHALL BE CONSTRUCTED PRIOR TO ACCEPTANCE OF CURB & GUTTER.
13. CONSTRUCTION TRAFFIC CONTROL COST INCIDENTAL TO PAVING ITEMS.
14. MANHOLE RIM & CATCH BASIN ELEVATIONS ARE APPROX. THE CONTRACTOR WILL VERIFY AND CONSTRUCT TO MATCH FINAL PAVEMENT GRADES.
15. FIRE HYDRANT FLANGE ELEVATIONS SHOWN ARE APPROX. THE CONTRACTOR WILL VERIFY AND CONSTRUCT TO FINAL CURB ELEVATIONS PER COA. DETAIL 2340.

Bohannon & Huston

 Courtyard One 7500 JEFFERSON NE Albuquerque NEW MEXICO 87109
 ENGINEERS PLANNERS PHOTOGRAMMETRISTS SURVEYORS SOFTWARE DEVELOPERS

AS-BUILT

CRANE DRIVE / STUB
UTILITY PLAN & PROFILE
TIMARRON WEST UNIT 2

City Engineer Approval

APPROVED

MAY 2 2 1990

CITY ENGINEER

p:\bhmain\99395.CDP.DESIGN.PNP\UPNP-CRANE.DWG

SCALE: 1" = 50' (HORIZ.)
1" = 10' (VERT.)

BHI JOB NO. 99395

Copyright Rohrer and Klotz 1999
Date: 2/8/99


WATER & SANITARY SEWER SERVICES					
LOT NUMBER	WL STATION & OFFSET	WL TYPE	SAS STATION & OFFSET	SAS LEN. - I.D.	TOP OF PIPE AT PLUG (W/RISE)
M	23+19.35, 9.50' LT.	DOUBLE	N/A	N/A	N/A
107			22+97.99, 0.5' RT	32.50'	5185.67 (6)
108	22+29.38, 9.50' LT.	DOUBLE	22+52.99, 0.5' RT	32.50'	5185.91 (5)
109			22+07.99, 0.5' RT	32.50'	5199.49 (7)
110	21+39.38, 9.50' LT.	DOUBLE	21+64.45, 0.5' RT	32.50'	5202.29 (8)
111			21+17.99, 0.5' RT	32.50'	5205.23 (9)
112	20+49.38, 9.50' LT.	DOUBLE	20+72.99, 0.5' RT	32.50'	5205.98 (7)
113			20+27.99, 0.5' RT	32.50'	5209.56 (9)
114	20+02.99, 9.50' LT.	SINGLE	19+80.00, 0.5' RT	32.49'	5211.86 (9)
115	19+07.47, 6.49' LT.	SINGLE	19+32.58, 2.77' RT	30.25'	5212.83 (7)
116	18+65.64, 7.18' LT.	DOUBLE	18+86.67, 3.47' RT	29.53'	5213.69 (5)
117			18+37.33, 1.33' RT	31.90'	5216.17 (5)
118	17+80.55, 9.50' LT.	DOUBLE	18+04.43, 0.5' RT	32.41'	5216.44 (4)
119			17+59.71, 0.5' RT	32.50'	5218.47 (5)

WATERLINE CURVE DATA TABLE					
No.	PI STA.	DELTA	TANGENT	ARC	RADIUS
C1	18+98.50	22°18'34"	52.25'	103.18'	265.00'


WATERLINE TANGENT DATA		
No.	BEARING	DISTANCE
T1	S 67°37'38" E	135.15'
T2	S 89°56'22" E	403.87'

SANITARY SEWER LINE CURVE DATA TABLE					
No.	PI STA.	DELTA	TANGENT	ARC	RADIUS
C2	18+98.50	22°18'34"	54.23'	107.08'	275.00'

SANITARY SEWER LINE TANGENT DATA		
No.	BEARING	DISTANCE
T3	S 67°37'38" E	137.16'
T4	S 89°56'22" E	403.91'

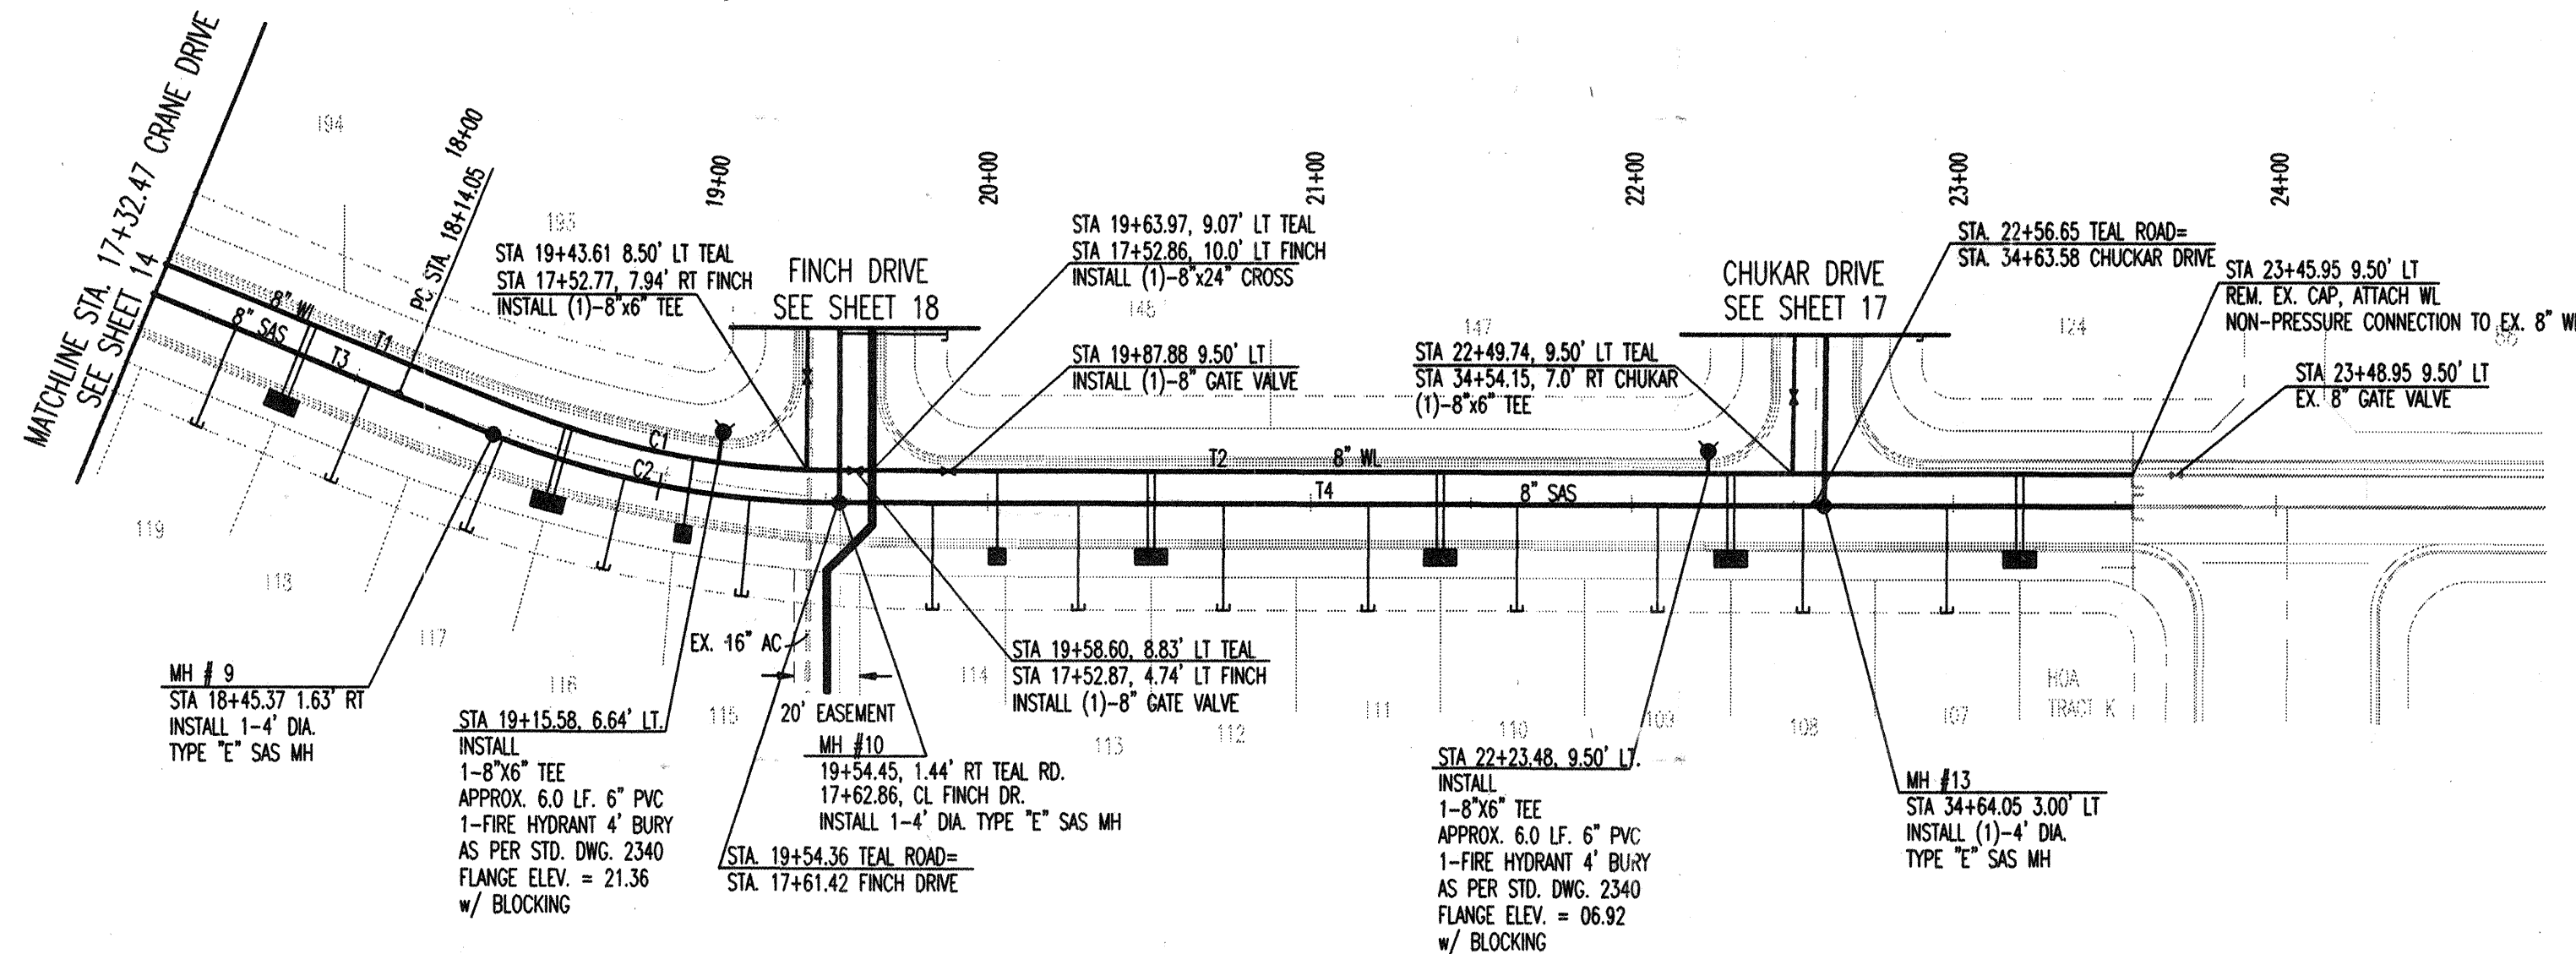

TEAL ROAD

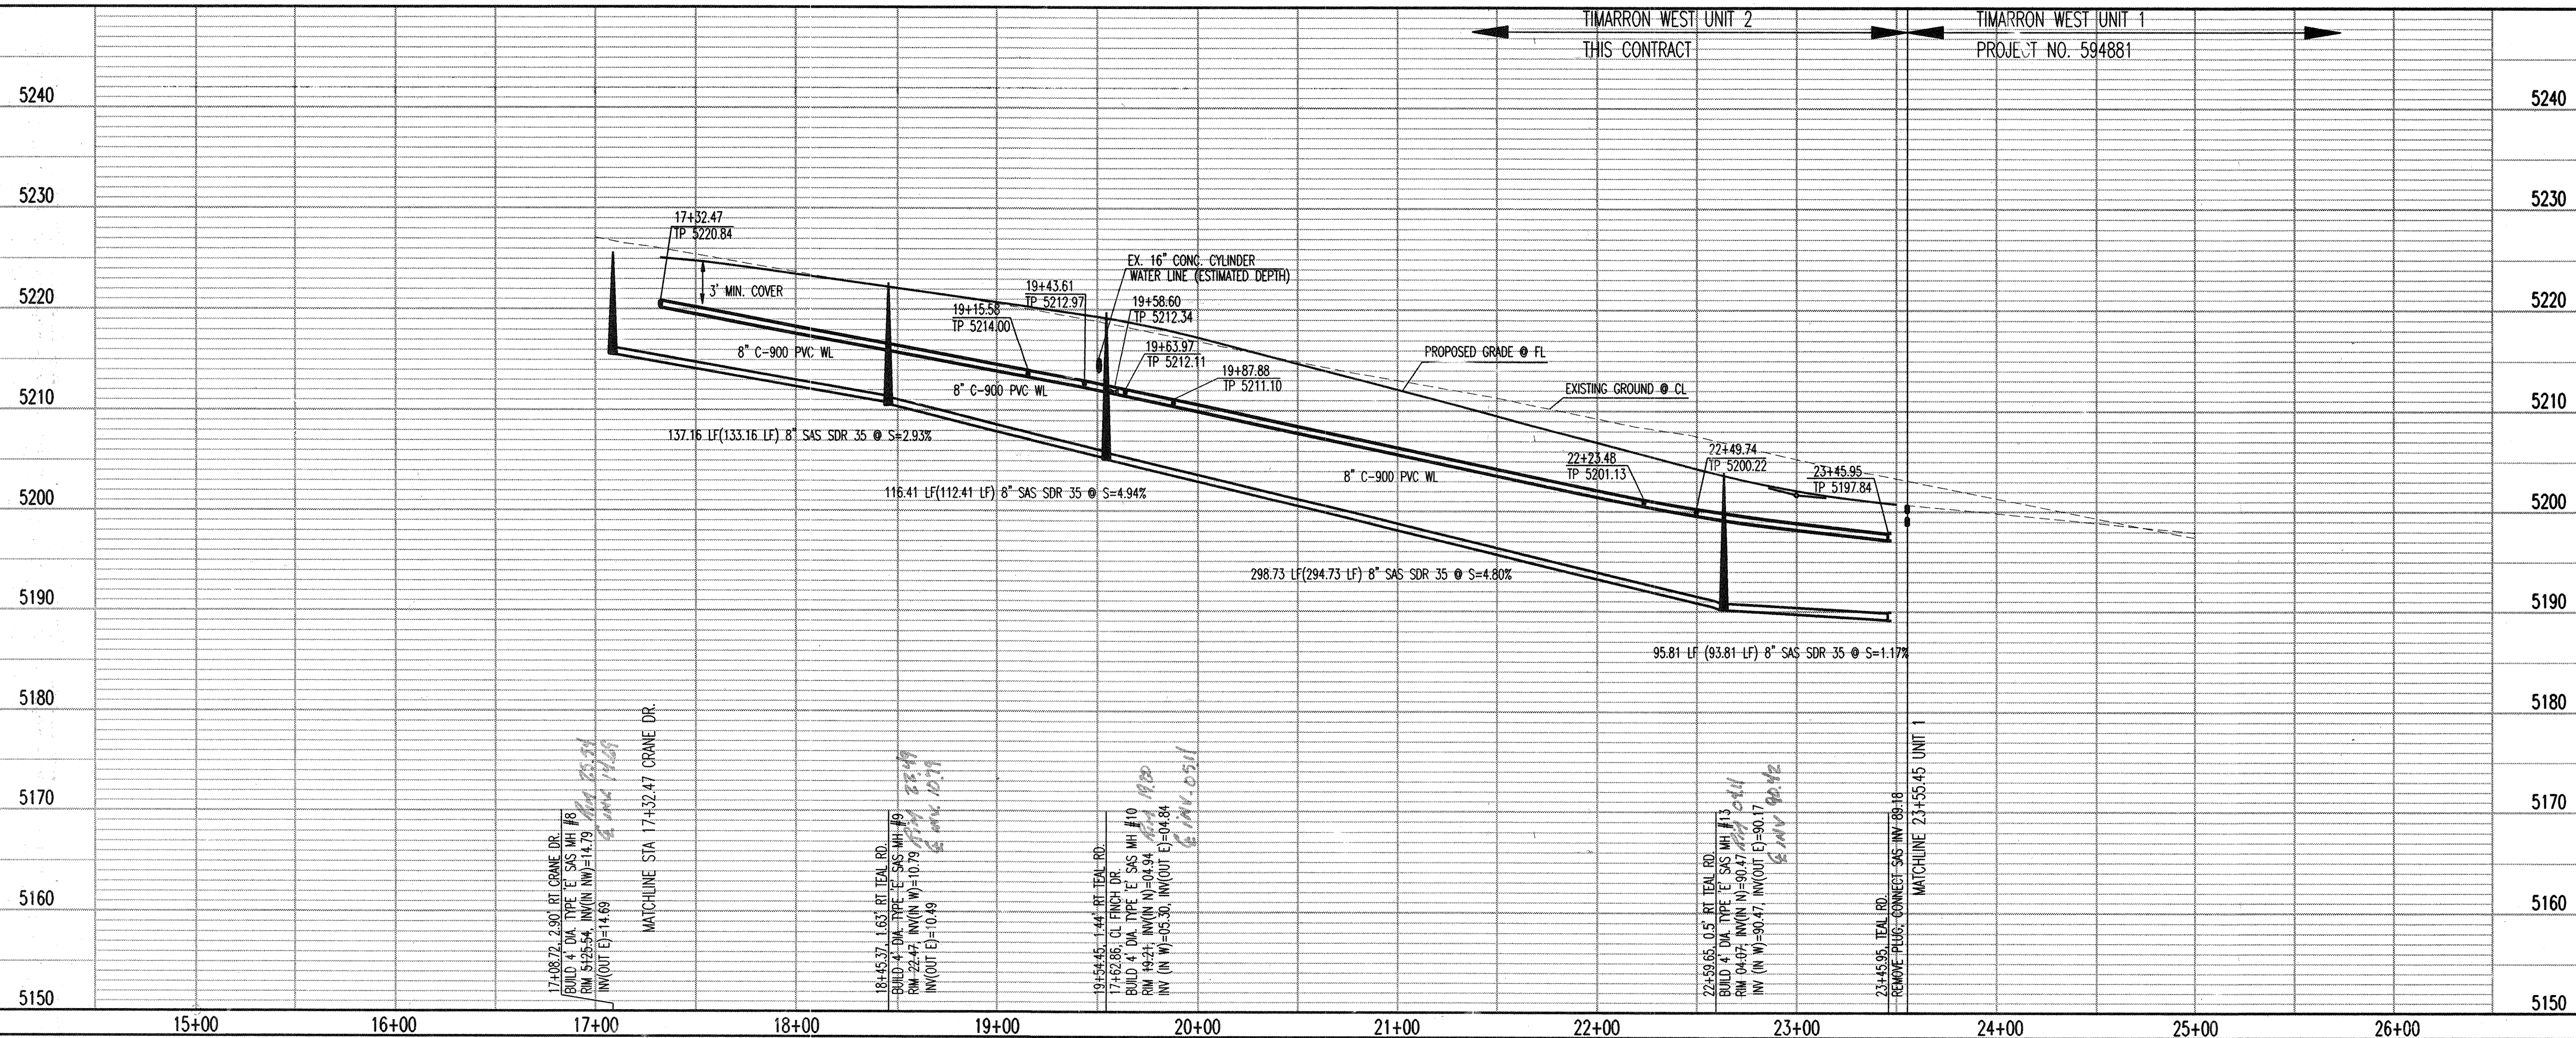

NOTES:

1. THE CONTRACTOR SHALL FIELD VERIFY ALL EXISTING PAVING AND UTILITY LOCATIONS AND NOTIFY THE ENGINEER IMMEDIATELY OF ANY DISCREPANCIES. NOTIFICATION SHALL BE IN SUCH A MANNER AS TO ALLOW THE ENGINEER TIME TO MAKE REVISIONS PRIOR TO CONSTRUCTION. FAILURE TO DO SO MAY RESULT IN CONTRACTOR RESPONSIBILITY FOR RESOLUTION OF DISCREPANCIES.
2. ALL CURB RETURN RADII SHALL BE 25' UNLESS OTHERWISE SPECIFIED.
3. ALL CURVE DATA AND DIMENSIONS REFER TO FACE OF CURB UNLESS OTHERWISE SPECIFIED.
4. GRADE ELEVATIONS, WHERE NOTED, ARE F.L. OF CURB UNLESS OTHERWISE SPECIFIED.
5. CONTRACTOR IS TO INSTALL A 4" X 4" X 5' POST AND END AT THE END OF EACH SANITARY SEWER SERVICE.
6. CONTRACTOR IS RESPONSIBLE FOR REPAIR AND/OR REPLACEMENT OF ALL UTILITY CONDUITS AND EXISTING LINES.
7. ANY ADDITIONAL GRADING REQUIRED TO MATCH PROPOSED STREET GRADES SHALL BE INCIDENTAL TO PAVING ITEMS.
8. CONTRACTOR SHALL PROVIDE THE INSPECTORS, (CITY AND PRIVATE) WITH THE PROPOSED HYDROSTATIC TESTING PLAN. THE PLAN MUST BE APPROVED BEFORE TESTING OPERATIONS BEGIN.
9. CONTRACTOR SHALL PARK EQUIPMENT AND VEHICLES AS NOT TO INTERFERE WITH NORMAL ACTIVITIES OF RESIDENTS OR OTHER CONTRACTORS ON SITE.
10. ANY DAMAGE TO THE EXISTING FACILITIES (CURB & GUTTER), PAVEMENT, CONDUITS, LANDSCAPING, UTILITY LINES, ETC.) DURING CONSTRUCTION SHALL BE REPLACED AT THE CONTRACTORS' EXPENSE.
11. REMOVAL OF THE EXISTING CURB AND GUTTER SHALL BE AS PER COA STD. DWG. 2415 (SAWCUT ONLY).
12. WHEELCHAIR RAMPS SHALL BE CONSTRUCTED PRIOR TO ACCEPTANCE OF CURB & GUTTER.
13. CONSTRUCTION TRAFFIC CONTROL COST INCIDENTAL TO PAVING ITEMS.
14. MANHOLE RIM & CATCH BASIN ELEVATIONS ARE APPROX. THE CONTRACTOR WILL VERIFY AND CONSTRUCT TO MATCH FINAL PAVEMENT GRADES.
15. FIRE HYDRANT FLANGE ELEVATIONS SHOWN ARE APPROX. THE CONTRACTOR WILL VERIFY AND CONSTRUCT TO FINAL CURB ELEVATIONS PER COA. DETAIL 2340.

Bohannon & Huston
Countywide One 7500 JEFFERSON NE ALBUQUERQUE NEW MEXICO 87109
ENGINEERS PLANNERS PHOTOGRAMMETRISTS SURVEYORS SOFTWARE DEVELOPERS


CITY OF ALBUQUERQUE
PUBLIC WORKS DEPARTMENT
ENGINEERING DEVELOPMENT GROUP

AS-BUILT		TEAL ROAD UTILITY PLAN & PROFILE TIMARRON WEST UNIT 2	
Design Review Committee	City Engineer Approval	Mo./Day/Yr.	Mo./Day/Yr.
APPROVED	APPROVED		
DESIGN REVIEW COMMITTEE	CITY ENGINEER		

City Project No. 612781 Zone Map No. M-8 Sheet 15 Of 24

* STATION ALONG SURVEY ALIGNMENT 'A'


No.	BEARING	DISTANCE
T1	S 89°22'37" E	869.40'

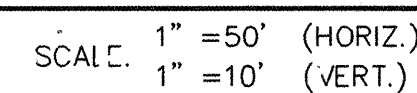

1. THE CONTRACTOR SHALL FIELD VERIFY ALL EXISTING PAVING AND UTILITY LOCATIONS AND NOTIFY THE ENGINEER IMMEDIATELY OF ANY DISCREPANCIES. NOTIFICATION WILL BE IN SUCH A MANNER AS TO ALLOW THE ENGINEER TIME TO MAKE REVISIONS PRIOR TO CONSTRUCTION. FAILURE TO DO SO MAY RESULT IN CONTRACTOR RESPONSIBILITY FOR RESOLUTION OF DISCREPANCIES.
2. ALL CURB RETURN RADII SHALL BE 25' UNLESS OTHERWISE SPECIFIED.
3. ALL CURVE DATA AND DIMENSIONS REFER TO FACE OF CURB UNLESS OTHERWISE SPECIFIED.
4. GRADE ELEVATIONS, WHERE NOTED, ARE FL OF CURB UNLESS OTHERWISE SPECIFIED.
5. CONTRACTOR IS TO INSTALL A 4" X 4" X 5' POST AND END AT THE END OF EACH SANITARY SERVICE LINE.
6. CONTRACTOR IS RESPONSIBLE FOR REPAIR AND/OR REPLACEMENT OF ALL UTILITY CONDUITS AND EXISTING LINES.
7. ANY ADDITIONAL GRADING REQUIRED TO MATCH PROPOSED STREET GRADES SHALL BE INCIDENTAL TO PAVING ITEMS.
8. CONTRACTOR SHALL PROVIDE THE INSPECTORS, (CITY AND PRIVATE) WITH THE PROPOSED HYDROSTATIC TESTING PLAN. THE PLAN MUST BE APPROVED BEFORE TESTING OPERATIONS BEGIN.
9. CONTRACTOR SHALL PARK EQUIPMENT AND VEHICLES AS NOT TO INTERFERE WITH NORMAL ACTIVITIES OF RESIDENTS OR OTHER CONTRACTORS ON SITE.
10. ANY DAMAGE TO THE EXISTING FACILITIES (CURB & GUTTER), PAVEMENT, CONDUITS, LANDSCAPING, UTILITY LINES, ETC.) DURING CONSTRUCTION SHALL BE REPLACED AT THE CONTRACTORS' EXPENSE.
11. REMOVAL OF THE EXISTING CURB AND GUTTER SHALL BE AS PER COA STD. DWG. 2415 (SAWCUT ONLY).
12. WHEELCHAM RAMPS SHALL BE CONSTRUCTED PRIOR TO MAKE VESICLES PRIOR TO CURB.
13. CONSTRUCTION TRAFFIC CONTROL COST INCIDENTAL TO PAVING ITEMS.
14. MANHOLE RIM & CATCH BASIN ELEVATIONS ARE APPROX. THE CONTRACTOR WILL VERIFY AND CONSTRUCT TO MATCH FINAL PAVEMENT GRADES.
15. FIRE HYDRANT FLANGE ELEVATIONS SHOWN ARE APPROX. THE CONTRACTOR WILL VERIFY AND CONSTRUCT TO MATCH CURB ELEVATIONS PER COA DETAIL 2340.

WATER & SANITARY SEWER SERVICES					
LOT NUMBER	STATION & OFFSET	WL TYPE	SAS STATION & OFFSET	SAS LENGTH	TOP OF PIPE AT PLUG (W/RISE)
124	33+88.13, 7.00' RT	SINGLE	34+02.83, 3.00' LT.	20.00'	5195.32 (4)
125	33+43.13, 7.00' RT.	DOUBLE	33+85.63, 3.00' LT.	30.00'	5194.84 (3)
126			33+20.83, 3.00' LT.	30.00'	5194.40 (2)
127	32+53.13, 7.00' RT.	DOUBLE	32+75.63, 3.00' LT.	30.00'	5193.96 (1)
128			32+30.63, 3.00' LT.	30.00'	5193.52 (N/A)
129	29+13.22, 7.00' RT.	SINGLE	29+35.72, 3.00' LT.	30.00'	5195.27 (N/A)
130			28+90.72, 3.00' LT.	30.00'	5195.64 (N/A)
131	28+68.22, 7.00' RT.	DOUBLE	28+45.72, 3.00' LT.	30.00'	5195.91 (N/A)
132			28+17.95, 3.00' LT.	30.00'	5196.08 (N/A)
133	27+78.45, 7.00' RT.	DOUBLE	SEE SHEET XX	---	---
134			SEE SHEET XX	---	---
135	27+82.21, 7.00' RT.	DOUBLE	28+21.11, 3.00' LT.	36.00'	5196.18 (N/A)
136			28+49.71, 3.00' LT.	36.00'	5196.01 (N/A)
137	28+72.21, 7.00' RT.	DOUBLE	28+94.71, 3.00' LT.	36.00'	5195.74 (N/A)
138	29+19.55, 7.00' RT.	SINGLE	29+39.71, 3.00' LT.	36.00'	5195.47 (N/A)
139	30+07.21, 7.00' RT.	SINGLE	29+84.71, 3.00' LT.	36.00'	5195.20 (N/A)
140	30+52.21, 7.00' RT.	DOUBLE	30+29.71, 3.00' LT.	36.00'	5194.93 (N/A)
141			30+77.21, 3.00' LT.	36.00'	5195.35 (1)
142	32+06.00, 7.00' RT.	DOUBLE	31+85.50, 3.00' LT.	36.00'	5194.01 (N/A)
143			32+30.63, 3.00' LT.	36.00'	5194.36 (1)
144	33+06.00, 7.00' RT.	DOUBLE	32+73.50, 3.00' LT.	36.00'	5194.81 (2)
145			33+18.50, 3.00' LT.	36.00'	5195.24 (3)
146	33+86.00, 7.00' RT.	DOUBLE	33+65.63, 3.00' LT.	36.00'	5195.67 (4)
147			34+08.84, 3.00' LT.	36.00'	5196.82 (6)

WATERLINE TANGENT DATA TABLE			SAS TANGENT DATA TABLE		
No.	BEARING	DISTANCE	No.	BEARING	DISTANCE
T1	S 00°37'23" W	756.94'	T2	S 00°37'23" W	411.78'
			T3	S 00°37'23" W	239.05'

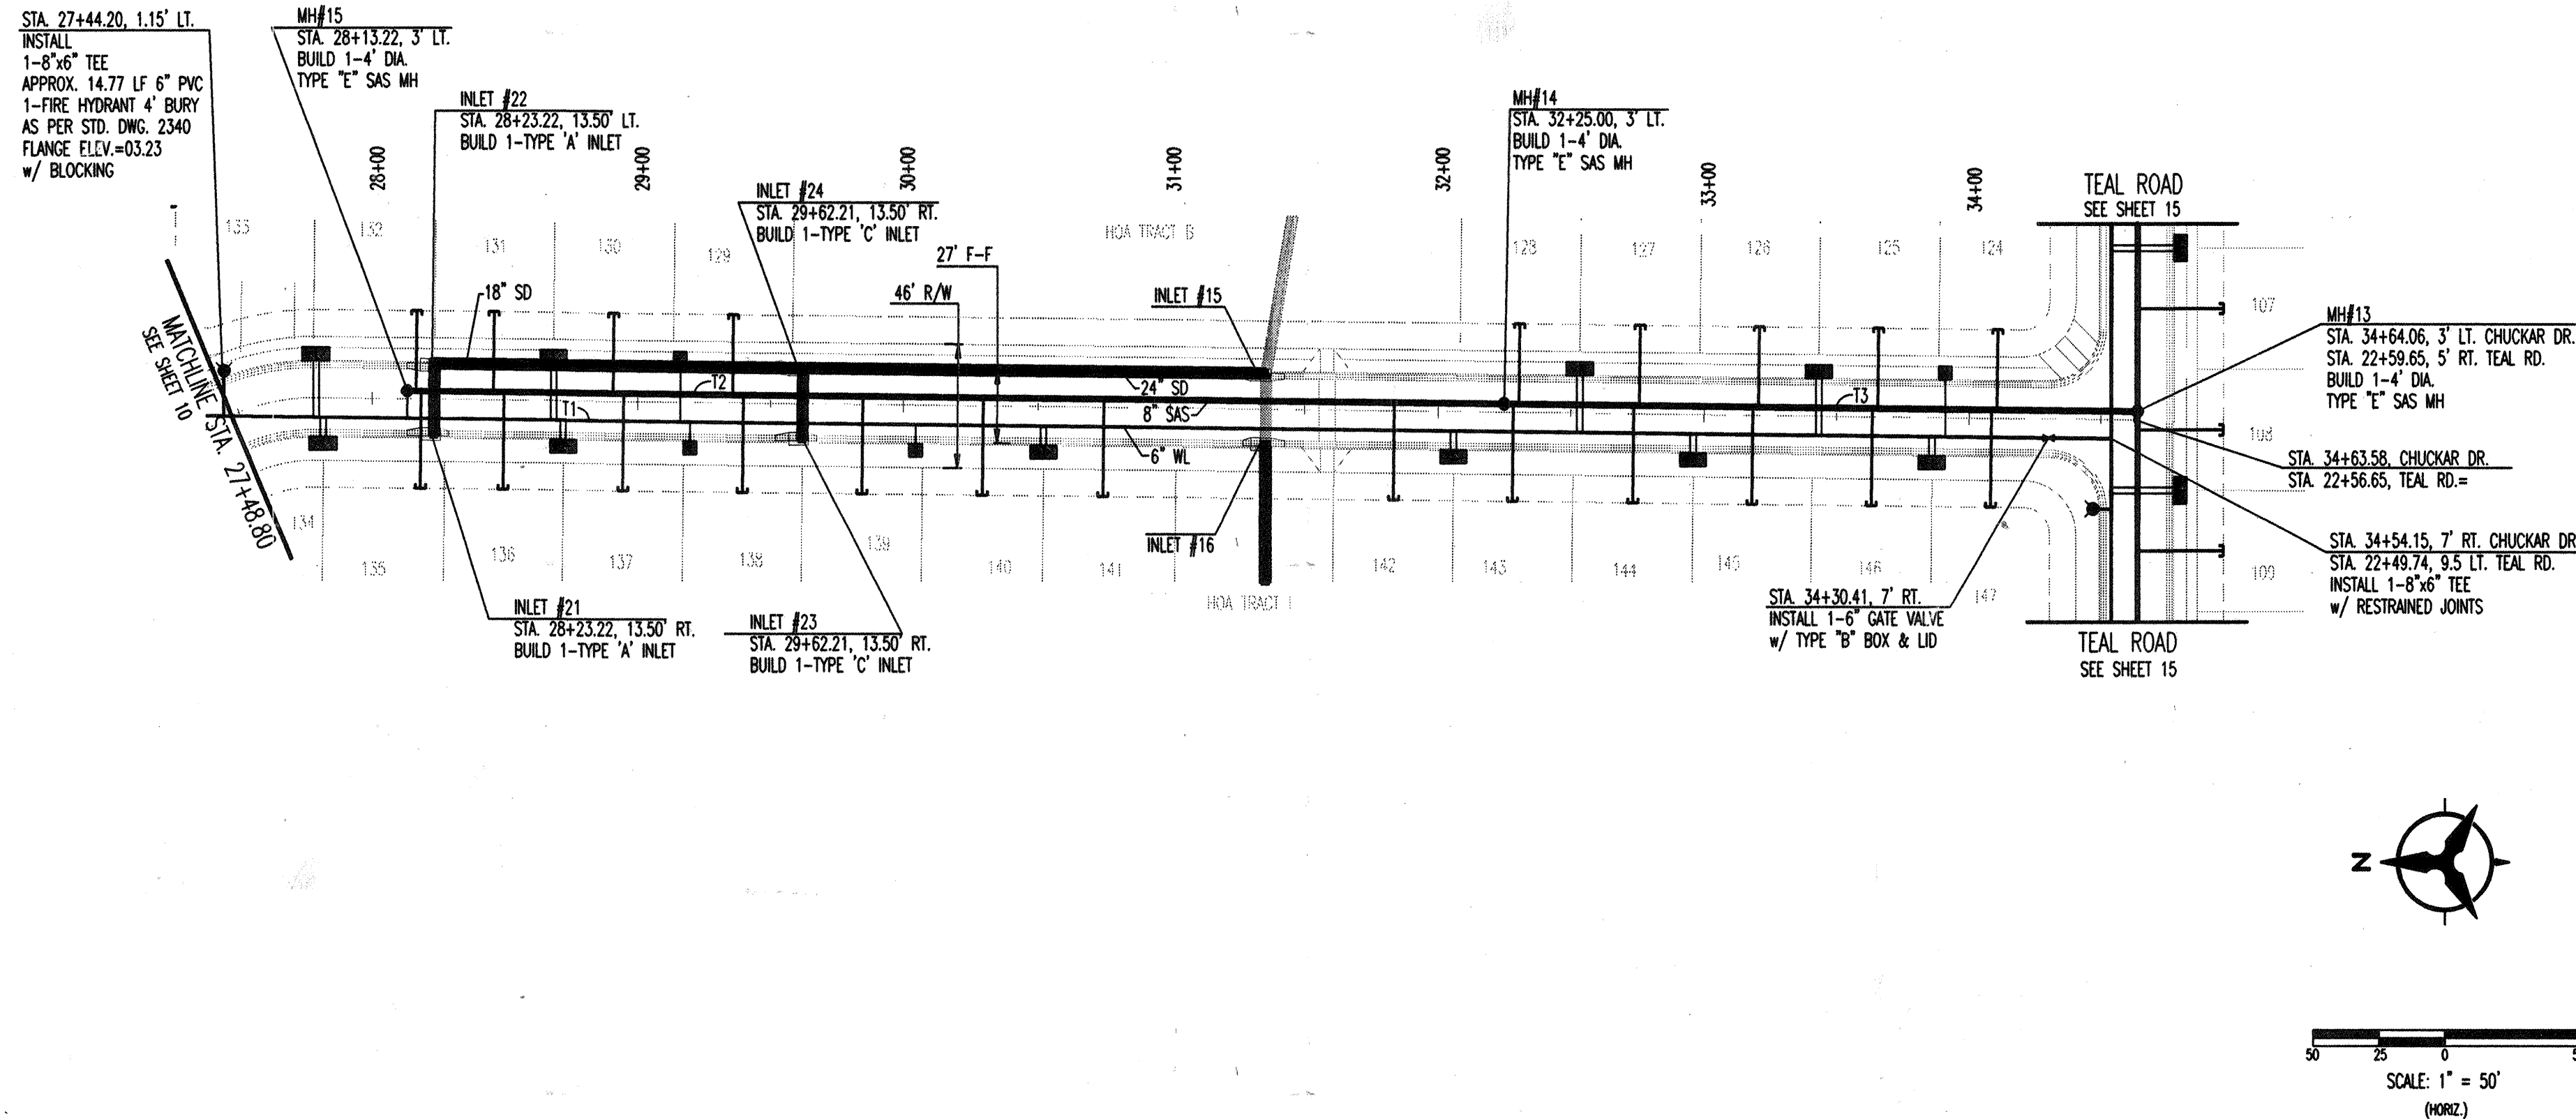


AS-BUILT

NOTES:

1. THE CONTRACTOR SHALL FIELD VERIFY ALL EXISTING PAVING AND UTILITY LOCATIONS AND NOTIFY THE ENGINEER IMMEDIATELY OF ANY DISCREPANCIES. NOTIFICATION WILL BE IN SUCH A MANNER AS TO ALLOW THE ENGINEER TIME TO MAKE REVISIONS PRIOR TO CONSTRUCTION. FAILURE TO DO SO MAY RESULT IN CONTRACTOR RESPONSIBILITY FOR RESOLUTION OF DISCREPANCIES.
2. ALL CURB RETURN RADII SHALL BE 25' UNLESS OTHERWISE SPECIFIED.
3. ALL CURVE DATA AND DIMENSIONS REFER TO FACE OF CURB UNLESS OTHERWISE SPECIFIED.
4. GRADE ELEVATIONS, WHERE NOTED, ARE FL OF CURB UNLESS OTHERWISE SPECIFIED.
5. CONTRACTOR IS TO INSTALL A 4" X 4" X 5' POST AND END AT THE END OF EACH SANITARY SEWER SERVICE.
6. CONTRACTOR IS RESPONSIBLE FOR REPAIR AND/OR REPLACEMENT OF ALL UTILITY CONDUITS AND EXISTING LINES.
7. ANY ADDITIONAL GRADING REQUIRED TO MATCH PROPOSED STREET GRADES SHALL BE INCIDENTAL TO PAVING ITEMS.
8. CONTRACTOR SHALL PROVIDE THE INSPECTORS, (CITY AND PRIVATE) WITH THE PROPOSED HYDROSTATIC TESTING PLAN. THE PLAN MUST BE APPROVED BEFORE TESTING OPERATIONS BEGIN.
9. CONTRACTOR SHALL PARK EQUIPMENT AND VEHICLES AS NOT TO INTERFERE WITH NORMAL ACTIVITIES OF RESIDENTS OR OTHER CONTRACTORS ON SITE.
10. ANY DAMAGE TO THE EXISTING FACILITIES (CURB & GUTTER), PAVEMENT, CONDUITS, LANDSCAPING, UTILITY LINES, ETC.) DURING CONSTRUCTION SHALL BE REPLACED AT THE CONTRACTORS' EXPENSE.
11. REMOVAL OF THE EXISTING CURB AND GUTTER SHALL BE AS PER COA STD. DWG. 2415 (SAWCUT ONLY).
12. WHEELCHAIR RAMPS SHALL BE CONSTRUCTED PRIOR TO ACCEPTANCE OF CURB & GUTTER.
13. CONSTRUCTION TRAFFIC CONTROL COST INCIDENTAL TO PAVING ITEMS.
14. MANHOLE RIM & CATCH BASIN ELEVATIONS ARE APPROX. THE CONTRACTOR WILL VERIFY AND CONSTRUCT TO MATCH FINAL PAVEMENT GRADES.
15. FIRE HYDRANT FLANGE ELEVATIONS SHOWN ARE APPROX. THE CONTRACTOR WILL VERIFY AND CONSTRUCT TO FINAL CURB ELEVATIONS PER COA. DETAIL 2340.

SCANNED BY
MESA REPRO

CHUKAR DRIVE

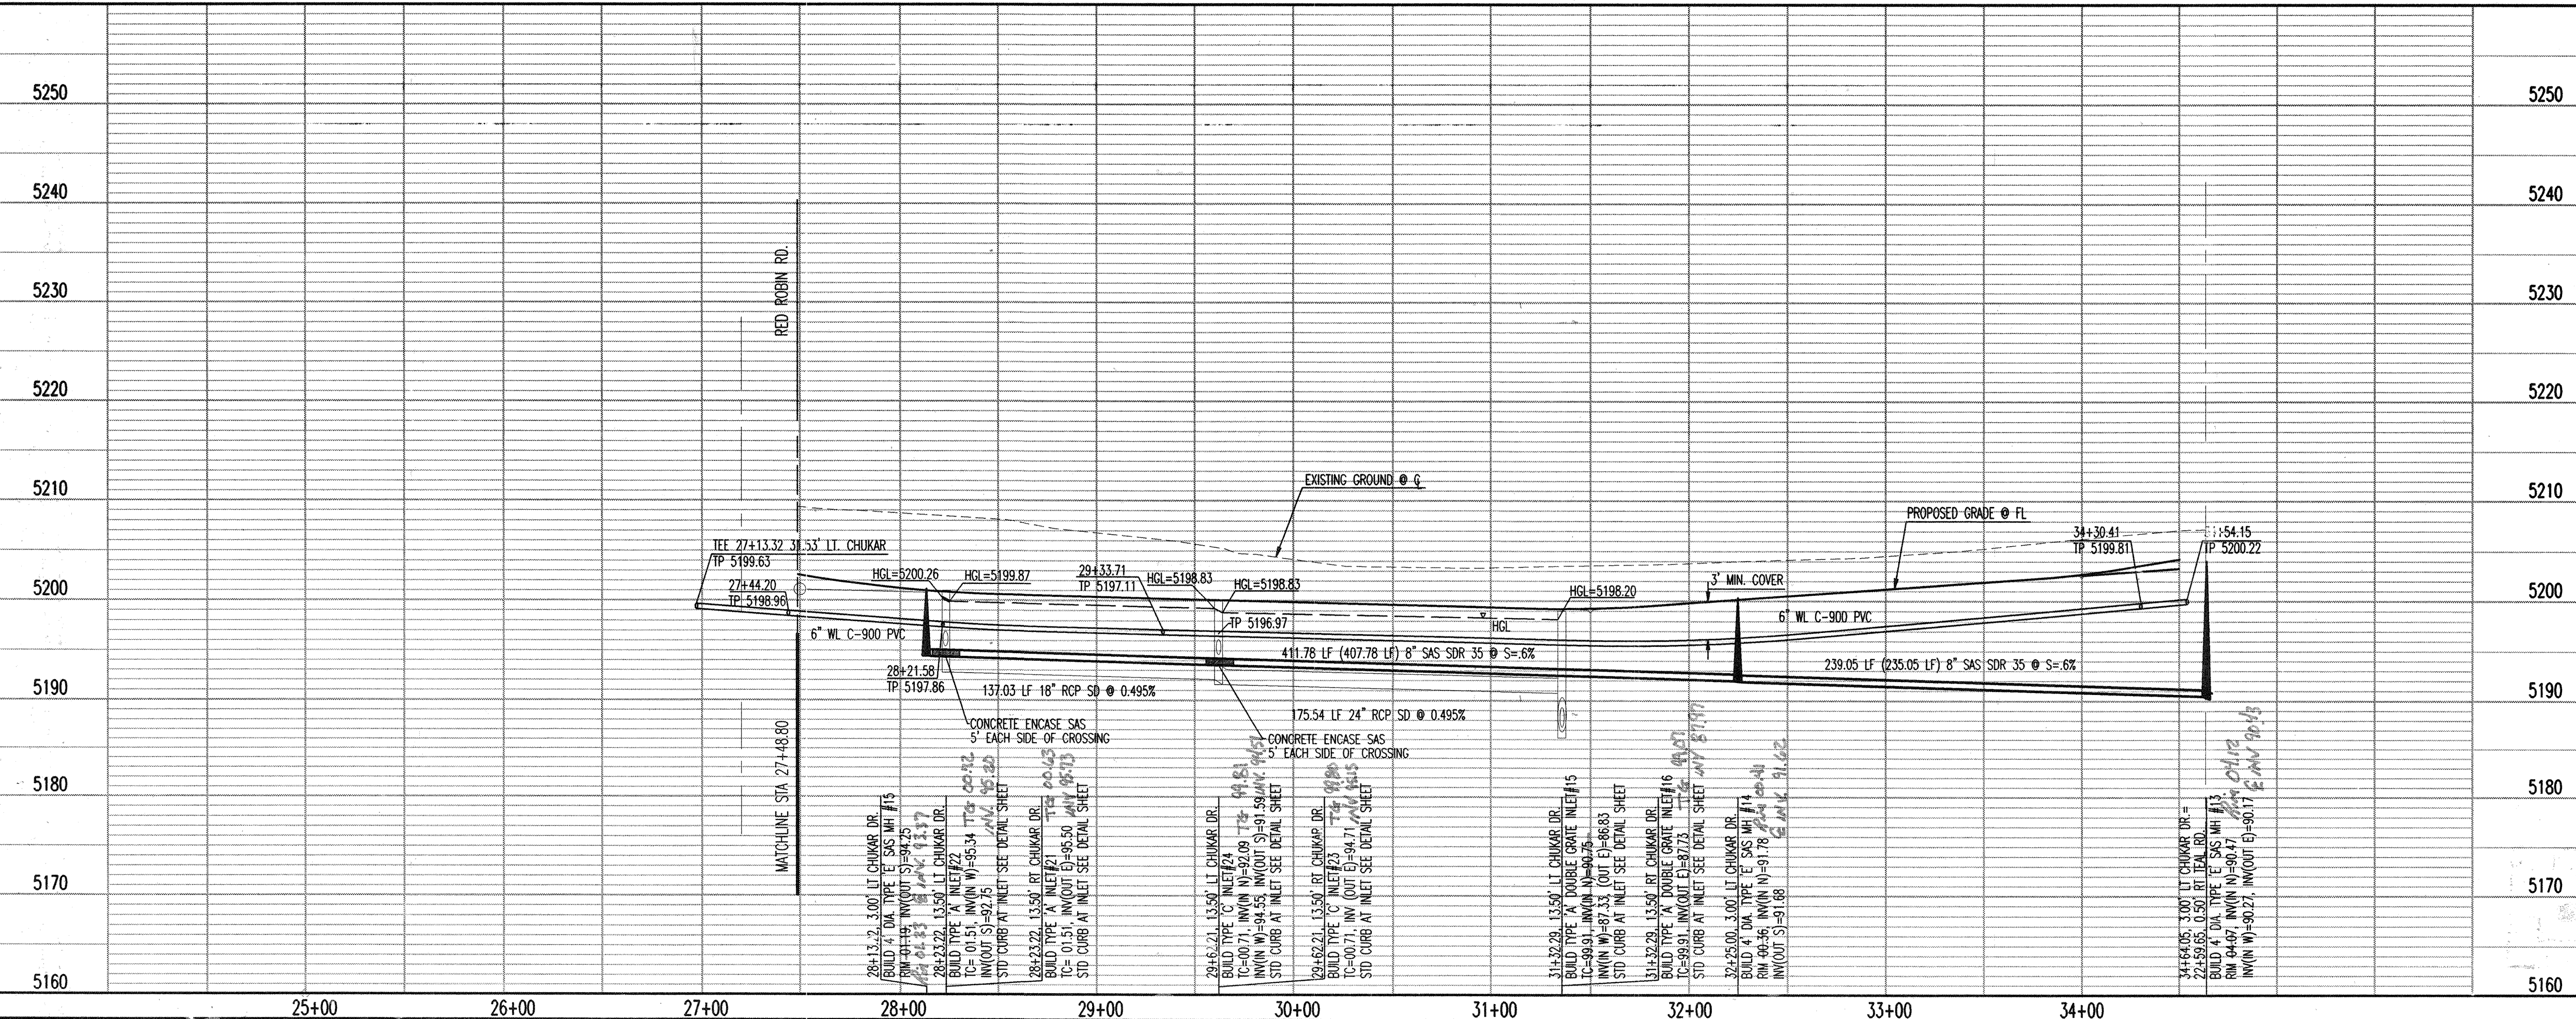

Bohannon & Huston
Countywide 7500 JEFFERSON NE Albuquerque NEW MEXICO 87109
ENGINEERS PLANNERS PHOTOGRAMMETRISTS SURVEYORS SOFTWARE DEVELOPERS

CITY OF ALBUQUERQUE
PUBLIC WORKS DEPARTMENT
ENGINEERING DEVELOPMENT GROUP


CHUKAR DRIVE
UTILITY PLAN & PROFILE
TIMARRON WEST UNIT 2

Design Review Committee City Engineer Approval

City Project No. 612781 Zone Map No. M-8 Sheet 17 Of 24

Mo./Day/Yr. Mo./Day/Yr.

City Engineer

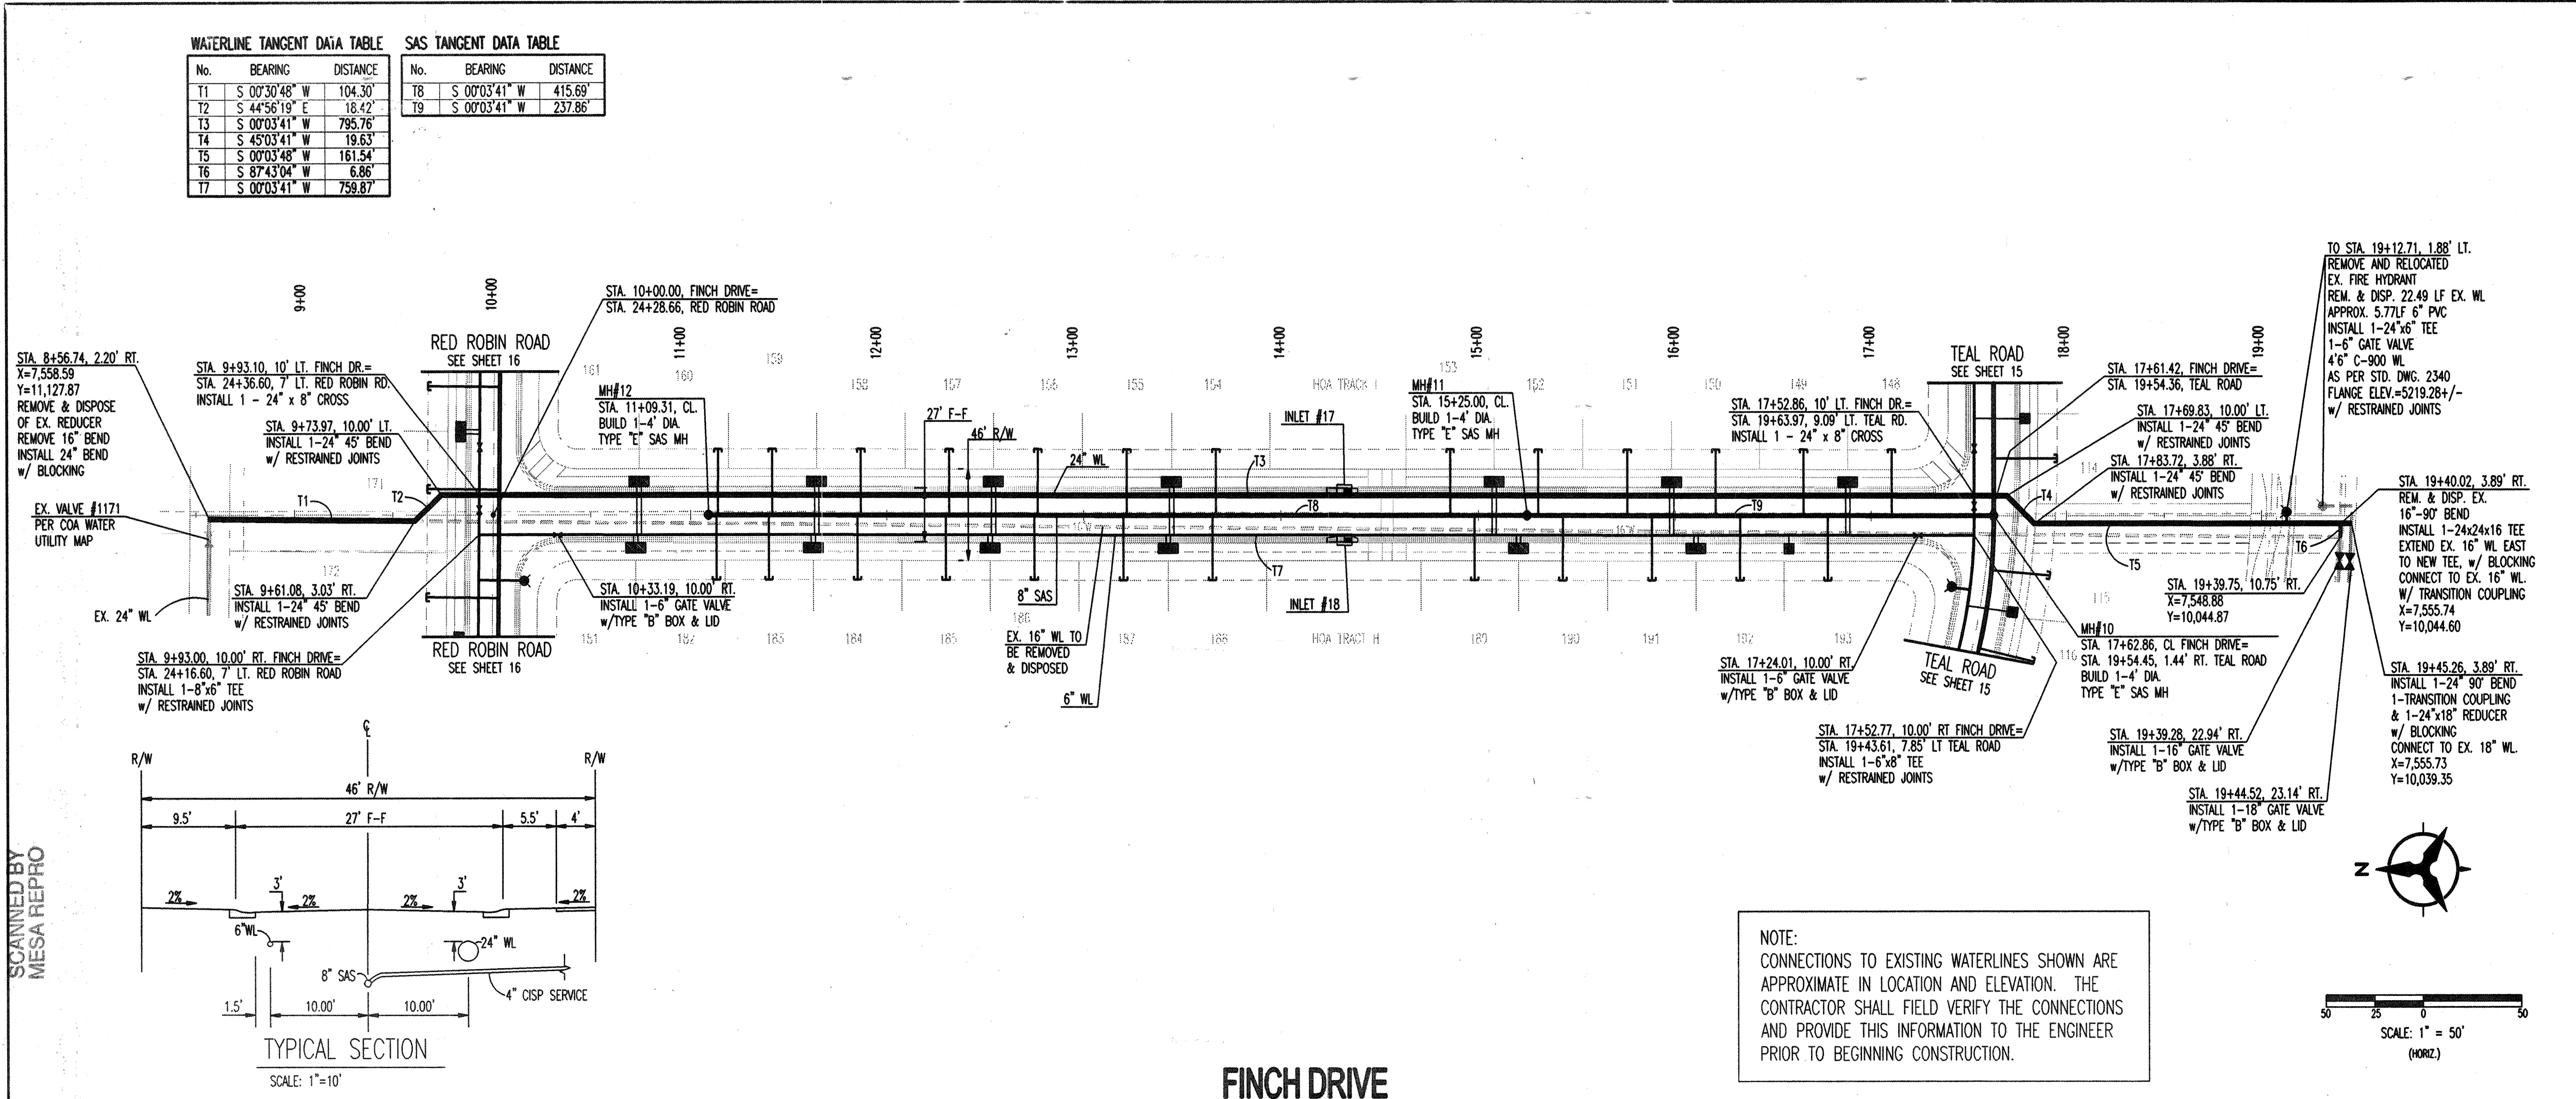

NOTES:

- THE CONTRACTOR SHALL FIELD VERIFY ALL EXISTING PAVING AND UTILITY LOCATIONS AND NOTIFY THE ENGINEER IMMEDIATELY OF ANY DISCREPANCIES. NOTIFICATION WILL BE IN SUCH A MANNER AS TO ALLOW THE ENGINEER TIME TO MAKE REVISIONS PRIOR TO CONSTRUCTION. FAILURE TO DO SO MAY RESULT IN CONTRACTOR RESPONSIBILITY FOR RESOLUTION OF DISCREPANCIES.
- ALL CURB RETURN RADII SHALL BE 25' UNLESS OTHERWISE SPECIFIED.
- ALL CURVE DATA AND DIMENSIONS REFER TO FACE OF CURB UNLESS OTHERWISE SPECIFIED.
- GRADE ELEVATIONS, WHERE NOTED, ARE FL. OF CURB UNLESS OTHERWISE SPECIFIED.
- CONTRACTOR IS TO INSTALL A 4" X 4" X 5' POST AND END AT THE END OF EACH SANITARY SEWER SERVICE.
- CONTRACTOR IS RESPONSIBLE FOR REPAIR AND/OR REPLACEMENT OF ALL UTILITY CONDUITS AND EXISTING LINES.
- ANY ADDITIONAL GRADING REQUIRED TO MATCH PROPOSED STREET GRADES SHALL BE INCIDENTAL TO PAVING ITEMS.
- CONTRACTOR SHALL PROVIDE THE INSPECTORS, (CITY AND PRIVATE) WITH THE PROPOSED HYDROSTATIC TESTING PLAN. THE PLAN MUST BE APPROVED BEFORE TESTING OPERATIONS BEGIN.
- CONTRACTOR SHALL PARK EQUIPMENT AND VEHICLES AS NOT TO INTERFERE WITH NORMAL ACTIVITIES OF RESIDENTS OR OTHER CONTRACTORS ON SITE.
- ANY DAMAGE TO THE EXISTING FACILITIES (CURB & GUTTER), PAVEMENT, CONDUITS, LANDSCAPING, UTILITY LINES, ETC.) DURING CONSTRUCTION SHALL BE REPLACED AT THE CONTRACTORS' EXPENSE.
- REMOVAL OF THE EXISTING CURB AND GUTTER SHALL BE AS PER COA STD. DWG. 2415 (SAW-CUT ONLY).
- WHEELCHAIR RAMPS SHALL BE CONSTRUCTED PRIOR TO ACCEPTANCE OF CURB & GUTTER.
- CONSTRUCTION TRAFFIC CONTROL COST INCIDENTAL TO PAVING ITEMS.
- MANHOLE RIM & CATCH BASIN ELEVATIONS ARE APPROX. THE CONTRACTOR WILL VERIFY AND CONSTRUCT TO MATCH FINAL PAVEMENT GRADES.
- FIRE HYDRANT FLANGE ELEVATIONS SHOWN ARE APPROX. THE CONTRACTOR WILL VERIFY AND CONSTRUCT TO FINAL CURB ELEVATIONS PER COA DETAIL 2340.

AS-BUILT INFORMATION

CONTRACTOR	DATE	BY	DATE	BY	DATE	BY

BENCH MARKS

STATION	AS MONUMENT	7-1/2" LOCATED AT THE ESE CORNER OF	DATE	BY

SURVEY INFORMATION

NO.	DATE	BY

ENGINEER'S SEAL

REVISIONS

No.	Date	By

Bohannon & Huston

Courtyard One 7500 JEFFERSON NE ALBUQUERQUE NEW MEXICO 87109

ENGINEERS PLANNERS PHOTOGRAMMETRISTS SURVEYORS SOFTWARE DEVELOPERS

CITY OF ALBUQUERQUE
PUBLIC WORKS DEPARTMENT
ENGINEERING DEVELOPMENT GROUP

FINCH DRIVE
UTILITY PLAN & PROFILE
TIMARRON WEST UNIT 2

AS-BUILT

Design Review Committee

City Engineer Approval

Mo./Day/Yr.

City Project No. 612781


Zone Map No. M-8

Sheet 18

Copyright Bohannon & Huston 1998
Date: 4/15/99


NOTE:
THE CONTRACTOR SHALL FIELD VERIFY
ALL EXISTING UTILITY LOCATIONS AND
NOTIFY THE ENGINEER IMMEDIATELY OF
ANY DISCREPANCIES.

DE VARGAS STORM DRAIN

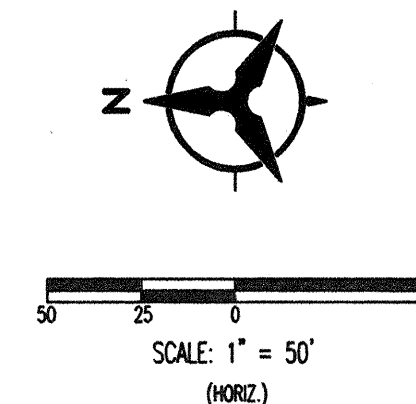
[illegible]

SCALE: 1" = 50' (HORIZ.)
1" = 10' (VERT.)



15. FIRE HYDRANT FLANGE ELEVATIONS SHOWN ARE APPROX. THE CONTRACTOR WILL VERIFY AND CONSTRUCT TO FINAL CURB ELEVATIONS PER COA. DETAIL 2340.

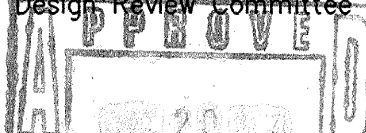AS-BUILT DE VARGAS STORM DRAIN UTILITY PLAN & PROFILE TIARRON WEST UNIT 2				
Design Review Committee 	City Engineer Approval 	Lost Design Update	Mo./Day/Yr.	Mo./Day/Yr.
City Project No. 612781	Zone Map No. M-8	Sheet 19	Of 24	

SCANNED BY
MESA REPRO

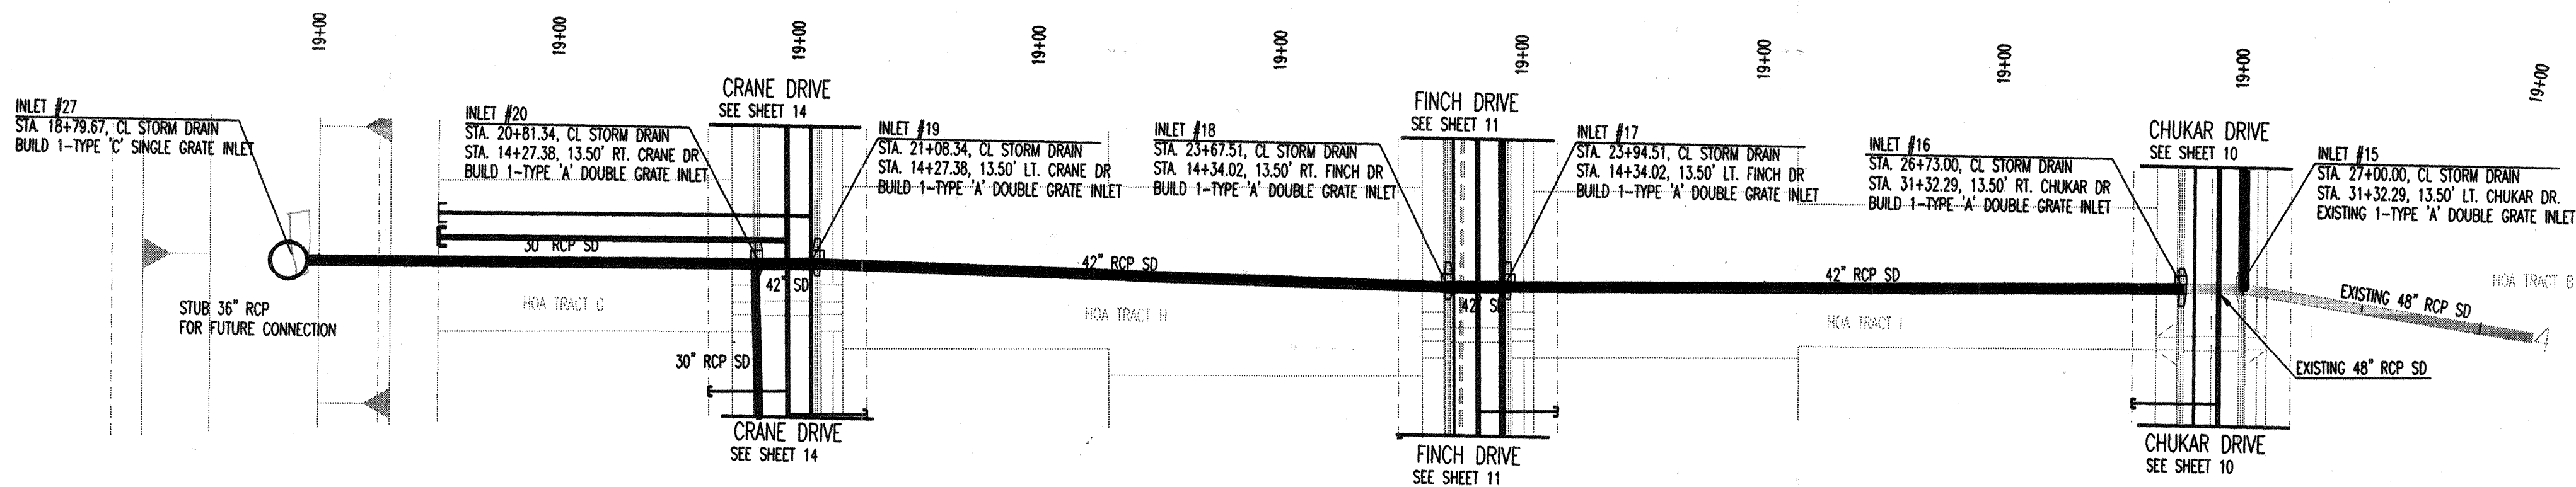

MAIN STORM DRAIN LINE

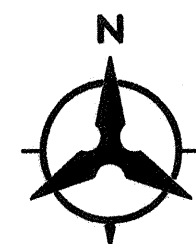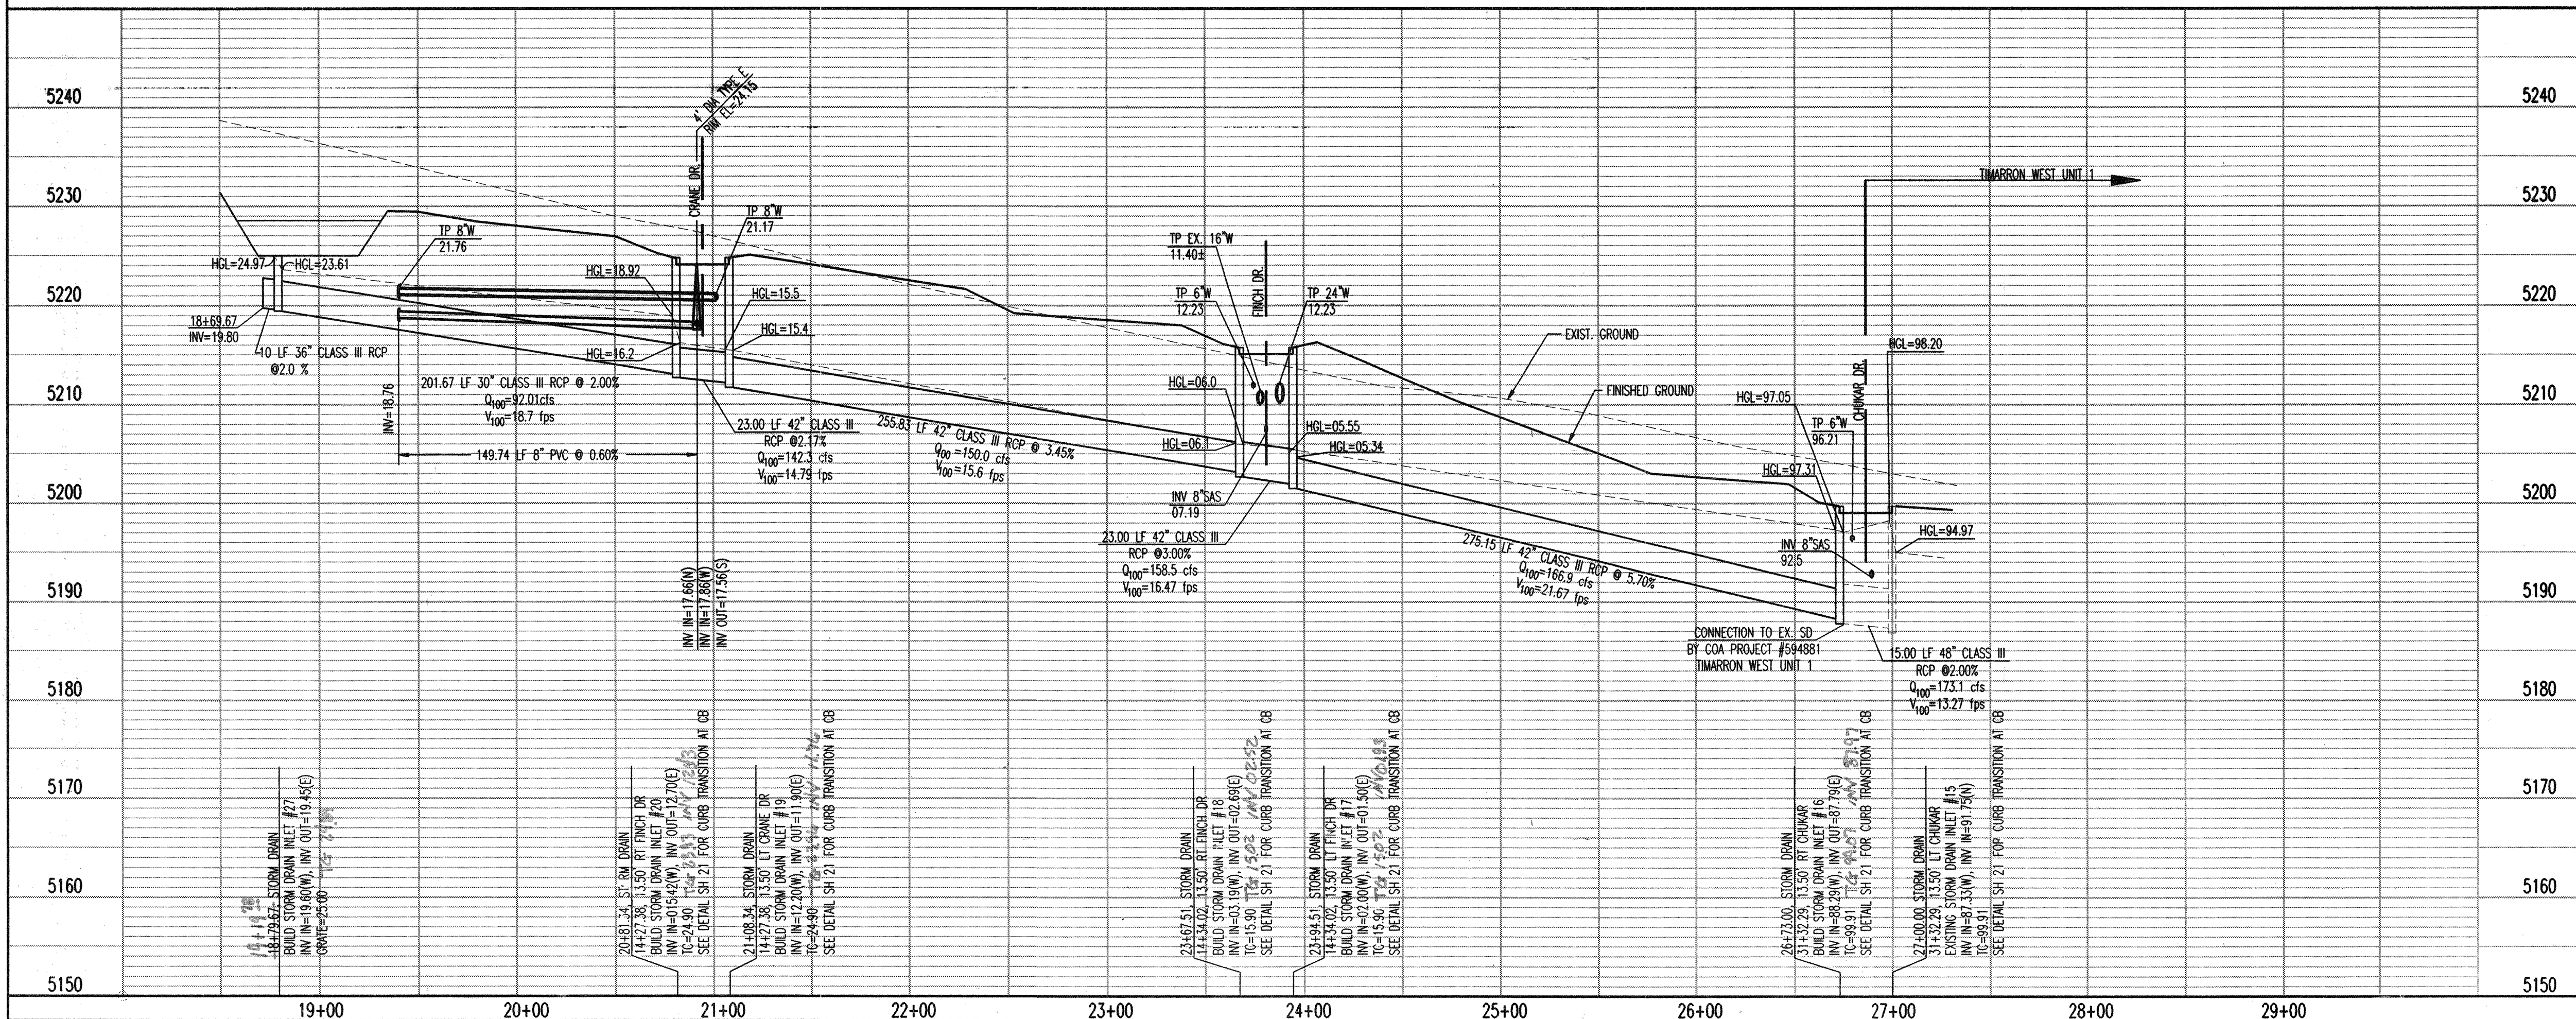

SCALE: 1" = 50' (HORIZ.)
1" = 10' (VERT.)

NOTES:

1. THE CONTRACTOR SHALL FIELD VERIFY ALL EXISTING PAVING AND UTILITY LOCATIONS AND NOTIFY THE ENGINEER IMMEDIATELY OF ANY DISCREPANCIES. NOTIFICATION WILL BE IN SUCH A MANNER AS TO ALLOW THE ENGINEER TIME TO MAKE REVISIONS PRIOR TO CONSTRUCTION. FAILURE TO DO SO MAY RESULT IN CONTRACTOR RESPONSIBILITY FOR RESOLUTION OF DISCREPANCIES.
2. ALL CURB RETURN RADI SHALL BE 25' UNLESS OTHERWISE SPECIFIED.
3. ALL CURB DATA AND DIMENSIONS REFER TO FACE OF CURB UNLESS OTHERWISE SPECIFIED.
4. GRADE ELEVATIONS, WHERE NOTED, ARE FL OF CURB UNLESS OTHERWISE SPECIFIED.
5. CONTRACTOR IS TO INSTALL A 4" X 4" X 5' POST AND END AT THE END OF EACH SANITARY SEWER SERVICE.
6. CONTRACTOR IS RESPONSIBLE FOR REPAIR AND/OR REPLACEMENT OF ALL UTILITY CONDUITS AND EXISTING LINES.
7. ANY ADDITIONAL GRADING REQUIRED TO MATCH PROPOSED STREET GRADES SHALL BE INCIDENTAL TO PAVING ITEMS.
8. CONTRACTOR SHALL PROVIDE THE INSPECTORS, (CITY AND PRIVATE) WITH THE PROPOSED HYDROSTATIC TESTING PLAN. THE PLAN MUST BE APPROVED BEFORE TESTING OPERATIONS BEGIN.
9. CONTRACTOR SHALL PARK EQUIPMENT AND VEHICLES AS NOT TO INTERFERE WITH NORMAL ACTIVITIES OF RESIDENTS OR OTHER CONTRACTORS ON SITE.
10. ANY DAMAGE TO THE EXISTING FACILITIES (CURB & GUTTER), PAVEMENT, CONDUITS, LANDSCAPING, UTILITY LINES, ETC.) DURING CONSTRUCTION SHALL BE REPLACED AT THE CONTRACTORS' EXPENSE.
11. REMOVAL OF THE EXISTING CURB AND GUTTER SHALL BE AS PER COA STD. DWG. 2415 (SAWCUT ONLY).
12. WHEELCHAIR RAMPS SHALL BE CONSTRUCTED PRIOR TO ACCEPTANCE OF CURB & GUTTER.
13. CONSTRUCTION TRAFFIC CONTROL COST INCIDENTAL TO PAVING ITEMS.
14. MANHOLE RIM & CATCH BASIN ELEVATIONS ARE APPROX. THE CONTRACTOR WILL VERIFY AND CONSTRUCT TO MATCH FINAL PAVEMENT GRADES.
15. FIRE HYDRANT FLANGE ELEVATIONS SHOWN ARE APPROX. THE CONTRACTOR WILL VERIFY AND CONSTRUCT TO FINAL CURB ELEVATIONS PER COA DETAIL 2340.

AS-BUILT INFORMATION		BENCH MARKS		SURVEY INFORMATION		ENGINEER'S SEAL	
CONTRACTOR	DATE	STATION IS ACS MONUMENT	DATE	NO.	DATE	By	REVISIONS
BOHANNAN & HUSTON	3/99	DE VARGAS ROAD AND DEL MISTO DRIVE SW, EXPOSED TO TOP OF CONCRETE	3/99				DESIGN
ACCEPTED BY	DATE	CURB DESCRIPTION: ACS 1 3/4" ALUMINUM DISK, STAMPED "ACS BUL 6-10"					
REVISIONS	DATE	ELEVATION=574.07					
NO.	DATE						
MICRO-FILM INFORMATION		RECORDED BY		DATE		NO.	

Bohannon & Huston
Countywide 7500 JEFFERSON NE ALBUQUERQUE NEW MEXICO 87109
ENGINEERS PLANNERS PHOTOGRAMMETRISTS SURVEYORS SOFTWARE DEVELOPERS

CITY OF ALBUQUERQUE
PUBLIC WORKS DEPARTMENT
ENGINEERING DEVELOPMENT GROUP


AS-BUILT MAIN STORM DRAIN LINE
UTILITY PLAN & PROFILE
TIMARRON WEST UNIT 2

Design Review Committee: APPROVED MAY 20 1999
City Engineer: APPROVED MAY 20 1999


City Project No. 612781
Zone Map No. M-8
Sheet 20 Of 24

Copyright Bohannon & Huston 1999
Date: 2/8/99

SCANNED BY
MESA REPRO

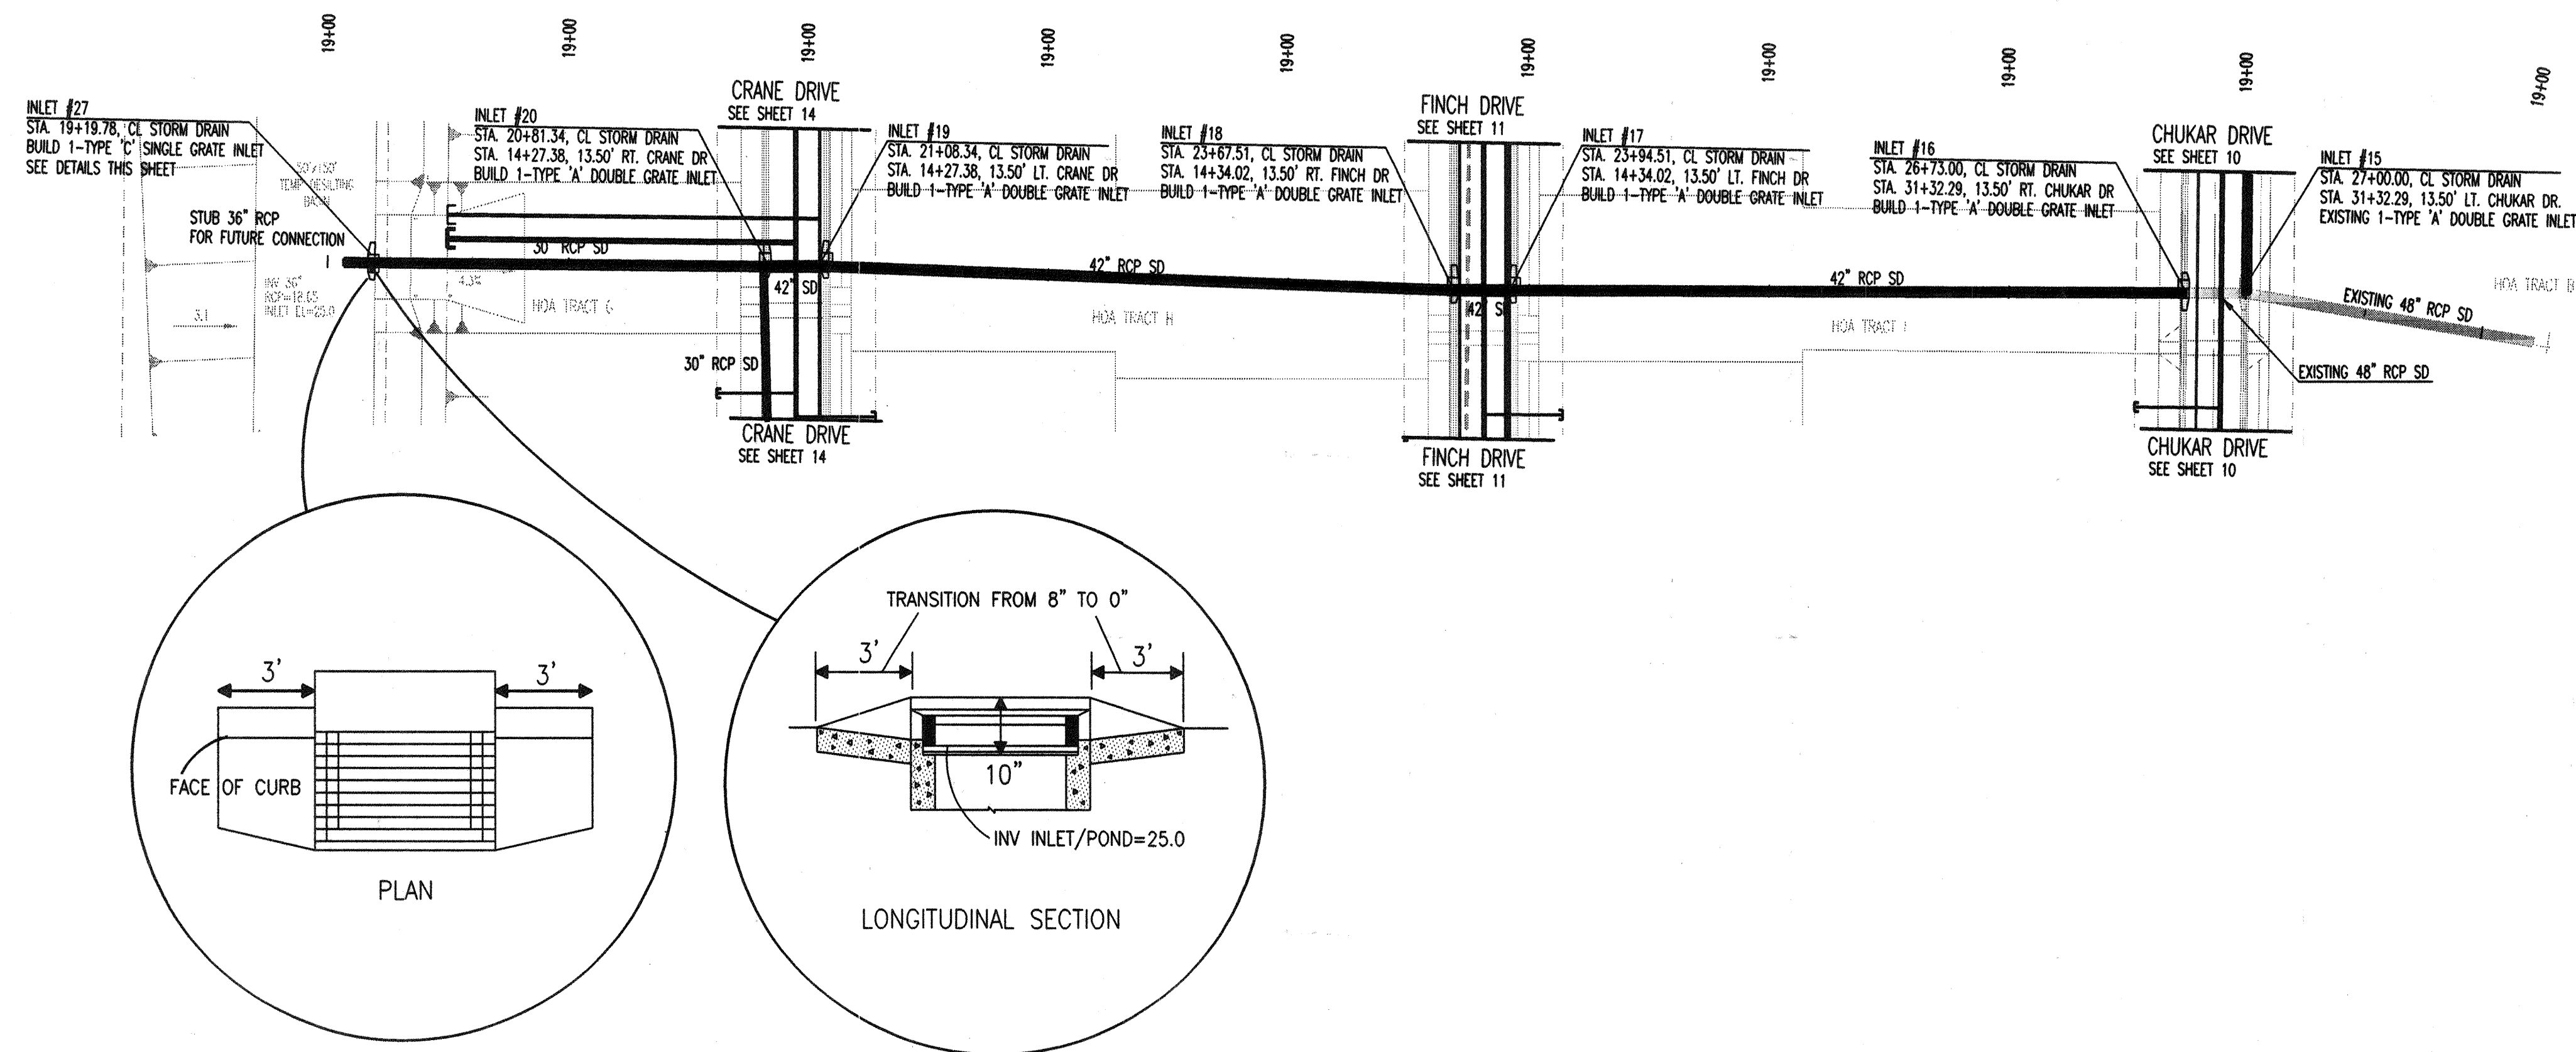

MAIN STORM DRAIN LINE

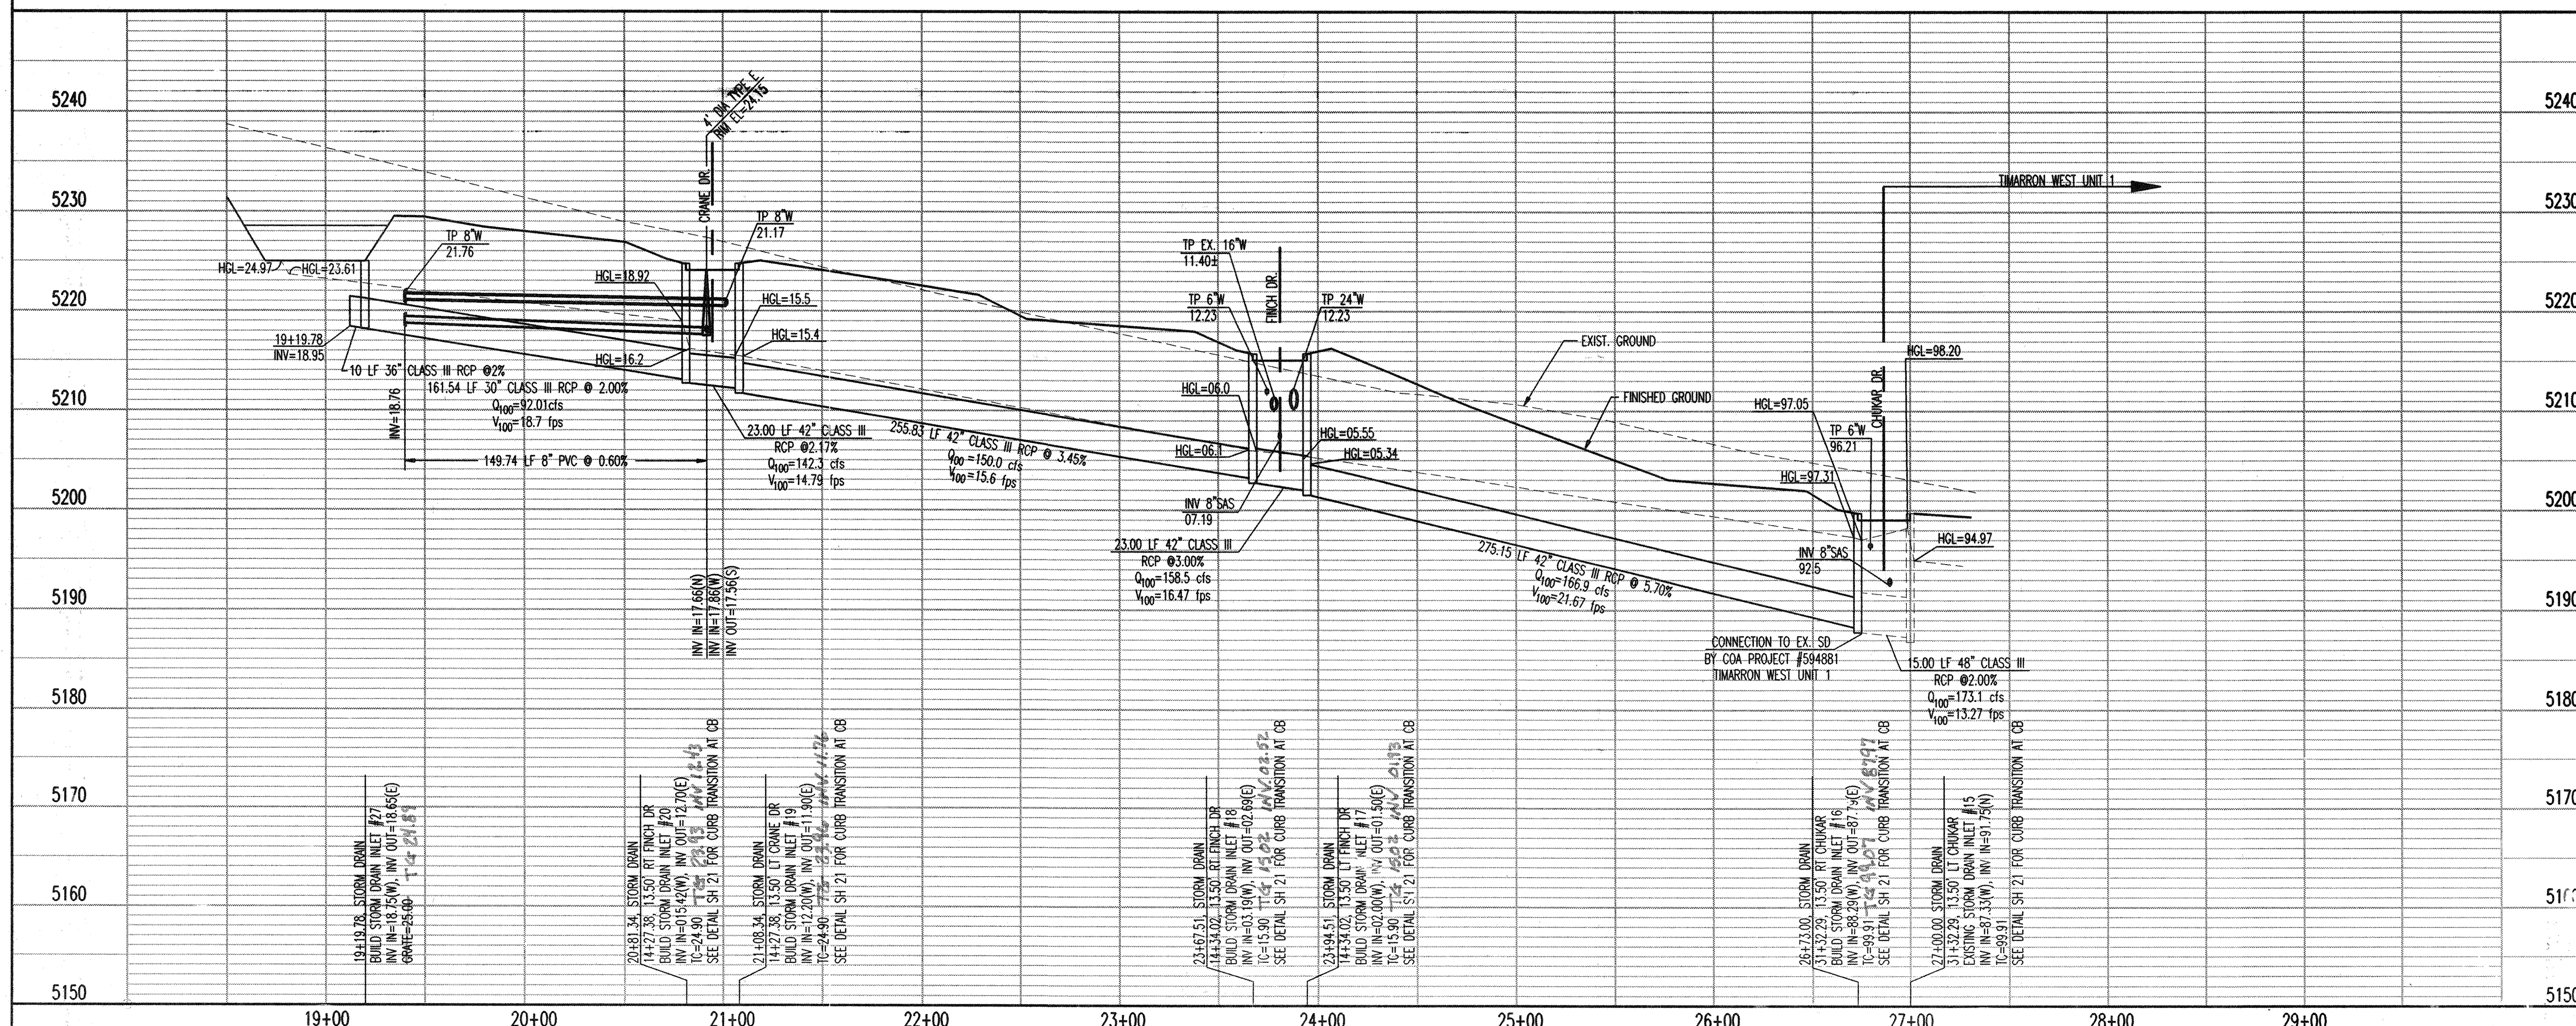

SCALE: 1" = 30' (HORIZ.)
1" = 10' (VERT.)

BHL JOB NO 99325





Copyright ©
Date: 4/8/99

NOTES:

1. THE CONTRACTOR SHALL FIELD VERIFY ALL EXISTING PAVING AND UTILITY LOCATIONS AND NOTIFY THE ENGINEER IMMEDIATELY IF ANY DISCREPANCIES. NOTIFICATION WILL BE IN SUCH A MANNER AS TO ALLOW THE ENGINEER TIME TO MAKE REVISIONS PRIOR TO CONSTRUCTION. FAILURE TO DO SO MAY RESULT IN CONTRACTOR RESPONSIBILITY FOR RESOLUTION OF DISCREPANCIES.
2. ALL CURB RETURN RADI SHALL BE 25' UNLESS OTHERWISE SPECIFIED.
3. ALL CURVE DATA AND DIMENSIONS REFER TO FACE OF CURB UNLESS OTHERWISE SPECIFIED.
4. GRADE ELEVATIONS, WHERE NOTED, ARE FL. OF CURB UNLESS OTHERWISE SPECIFIED.
5. CONTRACTOR IS TO INSTALL A 4" X 4" X 5' POST AND END AT THE END OF EACH SANITARY SEWER SERVICE.
6. CONTRACTOR IS RESPONSIBLE FOR REPAIR AND/OR REPLACEMENT OF ALL UTILITY CONDUITS AND EXISTING LINES.
7. ANY ADDITIONAL GRADING REQUIRED TO MATCH PROPOSED STREET GRADES SHALL BE INCIDENTAL TO PAVING ITEMS.
8. CONTRACTOR SHALL PROVIDE THE INSPECTORS, (CITY AND PRIVATE) WITH THE PROPOSED HYDROSTATIC TESTING PLAN. THE PLAN MUST BE APPROVED BEFORE TESTING OPERATIONS BEGIN.
9. CONTRACTOR SHALL PARK EQUIPMENT AND VEHICLES AS NOT TO INTERFERE WITH NORMAL ACTIVITIES OF RESIDENTS OR OTHER CONTRACTORS ON SITE.
10. ANY DAMAGE TO THE EXISTING FACILITIES (CURB & GUTTER), PAVEMENT, CONDUITS, LANDSCAPING, UTILITY LINES, ETC.) DURING CONSTRUCTION SHALL BE REPLACED AT THE CONTRACTORS' EXPENSE.
11. REMOVAL OF THE EXISTING CURB AND GUTTER SHALL BE AS PER COA STD. DWG. 2415 (SAWCUT ONLY).
12. WHEELCHAIR RAMPS SHALL BE CONSTRUCTED PRIOR TO ACCEPTANCE OF CURB & GUTTER.
13. CONSTRUCTION TRAFFIC CONTROL COST INCIDENTAL TO PAVING ITEMS.
14. MANHOLE RIM & CATCH BASIN ELEVATIONS ARE APPROX. THE CONTRACTOR WILL VERIFY AND CONSTRUCT TO MATCH FINAL PAVEMENT GRADES.
15. FIRE HYDRANT FLANGE ELEVATIONS SHOWN ARE APPROX. THE CONTRACTOR WILL VERIFY AND CONSTRUCT TO FINAL CURB ELEVATIONS PER COA DETAIL 2340.

[illegible]

SCANNED BY
MESA REPRO

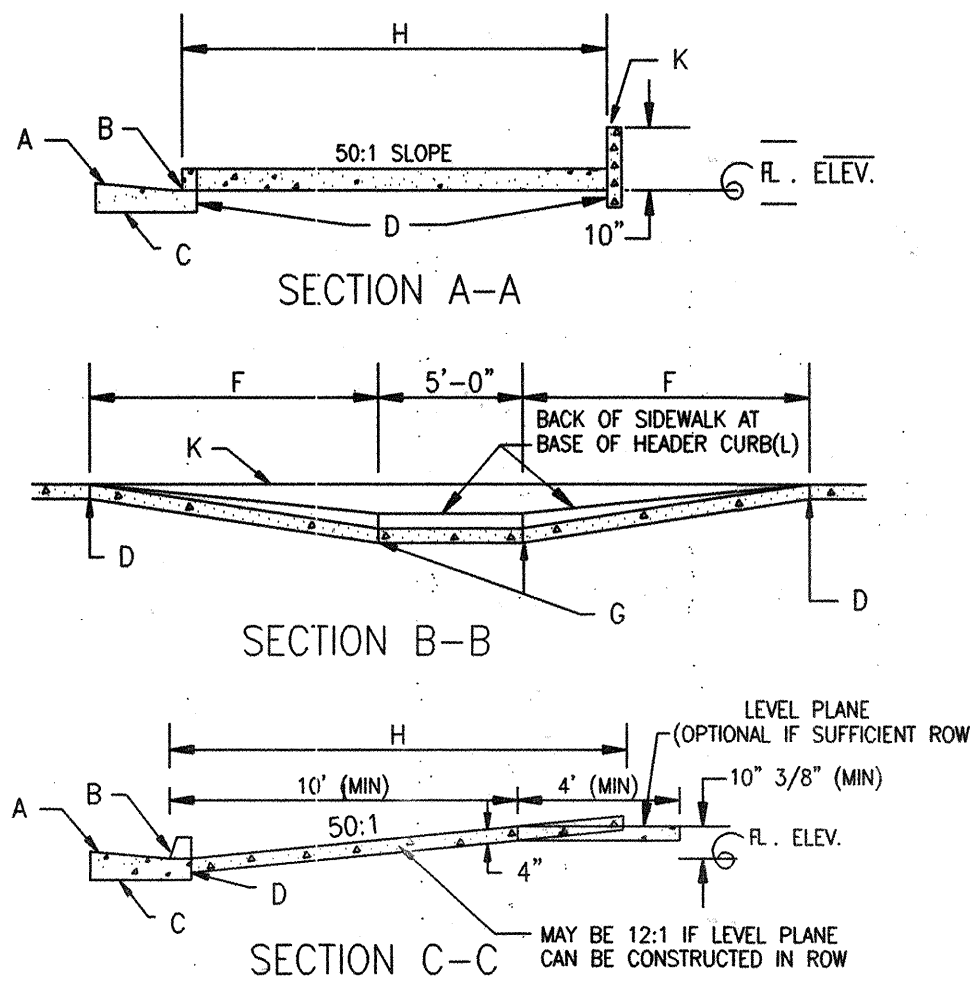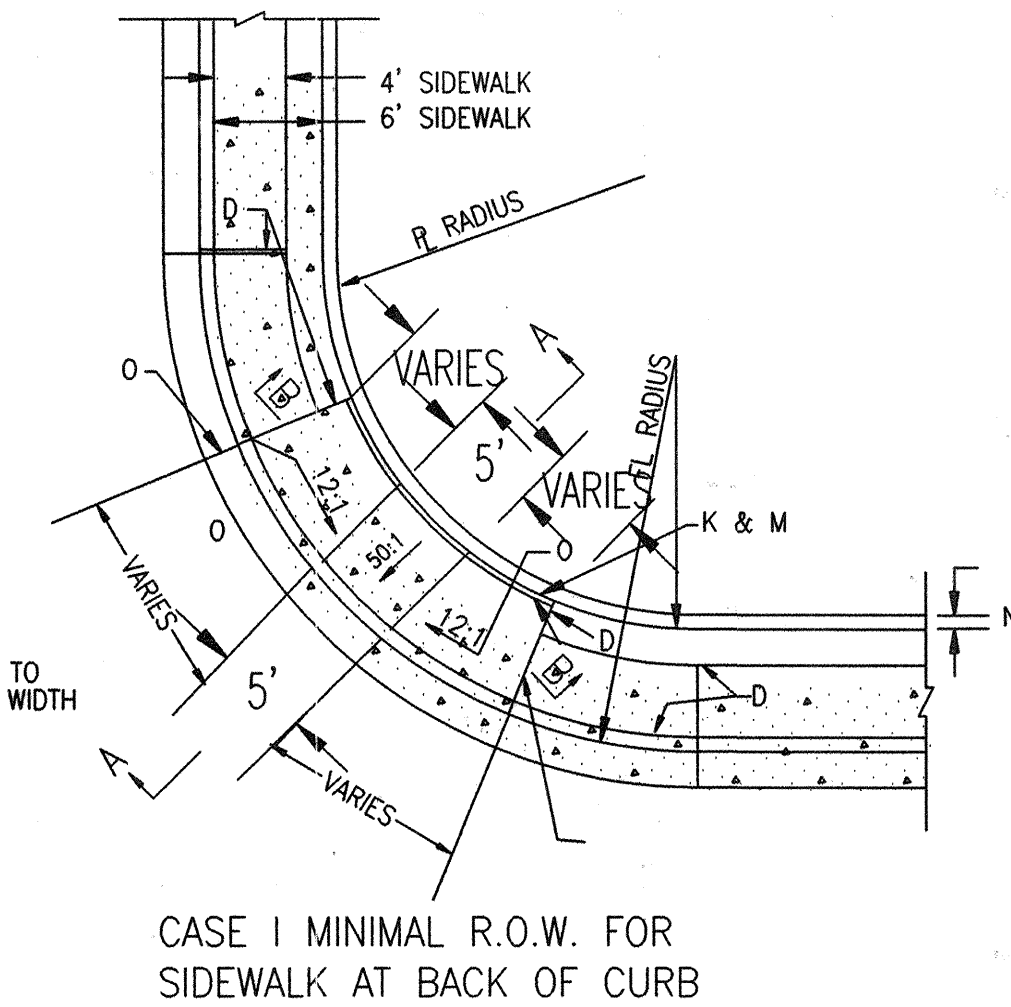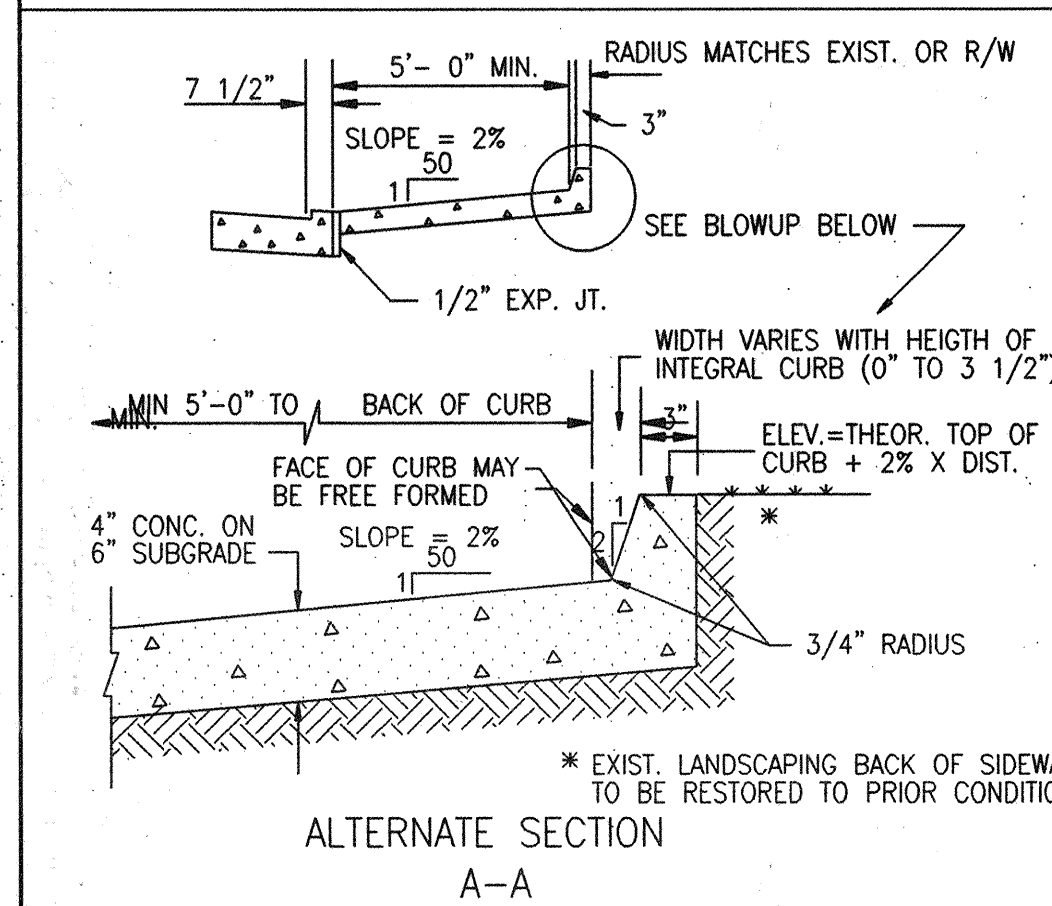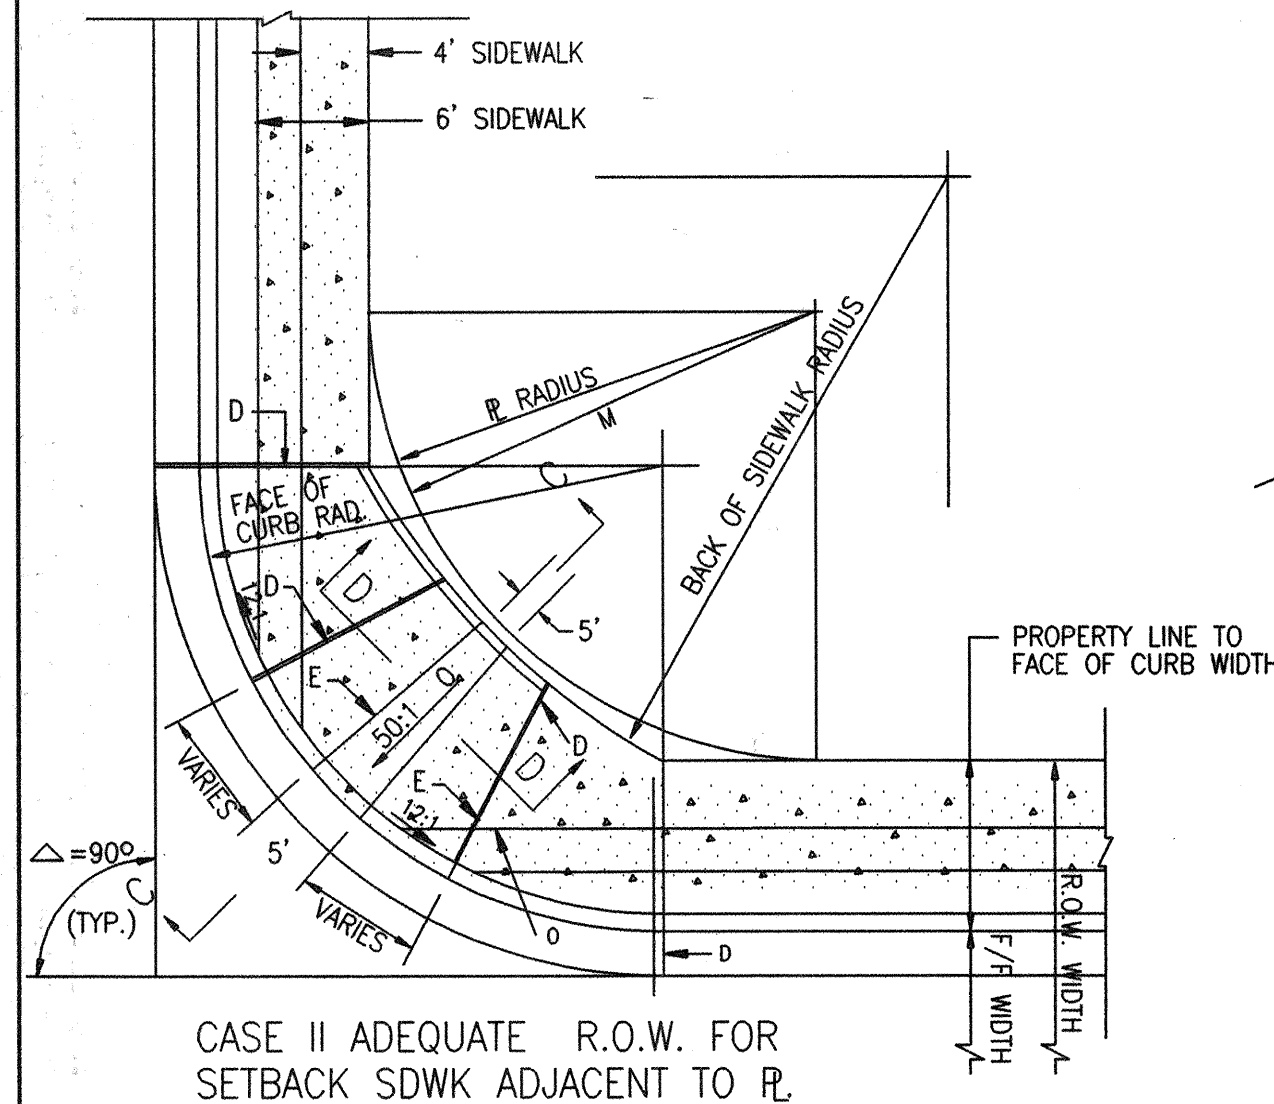


GENERAL NOTES:

1. CURB ACCESS RAMP ARE NORMALLY TO BE LOCATED AT THE CENTER OF THE RETURN OR AS DIRECTED BY THE CITY TRAFFIC ENGINEER.
2. SURFACE TEXTURE OF CURB ASSESS RAMP SHALL BE OBTAINED BY HEAVY BROOMING (TEXTURE DEPTH .035"), TRANSVERSE TO THE SLOPE OF THE RAMP.
3. GUTTER FLOWLINE PROFILE SHALL BE MAINTAINED THROUGH THE AREA OF THE RAMP. DRAINAGE CATCH BASIN STRUCTURES SHALL NOT BE PLACED IN LINE WITH RAMP.
4. WIDTH OF SIDEWALK AND RAMP MUST BE MAINTAINED AT A MINIMUM OF 5'-0" THROUGH ENTIRE RAMP LENGTH.

CONSTRUCTION NOTES:


- A. SLOPE OF GUTTER DEPENDENT ON REQUIREMENTS FOR VALLEY GUTTER.
- B. 1/4" UP ABOVE FLOW LINE (VERTICAL). SEE STD. DWG 2415
- C. CURB & GUTTER (SEE STD. DWG 2415 - GUTTER AT THE CURB ACCESS RAMP).
- D. 1/2" EXPANSION JOINT.
- E. PARALLEL LINES - TOP AND BOTTOM OF RAMP.
- F. 12:1 SLOPE AT FACE OF CURB. (SEE STD. DWG 2418)
- G. CONTRACTION (DUMMY) JOINT.
- H. VARIES WITH AVAILABLE R.O.W.
- J. VARIABLE.
- K. HEADER CURB, SEE DWG. 2415.
- L. BACK OF SIDEWALK.
- M. BACK OF SIDEWALK RADIUS TO BE ESTABLISHED SO AS TO MAINTAIN A 5'-0" RAMP WIDTH (MINIMUM) OR MORE THROUGHOUT. SEE STD. DWG 2440 (NOTE 5) IF LESS THAN 5'-0" IS AVAILABLE DUE TO UNTIMELY UNRESOLVABLE CONSTRAINTS.
- N. 4 1/2" MAX.
- O. 12:1 SLOPE MAXIMUM ON RAMP.
- P. ANY PRIVATE LANDSCAPING AND OR IRRIGATION SHALL BE RESTORED TO ORIGINAL CONDITION. SHOULD ANY PRIVATE IMPROVEMENT NEED TO BE REMOVED, OWNER MUST BE NOTIFIED.

IR RAD	CURB RAD	CURB WIDTH	BACK SW RAD
90°	25'	25'	4'
90°	30'	25'	4'
90°	30'	30'	4'
90°	30'	30'	4'

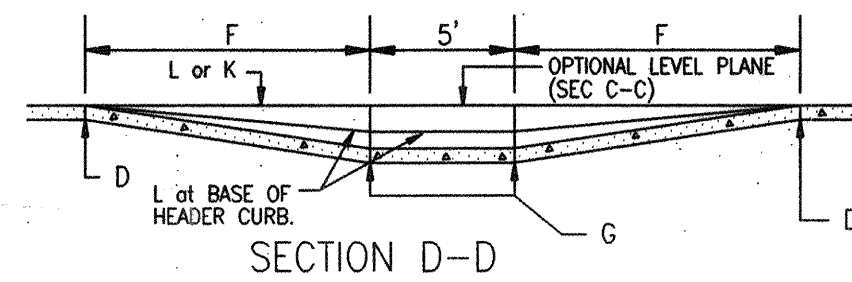

REVISIONS	DATE	DESCRIPTION
11/14/91		

CITY OF ALBUQUERQUE
PAVING
WHEEL CHAIR RAMP
DWG. 2441
AUG. 1986

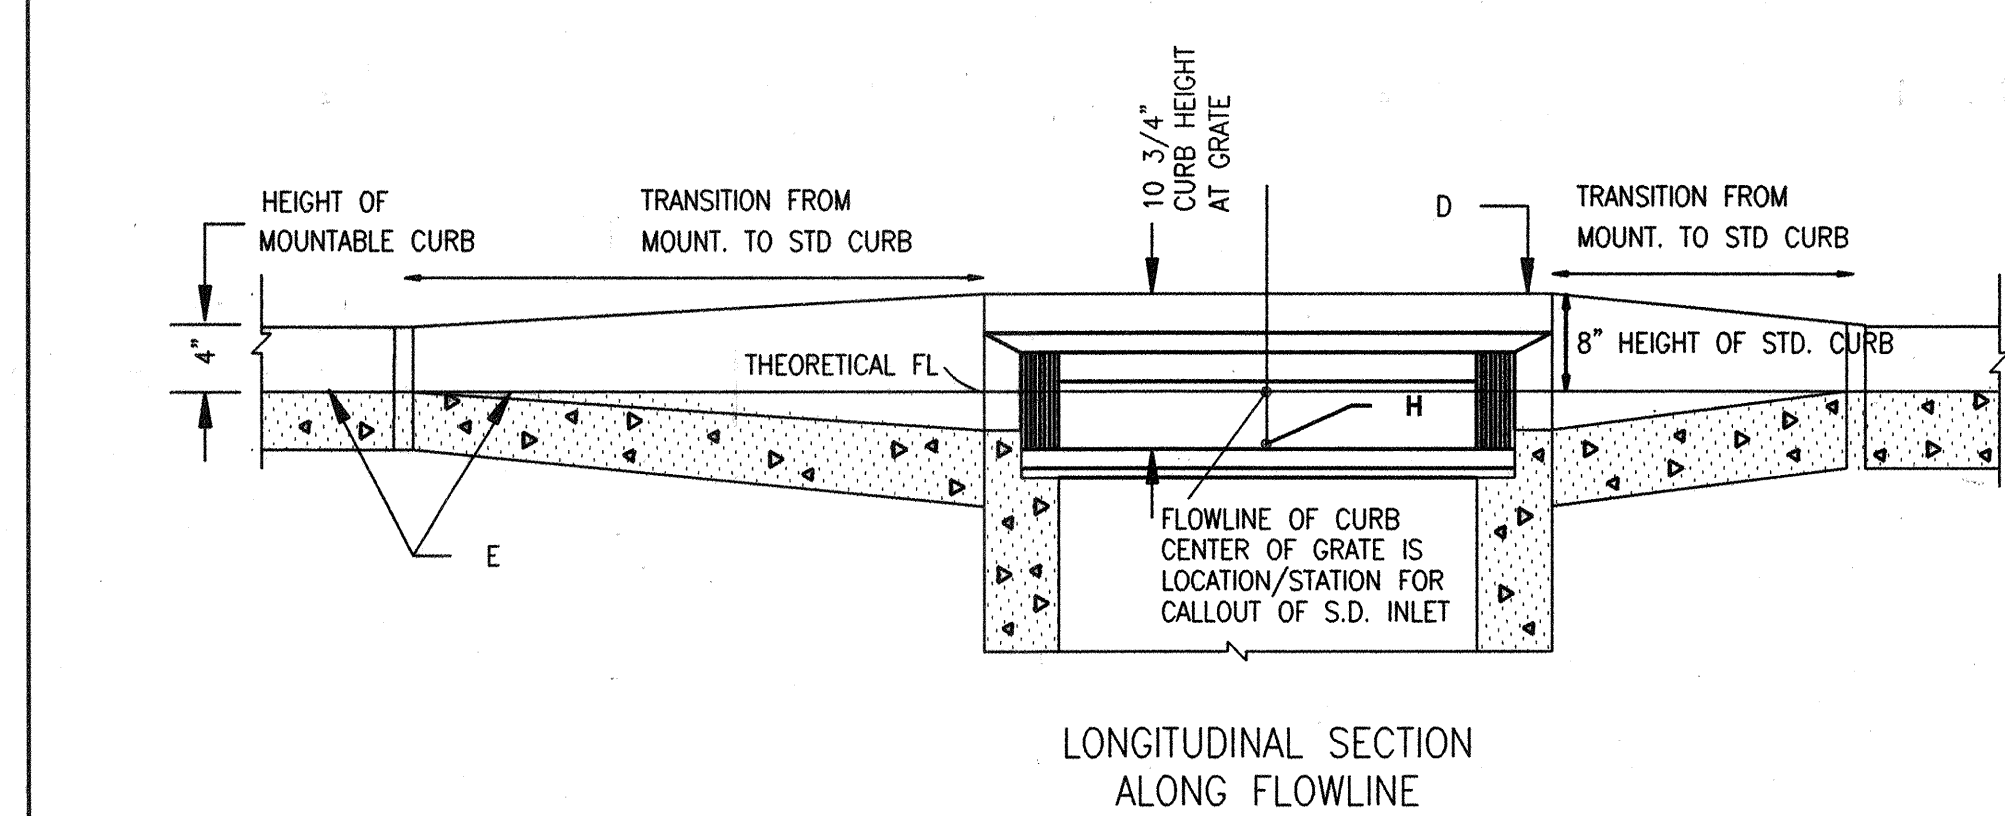

GENERAL NOTES:


1. DETAILS FOR PLACING CATCH BASIN. STANDARD CURB AND GUTTER.

CONSTRUCTION NOTES:


- A. STANDARD CURB AND GUTTER.
- B. STRAIGHT GRADE.
- C. EXPANSION JOINT.
- D. TOP OF CURB.
- E. FLOWLINE.
- F. FOR FRAME & GRATE SEE DWG. 2216, 2220 & 2221.
- G. DIRECTION OF FLOW.
- H. POINT OF MEASUREMENT FOR TOP OF GRATE ELEVATION.
- J. PROVIDE 5 FEET TRANSITION EACH SIDE OF CATCH BASIN, WHEN INSTALLING AT SAC POINT IN INSTALLATIONS OTHER THAN AT CURB RETURN.

REVISIONS	DATE	DESCRIPTION


CITY OF ALBUQUERQUE
DRAINAGE
STORM INLET
GUTTER TRANSITION
REV. DWG. 2207
AUG. 1986

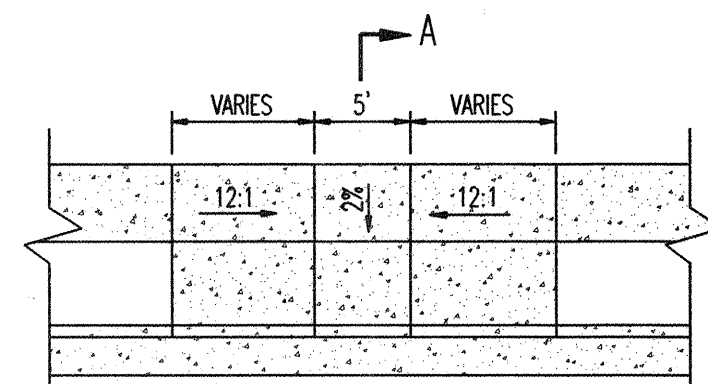


CASE III WHEEL CHAIR RAMP
NOT TO SCALE

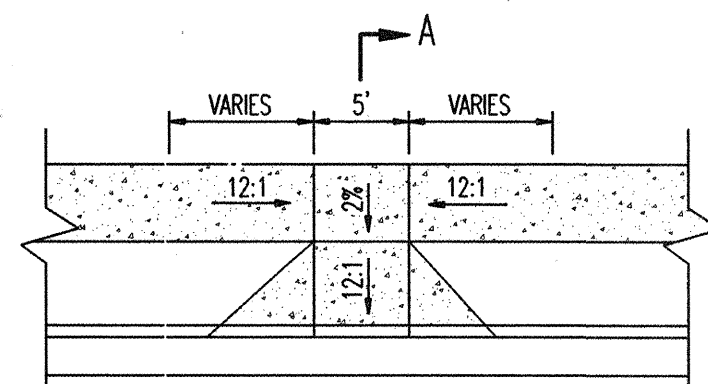

CASE IV WHEEL CHAIR RAMP
NOT TO SCALE

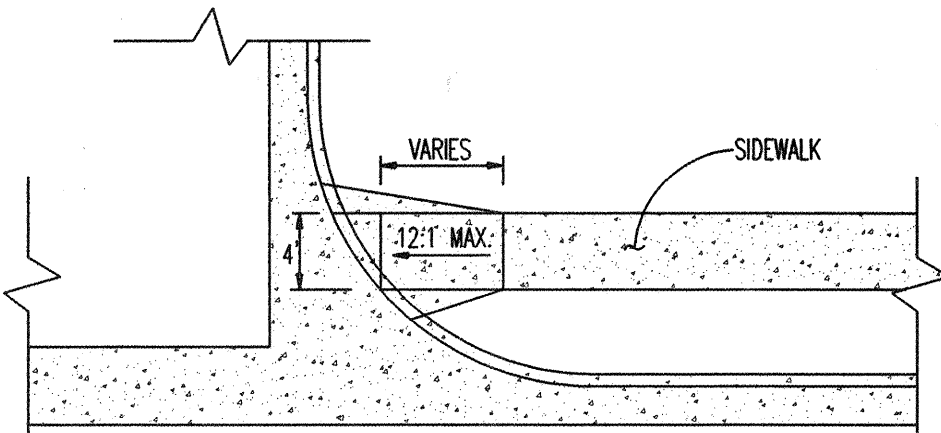

CASE VI WHEEL CHAIR RAMP
NOT TO SCALE

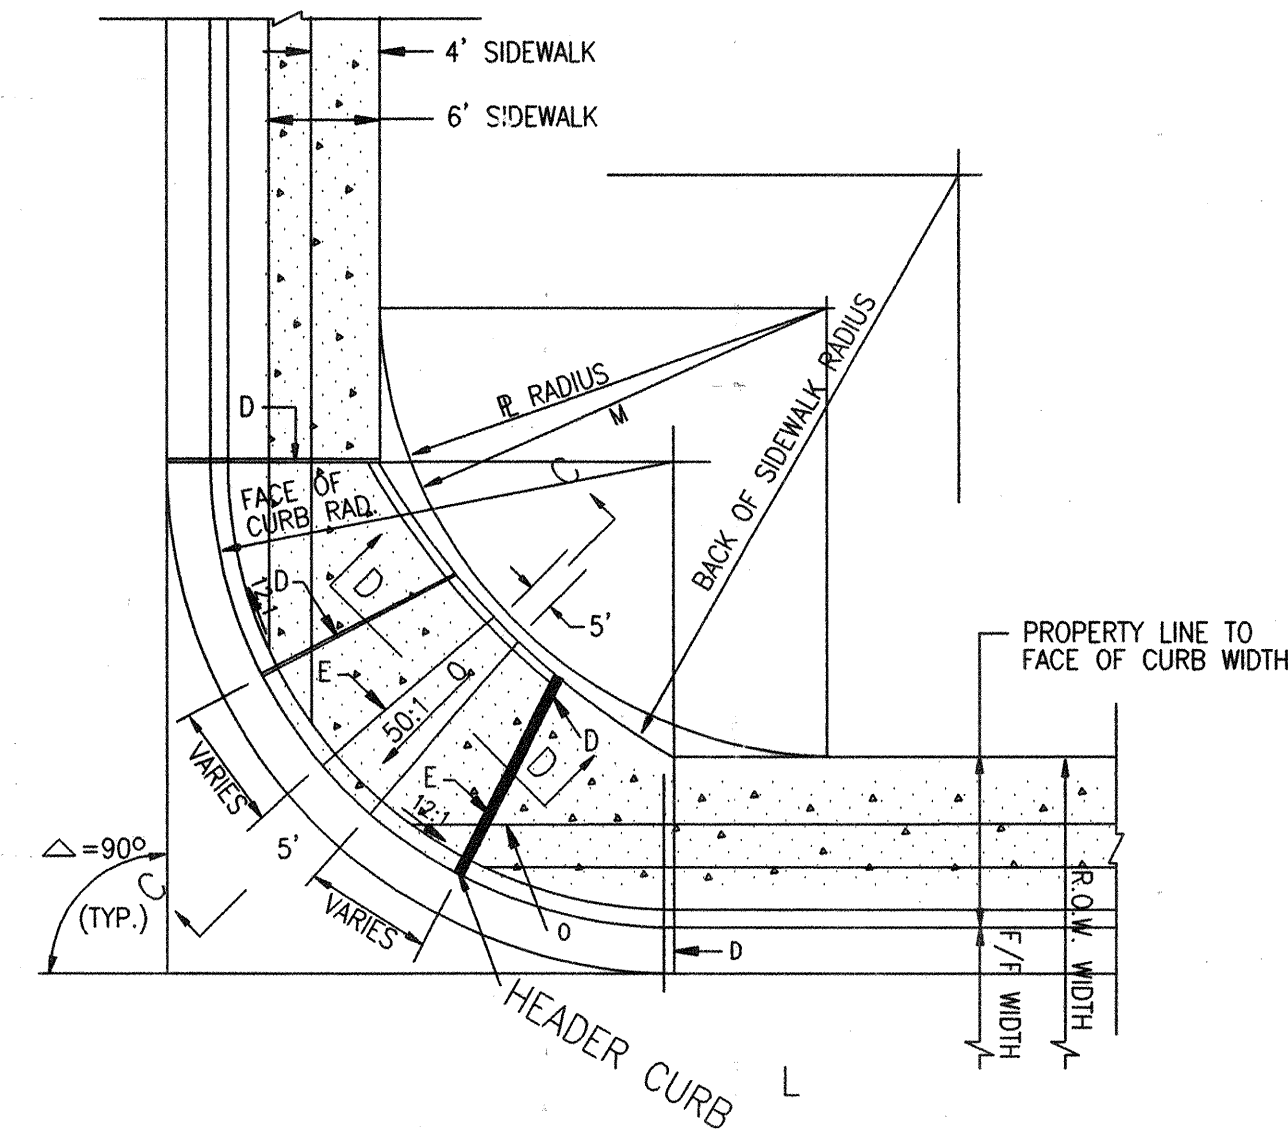

CASE V WHEEL CHAIR RAMP
NOT TO SCALE

Bohannon & Huston
Courtney One 7500 JEFFERSON NE Albuquerque NEW MEXICO 87109
ENGINEERS PLANNERS PHOTOGRAMMETRISTS SURVEYORS SOFTWARE DEVELOPERS

CITY OF ALBUQUERQUE
PUBLIC WORKS DEPARTMENT
ENGINEERING DEVELOPMENT GROUP

AS-BUILT TIMARRON WEST UNITS 2
GENERAL PLAN DETAILS

Design Review Committee	City Engineer Approval	Mo./Day/Yr.	Mo./Day/Yr.
APPROVED MAY 20 1999 DESIGN REVIEW COMMITTEE	APPROVED MAY 20 1999 CITY ENGINEER		

City Project No.	Zone Map No.	Sheet	Of
612781	M-8	21	24

CONSTRUCTION TRAFFIC CONTROL GENERAL NOTES

1. CONTRACTOR MUST OBTAIN FROM CONSTRUCTION COORDINATION AN EXCAVATION/BARRICADING PERMIT BEFORE ENGAGING IN ANY CONSTRUCTION, MAINTENANCE OR REPAIR WORK IN ANY OF THE CITY OF ALBUQUERQUE'S RIGHTS-OF-WAY. EMERGENCY WORK THAT WOULD PRESERVE LIFE OR PROPERTY IS EXCLUDED WITH THE UNDERSTANDING, THAT A PERMIT SHALL BE OBTAINED WITHIN 24 TO 48 HOURS.

2. CONTRACTOR SHALL AT THE TIME OF PERMIT REQUEST, SUBMIT FOR APPROVAL BY CONSTRUCTION COORDINATION, A TRAFFIC CONTROL PLAN DETAILING ALL EXISTING TOPOGRAPHY SUCH AS LANE WIDTHS, DRIVEWAYS, AND BUSINESS/RESIDENTIAL ACCESSES. THE TRAFFIC CONTROL PLAN SHALL INCLUDE ALL PHASES OF WORK AND SCHEDULES INVOLVED IN THE CONSTRUCTION PROJECT. ANY SEPARATE PHASES OF A CONSTRUCTION PROJECT SHALL BE GIVEN AN INDIVIDUAL PERMIT EACH. BLANKET PERMITS WILL NOT BE ISSUED.

3. THESE TYPICAL TRAFFIC CONTROL PLANS DO NOT REFLECT THE EXISTING TOPOGRAPHY SUCH AS DRIVEWAYS, LANE WIDTHS, AND BUSINESS/RESIDENTIAL ACCESSES. EVERY LOCATION THAT REQUIRES CONSTRUCTION TRAFFIC CONTROL SHALL HAVE A DETAILED TRAFFIC CONTROL PLAN SHOWING ALL EXISTING TOPOGRAPHY.

4. CONSTRUCTION SHALL NOT BEGIN UNLESS A TRAFFIC CONTROL PLAN HAS BEEN APPROVED AND VERIFIED BY CONSTRUCTION COORDINATION.

5. CONSTRUCTION COORDINATION SHALL BE NOTIFIED 48 HOURS PRIOR TO ANY TRAFFIC CONTROL CHANGES NEEDED BY CONTRACTOR, THAT WERE NOT PREVIOUSLY APPROVED. THESE TRAFFIC CONTROL CHANGES SHALL BE REQUESTED IN WRITING ACCOMPANIED WITH A TRAFFIC CONTROL PLAN REFLECTING SUCH CHANGES.

6. ALL CONSTRUCTION TRAFFIC CONTROL DEVICES SHALL COMPLY TO THE MANUAL ON UNIFORM TRAFFIC CONTROL DEVICES (MUTCD), LATEST EDITION. IT IS THE RESPONSIBILITY OF THE CONTRACTOR TO INSTALL, SERVICE AND MAINTAIN ALL TRAFFIC CONTROL DEVICES. TRAFFIC CONTROL DEVICES SHALL NOT BE REMOVED OR ALTERED IN ANY WAY WITHOUT THE APPROVAL OF CONSTRUCTION COORDINATION, PER SECTION 6A-4 OF THE MUTCD, LATEST EDITION.

7. THE CONSTRUCTION TRAFFIC CONTROL INITIAL SET-UP SHALL BE BY AN AMERICAN TRAFFIC SAFETY SERVICES ASSOCIATION (ATSSA) CERTIFIED WORKSITE TRAFFIC SUPERVISOR. THE MAINTENANCE AND SERVICING SHALL ALSO BE DONE BY AN ATSSA CERTIFIED WORKSITE TRAFFIC SUPERVISOR OR EQUIVALENT.

8. CONTRACTOR IS RESPONSIBLE TO MAINTAIN AND SERVICE ALL TRAFFIC CONTROL DEVICES 24 HOURS A DAY, 7 DAYS A WEEK THROUGHOUT LENGTH OF PROJECT. CONTRACTOR IS RESPONSIBLE THAT ALL TRAFFIC CONTROL DEVICES COMPLY WITH THE MUTCD, LATEST EDITION.

9. ALL ADVANCE WARNING SIGNS SHALL BE DOUBLE INDICATED WHENEVER THERE ARE MULTI-LANE TRAFFIC IN ANY ONE GIVEN DIRECTION AND THERE IS SUFFICIENT MEDIAN SPACE.

10. ALL BARRICADES IN ALL TAPERS AND TANGENTS SHALL BE PLACED APART, A DISTANCE MEASURED IN FEET, EQUAL TO THAT OF THE POSTED SPEED LIMIT. NO EXCEPTIONS UNLESS APPROVED BY CONSTRUCTION COORDINATION PER MUTCD SECTION 6A-4.

11. ALL WORK IN ARTERIAL ROADWAYS SHALL BE ON A CONTINUOUS 24 HOUR PER DAY BASIS UNTIL COMPLETED.

12. CONTRACTOR IS RESPONSIBLE TO PROVIDE CONSTRUCTION COORDINATION, A WEEKLY LOG OF DAILY INSPECTIONS OF BARRICADE AND MAINTENANCE SCHEDULES ON PROJECTS THAT ARE OVER ONE WEEK DURATION.

13. EQUIPMENT OR MATERIALS SHALL NOT BE STORED WITHIN 15 FEET OF A TRAVELLED TRAFFIC LANE DURING NON-WORKING HOURS WITHOUT THE APPROVAL OF CONSTRUCTION COORDINATION.

14. CONTRACTOR SHALL PROVIDE AND MAINTAIN A SAFE AND ADEQUATE MEANS OF CHANNELIZING PEDESTRIAN TRAFFIC AROUND AND THROUGH THE CONSTRUCTION AREA.

15. CONTRACTOR IS RESPONSIBLE FOR OBLITERATION OF ANY CONFLICTING STRIPING AND RESPONSIBLE FOR ALL TEMPORARY STRIPING.

16. CONTRACTOR SHALL MAINTAIN ACCESS TO ALL FACILITIES, BUSINESSES AND/OR RESIDENTS AT ALL TIMES.

17. CONTRACTOR SHALL PROVIDE ACCESS SIGNS FOR BUSINESSES LOCATED WITHIN THE CONSTRUCTION AREA UNDER THE SUPERVISION OF CONSTRUCTION COORDINATION. EACH ACCESS SIGN SHALL HAVE 5 INCH, WHITE OPAQUE LETTERING ON BLUE REFLECTORIZED BACKGROUND. ACCESS SIGNS SHALL BE CONSIDERED INCIDENTAL TO THE BID AND NOT PART OF THE CONTRACT UNLESS OTHERWISE STATED. NO MORE THAN 3 BUSINESSES SHALL BE LISTED ON A ACCESS SIGN. SHOPPING CENTERS AND MALLS SHALL BE LISTED AS SUCH.

18. ALL ADVANCE WARNING SIGNS SHALL MEET THE MINIMUM REFLECTIVE INTENSITY REQUIREMENTS SET FORTH BY THE CITY OF ALBUQUERQUE. CONSTRUCTION COORDINATION SHALL DETERMINE ALL REQUIREMENTS AND APPROVE OR DISAPPROVE ANY ADVANCE WARNING SIGN PER SECTION 6A-4 OF THE MUTCD, LATEST EDITION.

19. 48 HOURS PRIOR TO OCCUPANCY OR CLOSING OF A RIGHT-OF-WAY, CONTRACTOR SHALL NOTIFY: POLICE, FIRE DEPARTMENT, SCHOOLS, HOSPITALS, TRANSIT AUTHORITY, BUSINESSES AND/OR RESIDENTS THAT WILL BE AFFECTED BY THE CONSTRUCTION.

20. ANY FIELD ADJUSTMENTS SHALL BE APPROVED BY CONSTRUCTION COORDINATION.

21. EXCAVATIONS SHALL BE PLATED, TEMPORARILY PATCHED OR RESURFACED PRIOR TO OPENING OF TRAFFIC. A MINIMUM OF 11 FEET SHALL BE PROVIDED FOR TRAFFIC IN ANY GIVEN DIRECTION. CONTRACTOR IS RESPONSIBLE FOR ANY WORK INVOLVED IN SATISFYING THESE REQUIREMENTS.

22. CONTRACTOR SHALL AT ALL TIMES COMPLY WITH THE FOLLOWING:
1. STANDARDS AND REQUIREMENTS SET FORTH IN THE MANUAL ON UNIFORM TRAFFIC CONTROL DEVICES, LATEST EDITION.
2. THE CITY OF ALBUQUERQUE TRAFFIC CODE, LATEST EDITION.
3. SECTION 19 OF THE CITY OF ALBUQUERQUE'S STANDARD SPECIFICATIONS FOR PUBLIC WORK CONSTRUCTION, AS WELL AS OTHER SECTIONS.


23. FAILURE TO COMPLY WITH ANY OF THE ABOVE MENTIONED, WILL BE ADEQUATE CAUSE TO CEASE ALL WORK ON ANY CONSTRUCTION PROJECT. WORK WILL NOT RESUME UNTIL ALL REQUIREMENTS ARE ADDRESSED AND APPROVED BY CONSTRUCTION COORDINATION.

24. ALL TRAFFIC CONTROL DEVICES SHALL BE KEPT IN NEW-CLEAN CONDITION. WASHING OF EQUIPMENT IS INCIDENTAL TO IT'S PLACEMENT AND MAINTENANCE.


25. TRAFFIC CONTROL STANDARDS APPLY ONLY WHERE THE CONSTRUCTION TRAFFIC CONTROL PLANS ARE NOT SPECIFIC.

26. ADVANCE WARNING SIGNS SHALL BE 36"x36" MIN. WITH SUPER ENGINEERING GRADE SHEETING OR BETTER. MOUNTING HEIGHT AT TOP OF SIGN SHALL BE THE SAME AS FOR A 48" SIGN AS INDICATED IN THE M.U.T.C.D.

27. CONTRACTOR SHALL MAINTAIN A GRAFFITI-FREE WORKSITE. ALL GRAFFITI SHALL BE PROMPTLY REMOVED FROM ALL EQUIPMENT, BOTH PERMANENT AND TEMPORARY.

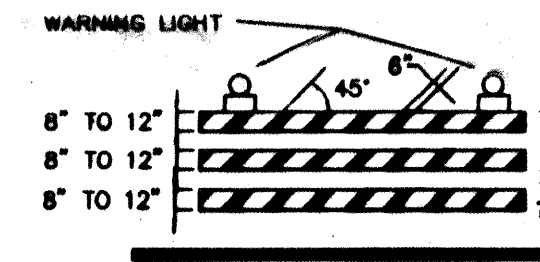


TYPE III BARRICADE

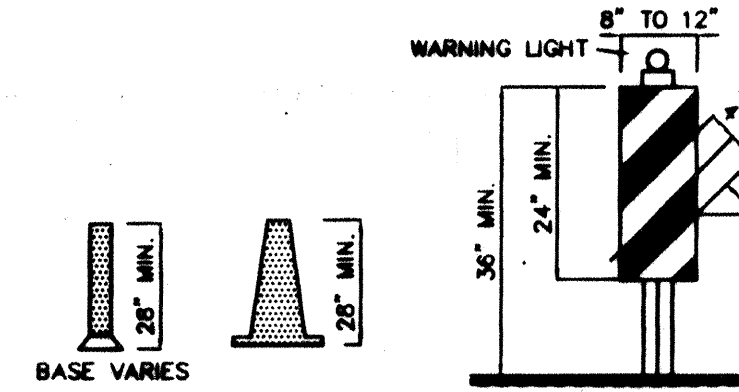


VERTICAL PANEL

CONES


BASE VARIES

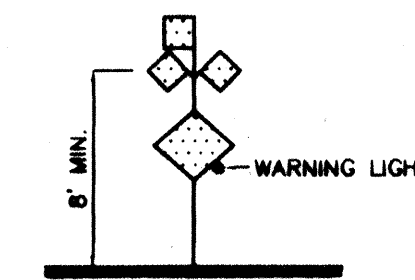


HIGH LEVEL WARNING DEVICE

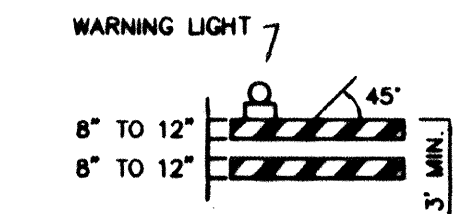


TYPE I BARRICADE

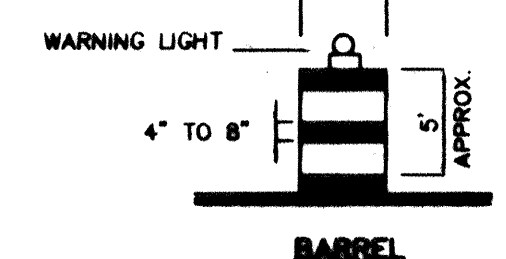

BARREL

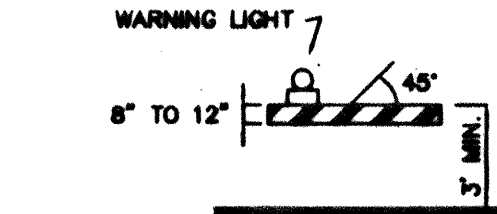

TYPE I BARRICADE

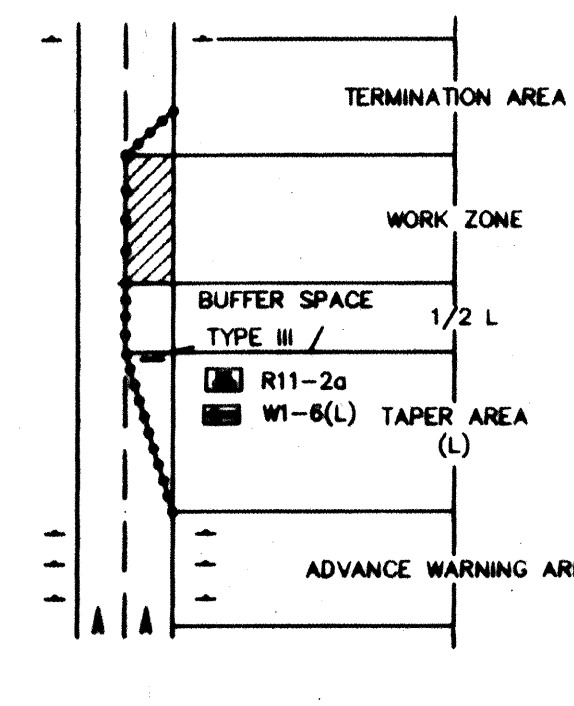

TRAFFIC CONTROL ELEMENTS

LEGEND

WORK AREA
BARRICADE - TYPE I, TYPE II, OR BARREL
BARRICADE - TYPE III
VERTICAL PANEL
WARNING SIGN
DISTANCE BETWEEN SIGNS - A DISTANCE MEASURED IN FEET EQUAL TO A VALUE OF TEN TIMES THE SPEED LIMIT OF THE STREET
FLAGMAN POSITION
SPACING BETWEEN BARRICADES - A DISTANCE MEASURED IN FEET EQUAL TO THE SPEED LIMIT OF THE STREET
TAPER LENGTH - SEE CHART BELOW
THE TANGENT LENGTH IS EQUAL TO THE TAPER LENGTH FOR A GIVEN STREET.

TAPER REQUIREMENTS

SPEED LIMIT (MPH)	TAPER LENGTH (L) (FEET)			MINIMUM NUMBER OF DEVICES FOR TAPER	MAXIMUM DEVICE SPACING IN FEET	
	10' LANE	11' LANE	12' LANE		ALONG TAPER	AFTER TAPER
20	70	75	80	5	20	20
25	105	115	125	6	25	25
30	150	165	180	7	30	30
35	205	225	245	8	35	35
40	270	295	320	9	40	40
45	450	495	540	13	45	45
50	500	550	600	13	50	50
55	550	605	660	13	55	55

RECOMMENDED SIGN SPACING(D) FOR ADVANCE WARNING SIGN SERIES

SPEED MILES PER HOUR	MINIMUM DISTANCE IN FEET	
	BETWEEN SIGNS	FROM LAST SIGN TO TAPER
0-20	10 X SPEED LIMIT	10 X SPEED LIMIT
25-30	10 X SPEED LIMIT	10 X SPEED LIMIT
30-35	10 X SPEED LIMIT	10 X SPEED LIMIT
40-45	10 X SPEED LIMIT	10 X SPEED LIMIT
50-60	10 X SPEED LIMIT	10 X SPEED LIMIT

TAPER CRITERIA

TYPE OF TAPER	TAPER LENGTH
UPSTREAM TAPER:	
MERGING TAPER	L MINIMUM
SHIFTING TAPER	1/2 L MINIMUM
SHOULDER TAPER	1/2 L MINIMUM
TWO-WAY TRAFFIC TAPER	100 FEET MAXIMUM
DOWNSTREAM TAPERS	100 FEET PER LANE

TAPER LENGTH COMPUTATION


SPEED LIMIT	L =
40 MPH OR LESS	$L = \frac{WS^2}{60}$
45 MPH OR GREATER	$L = W \times S$

L = TAPER LENGTH
W = WIDTH OF OFFSET IN FEET
S = POSTED SPEED OR OFF-PEAK 85-PERCENTILE SPEED IN MPH


AS-BUILT

CITY OF ALBUQUERQUE PUBLIC WORKS DEPARTMENT ENGINEERING DEVELOPMENT GROUP			
TITLE: SIGNING AND CONSTRUCTION TRAFFIC CONTROL STANDARDS			
DESIGN REVIEW COMMITTEE APPROVED 2010	CITY ENGINEER APPROVAL APPROVED 2010	LAST UPDATE	
PROJECT NO.	MAP NO. M-8	SHEET 23 OF 24	

SIGN FACE DETAILS

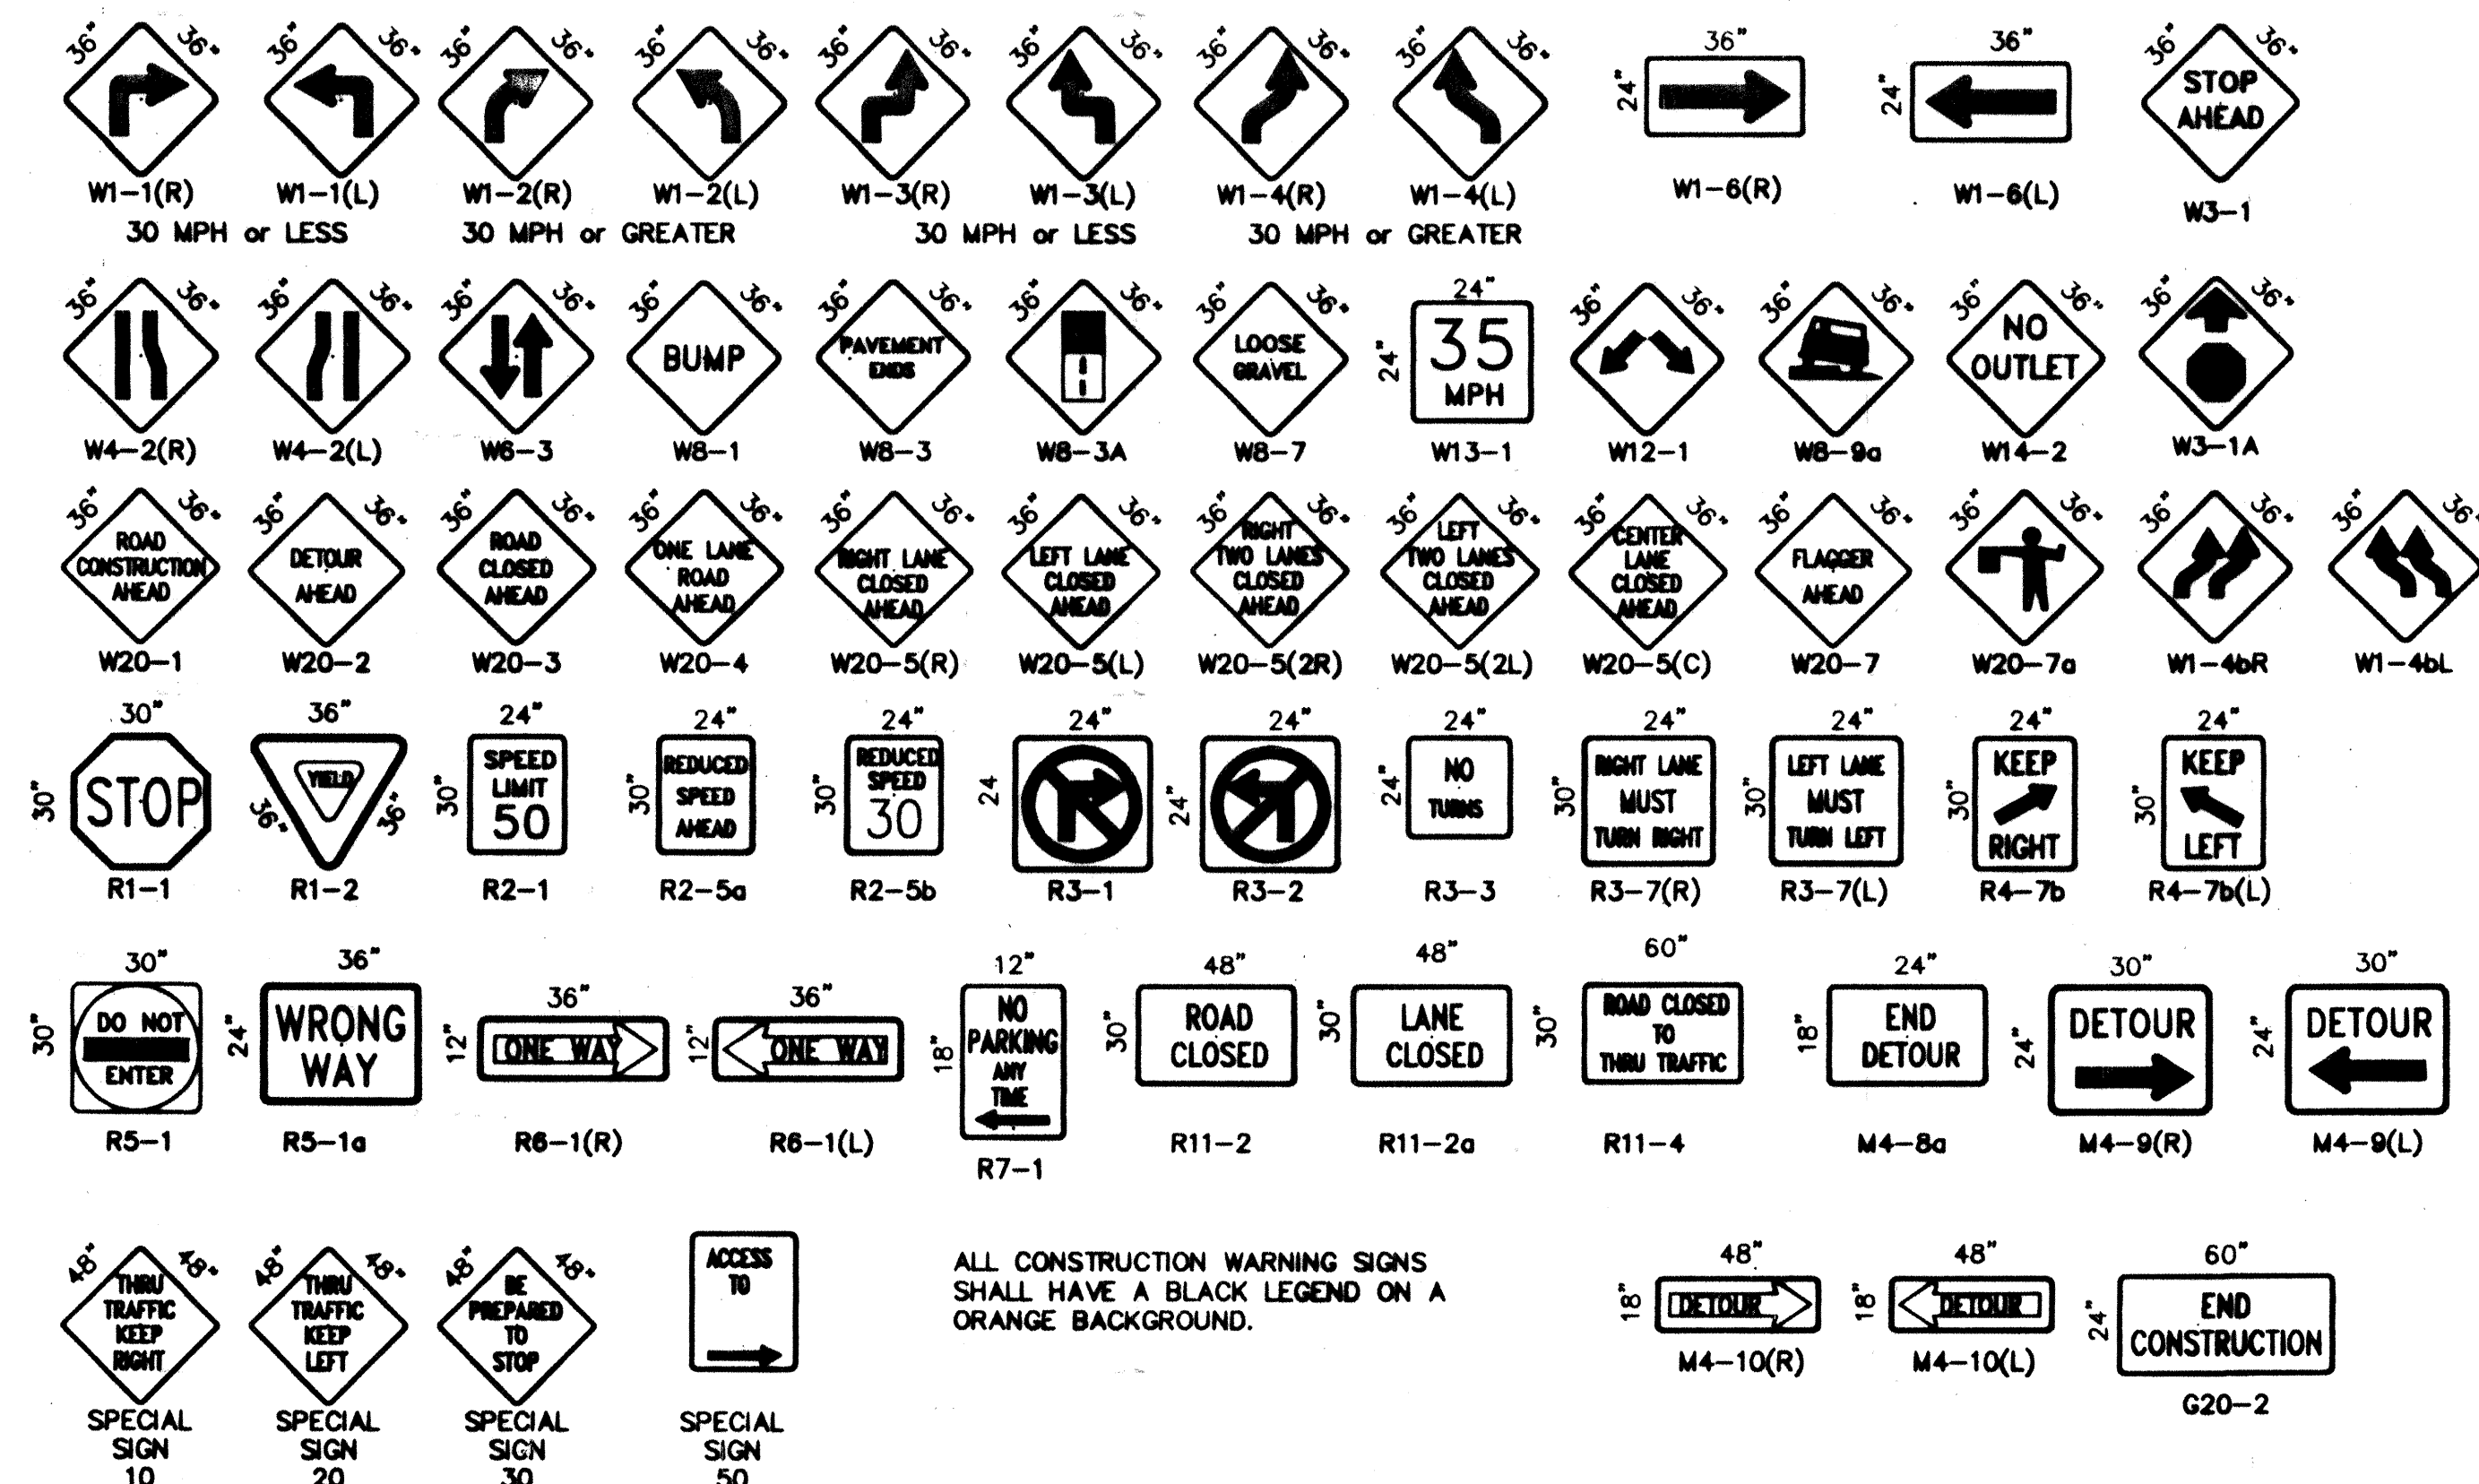


ALL CONSTRUCTION WARNING SIGNS SHALL HAVE A BLACK LEGEND ON A ORANGE BACKGROUND.

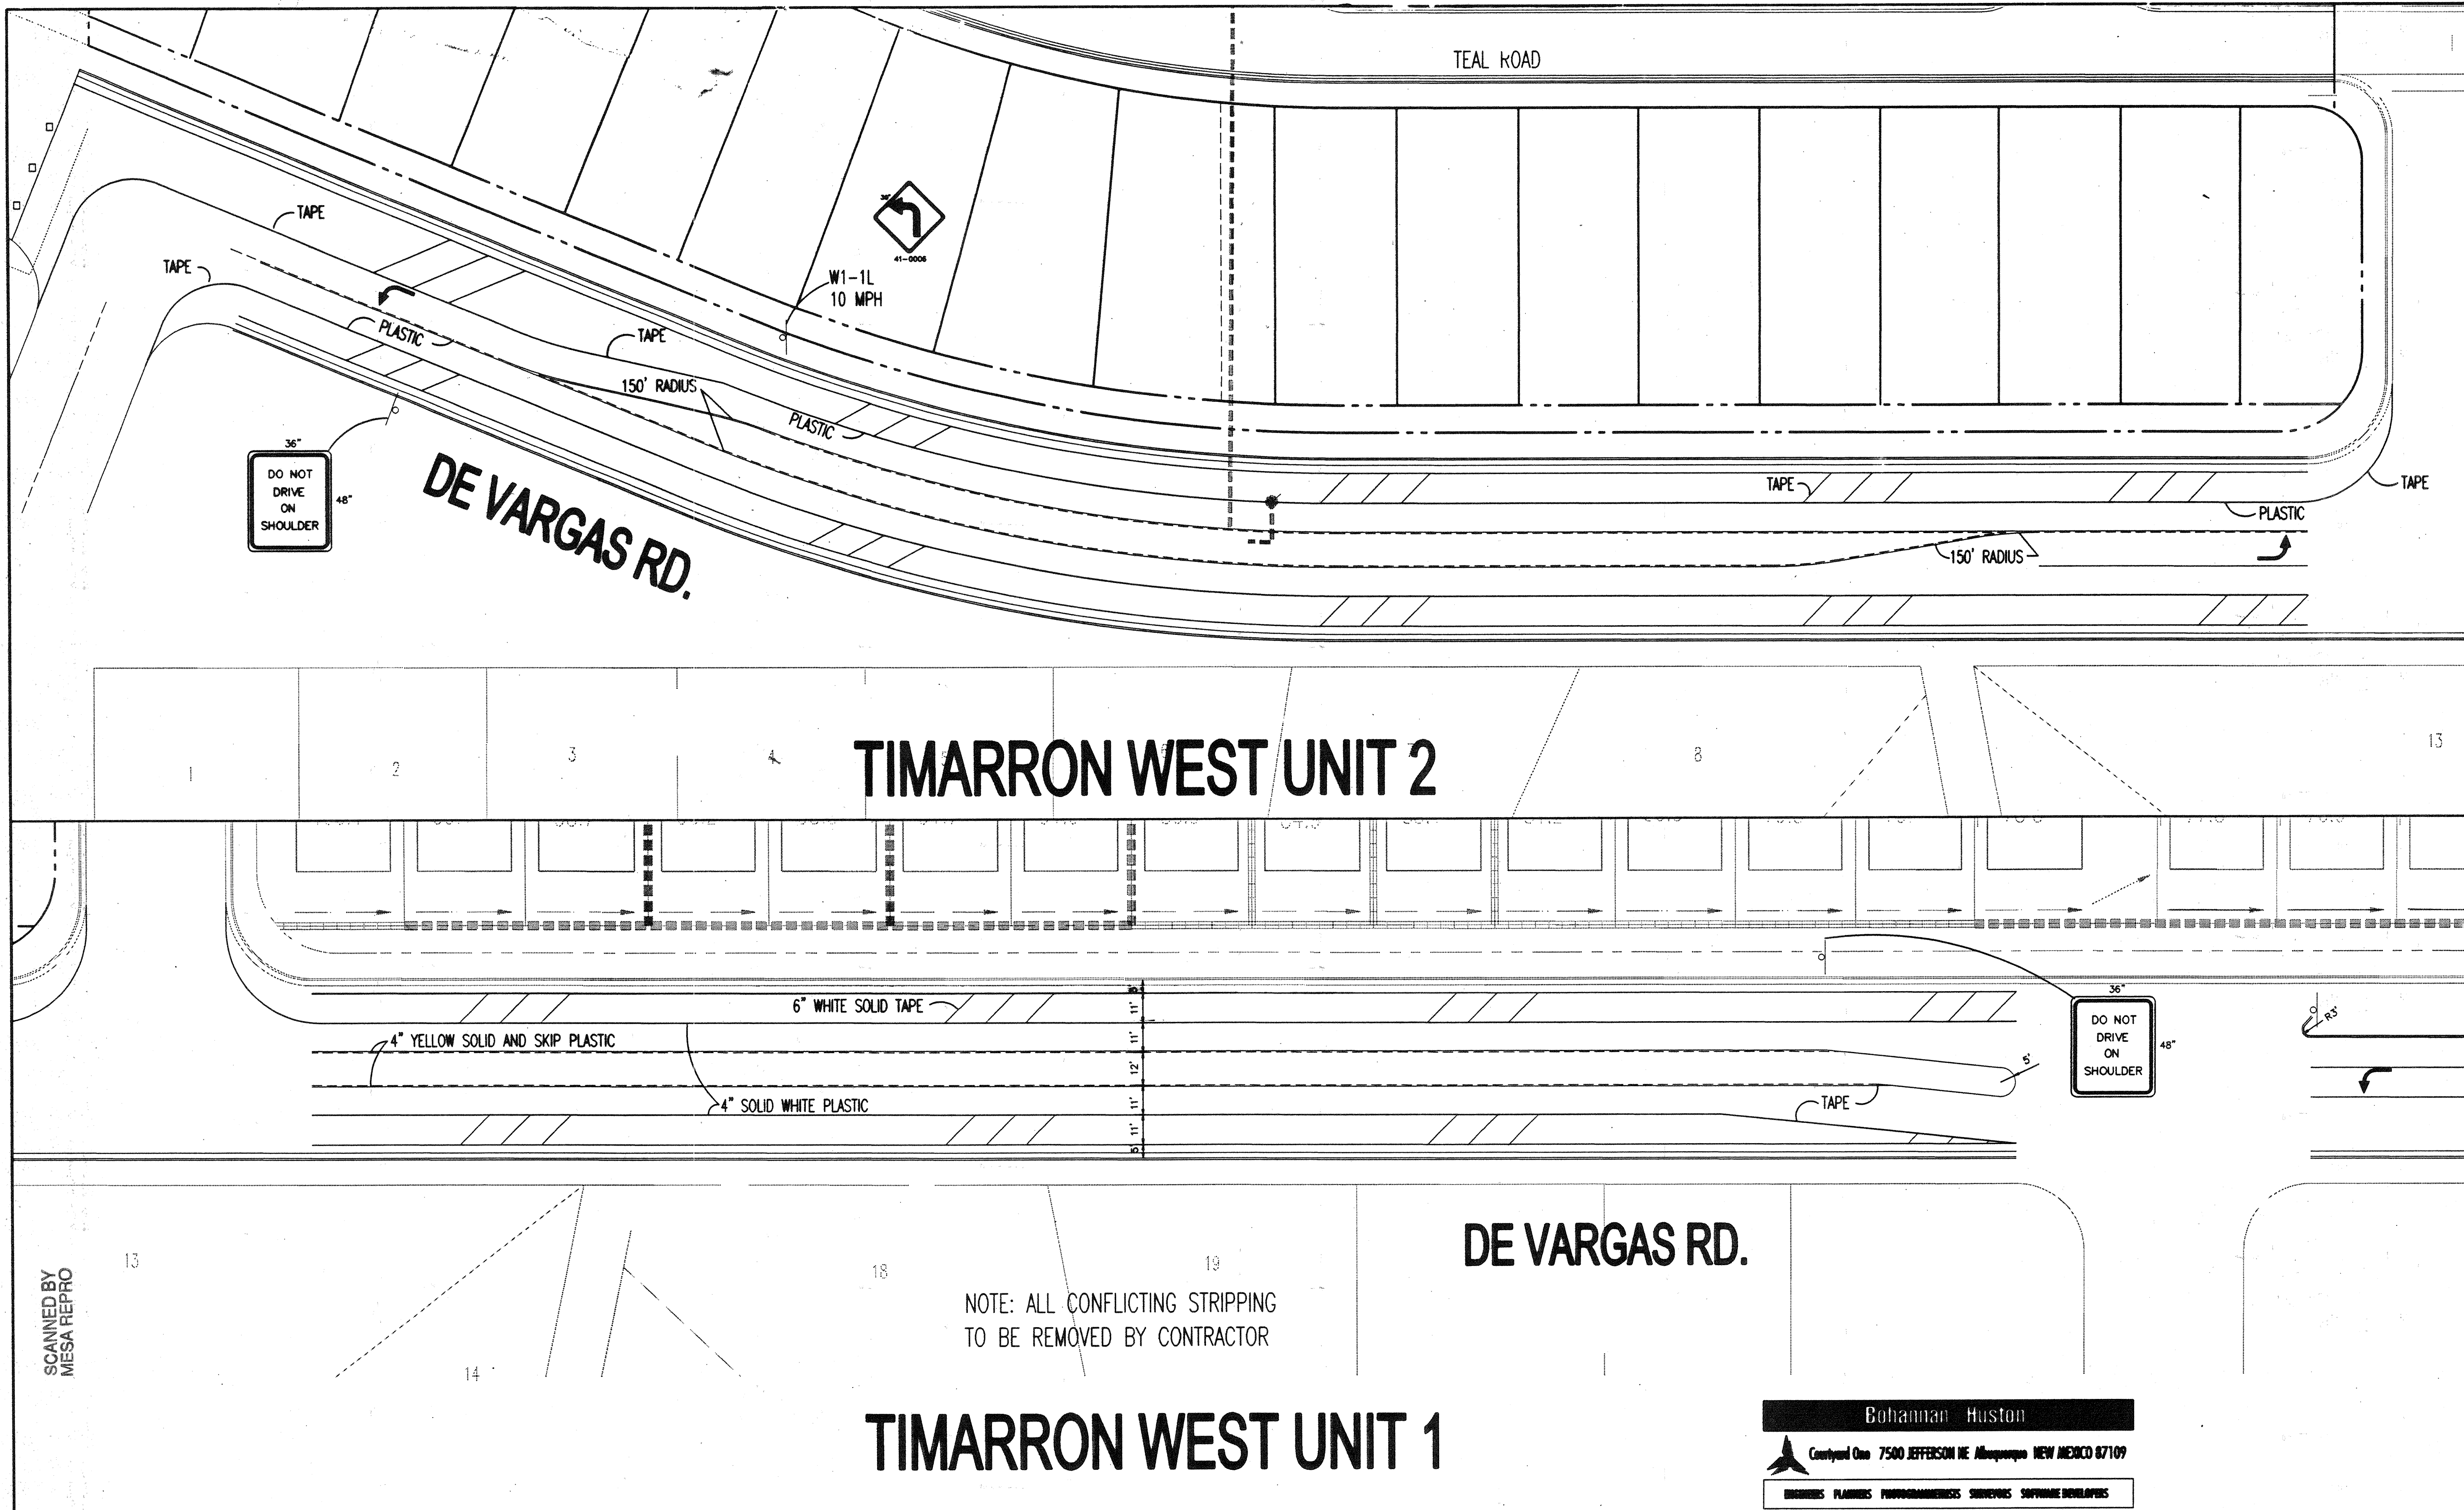


SCANNED BY
MESA REPRO

NOTE: ALL CONFLICTING STRIPPING
TO BE REMOVED BY CONTRACTOR


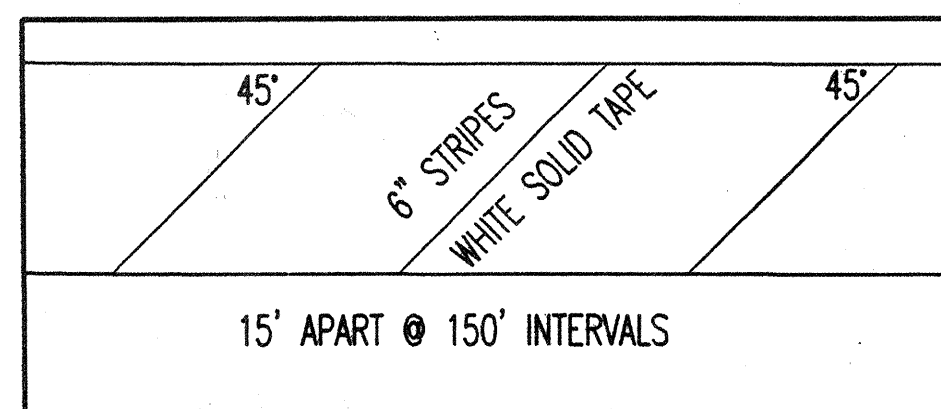


BIKE LANE STRIPES

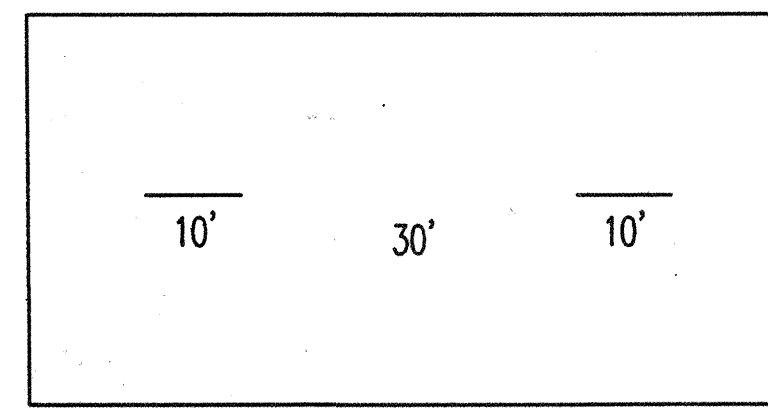

SKIP PATTERN

Bohannon Huston
Copyright © 1999 7500 JEFFERSON NE ALBUQUERQUE NEW MEXICO 87109
DESIGN PLANNING PROGRAMMING SURVEYS SOFTWARE DEVELOPMENT

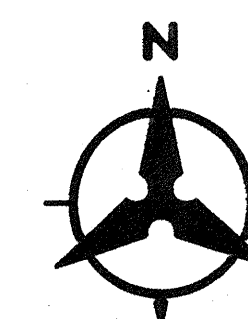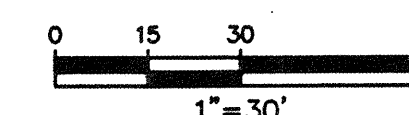


CITY OF ALBUQUERQUE
PUBLIC WORKS DEPARTMENT
ENGINEERING DEVELOPMENT GROUP

AS-BUILT TIMARRON WEST UNIT 2
DE VARGAS STRIPING PLAN

Design Review Committee	City Engineer Approval	Mo./Day/Yr.	Mo./Day/Yr.
APPROVE MAY 20 1999 DESIGN REVIEW COMMITTEE	APPROVE MAY 20 1999 CITY ENGINEER		


City Project No. 612781 Zone M8 Sheet 24 Of 24

AS-BUILT INFORMATION		BENCH MARKS		SURVEY INFORMATION		ENGINEER'S SEAL	
CONTRACTOR	DATE	NO.	BY	NO.	BY		
DATE	DATE	DATE	DATE	DATE	DATE		
DATE	DATE	DATE	DATE	DATE	DATE	REMARKS	By
DATE	DATE	DATE	DATE	DATE	DATE	REVISIONS	
DATE	DATE	DATE	DATE	DATE	DATE	DESIGN	
DATE	DATE	DATE	DATE	DATE	DATE	DESIGNED BY: EES	DATE: 4/99
DATE	DATE	DATE	DATE	DATE	DATE	DRAWN BY: JAJ	DATE: 4/99
DATE	DATE	DATE	DATE	DATE	DATE	CHECKED BY: RLB	DATE: 4/99

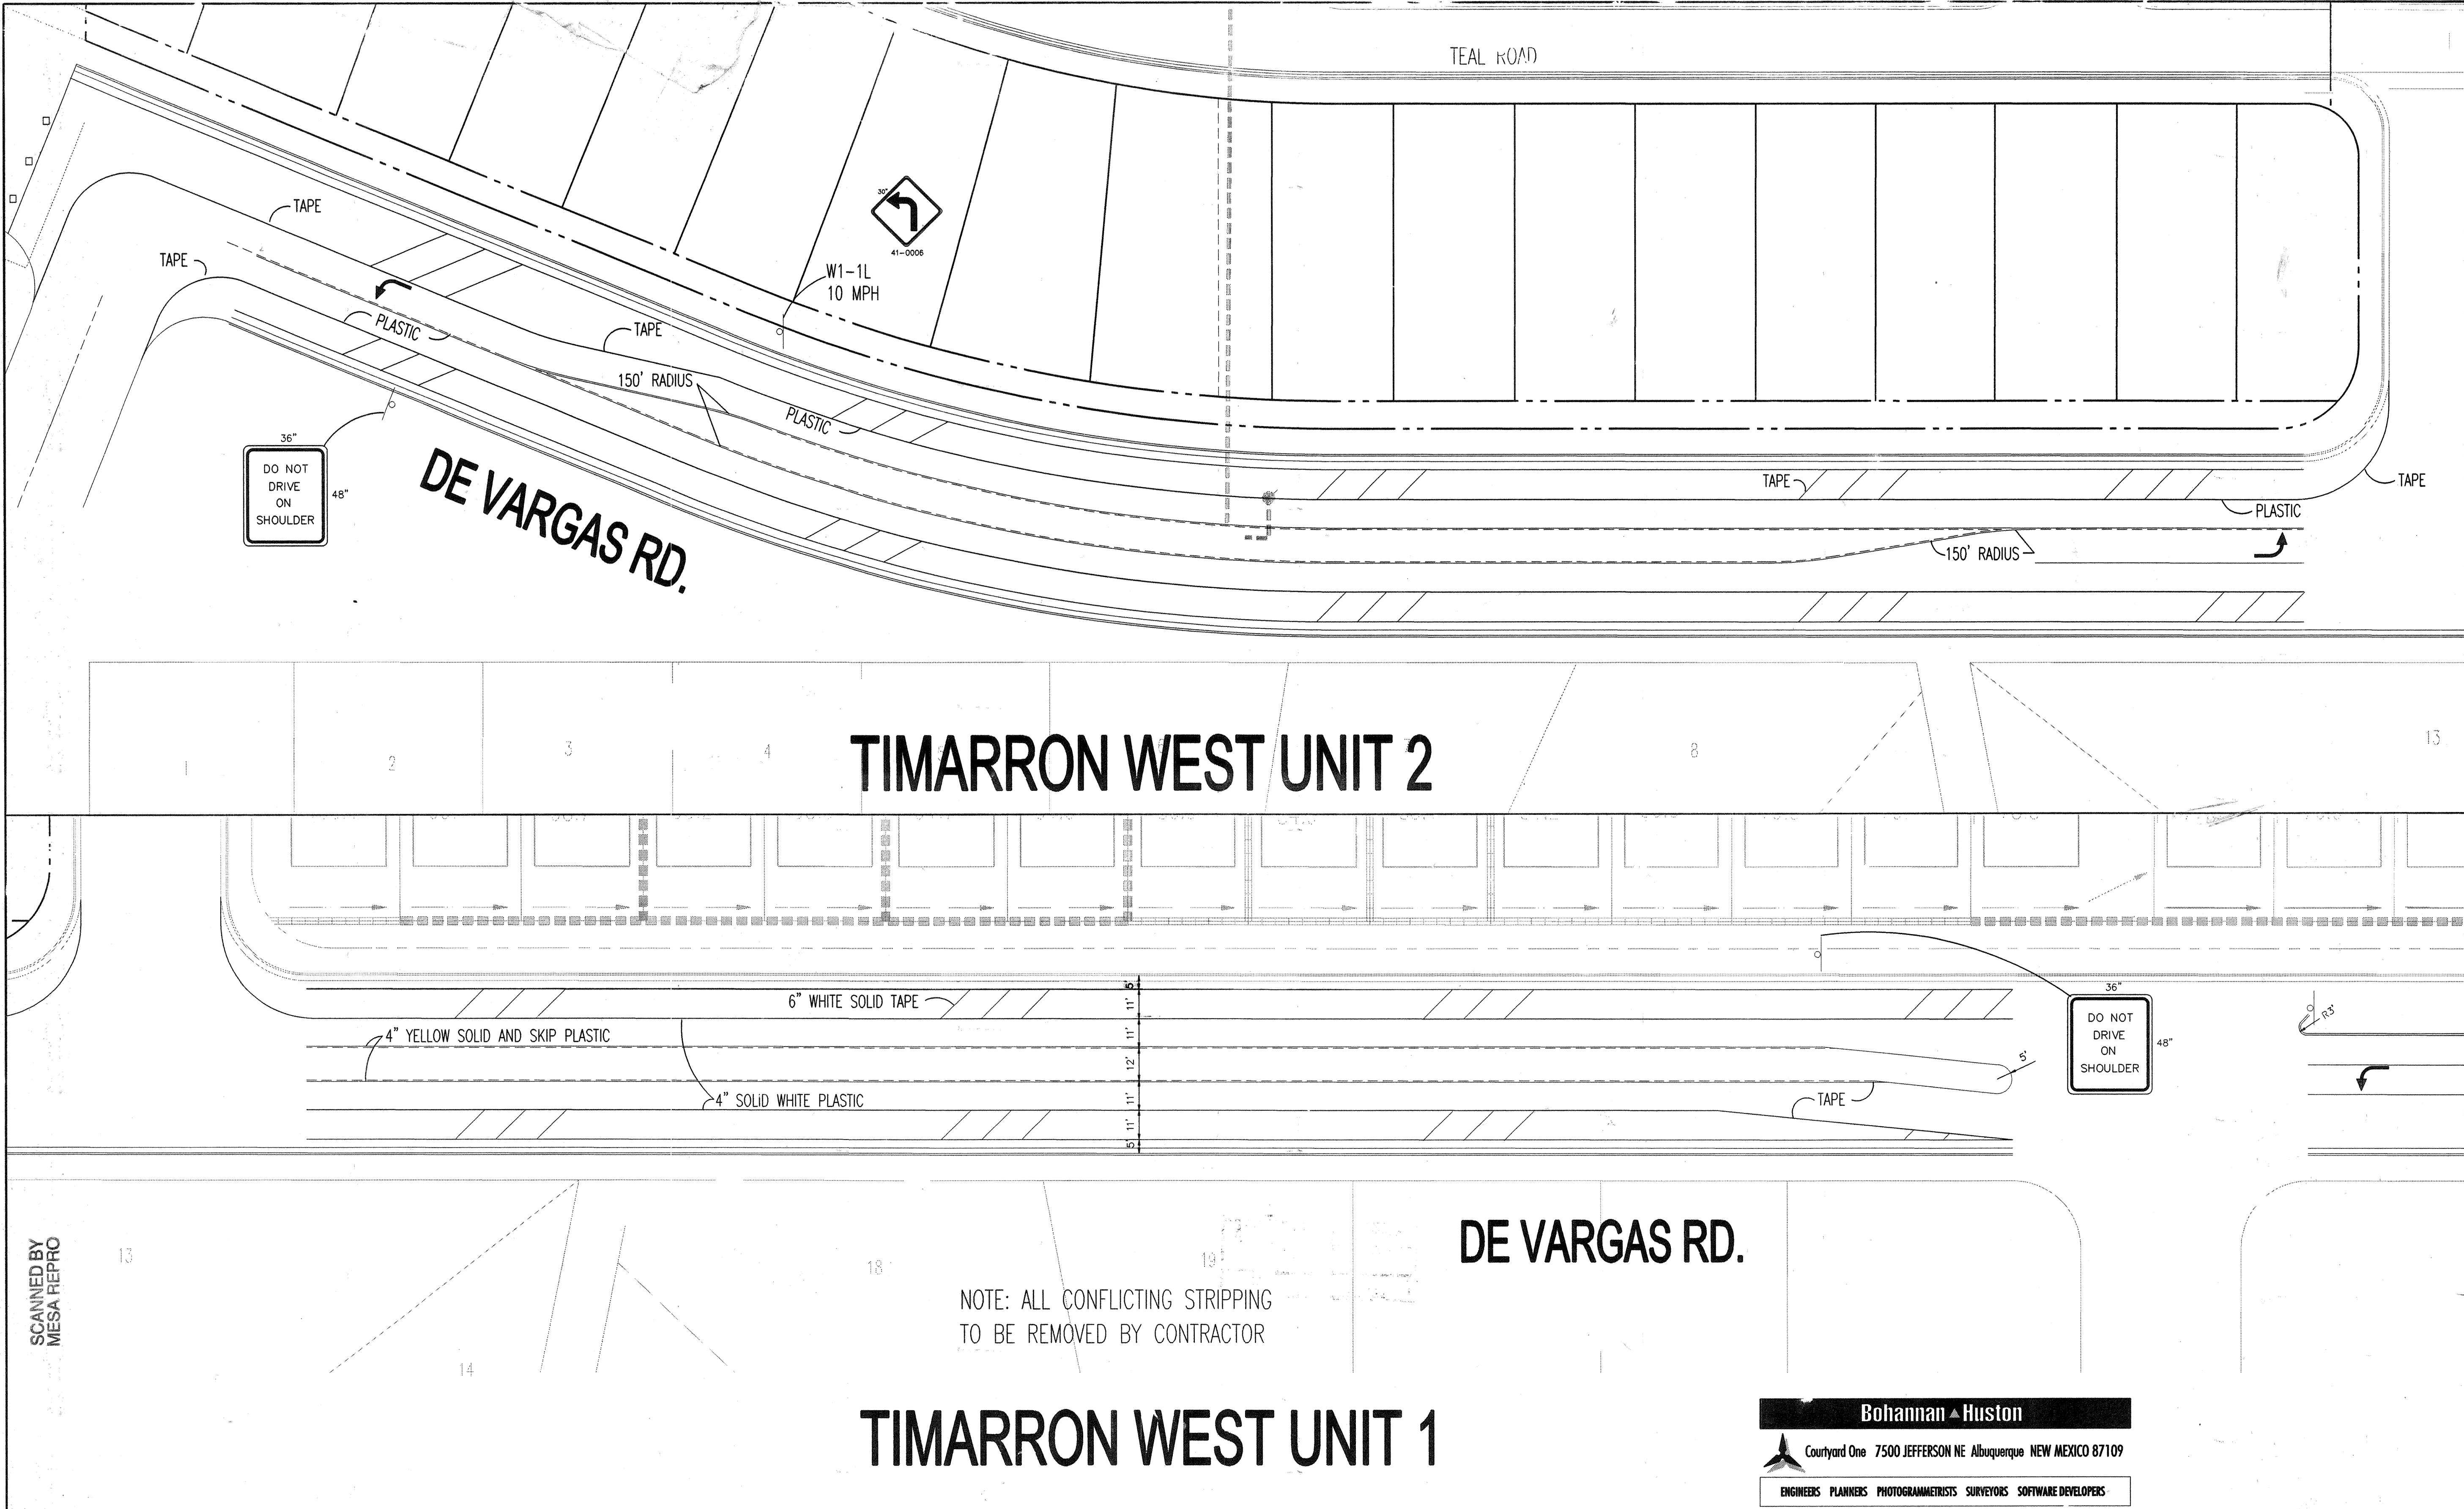


SCANNED BY
MESA REPRO

NOTE: ALL CONFLICTING STRIPPING
TO BE REMOVED BY CONTRACTOR

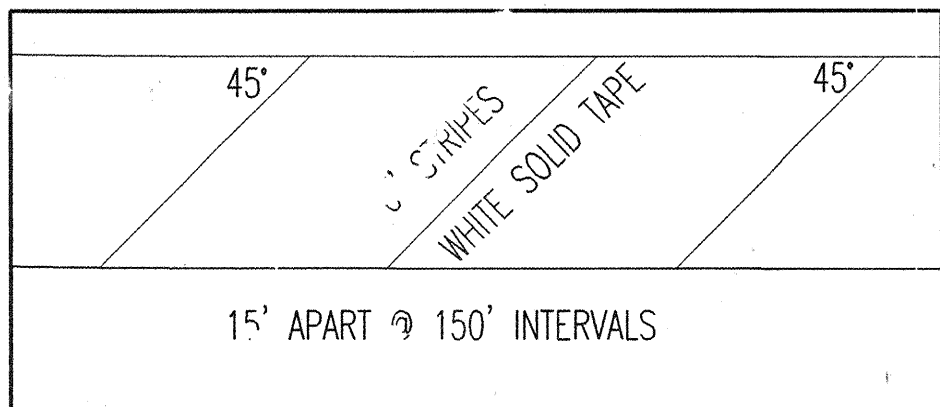


BIKE LANE STRIPES

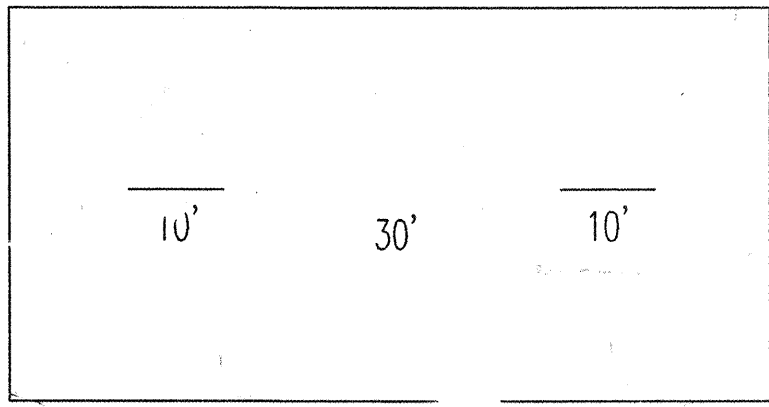

SKIP PATTERN

Bohannon & Huston
Court yard One 7500 JEFFERSON NE ALBUQUERQUE NEW MEXICO 87109
ENGINEERS PLANNERS PHOTOGRAMMETRISTS SURVEYORS SOFTWARE DEVELOPERS

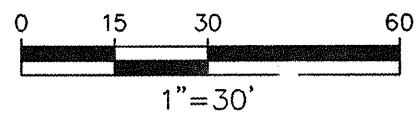

CITY OF ALBUQUERQUE
PUBLIC WORKS DEPARTMENT
ENGINEERING DEVELOPMENT GROUP

AS-BUILT TIMARRON WEST UNIT 2
DE VARGAS STRIPING PLAN

Design	Review	Committee	City Engineer	Approval	Mo./Day/Yr.	Mo./Day/Yr.
APPROVED	APPROVED	APPROVED	APPROVED	APPROVED	4/99	4/99

City Project No. 612781

244