


RECORD DRAWING
Drawing revised to reflect the best information available. Do not use without field verification.

P-12


MATCH LINE STA 291+00
SEE SHEET 2-86

SCANNED BY
MESA REPRO

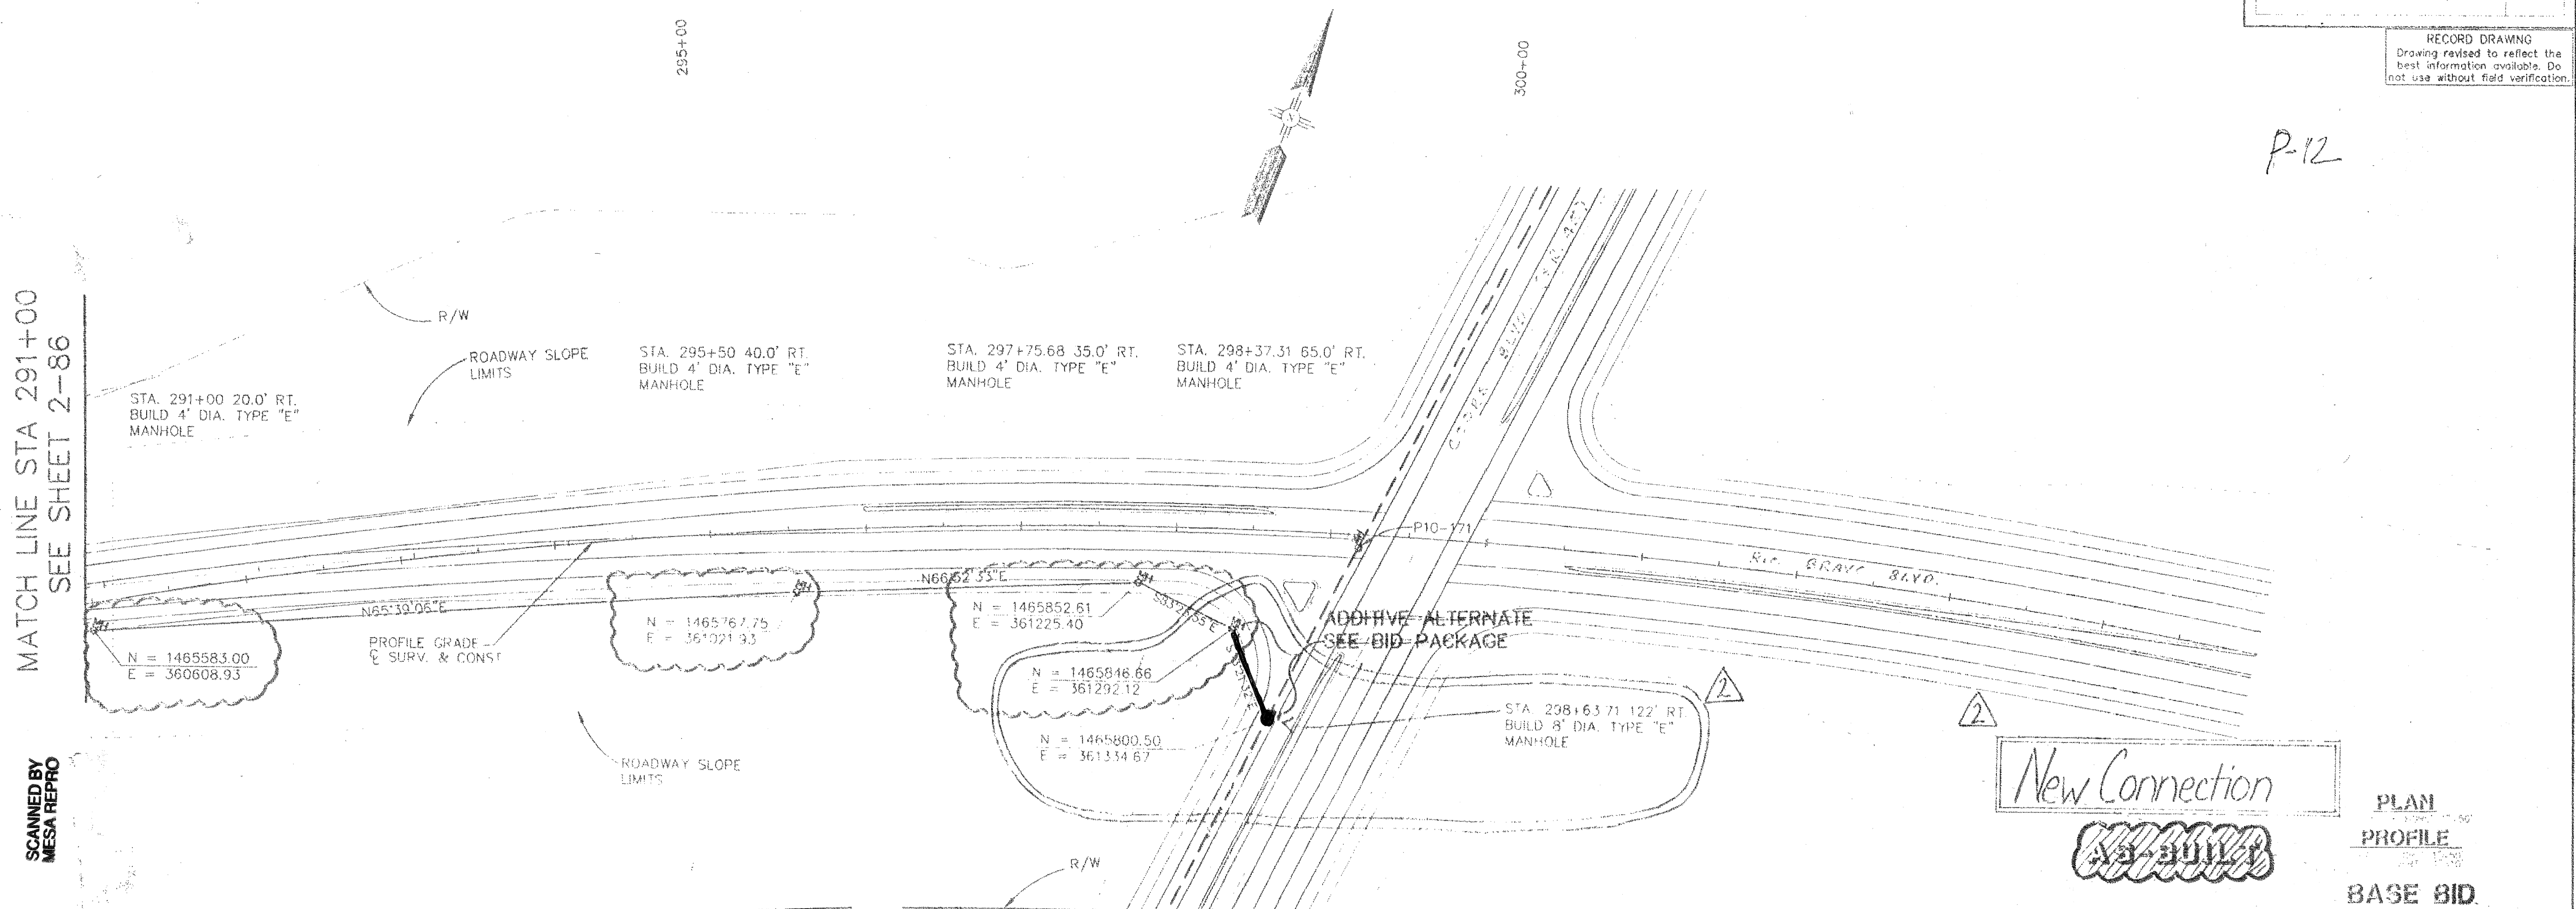

New Connection
AS BUILTS

PLAN
PROFILE
BASE BID

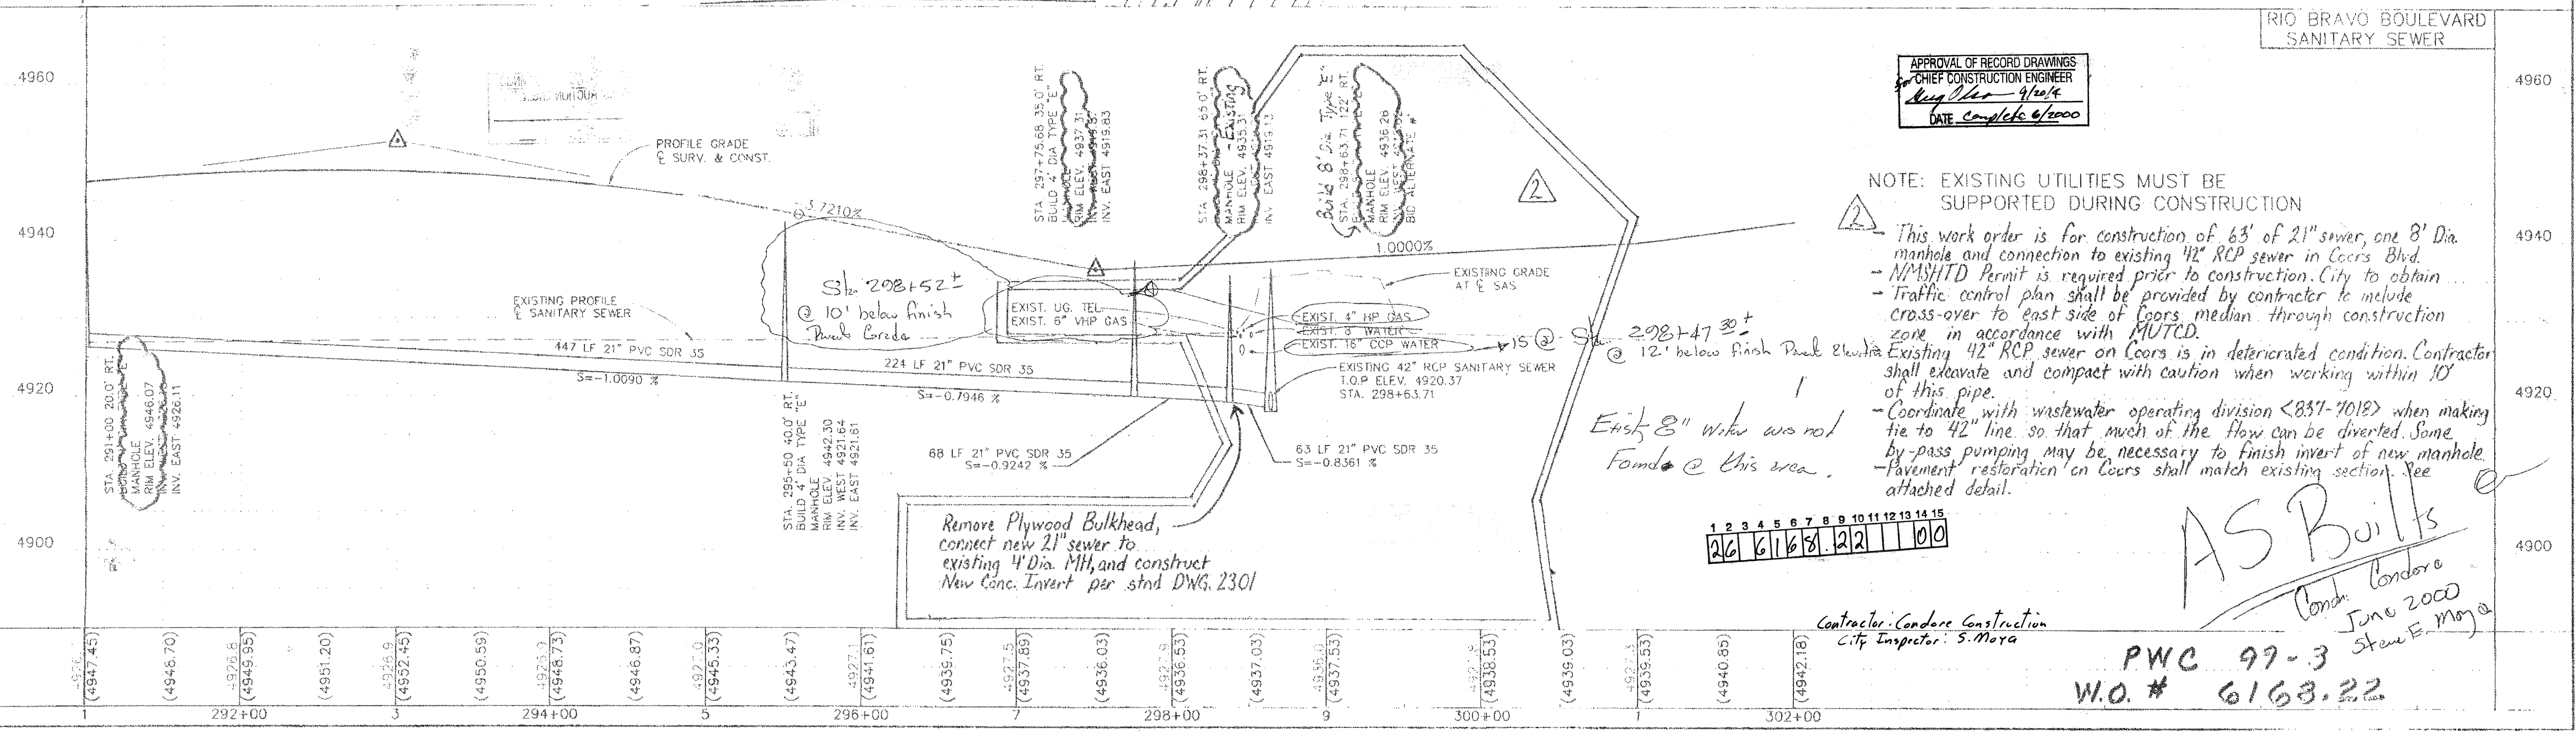

APPROVAL OF RECORD DRAWINGS
CHIEF CONSTRUCTION ENGINEER
DATE: 6/20/00

NOTE: EXISTING UTILITIES MUST BE SUPPORTED DURING CONSTRUCTION

This work order is for construction of 63' of 21" sewer, one 8' Dia. manhole and connection to existing 42" RCP sewer in Coors Blvd.

- NMSHTD Permit is required prior to construction. City to obtain
- Traffic control plan shall be provided by contractor to include cross-over to east side of Coors median through construction zone in accordance with MUTCD.
- Existing 42" RCP sewer on Coors is in deteriorated condition. Contractor shall excavate and compact with caution when working within 10' of this pipe.
- Coordinate with wastewater operating division (831-7012) when making tie to 42" line so that much of the flow can be diverted. Some by-pass pumping may be necessary to finish invert of new manhole.
- Pavement restoration on Coors shall match existing section. See attached detail.

1 2 3 4 5 6 7 8 9 10 11 12 13 14 15
26 61 68.22 100

AS BUILTS
Cond. Condore
June 2000
Steve E. Moya

PWC 97-3
W.O. # 6168.22

Contractor: Condore Construction
City Inspector: S. Moya

Remove Plywood Bulkhead, connect new 21" sewer to existing 4" Dia. MH, and construct New Conc. Invert per std. DWG. 2301