


CONSTRUCTION PLANS
FOR
SAWMILL CROSSING
UNIT 1
ALBUQUERQUE, NEW MEXICO

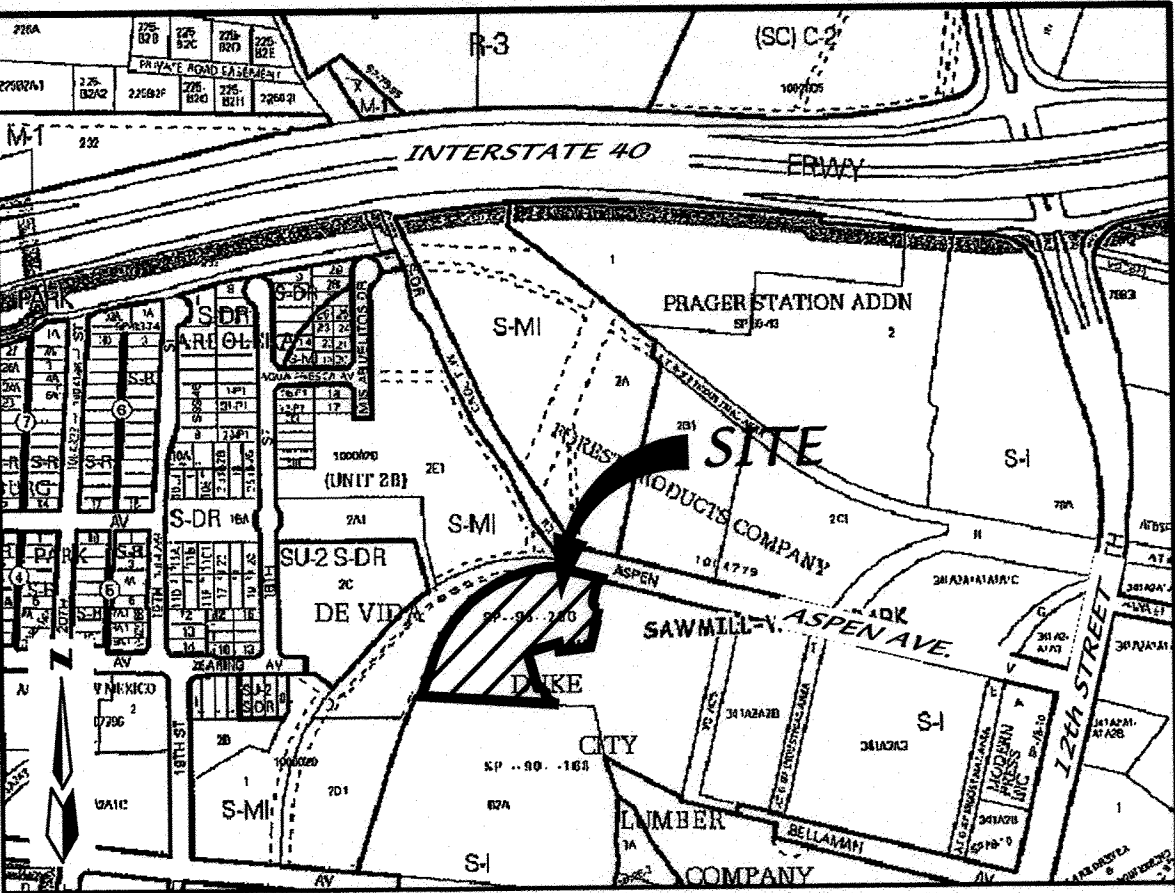

VICINITY MAP
GENERAL NOTES
SCALE: NONE

NOTICE TO CONTRACTORS

1. AN EXCAVATION/CONSTRUCTION PERMIT WILL BE REQUIRED BEFORE BEGINNING ANY WORK WITHIN THE CITY RIGHT-OF-WAY.
2. ALL WORK DETAILED ON THESE PLANS TO BE PERFORMED UNDER CONTRACT SHALL, EXCEPT AS OTHERWISE STATED OR PROVIDED FOR HEREON, BE CONSTRUCTED IN ACCORDANCE WITH THE CITY OF ALBUQUERQUE STANDARD SPECIFICATIONS FOR PUBLIC WORKS CONSTRUCTION, 1986 EDITION AS REVISED THROUGH UPDATE #8.
3. TWO WORKING DAYS PRIOR TO ANY EXCAVATION, THE CONTRACTOR MUST CONTACT NEW MEXICO ONE CALL SYSTEM (260-1990) FOR LOCATION OF EXISTING UTILITIES.
4. PRIOR TO CONSTRUCTION, THE CONTRACTOR SHALL EXCAVATE AND VERIFY THE HORIZONTAL AND VERTICAL LOCATIONS OF ALL OBSTRUCTIONS. SHOULD A CONFLICT EXIST, THE CONTRACTOR SHALL NOTIFY THE ENGINEER IMMEDIATELY SO THAT THE CONFLICT CAN BE RESOLVED WITH A MINIMUM AMOUNT OF DELAY.
5. SEVEN (7) WORKING DAYS PRIOR TO BEGINNING OF CONSTRUCTION, THE CONTRACTOR SHALL SUBMIT TO CONSTRUCTION COORDINATION DIVISION A DETAILED CONSTRUCTION SCHEDULE. TWO (2) WORKING DAYS PRIOR TO THE START OF CONSTRUCTION, THE CONTRACTOR SHALL OBTAIN A BARRICADING PERMIT FROM THE CONSTRUCTION COORDINATION DIVISION. CONTRACTOR SHALL NOTIFY THE CONSTRUCTION COORDINATION ENGINEER (924-3400) PRIOR TO OCCUPYING AN INTERSECTION. REFER TO SECTION 19 OF THE GENERAL CONDITIONS OF THE STANDARD SPECIFICATIONS.
6. ALL WORK AFFECTING ARTERIAL ROADWAYS REQUIRES TWENTY-FOUR HOUR CONSTRUCTION.
7. ALL STREET STRIPING ALTERED OR DESTROYED SHALL BE REPLACED WITH PLASTIC REFLECTORIZED PAVEMENT MARKING BY CONTRACTOR TO THE SAME LOCATION AS WAS EXISTING, OR AS INDICATED BY THIS PLAN SET.
8. CONTRACTOR SHALL NOTIFY THE ENGINEER NOT LESS THAN SEVEN (7) DAYS PRIOR TO STARTING WORK IN ORDER THAT THE CITY SURVEYOR MAY TAKE NECESSARY MEASURES TO INSURE THE PRESERVATION OF SURVEY MONUMENTS. CONTRACTOR SHALL NOT DISTURB PERMANENT SURVEY MONUMENTS WITHOUT THE CONSENT OF THE CITY SURVEYOR AND SHALL NOTIFY THE CITY SURVEYOR AND BEAR THE EXPENSE OF REPLACING ANY THAT MAY BE DISTURBED WITHOUT PERMISSION. REPLACEMENT SHALL BE DONE ONLY BY THE CITY SURVEYOR. WHEN A CHANGE IS MADE IN THE FINISHED ELEVATIONS OF THE PAVEMENT OF ANY ROADWAY IN WHICH A PERMANENT SURVEY MONUMENT IS LOCATED, CONTRACTOR SHALL, AT HIS OWN EXPENSE, ADJUST THE MONUMENT COVER TO THE NEW GRADE UNLESS OTHERWISE SPECIFIED. REFER TO SECTION 4.4 OF THE GENERAL CONDITIONS OF THE STANDARD SPECIFICATIONS.
9. CONTRACTOR SHALL RECORD DATA ON ALL UTILITY LINES AND ACCESSORIES AS REQUIRED BY THE CITY OF ALBUQUERQUE FOR THE PREPARATION OF "AS CONSTRUCTED" DRAWINGS. CONTRACTOR SHALL NOT COVER UTILITY LINES AND ACCESSORIES UNTIL ALL DATA HAVE BEEN RECORDED.
10. CONTRACTOR SHALL MAINTAIN A GRAFFITI-FREE WORK SITE. CONTRACTOR SHALL PROMPTLY REMOVE ANY GRAFFITI FROM ALL EQUIPMENT, WHETHER PERMANENT OR TEMPORARY.
11. THE CONTRACTOR SHALL COORDINATE WITH THE WATER AUTHORITY SEVEN (7) DAYS IN ADVANCE OF PERFORMING WORK THAT WILL AFFECT THE PUBLIC WATER OR SANITARY SEWER INFRASTRUCTURE. WORK REQUIRING SHUTOFF OF FACILITIES DESIGNATED AS MASTER PLAN FACILITIES MUST BE COORDINATED WITH THE WATER AUTHORITY 14 DAYS IN ADVANCE OF PERFORMING SUCH WORK. ONLY WATER AUTHORITY CREWS ARE AUTHORIZED TO OPERATE PUBLIC VALVES. SHUTOFF REQUESTS MUST BE MADE ONLINE AT [HTTP://ABQWA.ORG/CONTENT/VIEW/463/728/](http://abqwa.org/content/view/full/463/728/)
12. RCP SHALL BE INSTALLED SO THAT THE JOINT GAP AT THE HOME POSITION SHALL CONFORM TO THE APPROVED MANUFACTURER'S RECOMMENDATIONS. MANUFACTURER'S RECOMMENDED JOINT GAP TOLERANCES FOR EACH PIPE SIZE AND TYPE SHALL BE SUBMITTED TO THE ENGINEER FOR APPROVAL PRIOR TO PLACEMENT OF PIPE. RCP JOINTS SHALL NOT BE GROUTED UNLESS DIRECTED BY THE ENGINEER AFTER CITY APPROVAL.
13. ALL EXCAVATION, TRENCHING, AND SHORING ACTIVITIES MUST BE CARRIED-OUT IN ACCORDANCE WITH OSHA 29 CFR 1926.650 SUBPART P.
14. ELECTRONIC MARKER DEVICE (EMD) WILL BE PLACED ACCORDING TO SECTION 170 OF THE CITY OF ALBUQUERQUE STANDARD SPECIFICATIONS FOR PUBLIC WORKS CONSTRUCTION, 1986 EDITION AS REVISED THROUGH UPDATE #8.
15. PRIVATE STREETS REQUIRE STREET NAME SIGNS, STOP SIGNS, AND ANY NECESSARY STRIPING (DEVELOPER'S RESPONSIBILITY).
16. CONTRACTOR SHALL ASSUME RESPONSIBILITY FOR ANY DAMAGE TO EXISTING PAVEMENT, PAVEMENT MARKINGS, CURB & GUTTER, HANDICAP RAMPS AND SIDEWALK DURING CONSTRUCTION APART FROM THOSE SECTIONS INDICATED FOR REMOVAL ON THE PLANS AND SHALL REPAIR OR REPLACE, PER CITY OF ALBUQUERQUE STANDARDS, AT HIS OWN EXPENSE.

THE FOLLOWING NOTES ALSO APPLY WHEN CHECKED

- ☒ ALL UTILITIES AND UTILITY SERVICE LINES SHALL BE INSTALLED PRIOR TO PAVING.
- ☒ BACKFILL COMPACTION SHALL BE ACCORDING TO SPECIFIED STREET USE.
- ☐ TACK COAT REQUIREMENTS SHALL BE DETERMINED BY THE ENGINEER.
- ☒ SIDEWALK AND WHEELCHAIR RAMPS WITHIN THE CURB RETURNS SHALL BE CONSTRUCTED WHEREVER A NEW CURB RETURN IS CONSTRUCTED.
- ☐ IF CURB IS DEPRESSED FOR A DRIVEPAD, THE DRIVEPAD SHALL BE CONSTRUCTED PRIOR TO ACCEPTANCE OF CURB AND GUTTER.
- ☐ ALL STORM DRAINAGE FACILITIES SHALL BE COMPLETED PRIOR TO FINAL ACCEPTANCE.

NOTE:
CONTRACTOR SHALL PROVIDE AND MAINTAIN ALL CONSTRUCTION SIGNING UNTIL PROJECT HAS BEEN ACCEPTED BY THE CITY OF ALBUQUERQUE.

CAUTION:
NOTE THAT ALL EXISTING UTILITIES MAY NOT BE SHOWN. ALL EXISTING SERVICE CONNECTIONS ARE NOT SHOWN. ANY EXISTING UTILITIES THAT ARE SHOWN ARE APPROXIMATE LOCATION ONLY. IT SHALL BE THE SOLE RESPONSIBILITY OF THE CONTRACTOR TO CONTACT ALL THE UTILITY OWNERS AND TO CONDUCT ALL NECESSARY FIELD INVESTIGATIONS PRIOR TO ANY EXCAVATIONS TO DETERMINE THE ACTUAL LOCATION OF UTILITIES AND OTHER IMPROVEMENTS. DISTURBANCE OF EXISTING UTILITIES SHALL BE REPLACED AT THE CONTRACTOR'S EXPENSE.

dmg D. MARK GOODWIN & ASSOCIATES, P.A.
CONSULTING ENGINEERS
P. O. BOX 90606
ALBUQUERQUE, NEW MEXICO 87199
(505) 828-2200, FAX (505) 797-9539

REV.	11A	DATE	12/9/2013	USER DEPARTMENT	DATE	11/19/13
ENGINEERS STAMP & SIGNATURE	APPROVALS	ENGINEER	DATE	APPROVED FOR CONSTRUCTION	DATE	4-17-13

	DRC CHAIRMAN		
	TRANSPORTATION		
	WATER/WASTEWATER		
	HYDROLOGY		
	CIP		
CONSTR. MNGMT.			
CONSTR. COORD.			
CITY PROJECT NO.		617586	
SHEET		OF 11	

DRB NO. 1009046

RECORD DRAWING
CERTIFICATE OF SUBSTANTIAL COMPLIANCE ON PLANS

I, John MacKenzie, NMPE 11819, of the firm Mark Goodwin & Associates, P.A., a Registered Professional Engineer in the State of New Mexico, do hereby certify, to the best of my knowledge and belief, that the infrastructure installed as part of this project has been inspected by me or by a qualified person under my direct supervision, and has been constructed in accordance with the plans and specifications approved by the City Engineer and that the original design intent of the approved plans has been met, except as noted by me on the as-built construction drawings. This Certification is based on site inspections by me or personnel under my direction, and survey information provided by Jason Smith, NMPS number 17122.

John M. MacKenzie NMPE 11819

I, John MacKenzie, certify that this electronic version is identical to the original reproducible APPROVED FOR CONSTRUCTION drawings signed by me on November 6, 2012 and February 18, 2013.

(on cover sheet only put:)

This set of drawings is accepted for RECORD purposes by John M. MacKenzie on Feb 24, 2014

26-6175.06-2014

SHEET NO.	SHEET NO.
1	TITLE SHEET
2	PLAT
3	GRADING & DRAINAGE PLAN
4	MASTER PAVING PLAN
5	PAVING AND UTILITY DETAILS
6-7	PAVING IMPROVEMENTS
8	MASTER UTILITY PLAN
9-11	UTILITY IMPROVEMENTS
11A	SPILLWAY CHANNEL



PLAT FOR
SAWMILL CROSSING UNIT 1
WITHIN

THE TOWN OF ALBUQUERQUE GRANT
PROJECTED SECTION 7
TOWNSHIP 10 NORTH, RANGE 3 EAST, NMPM
CITY OF ALBUQUERQUE
BERNALILLO COUNTY, NEW MEXICO
DECEMBER, 2013

EASEMENT KEYED NOTES:

PUBLIC UTILITY EASEMENTS (PUE)

Shown on this plat are granted for the common and joint use of:

Public Service Company of New Mexico, ("PNM"), a New Mexico corporation, (PNM Electric) for installation, maintenance, and service of overhead and underground electrical lines, transformers, and other equipment and related facilities reasonably necessary to provide electrical services.

New Mexico Gas Company for installation, maintenance, and service of natural gas lines, valves and other equipment and facilities reasonably necessary to provide natural gas services.

CenturyLink QC for the installation, maintenance, and service of such lines, cable, and other related equipment and facilities reasonably necessary to provide communication services.

XENITY for the installation, maintenance, and service of such lines, cable, and other related equipment and facilities reasonably necessary to provide Cable services.

included, is the right to build, rebuild, construct, reconstruct, locate, relocate, change, remove, replace, modify, renew, operate and maintain facilities for purposes described above, together with free access to, from, and over said easements, with the right and privilege of going upon, over and across adjoining lands of Grantor for the purposes set forth herein and with the right to utilize the right of way and easement to extend services to customers of Grantee, including sufficient working area space for electric transformers, with the right and privilege to trim and remove trees, shrubs or bushes which interfere with the purposes set forth herein. No building, sign, pool (aboveground or subsurface), hot tub, concrete or wood pool decking, or other structure shall be erected or constructed on said easements, nor shall any well be drilled or operated thereon. Property owners shall be solely responsible for correcting any violations of National Electrical Safety Code by construction of pools, decking, or any structures adjacent to or near easements shown on this plat.

Easements for electric transformer/switchgears, as installed, shall extend ten (10) feet in front of transformer/switchgear doors and five (5) feet on each side.

Disclaimer

In approving this plat, Public Service Company of New Mexico (PNM) and New Mexico Gas Company (NMGC) did not conduct a Title Search of the properties shown hereon. Consequently, PNM and NMGC do not wolve or release any easement or easement rights which may have been granted by prior plat, replat or other document and which are not shown on this plat.

- 1

75' RESERVED FOR PUBLIC UTILITIES BY VACATION ORDINANCE NO. 2425
(03-16-1965, BK. MISC 50, PG. 848-854)
(HATCHED PORTION VACATED WITH 13DRB-70518)

2

20' SANITARY SEWER EASEMENT BY VACATION ORDINANCE NO. 2425
(03-16-1965, BK. MISC 50, PG. 848-854)

3

10' PNM EASEMENT
(06-25-1968, BK. MISC 107, PG. 297-30)
10' PNM EASEMENT BY JUDGEMENT (06-25-1968, BK. MISC 107, PG. 301-304)
(HATCHED PORTION VACATED WITH 13DRB-70518)

4

5' PNM EASEMENT
(03-18-1950, BK. D135, PG. 547-549)

5

30' COA PERMANENT UTILITY EASEMENT BY JUDGEMENT
(04-09-1968, BK. MISC 99, PG. 776-780)

6

17' RAILROAD EASEMENT
(10-24-2003, BK. A67, PG. 4653)
(HATCHED PORTION VACATED WITH 13DRB-70518)

7

20' NON-EXCLUSIVE RAILWAY EASEMENT
(01-24-1980, BK. D113A, PG. 278-280)
(HATCHED PORTION VACATED WITH 13DRB-70518)

8

20' COA PUBLIC WATERLINE EASEMENT CENTERED ON EXISTING WATERLINE. LOCATION IS APPROXIMATE
(09-17-1990, 90C-222)
(HATCHED PORTION VACATED WITH 13DRB-70518)

9

10' OWEST EASEMENT
(08-06-2003, BK. A61, PG. 8569)

10

20' COA PUBLIC WATERLINE EASEMENT
(08-23-2010, 2010C-103)

11

20' COA PUBLIC ACCESS EASEMENT MAINTAINED BY OWNERS OF SAWMILL VILLAGE
(08-23-2010, 2010C-103)

12

17.4' X 35' COA PUBLIC WATERLINE EASEMENT
(08-23-2010, 2010C-103)

13

10' PNM EASEMENT
(01-07-1953, BK. D228, PG. 93-96)

14

COA PUBLIC TEMPORARY TURN-AROUND EASEMENT
(05-25-1990, 90C-135)

15

10' PUE
(05-17-1996, 96C-204)

16

5' PNM ANCHOR EASEMENT
(05-17-1996, 96C-204)

17

7' UTILITY EASEMENT
(04-04-1978, D8-102)

18

20' COA PUBLIC EMERGENCY ACCESS EASEMENT
(10-06-2005, 2005C-325)

19

30' BN & SF RAILWAY COMPANY EASEMENT
(04-11-2005, 2005C-106)

20

COA PUBLIC DRAINAGE EASEMENT
(04-11-2005, 2005C-106)

21

10' PNM ANCHOR EASEMENT
(04-11-2005, 2005C-106)

22

20' RAILROAD TRACK EASEMENT
(12-02-2003, BK. A63, PG. 5318)
(TO BE VACATED BY THIS PLAT)

23

EXISTING PUBLIC ROADWAY EASEMENT
(01-25-2013, DOC. #201300)

24

NEW 5' PUBLIC UTILITY EASEMENT, ALONG THE BACK OF LOTS 5 & 6 AND ALONG THE BACK & SIDE OF LOT 7, GRANTED WITH THIS PLAT.
(SEE EASEMENT DETAIL "B" ON SHEET 3).

25

EXISTING 20' PNM EASEMENT
(04-18-2013, DOC #2013043075)

26

NEW 20 FOOT PUBLIC SANITARY SEWER EASEMENT GRANTED TO ABCWUA WITH THIS PLAT.

27

NEW 5x5 FOOT WIDE LANDSCAPE EASEMENT GRANTED TO LOT 1 AND TO BE MAINTAINED BY UNDERLYING PROPERTY OWNER BY THIS PLAT.

28

NEW 20 FOOT PUBLIC WATER LINE EASEMENT GRANTED TO ABCWUA WITH THIS PLAT.

29

NEW 20 FOOT PUBLIC SANITARY SEWER EASEMENT GRANTED TO ABCWUA WITH THIS PLAT.

30

NEW 3 FOOT PRIVATE DRAINAGE EASEMENT GRANTED TO AND FOR THE BENEFIT OF LOTS 68 & 69 AND TRACT C BY THIS PLAT AND TO BE MAINTAINED BY UNDERLYING PROPERTY OWNERS.

31

NEW 3' PRIVATE DRAINAGE EASEMENT GRANTED TO AND FOR THE BENEFIT OF LOTS 1-4 WITH THIS PLAT AND TO BE MAINTAINED BY UNDERLYING PROPERTY OWNERS. (SEE EASEMENT DETAIL ON SHEET 2.).

32

NEW 3' PRIVATE DRAINAGE EASEMENT GRANTED TO AND FOR THE BENEFIT OF LOTS 5-7 WITH THIS PLAT AND TO BE MAINTAINED BY UNDERLYING PROPERTY OWNERS. (SEE EASEMENT DETAIL "B" ON SHEET 3.)

33

NEW 3' PRIVATE DRAINAGE EASEMENT GRANTED TO AND FOR THE BENEFIT OF LOTS 8-11 WITH THIS PLAT AND TO BE MAINTAINED BY UNDERLYING PROPERTY OWNERS.

34

NEW 3' PRIVATE DRAINAGE EASEMENT GRANTED TO AND FOR THE BENEFIT OF LOTS 12-14 WITH THIS PLAT AND TO BE MAINTAINED BY UNDERLYING PROPERTY OWNERS.

35


NEW 3' PRIVATE DRAINAGE EASEMENT GRANTED TO AND FOR THE BENEFIT OF LOTS 15-18 WITH THIS PLAT AND TO BE MAINTAINED BY UNDERLYING PROPERTY OWNERS. SEE EASEMENT DETAIL "C" ON SHEET 3.

36

NEW PUBLIC WATERLINE EASEMENT GRANTED TO ABCWUA WITH THIS PLAT. (WIDTH VARIES-SEE EASEMENT DETAIL "C" ON SHEET 3).

37

NEW 3' PUBLIC SIDEWALK EASEMENT GRANTED WITH THIS PLAT TO THE CITY OF ALBUQUERQUE.
(SEE EASEMENT DETAIL "A" ON SHEET 3).
-
- P.O. BOX 30701, ALBO., N.M. 87190
- Scale: AS SHOWN
- Drawn: DER
Date: 2/18/2014
- Checked: ALS
Job: A11047
- Sheet 5 of 5
- F:\A11047\A11047 Sawmill Crossing\PLATS\FINAL PLATS\Revised Final Plat\A11047 REVISED FP COVER UNIT.dwg Last saved by Dwayne Jotted: 2/26/14
- F:\A11047\A11047 Sawmill Crossing\PLATS\FINAL PLATS\Revised Final Plat\A11047 REVISED FP COVER UNIT.dwg 2/26/2014 8:23:48 AM DFR

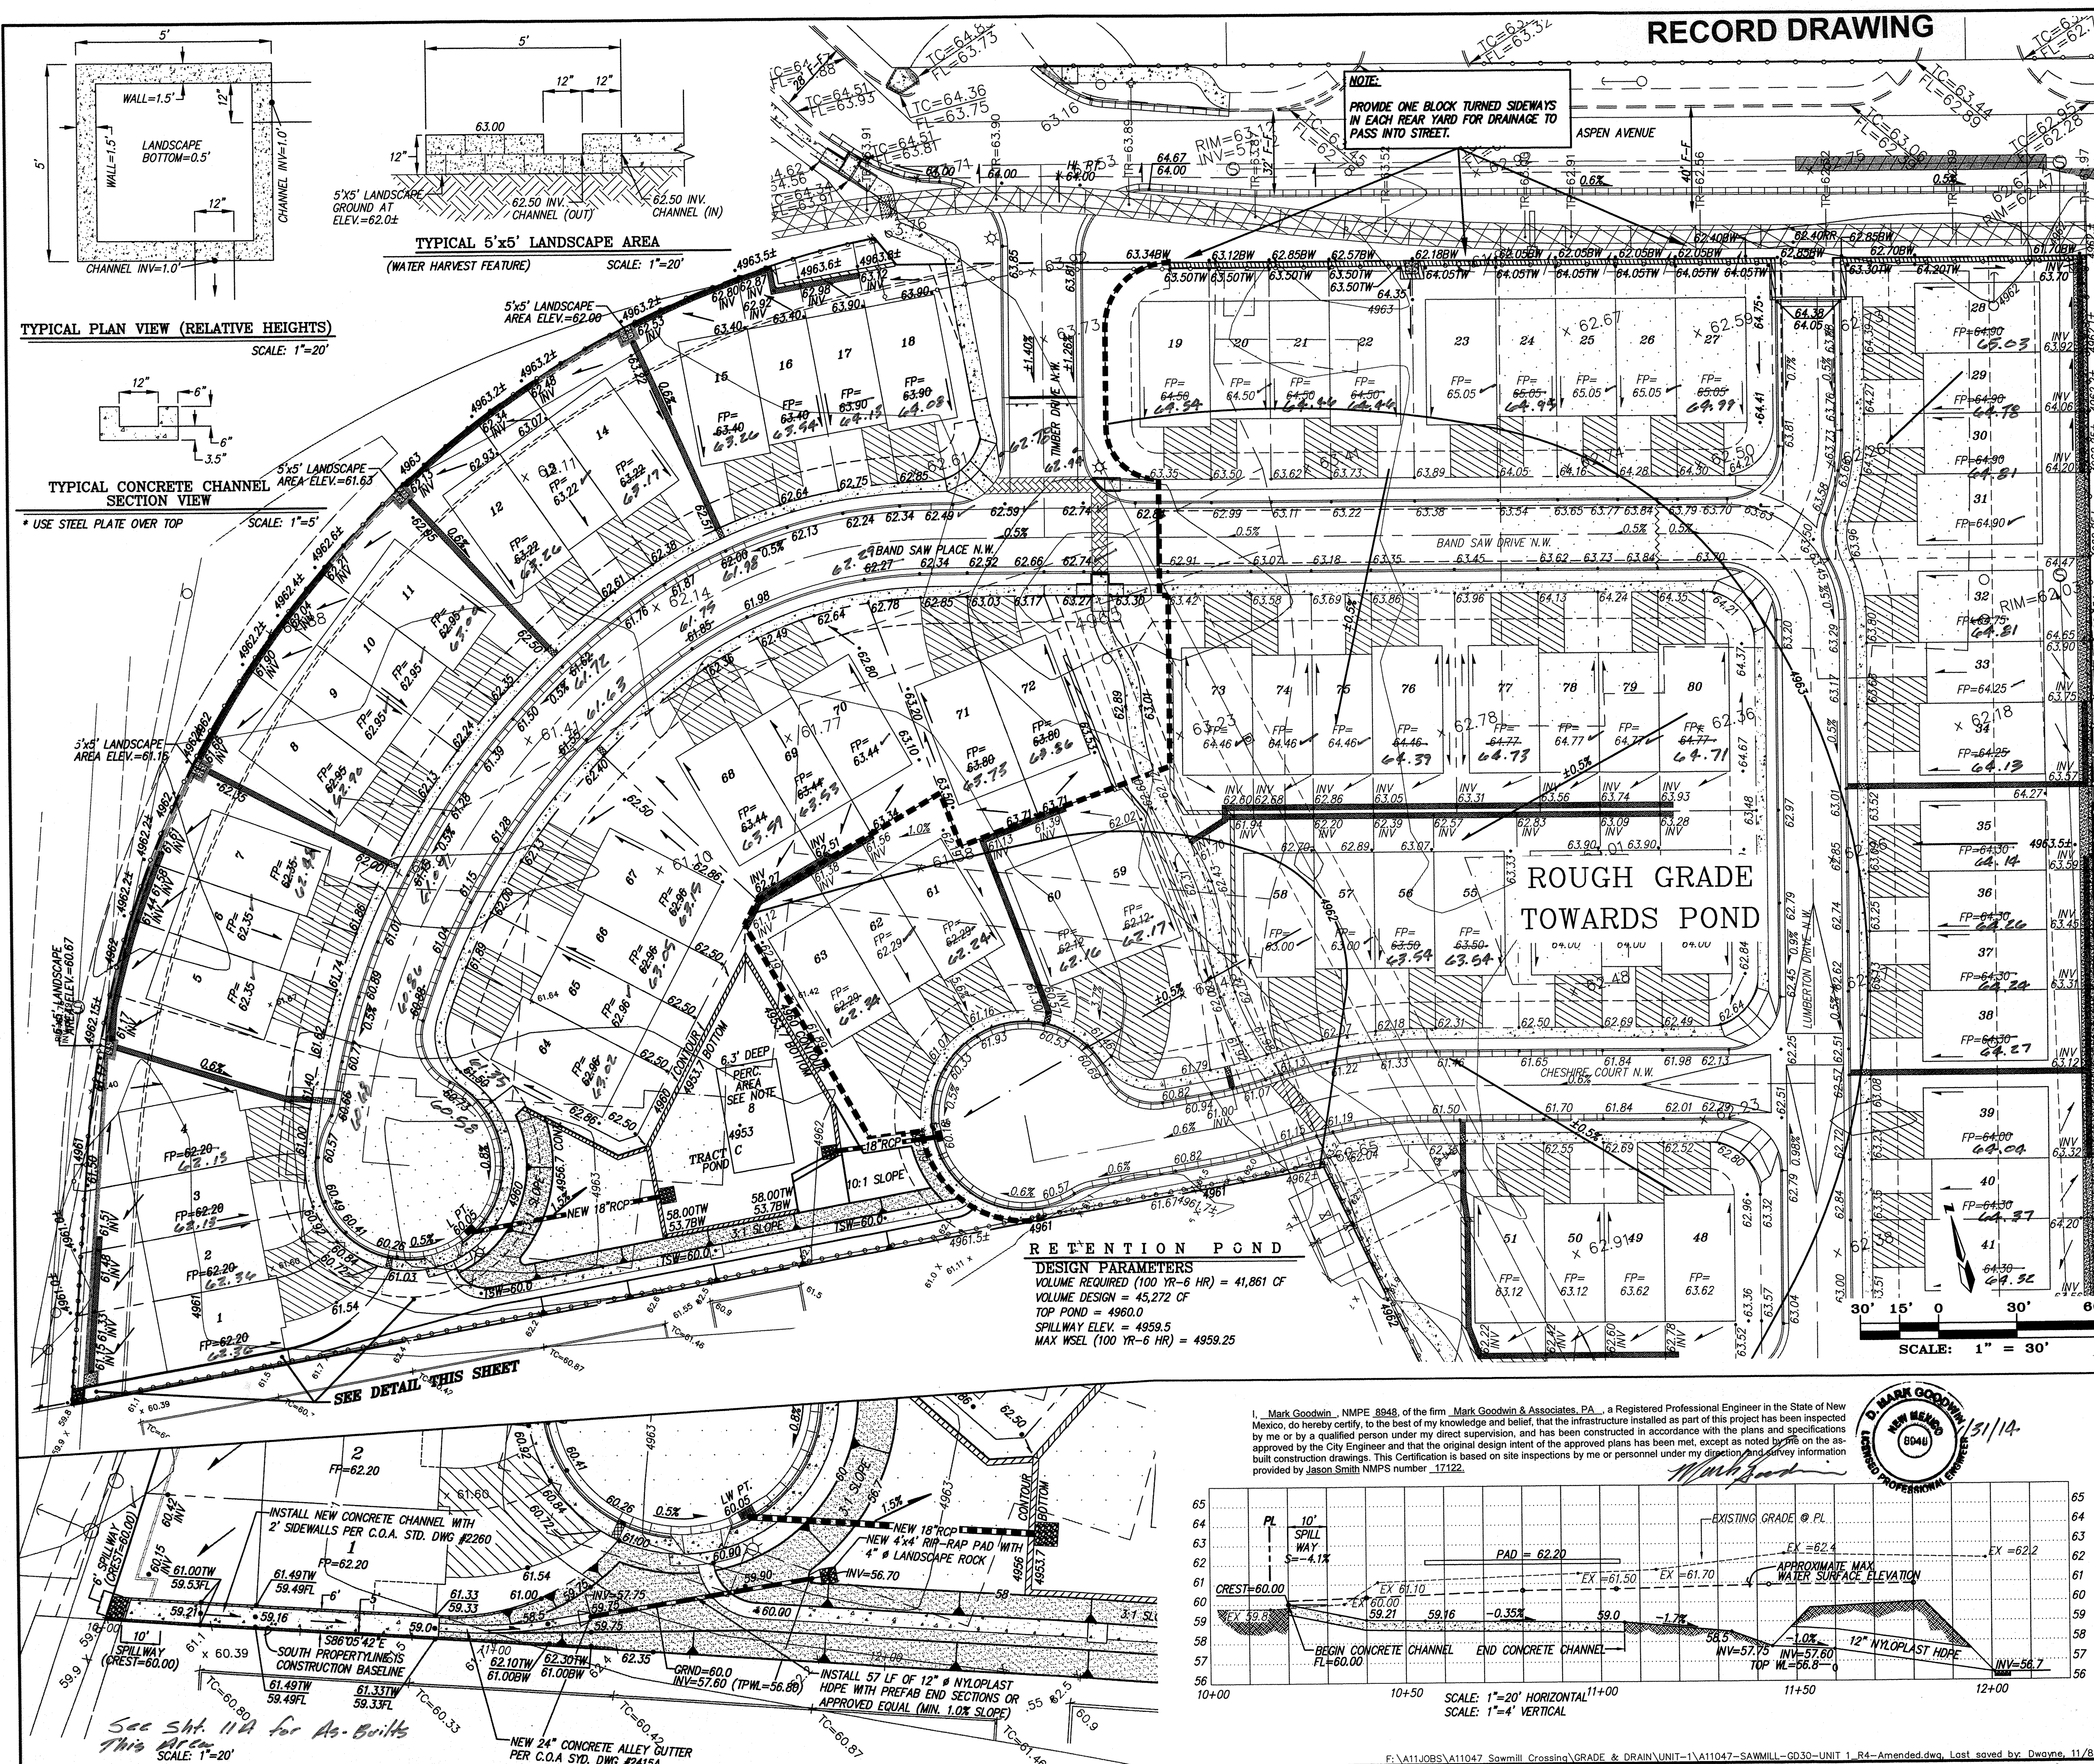

VICINITY MAP H-13-Z

LEGAL DESCRIPTION
LOT B-1-A-2, DUKE CITY LUMBER COMPANY ADDITION

LEGEND

- EXIST. TOP CURB/FLOWLINE
- EXIST. CONCRETE/SIDEWALK
- EXIST. SPOT ELEVATION
- EXIST. FIRE HYDRANT
- EXIST. GUY WIRE
- EXIST. OVERHEAD ELECTRIC
- EXIST. POWER POLE
- EXIST. SANITARY SEWER MANHOLE
- EXIST. WATER VALVE
- EXIST. RAILROAD TRACKS
- EXIST. SIGN
- EXIST. DROP INLET
- EXIST. TELEPHONE PEDESTAL
- EXIST. WATER METER
- EXIST. STORM DRAIN MANHOLE
- NEW PROPERTY LINE
- NEW LOT LINES
- NEW RIGHT-OF-WAY
- NEW CENTER LINE
- NEW MOUNTABLE CURB & GUTTER
- NEW STANDARD CURB & GUTTER
- NEW SPOT ELEVATION
- NEW SWALE
- NEW FINISHED PAD ELEVATION
- NEW RUNOFF DIRECTION
- NEW WATER BLOCK
- NEW RETAINING WALL
- NEW GARDEN WALL
- NEW SIDEWALK GRATE
- NEW STORM DRAIN INLET
- NEW SLOPE
- NEW STORM DRAIN LINE
- NEW CONTOUR
- NEW TOWNHOME ROOF RUNOFF TO FRONT YARD
- NEW 6" CRUSHER FINE TRAIL
- NEW 1" WIDE DRAINAGE CHANNEL
- NEW EXIST. RAILROAD TRACK NO CONSTRUCTION ZONE
- NEW LANDSCAPE AREA
- NEW OPENING IN WALL TO ALLOW RUNOFF TO PASS
- NEW SIDEWALK
- NEW DRIVE PADS
- NEW PHASE LINE
- NEW OFFSITE PAVEMENT

AS BUILT INFORMATION

CONTRACTOR: *Franklin's*

DATE: *9/13*

STAMPED BY: *Chris Smith*

DATE: *1/14*

REVISIONS:

NO. DATE DESCRIPTION

1/1/24 New G+D Replaces sheet 3

DESIGNED BY: *DLH* DATE: *03/12*

DRAWN BY: *ACH* DATE: *03/12*

CHECKED BY: *DMG* DATE: *03/12*

ENGINEER'S SEAL

John M. Goodwin

REVISIONS

NO. DATE DESCRIPTION

1/1/24 New G+D Replaces sheet 3

MARK GOODWIN & ASSOCIATES, P.A.
CONSULTING ENGINEERS
P.O. BOX 90606
ALBUQUERQUE, NEW MEXICO 87199
(505) 828-2200, FAX (505) 797-9339

CITY OF ALBUQUERQUE
PUBLIC WORKS DEPARTMENT

TITLE:
SAWMILL CROSSING - UNIT 1
GRADING & DRAINAGE PLAN


DESIGN REVIEW COMMITTEE CITY ENGINEER APPROVAL


Not For Construction


CITY PROJECT NO. **617586** ZONE MAP NO. **H-13-Z** SHEET **38** OF **11**

F:\A11\085\A11047 Sawmill Crossing\GRADE & DRAIN\UNIT-1\A11047-SAWMILL-CROSSING-UNIT 1 R4-Amended.dwg, 1/7/2013 1:14:04 PM, DER

For Information Only

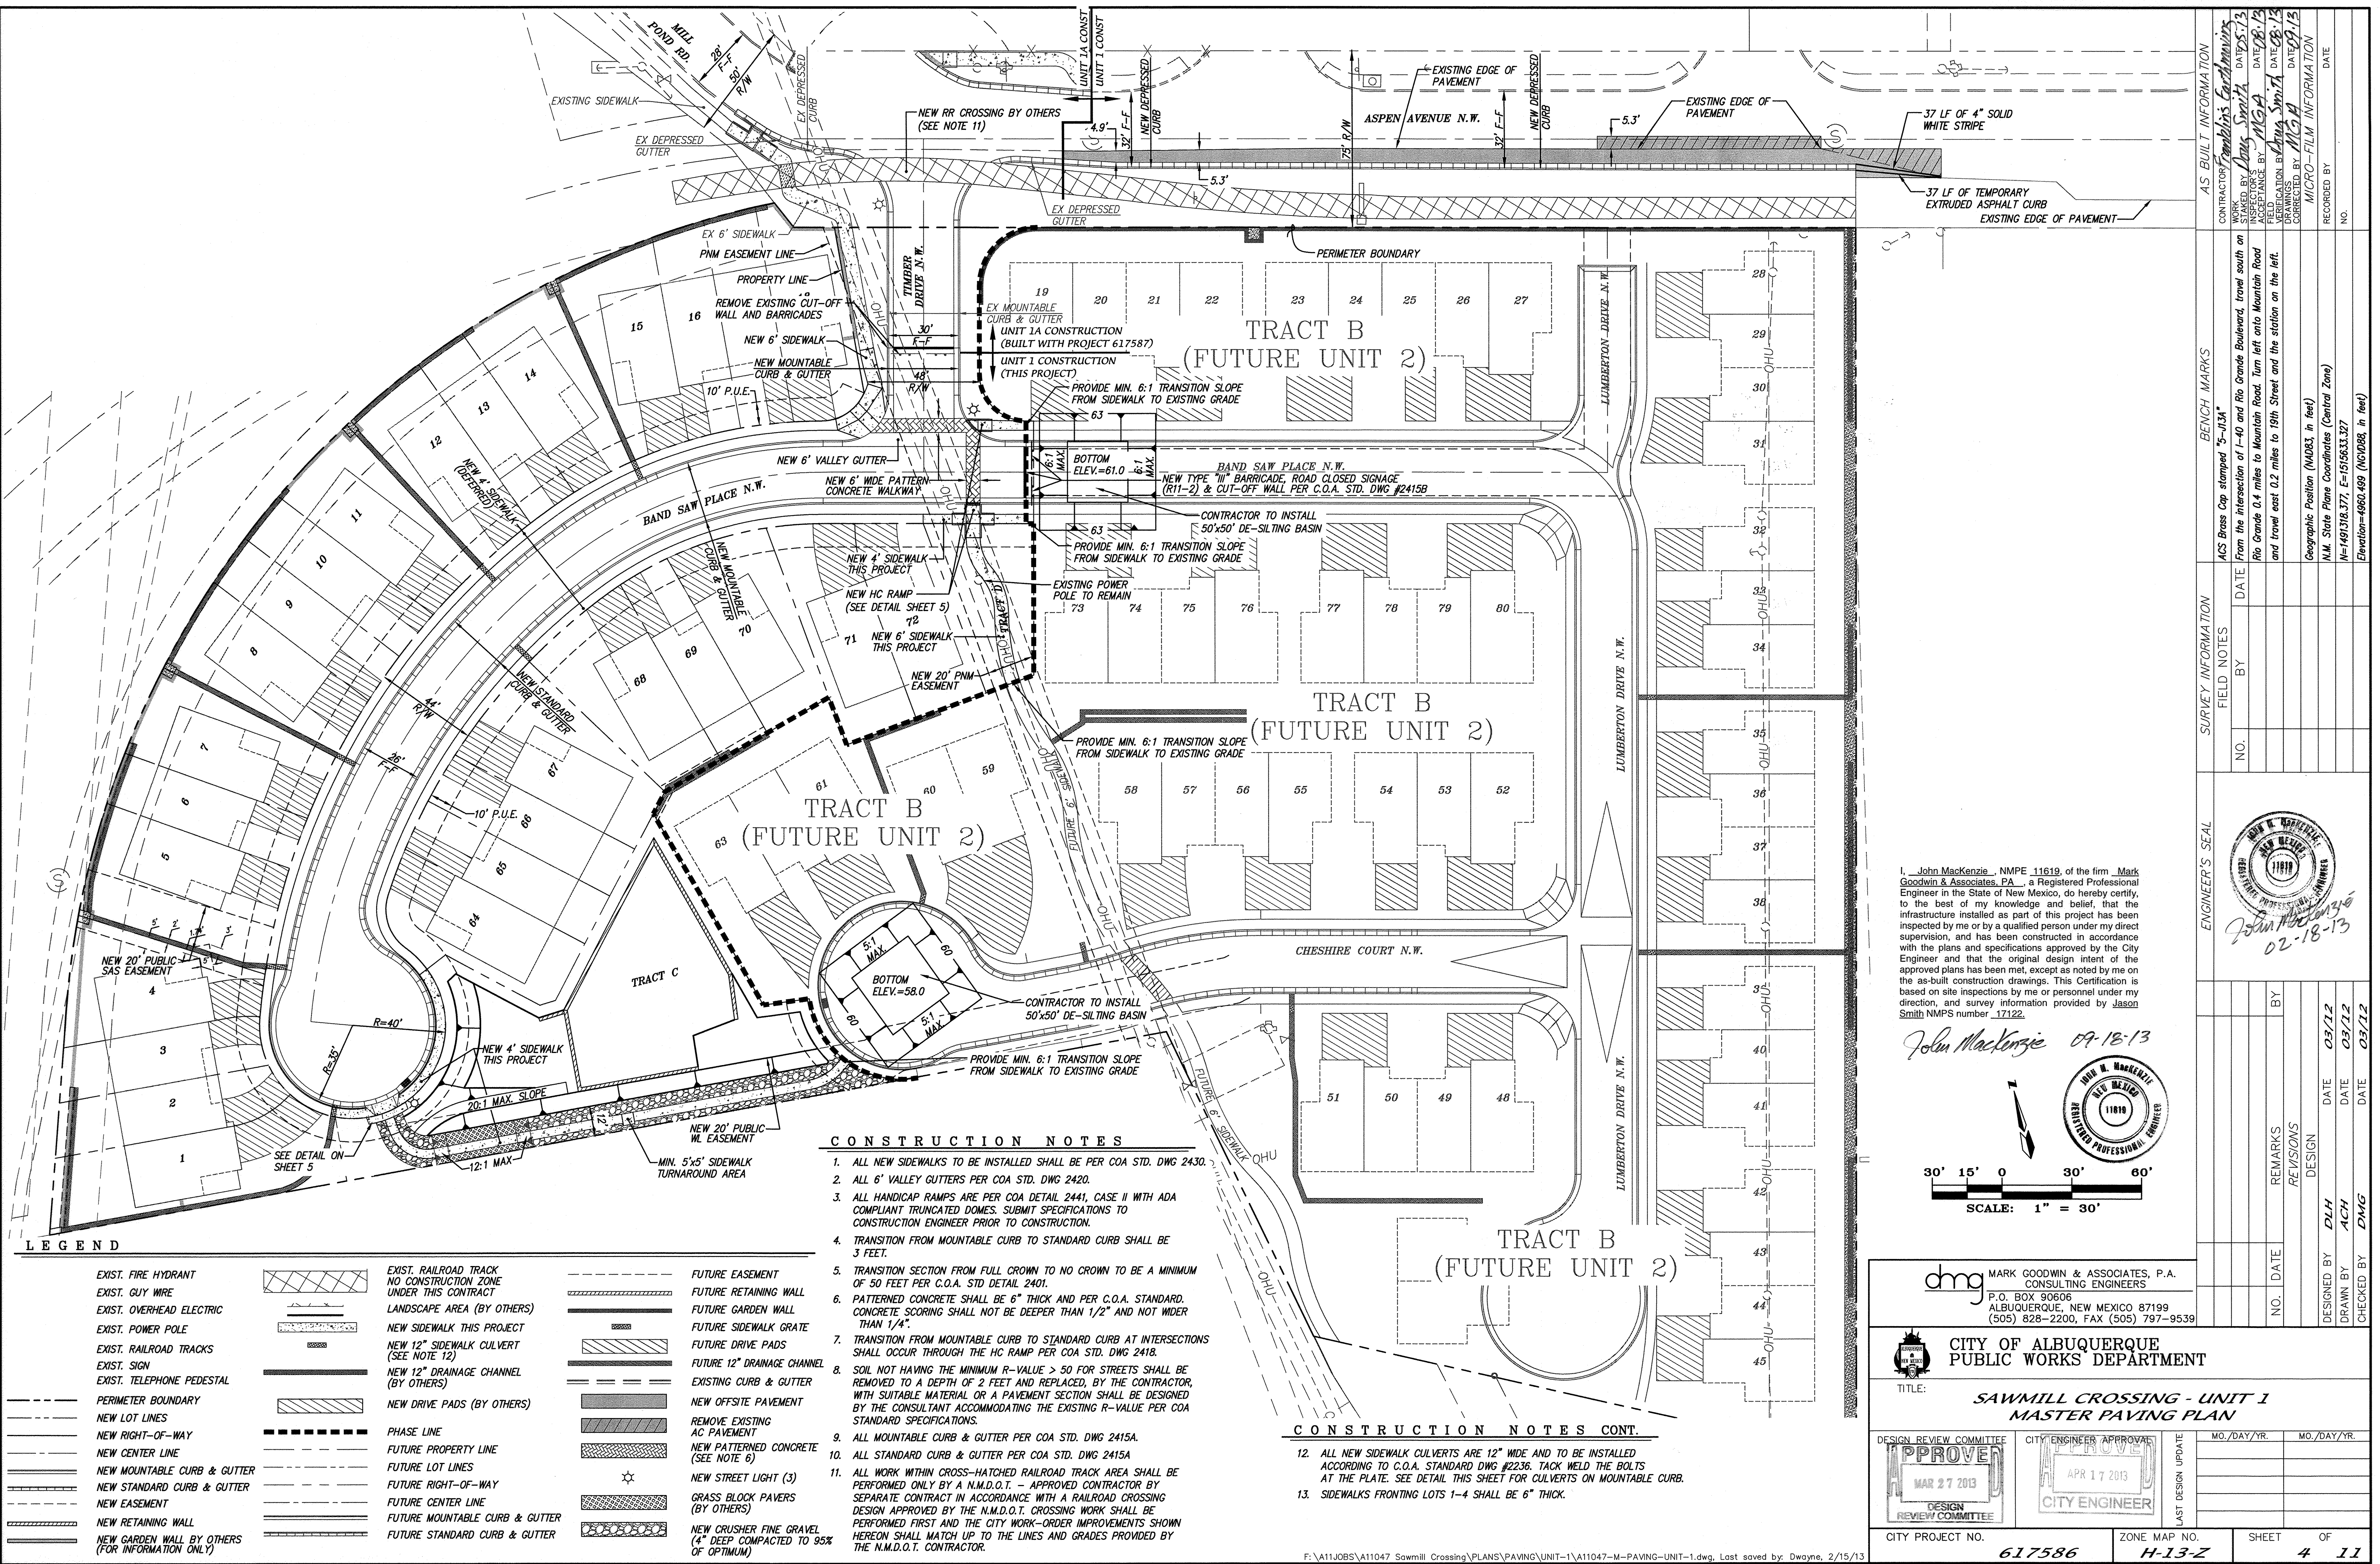

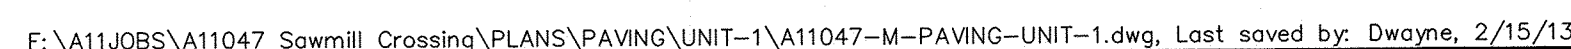

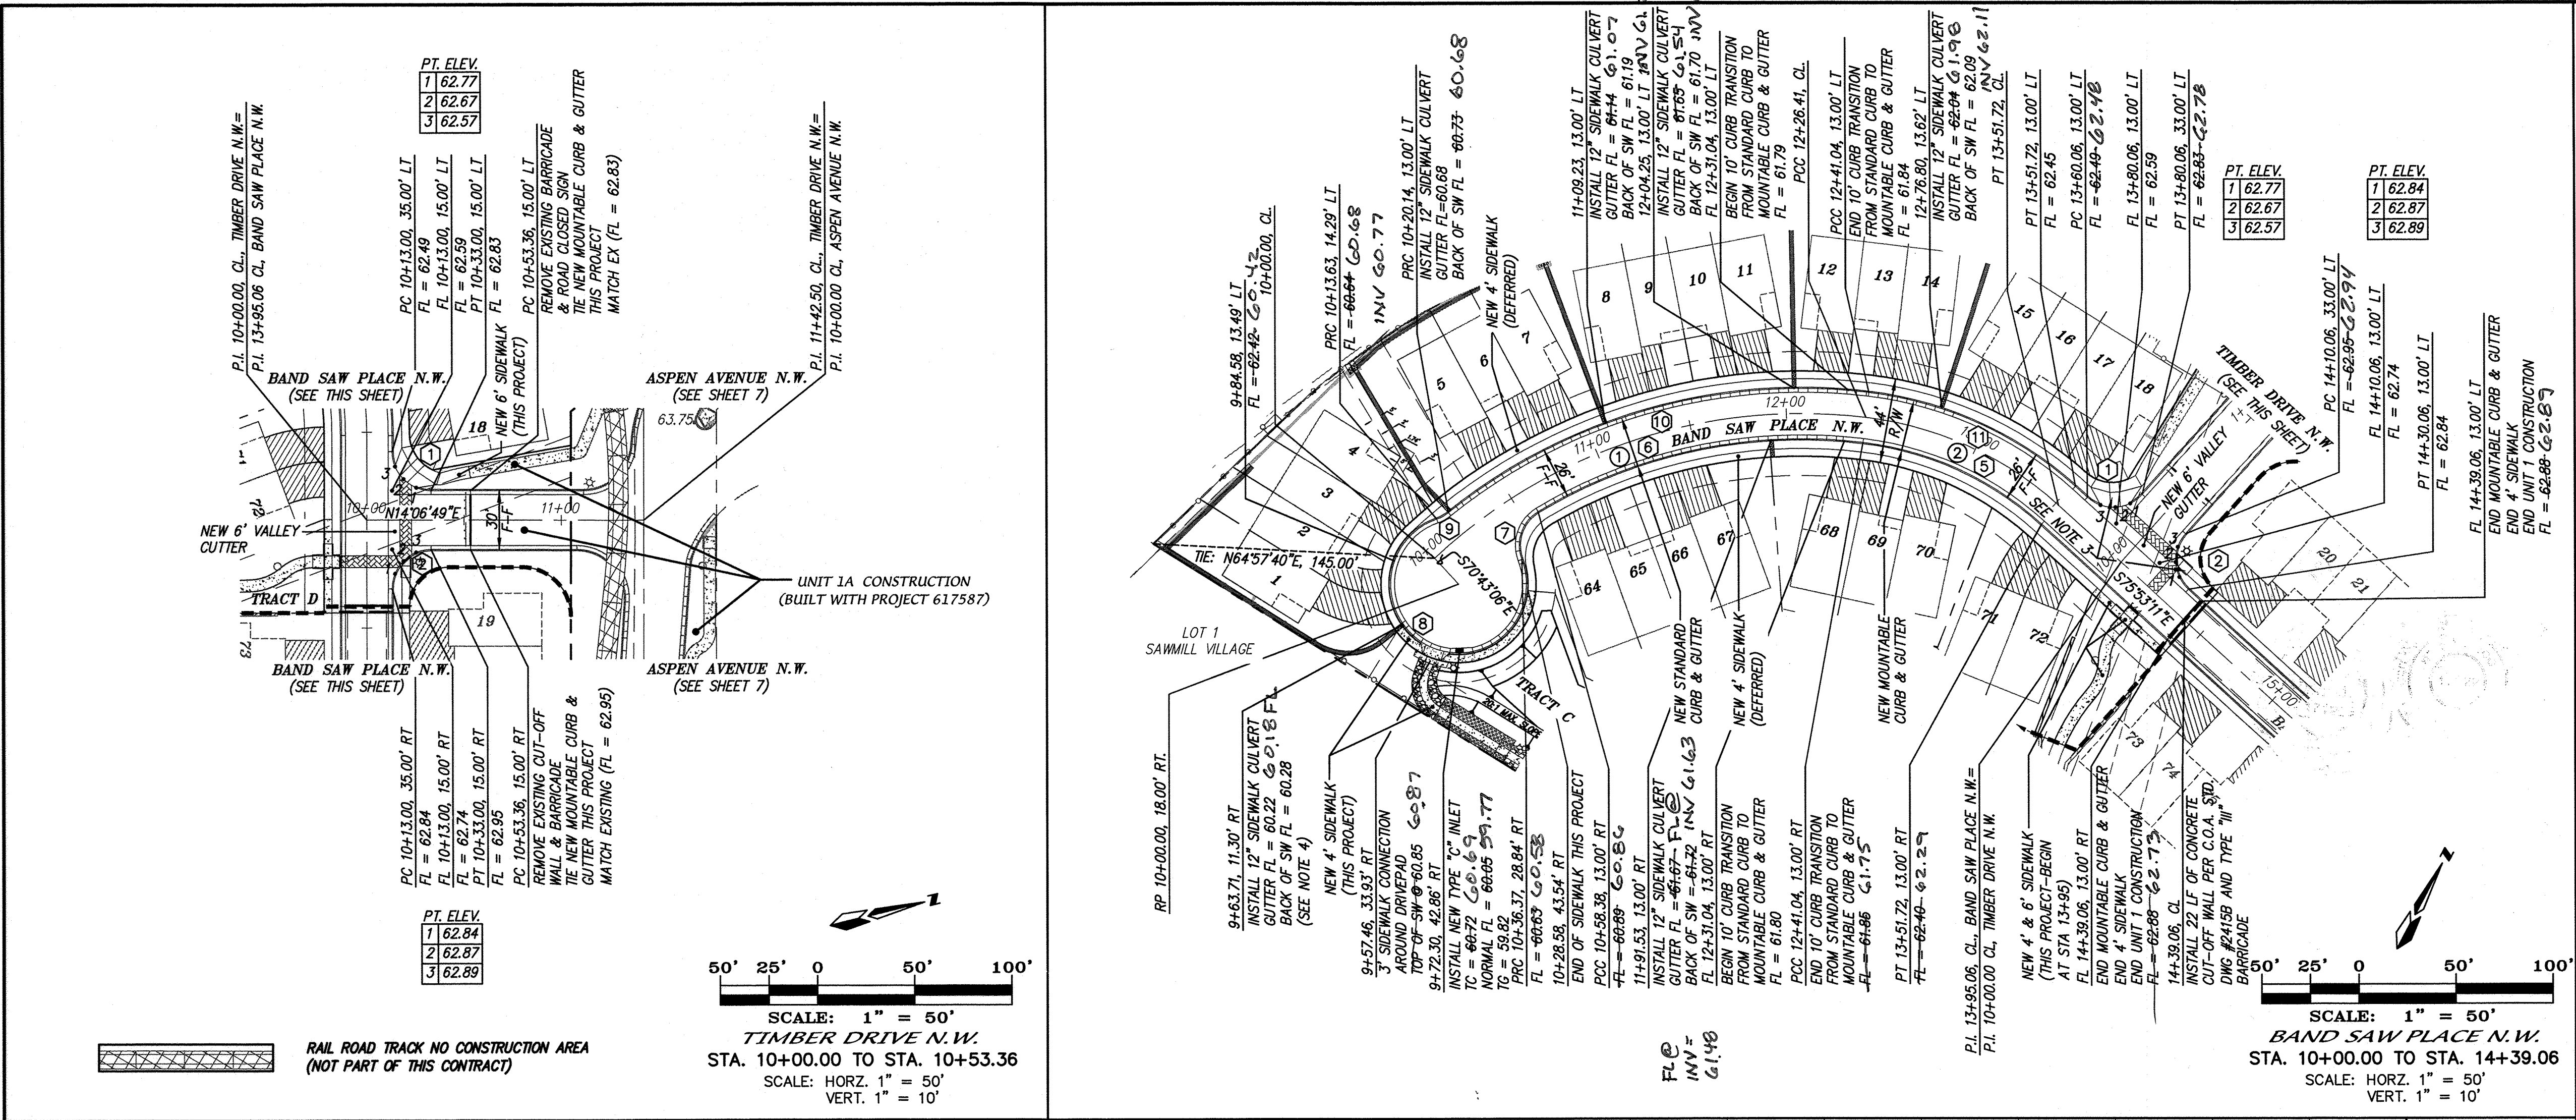


- NOTES
1. ALL STATIONING IS BASED ON THE CENTERLINE OF PUBLIC ROADWAY.
 2. STORM DRAIN INLETS SHALL BE INSTALLED PER C.O.A. STD. DWG #2205 AND GRATES PER C.O.A. STD. DWG # 2220.
 3. INSTALL (WHEELCHAIR) CURB ACCESS RAMPS PER C.O.A. STD. DWG #2441 (CASE II).
 4. TRANSITION FROM STANDARD CURB & GUTTER TO MOUNTABLE CURB & GUTTER SHALL BE OVER A DISTANCE OF 3'.

CURVE DATA - DESCRIBES CENTERLINE

① Δ=49°36'05" L=241.04 R=278.43 Tan=128.66	② Δ=35°13'50" L=110.68 R=180.00 Tan=57.15
---	--

CURVE DATA - DESCRIBES FACE OF NEW CURB

① Δ=89°59'20" L=31.42 R=20.00 Tan=20.00	② Δ=90°00'04" L=31.42 R=20.00 Tan=20.00	③ Δ=87°25'11" L=38.14 R=25.00 Tan=23.90
④ Δ=93°30'39" L=40.80 R=25.00 Tan=26.58	⑤ Δ=35°13'50" L=102.69 R=167.00 Tan=53.02	⑥ Δ=37°35'14" L=174.13 R=265.43 Tan=90.33
⑦ Δ=80°16'10" L=28.02 R=20.00 Tan=16.86	⑧ Δ=272°24'23" L=166.40 R=35.00 Tan=-33.56	⑨ Δ=20°00'26" L=6.98 R=20.00 Tan=3.53
⑩ Δ=45°27'28" L=231.22 R=291.43 Tan=122.08	⑪ Δ=35°13'50" L=118.67 R=193.00 Tan=61.28	

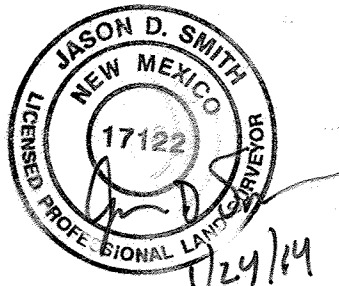

I, JASON D. SMITH, NEW MEXICO PROFESSIONAL SURVEYOR, HEREBY CERTIFY THAT THIS AS-BUILT SURVEY WAS PREPARED FROM AN ACTUAL GROUND SURVEY PERFORMED BY ME OR UNDER MY SUPERVISION, THAT I AM RESPONSIBLE FOR THIS SURVEY, THAT THIS SURVEY IS TRUE AND CORRECT TO THE BEST OF MY KNOWLEDGE AND BELIEF.

I, John MacKenzie, NMPE 11619, of the firm Mark Goodwin & Associates, P.A., a Registered Professional Engineer in the State of New Mexico, do hereby certify, to the best of my knowledge and belief, that the infrastructure installed as part of this project has been inspected by me or by a qualified person under my direct supervision, and has been constructed in accordance with the plans and specifications approved by the City Engineer and that the original design intent of the approved plans has been met, except as noted by me on the as-built construction drawings. This Certification is based on site inspections by me or personnel under my direction, and survey information provided by Jason Smith NMPS number 17122.




MARK GOODWIN & ASSOCIATES, P.A.
CONSULTING ENGINEERS
P.O. BOX 90606
ALBUQUERQUE, NEW MEXICO 87199
(505) 828-2200, FAX (505) 797-9539



CITY OF ALBUQUERQUE
PUBLIC WORKS DEPARTMENT

TITLE: SAWMILL CROSSING - UNIT 1
TIMBER DRIVE & BAND SAW PLACE
PAVING PLAN AND PROFILE

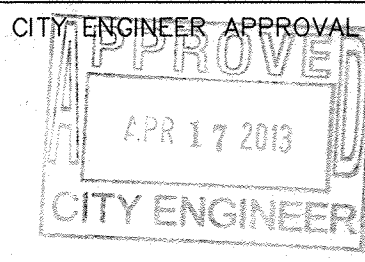

DESIGN REVIEW COMMITTEE
APPROVED
MAR 27 2013
DESIGN REVIEW COMMITTEE

CITY ENGINEER APPROVAL
APPROVED
APR 17 2013
CITY ENGINEER

CITY PROJECT NO.

ZONE MAP NO.


SHEET OF

617586

H-13-Z

6 11

RECORD DRAWING

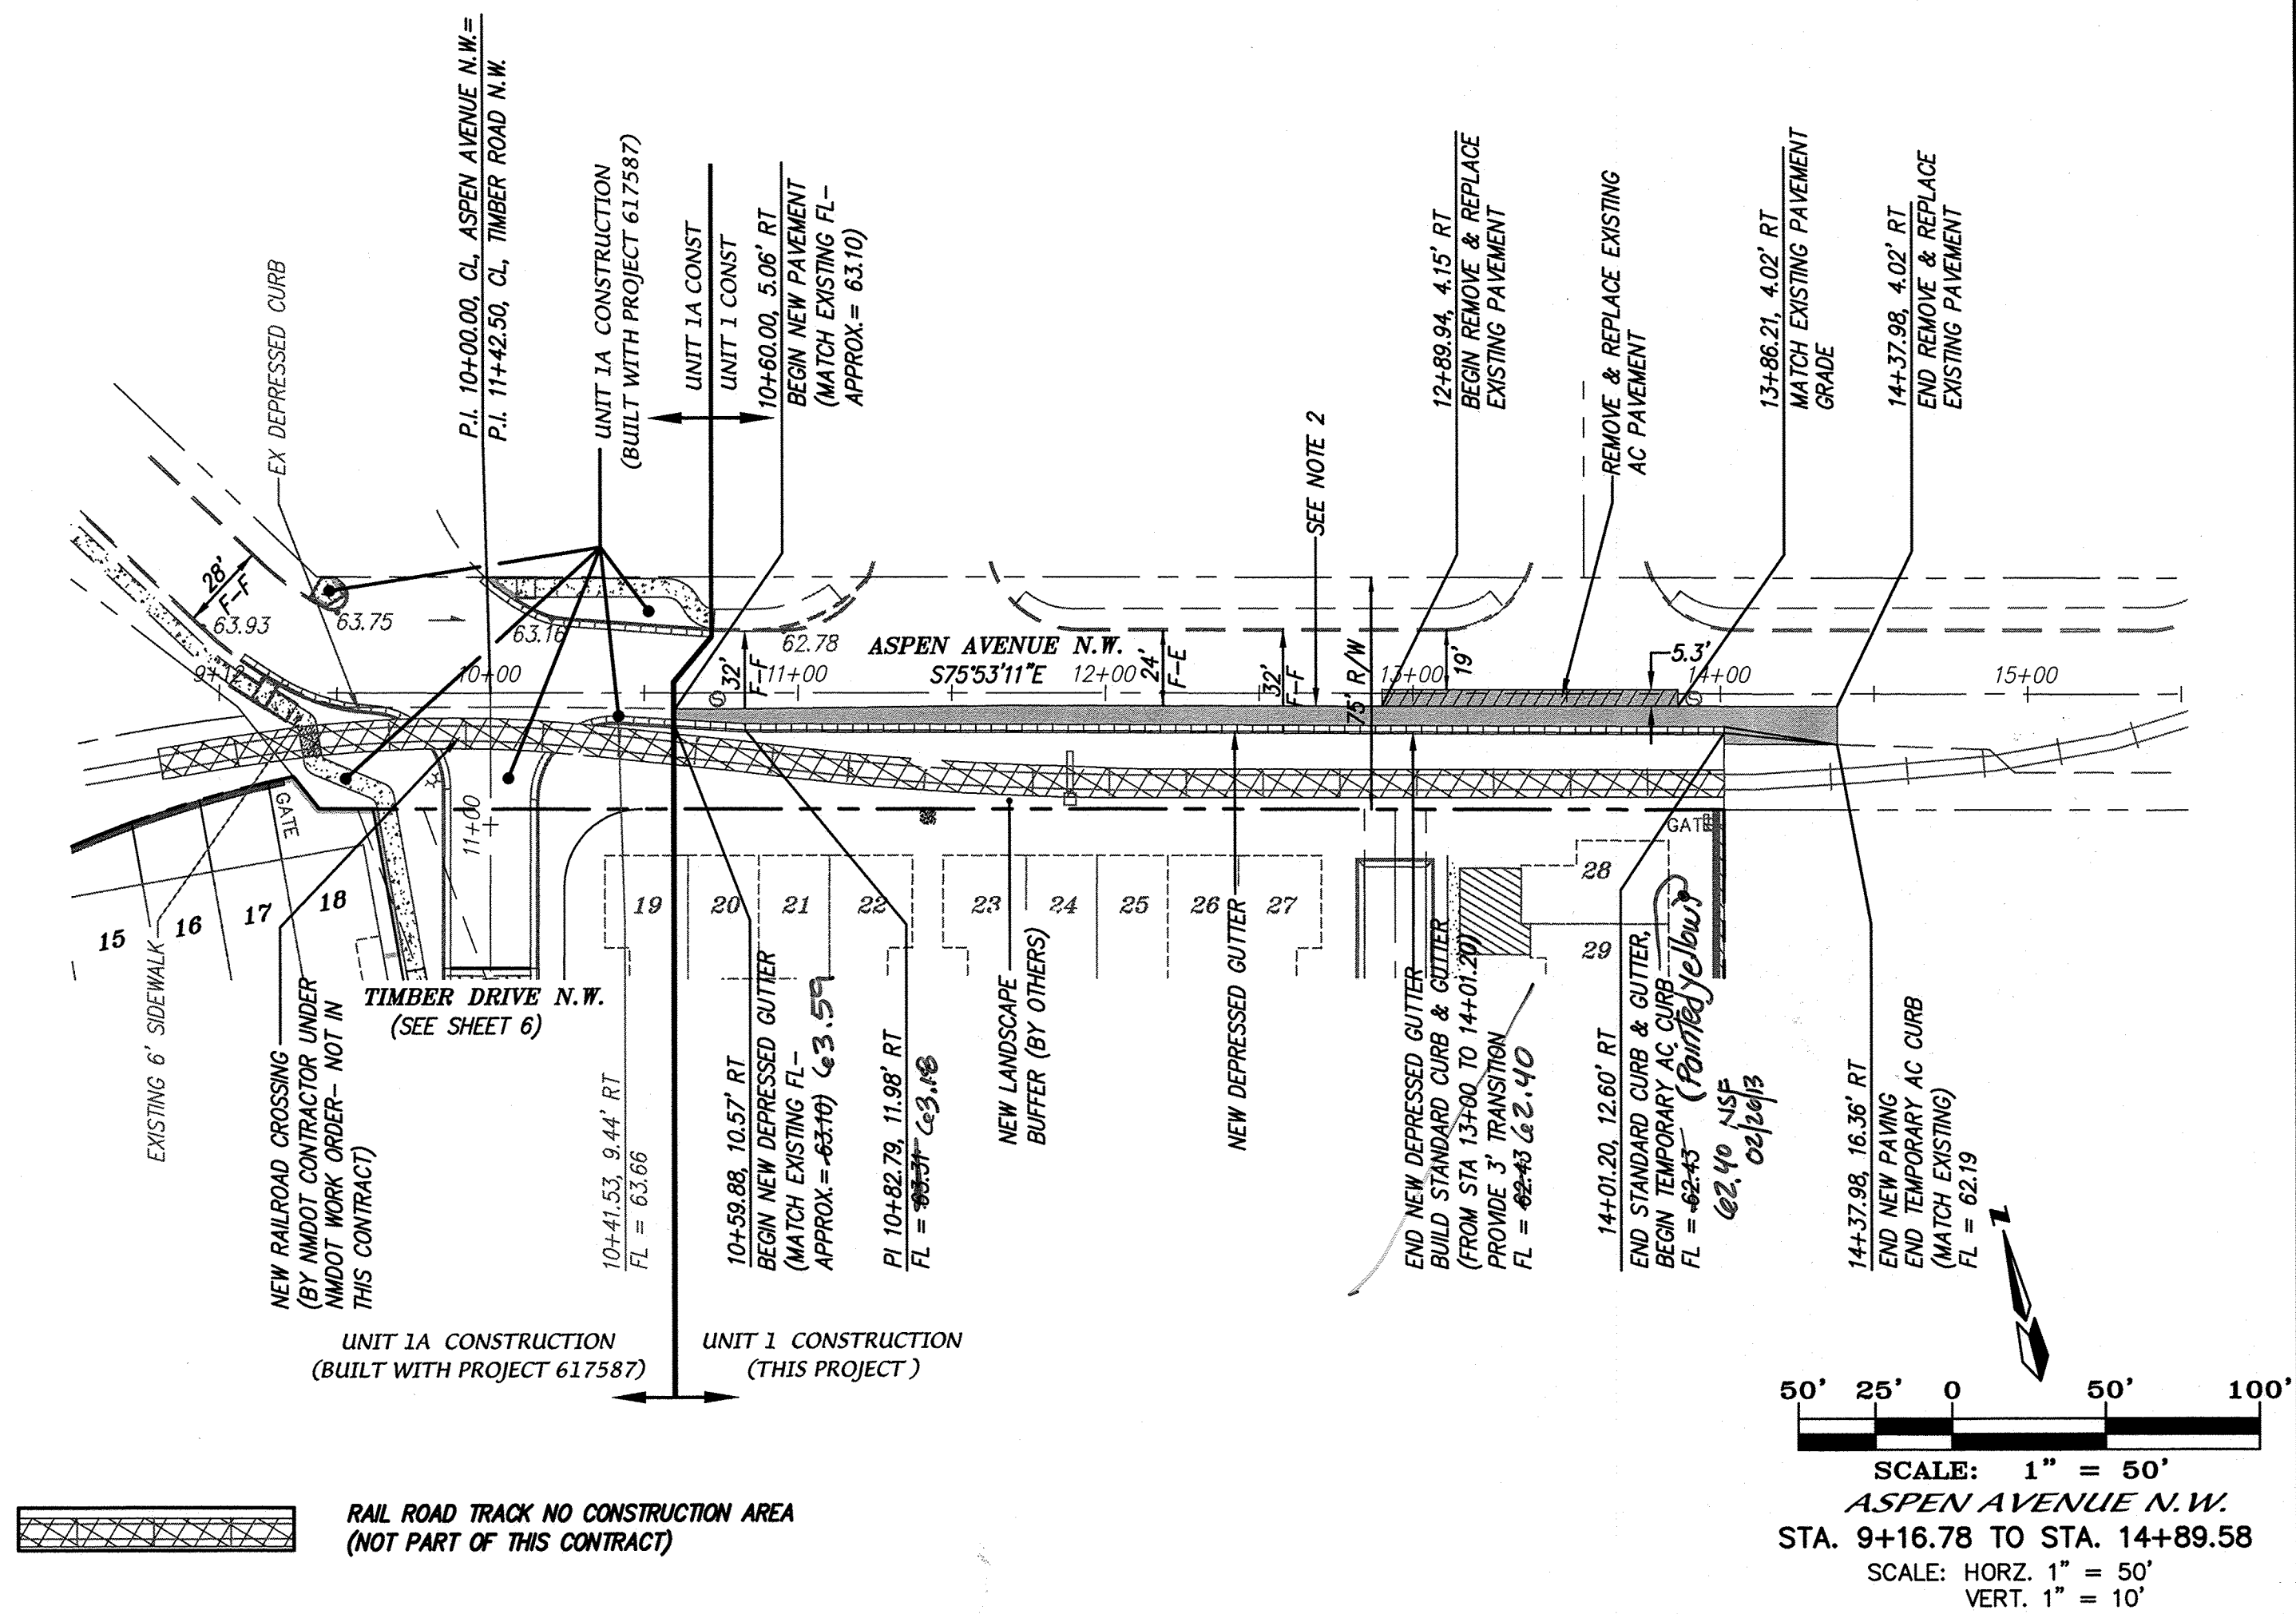[illegible]

NOTES

1. ALL STATIONING IS BASED ON THE CENTERLINE OF PUBLIC ROADWAY.
2. AT LEAST 6" OF EXISTING PAVEMENT ON ASPEN SHALL BE SAWCUT OFF EXISTING PAVEMENT EDGE SO THAT A CLEAN SURFACE IS OBTAINED.
3. NEW PAVING ON ASPEN AVE SHALL BE SLOPED TO DRAIN NORTH TOWARDS EXISTING FLOWLINE ALONG NORTH SIDE OF ASPEN AVE NW, EXCEPT BETWEEN STA. 134+00 AND 144+01.
4. SEE SHEET 4 FOR STRIPING INFORMATION.

I, JASON D. SMITH, A NEW MEXICO PROFESSIONAL SURVEYOR, HEREBY CERTIFY THAT THIS AS-BUILT SURVEY WAS PREPARED FROM AN ACTUAL GROUND SURVEY PERFORMED BY ME OR UNDER MY SUPERVISION, THAT I AM RESPONSIBLE FOR THIS SURVEY, THAT THIS SURVEY IS TRUE AND CORRECT TO THE BEST OF MY KNOWLEDGE AND BELIEF.

I, John MacKenzie, NMPE 11619, of the firm Mark Goodwin & Associates, PA, a Registered Professional Engineer in the State of New Mexico, do hereby certify, to the best of my knowledge and belief, that the infrastructure installed as part of this project has been inspected by me or by a qualified person under my direct supervision, and has been constructed in accordance with the plans and specifications approved by the City Engineer and that the original design intent of the approved plans has been met, except as noted by me on the as-built construction drawings. This Certification is based on site inspections by me or personnel under my direction, and survey information provided by Jason Smith NMPS number 17122.

John MacKenzie 09.18.13



 MARK GOODWIN & ASSOCIATES, P.A.
CONSULTING ENGINEERS

P.O. BOX 90606
ALBUQUERQUE, NEW MEXICO 87199
(505) 828-2200, FAX (505) 797-9538




CITY OF ALBUQUERQUE
PUBLIC WORKS DEPARTMENT

TITLE: *SAWMILL CROSSING - UNIT 1*
ASPEN AVENUE N.W.
PAVING PLAN AND PROFILE

DESIGN REVIEW COMMITTEE		CITY ENGINEER APPROVAL		MO./DAY/YR.	MO./DAY/YR.
		LAST DESIGN UPDATE			

SURVEY INFORMATION		BENCH MARKS		AS BUILT INFORMATION	
NO.	FIELD NOTES	DATE		CONTRACTOR	WORKS
	ACS Brass Cap stamped "5-13A"			<i>Franklin's Earthmoving</i>	
	From the intersection of I-40 and Rio Grande Boulevard, travel south on Rio Grande 0.4 miles to Mountain Road. Turn left onto Mountain Road and travel east 0.2 miles to 19th Street and the station on the left.			INSPECTOR'S ACCEPTANCE BY	DATE: 5-13-13
				VERIFICATION BY	DATE: 5-13-13
	Geographic Position (NAD83, in feet)			CORRECTED BY	DATE: 5-13-13
	N.M. State Plane Coordinates (Central Zone)			MICRO-FILM INFORMATION	
	N=1491318.377, E=1515633.327			RECORDED BY	DATE
	Elevation=4960.499 (NGVD83, in feet)			NO.	


[illegible]

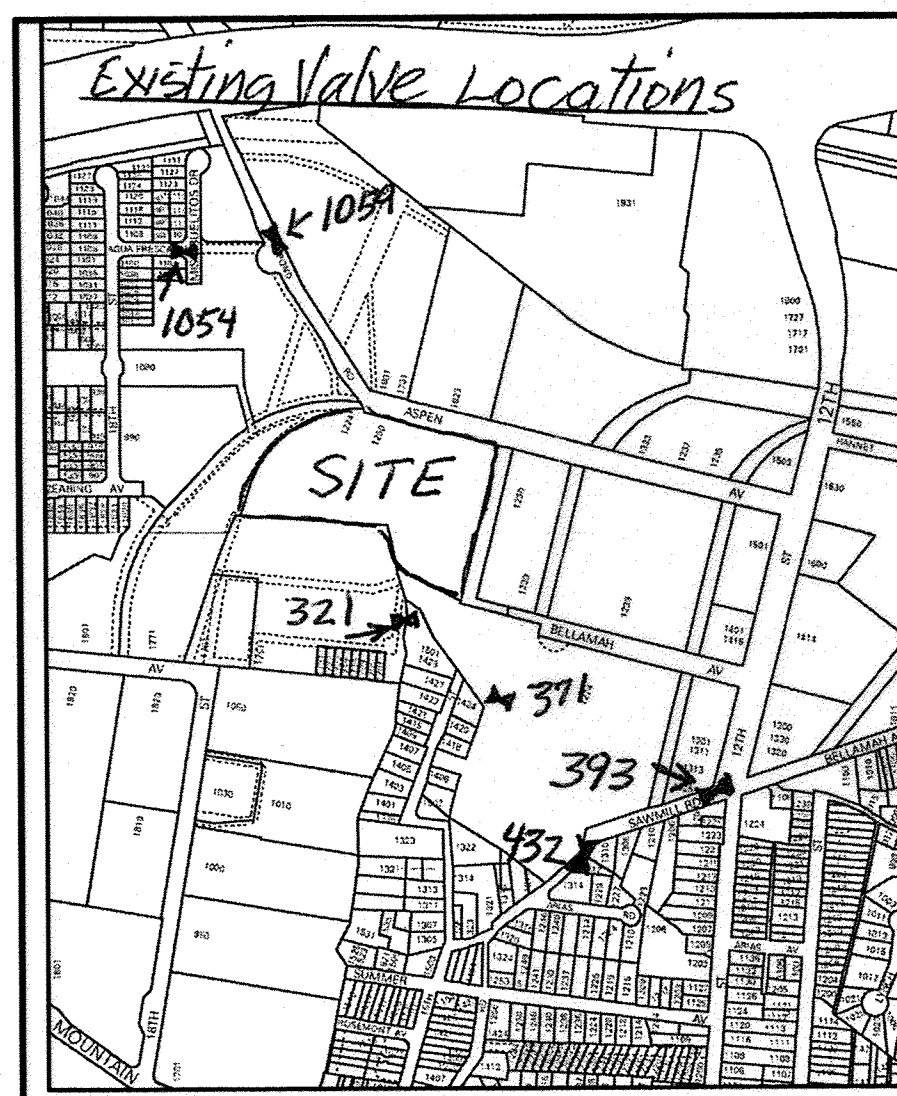

I, John MacKenzie, NMPE 11619, of the firm Mark Goodwin & Associates, P.A., a Registered Professional Engineer in the State of New Mexico, do hereby certify, to the best of my knowledge and belief, that the infrastructure installed as part of this project has been inspected by me or by a qualified person under my direct supervision, and has been constructed in accordance with the plans and specifications approved by the City Engineer and that the original design intent of the approved plans has been met, except as noted by me on the as-built construction drawings. This Certification is based on site inspections by me or personnel under my direction, and survey information provided by Jason Smith NMPS number 17122.

John MacKenzie
09.18.13

- WATER VALVE SHUT-OFF PLAN**
- CONTRACTOR SHALL MAKE SHUT OFF REQUEST ONLINE AT <http://abcwua.org/content/view/463/729/>
 - VALVES SHALL ONLY BE OPERATED BY WATER AUTHORITY EMPLOYEES.
 - FOR NON-PRESSURE CONNECTIONS, SHUT OFF EXISTING VALVES #321, #371, #393 AND #432 SOUTH OF SITE. NORTH OF SITE SHUT OFF EXISTING VALVE #1161, OR #1054 AND #1059, IF NECESSARY.

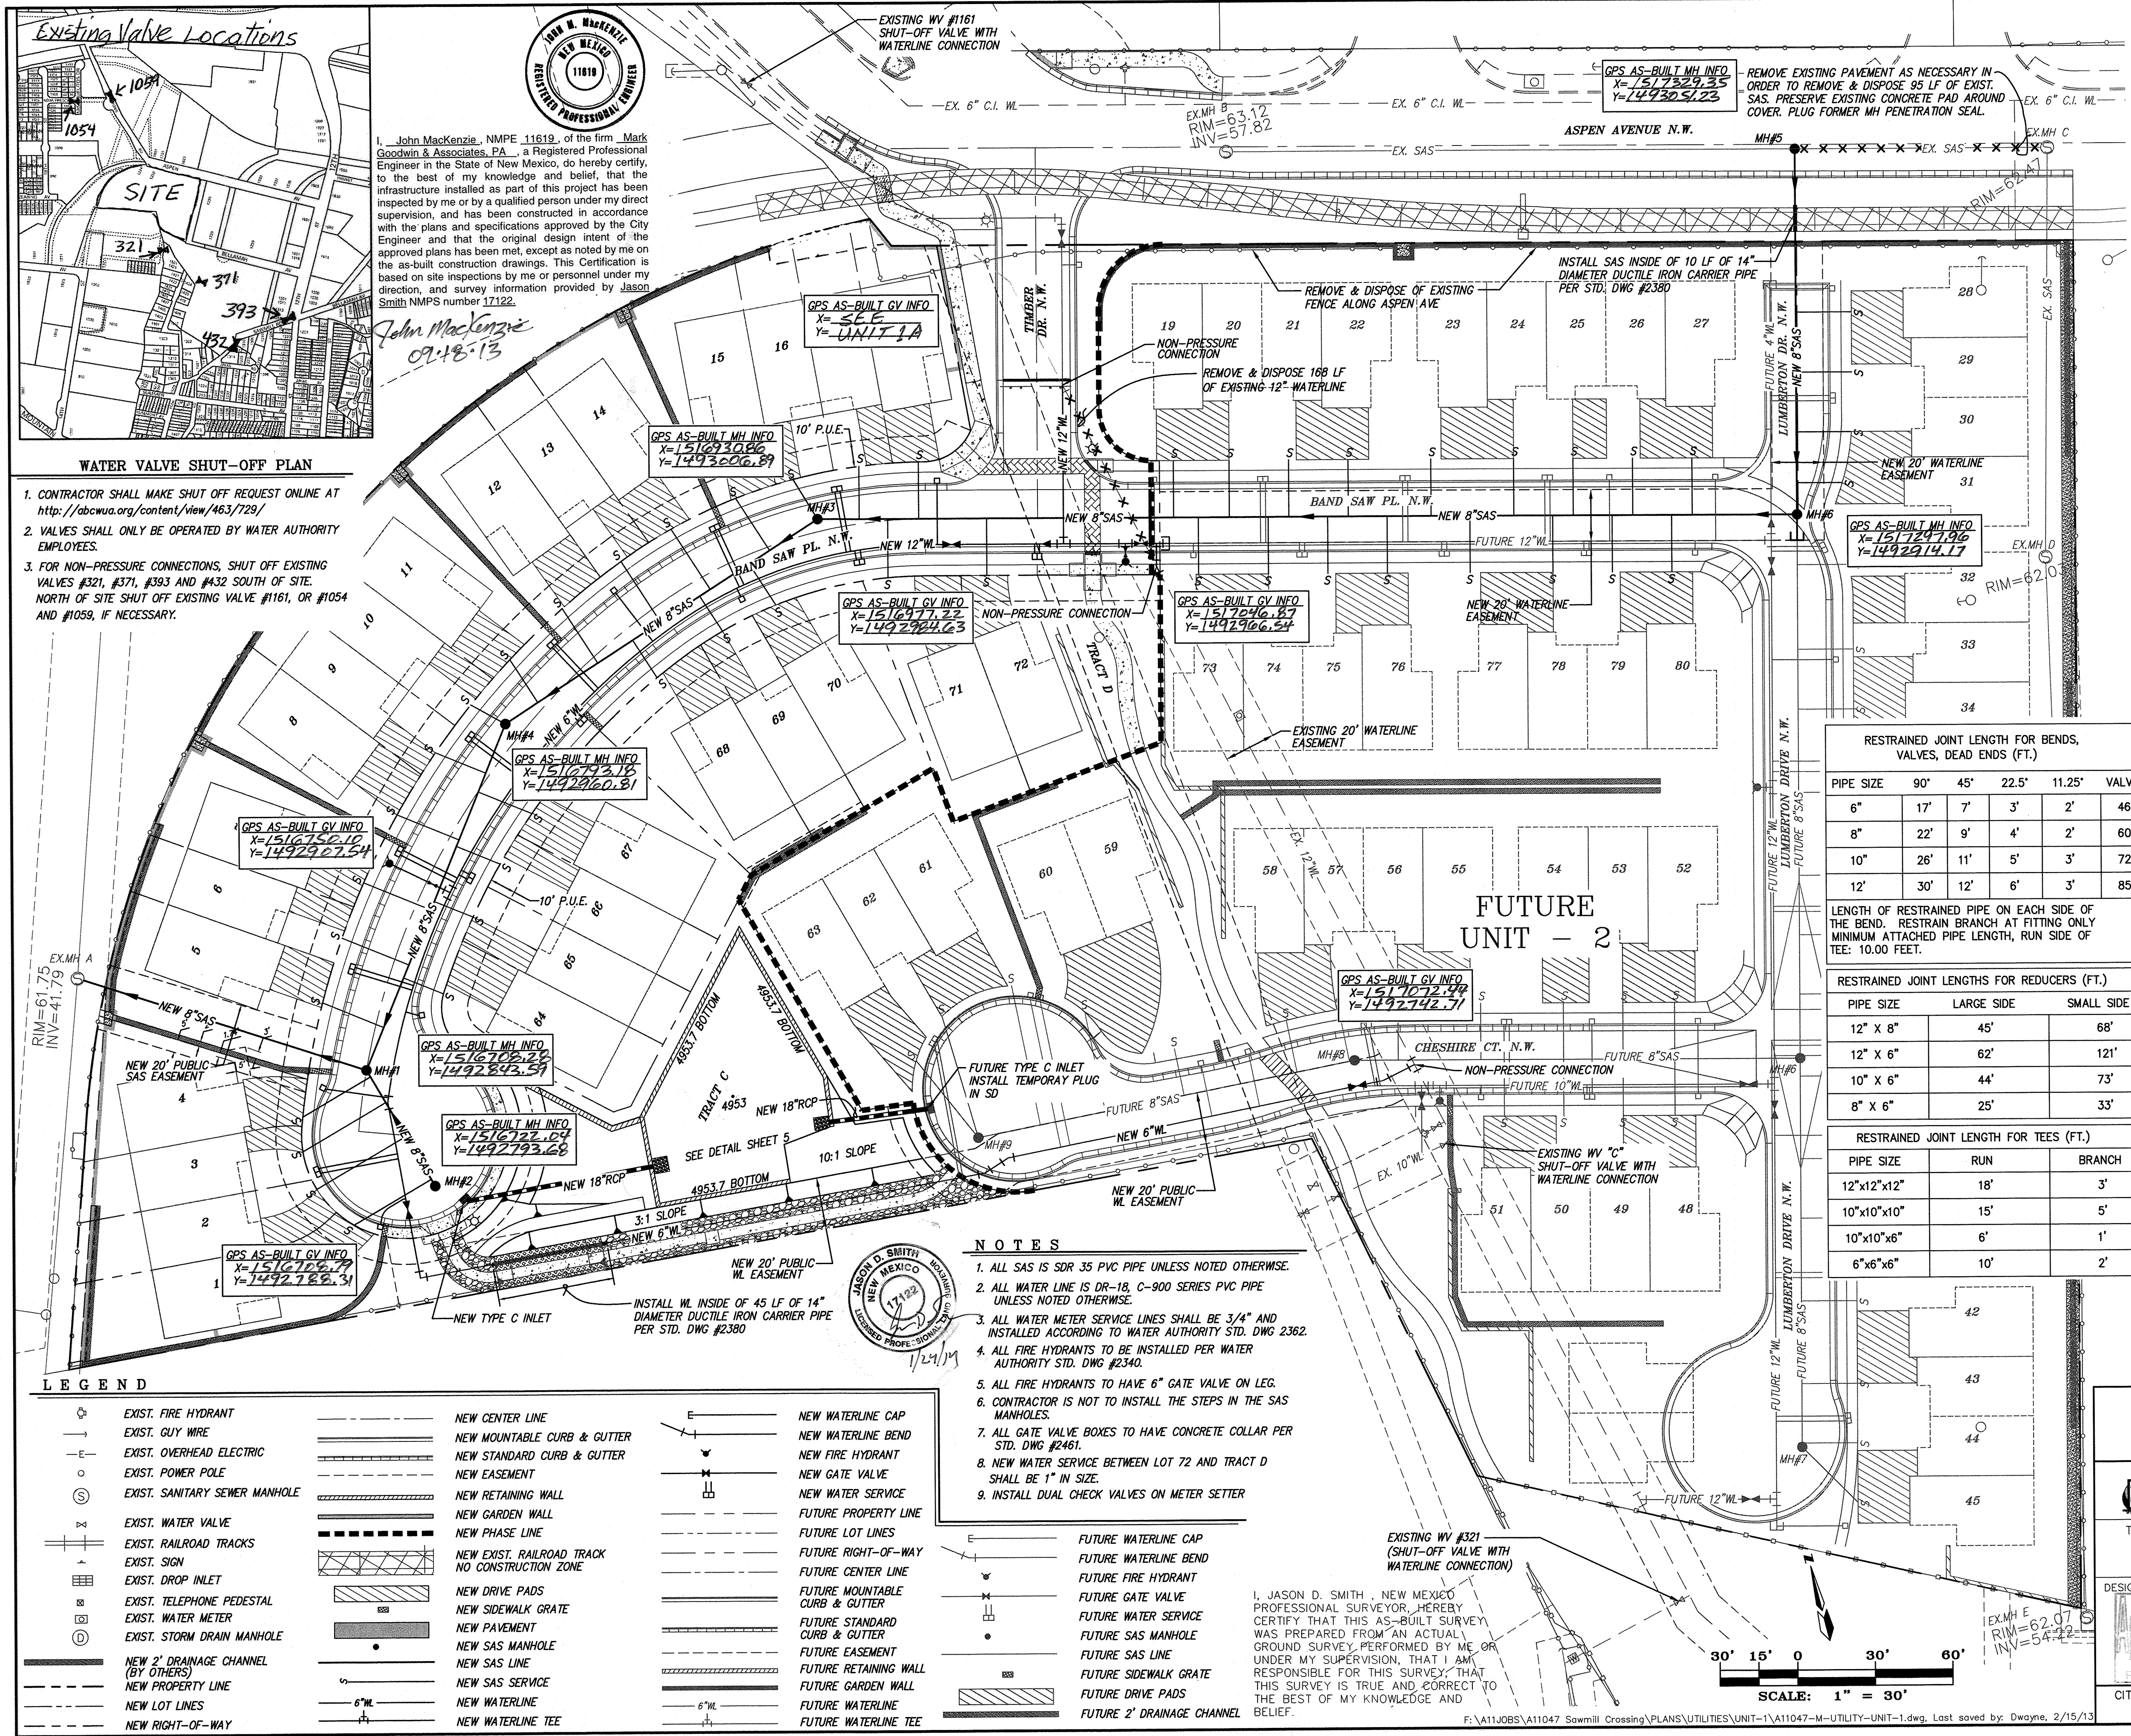


LEGEND			
	EXIST. FIRE HYDRANT		NEW CENTER LINE
	EXIST. GUY WIRE		NEW MOUNTABLE CURB & GUTTER
	EXIST. OVERHEAD ELECTRIC		NEW STANDARD CURB & GUTTER
	EXIST. POWER POLE		NEW EASEMENT
	EXIST. SANITARY SEWER MANHOLE		NEW RETAINING WALL
	EXIST. WATER VALVE		NEW GARDEN WALL
	EXIST. RAILROAD TRACKS		NEW PHASE LINE
	EXIST. SIGN		NEW EXIST. RAILROAD TRACK NO CONSTRUCTION ZONE
	EXIST. DROP INLET		NEW DRIVE PADS
	EXIST. TELEPHONE PEDESTAL		NEW SIDEWALK GRATE
	EXIST. WATER METER		NEW PAVEMENT
	EXIST. STORM DRAIN MANHOLE		NEW SAS MANHOLE
	NEW 2' DRAINAGE CHANNEL (BY OTHERS)		NEW SAS LINE
	NEW PROPERTY LINE		NEW SAS SERVICE
	NEW LOT LINES		NEW WATERLINE
	NEW RIGHT-OF-WAY		NEW WATERLINE TEE
	NEW WATERLINE CAP		NEW WATERLINE BEND
	NEW FIRE HYDRANT		NEW GATE VALVE
	NEW WATER SERVICE		FUTURE PROPERTY LINE
	FUTURE LOT LINES		FUTURE RIGHT-OF-WAY
	FUTURE CENTER LINE		FUTURE WATERLINE CAP
	FUTURE WATERLINE BEND		FUTURE FIRE HYDRANT
	FUTURE GATE VALVE		FUTURE WATER SERVICE
	FUTURE SAS MANHOLE		FUTURE SAS LINE
	FUTURE SAS SERVICE		FUTURE SIDEWALK GRATE
	FUTURE DRIVE PADS		FUTURE 2' DRAINAGE CHANNEL

- NOTES**
- ALL SAS IS SDR 35 PVC PIPE UNLESS NOTED OTHERWISE.
 - ALL WATER LINE IS DR-18, C-900 SERIES PVC PIPE UNLESS NOTED OTHERWISE.
 - ALL WATER METER SERVICE LINES SHALL BE 3/4" AND INSTALLED ACCORDING TO WATER AUTHORITY STD. DWG 2362.
 - ALL FIRE HYDRANTS TO BE INSTALLED PER WATER AUTHORITY STD. DWG #2340.
 - ALL FIRE HYDRANTS TO HAVE 6" GATE VALVE ON LEG.
 - CONTRACTOR IS NOT TO INSTALL THE STEPS IN THE SAS MANHOLES.
 - ALL GATE VALVE BOXES TO HAVE CONCRETE COLLAR PER STD. DWG #2461.
 - NEW WATER SERVICE BETWEEN LOT 72 AND TRACT D SHALL BE 1" IN SIZE.
 - INSTALL DUAL CHECK VALVES ON METER SETTER

RESTRAINED JOINT LENGTH FOR BENDS, VALVES, DEAD ENDS (FT.)					
PIPE SIZE	90°	45°	22.5°	11.25°	VALVE
6"	17'	7'	3'	2'	46'
8"	22'	9'	4'	2'	60'
10"	26'	11'	5'	3'	72'
12"	30'	12'	6'	3'	85'

LENGTH OF RESTRAINED PIPE ON EACH SIDE OF THE BEND. RESTRAIN BRANCH AT FITTING ONLY. MINIMUM ATTACHED PIPE LENGTH, RUN SIDE OF TEE: 10.00 FEET.		
PIPE SIZE	LARGE SIDE	SMALL SIDE
12" X 8"	45'	68'
12" X 6"	62'	121'
10" X 6"	44'	73'
8" X 6"	25'	33'

RESTRAINED JOINT LENGTH FOR TEES (FT.)		
PIPE SIZE	RUN	BRANCH
12"x12"x12"	18'	3'
10"x10"x10"	15'	5'
10"x10"x6"	6'	1'
6"x6"x6"	10'	2'

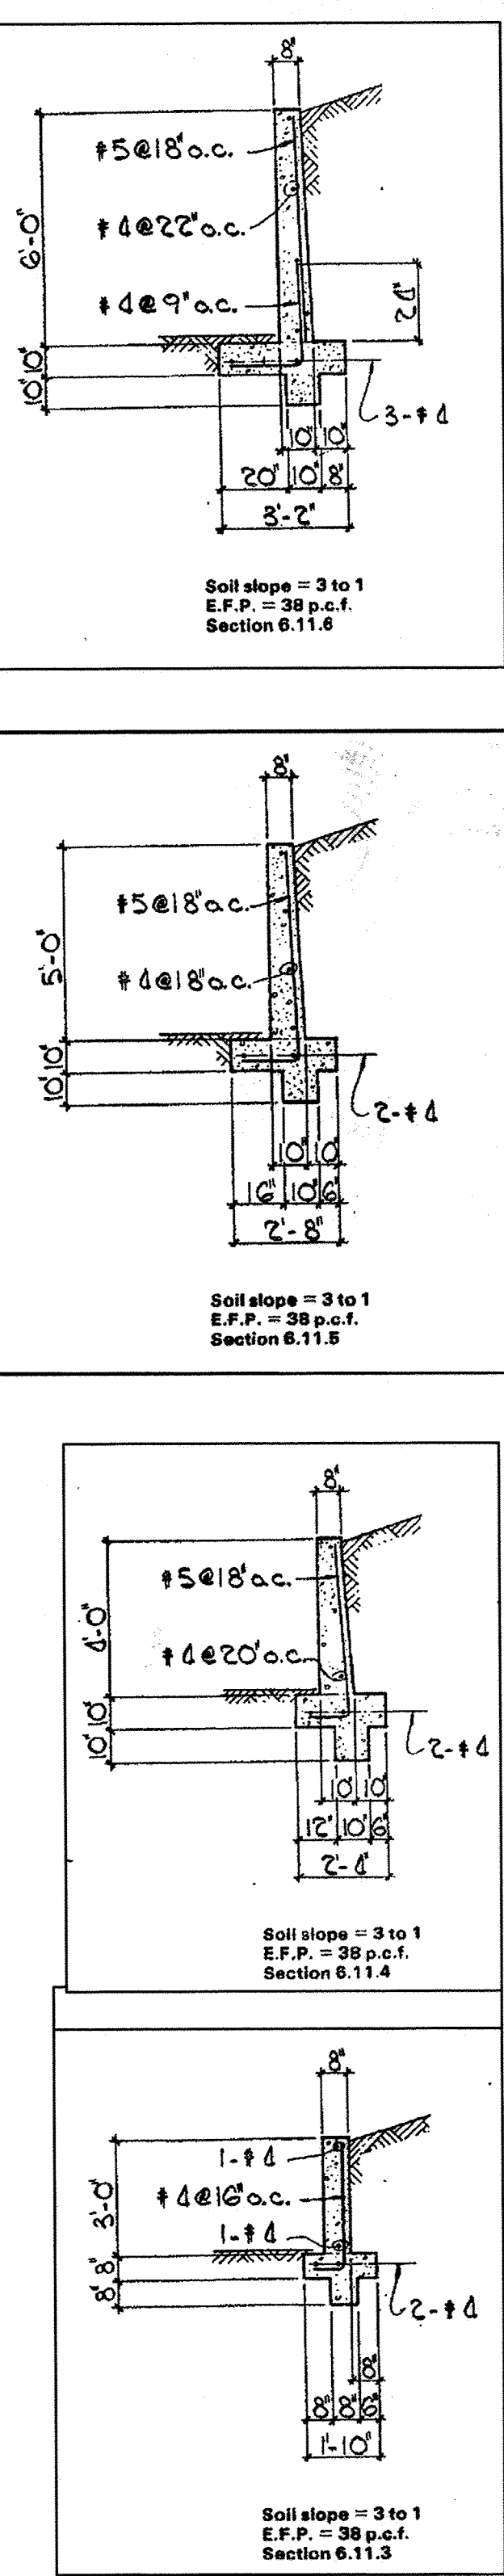

POND RETAINING WALL DETAILS
N.T.S.

dmg MARK GOODWIN & ASSOCIATES, P.A.
CONSULTING ENGINEERS
P.O. BOX 90606
ALBUQUERQUE, NEW MEXICO 87199
(505) 828-2200, FAX (505) 797-9539

**CITY OF ALBUQUERQUE
PUBLIC WORKS DEPARTMENT**


TITLE: **SAWMILL CROSSING - UNIT 1
MASTER UTILITY PLAN**

DESIGN REVIEW COMMITTEE	CITY ENGINEER APPROVAL	MO./DAY/YR.	MO./DAY/YR.
APPROVED MAR 27 2013	APPROVED APR 17 2013		
DESIGN REVIEW COMMITTEE	CITY ENGINEER	LAST DESIGN UPDATE	


CITY PROJECT NO.	ZONE MAP NO.	SHEET	OF
617586	H-13-Z	8	11

I, John Mackenzie, NMPE 11619, of the firm, Mark Goodwin & Associates, P.A., a Registered Professional Engineer in the State of New Mexico, do hereby certify, to the best of my knowledge and belief, that the infrastructure installed as part of this project has been inspected by me or by a qualified person under my direct supervision, and has been constructed in accordance with the plans and specifications approved by the City Engineer and that the original design intent of the approved plans has been met, except as noted by me on the as-built construction drawings. This Certification is based on site inspections by me or personnel under my direction, and survey information provided by Jason Smith NMPS number 17122.

John Mackenzie 09.18.13

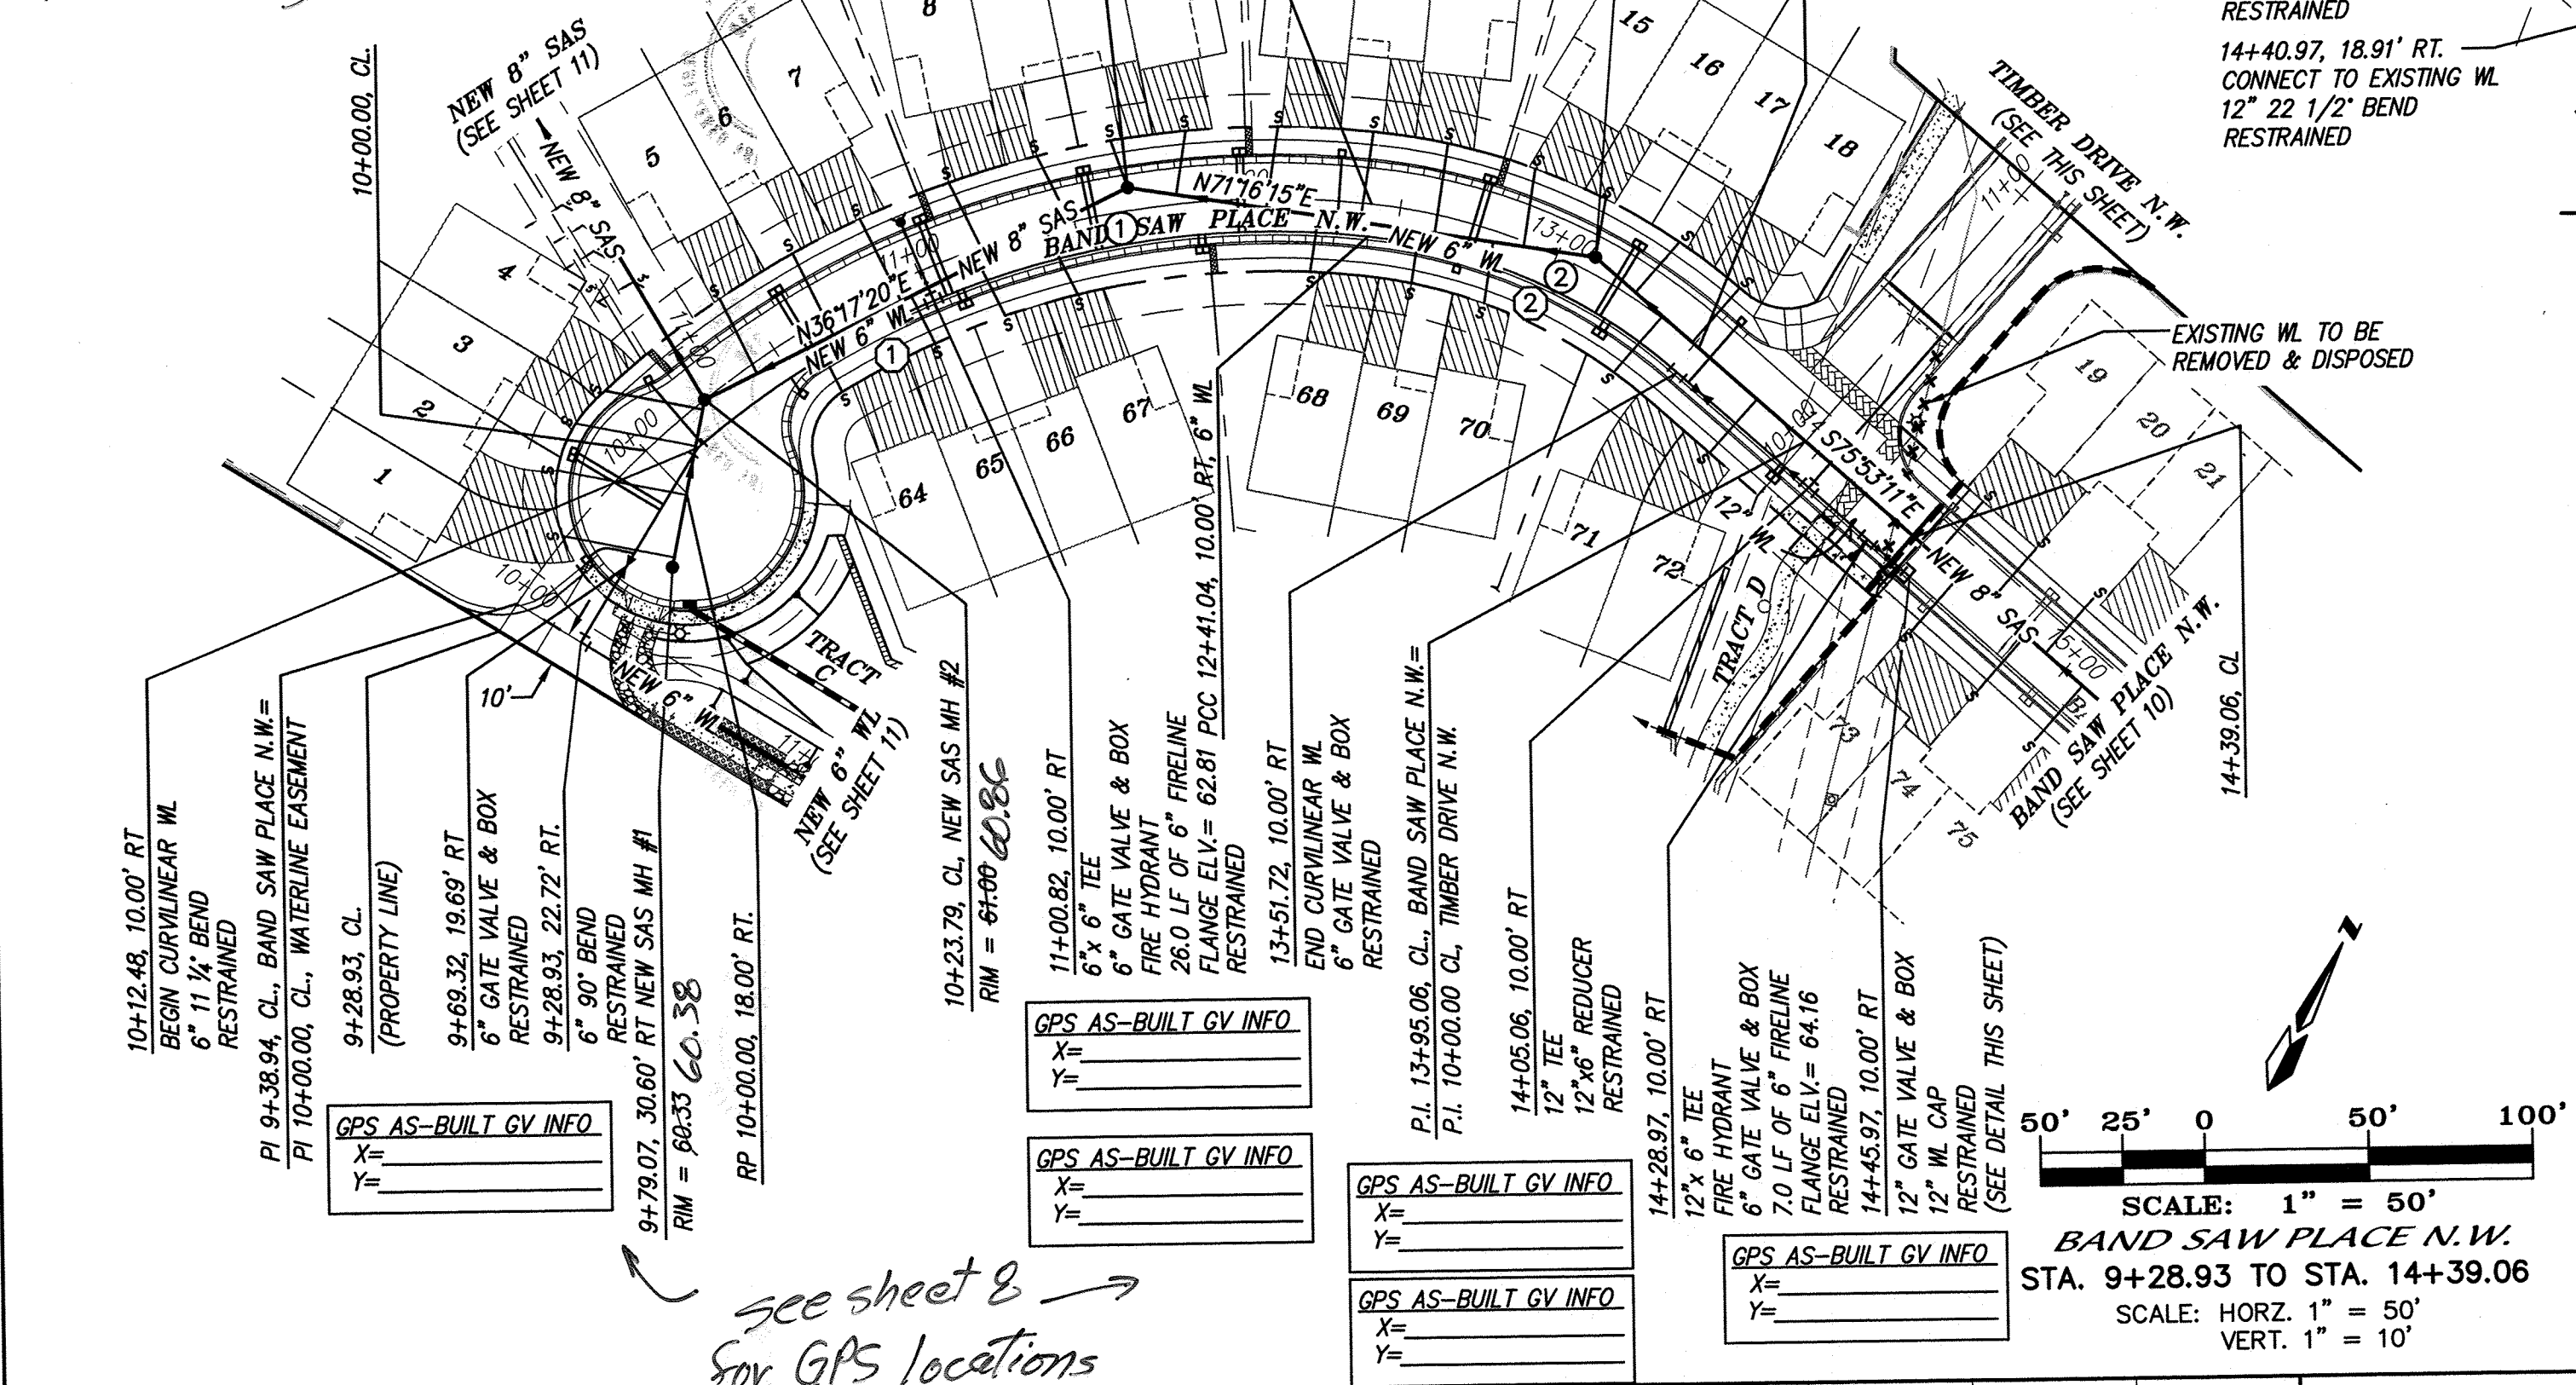

NOTES
1. ALL STATIONING IS BASED ON THE CENTERLINE OF PUBLIC ROADWAY.

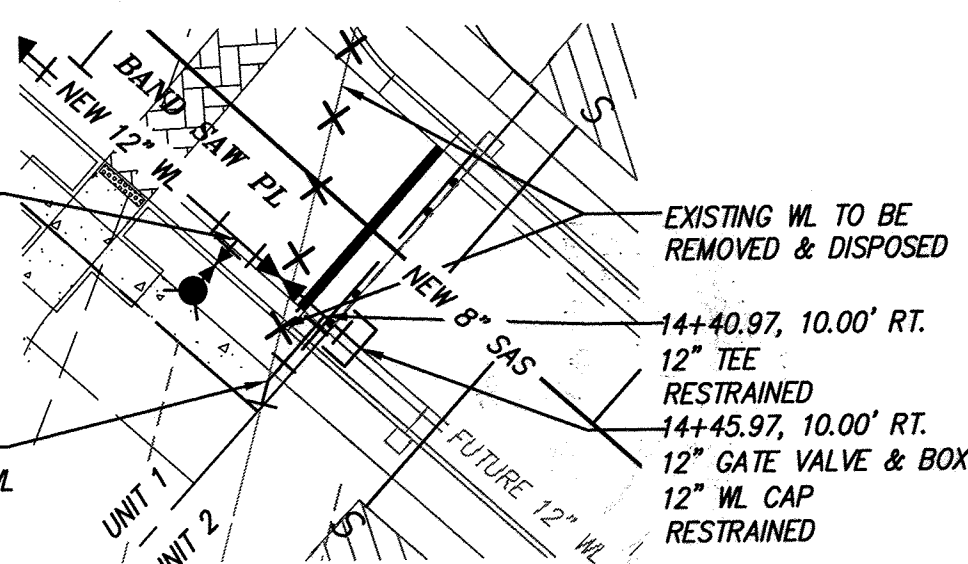


CURVE DATA - DESCRIBES CENTERLINE

① Δ=49°36'05" L=241.04 R=278.43 Tan=128.66	② Δ=35°13'50" L=110.68 R=180.00 Tan=57.15
---	--

CURVE DATA - DESCRIBES NEW WATERLINE

① Δ=50°54'13" L=238.48 R=268.43 Tan=127.76	② Δ=35°13'50" L=104.53 R=170.00 Tan=53.98
---	--

I, JASON D. SMITH, NEW MEXICO PROFESSIONAL SURVEYOR, HEREBY CERTIFY THAT THIS AS-BUILT SURVEY WAS PREPARED FROM AN ACTUAL GROUND SURVEY PERFORMED BY ME OR UNDER MY SUPERVISION. THAT I AM RESPONSIBLE FOR THIS SURVEY, THAT THIS SURVEY IS TRUE AND CORRECT TO THE BEST OF MY KNOWLEDGE AND BELIEF.

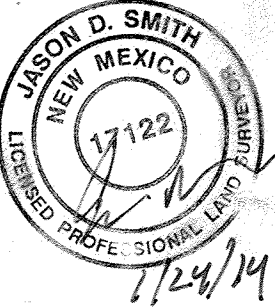

SANITARY SEWER SERVICES



LOT	STATION AT PUE	INV. ELEV. AT PUE	LENGTH AT PUE
1	9+63.68	56.34	34.71'
2	9+77.50	55.31	40.00'
3	9+90.90	54.38	37.21'
4	10+09.56	53.59	27.40'
5	10+44.96	53.65	25.45'
6	10+69.25	53.79	27.85'
7	10+90.57	53.93	28.08'
8	11+17.67	54.09	25.82'
9	11+43.73	54.26	21.00'
10	11+65.05	54.39	15.25'
11	11+86.39	54.69	19.73'
12	12+12.56	54.98	25.09'
13	12+39.54	55.21	27.86'
14	12+60.10	55.35	27.70'
15	12+84.78	55.46	24.03'
16	13+08.30	55.26	18.05'
17	13+28.84	55.29	20.37'
18	13+49.38	55.42	21.98'
19	14+47.72	56.08	22.00'
20	14+69.26	56.21	22.00'
21	14+92.26	56.35	22.00'
64	10+61.05	53.68	16.59'
65	10+95.73	53.87	16.09'
66	11+20.71	54.00	16.20'
67	11+45.77	54.23	22.35'
68	12+23.27	54.78	17.23'
69	12+57.79	54.96	16.10'
70	12+84.02	55.12	18.95'
71	13+35.06	55.35	22.68'
72	13+75.33	55.60	22.00'
73	14+57.26	56.14	22.00'
74	14+84.26	56.30	22.00'
75	15+07.26	56.44	22.00'



MARK GOODWIN & ASSOCIATES, P.A.
CONSULTING ENGINEERS
P.O. BOX 90606
ALBUQUERQUE, NEW MEXICO 87199
(505) 828-2200, FAX (505) 797-9539




CITY OF ALBUQUERQUE
PUBLIC WORKS DEPARTMENT

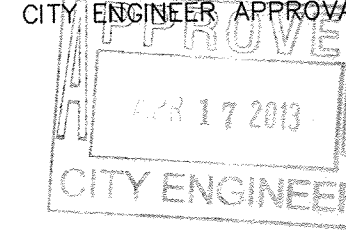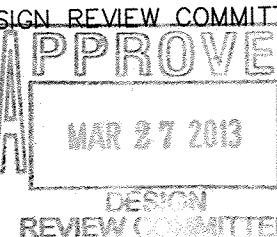

DESIGN REVIEW COMMITTEE	CITY ENGINEER APPROVAL	MO./DAY/YR.
APPROVE	APPROVE	
REVIEW COMMITTEE	CITY ENGINEER	


CITY PROJECT NO.	ZONE MAP NO.	SHEET	OF
617586	H-13-Z	9	11

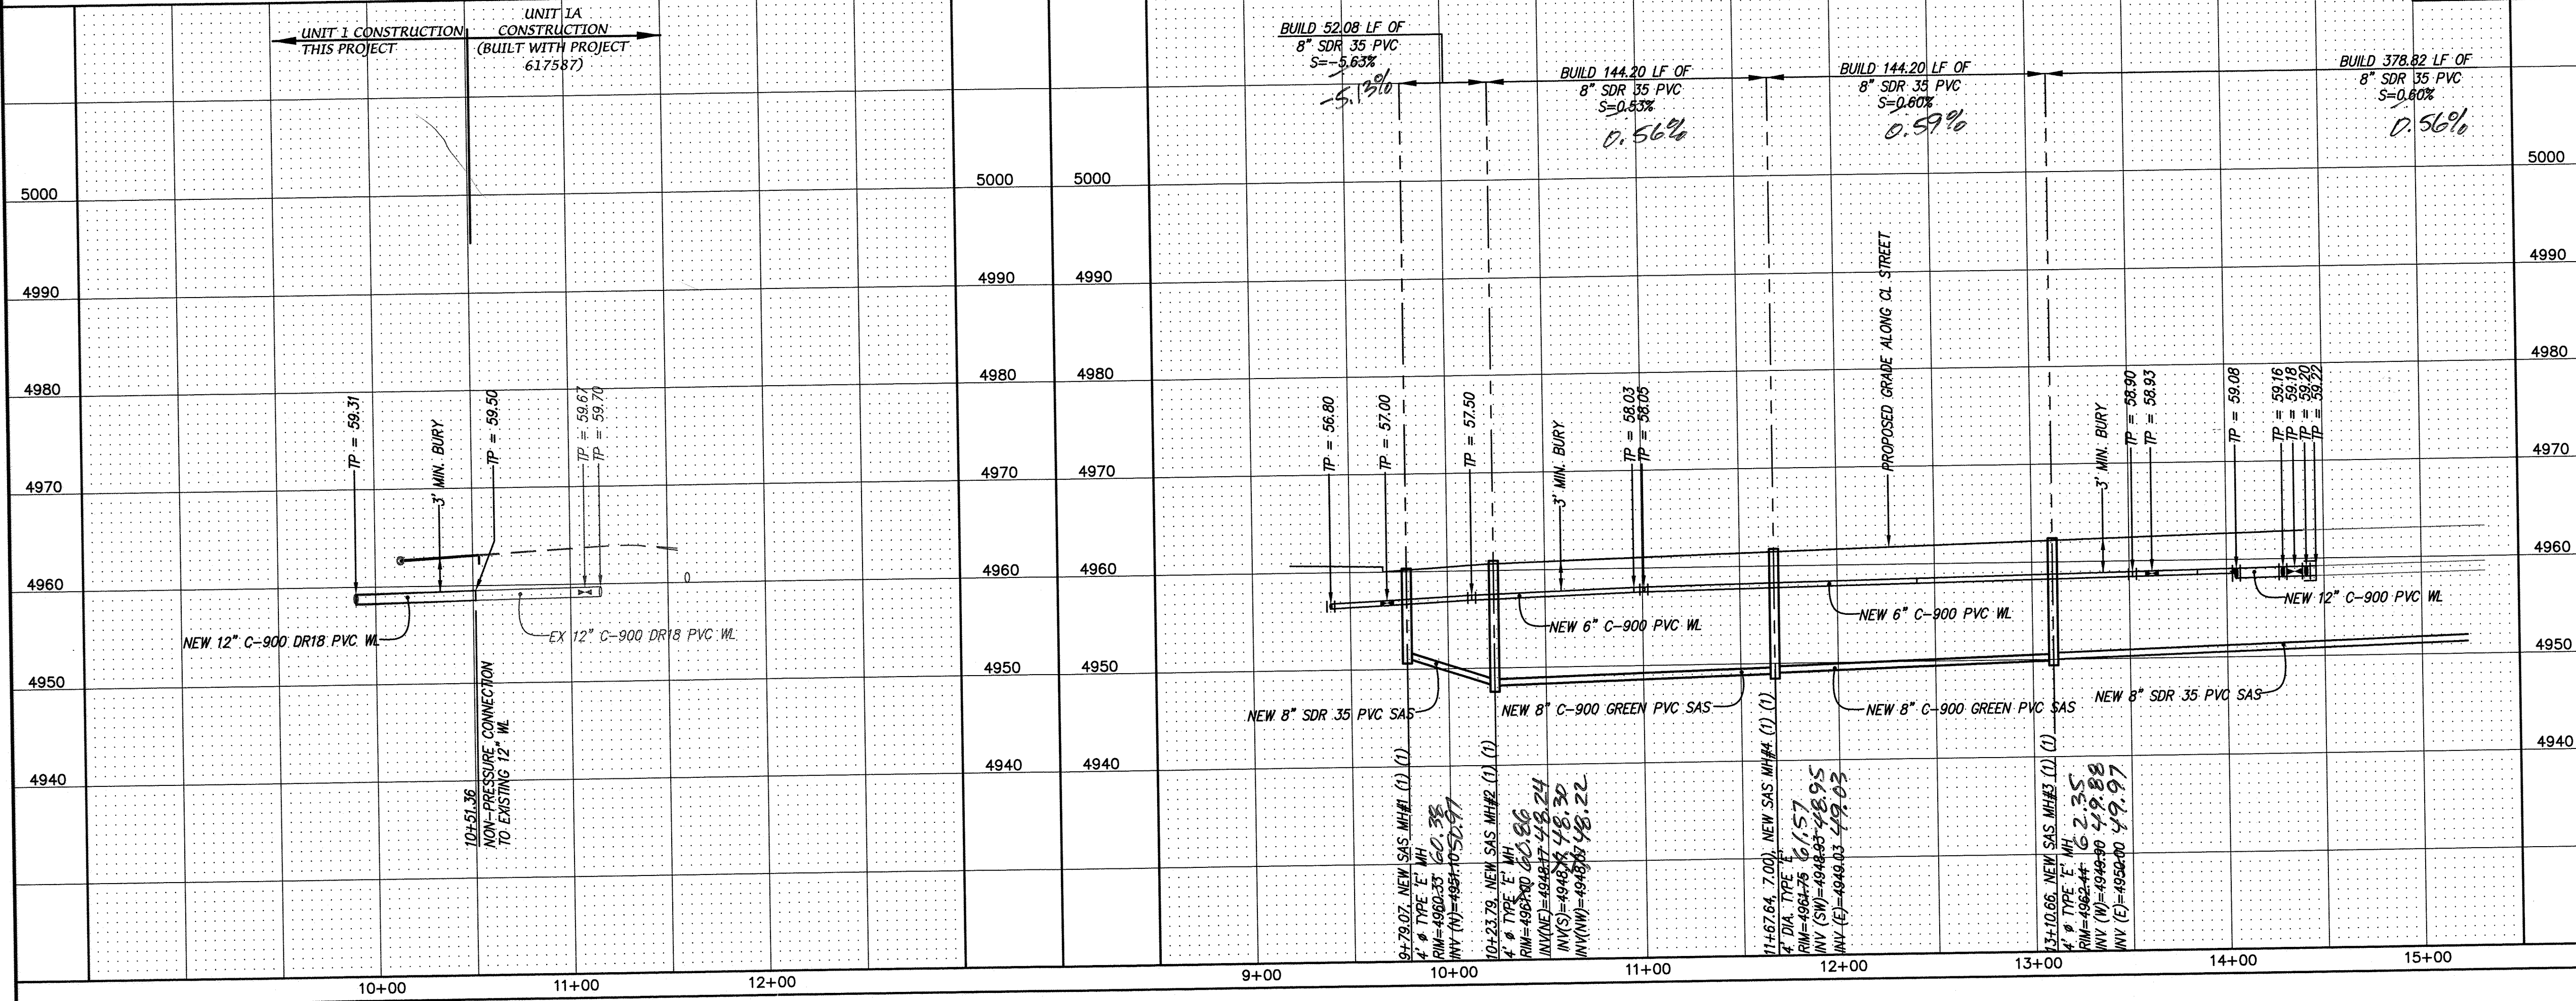

- NOTES
1. ALL STATIONING IS BASED ON THE CENTERLINE OF PUBLIC ROADWAY OR CENTERLINE OF PUBLIC EASEMENT.
 2. INSTALL ALL WATER LINE CARRIER PIPE PER STD. DWG #2380.

CURVE DATA - DESCRIBES CENTERLINE

① Δ=38°11'50"
L=50.00
R=75.00
Tan=25.97

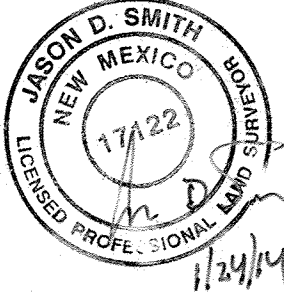

SANITARY SEWER SERVICES			
LOT	STATION AT PUE	INV. ELEV. AT PUE	LENGTH AT PUE
19	14+47.72	56.08	22.00'
20	14+69.26	56.21	22.00'
21	14+92.26	56.35	22.00'
22	15+15.26	56.49	22.00'
23	15+47.26	56.68	22.00'
24	15+79.26	56.88	22.00'
25	16+02.26	57.02	22.00'
26	16+25.26	57.15	22.00'
27	16+48.26	57.29	22.00'
28	10+89.11	58.10	21.50'
29	10+66.11	57.96	21.50'
30	10+44.35	57.82	21.23'
31	10+28.12	57.62	17.38'
71	13+35.06	55.35	22.68'
72	13+75.33	55.60	22.00'
73	14+57.26	56.14	22.00'
74	14+84.26	56.30	22.00'
75	15+07.26	56.44	22.00'
76	15+30.26	56.58	22.00'
77	15+62.26	56.77	22.00'
78	15+94.26	56.96	22.00'
79	16+17.26	57.10	22.00'
80	16+40.26	57.24	22.00'

I, JASON D. SMITH, NEW MEXICO
PROFESSIONAL SURVEYOR, HEREBY
CERTIFY THAT THIS AS-BUILT SURVEY
WAS PREPARED FROM AN ACTUAL
GROUND SURVEY PERFORMED BY ME OR
UNDER MY SUPERVISION, THAT I AM
RESPONSIBLE FOR THIS SURVEY, THAT
THIS SURVEY IS TRUE AND CORRECT TO
THE BEST OF MY KNOWLEDGE AND
BELIEF.

I, John MacKenzie, NMPE 11619, of the firm Mark Goodwin & Associates, P.A., a Registered Professional Engineer in the State of New Mexico, do hereby certify, to the best of my knowledge and belief, that the infrastructure installed as part of this project has been inspected by me or by a qualified person under my direct supervision, and has been constructed in accordance with the plans and specifications approved by the City Engineer and that the original design intent of the approved plans has been met, except as noted by me on the as-built construction drawings. This Certification is based on site inspections by me or personnel under my direction, and survey information provided by Jason Smith NMPS number 17122.

John MacKenzie 09-18-13




dmg MARK GOODWIN & ASSOCIATES, P.A.
CONSULTING ENGINEERS
P.O. BOX 90606
ALBUQUERQUE, NEW MEXICO 87199
(505) 828-2200, FAX (505) 797-9539



CITY OF ALBUQUERQUE
PUBLIC WORKS DEPARTMENT

TITLE: SAWMILL CROSSING - UNIT 1
BAND SAW PLACE & LUMBERTON DRIVE N.W.
UTILITY PLAN AND PROFILE

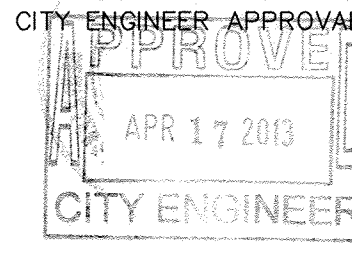

CITY PROJECT NO.


ZONE MAP NO.

SHEET OF

617586

H-13-Z

10 11

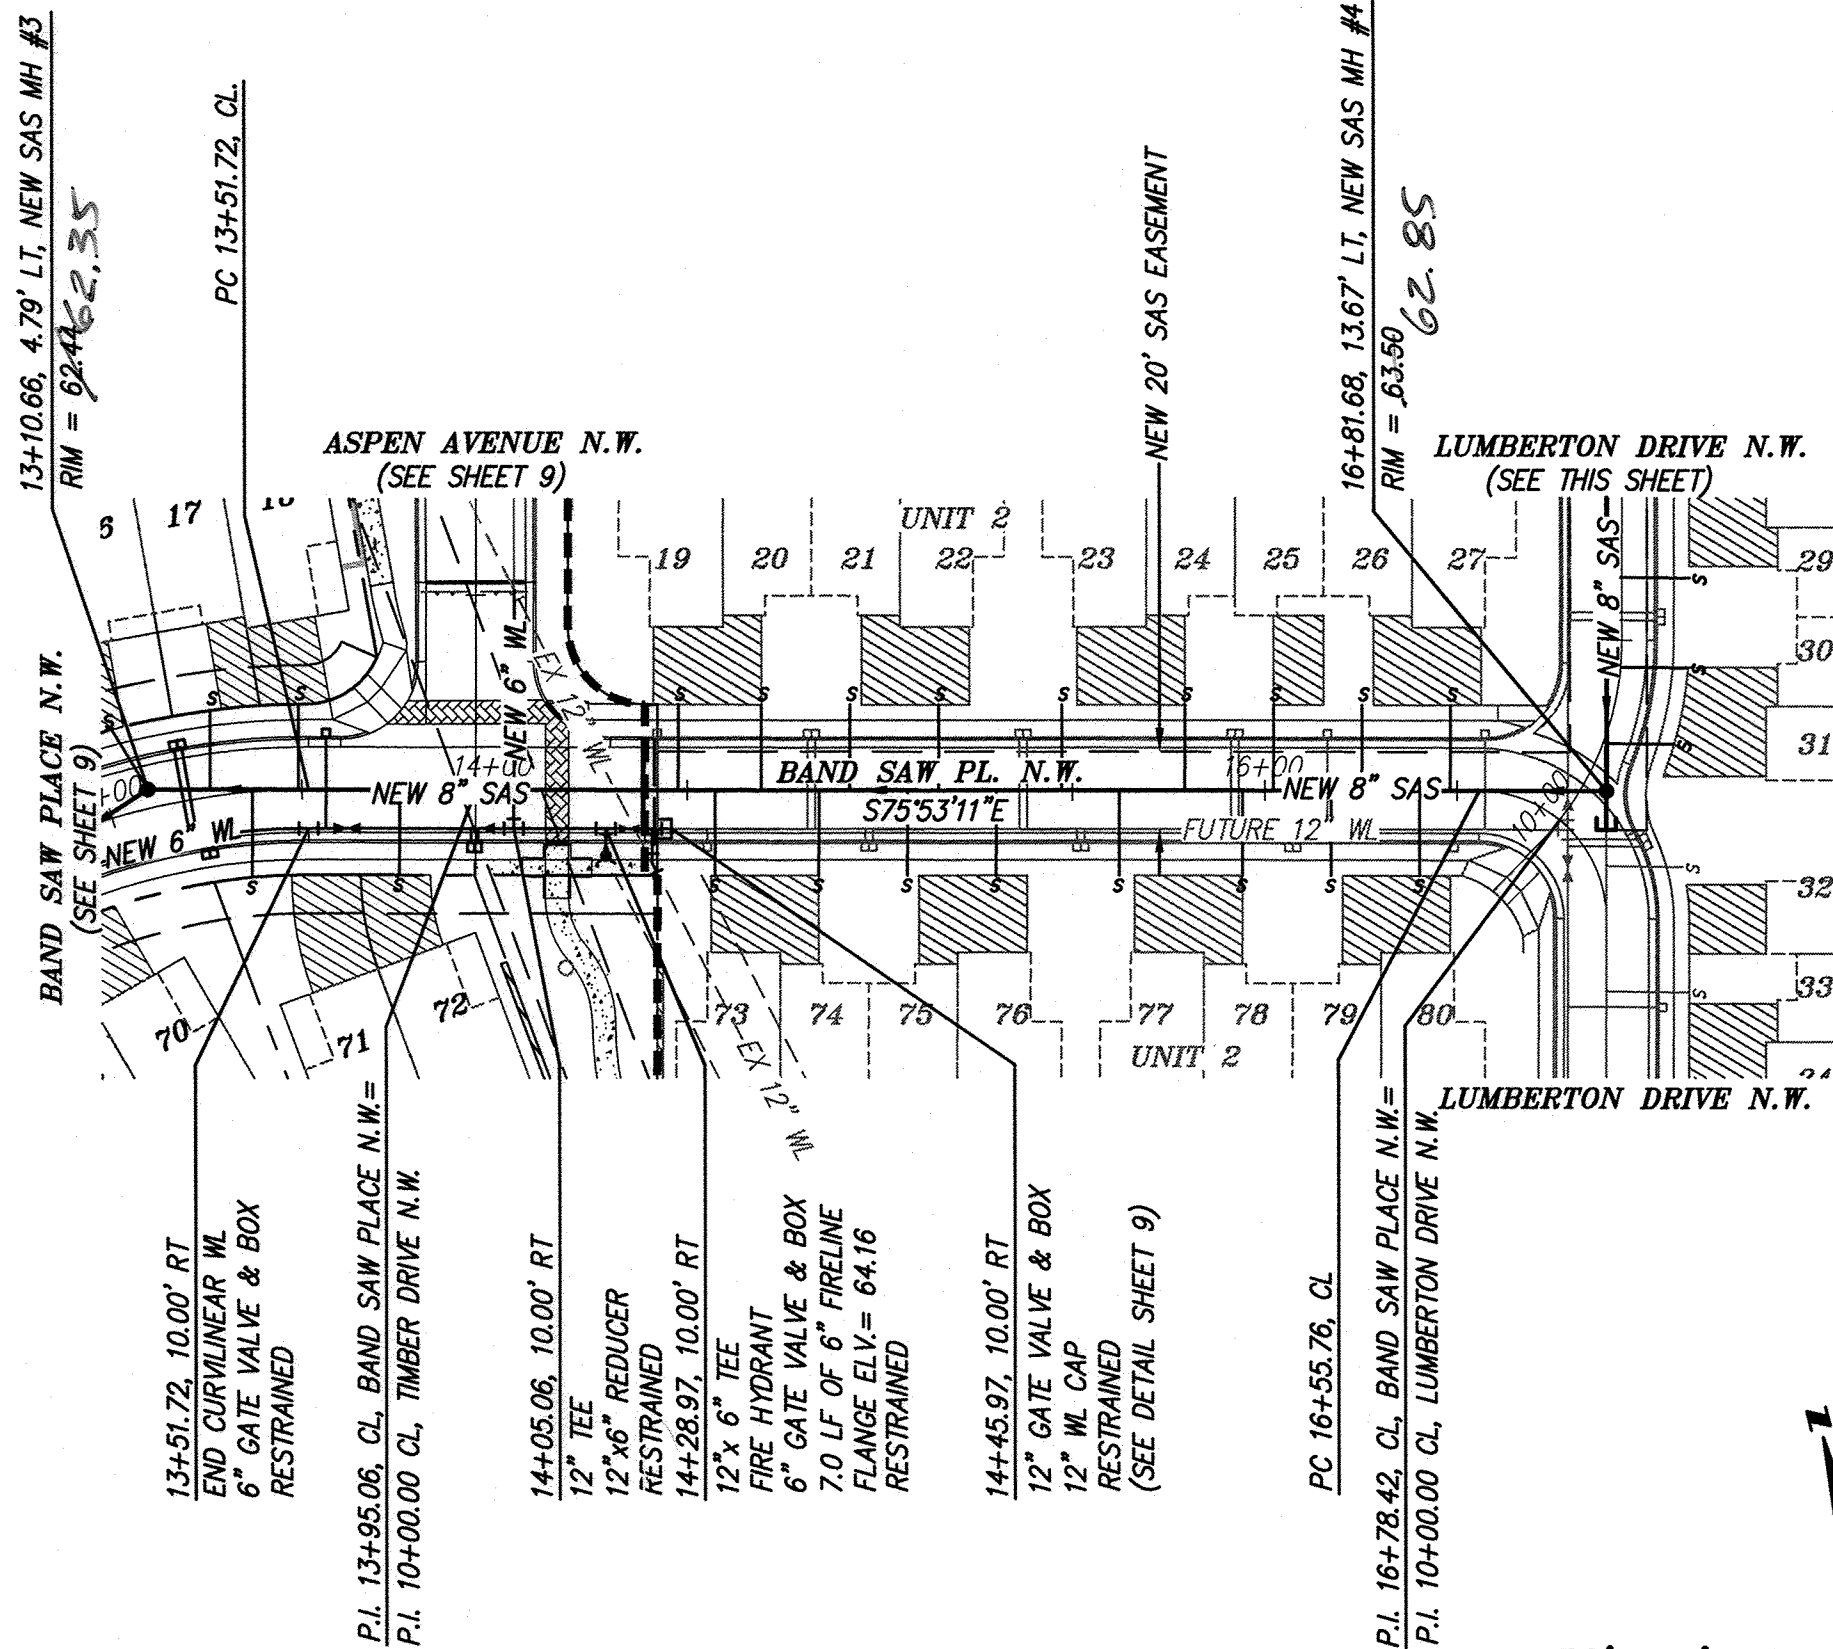


GPS AS-BUILT GV INFO
X=
Y=




GPS AS-BUILT GV INFO
X=
Y=


GPS AS-BUILT GV INFO
X=
Y=

SCALE: 1" = 50'
BAND SAW PLACE N.W.
STA. 13+10.66 TO STA. 16+81.68
SCALE: HORIZ. 1" = 50'
VERT. 1" = 10'

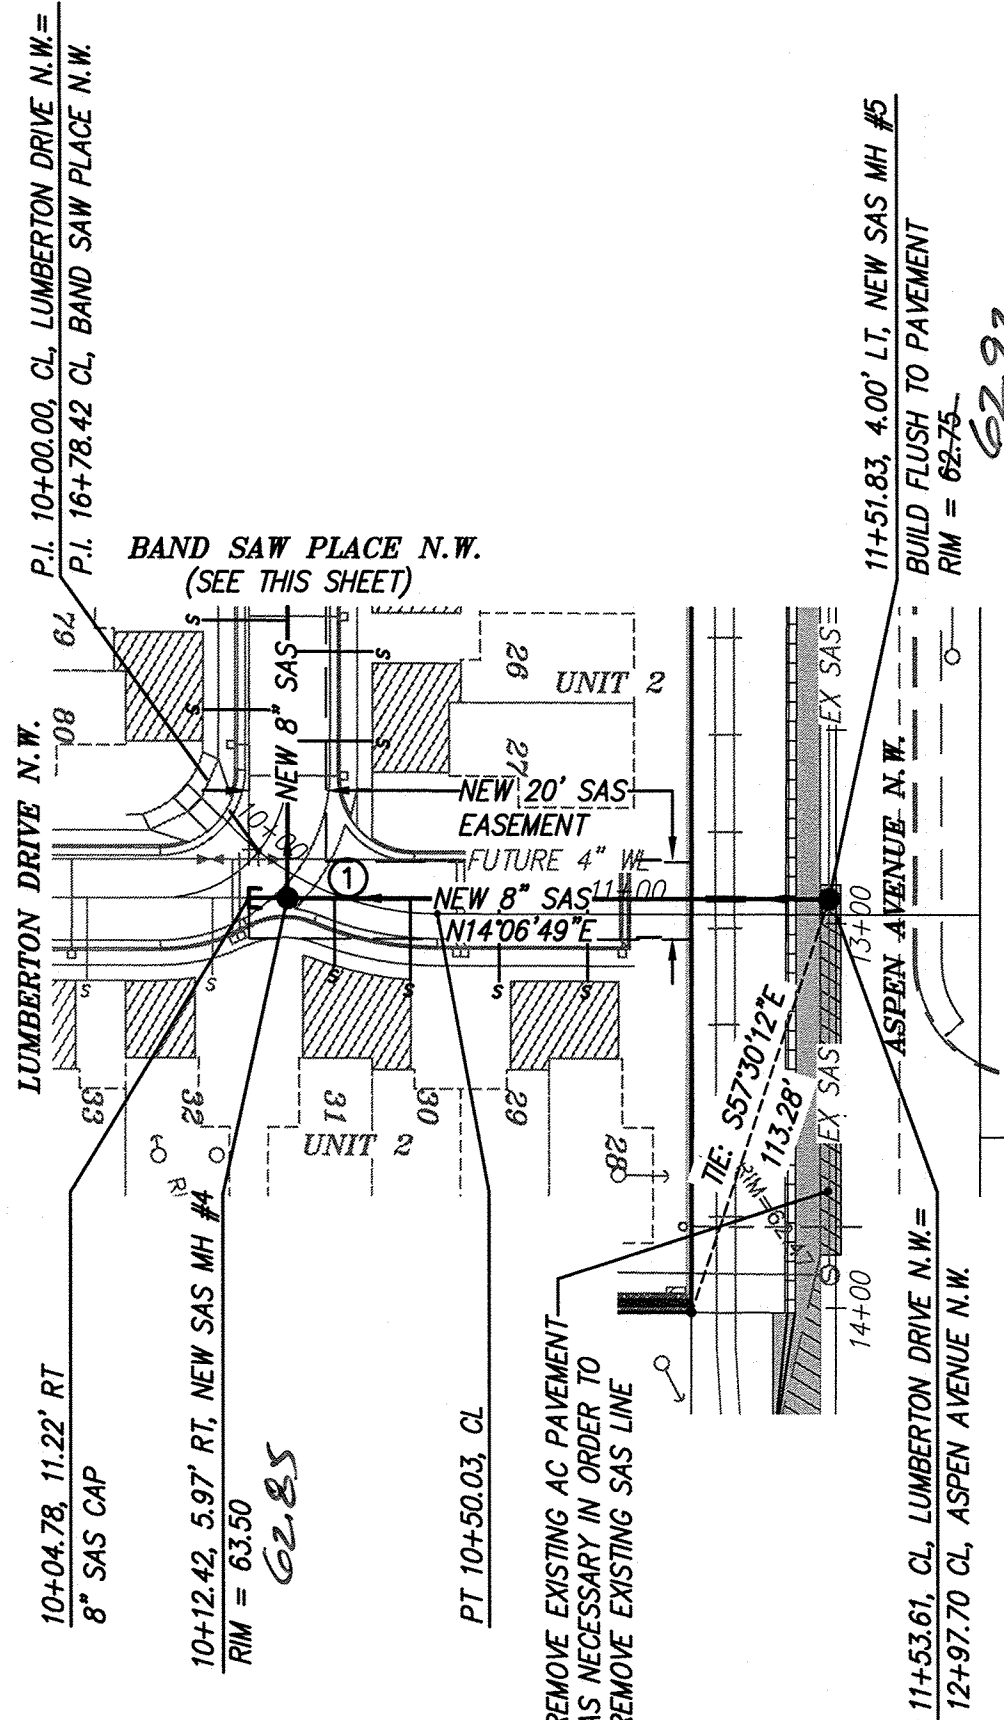






SCALE: 1" = 50'
LUMBERTON DRIVE N.W.
STA. 10+00.00 TO STA. 11+53.61
SCALE: HORIZ. 1" = 50'
VERT. 1" = 10'

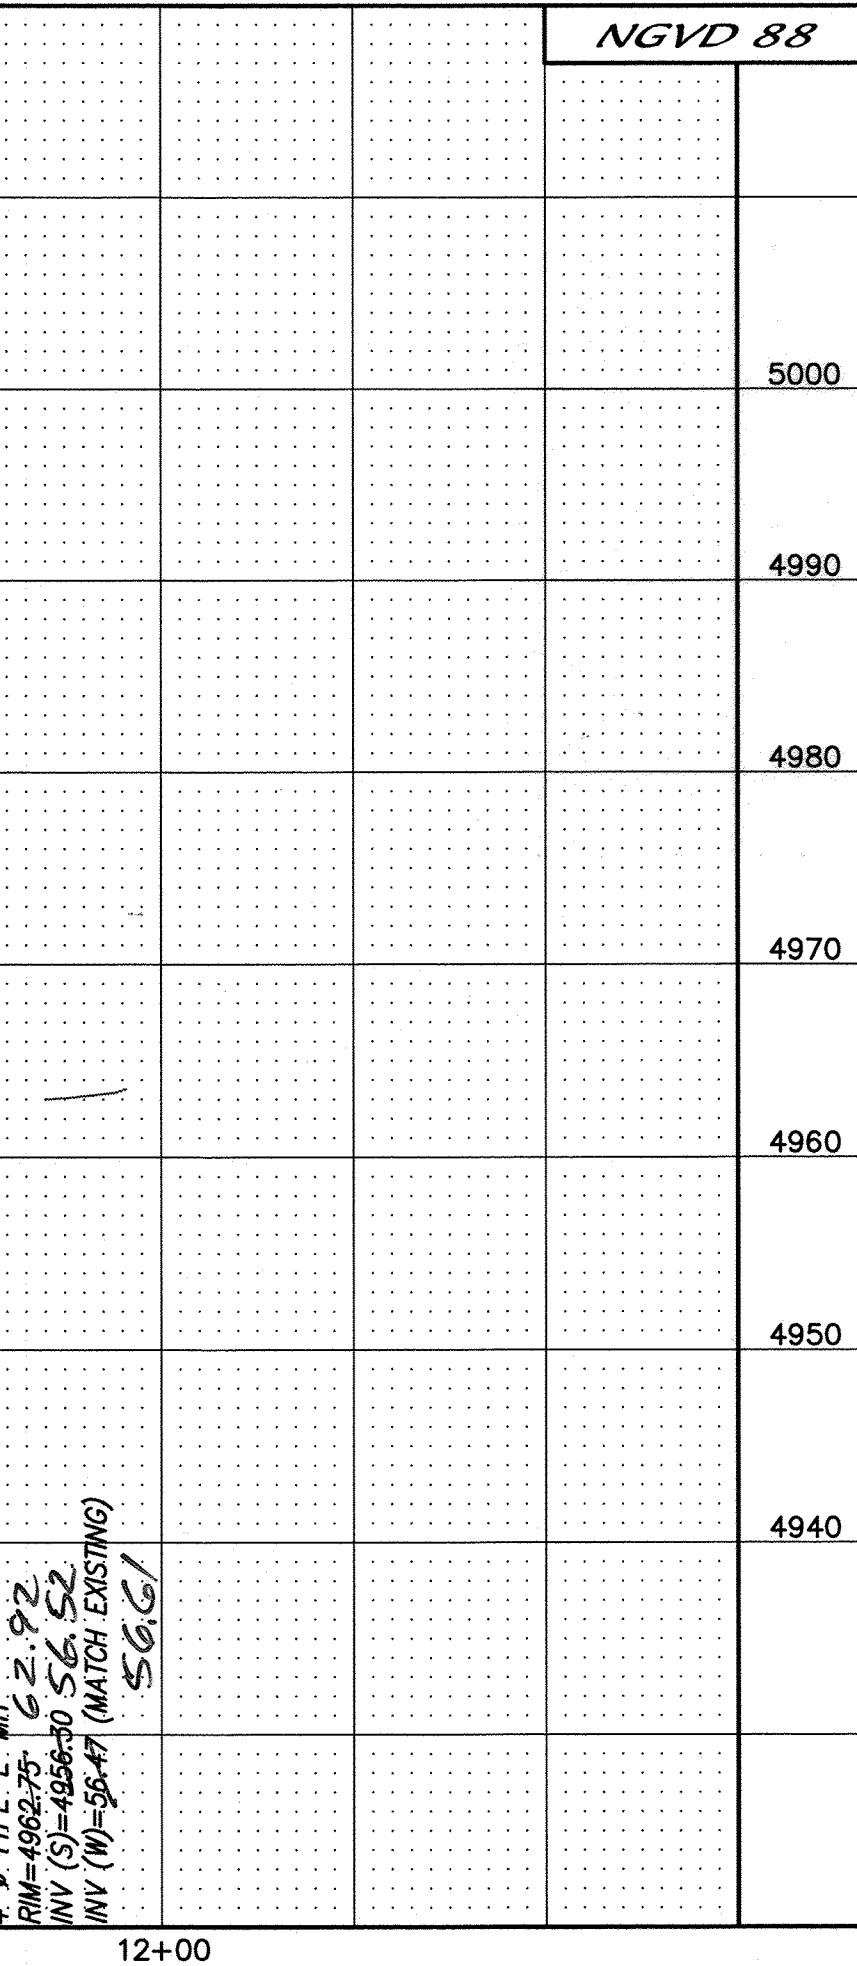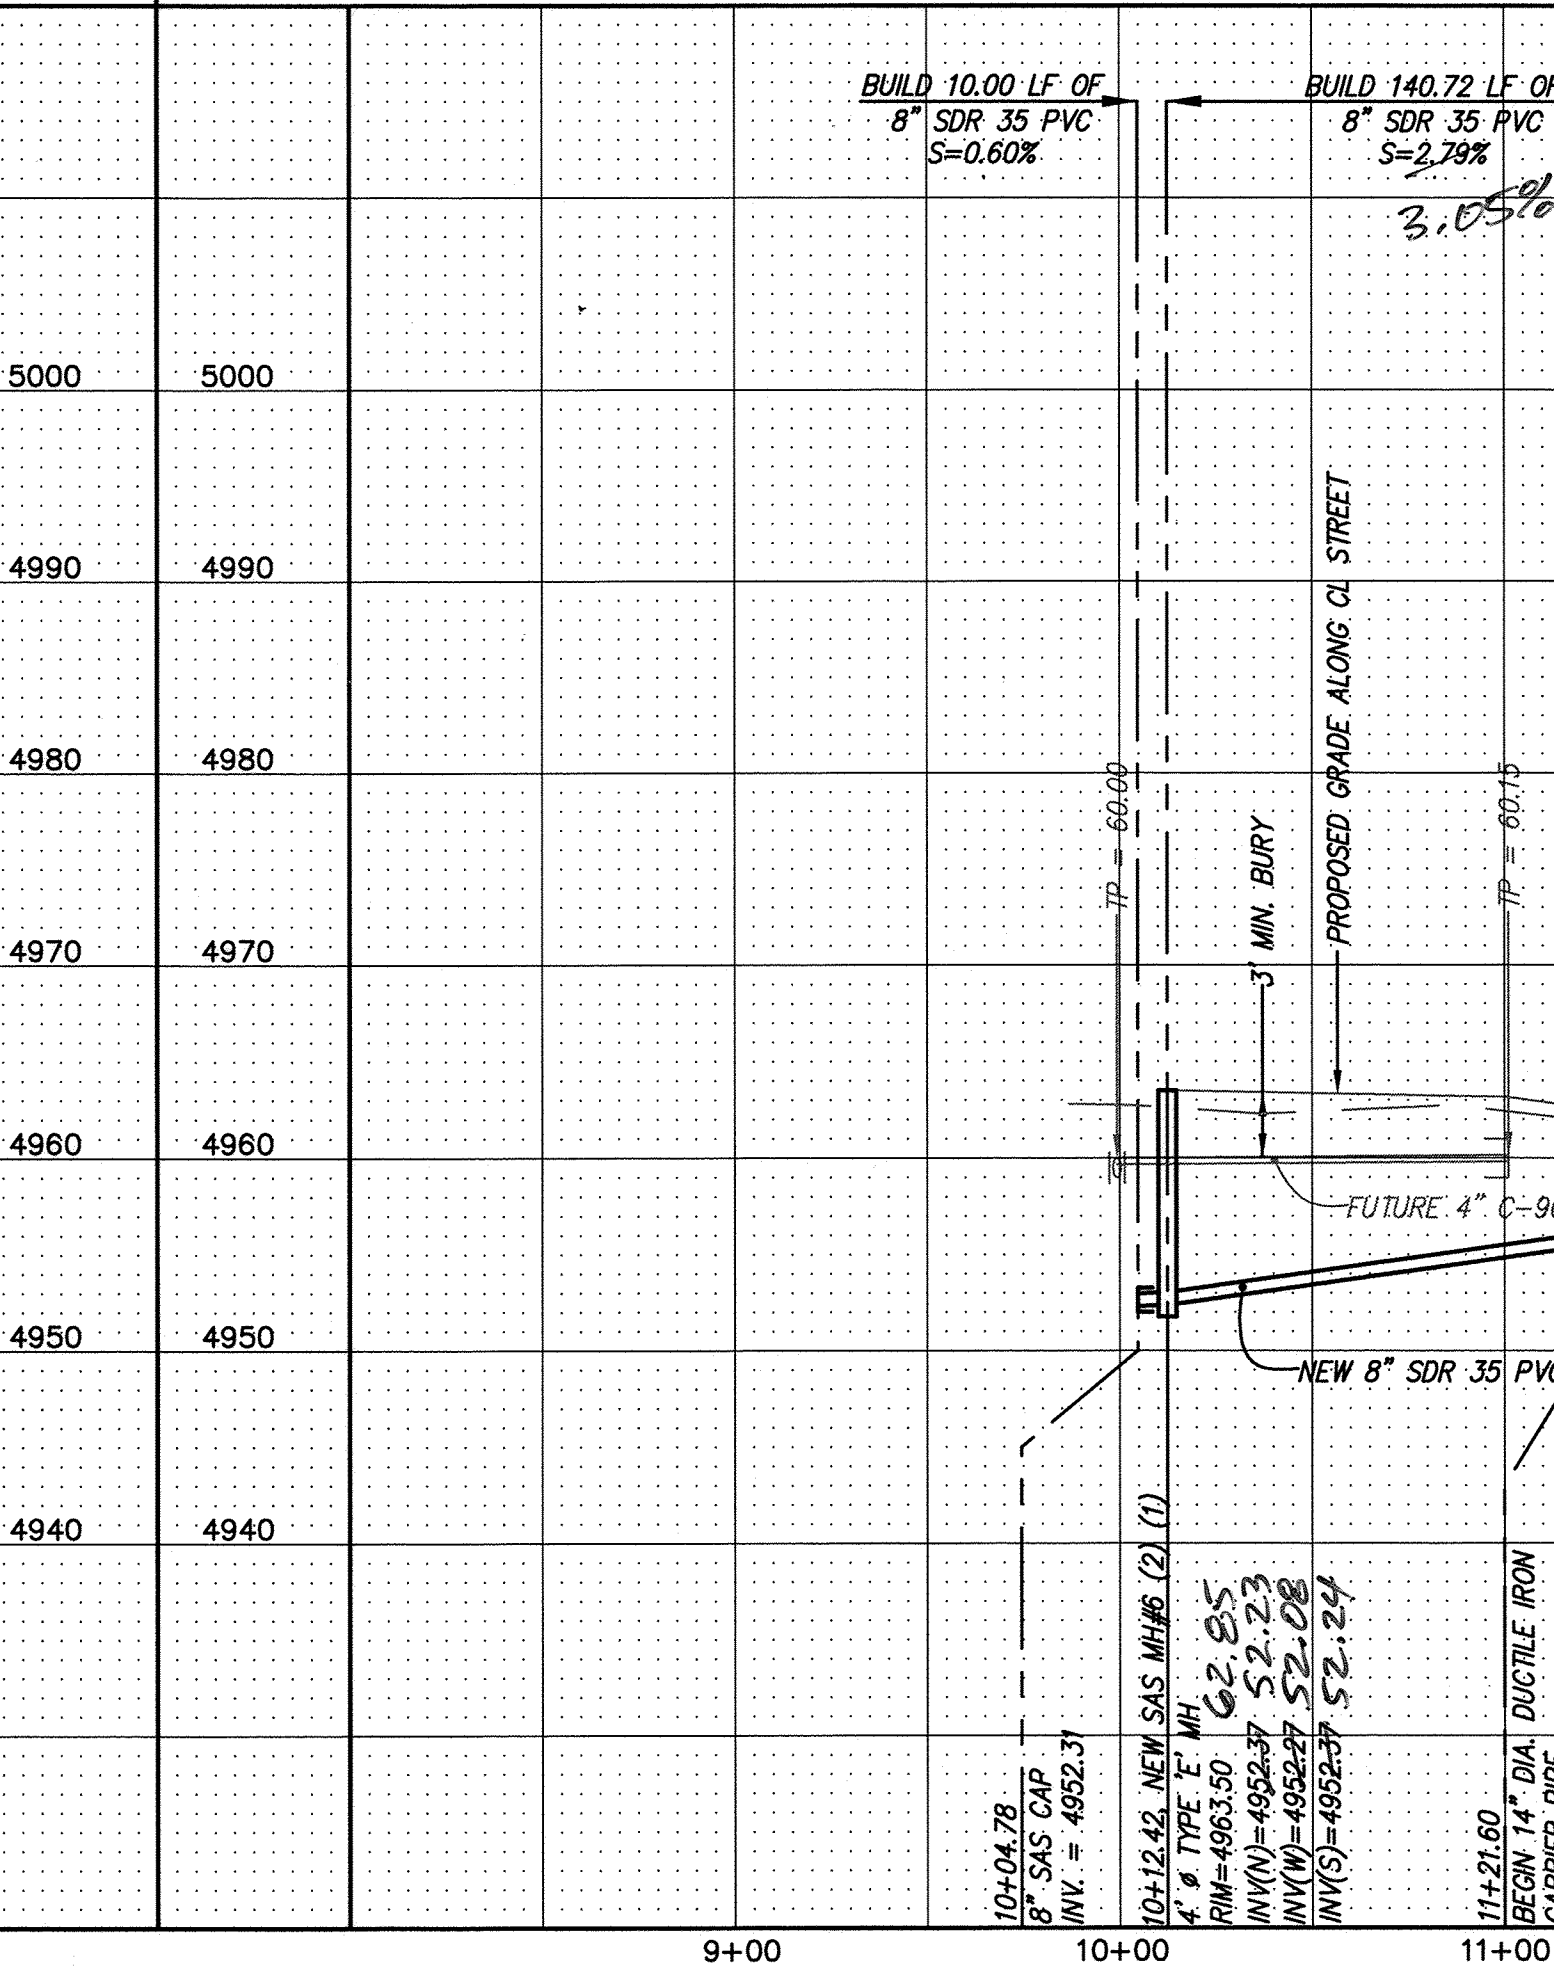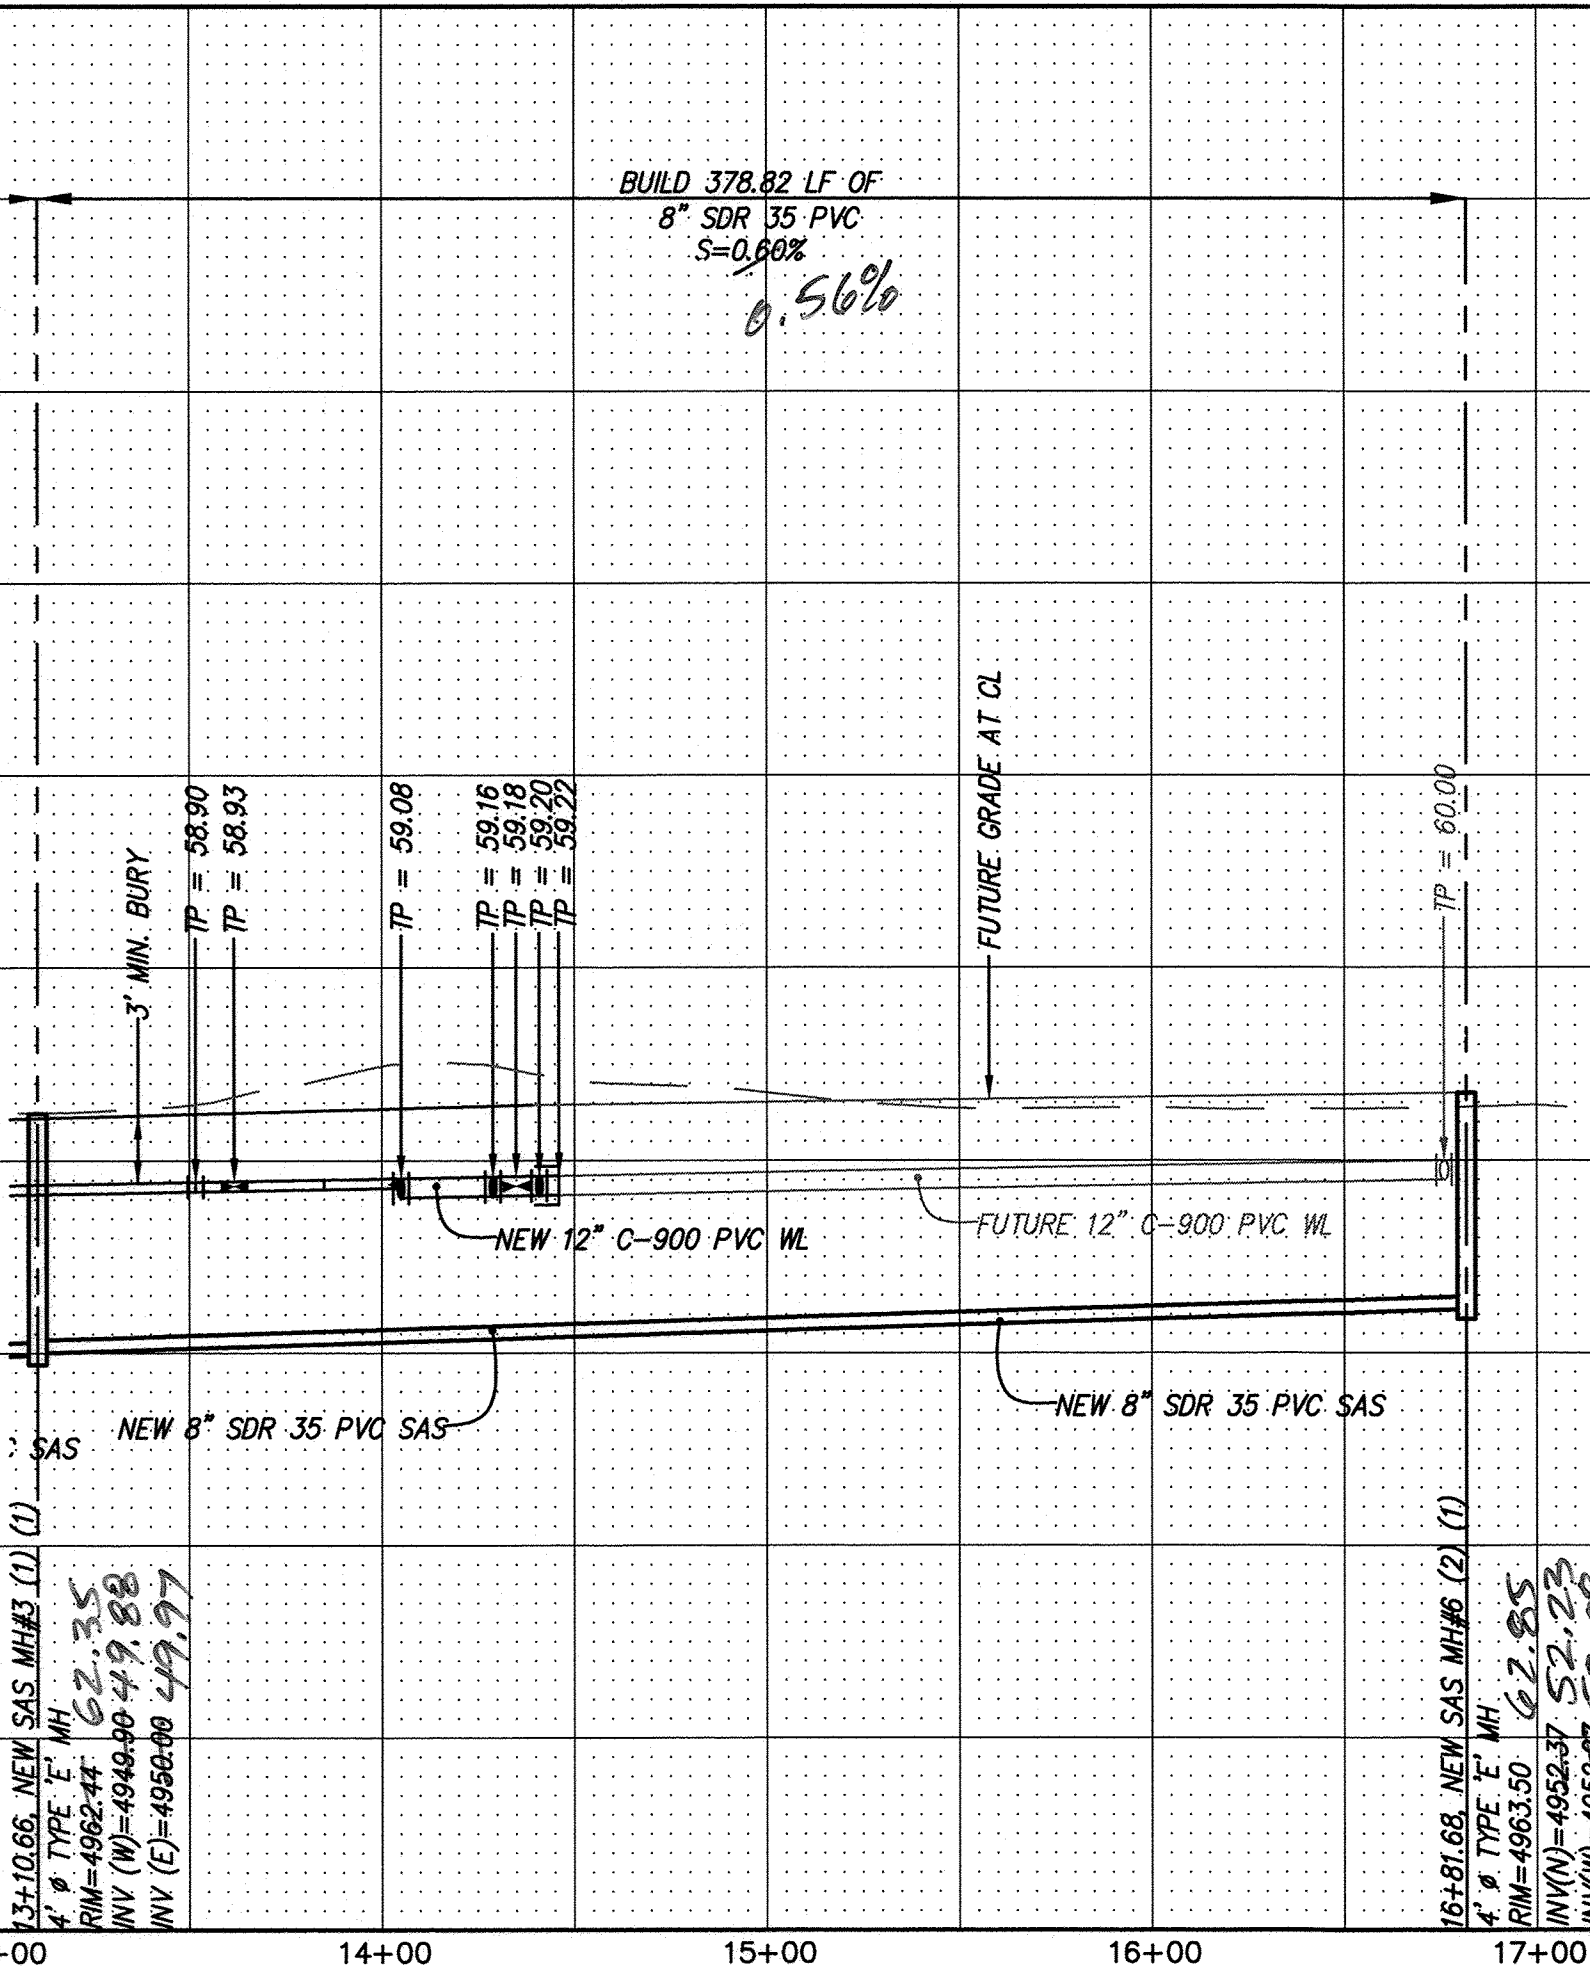

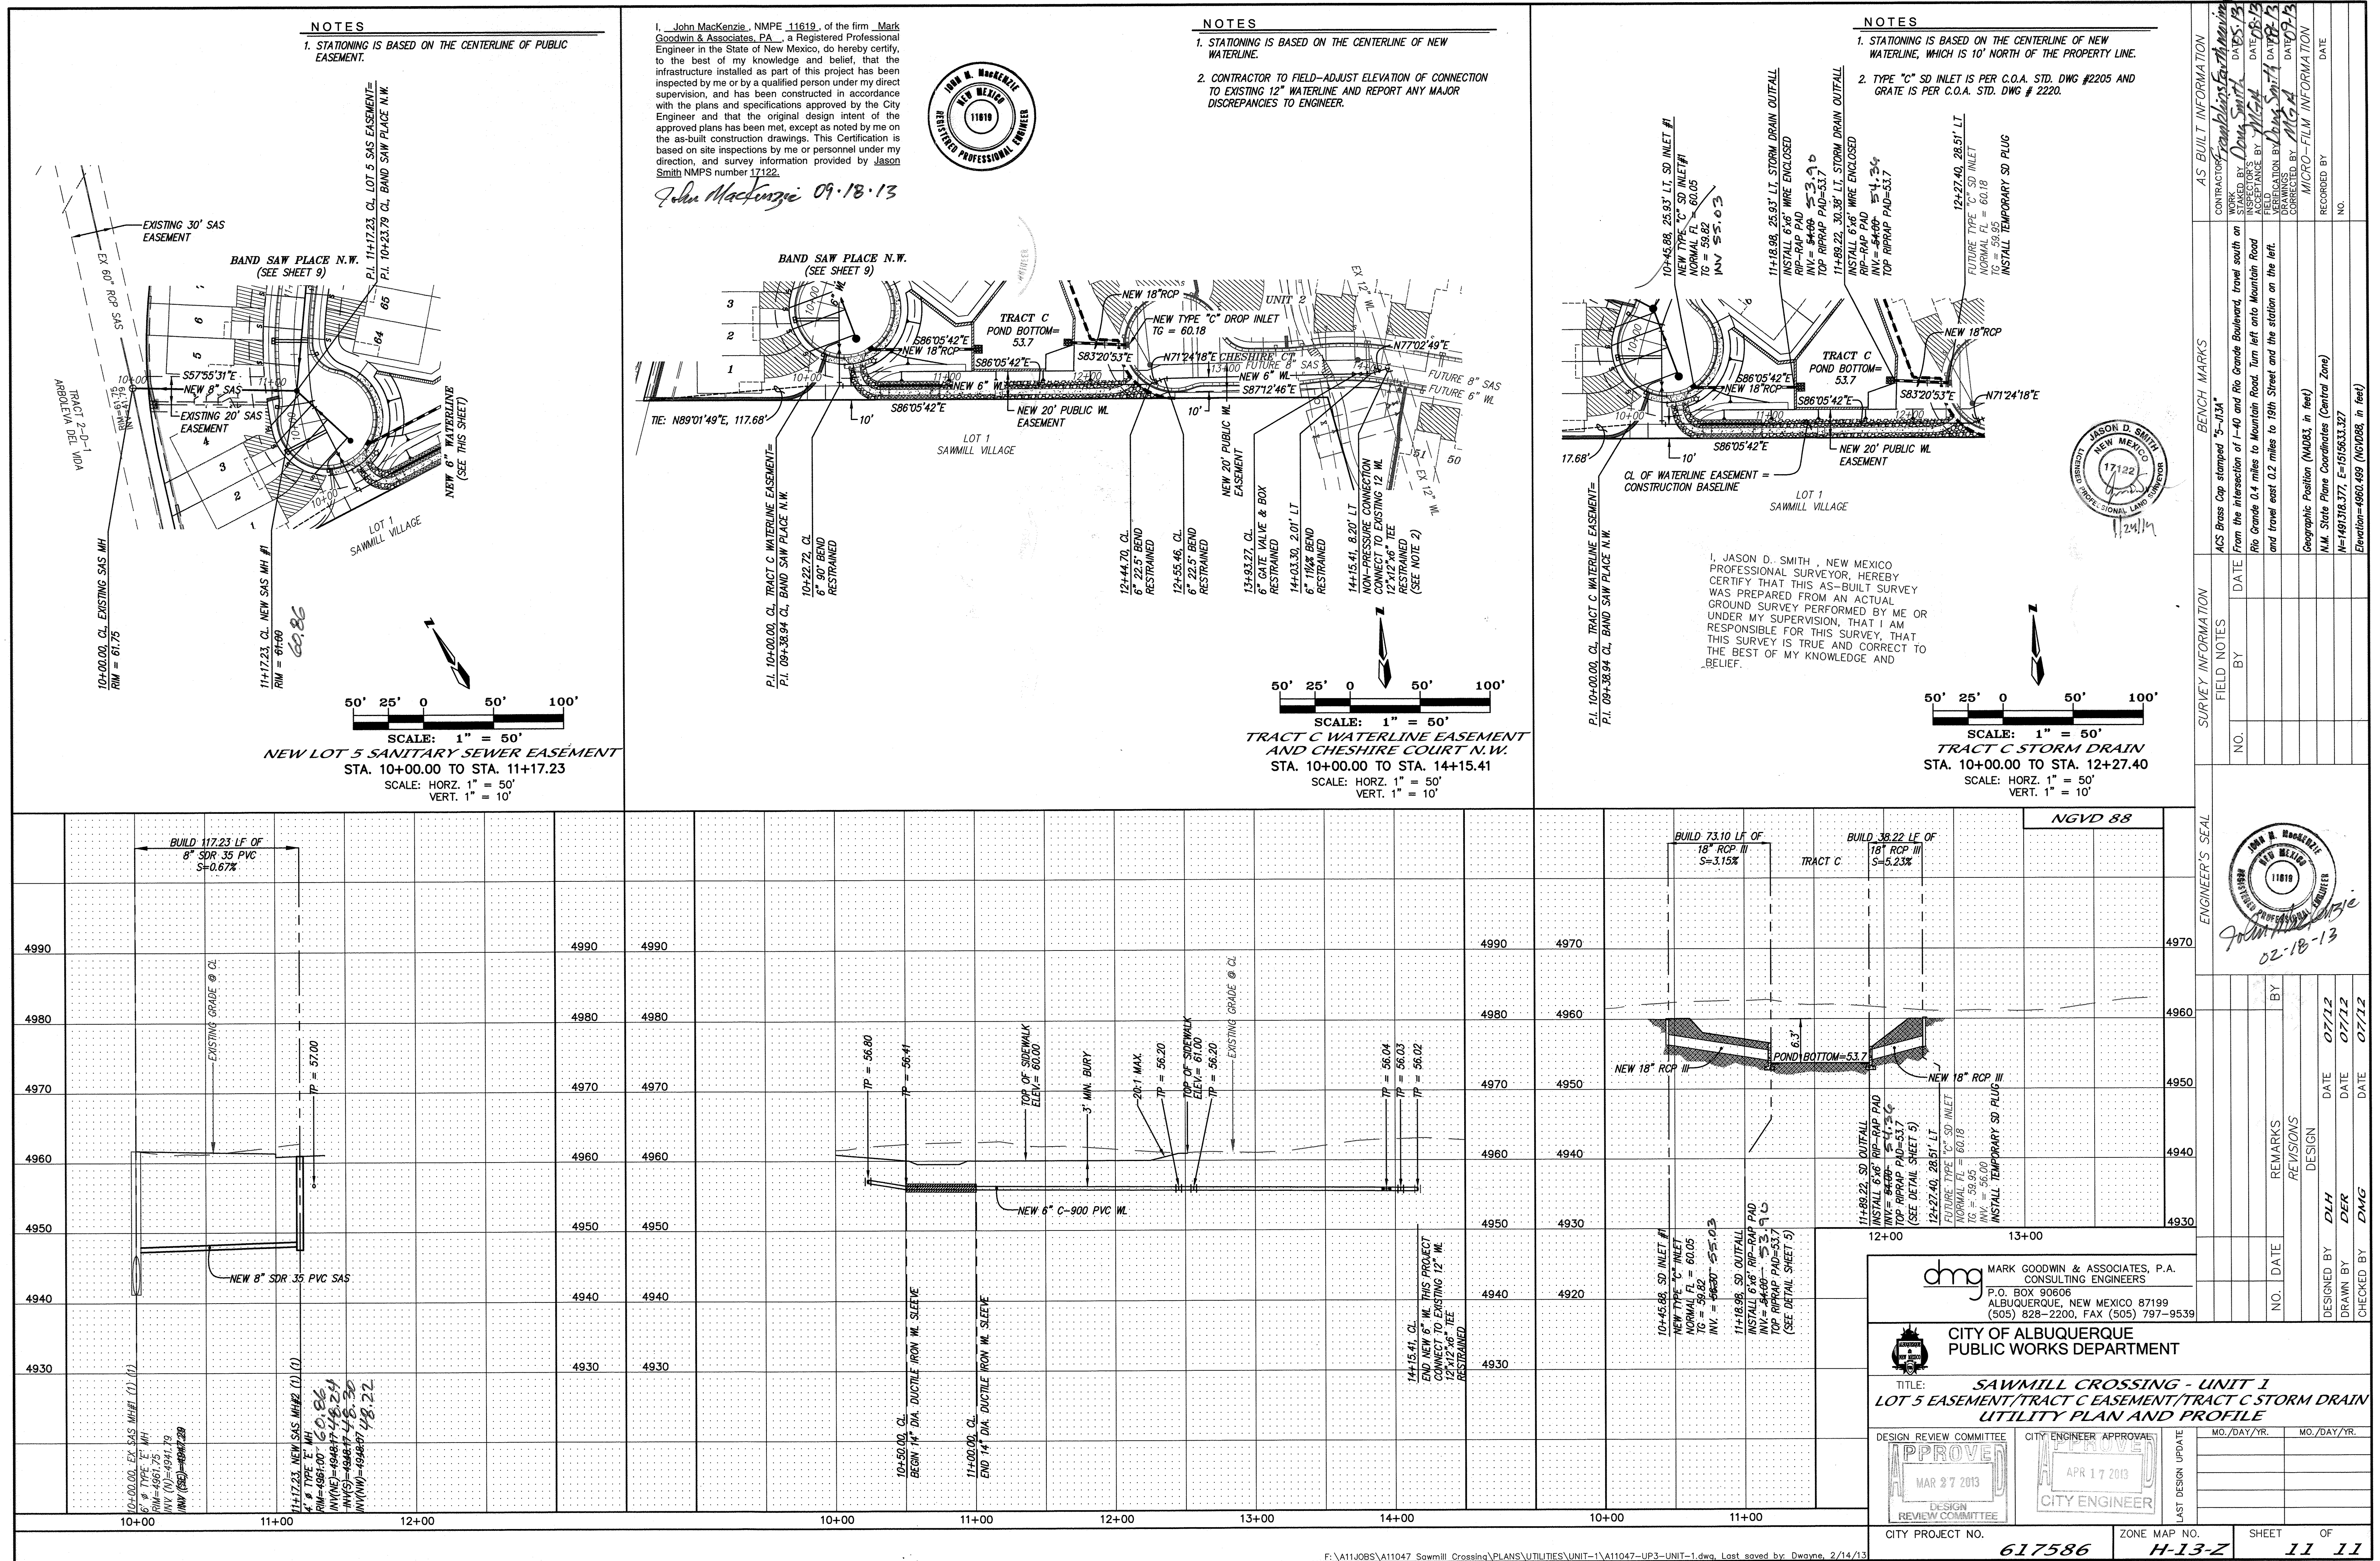

KEYED NOTES

- STATIONING IS BASED ON THE SOUTH PROPERTY LINE.
- CONCRETE CHANNEL SHOWN HEREON SHALL BE INSTALLED IN ACCORDANCE WITH C.O.A. STANDARD DWG #2260.
- HDPE PIPE AND OUTFALL EROSION PROTECTION TO BE INSTALLED BY OTHERS.
- NEW CONCRETE ALLEY GUTTER TO BE INSTALLED BY OTHERS.
- TRANSITION FROM FLAT BOTTOM CHANNEL (WEST) TO 4" INVERTED CROWN (EAST) WITHIN 10'.

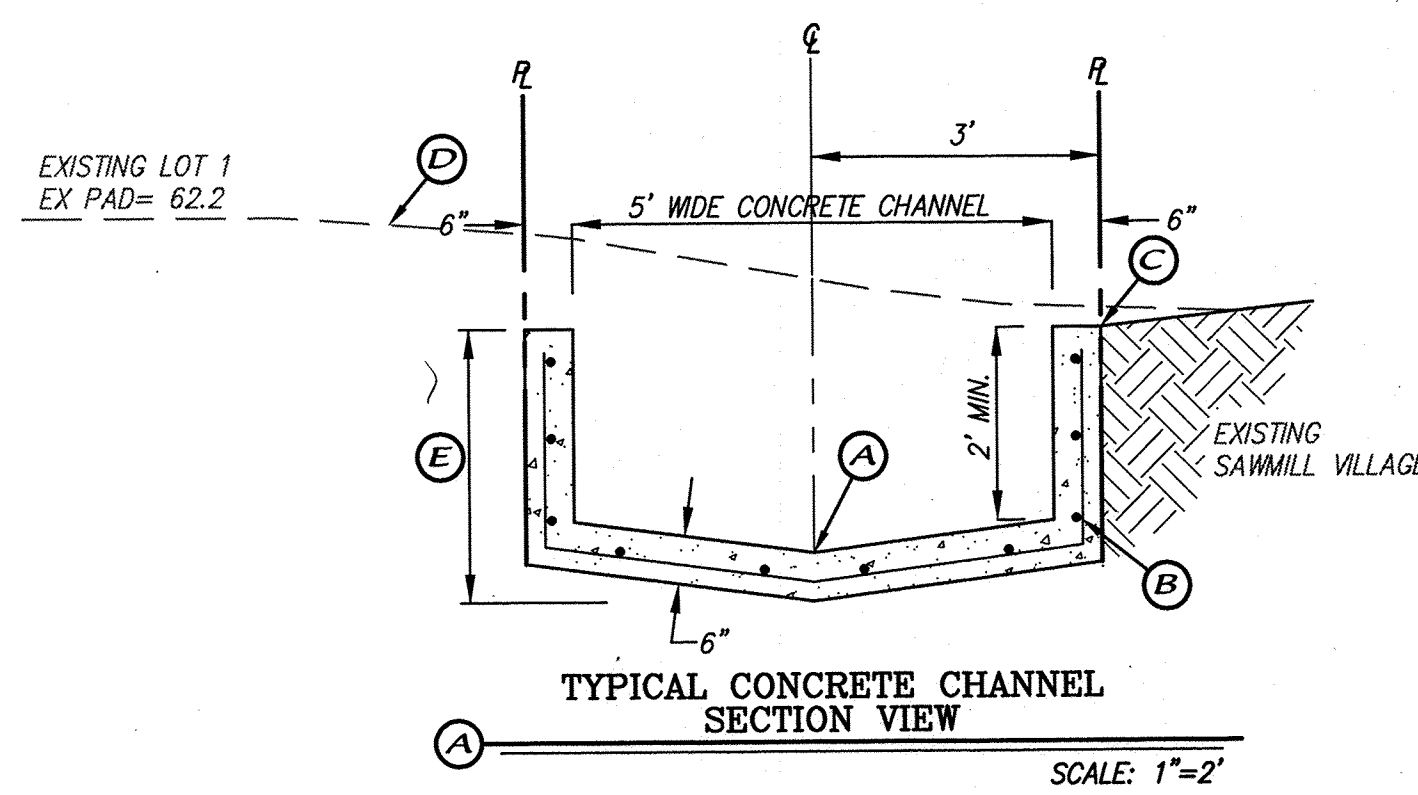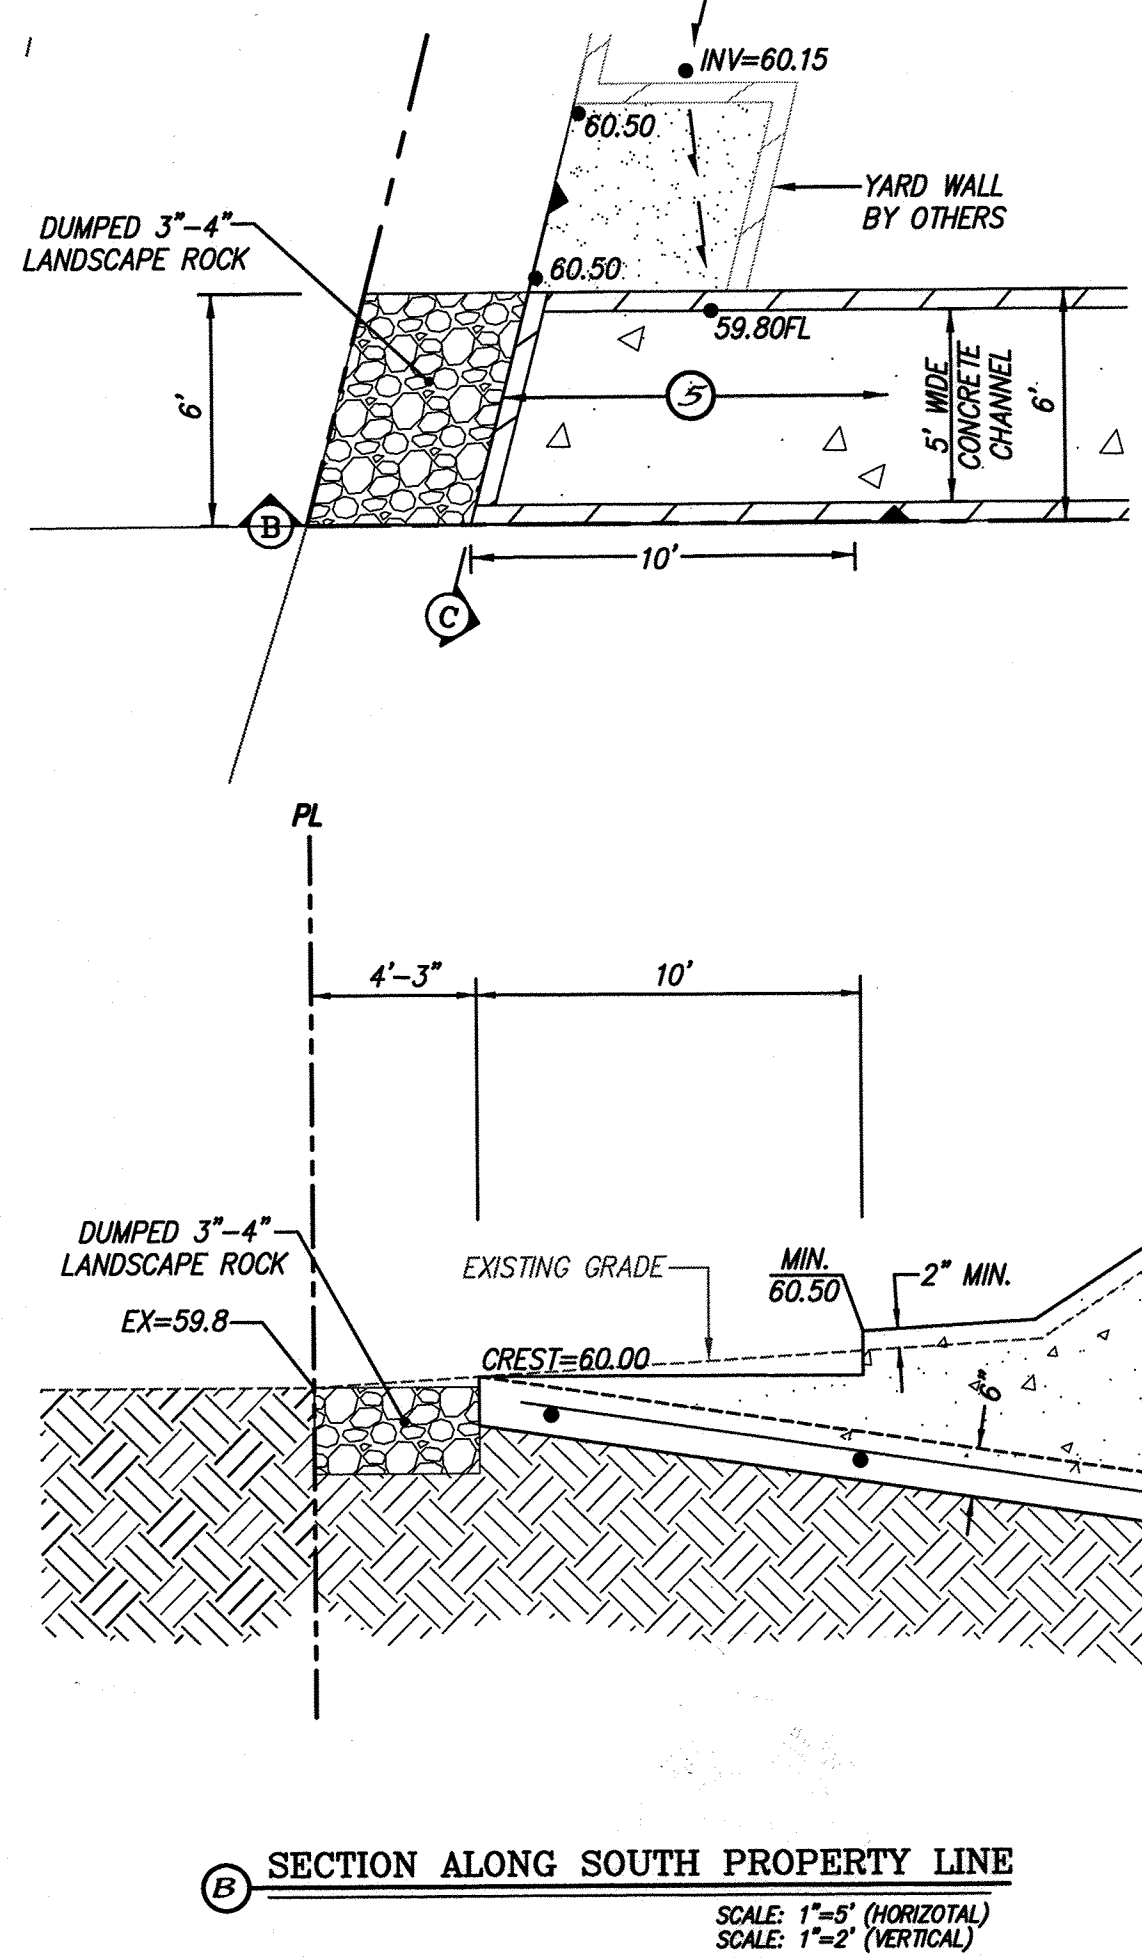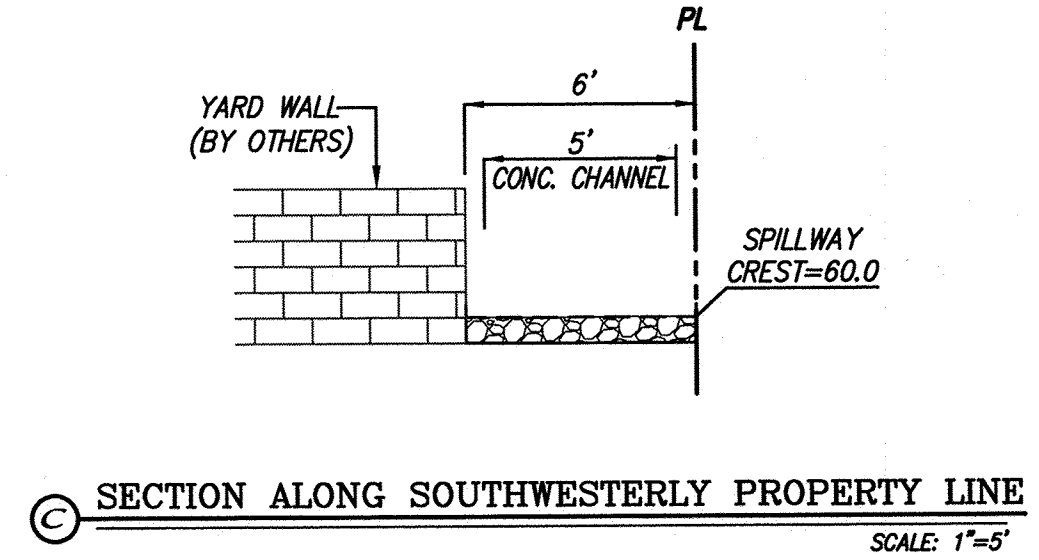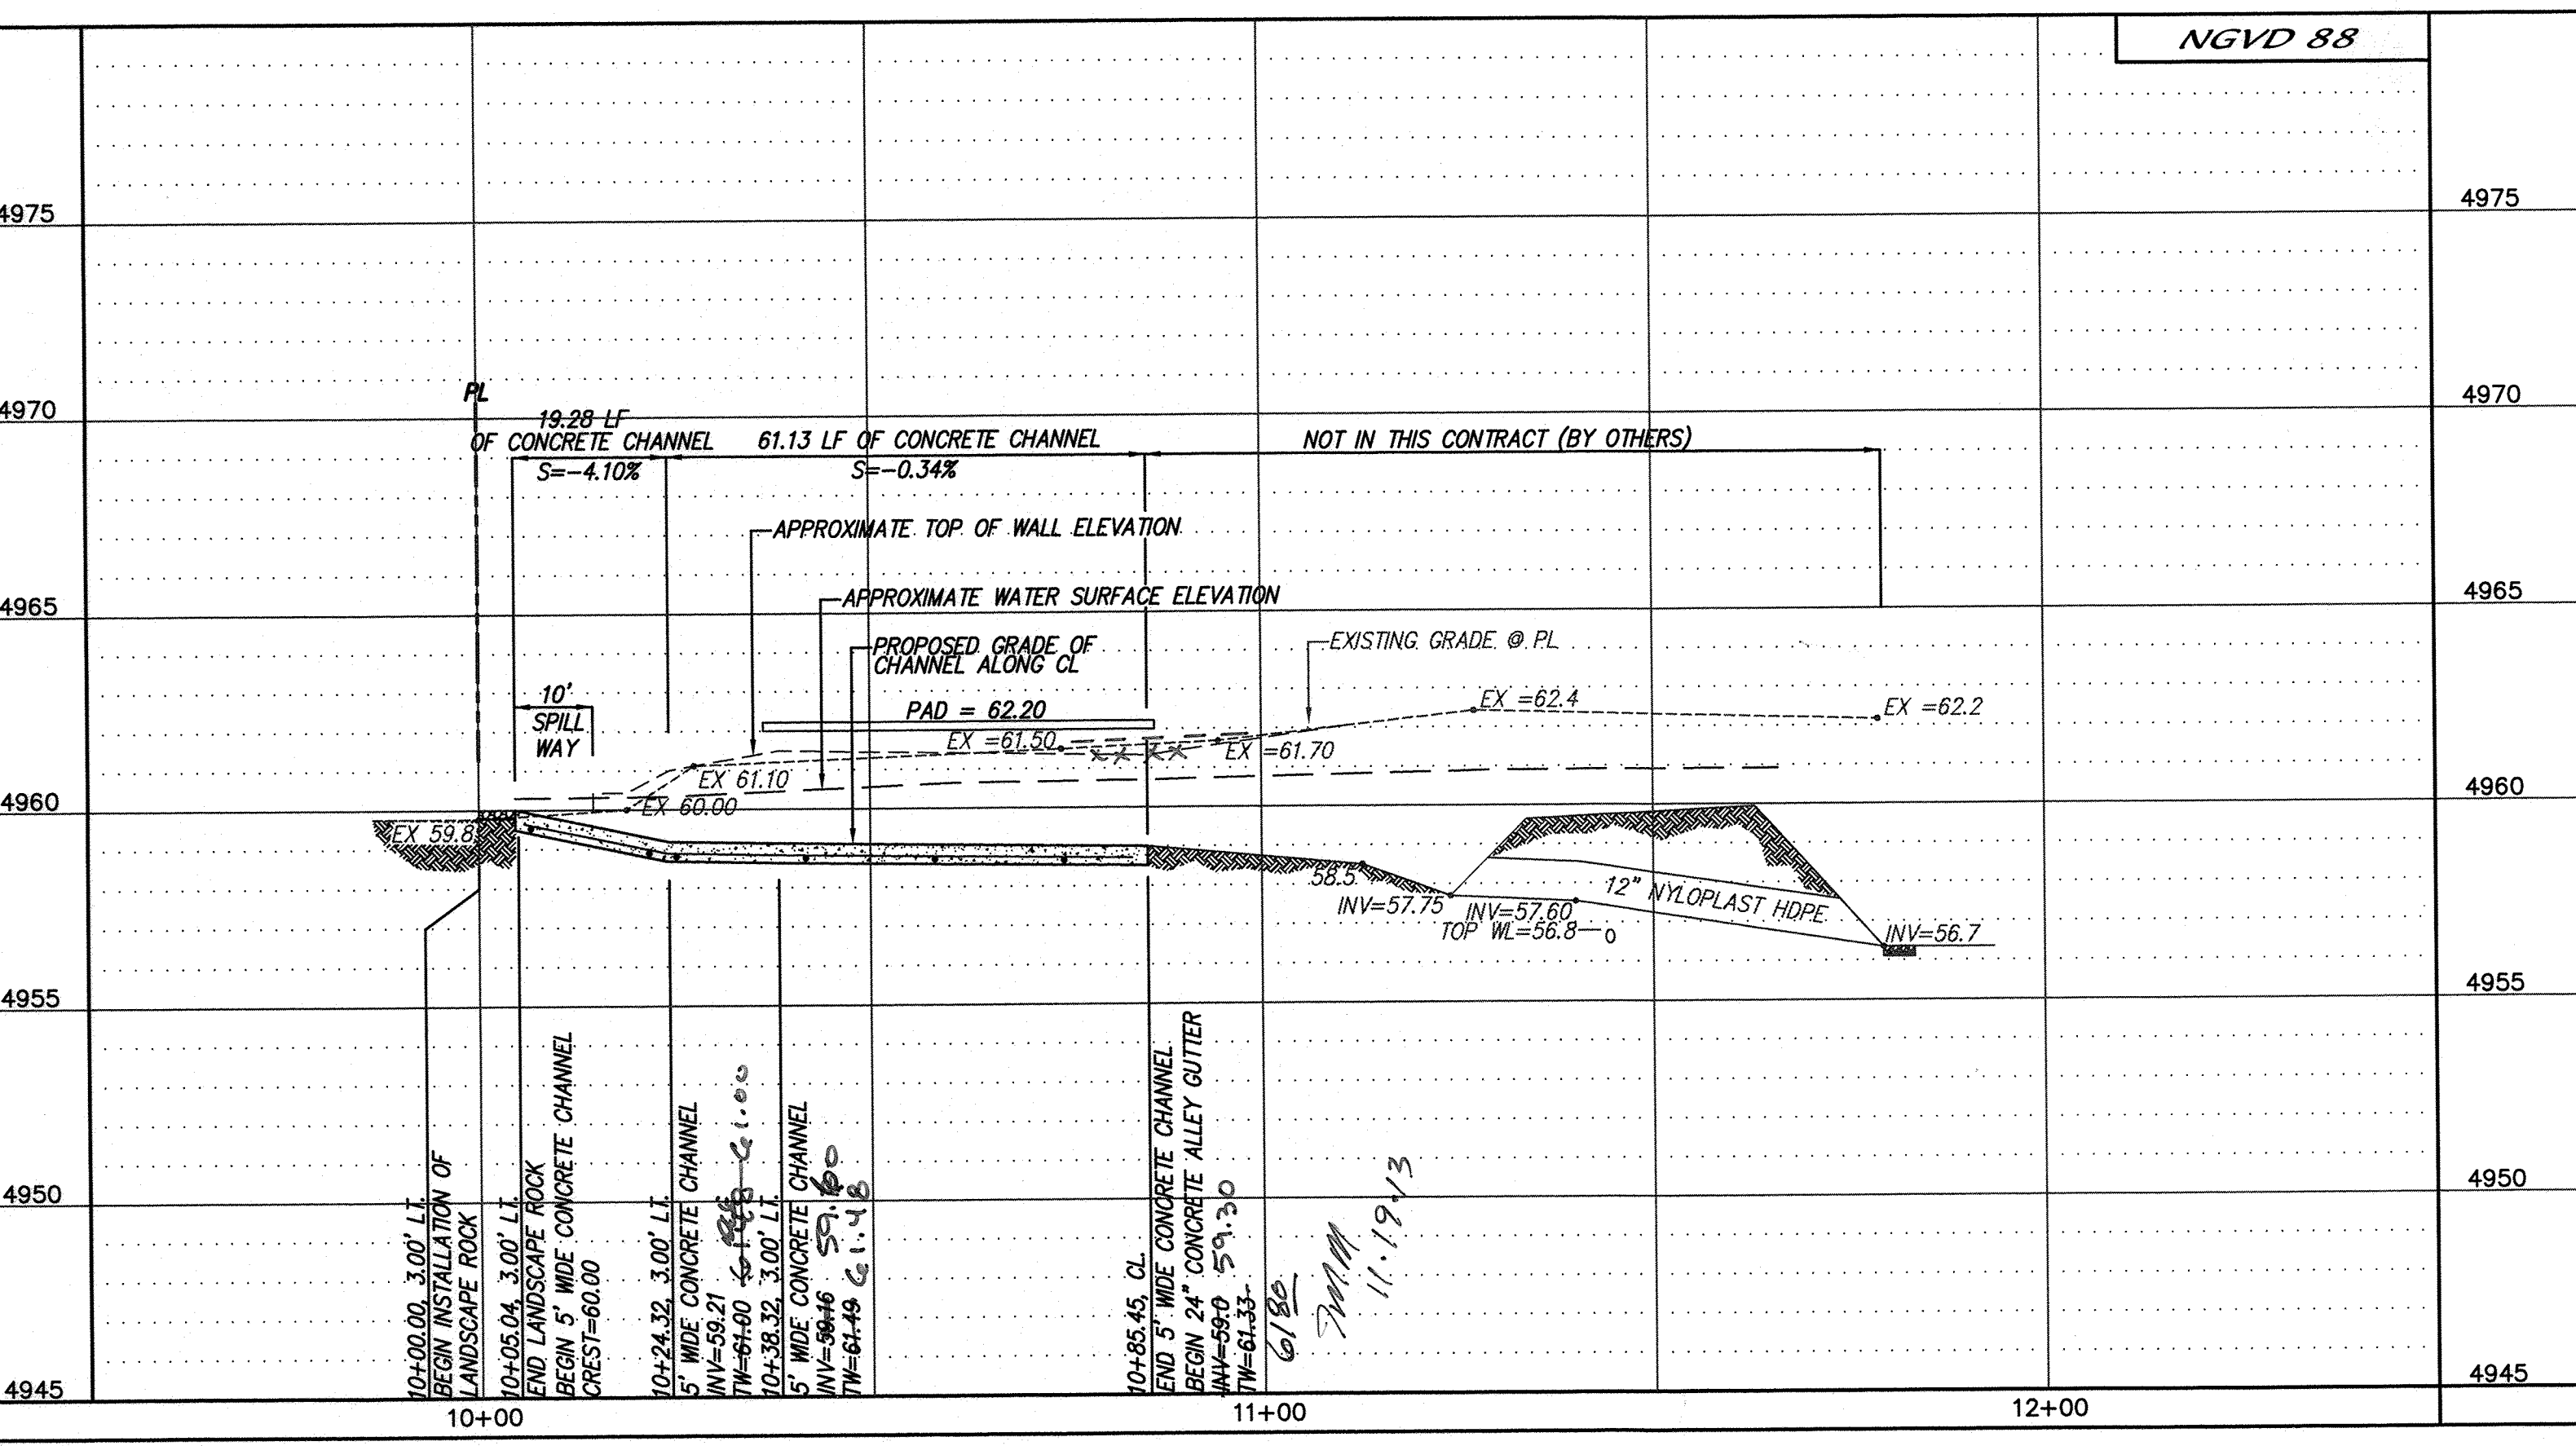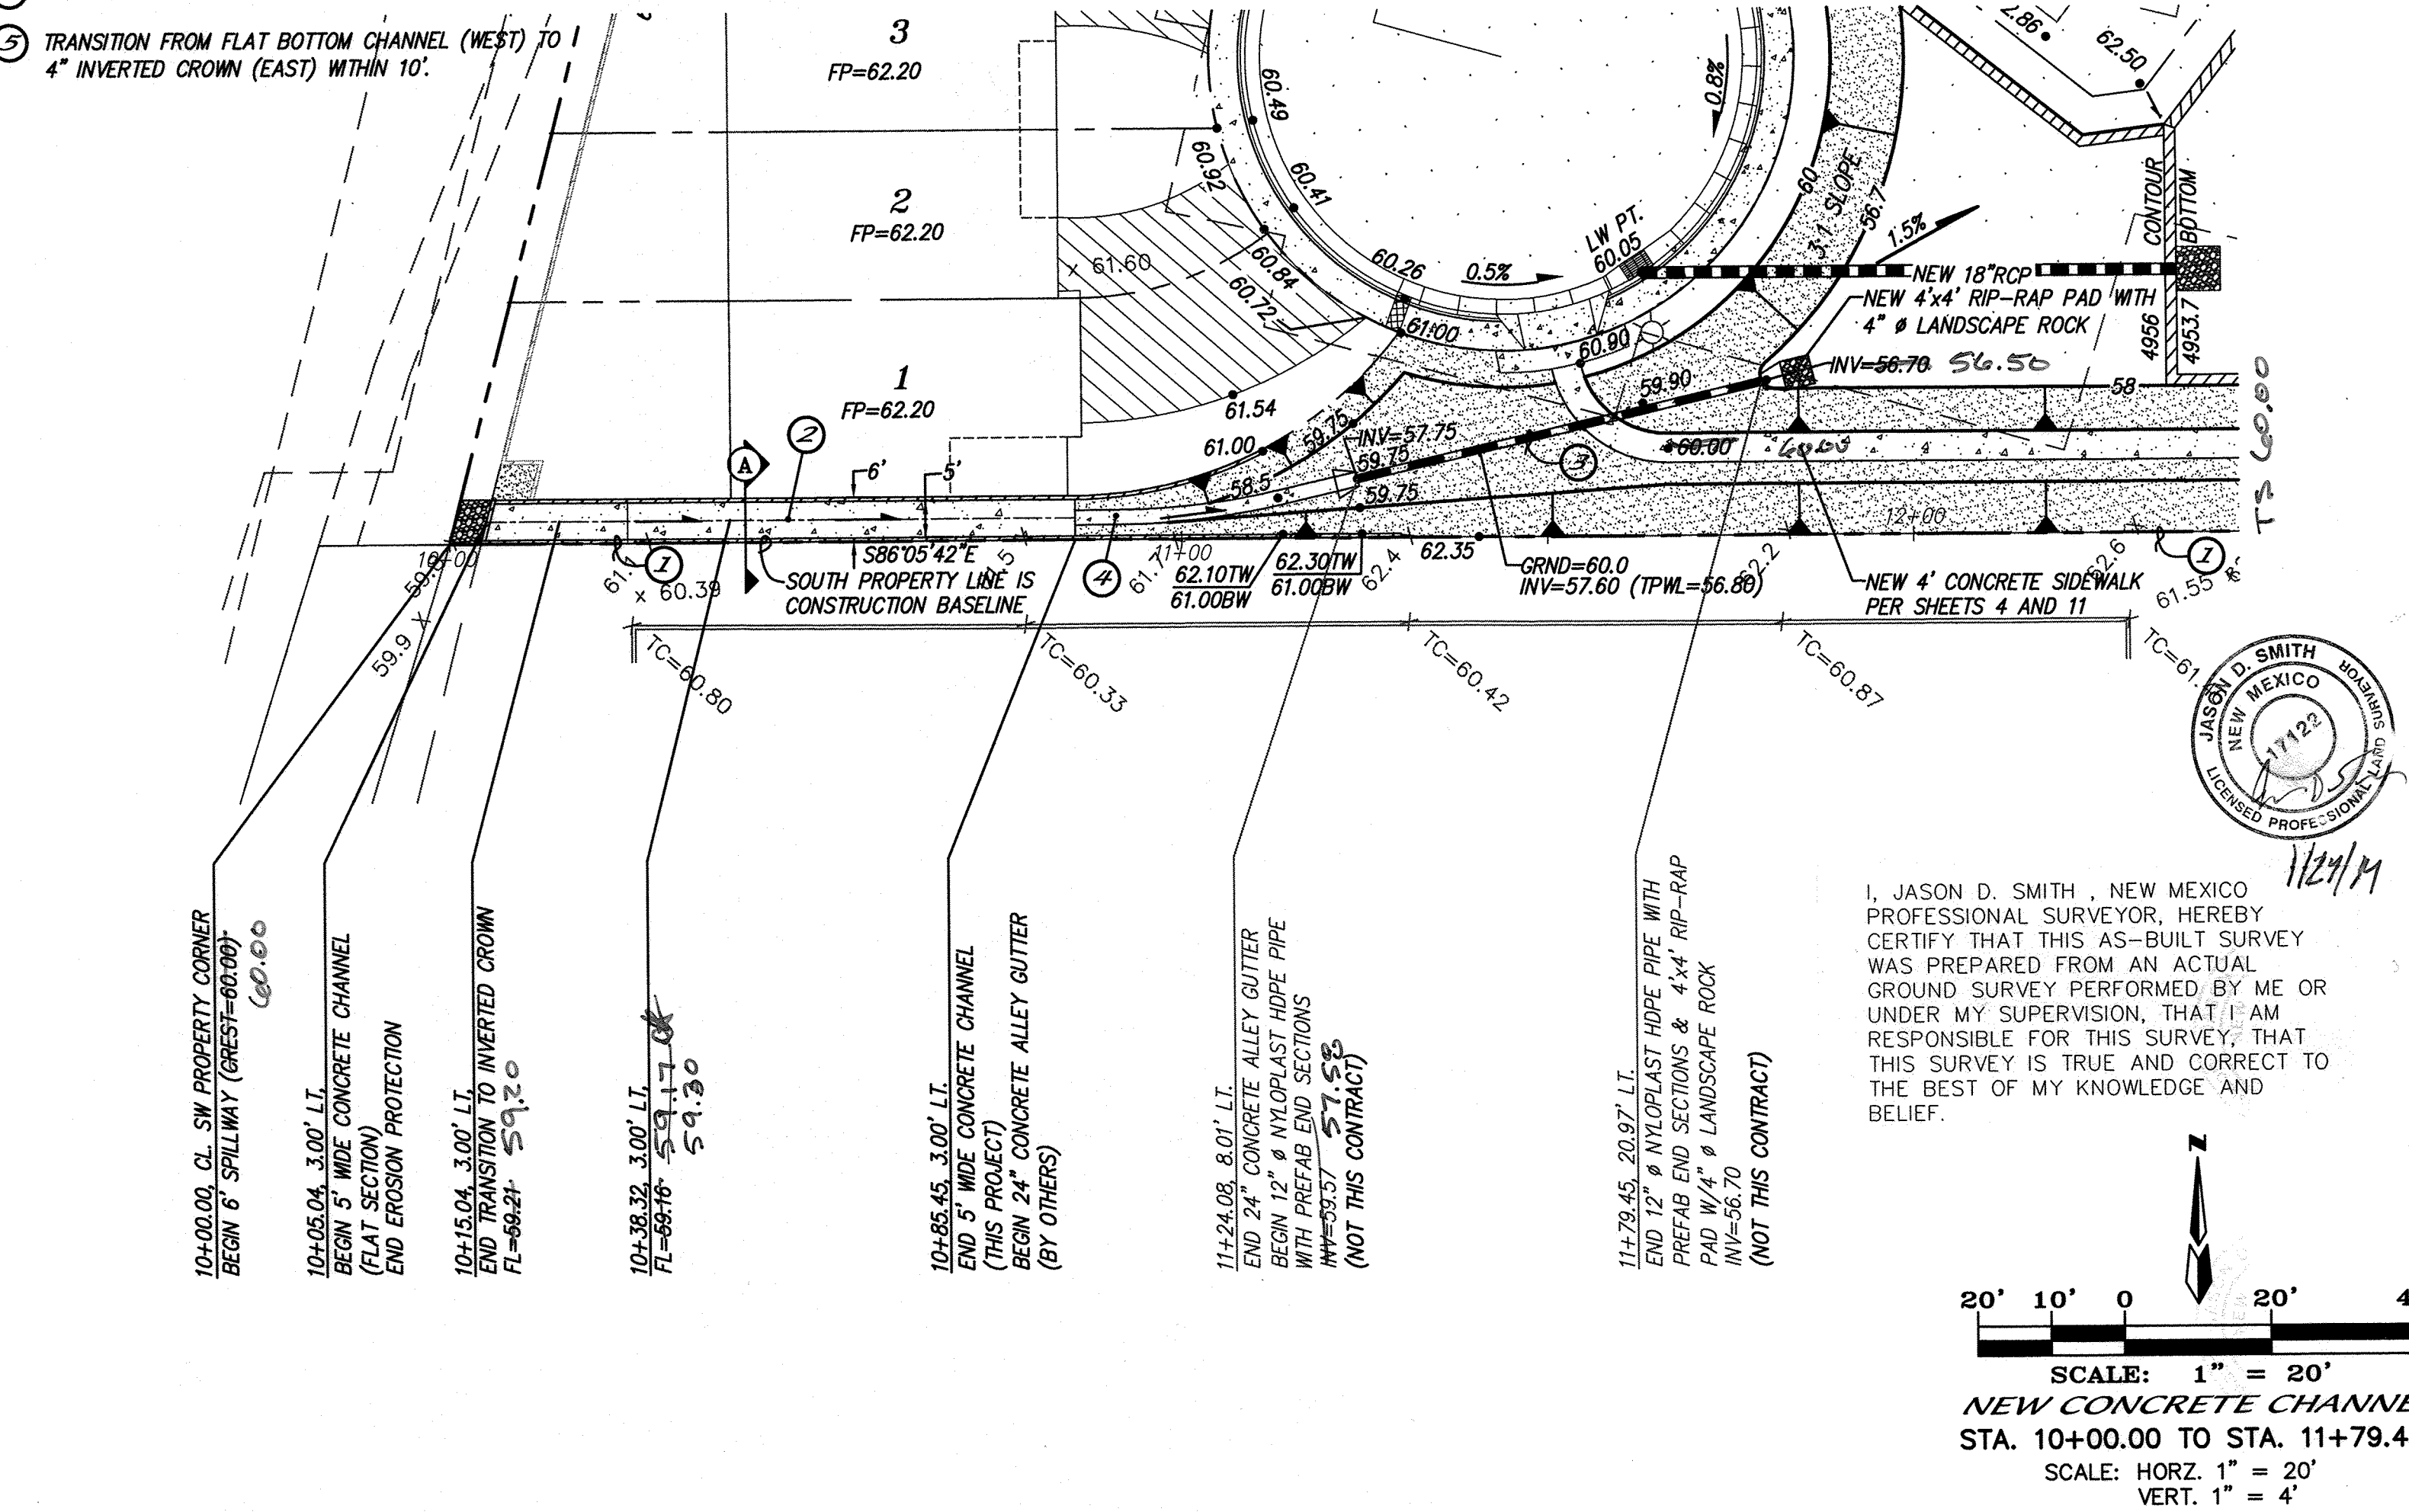

- DETAIL KEYED NOTES
- 4" INVERTED CROWN
 - INSTALL REINFORCEMENT PER C.O.A. STANDARD DWG #2260.
 - ADJUST PERIMETER GRADE (±0.2') AS NECESSARY AND RETURN SURFACE LANDSCAPING TO ORIGINAL CONDITION.
 - EXISTING GRADE
 - EXCAVATE CHANNEL SECTION AS NECESSARY.

MARK GOODWIN & ASSOCIATES, P.A.
CONSULTING ENGINEERS
P.O. BOX 90608
ALBUQUERQUE, NEW MEXICO 87199
(505) 828-2200, FAX (505) 797-9539

CITY OF ALBUQUERQUE
PUBLIC WORKS DEPARTMENT

TITLE: SAWMILL CROSSING - UNIT 1
NEW CONCRETE CHANNEL
UTILITY PLAN AND PROFILE

DESIGN REVIEW COMMITTEE: APPROVED NOV 23 2011
CITY ENGINEER APPROVAL: APPROVED DEC 9 2011
LAST DESIGN UPDATE: []

CITY PROJECT NO. 617586 ZONE MAP NO. H-13-Z SHEET 11A 11