

1 2 3 4 5 6 7 8 9 10 11 12 13 14 15
26 16 17 18 100

SCANNED
BY PLN

CONSTRUCTION PLANS
FOR
VENTANA RANCH WEST
PUBLIC IMPROVEMENT DISTRICT / ADDITIONAL
BACKBONE ROADWAY AND
STORM DRAIN IMPROVEMENTS
PHASE 2
ALBUQUERQUE, NEW MEXICO
INDEX


SHEET NUMBER	DESCRIPTION
1	TITLE SHEET
2-4	PLAT
5	SITE DESCRIPTION PLAN
6	OVERALL PAVING AND STORM DRAIN PLAN
7	PAVING AND STORM DRAIN DETAILS
8	PAVING AND STORM DRAIN PLAN & PROFILE SHEETS VENTANA RIDGE ROAD STA. 0+00.00 - 10+00.00
9	VENTANA RIDGE ROAD STA. 10+00.00 - 19+00.00
10	VENTANA RIDGE ROAD STA. 19+00.00 - 25+00.00
11	SIGNING AND STRIPING PLAN
12	TRAIL PLAN

SURVEYOR'S CERTIFICATION
"I, Timothy Aldrich, a duly qualified Registered Professional Land Surveyor under the laws of the State of New Mexico, do hereby certify that the 'as-built' information shown on these drawings was obtained from field construction and 'as-built' surveys performed by me or under my supervision, that the 'as-built' information shown on these drawings was added by me or under my supervision, and that this 'as-built' information is true and correct to the best of my knowledge and belief." Aldrich Land Surveying is not responsible for any of the design concepts, calculations, or omissions of record drawings.
Timothy Aldrich, P.S. No. 7719 Date 12-20-05




RECORD DRAWINGS

I, Patrick J. Conley of the firm of Smith Engineering Company, A Registered Professional Engineer in the State of New Mexico, do hereby state, to the best of my knowledge and belief, that the infrastructure installed as part of this project has been inspected by a qualified person under my direct supervision and has been constructed in general accordance with the plans and specifications, while someone from Smith Engineering Company was onsite, approved by the City Engineer and that the original design intent of the approved plans has been met, except as noted on the as-built construction drawings. The Certification is based on site inspections by me or personnel under my direction, and as-built survey information provided by TIM ALDRICH (Surveyor Name) NMPS number 7719 (PS#).

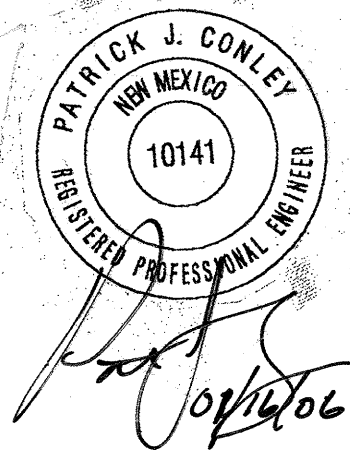

APPROVED AS RECORD DRAWINGS
DESIGN REVIEW SECTION
CITY CONSTRUCTION ENGINEER
DATE 3/15/06

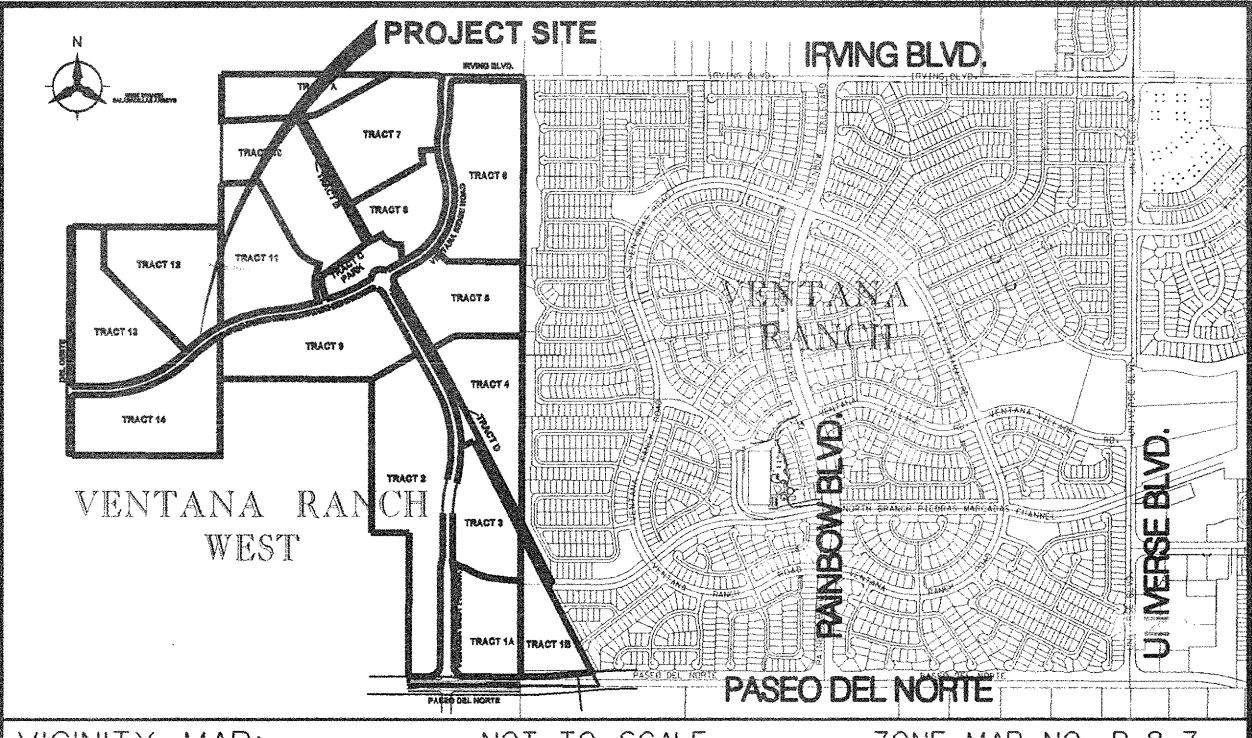

NOTICE TO CONTRACTORS


- AN EXCAVATION/CONSTRUCTION PERMIT WILL BE REQUIRED BEFORE BEGINNING ANY WORK WITHIN THE CITY RIGHT-OF-WAY.
- ALL WORK DETAILED ON THESE PLANS TO BE PERFORMED UNDER CONTRACT SHALL, EXCEPT AS OTHERWISE STATED OR PROVIDED FOR HEREON, BE CONSTRUCTED IN ACCORDANCE WITH THE CITY OF ALBUQUERQUE STANDARD SPECIFICATIONS FOR PUBLIC WORKS CONSTRUCTION, 1986 EDITION AS REVISED THROUGH UPDATE No. 7.
- TWO WORKING DAYS PRIOR TO ANY EXCAVATION, THE CONTRACTOR MUST CONTACT NEW MEXICO ONE CALL SYSTEM (260-1990) FOR LOCATION OF EXISTING UTILITIES.
- PRIOR TO CONSTRUCTION, THE CONTRACTOR SHALL EXCAVATE AND VERIFY THE HORIZONTAL AND VERTICAL LOCATIONS OF ALL OBSTRUCTIONS. SHOULD A CONFLICT EXIST, THE CONTRACTOR SHALL NOTIFY THE ENGINEER OR SURVEYOR IMMEDIATELY SO THAT THE CONFLICT CAN BE RESOLVED WITH A MINIMUM AMOUNT OF DELAY.
- FIVE (5) WORKING DAYS PRIOR TO BEGINNING CONSTRUCTION, THE CONTRACTOR SHALL SUBMIT, TO THE CONSTRUCTION COORDINATION DIVISION, A DETAILED CONSTRUCTION SCHEDULE. TWO (2) WORKING DAYS PRIOR TO CONSTRUCTION, THE CONTRACTOR SHALL OBTAIN A BARRICADING PERMIT FROM THE CONST. COORDINATION DIVISION. CONTRACTOR SHALL NOTIFY CONSTRUCTION COORDINATION ENGINEER (924-3400) PRIOR TO OCCUPYING AN INTERSECTION. REFER TO SECTION 19 OF THE GENERAL CONDITIONS OF THE STANDARD SPECIFICATIONS.
- ALL WORK AFFECTING ARTERIAL ROADWAYS REQUIRES TWENTY-FOUR HOUR CONSTRUCTION.
- ALL STREET STRIPING ALTERED OR DESTROYED SHALL BE REPLACED W/ PLASTIC REFLECTORIZED PAVEMENT MARKING BY CONTRACTOR TO THE SAME LOCATION AS EXISTING, OR AS INDICATED BY THIS PLAN SET.
- CONTRACTOR SHALL NOTIFY THE ENGINEER NOT LESS THAN SEVEN (7) DAYS PRIOR TO STARTING WORK IN ORDER THAT THE CITY SURVEYOR MAY TAKE NECESSARY MEASURES TO INSURE THE PRESERVATION OF SURVEY MONUMENTS. CONTRACTOR SHALL NOT DISTURB PERMANENT SURVEY MONUMENTS WITHOUT THE CONSENT OF THE CITY SURVEYOR AND SHALL NOTIFY THE CITY SURVEYOR AND BEAR THE EXPENSE OF REPLACING ANY THAT MAY BE DISTURBED WITHOUT PERMISSION. REPLACEMENT SHALL BE DONE ONLY BY THE CITY SURVEYOR. WHEN A CHANGE IS MADE IN THE FINISHED ELEVATIONS OF THE PAVEMENT OF ANY ROADWAY IN WHICH A PERMANENT SURVEY MONUMENT IS LOCATED, CONTRACTOR SHALL, AT HIS OWN EXPENSE, ADJUST THE MONUMENT COVER TO THE NEW GRADE UNLESS OTHERWISE SPECIFIED. REFER TO SECTION 4.4 OF THE GENERAL CONDITIONS OF THE STANDARD SPECIFICATIONS.
- CONTRACTOR SHALL RECORD DATA ON ALL UTILITY LINES AND ACCESSORIES AS REQUIRED BY THE CITY OF ALBUQUERQUE FOR THE PREPARATION OF "AS CONSTRUCTED" DRAWINGS. CONTRACTOR SHALL NOT COVER UTILITY LINES AND ACCESSORIES UNTIL ALL DATA HAS BEEN RECORDED.
- CONTRACTOR SHALL MAINTAIN A GRAFFITI-FREE WORK SITE. CONTRACTOR SHALL PROMPTLY REMOVE ANY GRAFFITI FROM ALL EQUIPMENT, WHETHER PERMANENT OR TEMPORARY.
- CONTRACTOR SHALL COORDINATE WITH THE CITY OF ALBUQUERQUE WATER SYSTEMS DIVISION (857-8200) FIVE WORKING DAYS IN ADVANCE OF ANY WORK THAT MAY AFFECT EXISTING PUBLIC WATER OR SEWER UTILITIES. EXISTING VALVES TO BE OPERATED BY CITY PERSONNEL ONLY. CONTRACTOR SHALL CONTACT THE WATER SYSTEMS DIVISION THREE (3) DAYS PRIOR TO NEEDING VALVES TURNED ON OR OFF.

THE FOLLOWING NOTES ALSO APPLY WHEN CHECKED


- ☒ ALL UTILITIES AND UTILITY SERVICE LINES SHALL BE INSTALLED PRIOR TO PAVING.
- ☒ BACKFILL COMPACTION SHALL BE ACCORDING TO SPECIFIED STREET USE.
- ☐ TACK COAT REQUIREMENTS SHALL BE DETERMINED BY THE CITY ENGINEER.
- ☒ SIDEWALKS AND WHEELCHAIR RAMPS WITHIN THE CURB RETURNS SHALL BE CONSTRUCTED WHEREVER A NEW CURB RETURN IS CONSTRUCTED.
- ☐ IF CURB IS DEPRESSED FOR A DRIVEPAD, THE DRIVEPAD SHALL BE CONSTRUCTED PRIOR TO ACCEPTANCE OF CURB AND GUTTER.
- ☒ ALL STORM DRAINAGE FACILITIES SHALL BE COMPLETED PRIOR TO FINAL ACCEPTANCE.
- ☒ THE REQUESTOR OR DEVELOPER SHALL BE RESPONSIBLE FOR REPAIR OR REPLACEMENT OF ALL CURB AND GUTTER OR SIDEWALK DAMAGED AFTER APPROVAL BY THE CITY ENGINEER OF WORK COMPLETED BY THE CONTRACTOR.

REV.	SHEETS	CITY ENGINEER	DATE	USER DEPARTMENT	DATE	USER DEPARTMENT	DATE
ENGINEERS STAMP & SIGNATURE		APPROVALS		ENGINEER		DATE	
		DRC Chairman			9-16-04	APPROVED FOR CONSTRUCTION City Engineer Date 9-21-04	
		Transportation			9/7/04		
		Water/Wastewater			9/7/04		
		Hydrology			9/7/04		
		CIP			9-16-04		
DRB CASE NUMBER		CITY PROJECT NO.		SHEET		OF	
1002778		617685		1		12	

**BULK LAND PLAT FOR
VENTANA RANCH WEST**
WITHIN THE CITY OF ALBUQUERQUE
AND BERNALILLO COUNTY, NEW MEXICO
FEBRUARY, 2004

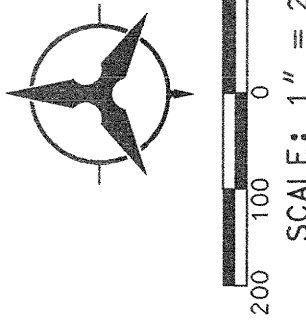

NOTE: SEE SHEET 6 FOR CURVE & TANGENT DATA

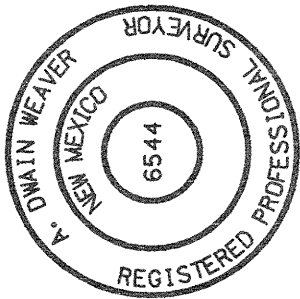


SHEET 6
SHEET 4
SHEET 3

Bohannon & Huston
Engineering & Spatial Data • Advanced Technologies



Courtyard 1 7500 Jefferson St. NE Albuquerque, NM 87109-4335
ENGINEERING & SPATIAL DATA • ADVANCED TECHNOLOGIES

P:\040237\040237Phase2\PHD Plans\040237Phase2.dgn JOB NO. 040237-002
03/27/2004
aromero

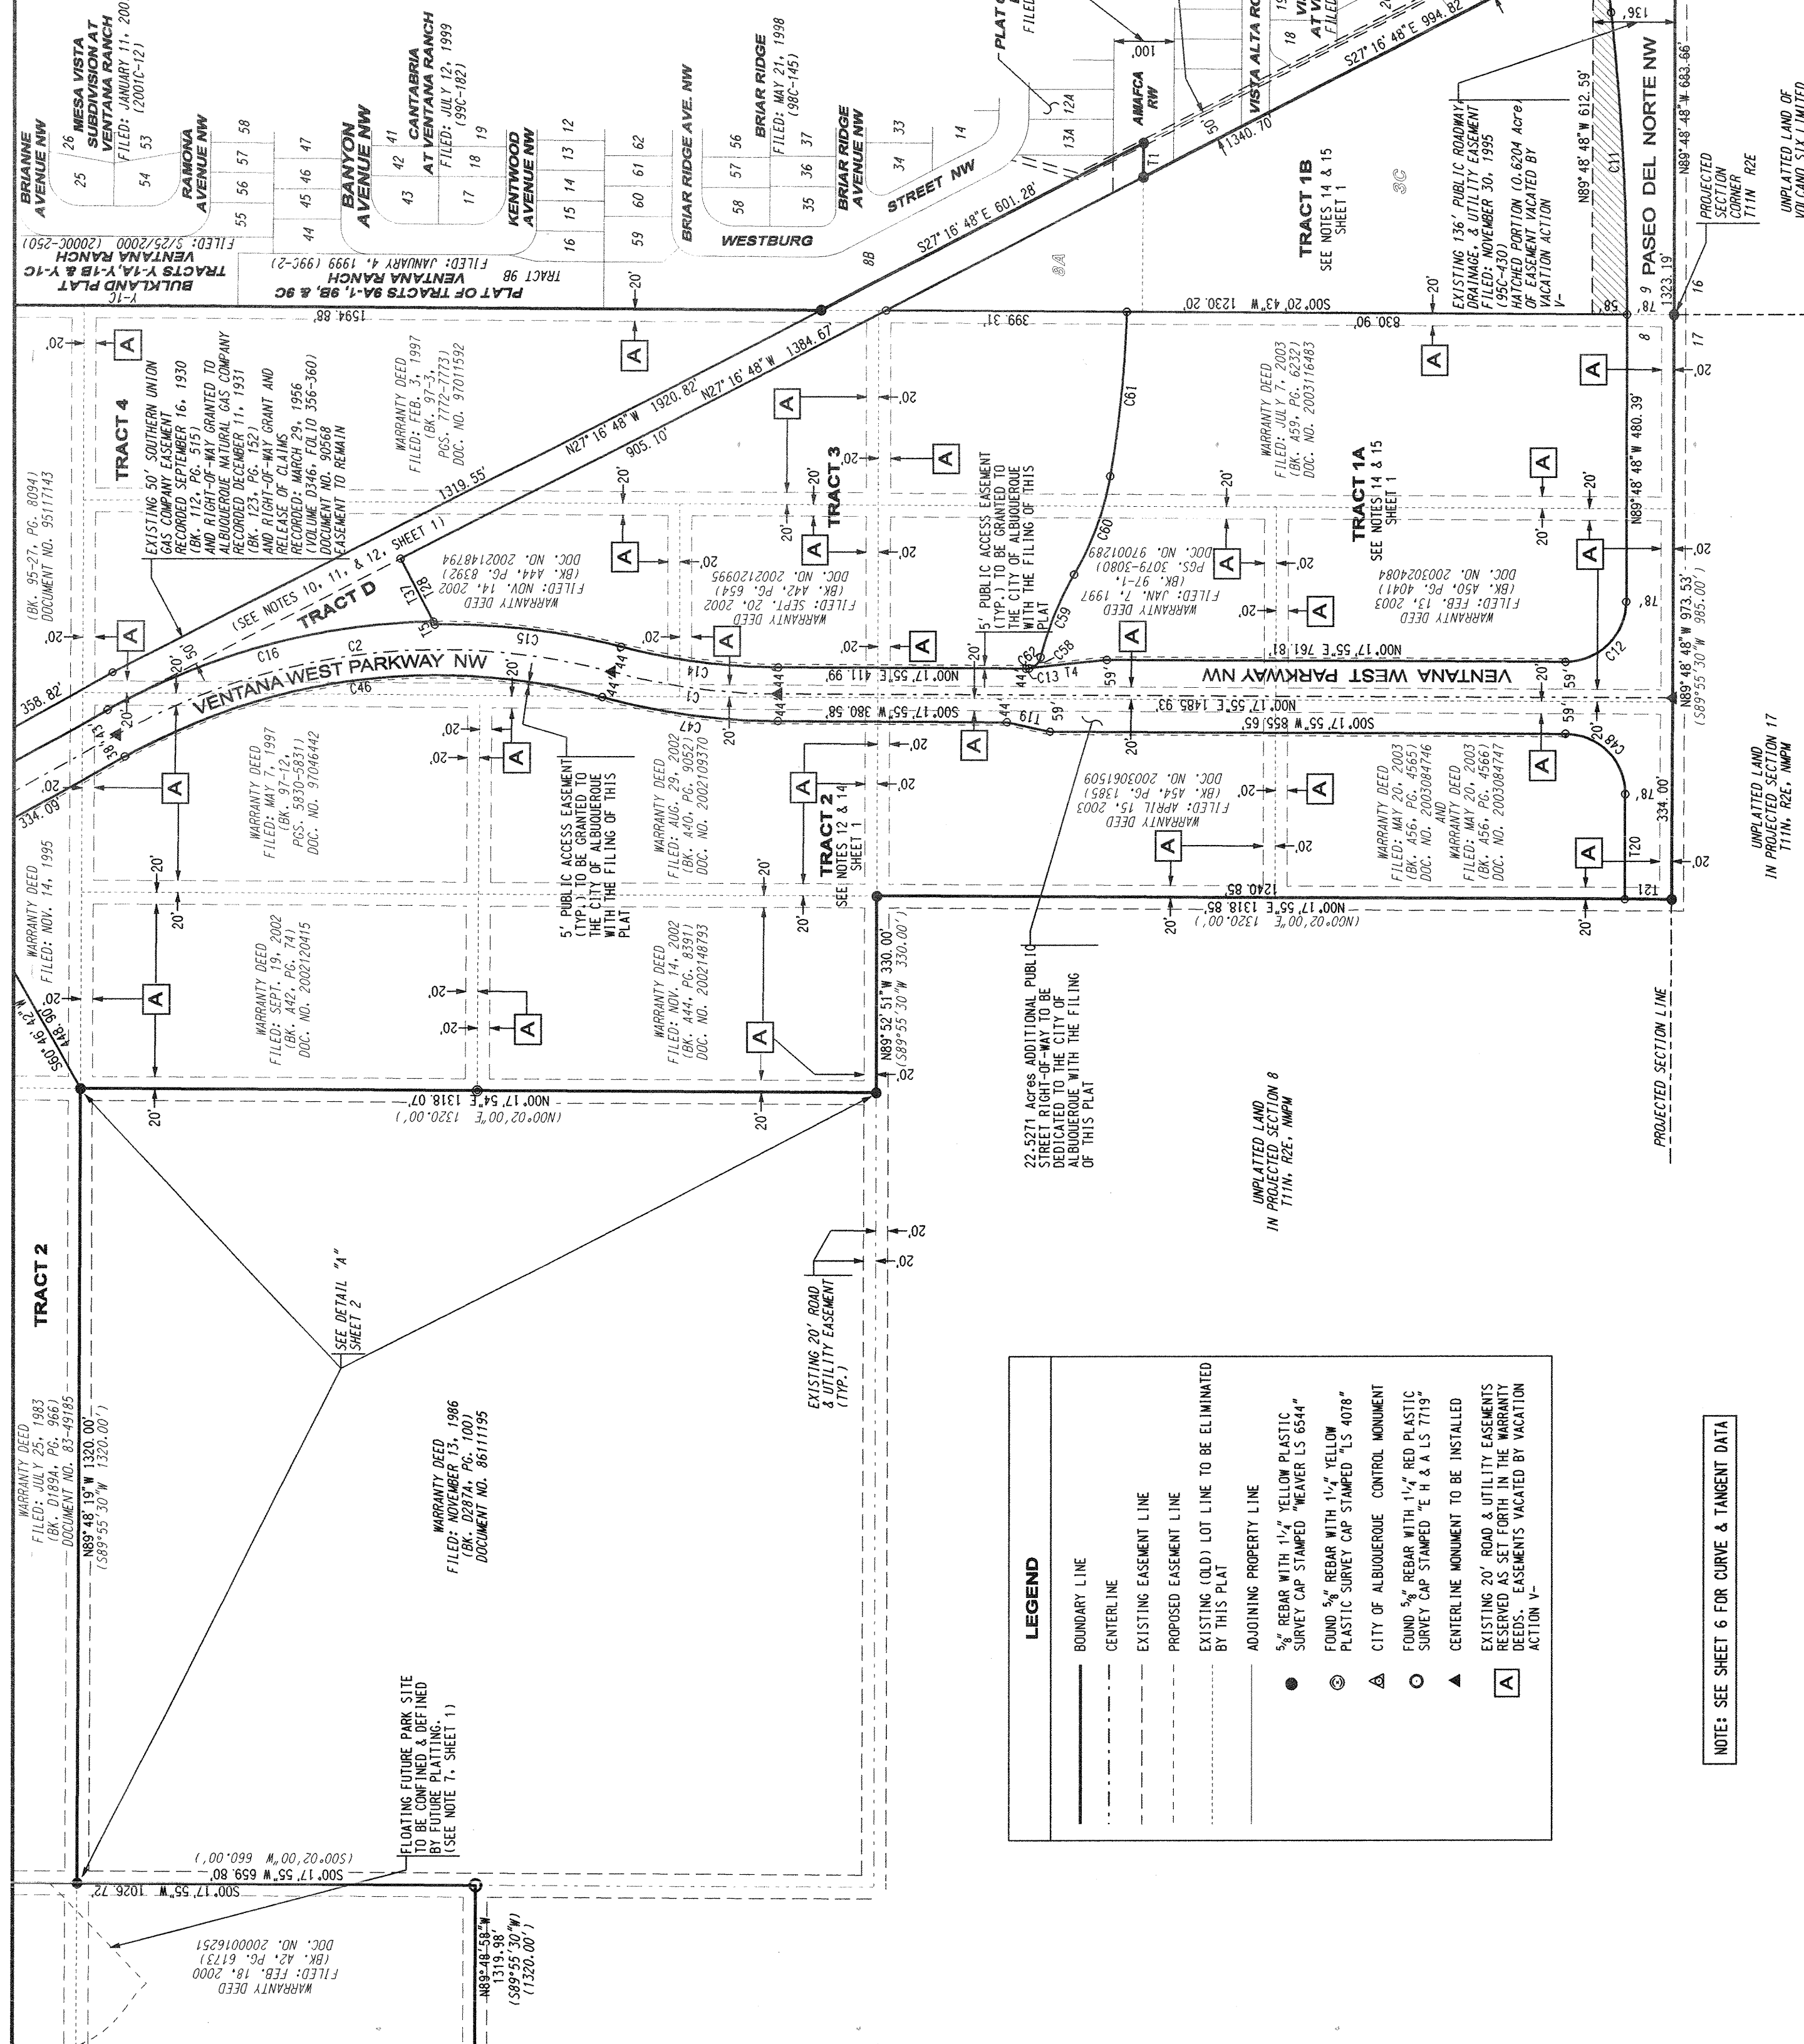

NOTE: SEE SHEET 6 FOR CURVE & TANGENT DATA

**BULK LAND PLAT FOR
VENTANA RANCH WEST**
WITHIN THE CITY OF ALBUQUERQUE
AND BERNALILLO COUNTY, NEW MEXICO
FEBRUARY, 2004

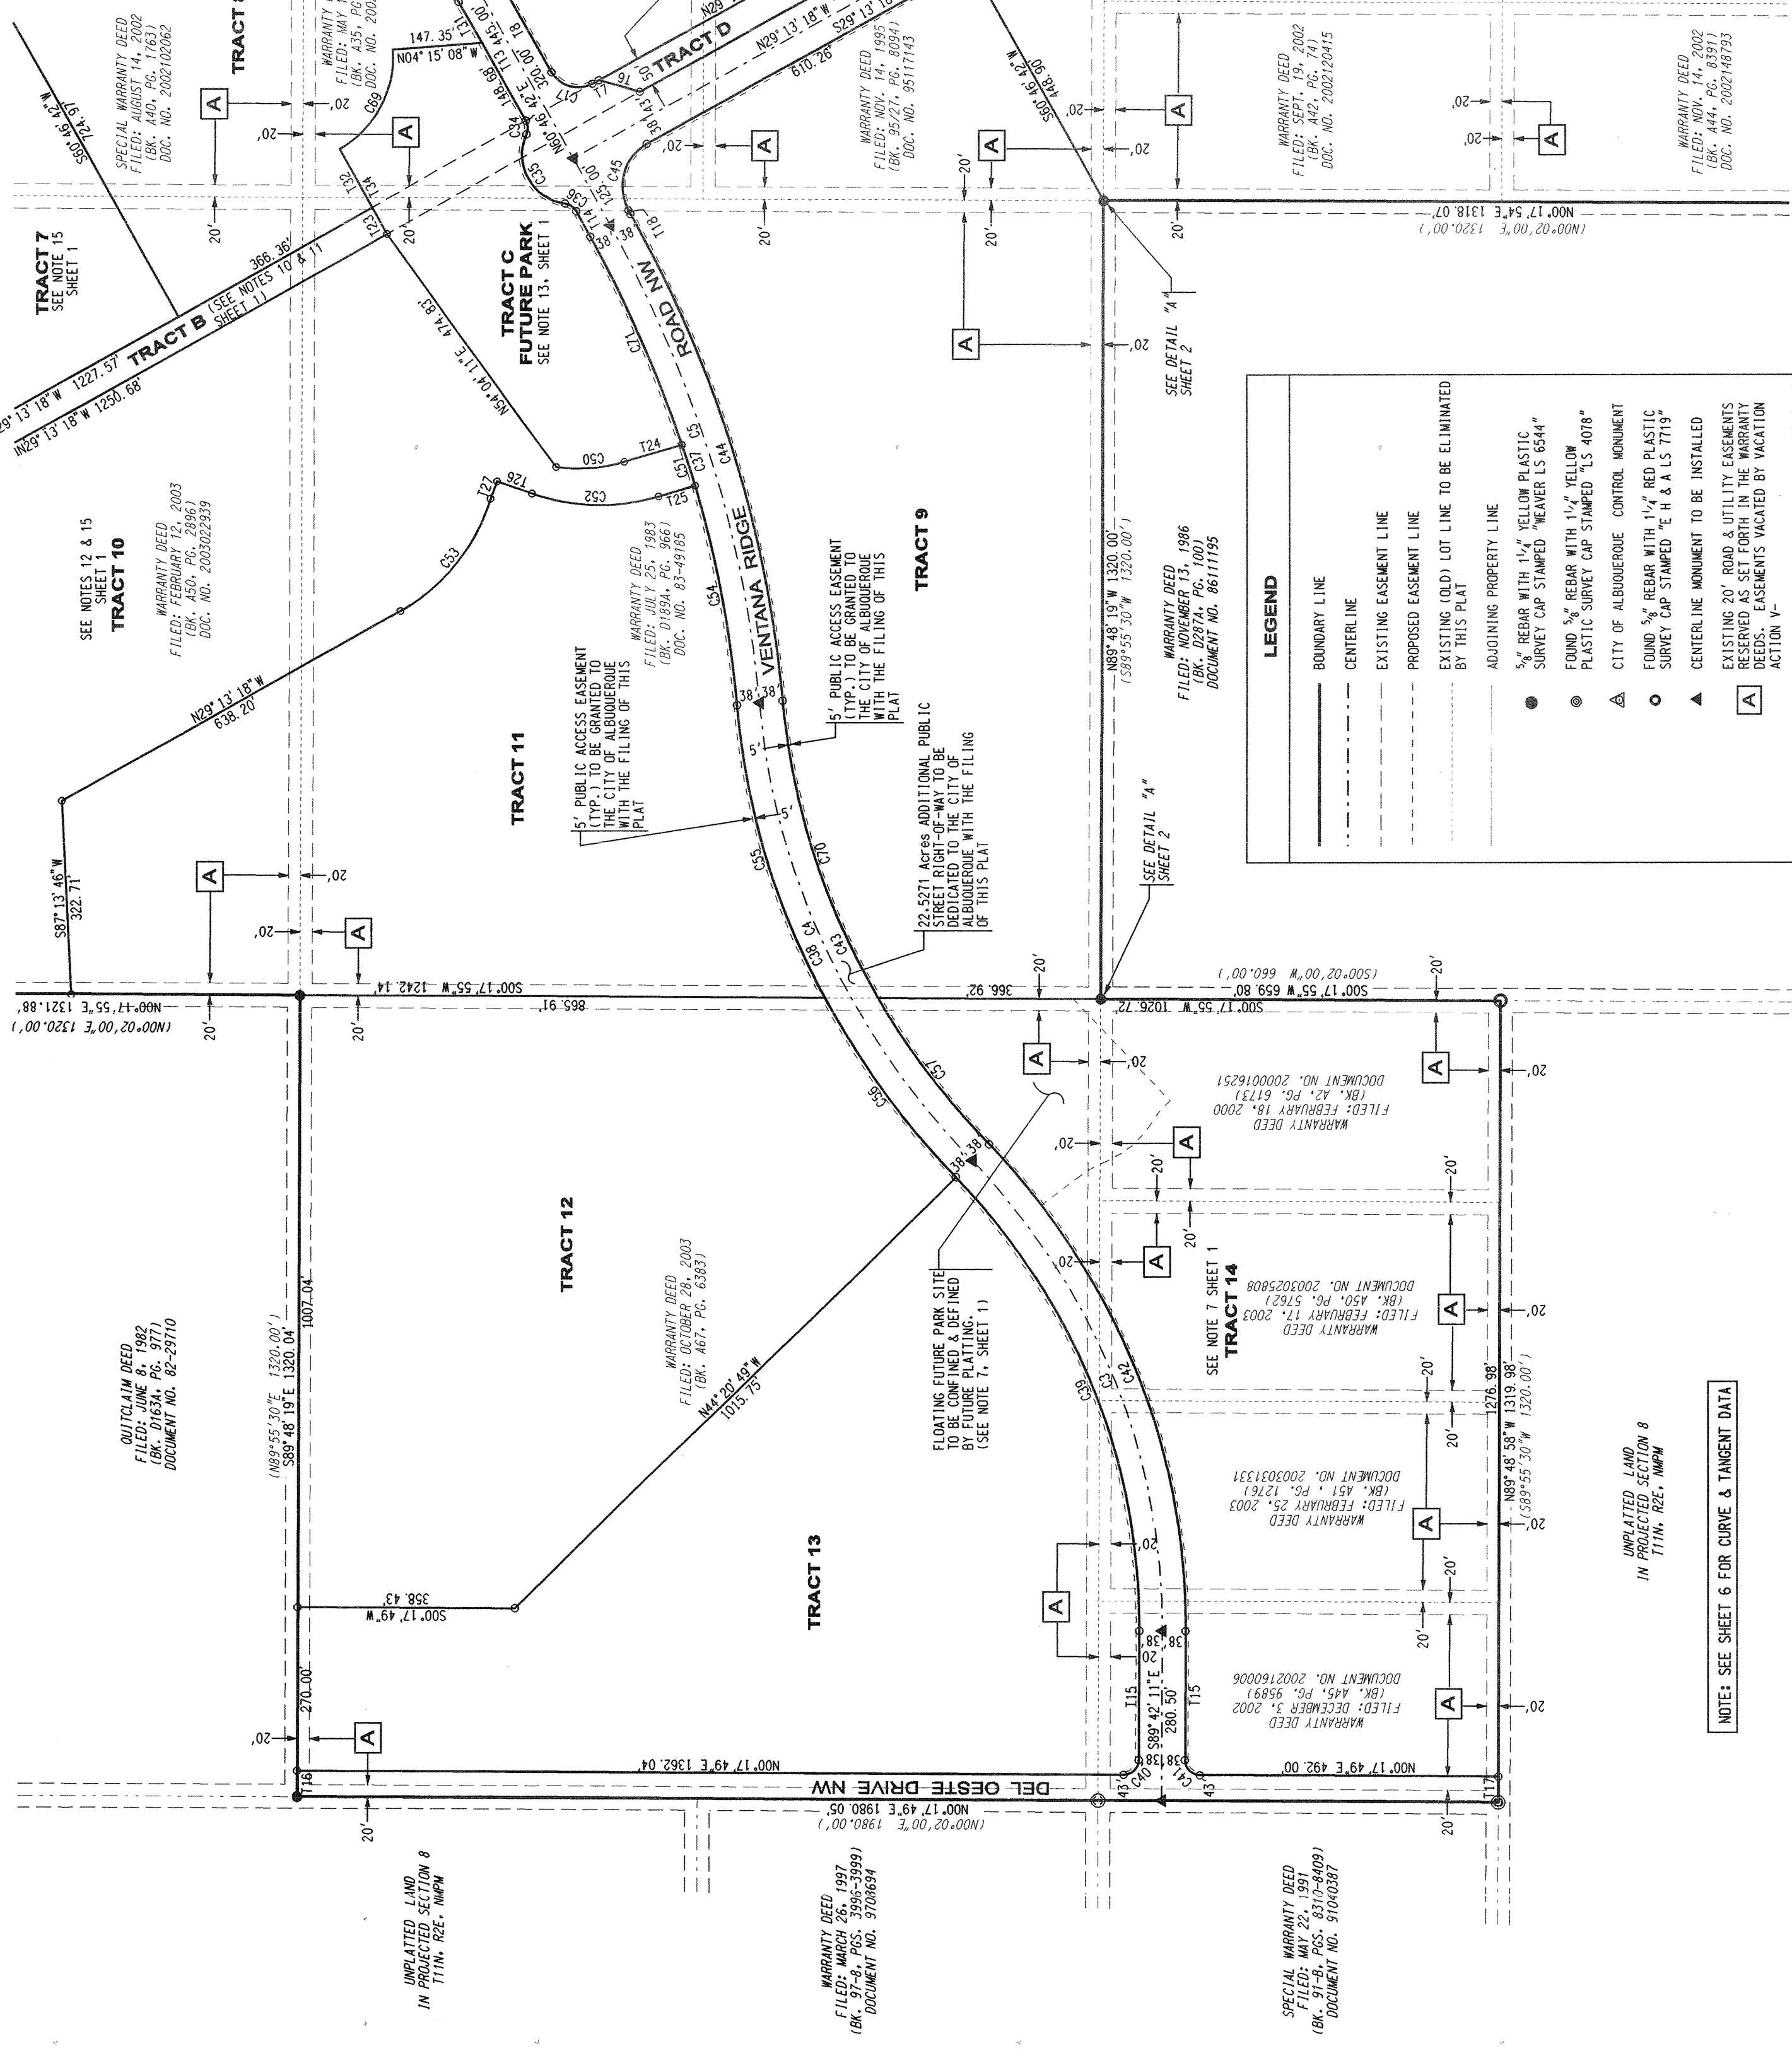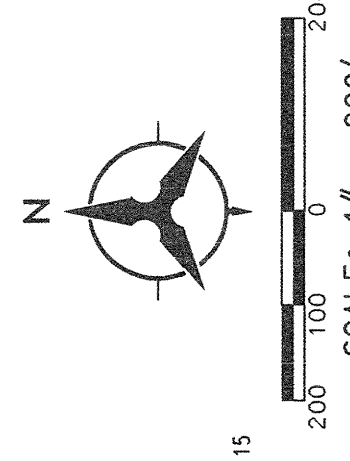



NOTE: SEE SHEET 6 FOR CURVE & TANGENT DATA

Bohannon & Huston
Engineering & Spatial Data • Advanced Technologies

Courtyard 1 7500 Jefferson St. NE Albuquerque, NM 87109-4335
ENGINEERING & SPATIAL DATA • ADVANCED TECHNOLOGIES

P:\040237\040237Phase2\PHD Plans\040237Phase2.dgn JOB NO. 040237-002
03/27/2004
aromero

SCANNED BY PLN

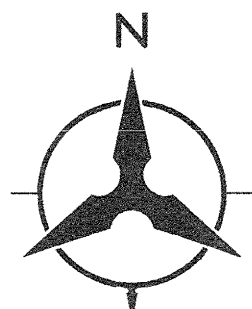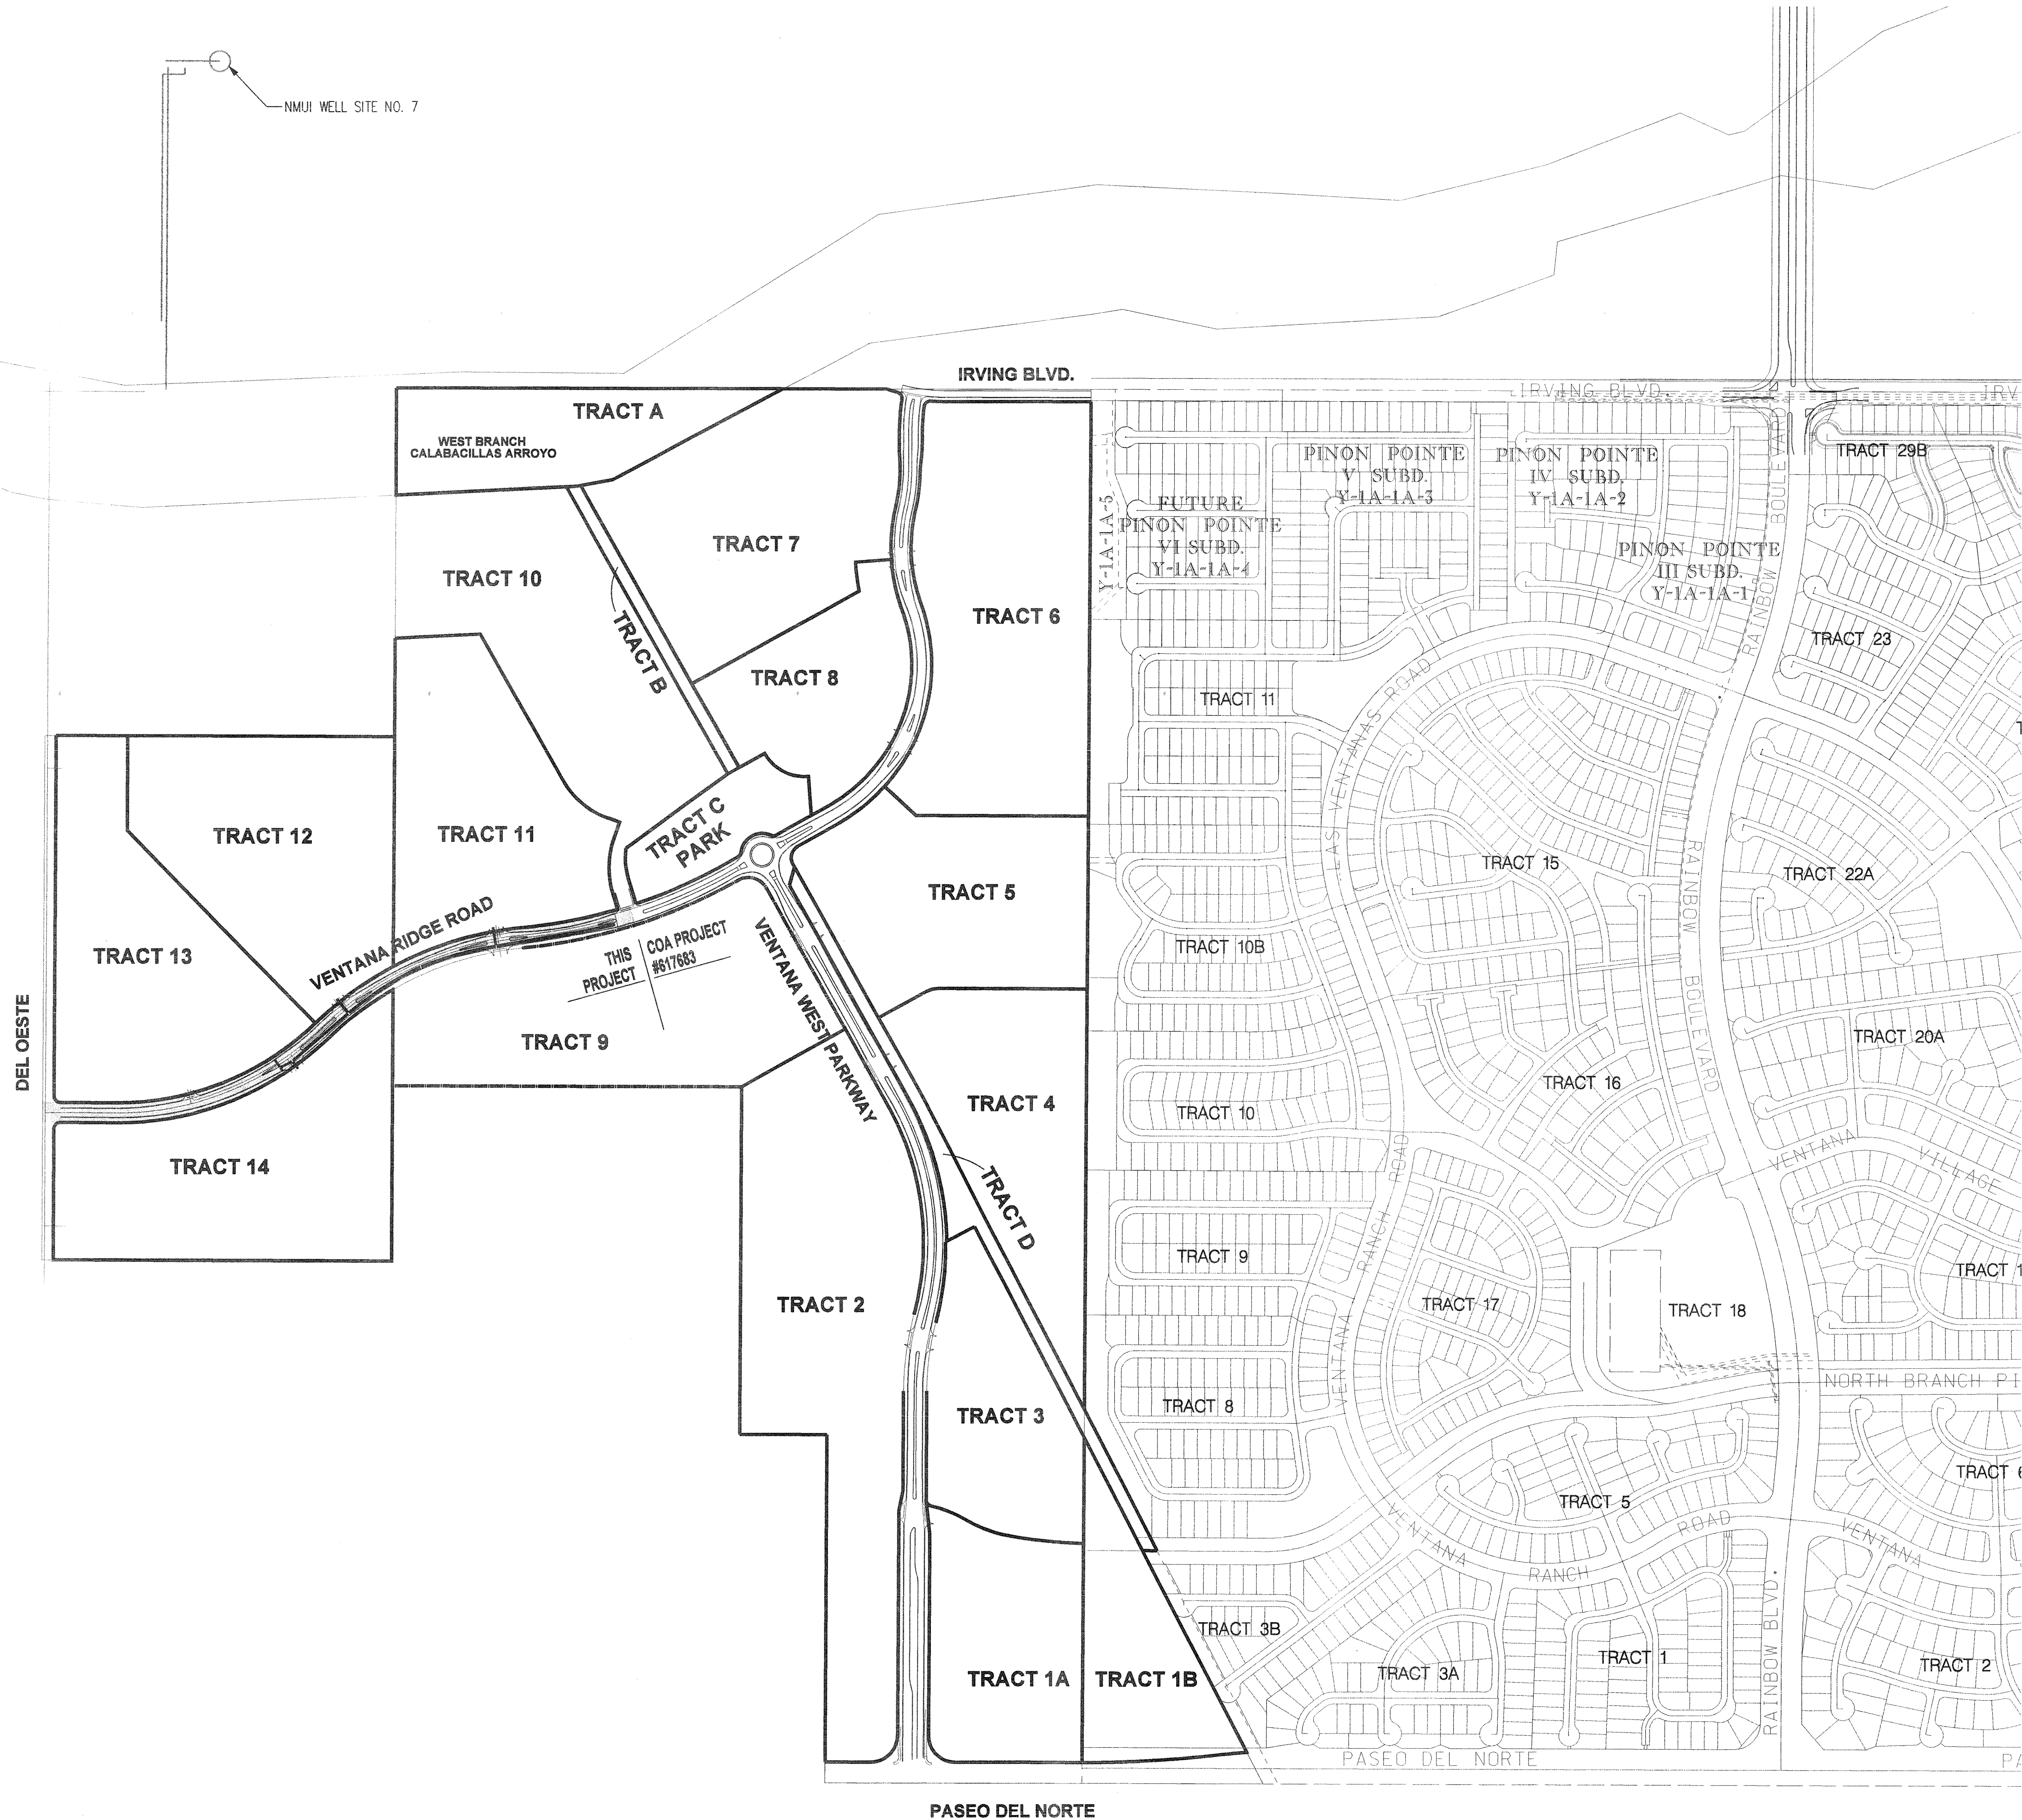


NOT TO SCALE

UTILITY IMPROVEMENTS THIS PROJECT

Bohannon & Huston Court yard 7500 Jefferson St. NE Albuquerque, NM 87109-4335 ENGINEERING • SPATIAL DATA • ADVANCED TECHNOLOGIES	
CITY OF ALBUQUERQUE PUBLIC WORKS DEPARTMENT ENGINEERING DEVELOPMENT GROUP	
BACKBONE ROADWAY & STORM DRAIN IMPROVEMENTS - PHASE 2 SITE DESCRIPTION PLAN	
DESIGN REVIEW COMMITTEE APPROVED SEP 16 2004 DESIGN REVIEW COMMITTEE	CITY ENGINEER APPROVAL LAST DESIGN UPDATE MO./DAY/YR. MO./DAY/YR.
CITY PROJECT NO. 617685	ZONE MAP NO. B-8-Z SHEET 5 OF 12

--	--	

SCANNED BY *ALW*

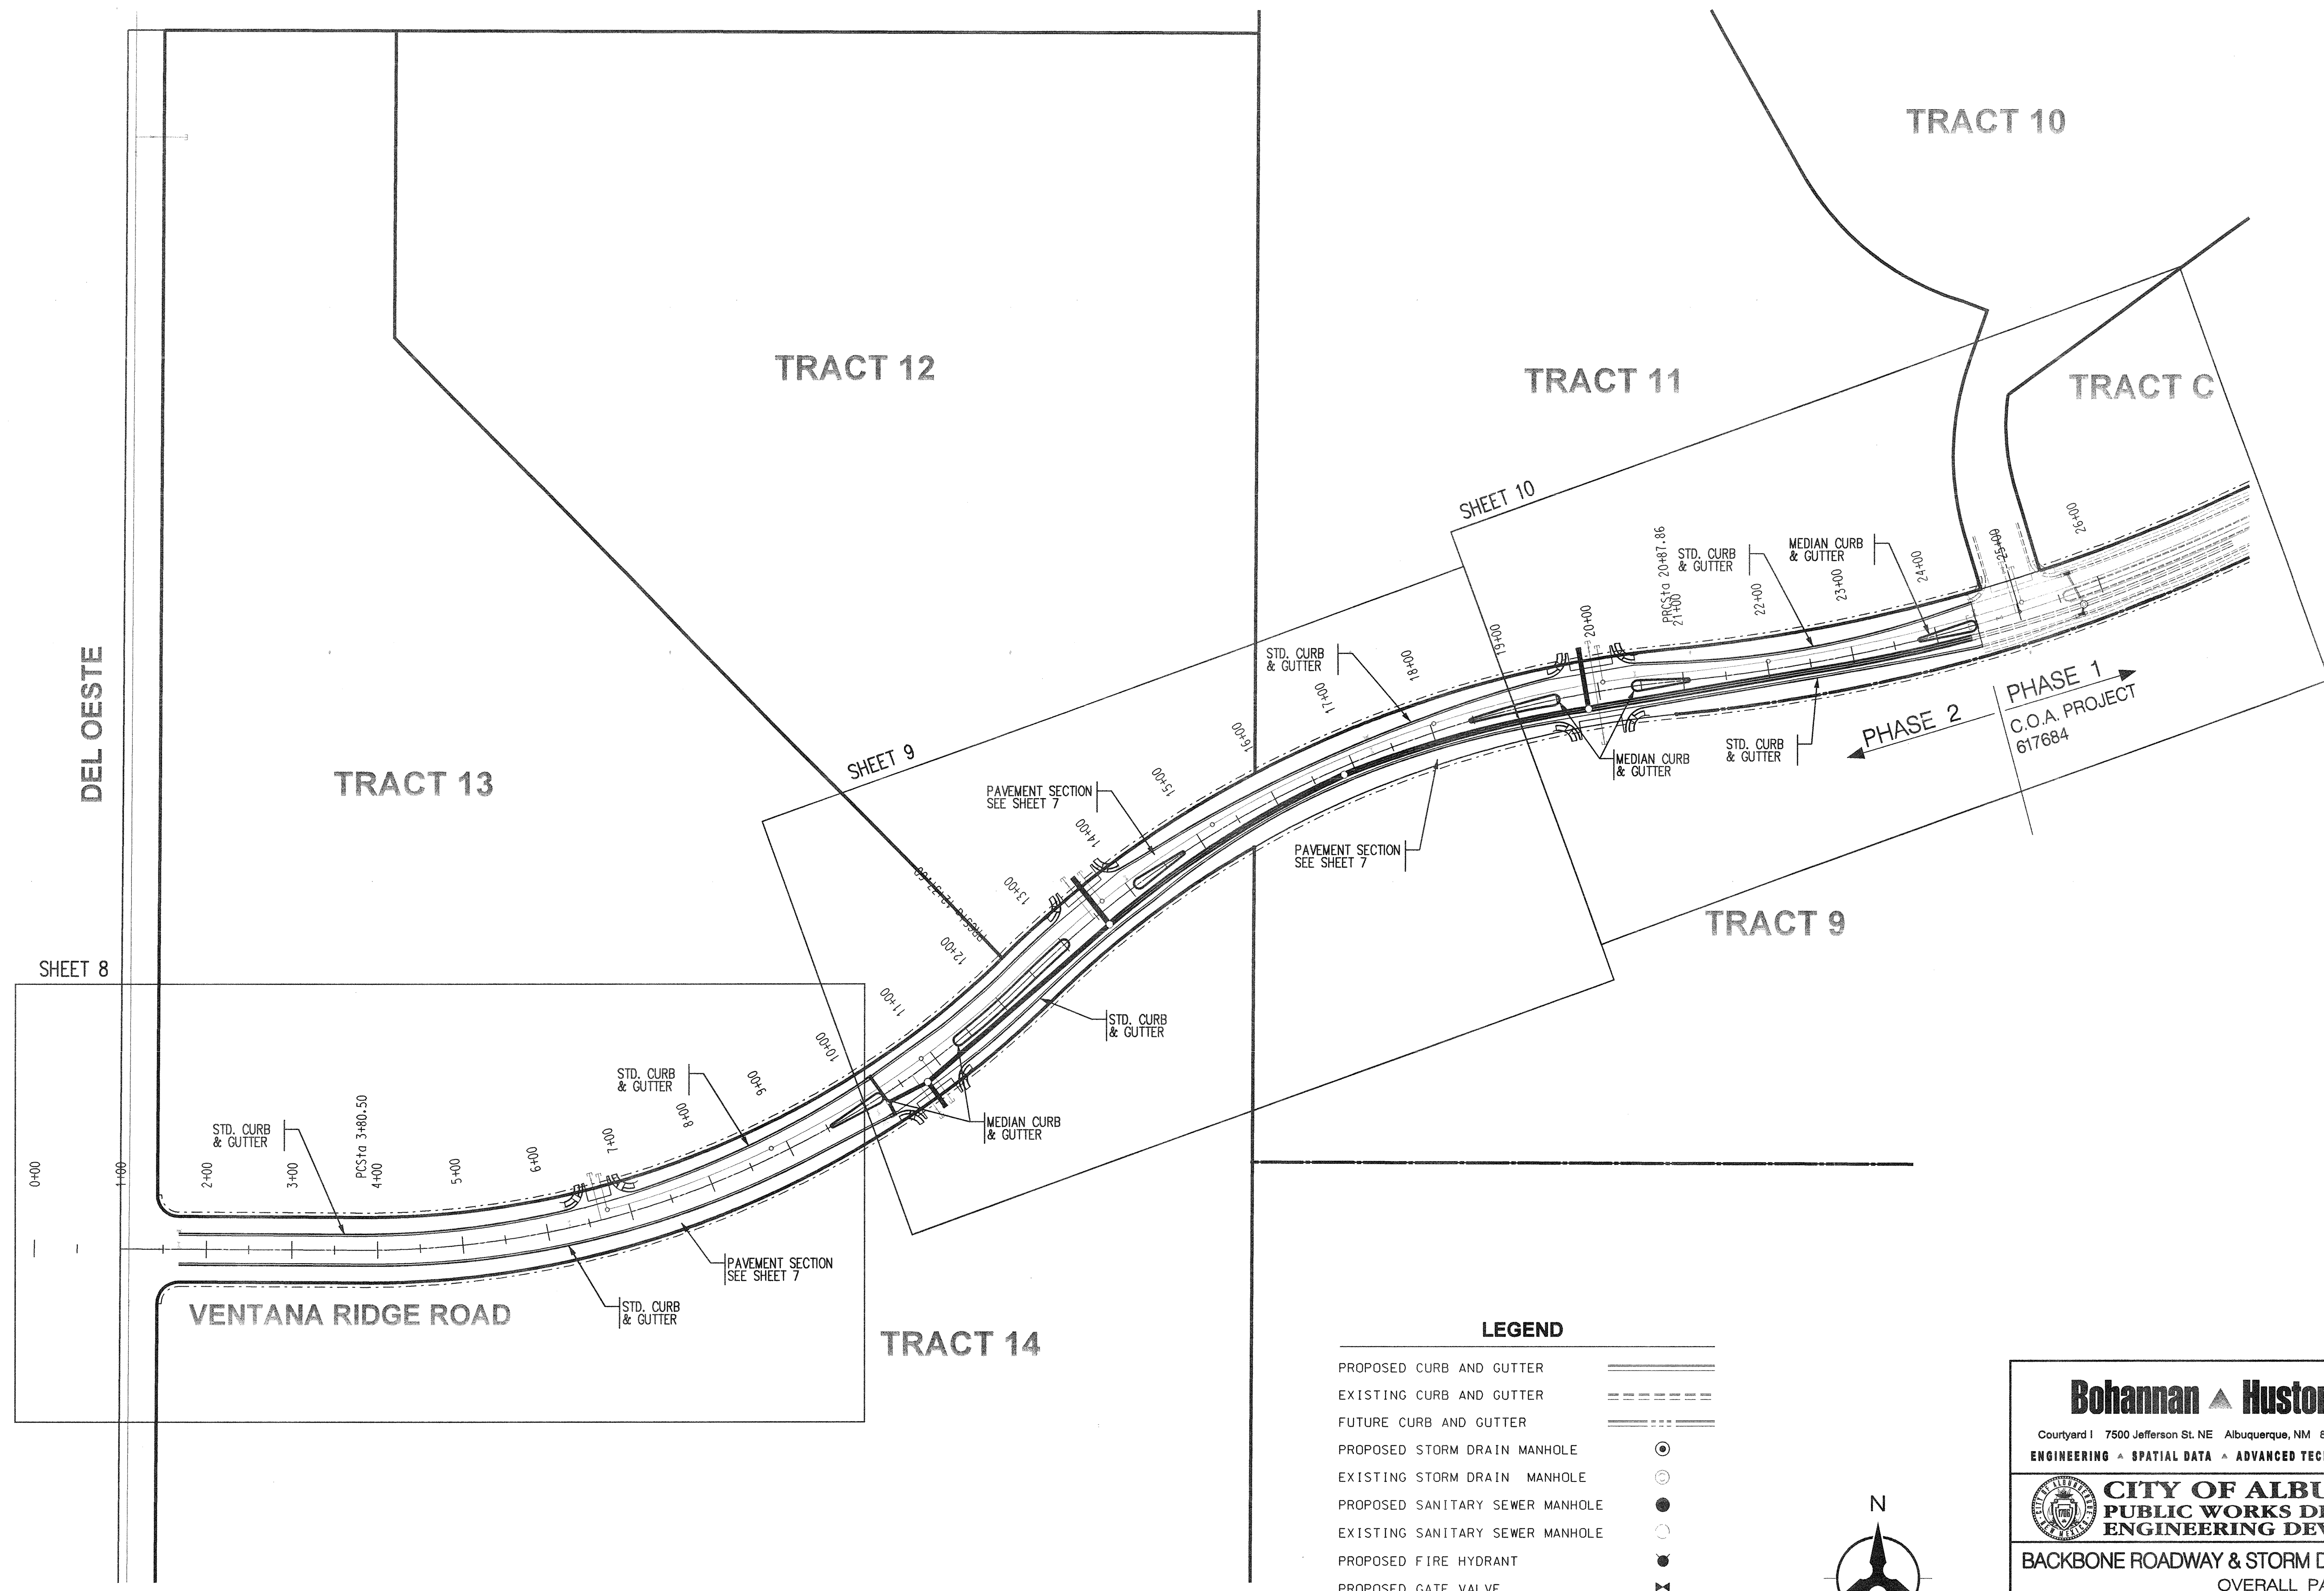


07-SEP-2004
P:\040237.dwg\040237Phase2PID Plan\040237PS-2CPAVE.dwg

BHI JOB NO. 04 0237

Bohannon  **Huston**
Court yard 1 7500 Jefferson St. NE Albuquerque, NM 87109-4335
ENGINEERING • SPATIAL DATA • ADVANCED TECHNOLOGIES

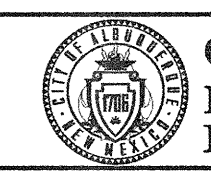**CITY OF ALBUQUERQUE**
PUBLIC WORKS DEPARTMENT
ENGINEERING DEVELOPMENT GROUP
BACKBONE ROADWAY & STORM DRAIN IMPROVEMENTS - PHASE 2
OVERALL PAVING PLAN

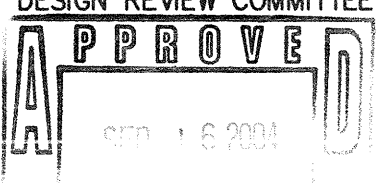DESIGN REVIEW COMMITTEE

CITY PROJECT NO. 617685

CITY ENGINEER APPROVAL

LAST DESIGN UPDATE

NO.	DATE	REVISIONS
1	3/2004	DESIGN
2	3/2004	DESIGN
3	3/2004	DESIGN
4	4/2004	DESIGN

DESIGNED BY KGP/JPP
DATE 3/2004

DRAWN BY BS/ARR
DATE 3/2004

CHECKED BY KGP
DATE 4/2004

ZONE MAP NO. B-8-Z

SHEET 6 OF 12

ENGINEER'S SEAL		SURVEY INFORMATION		BENCH MARKS		AS-BUILT INFORMATION	
		FIELD NOTES		ACS BRASS TABLET STAMPED "2-BIO 1980"		CONTRACTOR <i>Sundance</i>	
		NO.	BY	GEOGRAPHIC POSITION (NAD 1927)		WORKS BY <i>AS</i>	INSPECTED BY <i>AS</i>
				N.M. STATE PLANE COORDINATES (CENTRAL ZONE)		DATE <i>5/2/05</i>	DATE <i>5/2/05</i>
				X=357,543.73 Y=1,527,976.48		DATE <i>5/2/05</i>	DATE <i>5/2/05</i>
				GROUND-TO-GRID FACTOR = .9986354		DRAWINGS CORRECTED BY <i>AS</i>	
				DELTA ALPHA -00'16"30"		MICRO-FILM INFORMATION	
				NGVD 1929 ELEVATION = 5429.35		RECORDED BY	
						NO.	

BHI JOB NO. 04 0237

SCANNED BY *ALW*

A) FLOWLINE DATA FOR CURB RETURN					B) FLOWLINE DATA FOR CURB RETURN				
PC	80.11	D	= 91'36"19"		PC	77.74	D	= 92'55"42"	
1	80.10	R	= 25.00'		1	78.11	R	= 25.00'	
2	80.08	T	= 25.71'		2	78.49	T	= 26.31'	
3	80.07	L	= 39.97'		3	78.86	L	= 40.55'	
PT	80.06	C	= 35.85'		PT	79.24	C	= 36.25'	
PI	79.35				PI	78.46			
PC STA. 6+52.39, 46.21' LT.					PC STA. 7+12.27, 21.58' LT.				
PT STA. 6+26.63, 20.50' LT.					PT STA. 6+85.81, 47.21' LT.				
PI STA. 6+52.83, 20.51' LT.					PI STA. 6+85.44, 20.90' LT.				
RAD STA. 6+26.31, 45.50' LT.					RAD STA. 7+11.91, 46.57' LT.				

CL Curve Table				
ID	ARC	RADIUS	DELTA	TANGENT
CC1	857.10'	1100.00'	44°38'38"	451.63'


CL Tangent Table		
ID	BEARING	LENGTH
CT1	S89°42'11"E	280.50'

Median Curb Point Table		
STATION	OFFSET	ELEVATION
1	9+56.23	1.99' LT. 5571.68
2	9+56.35	2.00' RT. 5571.62


Median Curb Curve Table				
ID	ARC	RADIUS	DELTA	TANGENT
C1	6.02'	2.00'	172°36'08"	30.94'

Median Curb Tangent Table		
ID	BEARING	LENGTH
T1	S54°59'05"W	61.86'
T2	S62°23'02"W	61.86'

0+00 PDBSta 0+00.00

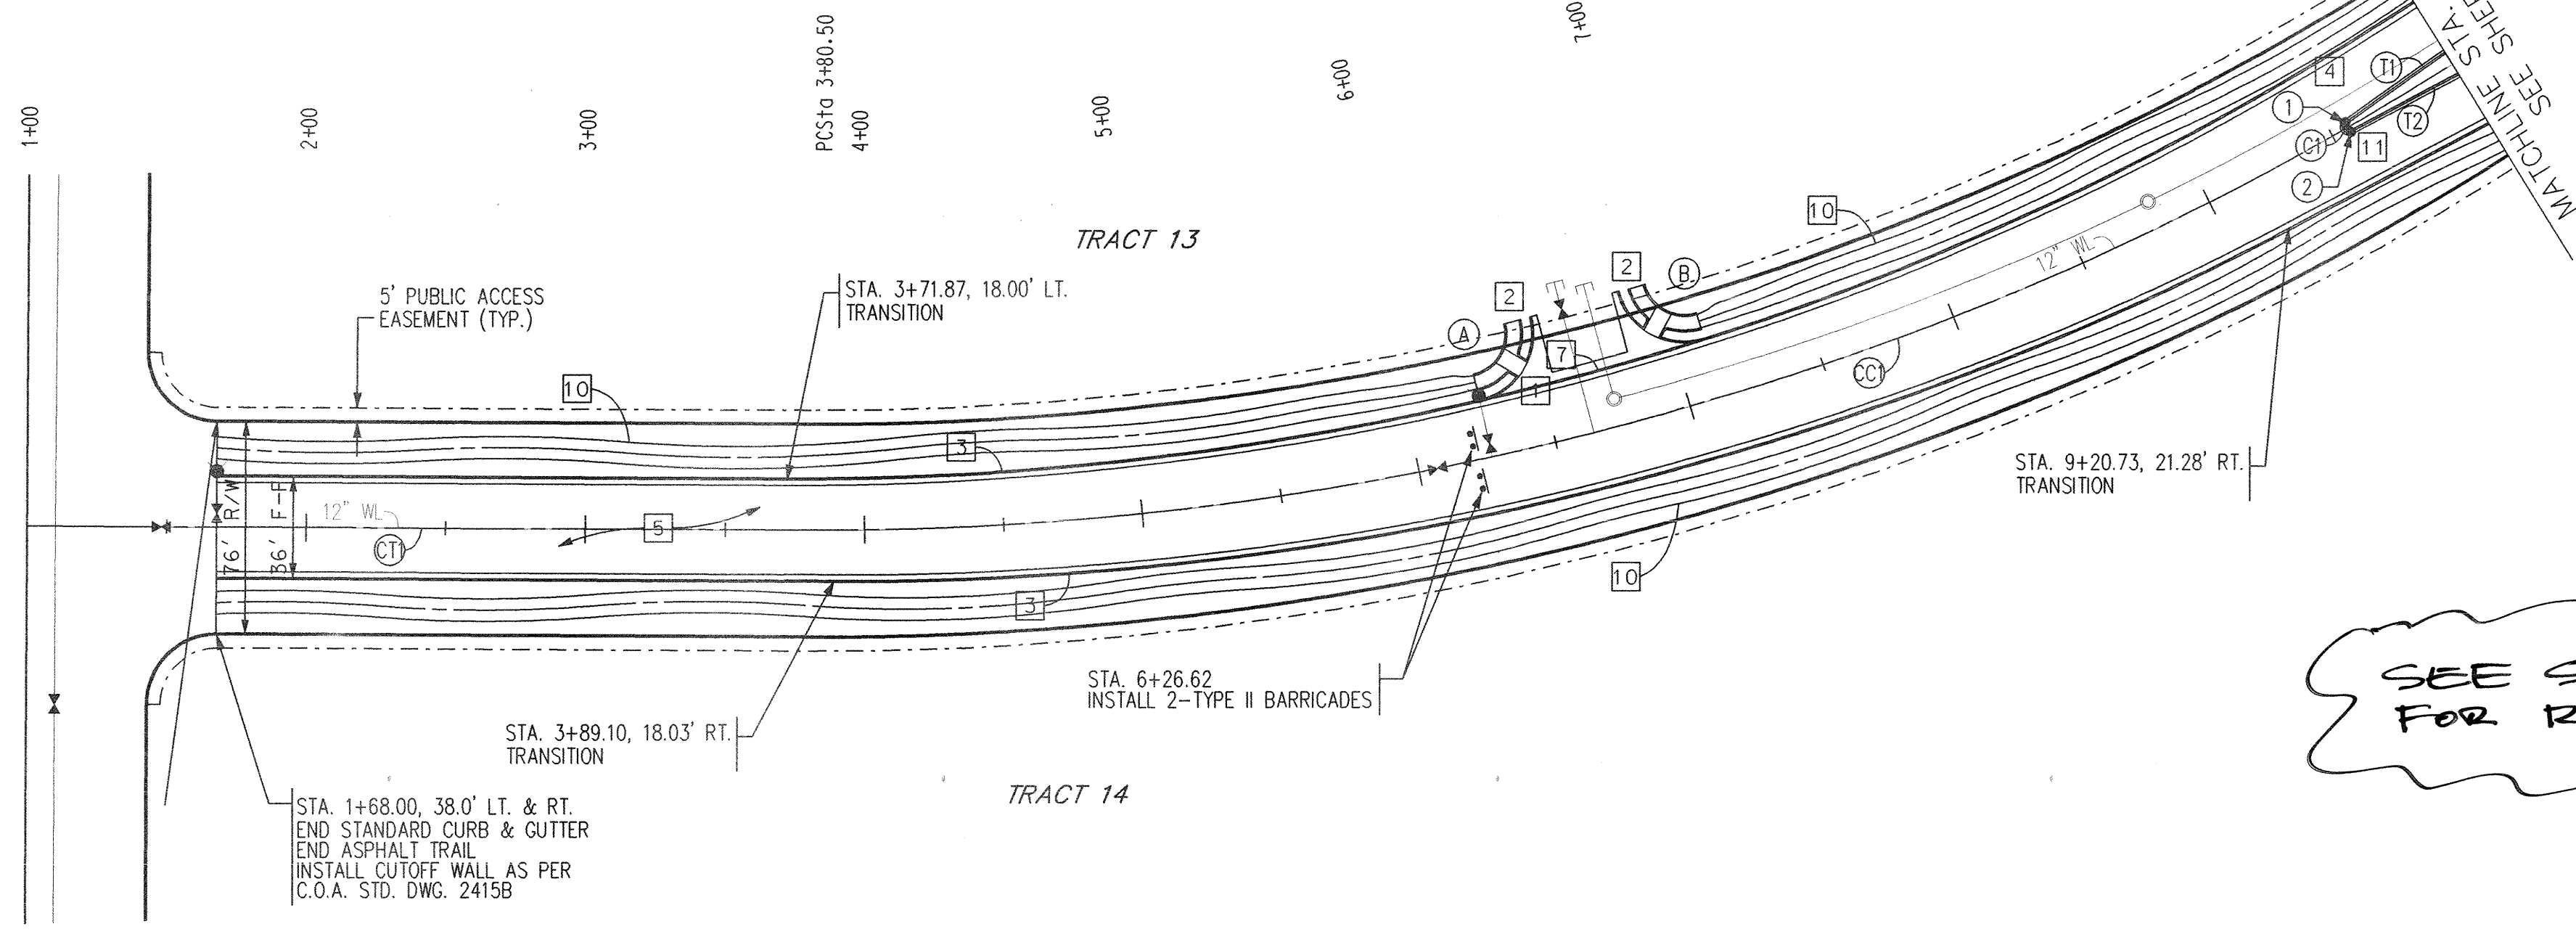

VENTANA RIDGE ROAD 0+00.00 - 10+00.00

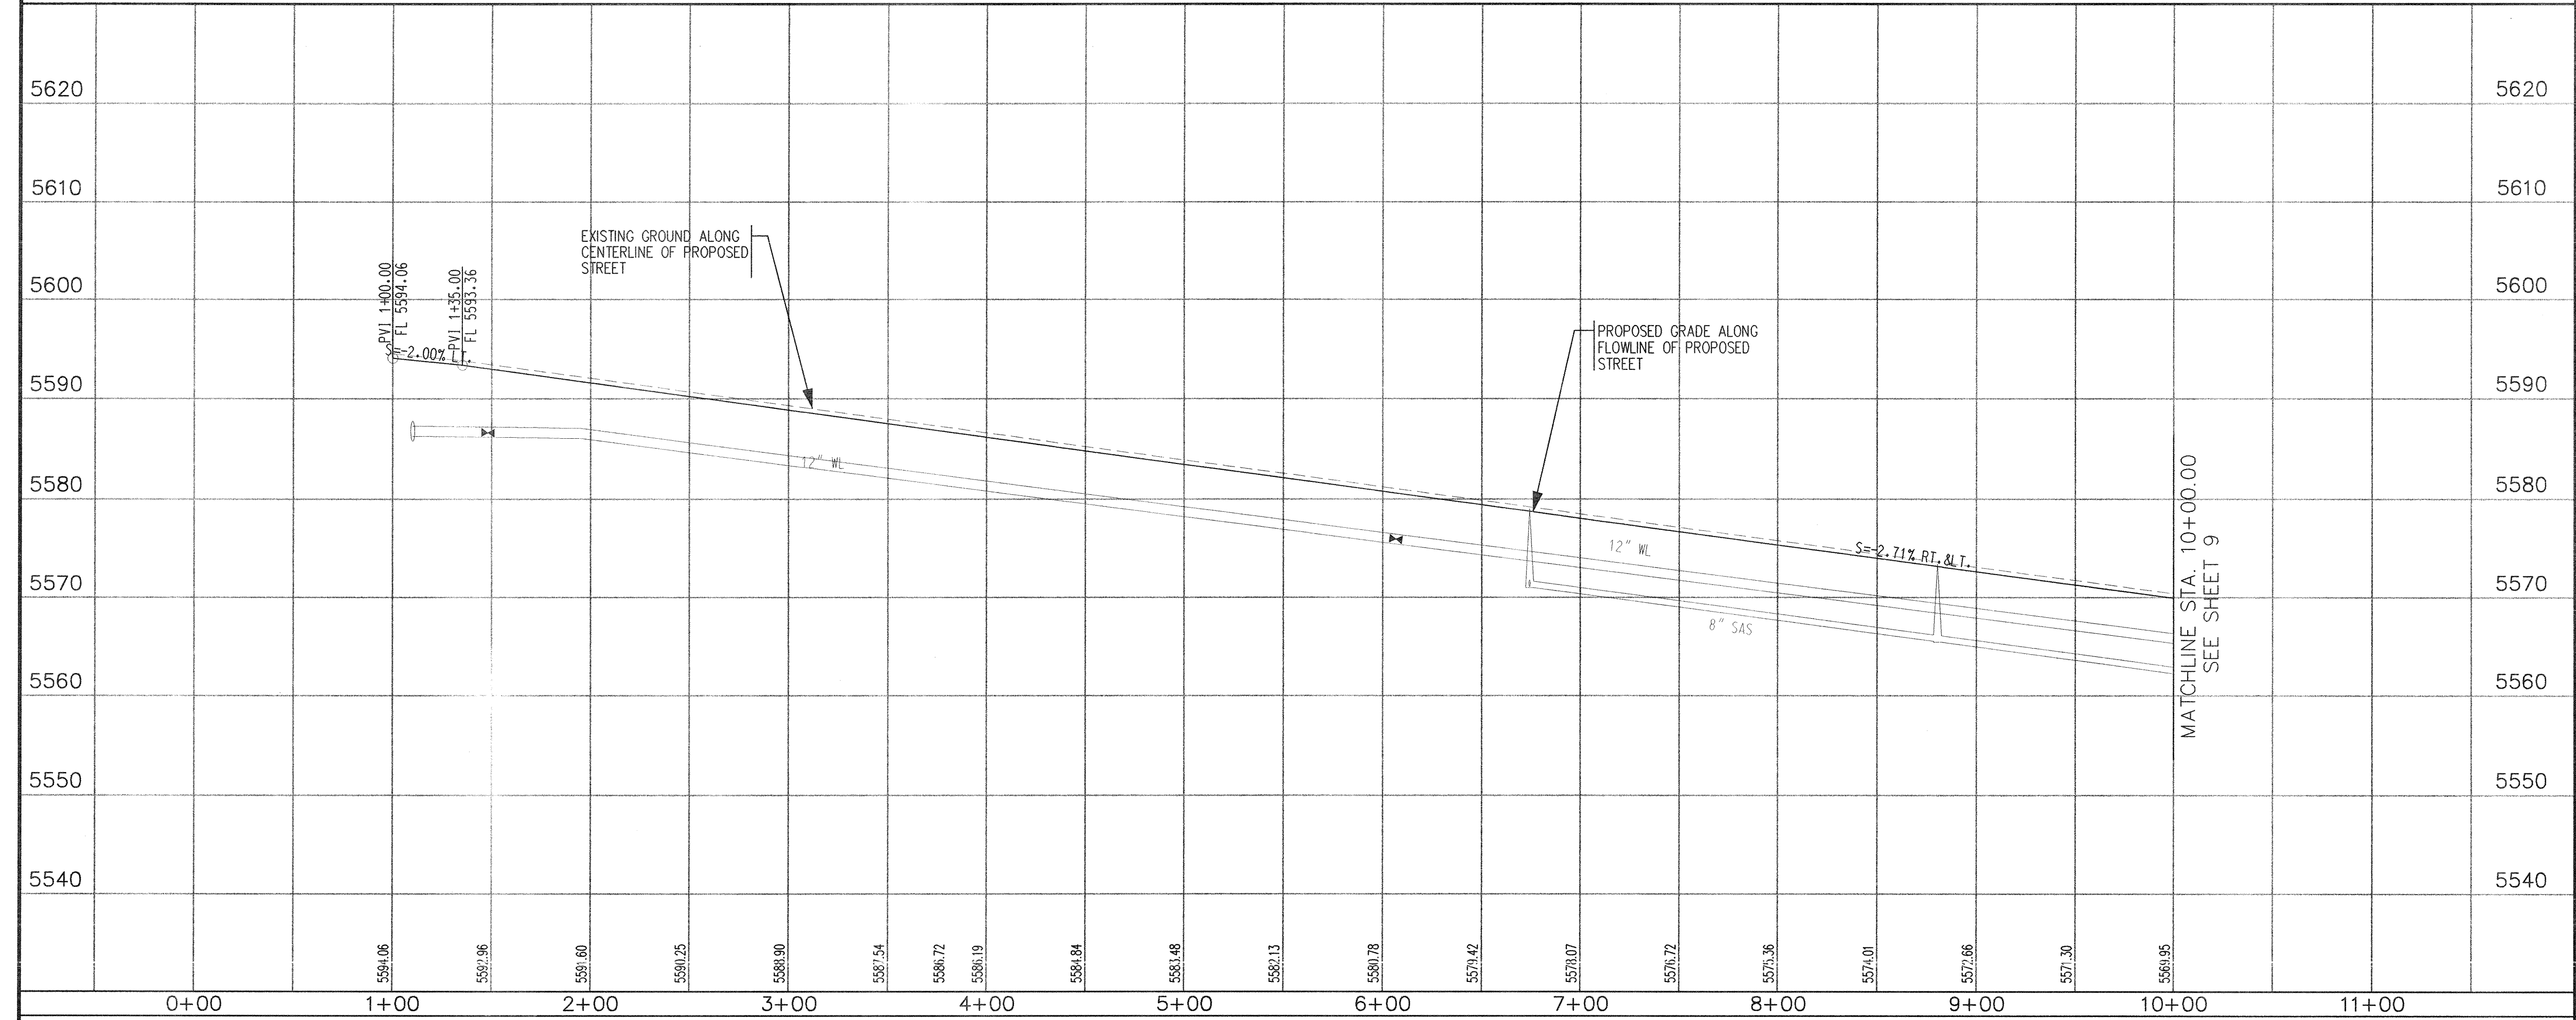

NOTES

- THE CONTRACTOR SHALL FIELD VERIFY ALL EXISTING UTILITY LOCATIONS AND NOTIFY THE ENGINEER IMMEDIATELY OF ANY DISCREPANCIES.
- ALL CURB RETURN RADIUS SHALL BE 25' UNLESS OTHERWISE SPECIFIED.
- ALL CURVE DATA AND DIMENSIONS REFER TO FACE OF CURB UNLESS OTHERWISE SPECIFIED.
- GRADE ELEVATIONS, WHERE NOTED, ARE ALONG FLOWLINE OF STANDARD CURB UNLESS OTHERWISE SPECIFIED.
- NO WORK SHALL BE UNDERTAKEN WITHIN EXISTING 50' GASLINE EASEMENT WITHOUT FIRST CONTACTING PNM.
- CONTRACTOR IS RESPONSIBLE FOR REPAIR AND/OR REPLACEMENT OF ALL UTILITY CONDUITS AND EXISTING LINES.
- ANY ADDITIONAL GRADING REQUIRED TO MATCH PROPOSED STREET GRADES SHALL BE INCIDENTAL TO PAVING ITEMS.
- CONTRACTOR SHALL PROVIDE THE INSPECTORS, (CITY AND PRIVATE) WITH THE PROPOSED HYDROSTATIC TESTING PLAN. THE PLAN MUST BE APPROVED BEFORE TESTING OPERATIONS BEGIN.
- CONTRACTOR SHALL PARK EQUIPMENT AND VEHICLES AS NOT TO INTERFERE WITH NORMAL ACTIVITIES OF RESIDENTS OR OTHER CONTRACTORS ON SITE.
- ANY DAMAGE TO THE EXISTING FACILITIES (CURB & GUTTER, PAVEMENT, CONDUITS, LANDSCAPING, UTILITY LINES, ETC.) DURING CONSTRUCTION SHALL BE REPLACED AT THE CONTRACTORS' EXPENSE.
- WATER AND SEWER LINES, WHERE SHOWN, ARE FOR REFERENCE ONLY. REFER TO CITY OF ALBUQUERQUE PROJECT # 617684 FOR CONSTRUCTION DOCUMENTS.
- WHEELCHAIR RAMPS SHALL BE CONSTRUCTED PRIOR TO ACCEPTANCE OF CURB & GUTTER.
- ALL EXCAVATION, TRENCHING AND SHORING ACTIVITIES MUST BE CARRIED-OUT IN ACCORDANCE WITH OSHA 29 CFR 1926.650 SUBPART P.
- CONTRACTOR MUST MAINTAIN TWO-WAY TRAFFIC AT ALL TIMES ON PASEO DEL NORTE. THE USE OF AN UNPAVED DETOUR FOR UP TO TWO DAYS WILL BE ALLOWED WITH PROPER BARRICADING.

KEYED GENERAL NOTES

- INSTALL 6' CONCRETE VALLEY GUTTER AS PER STD. DWG. 2420
- INSTALL WHEELCHAIR RAMP AS PER DETAIL SHEET 7
- STD. CURB & GUTTER AS PER STD. DWG. 2415A TINTED SAN DIEGO BUFF
- MEDIAN CURB & GUTTER AS PER STD. DWG. 2415B
- PAVEMENT SECTION "A" SEE TYPICAL SECTION SHEET 7
- (NOT USED)
- TEMPORARY ASPHALT CURB AS PER STD. DWG 2415B
- INSTALL WHEELCHAIR RAMP AT ROUNDABOUT AS PER DETAIL SHEET 7
- MOUNTABLE MEDIAN CURB AND GUTTER AS PER STD. DWG. 2415B. TINTED SAN DIEGO BUFF
- BUILD 8' ASPHALT TRAIL AS PER DETAIL SHEET 7
- CONSTRUCT MEDIAN NOSE AS PER DETAIL SHEET 7

ENGINEER'S SEAL

James Paul Forrester
NEW MEXICO
16586
9-7-09
REGISTERED PROFESSIONAL ENGINEER

REVISIONS

NO.	DATE	REMARKS
1	3/2004	DESIGN
2	3/2004	DESIGN
3	3/2004	DESIGN

BOHANNAN HUSTON

Courtyard I 7500 Jefferson St. NE Albuquerque, NM 87109-4335
ENGINEERING • SPATIAL DATA • ADVANCED TECHNOLOGIES

CITY OF ALBUQUERQUE

PUBLIC WORKS DEPARTMENT
ENGINEERING DEPARTMENT GROUP
BACKBONE ROADWAY & STORM DRAIN IMPROVEMENTS - PHASE 2
PAVING PLAN & PROFILE
VENTANA RIDGE ROAD 0+00.00 - 10+00.00

APPROVED

SEP 16 2004
DESIGN REVIEW COMMITTEE

CITY PROJECT NO.

617685

ZONE MAP NO.

B-8-Z


SHEET

8 OF 12

SCANNED BY PLW

A FLOWLINE DATA FOR CURB RETURN				B FLOWLINE DATA FOR CURB RETURN				C FLOWLINE DATA FOR CURB RETURN				D FLOWLINE DATA FOR CURB RETURN			
PC	80.11	D	91°36'19"	PC	77.74	D	92°55'42"	PC	79.74	D	91°45'37"	PC	77.46	D	93°59'29"
1	80.16	R	25.00'	1	78.11	R	25.00'	1	79.91	R	25.00'	1	77.78	R	25.00'
2	80.08	T	25.71'	2	78.49	T	26.31'	2	80.07	T	25.78'	2	78.11	T	26.81'
3	80.07	L	39.97'	3	78.86	L	40.55'	3	80.24	L	40.04'	3	78.43	L	41.01'
PT	80.06	C	35.85'	PT	79.24	C	36.25'	PT	80.40	C	35.89'	PT	78.76	C	36.57'
PI	79.35			PI	78.46			PI	79.69			PI	78.20		
PC STA. 6+162.39, 46.21' LT.				PC STA. 7+12.27, 21.58' LT.				PC STA. 7+22.57, 21.71' LT.				PC STA. 6+96.12, 47.81' LT.			
PT STA. 6+26.63, 20.50' LT.				PT STA. 6+85.81, 47.21' LT.				PT STA. 6+96.12, 47.81' LT.				PT STA. 6+95.26, 21.35' LT.			
PI STA. 6+52.83, 20.51' LT.				PI STA. 6+85.81, 47.21' LT.				PI STA. 6+95.26, 21.35' LT.				PI STA. 6+95.26, 21.35' LT.			
RAD STA. 6+26.31, 45.50' LT.				RAD STA. 7+11.91, 46.57' LT.				RAD STA. 7+22.22, 46.71' LT.				RAD STA. 7+22.22, 46.71' LT.			

0+00 PDBS TO 0+00.00

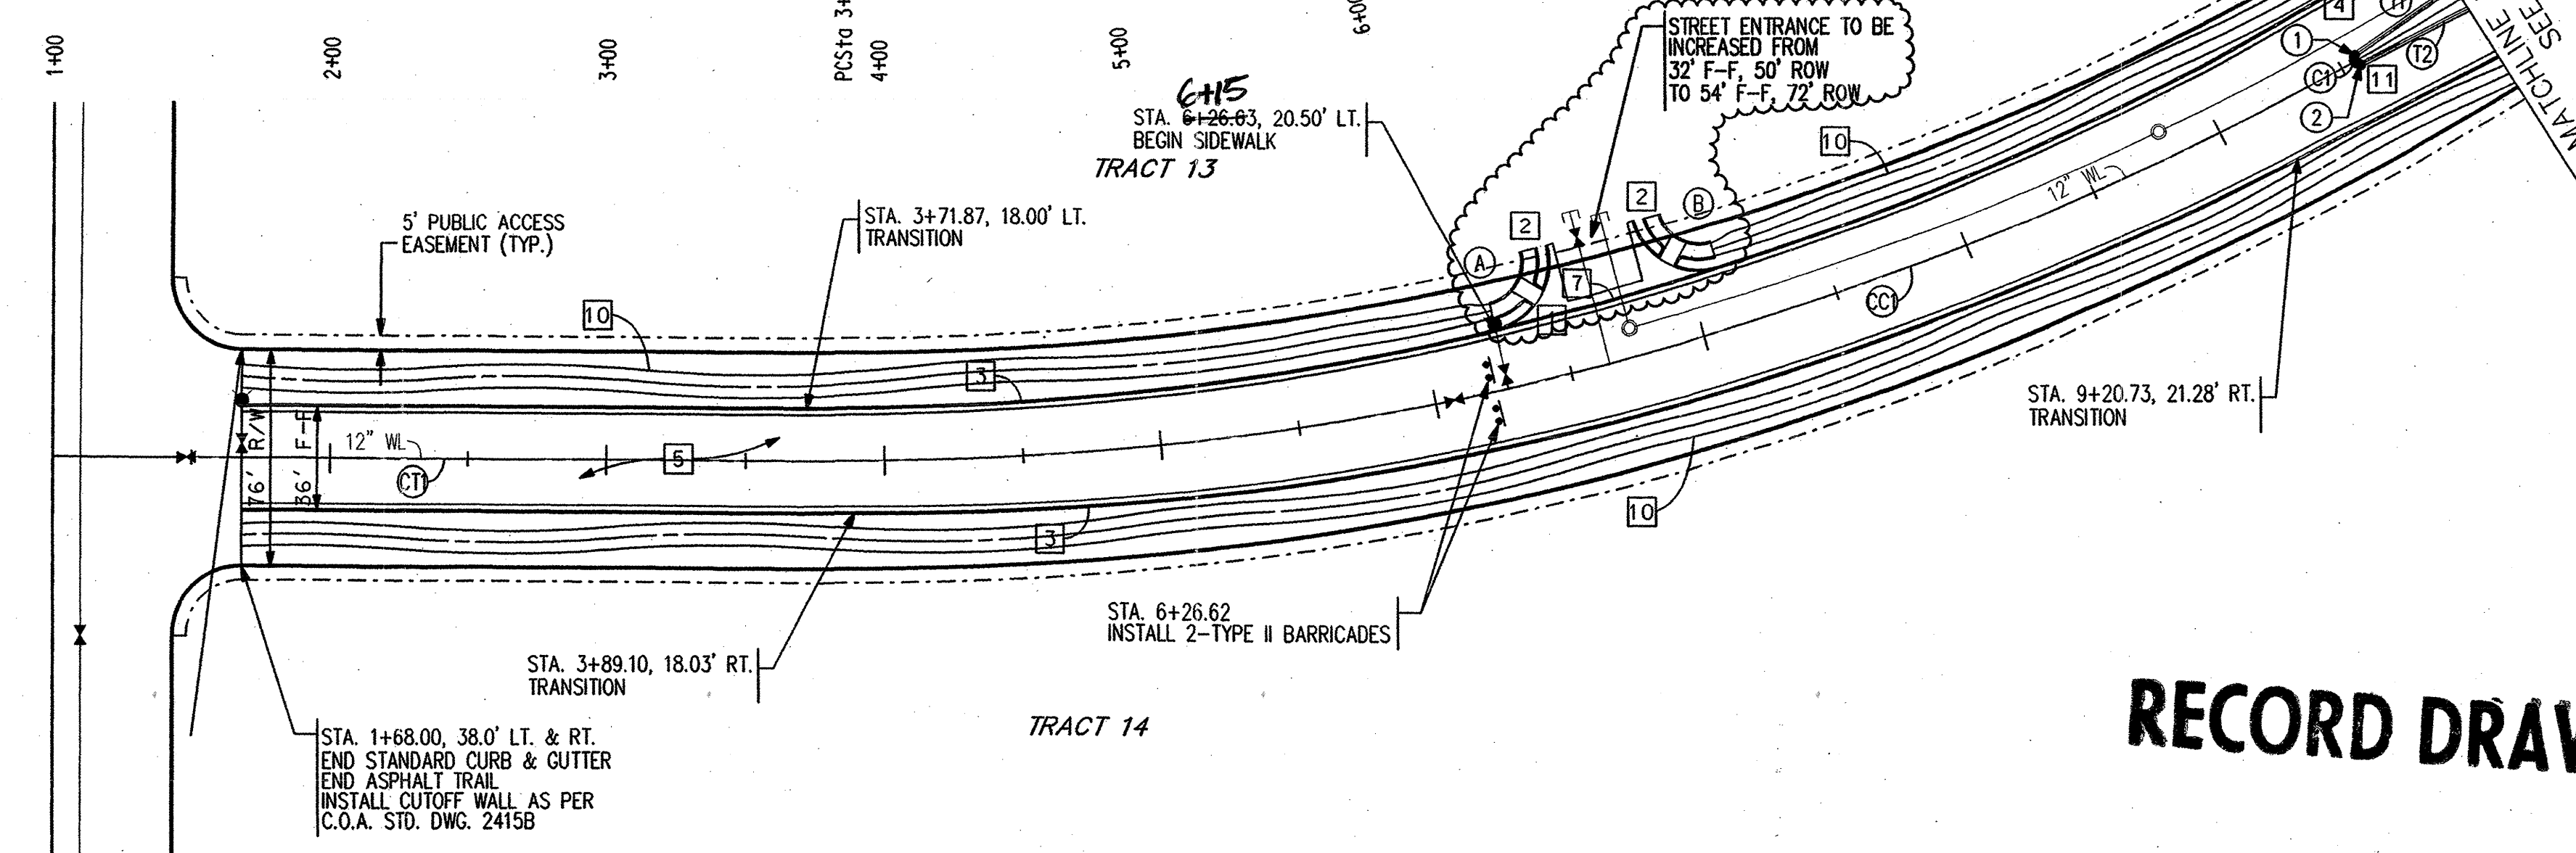

CL Curve Table				
ID	ARC	RADIUS	DELTA	TANGENT
CC1	857.10'	1100.00'	44°38'38"	451.63'


CL Tangent Table		
ID	BEARING	LENGTH
CT1	S89°42'11"E	280.50'

Median Curb Point Table		
STATION	OFFSET	ELEVATION
1	9+56.23	1.99' LT. 5571.68
2	9+56.35	2.00' RT. 5571.62


Median Curb Curve Table				
ID	ARC	RADIUS	DELTA	TANGENT
CI	6.02'	2.00'	172°36'08"	30.94'

Median Curb Tangent Table		
ID	BEARING	LENGTH
T1	S54°59'05"W	61.86'
T2	S62°23'02"W	61.86'

RECORD DRAWINGS

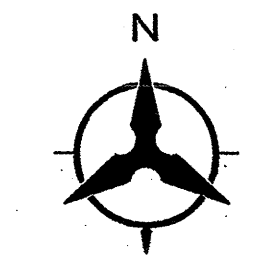

VENTANA RIDGE ROAD 0+00.00 - 10+00.00

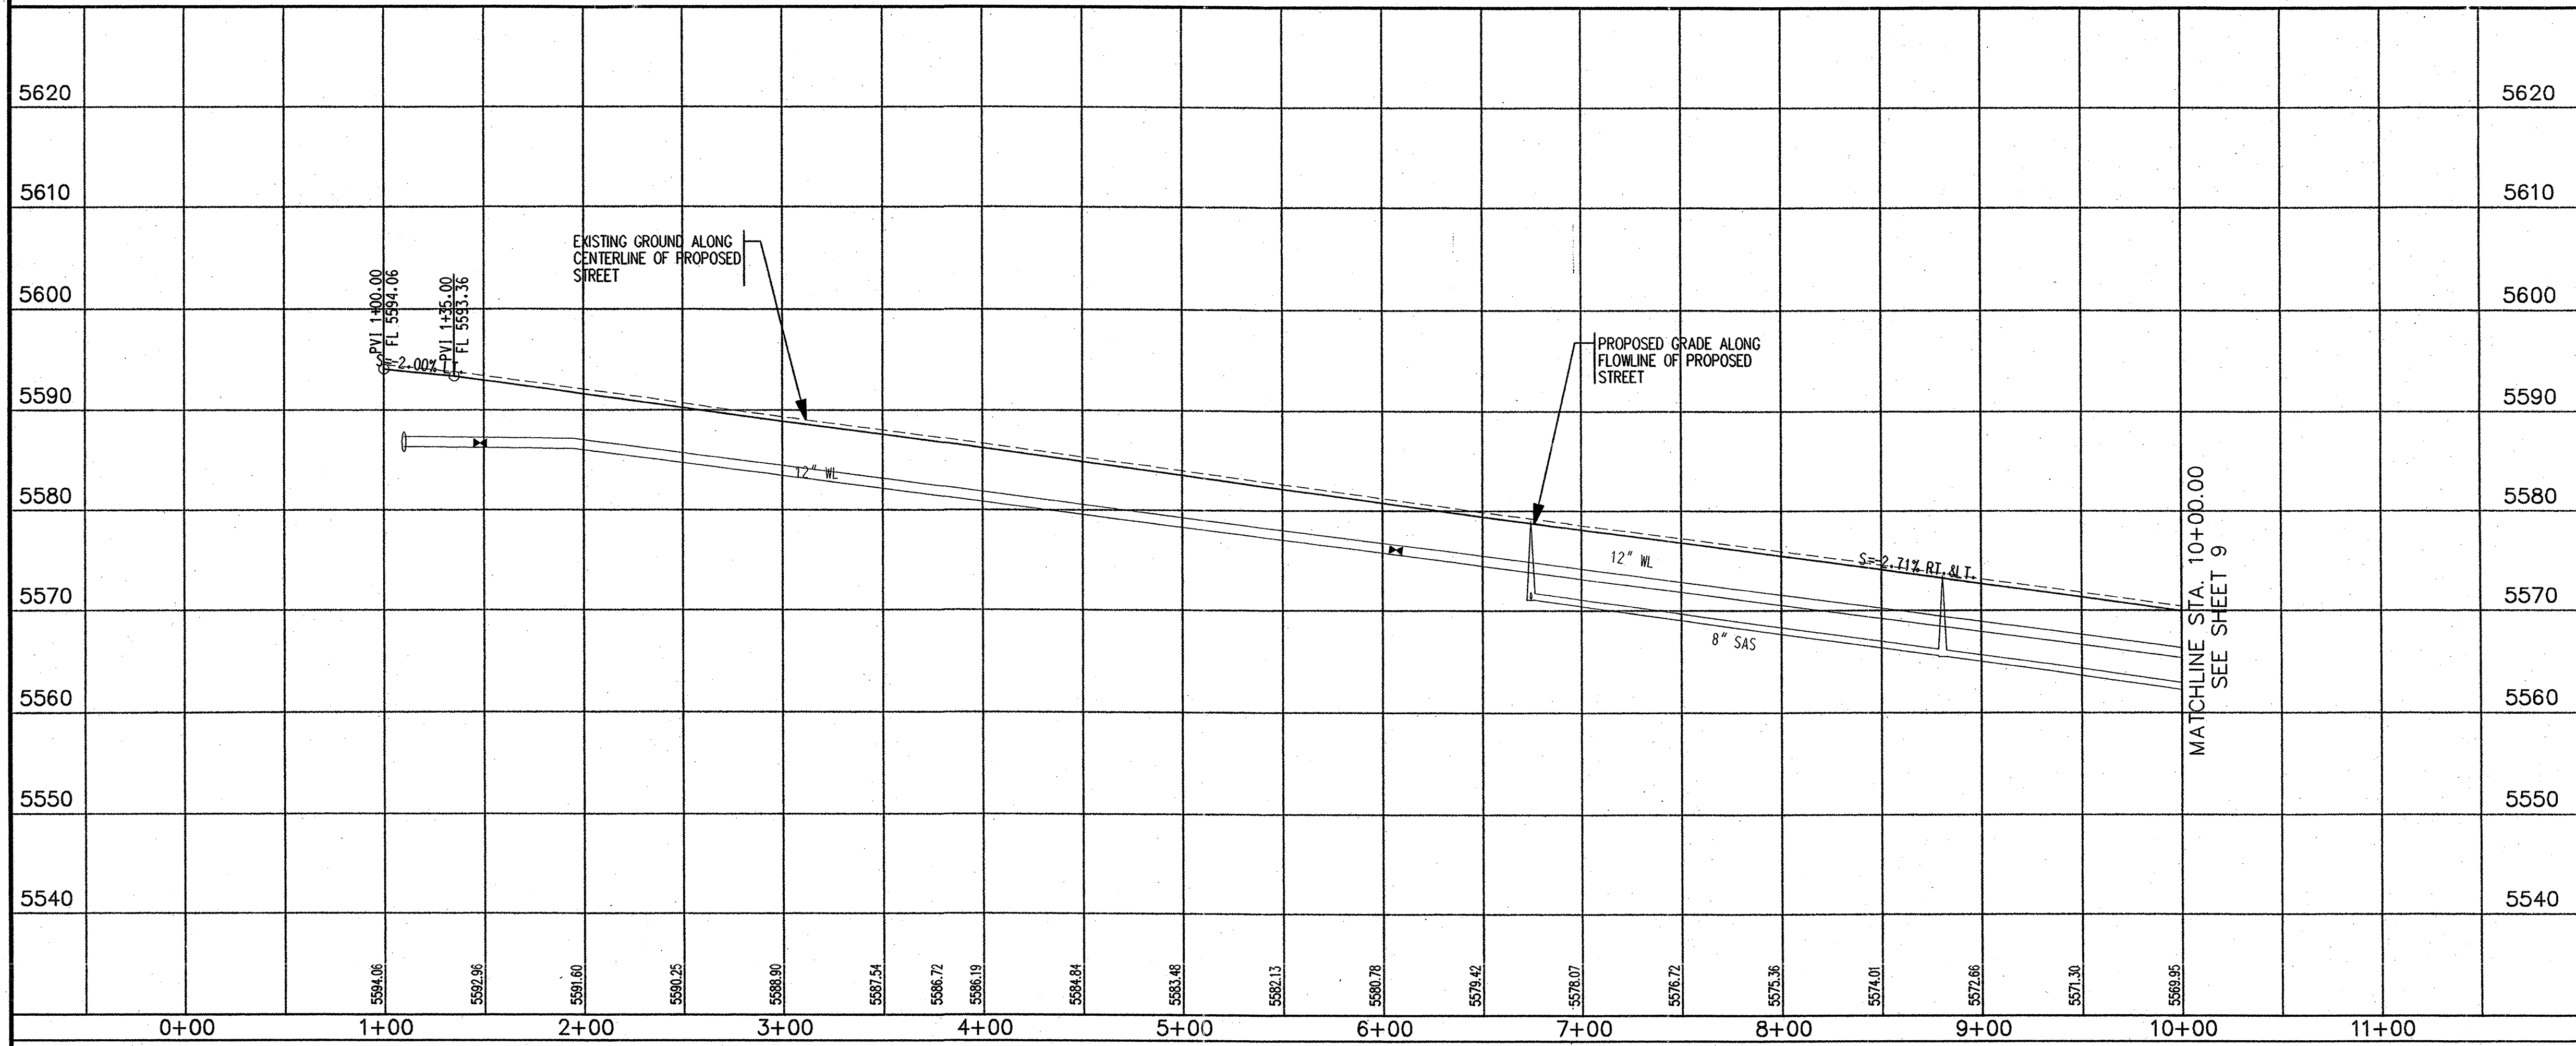

NOTES

- THE CONTRACTOR SHALL FIELD VERIFY ALL EXISTING UTILITY LOCATIONS AND NOTIFY THE ENGINEER IMMEDIATELY OF ANY DISCREPANCIES.
- ALL CURB RETURN RADI SHALL BE 25' UNLESS OTHERWISE SPECIFIED.
- ALL CURVE DATA AND DIMENSIONS REFER TO FACE OF CURB UNLESS OTHERWISE SPECIFIED.
- GRADE ELEVATIONS, WHERE NOTED, ARE ALONG FLOWLINE OF STANDARD CURB UNLESS OTHERWISE SPECIFIED.
- NO WORK SHALL BE UNDERTAKEN WITHIN EXISTING 50' GASLINE EASEMENT WITHOUT FIRST CONTACTING PHM.
- CONTRACTOR IS RESPONSIBLE FOR REPAIR AND/OR REPLACEMENT OF ALL UTILITY CONDUITS AND EXISTING LINES.
- ANY ADDITIONAL GRADING REQUIRED TO MATCH PROPOSED STREET GRADES SHALL BE INCIDENTAL TO PAVING ITEMS.
- CONTRACTOR SHALL PROVIDE THE INSPECTORS, (CITY AND PRIVATE) WITH THE PROPOSED HYDROSTATIC TESTING PLAN. THE PLAN MUST BE APPROVED BEFORE TESTING OPERATIONS BEGIN.
- CONTRACTOR SHALL PARK EQUIPMENT AND VEHICLES AS NOT TO INTERFERE WITH NORMAL ACTIVITIES OF RESIDENTS OR OTHER CONTRACTORS ON SITE.
- ANY DAMAGE TO THE EXISTING FACILITIES (CURB & GUTTER, PAVEMENT, CONDUITS, LANDSCAPING, UTILITY LINES, ETC.) DURING CONSTRUCTION SHALL BE REPLACED AT THE CONTRACTORS' EXPENSE.
- WATER AND SEWER LINES, WHERE SHOWN, ARE FOR REFERENCE ONLY. REFER TO CITY OF ALBUQUERQUE PROJECT # 617684 FOR CONSTRUCTION DOCUMENTS.
- WHEELCHAIR RAMPS SHALL BE CONSTRUCTED PRIOR TO ACCEPTANCE OF CURB & GUTTER.
- ALL EXCAVATION, TRENCHING AND SHORING ACTIVITIES MUST BE CARRIED-OUT IN ACCORDANCE WITH OSHA 29 CFR 1926.650 SUBPART P.
- CONTRACTOR MUST MAINTAIN TWO-WAY TRAFFIC AT ALL TIMES ON PASEO DEL NORTE. THE USE OF AN UNPAVED DETOUR FOR UP TO TWO DAYS WILL BE ALLOWED WITH PROPER BARRICADING.

KEYED GENERAL NOTES

- INSTALL 6" CONCRETE VALLEY GUTTER AS PER STD. DWG. 2420
- INSTALL WHEELCHAIR RAMP AS PER DETAIL SHEET 7
- STD. CURB & GUTTER AS PER STD. DWG. 2415A TINTED SAN DIEGO BUFF
- MEDIAN CURB & GUTTER AS PER STD. DWG. 2415B
- PAVEMENT SECTION "A" SEE TYPICAL SECTION SHEET 7
- (NOT USED)
- TEMPORARY ASPHALT CURB AS PER STD. DWG 2415B
- INSTALL WHEELCHAIR RAMP AT ROUNDABOUT AS PER DETAIL SHEET 7
- MOUNTABLE MEDIAN CURB AND GUTTER AS PER STD DWG. 2415B. TINTED SAN DIEGO BUFF
- BUILD 8" ASPHALT TRAIL AS PER DETAIL SHEET 7
- CONSTRUCT MEDIAN NOSE AS PER DETAIL SHEET 7

AS-BUILT INFORMATION

CONTRACTOR: SUNDANCE
MARKED BY: HLS
DATE: 12/05
ACCEPTANCE BY: SEC
DATE: 12/05
FIELD CHECK BY: ALS
DATE: 12/05
DRAWINGS CORRECTED BY: ALS
MICRO-FILM INFORMATION
RECORDED BY: NO
DATE:

BENCH MARKS

ACS BRASS TABLE STAMPED 2-B10 1980
GEOGRAPHIC POSITION (NAD 1927)
N.M. STATE PLANE COORDINATES
(CENTRAL ZONE)
X=357,543.73 Y=1,527,976.48
GROUND-TO-GRID FACTOR = .99966354
DELTA ALPHA = -0016'30"
NGVD 1929 ELEVATION = 5429.35

SURVEY INFORMATION

DATE: NO. BY: FIELD NOTES: NO. BY: ENGINEER'S SEAL: NO. DATE: REMARKS: NO. DATE: REVISIONS: NO. DATE: DESIGN: NO. DATE: CHECKED BY: NO. DATE:

Bohannon & Huston

Courtyard | 7500 Jefferson St. NE Albuquerque, NM 87109-4335
ENGINEERING • SPATIAL DATA • ADVANCED TECHNOLOGIES


CITY OF ALBUQUERQUE

PUBLIC WORKS DEPARTMENT
ENGINEERING DEVELOPMENT GROUP
BACKBONE ROADWAY & STORM DRAIN IMPROVEMENTS - PHASE 2
PAVING PLAN & PROFILE
VENTANA RIDGE ROAD 0+00.00 - 10+00.00

DESIGN REVIEW COMMITTEE	CITY ENGINEER APPROVAL	MO./DAY/YR.	MO./DAY/YR.

CITY PROJECT NO. 617685 ZONE MAP NO. B-8-Z SHEET 8A OF 12

NUMBER	Q(cfs)	V(f/s)	DEPTH	LENGTH	SIZE	SLOPE
ST1	5.50	16.79	4.33"	36.78'	18"	16.92
ST2	5.50	18.13	4.10"	16.07'	18"	21.05
ST3	11.0	13.59	7.31"	51.46'	24"	5.82
ST4	69.0	11.38	28.80"	36.14'	36"	1.12
ST5	80.0	16.81	22.97"	280.38'	36"	2.65
ST6	11.0	12.76	39.08"	69.45'	42"	1.21
SC1	199.0	18.19	35.06"	325.78'	54"	1.79
SC2	199.0	17.15	36.96"	296.00'	54"	1.55

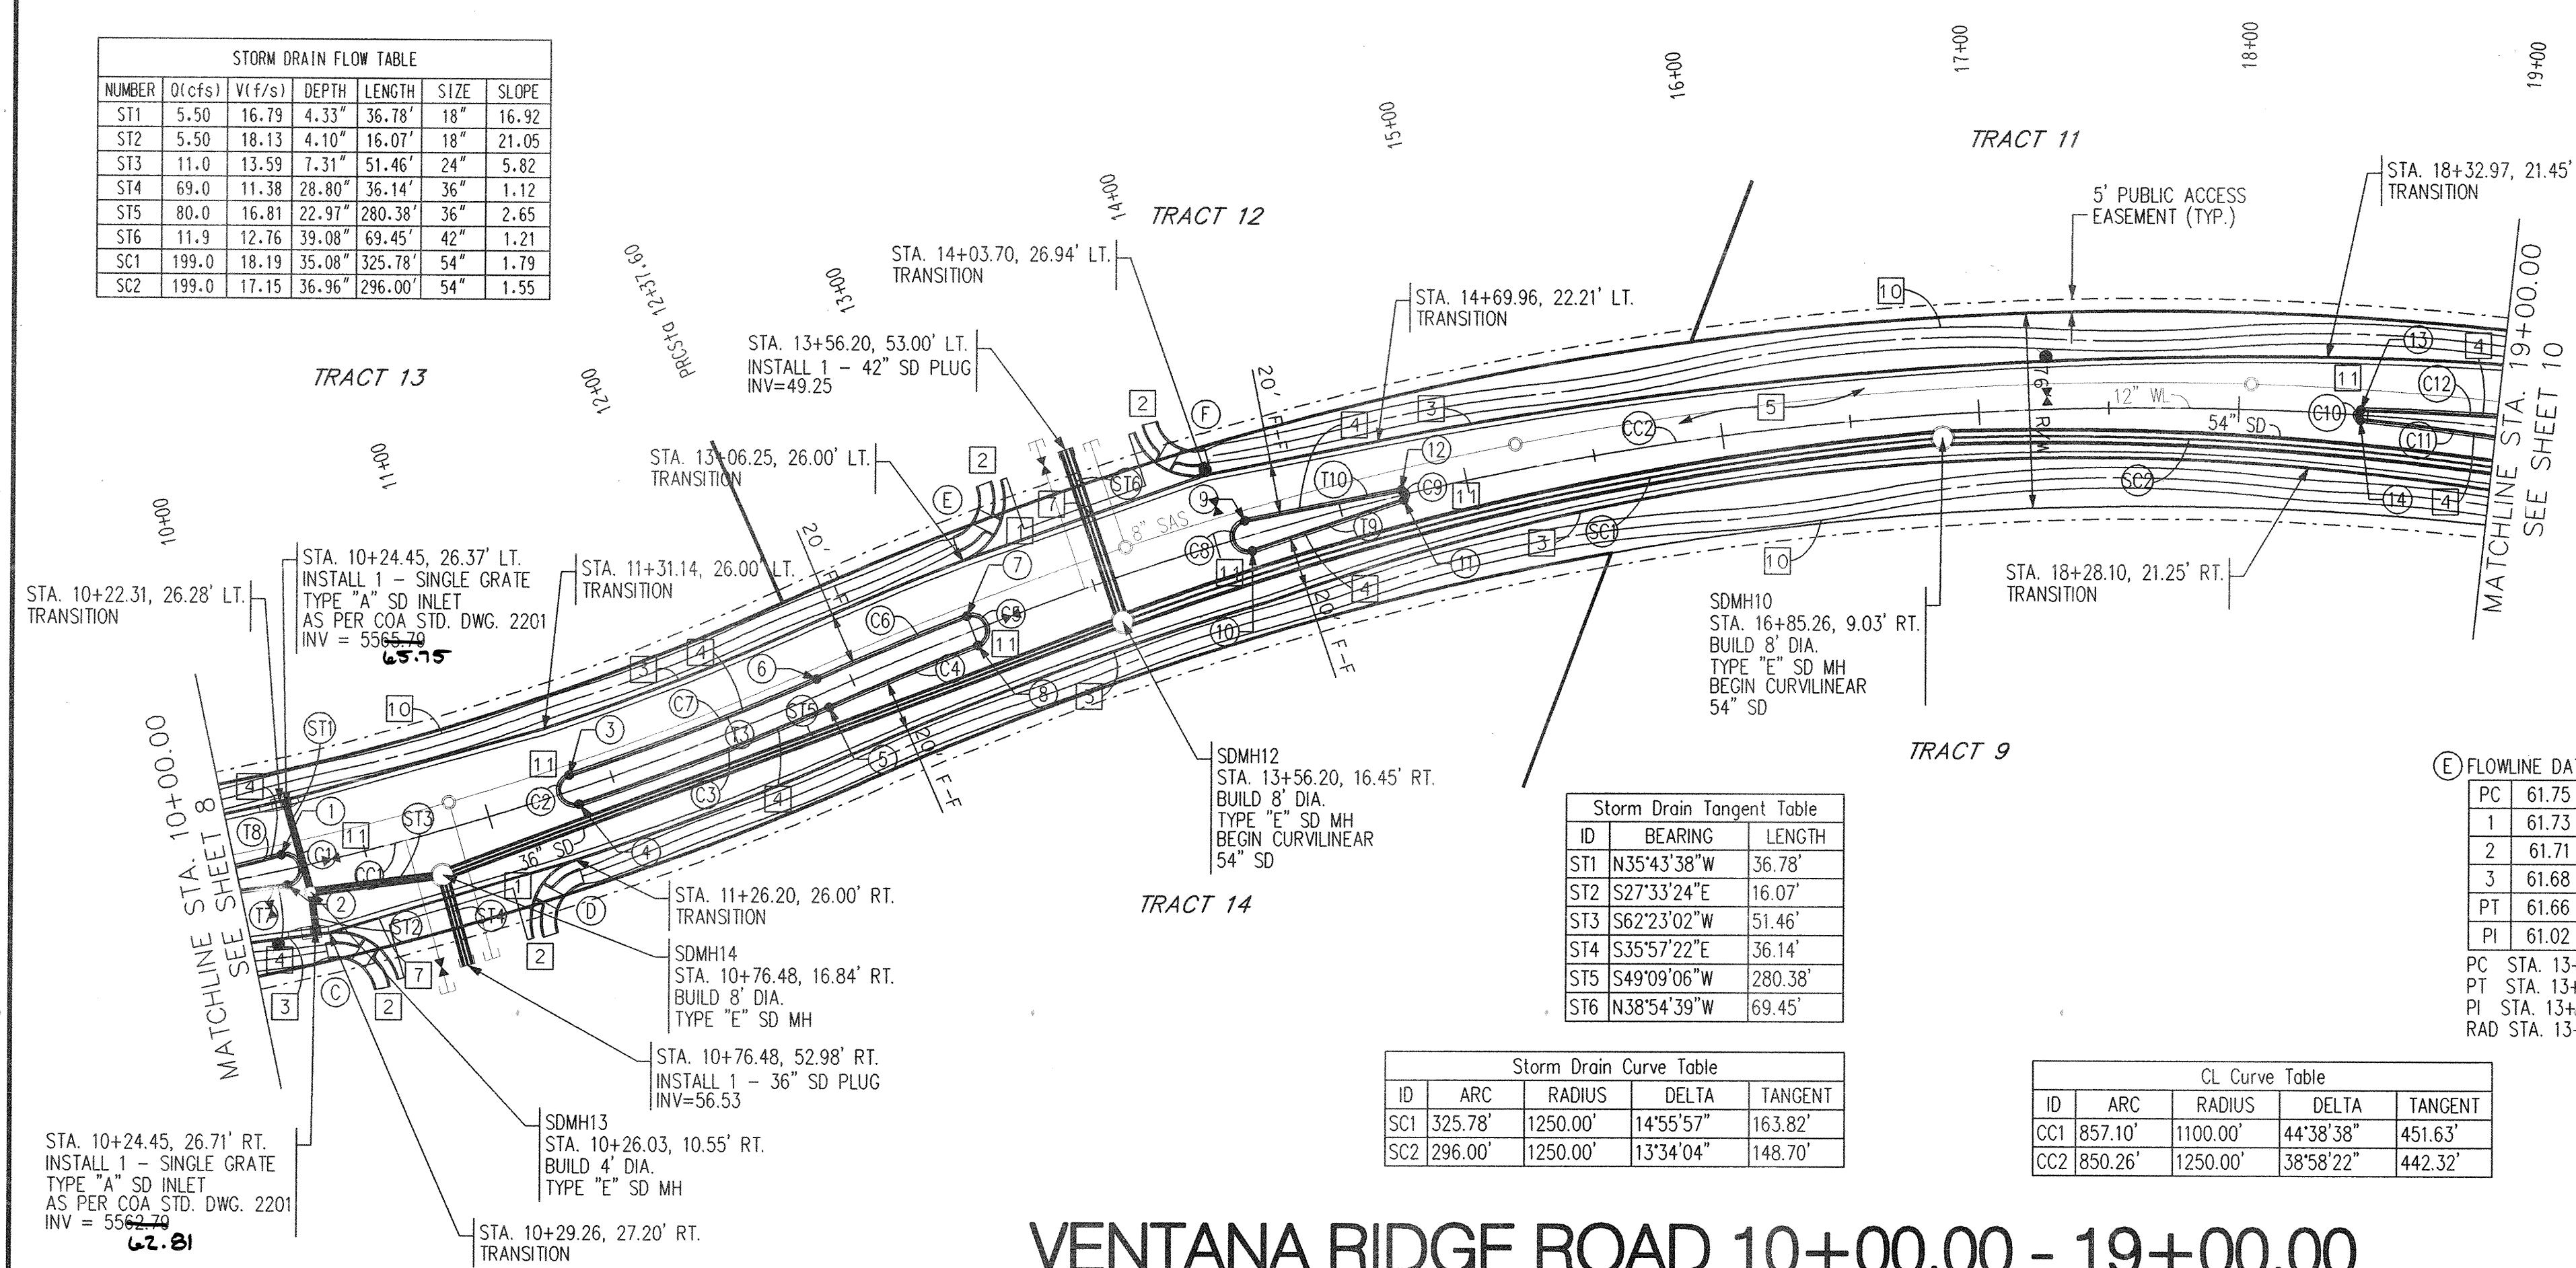

ID	ARC	RADIUS	DELTA	TANGENT
SC1	325.78'	1250.00'	14°55'57"	163.82'
SC2	296.00'	1250.00'	13°34'04"	148.70'

CL Curve Table				
ID	ARC	RADIUS	DELTA	TANGENT
CC1	857.10'	1100.00'	44°38'38"	451.63'
CC2	850.26'	1250.00'	38°58'22"	442.32'

ID	BEARING	LENGTH
T7	S62°23'02"W	61.86'
T8	S54°59'05"W	61.86'
T9	S51°23'26"W	61.86'
T10	S58°47'22"W	61.86'

ID	ARC	RADIUS	DELTA	TANGENT
C1	19.62'	6.00'	187°23'57"	-----
C2	18.85'	6.00'	180°00'00"	-----
C3	103.61'	1106.00'	05°22'03"	51.84'
C4	62.02'	1244.00'	02°51'23"	31.01'
C5	18.85'	6.00'	180°00'00"	-----
C6	62.61'	1256.00'	02°51'23"	31.31'
C7	102.49'	1094.00'	05°22'03"	51.28'
C8	19.62'	6.00'	187°23'59"	-----
C9	6.02'	2.00'	172°36'05"	30.93'
C10	6.28'	2.00'	180°00'00"	-----
C11	99.76'	1245.00'	04°35'28"	49.91'
C12	100.46'	1251.58'	04°35'56"	50.26'

(C) FLOWLINE DATA FOR CURB RET.

PC	69.16	D = 81°39'40"
1	69.18	R = 25.00'
2	69.20	T = 21.60'
3	69.22	L = 35.63"
PT	69.24	C = 32.69'
PI	68.59	

PC STA. 10+29.26, 27.20' RT.
PT STA. 10+50.68, 51.21' RT.
PI STA. 10+50.19, 29.62' RT.
RAD STA. 10+26.82, 52.67' RT.

D) FLOWLINE DATA FOR CURB RETURN	
PC	67.88
1	67.55
2	67.21
3	66.87
PT	66.53
PI	67.16

$D = 87'24''39"$
 $R = 25.00'$
 $T = 23.89'$
 $L = 38.14'$
 $C = 34.55'$

PC STA. 11+02.31, 50.14' RT.
PT STA. 11+26.20, 26.00' RT.
PI STA. 11+02.86, 26.25' RT.
RAD STA. 11+26.20, 51.00' RT.



E FLOWLINE DATA FOR CURB RETURN	
PC	61.75
1	61.73
2	61.71
3	61.68
PT	61.66
PI	61.02

(F) FLOWLINE DATA FOR CURB RETURN

PC	59.02
1	59.32
2	59.63
3	59.94
PT	60.24
PI	59.59


D = 82°17'59"
R = 25.00'
T = 21.85'
L = 35.91'
C = 32.90'

PC STA. 14+03.83, 26.93' LT.
PT STA. 13+82.54, 51.05' LT.
PI STA. 13+82.54, 59.21' LT.
RAD STA. 14+06.14, 28.81' LT.

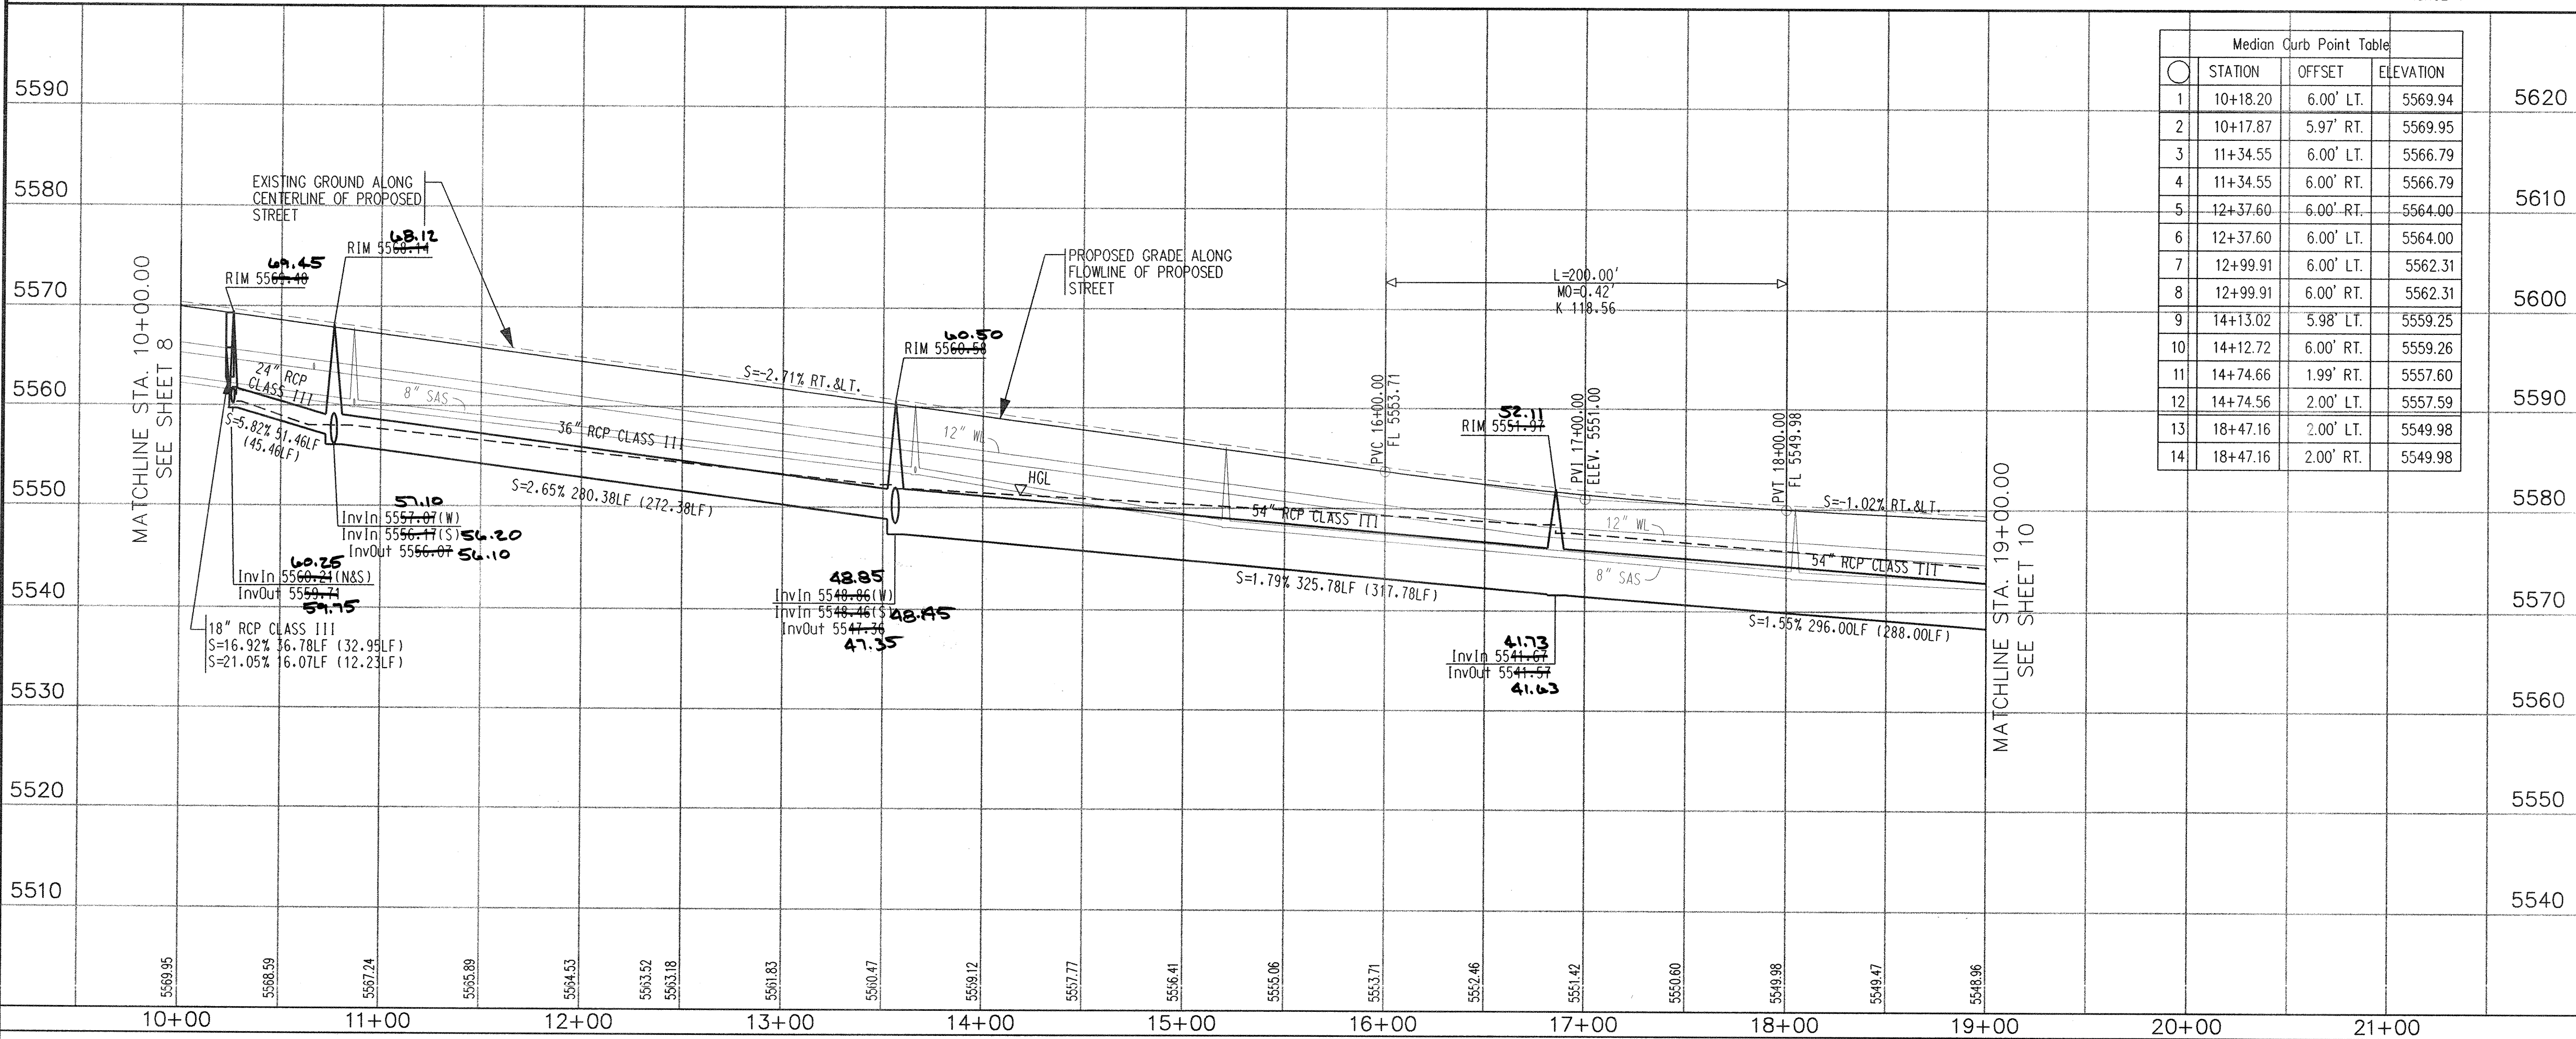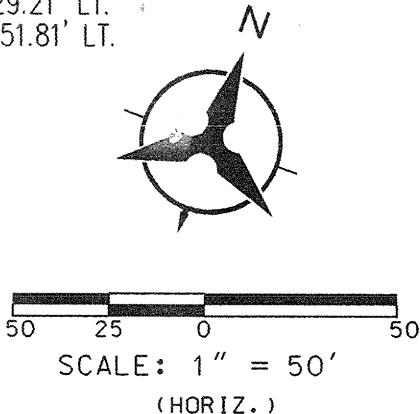


NOTES

KEYED GENERAL NOTES

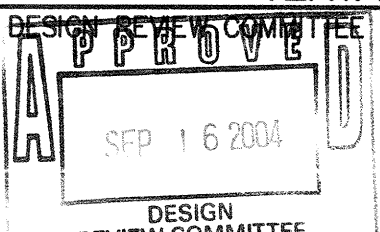		COURT YARD I 7500 Jefferson St. NE Albuquerque, NM 87109-4335 ENGINEERING ▴ SPATIAL DATA ▴ ADVANCED TECHNOLOGIES		NO. DATE 		DESIGNED BY 		DRAWN BY 		CHECKED BY 	
		CITY OF ALBUQUERQUE PUBLIC WORKS DEPARTMENT ENGINEERING DEVELOPMENT GROUP									
BACKBONE ROADWAY & STORM DRAIN IMPROVEMENTS - PHASE 2 PAVING PLAN & PROFILE VENTANA RIDGE ROAD 10+00.00 - 19+00.00											
DESIGN REVIEW COMMITTEE 			CITY ENGINEER APPROVAL 			LAST DESIGN UPDATE 		MO./DAY/YR. 		MO./DAY/YR. 	
CITY PROJECT NO. 617685			ZONE MAP NO. B-8-Z			SHEET 9		OF 12			

SCANNED BY P&W

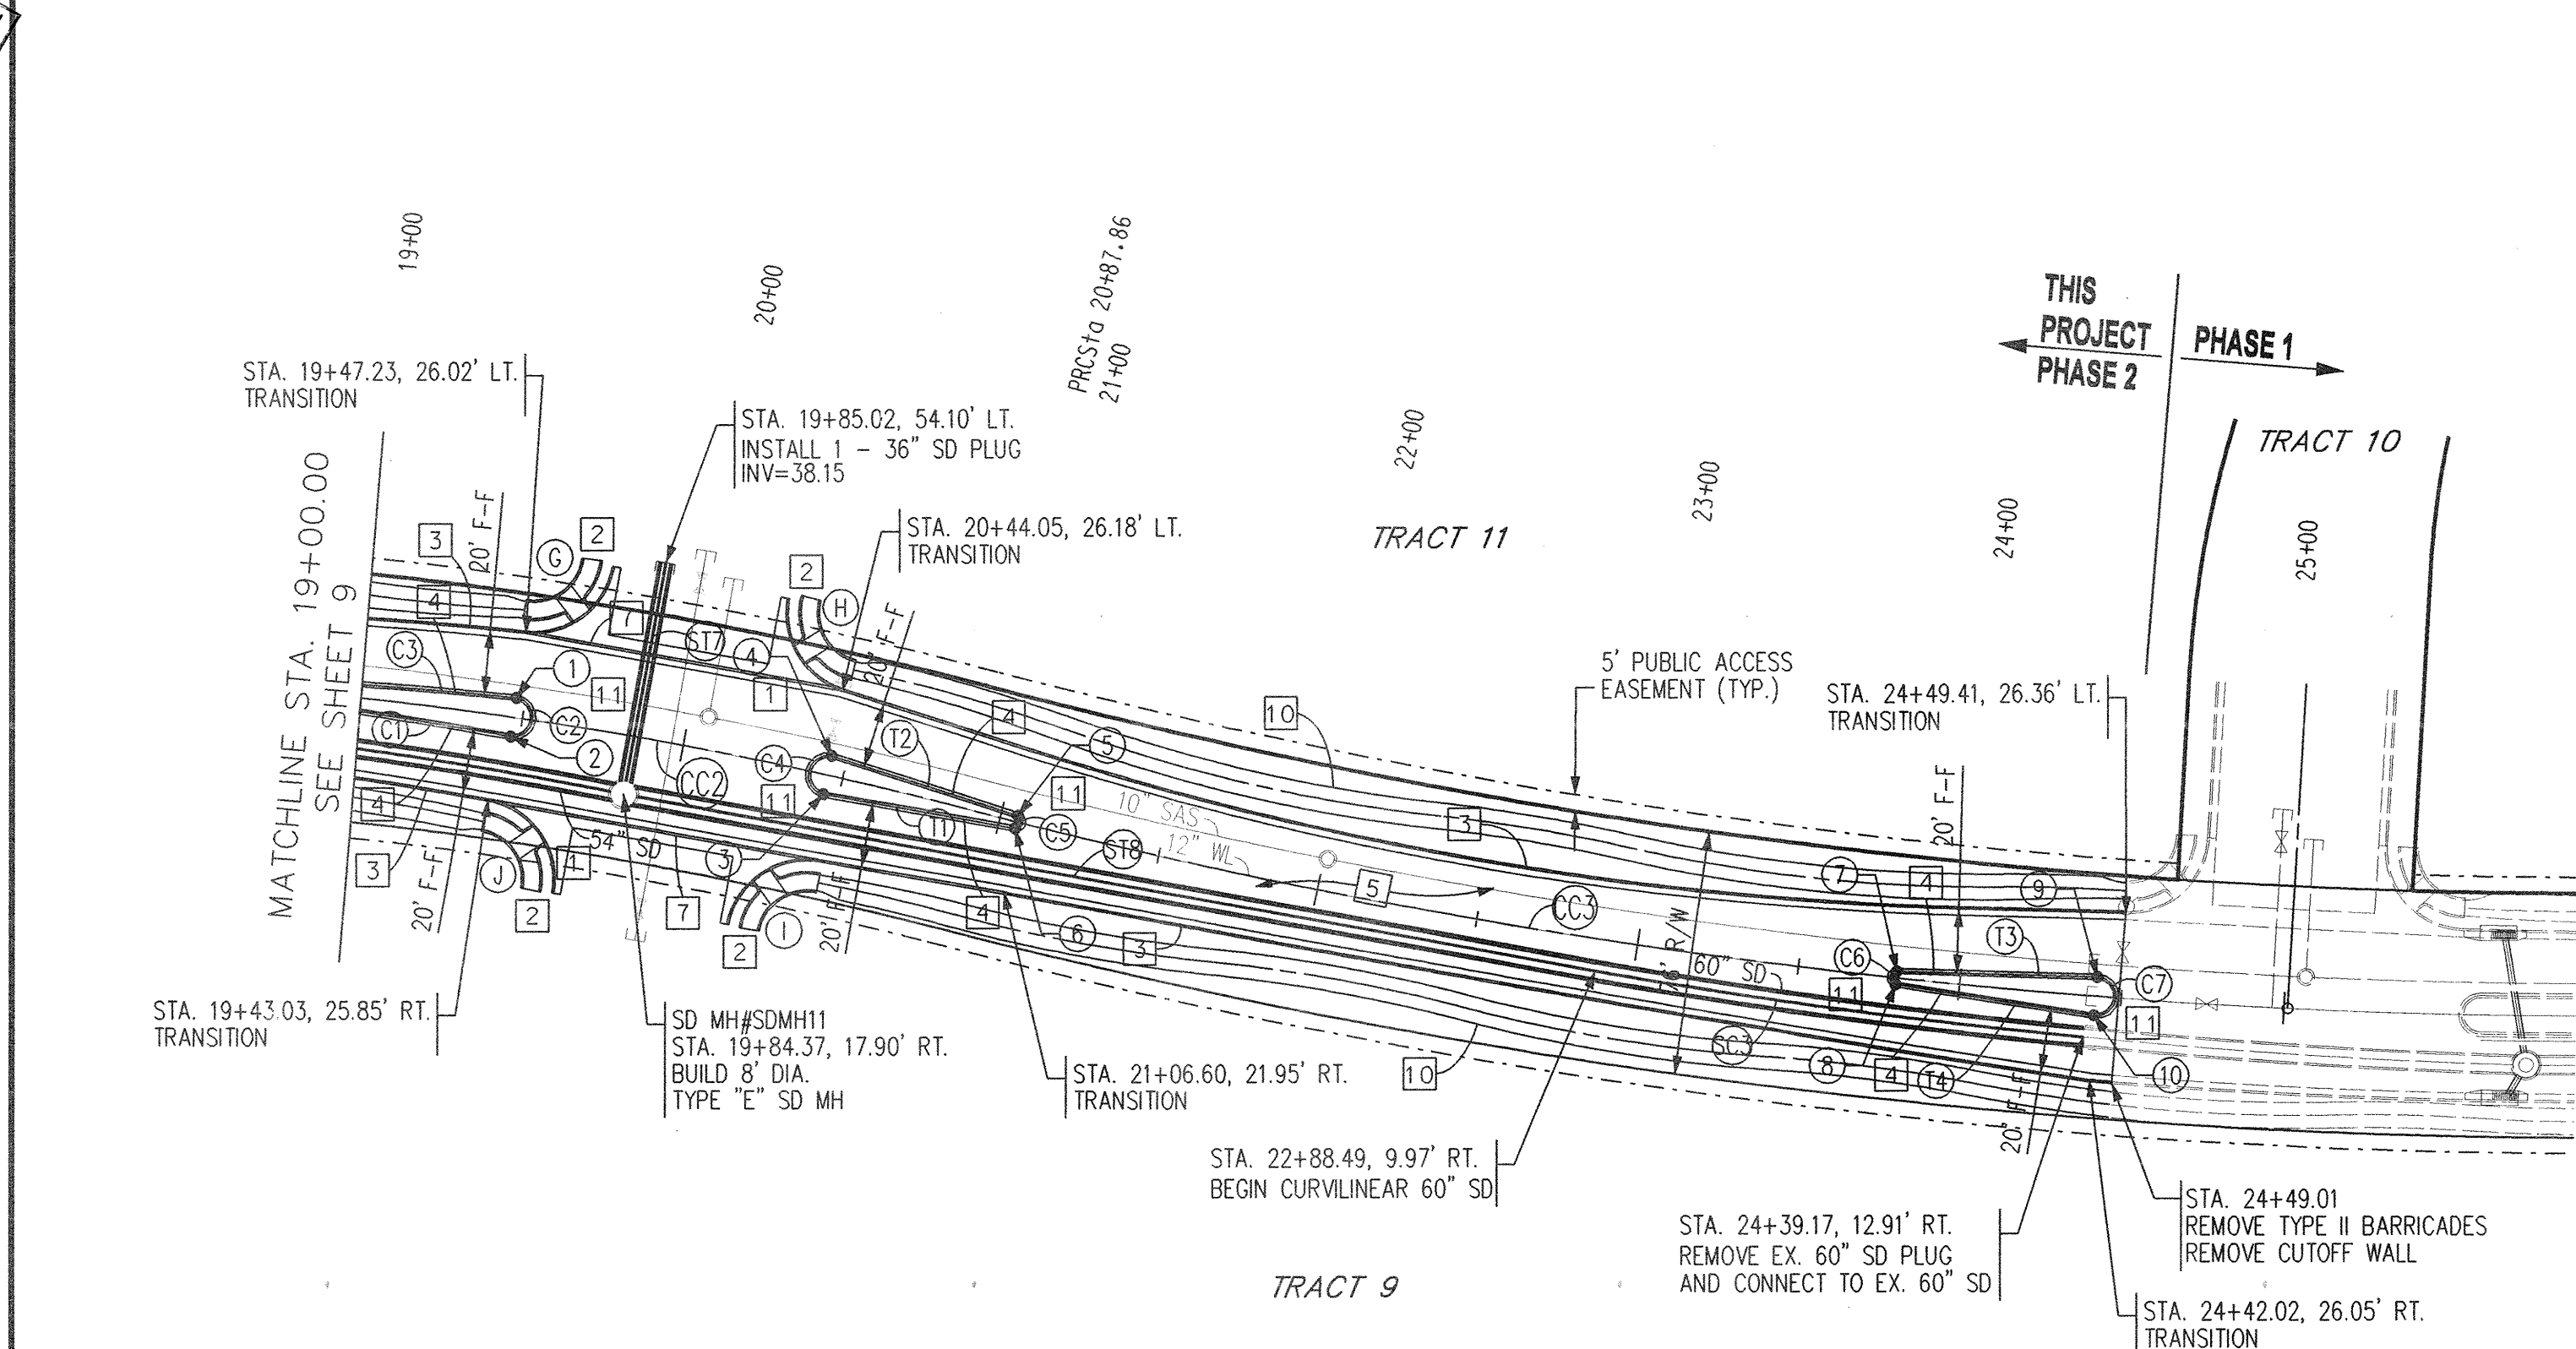

G) FLOWLINE DATA FOR CURB RETURN				H) FLOWLINE DATA FOR CURB RETURN			
PC	48.95	D = 85'30"49"		PC	47.49	D = 82'45"47"	
1	48.83	R = 25.00'		1	47.71	R = 25.00'	
2	48.72	T = 23.12'		2	47.93	T = 22.03'	
3	48.60	L = 37.31'		3	48.15	L = 36.11'	
PT	48.48	C = 33.94'		PT	48.37	C = 33.05'	
PI	48.25			PI	47.71		
PC STA. 19+70.23, 50.24' LT.				PC STA. 20+44.05, 26.18' LT.			
PT STA. 19+47.15, 26.01' LT.				PT STA. 20+22.15, 50.32' LT.			
PI STA. 19+69.76, 27.12' LT.				PI STA. 20+22.59, 28.30' LT.			
RAD STA. 19+46.22, 50.99' LT.				RAD STA. 20+46.16, 51.08' LT.			

I) FLOWLINE DATA FOR CURB RETURN				J) FLOWLINE DATA FOR CURB RETURN			
PC	48.44	D = 89'36"42"		PC	48.52	D = 90'05"55"	
1	48.19	R = 25.00'		1	48.64	R = 25.00'	
2	47.94	T = 24.83'		2	48.76	T = 25.04'	
3	47.69	L = 39.10'		3	48.89	L = 39.31'	
PT	47.44	C = 35.24'		PT	49.01	C = 35.39'	
PI	47.70			PI	48.26		
PC STA. 20+24.36, 51.63' RT.				PC STA. 19+43.03, 25.85' RT.			
PT STA. 20+49.13, 25.84' RT.				PT STA. 19+68.02, 51.65' RT.			
PI STA. 20+23.78, 26.81' RT.				PI STA. 19+68.60, 26.62' RT.			
RAD STA. 20+50.41, 50.81' RT.				RAD STA. 19+41.97, 50.83' RT.			

Median Curb Point Table		
STATION	OFFSET	ELEVATION
1	19+47.22	6.00' LT. 5548.96
2	19+47.16	6.00' RT. 5548.96
3	20+45.22	6.00' RT. 5547.96
4	20+45.16	6.00' LT. 5547.96
5	21+05.19	2.00' LT. 5547.35
6	21+05.19	2.00' RT. 5547.35
7	23+80.24	1.99' LT. 5544.79
8	23+80.30	2.00' RT. 5544.79
9	24+42.10	5.99' LT. 5544.24
10	24+41.92	5.98' RT. 5544.24


Median Curb Curve Table				
ID	ARC	RADIUS	DELTA	TANGENT
C1	99.76'	1245.00'	04'35"28"	49.91'
C2	18.85'	6.00'	179'59"56"	-----
C3	100.46'	1251.58'	04'35"56"	50.26'
C4	18.85'	6.00'	179'59"56"	-----
C5	6.28'	2.00'	180'00"00"	-----
C6	6.02'	2.00'	172'36"07"	30.94'
C7	19.62'	6.00'	187'23"58"	-----

CL Curve Table				
ID	ARC	RADIUS	DELTA	TANGENT
CC2	850.26'	1250.00'	38'58"22"	442.32'
CC3	361.34'	2000.00'	10'21"05"	181.16'


STORM DRAIN FLOW TABLE						
NUMBER	Q(cfs)	V(f/s)	DEPTH	LENGTH	SIZE	SLOPE
ST7	46.0	13.53	17.46"	72.00'	36"	2.11
ST8	245.0	15.08	46.25"	304.00'	60"	1.00
SC3	245.0	17.42	140.40"	152.00'	60"	1.40

Storm Drain Curve Table				
ID	ARC	RADIUS	DELTA	TANGENT
SC3	152.00'	1990.00'	04'22"35"	76.04'

Median Curb Tangent Table		
ID	BEARING	LENGTH
T1	N80°02'10"E	59.97'
T2	N87°39'40"E	60.29'
T3	N71°39'28"E	61.87'
T4	N79°03'23"E	61.87'

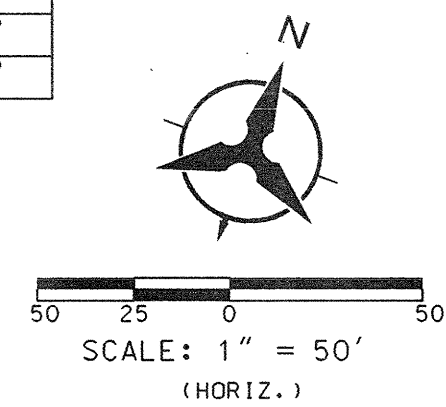

VENTANA RIDGE ROAD 19+00.00 - 25+00.00

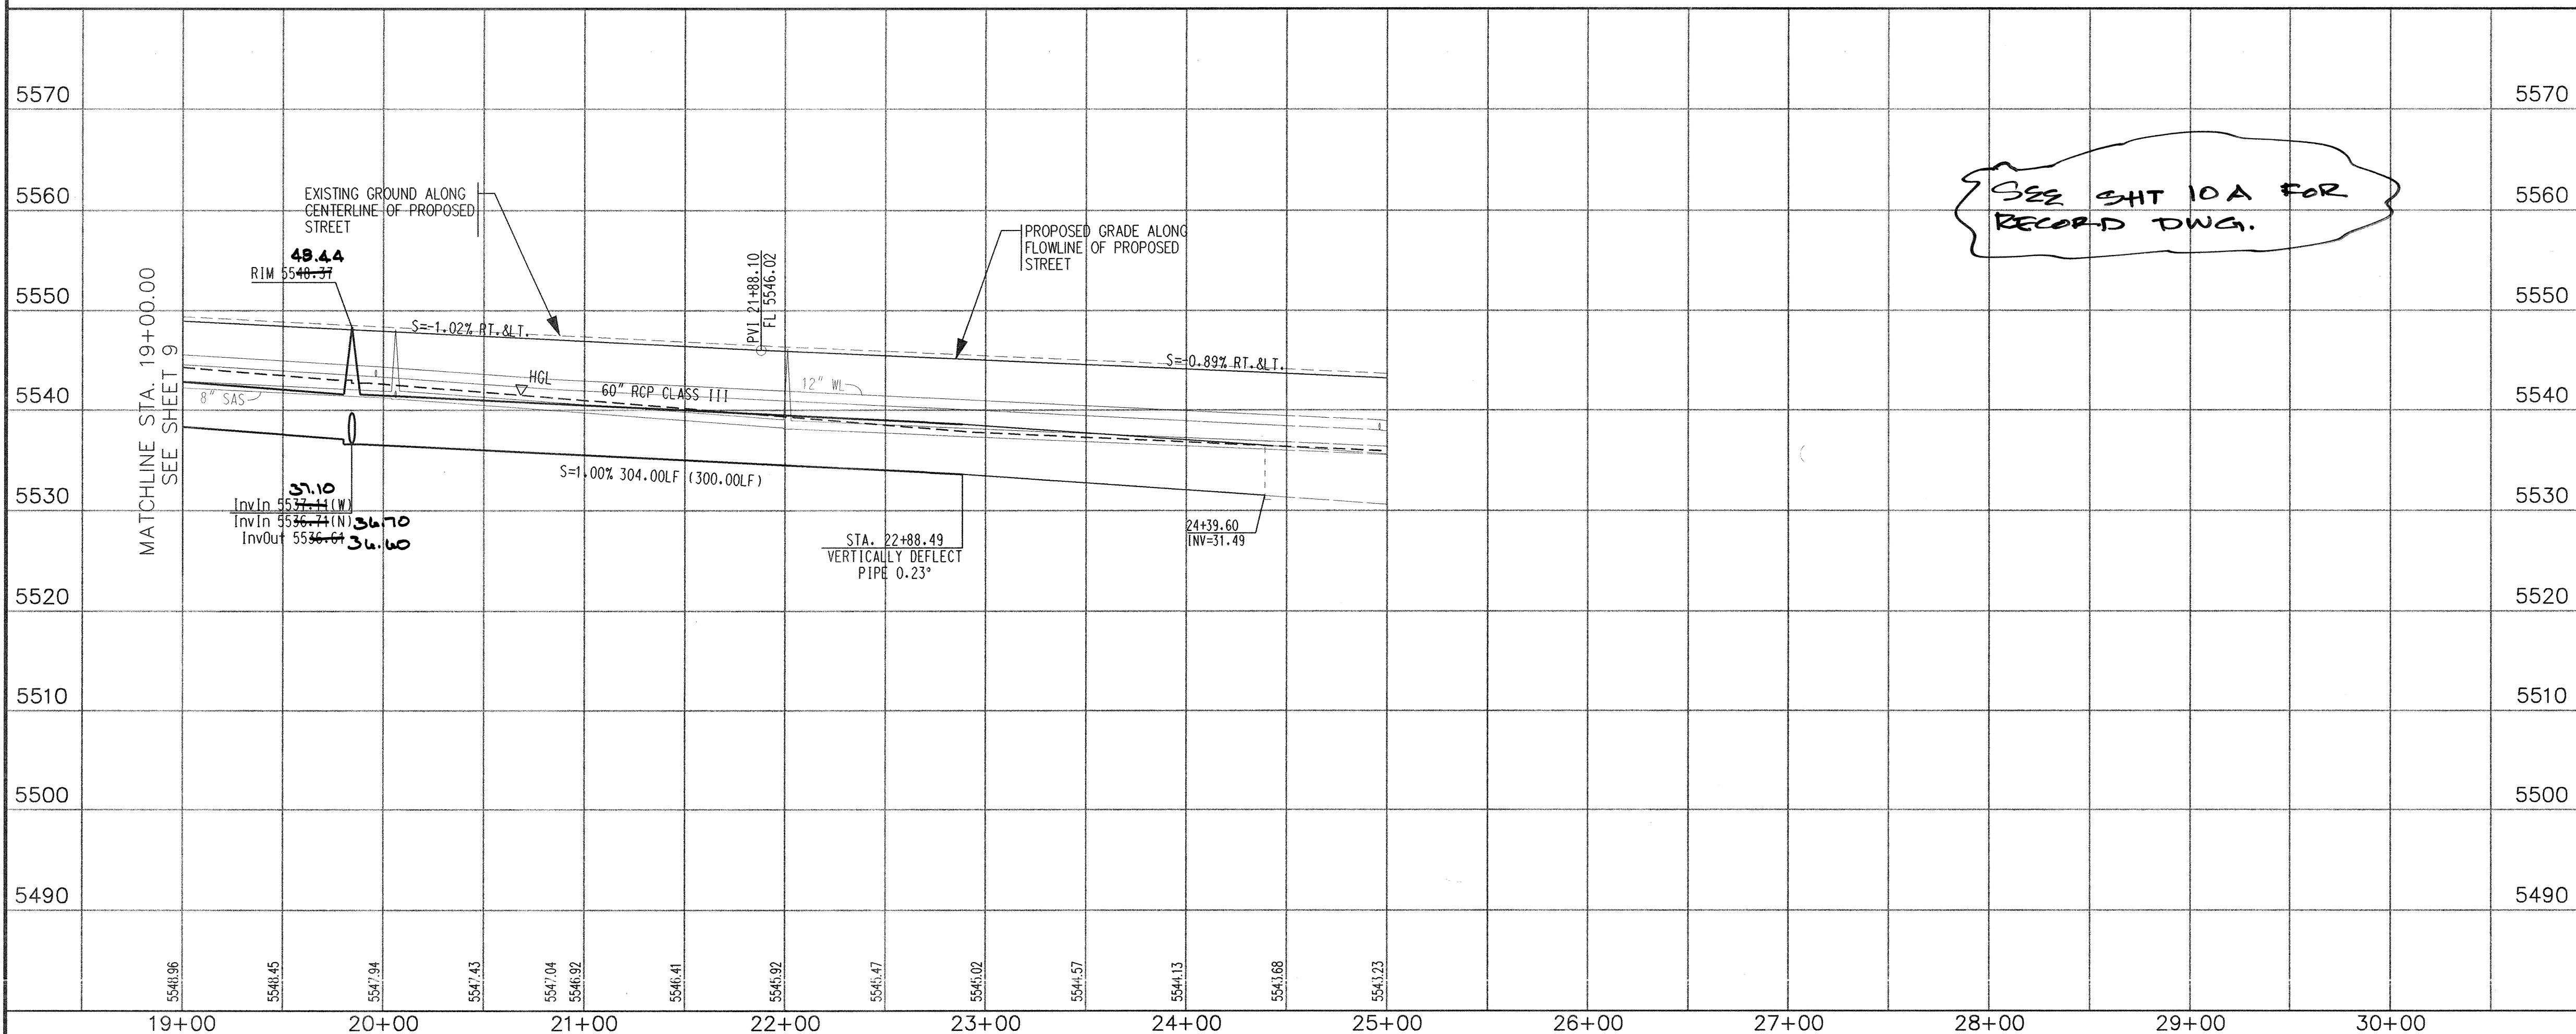

NOTES

- THE CONTRACTOR SHALL FIELD VERIFY ALL EXISTING UTILITY LOCATIONS AND NOTIFY THE ENGINEER IMMEDIATELY OF ANY DISCREPANCIES.
- ALL CURB RETURN RADII SHALL BE 25' UNLESS OTHERWISE SPECIFIED.
- ALL CURVE DATA AND DIMENSIONS REFER TO FACE OF CURB UNLESS OTHERWISE SPECIFIED.
- GRADE ELEVATIONS, WHERE NOTED, ARE ALONG FLOWLINE OF STANDARD CURB UNLESS OTHERWISE SPECIFIED.
- NO WORK SHALL BE UNDERTAKEN WITHIN EXISTING 50' GASLINE EASEMENT WITHOUT FIRST CONTACTING PNM.
- CONTRACTOR IS RESPONSIBLE FOR REPAIR AND/OR REPLACEMENT OF ALL UTILITY CONDUITS AND EXISTING LINES.
- ANY ADDITIONAL GRADING REQUIRED TO MATCH PROPOSED STREET GRADES SHALL BE INCIDENTAL TO PAVING ITEMS.
- CONTRACTOR SHALL PROVIDE THE INSPECTORS, (CITY AND PRIVATE) WITH THE PROPOSED HYDROSTATIC TESTING PLAN. THE PLAN MUST BE APPROVED BEFORE TESTING OPERATIONS BEGIN.
- CONTRACTOR SHALL PARK EQUIPMENT AND VEHICLES AS NOT TO INTERFERE WITH NORMAL ACTIVITIES OF RESIDENTS OR OTHER CONTRACTORS ON SITE.
- ANY DAMAGE TO THE EXISTING FACILITIES (CURB & GUTTER, PAVEMENT, CONDUITS, LANDSCAPING, UTILITY LINES, ETC.) DURING CONSTRUCTION SHALL BE REPLACED AT THE CONTRACTORS' EXPENSE.
- WATER AND SEWER LINES, WHERE SHOWN, ARE FOR REFERENCE ONLY. REFER TO CITY OF ALBUQUERQUE PROJECT # 617684 FOR CONSTRUCTION DOCUMENTS.
- WHEELCHAIR RAMPS SHALL BE CONSTRUCTED PRIOR TO ACCEPTANCE OF CURB & GUTTER.
- ALL EXCAVATION, TRENCHING AND SHORING ACTIVITIES MUST BE CARRIED-OUT IN ACCORDANCE WITH OSHA 29 CFR 1926.650 SUBPART P.
- CONTRACTOR MUST MAINTAIN TWO-WAY TRAFFIC AT ALL TIMES ON PASSED DEL NORTE. THE USE OF AN UNPAVED DETOUR FOR UP TO TWO DAYS WILL BE ALLOWED WITH PROPER BARRICADING.

KEYED GENERAL NOTES

- INSTALL 6' CONCRETE VALLEY GUTTER AS PER STD. DWG. 2420
- INSTALL WHEELCHAIR RAMP AS PER DETAIL SHEET 7
- STD. CURB & GUTTER AS PER STD. DWG. 2415A TINTED SAN DIEGO BUFF
- MEDIAN CURB & GUTTER AS PER STD. DWG. 2415B
- PAVEMENT SECTION "A" SEE TYPICAL SECTION SHEET 7
- (NOT USED)
- TEMPORARY ASPHALT CURB AS PER STD. DWG. 2415B
- INSTALL WHEELCHAIR RAMP AT ROUNDABOUT AS PER DETAIL SHEET 7
- MOUNTABLE MEDIAN CURB AND GUTTER AS PER STD DWG. 2415B. TINTED SAN DIEGO BUFF
- BUILD 8' ASPHALT TRAIL AS PER DETAIL SHEET 7
- CONSTRUCT MEDIAN NOSE AS PER DETAIL SHEET 7

ENGINEER'S SEAL

JAMES R. BOHANNAN
NEW MEXICO
16586
9-7-04
REGISTERED PROFESSIONAL ENGINEER

REVISIONS

NO.	DATE	BY	REMARKS
1	3/2004	JP/KGP	DESIGN
2	3/2004	BS/ARR	REVISIONS
3	3/2004	KGP	UPDATE

Bohannon & Huston

Courtyard I 7500 Jefferson St. NE Albuquerque, NM 87109-4335
ENGINEERING • SPATIAL DATA • ADVANCED TECHNOLOGIES

CITY OF ALBUQUERQUE

PUBLIC WORKS DEPARTMENT
ENGINEERING DEVELOPMENT GROUP

BACKBONE ROADWAY & STORM DRAIN IMPROVEMENTS - PHASE 2

PAVING PLAN & PROFILE
VENTANA RIDGE ROAD 19+00.00- 25+00.00

APPROVED

SEP 16 2004
DESIGN REVIEW COMMITTEE

CITY ENGINEER APPROVAL


NO. / DAY / YR. MO. / DAY / YR.

LAST DESIGN UPDATE

NO. / DAY / YR. MO. / DAY / YR.

CITY PROJECT NO. **617685** ZONE MAP NO. **B-8-Z** SHEET **10** OF **12**

SCANNED
BY PLW

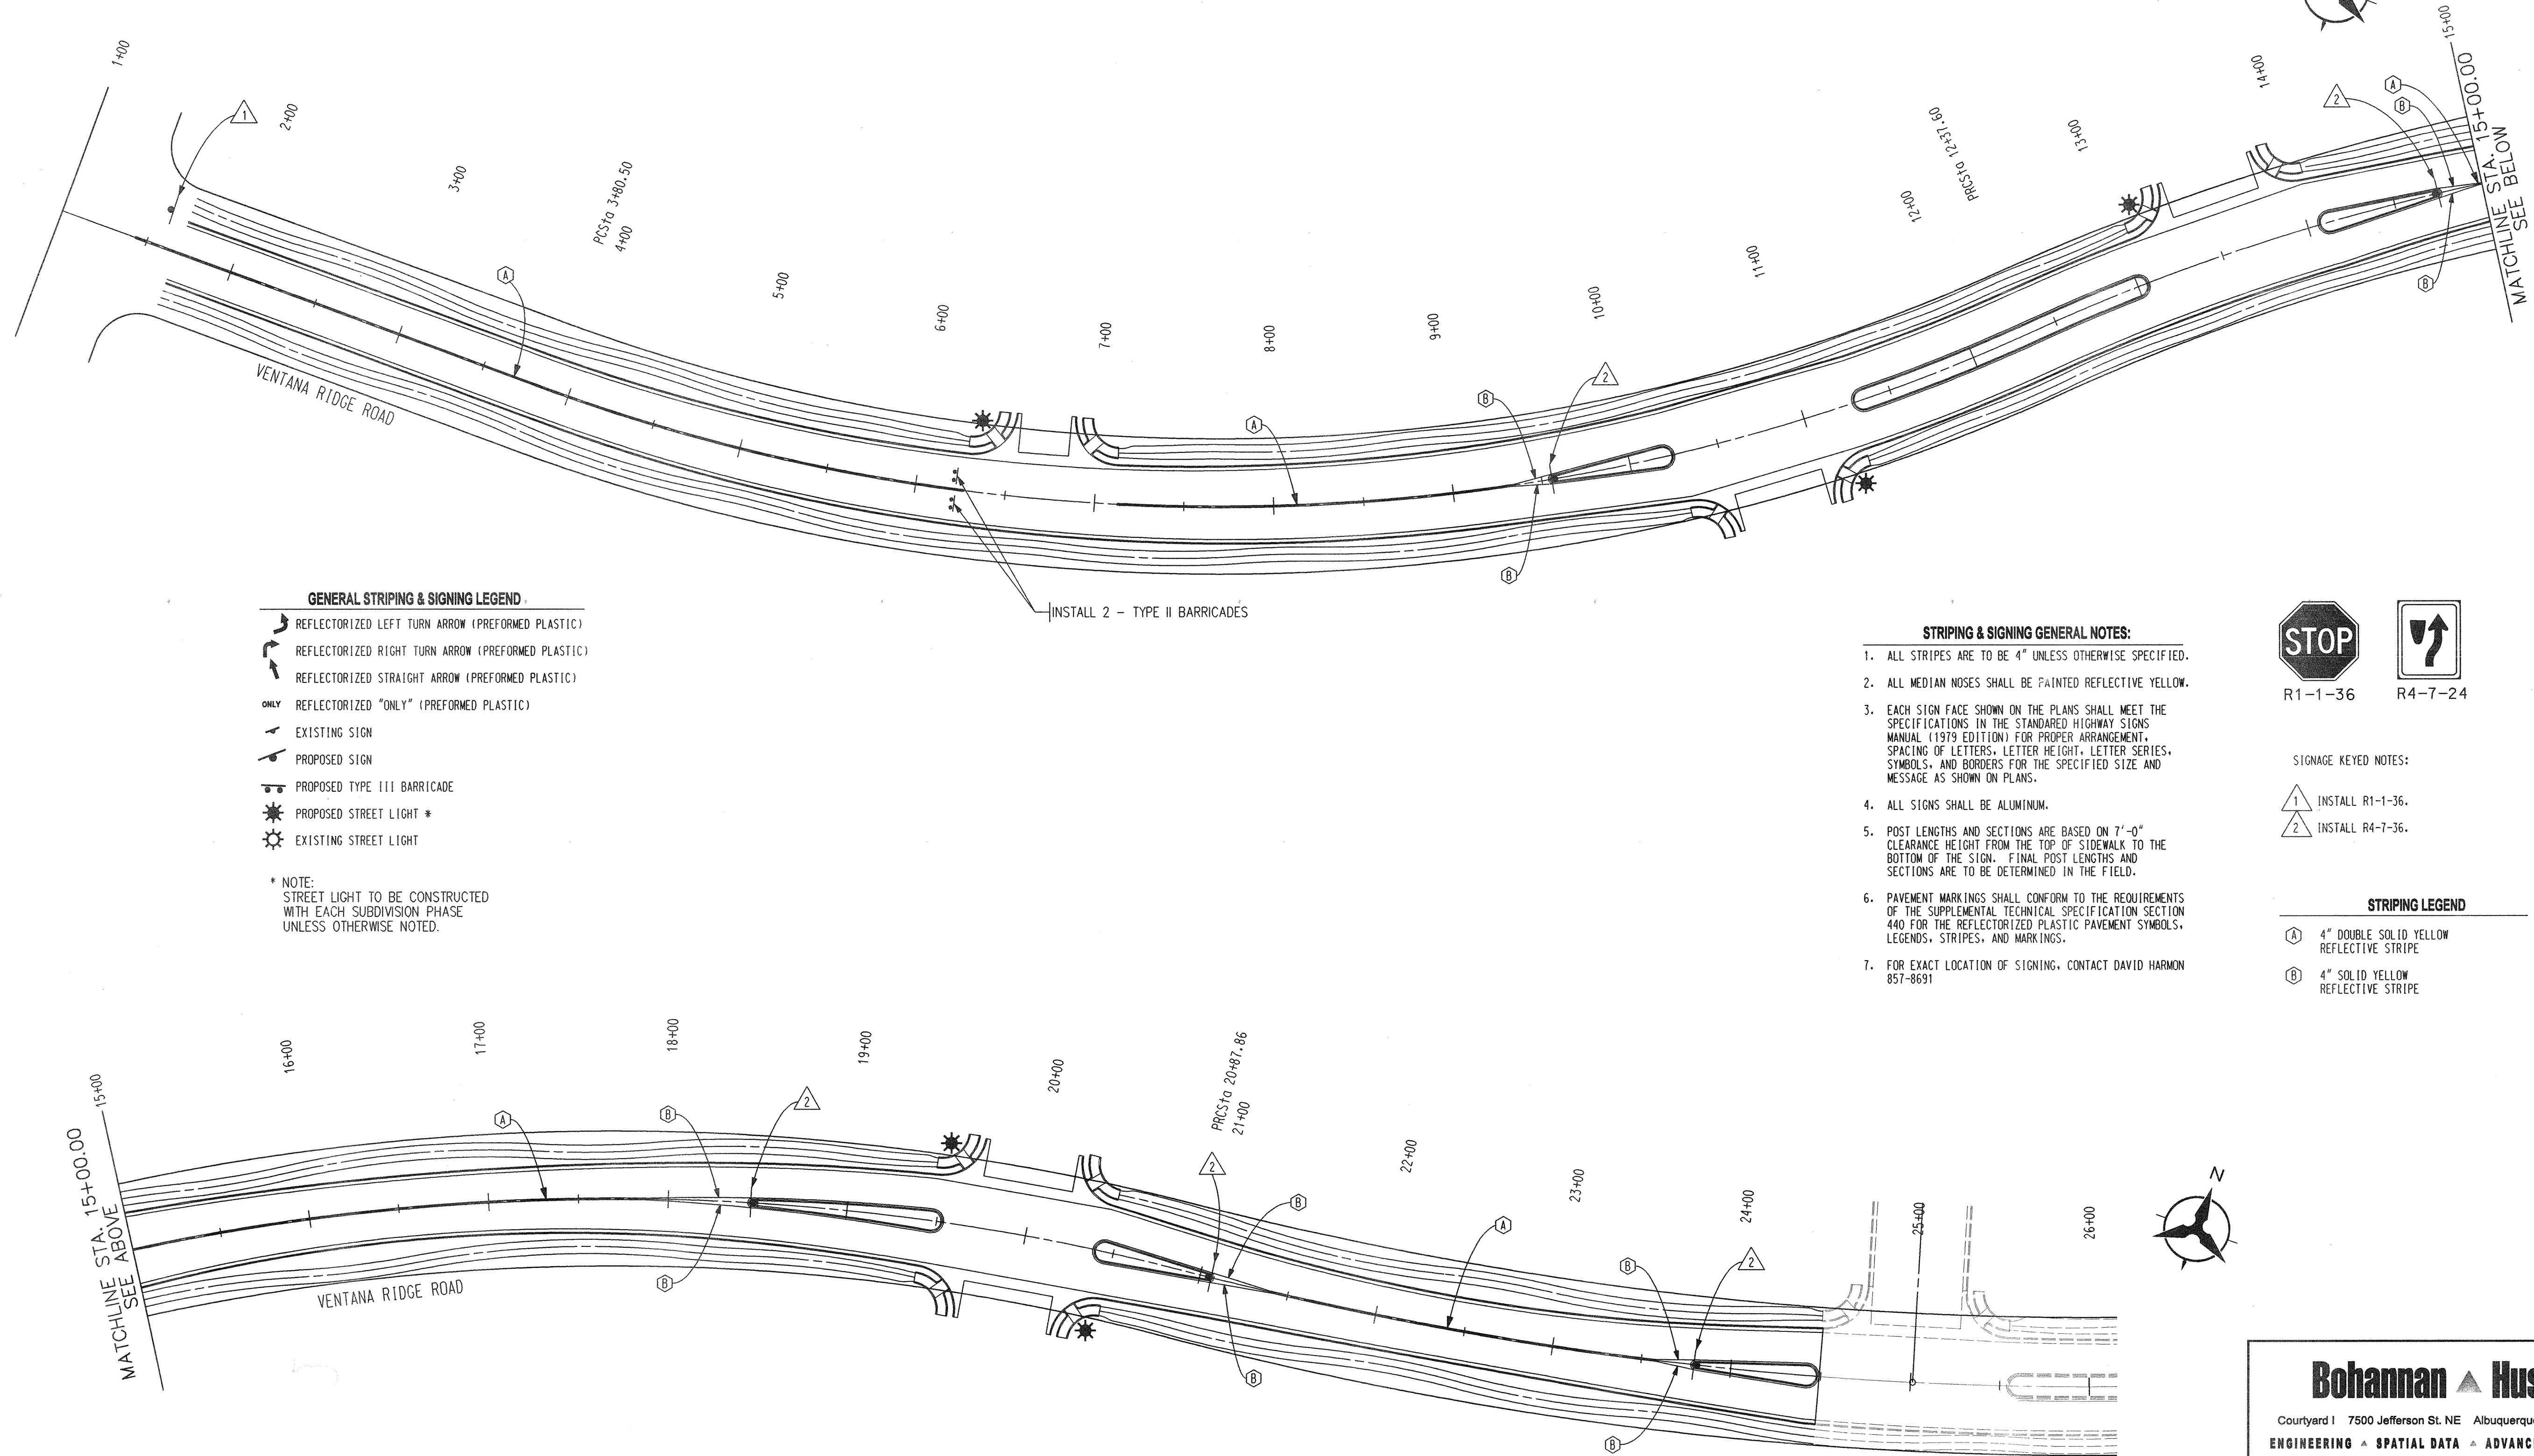


- GENERAL STRIPING & SIGNING LEGEND**
- REFLECTORIZED LEFT TURN ARROW (PERFORMED PLASTIC)
 - REFLECTORIZED RIGHT TURN ARROW (PERFORMED PLASTIC)
 - REFLECTORIZED STRAIGHT ARROW (PERFORMED PLASTIC)
 - ONLY REFLECTORIZED "ONLY" (PERFORMED PLASTIC)
 - EXISTING SIGN
 - PROPOSED SIGN
 - PROPOSED TYPE III BARRICADE
 - PROPOSED STREET LIGHT *
 - EXISTING STREET LIGHT

* NOTE:
STREET LIGHT TO BE CONSTRUCTED
WITH EACH SUBDIVISION PHASE
UNLESS OTHERWISE NOTED.

INSTALL 2 - TYPE II BARRICADES


- STRIPING & SIGNING GENERAL NOTES:**
- ALL STRIPES ARE TO BE 4" UNLESS OTHERWISE SPECIFIED.
 - ALL MEDIAN NOSES SHALL BE PAINTED REFLECTIVE YELLOW.
 - EACH SIGN FACE SHOWN ON THE PLANS SHALL MEET THE SPECIFICATIONS IN THE STANDARD HIGHWAY SIGNS MANUAL (1979 EDITION) FOR PROPER ARRANGEMENT, SPACING OF LETTERS, LETTER HEIGHT, LETTER SERIES, SYMBOLS, AND BORDERS FOR THE SPECIFIED SIZE AND MESSAGE AS SHOWN ON PLANS.
 - ALL SIGNS SHALL BE ALUMINUM.
 - POST LENGTHS AND SECTIONS ARE BASED ON 7'-0" CLEARANCE HEIGHT FROM THE TOP OF SIDEWALK TO THE BOTTOM OF THE SIGN. FINAL POST LENGTHS AND SECTIONS ARE TO BE DETERMINED IN THE FIELD.
 - PAVEMENT MARKINGS SHALL CONFORM TO THE REQUIREMENTS OF THE SUPPLEMENTAL TECHNICAL SPECIFICATION SECTION 440 FOR THE REFLECTORIZED PLASTIC PAVEMENT SYMBOLS, LEGENDS, STRIPES, AND MARKINGS.
 - FOR EXACT LOCATION OF SIGNING, CONTACT DAVID HARMON 857-8691

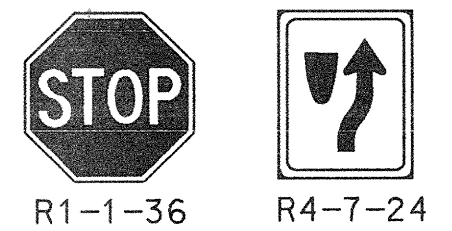

SIGNAGE KEYED NOTES:

- 1 INSTALL R1-1-36.
- 2 INSTALL R4-7-24.

- STRIPING LEGEND**
- A 4" DOUBLE SOLID YELLOW REFLECTIVE STRIPE
 - B 4" SOLID YELLOW REFLECTIVE STRIPE

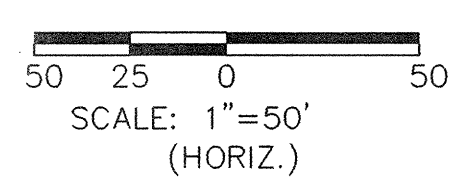

Bohannon & Huston

Courtyard I 7500 Jefferson St. NE Albuquerque, NM 87109-4335

ENGINEERING • SPATIAL DATA • ADVANCED TECHNOLOGIES

CITY OF ALBUQUERQUE

PUBLIC WORKS DEPARTMENT

ENGINEERING DEVELOPMENT GROUP

BACKBONE ROADWAY & STORM DRAIN IMPROVEMENTS - PHASE 2

SIGNING AND STRIPING PLAN

DESIGN REVIEW COMMITTEE

SEP 16 2004

DESIGN REVIEW COMMITTEE

CITY PROJECT NO. 617685

ZONE MAP NO. B-8-Z

SHEET 11 OF 12

DESIGNED BY KGP/JPP

DRAWN BY BS/ARR

CHECKED BY KGP

DATE 3/2004

DATE 3/2004

DATE 3/2004

REMARKS

REVISIONS


DESIGN

APPROVE

CITY ENGINEER APPROVAL


LAST DESIGN UPDATE

SCANNED BY PLW

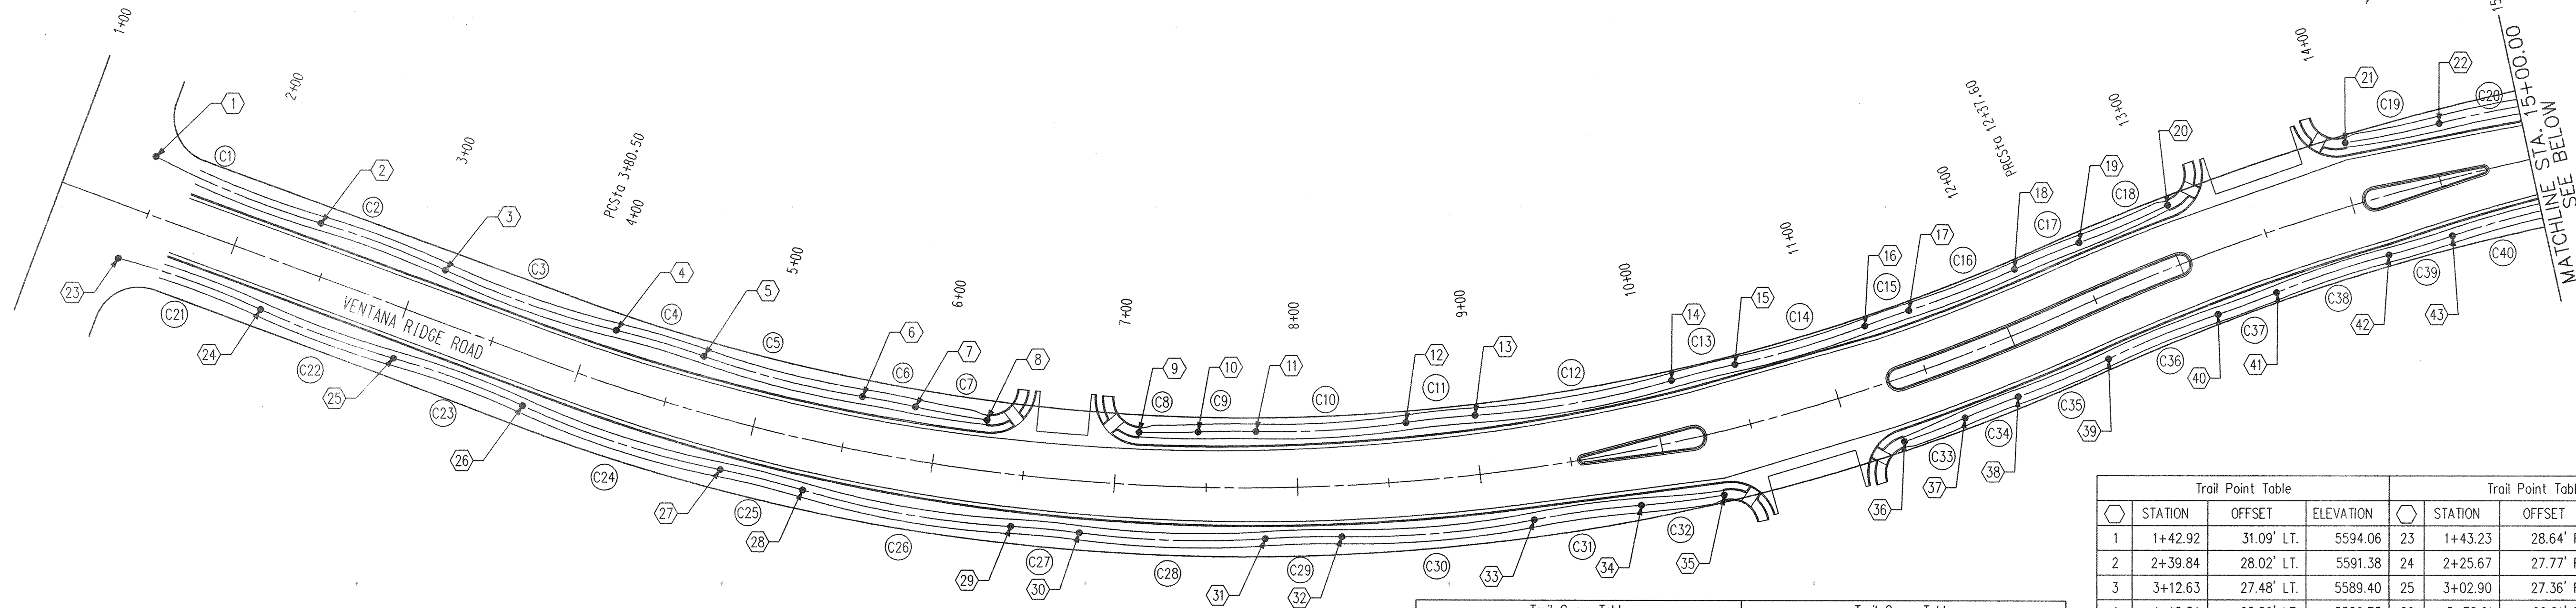


Trail Curve Table					Trail Curve Table				
ID	ARC	RADIUS	DELTA	TANGENT	ID	ARC	RADIUS	DELTA	TANGENT
C1	97.12'	500.00'	11°07'46"	48.71'	C21	82.54'	500.00'	09°27'30"	41.36'
C2	72.86'	500.00'	08°20'55"	36.49'	C22	77.31'	500.00'	08°51'31"	38.73'
C3	99.04'	500.00'	11°20'58"	49.68'	C23	75.18'	500.00'	08°36'56"	37.66'
C4	49.82'	500.00'	05°42'31"	24.93'	C24	113.35'	500.00'	12°59'21"	56.92'
C5	89.64'	500.00'	10°16'21"	44.94'	C25	46.51'	500.00'	05°19'46"	23.27'
C6	29.46'	500.00'	03°22'34"	14.73'	C26	115.65'	500.00'	13°15'10"	58.08'
C7	39.77'	500.00'	04°33'28"	19.90'	C27	37.68'	500.00'	04°19'04"	18.85'
C8	31.98'	500.00'	03°39'54"	16.00'	C28	101.38'	500.00'	11°37'03"	50.87'
C9	31.53'	500.00'	03°36'46"	15.77'	C29	42.18'	500.00'	04°50'00"	21.10'
C10	82.29'	500.00'	09°25'46"	41.24'	C30	105.54'	500.00'	12°05'38"	52.97'
C11	37.93'	500.00'	04°20'48"	18.97'	C31	58.83'	500.00'	06°44'28"	29.45'
C12	108.89'	500.00'	12°28'40"	54.66'	C32	45.51'	500.00'	05°12'54"	22.77'
C13	35.64'	500.00'	04°05'02"	17.83'	C33	35.48'	500.00'	04°03'57"	17.75'
C14	74.26'	500.00'	08°30'33"	37.20'	C34	31.05'	500.00'	03°33'30"	15.53'
C15	25.38'	500.00'	02°54'28"	12.69'	C35	53.40'	500.00'	06°07'07"	26.72'
C16	61.80'	500.00'	07°04'55"	30.94'	C36	64.58'	500.00'	07°24'02"	32.34'
C17	38.31'	500.00'	04°23'25"	19.17'	C37	33.99'	500.00'	03°53'43"	17.00'
C18	52.49'	500.00'	06°00'54"	26.27'	C38	64.87'	500.00'	07°25'59"	32.48'
C19	52.42'	500.00'	06°00'23"	26.23'	C39	36.41'	500.00'	04°10'21"	18.21'
C20	75.14'	500.00'	08°36'36"	37.64'	C40	136.77'	500.00'	15°40'21"	68.81'

Trail Point Table			Trail Point Table				
STATION	OFFSET	ELEVATION	STATION	OFFSET	ELEVATION		
1	1+42.92	31.09' LT.	5594.06	23	1+43.23	28.64' RT.	5594.01
2	2+39.84	28.02' LT.	5591.38	24	2+25.67	27.77' RT.	5591.76
3	3+12.63	27.48' LT.	5589.40	25	3+02.90	27.36' RT.	5589.66
4	4+12.34	28.89' LT.	5586.73	26	3+78.01	26.81' RT.	5587.62
5	4+63.49	29.68' LT.	5585.36	27	4+88.52	27.08' RT.	5584.61
6	5+55.49	28.83' LT.	5582.82	28	5+33.89	27.38' RT.	5583.38
7	5+85.74	28.69' LT.	5581.99	29	6+46.48	28.43' RT.	5580.34
8	6+26.53	27.62' LT.	5580.85	30	6+83.20	28.39' RT.	5579.35
9	7+11.96	28.70' LT.	5578.55	31	7+81.91	28.07' RT.	5576.66
10	7+44.79	30.20' LT.	5577.58	32	8+23.03	28.12' RT.	5575.54
11	7+77.20	30.76' LT.	5576.80	33	9+25.77	28.46' RT.	5572.76
12	8+61.82	32.03' LT.	5574.51	34	9+83.01	30.17' RT.	5571.20
13	9+00.89	32.16' LT.	5573.44	35	10+27.04	34.20' RT.	5570.01
14	10+12.91	32.79' LT.	5570.39	36	11+26.84	33.14' RT.	5567.31
15	10+49.65	33.20' LT.	5569.38	37	11+61.28	32.06' RT.	5566.36
16	11+26.15	33.10' LT.	5567.32	38	11+91.45	31.90' RT.	5565.54
17	11+52.31	33.12' LT.	5566.63	39	12+43.63	32.38' RT.	5564.13
18	12+15.99	32.89' LT.	5564.89	40	13+09.90	32.89' RT.	5562.35
19	12+54.50	32.12' LT.	5563.84	41	13+45.50	32.78' RT.	5561.41
20	13+05.62	33.14' LT.	5562.48	42	14+11.36	32.06' RT.	5559.59
21	14+05.92	33.94' LT.	5559.76	43	14+48.70	31.15' RT.	5558.60
22	14+56.89	30.43' LT.	5558.38				

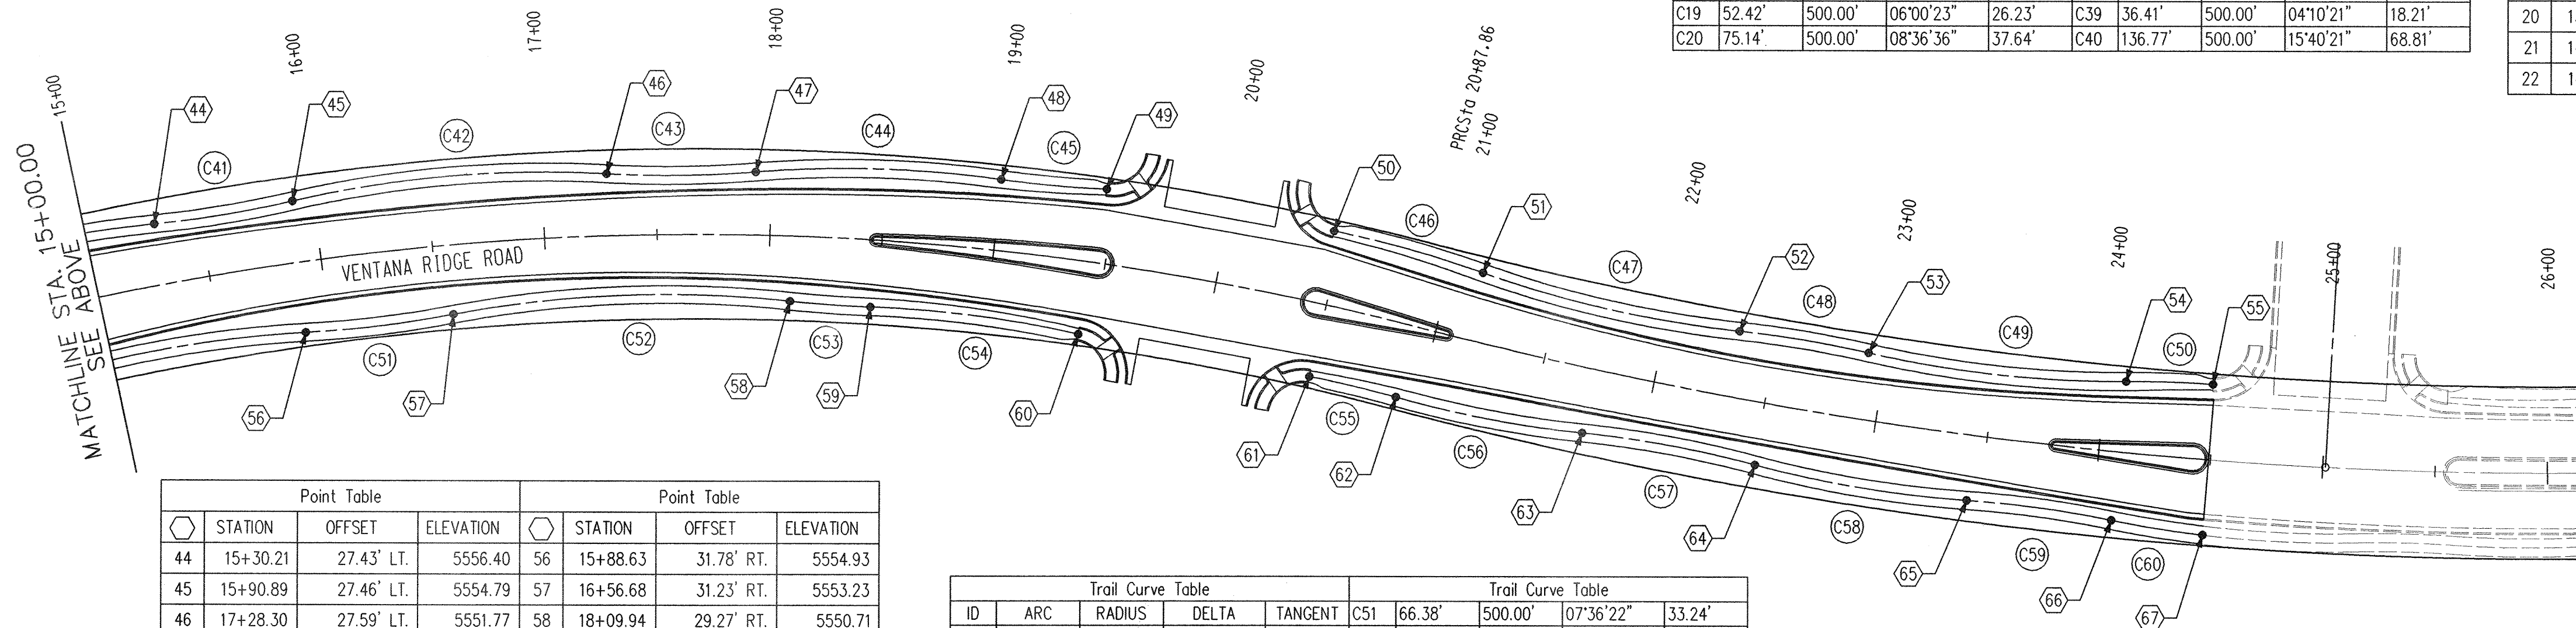

Point Table			Point Table				
STATION	OFFSET	ELEVATION	STATION	OFFSET	ELEVATION		
44	15+30.21	27.43' LT.	5556.40	56	15+88.63	31.78' RT.	5554.93
45	15+90.89	27.46' LT.	5554.79	57	16+56.68	31.23' RT.	5553.23
46	17+28.30	27.59' LT.	5551.77	58	18+09.94	29.27' RT.	5550.71
47	17+93.10	28.07' LT.	5550.87	59	18+46.65	30.18' RT.	5550.32
48	18+99.88	31.63' LT.	5549.77	60	19+42.48	32.96' RT.	5549.33
49	19+45.95	33.12' LT.	5549.29	61	20+49.82	32.94' RT.	5548.23
50	20+46.01	33.21' LT.	5548.27	62	20+90.16	32.61' RT.	5547.87
51	21+13.89	31.01' LT.	5547.63	63	21+73.44	28.70' RT.	5547.02
52	22+33.17	29.49' LT.	5546.51	64	22+50.52	27.71' RT.	5546.31
53	22+92.18	29.62' LT.	5545.97	65	23+44.48	28.94' RT.	5545.95
54	24+09.25	31.40' LT.	5544.85	66	24+08.55	30.38' RT.	5544.84
55	24+48.57	33.46' LT.	5544.49	67	24+48.97	33.35' RT.	5544.49

Trail Curve Table					Trail Curve Table				
ID	ARC	RADIUS	DELTA	TANGENT	C51	66.38'	500.00'	07°36'22"	33.24'
C41	62.05'	500.00'	07°06'36"	31.06'	C52	150.03'	500.00'	17°11'33"	75.58'
C42	140.84'	500.00'	16°08'20"	70.89'	C53	35.85'	500.00'	04°06'31"	17.93'
C43	66.28'	500.00'	07°35'42"	33.19'	C54	93.57'	500.00'	10°43'20"	46.92'
C44	109.57'	500.00'	12°33'22"	55.01'	C55	39.39'	500.00'	04°30'48"	19.70'
C45	47.30'	500.00'	05°25'14"	23.67'	C56	84.75'	500.00'	09°42'42"	42.48'
C46	68.65'	500.00'	07°51'59"	34.38'	C57	78.24'	500.00'	08°57'58"	39.20'
C47	117.74'	500.00'	13°29'32"	59.14'	C58	95.43'	500.00'	10°56'09"	47.86'
C48	58.17'	500.00'	06°39'55"	29.12'	C59	65.08'	500.00'	07°27'27"	32.58'
C49	115.54'	500.00'	13°14'23"	58.03'	C60	41.18'	500.00'	04°43'09"	20.60'
C50	38.74'	500.00'	04°26'22"	19.38'					

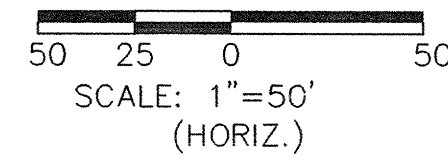

Bohannon & Huston
Courtyard | 7500 Jefferson St. NE | Albuquerque, NM 87109-4335
ENGINEERING • SPATIAL DATA • ADVANCED TECHNOLOGIES

CITY OF ALBUQUERQUE
PUBLIC WORKS DEPARTMENT
ENGINEERING DEVELOPMENT GROUP
BACKBONE ROADWAY & STORM DRAIN IMPROVEMENTS - PHASE 2
TRAIL PLAN

DESIGNED BY KGP/JPP
DRAWN BY BS/ARR
CHECKED BY KGP

DATE 3/2004
DATE 3/2004
DATE 3/2004

APPROVED
SEP 16 2004
DESIGN REVIEW COMMITTEE

CITY ENGINEER APPROVAL

CITY PROJECT NO. 617685

ZONE MAP NO. B-8-Z

SHEET 12 OF 12

ENGINEER'S SEAL		SURVEY INFORMATION		BENCH MARKS		AS-BUILT INFORMATION	
		FIELD NOTES		ACCS BRASS TABLE STAMPED "2-BIO 1980"		CONTRACTOR: Sundance	
NO. DATE		BY DATE		GEOGRAPHIC POSITION (NAD 1927)		WORK BY: [Signature]	
REVISIONS		NO. BY		N.M. STATE PLANE COORDINATES		ACCEPTANCE BY: [Signature]	
DESIGN		NO. BY		(CENTRAL ZONE)		FIELD BY: [Signature]	
CITY PROJECT NO. 617685		NO. BY		X=357,543.73 Y=1,527,976.48		DATE 12-05	
ZONE MAP NO. B-8-Z		NO. BY		DELTA ALPHA -00°16'30"		DATE 12-05	
SHEET 12 OF 12		NO. BY		GROUND-TO-GRID FACTOR = .99966354		DATE 12-05	
BHI JOB NO. 04 0237		NO. BY		DELTA ALPHA -00°16'30"		DATE 12-05	
		NO. BY		NOVD 1929 ELEVATION = 5429.35		DATE 12-05	