

SCANNED BY
MESA REPRO

CONSTRUCTION PLANS FOR VENTANA RANCH WEST BACKBONE WATER & SANITARY SEWER IMPROVEMENTS - PHASE 2 ALBUQUERQUE, NEW MEXICO


INDEX

SHEET NUMBER	DESCRIPTION
1	TITLE SHEET
2 - 4	PLAT
5	SITE DESCRIPTION PLAN
6	OVERALL UTILITY PLAN
	UTILITY PLAN AND PROFILE SHEETS
7	VENTANA RIDGE ROAD STA. 0+00.00 - 10+00.00
8	VENTANA RIDGE ROAD STA. 10+00.00 - 19+00.00
9	VENTANA RIDGE ROAD STA. 19+00.00 - 25+00.00
10	DEL OESTE STA. 0+00.00 - 11+00.00
11	DEL OESTE STA. 11+00.00 - 22+00.00
12	DEL OESTE STA. 22+00.00 - 32+00.00
13	DEL OESTE STA. 32+00.00 - 35+00.00 NORTH BOUNDARY WL STA. 60+00 - 66+00

SURVEYOR'S CERTIFICATION


"I, Timothy Aldrich, a duly qualified Registered Professional Land Surveyor under the laws of the State of New Mexico, do hereby certify that the 'as-built' information shown on these drawings was obtained from field construction and 'as-built' surveys performed by me or under my supervision, that the 'as-built' information shown on these drawings was added by me or under my supervision, and that this 'as-built' information is true and correct to the best of my knowledge and belief." Aldrich Land Surveying is not responsible for any of the design concepts, calculations, engineering or intent of the record drawings.

Timothy Aldrich, P.S. No. 7719 Date 8-31-04

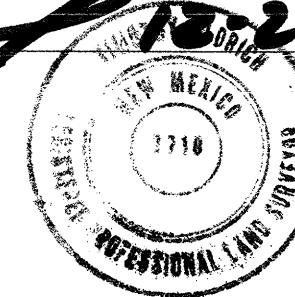

Bohannon & Huston

Courtyard I 7500 Jefferson St. NE Albuquerque, NM 87109-4335
ENGINEERING • SPATIAL DATA • ADVANCED TECHNOLOGIES

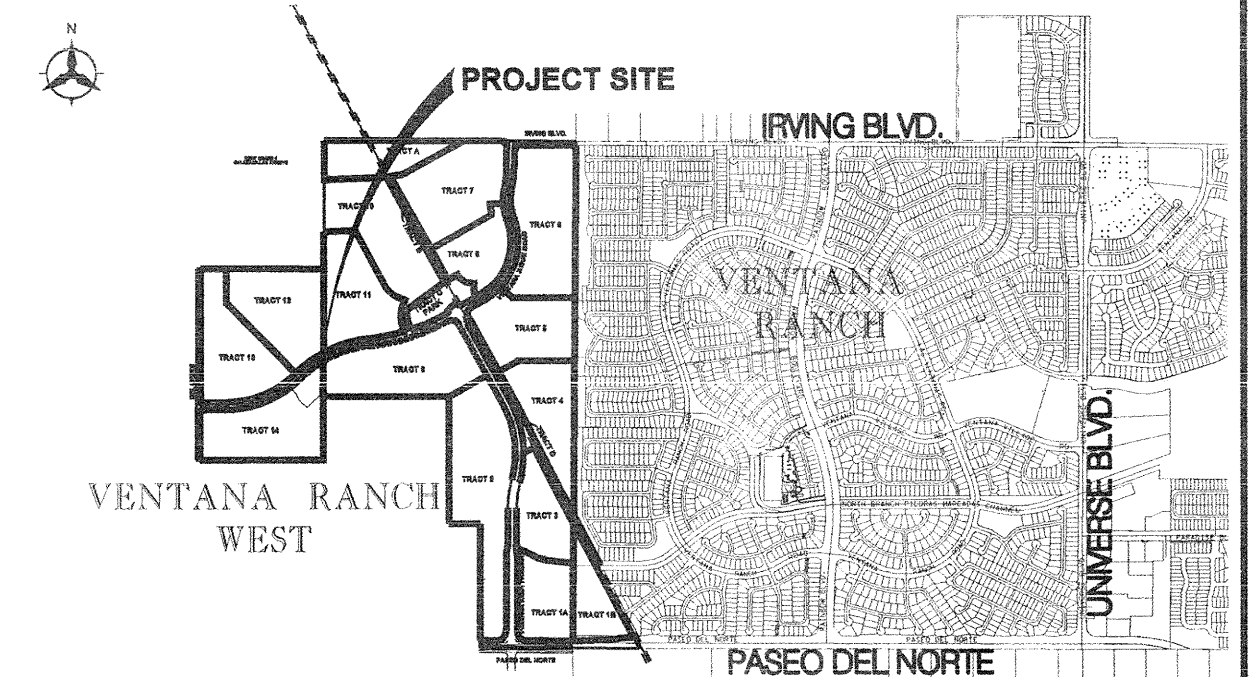


VICINITY MAP: NOT TO SCALE ZONE MAP NO. B-8-Z

NOTICE TO CONTRACTORS

- ALL WORK DETAILED ON THESE PLANS TO BE PERFORMED UNDER CONTRACT SHALL, EXCEPT AS OTHERWISE STATED OR PROVIDED FOR HEREON, BE CONSTRUCTED IN ACCORDANCE WITH THE CITY OF ALBUQUERQUE STANDARD SPECIFICATIONS FOR PUBLIC WORKS CONSTRUCTION, 1986 EDITION AND SHALL INCLUDE UPDATE No. 7.
- TWO WORKING DAYS PRIOR TO ANY EXCAVATION, THE CONTRACTOR MUST CONTACT NEW MEXICO ONE CALL SYSTEM (260-1990) FOR LOCATION OF EXISTING UTILITIES.
- PRIOR TO CONSTRUCTION, THE CONTRACTOR SHALL EXCAVATE AND VERIFY THE HORIZONTAL AND VERTICAL LOCATIONS OF ALL OBSTRUCTIONS. SHOULD A CONFLICT EXIST, THE CONTRACTOR SHALL NOTIFY THE ENGINEER OR SURVEYOR IMMEDIATELY SO THAT THE CONFLICT CAN BE RESOLVED WITH A MINIMUM AMOUNT OF DELAY.
- FIVE (5) WORKING DAYS PRIOR TO BEGINNING CONSTRUCTION, THE CONTRACTOR SHALL SUBMIT TO CONSTRUCTION COORDINATION DIVISION A DETAILED CONSTRUCTION SCHEDULE TWO (2) WORKING DAYS PRIOR TO CONSTRUCTION. THE CONTRACTOR SHALL OBTAIN A BARRICADING PERMIT FROM THE CONST. COORDINATION DIVISION. CONTRACTOR SHALL NOTIFY BARRICADE ENGINEER (924-3400) PRIOR TO OCCUPYING AN INTERSECTION. REFER TO SECTION 19 OF THE GENERAL CONDITIONS OF THE STANDARD SPECIFICATIONS.
- ALL PERMANENT STREET STRIPING ALTERED OR DESTROYED SHALL BE REPLACED W/ PLASTIC REFLECTORIZED PAVEMENT MARKING BY CONTRACTOR TO LOCATION AS EXISTING OR AS INDICATED BY THIS PLAN SET.
- CONTRACTOR SHALL NOTIFY THE ENGINEER NOT LESS THAN SEVEN (7) DAYS PRIOR TO STARTING WORK IN ORDER THAT THE CITY SURVEYOR MAY TAKE NECESSARY MEASURES TO INSURE THE PRESERVATION OF SURVEY MONUMENTS. CONTRACTOR SHALL NOT DISTURB PERMANENT SURVEY MONUMENTS WITHOUT THE CONSENT OF THE CITY SURVEYOR AND SHALL NOTIFY THE CITY SURVEYOR AND BEAR THE EXPENSE OF REPLACING ANY THAT MAY BE DISTURBED WITHOUT PERMISSION. REPLACEMENT SHALL BE DONE ONLY BY THE CITY SURVEYOR. WHEN A CHANGE IS MADE IN THE FINISHED ELEVATIONS OF THE PAVEMENT OF ANY ROADWAY IN WHICH A PERMANENT SURVEY MONUMENT IS LOCATED, CONTRACTOR SHALL, AT HIS OWN EXPENSE, ADJUST THE MONUMENT COVER TO THE NEW GRADE, UNLESS OTHERWISE SPECIFIED. REFER TO SECTION 4.4 OF THE GENERAL CONDITIONS OF THE STANDARD SPECIFICATIONS.
- ANY WORK WITHIN AN ARTERIAL ROADWAY REQUIRES TWENTY-FOUR HOUR CONSTRUCTION.
- ALL UTILITY WORK SHALL BE CONSTRUCTED IN ACCORDANCE WITH NEW MEXICO UTILITIES, INC. SPECIFICATIONS FOR WATER AND WASTEWATER FACILITIES (MOST RECENT REVISIONS).
- THE CONTRACTOR SHALL NOTIFY NEW MEXICO UTILITIES (898-2661) THREE WORKING DAYS PRIOR TO BEGINNING THE CONSTRUCTION OF THE UTILITIES.
- CONTRACTOR SHALL MAINTAIN A GRAFFITI-FREE WORK SITE. CONTRACTOR SHALL PROMPTLY REMOVE ANY GRAFFITI FROM ALL EQUIPMENT, WHETHER PERMANENT OR TEMPORARY.
- FOR STORM DRAIN CONSTRUCTION, RCP PIPE JOINTS SHALL NOT BE GROUTED PRIOR TO FINAL INSPECTION. FINAL INSPECTION WILL DETERMINE JOINTS TO BE GROUTED FOR FINAL ACCEPTANCE OF THE CONSTRUCTION.


THE FOLLOWING NOTES ALSO APPLY WHEN CHECKED

- ☒ ALL UTILITIES AND UTILITY SERVICE LINES SHALL BE INSTALLED PRIOR TO PAVING.
- ☒ BACKFILL COMPACTION SHALL BE ACCORDING TO SPECIFIED STREET USE.
- ☐ TACK COAT REQUIREMENTS SHALL BE DETERMINED BY THE ENGINEER.
- ☒ SIDEWALKS AND WHEELCHAIR RAMPS WITHIN THE CURB RETURNS SHALL BE CONSTRUCTED WHEREVER A NEW CURB RETURN IS CONSTRUCTED.
- ☐ IF CURB IS DEPRESSED FOR A DRIVEPAD, THE DRIVEPAD SHALL BE CONSTRUCTED PRIOR TO ACCEPTANCE OF CURB AND GUTTER.
- ☐ ALL STORM DRAINAGE FACILITIES SHALL BE COMPLETED PRIOR TO FINAL ACCEPTANCE.
- ☒ THE REQUESTOR OR DEVELOPER SHALL BE RESPONSIBLE FOR REPAIR OR REPLACEMENT OF ALL CURB AND GUTTER OR SIDEWALK DAMAGED AFTER APPROVAL BY THE CITY ENGINEER OF WORK COMPLETED BY THE CONTRACTOR.

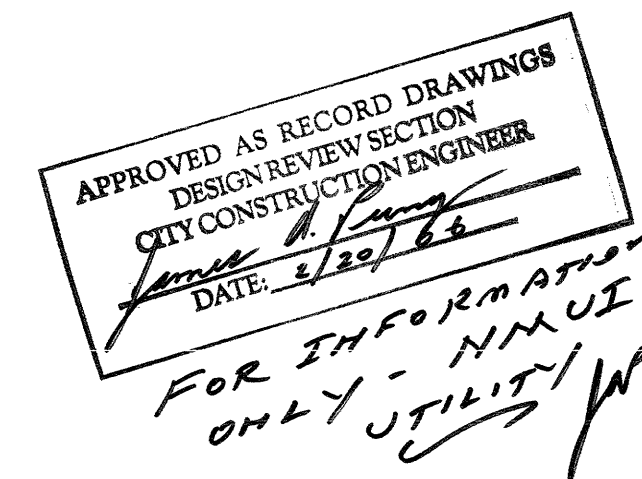

REV.	SHEETS	CITY ENGINEER	DATE	USER DEPARTMENT	DATE	USER DEPARTMENT	DATE
ENGINEERS STAMP & SIGNATURE		APPROVALS	ENGINEER	DATE	*****		
		DRC Chairman		9-16-04	APPROVED FOR CONSTRUCTION		
		Transportation		9/7/04			
		Water/Wastewater		9/7/04			
		Hydrology		9/7/04			
		CIP		9/7/04			
		Const. Mngmt.		9-16-04			
		Const. Coord.		9/16/04			
		NMUI		9/30/04			
DRB CASE NUMBER		CITY PROJECT NO.		SHEET		OF	
1002778		617686		1		13	

SCANNED BY
MESA REPRO

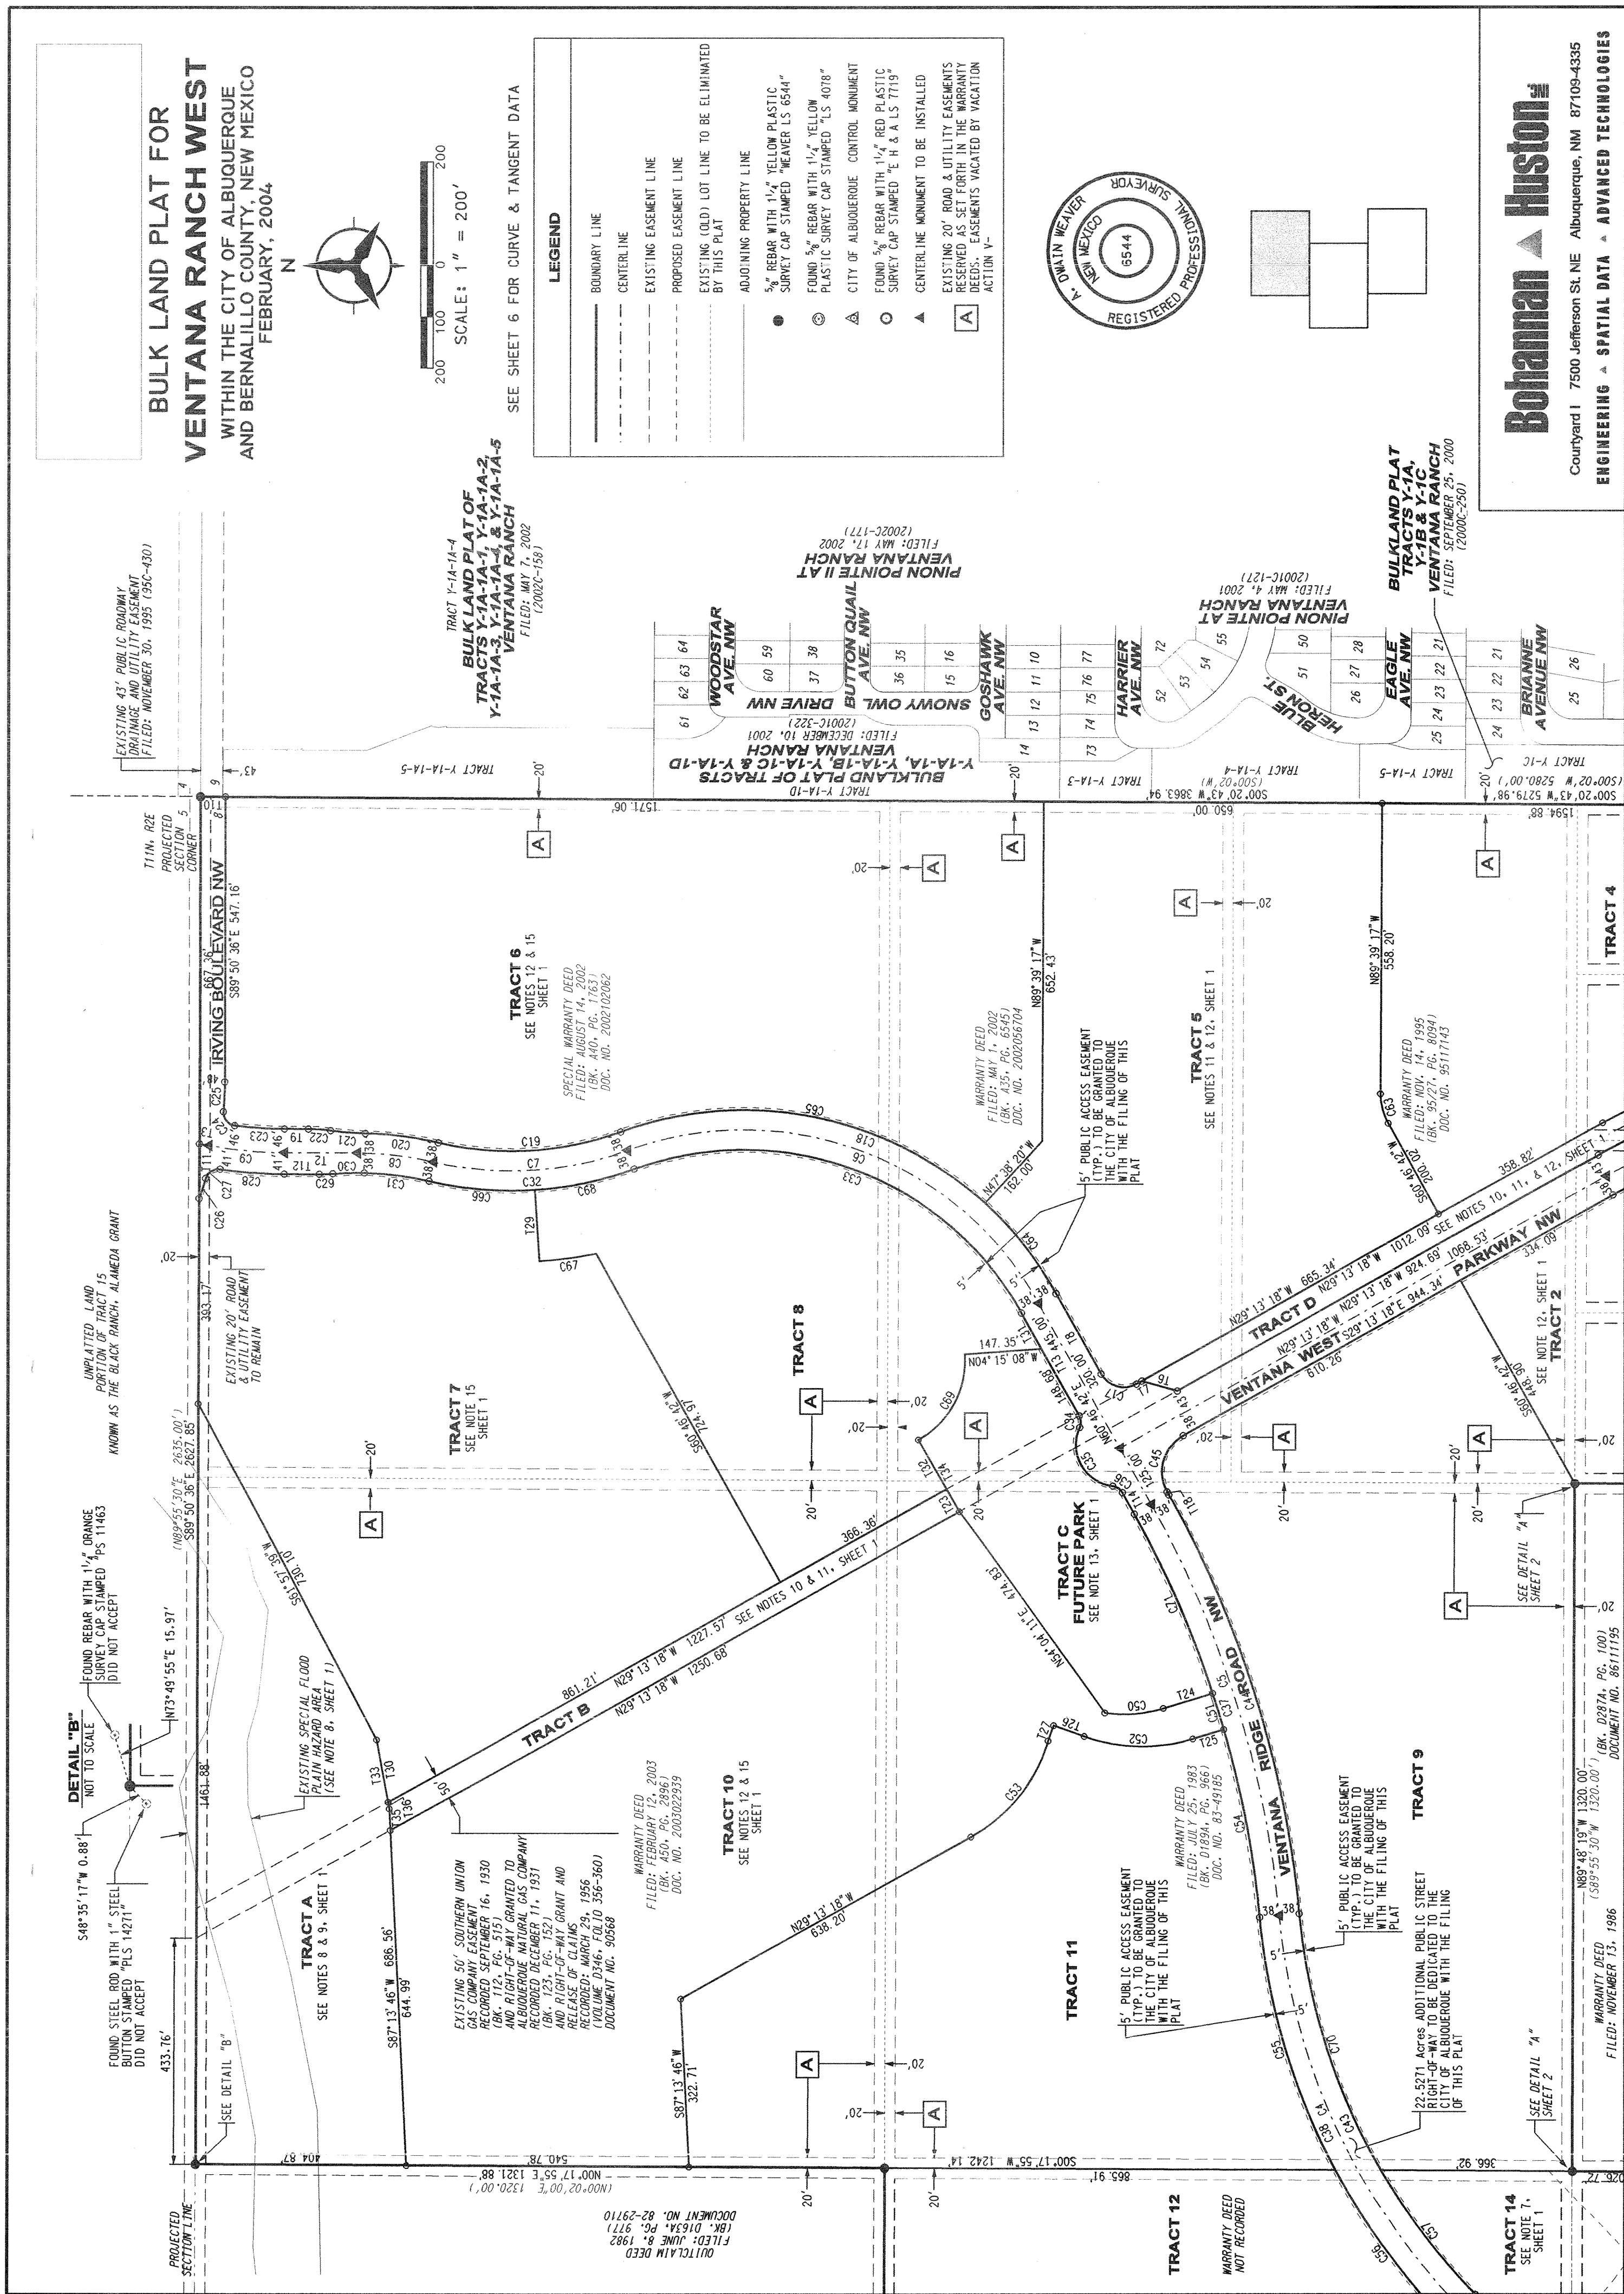

Bohannon & Huston
Courtney I 7500 Jefferson St. NE Albuquerque, NM 87109-4335
ENGINEERING & SPATIAL DATA & ADVANCED TECHNOLOGIES

P:\040237\csp\040237Phase2\NonPD Plans\040237Plan3.dgn
06.06.04
06.06.04
06.06.04

**BULK LAND PLAT FOR
VENTANA RANCH WEST**
WITHIN THE CITY OF ALBUQUERQUE
AND BERNALILLO COUNTY, NEW MEXICO
FEBRUARY, 2004

TRACT AREAS		
TRACT	GROSS AREA	NET AREA
TRACT 1A	11.6875 Acres	11.5885 Acres
TRACT 1B	8.8628 Acres	8.8628 Acres
TRACT 2	28.5843 Acres	28.2884 Acres
TRACT 3	11.2837 Acres	11.1689 Acres
TRACT 4	15.0245 Acres	15.0245 Acres
TRACT 5	15.5785 Acres	15.5241 Acres
TRACT 6	23.4495 Acres	23.2773 Acres
TRACT 7	19.4002 Acres	19.3212 Acres
TRACT 8	10.0424 Acres	9.9124 Acres
TRACT 9	21.1594 Acres	20.9172 Acres
TRACT 10	20.2511 Acres	20.2428 Acres
TRACT 11	16.6044 Acres	16.5035 Acres
TRACT 12	18.2902 Acres	18.2479 Acres
TRACT 13	17.9029 Acres	17.7797 Acres
TRACT 14	19.3506 Acres	19.1856 Acres *
TRACT A	9.7375 Acres	
TRACT B	1.4215 Acres	
TRACT C	4.2840 Acres	3.8875 Acres
TRACT D	3.7177 Acres	
RW	22.5271 Acres	
TOTAL	299.2179 Acres	

* 2 ACRES FOR FUTURE PARK SITE WAS DEPARTMENT FROM TRACT 14 GROSS TOGETHER WITH 5' EASEMENT


CURVE DATA		
ID	DELTA	TANGENT
C1	147.30	278.53
C2	140.01	1100.00
C3	44.38	857.70
C4	38.97	1250.00
C5	39.59	850.00
C6	55.47	916.46
C7	194.01	377.07
C8	33.14	77.07
C9	107.27	800.00
C10	96.30	800.00
C11	96.30	800.00
C12	96.30	800.00
C13	14.16	100.00
C14	14.16	100.00
C15	15.34	310.94
C16	15.34	310.94
C17	50.00	78.54
C18	33.14	77.07
C19	33.14	77.07
C20	11.47	21.44
C21	11.47	21.44
C22	11.47	21.44
C71	11.47	21.44

TANGENT DATA		
ID	BEARING	DISTANCE
T1	N89°39'18" E	56.43
T2	N89°39'18" E	56.43
T3	N89°39'18" E	56.43
T100	N89°39'18" E	56.43

Bohannon & Huston
Courtney I 7500 Jefferson St. NE Albuquerque, NM 87109-4335
ENGINEERING & SPATIAL DATA & ADVANCED TECHNOLOGIES

P:\040237\csp\040237Phase2\NonPD Plans\040237Plan3.dgn
06.06.04
06.06.04
06.06.04

SCANNED BY
MESA REPRO

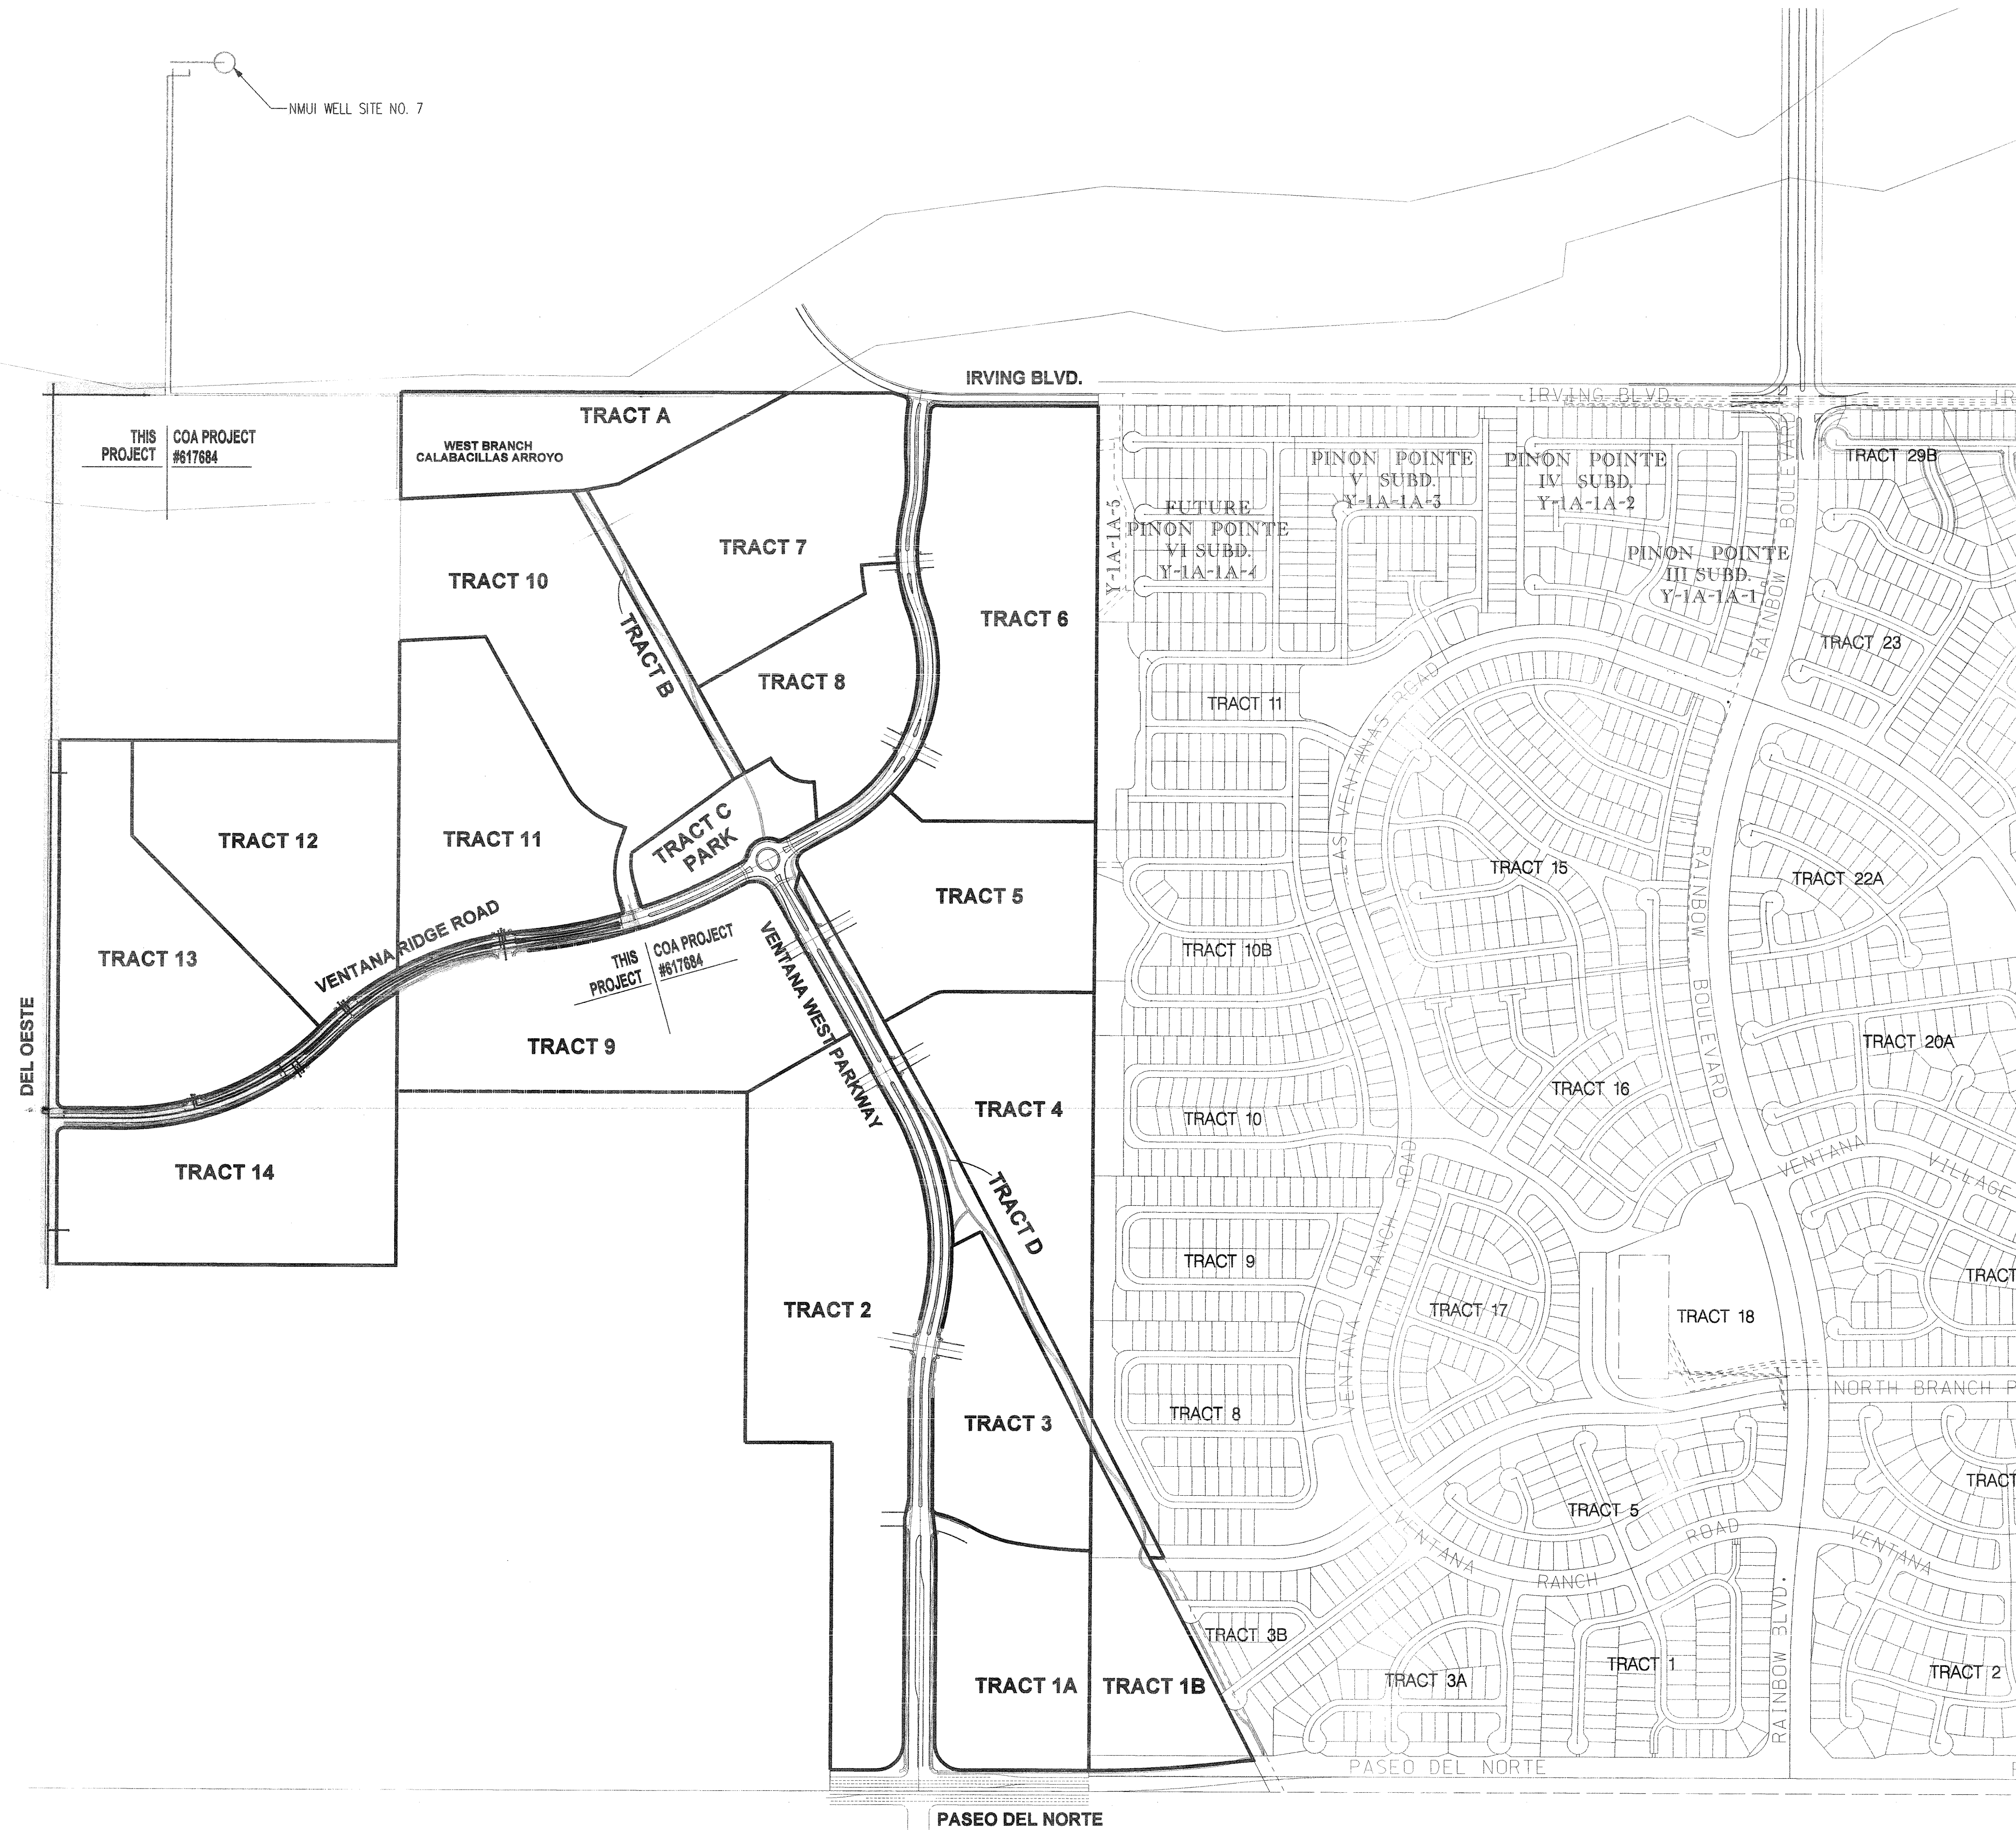

27-AUG-2004
P:\040237\040237Phase2\Map\10_Plan\040237Phase2SITEPLAN.dgn

BHI JOB NO. 04 0237

Bohannon & Huston Court yard 7500 Jefferson St. NE Albuquerque, NM 87109-4335 ENGINEERING • SPATIAL DATA • ADVANCED TECHNOLOGIES	
CITY OF ALBUQUERQUE PUBLIC WORKS DEPARTMENT ENGINEERING DEVELOPMENT GROUP	
BACKBONE WATER & SANITARY SEWER IMPROVEMENTS - PHASE 2 SITE DESCRIPTION PLAN	
DESIGN REVIEW COMMITTEE APPROVED DESIGN REVIEW COMMITTEE	CITY ENGINEER APPROVAL APPROVED CITY ENGINEER
CITY PROJECT NO. 617686	ZONE MAP NO. B-8-Z
SHEET 5	OF 13

ENGINEER'S SEAL James Paul Poorbaugh NEW MEXICO 16586 8-31-04 REGISTERED PROFESSIONAL ENGINEER		SURVEY INFORMATION FIELD NOTES NO. BY DATE		BENCH MARKS ACS BRASS TABLE STAMPED 2-BIO 1980 GEOGRAPHIC POSITION (NAD 1927) N.M. STATE PLANE COORDINATES (CENTRAL ZONE) X=357,543.73 Y=1,527,976.48 GROUND-TO-GRID FACTOR = .99966354 DELTA ALPHA = 0016'30" NGVD 1929 ELEVATION = 5429.35		AS-BUILT INFORMATION CONTRACTOR Sundance INSPECTOR'S STAMPED BY DATE 12/05 VERIFICATION BY DATE 12/05 DRAWN BY DATE 12/05 RECORDED BY DATE NO.	
NO. DATE REMARKS BY		DESIGNED BY KGP /JPP DATE 3/2004		DRAWN BY BS DATE 3/2004		CHECKED BY KGP DATE 3/2004	

27-AUG-2004
P:\040237\cdp\040237Phase2\NonPID Plans\040237Ph20UTIL.dwg



APPROVED:  DATE: 1/31/04




BACKBONE WATER & SANITARY SEWER IMPROVEMENTS - PHASE 2
OVERALL UTILITY PLAN


CITY PROJECT NO.	ZONE MAP NO.	SHEET	OF
617686	B-8-Z	6	13

[illegible]

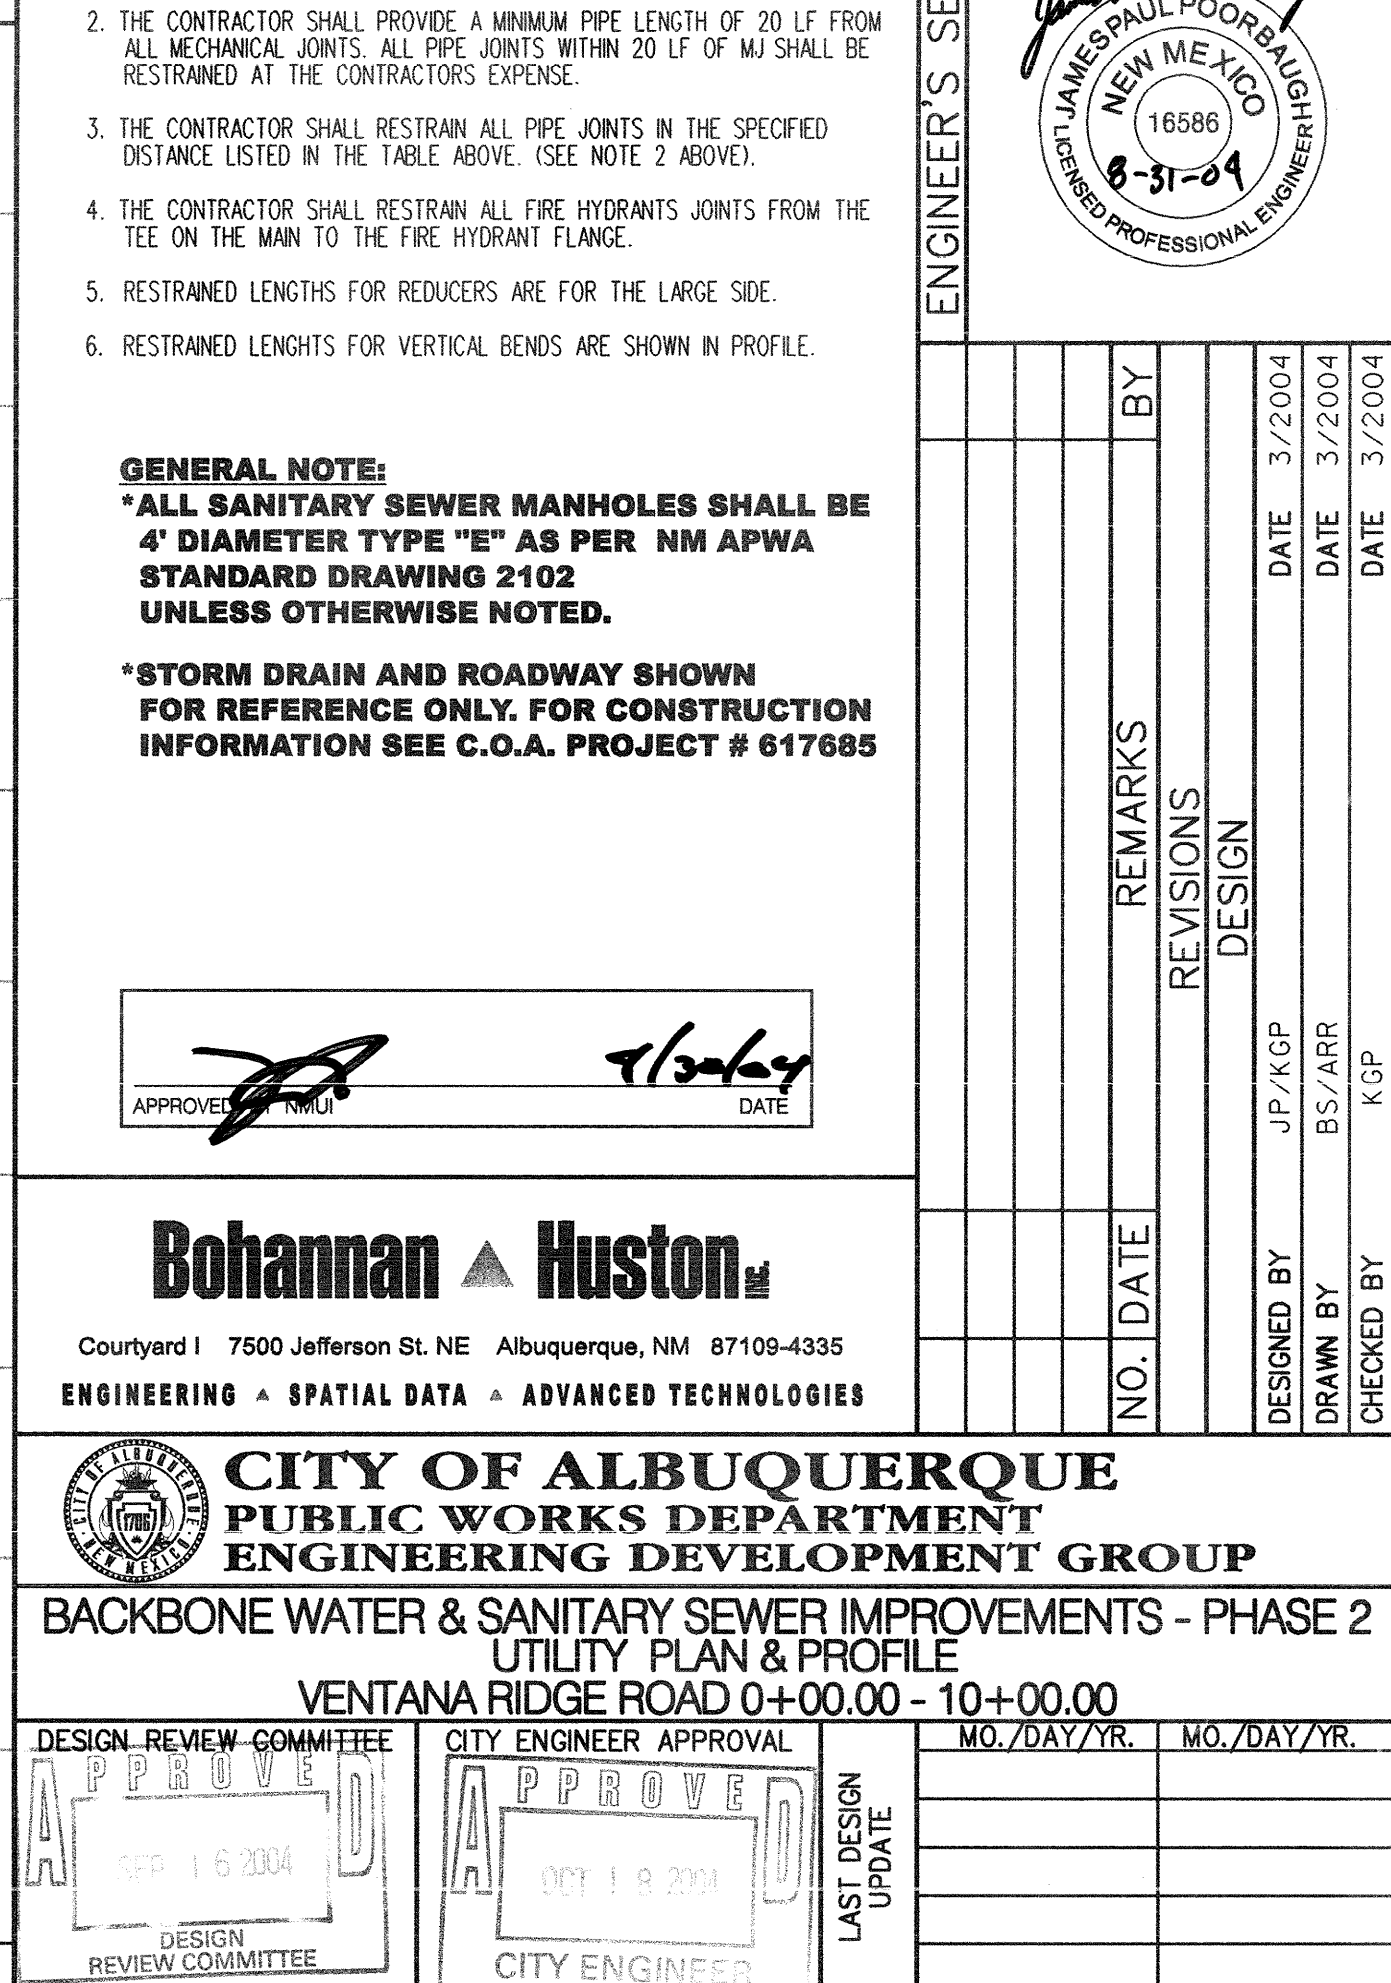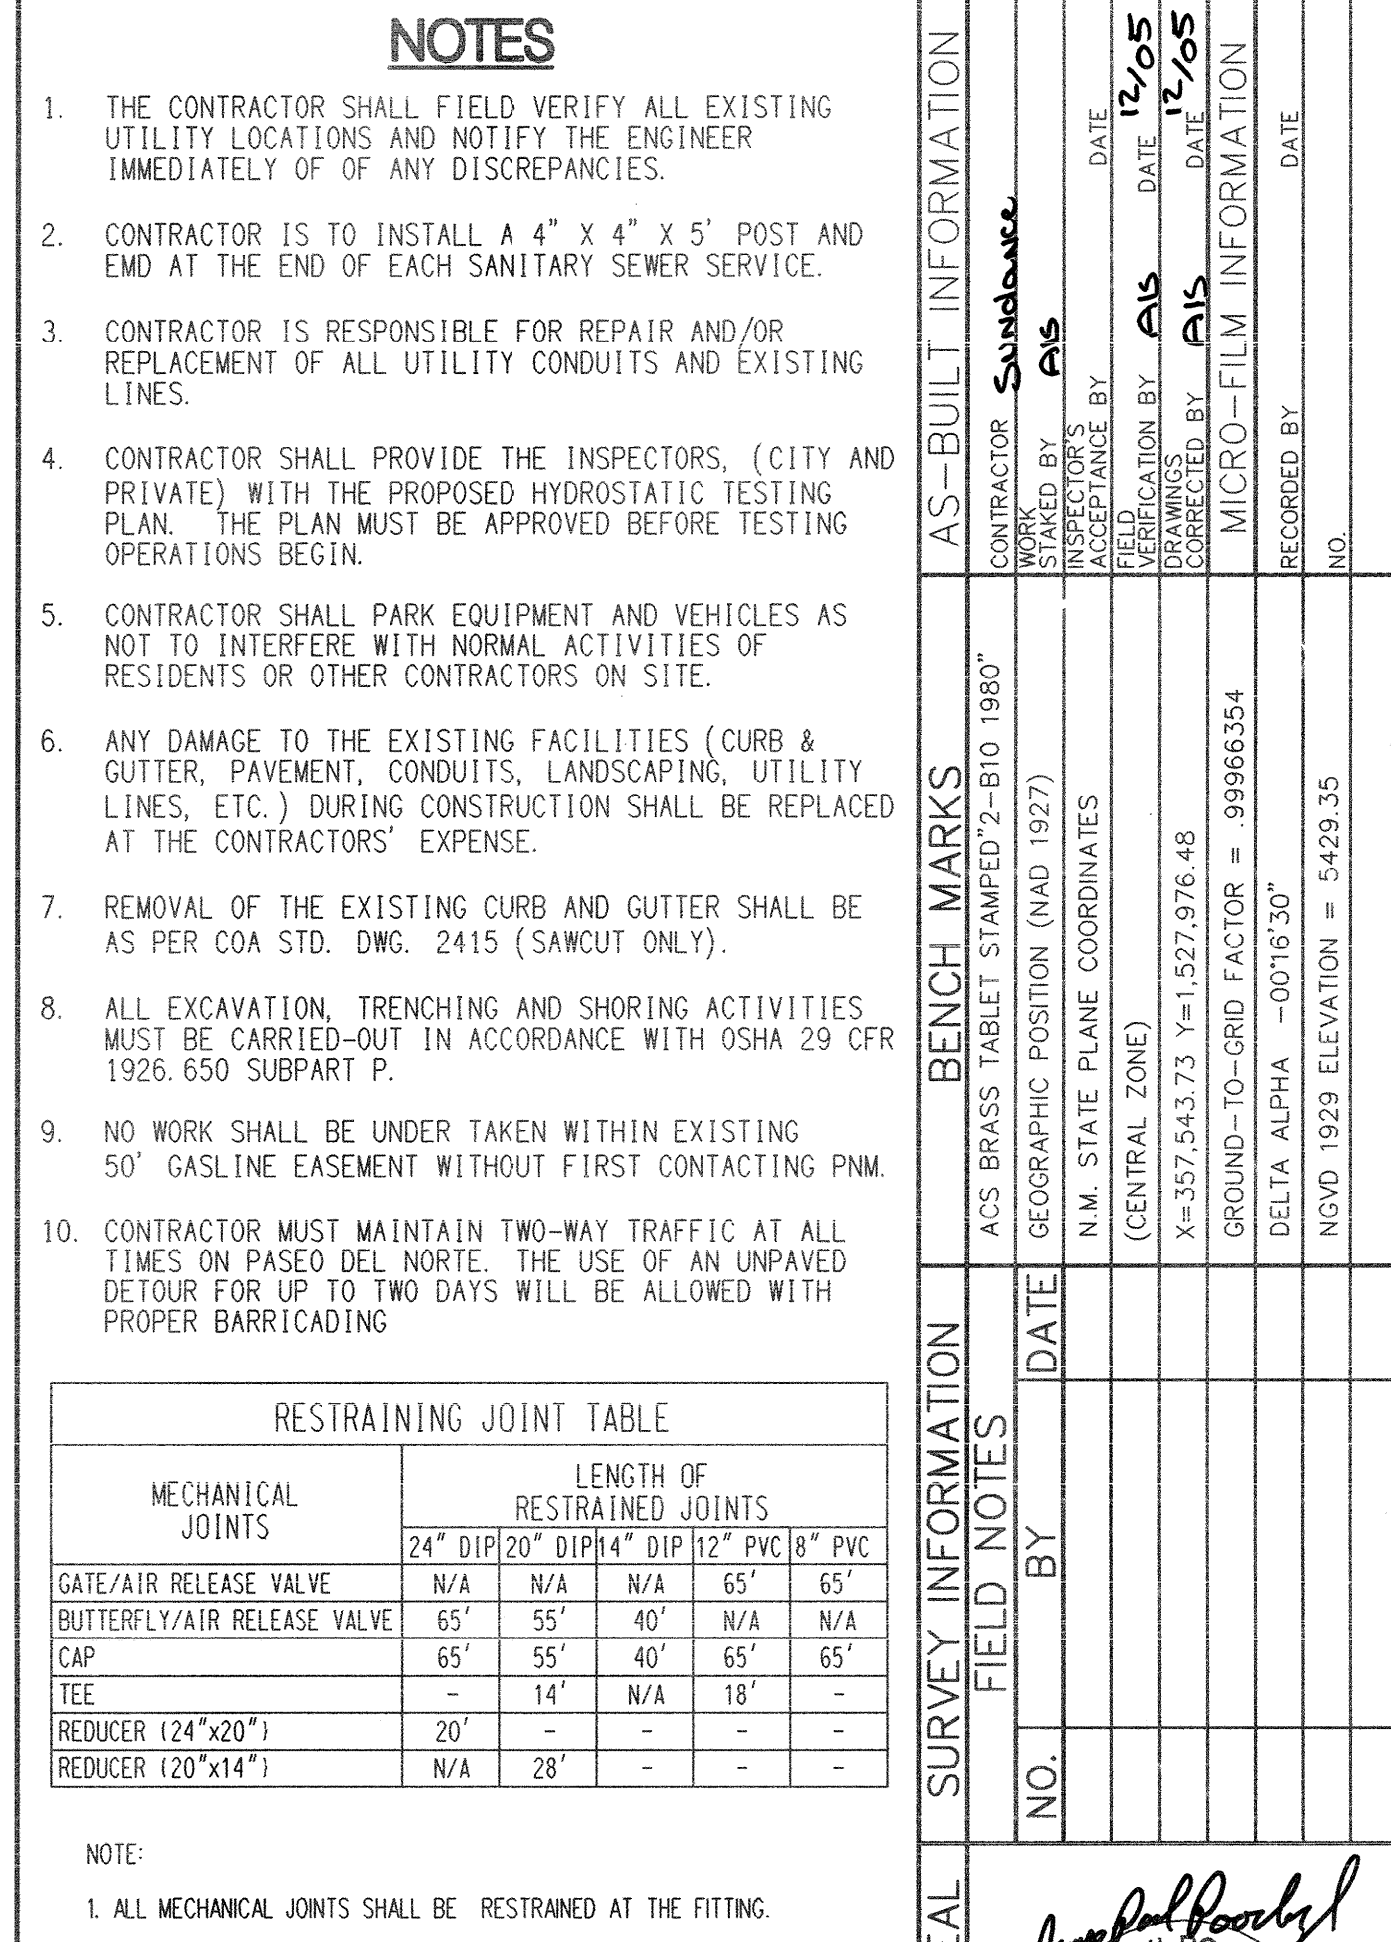

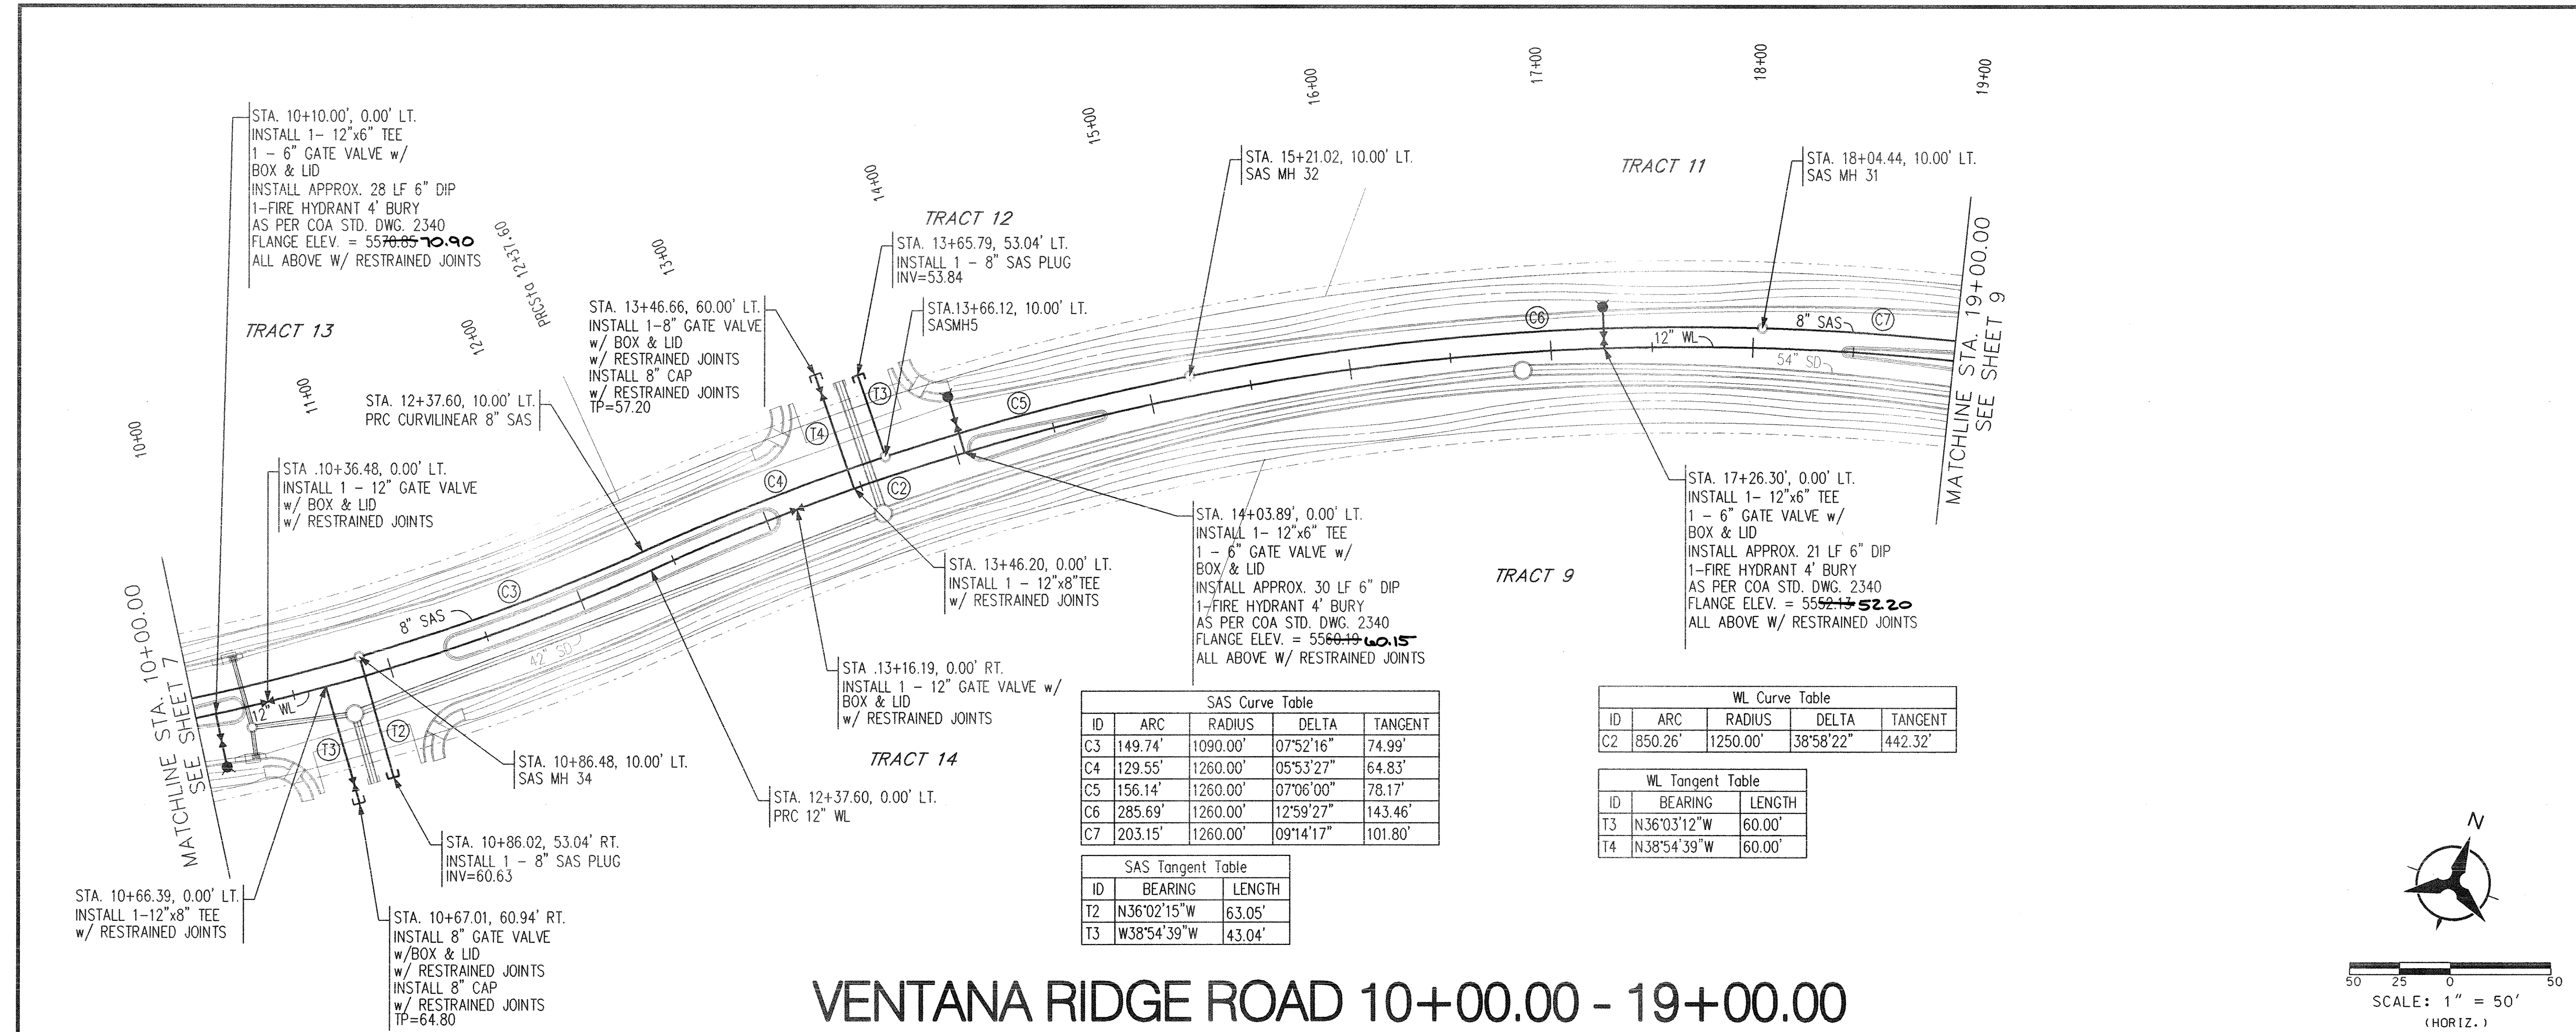

VENTANA RIDGE ROAD 10+00.00 - 19+00.00

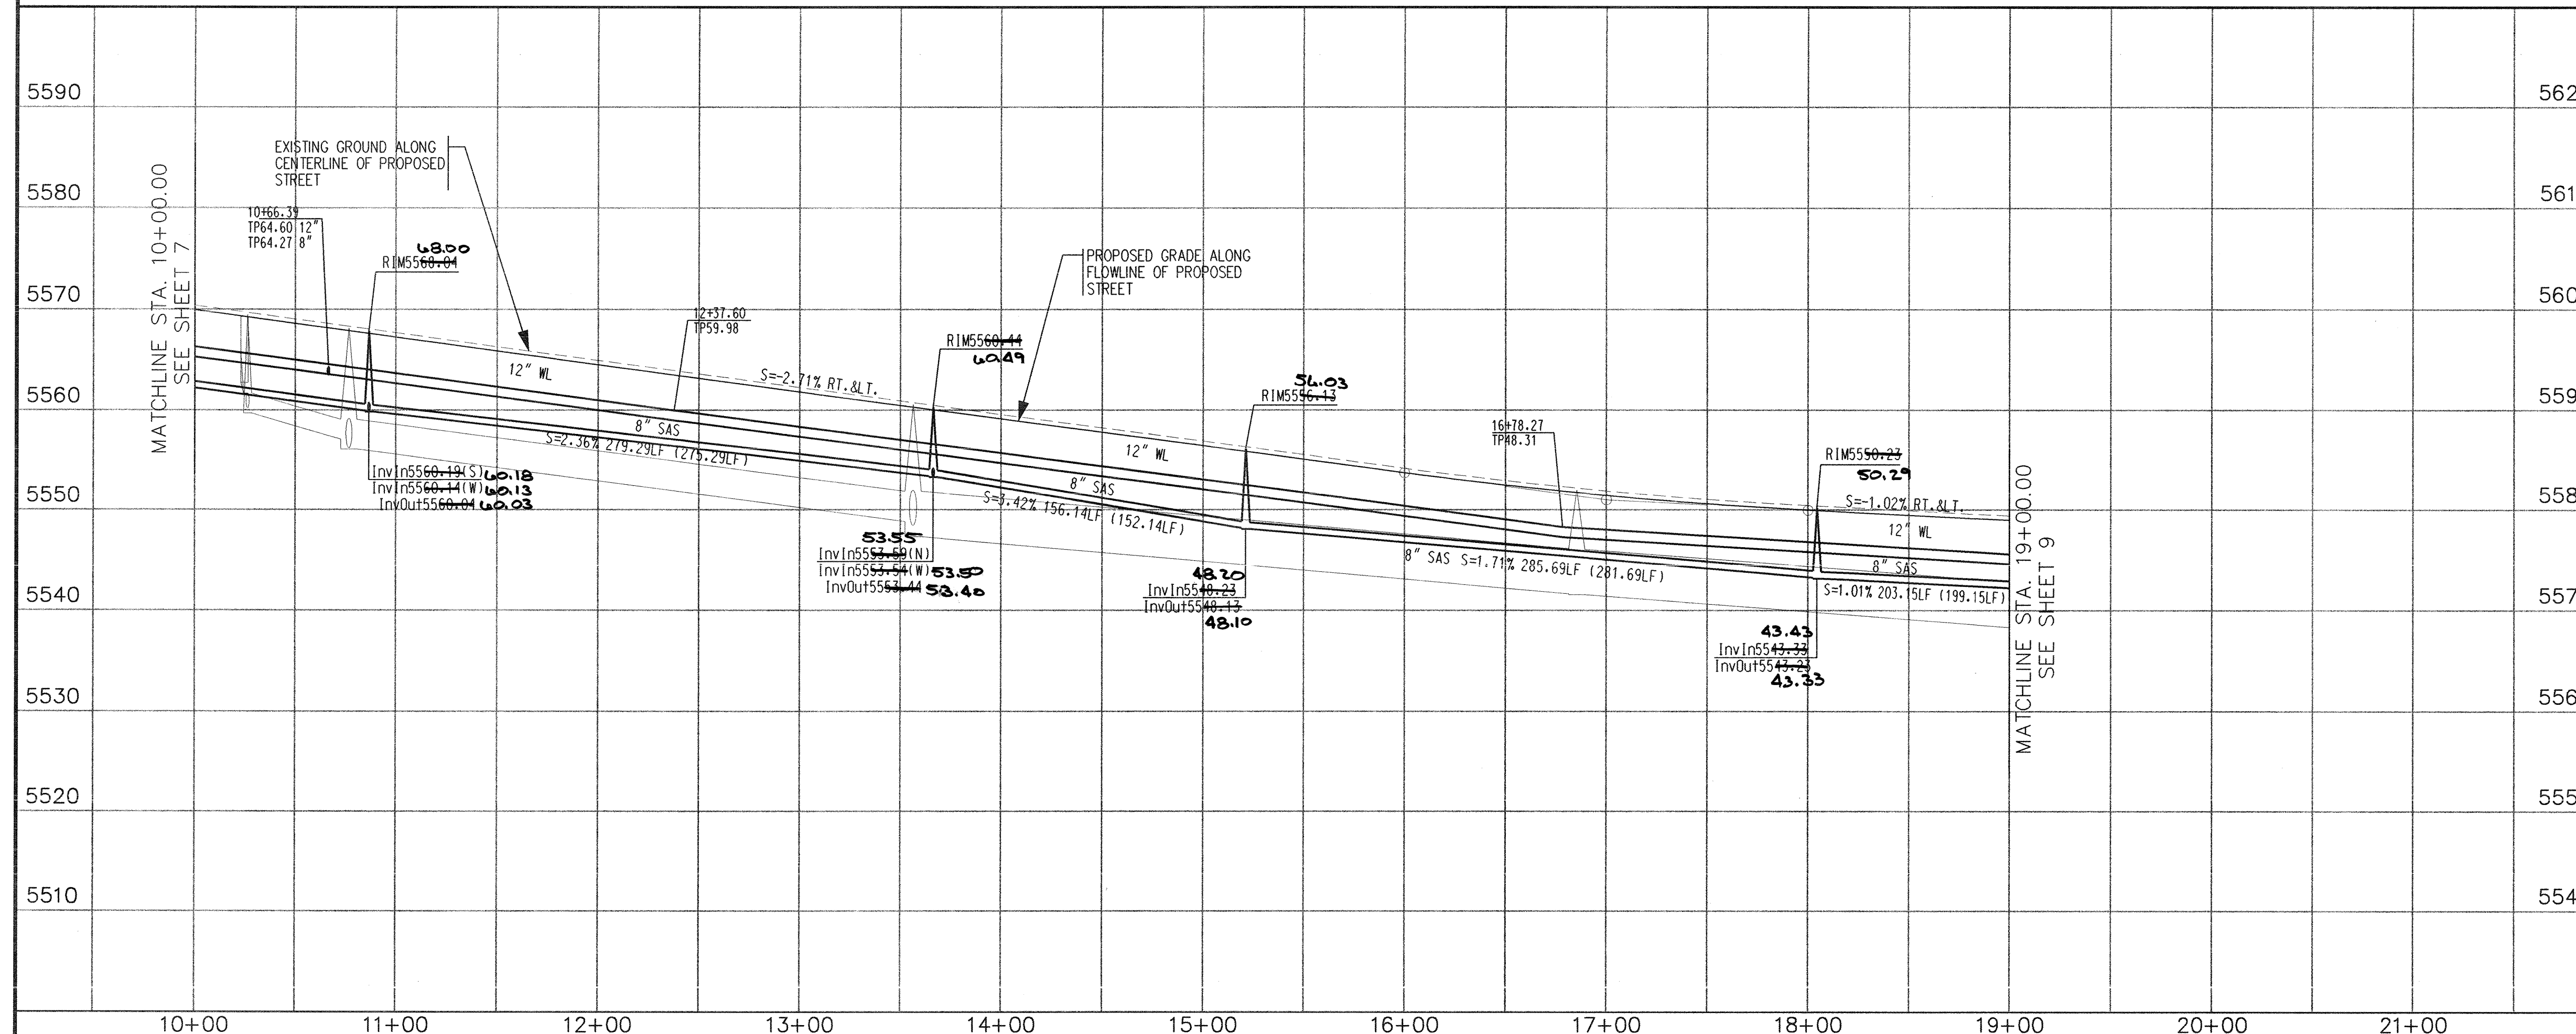

NOTES

- THE CONTRACTOR SHALL FIELD VERIFY ALL EXISTING UTILITY LOCATIONS AND NOTIFY THE ENGINEER IMMEDIATELY OF ANY DISCREPANCIES.
- CONTRACTOR IS TO INSTALL A 4" X 4" X 5' POST AND EMD AT THE END OF EACH SANITARY SEWER SERVICE.
- CONTRACTOR IS RESPONSIBLE FOR REPAIR AND/OR REPLACEMENT OF ALL UTILITY CONDUITS AND EXISTING LINES.
- CONTRACTOR SHALL PROVIDE THE INSPECTORS, (CITY AND PRIVATE) WITH THE PROPOSED HYDROSTATIC TESTING PLAN. THE PLAN MUST BE APPROVED BEFORE TESTING OPERATIONS BEGIN.
- CONTRACTOR SHALL PARK EQUIPMENT AND VEHICLES AS NOT TO INTERFERE WITH NORMAL ACTIVITIES OF RESIDENTS OR OTHER CONTRACTORS ON SITE.
- ANY DAMAGE TO THE EXISTING FACILITIES (CURB & GUTTER, PAVEMENT, CONDUITS, LANDSCAPING, UTILITY LINES, ETC.) DURING CONSTRUCTION SHALL BE REPLACED AT THE CONTRACTORS' EXPENSE.
- REMOVAL OF THE EXISTING CURB AND GUTTER SHALL BE AS PER COA STD. DWG. 2415 (SAWCUT ONLY).
- ALL EXCAVATION, TRENCHING AND SHORING ACTIVITIES MUST BE CARRIED-OUT IN ACCORDANCE WITH OSHA 29 CFR 1926.650 SUBPART P.
- NO WORK SHALL BE UNDER TAKEN WITHIN EXISTING 50' GASLINE EASEMENT WITHOUT FIRST CONTACTING PNM.
- CONTRACTOR MUST MAINTAIN TWO-WAY TRAFFIC AT ALL TIMES ON PASEO DEL NORTE. THE USE OF AN UNPAVED DETOUR FOR UP TO TWO DAYS WILL BE ALLOWED WITH PROPER BARRICADING.

AS-BUILT INFORMATION

CONTRACTOR	Sundata
INSPECTOR'S NAME	ALS
DATE	12/05
INSPECTOR'S NAME	ALS
DATE	12/05
INSPECTOR'S NAME	ALS
DATE	12/05
INSPECTOR'S NAME	ALS
DATE	12/05

RESTRaining JOINT TABLE

MECHANICAL JOINTS	LENGTH OF RESTRAINED JOINTS			
	24" DIP	20" DIP	12" DIP	8" DIP
GATE/AIR RELEASE VALVE	N/A	N/A	N/A	65'
BUTTERFLY/AIR RELEASE VALVE	65'	55'	40'	N/A
CAP	65'	55'	40'	65'
TEE	-	14'	N/A	18'
REDUCER (24"x20")	20'	-	-	-
REDUCER (20"x14")	N/A	28'	-	-

ENGINEER'S SEAL

James Paul Boecking
JAMES PAUL BOECKING
NEW MEXICO
16586
8-31-04
REGISTERED PROFESSIONAL ENGINEER

GENERAL NOTE:

*ALL SANITARY SEWER MANHOLES SHALL BE 4' DIAMETER TYPE "E" AS PER NM APWA STANDARD DRAWING 2102 UNLESS OTHERWISE NOTED.

*STORM DRAIN AND ROADWAY SHOWN FOR REFERENCE ONLY. FOR CONSTRUCTION INFORMATION SEE C.O.A. PROJECT # 617685

REVISIONS

NO.	DATE	REMARKS
1	3/2004	DESIGN
2	3/2004	DESIGN
3	3/2004	DESIGN

Bohannon & Huston

Courtyard I 7500 Jefferson St. NE Albuquerque, NM 87109-4335
ENGINEERING • SPATIAL DATA • ADVANCED TECHNOLOGIES

CITY OF ALBUQUERQUE

PUBLIC WORKS DEPARTMENT
ENGINEERING DEVELOPMENT GROUP
BACKBONE WATER & SANITARY SEWER IMPROVEMENTS - PHASE 2
UTILITY PLAN & PROFILE
VENTANA RIDGE ROAD 10+00.00 - 19+00.00

DESIGN REVIEW COMMITTEE

APPROVED
DESIGN REVIEW COMMITTEE

CITY ENGINEER APPROVAL

APPROVED
CITY ENGINEER

DESIGN REVIEW COMMITTEE

APPROVED
DESIGN REVIEW COMMITTEE

CITY ENGINEER APPROVAL

APPROVED
CITY ENGINEER


DESIGN REVIEW COMMITTEE

APPROVED
DESIGN REVIEW COMMITTEE

CITY ENGINEER APPROVAL

APPROVED
CITY ENGINEER

DESIGN

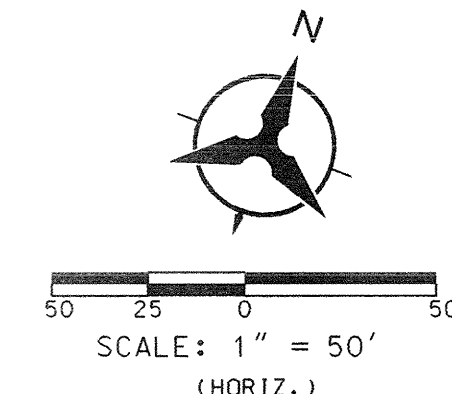

RESTRAINING JOINT TABLE						
MECHANICAL JOINTS	LENGTH OF RESTRAINING JOINTS					
	24" DIP	20" DIP	14" DIP	4" DIP	12" PVC	8" PVC
GATE/AIR RELEASE VALVE	N/A	N/A	N/A	65"	65"	
BUTTERFLY/AIR RELEASE VALVE	65"	55"	40"	N/A	N/A	
CAP	65"	55"	40"	65"	65"	
TEE	-	14"	N/A	18"	-	
REDUCER (24"x20")	20"	-	-	-	-	
REDUCER (20"x14")	N/A	28"	-	-	-	

NOTE:

- ALL MECHANICAL JOINTS SHALL BE RESTRAINED AT THE FITTING.
- THE CONTRACTOR SHALL PROVIDE A MINIMUM PIPE LENGTH OF 20 LF FROM ALL MECHANICAL JOINTS. ALL PIPE JOINTS WITHIN 20 LF OF MJ SHALL BE RESTRAINED AT THE CONTRACTORS' EXPENSE.
- THE CONTRACTOR SHALL RESTRAIN ALL PIPE JOINTS IN THE SPECIFIED DISTANCE LISTED IN THE TABLE ABOVE. (SEE NOTE 2 ABOVE).
- THE CONTRACTOR SHALL RESTRAIN ALL FIRE HYDRANTS JOINTS FROM THE TEE ON THE MAIN TO THE FIRE HYDRANT FLANGE.
- RESTRAINED LENGTHS FOR REDUCERS ARE FOR THE LARGE SIDE.
- RESTRAINED LENGTHS FOR VERTICAL BENDS ARE SHOWN IN PROFILE.

GENERAL NOTE:
***ALL SANITARY SEWER MANHOLES SHALL BE 4' DIAMETER TYPE "E" AS PER NM APWA STANDARD DRAWING 2102 UNLESS OTHERWISE NOTED.**

***STORM DRAIN AND ROADWAY SHOWN FOR REFERENCE ONLY. FOR CONSTRUCTION INFORMATION SEE C.O.A. PROJECT # 617685**

APPROVED BY:

7/3-64
 DATE

Bohannon & Huston, Inc.

Court yard | 7500 Jefferson St. NE Albuquerque, NM 87109-4335

ENGINEERING ▴ SPATIAL DATA ▴ ADVANCED TECHNOLOGIES

CITY OF ALBUQUERQUE

PUBLIC WORKS DEPARTMENT

ENGINEERING DEVELOPMENT GROUP

BACKBONE WATER & SANITARY SEWER IMPROVEMENTS - PHASE 2
 UTILITY PLAN & PROFILE
 VENTANA RIDGE ROAD 19+00.00- 25+00.00

DESIGN REVIEW COMMITTEE	CITY ENGINEER APPROVAL	MO. / DAY / YR.	MO. / DAY / YR.
APPROVED OCT 15 2004 DESIGN REVIEW COMMITTEE	APPROVED OCT 18 2004 CITY ENGINEER		

DESIGN REVIEW COMMITTEE

CITY PROJECT NO.

617686

LAST DESIGN UPDATE

ZONE MAP NO.


B-8-Z

SHEET


9

OF

13

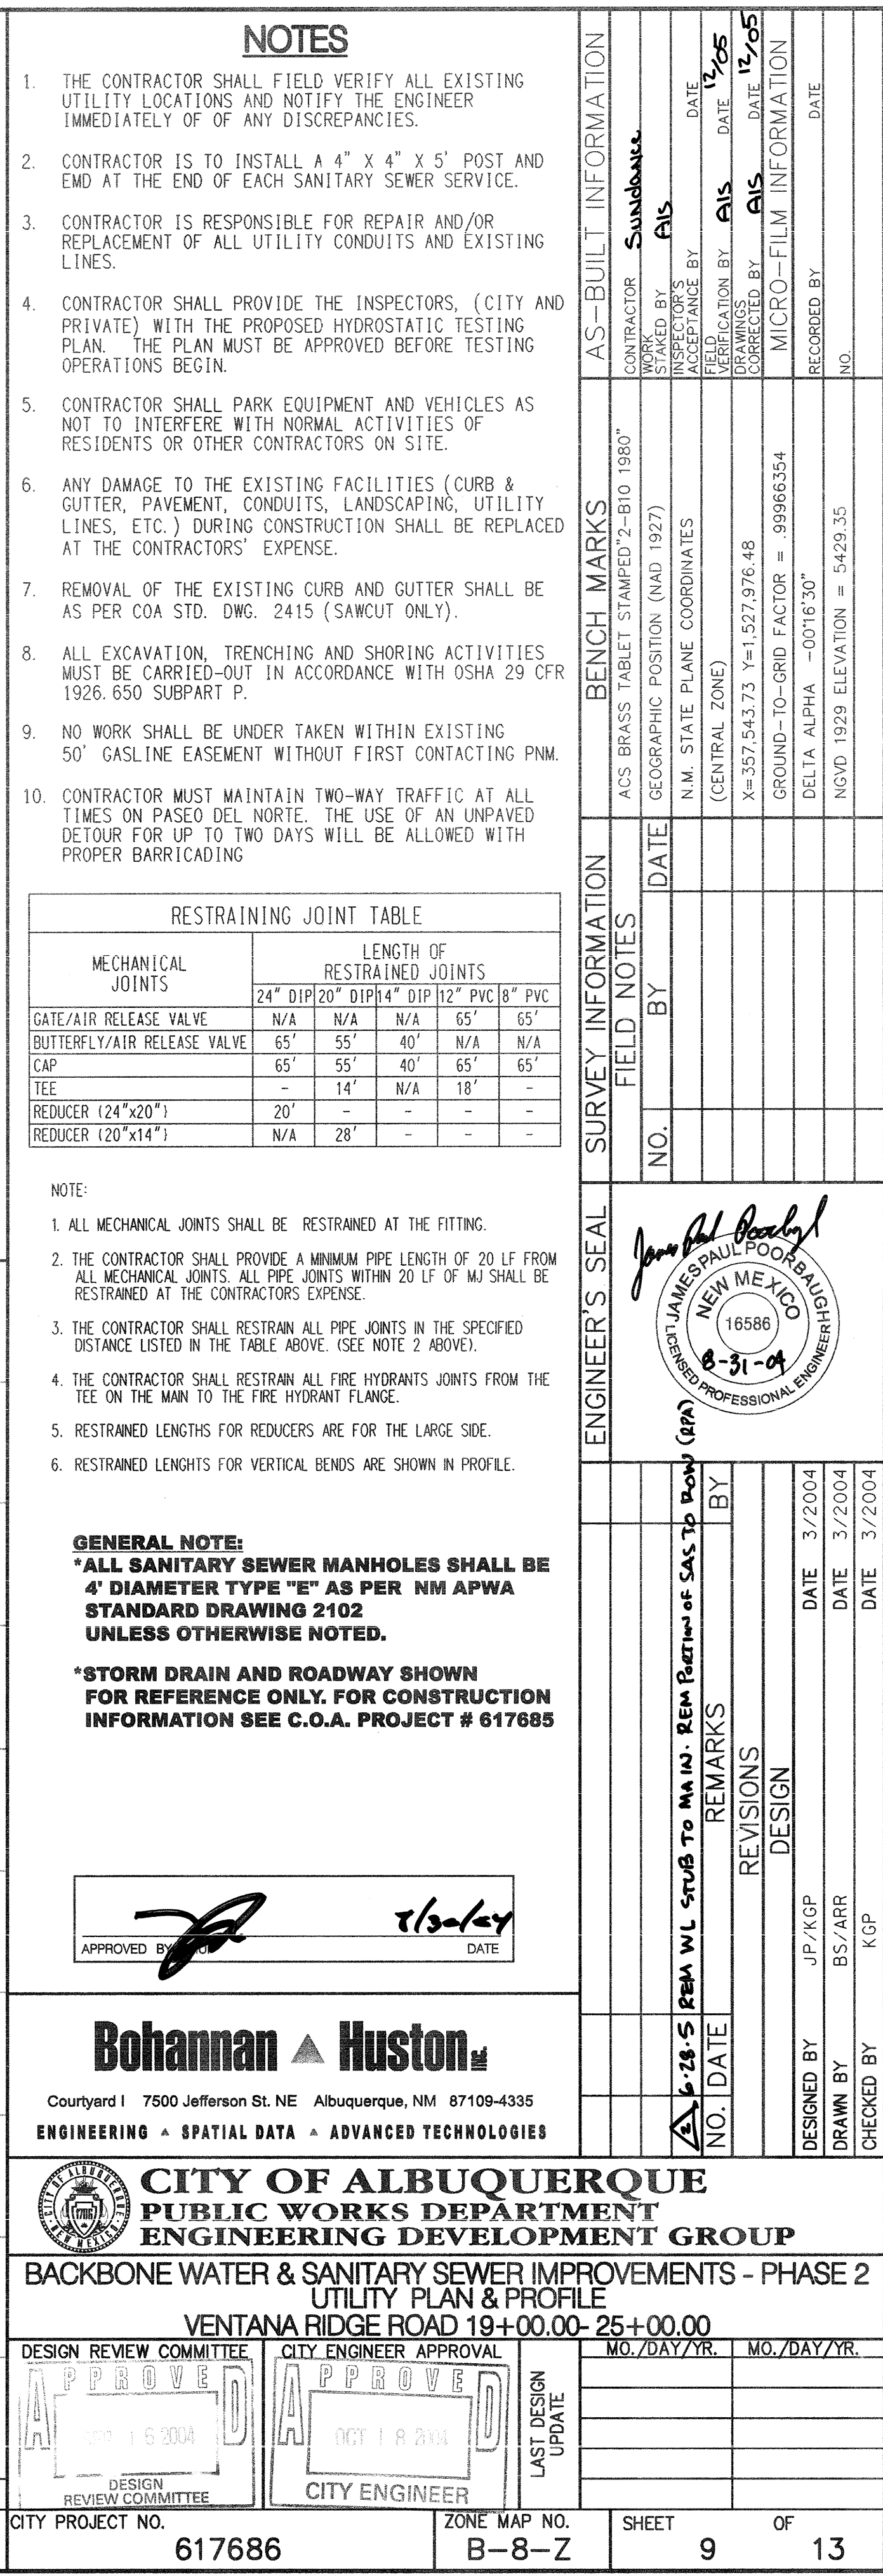



APPROVED BY
JESSE REPRO

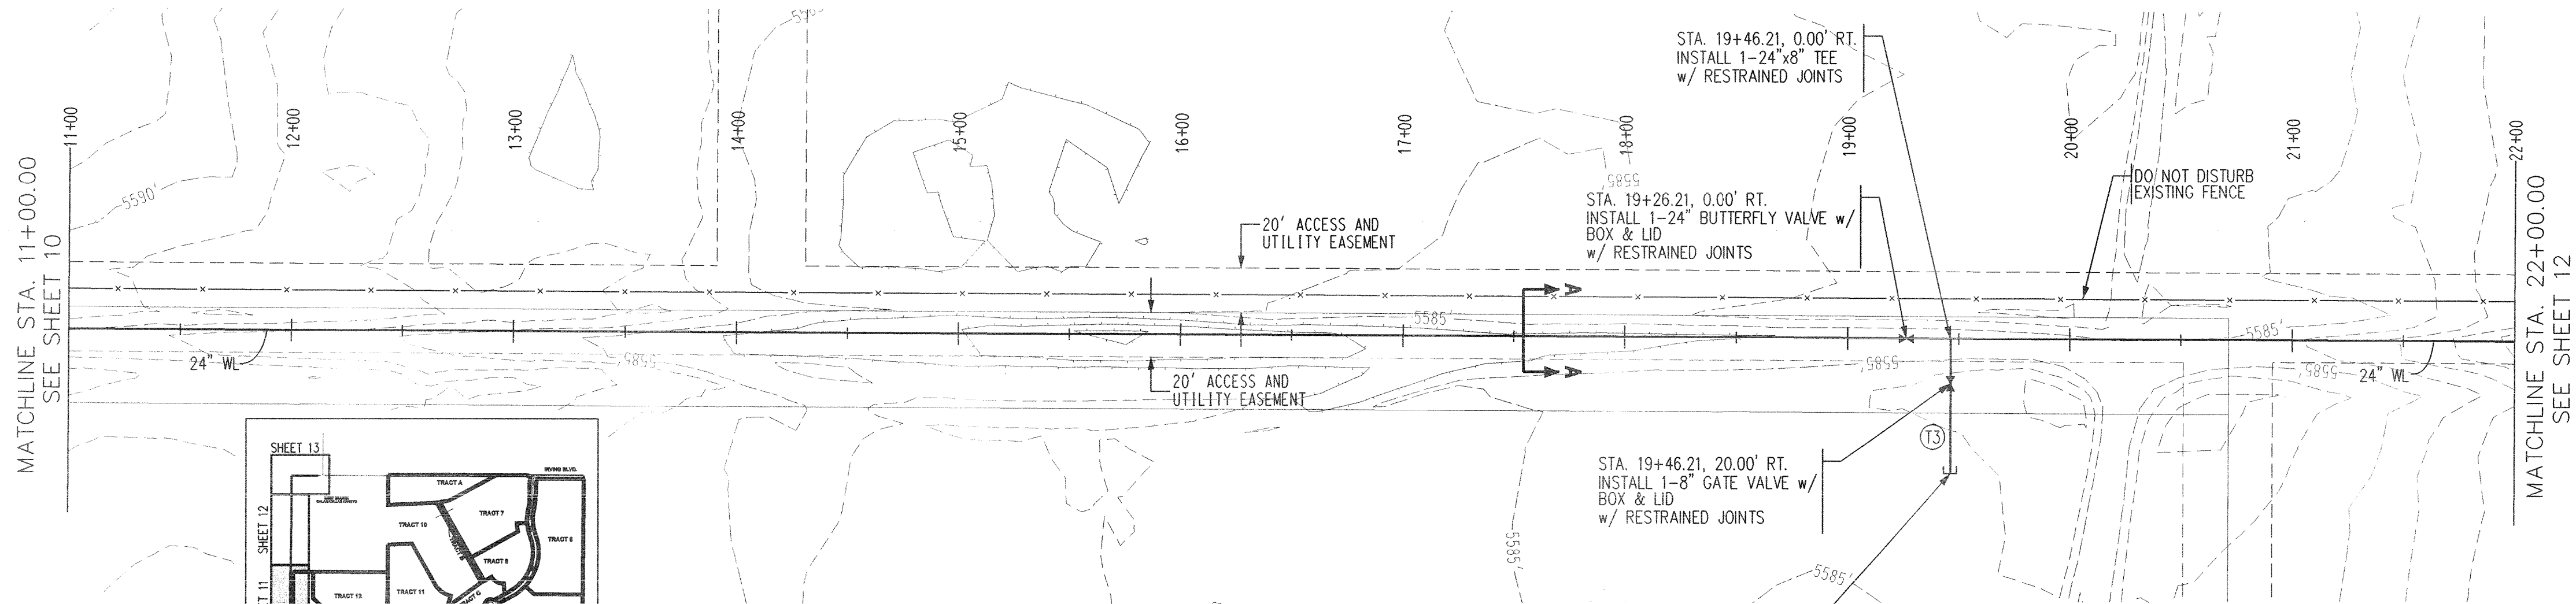

WL Tangent Table		
ID	BEARING	LENGTH
13	N89°48'19"W	60.00'

DEL OESTE 11+00.00 - 22+00.00

BERM A-A
NOT TO SCALE

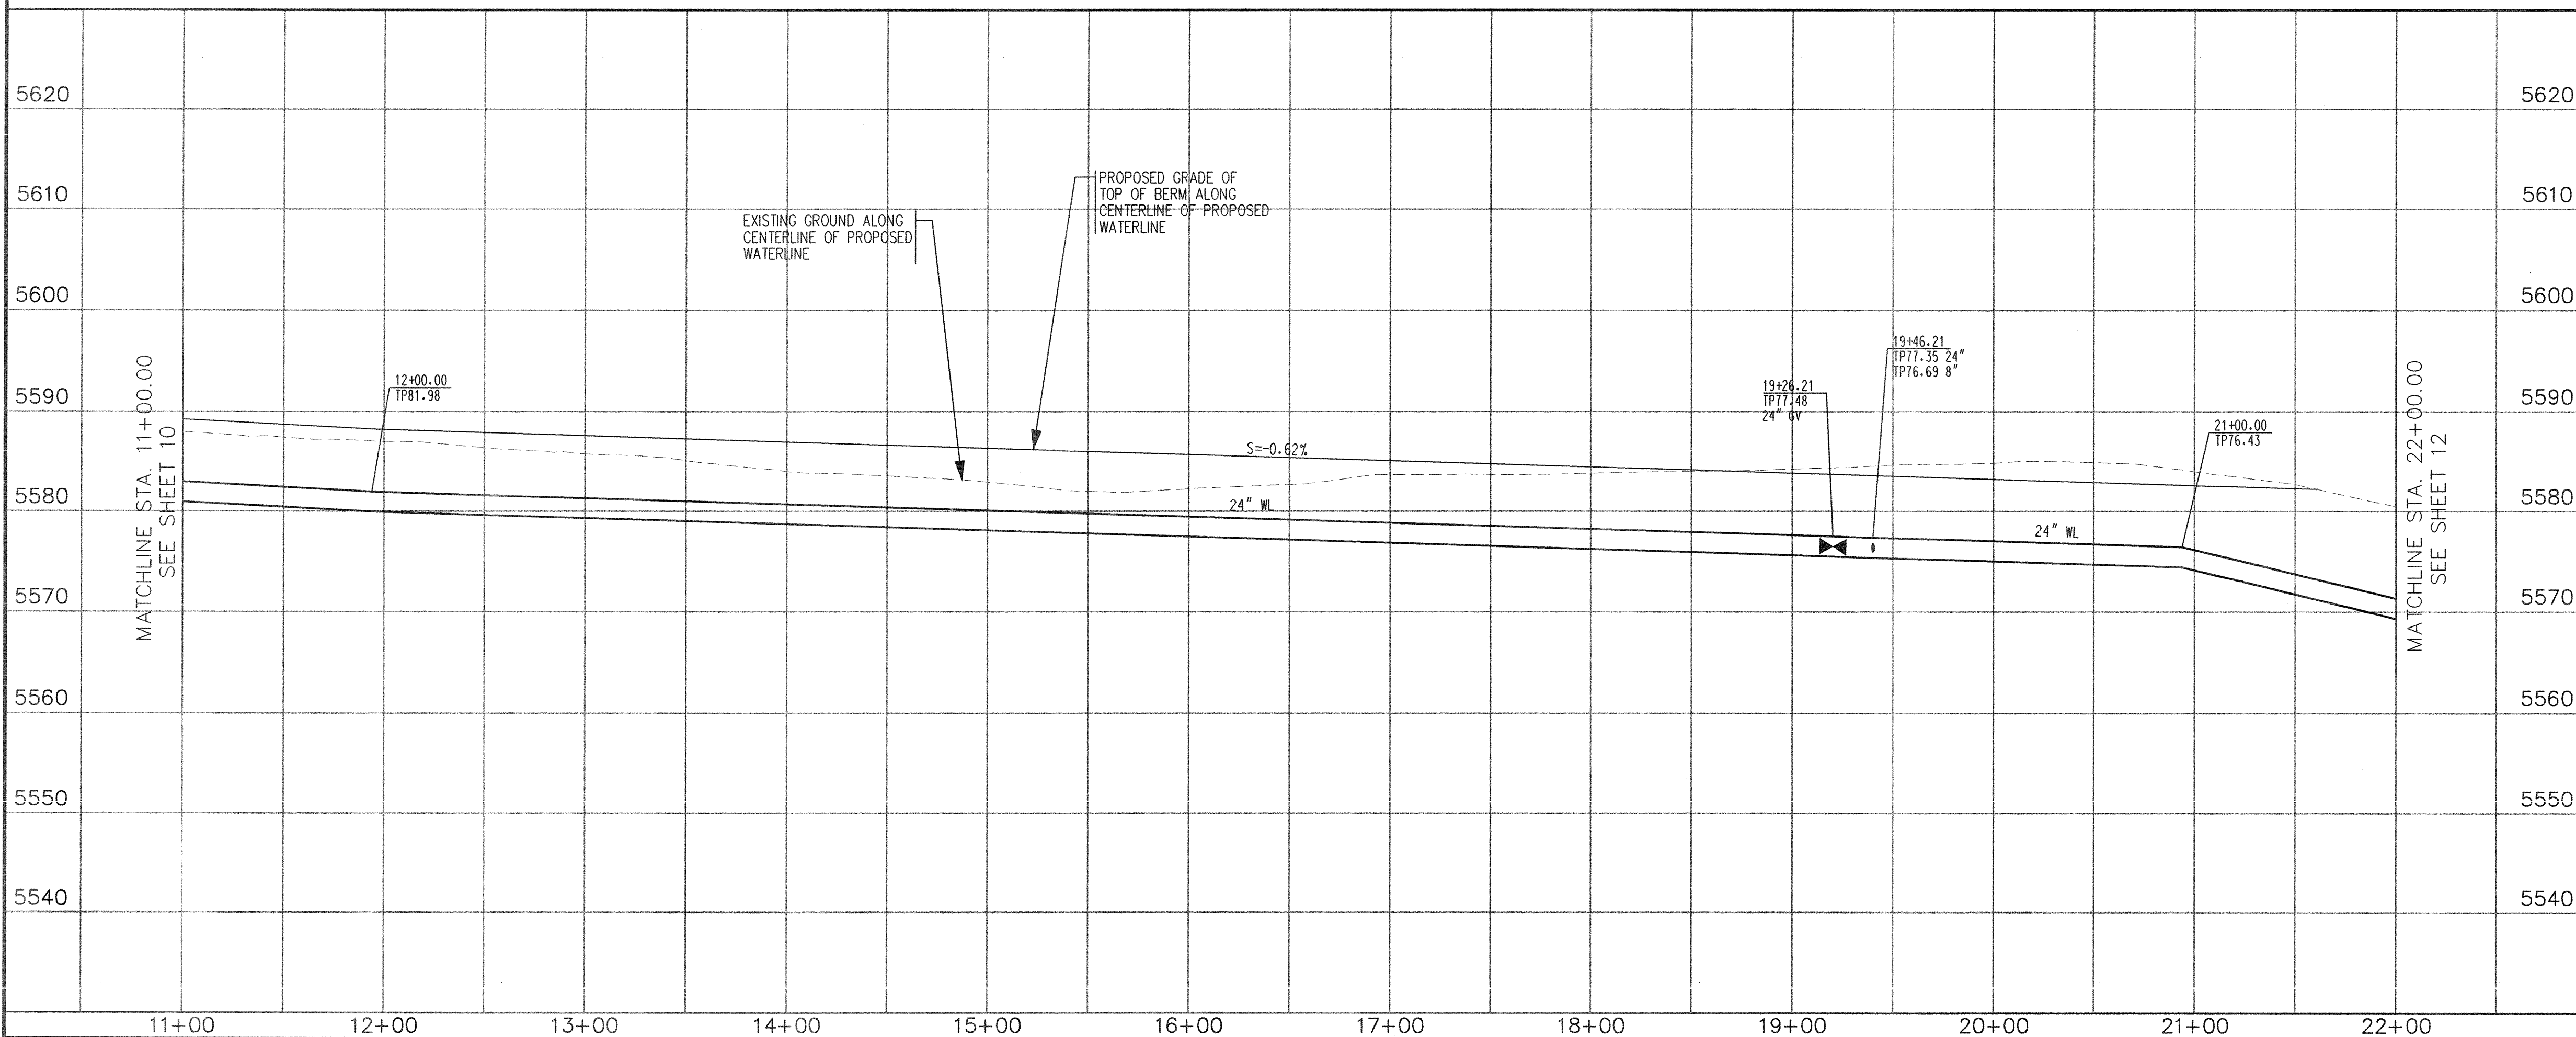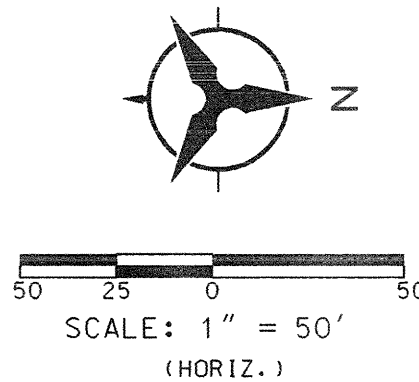

NOTES

- THE CONTRACTOR SHALL FIELD VERIFY ALL EXISTING UTILITY LOCATIONS AND NOTIFY THE ENGINEER IMMEDIATELY OF ANY DISCREPANCIES.
- CONTRACTOR IS TO INSTALL A 4" X 4" X 5' POST AND EMD AT THE END OF EACH SANITARY SEWER SERVICE.
- CONTRACTOR IS RESPONSIBLE FOR REPAIR AND/OR REPLACEMENT OF ALL UTILITY CONDUITS AND EXISTING LINES.
- CONTRACTOR SHALL PROVIDE THE INSPECTORS, (CITY AND PRIVATE) WITH THE PROPOSED HYDROSTATIC TESTING PLAN. THE PLAN MUST BE APPROVED BEFORE TESTING OPERATIONS BEGIN.
- CONTRACTOR SHALL PARK EQUIPMENT AND VEHICLES AS NOT TO INTERFERE WITH NORMAL ACTIVITIES OF RESIDENTS OR OTHER CONTRACTORS ON SITE.
- ANY DAMAGE TO THE EXISTING FACILITIES (CURB & GUTTER, PAVEMENT, CONDUITS, LANDSCAPING, UTILITY LINES, ETC.) DURING CONSTRUCTION SHALL BE REPLACED AT THE CONTRACTORS' EXPENSE.
- REMOVAL OF THE EXISTING CURB AND GUTTER SHALL BE AS PER COA STD. DWG. 2415 (SAWCUT ONLY).
- ALL EXCAVATION, TRENCHING AND SHORING ACTIVITIES MUST BE CARRIED-OUT IN ACCORDANCE WITH OSHA 29 CFR 1926.650 SUBPART P.
- NO WORK SHALL BE UNDER TAKEN WITHIN EXISTING 50' GASLINE EASEMENT WITHOUT FIRST CONTACTING PNM.
- CONTRACTOR MUST MAINTAIN TWO-WAY TRAFFIC AT ALL TIMES ON PASEO DEL NORTE. THE USE OF AN UNPAVED DETOUR FOR UP TO TWO DAYS WILL BE ALLOWED WITH PROPER BARRICADING.

RESTRAINING JOINT TABLE

MECHANICAL JOINTS	LENGTH OF RESTRAINED JOINTS					
	24" DIP	20" DIP	16" DIP	12" DIP	8" DIP	6" DIP
GATE/AIR RELEASE VALVE	N/A	N/A	N/A	65'	65'	65'
BUTTERFLY/AIR RELEASE VALVE	65'	55'	40'	N/A	N/A	N/A
CAP	65'	55'	40'	65'	65'	65'
TEE	-	14'	N/A	18'	-	-
REDUCER (24"x20")	20'	-	-	-	-	-
REDUCER (20"x14")	N/A	28'	-	-	-	-

NOTE:

- ALL MECHANICAL JOINTS SHALL BE RESTRAINED AT THE FITTING.
- THE CONTRACTOR SHALL PROVIDE A MINIMUM PIPE LENGTH OF 20 LF FROM ALL MECHANICAL JOINTS. ALL PIPE JOINTS WITHIN 20 LF OF MJ SHALL BE RESTRAINED AT THE CONTRACTORS EXPENSE.
- THE CONTRACTOR SHALL RESTRAIN ALL PIPE JOINTS IN THE SPECIFIED DISTANCE LISTED IN THE TABLE ABOVE. (SEE NOTE 2 ABOVE).
- THE CONTRACTOR SHALL RESTRAIN ALL FIRE HYDRANTS JOINTS FROM THE TEE ON THE MAIN TO THE FIRE HYDRANT FLANGE.
- RESTRAINED LENGTHS FOR REDUCERS ARE FOR THE LARGE SIDE.
- RESTRAINED LENGTHS FOR VERTICAL BENDS ARE SHOWN IN PROFILE.

GENERAL NOTE:

*ALL SANITARY SEWER MANHOLES SHALL BE 4' DIAMETER TYPE "E" AS PER NM APWA STANDARD DRAWING 2102 UNLESS OTHERWISE NOTED.

*STORM DRAIN AND ROADWAY SHOWN FOR REFERENCE ONLY. FOR CONSTRUCTION INFORMATION SEE C.O.A. PROJECT # 617685

APPROVED:  DATE: 

Bohannon & Huston
Courtney 1 7500 Jefferson St. NE Albuquerque, NM 87109-4335
ENGINEERING • SPATIAL DATA • ADVANCED TECHNOLOGIES

CITY OF ALBUQUERQUE
PUBLIC WORKS DEPARTMENT
ENGINEERING DEVELOPMENT GROUP

BACKBONE WATER & SANITARY SEWER IMPROVEMENTS - PHASE 2
UTILITY PLAN & PROFILE
DEL OESTE 11+00.00 - 22+00.00

DESIGN REVIEW COMMITTEE
APPROVED
SEP 16 2004
DESIGN REVIEW COMMITTEE

CITY ENGINEER APPROVAL
APPROVED
OCT 13 2004
CITY ENGINEER

CITY PROJECT NO. 617686

ZONE MAP NO. B-8-Z

SHEET 11 OF 13

30-AUG-2004
P:\040237\cso\040237\Phase2\NonPD_Plan\040237\PH2\p05.dwg

BHI JOB NO. 04 0237

SCALE: 1" = 50' (HORIZ.)
1" = 10' (VERT.)


AS-BUILT INFORMATION			
CONTRACTOR	Stantec	DATE	12/05
WORKS	AS	DATE	12/05
STAMPED BY	AS	DATE	12/05
ACCEPTANCE BY	AS	DATE	12/05
FIELD CORRECTION BY	AS	DATE	12/05
REVISIONS	AS	DATE	12/05
CORRECTED BY	AS	DATE	12/05
RECORDED BY	AS	DATE	12/05
NO.			

BENCH MARKS			
ACS BRASS TABLE STAMPED	2-B10 1980		
GEODATUM POSITION (NAD 1977)			
N.M. STATE PLANE COORDINATES			
(CENTRAL ZONE)			
X=357,543.73 Y=1,527,976.48			
GROUND-TO-GRID FACTOR = 99966354			
DELTA ALPHA = -0016'30"			
NOV 1929 ELEVATION = 5429.35			


SURVEY INFORMATION			
NO.	BY	DATE	

ENGINEER'S SEAL			
NO.	DATE	REMARKS	BY



DESIGNED BY	JP/KGP	DATE	3/2004
DRAWN BY	BS/ARR	DATE	3/2004
CHECKED BY	KGP	DATE	3/2004

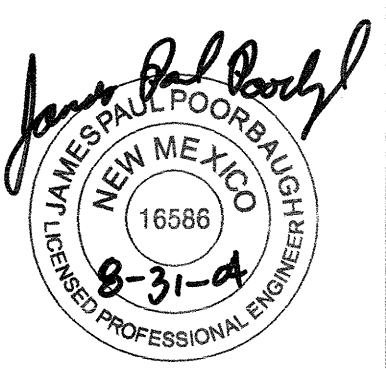

SCANNED BY
MESA REPRO

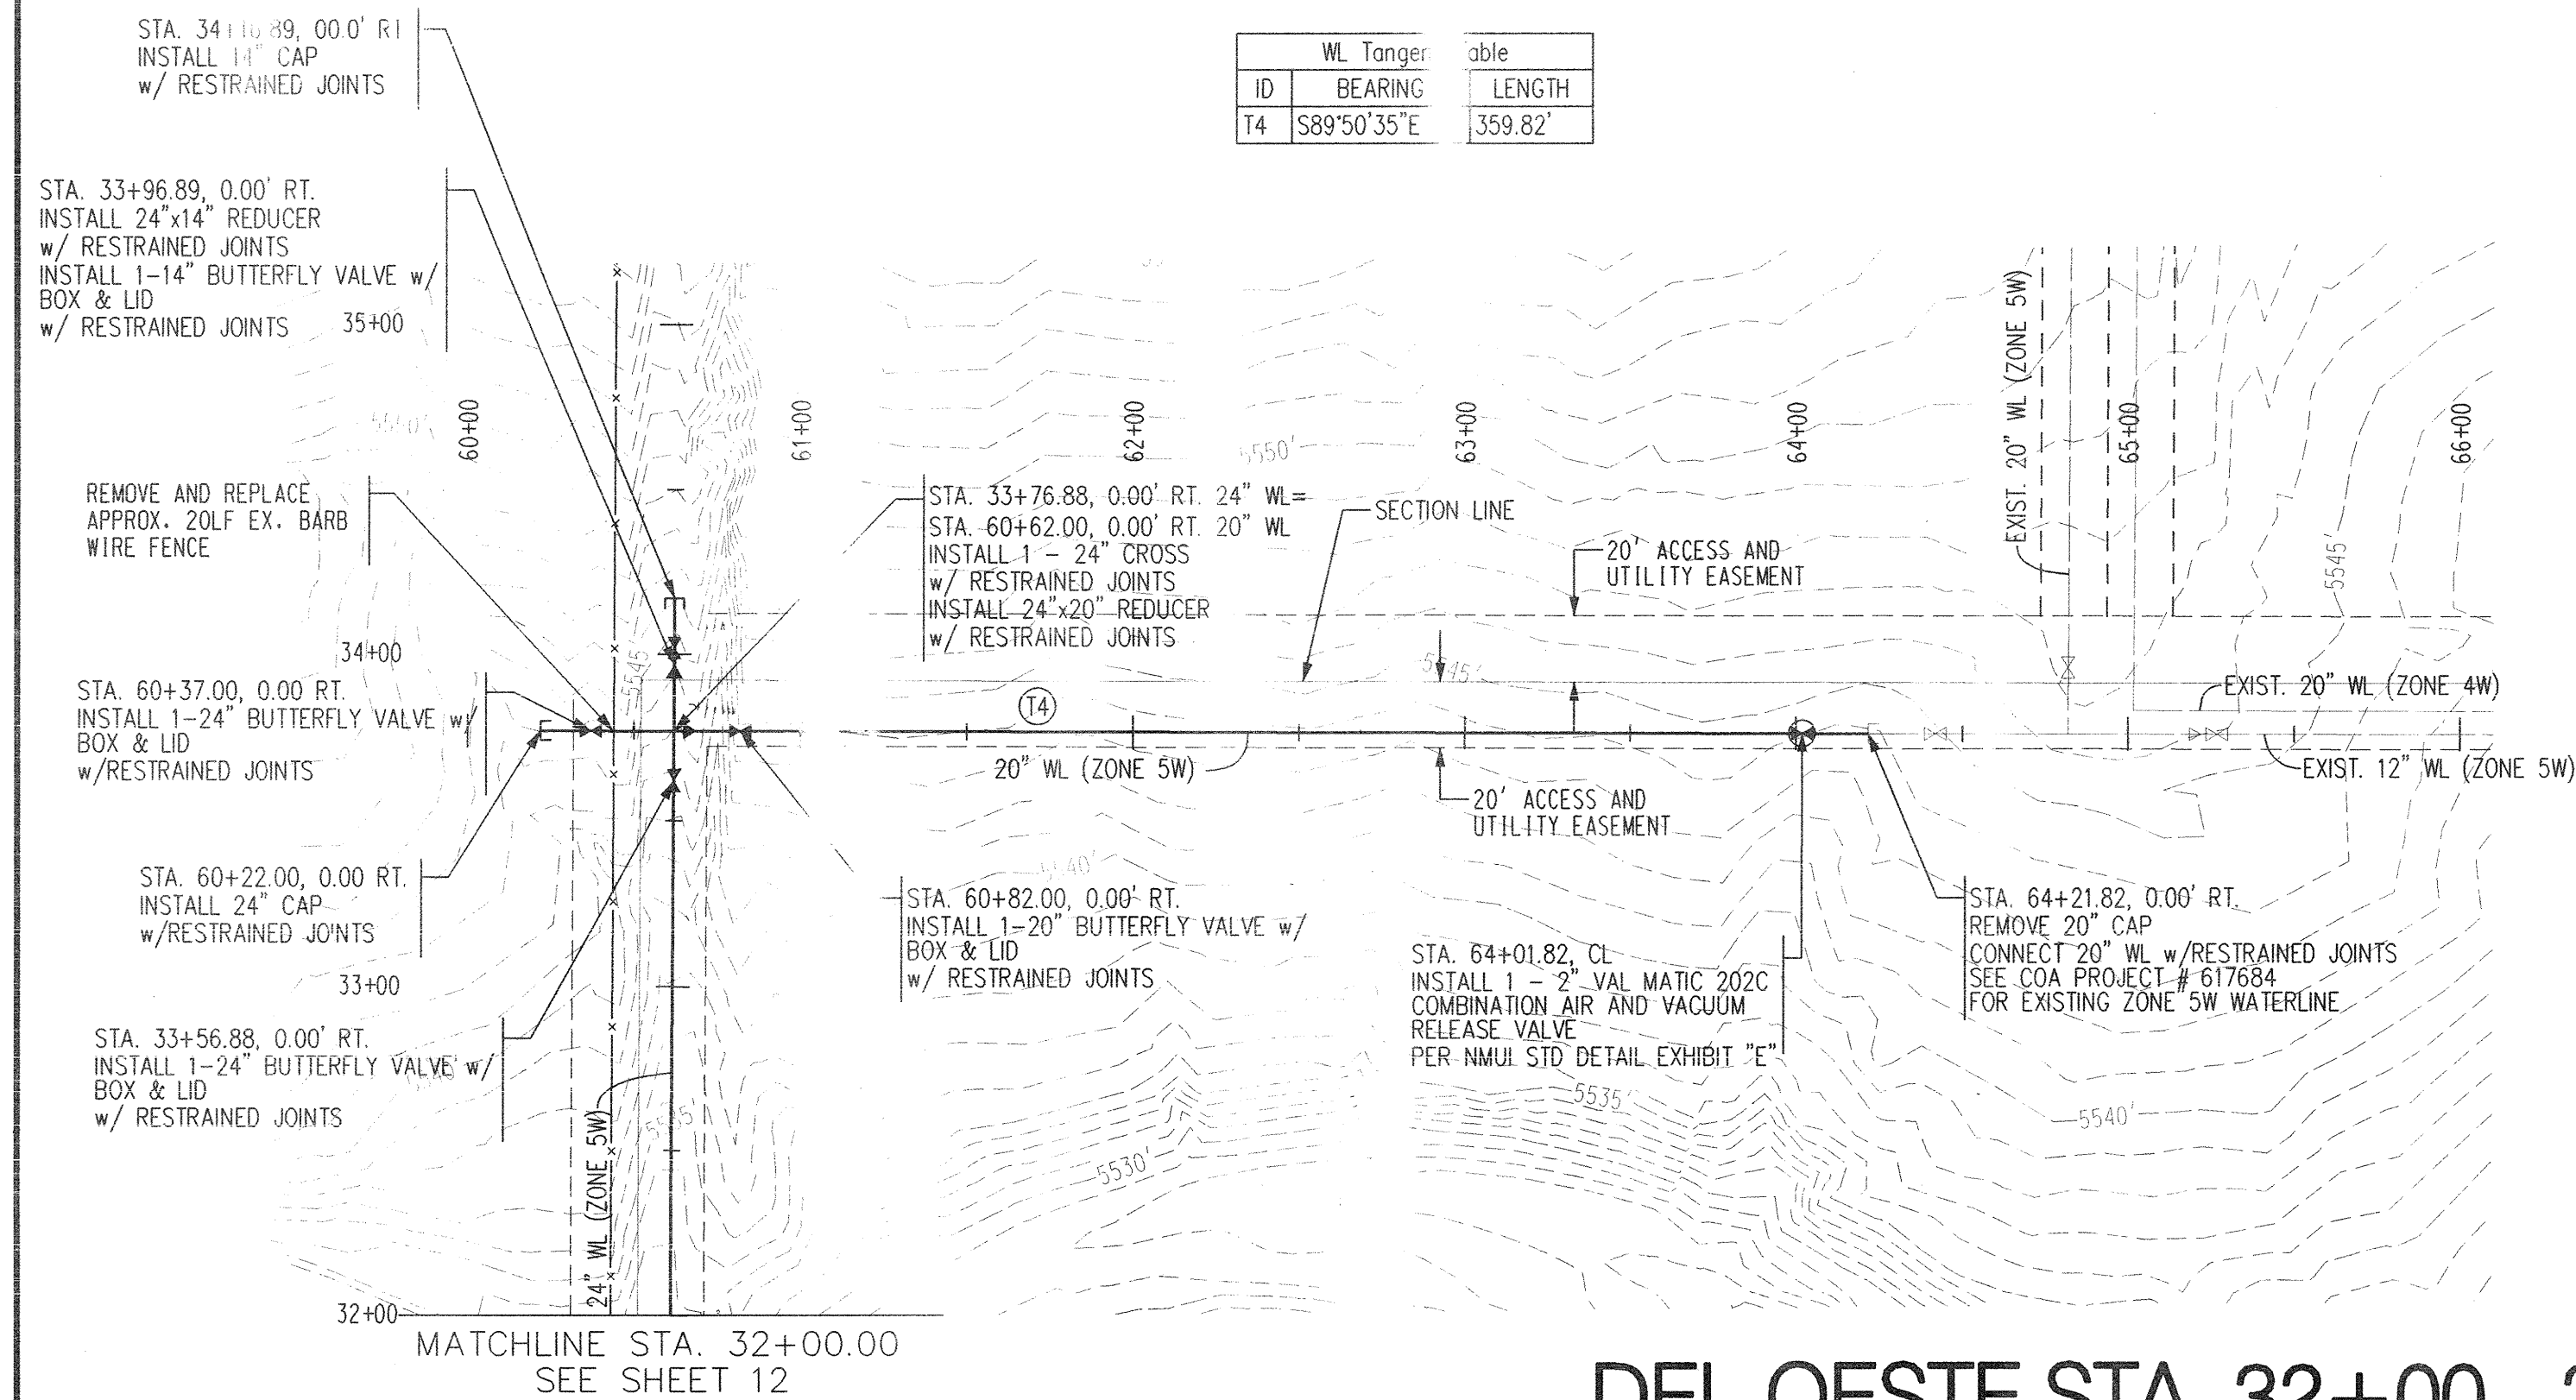

DEL OESTE STA. 32+00 - 35+00
NORTH BOUNDARY WL STA. 60+00 - 66+00

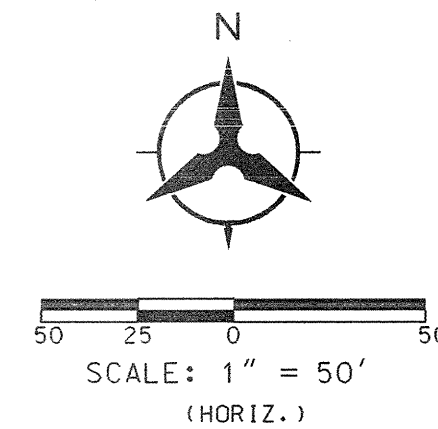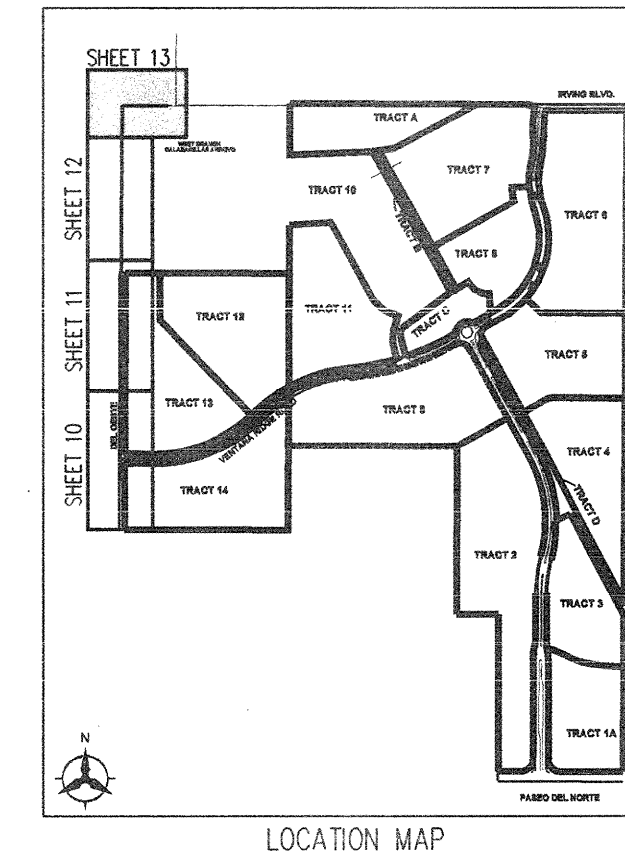

NOTES

- THE CONTRACTOR SHALL FIELD VERIFY ALL EXISTING UTILITY LOCATIONS AND NOTIFY THE ENGINEER IMMEDIATELY OF ANY DISCREPANCIES.
- CONTRACTOR IS TO INSTALL A 4" X 4" X 5' END AT THE END OF EACH SANITARY SEWER SERVICE.
- CONTRACTOR IS RESPONSIBLE FOR REPAIR AND/OR REPLACEMENT OF ALL UTILITY CONDUITS AND EXISTING LINES.
- CONTRACTOR SHALL PROVIDE THE INSPECTORS, (CITY AND PRIVATE) WITH THE PROPOSED HYDROSTATIC TESTING PLAN. THE PLAN MUST BE APPROVED BEFORE TESTING OPERATIONS BEGIN.
- CONTRACTOR SHALL PARK EQUIPMENT AND VEHICLES AS NOT TO INTERFERE WITH NORMAL ACTIVITIES OF RESIDENTS OR OTHER CONTRACTORS ON SITE.
- ANY DAMAGE TO THE EXISTING FACILITIES (CURB & GUTTER, PAVEMENT, CONDUITS, LANDSCAPING, UTILITY LINES, ETC.) DURING CONSTRUCTION SHALL BE REPLACED AT THE CONTRACTORS' EXPENSE.
- REMOVAL OF THE EXISTING CURB AND GUTTER SHALL BE AS PER COA STD. DWG. 2415 (SAWCUT ONLY).
- ALL EXCAVATION, TRENCHING AND SHORING ACTIVITIES MUST BE CARRIED-OUT IN ACCORDANCE WITH OSHA 29 CFR 1926.650 SUBPART P.
- NO WORK SHALL BE UNDER TAKEN WITHIN EXISTING 50' GASLINE EASEMENT WITHOUT FIRST CONTACTING PNM.
- CONTRACTOR MUST MAINTAIN TWO-WAY TRAFFIC AT ALL TIMES ON PASO DEL NORTE. THE USE OF AN UNPAVED DETOUR FOR UP TO TWO DAYS WILL BE ALLOWED WITH PROPER BARRICADING.

MECHANICAL JOINTS	LENGTH OF RESTRAINED JOINTS					
	24" DIP 20"	20" DIP 14"	14" DIP 12"	12" DIP 8"	8" DIP 6"	6" DIP 4"
GATE/AIR RELEASE VALVE	N/A	N/A	N/A	65'	65'	65'
BUTTERFLY/AIR RELEASE VALVE	65'	55'	40'	N/A	N/A	N/A
CAP	65'	55'	40'	65'	65'	65'
TEE	-	14'	N/A	18'	-	-
REDUCER (24"x20")	20'	-	-	-	-	-
REDUCER (20"x14")	N/A	28'	-	-	-	-

GENERAL NOTE:
*ALL SANITARY SEWER MANHOLES SHALL BE 4' DIAMETER TYPE "E" AS PER NM APWA STANDARD DRAWING 2102 UNLESS OTHERWISE NOTED.
*STORM DRAIN AND ROADWAY SHOWN FOR REFERENCE ONLY. FOR CONSTRUCTION INFORMATION SEE C.O.A. PROJECT # 617685

Bohannon & Huston
Court yard | 7500 Jefferson St. NE Albuquerque, NM 87109-4335
ENGINEERING & SPATIAL DATA & ADVANCED TECHNOLOGIES

CITY OF ALBUQUERQUE
PUBLIC WORKS DEPARTMENT
ENGINEERING DEVELOPMENT GROUP
BACKBONE WATER & SANITARY SEWER IMPROVEMENTS - PHASE 2
UTILITY PLAN & PROFILE
DEL OESTE 32+00 - 35+00 & NORTH BNDRY WL 60+00 - 66+00

DESIGN REVIEW COMMITTEE
CITY ENGINEER APPROVAL
OCT 18 2004
LAST DESIGN UPDATE

CITY PROJECT NO. 617686
ZONE MAP NO. B-8-Z
SHEET 13 OF 13