
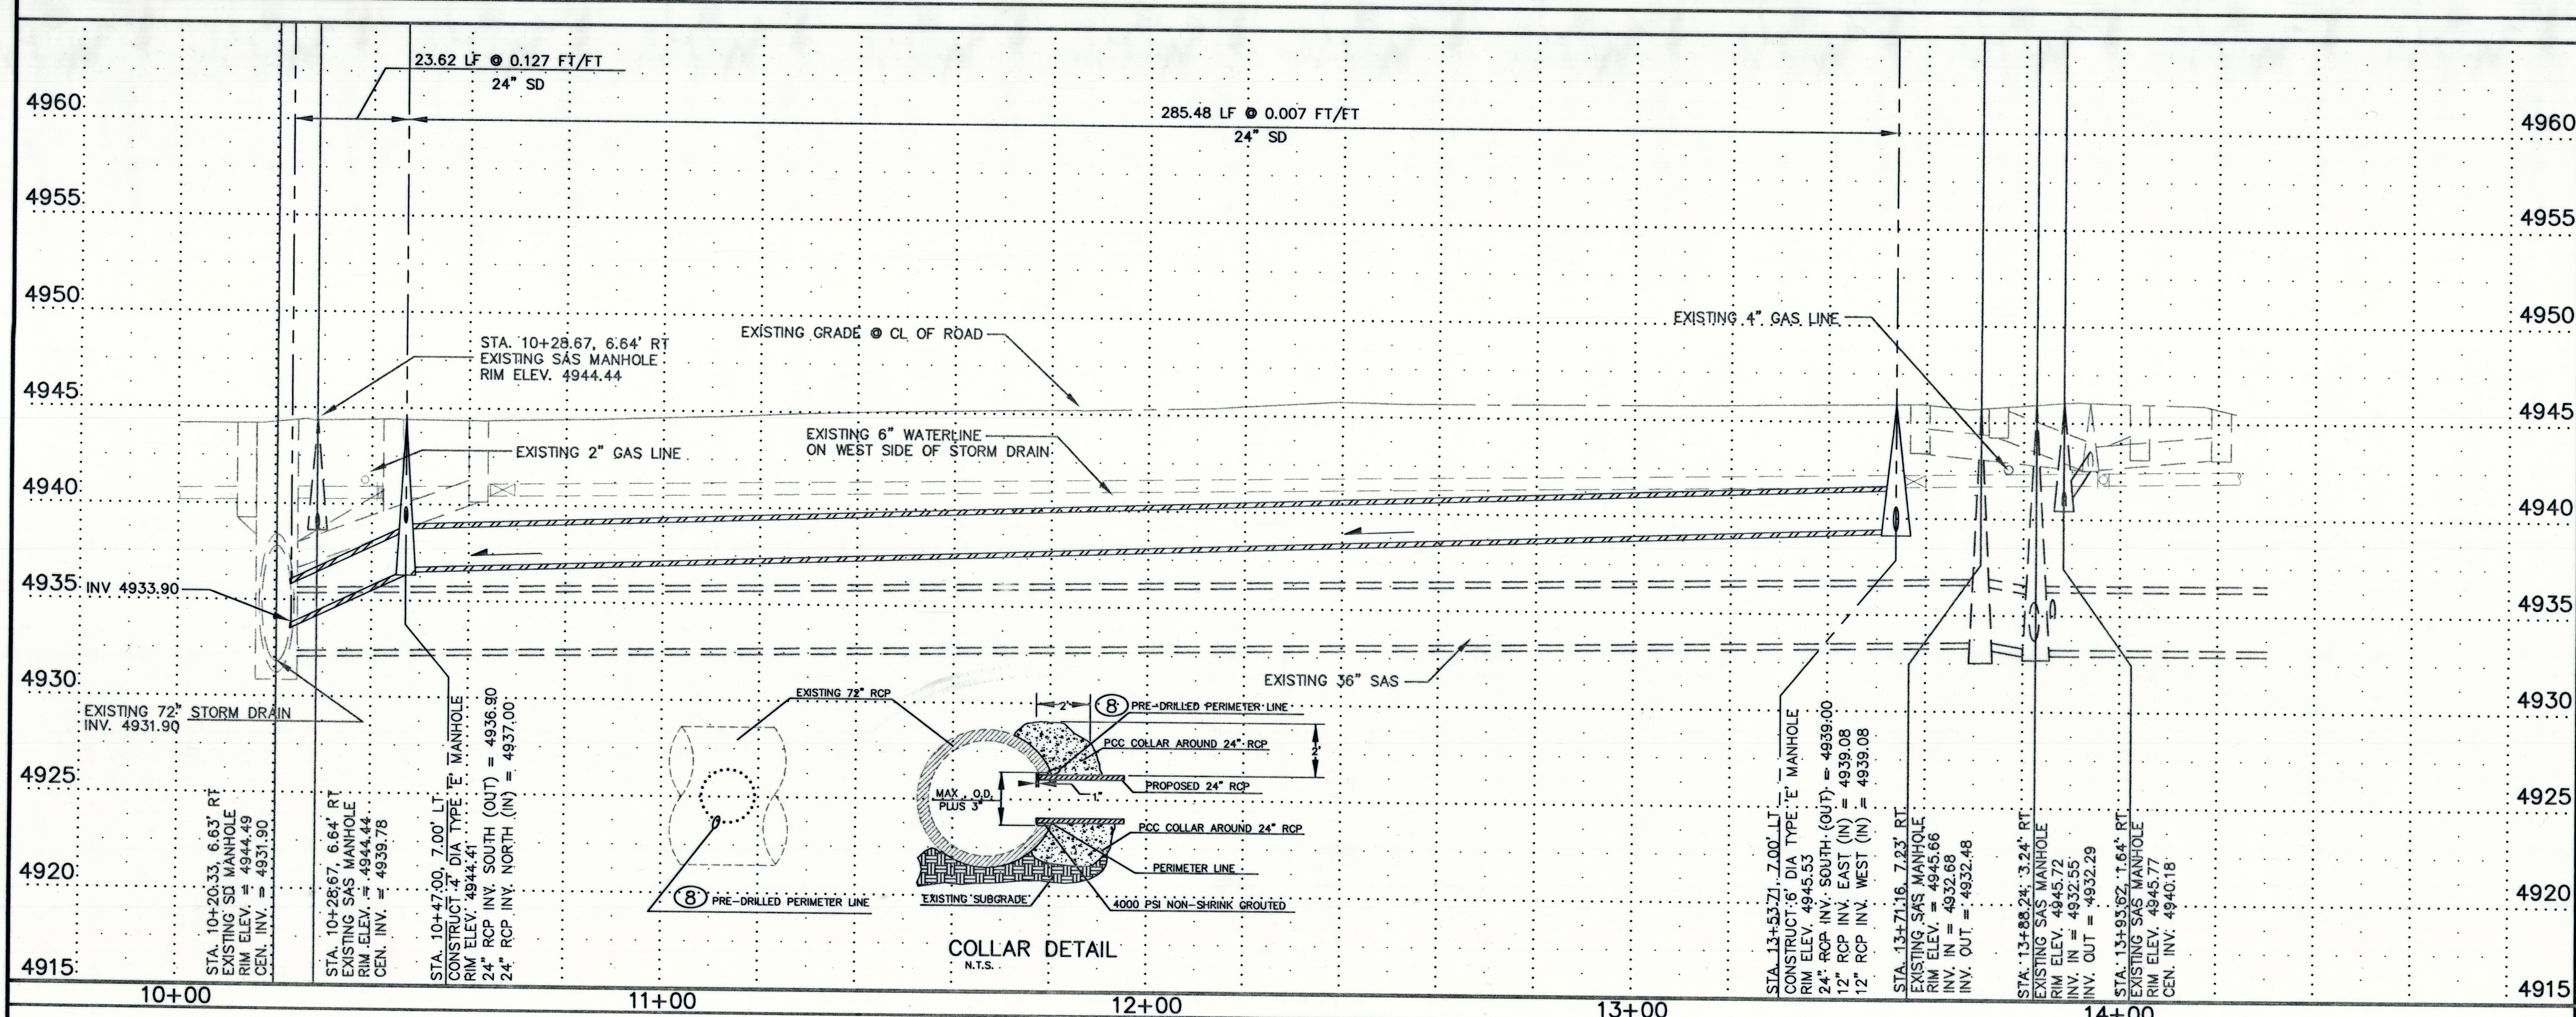


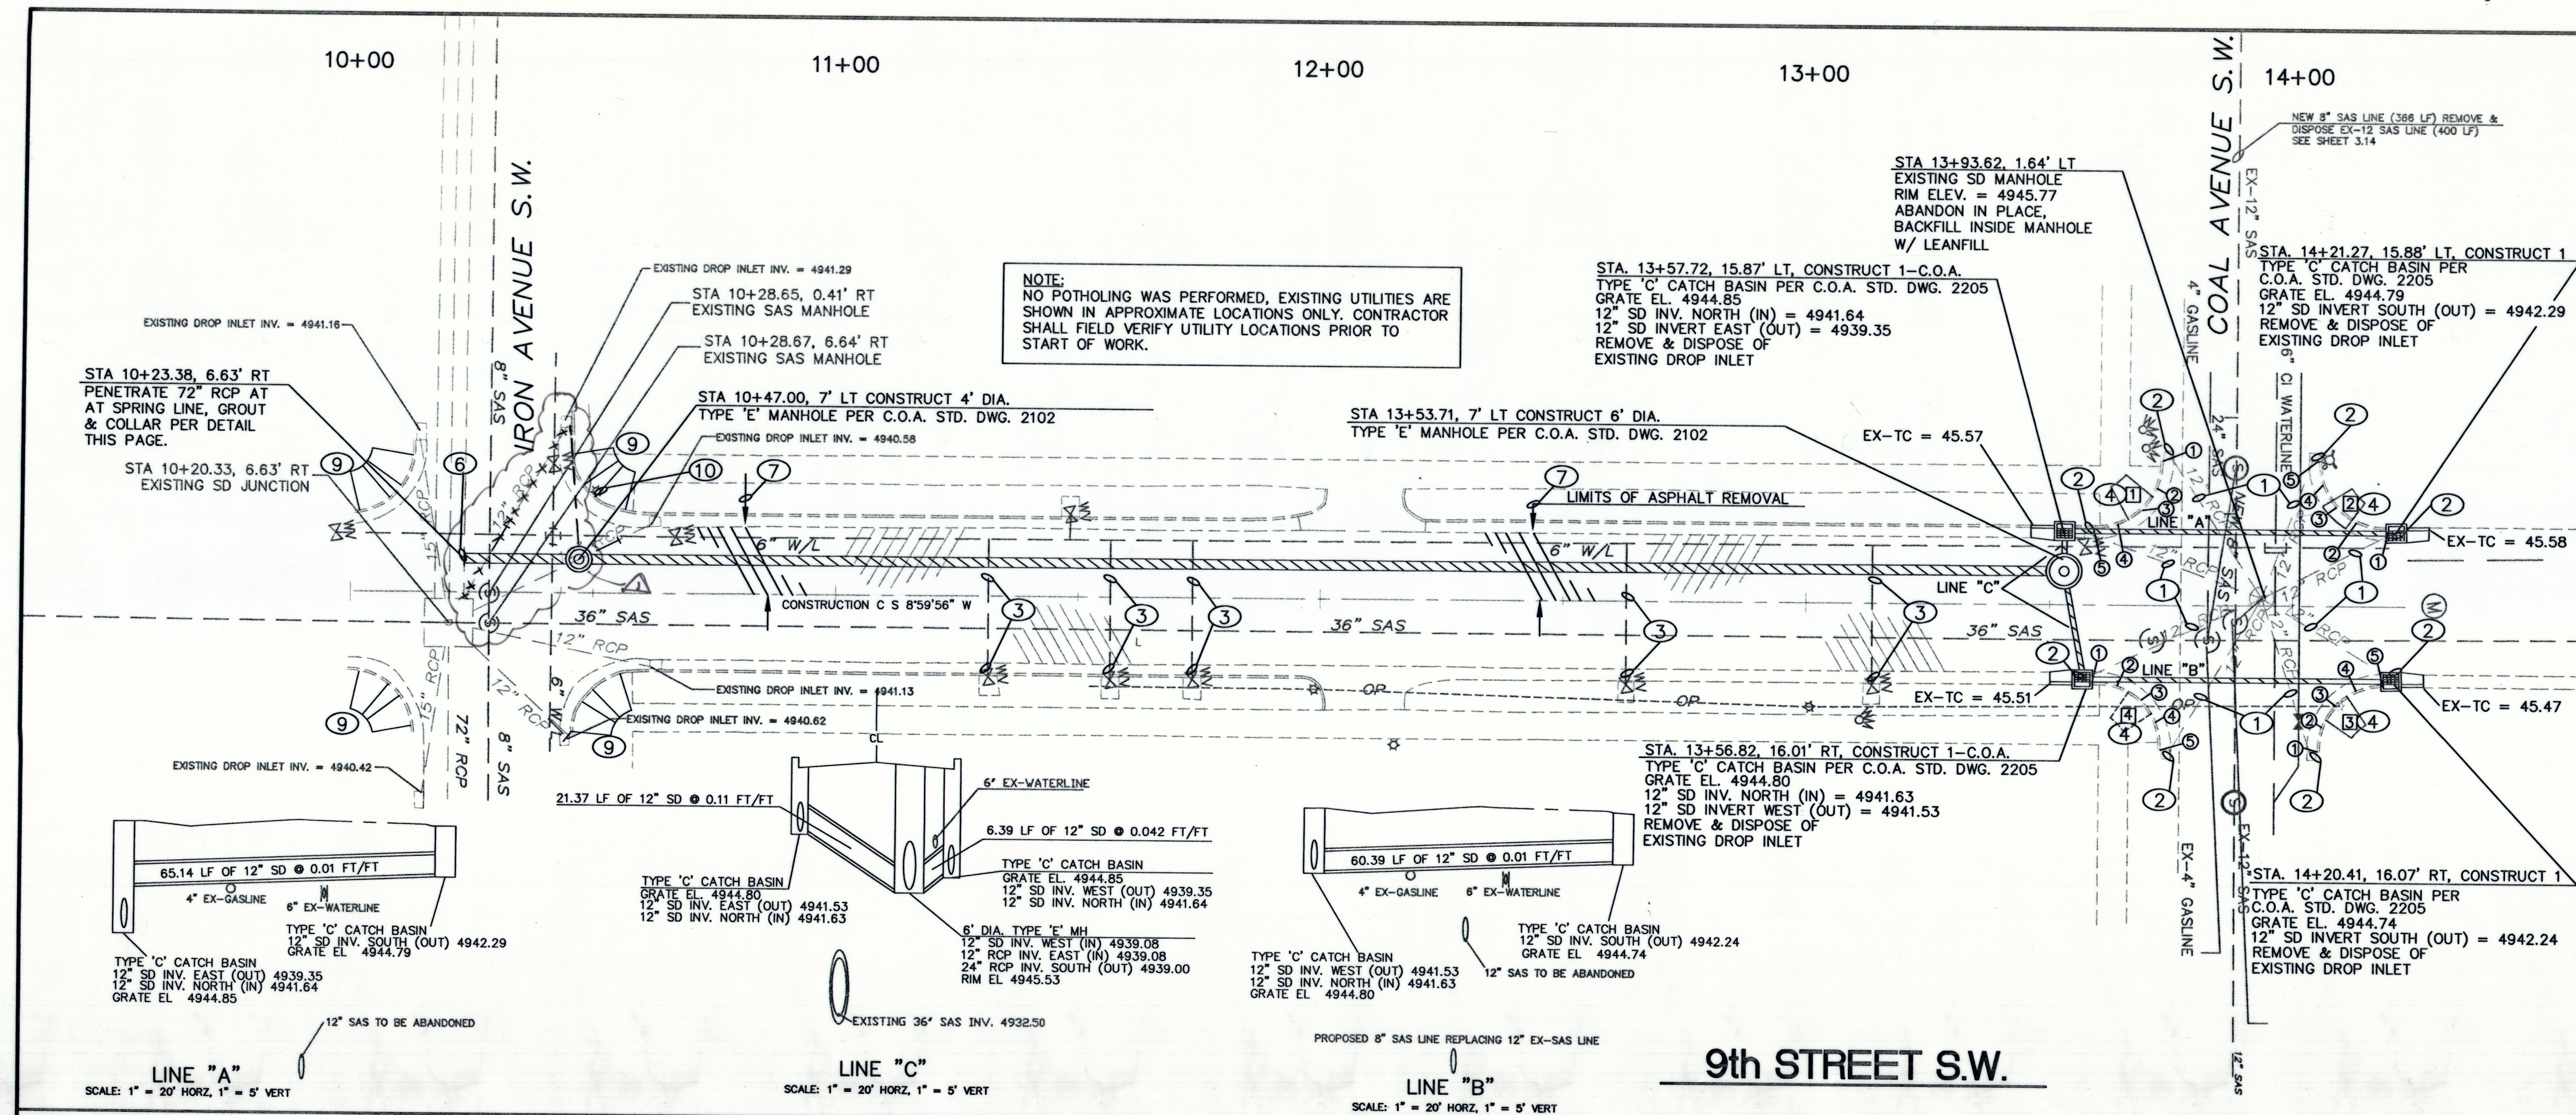

KEYED NOTES:

- ABANDON 12" RCP & CONNECTOR PIPES IN PLACE & FILL WITH LEANFILL. IF EXISTING 12" CONNECTOR CONFLICTS WITH PROPOSED CONNECTOR PIPE, REMOVE AFFECTED 12" CONNECTOR PIPE.
- REMOVE EXISTING CATCH BASINS
- EXISTING WATER SERVICE & METER. CONTRACTOR SHALL FIELD VERIFY LOCATION PRIOR TO START OF WORK.
- RETURNS TO BE RECONSTRUCTED AT ELEVATIONS SHOWN. SEE SHEET 3.14 FOR BUILD NOTE ON RETURNS.
- NOT USED
- CONNECT NEW 24" STORM DRAIN INTO EXISTING 72" STORM DRAIN.
- REMOVE, DISPOSE & REPLACE 450 S.Y. OF ASPHALT PAVEMENT PER C.O.A. STD. DWG. 2465.
- CONTRACTOR SHALL PRE-DRILL THE 72" RCP SD PIPE ALONG THE PERIMETER LINE OF THE PROPOSED 24" SD PIPE, PRIOR TO USING ANY IMPACT OR HAMMERING DEVICE TO PENETRATING THE WALL OF THE 72" STORM DRAIN PIPE. THE CONTRACTOR SHALL USE A 3/4" BIT WITH HOLES @ 3" ON CENTER ALONG PERIMETER LINE.
- HANDICAP RAMPS TO BE CONSTRUCTED PER C.O.A. STD DWGS 2418, 2440, 2441 & TO MATCH EXISTING ELEVATIONS.
- UTILITY POLE TO REMAIN WITH HANDICAP RAMP TO BE BUILT AROUND UTILITY POLE UNLESS OTHERWISE DIRECTED BY C.O.A. PROJECT MANGER TO RELOCATE.

RECORD DRAWING

I, THE UNDERSIGNED, A REGISTERED PROFESSIONAL ENGINEER IN THE STATE OF NEW MEXICO, DO HEREBY CERTIFY THAT THE INDICATED RECORD DRAWINGS ARE BASED UPON INFORMATION PROVIDED BY THE CONSTRUCTION CONTRACTOR IN THE FORM OF RED-LINED CONSTRUCTION DRAWING MARKUPS TO THE ORIGINAL DESIGN DRAWINGS. THE TRANSFER OF THE INFORMATION HEREIN IS TRUE AND CORRECT TO THE BEST OF MY KNOWLEDGE AND BELIEF. HOWEVER, I HAVE NOT VERIFIED THE ACCURACY AND/OR COMPLETENESS OF THE INFORMATION PROVIDED BY THE CONSTRUCTION CONTRACTOR AND SHALL NOT BE RESPONSIBLE FOR ERRORS OR OMISSIONS THAT MAY BE INCORPORATED AS A RESULT OF ERRONEOUS INFORMATION PROVIDED BY OTHERS. ALL INFORMATION INCLUDING VERTICAL AND HORIZONTAL DIMENSIONS SHOULD BE FIELD VERIFIED PRIOR TO USE ON FUTURE PROJECTS.

NOTE: QUARTER POINTS 1 & 5 ARE AT EXISTING TC ELEVATIONS.

TC	FL
1	45.67 45.06
2	45.65 45.01
3	45.63 44.97
4	45.61 44.92
5	45.59 44.87

TC	FL
1	45.52 44.79
2	45.55 44.83
3	45.53 44.86
4	45.50 44.90
5	45.48 44.93

TC	FL
1	45.65 44.90
2	45.61 44.86
3	45.56 44.82
4	45.51 44.78
5	45.47 44.74

TC	FL
1	45.53 44.80
2	45.62 44.93
3	45.71 44.98
4	45.80 45.07
5	45.90 45.16

ENGINEERS SEAL

189624m
Smith Engineering Company
A Full Service Engineering Company
6000 Olympic Boulevard, N.E. Suite 6000 Albuquerque, New Mexico 87110

CITY OF ALBUQUERQUE
PUBLIC WORKS DEPARTMENT
ENGINEERING DEVELOPMENT GROUP

TITLE: **9TH STREET S.W. : STA. 10+00 TO 14+19**

DESIGNED BY: JAB DATE: 10/99
DRAWN BY: JAB DATE: 10/99
CHECKED BY: PJC DATE: XX/XX